Notes Ck'd by		Survey of	
Map No.		JN	Tape Std °F
Office Work		Surveyed by	
Checked		Notes	Date
Date		Indexed	

F.B. 2951 Pg.

Page	Job	Description
		SOUTH CENTRAL DIST. OFFICE 0022.24 DEPT. PUBLIC SOCIAL SERVICES
5-6	Index	
7-18	Bdry.	Bdry. survey - Central Ave. bet. 107th & 108th St.
19-22	B.M.	Bench levels for const. & control P. T. Sht. H-166
23-32	Bdry.	Monumenting Bdry.
33-34	Topo.	Location of Bdry. Fences.
35-36	Index	
37-40	Bdry.	Add'l property lines E. of Central Ave., bet. 107th St. & 108th St.
41-43	Topo.	Loc. of imp. along E. line of Lot 781.
		SOUTH CENTRAL DIST. OFFICE BLDG. DEPT. OF PUBLIC SOCIAL SERVICES J.N. 9000.02
45-47	B.M.	Bench levels to establish vertical control for construction.
		ALHAMBRA MUNICIPAL COURT BLDG. 0053.00
55-58	B.M.	Bench levels
59-60	Index	
61-68	C.L. Bdry.	Bdry. & C.L. survey between 1st. & 2nd streets, & between Commonwealth Street. & Mission Road.

Notes: Any Additions or Changes on this Sheet Must Be Made or Circled in Red Ink With Date and Name of Person Making Change

Do not extend this side of this line.

PLEASE RETURN TO
LOS ANGELES COUNTY ENGINEER
403 Los Angeles County Engineering Bldg.

76P3098 CE #310 8-68

Microfilmed April 85

F.B. 2951 Pg.

Page	Job	Description
		ALHAMBRA MUNICIPAL COURT BLDG. Con't. 0053.00
69-78	C.L.	Additional work on C.L. & Bdry. survey.
79-87	C.L.	Add'l. survey showing lines of occupation in Block "B", of Del Go Shar Tract M.R. 14-67
89-90	Bdry.	Monumenting corners - South side of Beacon Street.

PLEASE RETURN TO
LOS ANGELES COUNTY ENGINEER
403 LOS ANGELES COUNTY ENGINEERING BLDG.

Do not extend this side of this line.

Note: Any Additions or Changes on this Sheet Must be Made or Circled in Red Ink With Date and Name of Person Making Change

Notes Ck'd by	Survey of SO CENTRAL DIST PUB SOC SERV
Map No. B-5023	JN 00224 Tape 205 Std 64°F
Office Work H. H. F. DONG	Surveyed by A.C. GUIZADO
Checked J. A. CHURCH	Notes J.A. MOODY Date 3-29-68
Date JUL	Indexed C. J. GALLI APR 5 68

F.B. 2951 Pg. 5

TM 00224

SOUTH CENTRAL DISTRICT OFFICE DEPT. PUBLIC SOCIAL SERVICES - PROPERTY LINES

PROPERTY LINES
CENTER LINE

SEE PAGE 35 M.B.

PARTY
A.C. GUIZADO
J.A. MOODY
N.J. SMITH
J.E. HENDERSON

Notes: Any Additions or Changes on this Sheet Must be Made or Circled in Red Ink With Date and Name of Person Making Change

Do not extend this side of this line.

PLEASE RETURN TO
LOS ANGELES COUNTY ENGINEER
1403 Los Angeles County Engineering Bldg.

7823-09S CE #310 5-66

PLEASE RETURN TO
LOS ANGELES COUNTY ENGINEER
403 LOS ANGELES COUNTY ENGINEERING BLDG.

Note: Any Additions or Changes on this Sheet Must be Made or Circled in Red Ink With Date and Name of Person Making Change

Do not extend this side of this line.

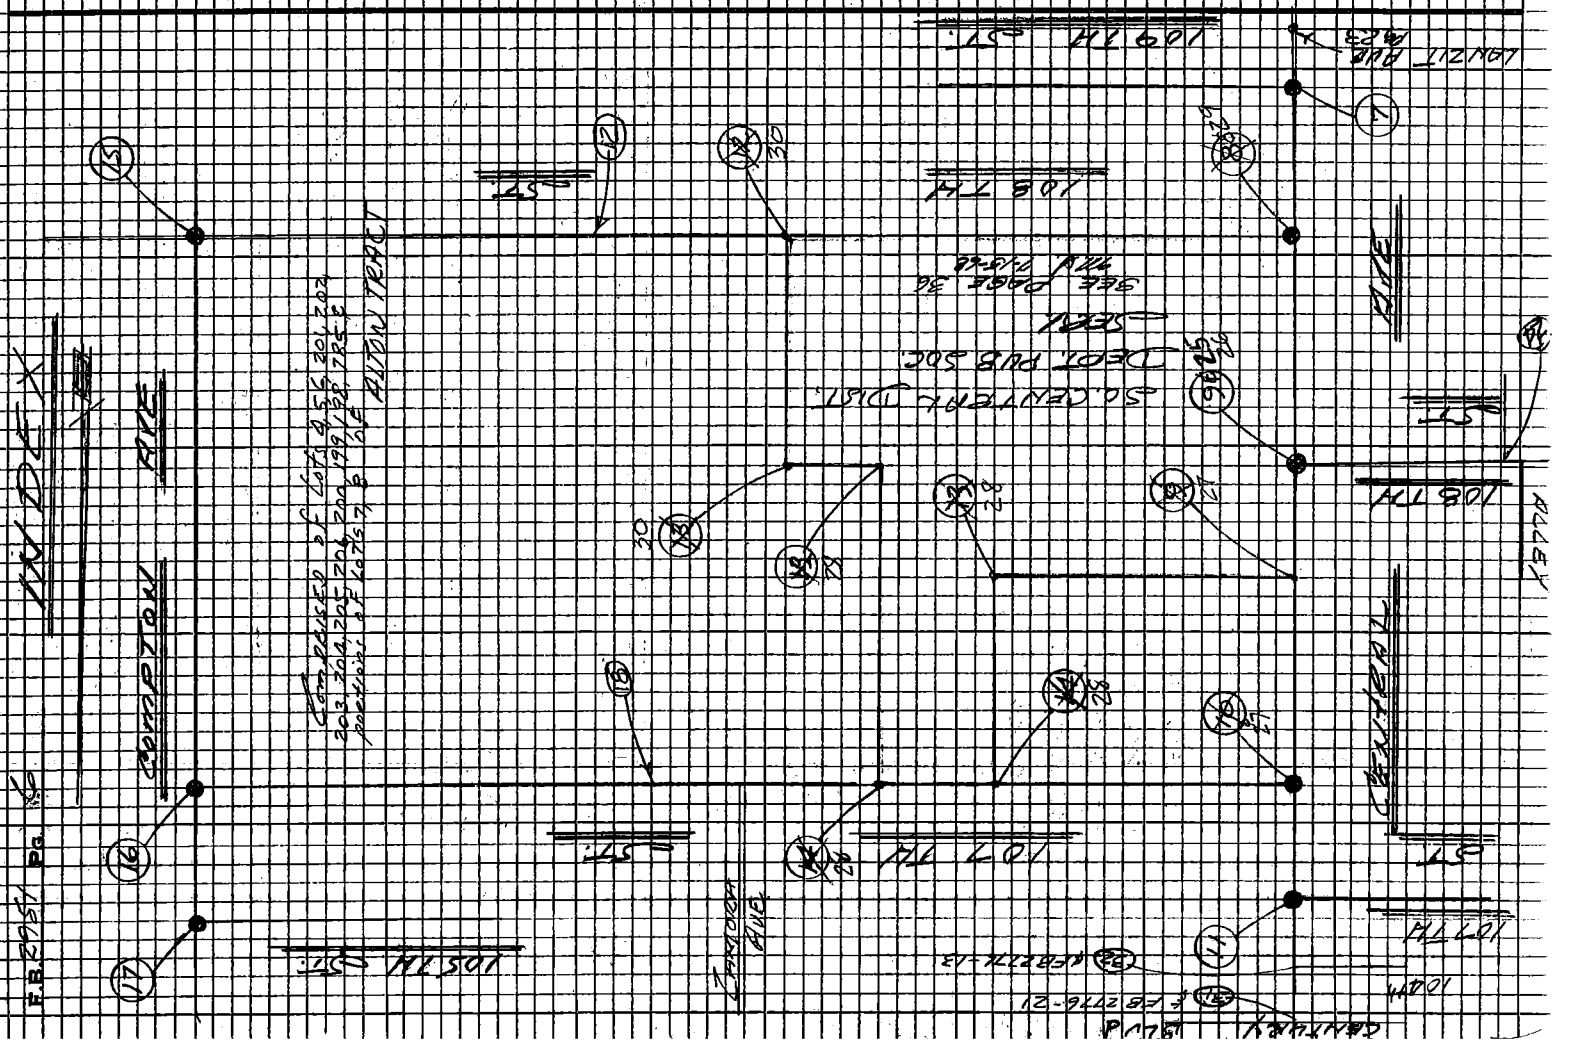
ALLEY
ALLEY
ALLEY

W.S. 26, C-1

Notes Ck'd by J. A. CHURCH
Map No. 8-5023
Office Work H. H. F. DONG
Checked J. A. CHURCH
Date 5 31 '68

Survey of CO. CENTRAL DEFENCE DEPT. PUB. WORKS SERV.
JN 00ZR24 Tape 205 Std 84 °F
Surveyed by A. C. GUIZADO
Notes J.M. MOODY Date 3-28-68
Indexed C. J. GALLI

F.B. 2751 Pg. 7

Cont from Pg. 3

(50) (50)

Fd R.R. SPK PER F.B. 901-28 SET SD. P.M. 0.02 EAST USED FOR LINE NO. CSB VEN-2

SET L.A.CO. ENGR TAG

SET L.A.CO. ENGR TAG

109 TH

(30)

SET NAIL & TAG

0.05

0.06

0.02

Fd CHIS X NO REF.

40.21

SET

(32)

0.5

S 5° 44' E

SET L.A. CO. ENGR TAG

PK NAIL & TAG

Fd SD NO. SPK W/ P.M. NO. REF.

CENTER LINE

(50) (50)

Cont To Pg 23

Notes: Any Additions or Changes on this Sheet Must be Made or Circled in Red Ink With Date and Name of Person Making Change

Do not extend this side of this line.

PLEASE RETURN TO
LOS ANGELES COUNTY ENGINEER
403 LOS ANGELES COUNTY ENGINEERING BLDG.

76P5038 CE #310 5-66

F.B. 7951 Pg. 8

Cont. to & from Pg. 9

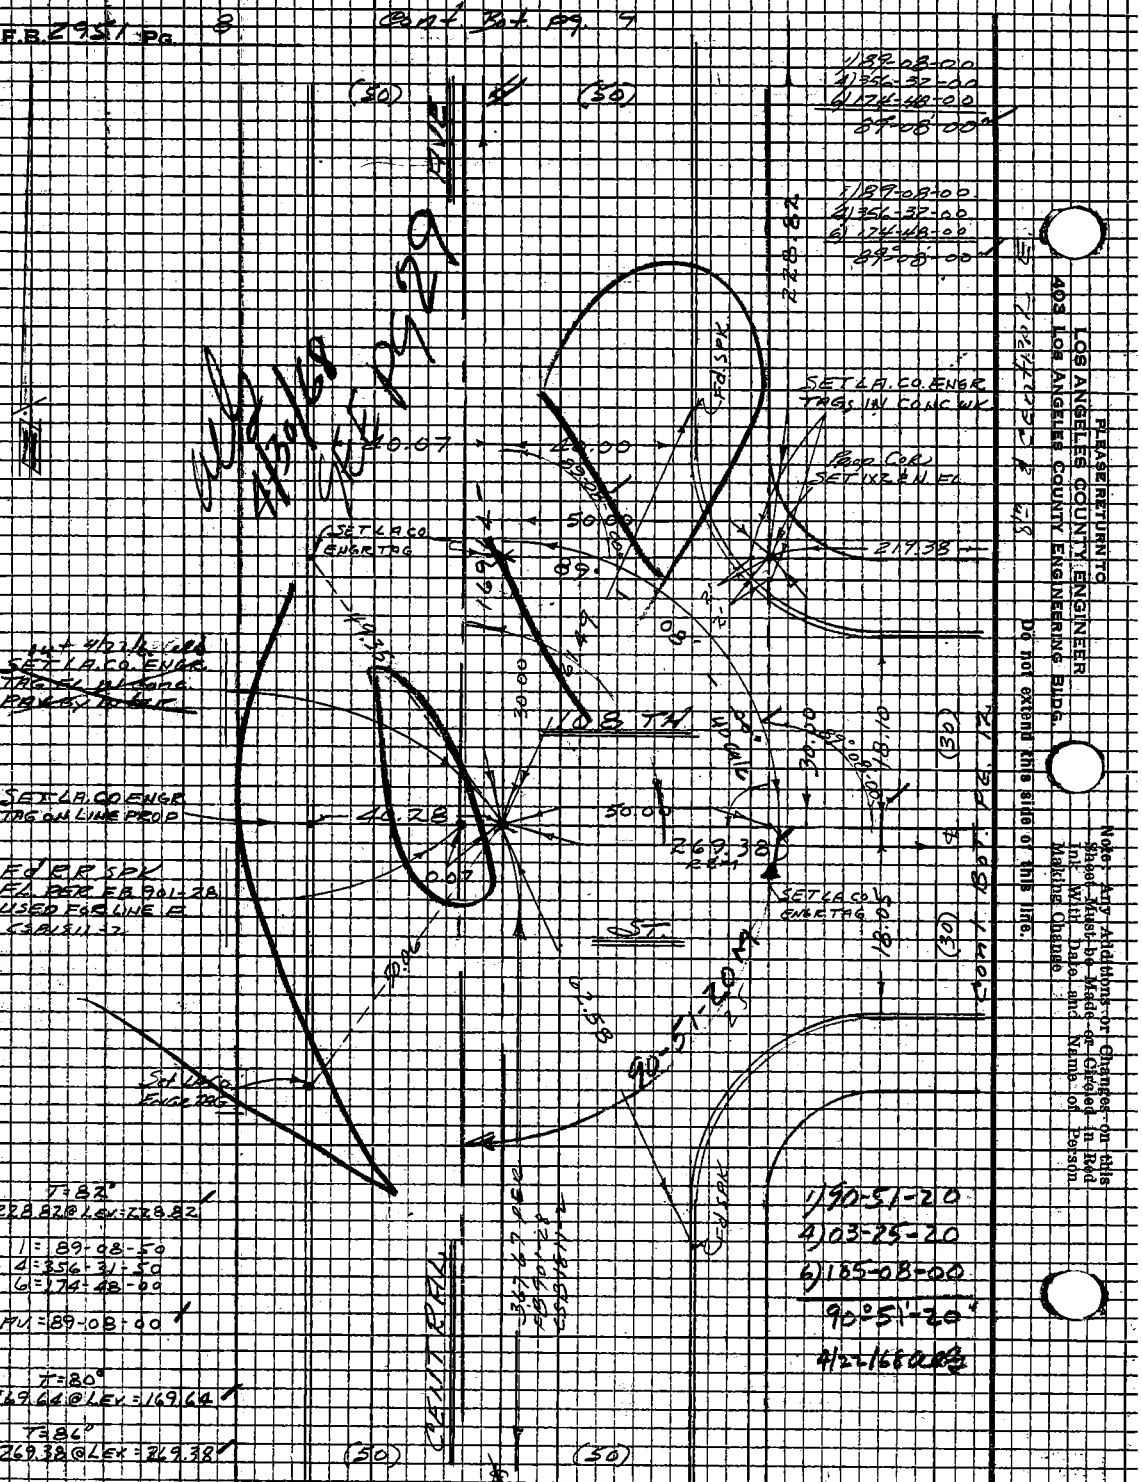

PLEASE RETURN TO
LOS ANGELES COUNTY ENGINEER
403 LOS ANGELES COUNTY ENGINEERING BLDG.
Do not extend this side of this line.

Note: Any Additions or Changes on this Sheet Must be Made or Circled in Red Ink With Date and Name of Person Making Change

Notes Ck'd by J. A. CHURCH
Map No. B-3023
Office Work H. H. E. DONG
Checked J. A. CHURCH
Date JUL 31 '62

Survey of 50, 51ST. OFFICE PUB. WORKS SERVICE
JN 002224 Tape 205 Std 84° F
Surveyed by AC GUAZARDO
Notes J. K. MOODY Date 3-23-62
Indexed C. J. GALL

F.B. 2951 Pg. 9

Cont. Bak Pg 10

(50) (50)

SET LA. CO. ENGR TAG IN CONC. WK 149.38 RDM

SET LA CO. ENGR TAG IN WOOD HUB

Cont. Left Pg 13

50.00

FD L.S. 8T. ENCASED IN 4" I.P. W/CONC. PLUG REF. FD 9.90'-29 LA. C.I.X 15610-45, ON 12" ILLEGIBLE LA. C.I.X MON. COVER, FD FT. ON LINE BETWEEN 107TH ST W. & 109TH ST. E 593 181-2

198.00

89.19

108 TH

4 PT. CEEPS 25

FD L&T 15610-45

0.00'

165.40

FD L&T

FD L&T 15610-45

1/30-52-00
4/23-28-20
6/1185-13-30
90°-52-05E

108.81

73.80'

198.01 @ LEV. = 198.00
89.19 @ LEV. = 89.19
108.81 @ LEV. = 108.81

(50) (50)

Cont. From TOR Pg 8

Dept

PLEASE RETURN TO
LOS ANGELES COUNTY ENGINEER
403 Los Angeles County Engineering Bldg.

Do not extend this line of this line.

Note: Any Additions or Changes on this Sheet Must be Made or Circled in Red Ink With Date and Name of Person Making Change

7625-05 CE #310 5-56

F.B. 2915 Pg. 10

Cont. To Pg. 11

Cont. From Top Pg. 9

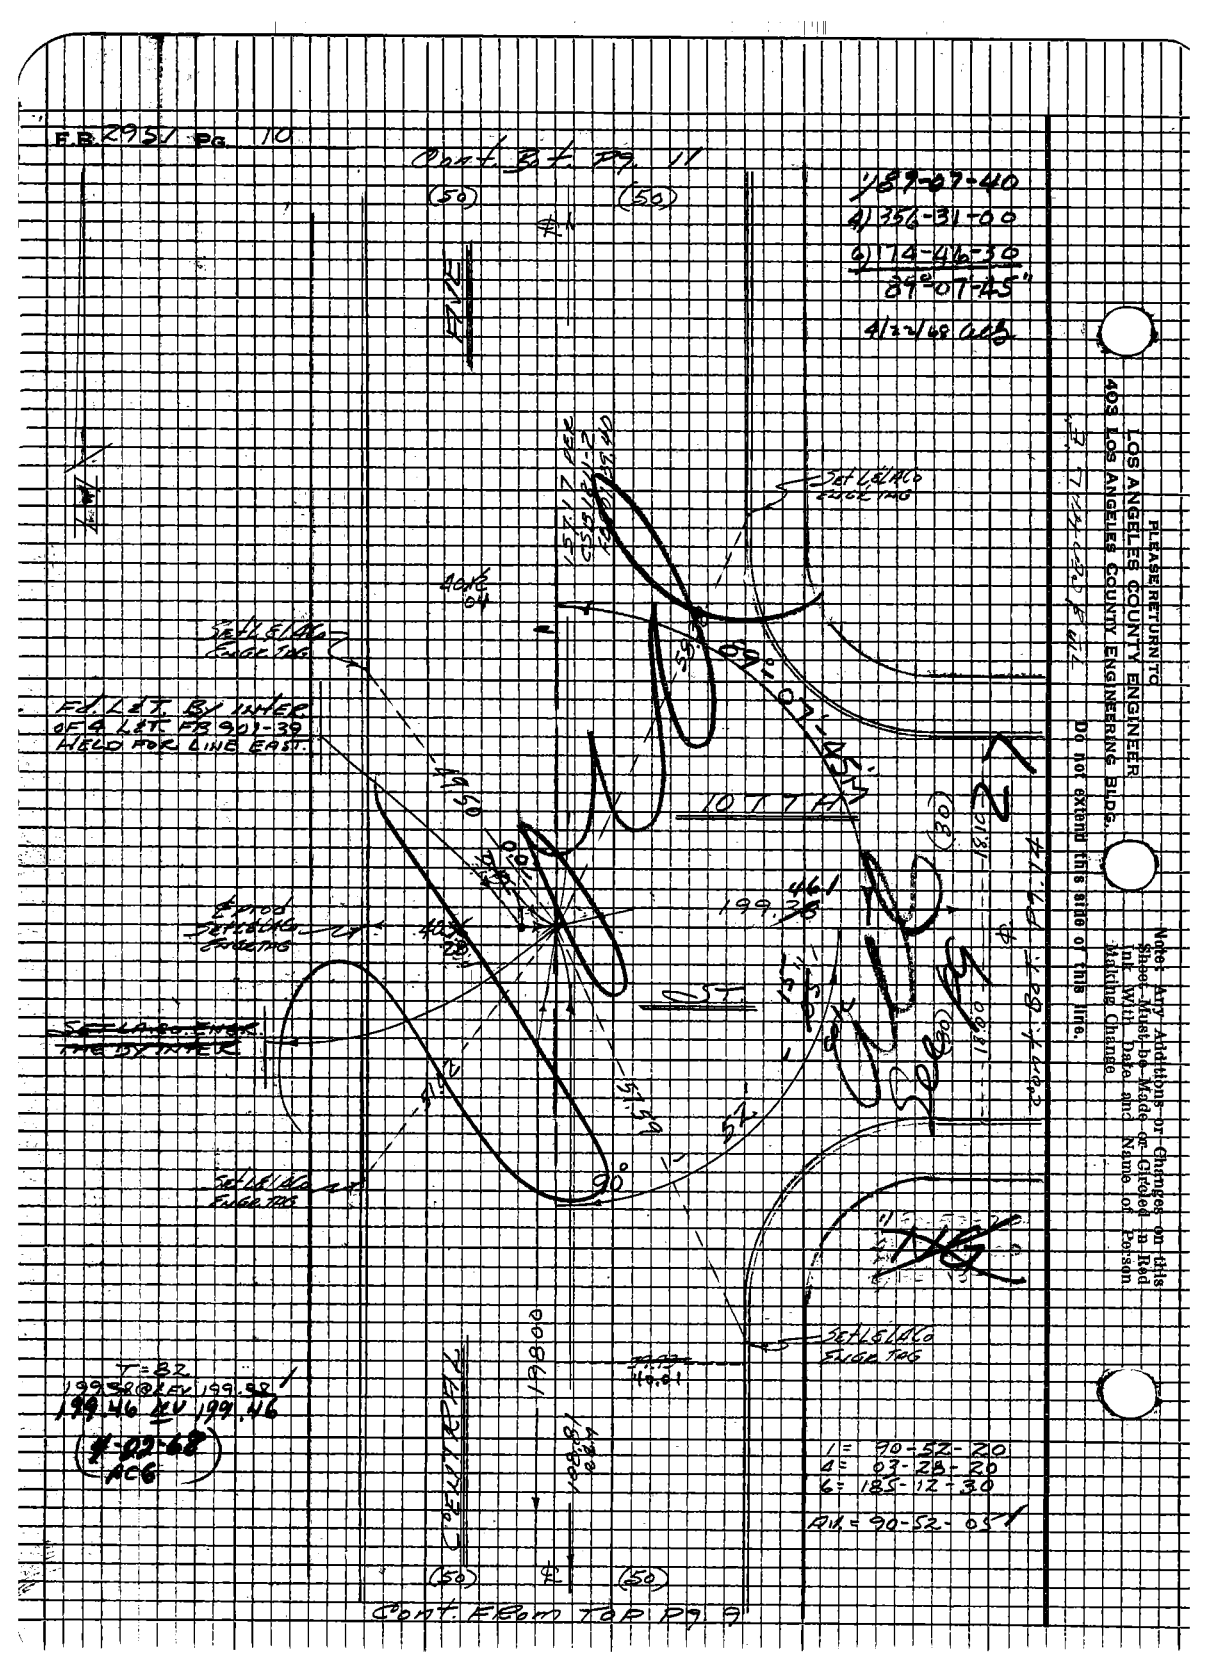
(50)
#1
(50)
#1
Set L&LS Engr Tag
Set L&LS Engr Tag
Set L&LS Engr Tag

Notes C'k'd by J. A. CHURCH
Map No. B-5023
Office Work H. H. F. DONG
Checked J. A. CHURCH
Date JUL 31 '68

Survey of 30 CENTRAL DIST PUB. DOC. SURVEY
JN 00222.24 Tape 205 Std 84 °F
Surveyed by A. C. GUZMAN
Notes J. H. MOODY Date 3-28-68
Indexed C. J. GALLI

F.B. 2951 Pg. 11

W.S. 26, C.1

SEE PG 32

EDGE

EDGE

ED LET PER FB 901-40 BK SIDE conc. WK

10.7 TH.

ED LET ON SURFACE, conc. PAR. FB 901-40 USED FOR LINE SO

14.26

ED LET PER FB 901-40 IN conc. PAV.

0.08

ST.

W.S. 4/30/68

ED LET PER FB 901-40 BK SIDE PAVE WK

SET L.A. CO. ENGR. TBG.

Cont. FROM TOP PG. 10

27

Note: Any Additions or Changes on this Sheet Must be Made or Circled in Red Ink With Date and Name of Person Making Change

Do not extend this side of this line.

PLEASE RETURN TO
LOS ANGELES COUNTY ENGINEER
403 Los Angeles County Engineering Bldg.

7-68 3093 CE #310 5-66

FB 498/ Pg 12

Cont. fr. Pg 11

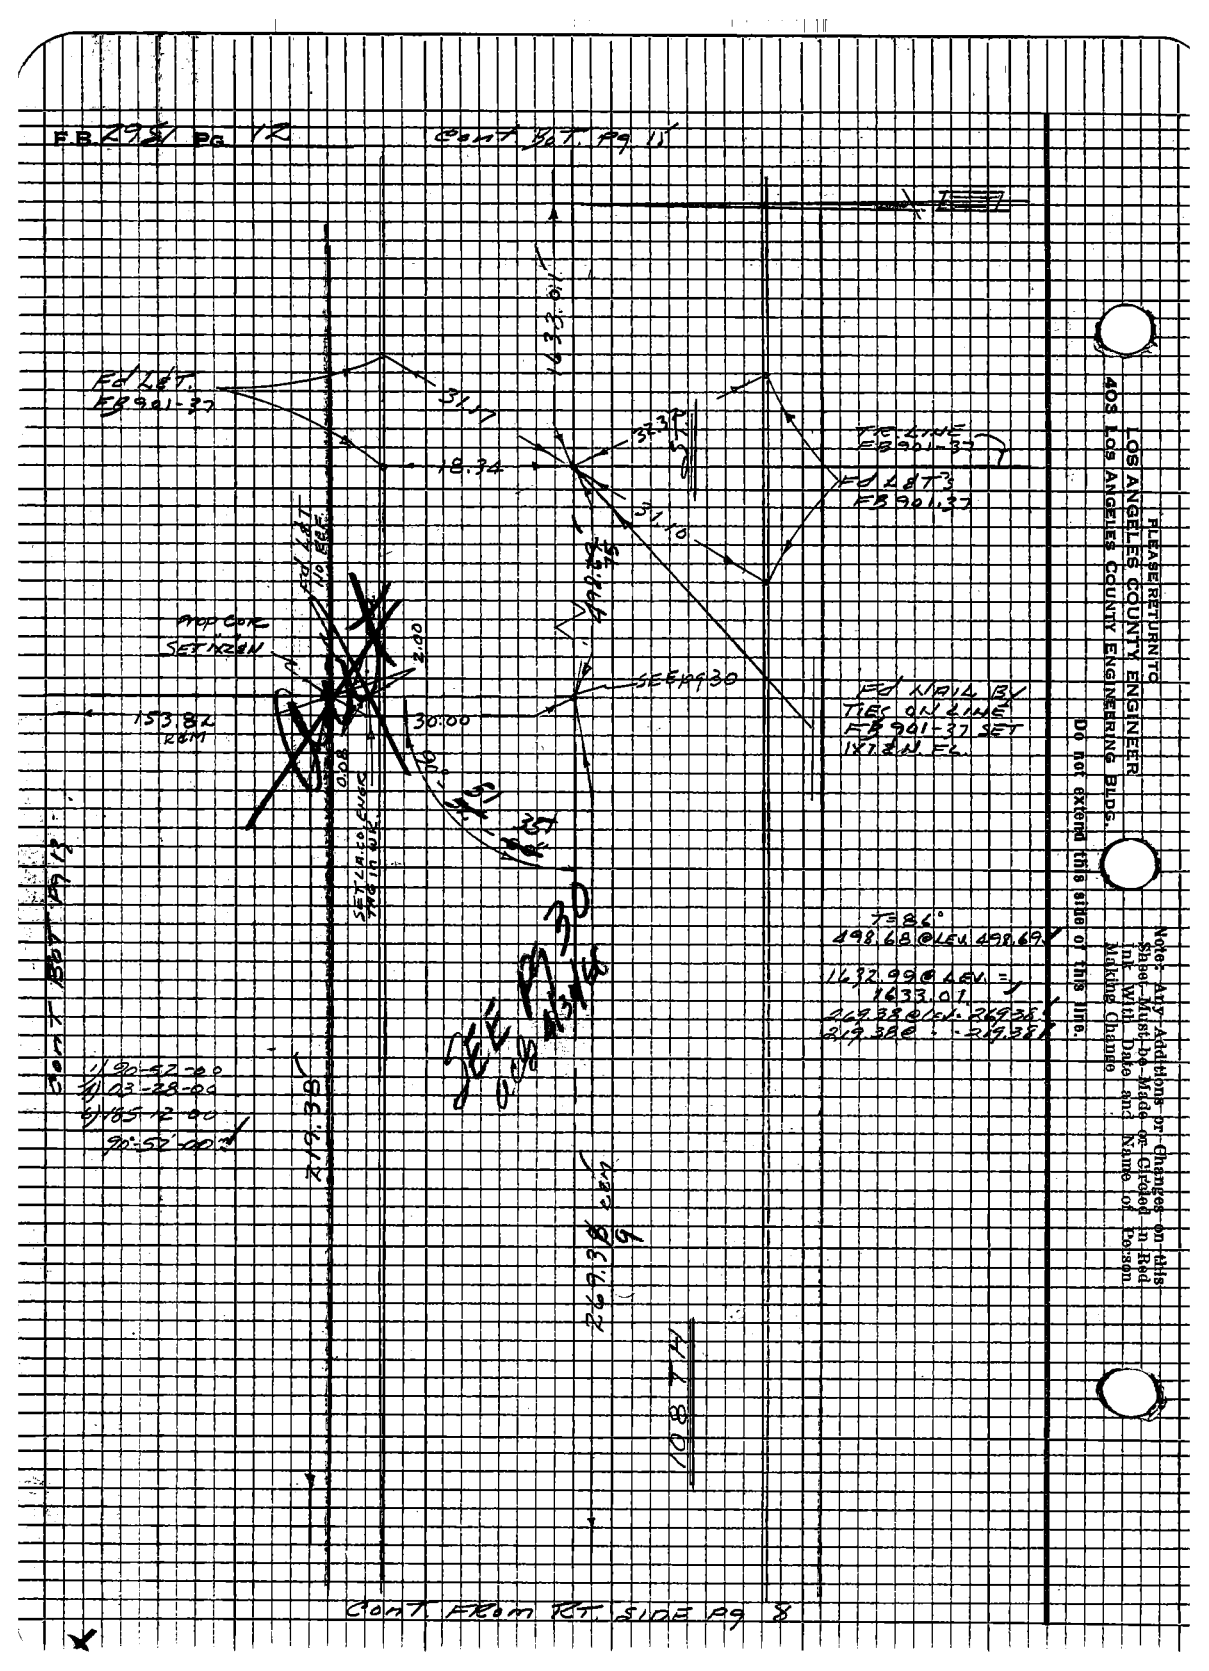

Cont. from Rt. side Pg 8

Note: Any Additions or Changes on this Sheet Must Be Made or Circled in Red ink With Date and Name of Person Making Change

LOS ANGELES COUNTY ENGINEER
405 LOS ANGELES COUNTY ENGINEERING BLDG.

PLEASE RETURN TO

Do not extend this side of this line.

Notes Ck'd by J. A. CHURCH
Map No. B-5023
Office Work H. H. F. DONG
Checked J. A. CHURCH
Date MAY 1 '68

Survey of SO. CENTRAL DIST. DEPT. PUB. SOC. SERV.
JN 00224 Tape 205 Std 84 °F
Surveyed by R.E. GUZMAN
Notes J.R. MOODY Date 3-29-68
Indexed C. J. GALLI

F.B. 2957 Pg. 13

Cont. from F.B. 2957, Pg. 14

1) 90-52-00
2) 123-28-20
3) 185-12-20
90°52'05" /

Cont. from F.B. 2957, Pg. 14

1" = 80'

1) 89-08-00
2) 356-32-00
3) 174-48-00
89°08'00" /

149.38 rec

Trap Cor Set 1/2 EAN Flush

153.81 rec

Trap Cor Set 1/2 EAN Flush

Set Nail in Pavt

50.00 rec

Trap Cor Set 1/2 EAN Flush

80.00 rec

Sep 28, 30

SO. CENTRAL DIST.
DEPT PUB. SOC. SERV. SITE

1) 89-08-00
2) 356-32-00
3) 174-48-00
89°08'00" /

153.81 rec

T=86°
123.82 LEN = 153.82 /
50.00 " = 50.00 /
153.81 " = 153.81 /
78.81 " = 78.81 /
149.38 " = 149.38 /

Cont. from Lt. Pg. 12

Notes: Any Additions or Changes on this Sheet Must be Made or Circled in Red Ink With Date and Name of Person Making Change

Do not extend this side of this line.

PLEASE RETURN TO
LOS ANGELES COUNTY ENGINEER
403 LOS ANGELES COUNTY ENGINEERING BLDG.

762309 CE #310 8-66

PLEASE RETURN TO
LOS ANGELES COUNTY ENGINEER
405 Los Angeles County Engineering Bldg.

Note: Any Additions or Changes on this Sheet Must be Made or Circled in Red Ink With Date and Name of Person Making Change

Do not extend this side of this line.

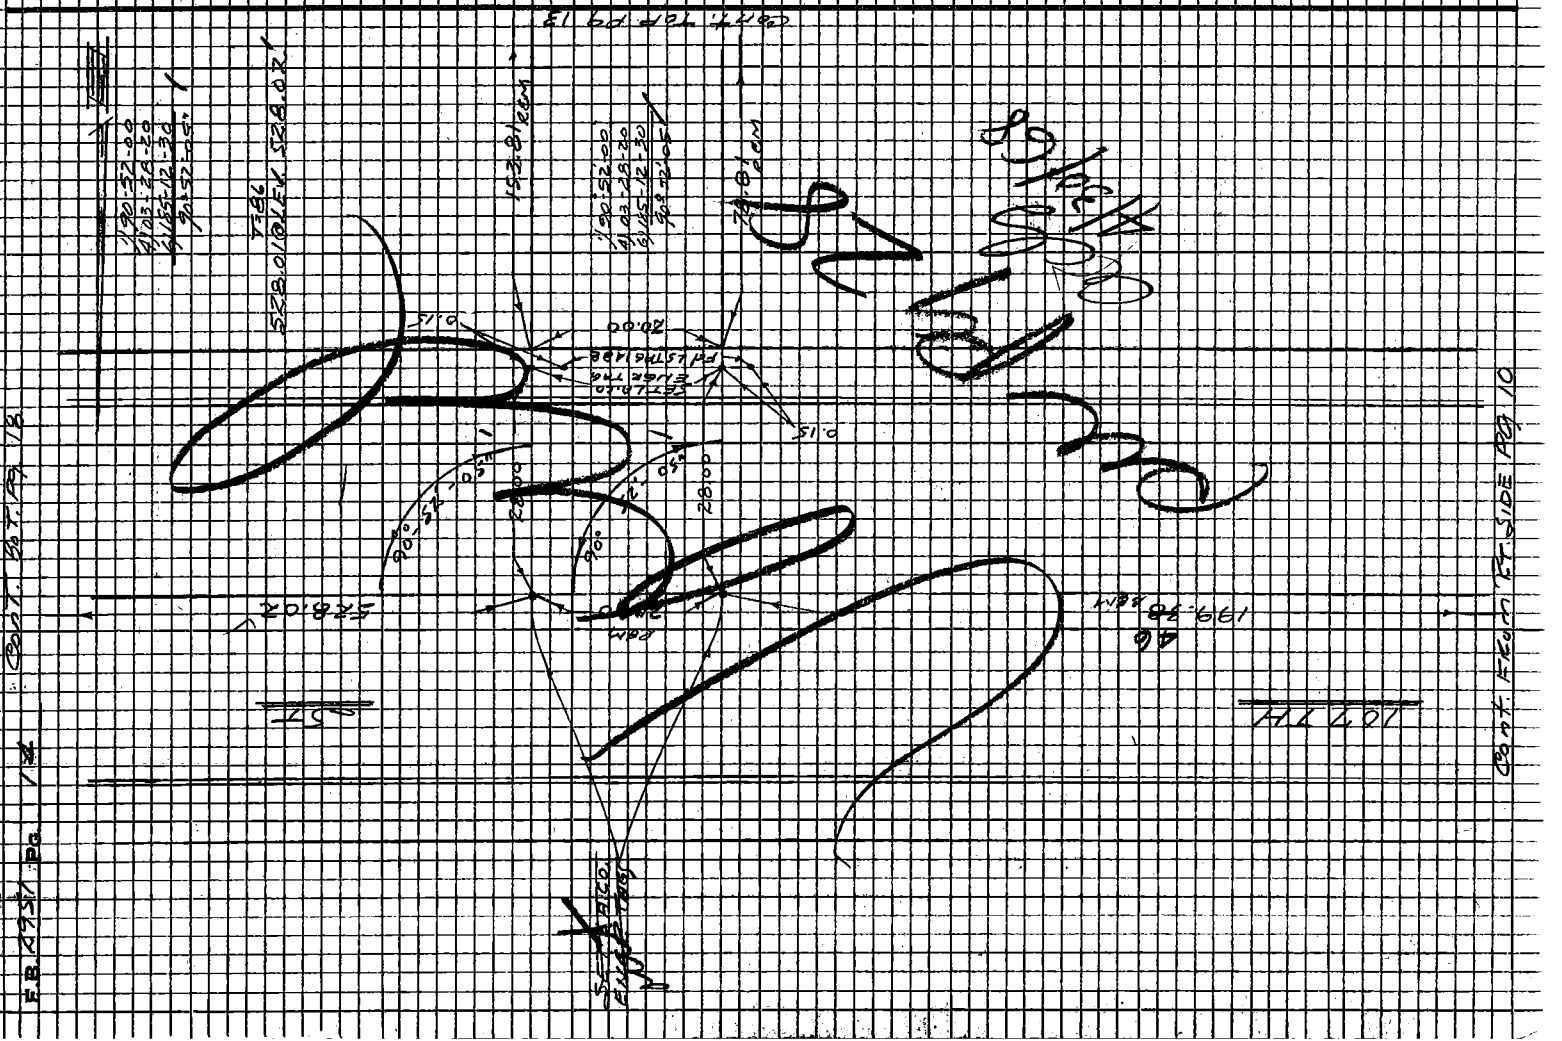

Notes Ck'd by J. A. CHURCH
Map No. 6-5043
Office Work H. H. F. DONG
Checked J. A. CHURCH
Date JUL 31 '68

Survey of 39 CENTRAL DIST PUB. SVC. SERV.
JN00222.4 Tape 205 Std 84 °F
Surveyed by A.E.GUTIERREZ
Notes J.A.MOODY Date 3-25-68
Indexed C. I GALLI

F.B. 2951 Pg. 15

W.S. 26.0-1

Notes: Any Additions or Changes on this Sheet Must Be Made or Circled in Red Ink With Date and Name of Person Making Change

Do not extend this side of this line.

PLEASE RETURN TO
LOS ANGELES COUNTY ENGINEER
403 Los Angeles County Engineering Bldg.

Jobsos CE #310 5-66

SET PM ON LID BK FD & TAN PM ON MAIN RAMP & TRUCK TRAIL AT DAS BY FOR SET PER FB 901-37 CSB 18 11-1

COMPTON

FD LET.

RAMP

FD LET.

FD LET.

FD LET.

FB 2751 Pg 16

Cont. Bet. Bet 17

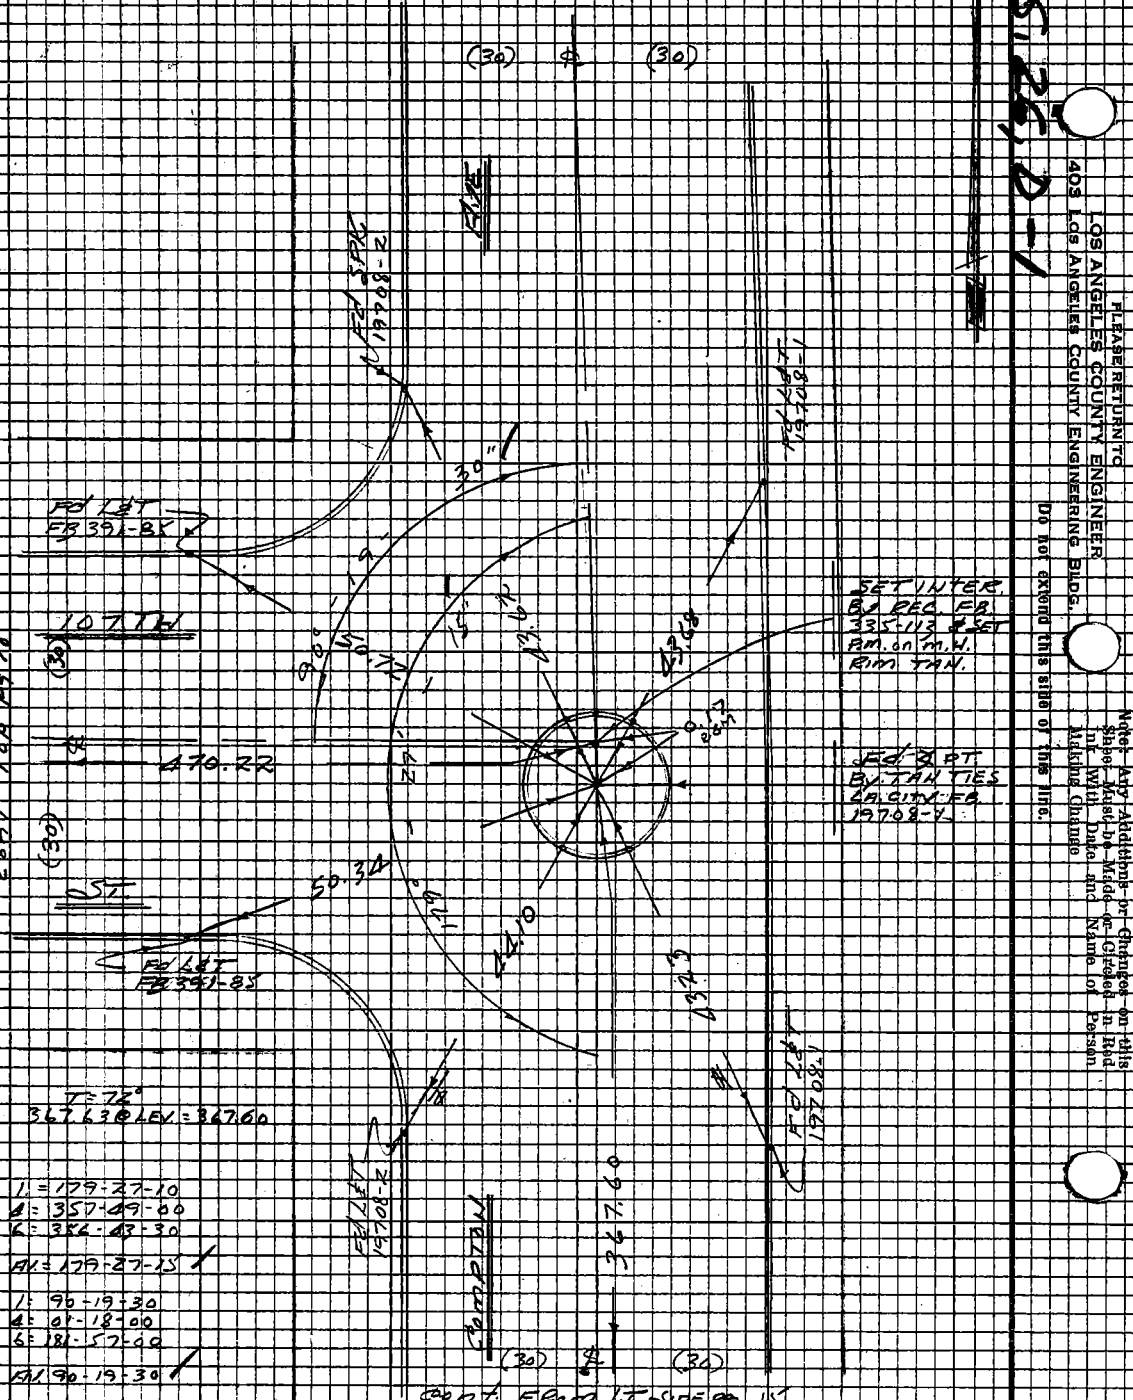
(30)
(30)
2-1970-LT
1-1970-LT
30"
FD LBT
FB 391-85
10 TTW
(30)
470.22
90°
50.34
1-42
0.28
1-42
1-42
1-42

W.S.E.S. 2-1

Notes Ck'd by T. A. CHURCH	Survey of SO. CENTRAL DIST. FLOOD DEC. SURVEY
Map No. B-5023	JN 00212 Z4 Tape 205 Std 84-°F
Office Work H. H. F. DONG	Surveyed by E.A.GUEVARA &
Checked T. A. CHURCH	Notes J. MOODY Date 3-29-68
Date JUL 31 '68	Indexed Mrs. J. GALL

F.B. 2951 Pg. 17

Notes: Any Additions or Changes on this Sheet Must be Made or Circled in Red Ink With Date and Name of Person Making Change

Do not extend this side of this line.

PLEASE RETURN TO
LOS ANGELES COUNTY ENGINEER
405 Los Angeles County Engineering Bldg.

7-65 OSS CE #310 5-65

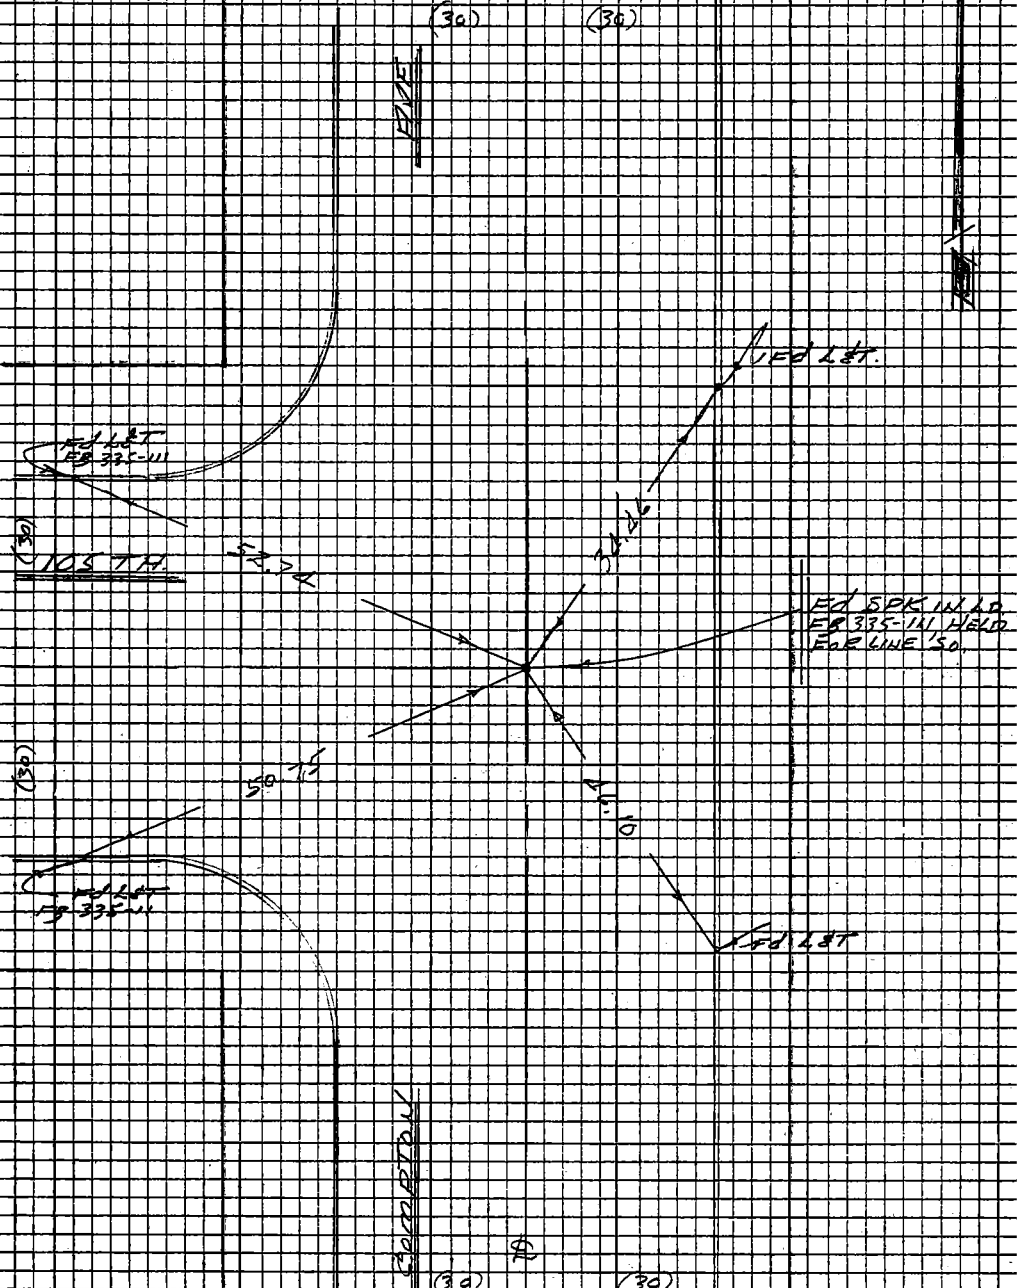

F.B. 2751 Pg. 18

From Rt. Side Pg. 16

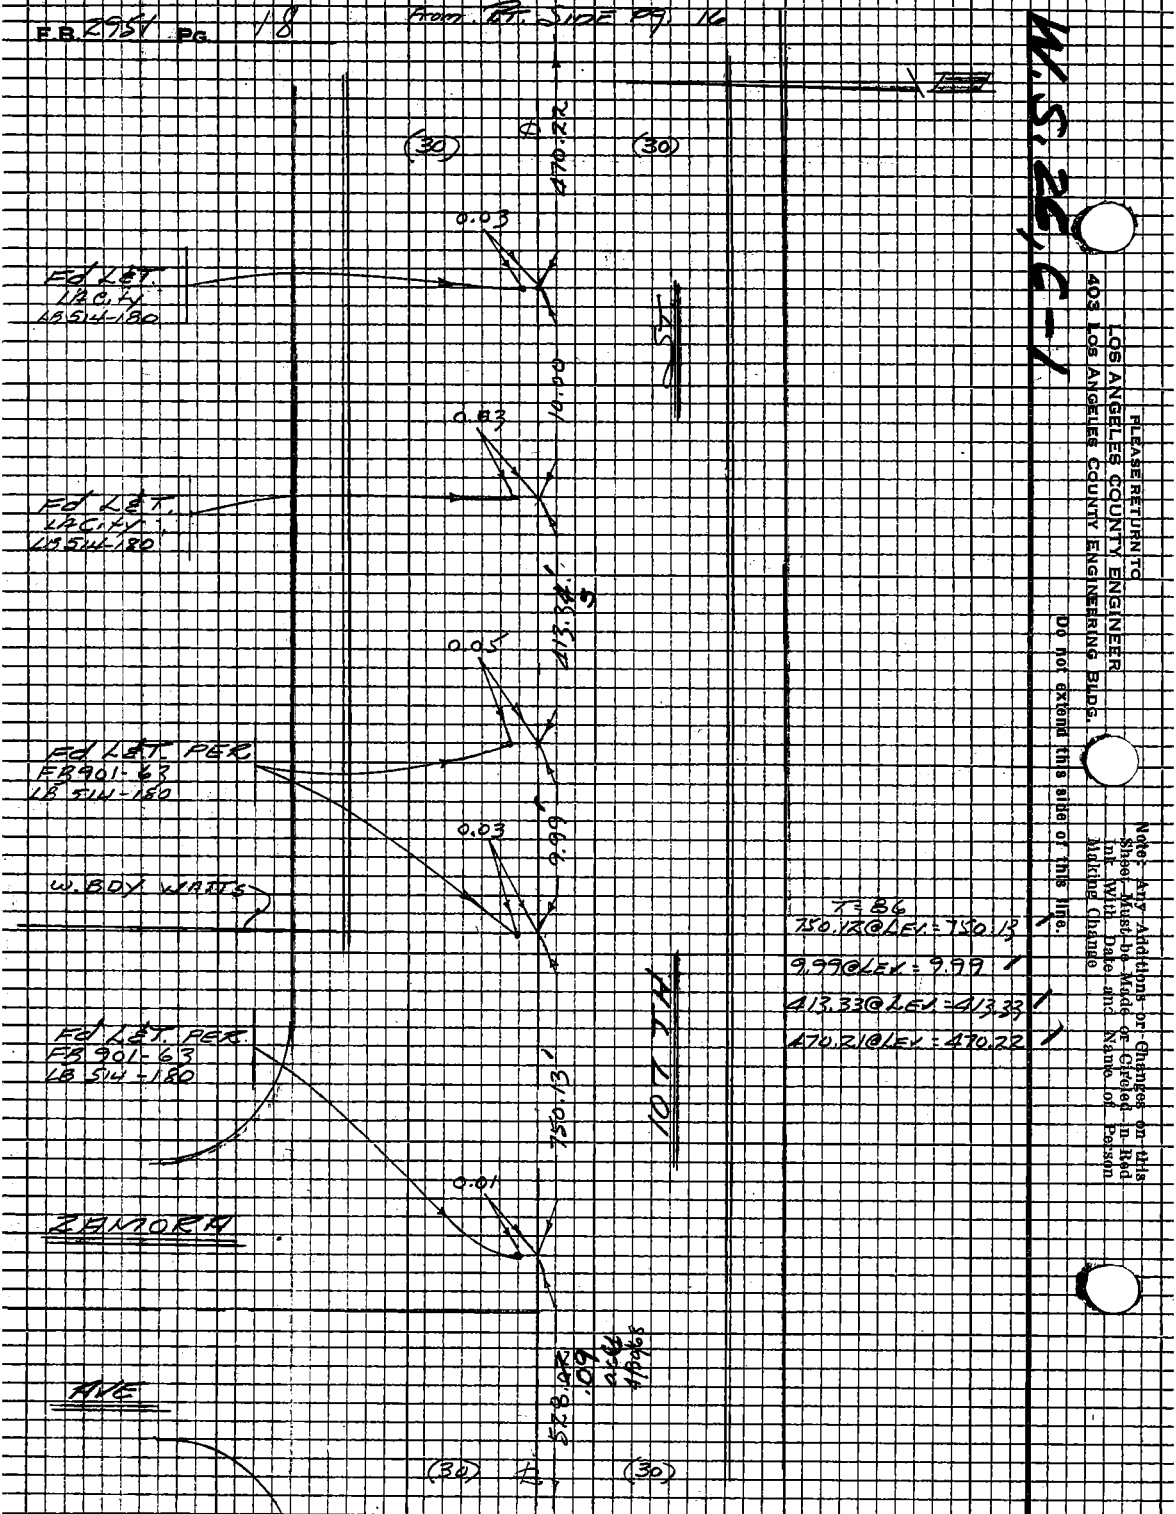

T=86
750.13@LEV=750.13 ✓
9.99@LEV=9.99 ✓
413.33@LEV=413.33 ✓
470.21@LEV=470.22 ✓

W.S. 25, C-1

LOS ANGELES COUNTY ENGINEER
403 LOS ANGELES COUNTY ENGINEERING BLDG.

PLEASE RETURN TO

Do not extend this side of this info.

Note: Any Additions or Changes on this Sheet Must be Made or Circled in Red Ink With Date and Name of Person Making Change

Profile No. | Notes Red | Date | Notes Chkd. | Date
X-Sec. No. | Plotted | Date | Checked | Date

0022.24 Job No. | Division No.

F.B. 2951 Pg. 19

Survey of SO CENTRAL DIST. SOC. SER.
Survey by M. SOTRO Notes RS Date 3-20-68
Map No. | Indexed C.J. GALLI Date

J.N. 0022.24

SOUTH CENTRAL DISTRICT
OFFICE DEPT. PUBLIC
SOCIAL SERVICES.

BENCH LEVELS
FOR CONSTRUCTION &
CONTROL PT. SHEET
H-166

SEE
ROAD DEPT BENCHES
WATTS (1965)

PARTY.
SOTRO
SMITH
MASSEY

STATION	B.S.	H.I.	F.S.	ELEV.

NOTE: ANY ADDITIONS OR CHANGES ON THIS SHEET MUST BE MADE OR CIRCLED IN RED INK, WITH DATE AND NAME OF PERSON MAKING CHANGE.

Do not extend notes this side of this line.

PLEASE RETURN TO
LOS ANGELES COUNTY ENGINEER
403 Los Angeles County Engineering Bldg.

76-1-298 CE 907 2-63

76-L-298 CE 307 2-63

PLEASE RETURN TO
LOS ANGELES COUNTY ENGINEER
403 Los Angeles County Engineering Bldg.

NOTE: ANY ADDITIONS OR CHANGES ON THIS SHEET MUST BE MADE OR CIRCLED IN RED INK, WITH DATE AND NAME OF PERSON MAKING CHANGE

Do not extend notes this side of this line.

F.B. 2951 Pg. 20 | Job No. 0022.24 | Division No. | Notes Red | Plotted | Profile
Survey of SO. CENTRAL DIST. SOA. 582. | Date | No. | X-Sec.
Survey by M. ASTRO Notes R. SMITH | Notes Ckd. | Checked
Indexed L. HALL | Date | Date | No.

STATION	B. S.	H. I.	F. S.	ELEV.	
FD BM BY 3764				106.838	BM BY 3764 EL 106.838 WATTS 1965 CENTRAL AVE & 105TH ST. S.E. COR. 8' EAST OF E. CURB RETURN SQ HD SPK IN LEAD IN CONC CURB.
	4.090	110.928			
T.P.			5.183	105.745	SPK
	5.349	111.094			
T.P.			6.067	105.027	SPK
	6.090	110.117			
T.P.			5.747	104.370	SPK
	4.781	109.151			
T.P.			4.710	104.441	SPK
	5.328	109.769			
FD. BM BY 3763			5.639	104.130	BM BY 3763 EL. 104.137 WATTS 1965 L+TAG IN CB CENTRAL AVE 38' ± E & 0.4 ± FROM 108TH ST. (EXCEPT 46.3 ± L+ BRASS NAIL)

76-L-298 CE 307 2-63

PLEASE RETURN TO
LOS ANGELES COUNTY ENGINEER
403 LOS ANGELES COUNTY ENGINEERING BLDG.

NOTE: ANY ADDITIONS OR CHANGES ON THIS SHEET MUST BE MADE OR CIRCLED IN RED INK, WITH DATE AND NAME OF PERSON MAKING CHANGE.

Do not extend notes this side of this line.

Profile Notes Red. Date Plotted Date
No. X.Sec. Notes Chkd. Date Checked Date
Job No. 0022.74 Division No. Survey of SO. CENTRAL DIST. SEC. SER.
Survey by M. SOTO Notes R.S. Date 3.20.68
Map No. Indexed G.J. GALLI Date
F.B. 2951 PG. 27

STATION	B. S.	H. I.	F. S.	ELEV.	
BM BI 3763				104 130	
	5 492	109 622			
TBM # 1 SET			6 323	103 299	TBM # 1 EL. 108TH ST. NO. SIDE 262'± # ℄ CENTRAL AVE. SET BT. SPK IN LEAD IN CONC CB.
	6 237	109 536			
TBM # 2 SET			6 019	103 517	TBM # 2 EL. CENTRAL AVE & 108TH ST. S.E. COR. 1½ FT. SO OF SO. CB RETURN FD 5/8 HD SPK IN LEAD IN CONC CB.
	5 610	109 127			
TBM # 3 SET			4 699	104 428	TBM # 3 EL. CENTRAL AVE E. SIDE 119'± NO. OF 108TH ST & WEST PROD. SET BT. SPK IN LEAD IN CONC CB.
	5 170	109 598			
T.P. 1			5 100	104 498	SPK
	5 302	109 800			
T.P. 2			4 632	105 168	SPK

76-L-298 CE 307 2-63

PLEASE RETURN TO
LOS ANGELES COUNTY ENGINEER
403 Los Angeles County Engineering Bldg.

NOTE: ANY ADDITIONS OR CHANGES ON THIS SHEET MUST BE MADE OR CIRCLED IN RED INK, WITH DATE AND NAME OF PERSON MAKING CHANGE

Do not extend notes this side of this line.

F.B. 2951 Pg. 24

Survey of So. CENTRAL DIST SOC. SER. Date Notes Red Plotted Profile

Survey by N. SOTO Notes R. SMITH Notes Cbkd Checked X-Sec.

Indexed Mr. GALL Date APR 5 '68 Date Date No.

Job No. 0022.24 Division No. No.

STATION	B. S.	H. I.	F. S.	ELEV.	
T.P				105 168	
	5 348	110 516			
T.P.			3 778	106 738	SPK.
	5 083	111 821			
BM BY 3764			4 991	106 830	BM BY 3764, EL = 106.838 SEE THIS F.B. Pg 1 FOR DESCRIPTION

W.S. 26 C 1

Notes Ck'd by J. A. CHURCH	Survey of SO. CENTRAL DIST. OFF. DEPT. PUB. SOC. SERV.
Map No. 5023	JN 00 22.24 Tape 205 Std 84 °F
Office Work H. H. F. DONG	Surveyed by R.C. GALLARDO
Checked J. A. CHURCH	Notes I.R. MOODY Date 4-23-68
Date 5 3 68	Indexed C. J. GALLI MAY 3 '68

F.B. 2951 Pg. 23

TO & PT SEE DR 25
CON'T BTM IPS 7, 29

P.C.

SET LA.CO. ENGR. TAG

FD SQ HD SPK IN HD. POSSIBLE REPLACEMENT FOR CU TACK REF. F.B. 901-27 USED FOR LINE NORTH

LANE IT

NOT PROVEN

AVE

REPLACED CHISEL W/LA. CO. ENGR. TAG

FD CHISEL NOT CHECKED FOR PROD

40.28

SET LA. CO. ENGR. TAG

FD SPK SET PM

CENTRAL

Note: Any Additions or Changes on this Sheet Must be Made or Circled in Red Ink With Date and Name of Person Making Change

Do not extend this side of this line.

PLEASE RETURN TO
LOS ANGELES COUNTY ENGINEER
403 Los Angeles County Engineering Bldg.

7825098 CE #310 8-66

F.B. 2951 Pg. 24

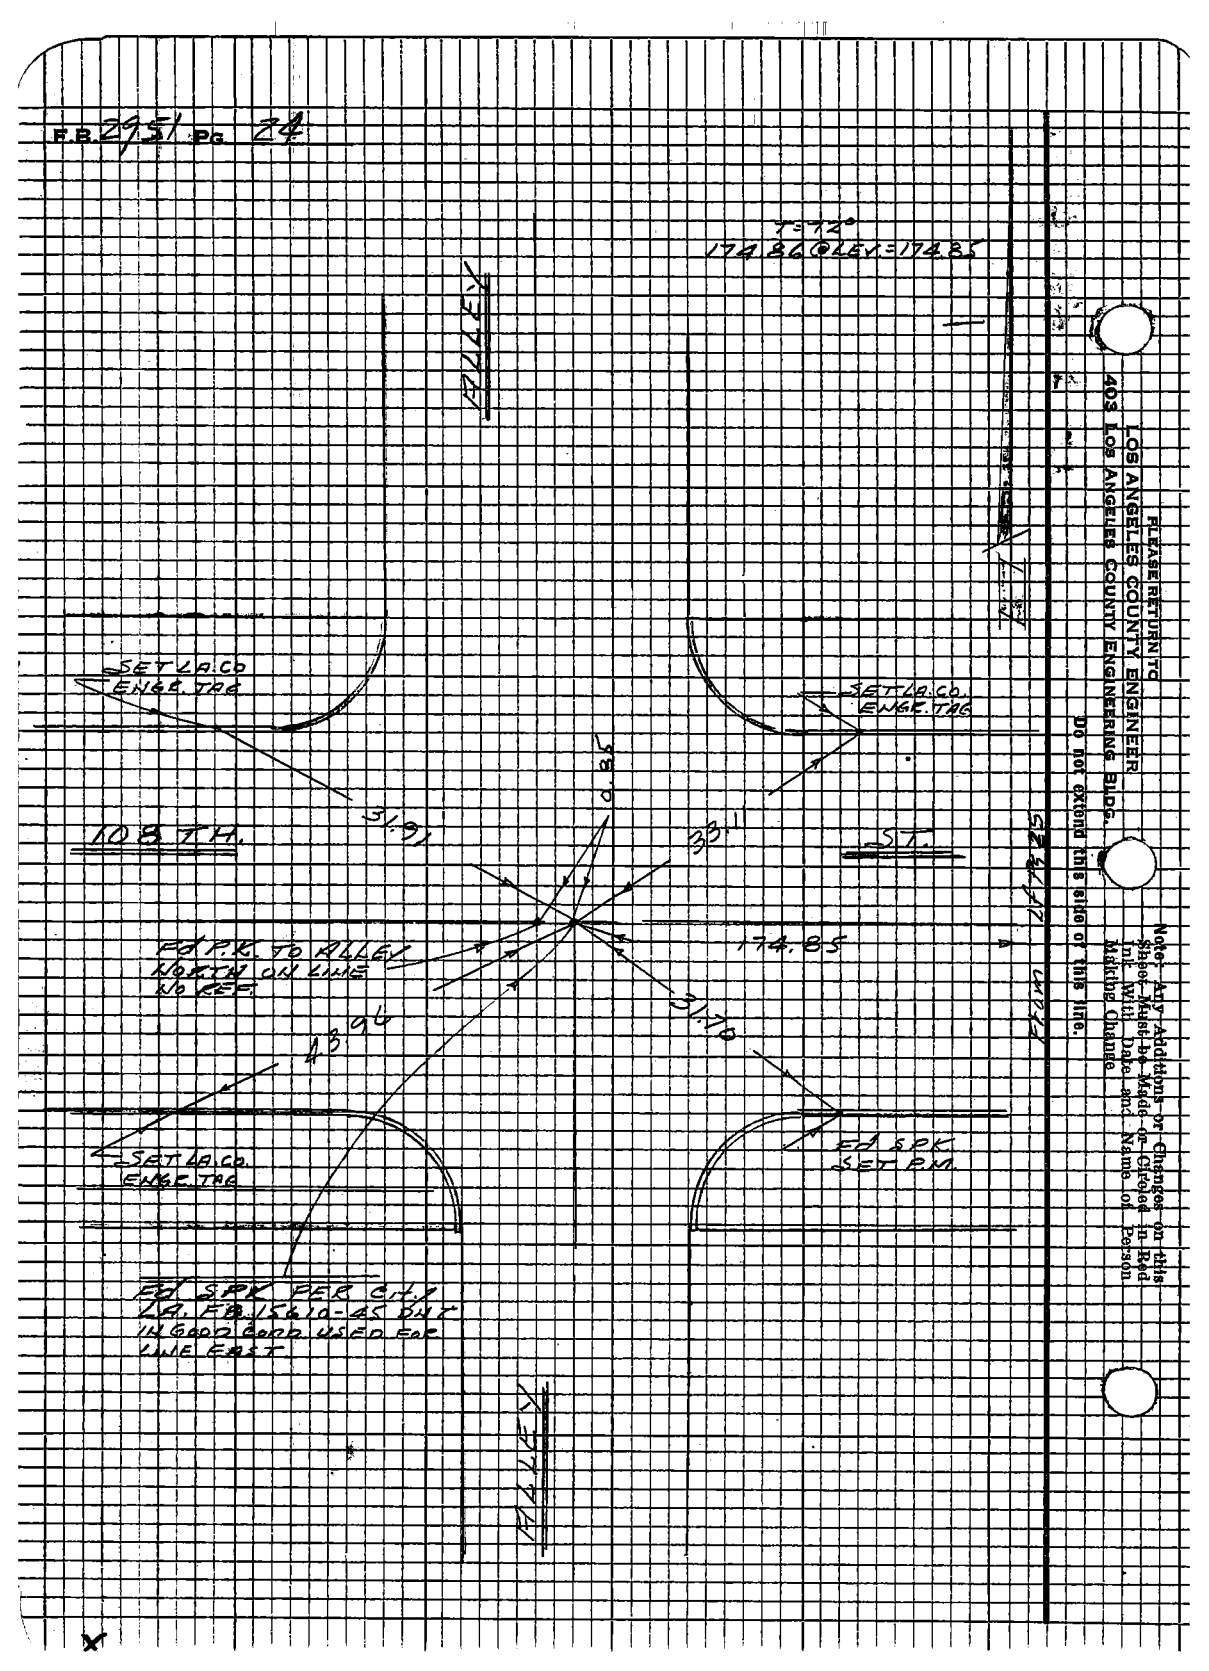

PLEASE RETURN TO
LOS ANGELES COUNTY ENGINEER
403 LOS ANGELES COUNTY ENGINEERING BLDG.

Do not extend this side of this line.

Note: Any Additions or Changes on this Sheet Must be Made or Circled in Red Ink With Date and Name of Person Making Change

50 CENTRAL AVE

Notes Ck'd by: [illegible]
Map No. B-5023
Office Work by: H. H. E. DONG
Checked: J. A. CHURCH
Date: JUL 31 '68

Survey of: Rive. Sec. Sew.
JN 0222.24 Tape 205 Std 84 °F
Surveyed by: Curtado AC.
Notes: ACG Date: Apr 22 1968
Indexed by: C. J. GALLI

F.B. 2951 Pg. 25

W. 5, 26, 6-7

Note: Any Additions or Changes on this Sheet Must be Made or Circled in Red Ink With Date and Name of Person Making Change

Do not extend this line.

PLEASE RETURN TO
LOS ANGELES COUNTY ENGINEER
405 Los Angeles County Engineering Bldg.

16P5098 CE #310 8-68

CENTRAL AVE

Fd 3/4" IP w/d plug & tk replaced w/ Cen & Brad N&L pee FB 901-29 dn 22° SET 2-2" ch w/ Surface ties on walk

Fd 3/4" IP w/d plug & tk replaced w/ cen & Brad N&L pee FB 901-29 dn 29° SET 2-2" ch w/ Surface ties on walk

Fd 3/4" IP w/d plug & tk replaced w/ Cen & Brad N&L pee FB 901-29 dn 25° SET 2-2" ch w/ Surface ties on walk

Fd Sq Bolt in D, FB 901-29 FB 1560-45

Fd Nail & Shr

Fd Nail & Shr

Fd Nail & Shr

PLEASE RETURN TO
LOS ANGELES COUNTY ENGINEER
403 Los Angeles County Engineering Bldg.

Note: Any Additions or Changes on this Sheet Must be Made or Circled in Red Ink With Date and Name of Person Making Change

Do not extend this side of this line.

W.S. 26, C-1

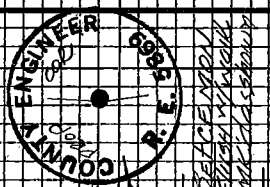

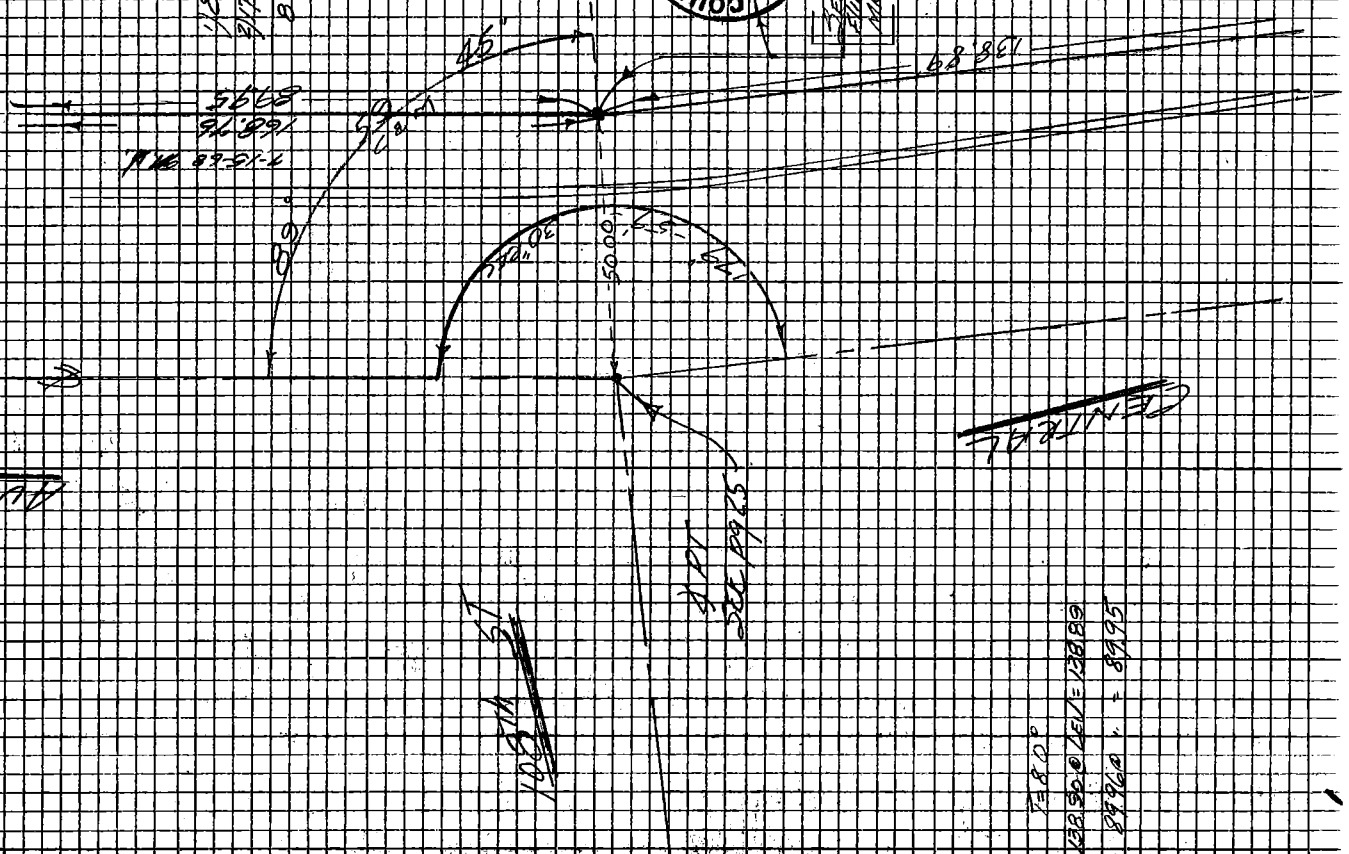
45°
138.89
50.00
90°
40'
S 43° 45' E
1189.37
S 46° 14' 23" W
1189.37
S 46° 14' 23" W
1189.37
S 46° 14' 23" W

So Central Dist

Notes Ck'd by: J. A. CHURCH		Survey of: Rte 605 South	F.B. 2931 Pg. 27
Map No. 8-5023		JN 002274 Tape 705 Std 60 °F	
Office Work: H. H. F. DONG		Surveyed by: AC Galluzzo	
Checked: J. A. CHURCH		Notes: ACG Date: 3/6/68	
Date: JUL 31 '68		Indexed: J. J. GALLI	

W.S. 25, C-1

Note: Any Additions or Changes on this Sheet Must Be Made or Circled in Red Ink With Date and Name of Person Making Change

Do not extend this side of this line

PLEASE RETURN TO
LOS ANGELES COUNTY ENGINEER
403 LOS ANGELES COUNTY ENGINEERING BLDG.

Cont'd

Sta. 49+44.32

1) 89°-07'-40"
2) 356-31-00
3) 174-46-30
89°-07'-45"

TOAT 3274
MB 35-86

SET MONUMENT ON A-B LOT and B-C 39.44 HELD FOR EAST

SET L&LAGO ENGR TAG

SET L&LAGO ENGR TAG

SET BRASS NAIL in Id BY INT

SET L&LAGO ENGR TAG on C prod

SET L&LAGO ENGR TAG

SET L&LAGO ENGR TAG

SET L&LAGO ENGR TAG

SET REMON Flush Mkd as shown

REMOVED 7-16-68 M.D.

107th ST

199.39 M&T

RE RAMSDELL TRACT #2

1) 89-07-50
2) 356-31-20
3) 174-47-00
89°-07'-50"

Te 80°
108.81 @ Tel = 108.81
199.80 @ " = 199.39

COUNTY ENGINEER
R. E. 5809

7695095 CE #310 5-66

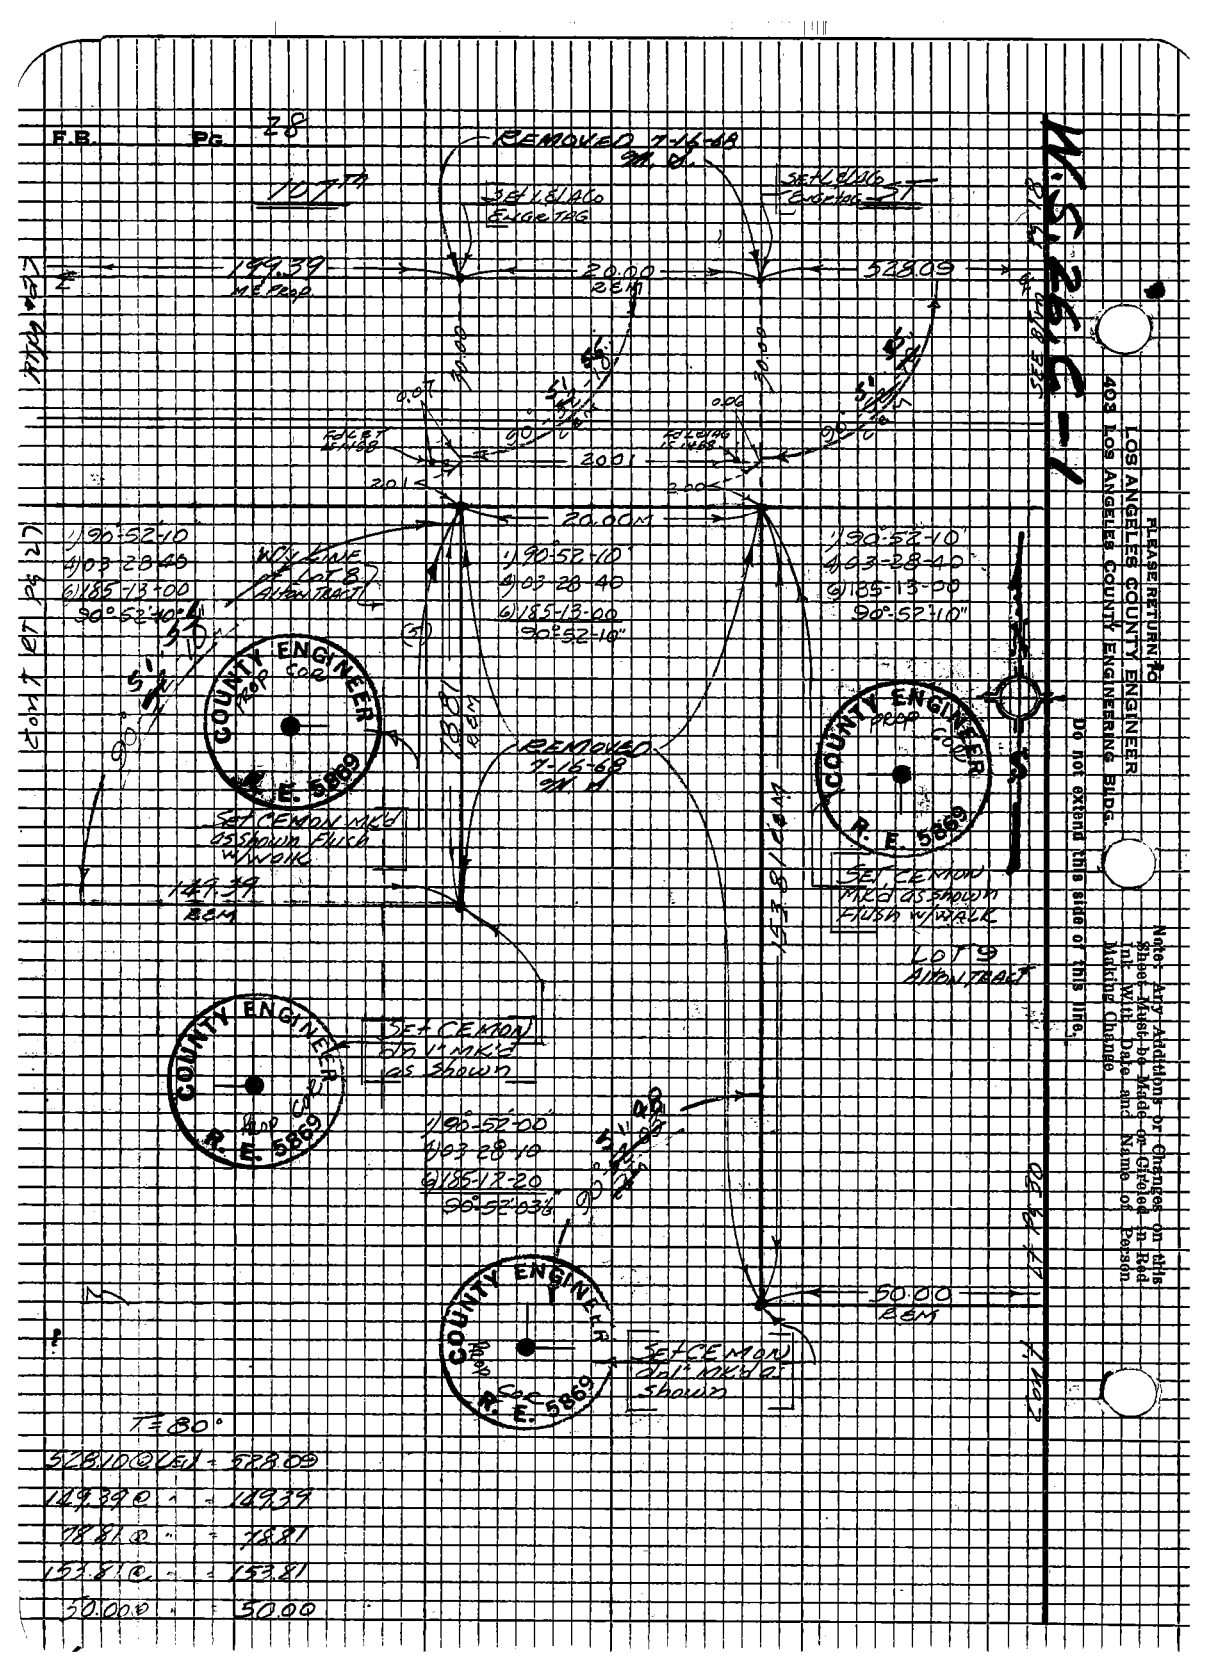
F.B. Pg 28
REMOVED 7-16-68
SET L&T/TAG
78.81 @ " = 78.81
153.81 @ " = 153.81
50.00 @ " = 50.00
PLEASE RETURN TO
LOS ANGELES COUNTY ENGINEER
403 LOS ANGELES COUNTY ENGINEERING BLDG.
Do not extend this side of this line.
Note: Any Additions or Changes on this Sheet Must be Made or Circled in Red Ink With Date and Name of Person Making Change

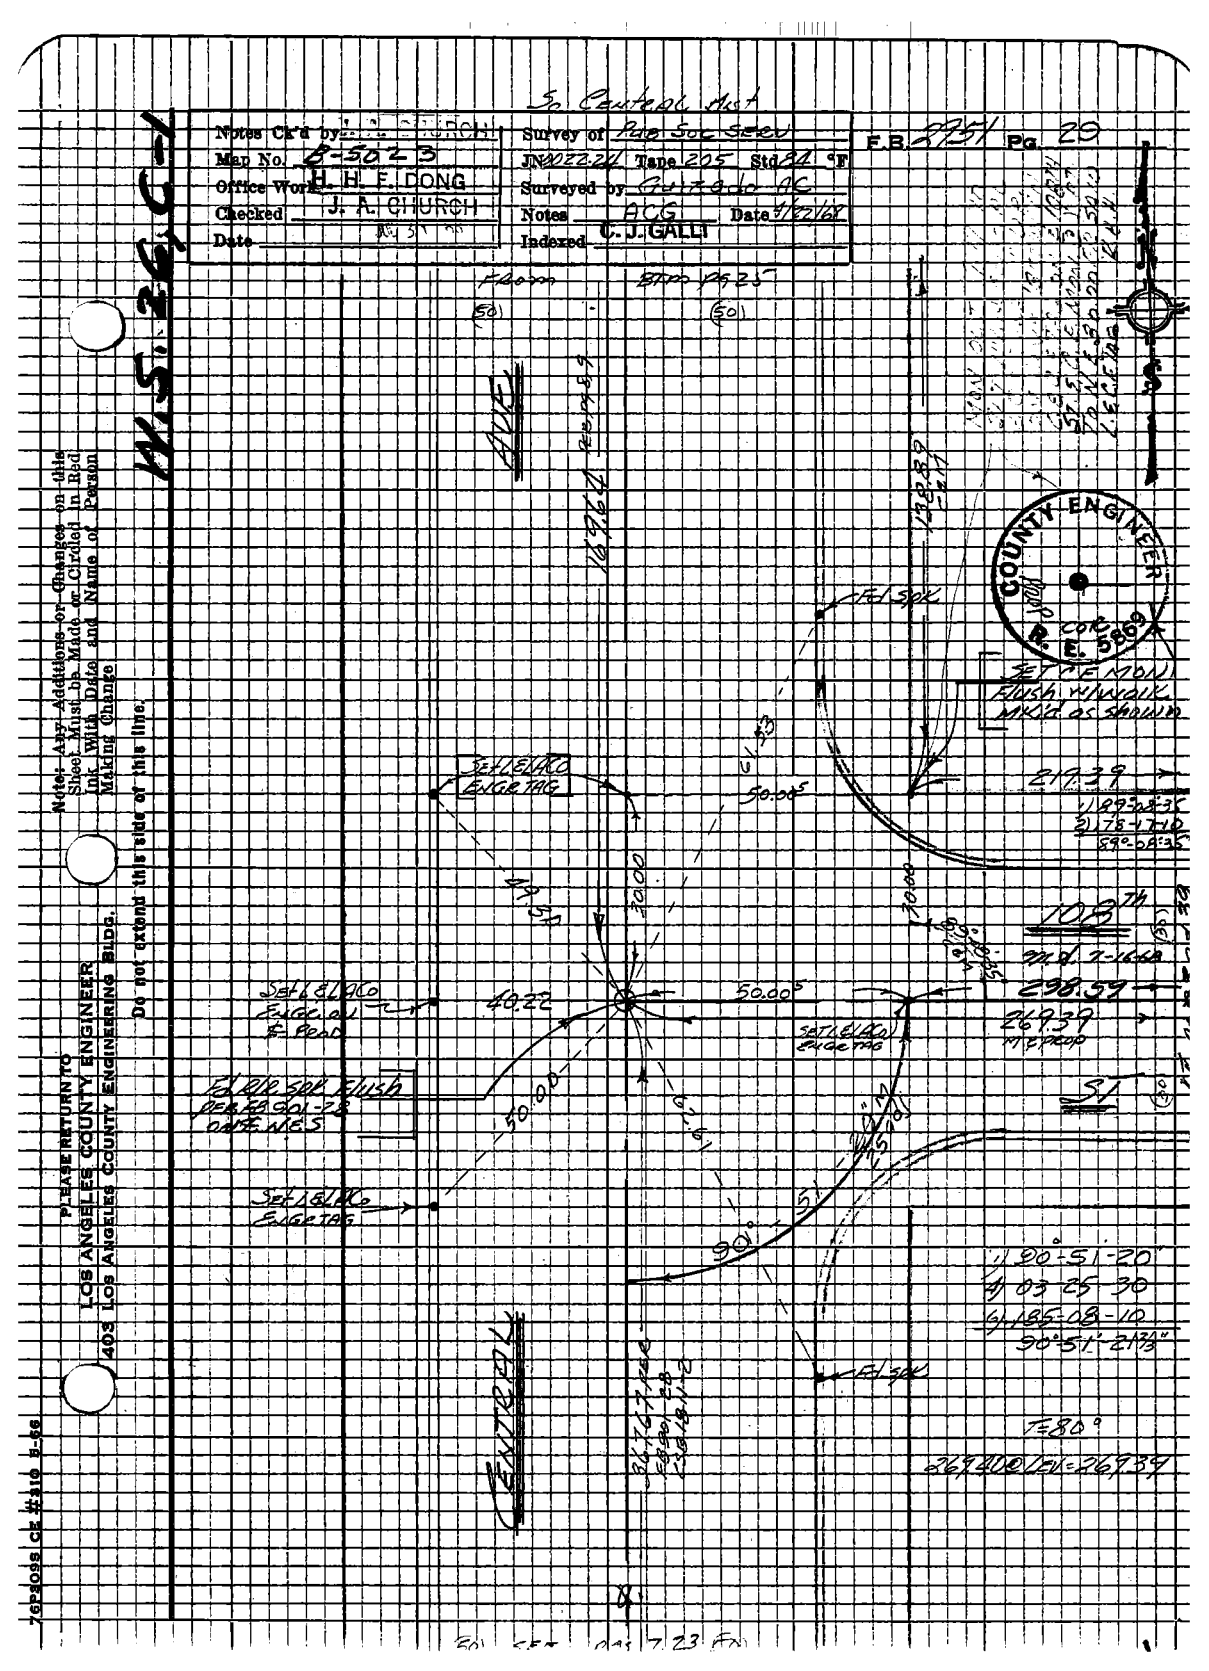
Notes Ck'd by J. A. CHURCH
Map No. B-5023
Office Work H. H. F. DONG
Checked J. A. CHURCH
Date
Survey of Rds Soc Seed
JN 0022.21 Tape 205 Std 81 °F
Surveyed by Gutierrez AC
Notes AC/G Date 1/22/68
Indexed C. J. GALLI
F.B. 8251 Pg. 29
W.S. 36 C-1
Note: Any Additions or Changes on this Sheet Must be Made or Circled in Red Ink With Date and Name of Person Making Change
Do not extend this side of this line.
PLEASE RETURN TO
LOS ANGELES COUNTY ENGINEER
403 Los Angeles County Engineering Bldg.
COUNTY ENGINEER
R. COR.
E. 586.9
SET LEAD & ENGR TAG
SET NAIL FLUSH W/WALK MKD AS SHOWN
E19.39
1 89°-08'-35"
2 178°-17'-10"
89°-08'-35"
E98.52
26.39 MEASD
SET LEAD & ENGR TAG
SET LEAD & ENGR TAG
E 0.26 SOC FLUSH
SET LEAD & ENGR TAG
90°
1 90°-51'-20"
2 03°-25'-30"
3 185°-08'-10"
90°-51'-21.3"
T=80.9
26.93 @ E=26.93
7GP2015 CK #310 8-68

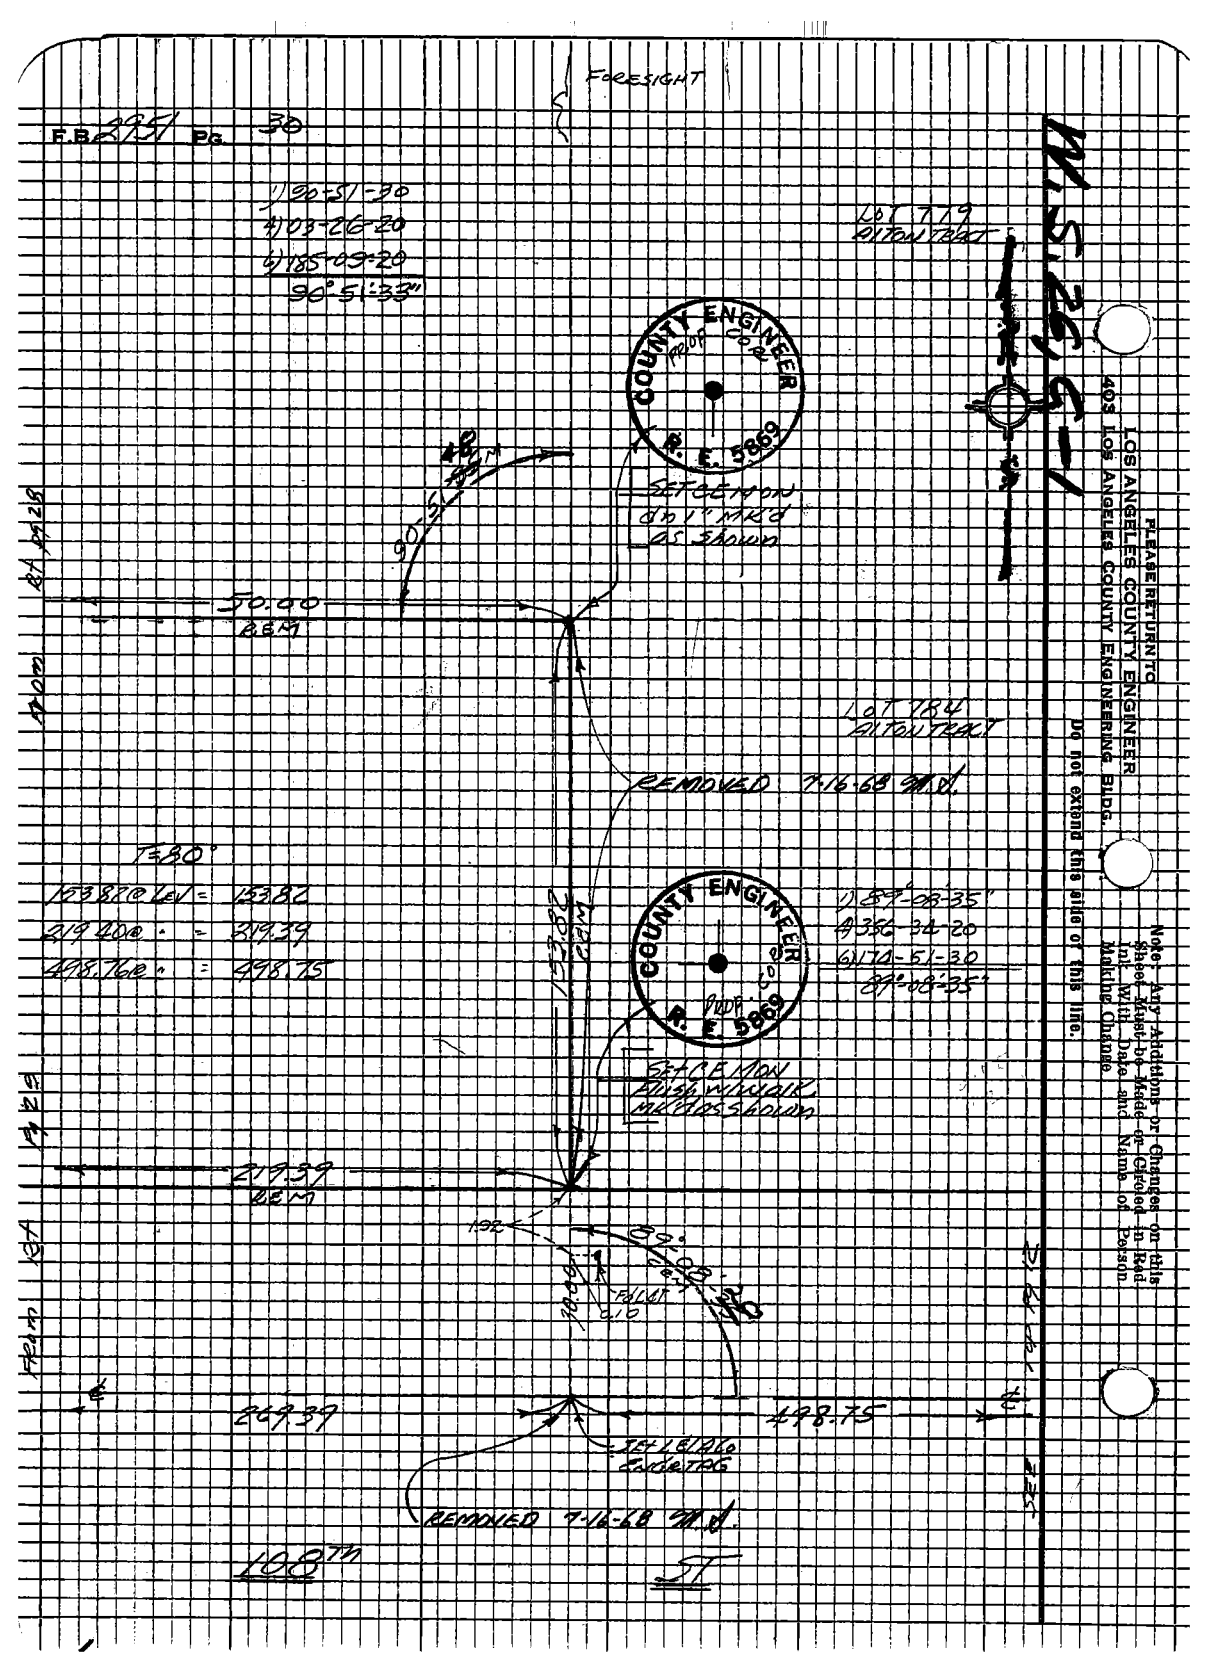
F.B. 4951 Pg. 30
FORESIGHT
1) 90-51-30
4) 103-26-20
6) 185-09-20
90°-51'-35"
LOT 719
OLTON TRACT
COUNTY ENGINEER
PROJ. COR.
R. E. 5869
SET CENTER PRINT "1 AP" AS SHOWN
50.00 REM
LOT 784
OLTON TRACT
REMOVED 7-16-68 M.M.
T=30'
153.82 @ Rad = 153.82
219.20 @ " = 219.39
498.76 @ " = 498.75
COUNTY ENGINEER
PROJ. COR.
R. E. 5869
1) 89°-08-35"
4) 36°-34-20
6) 174°-51-30
89°-08-35"
SET CENTER PUNCH IN HUB AS SHOWN
219.39 REM
498.75
SET L.B.&L. No. 5869 TACK
REMOVED 7-16-68 M.M.
108.7m
ST
403 LOS ANGELES COUNTY ENGINEERING BLDG.
LOS ANGELES COUNTY ENGINEER
PLEASE RETURN TO
Note: Any Additions or Changes on this Sheet Must be Made or Circled in Red Ink With Date and Name of Person Making Change
Do not extend this side of this line.

W.S. 7-B-6

Notes Ck'd by T. A. CHURCH
Map No. B-5023
Office Work H. H. F. DONG
Checked J. A. CHURCH
Date 6-14-68

Survey of Rds. Sec. 32 etc.
JN 0022.24 Tape 20± Std 24 "F"
Surveyed by Gardena D.C.
Notes H.C.C. C.J. GALLI Date 4/24/68
Indexed

F.B. 8951 Pg. 31

NOTE: THIS PAGE ADDED BY DCG PER FB 2776 PG 21 & USED SAME FOR E & SOUTH

SEE Bkm FB 2776 Pg 23

L.A. City DEPT OF WATER & POWER

(50) (50)

N

Ave

152.48

FD 1/2" IRN EL 3.12' BC. CAD CITY OF L.A. TRONEFOSE STAMPED LAD 12 25 MKD "WATER & P 1964" C.I. NOT VISITED 1968

FD 3/4" IPE BENT DISC. BC. EB 3/127-47 901-47 CITY OF LA 20107-B

3999 3998

39

39

FILLET

FILLET

FILLET

90°

90°

90°

CENTURY

BLVD

11.46

11.46

13.46

37.46

33.33

127.43

151.53

7104

0.06

FILLET

FILLET near BK of curb

40.02

3998

90°

91

Ave

CENTURY

(50) (50)


SEE FB 2776 Pg 23

SEE FB 2776 Pg 21

Note: Any Additions or Changes on this Sheet Must be Made or Circled in Red Ink With Date and Name of Person Making Change

Do not extend this side of this line.

PLEASE RETURN TO
LOS ANGELES COUNTY ENGINEER
403 Los Angeles County Engineering Bldg.

7695 | CK #310 8-65

F.B. 2751 Pg. 32

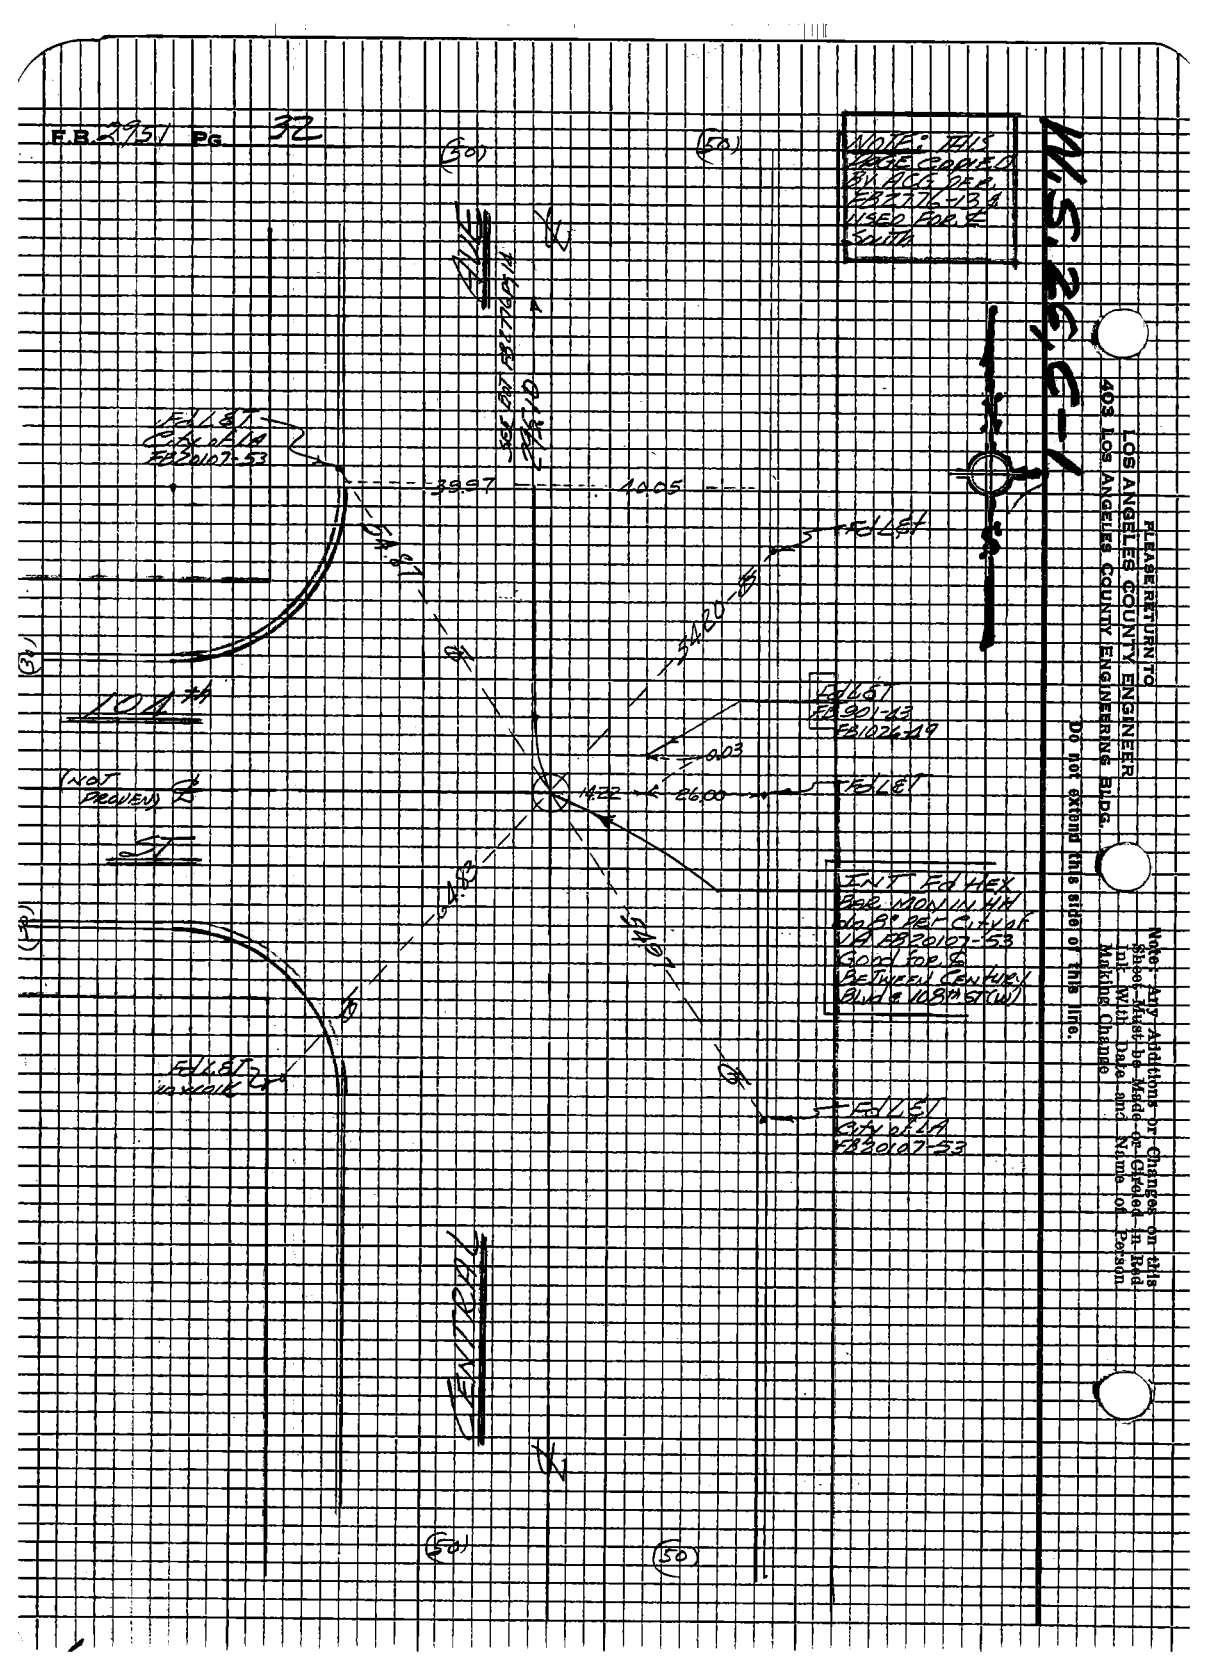

PLEASE RETURN TO
LOS ANGELES COUNTY ENGINEER
403 LOS ANGELES COUNTY ENGINEERING BLDG.

Do not extend this side of this line.

Note: Any Additions or Changes on this Sheet Must be Made or Checked in Red Ink With Date and Name of Person Making Change

So Central Dist

Notes Ck'd by J. A. CHURCH		Survey of Pub Soc. Serv	F.B. 2951 Pg. 33
Map No. B-5023		JN 0022 24 Tape 228 Std 64 °F	
Office Work H. H. F. DONG		Surveyed by Quirado AG	
Checked J. A. CHURCH		Notes DCS Date 5-2-68	
Date MAY 29 '68		Indexed C. J. GALLI MAY 3 '68	

JOB NO 0022.24

So Central District

Public Social Service

Location of

Boundary FENCES

Quirado

Moody, Smith, Henderson, Beaudry

Note: Any Additions or Changes on this Sheet Must be Made or Circled in Red Ink With Date and Name of Person Making Change

Do not extend this side of this line.

PLEASE RETURN TO
LOS ANGELES COUNTY ENGINEER
403 Los Angeles County Engineering Bldg.

7-6230-3 CK #310 5-68

F.B. 2951 Pg. 34

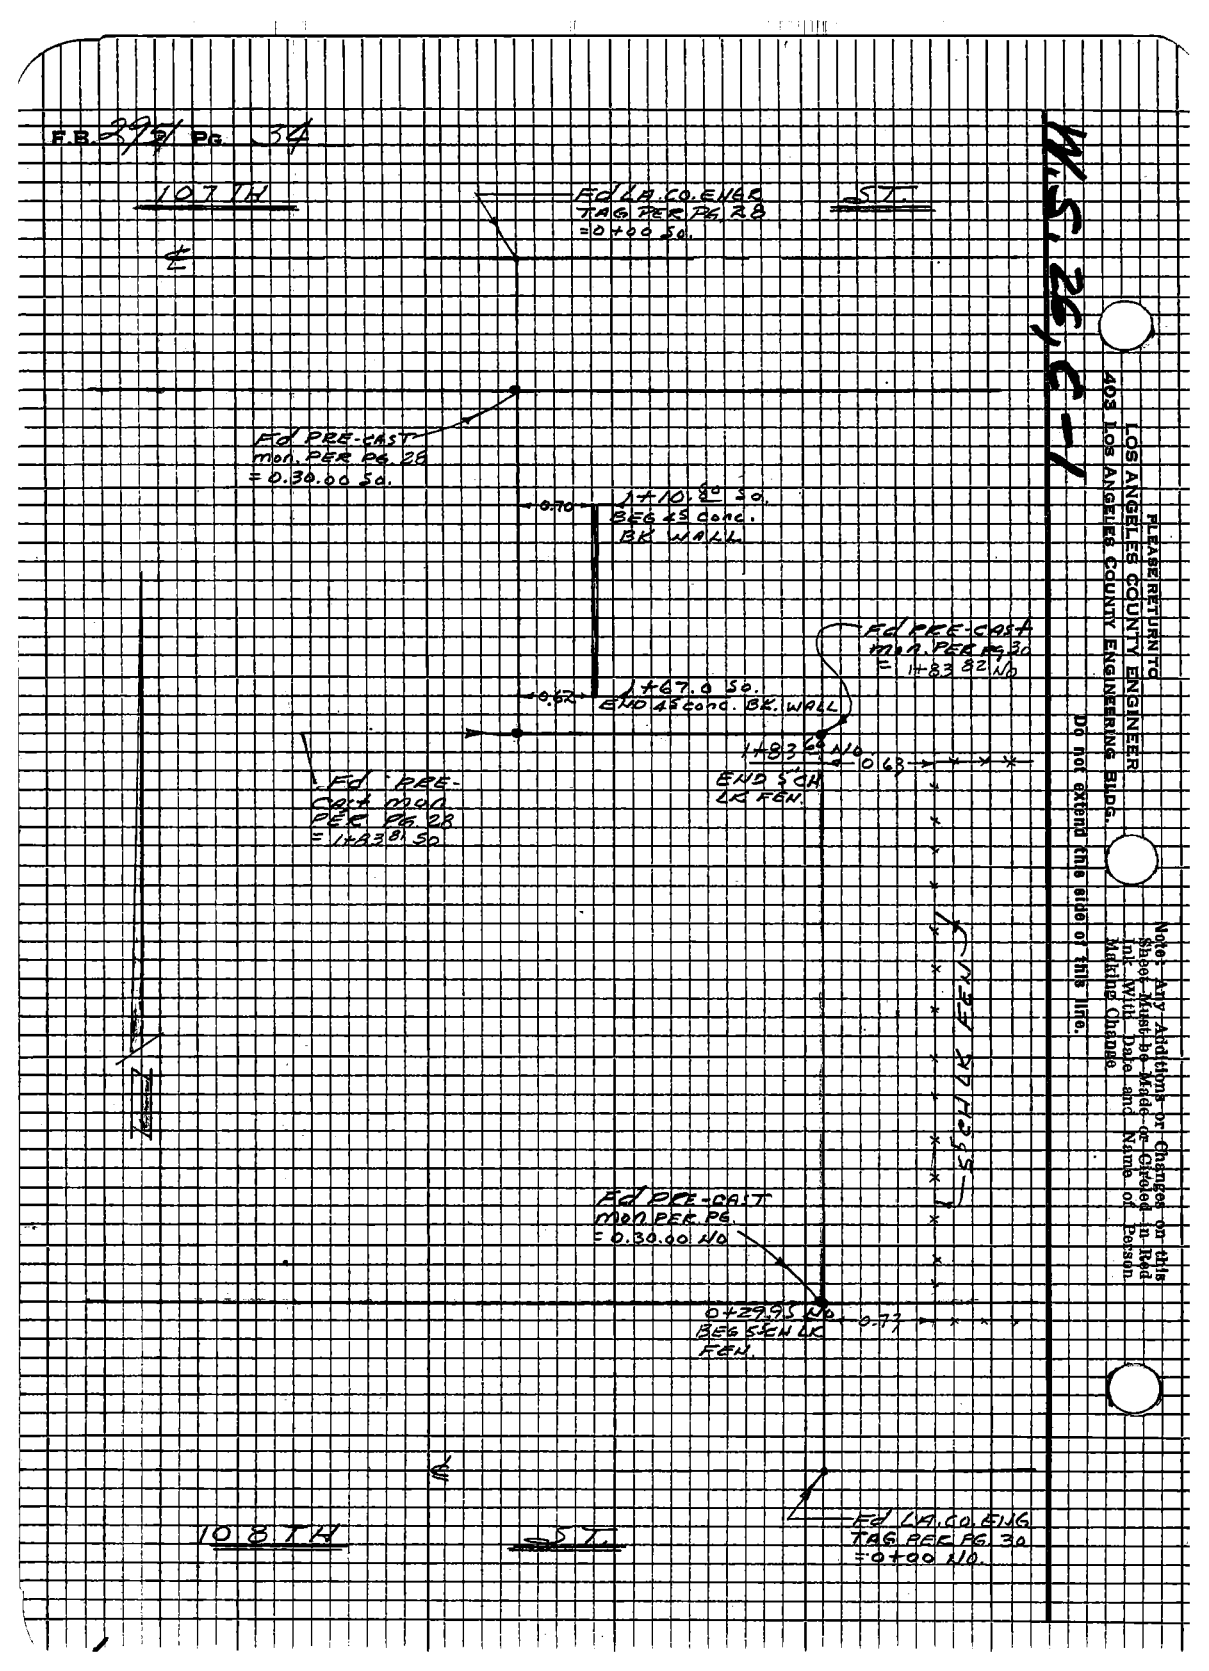

WMS 25 C-1

PLEASE RETURN TO
LOS ANGELES COUNTY ENGINEER
403 LOS ANGELES COUNTY ENGINEERING BLDG.

DO not extend this side of this line.

Note: Any Additions or Changes on this Sheet Must be Made or Circled in Red Ink With Date and Name of Person Making Change

Notes Ck'd by: J. A. CHURCH		Survey of: SOUTH CENT. DIST. OFFICE	F.B. 2951 Pg. 35
Map No. B-50123		J.N. 0022.24 Tape 0215 Std. 68°F	
Office Work: H. H. F. DONG		Surveyed by: M. SOTELO	
Checked: J. A. CHURCH		Notes: M. S. Date: 11-68	
Date: 11-31-68		Indexed:	

J.N. 0022.24

SOUTH CENTRAL DISTRICT OFFICE
DEPARTMENT
OF
PUBLIC SOCIAL SERVICE

ADDITIONAL
PROPERTY LINES

REFERENCE: E.E. RAMSAUR TRACT NO. 2
ALTON TRACT
F.B. 2951

SOTELO
SMITH
MASSEY
MOHR

PLEASE RETURN TO
LOS ANGELES COUNTY ENGINEER
402 LOS ANGELES COUNTY ENGINEERING BLDG.

Note: Any Additions or Changes on this Sheet Must be Made or Circled in Red Ink With Date and Name of Person Making Change

Do not extend this line of this line.

7683DS ck #310 F-66

PLEASE RETURN TO
LOS ANGELES COUNTY ENGINEER
403 Los Angeles County Engineering Bldg.

Note: Any Additions or Changes on this Sheet Must be Made or Circled in Red Ink With Date and Name of Person Making Change

Do not extend this side of this line.

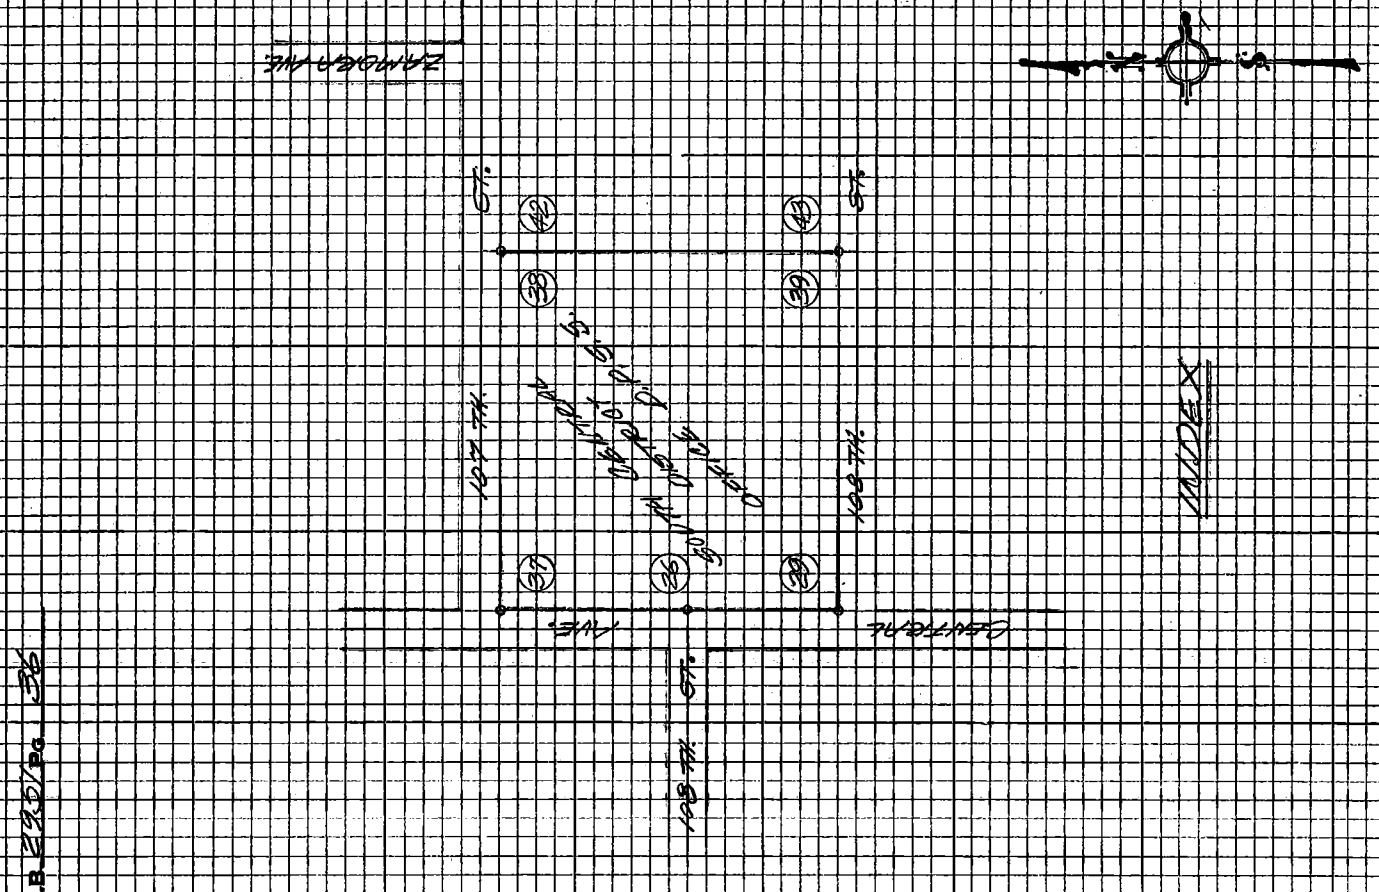

7693093 CE #310 E-66

PLEASE RETURN TO
LOS ANGELES COUNTY ENGINEER
403 LOS ANGELES COUNTY ENGINEERING BLDG.

Note: Any Additions or Changes on this Sheet Must be Made or Circled in Red Ink With Date and Name of Person Making Change

Do not extend this side of this line.

W.S. 26, C-1

30.00 @ T60° = 30.00
165.76 @ T88° = 165.76

50.00 @ T 60° = 50.00
298.56 @ T82° = 298.56

INT. RECD. W&L PAGE 37

PC 1000 + 96.79 AH RECD. PAGE 27

CENTRAL AVE.

(60) (60) (50) (50)

1028

50.00

30.00

21.01

165.76

R/W

90°

S 17° W

298.56

306.58 R/W

EXIST. 12" V.C.P. S.D.

EXIST. 12" V.C.P. S.D.

EXIST. 12" V.C.P. S.D.

PLEASE RETURN TO
LOS ANGELES COUNTY ENGINEER
403 LOS ANGELES COUNTY ENGINEERING BLDG.

Note: Any Additions or Changes on this Sheet Must be Made or Circled in Red Ink With Date and Name of Person Making Change

Do not extend this side of this line.

W.S.26,C-1

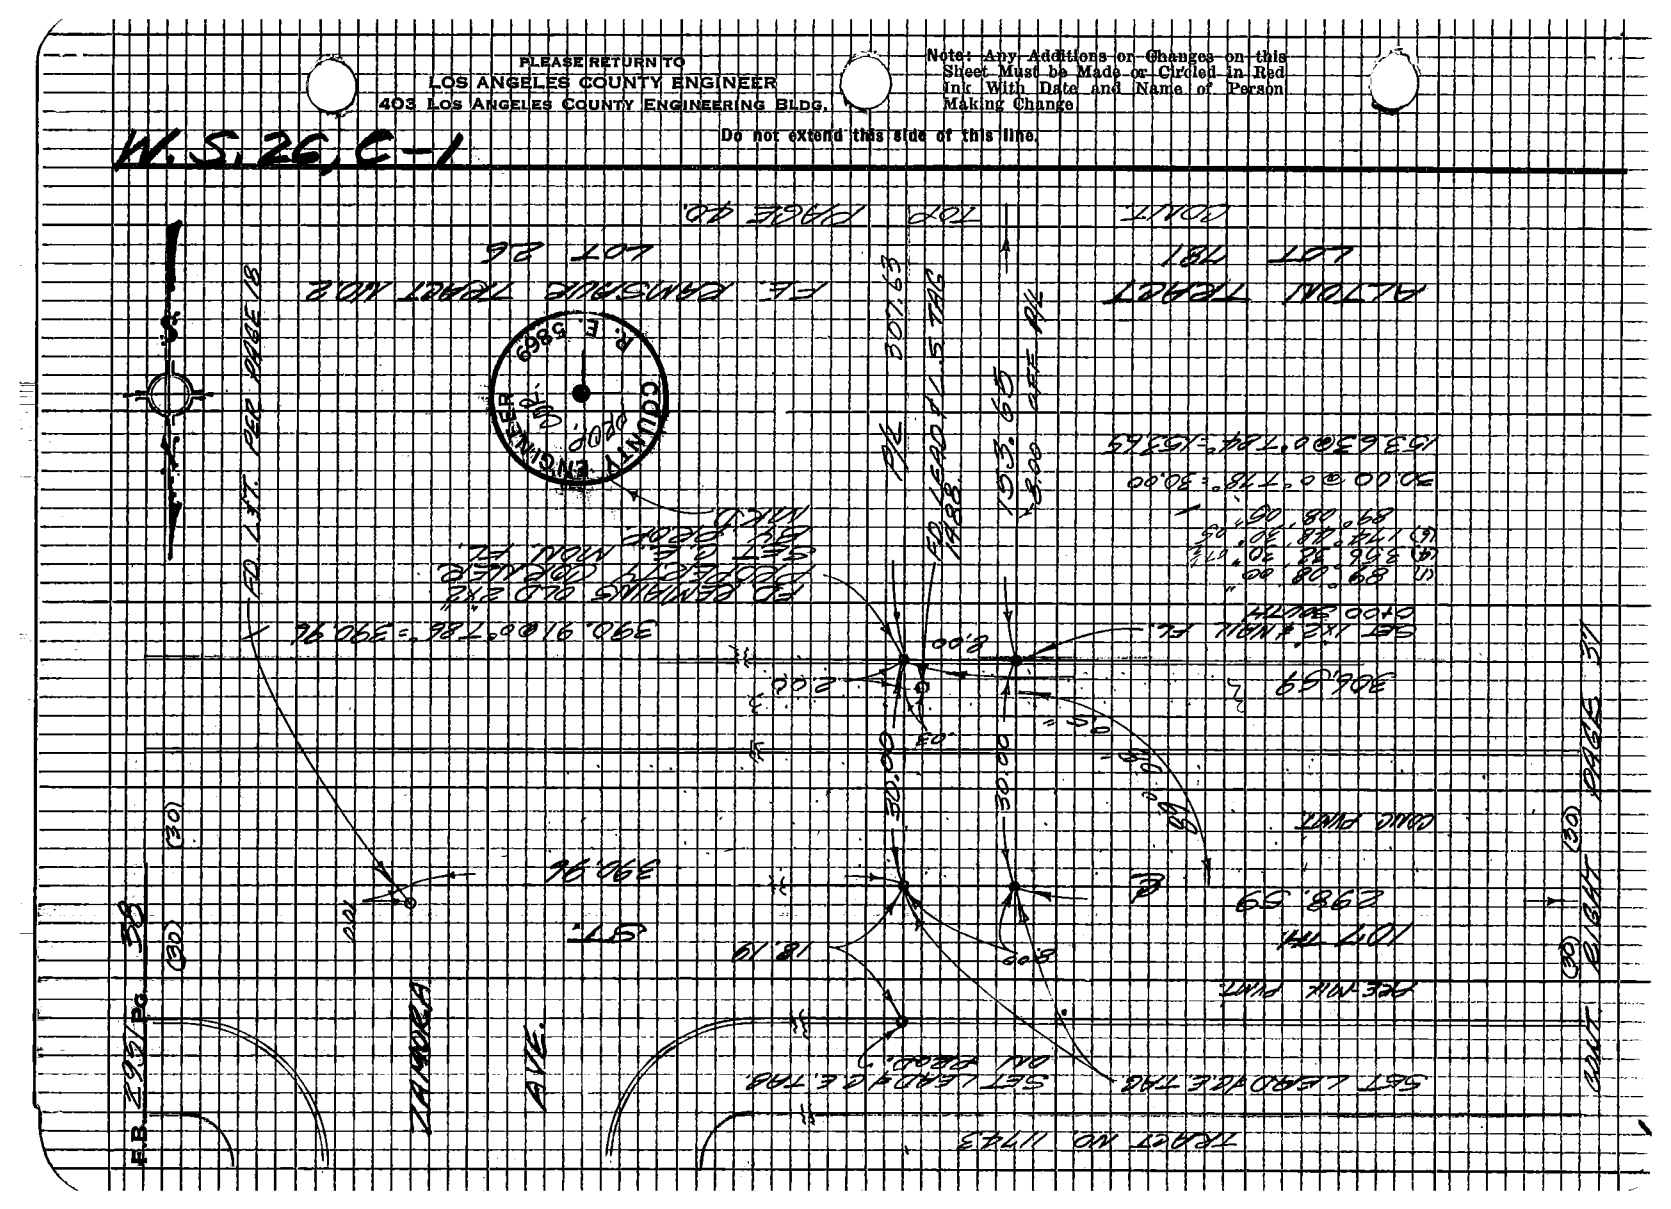

76PADSS CE #210 5-46

PLEASE RETURN TO
LOS ANGELES COUNTY ENGINEER
403 LOS ANGELES COUNTY ENGINEERING BLDG.

Note:- Any Additions or Changes on this Sheet Must be Made or Circled in Red Ink With Date and Name of Person Making Change

Do not extend this side of this line.

M.S. 26, C-1

COMP. BDY.

ALTON TRACT


























ST.

(30)

(30)

(30)

(30)

COUNTY ENGINEER SURVEY PROJ. L.A. CO. 5889

Notes Chkd by J. A. CHURCH
Map No. S-5023
Office Work H. H. F. DONG
Checked J. A. CHURCH
Date 1-31-58

Survey of Comp. Cor. Adj. JN22 Trans 22 Std 65 'N
Surveyed by M. L. Scott
Notes
Indexed
Date 7-22-58

F B 2987 Pg. 39

PLEASE RETURN TO
LOS ANGELES COUNTY ENGINEER
403 Los Angeles County Engineering Bldg.

Note: Any Additions or Changes on this Sheet Must be Made or Circled in Red Ink With Date and Name of Person Making Change

Do not extend this side of this line.

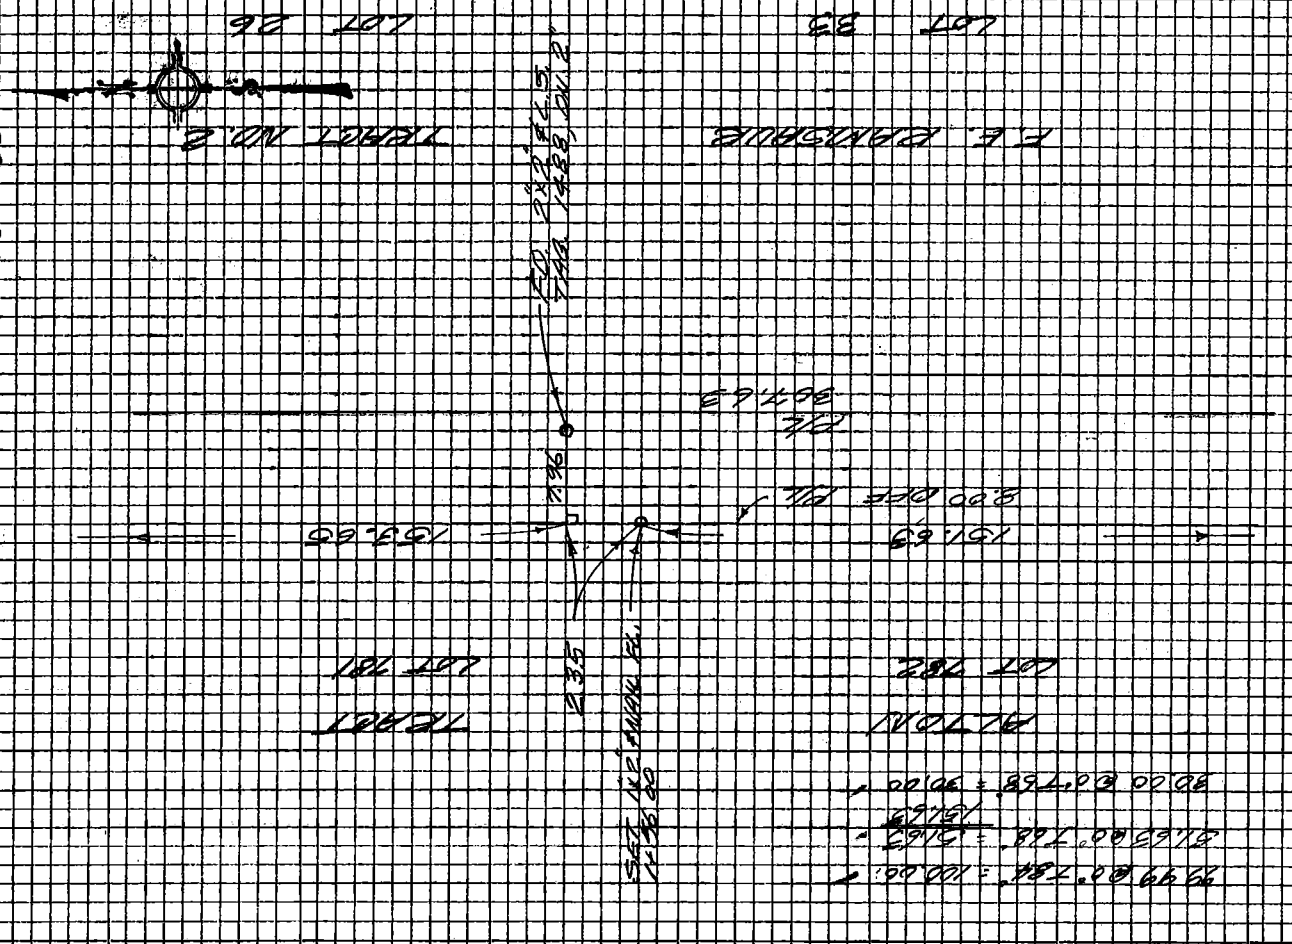

Notes Ck'd by	Survey of SOUTH CENTRAL 455 F.B. 2951 Pg. 44
Map No.	JN 00224 Tape Std 68 °F
Office Work	Surveyed by M. SOTRO
Checked	Notes M.S. Date 7-12-68
Date	Indexed

J.N. 00224

SOUTH CENTRAL

DISTRICT OFFICE

DEPARTMENT OF SOCIAL

SERVICE

LOCATION OF IMPROVEMENTS ALONG

EAST LINE LOT 181, ALTON TRACT

AS AMENDED

SOTRO

SMITH

MASSEY

M049

PLEASE RETURN TO
LOS ANGELES COUNTY ENGINEER
1403 LOS ANGELES COUNTY ENGINEERING BLDG.

Do not extend this side of this line.

Notes: Any Additions or Changes on this Sheet Must be Made or Circled in Red Ink With Date and Name of Person Making Change

7SP309 CK #310 5-68

F.B. 2951 Pg. 42

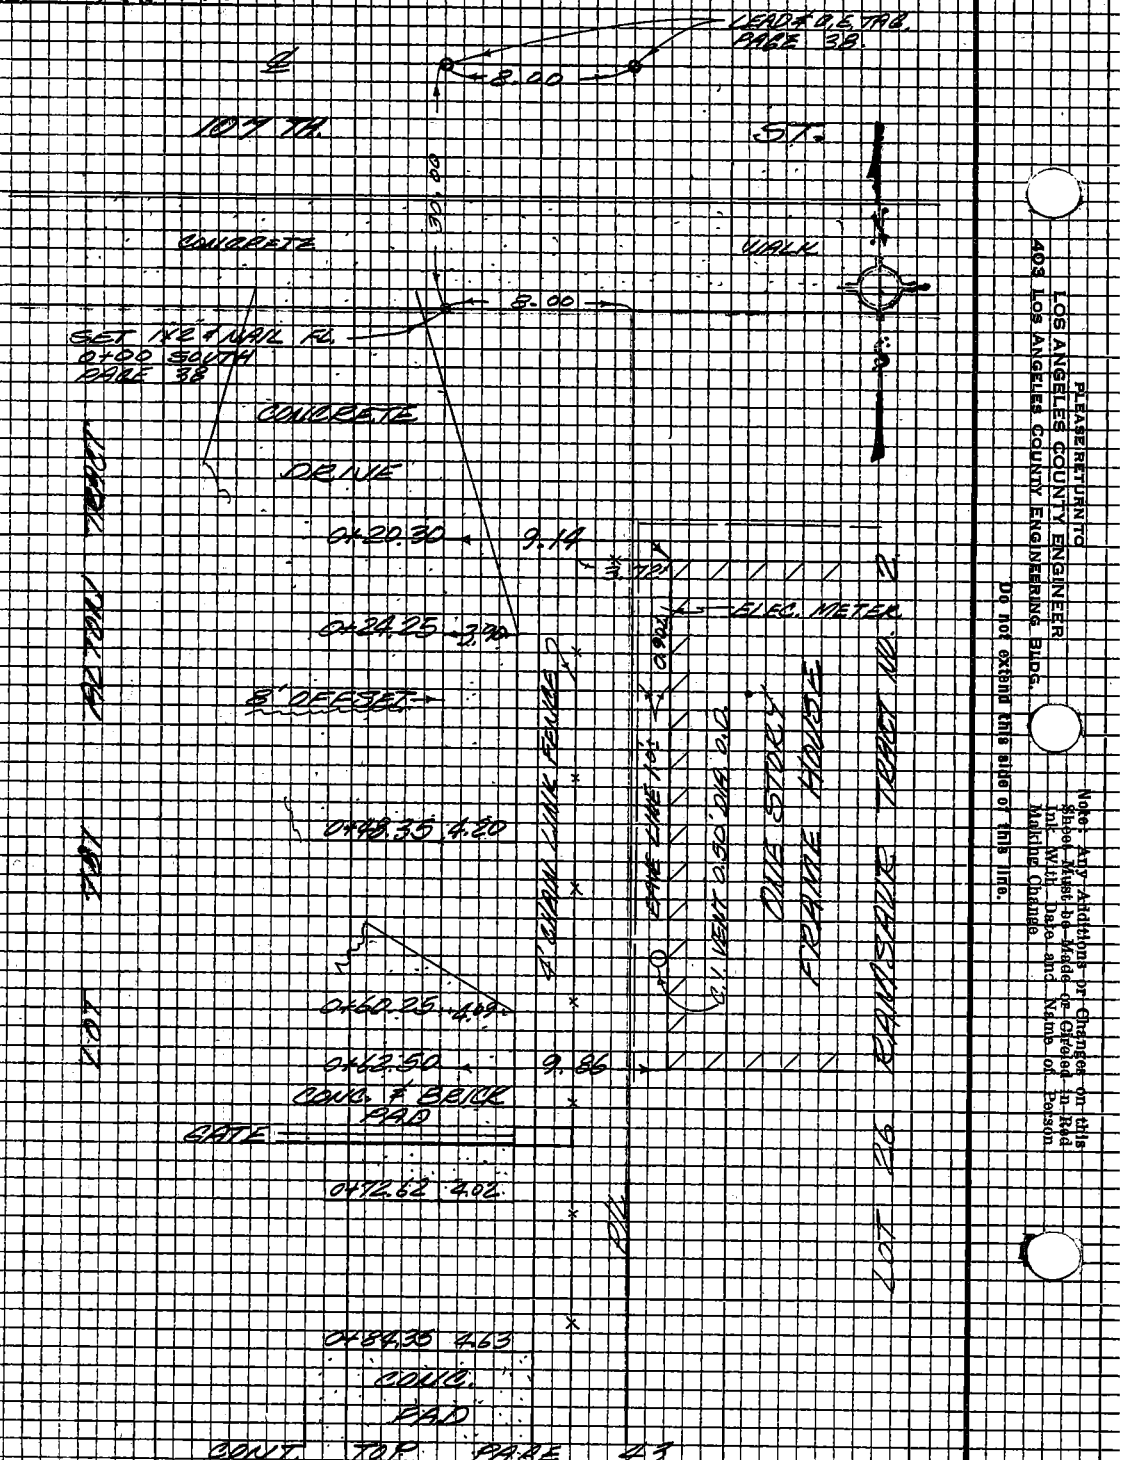
LEAD & O.E. TAG PAGE 38
R=8.00
107 TH.
S.T.
CONCRETE
WALK
8.00
SET NAIL & WASH. RT. 0+00 SOUTH PAGE 38
CONCRETE
DRIVE
0+20.30
9.14
0+24.25
3.96
8' FENCE
0+48.35 4.20
0+60.25 4.09
0+62.50
CONC. & BRICK PAD
GATE
9.86
0+72.62 4.02
0+84.36 4.63
CONC. PAD
CONT. TOP PAGE 43
WOOD FENCE
ELEC. METER
WOOD FENCE
WOOD FENCE
WOOD FENCE

Notes Ck'd by
Map No.
Office Work
Checked
Date

Survey of S. CENTRAL DIST. DR. 55
IN 2022 Tape 2215 Std 68 °F
Surveyed by M. SOTRO
Notes M. S. Date 7-1968
Indexed

F.B. 2951 Pg. 45

CONT. FROM PAGE 42.

0+84.7 ← 5.93 ← FENCE CHANGES TO Ø CHAIN LINE

CONT. ON PAGE

17+04.80 4.62

Ø CHAIN LINE

14+52.69 → 6.25 → END Ø CHAIN LINE FENCE

17+36.00
1/2" IV NAIL
PAGE 40

BEGINNING OLD 3 BOARD FENCE

14+81.90 ← 10.28 →

8' OFFSET →

2+09.90 ← 10.65 →

2+40.08 ← 11.00 →

2+90.09 ← 11.47 →

END BOARD FENCE

8' CHAIN LINK FENCE

3+07.39 → 6.85 →

CONT. ON PAGE

108 TH. ST.

Ø

← 8.00 →

5437.63
NAIL PAGE 39

S.W. CR. PAGE 39

Notes: Any Additions or Changes on this Sheet Must be Made or Circled in Red Ink With Date and Name of Person Making Change

Do not extend this side of this line.

PLEASE RETURN TO
LOS ANGELES COUNTY ENGINEER
403 Los Angeles County Engineering Bldg.

76-2058 CE #210 8-68

Profile No. | Notes Red Date | Plotted Date | Job No. 9000.02 | Division No. 11 | F.B. 2951 Pg. 45

X-Sec. No. | Notes Ck'd. Date OCT 1 1970 | Checked Date | Survey of P.S.S. So. CENTRAL DIST. OFFICE BLDG | Survey by R.B.H. | Notes R.B.H. Date 9-17-70 | Map No. | Indexed G.L. DAVIS Date SEP 25 70

P.S.S. SOUTH CENTRAL DISTRICT OFFICE BUILDING

J.N. 9000.02

BENCH LEVELS ON PROP. COR.'S TO ESTABLISH VERTICAL CONTROL FOR CONSTRUCTION.

BASED ON T.B.M. #2 EL. = 103.517, F.B. 2951-21

SEPT. 17, 1970

HOBSON
YASUI
CROWDER

STATION	B.S.	H.I.	F.S.	ELEV.

NOTE: ANY ADDITIONS OR CHANGES ON THIS SHEET MUST BE MADE OR CIRCLED IN RED INK, WITH DATE AND NAME OF PERSON MAKING CHANGE.

Do not extend notes this side of this line.

PLEASE RETURN TO
LOS ANGELES COUNTY ENGINEER
403 Los Angeles County Engineering Bldg.

76-L-298 CE 307 2-63

76-L-298 CE 307 2-63

PLEASE RETURN TO
LOS ANGELES COUNTY ENGINEER
403 LOS ANGELES COUNTY ENGINEERING BLDG.

NOTE: ANY ADDITIONS OR CHANGES ON THIS SHEET MUST BE MADE OR CIRCLED IN RED INK, WITH DATE AND NAME OF PERSON MAKING CHANGE

Do not extend notes this side of this line.

F.B. 2951 PG. 46 Job No. 9000.02 Division No. 11 Notes Red. Plotted. Profile
Survey of P.S.S. So. Central Dist. Office Bldg. Date. No. X-Sec.
Survey by R.B.H. Notes R.B.H. Notes Chkd. Checked. No.
Indexed G.H.BAKER Date Date Date

STATION	B.S.	H.I.	F.S.	ELEV.	
FD. B.M. BY 3763				104.137	B.M. BY 3763 ELEV. = 104.137 WOLTS 1965 L.+ B.M., E. C.B. CENTRAL AVE., 38'± E. & ON ℄ PROD. 108TH ST. (EXCEPT 40'± ℄ LE BR. WOLTS (ABOVE DESCRIPTION) PER F.B. 2951-20)
		N.G. → NAIL HAS BEEN REMOVED R.B.H. 9-17-70			
FD. T.B.M. #2	4.848	108.365		103.517	T.B.M. #2 ELEV. = 103.517 F.B. 2951-21 CENTRAL AVE. & 108TH ST., S.E. COR. 1'± SO. OF THE SO. C.B. RETURN. SO. HD. SPK. IN LEAD IN CONC. C.B.
S.W. PR. COR.	6.212	109.312	5.765	103.100	S.W. PROP. COR. (SEE PG. 29 FOR LOCATION) 1" I.P., CONC. PL. E.C.E. TAG, 8.' BELOW G. OF WALK
PR. COR.	4.974	109.550	4.736	104.576	PROP. COR. ⌀ PT. IN W. P/L (SEE PG. 26 FOR LOC. C.E. MON. FL. W/WALK
N.W. PR. COR.	4.559	109.420	4.669	104.881	N.W. PROP. COR. (SEE PG. 37 FOR LOCATION) C. E. C. E. TAG IN WALK
T.P.	4.472	109.441	4.443	104.971	T.P.

76-L-296 CE 307 2-63

PLEASE RETURN TO
LOS ANGELES COUNTY ENGINEER
403 LOS ANGELES COUNTY ENGINEERING BLDG.

NOTE: ANY ADDITIONS OR CHANGES ON THIS SHEET MUST BE MADE OR CIRCLED IN RED INK, WITH DATE AND NAME OF PERSON MAKING CHANGE.

Do not extend notes this side of this line.

Profile Notes Red Plotted Job No. 800.02 Division No. 11 F.B. 2951 Pg. 47
No. X-Sec. Date Date Survey of P.S.S. SO CENTRAL DIST. OFFICE BLDG
Notes C.E.M. MANOR Checked Survey by E.B.H. Notes E.B.H. Date 9.17.70
No. Date OCT 1 1970 Date Map No. Indexed C.L. CAIN Date SEP 25 70

STATION	B. S.	H. I.	F. S.	ELEV.	
		109 449			
N.E. PR. COR.	5 165	109 432	5 182	104 267	N.E. PROP. COR. (SEE PG 38 FOR LOCATION) C.E. MON, FLUSH.
T.P.	4 337	109 690	4 079	105 353	T.P.
S.E. PR. COR.	4 818	108 379	6 189	103 501	S.E. PROP. COR. (SEE PG 39 FOR LOCATION) C.E. MON, FLUSH.
T.P.	5 548	108 526	5 401	102 978	T.P.
T.B.M. #2			5 011	103 515	T.B.M. #2 ELEV. = 103.517 F.B. 2951-21 (SEE Pg. 46 FOR DESCRIPTION)
	44 019		44 975		

0053.00

F.B. 7951 PG. 55

Profile No. | Notes Red | Date | Plotted | Date | Job No. | Division No.

X-Sec. No. | Notes Chkd. | Date | Checked | Date | Map No.

Survey of ALHAMBRA MUNICIPAL COURT BLDG

Survey by PETRI. Notes MOODY Date 9-69

Indexed C.T. GALLI Date SEP 1969

IN 0053.00

ALHAMBRA MUNICIPAL COURT BLDG.

BENCH LEVELS

9-1-69

PETRI.

GOBLE
MOODY
C. BEAND

STATION	B. S.	H. I.	F. S.	ELEV.

NOTE: ANY ADDITIONS OR CHANGES ON THIS SHEET MUST BE MADE OR CIRCLED IN RED INK, WITH DATE AND NAME OF PERSON MAKING CHANGE.

Do not extend notes this side of this line.

PLEASE RETURN TO
LOS ANGELES COUNTY ENGINEER
403 Los Angeles County Engineering Bldg.

76-L-208 CE 307 2-63

F.B. 2957 Pg. 86 | 0053.00 | Job No. | Division No. | Notes Red | Plotted | Profile

Survey of ALHAMBRA MUNICIPAL COURT BLDG | Date | Date | No.

Survey by PETRI | Notes MOODY | Notes Chkd | Checked | X-Sec.

Indexed [illegible] | Date | Date | Date | No.

BENCH LEVEL INDEX

STATION	B.S.	H.I.	F.S.	ELEV.

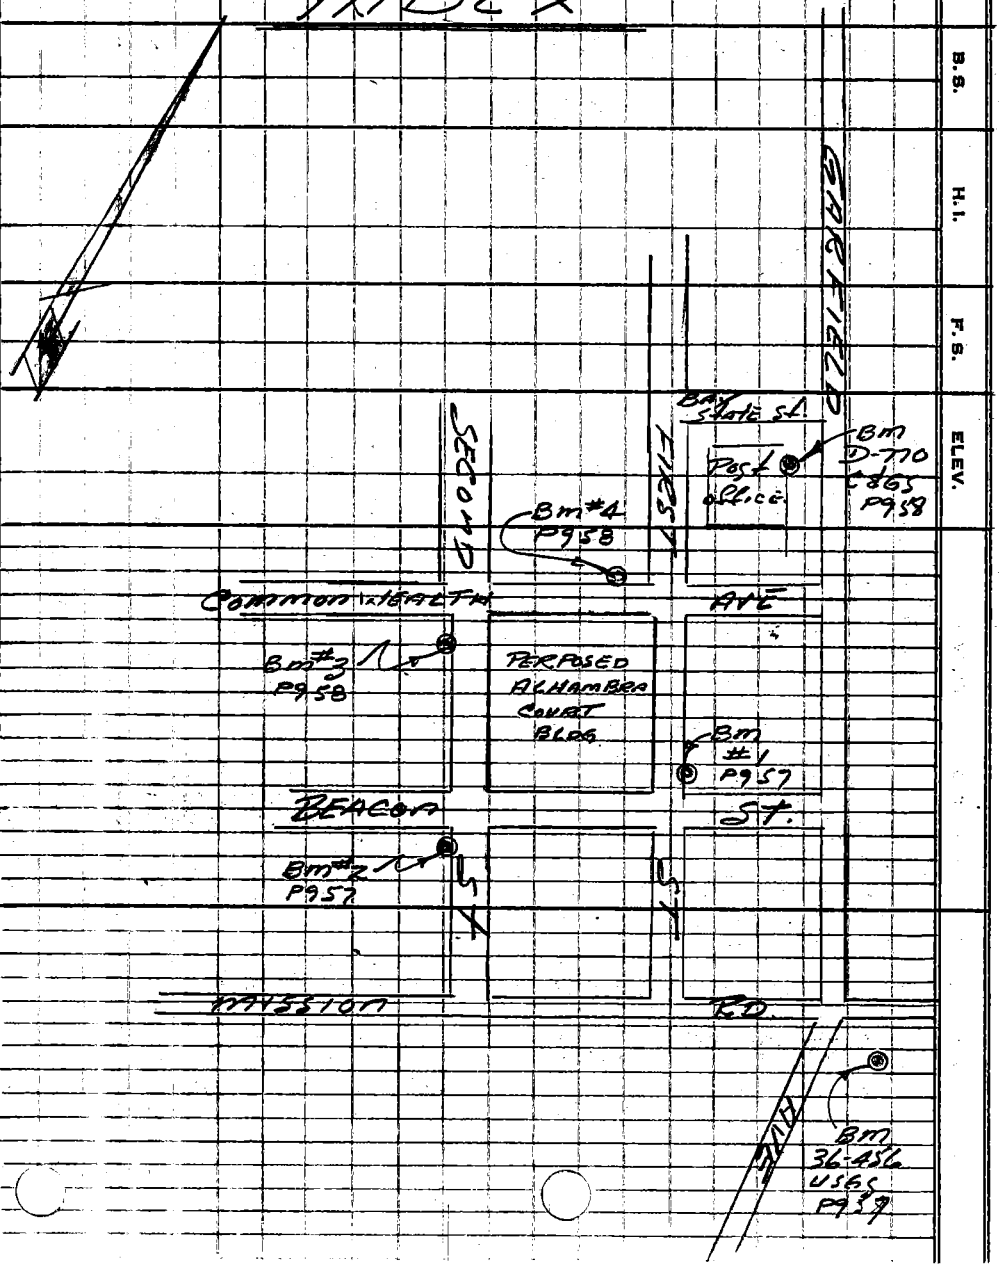

PLEASE RETURN TO
LOS ANGELES COUNTY ENGINEER
409 LOS ANGELES COUNTY ENGINEERING BLDG.

Do not extend notes this side of this line.

NOTE: ANY ADDITIONS OR CHANGES ON THIS SHEET MUST BE MADE OR CIRCLED IN RED INK, WITH DATE AND NAME OF PERSON MAKING CHANGE

76-L-298 CE 307 2-63

76-L-298 CE 307 2-68

PLEASE RETURN TO
LOS ANGELES COUNTY ENGINEER
403 LOS ANGELES COUNTY ENGINEERING BLDG.

NOTE: ANY ADDITIONS OR CHANGES ON THIS SHEET MUST BE MADE OR CIRCLED IN RED INK, WITH DATE AND NAME OF PERSON MAKING CHANGE.

Do not extend notes this side of this line.

Profile Notes Red Plotted Job No. 0053.00 Division No. F.B. 2951 Pg. 57
No. X-Sec. Date Date Survey of ALHAMBRA MUNICIPAL COURT BLDG
No. Notes Chkd. Checked Survey by PETRI Notes Moody Date 9-69
Date Map No. Indexed D.D. GALLI Date SEP 1969

STATION	B. S.	H. I.	F. S.	ELEV.	
L. M.B-36=456				456 239	BM B 36-456 USGS, QUAD 34118.2-9.2
	5988	462 227			FAIRFIELD AVE & MISSION RD. C.L.(ALHAMBRA)
T.P.			6092	456 135	24.2' So. of So. RAIL, 14.5' E OF E. EDGE of SIDE
	5983	462 118			WALK, 21565 B.M. CO.P. MON. (EL=456.239)
T.P			2455	459 663	
	6103	465 766			
T.P.			2355	463 411	
	5710	469 121			
T.P			3135	465 986	
	5812	471 798			
T.P.			3790	468 008	
	5012	473 020			
ET BM. #1			3803	469 217	BM #1 ELEV = 469.217 FB 2951-57
	4653	473 870			FIRST ST. & BEACON ST. N.E. COR, SET
T.P.			4135	469 735	SPK & LEAD IN CB, 7' N'LY OF N'LY C.R.
	5340	475 075			
ET BM #2			4772	470 803	BM #2 ELEV = 470.803 FB. 2951-57
	5310	476 113			SECOND ST. & BEACON ST. S.W. COR. SET SPK
T.P.			4702	471 411	& LEAD IN CB. 7' S'LY OF S'LY C.R.

76-L-298 CE 307 2-63

PLEASE RETURN TO
LOS ANGELES COUNTY ENGINEER
403 LOS ANGELES COUNTY ENGINEERING BLDG.

NOTE: ANY ADDITIONS OR CHANGES ON THIS SHEET MUST BE MADE OR CIRCLED IN RED INK, WITH DATE AND NAME OF PERSON MAKING CHANGE

Do not extend notes this side of this line.

F.B. 2951 Pg. 58 — Job No. 0053.00 — Division No. — Notes Red — Plotted — Profile
Survey of ALHAMBRA MUNICIPAL COURT BLDG. — Date — No. — X-Sec.
Survey by PETRU — Notes MOODY — Notes Chkd. — Checked — No.
Indexed P.R. BALL — Date — Date — Date

STATION	B. S.	H. I.	F. S.	ELEV.	
	4948	476359			
SET BM #3			3960	472399	BM #3 ELEV. = 472.399 FB. 2951-58
	5745	478144			SECOND ST & COMMONWEALTH AVE S.W. COR
T.P.			3740	474404	SET SPK & LEAD IN CB. 5' S'LY OF S'LY C.R.
	5150	479554			
SET BM #4			4840	474714	BM #4 ELEV. = 474.714 FB. 2951-58
	4725	479439			COMMONWEALTH AVE & FIRST ST. N.W. COR
T.P.			6117	473322	SET SPK & LEAD IN CB. 5' W'LY OF W'LY C.R.
	3020	476342			
TP			3080	473262	
	6152	479414			
TP			3222	476192	
	5738	481930			
TP			3725	478205	
	5405	483610			
Fd BM D 770			0312	483298	BM D-770 ELEV.: 483.300 QUAD 34 1182 PG 103, (CO. Y. ALHAMBRA) GARFIELD AVE & BAY STATE ST Fd CO'S 65 B.M DISK VERTICALLY IN N.E. WALL OF POST OFFICE BLDG, 0.5' S.E OF N. COR., 2.9' UP FROM GROUND

COURT BLDG.

Notes Ckd. by R. HILARIO	Survey of ALHAMBRA MUN.
Map No. LB-60-3 P.M. 1	UN 0053.00 Tape Std. 68° F
Office Work T. ABE	Surveyed by J.P. MENTHE
Checked R. HILARIO	Notes J.P.M. Date 9-10-69
Date 3-19-70	Indexed C.L. GALLI 9-19-69

F.B. 2951 Pg. 39

Note: Any Additions or Changes on This Sheet Must be Made or Circled in Red Ink With Date and Name of Person Making Change.

Do not extend this side of this line.

PLEASE RETURN TO
LOS ANGELES COUNTY ENGINEER
403 LOS ANGELES COUNTY ENGINEERING BLDG.

ALHAMBRA

MUNICIPAL COURT BUILDING

SITE

U.N. 0053.00

ALHAMBRA
F.B. 6-17
6-18

TRACTS
DET. G. STARK
TR. No. 5583

J.P. MENTHE
V. MOON
T. OHASHI
R.R. RODRIGUEZ

7BF3095 CE#310 1-65

F.B. 295-51 PG. 60

TRACT
DEL GO SHAR
M.B. 3 - PG. 299

LOS ANGELES COUNTY ENGINEER
403 LOS ANGELES COUNTY ENGINEERING BLDG.

PLEASE RETURN TO

Do not extend this side of this line.

Note: Any Additions or Changes on This Sheet Must be Made or Circled in Red Ink. With Date and Name of Person Making Change.

SOMMERSET

STREET

MUNICIPAL COURT BOUNDARY

ARLINGTON AVENUE

BEACON

STREET

CHARLFIELD

SEDGWICK

AVENUE

MISSION

ROAD

64

68

71

69

70

67

66

90

88

89

63

57

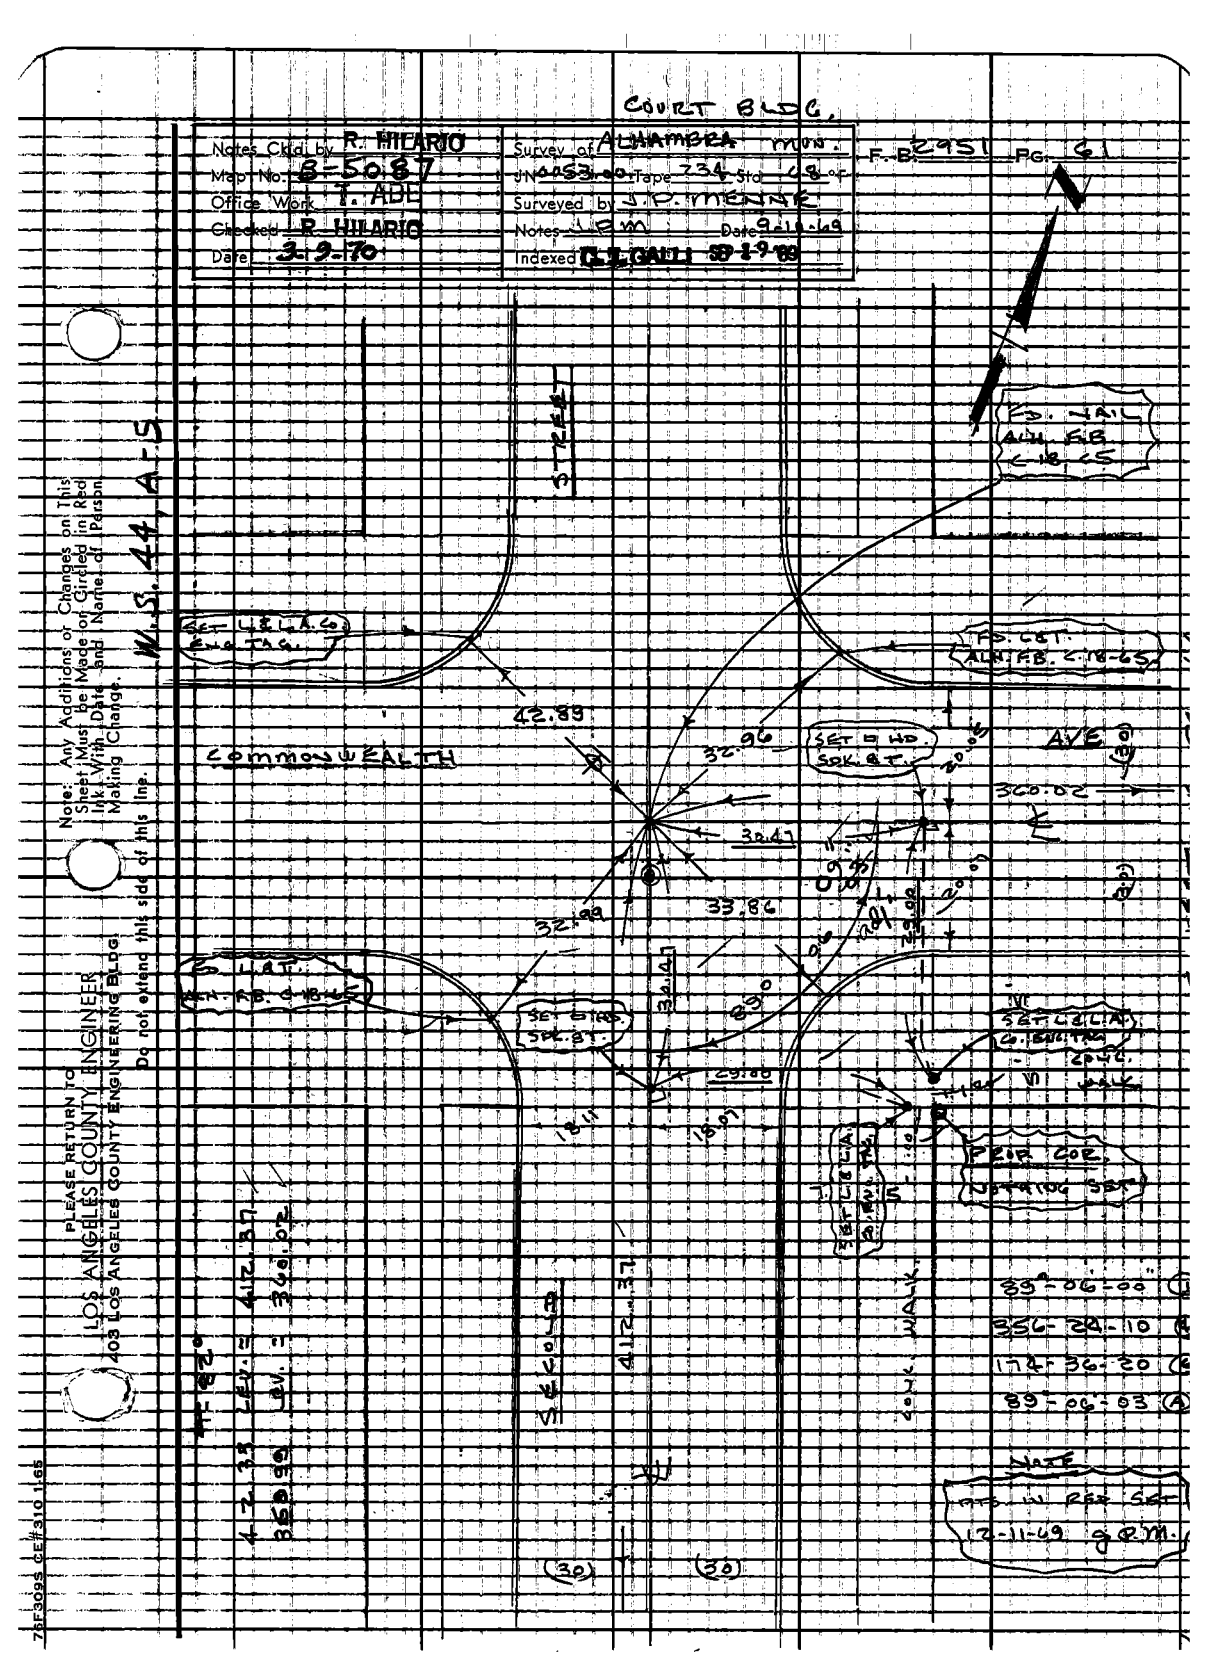

Z6F309S CE#310 1-65

To Bottom of PG. 61

W.S. 44, A-5

F.B. 2951 PG. 66

90-53-40 (D)
3 35 40 (C)
185-27-40 (B)
90° 33' 47" (A)

(30) (30)

41.12 SET

SET L & L.A. CO. END. TAG.

SET ⊡ HD SPK. BT.

SET L & L.A. CO. END. TAG.

SET L & L.A. CO. END. TAG.

NOTE
PTS. IN ROD SET 12-14-69 BRM.
DIST. MEAS. @ 1.00'

30.31 29.53 29.76 45" 90.0 359.87 29.53 30.43 SOUTH

SET ⊡ HD SPK. BT.














COURT BLDG.

Notes Ckd by R. HILARIO
Map No. B-5087
Office Work P. ABE
Checked R. HILARIO
Date 3-2-70

Survey of ALHAMBRA Mun.
UN 4053.00 Tape 234 Sta C 8 °F
Surveyed by J. DIMENTO
Notes 11 8 m Date 9-11-69
Indexed [illegible]

F.B. 2951 Pg. 63

To Bottom of Pg. 62

(30) (30)

STREET

2+00.51
FD. L & R.C.E.
11978

1+10.82
FD. L&T

1+00.54
FD. L & R.C.E.
11978

0+76.81
FD. L&T

MEAS. @ B.C.

SET L.S.D.A. CONCRETE ON CROSS GUTTER

F.D. P.K. ALUM. RB 4-11-11

F.D. P.K. IN RIM OF MANHOLE

M 155104

ROAD

FD. L.&T.

Note: Any Additions or Changes on This Sheet Must be Made or Circled in Red Ink With Date and Name of Person Making Change.

Do not extend this side of this line.

PLEASE RETURN TO
LOS ANGELES COUNTY ENGINEER
403 LOS ANGELES COUNTY ENGINEERING BLDG.

M.S. 24, A-5

7BF309S CE#310 1-65

F B 295 1 PG 44

W.S. 44, A-5

LOS ANGELES COUNTY ENGINEER
403 LOS ANGELES COUNTY ENGINEERING BLDG

PLEASE RETURN TO

Do not extend this side of this line.

Note: Any Additions or Changes on This Sheet Must be Made or Circled in Red Ink With Date and Name of Person Making Change.

STREET

FD. L&T. ALH. F.B. C-18-61

FD. ⊕ P.M. in MANHOLE R.M. ALH. F.B. C-18-61

FD. L&T. ALH. F.B. C-18-61

COMMONWEALTH (80')

SET □ HD SPK & T.

340.02

305.02

N 0° 20' E

29.54

29.00

R = 50.00

33.13

32.95

33.61

33.01

50' adj. to C.

29.54

FD. L&T. ALH. F.B. C-18-61

SET □ HD. SPK & T.

FD. L&T. ALH. F.B. C-18-61

SET L.C.&A. 20' ENG.

29.00

18.11

17.95

2' CONC. BLOCK WALL

12.72

FD. ⊕ COR. NOTHING SET

SET L.C.&A. 20' ENG.

NOTE

PTS. 1 & 2 RED SET 12-11-69 J.P.M.

90° 52' 30" (L)

03-31-00 (R)

185-16-30 (C)

90° 52' 45" (A)

T = 82°

412.34 ELEV. = 412.38

364.99 ELEV. = 305.02

412.38

(30)

(30)

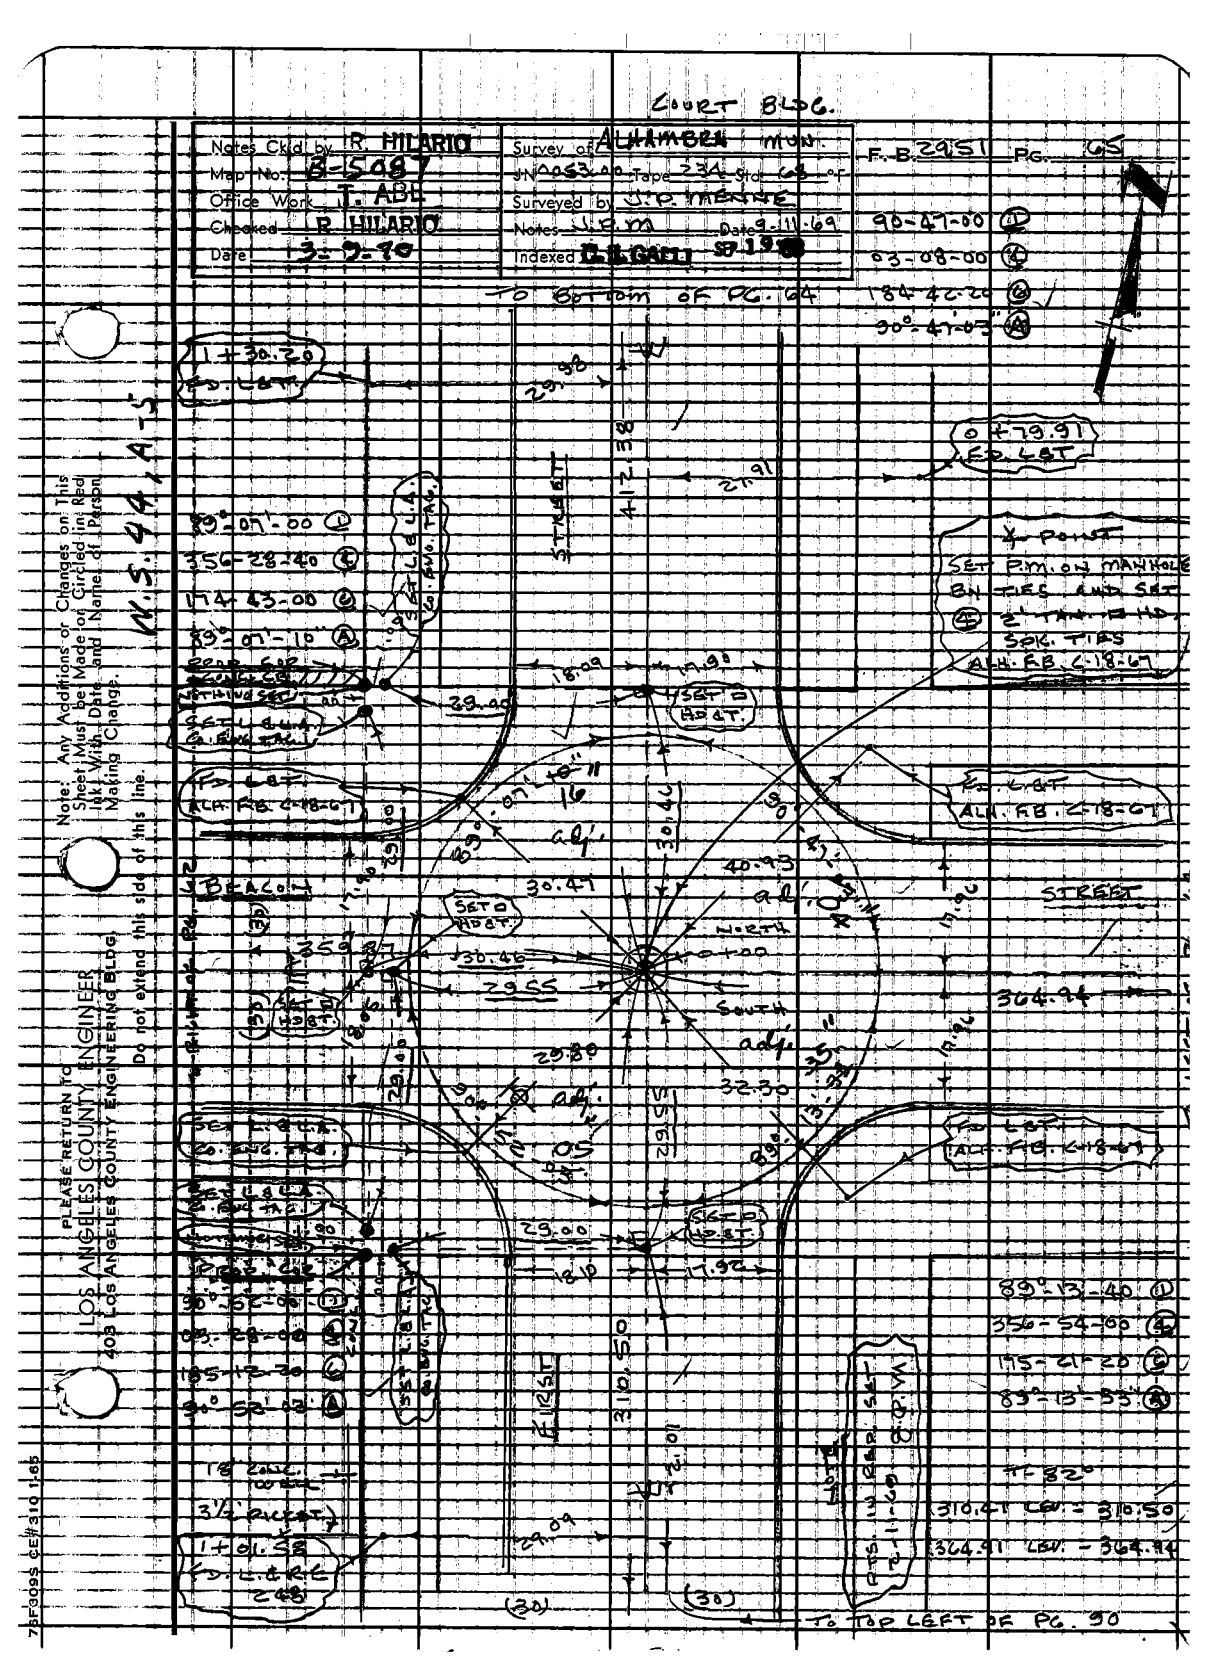
COURT BLDG.
Notes Ckd by R. HILARIO
Map No. B-5087
Office Work T. ABL
Checked R. HILARIO
Date 3-7-70
Survey of ALHAMBRA (MUN.
JN 0053-00 Tape 234 Std. 68 "F"
Surveyed by J.P. MARINE
Notes J.G.M. Date 9-11-69
Indexed R.L. GALLI SP 13
F.B. 2951 PG. 65
90-47-00 (D)
03-08-00 (C)
184-42-20 (B)
30°-47-03" (A)
TO BOTTOM OF PG. 64
1+30.20
P.C. L&T
89-07-00 (D)
356-28-40 (C)
174-43-00 (B)
89°-07'-10" (A)
Set L&T.
Set L&T.
Set L&T.

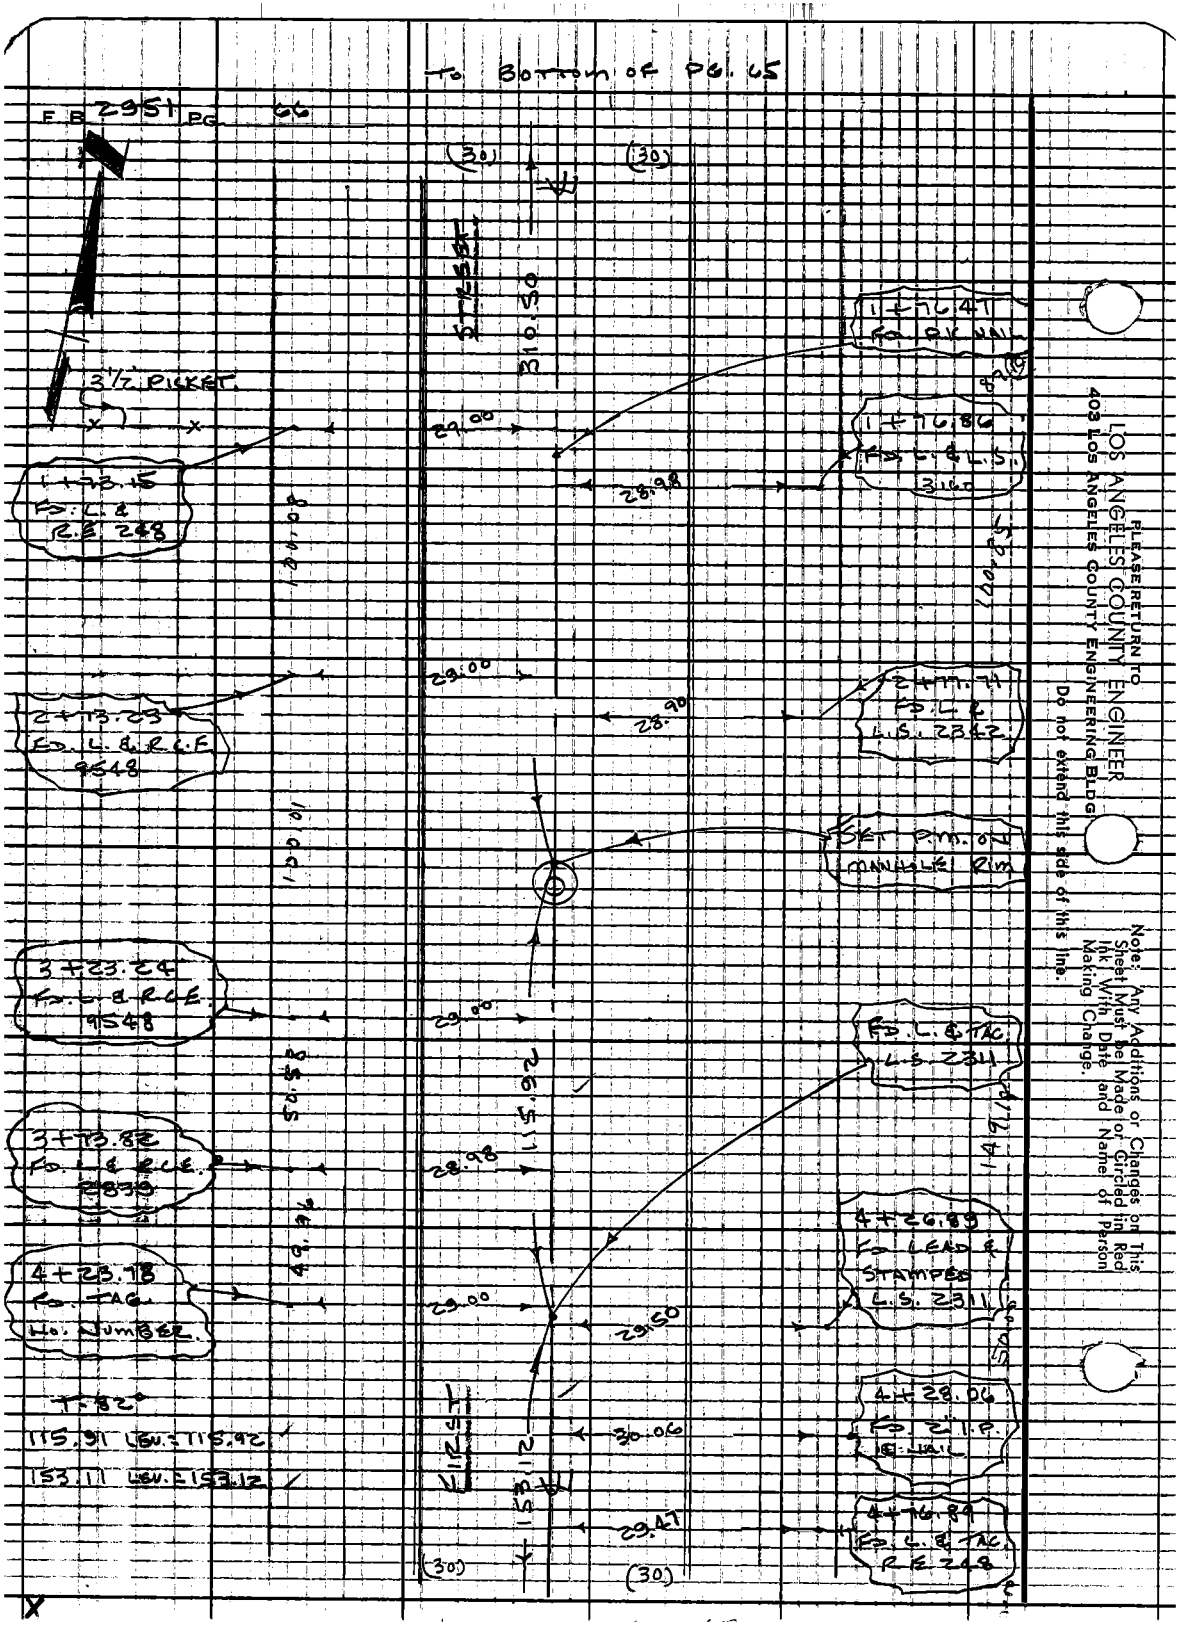

LOS ANGELES COUNTY ENGINEER
403 LOS ANGELES COUNTY ENGINEERING BLDG.
PLEASE RETURN TO

Do not extend this side of this line.

Note: Any Additions or Changes on This Sheet Must be Made or Circled in Red Ink, With Date and Name of Person Making Change.

COURT BLDG.

Notes Cktd by R. HILARIO	Survey of ALHAMBRA NWD.
Map No. B-5087	SN 0053-00 Tape 234 Sht 68 of F
Office Work I. AUE	Surveyed by J.P. MARTINEZ
Checked R. HILARIO	Notes — Date 9-12-69
Date 3-2-70	Indexed B.L. GALT 3-19-70

F.B. 295 Pg. 61

TO BOTTOM OF PG. 66

Note: Any Additions or Changes on This Sheet Must be Made on Girded in Red Ink With Date and Name of Person Making Change.

Do not extend this side of this line.

LOS ANGELES COUNTY ENGINEER
403 LOS ANGELES COUNTY ENGINEERING BLDG
PLEASE RETURN TO

76F309S DE#310 1/65

W.S. 4 4, 4-5

(30') STREET (30')

153.11

80°-00-00 ①
348-00-30 ④
162-00-20 ⑥
87°-00-08 Ⓐ

29.98

S+26.89
F.S. L.&T. FAC
R.E. 248

F.S. L.&T.
ALH. F.B. 2-17-71

F.S. L.&T.
ALH. F.B. 2-17-71

NOTE:
THIS PT. IS
R.& NO. OF
BACK OF WALK

S+76.89
F.S. 2'H.R. &
T.A.C. R.E. 248

29.98

74.95

18.00

118.00

81.70

80.00

17.03

12.30

2.99

300.04

F.S. L.&T.
ALH. F.B. 2-17-71

F.S. P.K. NAIL
ALH. F.B. 2-17-71

MISSION

ROAD

SET L.&T.A.C.
ENG. TAC. TAC PROP.

NEW CURB

M.T. 84, A-5

LOS ANGELES COUNTY ENGINEER
403 Los Angeles County Engineering Bldg.

PLEASE RETURN TO

Do not extend this side of this line.

Note: Any Additions or Changes or This Sheet Must be Made or Circled in Red Ink With Date and Name of Person Making Change.

F.B. 295 I PG. 68

COMMONWEALTH

STREET

365.02

BEACON

STREET

364.94

GARFIELD

AVENUE

66

F.D. 3" I.P.
ALH. F.B. 2-18-51

SPK
ALH. F.B. 2-18-51

I.P.
SPK. REF.
TOP CURBS
ALH. F.B. 2-18-51

SD 1 PG 44 TO 46 INCL

P.D. 44 TO 46 INCL

COURT BLDG.

Notes Ck'd by R. HILARIO	Survey of ALHAMBRA MUN.
Map No. B-5087	JN 0053.00 Tape 234 Sta 68+F
Office Work J. ABL	Surveyed by J.P. MENNE
Checked R. HILARIO	Notes 11 & 12 Date 10-23-69
Date 3-9-70	Indexed C.J. GALLI MW 3/80

F.B. 2551 Pg. 69

ADDITIONAL WORK.

ALHAMBRA

MUNICIPAL COURT BUILDING

SITE

J.O. 0053.00

J.P. MENNE

J.A. MOODY

R.R. RODRIGUEZ

R. MASSEY

Note: Any Additions or Changes on this Sheet Must be Made or Circled in Red Ink With Date and Name of Person Making Change.

Do not extend this side of this line.

PLEASE RETURN TO
LOS ANGELES COUNTY ENGINEER
403 Los Angeles County Engineering Bldg.

76F9068 CE #810 9-67

PLEASE RETURN TO
LOS ANGELES COUNTY ENGINEER
403 LOS ANGELES COUNTY ENGINEERING BLDG.

Do not extend this side of this line.

Note: Any Additions or Changes on this Sheet Must be Made or Circled in Red Ink With Date and Name of Person Making Change.

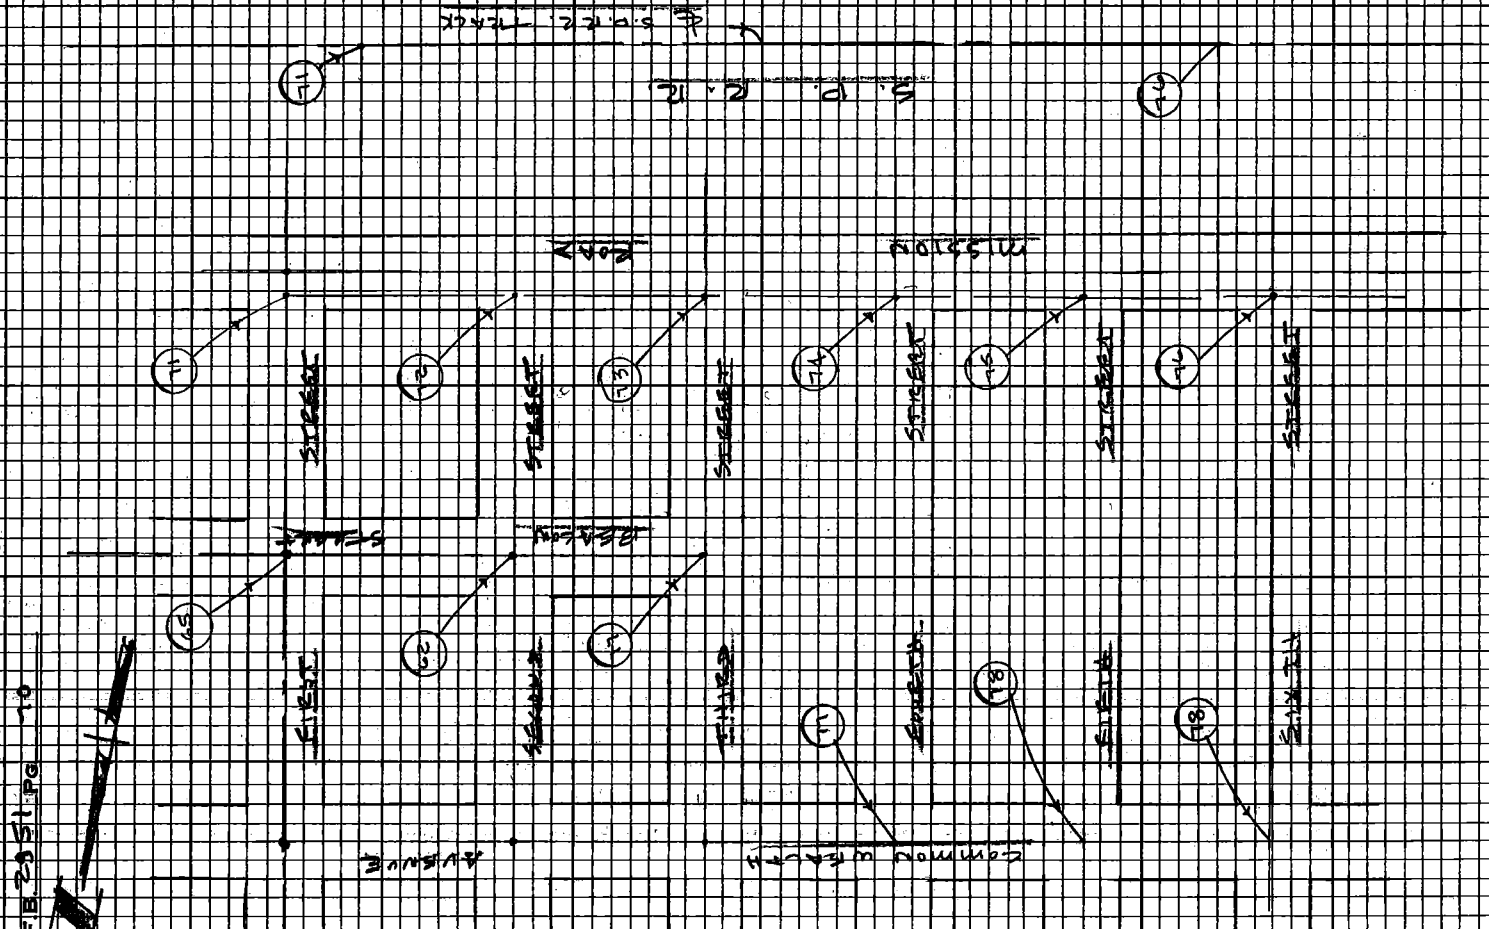
AVENUE
STREET
STREET
STREET
STREET
STREET
STREET
STREET
STREET
STREET
STREET
STREET
AVENUE
AVENUE
AVENUE

COURT BL PG.

Notes Ck'd by R. HILARIO	Survey of ALHAMBRA MVU.
Map No. B-5087	Jn 0053.00 Tape 234 Sta 68 F
Office Work T. ABE	Surveyed by J.P. MENNE
Checked R. HILARIO	Notes LD M Date 10-23-69
Date 3.9.70	Indexed C.J. GALLI 3-'69

F.B. 295 I PG 71

Note: Any Additions or Changes on this Sheet Must be Made or Circled in Red Ink With Date and Name of Person Making Change.

W.S. 44, A-5

PLEASE RETURN TO
LOS ANGELES COUNTY ENGINEER
403 Los Angeles County Engineering Bldg.
Do not extend this side of this line.

87°-00-20" ①
348-01-15 ④
162-02-00 ⑤
87°-00-20" ⑥

T-68°10
LEVEL
49.80 337.28
65.03 15.83
9.00 1.20
22.79 6.12
90°-00-00
180-00-00 ⑦

337.28 S 89°-00'-00" E

BACK WALL

5.16

22.79

1.20

15.83

6.12

FIRST STREET

N 0°-00'-20" E 153.12

FD. C.&T. F.B. 295 I

SET L. & L.A. CO. ENG. TAG. BY INTERSECT

FD. P.K. PC 67

SET P.M. ON ℄ 1 ST. ST. & MEAS. TO CTR. OF MANHOLE TO P.M.'S FOUND TO ESTABLISH ℄ OF MISSION RD.

MISSION ROAD

S.P.

R.R.

S 90°-00'-00" E

65.03

SET N.ET. ON SPLIT OF RAILS SEARCHED FOR PTS. ON PROP. L.O. NOTHING FOUND

FD. CONC. BLOCK WALL

FD. 2½" I.P. 0.22 E. & 2.00 N.

7815098 CE#810 9/67

To LEFT of Pg. 71

W.S. 44 A-5

F.B. 2051 Pg. 12

PLEASE RETURN TO
LOS ANGELES COUNTY ENGINEER
403 Los Angeles County Engineering Bldg.

Do not extend this side of this line.

Note: Any Additions or Changes on this Sheet Must be Made or Checked in Red Ink With Date And Name of Person Making Change.

93°-01'-17" (M)
93°-01'-30" (L)
<S.89°58'37"W.>

Fd. U.S.C. & G.S. 2" I.P. 0.33' Below Surface In Well Flush with Ground

Fd. L.A.C.E. 3/4" I.P. 0.48

COURT BLDG.

Notes Ck'd by R. HILARIO	Survey of ALHAMBRA
Map No. B-5087	JN 00533.00 Tape 234 Std 68°F
Office Work J. ABL	Surveyed by J.P. MENUE
Checked R. HILARIO	Notes J.C.M. Dated 10-23-69
Date 2-9-70	Indexed D.G. GALLI MW 3'69

F.B. 2951 Pg. 13

To Bottom of Pg. 72

SET L.&L.A.Co. ENG. TAG. BY INTERSECTION

P.O.C. 1-7-70

P.K. ALH. F.B. C-17-70

F.B. C-17-70 S 43.81

43.72

32.48

30.72

0+00

15.84

65.25

31.58

21.89

0+01.91

MEAS. TO CTR. OF MANHOLE NO. P.M.'S FOUND

THIRD STREET

F.B. L&T F.B. C-17-70

S 89°-57'-40" E

S 89°-57'-40" E 201.48

F.B. L.&T. TOP 18" CONC. WALL

36.08

CONC. WALL

201.48' M.L.

ZONE 2

MISSION

S. P. R. R.

F.B. L.&T. TAG L.S. 2661

T-68°-20 LEWIS

SET +

43.72 / 65.25

31.58 / 201.48

32.48 / 176.28

30.72 / 176.28

31.58

(50)

Note: Any Additions or Changes on this Sheet Must be Made or Circled in Red Ink With Date and Name of Person Making Change.

W.S. 44 A-5

To Right Top of Pg. 71

Do not extend this side of this line.

PLEASE RETURN TO
LOS ANGELES COUNTY ENGINEER
403 Los Angeles County Engineering Bldg.

76F3008 CE#810 9/67

W.S.B. E-5
PLEASE RETURN TO
LOS ANGELES COUNTY ENGINEER
403 LOS ANGELES COUNTY ENGINEERING BLDG.
Do not extend this side of this line.
Note: Any Additions or Changes on this Sheet Must be Made or Circled in Red Ink With Date and Name of Person Making Change.
F.B. 295 PG 14
F.B. & L.
F.B. 2-17-70
Fd. L. & TAG
4.5 266
F.B. 2-17-70
966.80
0+00
FOUND
SET L.S.L.A.G.
ENG. TAC. BY
CENTERLINE
Fd. L&T
Fd. L&T
Fd. L&T

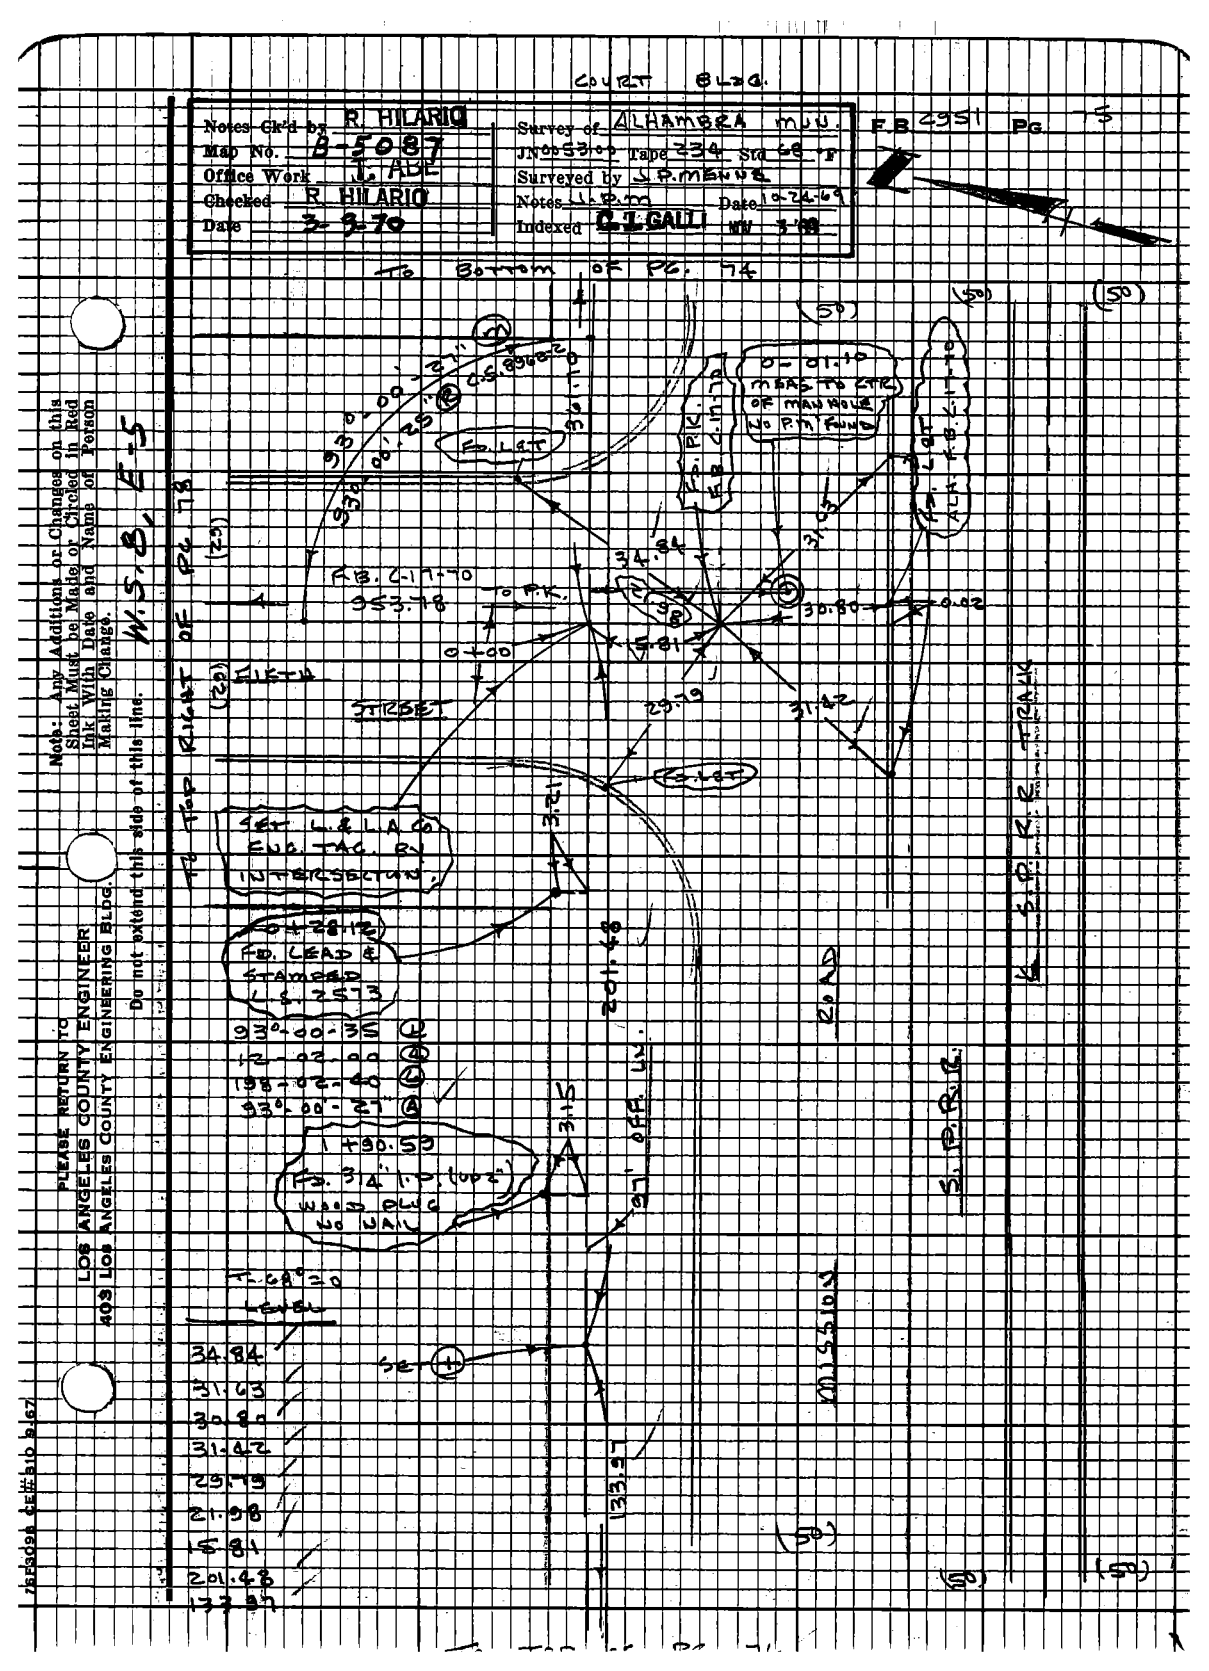
To Bottom of Pg. 74
Note: Any Additions or Changes on this Sheet Must be Made or Ticked in Red Ink With Date and Name of Person Making Change.
W.S. 8, E-5
To Map Right of Pg. 74
(23)
(22)
(50)
(50)
(50)
(50)
(50)
(50)
SET L.&.L.A.CO. ENG. TAG. B.C. INTERSECTION
FD. LEAD & STAMPED
FD. 3/4" I.P. TOP 2"
FD. LEAD & TAG
FD. L&T
FD. L&T
FD. L&T

TO Bottom of Pg. 75

F.B. 2351 PG. 76

N.S.B.E.-S.

PLEASE RETURN TO
LOS ANGELES COUNTY ENGINEER
403 Los Angeles County Engineering Bldg.

Do not extend this side of this line.

Note: Any Additions or Changes on this Sheet Must Be Made or Circled in Red Ink With Date and Name of Person Making Change.

T-68°-D
L BUBL

39.30
91.00
23.56
25.68
21.60

SET

92°-58-50 (1)
11-55-40 (2)
197-53-20 (3)
92°-58-50 (4)

FD. L. & TAC.
R.E. 2344

BACK WALK

S.E.

3.13

39.30

3.13

92°-58'-50"

58.53

68.00

92.00

SIXTH STREET

22.83

N 3.56 E

21.60

0+00

0+68.00

25.68

FD. PK.
F.B. C-17-70

SET L. & L.A. Co.
ENG. TAC. B.L.
INTERSECTIONS

FD. PK.
F.B. C-17-70

MEAS. TO
CTR. OF MANHOLE
NO P.M. Found

S.P.R.R.

S.P.R.R. TRACK

133.69 L

87.00 Rad.

90°-00'-00"

ENDS OF CALLS

(50)

(50)

(50)

(25)

(25)

87.00 Rad.

75F3098 CE#310 9-67

PLEASE RETURN TO
LOS ANGELES COUNTY ENGINEER
403 Los Angeles County Engineering Bldg.

Note: Any Additions or Changes on this Sheet Must be Made or Circled in Red Ink With Date and Name of Person Making Change.

Do not extend this side of this line. W.S. 8, E-5 & W.S. 44, A-5

Notes Ck'd by R. HILARIO
Map No. B-5087
Office Work R. HILARIO
Checked R. HILARIO
Date 3-2-70

Survey of ALHAMBRA Min.
Intersection Tape 2.24 Std 66.1'
Surveyed by J. PIMENTEL
Notes Learn Date 10-24-69
Indexed D. GALLI Date NOV 3 '69

F.B. 251 Pg. 11

COURT BLDG.

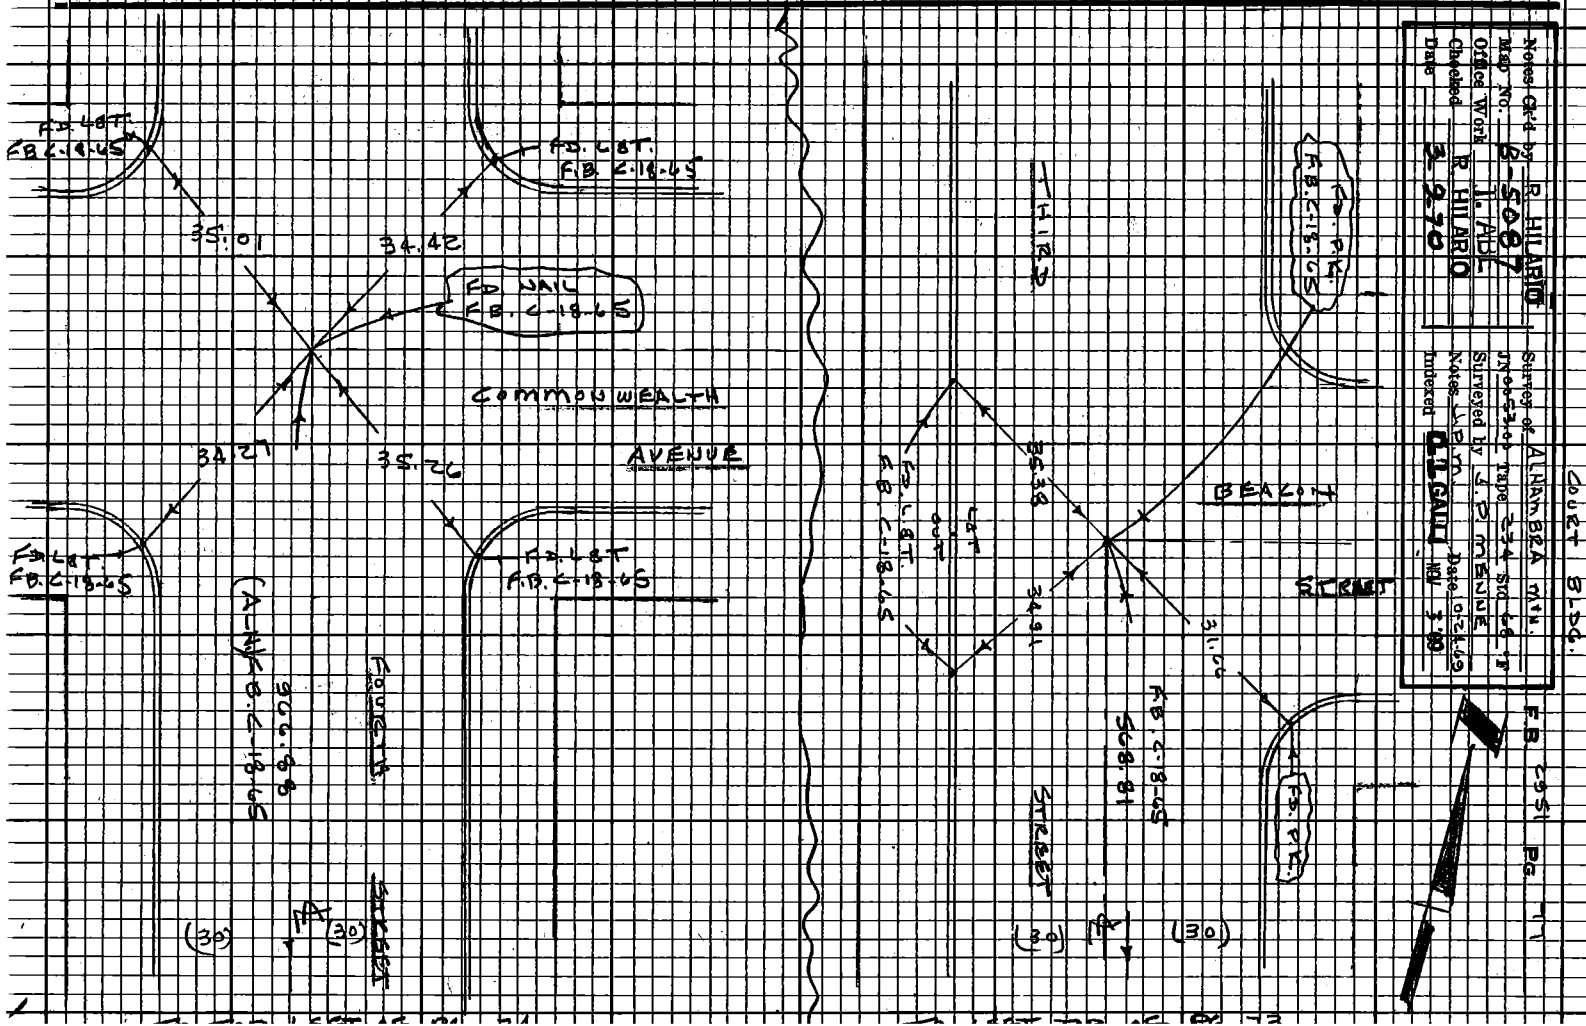

PLEASE RETURN TO
LOS ANGELES COUNTY ENGINEER
403 LOS ANGELES COUNTY ENGINEERING BLDG.

Note: Any Additions or Changes on this Sheet Must be Made or Circled in Red Ink With Date and Name of Person Making Change.

Do not extend this side of this line.

W.S. 8, E-5

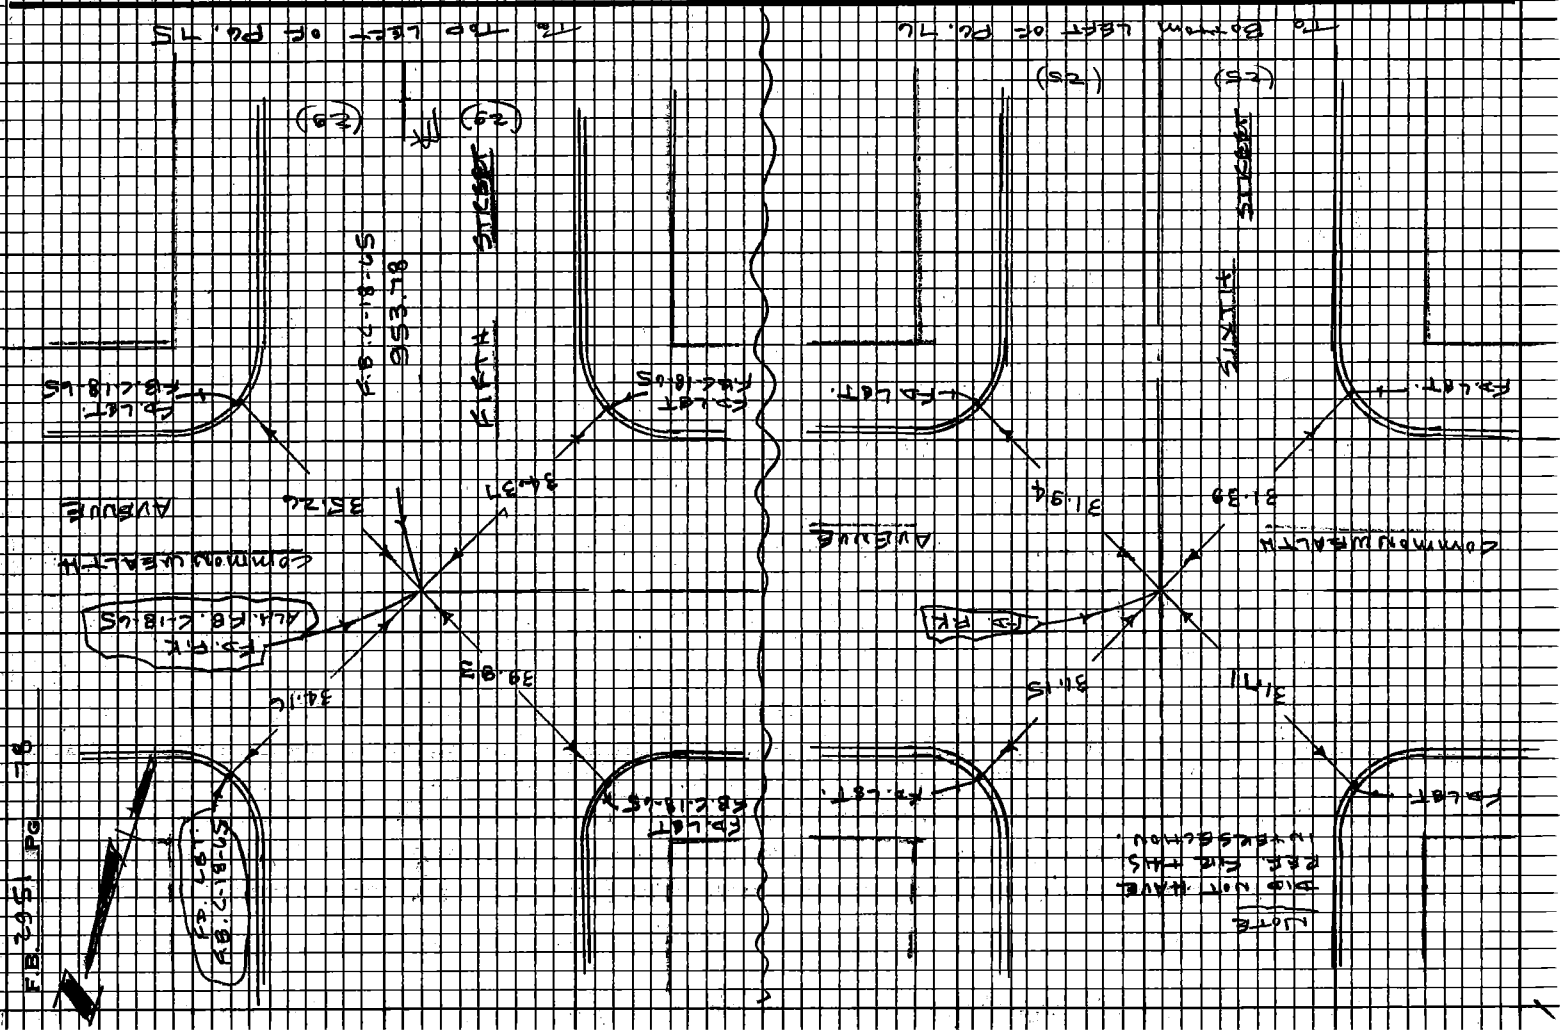

COURT BLDG.

Notes Ck'd by R HILARIO	Survey of ALHAMBRA M.N.J.
Map No. B 5087	J.N. 0053.00 Tape 234 Std 66'F
Office Work T. ABL	Surveyed by J.D MENNE
Checked R. HILARIO	Notes J.P.M Date
Date 3.9.70	Indexed C.J.GALLI NOV 25 '69

F.B. 2951 PG 79

DEL GO SHAR

TRACT

MR. 1-67

BLOCK "B"

SURVEY SHOWING LINES

OF OCCUPATION IN

ABOVE BLOCK "B"

J.P. MENNE

J.A. MOODY

R.G. MASSEY

R.R. RODRIGUEZ

PLEASE RETURN TO
LOS ANGELES COUNTY ENGINEER
403 Los Angeles County Engineering Bldg.

Note: Any Additions or Changes on this Sheet Must be Made or Circled in Red Ink With Date and Name of Person Making Change.

Do not extend this side of this line.

7bFSC08 CE#810 9/67

F.B. 2051 PG 89

NOTE

TO LOCATE THE LINES OF OCCUPATION IN BLOCK "B" DEL GO SHAR TRACT I SET CROSS ON CONCRET WALK ON A FOOT OFFSET LINE @ RECORD DISTANCE FROM ℄ BEACON ST. MEASURING SOUTH. AT EACH POINT I MEASURED THE SAME ANGLE THAT WAS MEASURED AT THE INTERSECTION OF BEACON & FIRST & BEACON & SECOND.

J. P. Mumm

PLEASE RETURN TO
LOS ANGELES COUNTY ENGINEER
403 Los Angeles County Engineering Bldg.

Do not extend this side of this line.

Note: Any Additions or Changes on this Sheet Must be Made or Checked in Red Ink With Date and Name of Person Making Change.

76-L-298 CE 307 5-66

PLEASE RETURN TO
LOS ANGELES COUNTY ENGINEER
403 LOS ANGELES COUNTY ENGINEERING BLDG.

NOTE: ANY ADDITIONS OR CHANGES ON THIS SHEET MUST BE MADE OR CIRCLED IN RED INK, WITH DATE AND NAME OF PERSON MAKING CHANGE.

Do not extend notes this side of this line.

Profile Notes Red ____ Plotted ____ Job No. 90002 Division No. // F. B. 2951 Pg. 101
No. ____ Date ____ Date ____ Survey of P.S.S. S. CENTRAL DIST. OFFICE BLDG.
X-Sec. Notes Ch'k'd. ____ Checked ____ Survey by R. CHARDS Notes W.A.R. Date 11/7/
No. ____ Date ____ Date ____ Map No. ____ Indexed C. J. GALL Date ____

STATION	B. S.	H. I.	F. S.	ELEV.	FIN GRADE	ROCK GRADE	DIRT GRADE
INE "J"							
0+09±	CURB				105.32 ✓		
+25					105.48		104.90 ✓
+42±	BK. RIDGE LINE				105.63		105.05 ✓
+50	F. L.				105.56		104.98 ✓
+	CURB				105.85		
J" + 12'	TO WEST						
+25	RIDGE LINE				105.50		104.92 ✓
INE "K"							
0+09	CURB & RIDGE LINE				105.53 ✓		
+25					105.36		104.78 ✓
+50	F. L.				105.19		104.61 ✓
+	CURB				105.48 ✓		

76-L-298 CE 307 5-66

PLEASE RETURN TO
LOS ANGELES COUNTY ENGINEER
403 Los Angeles County Engineering Bldg.

NOTE: ANY ADDITIONS OR CHANGES ON THIS SHEET MUST BE MADE OR CIRCLED IN RED INK, WITH DATE AND NAME OF PERSON MAKING CHANGE.

Do not extend notes this side of this line.

F.B. 2951 Pg. 102 Job No. Division No. Notes Red Plotted Profile
Survey of Date No. X-Sec.
Survey by C. J. GALLI Notes Date Notes Chk'd Checked No.
Indexed Date Date

STATION	B. S.	H. I.	F. S.	ELEV.	FIN GRADE	ROCK GRADE	DIRT GRADE
"							
LINE "L"							
0+09	CURB				105.17 ✓		
+25					105.00		104.42 ✓
+50	F.L.				104.83		104.25 ✓
+69±	CURB				105.12 ✓		
LINE "M"							
0+09	CURB.				104.81 ✓		
+25					104.65		104.07 ✓
+50±	F.L. & TOP C.B.			104.5	104.48		103.90
+	CURB				104.74 ✓		
LINE "N"							
0+09	CURB				104.92 ✓		
+25	"	#3 Bolt		104.8	104.71		
+50	"	"		104.62	104.68		
+	"				104.85 ✓		

Notes Ck'd by
Map No.
Office Work
Checked
Date

Survey of R.S.S. OFFICE BLDG.
J.N. 900002 Tape — Std — °F
Surveyed by W.A. RICHARDS
Notes W.A.R. Date 11/71
Indexed C. J. GALLI JAN 17 '72

F.B. 2951 PG. 103

J.N. 900002

R.S.S. CENTRAL DISTRICT OFFICE BUILDING

SPECS. NO. 2786

STAKING SKETCH FOR PARKING LOT PAVING

FOR FIN. DIRT GRADES, SEE PGS. 91-102, INC.

GRADES ARE BASED UPON CONTRACT DRAWINGS PG. C-2.

SURVEY REQUESTED BY CONSTRUCTION DIVISION

RICHARDS
LEGAULT
LIEBER
TURRILL

Note: Any Additions or Changes on this Sheet Must be Made or Circled in Red Ink, With Date and Name of Person Making Change.

Do not extend this side of this line.

PLEASE RETURN TO
COUNTY OF LOS ANGELES
DEPARTMENT OF COUNTY ENGINEER
403 LOS ANGELES COUNTY ENGINEERING BLDG

76F309S ICE#310 3-68

F.B. 2952 Pg. 104

STAKING LAYOUT

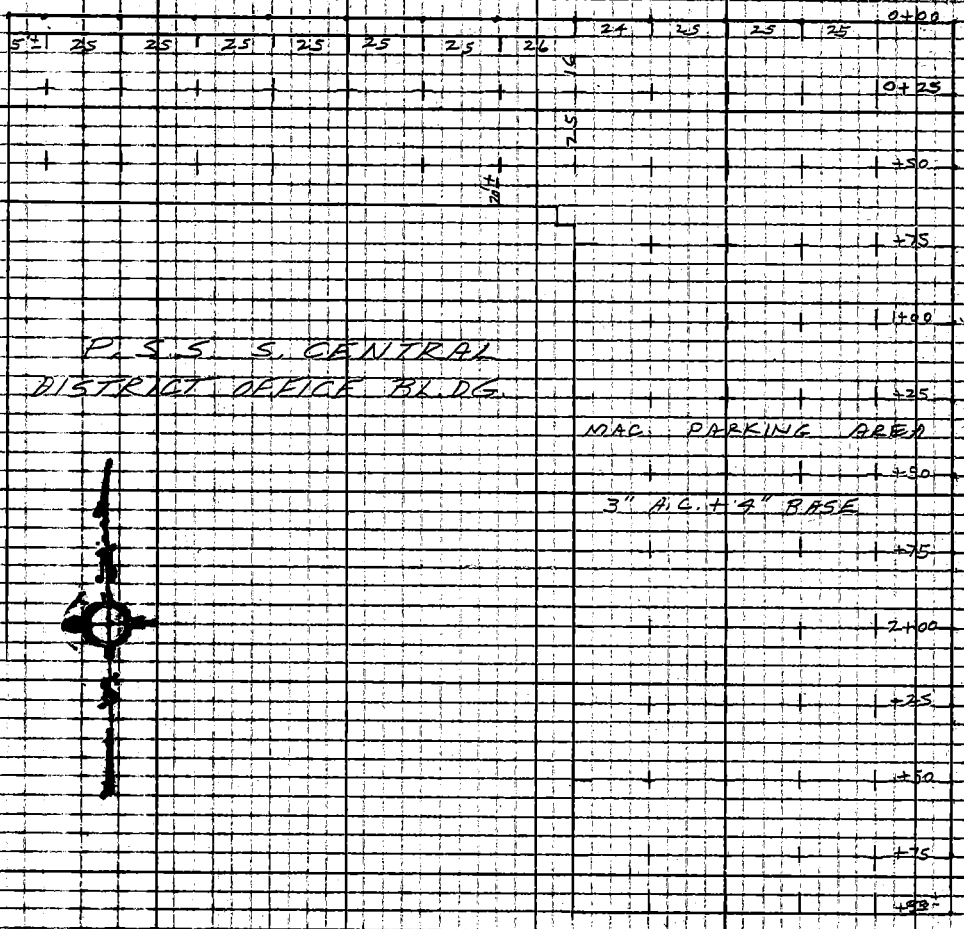

P.S.S. S. CENTRAL DISTRICT OFFICE BLDG.

SET 1x2 STAKES TO FINISH SUB-GRADE. (FIN. GRADE - 7")

108TH ST.

CENTRAL AVE.

PLEASE RETURN TO
COUNTY OF LOS ANGELES
DEPARTMENT OF COUNTY ENGINEER
403 LOS ANGELES COUNTY ENGINEERING BLDG.

Do not extend this side of this line.

Note: Any Additions or Changes on This Sheet Must Be Made or Circled in Red Ink With Date and Name of Person Making Change.

ALHAMBRA MUNICIPAL

Notes Ck'd by	Survey of COURTS BLDG.
Map No.	JN 7777.02 Tape 015 Std 68
Office Work	Surveyed by J.P. MENNE
Checked	Notes J.P.M. Date 5-9-72
Date	Indexed

F.B. 2951 PG. 105

Note: Any Additions or Changes on This Sheet Must be Made or Circled in Red Ink With Date and Name of Person Making Change.

Do not extend this side of this line.

PLEASE RETURN TO
COUNTY OF LOS ANGELES
DEPARTMENT OF COUNTY ENGINEER
403 LOS ANGELES COUNTY ENGINEERING BLDG.

ALHAMBRA MUNICIPAL

COURTS BUILDING

150 E. COMMONWEALTH AVE

ALHAMBRA

J.N. 7777.02

CONSTRUCTION STAKES

LINE 'D' A-2 - 5'

PER PLANS

SHEET A-1

J.P. MENNE

L. JONES

L. MANLEY

J. MUNOZ

R. LUCIFER

76F309 CE#310 3-69

F.B. 2951 PG. 106

LINE "D" & "S" TAKEN FROM SHEET A-1 OF SPEC. NO. 2849 CAP. PROJ. 7177

COMMONWEALTH STREET

80'

30'

158.79

141.22'

30'

80.43

⊙ = SET IXZ & V. (DN. 12")

30°-00'-00"

LINE "A"

80.13

80'

30'

30'

ALONDRA STREET

90°-00'-00"

90°-00'-00"

90°-00'-00"

90°-00'-00"

30'

177.10

182.28'

BEACON STREET TO BE VACATED

PLEASE RETURN TO COUNTY OF LOS ANGELES DEPARTMENT OF COUNTY ENGINEER 403 LOS ANGELES COUNTY ENGINEERING BLDG.

Do not extend this side of this line.

Note: Any Additions or Changes on This Sheet Must be Made or Circled in Red Ink With Date and Name of Person Making Change.