Notes Ck'd by	Survey of
Map No.	JN Tape Std °F
Office Work	Surveyed by
Checked	Notes Date
Date	Indexed

F.B. 3170 PG.

Page	Job	Description
		S.E. PROB. DEPT. 0018.11
5-6	Index	
7-12	Bdry.	Survey
13-18	Levels	Bench levels
		92ND STREET 0096.66
23-27	Index	
29-188	C.L.	Of Streets in area bounded by Central Ave. on the W., Alameda & on the E., Firestone on the N. & 97th St. on the South
189-191	Index	
192-220	C.L.	On 92nd St. fr. Central Ave. W. to Wadsworth Ave. & Prelim. Survey for C.L. on Southern Ave. fr. Alameda St. E. to Santa Fe.

Microfilmed Feb 85.

3170
PLEASE RETURN
LOS ANGELES COUNTY ENGINEER

Notes Ck'd by	Survey of S.E. PROBATION DEPT.	F. B. 3170 PG. 5
Map No. B-2884	JN 0018.11 Tape Std °F	
Office Work G. D. BAILEY	Surveyed by R.B. HOBSON	
Checked	Notes R.B.H. Date 2-10-64	
Date	Indexed C. J. GALIN MAR 6 '64	

SOUTHEAST PROBATION DEPT.
J.N. 0018.11

BOUNDARY SURVEY

FEB. 10TH, 1964
HOBSON
FRONK
SOMMENSCHEIN
CROWDER

Note: Any Additions or Changes on This Sheet Must be Made or Circled in Red Ink With Date and Name of Person Making Change.

Do not extend this side of this line.

PLEASE RETURN TO
LOS ANGELES COUNTY ENGINEER
403 Los Angeles County Engineering Bldg.

76F309S CE # 310 3-61

PLEASE RETURN TO
LOS ANGELES COUNTY ENGINEER
403 LOS ANGELES COUNTY ENGINEERING BLDG.

Do not extend this side of this line.

Note: Any Additions or Changes on This Sheet Must be Made or Circled in Red Ink With Date and Name of Person Making Change.

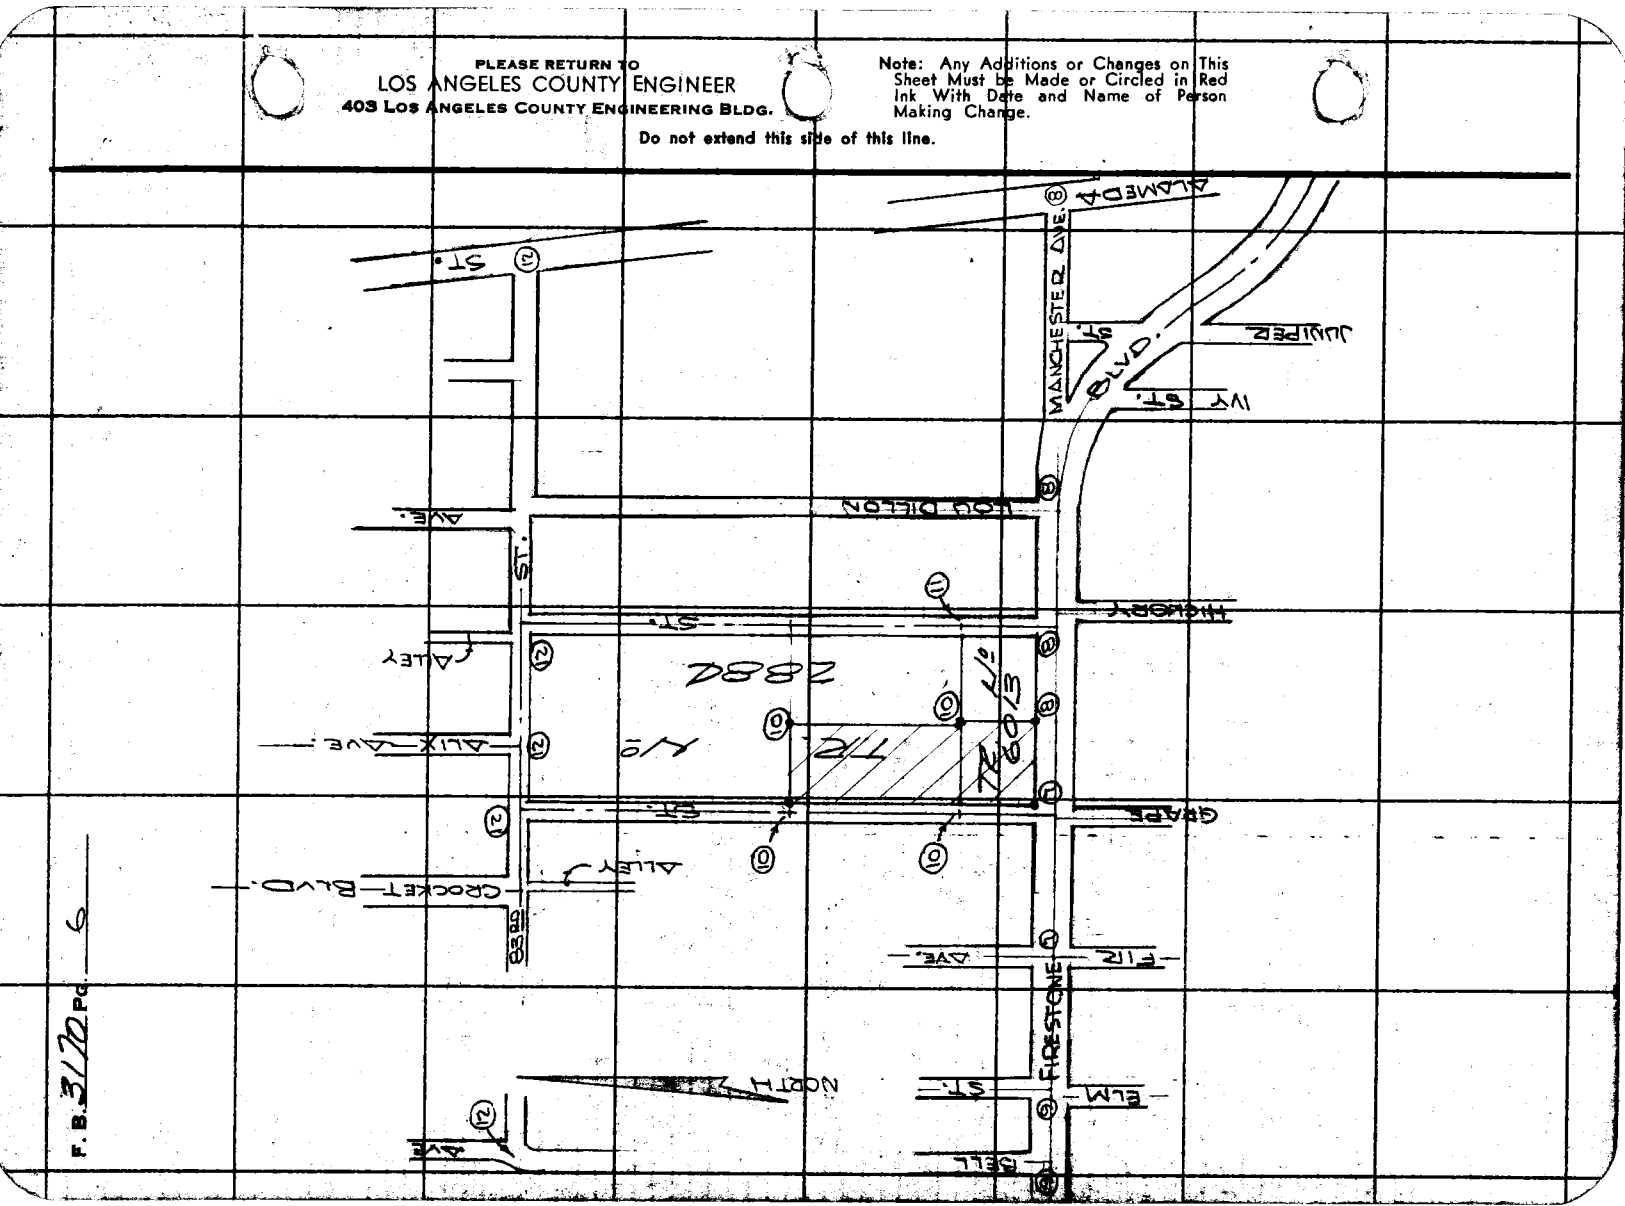

Notes Ck'd by W. J. BRENNER	Survey of S.E. PROB. DEPT.	F. B. 3170 PG. 7
Map No. B-2884	JN 0018.11 Tape 0225 Std 68 °F	① 90° 20' 00"
Office Work G. D. BAILEY	Surveyed by R.B. HOBSON	④ 361° 21' 15"
Checked W. J. BRENNER	Notes R.B.H. Date 2-10-64	⑥ 182° 02' 15"
Date MAY 15 1964	Indexed G. J. GALLS	90° 20' 22½"

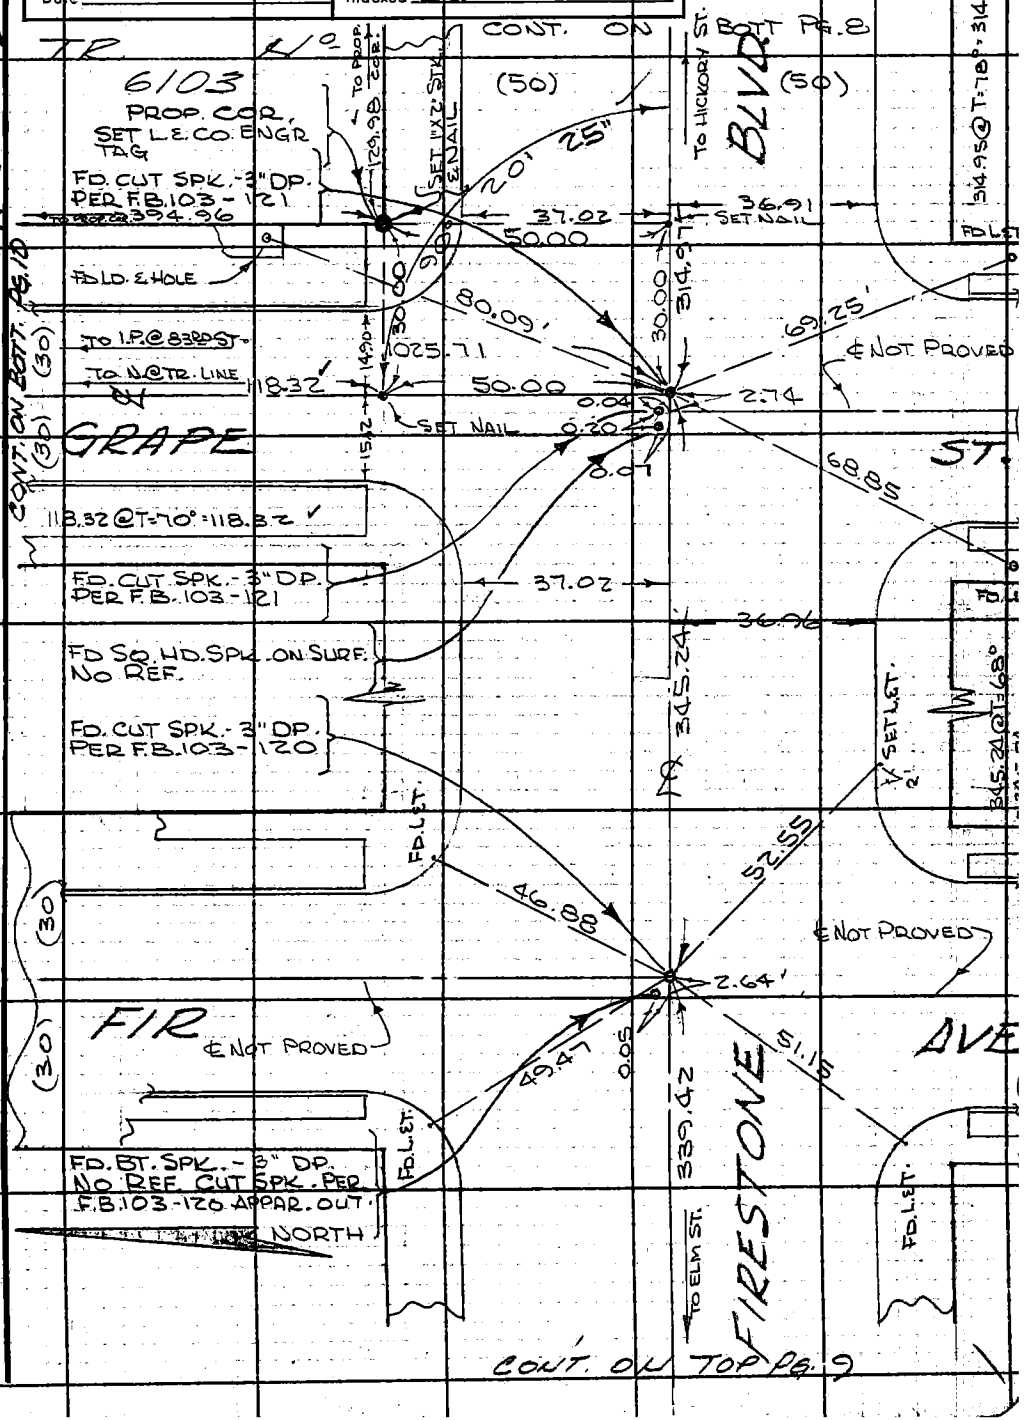

Note: Any Additions or Changes on This Sheet Must be Made or Circled in Red Ink With Date and Name of Person Making Change.

Do not extend this side of this line.

PLEASE RETURN TO
LOS ANGELES COUNTY ENGINEER
403 LOS ANGELES COUNTY ENGINEERING BLDG.

76F309S CE # 310 3-61

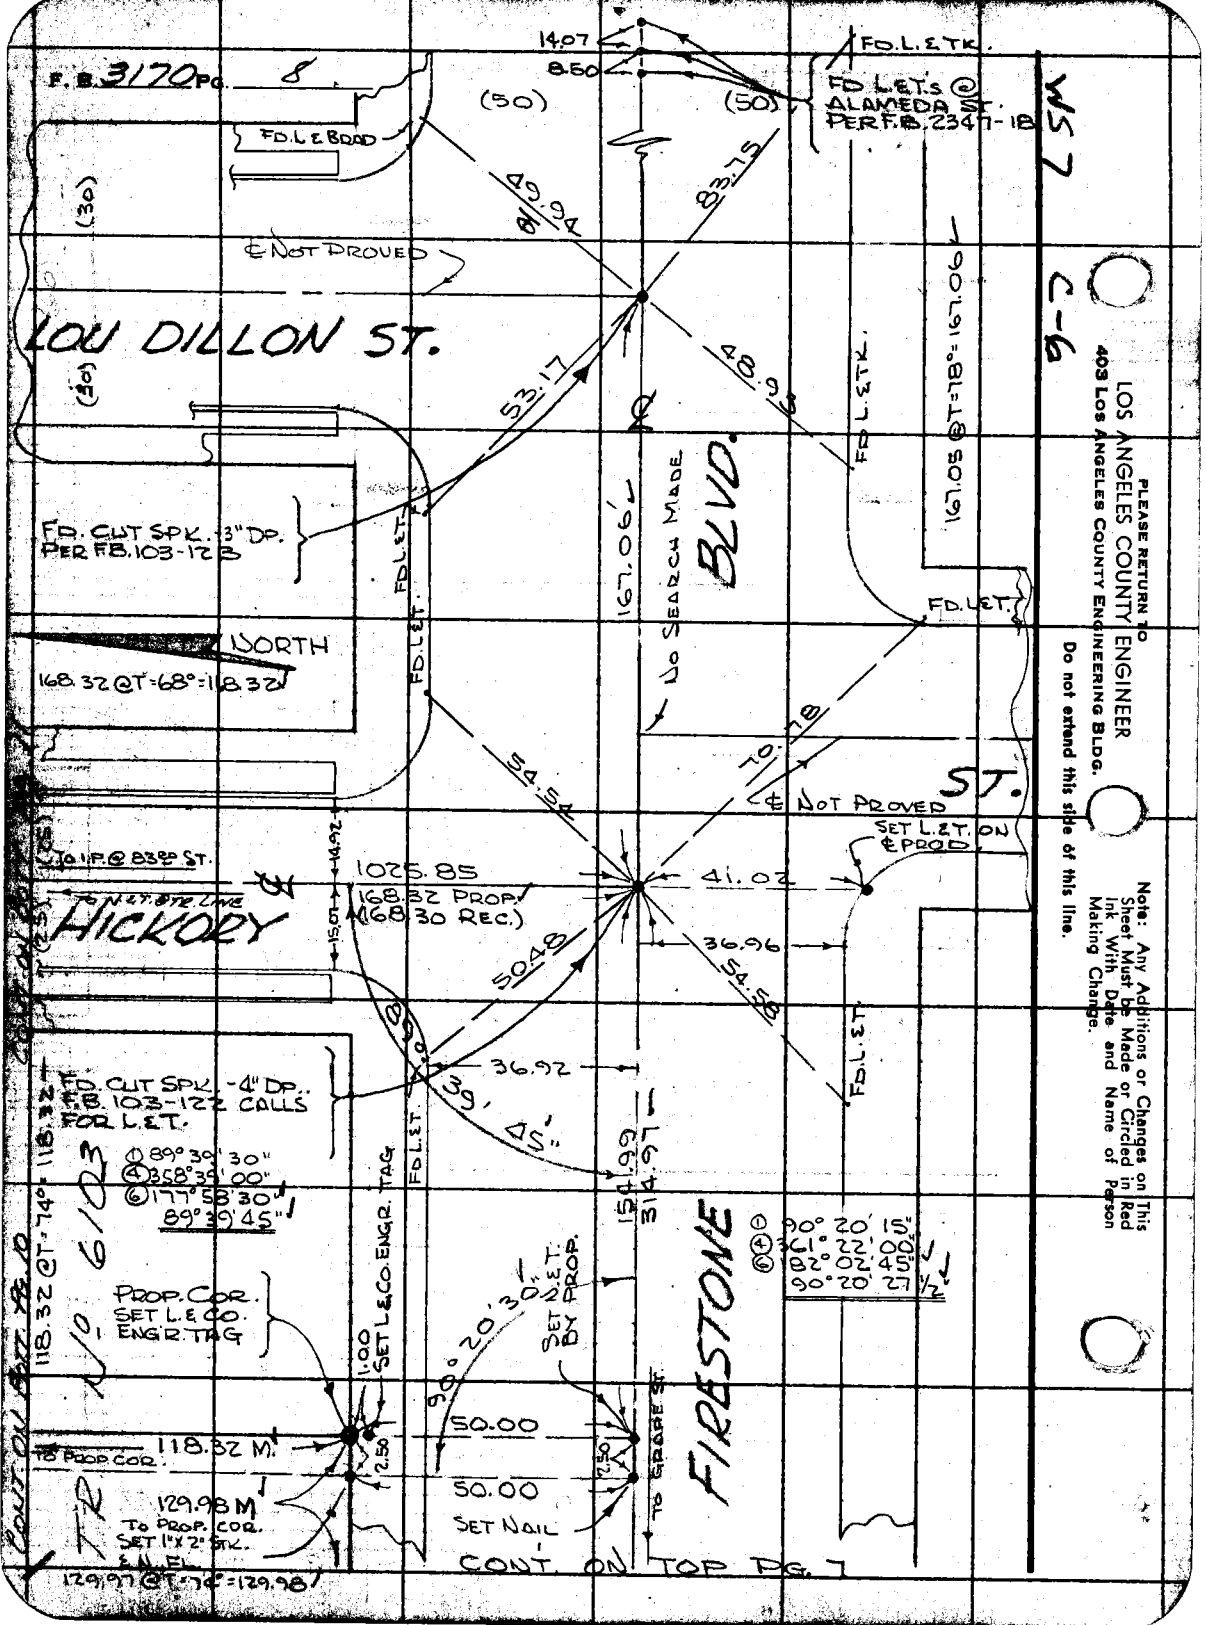
F.B. 3170 PG. 8
14.07
8.50
FD. L. & TK.
FD. L. & T.S @ ALAMEDA ST. PER F.B. 2347-18
(50)
(50)
FD. L. & BOAD
(30)
(30)
49.94
83.75
℄ NOT PROVED
LOU DILLON ST.
53.17
48.93
FD. L. & TK.
167.05 @ T=78°=167.06
FD. CUT SPK. 3" DP. PER F.B. 103-123
FD. L. & T.
167.06'
NO SEARCH MADE
BLVD.
FD. L. & T.
NORTH
168.32 @ T=68°=168.32
54.54
70.78
℄ NOT PROVED
ST.
SET L. & T. ON ℄ PROD.
TO I.P. @ 83RD ST.
14.92
1025.85
41.02
168.32 PROP. (168.30 REC.)
TO N. & T. ℄ TR. LINE
HICKORY
15.07
50.48
36.96
54.58
FD. L. & T.
36.92
FD. CUT SPK. -4" DP. F.B. 103-122 CALLS FOR L. & T.
① 89° 39' 30"
④ 358° 39' 00"
⑥ 177° 58' 30"
89° 39' 45"
39' 45"
FD. L. & T.
154.99
314.97
① 90° 20' 15"
④ 361° 22' 00"
⑥ 182° 02' 45"
90° 20' 27 1/2"
118.32 @ T=74°=118.32
N° 6103
PROP. COR. SET L. & CO. ENGR. TAG
1.00
SET L. & CO. ENGR. TAG
90° 20' 30"
SET N. & T. BY PROP.
FIRESTONE
50.00
118.32 M.
TO PROP. COR.
2.50
2.50
TO GRADE ST.
50.00
129.98 M
TO PROP. COR. SET 1" X 2" STK. & N. FL.
SET NAIL
129.97 @ T=74°=129.98
CONT. ON TOP PG. 7
CONT. ON BOTT. PG. 10
WS 7
C-6
PLEASE RETURN TO
LOS ANGELES COUNTY ENGINEER
403 LOS ANGELES COUNTY ENGINEERING BLDG.
Do not extend this side of this line.
Note: Any Additions or Changes on This Sheet Must be Made or Circled in Red Ink With Date and Name of Person Making Change.

Notes Ck'd by W. J. BRENNER
Map No. B-2884
Office Work G. D. BAILEY
Checked W. J. BRENNER
Date MAY 15 1964

Survey of S.E. PROB. DEPT.
JN 0018.11 Tape 0225 Std 68 °F
Surveyed by R.B. HOBSON
Notes R.B.H. Date 2-17-64
Indexed B. J. GALL

F. B. 3170 PG. 9

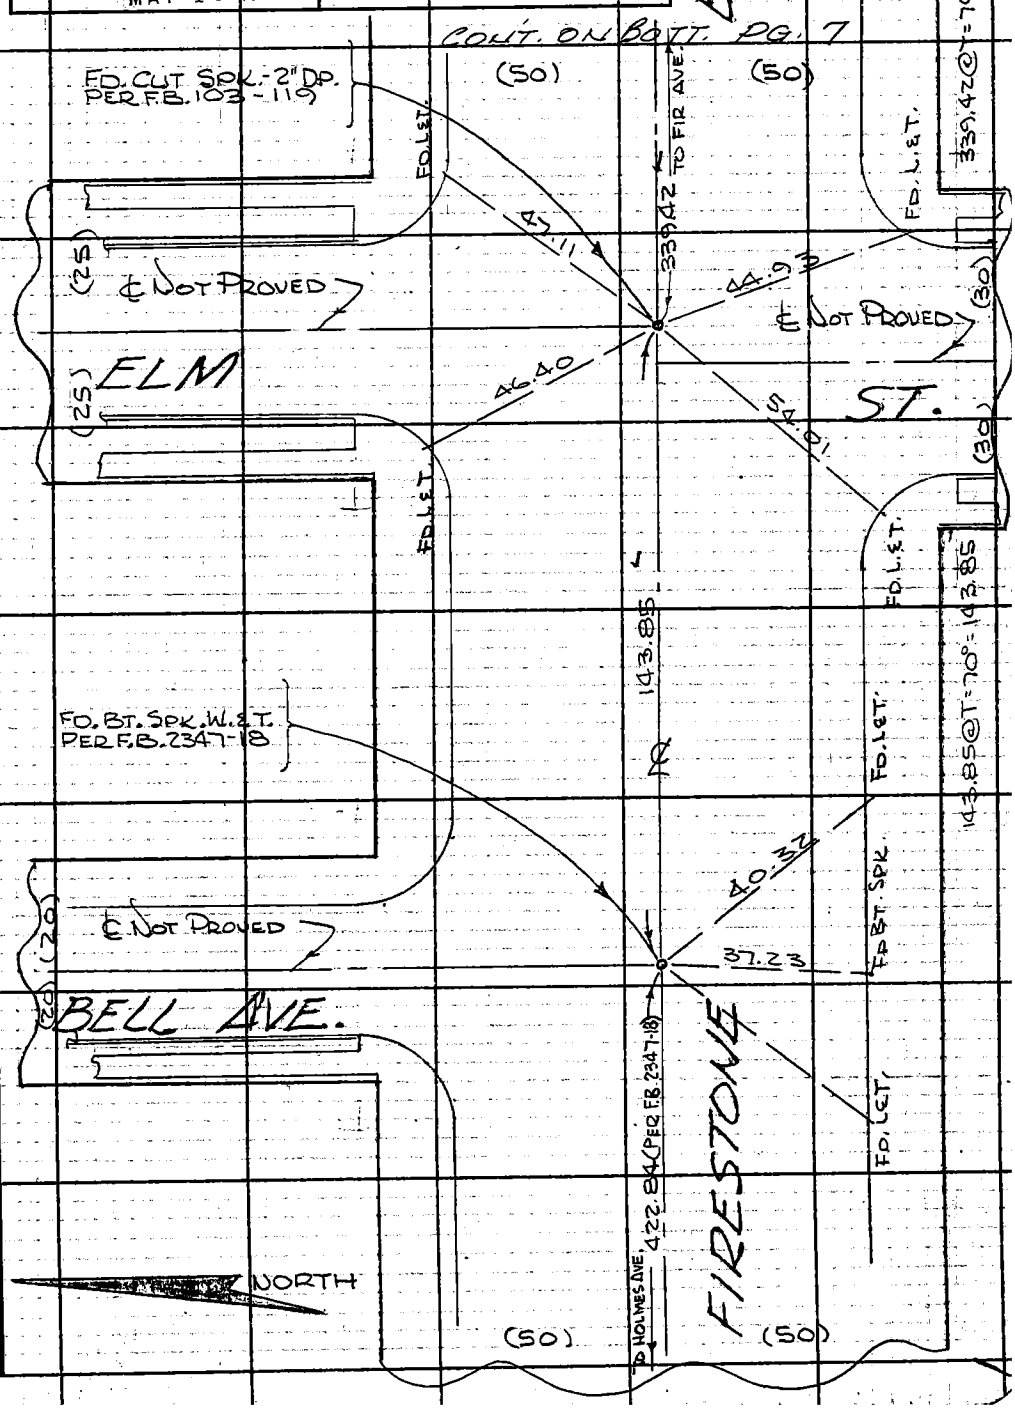

Note: Any Additions or Changes on This Sheet Must be Made or Circled in Red Ink With Date and Name of Person Making Change.

Do not extend this side of this line.

PLEASE RETURN TO
LOS ANGELES COUNTY ENGINEER
403 LOS ANGELES COUNTY ENGINEERING BLDG.

76F3095 CE # 310 3-61

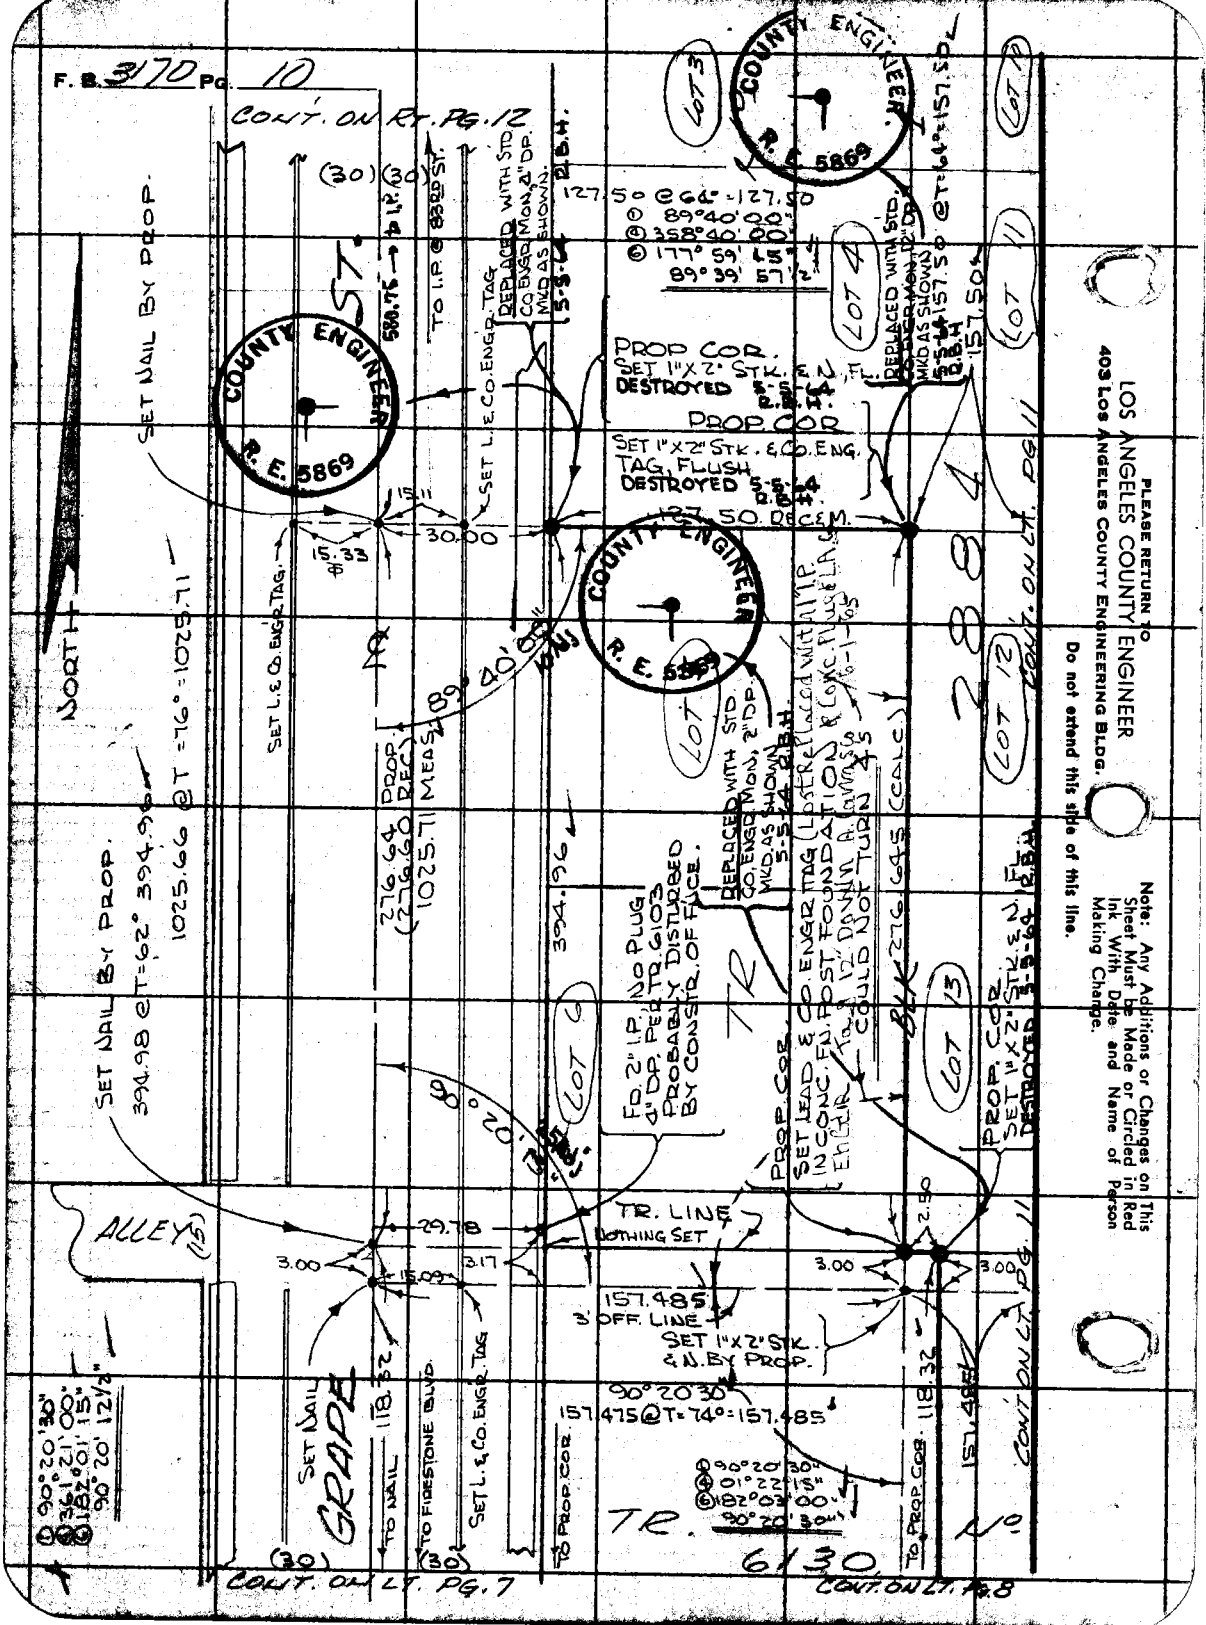
F. B. 3170 Pg. 10
CONT. ON RT. PG. 12
COUNTY ENGINEER R. E. 5869
LOT 3
LOT 4
LOT 10
LOT 11
LOT 12
LOT 13
LOT 6
ST.
NORTH
SET NAIL BY PROP.
SET L. & CO. ENGR. TAG.
REPLACED WITH STD. CO. ENGR. MON. 2" DP. MKD. AS SHOWN. 5-5-64 R.B.H.
127.50 @ 64° = 127.50
① 89°40'00"
④ 358°40'00"
⑥ 177°59'45"
89°39'57½"
PROP. COR. SET 1"X2" STK. & N. FL. DESTROYED 5-5-64 R.B.H.
PROP. COR. SET 1"X2" STK. & CO. ENG. TAG, FLUSH DESTROYED 5-5-64 R.B.H.
127.50 REC & M.
30.00
15.33
15.11
89°40'00"
276.64 PROP. (276.60 REC.) 1025.71 MEAS.
394.96
1025.66 @ T = 76° = 1025.71
394.98 @ T = 62° 394.96
FD. 2" I.P. NO PLUG 4" DP. PER TR. 6103 PROBABLY DISTURBED BY CONSTR. OF FNCE.
TR
PROP. COR. SET LEAD & CO. ENGR. TAG (LOST REPLACED WITH I.P. IN CONC. FN. POST FOUNDATION & CONC. PLUG & LA. 6-1-65) TO 12" DOWN A. CAVINESS COULD NOT TURN 4.5
276.645 (CALC.)
PROP. COR. SET 1"X2" STK. & N. FL. DESTROYED 5-5-64 R.B.H.
ALLEY (15)
TR. LINE NOTHING SET
29.78
3.00
3.17
15.09
157.485 3' OFF. LINE
SET 1"X2" STK. & N. BY PROP.
90°20'30"
157.475 @ T = 74° = 157.485
① 90°20'30"
④ 01°22'15"
⑥ 182°03'00"
90°20'30"
SET NAIL
GRAPE
118.32
TO NAIL
TO FIRESTONE BLVD.
SET L. & CO. ENGR. TAG
TO PROP. COR.
TO PROP. COR.
TR. 6130 No.
CONT. ON LT. PG. 7
CONT. ON LT. PG. 8
CONT. ON LT. PG. 11
2884
① 90°20'30"
④ 361°21'00"
⑥ 182°01'15"
90°20'12½"
PLEASE RETURN TO
LOS ANGELES COUNTY ENGINEER
403 LOS ANGELES COUNTY ENGINEERING BLDG.
Do not extend this side of this line.
Note: Any Additions or Changes on This Sheet Must be Made or Circled in Red Ink With Date and Name of Person Making Change.

Notes Ck'd by W. J. BRENNER	Survey of S.E. PROP. DEPT.
Map No. B-2884	JN 0018.11 Tape 0225 Std 68 °F
Office Work G. D. BAILEY	Surveyed by R.B. HOBSON
Checked W. J. BRENNER	Notes R.B.H. Date 2-17-64
Date MAY 15 1964	Indexed J. GALLI

F. B. 3170 PG. 11

CONT. ON RT. PG. 12

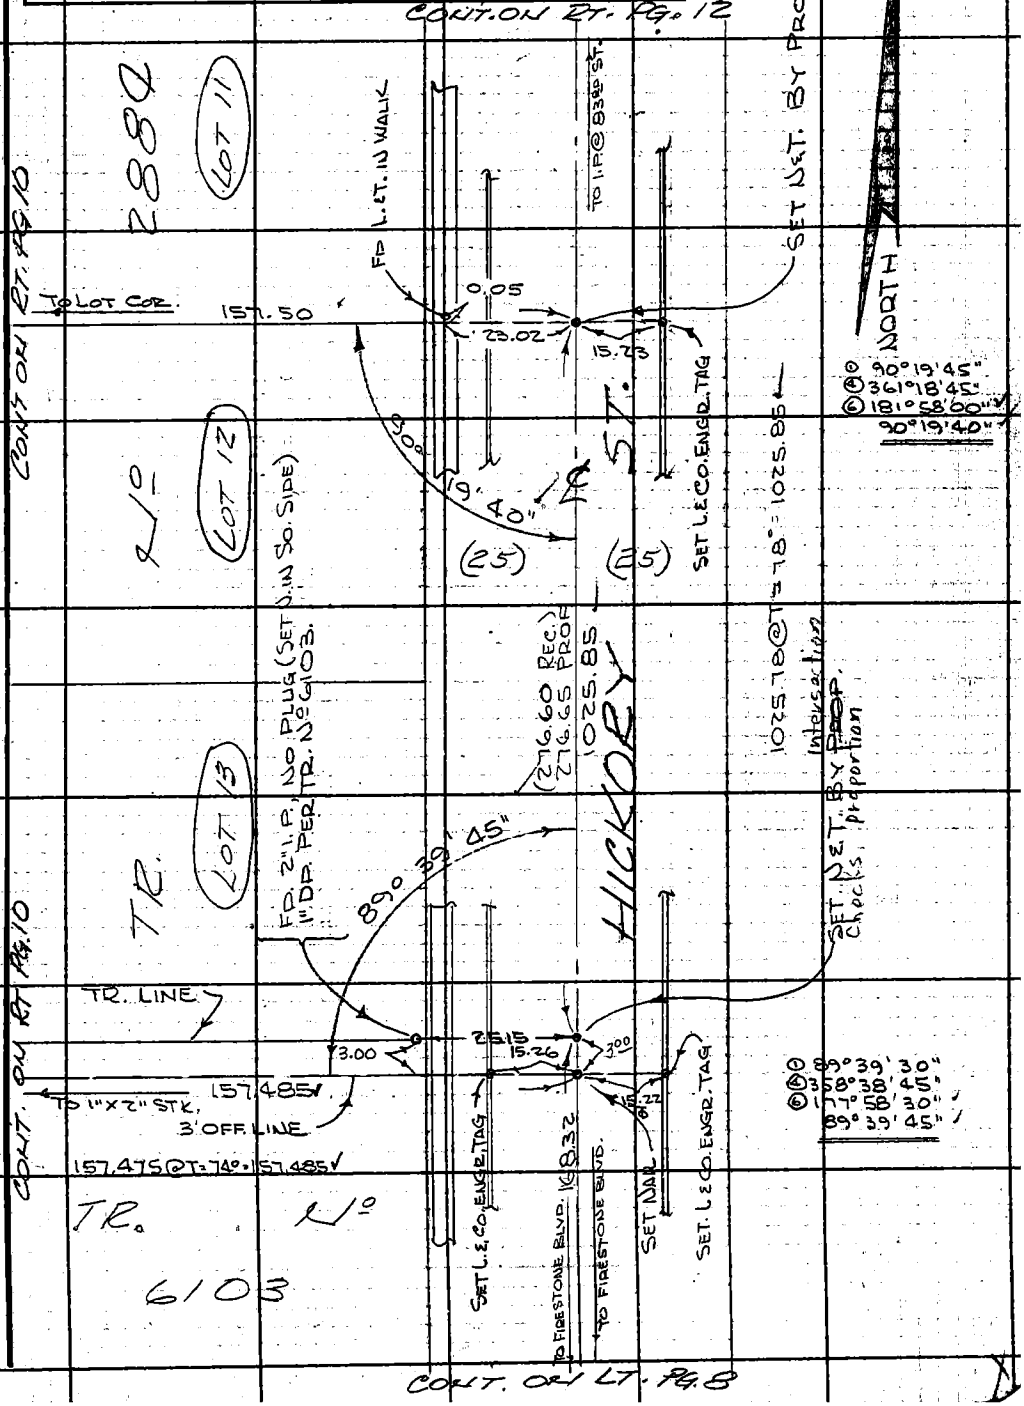

CONT. ON LT. PG. 8

Note: Any Additions or Changes on This Sheet Must be Made or Circled in Red Ink With Date and Name of Person Making Change.

Do not extend this side of this line.

PLEASE RETURN TO
LOS ANGELES COUNTY ENGINEER
403 LOS ANGELES COUNTY ENGINEERING BLDG.

76F3095 CE # 310 3-61

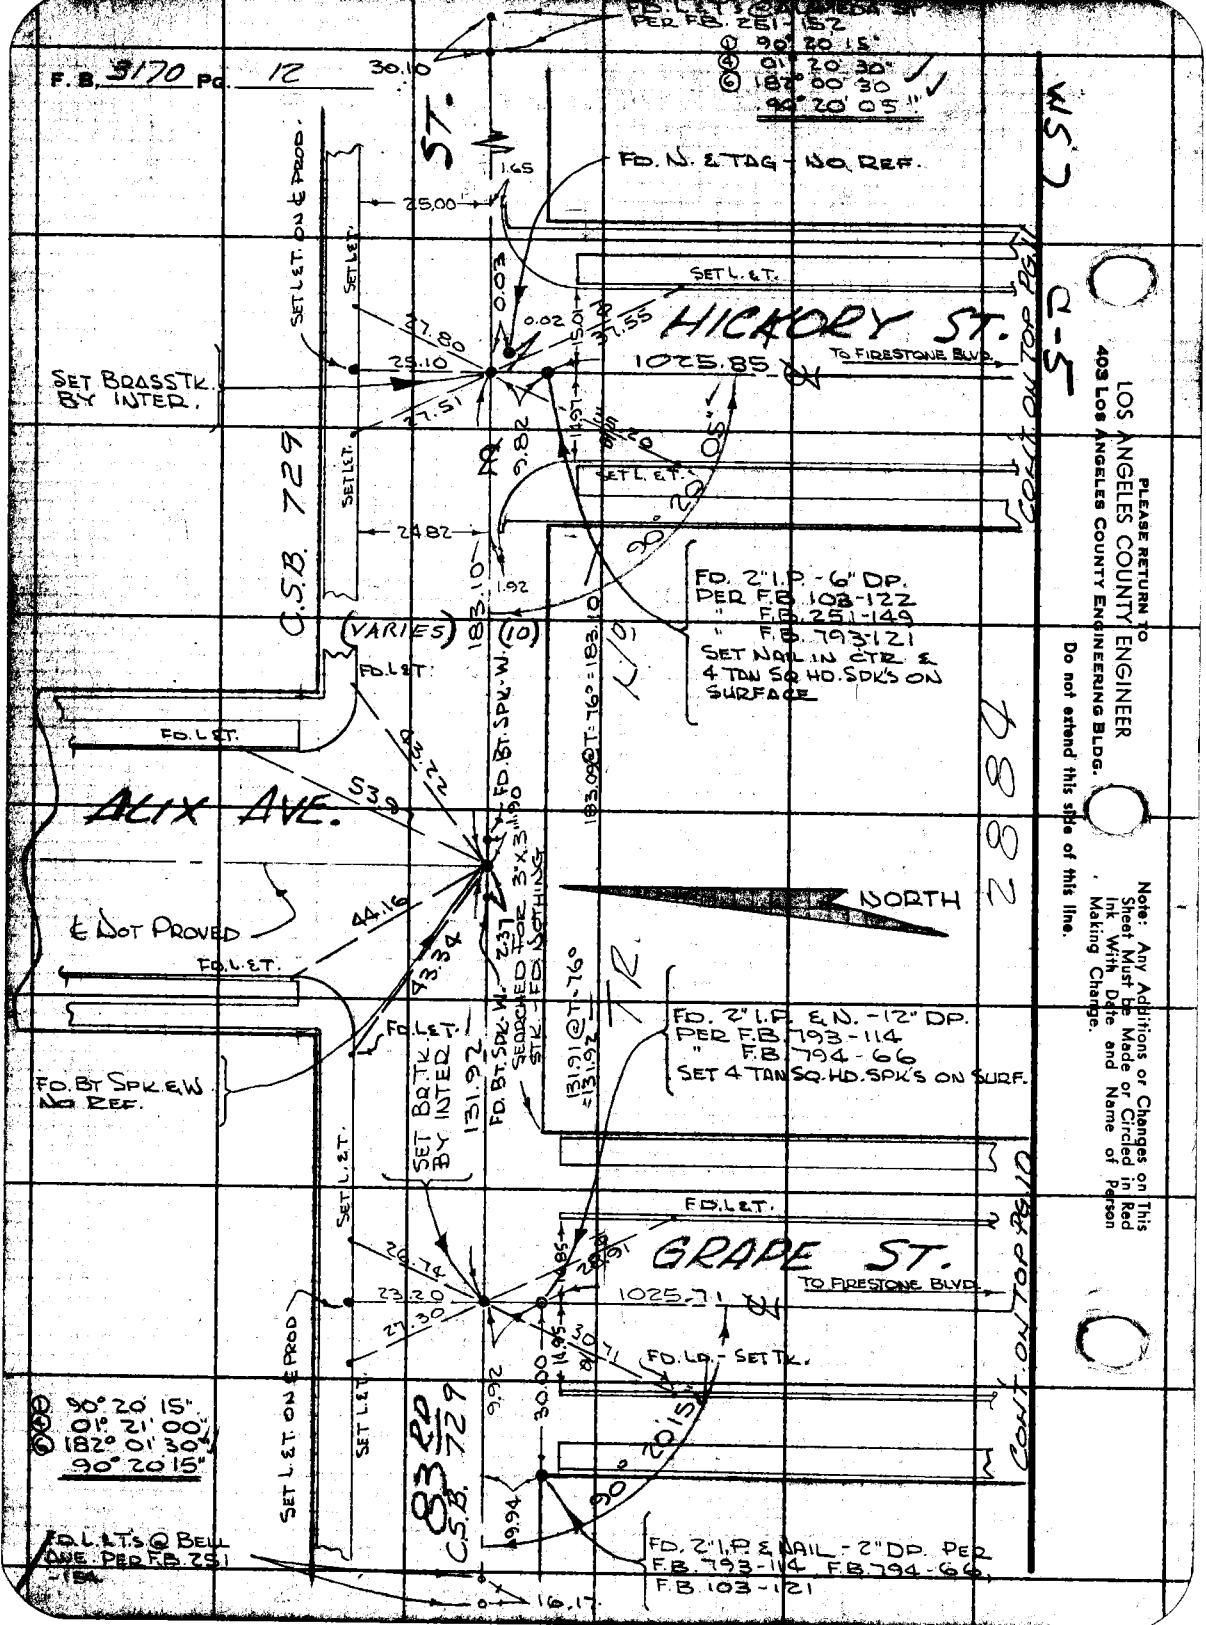
F.B. 3170 PG. 12
FD. L.&T.'s @ ALAMEDA ST. PER F.B. 251-152
① 90° 20' 15"
④ 01° 20' 30"
⑥ 182° 00' 30"
90° 20' 05"
30.10
ST.
FD. N. & TAG - NO REF.
1.65
25.00
SET L.&T. ON ℄ PROD.
SET L.&T.
SET L.&T.
0.03
0.02
27.80
25.10
27.51
37.55
HICKORY ST.
1025.85
TO FIRESTONE BLVD.
SET BRASS TK. BY INTER.
C.S.B. 729
SET L.&T.
SET L.&T.
24.82
1.92
183.10
(VARIES)
(10)
FD. 2" I.P. - 6" DP. PER F.B. 103-122
" F.B. 251-149
" F.B. 793-121
SET NAIL IN CTR. & 4 TAN SQ. HD. SPK'S ON SURFACE
FD. L.&T.
FD. L.&T.
ALIX AVE.
53.97
43.22
FD. BT. SPK. W.
183.09 @ T-76° = 183.10
NORTH
℄ NOT PROVED
44.16
43.34
FD. L.&T.
FD. L.&T.
FD. BT SPK. & W. NO REF.
SET BR. TK. BY INTER.
131.92
FD. BT. SPK. W.
SEARCHED FOR 3"x3" STK. - FD. NOTHING
131.91 @ T-76° = 131.92
FD. 2" I.P. & N. - 12" DP. PER F.B. 793-114
" F.B. 794-66
SET 4 TAN SQ. HD. SPK'S ON SURF.
SET L.&T.
FD. L.&T.
GRAPE ST.
26.74
23.20
27.30
1025.71
TO FIRESTONE BLVD.
FD. LD. - SET TK.
30.00
9.92
90° 20' 15"
① 90° 20' 15"
④ 01° 21' 00"
⑥ 182° 01' 30"
90° 20' 15"
SET L.&T. ON ℄ PROD.
SET L.&T.
83 RD
C.S.B. 729
9.94
FD. L.&T.'s @ BELL AVE. PER F.B. 251-154
FD. 2" I.P. & NAIL - 2" DP. PER F.B. 793-114 F.B. 794-66, F.B. 103-121
16.17
CONT. ON TOP PG. 11
CONT. ON TOP PG. 10
S-5
2884
PLEASE RETURN TO
LOS ANGELES COUNTY ENGINEER
403 LOS ANGELES COUNTY ENGINEERING BLDG.
Do not extend this side of this line.
Note: Any Additions or Changes on This Sheet Must be Made or Circled in Red Ink With Date and Name of Person Making Change.

NOTES RED. _____ JOB NO. 0018.11 SURVEY OF S.E. PROB. DEPT.
DATE _____ SURVEY BY R.B. HOBSON
NOTES CHKD. W. J. BRENNER NOTES BY R.B.H. DATE FEB. 25TH, 1964
DATE _____ INDEXED R. J. GALL DATE MRS '64

F.B. PG.

NOTE: ANY ADDITIONS OR CHANGES ON THIS SHEET MUST BE MADE OR CIRCLED IN RED INK, WITH DATE AND NAME OF PERSON MAKING CHANGE.

Do not extend notes this side of this line

PLEASE RETURN TO
LOS ANGELES COUNTY SURVEYOR
315 CIVIC CENTER BLDG.

DESCRIPTION	ADJ. ELEV.	3RD RUN	2ND RUN	DIFF.	1ST RUN	B.M.
SOUTH EAST PROB. DEPT.						
J.N. 0018.11						
BENCH LEVELS						
		FEB. 25TH 1964				
		HOBSON				
		FRONIK				
		SONNENSCHEIN				
		GROUNDER				

76S420 353 2M 3-48

FORM 353 2M 3-48

PLEASE RETURN TO
LOS ANGELES COUNTY SURVEYOR
315 CIVIC CENTER BLDG.

NOTE: ANY ADDITIONS OR CHANGES ON THIS SHEET MUST BE MADE OR CIRCLED IN RED INK, WITH DATE AND NAME OF PERSON MAKING CHANGE.

Do not extend notes this side of this line

B.M.	1ST RUN	DIFF.	2ND RUN	3RD RUN	ADJ. ELEV.	DESCRIPTION
B.M. #5-5	139.095					B.M. No 5-5 ELEV. 139.095 (1960 ADJ.) F.B. 1206-10 IN LOS ANGELES AT THE INTERSECTION OF ALAMEDA & NADEAU STS. ON THE ℄ OF NADEAU ST. 2 ABOUT 1.0 W. OF THE E. CB ON ALAMEDA ST. PRODUCED IN A WELL PROTECTED WITH A CAST IRON COVER MARKED "COUNTY SURVEYOR MONUMENT". A STD. L.A. COUNTY SURVEY CONTROL SYSTEM DISK STAMPED "WATTS 1-4A 1938 R.E. 2177" SET IN THE TOP OF A CONCRETE POST ABOUT 12" BELOW THE SURFACE
+	5.088		5.032			
H.I.	144.183	-0.793	-0.793			
−	5.881		5.825			
T.P.	138.302				138.300	
+	4.424		4.393			
H.I.	142.726	-1.338	-1.339			
−	5.762		5.732			
T.P.	136.964				136.963	
+	3.876		3.845			
H.I.	140.840	-1.532	-1.528			
−	5.408		5.373			
T.P.	135.432				135.428	
+	4.035		4.009			
H.I.	139.467	-1.438	-1.439			
−	5.473		5.448			
T.P.	133.994				133.989	
+	4.175		4.131			
H.I.	138.169	+1.074	+1.074			
−	3.101		3.057			
B.M. #5-6	135.068				135.063	B.M. No 5-6 ELEV. = 135.063 (1960 ADJ.) F.B. 1206-11 IN FIRESTONE PARK (FORMERLY FLORENCE) ON THE SO. PACIFIC R.R. ABUTMENT 0.4 MILES N. OF THE FIRESTONE BLVD. CROSSING AND ABOUT 90' N. OF THE RAILROAD STA. & 11' E. OF THE NEAREST RAIL. A STD. DISK STAMPED "A-33 1920" AND SET IN THE TOP OF A SMALL IRREGULAR GRANITE POST
+	2.182		2.139			
H.I.	137.250	-3.303	-3.302			
−	5.485		5.441			
T.P.	131.765				131.761	
+	4.270		4.226			
H.I.	136.035	-1.164	-1.165			
−	5.434		5.391			
T.P.	130.601				130.598	

JOB NO. 0018.11 SURVEY OF S.E. PROB. DEPT.
SURVEY BY R.B. HOBSON DATE 2-25-64
NOTES BY R.B.H. DATE
INDEXED B. J. GALLI DATE
NOTES RED. DATE
NOTES CHKD. W. J. BRENNER DATE
F.B. 3170 PG. 12

76S 420 353 2M 3-48

PLEASE RETURN TO
LOS ANGELES COUNTY SURVEYOR
315 CIVIC CENTER BLDG.

NOTE: ANY ADDITIONS OR CHANGES ON THIS SHEET MUST BE MADE OR CIRCLED IN RED INK, WITH DATE AND NAME OF PERSON MAKING CHANGE.

Do not extend notes this side of this line

B.M.	1ST RUN	DIFF.	2ND RUN	3RD RUN	ADJ. ELEV.	DESCRIPTION
T.P.	130.601				130.598	
+	4.089		4.049			
H.I.	134.690	-0.936	-0.933			
-	5.025		4.982			
T.P.	129.665				129.663	
+	5.075		5.049			
H.I.	134.740	-0.054	-0.051			
-	5.129		5.100			
T.P.	129.611				129.610	
+	4.983		4.955			
H.I.	134.594	-0.035	-0.036			
-	5.018		4.991			
T.P.	129.576				129.576	
+	5.059		5.041			
H.I.	134.635	-0.272	-0.272			
-	5.331		5.313			
T.P.	129.304				129.305	
+	5.394		5.361			
H.I.	134.698	+0.835	+0.835			
-	4.559		4.526			
T.P.	130.139				130.141	
+	5.067		5.053			
H.I.	135.206	+0.050	0.049			
-	5.017		5.004			
B.M. C-116	130.189				130.192	B.M. C-116 ELEV. F.B. 6 BRD ST. & GRADE ST., S.W. COR. SPK. IN W. CB. SO. OF N. END CB. (CHISELED INSCRIPTION C-116)
+	4.028		4.072			
H.I.	134.217	-1.767	-1.768			
-	5.795		5.840			
T.P.	128.422				128.426	

NOTES RED. _____ JOB NO. 0018.11 SURVEY OF S.E. PROB DEPT.
DATE _____ SURVEY BY R.B. HOBSON
NOTES CHKD. W. J. BRENNER NOTES BY R.B.H. DATE 2-25-64
DATE _____ INDEXED E. J. GALLI DATE _____

F.B. _____ PG. 10

FORM 353 2M 3-48

PLEASE RETURN TO
LOS ANGELES COUNTY SURVEYOR
315 CIVIC CENTER BLDG.

NOTE: ANY ADDITIONS OR CHANGES ON THIS SHEET MUST BE MADE OR CIRCLED IN RED INK, WITH DATE AND NAME OF PERSON MAKING CHANGE.

Do not extend notes this side of this line

B.M.	1ST RUN	DIFF.	2ND RUN	3RD RUN	ADJ. ELEV.	DESCRIPTION
T.P.	128.422				128.426	
+	5.119		5.075			
H.I.	133.541	-1.409	-1.413			
-	6.528		6.488			
T.P.	127.013				127.017	
+	4.569		4.546			
H.I.	131.582	-0.470	-0.470			
-	5.039		5.016			
T.B.M. #1	126.543				126.547	T.B.M. #1 ELEV. = GRADE ST. @ APT. 444.96' N/O. OF THE ℄ OF FIRESTONE BLVD. - A L.&CO. ENGR. TAG. IN THE W. CURB. (N.P.L. PROD.)
+	3.952		3.935			
H.I.	130.495	-1.186	-1.187			
-	5.138		5.122			
T.P.	125.357				125.361	
+	4.654		4.619			
H.I.	130.011	-0.759	-0.759			
-	5.413		5.378			
(SET) T.B.M. #2	124.598				124.603	T.B.M. #2 ELEV. = FIRESTONE BLVD. & GRADE ST. N.E. COR. BT. SPK. IN CB. 5' N. OF N. END CB. RETURN. (CTR. OF CATCH BASIN)
+	5.246		5.183			
H.I.	129.844	-0.882	-0.884			
-	6.128		6.067			
T.P.	123.716				123.721	
+	5.749		5.728			
H.I.	129.465	+0.723	+0.724			
-	5.026		5.004			
T.P.	124.439				124.444	
+	6.291		6.272			
H.I.	130.730	+1.346	+1.346			
-	4.945		4.926			
T.P.	125.785				125.790	

JOB NO. 0018.11 SURVEY OF S.E. PROB. DEPT.
SURVEY BY R.B. HOBSON
NOTES BY R.B.H. DATE 2-26-64
INDEXED S. J. GALL DATE
NOTES RED. DATE
NOTES CHKD. W. J. BRENNER DATE

F.B. 10 PG. 16

766420 353 2M 3-48

PLEASE RETURN TO
LOS ANGELES COUNTY SURVEYOR
315 CIVIC CENTER BLDG.

NOTE: ANY ADDITIONS OR CHANGES ON THIS SHEET MUST BE MADE OR CIRCLED IN RED INK, WITH DATE AND NAME OF PERSON MAKING CHANGE.

Do not extend notes this side of this line

B.M.	1ST RUN	DIFF.	2ND RUN	3RD RUN	ADJ. ELEV.	DESCRIPTION
T.P.	125.785				125.790	
+	6.370		6.357			
H.I.	132.155	+1.441	+1.442			
-	4.929		4.915			
T.P.	127.226				127.231	
+	6.235		6.218			
H.I.	133.461	+1.044	+1.046			
-	5.191		5.172			
T.P.	128.270				128.275	
+	6.072		6.046			
H.I.	134.342	+1.422	+1.424			
-	4.650		4.622			
T.P.	129.692				129.697	
+	4.883		4.868			
H.I.	134.575	-0.084	-0.083			
-	4.967		4.951			
T.P.	129.608				129.613	
+	4.874		4.849			
H.I.	134.482	-0.003	-0.002			
-	4.877		4.851			
T.P.	129.605				129.610	
+	5.064		5.033			
H.I.	134.669	+0.236	+0.237			
-	4.828		4.796			
T.P.	129.841				129.846	
+	4.814		4.791			
H.I.	134.655	+0.806	+0.805			
-	4.008		3.986			
T.P.	130.647				130.652	

NOTES RED. _____ JOB NO. 0018.11 SURVEY OF S.E. PROB. DEPT.
DATE _____ SURVEY BY R.B. HOBSON
NOTES CHKD. W. J. BRENNER NOTES BY R.B.H. DATE 2-26-64
DATE _____ INDEXED _____ E. J. GALLI DATE _____

F.B. _____ PG. _____

FORM 353 2M 3-48

PLEASE RETURN TO
LOS ANGELES COUNTY SURVEYOR
315 CIVIC CENTER BLDG.

NOTE: ANY ADDITIONS OR CHANGES ON THIS SHEET MUST BE MADE OR CIRCLED IN RED INK, WITH DATE AND NAME OF PERSON MAKING CHANGE.

Do not extend notes this side of this line

B.M.	1ST RUN	DIFF.	2ND RUN	3RD RUN	ADJ. ELEV.	DESCRIPTION
T.P.	130.647				130.652	
+	5.314		5.263			
H.I.	135.961	+1.932	+1.931			
-	3.382		3.332			
T.P.	132.579				132.585	
+	4.244		4.173			
H.I.	136.823	+0.576	+0.576			
-	3.668		3.597			
T.P.	133.155				133.161	
+	5.217		5.186			
H.I.	138.372	+1.902	+1.903			
-	3.315		3.283			
B.M. #5-6	135.057				135.063	B.M. No 5-6 ELEV. = 135.063 (1960 ADJ.) FB 1206-11
						SEE PG. 14 FOR DESCRIPTION

JOB NO 001811 SURVEY OF S.E. PROB. DEPT.
SURVEY BY R.B. HOBSON
NOTES BY R.B.H. DATE 2-26-62
INDEXED G. J. GALL DATE
NOTES RED. DATE
NOTES CHKD. W. L. BRENNER DATE

F.B. 3110 PG. 18

Notes Ck'd by J. Church	Survey of 92ND ST	F.B. 3170 PG. 23
Map No.	JN 0096.66 Tape Std °F	
Office Work	Surveyed by SPRIGGS	
Checked	Notes WALSH Date 9-15-65	
Date	Indexed C. J. GALLI MAR 1 8 '66	

JN 0096.66

92ND ST.

℄ SURVEY FROM CENTRAL AVE ELY TO ALAMEDA

INDEX: Pg's. 24, 25, 26, 27,

REFERENCE Field Books

LACoEngr.	LACoRdDept	LACdy	
FB 391	FB 334	FB 10633	SPRIGGS
" 700	" 427	" 10663	WALSH
" 794	(FQ) 107	" 12302	
" 807	(FC) 761	" 10662	SMITH
" 901	(FC) 897	" 10672	
" 986		" 13105	WORKMAN
" 2347		" 12310	
" 1300		" 15608	R. MASSEY
		" 21310	
		" 25602	
		" 23802	

Note: Any Additions or Changes on This Sheet Must be Made or Circled in Red Ink With Date and Name of Person Making Change.

Do not extend this side of this line.

PLEASE RETURN TO
LOS ANGELES COUNTY ENGINEER
403 LOS ANGELES COUNTY ENGINEERING BLDG.

76F309S CE#310 1-65

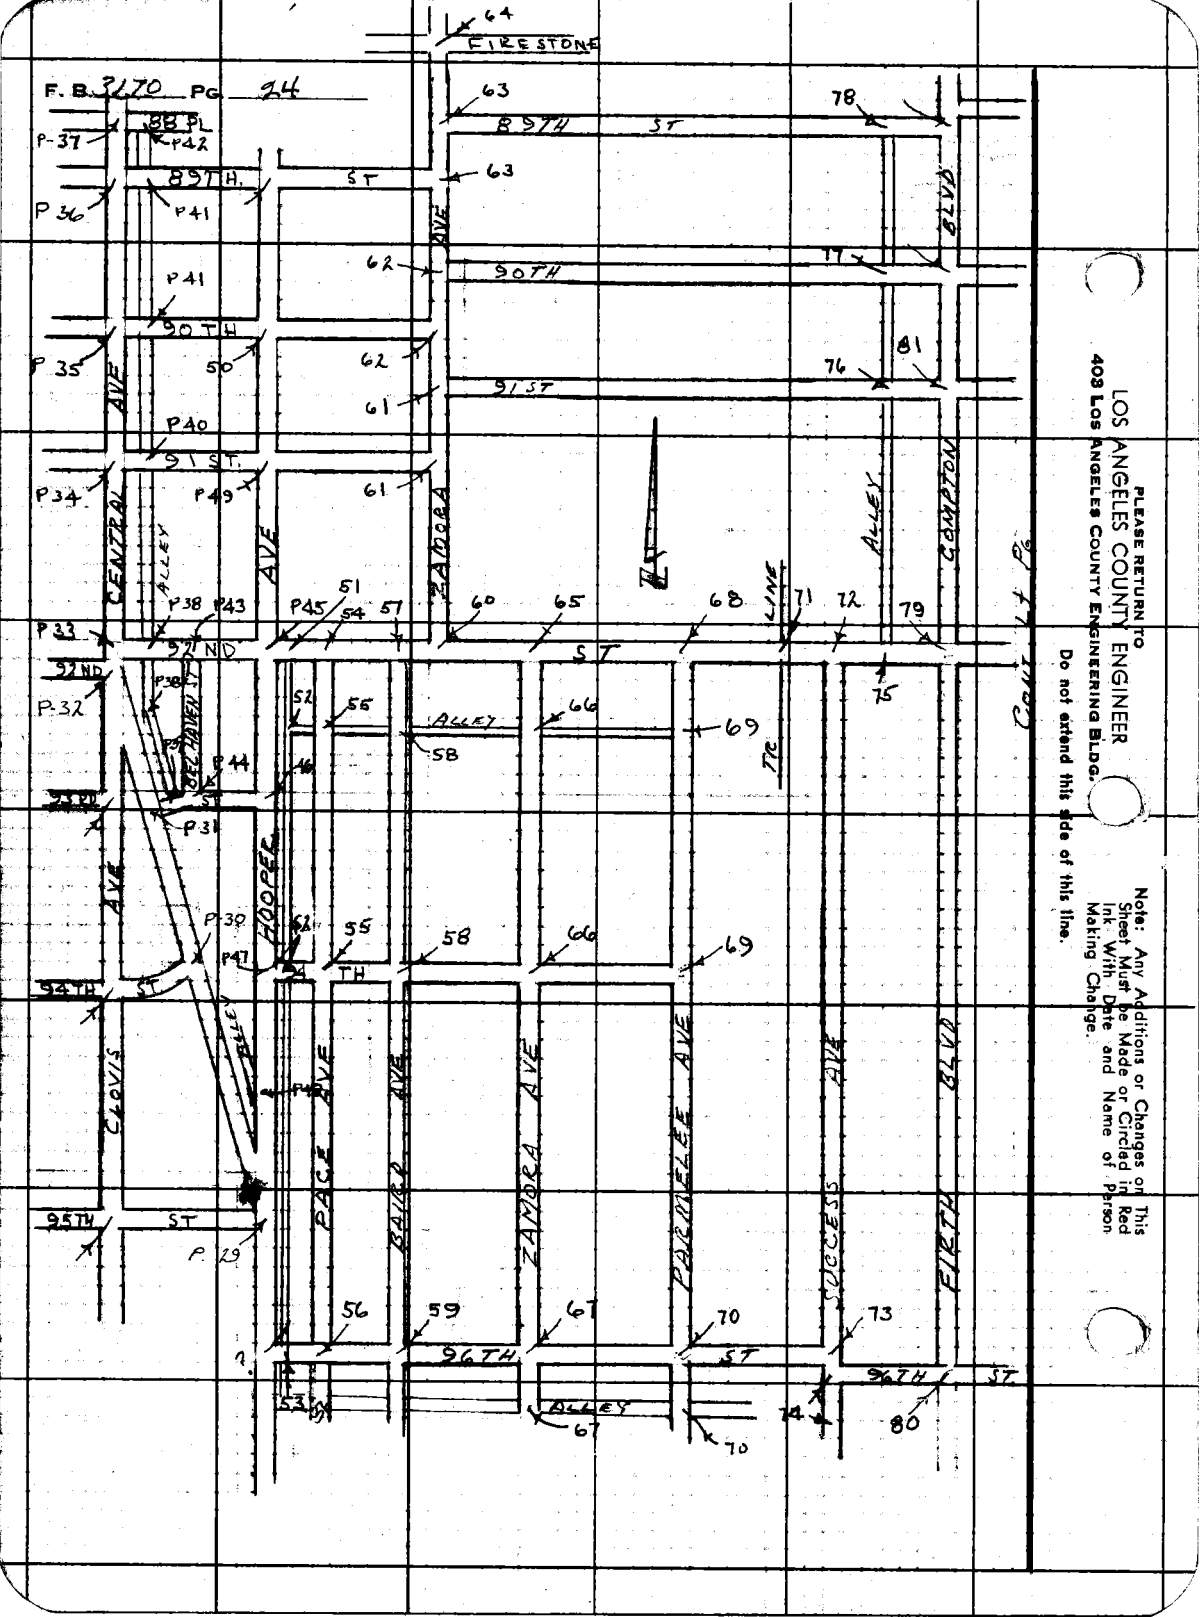

PLEASE RETURN TO
LOS ANGELES COUNTY ENGINEER
403 Los Angeles County Engineering Bldg.

Do not extend this side of this line.

Note: Any Additions or Changes on This Sheet Must be Made or Circled in Red Ink With Date and Name of Person Making Change.

Notes Ck'd by J. Church	Survey of 92 ND ST	F. B. 3170 PG. 25
Map No.	JN 009646 Tape Std °F	
Office Work	Surveyed by SPRIGGS	
Checked J. A. CHURCH	Notes WALSH Date 9-15-65	
Date JUL 7 '66	Indexed G. J. GALLI	

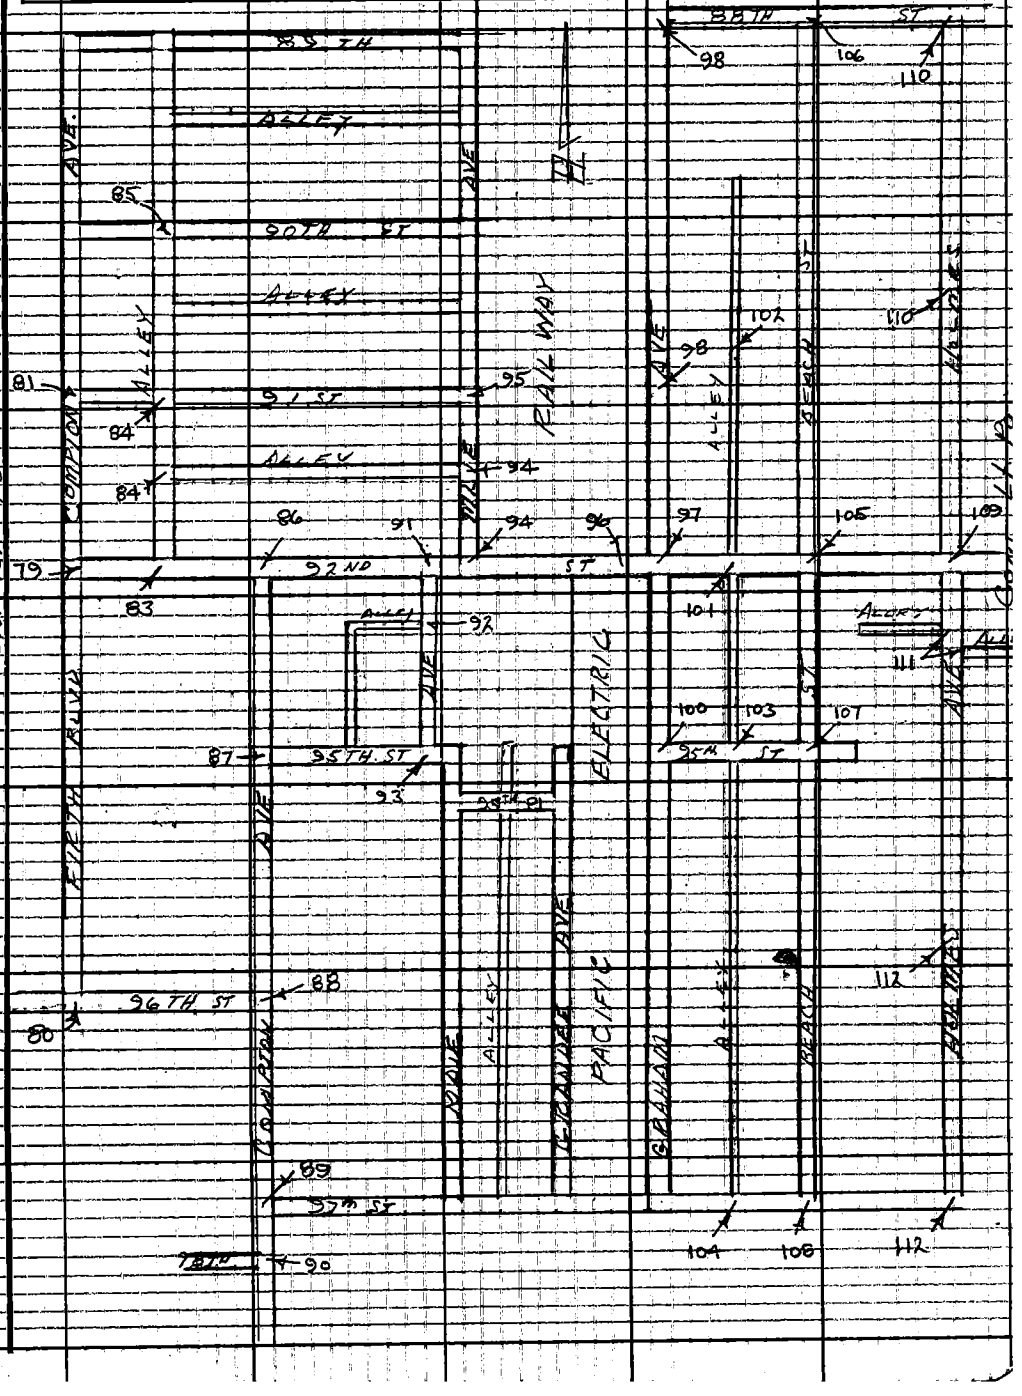

Note: Any Additions or Changes on This Sheet Must be Made or Circled in Red Ink With Date and Name of Person Making Change.

Do not extend this side of this line.

PLEASE RETURN TO
LOS ANGELES COUNTY ENGINEER
403 LOS ANGELES COUNTY ENGINEERING BLDG.

76F309S CE#310 1-65

F. B. 3170 PG 26

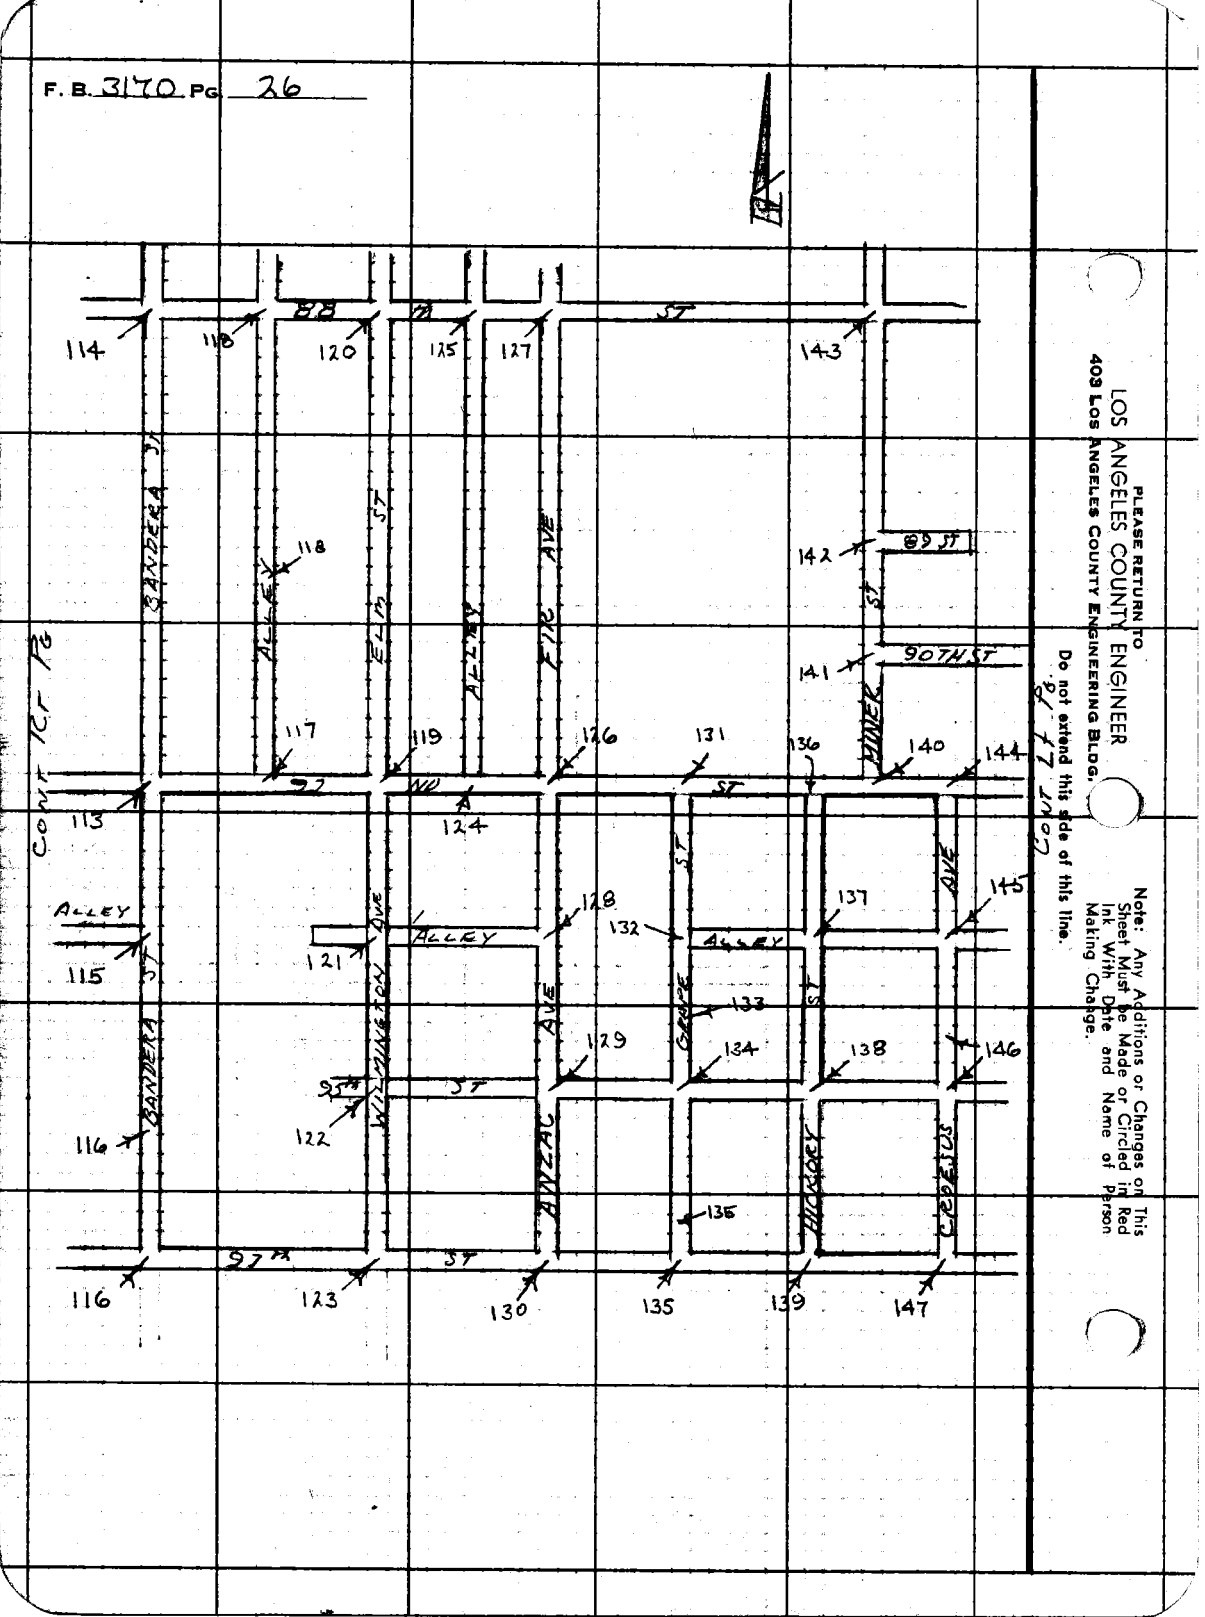

PLEASE RETURN TO
LOS ANGELES COUNTY ENGINEER
403 LOS ANGELES COUNTY ENGINEERING BLDG.

Do not extend this side of this line.

Note: Any Additions or Changes on This Sheet Must Be Made or Circled in Red Ink With Date and Name of Person Making Change.

Notes Ck'd by J. Church	Survey of 92ND ST
Map No.	JN 009666 Tape Std °F
Office Work	Surveyed by SPRIGGS
Checked J. A. CHURCH	Notes WALSH Date
Date 7-55	Indexed G. L. GALLE

F.B. 3170 PG. 27

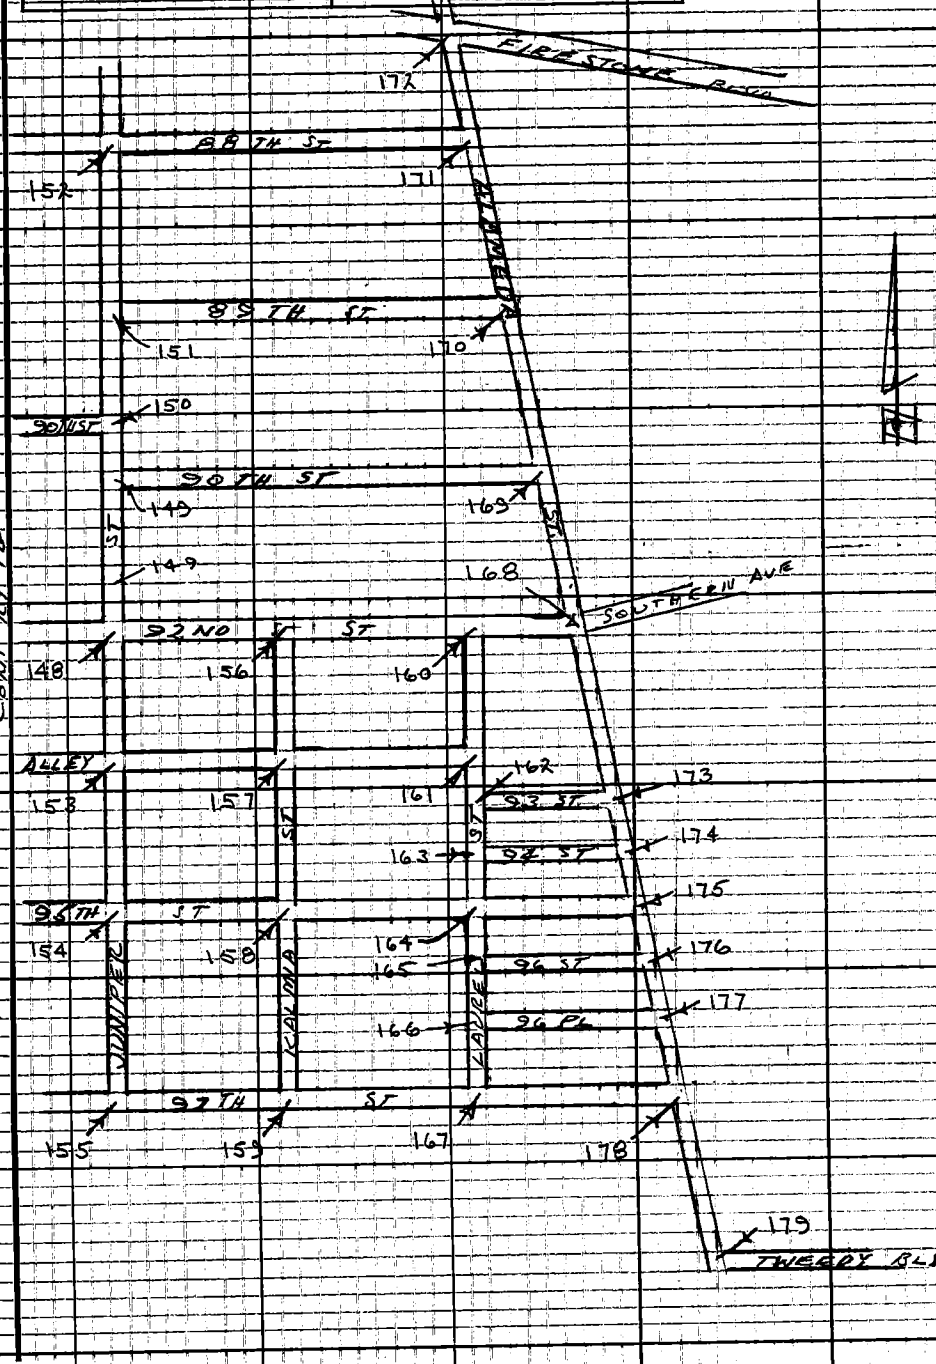

Note: Any Additions or Changes on This Sheet Must be Made of Circled in Red Ink With Date and Name of Person Making Change.

Do not extend this side of this line.

PLEASE RETURN TO
LOS ANGELES COUNTY ENGINEER
403 Los Angeles County Engineering Bldg.

76F3095 CE#310 1-65

F. B. 3170 PG 28

PLEASE RETURN TO
LOS ANGELES COUNTY ENGINEER
403 LOS ANGELES COUNTY ENGINEERING BLDG.

Do not extend this side of this line.

Note: Any Additions or Changes on This Sheet Must be Made or Circled in Red Ink With Date and Name of Person Making Change.

Notes Ck'd by J. Church	Survey of 92nd St.	F. B. 3170	PG. 29
Map No. B-3019	JN009616 Tape 0259 Std 68 °F		
Office Work	Surveyed by HHSpriggs		
Checked J. A. CHURCH	Notes HHS Date 9-15-65		
Date JUL 7 '66	Indexed G. A. GALLI MAR 1 8 '66		

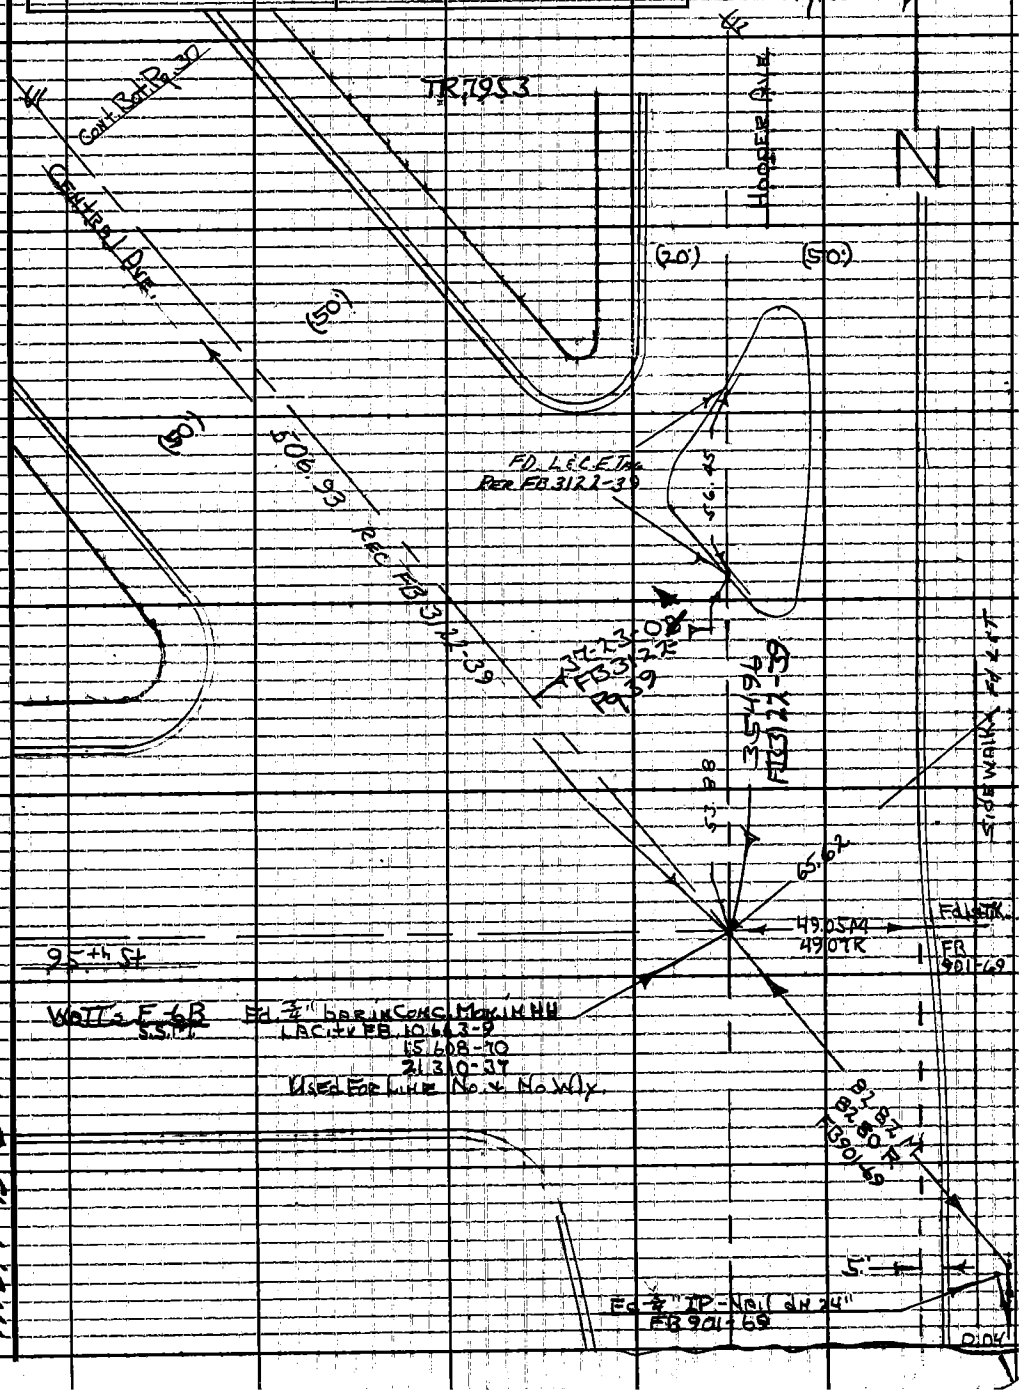

Note: Any Additions or Changes on This Sheet Must be Made or Circled in Red Ink With Date and Name of Person Making Change.

Do not extend this side of this line.

PLEASE RETURN TO
LOS ANGELES COUNTY ENGINEER
403 LOS ANGELES COUNTY ENGINEERING BLDG.

76F309S CE#310 1-65

PLEASE RETURN TO
LOS ANGELES COUNTY ENGINEER
403 LOS ANGELES COUNTY ENGINEERING BLDG.

Note: Any Additions or Changes on This Sheet Must be Made or Circled in Red Ink With Date and Name of Person Making Change.

Do not extend this side of this line.

W.S. 7 B-6

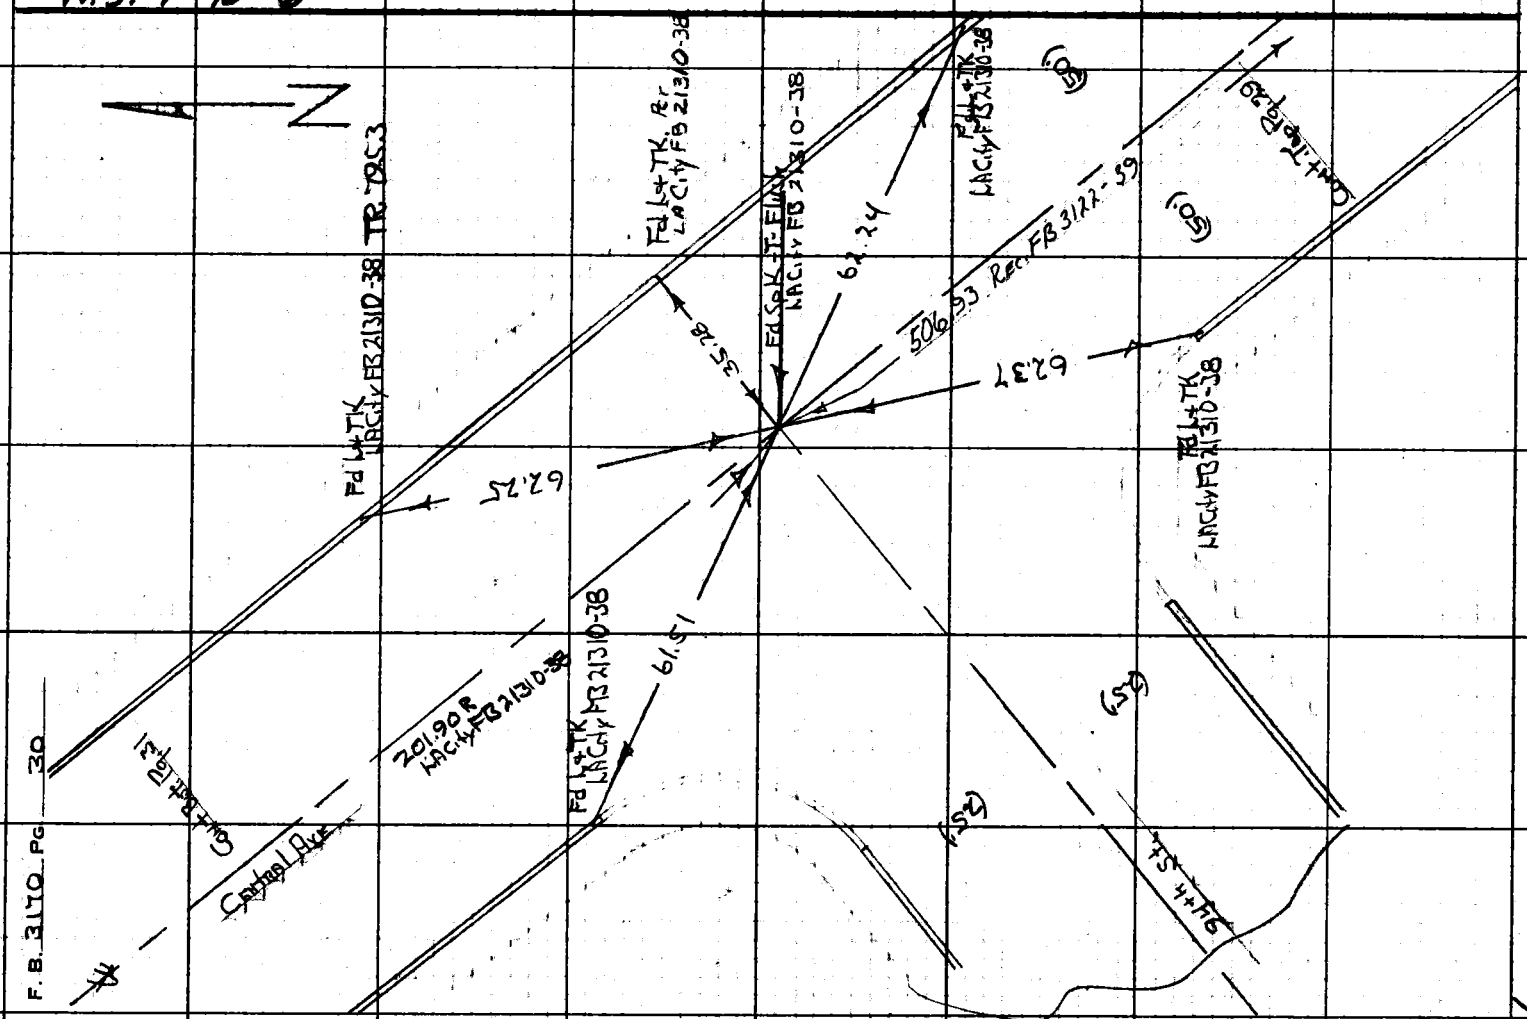

Notes Ck'd by J. Church
Map No. B-30 19
Office Work
Checked J. A. CHURCH
Date

Survey of 92nd St
JN 0096.66 Tape 0259 Std 68 °F
Surveyed by H.H. Spriggs
Notes HHS Date 9-15-65
Indexed C. J. GALL

F. B. 3170 PG. 31

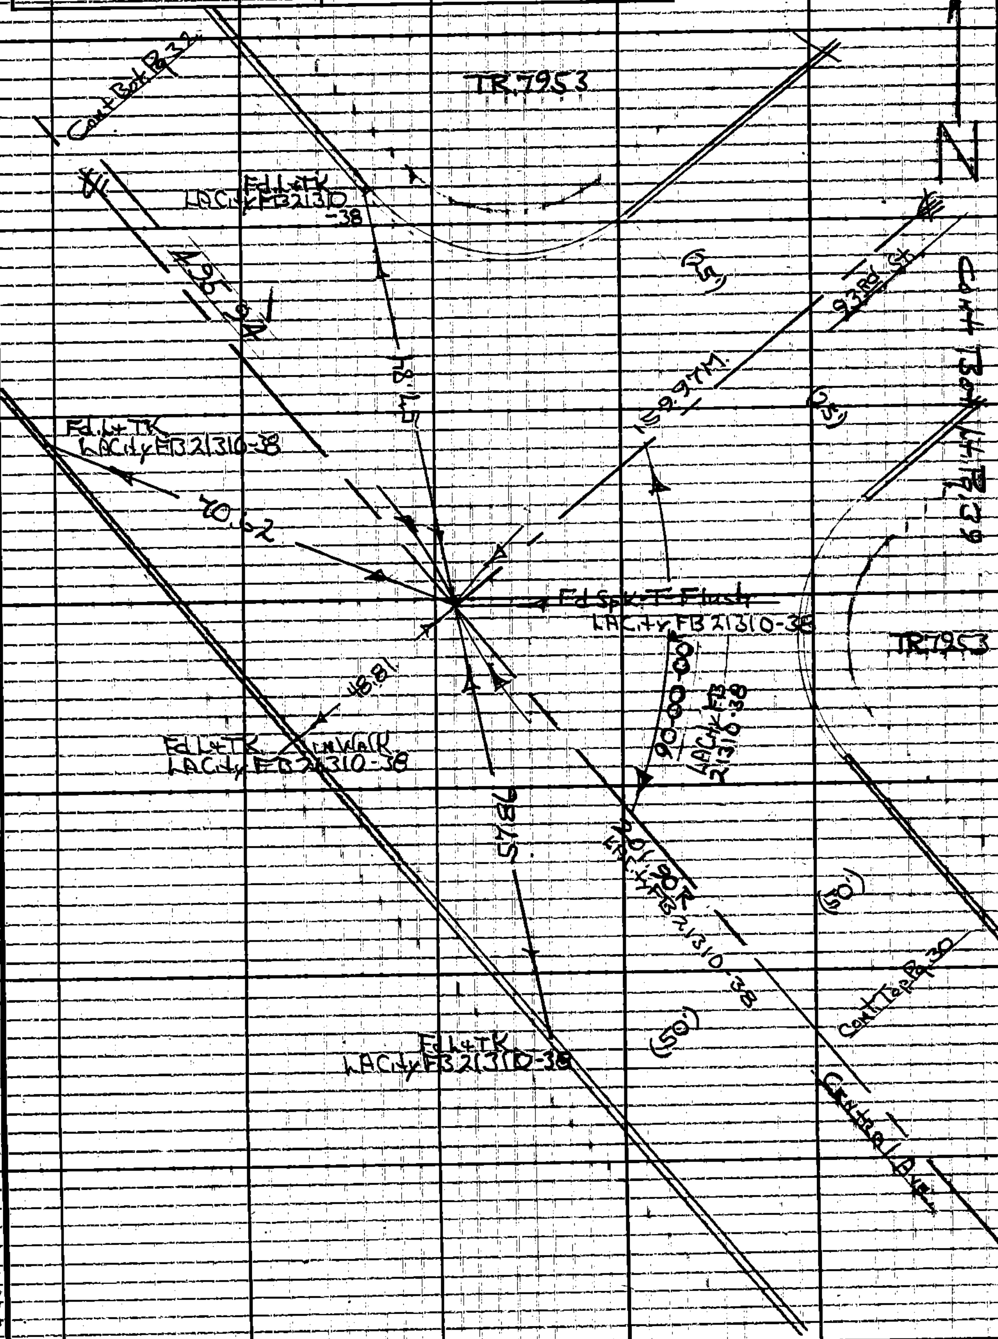

Note: Any Additions or Changes on This Sheet Must be Made or Circled in Red Ink With Date and Name of Person Making Change.

PLEASE RETURN TO
LOS ANGELES COUNTY ENGINEER
403 LOS ANGELES COUNTY ENGINEERING BLDG.

Do not extend this side of this line.

W.S. 7 B-6

76F309S CE#310 1-65

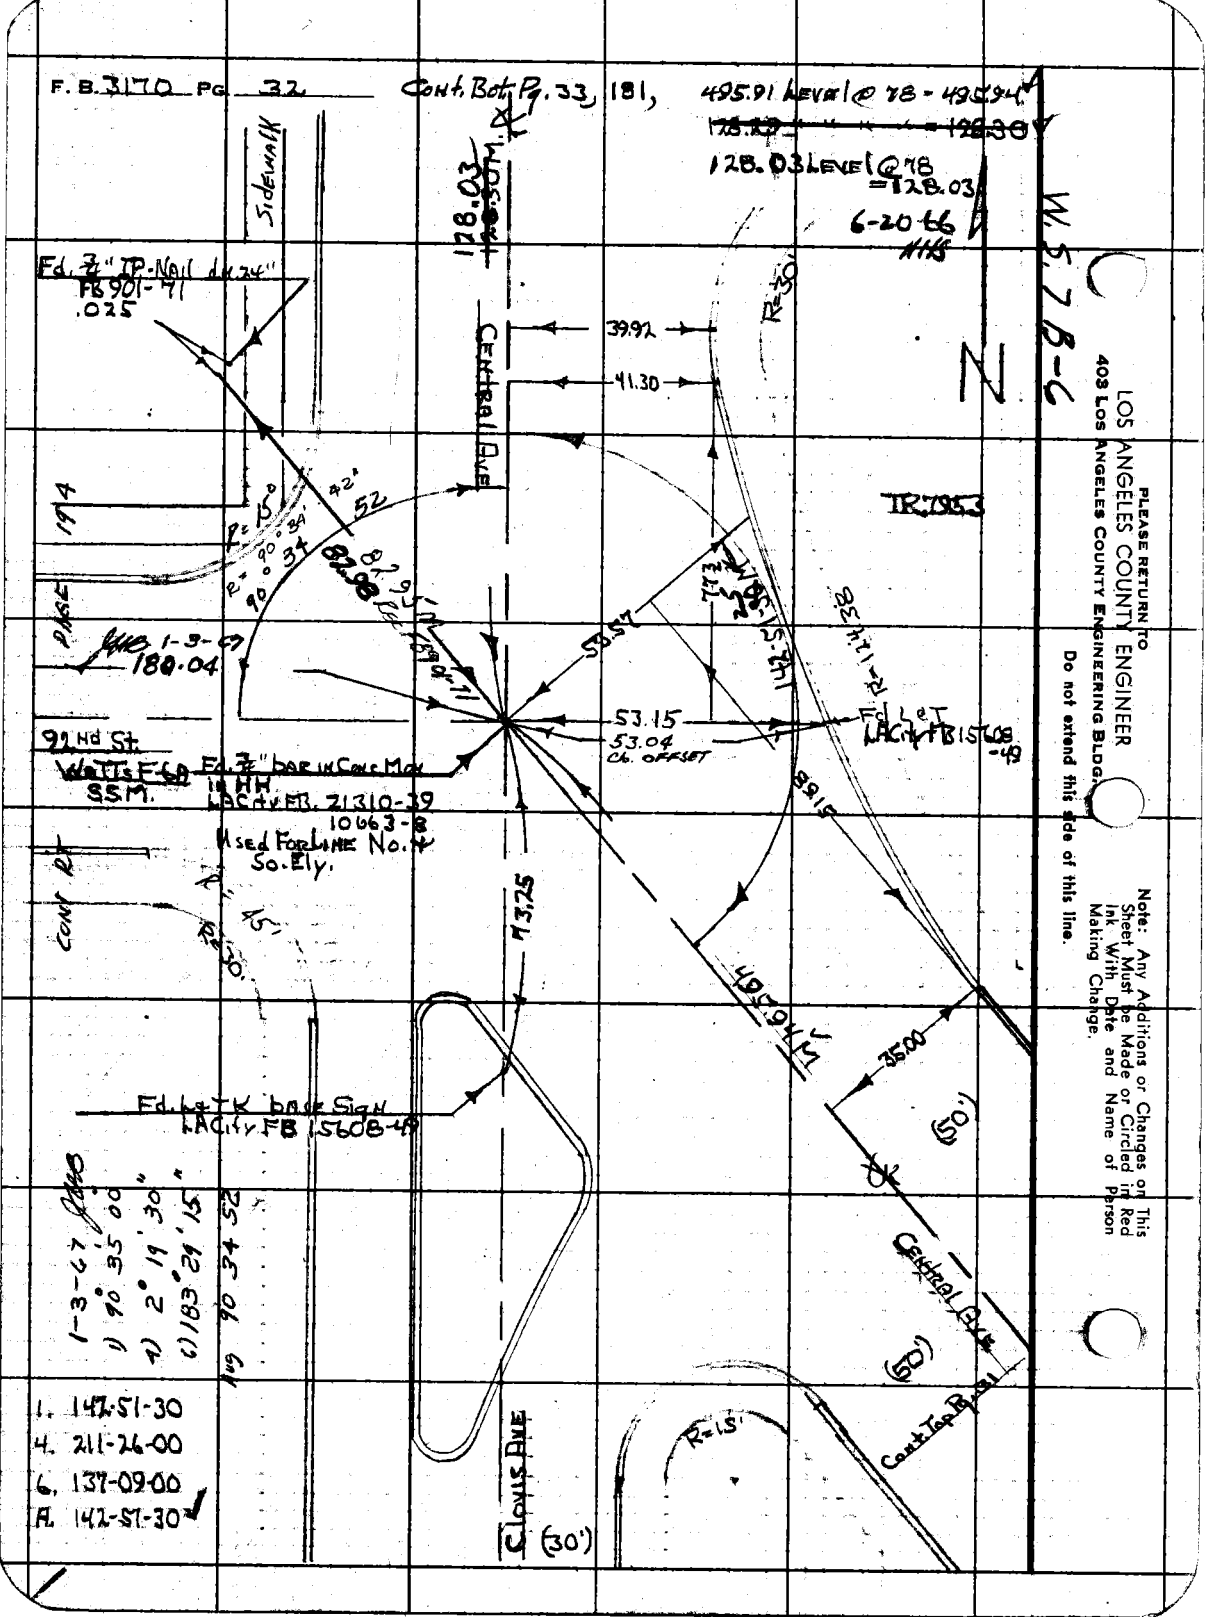
F. B. 3170 PG. 32
Cont. Bot. Pg. 33, 181,
495.91 Level @ 78 - 495.94
128.03 Level @ 78 = 128.03
6-20-66
W.S. 7 B-6
Sidewalk
Fd. 3/4" IP-Nail dn 24" FB 901-71 .025
128.03
Central Ave
39.92
41.30
R=30'
TR 7953
194
R=15°
R=90°34'
90°34'
42'
52
82.98
82.95
53.57
53.15
53.04 Ch. OFFSET
Fd L&T LACity FB 15608-49
1-3-67
180.04
92nd St.
Watts F-6A
SSM.
Fd. 3/4" bar in Conc Mon in HH LACity FB. 21310-39 10663-8
Used For Line No. 4 So. Ely.
Cont Rt
R=45'
R=30'
73.25
495.94
35.00
(50')
Fd. L&T K base Sign LACity FB 15608-49
1-3-67
1) 90°35'00"
2) 2°19'30"
3) 183°29'15"
Avg 90 34 52
Central Ave
(50')
Cont. Top Pg. 31
R=15'
Clovis Ave
(30')
1. 142-51-30
4. 211-26-00
6. 137-09-00
A. 142-51-30
PLEASE RETURN TO
LOS ANGELES COUNTY ENGINEER
403 LOS ANGELES COUNTY ENGINEERING BLDG.
Do not extend this side of this line.
Note: Any Additions or Changes on This Sheet Must be Made or Circled in Red Ink With Date and Name of Person Making Change.

Notes Ck'd by J. Church	Survey of 92nd St		F. B. 3170 PG. 33
Map No. B-3019	JN 0096.66 Tape 0259 Std 68 °F		
Office Work	Surveyed by HH Springs		
Checked J. A. CHURCH	Notes HHS Date 9-15-65		
Date JUL 7 '66	Indexed C. J. BALLI		

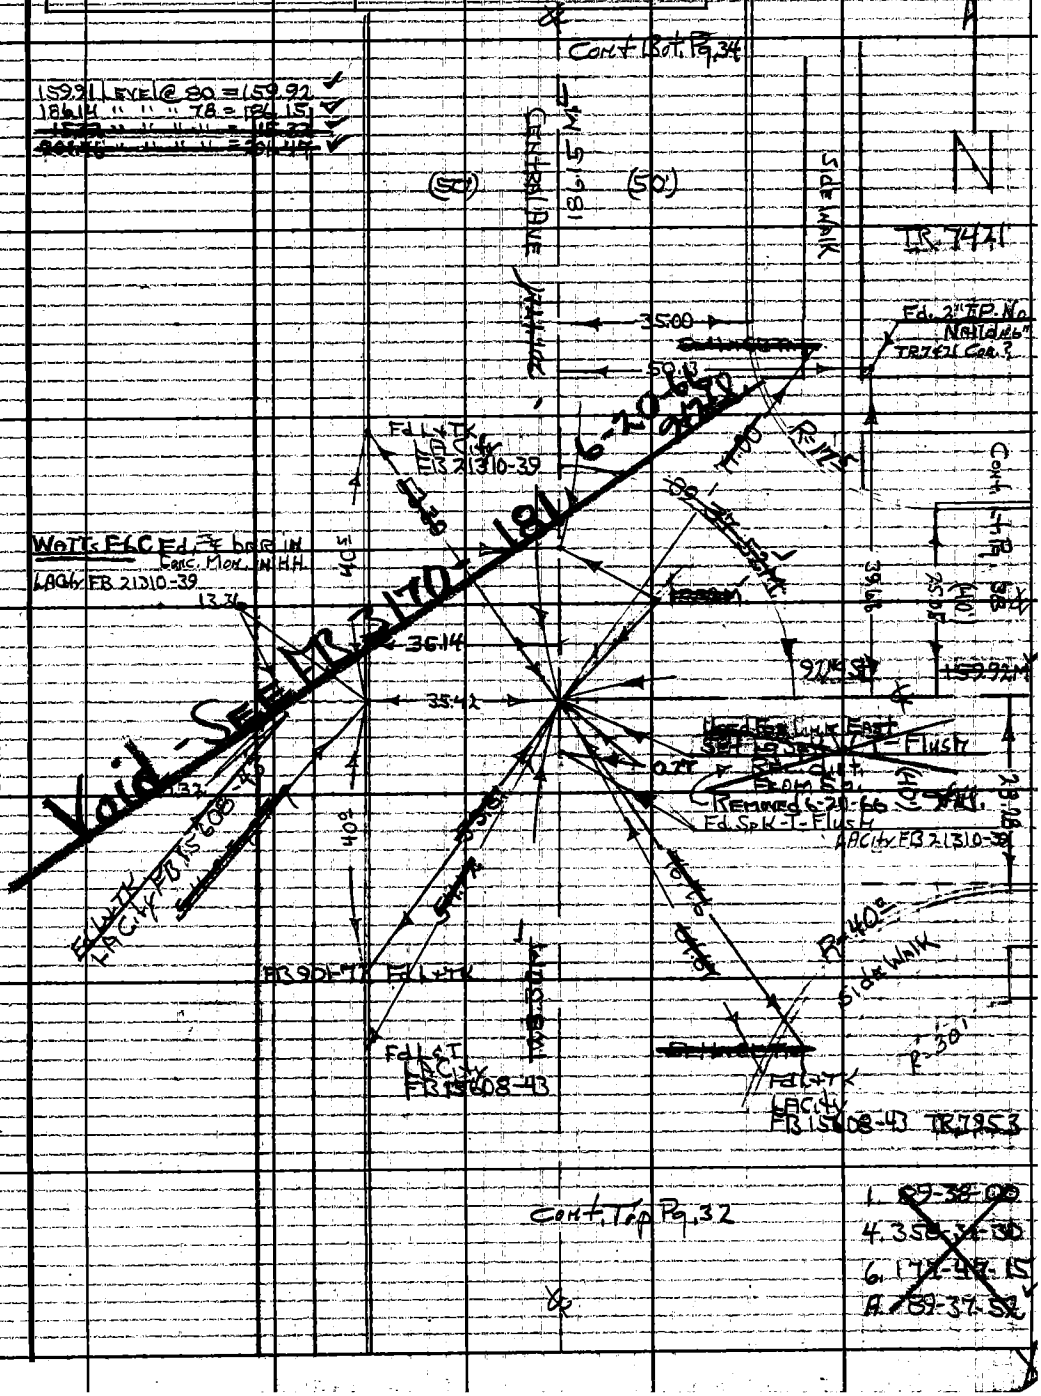

Note: Any Additions or Changes on This Sheet Must be Made or Circled in Red Ink With Date and Name of Person Making Change.

Do not extend this side of this line.

PLEASE RETURN TO
LOS ANGELES COUNTY ENGINEER
403 LOS ANGELES COUNTY ENGINEERING BLDG.

76F309S CE#310 1-65

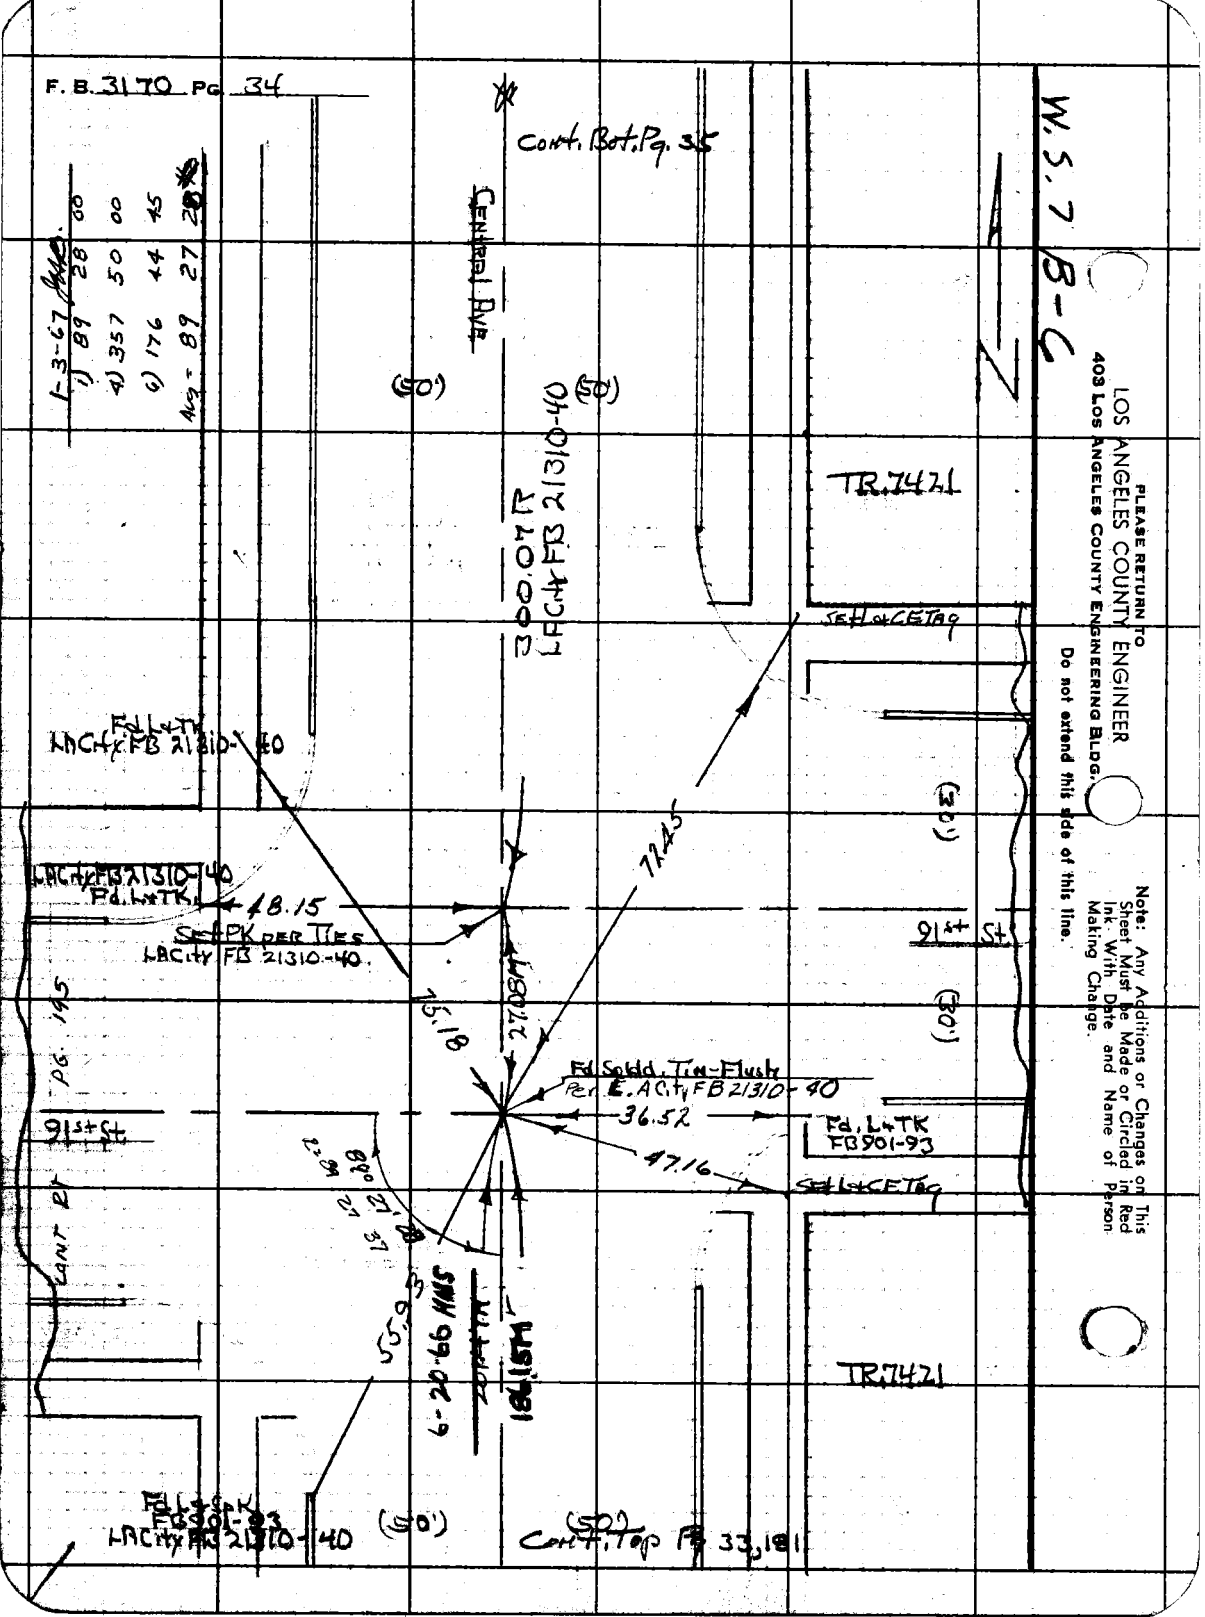
F. B. 3170 Pg. 34
Cont. Bot. Pg. 35
W.S. 7 B-6
1-3-67
1) 89 28 00
4) 357 50 00
6) 176 44 45
Avg = 89 27 28
Central Ave
(50')
(50')
300.07 R
LACity FB 21310-40
TR.7421
Set L&CE Tag
Fd L&TK
LACity FB 21310-40
LACity FB 21310-40
Fd. L&TK
48.15
Set PK per Ties
LACity FB 21310-40
72.45
(30')
91st St
(30')
75.18
27.08M
Fd Solid. Tin-Flush
Per E. ACity FB 21310-40
36.52
Fd. L&TK
FB 901-93
47.16
Set L&CE Tag
91st St
Lant Rd
55.93
6-20-66 HMS
186.15M
TR.7421
Fd L&SpK
FB 901-93
LACity FB 21310-40
(50')
(50')
Cont. Top Pg 33, 181
PLEASE RETURN TO
LOS ANGELES COUNTY ENGINEER
403 LOS ANGELES COUNTY ENGINEERING BLDG.
Do not extend this side of this line.
Note: Any Additions or Changes on This Sheet Must be Made or Circled in Red Ink With Date and Name of Person Making Change.

Notes Ck'd by J. Church	Survey of 92nd St.	F.B. 3170 PG. 35
Map No. B 3019	JN 0096.66 Tape 0759 Std 68 °F	
Office Work	Surveyed by HH Spriggs	
Checked J. A. CHURCH	Notes HHS Date 9-15-65	
Date JUL 7 66	Indexed G. J. GALLI	

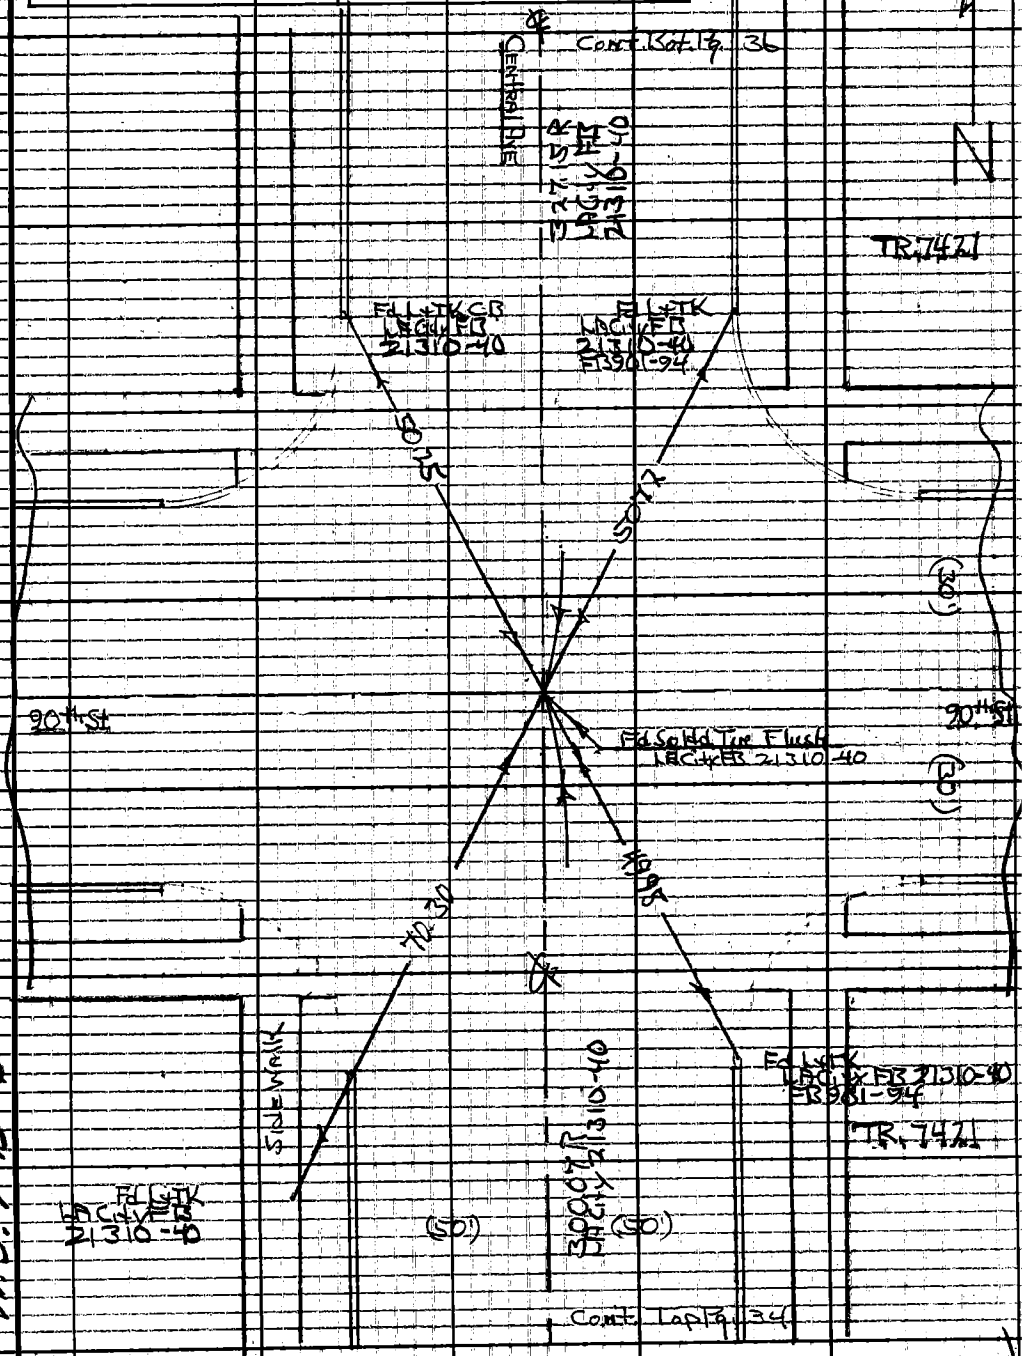

Note: Any Additions or Changes on This Sheet Must be Made or Circled in Red Ink With Date and Name of Person Making Change.

Do not extend this side of this line.

PLEASE RETURN TO
LOS ANGELES COUNTY ENGINEER
403 Los Angeles County Engineering Bldg.

W.S. 7 B-6

76F309S CE#310 1-65

PLEASE RETURN TO
LOS ANGELES COUNTY ENGINEER
403 LOS ANGELES COUNTY ENGINEERING BLDG.

Note: Any Additions or Changes on This Sheet Must be Made or Circled in Red Ink With Date and Name of Person Making Change.

Do not extend this side of this line.

W.S. 7 B-6

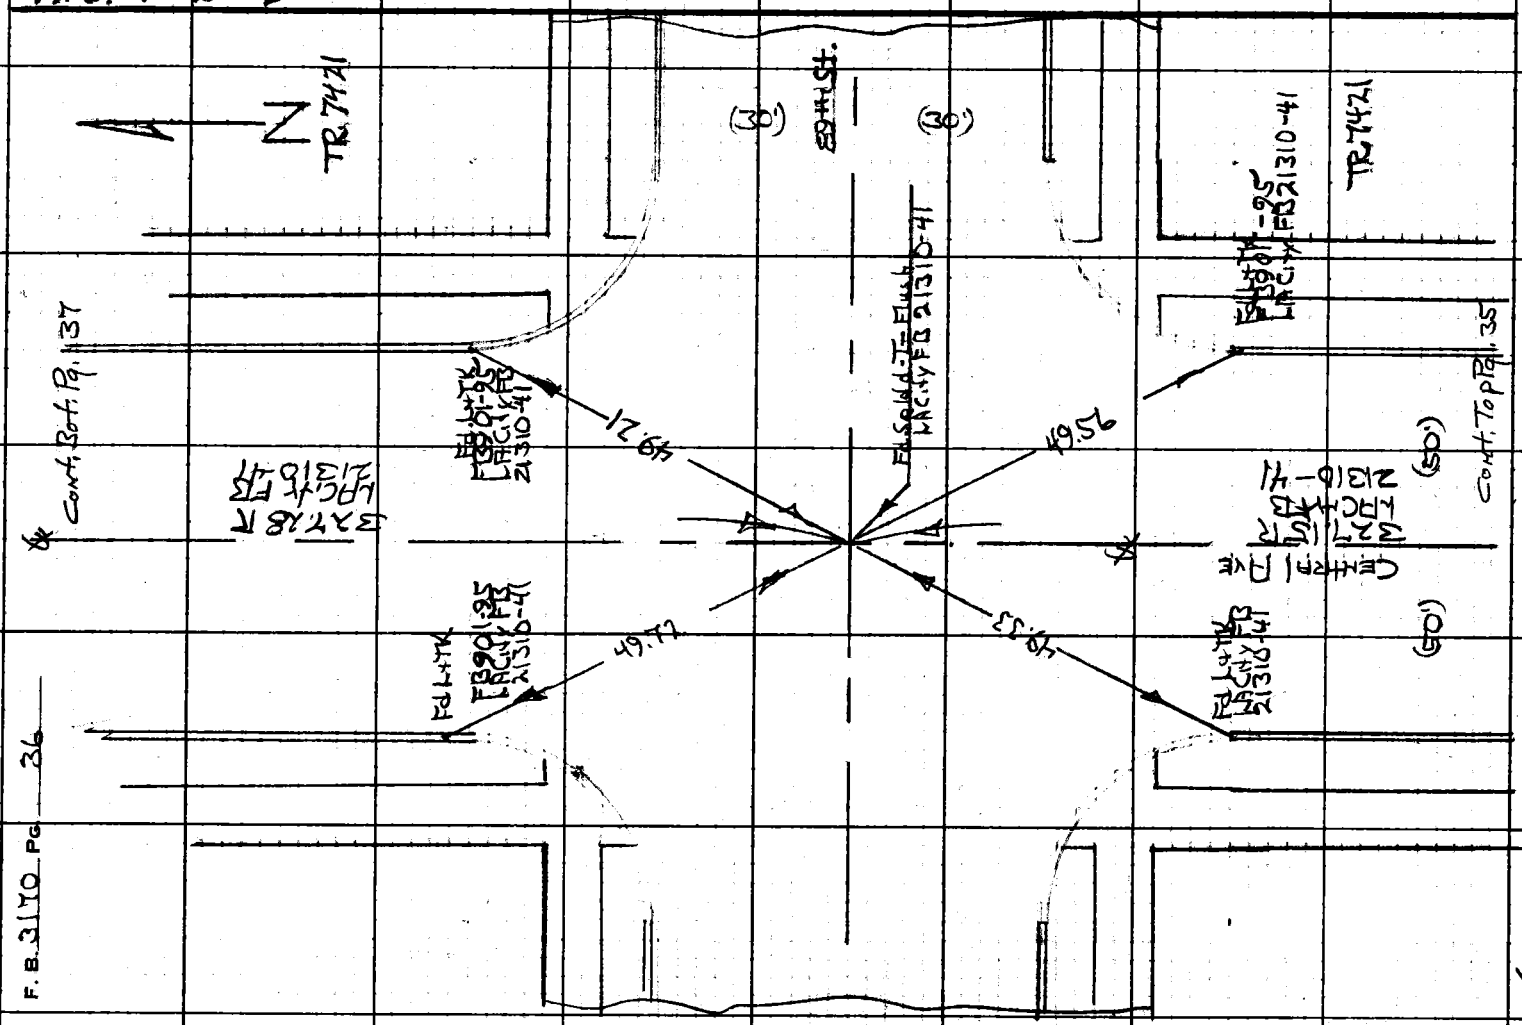

Notes Ck'd by J. Church	Survey of 92nd St		F. B. 3170 PG. 37
Map No. B-3019	JN 0096-66 Tape 0259 Std 68 °F		
Office Work	Surveyed by HHSprings		
Checked J. A. CHURCH	Notes HHS Date 9-21-65		
Date JL 7 '66	Indexed [illegible]		

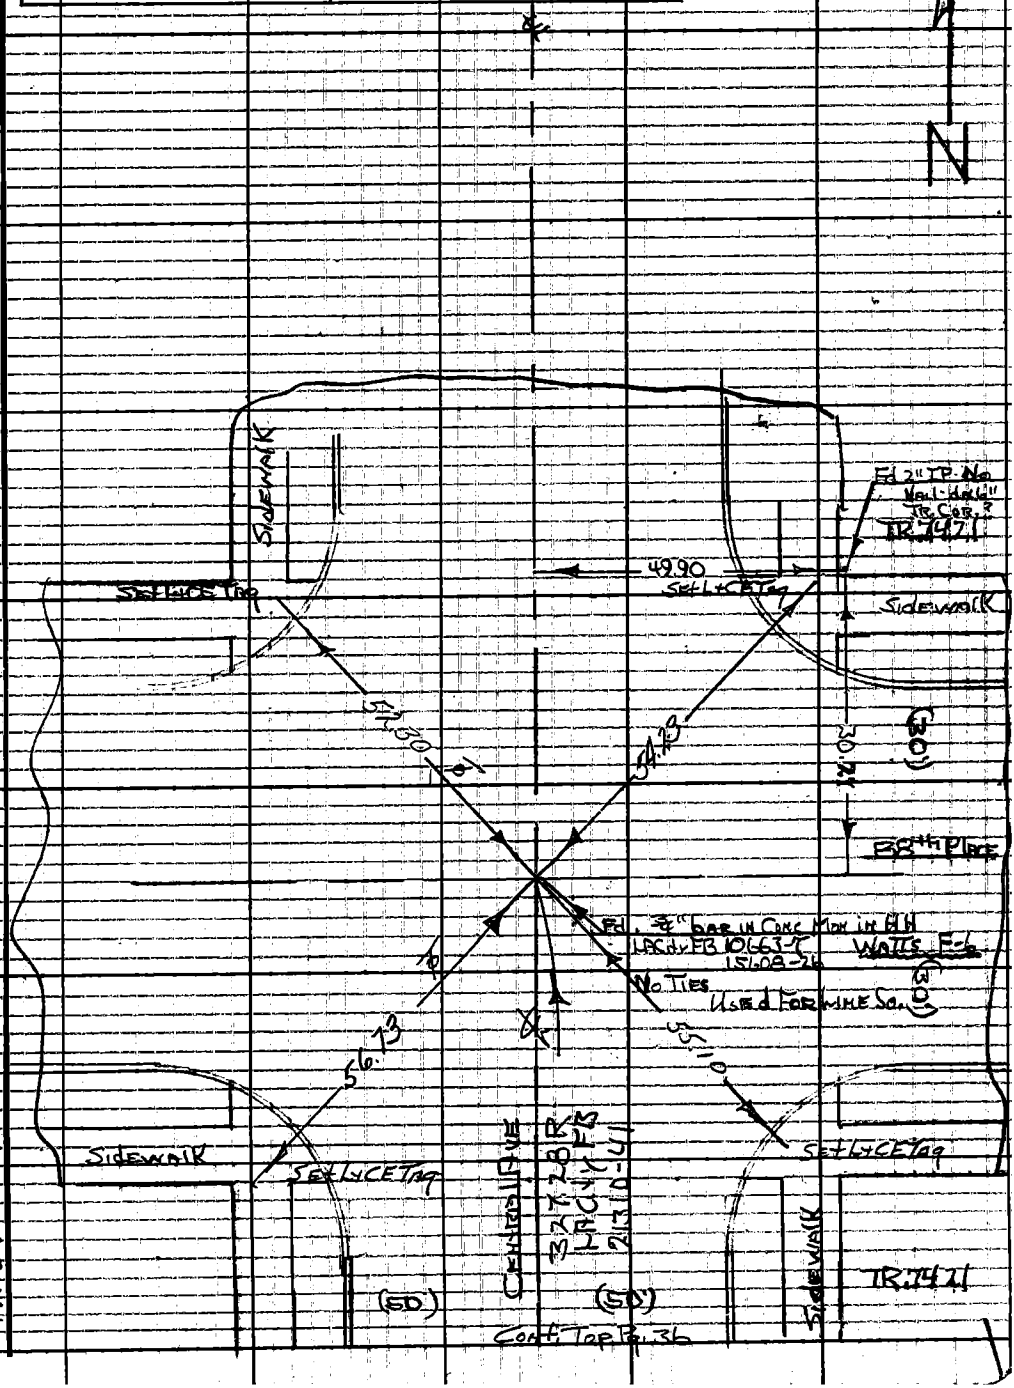

Note: Any Additions or Changes on This Sheet Must be Made or Circled in Red Ink With Date and Name of Person Making Change.

Do not extend this side of this line.

PLEASE RETURN TO
LOS ANGELES COUNTY ENGINEER
403 LOS ANGELES COUNTY ENGINEERING BLDG.

W.S.7 B-6

76F309S CE#310 1-65

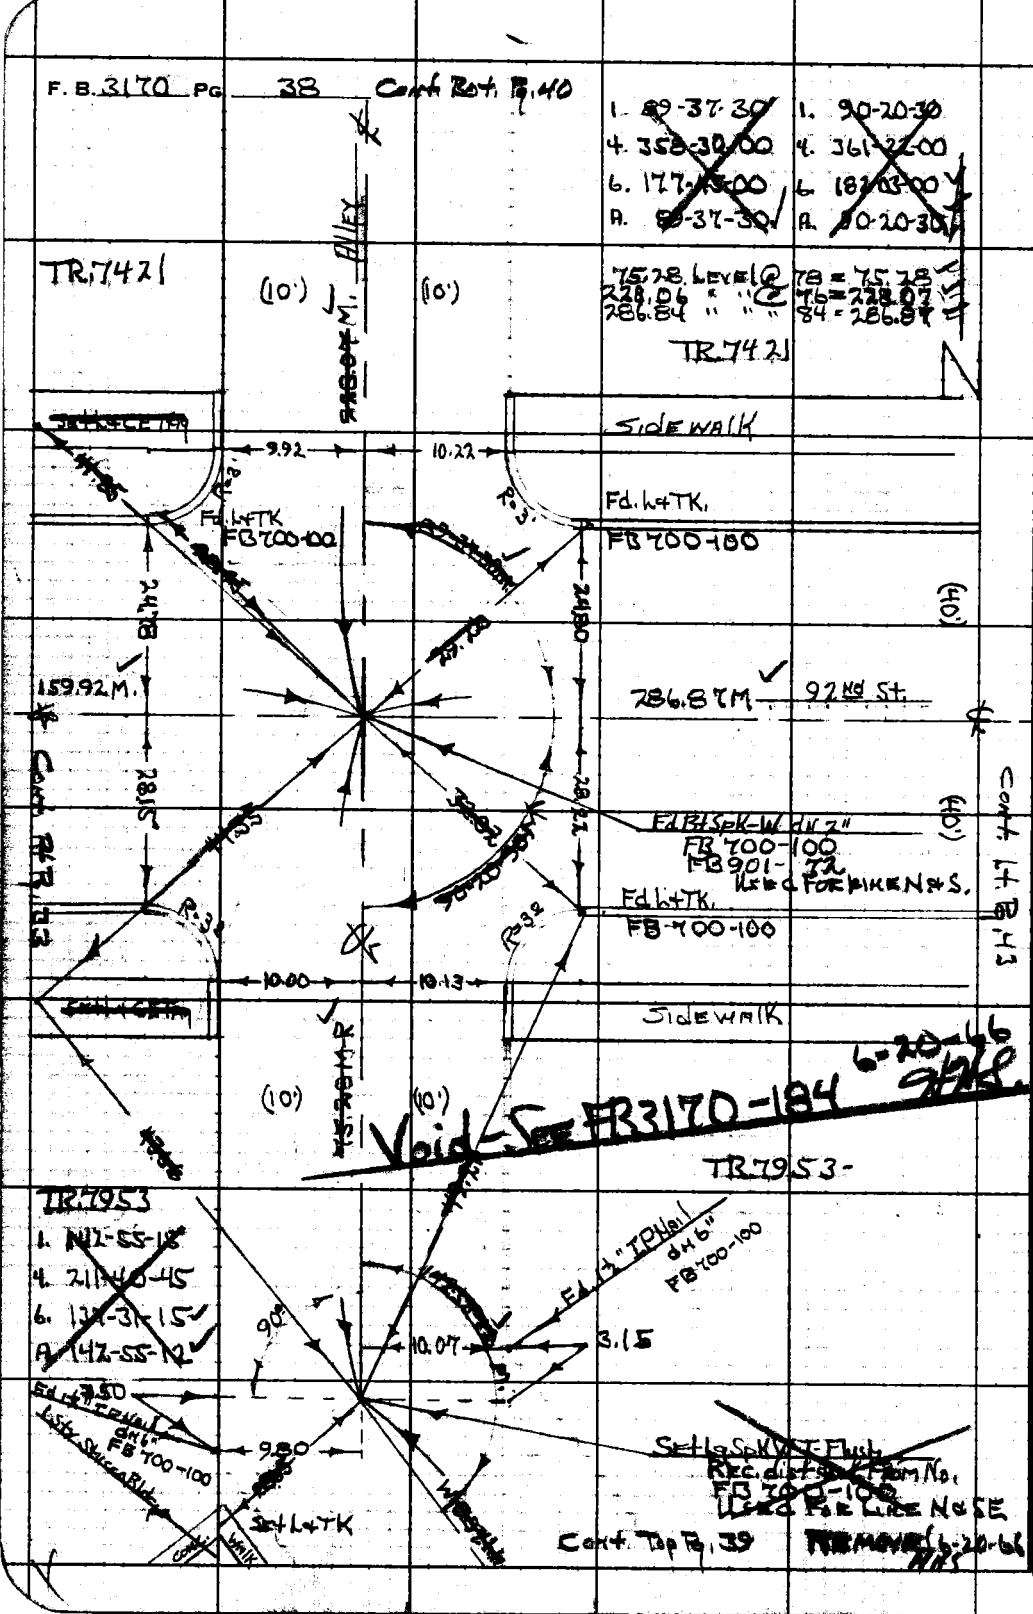

PLEASE RETURN TO
LOS ANGELES COUNTY ENGINEER
403 LOS ANGELES COUNTY ENGINEERING BLDG.
Do not extend this side of this line.

Note: Any Additions or Changes on This Sheet Must be Made or Circled in Red Ink With Date and Name of Person Making Change.

Notes Ck'd by J. Church	Survey of 92nd St		F. B. 3170 Pg. 39
Map No. B3019	JN 009L 66 Tape 0259 Std 68 °F		
Office Work	Surveyed by HHSpriggs		
Checked J. A. CHURCH	Notes HHS Date 9-21-65		
Date	Indexed		

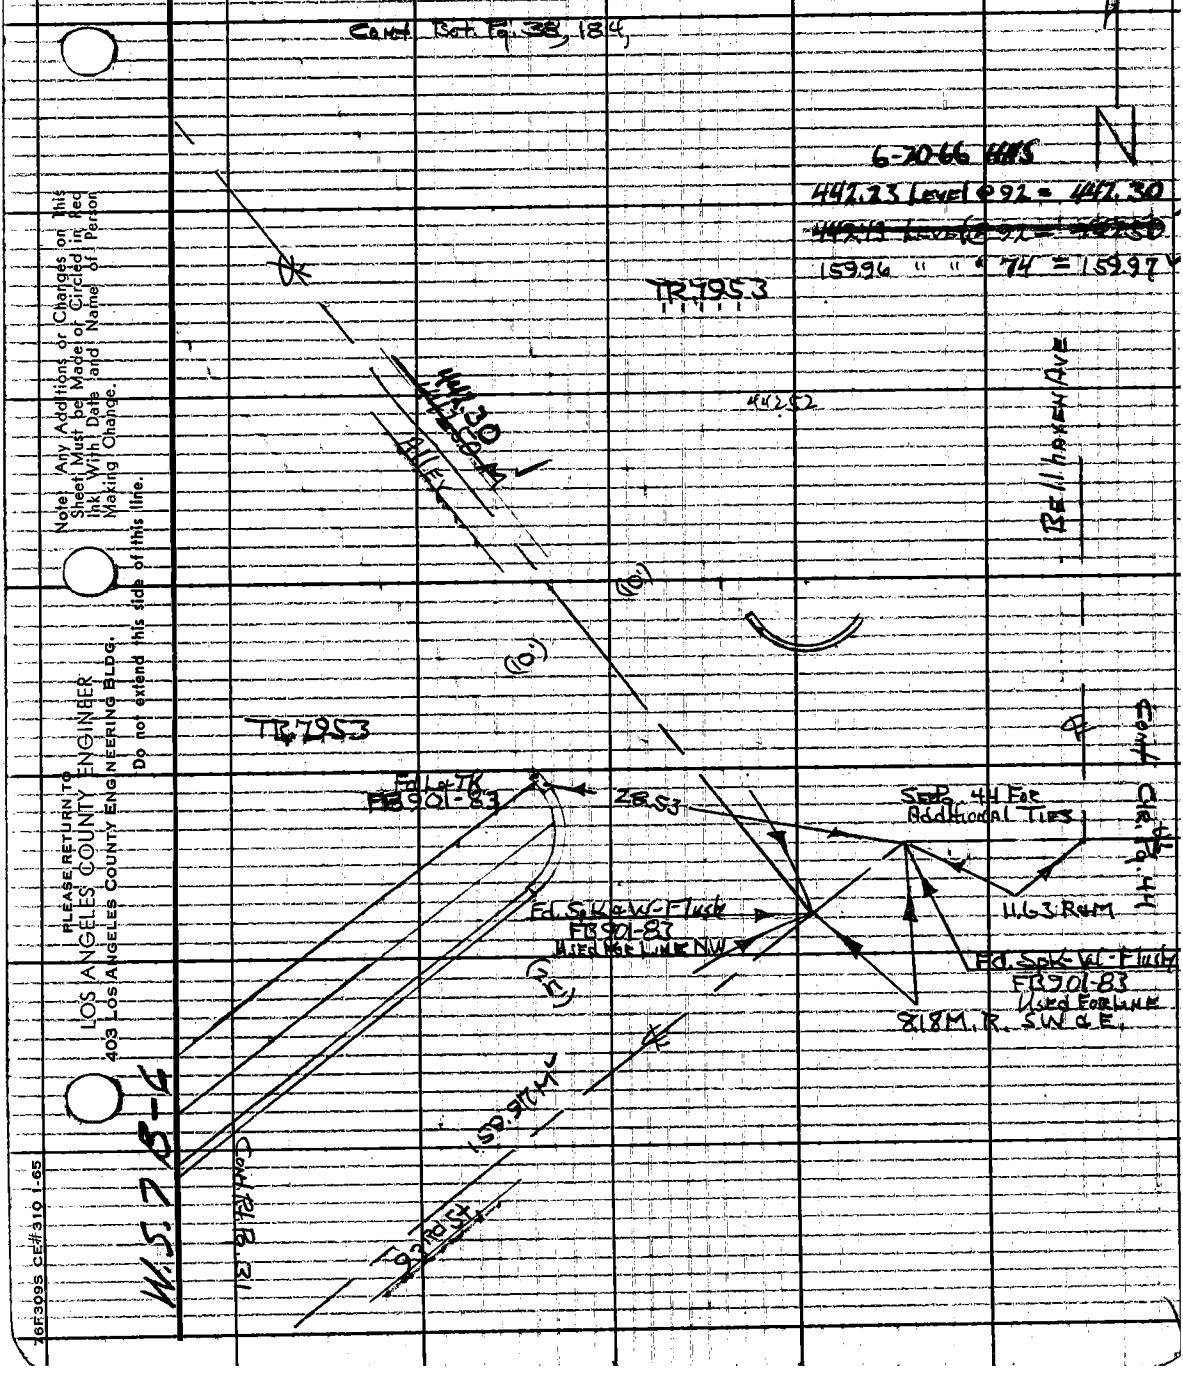

Note: Any Additions or Changes on This Sheet Must be Made or Circled in Red Ink With Date and Name of Person Making Change.

Do not extend this side of this line.

PLEASE RETURN TO
LOS ANGELES COUNTY ENGINEER
403 LOS ANGELES COUNTY ENGINEERING BLDG.

76F309S CE#310 1-65

F. B. 3170 Pg. 40

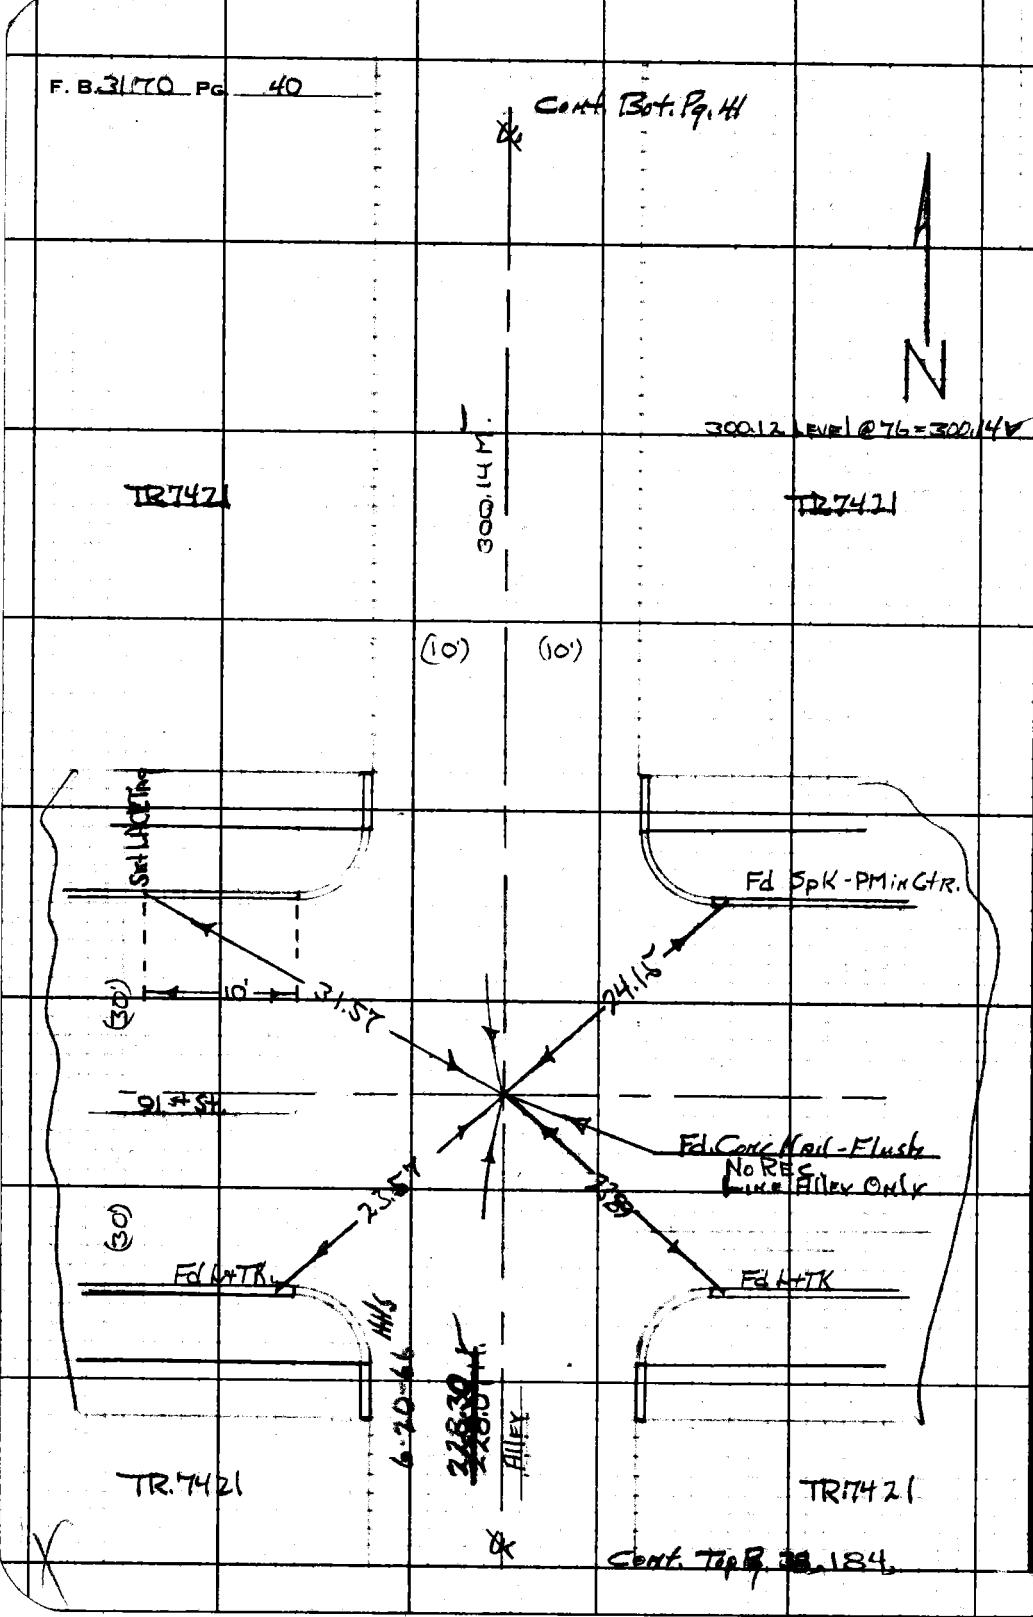

PLEASE RETURN TO
LOS ANGELES COUNTY ENGINEER
403 LOS ANGELES COUNTY ENGINEERING BLDG.
Do not extend this side of this line.

Note: Any Additions or Changes on This Sheet Must be Made or Circled in Red Ink With Date and Name of Person Making Change.

Notes Ck'd by d Church
Map No. B-3019
Office Work
Checked J. A. CHURCH
Date JUL 7 '66

Survey of 92nd St.
JN 009666 Tape 0259 Std 68 °F
Surveyed by H.H. Spriggs
Notes HHS Date 9-20-65
Indexed

F.B. 3170 Pg. 41

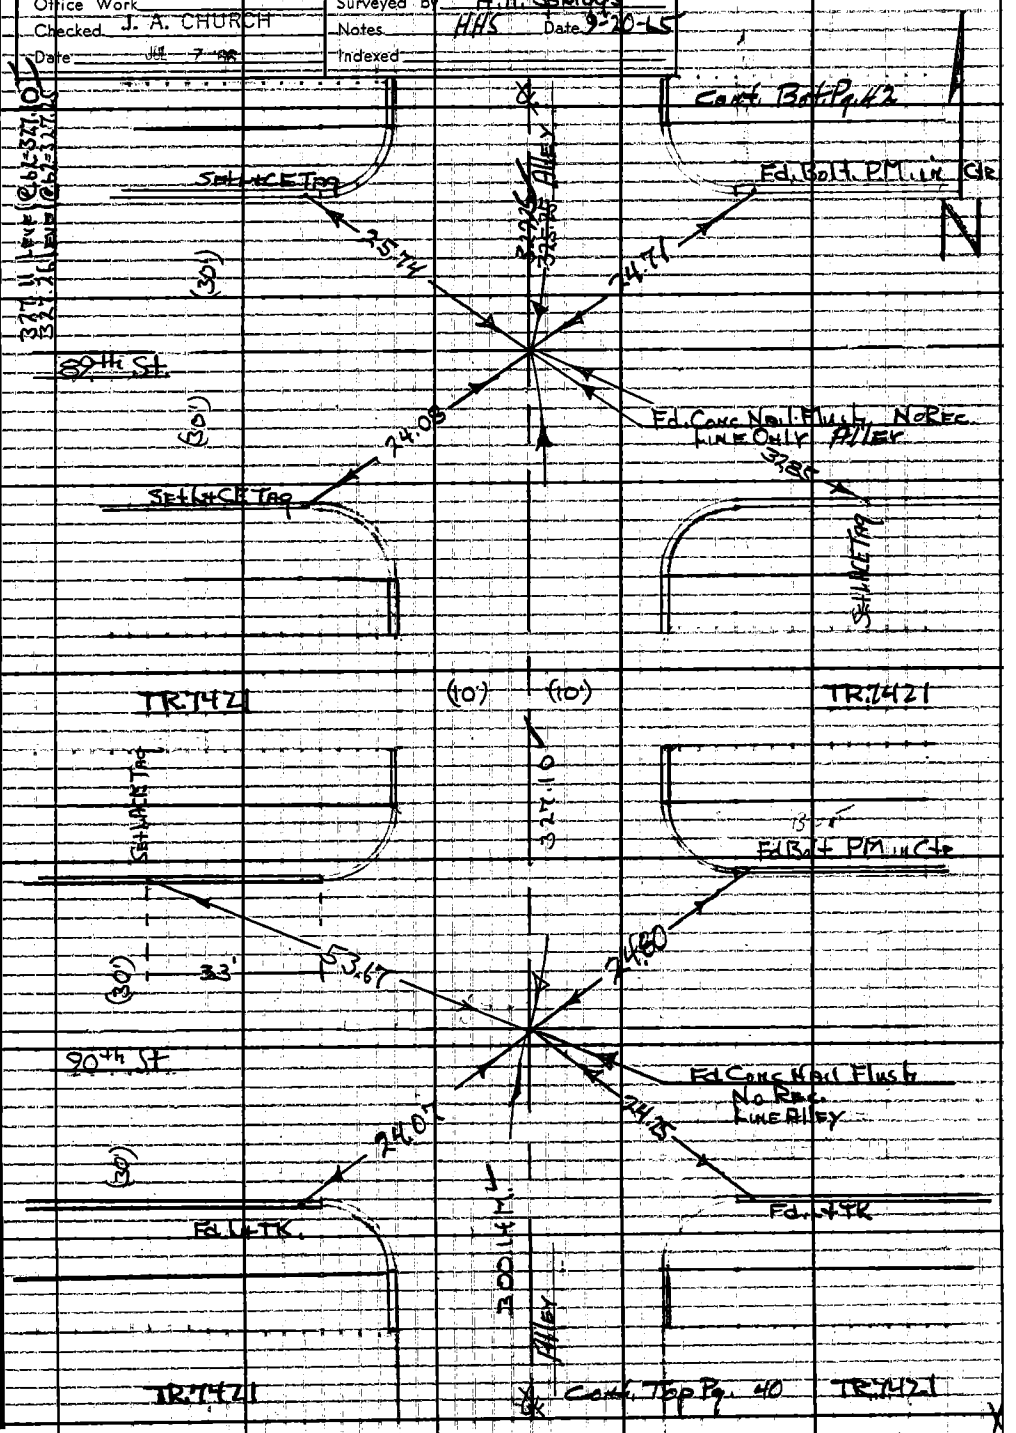

Note: Any Additions or Changes on This Sheet Must be Made or Circled in Red Ink With Date and Name of Person Making Change.

Do not extend this side of this line.

PLEASE RETURN TO
LOS ANGELES COUNTY ENGINEER
403 LOS ANGELES COUNTY ENGINEERING BLDG.

76F309S CE#310 1-65

F. B. 3170 PG 42

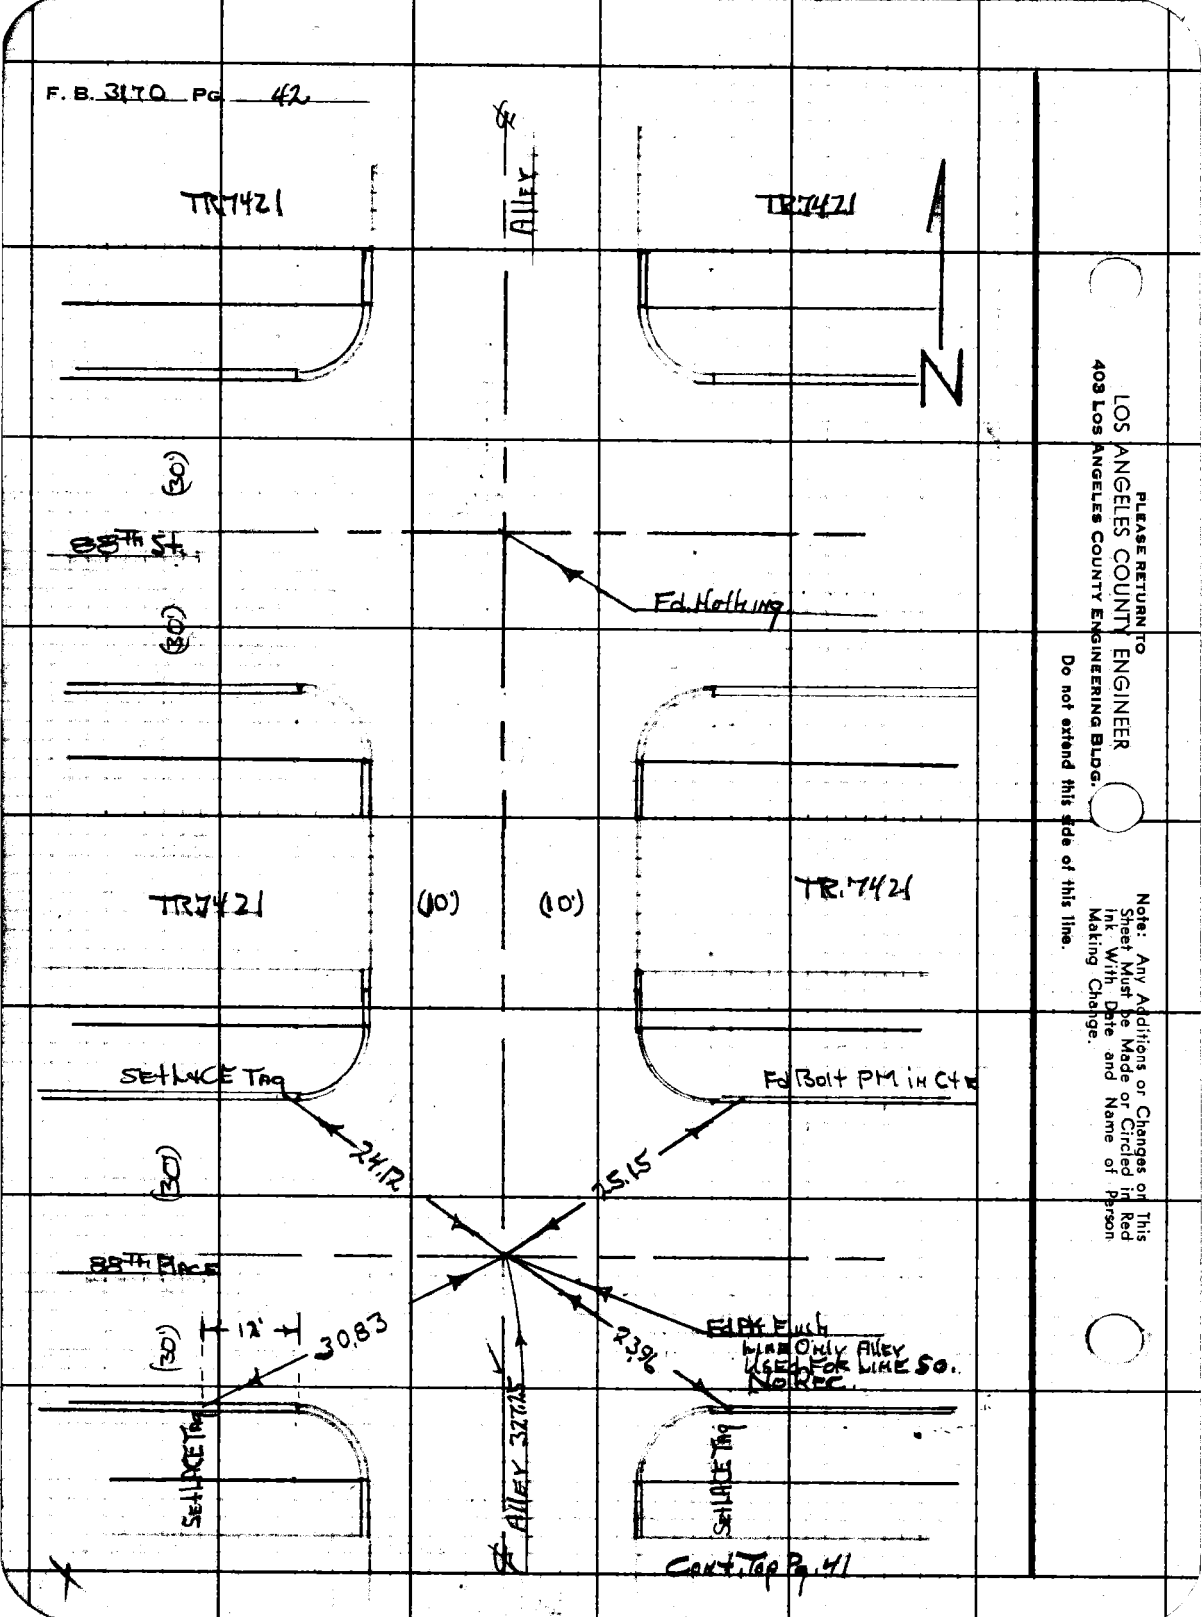

PLEASE RETURN TO
LOS ANGELES COUNTY ENGINEER
403 LOS ANGELES COUNTY ENGINEERING BLDG.

Do not extend this side of this line.

Note: Any Additions or Changes on This Sheet Must be Made or Circled in Red Ink With Date and Name of Person Making Change.

Notes Ck'd by J. Church	Survey of 92nd St.		F. B. 3170 PG. 43
Map No. B 3019	JN 0096 66 Tape 0259 Std 68 °F.		
Office Work	Surveyed by HHSpriggs		
Checked J. A. CHURCH	Notes HHS Date 9-21-65		
Date 7 66	Indexed C. J. GALLI		

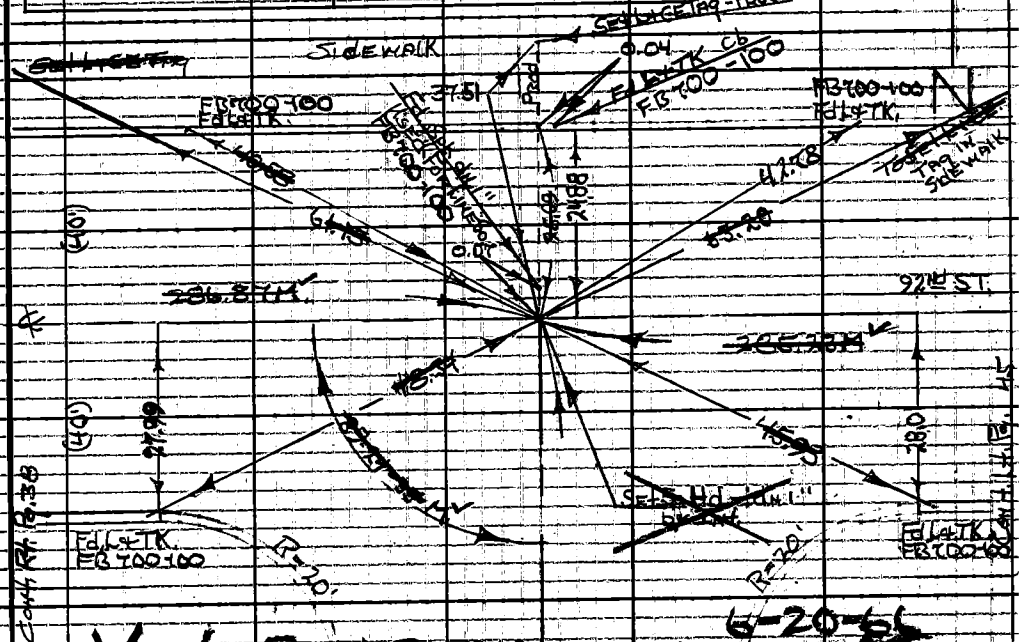

Void - See FB3170-185 6-20-66

1. 89-24-30
4. 357-38-30
6. 176-27-30
8. 89-24-35

(25) (25)

TR.7953

TR.7953

Belhaven St.

424.96 Level @ 82 = 425.00
285.23 Level @ 86 = 285.23

Cont. Top Pg. 44

Note: Any Additions or Changes on This Sheet Must be Made or Circled in Red Ink With Date and Name of Person Making Change.

Do not extend this side of this line.

PLEASE RETURN TO
LOS ANGELES COUNTY ENGINEER
403 LOS ANGELES COUNTY ENGINEERING BLDG.

76F309S CE#310 1-65

PLEASE RETURN TO
LOS ANGELES COUNTY ENGINEER
403 LOS ANGELES COUNTY ENGINEERING BLDG.

Note: Any Additions or Changes on This Sheet Must be Made or Circled in Red Ink With Date and Name of Person Making Change.

Do not extend this side of this line.

W.S. 7 B-6

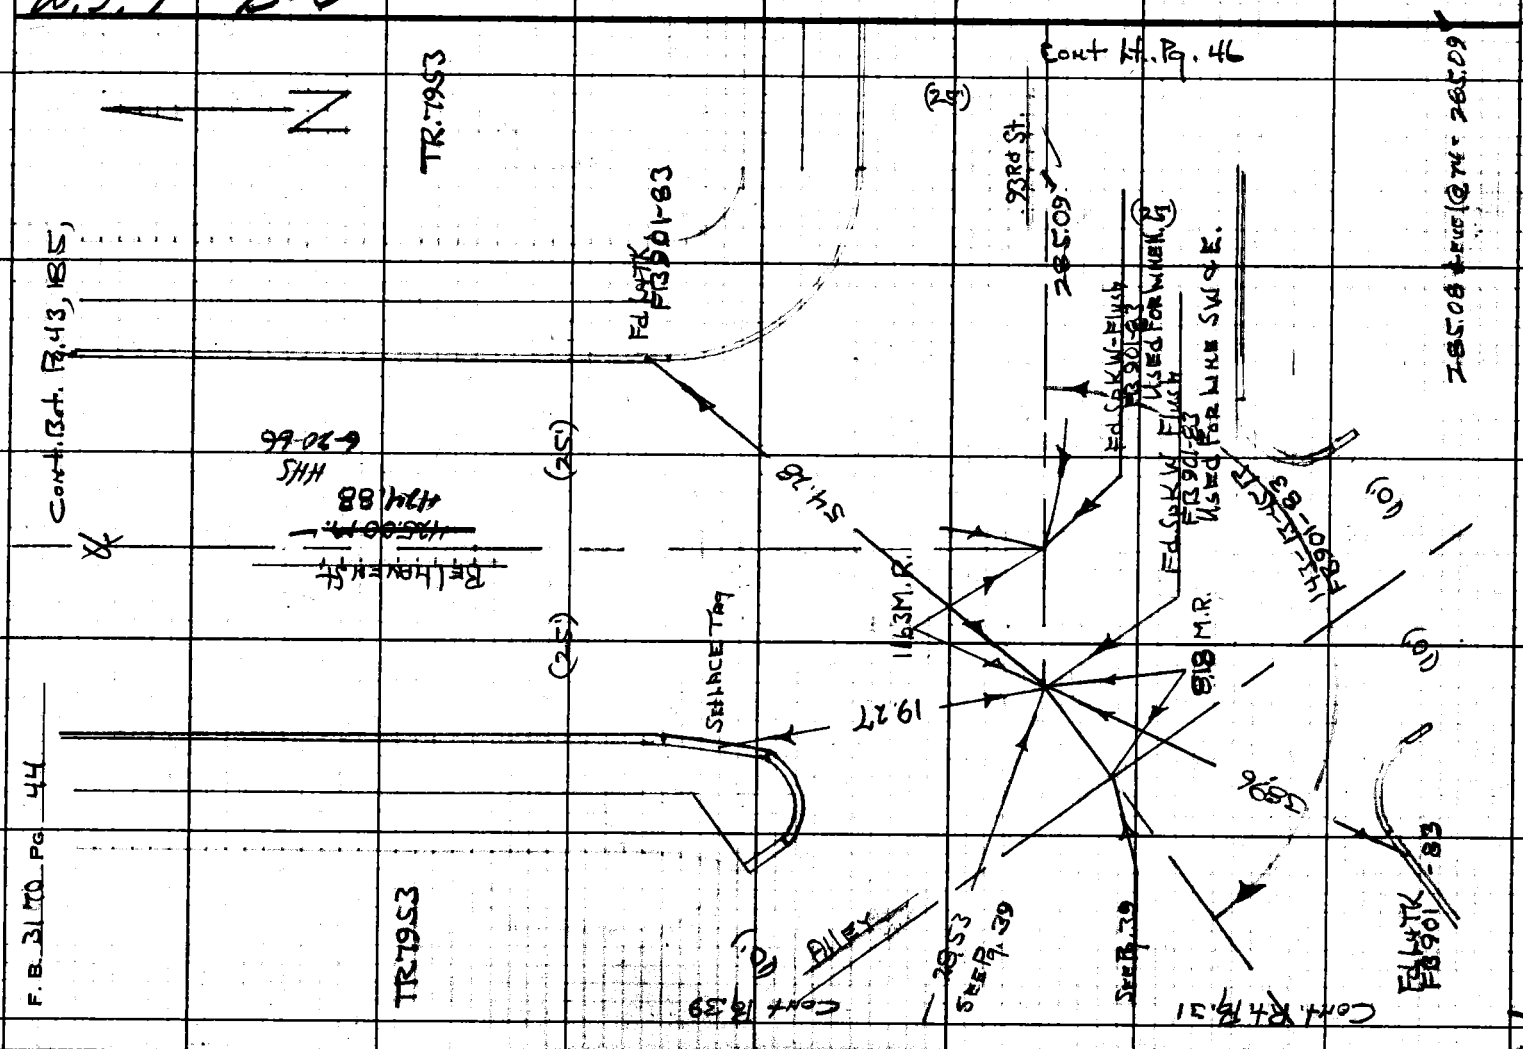

Notes Ck'd by J. Church	Survey of 92nd St		F.B. 3170 PG. 45
Map No. B3019	JN 0096.66 Tape 0259 Std 68 °F		
Office Work	Surveyed by HHSpriggs		
Checked J. A. CHURCH	Notes HHS Date 9-21-65		
Date 7-66	Indexed C. J. GALLI		

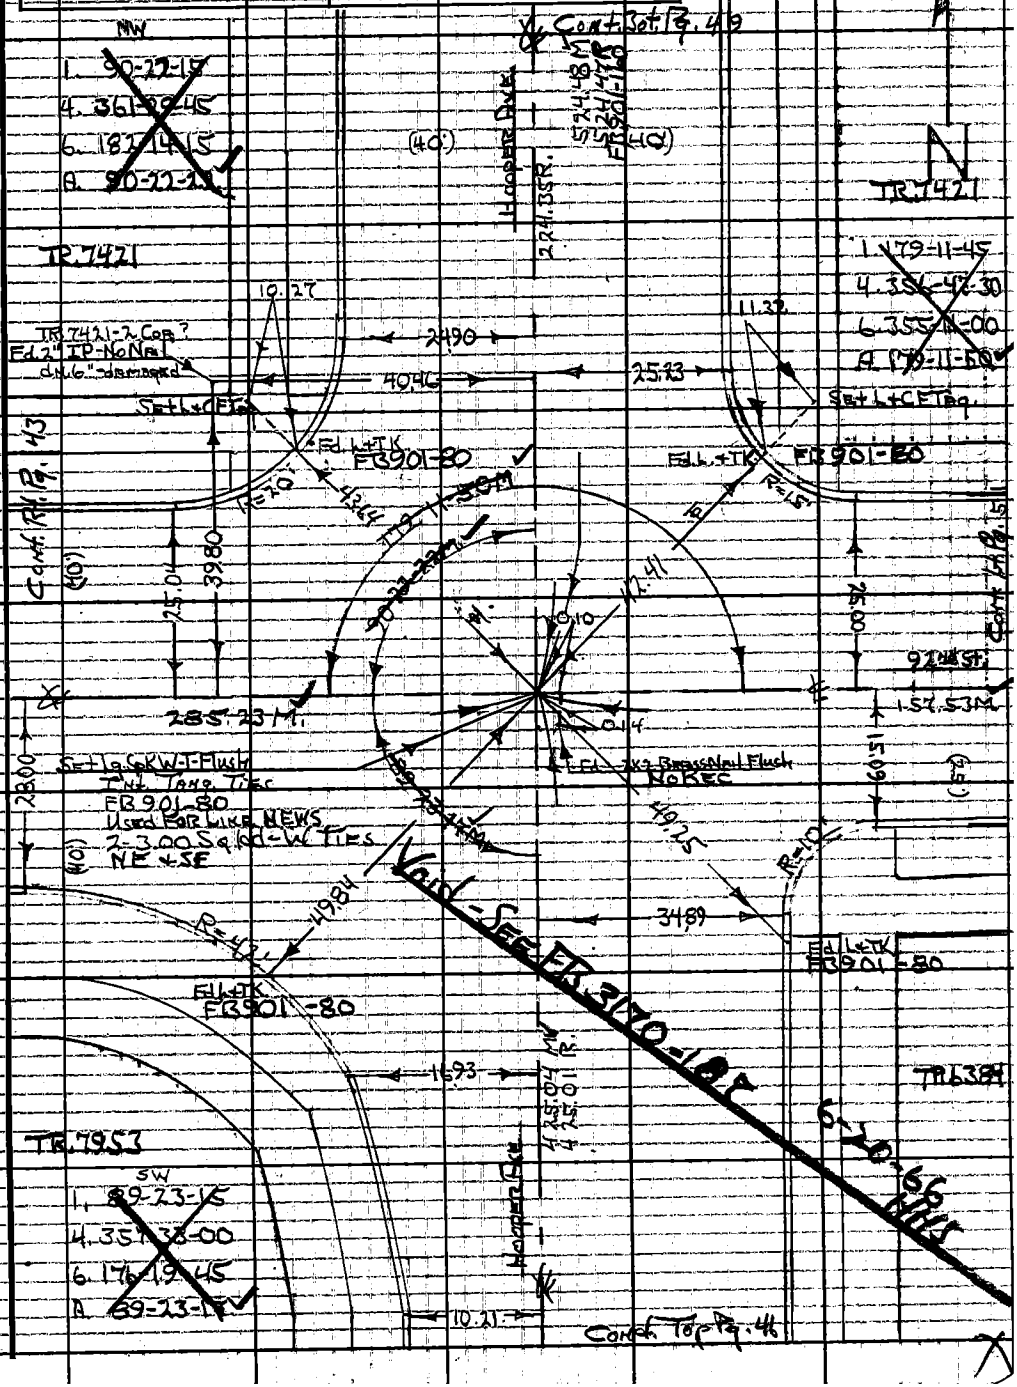

Note: Any Additions or Changes on This Sheet Must be Made or Circled in Red Ink With Date and Name of Person Making Change.

Do not extend this side of this line.

PLEASE RETURN TO
LOS ANGELES COUNTY ENGINEER
403 LOS ANGELES COUNTY ENGINEERING BLDG.

76F309S CE#310 1-65

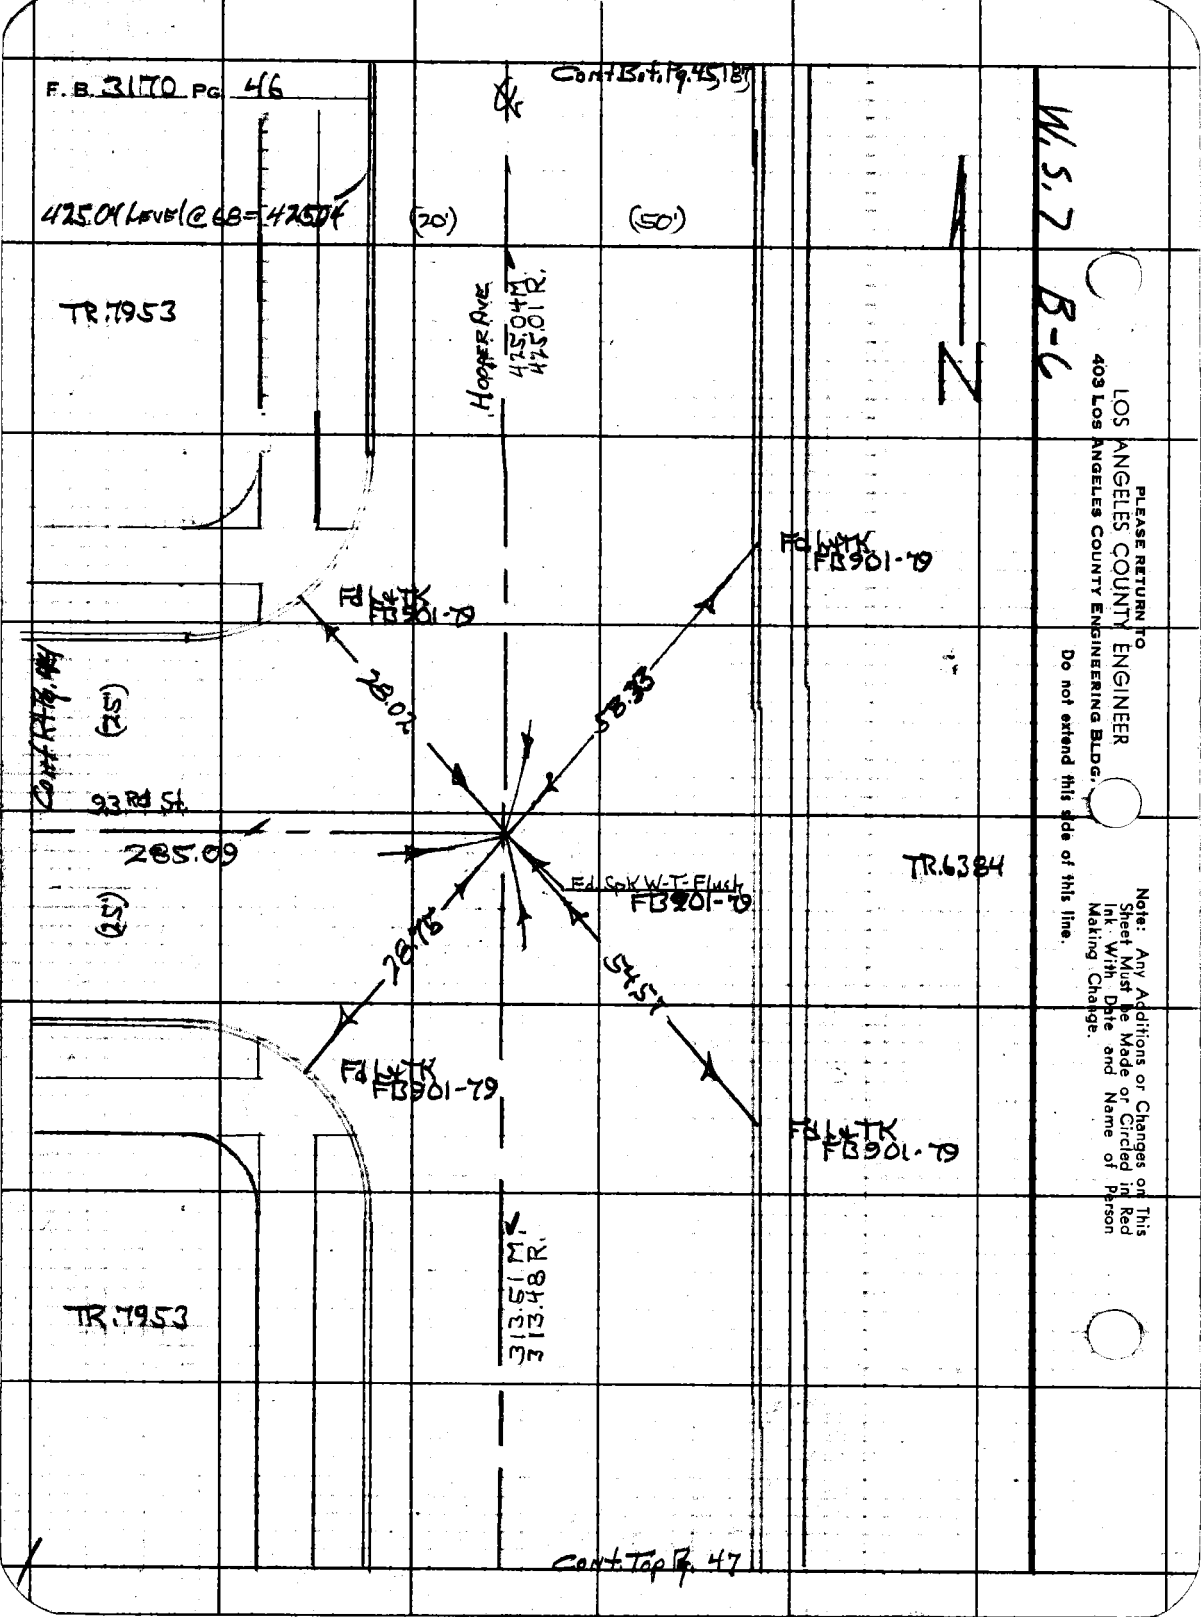
F. B. 3170 Pg. 46
Cont Bot. Pg. 45, 187
425.04 Level @ 68 = 425.04
(20')
(50')
TR. 7953
Hopper Ave
425.04 M.
425.01 R.
N
W. S. 7 B-6
Fd L&TK FB901-79
Fd L&TK FB901-79
28.02
58.33
Cont Rt Pg. 44
(25')
93 Rd St.
285.09
(25')
TR. 6384
Fd Spk W-T-Flush FB901-79
28.75
54.57
Fd L&TK FB901-79
Fd L&TK FB901-79
313.51 M.
313.48 R.
TR. 7953
Cont Top Pg. 47
PLEASE RETURN TO
LOS ANGELES COUNTY ENGINEER
403 Los Angeles County Engineering Bldg.
Do not extend this side of this line.
Note: Any Additions or Changes on This Sheet Must be Made or Circled in Red Ink With Date and Name of Person Making Change.

Notes Ck'd by J. Church	Survey of 92nd St.		F.B. 3170 Pg. 47
Map No. B-3019	JN 0096.66 Tape 0259 Std 68 °F		
Office Work	Surveyed by HH Spriggs		
Checked J. CHURCH	Notes HHS Date 9-21-65		
Date 11-7-65	Indexed C. J. GALLI		

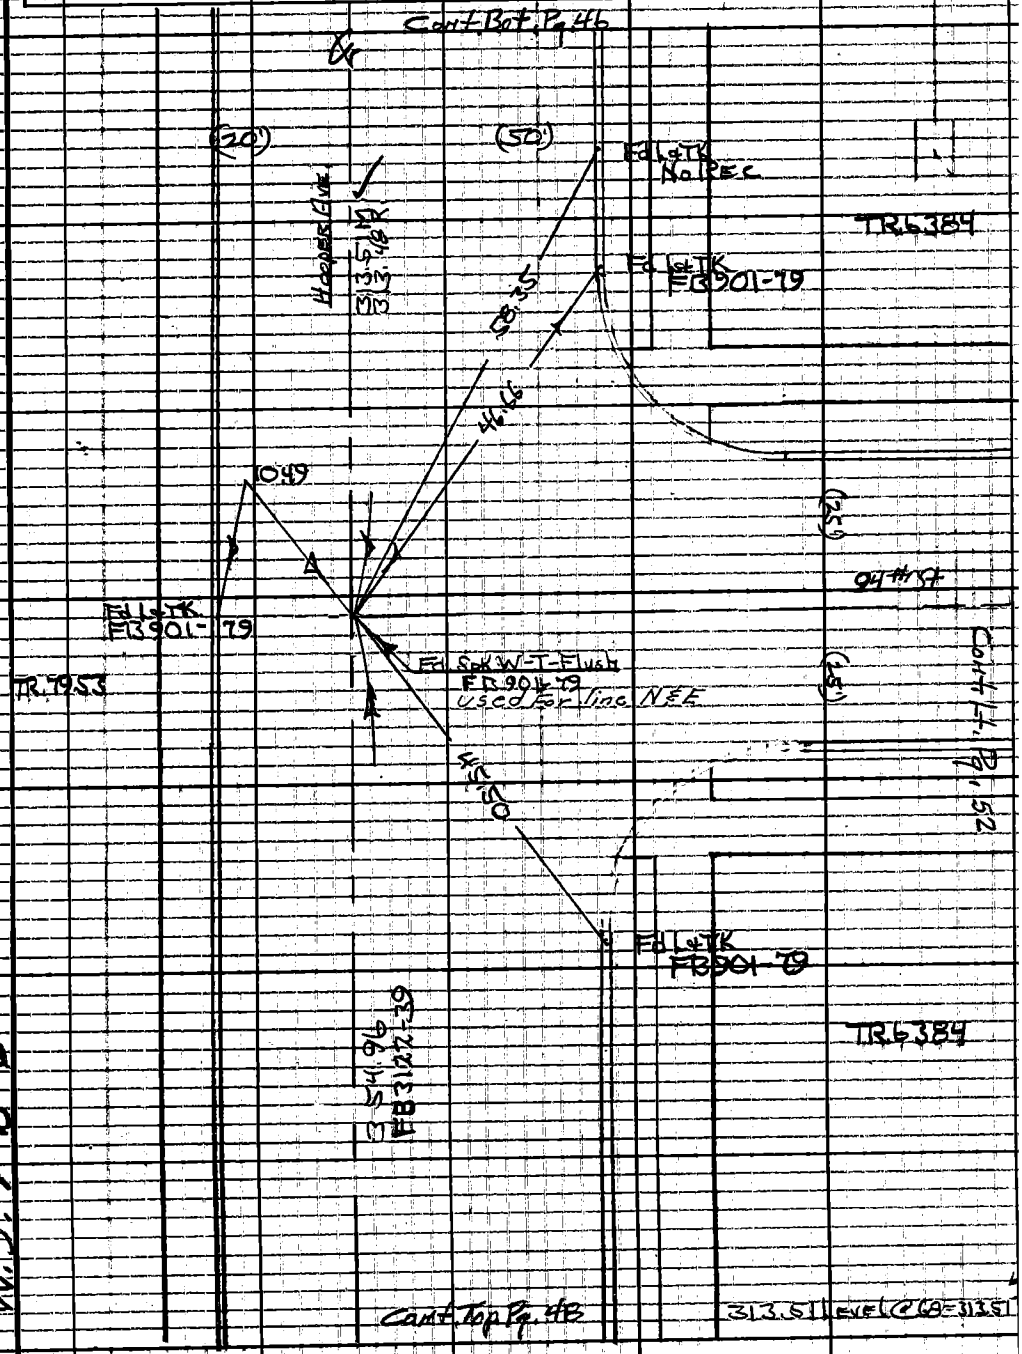

Note: Any Additions or Changes on This Sheet Must be Made or Circled in Red Ink With Date and Name of Person Making Change.

Do not extend this side of this line.

PLEASE RETURN TO
LOS ANGELES COUNTY ENGINEER
403 LOS ANGELES COUNTY ENGINEERING BLDG.

W.S. 7 B-C

76F309S CE#310 1-65

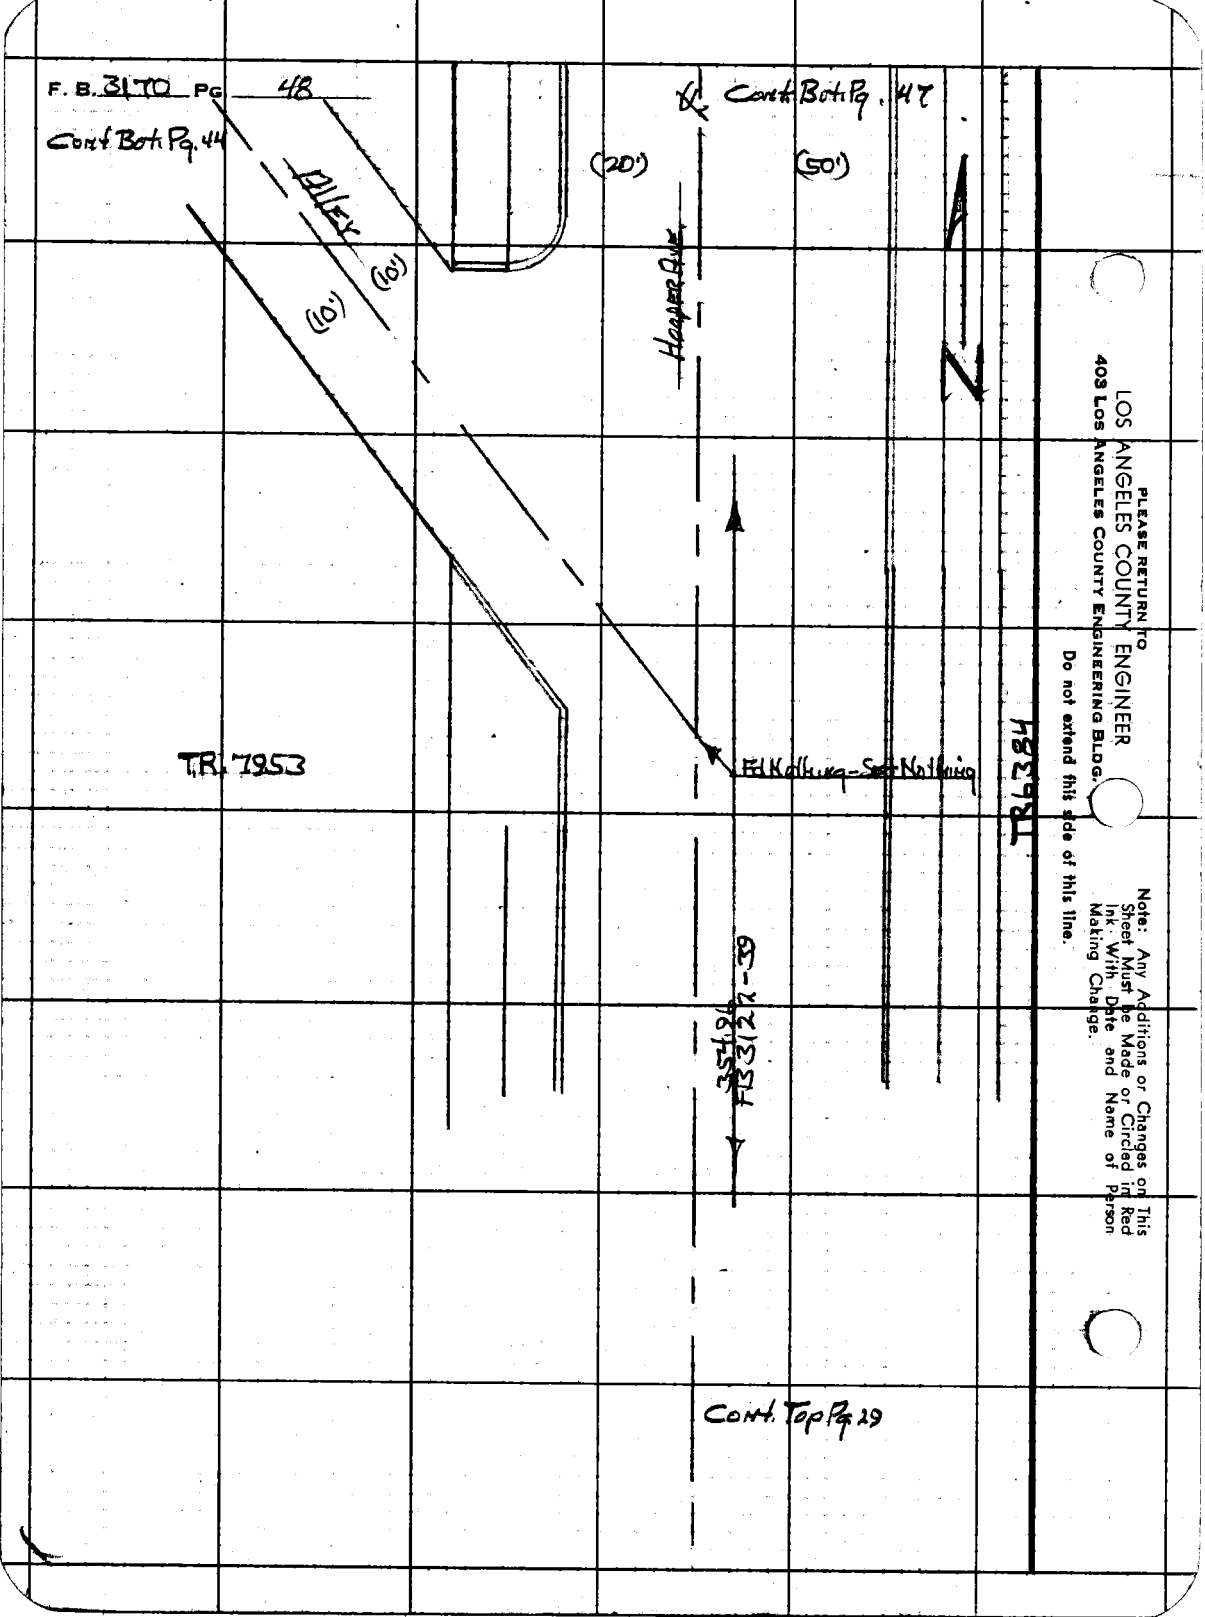
F. B. 3170 PG 48
Cont Bot Pg. 44
Cont Bot Pg. 47
(20')
(50')
Alley
(10')
(10')
Hooper Ave
N
T.R. 7953
Fd Nothing - Set Nothing
TR 6384
354.96
FB 3122-39
Cont. Top Pg 29
PLEASE RETURN TO
LOS ANGELES COUNTY ENGINEER
403 LOS ANGELES COUNTY ENGINEERING BLDG.
Do not extend this side of this line.
Note: Any Additions or Changes on This Sheet Must be Made or Circled in Red Ink With Date and Name of Person Making Change.

Notes Ck'd by J. Church	Survey of 92nd St.	F.B. 3170 PG. 49
Map No. 33019	JN 0096.66 Tape 0259 Std 68 °F	
Office Work	Surveyed by HH Spriggs	
Checked J. A. CHURCH	Notes HHS Date 9-22-65	
Date Jul 7 '66	Indexed C. J. GALLI	

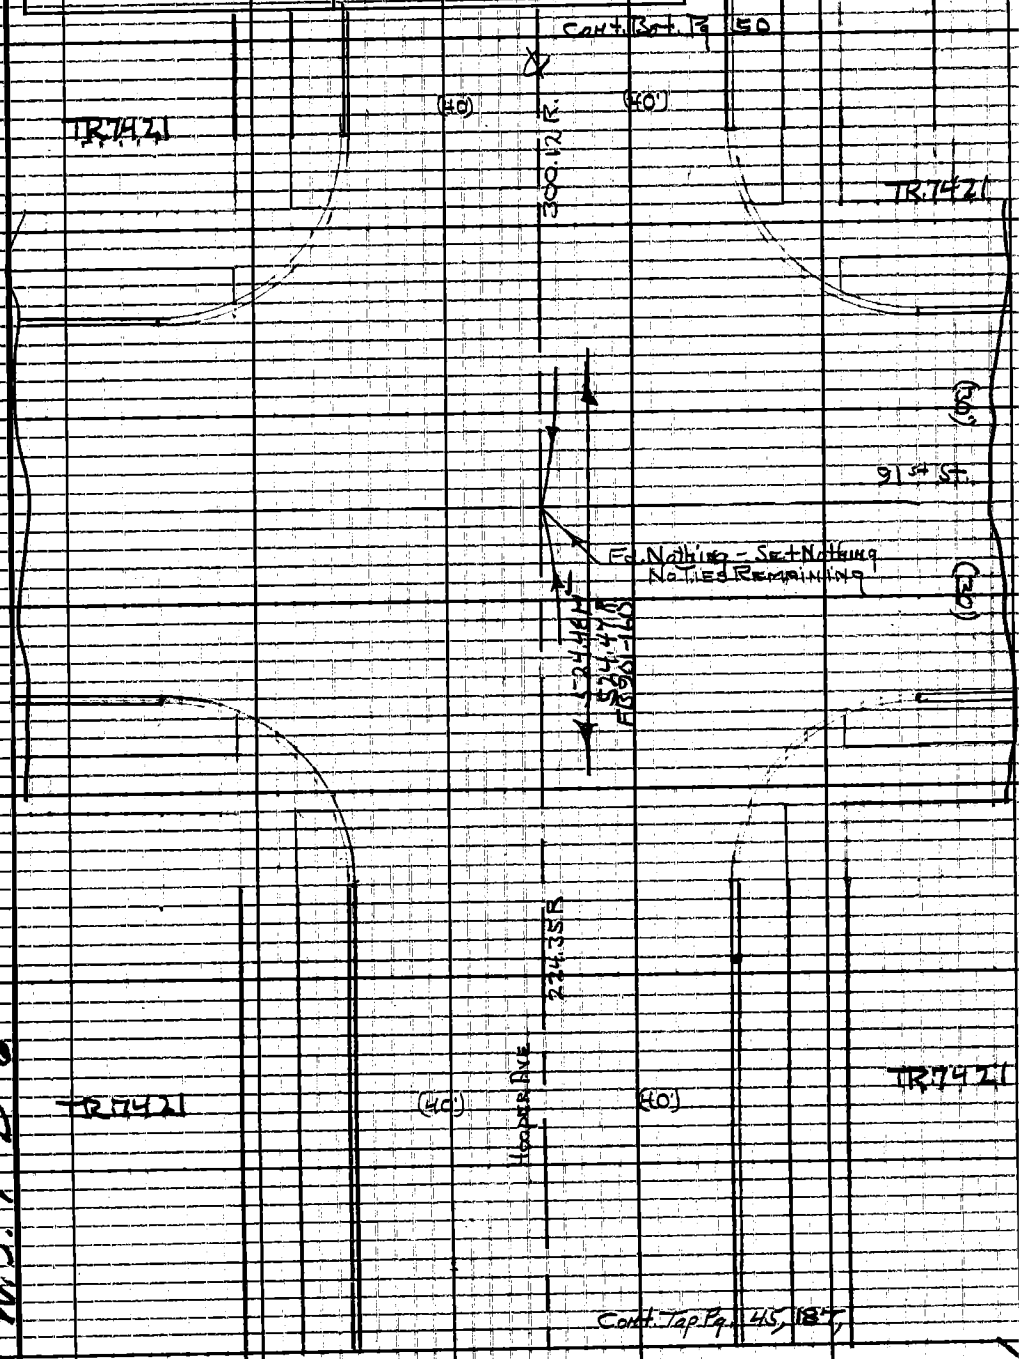

Note: Any Additions or Changes on This Sheet Must be Made or Circled in Red Ink With Date and Name of Person Making Change.

Do not extend this side of this line.

PLEASE RETURN TO
LOS ANGELES COUNTY ENGINEER
403 LOS ANGELES COUNTY ENGINEERING BLDG.

W.S. 7 B-6

76F309S CE#310 1-65

F. B. 3170 PG 50

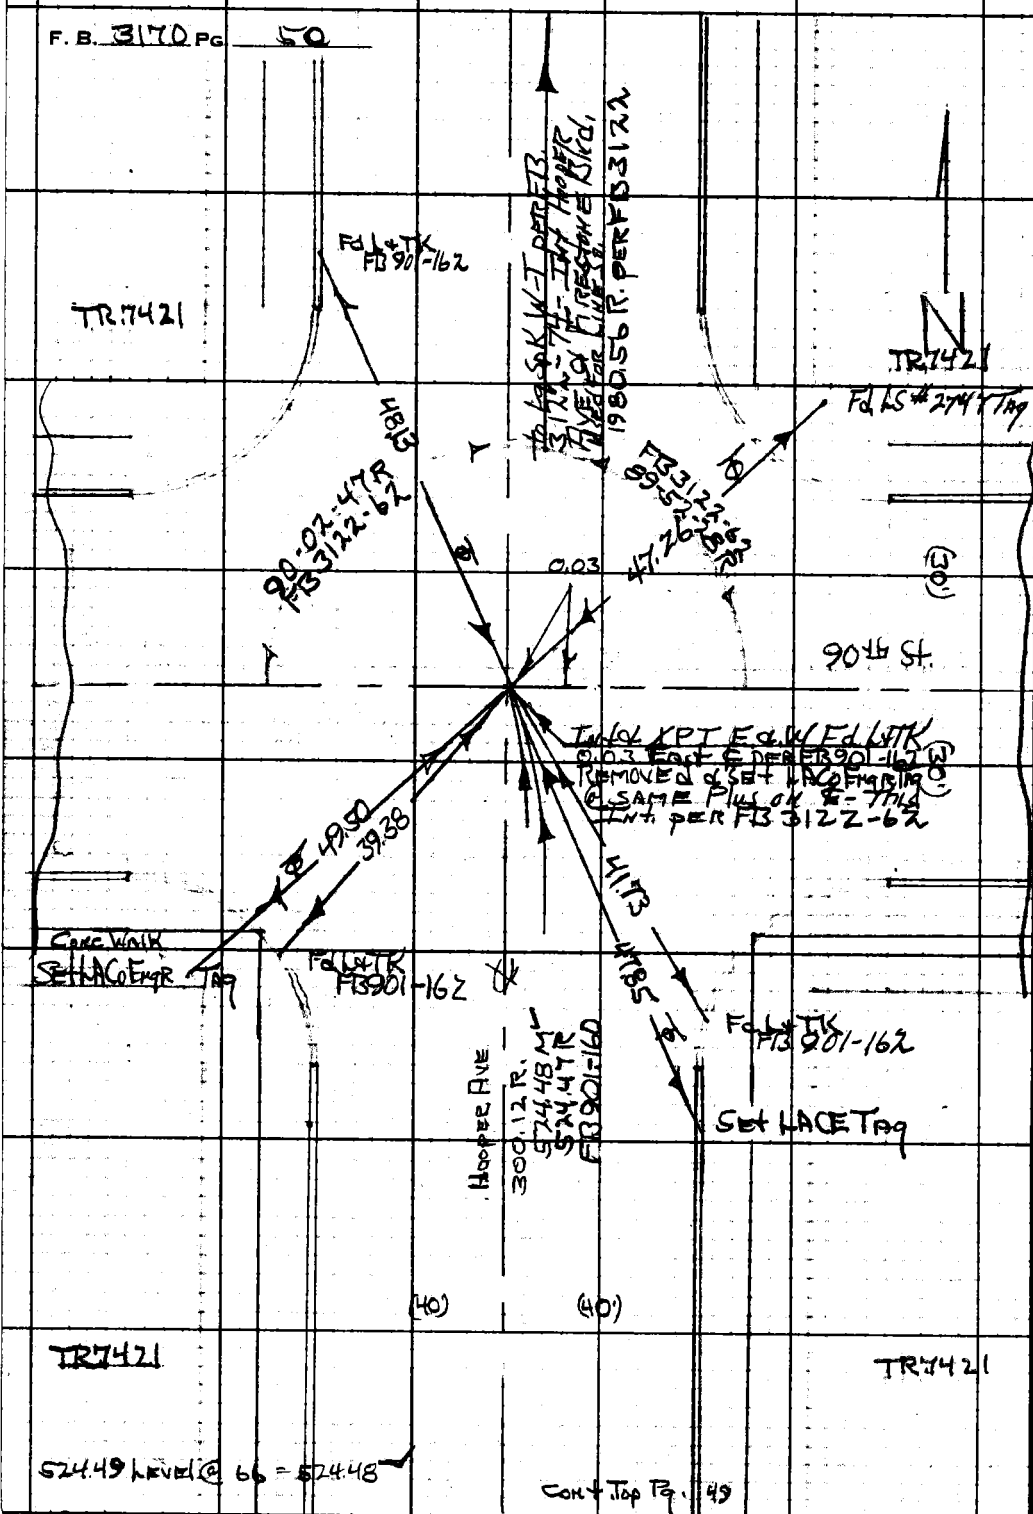

W.S.7 B-6

PLEASE RETURN TO
LOS ANGELES COUNTY ENGINEER
403 LOS ANGELES COUNTY ENGINEERING BLDG.

Do not extend this side of this line.

Note: Any Additions or Changes on This Sheet Must be Made or Circled in Red Ink With Date and Name of Person Making Change.

Notes Ck'd by J. Church	Survey of 92nd St.		F.B. 3170 PG. 51
Map No. B 3019	JN 0096.66 Tape 0259 Std 68 °F		
Office Work	Surveyed by HHS Briggs		
Checked J. CHURCH	Notes HHS	Date 9-22-65	
Date JUL 7 '66	Indexed C. J. GALLI		

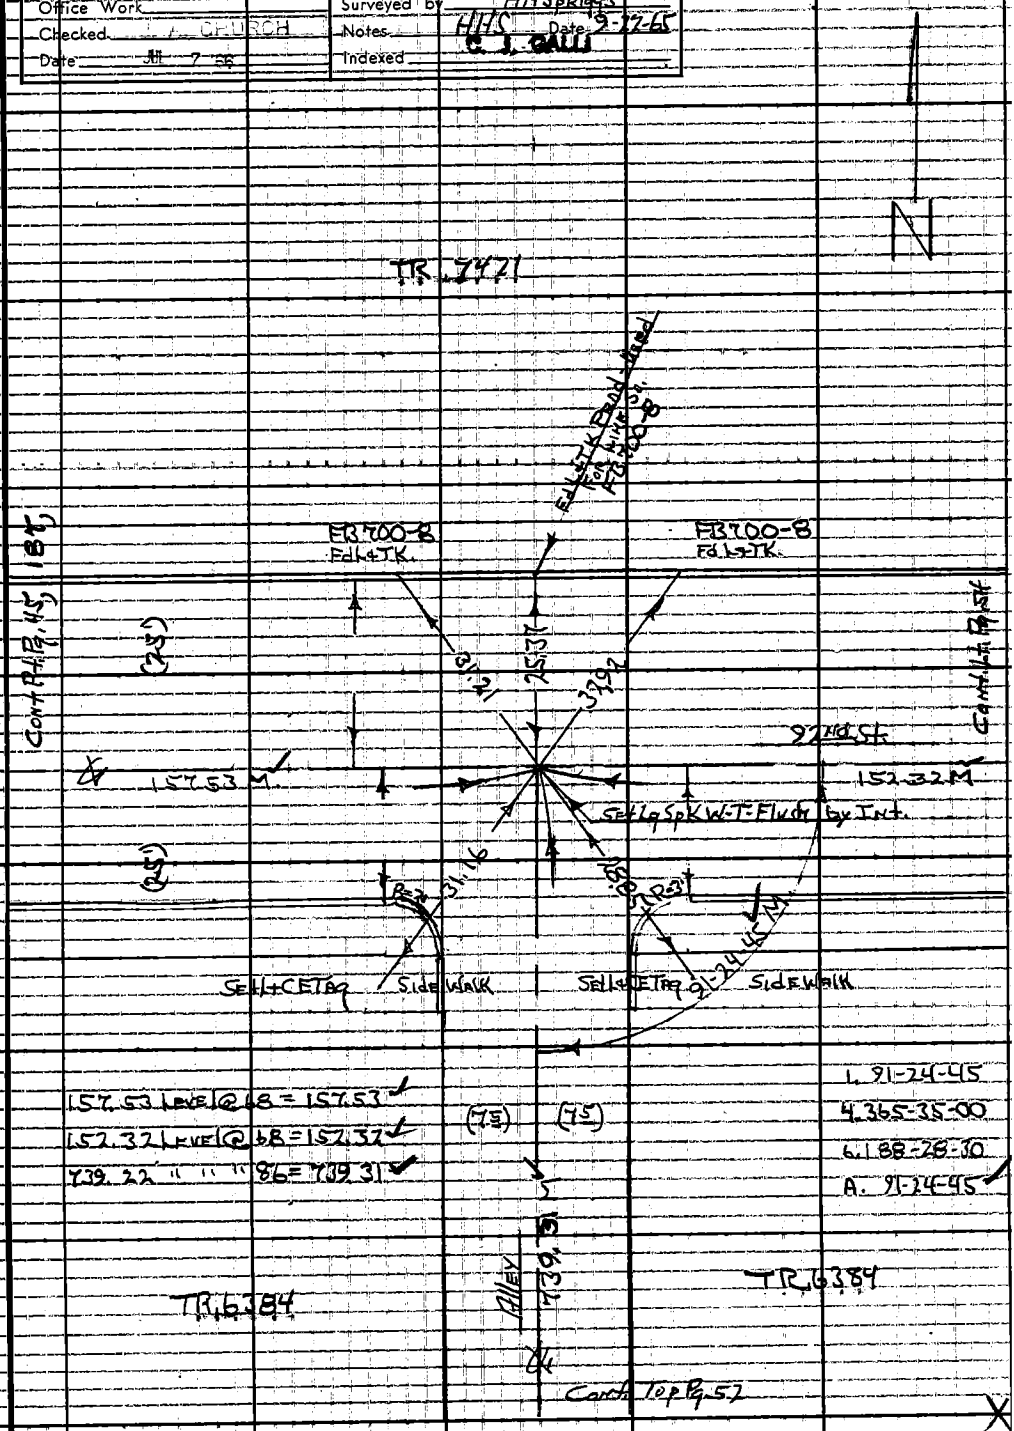

Note: Any Additions or Changes on This Sheet Must be Made or Circled in Red Ink With Date and Name of Person Making Change.

Do not extend this side of this line.

PLEASE RETURN TO
LOS ANGELES COUNTY ENGINEER
403 LOS ANGELES COUNTY ENGINEERING BLDG.

76F309S CE#310 1-65

F. B. 3170 PG. 52

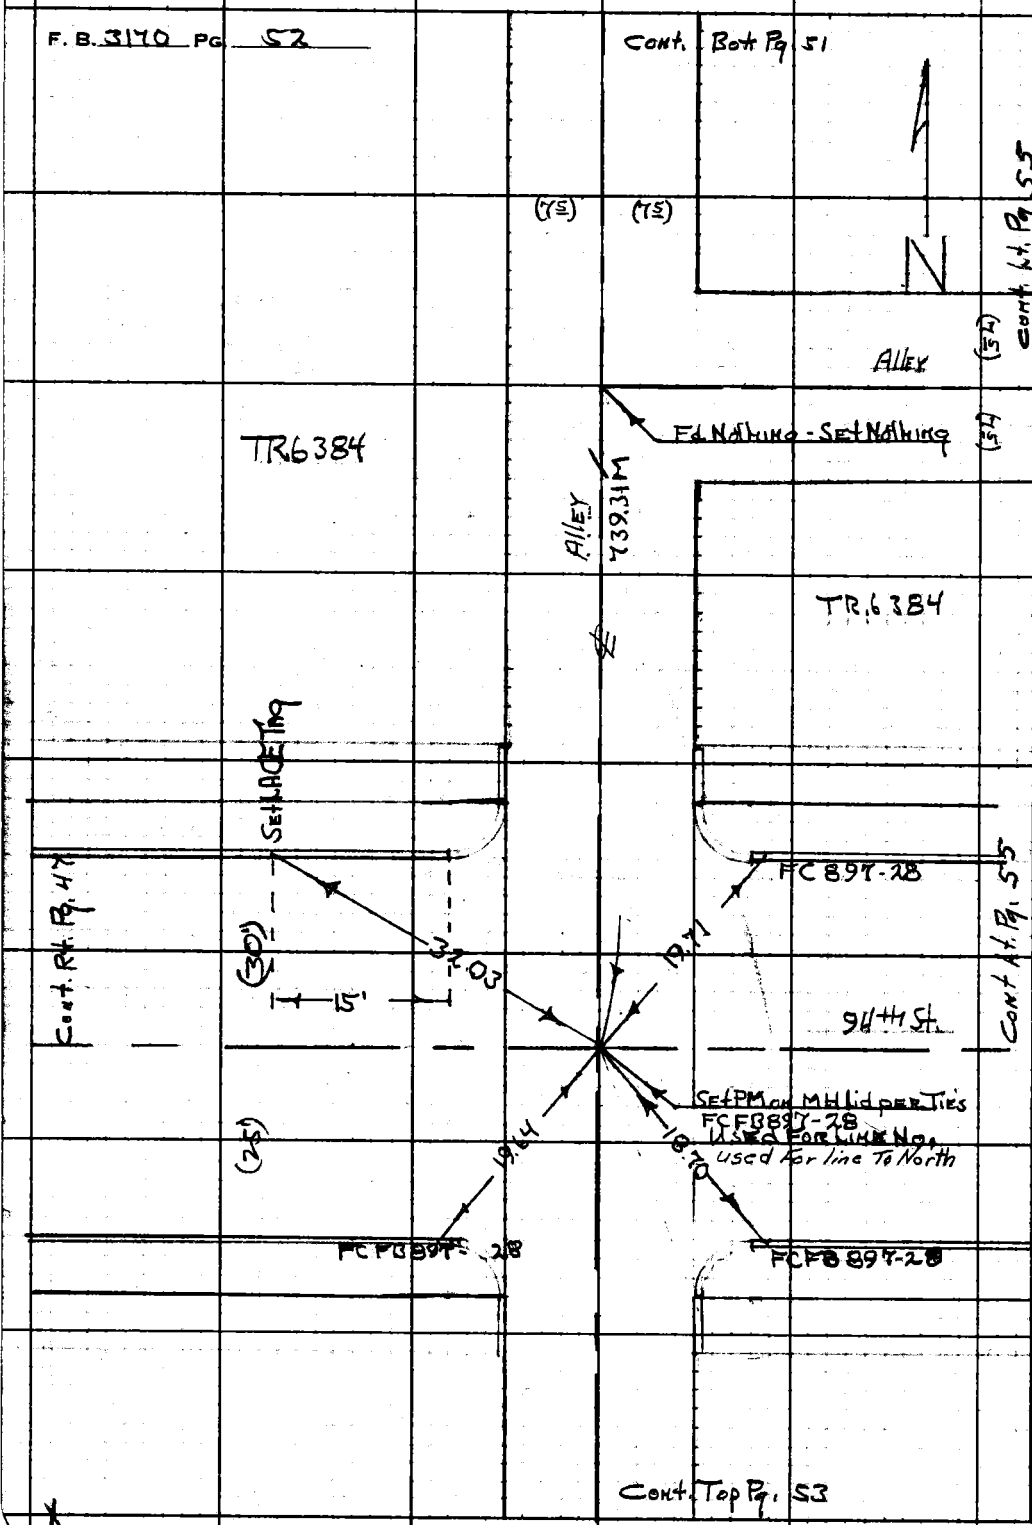

PLEASE RETURN TO
LOS ANGELES COUNTY ENGINEER
403 LOS ANGELES COUNTY ENGINEERING BLDG.

Do not extend this side of this line.

Note: Any Additions or Changes on This Sheet Must be Made or Circled in Red Ink With Date and Name of Person Making Change.

Notes Ck'd by J. Church	Survey of 92nd St.	F. B3170 PG. 53
Map No. B3009	JN 009666 Tape 0259 Std. 68 °F	
Office Work	Surveyed by HHS Spriggs	
Checked J. A. CHURCH	Notes HHS Date 9-22-65	
Date JUL 7 '66	Indexed C. J. DALLI MAR 8 '68	

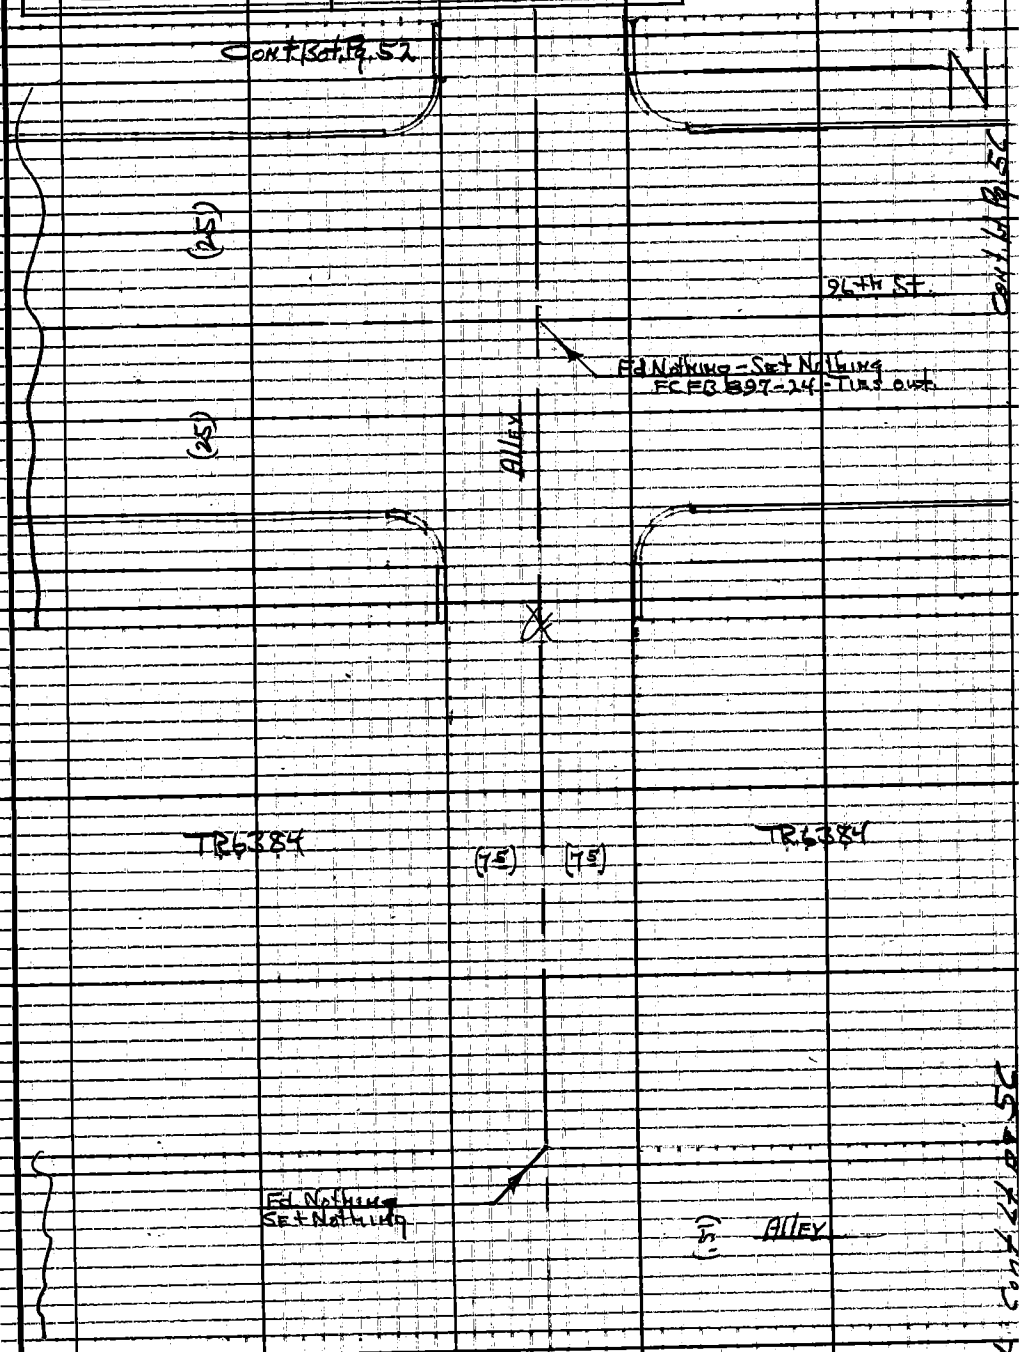

Note: Any Additions or Changes on This Sheet Must be Made or Circled in Red Ink With Date and Name of Person Making Change.

Do not extend this side of this line.

PLEASE RETURN TO
LOS ANGELES COUNTY ENGINEER
403 LOS ANGELES COUNTY ENGINEERING BLDG.

76F309S CE#310 1-65

F. B. 3170 PG. 54

290.01 LEVEL @ 68 = 290.01

147.54 " " " 86 = 147.56

1. 88-35-00
4. 354-20-00
6. 171-30-00
A. 88-35-00

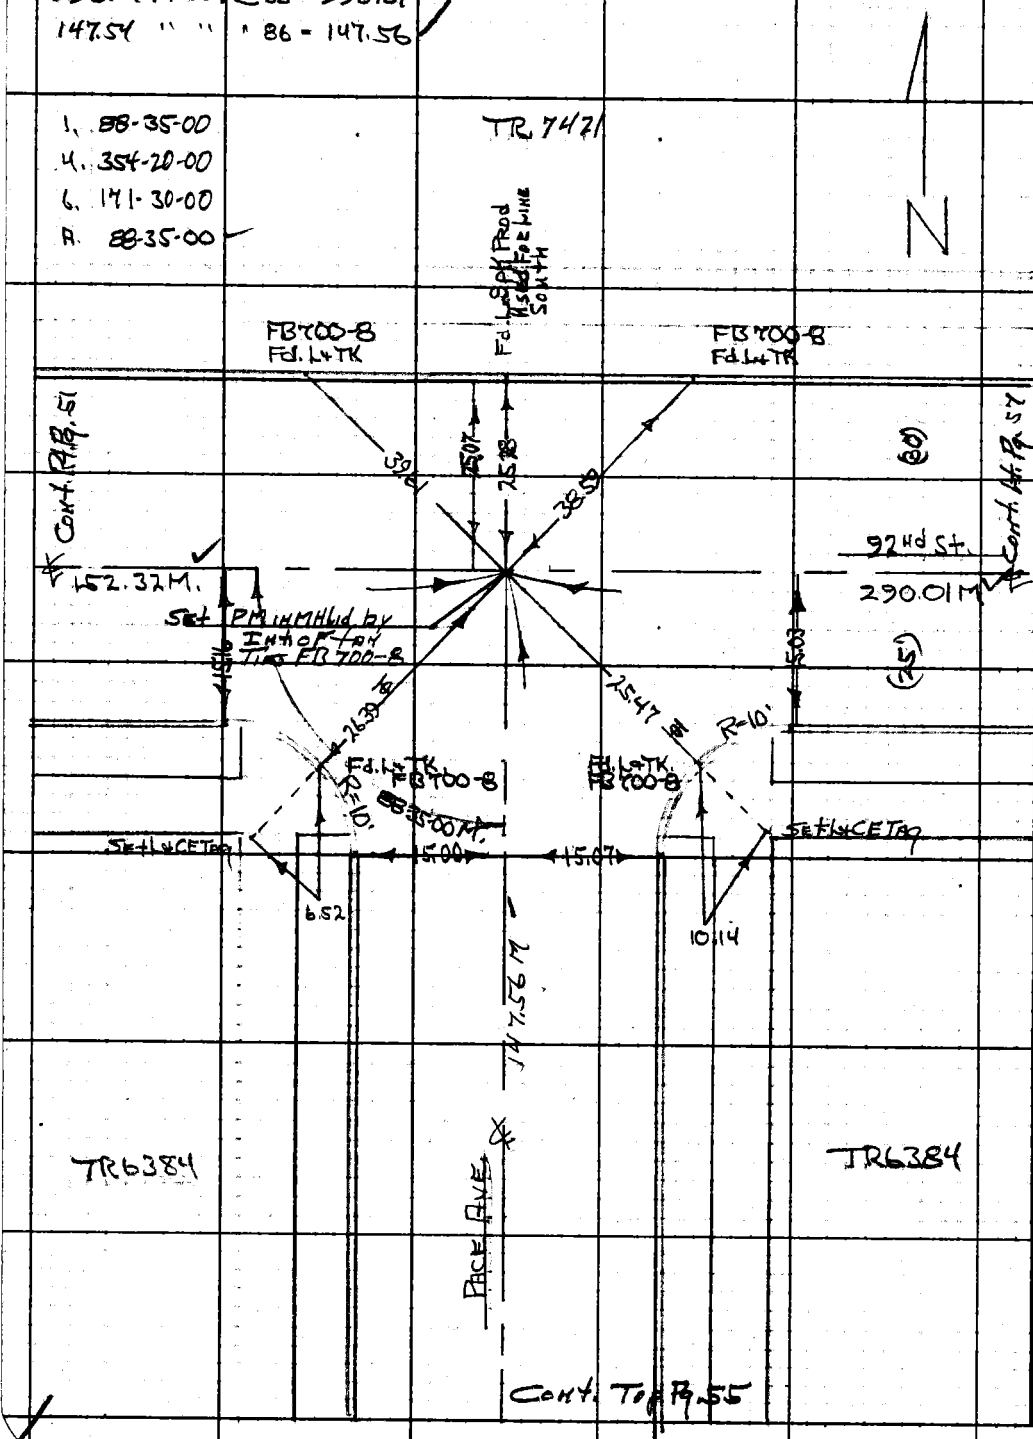

W.S. 7 B-6

PLEASE RETURN TO
LOS ANGELES COUNTY ENGINEER
403 LOS ANGELES COUNTY ENGINEERING BLDG.

Do not extend this side of this line.

Note: Any Additions or Changes on This Sheet Must be Made or Circled in Red Ink With Date and Name of Person Making Change.

Notes Ck'd by J. Church
Map No. B 3019
Office Work
Checked J. A. CHURCH
Date 7 '66

Survey of 92nd St.
JN 0096.66 Tape 0259 Std 68 °F.
Surveyed by HH Spriggs
Notes HHS Date 9-23-65
Indexed C. J. GALLI

F. B. 3170 PG. 55

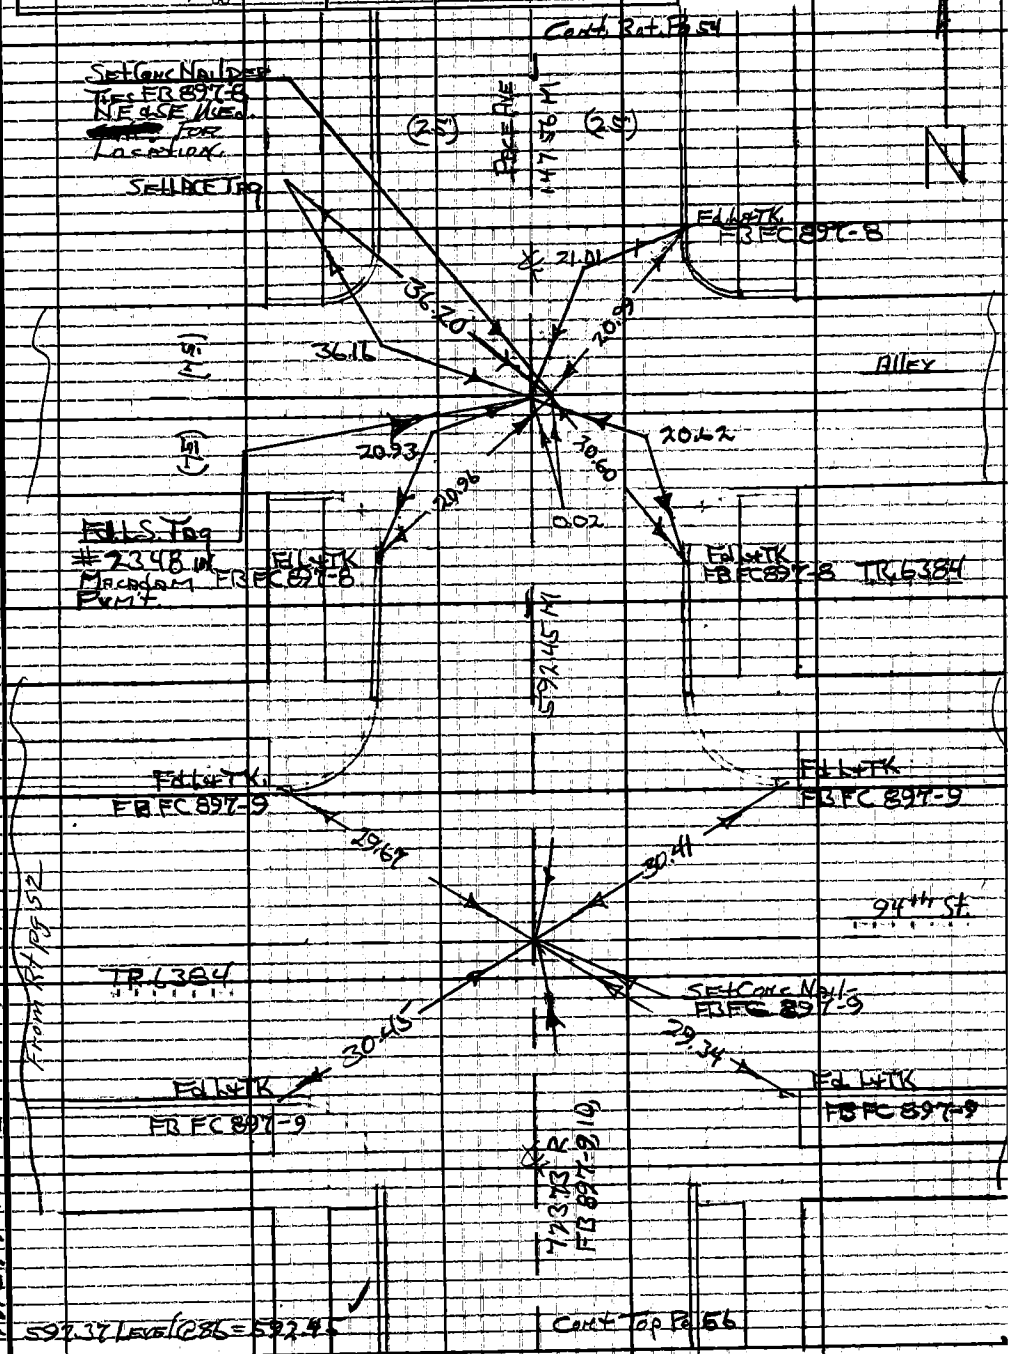

W.S. 7B-6

Note: Any Additions or Changes on This Sheet Must be Made or Circled in Red Ink With Date and Name of Person Making Change.

Do not extend this side of this line.

PLEASE RETURN TO
LOS ANGELES COUNTY ENGINEER
403 LOS ANGELES COUNTY ENGINEERING BLDG.

76F309S CE#310 1-65

F. B. 3170 Pg. 56

Cont Bot. Pg. 55

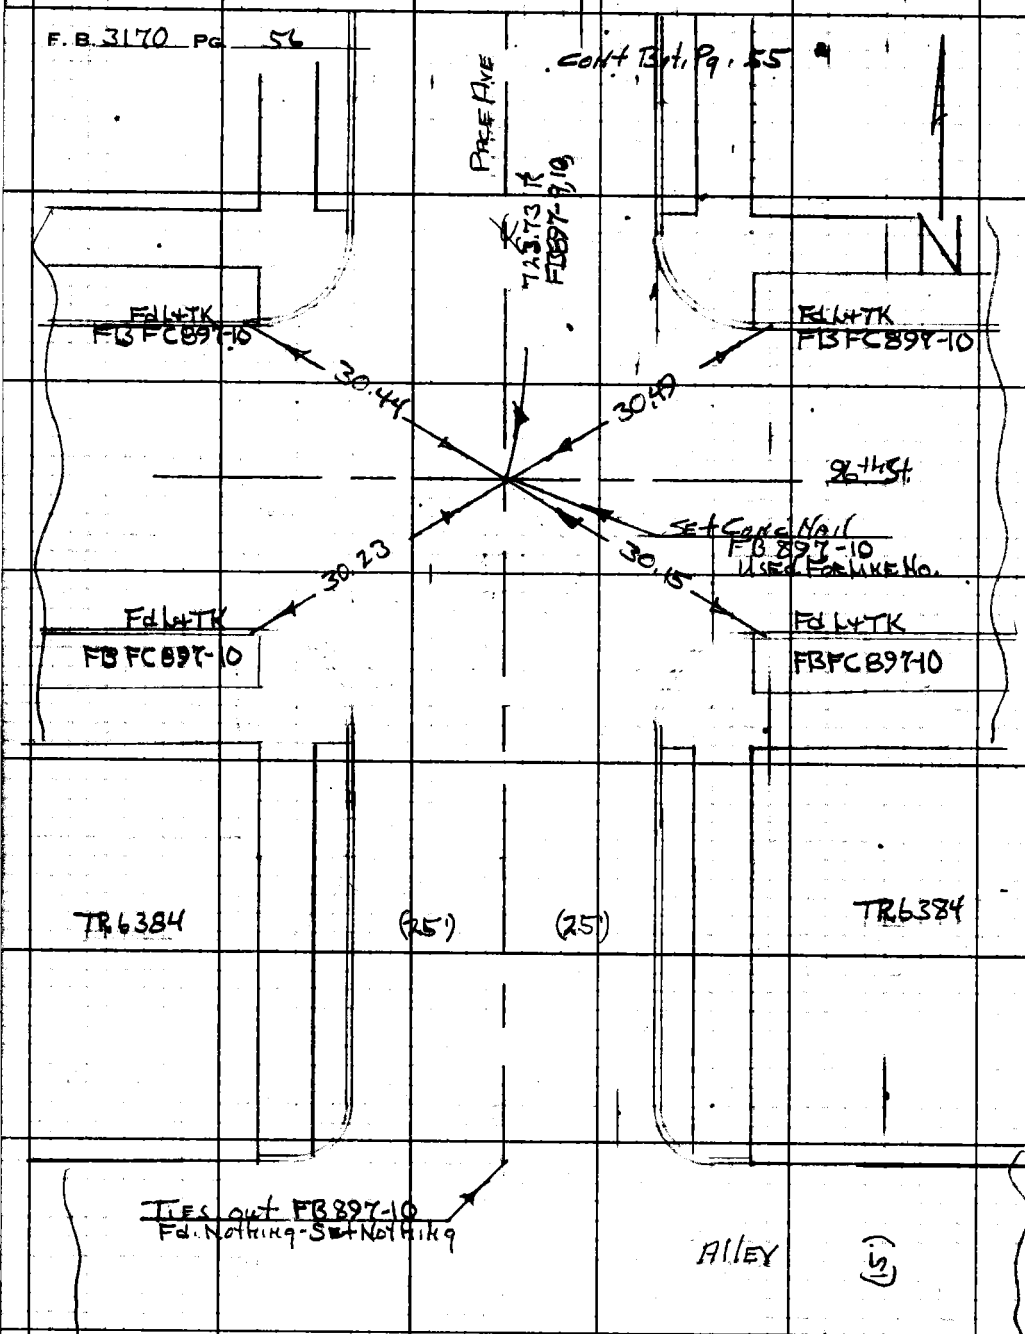

W.S. 7 B-6

PLEASE RETURN TO
LOS ANGELES COUNTY ENGINEER
403 LOS ANGELES COUNTY ENGINEERING BLDG.

Do not extend this side of this line.

Note: Any Additions or Changes on This Sheet Must be Made or Circled in Red Ink With Date and Name of Person Making Change.

Notes Ck'd by J. Church	Survey of 92nd St.		F. B. 3170 PG. 57
Map No. B-3019	JN 0096.66 Tape 0259 Std 68 °F		
Office Work	Surveyed by HH Spriggs		
Checked J. A. CHURCH	Notes HHS Date 9-27-65		
Date JUL 7 '66	Indexed		

121.86 LEVEL @ 64 = 121.86
149.05 " " " 78 = 149.06

TR 7421

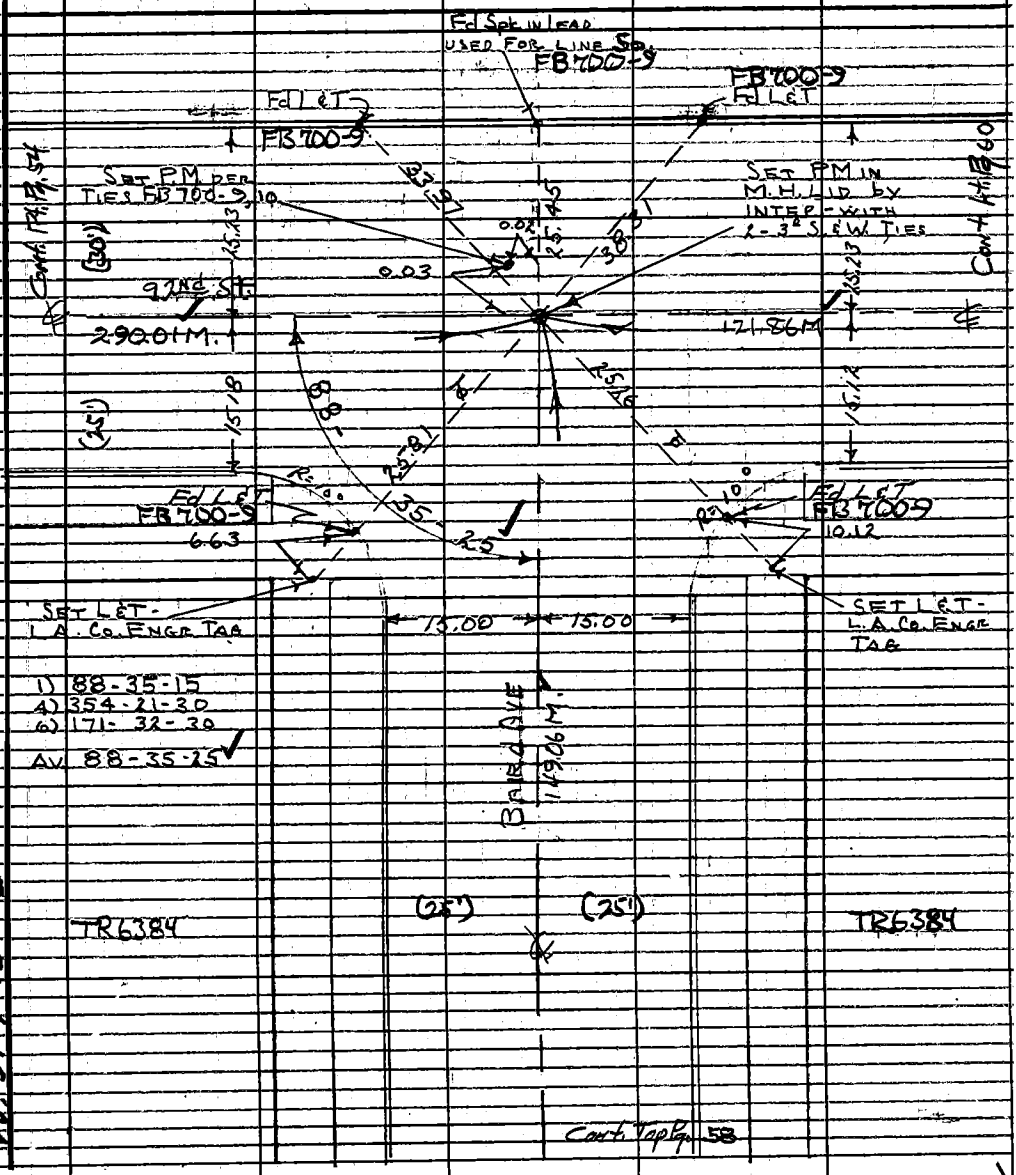

1) 88-35-15
4) 354-21-30
6) 171-32-30
Av. 88-35-25

Cont. Top Pg. 58

Note: Any Additions or Changes on This Sheet Must be Made or Circled in Red Ink With Date and Name of Person Making Change.

Do not extend this side of this line.

PLEASE RETURN TO
LOS ANGELES COUNTY ENGINEER
403 LOS ANGELES COUNTY ENGINEERING BLDG.

W. 5. 7 B-C

76F309S CE#310 1-65

F. B. 3170 PG 58

Cont. Bot. Pg. 57

592.24 Level @ 78 = 592.28

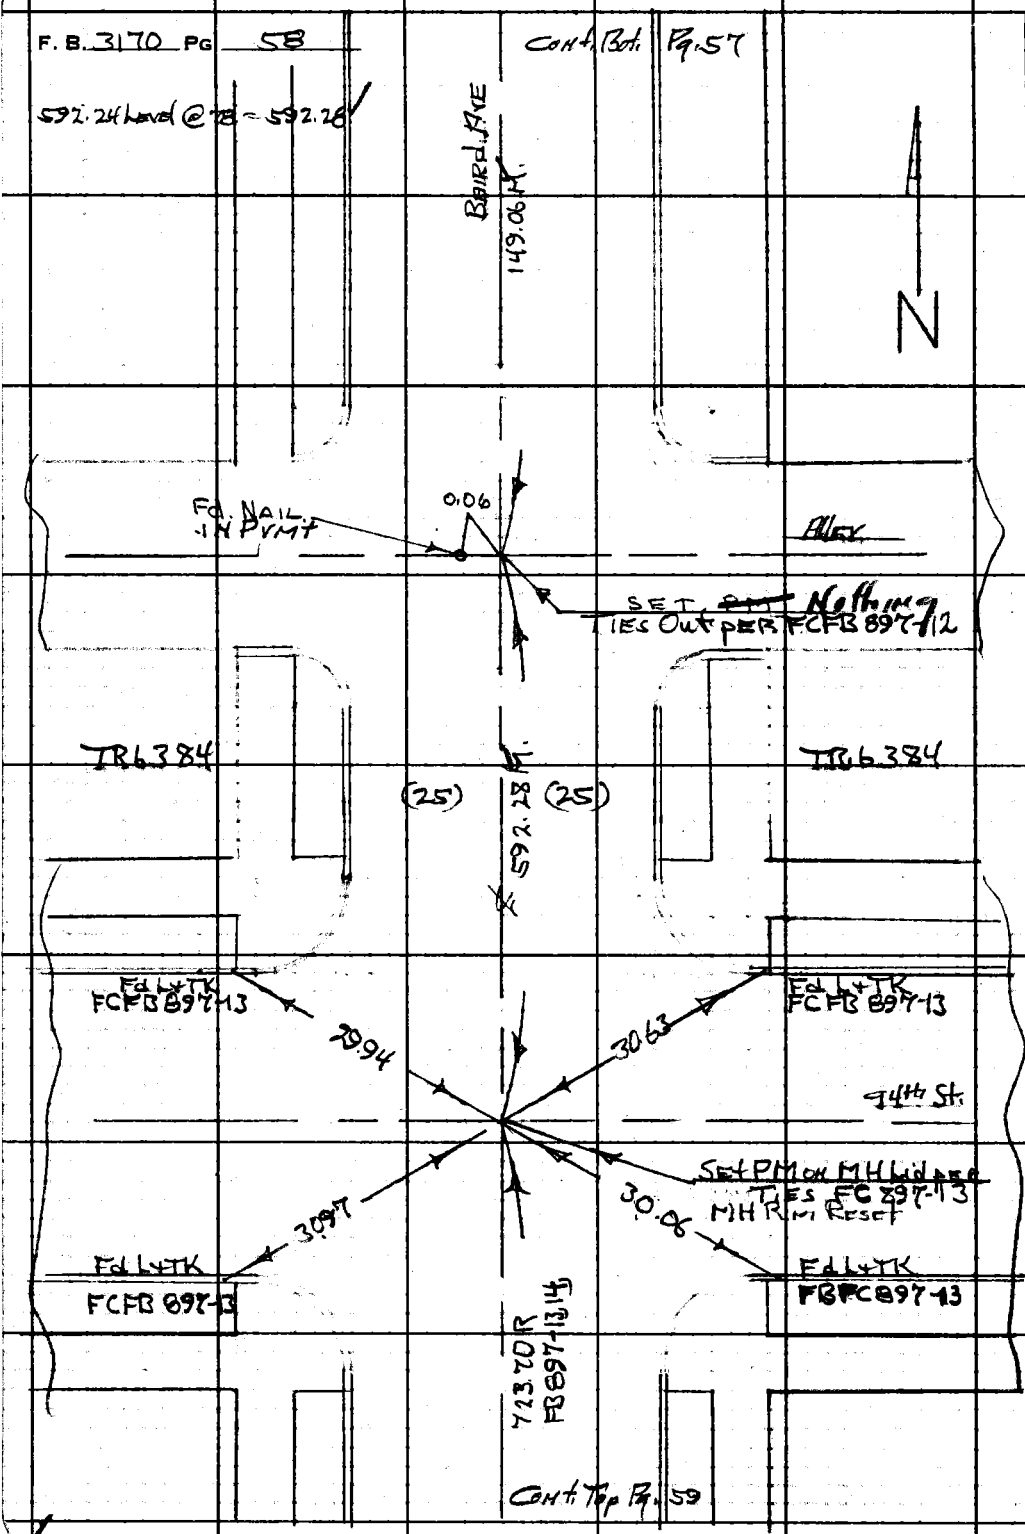

Cont. Top Pg. 59

W.S. 7 B-6

PLEASE RETURN TO
LOS ANGELES COUNTY ENGINEER
403 LOS ANGELES COUNTY ENGINEERING BLDG.

Do not extend this side of this line.

Note: Any Additions or Changes on This Sheet Must be Made or Circled in Red Ink With Date and Name of Person Making Change.

Notes Ck'd by J. Church
Map No. B3019
Office Work
Checked J. A. CHURCH
Date

Survey of 92nd St.
JN 0096.66 Tape 0259 Std 68 °F
Surveyed by HHSprings
Notes HHS Date 9-27-65
Indexed C. J. GALLE

F. B. 3170 PG. 59

Cont. Bot. Pg. 58

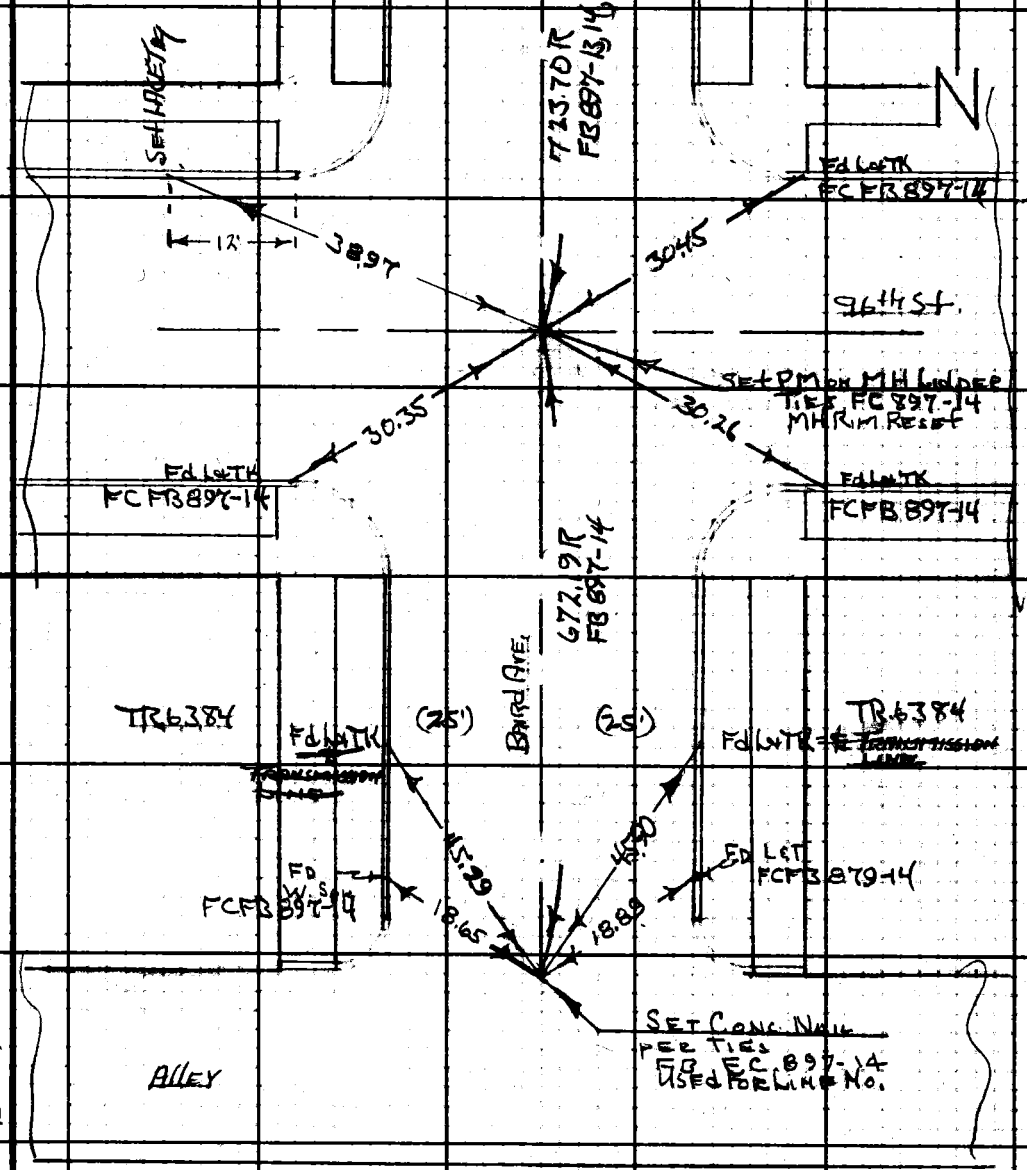

Note: Any Additions or Changes on This Sheet Must-be Made or Circled in Red Ink With Date and Name of Person Making Change.

Do not extend this stop to this line.

PLEASE RETURN TO
LOS ANGELES COUNTY ENGINEER
403 LOS ANGELES COUNTY ENGINEERING BLDG.

W.S. 7 B-6

76F309S CE #319 6-62

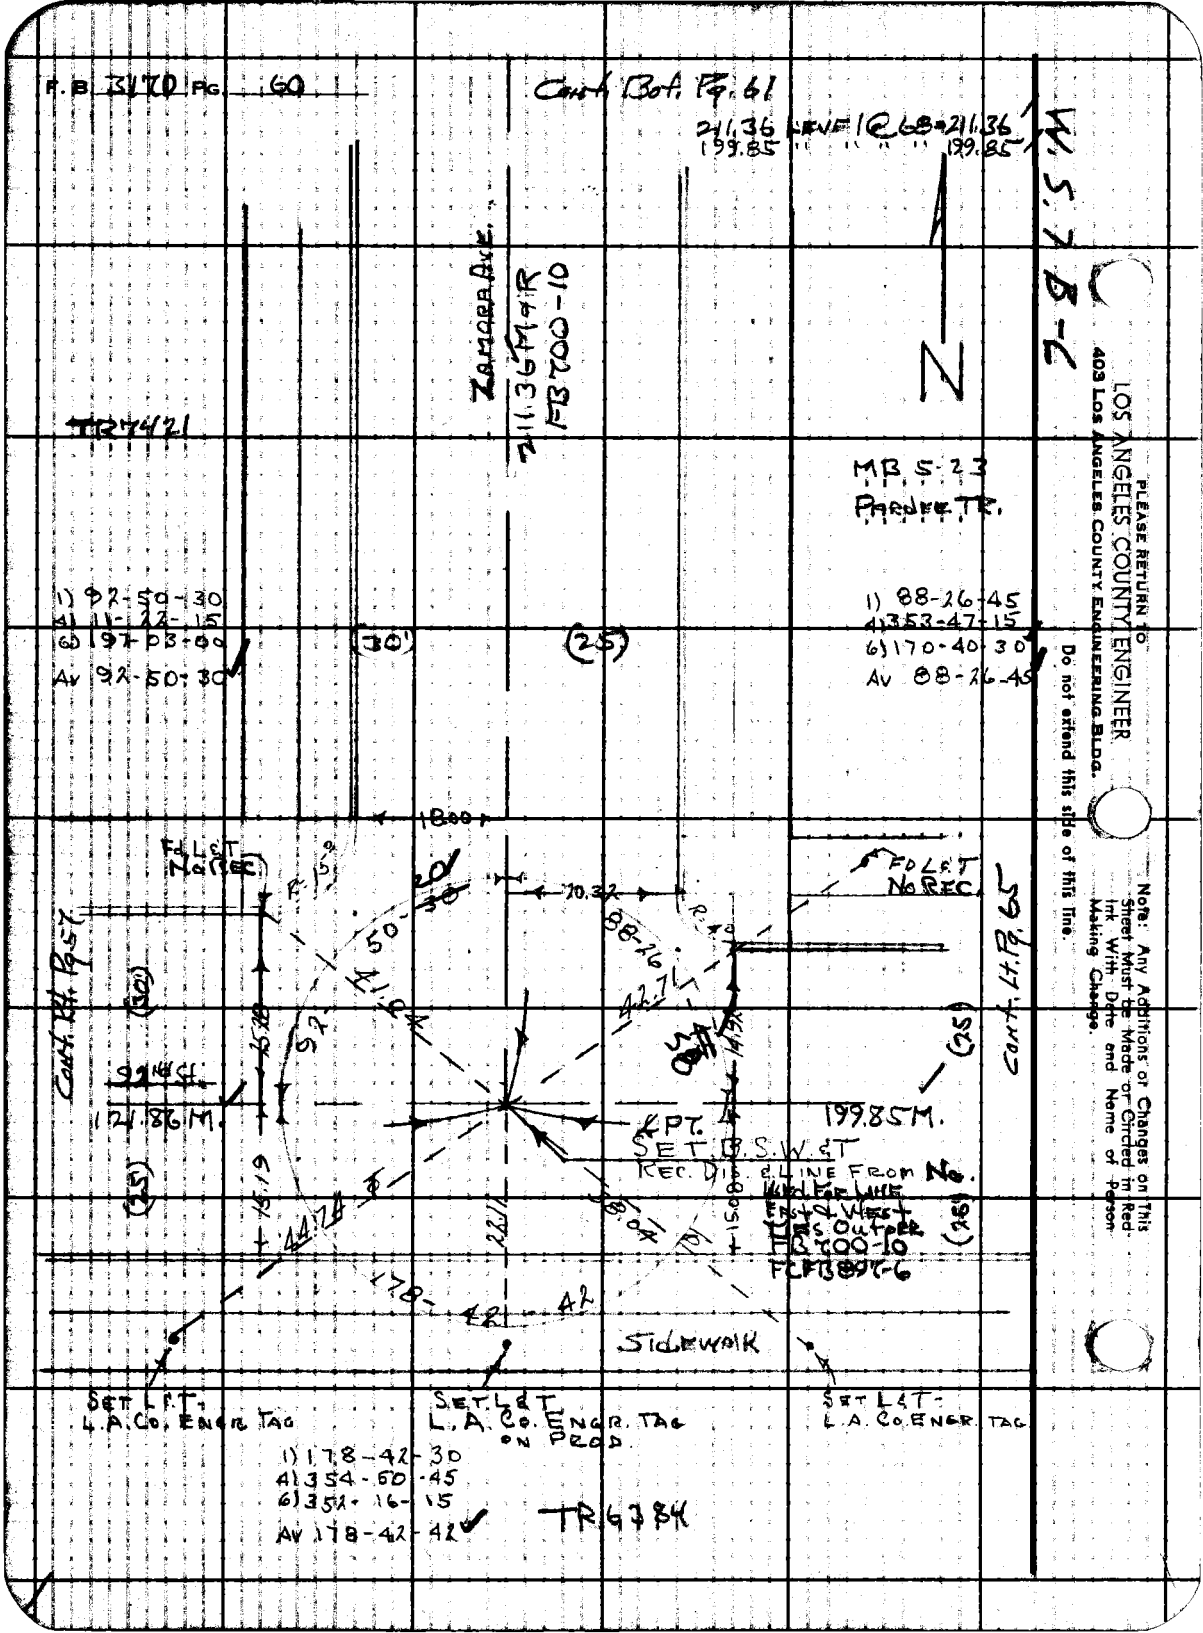

F.B. 3170 PG. 60
Cont. Bot. Pg. 61
211.36 LEVEL @ 68=211.36
199.85 " " " " 199.85
W.S. 7 B-C
N
ZAMORA AVE.
211.36 M & R
FB 700-10
TR 7421
MB 5-23
PARDEE TR.
1) 92-50-30
4) 11-22-15
6) 197-03-00
Av 92-50-30
(30')
(25)
1) 88-26-45
4) 353-47-15
6) 170-40-30
Av 88-26-45
1800
Fd L&T No REC.
FD L&T No REC.
Cont. Lt. Pg. 57
Cont. Lt. Pg. 65
(30')
(25)
(25)
(25)
121.86 M.
199.85 M.
SET B.S.W. & T
REC. DIS. & LINE FROM No. Used For Line East & West Ties Outer FB 700-10 FCFB 897-6
178-42-42
SIDEWALK
SET L&T L.A. CO. ENGR. TAG
SET L&T L.A. CO. ENGR. TAG ON PROD.
SET L&T L.A. CO. ENGR. TAG
1) 178-42-30
4) 354-50-45
6) 352-16-15
Av 178-42-42
TR 6784
PLEASE RETURN TO
LOS ANGELES COUNTY ENGINEER
403 LOS ANGELES COUNTY ENGINEERING BLDG.
Do not extend this side of this line.
Note: Any Additions or Changes on This Sheet Must be Made or Circled in Red Ink With Date and Name of Person Making Change.

Notes Ck'd by J. Church	Survey of 92nd St.		F. B. 3170 PG. 61
Map No. B3019	JN 0096.66 Tape 0259 Std 68 °F		
Office Work	Surveyed by HH Spriggs		
Checked J. A. CHURCH	Notes HHS Date 9-27-65		
Date	Indexed [illegible]		

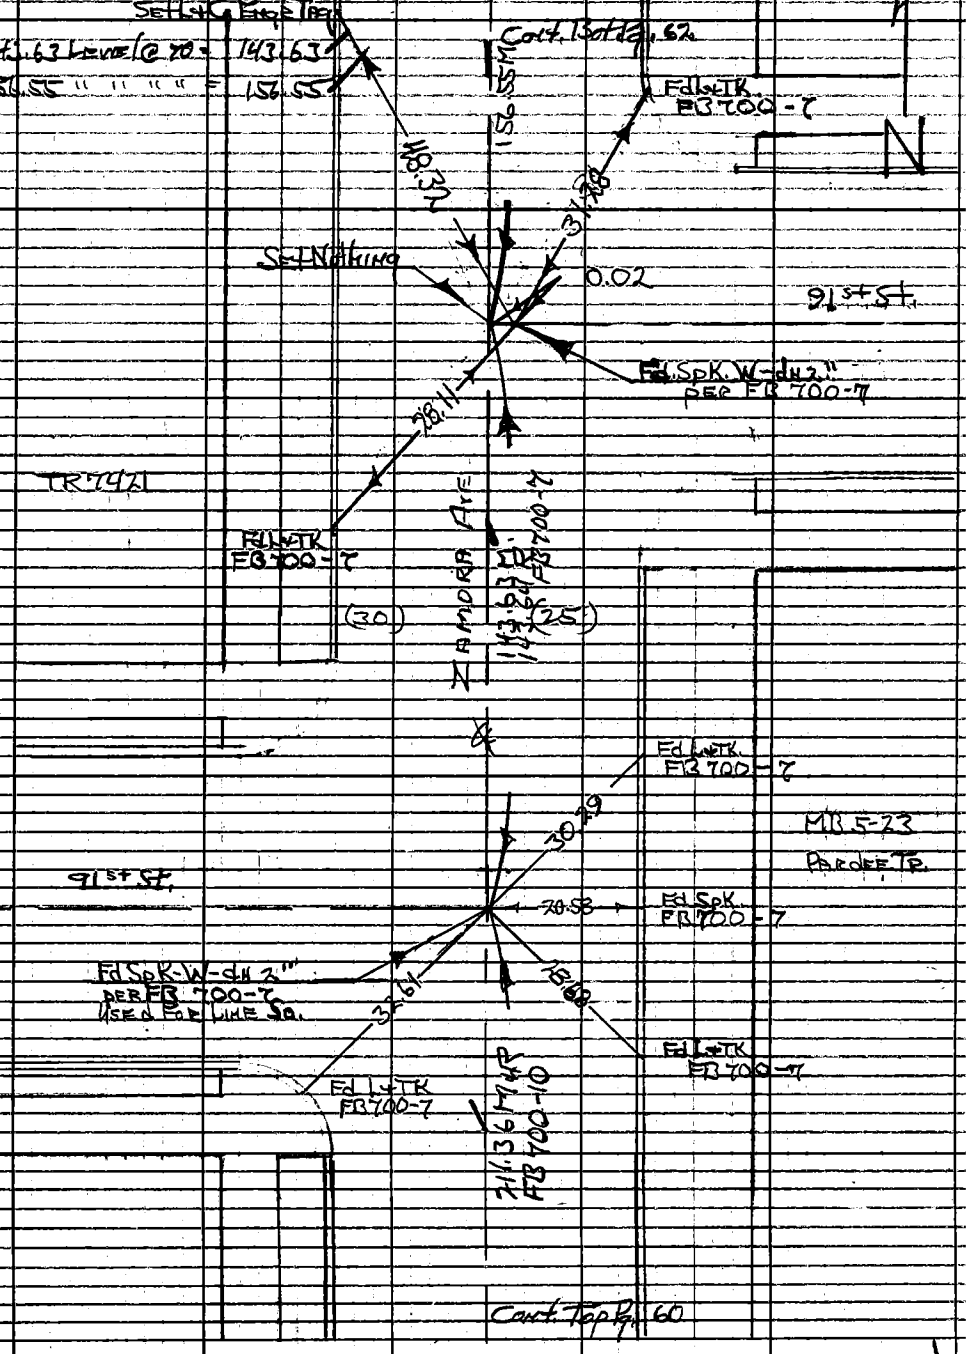

Note: Any Additions or Changes on This Sheet Must be Made or Circled in Red Ink With Date and Name of Person Making Change.

Do not extend this side of this line.

PLEASE RETURN TO
LOS ANGELES COUNTY ENGINEER
403 LOS ANGELES COUNTY ENGINEERING BLDG.

76F309S CE#310 1-65

F.B. 3170 PG 62

Cont. Bot. Pg. 63

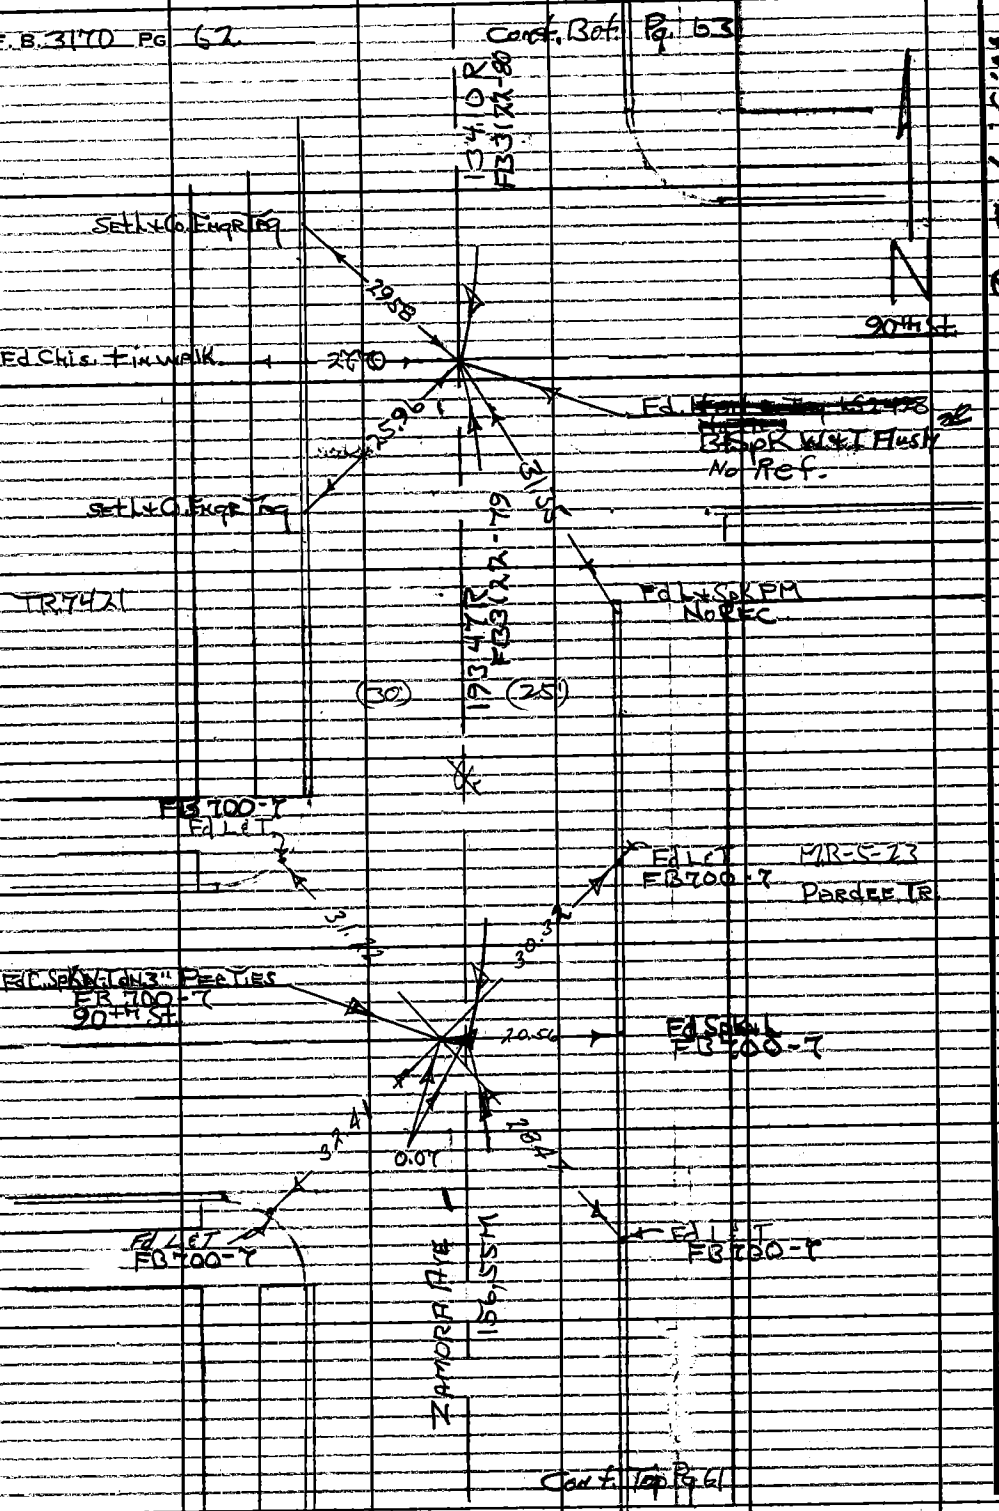

Cont. Top Pg 61

W.S. 7 B-6

LOS ANGELES COUNTY ENGINEER
403 LOS ANGELES COUNTY ENGINEERING BLDG.

PLEASE RETURN TO

Do not extend this side of this line.

Note: Any Additions or Changes on This Sheet Must be Made on Circled in Red Ink With Date and Name of Person Making Change.

Notes Ck'd by L. Church	Survey of 92nd St
Map No. B 3019	JN 0096.66 Tape 0259 Std 68 °F
Office Work J. A. CHURCH	Surveyed by H.H. Spriggs
Checked	Notes HHS Date 9-28-65
Date	Indexed C. J. GALLI

F.B. 3170 PG. 63

Cont. Bot. Pg. 64

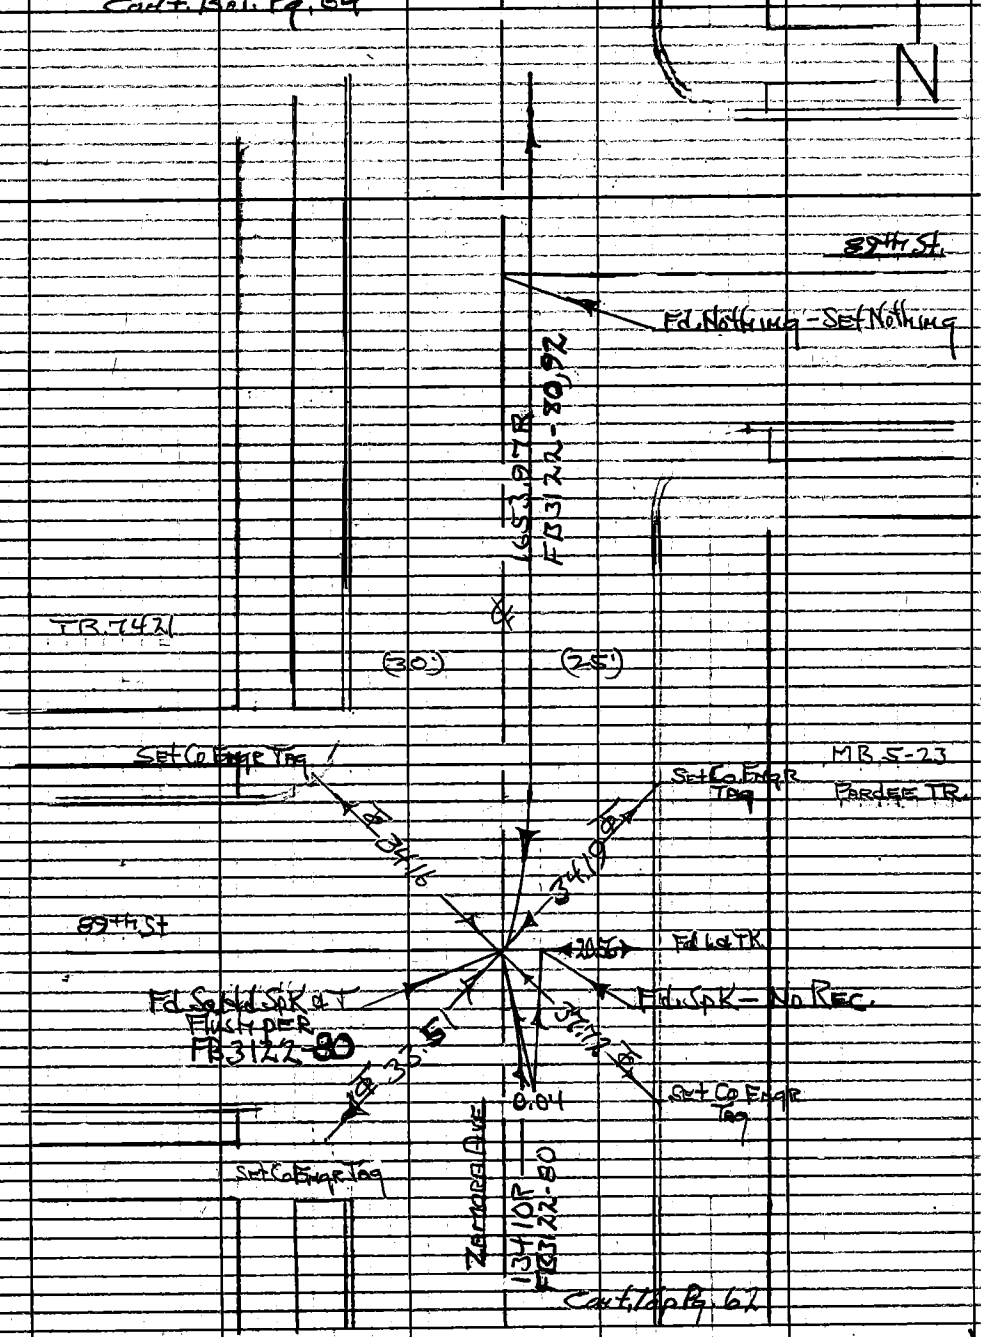

Cont. Top Pg. 62

W.S. 7 B-6

Note: Any Additions or Changes on This Sheet Must be Made or Circled in Red Ink With Date and Name of Person Making Change.

PLEASE RETURN TO
LOS ANGELES COUNTY ENGINEER
403 LOS ANGELES COUNTY ENGINEERING BLDG.
Do not extend this side of this line.

76F309S CE#310 1-65

F.B. 3170 PG. 64

LOS ANGELES COUNTY ENGINEER
403 LOS ANGELES COUNTY ENGINEERING BLDG.
PLEASE RETURN TO
Do not extend this side of this line.
Note: Any Additions or Changes on This Sheet Must be Made on Girded in Red Ink With Date and Name of Person Making Change.

Notes Ck'd by J. Church	Survey of 92nd St.		F.B. 3170 PG. 65
Map No. B 3019	JN 009.66 Tape 0259 Std 68 °F		
Office Work	Surveyed by H.H. Spriggs		
Checked J. A. CHURCH	Notes HHS Date 9-28-65		
Date	Indexed C. J. GALLS		

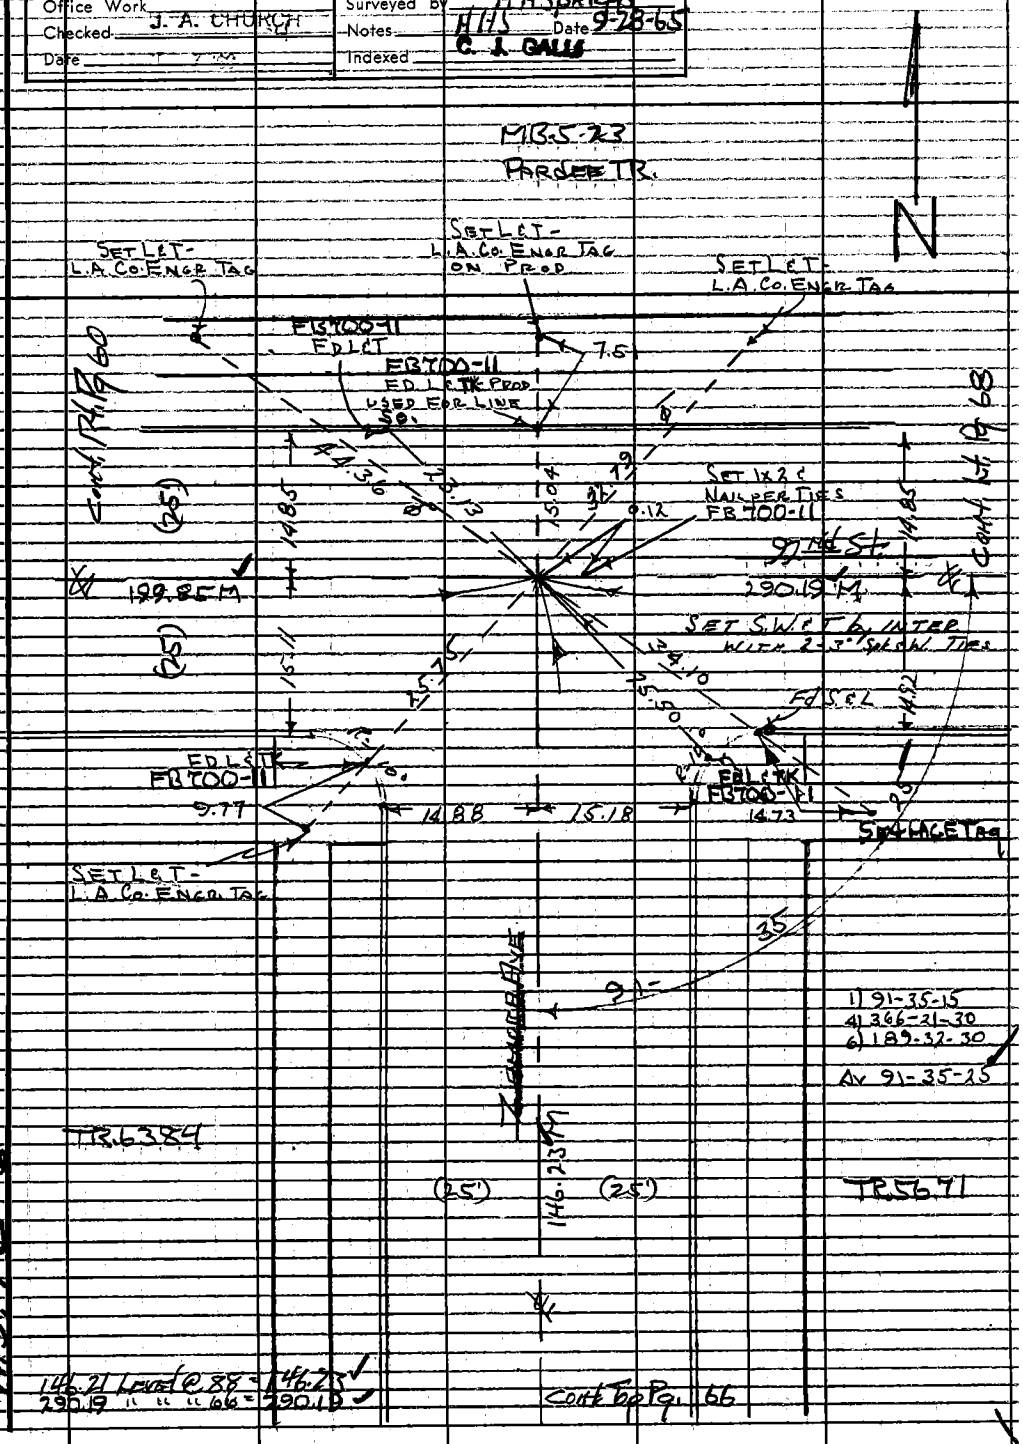

Note: Any Additions or Changes on This Sheet Must be Made or Circled in Red Ink With Date and Name of Person Making Change.

PLEASE RETURN TO
LOS ANGELES COUNTY ENGINEER
403 LOS ANGELES COUNTY ENGINEERING BLDG.
Do not extend this side of this line.

W.S. 7B-6

76F309S CE#310 1-65

F.B. 3170 PG. 66

Cont. Bot. Pg. 65

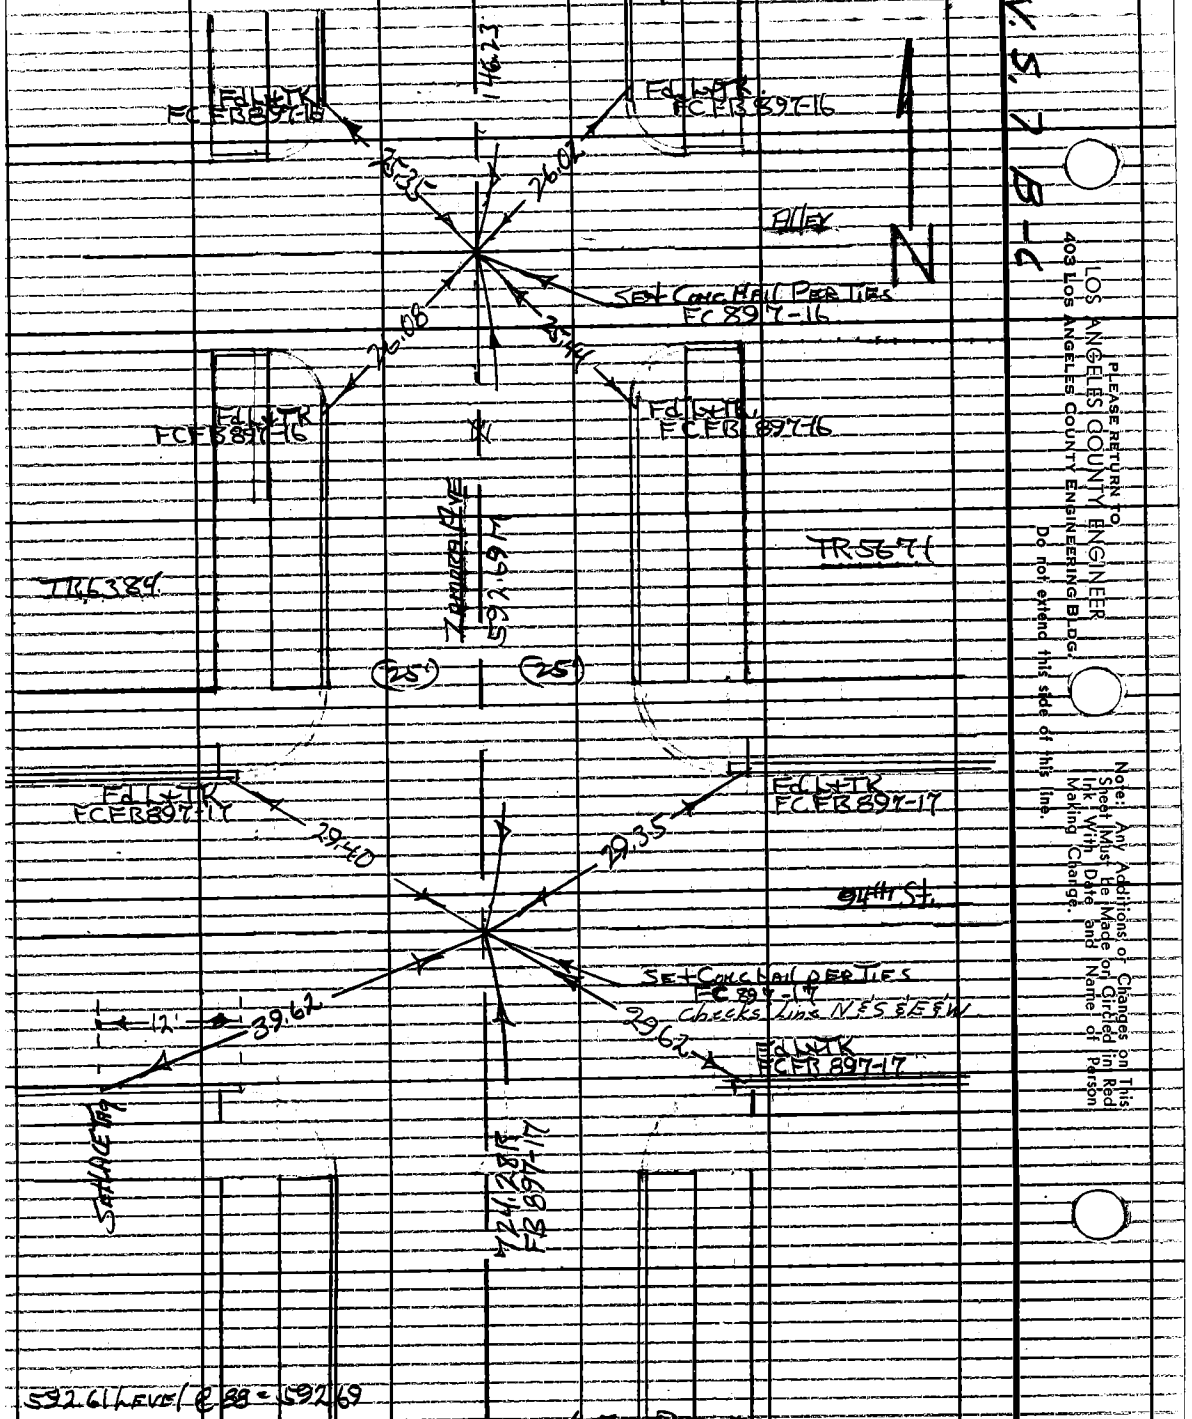

Cont. Top Pg. 67

LOS ANGELES COUNTY ENGINEER
403 LOS ANGELES COUNTY ENGINEERING BLDG.
PLEASE RETURN TO
Do not extend this side of this line.
Note: Any Additions or Changes on This Sheet Must be Made on Circled in Red Ink With Date and Name of Person Making Change.

Notes Ck'd by J. Church	Survey of 92nd St	F. B. 3170	Pg. 67
Map No. B3019	J.N. 0096.66 Tape 0259 Std 68 °F		
Office Work	Surveyed by HHSpriggs		
Checked J. A. CHURCH	Notes HHS Date 9-28-65		
Date	Indexed C. J. [illegible]		

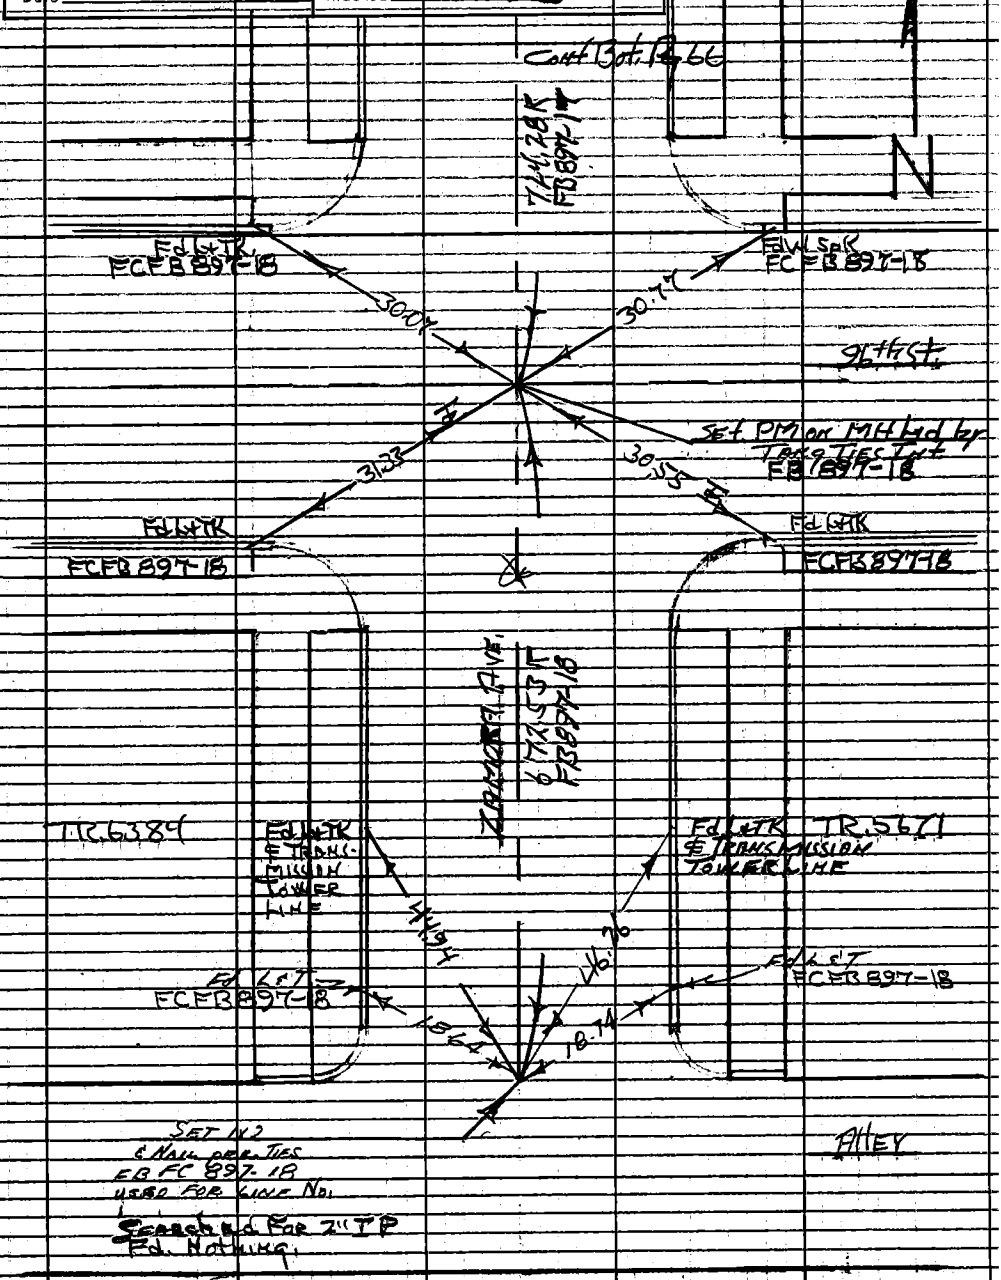

Note: Any Additions or Changes on This Sheet Must be Made or Circled in Red Ink With Date and Name of Person Making Change.

Do not extend this side of this line.

PLEASE RETURN TO
LOS ANGELES COUNTY ENGINEER
403 LOS ANGELES COUNTY ENGINEERING BLDG.

W.S. 7 B-6

76F309S CE#310 1-65

F.B. 3170 PG 68

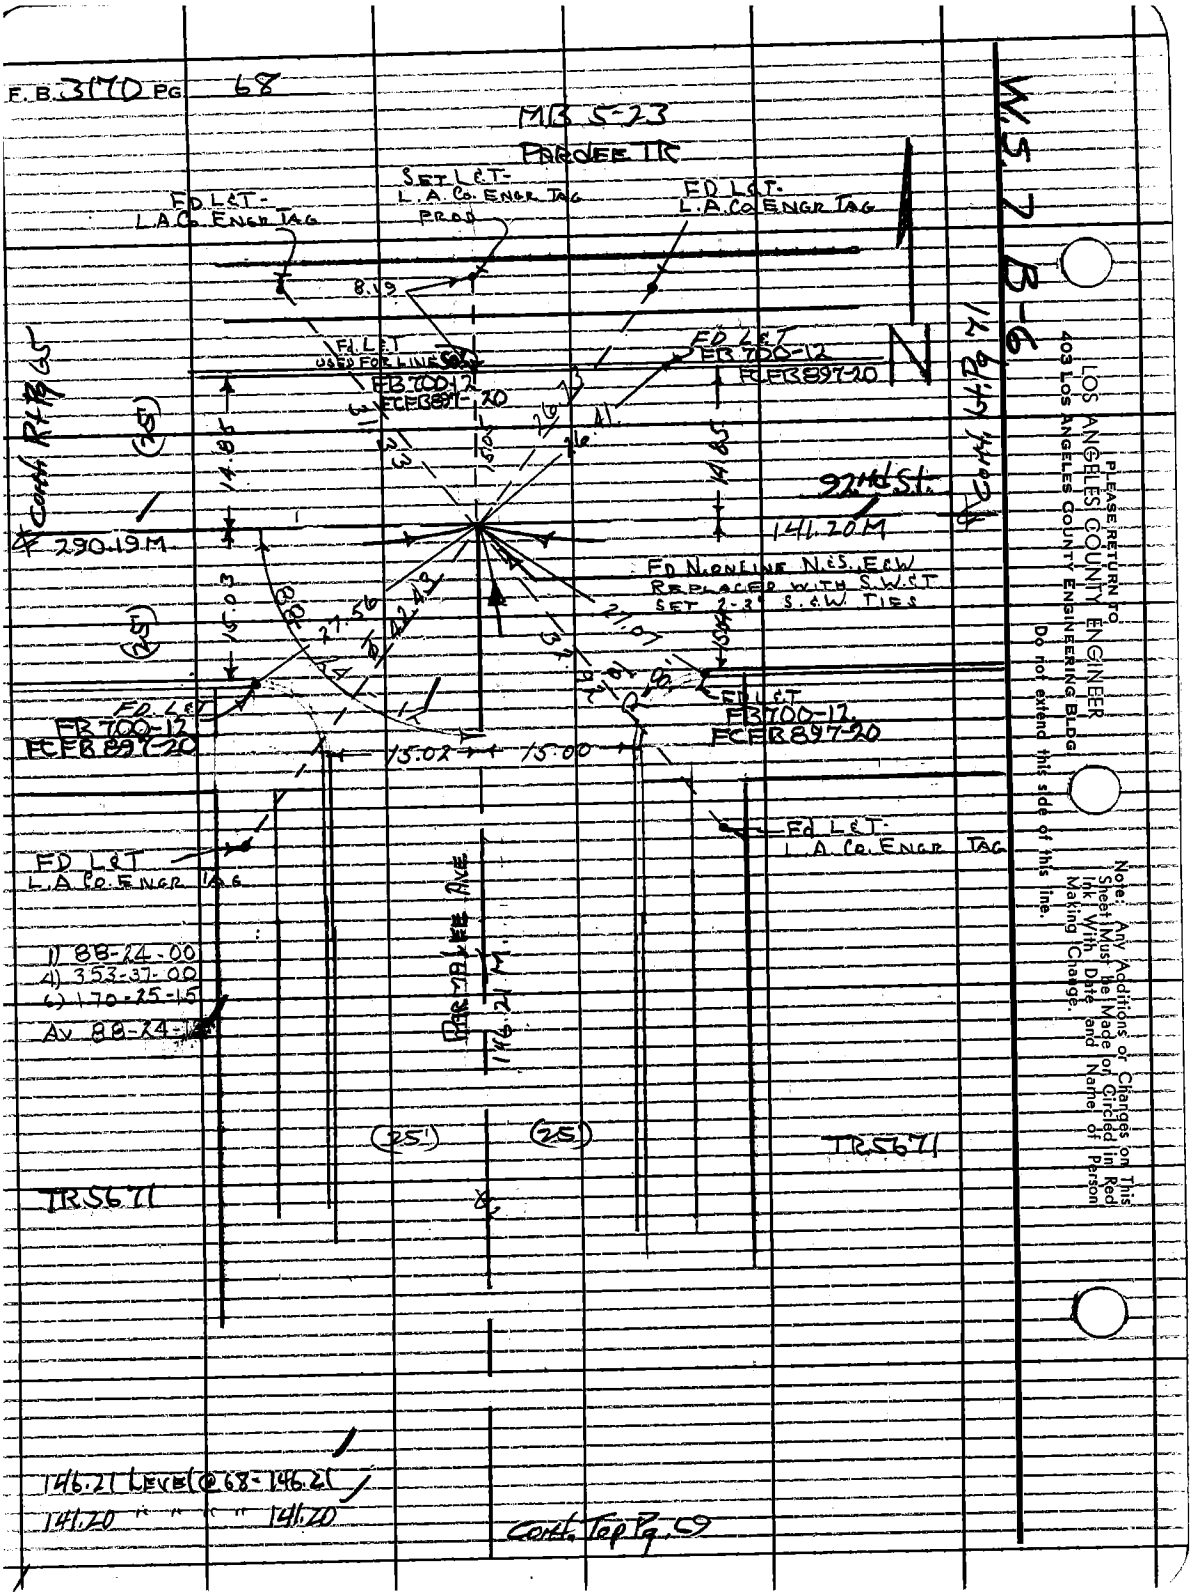

PLEASE RETURN TO
LOS ANGELES COUNTY ENGINEER
403 LOS ANGELES COUNTY ENGINEERING BLDG
Do not extend this side of this line.

Note: Any Additions or Changes on This Sheet Must be Made or Circled in Red Ink With Date and Name of Person Making Change.

Notes Ck'd by J. Church	Survey of 92nd St.		F.B. 3170 Pg. 69
Map No. B 3019	JN 0096.66 Tape 0259 Std 68 °F		
Office Work	Surveyed by HHSpriggs		
Checked J. CHURCH	Notes HHS Date 9-28-65		
Date	Indexed C. J. GALLI MAR 1 8 68		

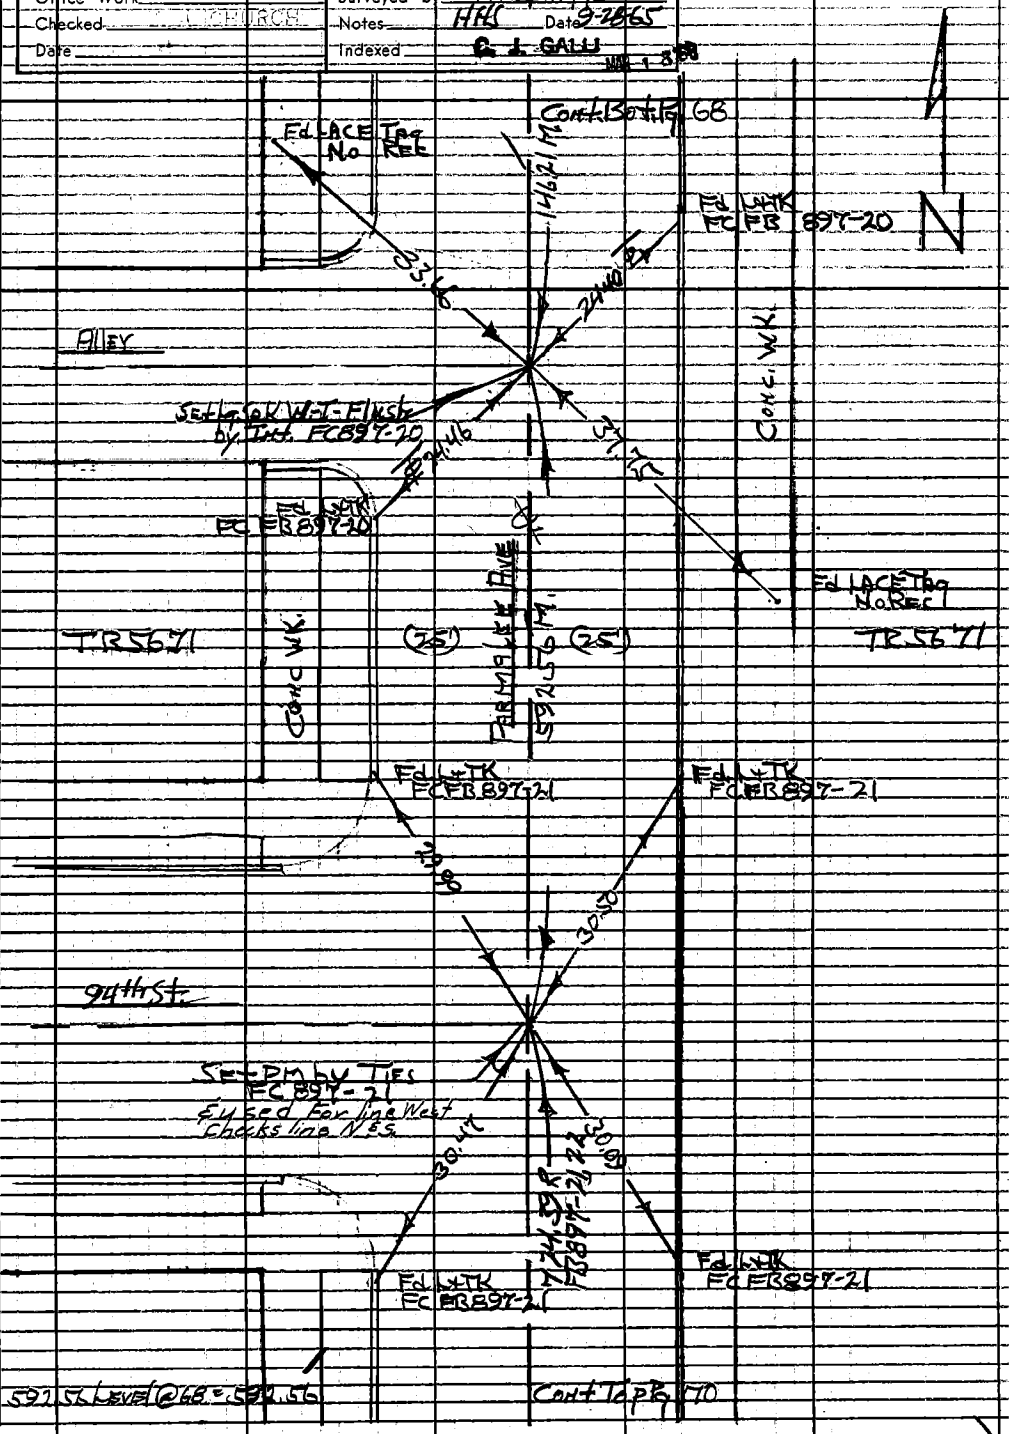

Note: Any Additions or Changes on This Sheet Must be Made or Circled in Red Ink With Date and Name of Person Making Change.

Do not extend this side of this line.

PLEASE RETURN TO
LOS ANGELES COUNTY ENGINEER
403 LOS ANGELES COUNTY ENGINEERING BLDG.

W.5.7 B-6

76F309S CE#310 1-65

F. B. 3170 PG 70

Cont Bot Pg 69

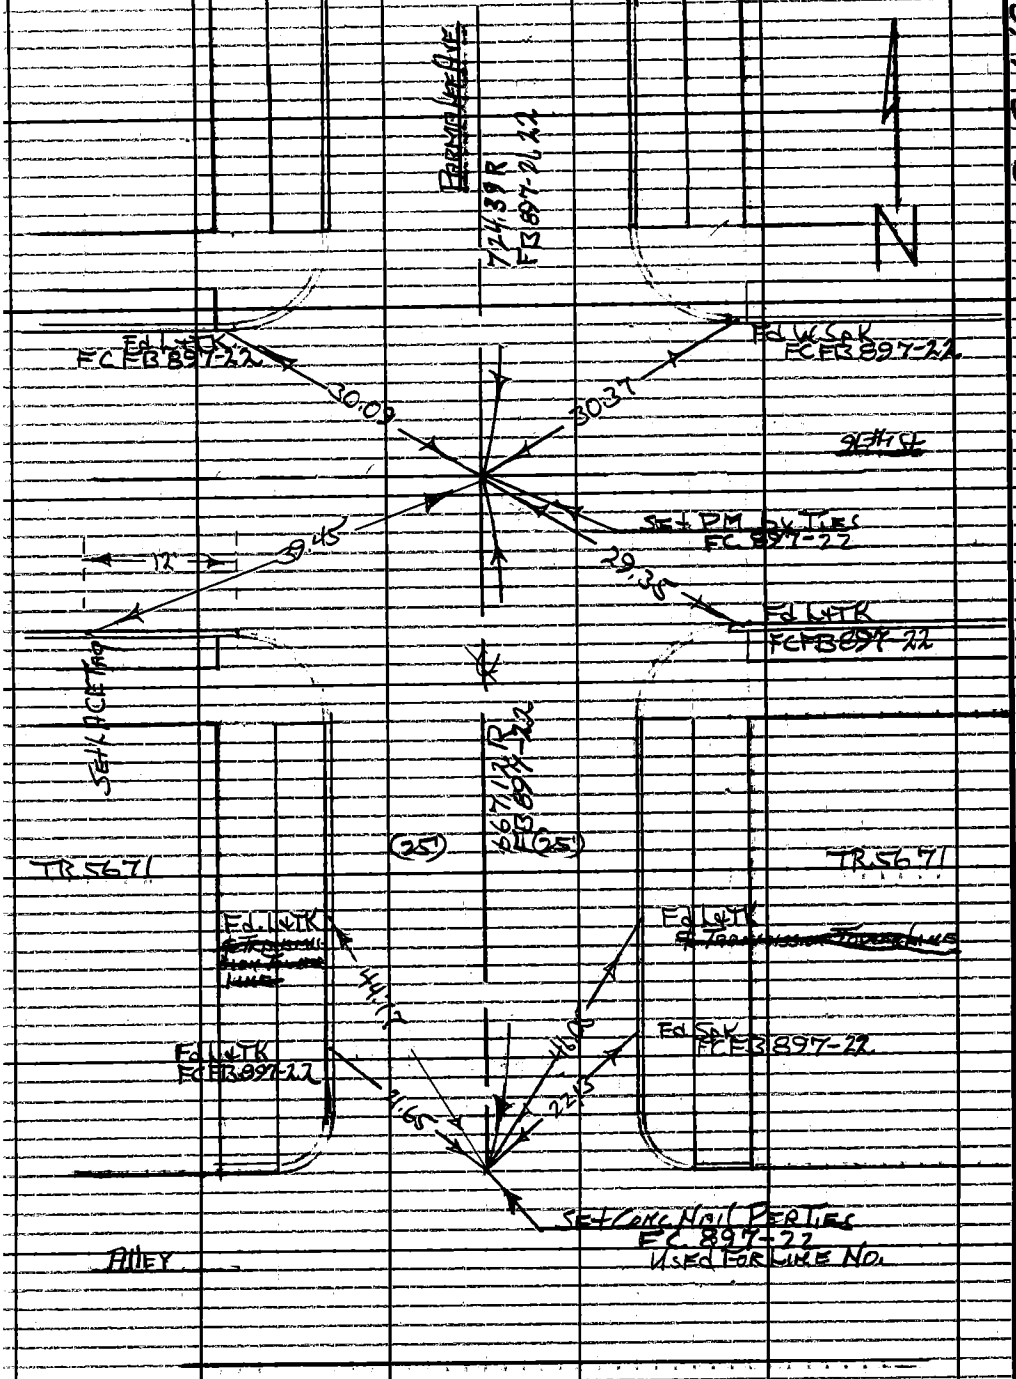

W.S. 7 B-6

PLEASE RETURN TO
LOS ANGELES COUNTY ENGINEER
403 LOS ANGELES COUNTY ENGINEERING BLDG.
Do not extend this side of this line.

Note: Any Additions or Changes on This Sheet Must be Made or Circled in Red Ink With Date and Name of Person Making Change.

Notes Ck'd by J. Church	Survey of 92nd St
Map No. B 3019	JN 009666 Tape 0259 Std 68 °F
Office Work	Surveyed by HH Spriggs
Checked [illegible] CHURCH	Notes HHS Date 9-26-65
Date [illegible]	Indexed C. J. GALLI

F. B. 3170 PG. 71

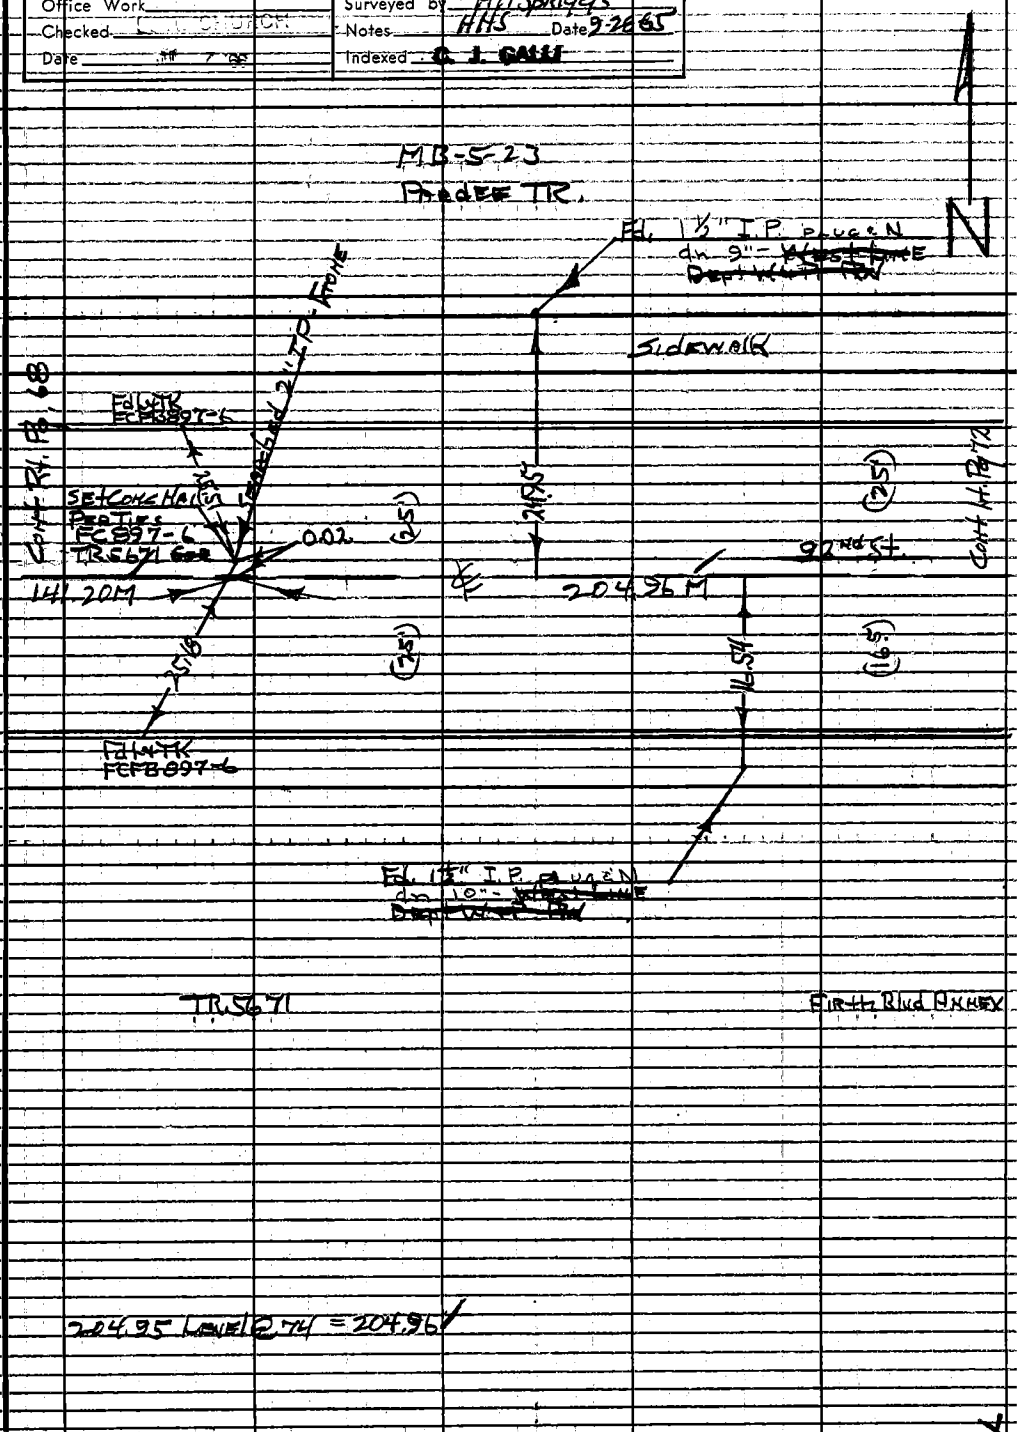

Note: Any Additions or Changes on This Sheet Must be Made or Circled in Red Ink With Date and Name of Person Making Change.

Do not extend this side of this line.

PLEASE RETURN TO
LOS ANGELES COUNTY ENGINEER
403 LOS ANGELES COUNTY ENGINEERING BLDG.

76F309S CE#310 1-65

F. B. 3170 PG 72

MB-5-23

PARDEE TR.

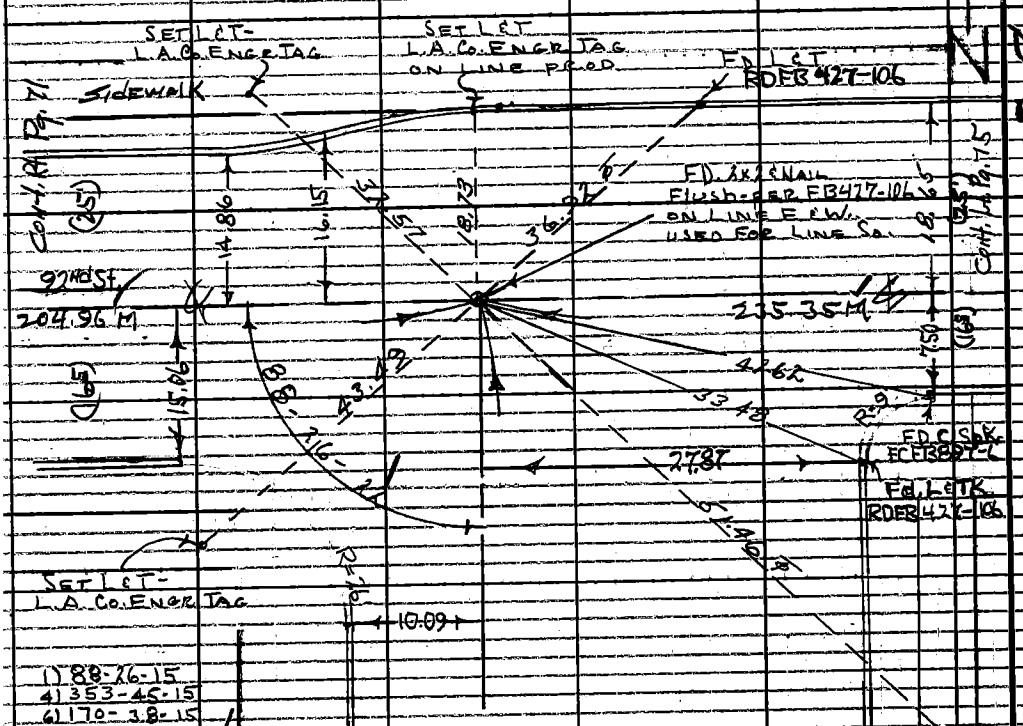

1463.07 LEVEL @ 80 = 1463.18

235.34 " " 76 = 235.35

Cont Top Pg. 73

PLEASE RETURN TO
LOS ANGELES COUNTY ENGINEER
403 LOS ANGELES COUNTY ENGINEERING BLDG.
Do not extend this side of this line.

Note: Any Additions or Changes on This Sheet Must Be Made or Circled in Red Ink With Date and Name of Person Making Change.

Notes Ck'd by J. Church	Survey of 92nd St.
Map No. B-3019	JN 009666 Tape 0259 Std 68 °F
Office Work	Surveyed by H.H. Spriggs
Checked J. A. CHURCH	Notes HHS Date 9-28-65
Date JUL 7 '66	Indexed C. J. GALLI

F. B. 3170 PG. 73

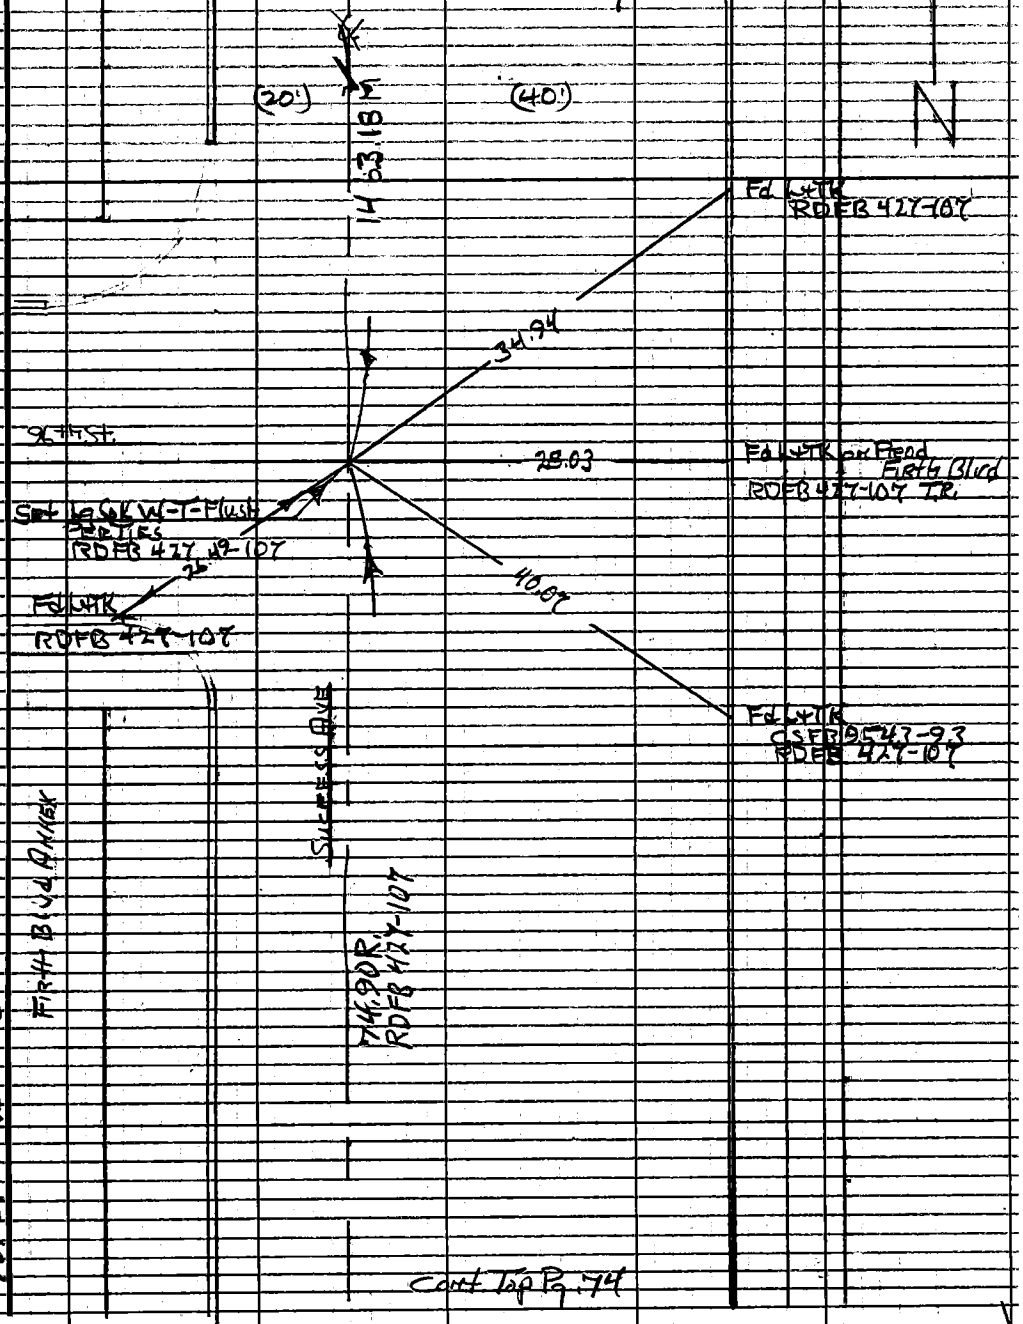

Note: Any Additions or Changes on This Sheet Must be Made or Circled in Red Ink With Date and Name of Person Making Change.

PLEASE RETURN TO
LOS ANGELES COUNTY ENGINEER
403 LOS ANGELES COUNTY ENGINEERING BLDG.
Do not extend this side of this line.

76F309S CE#310 1-65

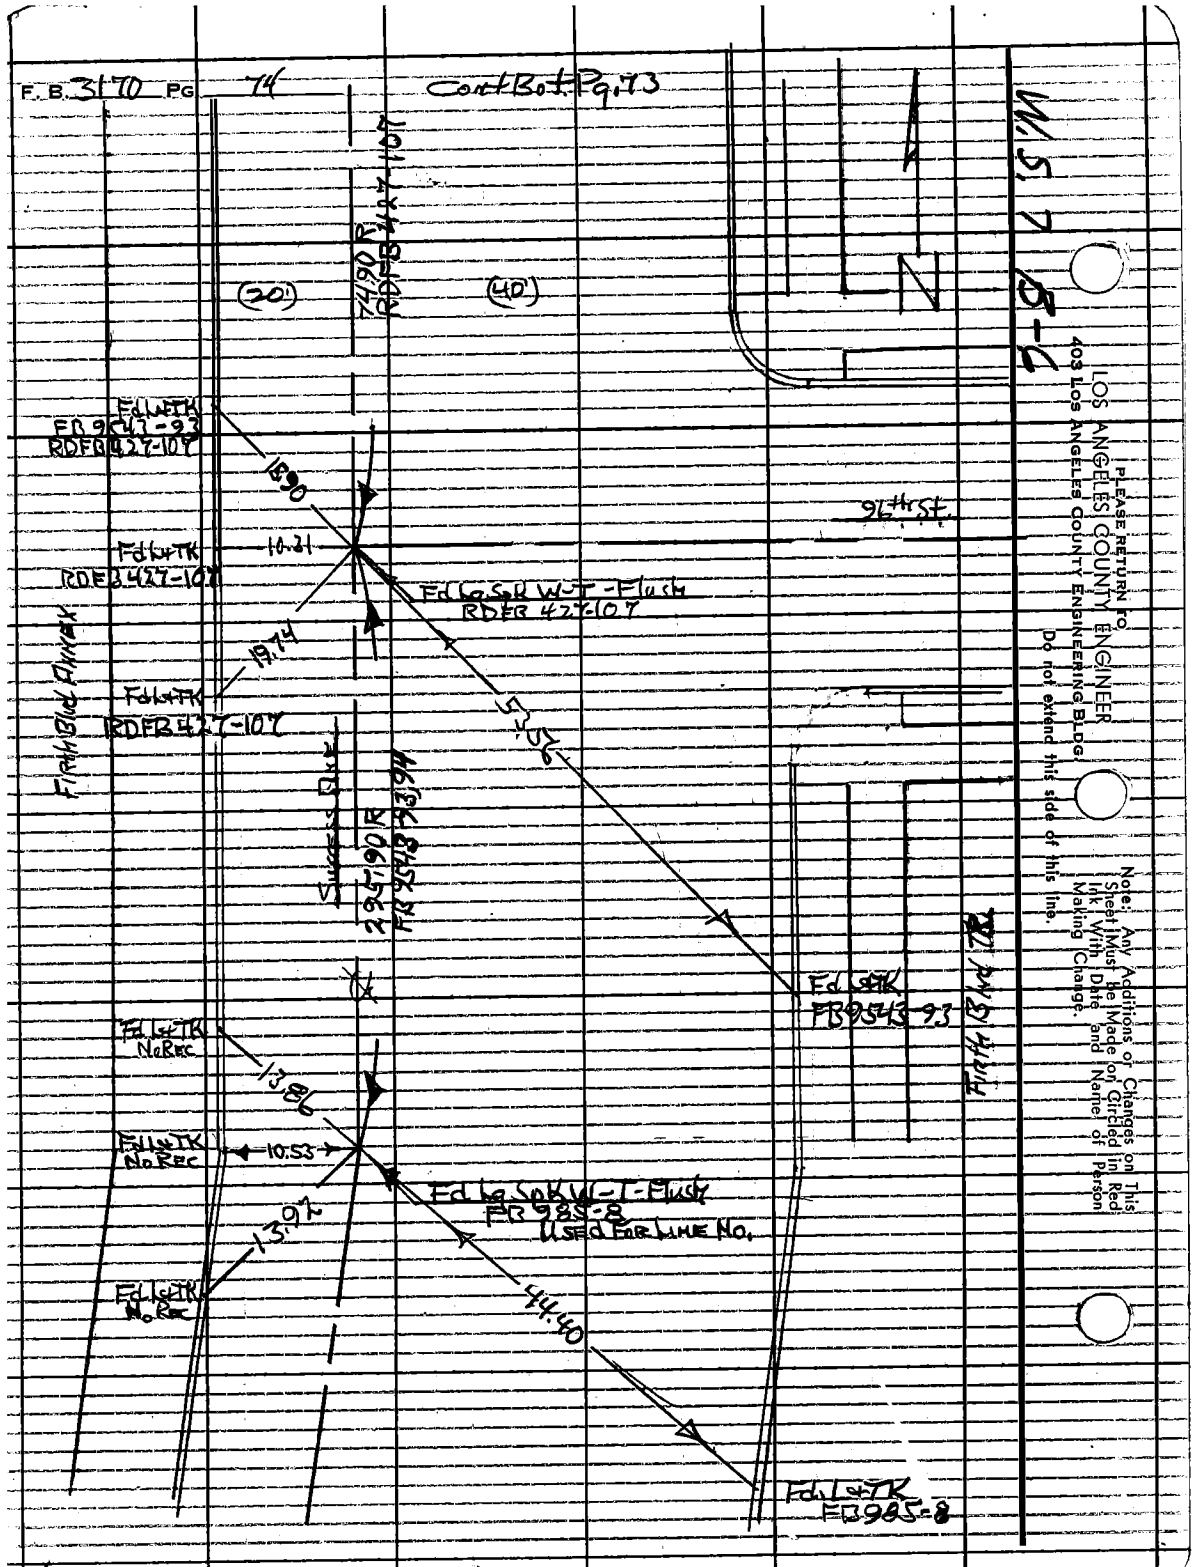
F. B. 3170 PG 74
Cont Bot Pg. 73
W.S. 7 B-6
N
(20')
(40')
7490 R
RDFB 427-107
Fd L&TK
FB 9543-93
RDFB 427-107
18.90
96th St.
Fd L&TK
RDFB 427-107
10.21
Fd Lg Spk W-T-Flush
RDFB 427-107
19.74
Fd L&TK
RDFB 427-107
53.56
Firth Blvd Annex
Success Ave
295.90 R
FB 9543-93
Fd L&TK
FB 9543-93
Firth Blvd
Fd L&TK
No Rec
13.86
Fd L&TK
No Rec
10.53
Fd Lg Spk W-T-Flush
FB 985-8
Used For Line No.
13.92
Fd L&TK
No Rec
44.40
Fd L&TK
FB 985-8
PLEASE RETURN TO
LOS ANGELES COUNTY ENGINEER
403 Los Angeles County Engineering Bldg.
Do not extend this side of this line.
Note: Any Additions or Changes on This Sheet Must be Made or Circled in Red Ink With Date and Name of Person Making Change.

Notes Ck'd by J. Church	Survey of 92nd St.	F. B. 3170	PG. 75
Map No. B 3019	JN 0096-66 Tape 0259 Std 68 °F		
Office Work	Surveyed by HHS Spriggs		
Checked J. A. CHURCH	Notes HHS Date 9-28-65		
Date JUL 7 '68	Indexed C. J. GALLI		

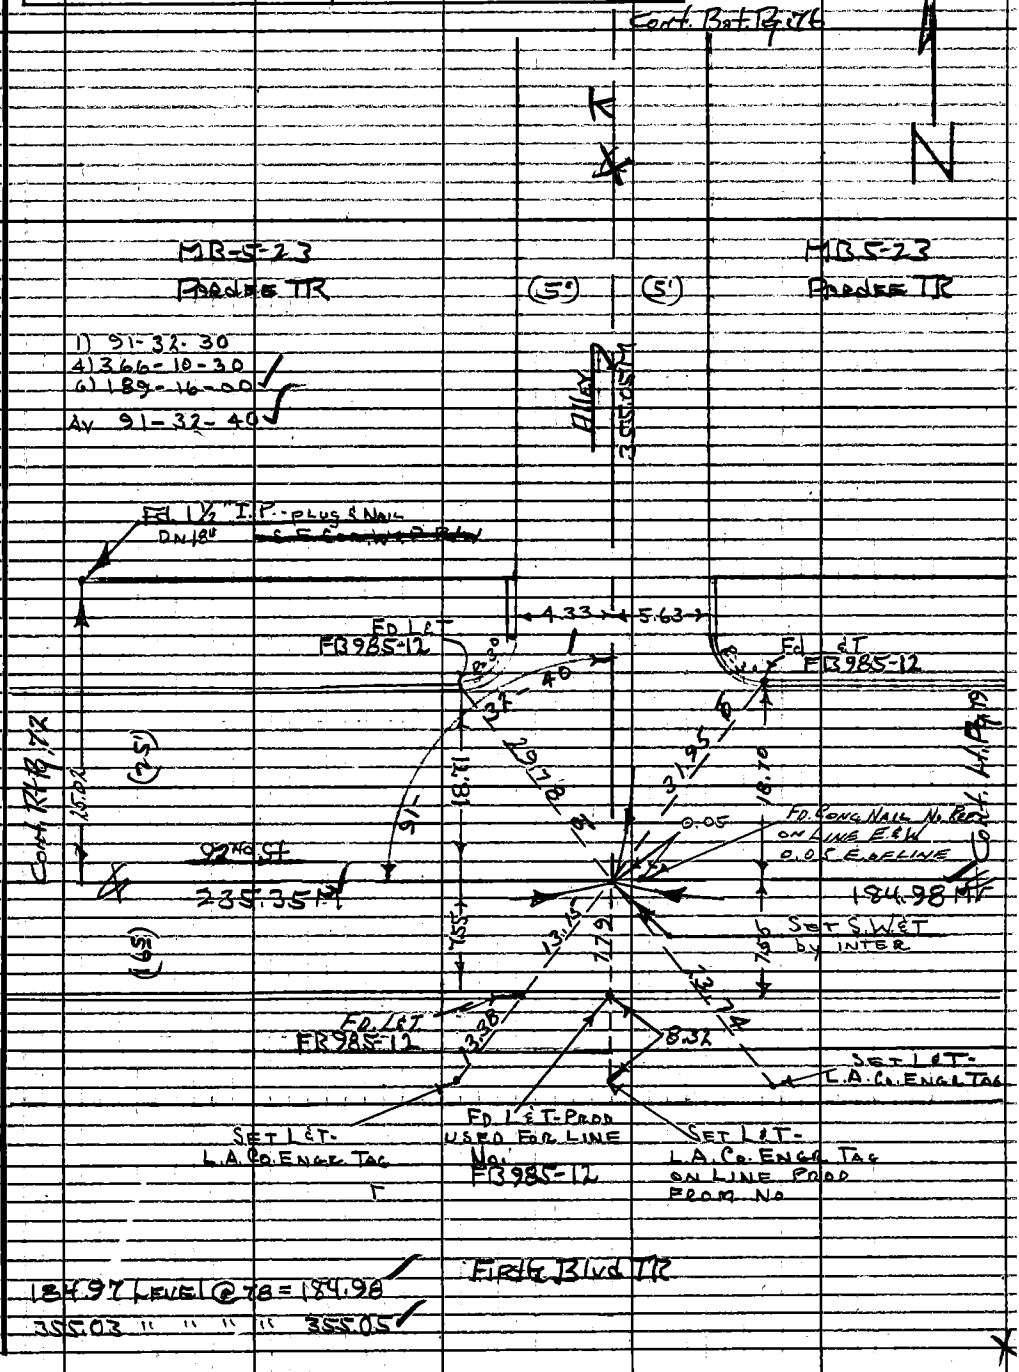

Note: Any Additions or Changes on This Sheet Must be Made or Circled in Red Ink With Date and Name of Person Making Change.

Do not extend this side of this line.

PLEASE RETURN TO
LOS ANGELES COUNTY ENGINEER
403 LOS ANGELES COUNTY ENGINEERING BLDG.

76F309S CE#310 1-65

F.B. 3170 PG 76

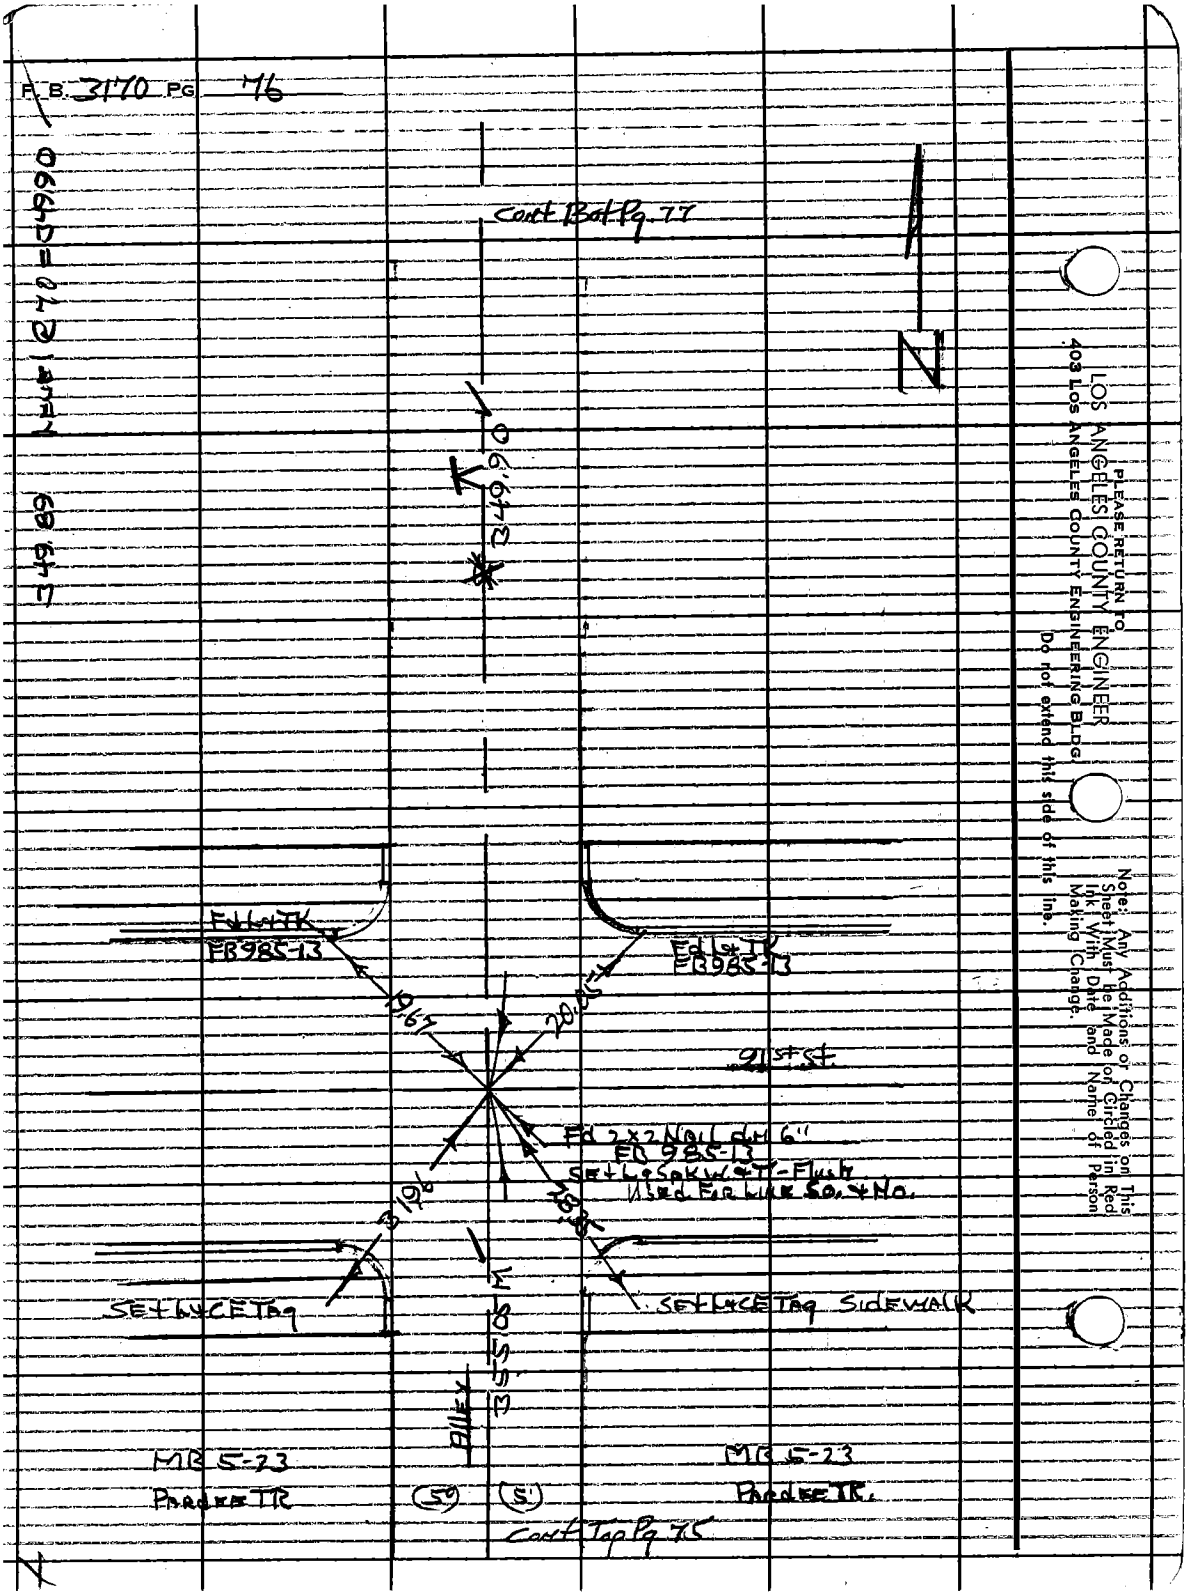

PLEASE RETURN TO
LOS ANGELES COUNTY ENGINEER
403 Los Angeles County Engineering Bldg.
Do not extend this side of this line.
Note: Any Additions or Changes on This Sheet Must be Made or Circled in Red Ink With Date and Name of Person Making Change.

Notes Ck'd by Jehurch	Survey of 92nd St.		F.B. 3170 PG. 77
Map No. B3019	JN 0096.66	Tape 0259 Std 68 °F	
Office Work	Surveyed by HH Sperggs		
Checked	Notes HHS	Date 9-28-65	
Date	Indexed C. J. GALLI		

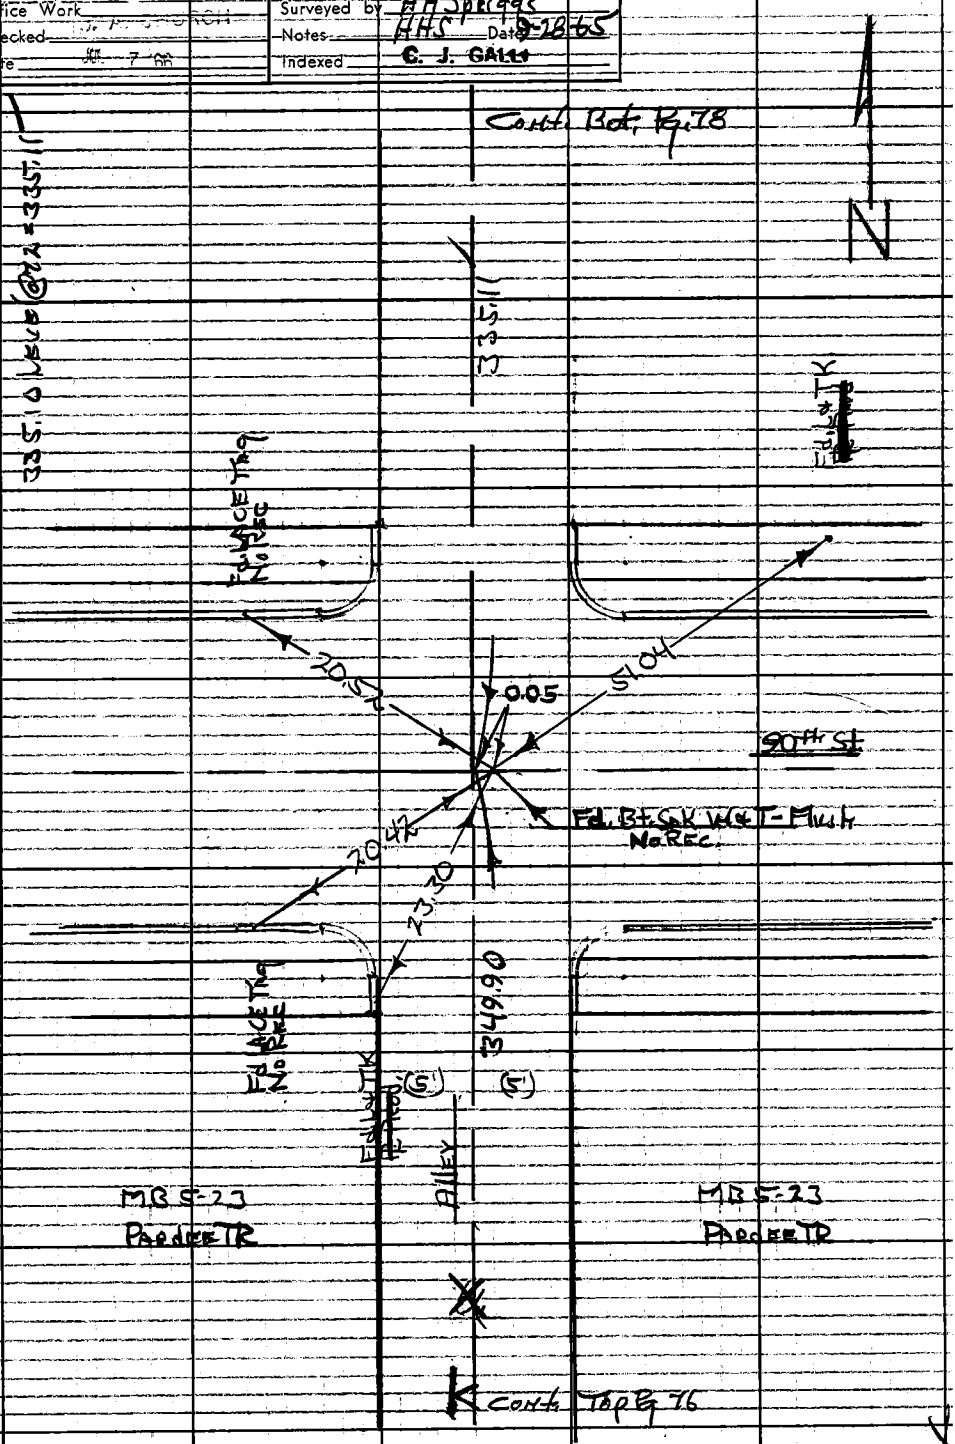

Note: Any Additions or Changes on This Sheet Must be Made or Circled in Red Ink With Date and Name of Person Making Change.

PLEASE RETURN TO
LOS ANGELES COUNTY ENGINEER
403 LOS ANGELES COUNTY ENGINEERING BLDG.
Do not extend this side of this line.

76F309S CE#310 1-65

E.B. 3170 PG 78

Cont. Top Pg. 77

PLEASE RETURN TO
LOS ANGELES COUNTY ENGINEER
403 LOS ANGELES COUNTY ENGINEERING BLDG.
Do not extend this side of this line.

Note: Any Additions or Changes on This Sheet Must Be Made on Circled in Red Ink With Date and Name of Person Making Change.

Notes Ck'd by J. Church	Survey of 92nd St	F. B. 3170	PG. 79
Map No. B3019	JN 0096.66 Tape 0259 Std 68 °F		
Office Work	Surveyed by HH Spriggs		
Checked	Notes HHS Date 9-24-65		
Date 7-66	Indexed G. J. GALLI		

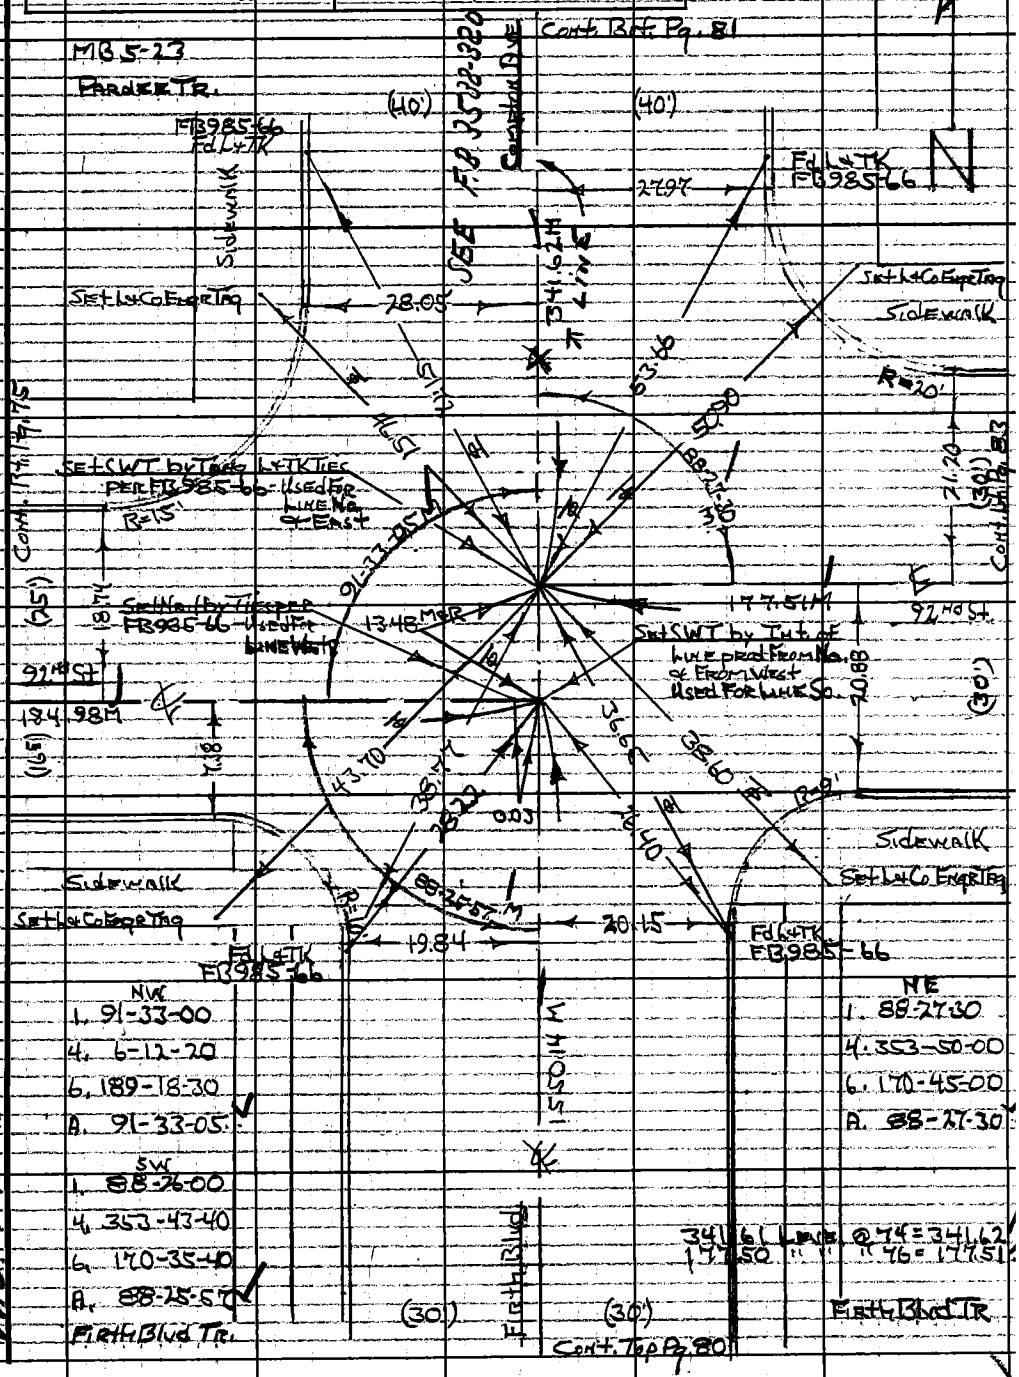

Note: Any Additions or Changes on This Sheet Must be Made or Circled in Red Ink With Date and Name of Person Making Change.

Do not extend this side of this line.

PLEASE RETURN TO
LOS ANGELES COUNTY ENGINEER
403 Los Angeles County Engineering Bldg.

W.S. 7 B-6

76F309S CE#310 1-65

F. B. ~~1370~~ 3170 PG. 80

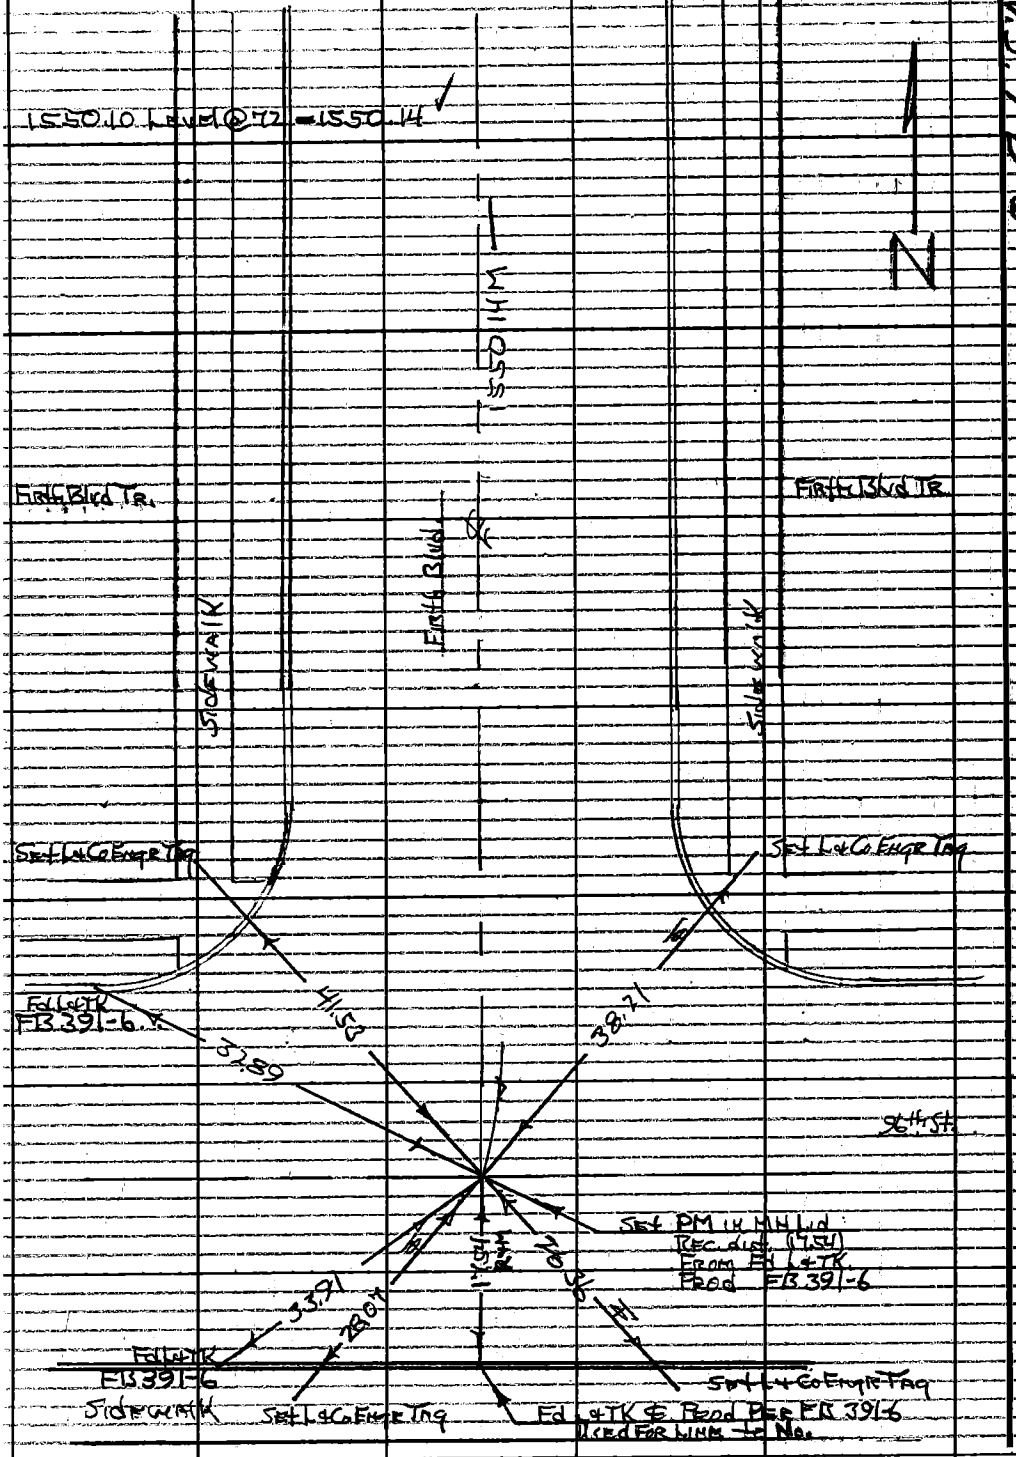

W.S. 7 B-6

N

PLEASE RETURN TO
LOS ANGELES COUNTY ENGINEER
403 LOS ANGELES COUNTY ENGINEERING BLDG.
Do not extend this side of this line.

Note: Any Additions or Changes on This Sheet Must Be Made or Circled in Red Ink With Date and Name of Person Making Change.

Notes Ck'd by J. Church	Survey of 92nd St.		F.B. 3170 Pg. 81
Map No. B 3019	JN 0096.66 Tape 0259 Std 68 °F		
Office Work	Surveyed by HHSpriggs		
Checked	Notes HHS Date 9-28-65		
Date	Indexed E. J. Gallo		

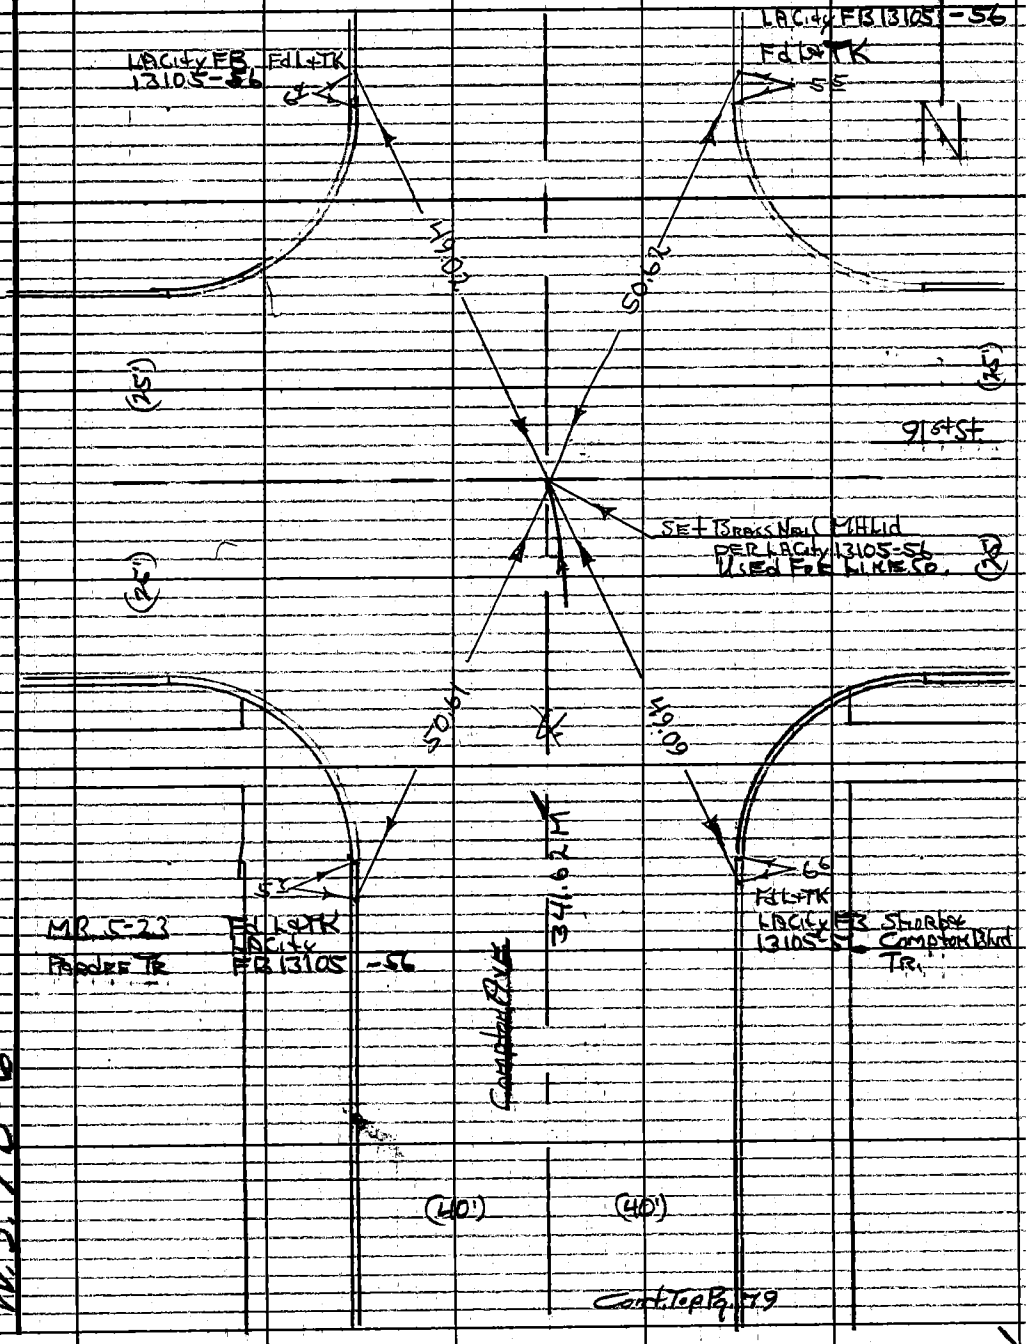

Cont. Top Pg. 79

W.S. 78-6

Note: Any Additions or Changes on This Sheet Must be Made or Circled in Red Ink With Date and Name of Person Making Change.

Do not extend this side of this line.

PLEASE RETURN TO
LOS ANGELES COUNTY ENGINEER
403 Los Angeles County Engineering Bldg.

76F309S CE#310 1-65

F. B. 3170 PG. 87

Note: For Continuation of Compton Ave. North SEE F.B. 3270

HHS

This survey of Compton Ave. was in process of completion in F.B. 3270

N

Compton Ave.

PLEASE RETURN TO
LOS ANGELES COUNTY ENGINEER
403 Los Angeles County Engineering Bldg.

Do not extend this side of this line.

Note: Any Additions or Changes on This Sheet Must Be Made or Circled in Red Ink With Date and Name of Person Making Change.

Notes Ck'd by J. Church	Survey of 92nd St.
Map No. B.3019	JN 002666 Tape 0259 Std 68 °F
Office Work	Surveyed by HH Spriggs
Checked J. A. CHURCH JUL 7 '68	Notes HHS Date 9-28-65
Date	Indexed C. J. CALLY MAR 1 '68

F. B. 3170 Pg. 83

Note: Any Additions or Changes on This Sheet Must be Made or Circled in Red Ink With Date and Name of Person Making Change.

Do not extend this side of this line.

PLEASE RETURN TO
LOS ANGELES COUNTY ENGINEER
403 LOS ANGELES COUNTY ENGINEERING BLDG.

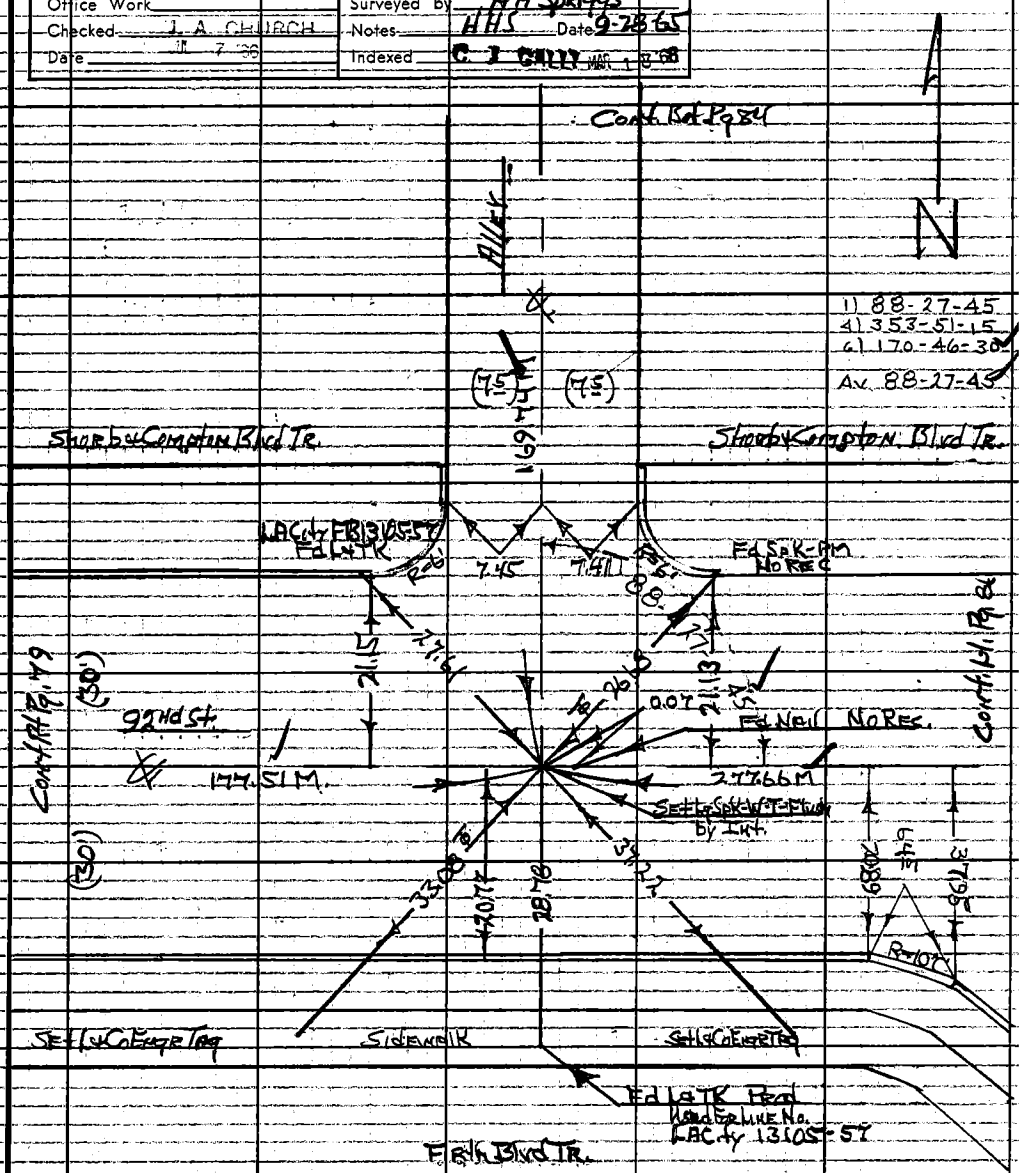

277.65 Level @ 74 = 277.66
169.73 " " " 76 = 169.74

16F309S CE#310 1-65

F.B. 3170 PG 84

Cont. B of Pg. 85

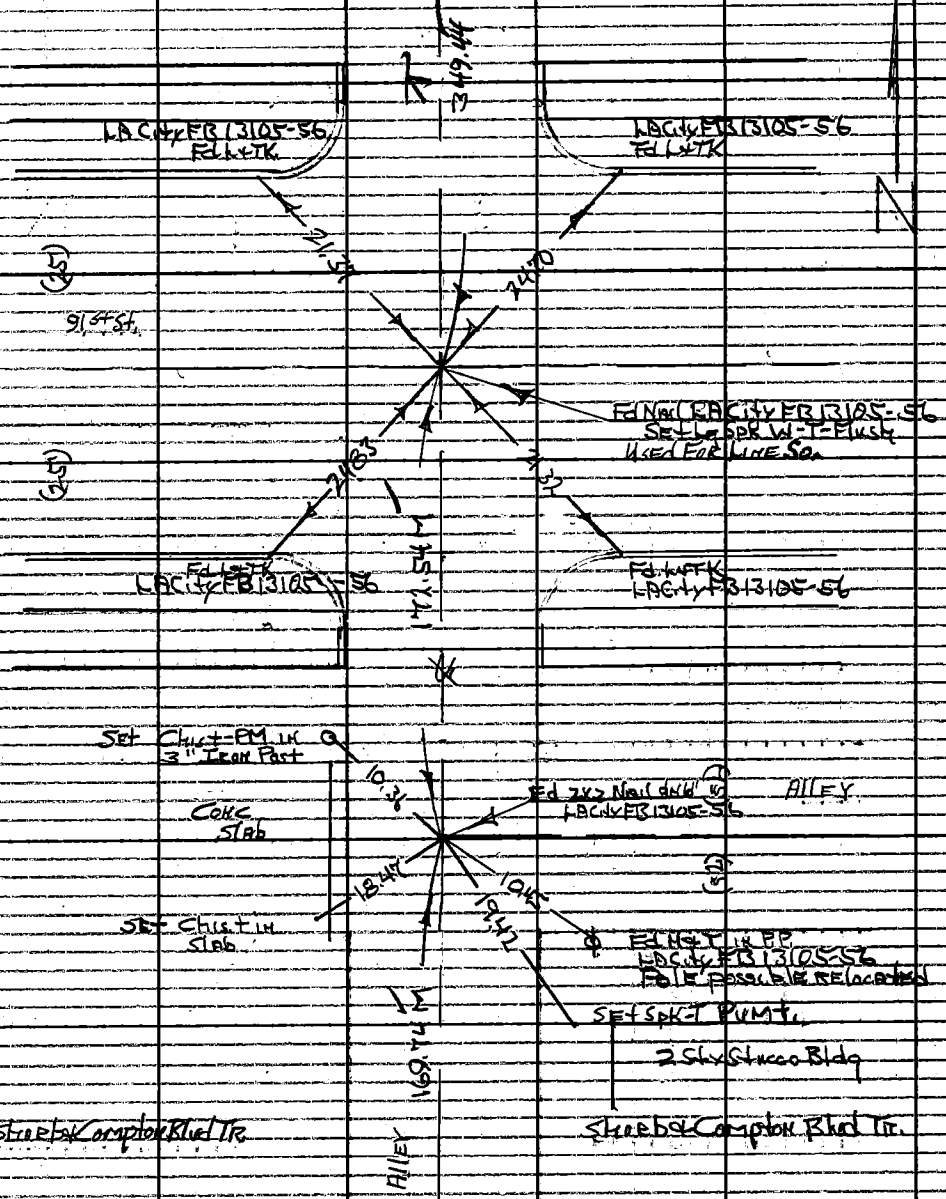

172.53 Level @ 76 = 172.54 ✓

349.93 " " " 72 - 349.44 ✓

Cont. Top Pg. 83

PLEASE RETURN TO
LOS ANGELES COUNTY ENGINEER
403 LOS ANGELES COUNTY ENGINEERING BLDG.
Do not extend this side of this line.

Note: Any Additions or Changes on This Sheet Must Be Made or Circled in Red Ink With Date and Name of Person Making Change.

Notes Ck'd by L. Church	Survey of 92nd St
Map No. B3019	JN 0096 66 Tape 0259 Std 68 °F
Office Work	Surveyed by H H Spriggs
Checked L. A. CHURCH	Notes HHS Date 9-28-65
Date Jul 7 '66	Indexed C. J. GALLI

F. B. 3170 PG. 85

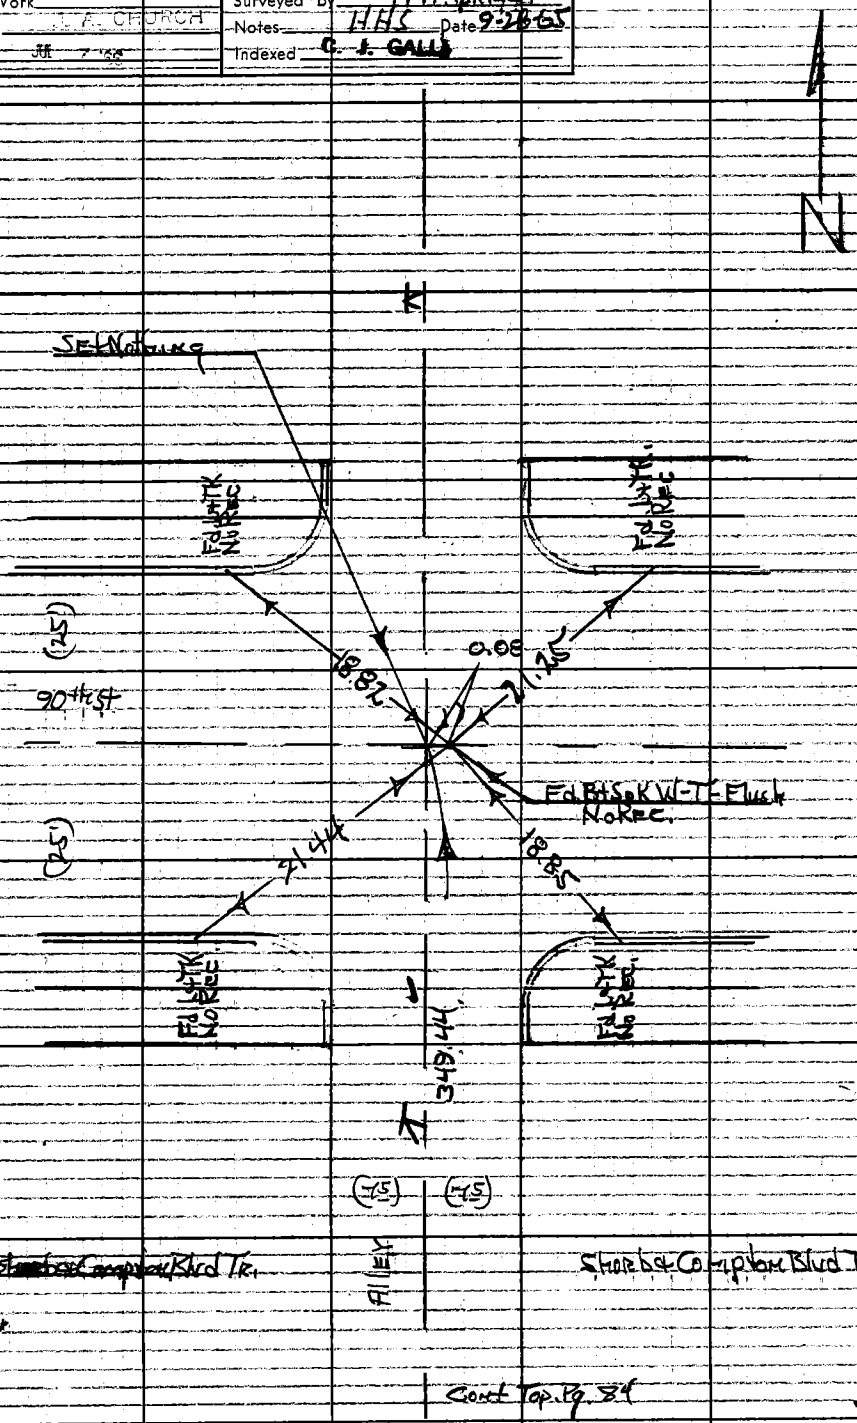

Cont Top Pg. 84

Note: Any Additions or Changes on This Sheet Must be Made or Circled in Red Ink With Date and Name of Person Making Change.

PLEASE RETURN TO
LOS ANGELES COUNTY ENGINEER
403 LOS ANGELES COUNTY ENGINEERING BLDG.
Do not extend this side of this line.

76F309S CE#310 1-65

F. B. 3170 PG 86

Shorb & Compton Blvd Tr.

SW	SE
1 88-20-00	1 91-41-00
4 353-19-30	4 366-43-15
6 169-59-45	6 190-04-45
A 88-19-57	A 91-40-47

29.92 Level @ 80 = 29.92

937.61 " " " " = 937.68

417.27 Level @ 68 = 417.27

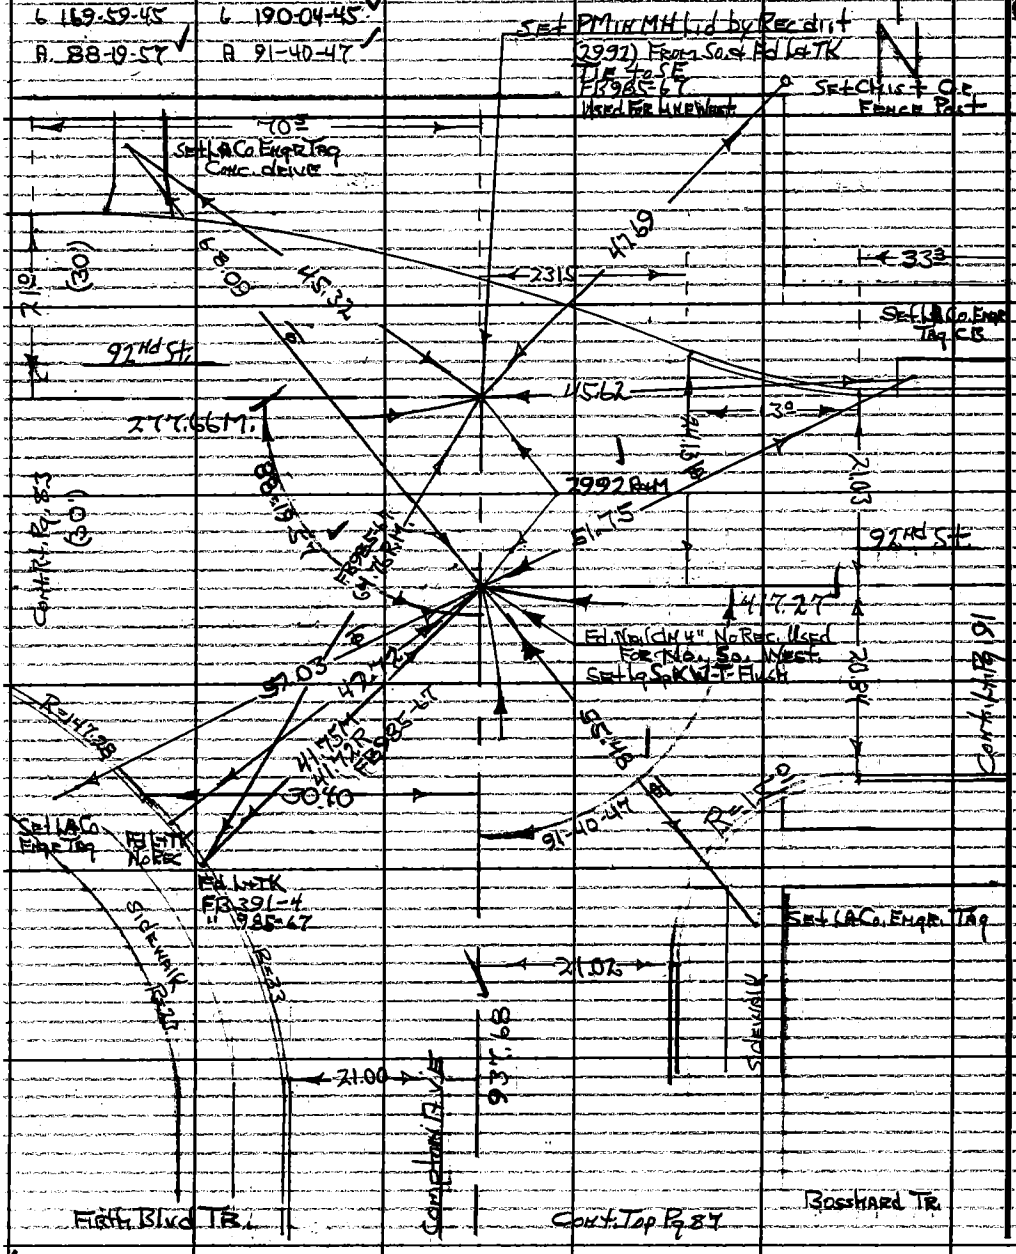

W.S. 7 B-6

PLEASE RETURN TO
LOS ANGELES COUNTY ENGINEER
403 LOS ANGELES COUNTY ENGINEERING BLDG.
Do not extend this side of this line.

Note: Any Additions or Changes on This Sheet Must Be Made or Circled in Red Ink With Date and Name of Person Making Change.

Notes Ck'd by J. Church	Survey of 92nd St.		F. B. 3170 PG. 87
Map No. B.30/9	JN 0096.66 Tape 0259 Std 68 °F		
Office Work	Surveyed by H H Spriggs		
Checked	Notes HHS	Date 10-27-65	
Date JUL 7 '66	Indexed G. J. GALLI		

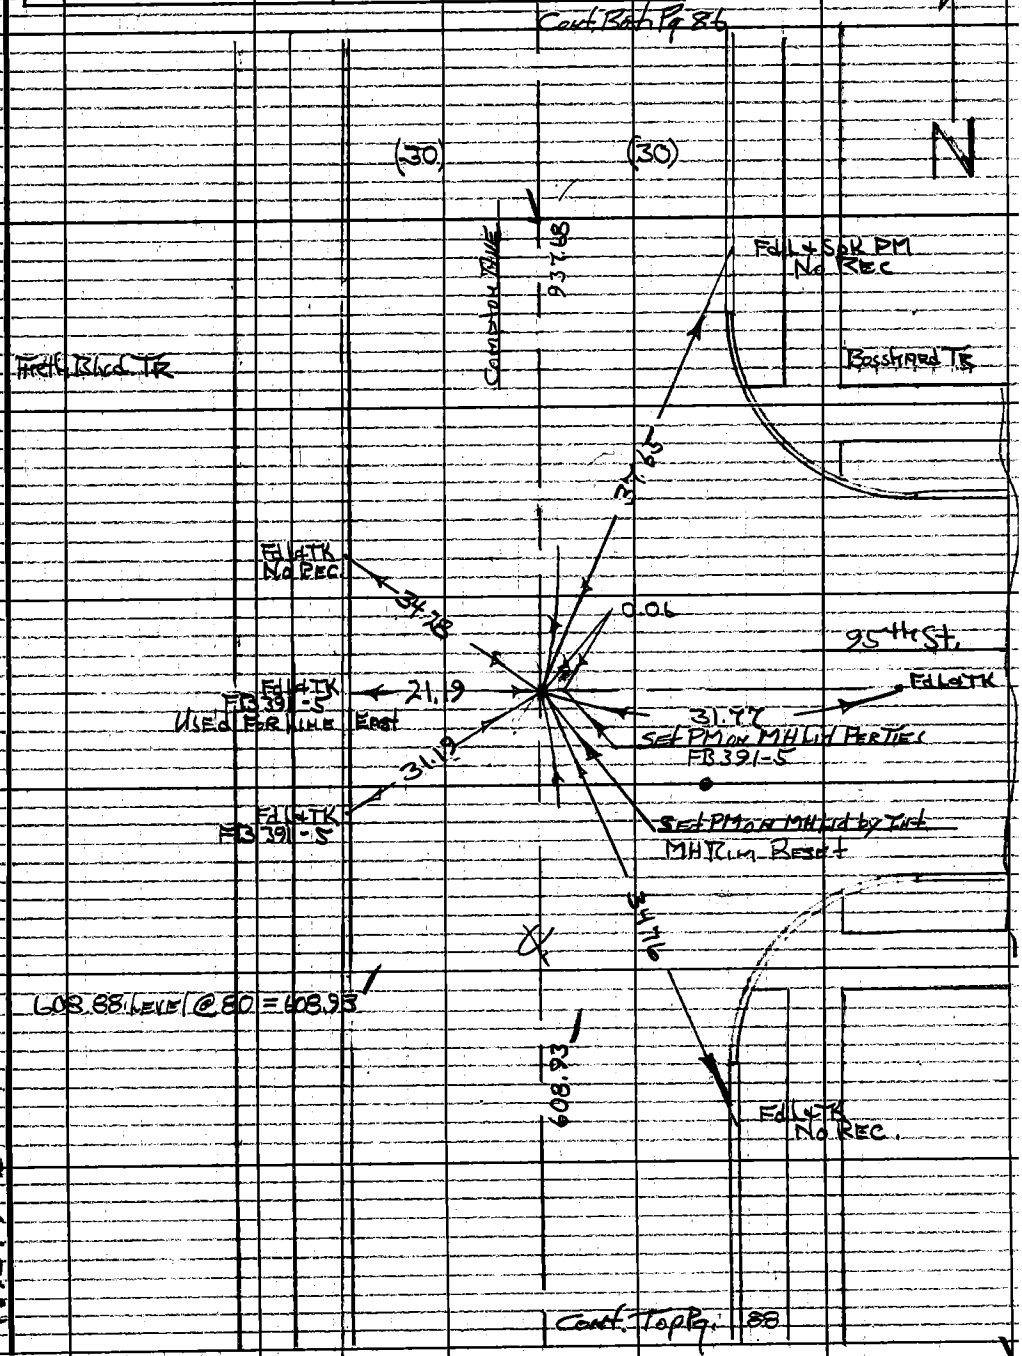

Note: Any Additions or Changes on This Sheet Must be Made or Circled in Red Ink With Date and Name of Person Making Change.

PLEASE RETURN TO
LOS ANGELES COUNTY ENGINEER
403 LOS ANGELES COUNTY ENGINEERING BLDG.
Do not extend this side of this line.

W.5.7 B-6

76F309S CE#310 1-65

F. B. 3170 PG. 88

Cont. Bot. Pg. 87

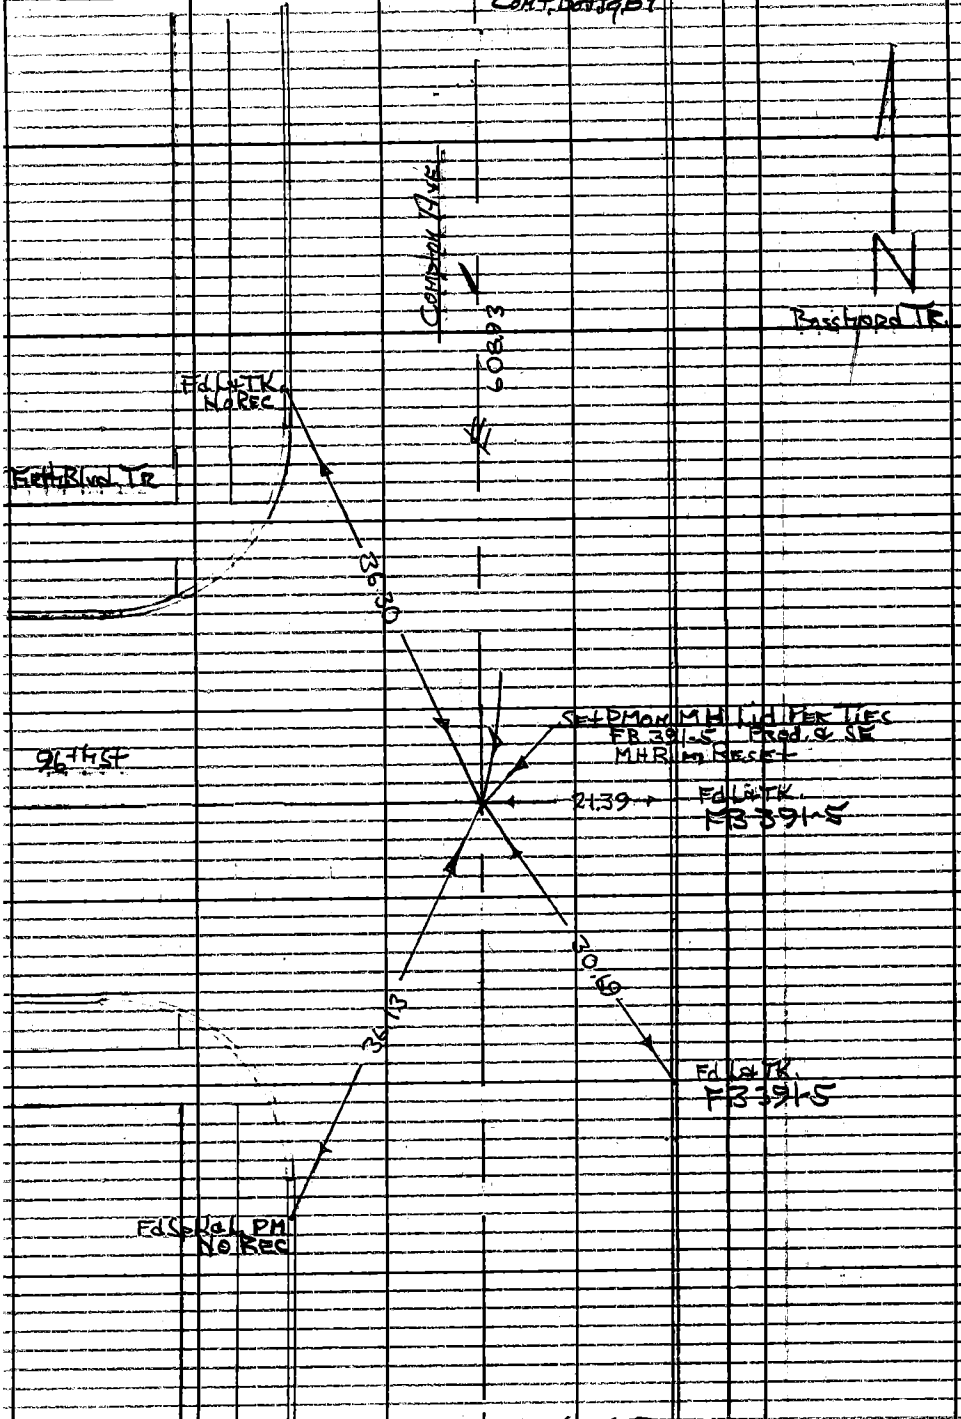

Cont. Top Pg. 89

W.S. 7 B-6

PLEASE RETURN TO
LOS ANGELES COUNTY ENGINEER
403 LOS ANGELES COUNTY ENGINEERING BLDG.
Do not extend this side of this line.

Note: Any Additions or Changes on This Sheet Must Be Made or Circled in Red Ink With Date and Name of Person Making Change.

Notes Ck'd by J. Church	Survey of 92nd St.
Map No. B 3019	JN 0096.66 Tape 0259 Std 68 °F
Office Work	Surveyed by HHS Briggs
Checked J. A. CHURCH	Notes HHS Date 10-26-65
Date JUL 7 '66	Indexed C. J. GALLI

F. B 3170 PG 89

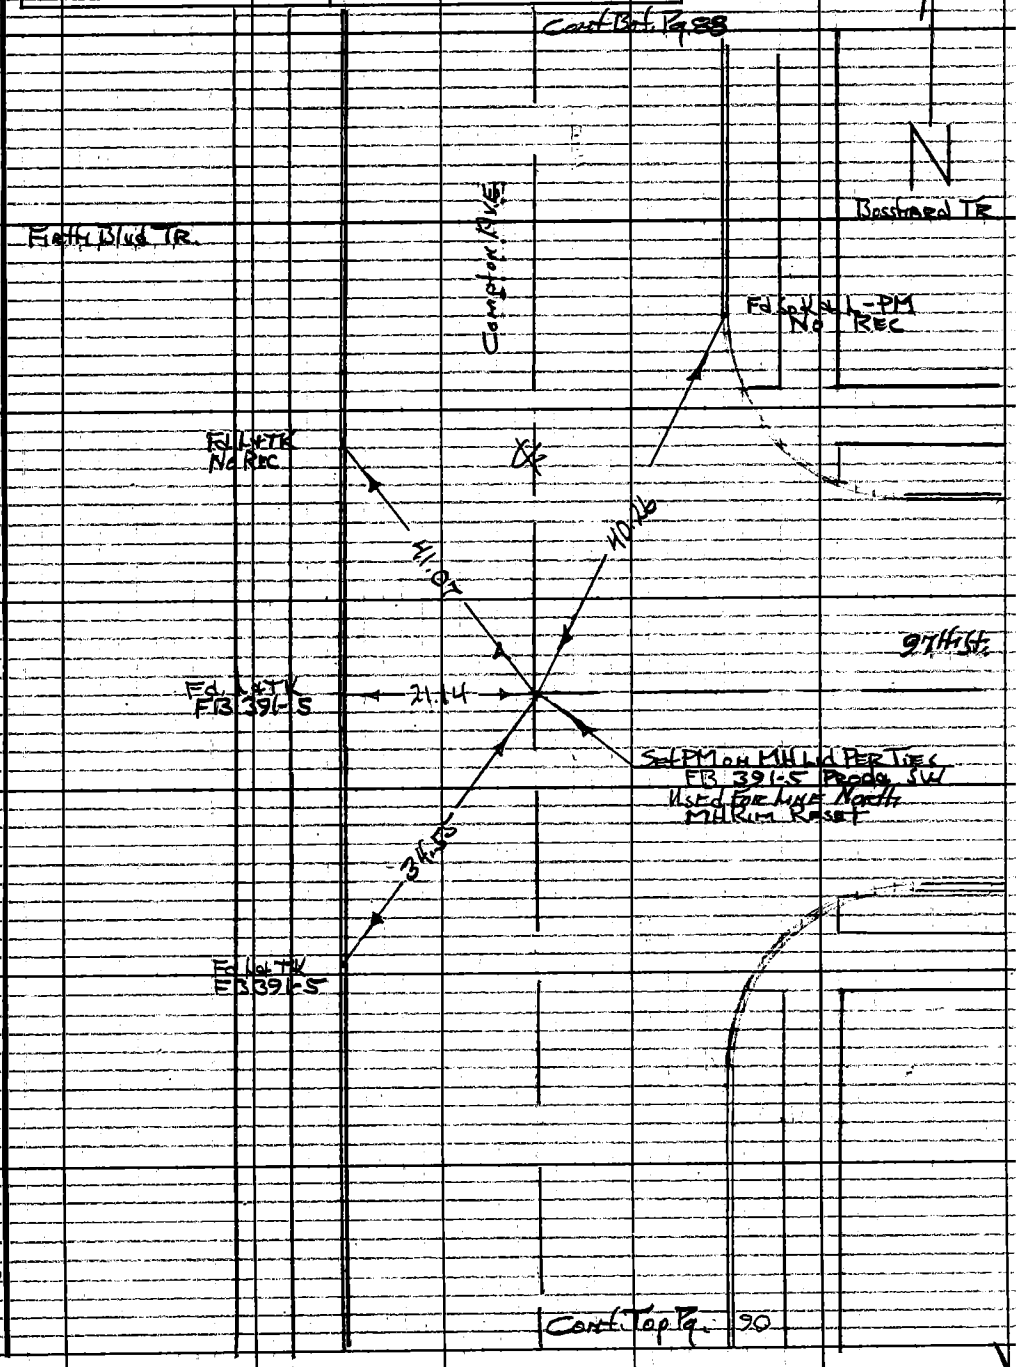

Note: Any Additions or Changes on This Sheet Must be Made or Circled in Red Ink With Date and Name of Person Making Change.

PLEASE RETURN TO
LOS ANGELES COUNTY ENGINEER
403 LOS ANGELES COUNTY ENGINEERING BLDG.
Do not extend this side of this line.

W.S. 7 B-6

76F309S CE#310 1-65

F. B. 3170 PG 90

Cont. Bot. Pg. 89

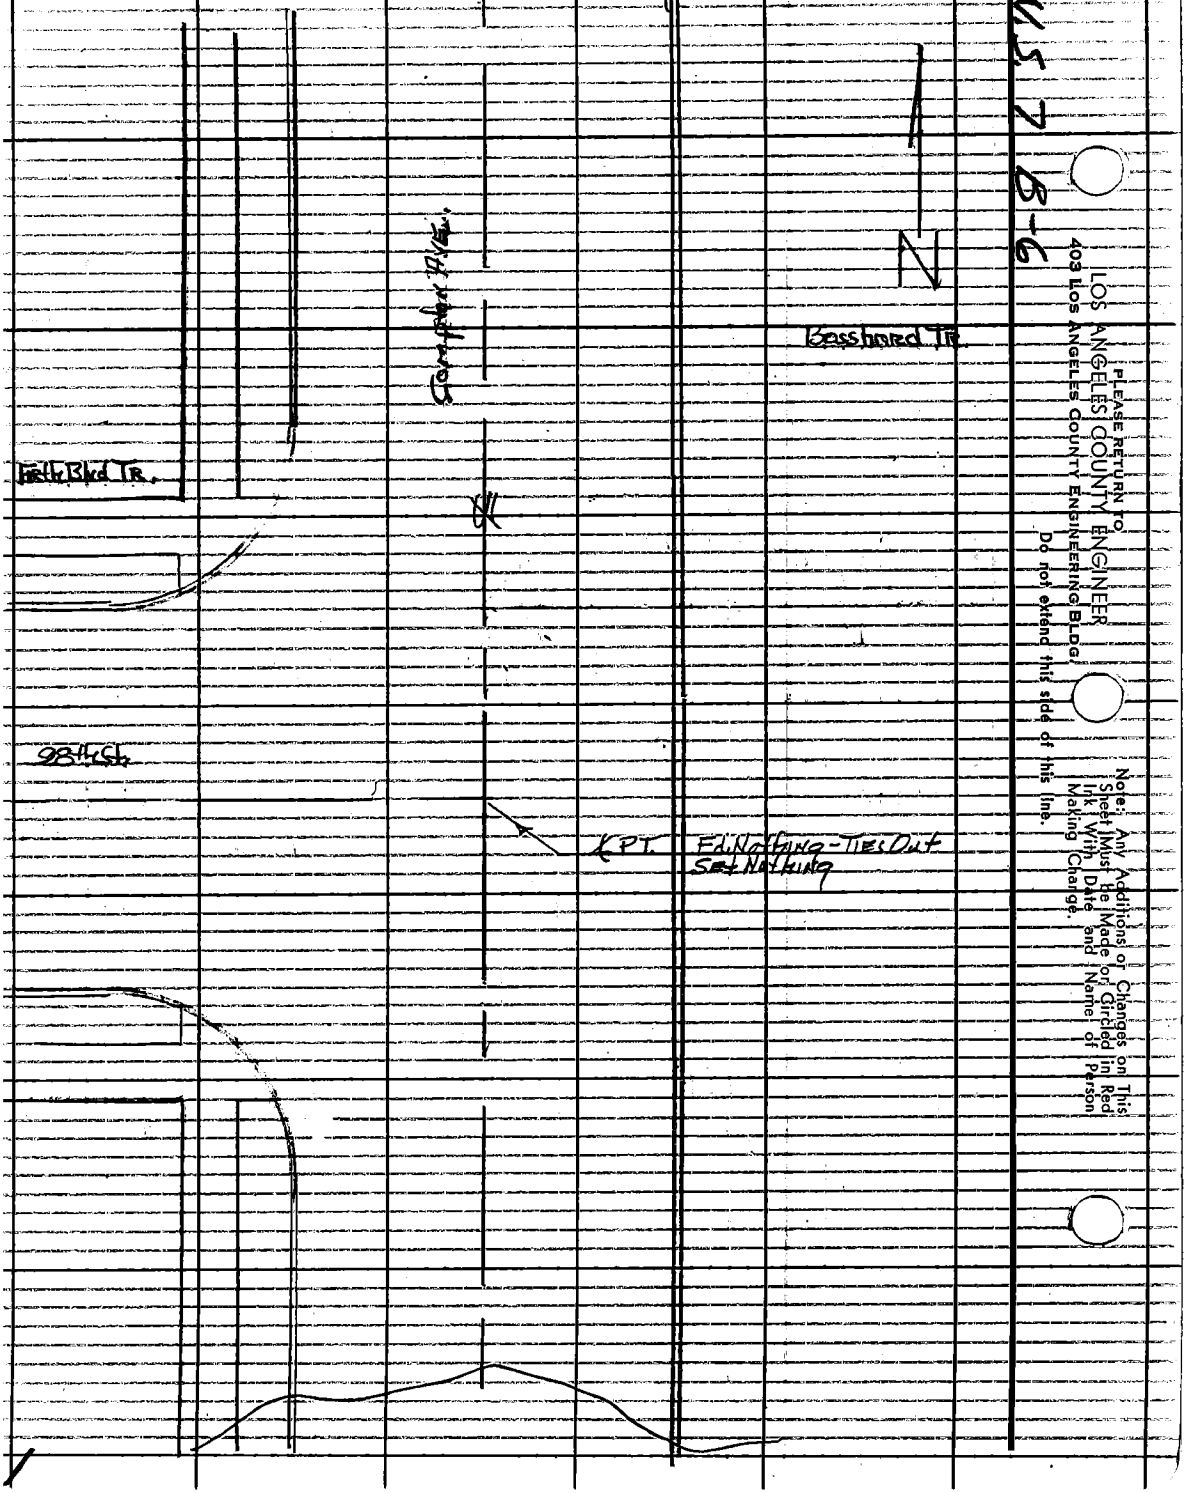

PLEASE RETURN TO
LOS ANGELES COUNTY ENGINEER
403 LOS ANGELES COUNTY ENGINEERING BLDG.
Do not extend this side of this line.
Note: Any Additions or Changes on This Sheet Must be Made or Circled in Red Ink With Date and Name of Person Making Change.

Notes Ck'd by J. Church	Survey of 92nd St		F. B. 3170 Pg. 91
Map No. B3019	JN 0096.66	Tape 0259	Std 68 °F
Office Work	Surveyed by H.H. Spriggs		
Checked J. A. CHURCH	Notes HHS	Date 10-27-65	
Date JUL 7 '66	Indexed C. J. GALLI		

Stipeb-Compton Blvd Tr

119.04 LEVEL @ 68 = 119.04

186.22 " " " 80 = 186.23

N

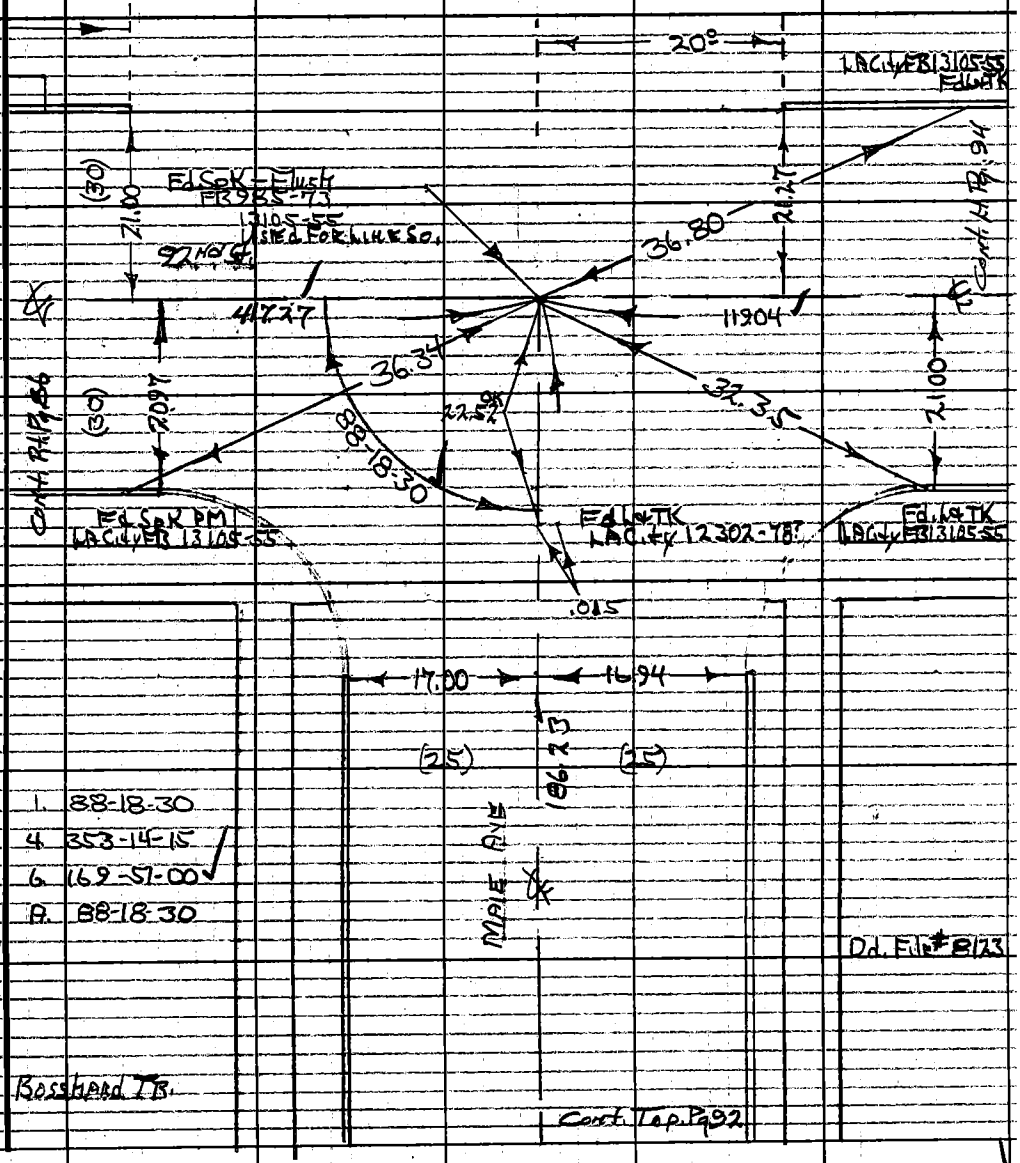

1. 88-18-30
4. 353-14-15
6. 169-51-00
A. 88-18-30

Dd. File # 8123

Bosshard Tr.

Cont. Top. Pg 92

W.S. 7 8-6

Note: Any Additions or Changes on This Sheet Must be Made or Circled in Red Ink With Date and Name of Person Making Change.

Do not extend this side of this line.

PLEASE RETURN TO
LOS ANGELES COUNTY ENGINEER
403 LOS ANGELES COUNTY ENGINEERING BLDG.

76F309S CE#310 1-65

Cont Bot Pg 91

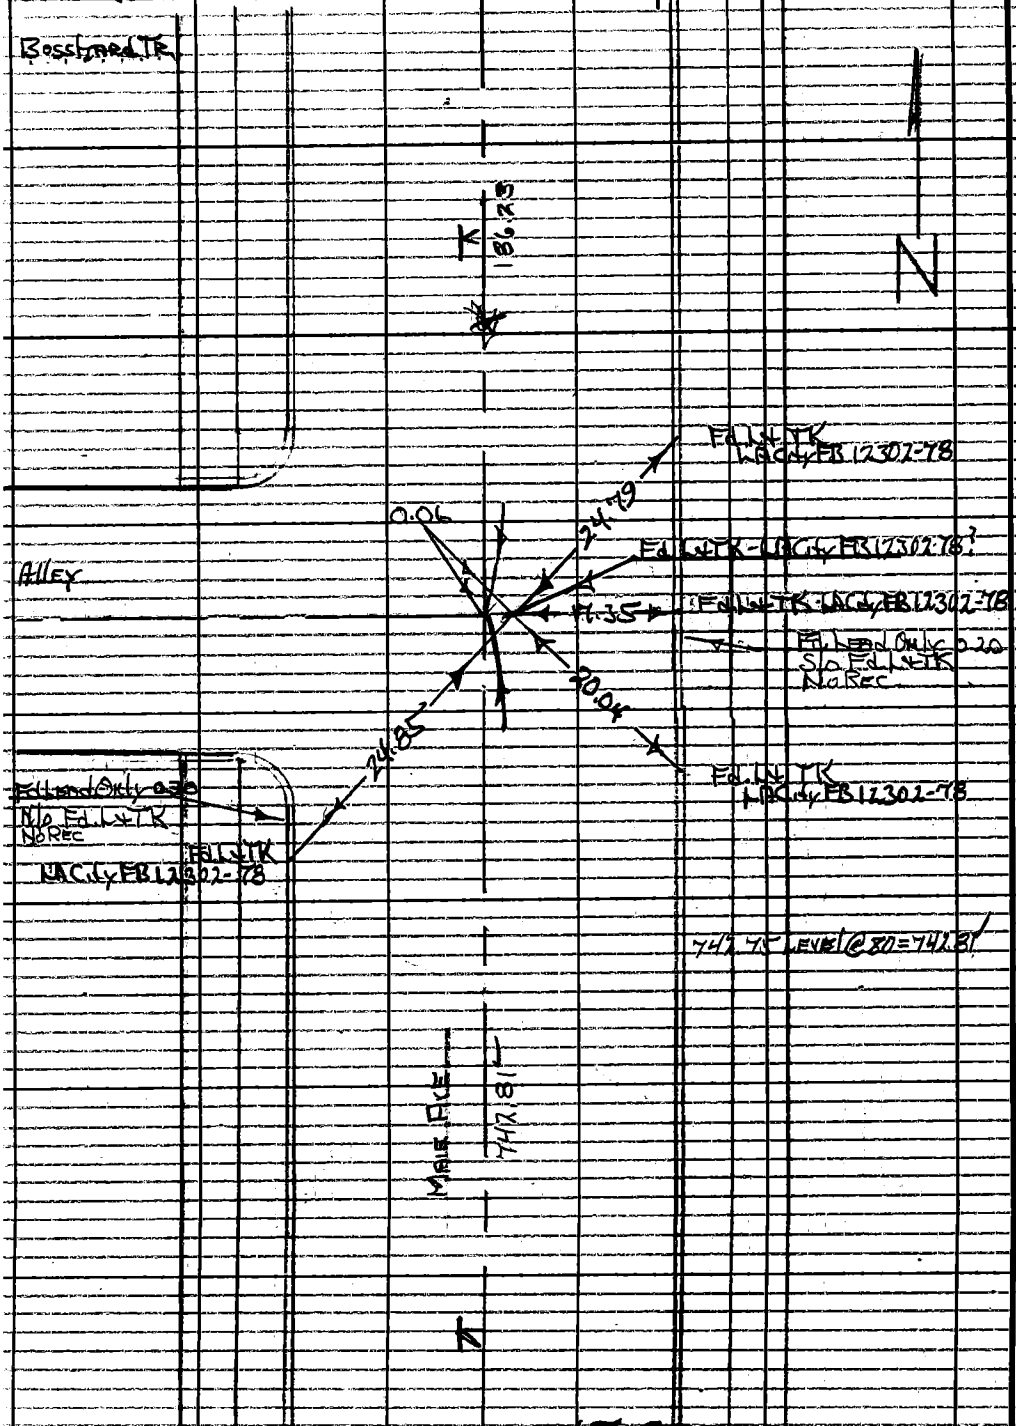

Cont Top Pg 93

PLEASE RETURN TO
LOS ANGELES COUNTY ENGINEER
403 LOS ANGELES COUNTY ENGINEERING BLDG.
Do not extend this side of this line.
Note: Any Additions or Changes on This Sheet Must be Made or Circled in Red Ink With Date and Name of Person Making Change.

Notes Ck'd by J. Church	Survey of 92nd St.
Map No. B3019	JN 009666 Tape 0759 Std 68 °F
Office Work	Surveyed by HH Spragg
Checked L. A. CHURCH	Notes HHS Date 10-27-65
Date JUL 7 '66	Indexed C. J. GALLI MAR 8 '68

F. B. 3170 PG. 93

Note: Any Additions or Changes on This Sheet Must be Made or Circled in Red Ink With Date and Name of Person Making Change.

Do not extend this side of this line.

PLEASE RETURN TO
LOS ANGELES COUNTY ENGINEER
403 Los Angeles County Engineering Bldg.

W.57 B-6

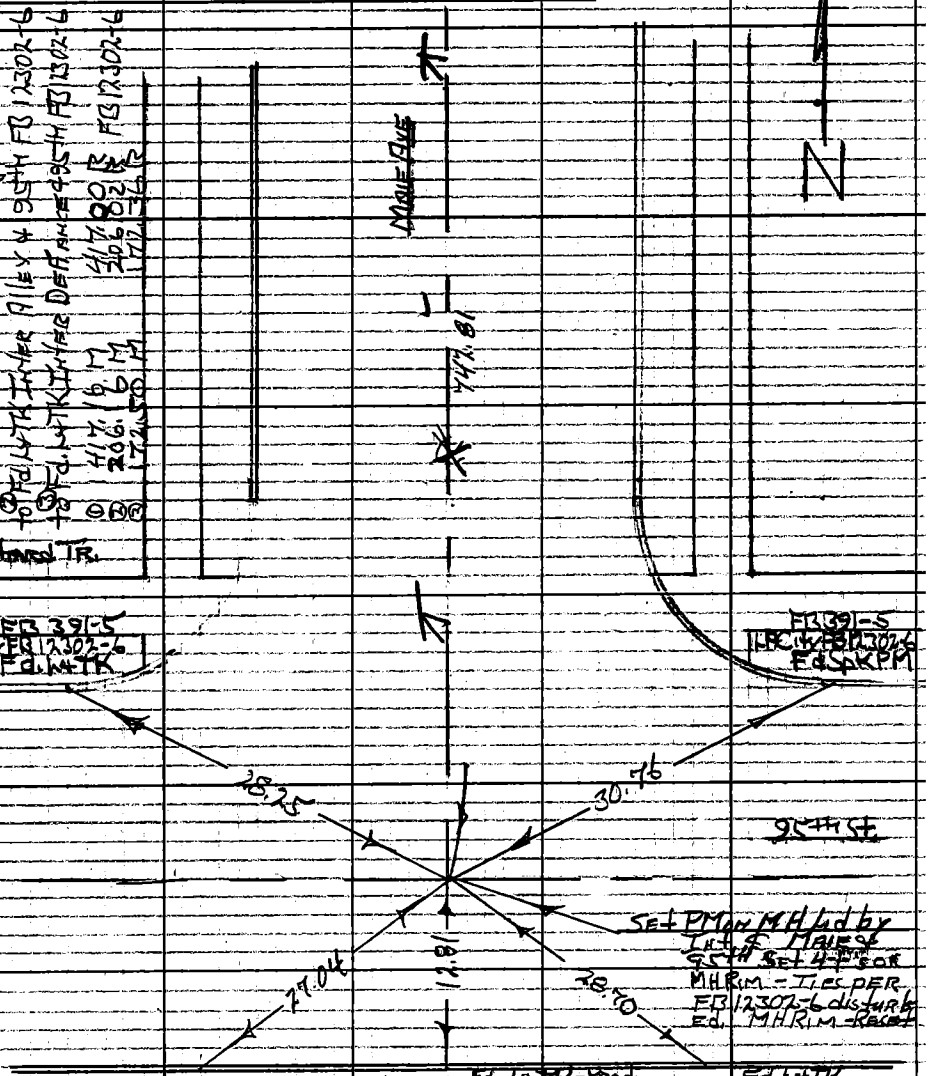

Note: Maple Ave. between 92nd St. & 95th St. is Concrete Pvmt. There is visual evidence @ Maple & 95th showing Pvmt shift So. due to expansion approx. 0.40

Alignment on 95th St. per Fd. L&TK. Road @ Compton Ave., Fd L&TK. Int. Alley East of Compton Ave LA City FB 12302-6, and Fd L&TK. Int. Defiance Ave, FB 12302-6

76F309S CE#3/10 1-65

F. B. 3170 PG 94

Cont. Bot Pg 95

~~LACity~~
~~Dept. of Water~~
~~& Power Pwr~~
Fd 1½" IP - [illegible]
No Ref

Alley

7.04

Fd Nothing - set Nothing
FB 13105-54 - Ties out

N

~~RE-RR Pwr~~

1. 90-04-00
4. 360-17-00
6. 180-26-00
8. 90-04-20

Sharbet Compton Blvd Tr.

Main Ave

209.70

(7')

(7')

LACity FB 13105-55
Fd L&TK

1.30

90-04-20

21.25

31.81

92nd St

119.04

Fd SpK-Flush
FB 985-67
13105-55

291.97

29.72

21.80

21.11

31.52

Fd L&TK
FB 985-67
LACity FB 13105-55

Fd SpK PM
No REC

Fd L&TK
FB 985-67
LACity FB 13105-55

Cont. Pt. Pg 91

Cont. Pt. Pg 96

(30)

(30)

291.97 Level @ 68 = 291.97
209.70 " " " 66 = 209.70

W.S. 7 B-6

PLEASE RETURN TO
LOS ANGELES COUNTY ENGINEER
403 LOS ANGELES COUNTY ENGINEERING BLDG.
Do not extend this side of this line.

Note: Any Additions or Changes on This Sheet Must Be Made on Circled in Red Ink With Date and Name of Person Making Change.

Notes Ck'd by J. Church	Survey of 92nd St
Map No. B 3019	JN 0096.66 Tape 0259 Std 68 °F
Office Work	Surveyed by HH Spriggs
Checked	Notes HHS Date 11-1-65
Date JUL 7 '58	Indexed C. J. GALLI

F. B. 3170 PG. 95

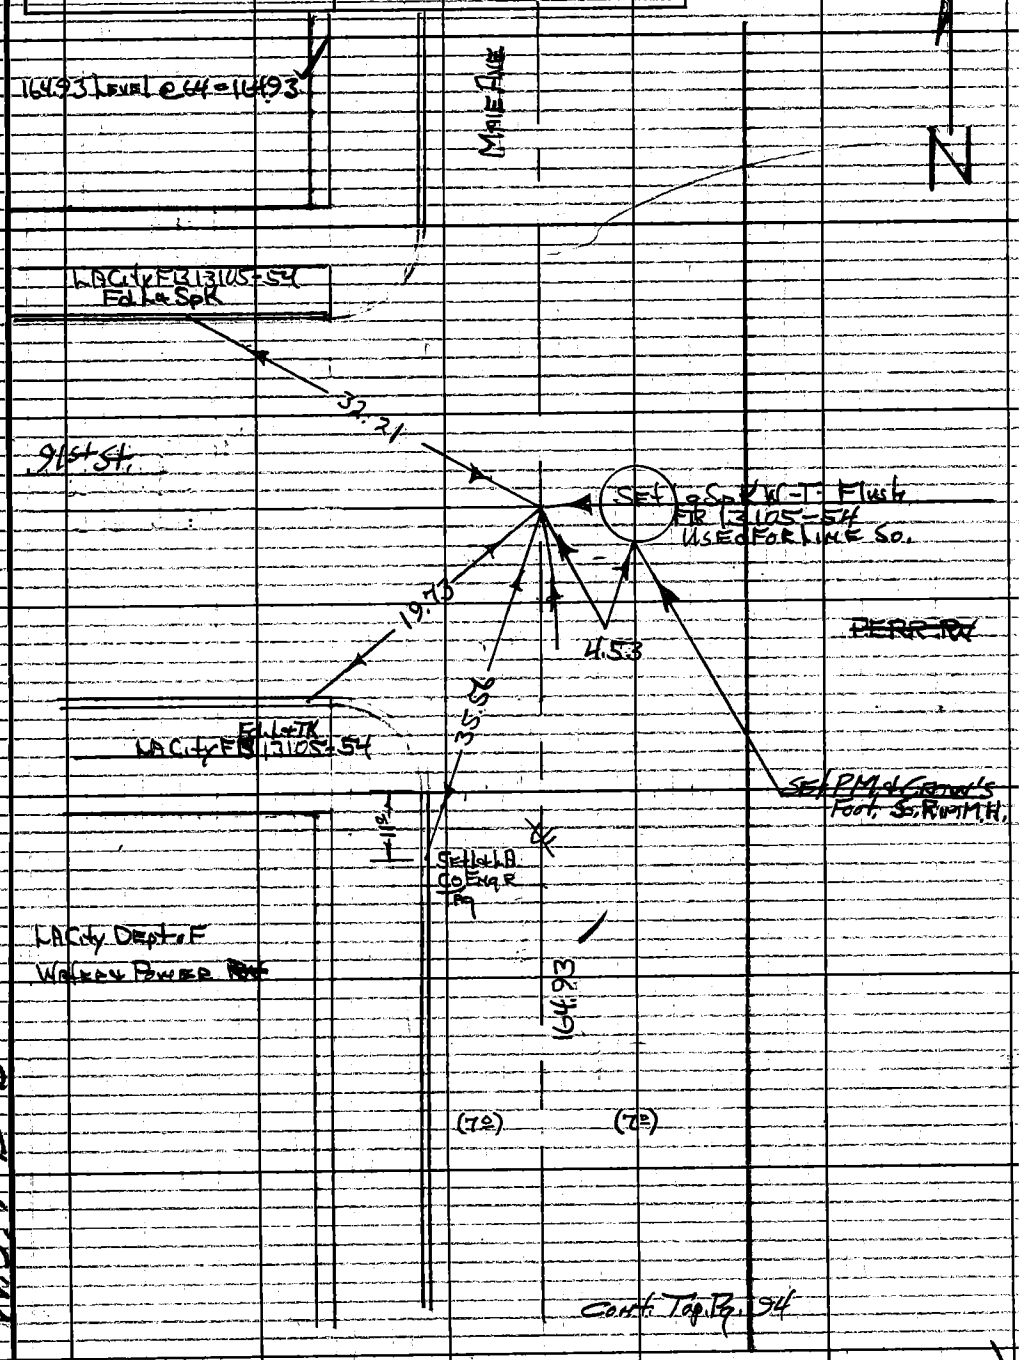

Note: Any Additions or Changes on This Sheet Must be Made or Circled in Red Ink With Date and Name of Person Making Change.

PLEASE RETURN TO
LOS ANGELES COUNTY ENGINEER
403 LOS ANGELES COUNTY ENGINEERING BLDG.
Do not extend this side of this line.

W.S. 7 B-6

76F309S CE#310 1-65

F. B. 3170 PG 96

111.09 LEVEL @66 = 111.09

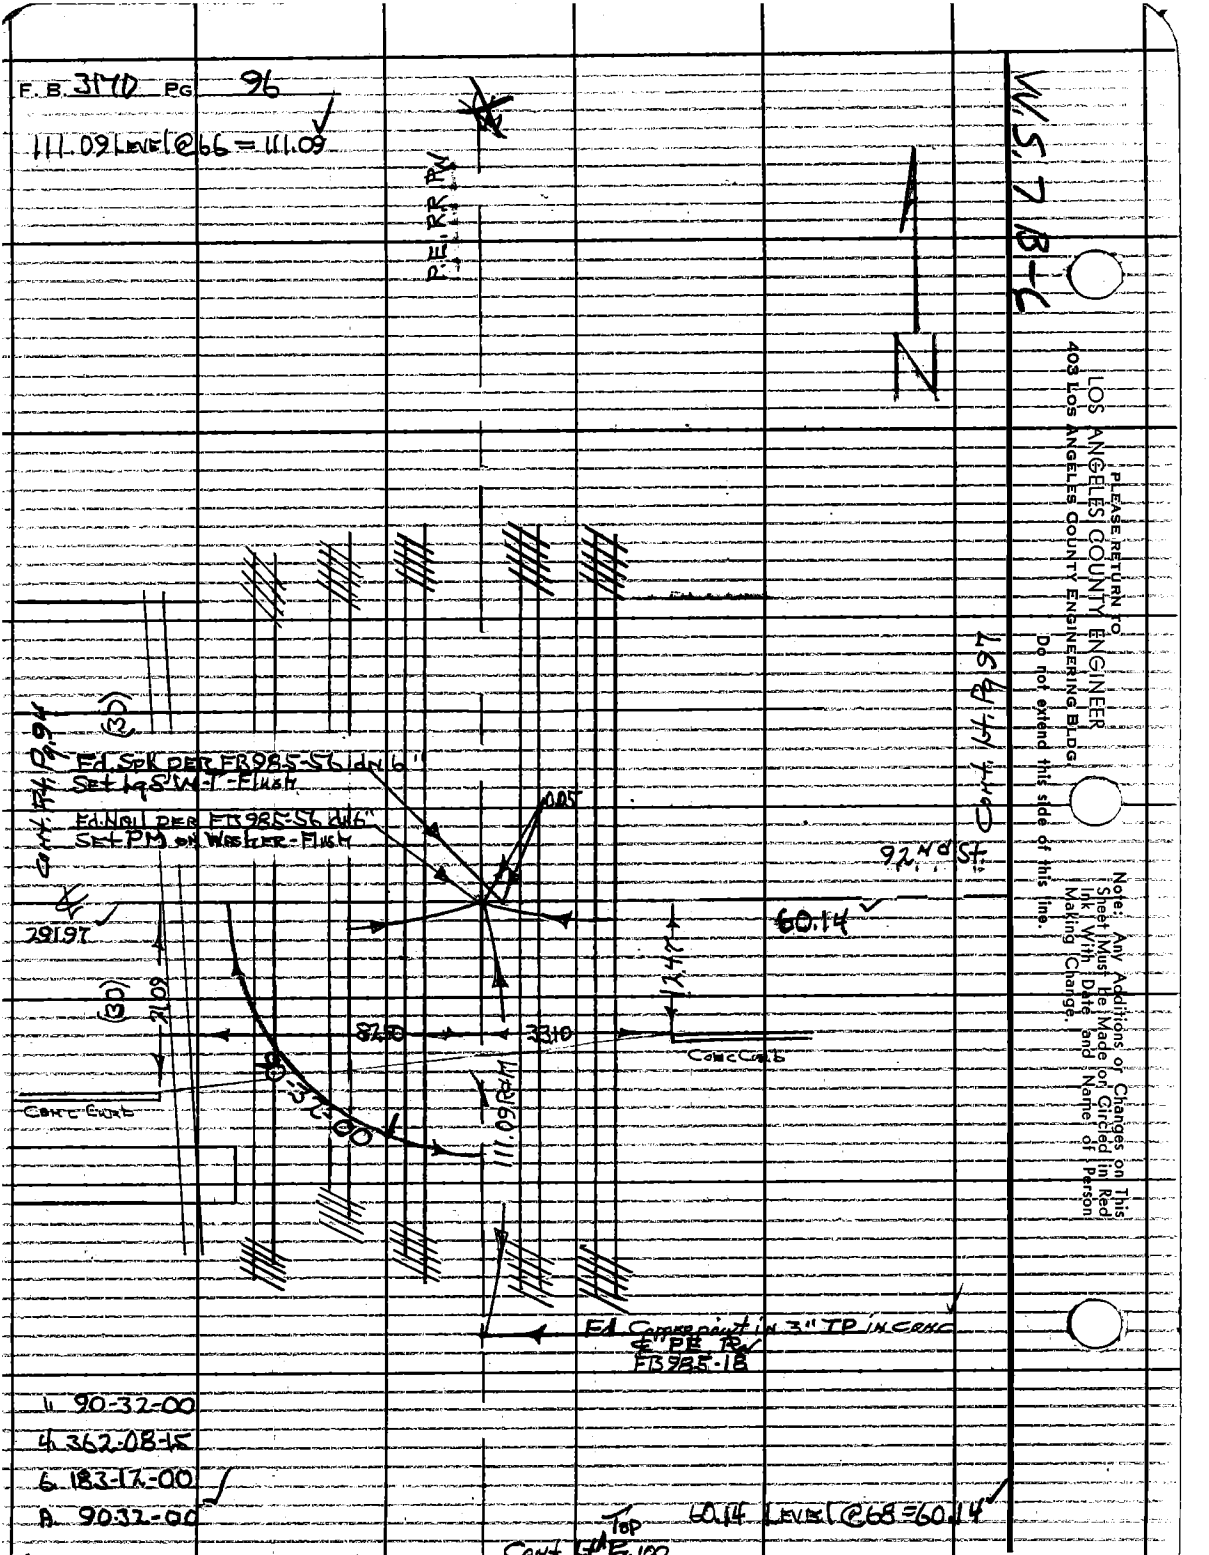

Notes Ck'd by J. Church
Map No. B3019
Office Work
Checked
Date 11 7 66

Survey of 92nd St.
J.N. 0096.66 Tape 0259 Std 68 °F
Surveyed by HH Springer
Notes HHS Date 11-19-65
Indexed C. J. GALLI

F. B. 3170 PG. 97

NE
1. 90-17-00
4. 01-08-15
6. 181-42-00
A. 90-17-00

NW
1. 89-28-30
4. 357-54-00
6. 176-57-00
A. 89-28-30

SW
1. 90-31-45
4. 362-07-00
6. 183-10-45
A. 90-31-47

SE
1. 89-42-30
4. 358-50-15
6. 178-15-45
A. 89-42-37

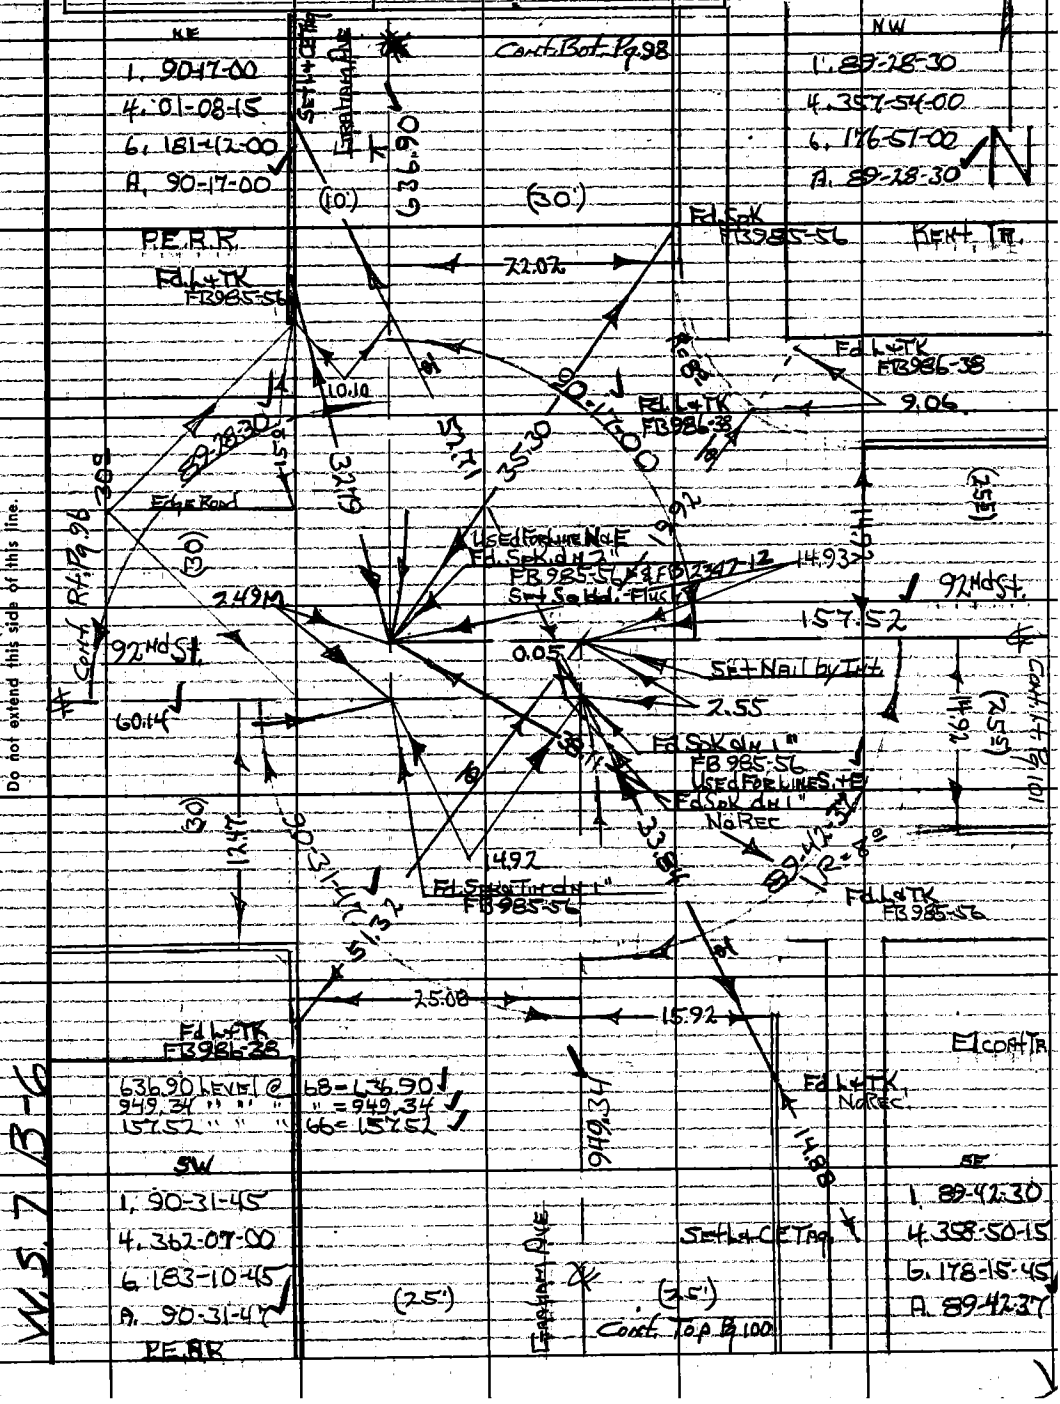

Note: Any Additions or Changes on This Sheet Must be Made or Circled in Red Ink With Date and Name of Person Making Change.

PLEASE RETURN TO
LOS ANGELES COUNTY ENGINEER
403 Los Angeles County Engineering Bldg.
Do not extend this side of this line.

B-16

76F309S CE#310 1-65

F. B. 3170 PG 98

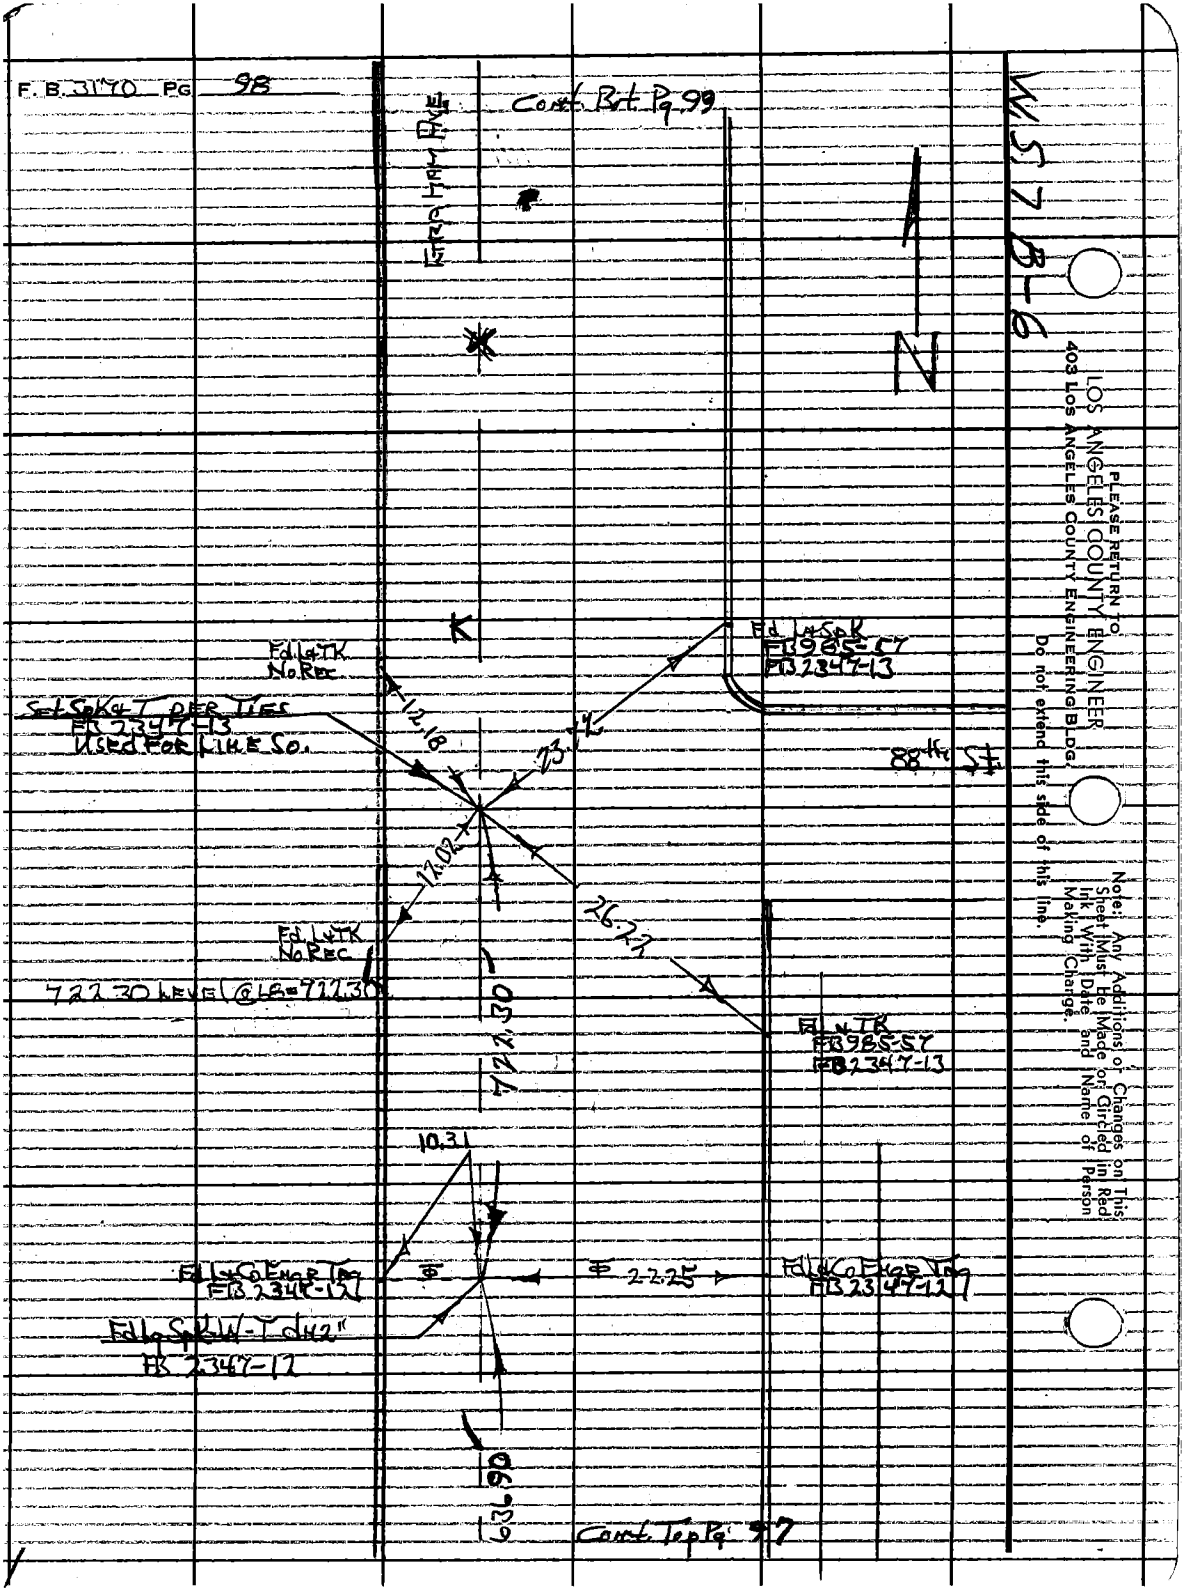

PLEASE RETURN TO
LOS ANGELES COUNTY ENGINEER
403 LOS ANGELES COUNTY ENGINEERING BLDG.
Do not extend this side of this line.

Note: Any Additions or Changes on This Sheet Must Be Made or Circled in Red Ink With Date and Name of Person Making Change.

Notes Ck'd by J. Church	Survey of 92nd St	F. B. 3170	Pg. 99
Map No. B 3019	JN 0096.66 Tape 0259 Std 68 °F		
Office Work	Surveyed by HHS Briggs		
Checked J. A. CHURCH	Notes HHS Date 11-19-65		
Date JUL 7 66	Indexed G. J. GALLI		

N

87th St.

Ed. Nothing Set Nothing
FB 2347-14 - Ties Out

Irrigation Ave

Cont. Top Pg. 98

Note: Any Additions or Changes on This Sheet Must be Made or Circled in Red Ink With Date and Name of Person Making Change.

PLEASE RETURN TO
LOS ANGELES COUNTY ENGINEER
403 LOS ANGELES COUNTY ENGINEERING BLDG.

Do not extend this side of this line.

W.S. 7 B-6

76F309S CE#310 1-65

F. B. 3170 PG 100

Cont. Bot Pg 97

LOS ANGELES COUNTY ENGINEER
403 Los Angeles County Engineering Bldg.
PLEASE RETURN TO
Do not extend this side of this line.
Note: Any Additions or Changes on This Sheet Must Be Made or Circled in Red Ink With Date and Name of Person Making Change.

Notes Ck'd by	Survey of 92nd ST	F. B. 3170 PG. 191
Map No. B 3019	JN 0096.66 Tape 0199 Std 6.8 °F	
Office Work	Surveyed by J. H. Brown	
Checked	Notes J. H. B. Date 1-67	
Date	Indexed C. J. GALLI	

pages Added April 13, 14 - 1967 JWB

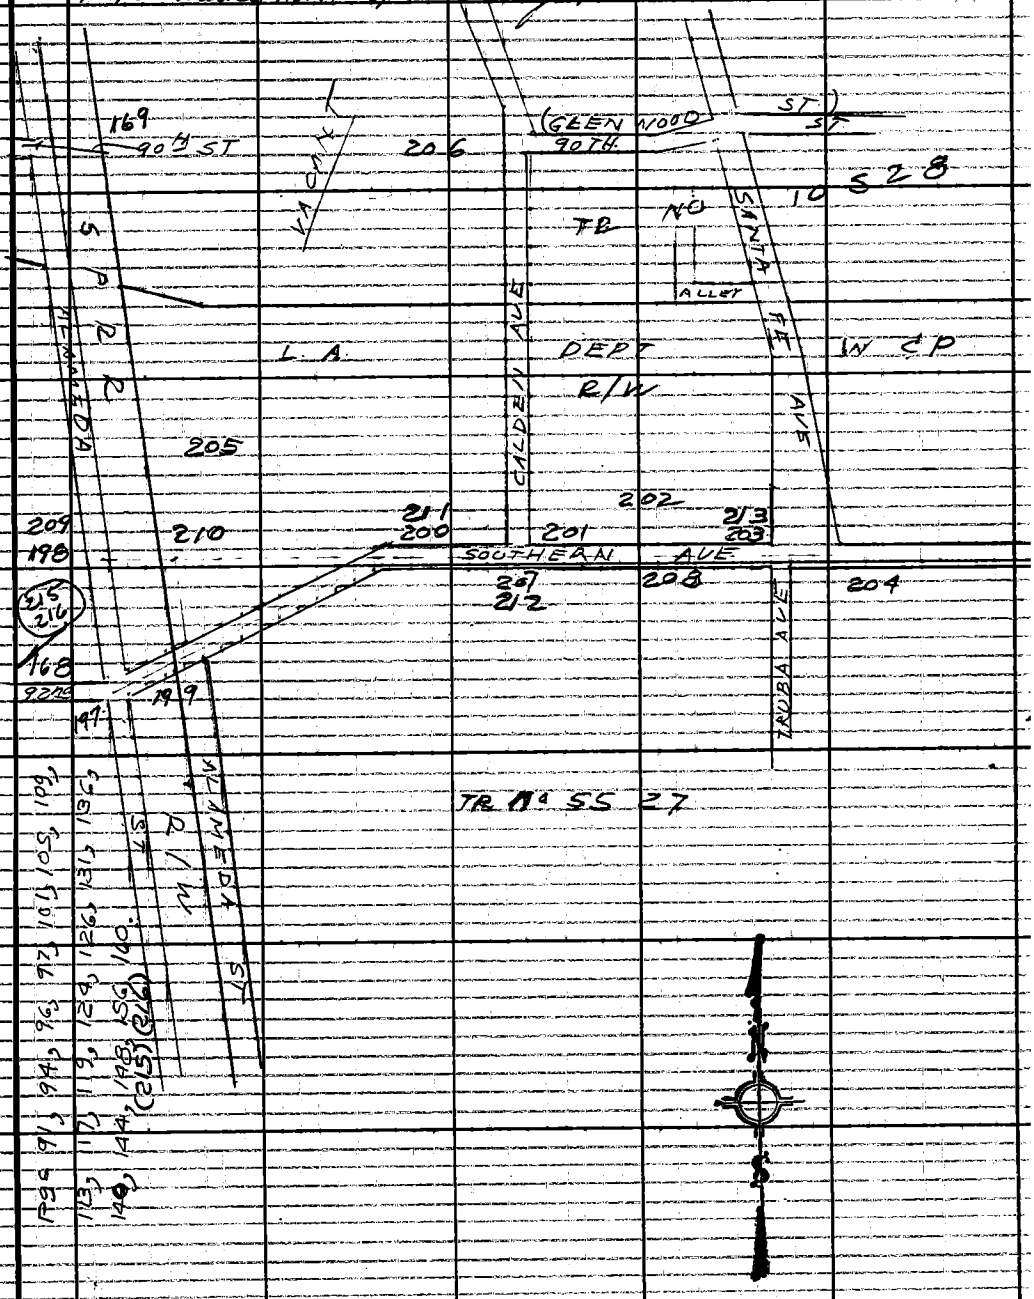

Note: Any Additions or Changes on This Sheet Must be Made or Circled in Red Ink With Date and Name of Person Making Change.

Do not extend this side of this line.

PLEASE RETURN TO
LOS ANGELES COUNTY ENGINEER
403 Los Angeles County Engineering Bldg.

76F309S CE #310 6-63

F. B. 3170 PG 102

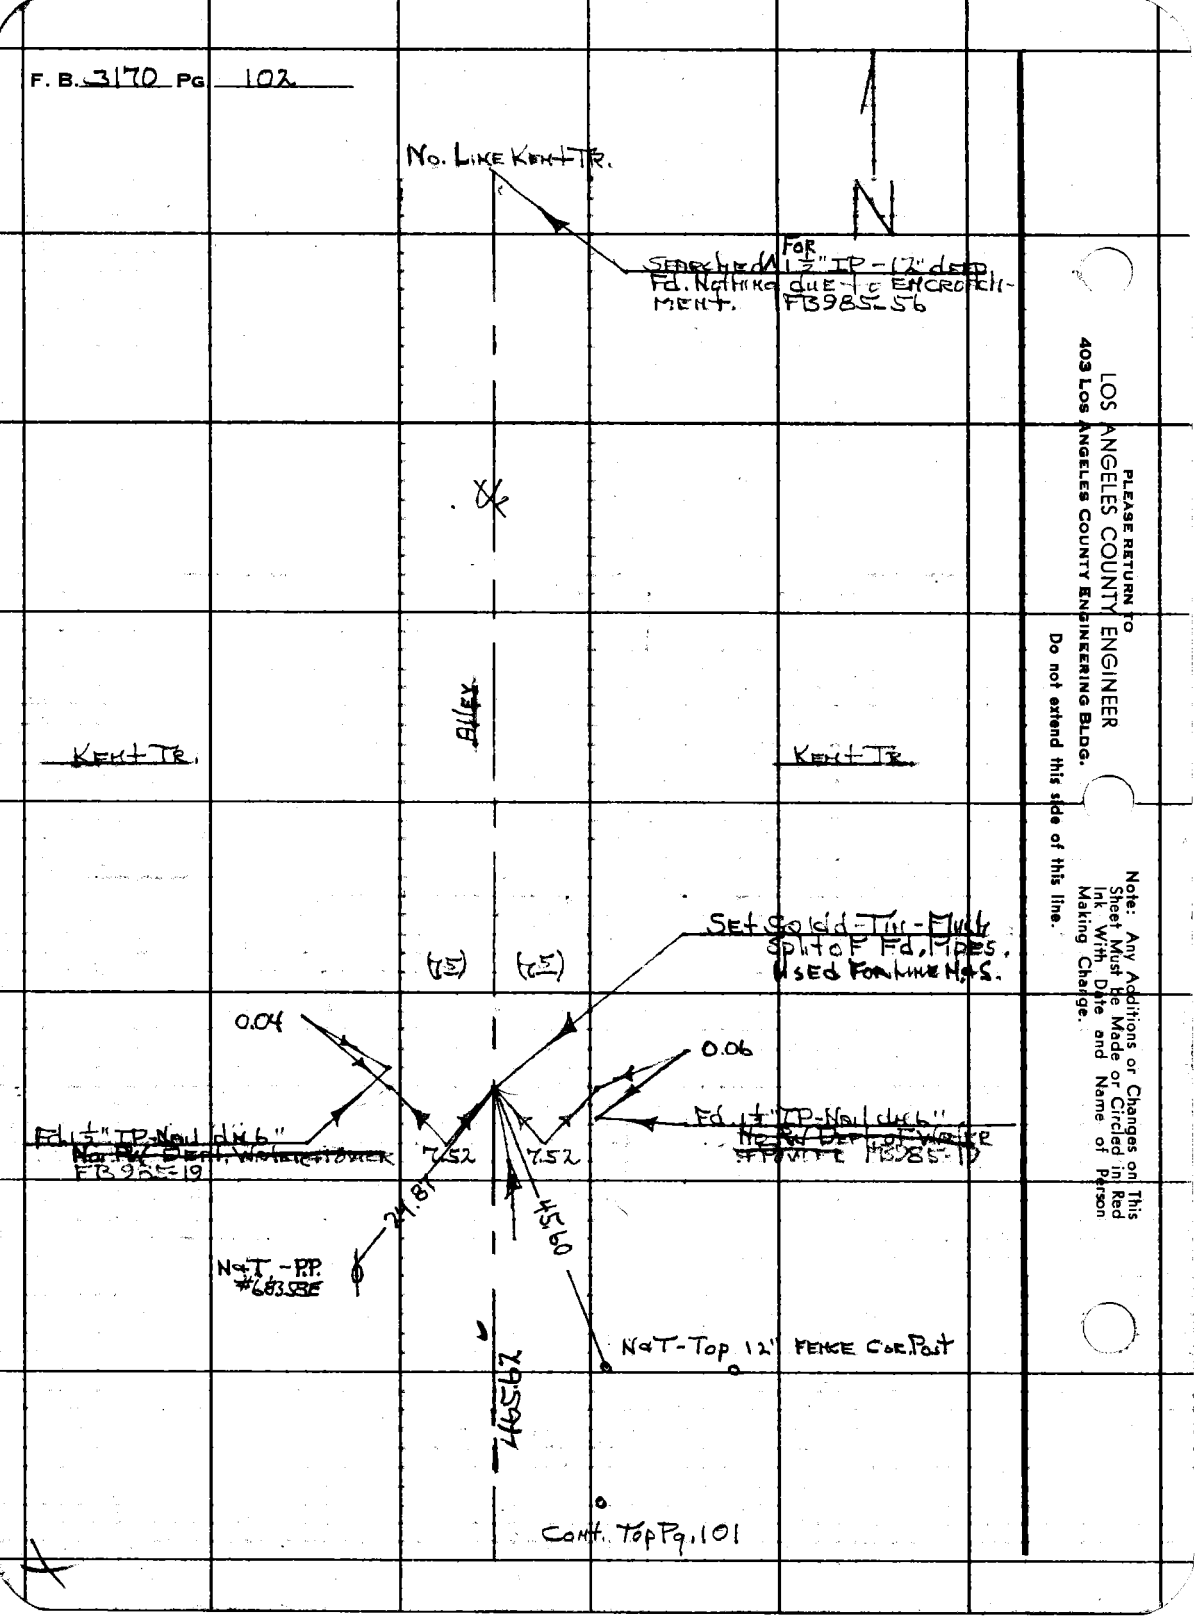

LOS ANGELES COUNTY ENGINEER
403 Los Angeles County Engineering Bldg.
PLEASE RETURN TO
Do not extend this side of this line.
Note: Any Additions or Changes on This Sheet Must Be Made or Circled in Red Ink With Date and Name of Person Making Change.

Notes Ck'd by
Map No. B3019
Office Work
Checked
Date

Survey of 92nd ST
JN 0096 Tape 0199 Std 68 °F
Surveyed by J. H. Brown
Notes J-H-B Date 12-66
Indexed G. J. GALLI

F. B. 3170 PG. 193

TR 6631 LOT 75

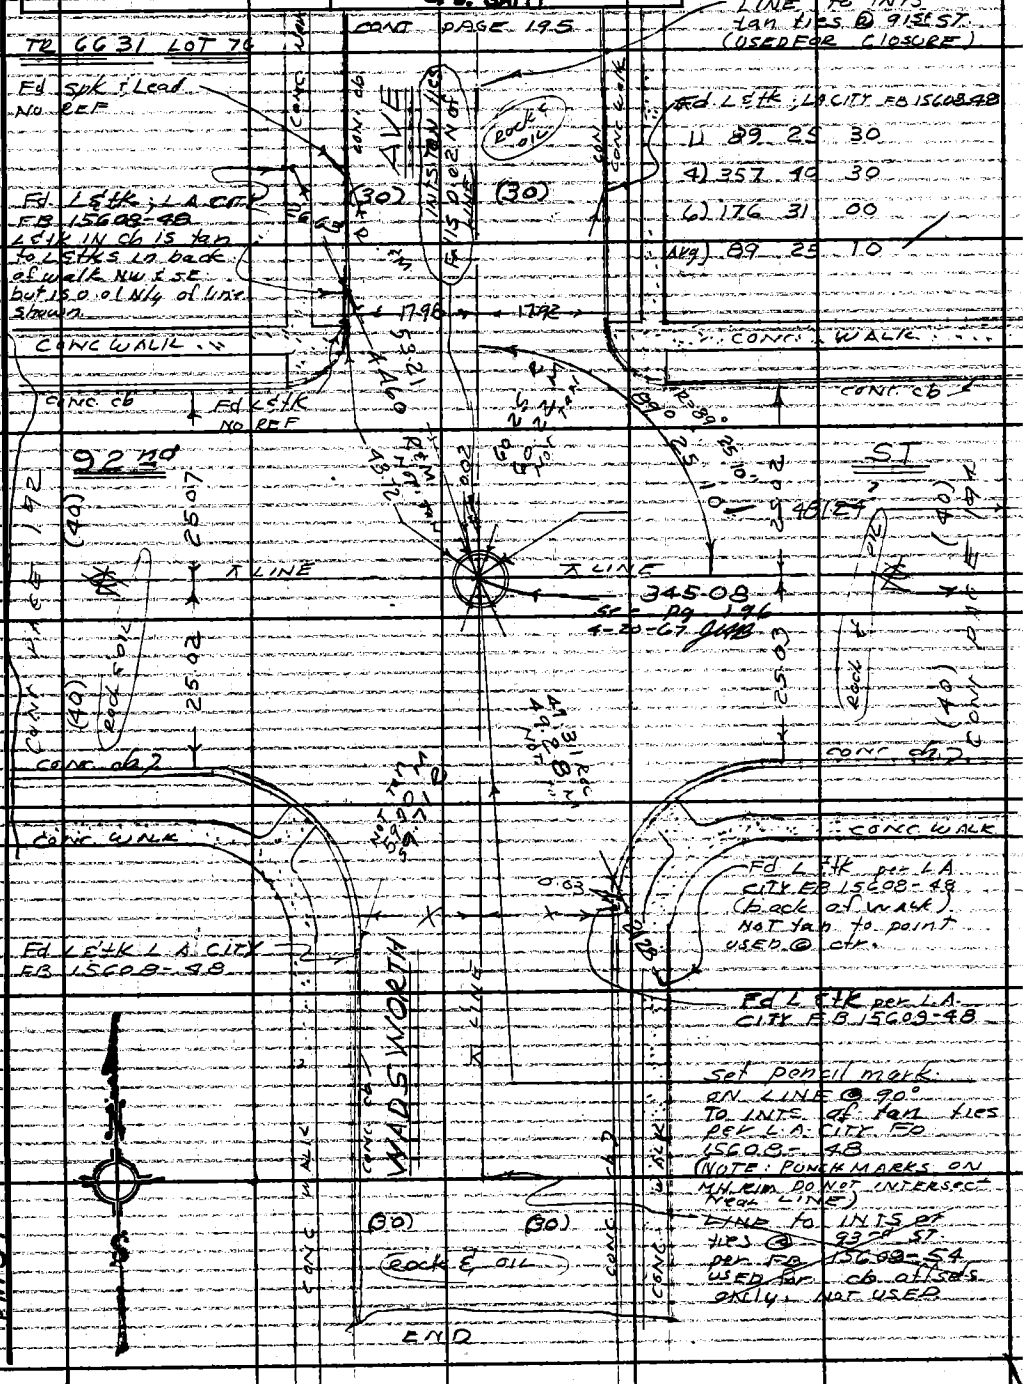

Note: Any Additions or Changes on This Sheet Must be Made or Circled in Red Ink With Date and Name of Person Making Change.

PLEASE RETURN TO
LOS ANGELES COUNTY ENGINEER
403 LOS ANGELES COUNTY ENGINEERING BLDG.
Do not extend this side of this line.

76F309S CE #310 6-63

W.S. 7 B-6

F. B. 3170 PG 104

Cont. Bot. Pg. 103

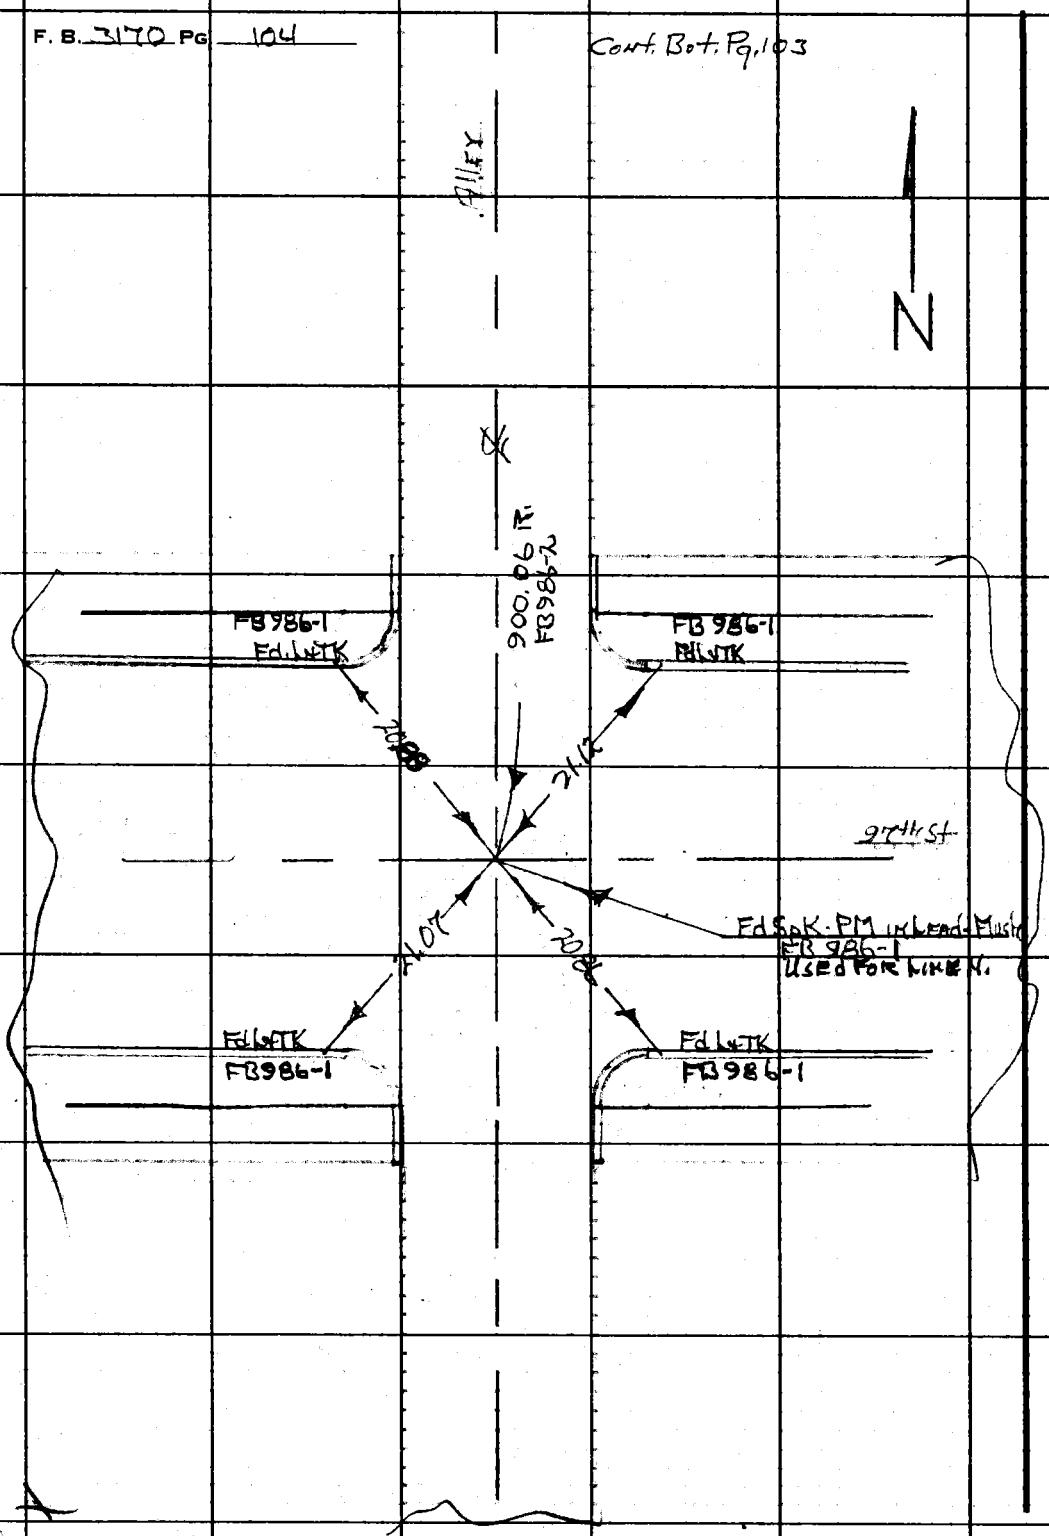

PLEASE RETURN TO
LOS ANGELES COUNTY ENGINEER
403 Los Angeles County Engineering Bldg.
Do not extend this side of this line.

Note: Any Additions or Changes on This Sheet Must be Made or Circled in Red Ink With Date and Name of Person Making Change.

Notes Ck'd by	Survey of 92nd ST.	F. B. 3170 PG. 195
Map No. B3019	JN0096-66 Tape 0199 Std 68 °F	
Office Work	Surveyed by J. H. Brown	
Checked	Notes J. H. B. Date 1-3-67	
Date	Indexed C. J. GALLI	

ST WIDTHS NOT DRAWN TO SCALE

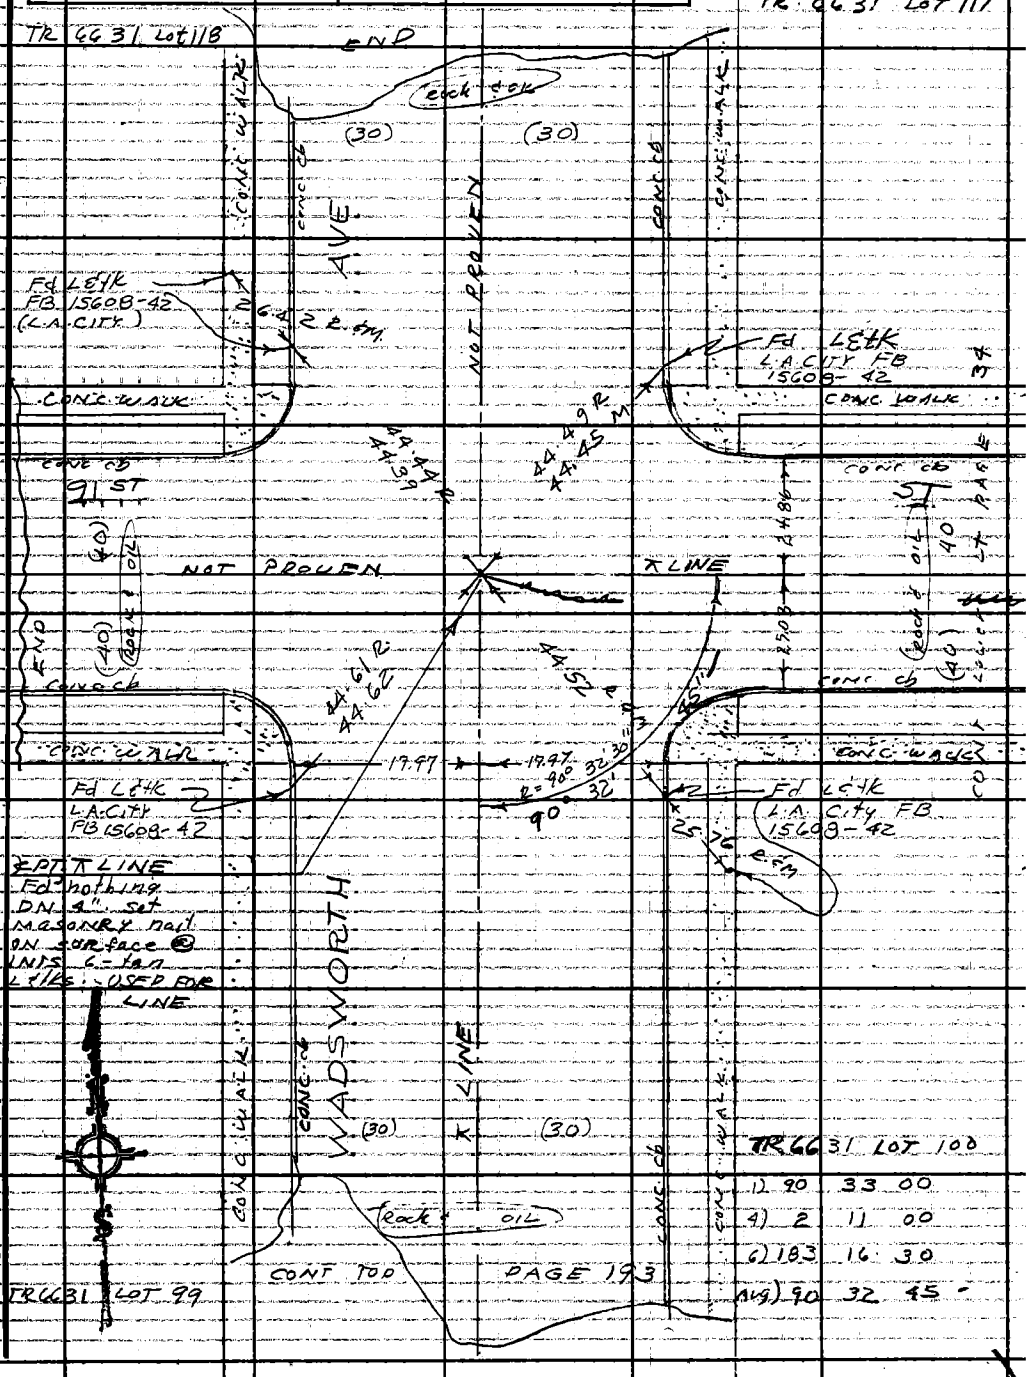

Note: Any Additions or Changes on This Sheet Must be Made or Circled in Red Ink With Date and Name of Person Making Change.

Do not extend this side of this line.

PLEASE RETURN TO
LOS ANGELES COUNTY ENGINEER
403 LOS ANGELES COUNTY ENGINEERING BLDG.

W.S. 76-6

76F309S CE #310 6-63

F. B. 3170 PG 106

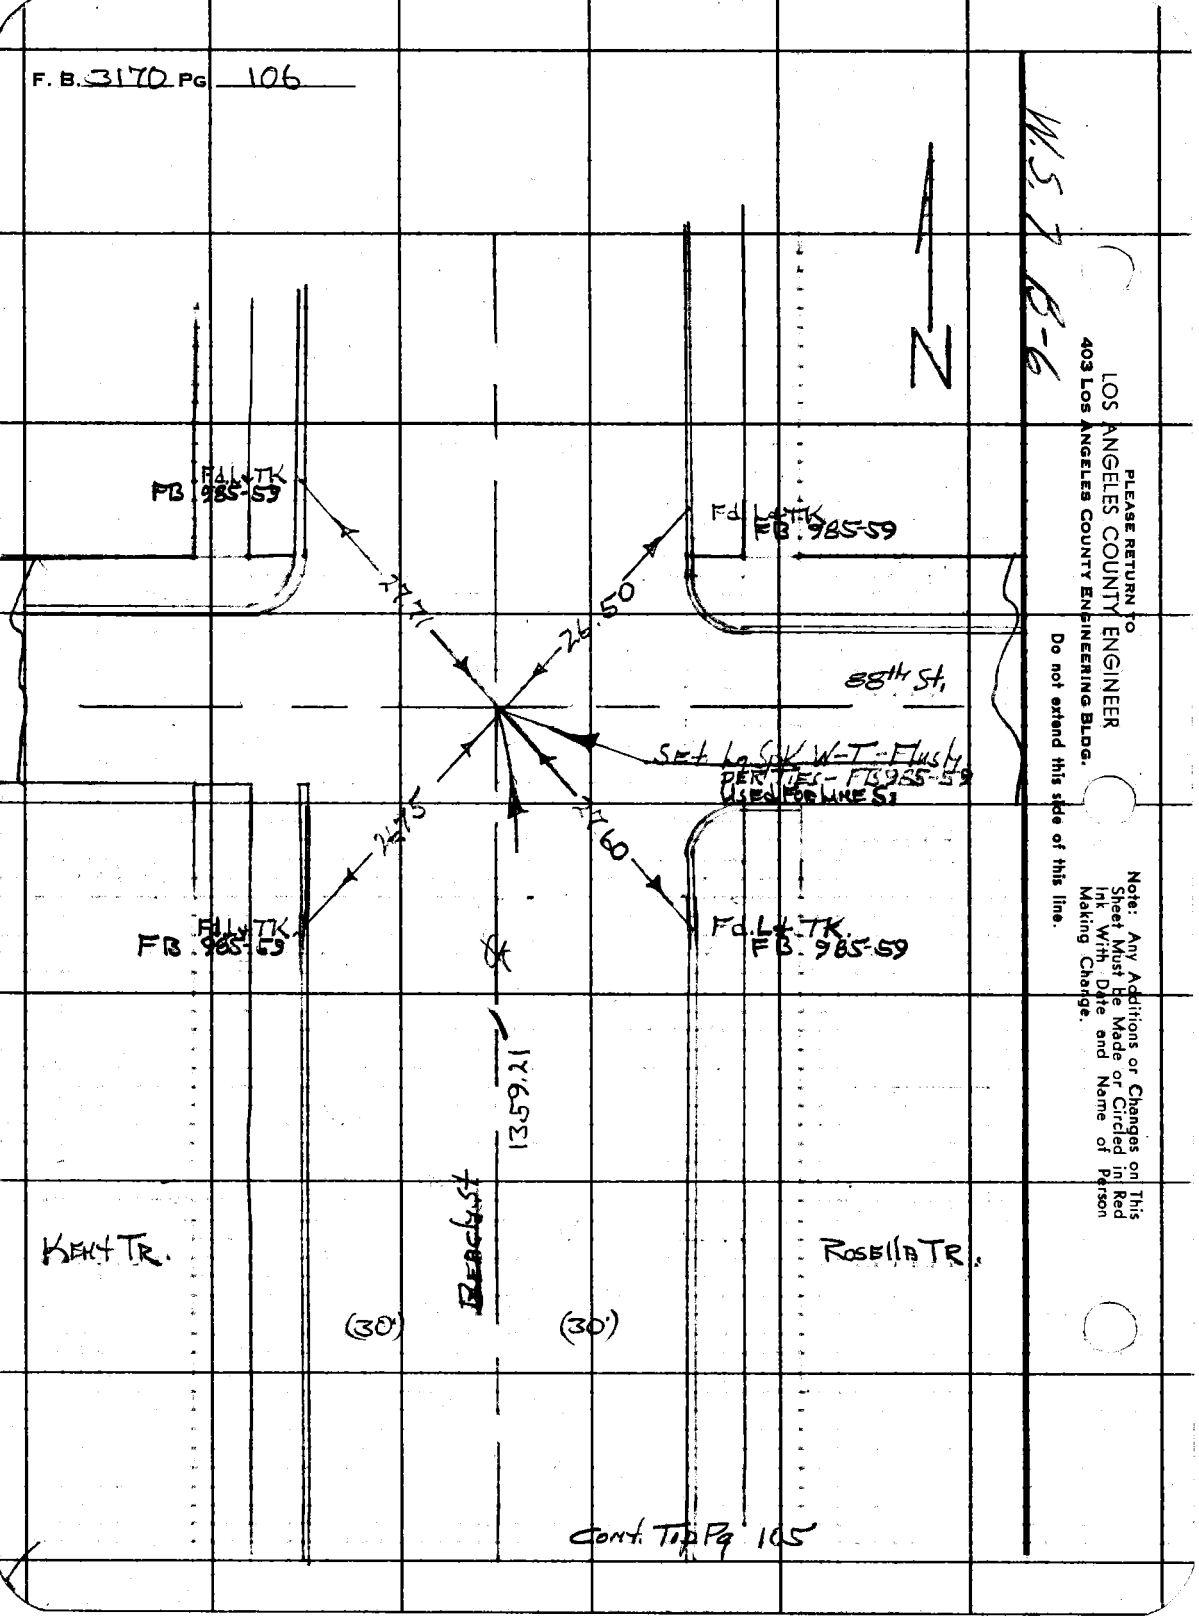

PLEASE RETURN TO
LOS ANGELES COUNTY ENGINEER
403 Los Angeles County Engineering Bldg.
Do not extend this side of this line.
Note: Any Additions or Changes on This Sheet Must Be Made or Circled in Red Ink With Date and Name of Person Making Change.

Notes Ck'd by	Survey of 92nd ST
Map No. B3019	JN 0096.66 Tape 0199 Std 68 °F
Office Work	Surveyed by J.H. BROWN
Checked	Notes J.H.B. Date 1-67
Date	Indexed C.J. GALLI

F.B. 3170 PG. 197

CONT PGS 196 & 199

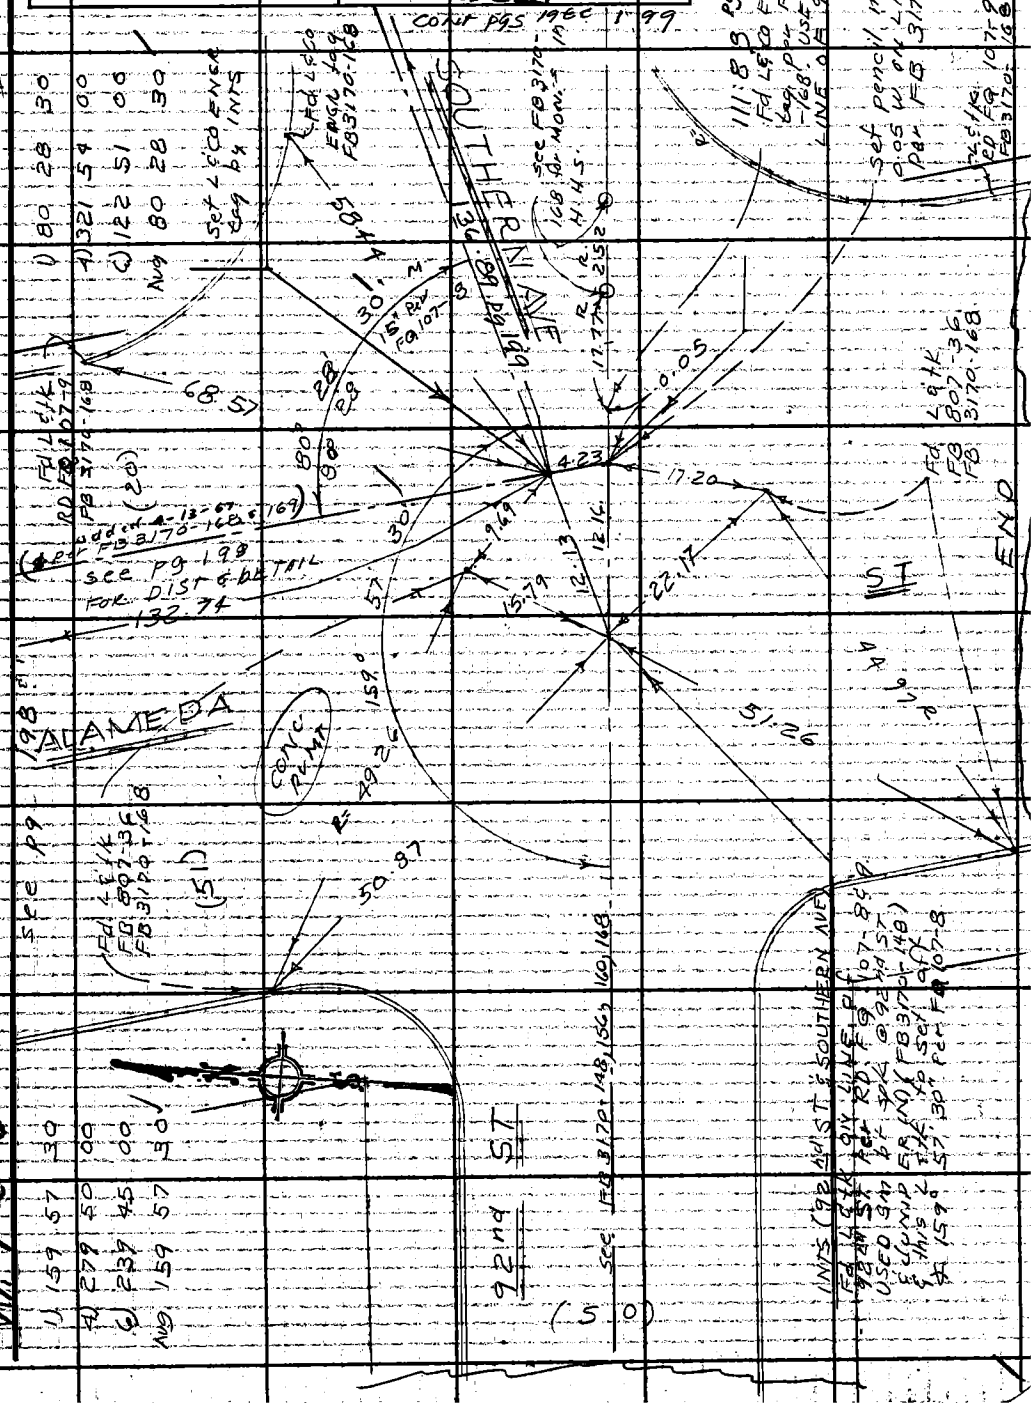

Note: Any Additions or Changes on This Sheet Must be Made or Circled in Red Ink With Date and Name of Person Making Change.

Do not extend this side of this line.

PLEASE RETURN TO
LOS ANGELES COUNTY ENGINEER
403 LOS ANGELES COUNTY ENGINEERING BLDG.

76F3098 CE #310 6/63

F. B. 3170 PG 108

Cont. Bot. Pg 107

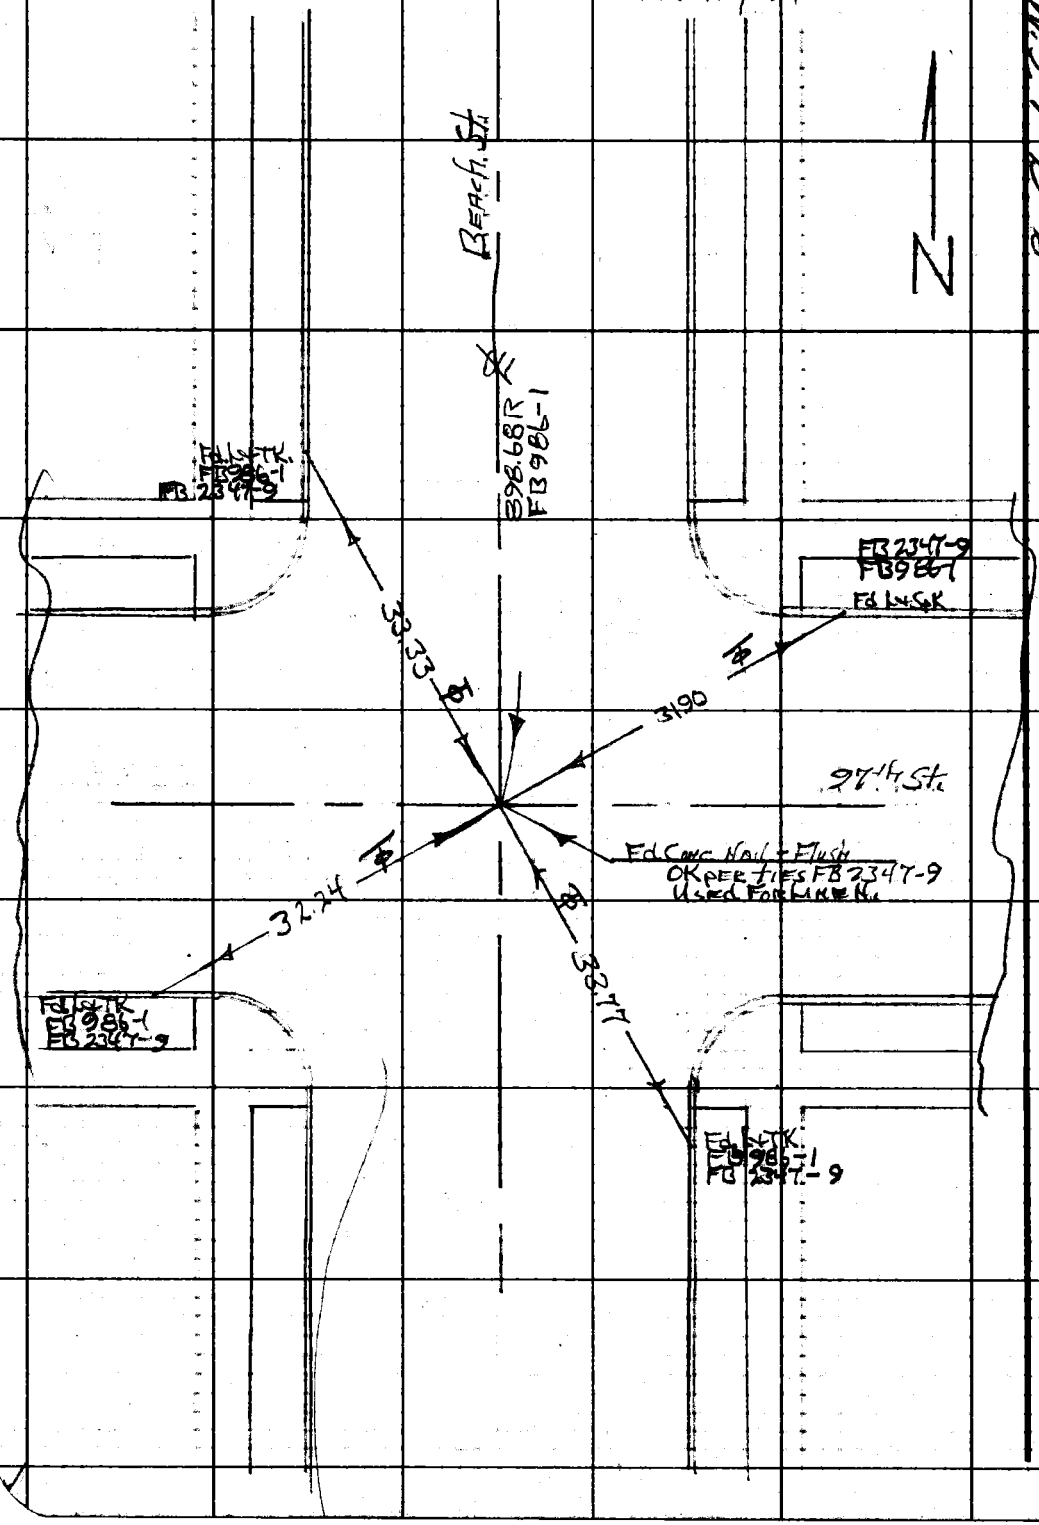

W.S.7 B-6

PLEASE RETURN TO
LOS ANGELES COUNTY ENGINEER
403 LOS ANGELES COUNTY ENGINEERING BLDG.

Do not extend this side of this line.

Note: Any Additions or Changes on This Sheet Must be Made or Circled in Red Ink With Date and Name of Person Making Change.

Notes Ck'd by L. Church	Survey of 92nd St.
Map No. B 3019	JN 009666 Tape 0259 Std 68 °F
Office Work	Surveyed by H.H. Spriggs
Checked	Notes HHS Date 11-9-65
Date	Indexed C. J. GALLI

F. B. 3170 PG. 109

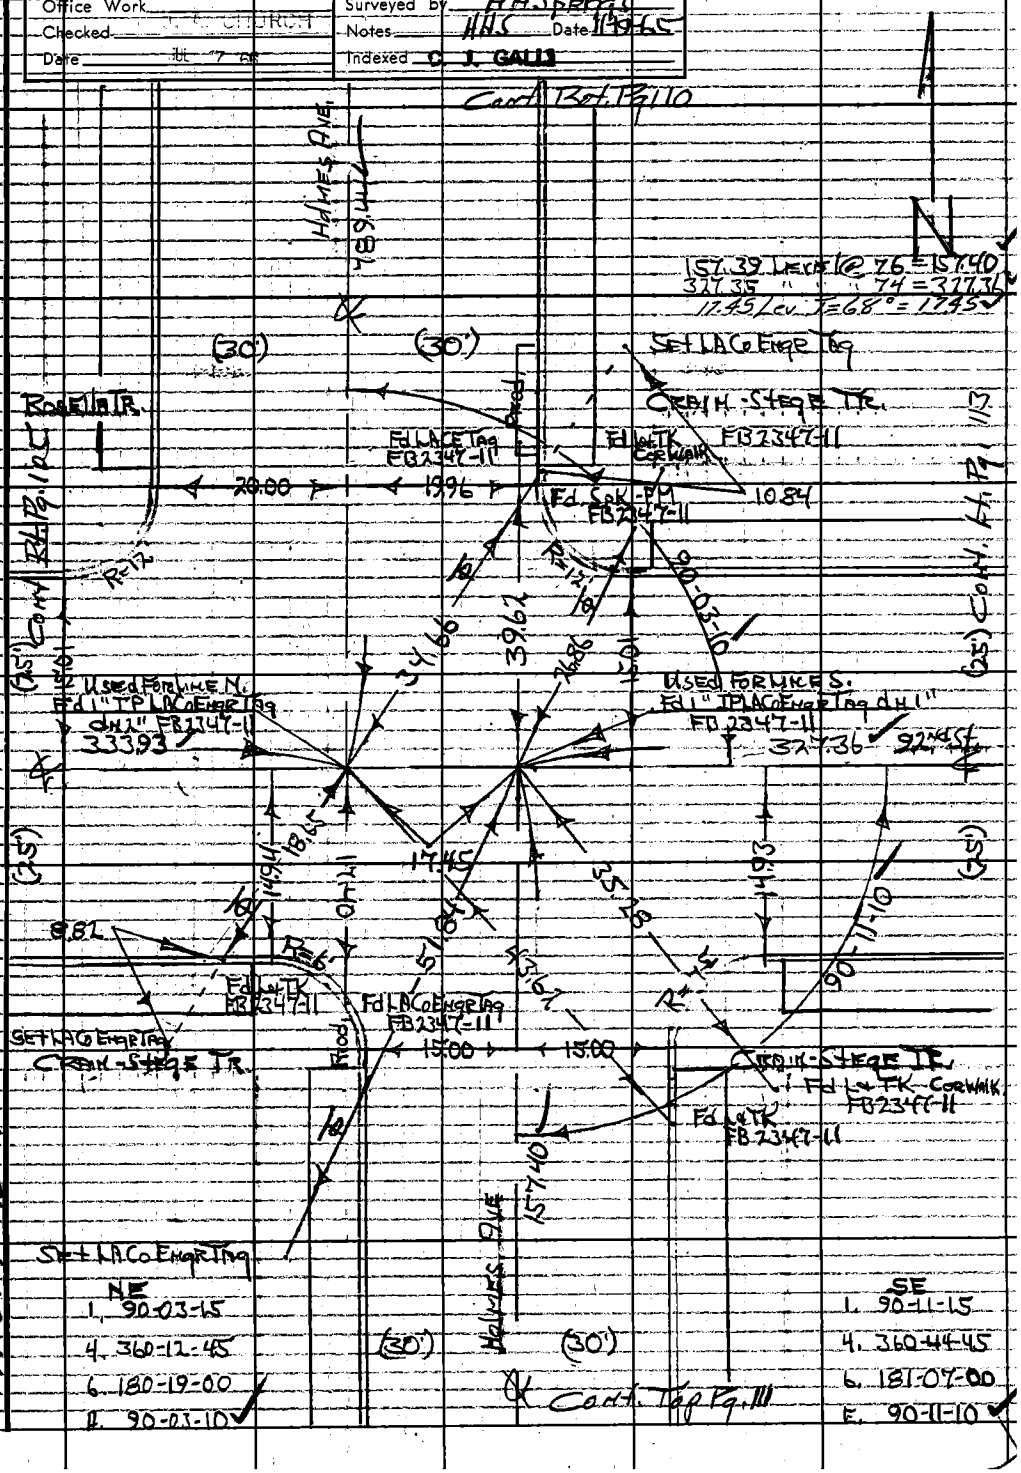

NE	SE
1. 90-03-15	1. 90-11-15
4. 360-12-45	4. 360-44-45
6. 180-19-00	6. 181-07-00
8. 90-03-10	8. 90-11-10

Note: Any Additions or Changes on This Sheet Must be Made or Circled in Red Ink With Date and Name of Person Making Change.

Do not extend this side of this line.

PLEASE RETURN TO
LOS ANGELES COUNTY ENGINEER
403 LOS ANGELES COUNTY ENGINEERING BLDG.

W.S.7 B-6

76F309S CE#310 1-65

F. B. 3170 PG. 110

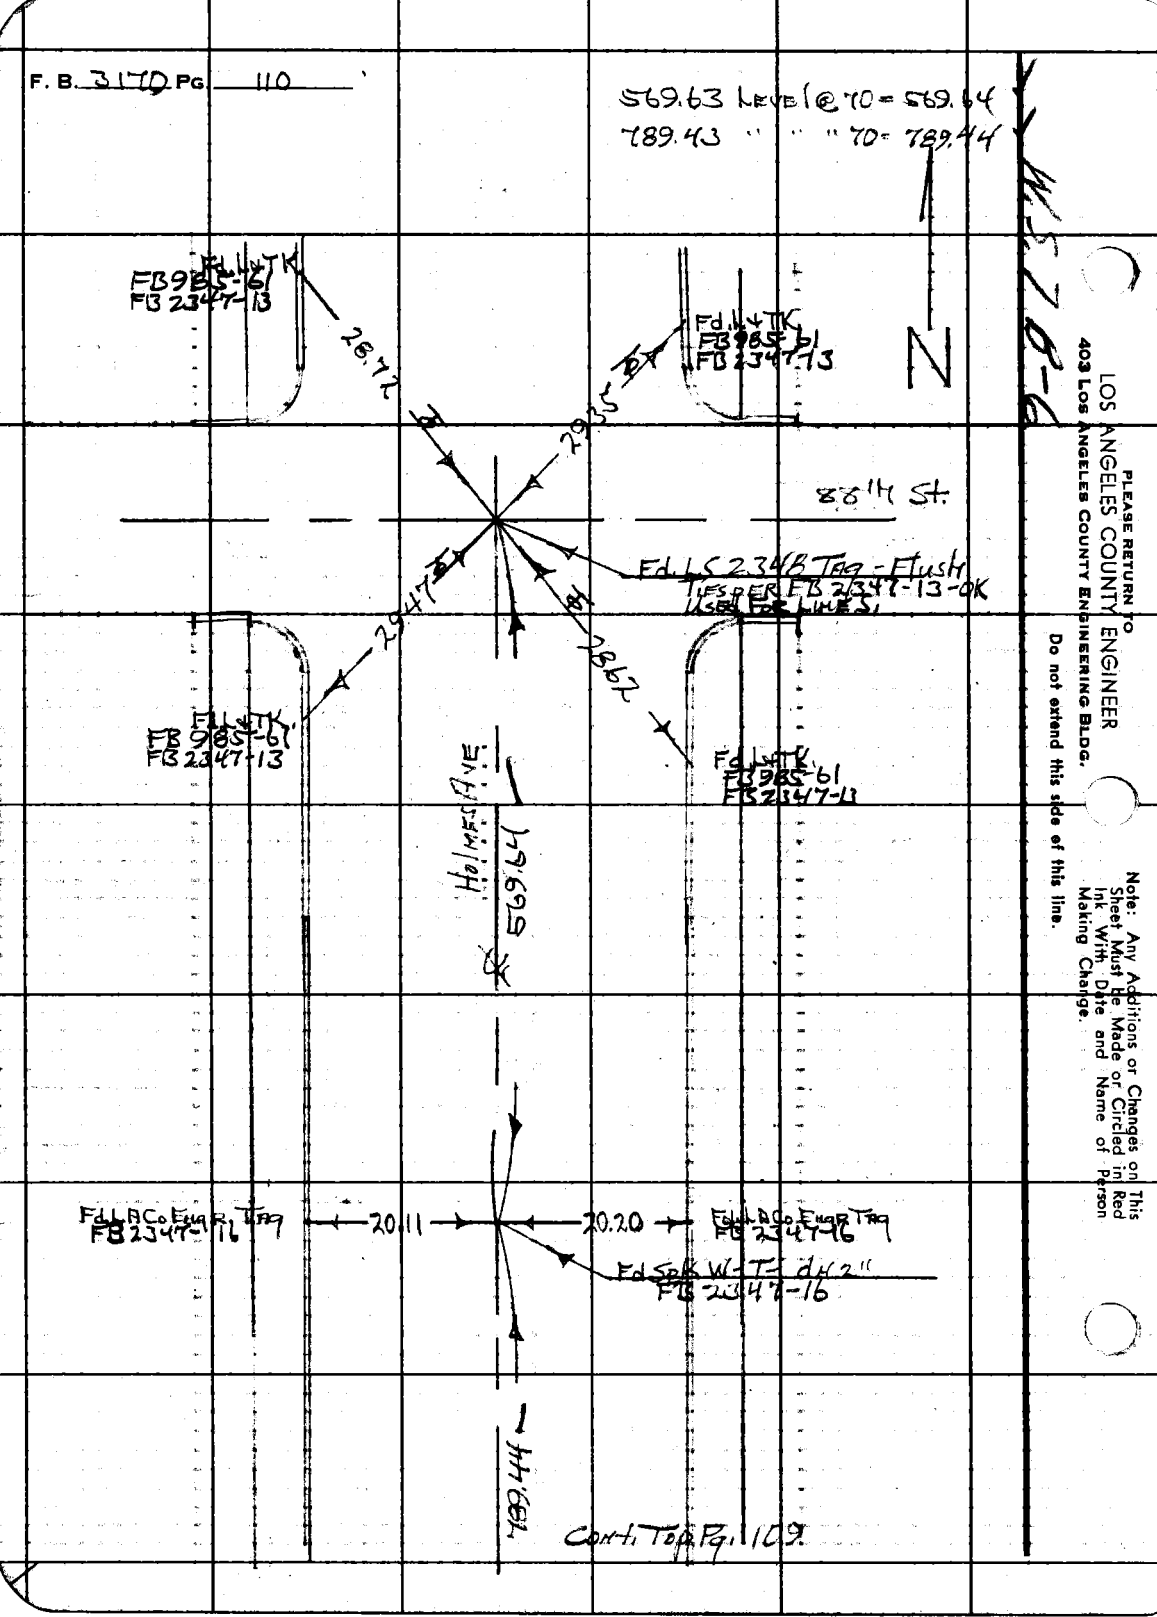

Cont. Top Pg. 109.

PLEASE RETURN TO
LOS ANGELES COUNTY ENGINEER
403 LOS ANGELES COUNTY ENGINEERING BLDG.

Do not extend this side of this line.

Note: Any Additions or Changes on This Sheet Must be Made or Circled in Red Ink With Date and Name of Person Making Change.

Notes Ck'd by J. Church	Survey of 92nd St.	F. B. 3170	Pg. 111
Map No. B 3019	JN 0096.66 Tape 0259 Std 68 °F		
Office Work	Surveyed by HHS Briggs		
Checked	Notes HHS Date 11-19-65		
Date	Indexed G. J. GALLI		

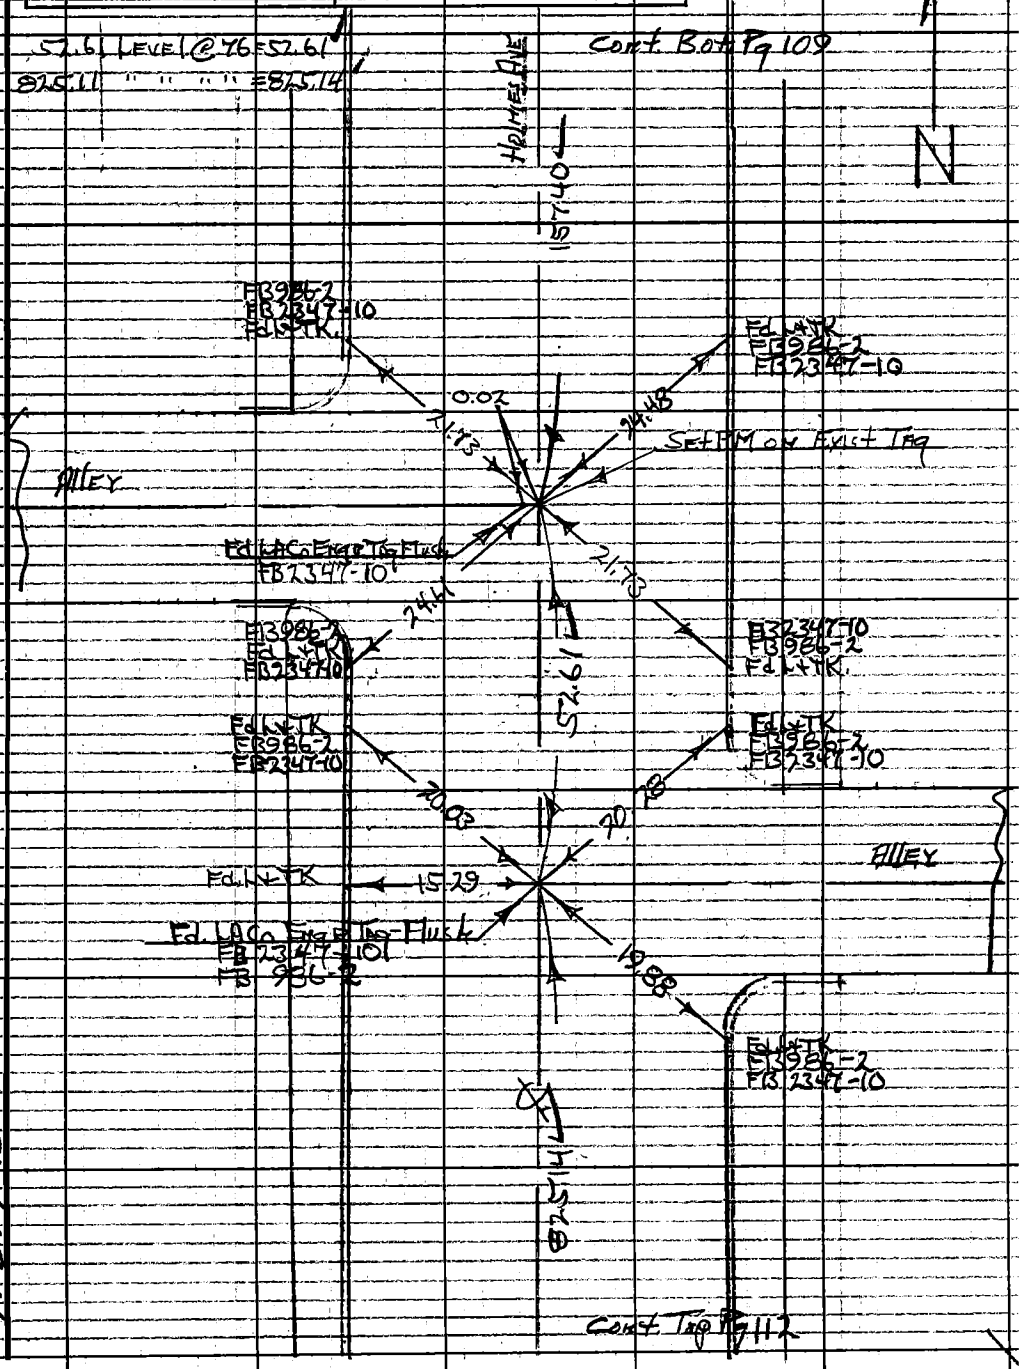

Note: Any Additions or Changes on This Sheet Must be Made or Circled in Red Ink With Date and Name of Person Making Change.

Do not extend this side of this line.

PLEASE RETURN TO
LOS ANGELES COUNTY ENGINEER
403 LOS ANGELES COUNTY ENGINEERING BLDG.

W.S. 7 B-6

76F309S CE#310 1-65

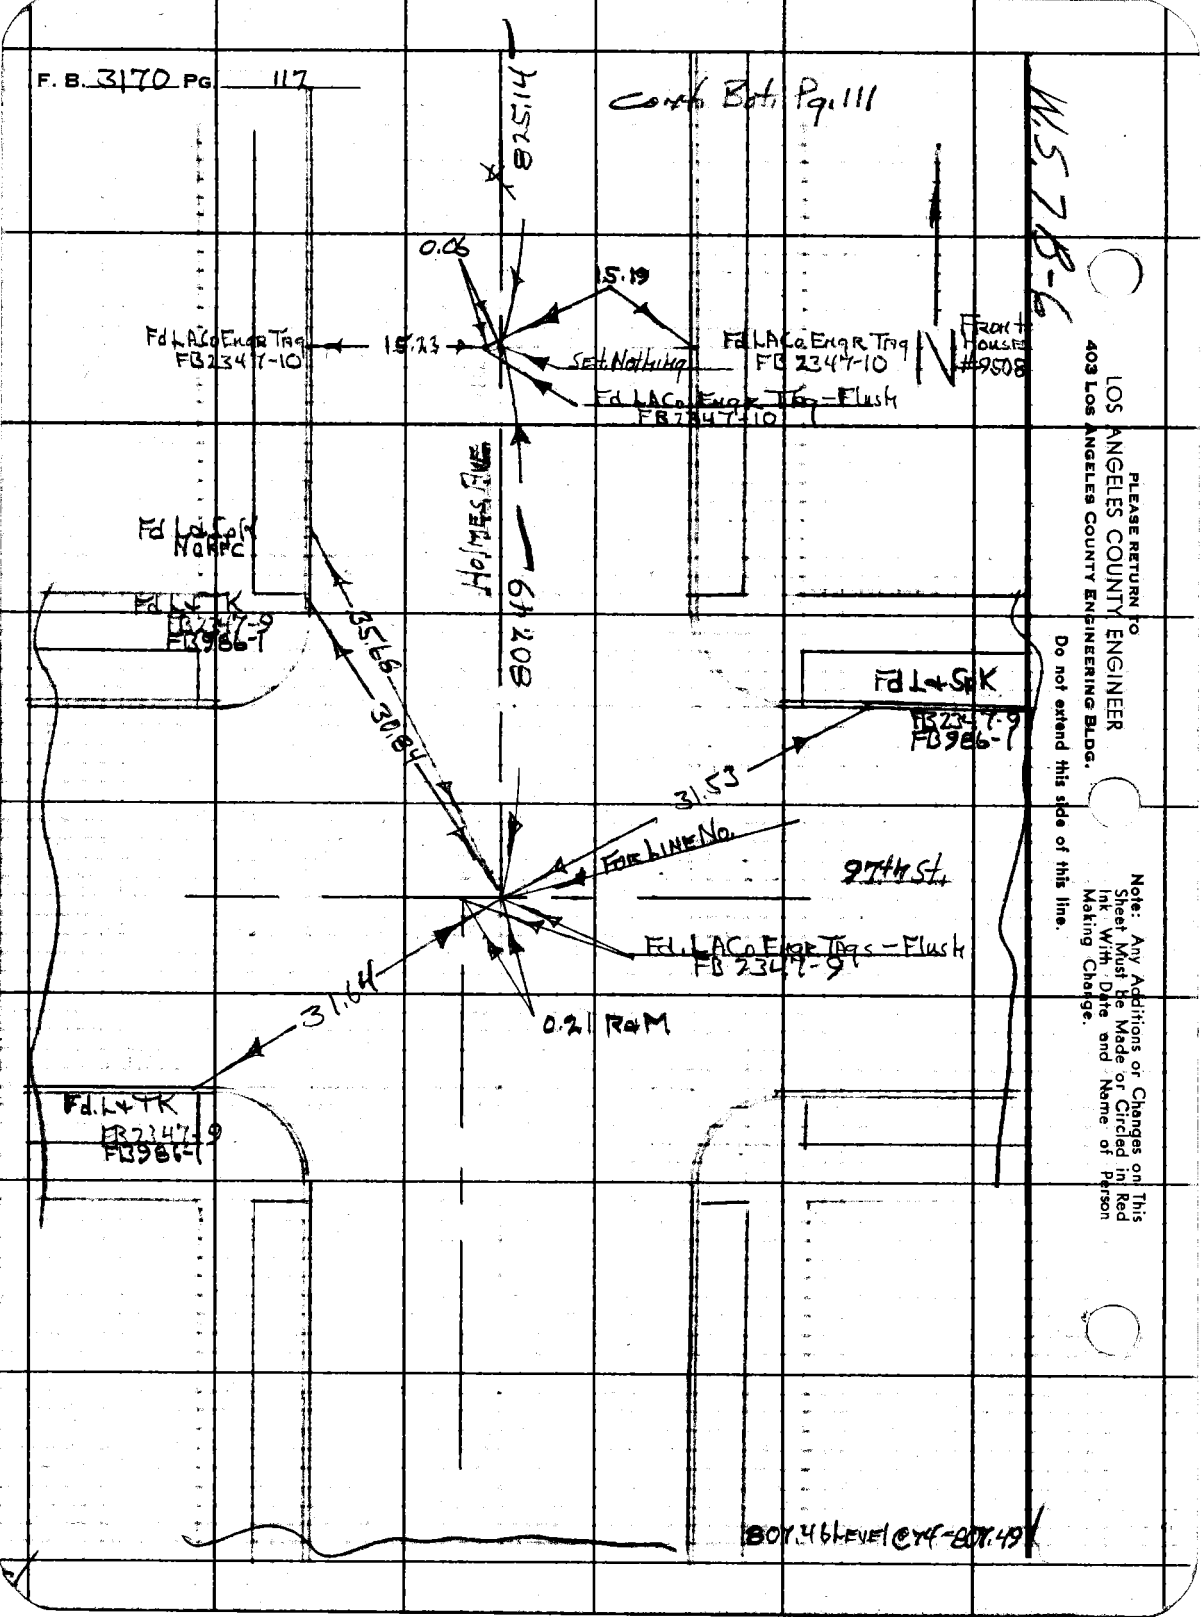

PLEASE RETURN TO
LOS ANGELES COUNTY ENGINEER
403 LOS ANGELES COUNTY ENGINEERING BLDG.

Do not extend this side of this line.

Note: Any Additions or Changes on This Sheet Must be Made or Circled in Red Ink With Date and Name of Person Making Change.

Notes Ck'd by J. Chavel	Survey of 92nd St		F.B. 3170 PG. 113
Map No. B3019	J.N. 0096.66 Tape 0259 Std. 68 °F		
Office Work	Surveyed by HH Spriggs		
Checked	Notes HHS Date 11-19-65		
Date	Indexed C. J. GALLINA 1-5-66		

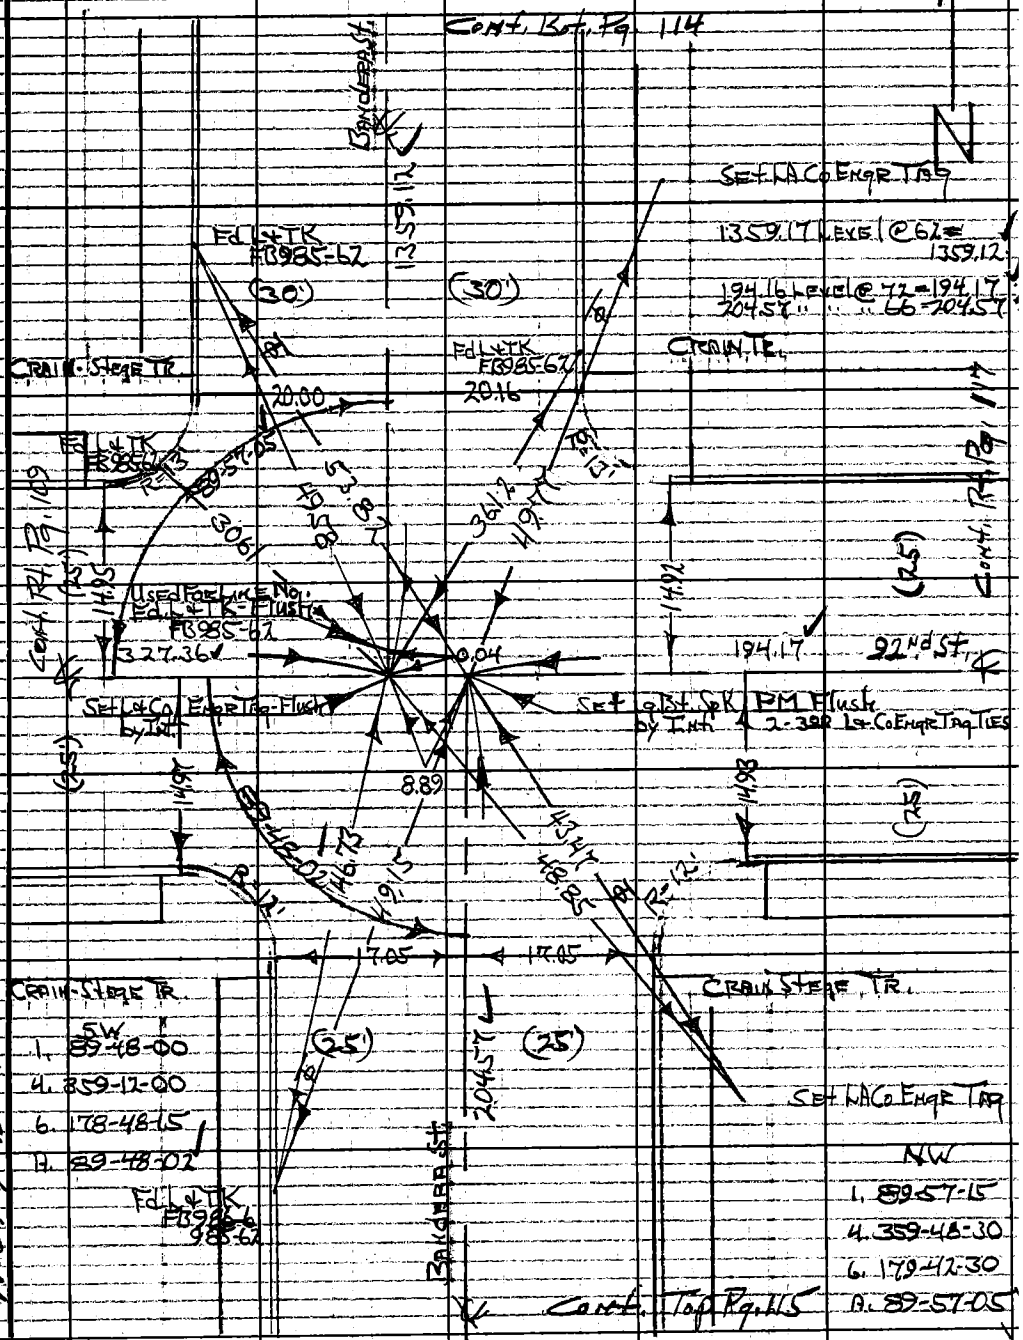

Note: Any Additions or Changes on This Sheet Must be Made or Circled in Red Ink With Date and Name of Person Making Change.

PLEASE RETURN TO
LOS ANGELES COUNTY ENGINEER
403 LOS ANGELES COUNTY ENGINEERING BLDG.
Do not extend this side of this line.

W.S. 7 B-6

76F309S CE#310 1-65

F. B. 3170 PG. 114

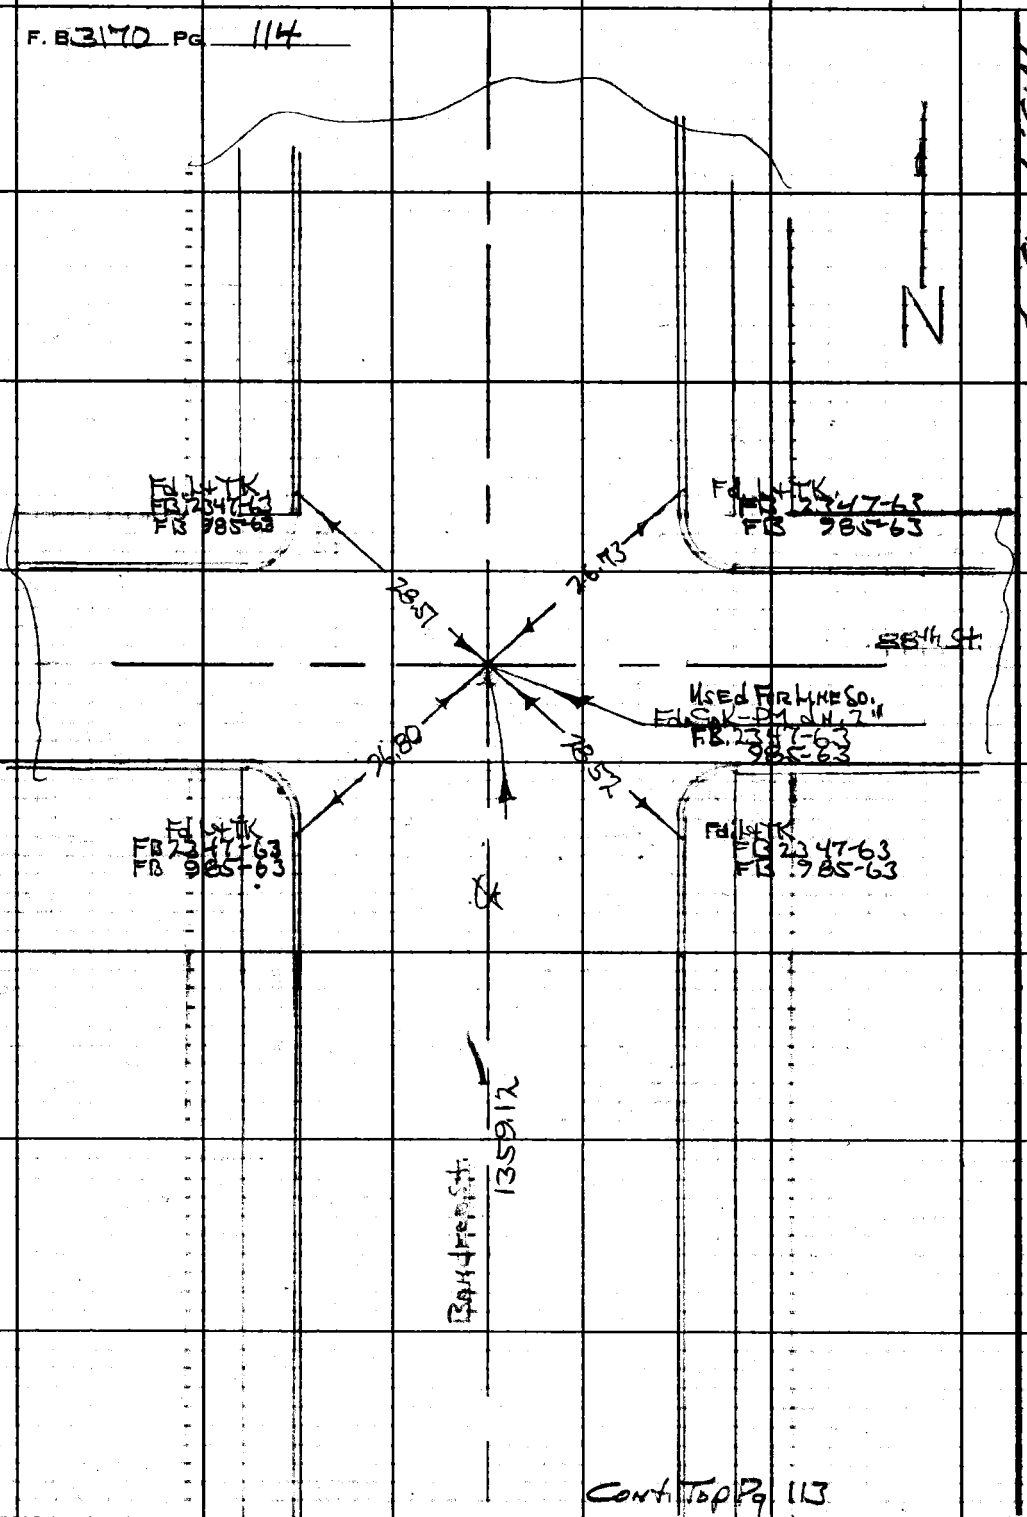

Cont. Top Pg 113

LOS ANGELES COUNTY ENGINEER
403 LOS ANGELES COUNTY ENGINEERING BLDG.

PLEASE RETURN TO

Do not extend this side of this line.

Note: Any Additions or Changes on This Sheet Must Be Made or Circled in Red Ink With Date and Name of Person Making Change.

Notes Ck'd by J. Church	Survey of 92nd St.
Map No. B3019	JN 009666 Tape 0259 Std 68 °F
Office Work	Surveyed by HH Spriggs
Checked I. A. CHURCH	Notes HHS Date 11-19-65
Date JUL 7 '66	Indexed C. J. GALLI

F. B. 3170 PG. 115

Cont Bot Pg. 113

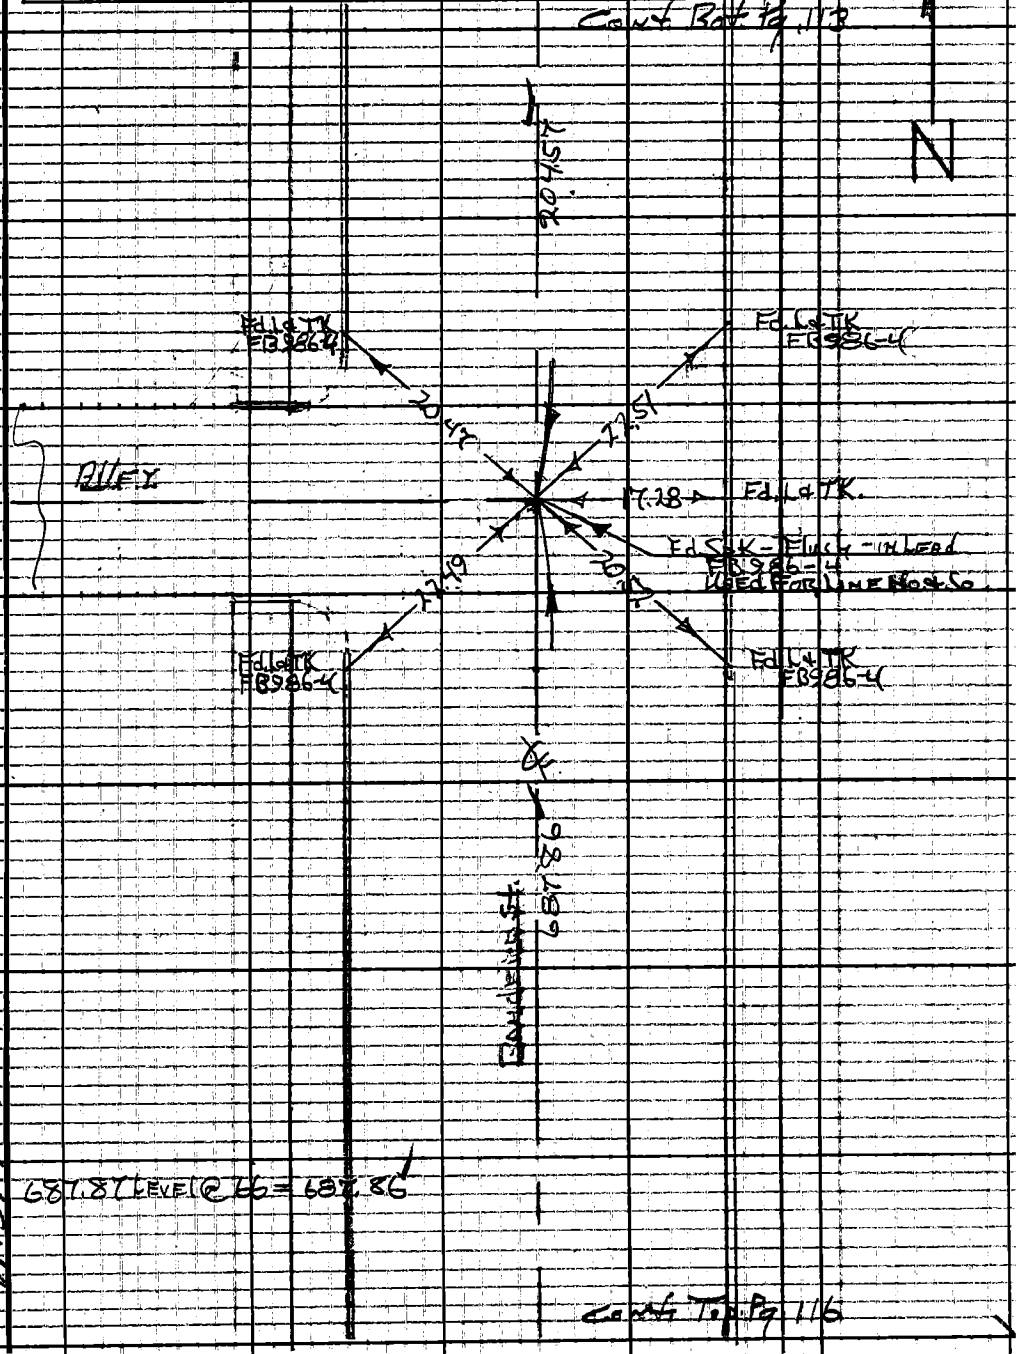

Cont Top Pg 116

Note: Any Additions or Changes on This Sheet Must be Made or Circled in Red Ink With Date and Name of Person Making Change.
Do not extend this side of this line.
PLEASE RETURN TO
LOS ANGELES COUNTY ENGINEER
403 LOS ANGELES COUNTY ENGINEERING BLDG.
76F309S CE#310 1-65

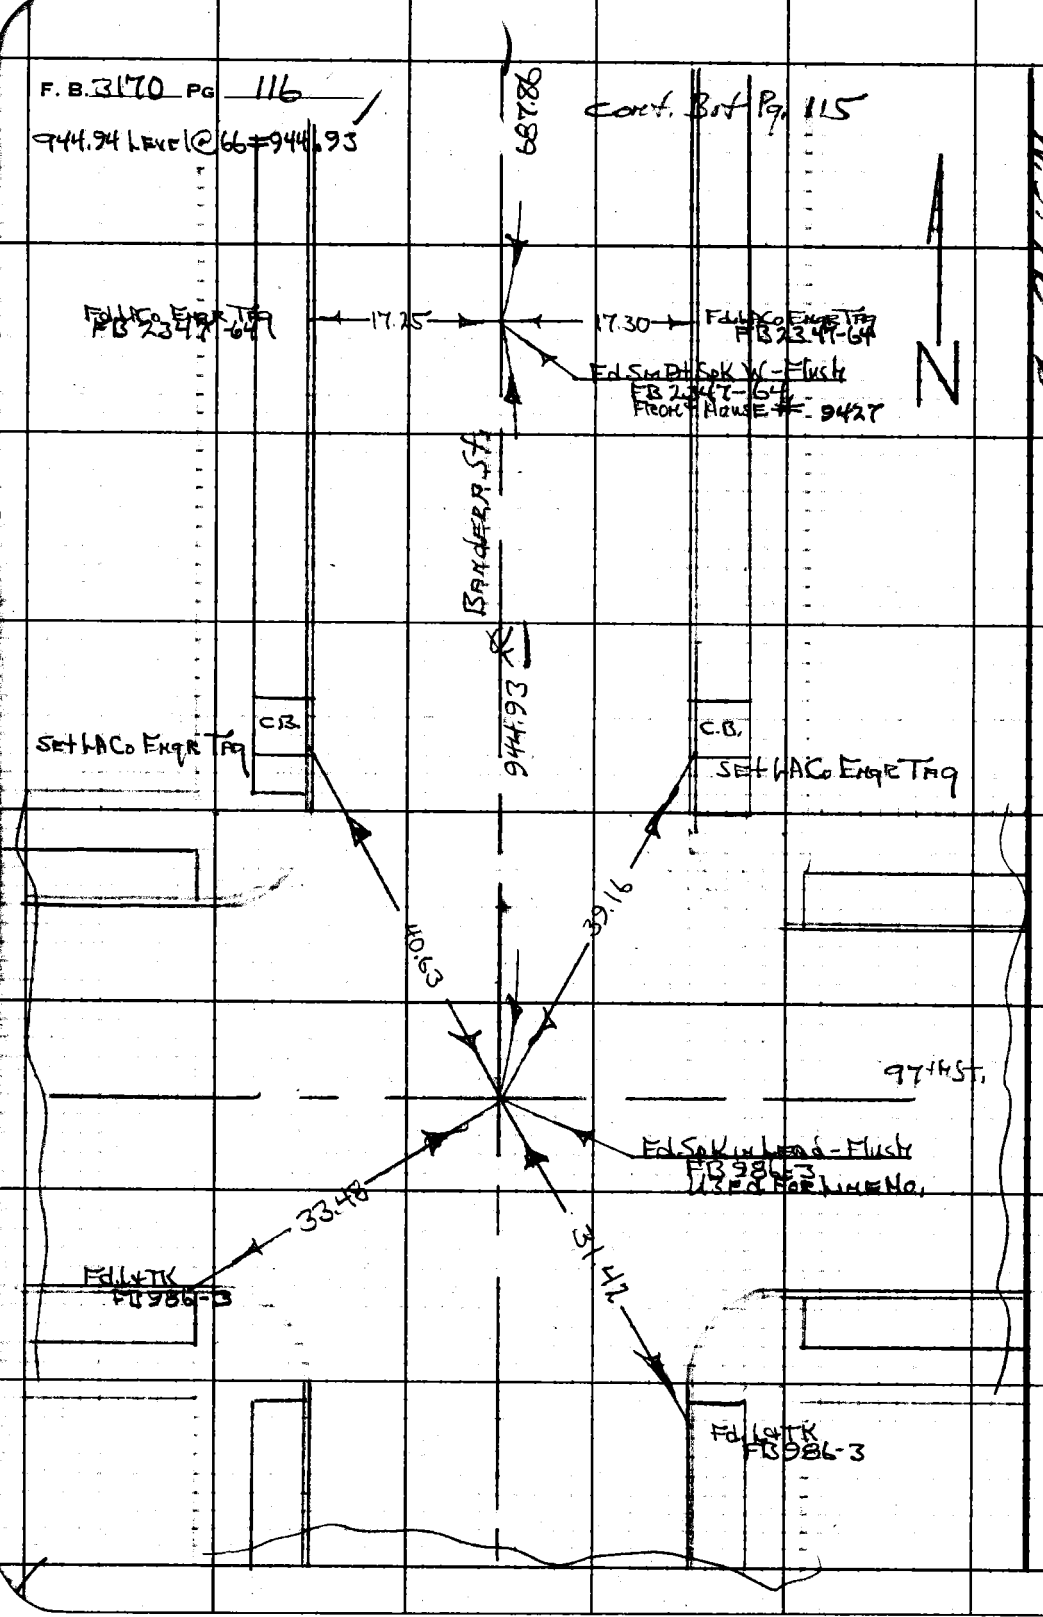

W.S. 78-6

PLEASE RETURN TO
LOS ANGELES COUNTY ENGINEER
403 LOS ANGELES COUNTY ENGINEERING BLDG.

Do not extend this side of this line.

Note: Any Additions or Changes on This Sheet Must be Made or Circled in Red Ink With Date and Name of Person Making Change.

Notes Ck'd by J. Church	Survey of 92nd St.	F.B. 3170 PG. 117
Map No. B 3019	JN 009466 Tape 0259 Std 68 °F	
Office Work	Surveyed by HH Springs	
Checked J. A. CHURCH	Notes HHS Date 1/19/65	
Date JU 7 00	Indexed C. J. GALLI	

370.10 LEVEL @ 68 = 370.10

Cont. Rot. Pg 118

N

CRAIN TR.

TR. 5863

1359.10 ALLEY 370.10

(10) (10)

90-10-04

9.18

Fd L+TK FB985-62

Cont. Rt. Pg 113

Cont. Lt. Pg 119

20°

2604

15.07 (16.5)

15.10

(25)

194.17

135.85 92nd St.

Fd. Conc Nail OK Per Ties FB985-62 Used For Line No.

25.82

15.00

15.21

FB985-62 Fd L+TK - Prod

Fd. L+TK's - Most Southerly One FB985-62

Set LACo Engr Tag

Conc. Walk

9.00

Set LACo Engr Tag Prod

Fd. Lead - No Nail - FB985-62 Reset LACo Engr Tag

Set LACo Engr Tag

14.87

15.17

135.85 LEVEL @ 72 = 135.85

CRAIN STEGE TR.

1. 90-10-00
4. 360-40-15
6. 181-00-15
A. 90-10-02

DONOHUE TR.

Note: Any Additions or Changes on This Sheet Must be Made or Circled in Red Ink With Date and Name of Person Making Change.

Do not extend this side of this line.

PLEASE RETURN TO
LOS ANGELES COUNTY ENGINEER
403 LOS ANGELES COUNTY ENGINEERING BLDG.

76F309S CE#310 1-65

F. B. 3170 PG 118

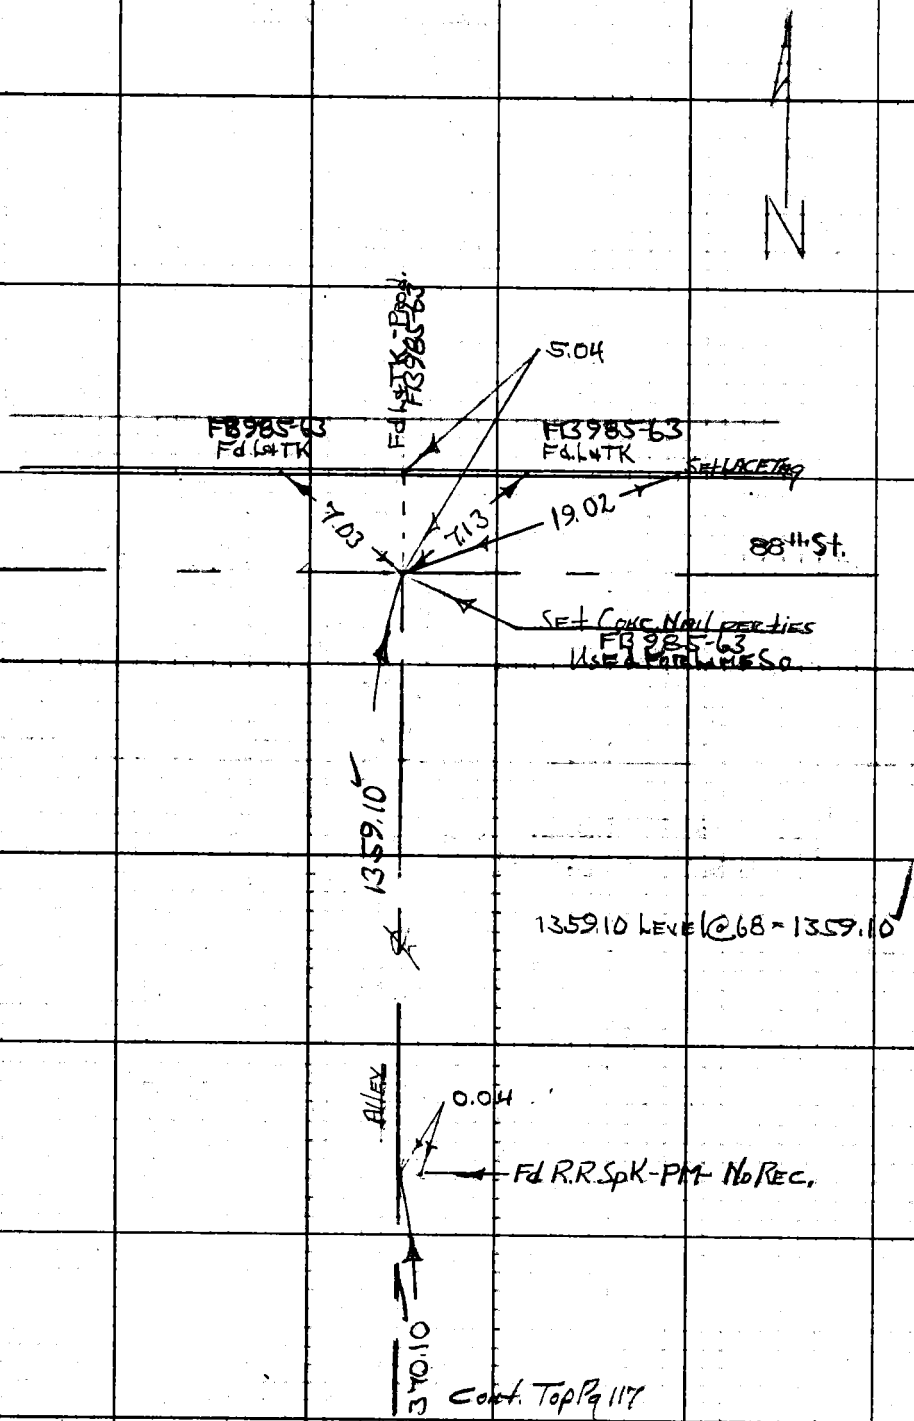

PLEASE RETURN TO
LOS ANGELES COUNTY ENGINEER
403 LOS ANGELES COUNTY ENGINEERING BLDG.

Do not extend this side of this line.

Note: Any Additions or Changes on This Sheet Must be Made or Circled in Red Ink With Date and Name of Person Making Change.

Notes Ck'd by J. Church	Survey of 92nd St.		F.B. 3170 PG. 119
Map No. B 3019	JN 009660	Tape 0759	Std 68 °F
Office Work	Surveyed by H.H. Springs		
Checked J. A. CHURCH	Notes HHS	Date 12-65	
Date JUL 7 '66	Indexed C. J. GALLI		

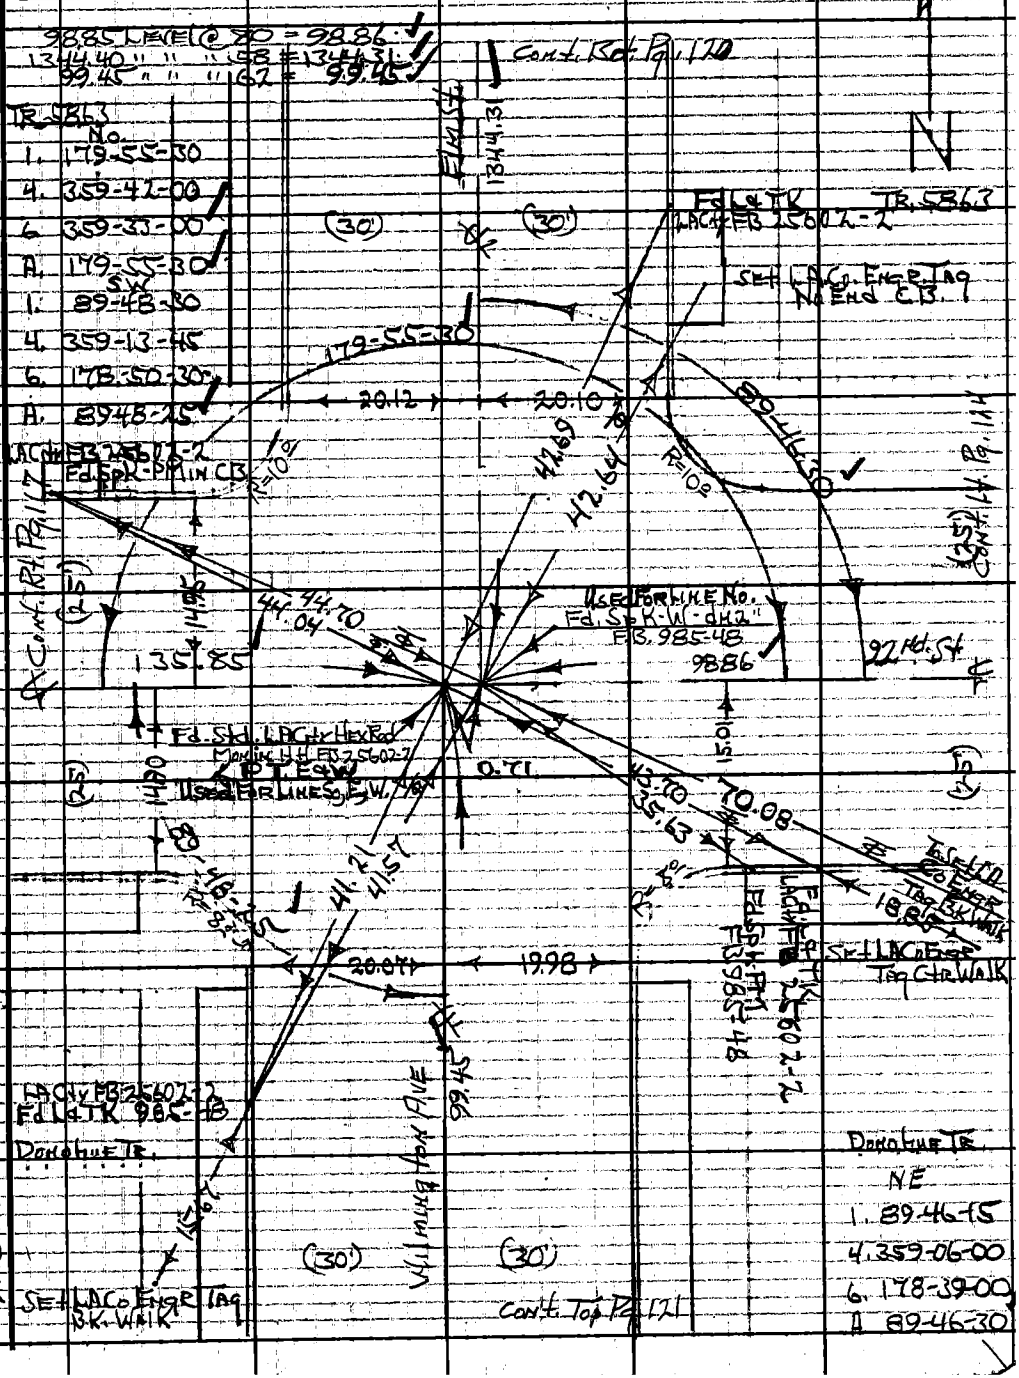

Note: Any Additions or Changes on This Sheet Must be Made or Circled in Red Ink With Date and Name of Person Making Change.

Do not extend this side of this line.

PLEASE RETURN TO
LOS ANGELES COUNTY ENGINEER
403 Los Angeles County Engineering Bldg.

W.S. 7 B-6

76F309S CE#310 1-65

F. B. 3170 PG. 120

W.S. 7 B-6

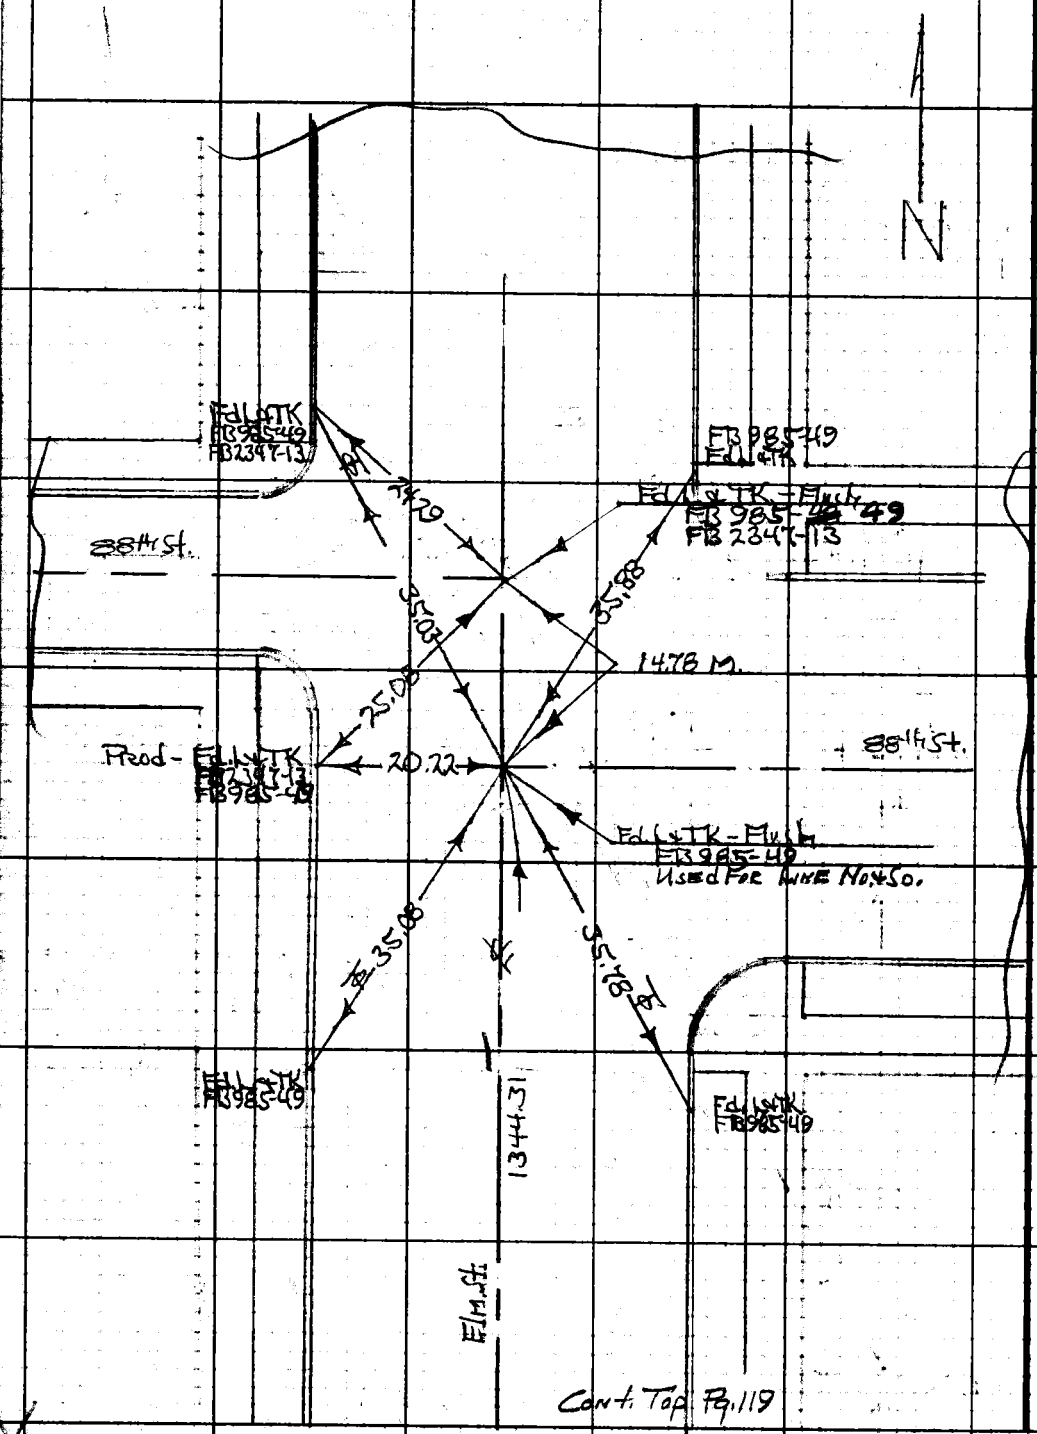

Cont. Top Pg. 119

PLEASE RETURN TO
LOS ANGELES COUNTY ENGINEER
403 LOS ANGELES COUNTY ENGINEERING BLDG.

Do not extend this side of this line.

Note: Any Additions or Changes on This Sheet Must be Made or Circled in Red Ink With Date and Name of Person Making Change.

Notes Ck'd by J. Church | Survey of 92nd St. | F. B3170 PG. 121
Map No. B3019 | JN 0096.16 Tape 0259 Std 68 °F
Office Work | Surveyed by HHS
Checked J. A. CHURCH | Notes HHS Date 12-1-65
Date | Indexed G. J. GALLI

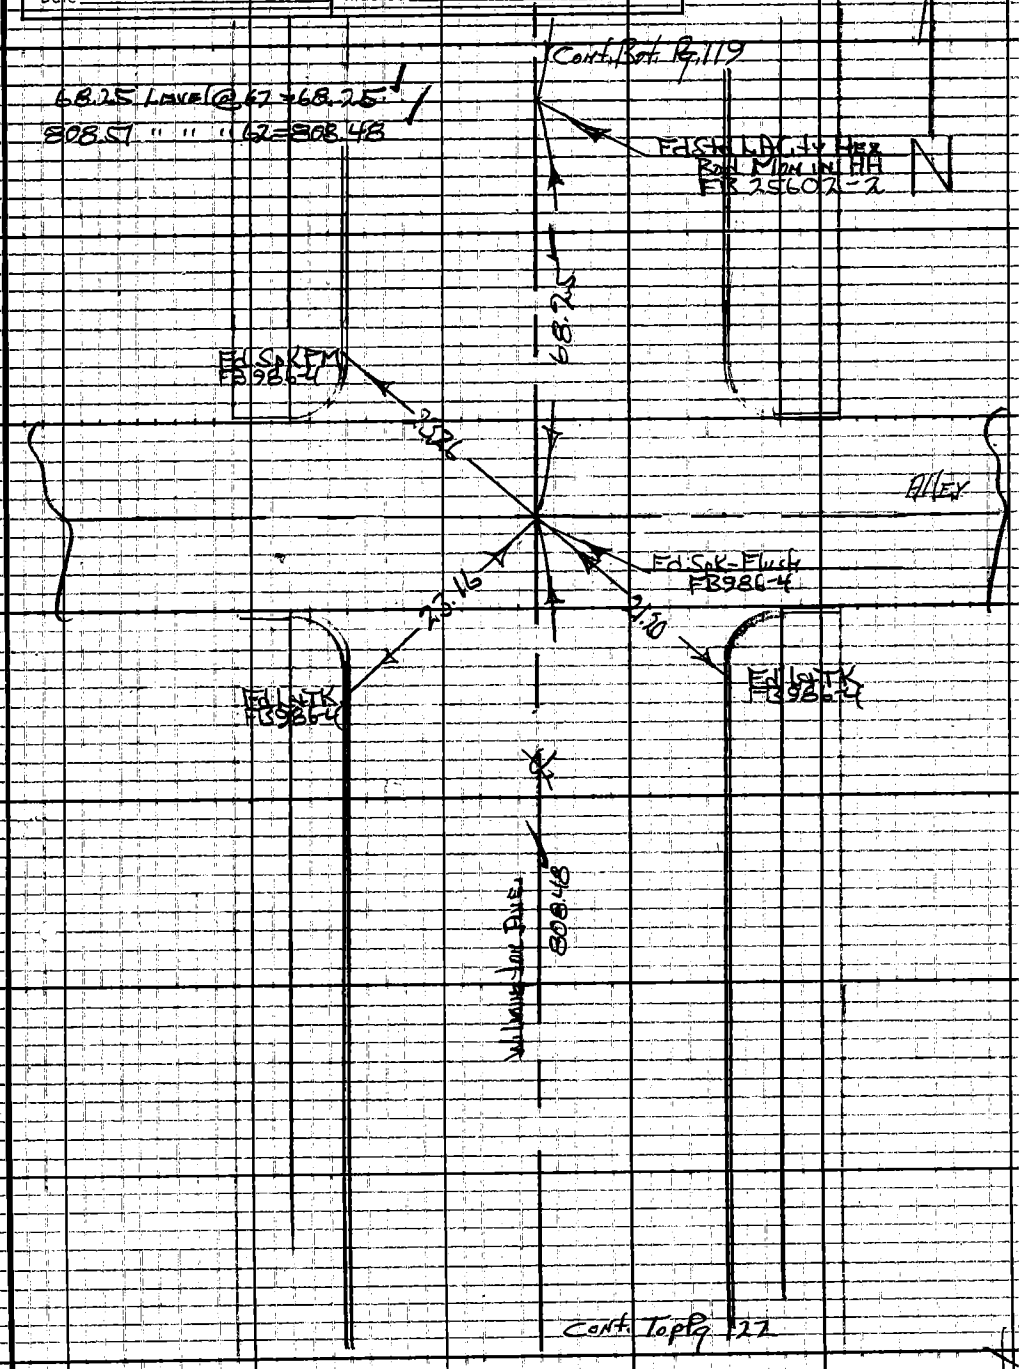

Note: Any Additions or Changes on This Sheet Must be Made or Circled in Red Ink With Date and Name of Person Making Change.

PLEASE RETURN TO
LOS ANGELES COUNTY ENGINEER
403 LOS ANGELES COUNTY ENGINEERING BLDG.
Do not extend this side of this line.

76F309S CE#310 1-65

F. B. 3170 Pg. 122

Cont. Bot. Pg 121

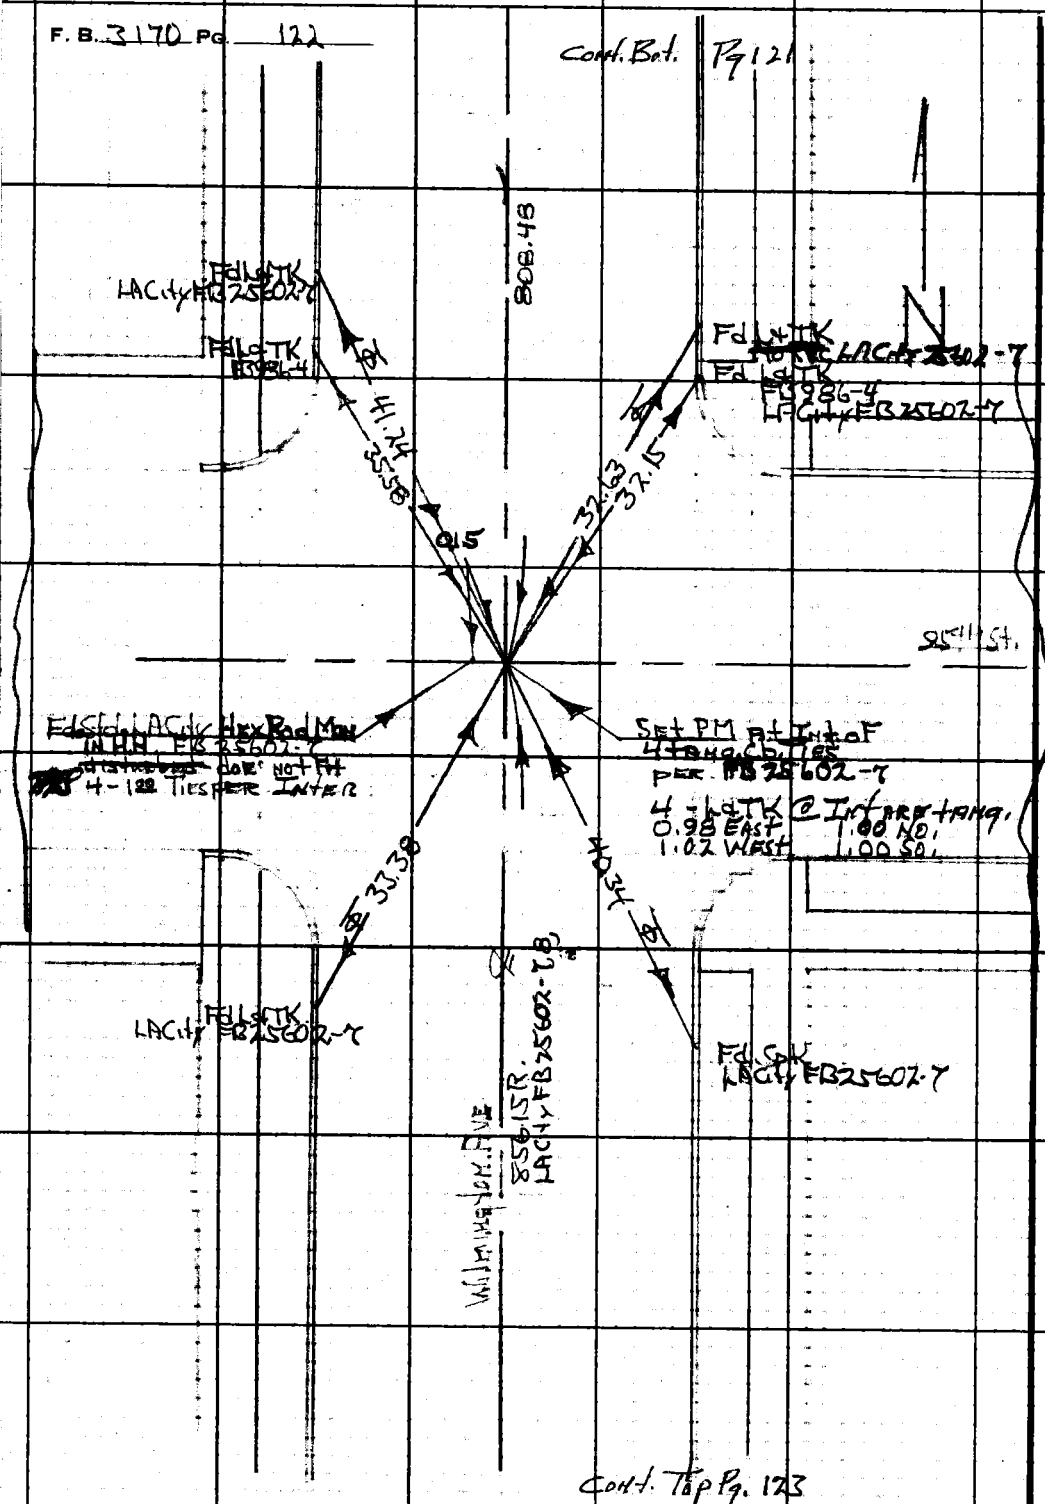

Cont. Top Pg. 123

W.S. 7 B-6

PLEASE RETURN TO
LOS ANGELES COUNTY ENGINEER
403 LOS ANGELES COUNTY ENGINEERING BLDG.

Do not extend this side of this line.

Note: Any Additions or Changes on This Sheet Must be Made or Circled in Red Ink With Date and Name of Person Making Change.

Notes Ck'd by L. Church	Survey of 92 Nd St		F.B. 3170 PG. 123
Map No. B3019	JN 009646 Tape 0259 Std 68 °F		
Office Work	Surveyed by HHS Sprekers		
Checked J. A. CHURCH	Notes HHS Date 12-1-65		
Date JUL 7 '66	Indexed C. J. GALLY		

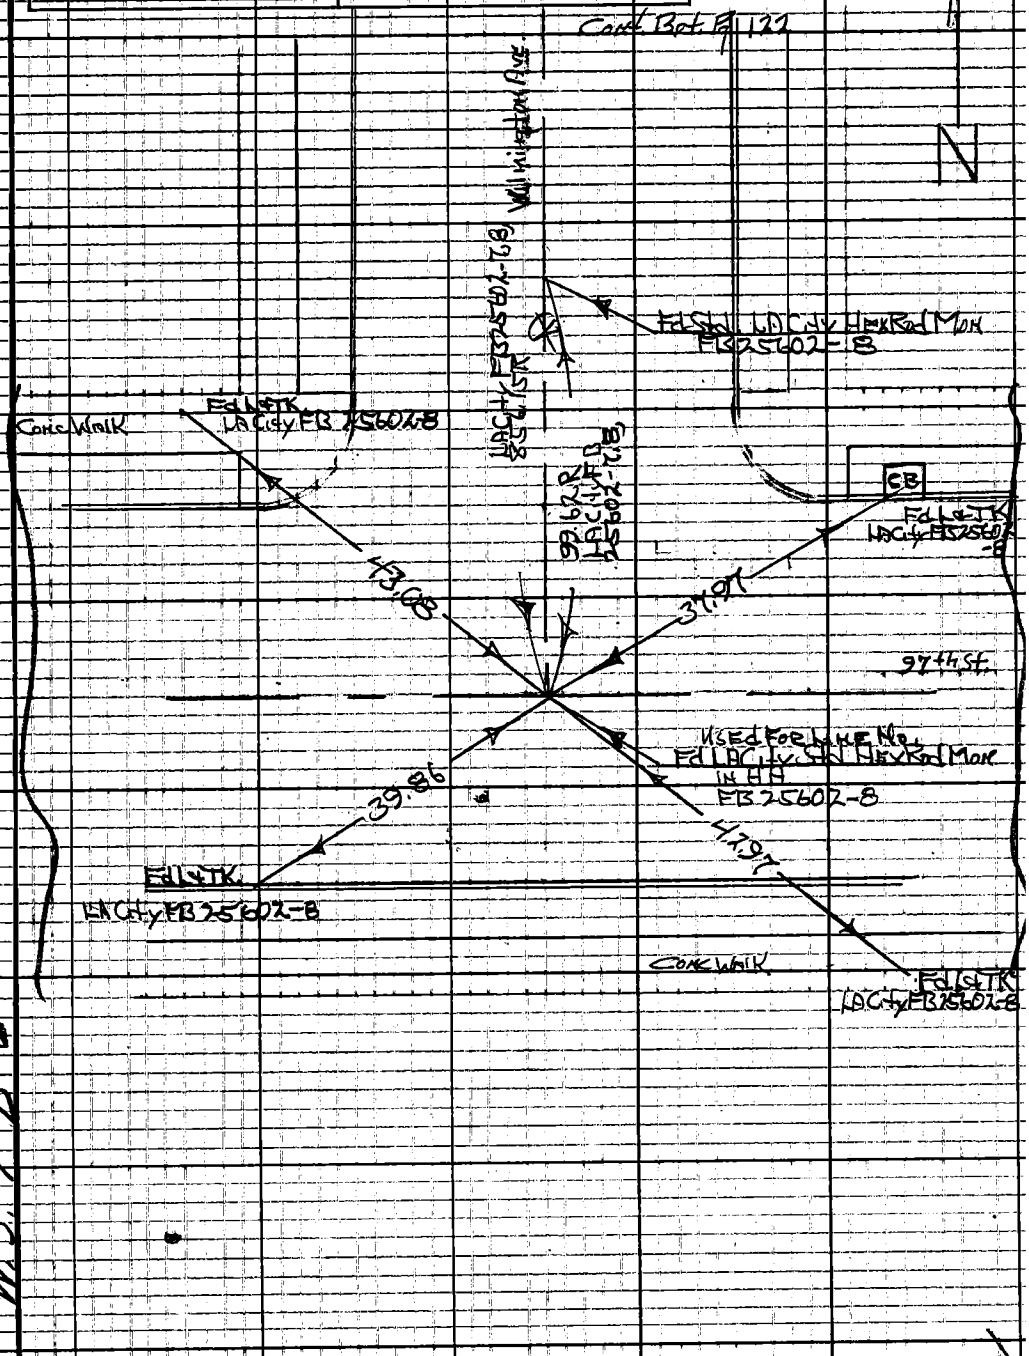

Note: Any Additions or Changes on This Sheet Must be Made or Circled in Red Ink With Date and Name of Person Making Change.

Do not extend this side of this line.

PLEASE RETURN TO
LOS ANGELES COUNTY ENGINEER
403 LOS ANGELES COUNTY ENGINEERING BLDG.

W.S. 7 B-6

76F309S CE#310 1-65

F. B. 3170 PG 124

Cont. Bot. Pg 125

1344.26 Level @ 56 = 1344.16

Alley

TR. 5863

Mogis Tr. #2

N

1344.16

(75) (75)

Set Nothing over Inner of 4 Fd PM's on Rim

Cont. Rt. Pg. 119

(25)

89-45-02

Cont. Lt. Pg. 126

(25)

Fd Std. LA Cty Hex Rod
Mon in HH
FB 23602
25602

98.86

73.33

.002

172.07 92nd St

Set PM by Int.
Fd PM's on MH Rim tube off
Set 2-3 oo Sq Hd. W. Ties East
FB 985-48

(25)

32.03

14.97

15.17

21.04

Fd. L&TK. FB 985-48

(25)

Set LACo Tag

Set LACo Engr. Tag

Conc Walk

8.92

12.19

Used for Line Nos

Set LACo Engr Tag - Prod.

Set LACo Engr. Tag

34.58

73.32 Level @ 80 = 73.33

1. 89-45-00 NE.
4. 359-00-15
6. 178-30-15
A. 89-45-02

172.06 Level @ 80 = 172.07

Donohue Tr.

PLEASE RETURN TO
LOS ANGELES COUNTY ENGINEER
403 Los Angeles County Engineering Bldg.

Do not extend this side of this line.

Note: Any Additions or Changes on This Sheet Must be Made or Circled in Red Ink With Date and Name of Person Making Change.

Notes Ck'd by L. Church
Map No. B. 3019
Office Work
Checked J. A. CHURCH
Date

Survey of 92nd St
JN 0096.66 Tape 67.59 Std 68 °F
Surveyed by HH Springer
Notes Date 12-1-65
Indexed C. J. GALLI

F. B. 3170 Pg. 125

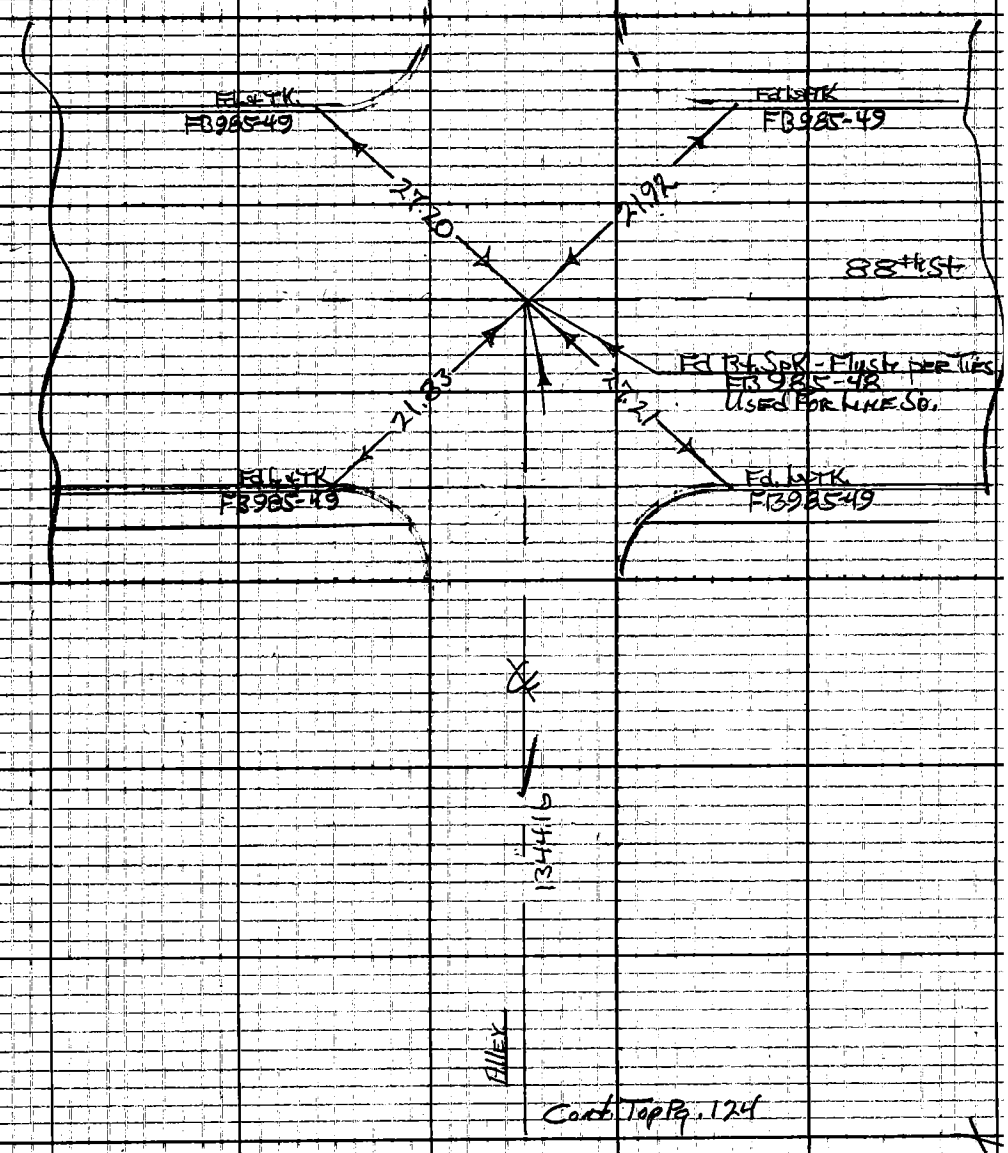

Note: Any Additions or Changes on This Sheet Must be Made or Circled in Red Ink With Date and Name of Person Making Change.

Do not extend this side of this line.

PLEASE RETURN TO
LOS ANGELES COUNTY ENGINEER
403 Los Angeles County Engineering Bldg.

76F3095 CE#310 1-65

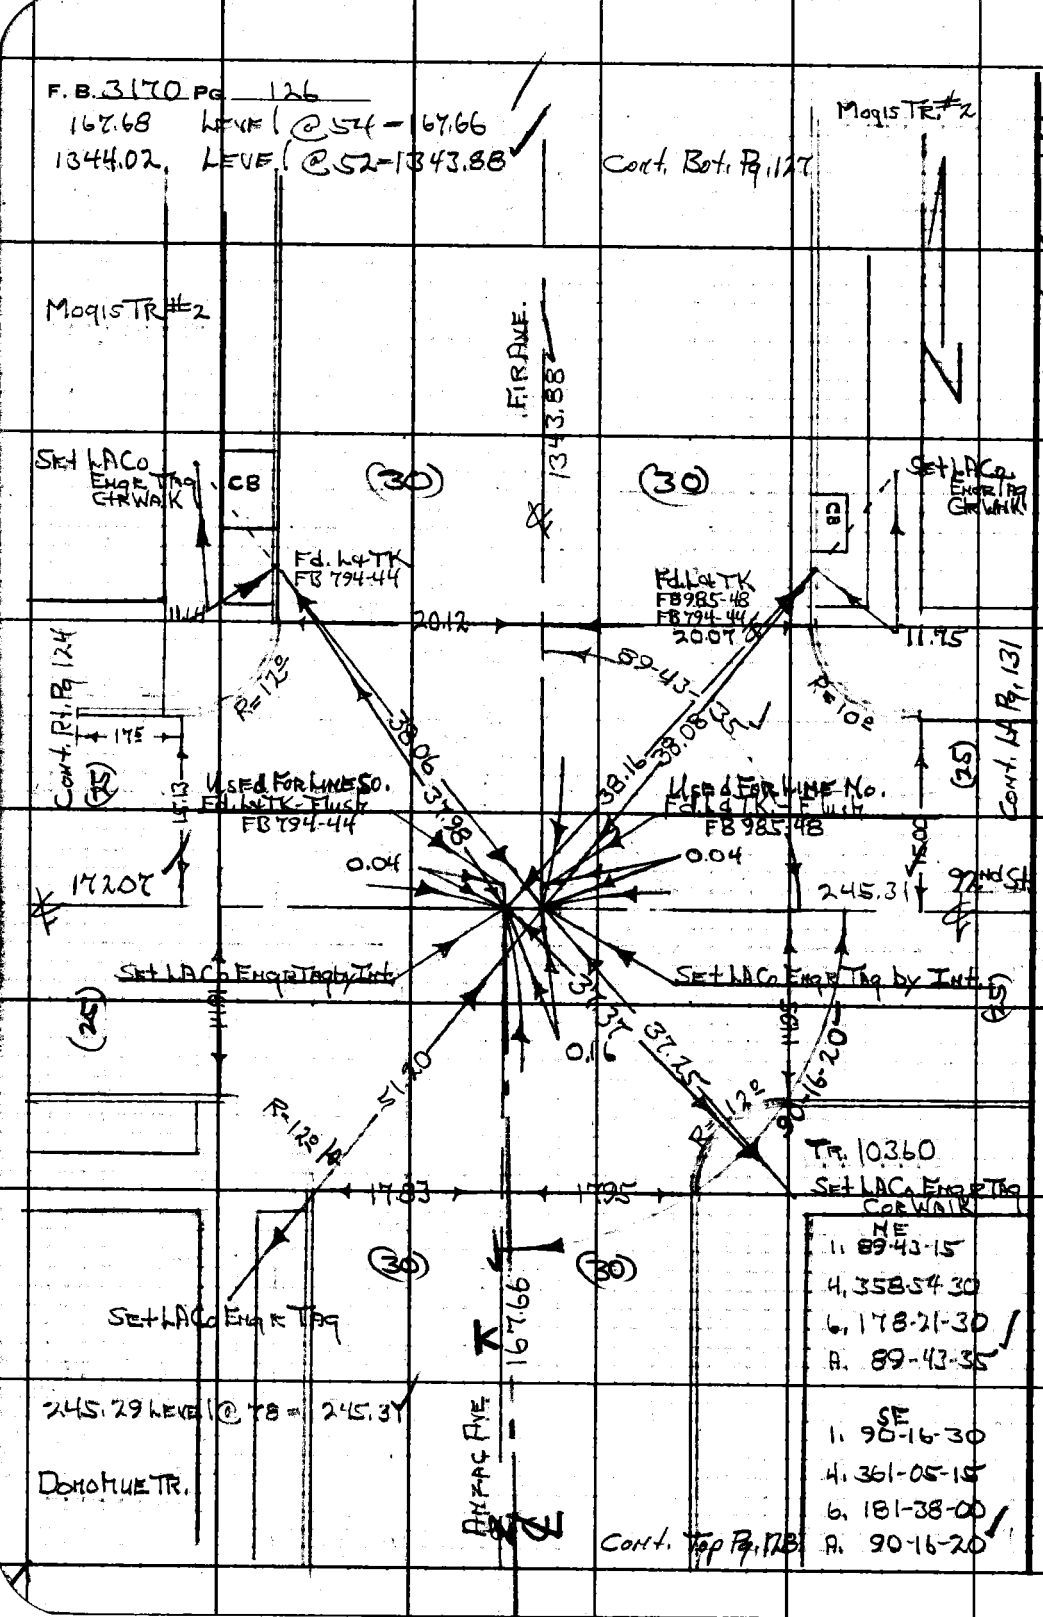

W.S. 2 B-6

PLEASE RETURN TO
LOS ANGELES COUNTY ENGINEER
403 LOS ANGELES COUNTY ENGINEERING BLDG.

Do not extend this side of this line.

Note: Any Additions or Changes on This Sheet Must be Made or Circled in Red Ink With Date and Name of Person Making Change.

Notes Ck'd by J. Church	Survey of 92nd St.
Map No. B3019	JN 0096.66 Tape 0259 Std 68 °F
Office Work	Surveyed by H.H. Spriggs
Checked J. A. CHURCH JUL 7 '66	Notes HHS Date 11-9-65
Date	Indexed C. J. GALLY

F.B. 3170 PG. 127

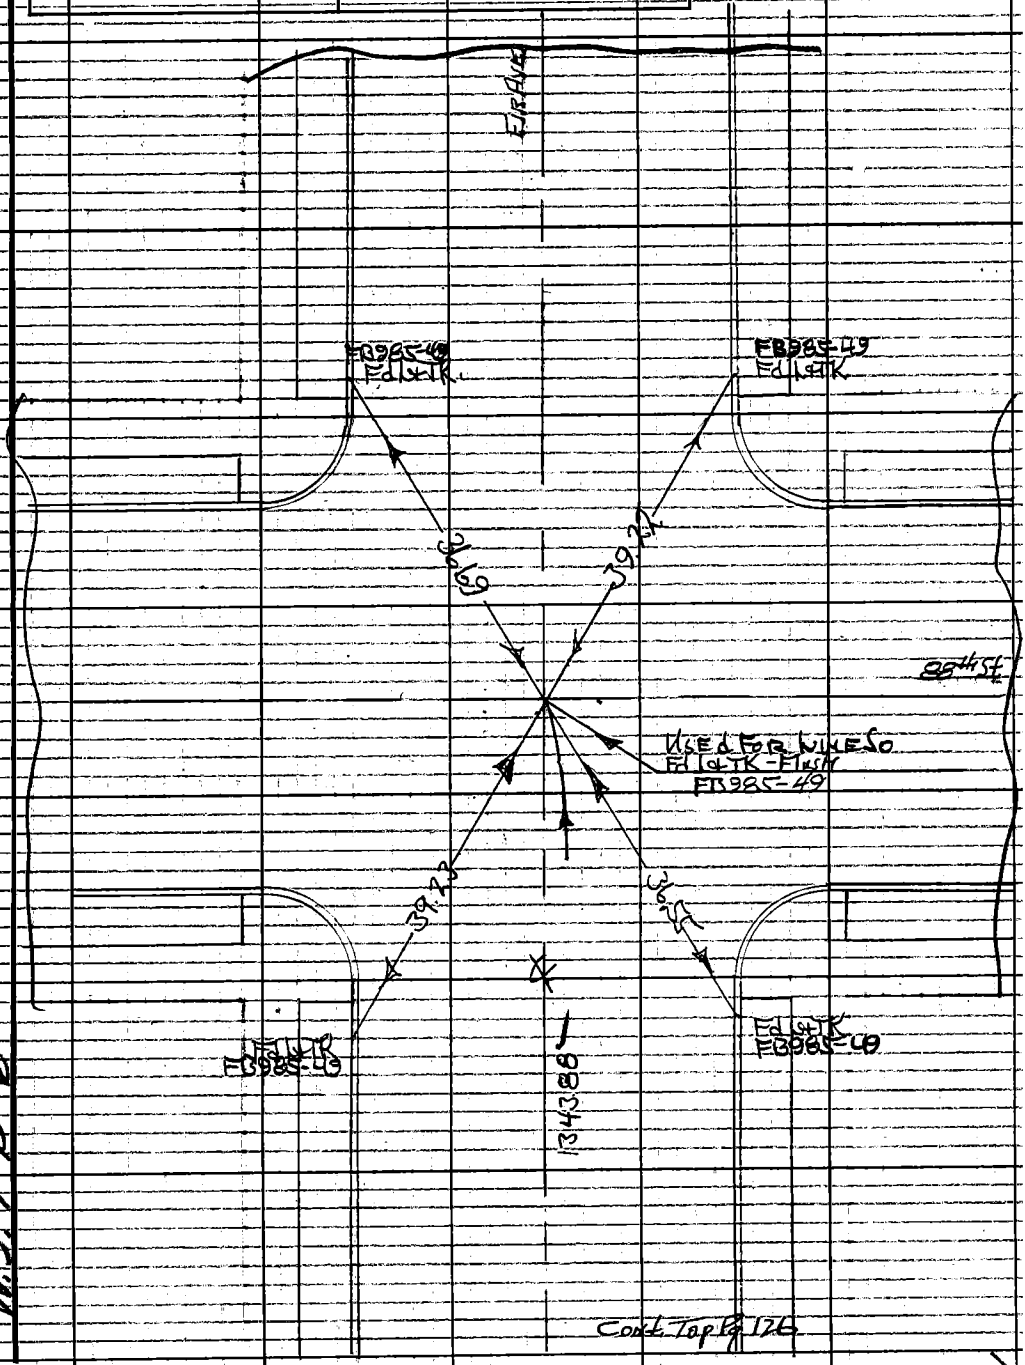

Cont. Top Pg 126

W.S. 7 B-6

Note: Any Additions or Changes on This Sheet Must be Made or Circled in Red Ink With Date and Name of Person Making Change.

PLEASE RETURN TO
LOS ANGELES COUNTY ENGINEER
403 LOS ANGELES COUNTY ENGINEERING BLDG.
Do not extend this side of this line.

76F309S CE#310 1-65

F. B. 3170 PG 128

Cont. Bot. Pg. 126

80853 LEXE (@ 54 = 80846

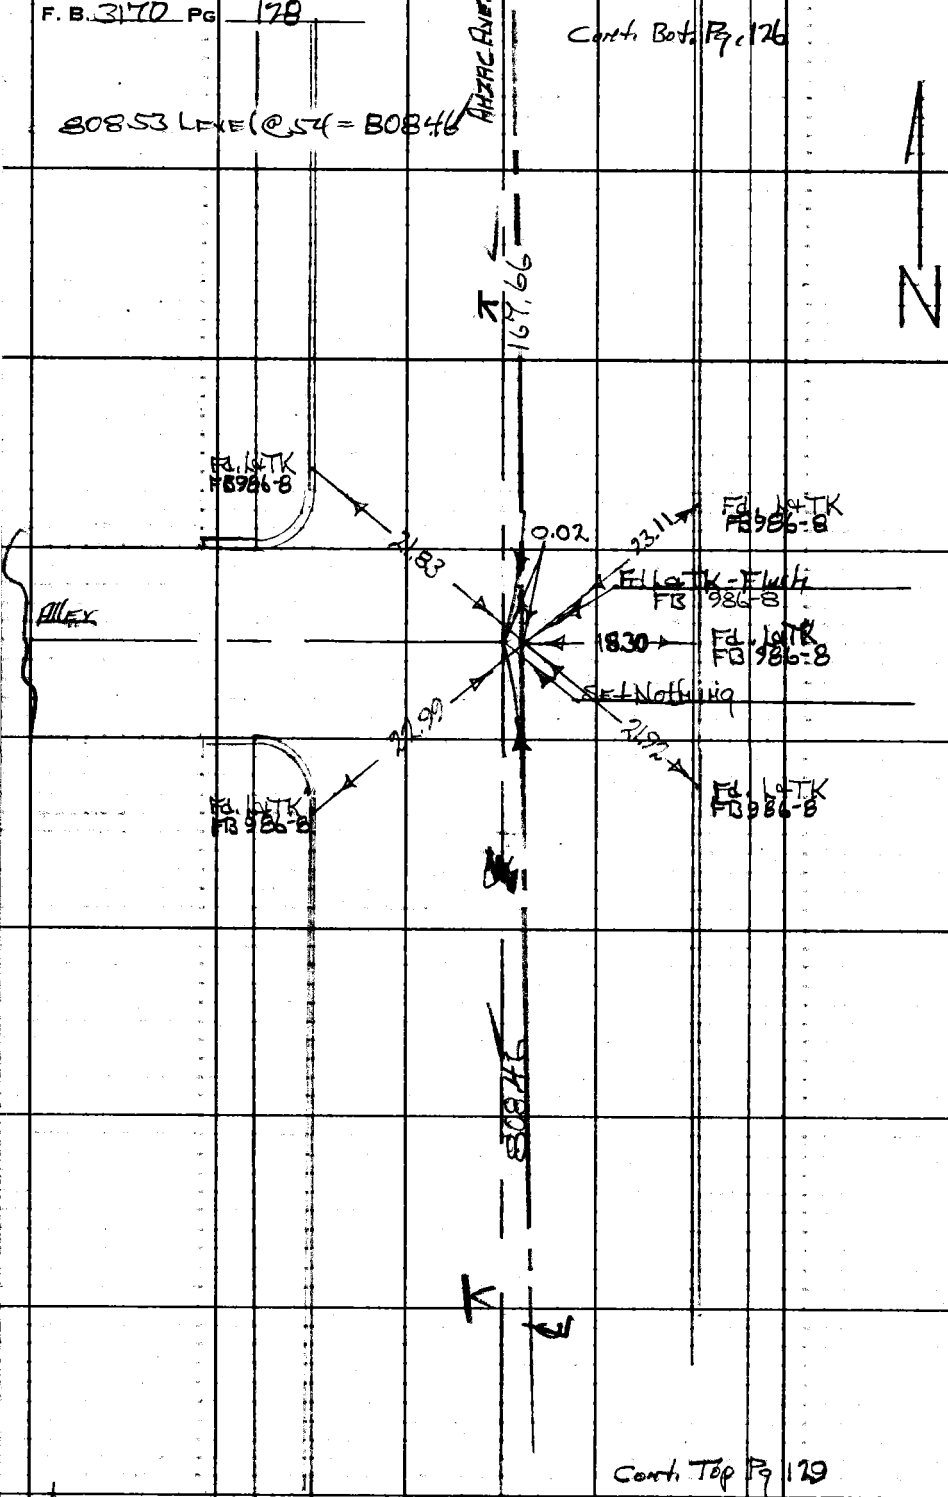

Cont. Top Pg 129

PLEASE RETURN TO
LOS ANGELES COUNTY ENGINEER
403 LOS ANGELES COUNTY ENGINEERING BLDG.

Do not extend this side of this line.

Note: Any Additions or Changes on This Sheet Must be Made or Circled in Red Ink With Date and Name of Person Making Change.

Notes Ck'd by J. Church	Survey of 92nd St.
Map No. B3019	JN 009666 Tape 0259 Std 68 °F
Office Work	Surveyed by HH Spriggs
Checked J. A. CHURCH	Notes HHS Date 1-24-65
Date JAN 7 '66	Indexed C. J. GALLS

F. B. 3170 PG. 129

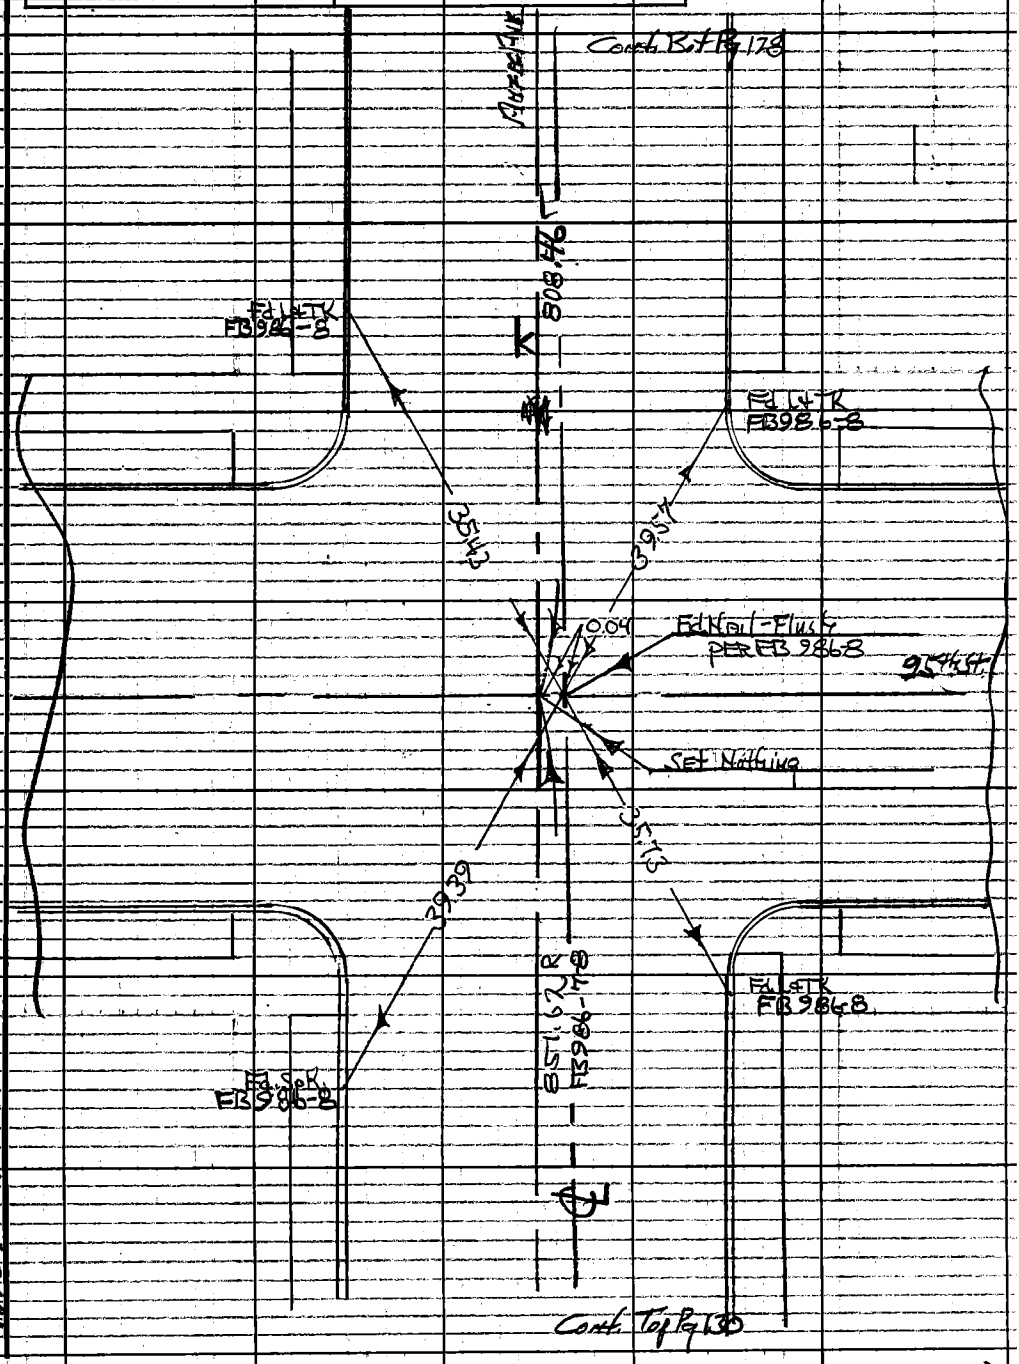

Note: Any Additions or Changes on This Sheet Must be Made or Circled in Red Ink With Date and Name of Person Making Change.

Do not extend this side of this line.

PLEASE RETURN TO
LOS ANGELES COUNTY ENGINEER
403 LOS ANGELES COUNTY ENGINEERING BLDG.

W.S. 7 B-6

76F309S CE#310 1-65

PLEASE RETURN TO
LOS ANGELES COUNTY ENGINEER
403 LOS ANGELES COUNTY ENGINEERING BLDG.

Note: Any Additions or Changes on This Sheet Must Be Made or Circled in Red Ink With Date and Name of Person Making Change.

Do not extend this side of this line.

W.S.7 B-6

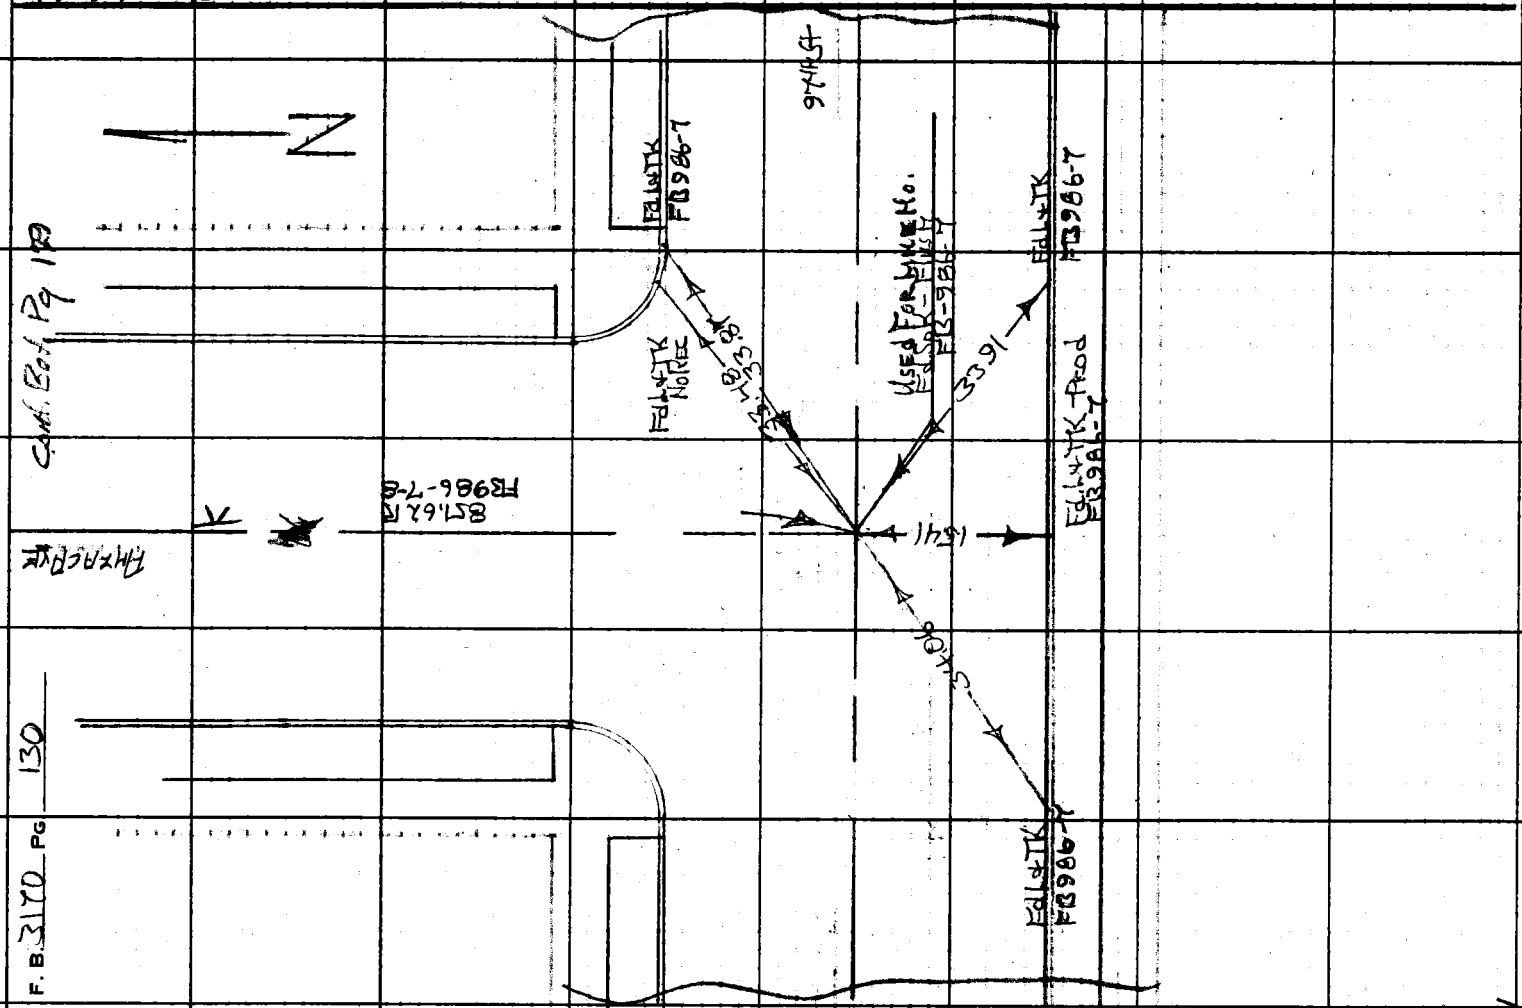

Notes Ck'd by J. Church	Survey of 92nd St.	F. Bc 3170	Pg. 131
Map No. B3019	JN 0096.66 Tape 0259 Std 68 °F		
Office Work	Surveyed by H.H. Spreggs		
Checked J. A. CHURCH	Notes HHS Date 12-1-65		
Date JUL 7 '66	Indexed C. J. GALLI		

SE
1. 90-10-45
4. 360-43-15
6. 181-05-15
A. 90-10-52 ✓
SW
1. 89-43-30
4. 358-55-00
6. 178-22-15
A. 89-43-42 ✓

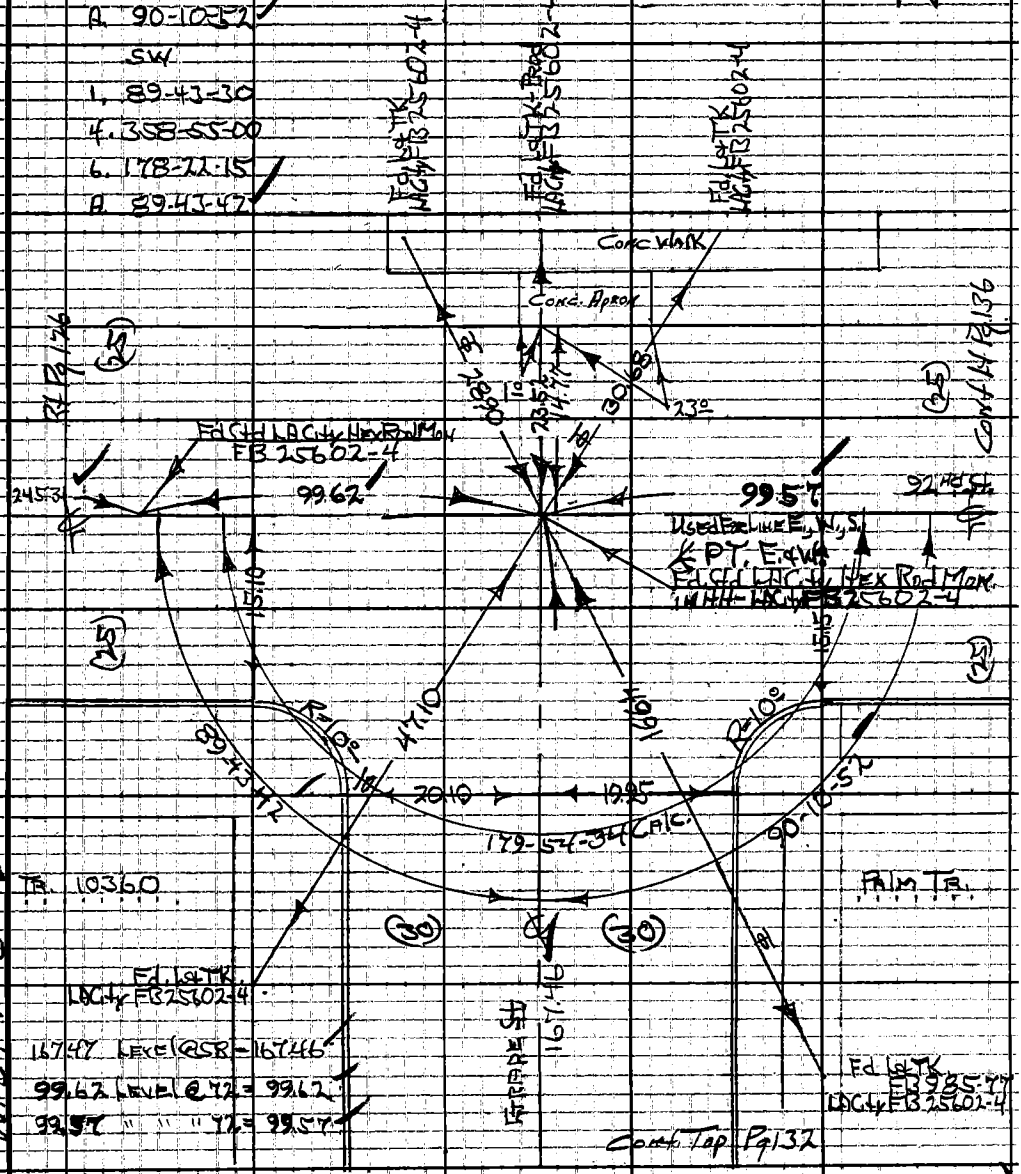

Note: Any Additions or Changes on This Sheet Must be Made or Circled in Red Ink With Date and Name of Person Making Change.

Do not extend this side of this line.

PLEASE RETURN TO
LOS ANGELES COUNTY ENGINEER
403 Los Angeles County Engineering Bldg.

76F309S CE#310 1-65

F. B. 3170 PG 132

Cont. Bot. Pg 131

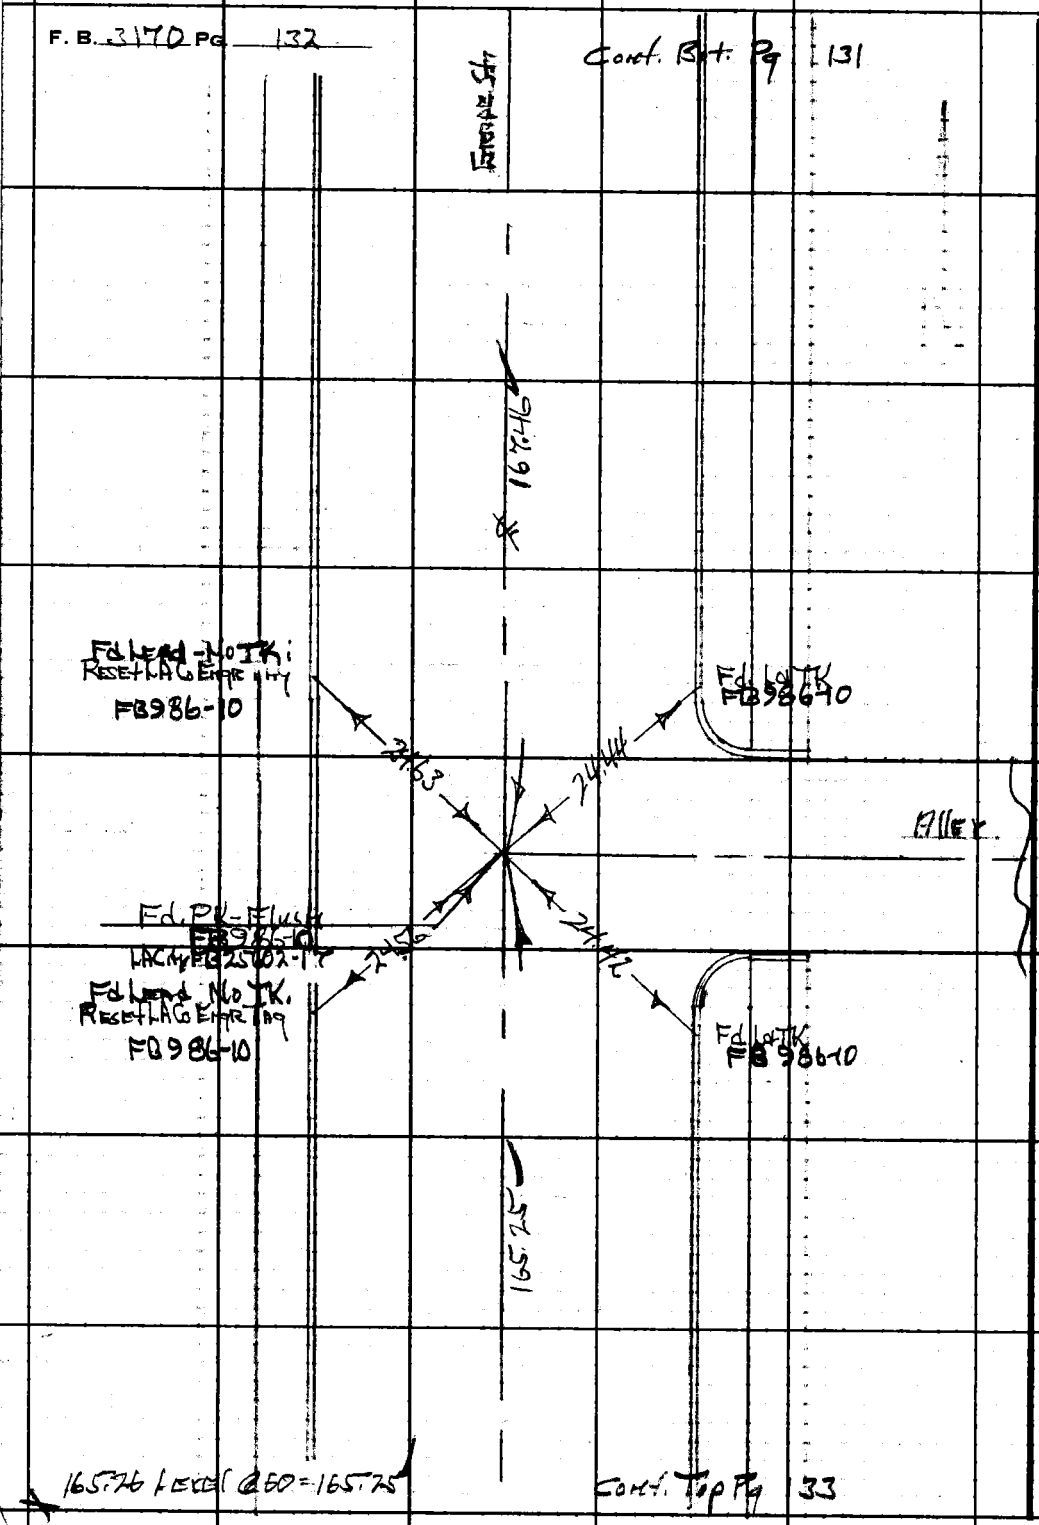

165.26 Level @ 60 = 165.25

Cont. Top Pg 133

PLEASE RETURN TO
LOS ANGELES COUNTY ENGINEER
403 LOS ANGELES COUNTY ENGINEERING BLDG.

Do not extend this side of this line.

Note: Any Additions or Changes on This Sheet Must be Made or Circled in Red Ink With Date and Name of Person Making Change.

Notes Ck'd by J. Church	Survey of 92nd St.		F. B. 3170 Pg. 133
Map No. B 3019	JN 009666 Tape 0259 Std 68 °F		
Office Work	Surveyed by HH Sprogs		
Checked J. A. CHURCH	Notes HHS Date 12-1-65		
Date Jul 7 '66	Indexed G. J. GALLI		

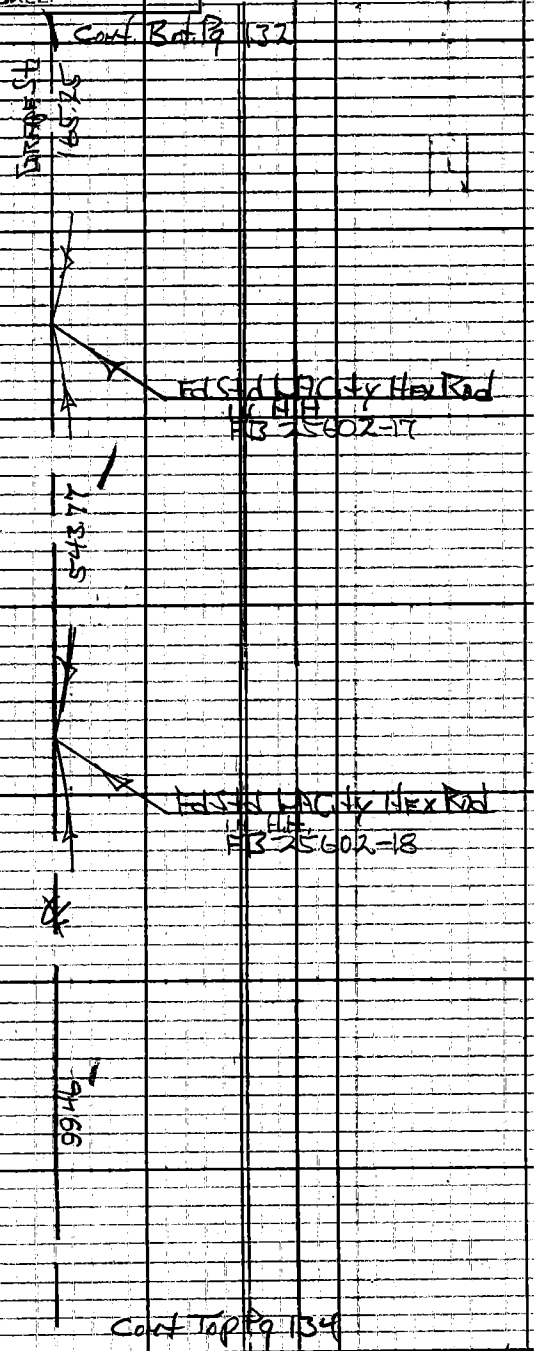

9947 Level @ SB = 99.46
543.81 Level @ SB = 543.77

Cont Top Pg 134

Note: Any Additions or Changes on This Sheet Must be Made or Circled in Red Ink With Date and Name of Person Making Change.

PLEASE RETURN TO
LOS ANGELES COUNTY ENGINEER
403 LOS ANGELES COUNTY ENGINEERING BLDG.
Do not extend this side of this line.

76F309S CE#310 1-65

F. B. 3170 PG. 134

Cont. Bot. Pg 133

W.S.7 C-6

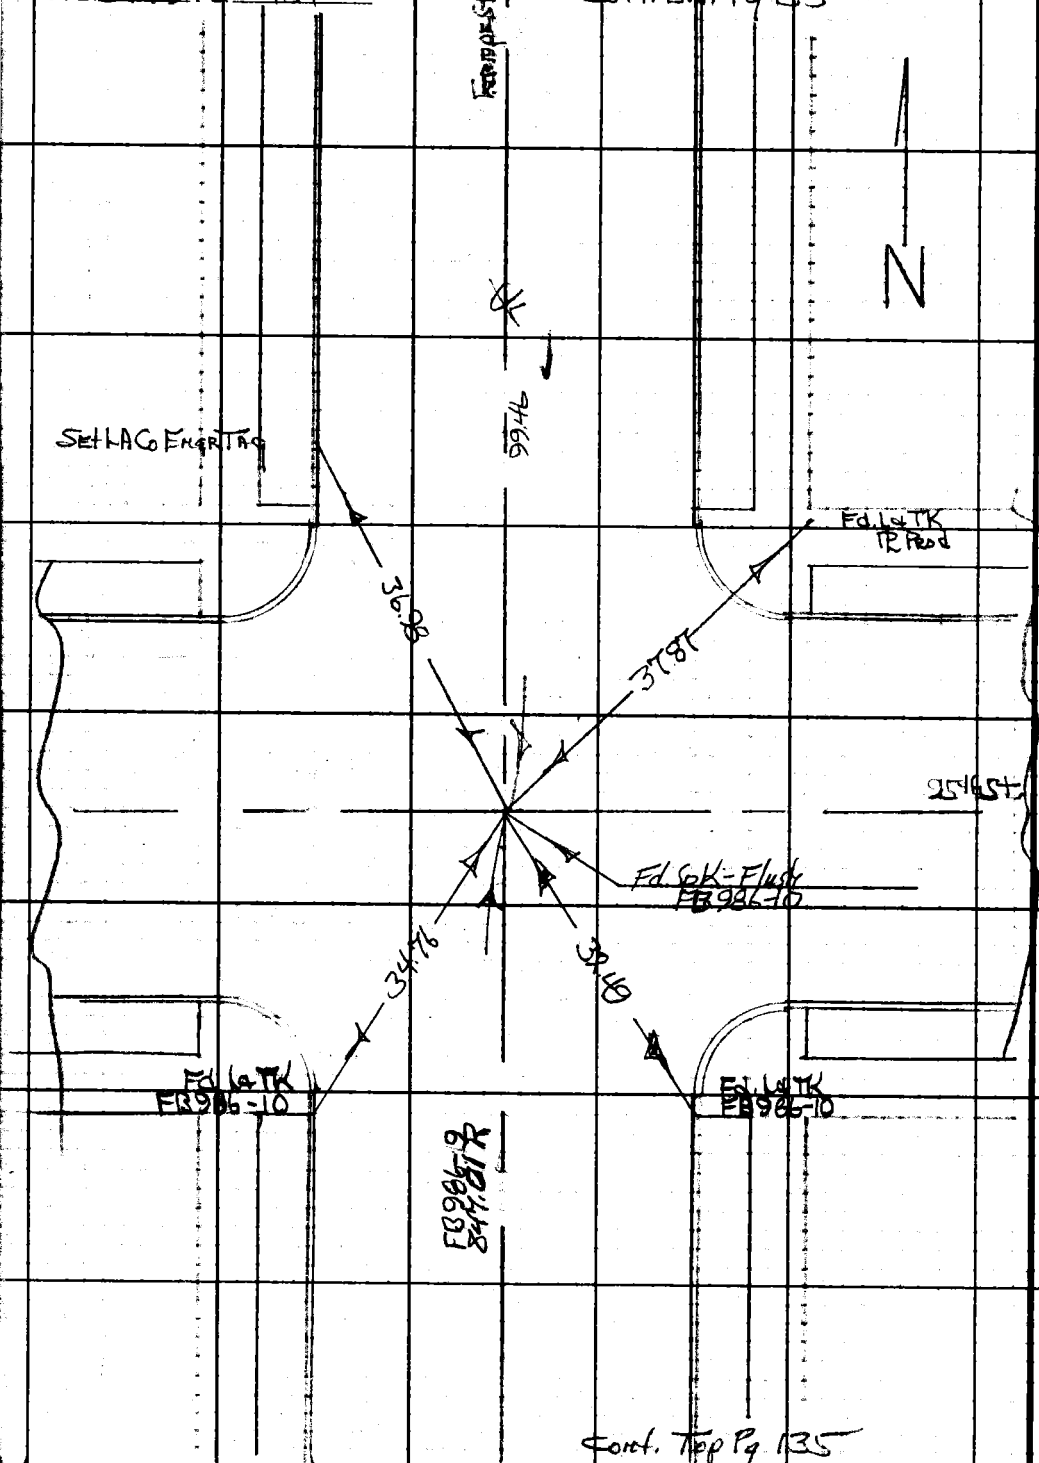

Cont. Top Pg 135

PLEASE RETURN TO
LOS ANGELES COUNTY ENGINEER
403 LOS ANGELES COUNTY ENGINEERING BLDG.

Do not extend this side of this line.

Note: Any Additions or Changes on This Sheet Must be Made or Circled in Red Ink With Date and Name of Person Making Change.

Notes Ck'd by J. Church	Survey of 92nd St.	F. B. 3170 PG. 135
Map No. B 3019	JN 009666 Tape 0259 Std 68 °F	
Office Work	Surveyed by HH Springs	
Checked J. A. CHURCH	Notes HHS Date 12-7-65	
Date JUL 7 '66	Indexed C. J. GALLI	

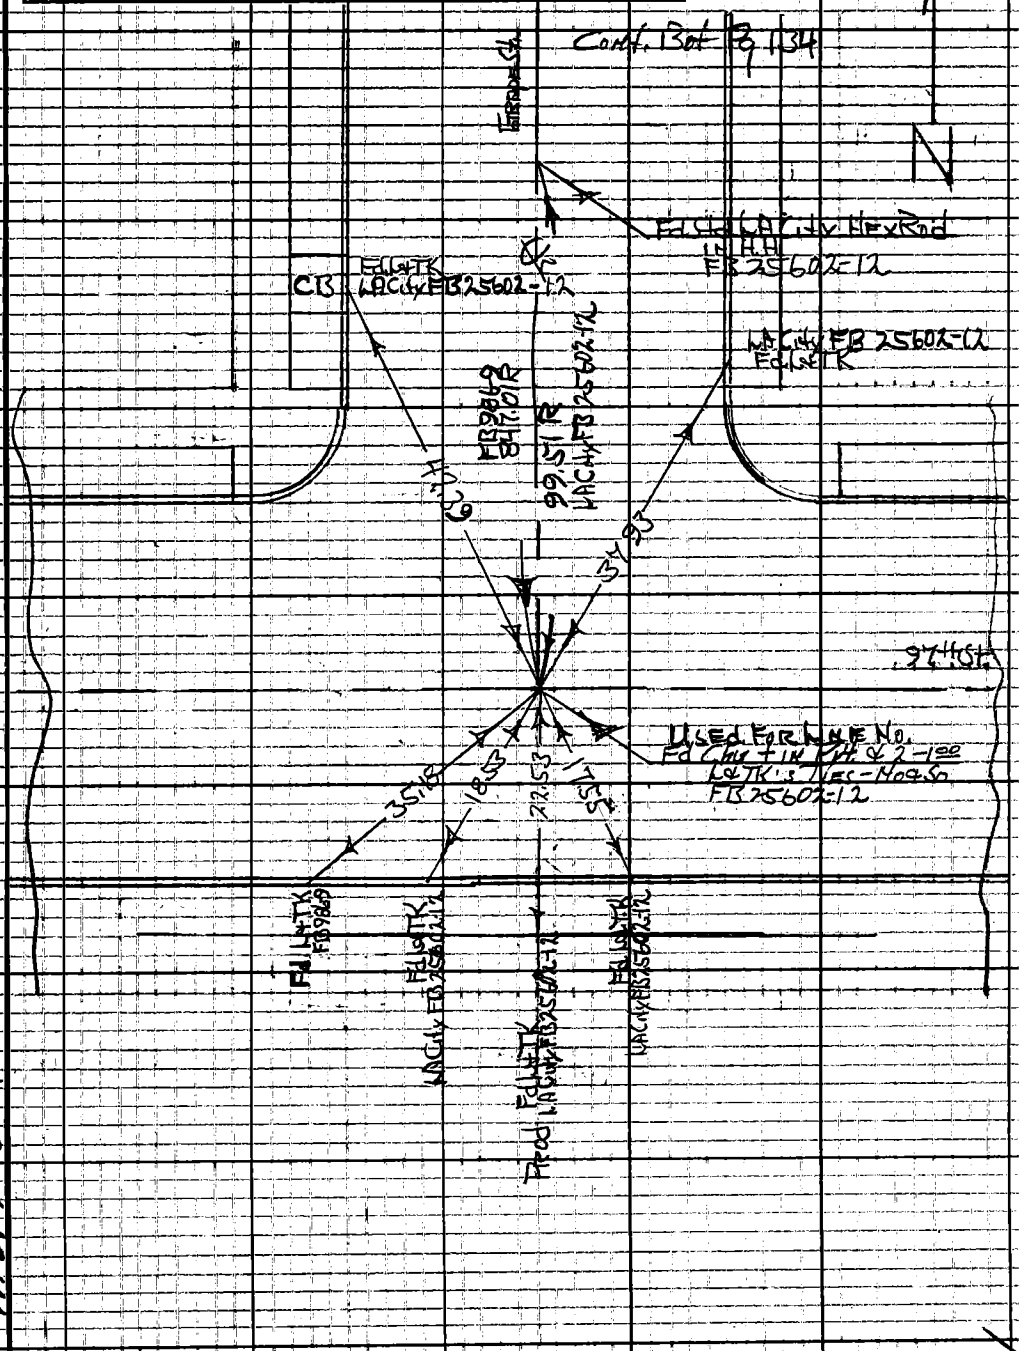

Note: Any Additions or Changes on This Sheet Must be Made or Circled in Red Ink With Date and Name of Person Making Change.

PLEASE RETURN TO
LOS ANGELES COUNTY ENGINEER
403 Los Angeles County Engineering Bldg.
Do not extend this side of this line.

W.S. 7 C-4

76F309S CE#310 1-65

F. B. 3170 PG. 136

W.5.7 C-6

195.02 Level @ 50° = 195.00 ✓
167.37 Level @ 60 = 167.36 ✓

SE	SW
1. 90-09-15	1. 89-49-15
4. 360-36-45	4. 359-16-45
6. 180-55-00	6. 178-55-15
A. 90-09-10	A. 89-49-12 ✓


N

PLEASE RETURN TO
LOS ANGELES COUNTY ENGINEER
403 LOS ANGELES COUNTY ENGINEERING BLDG.
Do not extend this side of this line.

Note: Any Additions or Changes on This Sheet Must be Made or Circled in Red Ink. With Date and Name of Person Making Change.

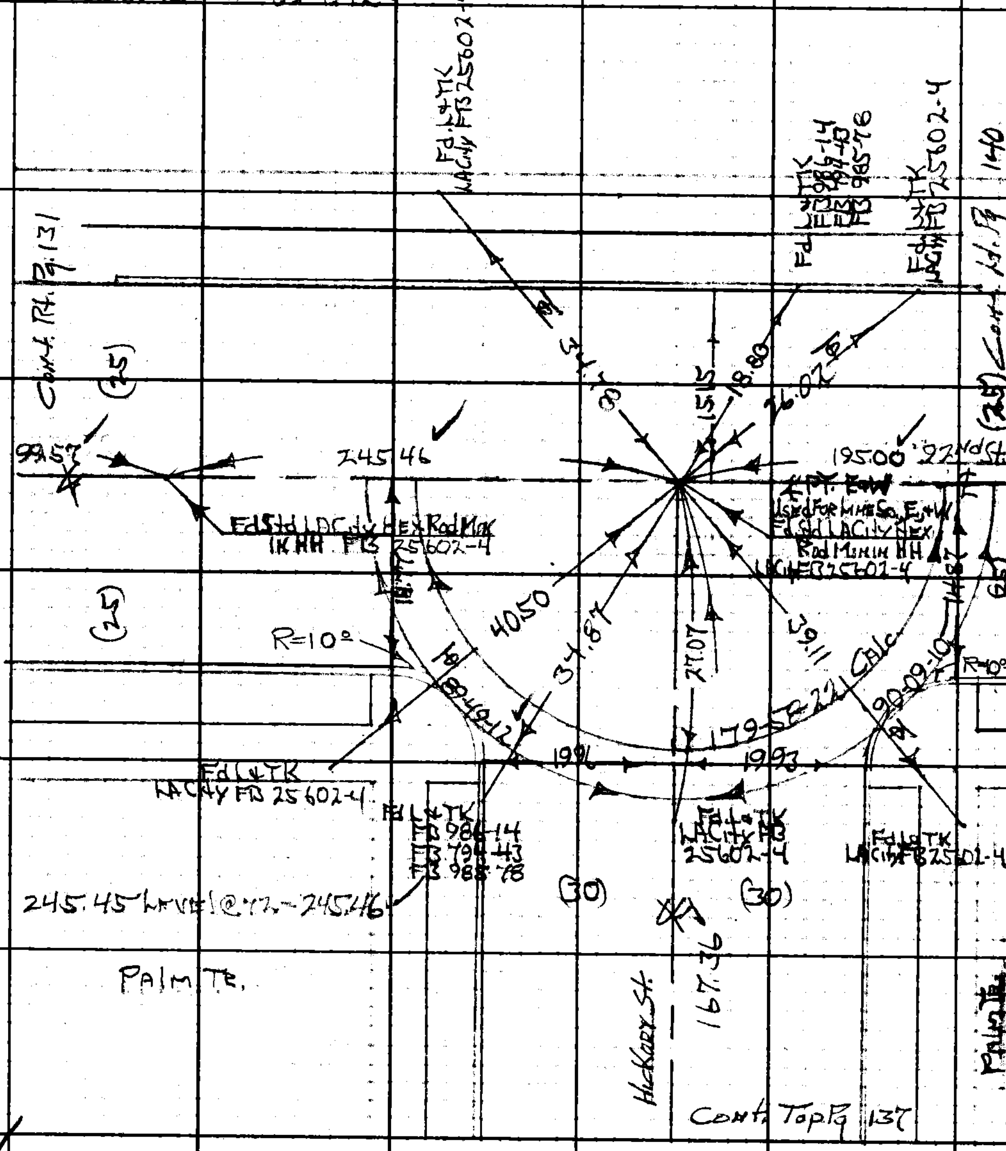

Notes Ck'd by J. Church	Survey of 92nd St.	F. B. 3170	Pg. 137
Map No. B 3019	JN 0096.66 Tape 0259 Std 68 °F		
Office Work	Surveyed by HHSpriggs		
Checked J. A. CHURCH	Notes HHS Date 12-1-65		
Date 7 '68	Indexed C. J. GALLI		

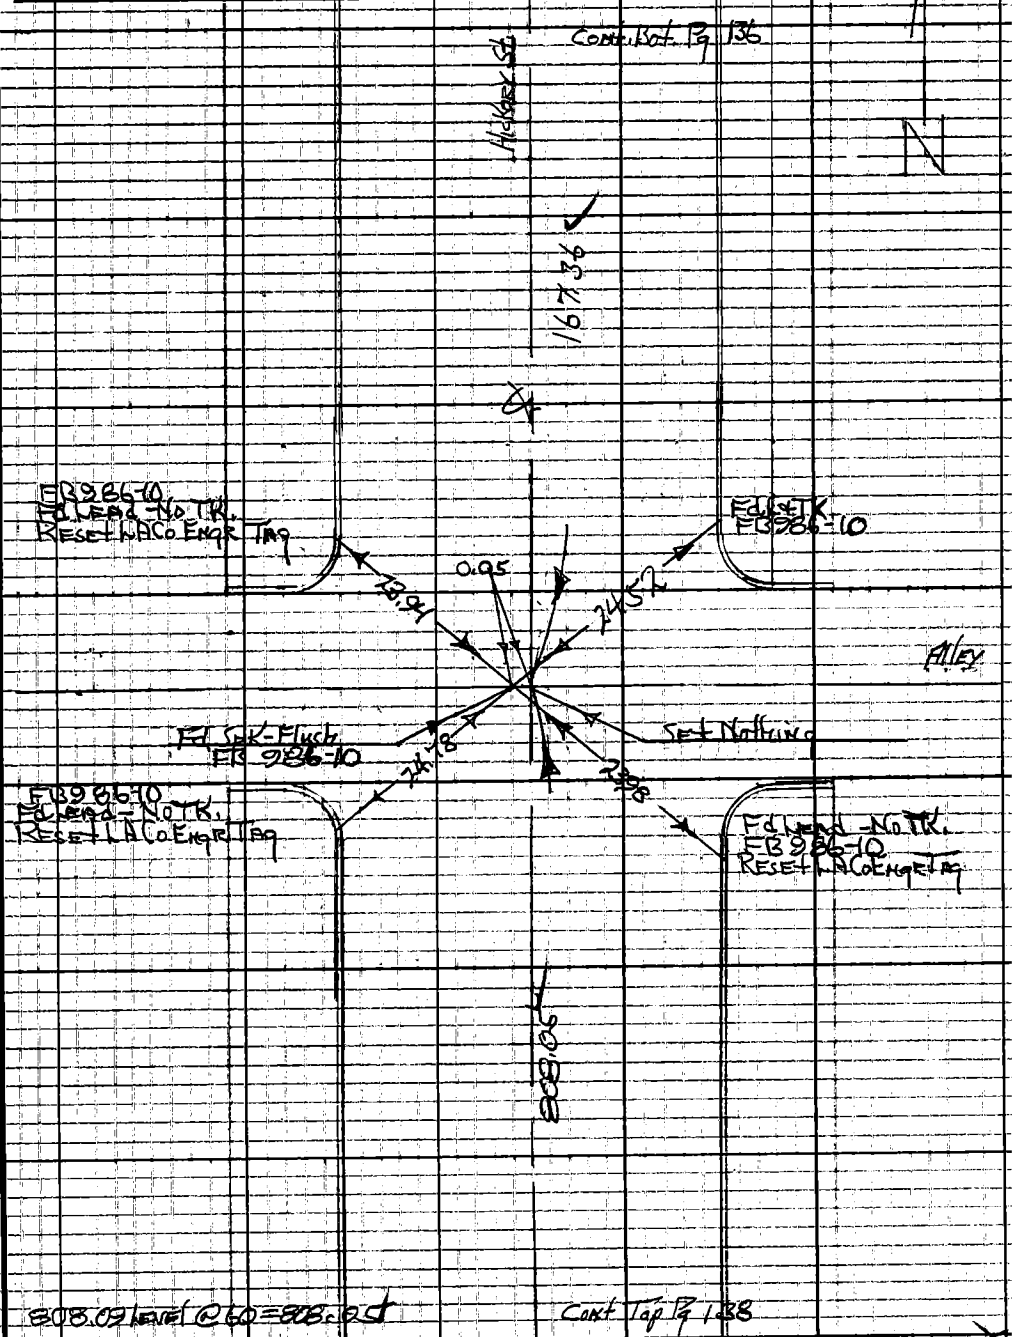

Note: Any Additions or Changes on This Sheet Must be Made or Circled in Red Ink With Date and Name of Person Making Change.

Do not extend this side of this line.

PLEASE RETURN TO
LOS ANGELES COUNTY ENGINEER
403 LOS ANGELES COUNTY ENGINEERING BLDG.

76F309S CE#310 1-65

F. B. 3170 PG 136

Cont. Bot Pg. 137

W.S. 7 C-6

Cont. Top Pg. 139

PLEASE RETURN TO
LOS ANGELES COUNTY ENGINEER
403 LOS ANGELES COUNTY ENGINEERING BLDG.

Do not extend this side of this line.

Note: Any Additions or Changes on This Sheet Must be Made or Circled in Red Ink With Date and Name of Person Making Change.

Notes Ck'd by J. Church	Survey of 92nd St	F. B. 3170 Pg. 139
Map No. B 3019	JN 0096.66 Tape 0259 Std 68 °F	
Office Work	Surveyed by HHSprigg	
Checked J. A. CHURCH	Notes HHS Date 12-1-65	
Date JUL 7 '66	Indexed C. J. GALLI	

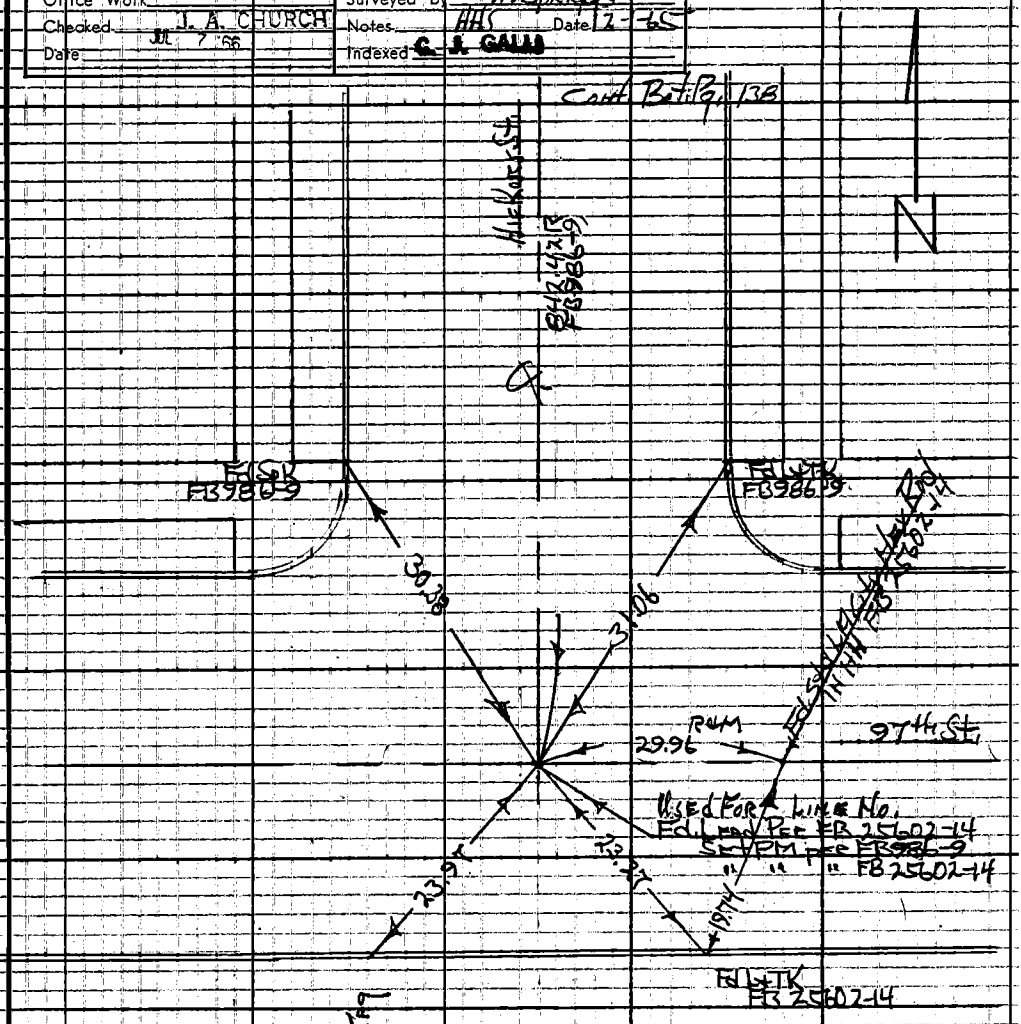

Note: Any Additions or Changes on This Sheet Must be Made or Circled in Red Ink With Date and Name of Person Making Change.

Do not extend this side of this line.

PLEASE RETURN TO
LOS ANGELES COUNTY ENGINEER
403 LOS ANGELES COUNTY ENGINEERING BLDG.

W. S. 7 C-6

76F309S CE#310 1-65

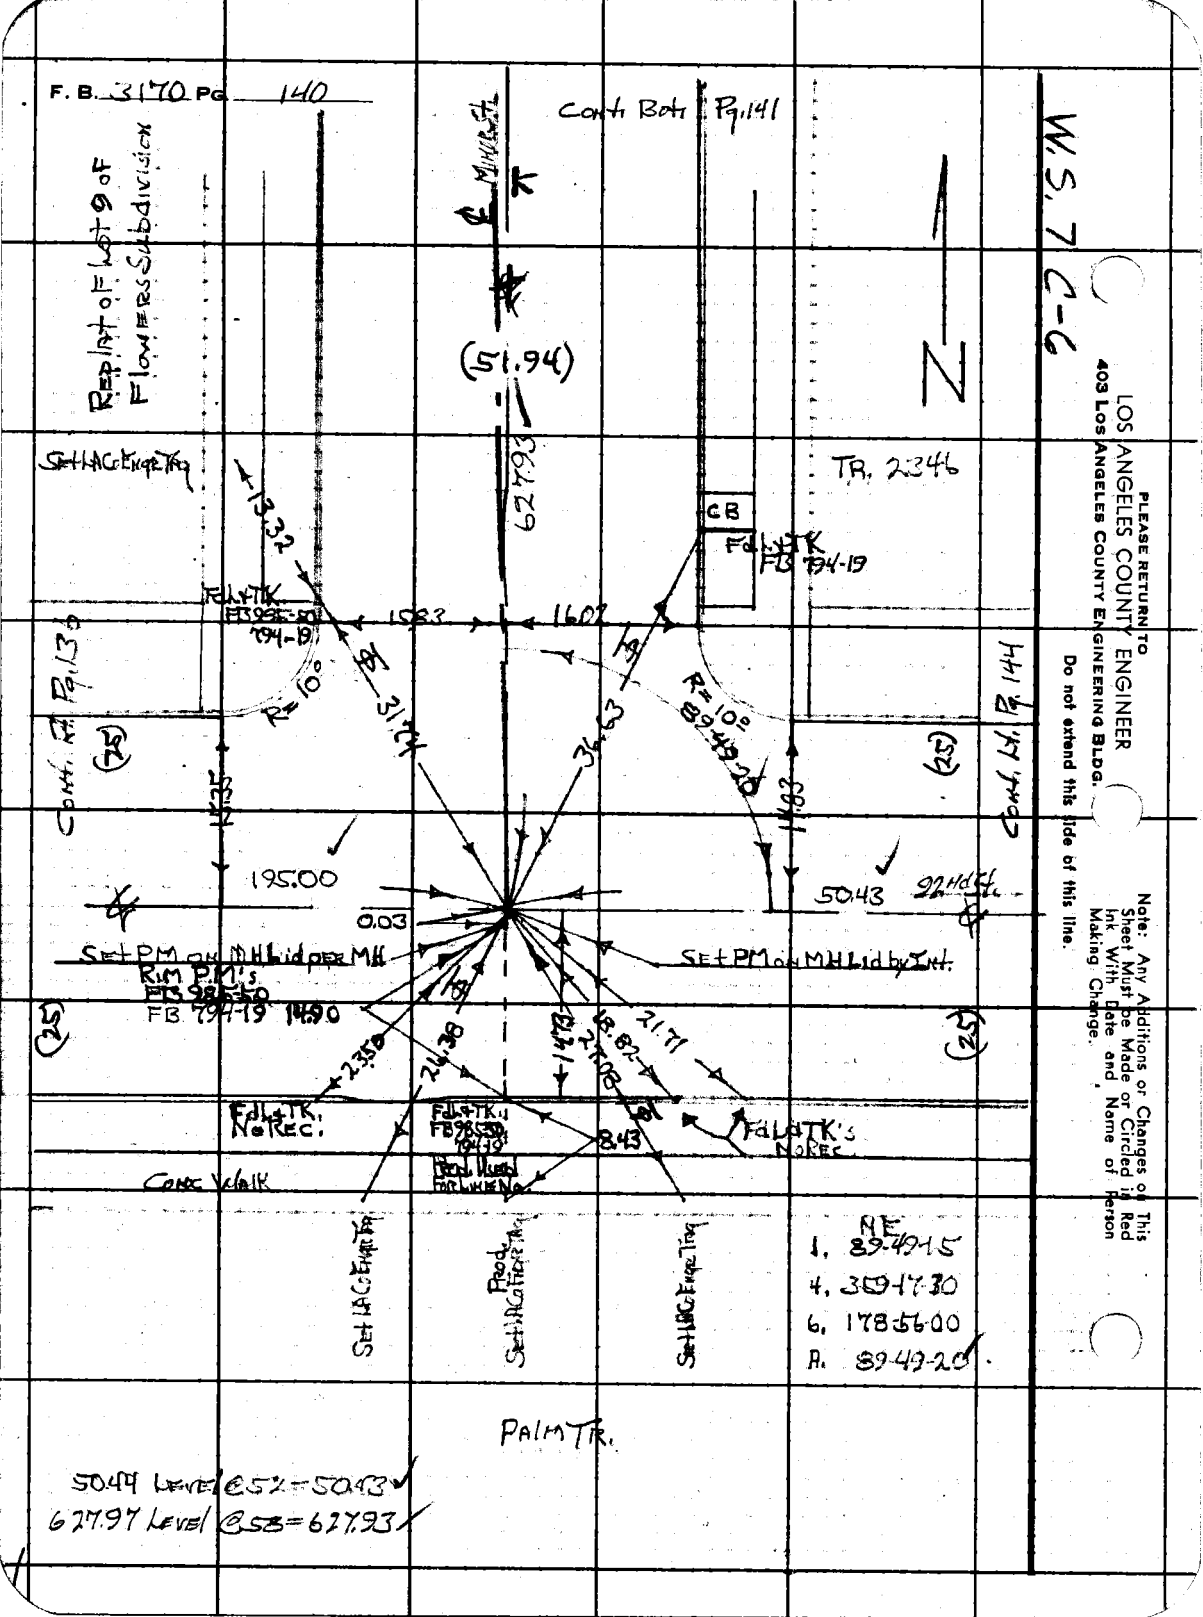
F. B. 3170 PG 140
Cont. Bot. Pg. 141
W.S. 7 C-6
Replat of Lot 9 of Flowers Subdivision
(51.94)
627.93
Set LACo Engr Tag
TR. 2346
CB
Fd L+TK FB 794-19
13.32
Fd L+TK FB 985-50 794-19
15.83
16.02
R=10°
31.74
36.63
R=10° 89-49-20
Cont. Rt. Pg. 136
Cont. Lt. Pg. 144
(25)
195.00
0.03
50.43
92nd St.
Set PM on MH Lid per MH
Set PM on MH Lid by Int.
Rim P.M.'s FB 985-50 FB 794-19 14.90
23.50
26.38
21.71
18.82
27.08
8.43
Fd L+TK No Rec.
Fd L+TK's No Rec.
Conc Walk
Set LACo Engr Tag
Prod. Set LACo Engr Tag
Set LACo Engr Tag
NE
1. 89-49-15
4. 359-17-30
6. 178-56-00
A. 89-49-20
PALM TR.
50.44 Level @ 52 = 50.43
627.97 Level @ 58 = 627.93
PLEASE RETURN TO
LOS ANGELES COUNTY ENGINEER
403 Los Angeles County Engineering Bldg.
Do not extend this side of this line.
Note: Any Additions or Changes on This Sheet Must be Made or Circled in Red Ink With Date and Name of Person Making Change.

Notes Ck'd by J. Church	Survey of 92nd St.	F. B. 3170	PG. 141
Map No. B 3019	JN 0096.66 Tape 0259 Std 68 °F		
Office Work	Surveyed by HH Spriggs		
Checked J. A. CHURCH	Notes HHS Date 12-1-65		
Date 7 '66	Indexed J. GALLI		

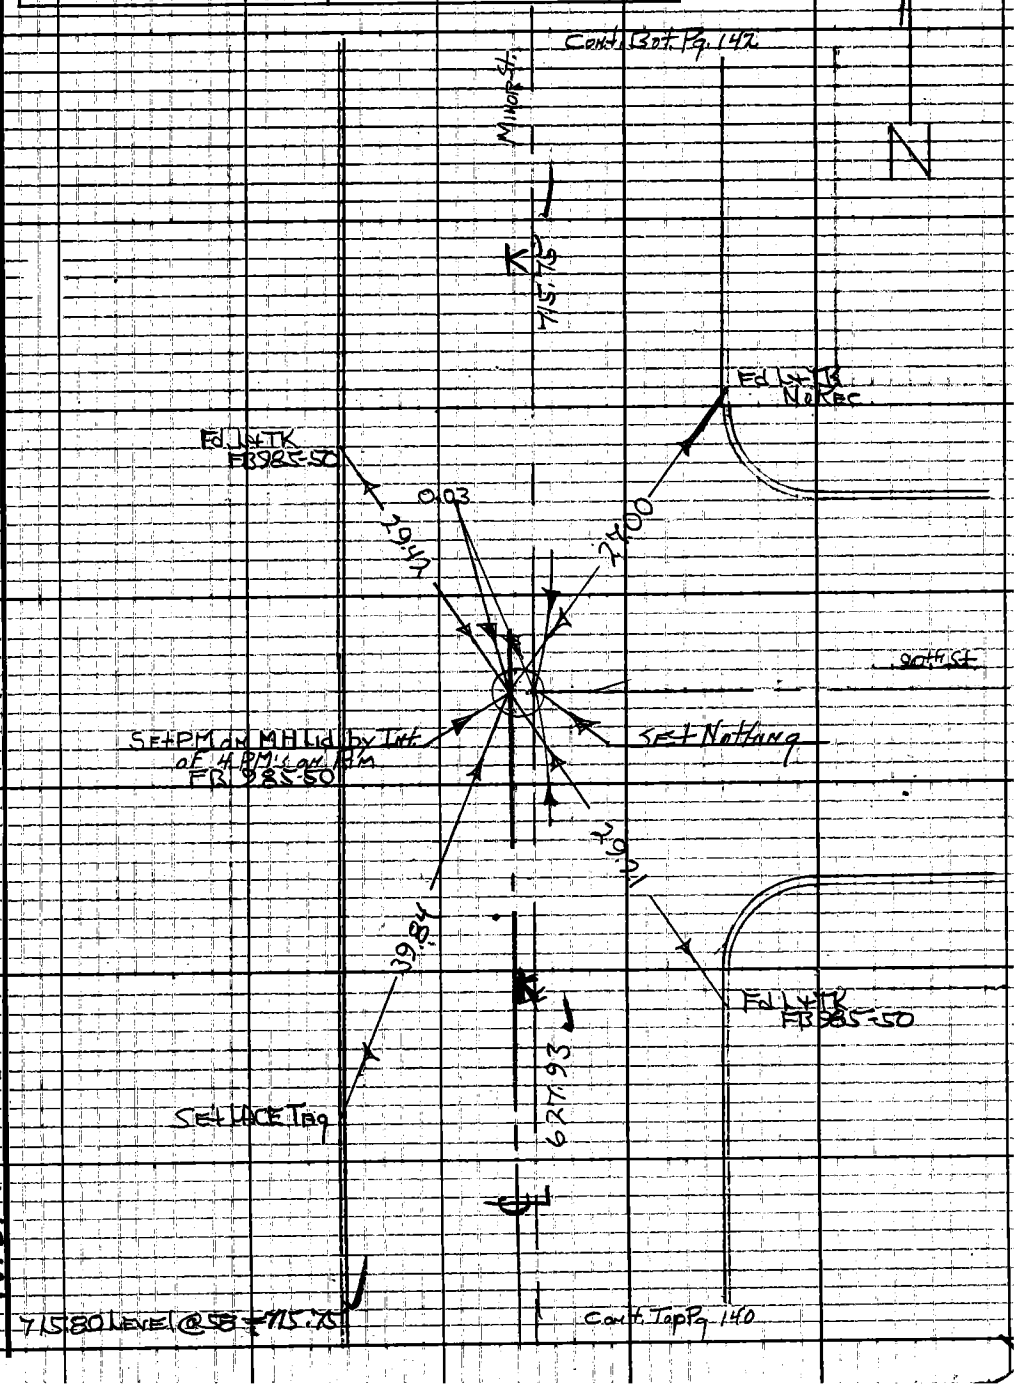

Note: Any Additions or Changes on This Sheet Must be Made or Circled in Red Ink With Date and Name of Person Making Change.

Do not extend this side of this line.

PLEASE RETURN TO
LOS ANGELES COUNTY ENGINEER
403 LOS ANGELES COUNTY ENGINEERING BLDG.

W.S. 7 C-6

75F309S CE#310 1-65

F. B. 3170 PG 142

Cont. Bot. Pg. 143

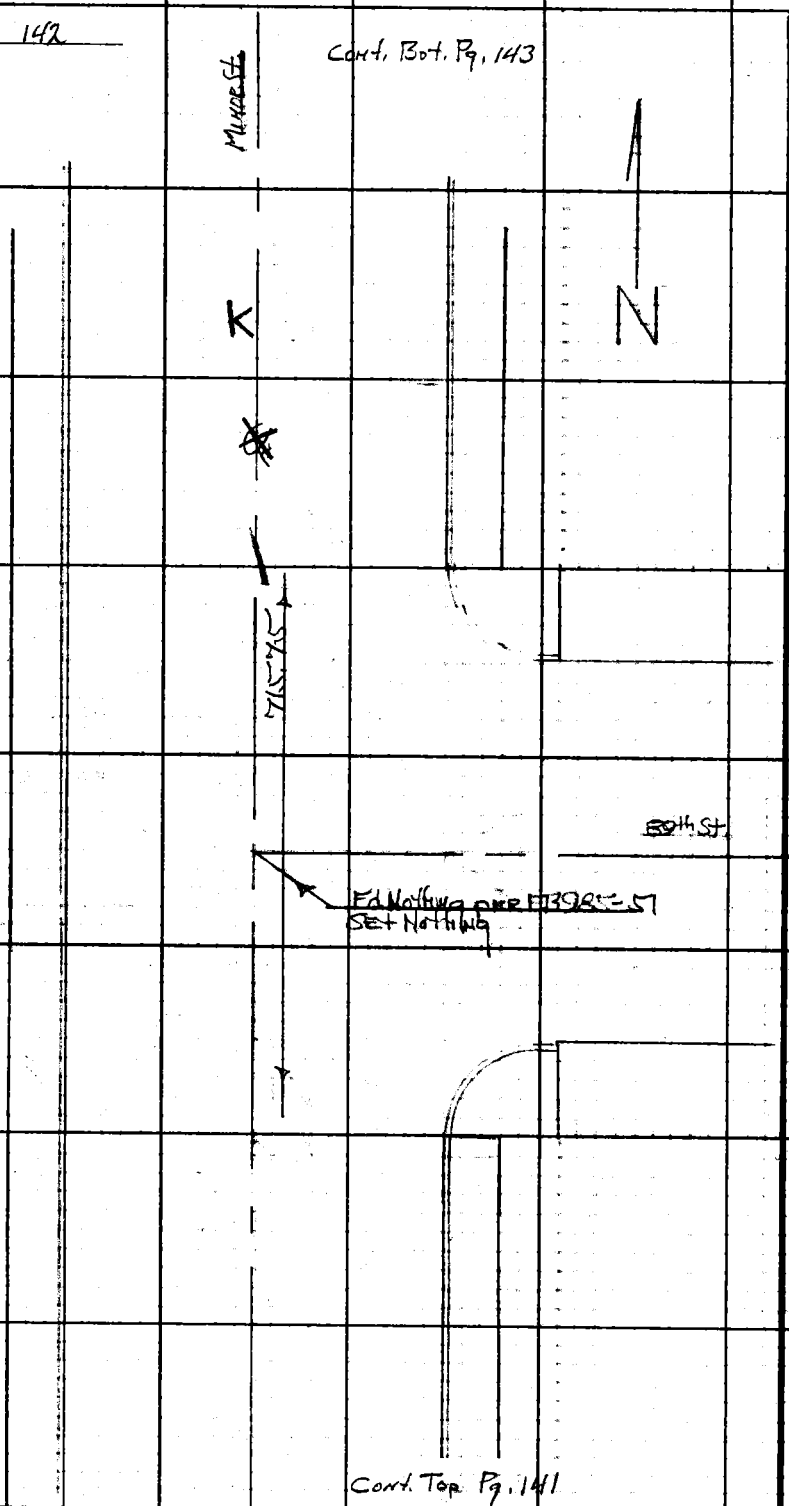

Cont. Top Pg. 141

PLEASE RETURN TO
LOS ANGELES COUNTY ENGINEER
403 LOS ANGELES COUNTY ENGINEERING BLDG.
Do not extend this side of this line.

Note: Any Additions or Changes on This Sheet Must be Made or Circled in Red Ink With Date and Name of Person Making Change.

Notes Ck'd by J. Church	Survey of 92nd St	F. B. 3170	PG. 143
Map No. B 3019	JN 003666 Tape 2259 Std 68 °F		
Office Work	Surveyed by HH Sprague		
Checked J. A. CHURCH JUL 1 '66	Notes HHC Date 12-1-65		
Date	Indexed C. J. GALLI		

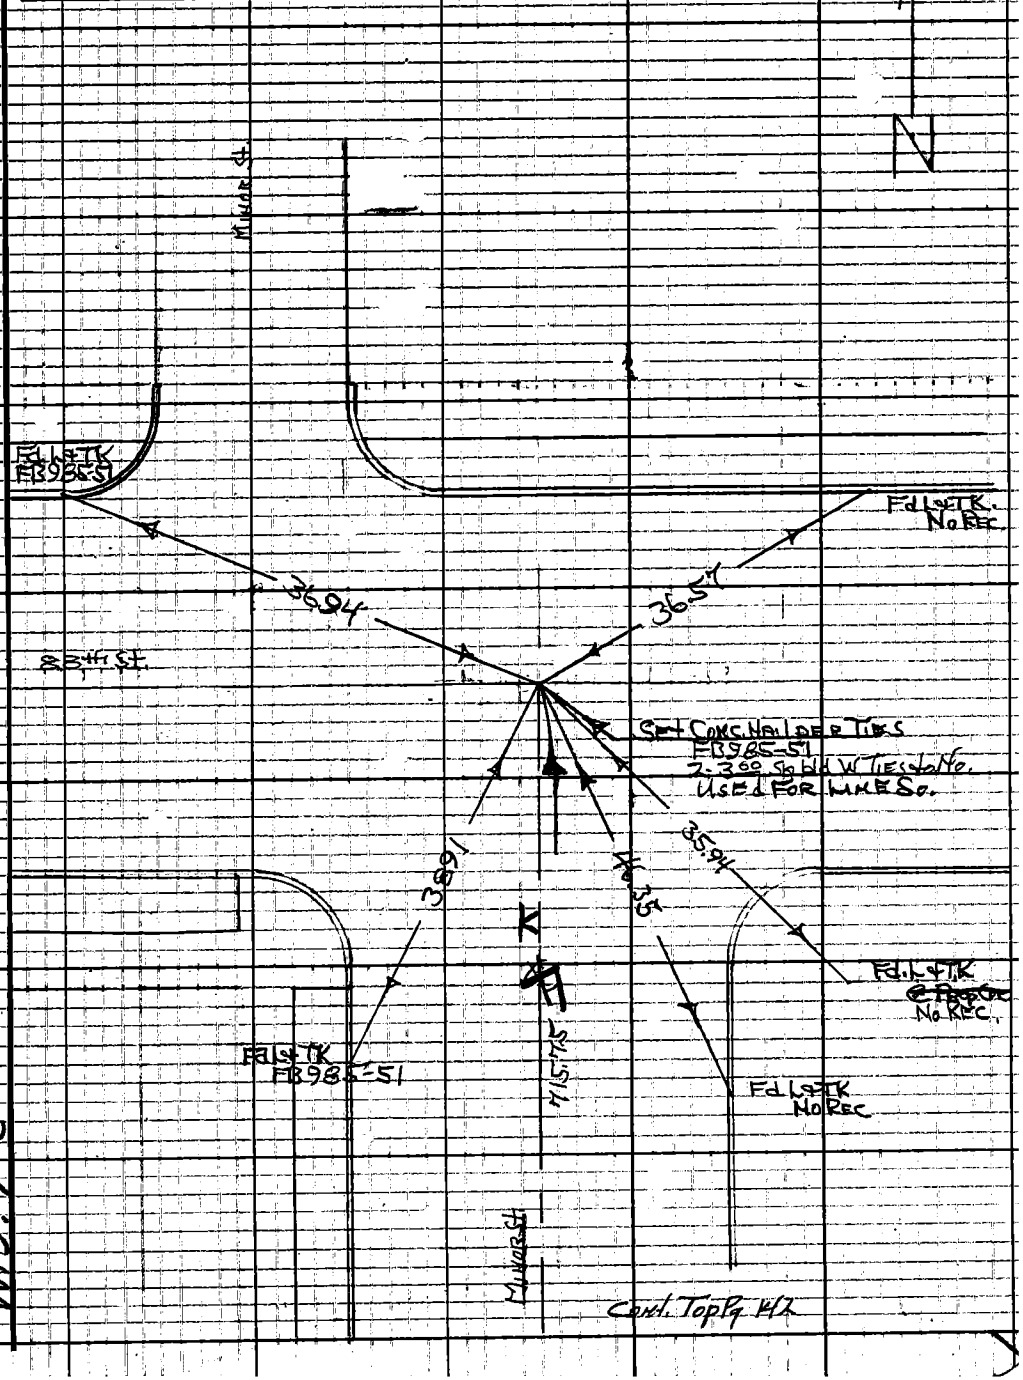

Cont. Top Pg 142

W.S. 7 C-C

Note: Any Additions or Changes on This Sheet Must be Made or Circled in Red Ink With Date and Name of Person Making Change.

PLEASE RETURN TO
LOS ANGELES COUNTY ENGINEER
403 LOS ANGELES COUNTY ENGINEERING BLDG.
Do not extend this side of this line.

76F309S CE#310 1-65

F. B. 3170 PG. 144

99.79 LEVEL @ 52 = 99.78
99.20 LEVEL @ 54 = 99.19
345.08 LEVEL @ 74 = 345.09

SE

1. 90-09-00
4. 360-36-00
6. 180-54-00
A. 90-09-00

TR. 2346

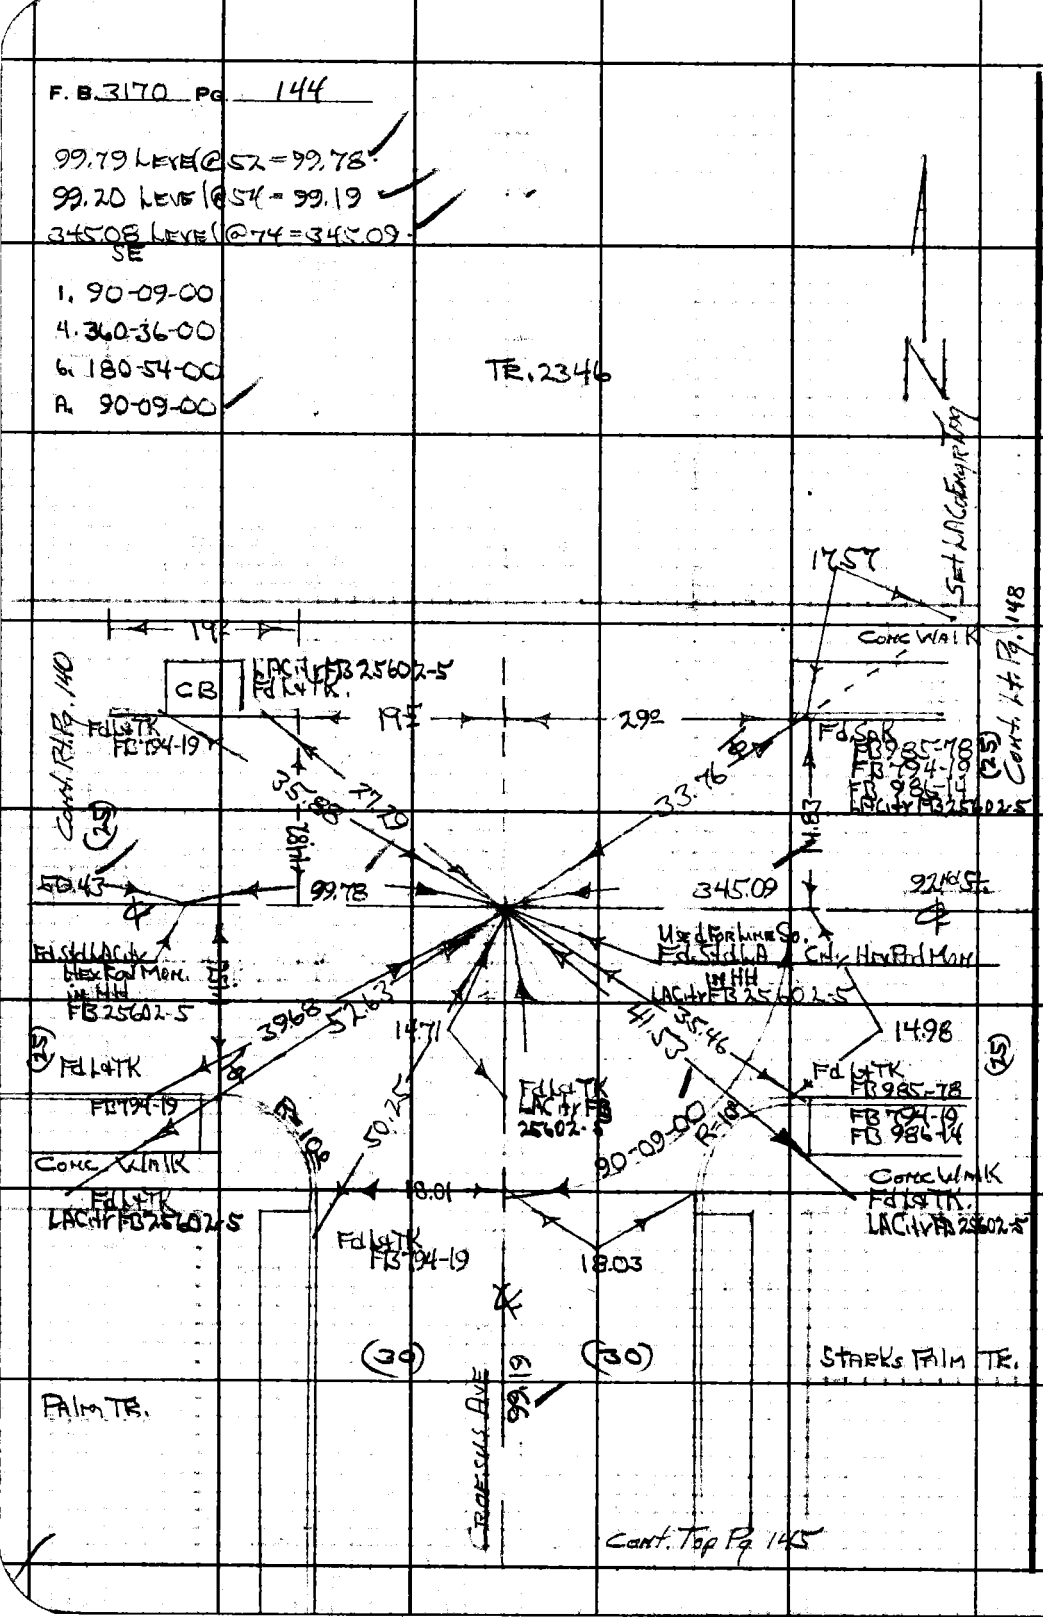

PLEASE RETURN TO
LOS ANGELES COUNTY ENGINEER
403 LOS ANGELES COUNTY ENGINEERING BLDG.

Do not extend this side of this line.

Note: Any Additions or Changes on This Sheet Must be Made or Circled in Red Ink With Date and Name of Person Making Change.

Notes Ck'd by J. Church	Survey of 92nd St.		F. B. 3170 PG. 145
Map No. B 3019	JN 0096.66	Tape 0259 Std 68 °F	
Office Work	Surveyed by HH Springs		
Checked J. A. CHURCH	Notes HHC	Date 12-1-65	
Date JUL 7 '66	Indexed C. J. GALLE		

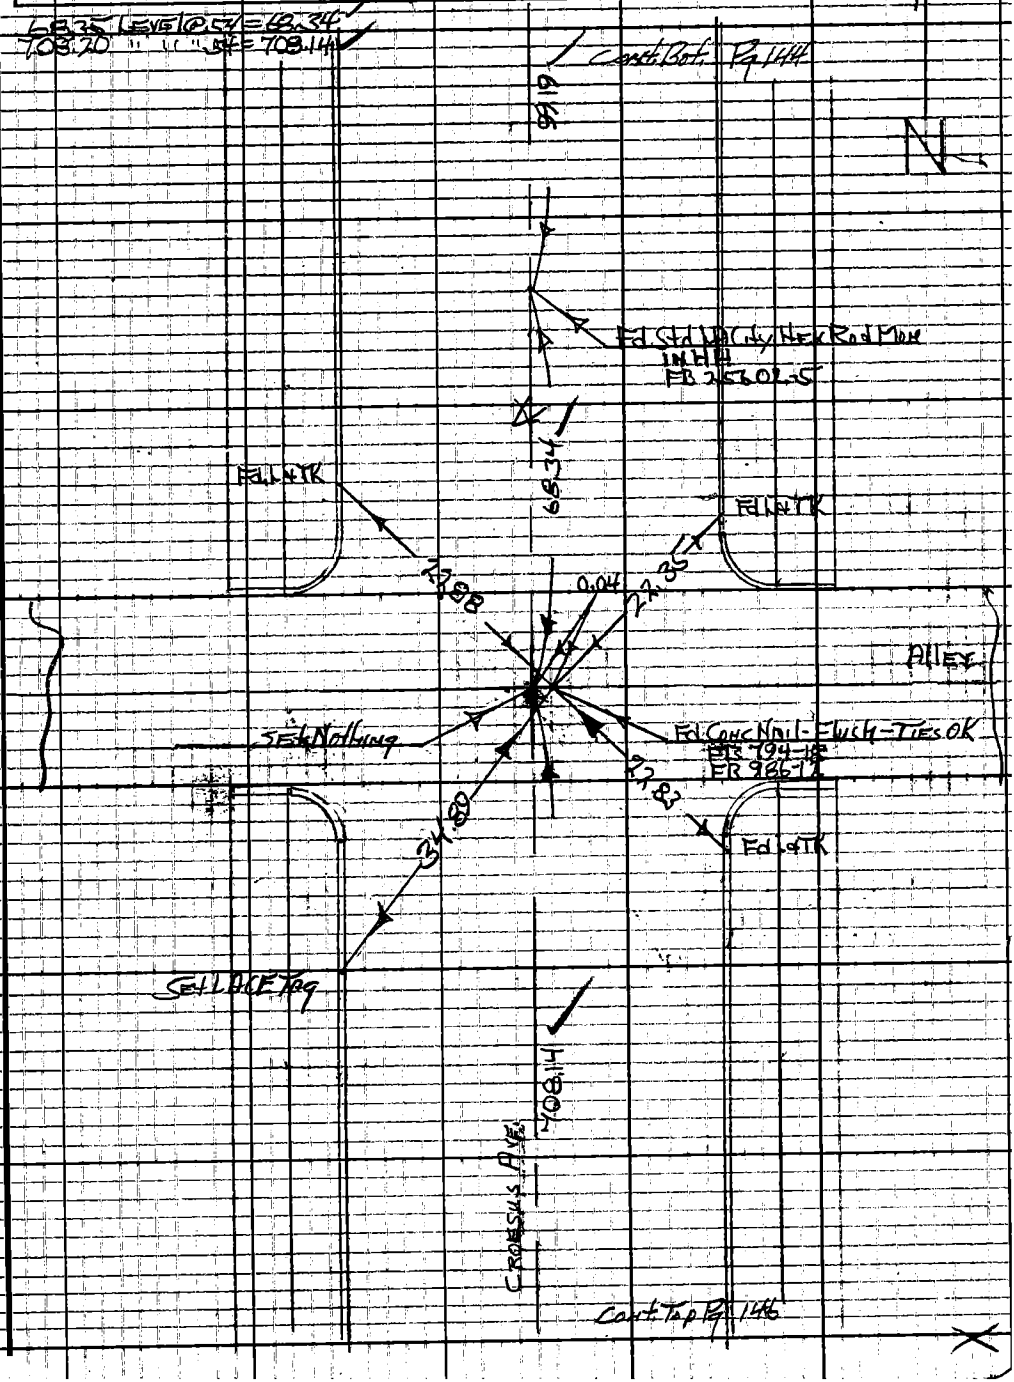

Note: Any Additions or Changes on This Sheet Must be Made or Circled in Red Ink With Date and Name of Person Making Change.

PLEASE RETURN TO
LOS ANGELES COUNTY ENGINEER
403 LOS ANGELES COUNTY ENGINEERING BLDG.
Do not extend this side of this line.

76F309S CE# 310 1-65

F. B. 3170 Pg 146

99.63 LEVEL @ 54 = 99.62

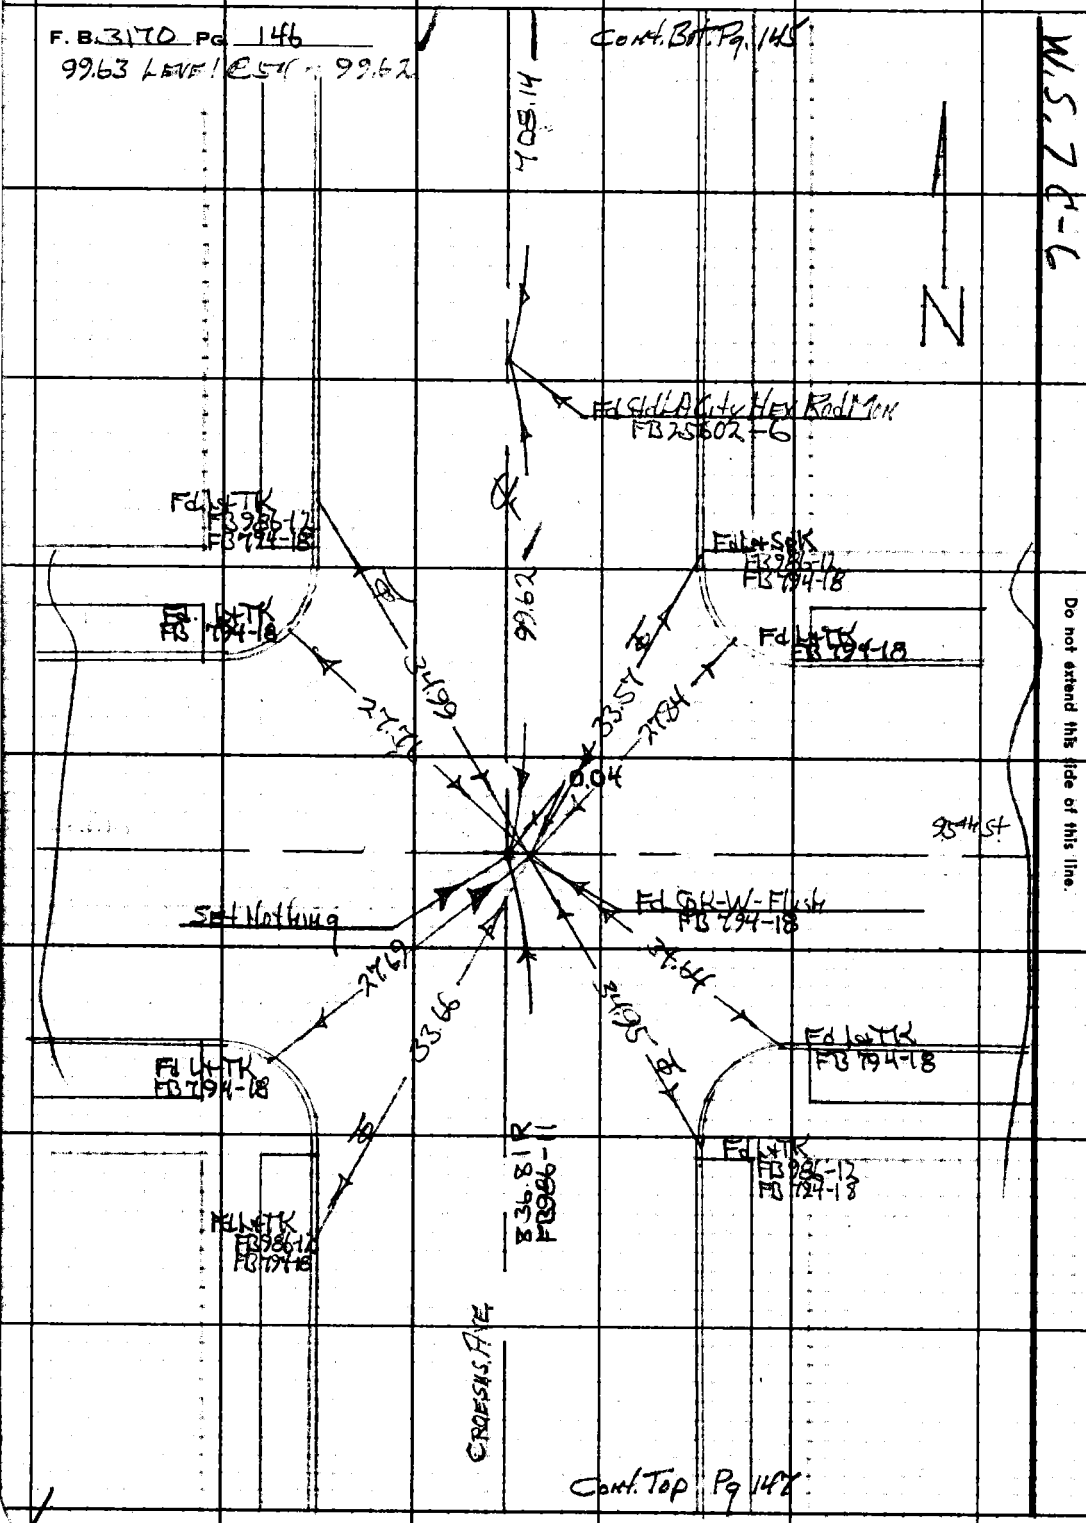

PLEASE RETURN TO
LOS ANGELES COUNTY ENGINEER
403 LOS ANGELES COUNTY ENGINEERING BLDG.

Do not extend this side of this line.

Note: Any Additions or Changes on This Sheet Must be Made or Circled in Red Ink With Date and Name of Person Making Change.

Notes Ck'd by J. Church	Survey of 92nd St
Map No. B 3019	JN 0036.66 Tape 0759 Std 68 °F
Office Work J. A. CHURCH	Surveyed by HH Spr(99)
Checked	Notes HHS Date 12-1-65
Date 7 '66	Indexed I. GALL

F. B. 3170 Pg. 147

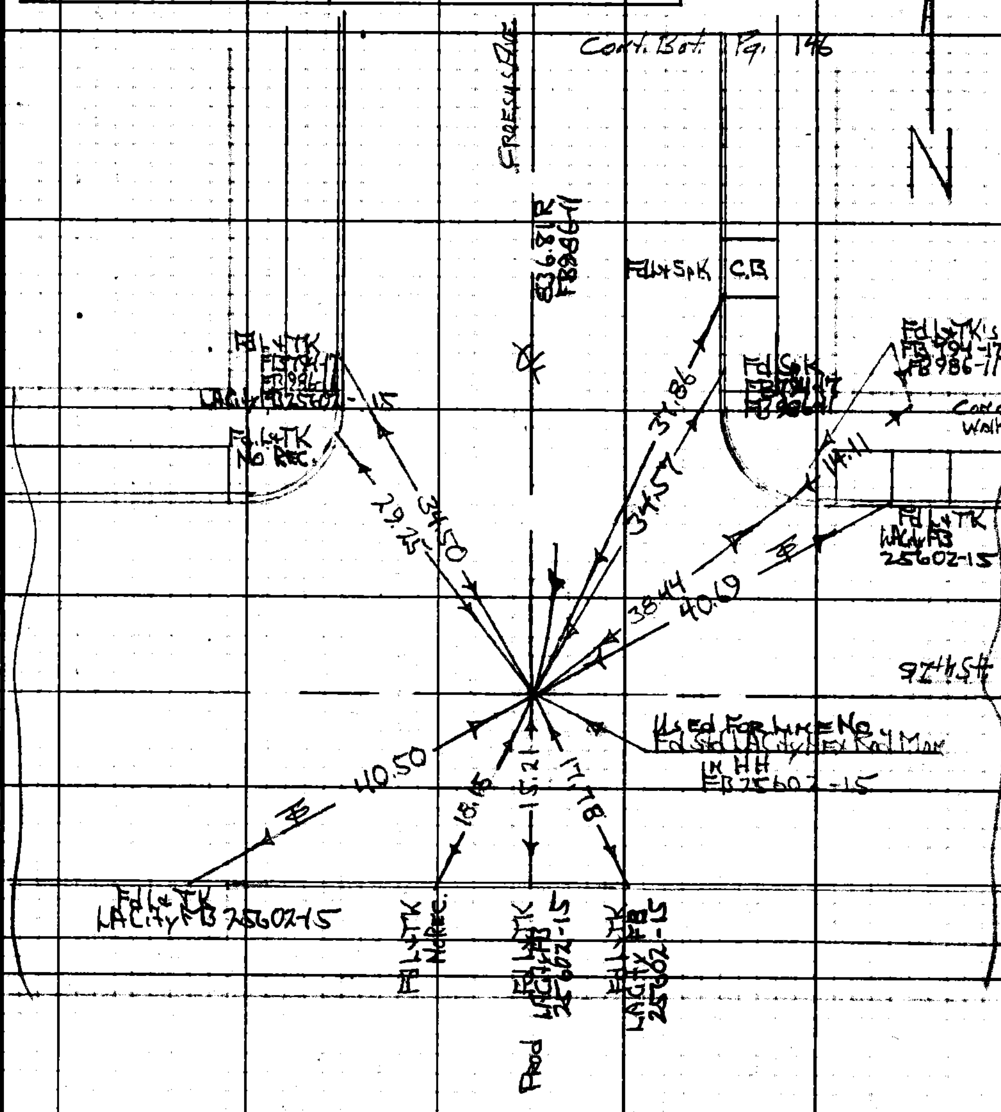

Note: Any Additions or Changes on This Sheet Must be Made or Circled in Red Ink With Date and Name of Person Making Change.

Do not extend this side of this line.

PLEASE RETURN TO
LOS ANGELES COUNTY ENGINEER
403 LOS ANGELES COUNTY ENGINEERING BLDG.

W.S. 7 C-C

76F309S CE#310 1-65

F. B. 3170 PG. 148

Cont. Bot. Pg. 149

975.24 LEVEL @ 66 = 975.23

1349.30 LEVEL @ 60 = 1349.23

336.12 LEVEL @ 64 = 336.11

NW

1. 90-11-15

4. 360-45-15

6. 181-07-30

A. 90-11-15

EBERLE VILLA TR.

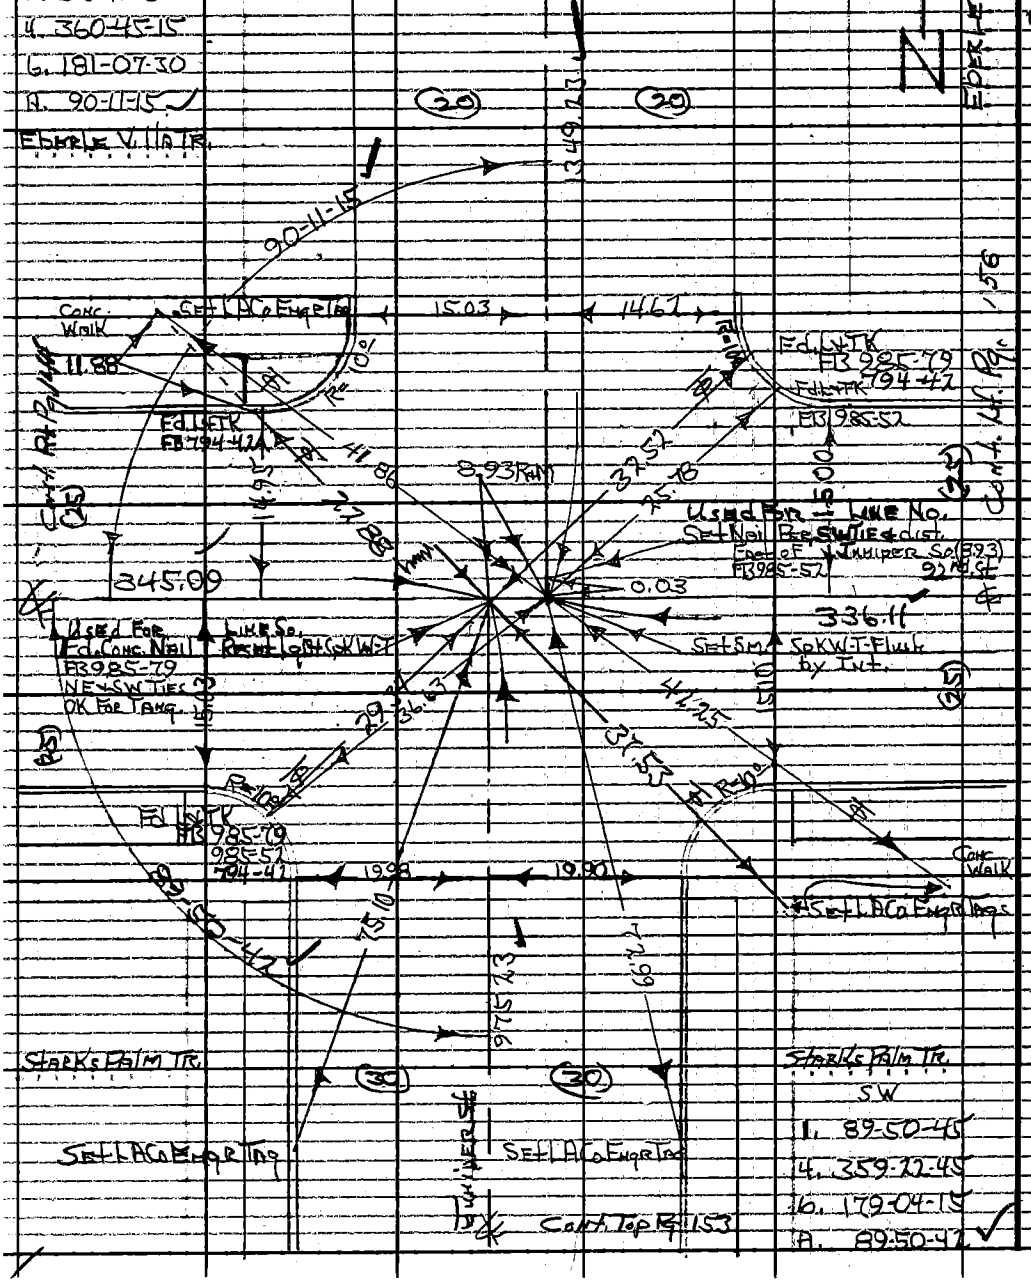

Starks Palm Tr.

SW

1. 89-50-45

4. 359-22-45

6. 179-04-15

A. 89-50-42

W.S. 7 C-6

PLEASE RETURN TO
LOS ANGELES COUNTY ENGINEER
403 LOS ANGELES COUNTY ENGINEERING BLDG.

Do not extend this side of this line.

Note: Any Additions or Changes on This Sheet Must be Made or Circled in Red Ink With Date and Name of Person Making Change.

Notes Ck'd by J. Church	Survey of 92nd St.
Map No. B3019	JN 0096.66 Tape 0259 Std 68 °F
Office Work	Surveyed by HH Spriggs
Checked [illegible]	Notes HHS Date 12-1-65
Date JUL 7 '66	Indexed G. L. GALLI

F. B. 3170 PG. 149

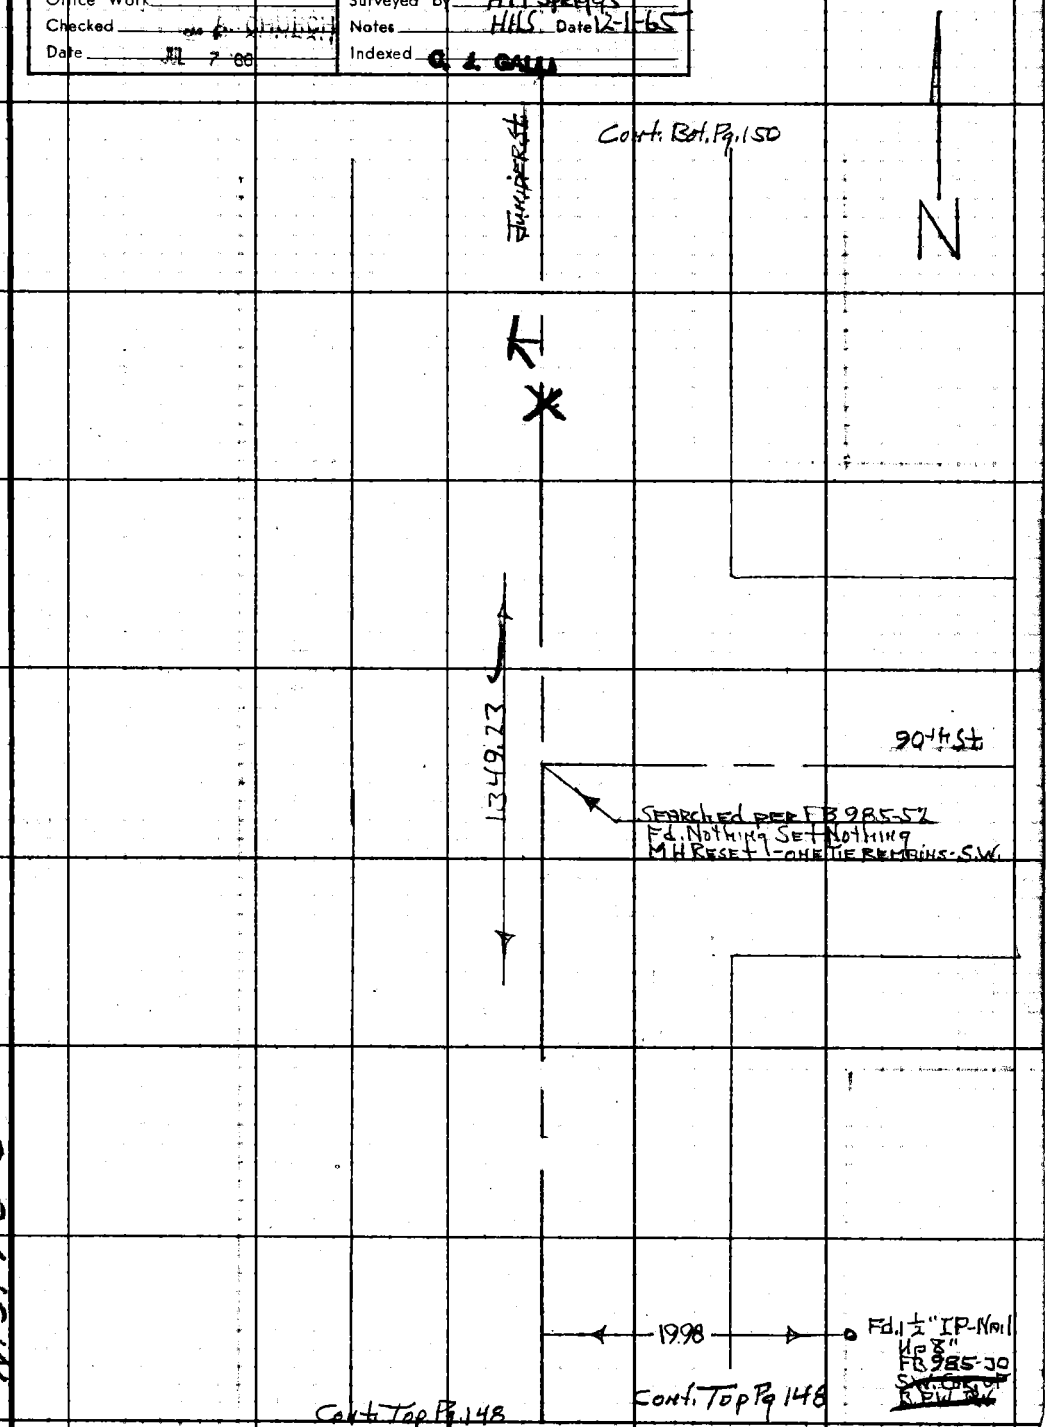

Note: Any Additions or Changes on This Sheet Must be Made or Circled in Red Ink With Date and Name of Person Making Change.

Do not extend this side of this line.

PLEASE RETURN TO
LOS ANGELES COUNTY ENGINEER
403 LOS ANGELES COUNTY ENGINEERING BLDG.

W. S. 7 C-6

75F309S CE#310 1-65

F.B. 3170 PG. 150

Cont. Bot. Pg. 151

W.S. 7 C-6

Sunder St.

N

1349.23

90th St.

Searched per FB 985-52
Fd Nothing Set Nothing
Mt. Reset - No Ties Remain

Fd. 2" I.P. Nail
d.n.6"
~~NE Cor. RD.~~
~~[illegible]~~

20.00

Cont. Top Pg 149

PLEASE RETURN TO
LOS ANGELES COUNTY ENGINEER
403 LOS ANGELES COUNTY ENGINEERING BLDG.
Do not extend this side of this line.

Note: Any Additions or Changes on This Sheet Must be Made or Circled in Red Ink With Date and Name of Person Making Change.

Notes Ck'd by V. Church	Survey of 92nd St
Map No. B 3019	JN 0096.66 Tape 0259 Std 68 °F
Office Work	Surveyed by H H Sprigg
Checked J. A. CHURCH	Notes [illegible] 12-1-65
Date [illegible] 7 '66	Indexed

F. B. 3170 PG. 151

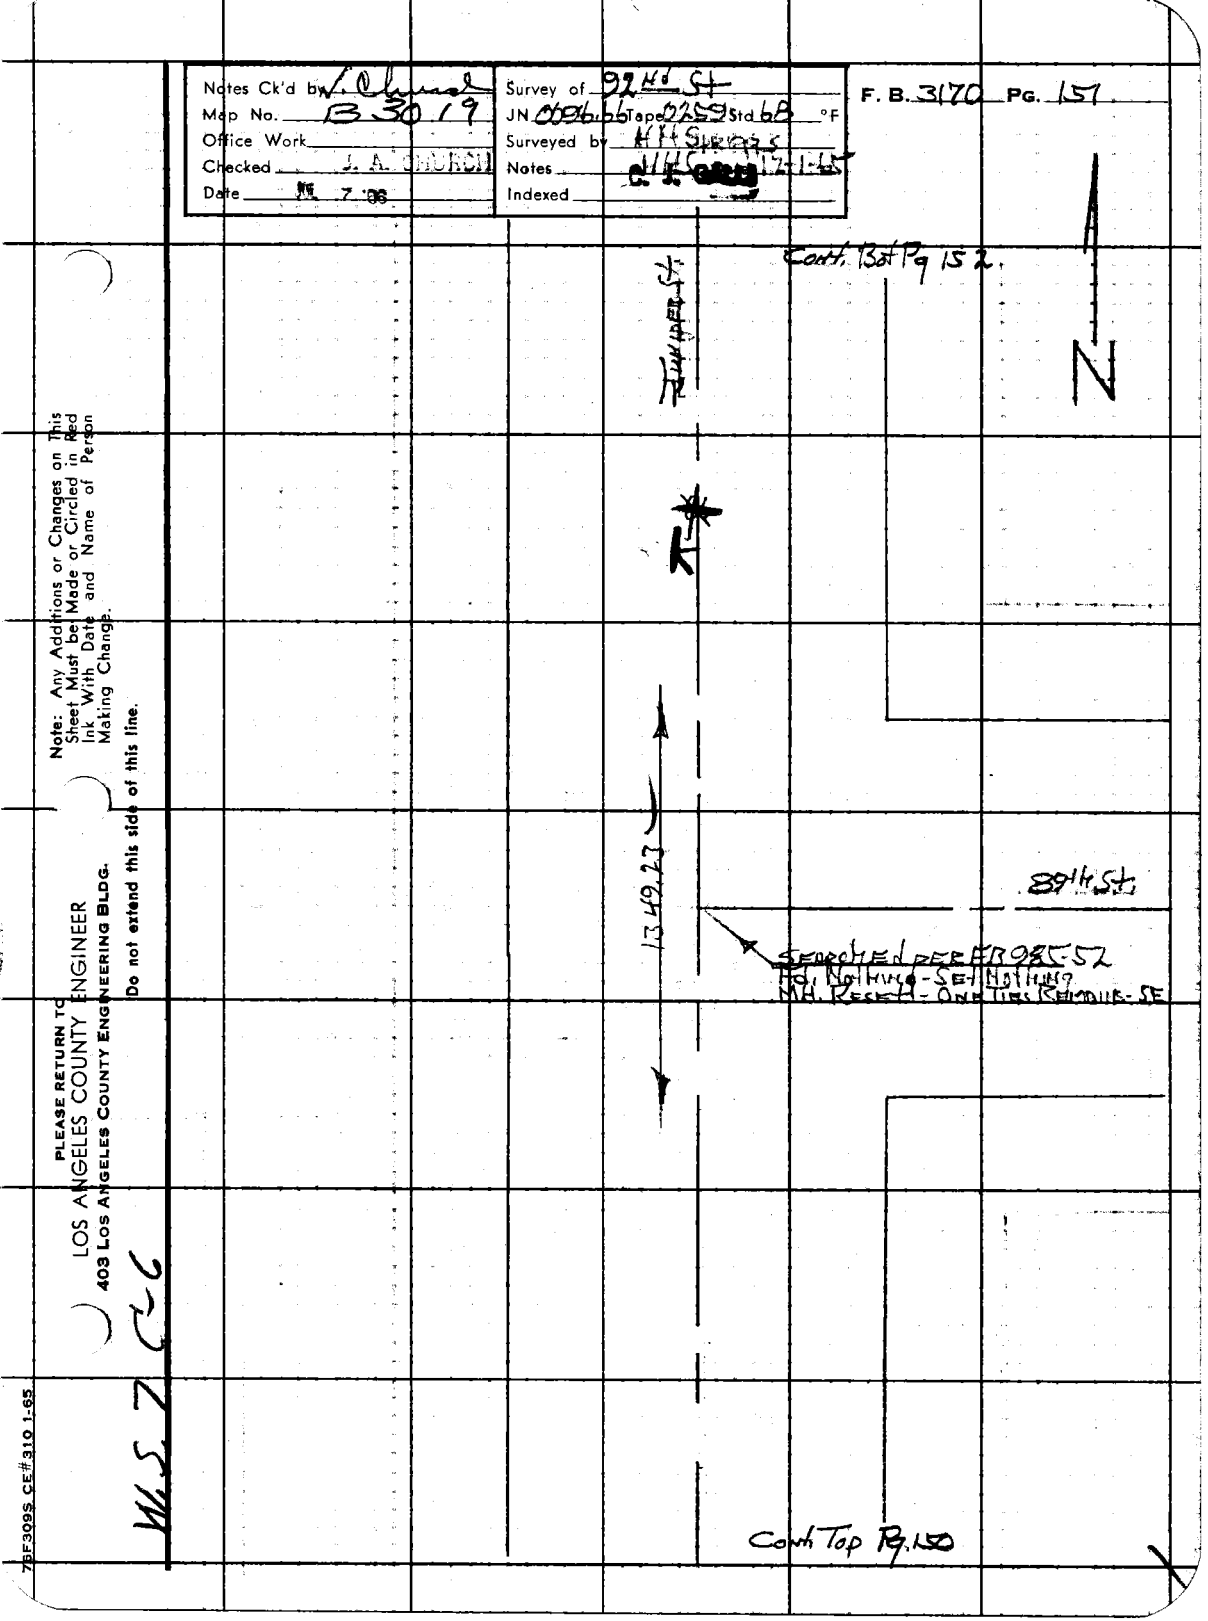

Note: Any Additions or Changes on This Sheet Must be Made or Circled in Red Ink With Date and Name of Person Making Change.

PLEASE RETURN TO
LOS ANGELES COUNTY ENGINEER
403 LOS ANGELES COUNTY ENGINEERING BLDG.

Do not extend this side of this line.

W.S. 7 C-6

76F309S CE#310 1-65

F.B. 3170 Pg. 152

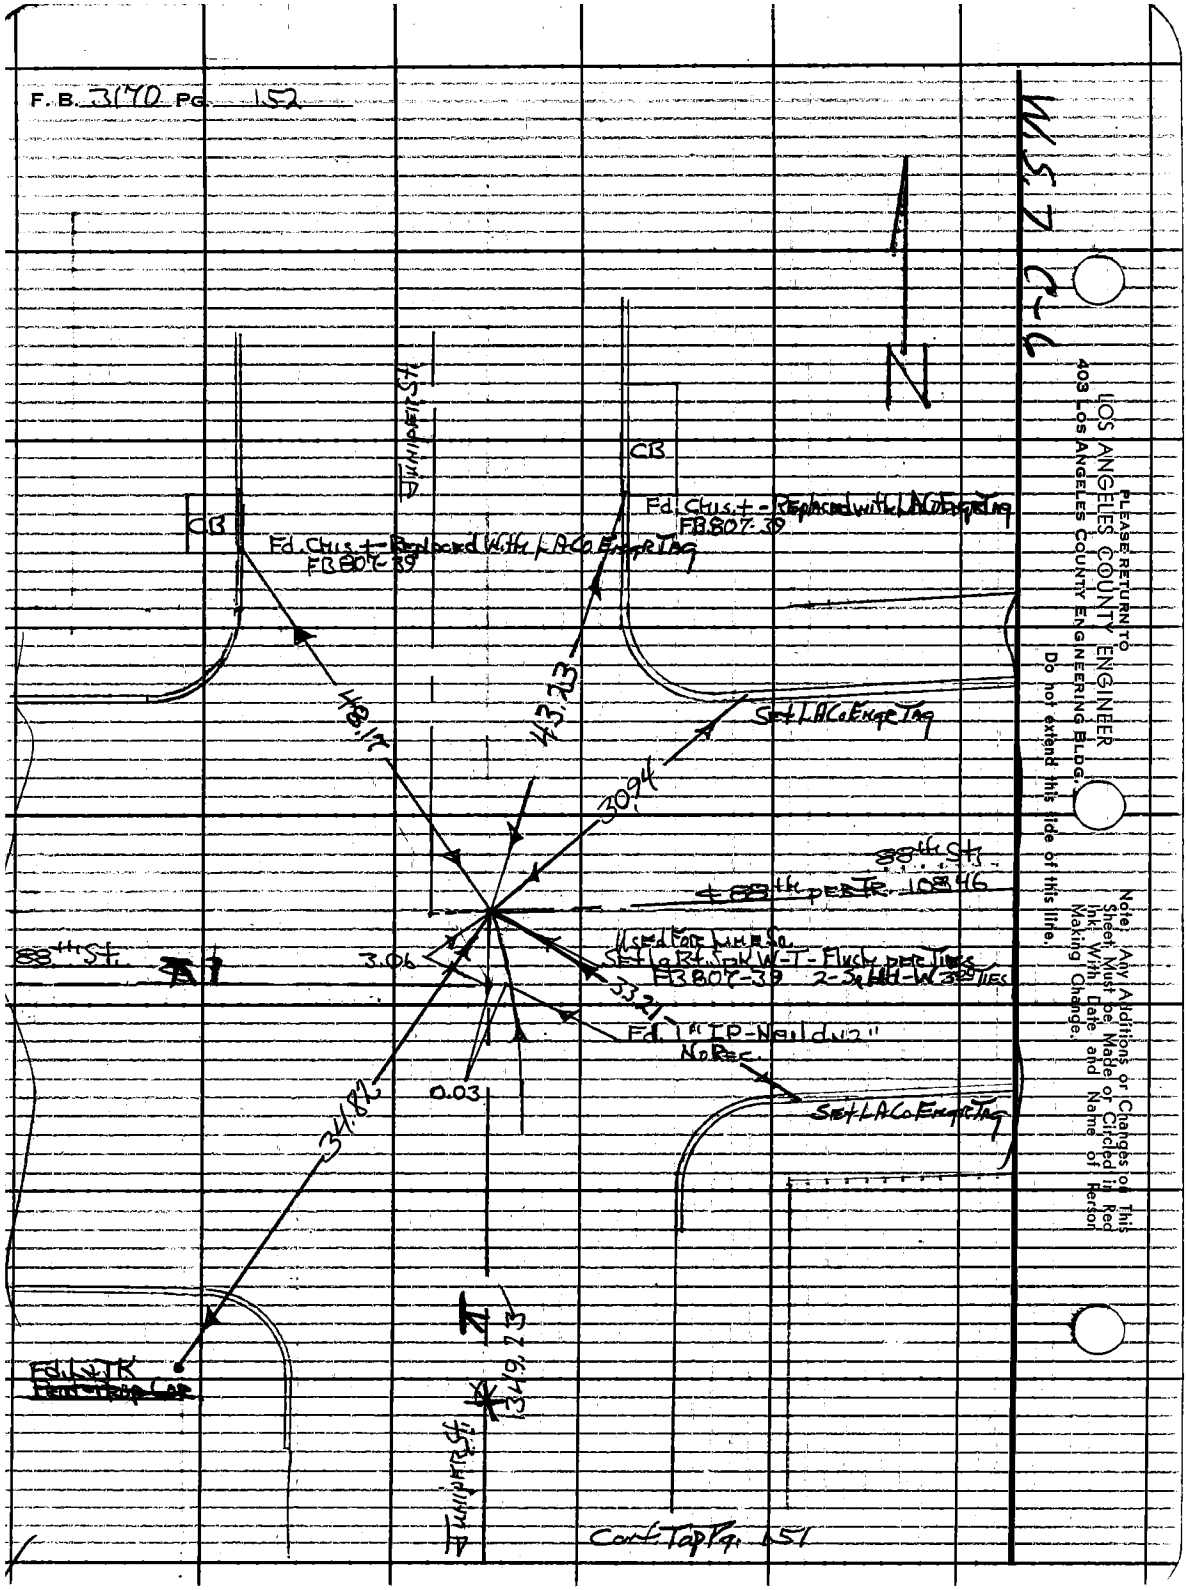

LOS ANGELES COUNTY ENGINEER
403 LOS ANGELES COUNTY ENGINEERING BLDG.
PLEASE RETURN TO
Do not extend this side of this line.
Note: Any Additions or Changes of This Sheet Must be Made or Circled in Red Ink, With Date and Name of Person Making Change.

Notes Ck'd by J. Church	Survey of 92nd St
Map No. B3019	JN 0096.66 Tape 0259 Std 68 °F
Office Work	Surveyed by H.H. Spriggs
Checked J. A. CHURCH	Notes HHS Date 12-20-65
Date JUL 7 '66	Indexed C. J. GALLI

F. B. 3170 PG. 153

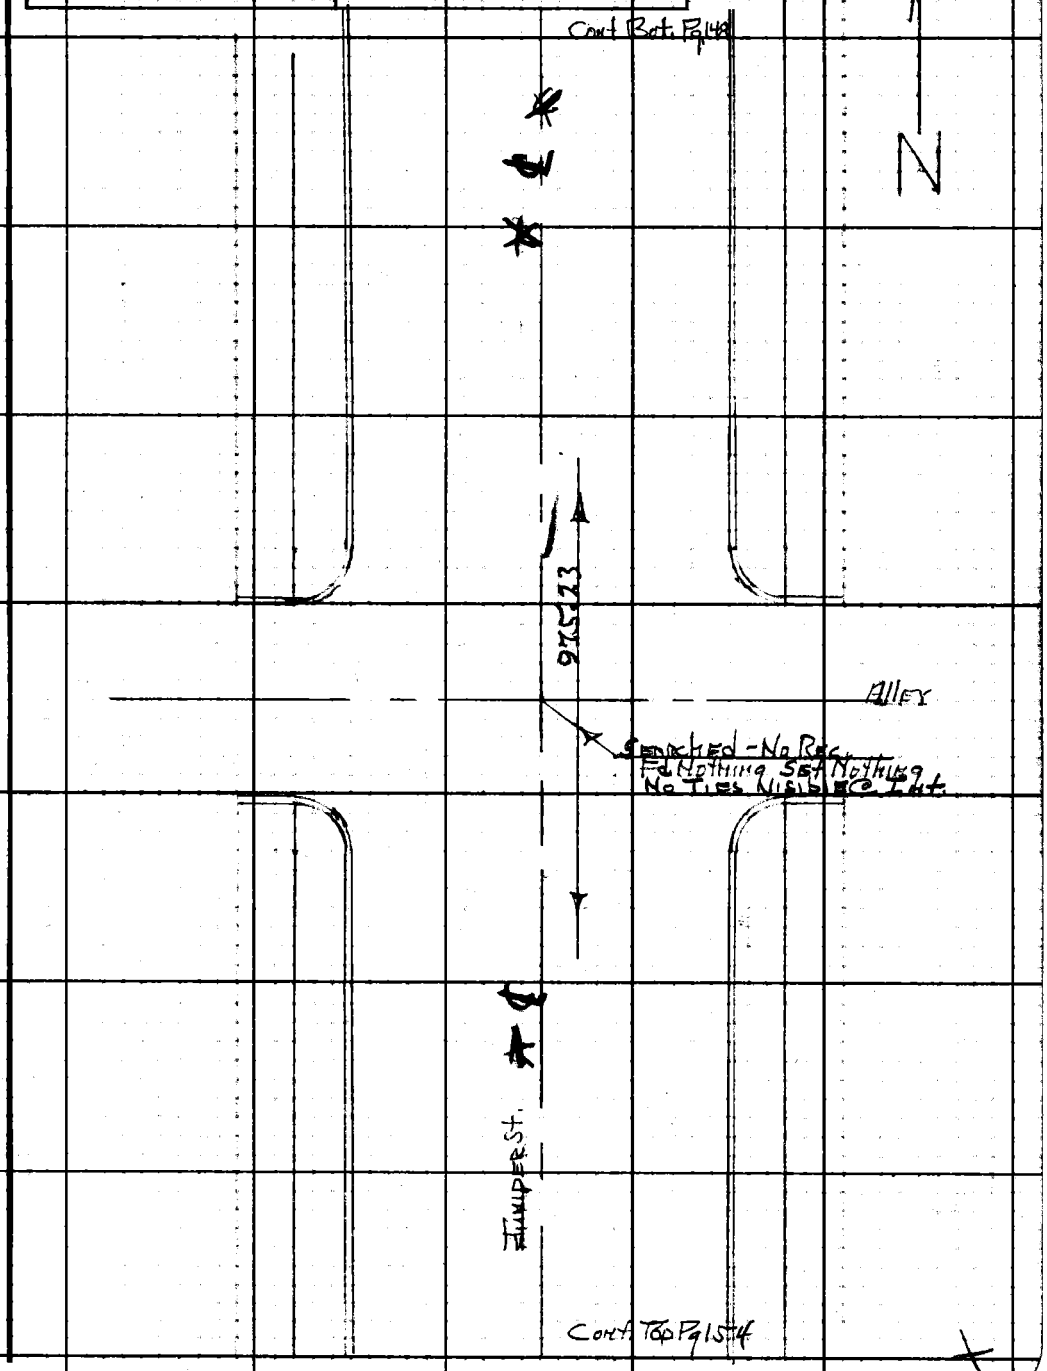

Note: Any Additions or Changes on This Sheet Must be Made or Circled in Red Ink With Date and Name of Person Making Change.

PLEASE RETURN TO
LOS ANGELES COUNTY ENGINEER
403 LOS ANGELES COUNTY ENGINEERING BLDG.

Do not extend this side of this line.

76F309S CE#310 1-65

F. B. 3170 PG. 154

Cont. Bot Pg. 153

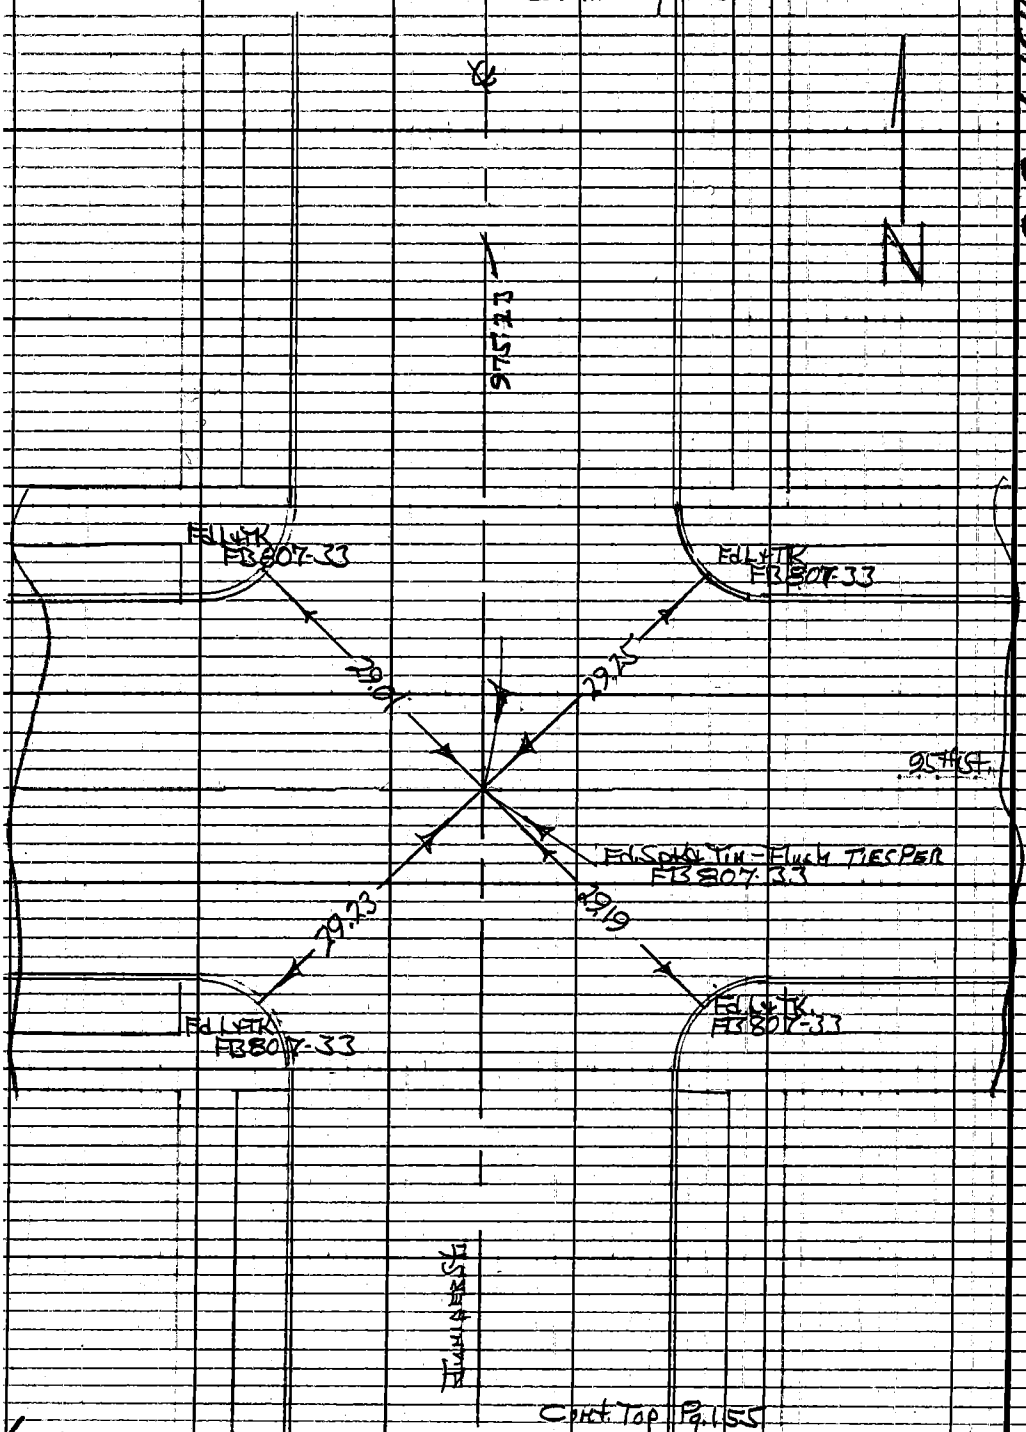

Cont. Top Pg. 155

W.S. 7 C-6

PLEASE RETURN TO
LOS ANGELES COUNTY ENGINEER
403 LOS ANGELES COUNTY ENGINEERING BLDG.
Do not extend this side of this line.
Note: Any Additions or Changes on This Sheet Must be Made or Circled in Red Ink With Date and Name of Person Making Change.

Notes Ck'd by J. Church
Map No. B.3019
Office Work
Checked J. A. CHURCH
Date JUL 7 '66

Survey of 92nd St
JN 009662 Tape 0259 Std 68 °F
Surveyed by H.H. Sprigg
Notes HHS Date 12-20-65
Indexed C. A. GALLE

F. B. 3170 PG. 155

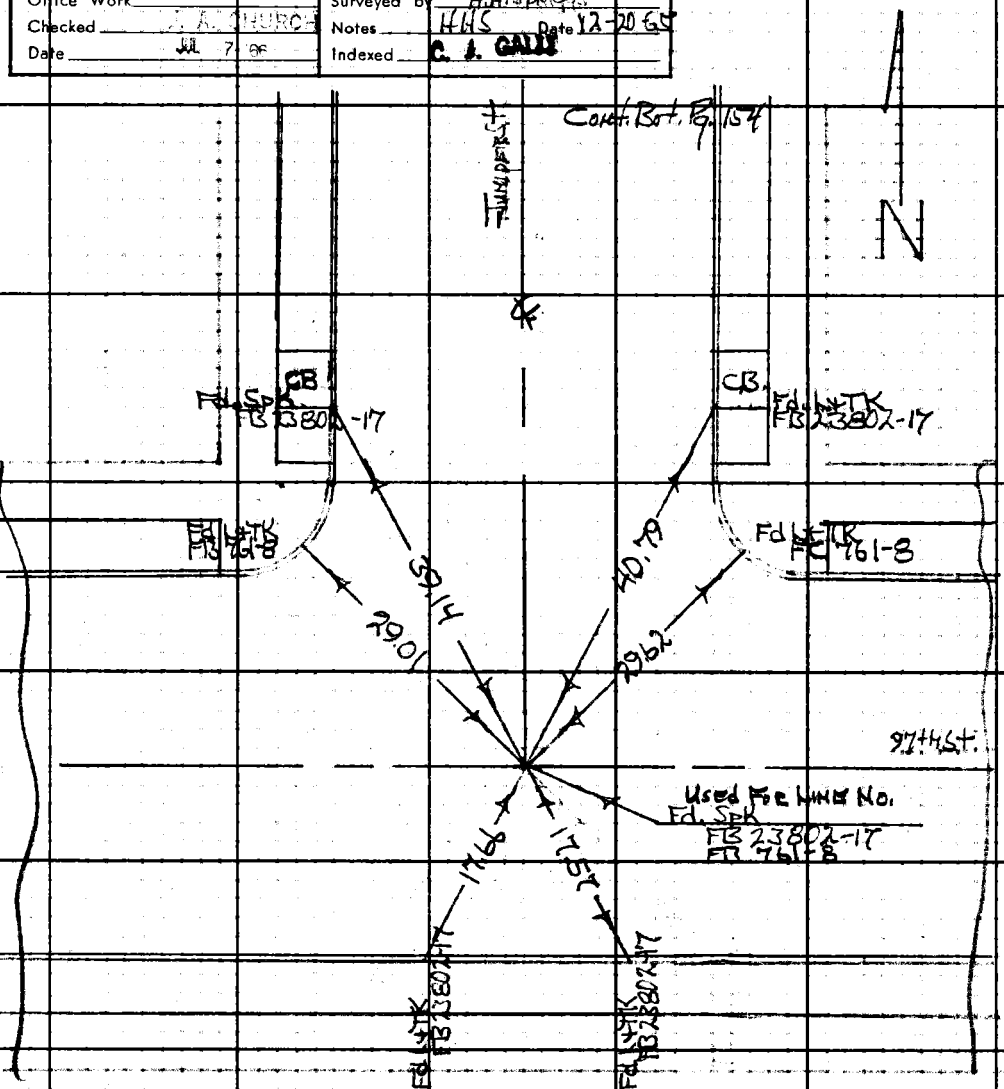

Note: Any Additions or Changes on This Sheet Must be Made or Circled in Red Ink With Date and Name of Person Making Change.

Do not extend this side of this line.

PLEASE RETURN TO
LOS ANGELES COUNTY ENGINEER
403 LOS ANGELES COUNTY ENGINEERING BLDG.

W.S. 7 C-6

76F309S CE#310 1-65

F.B. 3170 PG. 156

975.15 LEVEL @ 60 = 975.10 ✓

344.94 LEVEL @ 58 = 344.92 ✓

SW
1. 89-51-00
4. 359-23-30
6. 179-05-00 ✓
A. 89-50-50 ✓

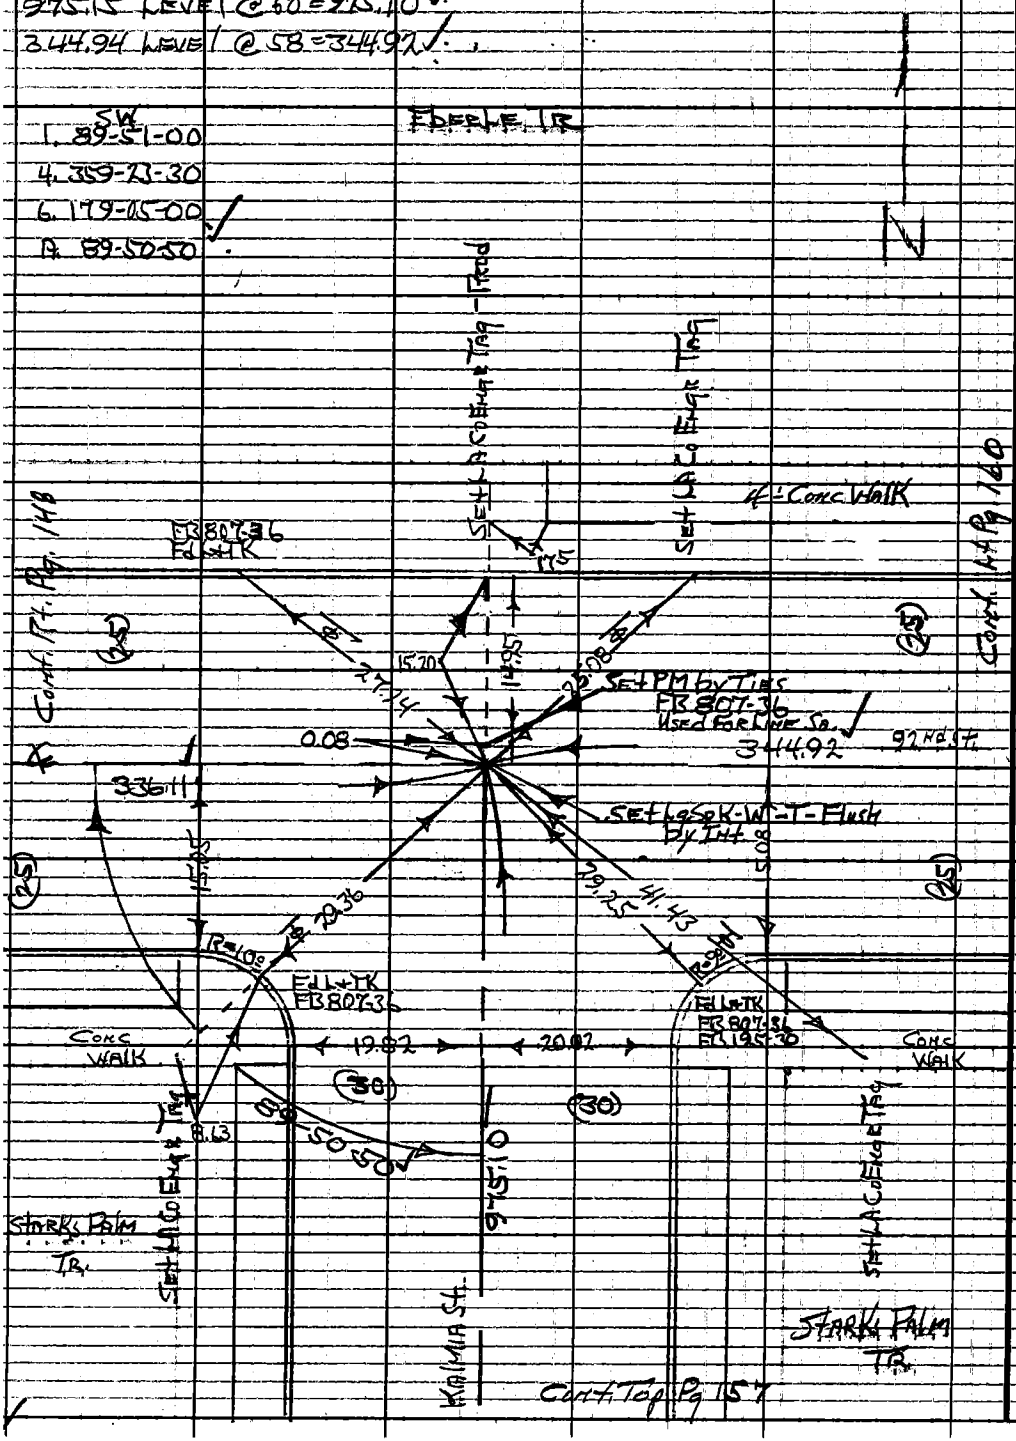

W.S. 7 C-6

PLEASE RETURN TO
LOS ANGELES COUNTY ENGINEER
403 LOS ANGELES COUNTY ENGINEERING BLDG.
Do not extend this side of this line.

Note: Any Additions or Changes on This Sheet Must be Made or Circled in Red Ink With Date and Name of Person Making Change.

Notes Ck'd by J. Church	Survey of 92nd St.
Map No. B3019	JN 009666 Tape 0259 Std 68 °F
Office Work	Surveyed by HHSprigg
Checked J. A. CHURCH	Notes HHS Date 12-20-65
Date JUL 7 '68	Indexed G. I. GALLI

F. B. 3170 PG. 157

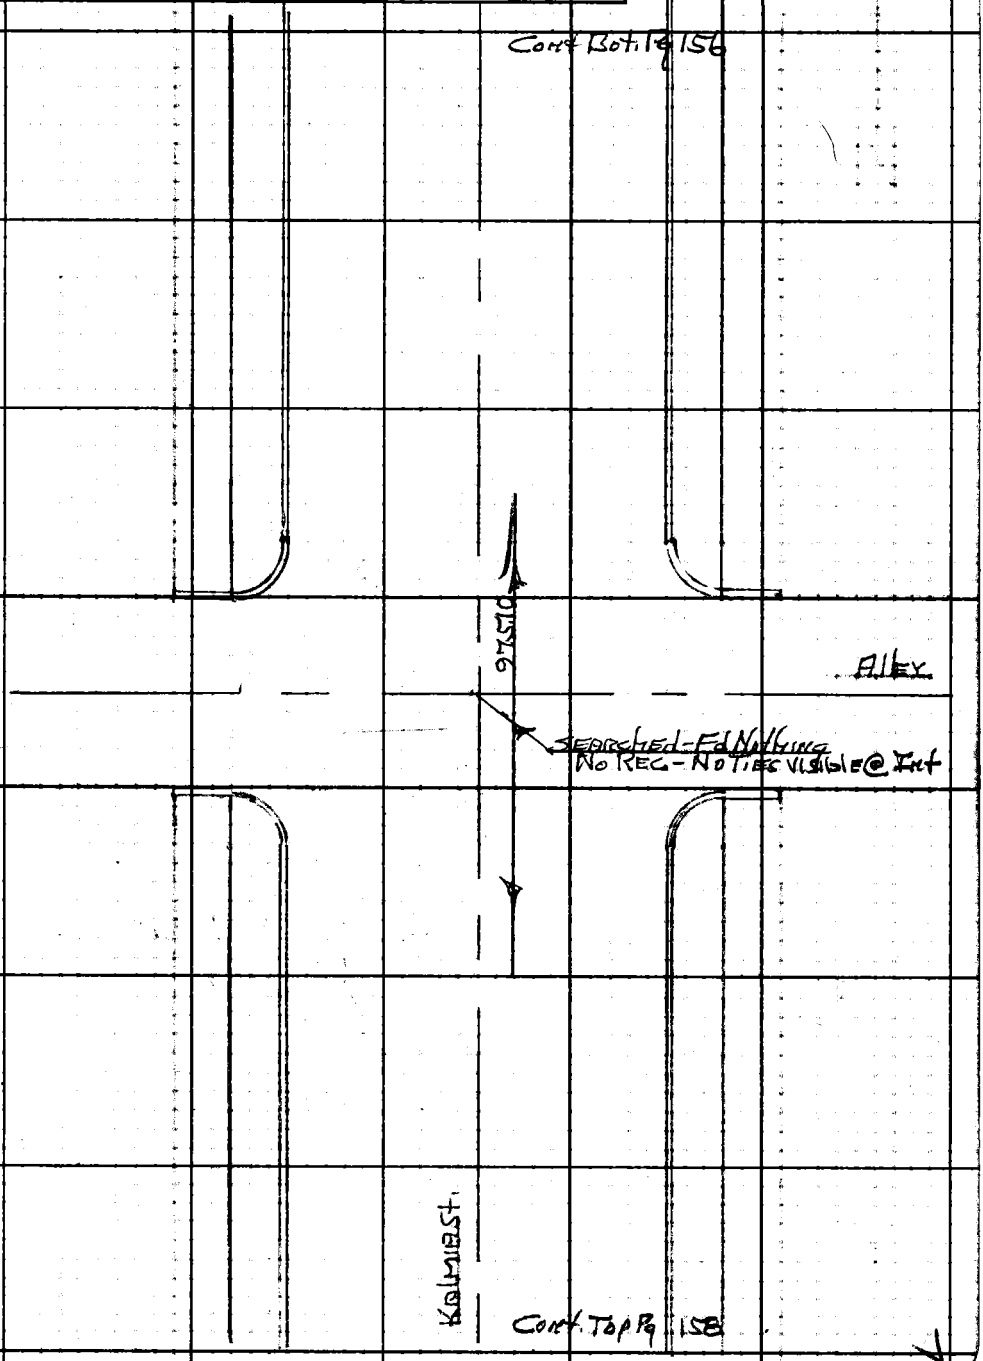

Note: Any Additions or Changes on This Sheet Must be Made or Circled in Red Ink With Date and Name of Person Making Change.

PLEASE RETURN TO
LOS ANGELES COUNTY ENGINEER
403 LOS ANGELES COUNTY ENGINEERING BLDG.

Do not extend this side of this line.

76F309S CE#310 1-65

F. B. 3170 PG. 158

Cont. Bot Pg 157

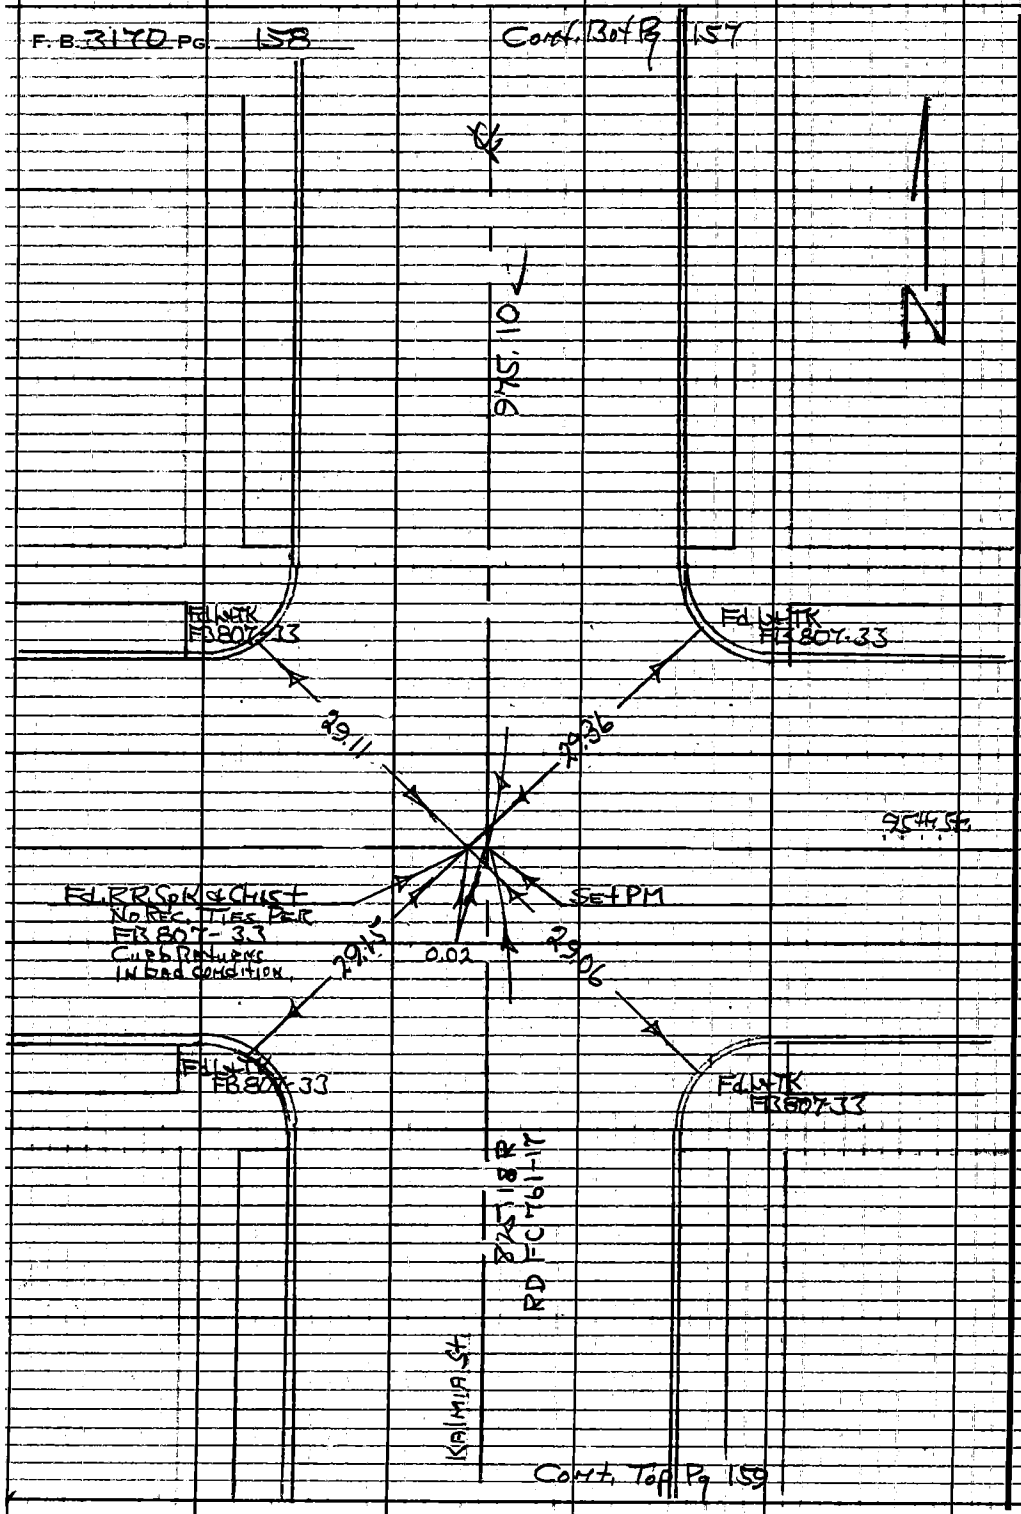

Cont. Top Pg 159

W.S. 7 C-6

PLEASE RETURN TO
LOS ANGELES COUNTY ENGINEER
403 LOS ANGELES COUNTY ENGINEERING BLDG.

Do not extend this side of this line

Note: Any Additions or Changes on This Sheet Must be Made or Circled in Red Ink With Date and Name of Person Making Change.

Notes Ck'd by J. Church	Survey of 92nd St
Map No. B 3019	JN 0096-69 Tape 0259 Std 68 °F
Office Work	Surveyed by H H Spriggs
Checked A. CHURCH	Notes HHS Date 12-20-65
Date 7 '66	Indexed C. J. GALLI

F. B. 3170 PG. 159

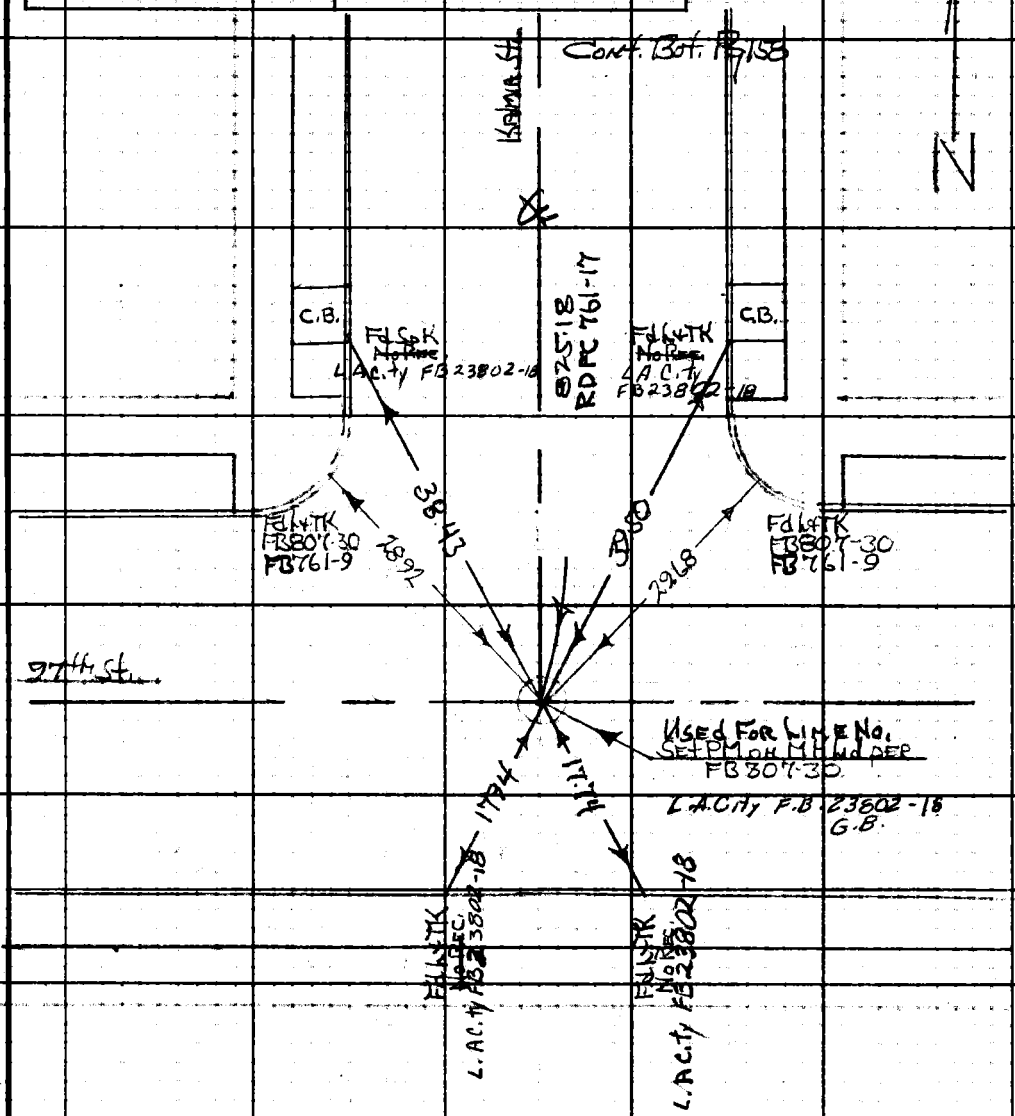

Note: Any Additions or Changes on This Sheet Must be Made or Circled in Red Ink With Date and Name of Person Making Change.

Do not extend this side of this line.

PLEASE RETURN TO
LOS ANGELES COUNTY ENGINEER
403 LOS ANGELES COUNTY ENGINEERING BLDG.

W.S. 7 C-C

76F309S CE#310 1-65

F.B. 3170 PG. 160

165.60 LEVEL @ 58 = 165.59

650.15 LEVEL @ 74 = 650.18

1. 89-51-15

4. 359-25-00

6. 179-07-30

8. 89-51-15

SAN ANTONIO RANCHO

This Pt. Fd. to be 0.14
No. FB 807-~~30~~ 36

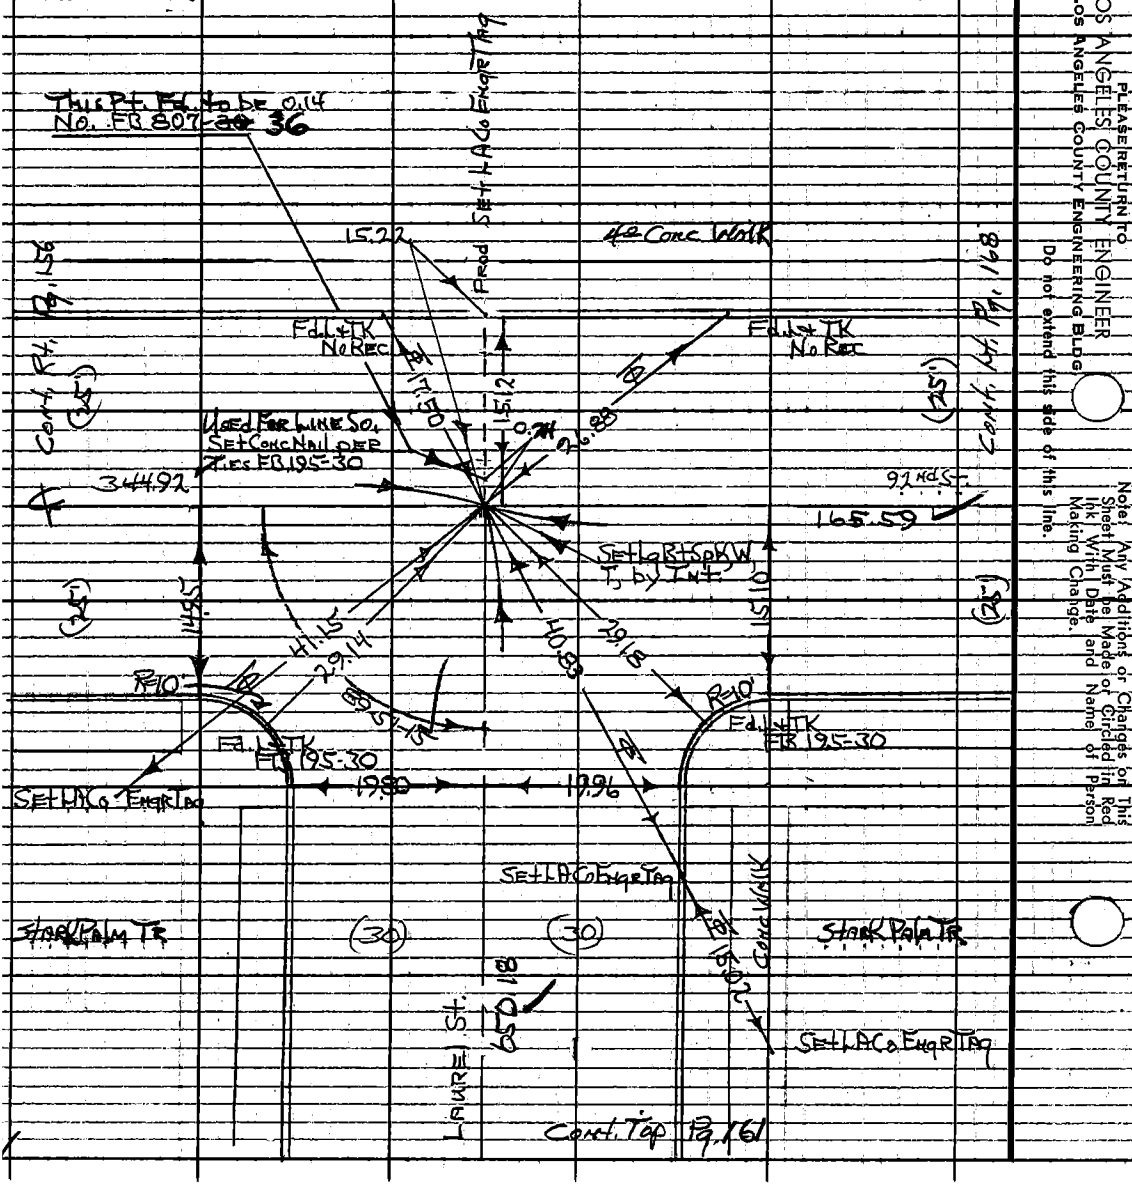

LOS ANGELES COUNTY ENGINEER
403 LOS ANGELES COUNTY ENGINEERING BLDG.

PLEASE RETURN TO

Do not extend this side of this line.

Note: Any Additions or Changes on This Sheet Must be Made or Circled in Red Ink With Date and Name of Person Making Change.

Notes Ck'd by J. Church	Survey of 92nd St.
Map No. B3019	JN 009666 Tape 0259 Std. 68 °F
Office Work	Surveyed by HHSpriggs
Checked J. A. CHURCH	Notes HHS Date 12-28-65
Date JUL 7 '66	Indexed C. J. GALLI

F. B. 3170 PG. 161

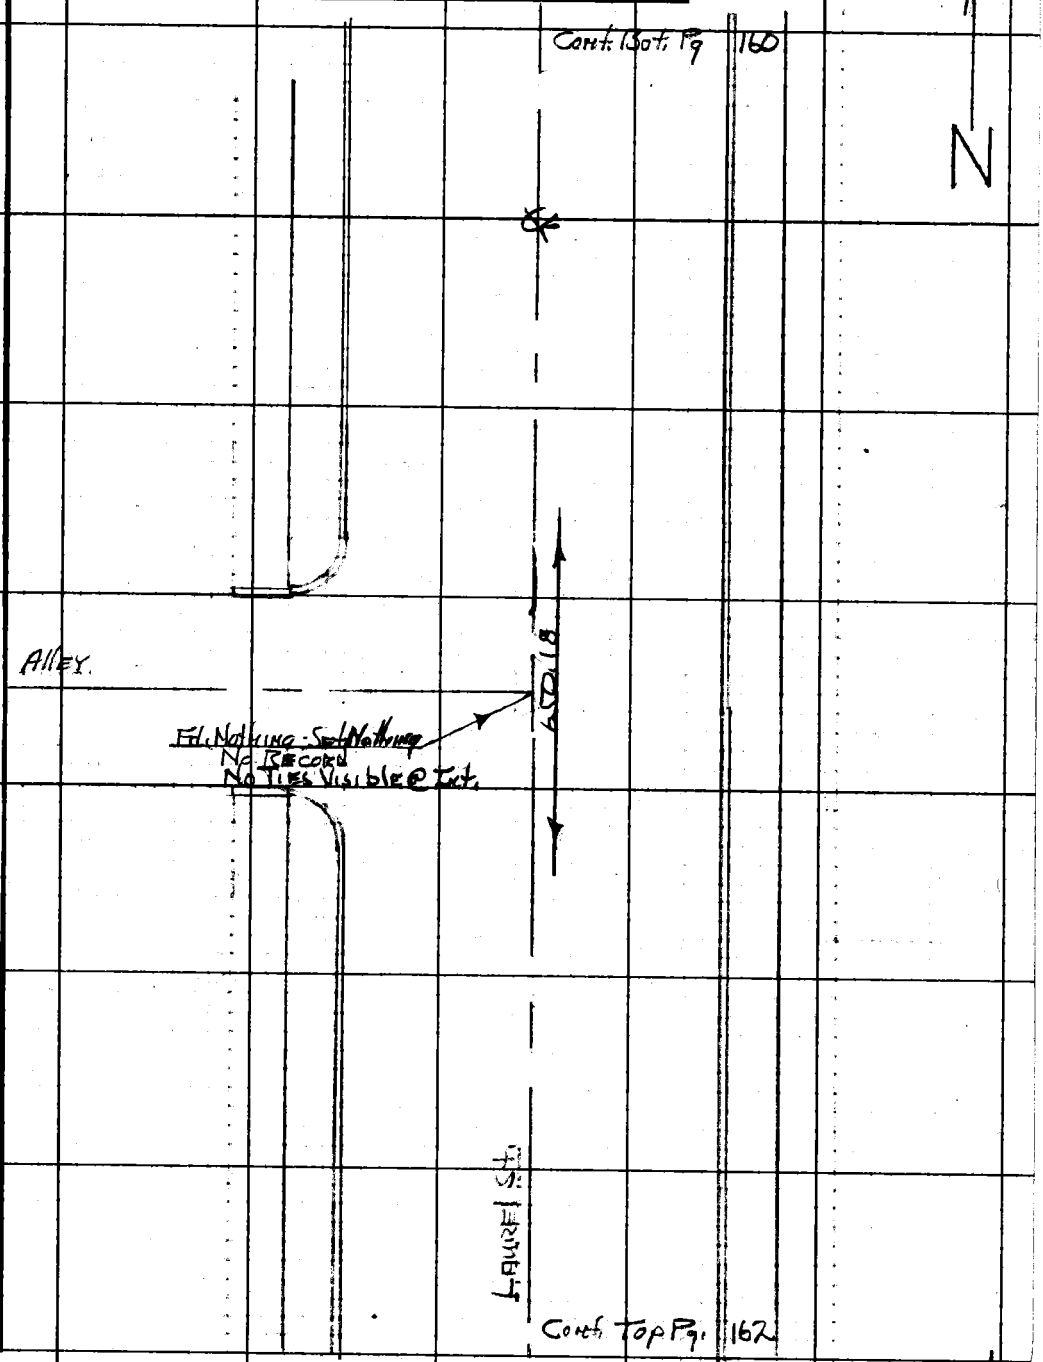

Note: Any Additions or Changes on This Sheet Must be Made or Circled in Red Ink With Date and Name of Person Making Change.

Do not extend this side of this line.

PLEASE RETURN TO
LOS ANGELES COUNTY ENGINEER
403 LOS ANGELES COUNTY ENGINEERING BLDG.

76F309S CE#310 1-65

PLEASE RETURN TO
LOS ANGELES COUNTY ENGINEER
403 LOS ANGELES COUNTY ENGINEERING BLDG.

Note: Any Additions or Changes on This Sheet Must be Made or Circled in Red Ink With Date and Name of Person Making Change.

Do not extend this side of this line.

W.S.7 C-6

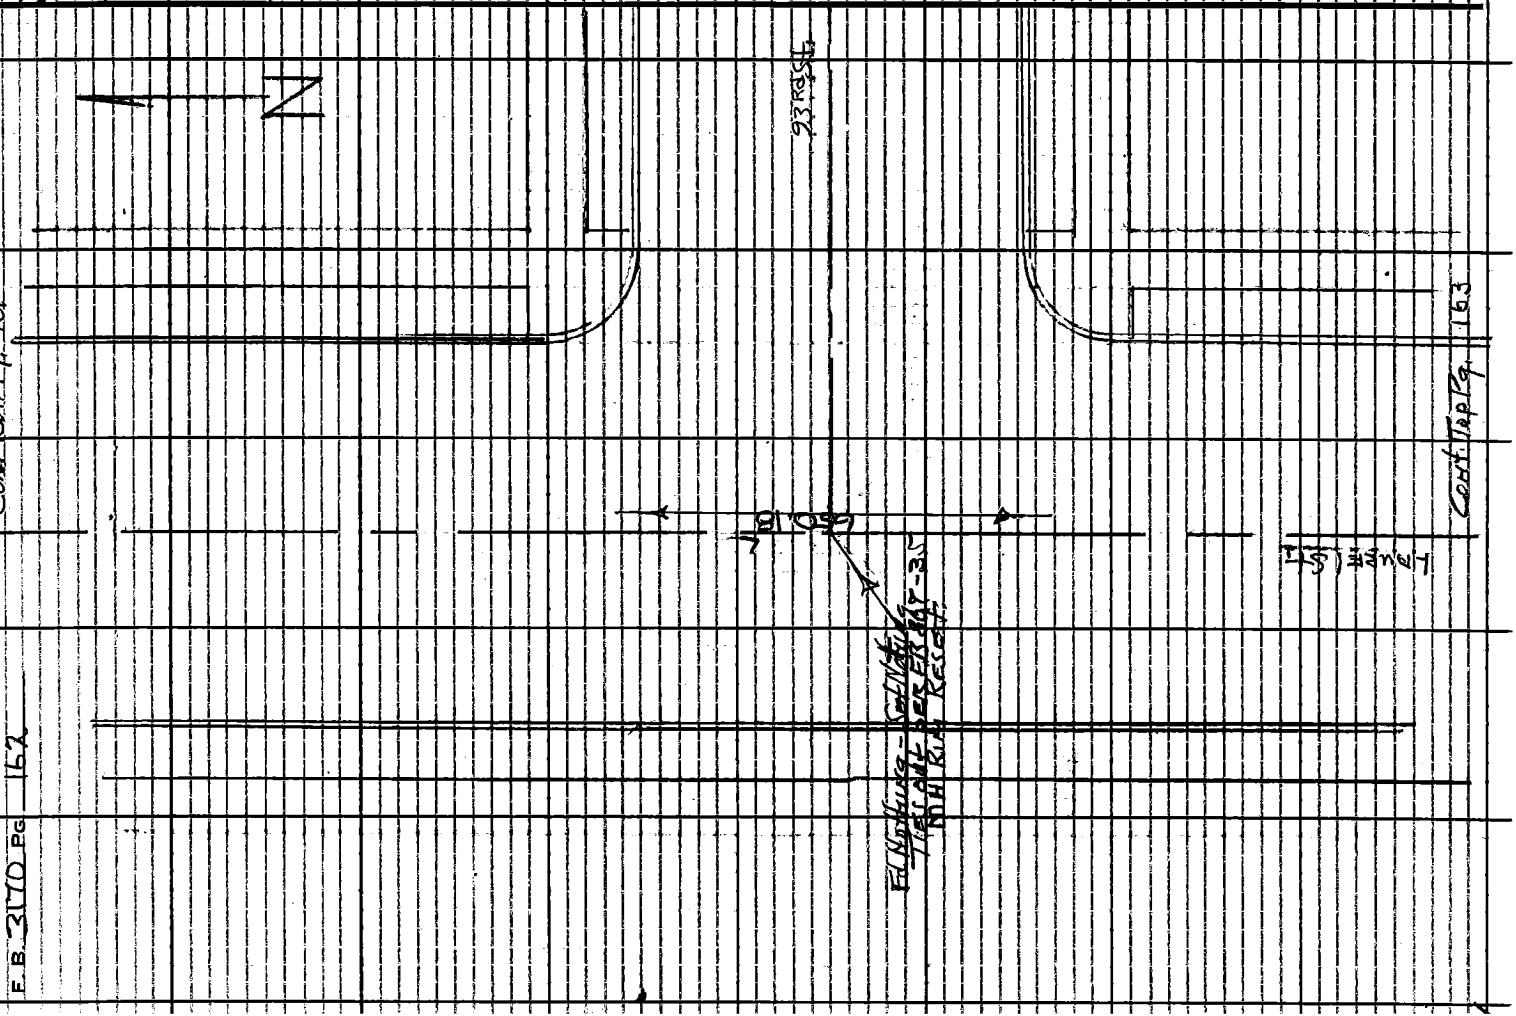

Notes Ck'd by [illegible]	Survey of 92nd St
Map No. B3019	JN0096.66 Tape 0259 Std 68 °F
Office Work	Surveyed by HHSpriggs
Checked J. A. CHURCH	Notes HHS Date 12-28-65
Date JUL 7 '66	Indexed C. J. GALES

F. B. 3170 PG. 163

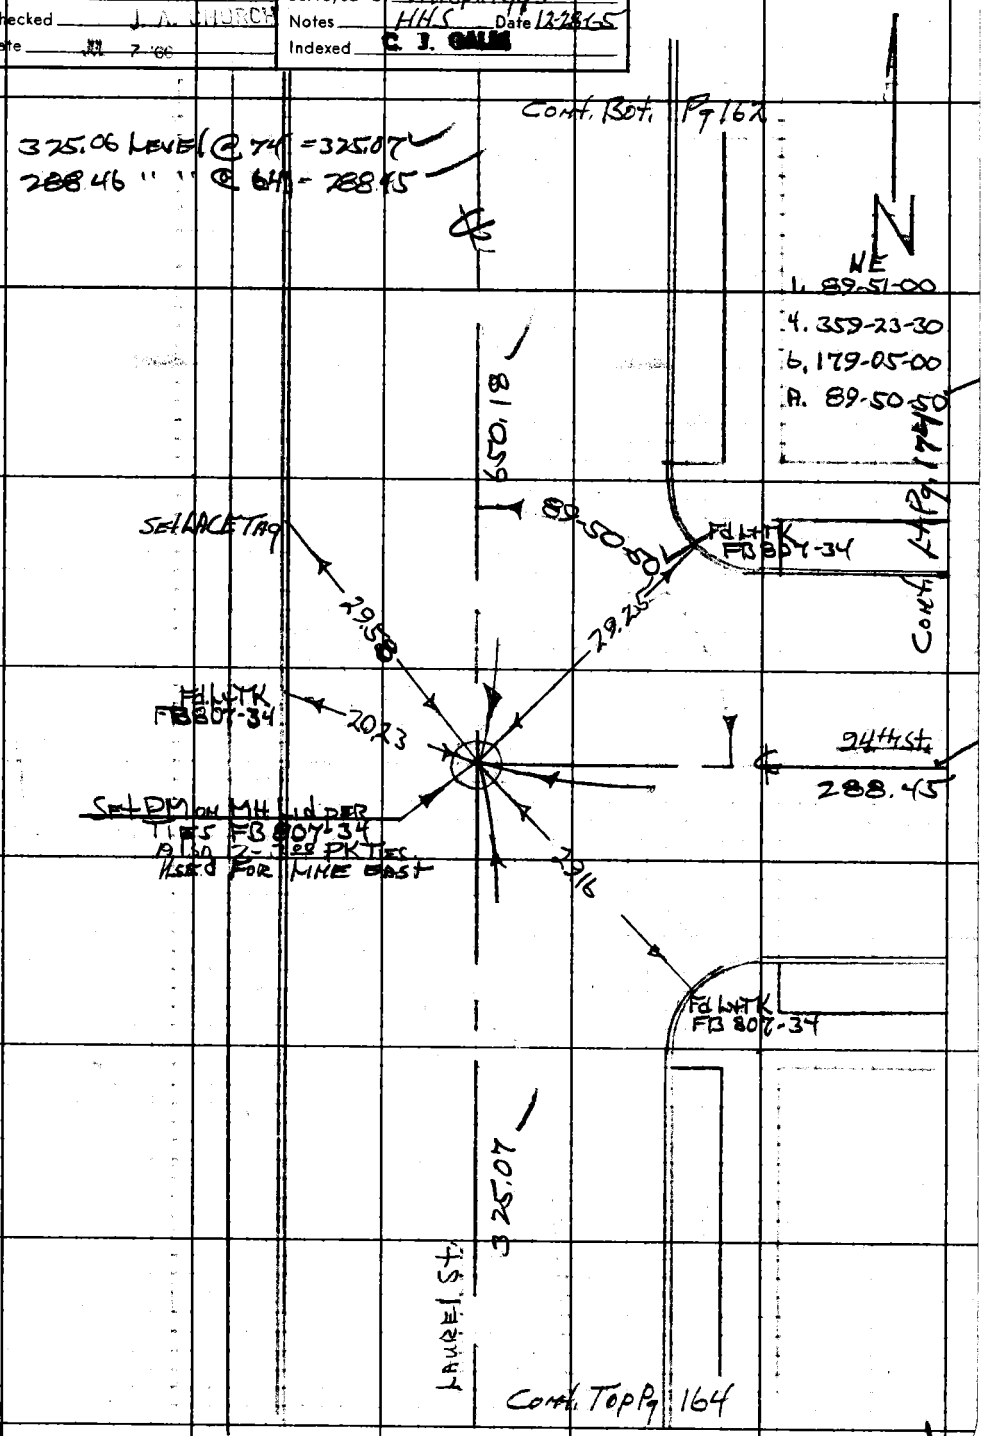

Note: Any Additions or Changes on This Sheet Must be Made or Circled in Red Ink With Date and Name of Person Making Change.

PLEASE RETURN TO
LOS ANGELES COUNTY ENGINEER
403 LOS ANGELES COUNTY ENGINEERING BLDG.

Do not extend this side of this line.

W. S. 7 C-6

76F309S CE#310 1-65

F.B. 3170 Pg. 164

Cont. Bot. Pg. 163

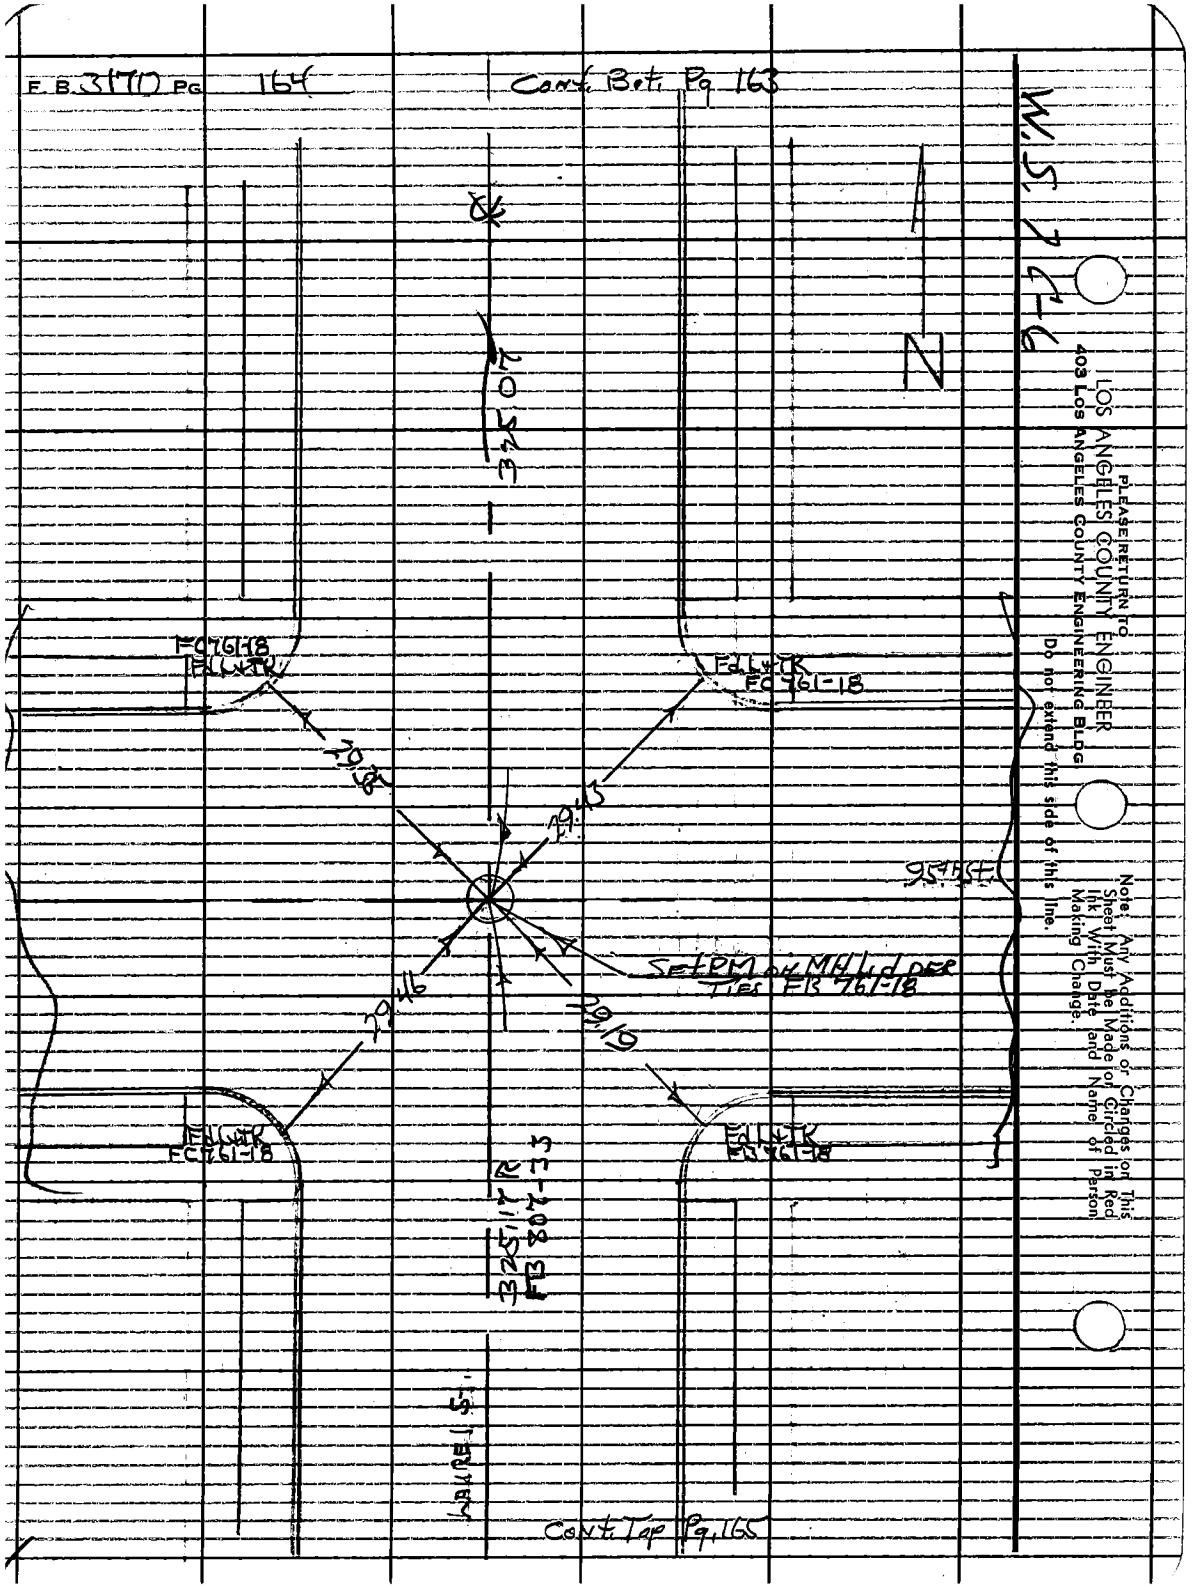

Notes Ck'd by [signature]	Survey of 92nd St.
Map No. B3D19	JN 009666 Tape 0259 Std 68 °F
Office Work	Surveyed by H.H. Spriggs
Checked L. A. CHURCH	Notes HHS Date 12-28-65
Date JUL 7 '66	Indexed C. J. [illegible] MAR 1 8 '66

F. B. 3170 PG. 165

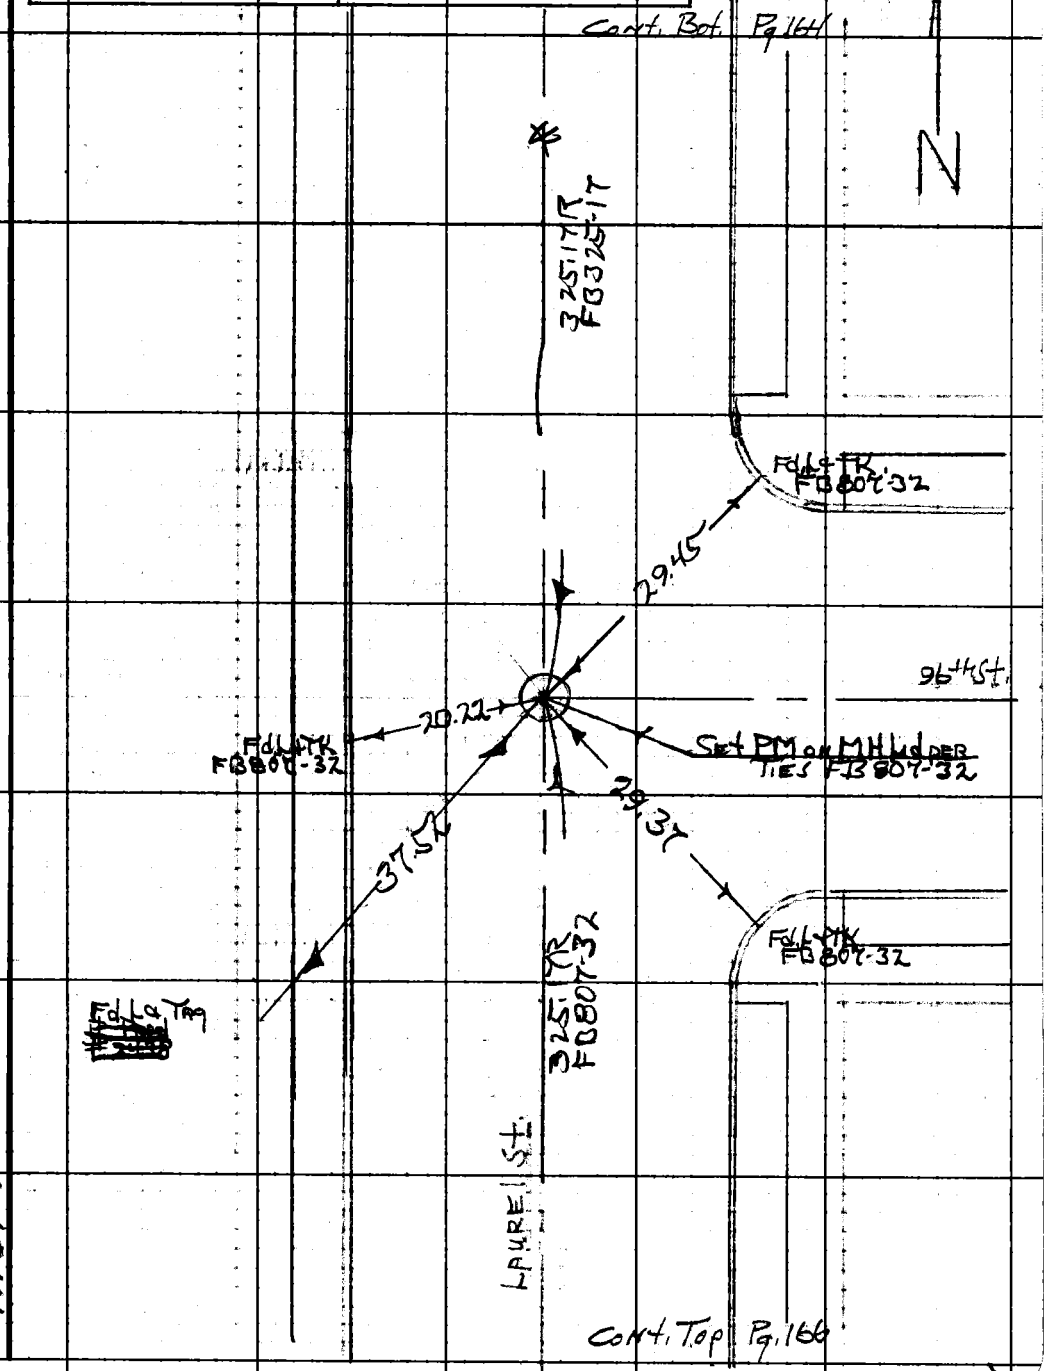

Note: Any Additions or Changes on This Sheet Must be Made or Circled in Red Ink With Date and Name of Person Making Change.

PLEASE RETURN TO
LOS ANGELES COUNTY ENGINEER
403 LOS ANGELES COUNTY ENGINEERING BLDG.

Do not extend this side of this line.

W.S. 7C-6

76F309S CE#310 1-65

F. B. 3170 PG 166

Cont. Bot. Pg. 165

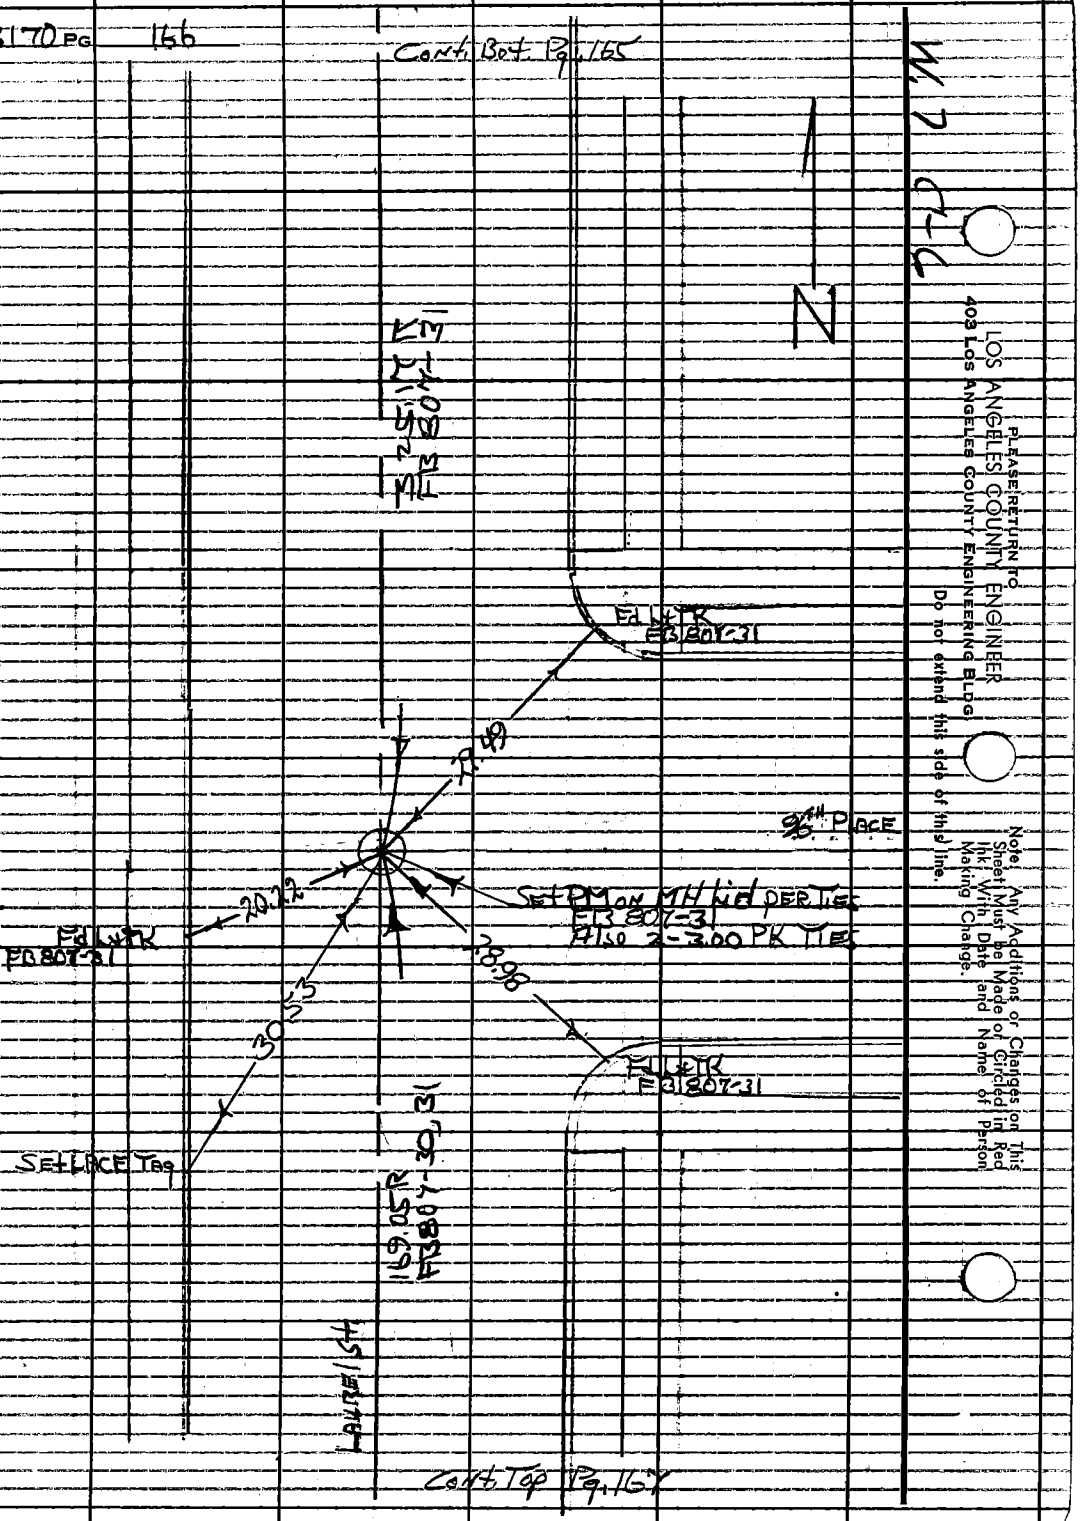

Cont. Top Pg. 167

PLEASE RETURN TO
LOS ANGELES COUNTY ENGINEER
403 LOS ANGELES COUNTY ENGINEERING BLDG.
Do not extend this side of the line.

Note: Any Additions or Changes on This Sheet Must be Made of Circled in Red Ink With Date and Name of Person Making Change.

Notes Ck'd by C. Johnson
Map No. B3019
Office Work
Checked J. A. CHURCH
Date JUL 7 1966

Survey of 92nd St
JN 0026.66 Tape 0252 Std 66B °F
Surveyed by H.H. Spraggs
Notes HHS Date 12-28-65
Indexed
G. J. GALLI

F. B. 3170 PG. 167

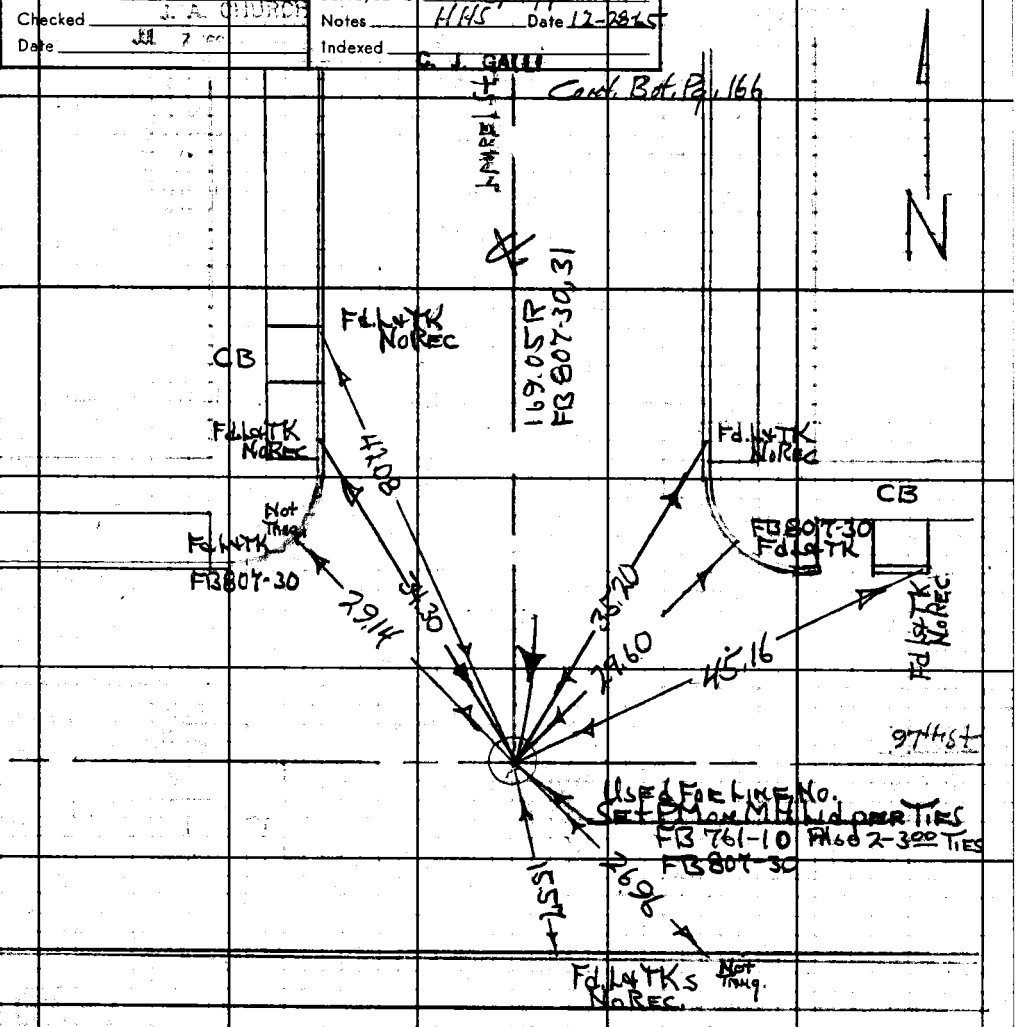

Note: Any Additions or Changes on This Sheet Must be Made or Circled in Red Ink With Date and Name of Person Making Change.

Do not extend this side of this line.

PLEASE RETURN TO
LOS ANGELES COUNTY ENGINEER
403 LOS ANGELES COUNTY ENGINEERING BLDG.

W.S. 7 C-6

76F309S CE#310 1-65

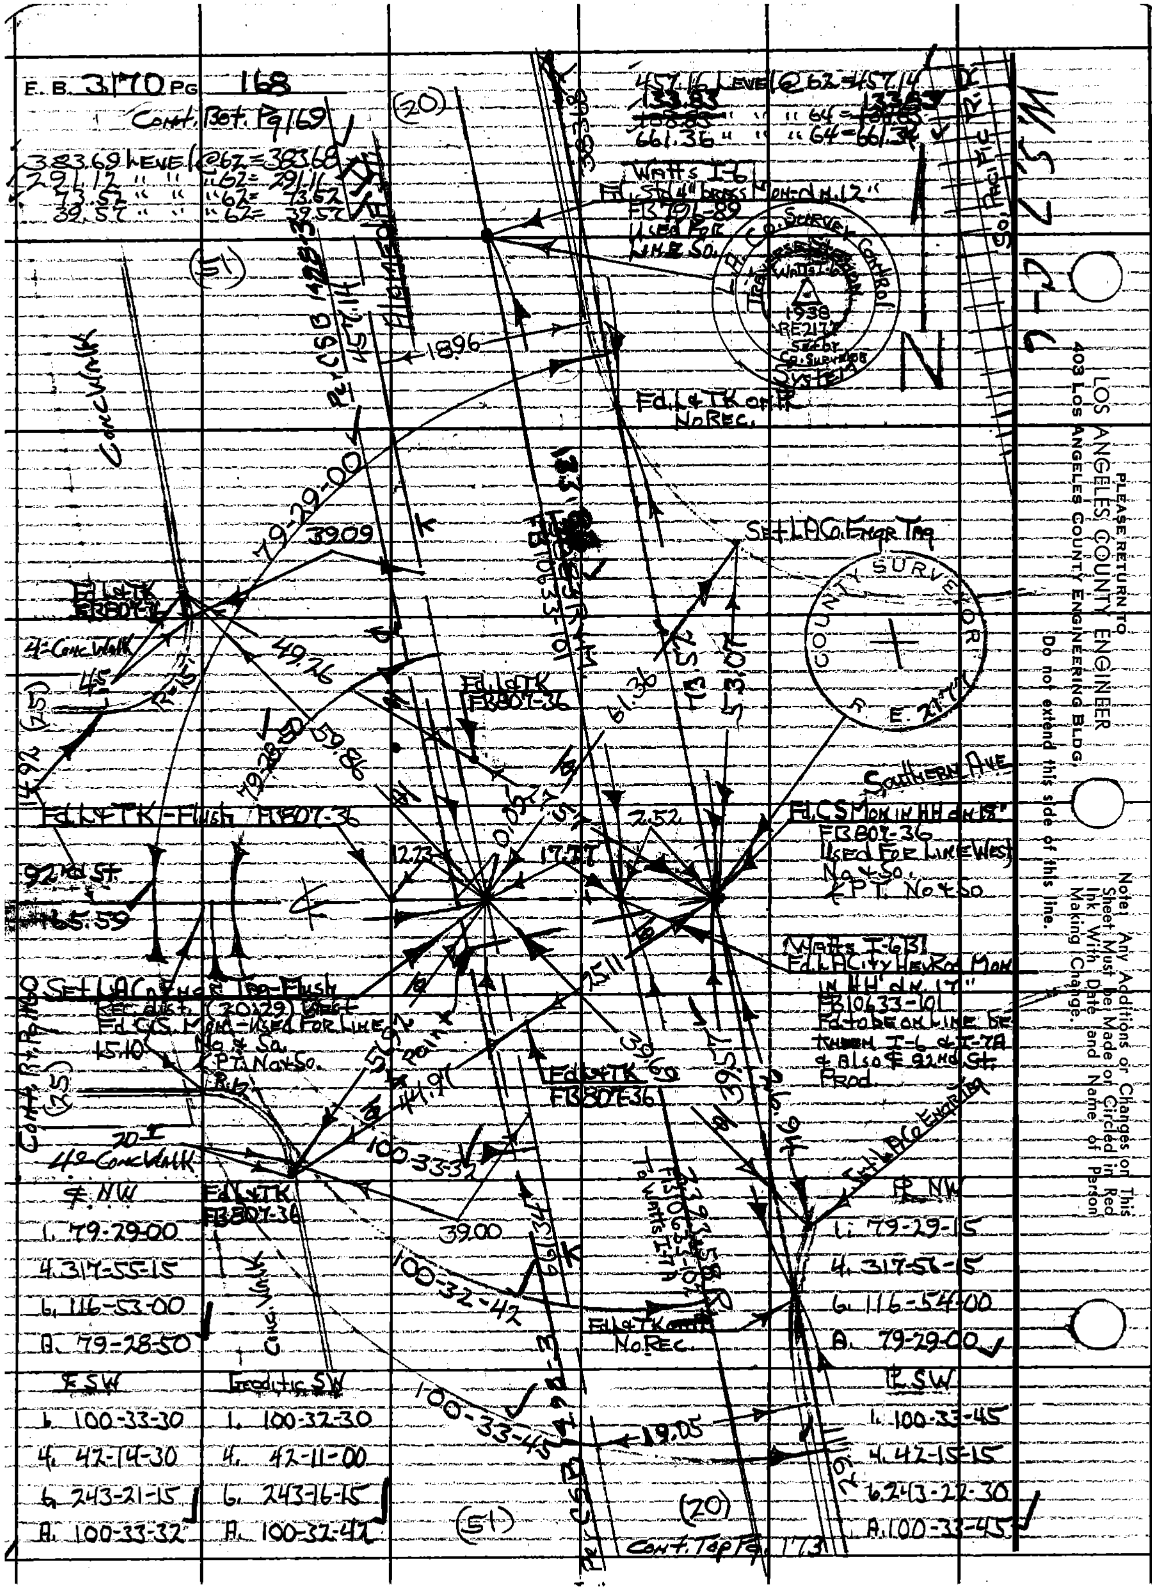

E. B. 3170 PG 168
Cont. Bot. Pg 169
383.69 Level @ 62 = 383.68
291.12 " " " 62 = 291.11
73.57 " " " 62 = 73.57
39.57 " " " 62 = 39.57
457.16 Level @ 62 = 457.14
661.36 " " " 64 = 661.34
Watts I-6
Fd. Std 4" brass Mon. dn. 12"
FB 796-89
Used For Line So.
L.A. Co. Survey Control
Traverse Station
Watts I-6
1938
RE 2177
Fd. L & TK on R
No Rec.
Set LACo. Engr Tag
Fd. L & TK
FB 807-36
4' Conc. Walk
Conc. Walk
49.76
39.09
79-29-00
18.96
Fd. L & TK
FB 807-36
Southern Ave
Fd. L & TK - Flush FB 807-36
Fd. C.S. Mon in HH dn 18"
FB 807-36
Used For Line West
No. & So.
& P.T. No. & So.
92nd St.
65.59
12.22
17.27
2.52
Watts I-6B
Fd. LA City Hev. Rod Mon in HH dn. 17"
FB 10633-101
Fd. to be on line between I-6 & I-7A
& also ℄ 92nd St. Prod.
Set LACo. Engr. Tag - Flush
Rec. dist. (20.29) West
Fd. C.S. Mon - Used For Line N
No. & So.
& P.T. No. & So.
15.10
Fd. L & TK 6.9
FB 807-36
20.1'
4' Conc. Walk
Fd. L & TK
FB 807-36
Set LACo. Engr Tag
℄ NW
1. 79-29-00
4. 317-55-15
6. 116-53-00
A. 79-28-50
℄ SW
1. 100-33-30
4. 42-14-30
6. 243-21-15
A. 100-33-32
Geodetic SW
1. 100-32-30
4. 42-11-00
6. 243-16-15
A. 100-32-42
39.00
100-33-32
100-32-42
100-33-45
Fd. L & TK on R
No. Rec.
19.05
PL NW
1. 79-29-15
4. 317-56-15
6. 116-54-00
A. 79-29-00
PL SW
1. 100-33-45
4. 42-15-15
6. 243-22-30
A. 100-33-45
(20)
(51)
Cont. Top Pg. 173
County Surveyor
R.E. 2177
PLEASE RETURN TO
LOS ANGELES COUNTY ENGINEER
403 LOS ANGELES COUNTY ENGINEERING BLDG
Do not extend this side of this line.
Note: Any Additions or Changes on This Sheet Must be Made or Circled in Red Ink With Date and Name of Person Making Change.

Notes Ck'd by T. Church	Survey of 92nd St
Map No. B 3019	JN 0096 66 Tape 0259 Std 68 °F
Office Work	Surveyed by HHSpriggs
Checked J. A. CHURCH	Notes HHS Date 1-7-65
Date 2 68	Indexed C. J. GALLI

F. B. 3170 PG. 169

Cont. Bot. Pg. 170

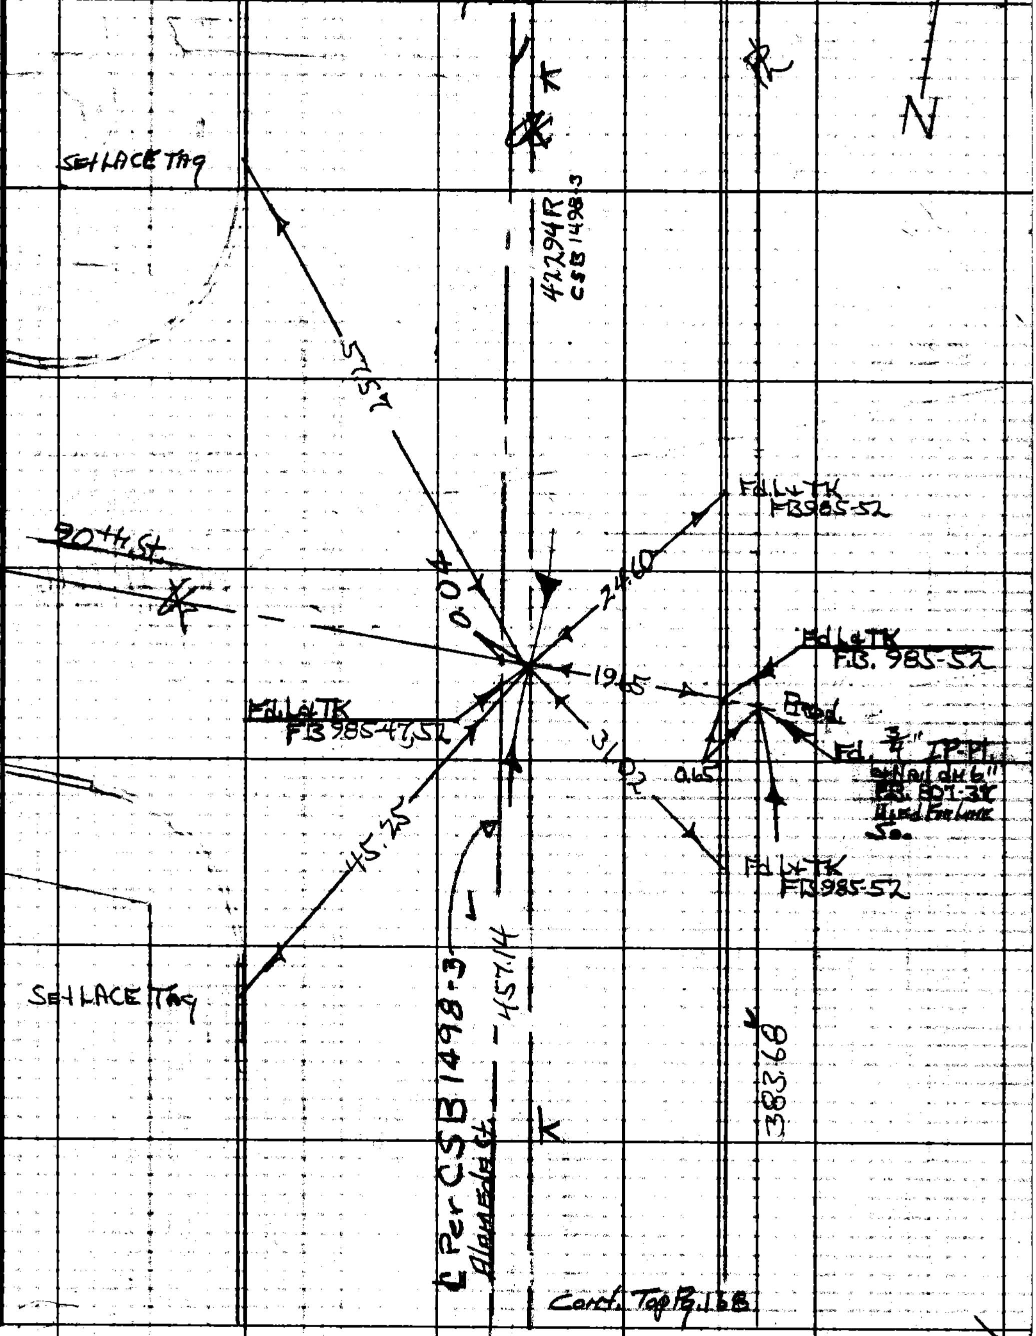

Cont. Top Pg. 168

W.S. 7 C-C

Note: Any Additions or Changes on This Sheet Must be Made or Circled in Red Ink With Date and Name of Person Making Change.

Do not extend this side of this line.

PLEASE RETURN TO
LOS ANGELES COUNTY ENGINEER
403 LOS ANGELES COUNTY ENGINEERING BLDG.

76F309S CE#310 1-65

PLEASE RETURN TO
LOS ANGELES COUNTY ENGINEER
403 LOS ANGELES COUNTY ENGINEERING BLDG.

Note: Any Additions or Changes on This Sheet Must Be Made or Circled in Red Ink With Date and Name of Person Making Change.

Do not extend this side of this line.

W.S. 7 C-6

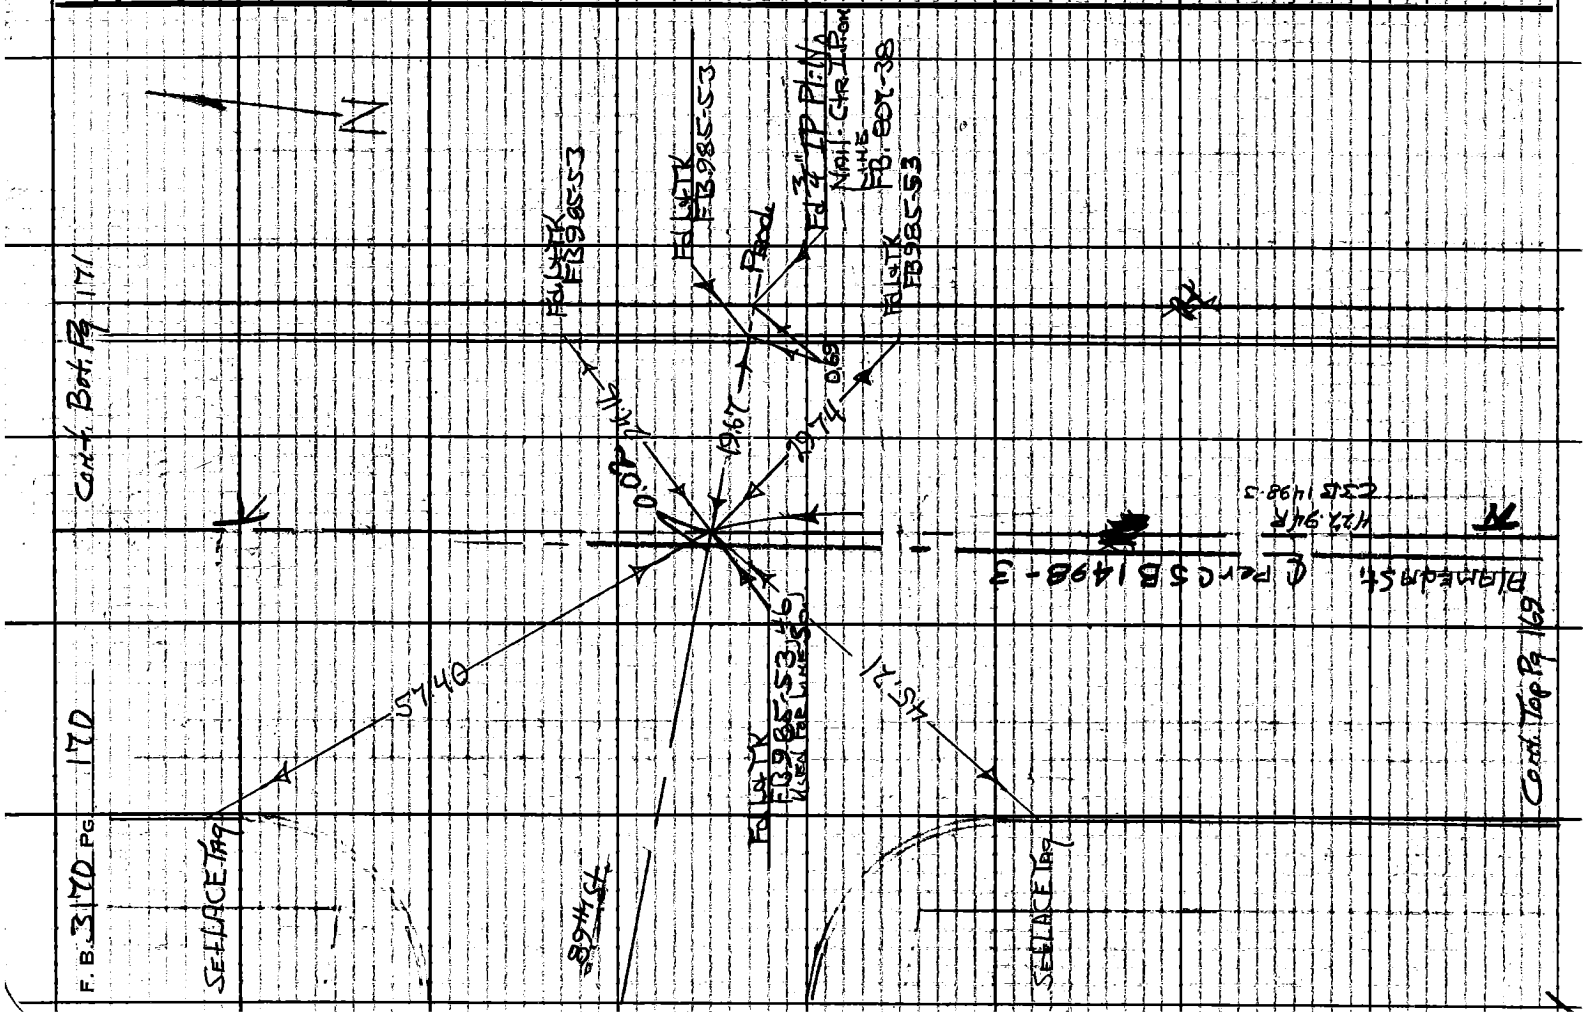

Notes Ck'd by L. Church	Survey of 92nd St.
Map No. B3019	JN 0096.66 Tape 0259 Std 68 °F
Office Work	Surveyed by HHSpriggs
Checked	Notes HHS Date 1-7-65
Date JUL 7 '65	Indexed C. J. GALLS

F. B. 3170 PG. 171

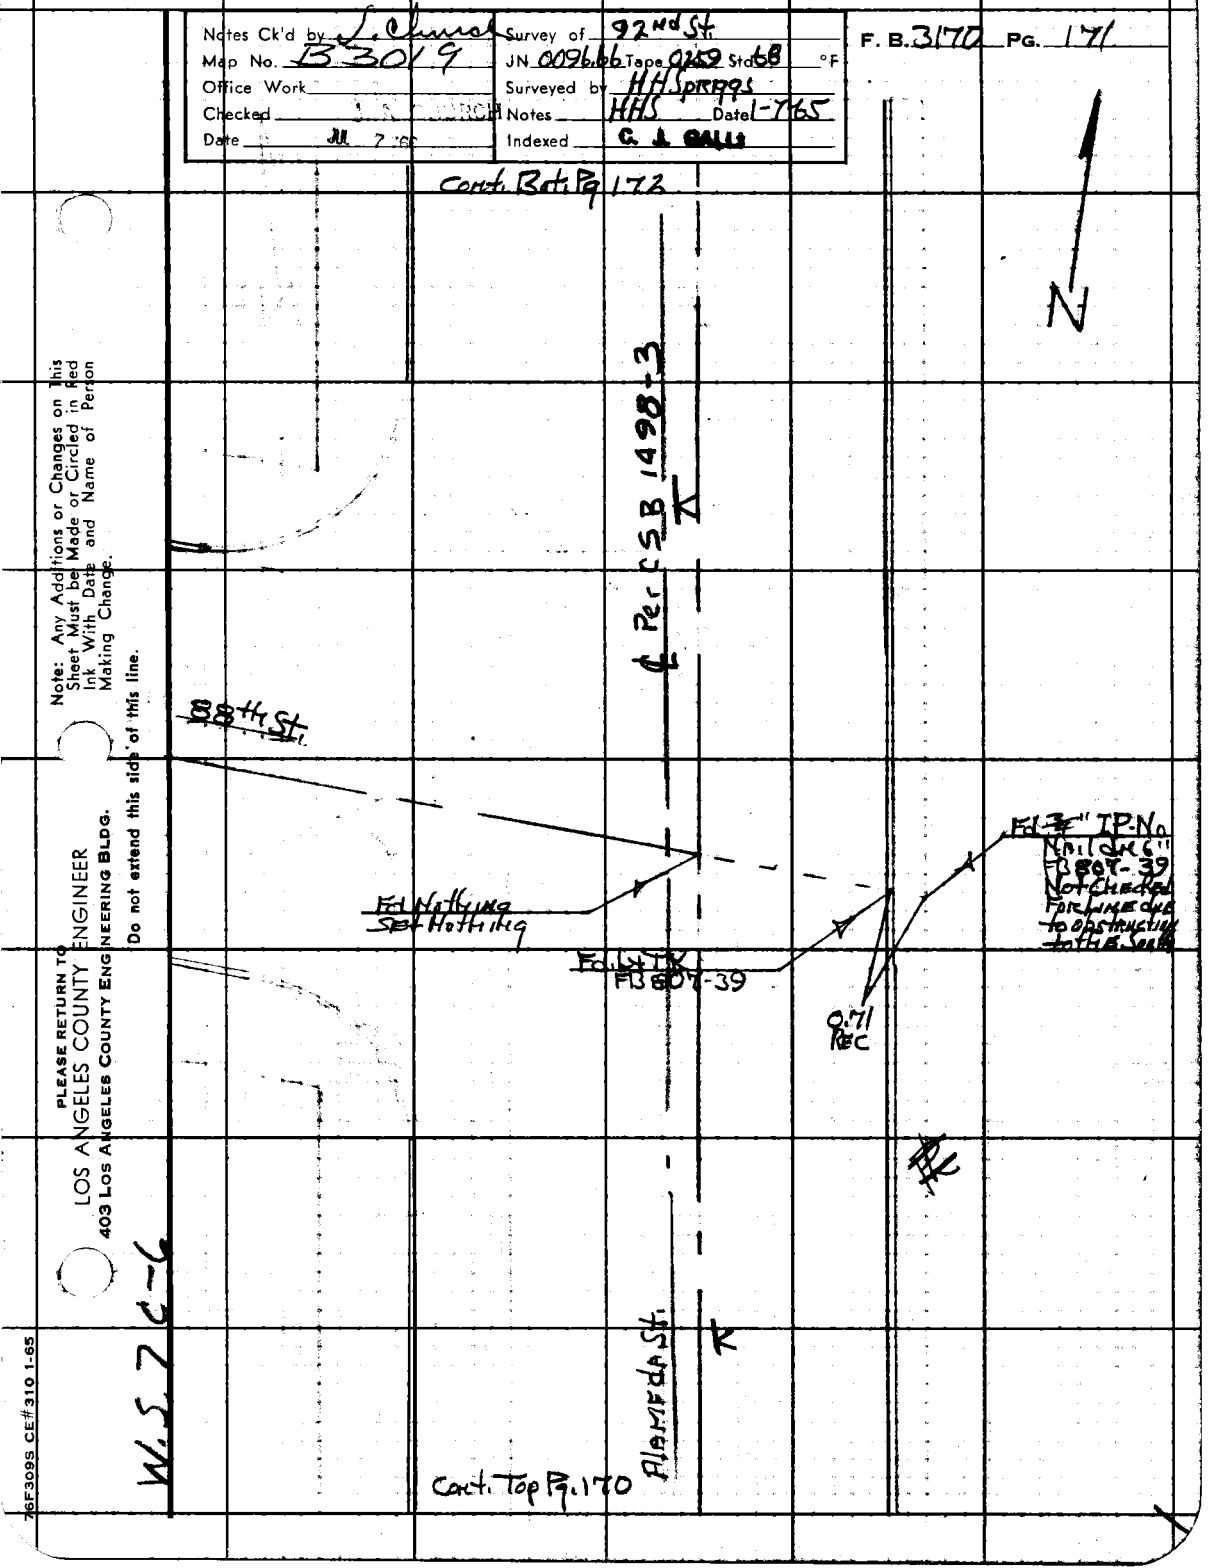

Note: Any Additions or Changes on This Sheet Must be Made or Circled in Red Ink With Date and Name of Person Making Change.

PLEASE RETURN TO
LOS ANGELES COUNTY ENGINEER
403 LOS ANGELES COUNTY ENGINEERING BLDG.

Do not extend this side of this line.

76F309S CE#310 1-65

F.B. 3170 PG. 172

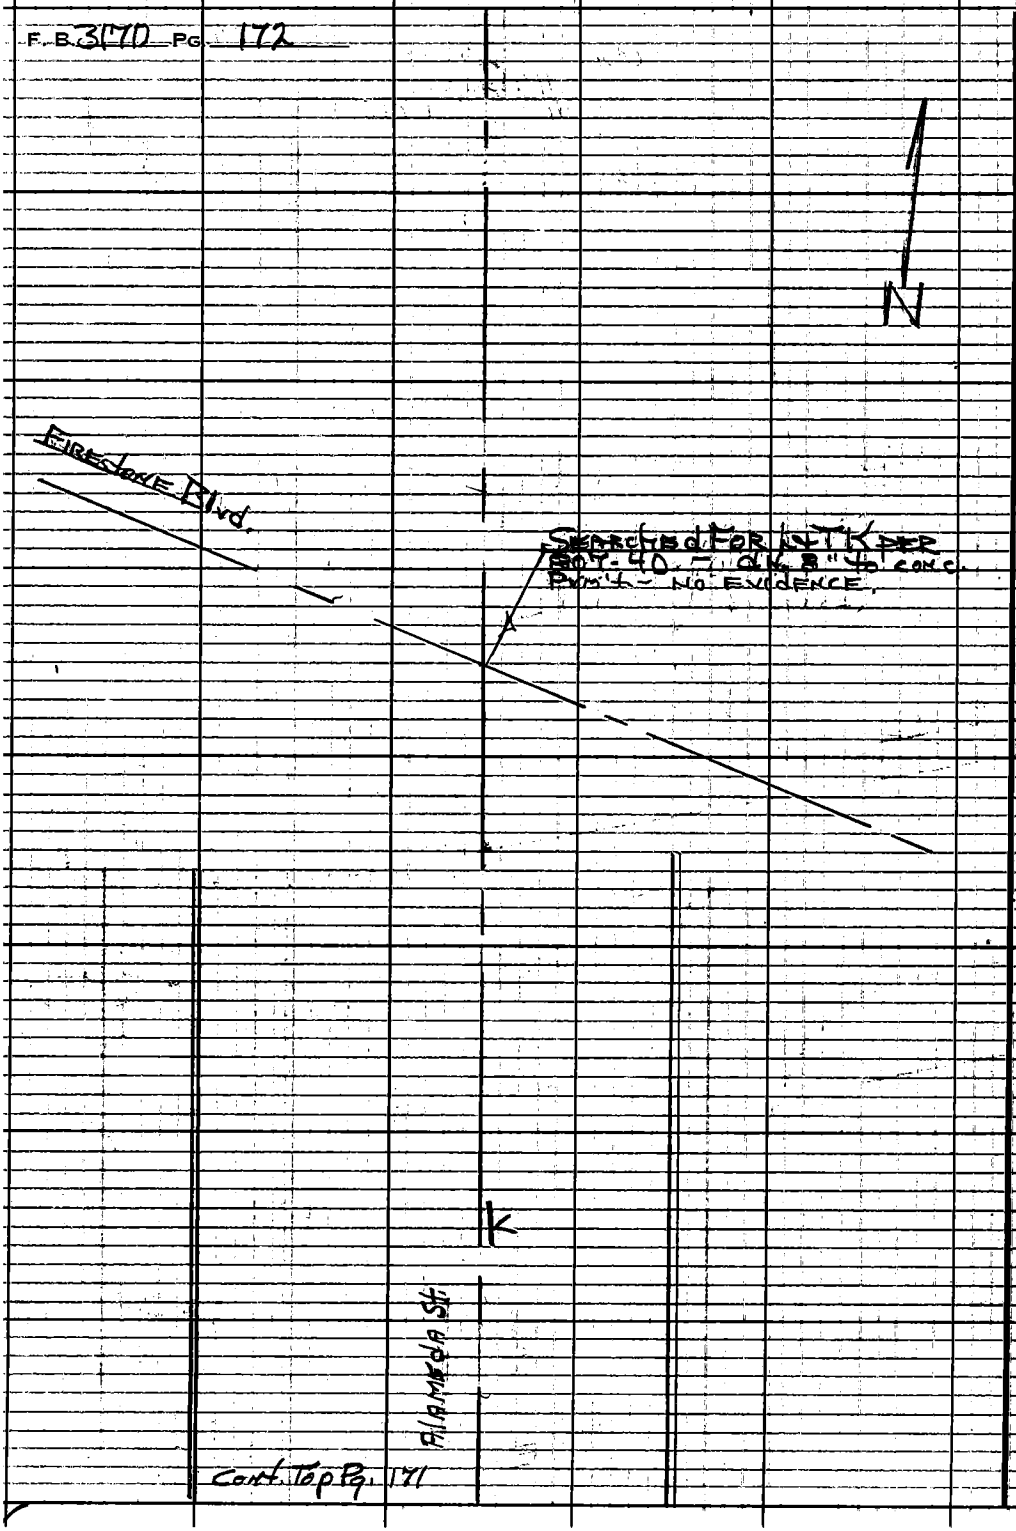

Cont. Top Pg. 171

W.S. 7 C-6

PLEASE RETURN TO
LOS ANGELES COUNTY ENGINEER
403 LOS ANGELES COUNTY ENGINEERING BLDG.
Do not extend this side of this line.
Note: Any Additions or Changes on This Sheet Must be Made or Circled in Red Ink With Date and Name of Person Making Change.

Notes Ck'd by J. Church	Survey of 92nd St.	F. B. 3170 Pg. 173
Map No. B 3019	JN 0096.66 Tape 0759 Std. 68 °F	
Office Work	Surveyed by HHS pr 1995	
Checked J. A. CHURCH	Notes HHS Date 1-7-65	
Date JUL 7 66	Indexed C. I. GALLI	

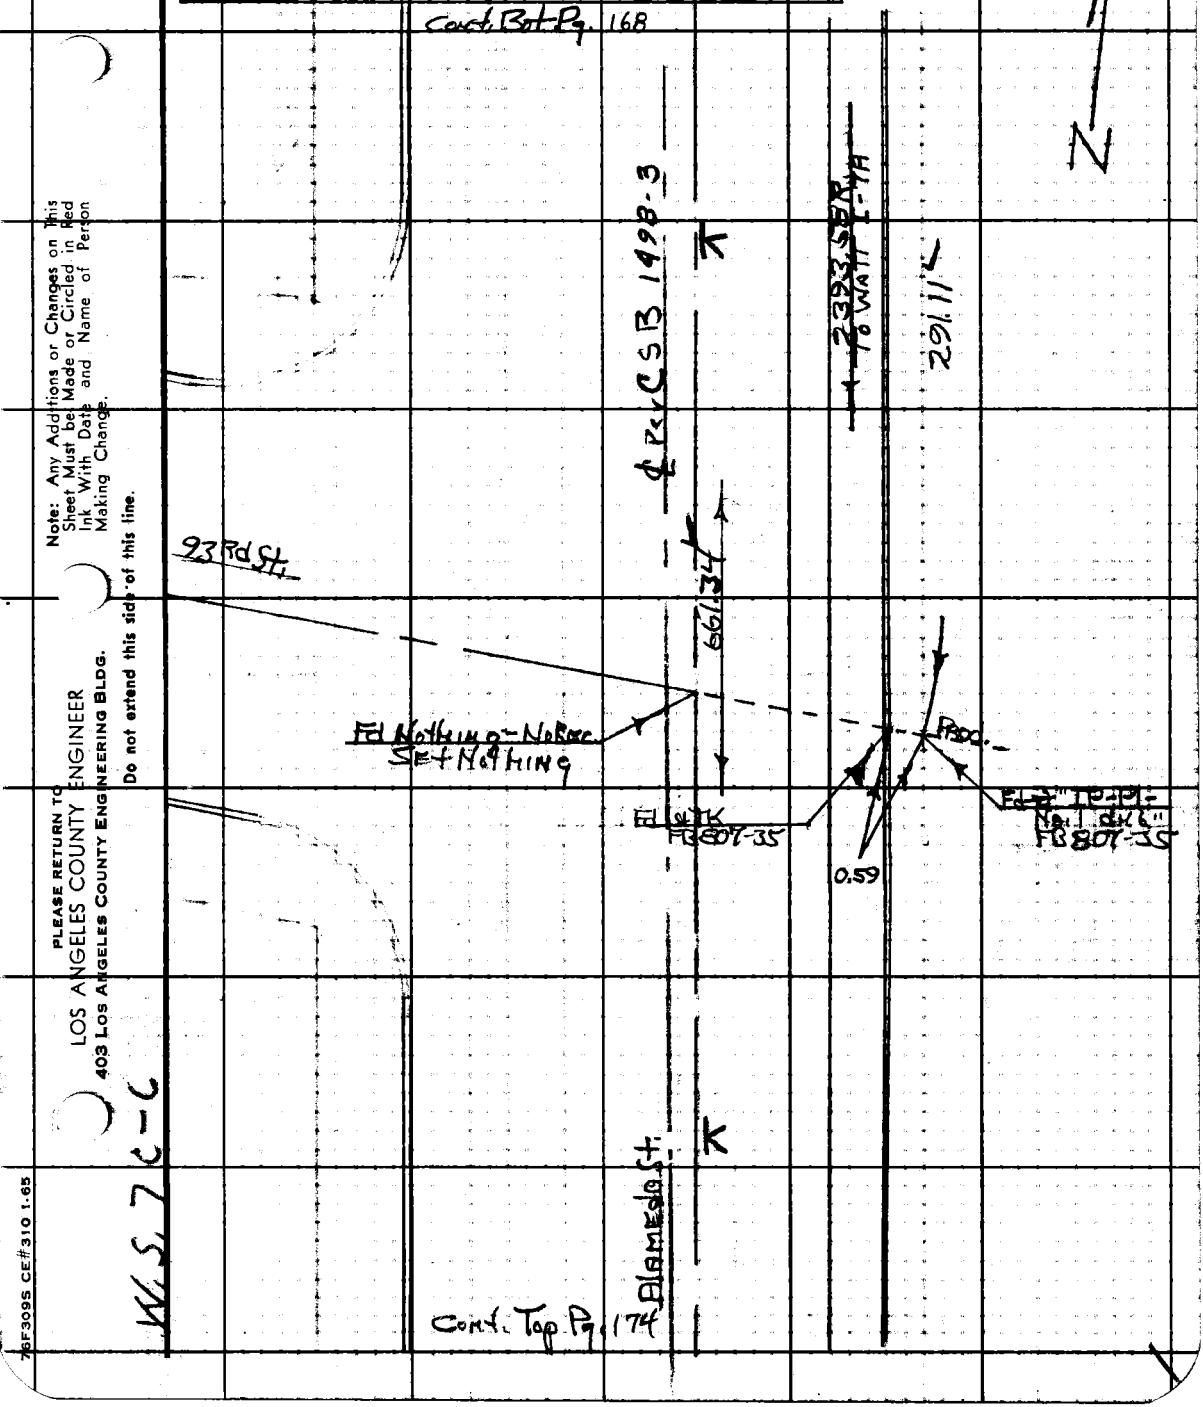

Note: Any Additions or Changes on This Sheet Must be Made or Circled in Red Ink With Date and Name of Person Making Change.

Do not extend this side of this line.

PLEASE RETURN TO
LOS ANGELES COUNTY ENGINEER
403 LOS ANGELES COUNTY ENGINEERING BLDG.

W.S. 7 C-C

76F309S CE#310 1-65

PLEASE RETURN TO
LOS ANGELES COUNTY ENGINEER
403 LOS ANGELES COUNTY ENGINEERING BLDG.

Note: Any Additions or Changes on This Sheet Must be Made or Circled in Red Ink With Date and Name of Person Making Change.

Do not extend this side of this line.

W.S. 7 C-6

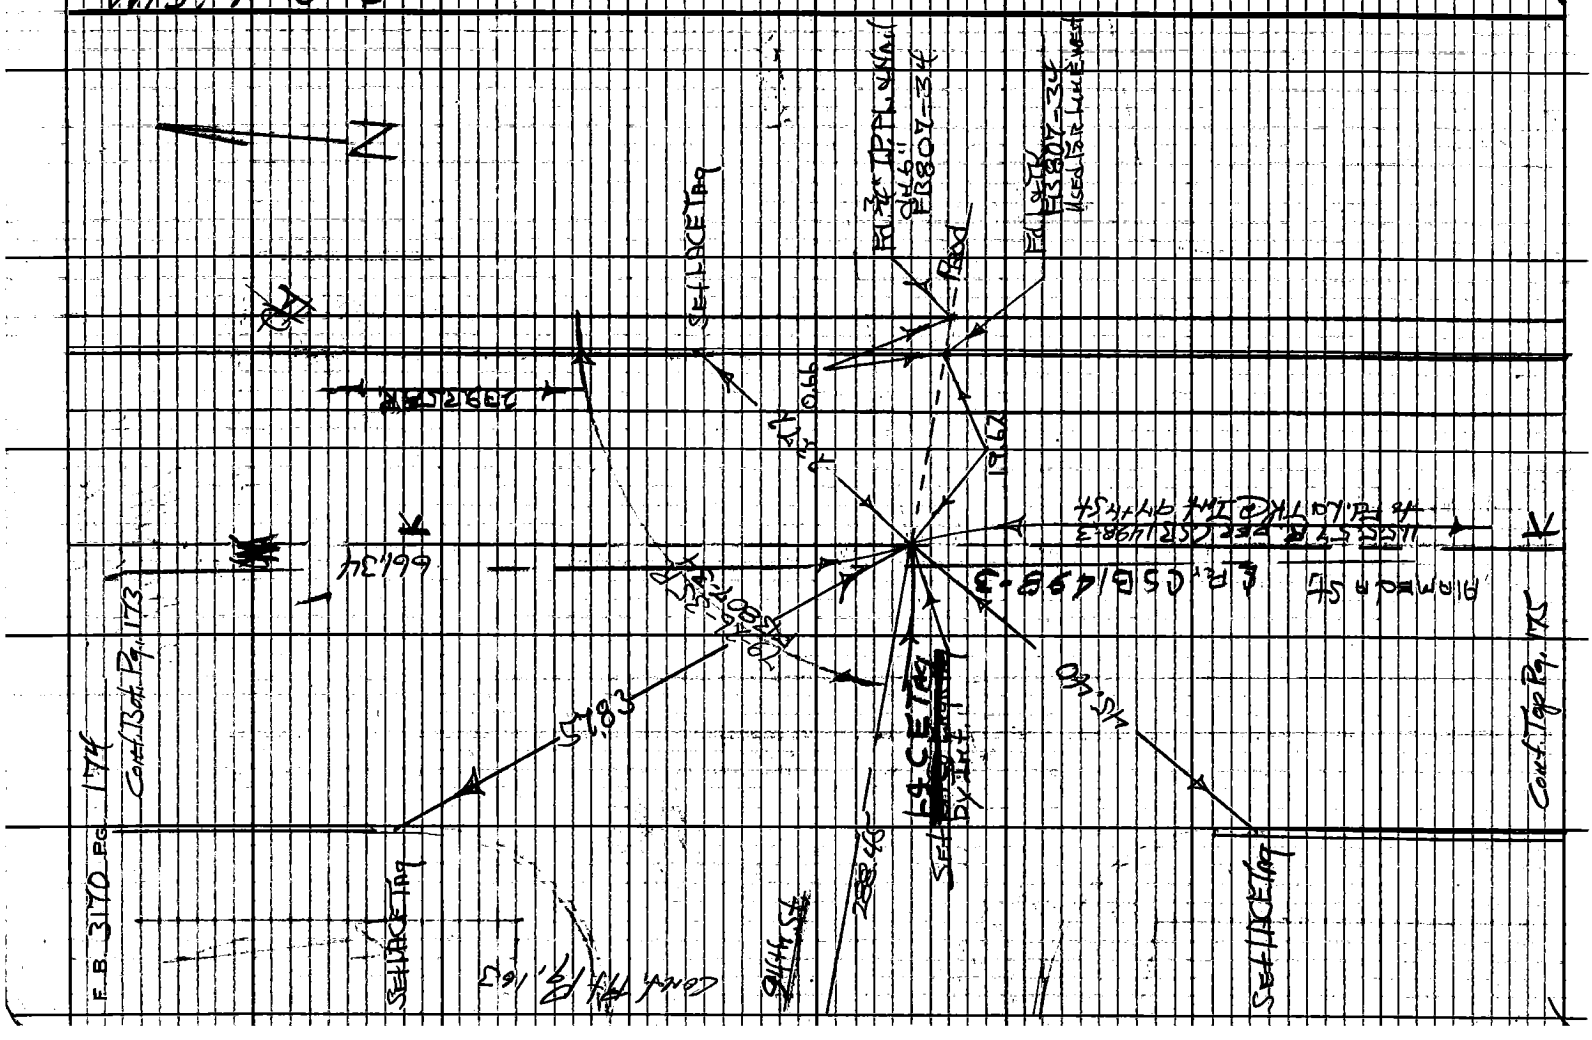

Notes Ck'd by L. Church	Survey of 92nd St.	F. B. 3170 PG. 175
Map No. B3019	JN 009666 Tape 0259 Std 68 °F	
Office Work	Surveyed by HHSpriggs	
Checked	Notes HHS Date 1-7-65	
Date	Indexed C. J. GALLI	

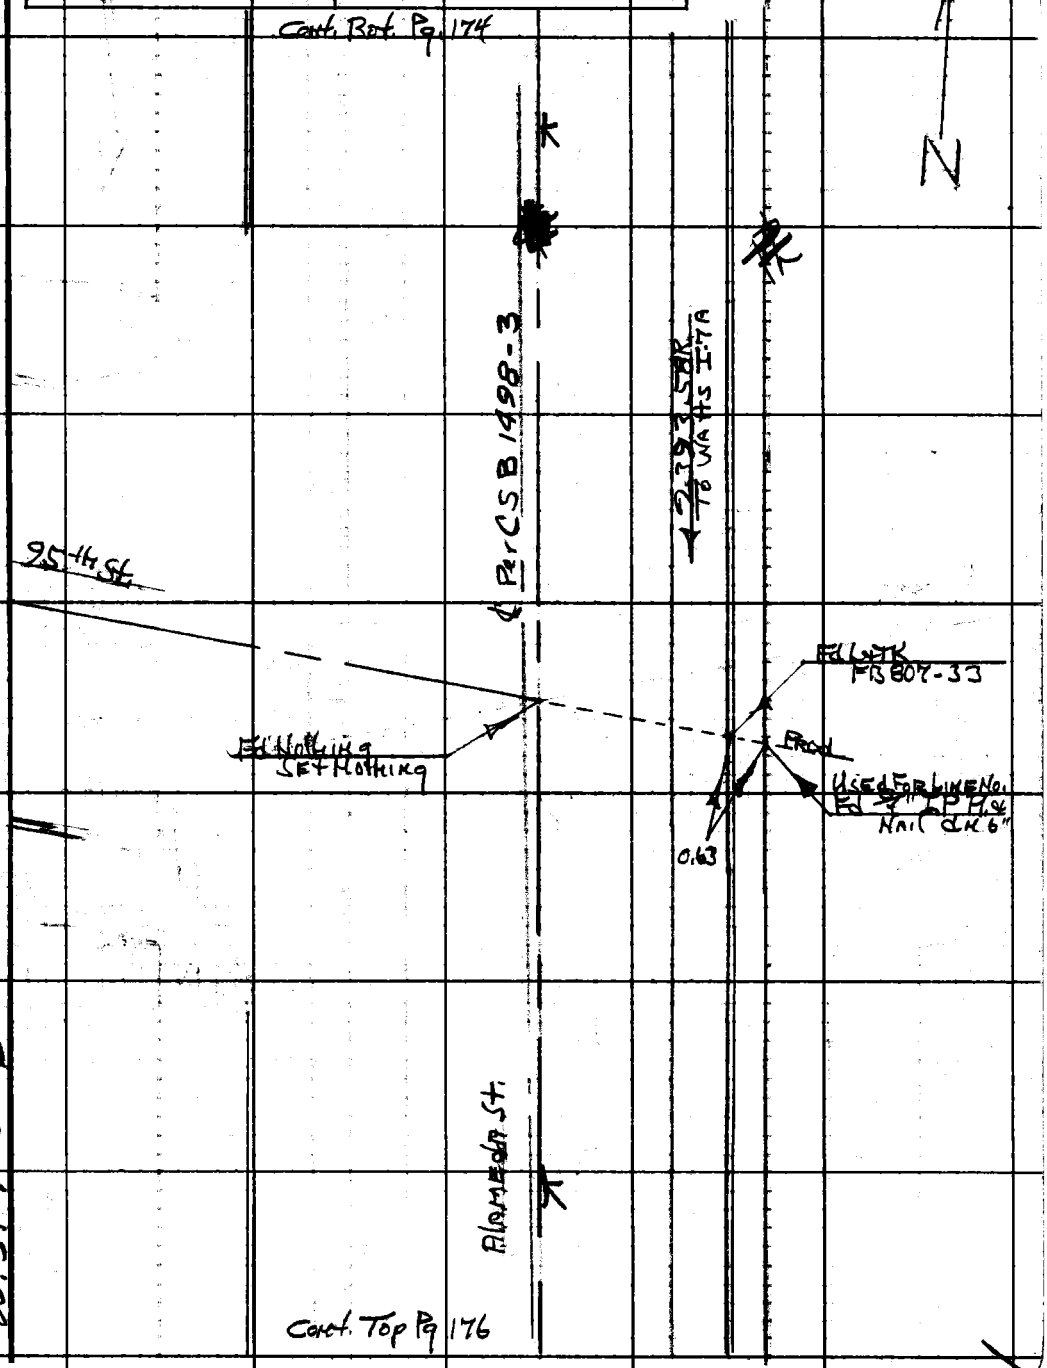

Note: Any Additions or Changes on This Sheet Must be Made or Circled in Red Ink With Date and Name of Person Making Change.

Do not extend this side of this line.

PLEASE RETURN TO
LOS ANGELES COUNTY ENGINEER
403 LOS ANGELES COUNTY ENGINEERING BLDG.

76F309S CE#310 1-65

F. B. 3170 PG. 176

Cont. Bot Pg 175

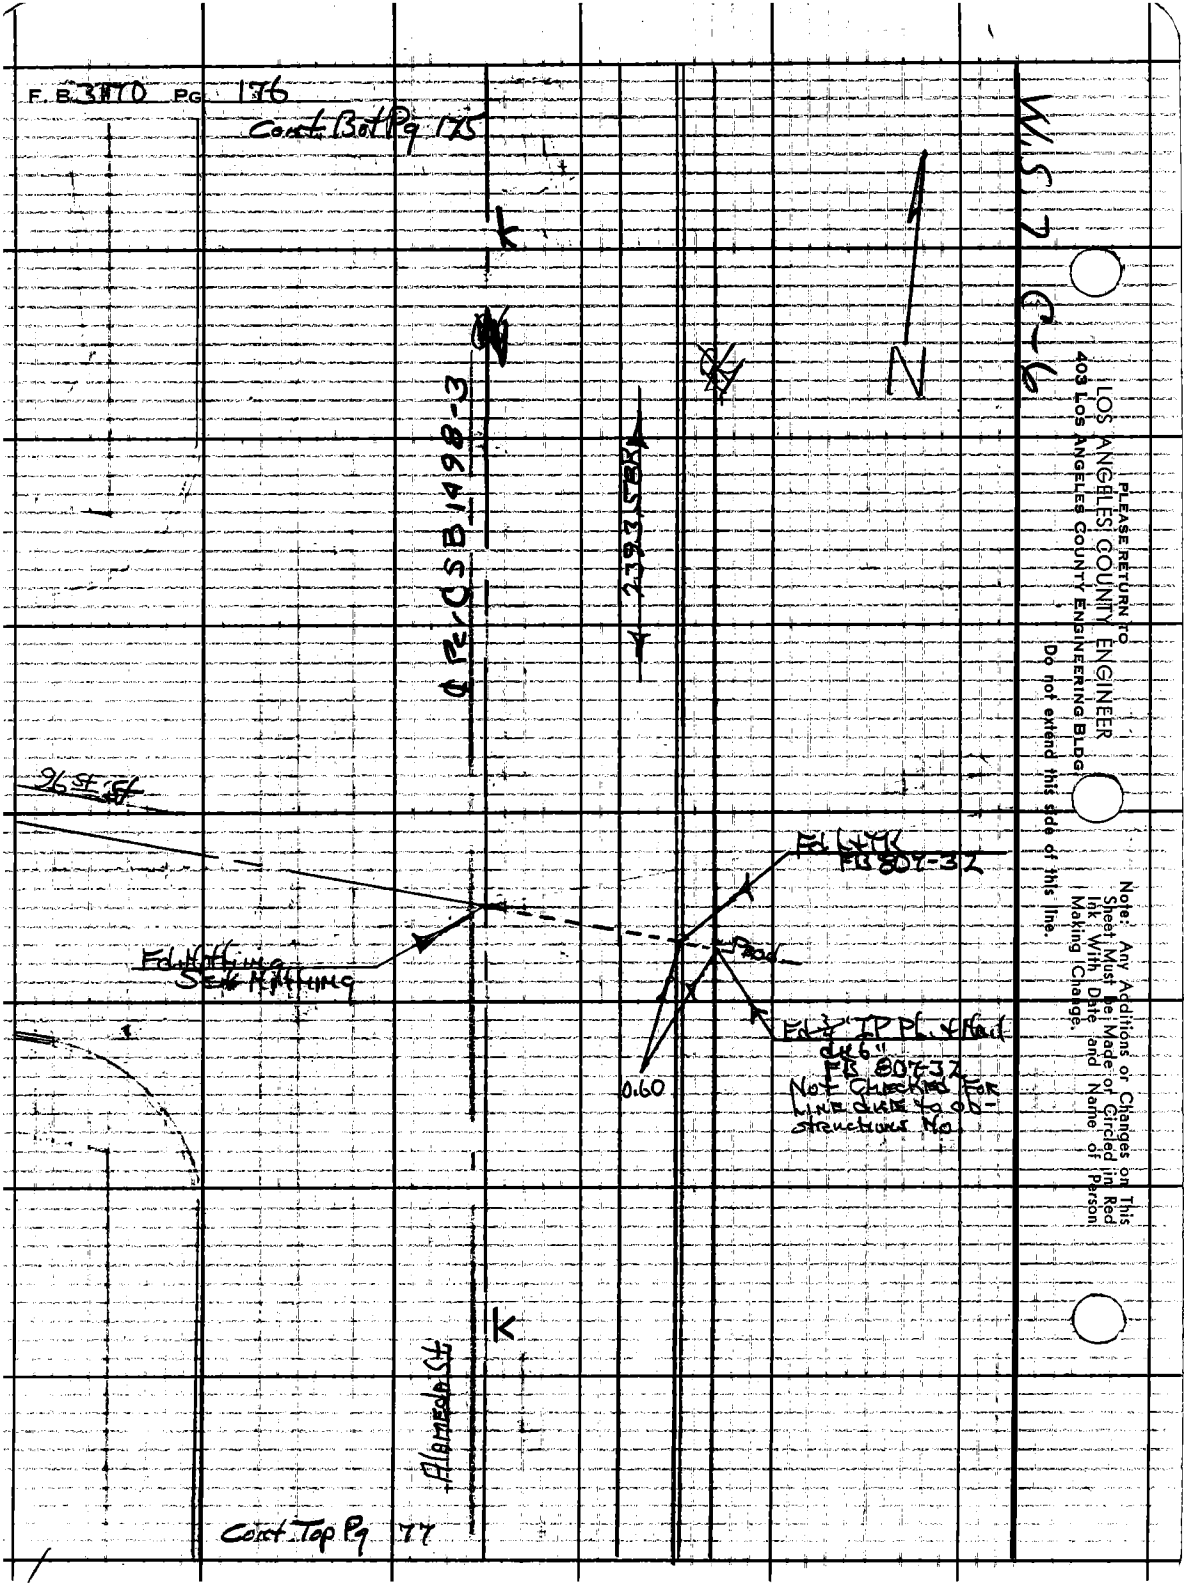

Cont. Top Pg 77

W.S. 7 C-6

PLEASE RETURN TO
LOS ANGELES COUNTY ENGINEER
403 LOS ANGELES COUNTY ENGINEERING BLDG
Do not extend this side of this line.

Note: Any Additions or Changes on This Sheet Must Be Made or Circled in Red Ink With Date and Name of Person Making Change.

Notes Ck'd by J. Chenal	Survey of 92nd St	F. B. 3170 Pg. 177
Map No. B3019	JN 0096-66 Tape 0259 Std 68 °F	
Office Work	Surveyed by HHS Spriggs	
Checked	Notes HHS Date 1-7-66	
Date	Indexed C. J. GALLI	

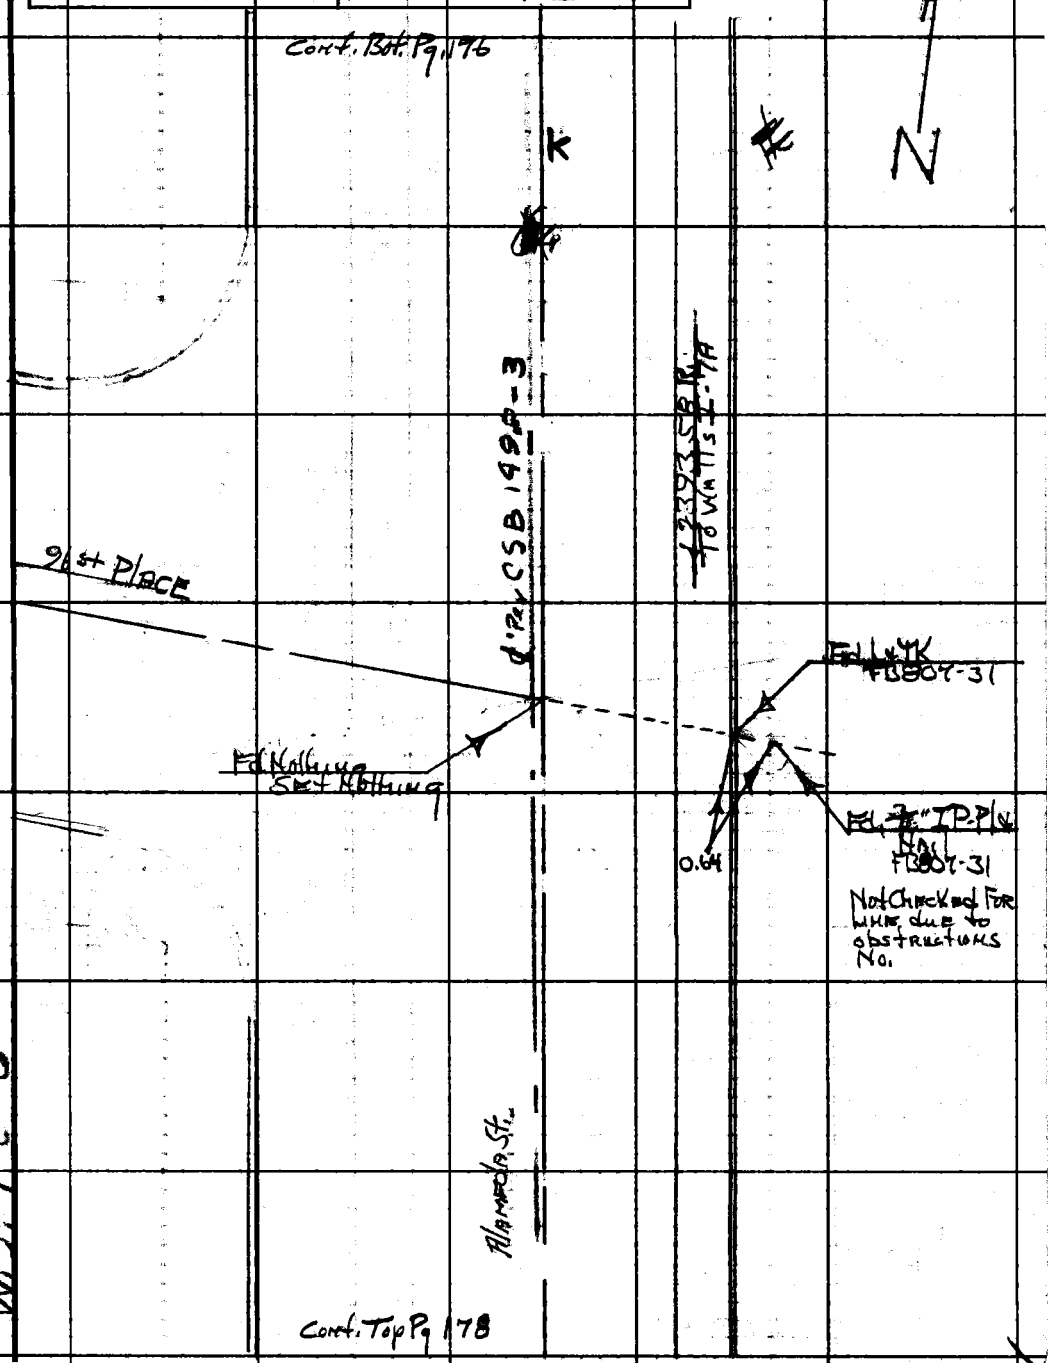

Note: Any Additions or Changes on This Sheet Must be Made or Circled in Red Ink With Date and Name of Person Making Change.

Do not extend this side of this line.

PLEASE RETURN TO
LOS ANGELES COUNTY ENGINEER
403 LOS ANGELES COUNTY ENGINEERING BLDG.

W.S. 7 C-6

76F309S CE#310 1-65

F.B. 3170 Pg. 178

Cont. Bot. Pg. 177

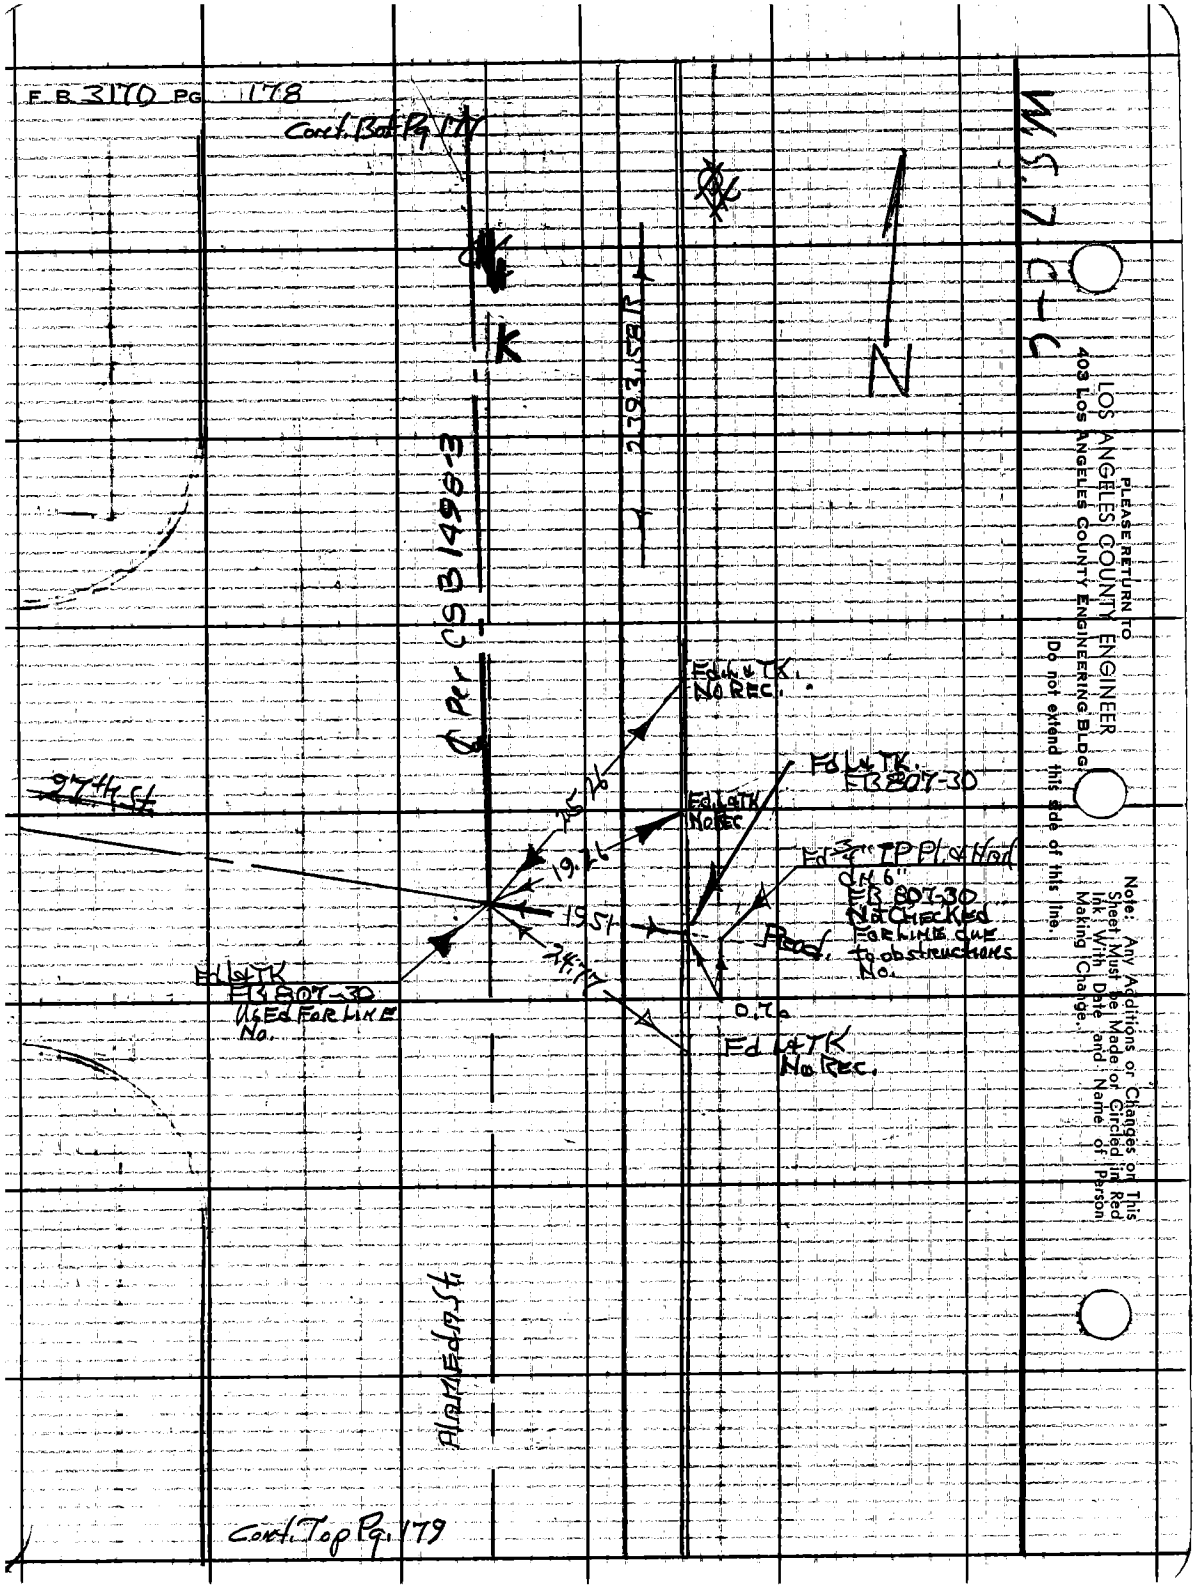

Cont. Top Pg. 179

PLEASE RETURN TO
LOS ANGELES COUNTY ENGINEER
403 Los Angeles County Engineering Bldg.
Do not extend this side of this line.
Note: Any Additions or Changes on This Sheet Must Be Made or Circled in Red Ink With Date and Name of Person Making Change.

Notes Ck'd by J. Church	Survey of 92nd St	F.B. 3170 Pg. 178
Map No. B 3019	JN 0096.66 Tape 0759 Std 68 °F	
Office Work	Surveyed by H.H. Spriggs	
Checked J. A. CHURCH	Notes HHS Date 1-7-66	
Date JUL 7 '66	Indexed C. de GALLI	

Cont. Bot. Pg. 178

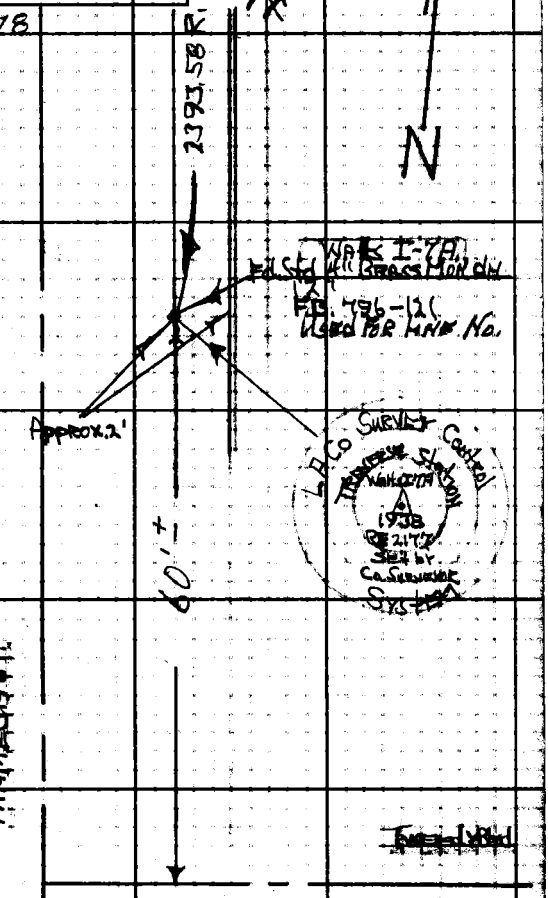

Note: Any Additions or Changes on This Sheet Must be Made or Circled in Red Ink With Date and Name of Person Making Change.

PLEASE RETURN TO
LOS ANGELES COUNTY ENGINEER
403 LOS ANGELES COUNTY ENGINEERING BLDG.

Do not extend this side of this line.

76F309S CE#310 1-65

Notes Ck'd by J. Church	Survey of 92nd St.
Map No. B-3019	JN 0096.66 Tape 0253 Std 68 °F
Office Work	Surveyed by HHSpragg5
Checked J. A. CHURCH	Notes HHS Date 6-16-66
Date 7 66	Indexed C. J. GALLI

F. B 3170 PG. 181

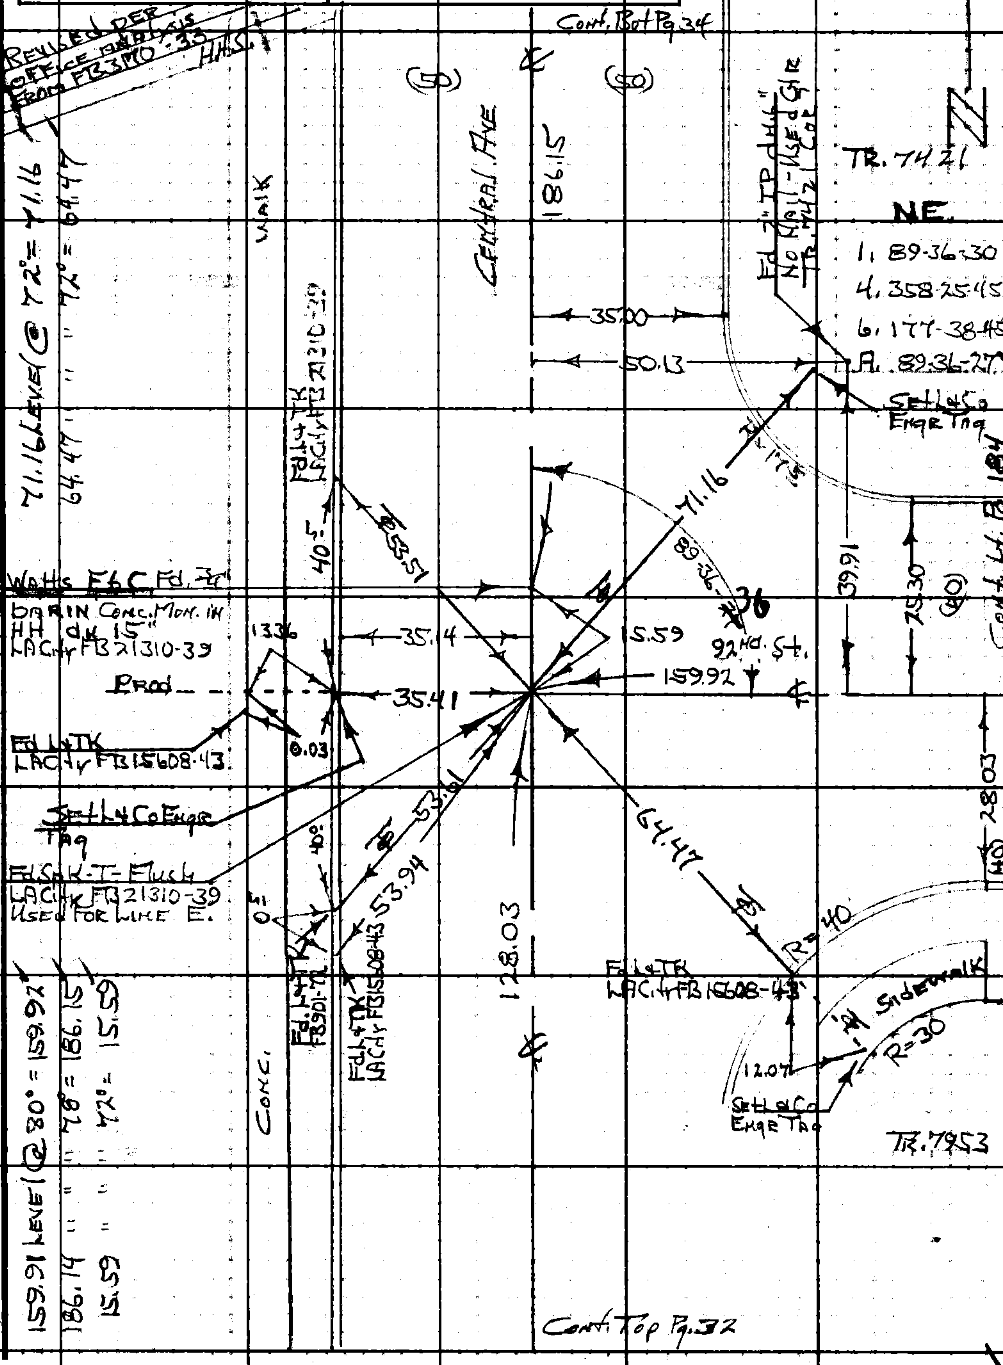

Note: Any Additions or Changes on This Sheet Must be Made or Circled in Red Ink With Date and Name of Person Making Change.

Do not extend this side of this line.

PLEASE RETURN TO
LOS ANGELES COUNTY ENGINEER
403 Los Angeles County Engineering Bldg.

76F309S CE#310 1-65

Notes Ck'd by L. Chmel	Survey of
Map No. B3019	JN Tape Std °F
Office Work	Surveyed by
Checked J. A. CHURCH	Notes Date
Date JUL. 7 '88	Indexed

F. B. 370 PG. 183

Blank

Note: Any Additions or Changes on This Sheet Must be Made or Circled in Red Ink With Date and Name of Person Making Change.

Do not extend this side of this line.

PLEASE RETURN TO
LOS ANGELES COUNTY ENGINEER
403 LOS ANGELES COUNTY ENGINEERING BLDG.

76F309S CE#310 1-65

F.B. 3170 Pg. 184

TR. 7421 OFFICE

REVISED PER OFFICE 1/14/01 KSLS FROM FB 3170 PG 38 HHS

Cont. Bot. Pg. 40

TR. 7421

1st Pilley Et Cemetery Lane

(10) (10)

Used For Line N&S.
Fd. 1" G.I. Spk-W. dn 3.5'
FB 700-100
FB 901-72

9.92 10.22

Set Lead Expr. Tag

Conc. Walk

Fd. 1" G.I. FB 700-100

Fd. 1" G.I. FB 700-100

Fd. 1" G.I. FB 700-100

Cont. Rt. Pg. 181

Cont. Rt. Pg. 181

278.30

R=3










159.92

0.23

286.84

92nd St.

X Point

51.81

27.93

27.93

42.74

42.74

Set Lead Expr. Tag

Conc. Walk

10.04 10.09

TR. 7953

(10) (10)

Set Lead Spk
W-T-Flush by
Inter. - 3-3.00
Sand-W Tiles N&E
& HW

44.78

49.78

10.48

10.48

Fd. 1" IP Wood Plug-Nail dn. 6"

Fd. 1" IP Wood Plug-Nail dn. 6"

143.00

143.00

Fd. 1" IP Wood Plug-Nail dn. 6"

FB 3170-38
Fd. 1" TK
Tiles
0.4'

1.5 x 1.5 Stucco Bldg.

Walk

1st Pilley Et Cemetery Lane

442.30

Cont. Top Pg. 39

TR. 7953

278.79 Used @ 278.30
TR 77 " 25.23
" 84 - 286.84
92 - 442.73

NE
1. 89-36-15
4. 358-25-00
6. 177-37-00
A. 89-36-15

SE
1. 90-16-15
4. 361-05-00
6. 181-37-30
A. 90-16-15

East
1. 143-00-15
4. 212-00-30
6. 138-01-00
A. 143-00-10

Used For Line N&S.
Set Lead Spk dn. 4'
Line of Fd. 1" IP
Set Lead Spk-W-T
Flush by 2-3.00 Sq.
Sand Washer Tiles-
N&E

LOS ANGELES COUNTY ENGINEER
403 LOS ANGELES COUNTY ENGINEERING BLDG.

PLEASE RETURN TO

Do not extend this side of this line.

Notes: Any Additions or Changes on This Sheet Must be Made or Circled in Red Ink With Date and Name of Person Making Change.

Notes Ck'd by S. Chunal	Survey of 92nd St	F. B 3170 Pg. 185
Map No. B 3019	JN 0096.66 Tape 0259 Std 68 °F	Revised per office analysis from FB 3170-43
Office Work	Surveyed by H.H. Spring 95	HHS
Checked J. A. CHURCH	Notes HHS Date 6-20-66	
Date JUL 7 '66	Indexed C. J. GALLI	

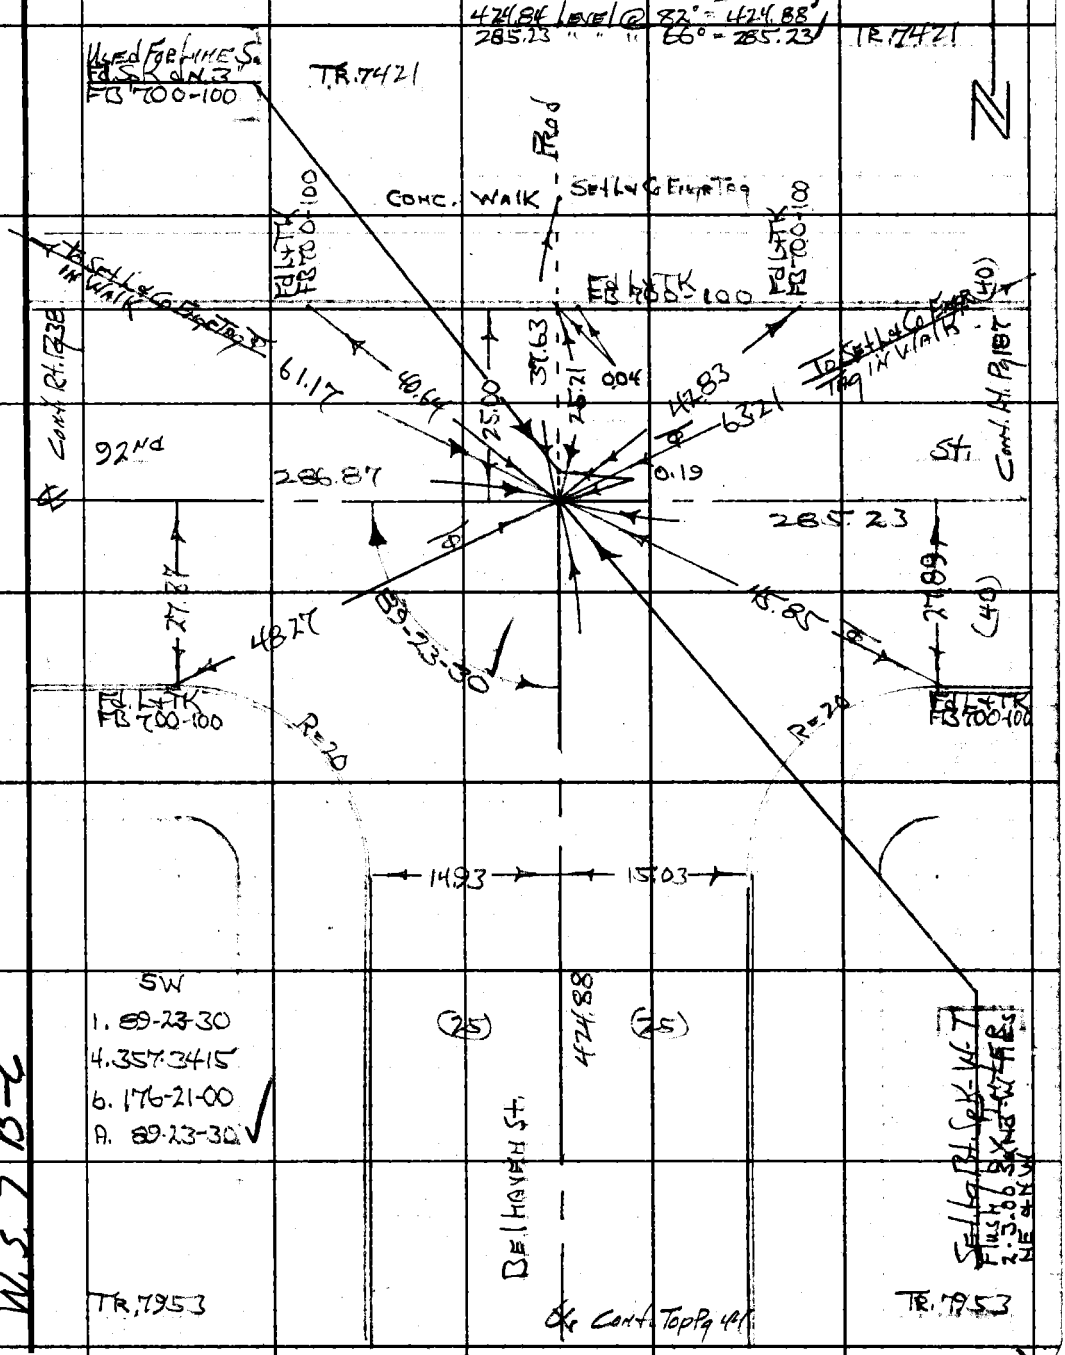

SW
1. 89-23-30
4. 357-3415
6. 176-21-00
A. 89-23-30

W.S. 7 B-C

Note: Any Additions or Changes on This Sheet Must be Made or Circled in Red Ink With Date and Name of Person Making Change.

Do not extend this side of this line.

PLEASE RETURN TO
LOS ANGELES COUNTY ENGINEER
403 LOS ANGELES COUNTY ENGINEERING BLDG.

76F309S CE#310 1-65

Notes Ck'd by J. Church
Map No. B3019
Office Work
Checked J. A. CHURCH
Date JUL 2 '66

Survey of 92nd St
JN 0096.66 Tape 0259 Std 68 °F
Surveyed by HHSpriggs
Notes HHS Date 6-20-66
Indexed C. J. GALLI

F. B 3170 Pg 187

Revised per office analysis from FB 3170-45 HHS

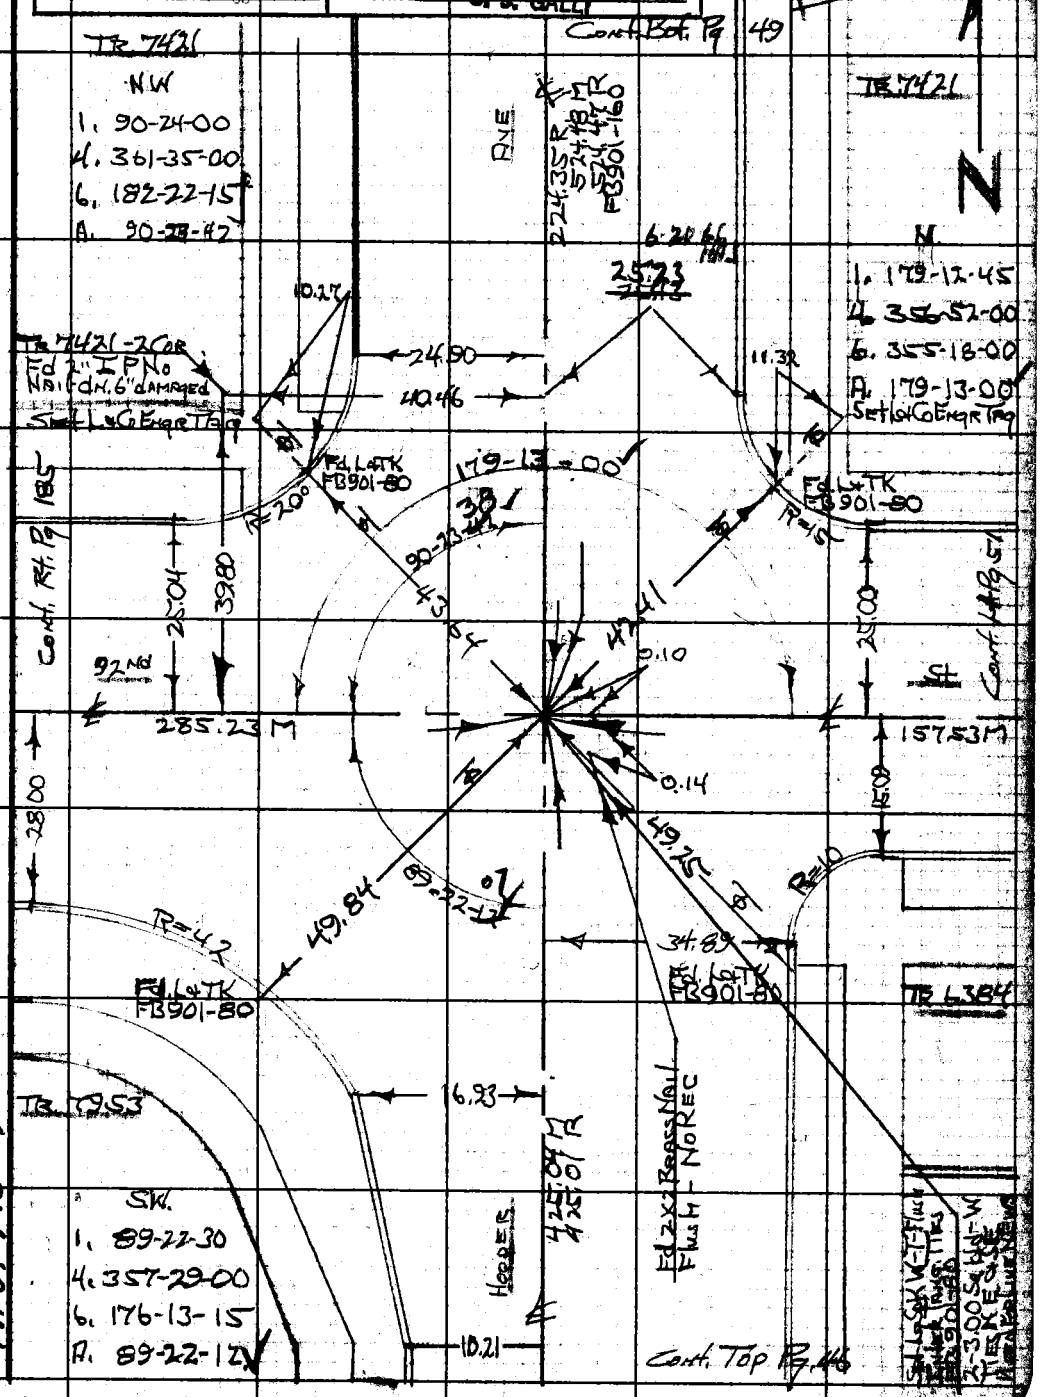

Note: Any Additions or Changes on This Sheet Must be Made or Circled in Red Ink With Date and Name of Person Making Change.

Do not extend notes this side of this line.

RETURN TO
LOS ANGELES COUNTY ENGINEER
700 LOS ANGELES COUNTY ENGINEERING BLDG.

76F309S CE #247—3-57

Notes Ck'd by	Survey of 92nd ST	F.B. 3170 PG. 189
Map No.	JN 009666 Tape 0199 Std 68 °F	
Office Work	Surveyed by J. H. Brown	
Checked	Notes J. H. B. Date 1-67	
Date	Indexed C. J. GALLI FEB 24 '67	

J. N. 009666

92nd ST.

CENTER LINE ON 92nd ST.
from CENTRAL AVE. West to WADSWORTH AVE.
&
PRELIMINARY SURVEY FOR CENTER LINE
ON SOUTHERN AVE. From ALAMEDA ST.
East to SANTA FE AVE.

Jan.	1967	J. H. BROWN
APRIL	1967 (REVISIONS)	W. E. NEWMAN
		H. E. FRONK
		A. L. GOBLE
		R. A. MOORE
		E. M. GOSHORN

Note: Any Additions or Changes on This Sheet Must be Made or Circled in Red Ink With Date and Name of Person Making Change.

Do not extend this side of this line.

PLEASE RETURN TO
LOS ANGELES COUNTY ENGINEER
403 LOS ANGELES COUNTY ENGINEERING BLDG.

76F3095 CE #310 8-63

F. B. 3170 PG. 190

INDEX

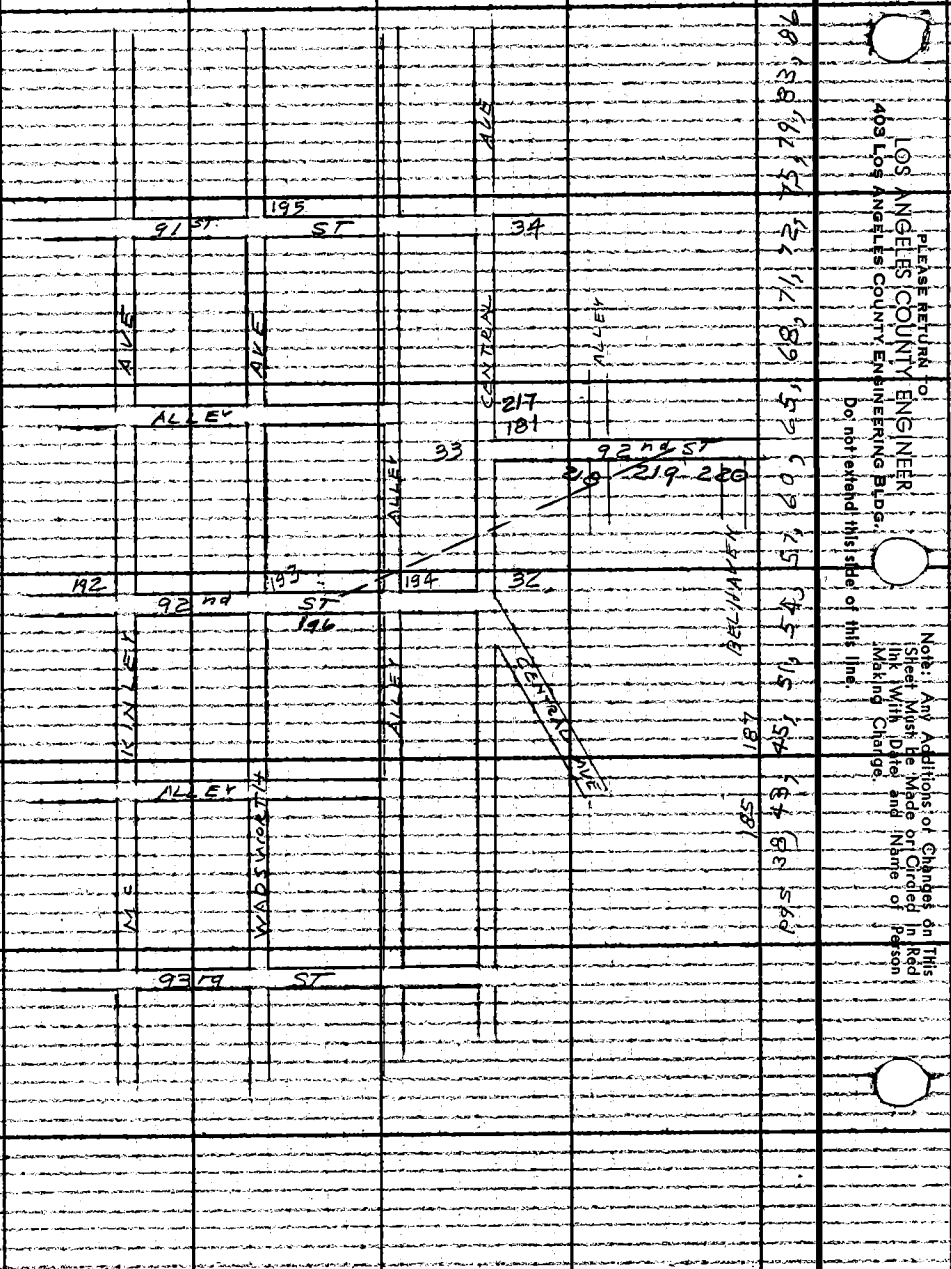

LOS ANGELES COUNTY ENGINEER
403 LOS ANGELES COUNTY ENGINEERING BLDG.
PLEASE RETURN TO
Do not extend this side of this line.
Note: Any Additions or Changes on This Sheet Must Be Made or Circled in Red Ink With Date and Name of Person Making Change.

Notes Ck'd by	Survey of 92nd ST	F. B. 3170 PG. 191
Map No. B 3019	JN 0096.66 Tape 0199 Std 6.8 °F	
Office Work	Surveyed by J. H. Brown	
Checked	Notes J. H. B Date 1-67	
Date	Indexed C. J. GALLI	

Pages Added April 13, 14 - 1967 JMB

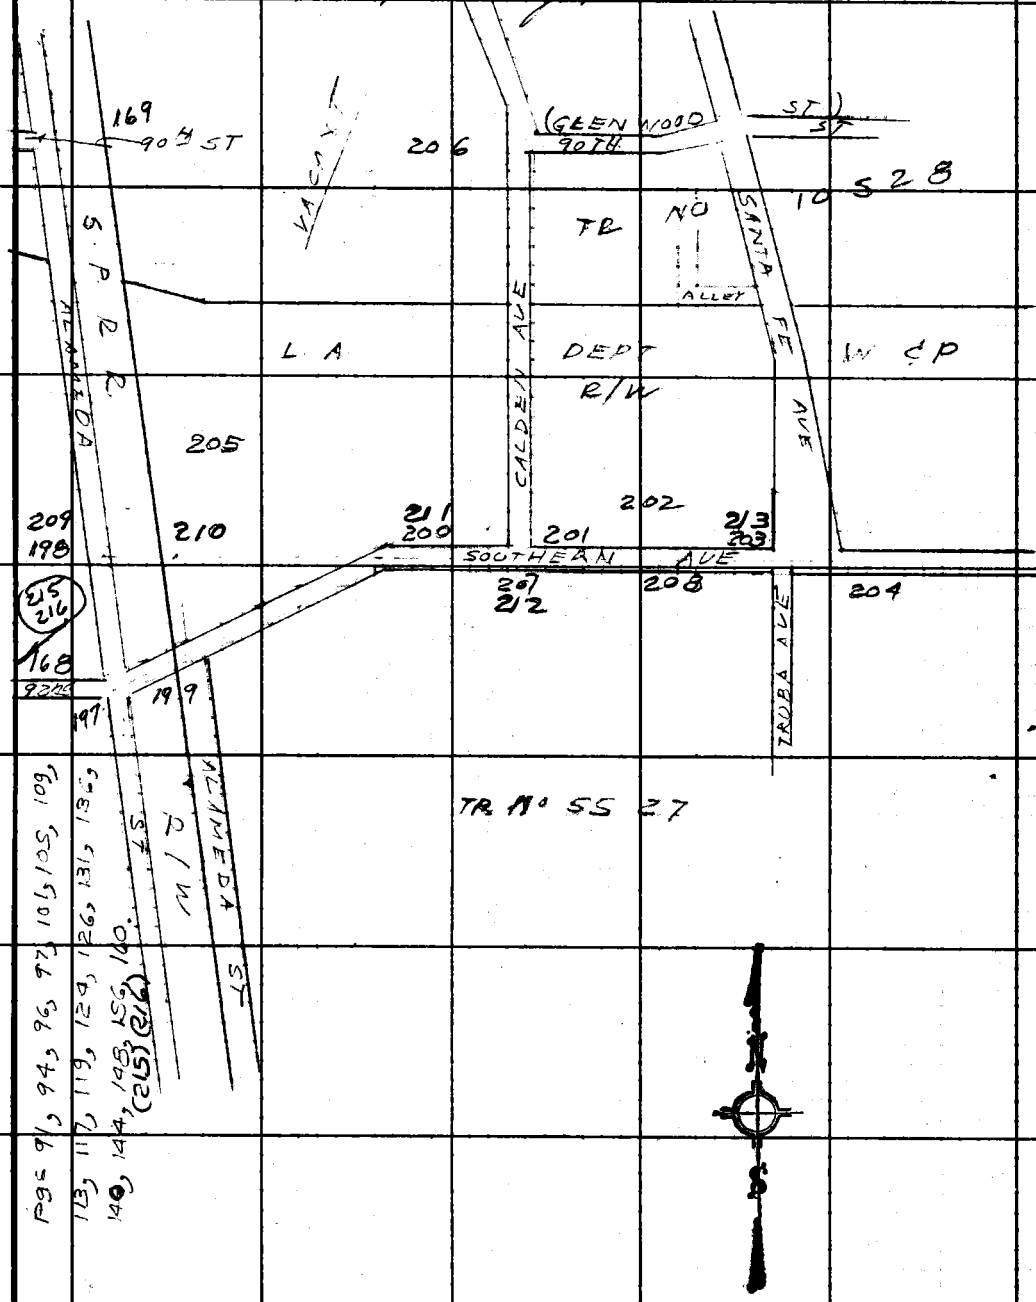

Note: Any Additions or Changes on This Sheet Must be Made or Circled in Red Ink With Date and Name of Person Making Change.

Do not extend this side of this line.

PLEASE RETURN TO
LOS ANGELES COUNTY ENGINEER
403 LOS ANGELES COUNTY ENGINEERING BLDG.

76F309S CE #310 6-63

PLEASE RETURN TO
LOS ANGELES COUNTY ENGINEER
403 LOS ANGELES COUNTY ENGINEERING BLDG.

Note: Any Additions or Changes on This Sheet Must be Made or Circled in Red Ink With Date and Name of Person Making Change.

Do not extend this side of this line.

W.S. 7 B-6

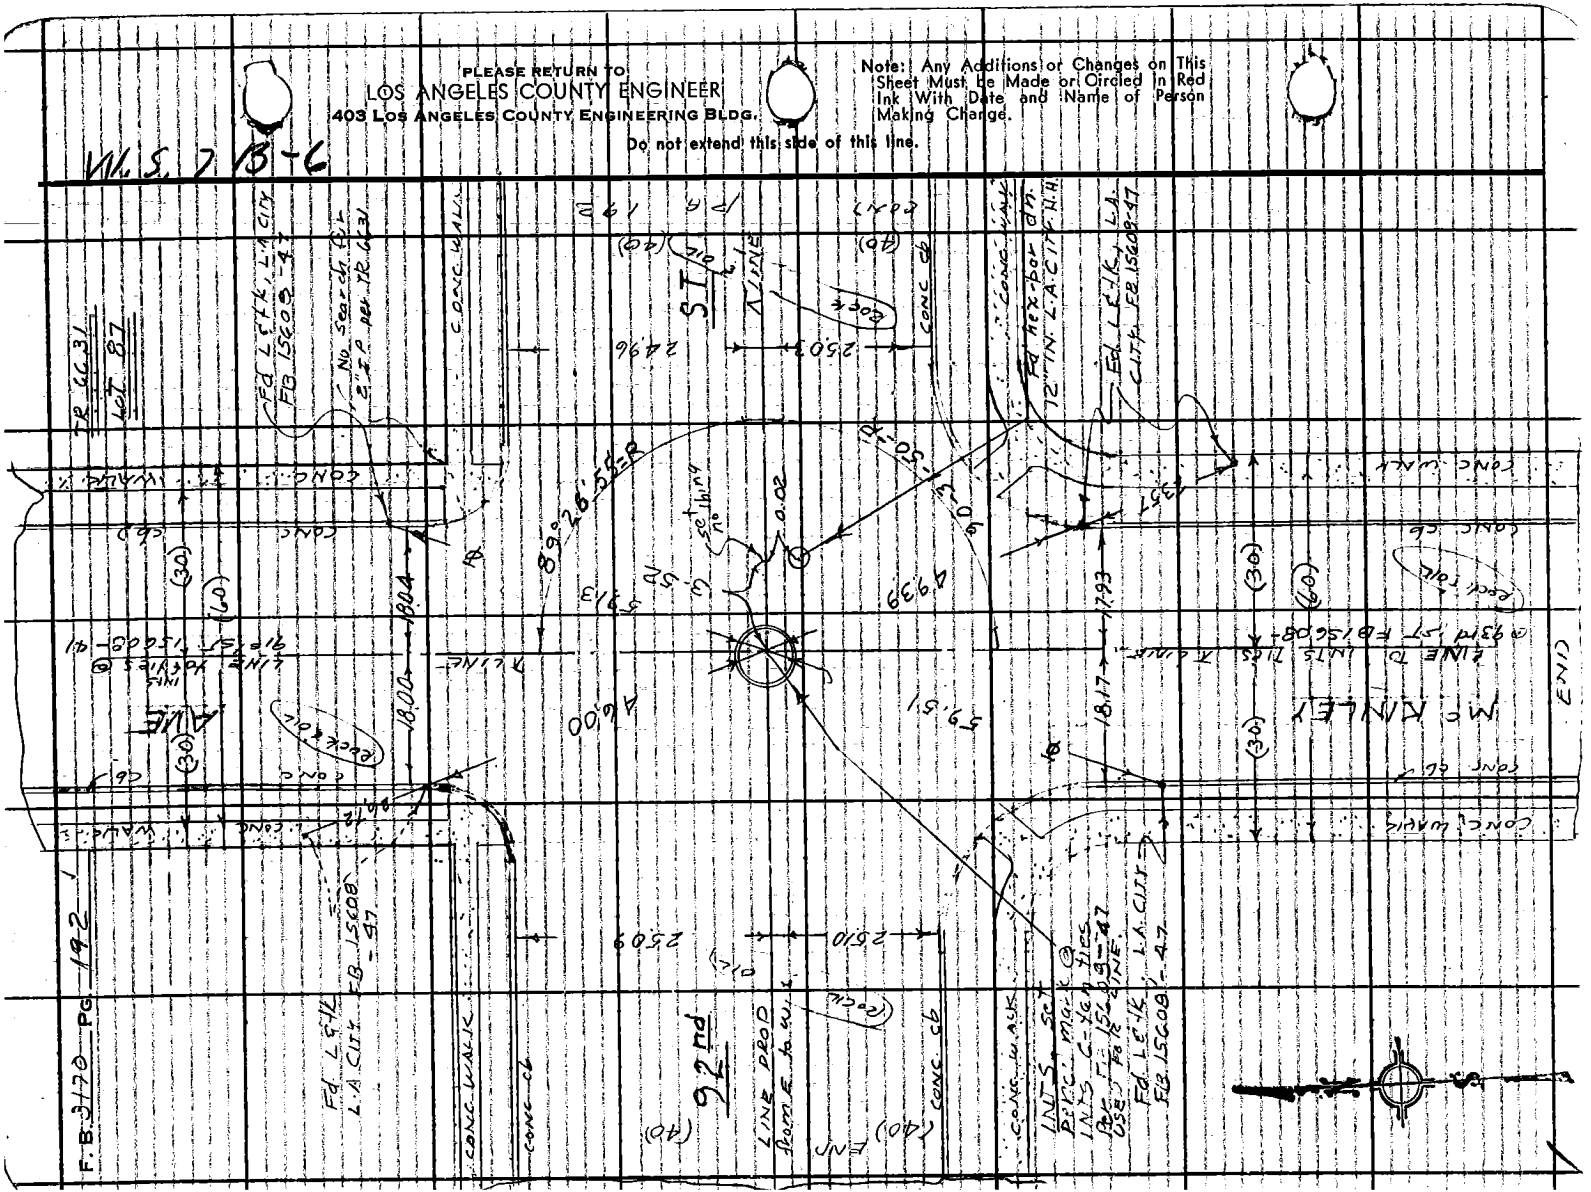

Notes Ck'd by	Survey of 92nd ST
Map No. B3019	JN 0096 Tape 0199 Std 68 °F
Office Work	Surveyed by J. H. Brown
Checked	Notes J. H. B Date 12-66
Date	Indexed G. J. GALLI

F. B. 3170 PG. 193

TR 6631 LOT 75

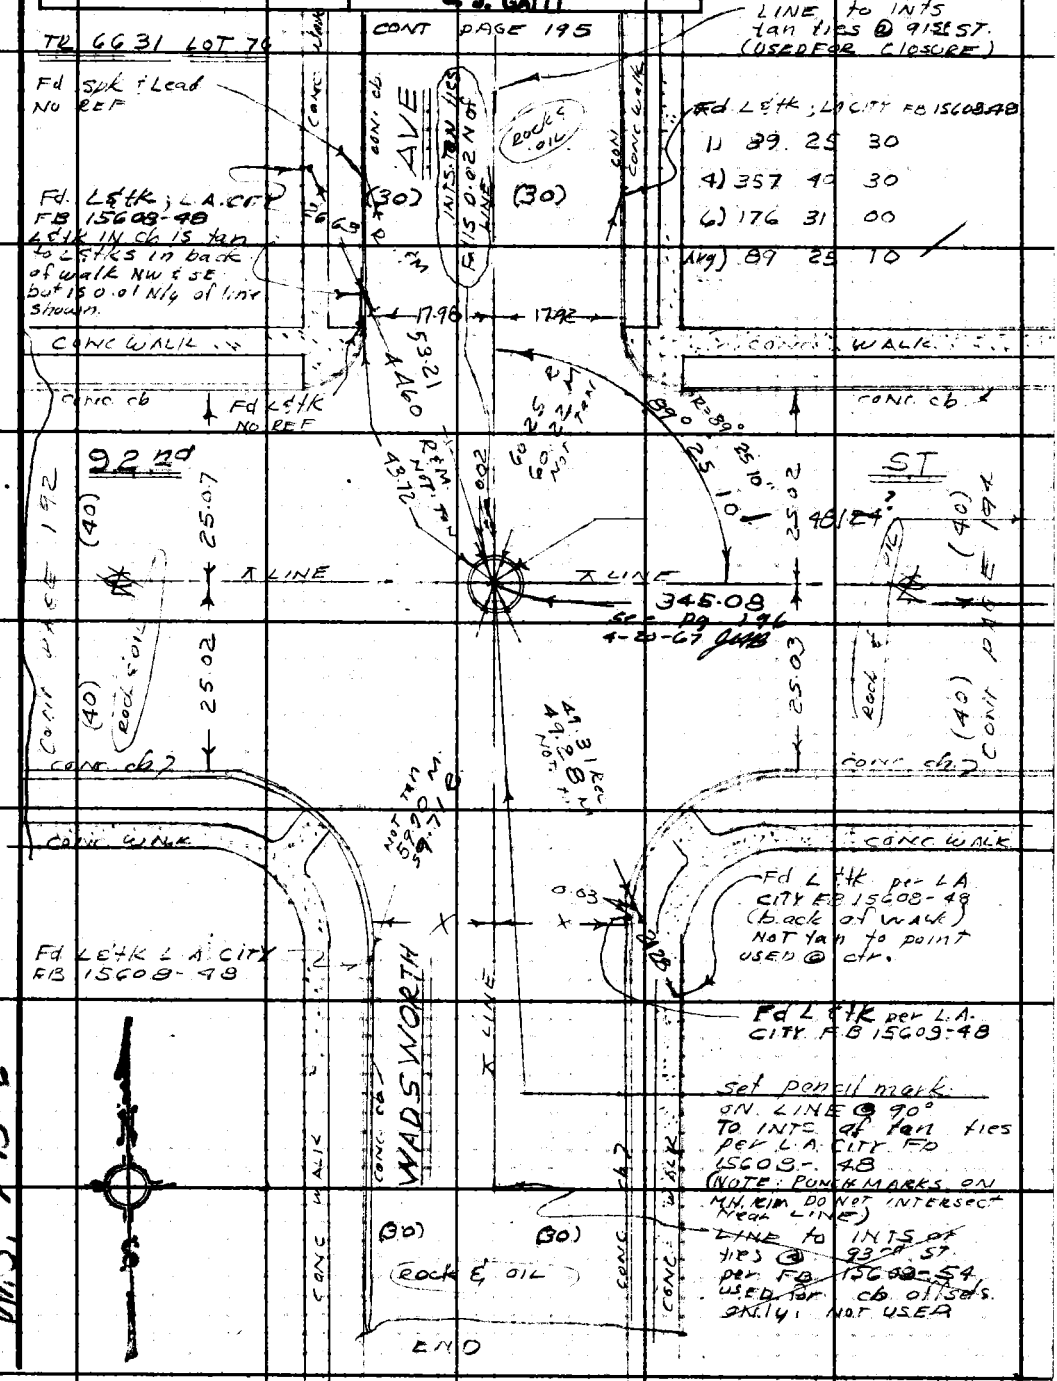

Note: Any Additions or Changes on This Sheet Must be Made or Circled in Red Ink With Date and Name of Person Making Change.

PLEASE RETURN TO
LOS ANGELES COUNTY ENGINEER
403 LOS ANGELES COUNTY ENGINEERING BLDG.

Do not extend this side of this line.

W.S. 7 B-6

76F309S CE #310 6-63

F. B 3170 PG 194

TR 6631 LOT 67
Tape # 0199 std @ 68°
12-28-66
481.26 Lev (T=62) = 481.24
481.26 Lev (T=62) = 481.24
Avg 481.24
Rec = 481.13 per L.A. CITY
FB 15608-48

Tape # 0199 std @ 68° 1-4-67
481.16 (T=74) = 481.18 } 481.19
481.18 (T=74) = 481.20

END

(2 0)

Rock & oil alley
has 2' conc gutter
in middle (new)

Tape # 0199 - std @ 68° 12-28-66
180.05 Lev (T=62) = 180.04
180.05 Lev (T=62) = 180.04
ok 1-4-67
Avg = 180.04
(Rec per FB 15608-49 = 180.00

TR 6631 LOT 66

New guess
Not proven
Alley being re-surfaced

set L & Co ENGR tag

set L & Co ENGR tag

CONC WALK

CONC WALK

CONC cb

CONC cb

92nd

ST

481.24

180.04

⊼ LINE

⊼ LINE

136.06

Sec 19, 196
4-20-67

CONT PAGE (40)

CONT PAGE (40)

CONC cb

CONC cb

CONC WALK

CONC WALK

Fd L & tk
FB 15608-49
(L.A. CITY)

Fd L & tk
L.A. CITY FB
15608-49

Fd spk (bead ½" dia)
in L in cb
L.A. CITY FB 15608-49

INTS
Fd nothing bn. 2"
set masonry nail
on surface on line
@ 90° to INTS ties per
L.A. CITY FB 15608-49
(INTS 3 ties falls 0.02
s of point used)

Not proven

Tape # 160 STD @ 84°
481.22 (T=70) = 481.18

Tape # 021 (first time used
from being standardized
in warehouse) STD @ 68
481.14 (T=70) = 481.15
481.14 (T=70) = 481.15
Avg = 481.15

(2 0)

ALLEY

Rock & oil alley
has 2' conc gutter
in middle

END

PLEASE RETURN TO
LOS ANGELES COUNTY ENGINEER
403 LOS ANGELES COUNTY ENGINEERING BLDG.
Do not extend this side of this line.

Note: Any Additions or Changes on This Sheet Must be Made or Circled in Red Ink With Date and Name of Person Making Change.

Notes Ck'd by	Survey of 92nd ST.
Map No. B3019	JN0096.66 Tape 0199 Std 68 °F
Office Work	Surveyed by J.H. Brown
Checked	Notes J.H.B. Date 1-3-67
Date	Indexed C. J. GALLI

F. B. 3170 PG. 195

ST WIDTHS NOT DRAWN TO SCALE.

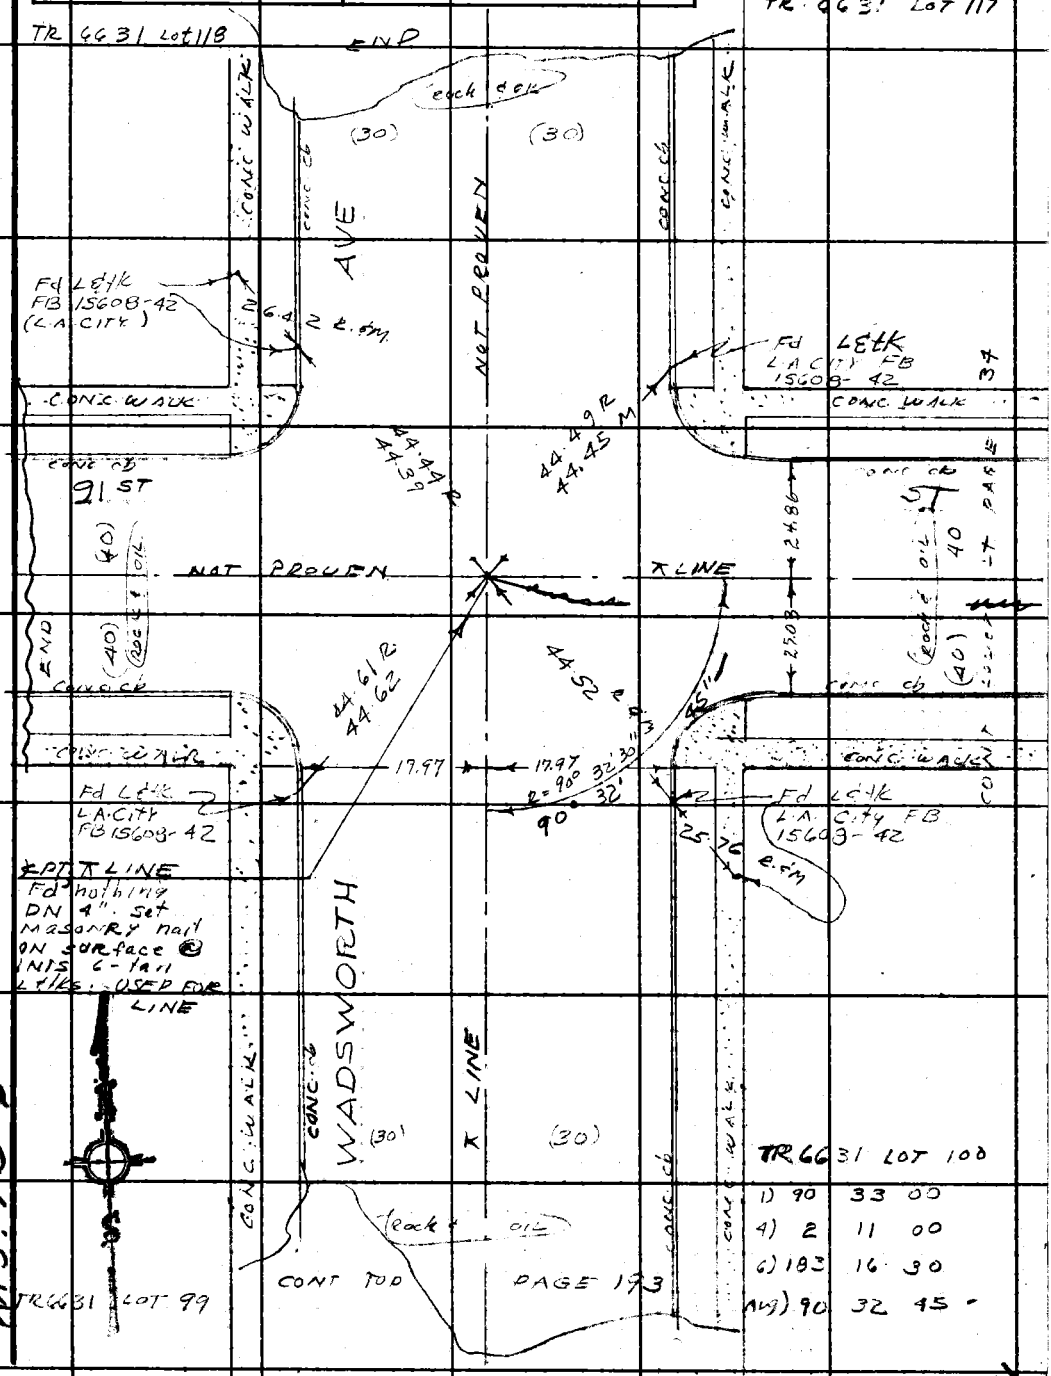

W.S. 7B-6

Note: Any Additions or Changes on This Sheet Must be Made or Circled in Red Ink With Date and Name of Person Making Change.

Do not extend this side of this line.

PLEASE RETURN TO
LOS ANGELES COUNTY ENGINEER
403 LOS ANGELES COUNTY ENGINEERING BLDG.

76F309S CE #310 6-63

F. B. 3170 PG 196

Contd. Bot. Pg. 219

CONT. LT. PAGE 194

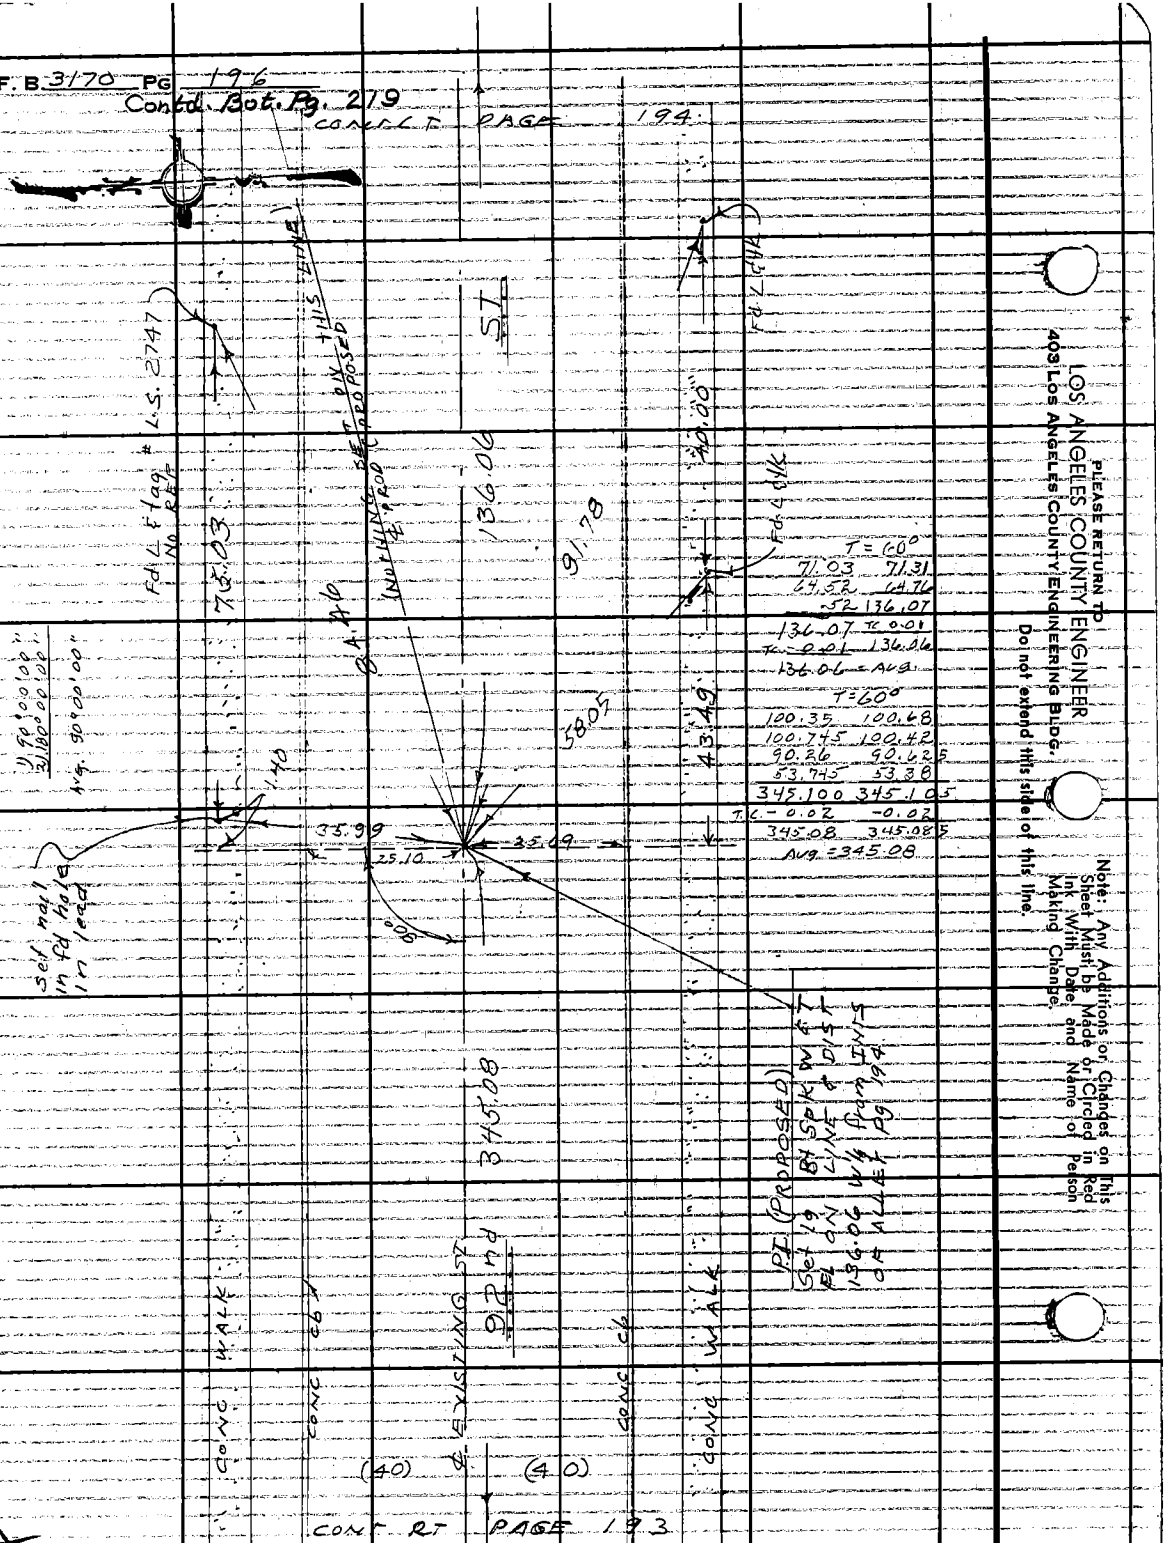

CONT. RT PAGE 193

PLEASE RETURN TO
LOS ANGELES COUNTY ENGINEER
403 Los Angeles County Engineering Bldg.
Do not extend this side of this line.
Note: Any Additions or Changes on This Sheet Must Be Made or Circled in Red ink With Date and Name of Person Making Change.

Notes Ck'd by	Survey of 92nd ST
Map No. B3019	JN 0096.66 Tape 0199 Std 68 °F
Office Work	Surveyed by J.H. BROWN
Checked	Notes J.H.B Date 1-67
Date	Indexed

F. B. 3170 PG. 197

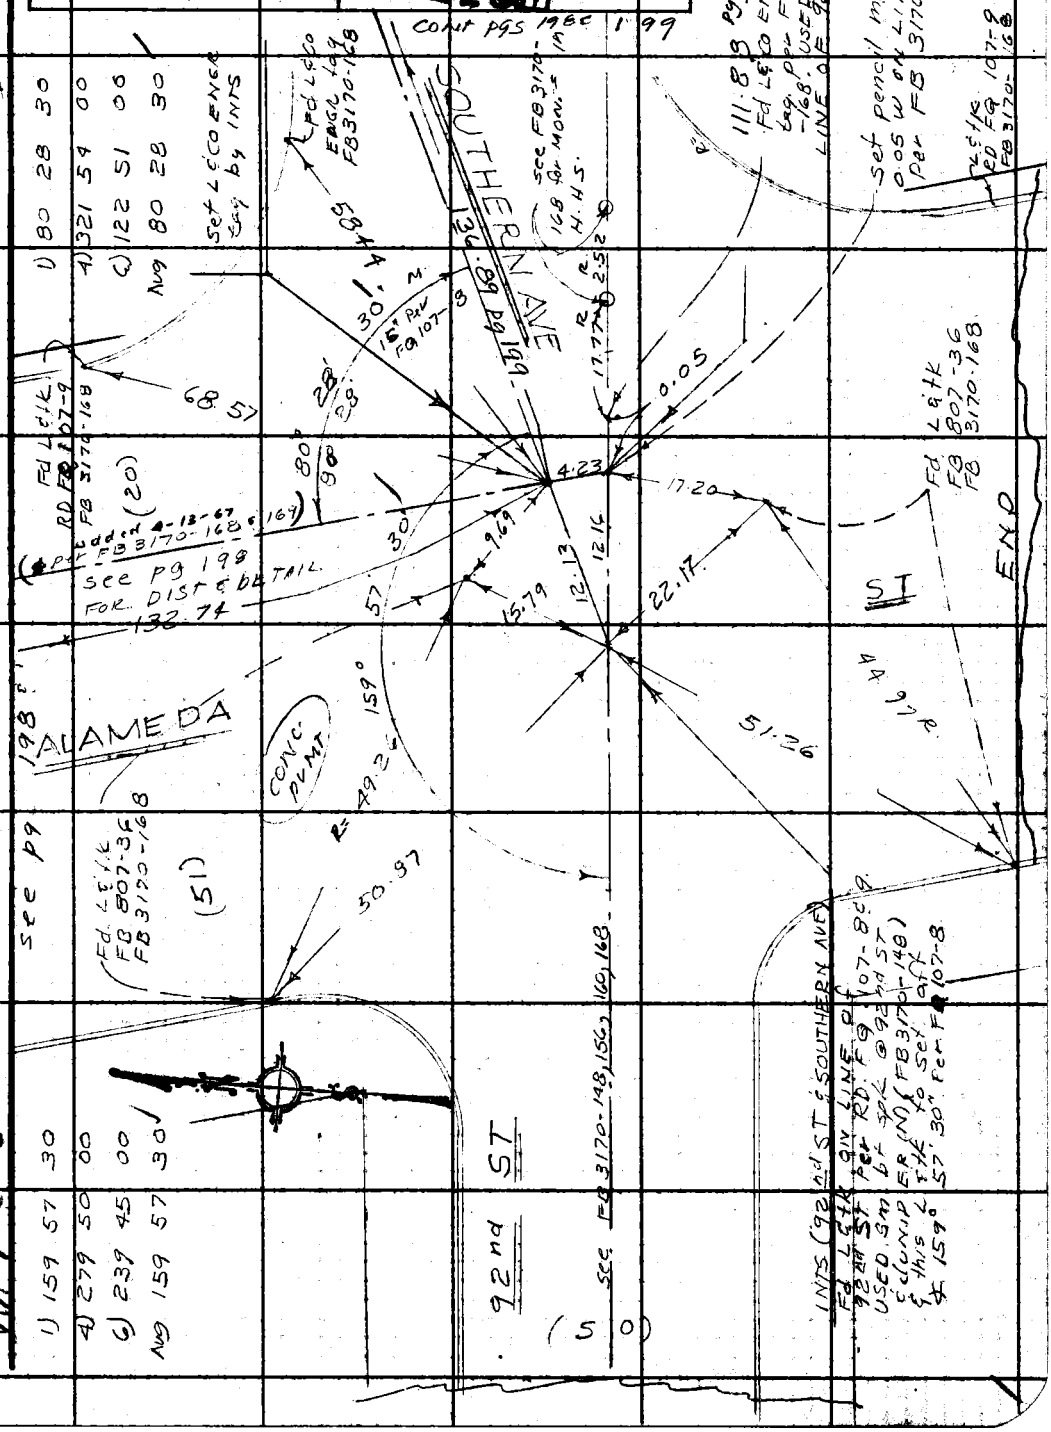

Note: Any Additions or Changes on This Sheet Must be Made or Circled in Red Ink With Date and Name of Person Making Change.

Do not extend this side of this line.

PLEASE RETURN TO
LOS ANGELES COUNTY ENGINEER
403 LOS ANGELES COUNTY ENGINEERING BLDG.

76F3099 CE #310 6/63

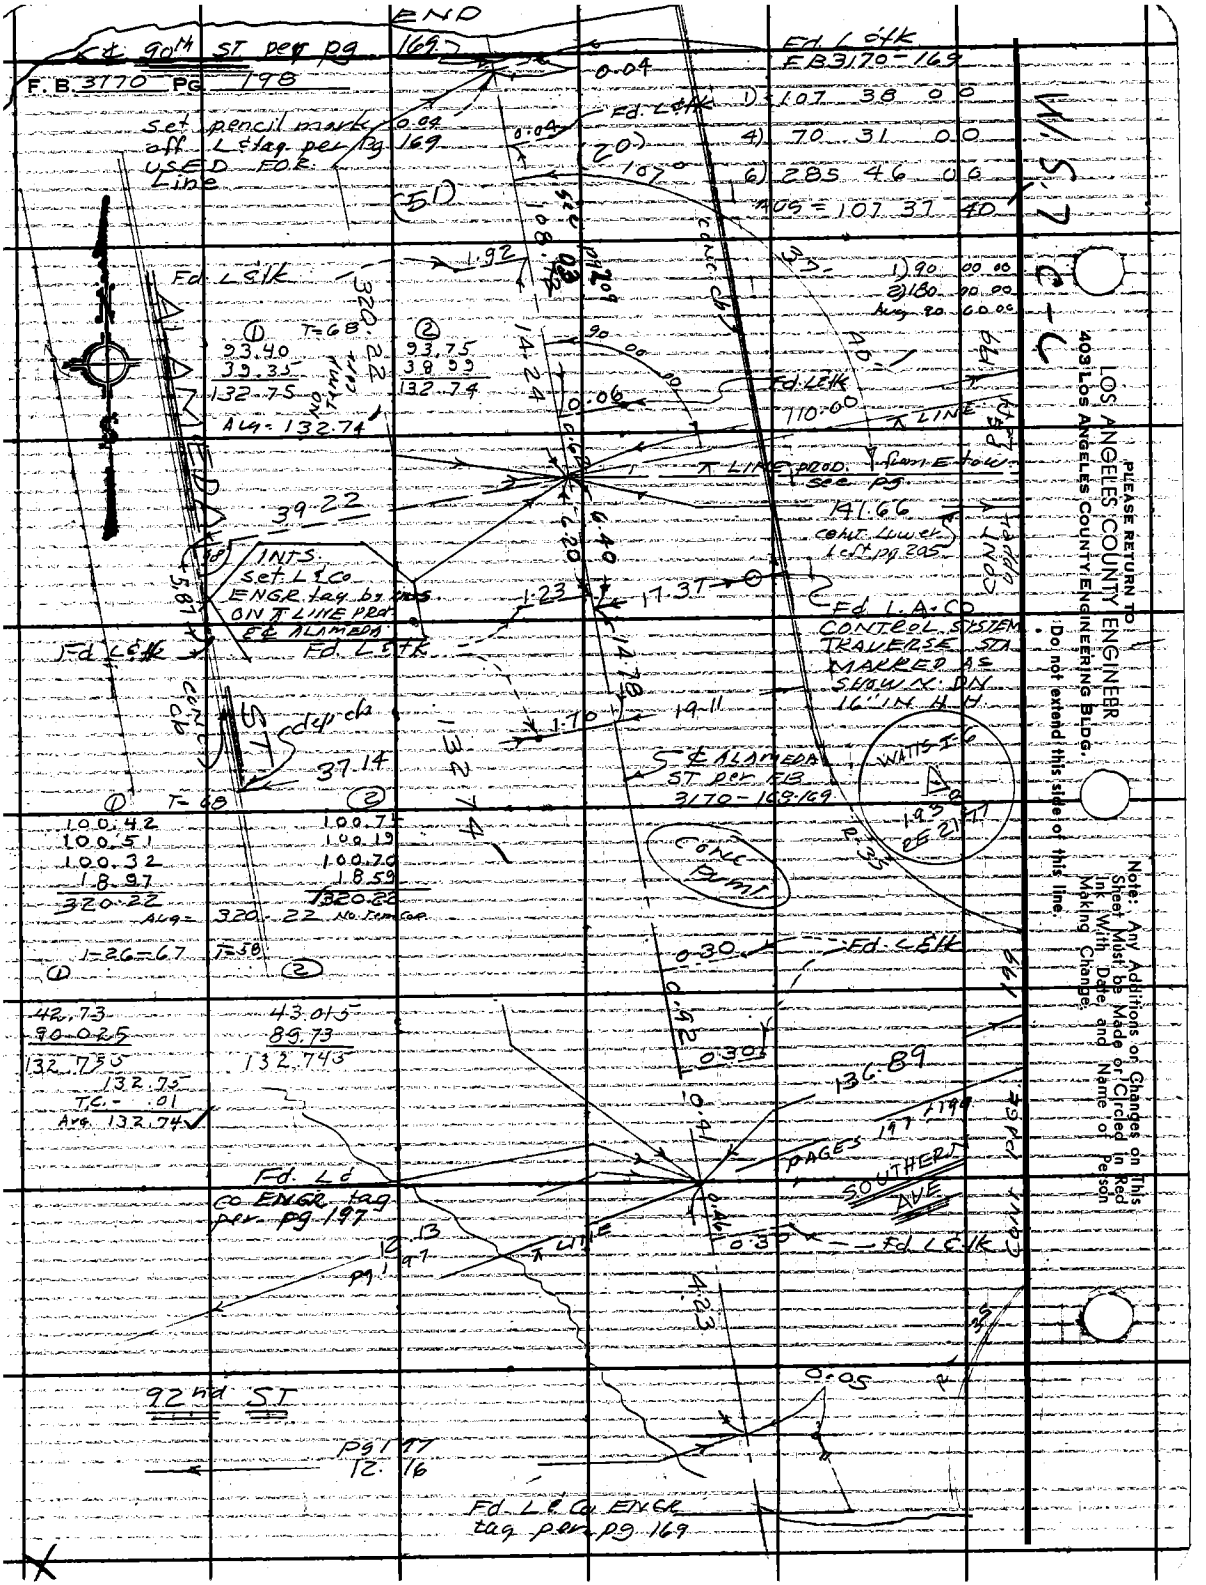

PLEASE RETURN TO
LOS ANGELES COUNTY ENGINEER
403 LOS ANGELES COUNTY ENGINEERING BLDG.
Do not extend this side of this line.

Note: Any Additions or Changes on This Sheet Must be Made or Circled in Red Ink With Date and Name of Person Making Change.

Notes Ck'd by
Map No. B3019
Office Work
Checked
Date

Survey of 92nd ST
JN 0096.66 Tape 0199 Std 68 °F
Surveyed by J. H. BROWN
Notes J.N.A. Date 1-67
Indexed C. J. GALLI

F.B. 3170 Pg. 199

1) 90 00 00
2) 180 00 00
Avg 90 00 00

1) T=64 2)
19.57 19.43
52.05 52.19
35.60 38.38
2.78
110.00 110.00
Avg=110.00
No Temp Corr

ALAMEDA ST

Set 1X2 110.00 from ℄ ALAMEDA @ 90°

Set nail 25.00 on line prod. USED FOR ⊼ LINE (APPROX ℄ ALAMEDA (EAST)

110.00

25.00

34.94

CONT pg 198

Set Lp. ℄ by INTS. No search near M.H.

Fd. nothing on 3 destroyed 4-13-67

T.G.&E. wires Removed 4-13-67

Set 1X2 5ft by INTS. Fl. Removed pg 209 & 210

40.05

Fd L&K

21.78

22.00

1) T=72 2)
20.65 20.83
45.07 49.88
19.52 49.72
26.42 26.22
141.66 141.65
Avg=141.66
No Temp Corr

Set L.E.Co. ENGR tag

15.07

CONT pg 205

Set Lg. Bt spk. W.S.T. by INTS.

17.69

SOUTHERN AVE

1) T=70 2)
54.82 55.13
13.26 12.95
43.46 48.17
25.35 20.64
Avg=136.89 No Temp Corr

136.89

137.89

140.28

27.29

Set nail

25.35

44.5

110.00

25.00

Set 39 spk. 110.00 from ℄ ALAMEDA @ 90°

Set nail on ⊼ LINE prod. USED for N-S ⊼ LINE

111.88

℄ Prod 92nd

Set sq spk. ST by INTS.

15.28

Fd 60d spk in base of LIGHT STAND. No REF.

Fd L.E.Co. ENGR tag. Fl. back of WALK pg

1) T=70 2)
49.74 50.04
35.33 35.03
24.98 24.93
0.85
110.00 110.00
Avg=110.00
No Temp Corr

21.65

20.12

25.0

1) T=72 2)
54.24 54.44
13.51 13.31
41.76 44.13
2.37
111.88 111.88

Note: Any Additions or Changes on This Sheet Must be Made or Circled in Red Ink With Date and Name of Person Making Change.

Do not extend this side of this line.

PLEASE RETURN TO: LOS ANGELES COUNTY ENGINEER 403 Los Angeles County Engineering Bldg.

W.5, 7 C-6

76F3098 CE #310 6-63

F.B. 3170 PG. 200

L. A. CITY POWER & LIGHT

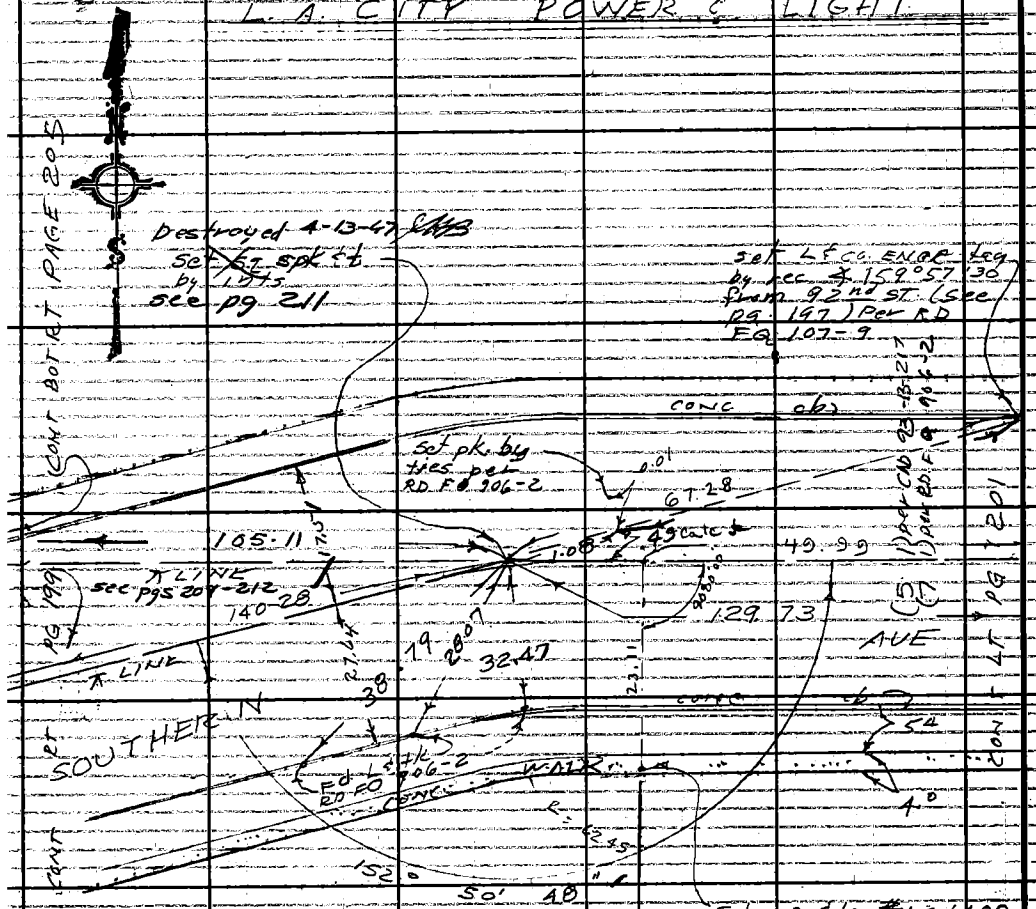

①	(T-68)	②	
100.	33	100.	77
39.	95	39.	50
140.	28	140.	27

1)	90	00	00
2)	180	00	00
Avg.	90	00	00

LOT 16

1)	152	50	45
4)	251	23	15
6)	197	04	45
Avg. =	152	50	48

LOT 17 T.R. 5527

LOS ANGELES COUNTY ENGINEER
403 Los Angeles County Engineering Bldg.
PLEASE RETURN TO
Do not extend this side of this line.
Note: Any Additions or Changes on This Sheet Must be Made or Circled in Red Ink With Date and Name of Person Making Change.

Notes Ck'd by	Survey of 92nd ST
Map No. B3019	JN 0096 66 Tape 0199 Std 68 °F
Office Work	Surveyed by J. H. BROWN
Checked	Notes J. H. B Date 1-67
Date	Indexed C. J. GALLI

F. B. 3170 PG. 201

1) 89	58	00
4) 359	52	15
6) 179	48	15
Avg 89	58	02

CONT PAGE 206

①	T.=64 ②
47.56	75.36
82.17	54.38
129.73	129.74

Avg = 129.73

①	T.=64 ②
100.30	100.75
100.50	100.04
100.31	100.70
100.81	100.41
100.29	100.69
42.69	42.30
544.90	544.89
-.01 T.C.	-.01
544.89	544.88

Avg = 544.88

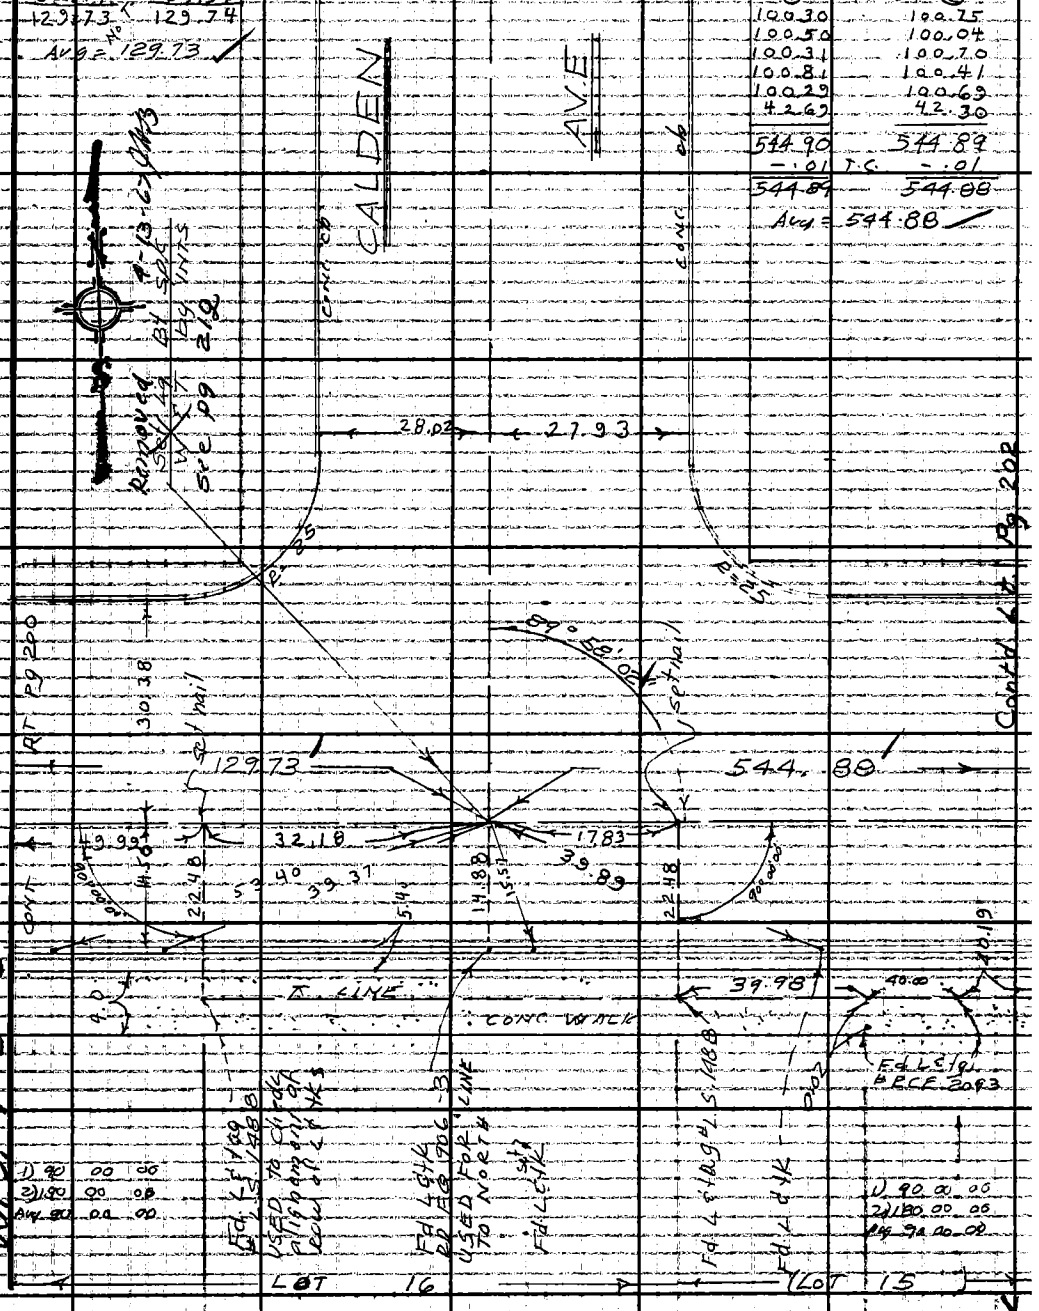

Contd Lot Pg 202

W.S. 7 C-6

Note: Any Additions or Changes on This Sheet Must be Made or Circled in Red Ink With Date and Name of Person Making Change.

Do not extend this side of this line.

PLEASE RETURN TO
LOS ANGELES COUNTY ENGINEER
403 LOS ANGELES COUNTY ENGINEERING BLDG.

76F309S CE #310 6-63

F.B. 3170 PG 202

Tower #70 FB 1301-74
H16 C.S.B-1882-2

1) 90 00 00
2) 180 00 00
Avg 90 00 00

L.A. DEPT W & P R/W
(B.P.S.)

75.50 Lev. T 58° = 75.50

84.89 Lev. T 58° = 84.88

82.68	82.78
33.74	33.64
116.42	116.42

116.42 Lev. T 58° = 116.41

①	②
100.375	100.87
100.58	100.08
100.32	100.72
100.69	100.28
100.34	100.79
100.765	100.315
100.35	100.80
39.20	38.76
742.620	742.615

742.62 Lev. T 60° = 742.58

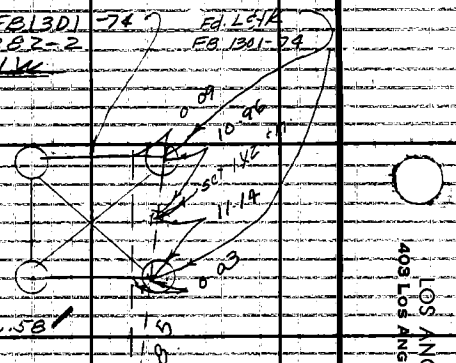

60.20	60.34
43.30	43.16
103.50	103.50

103.50 Lev. T 58° = 103.49

Fd. L&K
No. REF

TOWER # 265 D-2

75.50

Fd. L&K
No REF

103.49

Fd. L&K
FB 1301-74

0.09
10.96
set 1x2 ch
11.14
0.03

Fd nothing
DN. 3
1x2 &
Set nail
Per FB
1301-74

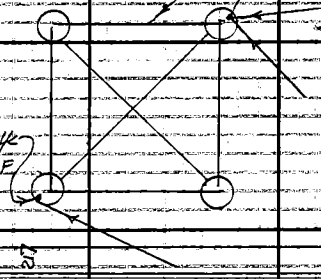

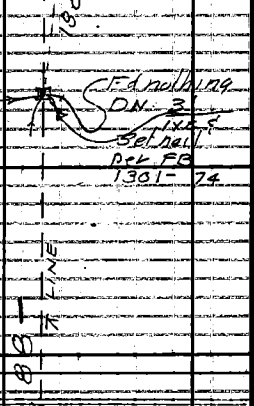

1885

84.88

⊼ LINE

conc. ch

116.41

98.00.00

set masonry
nail @ 90°
To 1x2 & nail

544.88

742.58

⊼ LINE

10.98

SOUTHERN AVE

21.55

22.70

CONT PAGE 201

(5 1) per CAD 93-B-27
(7 1) per Rd.

CONT PAGE 203

conc. ch

159.34 Pg

7.44

200.72 Pg
set nothing

0.83

Fd. L&K
No. REF
opp. CTR Tower #70 ???

Fd. L&K
No. REF
See Pg

LOT 11 TR 5527

PLEASE RETURN TO
LOS ANGELES COUNTY ENGINEER
403 Los Angeles County Engineering Bldg.
Do not extend this side of this line.

Note: Any Additions or Changes on This Sheet Must Be Made or Circled in Red Ink With Date and Name of Person Making Change.

Notes Ck'd by	Survey of 92nd ST
Map No. B-3019	JN 0096 CC Tape 0199 Std 68 °F
Office Work	Surveyed by H. Brown
Checked	Notes 114-B Date 1-67
Date	Indexed J. GALTI

F.B. 3170 PG. 203

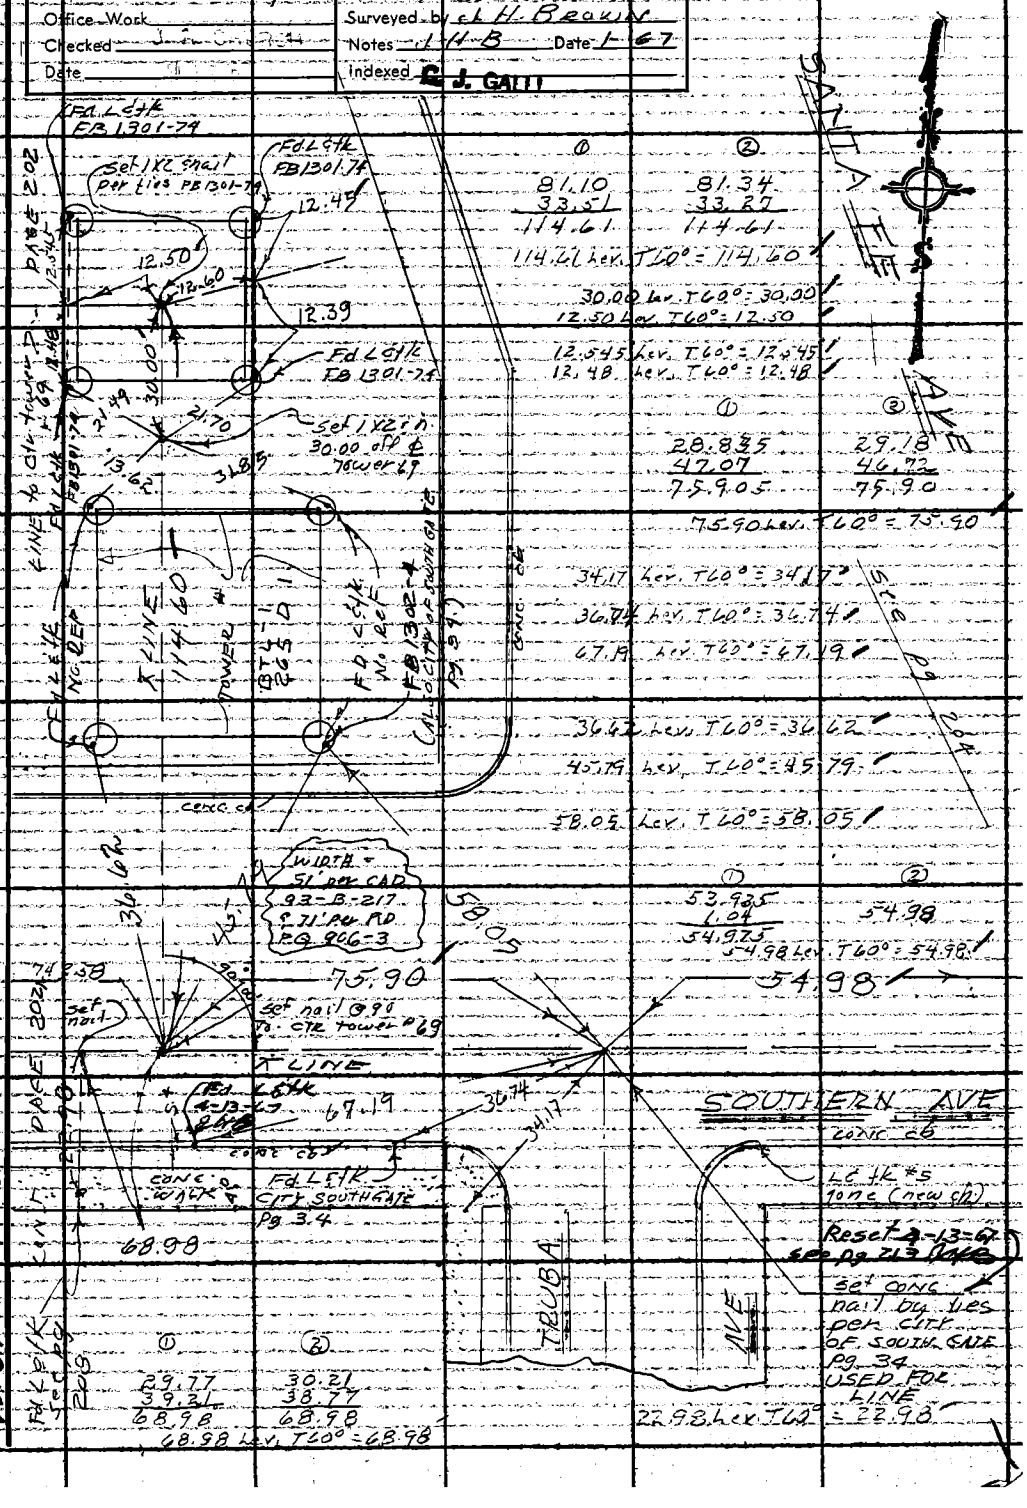

Note: Any Additions or Changes on This Sheet Must be Made or Circled in Red Ink With Date and Name of Person Making Change.

Do not extend this side of this line.

PLEASE RETURN TO
LOS ANGELES COUNTY ENGINEER
403 Los Angeles County Engineering Bldg.

W.S. 7 2-6

76F3095 GE #310 6-63

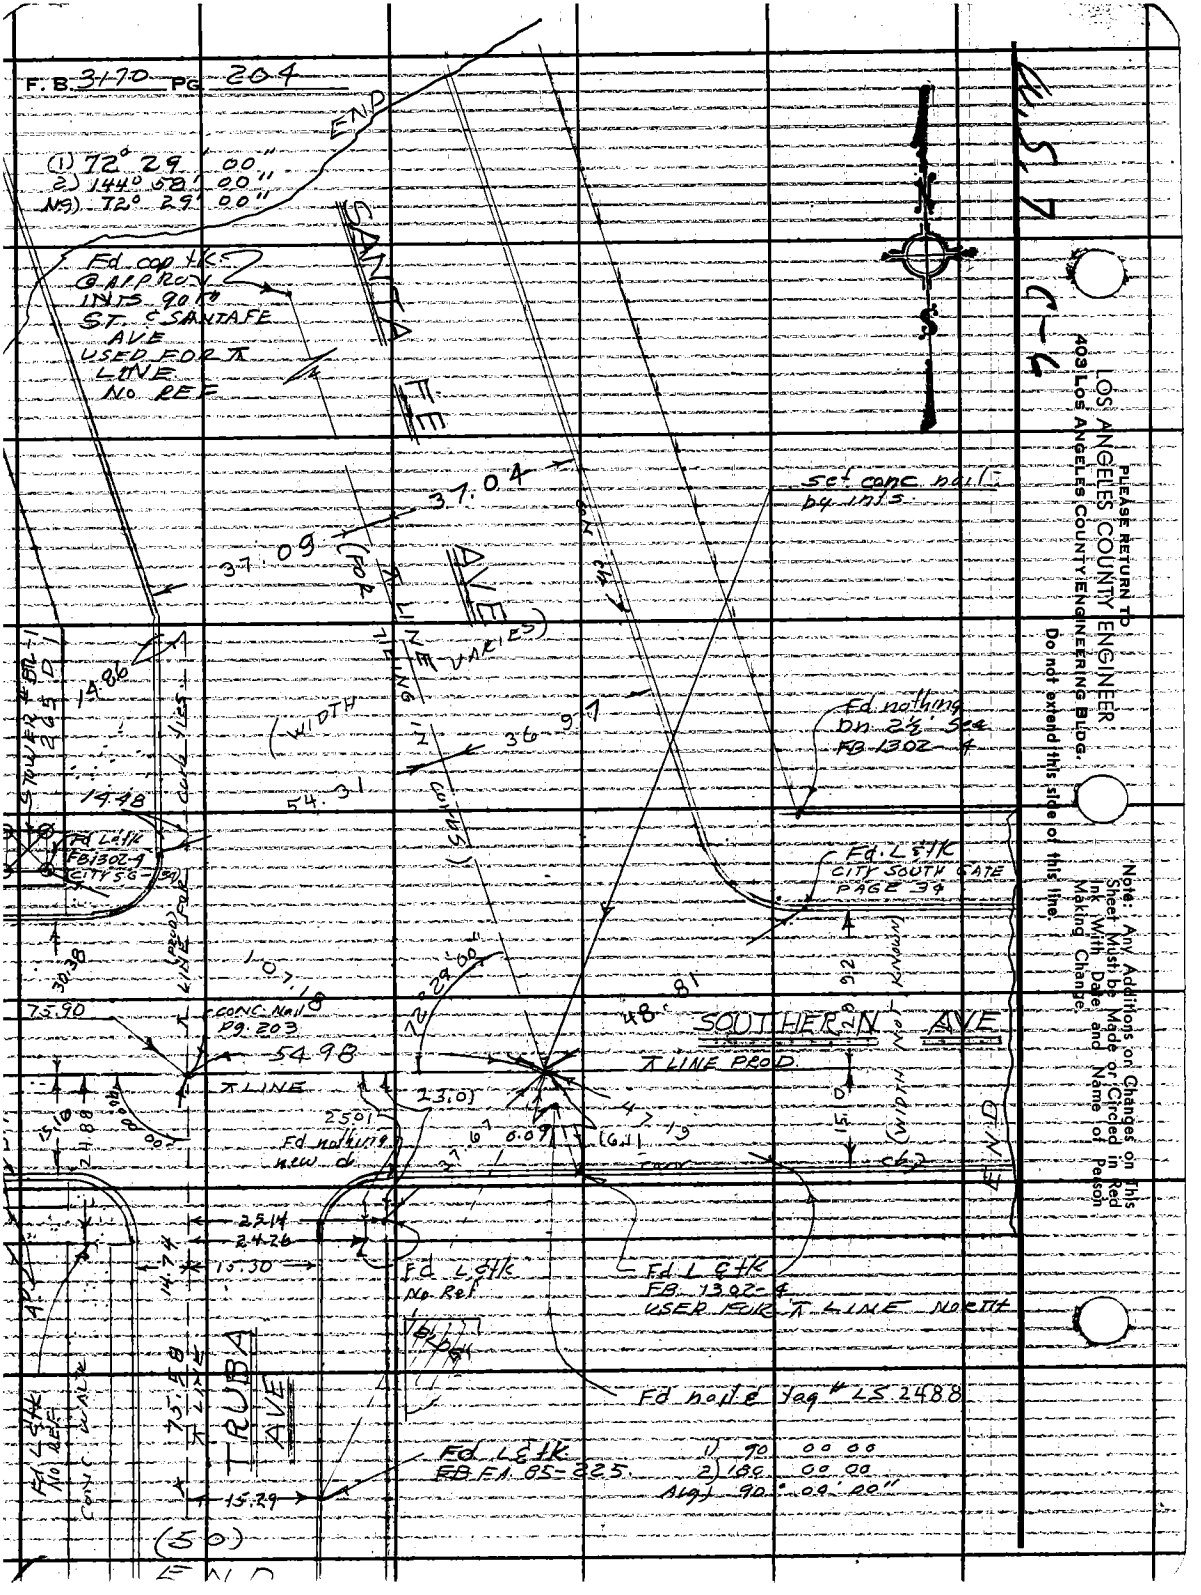
F. B. 3170 PG. 204
(1) 72° 29' 00"
2) 144° 58' 00"
NG) 72° 29' 00"
END
SANTA FE AVE
Fd cop tk @ APPROX INTS 90 ft ST. & SANTA FE AVE USED FOR ⊼ LINE NO REF
37.04
37.09
(FOR ⊼ LINE TIEING IN CURBS)
(WIDTH VARIES)
36.97
54.31
14.86
14.48
Fd L&tk FB 1302-4 CITY SG
Set conc nail by ints.
Fd nothing Dn 2½' See FB 1302-4
Fd L&tk CITY SOUTH GATE PAGE 34
30.38
75.90
CONC Nail Pg. 203
54.98
⊼ LINE
1.07.18
72° 29' 00"
48.81
SOUTHERN AVE
⊼ LINE PROD.
(WIDTH NOT KNOWN)
23.01
25.01
Fd nothing new d
6.09
(6.1)
47.19
15.10
24.88
25.14
24.26
15.30
14.74
Fd L&tk No Ref
Fd L&tk FB 1302-4 USED FOR ⊼ LINE NORTH
Fd nail & tag # LS 2488
TRUBA AVE
75.58
⊼ LINE
Fd L&tk FB FA 85-225
1) 90 00 00
2) 180 00 00
Avg) 90° 00' 00"
15.29
(50)
END
Fd L&tk No Ref
CONC WALK
PLEASE RETURN TO
LOS ANGELES COUNTY ENGINEER
403 LOS ANGELES COUNTY ENGINEERING BLDG.
Do not extend this side of this line.
Note: Any Additions or Changes on This Sheet Must be Made or Circled in Red Ink With Date and Name of Person Making Change.
4.5.7 C-6

Notes Ck'd by
Map No. B3019
Office Work
Checked
Date

Survey of 92nd ST
JN 0096.06 Tape 0199 Std 68 °F
Surveyed by J.H. Brown
Notes J.H.B. Date 1-67
Indexed C. J. GALLI

F. B. 3170 PG. 205

1) 170° 14' 00"
2) 340° 28' 00"
Avg) 170° 14' 00"

99.72
100.71
13.59
214.02 (T=80°)
03 T=0
214.02

1) 90° 00' 00"
2) 180° 00' 00"
Avg = 90° 00' 00"

Fd. nothing DN. 4.

Fd. nothing DN 3' Ref. FB 1301-76

S.B. 5

L. A. CITY
B. P. & L. R/W
(L.A. CITY DEPT. W&P)

85.00 (T=64) = 85.00
85.00 (T=68) = 85.00
Avg = 85.00

Fd. L&tk FB 1301-73 & 76

TOWER # 71 per FB 1301 = # 1142 VEL-CEN-1 (Also has GLO No 15) see CS B-1882-2

Fd. L&tk FB 1301-73 & 76

Fd. L&tk FB 1301-73 & 76

Fd. L&tk FB 1301-73 & 76

Fd. 1½" I.P. DN 10" FB 1301-74 (Put cem on rolled wood plug & nail)

Same

set nail

Fd. 1½" I.P. DN 10" FB 1301-76

Fd. L&tk No. Ref.

Fd. L&tk No. REF

TOWER # 265 D3 BTL-1.2 (Fd. nothing set nothing ⊙ctr)

Fd. L&tk

(MAY BE SAME AS CITY SOUTHGATE PAGE 25)

Fd. U.S.C.&G.S. BM # 1C 769 1945

Fd. L&tk No. REF

① T = 72
21.27 no ring
18.78 cont
40.05
40.05 Avg = 40.05

② 40.05
105.11

Fd. nothing Dn. 3' set 1½" & nail n.

by Utils. same as pg 199 Destroyed 4-13-67 JHB

pg 199 141.66

π LINE PAN

π LINE

24.23

40.05

① (T = 70)
65.97
39.24
105.11 avg

② 66.08
39.03
105.11

Set 1½" & nail ONE Rec dist. (85.00) 4-13-67 from 1½" I.P. & R/W PARTIES SHOWN FB 1301-74 USED FOR π LINE SOUTHERN AVE.

Fd. L&tk pg 199

Fd. L&tk Co. ENGR pg 199

26.24 R

(25)

Fd. nothing Set nothing

CONT PG 199

CONT LT → PAGE 240

Removed 4-13-67 JHB

MAY BE SAME AS CITY SOUTHGATE PAGE 3

Note: Any Additions or Changes on This Sheet Must be Made or Circled in Red Ink With Date and Name of Person Making Change.

Do not extend this side of this line.

PLEASE RETURN TO LOS ANGELES COUNTY ENGINEER
403 Los Angeles County Engineering Bldg.

FORM 3085 CE #310 6-63

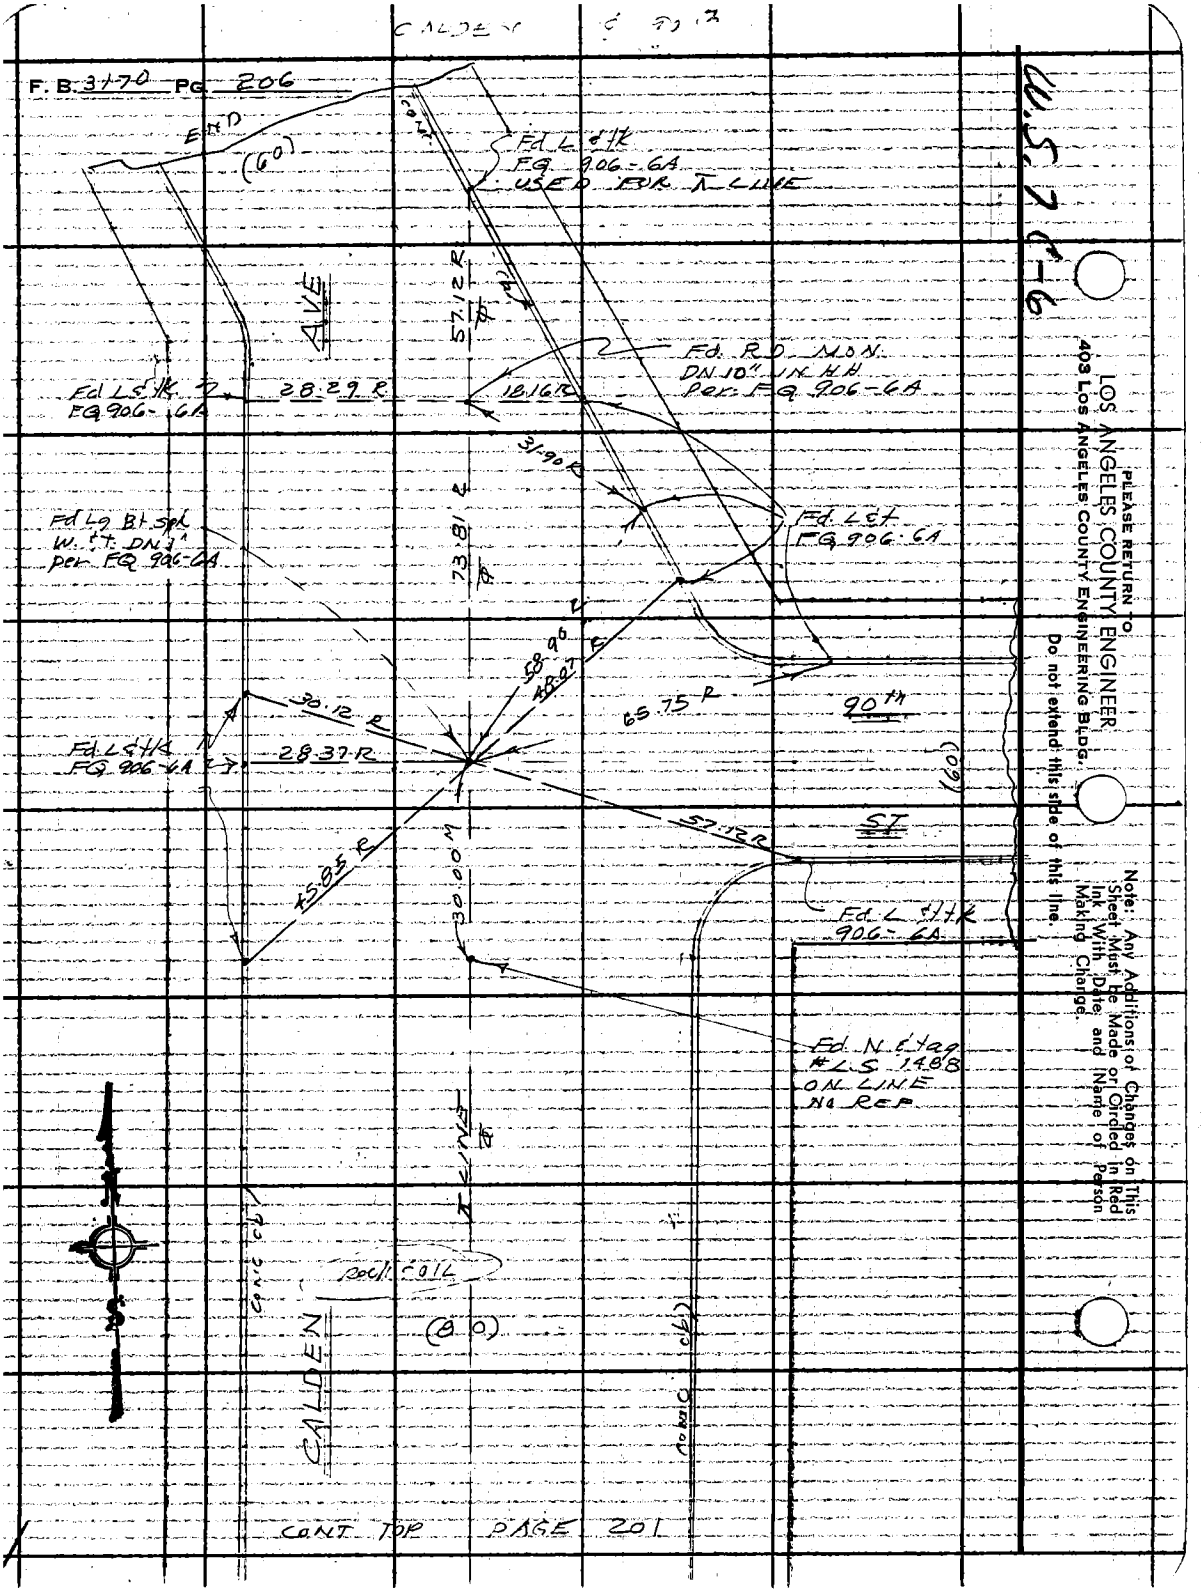
F. B. 3170 PG. 206
W.S. 7 C-6
END
(60)
Fd L & tk
FQ 906-6A
USED FOR ⊼ LINE
AVE
57.12 R
Fd. RD. MON.
DN 10" IN HH
Per FQ 906-6A
Fd L & tk
FQ 906-6A
28.29 R
18.16 R
31.90 R
Fd Lg Bt Spk
W. & T. DN 1"
per FQ 906-6A
73.81 R
Fd. L & t
FQ 906-6A
58.96 R
48.07 R
65.75 R
90th
30.12 R
Fd L & tk
FQ 906-6A
28.37 R
(60)
57.12 R
ST
45.85 R
30.00 M
Fd L & tk
906-6A
Fd. N & tag
#L.S. 1488
ON LINE
NO REF
⊼ LINE
CONC CB
Rock COIL
(80)
CALDEN
CONC CB
CONT TOP PAGE 201
PLEASE RETURN TO
LOS ANGELES COUNTY ENGINEER
403 LOS ANGELES COUNTY ENGINEERING BLDG.
Do not extend this side of this line.
Note: Any Additions or Changes on This Sheet Must be Made or Circled in Red Ink With Date and Name of Person Making Change.

Notes Ckd by
Map No. B3019
Office Work
Checked
Date

Survey of 92nd ST
JN 0096-66 Tape 0199 Std 68 °F
Surveyed by J. H. BROWN
Notes J. N. B. Date 1-67
Indexed C. J. GAITI

F. B. 3170 PG. 207

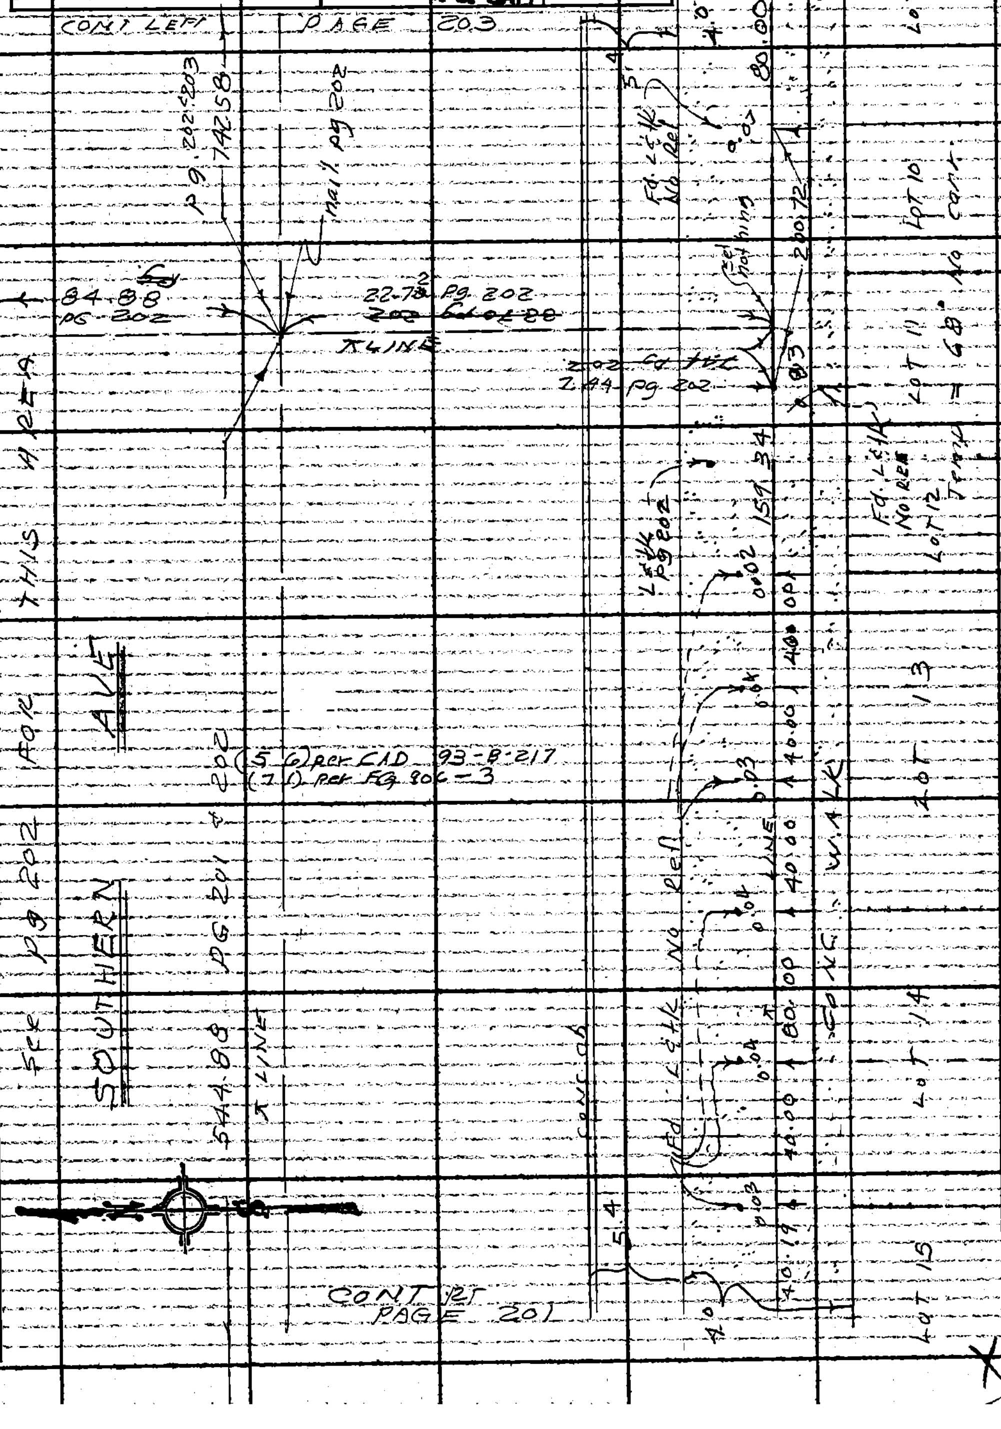

Note: Any Additions or Changes on This Sheet Must be Made or Circled in Red Ink With Date and Name of Person Making Change.

PLEASE RETURN TO
LOS ANGELES COUNTY ENGINEER
403 LOS ANGELES COUNTY ENGINEERING BLDG.

Do not extend this side of this line.

76F309S CE #310 6-63

F.B. 3170 PG 208

see page 202 & 203 for this area

SOUTHERN AVE

set Conc. nail @ 90° to Fd L&tk

742.58 Pgs 202 & 203

℄ LINE

68.88 Pg 203

90°00'00"

22-98

CONT PAGE

1) 90 00 00
2) 180 00 00
Avg 90 00 00

(5 6) per CAD 93-B-217
(7 1) per RD FB 906-3

Conc. cb

Fd. L&tk No REF

5.4

80.00 | 0.12 | 39.99 | 0.12 | 40.02 | 0.19 | 40.02 | 0.21 | 39.97 | 0.20 | 59.98 | 60.03 | 120.19

0.04

0.12

℄ LINE

Conc WALK

END LINE

USED FOR TRANSIT LINE

Fd. L & 8 tag LS 2428

LOT 6

Lot 9 Temp ± 60° No Cork Lot 8 Lot 7 Fd. L&tk No REF LOT 5

CONT TOP PAGE 207

PLEASE RETURN TO:
LOS ANGELES COUNTY ENGINEER
403 LOS ANGELES COUNTY ENGINEERING BLDG.
Do not extend this side of this line.

Note: Any Additions or Changes on This Sheet Must be Made or Circled in Red Ink With Date and Name of Person Making Change.

Notes Ck'd by	Survey of 92nd ST	F.B. 3170 PG. 209
Map No. B3019	JN 0096-66 Tape 0199 Std 68 °F	
Office Work	Surveyed by J. H. BROWN	
Checked	Notes J. H. B. Date 4-13-67	
Date	Indexed	

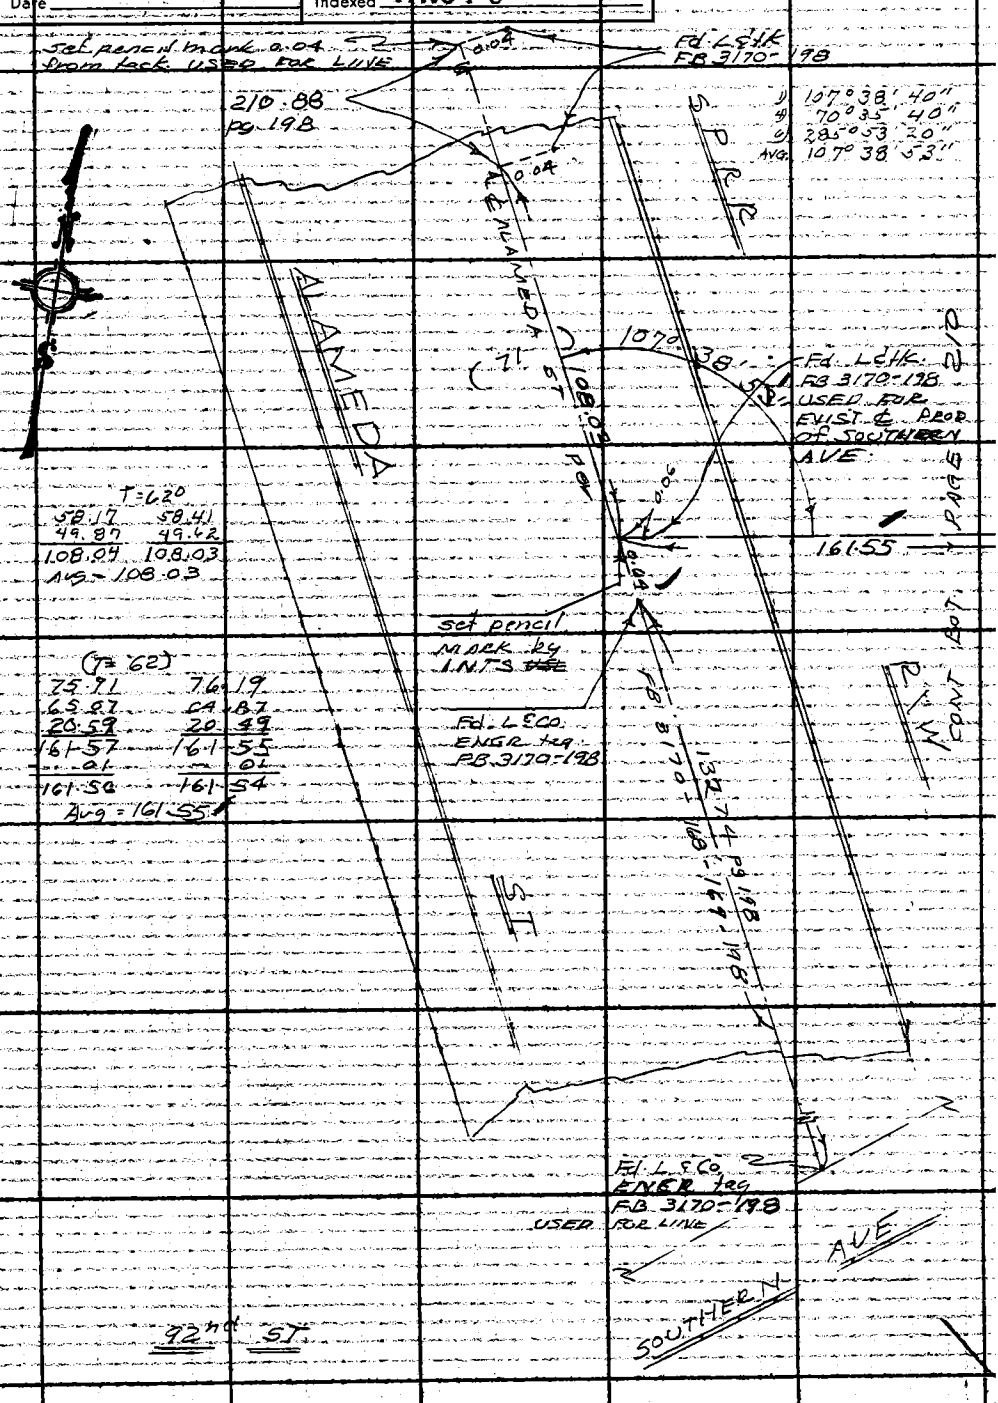

T=62°

58.17	58.41
49.87	49.62
108.04	108.03

Avg = 108.03

(T=62)

75.71	76.19
65.07	64.87
20.59	20.49
161.57	161.55
.01	.01
161.56	161.54

Avg = 161.55

Note! Any Additions or Changes on This Sheet Must be Made or Circled in Red Ink With Date and Name of Person Making Change.

Do not extend this side of this line.

PLEASE RETURN TO
LOS ANGELES COUNTY ENGINEER
403 LOS ANGELES COUNTY ENGINEERING BLDG.

W.S. 7 C-6

76F3095 CE #310 6-63

F.B. 3170 PG. 210

CONT. BOT PAGE 211

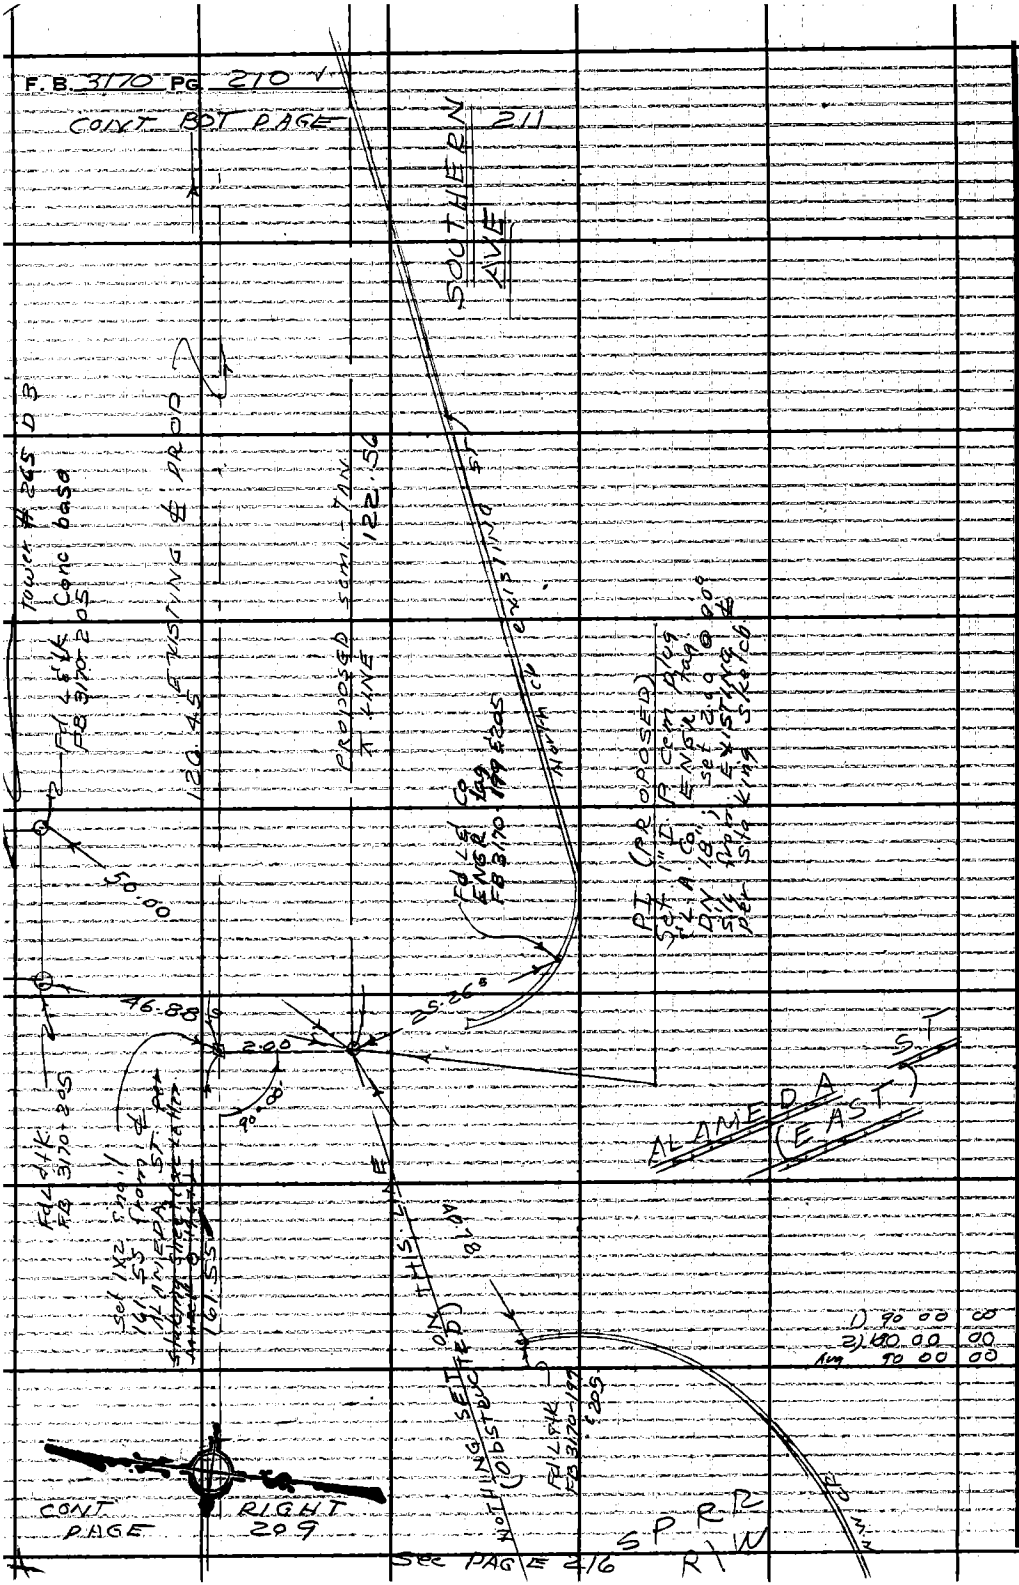

See PAGE 216

PLEASE RETURN TO
LOS ANGELES COUNTY ENGINEER
403 LOS ANGELES COUNTY ENGINEERING BLDG.

Do not extend this side of this line.

Note: Any Additions or Changes on This Sheet Must be Made or Circled in Red Ink With Date and Name of Person Making Change.

Notes Ck'd by	Survey of 92nd ST	F.B. 3170 PG. 211
Map No.	JN 0096-66 Tape 0199 Std 68 °F	
Office Work	Surveyed by d. H. Brown	
Checked	Notes J.N.B. Date 4-14-67	
Date	Indexed C. J. GALLI	

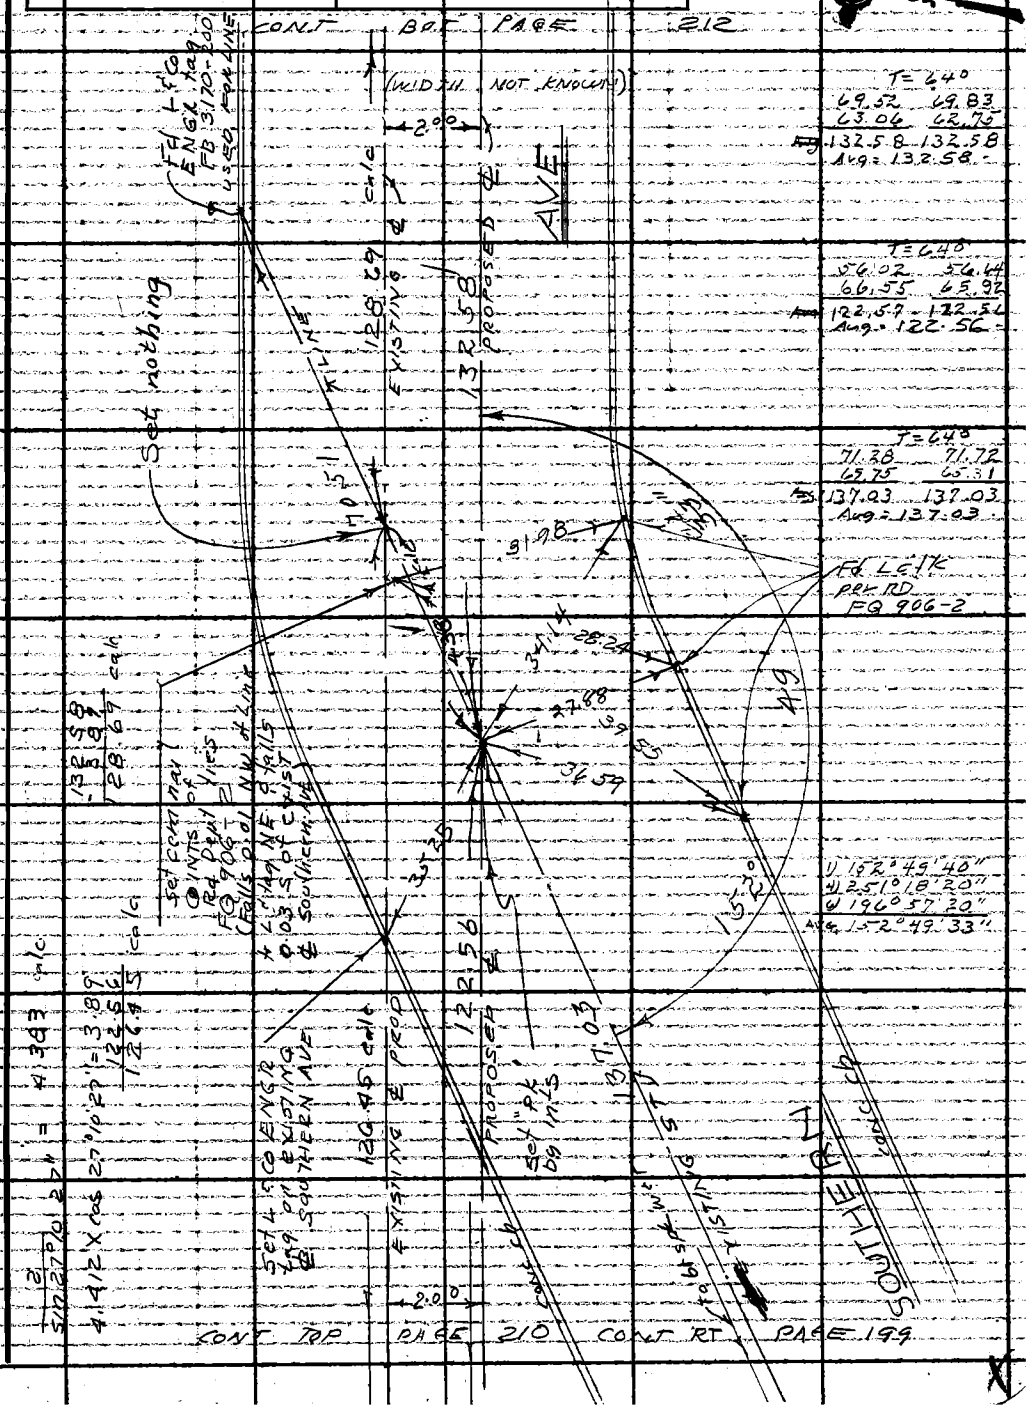

Note: Any Additions or Changes on This Sheet Must Be Made or Circled in Red Ink With Date and Name of Person Making Change.

Do not extend this side of this line.

PLEASE RETURN TO
LOS ANGELES COUNTY ENGINEER
403 LOS ANGELES COUNTY ENGINEERING BLDG.

76F309S CE #310 6-63

PLEASE RETURN TO
LOS ANGELES COUNTY ENGINEER
403 LOS ANGELES COUNTY ENGINEERING BLDG.

Note: Any Additions or Changes on This Sheet Must be Made or Circled in Red Ink With Date and Name of Person Making Change.

Do not extend this side of this line.

W.S. 2 C-6

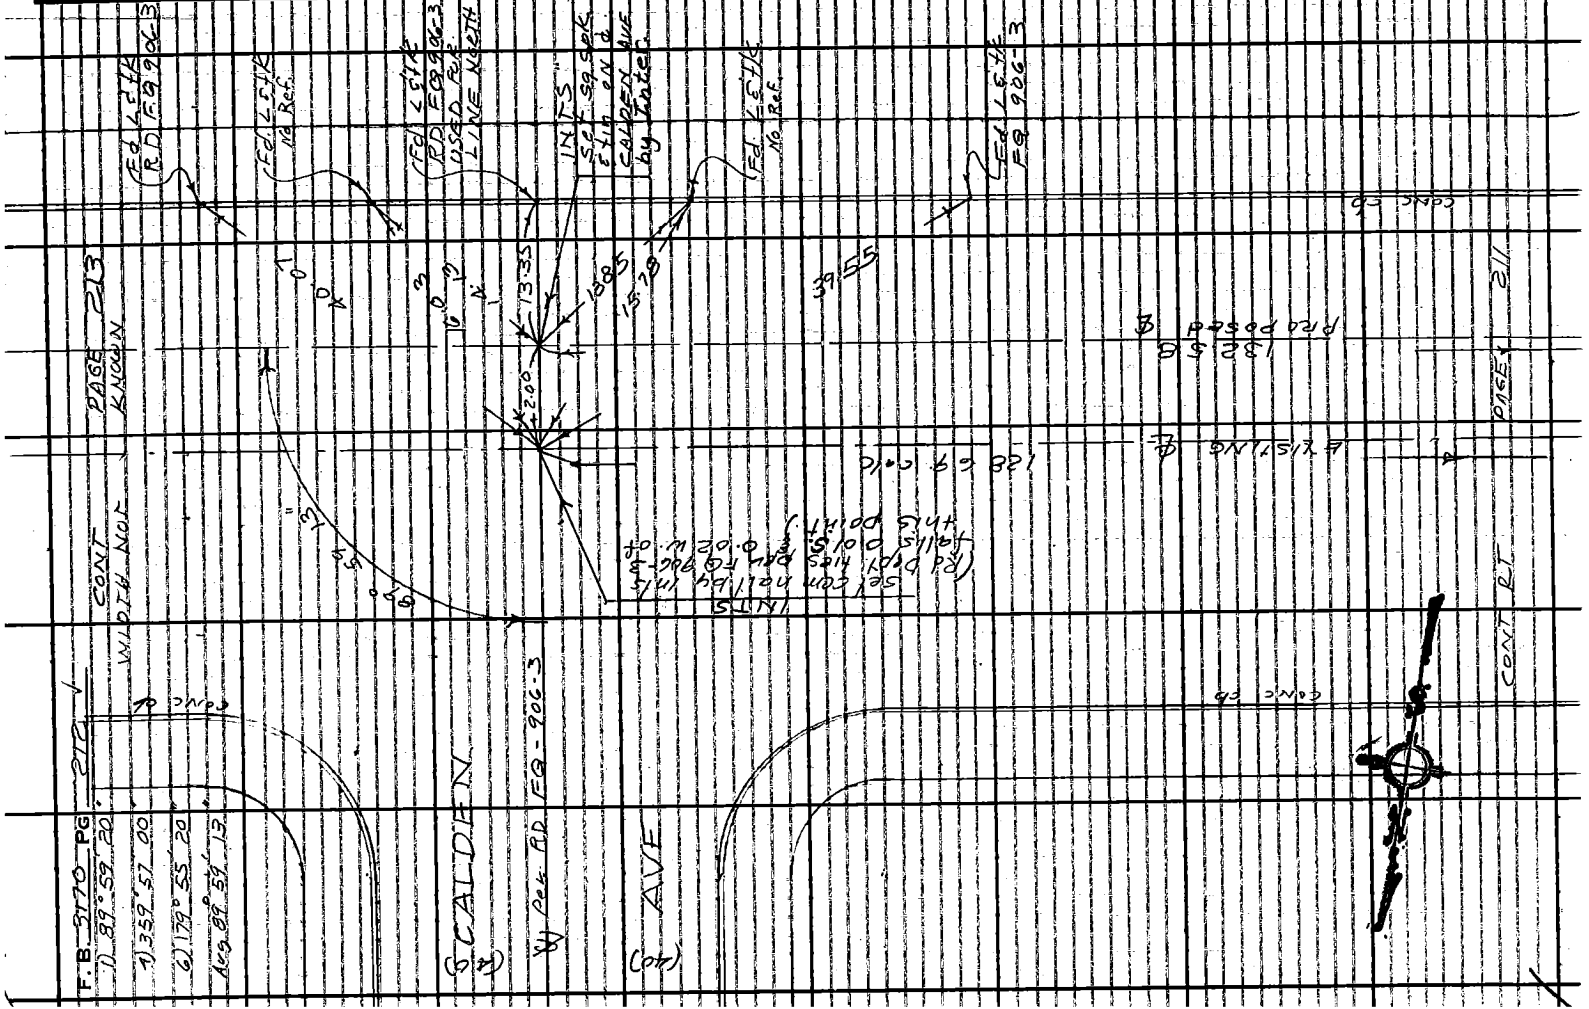

Notes Ck'd by	Survey of 92nd ST
Map No. B3019	JN0096-66 Tape 0199 Std 68 °F
Office Work	Surveyed by J. H. Brown
Checked	Notes cl H-B Date 4-14-67
Date	Indexed C. J. GALLI

F. B. 3170 PG. 213

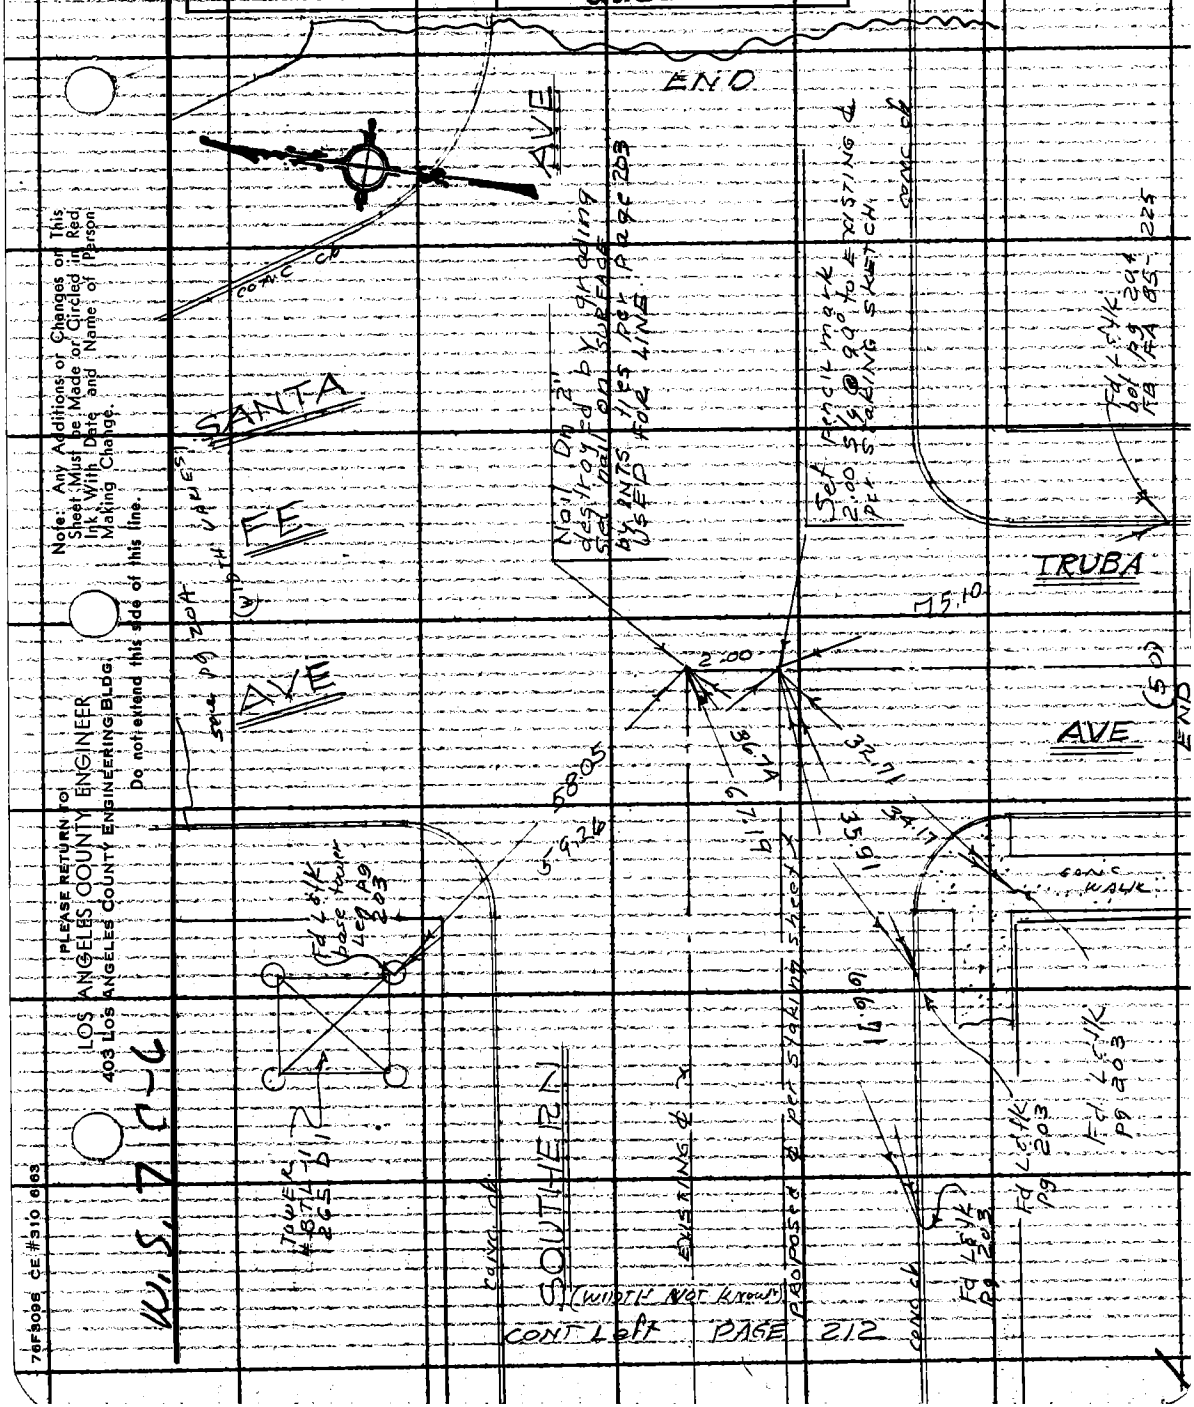

CONT Left PAGE 212

Note: Any Additions or Changes on This Sheet Must be Made or Circled in Red Ink With Date and Name of Person Making Change.

Do not extend this side of this line.

PLEASE RETURN TO:
LOS ANGELES COUNTY ENGINEER
403 LOS ANGELES COUNTY ENGINEERING BLDG.

76F3098 CE #310 6/63

Notes Ck'd by	Survey of 92nd ST
Map No. B3019	JN 0096.66 Tape 0199 Std 68 °F
Office Work	Surveyed by J.H. Brown
Checked	Notes J.H.B. Date 9-17-67
Date	Indexed C.J. GALLI

F.B. 317 PG. 215

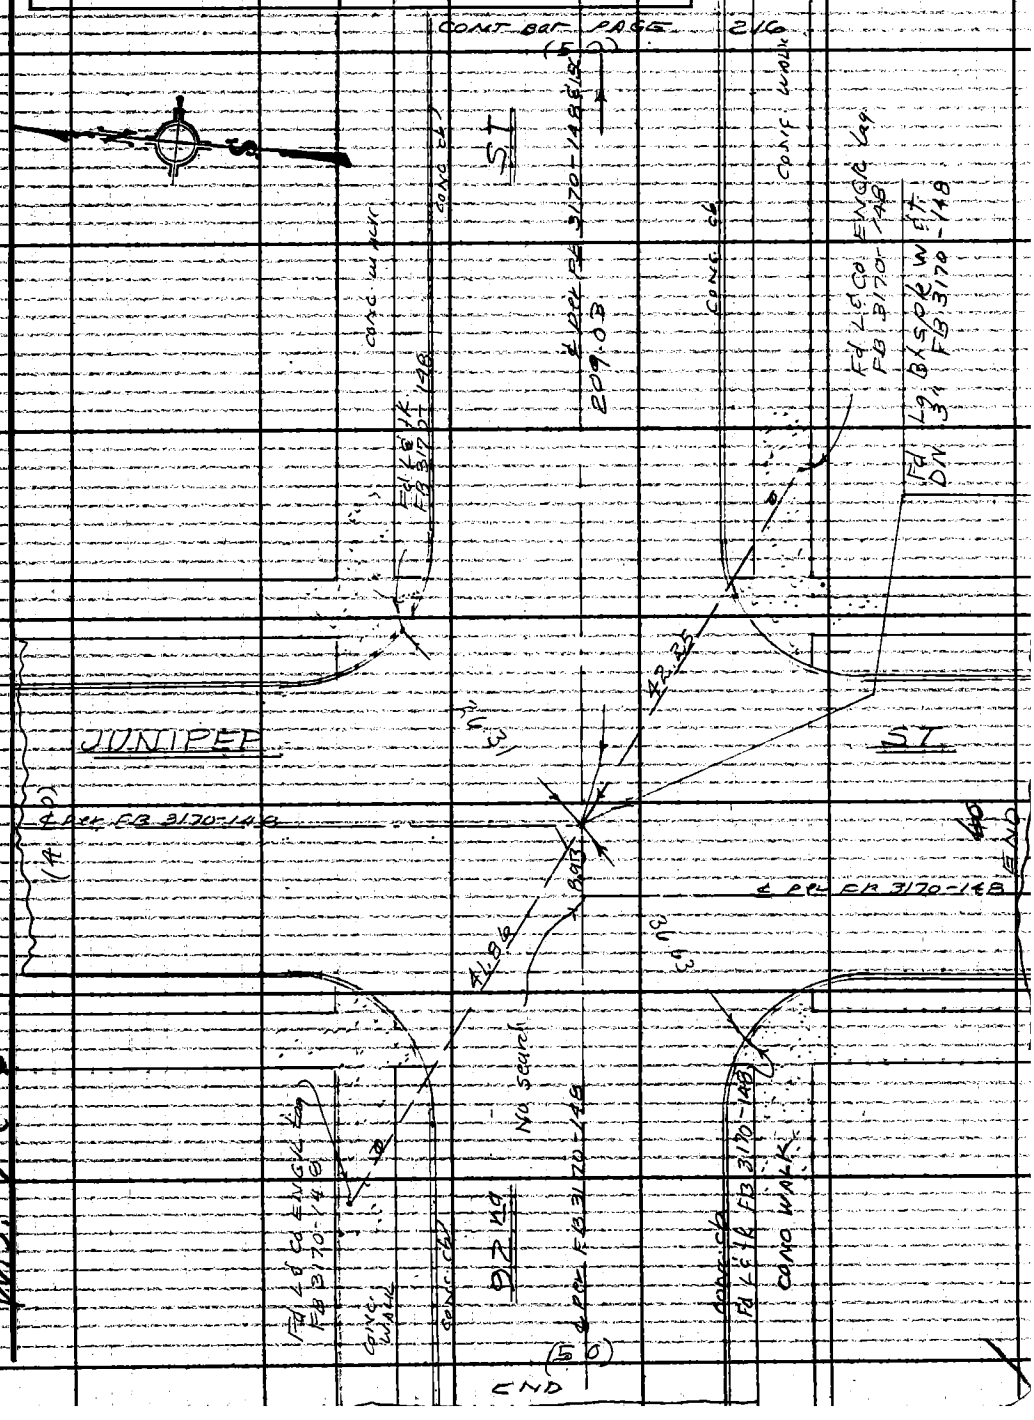

Note: Any Additions or Changes on This Sheet Must Be Made or Circled in Red Ink With Date and Name of Person Making Change.

Do not extend this side of this line.

PLEASE RETURN TO
LOS ANGELES COUNTY ENGINEER
403 LOS ANGELES COUNTY ENGINEERING BLDG.

W.S. 7 C-6

76F309S CE#310 6-63

PLEASE RETURN TO
LOS ANGELES COUNTY ENGINEER
403 Los Angeles County Engineering Bldg.

Note: Any Additions or Changes on This Sheet Must be Made or Circled in Red Ink With Date and Name of Person Making Change.

Do not extend this side of this line.

W.S. 7 C-C

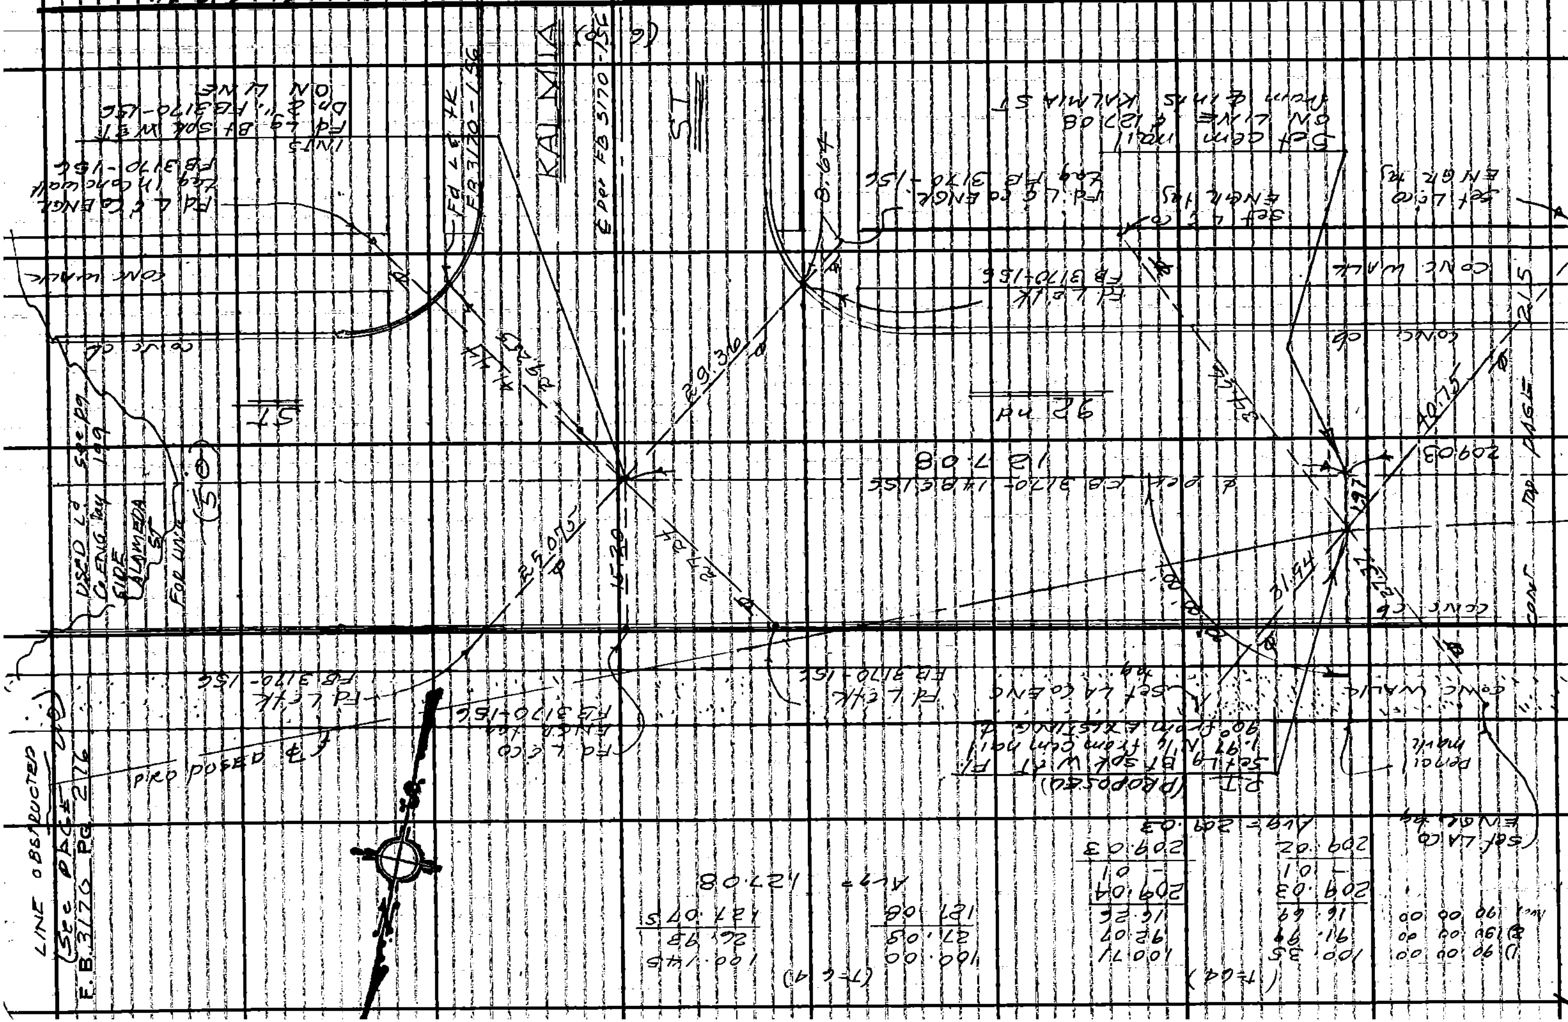

Notes Ck'd by [illegible]	Survey of 92nd ST
Map No. B 3019	JN 0096.6 Tape 0199 Std. 68 °F
Office Work	Surveyed by J. H. Brown
Checked [illegible]	Notes J. H. B. Date 4-17-67
Date JUL 17 '61	Indexed G. J. GALLI

F. B. 3170 PG. 217

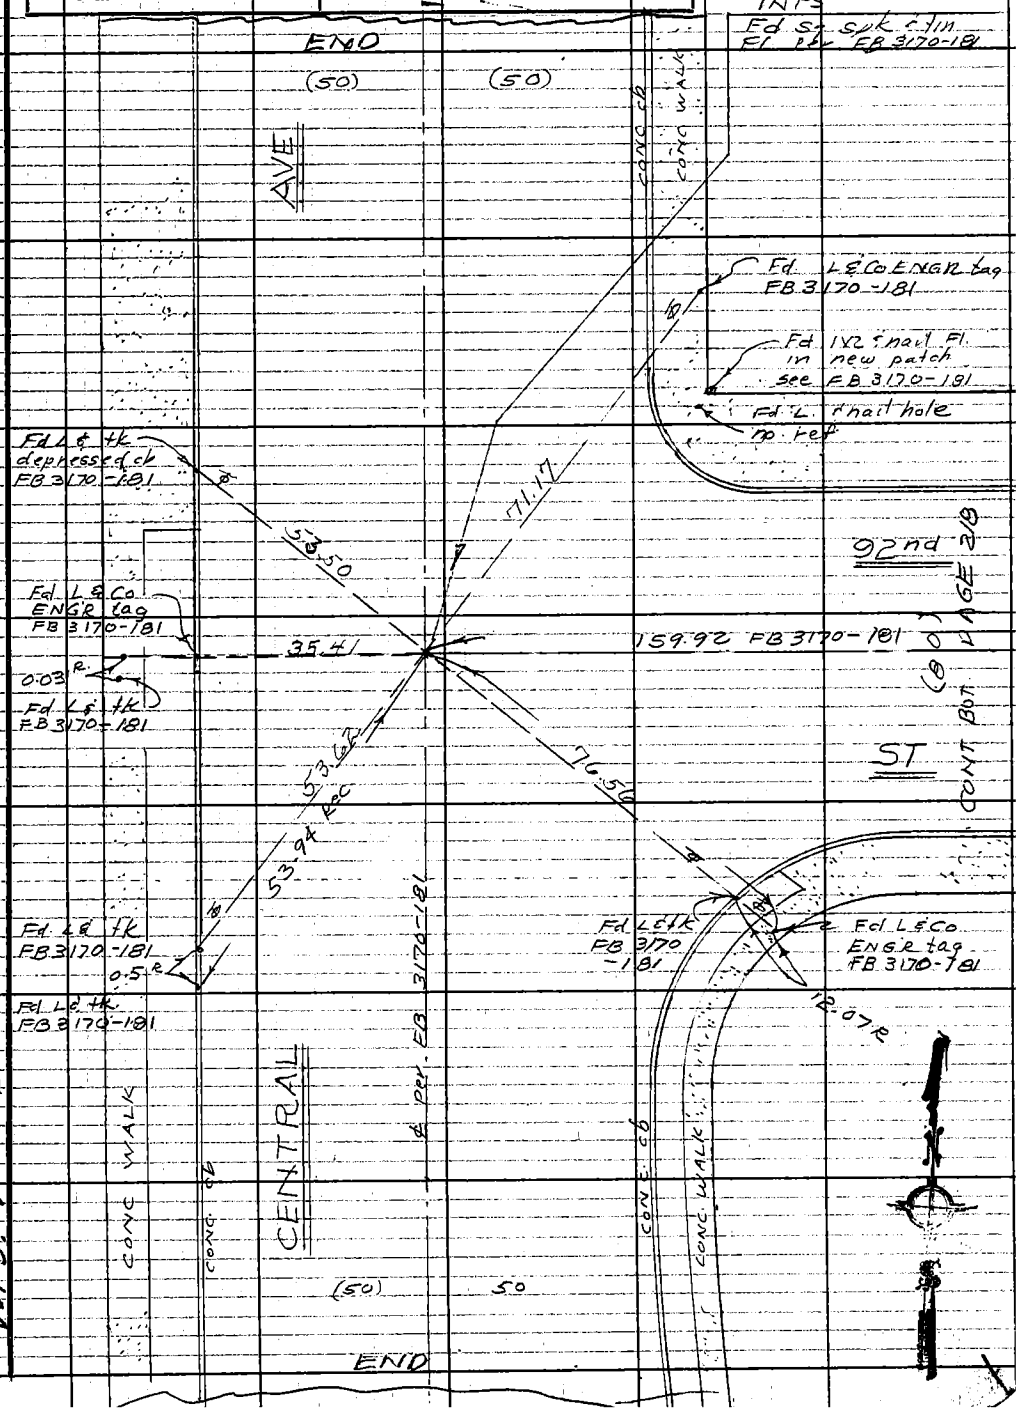

Note: Any Additions or Changes on This Sheet Must be Made or Circled in Red Ink With Date and Name of Person Making Change.

Do not extend notes this side of this line.

RETURN TO
LOS ANGELES COUNTY ENGINEER
700 LOS ANGELES COUNTY ENGINEERING BLDG.

W. S. 7 B-6

76F309S CE #247—3-57

RETURN TO
LOS ANGELES COUNTY ENGINEER
700 LOS ANGELES COUNTY ENGINEERING BLDG.

Note: Any Additions or Changes on This Sheet Must be Made or Circled in Red Ink With Date and Name of Person Making Change.

Do not extend notes this side of this line.

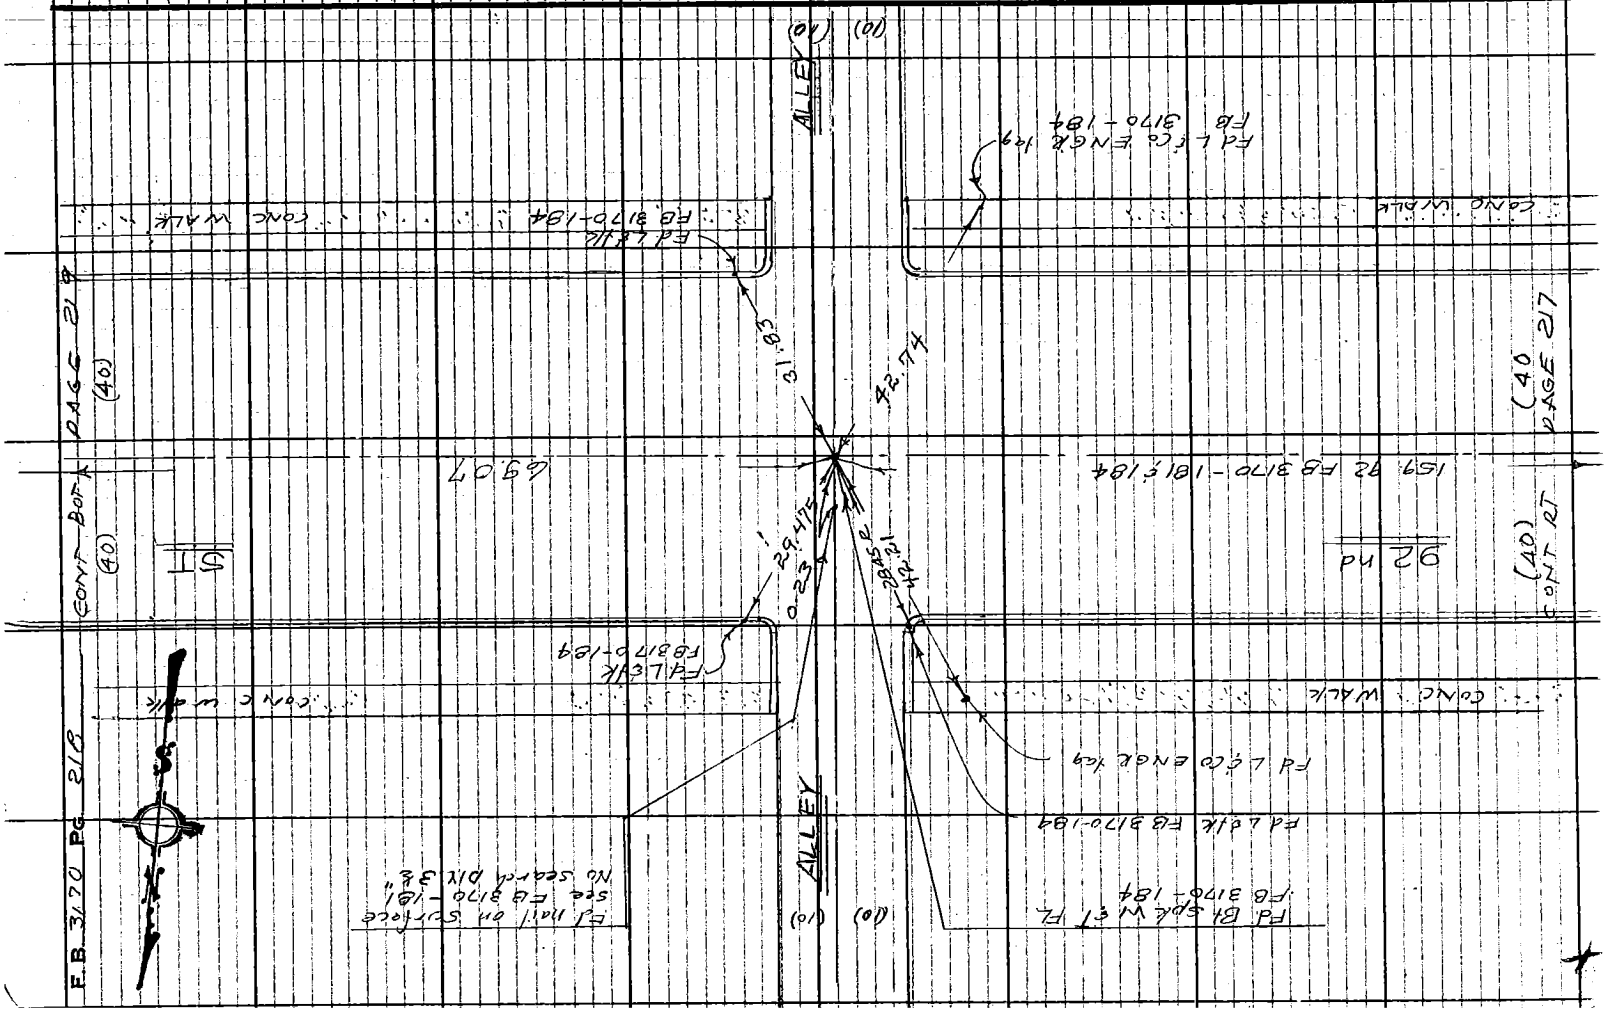

Notes Ck'd by J. A. CHURCH
Map No. B 3019
Office Work
Checked
Date

Survey of 92nd ST
JN 096-66 Tape 0199 Std 6.8 °F
Surveyed by J. H. Brown
Notes J. H. B. Date 4-17-67
Indexed C. J. GALLI

F. B. 317-0 PG. 219

CONT BOT PAGE 220

(40) 40

CONC WALK

CONC. ⌀

92nd ST

CONC. ⌀

CONC WALK

Set L & Co ENGR Lag

Set L & Co ENGR Lag

217.79

Fd L & Lag "BONE" HLS. No PEF

37.80

54.93

86.86

55.51

25.05

27.97

P.I. PROPOSE Set Lg Bt SPK WET FL

58.50

69.07

61.27

PROPOSE ⌀ see pg 196

EXIST ⌀

Fd L & K FB 3170-18A

Fd L & K FB 3170-19A

T = 58°

68.21	69.07
.86	
69.07	69.07

T = 58°

100.065	100.355
100.39	100.39
17.35	17.055
217.805	217.80
T-C -.01	-.01
217.795	217.79

Avg = 217.79

CONT TOP PAGE 218

Note: Any Additions or Changes on This Sheet Must be Made or Circled in Red Ink With Date and Name of Person Making Change.

Do not extend this side of this line.

PLEASE RETURN TO
LOS ANGELES COUNTY ENGINEER
403 LOS ANGELES COUNTY ENGINEERING BLDG.

76F3095 CE #310 6-63

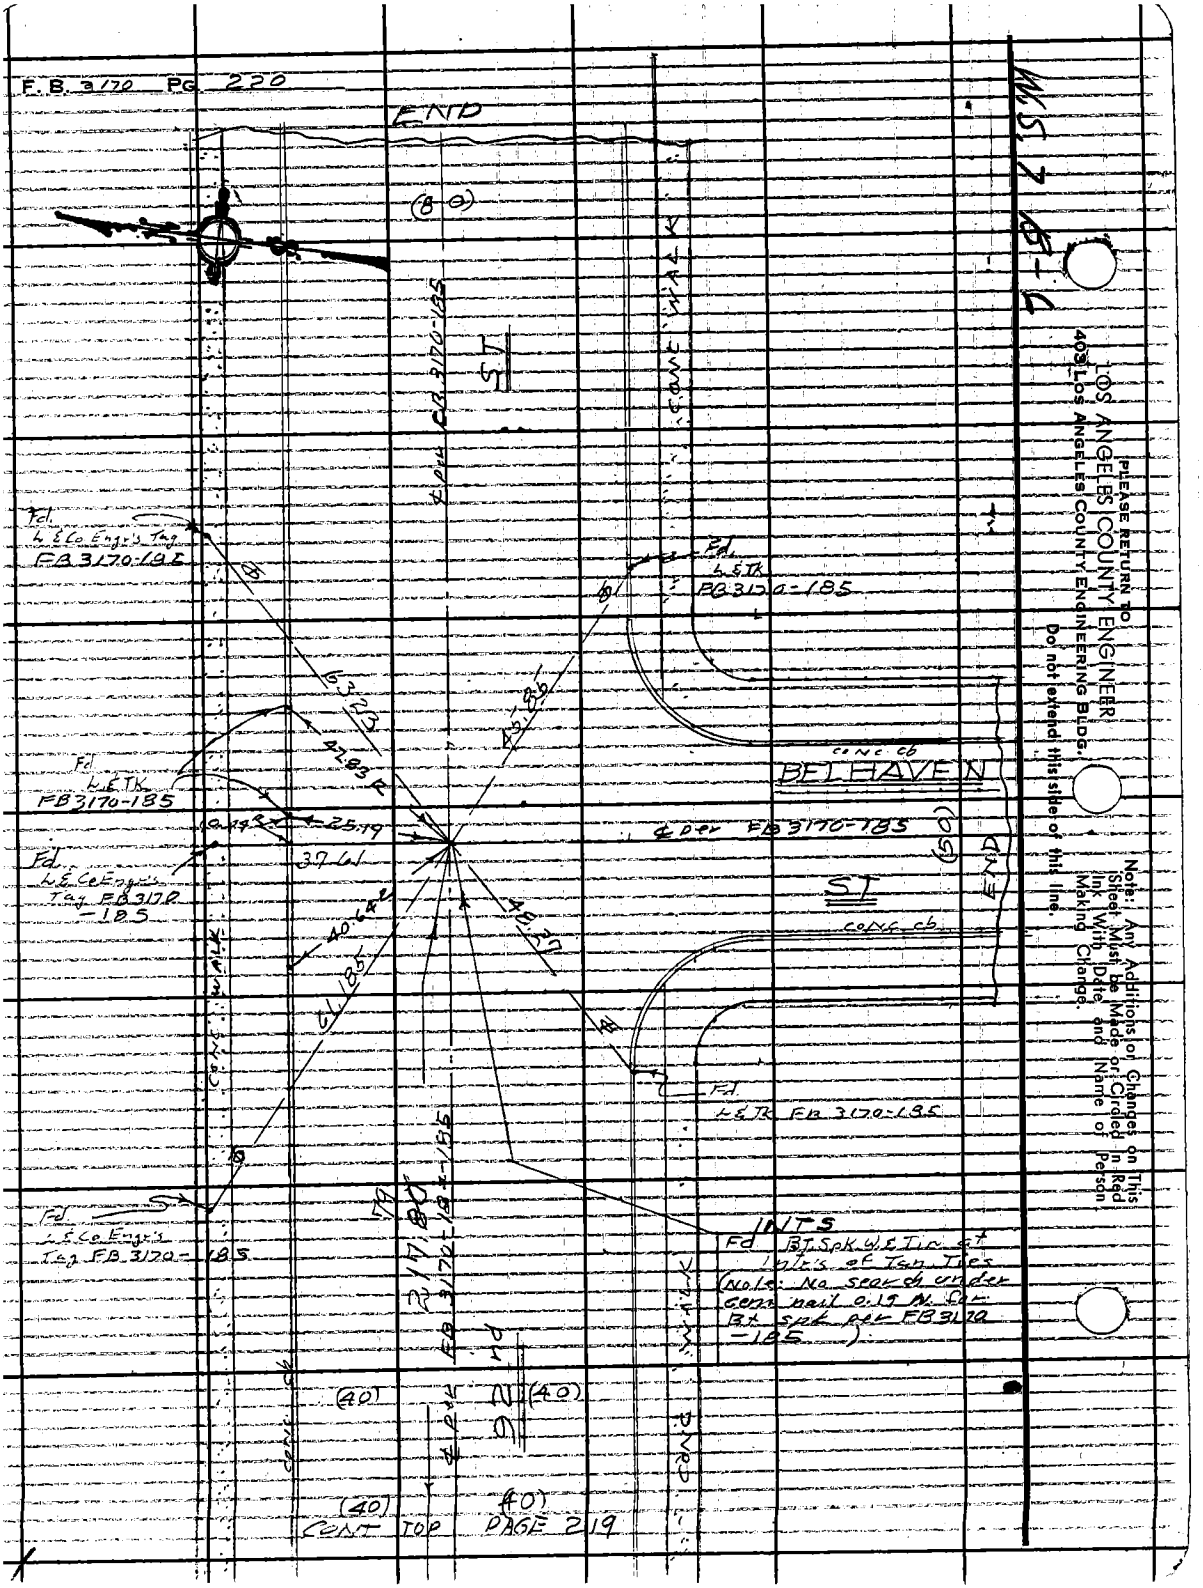
F.B. 3170 PG. 220
END
(80)
℄ per FB 3170-185
ST
CONC WALK
Fd. L & Co Engr's Tag FB 3170-185
Fd. L & TK FB 3170-185
63.23
47.83 R
45.86
Fd. L & TK FB 3170-185
0.14
25.19
37.61
Fd. L & Co Engr's Tag FB 3170-185
40.64
61.185
48.27
CONC WALK
CONC cb
BELHAVEN
℄ per FB 3170-185
(50)
END
ST
CONC cb
Fd. L & TK FB 3170-185
Fd. L & Co Engr's Tag FB 3170-185
217.80
℄ per FB 3170-185
92nd
INTS
Fd. BT. Spk W. & Tin at Int's of Tan Ties
(Note: No search under Conc nail 0.15 N. for Bt spk per FB 3170-185)
(40)
(40)
(40)
(40)
CONT TOP PAGE 219
W.S. 7 B-6
PLEASE RETURN TO
LOS ANGELES COUNTY ENGINEER
403 LOS ANGELES COUNTY ENGINEERING BLDG.
Do not extend this side of this line.
Note: Any Additions or Changes on This Sheet Must be Made or Circled in Red Ink With Date and Name of Person Making Change.