Notes Ck'd by	Survey of
Map No.	JN Tape Std °F
Office Work	Surveyed by
Checked	Notes Date
Date	Indexed

F. B. 3256 PG. 6

	FB 3256	F.B. 3157	
COATES		243 - 146 - 145 - 144 143 - 142 - 141 - 140 131	
STRINGER		242 - 139 - 138 - 137 136 - 135 - 134 - 133 132 - 131	
POMEROY		137 - 147 - 148 - 144	
HARRIS		130 - 129 - 128 - 127 126 - 245	
HERBERT	180 - 178	131 - 130 - 129 - 163 164 - 249 - 250	
MEISNER	181 - 182	164	
BUELAH	183 - 184 - 185 - 186 187 - 188 - 189 - 195 194 - 196 - 213		
DWIGGINS		244 - 97 - 98 - 97 - 96 95 - 94 - 93 - 92 - 91	
SNOW	227 - 226 - 225 - 203 226 - 221 - 222 - 223 224		
DOBINSON	219 - 218 - 213 - 214 215 - 216 - 217		
BONNIE BEACH & RAMBOZ	214 - 213 - 212 - 211 210 - 209 - 208 - 207 206 - 205 - 204 - 203 202 - 201 - 200 - 199 198 - 197	99 - 100 - 101 - 81 80 - 79 - 78 - 77 76 - 247	
MILLER			
Alley S. of City Terrace Pl.	232 - 233 - 234 - 236 237 - 240		
RAMBOZ	228 - 229 - 230 - 231	248 - 71 - 74	3158 99 - 100
Alley S. of Ramboz			
Alley E of Miller	237 - 238 - 239 - 230		
Alley W of Miller	224 - 225 - 228		

Microfilmed Feb. 85

PLEASE RETURN TO LOS ANGELES COUNTY ENGINEER
700 Los Angeles County Engineer Bldg.
...ons or Changes on ...e Made or Circled in Re... Name of Person ... Sheet ... ink ... pencil ... line.

F. B. 3256 PG. 1

Alley w. of Hazard	FB 3256	FB 3157 82-83-246	FB 3158
Woodmere & Alley		246	

PLEASE RETURN TO
LOS ANGELES COUNTY ENGINEER
900 LOS ANGELES COUNTY ENGINEERING BLDG.

Note: Any Additions or Changes on This Sheet Must be Made or Circled in Red Ink With Date and Name of Person Making Change.

Do not extend this side of this line.

F. B. 3256 PG. 1

Alley w. of Hazard	FB 3256	FB 3157 82-83-246	FB 3158
Woodmere & Alley		246	

PLEASE RETURN TO
LOS ANGELES COUNTY ENGINEER
900 LOS ANGELES COUNTY ENGINEERING BLDG.

Note: Any Additions or Changes on This Sheet Must be Made or Circled in Red Ink With Date and Name of Person Making Change.

Do not extend this side of this line.

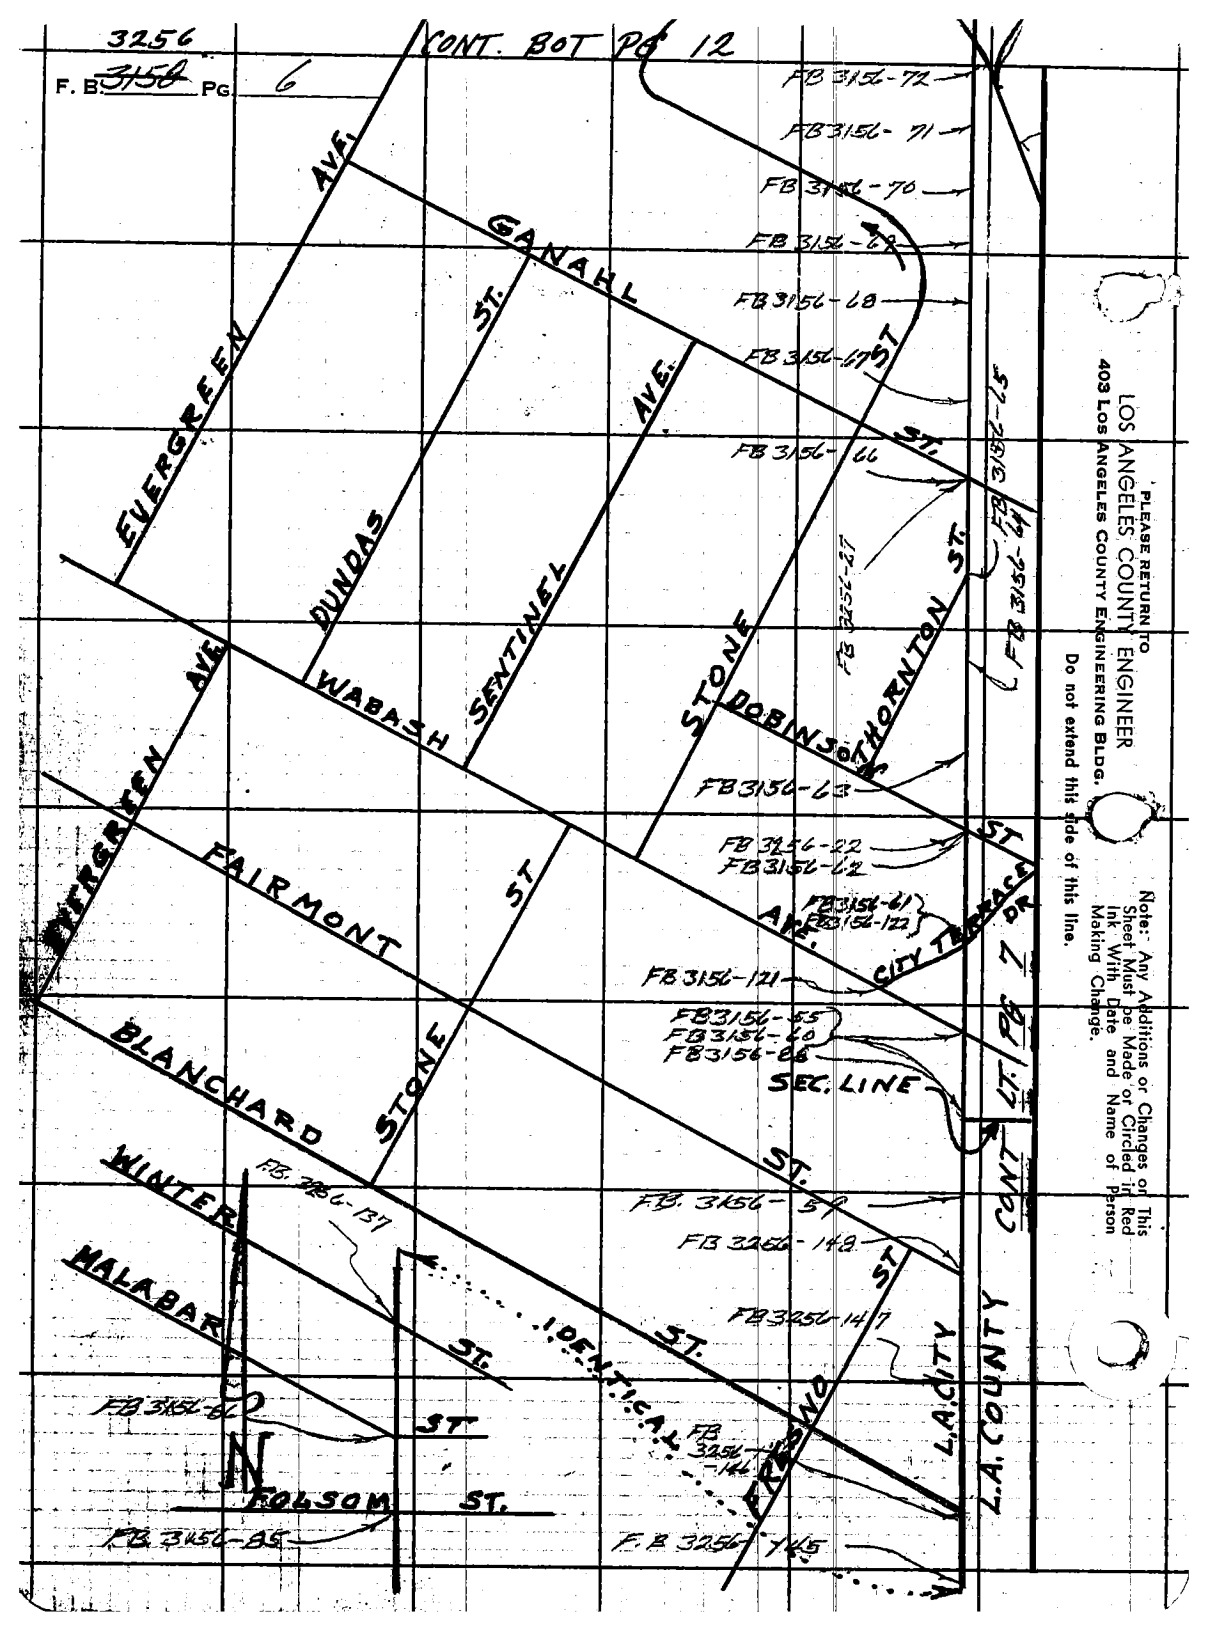
3256
F. B. 3156 Pg. 6
CONT. BOT PG 12
FB 3156-72
FB 3156-71
FB 3156-70
FB 3156-69
FB 3156-68
FB 3156-67
FB 3156-66
FB 3156-65
FB 3156-64
FB 3156-63
FB 3156-62
FB 3156-61
FB 3156-122
FB 3156-121
FB 3156-55
FB 3156-20
FB 3156-66
FB 3156-54
FB 3256-149
FB 3256-147
FB 3256-145
FB 3256-144
FB 3256-137
FB 3156-82
FB 3156-85
EVERGREEN AVE.
DUNDAS ST.
GANAHL ST.
SENTINEL AVE.
WABASH AVE.
STONE ST.
THORNTON ST.
FAIRMONT ST.
CITY TERRACE DR.
BLANCHARD ST.
WINTER ST.
MALABAR ST.
FOLSOM ST.
IDENTICAL
FRESNO ST.
SEC. LINE
L.A. CITY
L.A. COUNTY
PLEASE RETURN TO
LOS ANGELES COUNTY ENGINEER
403 LOS ANGELES COUNTY ENGINEERING BLDG.
Do not extend this side of this line.
Note: Any Additions or Changes or This Sheet Must be Made or Circled in Red Ink With Date and Name of Person Making Change.

Notes Ck'd by	Survey of ALAMITOS BAY
Map No.	JN 0882.40 Tape Std °F
Office Work	Surveyed by G.E. DREIER
Checked	Notes G.E. DREIER Date 5-65
Date	Indexed

F. B. 3249 PG. 7

RECOVERY & REFERENCE NEW & OLD STATIONS

STATION			PAGE NO.
S.L.C #1	℄ INT.	7th ST. & ULTIMO AVE.	9
S.L.C. #2	℄ INT.	7th ST. & SANTIAGO AVE	10
S.L.C. #3	℄ INT.	SANTIAGO AVE & COLORADO ST.	11
S.L.C. #4	℄ INT.	APPIAN WAY & MONROVIA AVE	12
S.L.C. #5	℄ INT.	APPIAN WAY & CLAREMONT AVE.	13
S.L.C. #6		2ND ST. & APPIAN WAY	14
S.L.C. #7	℄ ANGLE PT.	2ND ST. & RAVENNA DR.	15
S.L.C. #8	℄ INT.	2ND ST. & BAYSHORE AVE	16
S.L.C. #9	℄ PROD.	2ND ST. & LIVINGSTON DR.	17
L.B.H-3A	℄ INT.	XIMENO AVE & 7th ST.	20
L.B. J-3A		TOP LONG BEACH VETERANS HOSPITAL	19
L.B. J-3B		7th ST. & BELLFLOWER	18
L.B. H-5B		BENNETT AVE & XIMENO AVE.	21
L.B. K-7 "KNIGHT"		TOP DEPT. W.&P. SEAL BEACH PLANT	22
L.B. G-5B		1ST ST. & XIMENO AVE.	23
L.B. G-6 (CITY L.B)		OCEAN BLVD. & XIMENO AVE	24
L.B. I-6B		OCEAN BLVD. & BAYSHORE AVE	26
L.B. I-6~~B~~C		1ST ST. & BAYSHORE AVE.	25
L.B. I-6A		OCEAN BLVD.	39
L.B. I-7A		OCEAN BLVD & 64th PL.	40
L.B. I-7		64th PL. N. OF OCEAN BLVD.	40

ANGLES & DIRECTIONS MEASURED IN F.B.G. 1109-1 TO 47

F.B.G 1094-19

Noted on Index Card
Plotted on U.S. Quad. Sht.
Plotted on Thom. Bros. Map
Sketch on Rec. Data Card

Note: Any Additions or Changes on This Sheet Must Be Made or Circled in Red Ink With Date and Name of Person Making Change.

PLEASE RETURN TO
LOS ANGELES COUNTY ENGINEER
403 LOS ANGELES COUNTY ENGINEERING BLDG.

Do not extend this side of this line.

76F3095 CE #310 6-63

RETURN TO
LOS ANGELES COUNTY ENGINEER
900 LOS ANGELES COUNTY ENGINEERING BLDG.

Note: Any Additions or Changes on This Sheet Must be Made or Circled in Red Ink With Date and Name of Person Making Change.

Do not extend notes this side of this line.

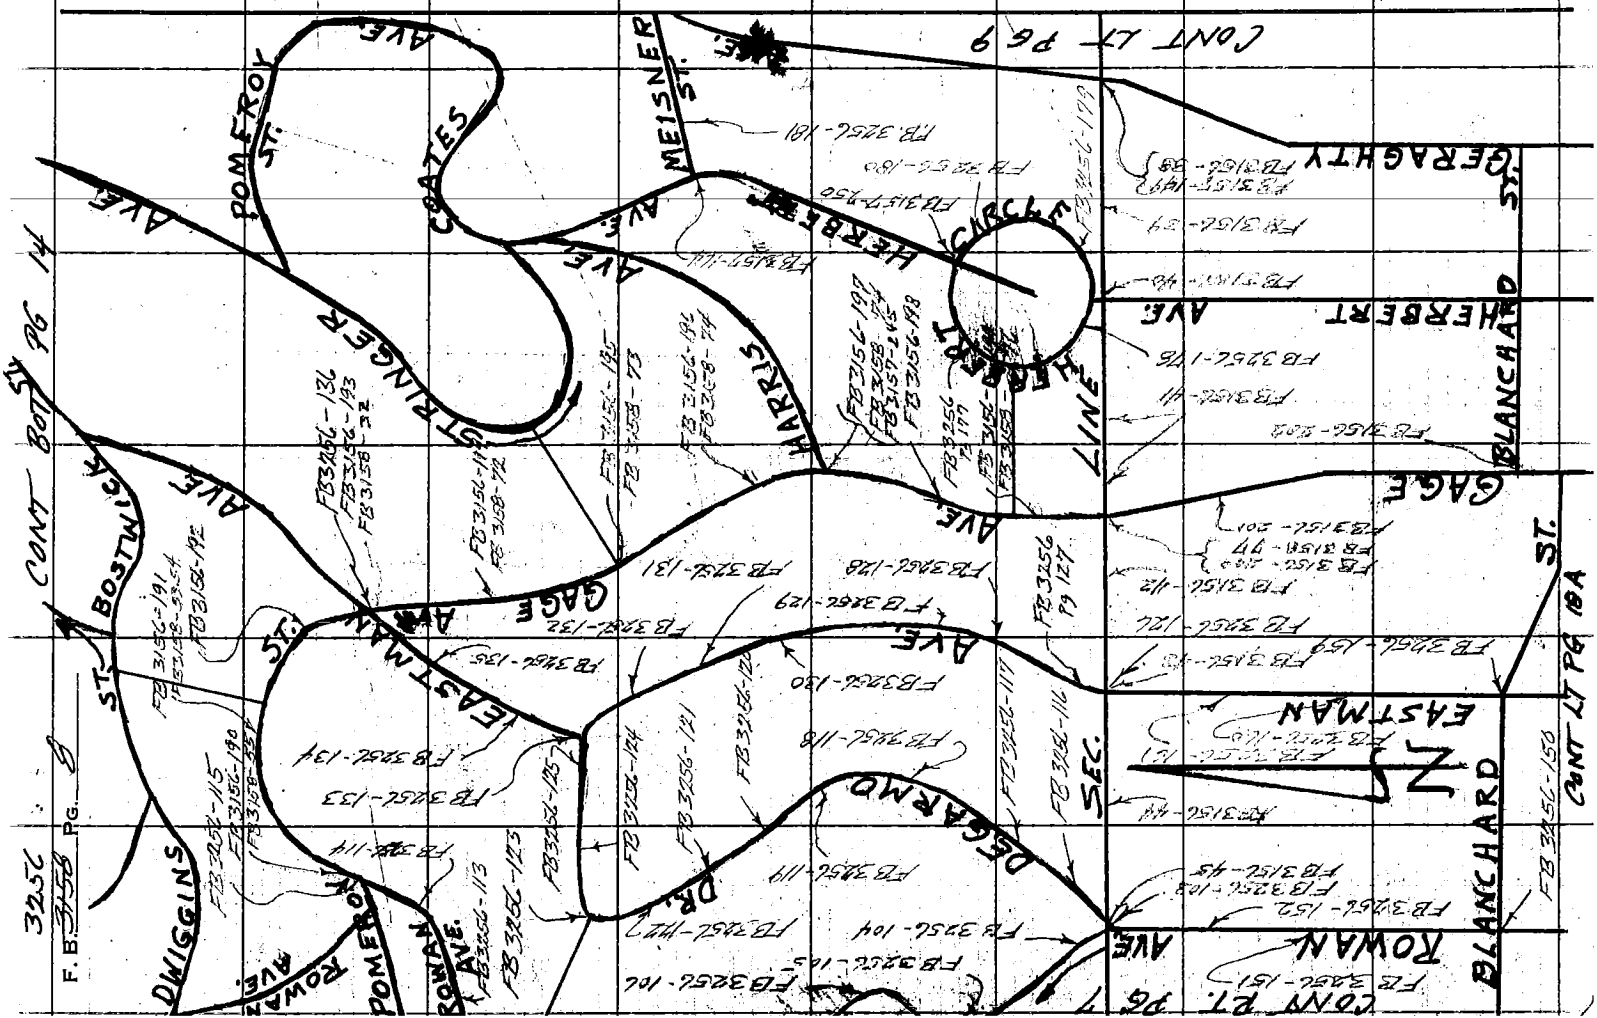

76F3095 C.E. #910 6-62

PLEASE RETURN TO
LOS ANGELES COUNTY ENGINEER
403 LOS ANGELES COUNTY ENGINEERING BLDG.

Note: Any Additions or Changes on This Sheet Must be Made or Circled in Red Ink With Date and Name of Person Making Change.

Do not extend this side of this line.

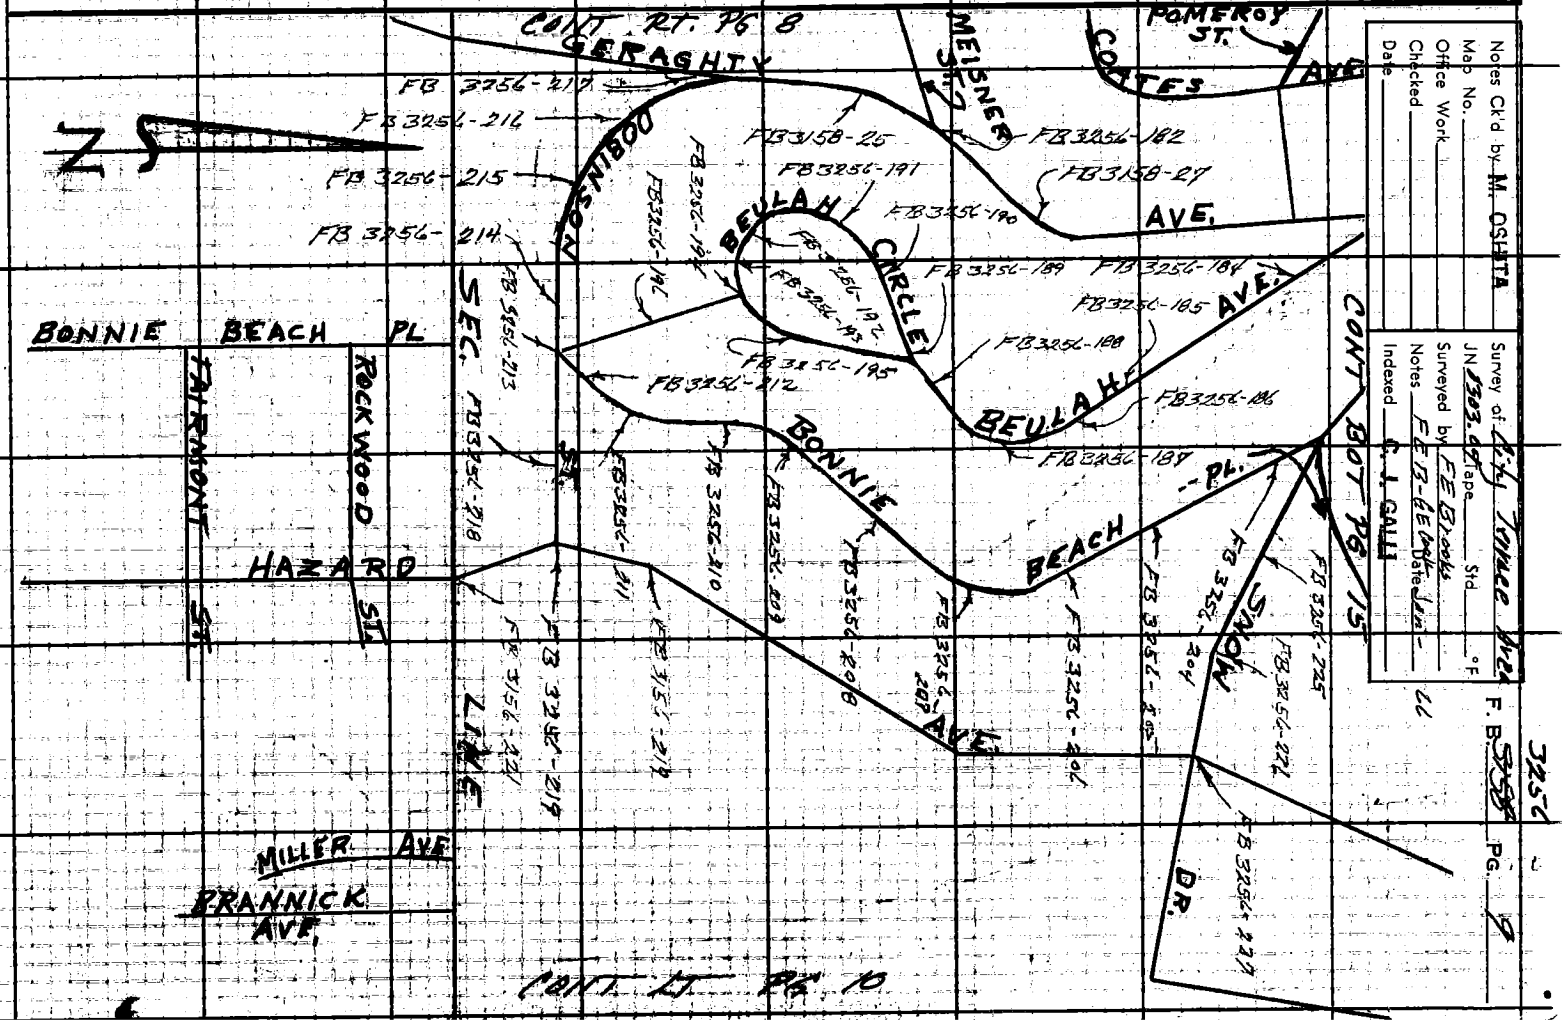

Notes Ck'd by M. OSHITA
Map No.
Office Work
Checked
Date

JN 1303.09 Tape Std °F.
Surveyed by F.E. Brooks
Notes F.E.B. Date Jan
Indexed C. J. GALLI

F. B. 3256 PG. 9

3256

PLEASE RETURN TO
LOS ANGELES COUNTY ENGINEER
403 LOS ANGELES COUNTY ENGINEERING BLDG.

Note: Any Additions or Changes on This Sheet Must Be Made or Circled in Red Ink With Date and Name of Person Making Change.

Do not extend this side of this line.

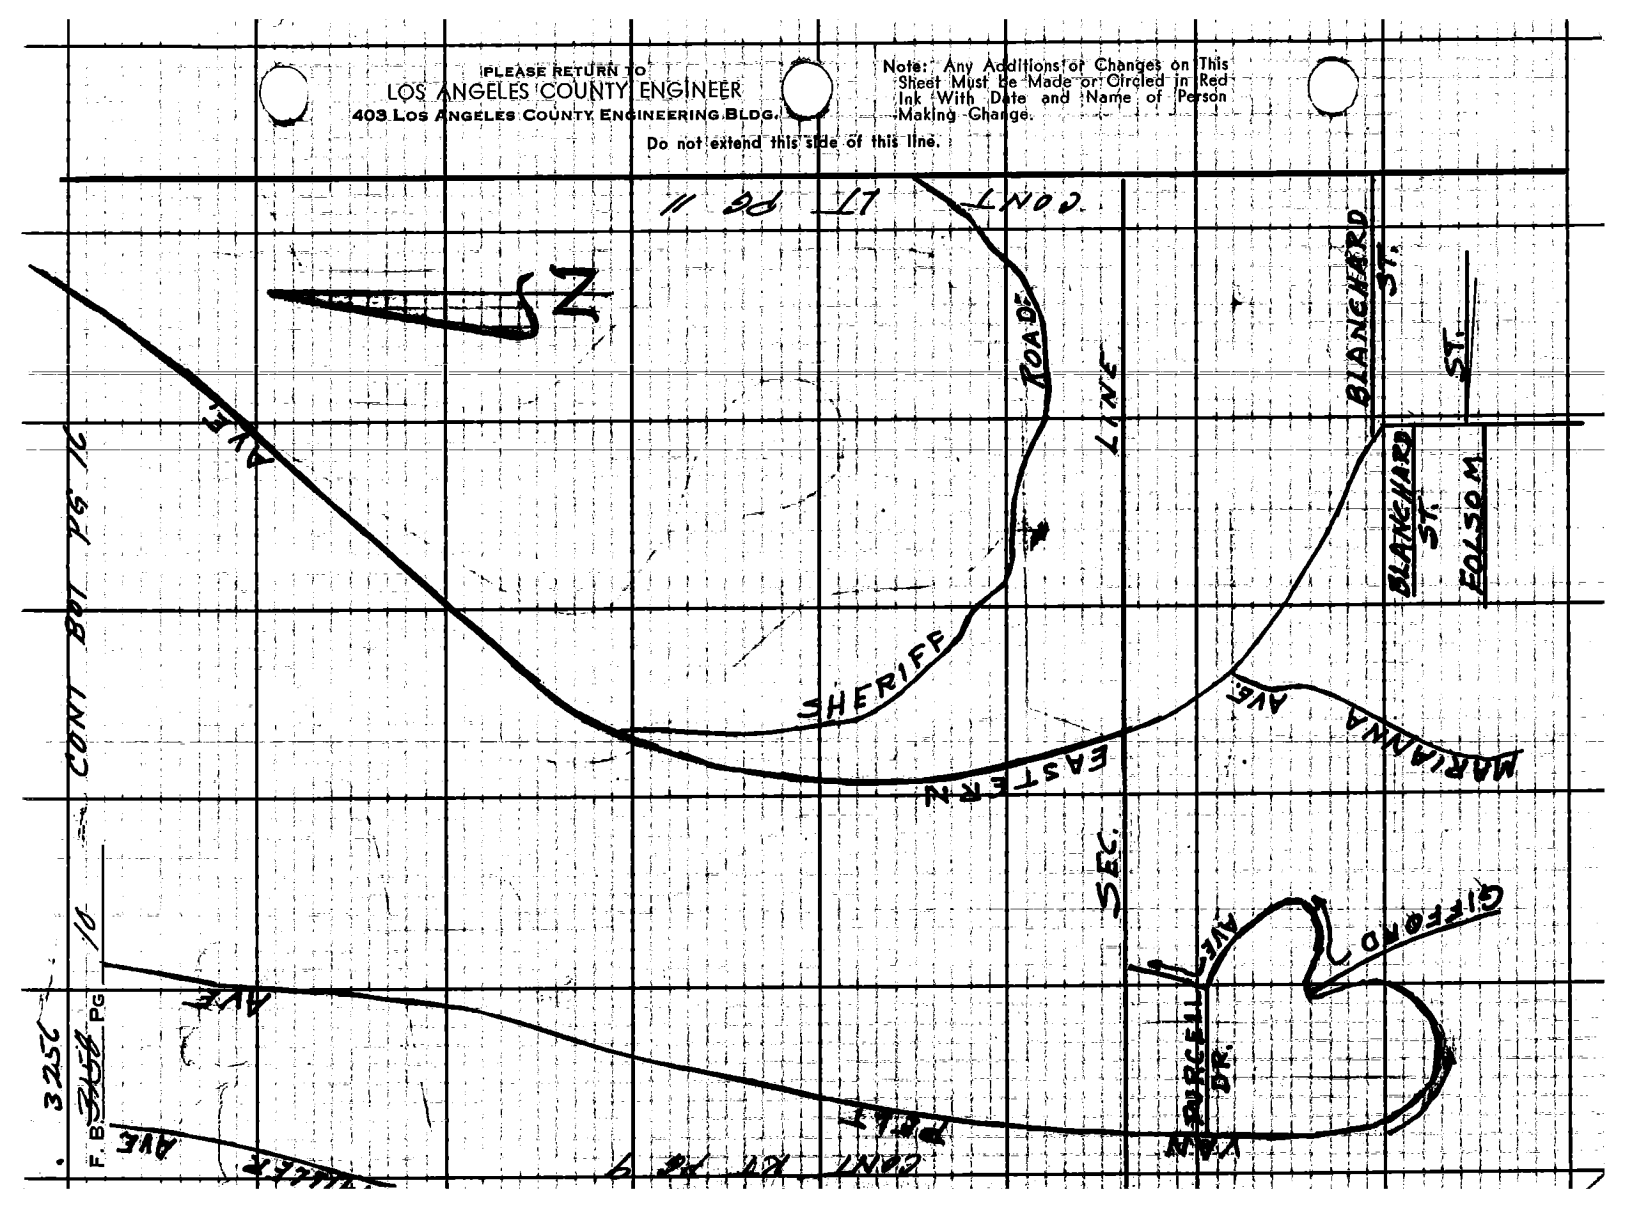

3256

Notes Ck'd by M. OSHITA
Map No.
Office Work
Checked
Date

Survey of City Terrace Area
JN 0303-04 Tape Std °F
Surveyed by F.E. Brooks
Notes F.E.B.-G.E. Cook Date 5-61 CC
Indexed C. J. GALLI

CONT BOT PG 17

CONT RT PG 10

SHERIFF ROAD

SEC. LINE

SEC. LINE

BLANCHARD ST.

N

Note: Any Additions or Changes on This Sheet Must be Made or Circled in Red Ink With Date and Name of Person Making Change.

Do not extend this side of this line.

PLEASE RETURN TO
LOS ANGELES COUNTY ENGINEER
403 Los Angeles County Engineering Bldg.

76F3095 CE #310 6-62

3256

F. B. 3156 PG. 12

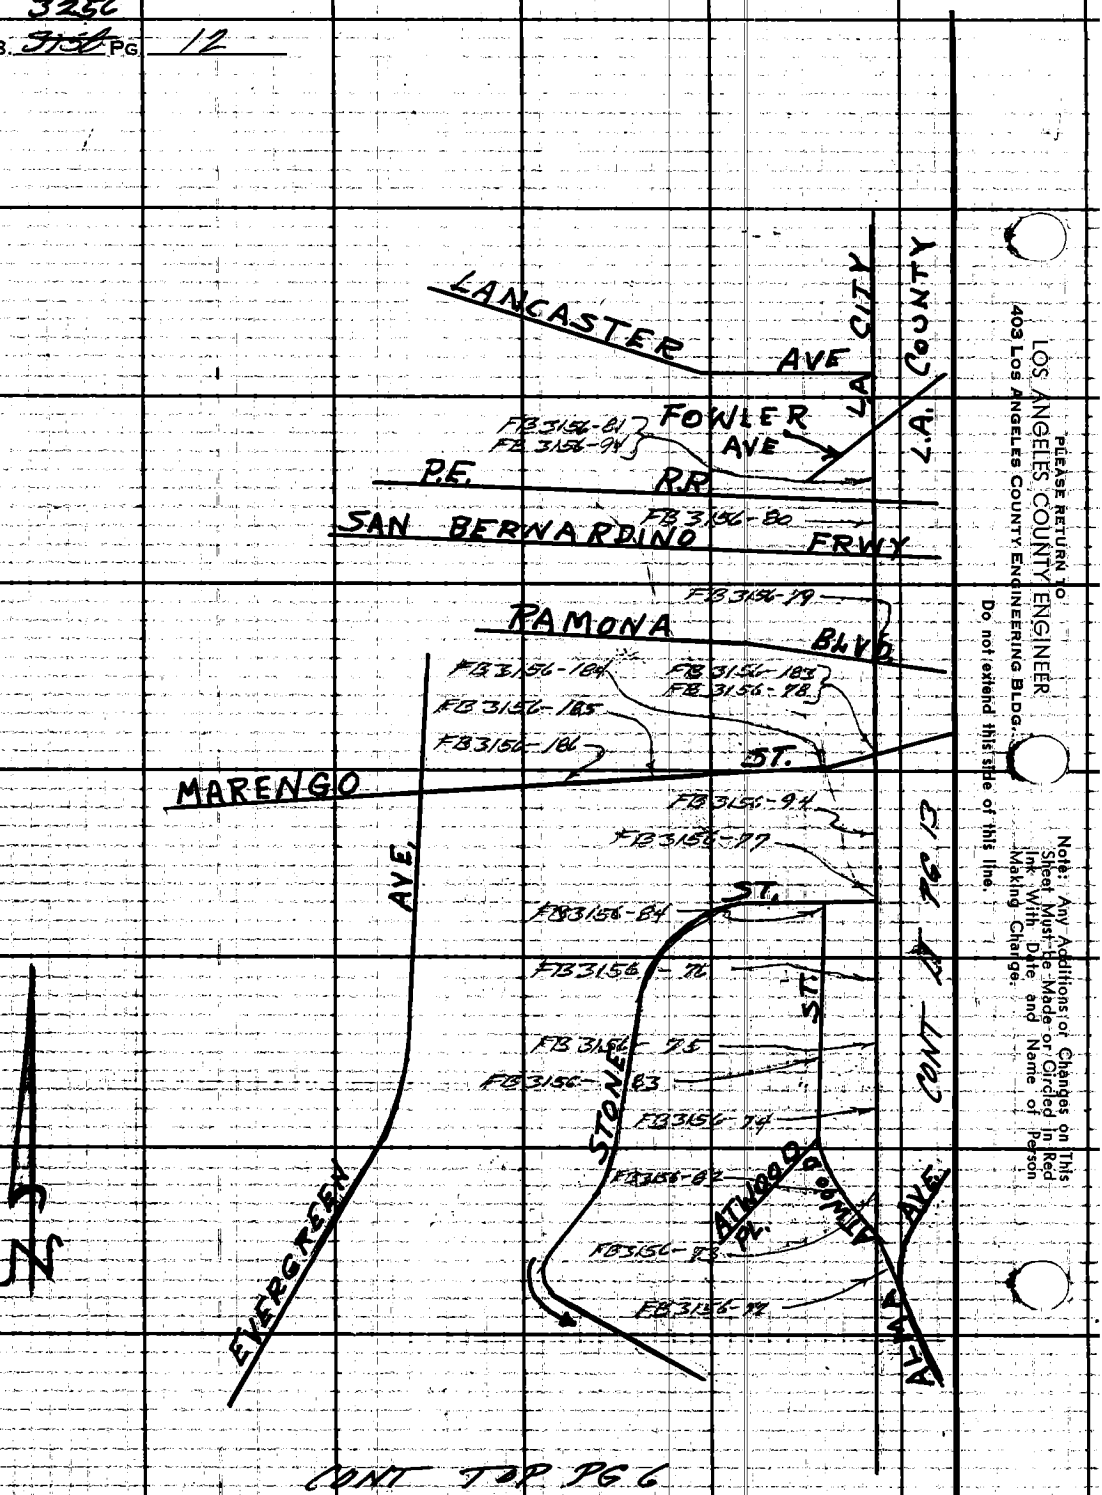

"PLEASE RETURN TO"
LOS ANGELES COUNTY ENGINEER
403 LOS ANGELES COUNTY ENGINEERING BLDG.

Do not extend this title of this line.

Note: Any Additions or Changes on This Sheet Must Be Made or Circled in Red Ink With Date and Name of Person Making Change.

3256

Notes Ck'd by M. OSHITA	Survey of City Terrace Area	F. B. ~~3158~~	Pg. 13
Map No.	JN 6302 64 Tape Std °F		
Office Work	Surveyed by FE Brooks		
Checked	Notes FE13 - GE Mobrate Sec		
Date	Indexed C. J. GALLI		

Note: Any Additions or Changes on This Sheet Must be Made or Circled in Red Ink With Date and Name of Person Making Change.

Do not extend this line.

PLEASE RETURN TO
LOS ANGELES COUNTY ENGINEER
403 Los Angeles County Engineering Bldg.

76F309S CE #310 6-62

FOWLER AVE
WHITESIDE AVE
P.E. R.R.
SAN BERNARDINO FRWY.
RAMONA BLVD.
MARENGO ST
CONT FROM PG 12
CONT TO PG 17
CONT FROM PG 17
AVE
CIRCLE
DRIVE
PLACE
DICKSON
RAMADA DR
FB 3256-91
FB 3256-90
3256

F. B. ~~3158~~ PG. 14

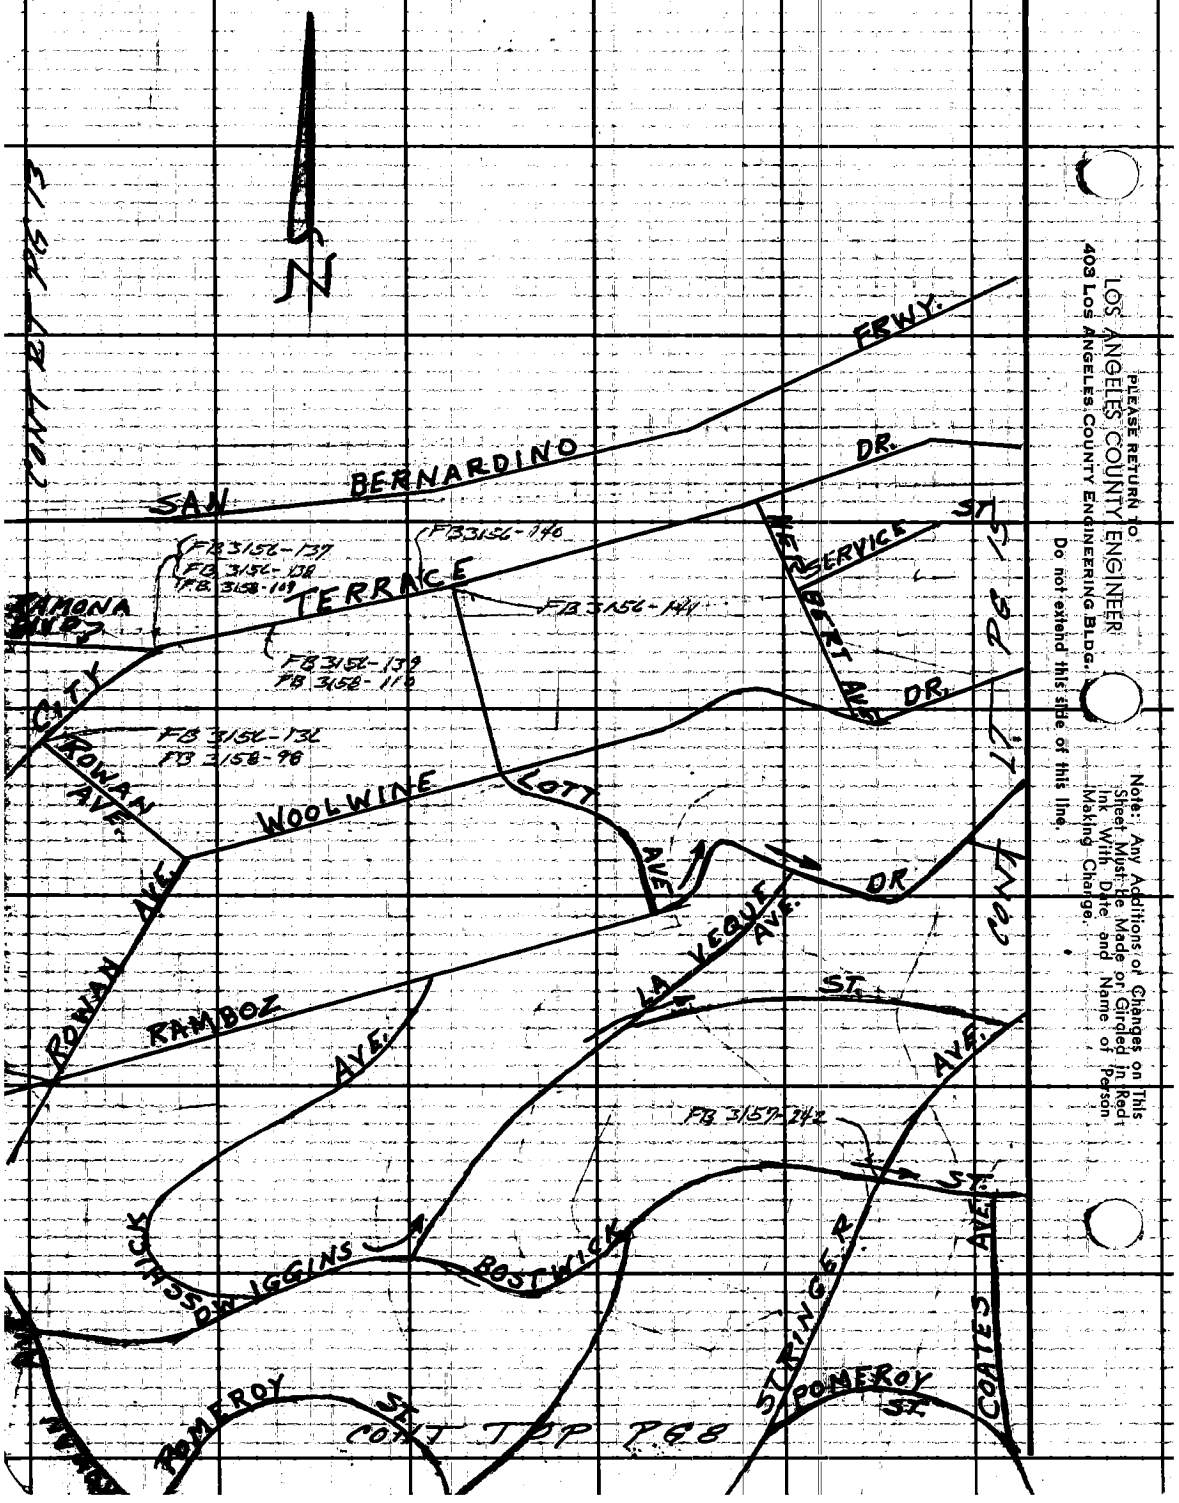

LOS ANGELES COUNTY ENGINEER
403 Los Angeles County Engineering Bldg.

PLEASE RETURN TO

Do not extend this side of this line.

Note: Any Additions or Changes on This Sheet Must be Made or Circled in Red Ink With Date and Name of Person Making Change.

76F309S S&E #247 11-58

PLEASE RETURN TO
LOS ANGELES COUNTY ENGINEER
700 LOS ANGELES COUNTY ENGINEERING BLDG.

Note: Any Additions or Changes on This Sheet Must be Made or Circled in Red Ink With Date and Name of Person Making Change.

Do not extend this side of this line.

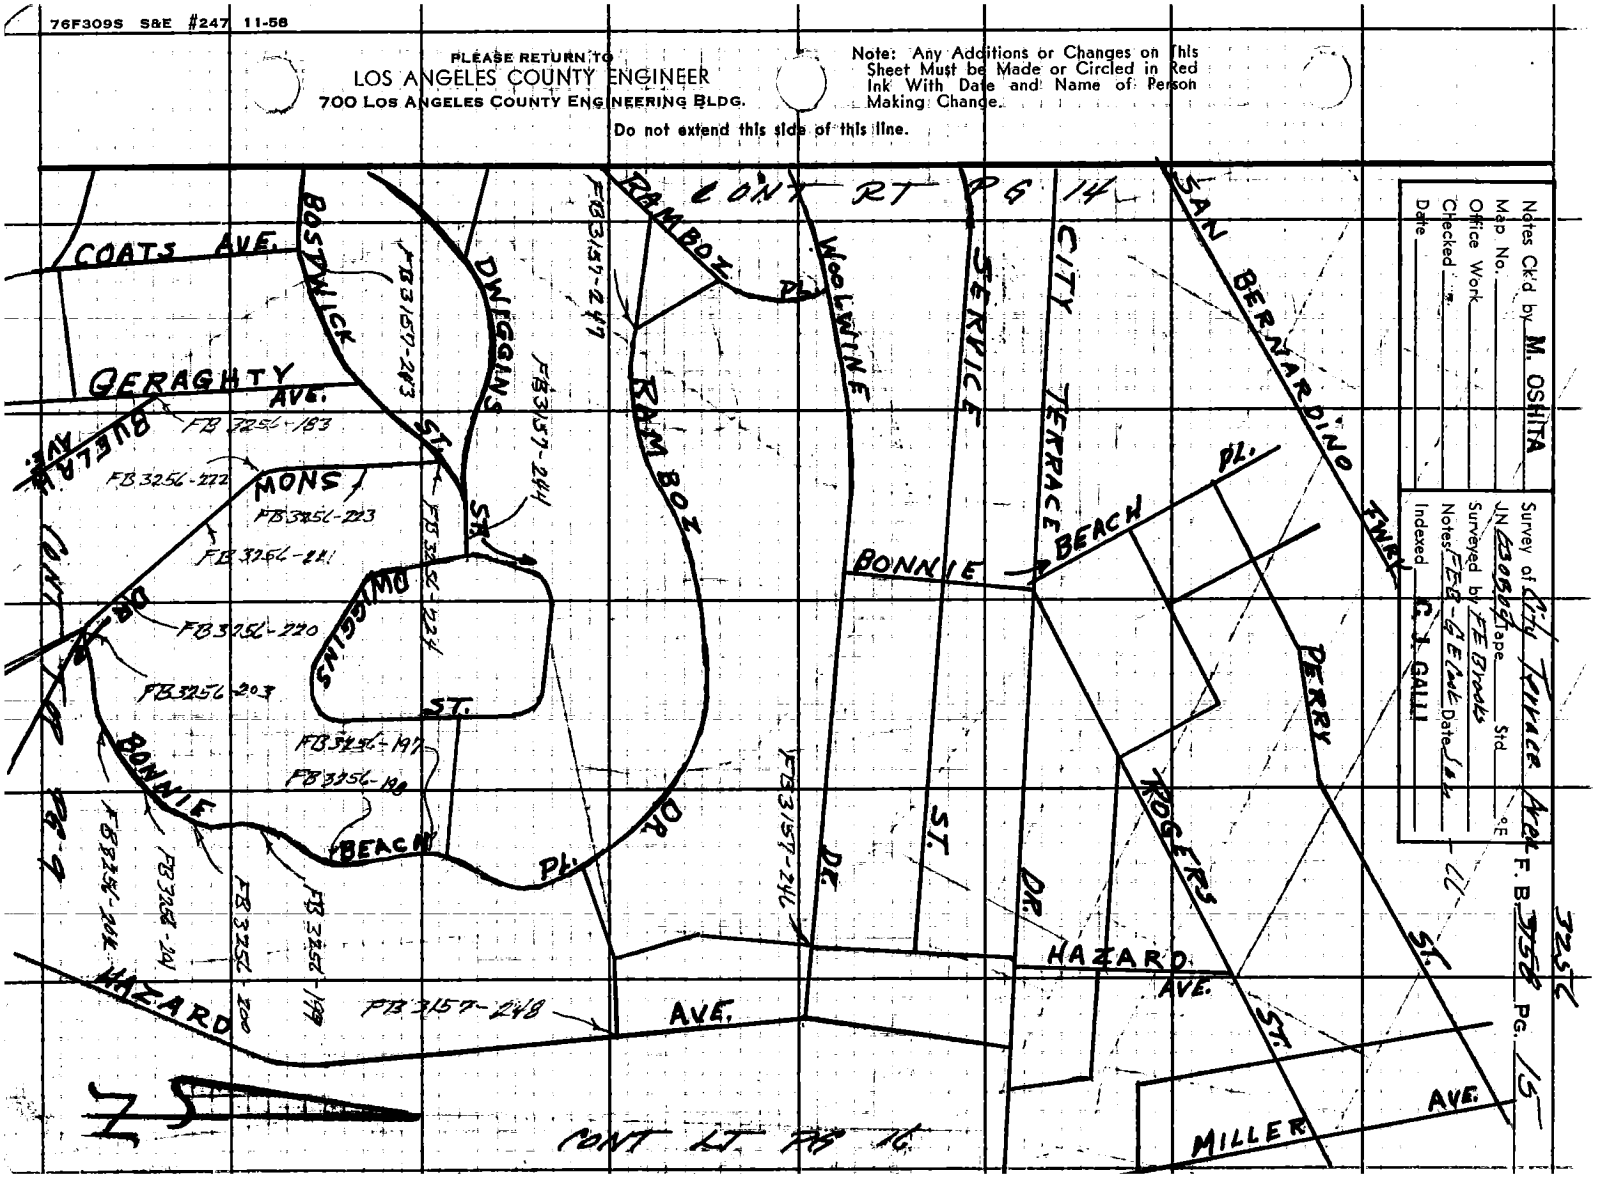

Notes Ck'd by M. OSHITA
Map No. _____
Office Work _____
Checked _____
Date _____

Survey of City Terrace Area
JN 23057 Tape _____ Std. _____ °E
Surveyed by FE Brooks
Notes FEB-GE Cook Date Jan
Indexed C. J. GALLI

F. B. 3256 PG. 15

PLEASE RETURN TO
LOS ANGELES COUNTY ENGINEER
700 LOS ANGELES COUNTY ENGINEERING BLDG.

Note: Any Additions or Changes on This Sheet Must be Made or Circled in Red Ink With Date and Name of Person Making Change.

Do not extend this side of this line.

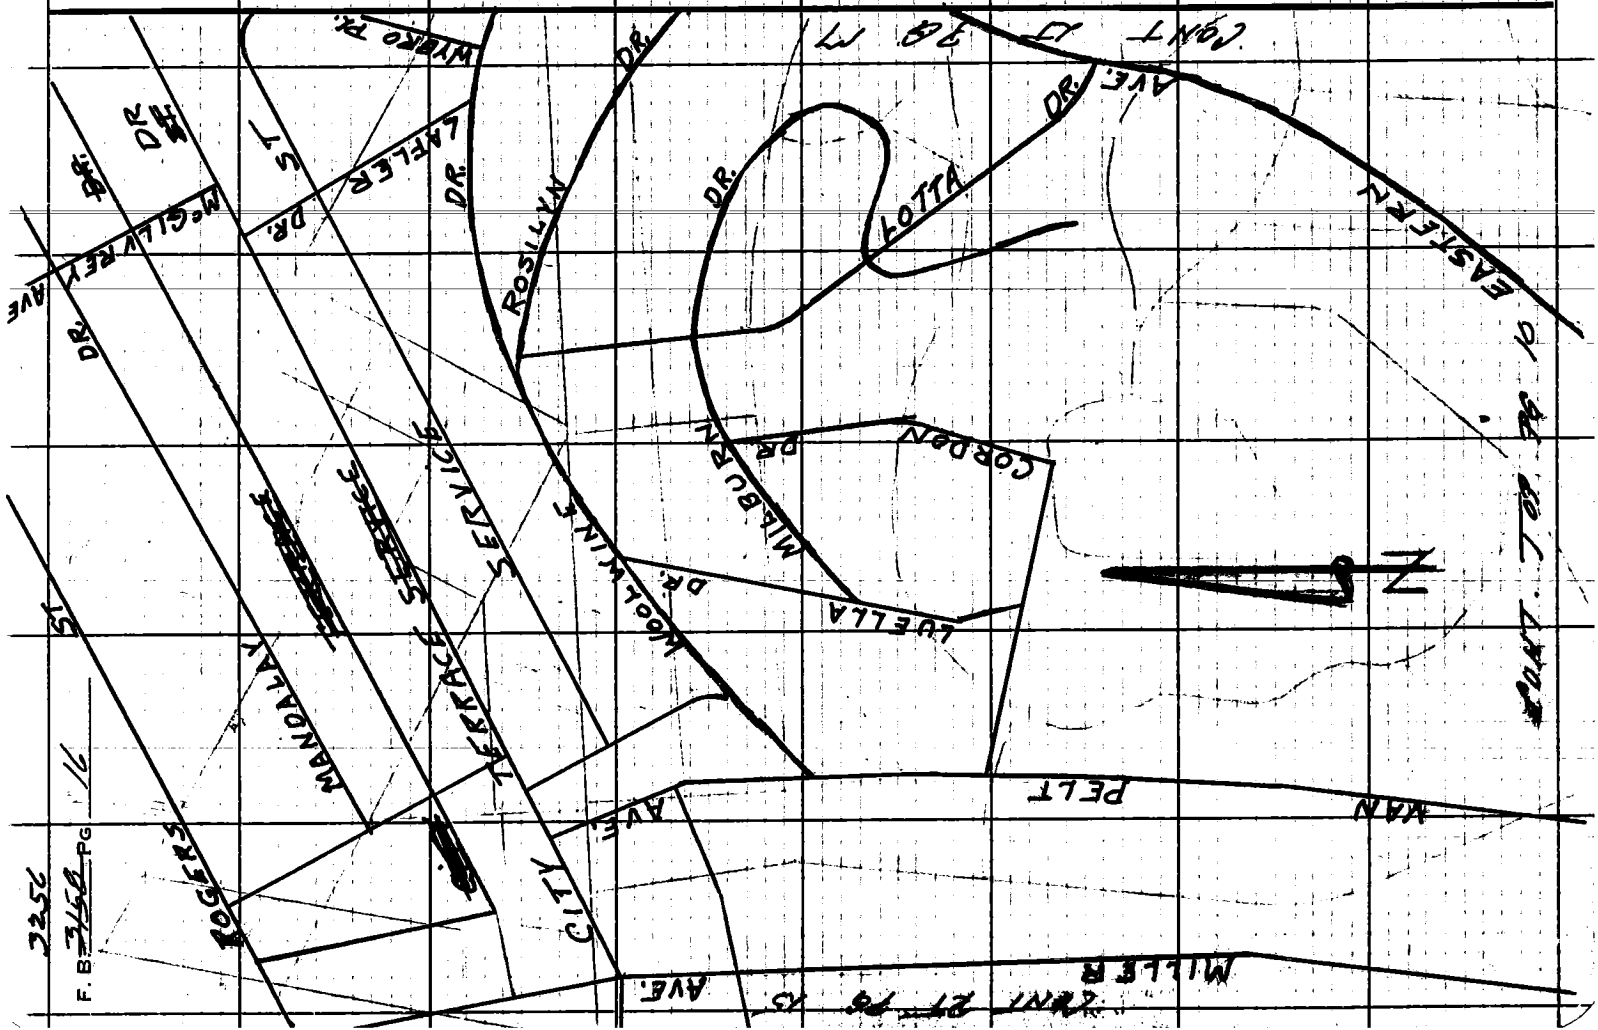

325-C

Notes Ck'd by M. OSHITA
Map No.
Office Work
Checked
Date

Survey of City Terrace Area
JN 0303.04 Tape Std °F
Surveyed by F.E. Brooks
Notes E.E.B - G.E. Book Date Jan -
Indexed C. J. CALL

F. B. 458 PG. 17

CONT RT PG 18

SERVICE ST.
WOOLWINE PL.
AVE.
COMLY ST.
WOOLWINE DR.
ROSILYN DR.
CONT RT PG 16
EASTERN
HAUCH ST.
HELLEN

Note: Any Additions or Changes on this Sheet Must be Made or Circled in Red Ink With Date and Name of Person Making Change.

Do not extend this side of this line.

PLEASE RETURN TO
LOS ANGELES COUNTY ENGINEER
700 Los Angeles County Engineering Bldg.

CONT TOP PG 11

76F3095 S&E #247 11-58

3256

F. B. 3158 Pg. 18

PLEASE RETURN TO
LOS ANGELES COUNTY ENGINEER
700 Los Angeles County Engineering Bldg.

Do not extend this side of this line.

Note: Any Additions or Changes on This Sheet Must be Made or Circled in Red Ink With Date and Name of Person Making Change.

Notes Ck'd by M. OSHITA
Map No.
Office Work
Checked
Date

Survey of CITY TERRACE AREA
JN 0303. of Tape Std °F
Surveyed by F E Brooks
Notes F.B. Date Jan - 64
Indexed C. J. GALLI

F. B. 3256 PG. 18A

FB 3256-149

FB 3256-144

ROWAN AVE.

CONT BOT PG 8

FB 3256-143

TOWNSEND AVE.

FB 3256-174

FB 3256-142

ST.

DITMAN ST.

FB 3256-141

FB 3256-171

HICKS AVE

FB 3256-140

FB 3256-167

WINTER

FB 3256-139

FB 3256-97

ALMA ST.

FB 3256-136

CONT BOT PG 7

FB 3256-145

FB 3256-137

L. A. COUNTY

L. A. CITY

Note: Any Additions or Changes on this Sheet Must be Made or Circled in Red Ink With Date and Name of Person Making Change.

Do not extend this side of this line.

PLEASE RETURN TO
LOS ANGELES COUNTY ENGINEER
403 Los Angeles County Engineering Bldg.

76F3095 CE # 310 3-61

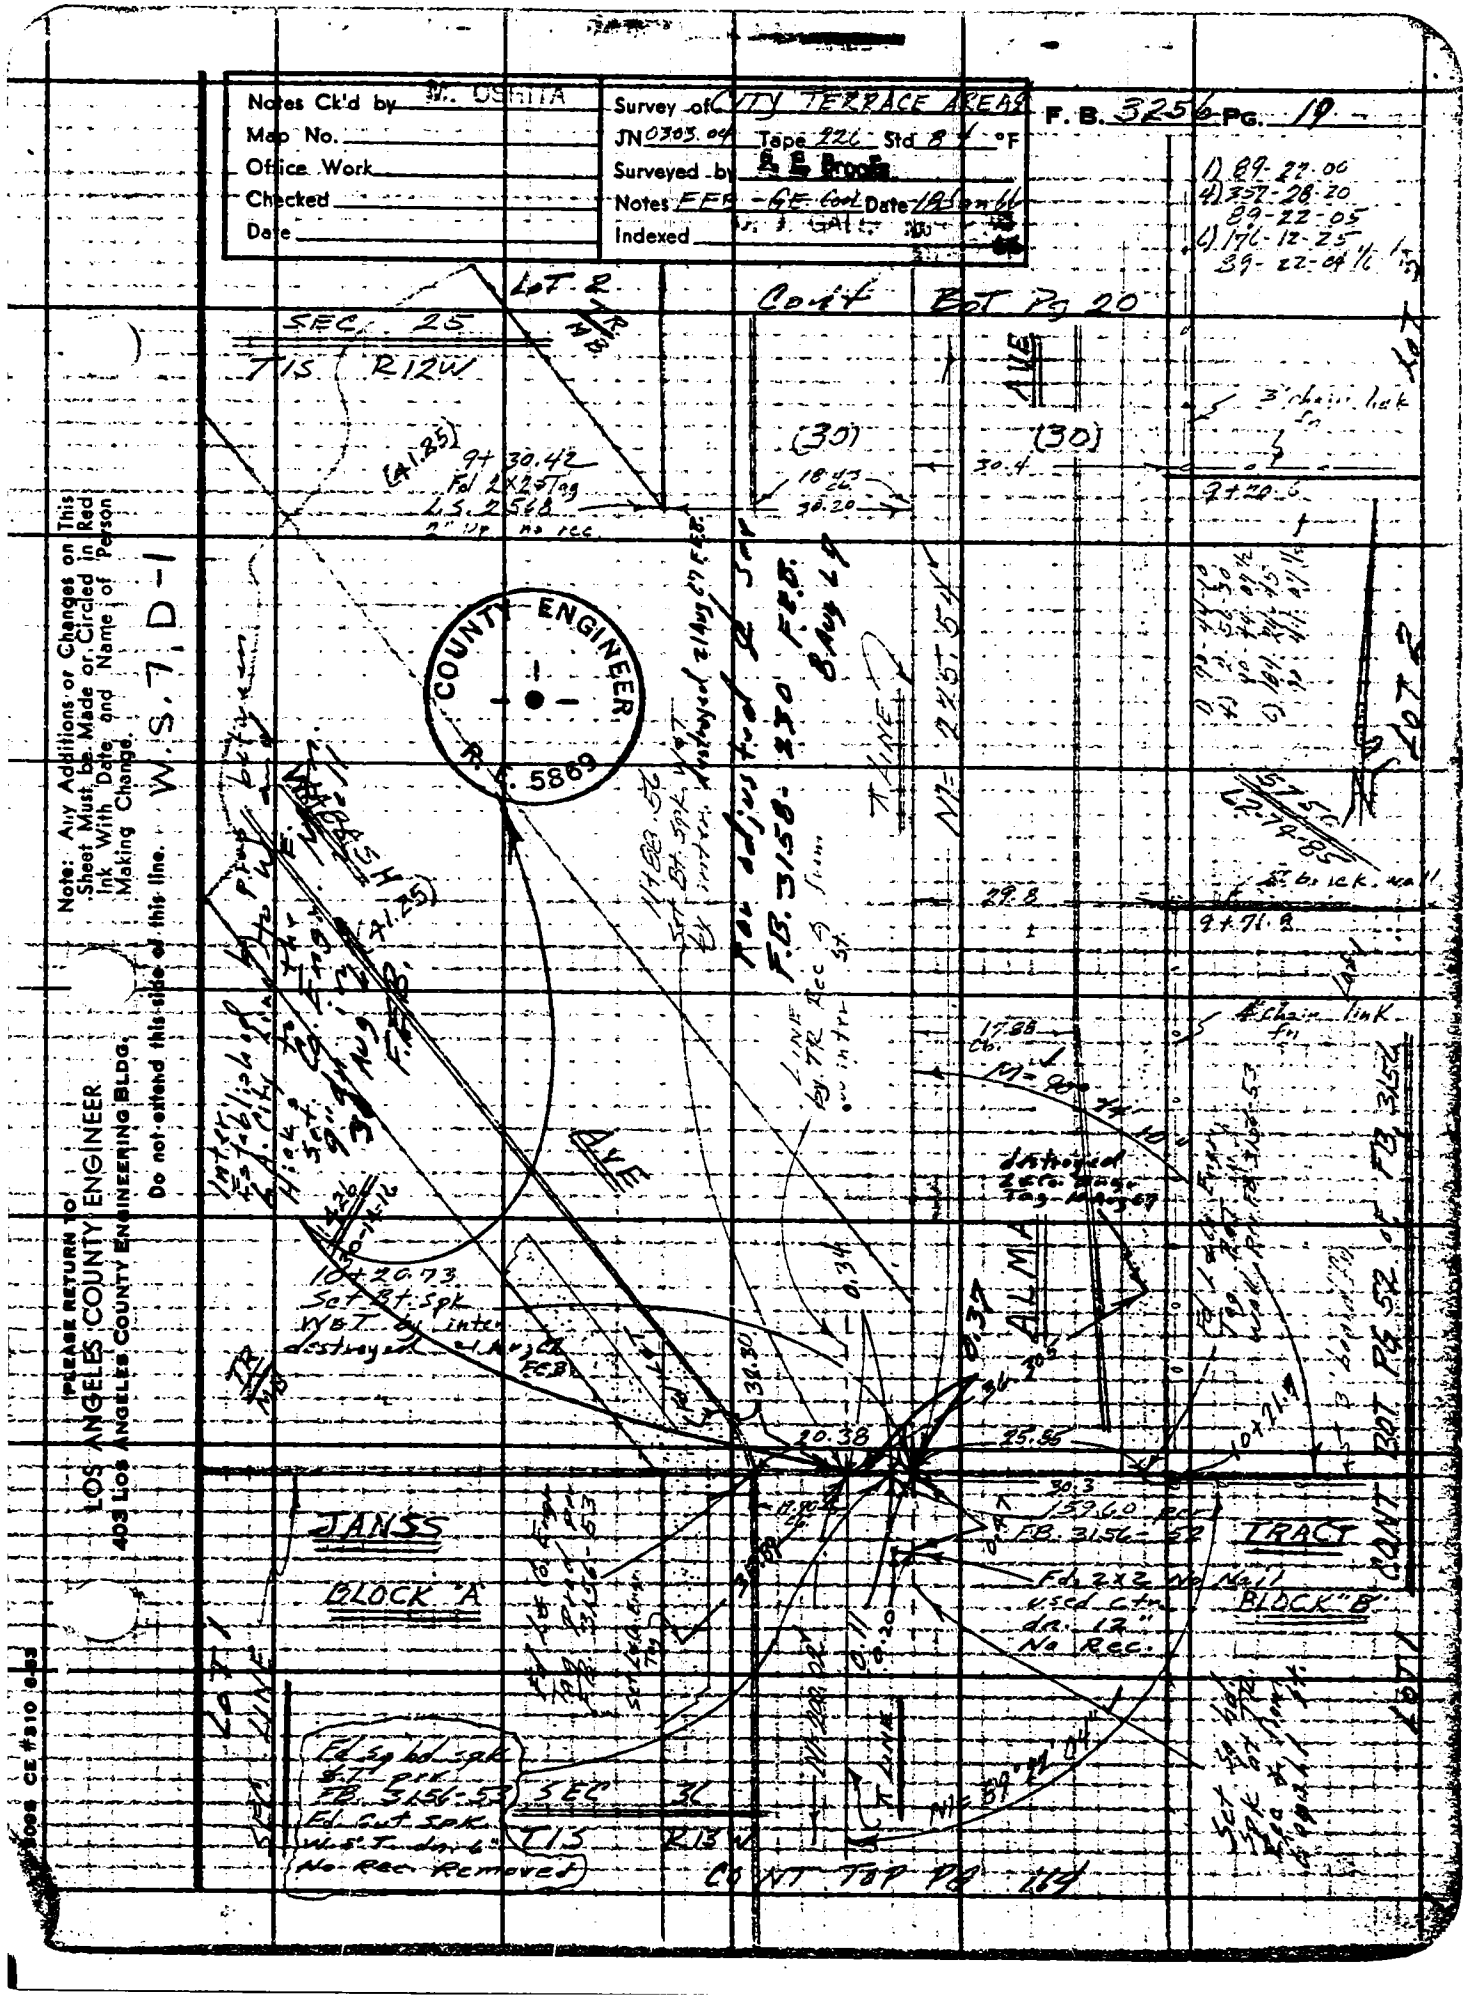
Notes Ck'd by
Map No.
Office Work
Checked
Date
Survey of CITY TERRACE AREAS
JN 0305.04 Tape 226 Std 8 °F
Surveyed by
Notes
Indexed
F. B. 325 Pg. 19
Cont'd Bot Pg 20
SEC. 25
T1S R12W
LOT 2
M.B.
AVE
(30)
3' chain link fn
Lot 2
Lot 1
COUNTY ENGINEER
R.S. 5869
W.S. 7, D-1
Note: Any Additions or Changes on This Sheet Must be Made or Circled in Red Ink With Date and Name of Person Making Change.
Do not extend this side of this line.
PLEASE RETURN TO
LOS ANGELES COUNTY ENGINEER
403 Los Angeles County Engineering Bldg.
F.B. 3158 - 330' F.B.
Bdy Lg
Int. Sec. Cor.
Set Bt. Spk. W'ly
Int. Westerly 2 Bldgs 0.7' F.B.

PLEASE RETURN TO
LOS ANGELES COUNTY ENGINEER
403 LOS ANGELES COUNTY ENGINEERING BLDG.

Do not extend this side of this line.

Note: Any Additions or Changes on This Sheet Must be Made or Circled in Red Ink With Date and Name of Person Making Change.

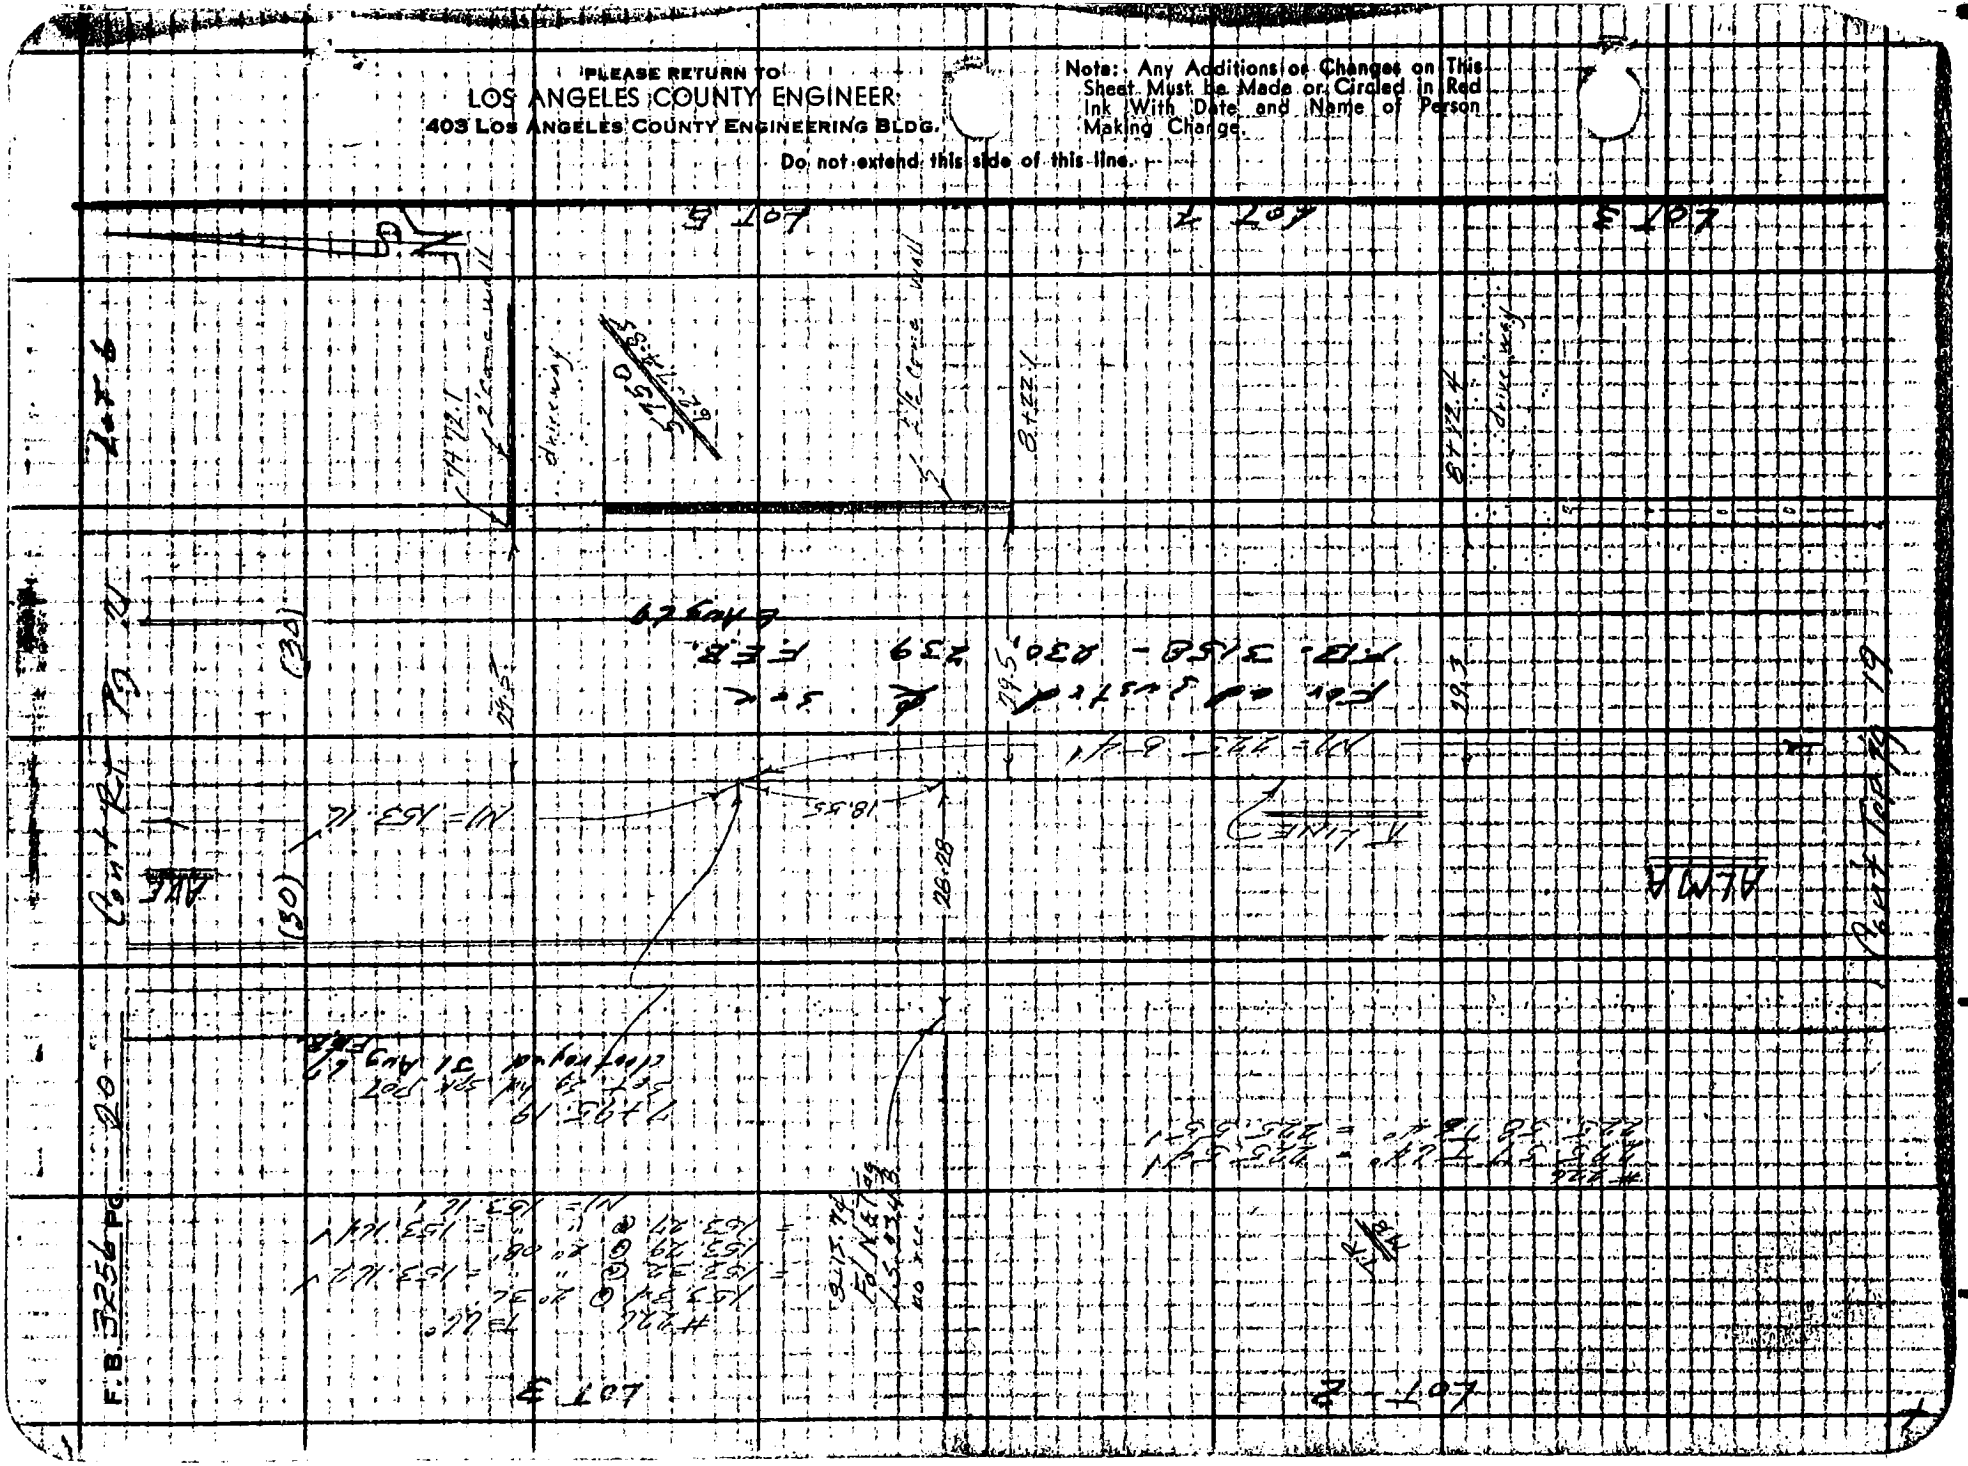

PLEASE RETURN TO
LOS ANGELES COUNTY ENGINEER
403 LOS ANGELES COUNTY ENGINEERING BLDG.

Note: Any Additions or Changes on This Sheet Must be Made or Circled in Red Ink With Date and Name of Person Making Change.

Do not extend this side of this line.

W.S. 7, D-1

Notes Ck'd by M. OSHITA
Map No.
Office Work
Checked
Date

Surveyed by E. E. Ross
Notes FEB.
Indexed K. V. GALLI
Date 11/6/45











PLEASE RETURN TO
LOS ANGELES COUNTY ENGINEER
403 LOS ANGELES COUNTY ENGINEERING BLDG.

Note: Any Additions or Changes on This Sheet Must Be Made in Circled in Red Ink With Date and Name of Person Making Change.

Do not extend this side of this line.

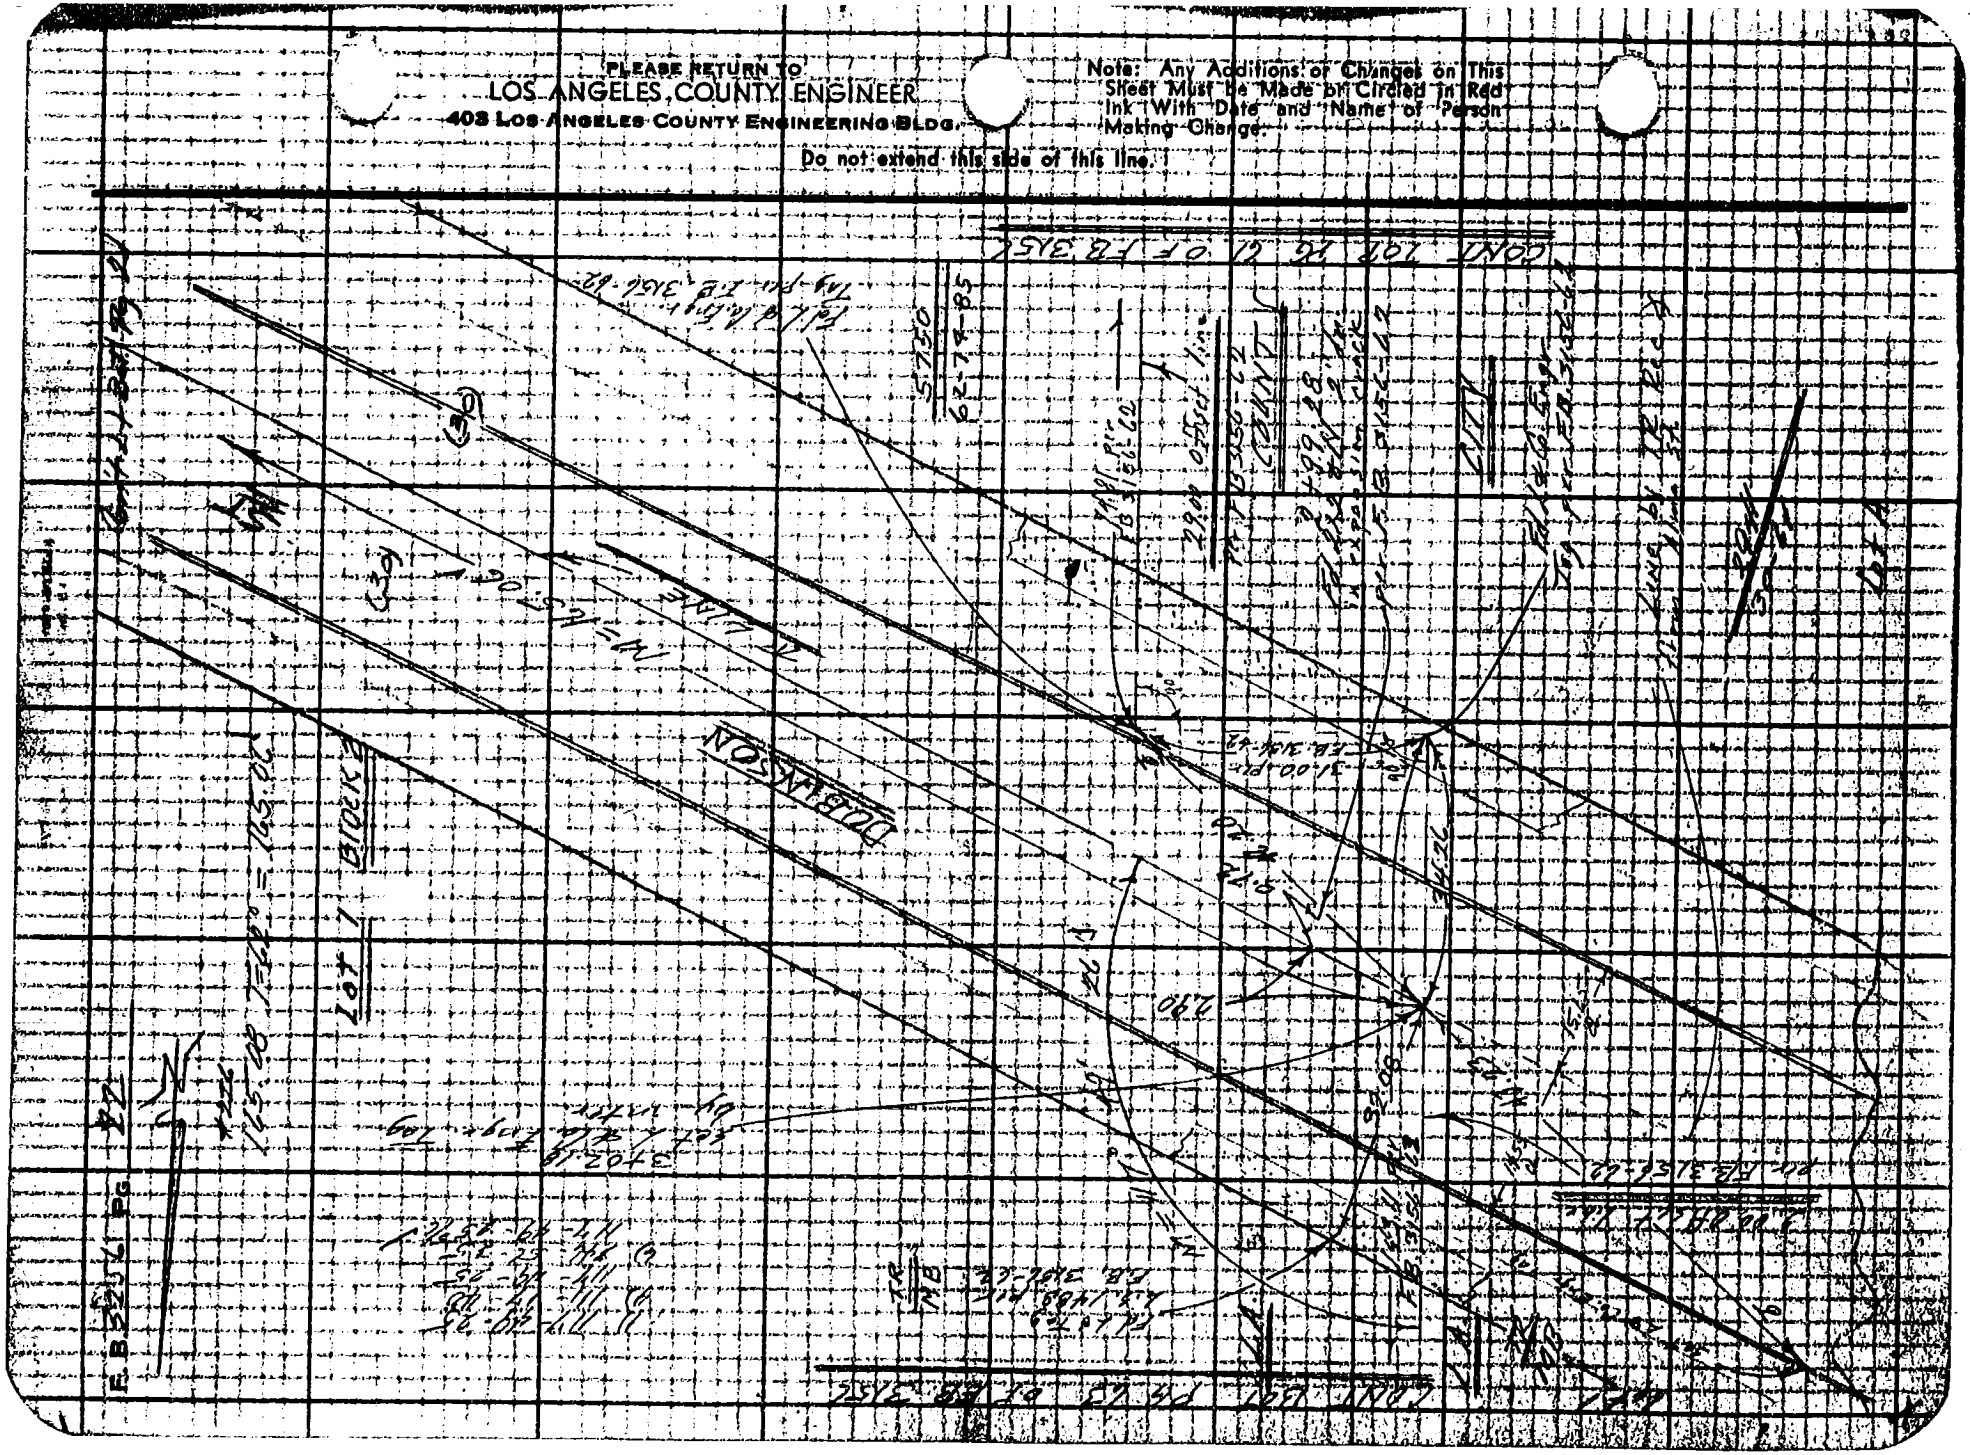

Notes Ck'd by M. OSHITA
Map No.
Office Work
Checked
Date

Survey of CITY TERRACE AREA 2 F.B. 3256 Pg. 23
JN 0505.01 Tape 22L Sta 0 °F
Surveyed by E. E. Brooks
Notes FBE Date 12 June 64
Indexed J. GILL

Cont Bot Pg 24

Please Return To:
LOS ANGELES COUNTY ENGINEER
405 Los Angeles County Engineering Bldg.

Note: Any Additions or Changes on This Sheet Must be Made or Circled in Red Ink With Date and Name of Person Making Change.
Do not extend this line.

70F3008 CCC #310 6-63

Lot 1 Block 2
Lot 2 Block 2
Lot 3 Block 2
Lot 4 Block 2
Lot 18 Block 11
Lot 17 Block 11

El 327.29 POT
set pencil mark
Fd Lat
no. P.C.C.
1.75
10.58
Inc
Cl
M=
101.54
drive way
4+31.1
29.3
(20)
(30)
drive way
3+59.0
19.8
drive way
4+81.8
30.1
4" chain link fn.
5+18.5
20.4
2 story
Stucco
Bldg
5+27.06
Fd Lat
no. P.C.C.
Cont Lot 20, 21

F.B. 3256 Pg. 24

Corr. Dot. By 25

Lot 4 Block 2

Lot 5 Block 2

Lot 6 Block 2

Lot 7 Block 2

Lot 8 Block 2

3705.25 P.O.T.
Set Nail & tack mark

(20)

(30)

Driveway

3.12

20.05

3708.87
Fd. 3/4" iron bar & tack in lead

Driveway
3758.0

20.0

3763.0
4' chain link fence

20.0

23.9

3730.7

5750
12 = 74.8

4' house

Driveway

29.8

3780.6

Cont. Top 23

Cont.

Lot 7

Lot 8

MB
PR

LOS ANGELES COUNTY ENGINEER
403 Los Angeles County Engineering Bldg.

PLEASE RETURN TO

Do not extend this side of this line.

Note: Any Additions or Changes on This Sheet Must Be Made or Circled in Red Ink With Date and Name of Person Making Change.

Notes Ck'd by M. OSHITA
Map No.
Office Work
Checked
Date

Survey of City Terrace Area R.
JN 6307.07 Tape 22C Std BV °F
Surveyed by E. E. Brooks
Notes FEB Date 17 Jan 66
Indexed C. J. GALLI

F.B. 3256 Pg. 25

CONT BT PG 26

Note: Any Additions or Changes on This Sheet Must be Made or Circled in Red Ink With Date and Name of Person Making Change.

Do not extend this side of this line.

PLEASE RETURN TO
LOS ANGELES COUNTY ENGINEER
402 Los Angeles County Engineering Bldg.
Los Angeles, California

76F3095 CE #310 6-62

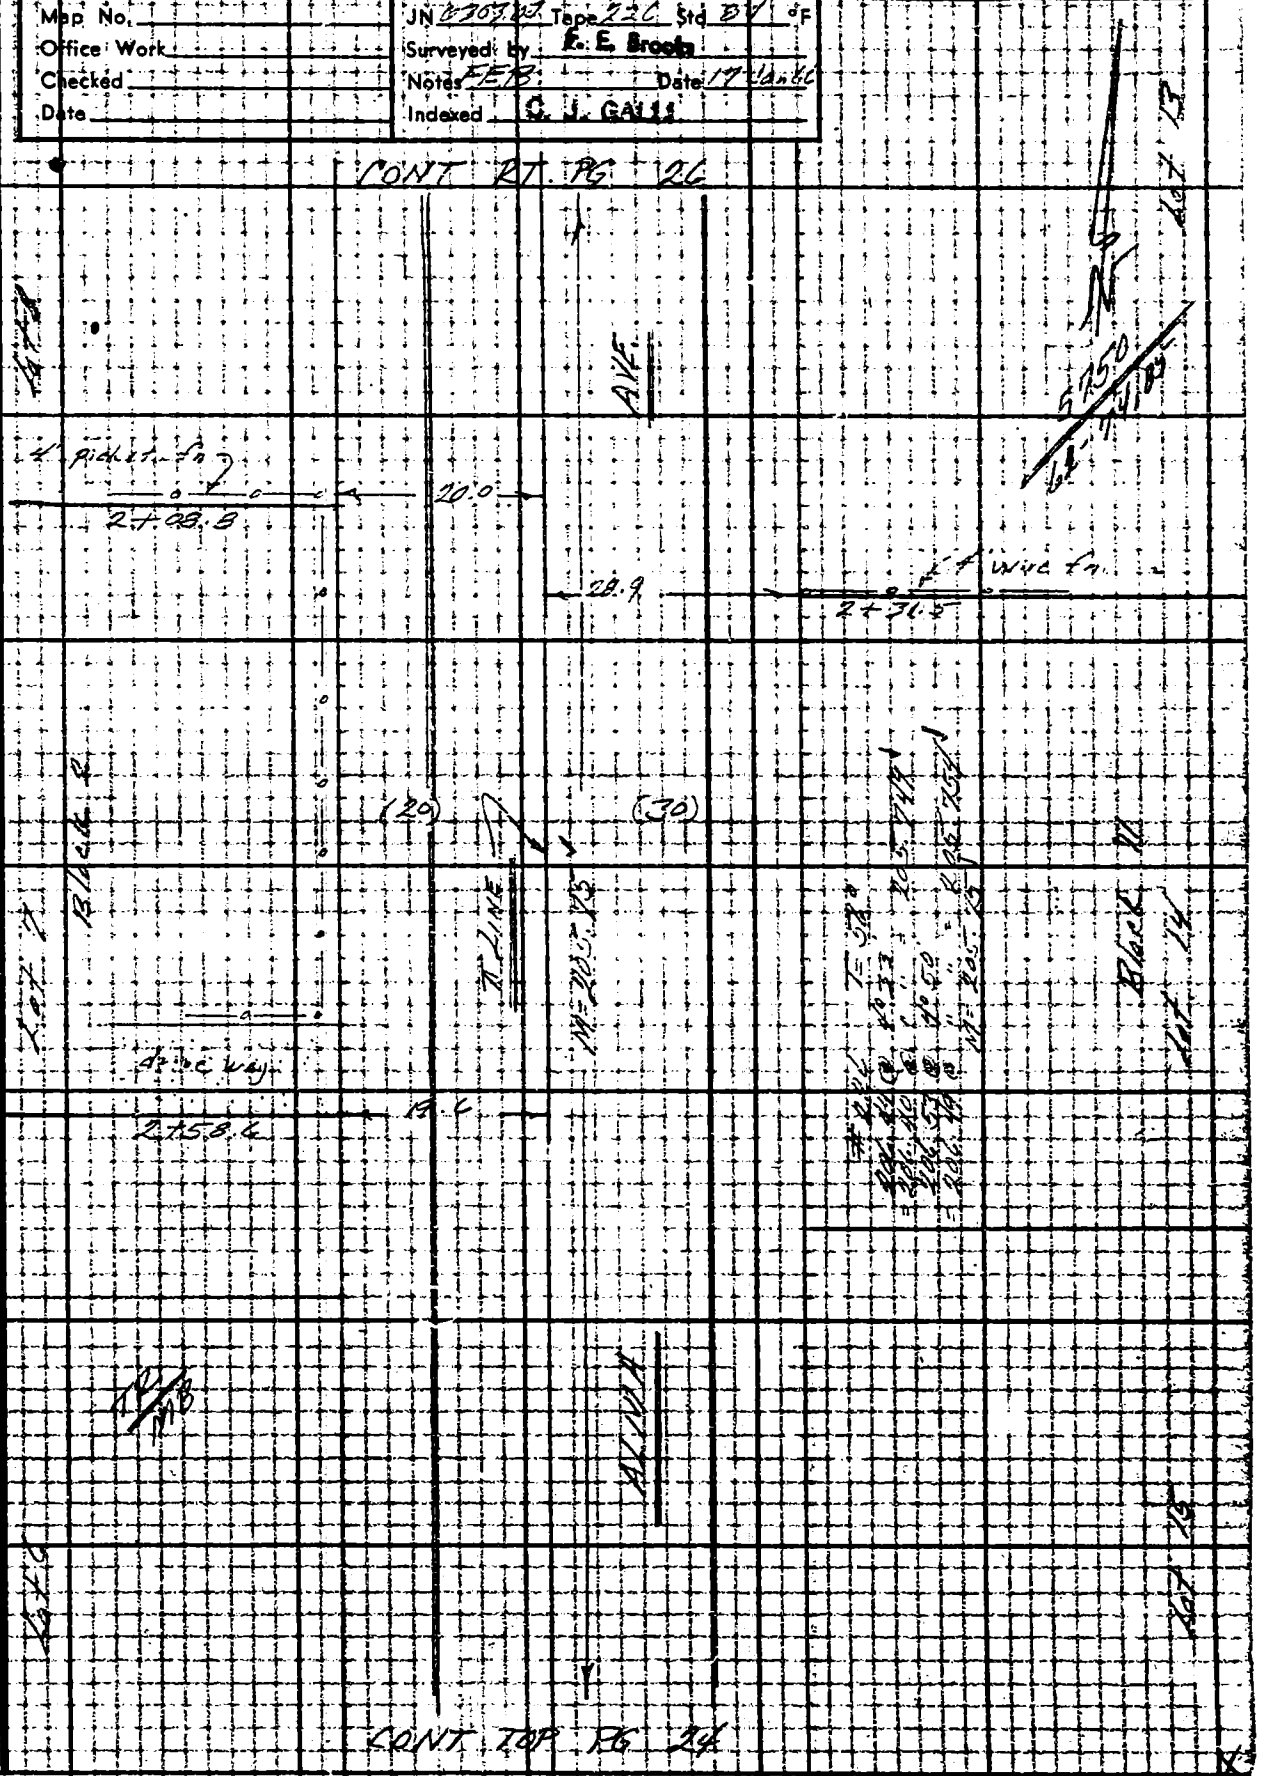

PLEASE RETURN TO
LOS ANGELES COUNTY ENGINEER
403 LOS ANGELES COUNTY ENGINEERING BLDG.

Note: Any Additions or Changes on This Sheet Must be Made or Circled in Red Ink With Date and Name of Person Making Change.

Do not extend this side of this line.

W.S.7, D-1

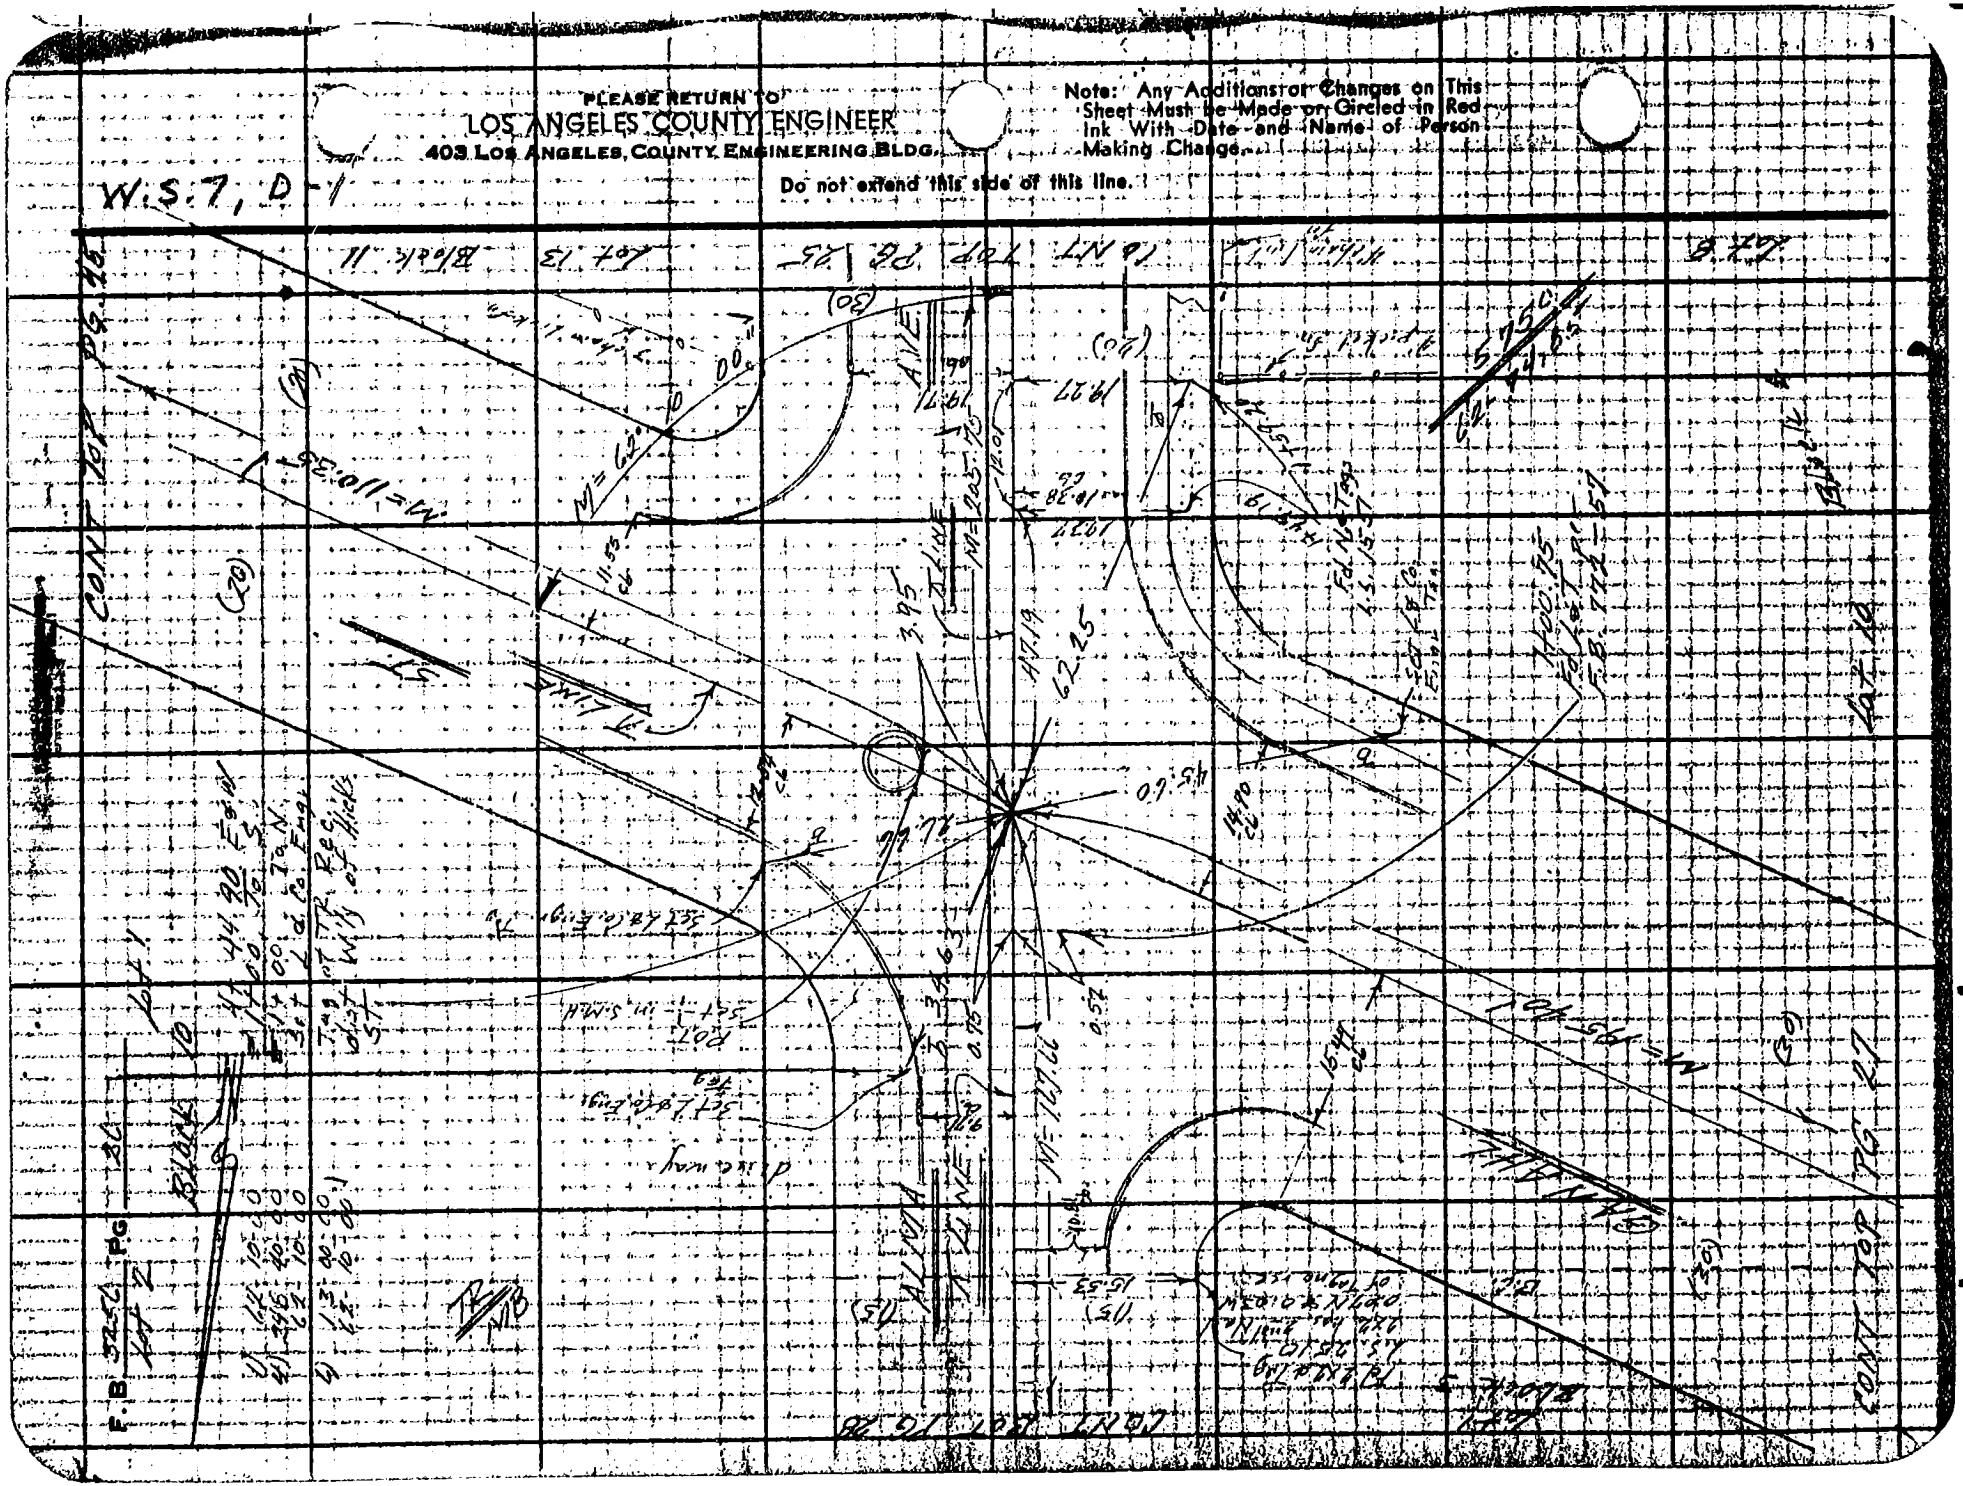

Notes Ck'd by: M. OSHITA
Map No.
Office Work
Checked
Date

Survey of: CITY TERRACE AREA
JN 0303.07 Tape 276 Std. 84 °F
Surveyed by: E. E. Brooks
Notes: FB - KM/LAM Date: 6 Jan 66
Indexed: S. J. GALLI

F. B. 3256 Pg. 27

Lot 1 Block 3 Lot 2 CONT BOT 26

W.S. 7, D-1

Notes: Any Additions or Changes on This Sheet Must Be Made or Circled in Red, Ink With Date and Name of Person Making Change.

Do not extend notes this side of this line.

RETURN TO LOS ANGELES COUNTY ENGINEER 900 Los Angeles County Engineering Bldg.

CONT BOT PG 27 OF FB 3156

Adj. Occ. Sur. Line per FB 3156-27

Fd. L.F.T. per F.B. 3156-66

Fd. L.F.T. per F.B. 3156-27

Fd. L.F.T. per F.B. 3156-66

153.00 per FB 3156-67

253.34 per FB 3156-45

THORNTON

L.A. COUNTY

L.A. CITY

CONT TOP PG 45 OF FB 3156

Block 4 Lot 10 Lot 9

1941

30 - 64

= 226 = 78°

196.15 @ 8° 12' " = 194.992

196.14 @ " " = 194.992

196.01 @ 6° 51' " = 194.978

196.00 @ " " = 194.978

14 = 194.98

Level = 0.42

Total = 195.40

11 12 10 -10 -

4) 240 40 -4 -

62 -10 -11 4

6) 13 -01 -0.5 -

58 -10 -10.5 6

6

7-68 CE #247—7-55

RETURN TO
LOS ANGELES COUNTY ENGINEER
700 LOS ANGELES COUNTY ENGINEERING BLDG.

Note: Any Additions or Changes on This Sheet Must be Made or Circled in Red Ink With Date and Name of Person Making Change.

Do not extend notes this side of this line.

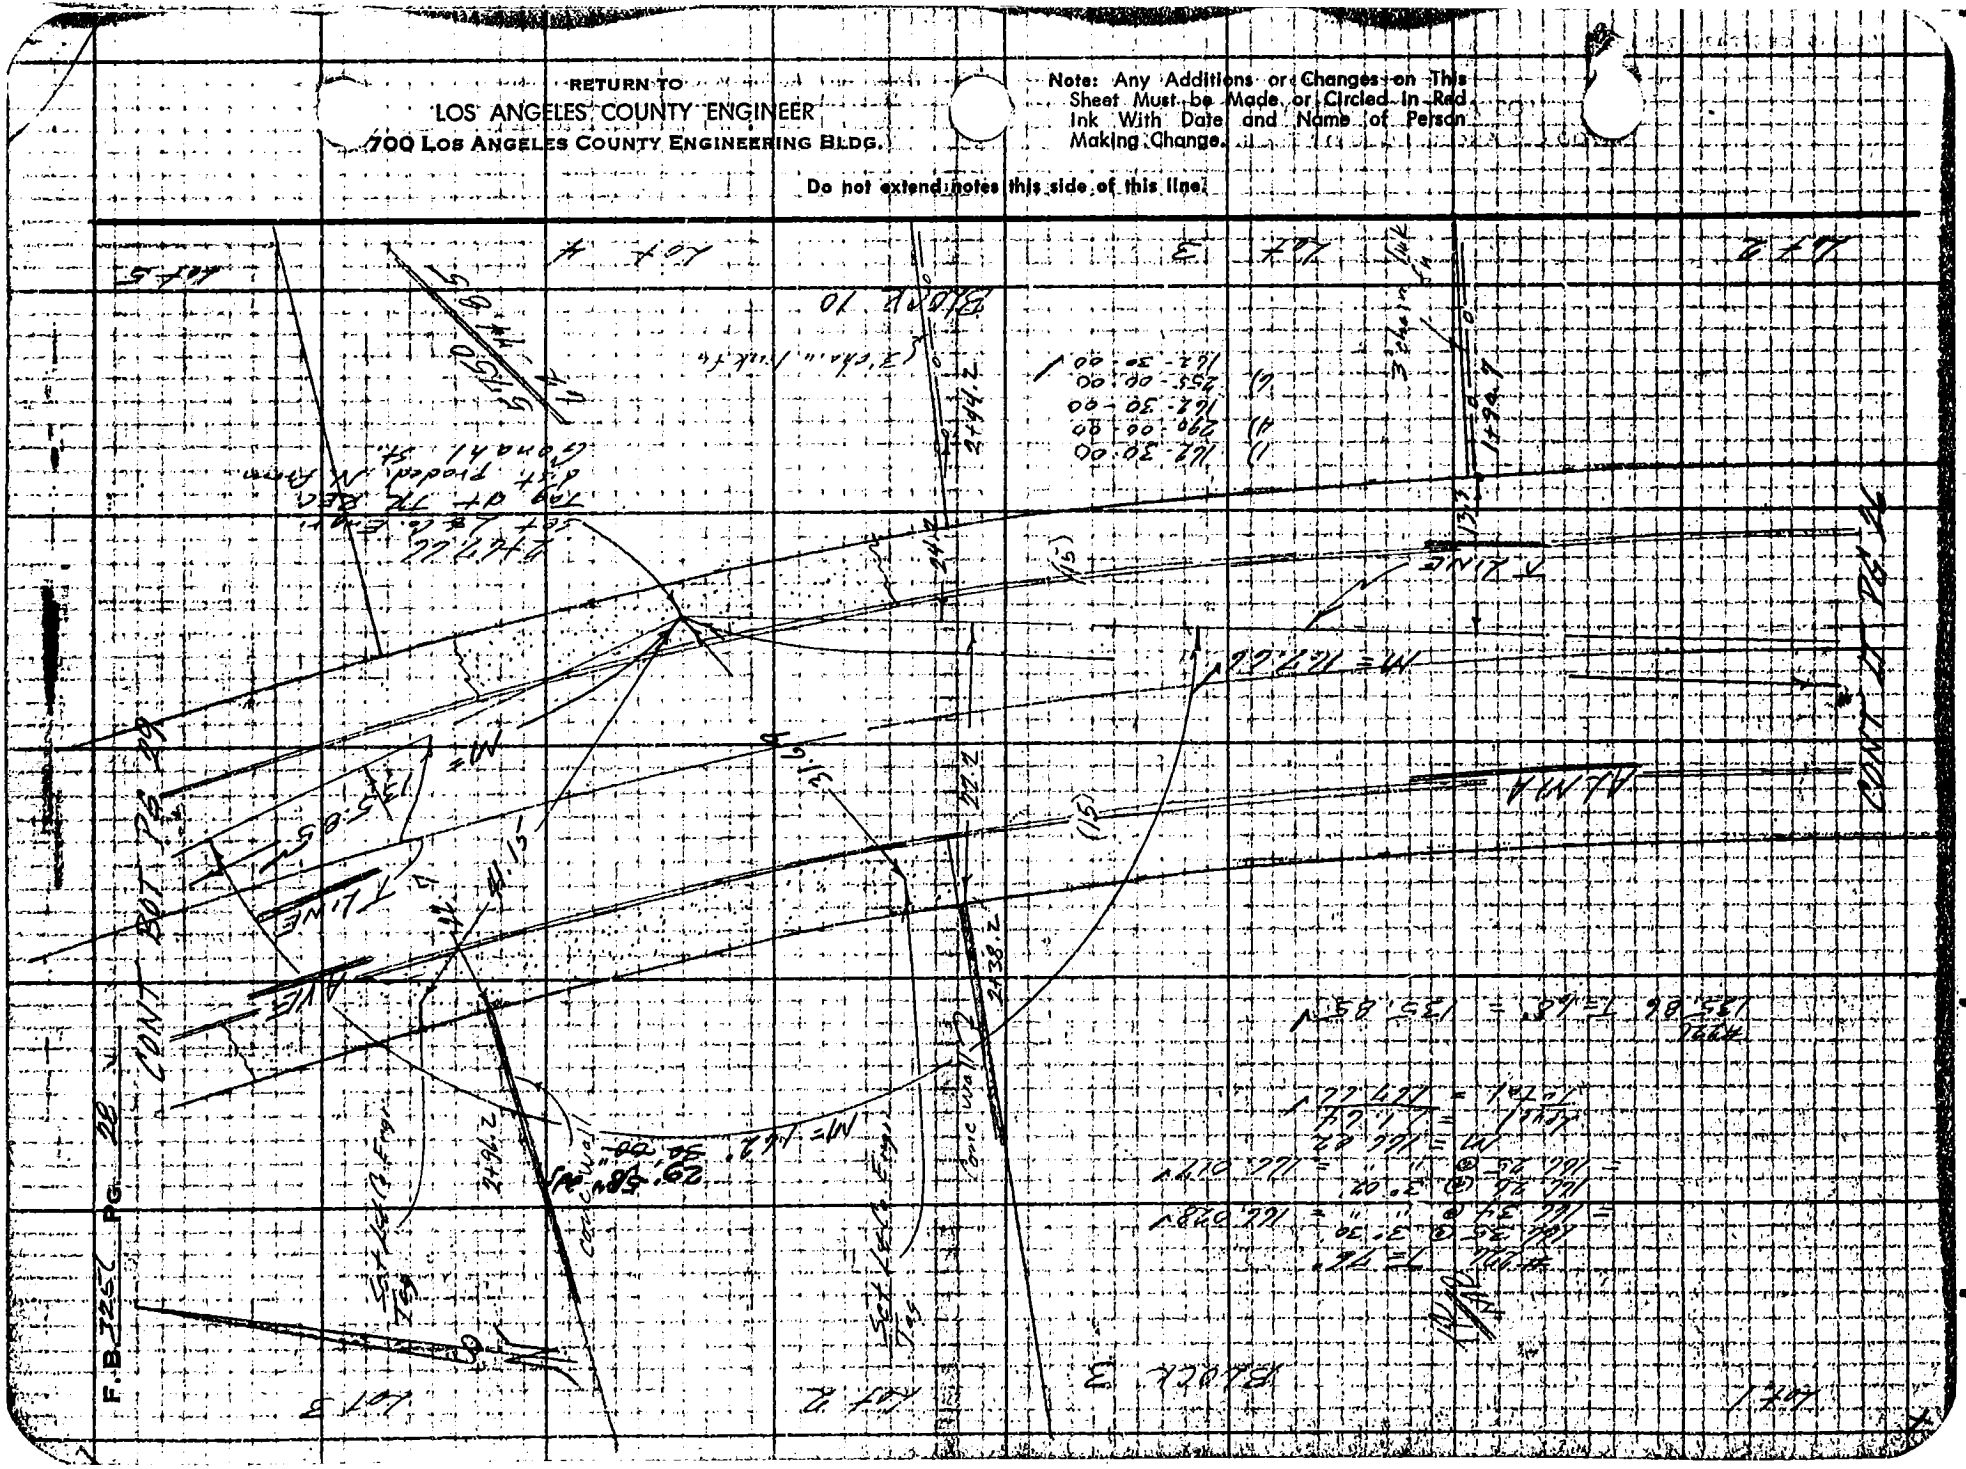

Notes Ck'd by M. OSHITA
Map No.
Office Work
Checked
Date

Survey of CITY TERRACE AREA F. B. 325 PG. 29
JN 0383.04 Tape 227 Std 64 °F
Surveyed by E. E. Brooks
Notes FEB. Date 22 Jan 64
Indexed GAL

CONT BOT PG 30

Notes: Any Additions or Changes on This Sheet Must be Made or Circled In Red Ink With Date and Name of Person Making Change.

Do not extend notes this side of this line.

RETURN TO LOS ANGELES COUNTY ENGINEER
900 Los Angeles County Engineering Bldg.

7-65 CE #247

Lot 9
Lot 8
Block 10
Lot 5
Lot 4
Lot 3
Lot 2
Lot 1
Alma Ave.
Alma Ave.
Block
Lot 6
Lot 7
3' board fn
4+47.5
15.6
4+03.51
Ex Let
42 +cc
E.C.
3+96.8
15.2
Block
Lot 1
Lot 2
TB
NB
2½ Chain Link
Conc Wall
3+44.5
17.0
Alma Ave.
N = 133.85
Lot 13
Lot 14
CONT TOP PG 26

RETURN TO
LOS ANGELES COUNTY ENGINEER
900 LOS ANGELES COUNTY ENGINEERING BLDG.

Note: Any Additions or Changes on This Sheet Must be Made or Circled in Red Ink With Date and Name of Person Making Change.

Do not extend notes this side of this line.

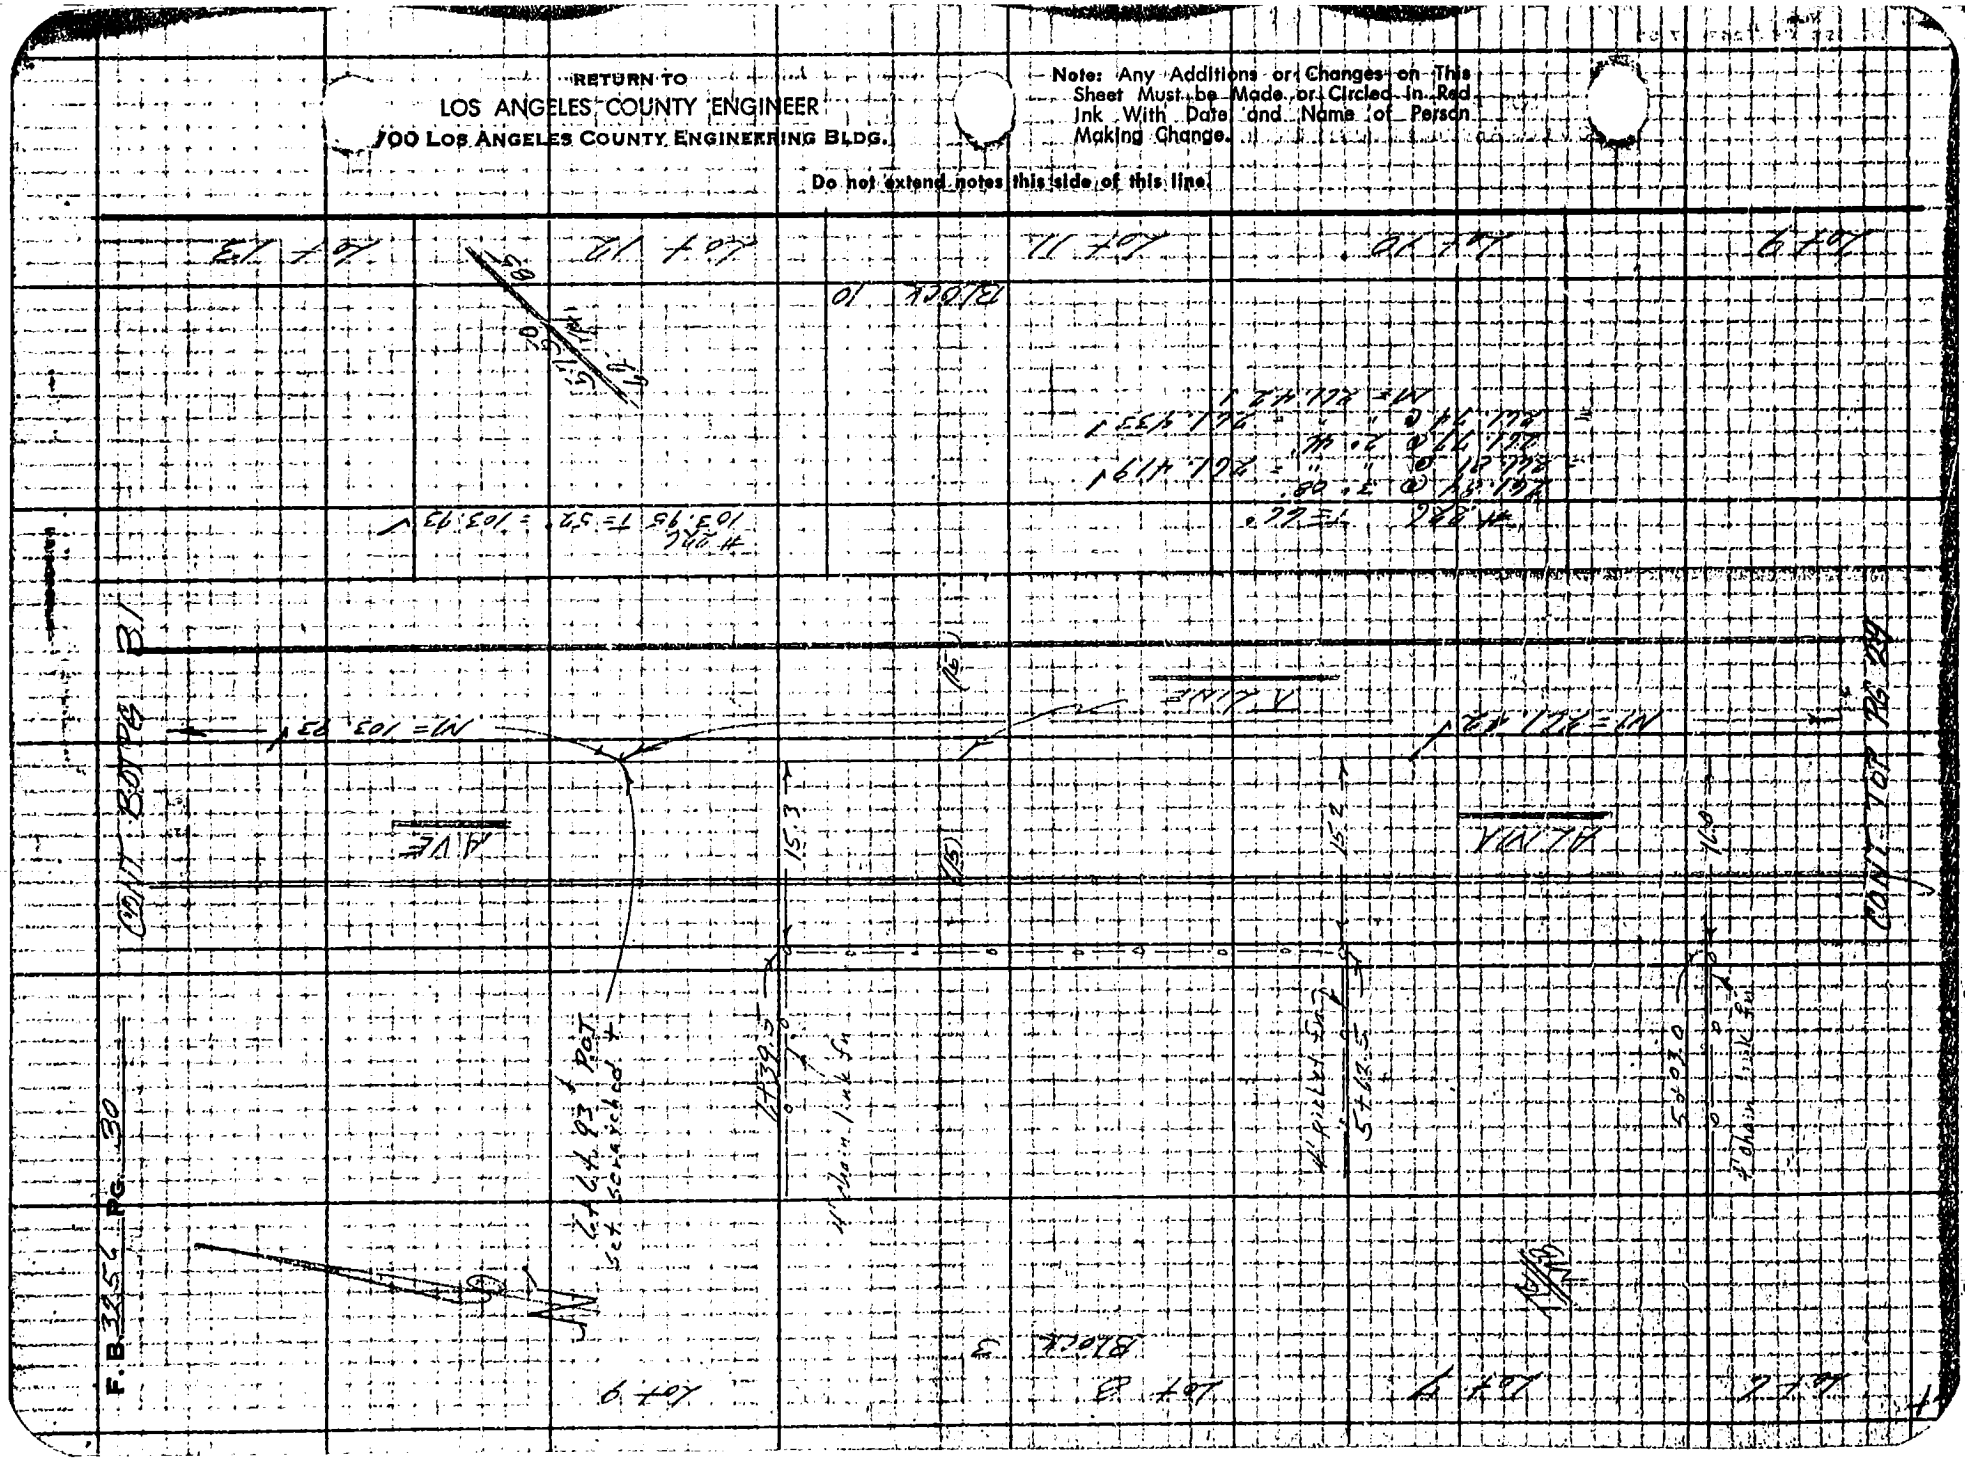
F.B. 3456 PG. 30
Block 3

Notes Ck'd by M. OSHITA
Map No.
Office Work
Checked
Date

Survey of DAY TERRACE AREA
JN 0303.01 Tape 2 2C Std 84 °F
Surveyed by E. Brooks
Notes F.E.B. Date 2/13 - 16, 66
Indexed

F. B. 3156 Pg. 31

CONT TOP PG 32

CONT BOT PG 33 OF FB 3156

(40)

N. WOOD

Fd Loc. Tag Engr. per F.B. 3156-72

4.00 OFFSET LINE Per F.B. 3156-72

Set Bt. Spk. w&T by instr

M=25.61

M=21.84

M=12.47

M=14.53

M=21.99

M=14.58

M=14.45

M=14.47

M=10.93

Fd Loc. Tag Engr. per F.B. 3156-72

8.00 per F.B. 3156-72

Fd Loc. Tag Engr. per F.B. 3156-72

Fd Loc. Tag Engr. per F.B. 3156-72

Fd Loc. Tag Engr.

RETURN TO
LOS ANGELES COUNTY ENGINEER
700 LOS ANGELES COUNTY ENGINEERING BLDG.

Note: Any Additions or Changes on This Sheet Must be Made or Circled in Red Ink With Date and Name of Person Making Change.

Do not extend notes this side of this line

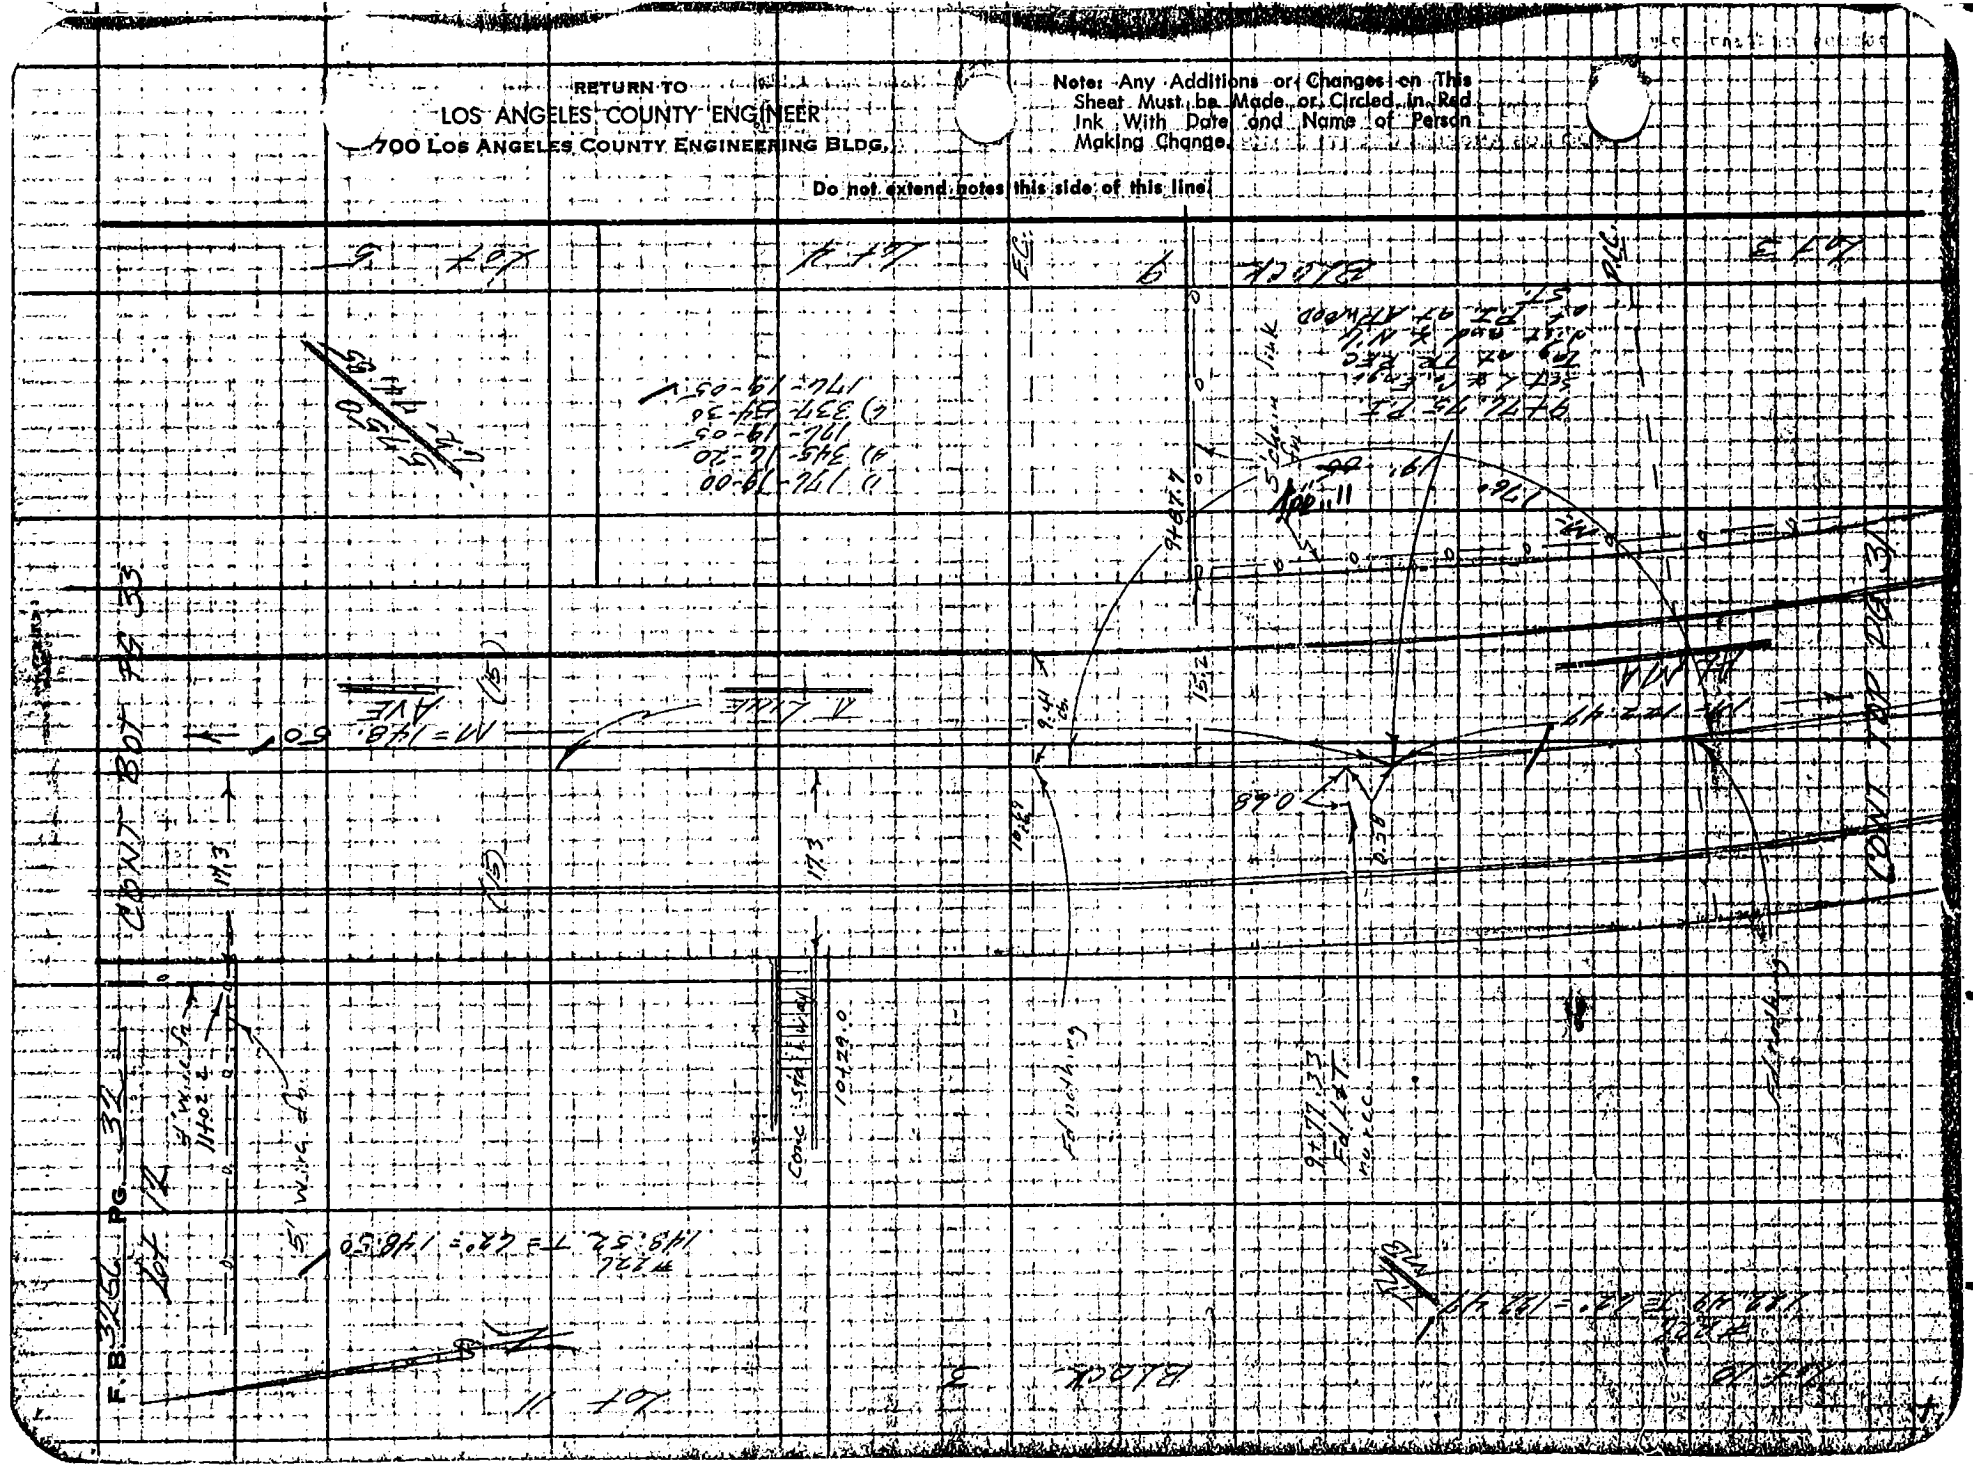

Notes Ck'd by M. OSHITA
Map No.
Office Work
Checked
Date

Survey of CITY TERRACE AREA
JN 0503.004 Tape 22C Std 64° oF
Surveyed by E. E. Brooks
Notes FE 8 Date 27 Jan 66
C. J. GALLI
Indexed

F. B. 2454 PG 33

CONT RT PG 34

Lot 14

Lot 8

4' chain link fn

B.C.

Block 3

Lot 13

Lot 9

Lot 12

Lot 10

Lot 11













11+58.28
FD L&T
L.S. 10273 stamped
on lead no acc

11+58.7

18.5

49.61

4' wire fn

(15)

(15)

11+25.25 P.I.
Set P&T
4' chain lk ft

11+08.20
FD L&T
L.S. 10273 stamped
on lead no acc

4' Conc Wall

N=148.99

COUNT TOP PG 32

RETURN TO
LOS ANGELES COUNTY ENGINEER
900 LOS ANGELES COUNTY ENGINEERING BLDG.

Note: Any Additions or Changes on This Sheet Must be Made or Circled In Red Ink With Date and Name of Person Making Change.

Do not extend notes this side of this line.

765098 CE #247—7-65

RETURN TO
LOS ANGELES COUNTY ENGINEER
700 LOS ANGELES COUNTY ENGINEERING BLDG.

Note: Any Additions or Changes on This Sheet Must be Made or Circled in Red Ink With Date and Name of Person Making Change.

Do not extend notes this side of this line.

W.S. 7, D-1

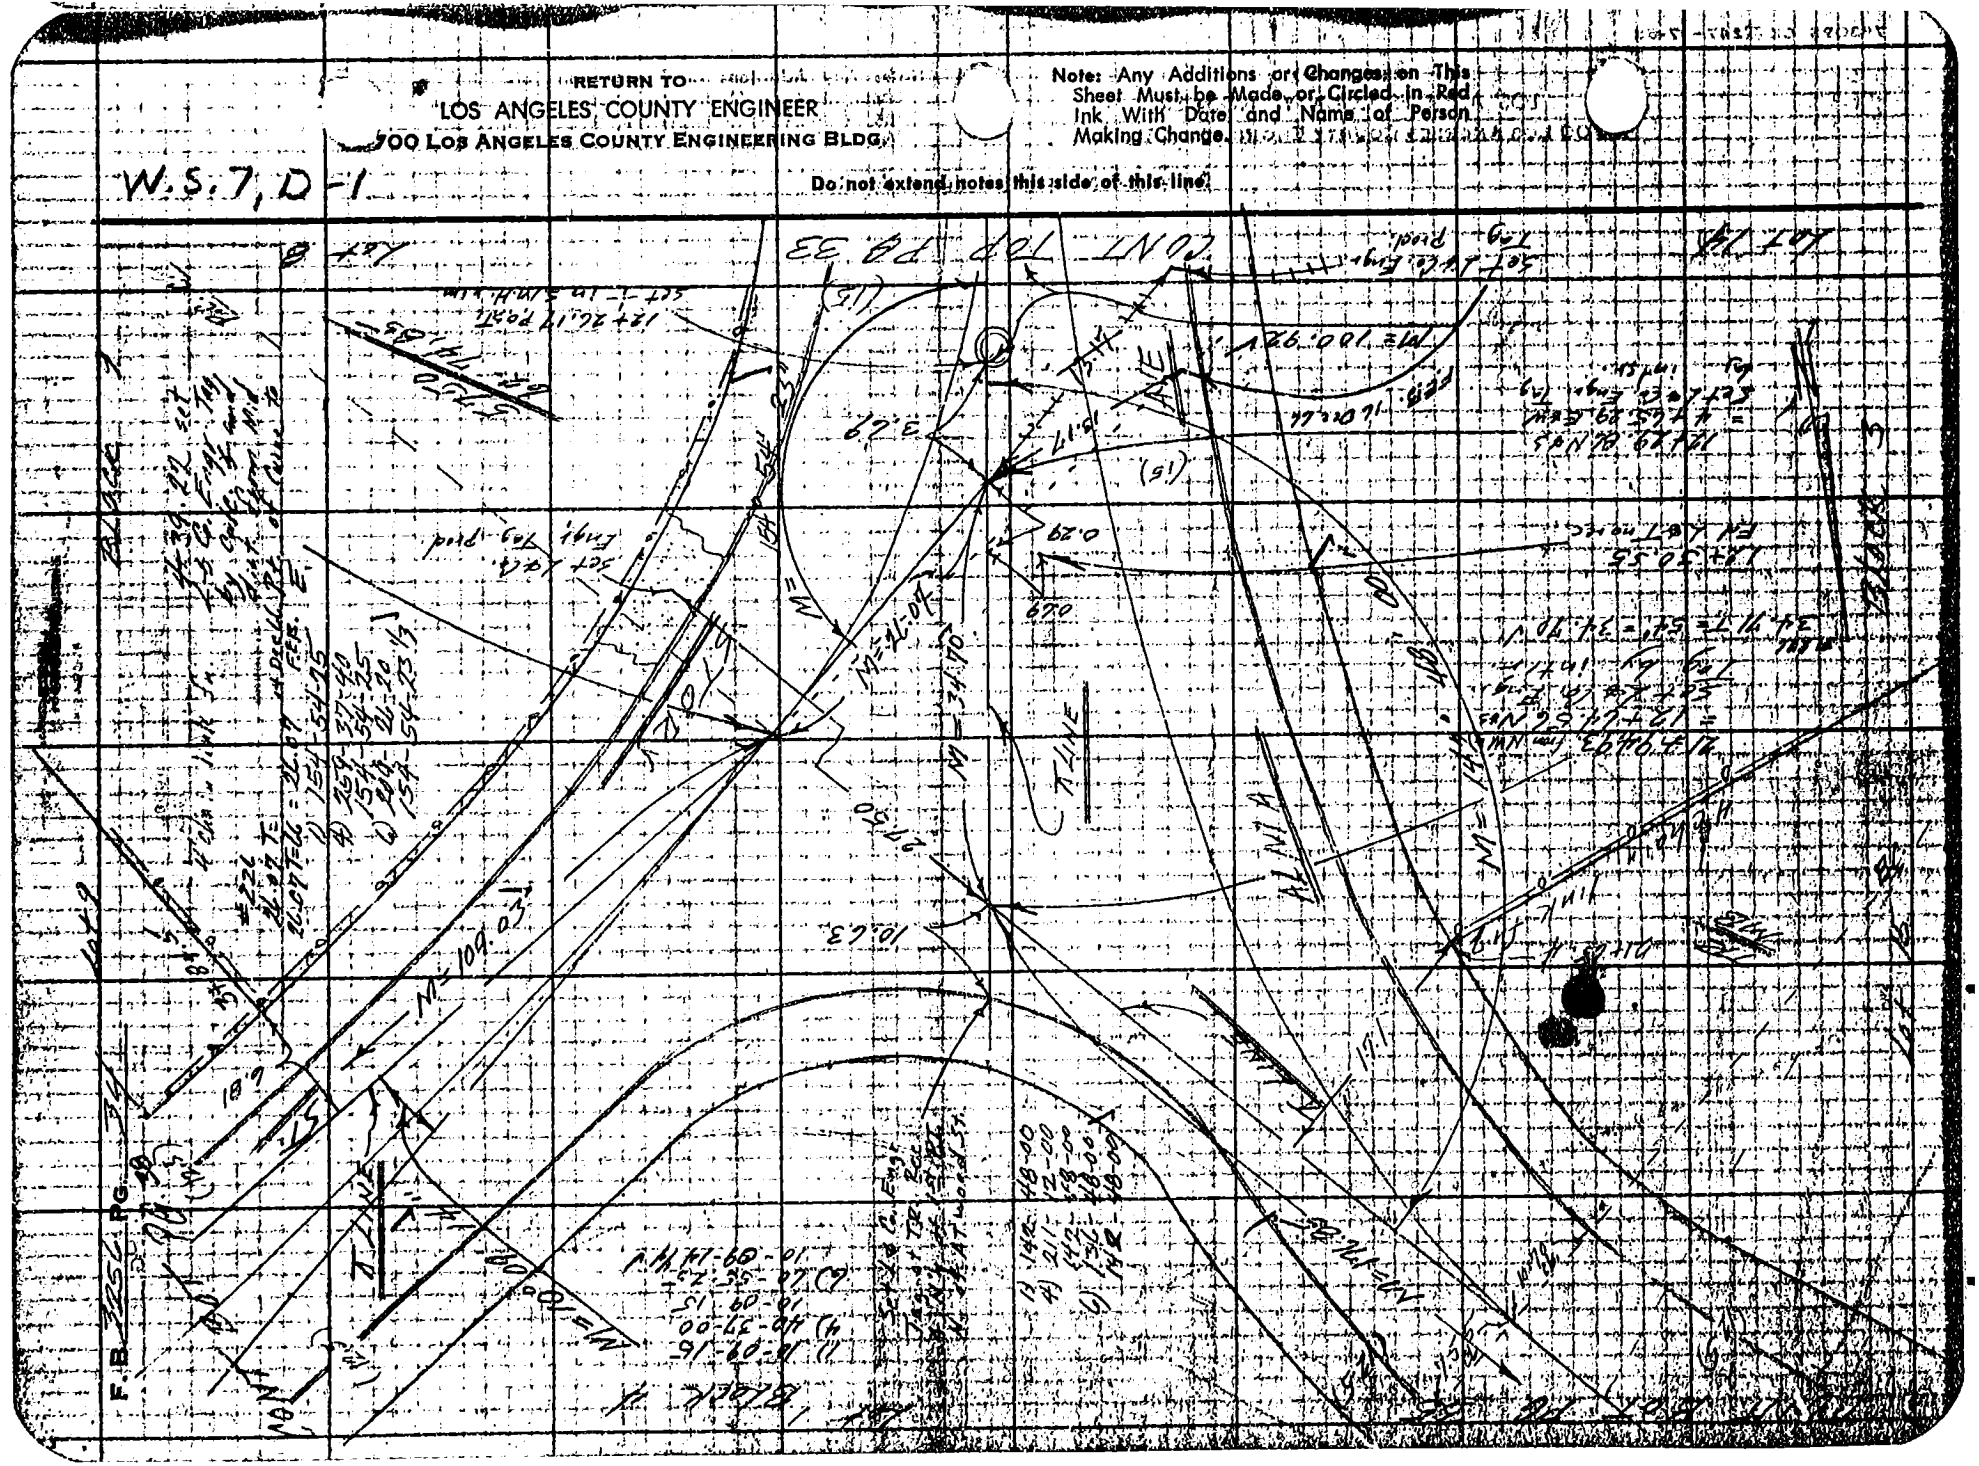

Notes Ck'd by M. OSHITA
Map No.
Office Work
Checked
Date

Survey of CITY TERRACE AREA #1
JN 1869.04 Tape 326 Std 68 °F
Surveyed by R. E. Brooks
Notes F.E.B. Date 7 FEB 66
Indexed C. I. GALLE

F. B. 3956 PG. 35

Lot 19

Lot 18

20+18.08
Set 2" I.P. conc. plug & Co. Engr. Tag 17" above the curb at Curb dist of A N'ly from E.C. T N.E per office calc.

20+22.36 Pd Lat

20+24.73 POST Set Lt Co. Engr. Tag

20+41.23 POST Set Lt Co. Engr. Tag

20+55.4

20+03.3

T LINE

M = 79.82 AVE

M = 111° 08'

BC

A LINE

(12.5)

(12.5)

5' hedge

V. hedge

conc block wall

5' board fence

chain link fence

Lot 14

Lot 15

Lot 16

Lot 17

Lot 20

Lot 21

Lot

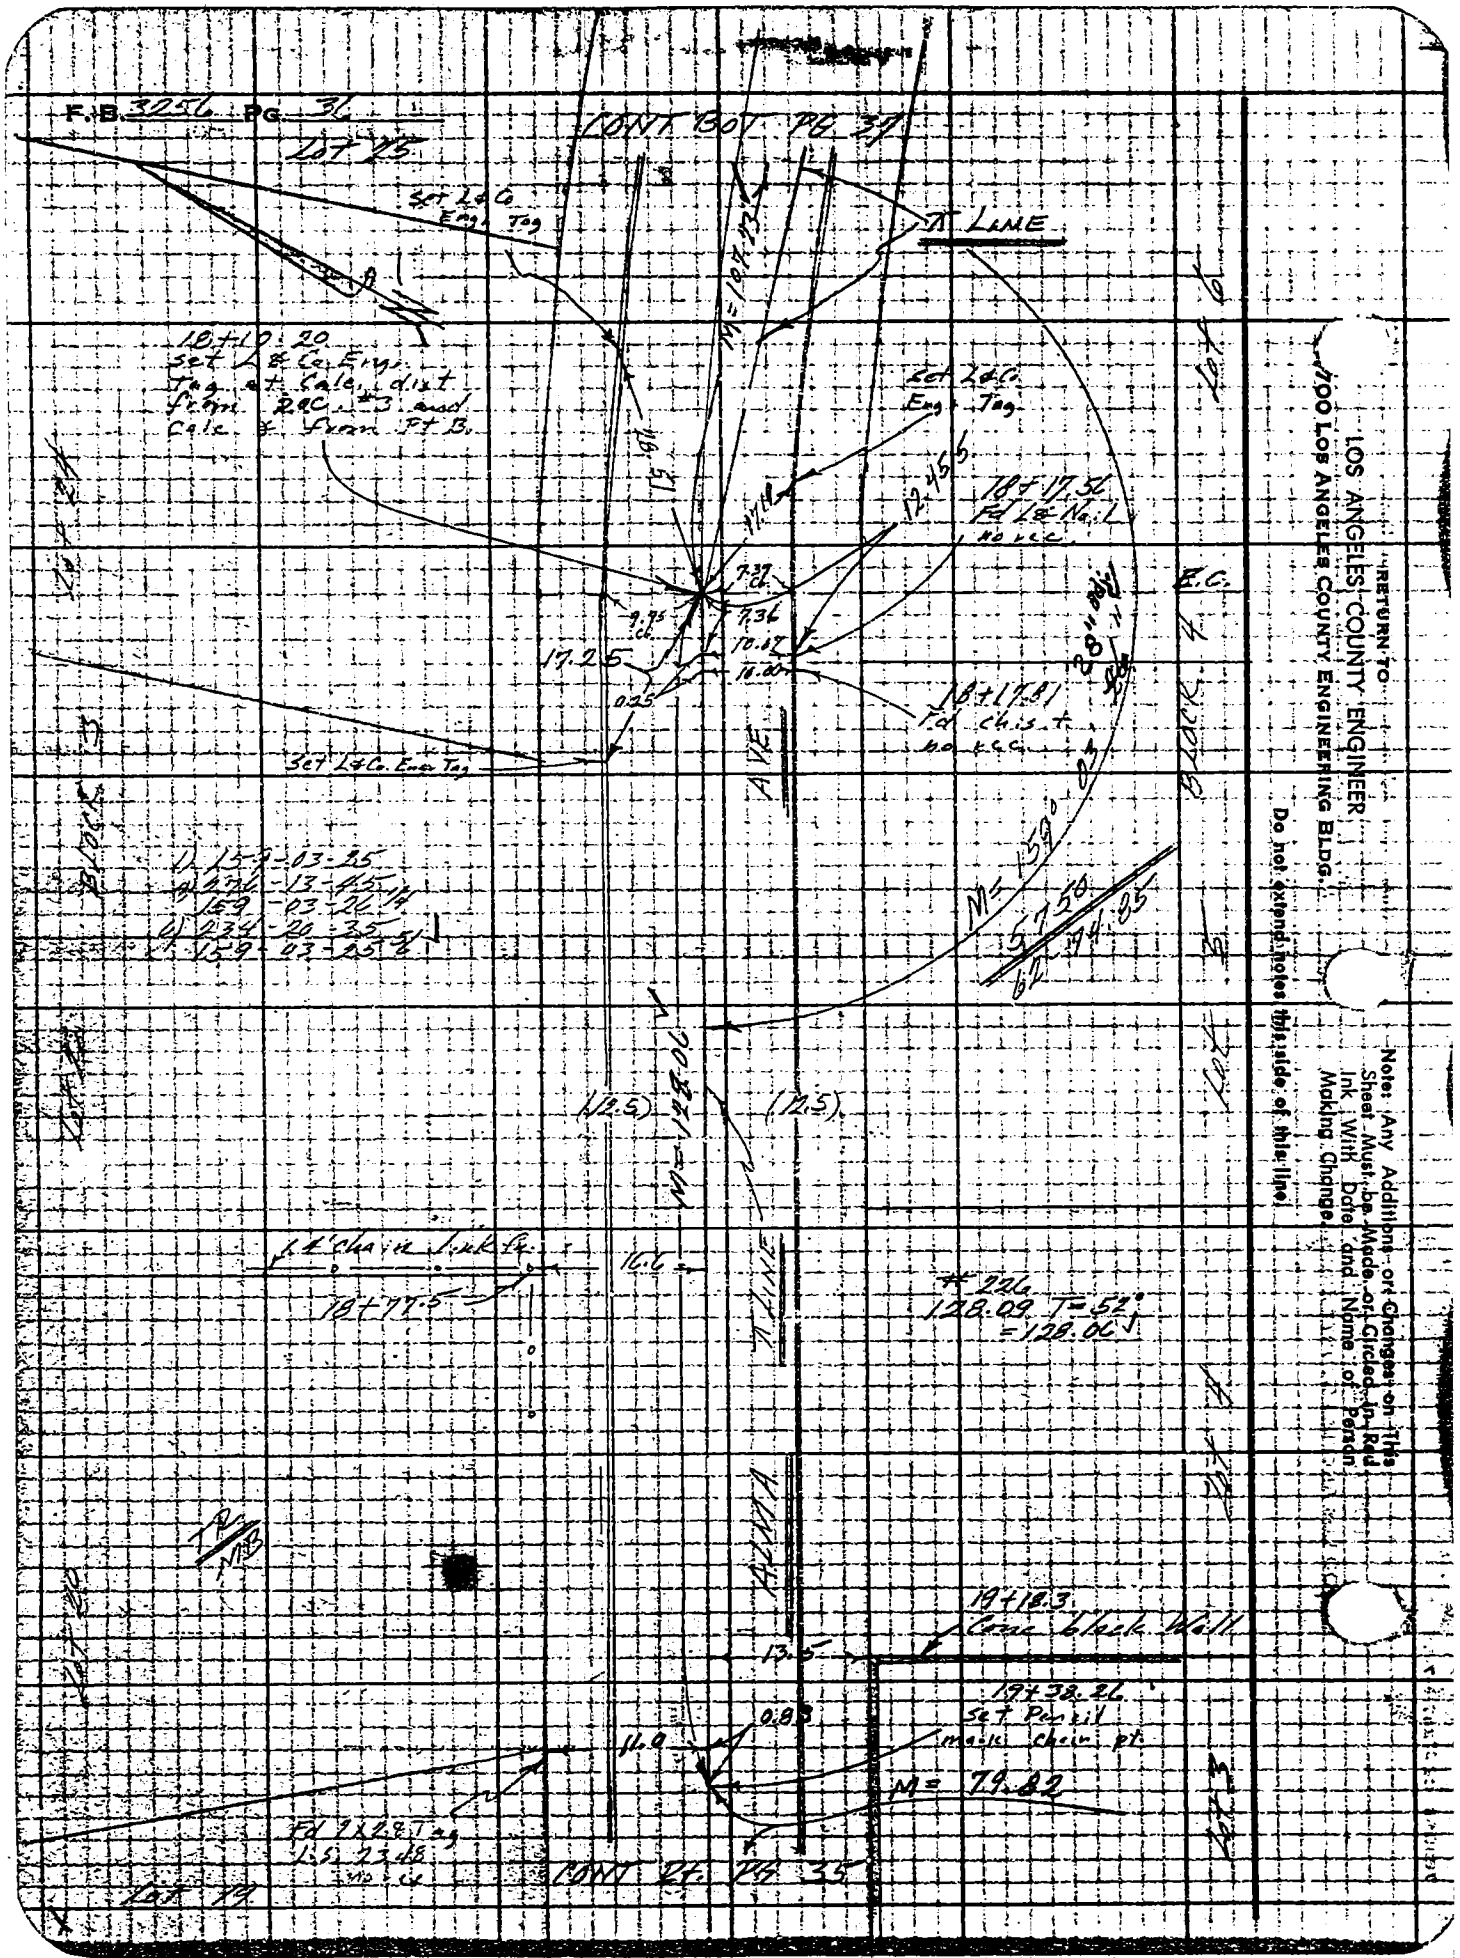

RETURN TO
LOS ANGELES COUNTY ENGINEER
700 LOS ANGELES COUNTY ENGINEERING BLDG.

Note: Any Additions or Changes on This Sheet Must be Made or Circled in Red Ink With Date and Name of Person Making Change

Do not extend notes this side of this line

Notes Ck'd by M. OSUITA
Map No.
Office Work
Checked
Date

Survey of CITY TERRACE AREA
JN 0303.01 Tape 22C Std 84 °F
Surveyed by E. E. Proctor
Notes FEB Date 4-Feb-66
Indexed C. J. GALLI

F. B 325C Pg 39

Note: Any Additions or Changes on This Sheet Must Be Made or Circled In Red Ink With Date and Name of Person Making Change.

Do not extend notes this side of this line.

RETURN TO
LOS ANGELES COUNTY ENGINEER
900 LOS ANGELES COUNTY ENGINEERING BLDG.

76808 CE #247—7-65

10+97.97 PT B
Set L.A. Co. Engr
Tag at calc
& end dist
W'ly of PT A

17+02.97 P.O.C. #3
Set L.A. Co. Engr. Tag
on line at Calc.
dist from PT B.

Set L.A. Co. Engr. Tags
1) 138-02-54
2) 192-27-30
3) 136-02-52 1/2
4) 108-41-10
5) 138-02-51 1/2

Set L.A. Co. Engr. Tag

F/L&T Tag L.S. 2348 Recd BONE

Cont Wall

CONT TOP PG 38

CONT TOP PG 58

Block 3

Hicks

Walk

Alma Ave

T Line

Ave

St

Lot 29

Lot 30

F.B 3256 Pg. 38

CONT BOOK 56

1) 169-50-45
4) 319-55-05
169-50-45
6) 29°-49'-35"
169-50-45 SLC

Conc wall

HUB 1.7

2+21.46
Set L.A.Co. Engr. Tag
at I.R. Rec. dist and
& W'ly of intsn
at HICKS AVE

2+02.7
Conc wall

(12.5)

(12.5)

N = 12.1

8.0

14.65

0.36

℄ LINE

Ext ch. ±
no rec.

9.20
9.40

8.23

8.30

9.9

B.C.

2+21.51
Fd L&T
no rec.

℄ Barn 6.00 ft.
2+30.9
17.5 off

Ext L&T
no rec.

N 69° 50' 45" E

24+57.4
Pinfact
Fd

#226 T = 66°
109.74 @ 9° 31' = 107.74
109.25 @ " " = 107.74
108.94 @ 6° 28' = 107.74
108.93 @ " " = 107.74
M = 107.74
Level = 1.29
Total = 109.03

1) 159-41-30
4) 278-41-10
159-41-32½
2) 238-09-15
159-41-32½

℄ LINE

N 69° 50' 45" E 60.00' = M

4" chain link fnc

#221 T = 72°
109.50 @ 10° 31' = 107.650
109.49 @ " " = 107.650
109.24 @ 9° 41' = 107.649
109.23 @ " " = 107.649
M = 107.65
Level = 1.38
Total = 109.03

Set L&T
L.A. Co. Engr.
Tag

13.51

24.85

Stucco
garage

P.I. noted

℄ LINE

3+30.19 M'ly pt
of Curve Set L.A.Co.
Engr. Tag at t.o.c. &
and dist. from B.C.

CONT

RETURN TO
LOS ANGELES COUNTY ENGINEER
700 Los Angeles County Engineering Bldg.

Note: Any Additions or Changes on This Sheet Must be Made or Circled in Red Ink With Date and Name of Person Making Change.

Do not extend notes this side of this line.

Notes Ck'd by M. OSUNA | Survey of CITY TERRACE AREA | F.B. 325 Pg. 39
Map No. | JN 0303.04 Tape 22C Std By F
Office Work | Surveyed by E.E. Brooks
Checked | Notes FEB G.E.Cook Date 29 Apr 66
Date | Indexed

Note: Any Additions or Changes on This Sheet Must be Made in Circles in Red Ink With Date and Name of Person Making Change.

Do not extend this side of this line.

PLEASE RETURN TO
LOS ANGELES COUNTY ENGINEER
402 LOS ANGELES COUNTY ENGINEERING BLDG.

Cont. for Sec 25

SEC 25
T.1S R.13W

Lot 12

Line pick from Sec 5

W.S. 7, D-1

Lot 13 Block 12 Subd

Lot 14

Lot 15




















PLEASE RETURN TO
LOS ANGELES COUNTY ENGINEER
403 LOS ANGELES COUNTY ENGINEERING BLDG.

Note: Any Additions or Changes on This Sheet Must be Made or Circled in Red Ink With Date and Name of Person Making Change

Do not extend this side of this line.

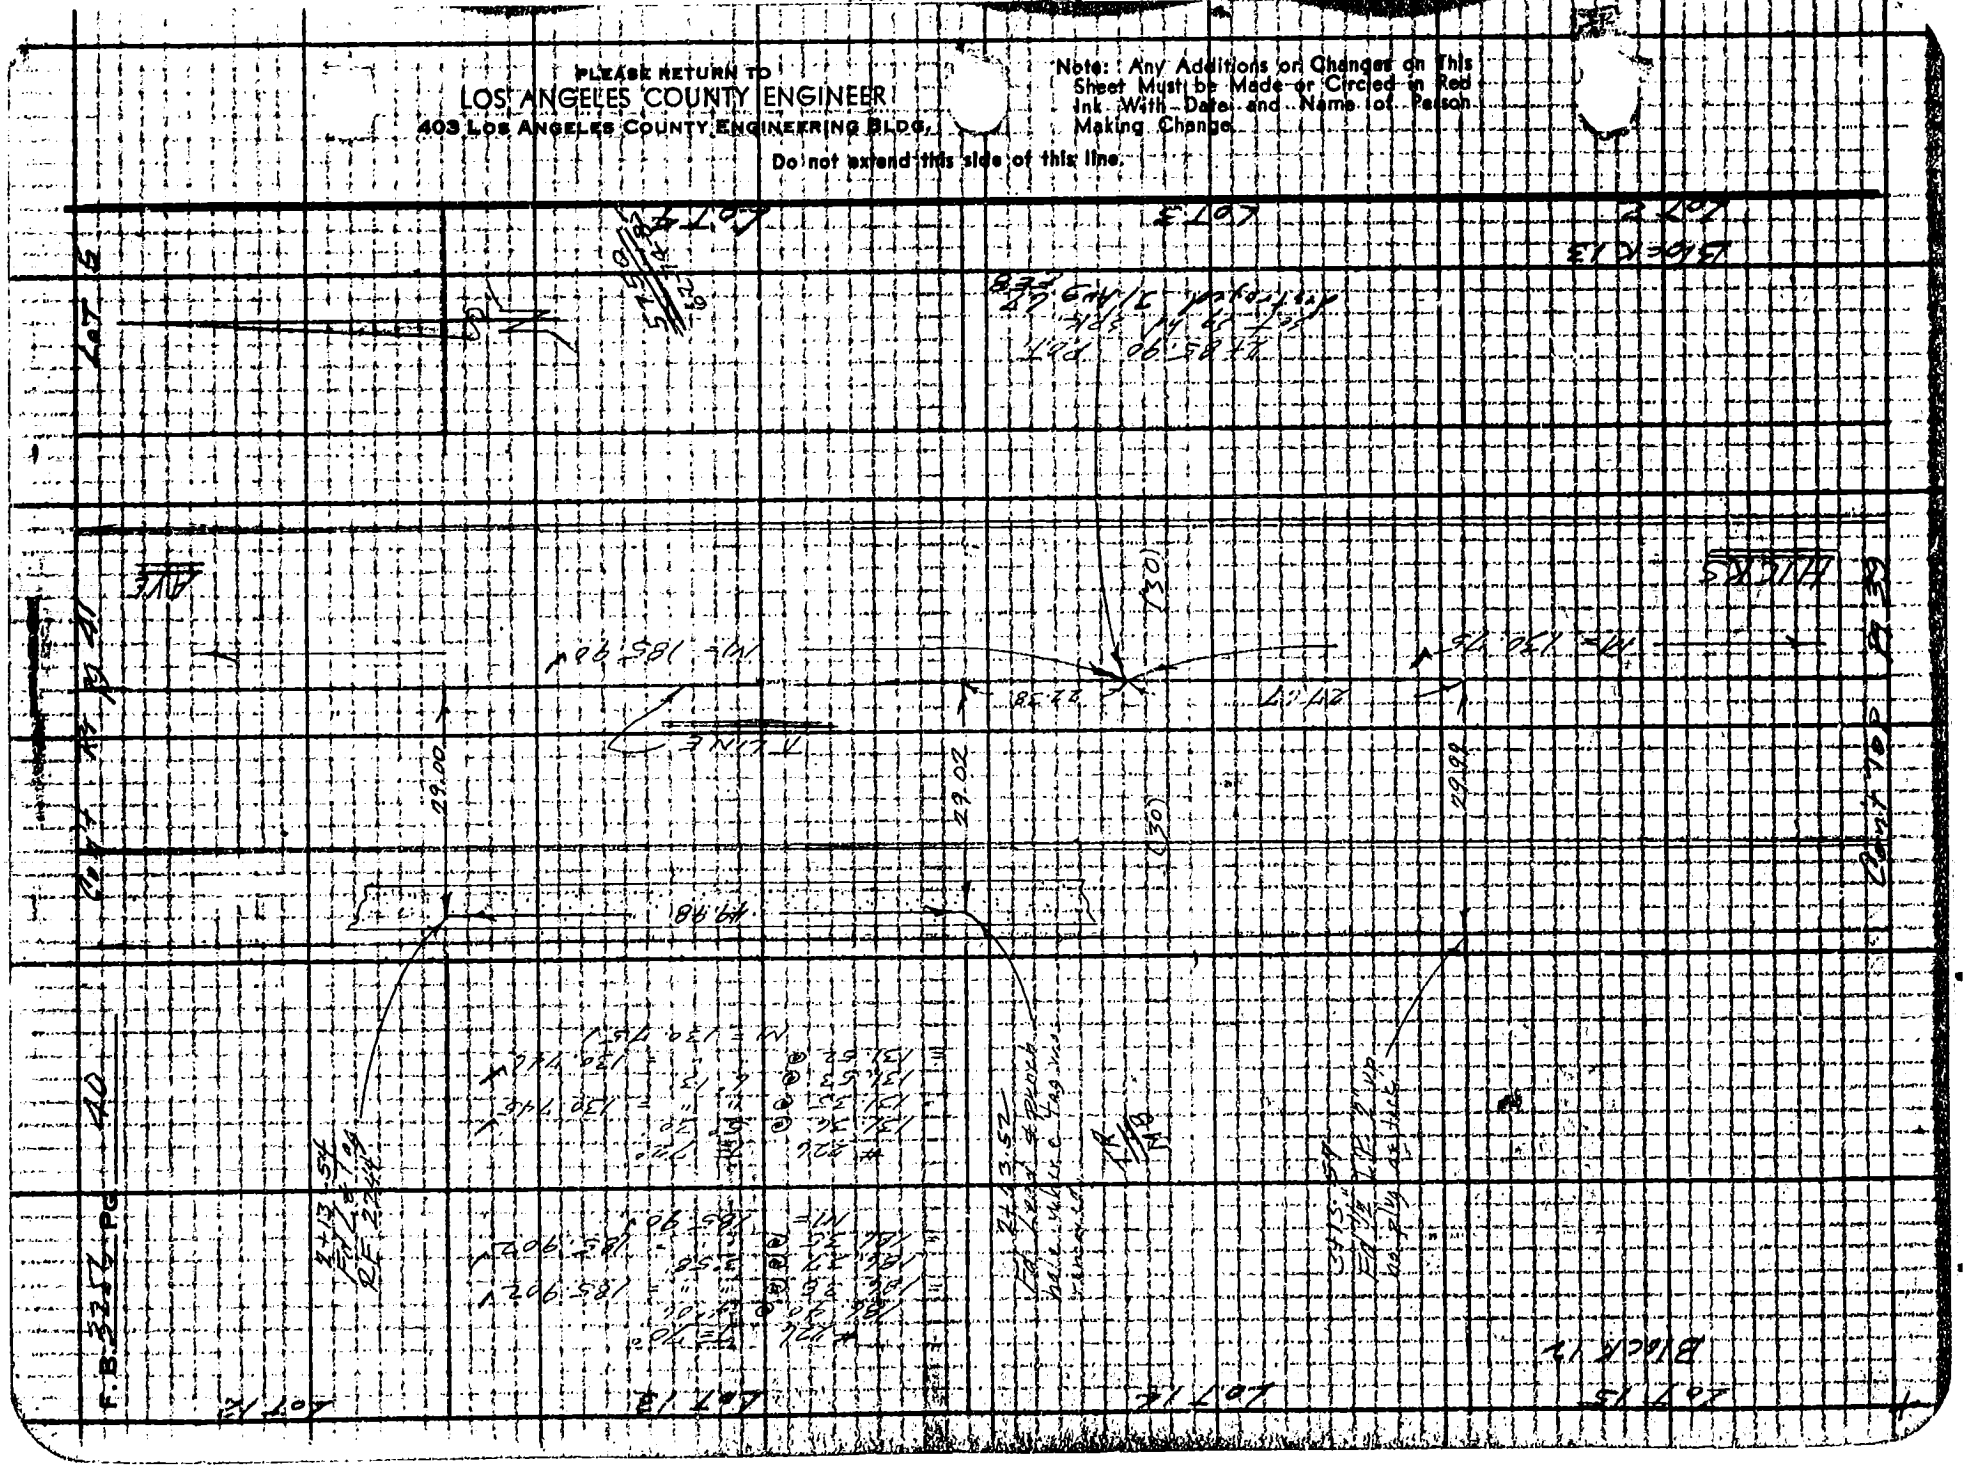

Notes Ck'd by: M. OSHITA
Map No.
Office Work
Checked
Date

Survey of: CITY TERRACE AREA
JN 0507'04 Tape 25' Std 84 °F
Surveyed by: E. E. Brooks
Notes: FEB - G.E. Cook Date: 5 Jan 66
Indexed: C. I. GALLI

F. B. 3256 Pg. 4

CONT BOT PG 126 OF FB 3156

W.S. 7, D-1

Notes: Any Additions or Changes on This Sheet Must Be Made or Circled in Red, Ink With Date and Name of Person Making Change.

Do not extend notes this side of this line.

RETURN TO
LOS ANGELES COUNTY ENGINEER
240 LOS ANGELES COUNTY ENGINEERING BLDG.

Lodge cf #247 7-58

For adjusted F.B. 241 F.B. 3156 F.E.B. Aug 67

Set Nail P.M. by Surv. 10 Aug 67 F.E.B.

Set Sm. P.M. in Rd. Dist. Mon. at TR Acc. Dist. W/4 of P/4 T.P. destroyed 10 Aug 67

AVE 1

A LINE

CONT TOP PG 125 OF FB 3156

RETURN TO
LOS ANGELES COUNTY ENGINEER
900 LOS ANGELES COUNTY ENGINEERING BLDG.

Note: Any Additions or Changes on This Sheet Must be Made or Circled in Red Ink With Date and Name of Person Making Change.

Do not extend notes this side of this line

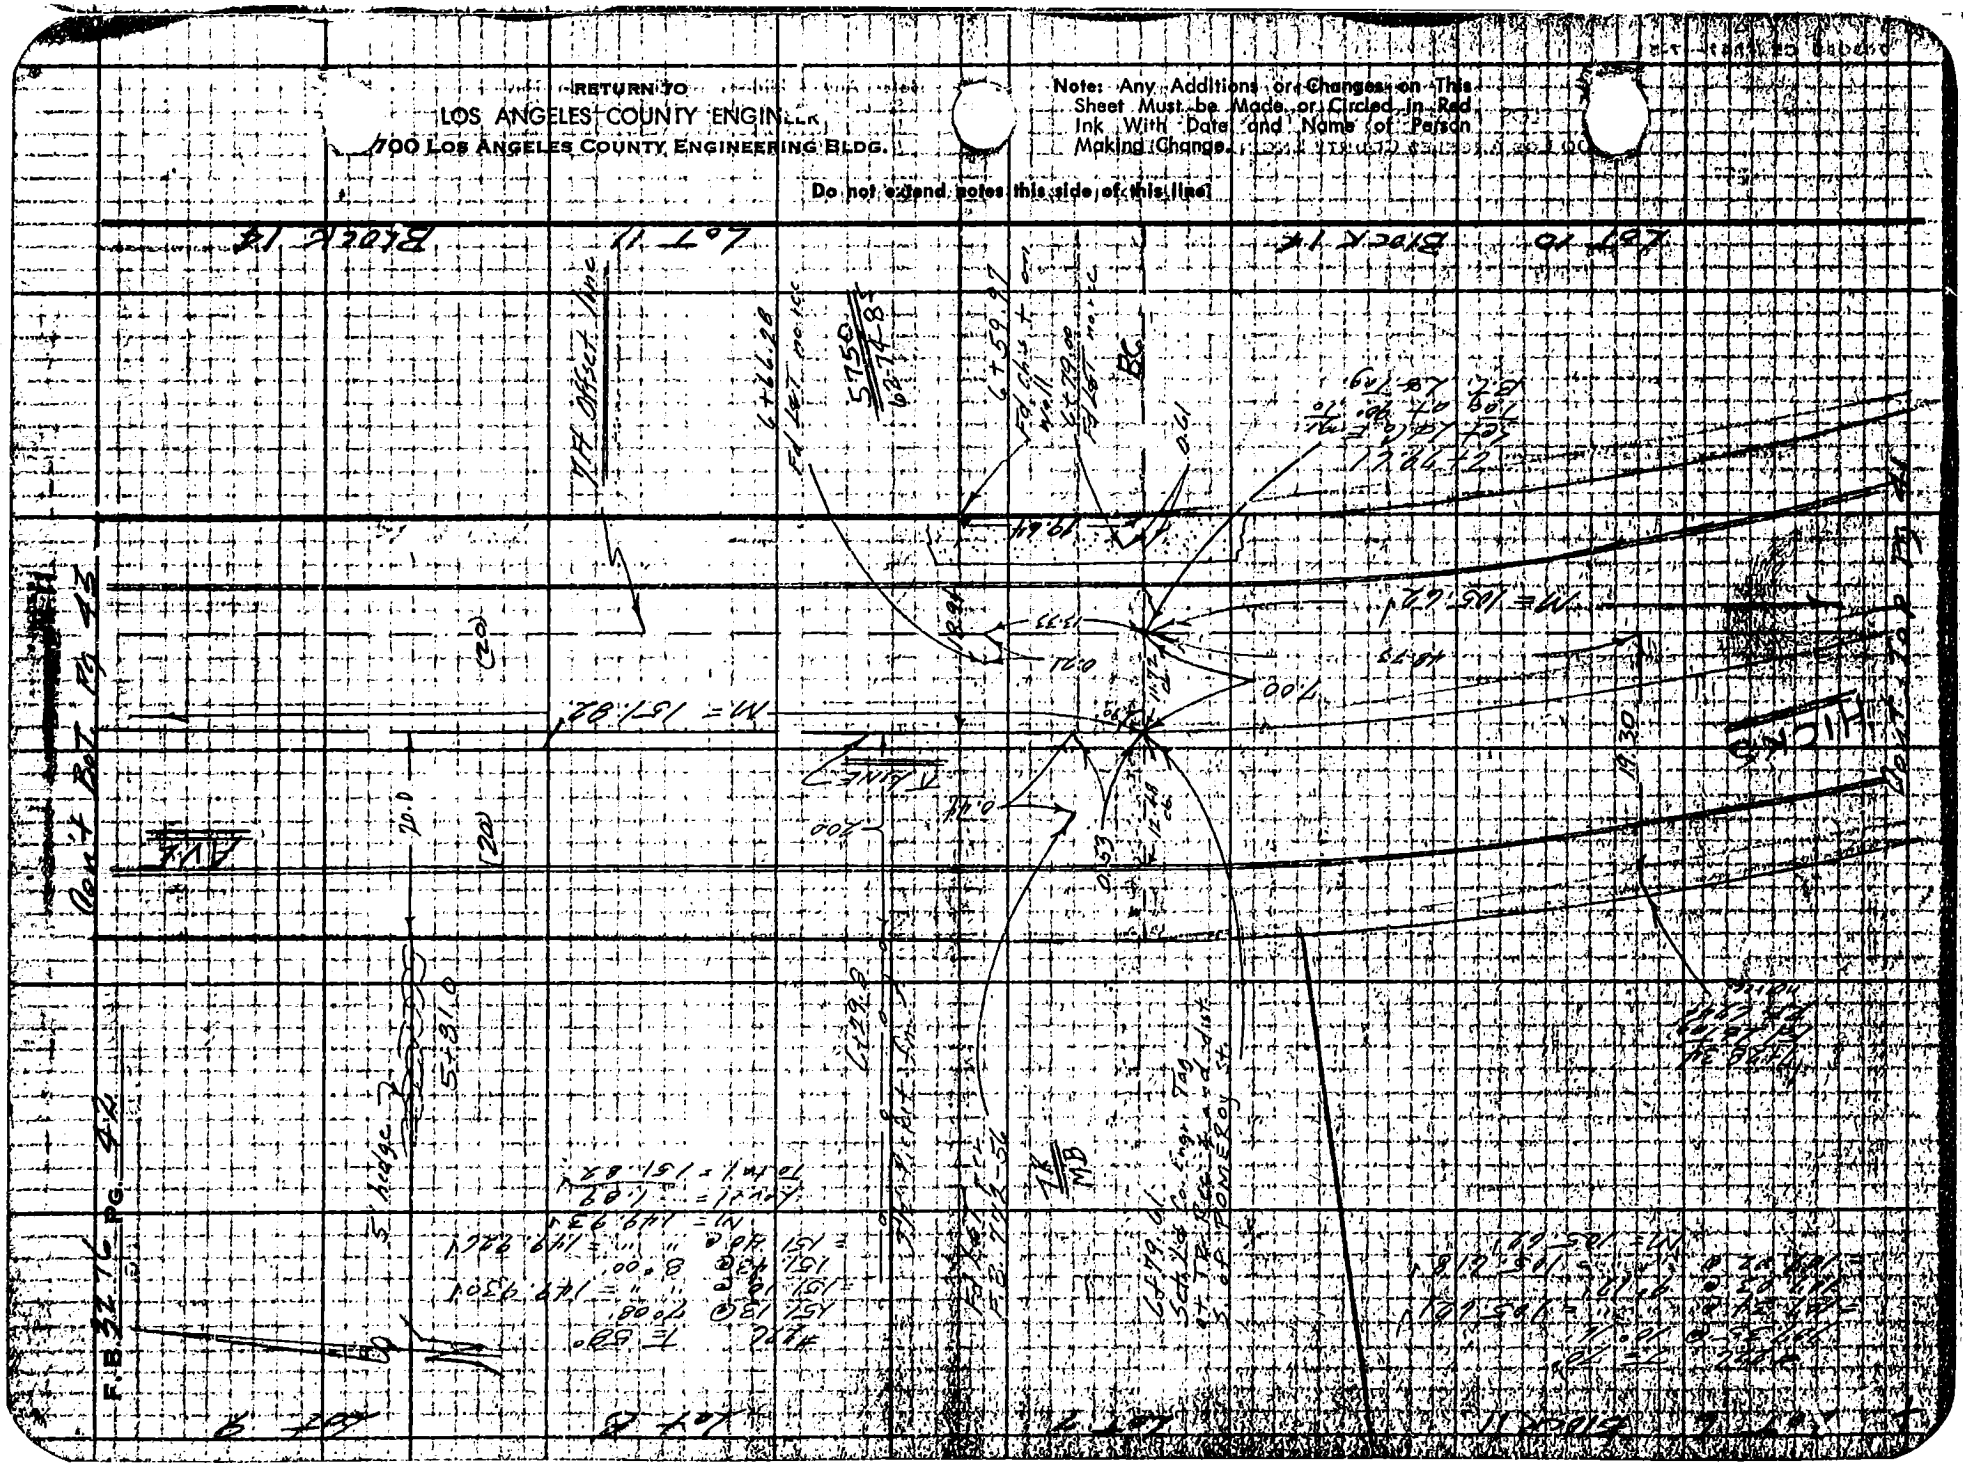
BLOCK 14
BLOCK 15
Notes Ck'd by M. OSHITA	Survey of CITY TERRACE AREA 4
Map No.	JN 0303.02 Tape 226 Std. 84 °F
Office Work	Surveyed by L.E. Brooks
Checked	Notes F.B. Date 6 Jan 66
Date	Indexed C. J. GALLI

F.B. ST 005 PG. 43

1) 62-10-00
2) 248-40-00
62-10-00
3) 13-00-00
62-10-00

CONT. FROM PG. 44

4+10.19 Fd L&T for F.B. 772-58 Set L&C Co. Engr. Tag

4+10.91 N45 = 1+00 To W Set L&C Co. Engr. Tag by TR Ext. of E.L. and dist. S. of POME Roof of ST.

Set L&C Co. Engr. Tag Pnd.

1) 90-00-15
2) 0-01-00
90-00-15
3) 180-01-30
90-00-15

7FT OFFSET LINE

4+30.59 Fd L&T I.S. 2510 Stmpd. in L no tie

Set L&C Co. Engr. Tag

Conc Retaining Wall

5+27.79 N Straddler Set L&T.

Set L&C Co. Engr. Tag by tie from

Fd L&T's no tie

Conc Drive

Set L&C Engr. Tag Pnd. at Calc. Point from P.C. To L

5+29.28 Fd L&T F.B. 772-58

5+29.16 N45 = 9+11.16 E40 Cemented C.A. Engr. Tag to align at property joint by tie

CONT. TO PG. 42

Note: Any Additions or Changes on This Sheet Must be Made or Circled in Red, Ink With Date and Name of Person Making Change.

W, S, 7, D-1

Do not extend note outside of this line.

RETURN TO LOS ANGELES COUNTY ENGINEER 900 LOS ANGELES COUNTY ENGINEERING BLDG.

703098 CE #2847—7-68

RETURN TO
LOS ANGELES COUNTY ENGINEER
700 LOS ANGELES COUNTY ENGINEERING BLDG.

Note: Any Additions or Changes on This Sheet Must be Made or Circled in Red Ink With Date and Name of Person Making Change.

Do not extend notes this side of this line.

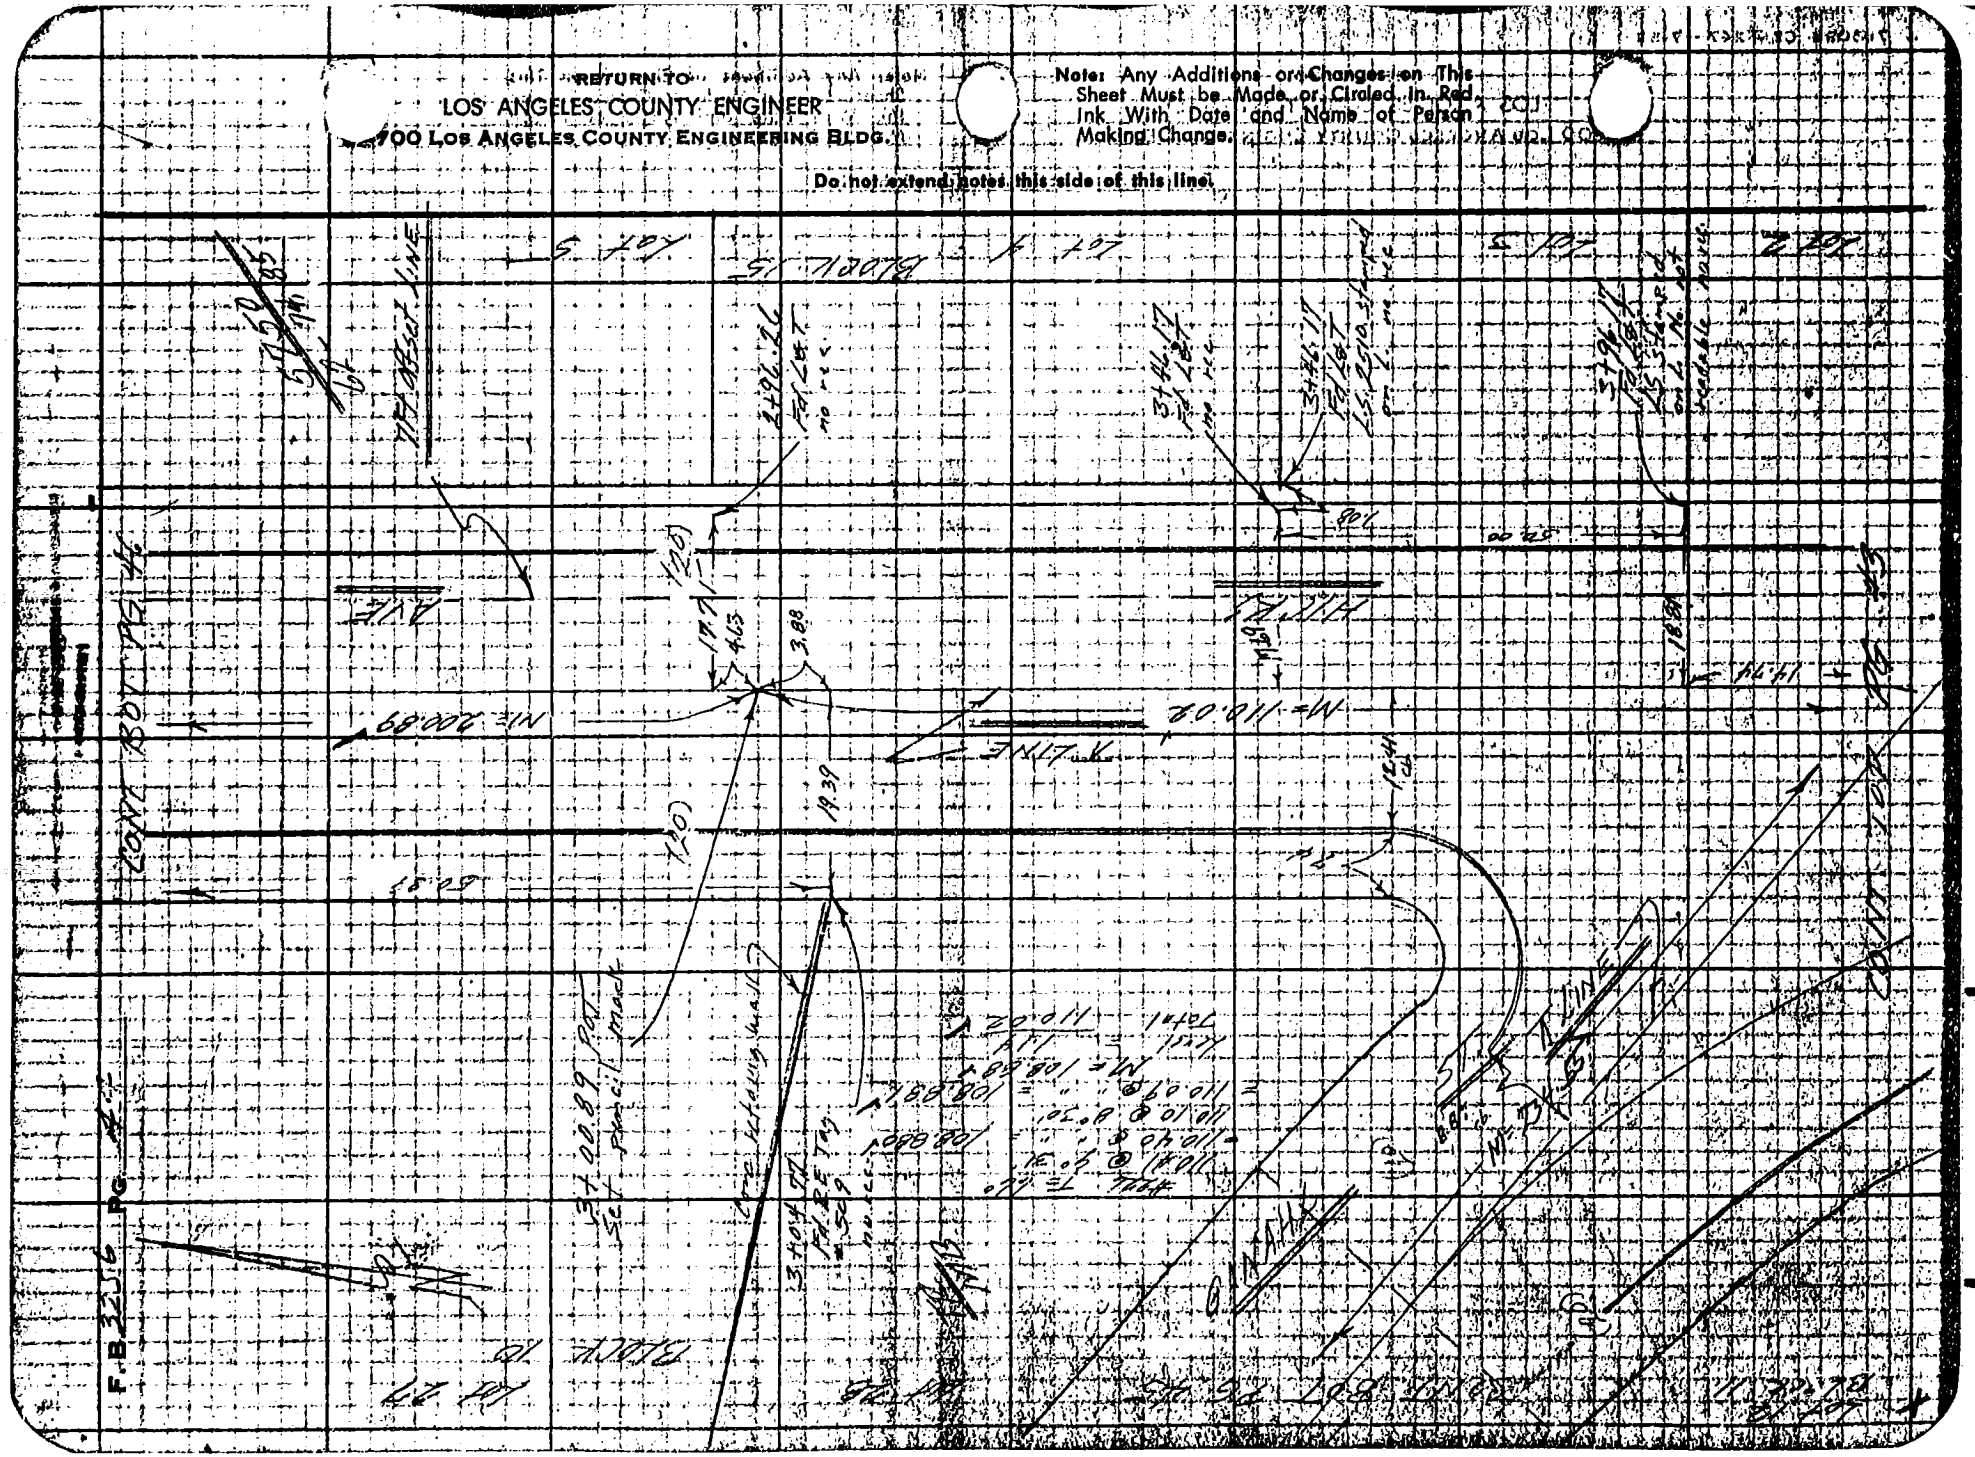

Notes Ck'd by M. OSHITA
Map No.
Office Work
Checked
Date

Survey of CITY TERRACE AREA
JN 23224 Tape 226 Std 2 °F
Surveyed by E. E. Brown
Notes FEB + SEC Date 10 Jan 61
Indexed G. J. GALLI

F.B. 3276 Pg. 45

Book TAP 5226

(29) (20)

LOT 13 BLOCK 11

N 11° 10' 35" W 1.80

3734.65 P.O.T.
Set ¾ bd. spk.

B.I.

LOT 12 BLOCK 11

LOT 14 BLOCK 11

Cont'd Pg 44

Note: Any Additions or Changes on This Sheet Must be Made or Circled in Red Ink With Date and Name of Person Making Change.

Do not extend this side of mil-line.

PLEASE RETURN TO
LOS ANGELES COUNTY ENGINEER
405 Los Angeles County Engineering Bldg.

ZF Form 68 #110 3-58

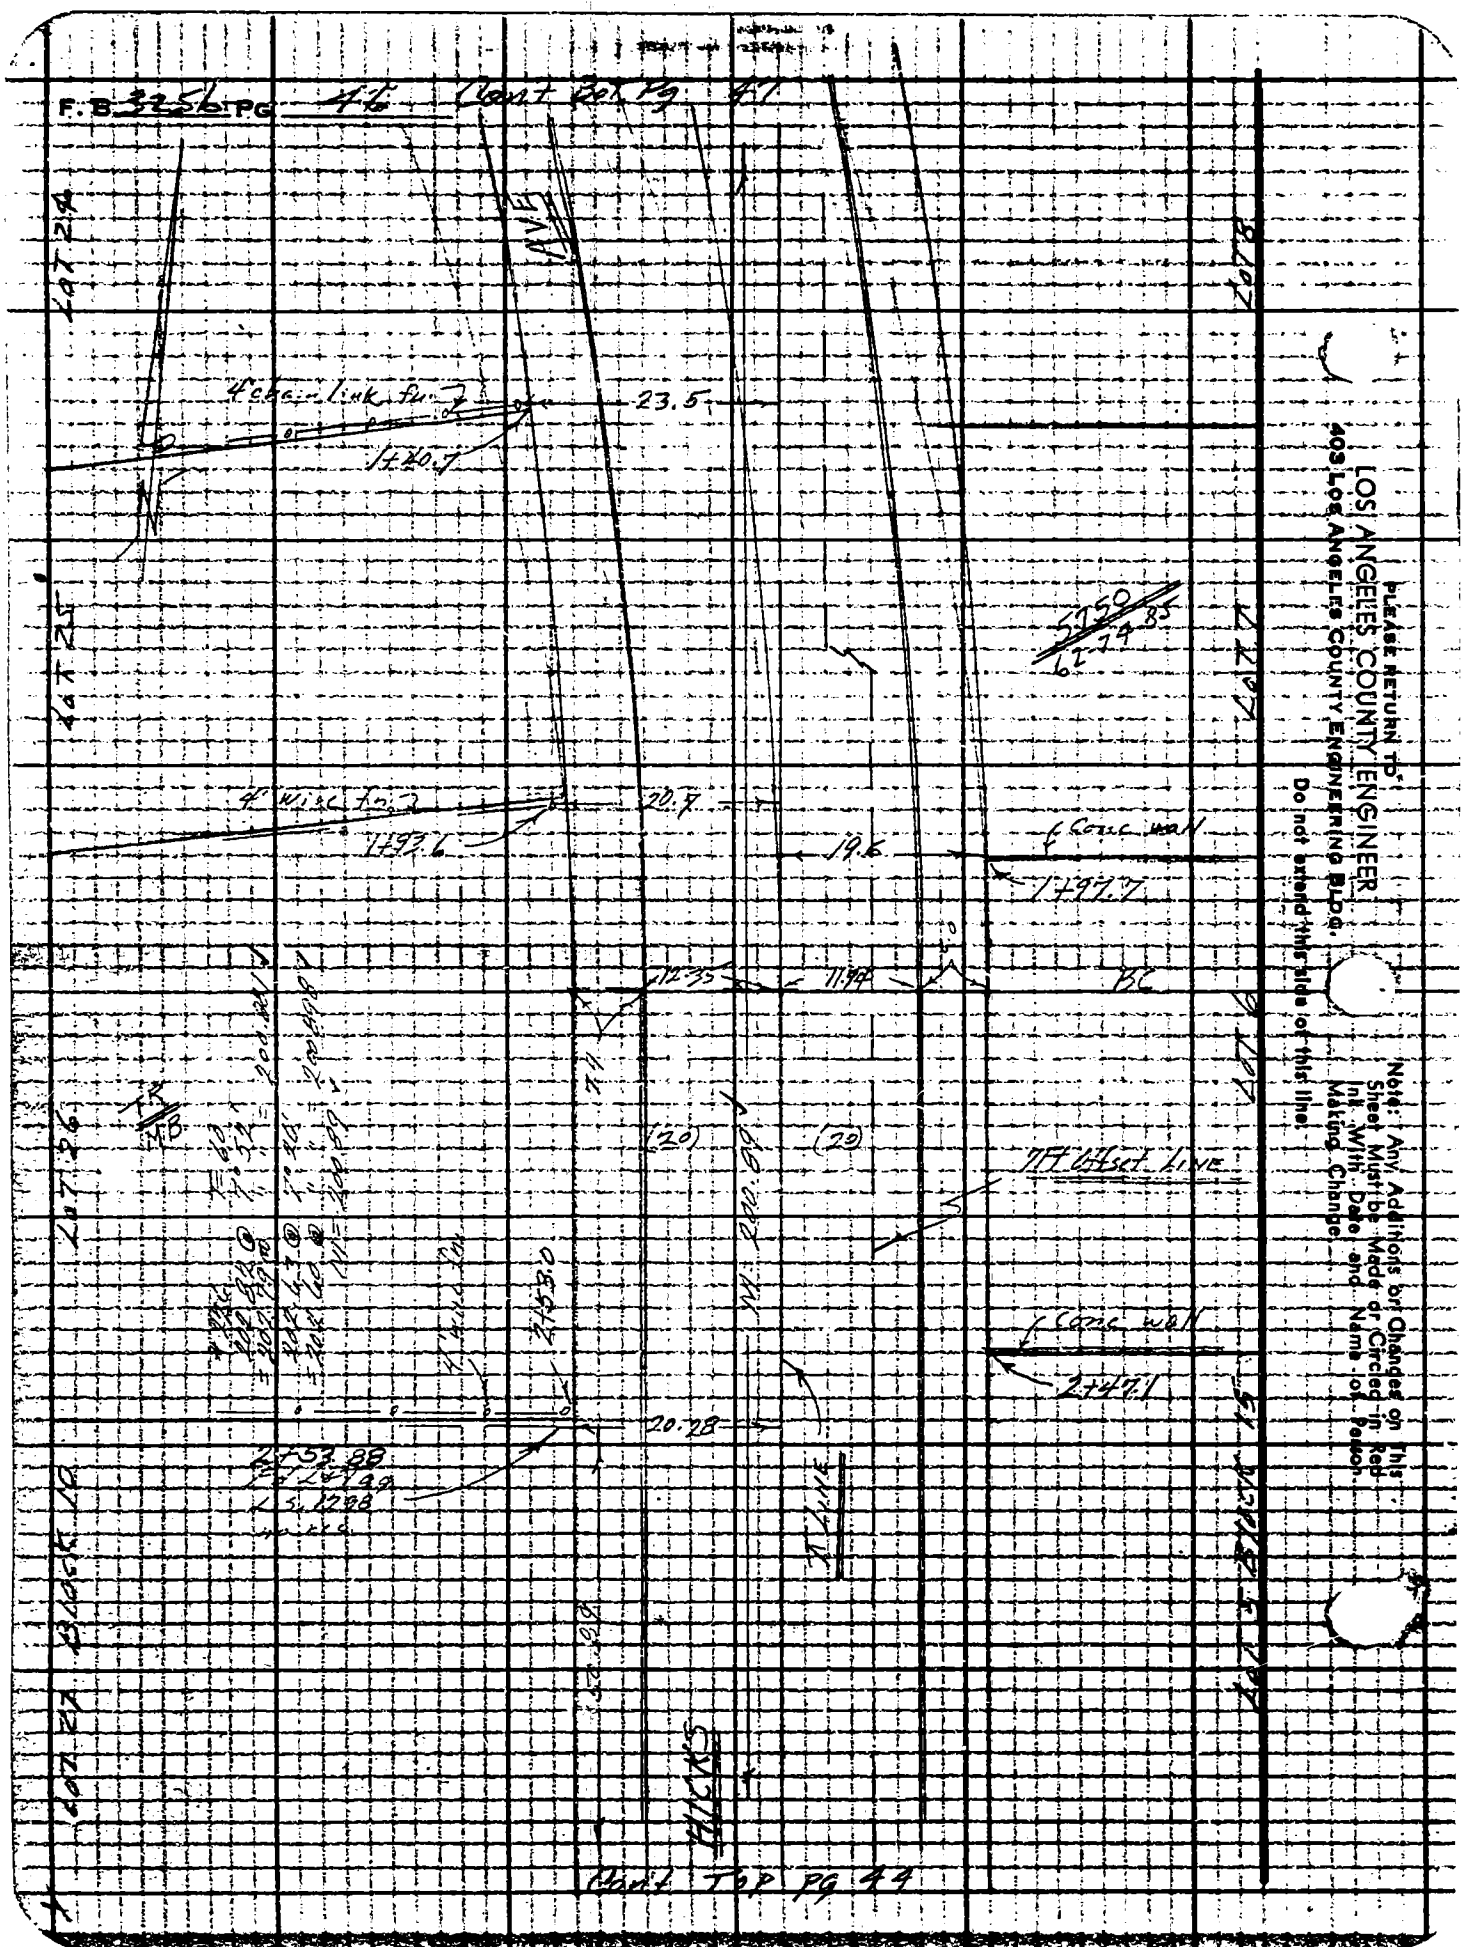
F.B 325 PG 46
Const Rel Pg 47
4" Conc. Link fw
23.5
1+20.7
4" W.L.C. fw
20.7
1+93.6
19.6
1+97.7
f Conc wall
2+49.1
TF Offset Line
20.28
2+53.88
Const Top Pg 44
LOS ANGELES COUNTY ENGINEER
Note: Any Additions or Changes on This Sheet Must be Made or Circled in Red Ink With Date and Name of Person Making Change
Do not extend this side of this line

Notes Ck'd by M. OSHITA | Survey of CITY TERRACE AREA | F.B. 3956 Pg. 47

Map No. | JN 0583:07 Tape 22C Std 84° F

Office Work | Surveyed by F. E. Brooks

Checked | Notes F.E.B. GEAR Date 6 Jan 66

Date | Indexed C. J. GALLI

CONT BOT PG 48

Note: Any Additions or Changes on This Sheet Must be Made or Circled in Red Ink With Date and Name of Person Making Change.

LOS ANGELES COUNTY ENGINEER
PLEASE RETURN TO
402 LOS ANGELES COUNTY ENGINEERING BLDG.
Do not extend this side of this line.

W.S.7.D.1

7 OF 1008 CE #310 R-53

CONC WALL

CONC BLOCK WALL

8+16.29 T.O.E.

= 1+00 N

1+00 S

Set L & C. Engr. Tag at TR. REC & and List from P.T. to E.

Set L & C. Engr. Tag good

(1) N 7°-30-00 E
(2) 312°-00-00
167°-30-00
(3) 285°-00-00
N 7°-30-00 E

Set L & C. Engr. Tag good

1+00.5 Set L & C. Engr. Tag for T.O. Offset Line A

OFF OFFSET LINE

(1) 136°-59'-55"
(2) 182°-58'-45"
136°-59'-56"
(3) 113°-59'-35"
136°-59'-55"

CONT TOP PG 48

F.B. 3856 PG. 48

Cont. Rt. Pg. 49

Lot 18

Lot 19

Lot 20

Lot 21

Block 10

Tract 3

3+79.1

4' chain link fence

R = 134.45

(20)

(20)

N 11° E

134.45

3+81.0

Hedge

8.0

3+32.0

4' chain link fence

8.6

3+89.7

4' Chain link fence

8.2

2+39.5

4' Chain link fence

8.2

3+09.84 POT

Set pencil mark

3' steel picket fence

9.5

12.22 ch.

11.80 ch.

Cont. Rt. Pg. 47

PLEASE RETURN TO
LOS ANGELES COUNTY ENGINEER
403 LOS ANGELES COUNTY ENGINEERING BLDG.

Note: Any Additions or Changes on This Sheet Must be Made or Circled in Red Ink With Date and Name of Person Making Change

Do not extend this side of this line.

Map No. | JN 750310 Tape TLC Std BF
Office Work | Surveyed by S.E. Brooks
Checked | Notes FEB SE Brooks Date FEB 1970 Cmp. GALL
Date | Indexed

CONT BOT PG 39

℄ LINE

(12.5) (12.5)

Back of Walk

Back of Walk

Set L&C Co. Engr. Tag prod

Ft = 9.22
Set L&C Co. Engr. Tag at TP. Rad. dist. N. of Pomeroy St.

WALK

℄ LINE

M = 134.45

Set L&C Co. Engr. Tag at TP. Back of from Pomeroy St.

Set L&C Co. Engr. Tag Prod.

M = 140

1) 96 = 45 = 05
2) 27 = 20 = 25
96 = 45 = 02
3) 220 = 30 = 45
96 = 45 = 02

1) 140 - 10 - 00
2) 200 - 40 - 00
140 = 10 = 00
3) 121 - 00 - 00
140 - 10 - 00

Block 10

Lot 18

Co. St. Bdy. Pg. 30

Lot 8

Lot 18

PLEASE RETURN TO
LOS ANGELES COUNTY ENGINEER
403 Los Angeles County Engineering Bldg.

Note: Any Additions or Changes on This Sheet Must Be Made or Circled in Red Ink With Date and Name of Person Making Change.

Do not extend this side of this line.

W.S. 17, D-1

7M2008 ck #110 Calif.

PLEASE RETURN TO
LOS ANGELES COUNTY ENGINEER
403 LOS ANGELES COUNTY ENGINEERING BLDG.

Note: Any Additions or Changes on This Sheet Must be Made or Circled in Red Ink With Date and Name of Person Making Change.

Do not extend this side of this line.

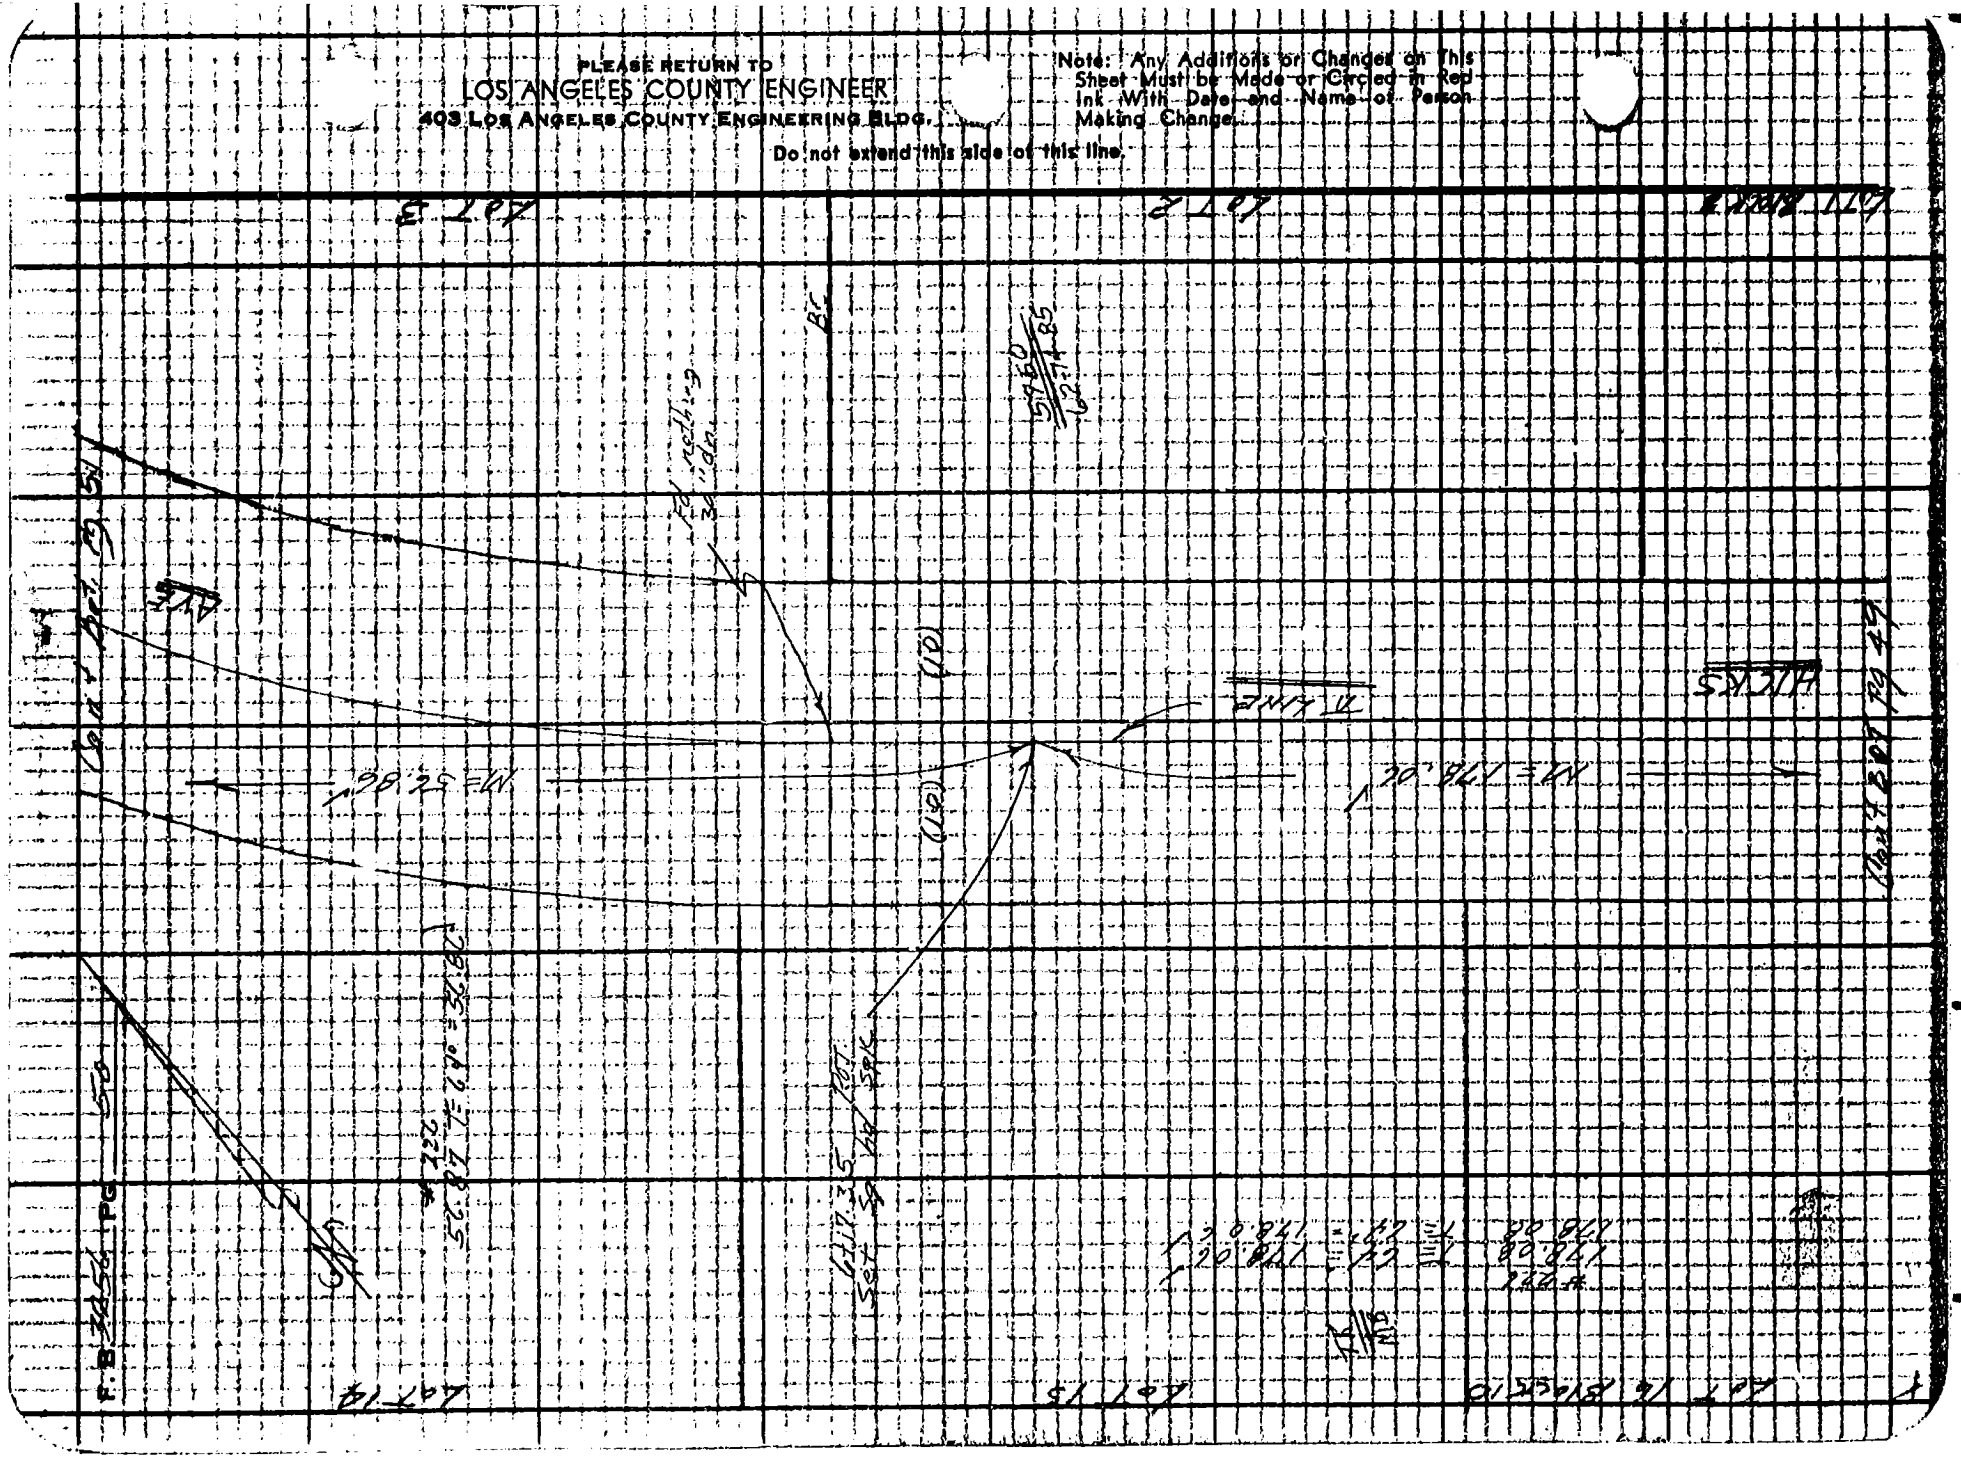

Notes Ck'd by: [illegible]	Survey of: CITY TERRACE AREA	F.B. 3456	Pg. 54
Map No.	JN° 303.04 Tape 200 Std. B ℄ F		
Office Work	Surveyed by: E. E. Brooks		
Checked	Notes FB Date 31 Jan 66		
Date	Indexed C. J. Gallo		

Note: Any Additions or Changes on This Sheet Must be Made or Circled in Red Ink With Date and Name of Person Making Change.

Do not extend this side of this line.

LOS ANGELES COUNTY ENGINEER
ROAD DEPARTMENT
LOS ANGELES COUNTY ENGINEERING BLDG.
108 Los Angeles, California

Lot L Block 3

CONT BDY PG 52

℄ LINE

WALK

Set BT SPK 6T in P.P. # 475.26 alk

M-89 44' E

Block 8

Block 9

Set BT. SPK N&T at split of ℄

143-12-55
217-51-40
143-12-55
143-12-55

37.73 T=52.0 = 37.72

Set 1/2" I.P. 0.5' Set Spike at I.R. Dec. # from BT To E.

Set BT SPK N&T

77-36-28
143-12-55

CONT TOP PG 50

F. B. 3454 : PG. 52

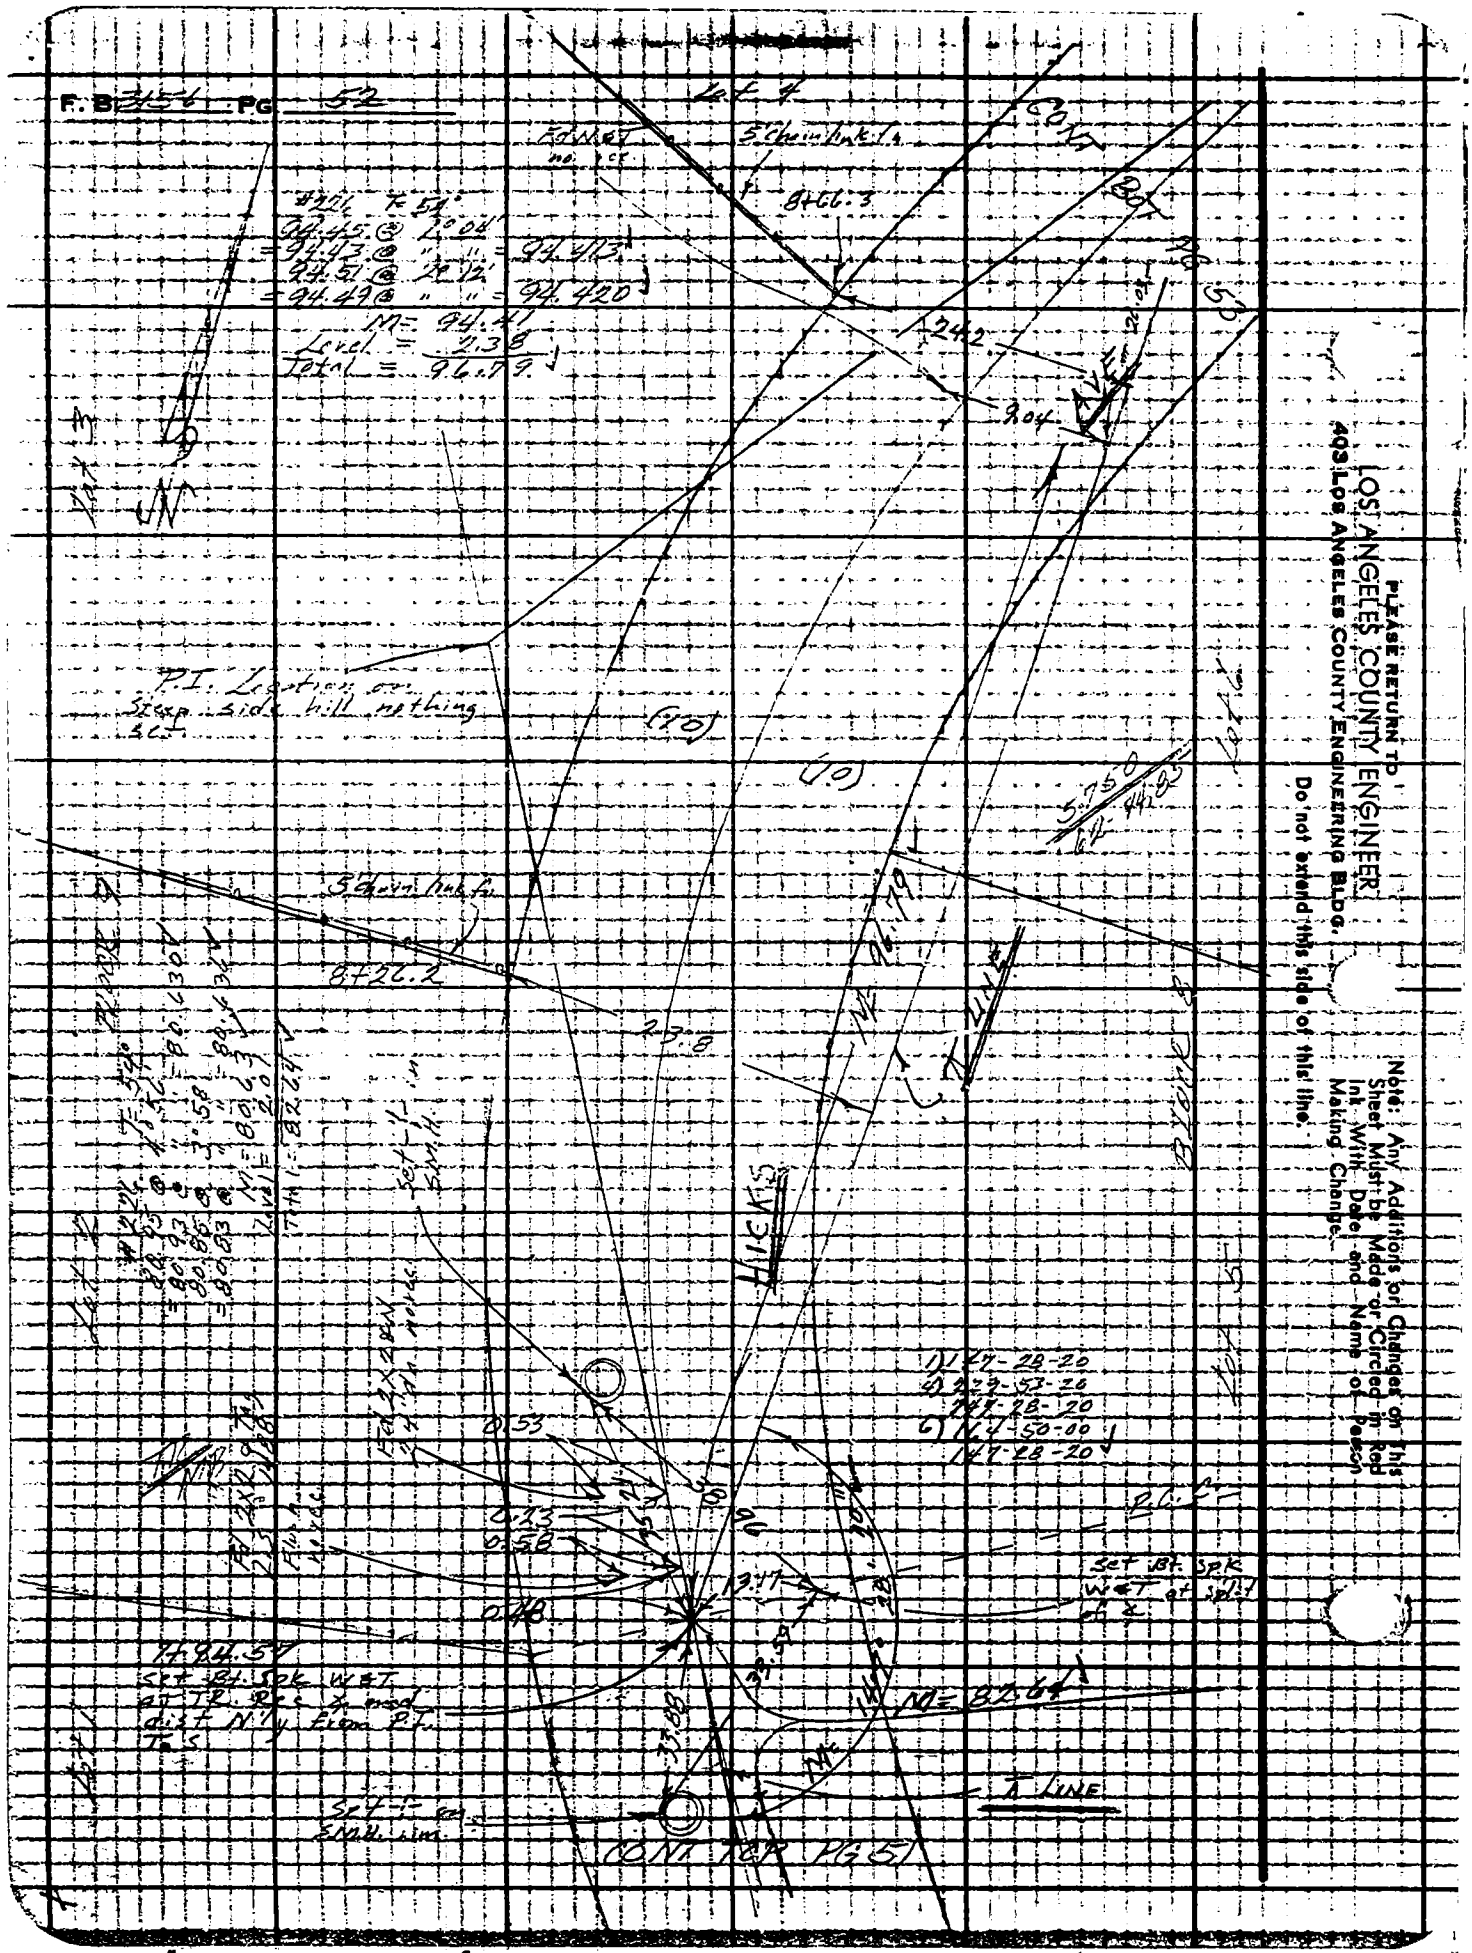
Lot 4
Set nail no tag
5' chain link f.
Set nail
Set nail
Set nail

Notes Ck'd by M. Sotura
Map No.
Office Work
Checked
Date

Survey of CITY TERRACE AREA
JN 0532.04 Tape 220 Std Beg °F
Surveyed by E. E. Brooks
Notes FEB 6 Clear Date 3 Feb 66
Indexed W. J. Galt

F. B. 325 Pg. 53

Note: Any Additions or Changes on This Sheet Must Be Made in Red Ink With Date and Name of Person Making Change.

PLEASE RETURN to
LOS ANGELES COUNTY ENGINEER
405 Los Angeles County Engineering Bldg.

Do not extend this side of this line.

ZONAR CF #110 A83

Dev. to Bot. Pg. 54

AVE

A LINE

D 147-28-20
D 259-53-20
D 147-28-20
D 164-50-00
147-28-20

LOT 18 Block 19

Set ⅝ in. S.M.H.

B+91.4

2" above in.

5.0

B+91.36
Set B.S.P.K.N.
at last calc. dist.
and 2 from P.C.
Tan. E.
Ed nothing 30" dn.

Set ⅝ in end of
3rd R.R. rail past Tan.
E. end of steel guard
rail.

E.C.

C.B. head wall

Set Lead
Expn. Top

A LINE

Cont. To Pg 52

PLEASE RETURN TO
LOS ANGELES COUNTY ENGINEER
403 LOS ANGELES COUNTY ENGINEERING BLDG.

Note: Any Additions or Changes on This Sheet Must be Made or Circled in Red Ink With Date and Name of Person Making Change.

Do not extend this side of this line.

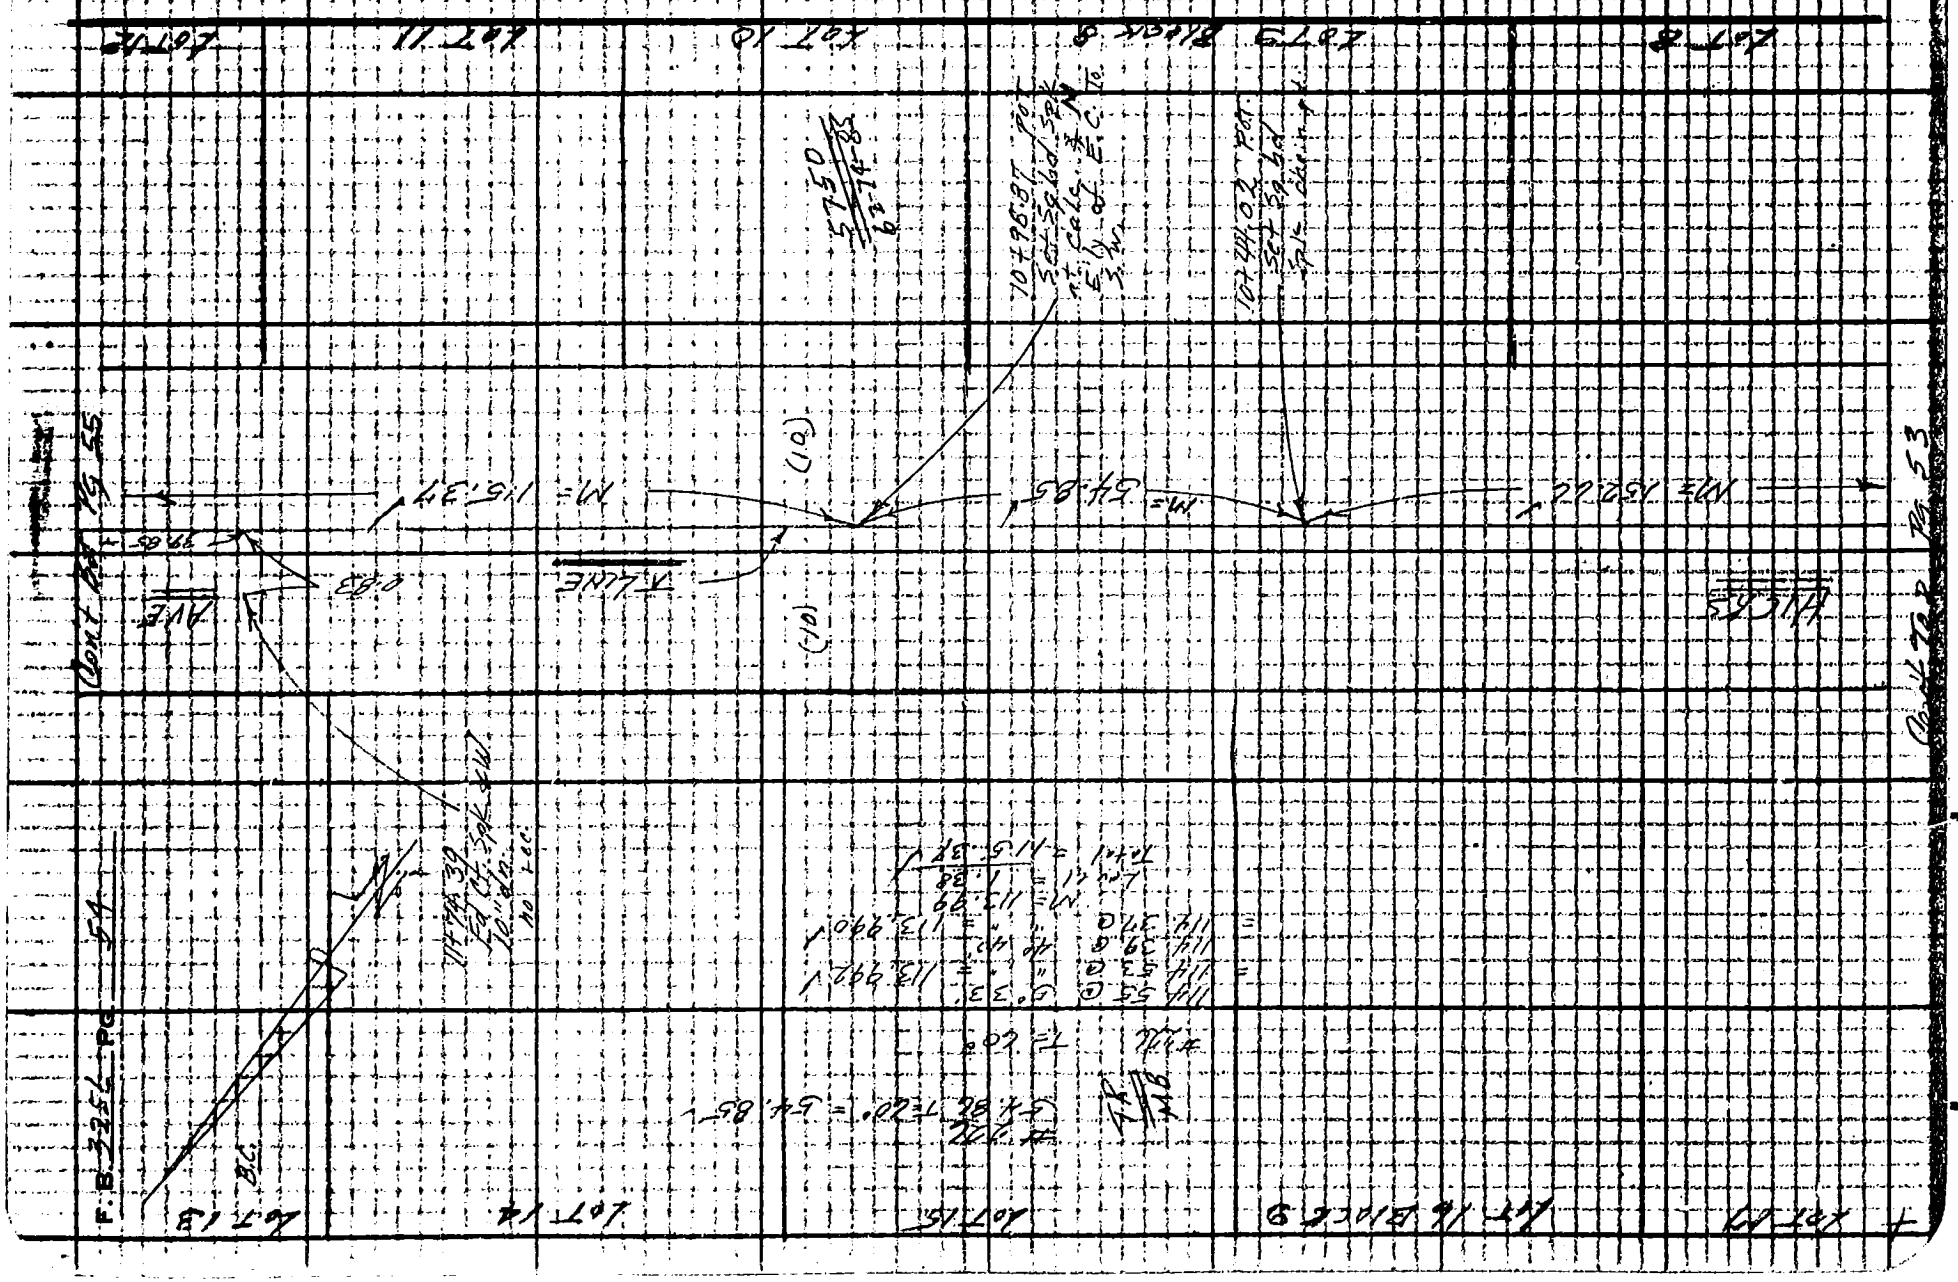

Notes Ck'd by M. OSHITA | Survey of CITY TERRACE AREA | F.B. 525 Pg. 56
Map No. | JN 3003.06 Tape 226 Std. 8' 9F
Office Work | Surveyed by E.E. Brooks
Checked | Notes FB & GE Book Date 3 Feb 66
Date | Indexed G. J. GALL

CONT FR PG 56

Note: Any Additions or Changes on This Sheet Must be Made or Circled in Red Ink With Date and Initials of Person Making Change.

Do not extend this side of this line.

PLEASE RETURN TO
LOS ANGELES COUNTY ENGINEER
402 Los Angeles County Engineering Bldg.

Cont To Pg 54

PLEASE RETURN TO
LOS ANGELES COUNTY ENGINEER
409 Los Angeles County Engineering Bldg.

Note: Any Additions or Changes on This Sheet Must be Made or Circled in Red Ink With Date and Name of Person Making Change.

Do not extend this side of this line.

W.S. 7, D-1

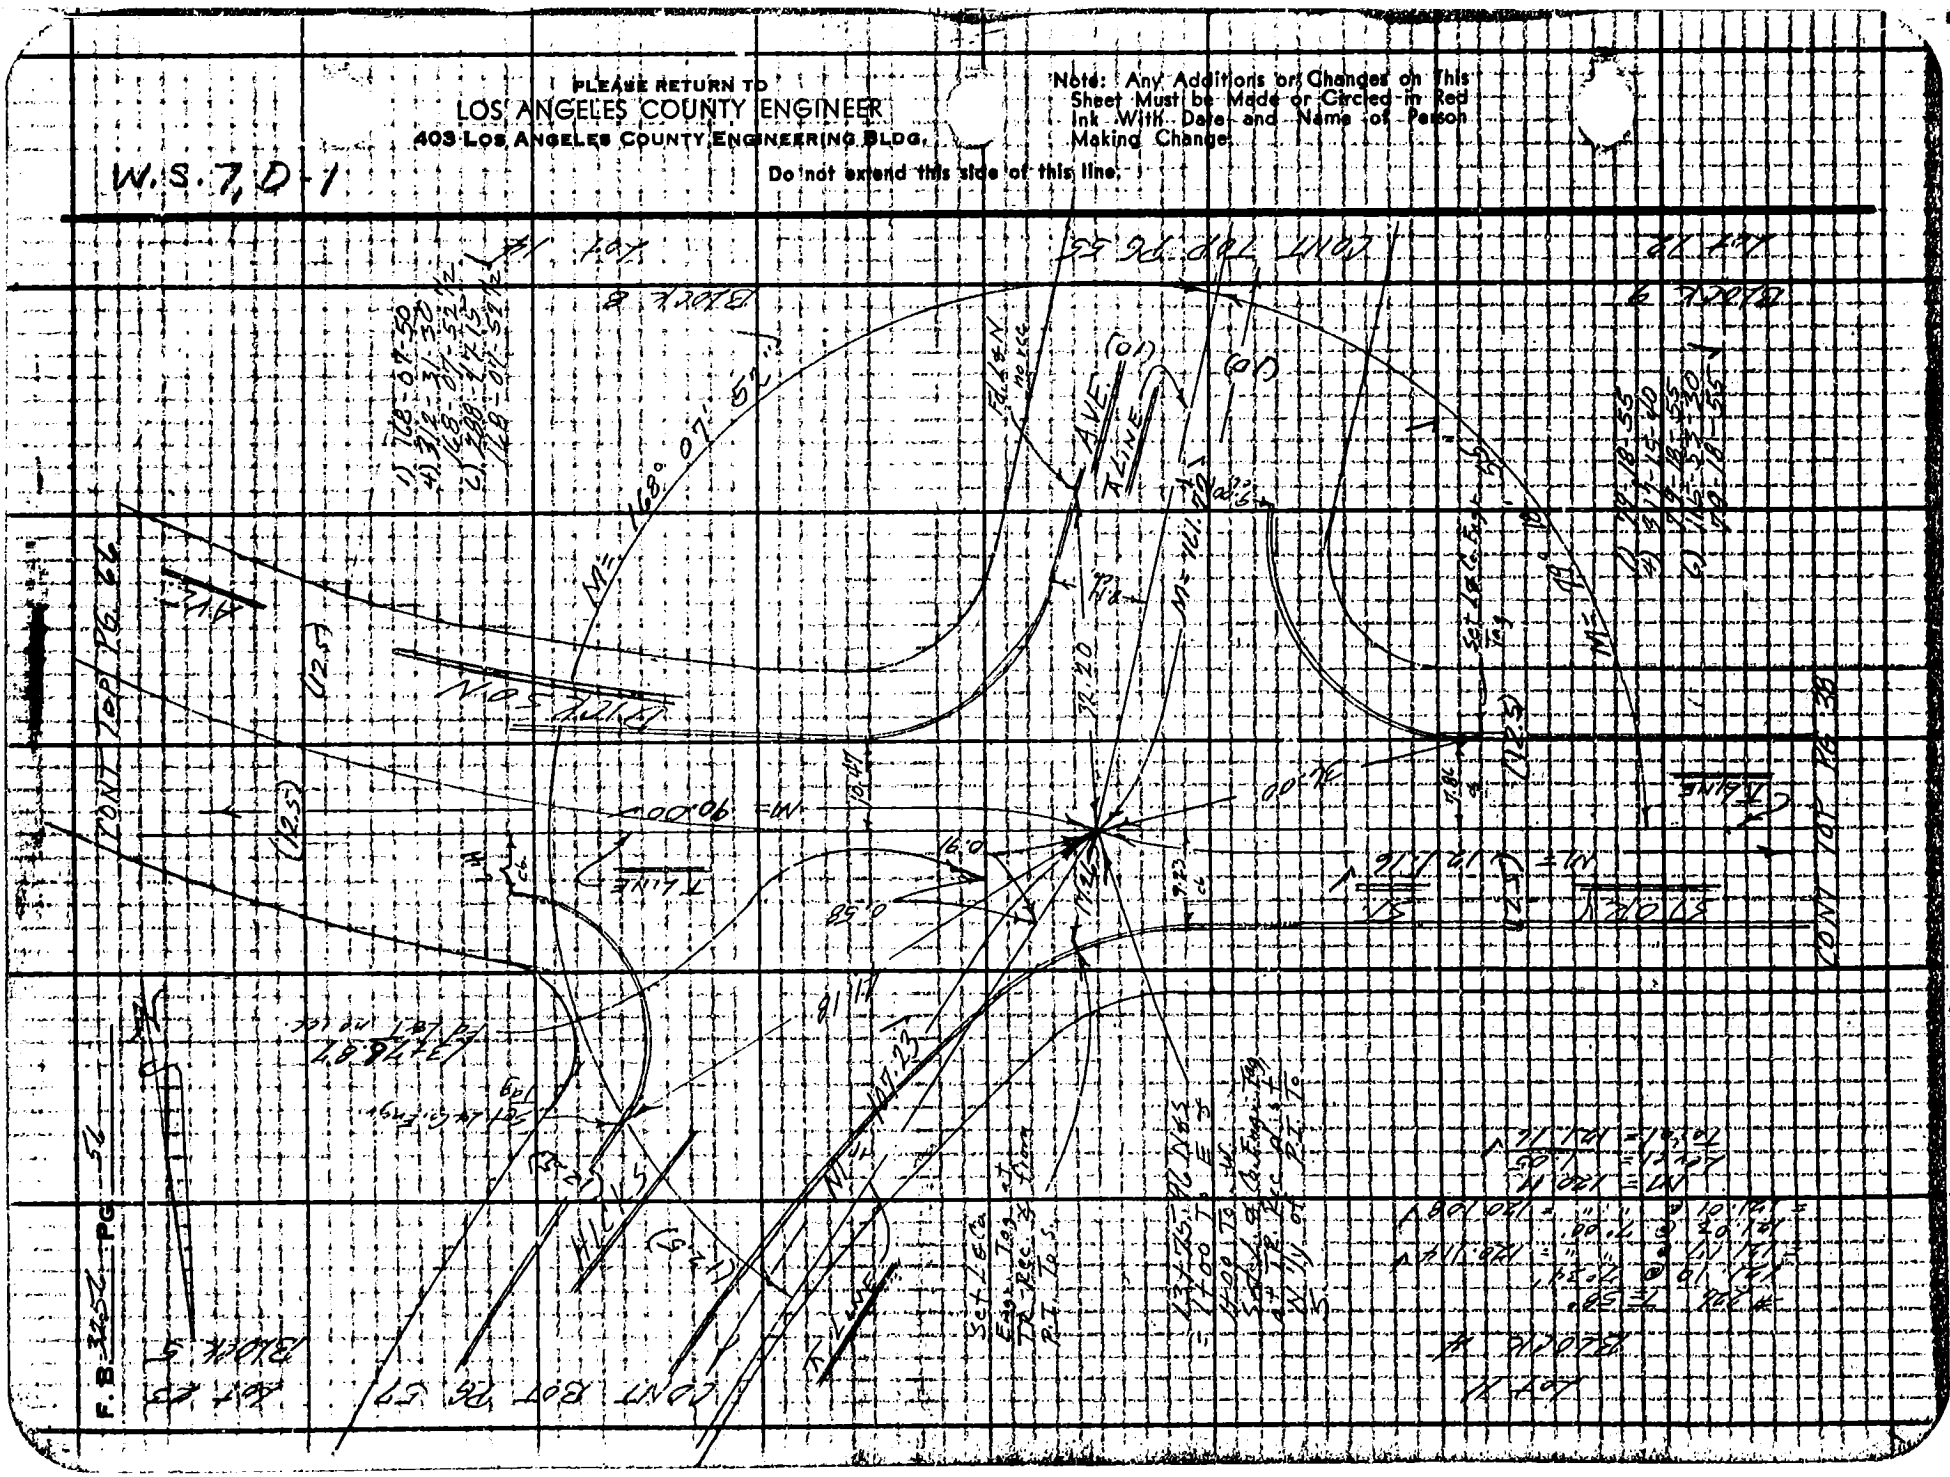

Notes Ck'd by M. OSHITA
Map No.
Office Work
Checked
Date

Survey of CITY TERRACE AREA
JN 0337.29 Tape 22E Std 24 1st
Surveyed by G. E. Bacon
Notes FEE 4 Feet Date 4 FEB 43
Indexed K. J. GALLI

F. B. 3256 Pg. 57

Cont'd Pat 3 58

Lot 5

Block 3

Lot 24
























Block 19

Block 20

Block

PLEASE RETURN TO
LOS ANGELES COUNTY ENGINEER
403 LOS ANGELES COUNTY ENGINEERING BLDG.

Do not extend this side of this line.

Note: Any Additions or Changes on This Sheet Must Be Made or Circled in Red Ink With Date and Name of Person Making Change.

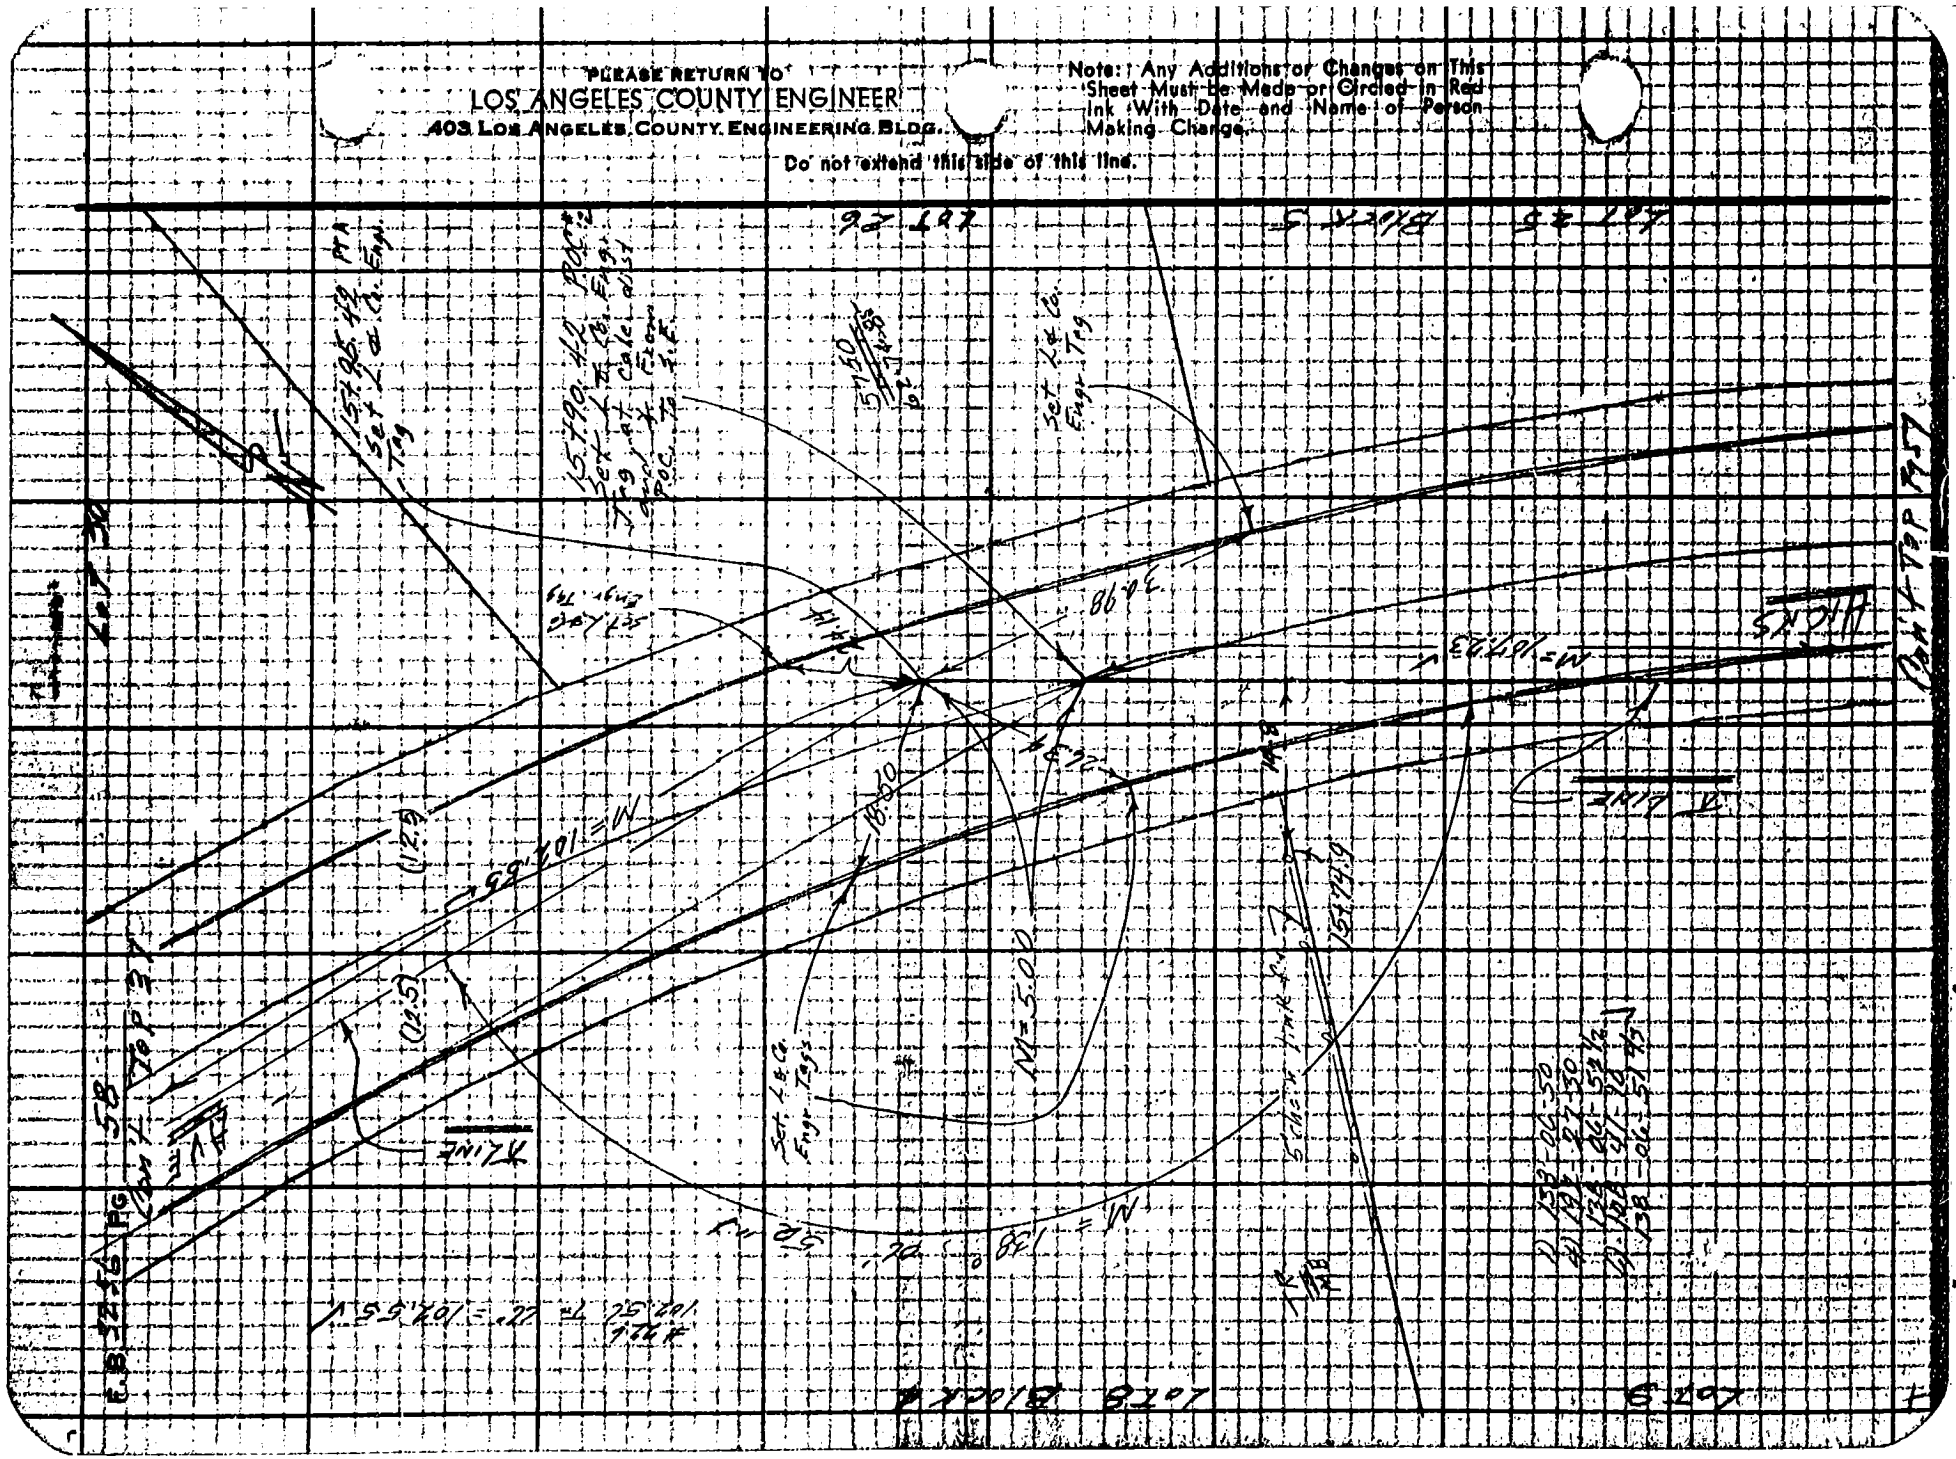
97+197
5+20.18
5+197
157.96 PI
Set L & C.
Engr. Tag
157.90 PI
Set L & C.
Engr. Tag
Set L & C.
Engr. Tags
N=5.00
N=10.00
N=10.00
N=10




Note: Any Additions or Changes on This Sheet Must be Made or Circled in Red Ink With Date and Name of Person Making Change.

Do not extend this line off of this line.

PLEASE RETURN TO
LOS ANGELES COUNTY ENGINEER
700 Los Angeles County Engineering Bldg.

CONT FROM PG 60

CONT TO PG 59

CONT FROM PG 59

CONT TO PG 61





























10+21.3

10+65.1

14.0

12.53

21.9

13.1

5.0

4' Walk

Lot 4

Lot 5

Lot 6



















PLEASE RETURN TO
LOS ANGELES COUNTY ENGINEER
700 LOS ANGELES COUNTY ENGINEERING BLDG.

Note: Any Additions or Changes on This Sheet Must be Made or Circled in Red Ink With Date and Name of Person Making Change.

Do not extend this side of this line.

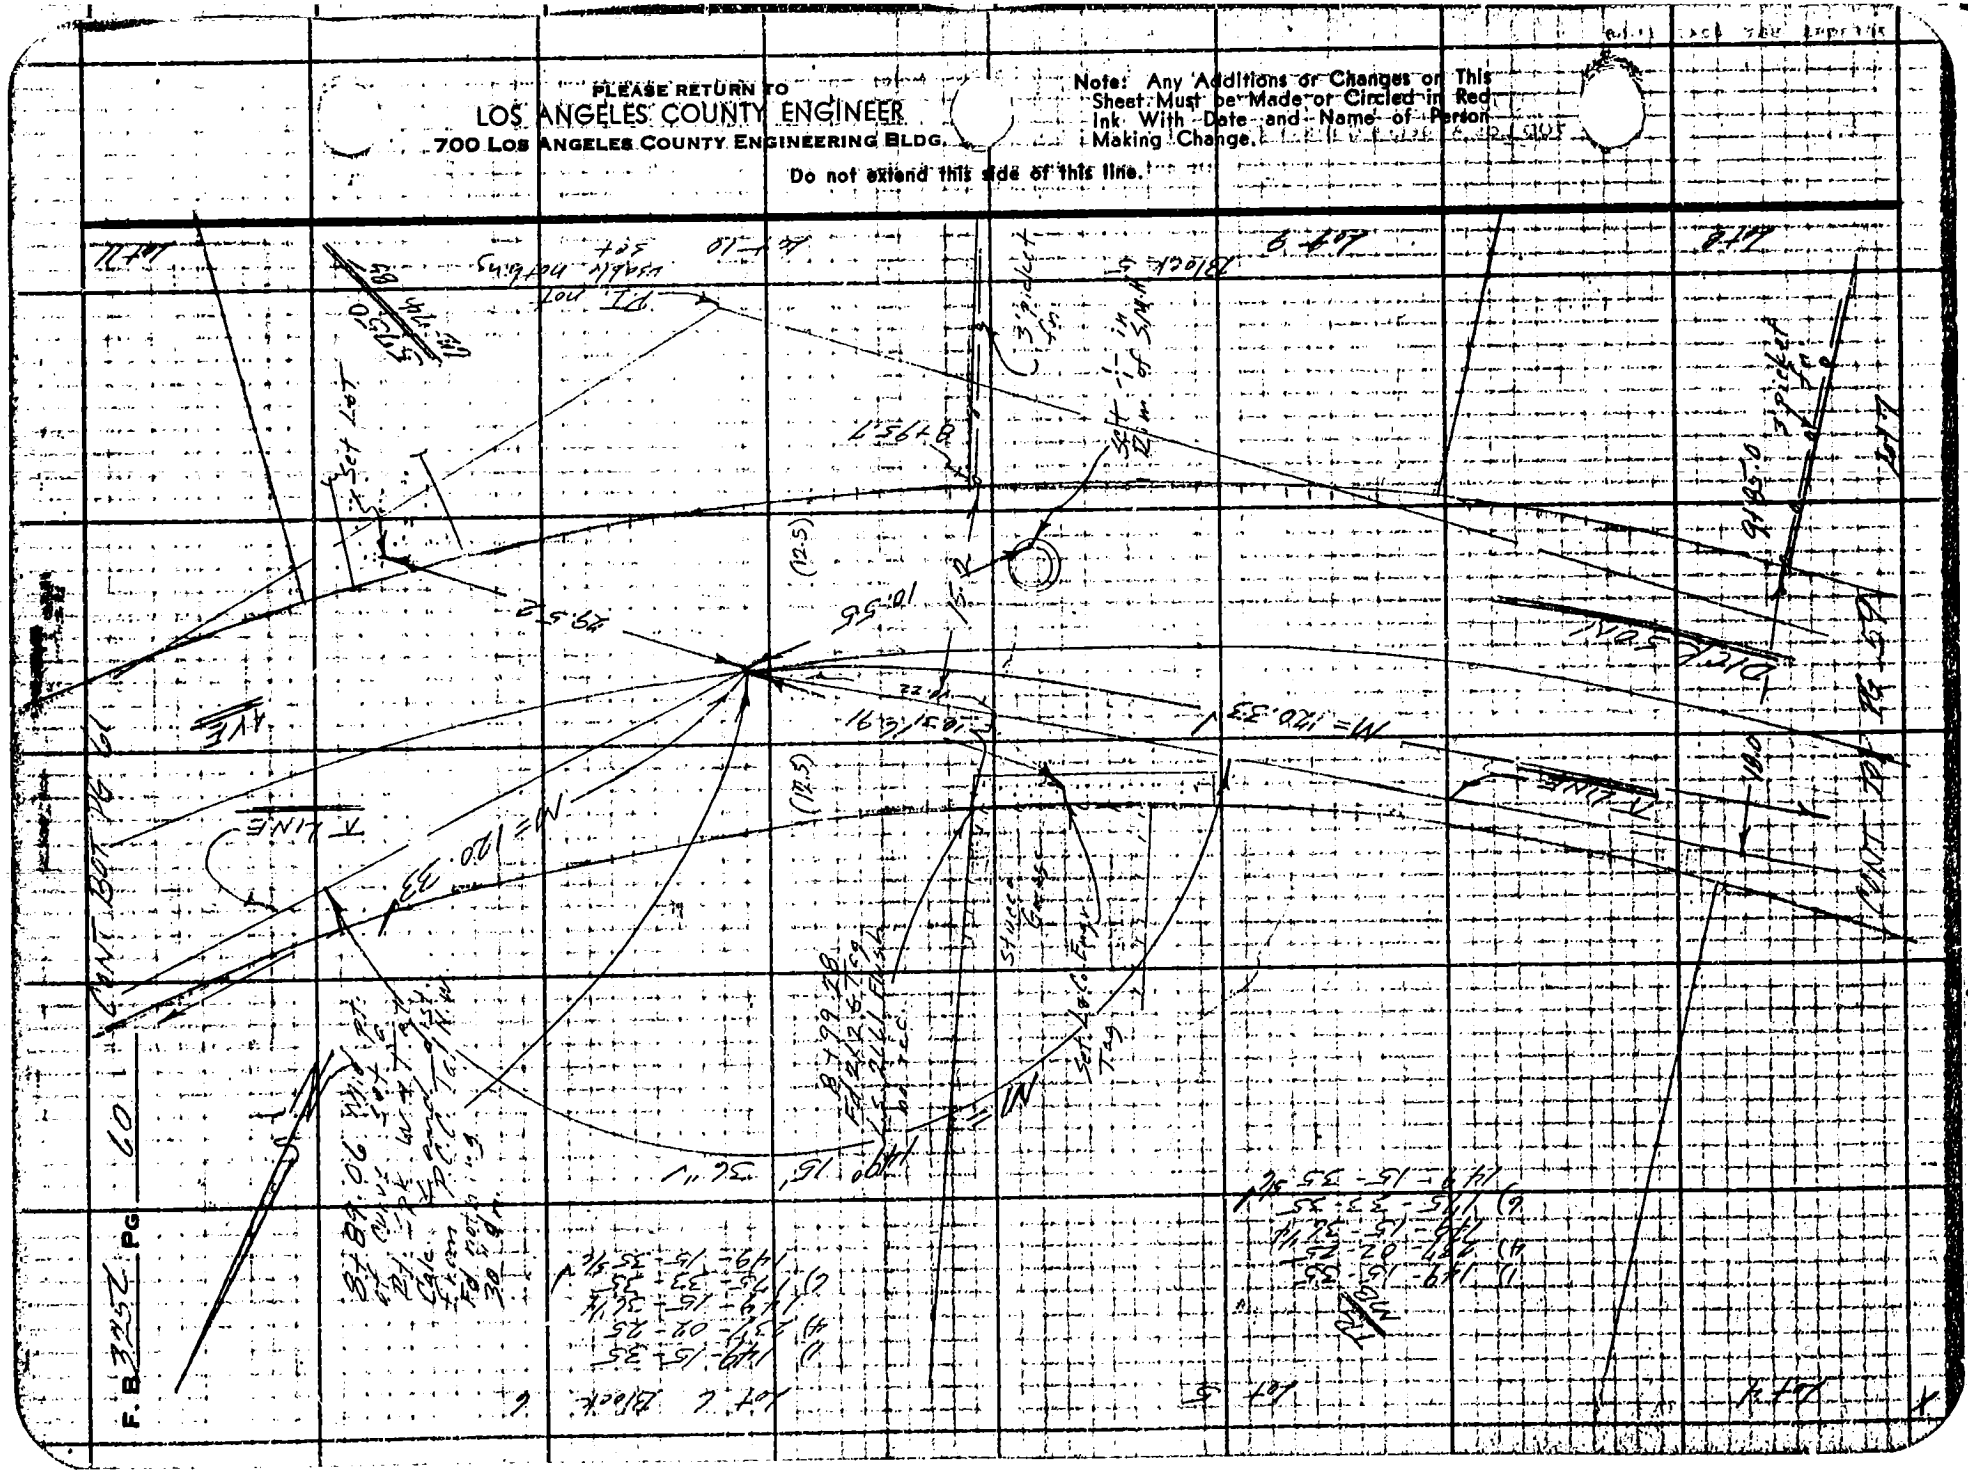

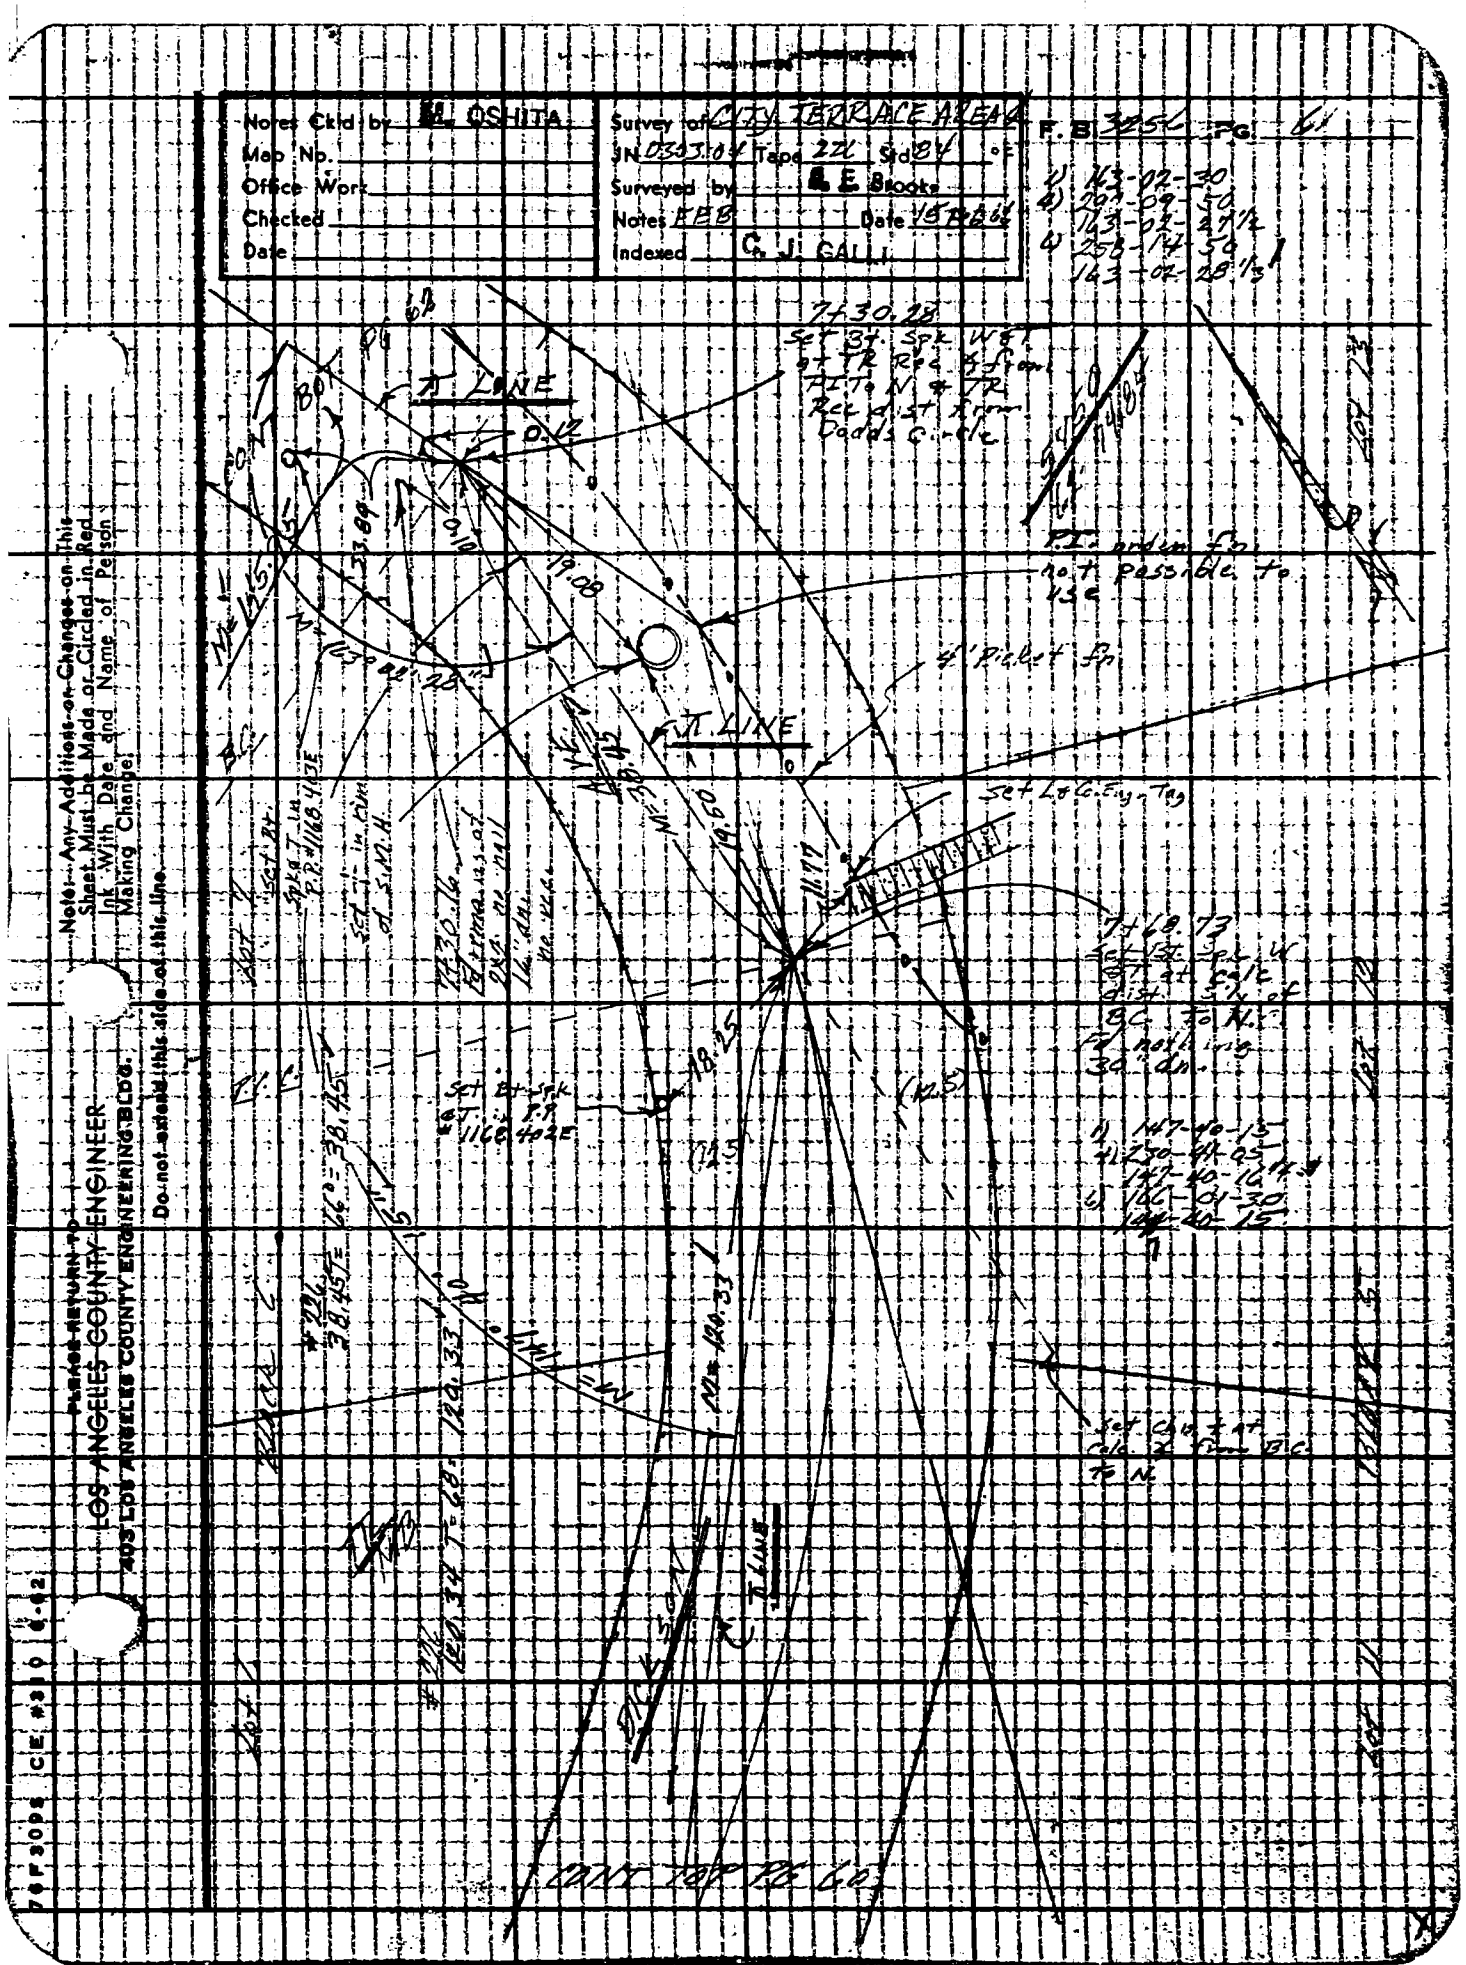
Notes Ckld by OSHITA
Map No.
Office Work
Checked
Date
Survey of CJ TERRACE AREA
JN 0353.04 Tape 22L Std 84 °F
Surveyed by E. Brooks
Notes EBB Date 10 Feb 64
Indexed C. J. GALLI
F. B. 325L Pg. 61
Note: Any Additions or Changes on This Sheet Must be Made or Circled in Red Ink With Date and Name of Person Making Change!
Do not install this side of this line
PLEASE RETURN TO
LOS ANGELES COUNTY ENGINEER
403 LOS ANGELES COUNTY ENGINEERING BLDG.
7 OF 20 DS CE #316 6-62
℄ LINE
Set B.T. Spk. W.F.
of TR. Rpt. Bears
Radial C. to C
Set Lead & Tack
Set B.T. Spk
F.P. #1168 4.02E
Set B.T. Spk
F.P. #1166 4.02E
Set Lead & Tack
Set Lead & Tack
Set Lead & Tack

PLEASE RETURN TO
LOS ANGELES COUNTY ENGINEER
403 LOS ANGELES COUNTY ENGINEERING BLDG.

Note: Any Additions or Changes on This Sheet Must be Made or Circled in Red Ink With Date and Name of Person Making Change.

Do not extend this side of this line.

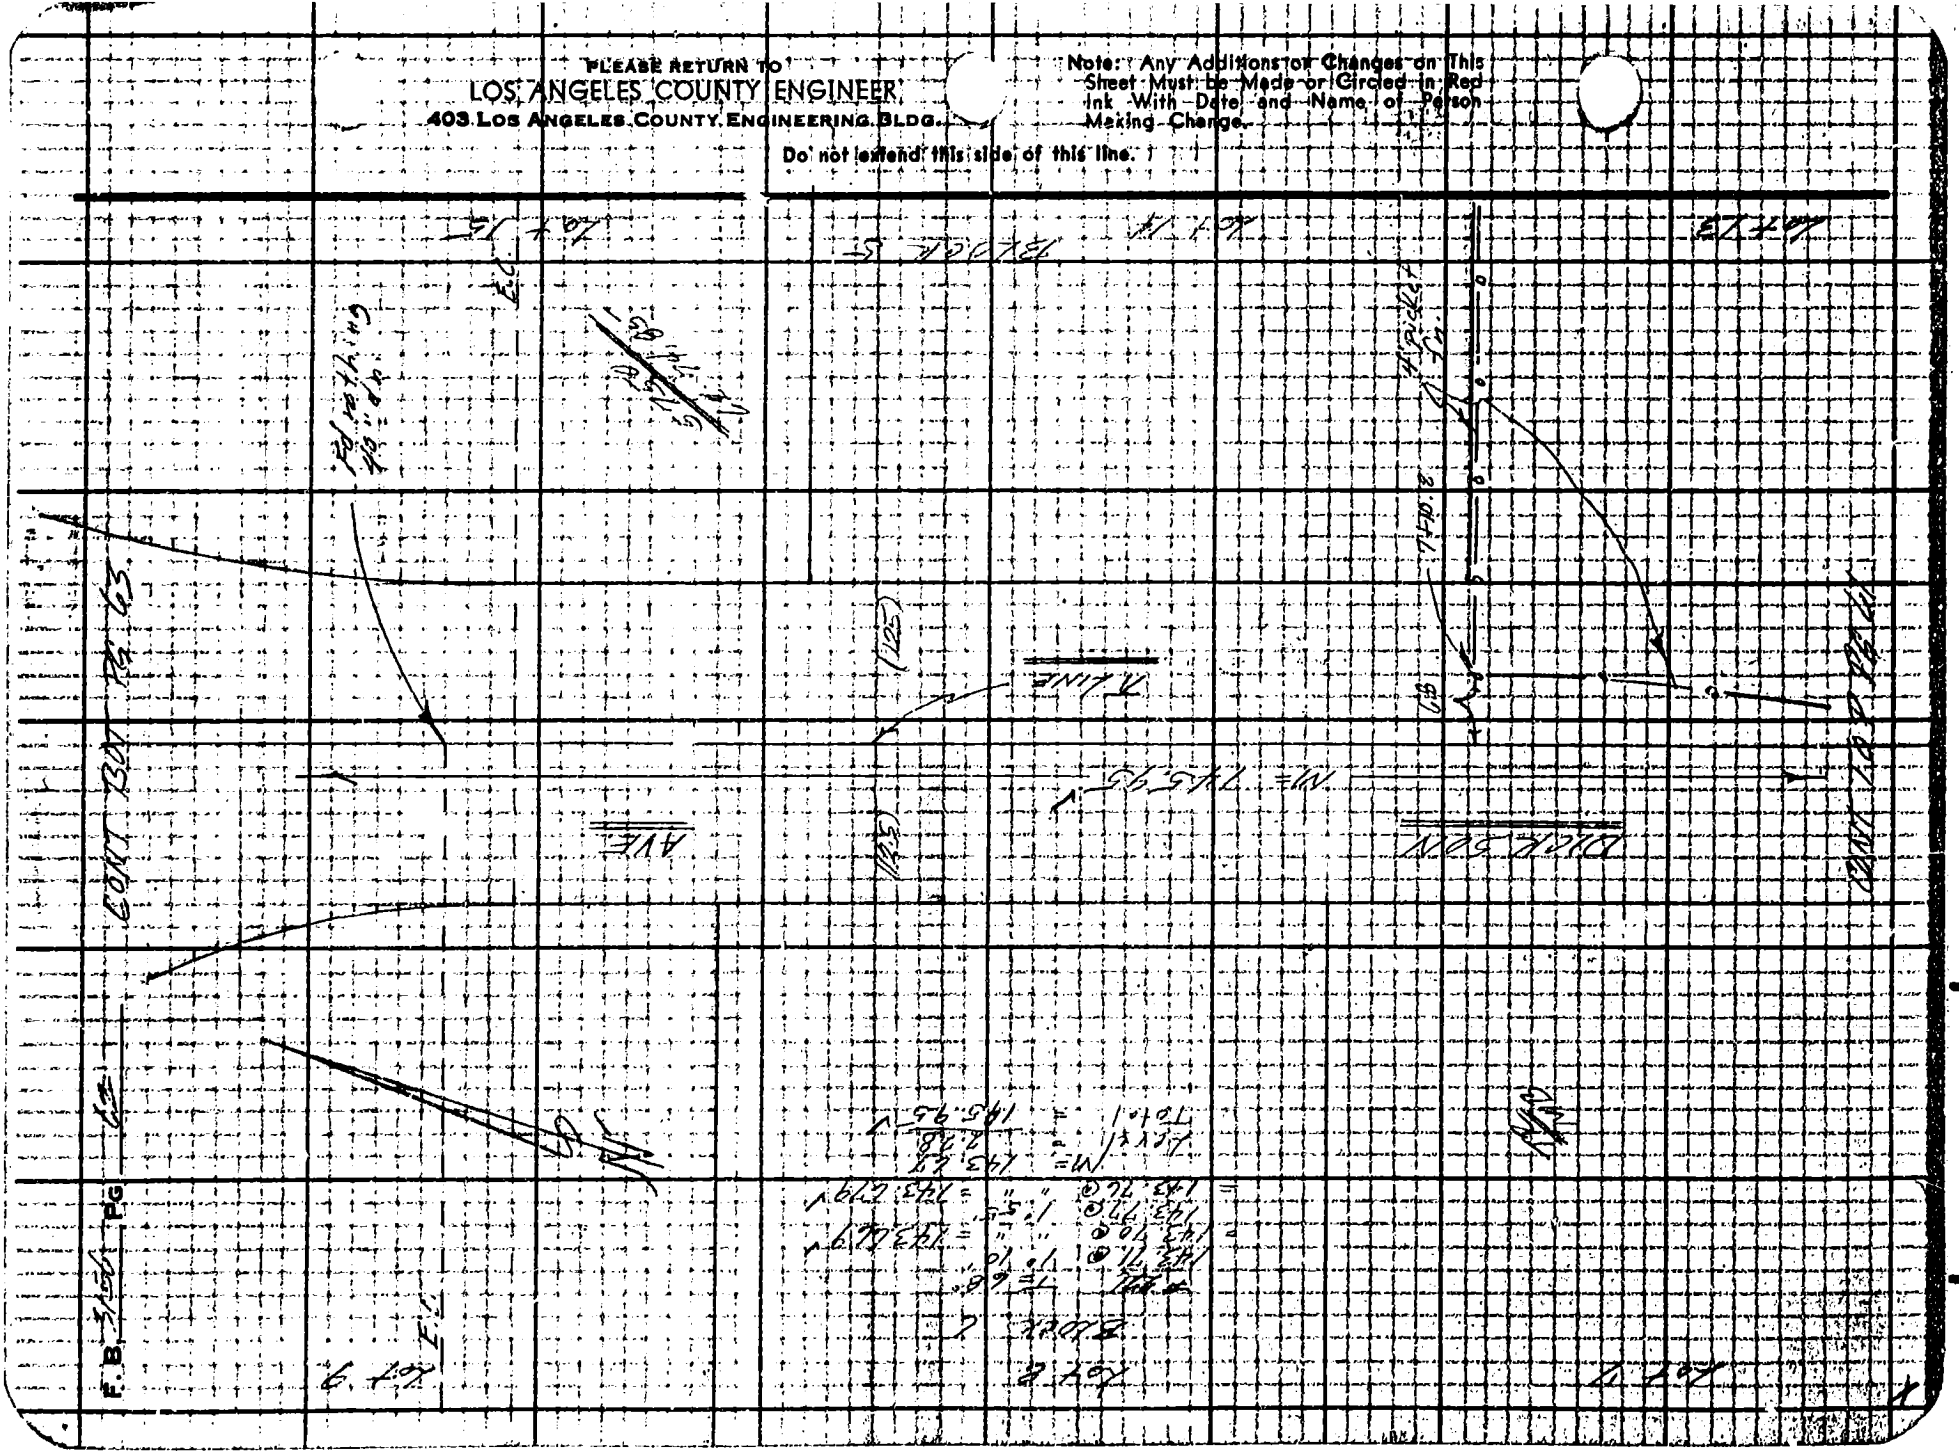

Notes Ck'd by M. OSHITA
Map No.
Office Work
Checked
Date









Note:: Any Additions or Changes on This Sheet Must be Made or Circled in Red Ink With Date and Name of Person Making Change.

Do not extend this side of this line.

POST RETURN TO:
LOS ANGELES COUNTY ENGINEER
405 LOS ANGELES COUNTY ENGINEERING BLDG.

7-67 3008 CE #310 6-62

















PLEASE RETURN TO
LOS ANGELES COUNTY ENGINEER
403 LOS ANGELES COUNTY ENGINEERING BLDG.

Note: Any Additions or Changes on This Sheet Must be Made or Circled in Red Ink With Date and Name of Person Making Change.

Do not extend this side of this line.

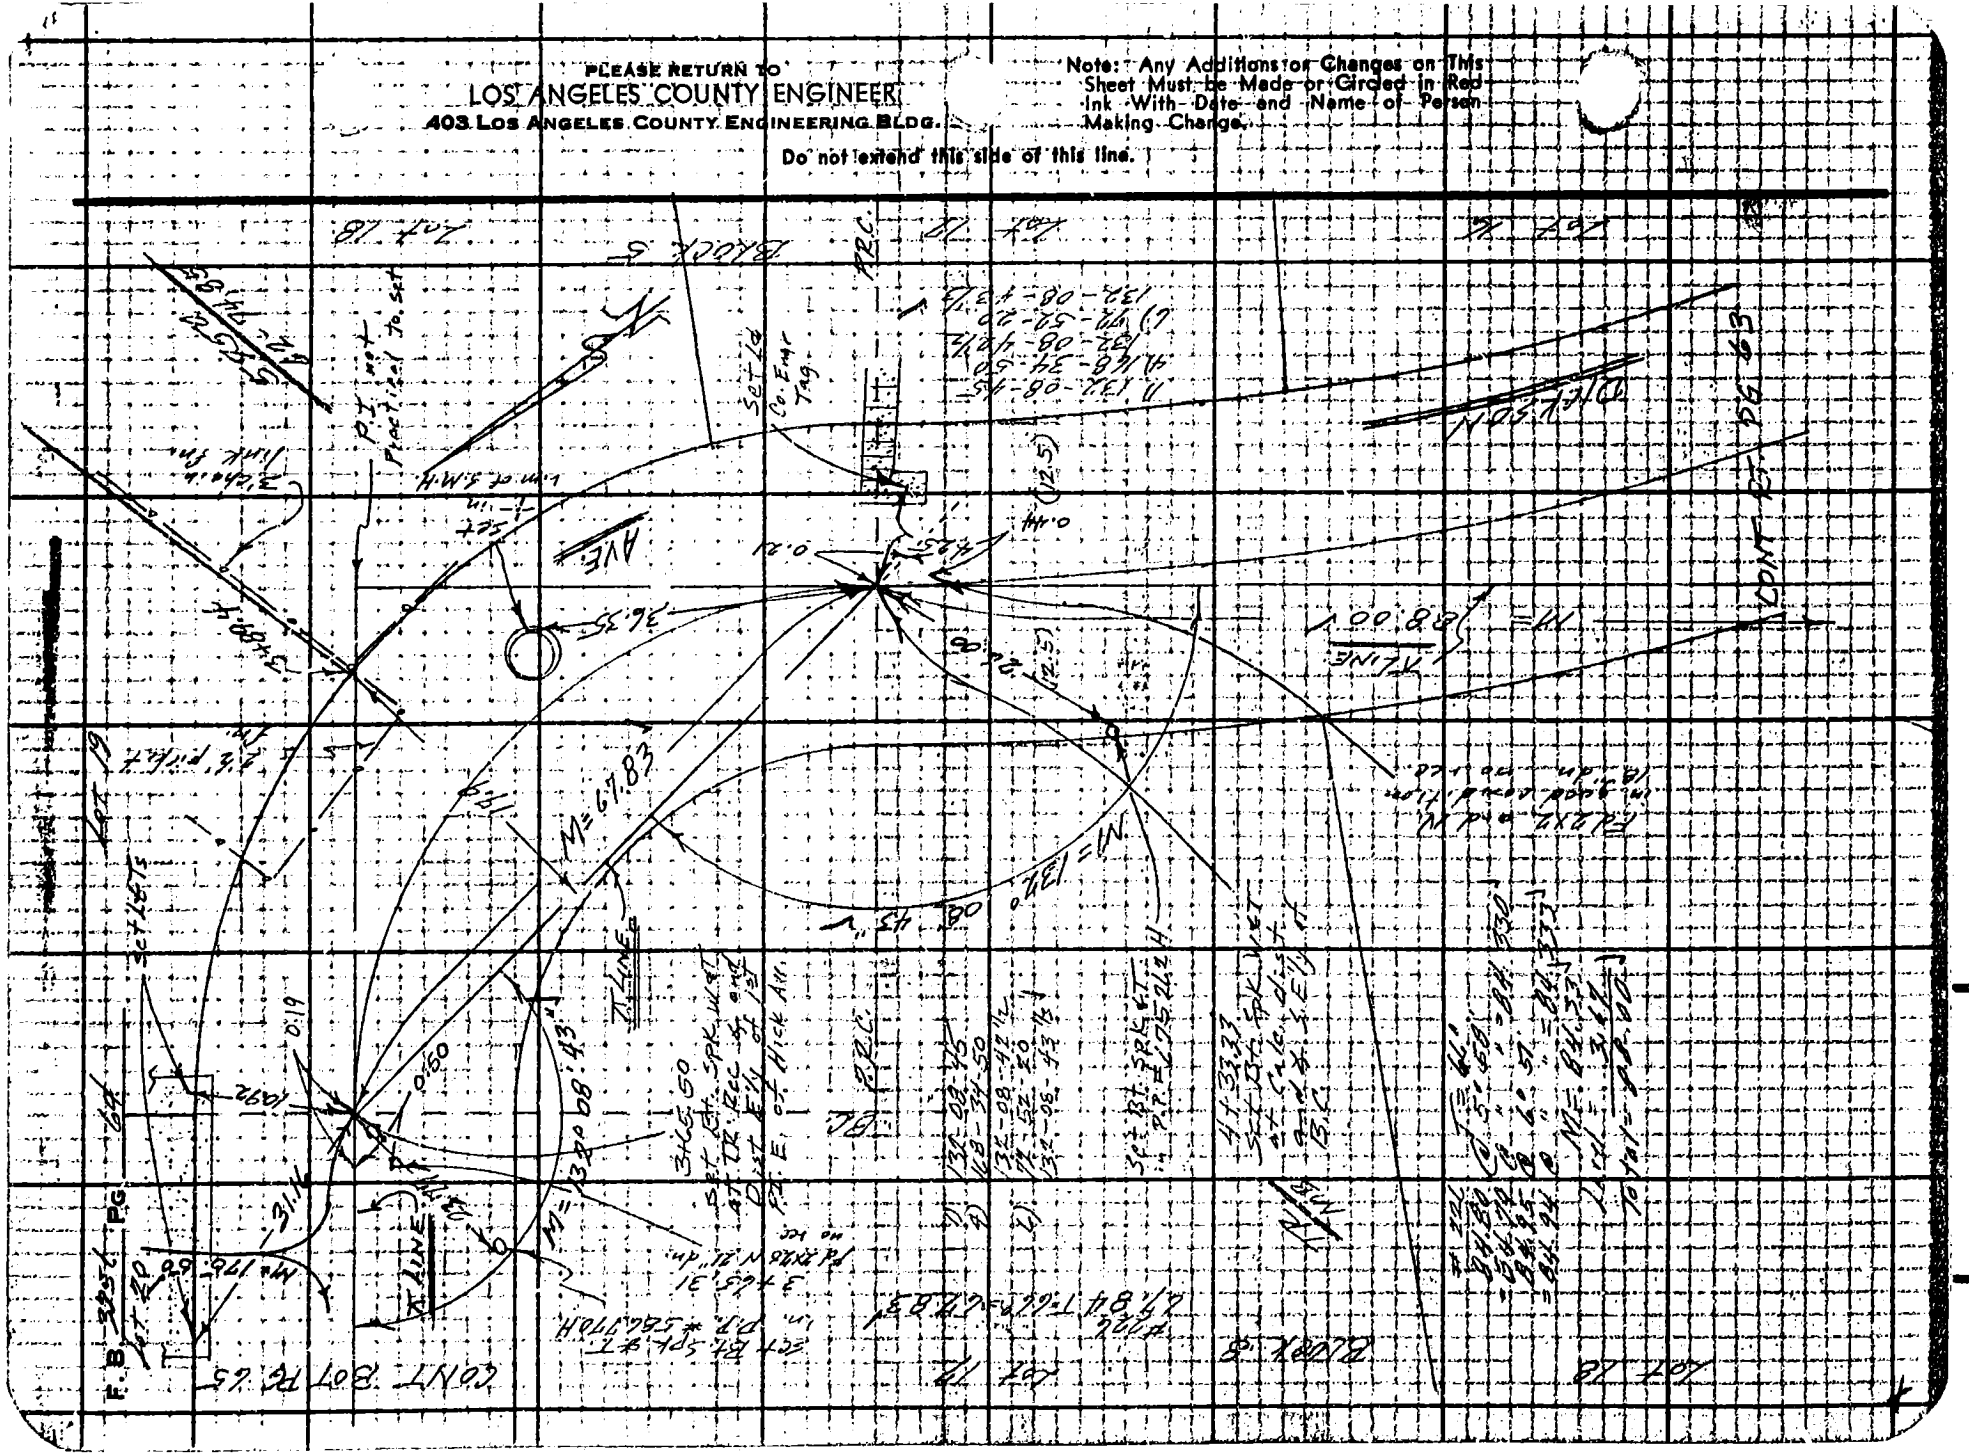
BLOCK C
CONT. BOT. PG. 45
CONT. FROM PG. 45
CONT. FROM PG. 45
CONT. FROM

76F3095 CE #310 6-02

PLEASE RETURN TO
LOS ANGELES COUNTY ENGINEER
403 LOS ANGELES COUNTY ENGINEERING BLDG.

Note: Any Additions or Changes on This Sheet Must be Made or Circled in Red Ink With Date and Name of Person Making Change.

Do not extend this side of this line.

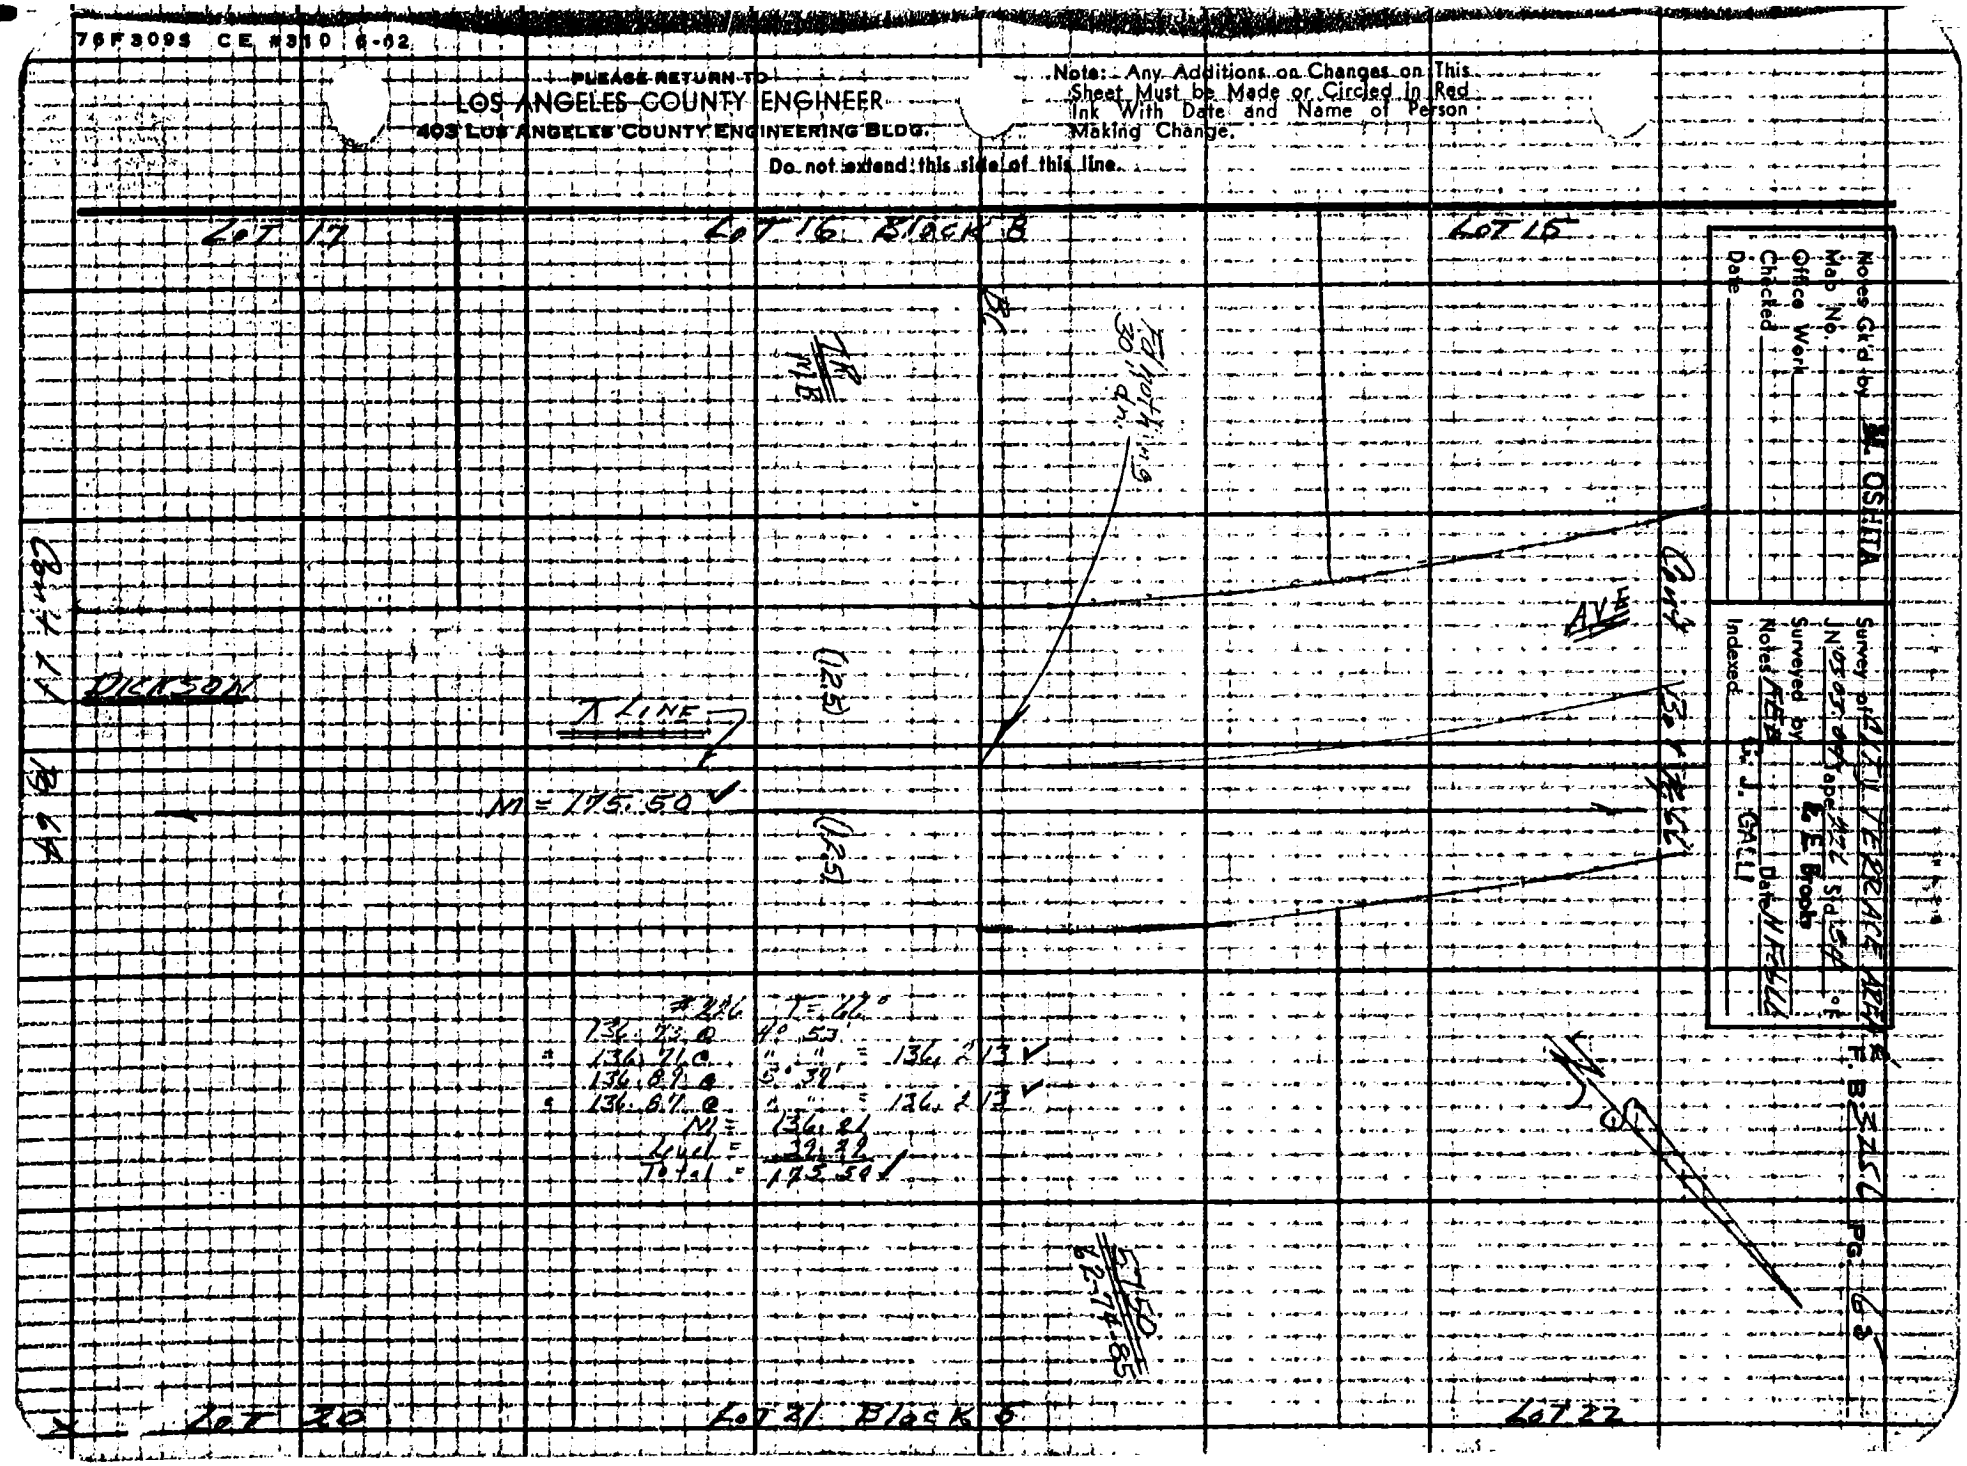

PLEASE RETURN TO
LOS ANGELES COUNTY ENGINEER
403 LOS ANGELES COUNTY ENGINEERING BLDG.

Note: Any Additions or Changes on This Sheet Must be Made or Circled in Red Ink With Date and Name of Person Making Change.

Do not extend this side of this line.

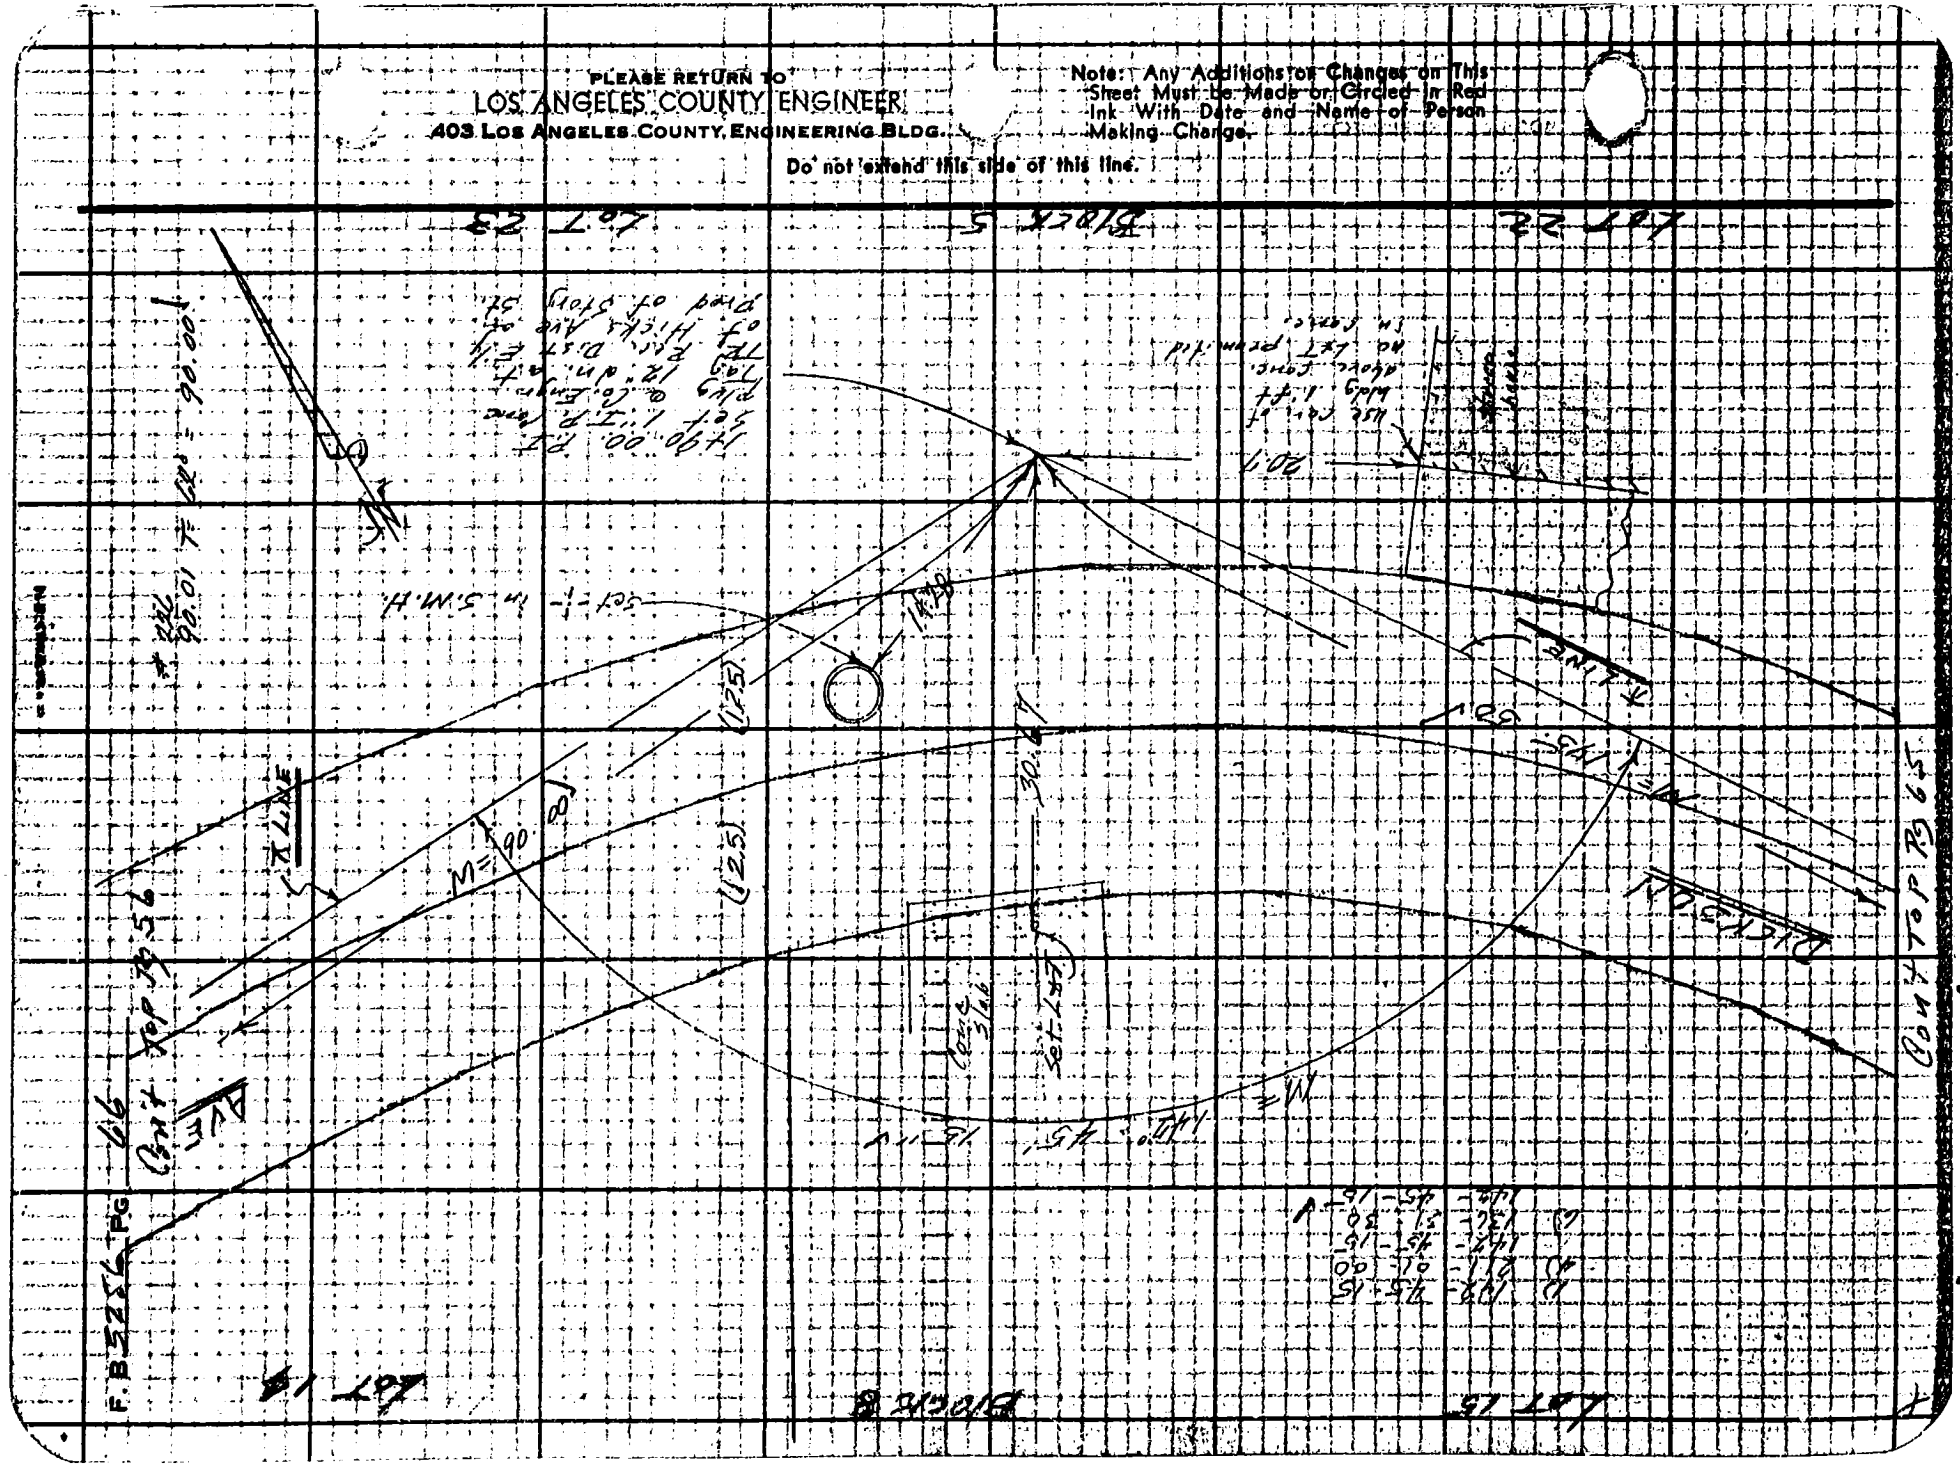

Notes Ck'd by M. OSHITA
Map No.
Office Work
Checked
Date

Survey of CITY TERRACE AREA
JN 0303.02 Tape 422 Std. B
Surveyed by E. E. Brooks
Notes FEB Date 24 FEB 66
Indexed C. J. GALLI

F. B. 3256 PG. 67

Note: Any Additions or Changes on This Sheet Must be Made or Circled in Red Ink With Date and Name of Person Making Change!

Do not extend this side of this line.

PLEASE RETURN TO
LOS ANGELES COUNTY ENGINEER
ENGINEERING BLDG.
108 LOS ANGELES COUNTY ENGINEER

70F3088 CE #816 (1-62)

CONT TOP PG. 68

PLEASE RETURN TO
LOS ANGELES COUNTY ENGINEER
403 LOS ANGELES COUNTY ENGINEERING BLDG.

Note: Any Additions or Changes on This Sheet Must be Made or Circled in Red Ink With Date and Name of Person Making Change.

Do not extend this side of this line.

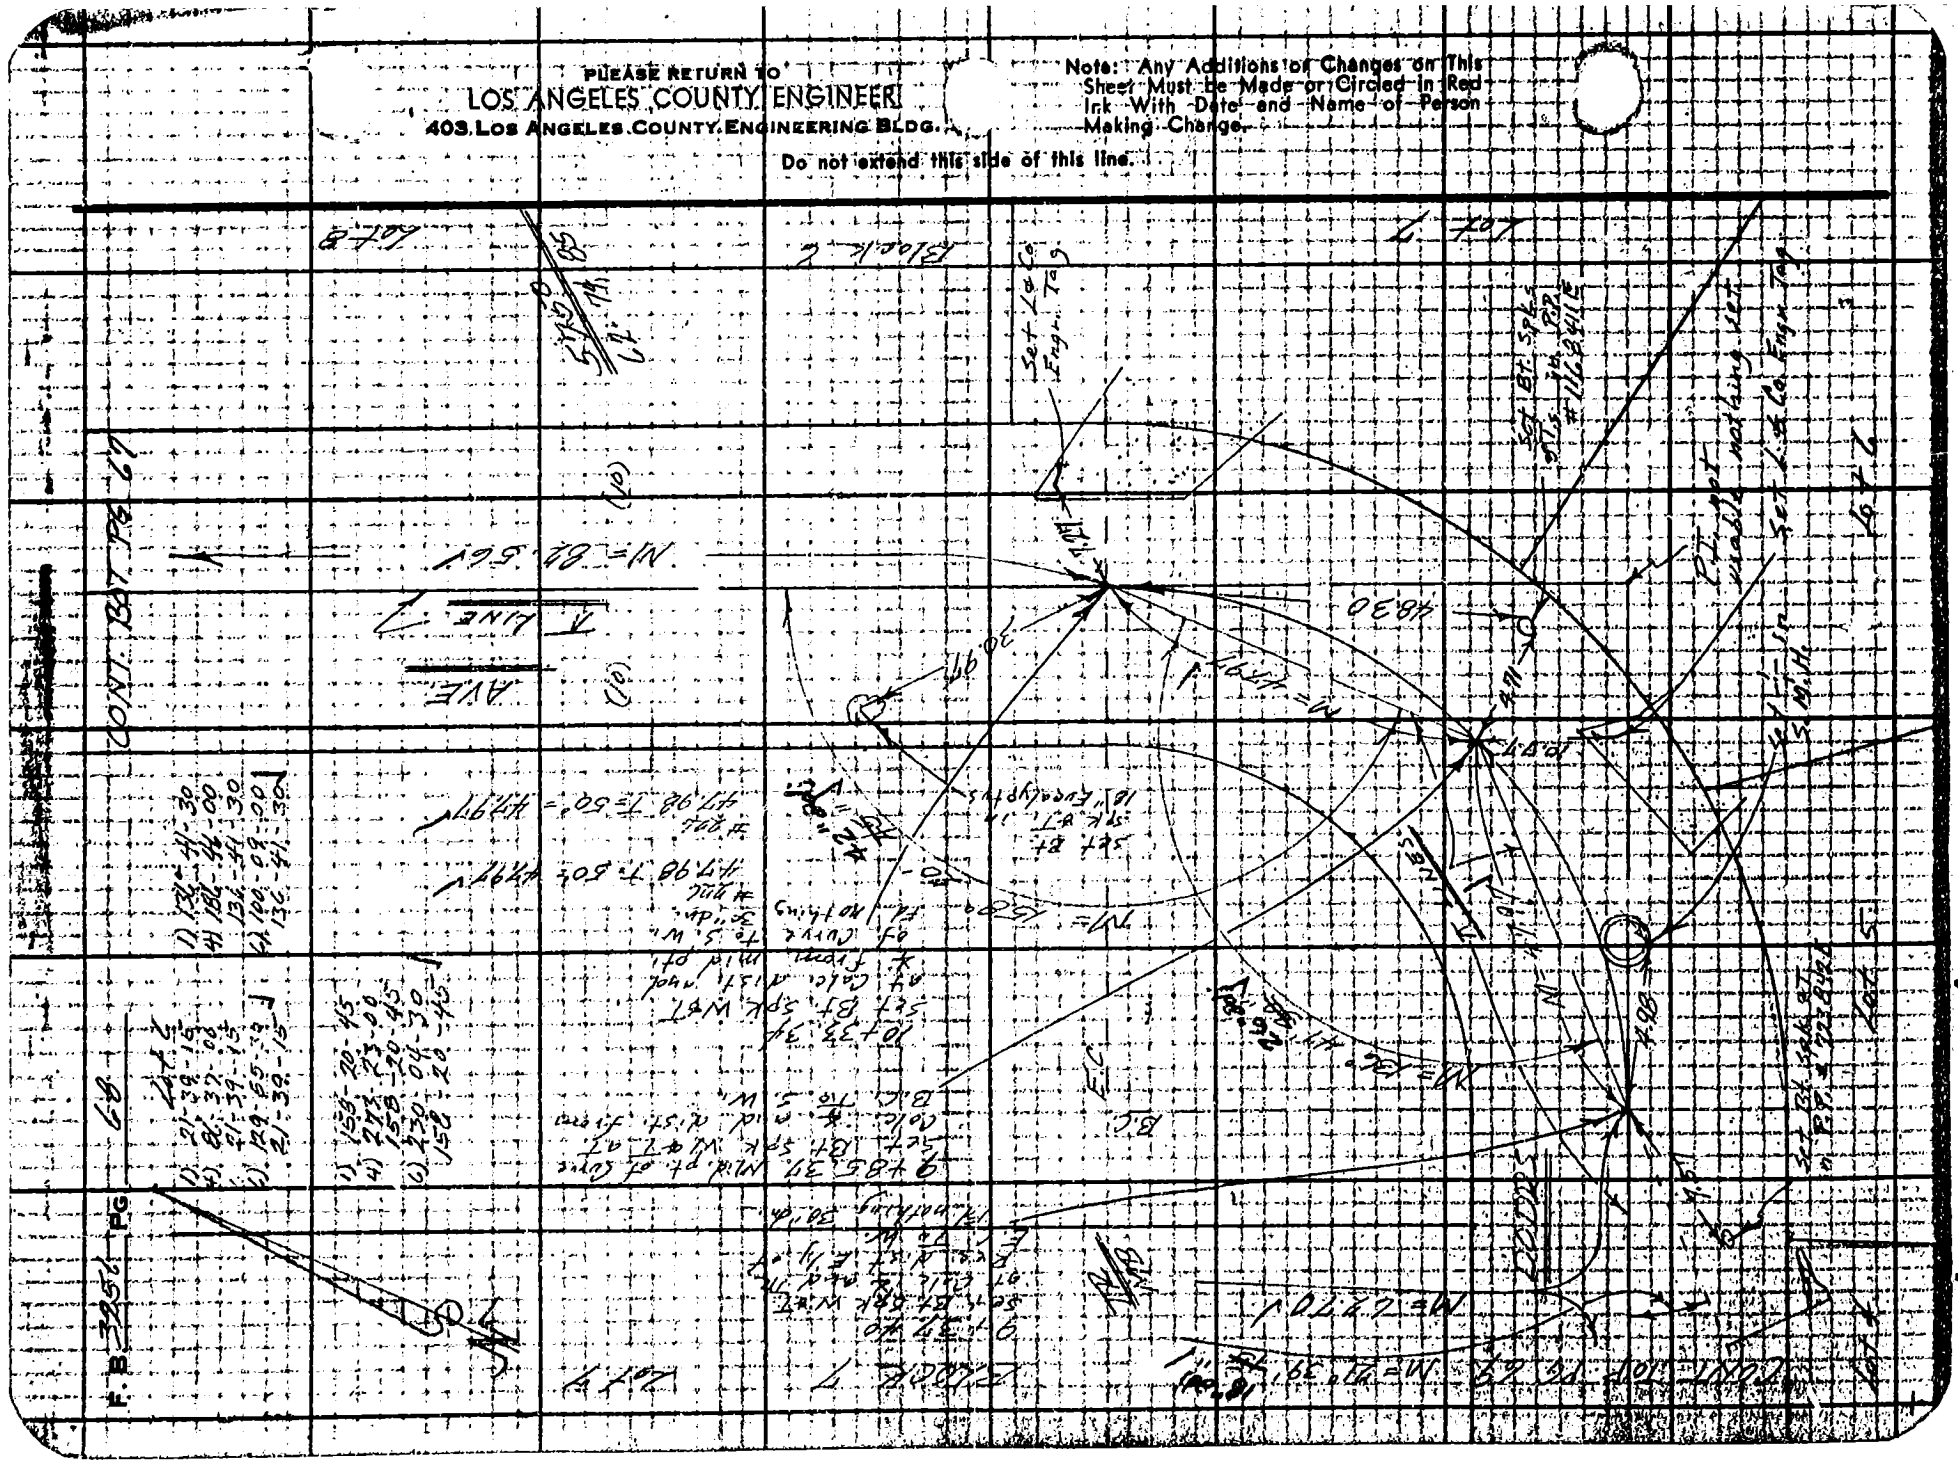

Notes Ck'd by M. OSHITA
Map No.
Office Work
Checked
Date

Survey of CITY TERRACE AREA #
JN 0303.04 Tape 226 Std 84 °F
Surveyed by P. E. Brooks
Notes F.E.B. Date 24 FEB 66
Indexed C. J. GALLI

F. B. 3256 PG. 69

Note: Any Additions or Changes on This Sheet Must be Made or Circled in Red Ink With Date and Name of Person Making Change.

PLEASE RETURN TO
LOS ANGELES COUNTY ENGINEER
403 Los Angeles County Engineering Bldg.
Do not extend this side of this line.

76F3095 CE #3100 6-62

Lot 2
#226 62.71 T= 50° =62.70
M = 62.70
CONT LT PG 68
9.93
1.43
B+74.70 TOT set Sq hd Spk
#226 T= 50°
133.84 @ 3° 21' = 133.581
133.81 @ " " = 133.581
133.93 @ 3° 55' = 133.586
133.90 @ " " = 133.586
M = 133.58
B+92.00 TOT. Set Bt. Spk N&T.
B+04.46 Fd remains of 2x2 Flush no rec.
#226 53.03 T=48° = 53.02
#226 50.89 T=50° = 50.88
AVE.
M = 106.67
Lot 3
Lot 59
Lot 2
Block 7
1) 138-29-15 4) 193-57-00 6) 110-55-30 138-29-15
1) 138-29-15 4) 193-57-00 6) 110-55-30 138-29-15
22" adj to "
(10)
M = 138.88
13.9
M = 138°
E.C.
B.C.
DODDS
0.09
0.13
Block C
Lot 9
7+41.12 Set Bt. Spk at Tale of Spur Tree N.W.
7+41.03 Fd remains of 2x2 no nail 12" dn. no rec
7+88.10 Set Bt. Spk at Tale of Rec'd dist. E.C. to
Set L&G. Engr Tag
Set Lot Cor in Fd chis +
Fd Bt. Spk in L. no rec.
DODDS
20.68
M = 111.34
0.03
0.12
0.32
19.28
36.60
P.E. not usable nothing set
WALK
CONT. BOT PG. 70
CIRCLE
11.95
6+87.27 Fd 2x2 Tag L.S. 488 Flush no rec
6+87.98 Fd 2x2 no nail 18" dn. no rec.
Set Lot
Lot 7
Block 8
Lot 1

F. B. 3256 PG 70

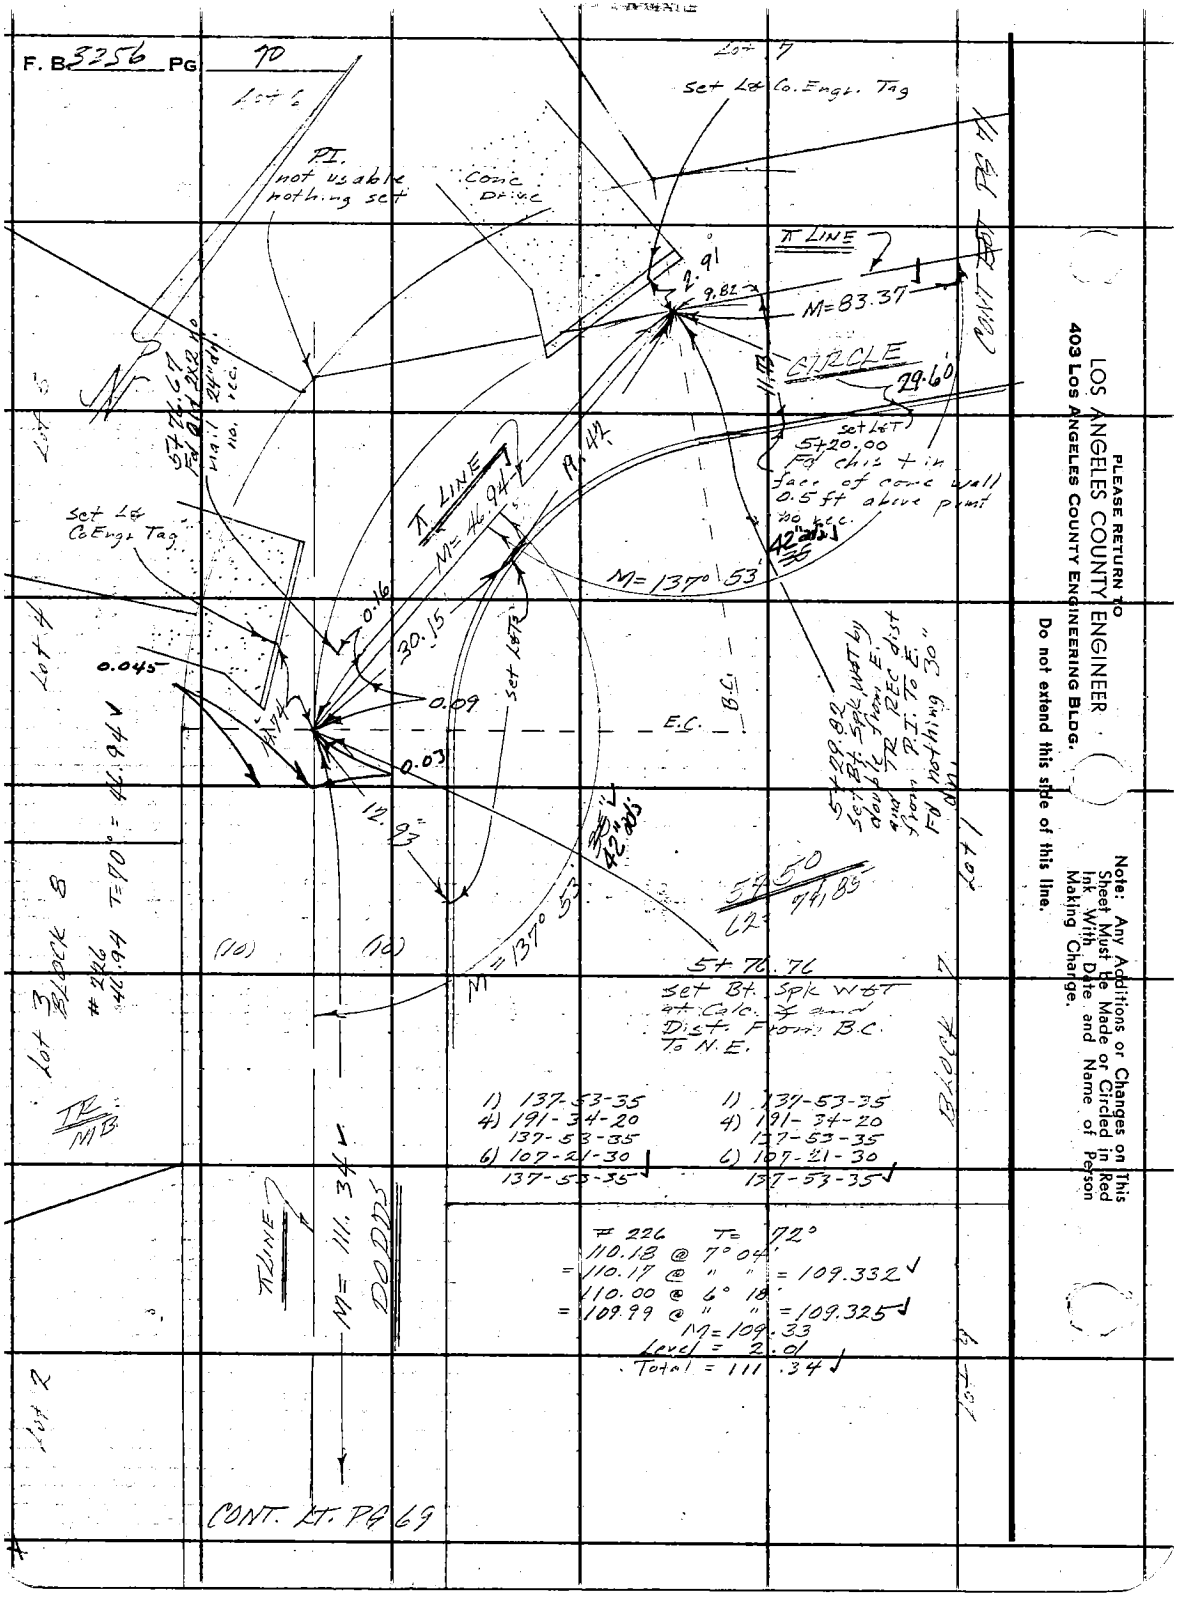

226 T= 72°

110.18 @ 7°04' = 109.332 ✓
110.17 @ " " = 109.332 ✓
110.00 @ 6° 18' = 109.325 ✓
109.99 @ " " = 109.325 ✓
M = 109.33
Level = 2.01
Total = 111.34 ✓

PLEASE RETURN TO
LOS ANGELES COUNTY ENGINEER
403 Los Angeles County Engineering Bldg.
Do not extend this side of this line.

Note: Any Additions or Changes on This Sheet Must Be Made or Circled in Red Ink With Date and Name of Person Making Change.

76F309S CE #310 6-62

PLEASE RETURN TO
LOS ANGELES COUNTY ENGINEER
403 LOS ANGELES COUNTY ENGINEERING BLDG.

Note: Any Additions or Changes on This Sheet Must be Made or Circled in Red Ink With Date and Name of Person Making Change.

Do not extend this side of this line.

Lot 7 | Lot 8 | Lot 9 | Lot 10 | Lot 11 | Lot 12

Block 9

#226 T= 60°
80.96 @ 4° 25' = 80.95 @ " " = 80.443
80.74 @ 4° 55' = 80.73 @ " " = 80.432
M = 80.43
Level = 2.94
Total = 83.37

TR
MB

3744.4

2496.9

6' Chain link fence

141

121.0

DODDS

CIRCLE

M= 222.84

M=83.37

Bk 4 Pg 70

℄ N LINE

(10)

(10)

#226 T= 58°
170.93 @ 5° 13' = 170.90 @ " " = 170.192
171.13 @ 5° 51' = 171.10 @ " " = 170.208
M= 170.20
Level = 52.65 T= 58° = 52.64
Total = 222.84

11440.45
Set 5/8" Rebar & Cap P.T. To E.

27150
82.79.85

Notes Ck'd by M. OSHITA
Map No.
Office Work
Checked
Date



Lot 1 | Lot 2 | Lot 3 Block 7 | Lot 4 | Lot 5

PLEASE RETURN TO
LOS ANGELES COUNTY ENGINEER
403 LOS ANGELES COUNTY ENGINEERING BLDG.

Note: Any Additions or Changes on This Sheet Must Be Made or Circled in Red Ink With Date and Name of Person Making Change.

Do not extend this side of this line.

W.S.7, E-1

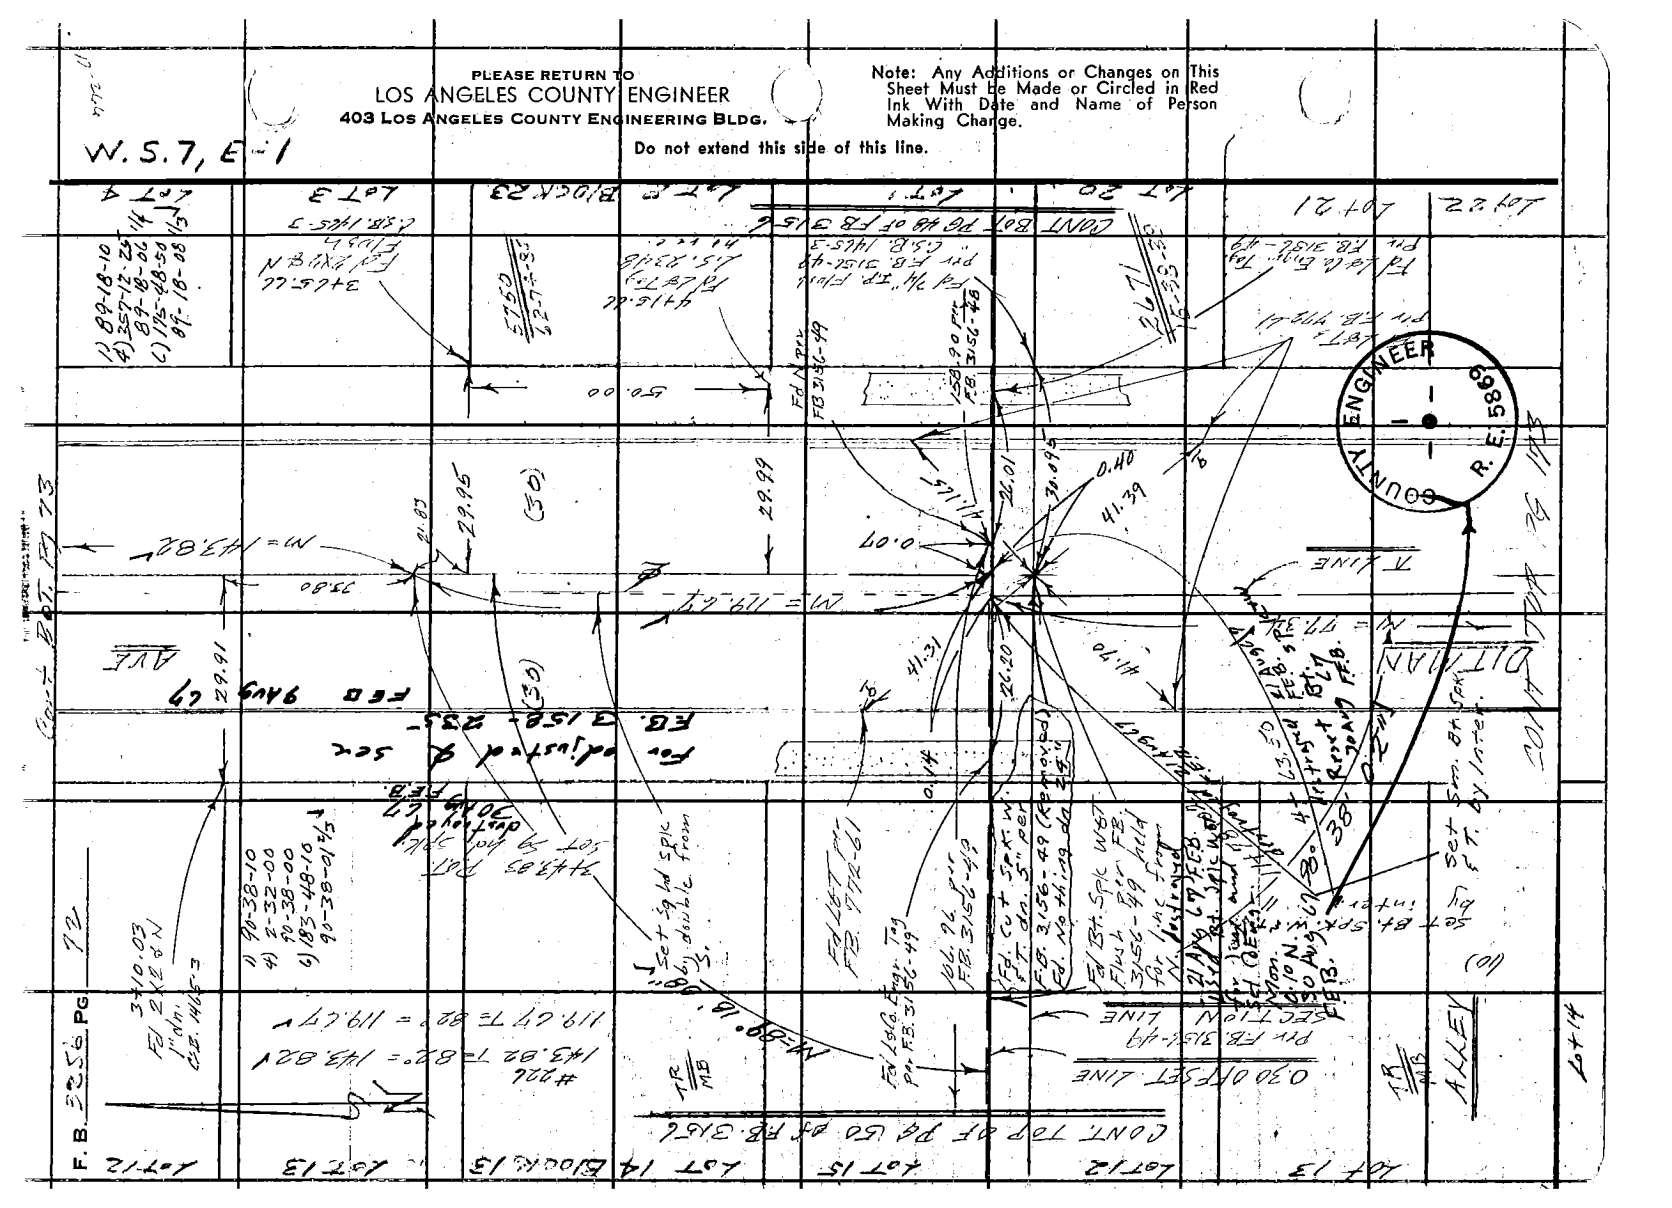

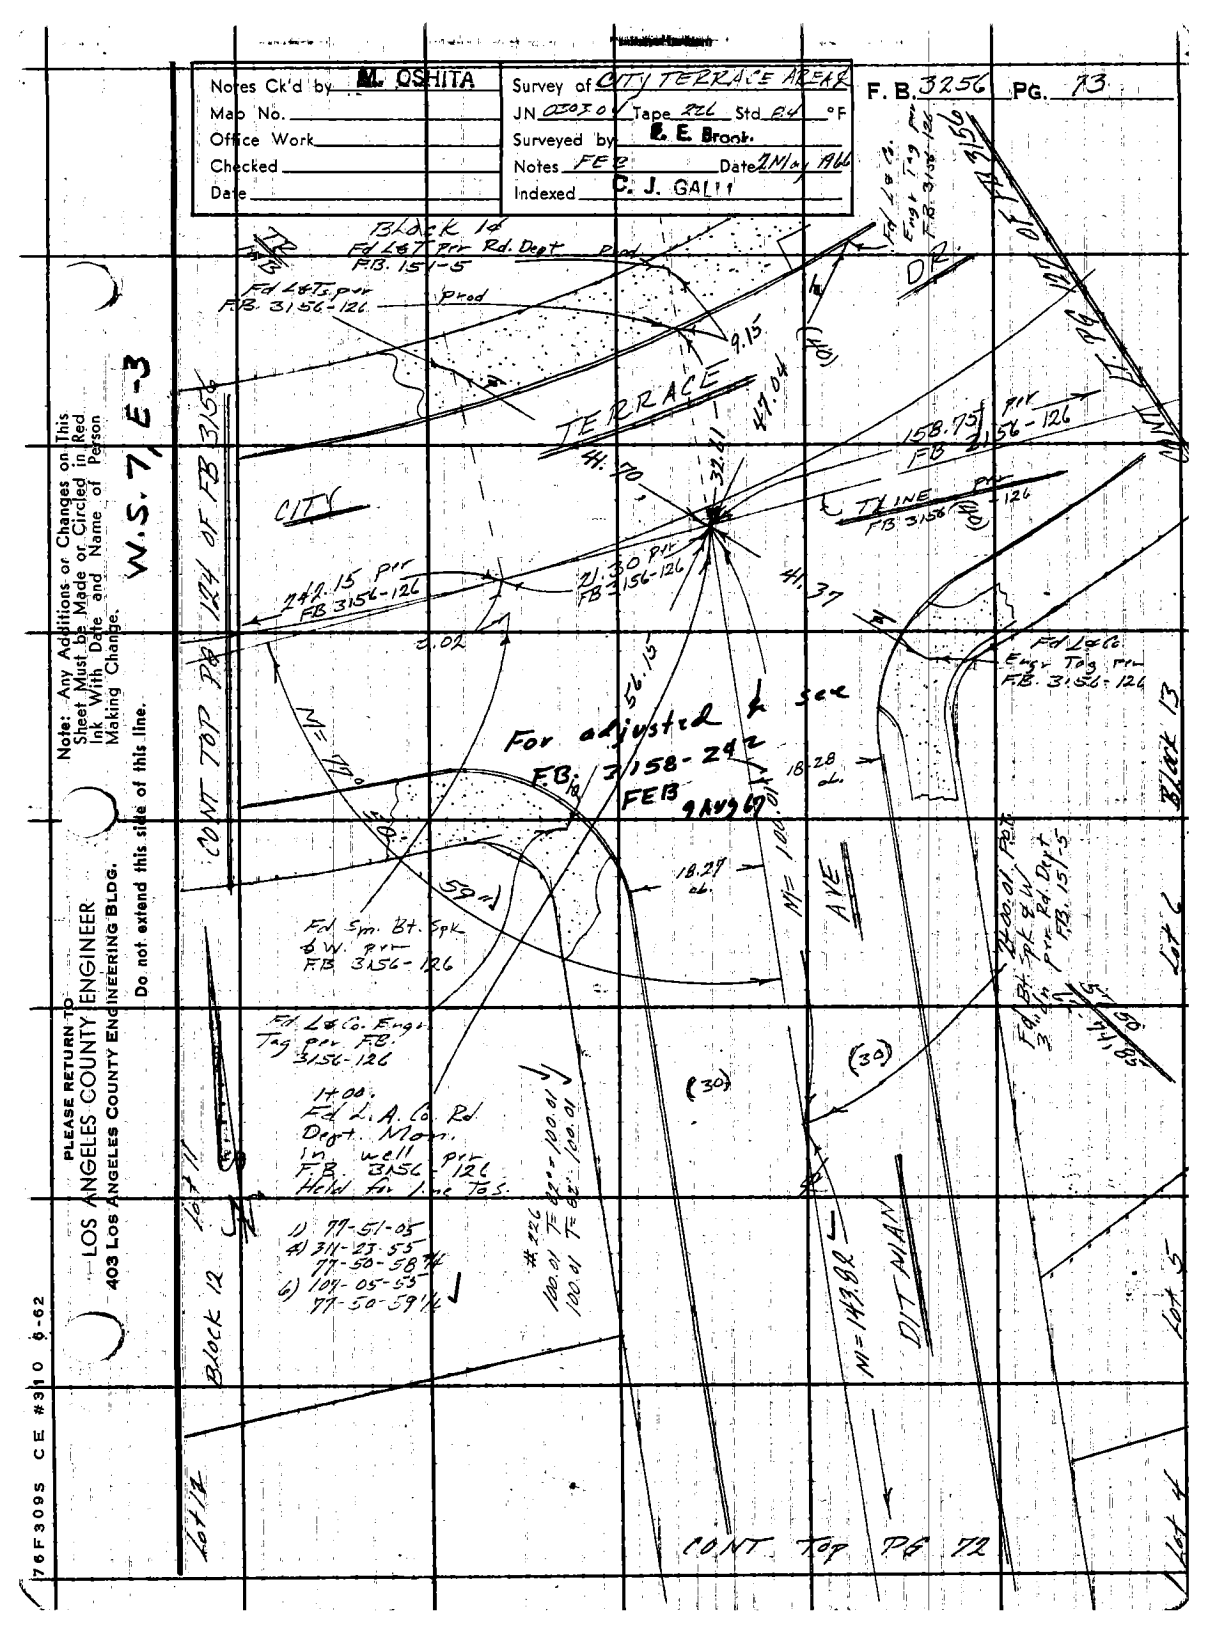
Notes Ck'd by M. OSHITA
Map No.
Office Work
Checked
Date
Survey of CITY TERRACE AREA
JN 02010 Tape RCL Std. B4 °F
Surveyed by R. E. Brook.
Notes FEB Date 2 May 1966
Indexed C. J. GALLI
F. B. 3256 PG. 73
W.S. 7, E-3
Note: Any Additions or Changes on This Sheet Must be Made or Circled in Red Ink With Date and Name of Person Making Change.
Do not extend this side of this line.
PLEASE RETURN TO
LOS ANGELES COUNTY ENGINEER
403 Los Angeles County Engineering Bldg.
76F3095 CE #3110 6-62
Block 14
Fd L&T Prr Rd. Dept prod
F.B. 151-5
Fd L&T. prr
F.B. 3156-126
prod
9.15
TERRACE
47.04
CITY
158.75 prr
F.B. 3156-126
T-LINE prr
F.B. 3156-126
(30)
32.41
41.10
41.37
CONT TOP PG 12 of F.B. 3156
N 44° 15' prr
F.B. 3156-126
21.30 prr
F.B. 3156-126
2.02
56.13
For adjusted ℄ see
F.B. 3158-242
F.E.B. 9 Aug 69
18.28 cl.
18.29 cl.
N = 100.01
AVE
Fd Sm. Bt. Spk & W. prr
F.B. 3156-126
Fd L&Co. Engr Tag prr F.B. 3156-126
59 rad
1+00
Fd L. A. Co. Rd Dept Mon. in well prr F.B. 3156 126
H&W for line T&S.
1) 99-51-05
4) 311-23-55
99-50-58¾
6) 109-05-53
99-50-59¾
#226
100.01 TE 42"
100.01 TE 42"
100.01
Fd L&C Engr Tag prr F.B. 3156-126
Fd Bt. Spk & W. in Prr F.B. 151-5
N = 143.92
DIT MAN
Block 13
Lot 6
Lot 5
Lot 4
Block 12
CONT TOP PG 72

PLEASE RETURN TO
LOS ANGELES COUNTY ENGINEER
403 LOS ANGELES COUNTY ENGINEERING BLDG.

Note: Any Additions or Changes on This Sheet Must Be Made or Circled in Red Ink With Date and Name of Person Making Change.

Do not extend this side of this line.

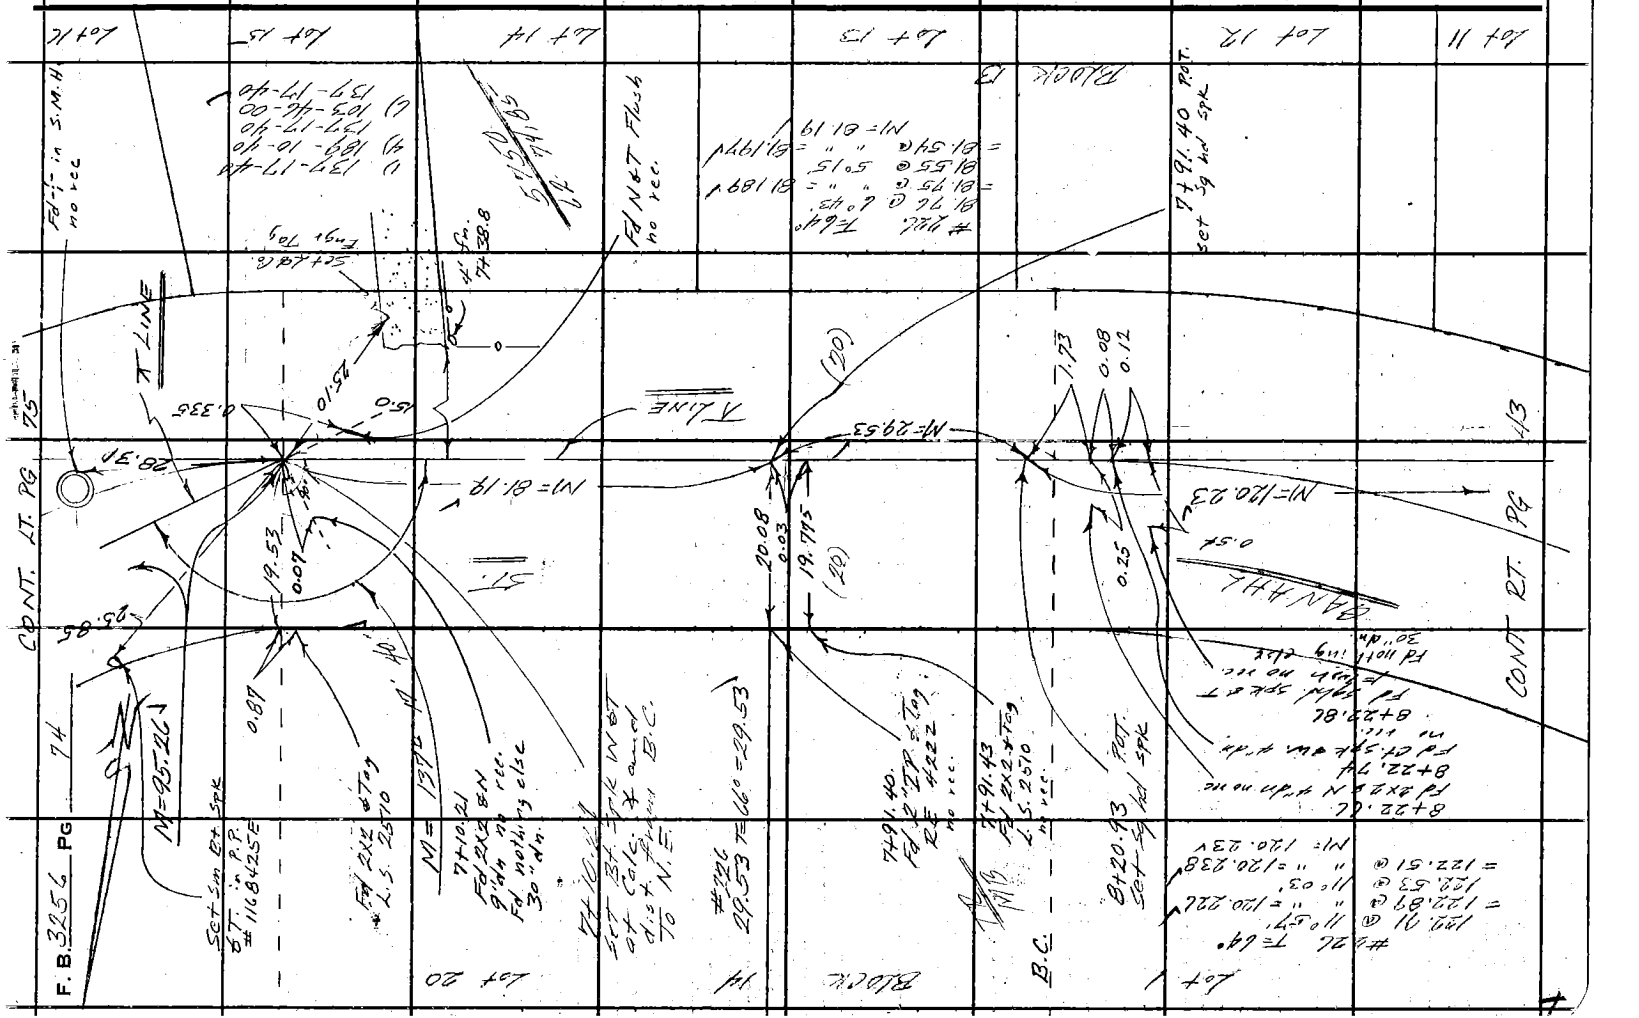
Lot 16
Lot 15
Lot 14
Lot 13
Block 13
Lot 12
Lot 11
Lot 20
Block 14
Lot
B.C.
F.B. 3256 PG
PG 74
CONT. LT. PG 73
CONT RT. PG 13
℄ LINE
℄ LINE
℄ LINE
CANAHAL
N=95°-27'W
N= 81°-19"
N= 29.53
N= 120.23"

Notes Ck'd by M. OSHITA
Map No.
Office Work
Checked
Date

Survey of CITY TERRACE AREA 8 F. B. 3206 PG. 95
JN 0303.01 Tape 226 Std. 84 °F
Surveyed by E. E. Brooks
Notes FF.B. GE Bk Date 19 JAN 06
Indexed C. J. GALLI

Cont from Pg 76

Note: Any Additions or Changes on This Sheet Must be Made or Circled in Red Ink With Date and Name of Person Making Change.

PLEASE RETURN TO LOS ANGELES COUNTY ENGINEER 403 Los Angeles County Engineering Bldg.

Do not extend this side of this line.

76F3095 CE #310 6-62

LOT 18 — LOT 19 — LOT 20 BLOCK 15 — LOT 1 BLOCK 16 — LOT 2 BLOCK 16 — LOT 1 BLOCK 14

5+64.9
22.0
St Iron Garage
137-17-40
189-10-40
137-17-40
103-46-00
137-17-40
137°
N=
40'
17'
137-17-40
E.H. Spk w 3"dia. no rec. Fd nothing else 30' dist.
Set L & Co Engr. Tag
(20)
N=120.65
A.L.
Concrete block wall
12.3
5+98.9
Fd L&T L.S. 2510 Stamped in lead C+27.04
5'chain link fn.
EC
14.83
A.L.
0.17
113.13
35.96
4.85
5+50
62.74-85
Set 1-in I.M.H.
90°
14.30°
CITY MAIN
TR
MB
Set L & T
30.0
C+40.0
4' chain link fn.
N=95.22
LINE
26.1
C+14.95
Set Bt. Spk w/ Tr Rec # at TR and 0.5' from P.I. To N.
C+48.0
C.L. LIVE OAK R.R. ST.
GANAHL
ST
30.1
24.2
C+87.0
C+93.0
WALK
3' Picket fn
C.L.
LOT 16 BLOCK 14
LOT 1 BLOCK 16

PLEASE RETURN TO
LOS ANGELES COUNTY ENGINEER
403 LOS ANGELES COUNTY ENGINEERING BLDG.

Note: Any Additions or Changes on This Sheet Must Be Made or Circled in Red Ink With Date and Name of Person Making Change.

Do not extend this side of this line.

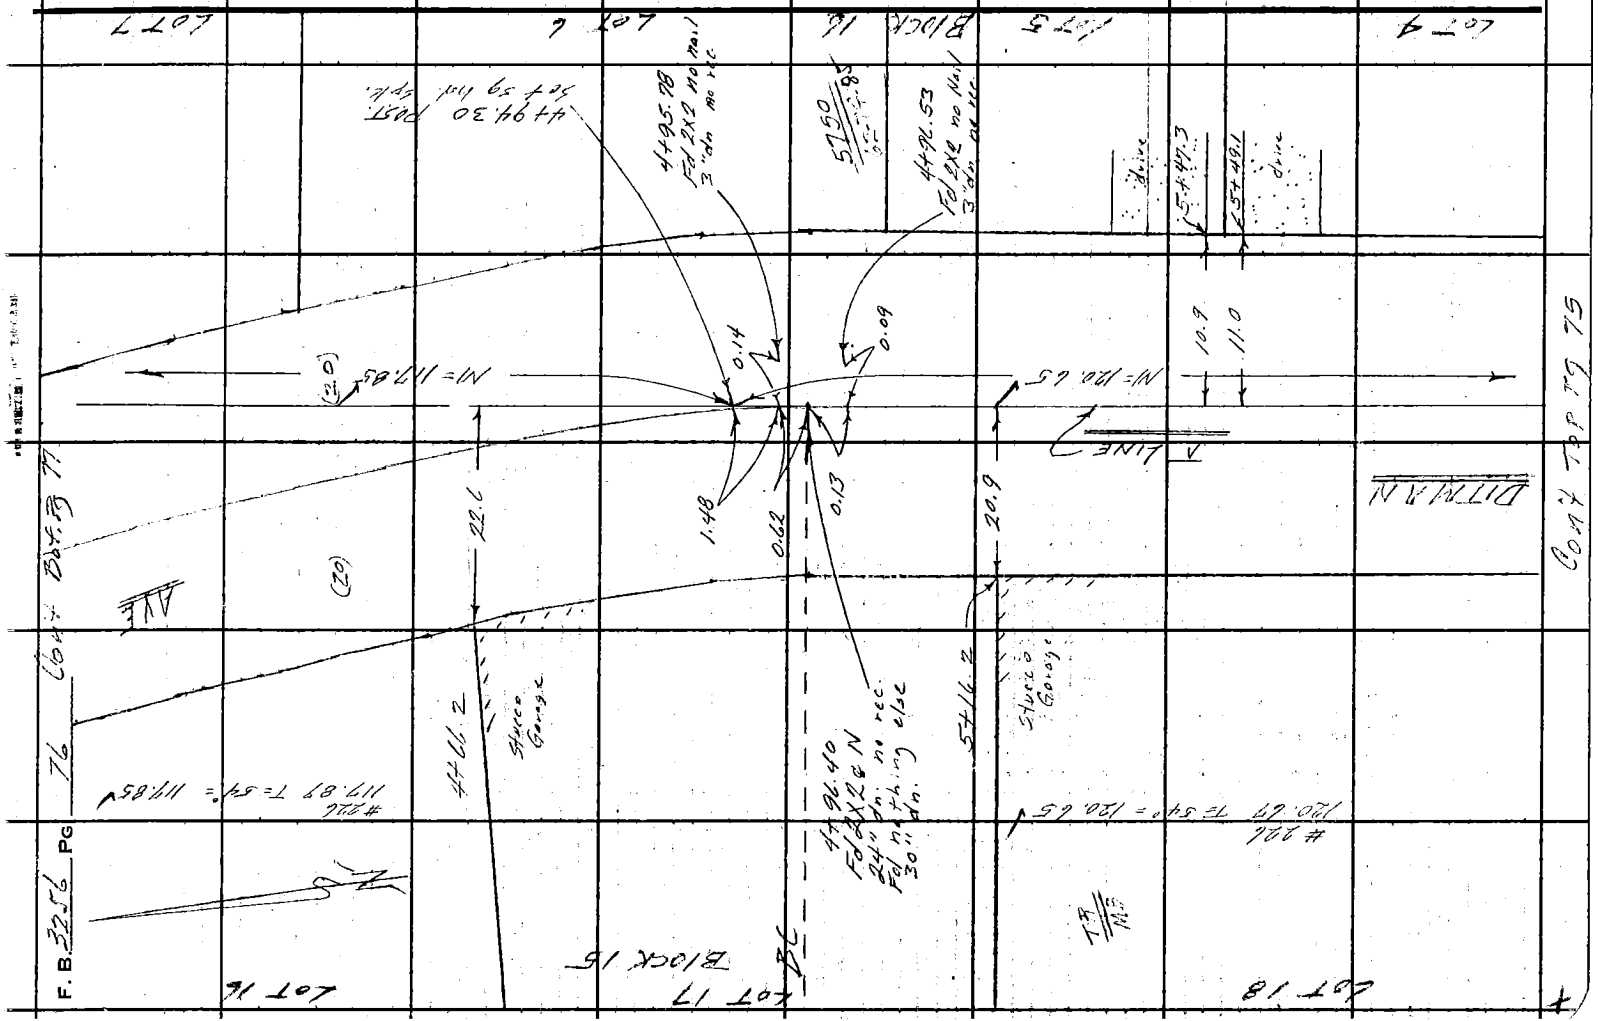
LOT 7
LOT 6
BLOCK 16
LOT 5
LOT 4
LOT 16
LOT 17
BLOCK 15
LOT 18
F.B. 325/6 PG
N1=117.85
N1=120.65
LINE
DITMAN
AVE
Cor. Top TS
Cor. Bot. TS
#226
117.89 T=54°=117.85
#226
120.67 T=54°=120.65
(20)
(20)
22.6
20.9
10.9
11.0
0.14
0.09
1.48
0.62
0.13
0.13
0.13

Notes Ck'd by M. OSHITA
Map No.
Office Work
Checked
Date

Survey of CITY TERRACE AREA E
JN 0303.01 Tape 22L Std 84 °F
Surveyed by F. E. Brooks
Notes FEB Date 12 Jan 66
Indexed C. J. GALLI

F. B. 325 L PG. 71

CONT BOT PG 78

1) 159-43-05
4) 276-52-10
159-43-02½
6) 238-16-20
159-43-03½

AVE

℄ LINE

Conc wall
4' Picket ℓ.

3+06.79
Fd 2X2 Tie
L.S. 257
no ecc.

3+05.2

21.80

19.2

(20)

(24)

42.21

Lot 13

Lot 14

Lot 15

Lot 16

Lot 17

Lot 18

Lot 19

Lot 20

Block 2

Block 3

Lot 12

Lot 11

Lot 10

Lot 9

Lot 8

Lot 7

Lot 6

Lot 5

Lot 4

Lot 3

Lot 2

Lot 1

Block 4

Block 5

Block

PLEASE RETURN TO
LOS ANGELES COUNTY ENGINEER
403 LOS ANGELES COUNTY ENGINEERING BLDG.

Note: Any Additions or Changes on This Sheet Must Be Made or Circled in Red Ink With Date and Name of Person Making Change.

Do not extend this side of this line.

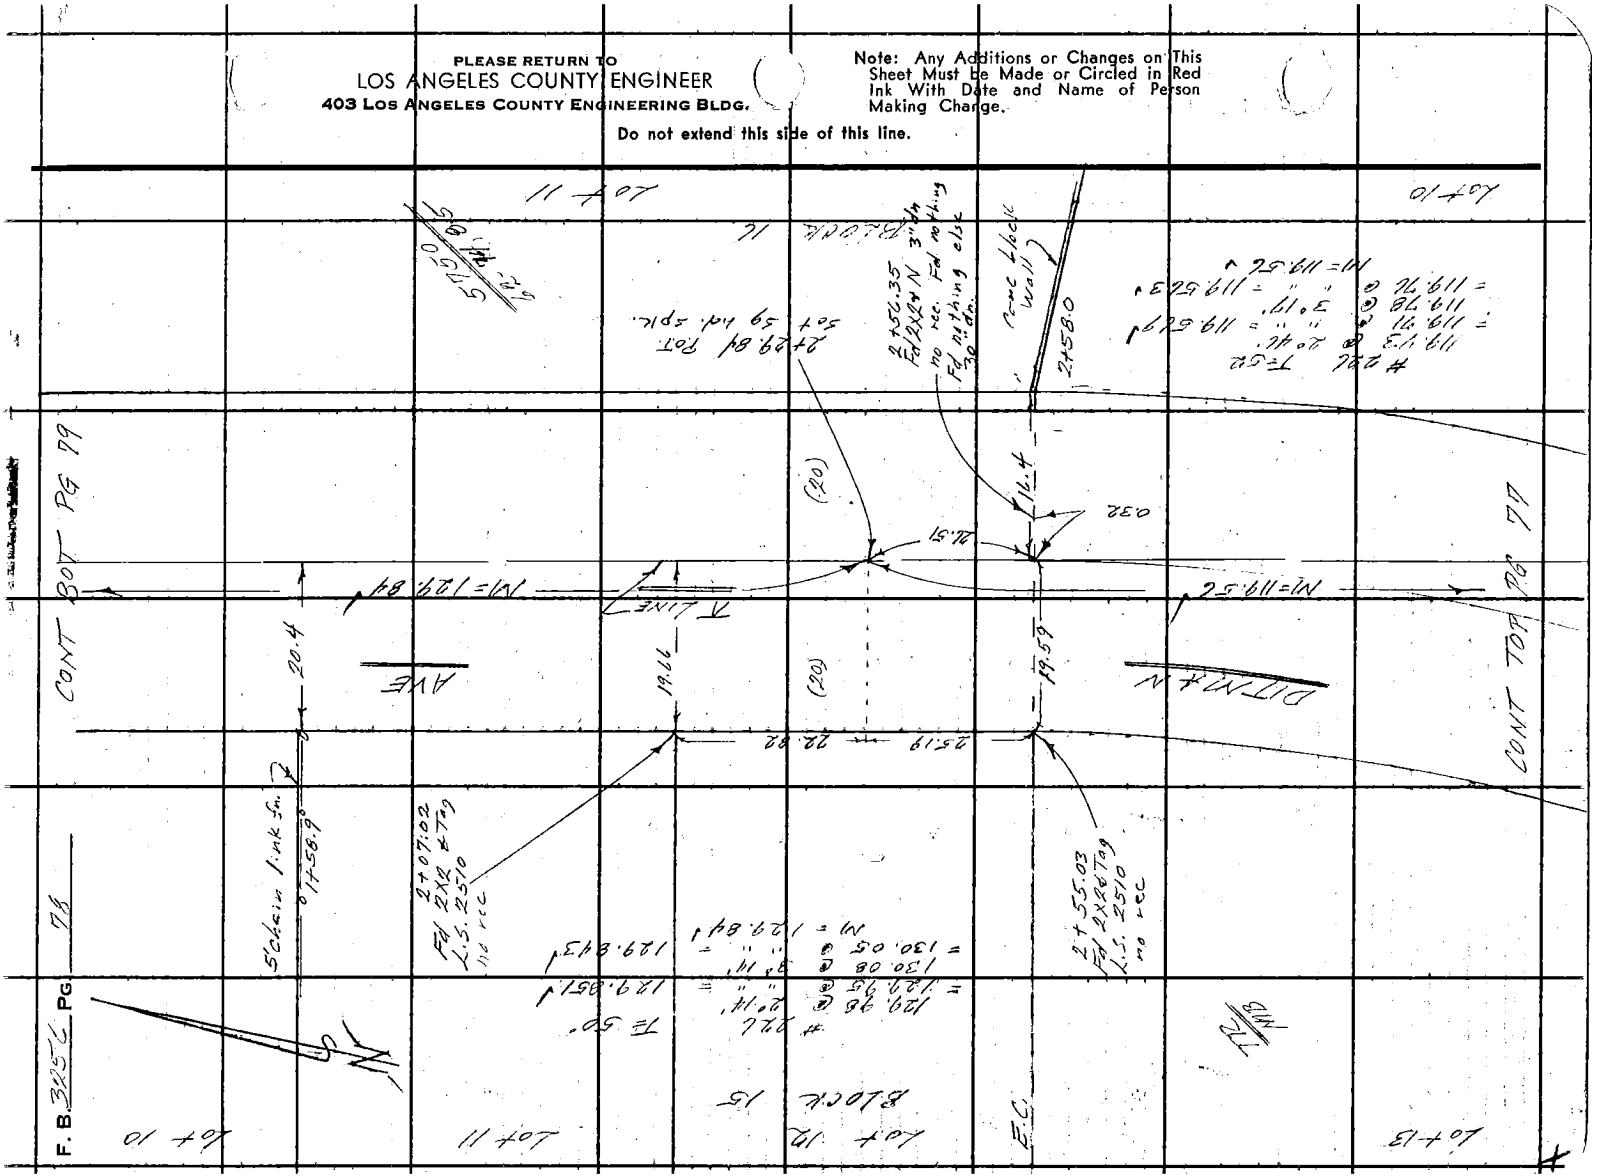

Notes Ck'd by M. OSHITA
Map No.
Office Work
Checked
Date

Survey of CITY TERRACE AREA
JN 2307.04 Tape #26 Std B4 °F
Surveyed by E. E. Brooks
Notes F.E.B Date 11 Jan 66
Indexed C. J. GALLI

F. B. 325 Pg. 79

W.S.7, D-1

Note: Any Additions or Changes on This Sheet Must be Made or Circled in Red Ink With Date and Name of Person Making Change.

Do not extend this side of this line.

PLEASE RETURN TO
LOS ANGELES COUNTY ENGINEER
403 LOS ANGELES COUNTY ENGINEERING BLDG.

D6F309S CE #310 6-62

Lot 10 Block 16

CONT TOP PG 80

CONT BAT PG 83

CONT BAT PG 81

CONT TOP PG 78

Block 5

Lot 11 Block 11

Lot 1 Block 11

Block 16

Lot 10

Block 16

ROMERO

DITMAN

M=114.89

M=197.21

M=253.03

M=68° 33' E

S10°50' E 22.90

S10°50' E 1700 Ties set Conc. N. at The Ero- Div. Line W. Terra- ce D. Tining in top of structure Fd 2&7

S 0°50' E 59.45 ft to W. edge of S. Mt. R. Dist. Ave. TR. City of Terrace Dr

S 0°50' E 59.45

0.20

22.90

T LINE

(15)

(20)

(30)

(45)

(60)

Fd Lot

Fd Lot

Fd Lot

St.

Ave.

TR

MB

5750
62-14-85


1) 68-33-23
4) 204-13-30
68-33-23½
6) 69-10-30
68-33-23½

PLEASE RETURN TO
LOS ANGELES COUNTY ENGINEER
403 LOS ANGELES COUNTY ENGINEERING BLDG.

Note: Any Additions or Changes on This Sheet Must Be Made or Circled in Red Ink With Date and Name of Person Making Change.

Do not extend this side of this line.

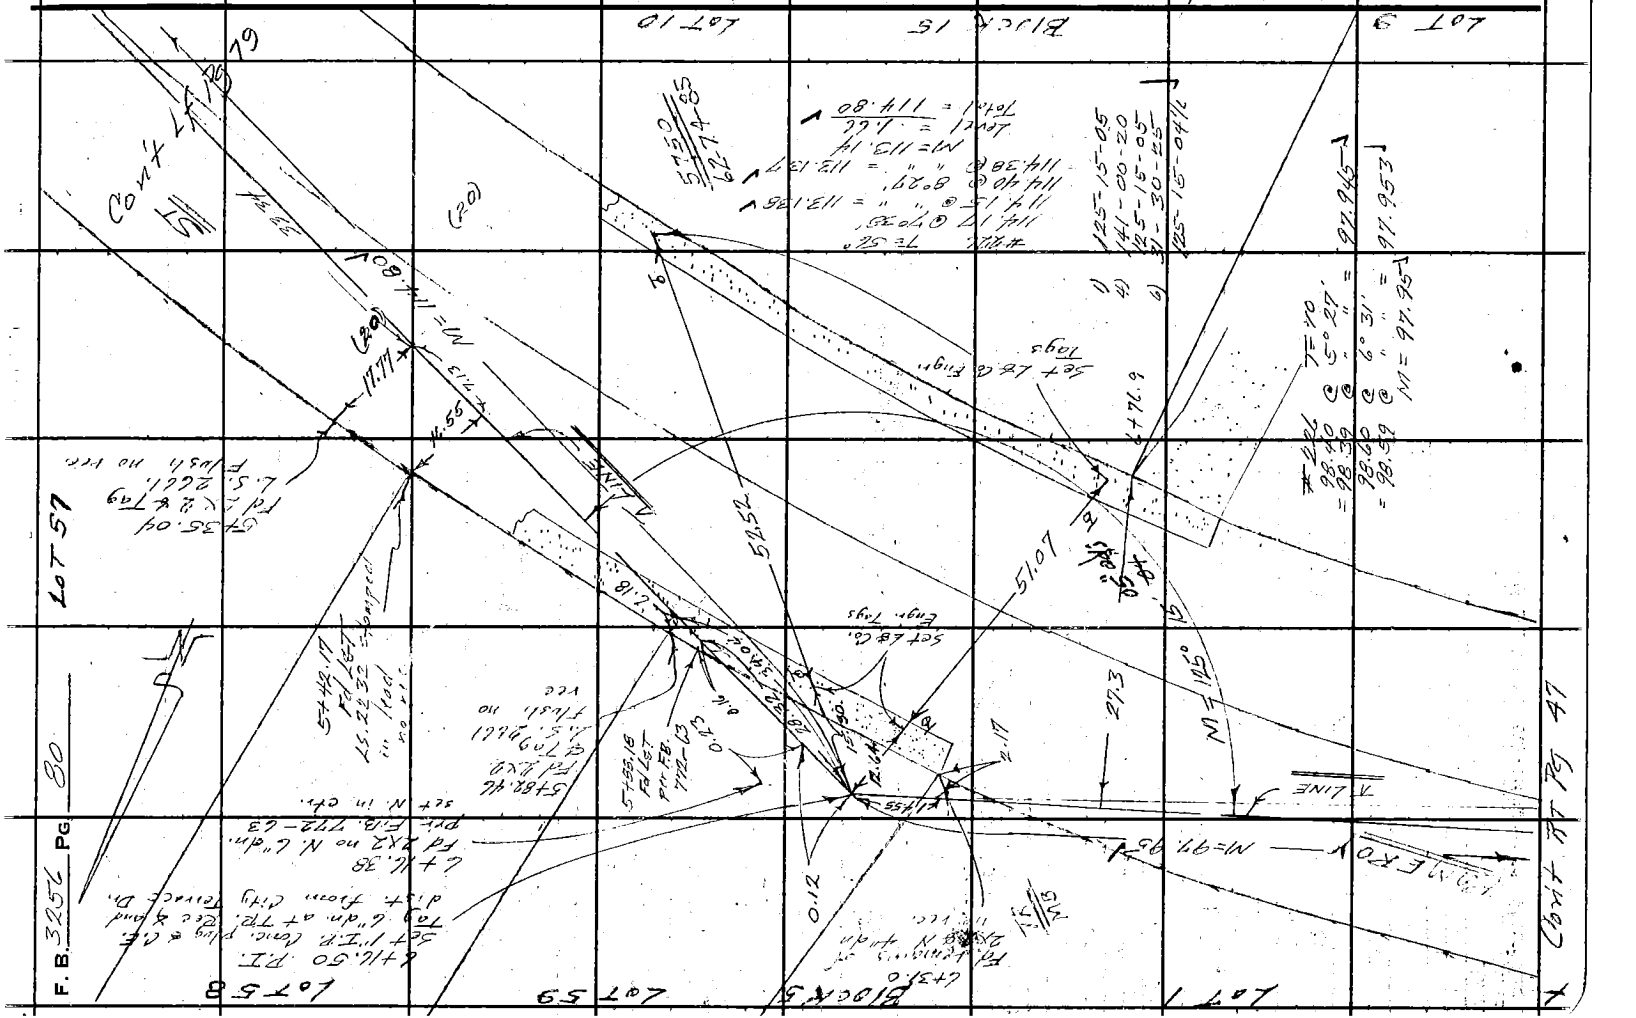

Notes Ck'd by M. OSHITA
Map No.
Office Work
Checked
Date

Survey of CITY TERRACE AREA 2
JN 0701 04 Tape 22L Std B-4 °F
Surveyed by E. E. Brooks
Notes F.E. B-GE. Cont Date 11-10-44
Indexed C. J. GALLI

F. B. 3256 Pg. 81

Lot 15

Lot 47 Cont Bot Pg 82

Conc block wall

2438.1 — 18.2 — 17.90 — 2+39.97 Ft Left No Ice

3' Hedge

M = 125.39

2+48.49 POT. Set ¾ bd spk.

(20) (20)

Lot 14

2+89.8 — 19.8 — 20.6 — 2+90.3 — 14' Hedge

Lot 16

Block 17

5750 / 6214.82

Lot 3

T LINE

M = 453.03

Total = 453.03

Lot 13

1" = 250.7 Ft











PLEASE RETURN TO
LOS ANGELES COUNTY ENGINEER
403 LOS ANGELES COUNTY ENGINEERING BLDG.

Note: Any Additions or Changes on This Sheet Must Be Made or Circled in Red Ink With Date and Name of Person Making Change.

Do not extend this side of this line.

W.S.7, E-1

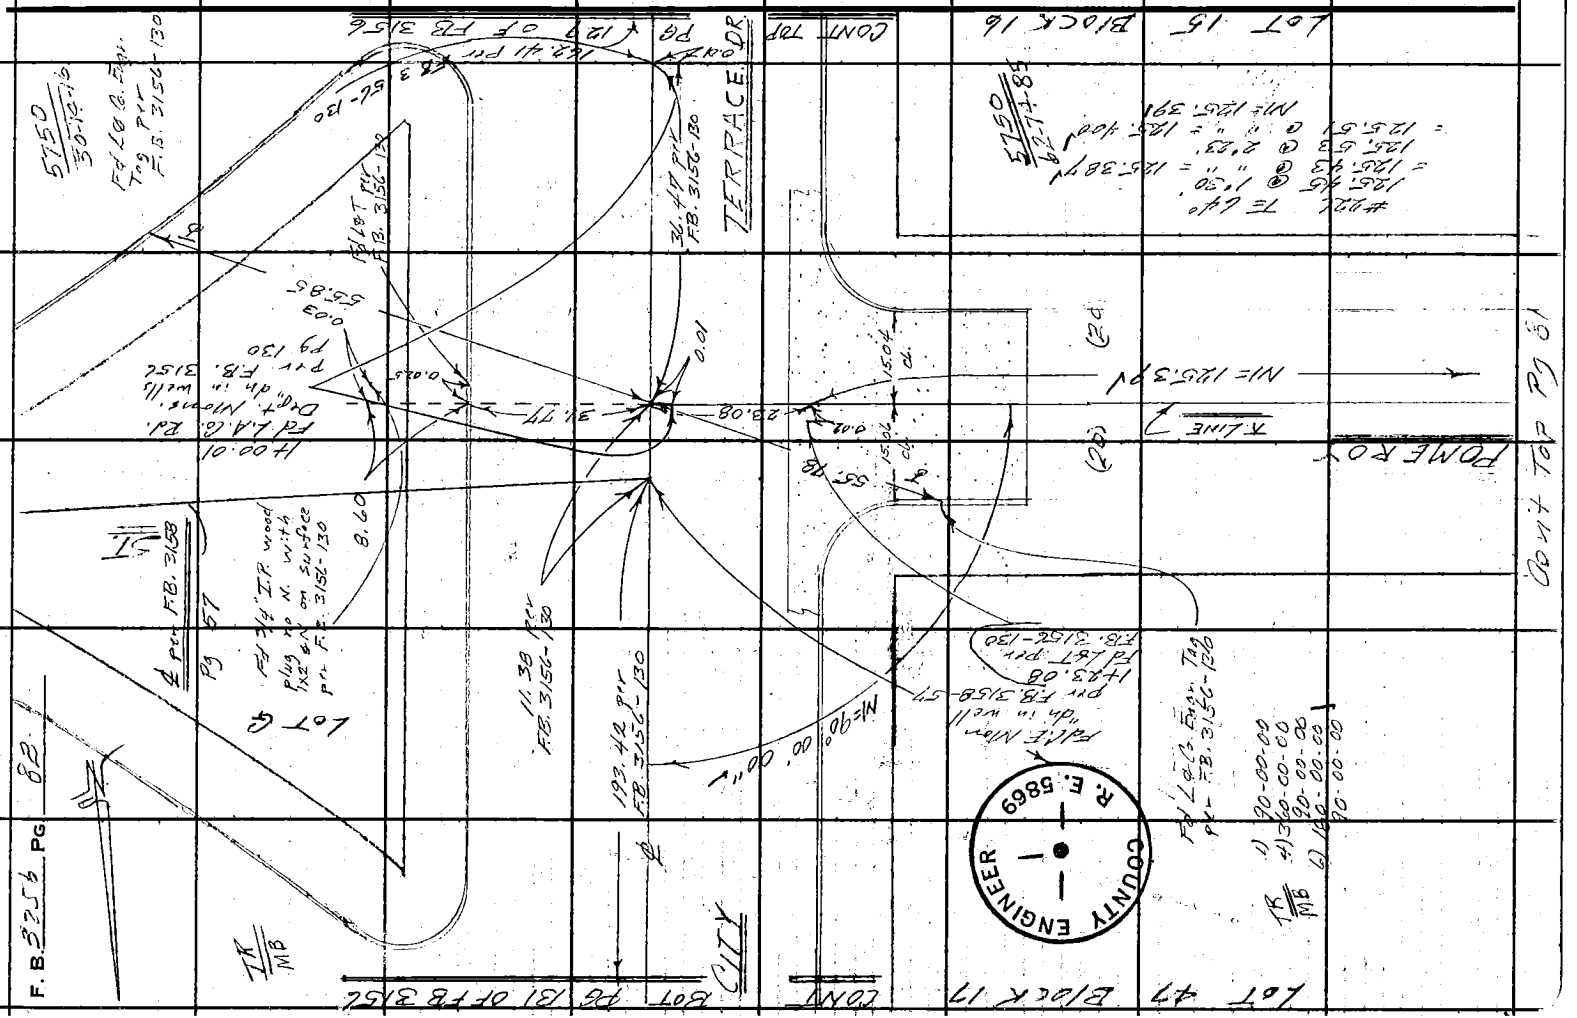
TERRACE DR
POME ROY
LOT 15 BLOCK 16
LOT 47 BLOCK 17
LOT G
CONT TOP PG 81
CONT TOP PG 31 OF FB 3156
CITY
COUNTY ENGINEER R.E. 5869
F.B. 3156 PG 82
FD LOS ANGELES CO. TOP PVT FB. 3156-130
FD 3/4" I.P. wood PLUG N. WITH ON SURFACE FB. 3156-130
FD 1/2" I.P. NO TAG
FD L&T PVT FB. 3156-130
FD L&T PVT FB. 3156-130
FD L.A.C. RD. CONT. MONUMS. WELL dh. in PVT FB. 3156 PG 130

Notes Ck'd by M. OSHITA
Map No.
Office Work
Checked
Date

Survey of CITY TERRACE AREA 2
JN 0505.02 Tape 776 Std 68° F
Surveyed by F. E. Brook
Notes FEB GE Cook Date 10 Nov 61
Indexed C. J. GALLI



















Note: Any Additions or Changes on This Sheet Must be Made or Circled in Red Ink With Date and Name of Person Making Change. Do not extend this side of this line.

PLEASE RETURN TO
LOS ANGELES COUNTY ENGINEER
403 LOS ANGELES COUNTY ENGINEERING BLDG.

17DF3095, CE #310 6-63

PLEASE RETURN TO
LOS ANGELES COUNTY ENGINEER
403 LOS ANGELES COUNTY ENGINEERING BLDG.

Note: Any Additions or Changes on This Sheet Must be Made or Circled in Red Ink With Date and Name of Person Making Change.

Do not extend this side of this line.

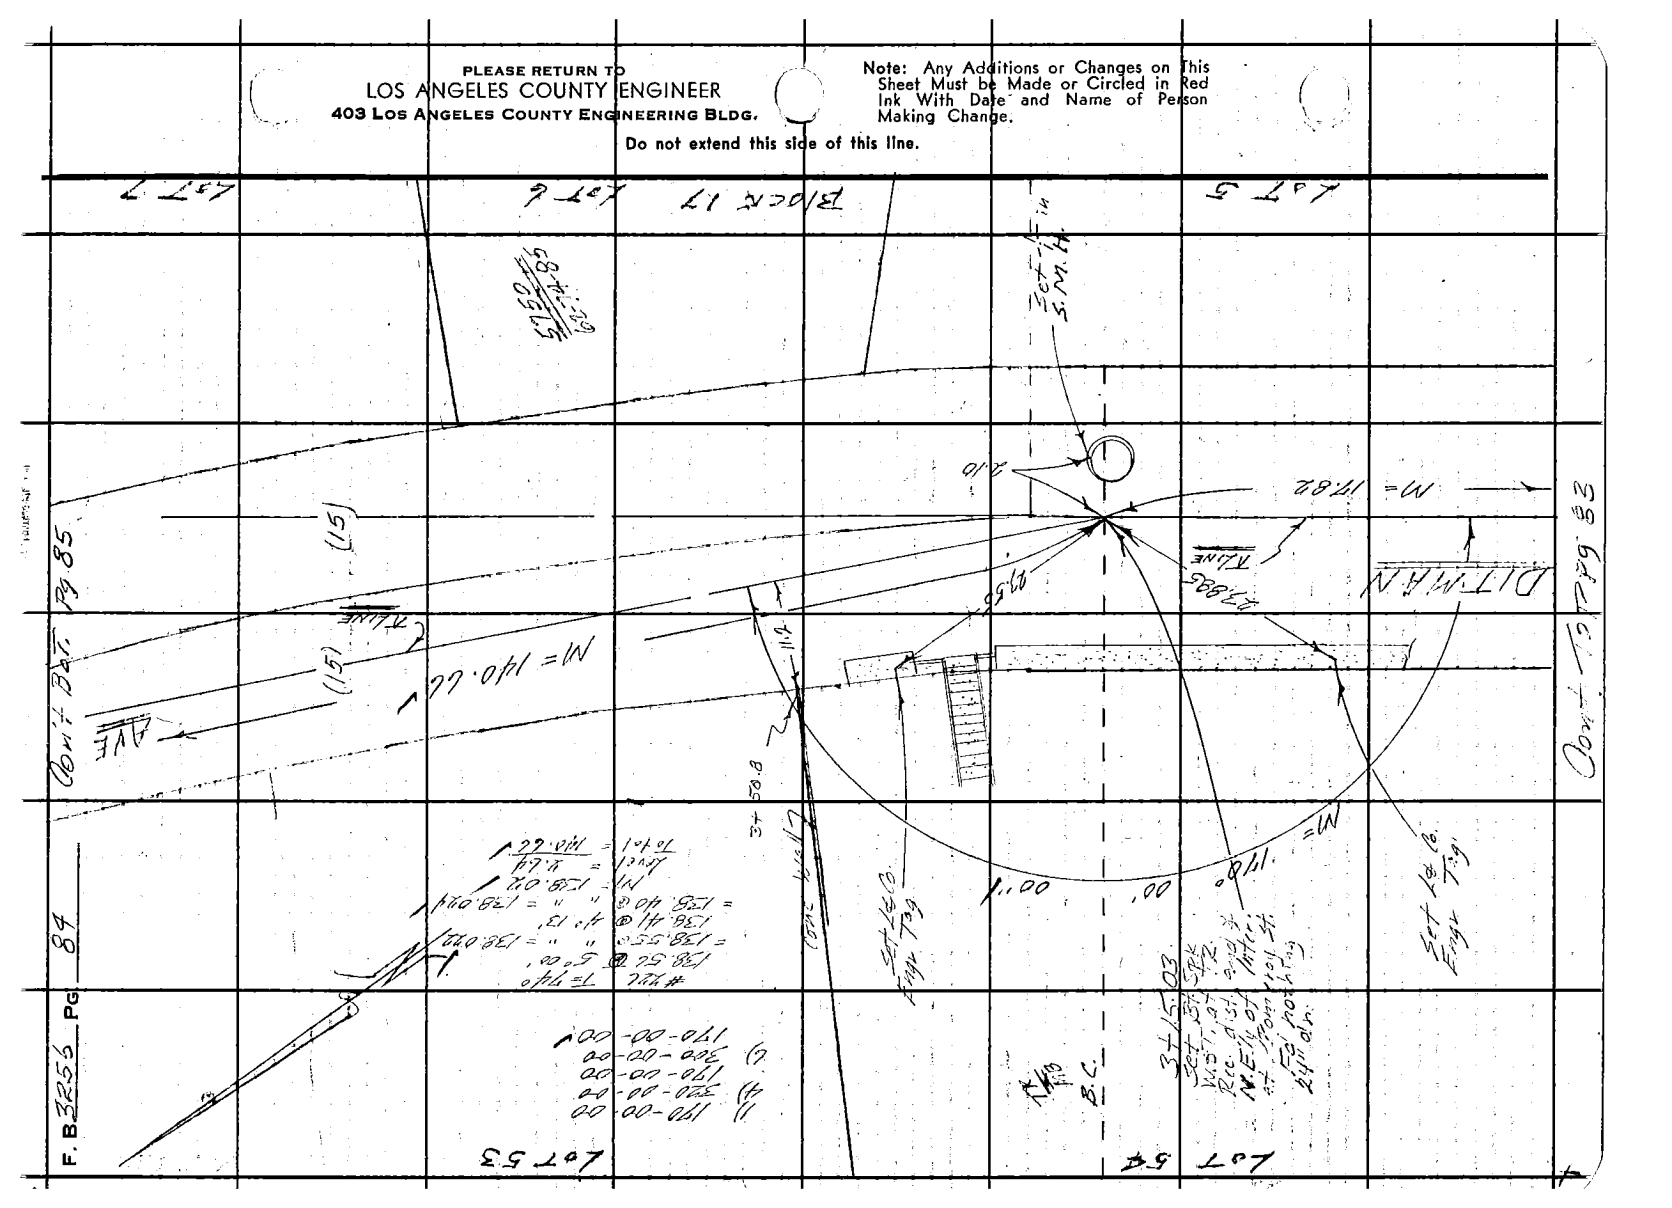

Notes Ck'd by M. OSHITA
Map No.
Office Work
Checked
Date

Survey of CITY TERRACE AREA 2 F. B. 3256 PG. 85
JN 0303.04 Tape 226 Std 84 °F
Surveyed by E. E. Brooks
Notes FEB. GEOD Date 11 March 66
Indexed C. J. GALLI

CONT BOT PG 86

#226
140.67 T=76°
= 140.66

Note: Any Additions or Changes on This Sheet Must be Made or Circled in Red Ink With Date and Name of Person Making Change.

Do not extend this side of this line.

PLEASE RETURN TO
LOS ANGELES COUNTY ENGINEER
403 Los Angeles County Engineering Bldg.

76F3095 CE. #310 6-62

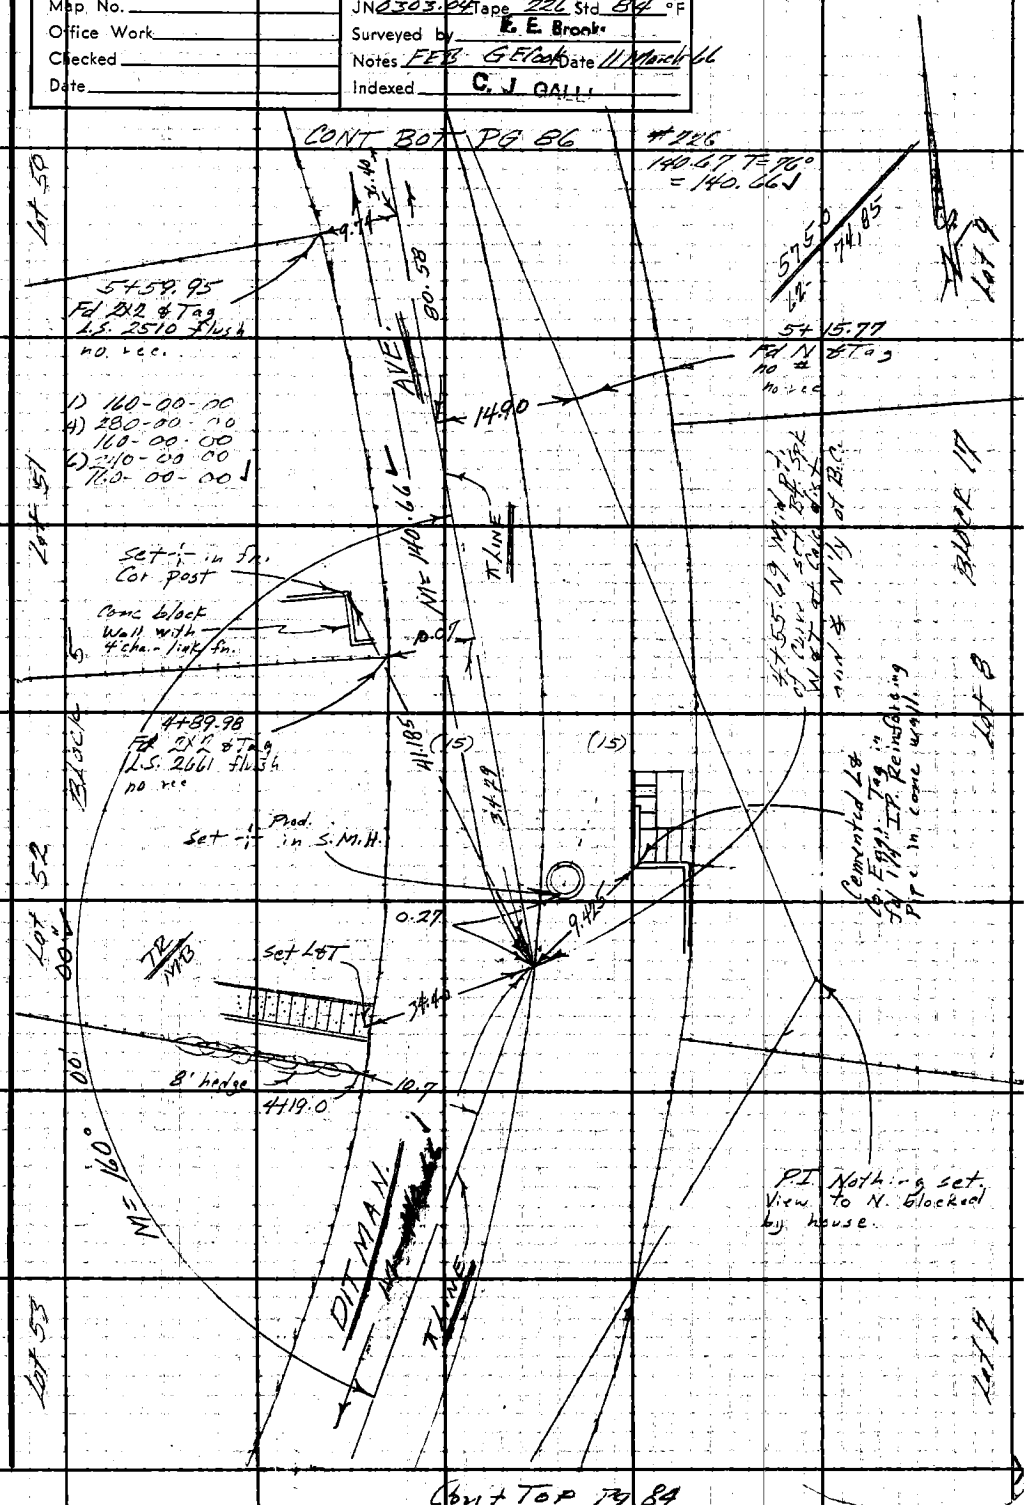

PLEASE RETURN TO
LOS ANGELES COUNTY ENGINEER
403 LOS ANGELES COUNTY ENGINEERING BLDG.

Note: Any Additions or Changes on This Sheet Must be Made or Circled in Red Ink With Date and Name of Person Making Change.

Do not extend this side of this line.

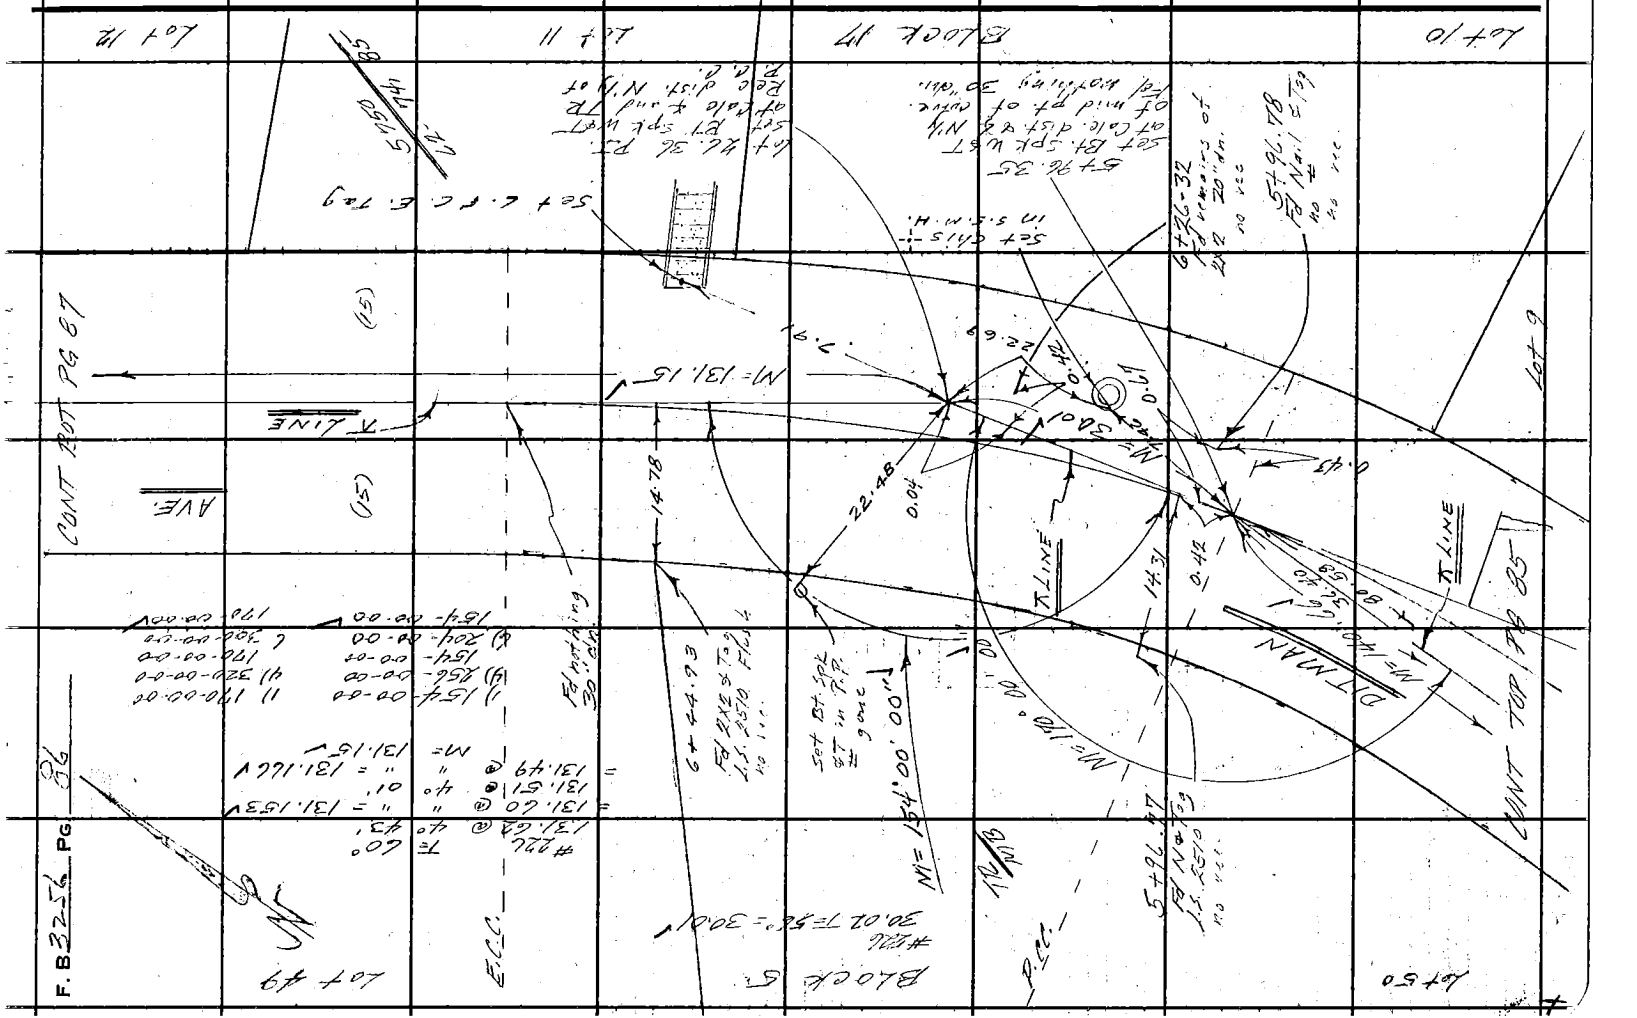

Notes Ck'd by M. OSHITA
Map No.
Office Work
Checked
Date

Survey of CITY TERRACE AREA
JN 0303.04 Tape 776 Std 84 °F
Surveyed by E. E. Brooks
Notes F.E.B. Date 14 March 66
Indexed C. J. GALLI

F. B. 3256 PG. 87

CONT BOT PG. 88

Note: Any Additions or Changes on This Sheet Must be Made or Circled in Red Ink With Date and Name of Person Making Change.
Do not extend this side of this line.

PLEASE RETURN TO
LOS ANGELES COUNTY ENGINEER
403 Los Angeles County Engineering Bldg.

76F3095 C.E. #310 6-62

Lot 47
Lot 48
Lot 49
Lot 13
Lot 12
Block
Block 17

1) 145-00-00
2) 90-00-00
3) 145-00-00
4) 90-00-00

Set Kerb. Engr. Tag
no rec.
Sta 4+54.52
Ext 5.62 Rt

12.12
5.97
20.53
7.01
(15)
8.13
9.9
7+36.5
4' hedge

Set X & Co. Engr. Tag.

℄ LINE
N = 81.19
57.49
5.750
62-14,85

Set ⊢ in fire hyd. 1.7 below bottom of head.

TC
MB
#1

0.18
40.23
N 145° 00' 00" W
B.C.
℄ LINE
N = 131.15
DIT MAIN

Sta 5+57.51 Post Set Spk W & T.S. Ext. Rea at Pt. To S.
Sta 5+45.28 Ext. 2.21 Rt. 4" Ø Conc. Mon. in 9" Ø Conc. Pipe
no rec.

CONT TOP PG 86

PLEASE RETURN TO
LOS ANGELES COUNTY ENGINEER
403 LOS ANGELES COUNTY ENGINEERING BLDG.

Note: Any Additions or Changes on This Sheet Must be Made or Circled in Red Ink With Date and Name of Person Making Change.

Do not extend this side of this line.

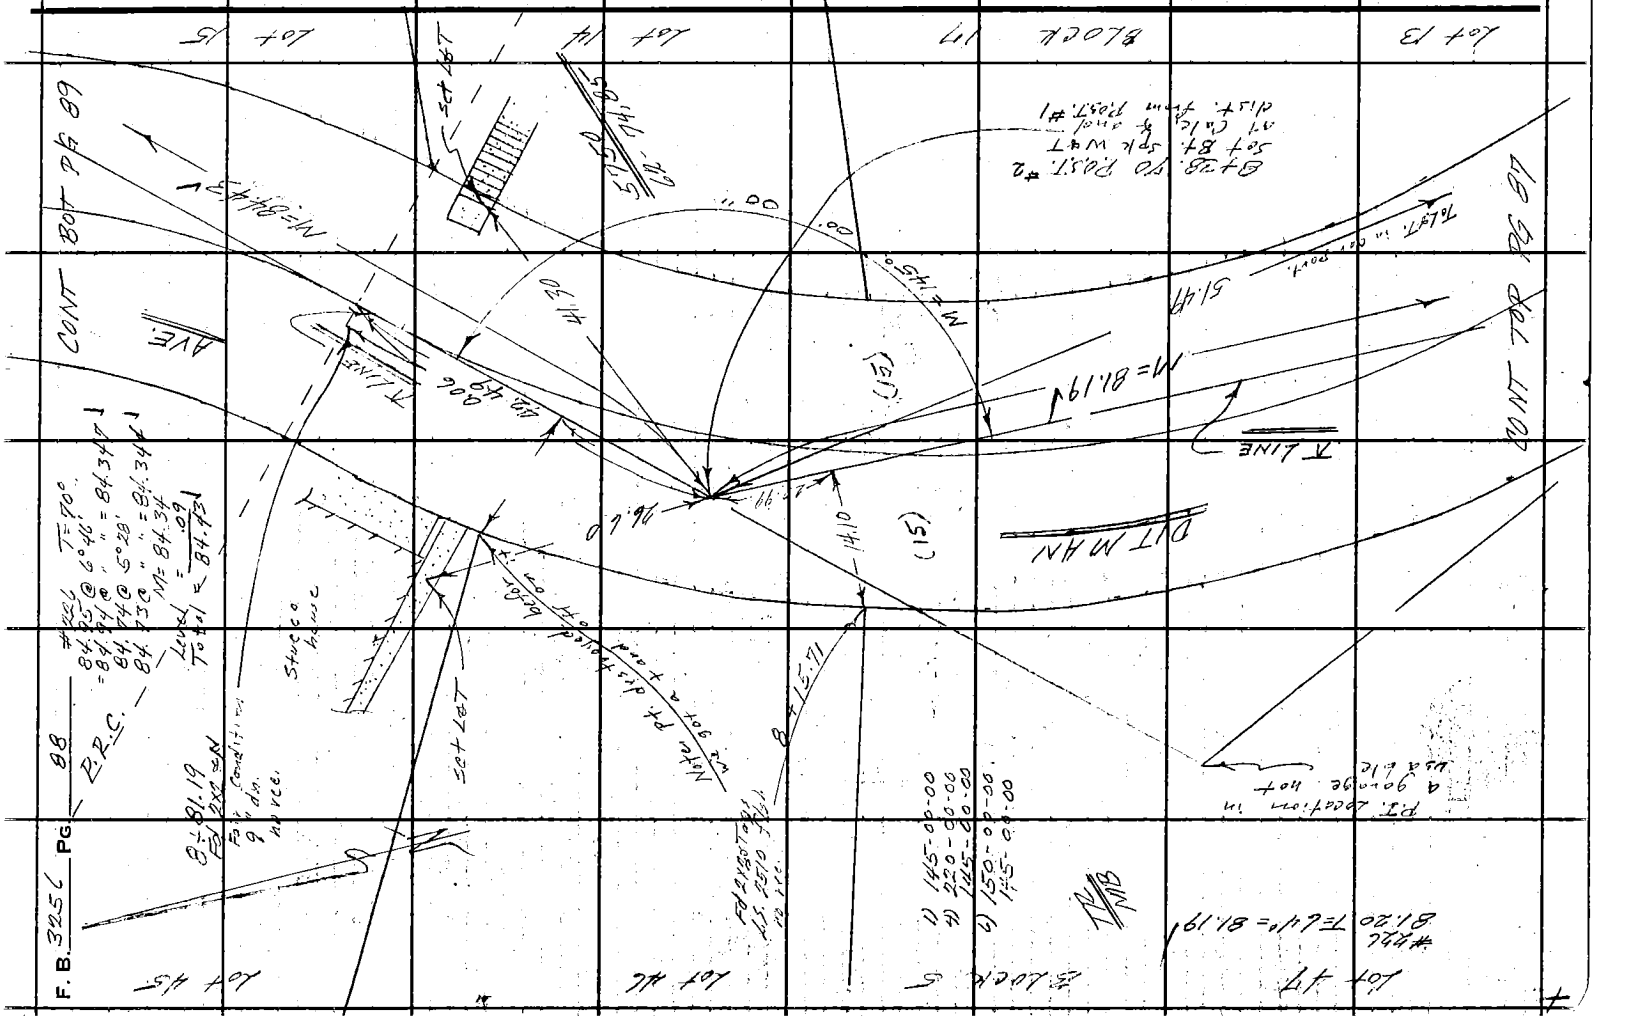
F.B. 3256 PG 88
BLOCK 17
Lot 13
Lot 14
Lot 15
Lot 16
Lot 17
CONT BOT PG 89
AVE
CONT ORT PG 89
T LINE
DIT MAN
Stucco house

Notes Ck'd by M. OSHITA
Map No.
Office Work
Checked
Date

Survey of CITY TERRACE AREA
JN 7303.06 Tape 276 Std 84 °F
Surveyed by E. E. Brooks
Notes F.E.-B. Date 15 March 6
Indexed E. J. GALLI

F. B. 3254 PG. 89

CONT BOT PG 90

CONT TOP PG 88

Note: Any Additions or Changes on This Sheet Must be Made or Circled in Red Ink With Date and Name of Person Making Change.

PLEASE RETURN TO LOS ANGELES COUNTY ENGINEER
403 Los Angeles County Engineering Bldg.
Do not extend this side of this line.

7GF3005 CE #310 8-63

PLEASE RETURN TO
LOS ANGELES COUNTY ENGINEER
403 LOS ANGELES COUNTY ENGINEERING BLDG.

Note: Any Additions or Changes on This Sheet Must be Made or Circled in Red Ink With Date and Name of Person Making Change.

Do not extend this side of this line.

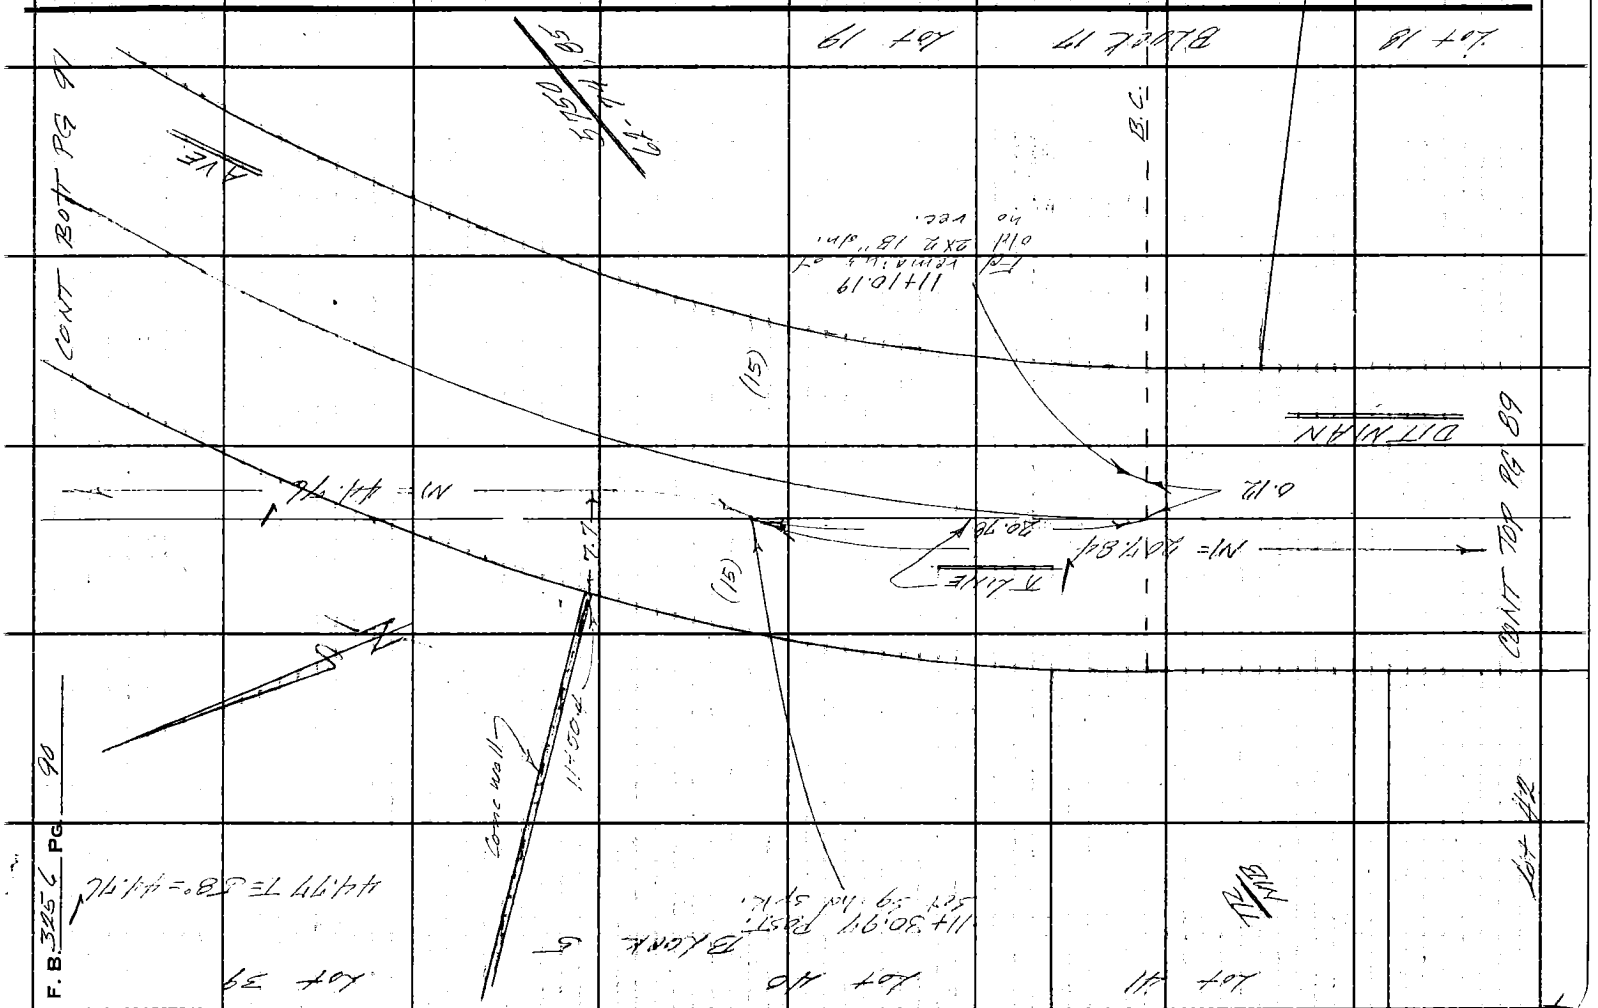

Notes Ck'd by M. OSHITA	Survey of CITY TERRACE ADD.
Map No.	JN 0707.00 Tape 200 Std 62 °F
Office Work	Surveyed by F. E. Brant
Checked	Notes FEB Date 15 Nov. 66
Date	Indexed C. J. GALLI

F. B. 3256 PG. 91

Lot 6

Block 28

Lot 5

L.A. CITY SCHOOL DIST.

Set Lead & Tack Tag

Set Lead & Tack Tag

Set Lead & Tack Tag

F.B. 3256 Pg. 92

CONT. B.O.T. PG. 93

Lot 10

3+81.3

24.1

Conc block wall

Lot 13

Lot 9

Block 18 DIST

L.A. CITY SCHOOL

Lot 8

N1= 176.72

5.750
62.74.85

Lot 12

3+18.7

24.6

Conc wall

Block 17

Lot 11

Lot 10

(25)

(25)

0.11

24.13.71

23.9

10.06

0.11

B.C.

Lot 20

N1= 170.55

Fd nothing 30' dr.

Lot 7

Fd nothing 30' dr.

2+12.9

26.6

4' conc block wall

Lot 6

CONT. R.T. PG. 91

Lot 19

PLEASE RETURN TO
LOS ANGELES COUNTY ENGINEER
403 Los Angeles County Engineering Bldg.

Do not extend this side of this line.

Note: Any Additions or Changes on This Sheet Must be Made or Circled in Red Ink With Date and Name of Person Making Change.

Notes Ck'd by M. OSHITA
Map No.
Office Work
Checked
Date

Survey of CITY TERRACE AREA
JN 0307-00 Tape 426 Std B-4 °F
Surveyed by L. E. Brooks
Notes F.E.B. Date 4 March 66
Indexed C. J. GALLT

F. B. 3158 PG: 93

BLOCK 2

Note: Any Additions of Changes on This Sheet Must Be Made or Circled in Red Ink With Date and Name of Person Making Change.

W.S. 7, E-1

PLEASE RETURN TO:
LOS ANGELES COUNTY ENGINEER
403 Los Angeles County Engineering Bldg.
Do not detach this side of this line.

76F3085 CE #310 6-64

CONT FOR PG 92

PLEASE RETURN TO
LOS ANGELES COUNTY ENGINEER
403 LOS ANGELES COUNTY ENGINEERING BLDG.

Note: Any Additions or Changes on This Sheet Must be Made or Circled in Red Ink With Date and Name of Person Making Change.

Do not extend this side of this line.

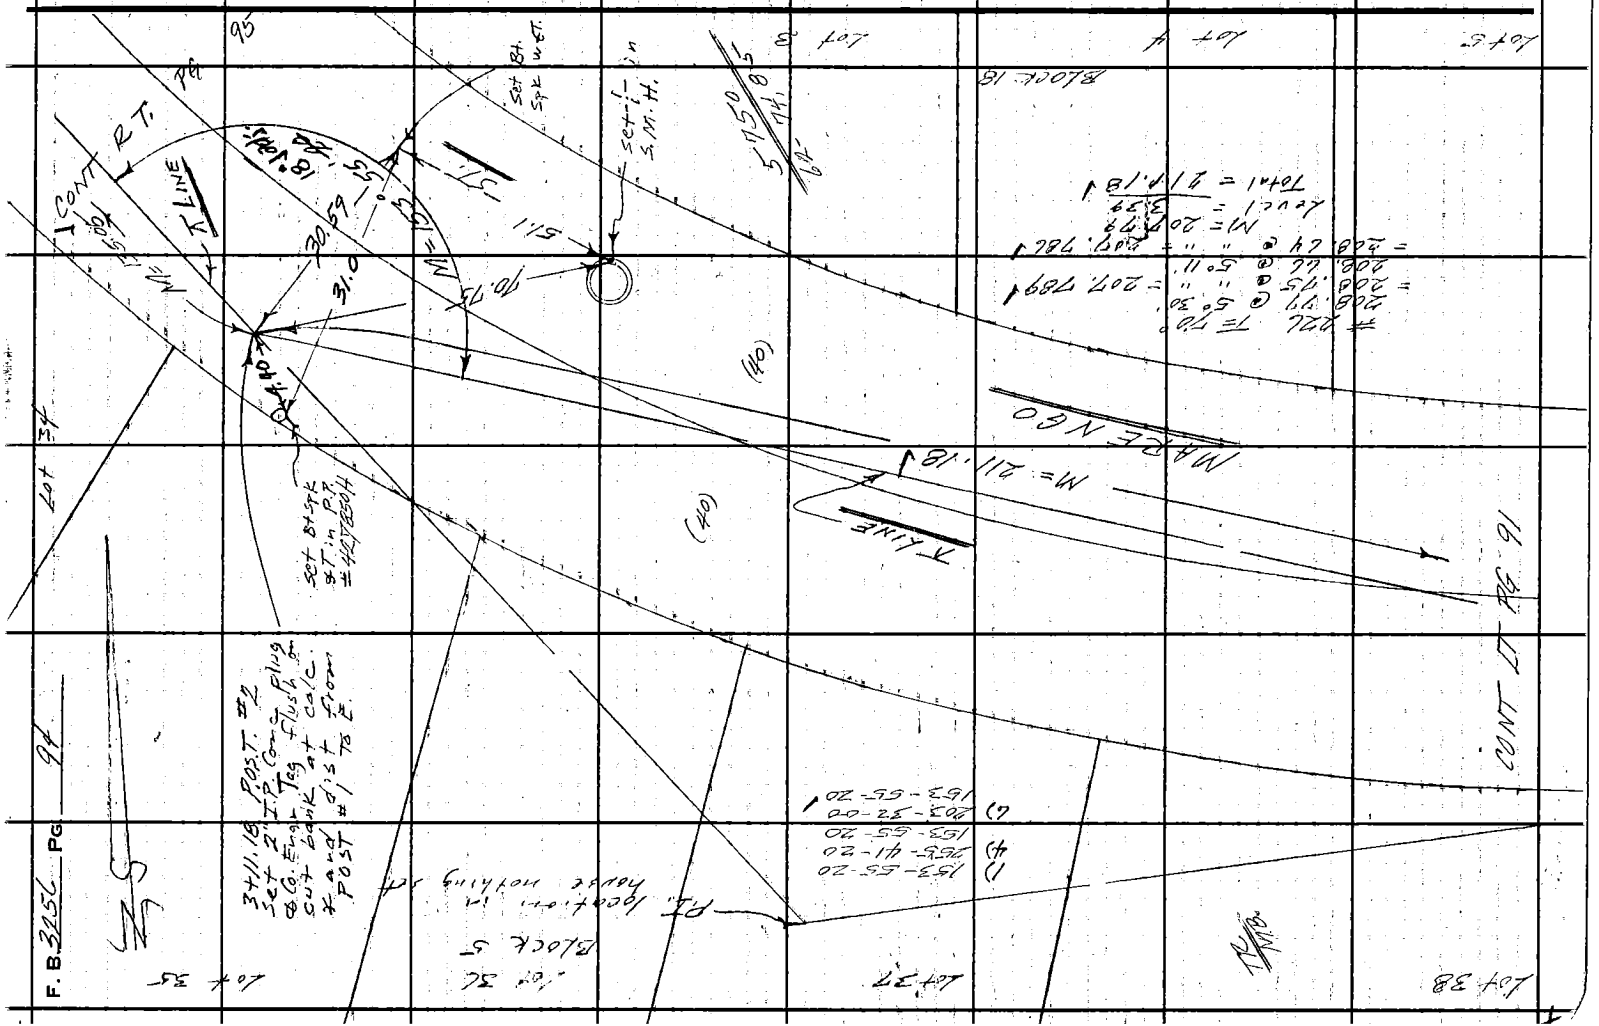
BLOCK 16
Lot 3
Lot 4
Lot 5
Lot 37
Lot 38
Lot 35
Lot 34
BLOCK 5
M.H.
Set B&T.
Set B&T in P.P. #HITCHCOCK
Set 2" I.P. Copper Plug Tag & Plug cut Book at calc. Point & Post #1 dist to E.
#2 Post

Notes Ck'd by M. OSHITA
Map No.
Office Work
Checked
Date

Survey of CITY TERRACE TRACT
JN 0303.04 Tape 226 Std 64 °F
Surveyed by E. E. Brook
Notes FEB Date 16 March 11
Indexed C. J. GALLI

F. B. 3256 PG. 95

CONT RT PG 96

CONT LT PG 96

Lot 32

Lot 33

Lot

PLEASE RETURN TO
LOS ANGELES COUNTY ENGINEER
403 LOS ANGELES COUNTY ENGINEERING BLDG.

Note: Any Additions or Changes on This Sheet Must be Made or Circled in Red Ink With Date and Name of Person Making Change.

Do not extend this side of this line.

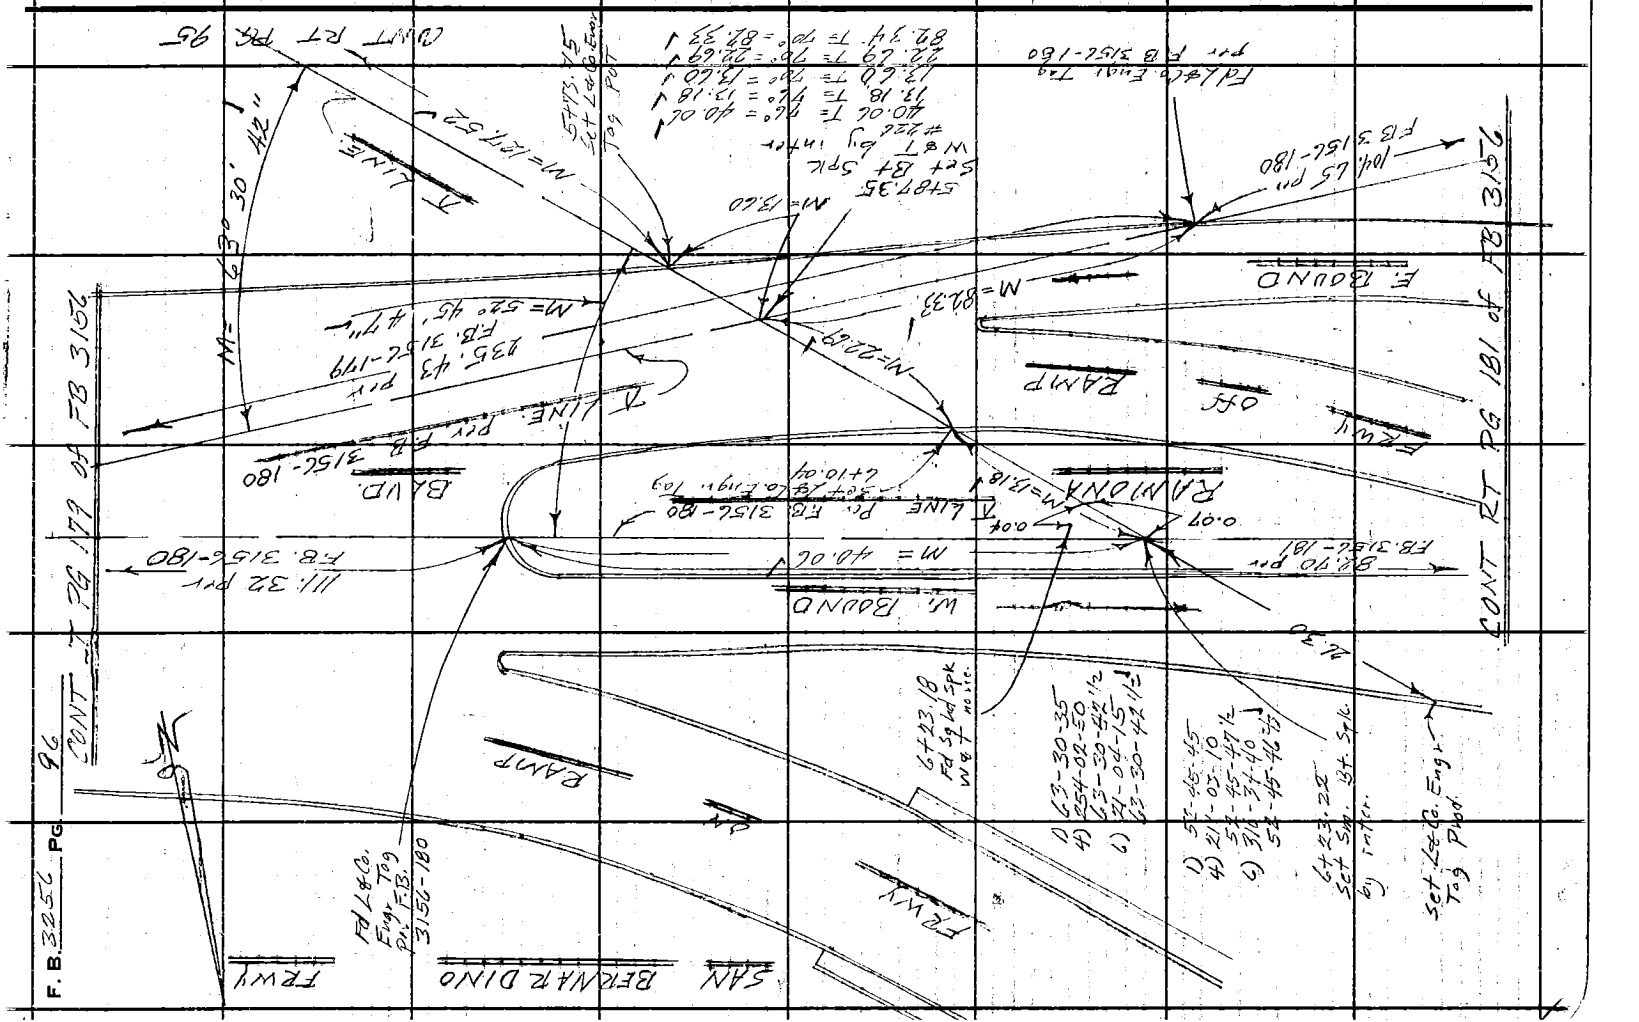
F. B. 3252 Pg 96
CONT RT PG 181 of FB 3152
CONT RT PG 179 of FB 3152
SAN BERNARDINO FRWY
RAMP
RAMONA
BLVD.
W. BOUND
E. BOUND
OFF
RAMP
FRWY
Fd L&Co. Engr. Tag on FB. 3156-180
Fd Sq Lead Spk W&T no sec.

Notes-Ck'd by M. OSHITA
Map No.
Office Work
Checked
Date

Survey of CITY TERRACE AREA 2
JN 0305.04 Tape 226 Std 80 °F
Surveyed by FE Brooks
Notes FE B Date 11 April 66
Indexed C. J. GAITY

F. B. 3156 PG. 97

CONT RT PG 154

Note: Any Additions or Changes on This Sheet Must Be Made or Circled in Red Ink With Date and (Name of Person Making Change.

Do not extend this side of this line.

PLEASE RETURN TO
LOS ANGELES COUNTY ENGINEER
403 Los Angeles County Engineering Bldg.
Los Angeles, California

CONT LT PG 158

76F3095 CE #310 (8-63)

PLEASE RETURN TO
LOS ANGELES COUNTY ENGINEER
403 LOS ANGELES COUNTY ENGINEERING BLDG.

Note: Any Additions or Changes on This Sheet Must be Made or Circled in Red Ink With Date and Name of Person Making Change.

Do not extend this side of this line.

W.S. 7, E-1

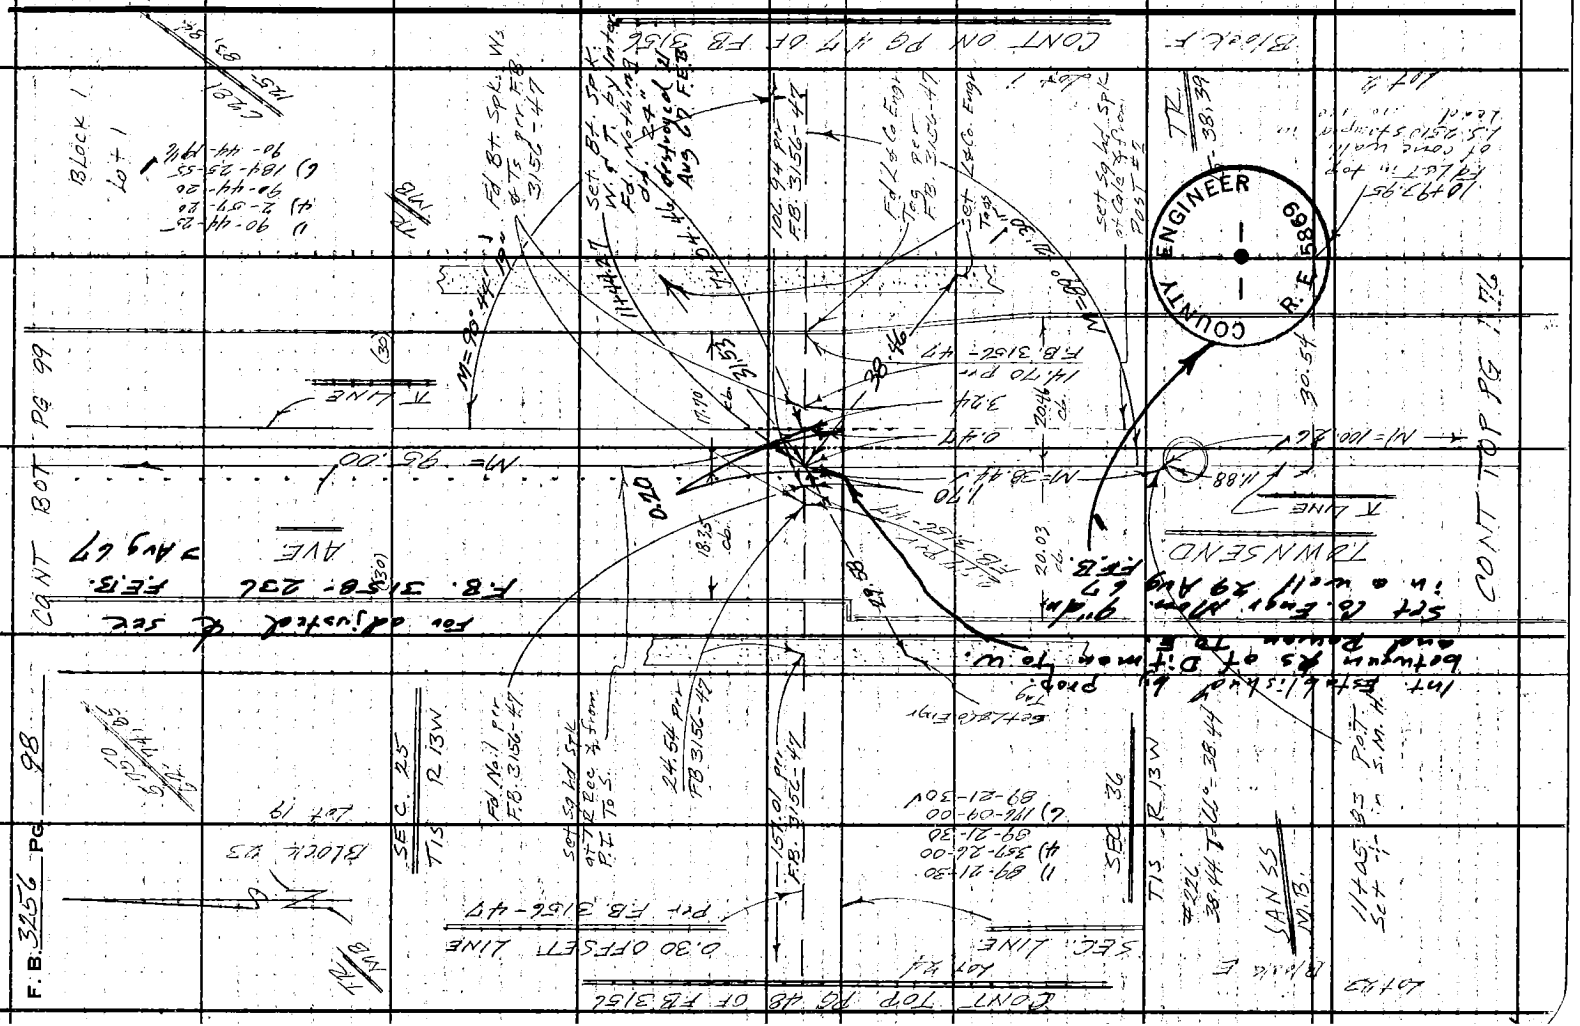

Notes Ck'd by N. OSHITA
Map No.
Office Work
Checked
Date

Survey of CITY TERRACE AREA
JN 0307.04 Tape 22' Std 84° °F
Surveyed by F. E. Brost
Notes FEB Date 4 May 66
Indexed U. J. GALLI

F. B. 3256 PG. 99

CONT BOT PG 100

Note: Any Additions or Changes on This Sheet Must be Made or Circled in Red Ink With Date and Name of Person Making Change.

PLEASE RETURN TO
LOS ANGELES COUNTY ENGINEER
403 LOS ANGELES COUNTY ENGINEERING BLDG.
Do not extend this side of this line.

7 OF 309S CE #310 8-63

AVE.


CONT TOP PG 98

PLEASE RETURN TO
LOS ANGELES COUNTY ENGINEER
403 LOS ANGELES COUNTY ENGINEERING BLDG.

Note: Any Additions or Changes on This Sheet Must be Made or Circled in Red Ink With Date and Name of Person Making Change.

Do not extend this side of this line.

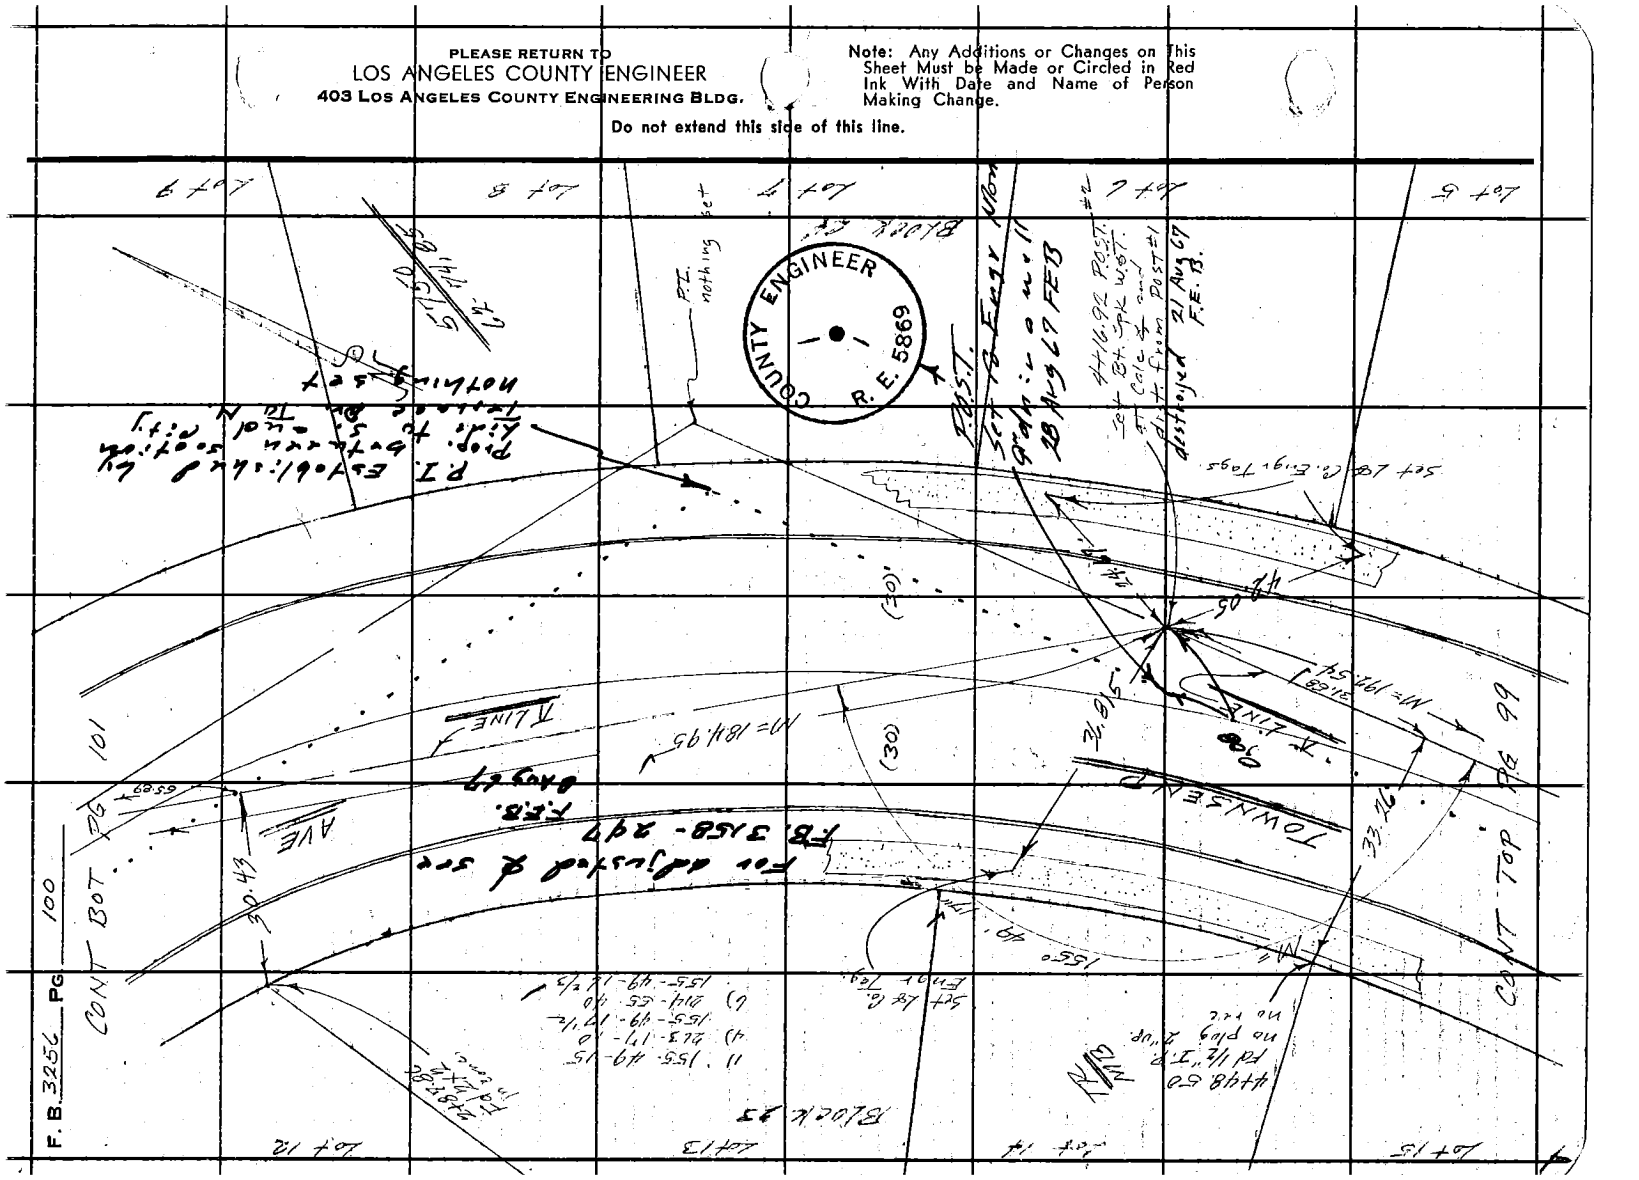

76F3095 OE #310 6-53

PLEASE RETURN TO
LOS ANGELES COUNTY ENGINEER
403 LOS ANGELES COUNTY ENGINEERING BLDG.

Note: Any Additions or Changes on This Sheet Must be Made or Circled In Red Ink With Date and Name of Person Making Change.

Do not extend this side of this line.

Notes Ck'd by M. SHIRA
Map No.
Office Work
Checked
Date
Notes
Indexed

Survey of MT. TERRACE AREA
JN 2257.04 Tape 226 Std 68° °F
Surveyed by F. E. Brooks
Notes FEB Date 4 Mar 68
T. T. [illegible]

F. B. 325 Pg. 101

Lot 12

BLOCK 83

#226
71.03 T = 44° = 71.02

CONT RT RS 102

AVE.

(30)

COUNTY ENGINEER R.E. 38699

P.O.S.T.
Set Lead Engr Tag
Mon in well
FEB

Set Lead Engr Tag

For additional d see
F.B. 3458 - 250
FEB 8 Aug 67
TOWNSEND

N 15° E 49.9' 17.4'

N 155° 49' 15" E 183.36'
to P.O.S.T. #1
N 203° 11' 10" E 183.44'
to P.O.S.T. #2
N 155° 49' 15" E 184.95'
to P.O.S.T. #3
Accepted = 184.95'

N = 184.95'

T LINE

T LINE

N = 71.02'

39.03

0.09

(30)

CONT TOP PG 100

Set scratched X in walk at TR Rec'd from City Terrace Dr.

Set Lead Engr Tag

2431.97 to P.O.S.T. #1
Set by Spike with Washer
Accepted 21 Aug 67
FEB

Lot 9 Lot 10 Lot 11 Block 44 Lot 12

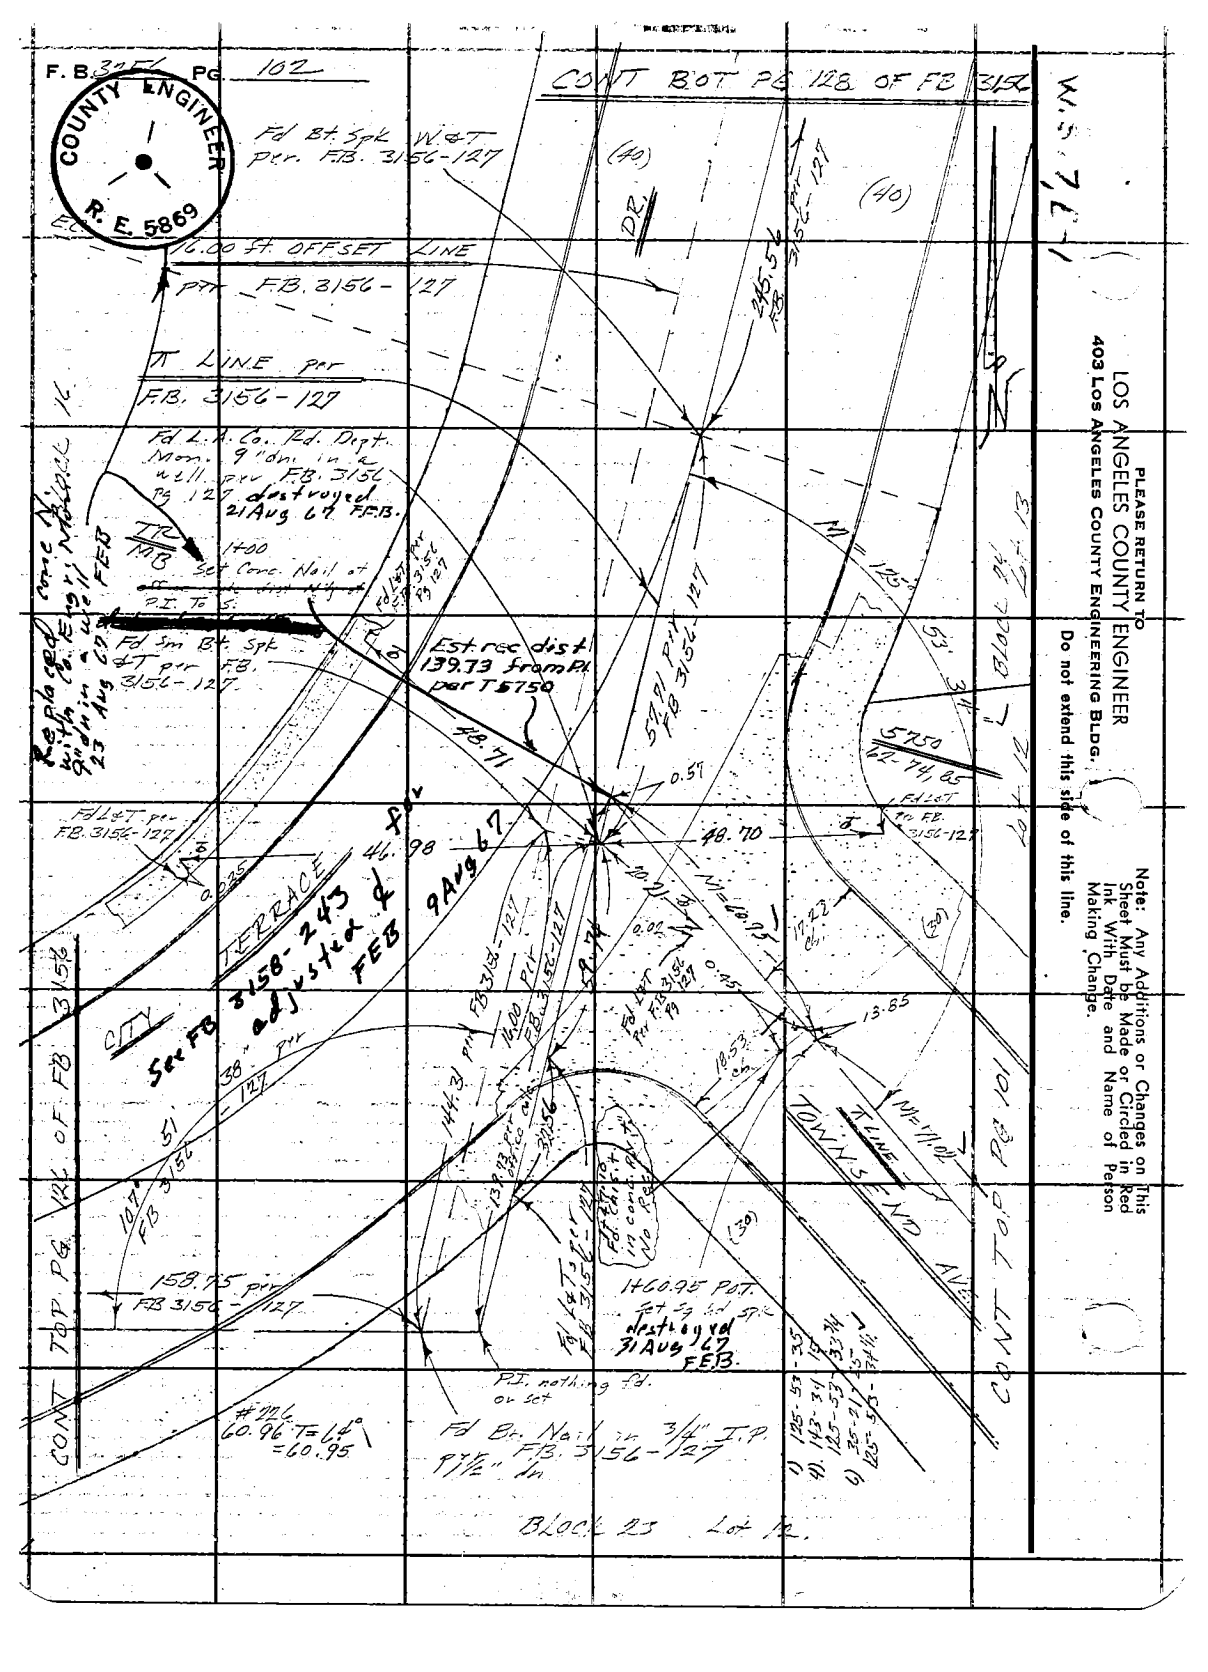

PLEASE RETURN TO
LOS ANGELES COUNTY ENGINEER
403 Los Angeles County Engineering Bldg.
Do not extend this side of this line.

Note: Any Additions or Changes on This Sheet Must be Made or Circled in Red Ink With Date and Name of Person Making Change.

Notes Ck'd by [illegible]
Map No.
Office Work
Checked
Date

Survey of CNTY TERRACE AREA #
JN 0303.04 Tape 22L Std 84 °F
Surveyed by FE Brooks
Notes FEB Date 21 April 66
Indexed [illegible]

F. B. 3256 Pg. 103

W.S. 7, E-1

Note: Any Additions or Changes on this Sheet Must be Made or Circled in Red Ink With Date and Name of Person Making Change.

Do not extend this side of this line.

PLEASE RETURN TO
LOS ANGELES COUNTY ENGINEER
700 Los Angeles County Engineering Bldg.

76F3095 S&E #247 11-58



























PLEASE RETURN TO
LOS ANGELES COUNTY ENGINEER
700 LOS ANGELES COUNTY ENGINEERING BLDG.

Note: Any Additions or Changes on This Sheet Must Be Made or Circled in Red Ink With Date and Name of Person Making Change.

Do not extend this side of this line.

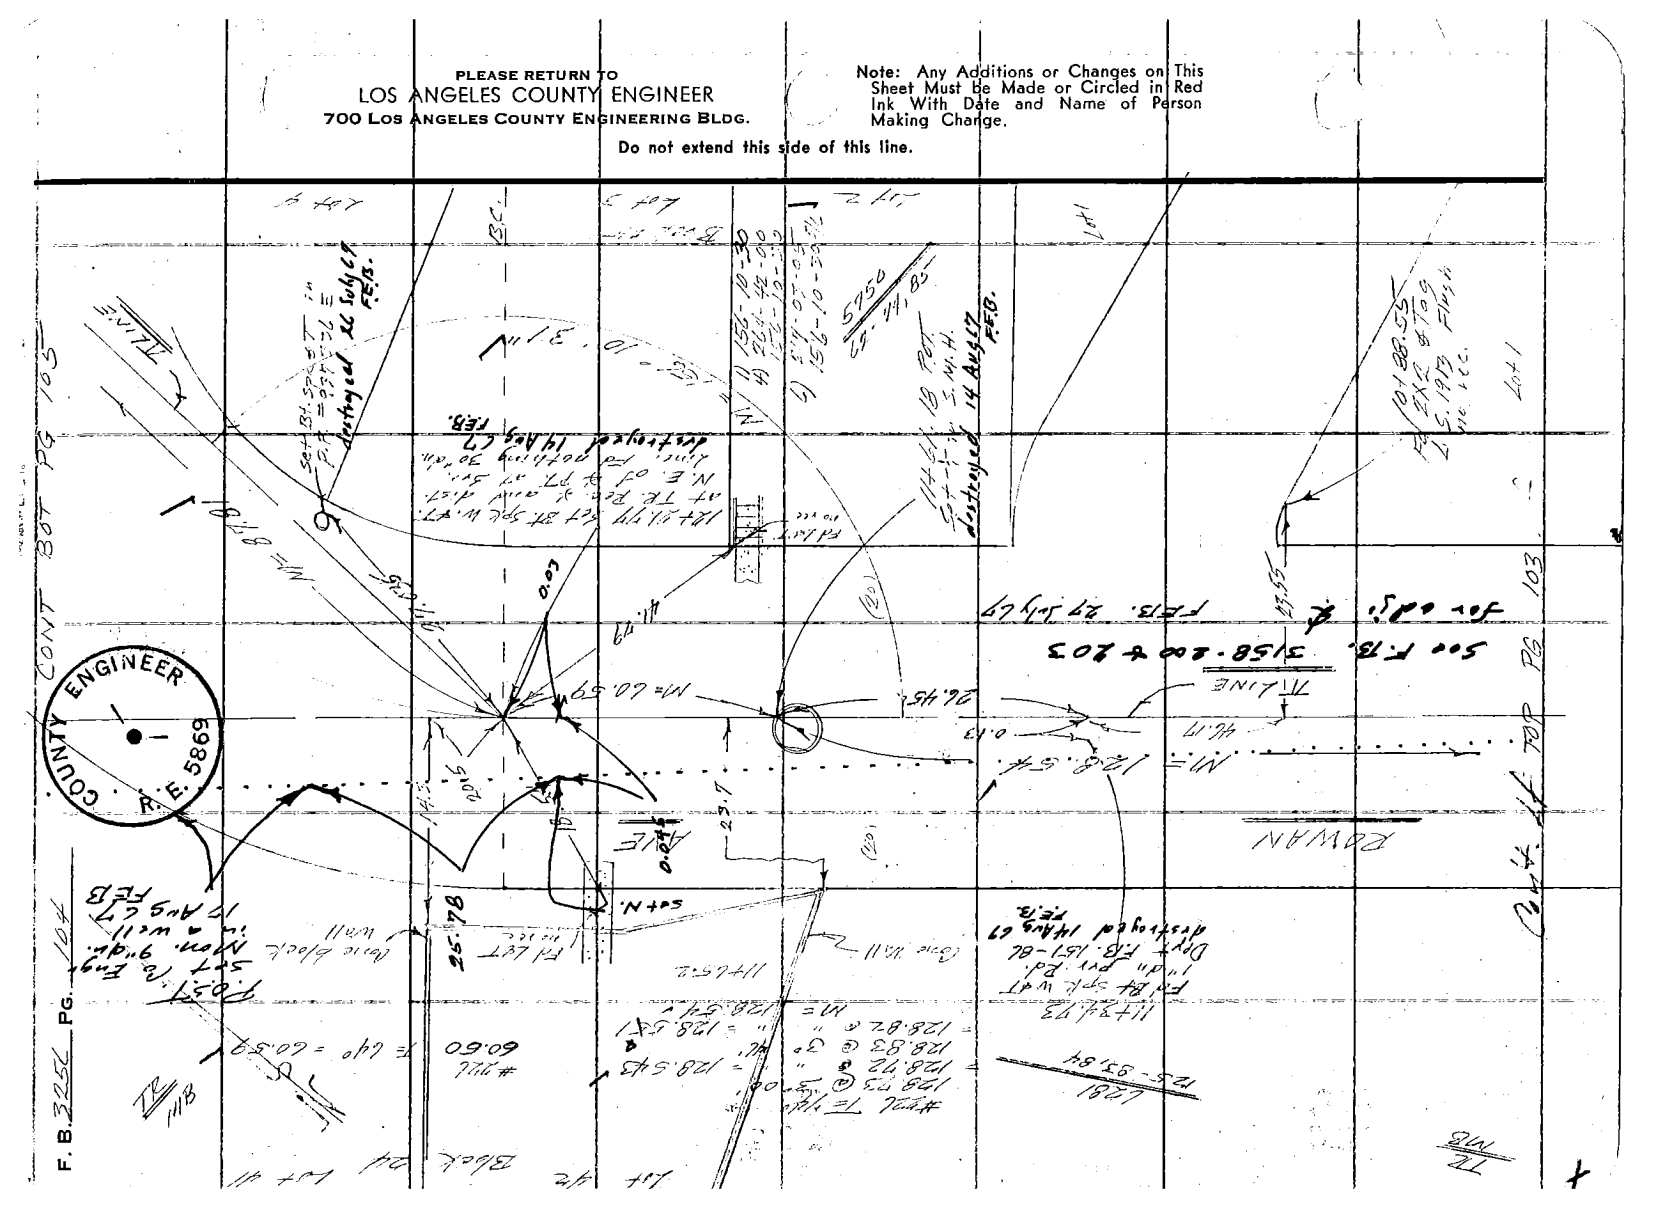

76F309S S&E #247 11-58

PLEASE RETURN TO
LOS ANGELES COUNTY ENGINEER
700 LOS ANGELES COUNTY ENGINEERING BLDG.

Note: Any Additions or Changes on This Sheet Must be Made or Circled in Red Ink With Date and Name of Person Making Change.

Do not extend this side of this line.

Notes Ck'd by [illegible]
Map No. ____
Office Work ____
Checked ____
Date ____

Survey of 24" Tunnel Area
JN 2703.04 Tape 220 Std. 54 °F
Surveyed by F.E.B. Date 13 Nov 67
Notes ____
Indexed ____

F. B. 3256 Pg. 105

Lot 41 — Lot 40 — Block 24 — Lot 39 — Lot 38

T.C. M.B.

#220 T=62° 87.62 @ 10° 30' = 87.41 @ " " = 86.115 ✓
87.35 @ 9° 36' = 87.34 @ " " = 86.117 ✓
M = 86.12
Level = 1.69
Total = 87.81 ✓

P.I. not Practical not to set

R.P. Established by prop. between So. line Ave. 3 and 4th Spk at Meissner St. nothing set

137+09.58. N'lid pt. of Alley Set Bt. Spk W&T at circ. & mid dist N'ly of B.C. destroyed 14 Aug 67 F.E.B.


124+81.5.

6' chain link Fe.

See F.B. 315E-203, 204

Fence adjusted F.E.B. 12 July 67

(20)

Set Bt. Spk & T in Guy pole #937338E

20.10

12.5

17.305

137+58.6

COUNTY ENGINEER R.E. 5869

ROWAN

T LINE

M = 87.81

CONT. TO PG 104

28.095

(20)

Set Bt. Spk & T

Rubble Retaining wall

Set Bt. Spk & T in top of bolt on Fire Hydrant

ALLEY

1.19

M = 87.81 ✓

T LINE

P.O.S.T. Set P.E. Engr's Mon. 9" dia. in 17 Aug 67 F.E.B.

10.36

1) 132°-21-00
2) 164.24 OST
132-21-05
3) 132-21-02-10
132-21-01 ✓
132°

Lot 4 — Block 25 — Lot 5

CONT. IT. PG 104

PLEASE RETURN TO
LOS ANGELES COUNTY ENGINEER
700 LOS ANGELES COUNTY ENGINEERING BLDG.

Note: Any Additions or Changes on This Sheet Must be Made or Circled in Red Ink With Date and Name of Person Making Change.

Do not extend this side of this line.

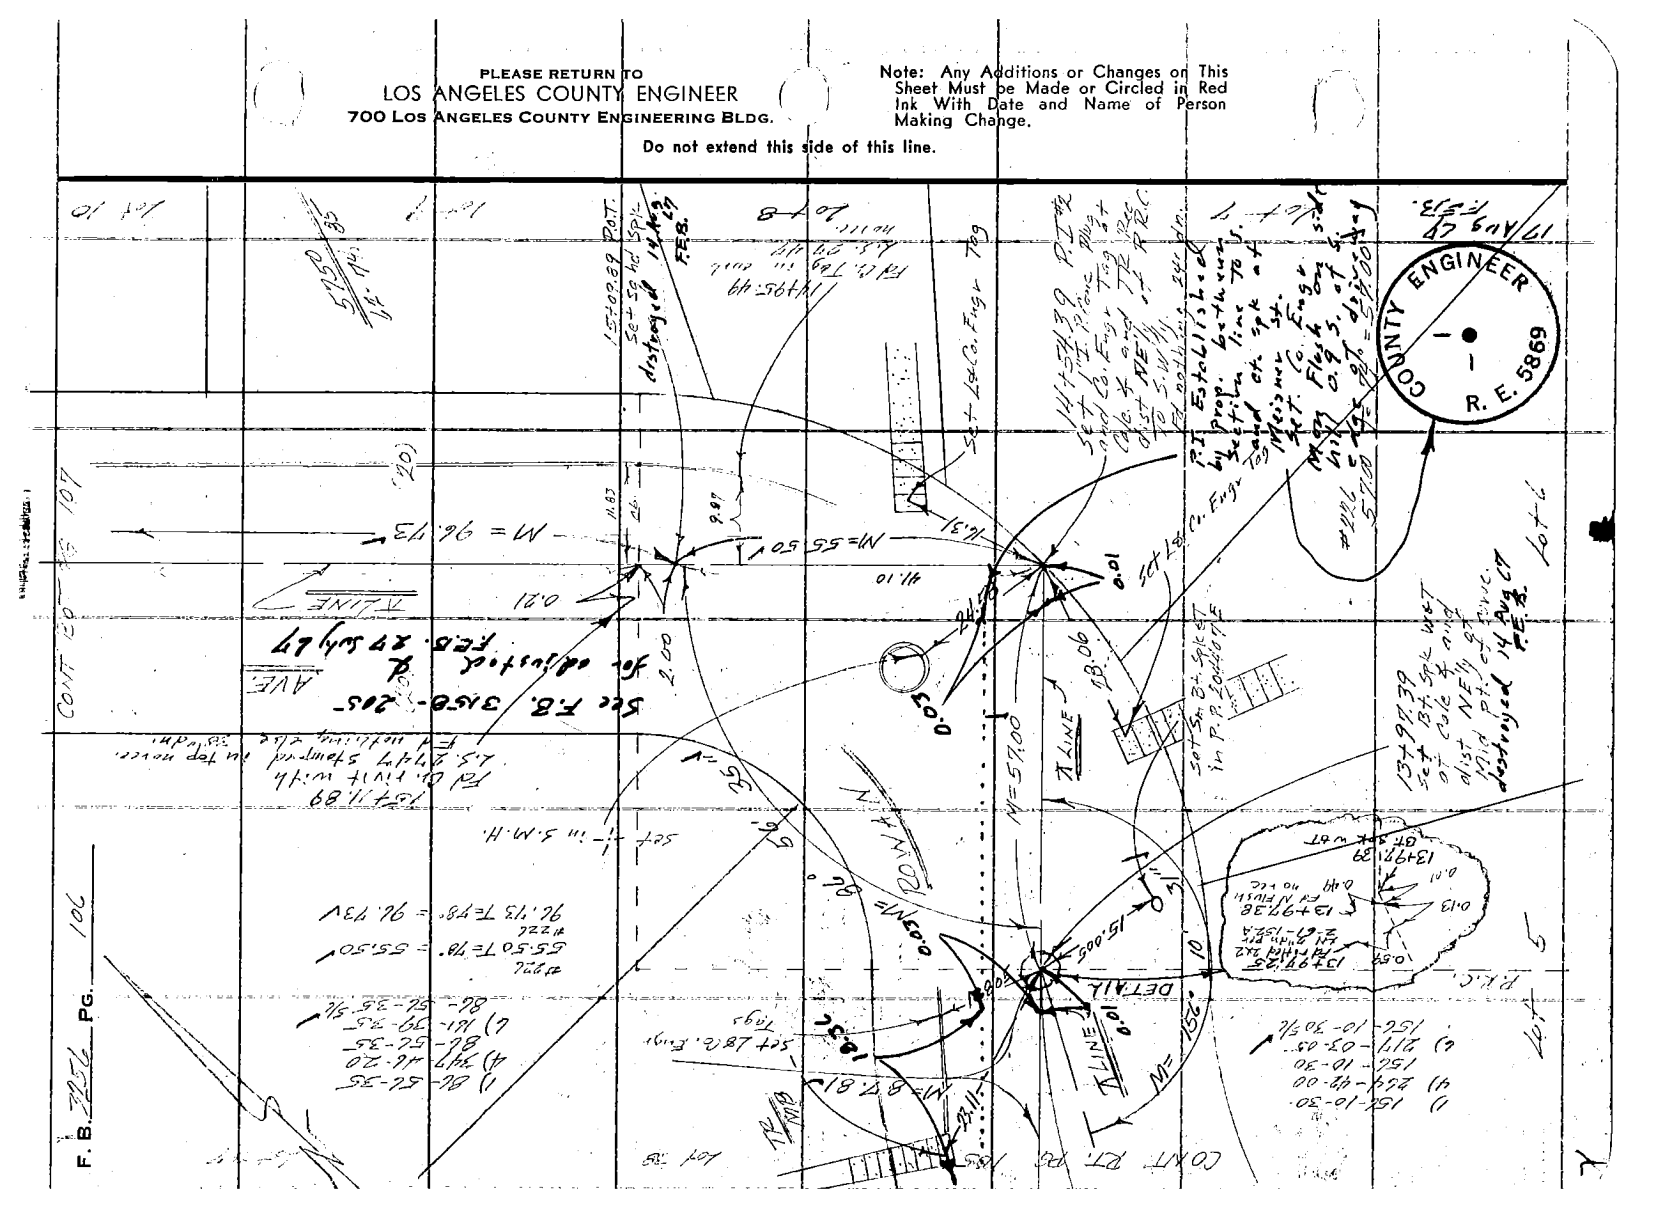

76F3098 S&E #247 11-58

PLEASE RETURN TO
LOS ANGELES COUNTY ENGINEER
700 LOS ANGELES COUNTY ENGINEERING BLDG.

Note: Any Additions or Changes on This Sheet Must be Made or Circled in Red Ink With Date and Name of Person Making Change.

Do not extend this side of this line.

Notes Ck'd by _____
Map No. _____
Office Work _____
Checked _____
Date _____

Survey of RT Vertical Grade Area
JN 2347 Tape Rel. Std. 8 1/2 °F
Surveyed by E. E. Brooks
Notes _____ Date 11 Aug 67
Indexed _____

F. B. 3158 PG. 107

Lot 37
Fd. Cr. Rivit Flush with L.S. 2747 No Rec. Removed
0.31
D.I. 0.78
D.I. #3
DETAIL
Lot 36
Lot 35
16+06.62 P.I. #3 Set Bt. Spk w/T. at TR Rec & and dist N'ly of P.I. #2
Fd. Nothing dn. 24" destroyed 14 Aug 67 F.E.B.
Lot 34
BLOCK 24
P.I. Established by prop. tie S. between Section and Ft. Spk set
Set C.L. Engr. Mon. in a well.
17 Aug 67 FEB
Lot 33
Lot 32
17+76.0
17+26.2
9" dm.
Conc. wall
CONT. BDY. PG 108
ROWAN
0.03
11.55
49.46
M=98.73
0.25
11.84 ch.
16.61
14.41
15.0
34.2/5
CONT. TOP PG 108
℄ LINE
M=255.51
14.4
15.9
23.6
R.E. 5869
COUNTY ENGINEER
℄ LINE
11.92
20.9
For adjusted ℄ see F.B. 3158-206
FEB 27 thy 67
M=154° 30' 30"
16+18.17
Set ⅄ in S.M.H.
Fd. Cr. Rivit Flush with L.S. 2747 no ↑↓C
Fd. Cr. Tack in curb L.S. 2747 no rec.
Fd. Nothing dn. 24"
#4RC
155.54 T=66.00 R=255.57
155.53 T=66.00 R=255.52
Lot 10
B.C.
Lot 11
E.C.
Block 25
Lot 12
Lot B
11) 154-30-30
4) 25B-02-00
15-34-30-30
0) 201-03-00
154-30-30

PLEASE RETURN TO
LOS ANGELES COUNTY ENGINEER
700 LOS ANGELES COUNTY ENGINEERING BLDG.

Note: Any Additions or Changes on This Sheet Must be Made or Circled in Red Ink With Date and Name of Person Making Change.

Do not extend this side of this line.

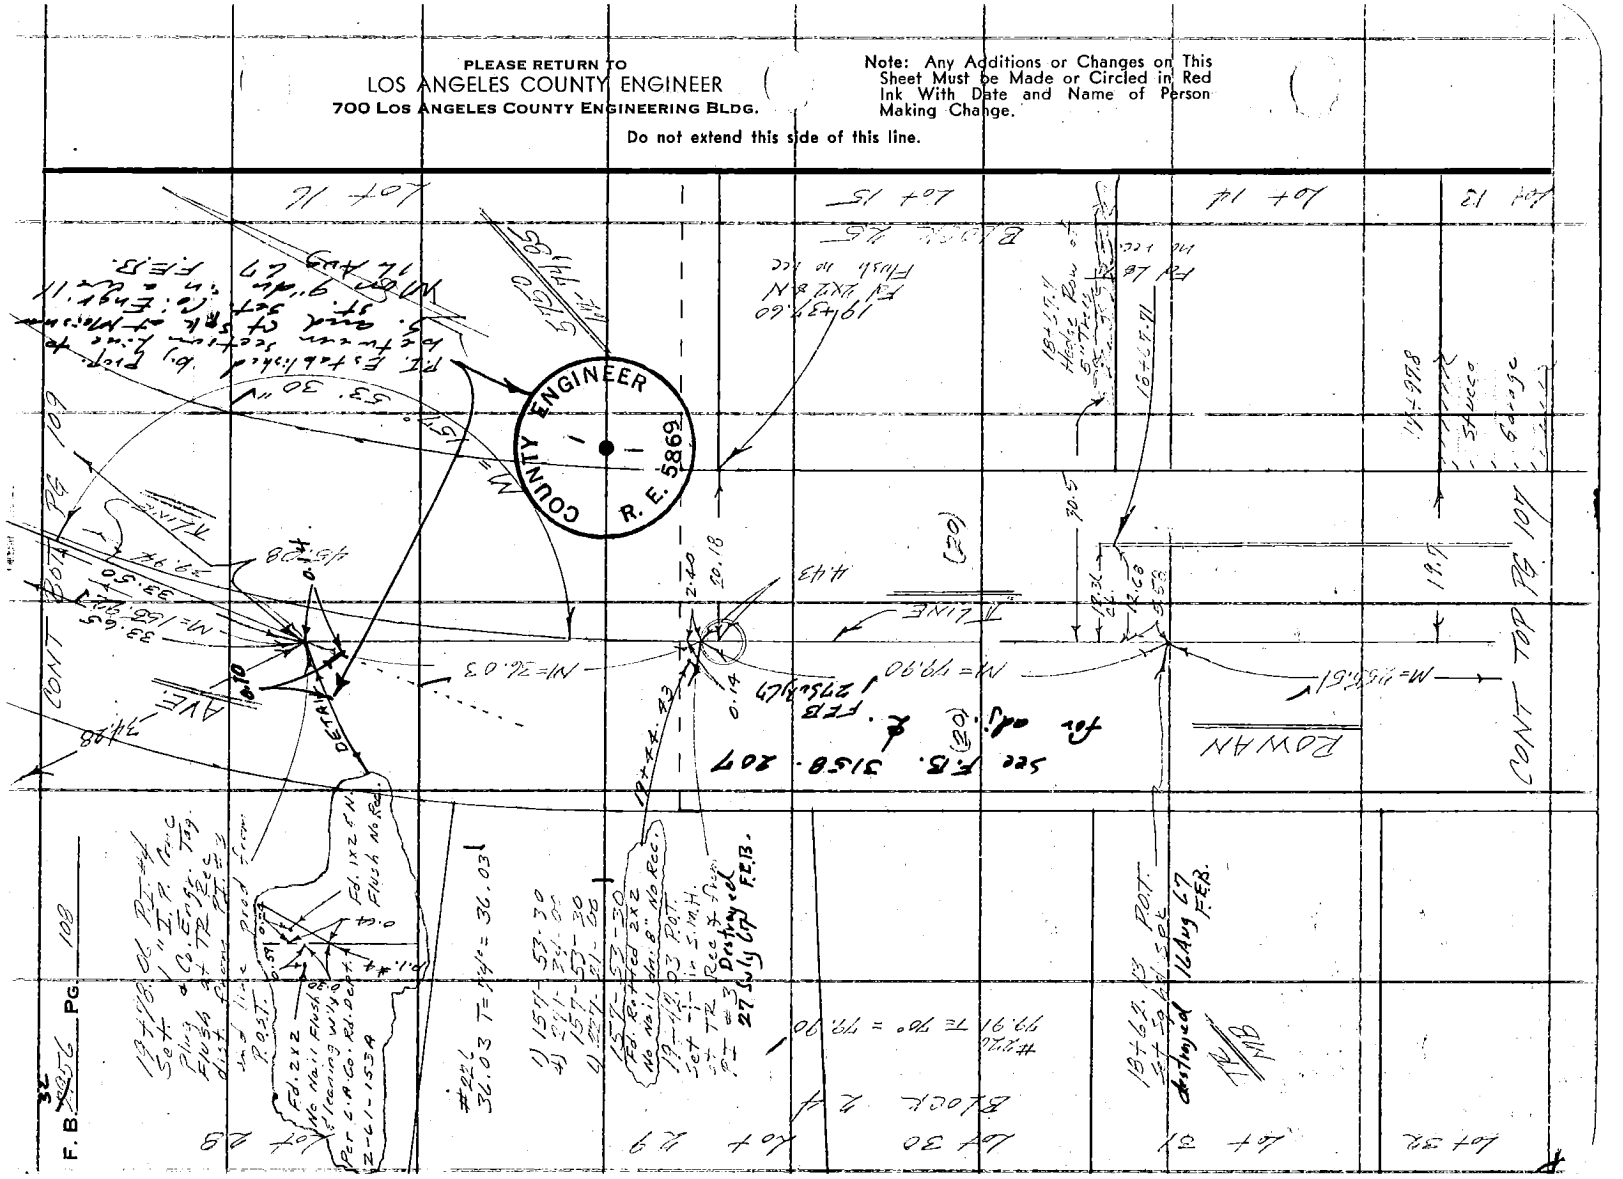

76F309S S&E #247 11-58

PLEASE RETURN TO
LOS ANGELES COUNTY ENGINEER
700 LOS ANGELES COUNTY ENGINEERING BLDG.

Note: Any Additions or Changes on This Sheet Must be Made or Circled in Red Ink With Date and Name of Person Making Change.

Do not extend this side of this line.

Notes Ck'd by M. OSHITA
Map No.
Office Work
Checked
Date

Survey of CITY TERRACE AREA
JN 0303 Tape 22L Std 84 °F
Surveyed by FEB Brumble
Notes
Indexed Date
G. J. GALLI

F. B. 325 L PG. 109

Lot 22

1 Frame Garage

6' Chain link fence

Lot 21

Block 34

Set BR. N. in Cor. of garage 20" above the floor

20+13.2

20+11.71
Fd. Kotted 2x2 No. Nail dn. 1.5' No Rec.

34.28

33.65

0.20

0.10

33.50

39.44

20.0

ROWAN

(30)

AVE.

CONT. 30 FT. WD.

M=155.92

℄ LINE

For adjusted ℄ see F.B. 3158-209, 208 (30) FEB & 7 July 67

45.08

15.45

Set L & C Finish Tag

#22L T= 174°
119.70 @ 4°41'
= 119.69 @ " " = 119.290
119.57 @ 3°53'
= 119.56 @ " " = 119.285
M= 119.29
Level = 36.63
Total = 155.92

S 1°50 E 44.44

20+11.56
Fd. Nail & Tin Dn. 2' No Rec. Removed

Lot 16

Lot 17

Block 35

PLEASE RETURN TO
LOS ANGELES COUNTY ENGINEER
700 LOS ANGELES COUNTY ENGINEERING BLDG.

Note: Any Additions or Changes on This Sheet Must be Made or Circled in Red Ink With Date and Name of Person Making Change.

Do not extend this side of this line.

W.O. 7 E-1

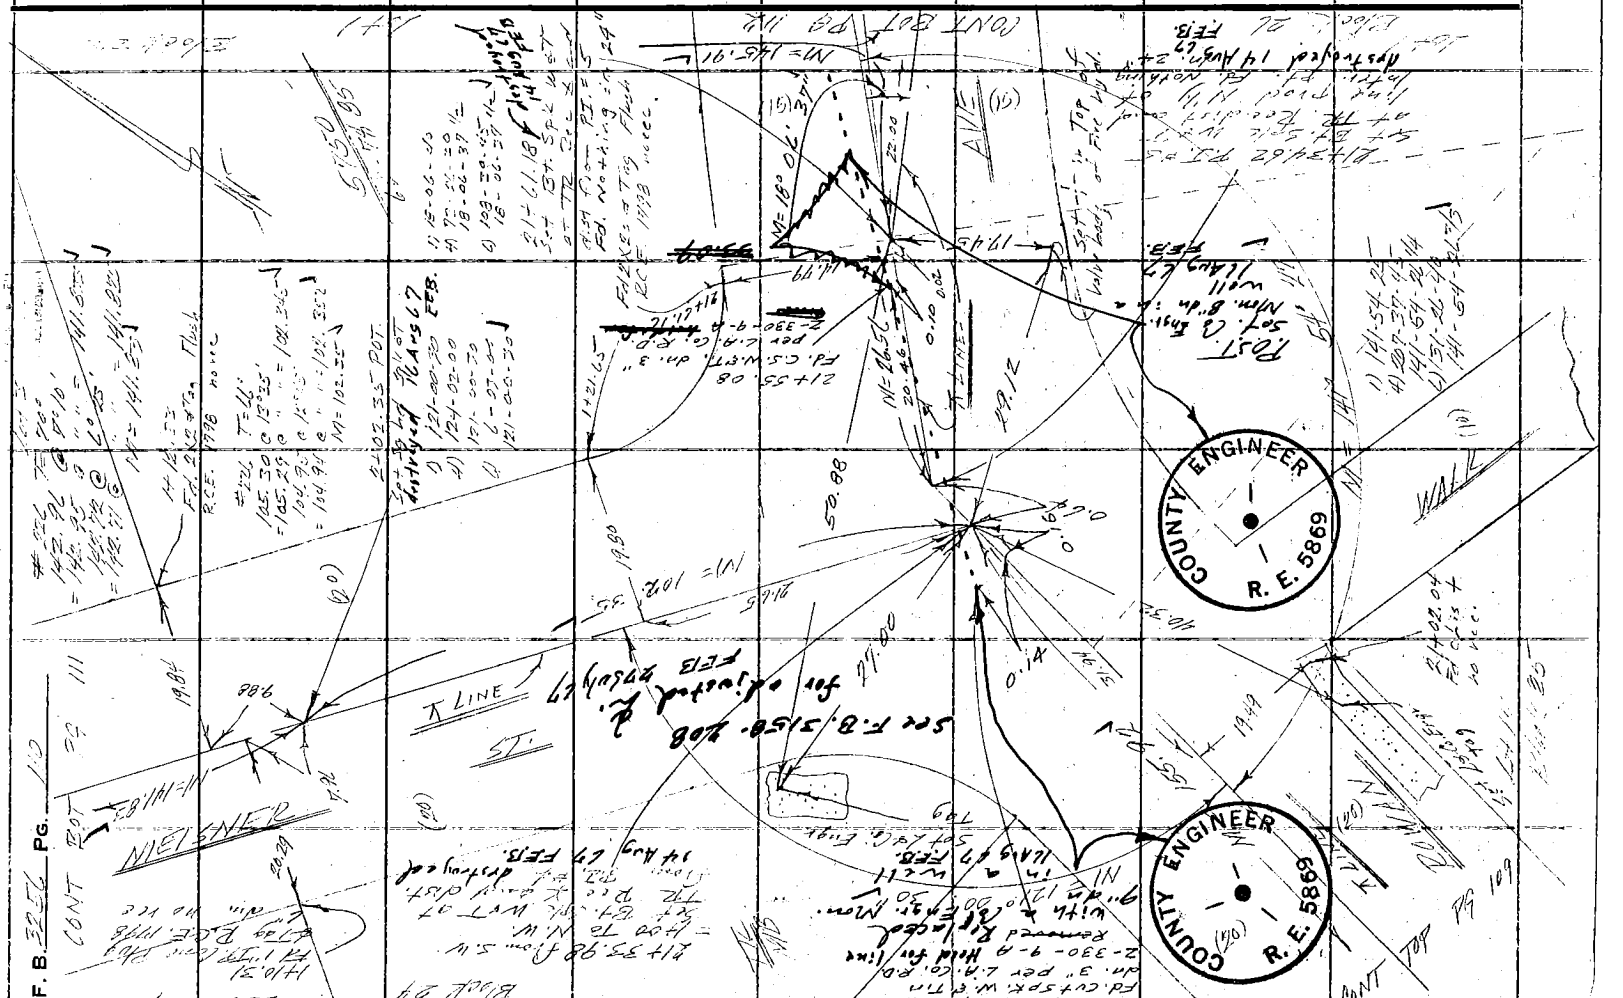

76F3095 S&E #247 11-58

PLEASE RETURN TO
LOS ANGELES COUNTY ENGINEER
700 LOS ANGELES COUNTY ENGINEERING BLDG.

Do not extend this side of this line.

Note: Any Additions or Changes on This Sheet Must be Made or Circled in Red Ink With Date and Name of Person Making Change.

W.S. 7, E-1

Notes Ck'd by M. OSHITA
Map No.
Office Work
Checked
Date

Survey of CITY TERRACE AREA
JN [illegible] Tape 1"=26' Std 84° °F
Surveyed by F.E.B. & [illegible]
Notes
Indexed C. J. GALI Date [illegible]

F. B. [illegible] PG. 111

























3rd HILL 18

POT

ENGINEER
COUNTY
R.E.

PLEASE RETURN TO
LOS ANGELES COUNTY ENGINEER
700 LOS ANGELES COUNTY ENGINEERING BLDG.

Note: Any Additions or Changes on This Sheet Must be Made or Circled in Red Ink With Date and Name of Person Making Change.

Do not extend this side of this line.

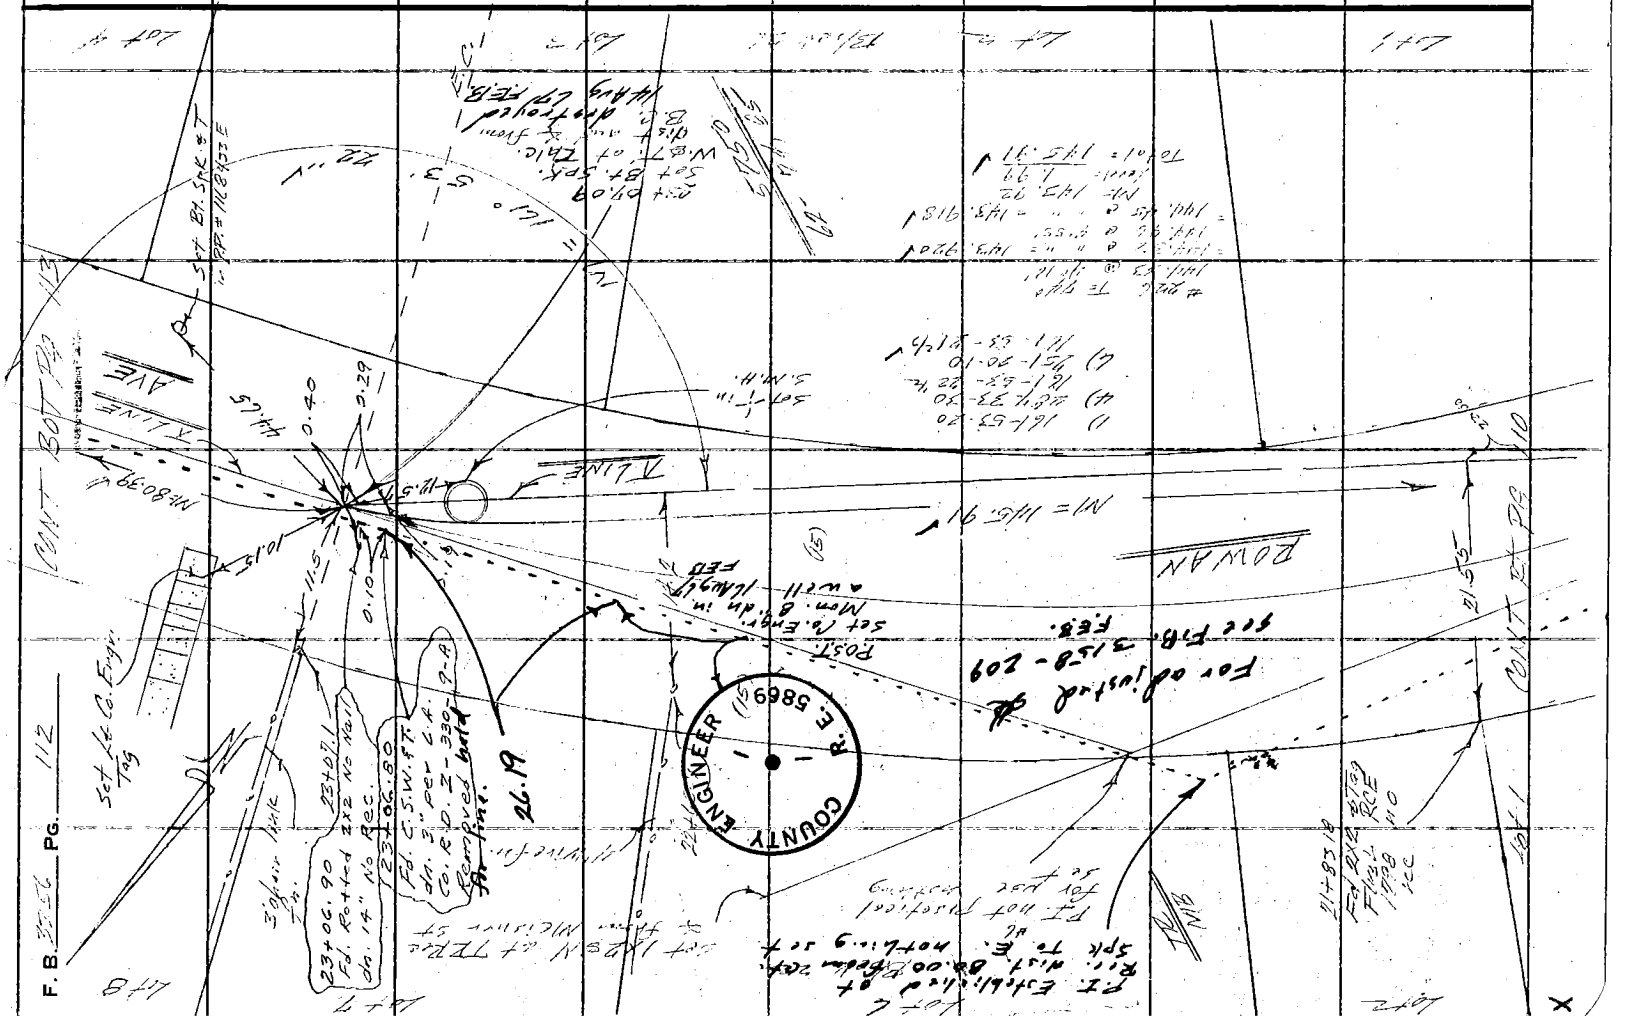

76F309S S&E #247 11-58

PLEASE RETURN TO
LOS ANGELES COUNTY ENGINEER
700 LOS ANGELES COUNTY ENGINEERING BLDG.

Note: Any Additions or Changes on This Sheet Must be Made or Circled in Red Ink With Date and Name of Person Making Change.

Do not extend this side of this line.

Notes Ck'd by [illegible] OSHITA
Map No. _____
Office Work _____
Checked _____
Date _____

Survey of CITY TERRACE AREA
JN 207704 Tape 226 Std. 84 °F
Surveyed by F.E.D. & E. Brook
Notes _____ Date 12 May 61
Indexed _____ Ck'd [illegible]

F. B. 3256 PG. 113

Lot B

Lot 9
BLOCK 22

Lot 10

B.C.

TR NB

Fd. C.S. W.P.T.
O.D. 2" I.P. C.O.
Removed Nothing Old B.M.

Used for 1.10

4" Iron Pipe

23+44.8

10.3

AVE.

CONT. FAT PG 114

25+25

80.39 T=8°00' = 80.39

0.2

Cont. Top Pg 112

ROWAN

8.5

M = 80.39

0.06

0.08

1.91

15-FEB
LS

(15)

84.93

℄ LINE

M = 83.40

(5)

See F.B. 3158-210
for adjusted ℄
F.E.B.

23+89.48 P.O.T.
Set Sq hd. Spk
Dest. Cond.
Nail & Tag
F.E.B.

5150
12-14-61

Lot 4

BLOCK 16

Lot 5

F. B. 3256 PG. 114

Cont. RT. P. 116

AVE

M=111.52

25+53.62 POST
Set 2" I.P. in Mon. C.L.
destroyed 14 Aug 67
F.E.B.

Fd. Nothing
dn. 18"

10.75

24+38.20
Fd Chis
X no rec

LOT 8

LOT 11

EC

#2+24
63.40 T= 90° = 93.40

#2+24
63.84 @ S 89° 57' E = 92.14
63.58 @ S 89° 57' E = 92.14
N1° 02' W

#226
122.61 T= 1.00° = 122.59

Set 8" Spk Nail
at Split of
Telephone Pole
F.E.B.

For adjusted ℄ see
F.B. 3, 59-211
F.E.B.

B2.14

1.99 M

5750
6-14-85

LOT 7

BLOCK 22

24+70.88 PT. #1
Set 2" I.P. Mon.
Plug and No. Engr.
Tag Flush at
C/L & TR Rec.
dist. from E.C. to
S.W. Fd. Nothing
dn. 18"
destroyed 15 Aug 67
F.E.B.

24+99.3
Fd L&T
no rec

T LINE

11.82

LOT 10

TR
M5

1210 29'

23.71

(15)

(15)

P.I. set
at Rec. Dist from
Ct. Spk W 87 To W.
Set Co Engr Mon
Flush on
Side L. 11
15 Aug 67
F.E.B.

COUNTY ENGINEER
R. E. 5869

N1°

KOWAN

11.59

Set 8" Spk
ST. in P.P.
#1168 45.4 E

84.93 T LINE

M=93.40

LOT 6

LOT 5

Cont To Pg 113

PLEASE RETURN TO
LOS ANGELES COUNTY ENGINEER
700 Los Angeles County Engineering Bldg.

Do not extend this side of this line.

Note: Any Additions or Changes on This Sheet Must be Made or Circled in Red Ink With Date and Name of Person Making Change.

76F309S S&E #247 11-58

PLEASE RETURN TO
LOS ANGELES COUNTY ENGINEER
700 LOS ANGELES COUNTY ENGINEERING BLDG.

Do not extend this side of this line.

Note: Any Additions or Changes on This Sheet Must be Made or Circled in Red Ink With Date and Name of Person Making Change.

W.S. 7, E-1

LOT 12 | LOT 11, BLOCK 12 | LOT 10 | LOT 9

COUNTY ENGINEER R.E. 5869

#226.
93.01 T=64° = 93.00

Set L&Co. Engr Tag

Inter. Set of TR Run dist. from P.I. Tag L&C. Set L.S. Engr. Mon. 10 "dia" in a well 15 Aug 69 F.E.B.

Set L&Co. Engr Tag, stpd by TR. Rec. 7 Prom. P.I. # adjusted 31 July 69 F.E.B.

CONT ON PG 190 OF F.B. 3156

PONTEROY

CONT ON PG 190 OF F.B. 3156

CONT ON PG 190 OF F.B. 3156

F.B. 3156 - 55

M=93.00

220.05 Prv F.B. 3156 - 190

For adjusted ℄ see F.B. 3156 - 212 F.E.B.

℄ LINE

M=151° 16' 10"

Set L&Co. Engr Tag.

Set ℄ Sta. 5+22.47 by F.E. North 24 Aug 69 F.E.B.

Monument Set Aug 69 F.E.B.

Found L&Co. Engr Tag F.B. 3156 - 190

ROWAN AVE

Cont. Top PG 114

5750 12-74-85

LOT 8, BLOCK 26 | LOT 9 | LOT 10 | LOT 11

1) 151-16-10
2) 245-04-40
3) 151-16-10
4) 187-37-00
151-16-10

Notes Ck'd by [illegible] OSHITA
Map No. ____
Office Work ____
Checked ____
Date ____

Survey of CITY TERRACE HEIGHTS
JN 07527 Tape 222 Std 66 °F
Surveyed by E.E. Brooks
Notes C.E. Cook FEB Date 26 Aug 69
Indexed ____ C. J. Gallo

F.B. 3225 PG. 115

F. B. 3256 PG. 116

Cont' Bot. Pg. 117

(15) (15)

DR

5750
62-74-85

LOT 1 BLOCK 25

T LINE

N = 1175.41

2+34.52 POT.
Set 5/8 i.d. spk at TA
Rec'd from Section
Line
destroyed 28 Aug 67
F.E.B.

TR
MB

For adjusted ties
F.B. 3158-201
F.E.B.
2 Aug 67

N1=21.86

T Tgt'o
@ 13°49' = 100.
@ 14°19' = 100.
@ 14°49' = 100.

Arcs:
102.65
103.64
103.20
103.59

LOT 2 BLOCK 2

2+00.66 POT
Set 5/8 ind spk.
destroyed
28 Aug 67
F.E.B.

6281
125-83-84

DE GARMO

N1 = 100.66

TR
MB

Cont' Rt Pg 105

PLEASE RETURN TO
LOS ANGELES COUNTY ENGINEER
700 LOS ANGELES COUNTY ENGINEERING BLDG.

Do not extend this side of this line.

Note: Any Additions or Changes on This Sheet Must be Made or Circled in Red Ink With Date and Name of Person Making Change.

Notes Ck'd by M. OSHITA	Survey of CITY TERRACE AREA
Map No.	JN 0307.01 Tape E-26 Std 64 °F
Office Work	Surveyed by P. E. Brook
Checked	Notes FCB GF Book Date 30 May 64
Date	Indexed C. J. GALLI

F. B. 3256 PG. 117

Cont to But Pg 118

LOT 29

LOT 30

LOT 31 BLOCK 25

LOT 1

LOT 15

LOT 16 BLOCK 34

LOT 1 BLOCK 2

LOT 2

DE

(15)

(15)

T= 78°
11.81 = 175.412
176.80 " = 175.423
178.02 " = 175.471
#246 " " 111°

5750
14.85
42'

3+43.5 Conc block wall

15.1

℄ LINE

Chain link fn.
3+16.1

13.4

175.41

M=

FD. 3158-BD, 2"

IR
MB

Conc wall
2+43.6

16.6

14.89

2+44.3
16.9 offset

3½ft chain link fn.

6281
125-83-84

2+44.26
FD 3X2 & N
Ellis
no acc

GARMO

DE

1.94

IR
MB

Cont to Pg 116

Note: Any Additions or Changes on This Sheet Must be Made or Circled in Red Ink With Date and Name of Person Making Change.

Do not extend this side of this line.

PLEASE RETURN TO
LOS ANGELES COUNTY ENGINEER
700 LOS ANGELES COUNTY ENGINEERING BLDG.

76F309S SAE #247 11-58

PLEASE RETURN TO
LOS ANGELES COUNTY ENGINEER
700 LOS ANGELES COUNTY ENGINEERING BLDG.

Note: Any Additions or Changes on This Sheet Must be Made or Circled in Red Ink With Date and Name of Person Making Change.

Do not extend this side of this line.

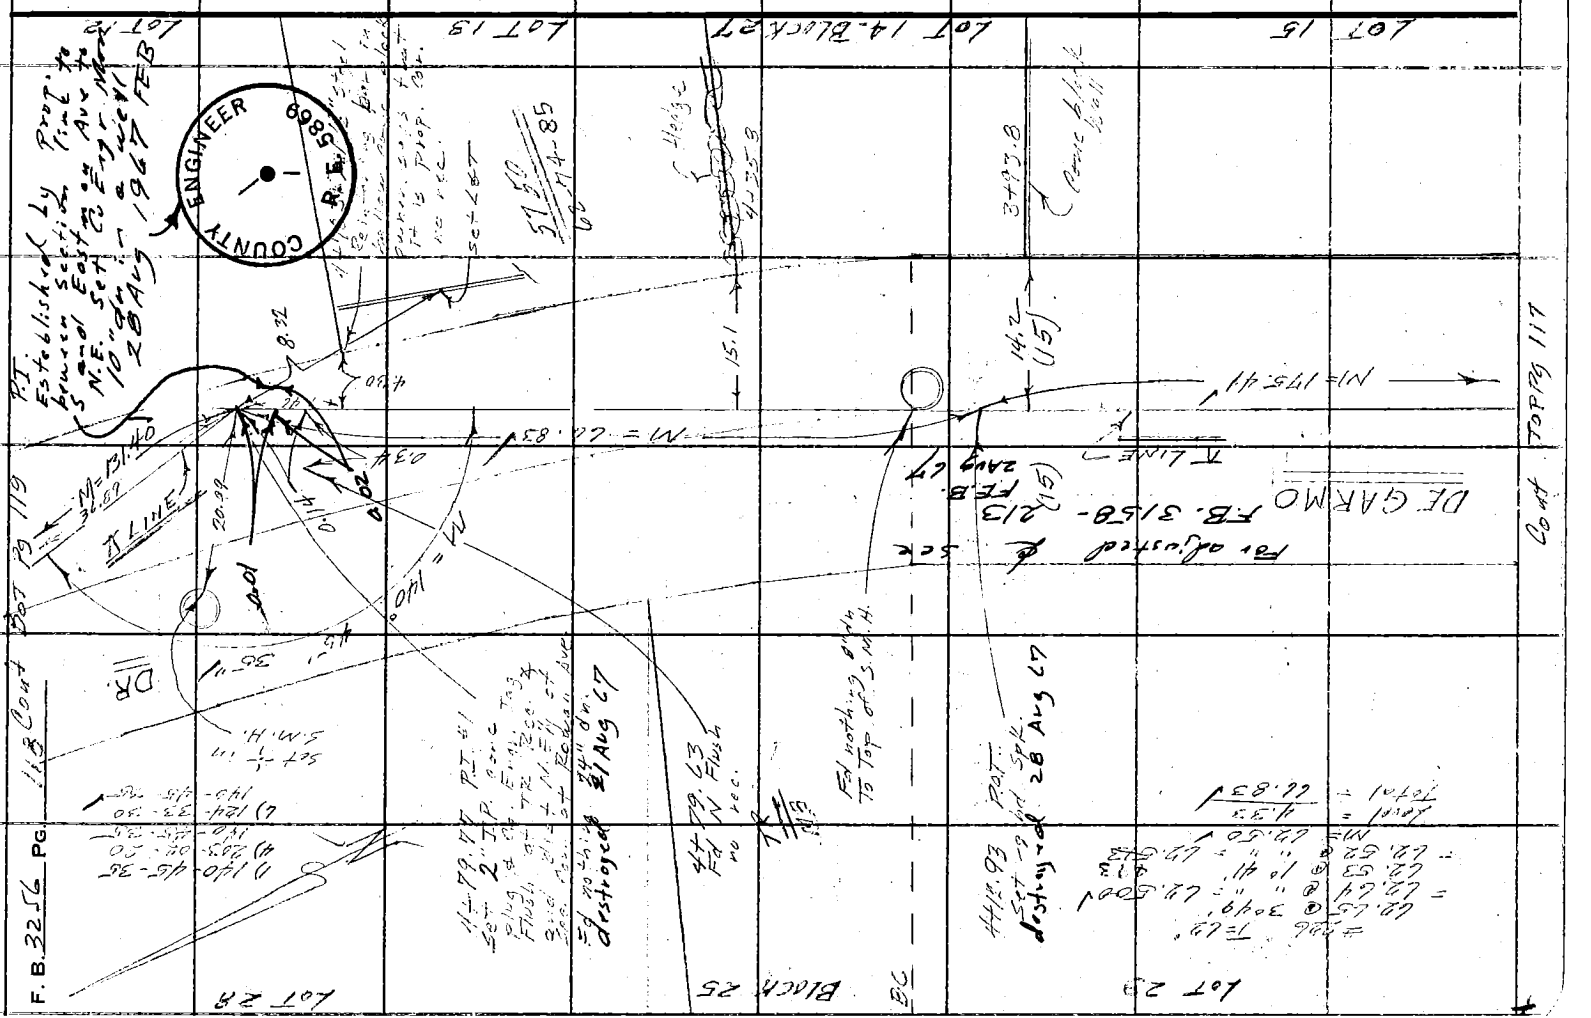
LOT 13
LOT 14-BLOCK 27
LOT 15
LOT 23
LOT 24
BLOCK 25
LOT 28
COUNTY ENGINEER
R.E. 5869
T LINE
DE GARMO
FB. 3158-213
FEB. 27 AUG 47
For adjusted ℄ see
DR
118 Court
F.B. 32-56 PG.
Bot 119
Cont Top Pg 117

76F309S S&E #247 11-58

PLEASE RETURN TO
LOS ANGELES COUNTY ENGINEER
700 LOS ANGELES COUNTY ENGINEERING BLDG.

Note: Any Additions or Changes on This Sheet Must be Made or Circled in Red Ink With Date and Name of Person Making Change.

Do not extend this side of this line.

Notes Ck'd by M. OSHITA
Map No. ____
Office Work ____
Checked ____
Date ____

Survey of CITY TERRACE AREA F. B. 3250 PG. 119
JN 0303. Off Tape 226 Std. 8W of F.
Surveyed by F. E. Brant.
Notes ____ Date 23 May 58
Indexed ____

LOT 28 | LOT 27 | BLOCK 25 | LOT 26

5774.17 Fd remains of 2x2 no N. 8"in P.C.P. Z-322-81A set N. on surface 2x2 no rec. on N.

5776.97 Fd N flush no rec.

TK IMB

5777.04 Fd Ct. Spk 4" dn. per FX 26-7

5779.12 Fd 2x2 no N. per Z-322 -81.12 4" dn. set N. in Ctr.

E.C.

DE GARMO

DR.

CONT TOP PG 119

CONT BOT PG 120

0.42 | 0.47 | 0.49 | 0.45

(115)

℄ LINE

36.89 | 32.20 | 34.05

N = 131.40

For adjusted ℄ see F.B. 0158-2x4

1959

0.07 | 0.08

21.0

#226 T=68°
131.87 @ 4° 43' = 131.412
131.86 @ " " = 131.412
131.74 @ 4° 04' = 131.398
131.73 @ " " = 131.398
N = 131.40

Fd Remains of Old 2x2 #7.0 C.S. 11797 Fence in S.E.L. Set in Side of Hollow Iron C.

Z 400.2

Cone & Brick Wall

5770 62-7-85

LOT 12 | LOT 11, BLOCK 27 | LOT 10 | LOT 9

PLEASE RETURN TO
LOS ANGELES COUNTY ENGINEER
700 LOS ANGELES COUNTY ENGINEERING BLDG.

Note: Any Additions or Changes on This Sheet Must be Made or Circled in Red Ink With Date and Name of Person Making Change.

Do not extend this side of this line.

W.S. 7, L-1

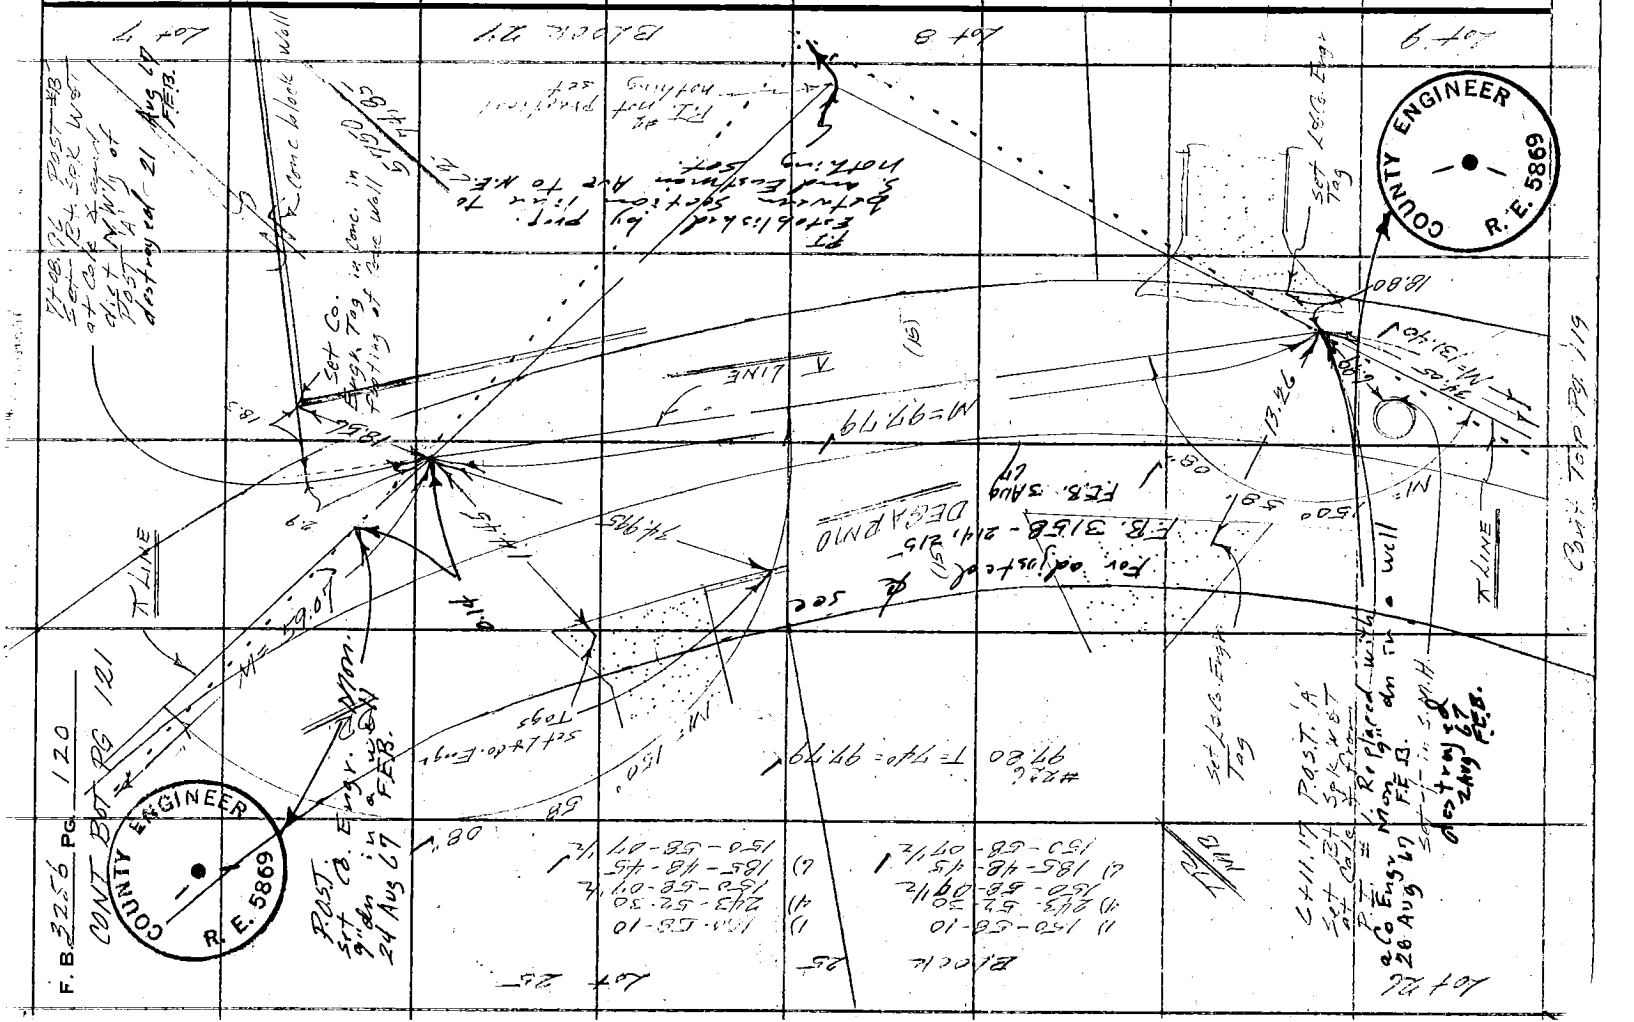
COUNTY ENGINEER
R.E. 5869
F.B. 3256 PG. 120
CONT. BUT RG 121
Lot 7
Lot 8
Lot 9
Lot 22
Lot 23
Block 27
Block 25
Set Tag
Set Co. Mon. in conc. block wall
Set Nail & Tag in face of curb
Set Nail & Tag
Set Nail & Tag in face of curb
Set Nail & Tag in face of curb
Set Nail & Tag in face of curb

76F3095 S&E #247 11-58

PLEASE RETURN TO
LOS ANGELES COUNTY ENGINEER
700 LOS ANGELES COUNTY ENGINEERING BLDG.

Note: Any Additions or Changes on This Sheet Must be Made or Circled in Red Ink With Date and Name of Person Making Change.

Do not extend this side of this line.

Notes Ck'd by CS/ITA
Map No.
Office Work
Checked
Date

Survey of CITY TERRACE AREA F. B. 3254 PG. 121
JN 0317.04 Tape 222 Std 67 °F
Surveyed by F. E. Brooks
Notes FEB Date 24 Aug 67
Indexed S. J. GALLI

Lot 25 | Lot 24 | Block 25 P.T. Established by Prop. between Section Line To S and E on Mon. Ave To N.E. Cor. Set in anvil 10 Aug 67 FEB | Lot 23 | Lot 22

#226
59.07 T=78°=59.07

7+43.40
Fd remains of old 2X2 & N 8" dn. Pvt. 2-3RP-81 & FX 26 Pvt.
Fd. nothing else 4" dn.

Set L&C. Engr. Tag

COUNTY ENGINEER R.E. 5869

DIR.

0.03

29.71

T-LINE

M = 98.40

For adjustment see F.B. 3158-216 F.E.B. 3 Aug 67

0.45

0.06

DE GARMO

S 18° 15' W

49.58

45°

M = 148° 16'

T-LINE

Set Sm. Bk. Spike in Top of Post 1' S.W. of Corner

PI #3 Set 2" Brass Cap Monument Flush at C.L. & End of Curve

Fd. Nothing 30" dn.

Lot 7 | Lot 6 | Block 27 | Lot 5

CONT TOP PG 120

CONT BOT PG 122

F. B. 3256 PG. 122

CONT BOT PG 123

Lot 19

Lot 20

Block 25 Lot 21

Lot 22

#226 T= 64°0
1681.57 @ " 0°31' = 180.340
1681.55 @ " 0°01' = 180.347
1681.38 @ " 0°01' = 180.347
N= 180.34
2.10
182.44

Level Total = 182.44

DE GAR INC

Fd adjoining R of Sec
F.B. 3256 - 5
216,227 FEB. 3 Alive

N= 182.44

N= 88.00

CONT TOP PG 121

9756.03 P.O.T.
set P.kd. spk.
dist 4.27
24 Aug FEB

Block 25 Lot 3

Lot 1

Lot 2

Lot 4

Lot 5

5250
6-74, 85

PLEASE RETURN TO
LOS ANGELES COUNTY ENGINEER
700 Los Angeles County Engineering Bldg.

Note: Any Additions or Changes on This Sheet Must be Made or Circled in Red Ink With Date and Name of Person Making Change.

Do not extend this side of this line.

Notes Ck'd by M. OSHITA	Survey of CITY TERRACE AREA
Map No.	JN 0303.04 Tape 226 Std Bd °F
Office Work	Surveyed by P. E. Brooks
Checked	Notes FEB Date 24 May 69
Date	Indexed C. I. Call

F. B. 3250 PG. 123

W.S. 7, E-1

Note: Any Additions or Changes on This Sheet Must be Made or Circled in Red Ink With Date and Name of Person Making Change.

Do not extend this side of this line.

PLEASE RETURN TO
LOS ANGELES COUNTY ENGINEER
700 Los Angeles County Engineering Bldg.

76F309S S&E #247 11-58

Lot 26 Block 26

11702.67 Mid pt. of Curve Set B+ spk West at Calc. & and dist. from B.C. to S. dist-oyed 21 Aug 69 F.E.B.

#226 64.20 T=78° = 64.20

WALK

(10)

COUNTY ENGINEER F.E. 5869

POST. Set Co. Engr. Mon. Grdg. in well 21 Aug 69 F.E.B.

Set 219 METSNER

adjusted FB. 3158 F.E.B. 3 Aug 69

Lot 18

Block 25

Set L & Co. Engr Tag

W.19

29.54

9.56

10.49

N=64.20

ST.

ℓ LINE

CONT FROM PG 124

40.55

(15)

DR.

Set L.M.H.

(15)

N=64.20

ℓ LINE

10438.47 Set B+ spk W of at TR. Rec'd and dist. N.W. of PT.

20" dia. 21 Aug 69 F.E.B.

Fd nothing destroyed

S 17° 49' E 141.80'

1) 63-07-15
4) 252-28-50
13-07-12½
4) 18-43-30
63-07-15

B.C.

Block 27

Lot 1

0.16

0.00

Lot 19

DE GARMO

ℓ LINE

N=148° 26' 23"

Set L & Co. Engr Tag

1) 148-26-25
4) 233-45-30
148-26-22½
4) 170-38-20
148-26-23½

CONT TOP PG 122

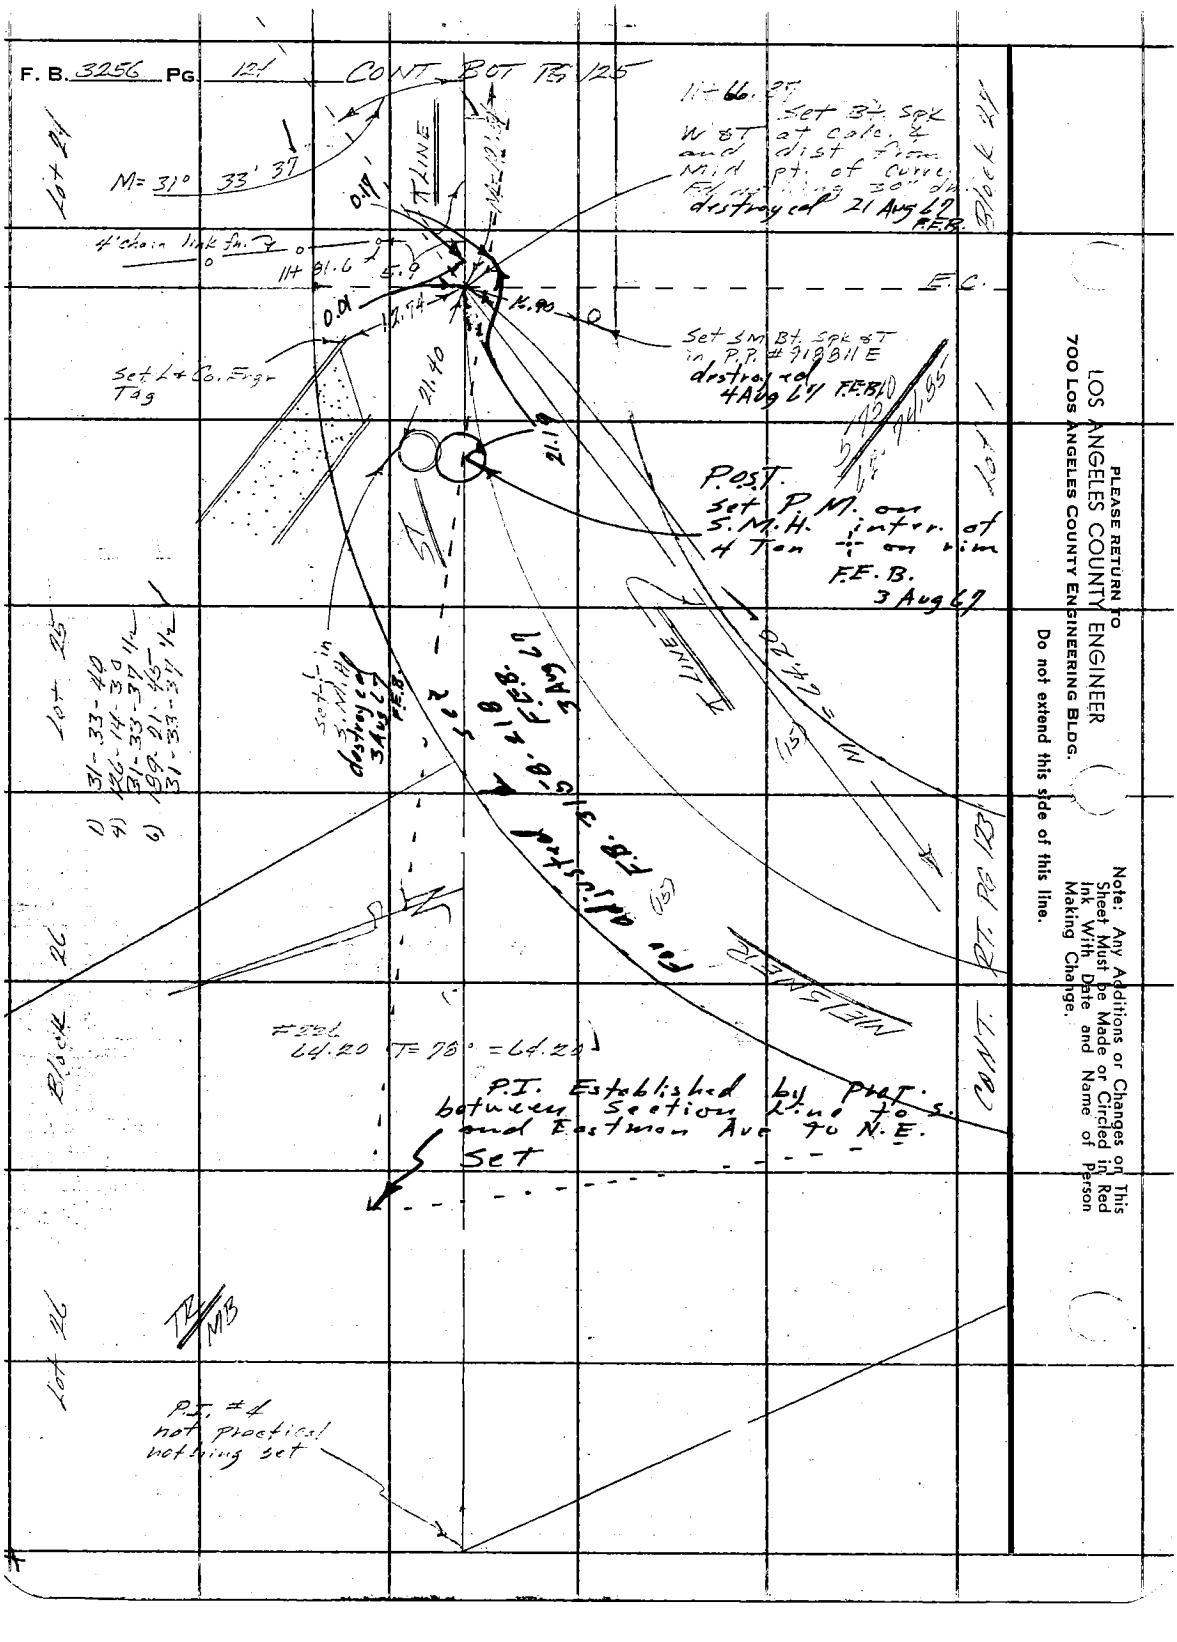
F. B. 3256 PG. 121
CONT. BOT TS 125
M= 31° 33' 37"
4' chain link fn. 2
114
81.6
5.9
0.0'
12.74
R.90
Set L & Co. Figr Tag
21.40
21.9
Set SM Bt. Spk. & T in P.P. # 918 B11 E
destroyed 4 Aug 69 F.E.B.
P.O.S.T.
Set P.M. on S.M.H. inter. of 4 Ton ± on v.m.
F.E.B.
3 Aug 69
Set L in S.M.H. destroyed 3 Aug 69 F.E.B.
Fnd P.B. 3 Aug 69 F.E.B.
Per dist. per P.B.
Fnd 64.20 (T= 78° = 64.24)
P.I. Established by Prof. S. between Section Line to and Eastmon Ave to N.E.
Set
TR/MB
P.I. #4 not Practical nothing set
Lot 24
Lot 25
Lot 26
Block 21
Block 26
Block 27
Block

76F3095 S&E #247 11-58

PLEASE RETURN TO
LOS ANGELES COUNTY ENGINEER
700 LOS ANGELES COUNTY ENGINEERING BLDG.

Note: Any Additions or Changes on This Sheet Must be Made or Circled in Red Ink With Date and Name of Person Making Change.

Do not extend this side of this line.

Notes Ck'd by M. OSHITA
Map No.
Office Work
Checked by
Date

Survey of CITY TERRACE AREA 4
JN 23076 Tape 226 Std. 84 °F
Surveyed by E. E. Brown
Notes FE B1-4/13 Date 25 May 64
Indexed

F. B. 3225 PG. 123

Lot 24 | Lot 23 | Block 24 | Lot 22 | Lot 21

11 MB

(13+68.41 P.O.T. Sta 54+50 Prolonged) R 43.5 FEET

MEISNER

(15)

CONT FR PG 124

CONT FR PG 133

℄ LINE

ST.
M = 56.52

M = 191.54

For adjusted ℄ see F.B. 3158 - 219 FEB. 4 Aug 67

14.37

1.00

(13+17.41 P.O.T. Sta 2+12.8 Prolonged L.S. 2570 R 41.4 FEET)

S 15° 0' W 141.85

#224 T = 60°
191.65 @ 3° 05' = 191.54
191.87 @ " "
191.73 @ 2° 42' = 191.537
191.75 @ " "
M = 191.54

#226 T = 58°
57.45 @ 10° 13' = 56.529
57.49 @ " "
57.19 @ 30 33' = 56.524
57.16 @ " "
M = 56.52

Lot 1 | Lot 2 | Block 29 Lot 35 | Lot 34

PLEASE RETURN TO
LOS ANGELES COUNTY ENGINEER
700 LOS ANGELES COUNTY ENGINEERING BLDG.

Note: Any Additions or Changes on This Sheet Must be Made or Circled in Red Ink With Date and Name of Person Making Change.

Do not extend this side of this line.

W.S.7, E-1

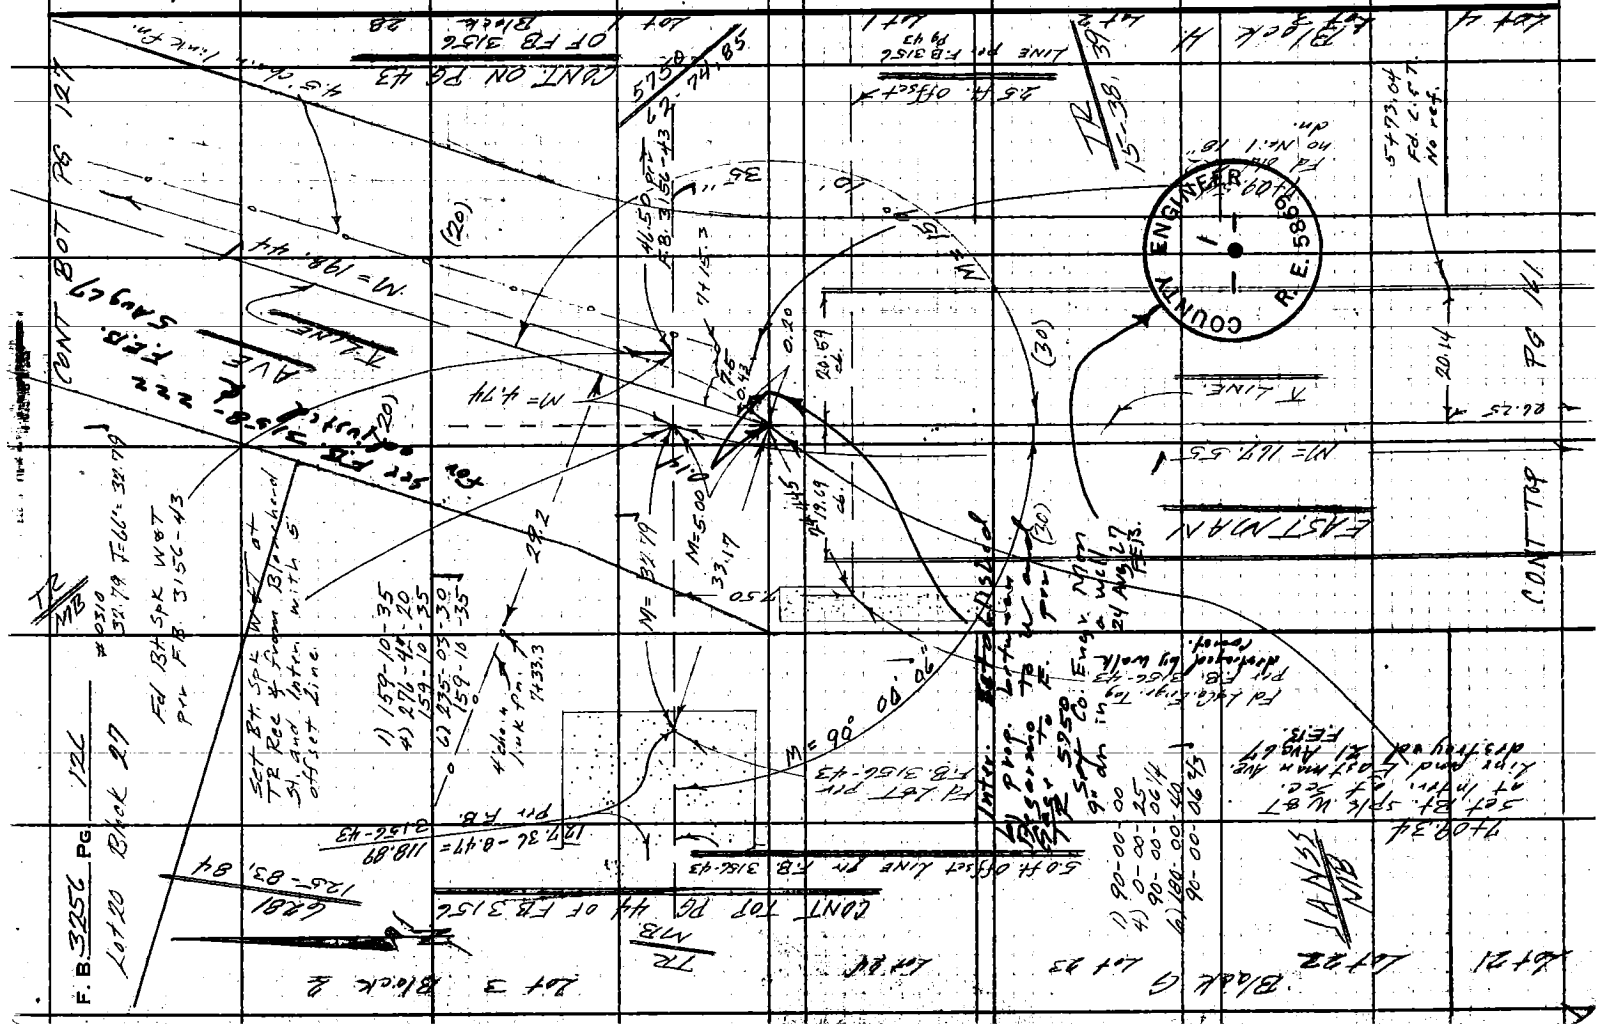

F.B. 3256 Pg 121
Lot 27 Block 27

76F3095 S&E #247 11-58

PLEASE RETURN TO
LOS ANGELES COUNTY ENGINEER
700 LOS ANGELES COUNTY ENGINEERING BLDG.

Note: Any Additions or Changes on This Sheet Must be Made or Circled in Red Ink With Date and Name of Person Making Change.

Do not extend this side of this line.

Notes Ck'd by B. Cohen
Map No.
Office Work
Checked
Date

Survey of CITY TERRACE KLEAN
JN 070705 Tape 100' Std. 62° F
Surveyed by F.E. Brook Date 4/Aug/67
Notes F.E.
Indexed J. Gaj

F. B. 3258 PG. 127

Lot 20 | Lot 21 | Lot 22 | Lot 23

Block 27

TR NB

Conc block retaining wall

Stucco

8+71.8

9+23.0

#224 T= 70°
100.60 @ 3°45' = 100.59 @ " " = 100.39 ✓
100.72 @ 4°36' = 100.71 @ " " = 100.38 ✓
NI = 100.37 ✓

EAST MAN AVE

EAST TOP PG 128

EAST BOT PG 128

(20)

221

220

℄ LINE

NI = 198.44 ✓

NI = 100.37 ✓

4.8

For adjusted ℄ see F.B. 3458 - 222, 223 F.E. 4 Aug 67

(20)

#226 T= 72°
200.33 @ 7°49' = 200.31 @ " " = 198.449 ✓
200.45 @ 5°05' = 200.43 @ " " = 198.437 ✓
NI = 198.44 ✓

8+12.0

#5 chain link fence

8+07.78 Edit. Scott's Hdwy. 25 Aug 67 F.E.B.

S 17°50' W 141.85'

Lot 1 | Lot 2 | Block 28 | Lot 3 | Lot 4 | Lot 5

PLEASE RETURN TO
LOS ANGELES COUNTY ENGINEER
700 LOS ANGELES COUNTY ENGINEERING BLDG.

Note: Any Additions or Changes on This Sheet Must be Made or Circled in Red Ink With Date and Name of Person Making Change.

Do not extend this side of this line.

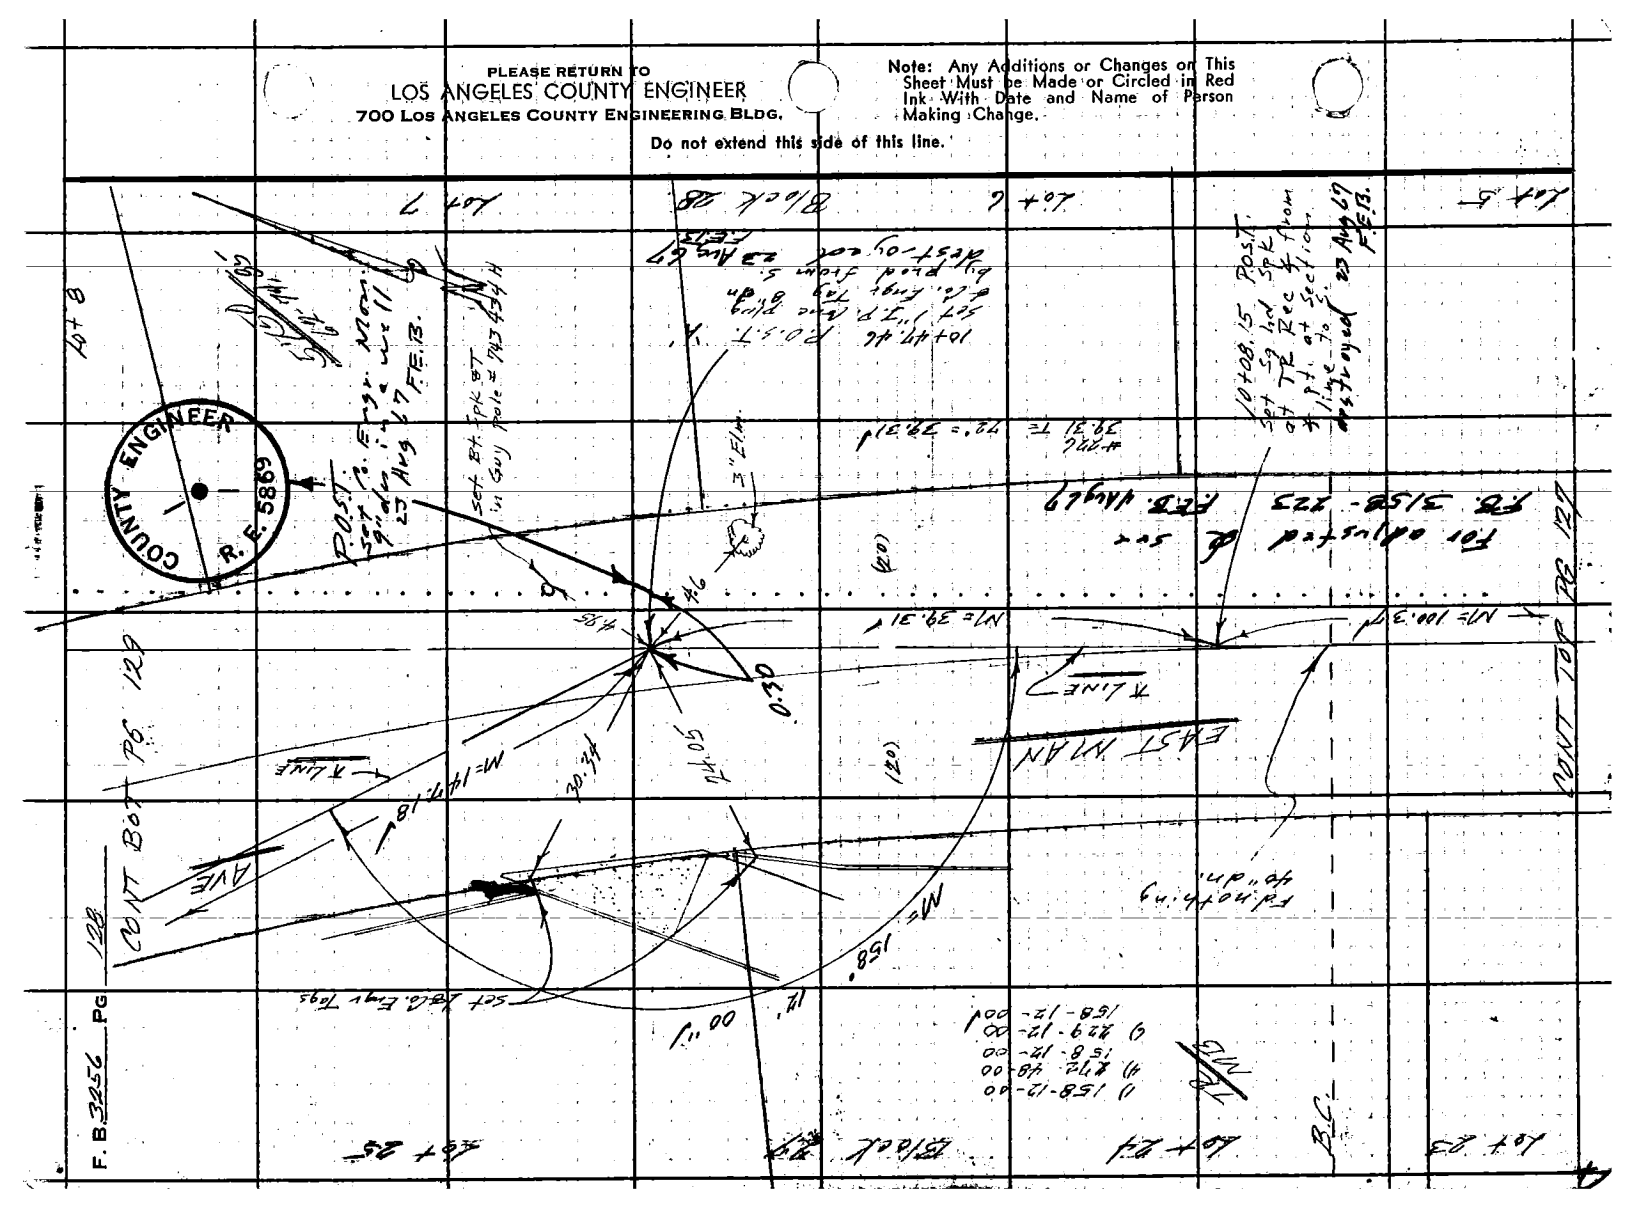

76F309S S&E #247 11-58

PLEASE RETURN TO
LOS ANGELES COUNTY ENGINEER
700 LOS ANGELES COUNTY ENGINEERING BLDG.

Note: Any Additions or Changes on This Sheet Must be Made or Circled in Red Ink With Date and Name of Person Making Change.

Do not extend this side of this line.

Notes Ck'd by [redacted] OSHITA
Map No.
Office Work
Checked
Date

Survey of SOUTH TERRACE AREA
JN 073074 Tape 22C Std. 64 °F
Surveyed by F.E. Brooks
Notes F.E. Date 6 June 67
Indexed F.E. BALL

F. B. 325C PG. 122

Lot 25 | Block 27 | Lot 26

#226
147.18 T= 80° = 147.18 ✓

TL M/B

Hdg. 114°08.3 tow

CONT BAT PG 130

AVE

N= 147.18 ✓ (20)

EAST MAIN

T LINE

182

CONT TOP PG 118

For adjusted d see
3158-224
F.E. 4Aug67 (20)
F.B.

PI #1 not useable nothing set

P.I. Established by Prof to between Line to S. and 100. inter. by of Cage to N. nothing set

F.E. 4Aug 67

S 150 04.74 W

Lot 6 | Block 28 | Lot 9

PLEASE RETURN TO
LOS ANGELES COUNTY ENGINEER
700 LOS ANGELES COUNTY ENGINEERING BLDG.

Note: Any Additions or Changes on This Sheet Must be Made or Circled in Red Ink With Date and Name of Person Making Change.

Do not extend this side of this line.

W.S.7, E-1

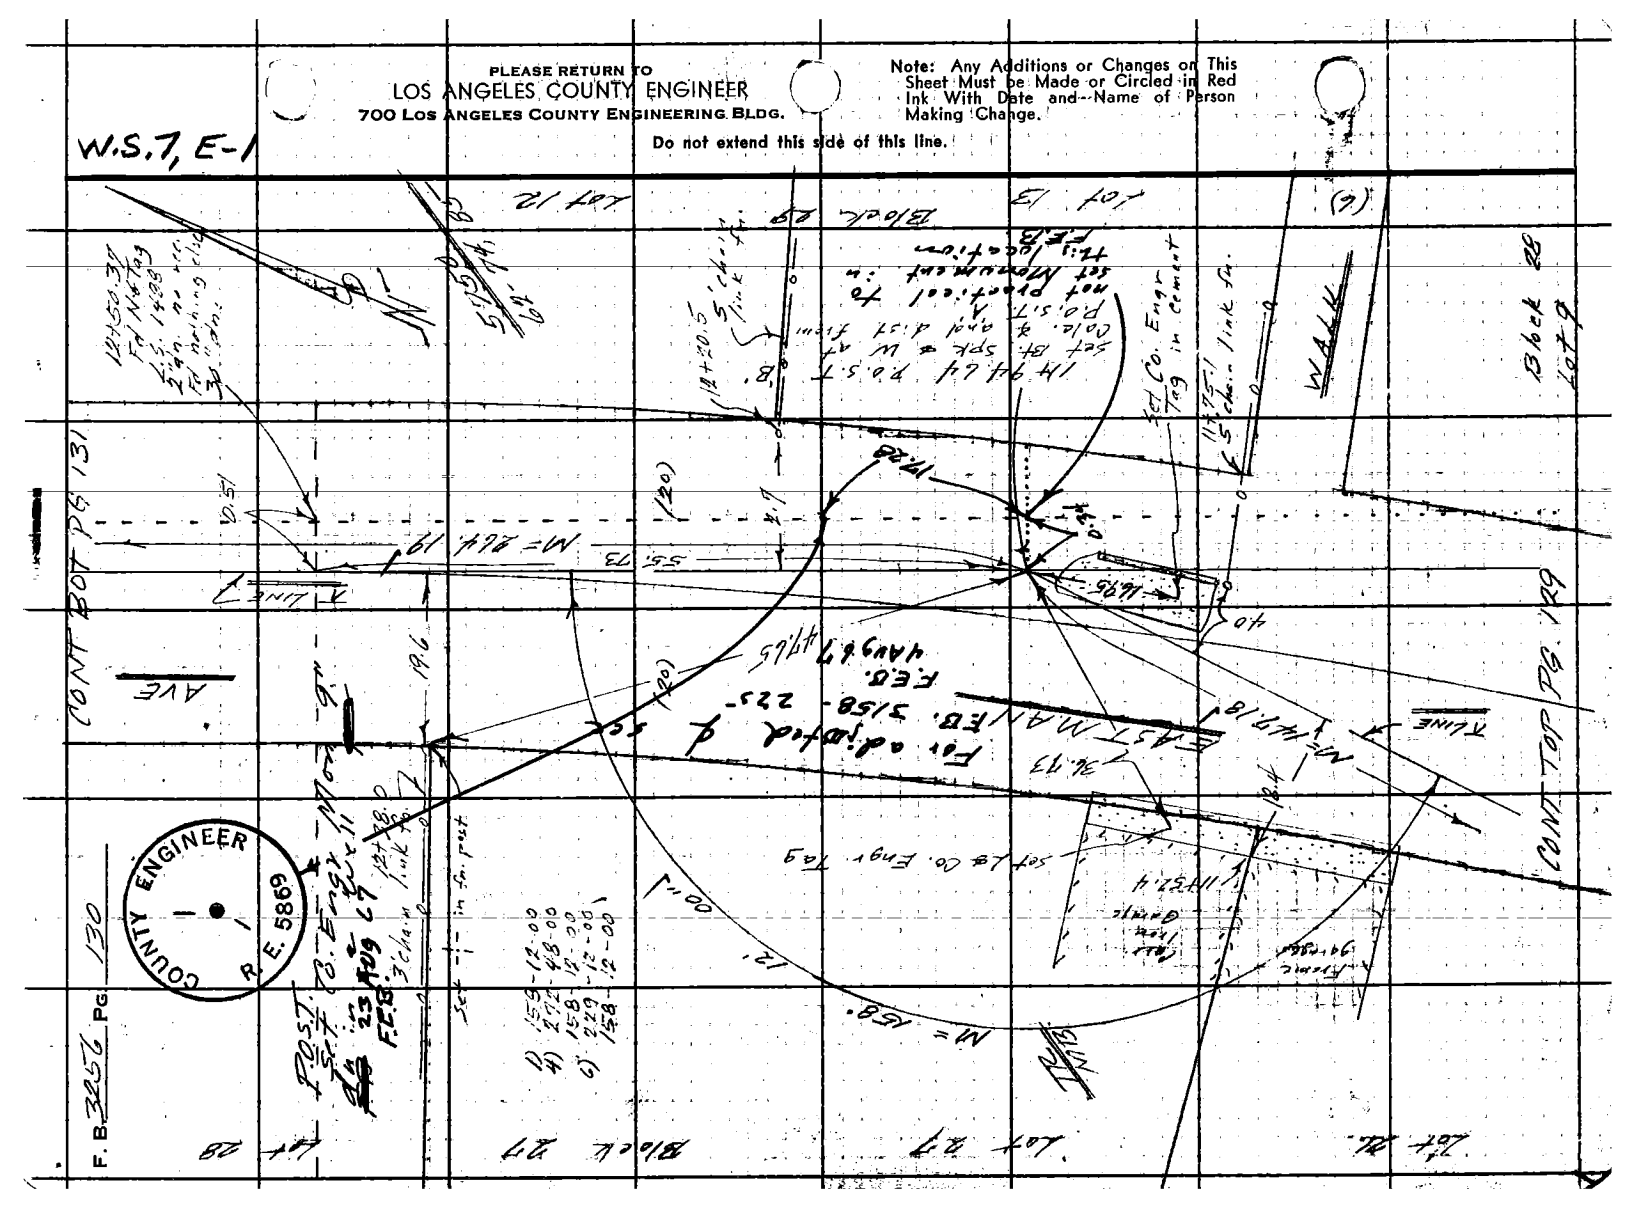

76F3095 S&E #247 11-58

PLEASE RETURN TO
LOS ANGELES COUNTY ENGINEER
700 LOS ANGELES COUNTY ENGINEERING BLDG.

Note: Any Additions or Changes on This Sheet Must be Made or Circled in Red Ink With Date and Name of Person Making Change.

Do not extend this side of this line.

Notes Ck'd by M. OSHITA
Map No.
Office Work
Checked
Date

Survey of CITY TERRACE ADDN
JN 27026 Tape 326 Std 84 °F
Surveyed by F.E. Brank
Notes F.B. Date 1/57 Amend
Indexed F. J. GALL


Lot 28 | Lot 29 | Block 27 | Lot 30

226
264.20 T= 78° = 264.19 ✓
264.20 T= 78° = 264.19 ✓

R
M1B

EAST MAIN

For adjustment & sec
FB. 3158-225

FEB
4 Aug 69

AVE



℄ LINE

M1 = 264.19 ✓

(SW)

2.4

13.6

13445 F 3"dia. IRON PIPE

13445 3"dia. IRON PIPE

5' N 60 E

50' M1

Lot 12 | Lot 11 | Block 49 Lot 10 | Lot 9

PLEASE RETURN TO
LOS ANGELES COUNTY ENGINEER
700 LOS ANGELES COUNTY ENGINEERING BLDG.

Note: Any Additions or Changes on This Sheet Must be Made or Circled in Red Ink With Date and Name of Person Making Change.

Do not extend this side of this line.

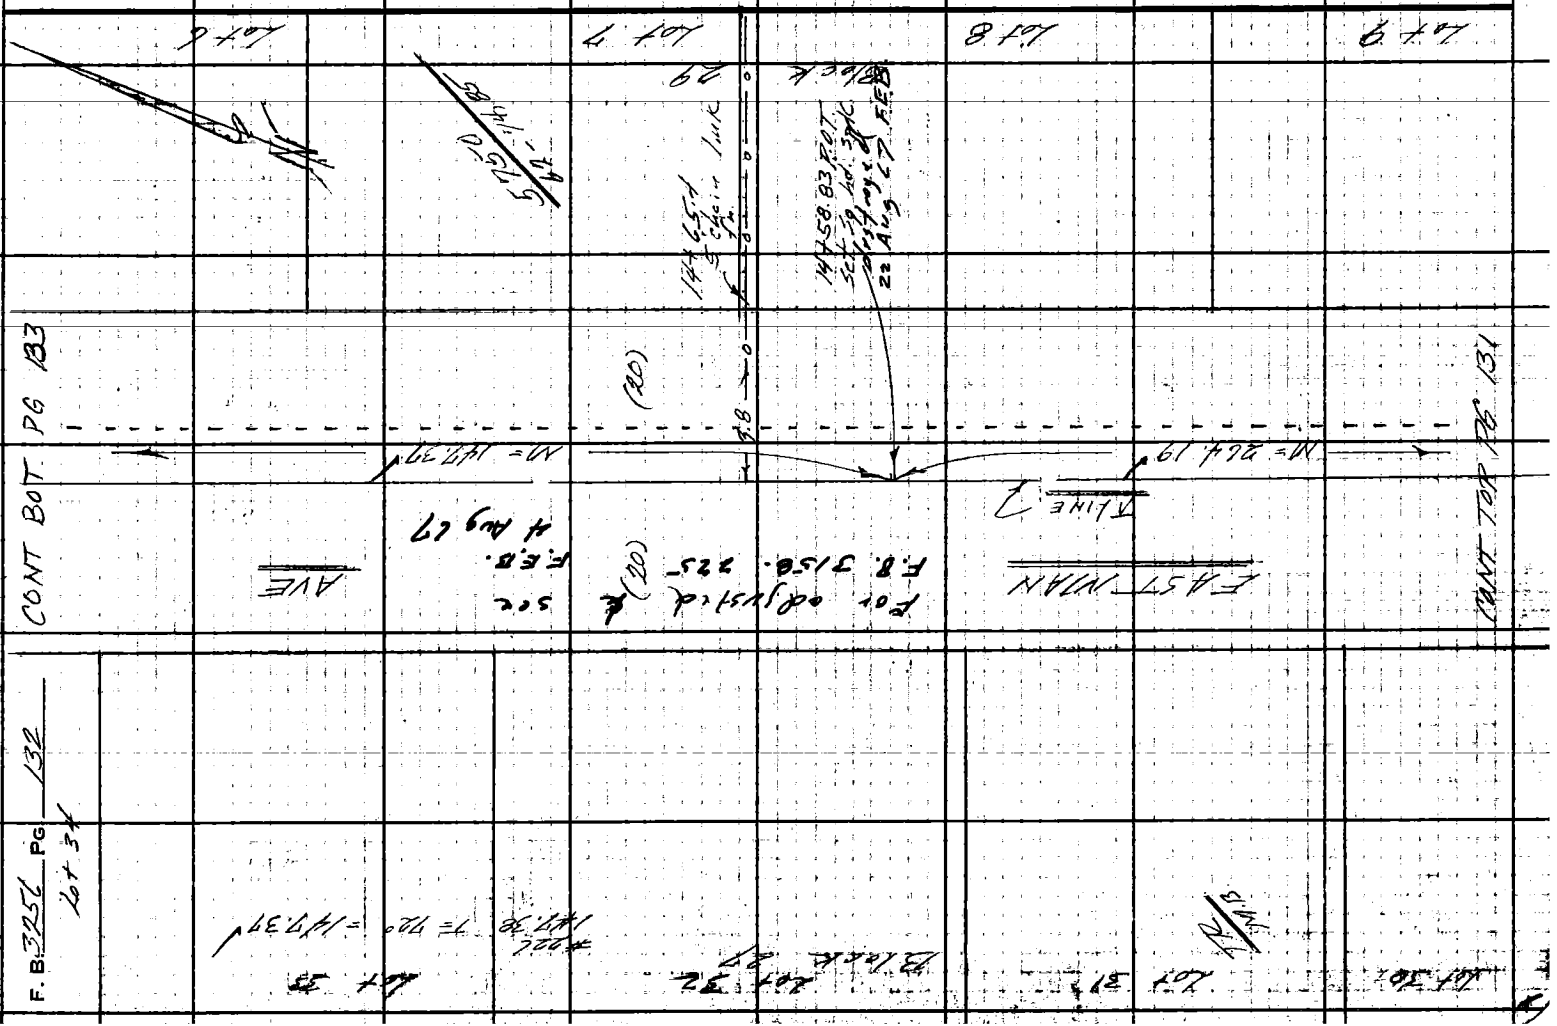

76F309S S&E #247 11-58

PLEASE RETURN TO
LOS ANGELES COUNTY ENGINEER
700 LOS ANGELES COUNTY ENGINEERING BLDG.

Do not extend this side of this line.

Note: Any Additions or Changes on This Sheet Must be Made or Circled in Red Ink With Date and Name of Person Making Change.

W.S. 7, E-1

Notes Ck'd by M. OSHITA
Map No.
Office Work
Checked
Date

Survey of City Terrace Area E
JN 01 01 Tape 226 Std 80' of
Surveyed by F.E. Brooks
Notes F.E. Date 11 June 68
Indexed E.J. GALLI

F.B. 325 PG. 133

Lot 34 Block 27

CONT TOP PG 125

Lot 21 Block 26

1) 119-36-55
4) 118-27-45
119-36-56 14
L) 35½-41-45
119-36-57½

M = 119° 36'

57"

Set Lt at Engr Sta

14745.11 E R/W = 16+06.20 N 43 Set P.M. in S.M.H. by inter. Set # in line. on destroyed.

(15)

M = 42.81

1.46

14+14.93 P.O.T. Set 5/8 bnd spk destroyed 22 Aug 67 F.E.B.
1) 102-27-20
4) 49-49-20
102-27-20
L) 254-44-00
102-27-20

14+49.01 P.T. 3 at Calc Pt. on dist. line destroyed 4 Aug 67 F.E.B.

14+54.33 Set 5/8 spk w/ shiner flush with ground 20" N 22 E 2.0 Set 5/8 spk w/ shiner flush with ground 20" N 22 E 2.0 destroyed 4 Aug 67 F.E.B.

COUNTY ENGINEER R.E. 5869

Set F.B. 3158 - 228 fee. adjusted &

F.E.B. 4 Aug 67

M = 42.81

0.18

0.54

43.00

14+37

(20)

EAST MAIN

P.I. established by F.E. prop. between sec. lines Set 5/8 bnd Case to N. Set 3/4" Eng. Mon. Fd N Flush 9" dn in

0.58

Fd nothing 30" dn

Rec. dist (43.00) ft.

Set 5/8 bnd spk at TR Rec & from w.s.

1) 137-55-25
4) 141-40
137-55-35
L) 137-32-30
137-55-25

INTER. Set P.M. on S.M.H. at from P.I. To N. on line.

Lot 6 Block 28 Lot 5

4' chain link fence

Lot 4

CONT TOP PG 132

CONT BOT PG 134

AVE

F.B. 325 PG. 133

PLEASE RETURN TO
LOS ANGELES COUNTY ENGINEER
700 LOS ANGELES COUNTY ENGINEERING BLDG.

Note: Any Additions or Changes on This Sheet Must be Made or Circled in Red Ink With Date and Name of Person Making Change.

Do not extend this side of this line.

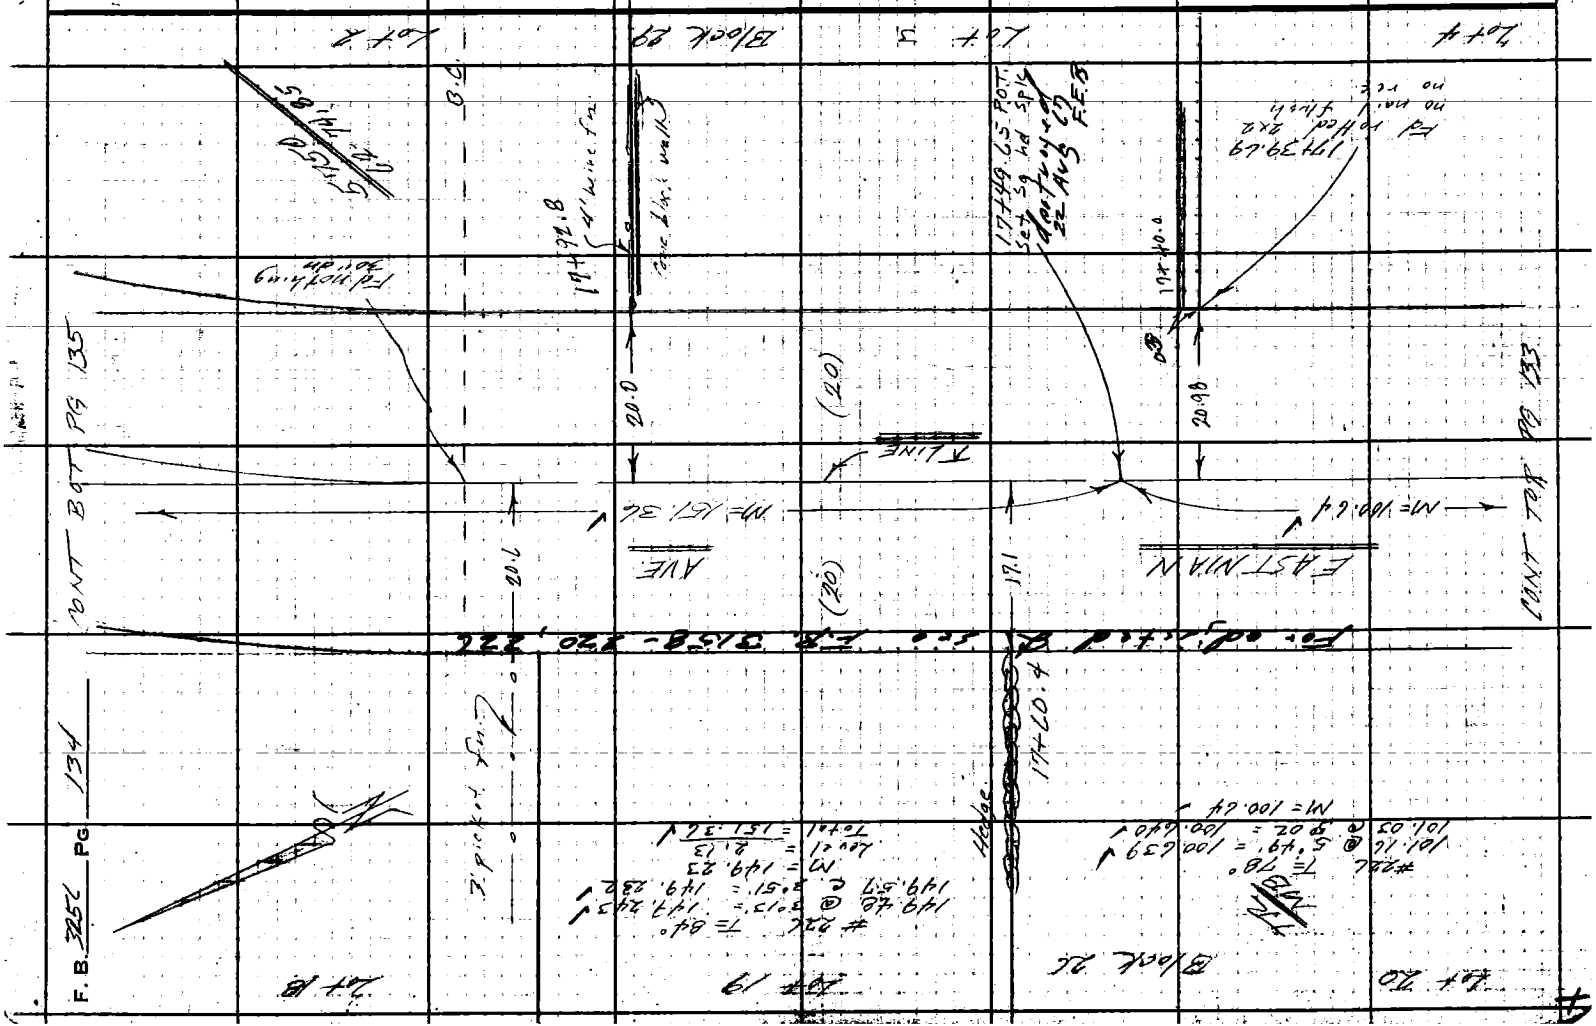
Lot 2
Block 29
Lot 3
Lot 4
Lot 19
Block 28
Lot 20
EAST MAIN
A LINE
EAST MAIN
Pg 135
Pg 134
F.B. 3256
N = 100.64
N = 151.36
20.0
20.98
17.1
19.1
7.08
Hedge
Fd nothing

Notes Ck'd by M. OSHITA
Map No.
Office Work
Checked
Date

Survey of CITY TERRACE AREA #
JN 0303.04 Tape 226 Std 84 °F
Surveyed by F. E. Brook
Notes F.E.B. Date 20 Sept 66
Indexed C. J. GALLI

F. B. 3256 PG. 135

Note: Any Additions or Changes on This Sheet Must be Made or Circled in Red Ink With Date and Name of Person Making Change.

Do not extend this side of this line.

PLEASE RETURN TO
LOS ANGELES COUNTY ENGINEER
700 Los Angeles County Engineering Bldg.

76E3005 S&F #247 11-58

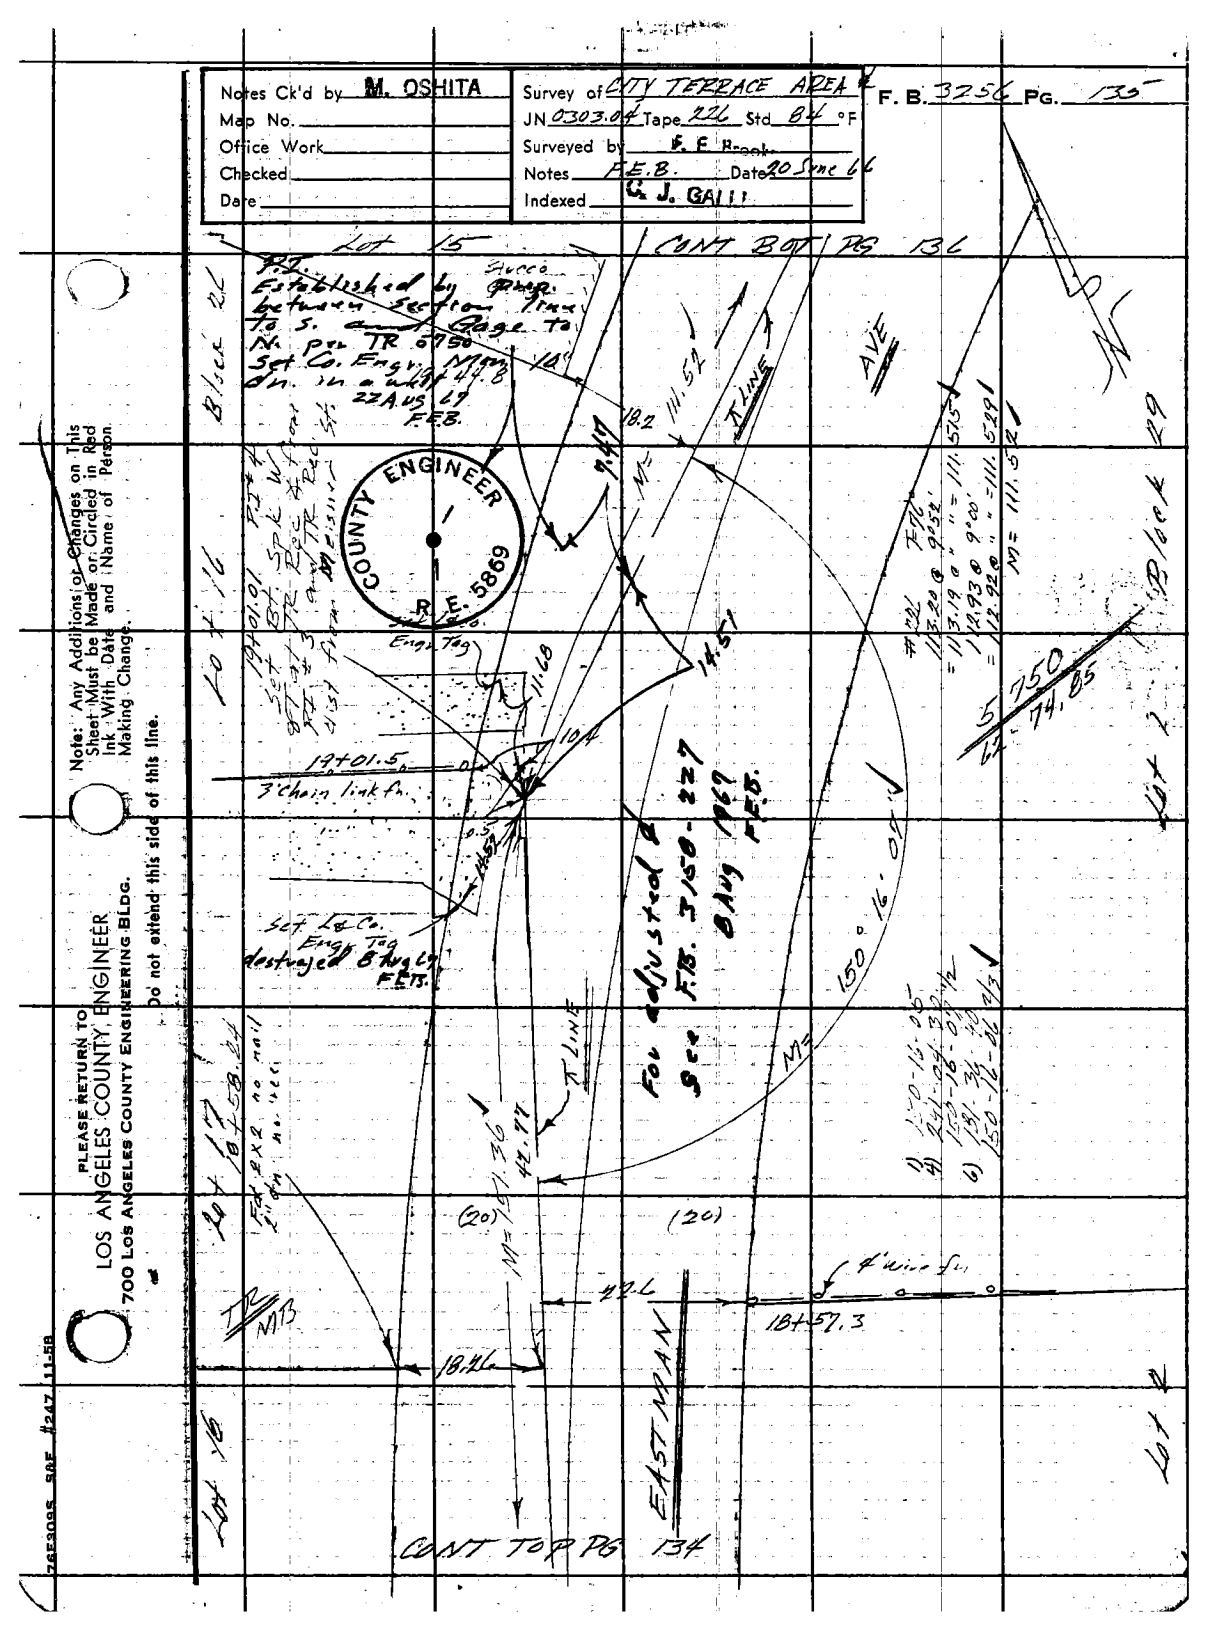
CONT BOT PG 136
Lot 15
Block 22
Lot 16
Lot 17
Lot 18
Lot 19
Block 29
Lot 1
Lot 2
Lot 3
Lot 4
AVE
COUNTY ENGINEER
R.E. 5869
Set Co. Engr. Mon.
Set Co. Engr. Tag
Set L.S. Co. Engr. Tag destroyed 8 Aug 67 F.E.B.
19+01.5
3 Chain link fn.
For adjusted & Sec. F.B. 3150-227 8 Aug 1967 F.E.B.
150.16' M
150.00' R
M=111.52
M=111.57
M=111.52
M=111.52
M=111.52

PLEASE RETURN TO
LOS ANGELES COUNTY ENGINEER
700 LOS ANGELES COUNTY ENGINEERING BLDG.

Note: Any Additions or Changes on This Sheet Must be Made or Circled in Red Ink With Date and Name of Person Making Change.

Do not extend this side of this line.

VV. S. 7, E-1

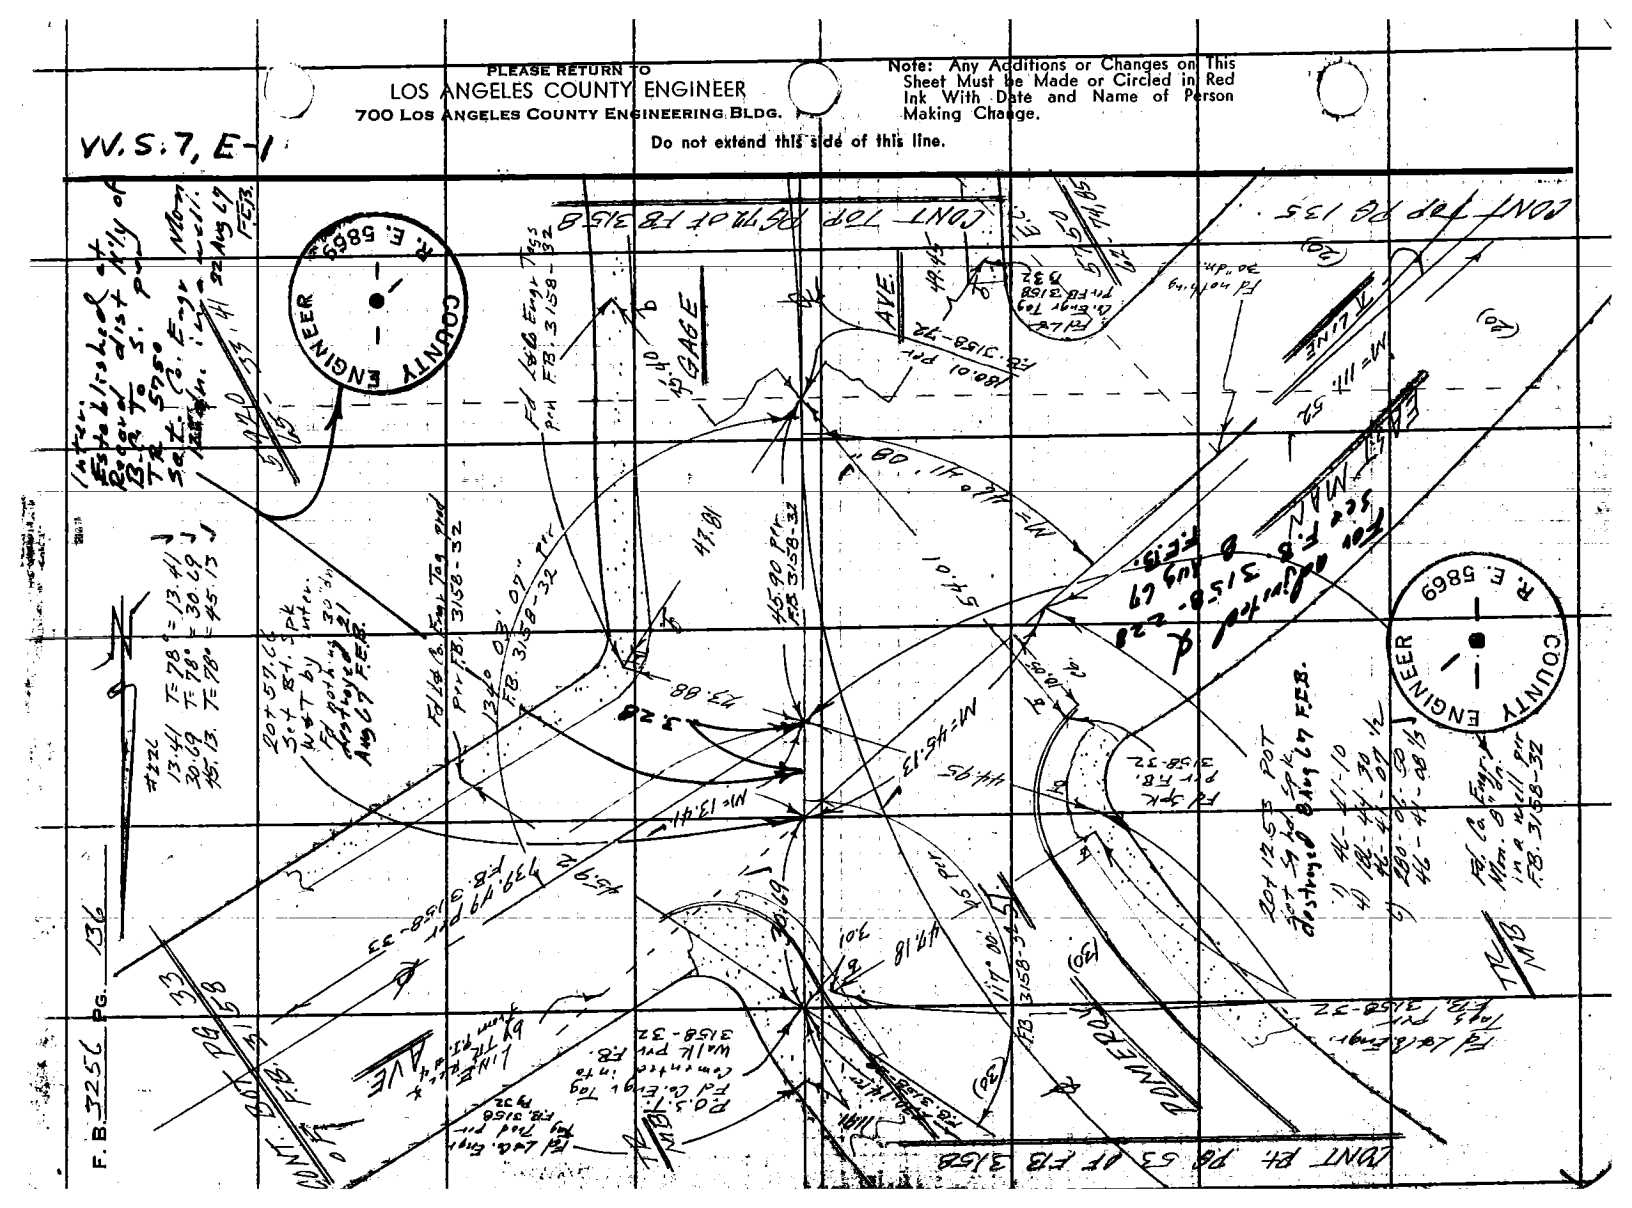
COUNTY ENGINEER
R. E. 5869
COUNTY ENGINEER
R. E. 5869
F.B. 3256 PG. 136
CONT. FR. PG. 53 OF F.B. 3158
CONT. FR. PG. 135
CONT. FR. PG. 135 OF F.B. 3158
GAGE AVE.

76F3095 CE # 310 3-61

PLEASE RETURN TO
LOS ANGELES COUNTY ENGINEER
403 LOS ANGELES COUNTY ENGINEERING BLDG.

Note: Any Additions or Changes on This Sheet Must be Made or Circled in Red Ink With Date and Name of Person Making Change.

Do not extend this side of this line.

W.S.7, D-1

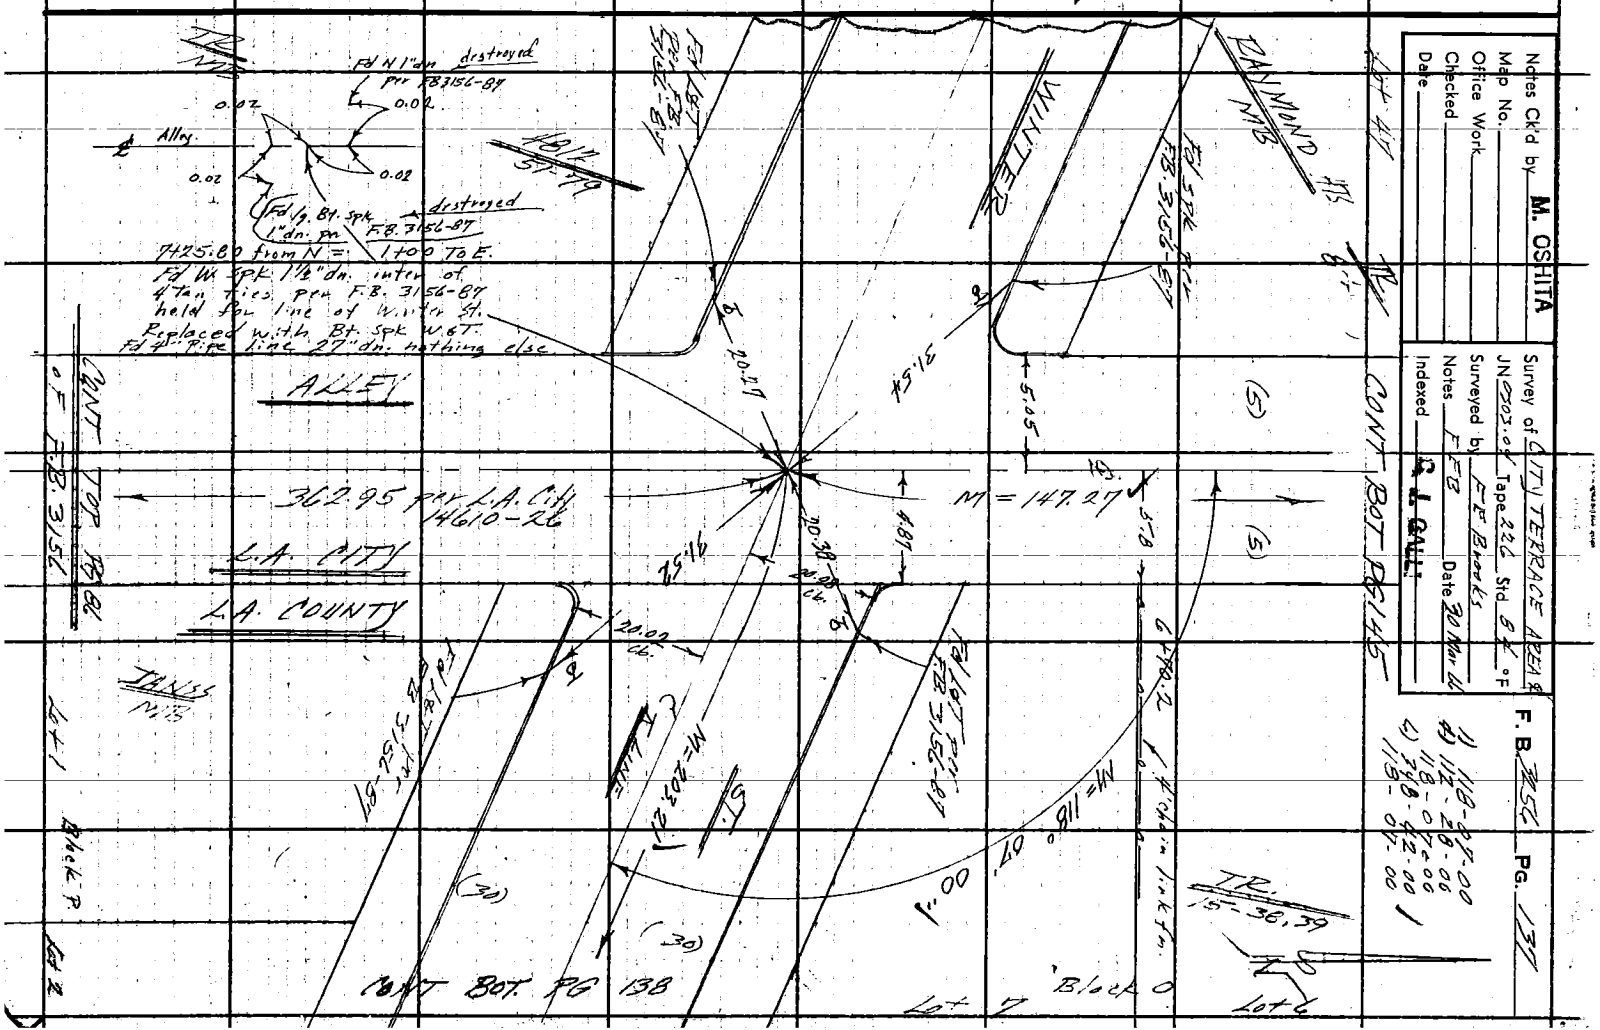

Notes Ck'd by M. OSHITA
Map No.
Office Work
Checked
Date

Survey of CITY TERRACE AREA
JN 2203.04 Tape 226 Std 68° F
Surveyed by E.F. Brooks
Notes FB Date 20 Mar 64
Indexed R. J. GALLI

F. B. 3156 Pg. 137

1) 118-28-00
118-02-00
2) 118-42-00
118-04-00

PLEASE RETURN TO
LOS ANGELES COUNTY ENGINEER
403 LOS ANGELES COUNTY ENGINEERING BLDG.

Note: Any Additions or Changes on This Sheet Must be Made or Circled in Red Ink With Date and Name of Person Making Change.

Do not extend this side of this line.

W.S. 7, D-1

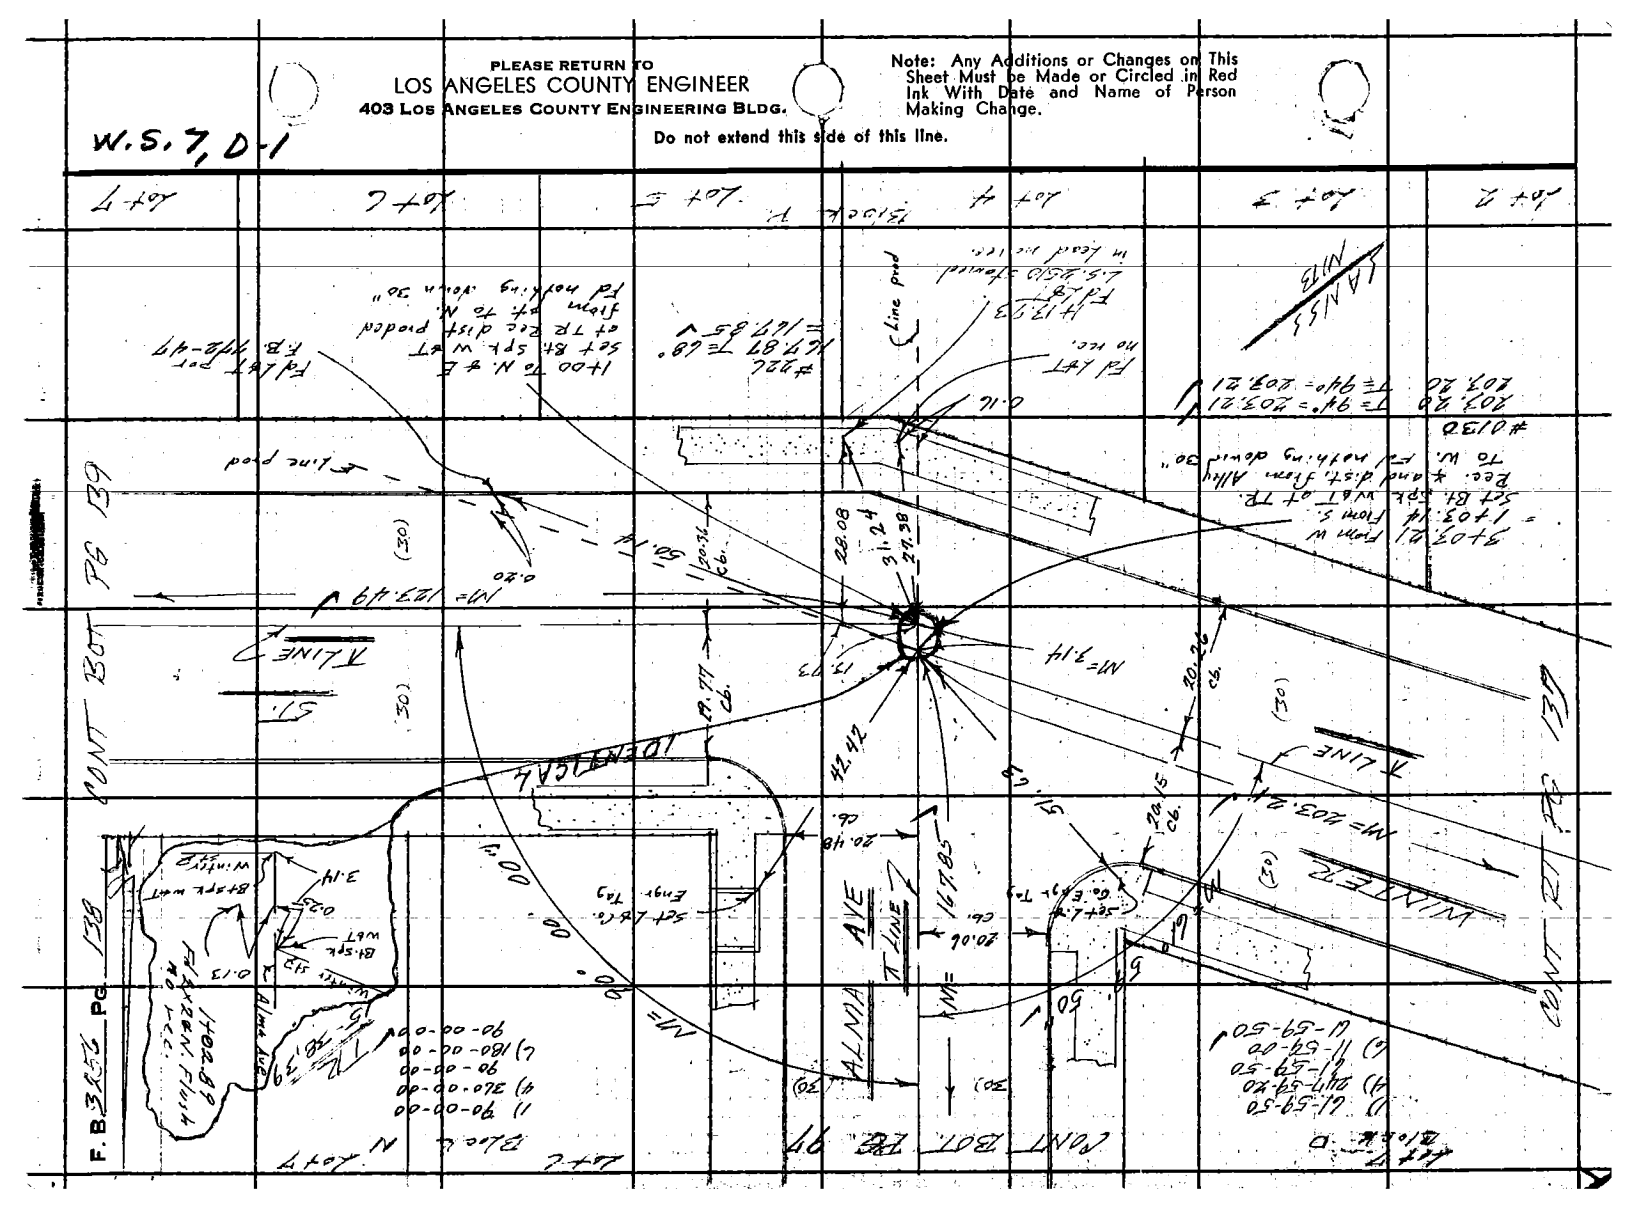
LOT 7
LOT 6
LOT 5
BLOCK Y
LOT 4
LOT 3
LOT 2
MONT BOT PG 139
T LINE
IDENTICAL
ALNIA AVE
MONT BOT TRE
F.B. 382/55 PG 139
Line prod
Fd LRT






































76F3095 CE # 310 3-61

PLEASE RETURN TO
LOS ANGELES COUNTY ENGINEER
403 LOS ANGELES COUNTY ENGINEERING BLDG.

Note: Any Additions or Changes on This Sheet Must be Made or Circled in Red Ink With Date and Name of Person Making Change.

Do not extend this side of this line.

Notes Ck'd by M. OSHITA
Map No.
Office Work
Checked
Date

Survey of CITY TERRACE AREA
JN 0303.04 Tape 0130 Std 68 °F
Surveyed by F.E. Brooks
Notes F.E.B. Date Apr. 1976
Indexed S. J. GALLI

F. B. 3255 Pg. 13

Lot 7 | Lot 8 | Block N | Lot 9 | Lot 10 | Lot 11

2+29.69 P.O.T. No Lic.

#0130
123.49 T=68° = 127.49
123.49 T=68° = 123.49

#0130
66.45 T=72° = 66.45

TP 15.38.39

CONT. EOT PS 140

EOT PS 138

WINTER ST.

(50)

4.20

M = 66.45

(30)

ST. LINE

M = 160.06

M = 123.49

2+23.49 P.O.T.
Set 3/4 hd hd spk

#226 T=72°
159.94 @ 3°56' = 159.353
159.73 @ " " = 159.353
159.88 @ 4°34' = 159.353
159.87 @ " " = 159.353
M = 159.35
Level = 0.71
Total 160.06

2+89.94 P.O.T.
Set 3/4 hd spk & T.

JAN 1113

Lot 7 | Lot 8 | Block P. | Lot 9 | Lot 10 | Lot 11

PLEASE RETURN TO
LOS ANGELES COUNTY ENGINEER
403 LOS ANGELES COUNTY ENGINEERING BLDG.

Note: Any Additions or Changes on This Sheet Must be Made or Circled in Red Ink With Date and Name of Person Making Change.

Do not extend this side of this line.

W.S.7, D-1

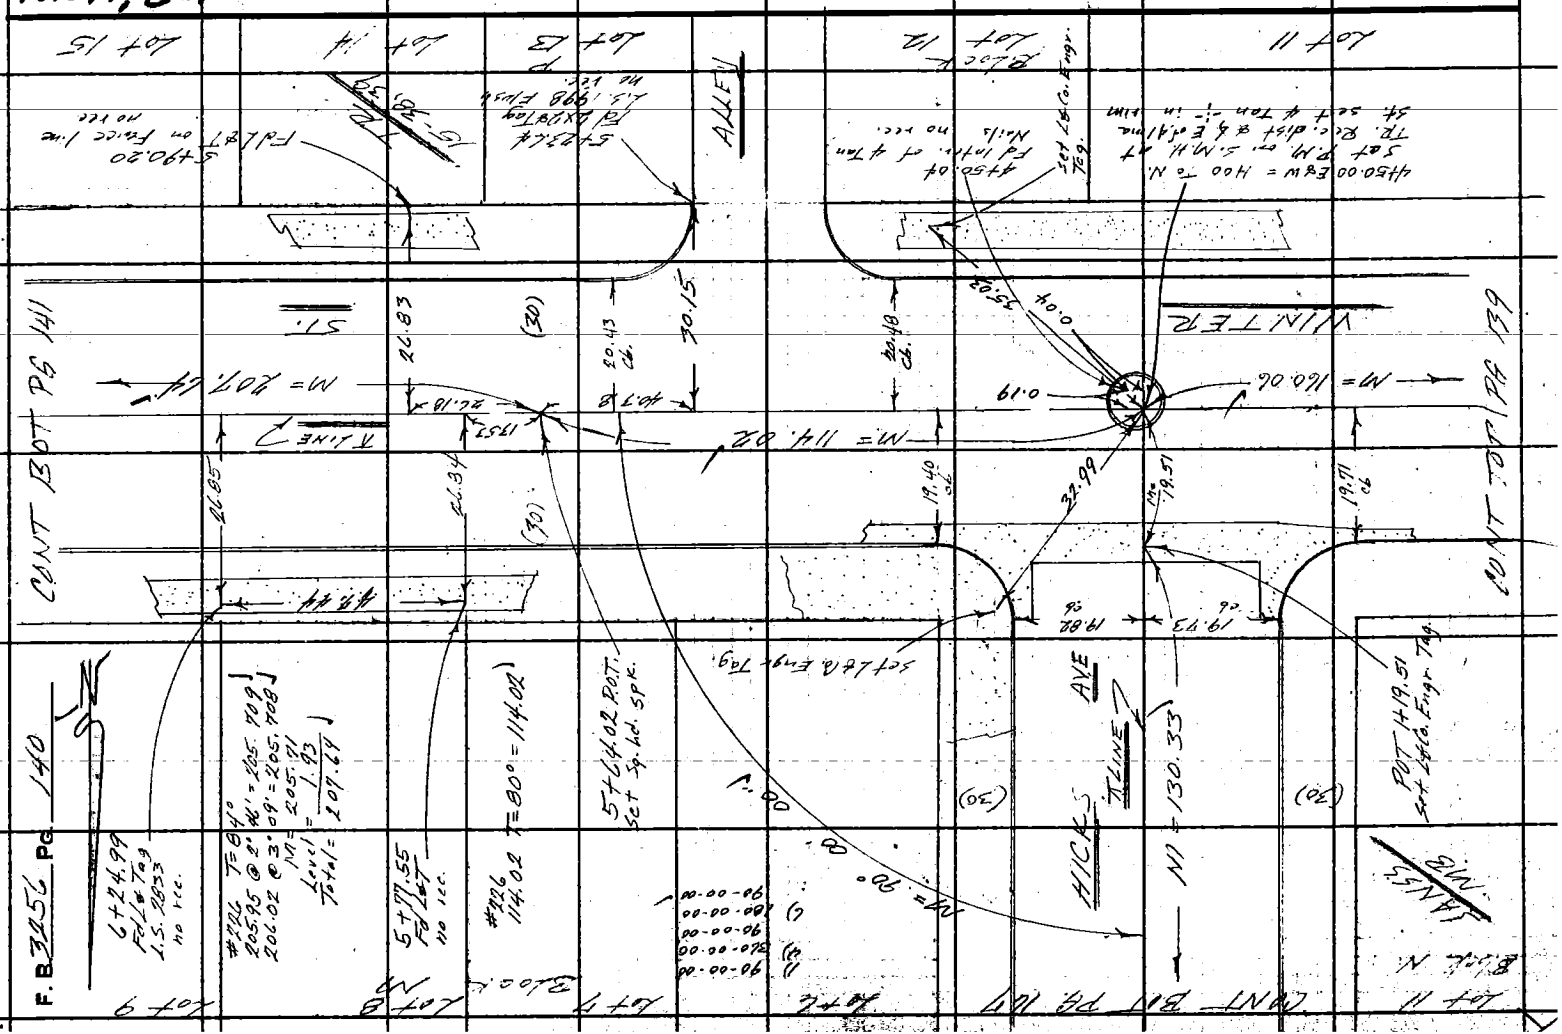
Lot 15
Lot 14
Lot 13
Lot 12
Lot 11
ALLEY
CENT BOT PG 141
CENT BOT PG 139
WINTER
HICKS AVE
HICKS AVE
Lot 9
Lot 8
Lot 7
Lot 10
Lot 11
F. B. 3155 Pg. 140
M = 207.24'
M = 114.02
M = 160.06
M = 130.33
N
S
E
W
POT 4 19.51 set Spike, Engr. Tag.
Set Spike, Engr. Tag.
5+79.55 POT. Set Sp. Lcl. Spk.
6+24.99 Fd L&T Tag 1.5.2033 no rec.
5+79.55 Fd L&T no rec.

Notes Ck'd by M. OSHITA
Map No.
Office Work
Checked
Date

Survey of CITY TERRACE AREA
JN 0303.04 Tape 226 Std 84 °F
Surveyed by FE Brooks
Notes FEB Date 4 Apr. 16
Indexed C. J. GALLI

F. B. 3256 PG. 141

CONT BOT PG 142

Note: Any Additions or Changes on This Sheet Must be Made or Circled in Red Ink With Date and Name of Person Making Change.

Do not extend this side of this line.

W, S, 7, E-1

PLEASE RETURN TO
LOS ANGELES COUNTY ENGINEER
403 LOS ANGELES COUNTY ENGINEERING BLDG.

DITMAN AVE.

WINTER

CONT TOP PG 140

76F3085 CE # 310 3-61

PLEASE RETURN TO
LOS ANGELES COUNTY ENGINEER
403 LOS ANGELES COUNTY ENGINEERING BLDG.

Note: Any Additions or Changes on This Sheet Must be Made or Circled in Red Ink With Date and Name of Person Making Change.

Do not extend this side of this line.

W.S.7, E-1

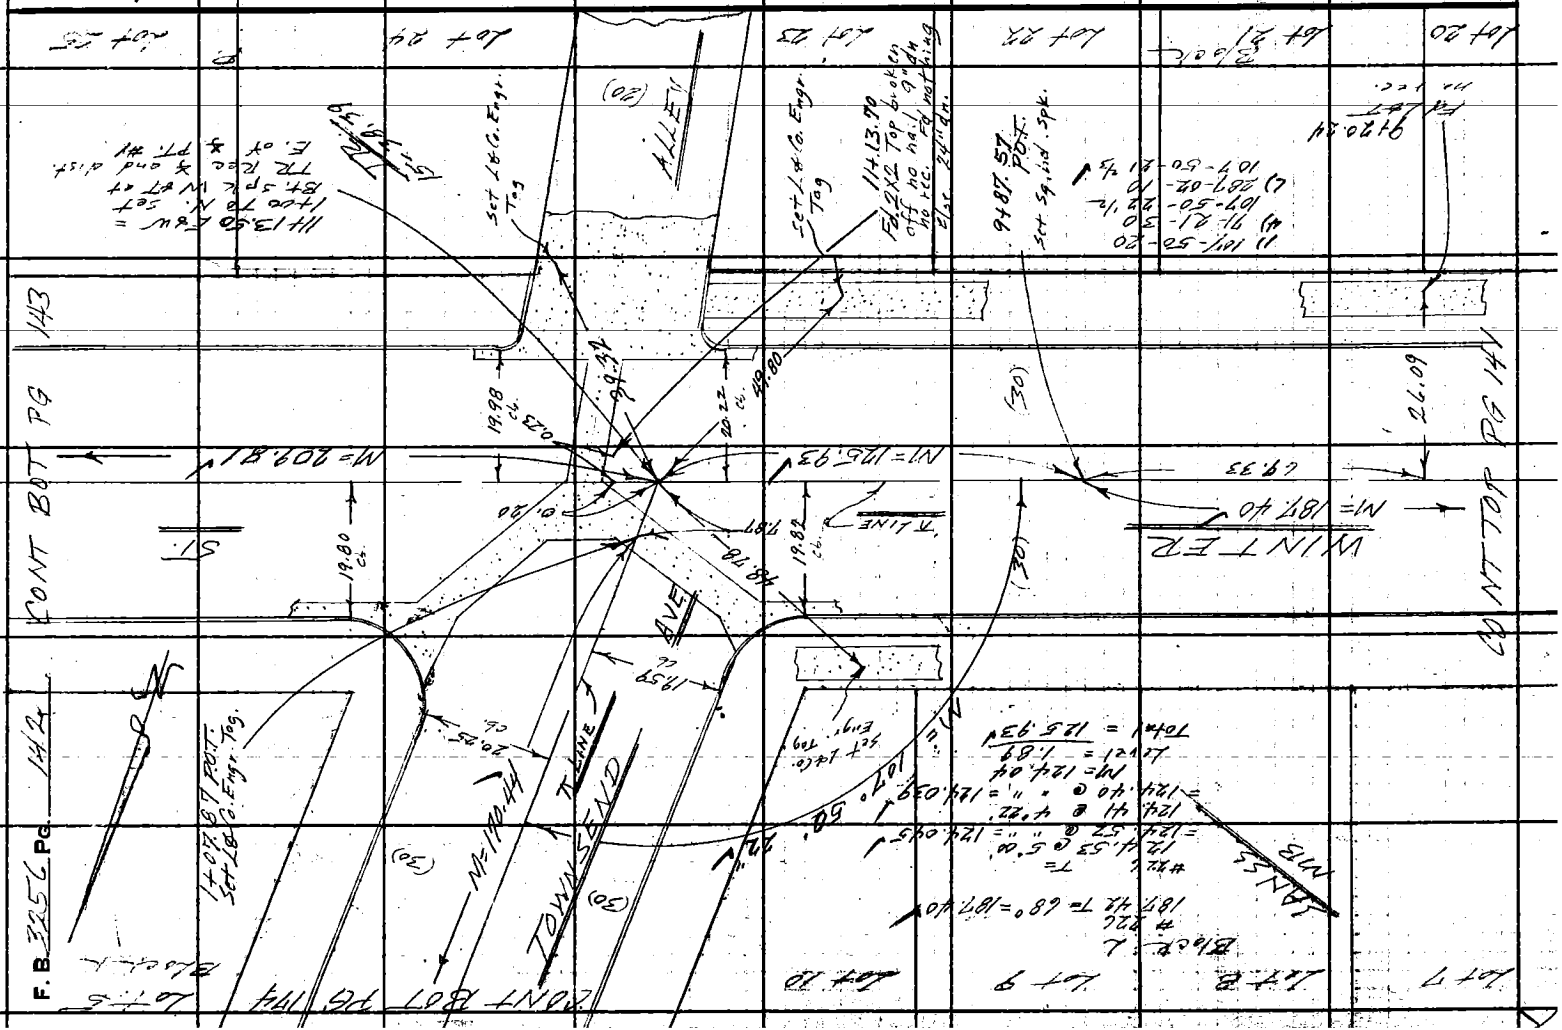

76F3095 CE # 310 3-61

PLEASE RETURN TO
LOS ANGELES COUNTY ENGINEER
403 LOS ANGELES COUNTY ENGINEERING BLDG.

Note: Any Additions or Changes on This Sheet Must be Made or Circled in Red Ink With Date and Name of Person Making Change.

Do not extend this side of this line.

Notes Ck'd by M. OSHITA
Map No.
Office Work
Checked
Date

Survey of CITY TERR. ARE AREA
JN 2293.01 Tape 22L Std. 84 °F
Surveyed by FE Brandt
Notes FE B Date 4 Apr 62
Indexed C. J. CAHILL

F. B. 335 Pg. 143

Lot 5 | Lot 6 | Lot 7 | Lot 8 | Lot 9 | Lot 10

Lot 6 12+69.80 Fd L&T 2 L.S. 2348 BP NE no rec.

13 Lot 6 12+69.80 Fd L&T 2 L.S. 2348 BONE no rec.

Fd L&T 2 L.S. 2348 BONE no rec.

#0130
262.37 T=66°= 262.37
262.38 T=66°= 262.38
M= 262.37

LANE 38 "

N= 168°

13+20.00

13+30.00

51.05

2.03

58.90

24.80 (30)

WINTER

℄ LINE

N= 209.81

POINT TO POINT

19.78 ch.

26.91 26.80

26.53 ch.

19.77 ch.

N= 262.37

℄ LINE

POINT AT POINT

2.16

20.07 ch.

2.42

26.50

30.14 ch.

Line prod

24.23 (30)

57°45'

49.25

#126 T=70°
180.18 @ 4°05' = 179.702
180.16 @ 4°04' = 179.710
180.32 @ " " = 179.710
180.30 @ " " = 179.710
N= 179.70

Level = 30.10
Total 209.81

12+76.48

Fd L&T 3 no rec.

1) 118-55-40
4) 315-42-30
118-55-30 1/2
4) 295-33-50
118-55-30 1/2

15-38.39

13+23.31 Set 8" sq spk Wandt & Hall in top of conc. hdwl. Fd 1/2" I.P. 0.07' E. & 0.47' N. of "L" in M.H. stamped

Lot 25 | Lot 26 | Lot 27 | Lot 28 | Lot 29 | Lot 30

PLEASE RETURN TO
LOS ANGELES COUNTY ENGINEER
403 LOS ANGELES COUNTY ENGINEERING BLDG.

Note: Any Additions or Changes on This Sheet Must be Made or Circled in Red Ink With Date and Name of Person Making Change.

Do not extend this side of this line.

W.S. 7, E-1

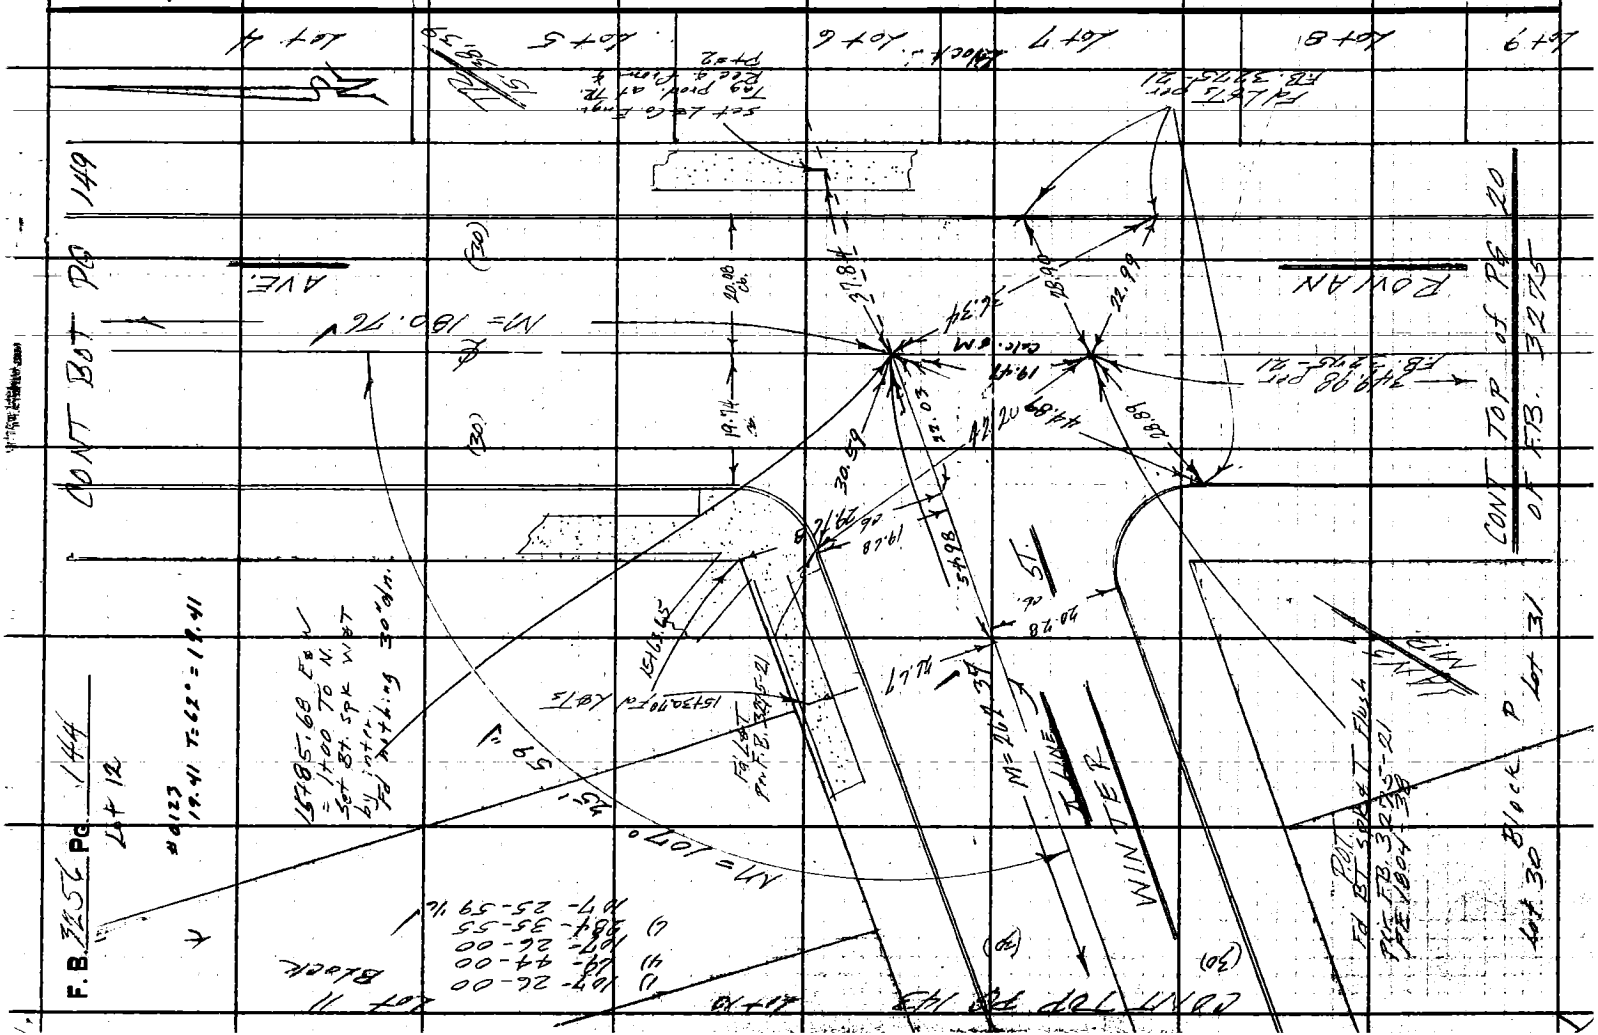

Notes Ck'd by M. OSHITA
Map No.
Office Work
Checked
Date

Survey of CITY TERRACE AREA E
JN 0303.04 Tape 2RL Std. 84 °F
Surveyed by FE Brooks
Notes FEB Date 31 March 66
Indexed C. J. GALLI

F. B. 325 & PG. 145

CONT BOT PG 1016

Note: Any Additions or Changes on this Sheet Must be Made or Circled in Red Ink With Date and Name of Person Making Change.

Do not extend this side of this line.

PLEASE RETURN TO
LOS ANGELES COUNTY ENGINEER
403 Los Angeles County Engineering Bldg.

76F3095 CE # 310 3-61

CONT TOP PG 1130

PLEASE RETURN TO
LOS ANGELES COUNTY ENGINEER
403 LOS ANGELES COUNTY ENGINEERING BLDG.

Note: Any Additions or Changes on This Sheet Must be Made or Circled in Red Ink With Date and Name of Person Making Change.

Do not extend this side of this line.

W.S.D-1

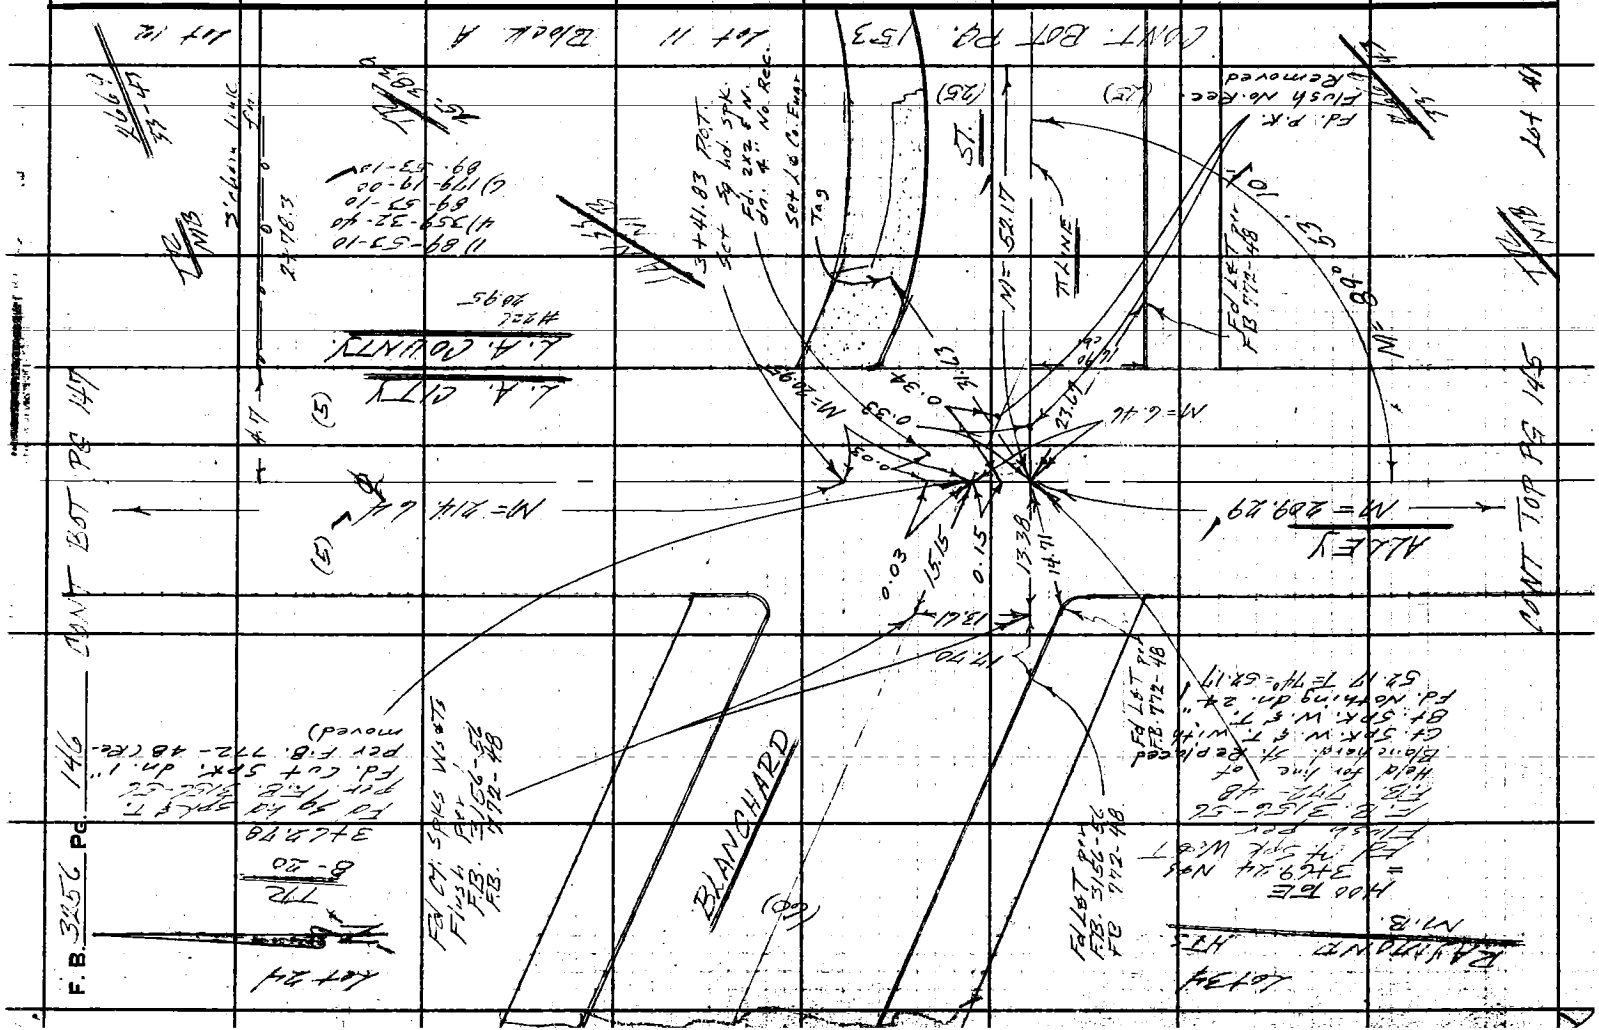
CONT. BOT. PG. 153
LOT 11
BLOCK A
LOT 12
LOT 14
CONT. TOP PG. 145
CONT BOT PG 147
L.A. COUNTY
L.A. CITY
ALLEY
ST.
BLANCHARD
3+41.83 POST. Set ¾ Hot. Spk. Fd. 2½" B.C. Dia. #. No Rec. Set I.C. Ctr. Tag
Fd. P.K. Flush No Rec. Removed
Fd. 1/2" I.P. F.B. 772-48
Fd. 1/2" I.P. F.B. 772-48
Fd. 1/2" I.P. F.B. 772-48

Notes Ck'd by M. OSHITA
Map No.
Office Work
Checked
Date

Survey of TERRACE AREA 2 F. B. 3256 Pg. 147
JN 2307.04 Tape 226 Std. 84 °F
Surveyed by F.E. Brooks
Notes FEB Date 30 Nov 66
Indexed C. J. GALLI

CONT POT PG 146

Note: Any Additions or Changes on This Sheet Must be Made or Circled in Red Ink With Date and Name of Person Making Change.

PLEASE RETURN TO
LOS ANGELES COUNTY ENGINEER
403 Los Angeles County Engineering Bldg.
Do not extend this side of this line.

76F3095 CE # 310 1-61

CONT TOP PG 146

PLEASE RETURN TO
LOS ANGELES COUNTY ENGINEER
403 LOS ANGELES COUNTY ENGINEERING BLDG.

Note: Any Additions or Changes on This Sheet Must be Made or Circled in Red Ink With Date and Name of Person Making Change.

Do not extend this side of this line.

W.S.7, D-1

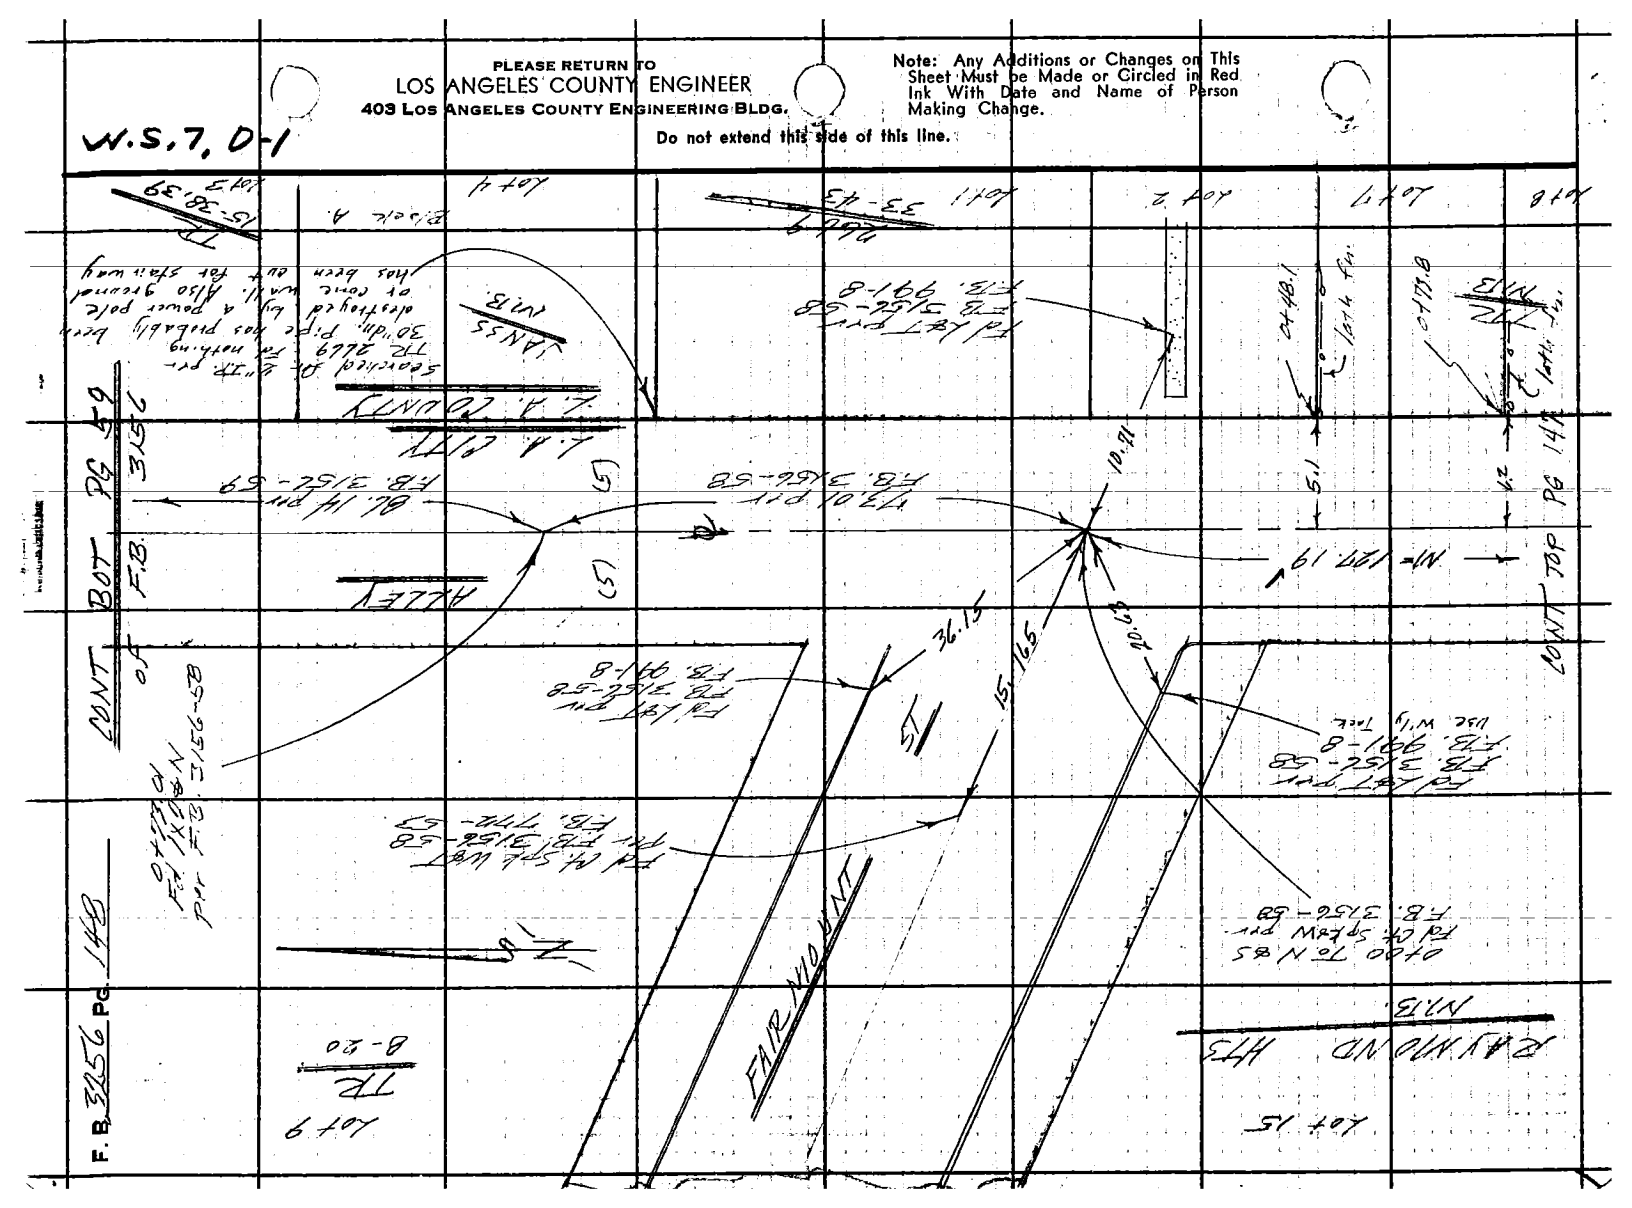

Notes Ck'd by M. OSHITA
Map No.
Office Work
Checked
Date

Survey of CITY TERRACE AREA 8
JN 0303.04 Tape 226 Std 64 °F
Surveyed by F.E. Brooks
Notes F.F.B. Date 20 Apr. 66
Indexed G. J. GALLI

F. B. 3256 PG. 149

CONT BOT PG 150

Note: Any Additions or Changes on this Sheet Must be Made or Circled in Red Ink With Date and Name of Person Making Change.
Do not extend this side of this line.

PLEASE RETURN TO
LOS ANGELES COUNTY ENGINEER
403 Los Angeles County Engineering Bldg.

Lot 15
#226
123.48
T=78°=123.48

Lot 14

Lot 13 Block K

Lot 12

#226
180.72
T=78°=180.72

123.48

AVE 20.98

3+40.06

Fd L&T tags
L.S. 7861
NO TCC

(30) (30)

SD. 04'

2+90.02

27.09

9.26

9.80

2+80.76 P.O.T.
Set ¾ hd. spk.

25.84

Fd L&T tags
NO TCC
2+70.96

2+65.63

25.87

M=180.72
ROMAN

CONT TOP PG 144

Lot 1

Block 1

Lot 2

Lot 3

Lot 4

76F3095 CE # 310 3-61

PLEASE RETURN TO
LOS ANGELES COUNTY ENGINEER
403 LOS ANGELES COUNTY ENGINEERING BLDG.

Note: Any Additions or Changes on This Sheet Must be Made or Circled in Red Ink With Date and Name of Person Making Change.

Do not extend this side of this line.

W.S.7, E-1

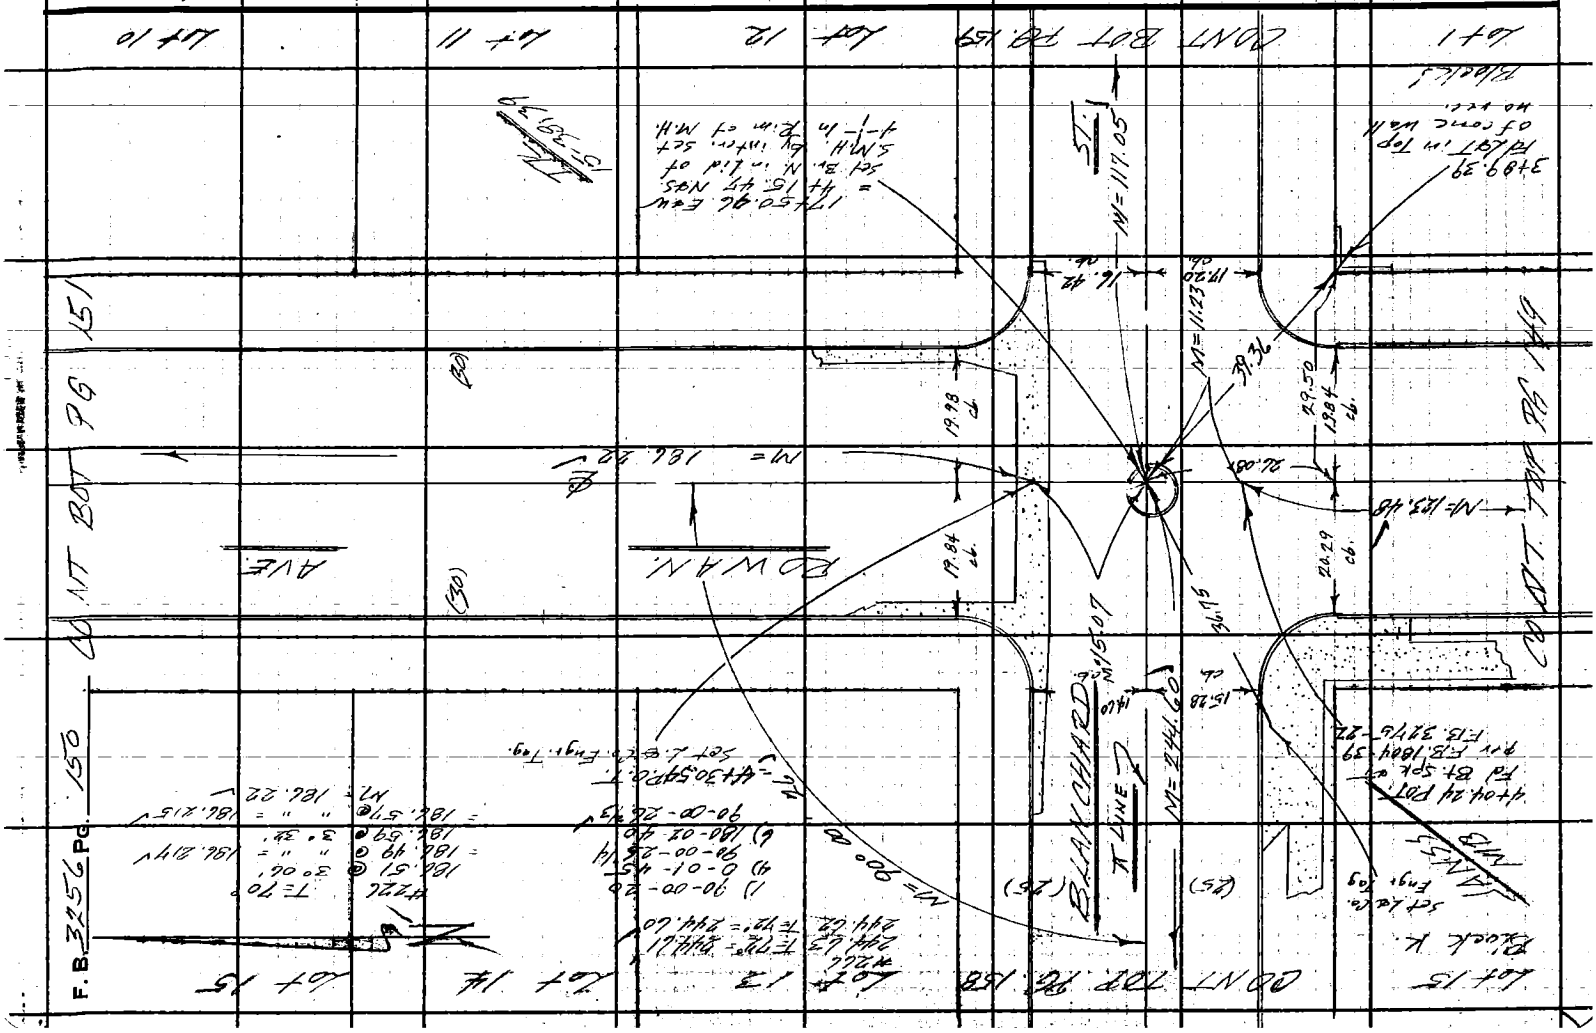

76F3095 CE # 310 3-61

PLEASE RETURN TO
LOS ANGELES COUNTY ENGINEER
403 LOS ANGELES COUNTY ENGINEERING BLDG.

Note: Any Additions or Changes on This Sheet Must be Made or Circled in Red Ink With Date and Name of Person Making Change.

Do not extend this side of this line.

Notes Ck'd by M. OSHITA
Map No.
Office Work
Checked
Date

Survey of CITY TERRACE AREA "L"
JN 0303.04 Tape 22L Std 64 °F
Surveyed by F.E. Brooks
Notes F.E.B. Date 2-APR-64
Indexed J. J. GALLI

F. B. 345 Pg. 157

Lot 15 | Lot 16 | Block F | Lot 17 | Lot 18

JAMES

VAN

DANT TOP PB 150

ROWAN

(80)

AVE.

M = 166.22'

℄

M = 264.27'

(80)

RONT BOT PB 157

#226 T = 72°
266.72 @ 1°-04'
= 266.30 @ " " = 264.276'
266.51 @ 1°24"
= 266.49 @ " " = 264.270'
M = 264.27'

64½ TL POIT. SOUTH 5 M.H.

15-38.39

Lot 10 | Lot 9 | Block G | Lot 8 | Lot 7

F. B. 3256 Pg. 152

CONT. BOT PG 103

PLEASE RETURN TO
LOS ANGELES COUNTY ENGINEER
403 Los Angeles County Engineering Bldg.

Note: Any Additions or Changes on This Sheet Must be Made or Circled in Red Ink With Date and Name of Person Making Change.

Do not extend this side of this line.

Lot 12

Lot 21

Lot 20

Block

Lot 19

Lot 18






















76F3095 CE # 310 3-61

PLEASE RETURN TO
LOS ANGELES COUNTY ENGINEER
403 LOS ANGELES COUNTY ENGINEERING BLDG.

Note: Any Additions or Changes on This Sheet Must be Made or Circled in Red Ink With Date and Name of Person Making Change.

Do not extend this side of this line. W.S.7, D-1

Notes Ck'd by M. OSHITA
Map No.
Office Work
Checked
Date

Survey of CITY TERRACE AREA F. B. 332-36 Pg. 153
JN 6107.04 Tape 226 Std. 84 °F
Surveyed by FE Brooks
Notes FE B
Indexed C. J. GALLI Date 7 April 64

Lot 41 Blk A CONT. BOT PG 16R

JAVSS NIB

1+26.56 Set Tie Co. Engr. Tag. R.O.T.

1+52.17 F&W = 1+00 To N.E. Set Br. N. in S.M.H. at TR. Rec. & mod dist E of E of Alley. Set 4 Tan -/- on M.H. R.im.

SYCAMORE

1) 41-59-15
4) 107-57-00
41-59-15
2) 291-55-30
41-59-15

TR. 15-38, 39

#226
161.05 T= 74° = 161.04
161.05 T= 74° = 161.04

CONT RT PG 14L

M= 52.17

18.00

11.10

25.92 =M

1+49 CL

1+82 CL

191=M

M= 42.59

15"

CONT BOT PG 14L

T LINE

M= 127.98

BLANCHARD ST.

29.18

25.45

1+34.17

1+43.77

#226 T=74°
128.54 @ 5°19' = 127.977
=128.53 @ " " = 127.977
128.62 @ 5°41' = 127.977
=128.61 @ " " = 127.977
M= 127.98

#226
26.56 T=68° = 26.54

1669
43
33

TR NIB

Fd L& Tags L.S. 2661 No. Tcc.

Lot 41 Lot 40 Lot 39 Lot 38 Lot 37

PLEASE RETURN TO
LOS ANGELES COUNTY ENGINEER
403 LOS ANGELES COUNTY ENGINEERING BLDG.

Note: Any Additions or Changes on This Sheet Must be Made or Circled in Red Ink With Date and Name of Person Making Change.

Do not extend this side of this line.

W.S. 7, D-1

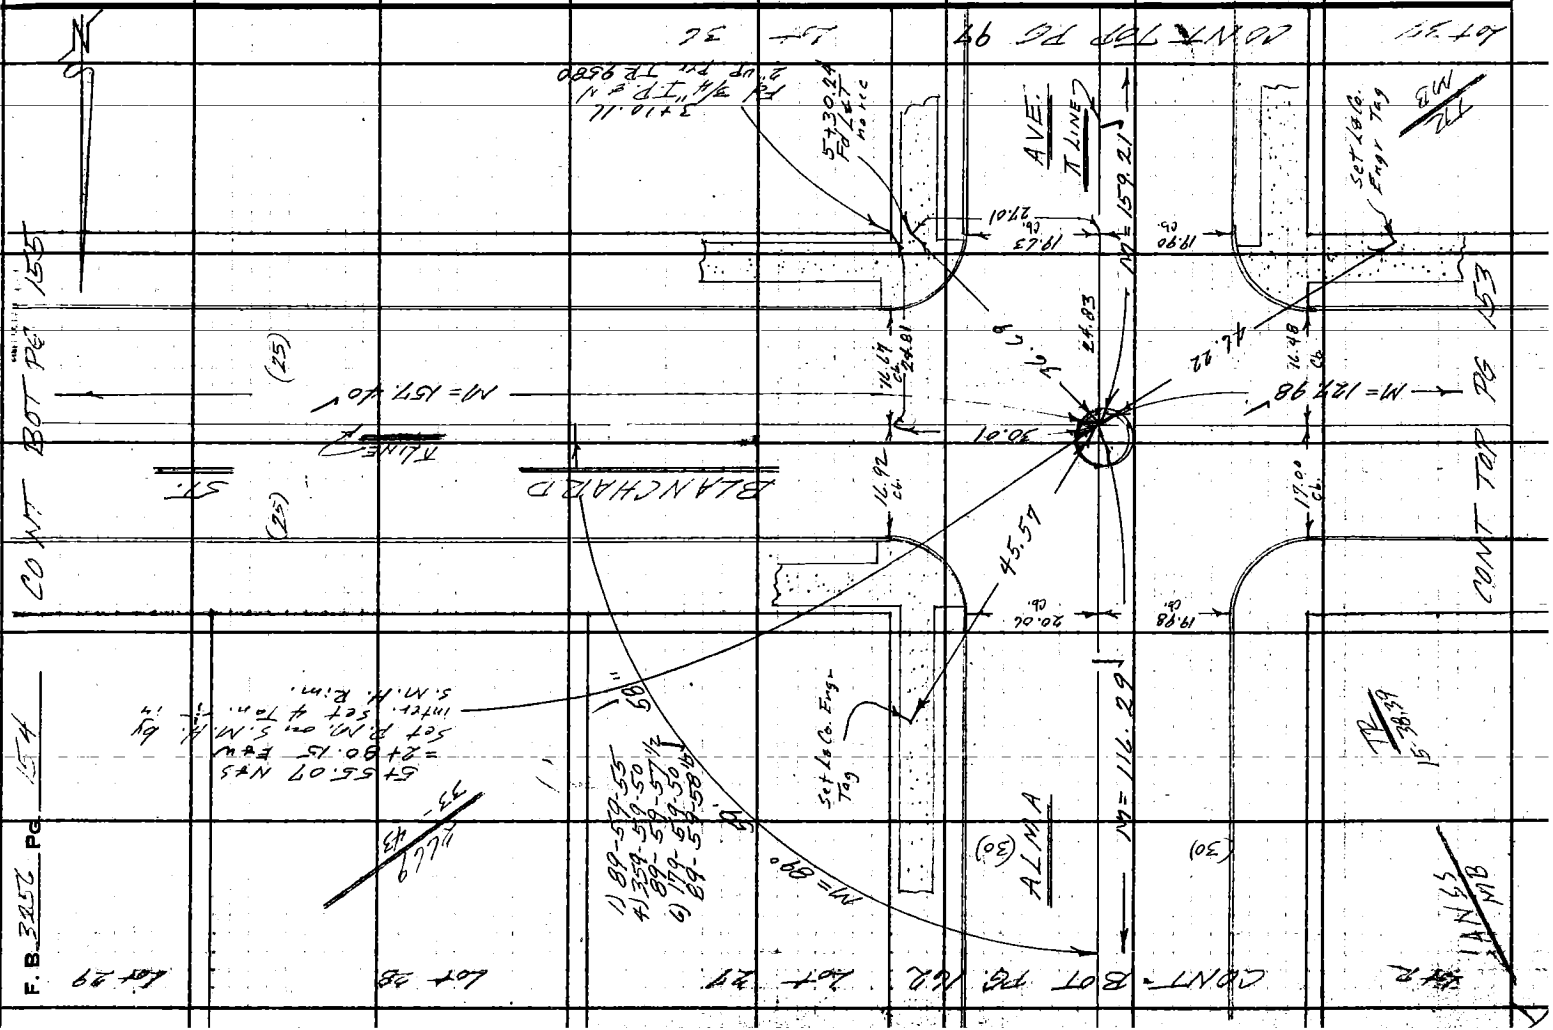
AVE.
A LINE
BLANCHARD
ALMA
CONT TAP PG 153
CONT TAP PG 97
CONT BOT PG 155
CONT BOT PG 152
M = 159.21
M = 157.40
M = 127.98
M = 116.29
M = 90°
45.59
30.01
20.00
19.90
19.73
27.01
19.28
17.00
16.92
14.69
24.81
42.22
46.03
46.48
Set L.S. Co. Engr. Tag
Set L.S. Co. Engr Tag
Set L.S. Co. Engr Tag
Set L.S. Co. Engr

76F3095 CE # 310 3-61

PLEASE RETURN TO
LOS ANGELES COUNTY ENGINEER
403 LOS ANGELES COUNTY ENGINEERING BLDG.

Note: Any Additions or Changes on This Sheet Must be Made or Circled in Red Ink With Date and Name of Person Making Change.

Do not extend this side of this line.

Notes Ck'd by M. OSHITA
Map No.
Office Work
Checked
Date

Survey of CITY TERRACE AREA
JN 2303.01 Tape 226 Std. 66 °F
Surveyed by FEB 13 marks
Notes
Indexed C. J. GATTI Date 13 April

F. B. 725 & PG. 155

Lot 29 | Lot 30 | Lot 31 | Lot 7 | Block C

TR N/B

4+30.14 Fd L&T no tcc.

4+60.12 Fd L&T U.S. 2510 stamped in lead no tcc.

4+31.36 Fd L&T no tcc.

TR 15-38, 39

29.98 | 71.24

CONT E'LY ON PG 154

BLANCHARD ST.

27.65 | 23.08 | 22.98

℄ LINE

11.41

N = 157.40 | N = 192.55

CONT FROM PG 154

#226 T=74°
157.56 @ 2°24'
= 157.56 @ " " = 157.406
157.63 @ 2°59'
= 157.62 @ " " = 157.405
N = 157.40

#226 T=74°
192.74 @ 2°24
= 192.73 @ " " = 192.560
192.81 @ 2°54'
= 192.80 @ " " = 192.553
N = 192.55

TR N/B

4+37.55 50 hd Pat. Sfc.

4467 3-43

9580 128-91, 92

Lot 36 | Lot 35 | Lot 32 | Lot 3 | Lot 2

PLEASE RETURN TO
LOS ANGELES COUNTY ENGINEER
403 LOS ANGELES COUNTY ENGINEERING BLDG.

Note: Any Additions or Changes on This Sheet Must be Made or Circled in Red Ink With Date and Name of Person Making Change.

Do not extend this side of this line.

W.S.7, D-1

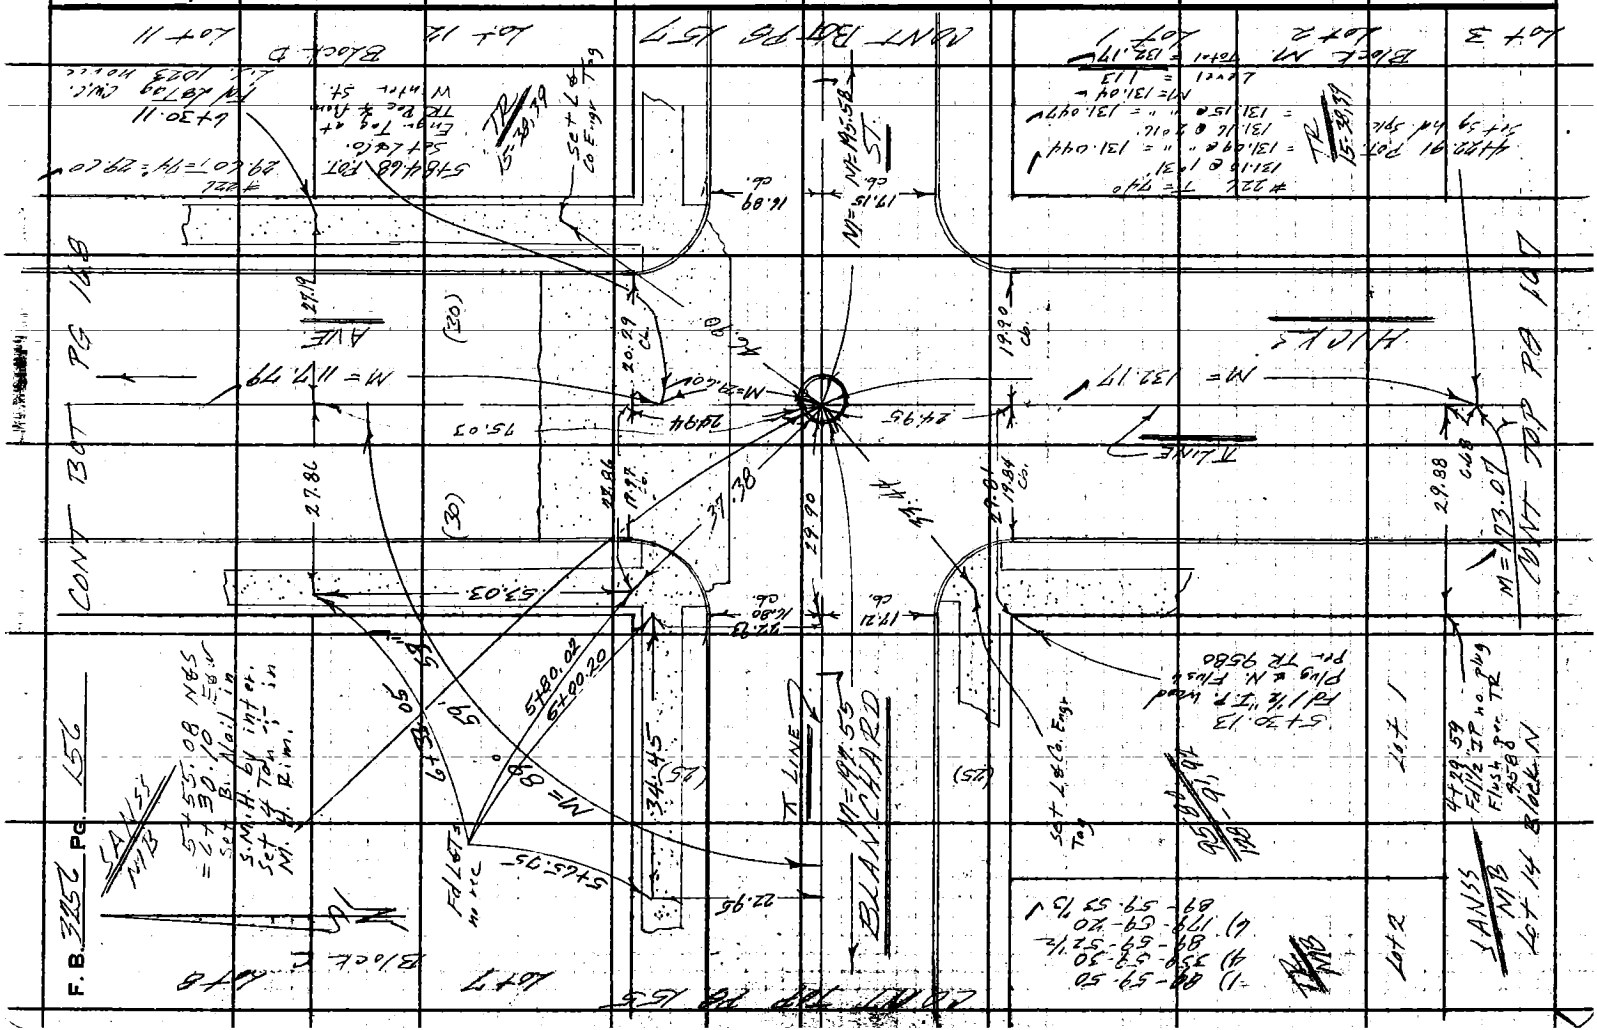
CONT BDY PG 148
CONT BDY PG 147
CONT BDY PG 147
CONT BDY PG 148
AVE
HILLS
T LINE
BLANCHARD
LANKERSHIM
Block D
Block M
Block C
Lot 12
Lot 11
Lot 10
Lot 9
Lot 8
Lot 7
Lot 3
Lot 2
Lot 1
M = 117.79
M = 132.17
M = 93.07

Notes Ck'd by M. OSHITA
Map No.
Office Work
Checked
Date

Survey of CITY TERRACE AREA
JN 0303.04 Tape 226 Std. B4 °F
Surveyed by F.E. Brooks
Notes F.E. B.-2M Kopp Date 15 Apr. 1964
Indexed C. J. GALLI

F. B. 3256 PG. 157

CONT BOT PG L58

Note: Any Additions or Changes on this Sheet Must be Made or Circled in Red Ink With Date and Name of Person Making Change.

Do not extend this side of this line.

W.S. 7, E-1

PLEASE RETURN TO
LOS ANGELES COUNTY ENGINEER
403 Los Angeles County Engineering Bldg.

76F909S CE # 310 3-61

Lot 12 Block E

St. 57.94 N45 E&W 94.80 to Spk W. Set Ø in conc. dn. 2" Fd. Nothing dn. 2"

ST. (25) (25) ℄ LINE

N=69.0

Set L&T Co. Engr Tag

16.75 cb. 17.18 cb.

N=200.74

Lot 1 Block E

1) 89-54-50
2) 359-54-20
3) 89-57-45
4) 179-57-45
5) 89-57-50 E

Lot 1

CONT BOT PG 1116

N=203.14

20.27 cb.

0.29

0.10

5-50

9480.41

9479.82

0.30

20.13 cb.

Fd. Nail in Pvt. dn. 4" No Rec. Removed

N=263.23

(30)

℄ LINE

DITMAN

19.55 cb.

0.02

31.09

19.47 cb.

(30)

AVE.

CONT TOP PG

46.19

16.79 cb.

17.19 cb.

Set L&T Co. Engr. Tag

#226 T=96° 179.96

Set L&T Co. Engr. Tag

#226 80.46 T=96° = 80.49

B+99.65 P.O.T. Set 3/4" d. Spk of TR Rec & from Alley To W.

Lot 13 Block D

Lot 14

Lot 15

Lot 16

B+25.68 P.O.T. Set -/- in Rim of S.M.H.

N=77.97

BLANCHARD

20.11

24.60

Lot 12 Block E

Fd. 1/2" Rd 2x2 Flush N. no rec.

N=195.58

#226 T=76° 195.66 @ 1° 38' = 195.650 " " = 195.569 195.72 @ 2° 01' = 195.71 @ " " = 195.588 N=195.59

Block N

Lot 1

CONT RT. PG L56

PLEASE RETURN TO
LOS ANGELES COUNTY ENGINEER
403 LOS ANGELES COUNTY ENGINEERING BLDG.

Note: Any Additions or Changes on This Sheet Must be Made or Circled in Red Ink With Date and Name of Person Making Change.

Do not extend this side of this line.

W.S.7, E-1

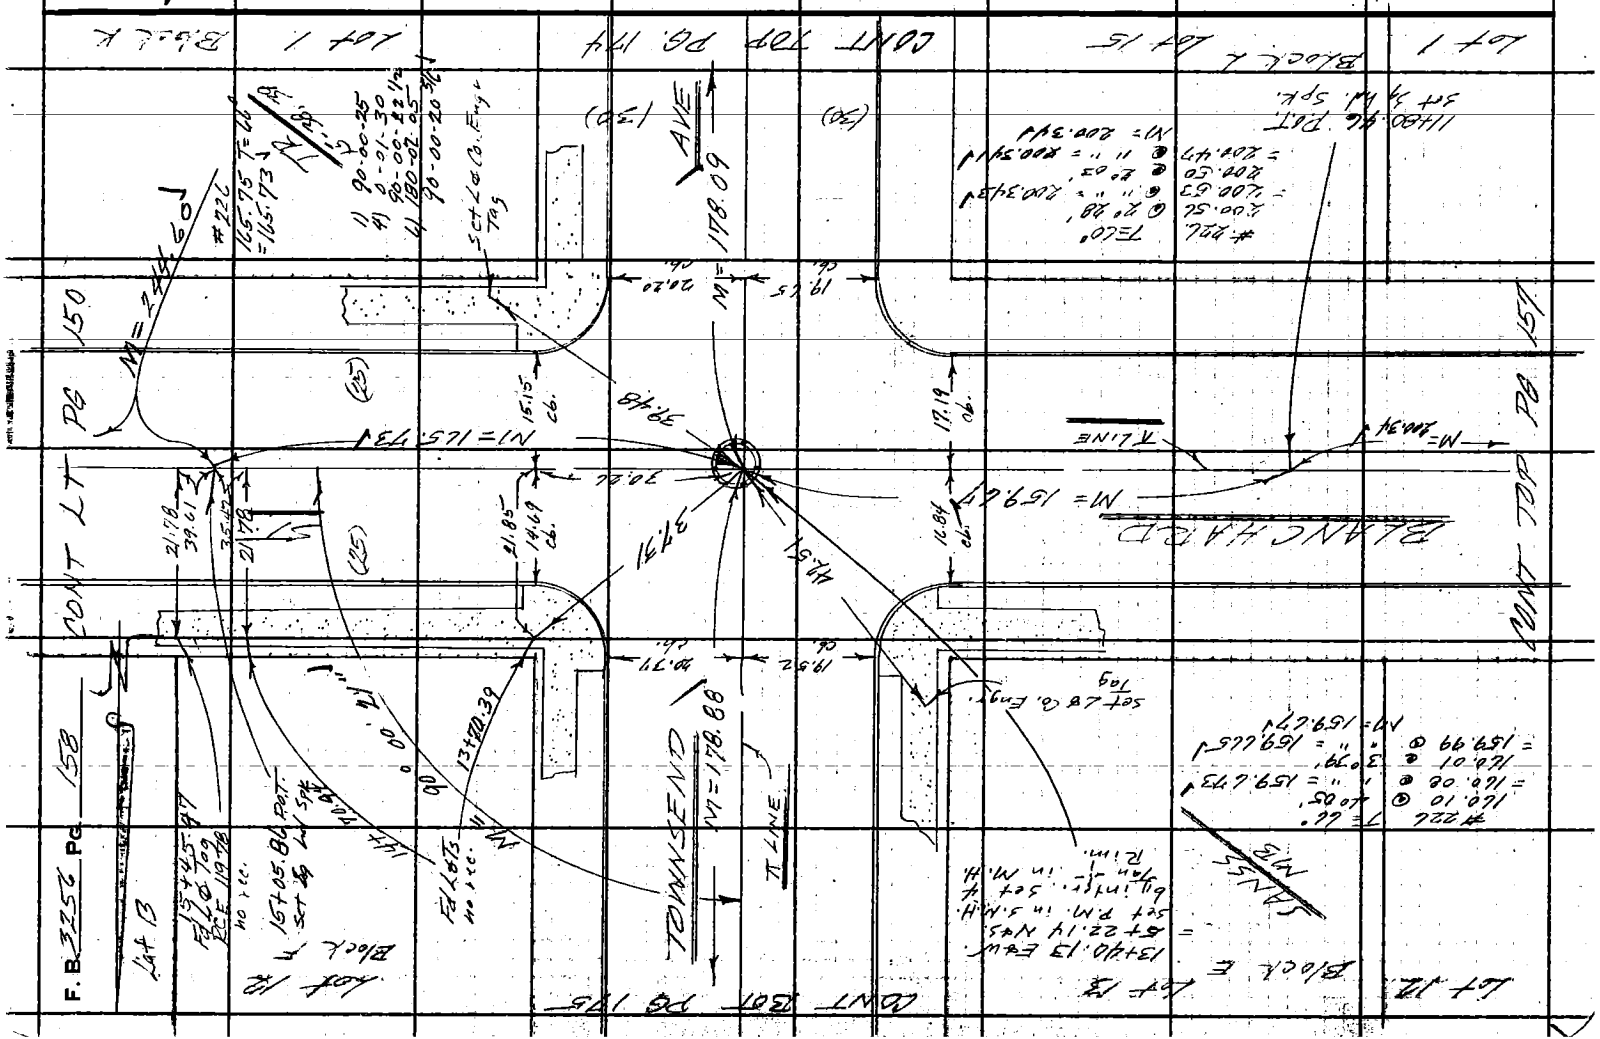

Notes Ck'd by M. OSHITA
Map No.
Office Work
Checked
Date

Survey of CITY TERRACE AREA
JN 0303.04 Tape 226 Std 84 °F
Surveyed by F.E. Brooks
Notes FEB - KM KOT Date 26 April 66
Indexed C. J. GALLI

F. B. 3256 Pg. 159

Note: Any Additions or Changes on this Sheet Must be Made or Circled in Red Ink With Date and Name of Person Making Change.

Do not extend this side of this line.

PLEASE RETURN TO
LOS ANGELES COUNTY ENGINEER
403 Los Angeles County Engineering Bldg.

W.S. 7, E-1

Lot 13 Block H.

LANES NO.

Set L&C.Engr. Tag Prog. by double from W.

Fd L.S. 3134 Flush no rec Fd nothing 30 Ne

Fd nail & tag 0.49.30 Fd LOT no rec

EASTMAN AVE

M=284.09

π LINE

(30)

0.30

0.73

5.96

20.32 cc

23.18

50.70

25.31

28.13

9.80 cc

9.88

29.70

26.68

16.79 cc

22.30

17.34 no.

100.00

#226 123.61 T=70° = 170788 P.O.T. Set L&C.Engr. Tag

1700 To N = 214.10.96 E on Lot Line Rec. dist. to R/W of Eastman Ave

M=119.34

M=123.61

M=117.05

19+91.12 P.O.T. Set Sq. hd. spk. by double fr. the W.

(25) (25)

π LINE

BLANCHARD

1) 90-00-00
4) 360-00-00
90-00-00
6) 180-00-00
90-00-00

90° = 117.05

T=

#226 123.61 T=70° = 170788 P.O.T. Set L&C.Engr. Tag

#226 117.06

Lot 13

Block G

Lot 12

Lot 1

Lot 2

Block

Lot 21

Lot 1

Lot 2

Block

Lot 1





















PLEASE RETURN TO
LOS ANGELES COUNTY ENGINEER
403 LOS ANGELES COUNTY ENGINEERING BLDG.

Note: Any Additions or Changes on This Sheet Must be Made or Circled in Red Ink With Date and Name of Person Making Change.

Do not extend this side of this line.

F.B. 3256 Pg. 160

Pg 161

CONT BOT

CONT LT Pg 159

Notes Ck'd by M. OSHITA	Survey of CITY TERRACE AREA 2
Map No.	JN 0303.04 Tape 226 Std 84 °F
Office Work	Surveyed by FE Brooks
Checked	Notes FE B.-K.M.K.S.P. Date 26 Apr. 166
Date	Indexed C. J. GALLI

F. B. 3256 Pg. 161

CONT BOT PG 126

Note: Any Additions or Changes on this Sheet Must be Made or Circled in Red Ink With Date and Name of Person Making Change.

PLEASE RETURN TO
LOS ANGELES COUNTY ENGINEER
403 Los Angeles County Engineering Bldg.
Do not extend this side of this line.

76F3095 CE # 310 3-61

CONT TOP PG 160

X

PLEASE RETURN TO
LOS ANGELES COUNTY ENGINEER
403 LOS ANGELES COUNTY ENGINEERING BLDG.

Note: Any Additions or Changes on This Sheet Must be Made or Circled in Red Ink With Date and Name of Person Making Change.

Do not extend this side of this line.

W.S.7, 0-1

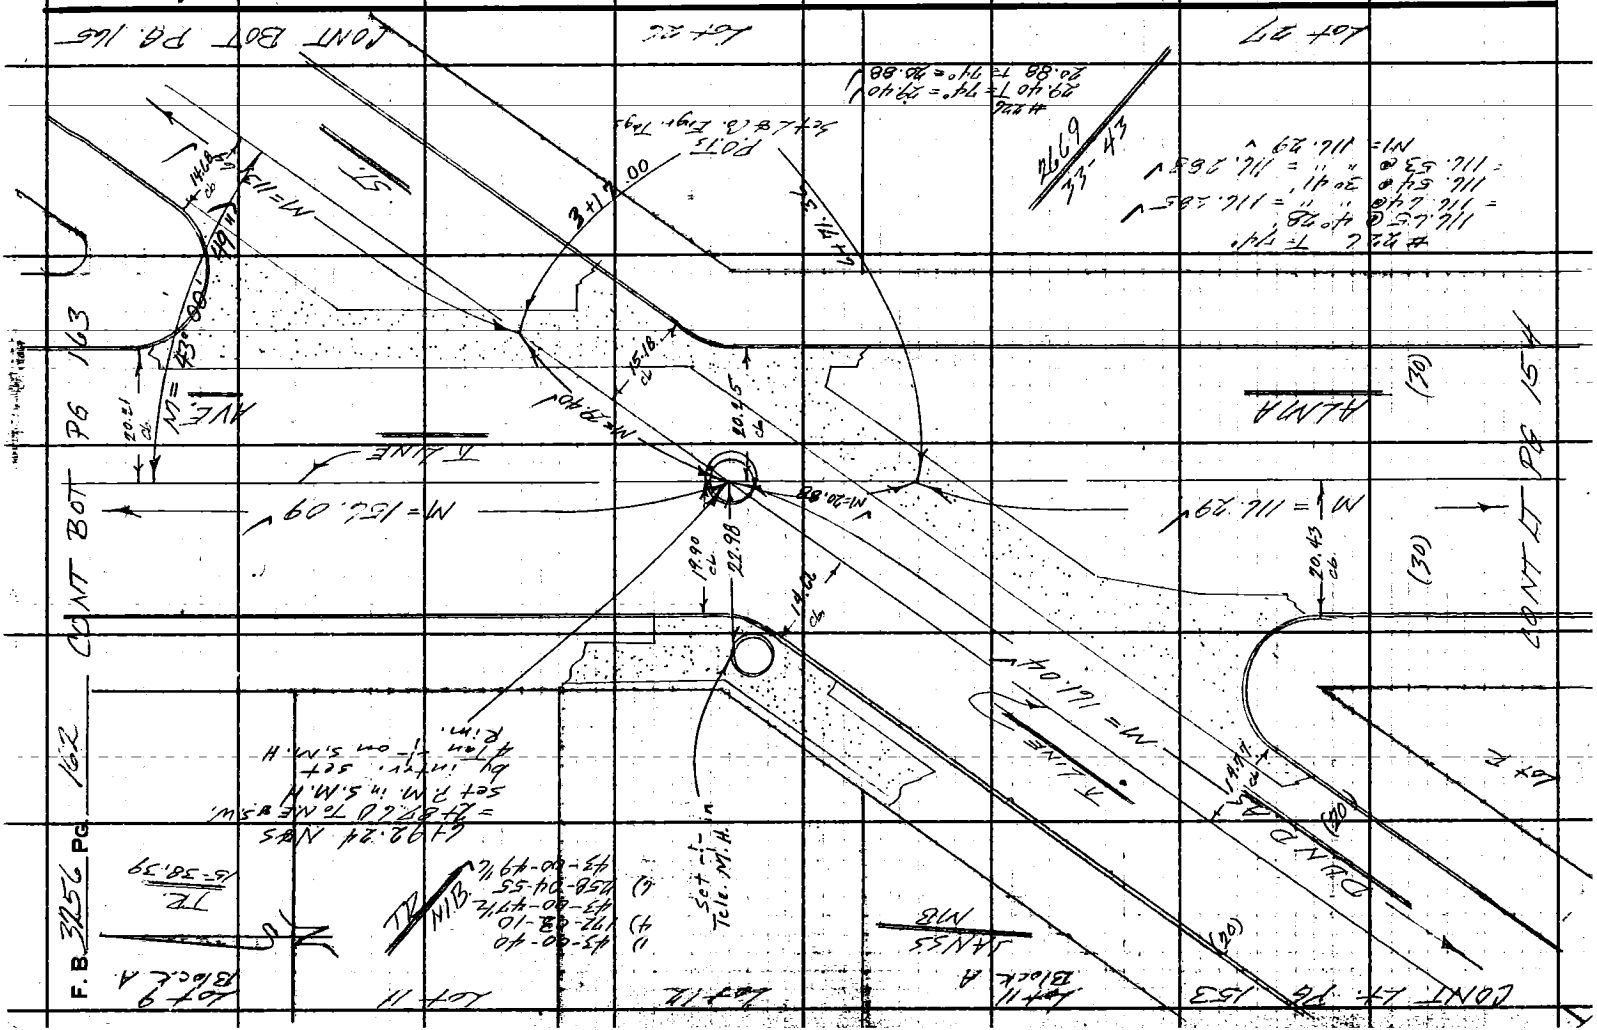

Notes Ck'd by M. OSHITA
Map No.
Office Work
Checked
Date

Survey of CITY TERRACE AREA 2
JN 0303.01 Tape 220 Std 64 °F
Surveyed by F E Brooks
Notes FE 13 Date 12 April 10
Indexed C. J. GALLI

F. B. 3256 Pg. 163

CONT BOTPG 164

Note: Any Additions or Changes on this Sheet Must be Made or Circled in Red Ink With Date and Name of Person Making Change.

PLEASE RETURN TO
LOS ANGELES COUNTY ENGINEER
403 Los Angeles County Engineering Bldg.
Do not extend this side of this line.

76F3095 CE # 310 3-61

CONT TOP PG 162

F. B. 3256 PG. 164

CONT BOT PG 19

PLEASE RETURN TO
LOS ANGELES COUNTY ENGINEER
403 Los Angeles County Engineering Bldg.

Do not extend this side of this line.

Note: Any Additions or Changes on This Sheet Must be Made or Circled in Red Ink With Date and Name of Person Making Change.

LOT 1





















Notes Ck'd by M. OSHITA
Map No.
Office Work
Checked
Date

Survey of CITY TERRACE AREA 2
JN 0303.04 Tape 226 Std 84 °F
Surveyed by F.E. Brooks
Notes F.E.B. Date 14 Apr. 1946
Indexed C. I. GALLI

F. B. 3256 Pg. 165

CONT BOT PG 166

Note: Any Additions or Changes on this Sheet Must be Made or Circled in Red Ink With Date and Name of Person Making Change.

Do not extend this side of this line.

PLEASE RETURN TO
LOS ANGELES COUNTY ENGINEER
403 Los Angeles County Engineering Bldg.

Lot 18
Lot 14
Lot 13
Lot 21
Lot 22
Lot 23
Lot 24
Lot 25
Lot 26

ST.

M 268.91

T LINE

2669
#3
31

(20) (20)

4+36.51
Fd 3/4" I.P.
no plug
Flush
no N
no tcc.

20.06

4+30.64 POT
Set Sq hd spk

5.87

N 113.64

DUNDAS

#226
113.63 T = 94.10 + 113.64

CONT RT PG 162

76F309S CE # 310 3-61

PLEASE RETURN TO
LOS ANGELES COUNTY ENGINEER
403 LOS ANGELES COUNTY ENGINEERING BLDG.

Note: Any Additions or Changes on This Sheet Must be Made or Circled in Red Ink With Date and Name of Person Making Change.

Do not extend this side of this line.

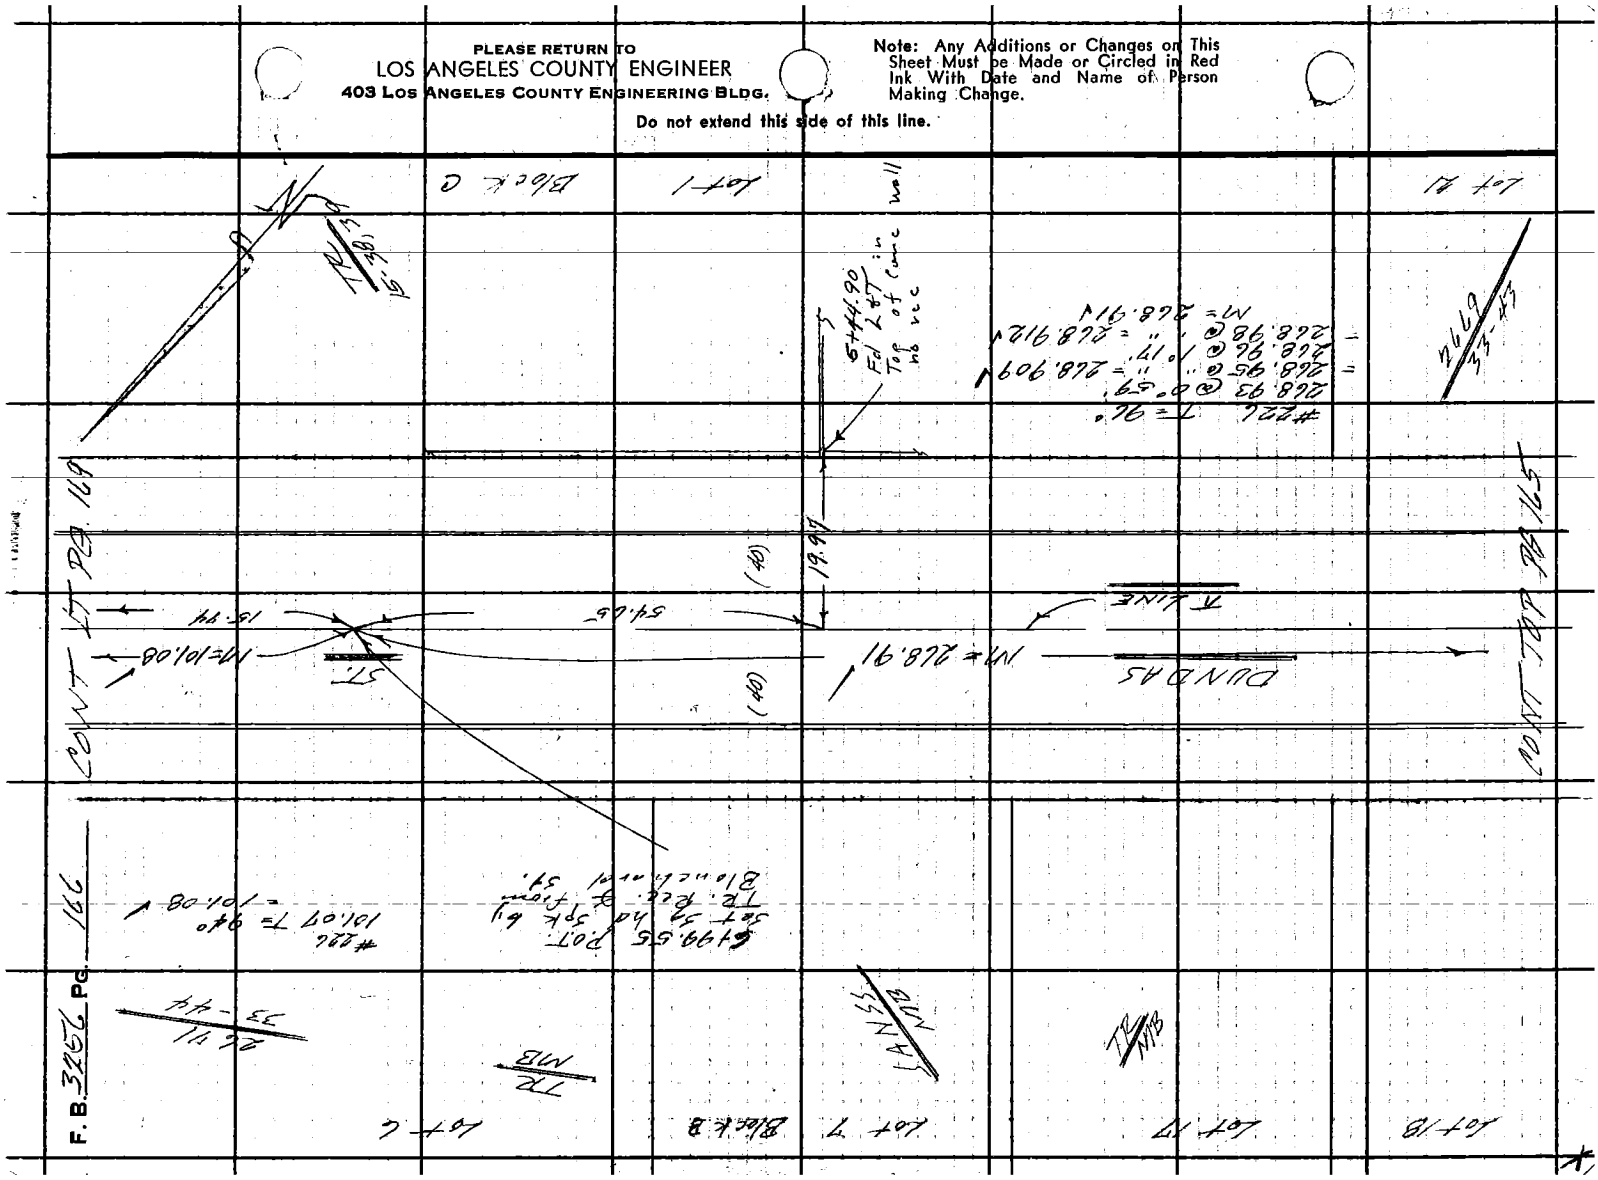

Notes Ck'd by M. OSHITA
Map No.
Office Work
Checked
Date

Survey of CITY TERRACE AR
JN 0303.04 Tape 226 Std 64 °F
Surveyed by F.E. Brooks.
Notes F.E.B. Date 13 Apr. 164
Indexed C. J. GALL

F. B. 3256 Pg. 167

CONT BOT PG 156

Note: Any Additions or Changes on This Sheet Must be Made or Circled in Red Ink With Date and Name of Person Making Change.

PLEASE RETURN TO
LOS ANGELES COUNTY ENGINEER
403 Los Angeles County Engineering Bldg.
Do not extend this side of this line.

76F309S CE # 310 3-61

Lot 14

Lot 13

Lot 12 Block N

JAN 33 MB

Lot 11

ST.

(30)

N1 = 177.04

℄ LINE

(30)

T= 48° 00' 00"
R= 130.32
L= 130.32
N1 = 130.32

#12 130.41 130.50 130.492

T= 90° 00' 00"
R= 130.32
L= 177.048
N1 = 130.32

#12 177.45 177.41 177.33 177.30

2749.84 P.O.T. Set Sq. hd. spk.

2742.49 Fd LBT L.S. 2999 stamped In lead

Fd LB Tags L.S. 2748 BONE holes

1471.82

26.79

23.99

29.02

56.84

26.87

N1 = 139.33

26.68

5 Yds

CONT LT. PG 140

Lot 4

Lot 5 Block 11

PLEASE RETURN TO
LOS ANGELES COUNTY ENGINEER
403 LOS ANGELES COUNTY ENGINEERING BLDG.

Note: Any Additions or Changes on This Sheet Must be Made or Circled in Red Ink With Date and Name of Person Making Change.

Do not extend this side of this line.

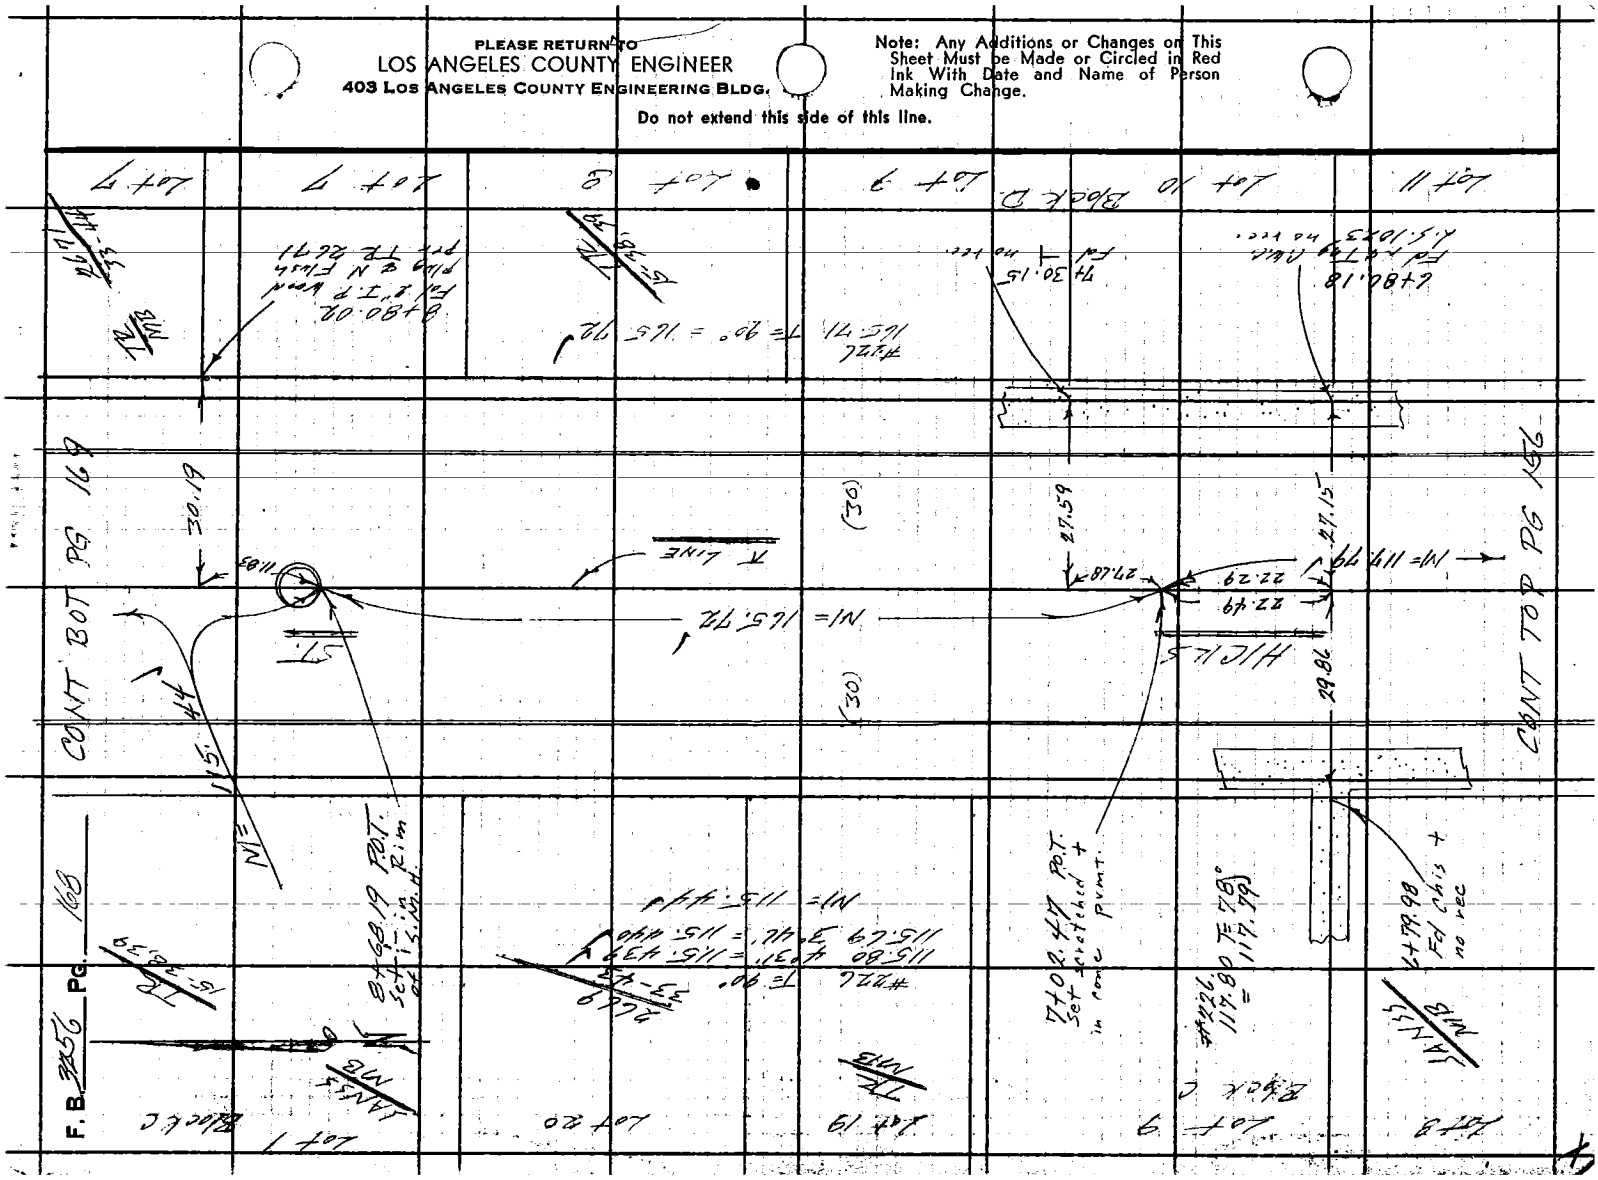

76F309S S&E #247 11-59

PLEASE RETURN TO
LOS ANGELES COUNTY ENGINEER
700 LOS ANGELES COUNTY ENGINEERING BLDG.

Do not extend this side of this line.

Note: Any Additions or Changes on This Sheet Must be Made or Circled in Red Ink With Date and Name of Person Making Change.

W.S.7, D-1

Notes Ck'd by M. OSHITA
Map No.
Office Work
Checked
Date

Survey of CITY TERRACE AREA
JN 2303 of Tape 226 Std. 84 °F
Surveyed by F.E. Brooks
Notes
Indexed Date April 64
C.J. GATT

F. B. 3254 PG. 169

Lot 1, Block C

CONT TOP PG 168

Lot 6

Lot 5

DUN RAS

M = 101.08 (2D)

Set L&C Engr. Tag

26.71
43-44

1) 43-00-40
4) 172-43-00
43-00-45
6) 258-04-40
43-00-46

JANSS

M = 115.49
Fd 1/2" I.P. No tag

Set Spike and PBT

Fd PK. in top of brick wall no tie

16.74

26.81

(2D)

N 43° 00' E = M = 99.00

℄ LINE

Set L&C Engr. Tag

HICKS

M = 115.44

(3D)

2.43

19.82 C.M. 2.85

℄ LINE

M = 83.73

M = 117.66

12.70

19.82 C.M.

AVE

CONT TOP PG 168

CONT BOT PG 170

18.71

10.61

10+67.36 N 85 E
= 8+00.63 NE 85 E
Set P.M. in S.M.H.
by interp. set 4 tan
-1- in Rim of M.H.

#246
83.92 T-41° = 83.73

Set L&C Engr. Tag Pinhd.

Set L&C Engr. Tag

TR 15.98, 79

Lot 7 | Lot 8 | Lot 9 | Lot 10 | Lot 4 | Block D | Lot 3

PLEASE RETURN TO
LOS ANGELES COUNTY ENGINEER
700 LOS ANGELES COUNTY ENGINEERING BLDG.

Note: Any Additions or Changes on This Sheet Must be Made or Circled in Red Ink With Date and Name of Person Making Change.

Do not extend this side of this line.

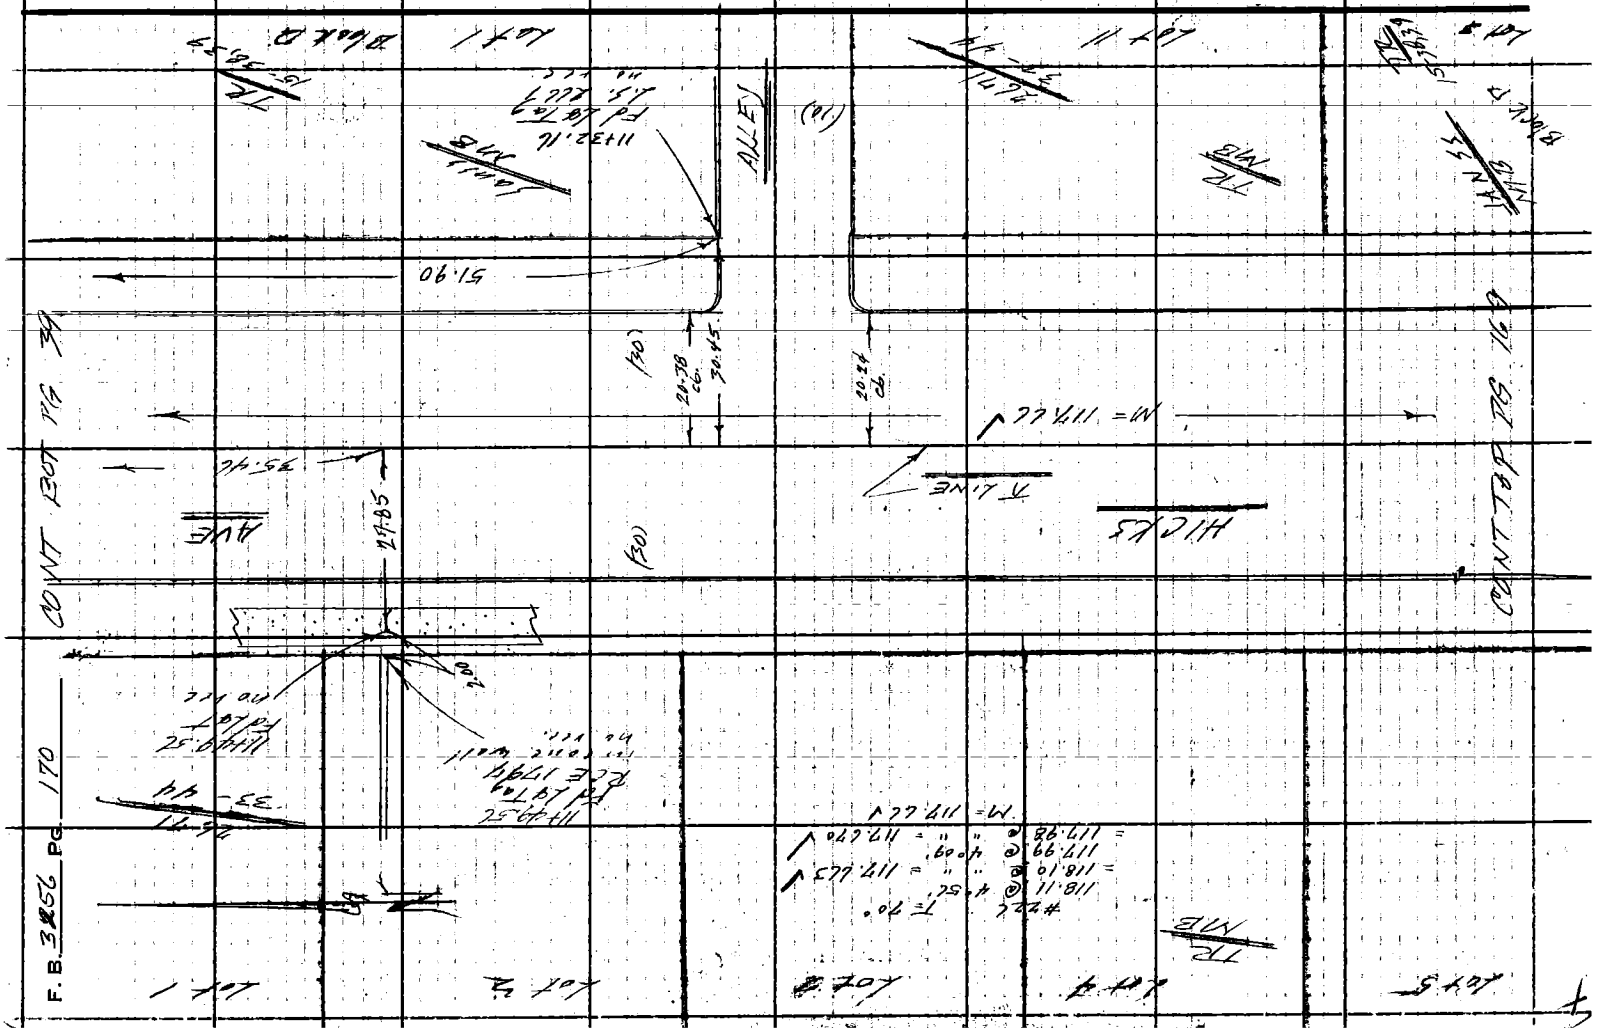

76F3095 S&E #247 11-58

PLEASE RETURN TO
LOS ANGELES COUNTY ENGINEER
700 LOS ANGELES COUNTY ENGINEERING BLDG.

Note: Any Additions or Changes on This Sheet Must be Made or Circled in Red Ink With Date and Name of Person Making Change.

Do not extend this side of this line.

Notes Ck'd by M. OSHITA
Map No.
Office Work
Checked
Date

Survey of CITY TERRACE AREA
JN 2395 of 2000 Std. Bk. of F. B. 335 & PG. 171
Surveyed by F E B-K.M.K's Date 15 April 44
Notes
Indexed C. J. CALLI

Lot 11 | Lot 12 | Lot 13 | Lot 14 | Lot 15 | Lot 16

Block 111

Ft. 111.03 Found Tag L.S. 2940 N. 11° E.C.

Ft. 111.03 Found Tag N. 11° E.C.

JAMES N. 19

0.30 E. 22.11

EDITH MAN

MONTEREY PL 141

CONT. RT PG 157

AVE.

(30)

T LINE

(30)

N1 = 169.07 ✓

N1 = 263.23 ✓

#226 169.05 T = 100° = 169.07 ✓

Sect. 14

* 226 T = 100°
235.54 @ 3° 30' = 235.08 ✓
235.64 @ " 30' = 235.09 ✓
235.64 @ " = 235.09 ✓
N1 = 235.09
Level = 28.14
Total = 263.23 ✓

TR 15-38.59

Block 2

Lot 6 | Lot 5 | Lot 4 | Lot 3 | Lot 2 | Lot 1

PLEASE RETURN TO
LOS ANGELES COUNTY ENGINEER
700 LOS ANGELES COUNTY ENGINEERING BLDG.

Note: Any Additions or Changes on This Sheet Must be Made or Circled in Red Ink With Date and Name of Person Making Change.

Do not extend this side of this line.

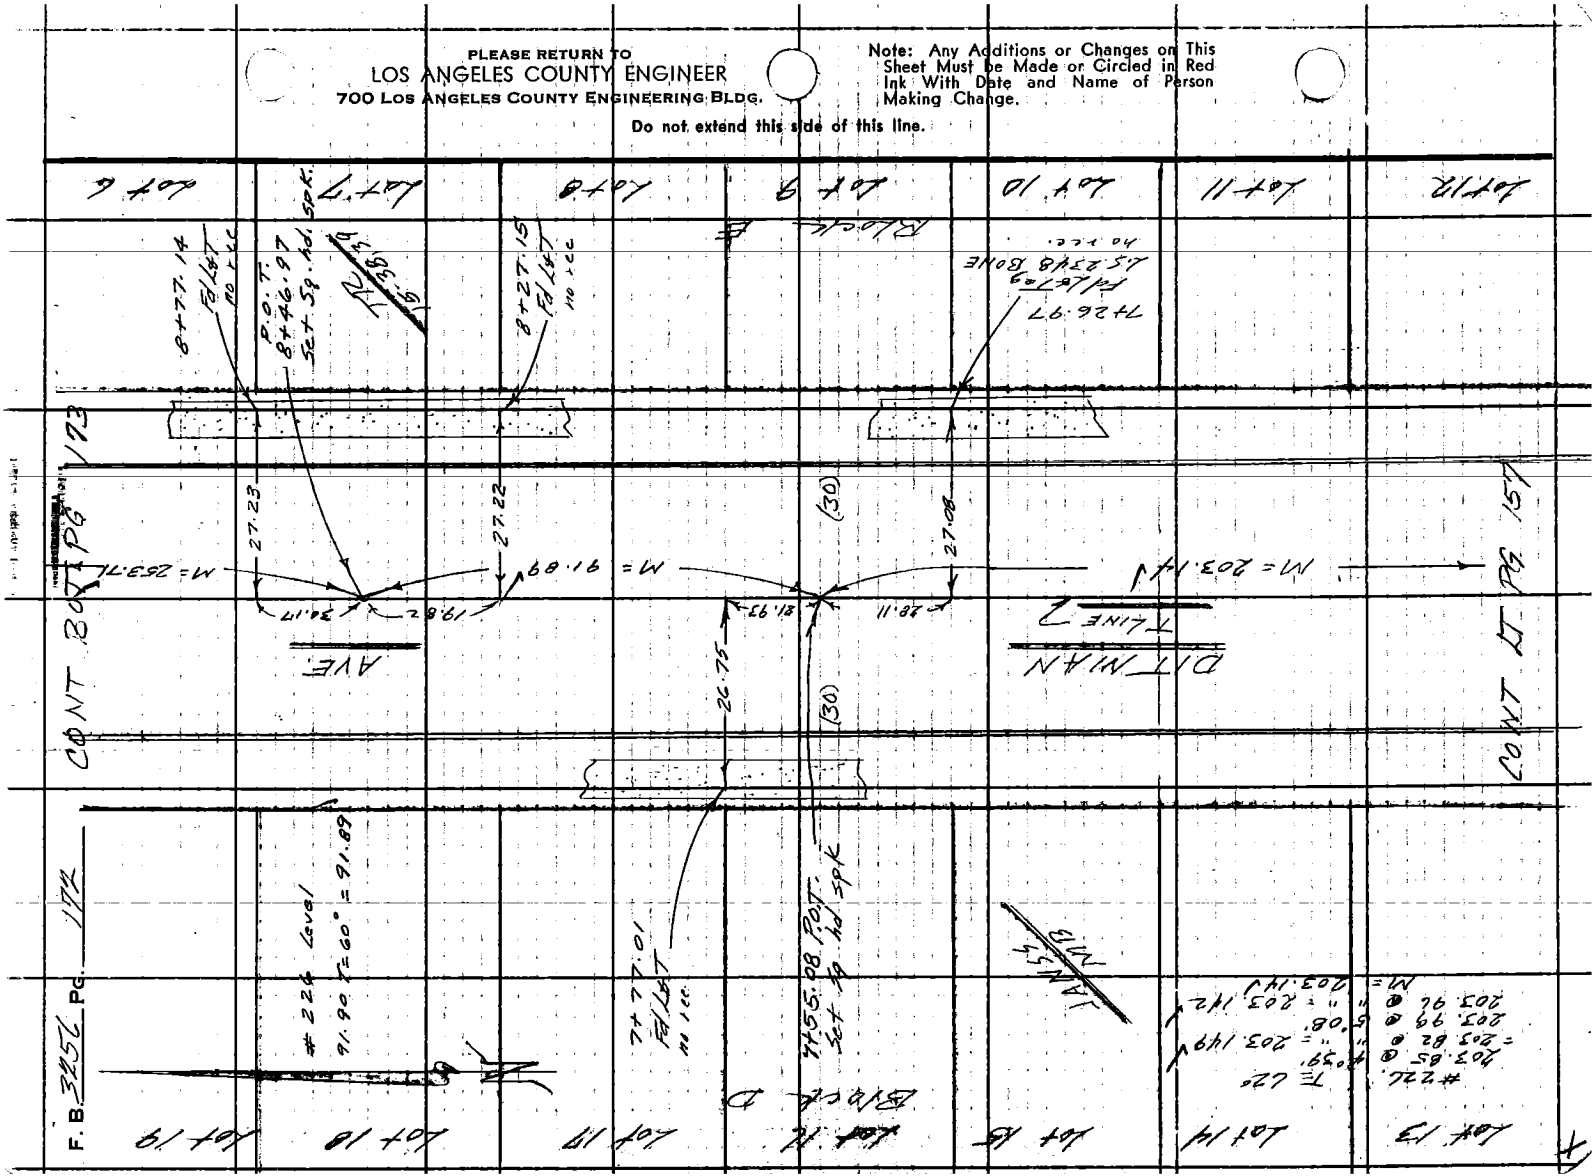

F. B. 3252 Pg. 177

Notes Ck'd by M. OSHITA
Map No.
Office Work
Checked
Date

Survey of CITY TERRACE AREA
JN 0305.04 Tape 200' Std 84 °F
Surveyed by FE Brooks
Notes FE B-LM.K.S. Date 18 Apr. 1966
Indexed C. T. GALLI

F. B. 3256 PG. 173

Note: Any Additions or Changes on This Sheet Must be Made or Circled in Red Ink With Date and Name of Person Making Change.

Do not extend this side of this line.

PLEASE RETURN TO
LOS ANGELES COUNTY ENGINEER
700 Los Angeles County Engineering Bldg.

76F3095 S&E #241 11-58

CONT ABOVE TO TR

Lot 14 Lot 15 Lot 16 Lot 17 Lot 18 Lot 19 Lot 20 Block D

Lot 21

Lot 22 Lot 23 Lot 24 Lot 25 Lot 26 Lot 27 Lot 28 Lot 29 Lot 30 Block E

AVE

ALLEY

DITMAN

TR MB

JANSS MTB

POT SPK.

TR MB

TR 15-38,39

(30) (30)

N = 252.84

N = 252.71

N = 253.71

#226
PT. 35 TE 62° = PT. 34

#226
1) 255.62 (T=60°)
= 255.58 @ 0°56'
= 253.711
2) 255.47 (T=60°)
= 255.43 @ 0°39'
= 253.710

TR 15-38,39

CONT TOP PG 172

PLEASE RETURN TO
LOS ANGELES COUNTY ENGINEER
700 LOS ANGELES COUNTY ENGINEERING BLDG.

Note: Any Additions or Changes on This Sheet Must Be Made or Circled in Red Ink With Date and Name of Person Making Change.

Do not extend this side of this line.

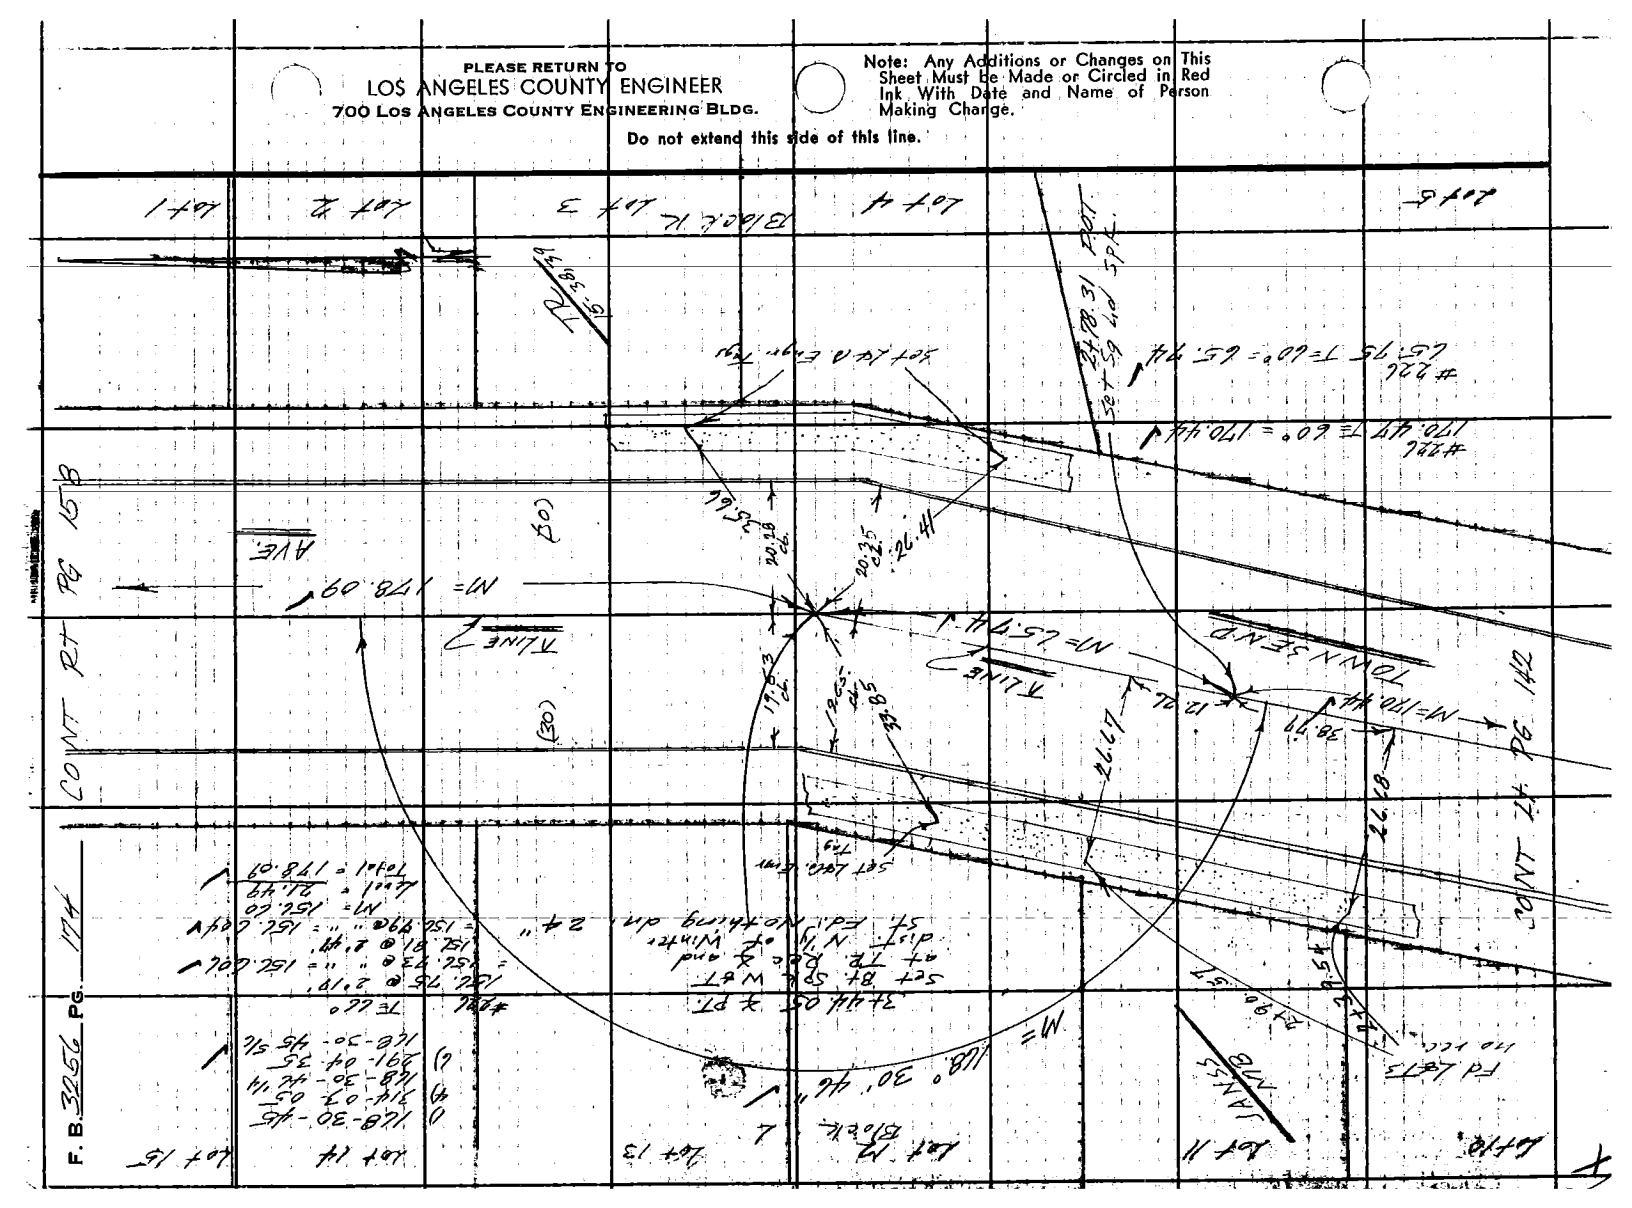
F.B. 3256 PG. 174
CONT RT
PG 15B
CONT LT
PG 14B
Lot 1
Lot 2
Lot 3
Block K
Lot 4
Lot 5
Lot 10
Lot 11
Lot 12
Lot 13
Lot 14
Lot 15
Lot M
Block L
TOWN SEND
JANES
AVE
N1= 178.09
Set Loc. Cmt
Set Loc. Cmt
Set Loc. Cmt

76F3098 S&E #247 11-58

PLEASE RETURN TO
LOS ANGELES COUNTY ENGINEER
700 LOS ANGELES COUNTY ENGINEERING BLDG.

Note: Any Additions or Changes on This Sheet Must be Made or Circled in Red Ink With Date and Name of Person Making Change.

Do not extend this side of this line.

Notes Ck'd by M. OSHITA
Map No.
Office Work
Checked
Date

Survey of CITY TERRACE AREA
JN 0303. Oly tape ZZC Std 84 °F
Surveyed by F.E.B. works
Notes F.E.B. Date MAR. 1966
Indexed C. J. GALLI

F. B. 3353 PG. 175

Lot 13 | Lot 14 | Lot 15 | Lot 16 | Lot 17

Block E

Fd L&T tag 2CE 11978

110 r.c.c.

47.76.47

47.46.44

JOINT LINE PG 158

TOWNSEND

(30)

AVE.

CONT BOT PG 176

T LINE

26.52 4.35 45.62 26.59

M = 178.88

M = 125.32

(30)

#226 T = 68°
160.53 @ 5° 30' = 159.971
160.51 @ " " = 159.971
160.41 @ 5° 48' = 159.96
160.59 @ " " = 159.97
M = 159.97
Level = 19.11
Total = 178.88

17401.02 SET 5/8 RBT SPK

#226 T = 66°
125.41 @ 2° 03' = 125.319
125.40 @ " " = 125.319
125.46 @ 2° 37' = 125.319
125.45 @ " " = 125.319
M = 125.32

R 15.38.39

Lot 12 | Lot 11 | Block F | Lot 10 | Lot 9 | Lot 8

PLEASE RETURN TO
LOS ANGELES COUNTY ENGINEER
700 LOS ANGELES COUNTY ENGINEERING BLDG.

Do not extend this side of this line.

Note: Any Additions or Changes on This Sheet Must be Made or Circled in Red Ink With Date and Name of Person Making Change.

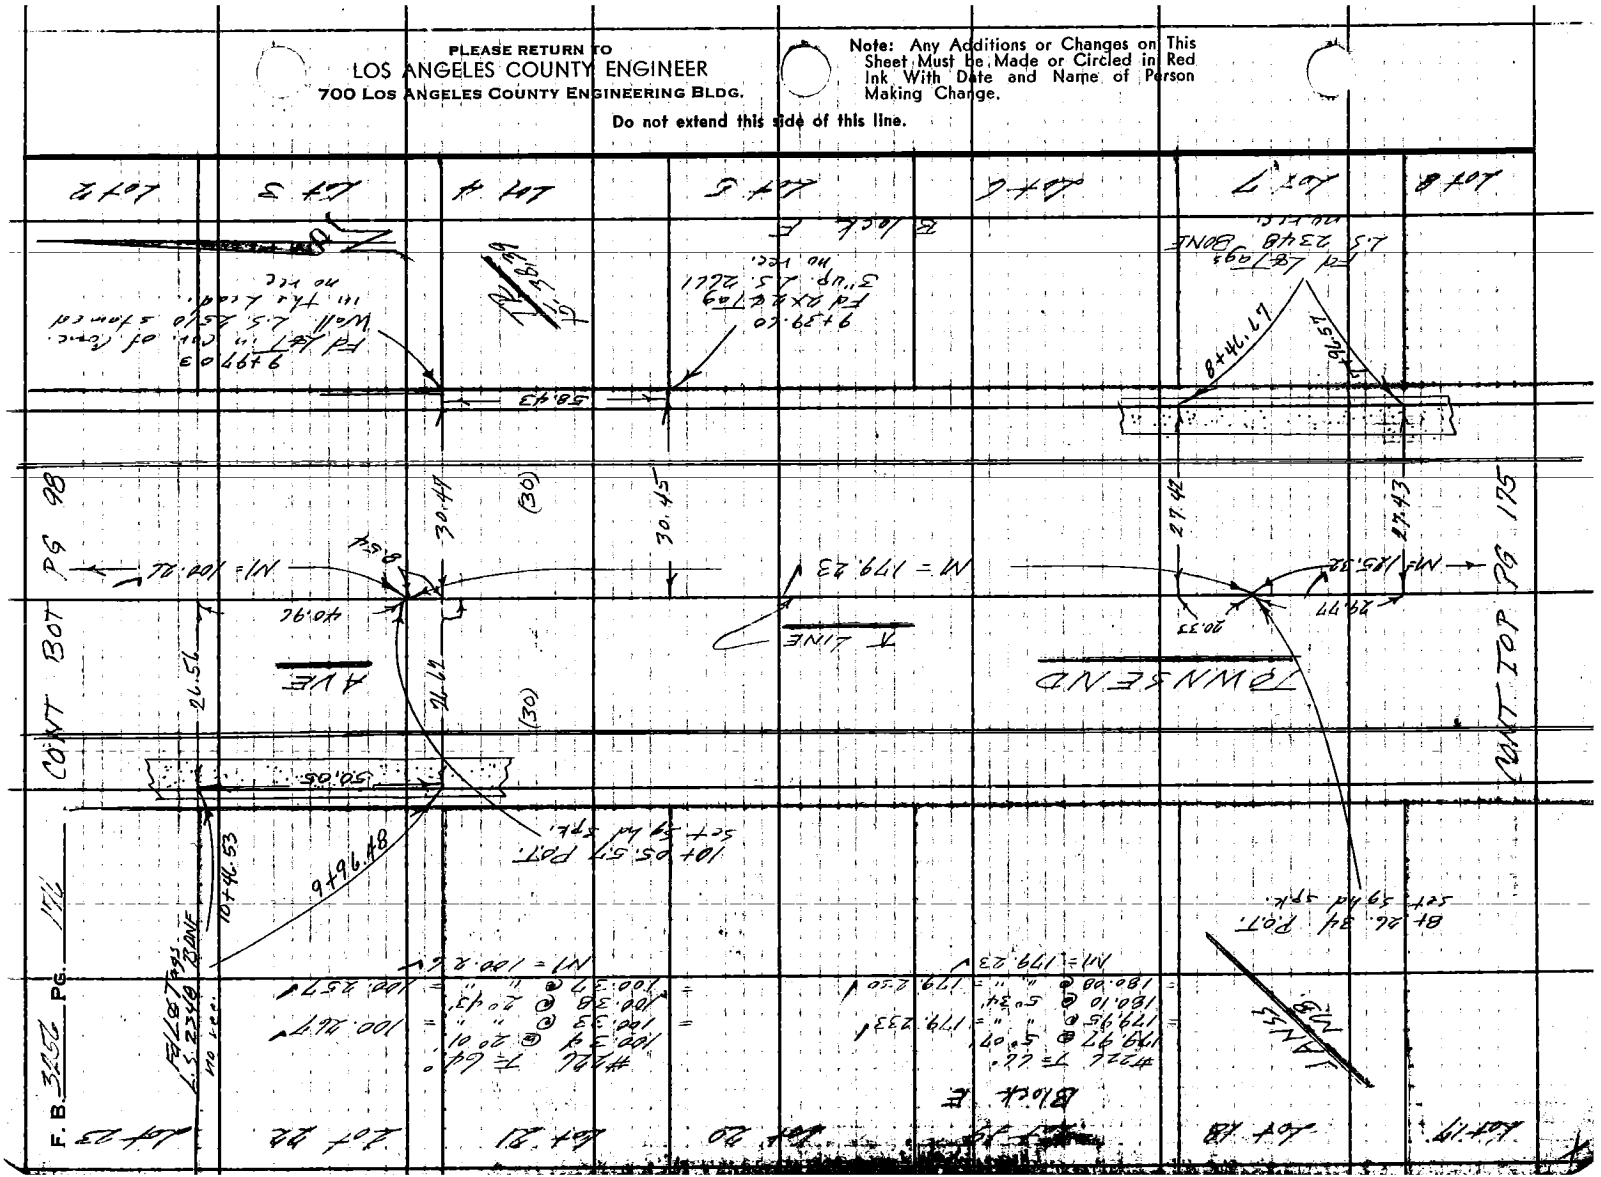
F. B. 3450 PG. 174
Lot 23
Lot 22
Lot 21
Lot 20
Block E
Lot 19
Lot 18
Lot 17
Lot 8
Lot 7
Lot 6
Lot 5
Lot 4
Lot 3
Lot 2
Lot 1
TOWNSEND
AVE
CONT BOT PG 98
CONT TOP PG 175
N1 = 179.23
N1 = 100.24
N1 = 185.32
30.49
30.45
(30)
(30)
58.43
58.06
95.72
40.92
85.54
27.42
29.77
20.33
17.43
17.96
8+96.48
10+48.53
10+05.57 P.O.T.
Sta 9+ Ahd Spk.
8+26.34 P.O.T.
Sta 9+ Ahd Spk.
9+29.60
Fd 0"x4"x18" Tag
3" up L.S. 2261
No Rec.
8+74.17
Fd LS/PPS
L.S. 2348
BONE
Fd LS/PPS
L.S. 2348
BONE

76F309S S&E #247 11-58

PLEASE RETURN TO
LOS ANGELES COUNTY ENGINEER
700 LOS ANGELES COUNTY ENGINEERING BLDG.

Note: Any Additions or Changes on This Sheet Must be Made or Circled in Red Ink With Date and Name of Person Making Change.

Do not extend this side of this line.

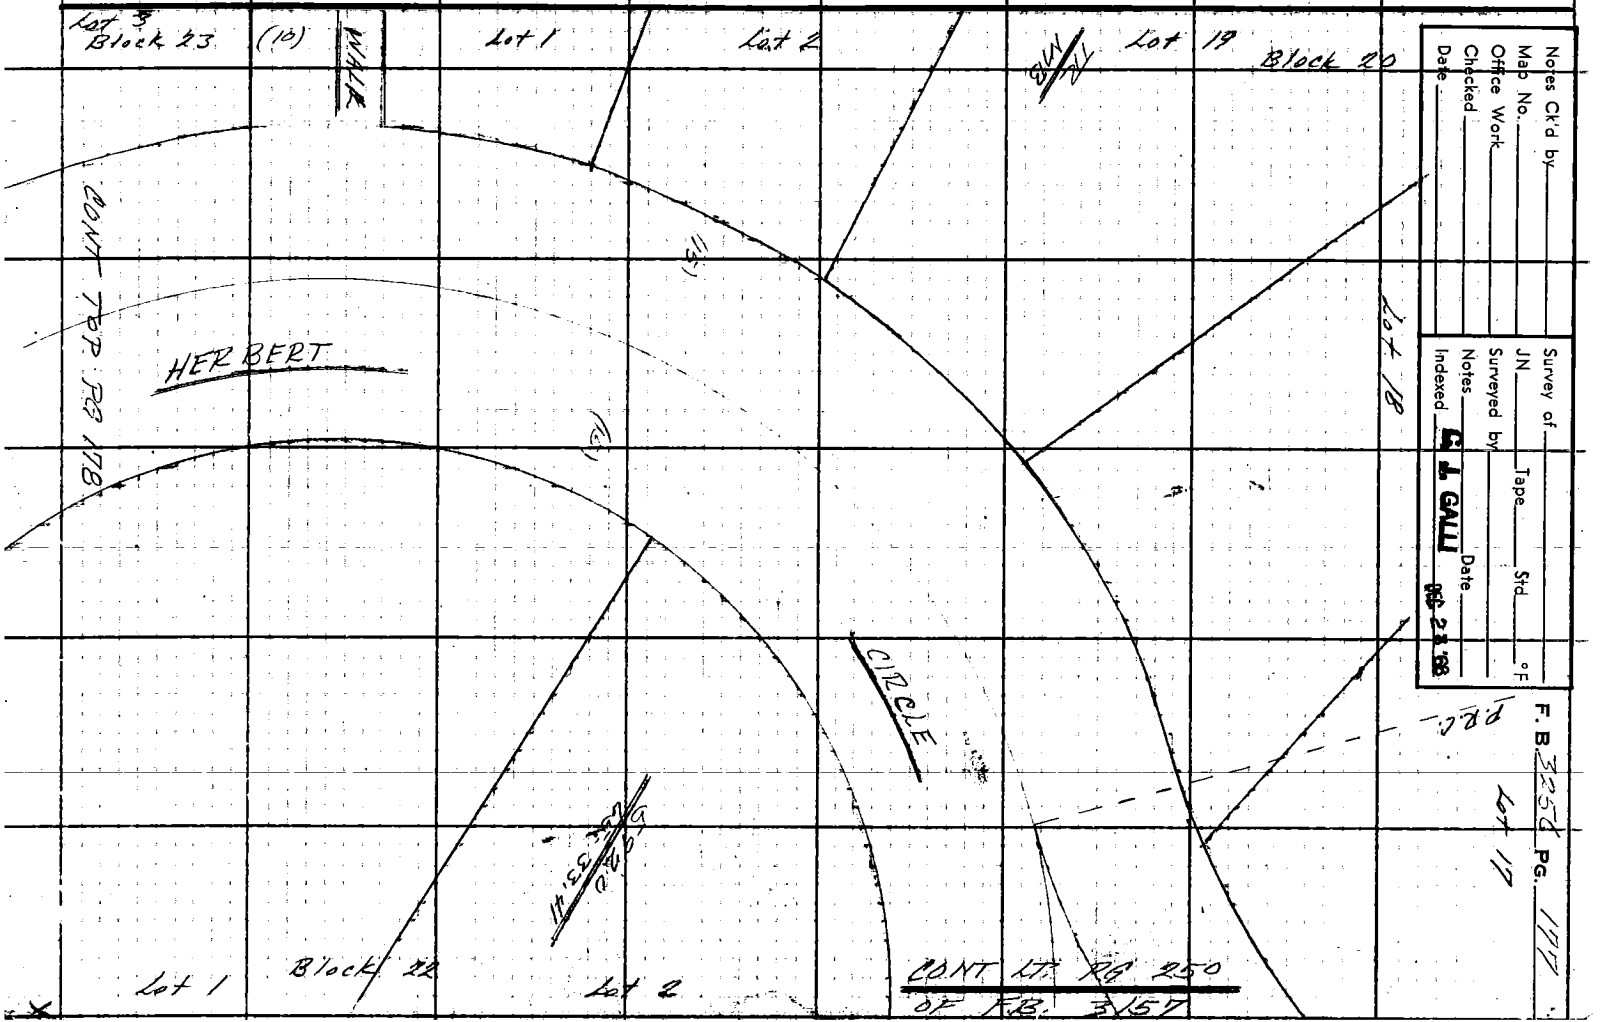

Notes Ck'd by
Map No.
Office Work
Checked
Date

Survey of
JN Tape Std °F
Surveyed by
Notes
Indexed G. J. GALLI Date DEC 28 '88


PLEASE RETURN TO
LOS ANGELES COUNTY ENGINEER
700 LOS ANGELES COUNTY ENGINEERING BLDG.

Note: Any Additions or Changes on This Sheet Must Be Made or Circled in Red Ink With Date and Name of Person Making Change.

Do not extend this side of this line.

W.S.7, E-1

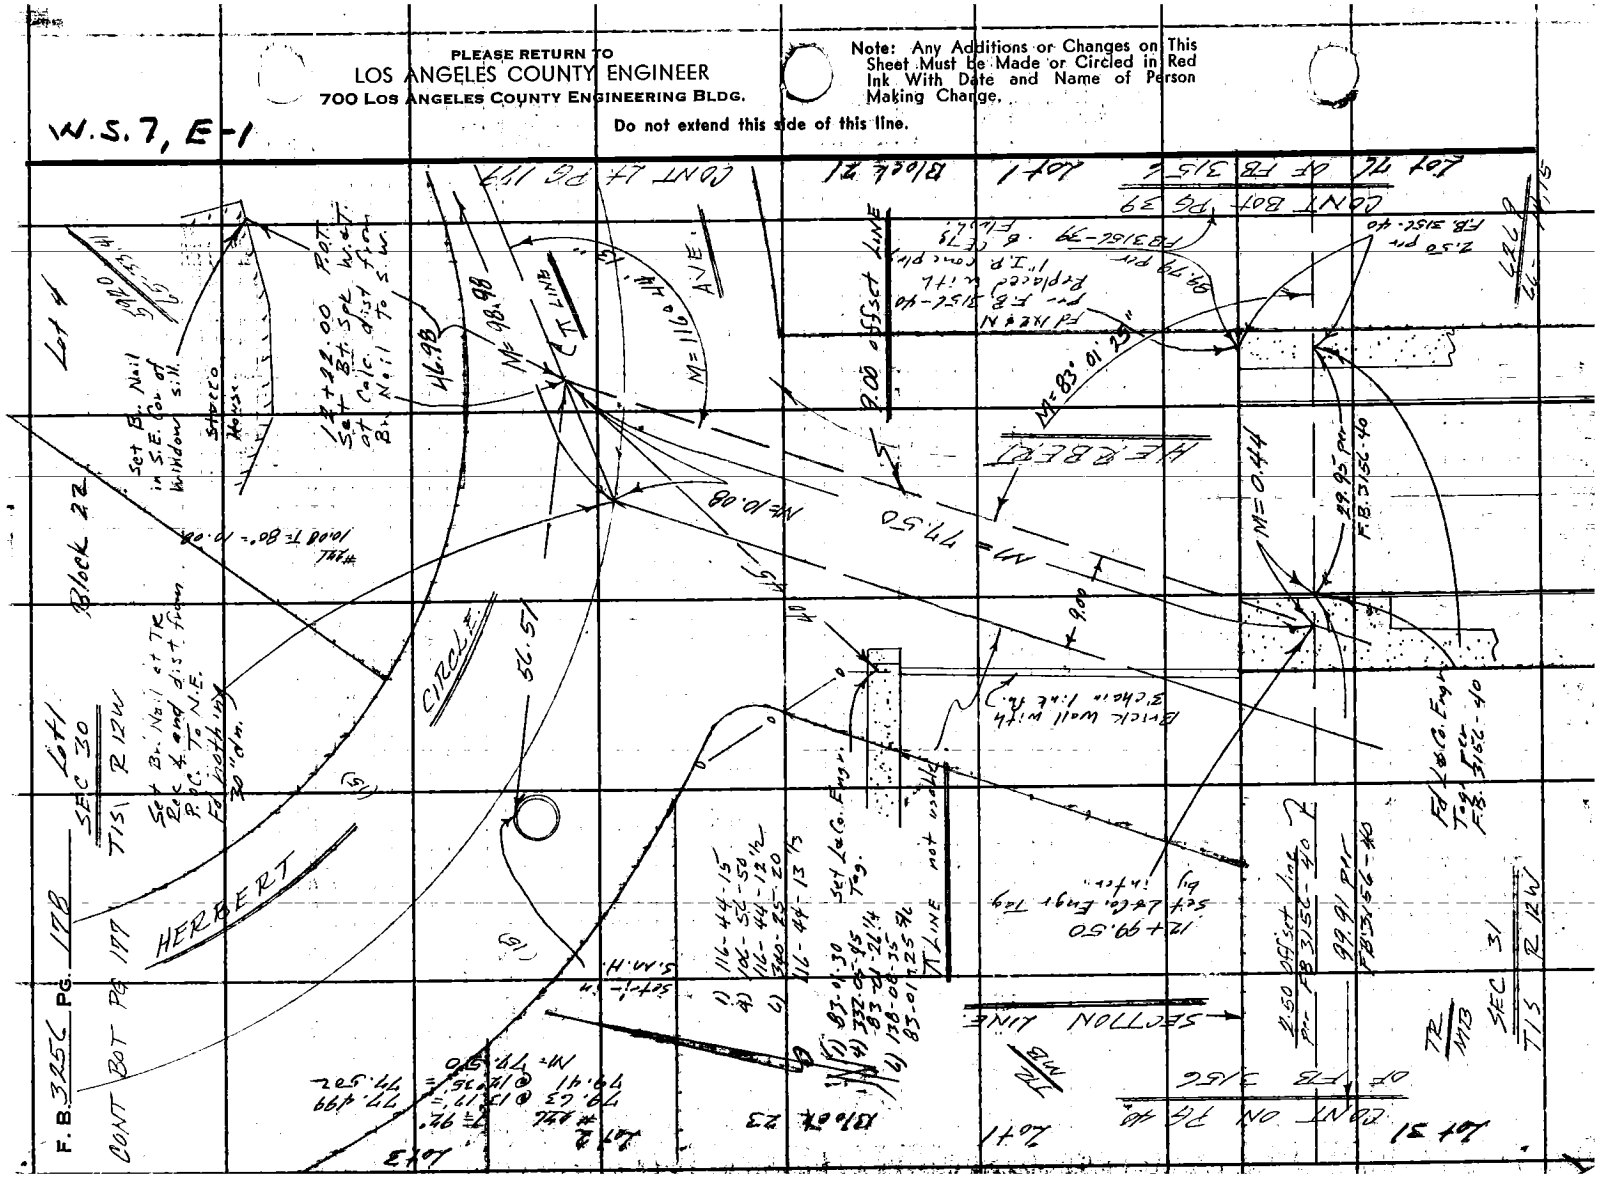
Block 22
Lot 4
Lot 1
Lot 2
Lot 3
Lot 13
Lot 14
Lot 15
HERBERT
CIRCLE
56. ST.
P.O.B. of Offset Line
M=110° 00' 00" E
M=83° 01' 25"
M=79.50
M=0.44
M=10.08
M=98.98
46.98
Set B.M. No. 1 in S.E. Co. of Window sill
Set B.M. No. 2 at Back & end dist from P.O.C. To N.E. Face of bldg.
Set Br. No. 1 at TK
Set Br. No. 2 at TK
Set L & Co. Engr. Tag.
Set L & Co. Engr. Tag by inters.
Brick wall with 3 chain link fences
Stucco House
Set L & Co. Engr. Tag
Set L & Co. Engr. Tag
Set L & Co. Engr. Tag

Notes Ck'd by	Survey of CITY TERRACE AREA
Map No.	JN 0303.04 Tape 100' Std 84 °F
Office Work	Surveyed by FE Brooks
Checked	Notes FEB Date 29 July 64
Date	Indexed

C. J. GALLI

F. B. 3256 PG. 179

CONT BOT PG 180

Block 22

Lot 3

Lot 4

Lot 5

Lot 1

Lot 2

Block 21

Lot 3

Lot 4

Lot 5

AVE.

Note: Any Additions or Changes on This Sheet Must be Made or Circled in Red Ink With Date and Name of Person Making Change.

Do not extend this side of this line.

PLEASE RETURN TO
LOS ANGELES COUNTY ENGINEER
700 LOS ANGELES COUNTY ENGINEERING BLDG.

76FA09S S&E #247 11-58

T= 80° = 65.69
T= 80° = 33.31
T=

#224 65.69 33.31

N= 65.69

℄ LINE

(15)

(15)

1) 121° 31-35
4) 146-26-15
124-31-33 3/4
6) 39-09-25
121-31-34 1/2

10+99.65 Fd 1/2 Hold 2x2 12" dia. 1.0 ft c.c.

24.83

10+99.79 P.O.T. Set 3/4rd Spk

Set L&Co Engr. Tag

Conc wall

0.14

11+11.8

5920

65-33,41

Set -/- in S.M.H.

TR MB

34"

31.

11+33.10 Pt. on Curve. Set Pt. Spk W&T at Calc. & and dist from P.R.C. To N.

N= 1160

N= 33.31

0552 80

24.32

16.12

8.28

11+31.85 Fd 2x2 L.S. 2510 no tic

N= 98.98

℄ LINE

Set L&Co. Engr Tag

#224 T= 78°
96.26 @ 3°14' = 96.14
96.39 @ 4°23' = 96.108
N= 96.11
Level = 2.87
Total = 98.98

HERBERT

Fd 3/4" I.P. no plug 1" up. no rec

PLEASE RETURN TO
LOS ANGELES COUNTY ENGINEER
700 LOS ANGELES COUNTY ENGINEERING BLDG.

Note: Any Additions or Changes on This Sheet Must be Made or Circled in Red Ink With Date and Name of Person Making Change.

Do not extend this side of this line.

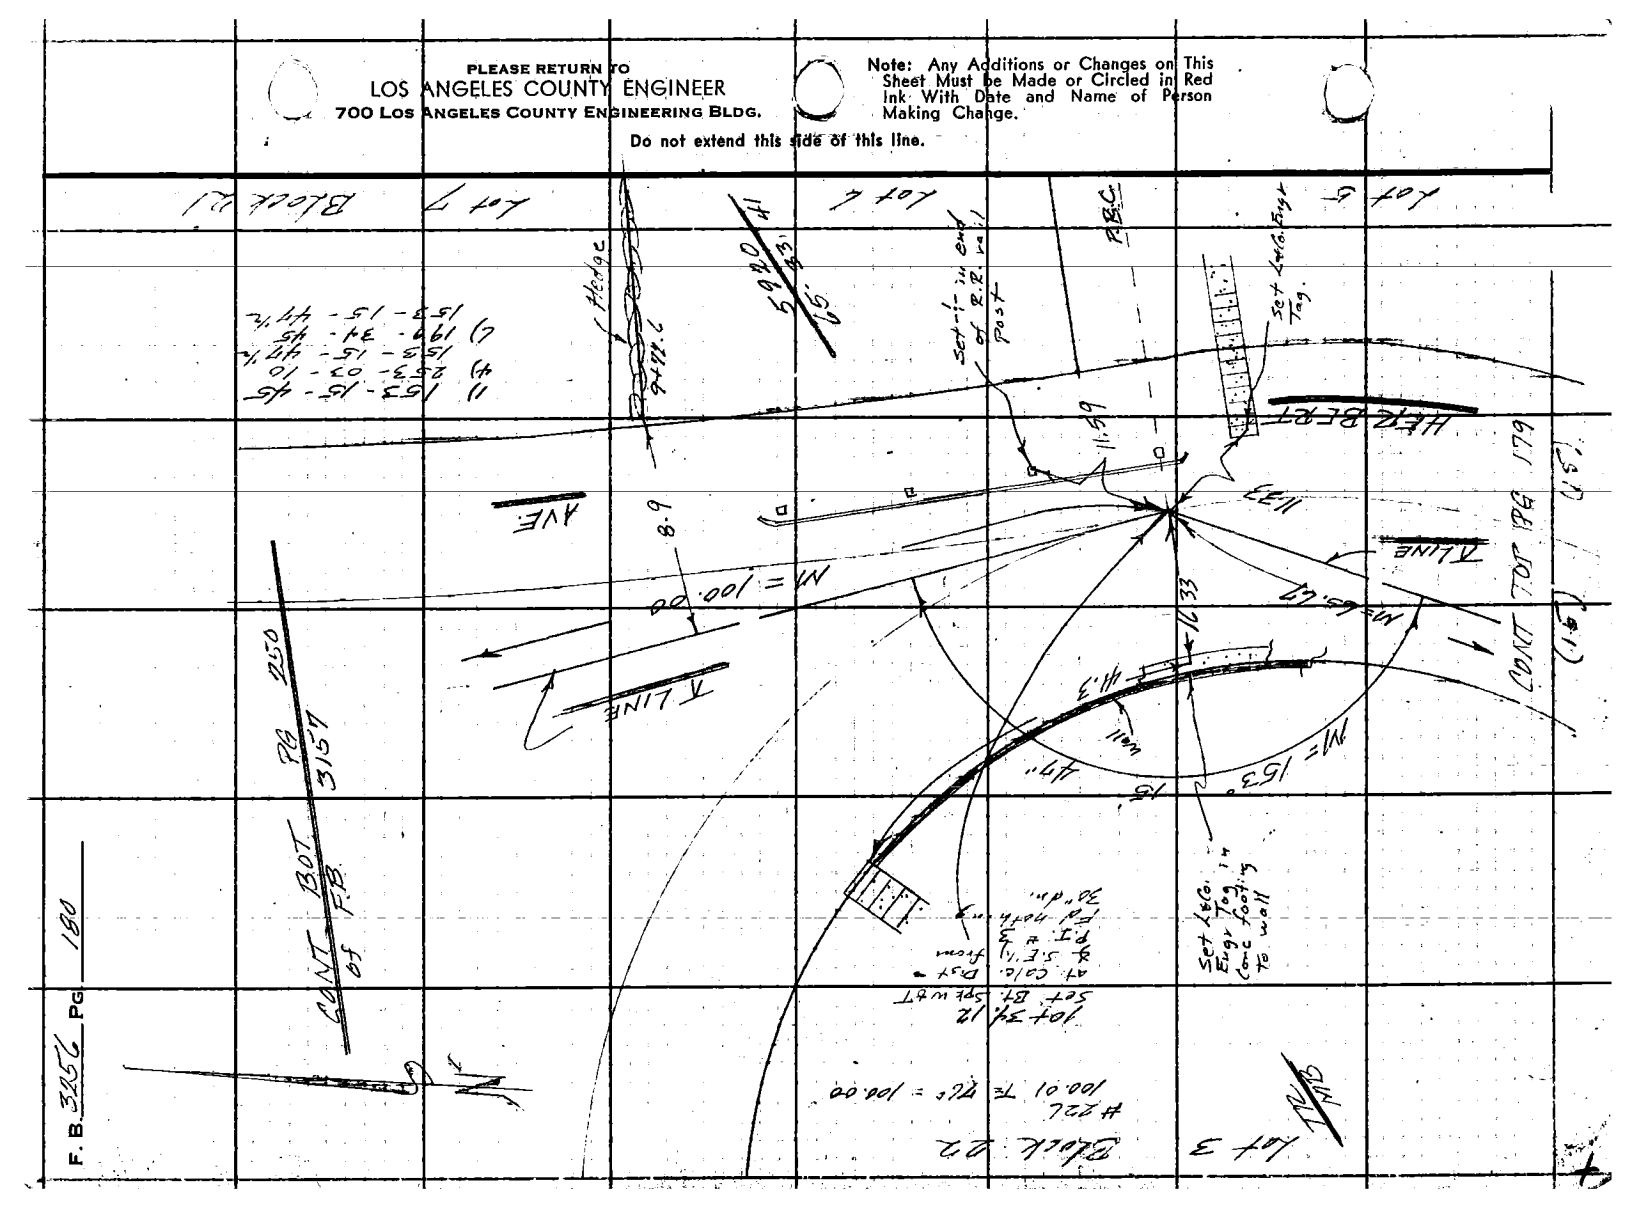

F.B. 3256 PG. 180

Notes Ck'd by
Map No.
Office Work
Checked
Date

Survey of CITY TERRACE AREA
JN 0203.04 Tape 226 Std 84 °F
Surveyed by F E Brooks
Notes FEB. Date 26 Jul 66
Indexed G. J. GALLI

F. B. 325 PG. 181

CONT BOT PG 182

Note: Any Additions or Changes on this Sheet Must be Made or Circled in Red Ink With Date and Name of Person Making Change.

Do not extend this side of this line.

PLEASE RETURN TO
LOS ANGELES COUNTY ENGINEER
700 Los Angeles County Engineering Bldg.

76F308S S&E #247 11-58

Lot 7
Lot 6
Block 17
Lot 5
Block 21
Lot 17
Lot 14
Lot 15
Lot 16

ST.

T LINE

#226 T= 80°
T° 30' = 191.080
T° 42" = 191.070
M= 191.07

(15) M= 191.07 (15)

192.74
192.63
192.81
=

14.7

3+65.9 4' chain link fence

5920
65-33, 41

4+01.48 P.O.T. Set -i- in S.M.H.

4+25.9 4' chain link fence

15.7

TR MB

WEISNER

M= 77.22

#226 77.22 T=80° 77.22

CONT RT PG 164
OF FB. 3157

PLEASE RETURN TO
LOS ANGELES COUNTY ENGINEER
700 LOS ANGELES COUNTY ENGINEERING BLDG.

Note: Any Additions or Changes on This Sheet Must be Made or Circled in Red Ink With Date and Name of Person Making Change.

Do not extend this side of this line.

W.S. 7, E-1

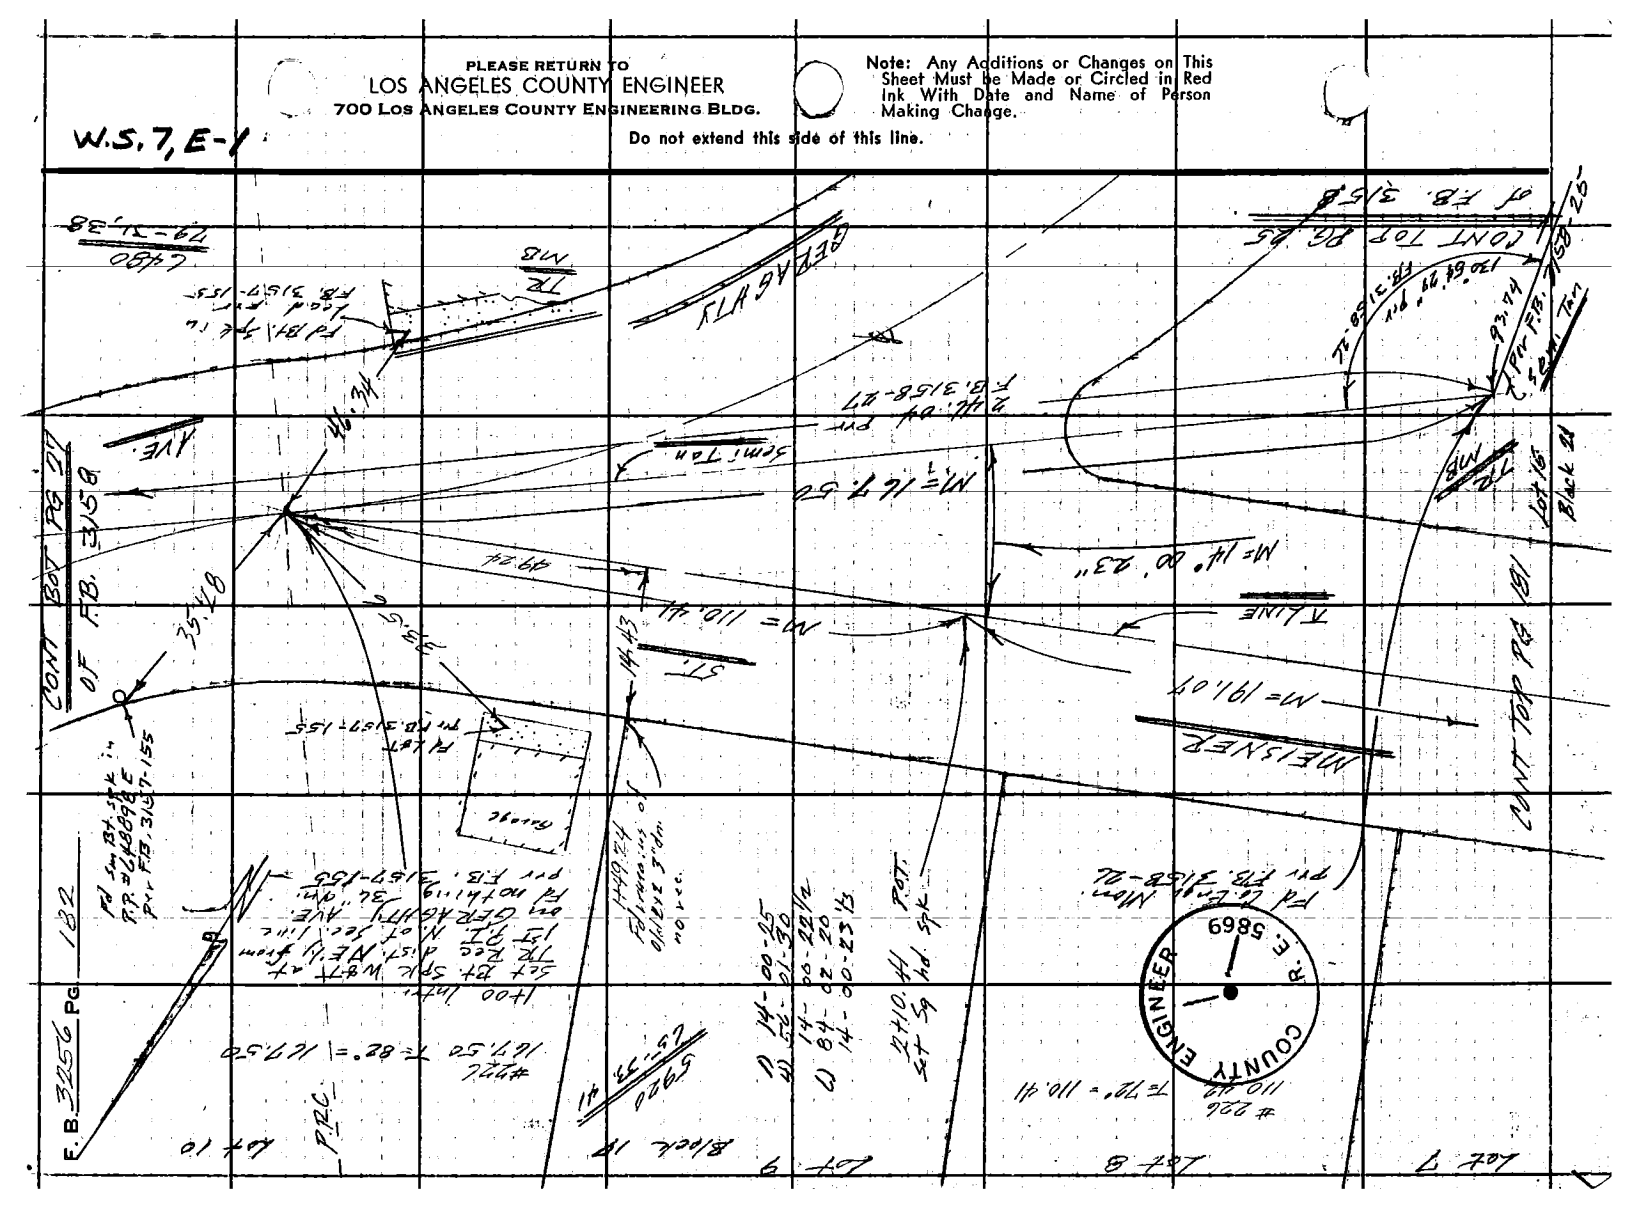

76F309S S&E #247 11-58

PLEASE RETURN TO
LOS ANGELES COUNTY ENGINEER
700 LOS ANGELES COUNTY ENGINEERING BLDG.

Note: Any Additions or Changes on This Sheet Must be Made or Circled in Red Ink With Date and Name of Person Making Change.

Do not extend this side of this line.

W.S. 7, E-1

Notes Ck'd by
Map No.
Office Work
Checked
Date

Survey of CITY TERRACE AREA E
JN 2303.01 Tape 22L Std. BV °F
Surveyed by F.E. Brents
Notes F.B. Date 5 Aug 44
Indexed C. J. GALLI



























6480 79-31,38

PLEASE RETURN TO
LOS ANGELES COUNTY ENGINEER
700 LOS ANGELES COUNTY ENGINEERING BLDG.

Note: Any Additions or Changes on This Sheet Must be Made or Circled in Red Ink With Date and Name of Person Making Change.

Do not extend this side of this line.

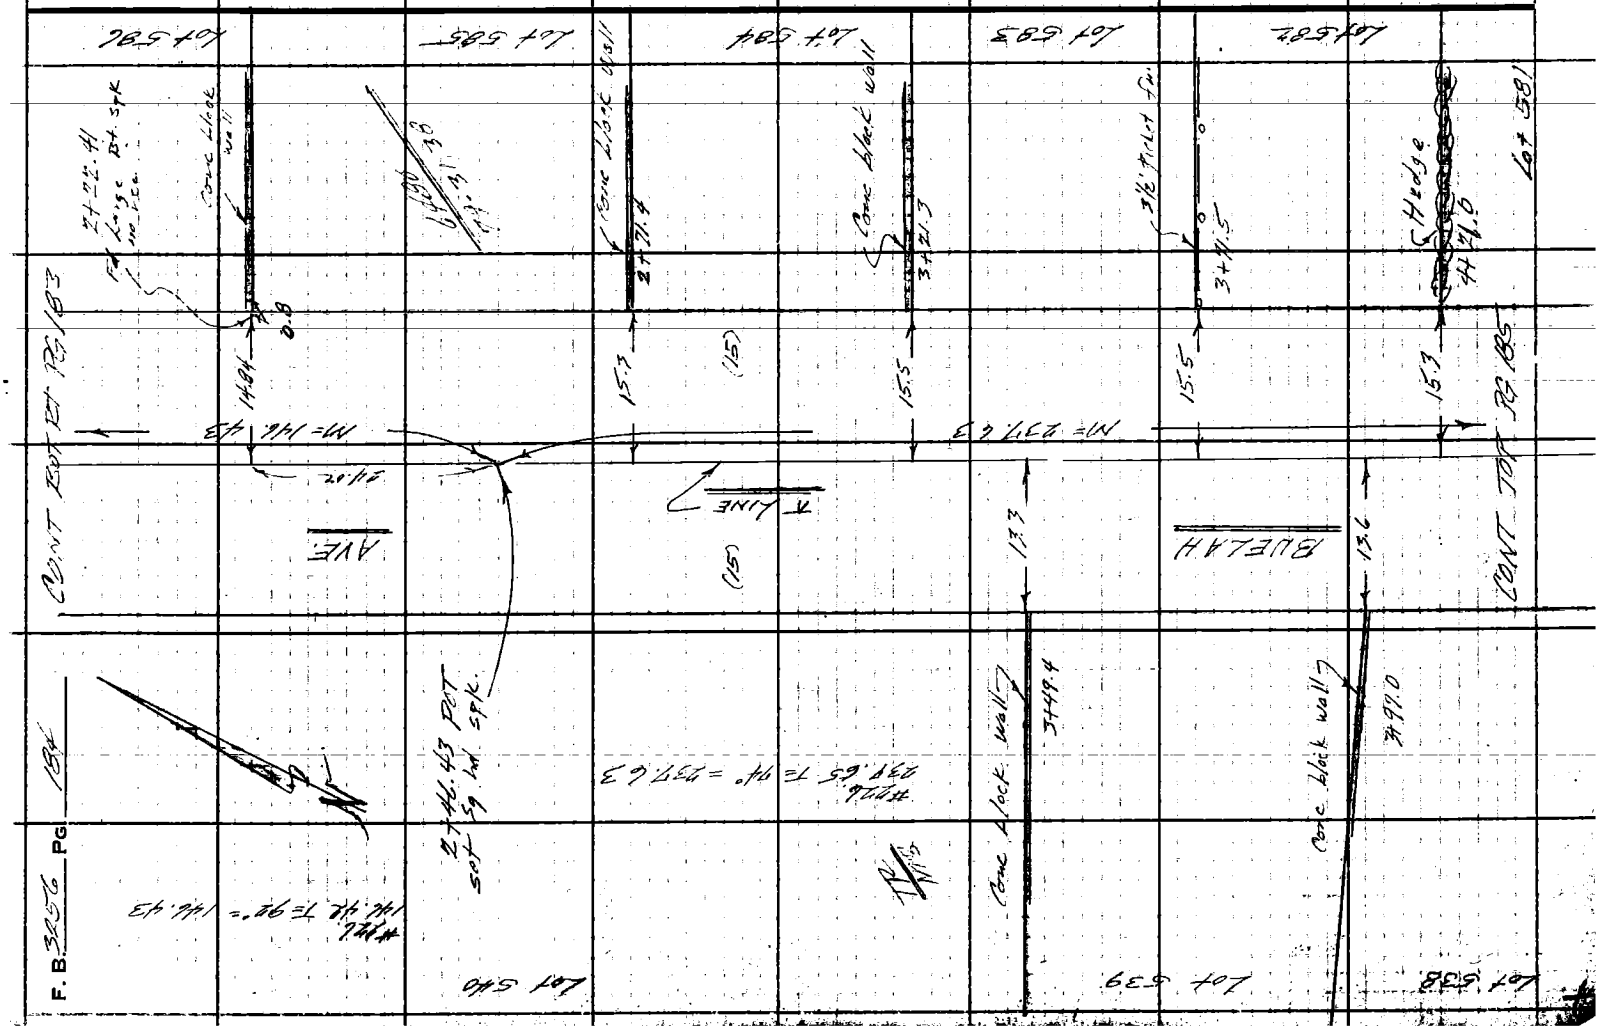
Lot 582
Lot 583
Lot 584
Lot 585
Lot 586
Lot 581
Lot 538
Lot 539
Lot 540
CONC. LINE
CONC. BLOCK WALL
HEDGE
BUELAH
AVE.
CONC. BLOCK WALL
CONC. BLOCK WALL
CONC. BLOCK WALL

Notes Ck'd by	Survey of CITY TERRACE AREA
Map No.	JN 0307.04 Tape 226 Std 68 °F
Office Work	Surveyed by F.E. Brooks
Checked	Notes F.E.B. Date 8 Aug 1966
Date	Indexed G. J. GALLI

F. B. 3256 Pg. 185

Note: Any Additions or Changes on this Sheet Must be Made or Circled in Red Ink With Date and Name of Person Making Change.

Do not extend this side of this line.

PLEASE RETURN TO
LOS ANGELES COUNTY ENGINEER
700 Los Angeles County Engineering Bldg.

76F309S 9&E #247 11-58

Lot 528

stucco garage

4449.4

cone block wall

13.7

CONT POT PG 184

4471.34
Fd IXZ & N
Flush no tcc

4472.5

4' chain link fnc

15.25

15.15

conc. slab

N = 137.63

19.92

Lot 581

Lot 541

AVE.

4484.06 POT.
set Sq hd. spk.

(05)

(15)

6450

Lot 580

4' picket fn.

walk

5+20.0

15.0

15.1

6+28.0

Lot 544

#226 126.41 Tan 80° = 126.41

#282 76.11 Tan 80° = 76.11

Lot 579

℄ LINE

126.41

15.1

6+79.0

4' picket fn.

Lot 543

5' wire fn.

9+06.0

14.8

BULEVARD

6+10.49 POT.
Set Sq. hd. spk.

B.C.

6+17.37
Fd 2X2 & N
5" dm. no tcc.

N = 1.40

0.07

11.14

14.93

6+21.88
Fd ¾" I.P. no plug
8" up no tcc.

TR/NTB

N = 76.11

Lot 578

Lot 544

Lot 577

CONT TOP PG 186

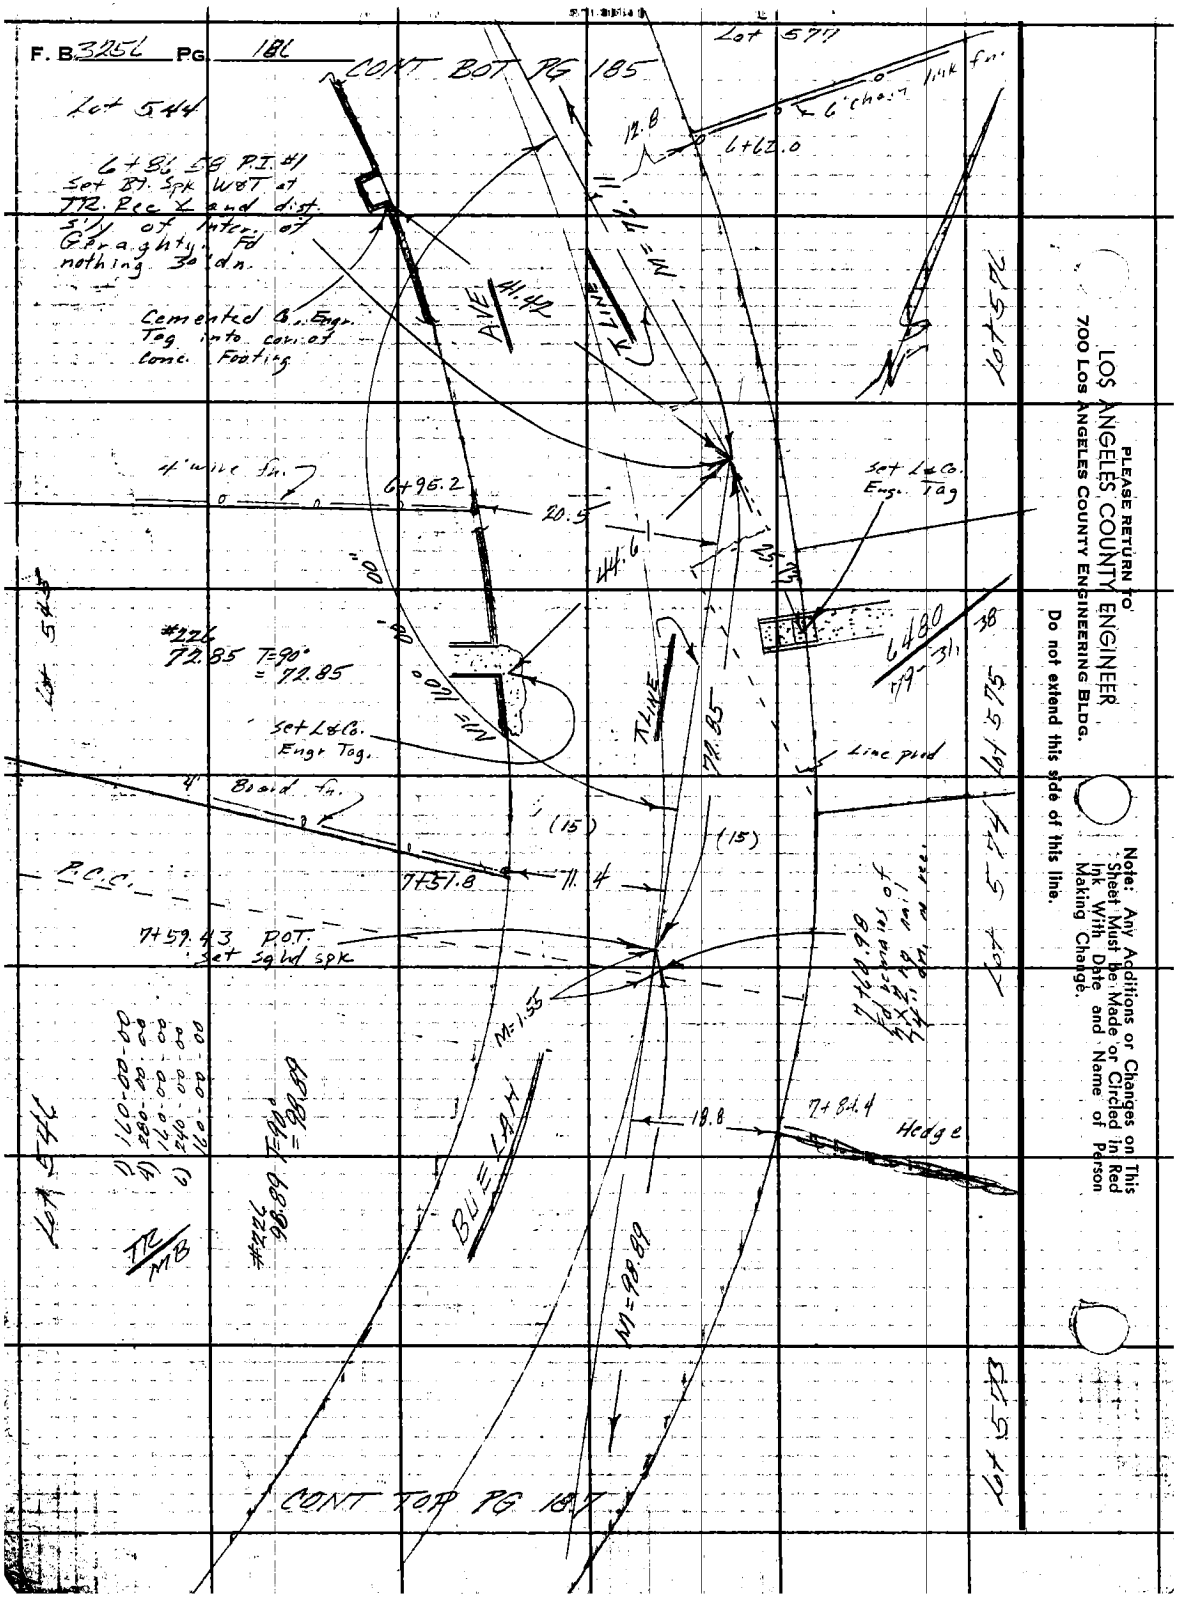

PLEASE RETURN TO
LOS ANGELES COUNTY ENGINEER
700 LOS ANGELES COUNTY ENGINEERING BLDG.

Do not extend this side of this line.

Note: Any Additions or Changes on This Sheet Must be Made or Circled in Red Ink With Date and Name of Person Making Change.

Notes Ck'd by	Survey of CITY TERRACE AREA E
Map No.	JN 0303-04 Tape 226 Std 84 °F
Office Work	Surveyed by F.E. Brooks
Checked	Notes F.E.B. Date 8 Aug 1944
Date	Indexed C. J. GALLI

F. B. 325 Pg. 187

CONT BOT PG 186

LOT 546

LOT 573

LOT 572

LOT 571

LOT 548

LOT 570

4' chain link fn.

B+17.3

Set ½" in fn. post

AVE

31.1

T LINE

N2

wire fn.

B+23.3

64.80

31.38

N= 98.89

45.70

N= 121° 05' 00"

121-05-00
121-05-00
121-30-00
121-05-00

(15)

(15)

1½" B.C. set in Tel. Bk. E 5050 SH

11.29

12.35

B+69.8

G.B

4' chain link fn.

Set ½" in fn. post

B+58.32 P.I. #2
Set 2" I.P. conc. plug & Co. Engr. Tag at TR Rad ⊥ and dist 5' ⊥ of P.I. #1. Ft nothing 84" dn.

TR
MB

BUELAH

T LINE

4' chain link fn.

9410.2

#226
95.46 Te 72° = 95.45

22.8

N= 95.45

8.8

9+05.3

4' chain link fn.

CONT TRPPS 188

Note: Any Additions or Changes on This Sheet Must be Made or Circled in Red Ink With Date and Name of Person Making Change.

Do not extend this side of this line.

PLEASE RETURN TO
LOS ANGELES COUNTY ENGINEER
700 Los Angeles County Engineering Bldg.

76F3095 S&E #247 11-58

PLEASE RETURN TO
LOS ANGELES COUNTY ENGINEER
700 LOS ANGELES COUNTY ENGINEERING BLDG.

Note: Any Additions or Changes on This Sheet Must be Made or Circled in Red Ink With Date and Name of Person Making Change.

Do not extend this side of this line.

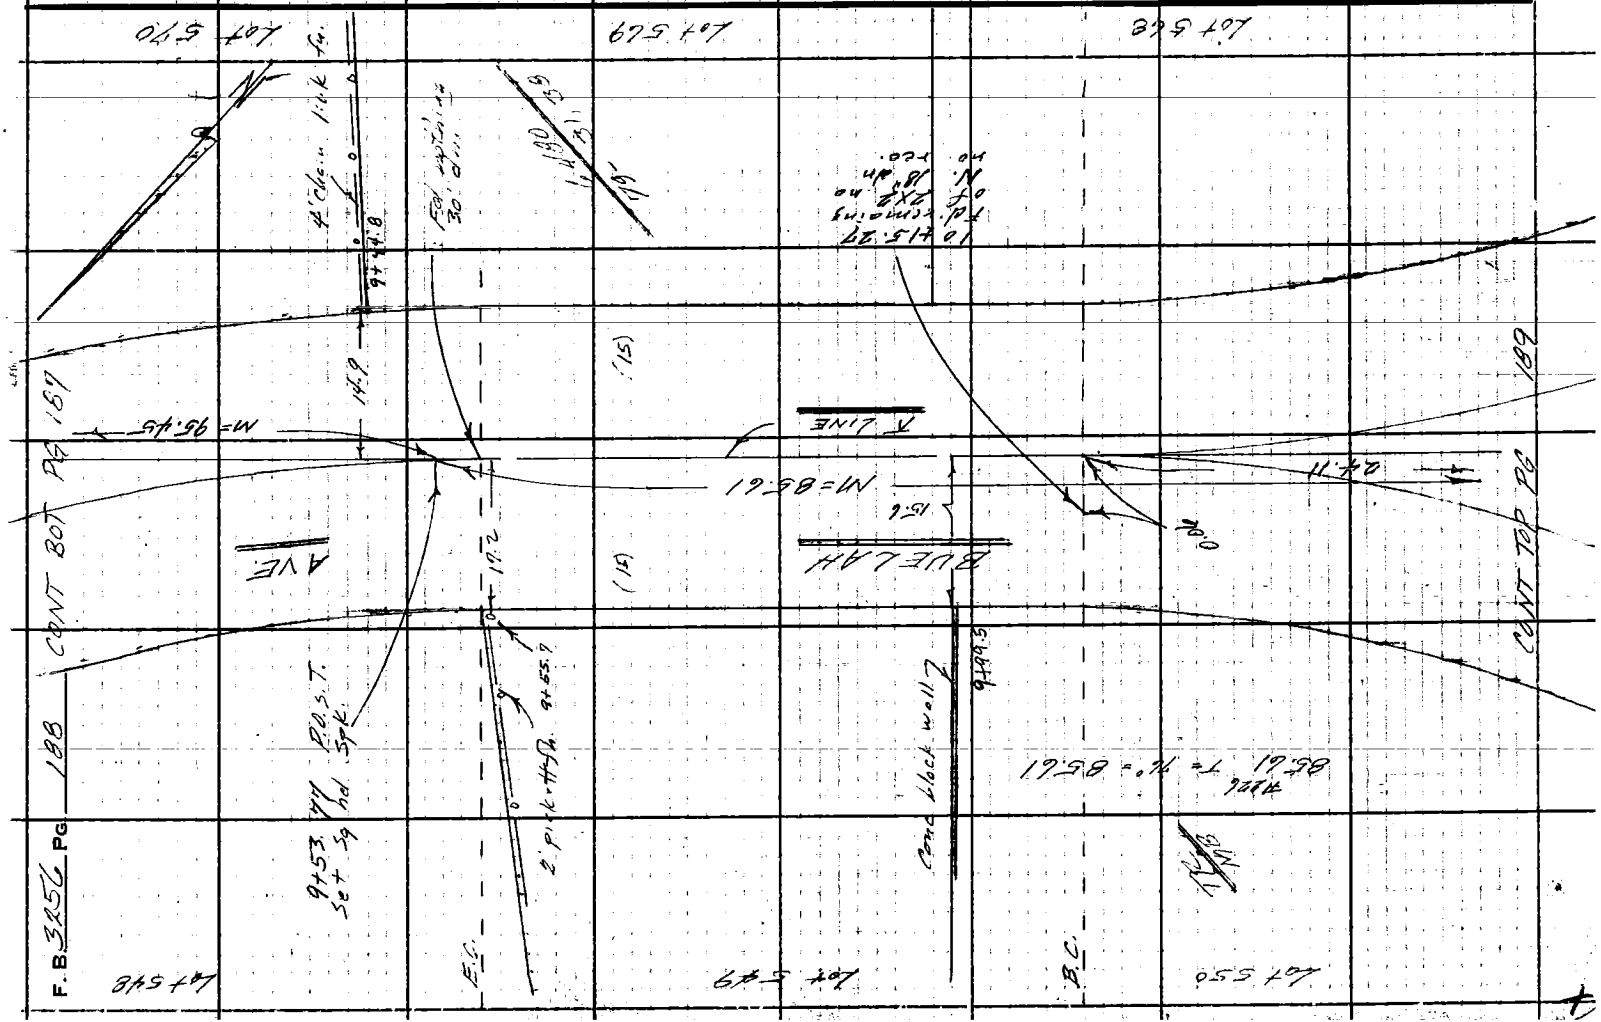

Notes Ck'd by	Survey of City TERRACE AREA 2
Map No.	JN 05 07.64 Tape 226 Std 64 °F
Office Work	Surveyed by FE Brooks
Checked	Notes FEB Date 9 Aug 1964
Date	Indexed C. J. GALLI

F. B. 3256 Pg. 189

CONT BOT PG 188

Lot 550

Set Lot

Conc block wall

Fd 2x2 Tag L.S. 2510 Flush no tie

1) N47°28'-25"E 39.40
2) S29°37'-40"E 24.45
3) N64°56'-30"E 39.25

CIRCLE

16.90

16.51

0.74

N 85.61

24.11

T LINE

39.94

Set Lot

Lot 551

10+39.38 P.I. #3
Set Bt. Spk W&T at TR REC & end dist. S.W'ly of P.I. #2. Fd nothing 30" dia.

BUELAH AVE.

N 14°40' E 89.25'

Lot 568

26.40

23.50

N = 199.94

T LINE

Set Bt. Spk B.T. to P.P. at 70+04 H

19.3

EC

Fd. nothing 30" dia.

CONT TOP PG 190

(15)

BUELAH

(15)

Fd. nothing 30" dia.

TR NIB

Fd. Nothing 30" dia.

Lot 590

CONT TOP PG. 195

Lot 566

Lot 568

Note: Any Additions or Changes on This Sheet Must be Made or Circled in Red Ink With Date and Name of Person Making Change.

Do not extend this side of this line.

W.S. 7, E-1

PLEASE RETURN TO
LOS ANGELES COUNTY ENGINEER
700 Los Angeles County Engineering Bldg.

76F309S S&E #247 11-58

PLEASE RETURN TO
LOS ANGELES COUNTY ENGINEER
700 LOS ANGELES COUNTY ENGINEERING BLDG.

Note: Any Additions or Changes on This Sheet Must be Made or Circled in Red Ink With Date and Name of Person Making Change.

Do not extend this side of this line.

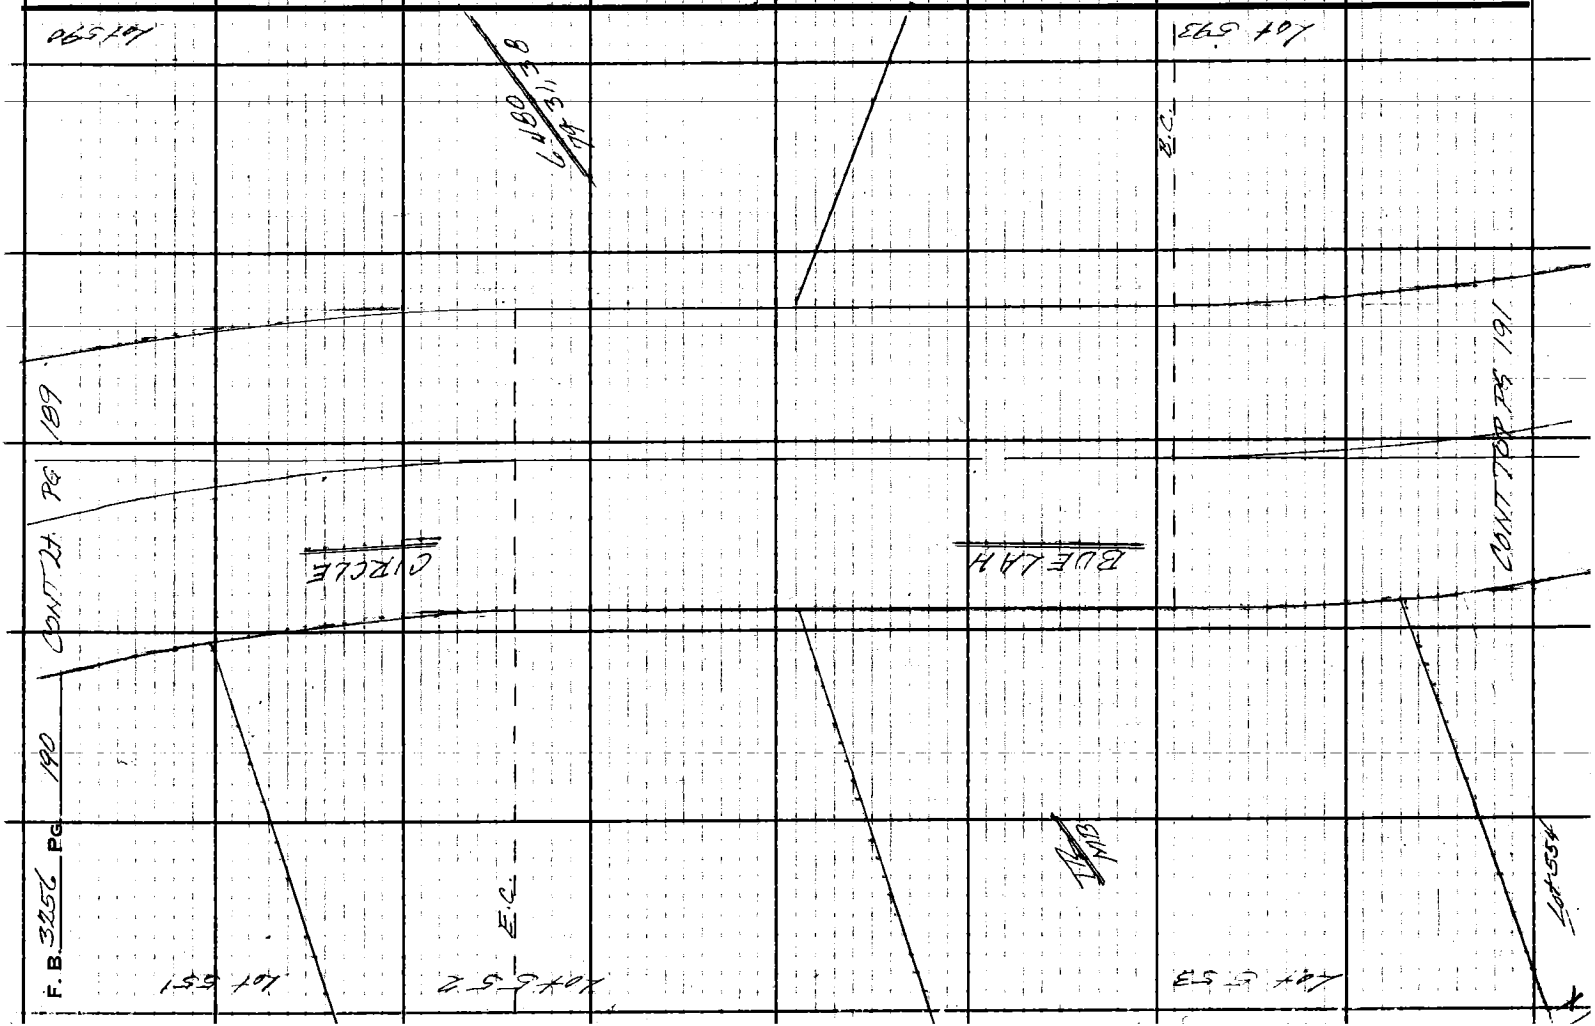

76F309S S&E #247 11-58

PLEASE RETURN TO
LOS ANGELES COUNTY ENGINEER
700 LOS ANGELES COUNTY ENGINEERING BLDG.

Note: Any Additions or Changes on this Sheet Must be Made or Circled in Red Ink With Date and Name of Person Making Change.

Do not extend this side of this line.

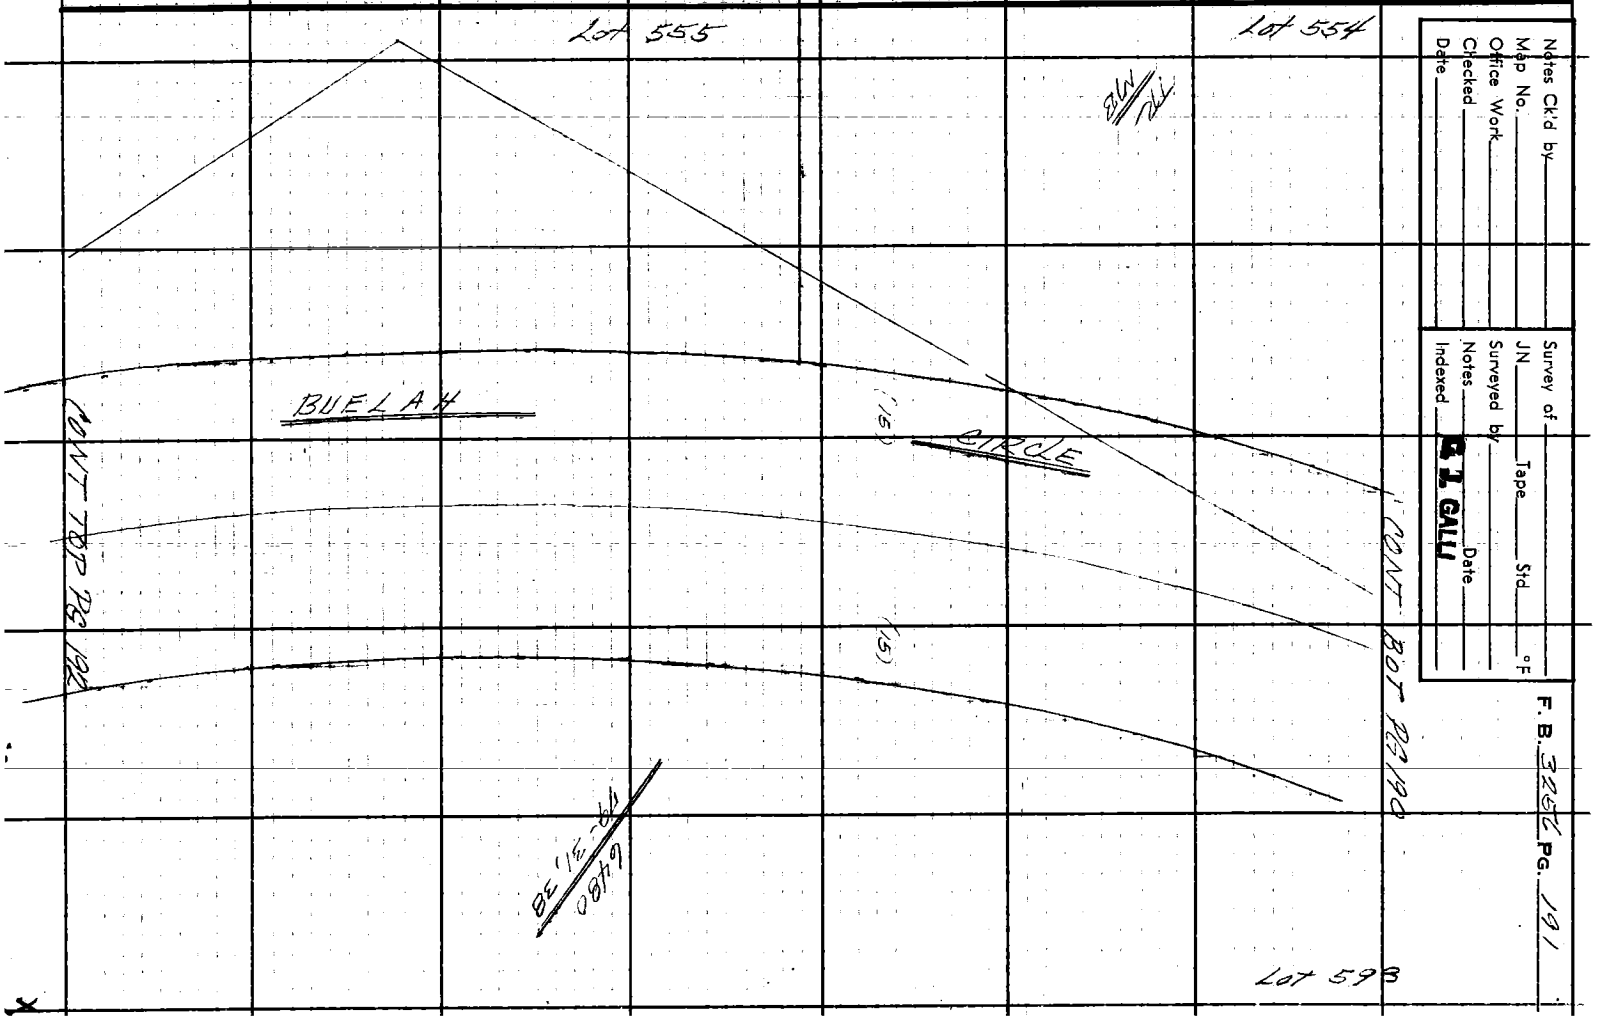

Notes Ck'd by
Map No.
Office Work
Checked
Date

Survey of
JN Tape Std °F
Surveyed by
Notes
Indexed Date

R. L. GALLI

F. B. 3262 PG. 191

PLEASE RETURN TO
LOS ANGELES COUNTY ENGINEER
700 LOS ANGELES COUNTY ENGINEERING BLDG.

Note: Any Additions or Changes on This Sheet Must be Made or Circled in Red Ink With Date and Name of Person Making Change.

Do not extend this side of this line.

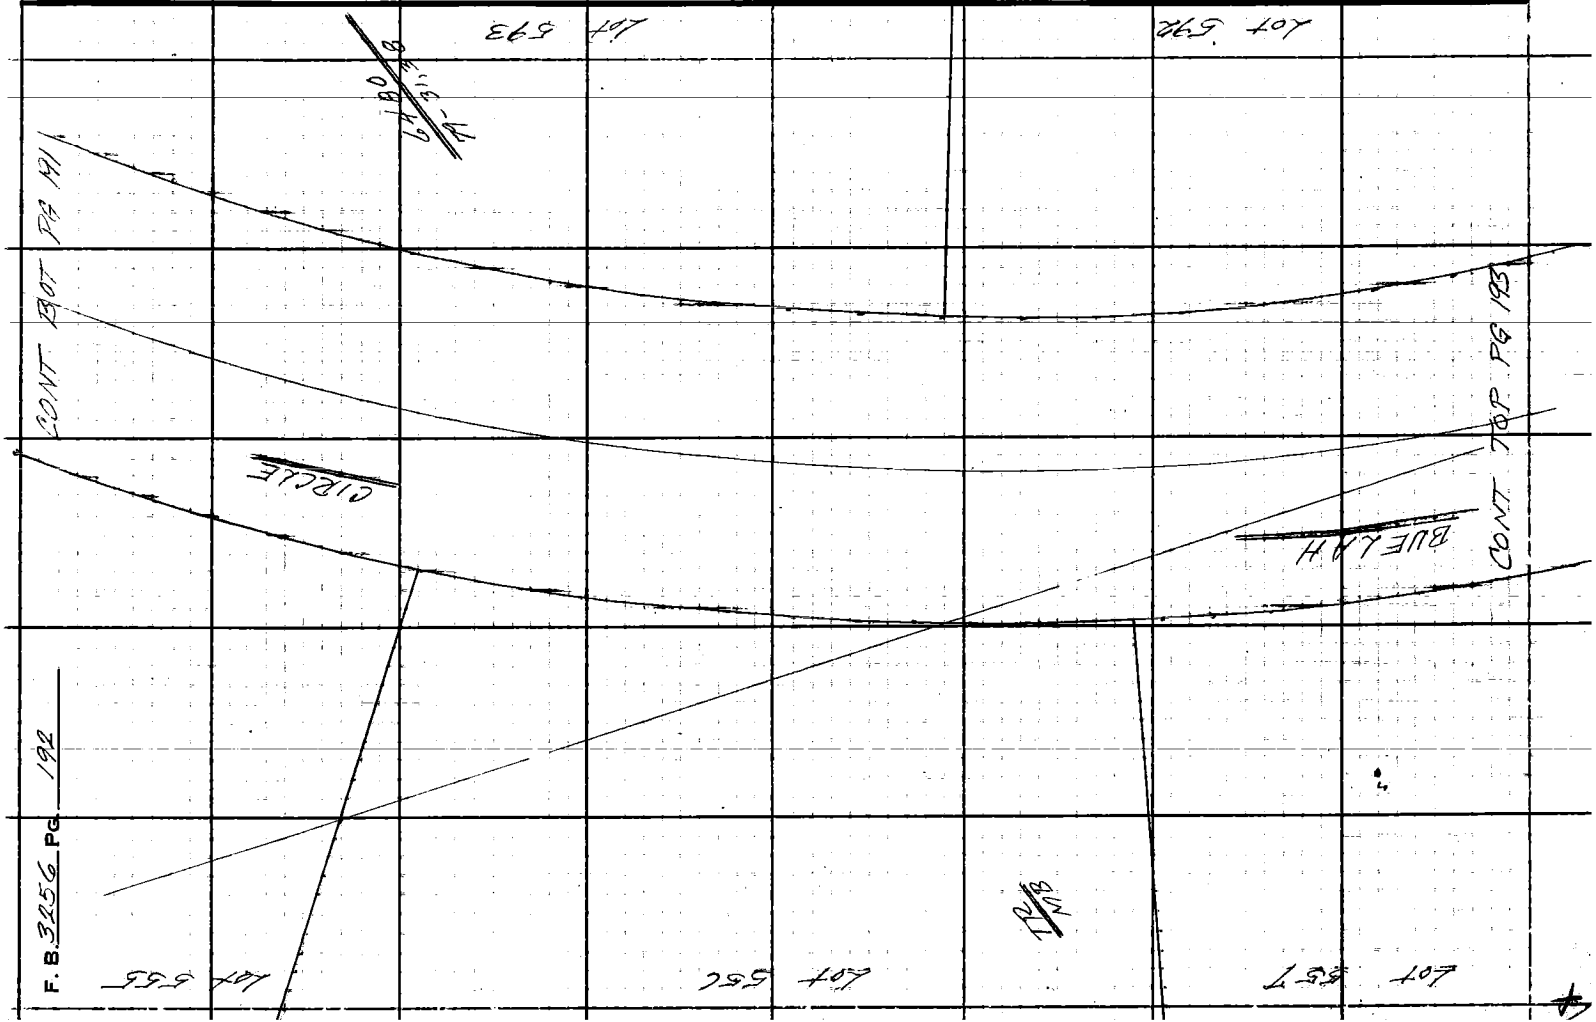

76F309S S&E #247 11-58

PLEASE RETURN TO
LOS ANGELES COUNTY ENGINEER
700 LOS ANGELES COUNTY ENGINEERING BLDG.

Note: Any Additions or Changes on This Sheet Must be Made or Circled in Red Ink With Date and Name of Person Making Change.

Do not extend this side of this line.

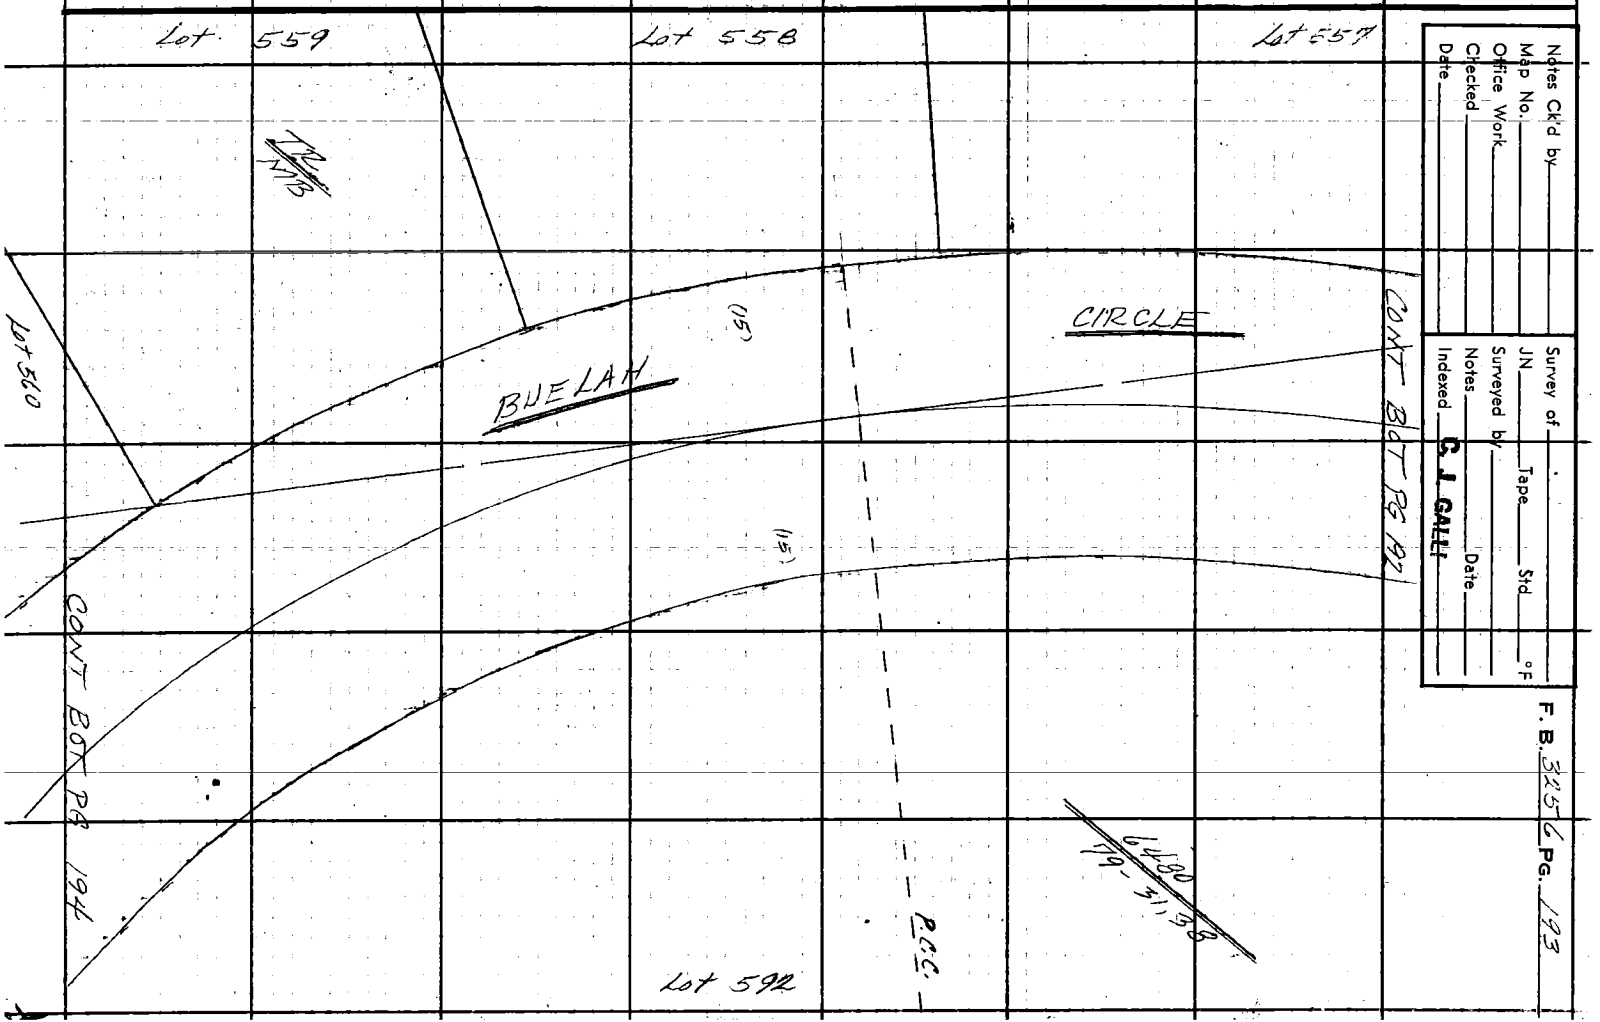

Notes Ck'd by
Map No.
Office Work
Checked
Date

Survey of
JN Tape Std °F
Surveyed by
Notes
Date
Indexed C. J. GALLI


PLEASE RETURN TO
LOS ANGELES COUNTY ENGINEER
700 LOS ANGELES COUNTY ENGINEERING BLDG.

Do not extend this side of this line.

Note: Any Additions or Changes on This Sheet Must be Made or Circled in Red Ink With Date and Name of Person Making Change.

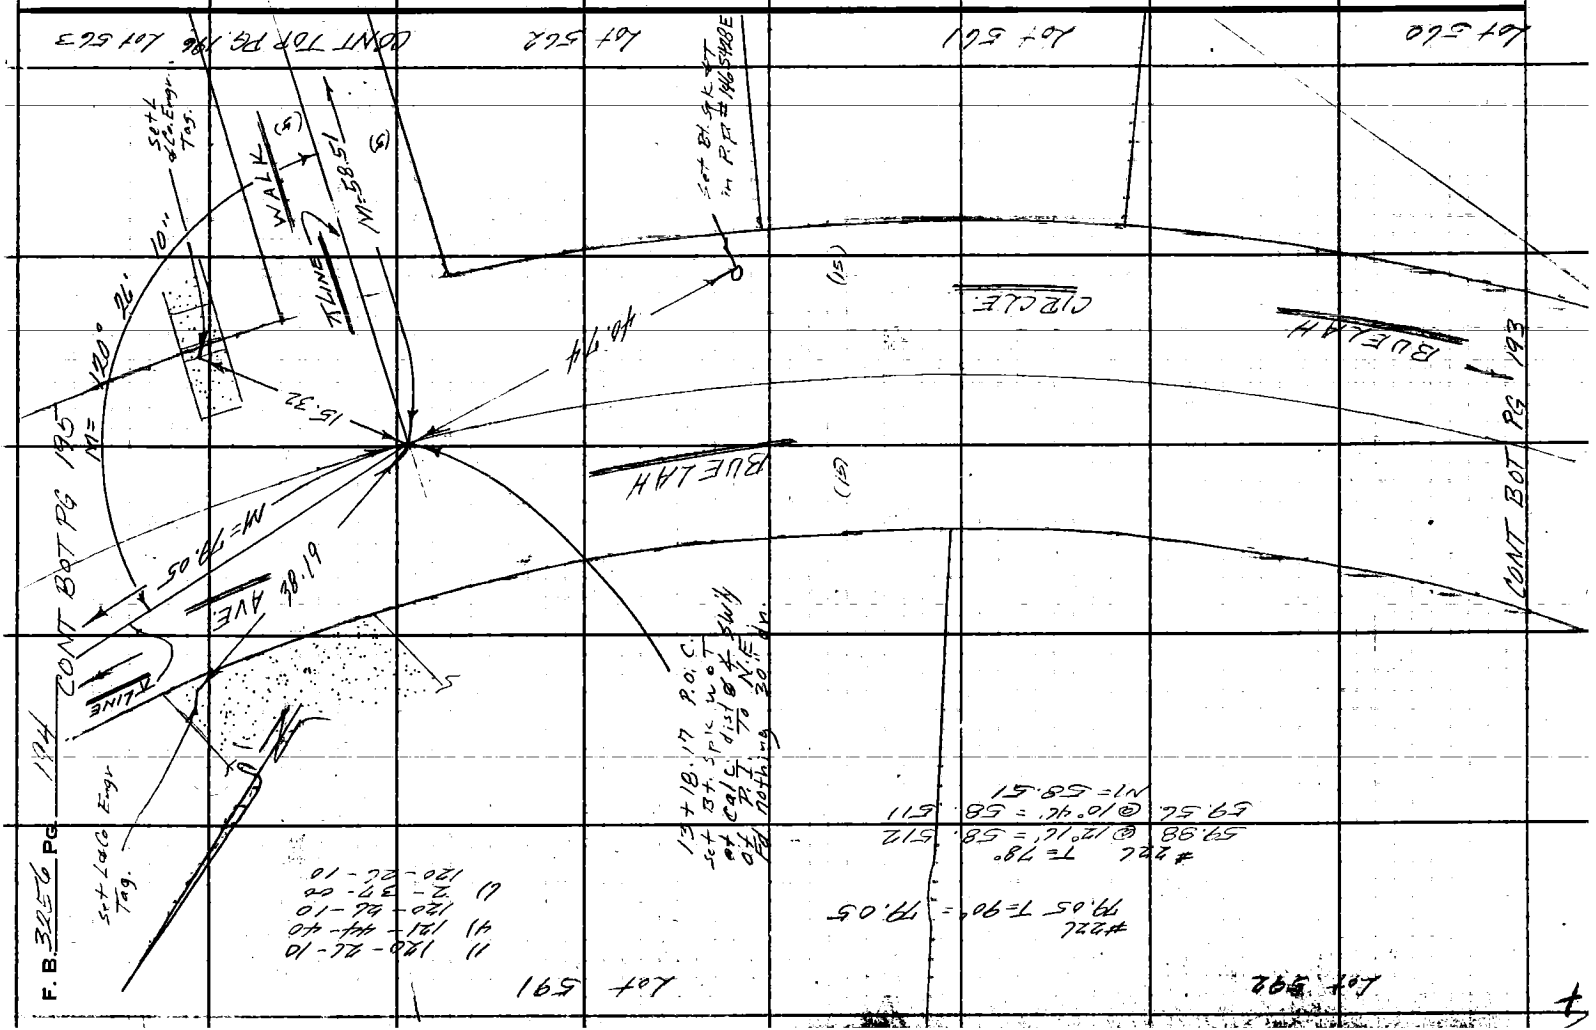

F. B. 3256 Pg 194

Notes Ck'd by	Survey of CITY TERRACE AREA 2
Map No.	JN 0307.04 Tape 221 Std 84 °F
Office Work	Surveyed by F.E. Brooks
Checked	Notes FEB. Date 2 Aug 1966
Date	Indexed G. J. GALLI

F. B. 3256 PG. 195

CONT BOT PG 189

1) 149-33-50
4) 149-15-20
149-33-50
6) 179-23-00
149-33-50

Set ⊣ in fn. cor.

11+79.3

16.1

4' chain link fn.

Lot 590

Lot 516

N= 192.74

C LINE

AVE.

6480
79-31-38

4' chain link fn.

12+10.9

19.4

Lot 515

R=148.10

50'

33'

B.C.

N=140°

25.38

12+39.12
Set B.T. Spk w ⊙T
at TRR of 4" I.C.
S.W'ly of P.J. #3.
F.T nothing 30" dn.

42.57

TR
M.B.

Set L.A. Co. Engr. Tag

set ⊣ in S.M.H.

C LINE

Lot 591

(15)

N= 79.05

(15)

Lot 564

BLELAH

Lot 563

CONT TOP PG 194

PLEASE RETURN TO
LOS ANGELES COUNTY ENGINEER
700 Los Angeles County Engineering Bldg.

Note: Any Additions or Changes on This Sheet Must be Made or Circled in Red Ink With Date and Name of Person Making Change.

Do not extend this side of this line.

76F3095 S&E #247 11-58

PLEASE RETURN TO
LOS ANGELES COUNTY ENGINEER
700 LOS ANGELES COUNTY ENGINEERING BLDG.

Do not extend this side of this line.

Note: Any Additions or Changes on This Sheet Must be Made or Circled in Red Ink With Date and Name of Person Making Change.

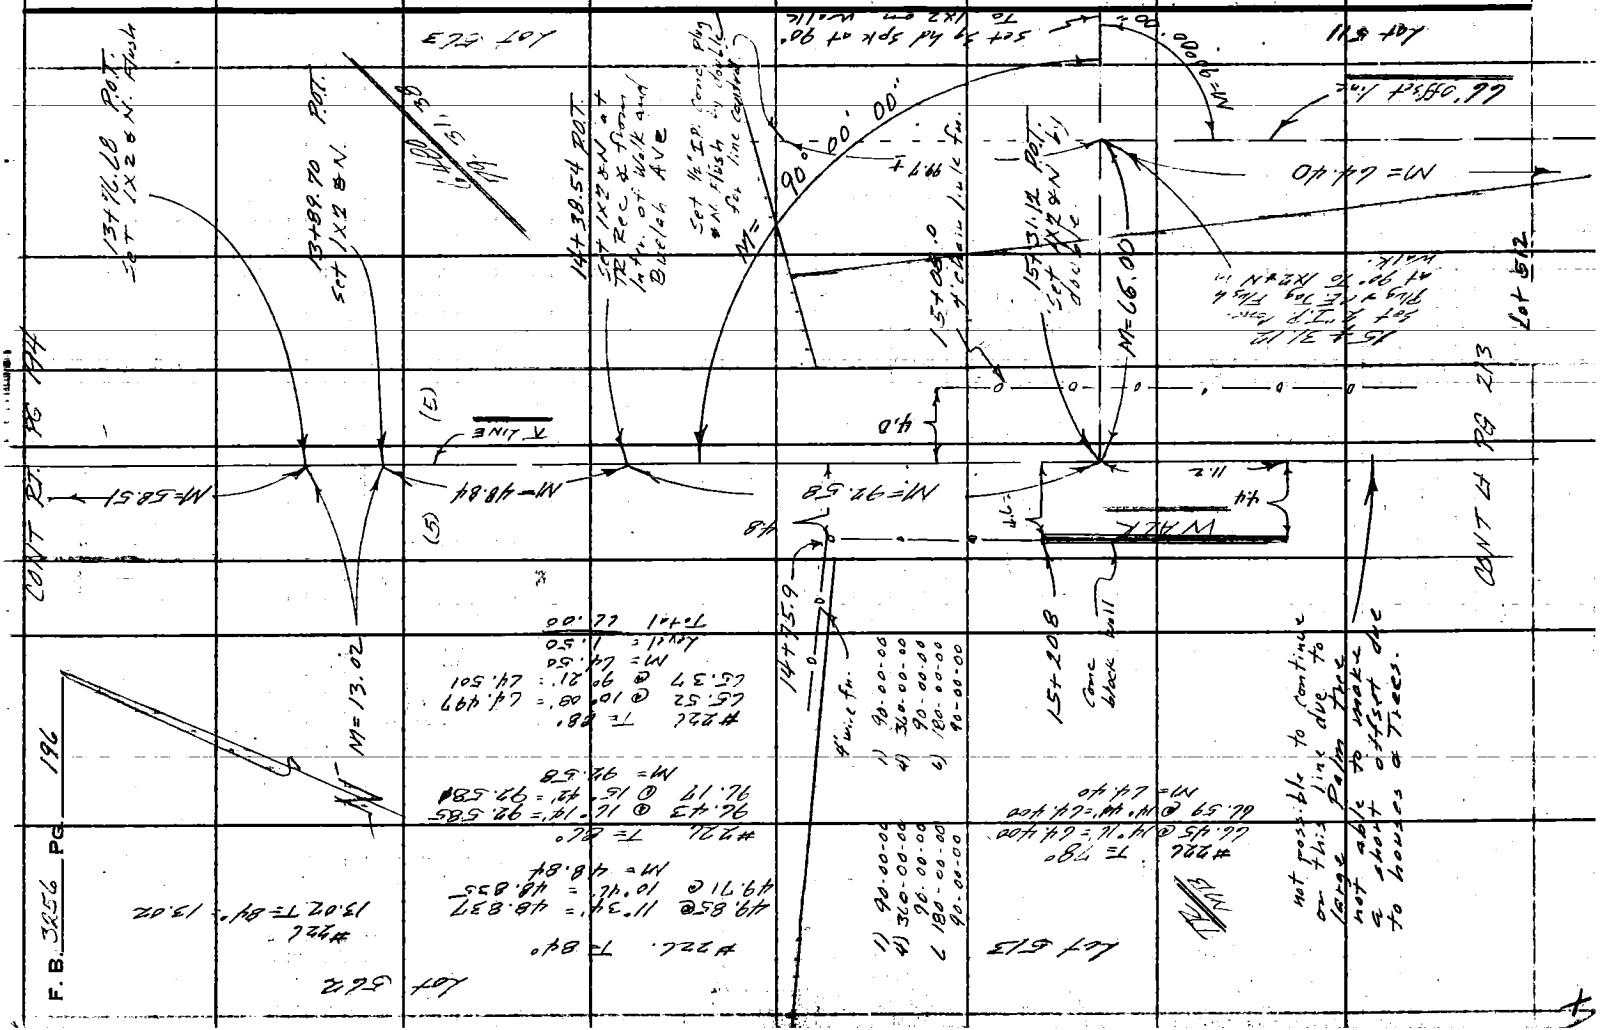
F. B. 3456 PG 196
CONT FR PG 194
CONT FR PG 213
Lot 612
Lot 613
Lot 612
Lot -1
Lot -2
Lot

76F309S S&E #247 11-58

PLEASE RETURN TO
LOS ANGELES COUNTY ENGINEER
700 LOS ANGELES COUNTY ENGINEERING BLDG.

Note: Any Additions or Changes on This Sheet Must be Made or Circled in Red Ink With Date and Name of Person Making Change.

Do not extend this side of this line.

Notes Ck'd by
Map No.
Office Work
Checked
Date

Survey of CITY TERRACE AREA
JN 0203.04 Tape KKO Std 64 °F
Surveyed by F.E. Brooks
Notes
Indexed C.L. CALL Date 4 Oct 61

F. B. 385 Pg. 127

Lot 310 | Lot 309 | Lot 308

1) 147-49-00
4) 238-39-55
147-39-58 3/4
4) 166-00-00
147-40-00

TR. N18°

147° 40' 00"

N1° E

Set L & Co. Engr Tag

Set L & Co. Engr Tag

28.375

(15) 29.075

N1° E 29.42

CONT' BUT PS 99

OF FB 3157

PL.

BONNIE BEACH

CENTER LINE

N1° E 129.39

CENTER LINE

14.30

14.00

19.08

(15)

1442.65

Fd 1½" I.P. conc plug on N. Flush with top of wall. owner says that pipe was driven over old axle

Fd nothing 3.0' elev.

Set L & Co. Engr Tag

CONC WALL

4.48 W

3.8

1496.95 P.O.T. Set 13" spk w&T at TR Rec # 169 from P.I. # 9

P.R.C.

CONT TOP PS 198

Lot 172

Lot 173

Lot 174

Lot 175

PLEASE RETURN TO
LOS ANGELES COUNTY ENGINEER
700 LOS ANGELES COUNTY ENGINEERING BLDG.

Note: Any Additions or Changes on This Sheet Must be Made or Circled in Red Ink With Date and Name of Person Making Change.

Do not extend this side of this line.

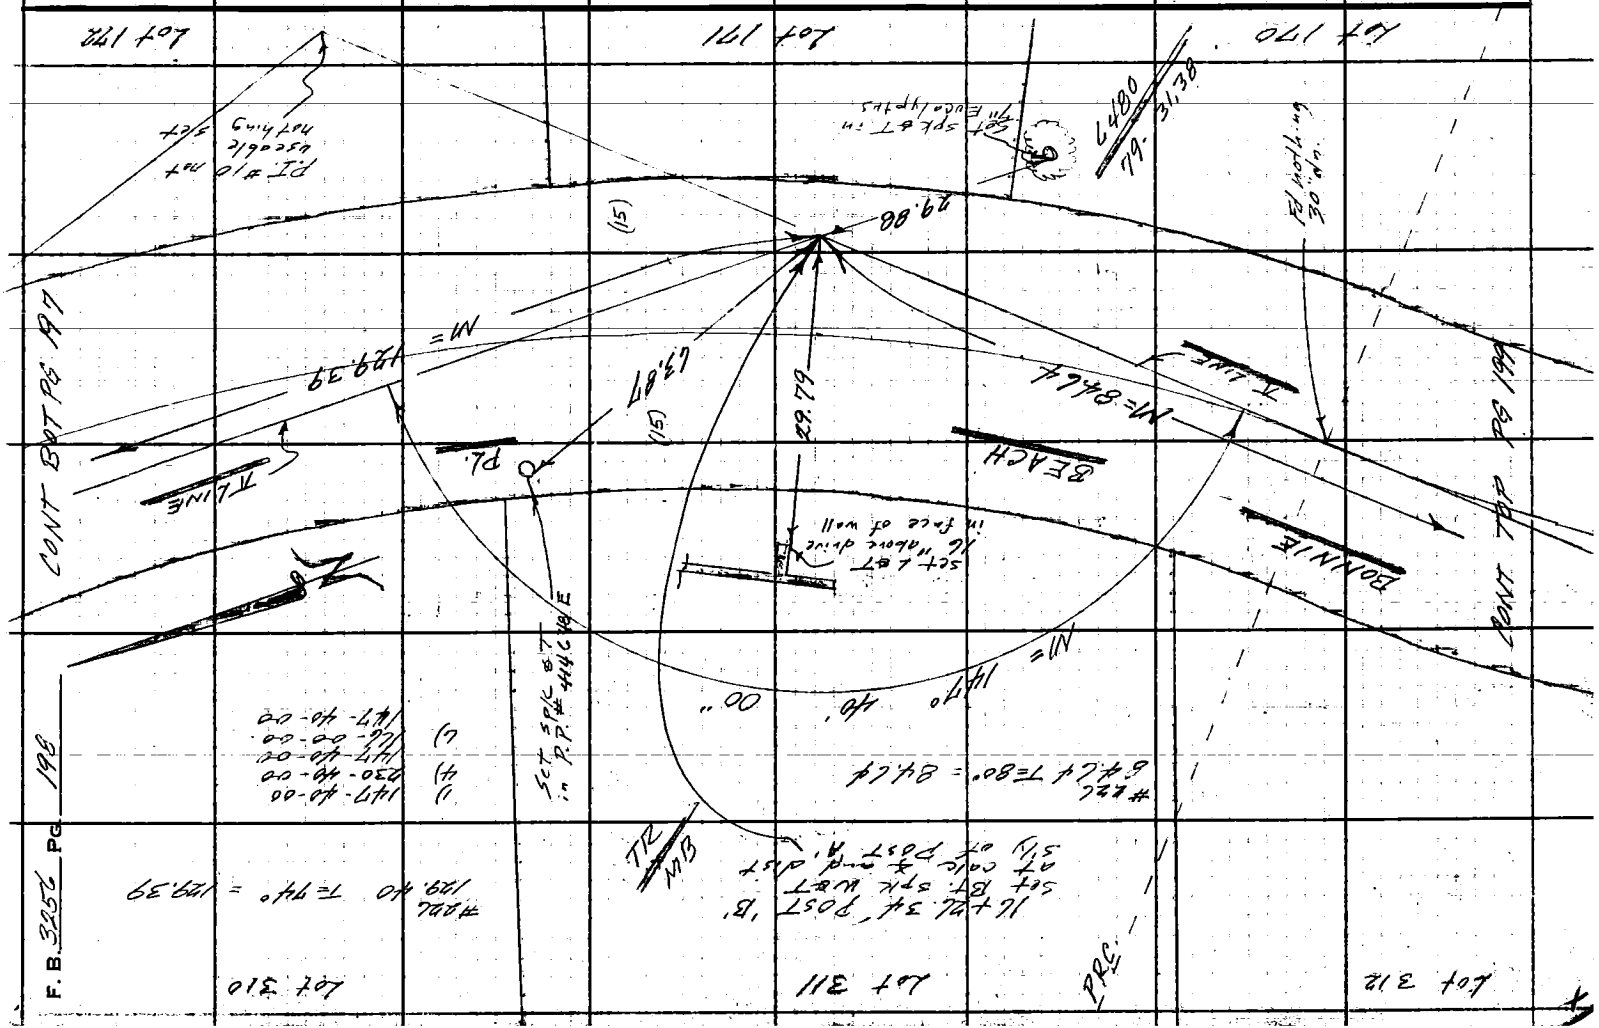
Lot 172
Lot 171
Lot 170
Lot 310
Lot 311
Lot 312
CONT SOUTH 197
TANGENT
BEACH
BOWDOIN
PRC
PT

76F3095 S&E #247 11-58

PLEASE RETURN TO
LOS ANGELES COUNTY ENGINEER
700 LOS ANGELES COUNTY ENGINEERING BLDG.

Note: Any Additions or Changes on This Sheet Must be Made or Circled in Red Ink With Date and Name of Person Making Change.

Do not extend this side of this line.

Notes Ck'd by
Map No.
Office Work
Checked
Date

Survey of CITY TERRACE HTS
JN 293.04 Tape 200 Std 64 °F
Surveyed by FEB. 13, 1965
Notes FEB. Date FEB 1965
Indexed C. J. GALLI

F. B. 3266 PG. 199

Lot 315 | Lot 314 | Lot 313 | Lot 312

1) 16-11-40
4) 64-46-40
1) 16-11-40
4) 97-10-00
16-11-40

#220
58.67 T=84°=58.67

1) 135° 40-00
4) 182-40-00
135-40-00
6) 94-00-00
135-40-00

S.M.H.

BONNIE BEACH

(150)

℄ LINE

N=144.97

N=58.67

N=84.64

℄ LINE

POINT TER PL 200

(150)

COUNT BAT 33 199

N=135° 40' 00"

17+10.98 P.T.=10
Set L.B. Co. Engr. Tag
at Face & end
dist SW'ly of
POST 'B' in Top
of S.M.H. Structure
2" below pvmt.

17+69.65
Set B.A. Spk W&T
at TR Rec'd and
dist SE'ly of
P.I. #50
Fd nothing 30" dn.

L 4800
179-31.38

Lot 168 | Lot 168 | Lot 169 | Lot 170

PLEASE RETURN TO
LOS ANGELES COUNTY ENGINEER
700 LOS ANGELES COUNTY ENGINEERING BLDG.

Note: Any Additions or Changes on This Sheet Must be Made or Circled in Red Ink With Date and Name of Person Making Change.

Do not extend this side of this line.

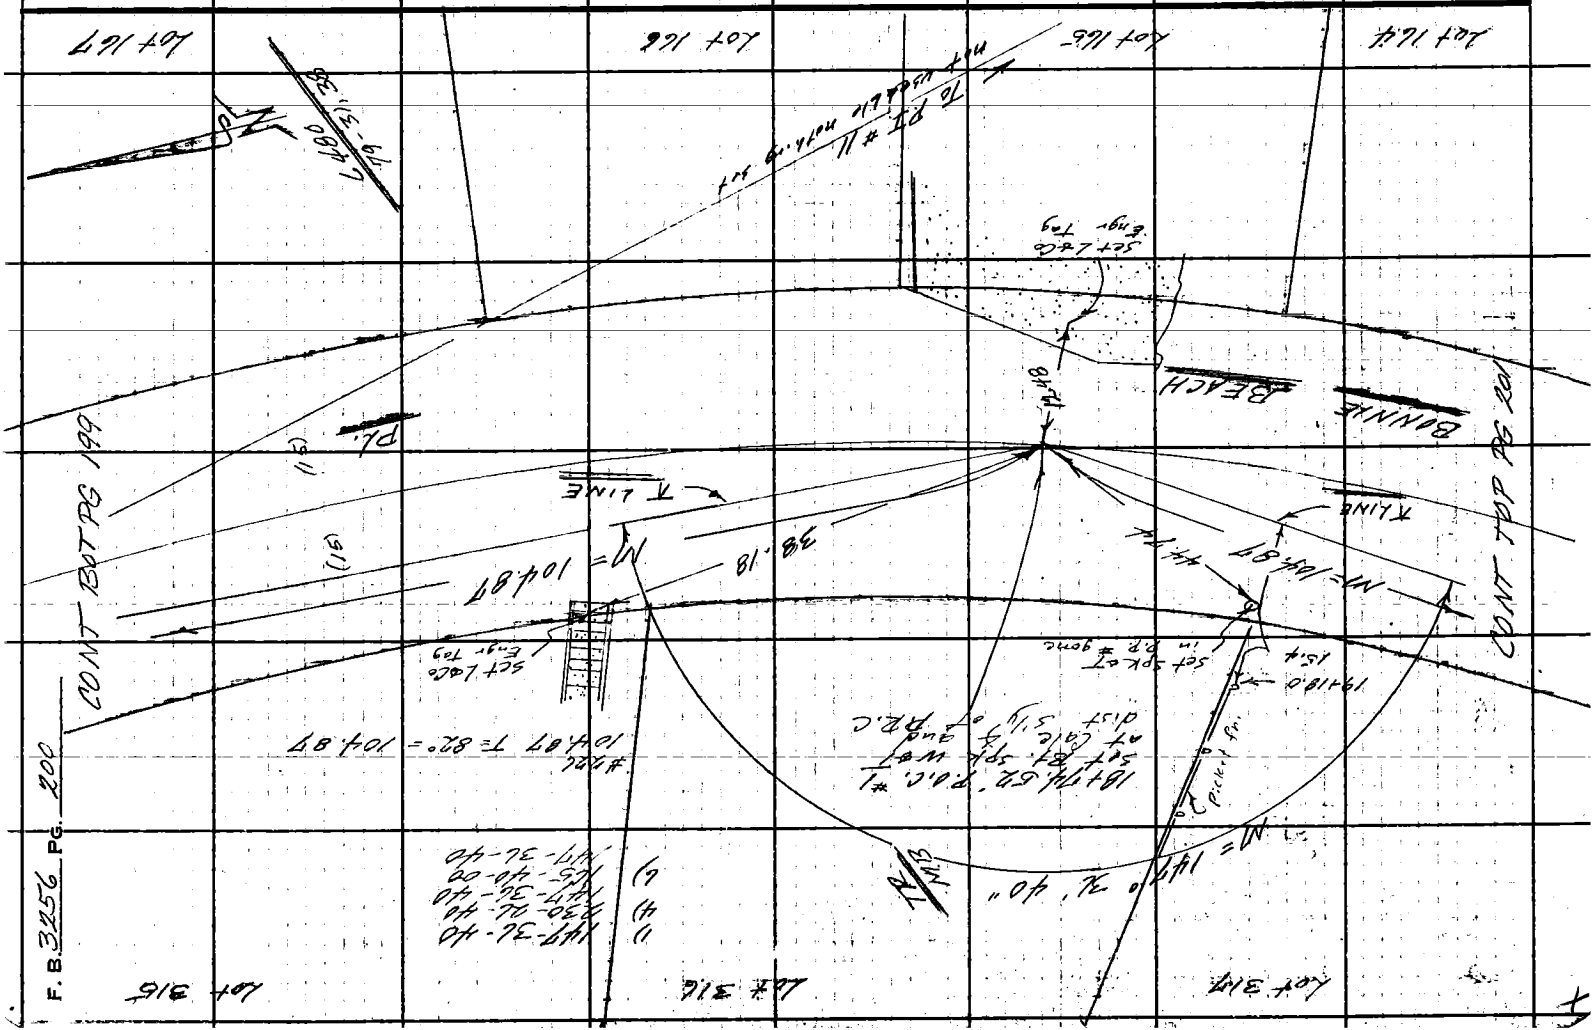

76F309S S&E #247 11-58

PLEASE RETURN TO
LOS ANGELES COUNTY ENGINEER
700 LOS ANGELES COUNTY ENGINEERING BLDG.

Note: Any Additions or Changes on This Sheet Must be Made or Circled in Red Ink With Date and Name of Person Making Change.

Do not extend this side of this line.

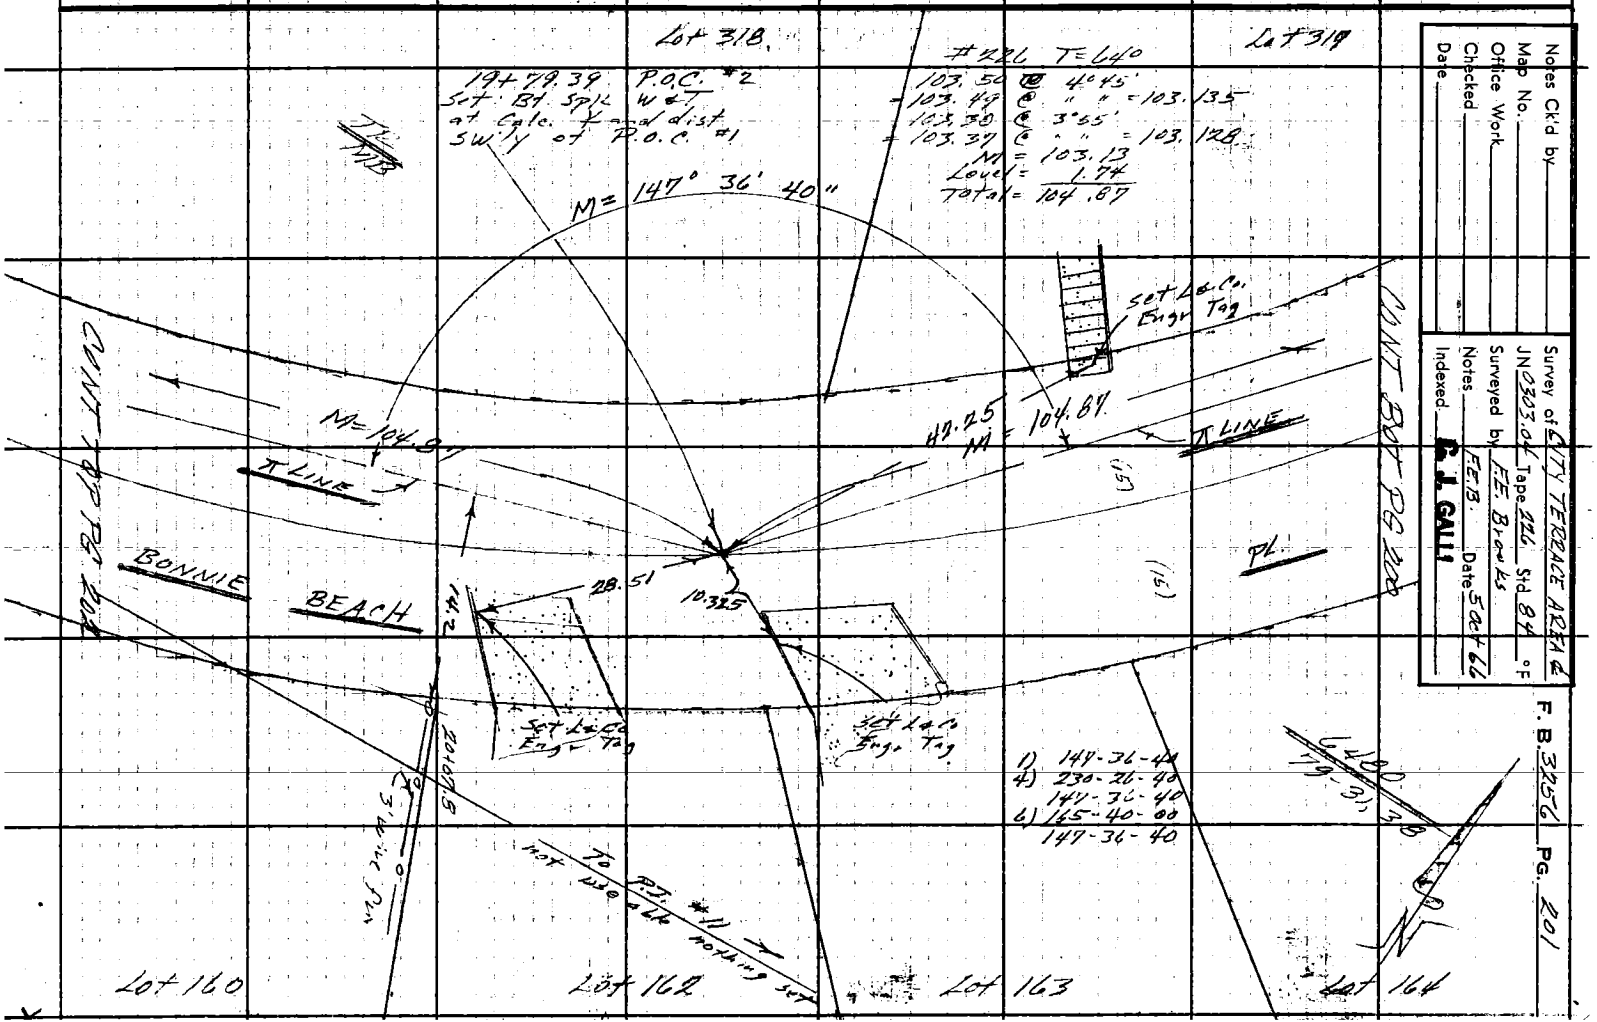

Notes Ck'd by
Map No.
Office Work
Checked
Date

Survey of CITY TERRACE AREA
JN 2303.04 Tape 22L Std 84 °F
Surveyed by F.E.B. Brooks
Notes
Indexed F. J. GALLI Date Sept 66

F. B. 3256 PG. 201

PLEASE RETURN TO
LOS ANGELES COUNTY ENGINEER
700 LOS ANGELES COUNTY ENGINEERING BLDG.

Note: Any Additions or Changes on This Sheet Must be Made or Circled in Red Ink With Date and Name of Person Making Change.

Do not extend this side of this line.

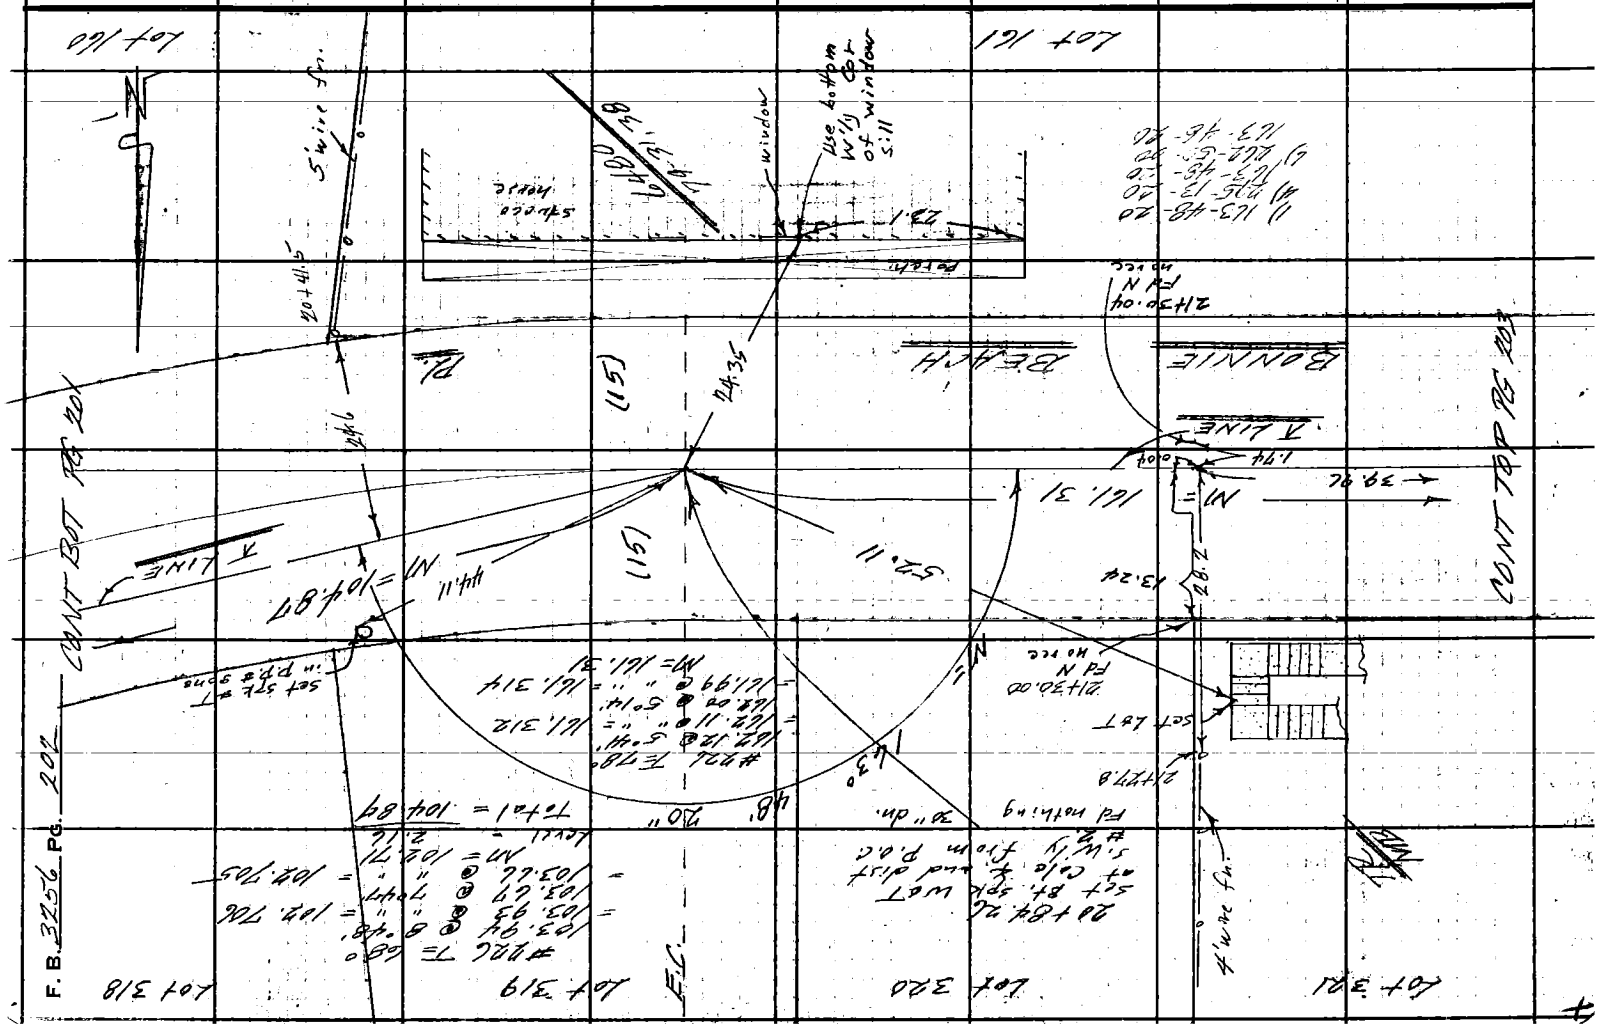

Notes Ck'd by	
Map No.	
Office Work	
Checked	
Date	

Survey of	BIT TERRACE AREA
JN	0337.01 Tape 5526 Std 34 °F
Surveyed by	FE BROOKS
Notes	FEB Date 15 SEPT 14
Indexed	C. J. GALLI

F. B. 3256 Pg. 203

Note: Any Additions or Changes on This Sheet Must be Made or Circled in Red Ink With Date and Name of Person Making Change.

Do not extend this side of this line.

PLEASE RETURN TO
LOS ANGELES COUNTY ENGINEER
700 Los Angeles County Engineering Bldg.

W.S. 7, E-1

CONT BOT PG 202

Lot 161

CONT TOP PG 205

CONT TOP PG 204

CONT BOT PG 220

Lot 484

Lot 485

BUNNE

BEACH

℄ LINE

DR.

PL.

Lot 322

Lot 323

Lot 423

℄ LINE

℄ LINE

21+70.14
Fd N.
no rec

21+84.46
Fd ExE & N
Flush no rec

5+74.44
Fd Ct Spk W & T
5" dn. P.T.
L.B. 630-140

Fd good 2X2 & Tag
L.S. 2348 BONE
Flush no tie

17+24.76 N&S
= 22+64.11 E&W
Set 2" I.P. Conc Plug
& Co. Eng. Tag
Flush by inter.
Fd nothing 24" dn

6+44.96 P.O.T.
Set Sq Lead Spk

16+66.43 P.O.T.
Set Sq Lead Spk
Stone P.T. #5

Fd No Evidence
of Ct Spk W & T
L.B. 630-142

1) 137-39-20
2) 190-13-35
3) 137-33-01 1/4
4) 105-20-00
137-33-20

1) 42-33-35
2) 250-14-10
3) 42-33-32 1/2
4) 15-21-20
42-33-33 1/2

13.27 N 90° 00' E
39.96
0.19
1.69
14.82
24.57
6.11
21.08
50.61
49.87
5.15
65.41
93.81
N = 161.31
N = 121.13
N 63° 49' E
N = 42° 33' 33"
N = 215.88
N = 18.54
N = 58.03
N = 205.38
66.07
73.09
70.25
40.09
21.79
5.49
20.11
33.
set 1/2" i.r.
Fd P.K. Nail
L.B. 630-140
Fd Ct Spk
set 1/2" i.r.
Set Ct Spk W & T
Lot 322 22+46.57 E
#226 58.04 T=42°0' = 550.07
18.54 T=6°0' = 18.54
#226 7.79 T= 18° = 3.79
set 1/2" on S.M.H
set 1/2" on S.M.H

76F3095 S&E #247 11-58

F. B. 3256 PG. 204

CONT FR PG 203

54.06

16+17.67
Fd. Ch. Spk. W&T
4" Sq. Brass
L.B. 630-142

O/S

P.L.

Lot 485

Lot 486

Lot 487

Lot 488

Lot 489

Lot 423

C 490
79°-31'-38"

A LINE

(15)

(15)

N = 203.38

#487
@ 6°22' = 203.317
@ 6°01' = 403.383
N = 403.38

204.43
204.64
204.50
204.51

157+13.49
Fd. Bk. Spk. W&T
Jones Bros. Rd. Dept
F.B. 522-80

BEACH

0.04

0.58

BONNIE

0.41

49.64

B.C.

157+12.91
Fd. Ch. Spk. W&T
4" Sq. Brass
L.B. 630-142

CONT TO PG 205

PLEASE RETURN TO
LOS ANGELES COUNTY ENGINEER
700 Los Angeles County Engineering Bldg.
Do not extend this side of this line.

Note: Any Additions or Changes on This Sheet Must be Made or Circled in Red Ink With Date and Name of Person Making Change.

76F309S S&E #247 11-58

PLEASE RETURN TO
LOS ANGELES COUNTY ENGINEER
700 LOS ANGELES COUNTY ENGINEERING BLDG.

Note: Any Additions or Changes on This Sheet Must be Made or Circled in Red Ink With Date and Name of Person Making Change.

Do not extend this side of this line.

Notes Ck'd by
Map No.
Office Work
Checked
Date

Survey of COUNTY TERRACE PARK
JN 0303. Tape 22½ Std 64 °F
Surveyed by FEB. Date 10-30-64
Notes C. J. GALLI
Indexed

Lot 492 | Lot 491 | Lot 490 | Lot 489

P.R.C.

1) 168-10-00
4) 312-40-00
5) 168-10-00
6) 289-00-00
168-10-00

#226
R=49.76 T=76.49

168° 10' 00"

N=

1) 15-00-00
4) 60-00-00
5) 15-00-00
6) 90-00-00
15-00-00

1463.27
Ft. N 45° 49' 30" E. from Mon. #5

1463.35 Pt. #5
Set Bt. Spk W
of Calc. & and
TR Rec. Dist. from
P.R.C. to S.E.

Set Spk & T
P.P. #805010E

N=15° 10' 00"

MONT TOP

T LINE

N=149.70

To P.T. # of nothing set

BONNIE BEACH

1411.6

0.06

T LINE

0.30

0.08

N=49.76

0.04

N=249.48

49.64

T LINE

1413.59
Set Bt. Spk W & T
at Calc. & and
Dist. 10 1/4 of
P.O.C. #5.

Ft. Ft. Spk
Lost #5 Dist.
Pt. N.B. 630-142
Found nothing else
To dig in.

6400
rig. 31,35

Lot 425 | Lot 424 | Lot 423

F. B. 322-4 PG. 22-5

COUNTY BOT. RS 204

PLEASE RETURN TO
LOS ANGELES COUNTY ENGINEER
700 LOS ANGELES COUNTY ENGINEERING BLDG.

Do not extend this side of this line.

Note: Any Additions or Changes on This Sheet Must Be Made or Circled in Red Ink With Date and Name of Person Making Change.

F. B. 3256 PG. 102

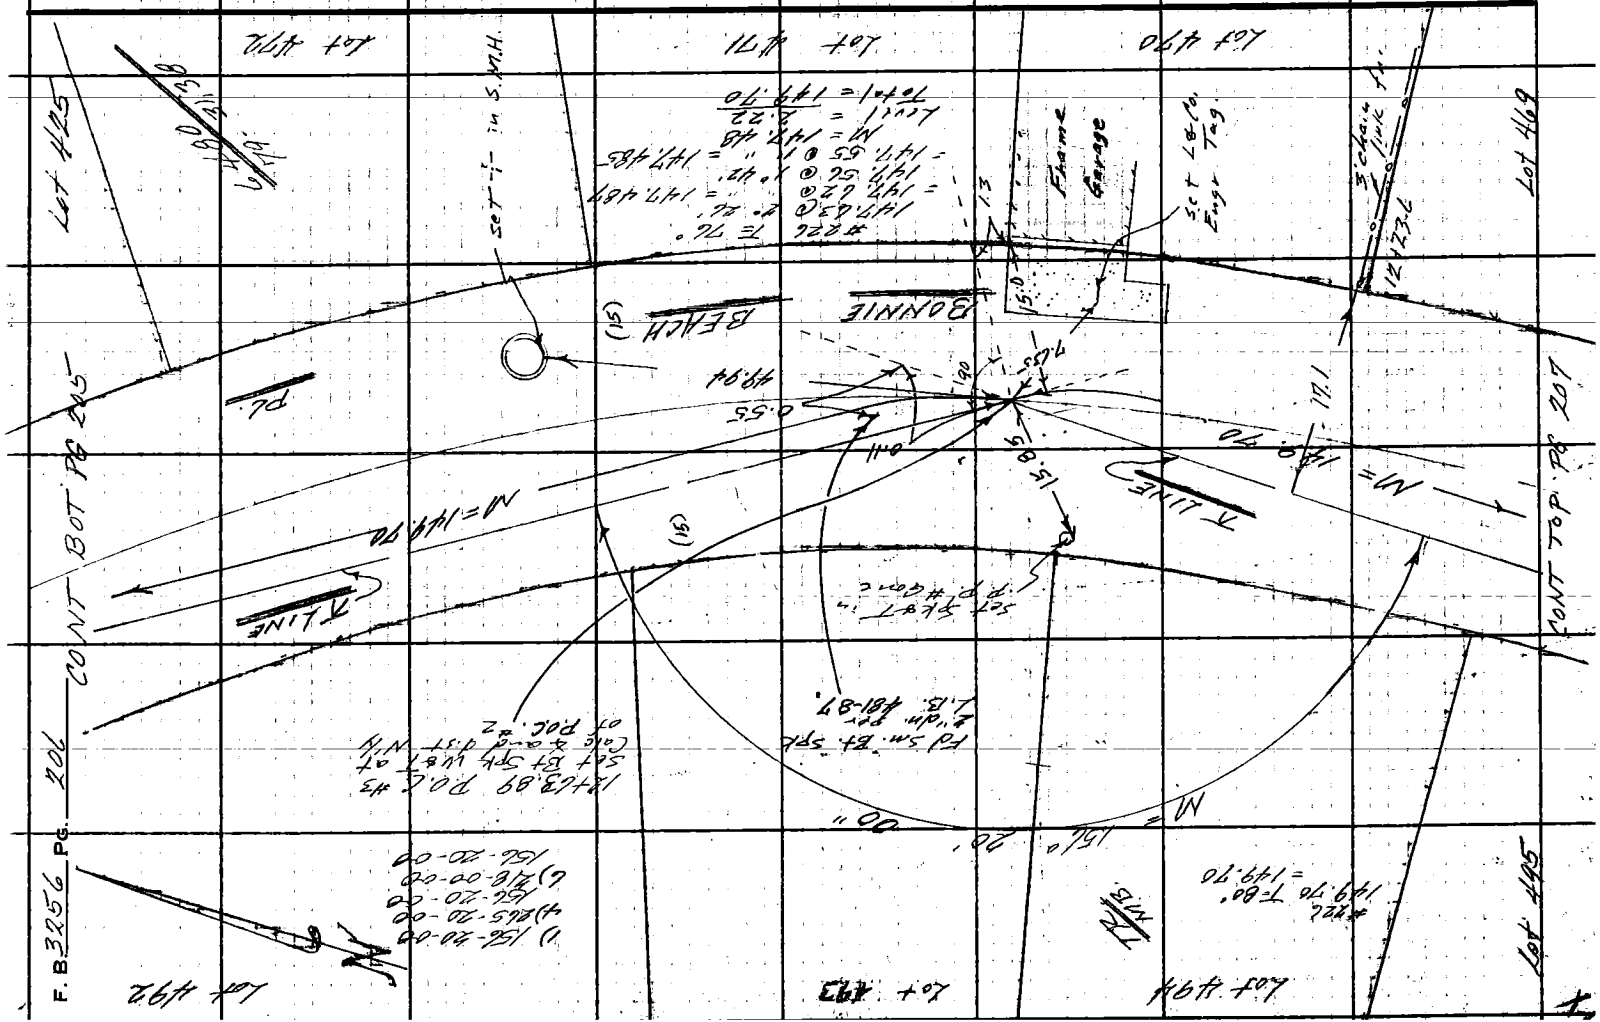
BEACH (15)
BONNIE
A LINE
N = 149.70

76F309S S&E #247 11-58

PLEASE RETURN TO
LOS ANGELES COUNTY ENGINEER
700 LOS ANGELES COUNTY ENGINEERING BLDG.

Note: Any Additions or Changes on This Sheet Must be Made or Circled in Red Ink With Date and Name of Person Making Change.

Do not extend this side of this line.

Lot 497 | Lot 496 | Lot 495

1) 156-20-00
4) 265-19-55
156-19-58¾
6) 218-00-00
156-20-00

Notes Ck'd by
Map No.
Office Work
Checked
Date

Survey of CITY TERRACE AREA
JN 0307 dk Tape 226 Std. 80 °F
Surveyed by F.E. Brooks
Notes F.E.B. Date 8/56 + 4/57
Indexed G.L. GALLI

F. B. 32856 PG. 20

226
149.971 T=76°=149.70

N= 156° 20' 00"

Set spk & T in P.P. # gone

BONNIE BEACH

℄ LINE

N= 149.70

17.52

27.78

(15)

PL.

PONT TOT PS 200

PONT BOT PS 200

Set spk & T in P.P. #26

11+14.18 POC #2
Set Bt. spk W&T at Pic X-ing Dist. N'ly of P.O.C. #1 Fd Ms evidenced by Bt. spk per L.B. 481-87

L 480
179-31.38

Lot 466 | Lot 467 | Lot 468 | Lot 469

PLEASE RETURN TO
LOS ANGELES COUNTY ENGINEER
700 LOS ANGELES COUNTY ENGINEERING BLDG.

Note: Any Additions or Changes on This Sheet Must Be Made or Circled in Red Ink With Date and Name of Person Making Change.

Do not extend this side of this line.

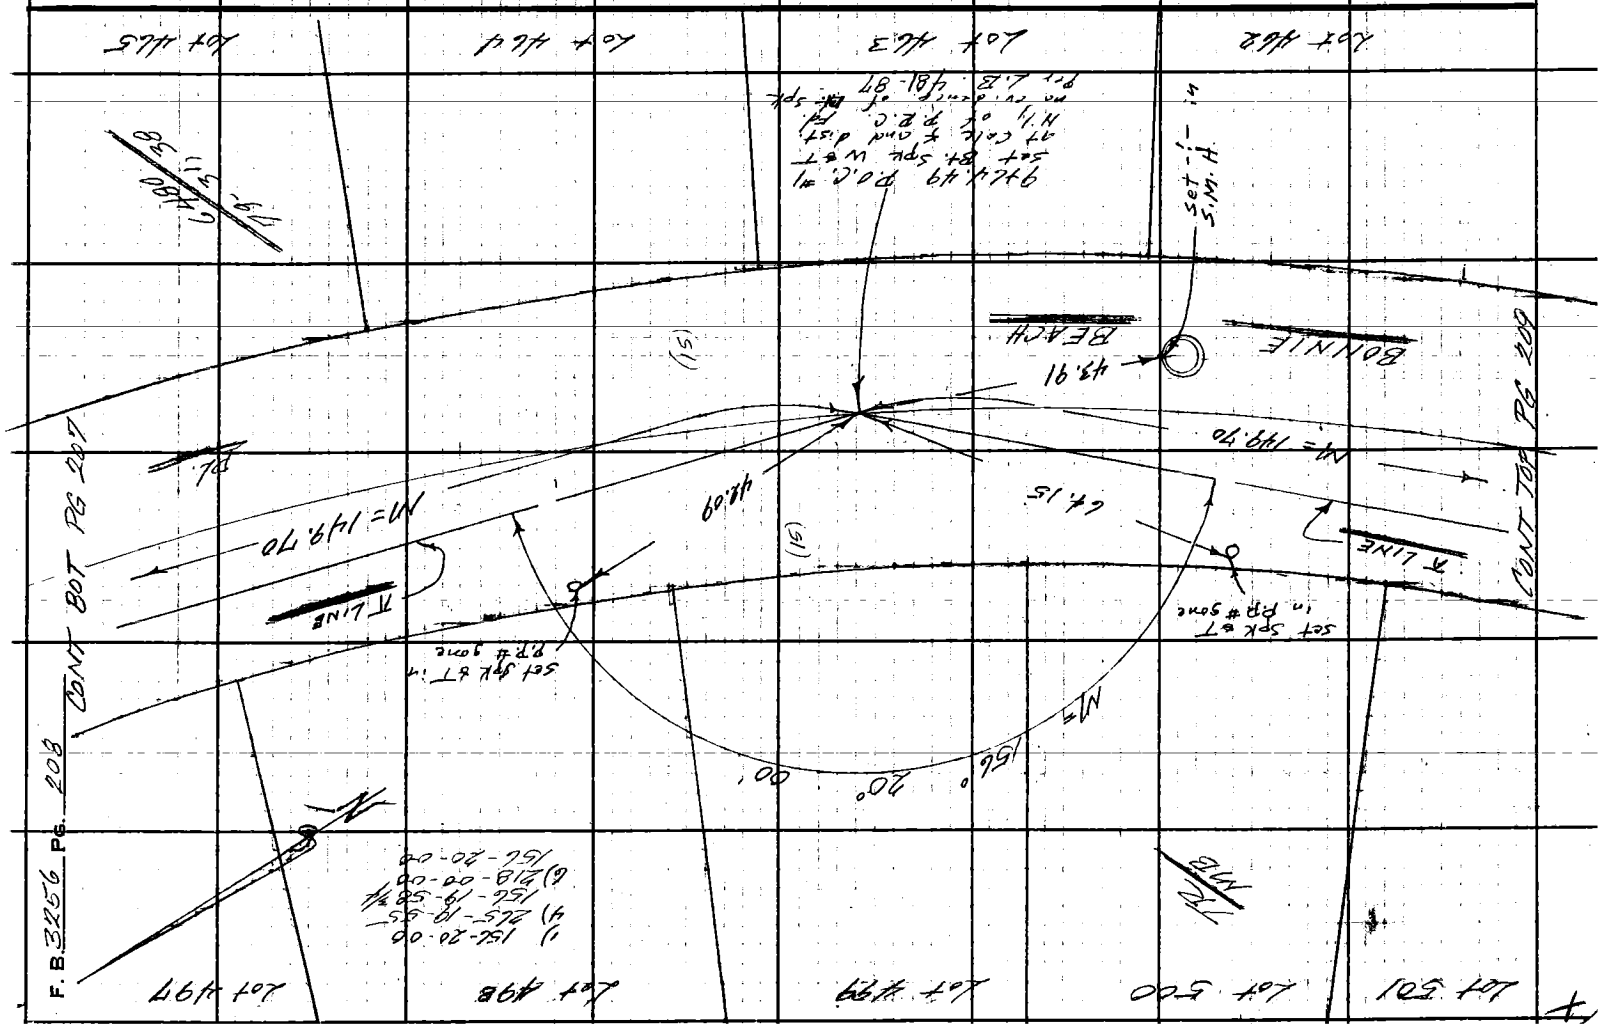

F.B. 3456 Pg. 208

76F3095 S&E #247 11-58

PLEASE RETURN TO
LOS ANGELES COUNTY ENGINEER
700 LOS ANGELES COUNTY ENGINEERING BLDG.

Note: Any Additions or Changes on This Sheet Must be Made or Circled in Red Ink With Date and Name of Person Making Change.

Do not extend this side of this line.

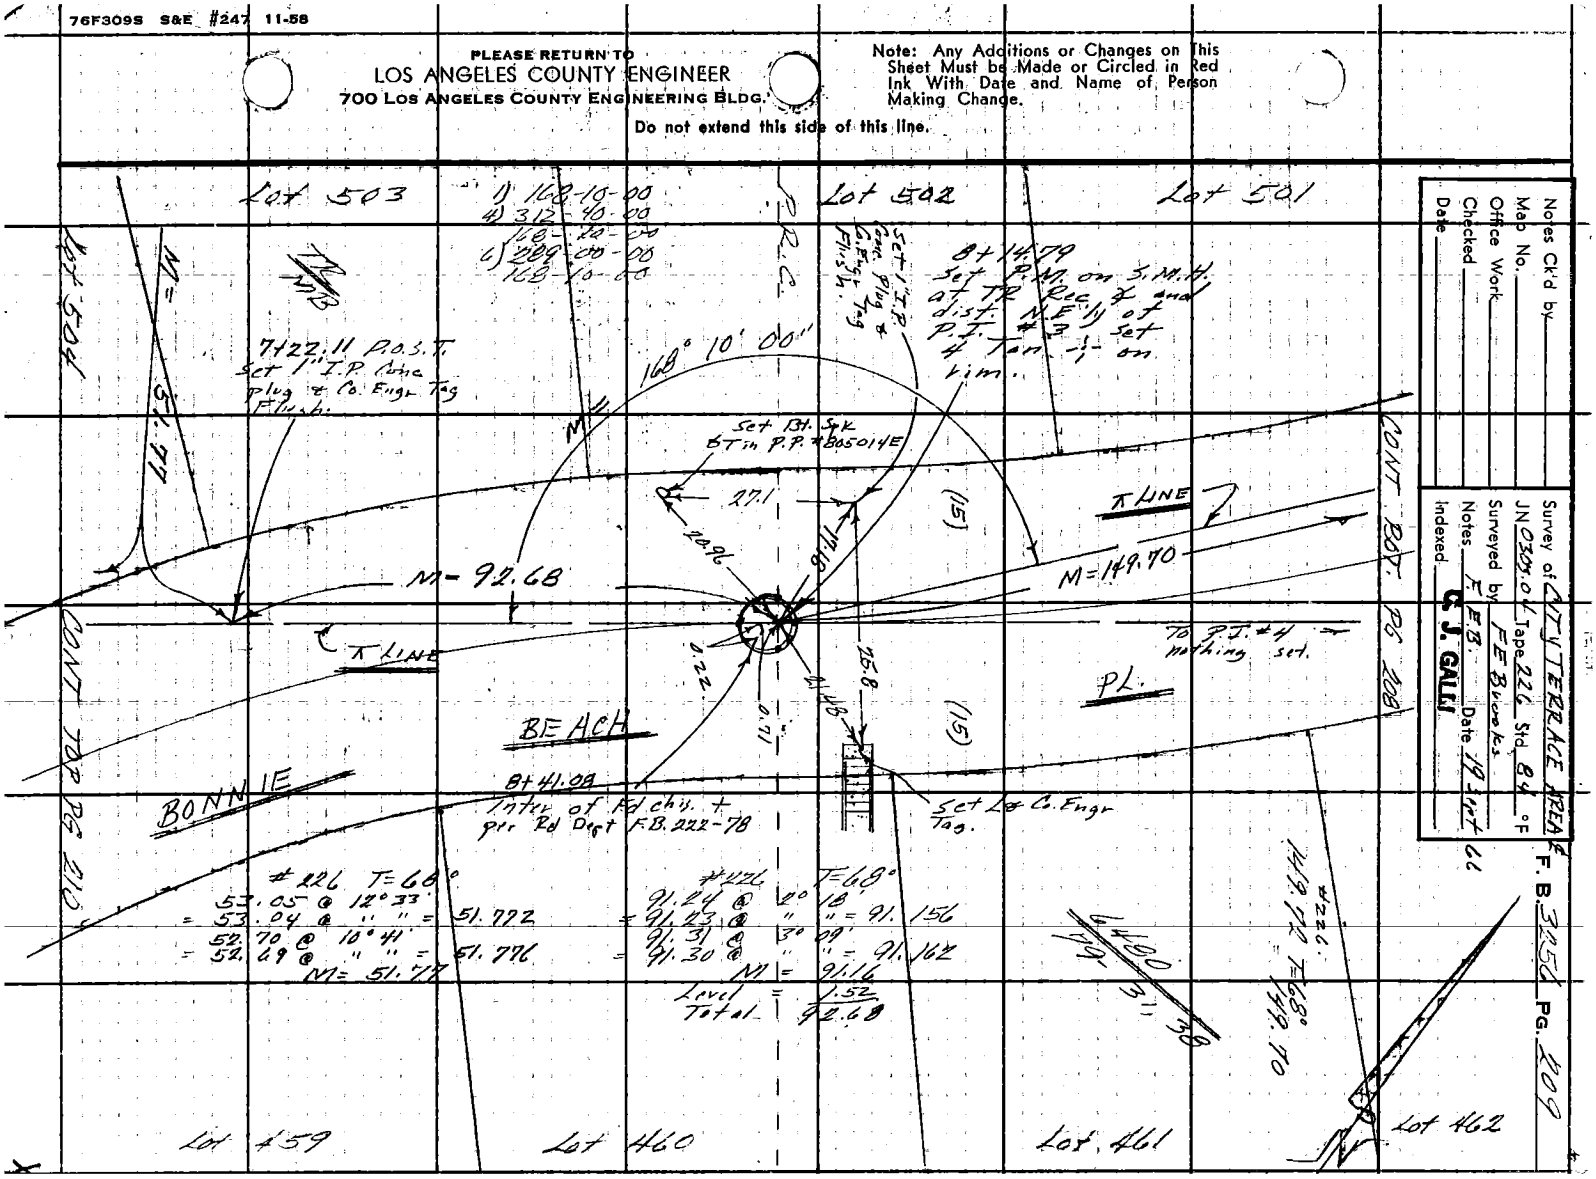

PLEASE RETURN TO
LOS ANGELES COUNTY ENGINEER
700 LOS ANGELES COUNTY ENGINEERING BLDG.

Note: Any Additions or Changes on This Sheet Must be Made or Circled in Red Ink With Date and Name of Person Making Change.

Do not extend this side of this line.

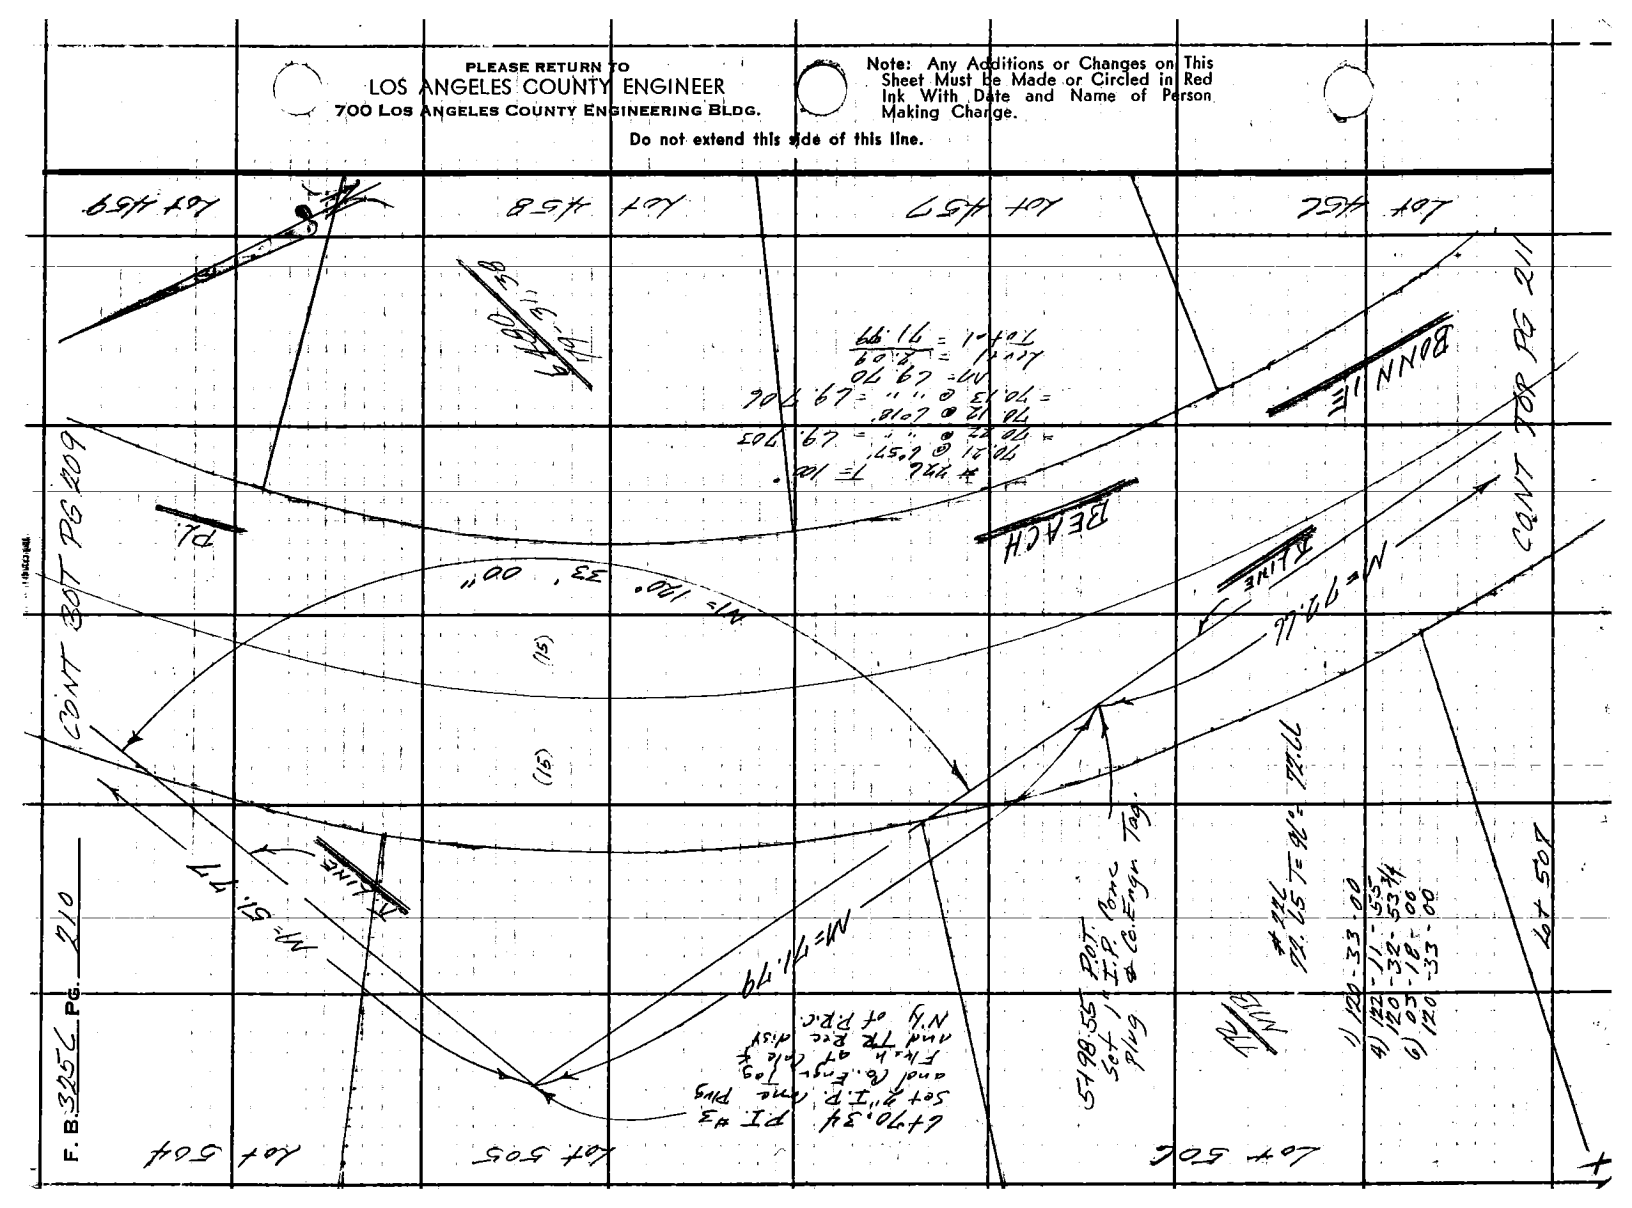

76F309S S&E #247 11-58

PLEASE RETURN TO
LOS ANGELES COUNTY ENGINEER
700 LOS ANGELES COUNTY ENGINEERING BLDG.

Note: Any Additions or Changes on This Sheet Must be Made or Circled in Red Ink With Date and Name of Person Making Change.

Do not extend this side of this line.

Notes Ck'd by
Map No.
Office Work
Checked
Date

Survey of CITY TERRACE ADD'N F. B. 32 PG. 21
JN 2307.04 Tape 22L Std. 64 °F
Surveyed by F.E. Brooks
Notes
Indexed Date 6 Sept 64
E. J. GALL

Lot 509 | Lot 508 | Lot 507

CONT TOP PG 2½

BONNIE BEACH

℄ LINE

M = 105.73

(15)

0.4±

M = 164° 40' 01"

5+25.78
Fd 2x2 ⊥ N
2" dm. no rec

P.C.

0.11

13.8±

0.02

(15)

PL.

0.17

M = 112.66

Set Bt. Spk & T in P.P. #1168550E

Fd sm. Bt. Spk 3" dn. per L.B. 481-89
Fd nothing else 30" dm.

1) 164-40-00
4) 298-40-00
164-40-00
6) 268-00-10
164-40-01 ½

CONT BOT PG 2½0

℄ LINE

4.535

14.3

(15)

19.7

20.40

4' Chain link fn.

4+89.7

Set ℄ & Co. Eng. Tag

#226
104.25
104.45

T = 90°
@ 4°44' = 103.59
@ 5°50' = 103.90

M = 103.90
Level = 1.83
Total = 105.73

5+25.09
Set Bt. Spk W&T at Calc. dist #4'B' N'ly of P.C.

Set +/- in S.M.H.

5+37.6

Conc block wall

6480 Y-31, 38

Lot 454 | Lot 455 | Lot 456

PLEASE RETURN TO
LOS ANGELES COUNTY ENGINEER
700 LOS ANGELES COUNTY ENGINEERING BLDG.

Note: Any Additions or Changes on This Sheet Must be Made or Circled in Red Ink With Date and Name of Person Making Change.

Do not extend this side of this line.

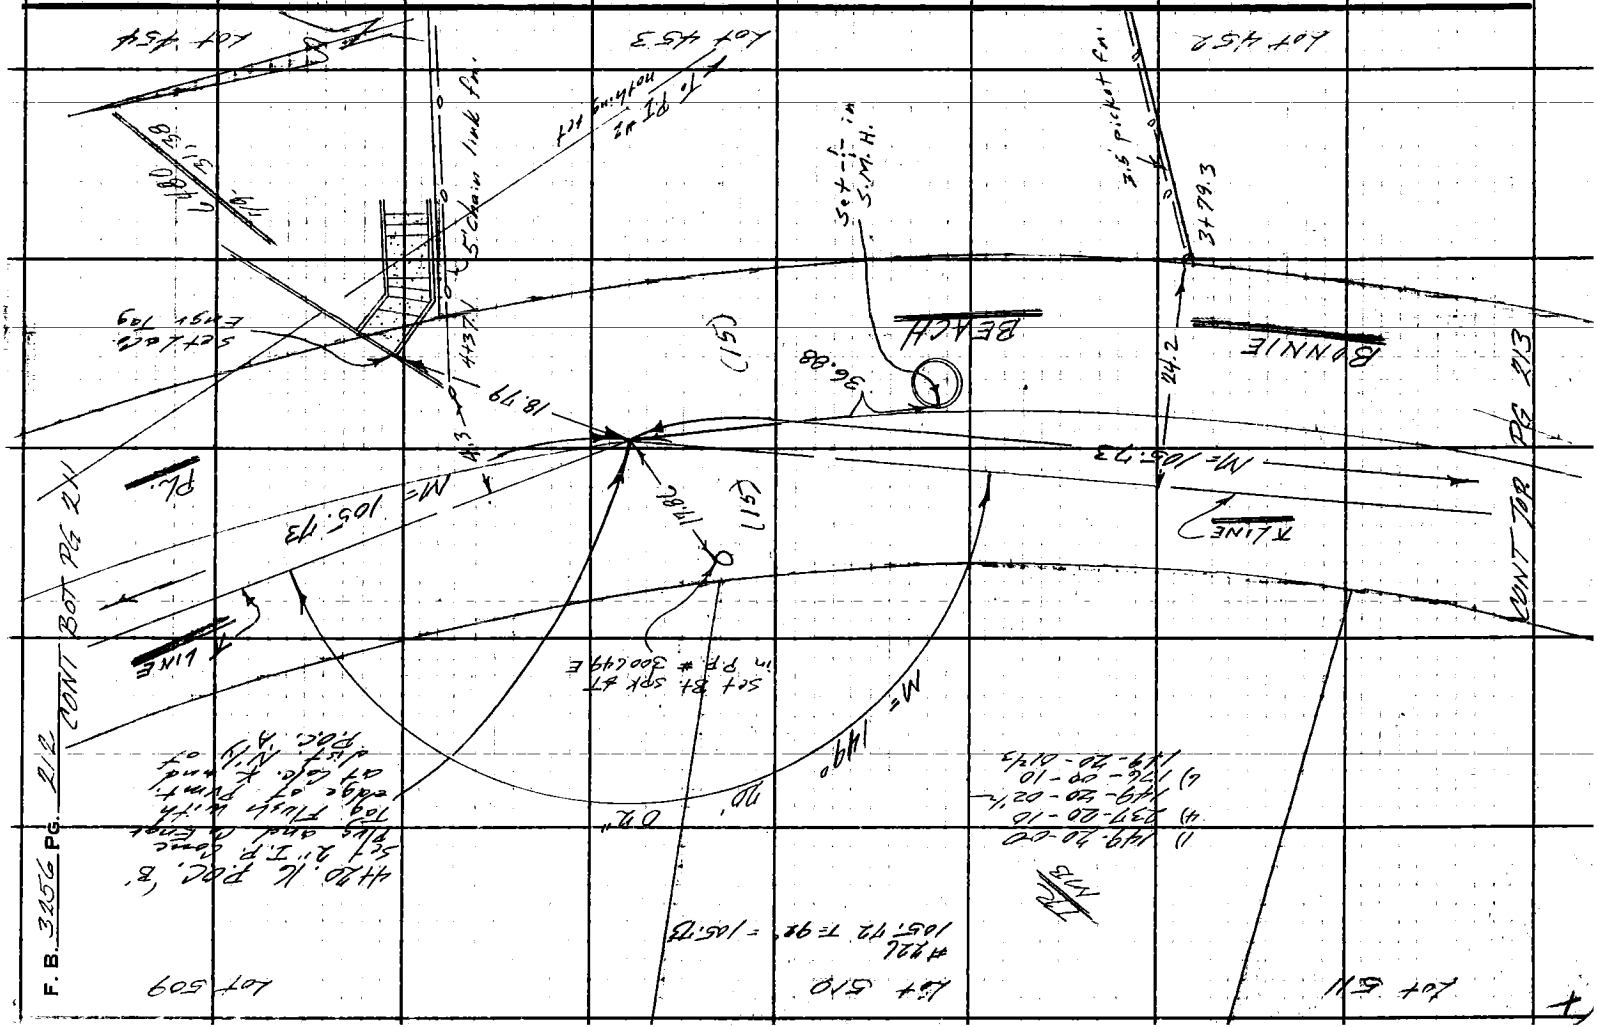

76F3095 S&E #247 11-58

PLEASE RETURN TO
LOS ANGELES COUNTY ENGINEER
700 LOS ANGELES COUNTY ENGINEERING BLDG.

Do not extend this side of this line.

Note: Any Additions or Changes on This Sheet Must be Made or Circled in Red Ink With Date and Name of Person Making Change.

W.S. 7, E-1

Notes Ck'd by
Map No.
Office Work
Checked
Date

Survey of CITY TERRACE ADDN
JN 2303-04 Tape 22L Std 64 °F
Surveyed by FE Brooks
Notes
Indexed S. L. GALLI Date 8 Sept 64

F. B. 3266 Pg. 213

CONT BOT PG. 196 Lot 513 not possible to run this line due to large Palm tree

Conc Garage

(5) (5)

W. ALLE

Hedge Fence

N 14°08' W 114.92

96

CONT TOP PG 214

Lot 513

Lot 602

Lot 603

Lot 512

Bf 99.63 Rd remains of 2X2 no N Flush no rec.

N 23 1/2" E P.P. with N. in top of wall

#226 101.63 T=84° =101.63

4.10 T=84°=4.10

11.86 T=84°=11.86

M=99.63

BONNIE

11.7

M=101.63

CONT BOT PG 196 Lot 511

#226 47.63 T=90° =47.63

66' Offset LINE

M=149.20

157 95.52 P.O.T. Set Bf. Spk W&T

M=64.40

0.78 W

M=11.86

℄ LINE

BEACH

31.45

11.86

M=4.10

M=105.73

PL

(15)

CONT BOT PG 212 Lot 452

3+14.43 POC 'A' Set Bf. Spk W&T of Calc & and dist from Edn. Rd Nothing 12" dn.

C 480 19.31, 38

To PJ

Set L&C Engr Tag 1104 Lying Set

3+10.33 F&W = 16+07.38 from N Set Bf. Spk W&T by interp.

1888

DOBINSON

15.3

Set 1" in S.M.H.

15.2

1) 94-58-20
4) 19-53-20
94-58-20
6) 209-49-55
94-58-19 1/2

4+42.2

Conc Block Wall

4+02.8

Chain link fn.

1) 149-20-56
4) 237-20-10
149-20-02 1/2
6) 176-00-10
149-20-01 1/2

3+63.2 Chain link fn.

15.11

14.9

M=120.89

M=7.60

3+63.6 Rd remains of 2X2 flush no rec

(15)

57.

Lot 602

Lot 601

Lot 600

CONT BOT PG 213

PLEASE RETURN TO
LOS ANGELES COUNTY ENGINEER
700 LOS ANGELES COUNTY ENGINEERING BLDG.

Note: Any Additions or Changes on This Sheet Must be Made or Circled in Red Ink With Date and Name of Person Making Change.

Do not extend this side of this line.

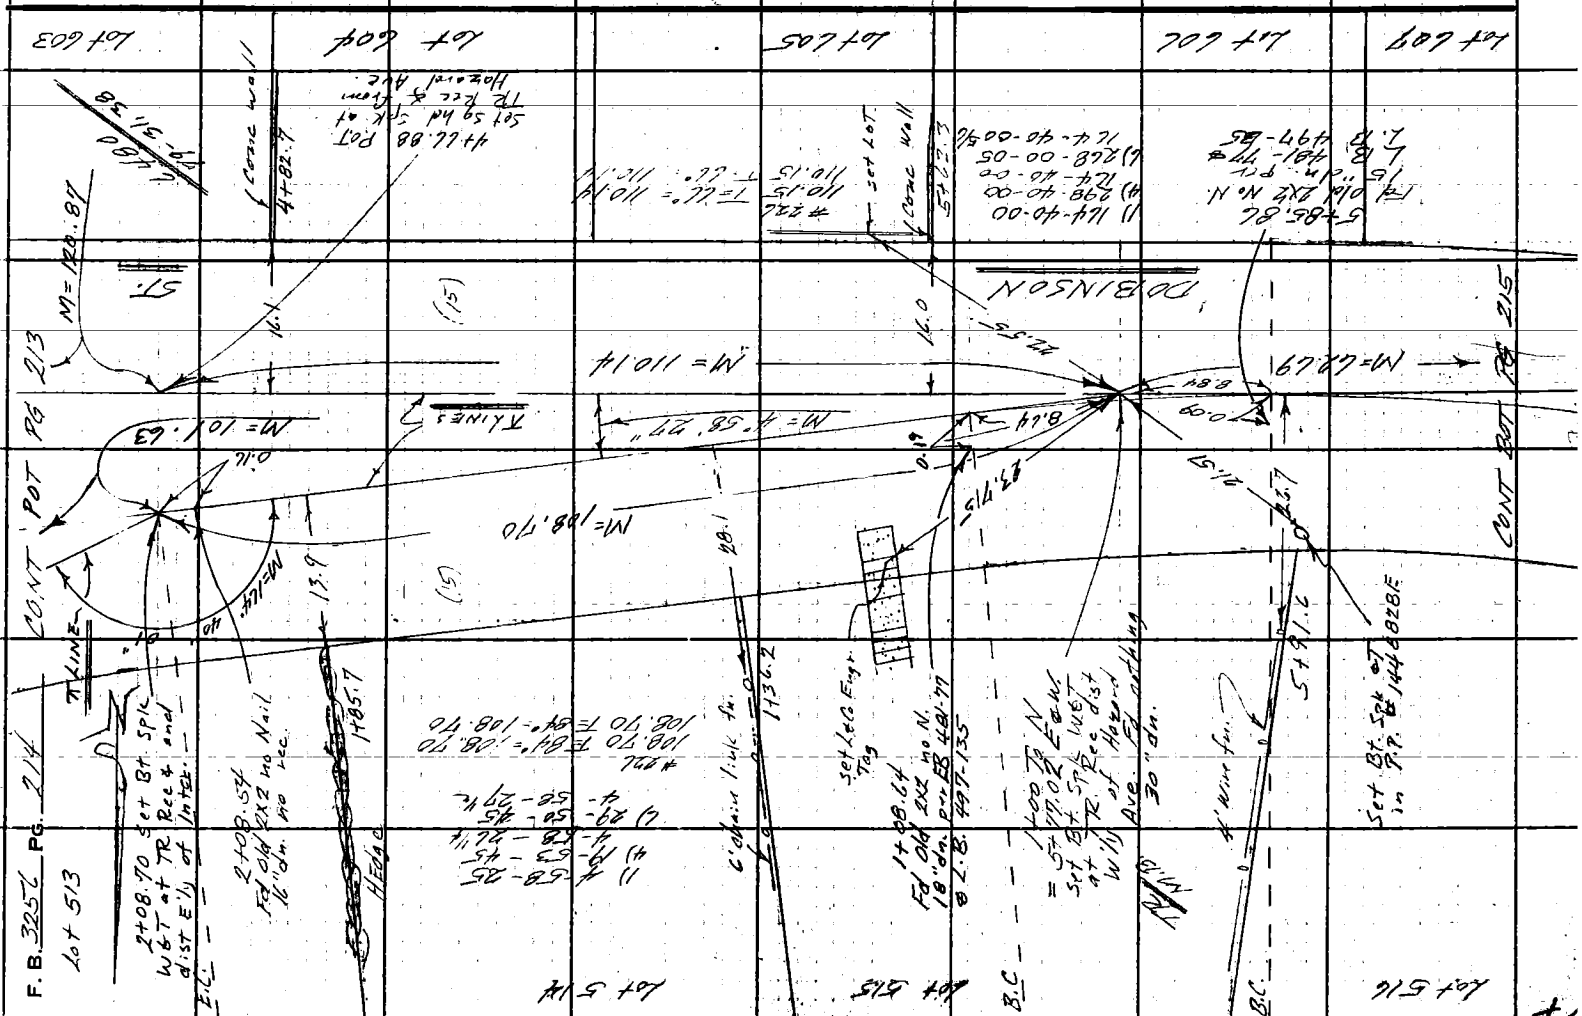

Notes Ck'd by
Map No.
Office Work
Checked
Date

Survey of CITY TERRACE AREA F. B. 3251 PG. 215
JN 0303 04 Tape 296 Std. 84 °F
Surveyed by F E Brooks
Notes F E B Date 12 Sept 61
Indexed C. J. GALLI

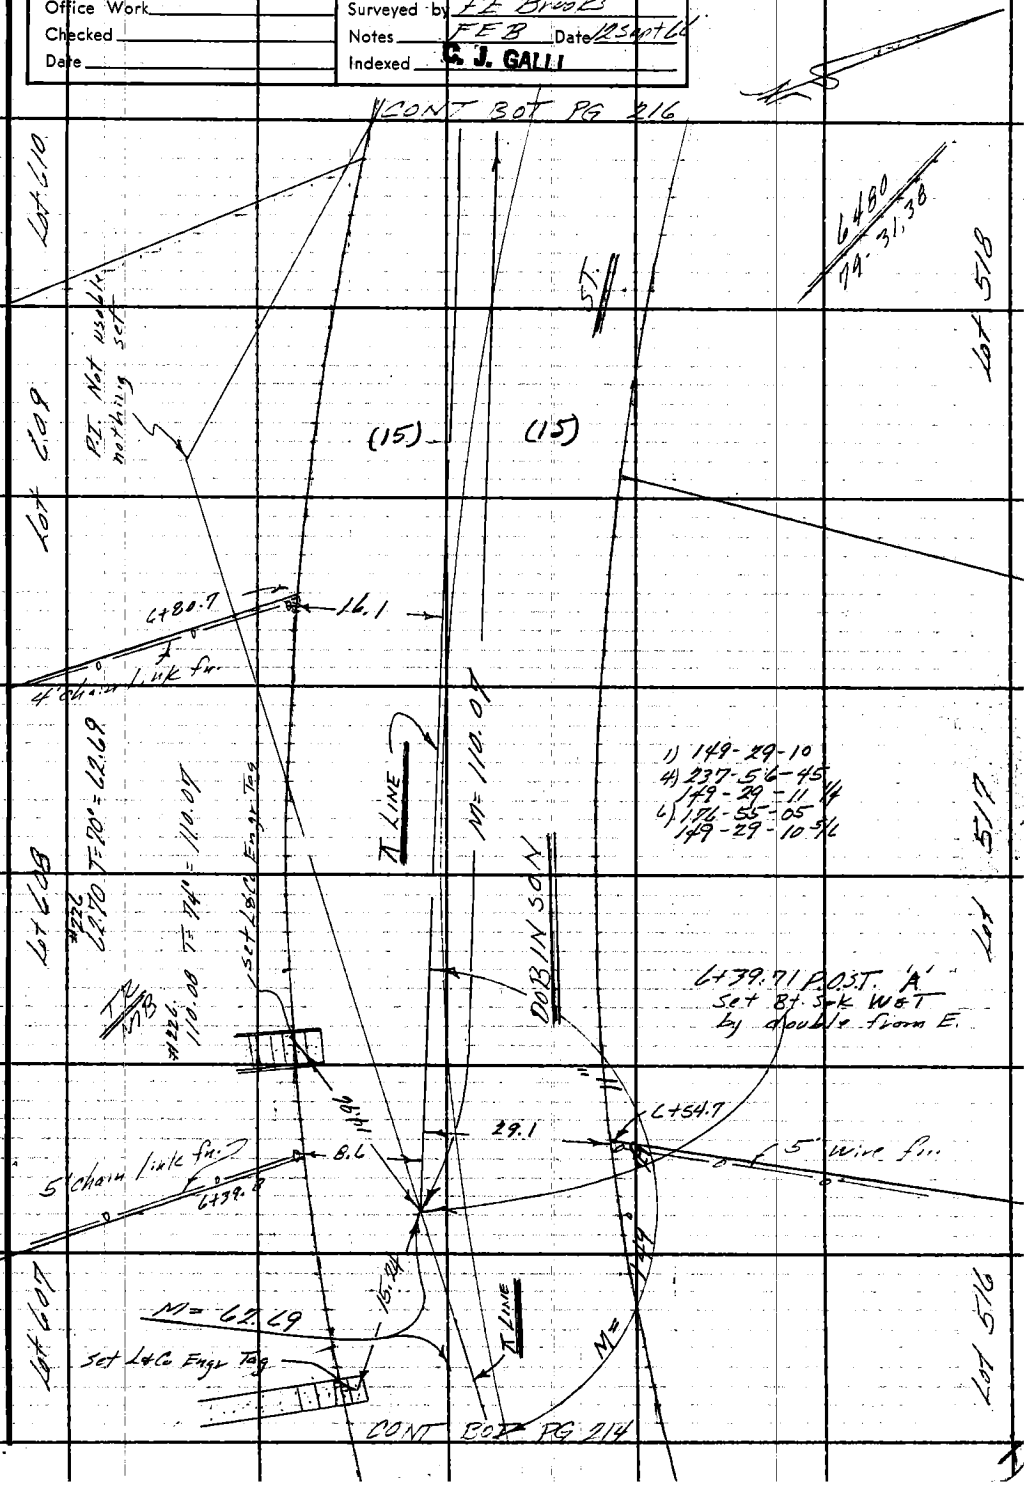

Note: Any Additions or Changes on this Sheet Must be Made or Circled in Red Ink With Date and Name of Person Making Change.

Do not extend this side of this line.

PLEASE RETURN TO
LOS ANGELES COUNTY ENGINEER
403 Los Angeles County Engineering Bldg.

76F309S CE # 310 3-61

PLEASE RETURN TO
LOS ANGELES COUNTY ENGINEER
403 LOS ANGELES COUNTY ENGINEERING BLDG.

Note: Any Additions or Changes on This Sheet Must be Made or Circled in Red Ink With Date and Name of Person Making Change.

Do not extend this side of this line.

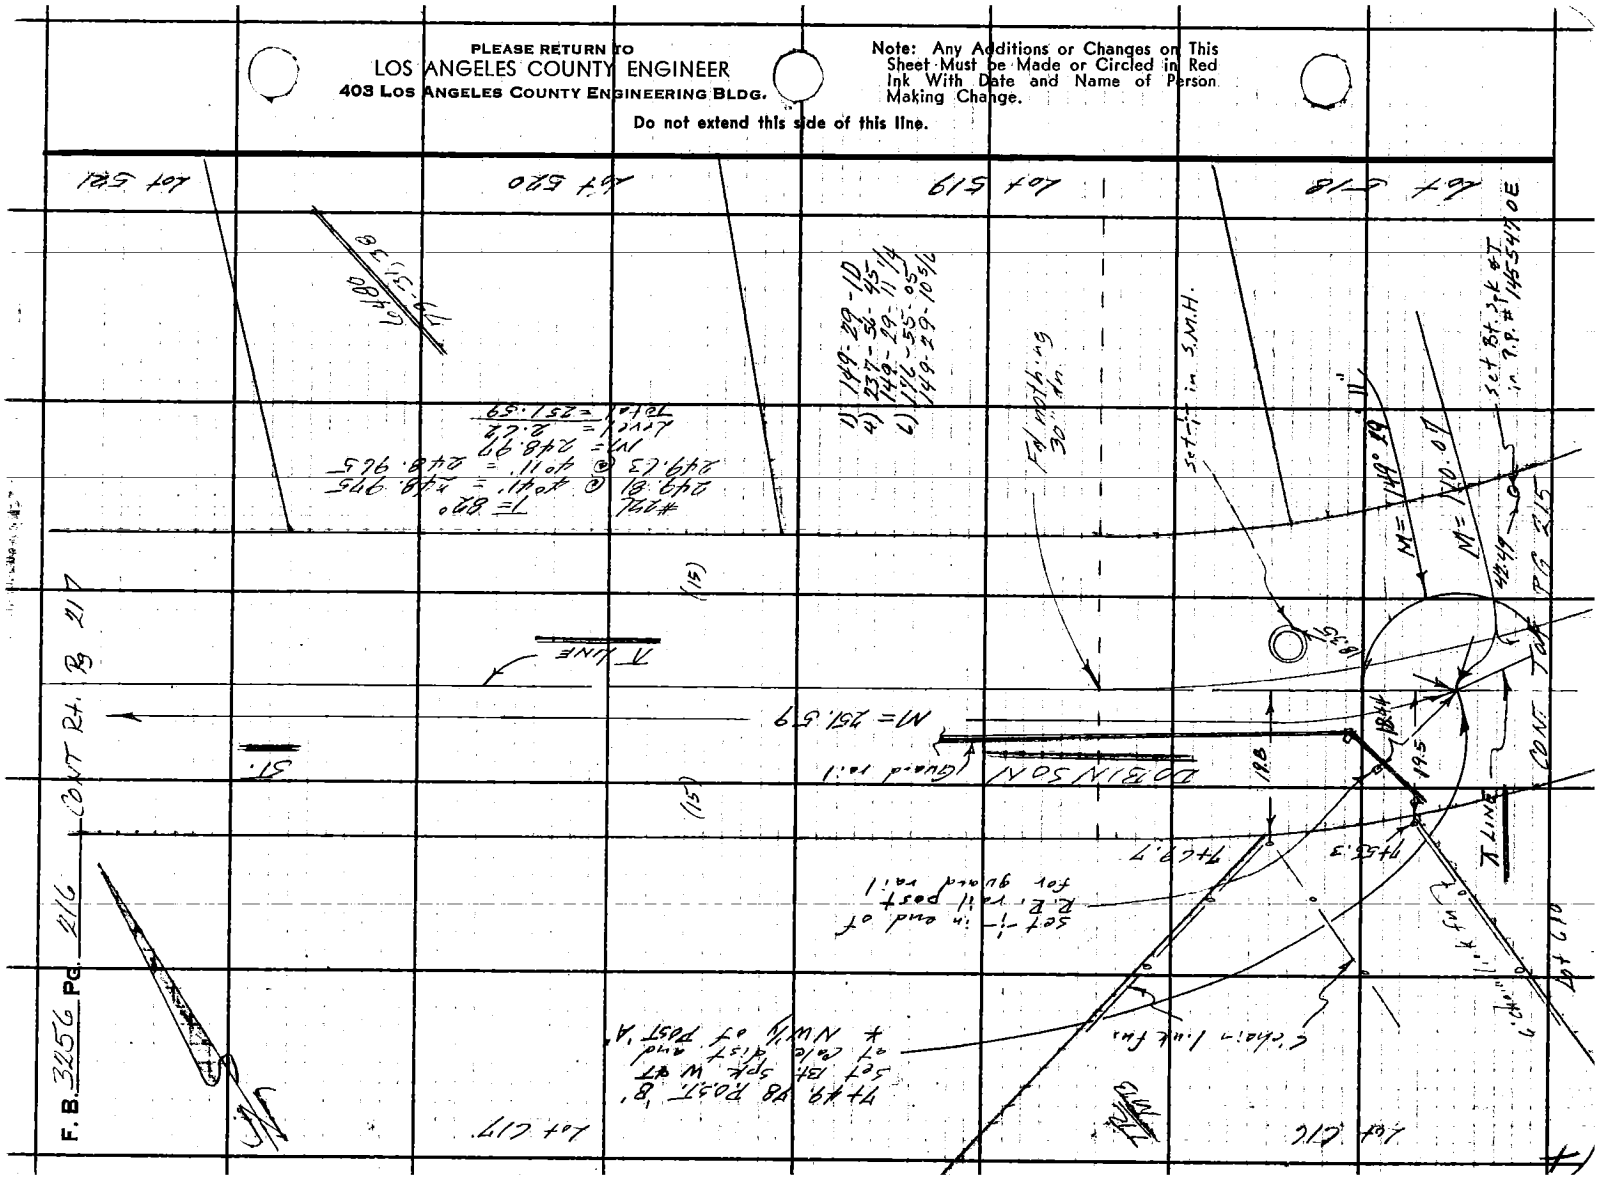

76F3095 CE # 310 9-61

PLEASE RETURN TO
LOS ANGELES COUNTY ENGINEER
403 LOS ANGELES COUNTY ENGINEERING BLDG.

Do not extend this side of this line.

Note: Any Additions or Changes on This Sheet Must be Made or Circled in Red Ink With Date and Name of Person Making Change.

W.S.7, E-1

Notes Ck'd by
Map No.
Office Work
Checked
Date

Survey of CITY TERRACE AREA F.B. 325 & Pg. 117
JN 2273 Tape 22L Std 34 °F
Surveyed by FEB & others
Notes FEB Date 12 Sept 61
Indexed S.J. GALLI

Lot 524

IP
N 73
34-45-20
139-01-20
34-45-20
208-31-55
34-45-19½

10+01.37
Set B.T. Spk W&T
by intsn. of
℄ of Geraghty and
line by Cole's Fiam
POST B to S.E.

5920
L=33.41

Fd L&T pnk
F.B. 3159-152

Fd L&T pnk
F.B. 3159-152

CONT BOT PG 25
F.B. 3158

GERAGHTY

AVE

29.935

28.33

N=9.50

228.42 pnk
F.B. 3158-24

197.90 pnk
F.B. 3158-25

(15)

(15)

(15)

N=34°45'19"E

N=151.69

18.11

Fd Sm. B.T. Spk
pnk F.B. 3158-24

9+81.0

Concrete block wall

#22L
Δ50 T=82.00 = 9.50

NOSIN 200

L=235

6480
79-31-58

Fd L&C.S. Engr.
Tag pnk F.B. 3159-152

(15)

CONT TOP PG 216

Lot 521

Lot 522

Lot 523

PLEASE RETURN TO
LOS ANGELES COUNTY ENGINEER
403 LOS ANGELES COUNTY ENGINEERING BLDG.

Note: Any Additions or Changes on This Sheet Must be Made or Circled in Red Ink With Date and Name of Person Making Change.

Do not extend this side of this line.

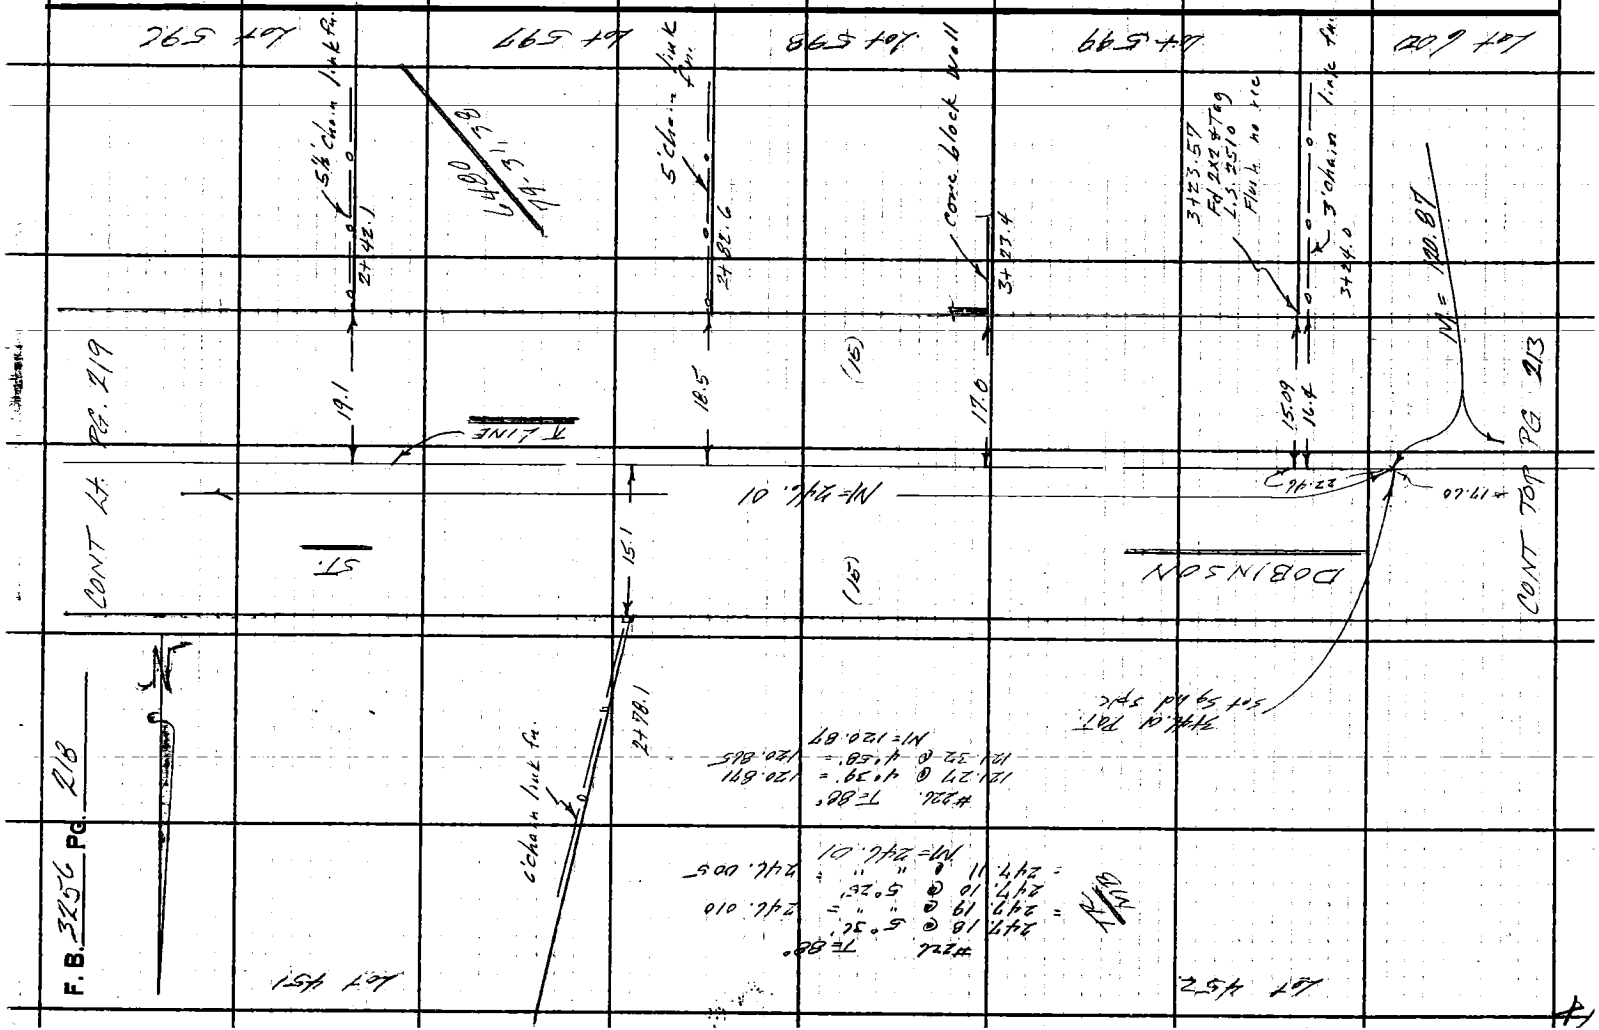

Notes Ck'd by
Map No.
Office Work
Checked
Date

Survey of CITY TERRACE AREAR
JN 0303.04 Tape 226 Std B4 °F
Surveyed by FE. Brooks
Notes FEB Date 8 Sept 66
Indexed C. J. GALLI

F. B. 3256 Pg. 219

CONT BOT PG 219 OF F.B. 3156

Note: Any Additions or Changes on This Sheet Must be Made or Circled in Red Ink With Date and Name of Person Making Change.

PLEASE RETURN TO
LOS ANGELES COUNTY ENGINEER
403 Los Angeles County Engineering Bldg.
Do not extend this side of this line.

W.S. 7, E-1

LOT 451

6480 79-31,38

FA 1BT

AVE

55.63

11.20 FB. 3156-220

DOBINSON

CONT TOP PG 218

(13)

N 24° 46' 01" W

ST.

(15)

LINE

14.04

60.13

LOT 5 PT

N 10° 01' 11" W

25.37 FB. 3156-220

58.16

9.94

9.90

26.40

FA 1BT & PT FB. 3156-220

4.00 FA 1BT & PT FB. 3156-220

E.C.

(25)

FA 5PK W. & T FB. 3156-220

HAZARD

LINE 2

1449.10 FB. 3156-220

64.64

(25)

1) 107-11-22
4) 68-45-30 1/2
107-11-22 1/2
6) 283-08-10
107-11-21 1/2

TR
MB

TR
MB

CONT TOP PG. 221 OF F.B. 3156

76F309S CE # 310 3-61

PLEASE RETURN TO
LOS ANGELES COUNTY ENGINEER
403 LOS ANGELES COUNTY ENGINEERING BLDG.

Note: Any Additions or Changes on This Sheet Must be Made or Circled in Red Ink With Date and Name of Person Making Change.

Do not extend this side of this line.

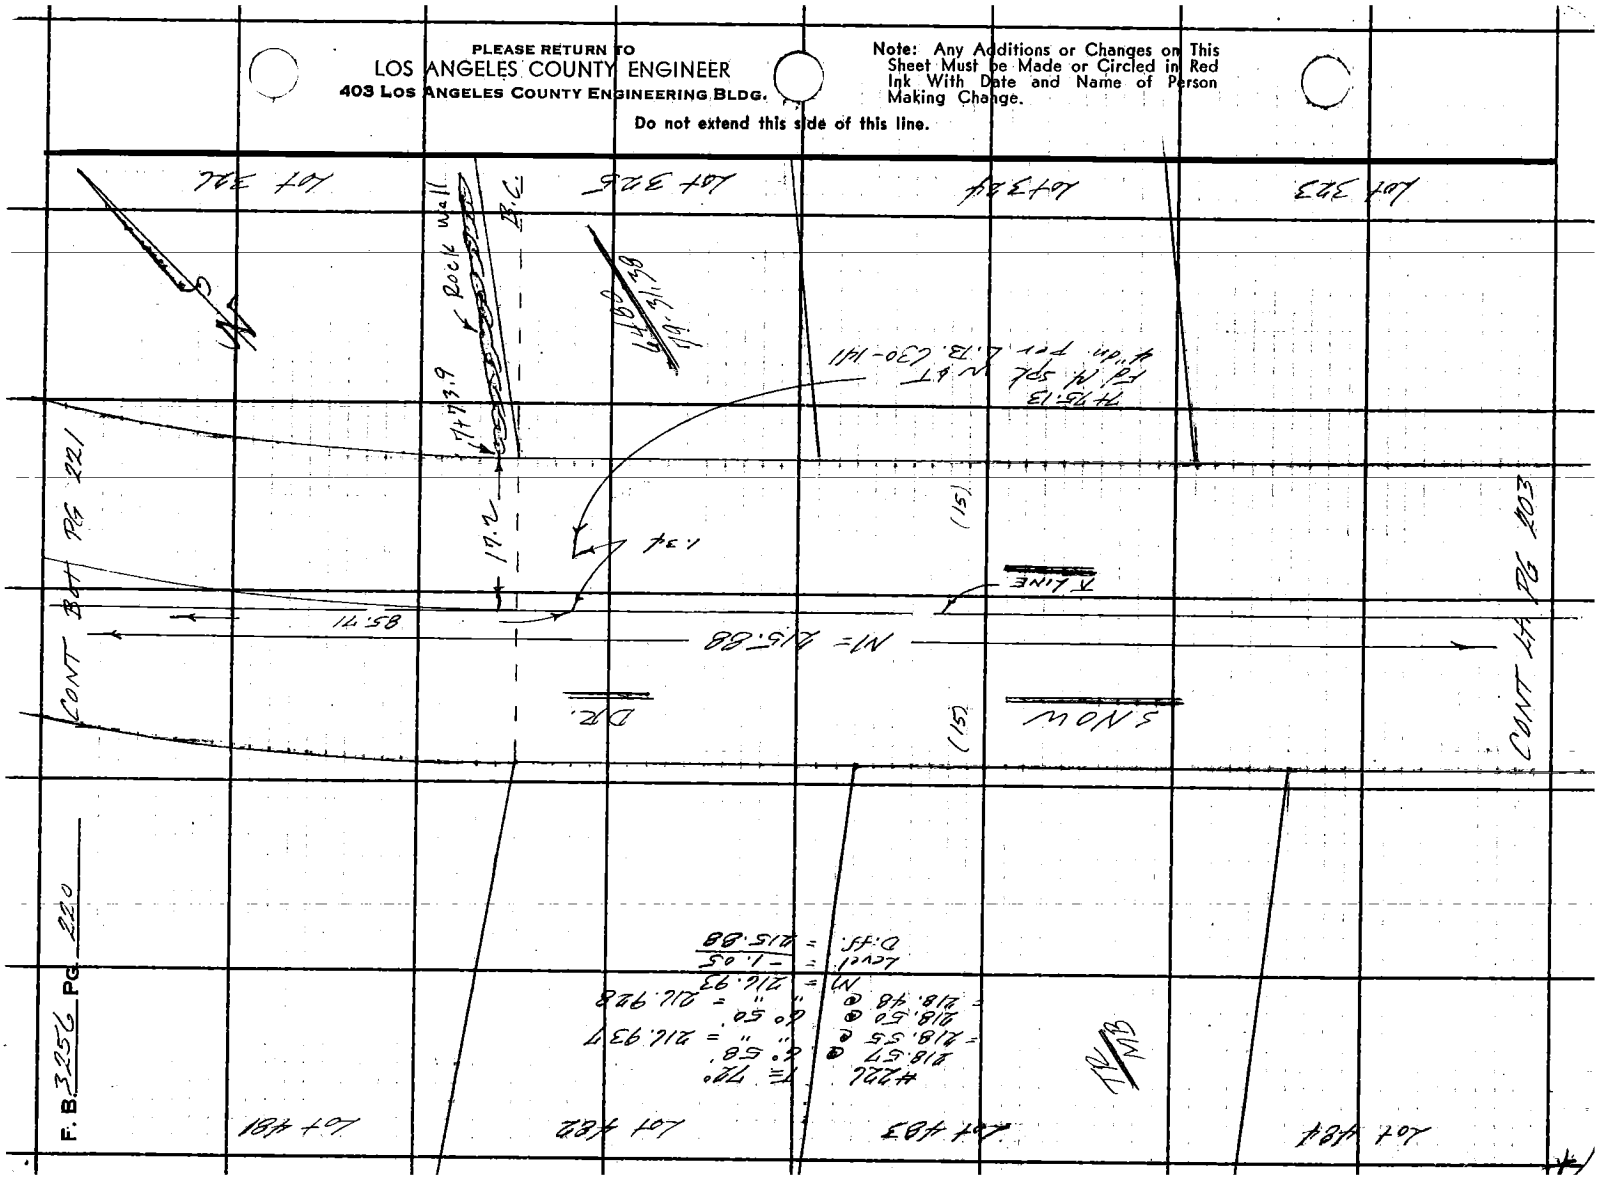

Notes Ck'd by	Survey of CITY TERRACE AREA
Map No.	JN 0705.04 Tape 226 Std 84 °F
Office Work	Surveyed by FE Brooks
Checked	Notes FEB. Date 15/04/66
Date	Indexed G. J. GALLI

F. B. 3256 Pg. 221

Lot #178

NOTE
Pull tie parallel to pvmt.

6' chain link fn.

9+45.58
Fd 60nail 2X 2&Tag
RE 10.72d
Flush no rec

Set Bt spk&T in P.P.# 32803E

#226 T= 84°
123.44 @ 8°43' = 122.014
123.64 @ 9°18' = 122.015
M = 122.01
Level = 2.04
Total = 124.05

CONT BOT PG 222

49.54
49.31
15.29

Lot #179

Lot 328

(15)

℄ LINE

M= 124.05

(15)

Note: Any Additions or Changes on this Sheet Must be Made or Circled in Red Ink With Date and Name of Person Making Change.

Do not extend this side of this line.

PLEASE RETURN TO
LOS ANGELES COUNTY ENGINEER
403 Los Angeles County Engineering Bldg.

B760.8 P.I. #3
Set Bt. spk W of TP Rec #4 and W'ly of #2.

Set at D.S. #2.

Ex. Manhole
30" dm.

6480
19-31,38

1) 156-05-20
4) 264-21-20
156-05-20
6) 216-32-00
156-05-20

Lot 329

Lot #180

TP MB

Set Spk BT in P.P.# 22878E

36.90

39.73

M= 156°05' 100'

Conc Wall

21.6

Set L&Co. Eng'r Tag B730.9

℄ LINE

S. MH

Set +/- in S.M.H.

Lot #181

M= 215.88
85.71

CONT TOP PG 220

Lot 326

76F305 CE # 310 3-61

PLEASE RETURN TO
LOS ANGELES COUNTY ENGINEER
403 LOS ANGELES COUNTY ENGINEERING BLDG.

Note: Any Additions or Changes on This Sheet Must be Made or Circled in Red Ink With Date and Name of Person Making Change.

Do not extend this side of this line.

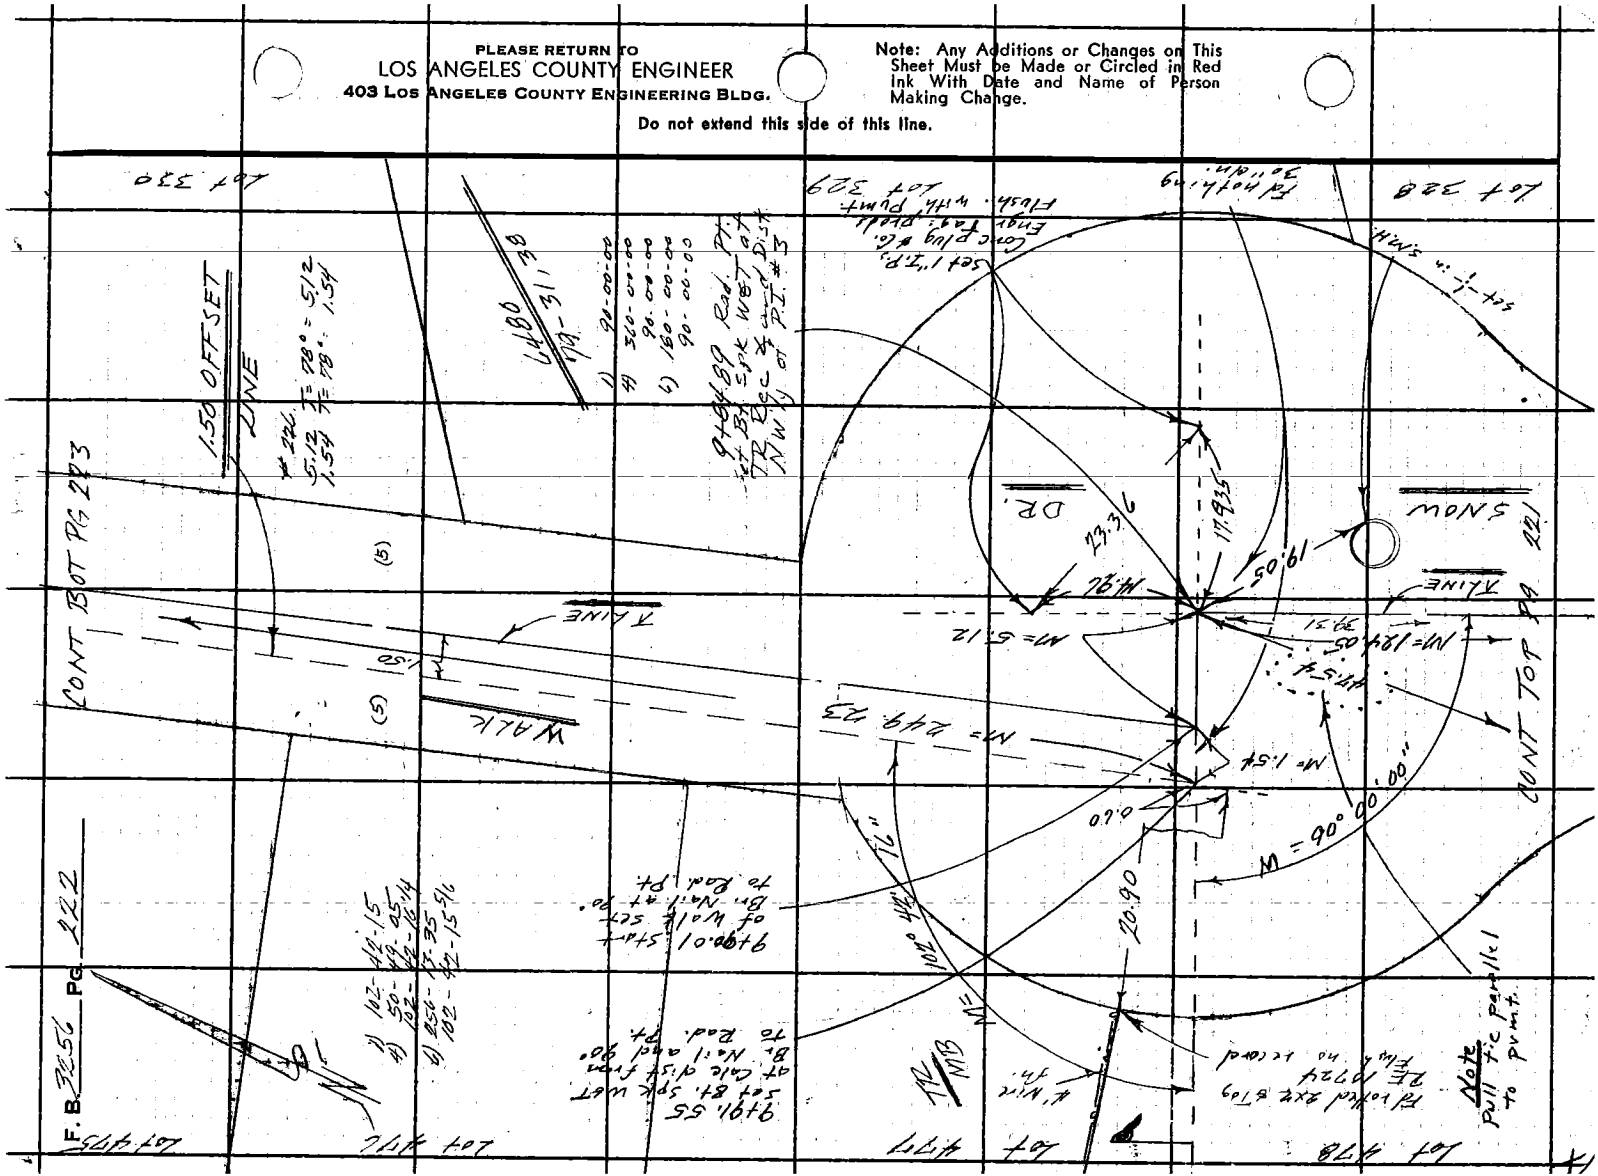

76F309S CE # 310 3-61

PLEASE RETURN TO
LOS ANGELES COUNTY ENGINEER
403 LOS ANGELES COUNTY ENGINEERING BLDG.

Note: Any Additions or Changes on This Sheet Must be Made or Circled in Red Ink With Date and Name of Person Making Change.

Do not extend this side of this line.

Notes Ck'd by
Map No.
Office Work
Checked
Date

Survey of CITY TERRACE AREA
JN 0808 Tape 216 Std 84 °F
Surveyed by FE Brooks 2-Sept 64
Notes
Indexed C. J. GALLI Date

F. B. 3250 PG. 223

Lot 405

Lot 404

Lot 403

1.50 FT. OFFSET LINE

Conc. Lodge Wall

WALK

M = 249.23

(S)

CENT BOT PG 224

CENT TOP PG 222

T. LINE

#226 TE 78°

257.84 @ 14° 50
257.83 @ " " = 249.236
258.01 @ 14° 59
258.00 @ " " = 249.218
M = 249.23

14.80 TO 31.38

Lot 330

Lot 331

F. B. 3256 Pg. 224

W.S. 7-8-1

12+79.40 Set B.t. Spk by intir W&T

#226 T=80°
111.04 @ 3°02' = 110.884
111.01 @ 2°38' = 110.892
M = 110.88

Fd nothing 30" dia.

DWIGGINS

ST.

388.04 P/R FB. 3158-12

M = 110.88 semi Tan

156.04 P/R FB. 3158-12

nothing Set

ST.

M = 38.62

78° 59' 49"

1) 78-59-30
2) 315-57-45
78-59-26 1/4
3) 113-56-55
78-59-29 1/2

M = 123.32

BOSTWICK

12+40.78 P.O.T. Set 1x2 ⊕N 0.1' TR Rec. ± 8.1' from the end of Snow Dr.

12+37.38 Fd 1x2 ⊕N no Tag 3" up P/R FB. 3157-89

1.50ft OFFSET LINE

℄ LINE

WALL

#226 38.62 T=80° = 38.62

(5)

Lot 473

CONT TOP PG 223

Lot 331

PLEASE RETURN TO LOS ANGELES COUNTY ENGINEER
403 Los Angeles County Engineering Bldg.

Do not extend this side of this line.

Note: Any Additions or Changes or This Sheet Must be Made or Circled in Red Ink With Date and Name of Person Making Change.

Notes Ck'd by
Map No.
Office Work
Checked
Date

Survey of CITY TERRACE AREA F.B. 325 Pg. 225
JN 0303.00 Tape 220 Std 84 °F
Surveyed by FE Brooks
F.E.B.
Notes
Date 1 Sept 66
Indexed
C. J. GALLI

Set Bt. spk & Tin P.P. # 905-00GLE / CONT RT. PG 203

5423.83 P.I. #2
Set Bt. Spk W. of
JR Reg Sta. on
S.E. NW'ly of P.I. #1

P.T. LINE

Note
Pull ties parallel
to pvmt.

Note
hold 2 Lobs at
P.I. for tie pull

Lot 163

Lot 161

Lot 160

Lot 159

Lot 158

Lot 157

D.C.

stucco house 1.6

Bottom of 5" x 14" vent under house

set ∫ on S.M.H.

B.C.

4700.77 P.O.T.
Set 3/4 Lid Spk

4' chain link fn.

4+35.34
Fd good 1/2 ø Tag
L.S. 2348 BOHE
Flush

1) 165-16-00
4) 301-04-00
1) 165-16-00
C) 271-36-00
165-16-00

CONT TOP PG. 226

Note: Any Additions or Changes on This Sheet Must be Made or Circled in Red Ink With Date and Name of Person Making Change.

PLEASE RETURN TO
LOS ANGELES COUNTY ENGINEER
403 Los Angeles County Engineering Bldg.
Do not extend this side of this line.

76F3095 CE # 310 3-61

PLEASE RETURN TO
LOS ANGELES COUNTY ENGINEER
403 LOS ANGELES COUNTY ENGINEERING BLDG.

Note: Any Additions or Changes on This Sheet Must be Made or Circled in Red Ink With Date and Name of Person Making Change.

Do not extend this side of this line.

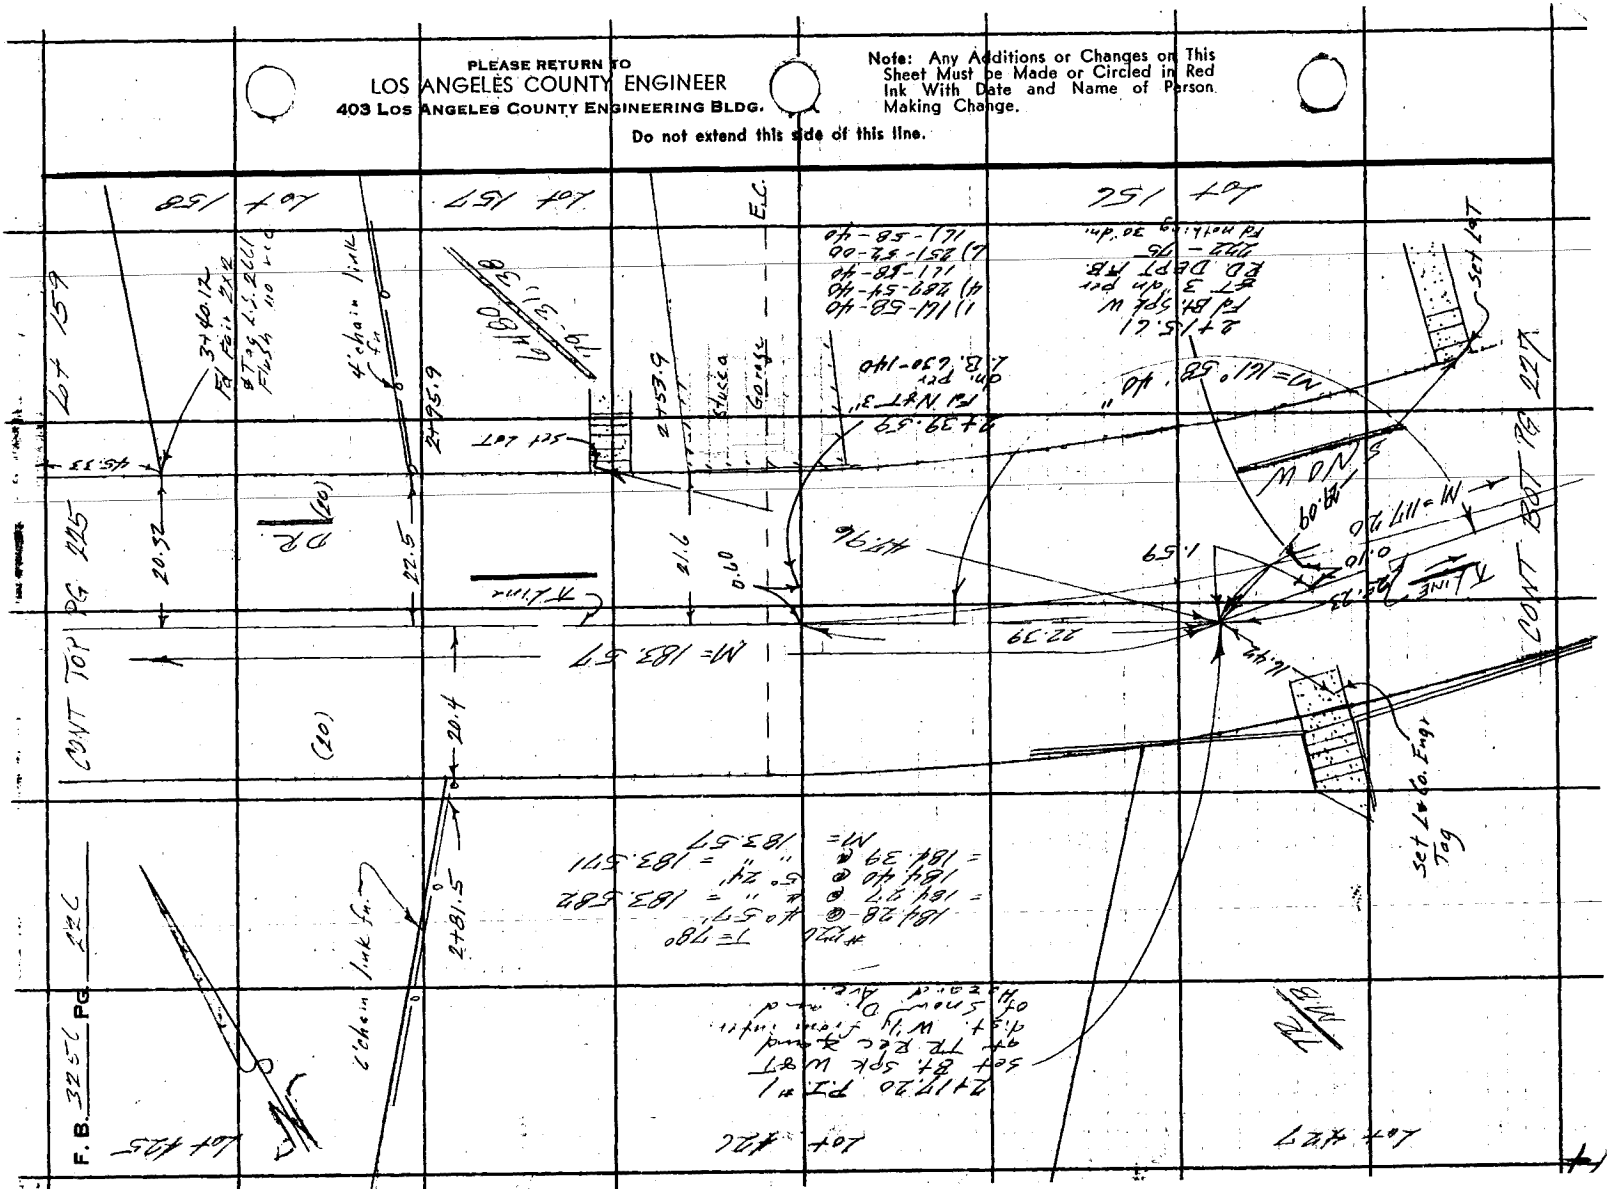

Notes Ck'd by
Map No. 1
Office Work
Checked
Date

Survey of CITY TERRACE AREA
JN 0303.04 Tape 226 Std 64 °F
Surveyed by F.E. Brooks
Notes FEB Date 30 Aug 1966
Indexed C. J. GALLI

F. B. 3256 Pg. 227

Note: Any Additions or Changes on this Sheet Must be Made or Circled in Red Ink With Date and Name of Person Making Change.

Do not extend this side of this line.

W.S. 7, E-1

PLEASE RETURN TO
LOS ANGELES COUNTY ENGINEER
403 Los Angeles County Engineering Bldg.

76F3095 CE # 310 3-61

CONT ON PG 214 OF F.B. 3156

Fd 3m. Bt. Spk ET pnt F.B. 3156-214 Replaced with Bt. Spk w ET

CONT BAT PG 213 OF F.B. 3156

HAZARD

T LINE

DR.

AVE

CONT TOP OF F.B.












Fd withing 3" dn.

#226 T=62°
115.62 @ 2°51' = 115.626
115.92 @ 3°39' = 115.684
NI = 115.68
Level = 1.52
Total = 117.20

CONT BAT PG 226

LOT 156

LOT 427

LOT 428

ESC

SIDWK

NI = 117.20

19.59

1+91.97

Lt 4'0"

Rt 4'0"

0.19

25.43

(20)

(25)

(26)

PLEASE RETURN TO
LOS ANGELES COUNTY ENGINEER
403 LOS ANGELES COUNTY ENGINEERING BLDG.

Note: Any Additions or Changes on This Sheet Must be Made or Circled in Red Ink With Date and Name of Person Making Change.

Do not extend this side of this line.

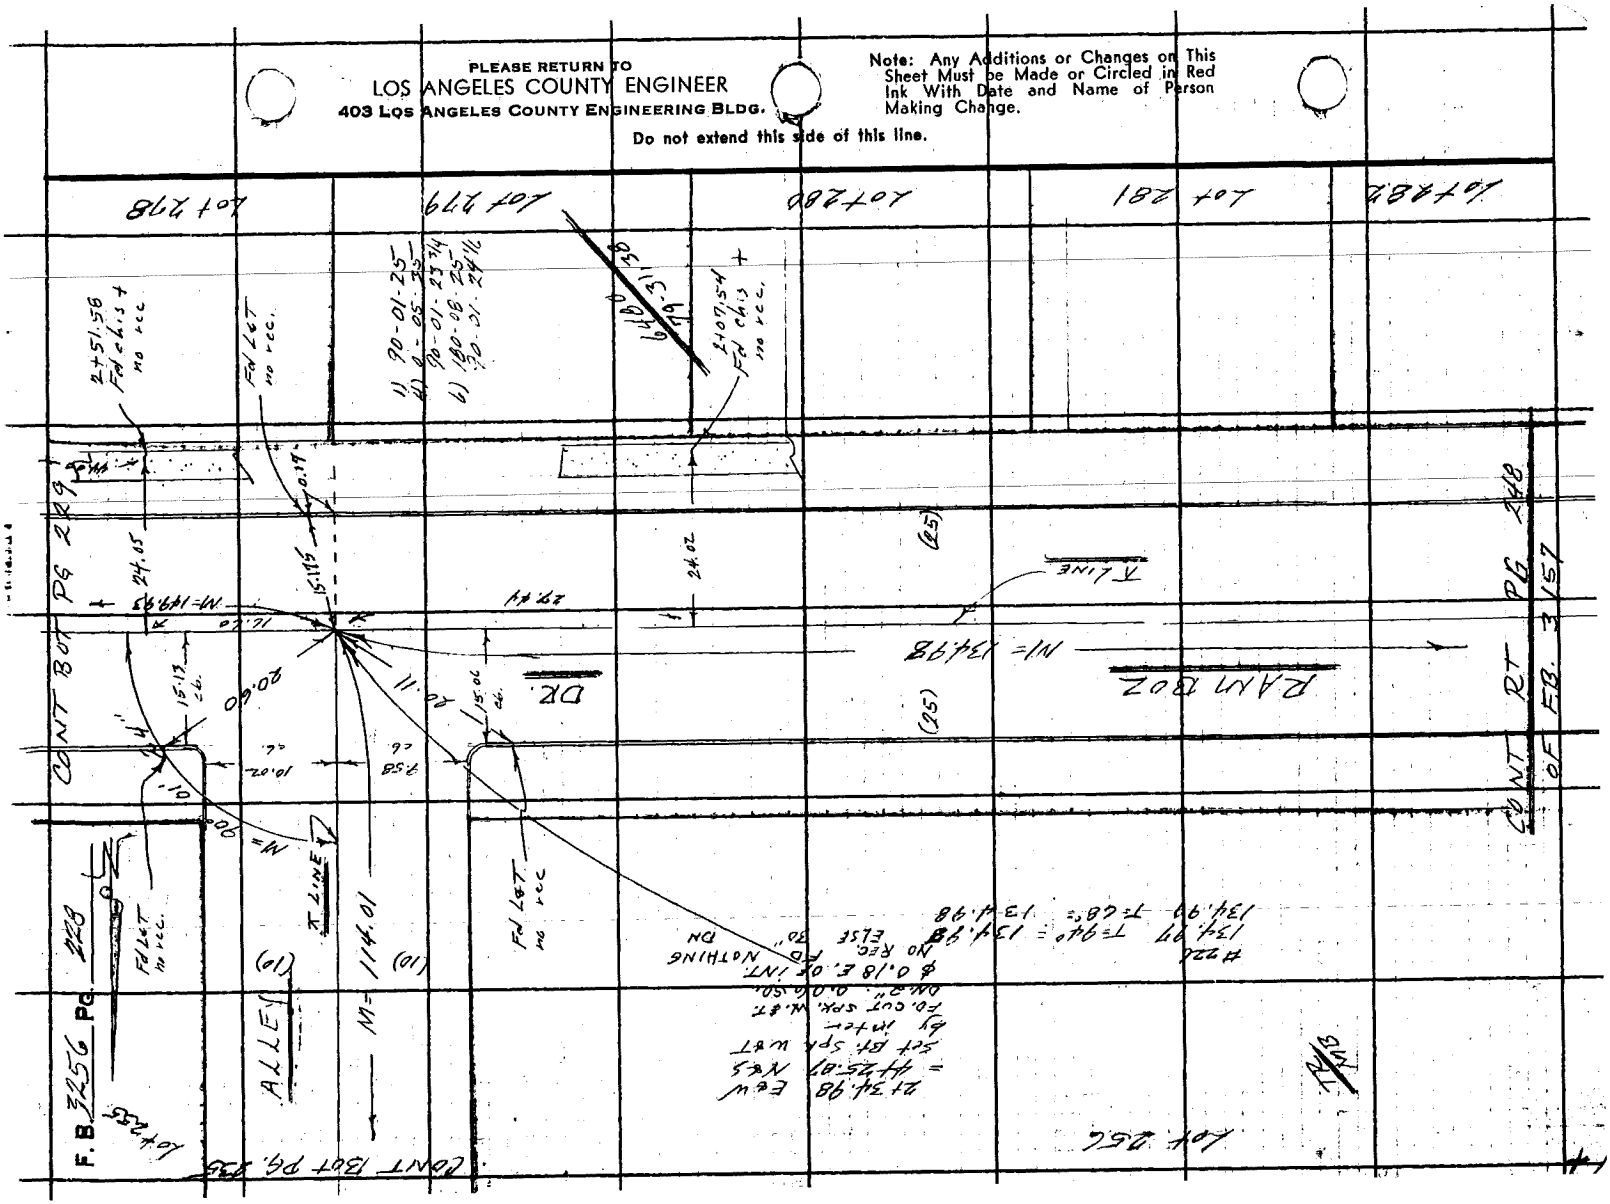

Notes Ck'd by
Map No.
Office Work
Checked
Date

Survey of City Terrace Area 4
JN 2302.64 Tape 226 Std 94 °F
Surveyed by F E Brooks
Notes F E B Date Nov 3-64
Indexed C. J. GALLI

F. B. 3156 Pg. 229

CONT LT BG 233

OFF B. 3156

64.80
19
31.38

DR.

℄ LINE

N 44° 54' 33" W 149.93

(25)

(25)

149.22

24.04

2+95.58
Fd ch. s t

RAIL ROAD

44.09

CONT TOP PG 228

LOT 255

LOT

LOT 256

LOT 257

LOT 258

Note: Any Additions or Changes on This Sheet Must be Made or Circled in Red Ink With Date and Name of Person Making Change.

Do not extend this side of this line.

PLEASE RETURN TO
LOS ANGELES COUNTY ENGINEER
403 Los Angeles County Engineering Bldg.

76F3085 CE # 310 3-61

PLEASE RETURN TO
LOS ANGELES COUNTY ENGINEER
403 LOS ANGELES COUNTY ENGINEERING BLDG.

Note: Any Additions or Changes on This Sheet Must be Made or Circled in Red Ink With Date and Name of Person Making Change.

Do not extend this side of this line.

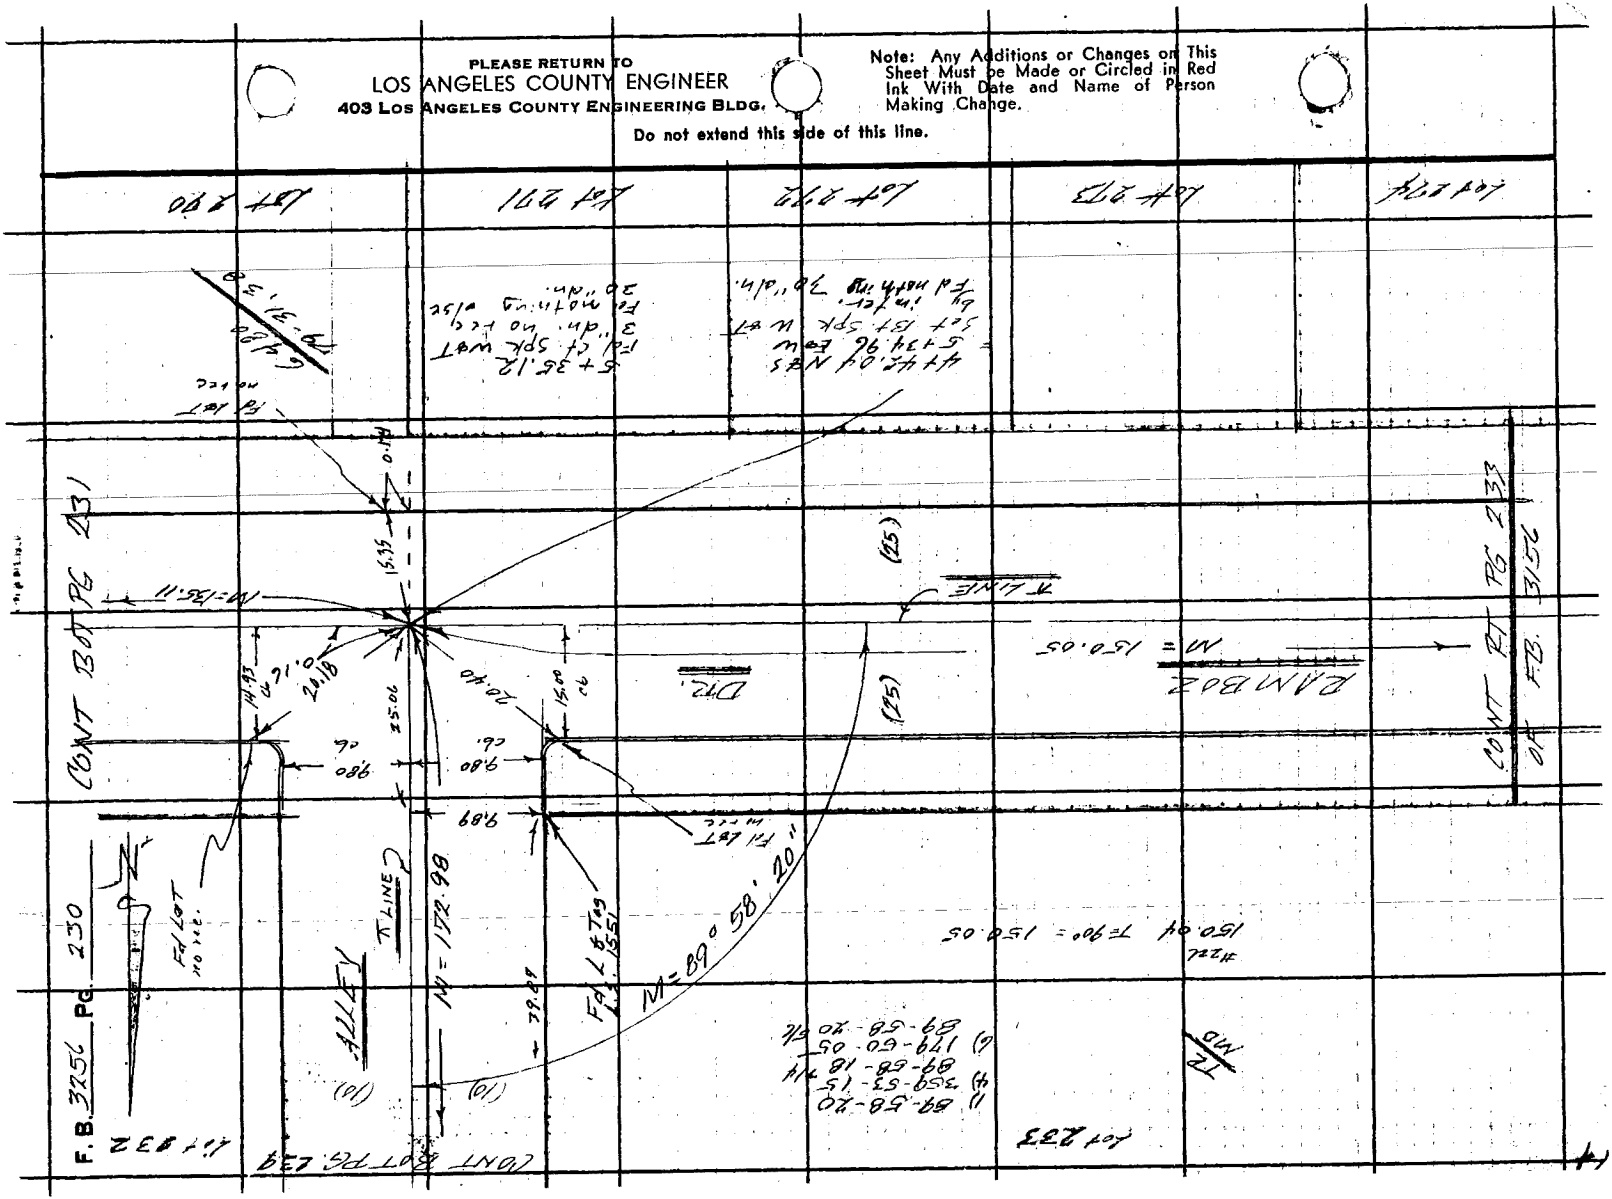

76F3095 CE # 310 3-61

PLEASE RETURN TO
LOS ANGELES COUNTY ENGINEER
403 LOS ANGELES COUNTY ENGINEERING BLDG.

Note: Any Additions or Changes on this Sheet Must be Made or Circled in Red Ink With Date and Name of Person Making Change.

Do not extend this side of this line.

W.S.7, E-1

Notes Ck'd by
Map No.
Office Work
Checked
Date

Survey of CITY TERRACE AREA E
JN 2303.04 Tape 22L Std 84 °F
Surveyed by F.E. Brooks
Notes
Indexed
F.E.B. Date 2/20/64
C. J. GALLI

F.B. 3156 PG. R31

CONT BOT PG 180 OF F.B. 3157

Lot 232

1) 89°58'15"
4) 359°52'55"
89°58'13"
4) 179°49'30"
89°58'15"

VAN PELT AVE.

(25) 122.87 FR FB 3157-181

(25)

E/L 3/4" Rd Spk & T Reset F.B. 3157-181 Replaced with Bk. Spk w. Tag

L 770.09

L 680
N 89°31'38" E

RAMBOZ

(125)

DR.

(125)

M= 135.11

T LINE

14.99

14.99

14.77

Fd Lead Plug FB 3157-181

0.05

25.99 FR FB 3157-181

40.18

23.47

20.07

WALK

(10)

Fd Lead Plug FB 3157-181

49.82 FR FB 3157-181

Fd Lead Plug FB 3157-181

118.93 FR FB 3157-181

F.B. 2954-PK

Fd Lead Plug Ft. Tag FB 3157-181

CONT LT PG 249 OF F.B. 3156

CONT TOP PG 230 OF F.B. 3157

#226 T= 60°
135.51 @ 4° 17" = 135.111
135.49 @ " " "
135.65 @ 4° 57" = 135.124
135.43 @ " " "
M= 135.11

Lot 208 Lot 209 Lot 208 Lot 207

PLEASE RETURN TO
LOS ANGELES COUNTY ENGINEER
403 LOS ANGELES COUNTY ENGINEERING BLDG.

Note: Any Additions or Changes on This Sheet Must be Made or Circled in Red Ink With Date and Name of Person Making Change.

Do not extend this side of this line.

W.S.7, E-1

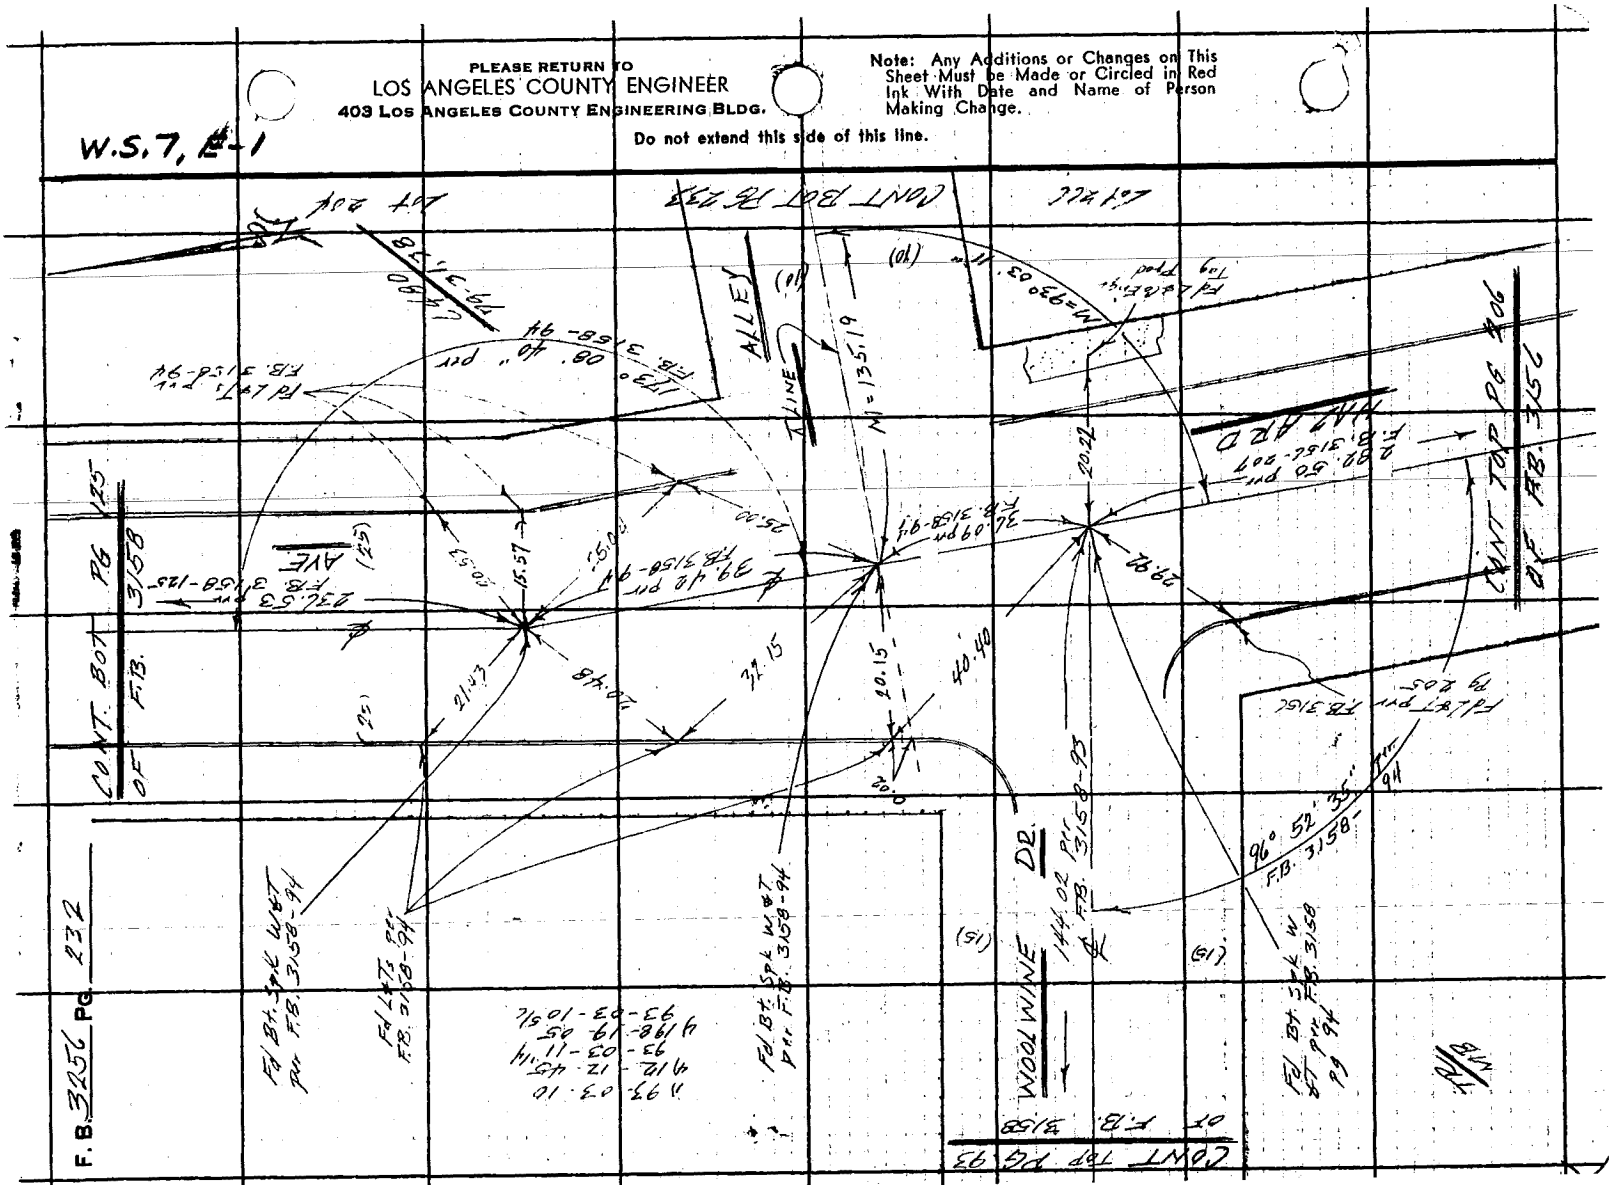

76F3095 CE # 310 3-61

PLEASE RETURN TO
LOS ANGELES COUNTY ENGINEER
403 LOS ANGELES COUNTY ENGINEERING BLDG.

Note: Any Additions or Changes on This Sheet Must be Made or Circled in Red Ink With Date and Name of Person Making Change.

Do not extend this side of this line.

Lot 204 | Lot 205 | Lot 206 | Lot 207

#226
135.18 T=92° = 135.19
135.21 T=68° = 135.20

T.L. N13

CONT RT PG 234

T. LINE

(10)

N 0 = 135.19

(10)

ALLEY

CONT RT PG 234

1980
1/19, 51, 38

Lot 166

Notes Ck'd by
Map No.
Office Work
Checked
Date

Survey of CITY TERRACE AREA &
JN 0203.04 Tape 22L Std 84 °F
Surveyed by F.E. Brooks
Notes F.E.B. Date 1 Nov 61
Indexed G. L. Gallet

F. B. 3256 Pg. 277

X

PLEASE RETURN TO
LOS ANGELES COUNTY ENGINEER
403 LOS ANGELES COUNTY ENGINEERING BLDG.

Note: Any Additions or Changes on This Sheet Must be Made or Circled in Red Ink With Date and Name of Person Making Change.

Do not extend this side of this line.

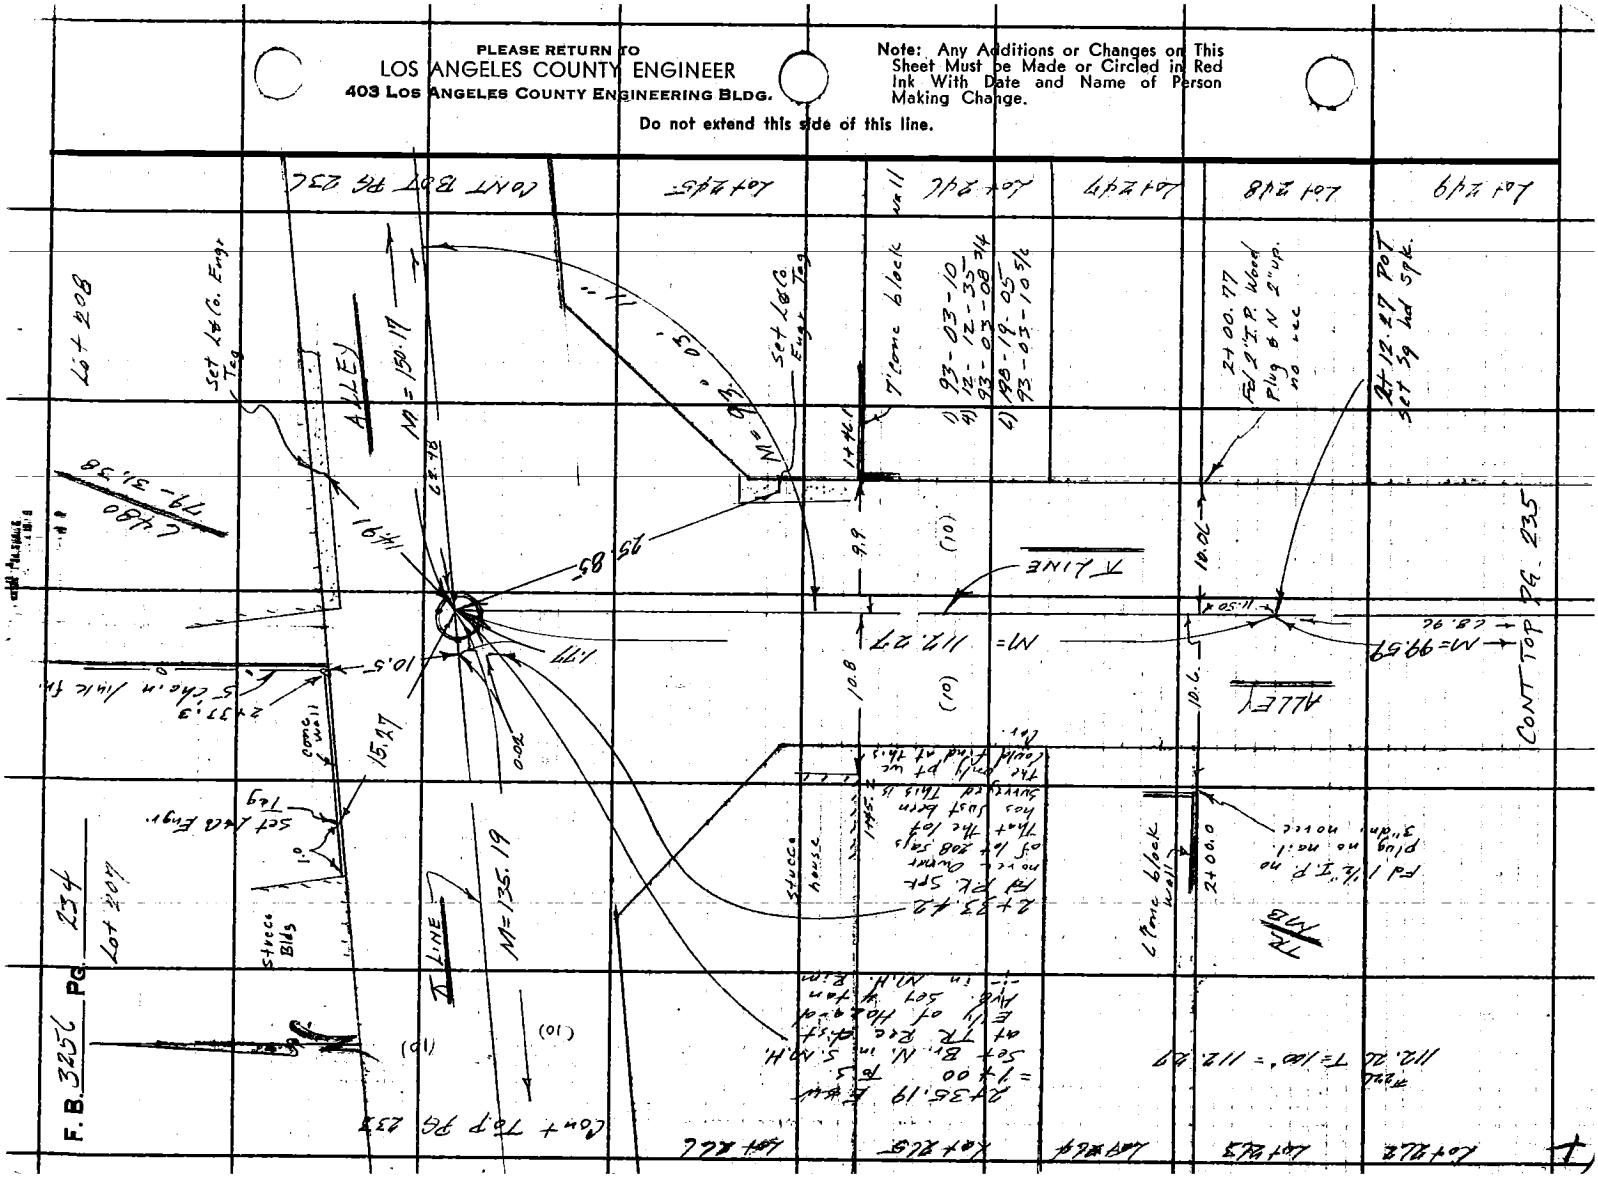

Notes Ck'd by
Map No.
Office Work
Checked
Date

Survey of CITY TERRACE AREA R
JN 0303.04 Tape 22L Std 84 °F
Surveyed by F.E. Brooks
Notes F.E.B. Date Nov 66
Indexed C. J. GALLI

F. B. 3256 Pg. 235

CONT BOT PG 234

Lot 262

3+41.8
12.8
Frame Garage

Lot 261

Lot 260

4' Picket fnc.
2+82.23 Fd Ch.i.s +
12.80

Lot 259

3+21.0
3' chain link fnc.

Lot 258

Lot 257

3+62.0
17.5
Frame Garage

Lot 256

CONT LT. PG 228

(10)
N 77° 54' E 99.59
(10)

ALLEY

10.1

2+51.5

10.0

3+01.0
Stucco
Garage

3+11.86 P.O.T.
Set sq hd sqk

10.1

3+51.0
5' brick wall

N 5° 01' W 114.01
℄ LINE

Lot 249

6480 ,8
119-31'

Stucco
Garage
#226
99.58 T=94° = 99.59

Lot 250

Lot 251

Lot 252

Lot 253

Lot 254

#226
114.94 @ 40
114.41 @ 31
114.28 @ 28
114.94 @ 40
114.01 @ 45
114.02 @ 45

Lot 255

Note: Any Additions or Changes on this Sheet Must be Made or Circled in Red Ink With Date and Name of Person Making Change.

Do not extend this side of this line.

PLEASE RETURN TO
LOS ANGELES COUNTY ENGINEER
403 Los Angeles County Engineering Bldg.

76F309S CE # 310 3-61

PLEASE RETURN TO
LOS ANGELES COUNTY ENGINEER
403 LOS ANGELES COUNTY ENGINEERING BLDG.

Note: Any Additions or Changes on This Sheet Must be Made or Circled in Red Ink With Date and Name of Person Making Change.

Do not extend this side of this line.

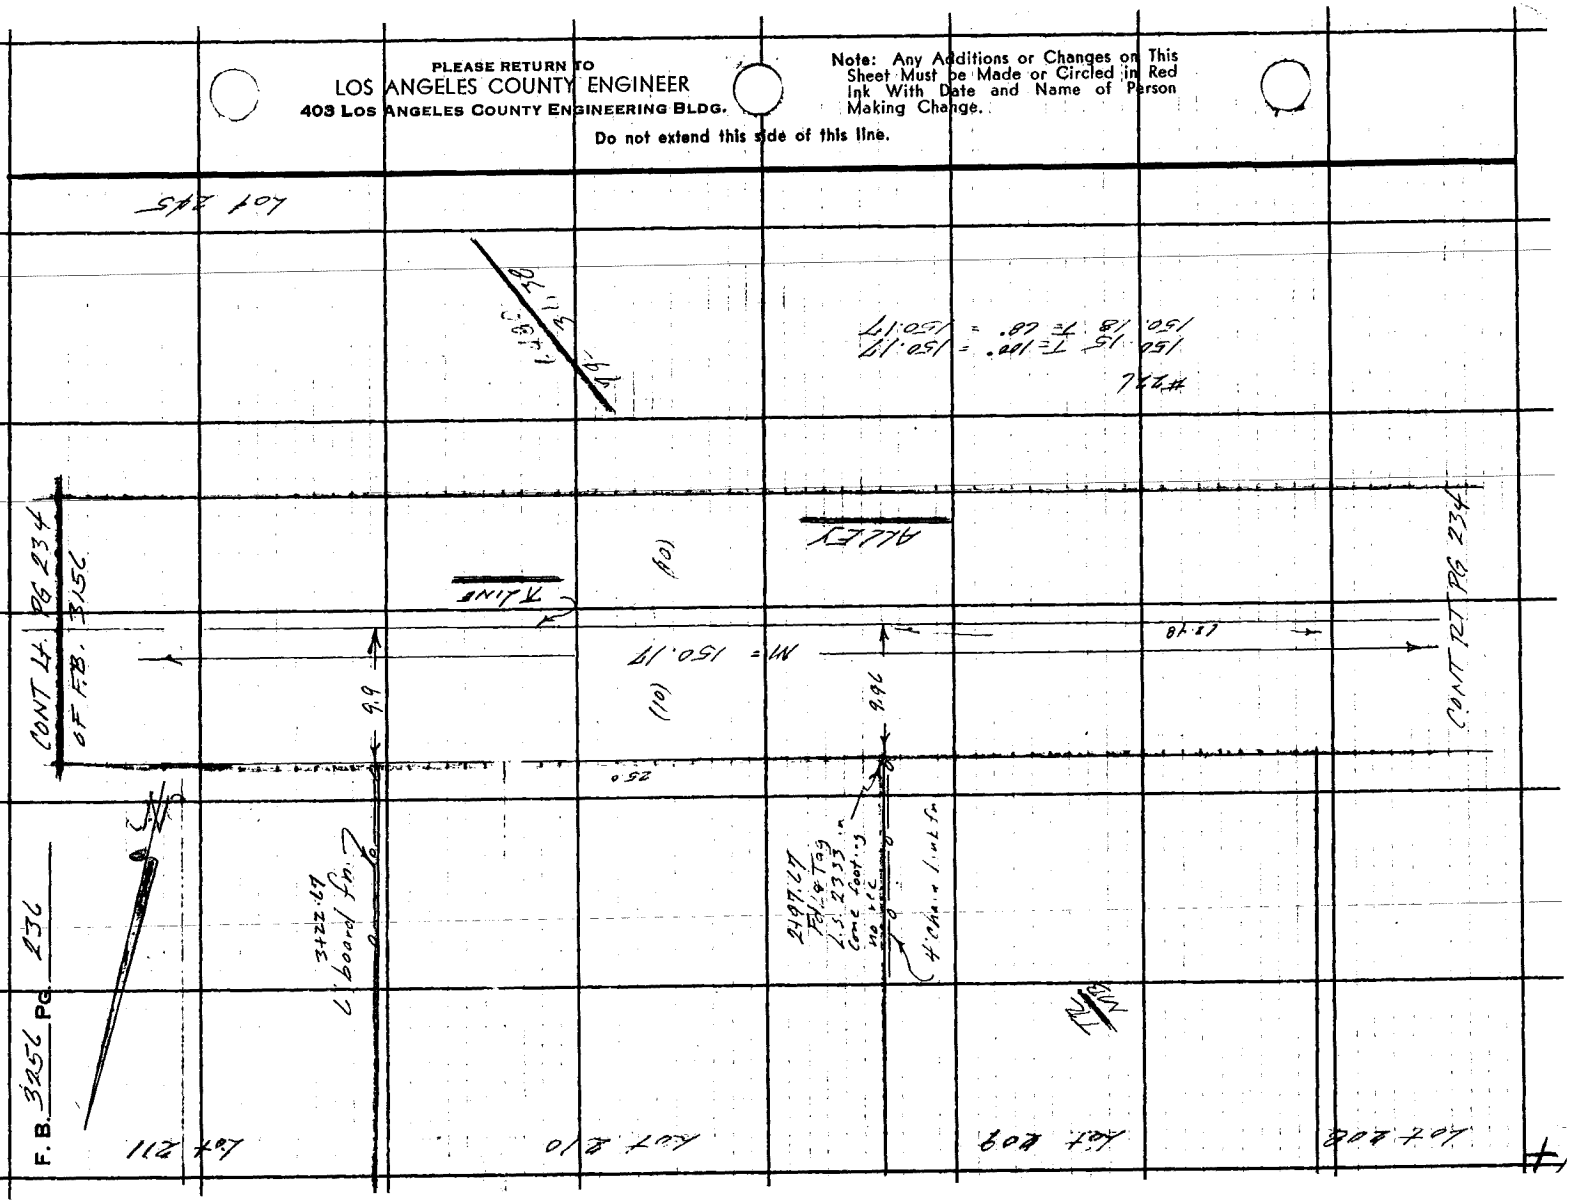

Notes Ck'd by
Map No.
Office Work
Checked
Date

Survey of CITY TERRACE AREA
JN 0307.04 Tape 226 Std 68 °F
Surveyed by F.E. Brooks
Notes F.E.B. Date 31 Oct 1962
Indexed C. J. GALLI

F. B. 3256 PG. 237

Note: Any Additions or Changes on this Sheet Must be Made or Circled in Red Ink With Date and Name of Person Making Change.

PLEASE RETURN TO
LOS ANGELES COUNTY ENGINEER
403 Los Angeles County Engineering Bldg.
Do not extend this side of this line.

7GF3099 CE # 310 3-61

CONT LOT PG 240

Lot 221

Lot 216

Lot 215

Lot 214

Lot 213

Lot 212

Lot 223

5+35.67 E&W = 1400 To S. Sct P.M. in S.M.H. at TR. Rec & from Hazard Ave and TR Rec. dist. from Inter. at Miller Ave. Set 4 Tan +/- on Rim

L 1400 79-36 38

Set L&Co. Engr. Tag

48.64

ALLEY

M=169.06

5+33.49 Fd P.K. spk. no rec

2.08

9.86

20.62

21.22

T LINE

39.63

10.30

10.28

Cent. Dist. PG 238

Set L&Co. Engr. Tag

M=86°56'

20.92

36.115

9.91

1+20.62

1+41.84

Fd 2X2 Tags flush R.E. 1682 no rec.

Stucco Bldg

Fd old 2x2 flush no.1 gone no rec.

1) 86-56-50
4) 347-47-20
86-50-50
L) 161-40-55
86-56-49½

150.21 T=90+

TR N43

(10)

T LINE

ALLEY

150.21

M=

Set L&Co. Engr. Tag.

low conc wall

10.4

4+60.0

CONT RT PG 234
OF F.B. 3156

Lot 224

Lot 223

PLEASE RETURN TO
LOS ANGELES COUNTY ENGINEER
403 LOS ANGELES COUNTY ENGINEERING BLDG.

Note: Any Additions or Changes on This Sheet Must be Made or Circled in Red Ink With Date and Name of Person Making Change.

Do not extend this side of this line.

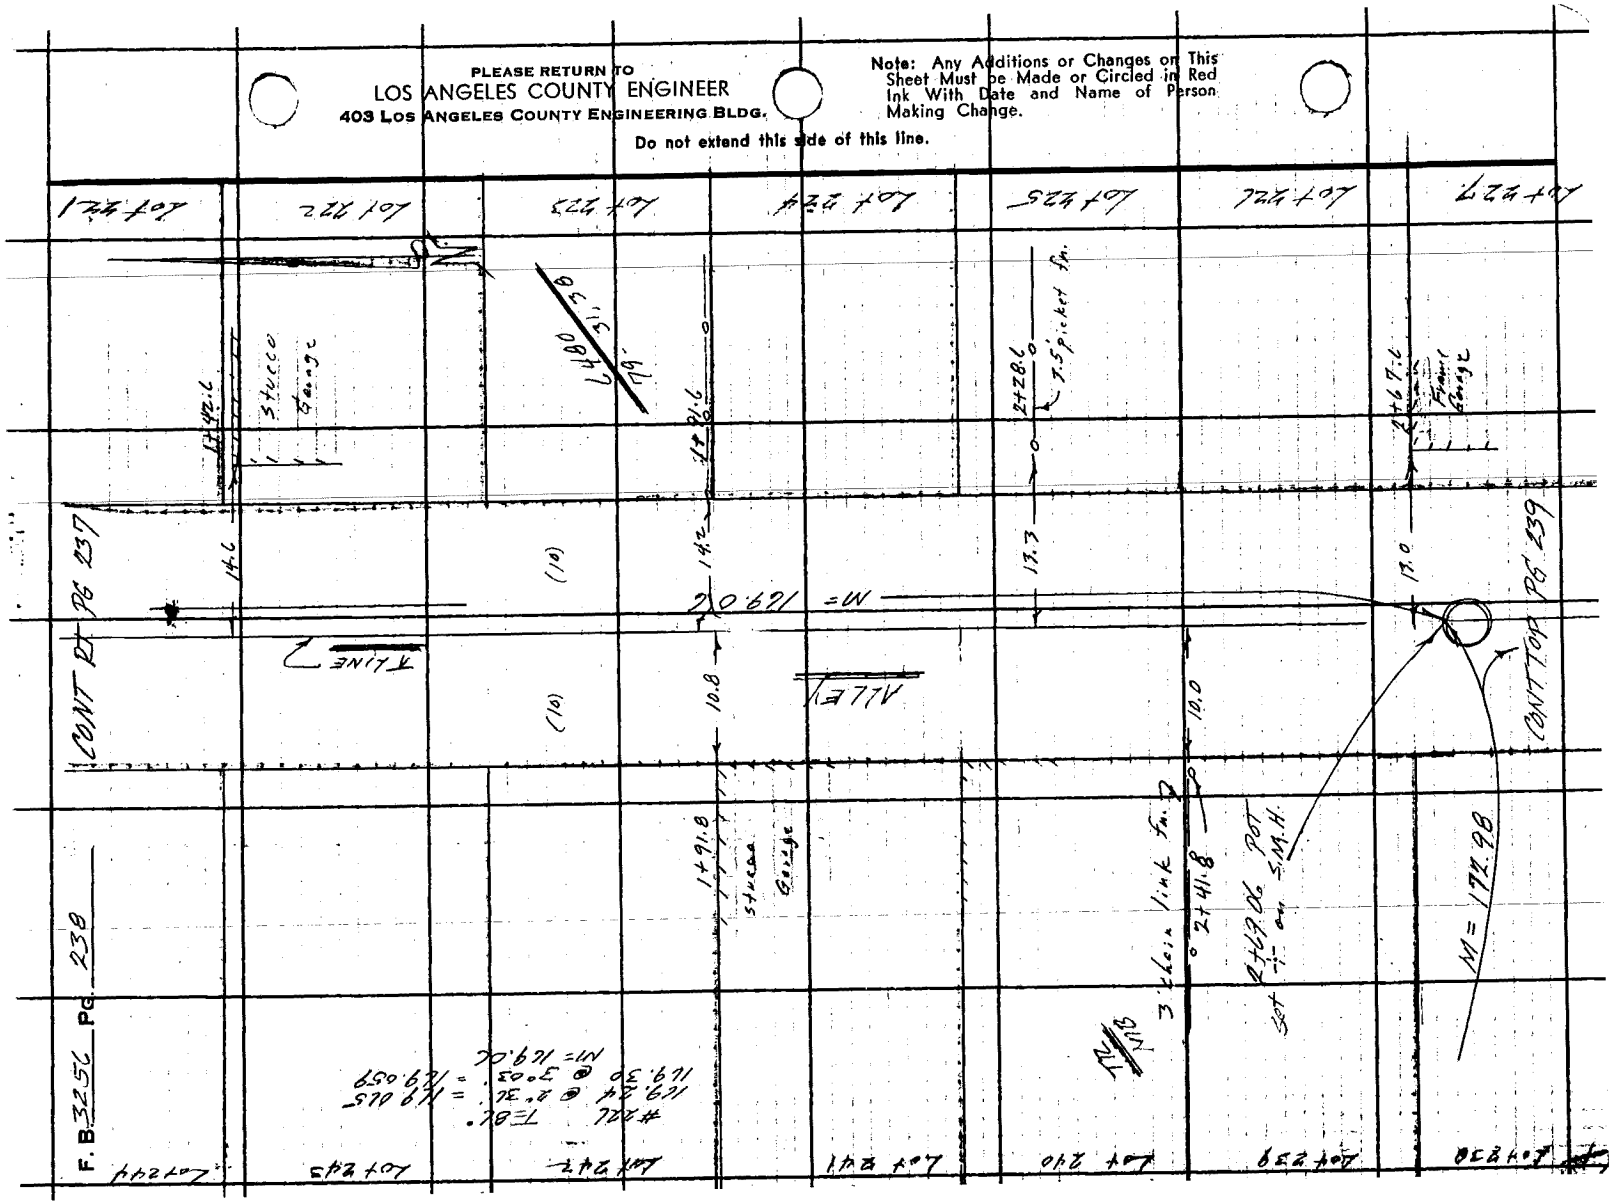

Notes Ck'd by
Map No.
Office Work
Checked
Date

Survey of CITY TERRACE AREA F. B. 3256 Pg. 239
JN 070704 Tape 22L Std 84 °F
Surveyed by FF BLANKS
Notes FEB Date 2NOV66
Indexed C. J. GALLI

CONT TO PG 239

Lot 237

Lot 238

3 Adobe Garage

10.4

2+97.0

12.9

3+05.2

Frame Garage

6480 / 49-31.38

Lot 227

Lot 228

Lot 229

Lot 230

Lot 231

Lot 232

Lot 233

Lot 234

Lot 235

#226

172.98 = 172.98

(10)

(10)

M = 172.98

ALLEY

T LINE

12.9

3+42.0

Frame Garage

4' Chain Link fn.

9.83

10.9

6' picket fn.

3+78.0

TW MB

Fd 2½" I.P.
no nail
no tag

37.80

CONT AT PG 230

Note: Any Additions or Changes on this Sheet Must be Made or Circled in Red Ink With Date and Name of Person Making Change.

Do not extend this side of this line.

PLEASE RETURN TO
LOS ANGELES COUNTY ENGINEER
403 LOS ANGELES COUNTY ENGINEERING BLDG.

76F309S CE # 310 3-61

PLEASE RETURN TO
LOS ANGELES COUNTY ENGINEER
403 LOS ANGELES COUNTY ENGINEERING BLDG.

Note: Any Additions or Changes on This Sheet Must be Made or Circled in Red Ink With Date and Name of Person Making Change.

Do not extend this side of this line.

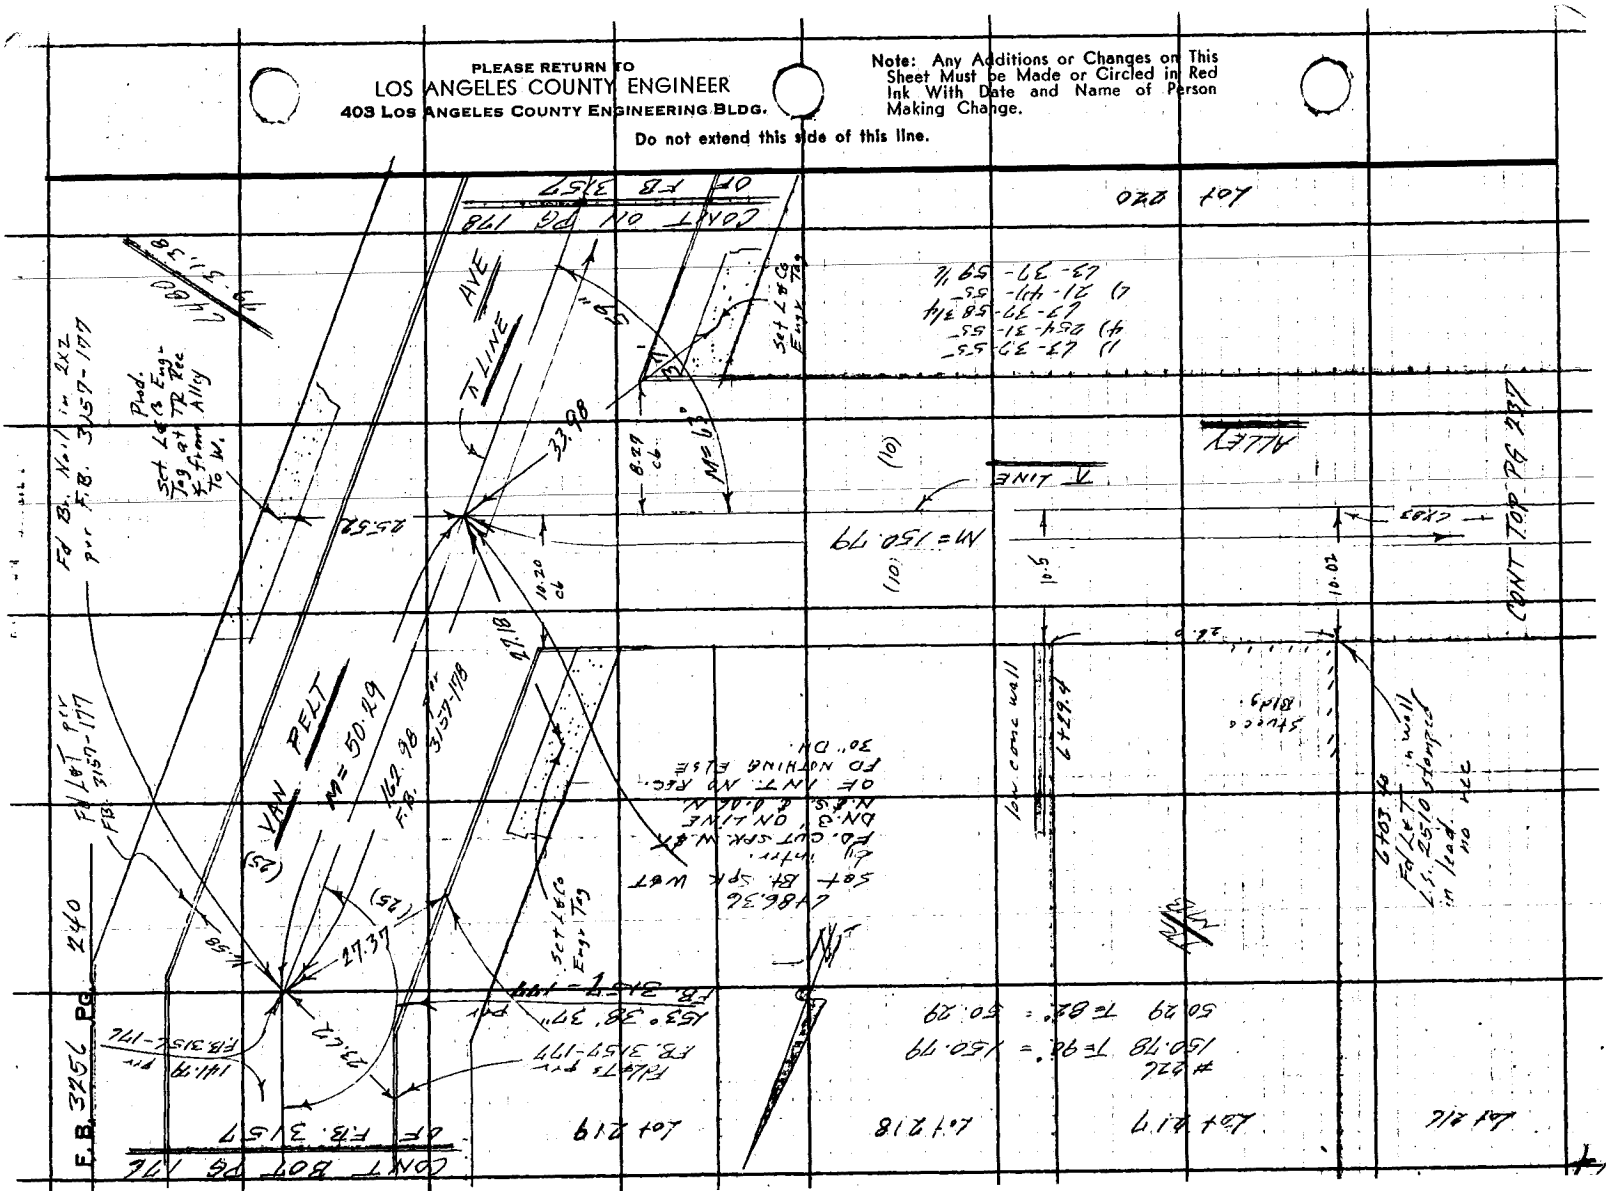

Notes Ck'd by	Survey of MT TERRACE AREA 2
Map No.	JN 0303.04 Tape 226 Std 84 °F
Office Work	Surveyed by FEBlooks
Checked	Notes FEB Date 27 Oct 64
Date	Indexed C. J. GALLI

F. B. 3256 Pg. 241

CONT BOT PG 247 OF FB. 3157

Note: Any Additions or Changes on this Sheet Must be Made or Circled in Ink With Date and Name of Person Making Change.

Do not extend this side of this line.

PLEASE RETURN TO LOS ANGELES COUNTY ENGINEER 700 Los Angeles County Engineering Bldg.

76F3095 S&E #247 11-56

W. S. 7, E-1

#226 T=84°
53.55 @ 2°51' = 53.483
53.74 @ 5°37' = 53.482
M = 53.48

248.37 P.O.T. set 1X2"GN by double

1) 114-39-00
2) 90-21-00
3) 114-39-00
4) 327-54-00
5) 114-39-00

N=53.48

DR.

Block 9

Lot 32

Lot 33

Lot 34

(15)

(15)

#226 T=84°
53.55 @ 2°51' = 53.483
53.74 @ 5°37' = 53.482
M = 53.48

59.20
L=53.41

RAMBOZ

P.L.

N=89.06

N=114°39'00"E

Set spk & T. in g.p. #L01208H

14-89.15 Lot 32

28.876

N=165.44

28.51

33.72

Set Lot

14.34

34.70.43 Set P.M. on S.M.H. by intf. Set P Tan ±. on rim.

#226 T=88°
166.55 @ 0°49' = 165.424
166.65 @ 6°58' = 165.420
M = 165.42

(15)

(15)

Lot 35

Lot 36

Lot 37

Lot 38

POINT TOP FB. 3158

POINT FB. 3158

PLEASE RETURN TO
LOS ANGELES COUNTY ENGINEER
700 LOS ANGELES COUNTY ENGINEERING BLDG.

Note: Any Additions or Changes on This Sheet Must be Made or Circled in Red Ink With Date and Name of Person Making Change.

Do not extend this side of this line.
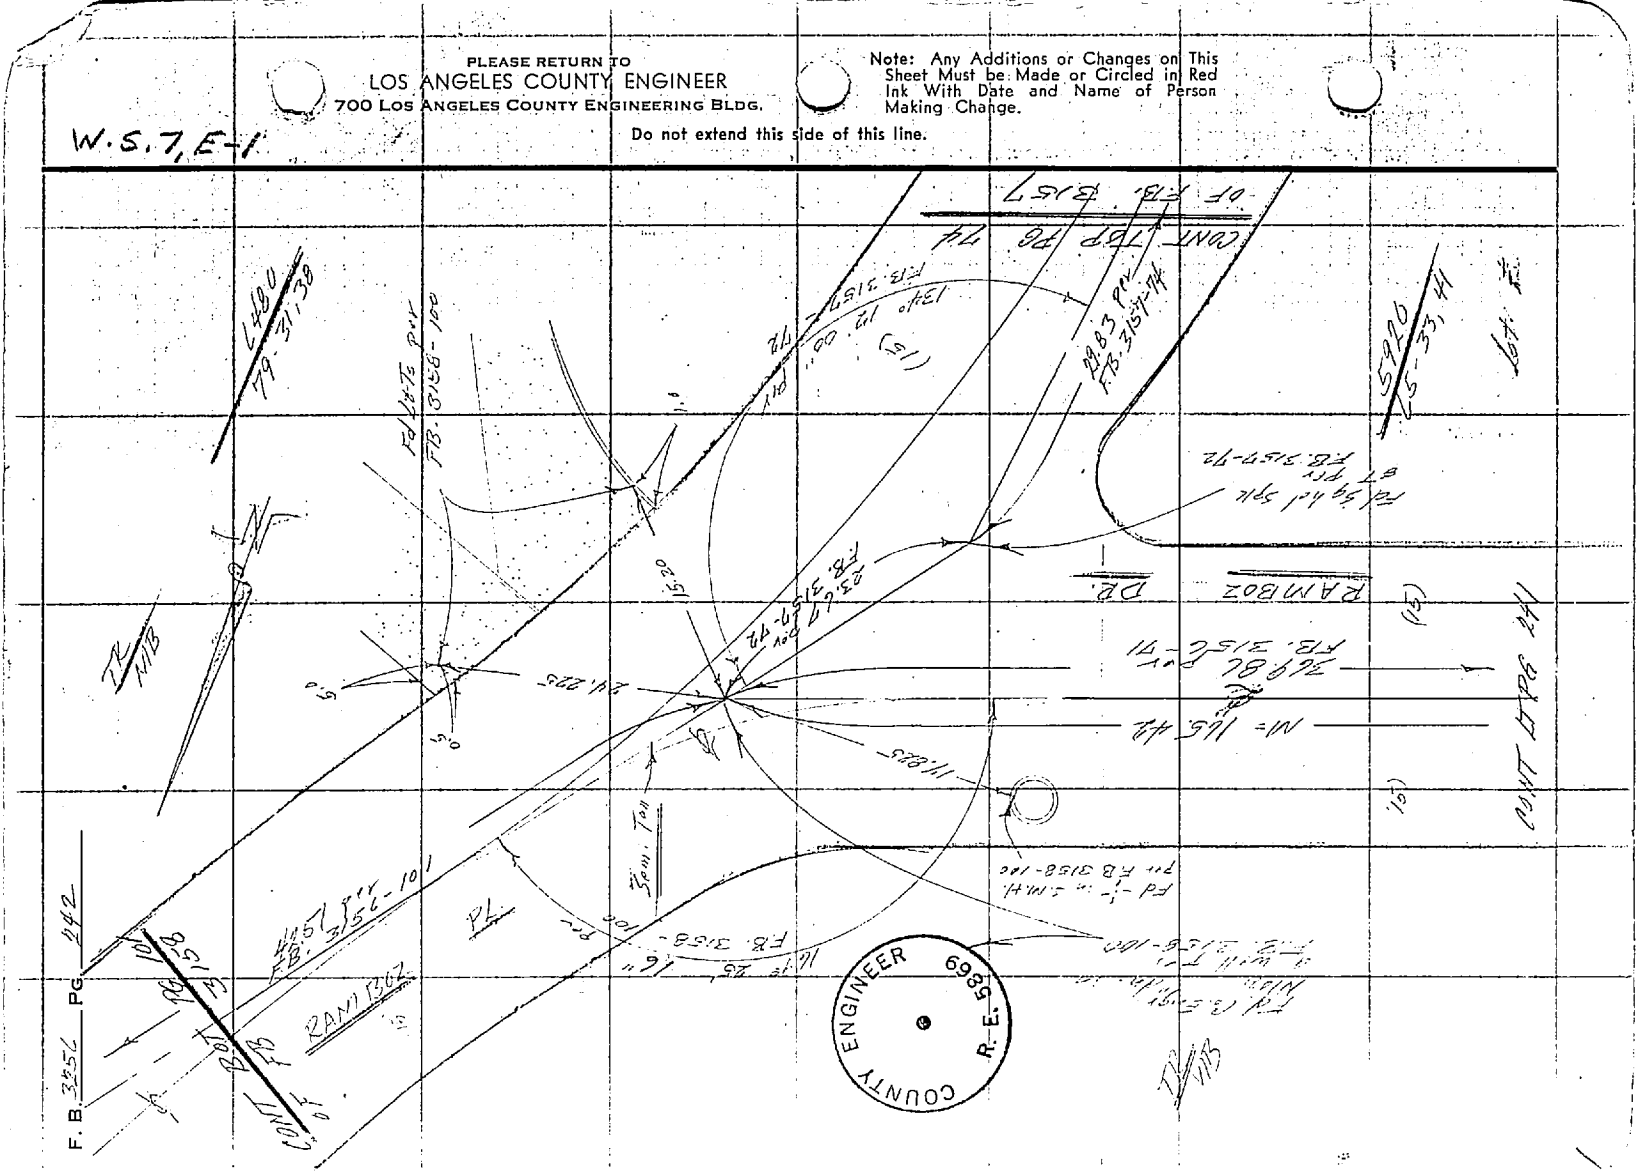
W.S.7, E-1