NOTES RED _____ JOB NO 6012.74 SURVEY OF S.D. Project #1274 F. B. 3309 Pg. 5

NOTES CHKD _____ NOTES BY FEB DATE Apr. 71

S.N. 6012.74

BENCH LEVELS

for

STORM DRAIN PROJECT

No 1274

Note

The notes were double recorded for a check.

FE Brooks

G. Guizado

R.A. Moore

Microfilmed March '85

769420 S & E-353 9-55

PLEASE RETURN TO
LOS ANGELES COUNTY ENGINEER
700 LOS ANGELES COUNTY ENGINEERING BLDG.

NOTE: ANY ADDITIONS OR CHANGES ON THIS SHEET MUST BE MADE OR CIRCLED IN RED INK, WITH DATE AND NAME OF PERSON MAKING CHANGE.

Do not extend notes this side of this line

JOB NO. 6012.74 SURVEY OF S.D. Project #1274
SURVEY BY F.E.B. Brooks
NOTES BY F.E.B. DATE 6 Mar 74
INDEXED O.J. GALLI DATE
NOTES RED. DATE
NOTES CHKD. R.L.B. DATE 5-13-74
F.B. 3369 PG. 6

B.M.	1ST RUN	DIFF.	2ND RUN	3RD RUN	ADJ. ELEV.
BM 44-13	453.207				
+	4.709		4.629		
⊼	457.916	+0.600	+0.598		
−	4.109		4.031		
TP 1	453.807				
+	4.449		4.399		
⊼	458.256	+0.220	+0.218		
−	4.229		4.181		
TP 2	454.027				
+	3.291		3.379		
⊼	457.318	-0.659	-0.658		
−	3.950		4.037		
TP 3	453.368				
+	3.169		3.261	3.237	
⊼	456.537	-1.604	-1.599	-1.602	
−	4.773		4.960	4.839	
TP 4	451.764				
+	4.240		4.209		
⊼	456.004	-1.610	-1.610		
−	5.850		5.819		
TP 5	450.154				
+	5.271		5.390		
⊼	455.425	+2.606	+2.607		
−	2.665		2.783		
TP 6	452.760				
+	3.350		3.240	3.350	
⊼	456.110	-0.663	-0.661	-0.663	
−	4.013		3.901	4.013	
TP 7	452.097				

DESCRIPTION

BM 44-13 Elev 453.207 FB 1366-115
Colima Rd (Anaheim Puente Rd) S. side
0.71 mile W. of Fullerton Rd. at
mileage marker 60/LA 21-59 A.L.A.
Co. Button Brass Cap set in a 17x14
cone post 2" lower than culvert
headwall.

765420 S & E-353 9-55

PLEASE RETURN TO
LOS ANGELES COUNTY ENGINEER
700 LOS ANGELES COUNTY ENGINEERING BLDG.

NOTE: ANY ADDITIONS OR CHANGES ON THIS SHEET MUST BE MADE OR CIRCLED IN RED INK, WITH DATE AND NAME OF PERSON MAKING CHANGE.

Do not extend notes this side of this line

NOTES RED _____ JOB NO. 402.71 SURVEY OF S.D. Project #1274 F.B. 1781 PG. 7
DATE _____ SURVEY BY F.E. Brooks DATE 5-13-71
DATE 5-13-71 INDEXED B.J. GALLI DATE 10-1-71

B.M.	1ST RUN	DIFF.	2ND RUN	3RD RUN	ADJ. ELEV.	DESCRIPTION
TP 7	452.099					
+	2.800		2.891	3.008		
=	454.897	-1.081	-1.086	1.082		
-	3.881		3.977	4.090		
TP 8	451.016					
+	4.430		4.543			
=	455.446	+1.047	+1.044			
-	3.383		3.499			
TP 9	452.063					
+	4.139		4.287			
=	456.202	+0.788	+0.788			
-	3.351		3.499			
TP 10	452.851					
+	4.323		4.407			
=	457.174	+0.134	+0.136			
-	4.189		4.271			
TP 11	452.985					
+	4.715		4.799	4.861		
=	457.700	+1.144	+1.148	+1.146		
-	3.571		3.651	3.715		
TP 12	454.129					
+	4.573		4.800			
=	458.702	+1.416	+1.419			
-	3.157		3.381			
TP 13	455.545					
+	5.140		4.999	5.107		
=	460.685	+3.412	+3.416	+3.414		
-	1.728		1.583	1.693		
TP 14	458.957					

765420 S & E-353 9-55

PLEASE RETURN TO
LOS ANGELES COUNTY ENGINEER
700 LOS ANGELES COUNTY ENGINEERING BLDG.

NOTE: ANY ADDITIONS OR CHANGES ON THIS SHEET MUST BE MADE OR CIRCLED IN RED INK, WITH DATE AND NAME OF PERSON MAKING CHANGE.

Do not extend notes this side of this line

JOB NO. 642.74 SURVEY OF S.D. Project No 1274 NOTES RED. DATE
SURVEY BY FEB. Brooks NOTES CHKD. RWB
NOTES BY FEB. DATE 6 Nov 71 DATE 5-15-72
INDEXED G.J. GALLI DATE
F.B. 3[illegible] PG. 8

B.M.		1ST RUN	DIFF.	2ND RUN	3RD RUN	ADJ. ELEV.	DESCRIPTION
TP	14	458.957					
+		7.470		7.573			
⊼		466.427	+5.028	+5.025			
−		2.442		2.548			
TP	15	463.985					
+		8.683		8.789			
⊼		472.668	+7.131	+7.130			
−		1.552		1.659			
TP	16	471.116					
+		8.257		8.180			
⊼		479.373	+6.420	+6.420			
−		1.837		1.760			
TP	17	477.536					
+		8.415		8.470			
⊼		485.951	+6.668	+6.670			
−		1.747		1.800			
TP	18	484.204					
+		9.779		9.621			
⊼		493.983	+7.456	+7.454			
−		2.323		2.167			
TP	19	491.660					
+		6.305		6.207			
⊼		497.965	+1.786	+1.786			
−		4.519		4.421			
TP	20	493.446					
+		5.115		4.999			
⊼		498.561	-1.850	-1.848			
−		6.965		6.847			
TP	21	491.596					

765420 S & E-353 9-55

PLEASE RETURN TO
LOS ANGELES COUNTY ENGINEER
700 LOS ANGELES COUNTY ENGINEERING BLDG.

NOTE: ANY ADDITIONS OR CHANGES ON THIS SHEET MUST BE MADE OR CIRCLED IN RED INK, WITH DATE AND NAME OF PERSON MAKING CHANGE.

Do not extend notes this side of this line

NOTES RED _____ JOB NO. L012.74 SURVEY OF S.D. Project # 12.74
DATE _____ SURVEY BY _____
FROM FIELD BOOKS _____ COMPUTED _____
DATE 3-13-74 INDEXED R. LEGATO DATE MAY 10 74
F.B. 1366 pg 2

B.M.	1ST RUN	DIFF.	2ND RUN	3RD RUN	ADJ. ELEV.	DESCRIPTION
TP 21	491.596					
+	4.351		4.440			
=	495.947	-2.918	- 2.917			
-	7.269		7.357			
TP 22	488.678					
+	2.185		2.060			
=	490.863	-6.885	-6.885			
-	9.070		8.945			
TP 23	481.793					
+	2.470		2.429			
=	484.263	-5.622	-5.621			
-	8.092		8.050			
TP 24	476.171					
+	2.200		2.249			
=	478.371	-6.721	-6.722			
-	8.921		8.971			
TP 25	469.450					
+	2.401		2.330			
=	471.851	-4.859	- 4.861			
-	7.260		7.191			
TP 26	464.591					
+	4.147		4.071			
=	468.738	-0.893	- 0.896			
-	5.040		4.967			
BM 44-11A	463.698					BM 44-11A Elev. 463.691 F.B. 1366-120 Colima Rd. (Fifth Ave) and Batson Ave N.W. Cor. L.A. Co Engr Brass Cap cemented into conc. slab at back of walk.
+	4.131		4.035			
=	467.829	-1.440	- 1.442			
-	5.571		5.477			
TP 27	462.258					

765420 S & E-353-9-55

PLEASE RETURN TO
LOS ANGELES COUNTY ENGINEER
700 LOS ANGELES COUNTY ENGINEERING BLDG.

NOTE: ANY ADDITIONS OR CHANGES ON THIS SHEET MUST BE MADE OR CIRCLED IN RED INK, WITH DATE AND NAME OF PERSON MAKING CHANGE.

Do not extend notes this side of this line

JOB NO. 2012.74 SURVEY OF S.D. Project # 1274 NOTES RED.
SURVEY BY EE Blocks DATE
NOTES BY IZED DATE 8 MAY 74 NOTES CHKD. RLB
INDEXED G.J. GALLI DATE 5-15-74

F.B. 3769 PG. 16

	B.M.	1ST RUN	DIFF.	2ND RUN	3RD RUN	ADJ. ELEV.	DESCRIPTION
TP	27	462.258					
+		3.735		3.670			
⊼		465.993	-3.614	-3.611			
-		7.349		7.281			
TP	28	458.644					
+		2.447		2.511			
⊼		461.091	-3.706	-3.709			
-		6.153		6.220			
TP	29	454.938					
+		1.247		1.453	1.587		
⊼		456.185	-5.472	-5.476	-5.473		
-		6.719		6.929	7.060		
BM	SD 1251	449.466				449.459	BM S.D. 1251 Elev 449.459
+		8.681		8.821			East wall of Flood Control channel N. of
⊼		458.147	+5.894	+5.892			Colima Rd. A. P.K. Spk set in lead
-		2.789		2.929			on E'ly Prod of the S. P/L of house
TP	30	455.360					#1470 Batson Ave.
+		6.521		6.667			
⊼		461.881	+3.692	+3.692			
-		2.829		2.975			
TP	31	459.052					
+		6.289		6.395			
⊼		465.341	+1.812	+1.814			
-		4.477		4.581			
TP	32	460.864					
+		5.762		5.850			
⊼		466.626	+0.792	+0.791			
-		5.370		5.459			
TP	33	461.256					

769420 S & E-353 9-55

PLEASE RETURN TO
LOS ANGELES COUNTY ENGINEER
700 LOS ANGELES COUNTY ENGINEERING BLDG.

NOTE: ANY ADDITIONS OR CHANGES ON THIS SHEET MUST BE MADE OR CIRCLED IN RED INK, WITH DATE AND NAME OF PERSON MAKING CHANGE.

Do not extend notes this side of this line

NOTES RED _____ JOB NO. 62.24 SURVEY OF S.D. Progress 1274
DATE _____ SURVEY BY FE Brooks F.B. 3369 PG. 11
NOTES CHKD. [illegible] NOTES BY [illegible] DATE [illegible]
DATE 3-[illegible] INDEXED [illegible] DATE [illegible]

B.M.	1ST RUN	DIFF.	2ND RUN	3RD RUN	ADJ. ELEV.	DESCRIPTION
TP 33	461.256					
+	6.030		6.141			
=	467.286	+1.688	+1.688			
-	4.342		4.453			
BM S.D. 1252	462.944				462.938	BM SD 1252 Elev. 462.938 Colima Rd. and Batson Ave S.E. Cor. PK spk in lead in conc base of light standard 290 ft ± E. of Batson Rd.
+	7.095		7.220			
=	470.039	+3.352	+3.351			
-	3.743		3.869			
TP 34	466.296					
+	5.211		5.300	5.245		
=	471.507	-0.646	-0.641	-0.644		
-	5.857		5.941	5.889		
TP 35	465.650					
+	4.240		4.299			
=	469.890	-1.430	-1.430			
-	5.670		5.729			
BM S.D. 1253	464.220				464.216	BM SD 1253 Elev. 464.216 Sellick Ave and Sierra Leone Ave S.W.Cor. PK Spk in lead in N.E. Cor. of catch basin 35± W. of Curb return
+	5.983		6.121			
=	470.203	+1.392	+1.392			
-	4.591		4.729			
TP 36	465.612					
+	6.113		6.179	6.191		
=	471.725	+1.084	+1.089	+1.086		
-	5.029		5.090	5.105		
TP 37	466.696					
+	6.075		5.999			
=	472.771	+1.452	+1.449			
-	4.623		4.550			
TP 38	468.148					

768420 S & E-353-9-55

PLEASE RETURN TO
LOS ANGELES COUNTY ENGINEER
700 LOS ANGELES COUNTY ENGINEERING BLDG.

NOTE: ANY ADDITIONS OR CHANGES ON THIS SHEET MUST BE MADE OR CIRCLED IN RED INK, WITH DATE AND NAME OF PERSON MAKING CHANGE.

Do not extend notes this side of this line

JOB NO. 6012.74 SURVEY OF S.D. Project #1274 NOTES RED.
SURVEY BY EE Brooks DATE
NOTES BY J. FEB DATE 8 Mar 71 NOTES CHKD. RCB
INDEXED O.J. GALL DATE DATE 5-13-71

F.B. 3369 PG. 12

B.M.		1ST RUN	DIFF.	2ND RUN	3RD RUN	ADJ. ELEV.	DESCRIPTION
TP	38	468.148					
+		6.453		6.365			
=		474.601	+2.202	+2.200			
-		4.251		4.165			
TP	39	470.350					
+		7.261		7.091			
=		477.611	+3.470	+3.471			
-		3.791		3.620			
TP	40	473.820					
+		6.285		6.175			
=		480.105	+2.282	+2.282			
-		4.003		3.893			
TP	41	476.102					
+		7.661		7.645			
=		483.763	+4.916	+4.916			
-		2.745		2.729			
TP	42	481.018					
+		5.817		5.749			
=		486.835	+0.902	+0.900			
-		4.915		4.849			
TP	43	481.920					
+		6.069		6.030			
=		487.989	+0.762	+0.761			
-		5.387		5.269			
TP	44	482.682					
+		5.635		5.571			
=		488.317	+1.836	+1.836			
-		3.799		3.735			
BM SD 1254		484.518					BM SD 1254

765420 S & E-353 9-55

PLEASE RETURN TO
LOS ANGELES COUNTY ENGINEER
700 LOS ANGELES COUNTY ENGINEERING BLDG.

NOTE: ANY ADDITIONS OR CHANGES ON THIS SHEET MUST BE MADE OR CIRCLED IN RED INK, WITH DATE AND NAME OF PERSON MAKING CHANGE.

Do not extend notes this side of this line

NOTES RED _____ JOB NO 6012.14 SURVEY OF S.D. Program #1204
DATE _____ SURVEY BY F.E. Bianchi
NOTES CHKD K.B.B. DATE 5-13-77 INDEXED G.L.GALLI DATE 5-19-77 PLATTED [illegible] DATE 5-20-77
F.B. 3340 PG. 13

B.M.	1ST RUN	DIFF.	2ND RUN	3RD RUN	ADJ. ELEV.	DESCRIPTION
BM SD 1254	484.518				484.518	BM S.D. 1254 Elev. 484.518
+	7.439		7.351			Alberca Dr. (cul de sac) W. side
⊼	491.957	+1.229	+1.226			140± ft S. of Vidora Dr. A P.K.
−	6.210		6.125			spk in lead in base of st. light std.
TP 45	485.747					
+	9.849		10.375			
+	495.596	+9.528	+9.525			
−	0.321		0.850			
TP 46	495.275					
+	7.971		7.852			
⊼	503.246	+3.781	+3.781			
−	4.190		4.071			
TP 47	499.056					
+	3.199		3.251			
⊼	502.255	−3.891	−3.890			
−	7.090		7.141			
BM S.D. 1255	495.165				495.164	BM S.D. 1255 Elev. 495.164
+	7.033		6.967			Farjardo St. S. Curb. opposite house
⊼	502.198	+4.628	+4.628			#18525 Bench Nail in head
−	2.405		2.339			1.2 ft E. of E. edge of catch basin.
TP 48	499.793					
+	7.401		7.467			
⊼	507.194	+3.986	+3.988			
−	3.415		3.479			
TP 49	503.779					
+	6.149		6.089			
⊼	509.928	+2.670	+2.668			
−	3.479		3.419			
TP 50	506.449					

765420 S & E-353 9-55

PLEASE RETURN TO
LOS ANGELES COUNTY ENGINEER
700 LOS ANGELES COUNTY ENGINEERING BLDG.

NOTE: ANY ADDITIONS OR CHANGES ON THIS SHEET MUST BE MADE OR CIRCLED IN RED INK, WITH DATE AND NAME OF PERSON MAKING CHANGE.

Do not extend notes this side of this line

JOB NO. 604.74 SURVEY OF S.D. Police #12 74 NOTES RED. DATE
SURVEY BY FE Brooks NOTES CHKD. RGB
NOTES BY FE B DATE 8 Mar 71 DATE 5-13-71
INDEXED C.J. GALLI DATE

F.B. 3569 PG. 14

	B.M.	1ST RUN	DIFF.	2ND RUN	3RD RUN	ADJ. ELEV.	DESCRIPTION
TP	50	506.449					
+		6.133		6.045			
⊼		512.582	+2.253	+2.254			
−		3.880		3.791			
TP	51	508.702					
+		5.841		5.695			
⊼		514.543	+1.718	+1.718			
−		4.123		3.977			
TP	52	510.420					
+		6.490		6.400			
⊼		516.910	+3.810	+3.809			
−		2.680		2.591			
TP	53	514.230					
+		8.319		8.235			
⊼		522.549	+7.639	+7.636			
−		0.680		0.599			
TP	54	521.869					
+		9.091		8.849			
⊼		530.960	+6.101	+6.102			
−		2.990		2.747			
TP	55	527.970					
+		3.820		3.673			
⊼		531.790	-2.985	-2.986			
−		6.805		6.659			
TP	56	524.985					
+		3.120		3.021	2.947		
⊼		528.105	-2.233	-2.238	-2.232		
−		5.353		5.259	5.180		
BM	SD 1256	522.752					BM SD 1256

765420 S & E-353 9-55

PLEASE RETURN TO
LOS ANGELES COUNTY ENGINEER
700 LOS ANGELES COUNTY ENGINEERING BLDG.

NOTE: ANY ADDITIONS OR CHANGES ON THIS SHEET MUST BE MADE OR CIRCLED IN RED INK, WITH DATE AND NAME OF PERSON MAKING CHANGE.

Do not extend notes this side of this line

NOTES RED _____ JOB NO _____ SURVEY OF S.D. Project #1244
DATE _____ SURVEY BY F.E. Brooks
NOTES CHKD. [illegible] NOTES BY _____ DATE 8-21-61
DATE _____ INDEXED _____ DATE _____

F.B. 3367 PG. 15

B.M.	1ST RUN	DIFF.	2ND RUN	3RD RUN	ADJ. ELEV.	DESCRIPTION
BM SD 1256	522.752				522.756	BM SD 1256 Elev. 522.756
+	6.910		7.009			Mescal St. S. curb in front of
⇈	529.662	+1.769	+1.770			house #18556. A.P.K. spk in
−	5.141		5.239			lead in N.W. Cor of S.D. Catch basin
TP 57	524.521					
+	6.963		6.881			
⇈	531.484	+2.313	+2.312			
−	4.650		4.569			
TP 58	526.834					
+	5.981		5.781			
⇈	532.815	+3.651	+3.651			
−	2.330		2.130			
TP 59	530.485					
+	8.610		8.539			
⇈	539.095	+3.533	+3.534			
−	5.077		5.005			
BM SD 1257	534.018				534.024	BM SD 1257 Elev. 534.024
+	6.470		6.355			Back lot line of house #2448 Alameda
⇈	540.488	+2.780	+2.780			Ave. A.P.K. spk in lead at cent. of
−	3.690		3.575			S.D. head wall
TP 60	536.798					
+	4.971		4.839			
⇈	541.769	+0.072	+0.074			
−	4.899		4.765			
BM SD 1258	536.870				536.878	BM SD 1258 Elev. 536.878
+	4.499		4.390			Back lot line of house #2450 Alameda
⇈	541.369	−1.022	−1.027			Ave. A.P.K. spk in lead at center
−	5.525		5.417			of S.D. headwall.
TP 61	535.844					

766420 S & E-353 9-55

PLEASE RETURN TO
LOS ANGELES COUNTY ENGINEER
700 LOS ANGELES COUNTY ENGINEERING BLDG.

NOTE: ANY ADDITIONS OR CHANGES ON THIS SHEET MUST BE MADE OR CIRCLED IN RED INK, WITH DATE AND NAME OF PERSON MAKING CHANGE.

Do not extend notes this side of this line

NOTES RED. DATE
NOTES CHKD. RDB DATE 5-13-71
JOB NO. Lo 12.74 SURVEY OF S.D Project #1274
SURVEY BY FE Brooks
NOTES BY FEB DATE 8 May 71
INDEXED C. J. GALL DATE
F. B. 3369 PG. 16

B.M.	1ST RUN	DIFF.	2ND RUN	3RD RUN	ADJ. ELEV.	DESCRIPTION
TP 61	535.844					
+	4.751		4.641			
⊼	540.595	+0.976	+0.979			
−	3.775		3.662			
TP 62	536.820					
+	6.681		6.753			
⊼	543.501	+5.082	+5.082			
−	1.599		1.671			
TP 63	541.902					
+	7.060		6.983			
⊼	548.962	+4.057	+4.056			
−	3.003		2.927			
BM SD 1259	545.959				545.970	BM SD 1259 Elev 545.970
+	8.611		8.911			120 ft ± E. of Doubletree Ln. and
⊼	554.570	+8.221	+8.220			345 ft ± N. of Aguiro St. A chis
−	0.390		0.691			+ in the N. Rim of a S.D. M.H.
TP 64	554.180					
+	8.709		8.785			
⊼	562.889	+6.580	+6.582			
−	2.129		2.203			
TP 65	560.760					
+	4.490		4.421			
⊼	565.250	−1.730	−1.729			
−	6.220		6.150			
TP 66	559.030					
+	4.020		4.080			
⊼	563.050	−0.530	−0.530			
−	4.550		4.610			
BM S.D 1260	558.500					BM SD 1260

765420 S & E-353 9-55

PLEASE RETURN TO
LOS ANGELES COUNTY ENGINEER
700 LOS ANGELES COUNTY ENGINEERING BLDG.

NOTE: ANY ADDITIONS OR CHANGES ON THIS SHEET MUST BE MADE OR CIRCLED IN RED INK, WITH DATE AND NAME OF PERSON MAKING CHANGE.

Do not extend notes this side of this line

B.M.	1ST RUN	DIFF.	2ND RUN	3RD RUN	ADJ. ELEV.	DESCRIPTION
BM SD 12C0	558.500				558.515	BM SD 12C0 Elev 558.515
+	5.306		5.430			Aguivo St. S. side at house #8542
⊼	563.800	+1.149	+1.151			P.K. spk. in lead in N.E. Cor of S.D.
-	4.151		4.279			Catch basin
TP C7	559.649					
+	5.863		5.941			
⊼	565.512	+1.780	+1.780			
-	4.083		4.161			
TP C8	561.429					
+	5.932		5.867			
⊼	567.361	+2.312	+2.314			
-	3.620		3.553			
BM SD 12C1	563.741				583.759	BM SD 12C1 Elev. 583.759
+	8.263		8.405			Aguiho St. and Gallio Ave S.E. Cor.
⊼	572.004	7.472	+7.472			PK spk in lead in S.W Cor of
-	0.791		0.933			Catch basin.
TP C9	571.213					
+	7.340		7.399			
⊼	578.553	+4.411	+4.414			
-	2.929		2.985			
BM SD 12C2	575.624				575.645	BM S.D. 12C2 Elev. 575.645
+	8.439		8.323			Gallio Ave and Fidalgo St. S.W.
⊼	584.063	+7.794	+7.794			Cor. P.K spk in lead 1.2 ft W.
-	0.645		0.529			of W end C.R.
TP 70	583.418					
+	10.059		10.219			
⊼	593.477	+9.800	+9.802			
-	0.259		0.417			
TP 71	593.218					

NOTES RED
DATE
NOTES CHKD. DATE 3-13-57
JOB NO. C012.74 SURVEY OF S.D. Project #12C4
SURVEY BY F.E. Brooks
NOTES BY DATE 3-11-57
INDEXED L.J. GATTI DATE 3-19-57
F.B. 3410 PG. 11

765420 S & E-353 9-55

PLEASE RETURN TO
LOS ANGELES COUNTY ENGINEER
700 LOS ANGELES COUNTY ENGINEERING BLDG.

NOTE: ANY ADDITIONS OR CHANGES ON THIS SHEET MUST BE MADE OR CIRCLED IN RED INK, WITH DATE AND NAME OF PERSON MAKING CHANGE.

Do not extend notes this side of this line

JOB NO. 6012.74 SURVEY OF S.D. Project #1244
SURVEY BY FE Brooks
NOTES BY FEB DATE 8 Nov 71
INDEXED G. J. GALLI DATE
NOTES RED. DATE
NOTES CHKD. R&B DATE 5-13-71

F.B. 3369 PG. 18

B.M.	1ST RUN	DIFF.	2ND RUN	3RD RUN	ADJ. ELEV.	DESCRIPTION
TP 71	593.218					
+	10.410		10.521			
⊼	603.628	+9.410	+9.410			
−	1.000		1.111			
BM SD 1263	602.628				602.651	BM SD 1263 Elev. 602.651
+	8.440		8.530			Gallio Ave and Kincroft St. S.E.
⊼	611.068	+7.917	+7.919			Cor. PK Spk in lead 2ft E. of
−	0.523		0.611			E. end C.R.
TP 72	610.545					
+	11.000		11.131			
⊼	621.545	+10.489	+10.490			
−	0.511		0.641			
TP 73	621.034					
+	6.091		6.018			
⊼	627.125	+1.951	+1.957			
−	4.140		4.067			
BM SD 1264	622.985				622.911	BM S.D. 1264 Elev. 622.911
+	4.503		4.580			Gallio Ave E. curb at house #2756
⊼	627.488	−0.044	−0.042			Rd. Dept BM Nail in lead.
−	4.547		4.622			
BM SD 1265	622.941				622.869	BM S.D. 1265 Elev. 622.869
+	11.510		11.639			Gallio Ave W. curb. at house #2757
⊼	634.451	+8.991	+8.991			Rd. Dept BM Nail in lead
−	2.519		2.648			
TP 74	631.932					
+	7.061		7.139			
⊼	638.993	+2.431	+2.430			
−	4.630		4.709			
TP 75	634.363					

768420 B & E-353 9-55

PLEASE RETURN TO
LOS ANGELES COUNTY ENGINEER
700 LOS ANGELES COUNTY ENGINEERING BLDG.

NOTE: ANY ADDITIONS OR CHANGES ON THIS SHEET MUST BE MADE OR CIRCLED IN RED INK, WITH DATE AND NAME OF PERSON MAKING CHANGE.

Do not extend notes this side of this line

B.M.	1ST RUN	DIFF.	2ND RUN	3RD RUN	ADJ. ELEV.	DESCRIPTION
TP 75	634.363					
+	2.821		2.709	2.803		
=	637.184	-4.688	-4.693	-4.697		
-	7.509		7.402	7.490		
TP 76	629.675					
+	1.530		1.460			
=	631.205	-7.720	-7.721			
-	9.250		9.181			
TP 77	621.955					
+	7.599		7.529			
=	629.554	+2.129	+2.129			
-	5.470		5.400			
TP 78	624.084					
+	4.353		4.427			
=	628.437	+1.622	+1.622			
-	2.731		2.805			
TP 79	625.706					
+	0.855		1.041			
=	626.561	-10.706	-10.708			
-	11.561		11.749			
TP 80	615.000					
+	2.935		3.061			
=	617.935	-8.566	-8.569			
-	11.501		11.630			
TP 81	606.434					
+	4.598		4.623			
=	611.032	+0.893	+0.892			
-	3.705		3.731			
BM SD 1211	607.327					BM S.D 1211

NOTES RED _____ JOB NO. 2012.44 SURVEY OF 2nd Division
DATE _____ SURVEY BY F.E. Brooks 12/44
NOTES CHKD. R.B.S. NOTES BY _____ DATE _____
DATE 5-25-71 INDEXED G. LGATTI DATE 5-10-71

F. B. 3369 Pg. 17

765420 S & E-353 9-55

PLEASE RETURN TO
LOS ANGELES COUNTY ENGINEER
700 LOS ANGELES COUNTY ENGINEERING BLDG.

NOTE: ANY ADDITIONS OR CHANGES ON THIS SHEET MUST BE MADE OR CIRCLED IN RED INK, WITH DATE AND NAME OF PERSON MAKING CHANGE.

Do not extend notes this side of this line

JOB NO. 6012.74 SURVEY OF S.D. Project # 1274 NOTES RED.
SURVEY BY E.E. Brooks DATE
NOTES BY F.E.B. DATE 9 Mar. 71 NOTES CHKD. R.C.B. 3-13-71
INDEXED J. GALL DATE

F.B. 7369 PG. 20

B.M.	1ST RUN	DIFF.	2ND RUN	3RD RUN	ADJ. ELEV.	DESCRIPTION
BM SD 12CC	607.327				607.256	BM S.D. 12CC Elev. 607.256
+	0.661		0.679			Dragonera Dr. and Batson Ave N.E. Cor.
⇈	607.988	-8.704	-8.702			PK Spk in Lead 2ft E of E end C.R.
-	9.365		9.381			
TP 82	598.623					
+	0.695		0.735			
⇈	599.318	-8.732	-8.734			
-	9.427		9.469			
TP 83	589.891					
+	0.665		0.710			
⇈	590.556	-8.326	-8.327			
-	8.991		9.037			
TP 84	581.565					
+	1.453		1.500			
⇈	583.018	-6.466	-6.465			
-	7.919		7.965			
BM SD 12C7	575.099				525.030	BM S.D. 12C7 Elev. 575.030
+	2.531		2.587			Batson Ave E. side of house #2650
⇈	577.630	-4.344	-4.344			PK Spk in lead.
-	6.875		6.931			
TP 85	570.755					
+	1.432		1.359	1.279		
⇈	572.187	-7.087	-7.083	-7.084		
-	8.519		8.442	8.363		
TP 86	563.668					
+	1.870		1.899			
⇈	565.538	-5.995	-5.992			
-	7.865		7.891			
TP 87	557.673					

765420 S & E-353 9-55

PLEASE RETURN TO
LOS ANGELES COUNTY ENGINEER
700 LOS ANGELES COUNTY ENGINEERING BLDG.

NOTE: ANY ADDITIONS OR CHANGES ON THIS SHEET MUST BE MADE OR CIRCLED IN RED INK, WITH DATE AND NAME OF PERSON MAKING CHANGE.

Do not extend notes this side of this line

NOTES RED _____ JOB NO. 6015.14 SURVEY OF S.D. Project #1269
DATE _____ SURVEY BY F.E. Brooks
NOTES CHKD. K.C. NOTES BY E.C.B. DATE 5-20-57 INDEXED R.J. GALLI DATE _____

F.B. 3369 PG. 4

B.M.	1ST RUN	DIFF.	2ND RUN	3RD RUN	ADJ. ELEV.	DESCRIPTION
TP 89	557.673					
+	3.373		3.429			
↑	561.046	-3.273	3.270			
-	6.646		6.699			
BM SD 1268	554.400				554.338	BM SD 1268 Elev. 554.338
+	2.239		2.279			Batson Ave and Aguilo St. N.E. Cor.
↑	556.639	-5.812	5.812			P.K. Spk in lead 35 ft N. of N end C.R.
-	8.051		8.091			
TP 88	548.588					
+	1.735		1.785			
↑	550.323	-6.056	6.054			
-	7.791		7.839			
TP 89	542.532					
+	3.070		3.120			
↑	545.602	-4.092	4.091			
-	7.162		7.211			
BM S.D. 1269	538.440				538.382	BM SD 1269 Elev. 538.382
+	2.981		3.030			Batson Ave W. Side at Bayrosa St.
↑	541.421	-4.527	4.525			PK spk in lead in curb at house #2461
-	7.508		7.555			
TP 90	533.913					
+	3.399		3.453	3.359		
↑	537.312	-3.262	3.266	3.262		
-	6.661		6.719	6.621		
BM SD 1270	530.651				530.595	BM SD 1270 Elev. 530.595
+	2.887		2.947			Batson Ave and Subido St. N.W. Cor.
↑	533.538	-4.744	4.744			PK spk in lead at N end C.R.
-	7.631		7.691			
TP 91	525.907					

765420 S & E 353 9-55

PLEASE RETURN TO
LOS ANGELES COUNTY ENGINEER
700 LOS ANGELES COUNTY ENGINEERING BLDG.

NOTE: ANY ADDITIONS OR CHANGES ON THIS SHEET MUST BE MADE OR CIRCLED IN RED INK, WITH DATE AND NAME OF PERSON MAKING CHANGE.

Do not extend notes this side of this line

JOB NO. 6012.74 SURVEY OF S.D. Project # 1274 NOTES RED. DATE
SURVEY BY F.E. Brooks NOTES CHKD. KGB
NOTES BY F.E.B. DATE 9 March 71 DATE 5-13-71
INDEXED G.J. GALLI DATE

F.B. 3319 PG. 22

B.M.	1ST RUN	DIFF.	2ND RUN	3RD RUN	ADJ. ELEV.	DESCRIPTION
TP 91	525.907					
+	4.399		4.322			
=	530.306	-1.520	-1.522			
-	5.919		5.844			
BM S.D. 1271	524.387				524.331	BM S.D. 1271 Elev. 524.331
+	4.961		5.030			Batson Ave and Muscal St N.W. Cor.
=	529.348	-1.248	-1.245			Small spk in lead 3ft N. of Mond A.R.
-	6.209		6.275			
TP 92	523.139					
+	5.390		5.499			
=	528.529	-0.300	-0.300			
-	5.690		5.799			
BM S.D. 1272	522.839				522.786	BM S.D. 1272 Elev. 522.786
+	4.277		4.242			Muscal St. S. curb at house # 18426
=	527.116	-1.913	-1.913			P.K. spk in lead.
-	6.190		6.155			
TP 93	520.926					
+	4.325		4.242			
=	525.251	-0.985	-0.987			
-	5.310		5.229			
BM S.D. 1273	519.941				519.889	BM S.D. 1273 Elev. 519.889
+	5.613		5.657			Muscal St. and Gallio Ave SE Cor.
=	525.554	+2.050	+2.050			PK spk in lead 10ft. E. of End A.R.
-	3.563		3.607			
TP 94	521.991					
+	6.671		6.621			
=	528.662	+2.572	+2.572			
-	4.099		4.049			
BM S.D. 1274	524.563					BM SD 1274

765420 S & E-353 9-55

PLEASE RETURN TO
LOS ANGELES COUNTY ENGINEER
700 LOS ANGELES COUNTY ENGINEERING BLDG.

NOTE: ANY ADDITIONS OR CHANGES ON THIS SHEET MUST BE MADE OR CIRCLED IN RED INK, WITH DATE AND NAME OF PERSON MAKING CHANGE.

Do not extend notes this side of this line

NOTES RED _____ JOB NO. 5-1211 SURVEY OF S.D. Project #1274
DATE _____ SURVEY BY [redacted] Fee Burris
DATE 5-13-71 INDEXED by J. GALLI DATE MAY 10 71
F. B. 336 Pg. 27

B.M.	1ST RUN	DIFF.	2ND RUN	3RD RUN	ADJ. ELEV.	DESCRIPTION
BM SD 1274	524.563				524.512	BM S.D. 1274 Elev. 524.512
+	3.483		3.559			Mescal St. S. curb at house #18518
⊼	528.046	- 3.348	- 3.350			P.K. Spk in lead.
−	6.831		6.909			
TP 95	521.215					
+	3.303		3.392			
⊼	524.518	- 1.550	- 1.550			
−	4.853		4.942			
TP 96	519.665					
+	5.875		5.979			
⊼	525.540	+ 2.053	+ 2.054			
−	3.822		3.925			
TP 97	521.718					
+	5.760		5.819			
⊼	527.478	+ 1.909	+ 1.909			
−	3.851		3.910			
TP 98	523.627					
+	5.975		5.880			
⊼	529.602	- 1.958	- 1.959			
−	7.933		7.839			
TP 99	521.669					
+	2.710		2.841			
⊼	524.379	- 4.337	- 4.338			
−	7.047		7.179			
TP 100	517.332					
+	3.360		3.431			
⊼	520.692	- 3.971	- 3.974			
−	7.331		7.405			
BM SD 1275	513.361					BM SD 1275

765420 S & E-353 9-55

PLEASE RETURN TO
LOS ANGELES COUNTY ENGINEER
700 LOS ANGELES COUNTY ENGINEERING BLDG.

NOTE: ANY ADDITIONS OR CHANGES ON THIS SHEET MUST BE MADE OR CIRCLED IN RED INK, WITH DATE AND NAME OF PERSON MAKING CHANGE.

Do not extend notes this side of this line

JOB NO. 6012.74 SURVEY OF S.D. Project # 1274 NOTES RED. DATE
SURVEY BY F.E. Brooks NOTES CHKD. RGB
NOTES BY F.E.B. DATE 9 May 71 DATE 5-13-71
INDEXED G.J. GALLI DATE

F. B 3369 Pg. 24

B.M.	1st RUN	DIFF.	2nd RUN	3rd RUN	ADJ. ELEV.	DESCRIPTION
SD BM 1275	513.361				513.311	BM S.D. 1275 Elev. 513.311
+	2.550		2.595			Batson Ave and Gallinaha St. N.W. Cor
⊼	515.911	- 4.327	4.330			P.K. Spk in lead 16 ft. N. of N end C.R.
-	6.899		6.905			
TP 101	509.034					
+	3.411		3.319			
⊼	512.445	- 3.742	3.742			
-	7.153		7.061			
TP 102	505.292					
+	4.959		5.075			
⊼	510.251	- 0.882	0.882			
-	5.841		5.957			
TP 103	504.410					
+	4.719		4.770			
⊼	509.129	+ 0.039	+ 0.040			
-	4.680		4.730			
SD BM 1276	504.449				504.400	BM SD 1276 Elev. 504.400
+	4.115		4.030			Batson Ave and Farjardo St. N.W. Cor
⊼	508.564	- 1.610	- 1.609			P.K. spk in lead at N end C.R.
-	5.725		5.639			
TP 104	502.839					
+	4.232		4.129	4.053		
⊼	507.071	- 2.007	- 2.001	- 2.006		
-	6.239		6.130	6.059		
TP 105	500.832					
+	4.347		4.440			
⊼	505.179	- 0.943	0.942			
-	5.290		5.382			
SD BM 1277	499.889					BM SD 1277

765420 S & E-353 9-55

PLEASE RETURN TO
LOS ANGELES COUNTY ENGINEER
700 LOS ANGELES COUNTY ENGINEERING BLDG.

NOTE: ANY ADDITIONS OR CHANGES ON THIS SHEET MUST BE MADE OR CIRCLED IN RED INK, WITH DATE AND NAME OF PERSON MAKING CHANGE.

Do not extend notes this side of this line

NOTES RED _____ JOB NO 6012.14 SURVEY OF S.D. Project 11294
DATE _____ SURVEY BY _____
DATE 5-13-71 INDEXED G.J. GALM DATE MAY 10 71

F.B. 3447 Pg. 23

B.M.		1ST RUN	DIFF.	2ND RUN	3RD RUN	ADJ. ELEV.	DESCRIPTION
BM SD 12 77		499.889				499.844	BM SD 1277 Elev. 499.844
+		6.499		6.525			Forjando St. N. curb at house # 1845
∧		506.388	+ 2.508	+ 2.506			P.K. Spk in lead.
−		3.991		4.019			
TP	106	502.397					
+		6.823		6.687			
∧		509.220	+0.956	+ 0.988			
−		5.831		5.699			
TP	107	503.383					
+		4.051		4.163			
∧		507.434	- 2.518	- 2.819			
−		6.869		6.982			
TP	108	500.565					
+		4.059		4.001			
∧		504.624	- 1.268	- 1.265			
−		5.327		5.272			
TP	109	499.297					
+		4.483		4.531			
∧		503.780	- 1.308	- 1.307			
−		5.791		5.838			
TP	110	497.989					
+		3.048		3.220			
∧		501.037	- 4.402	- 4.403			
−		7.450		7.623			
TP	111	493.587					
+		2.090		1.973			
∧		495.677	- 5.285	- 5.286			
−		7.375		7.259			
TP	112	488.302					

765420 S & E-353 9-55

PLEASE RETURN TO
LOS ANGELES COUNTY ENGINEER
700 LOS ANGELES COUNTY ENGINEERING BLDG.

NOTE: ANY ADDITIONS OR CHANGES ON THIS SHEET MUST BE MADE OR CIRCLED IN RED INK, WITH DATE AND NAME OF PERSON MAKING CHANGE.

Do not extend notes this side of this line

JOB NO. 6012.74 SURVEY OF S.D. Project #12 St
SURVEY BY FE Brandt
NOTES BY FEB DATE 10 March 71
INDEXED G.J. GALLI DATE
NOTES RED. DATE
NOTES CHKD. RGB DATE 5-13-71

F.B. 3719 Pg. 22

B.M.		1ST RUN	DIFF.	2ND RUN	3RD RUN	ADJ. ELEV.	DESCRIPTION
TP 112		488.302					
	+	3.425		3.503			
	=	491.727	-1.926	1.927			
	-	5.351		5.430			
TP 113		486.376					
	+	4.161		4.223			
	=	490.537	-0.720	0.722			
	-	4.881		4.945			
TP 114		485.656					
	+	4.297		4.347			
	=	489.953	-0.663	0.664			
	-	4.960		5.011			
TP 115		484.993					
	+	4.213		4.147			
	=	489.206	-0.762	0.762			
	-	4.975		4.909			
TP 116		484.231					
	+	3.463		3.537			
	=	487.694	-3.539	3.540			
	-	7.002		7.077			
TP 117		480.692					
	+	1.115		1.152			
	=	481.807	-6.306	6.309			
	-	7.421		7.461			
TP 118		474.386					
	+	2.552		2.589			
	=	476.938	-4.210	4.267			
	-	6.812		6.850			
TP 119		470.126					

765420 S & E-353 9-55

PLEASE RETURN TO
LOS ANGELES COUNTY ENGINEER
700 LOS ANGELES COUNTY ENGINEERING BLDG.

NOTE: ANY ADDITIONS OR CHANGES ON THIS SHEET MUST BE MADE OR CIRCLED IN RED INK, WITH DATE AND NAME OF PERSON MAKING CHANGE.

Do not extend notes this side of this line

NOTES RED [redacted] DATE [redacted]
JOB NO. C012.174 SURVEY OF S.D. Project #12174
SURVEY BY [redacted] DATE 5-13-71
INDEXED G. J. GALLO DATE MAY 10 71
F.B. 734 Pg. 21

B.M.	1ST RUN	DIFF.	2ND RUN	3RD RUN	ADJ. ELEV.	DESCRIPTION
TP 119	470.126					
+	3.021		3.091			
=	473.147	-5.099	5.099			
-	8.120		8.190			
TP 120	465.027					
+	2.762		2.799			
=	467.789	-1.297	1.296			
-	4.059		4.095			
BM 44-11A	463.730					BM 44-11A Elev. 463.691 FB 1346-120 Colima Rd (Fifth Ave) and Batson Ave N.W. Cor. L.A. Co Engr. Brass Cap Cemented into conc slap at back of walk

F. B. 3369 Pg. 28

JOB NO. _____ SURVEY OF _____ NOTES RED. _____

SURVEY BY _____ DATE _____

NOTES BY _____ DATE _____ NOTES CHKD. _____

INDEXED _____ DATE _____ DATE _____

B.M.	1ST RUN	DIFF.	2ND RUN	3RD RUN	ADJ. ELEV.	DESCRIPTION

Notes Chkd by	Survey of S.D. Project #1274
Map No.	JN 6012.74 Tape 2232 Std 68 °F
Office Work	Surveyed by FE Brooks
Checked	Notes F&B Date 10 Nov 71
Date	Indexed B. J. GALLI MAY 10 '72

F.B. ~~—~~ Pg. ~~—~~ 27

JN 6012.74

STORM DRAIN PROJECT

No 1274

LINE A CENTER LINE

From Existing channel N. of Colima Rd.

To Existing channel S. of Sierra Leone Ave.

FE Brooks
GO Grizado
RA Moore
T Ohashi

Note: Any Additions or Changes on This Sheet Must be Made or Circled in Red Ink With Date and Name of Person Making Change.

Do not write this side of this line.

PLEASE RETURN TO
COUNTY OF LOS ANGELES
DEPARTMENT OF COUNTY ENGINEER
403 LOS ANGELES COUNTY ENGINEERING BLDG.

76F309S CE#310 3-68

F. B. 3369 PG. 30

S.D. PROJ. 1274
LINE "A"

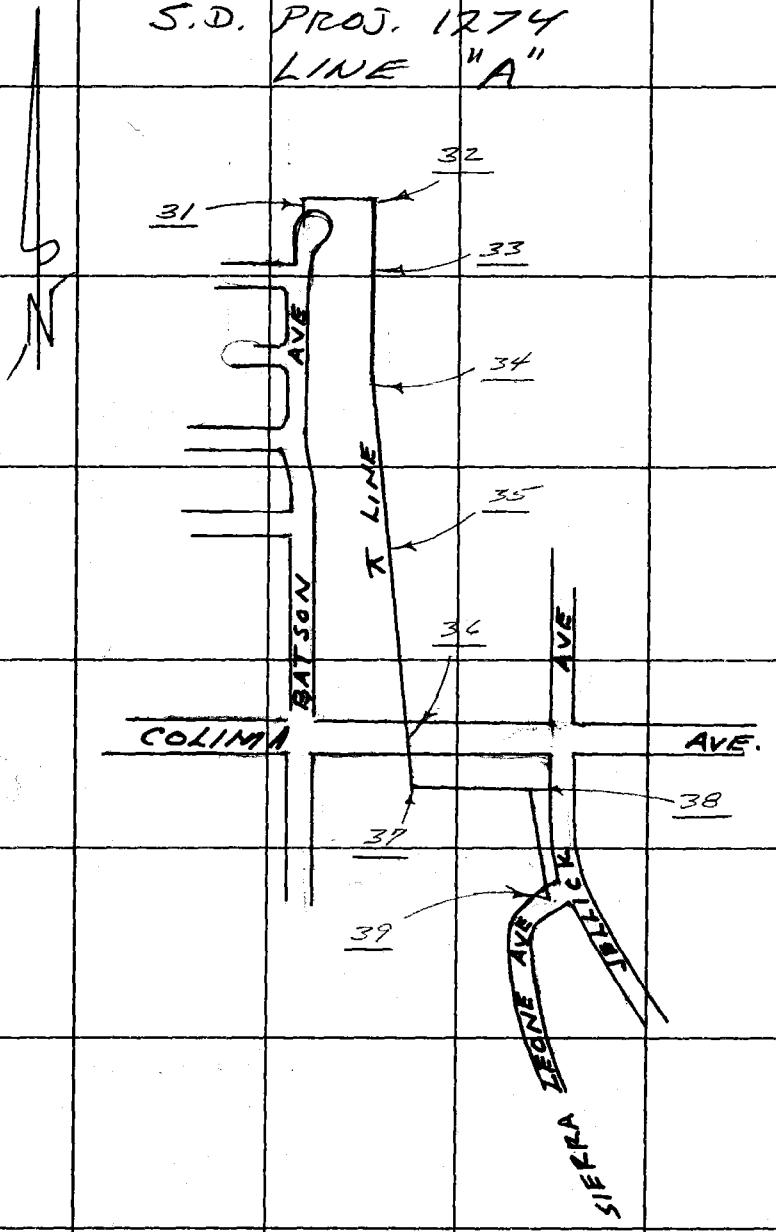

PLEASE RETURN TO
COUNTY OF LOS ANGELES
DEPARTMENT OF COUNTY ENGINEER
403 LOS ANGELES COUNTY ENGINEERING BLDG.

Do not extend this side of this line.

Note: Any Additions or Changes on This Sheet Must be Made or Circled in Red Ink With Date and Name of Person Making Change.

Notes Ck'd by H. HOLMAN
Map No.
Office Work
Checked
Date

Survey of
JN 60R.74 Tape 0232 Std LB
Surveyed by FE Brooks
Notes FE B Date 10 Mar 71
Indexed J. GALLI MAY 10 '71

F. B. 3710 PG. 31

Note: Any Additions or Changes on This Sheet Must be Made or Circled in Red Ink With Date and Name of Person Making Change.

Do not extend this side of this line.

PLEASE RETURN TO
COUNTY OF LOS ANGELES
DEPARTMENT OF COUNTY ENGINEER
403 LOS ANGELES COUNTY ENGINEERING BLDG.

76F309S CE#310 3-68

Prod. Set 1/2" Engr Tag.

Set 2" I.P. Cone plug & Engr tag by double from the S.

FLOOD CONTROL

50' 2.55

182.34 T=66°=182.34

R=38.

M=67.19'

M=182.34'

T LINE

39.57

31.11

18.00

30.31

41.36

M=55°-22'-52½"

23.69

41.68

Fd L&T Ref. FB 2093-116 FB 3903-114

Fd L&T Ref. FB 2093-116 FB 3903-114

Fd Lg BH Spk & T FB 2093-116 FB 3903-114

67.19 T=66° = 67.19'

BATSON AVE

20

Pin FB 3903-114

24358

1) 55°-22'-50"
2) 221-31-30"
3) 55-22-52½"
4) 332-17-20"
5) 55-22-53½"

TO Fd. Lg BH Spk & T AT MADONA ST
per F.B. 3903-73

PLEASE RETURN TO
COUNTY OF LOS ANGELES
DEPARTMENT OF COUNTY ENGINEER
403 LOS ANGELES COUNTY ENGINEERING BLDG.

Note: Any Additions or Changes on This Sheet Must be Made or Circled in Red Ink With Date and Name of Person Making Change.

Do not extend this side of this line.

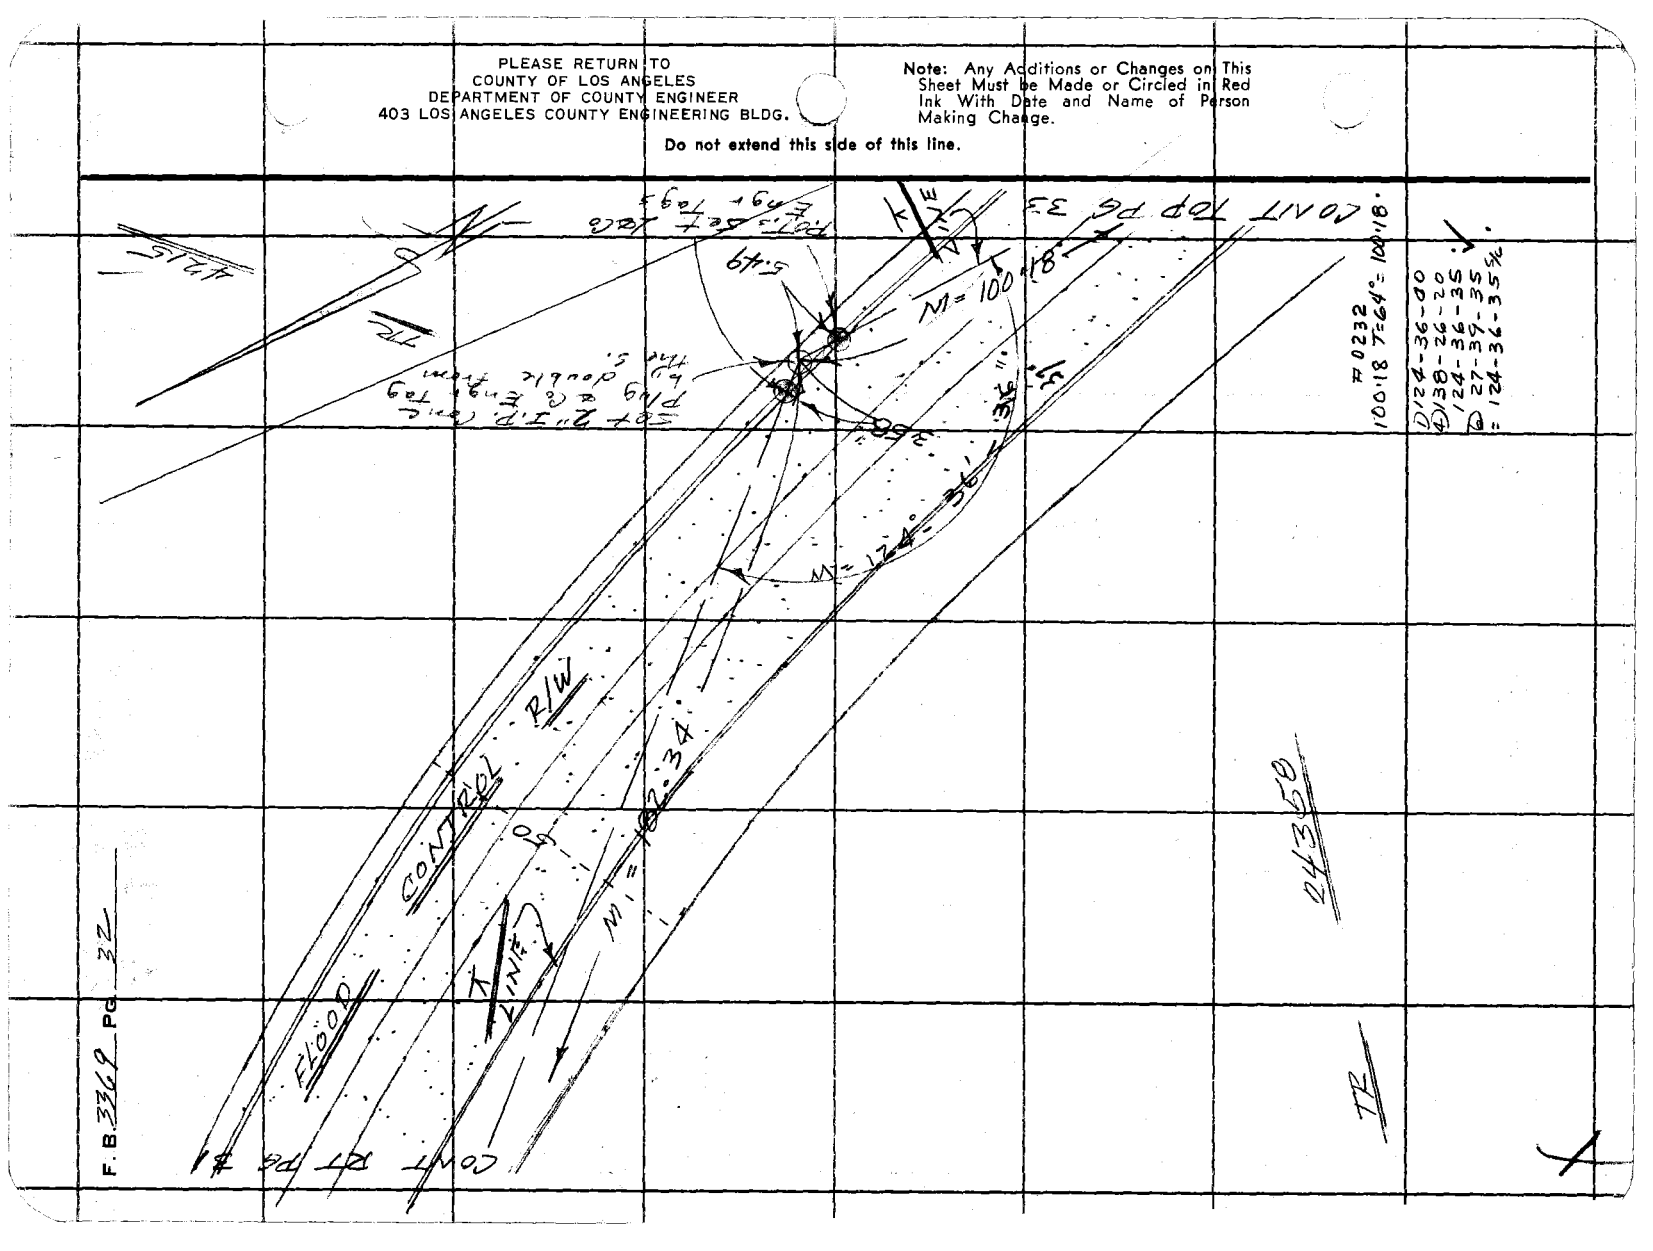

Notes Ck'd by H. HOLMAN
Map No.
Office Work
Checked
Date

Survey of
JN 2012 Tape 0775 Std 68 ft
Surveyed by F E Brooks
Notes F E B Date 10 Mar 71
Indexed E. J. GALLO MAY 10 '71

F. B. Pg.

CONT RT PG 32

#2435

Set L&Co Engr Tag in center of bottom of conc channel.

FLOOD CONTROL

CENTER LINE

M=501.79'

CONT TOP PG 34

Note: Any Additions or Changes on This Sheet Must be Made or Circled in Red Ink With Date and Name of Person Making Change.

Do not extend this side of this line.

PLEASE RETURN TO
COUNTY OF LOS ANGELES
DEPARTMENT OF COUNTY ENGINEER
403 LOS ANGELES COUNTY ENGINEERING BLDG.

76F309S CE#310 3-68

F. B. 3369 PG. 34

CONT BOT PG 33

TAPE # 0232

501.80 T=64°= 501.79

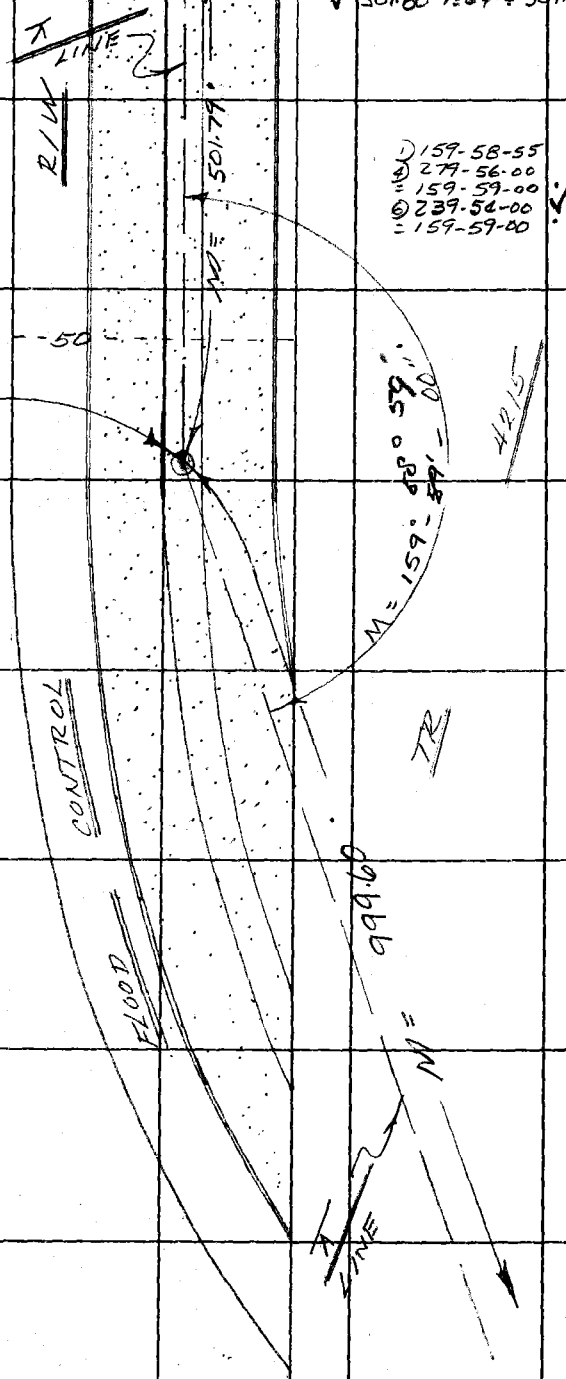

① 159-58-55
② 279-56-00
③ 159-59-00
④ 239-56-00
⑤ 159-59-00

PLEASE RETURN TO
COUNTY OF LOS ANGELES
DEPARTMENT OF COUNTY ENGINEER
403 LOS ANGELES COUNTY ENGINEERING BLDG.

Do not extend this side of this line.

Note: Any Additions or Changes on This Sheet Must be Made or Circled in Red Ink With Date and Name of Person Making Change.

Map No.	JN 02.74 Tape 0232 Std 68 °F
Office Work	Surveyed by FE Brooks
Checked	Notes FE B Date 10 Nov 71
Date	Indexed J. GALLI MAY 10 '71

CONT BOT PG 34

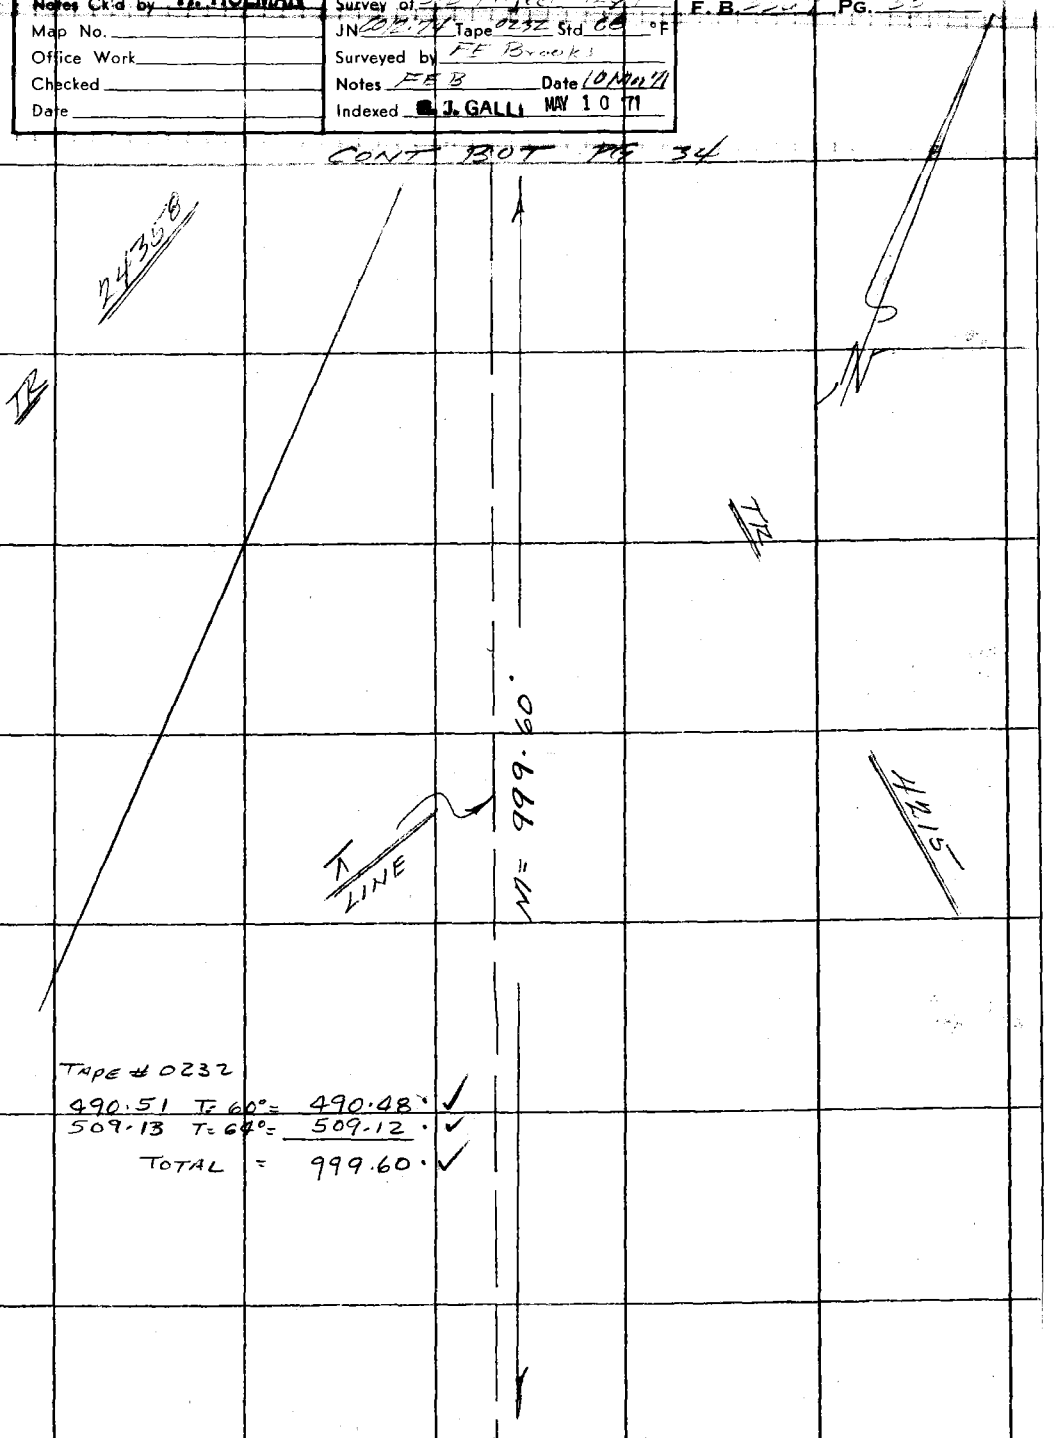

TAPE # 0232

490.51 T= 60°= 490.48' ✓
509.13 T= 60°= 509.12' ✓
TOTAL = 999.60' ✓

CONT LT PG 36

PLEASE RETURN TO
COUNTY OF LOS ANGELES
DEPARTMENT OF COUNTY ENGINEER
403 LOS ANGELES COUNTY ENGINEERING BLDG.

Note: Any Additions or Changes on This Sheet Must be Made or Circled in Red Ink With Date and Name of Person Making Change.

Do not extend this side of this line.

76F3095 E#310 3-68

F. B. 2369 PG. 36

To Fd Lg Bt Spk W & T of JELLICK AVE per F.B. 2750 - 38

50 — 50

AVE. (AVE)

N = 371.08'

F.B. 2369 PG 38

Set Lead & Tag,

#2 1/2

1) 71° - 25' - 55"
2) 285° - 43' - 20"
3) 71° - 25' - 00"
4) 68° - 35' - 50"

10499.60 Set Lg Bt. Spk West by Intsn.

N = 999.60

CONT BT PS 35

T LINE

N 11° E 1150.08' TIE

TIE

Set Lead & Tag,

84.18

L = 64.39

85.18

R = 119.96

Δ = 61° 11' 10"

CONT AT PS 37

TIE

COLLIMA (57th)

To Fd Lg. Bt. Spk at BATSON AVE per F.B. 2750 - 37

PLEASE RETURN TO
COUNTY OF LOS ANGELES
DEPARTMENT OF COUNTY ENGINEER
403 LOS ANGELES COUNTY ENGINEERING BLDG.

Do not extend this side of this line.

Note: Any Additions or Changes on This Sheet Must be Made or Circled in Red Ink With Date and Name of Person Making Change.

Notes Ck'd by H. HOLMAN	Survey of [illegible] F. B. [illegible] Pg. [illegible]
Map No.	JN [illegible] Tape 0232 Std [illegible] °F
Office Work	Surveyed by FE Bowles
Checked	Notes F.E.B. Date 11 Mar. 71
Date	Indexed S. J. GALLI MAY 10 71

Note: Any Additions or Changes on This Sheet Must be Made or Circled in Red Ink With Date and Name of Person Making Change.

Do not extend this side of this line.

PLEASE RETURN TO
COUNTY OF LOS ANGELES
DEPARTMENT OF COUNTY ENGINEER
403 LOS ANGELES COUNTY ENGINEERING BLDG.

76F309S CE#310 3-68

CONT LT PG 38

CONT RT PG. 36

#0232
256.92
119.96

T = 66° = 256.92
T = 64° = 119.96

1) 118-30-55
2) 118-30-55 int.
3) 118-30-55
4) 118-30-58 int.

N = 256.92

N = 118°

30'

57° 58'

T LINES

N = 119.96

48.30

12+19.56
Set Lg Bt. Spk W BT Flush in parking Lot.

49.11

Set Lg Bt Spks Ws BTs in parking lot.

Taste-Freeze bldg.

Set ½" in side of sign post at ground level

K

F. B 3369 PG 38

1) 121-13-30
4) 124-58-00
31-13-30
6) 07-20-40
AVG = 121-13-26 3/3

STANDARD
SERVICE
STATION

B317

Set L&LS Engr Tags.

CONT FROM PG 37

N = 256.92'

49.78'

36.54

N = 121-13-29" E

1476.48
Set L.S. Tag, Flush with BW
Double from South

℄ LINE

N = 260.16

TAPE #0232
260.15 T=74' = 260.16

CONT LT PG 39

SELLICK AVE.

30

PLEASE RETURN TO
COUNTY OF LOS ANGELES
DEPARTMENT OF COUNTY ENGINEER
403 LOS ANGELES COUNTY ENGINEERING BLDG.

Do not extend this side of this line.

Note: Any Additions or Changes on This Sheet Must be Made or Circled in Red Ink With Date and Name of Person Making Change.

Notes Ck'd by H. HOLMAN
Map No.
Office Work
Checked
Date

Survey of
Surveyed by F.E. Brooks
Notes FEB Date 12 Mo. 71
Indexed J. GALLI NOV 10 '71

F. B. PG.

W.S. 38 D-4

Note: Any Additions or Changes on This Sheet Must be Made or Circled in Red Ink With Date and Name of Person Making Change.

Do not extend this side of this line.

PLEASE RETURN TO
LOS ANGELES COUNTY ENGINEER
403 LOS ANGELES COUNTY ENGINEERING BLDG.

76F3095 CE #310 6/63

Fd L & T Ref FB 2750-21

Fd L & BT, SPK W&T Ref FB 2750-21

Fd L & BT Ref FB 2750-21

Fd L & Co Engr Tags Ref FB 2750-21

JELLICK AVE

SIERRA LEONE AVE

CONT BT FS

FLOOD CONTROL

R/W

0.01

0.025

20.29

29.01

29.28

37.68

N = 29.30

N = 36.10

N = 32.49

7.00

7.00

30

30

30

30

N = 260.16

Δ = 26° 56' 30" = W

0232
36.10 Ley T=74° = 36.10'
32.49 " T=74° = 32.49'
29.30 " T=74° = 29.30'

Set L & Co Engr Tags at 7 Ft off the E'ly wall of S.D. culvert

17+72.74 Set Lg BT Spk W&T by inter.

8317

To Fd Lg BT Spk W&T at B.C. per F.B. 2750 + 55

1) 94-05-55
2) 66-23-35
3) 94-05-53¾
4) 204-35-30
AVG. = 94-05-55

PLEASE RETURN TO
LOS ANGELES COUNTY ENGINEER
403 LOS ANGELES COUNTY ENGINEERING BLDG.

Note: Any Additions or Changes on This Sheet Must be Made or Circled in Red Ink With Date and Name of Person Making Change.

Do not extend this side of this line.

F. B. 3369 PG. 40

Notes Ck'd by	Survey of S.D. #1274 F.B. 2269 PG. 41
Map No.	JN 2012.74 Tape Std °F
Office Work	Surveyed by FE Brooks
Checked	Notes F.E.B. Date 5 Mar 74
Date	Indexed J. GALLO MAY 10 '74

J.N. 6012.74

STORM DRAIN PROJECT

No. 1274

LINE A

LOCATION OF IMPROVEMENTS

From Existing channel N. of Colima Rd.

To Existing channel S. of Sierra Leone Ave.

FE Brooks
GO Guizado
RA Moore
T Ohashi.

Note: Any Additions or Changes on this Sheet Must be Made or Circled in Red Ink With Date and Name of Person Making Change.

PLEASE RETURN TO
COUNTY OF LOS ANGELES
DEPARTMENT OF COUNTY ENGINEER
403 LOS ANGELES COUNTY ENGINEERING BLDG.

Do not extend this side of this line.

76F3095, CE#3103-68

F. B. 3369 PG 42

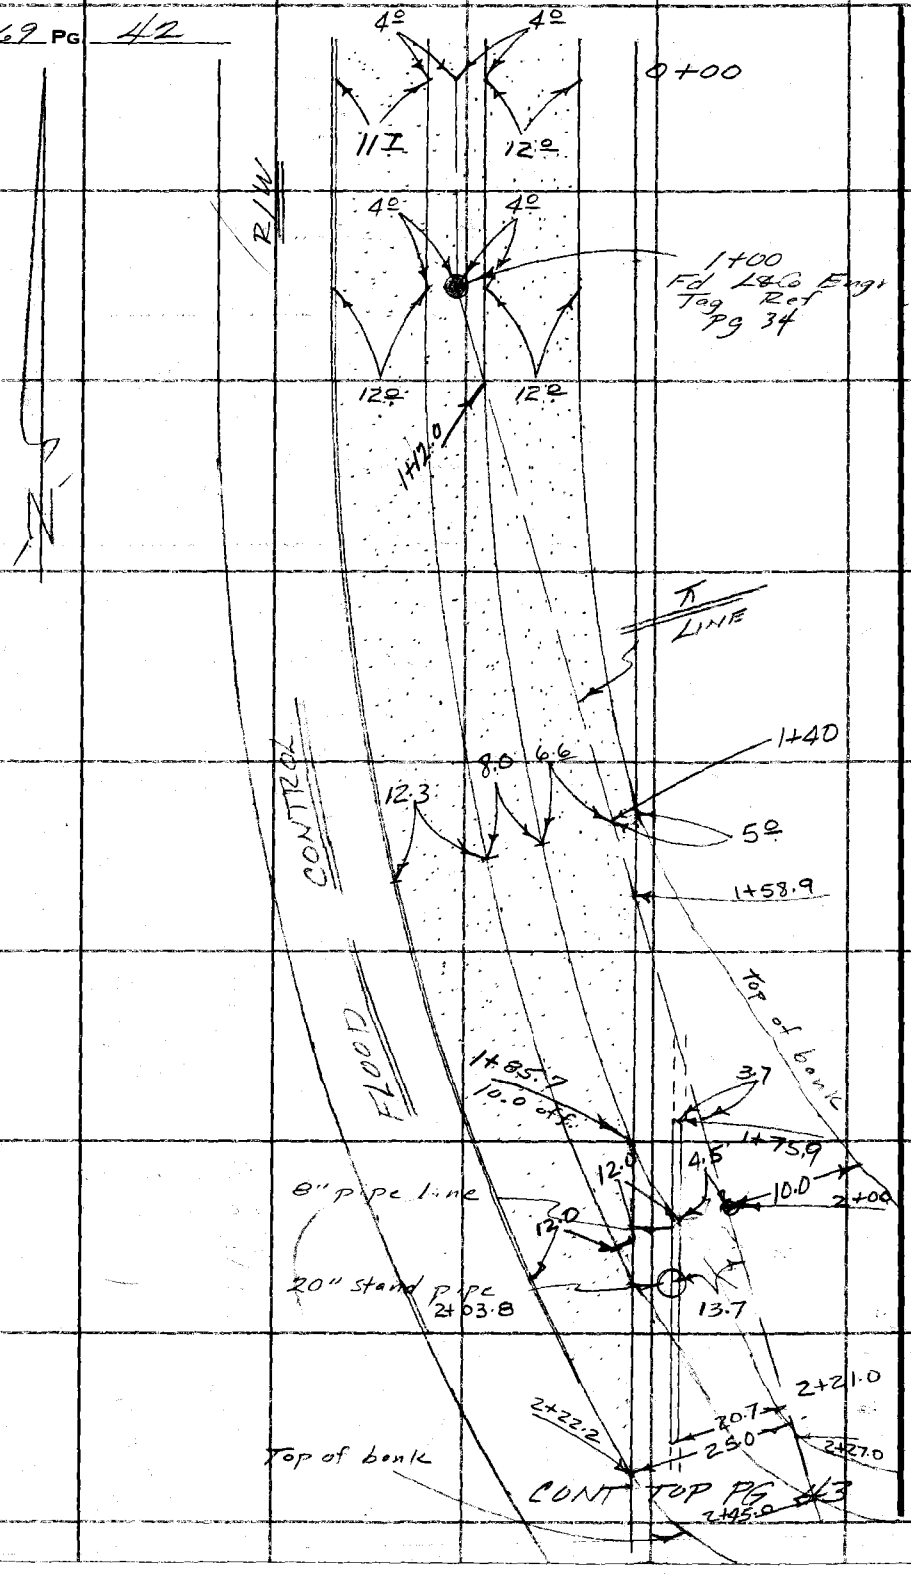

PLEASE RETURN TO
COUNTY OF LOS ANGELES
DEPARTMENT OF COUNTY ENGINEER
403 LOS ANGELES COUNTY ENGINEERING BLDG.

Do not extend this side of this line.

Note: Any Additions or Changes on This Sheet Must be Made or Circled in Red Ink With Date and Name of Person Making Change.

Notes Ck'd by	Survey of S.D. [illegible] F.B. [illegible] Pg.
Map No.	JN 20/2.74 Tape Std °F
Office Work	Surveyed by FE Brooks
Checked	Notes FEB. Date 15 Nov 71
Date	Indexed by J. GALLI NOV 10 '71

CONT BOT PG 42

8" Tree
2+29.5

10.5

2+52.0

39.0

12" Tree
2+60.0

2+74.0
6" Tree

35.0

53.0

2+96.0

3+00

33.5

20.5

7.5

Shrubs

14.0

55.0

3+05.0

Barn

LINE

3+19.0

55.0

Tree with
3-8" Trunks

Channel

Bank

Top of

Top of

3+46.0

45.0

Tree with
5-3" Trunks

3+54.0

CONT TOP PG 44

Note: Any Additions or Changes on This Sheet Must be Made or Circled in Red Ink With Date and Name of Person Making Change.

Do not extend this side of this line.

PLEASE RETURN TO
COUNTY OF LOS ANGELES
DEPARTMENT OF COUNTY ENGINEER
403 LOS ANGELES COUNTY ENGINEERING BLDG.

76F309S CE#310 3-68

F. B. 3369 PG 44

CONT BOT PG 43

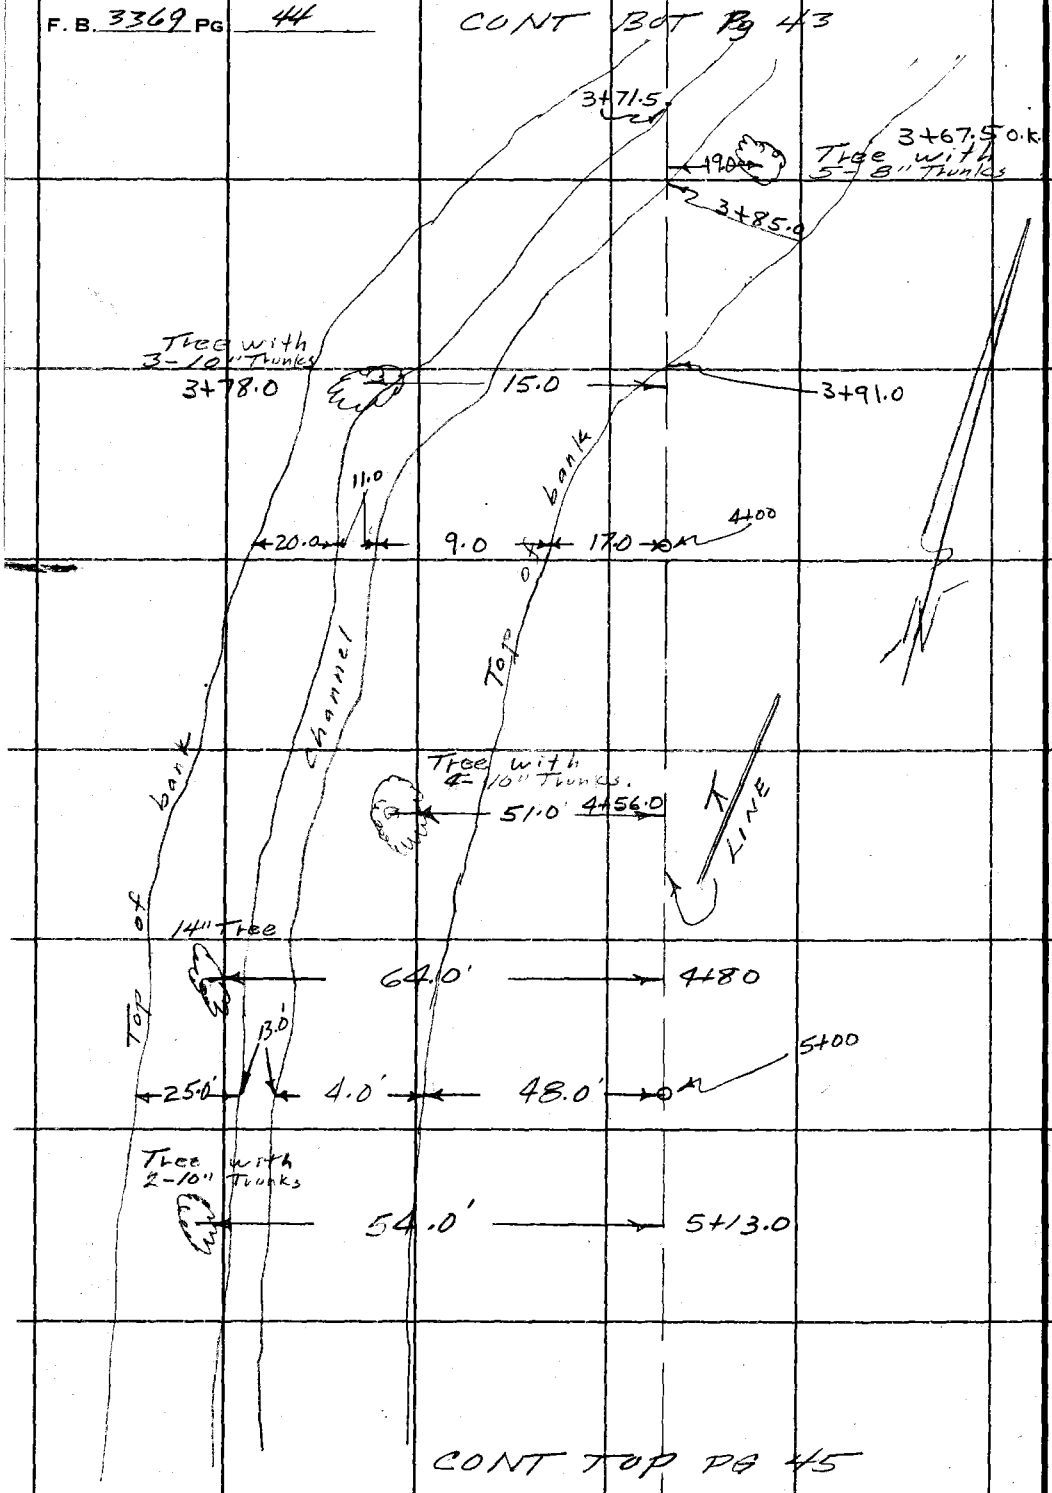

CONT TOP PG 45

PLEASE RETURN TO
COUNTY OF LOS ANGELES
DEPARTMENT OF COUNTY ENGINEER
403 LOS ANGELES COUNTY ENGINEERING BLDG.

Do not extend this side of this line.

Note: Any Additions or Changes on This Sheet Must be Made or Circled in Red Ink With Date and Name of Person Making Change.

Notes Ck'd by	Survey of S.D. Proj. Hollis
Map No.	JN 2012.74 Tape Std °F
Office Work	Surveyed by F.E. Brooks
Checked	Notes F E B Date 16 Nov 71
Date	Indexed B. J. GALLI NOV 10 '71

F.B. 2266 / PG. 2

CONT BOT PG 44

5" Tree — 60.0 — 5+36.5

7" Tree — 64.0 — 5+44.0

2 - Tree with 12" Trunks — 61.0 — 5+50.0

Bank of Channel

T LINE

5+82.0 Toe of cut bank

41.0 — 5+76.0

crest of cut bank

5+91.0

Top — 132 — 26.0 — Toe — 27.0 — 6+00

Tree with 4-10" Trunks — 160 — 74.0 — 6+17.5

50.0 — 6+25

70.0 — 6+26.0

6" Trees — 75.0 — 6+33.5

Large Shrub — 58.0 — 6+62.0

CONT TOP PG 46

Note: Any Additions or Changes on This Sheet Must be Made or Circled in Red Ink With Date and Name of Person Making Change.

Do not extend this side of this line.

PLEASE RETURN TO
COUNTY OF LOS ANGELES
DEPARTMENT OF COUNTY ENGINEER
403 LOS ANGELES COUNTY ENGINEERING BLDG.

76F3095 CE#310 3-68

F. B. 3369 PG 46

CONT BOT PG 45

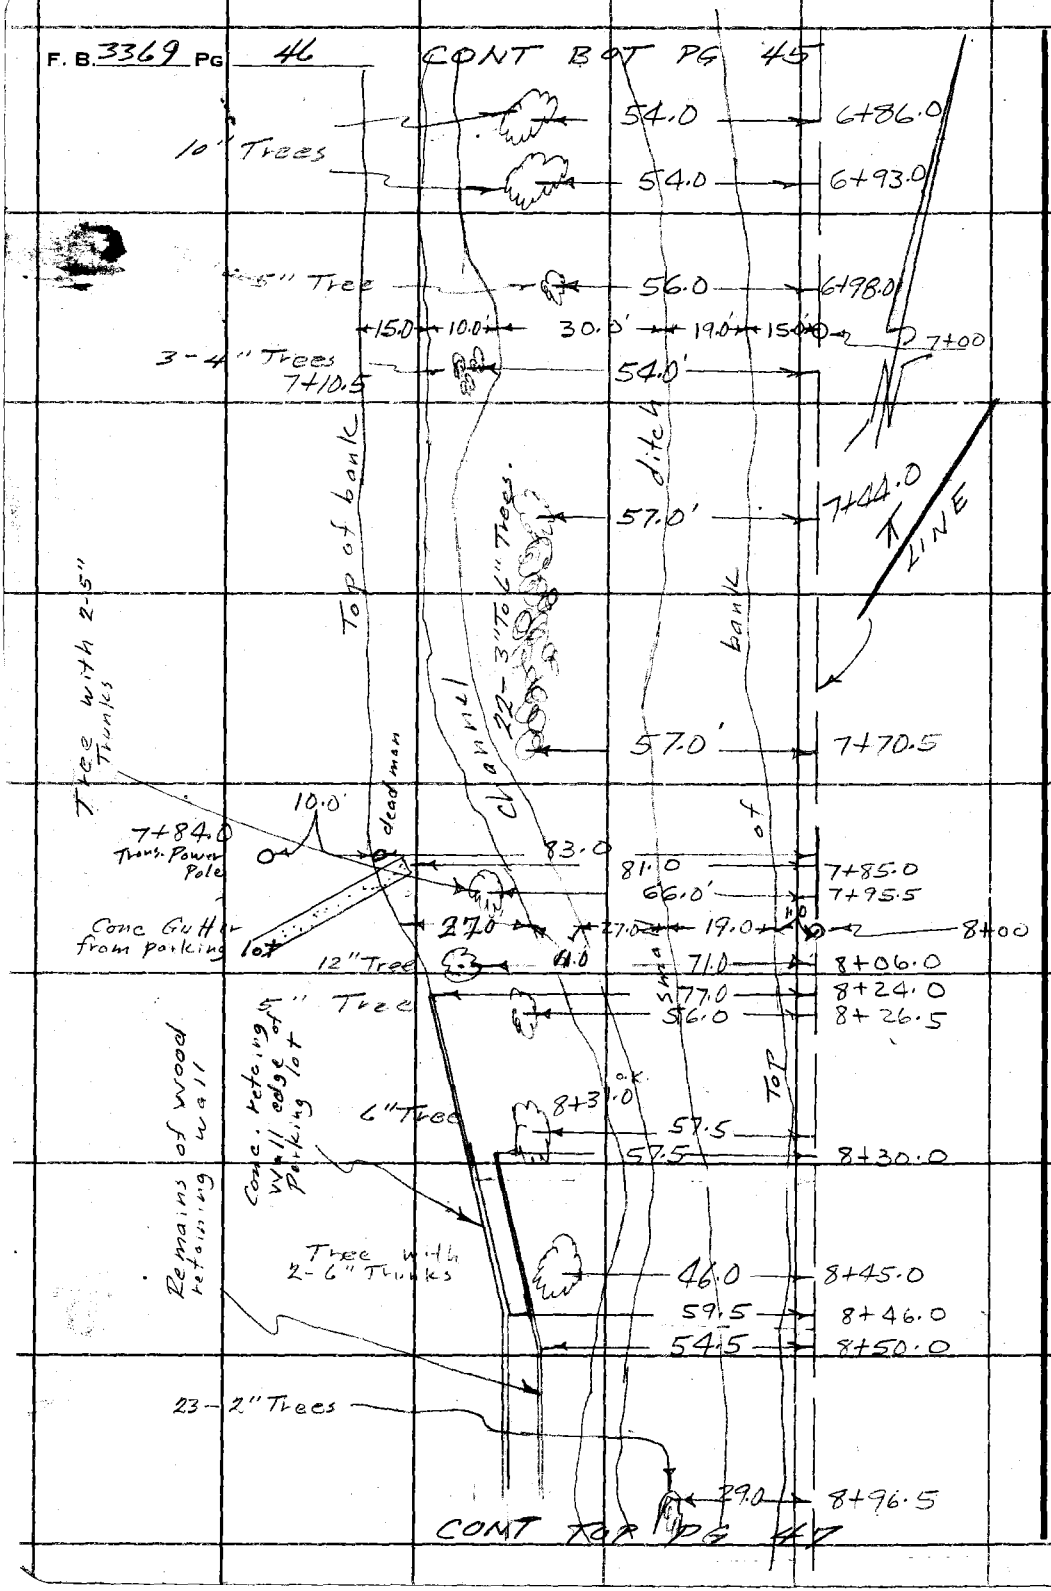

CONT TOP PG 47

PLEASE RETURN TO
COUNTY OF LOS ANGELES
DEPARTMENT OF COUNTY ENGINEER
403 LOS ANGELES COUNTY ENGINEERING BLDG.

Do not extend this side of this line.

Note: Any Additions or Changes on This Sheet Must Be Made or Circled in Red Ink With Date and Name of Person Making Change.

Notes Ck'd by	Survey of: L. D. Project #12774 F.B. 3364 Pg. 47
Map No.	JN 60 12 04 Tape Std °F
Office Work	Surveyed by FE Brooks
Checked	Notes FE 73 Date 16 MAR 71
Date	Indexed J. GALLI MAY 10 '71

Note: Any Additions or Changes on this Sheet Must be Made or Circled in Red Ink With Date and Name of Person Making Change.

PLEASE RETURN TO
COUNTY OF LOS ANGELES
DEPARTMENT OF COUNTY ENGINEER
403 LOS ANGELES COUNTY ENGINEERING BLDG.

Do not extend this side of this line.

CONT Bot PG 46

23 2" Trees

9+00

Small ditch

13.5 — 9.0 — 8.0 — 18.0 — 20.5 → 9+15.0

9+08.5

Retaining wall edge of parking lot.

Remains of wood retaining wall

16" Tree

57.0'

51.5 → 9+15.0

24.0 → 9+20.5

41.5 → 9+24.5

9.0

31.7 → 9+44.0

4" Tree

24.0 → 9+56.7

12" Tree

24.0 → 9+68.0

asphalt drain from parking lot

Top of bank

46.5 → 9+74.5

LINE

5" Tree

Channel

35.5 → 9+79.5

Tree with 2-10" Trunks

9+97.0

24.0

8" Tree

26.0'

14.5'

4.0'

23.5 → 10+05.0

4" Tree 9+94.5

9.0

bank

8.0'

10+00

18" Steel Post

10+08.0

42.5

Top

10+13.0

4" Tree

4.0'

84" Conc. Iron Pipe

BASEBALL OUTDOOR SIGN

12" Tree

29.0 → 10+21.5

11.2 → 10+29.7

Top of bank

CONT Lt. PG 48

76F3095 CE#310 3-68

F. B. 3369 PG. 48

PLEASE RETURN TO
COUNTY OF LOS ANGELES
DEPARTMENT OF COUNTY ENGINEER
403 LOS ANGELES COUNTY ENGINEERING BLDG.

Do not extend this side of this line.

Note: Any Additions or Changes on This Sheet Must be Made or Circled in Red Ink With Date and Name of Person Making Change.

COLIMA AVE.

1+99.60 N 85 = 1400 E&W
Ref. Rpt. 19 B4 Spk W 8.7 Pg. 32

1+97.4 S.M.H.
30.7

2 FT. GUTTER

Top of Bank

CONT. TO Sta 4+52.4

W.H.H 1+26.4
22.3

42.0

11+23.6

11+07.3

27.5

32.2

Channel

50.

16.1

2.2

1+16.4

1+31.4 C.B.

Storm Drain C.B.

Top of Bank

CONT. TO Sta 4+52.4

1402.0

Storm Drain C.B.

10+47.6

1400 E&W

15.0

10+55.2

CONT. BOT. Sta 4+17

18" CORR. IRON PIPE

"CORR. IRON PIPE"

CONC. WALK

2 FT. GUTTER

0.7 GUTTER

0.7 GUTTER

18" CORR. IRON PIPE

4.0

W.H.H 2+06.8
22.4

S.M.H. 2+75.5
30.5

Storm Drain C.B.

Notes Ck'd by	Survey of D-4 Project # 1244
Map No.	JN 6012.74 Tape Std °F
Office Work	Surveyed by F E Brooks
Checked	Notes F.E.B. Date 6 Mar 71
Date	Indexed L GALLI MAY 10 '71

F. B. 6364 Pg. 44

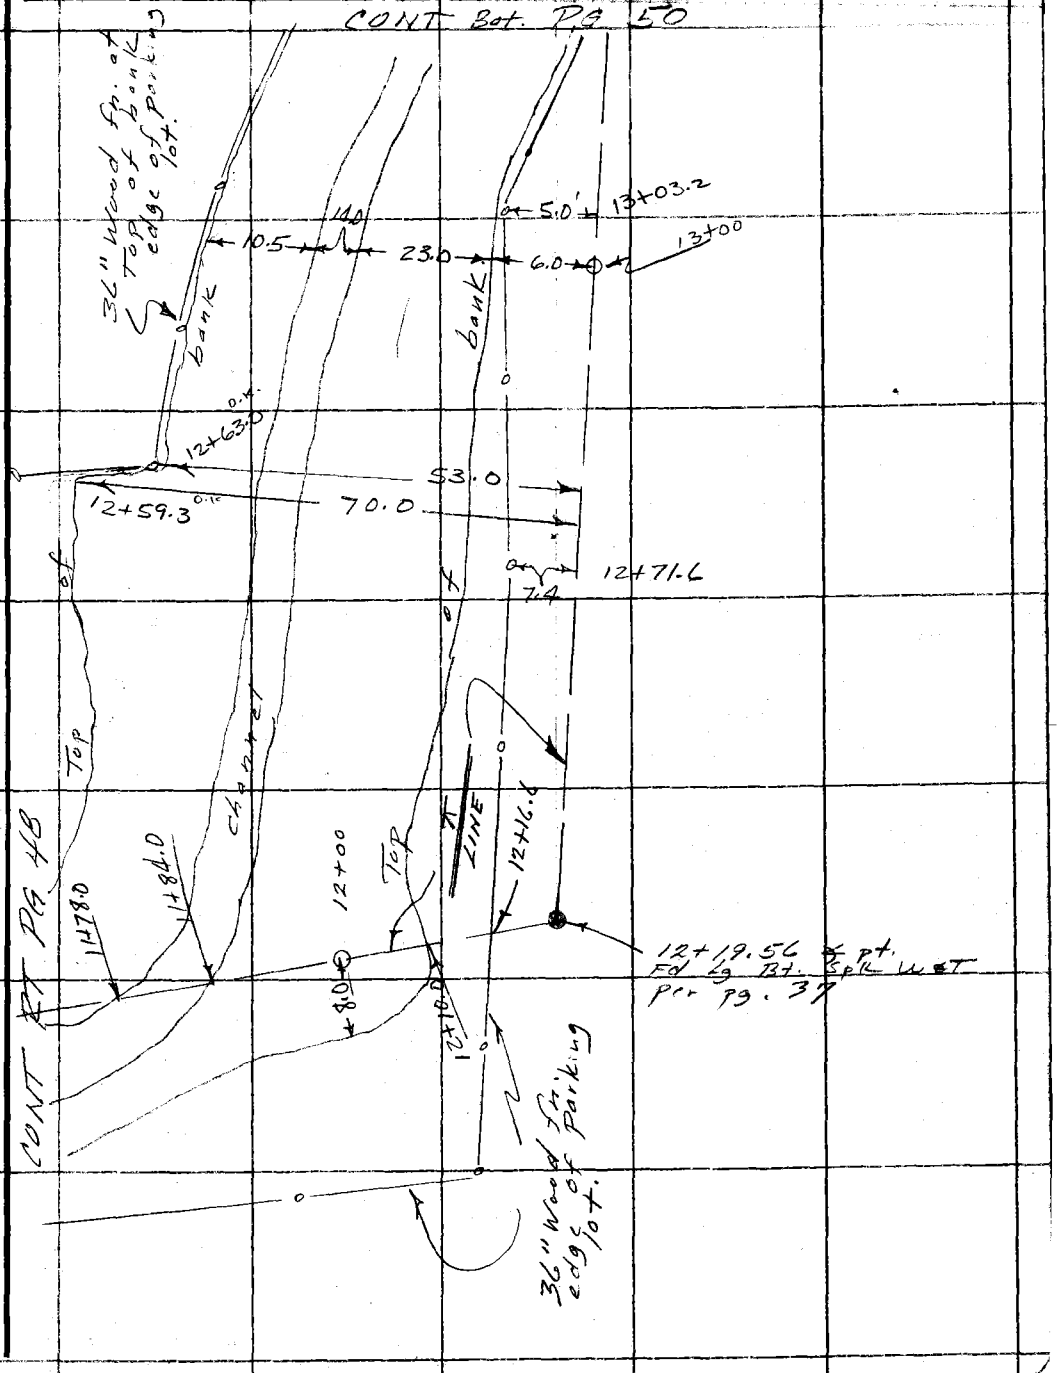

Note: Any Additions or Changes on This Sheet Must be Made or Circled in Red Ink With Date and Name of Person Making Change.

PLEASE RETURN TO
COUNTY OF LOS ANGELES
DEPARTMENT OF COUNTY ENGINEER
403 LOS ANGELES COUNTY ENGINEERING BLDG.

Do not extend this side of this line.

78F 3095 CE #310 3-68

F. B. 3369 PG 50

CONT LT PG 51

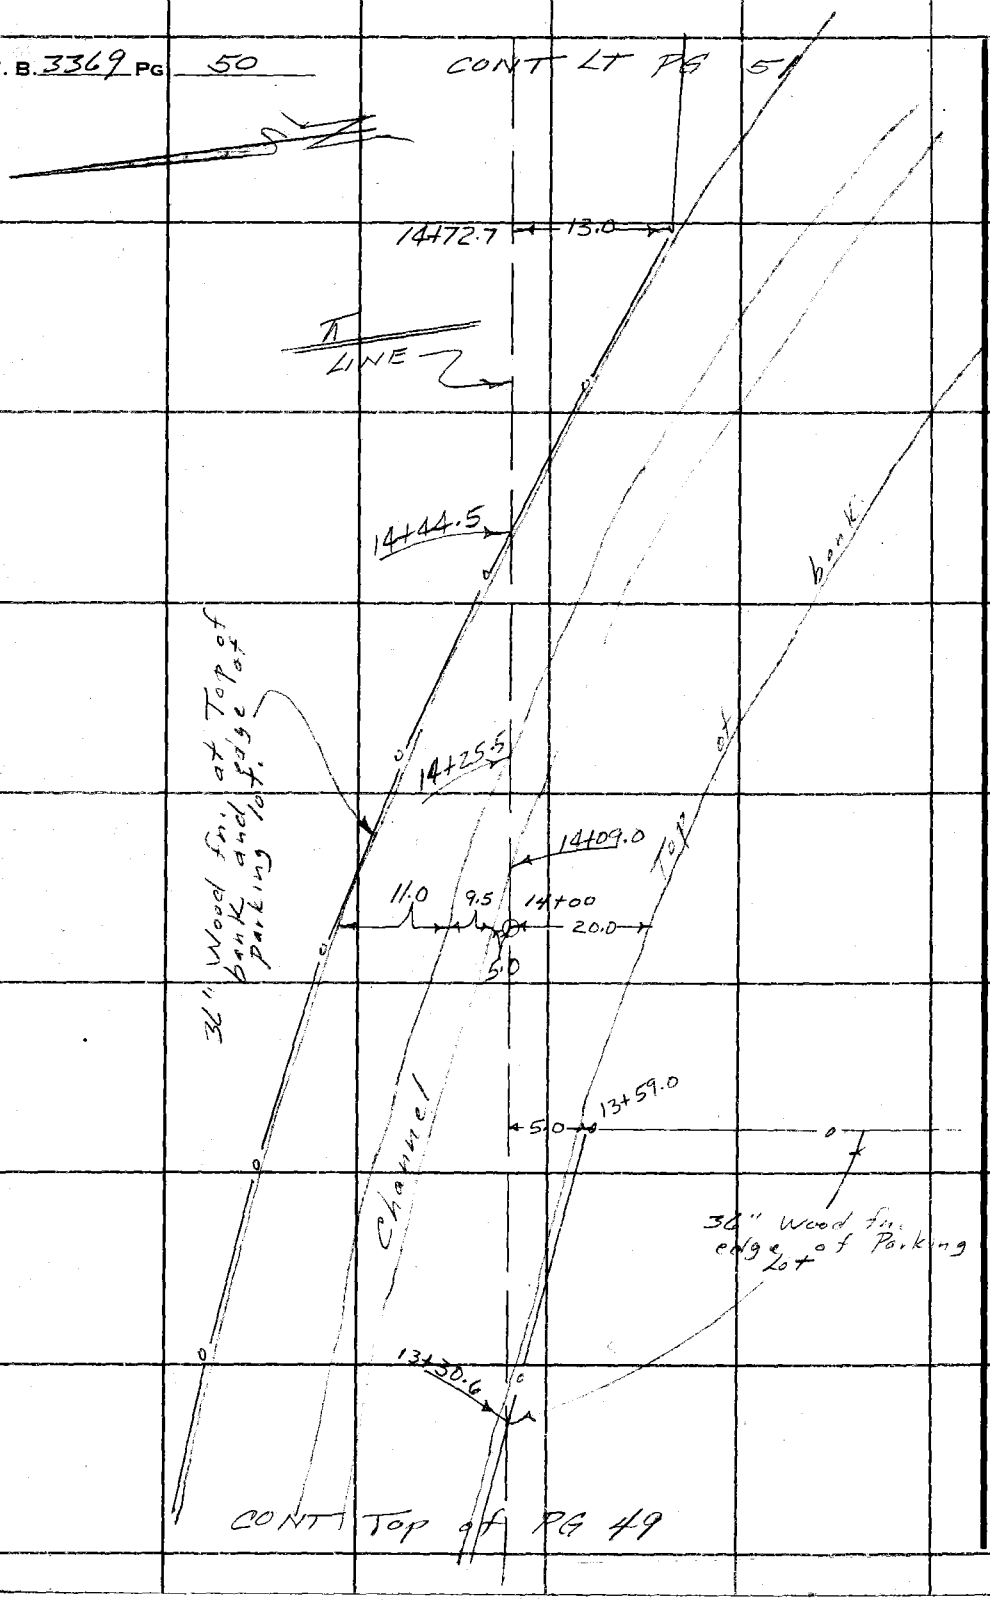

CONT Top of PG 49

PLEASE RETURN TO
COUNTY OF LOS ANGELES
DEPARTMENT OF COUNTY ENGINEER
403 LOS ANGELES COUNTY ENGINEERING BLDG.

Do not extend this side of this line.

Note: Any Additions or Changes on This Sheet Must be Made or Circled in Red Ink With Date and Name of Person Making Change.

Notes Ck'd by	Survey of S.D. Project #4474 F.B. 3364 Pg. 57
Map No.	JN 2012.74 Tape Std °F
Office Work	Surveyed by F.F. Brooks
Checked	Notes F.F.B. Date 16 mar 71
Date	Indexed O. J. GALLI MAY 10 '71

Note: Any Additions or Changes on this Sheet Must be Made or Circled in Red Ink, With Date and Name of Person Making Change.

Do not extend this side of this line.

PLEASE RETURN TO
COUNTY OF LOS ANGELES
DEPARTMENT OF COUNTY ENGINEER
403 LOS ANGELES COUNTY ENGINEERING BLDG.

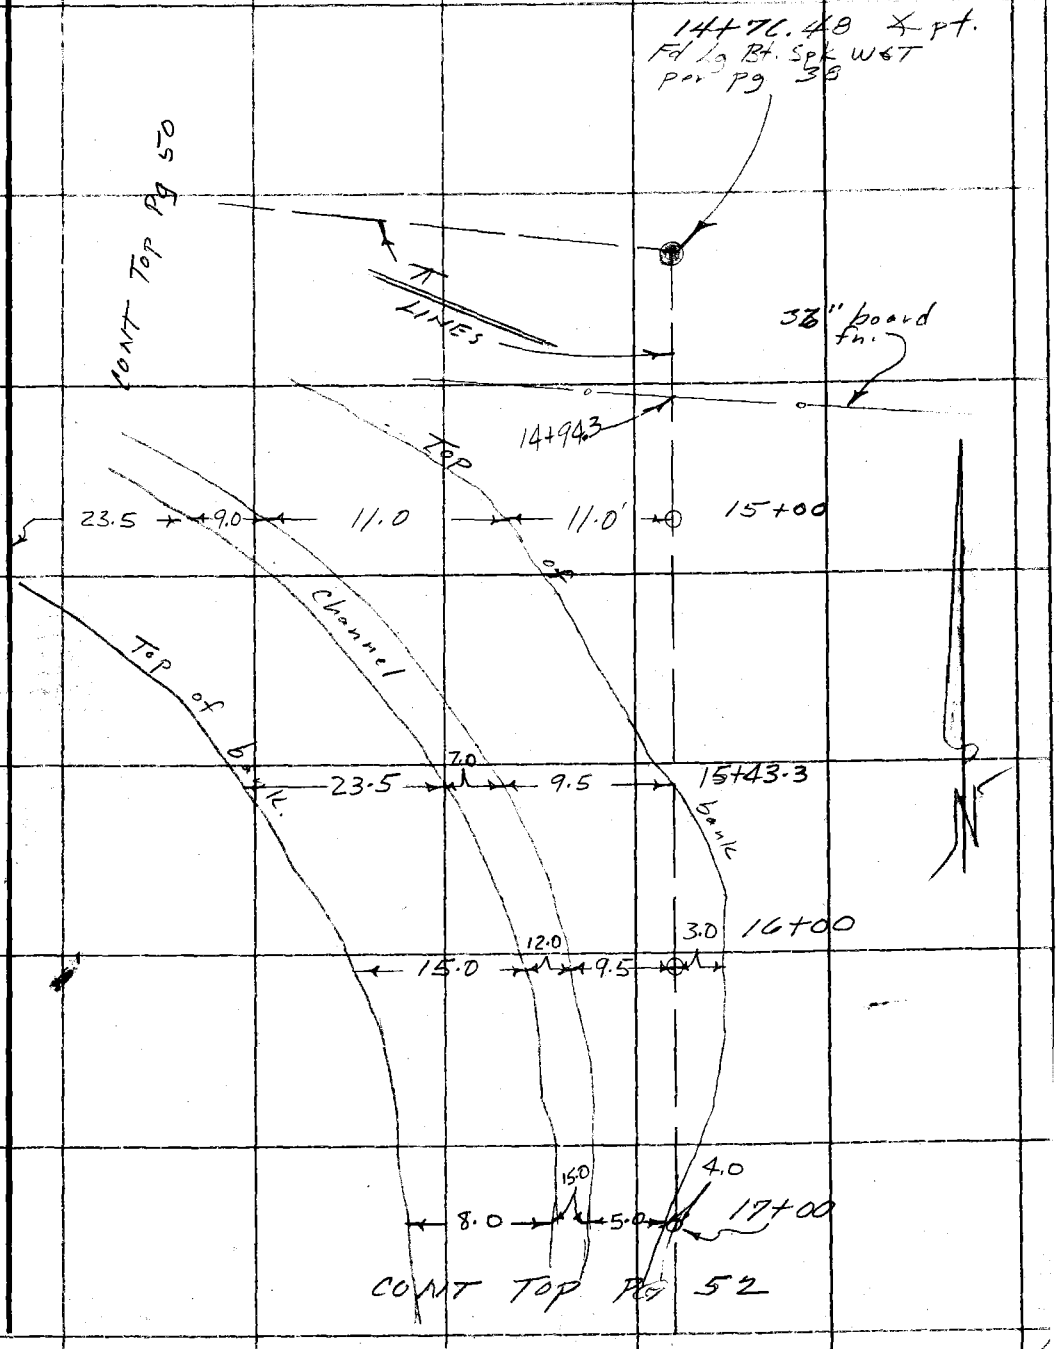

F. B. 3369 PG 52

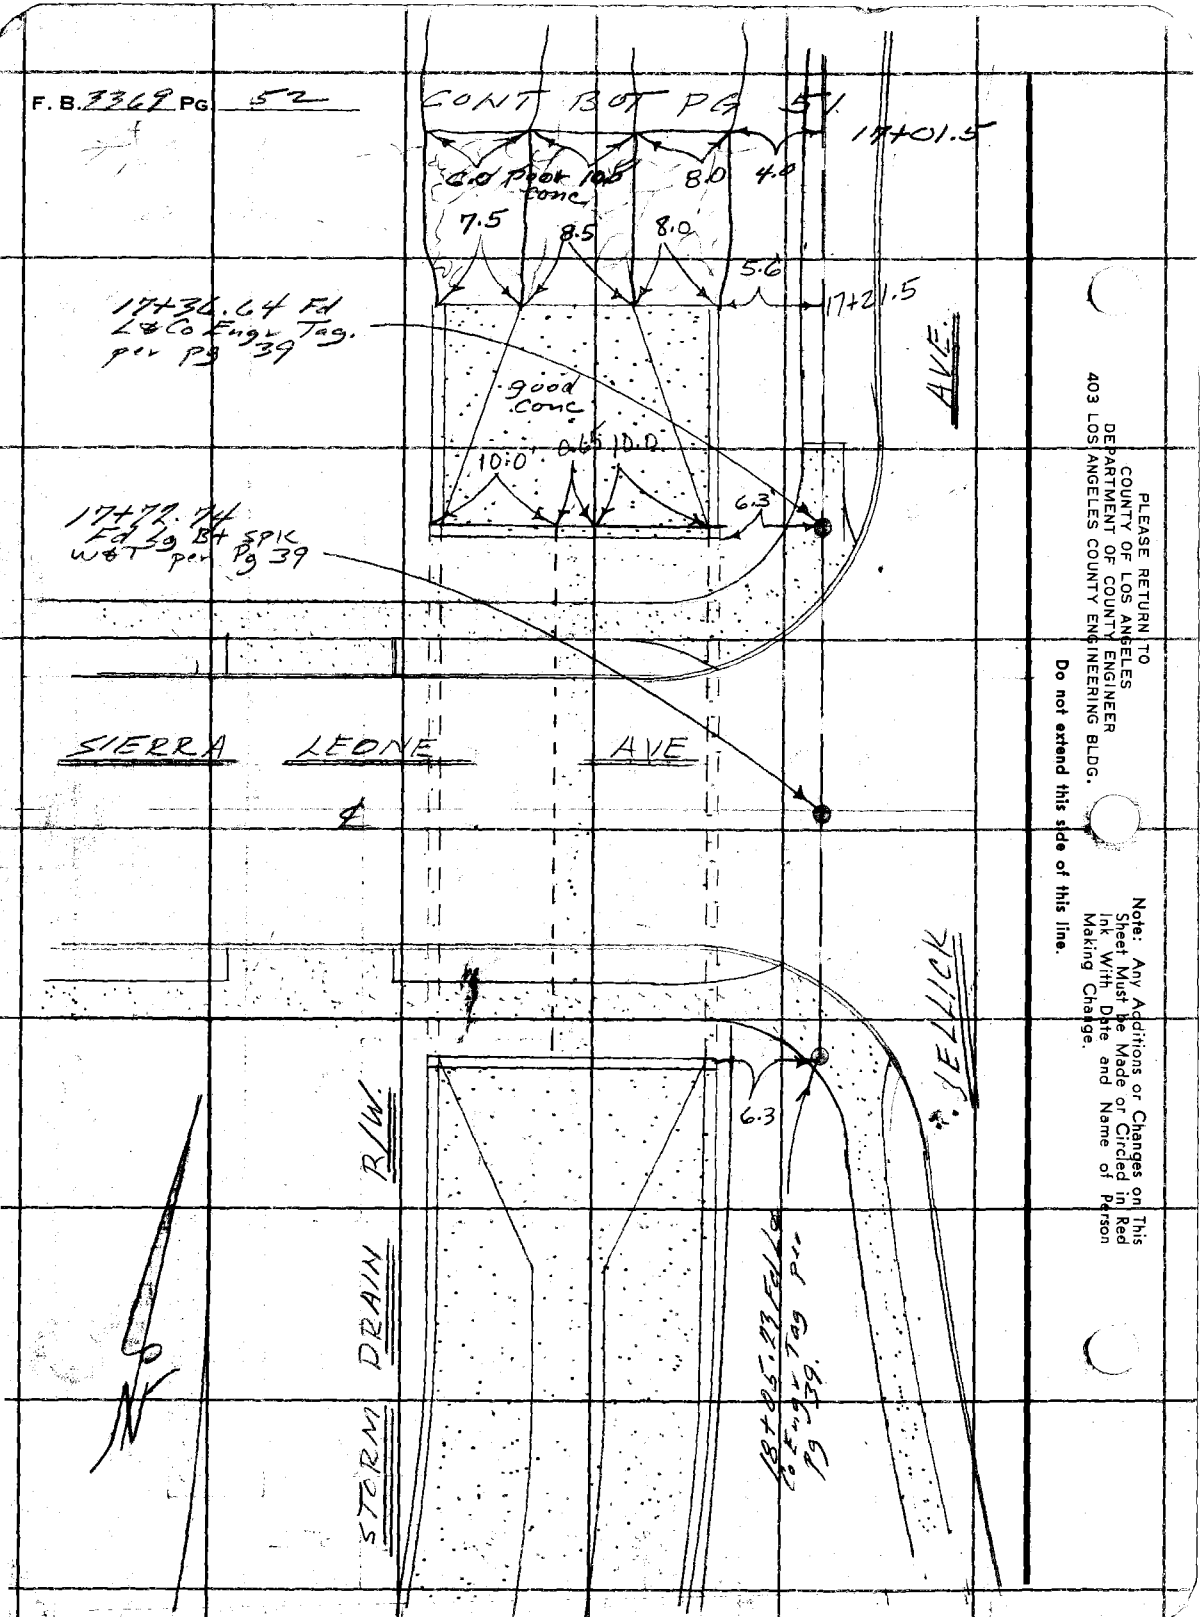

PLEASE RETURN TO
COUNTY OF LOS ANGELES
DEPARTMENT OF COUNTY ENGINEER
403 LOS ANGELES COUNTY ENGINEERING BLDG.

Note: Any Additions or Changes on This Sheet Must be Made or Circled in Red Ink With Date and Name of Person Making Change.

Do not extend this side of this line.

Profile No. _____ Notes Red _____ Date _____ Plotted _____ Date _____ Job No. 6018.24 Division No. 11 Survey of S. D. Project # 1274

F. B. _____ Pg. _____

No. _____ Date _____ Date _____ Map No. _____ Indexed _____ Date _____

IN CAIP 74

STORM DRAIN PROJECT

No 1274

LINE A

CROSS SECTIONS

From - existing channel N. of Colima Rd.

To - existing channel S. of Sierra Leona Ave.

STATION	B.S.	H.I.	F.S.	ELEV.
			FE Brooks GO Guizado RA Moore Tohashi	

NOTE: ANY ADDITIONS OR CHANGES ON THIS SHEET MUST BE MADE OR CIRCLED IN RED INK, WITH DATE AND NAME OF PERSON MAKING CHANGE.

PLEASE RETURN TO
LOS ANGELES COUNTY ENGINEER
700 Los Angeles County Engineering Bldg.

Do not extend notes this side of this line.

76 296 CE 307 11-58

76L-266 CE 307 11-58

PLEASE RETURN TO
LOS ANGELES COUNTY ENGINEER
700 LOS ANGELES COUNTY ENGINEERING BLDG.

NOTE: ANY ADDITIONS OR CHANGES ON THIS SHEET MUST BE MADE OR CIRCLED IN RED INK, WITH DATE AND NAME OF PERSON MAKING CHANGE.

Do not extend notes this side of this line.

F.B. 3369 Pg. 54 | Job No 6012.74 | Division No. 11 | Notes Red | Plotted | Profile
Survey of S.D. Project #1274 | Date 16 MAR. '71 | Date | No. | X-Sec.
Survey by EE Brooks Notes F.E.B. | Notes Ckd. | Checked | No.
Indexed [redacted] DAILY | Date | Date | Date

STATION	B. S.	H. I.	F. S.	ELEV.		
BM S.D. 1251				449 47	BM SD 1251 Elev. 449.466 FB 3369-10 East wall of Flood Control Channel N. of Colima Rd. A P.K. spk in lead on E'ly prod of the S. P/L of house # 1470 Batson Ave.	
					SOUTH OR ℄ LINE	
					Lt. or East ℄ line	Rt. or West.
0+00				44142	℄	
				44148		4.0 Rt edge of bottom
				44874		15.7 " Top of bank
				44145	4.0 Lt. edge of bottom	
				44873	16.0 " Top of bank.	
1+00				44214	℄	
				44215		4.0 Rt edge of bottom
				4500		16.0 " Top of bank
				44217	4.0 Lt edge of bottom	
				44944	16.0 " Top of bank.	
1+12.0				44222		℄ edge of bot.

761-298 CE 307 11-58

PLEASE RETURN TO
LOS ANGELES COUNTY ENGINEER
700 Los Angeles County Engineering Bldg.

NOTE: ANY ADDITIONS OR CHANGES ON THIS SHEET MUST BE MADE OR CIRCLED IN RED INK, WITH DATE AND NAME OF PERSON MAKING CHANGE.

Do not extend notes this side of this line.

Profile Notes Red No. X-Sec. Date
Plotted Date
Job No. [illegible] Division No. 11
Survey of S.D.P. 1 21 19 PM
No. Date Date Map No. Indexed W.J. GALLI Date 10-9
F.B. [illegible] PG. 55

STATION	B.S.	H.I.	F.S.	ELEV.	Lt. or East of Line	Rt. or West
1+40				449.71	5.0 Lt. cor and edge of channel	Top of bank
1+58.9				448.14		T edge of drain
1+75.9				446.72		3.7 Rt Top of 8" pipe line
1+85.7				442.50		10.0 Rt. bottom of cone channel
2+00				449.57		T
				444.4		4.5 Rt. edge of channel
				440.7		4.6 Rt bottom of channel
				442.55		16.5 Rt. bottom of cone channel
				450.5		28.5" Top of cone channel
2+21.0				449.45		20.7 Rt. Top of 8" pipe line
2+22.2				450.25		25.0 Rt cor. and edge of channel Top of bank
2+27.0				444.1		T edge of channel
				442.5		T bottom of channel

76L-298 CE 307 11-58 450.14 T.P

PLEASE RETURN TO
LOS ANGELES COUNTY ENGINEER
700 LOS ANGELES COUNTY ENGINEERING BLDG.

NOTE: ANY ADDITIONS OR CHANGES ON THIS SHEET MUST BE MADE OR CIRCLED IN RED INK, WITH DATE AND NAME OF PERSON MAKING CHANGE.

Do not extend notes this side of this line.

F.B. 3369 Pg. 52 | Profile | No. | X-Sec. | No.

Survey of SD Project #12 Pt | Job No. 6012.74 | Division No. 11 | Notes Red | Plotted

Survey by F.E. Brooks | Notes | Date 1/6 Mar. '74 | Date

Indexed C.T. (GAM) | Date | Notes Chkd | Checked

Date | Date

STATION	B.S.	H.I.	F.S.	ELEV.	Lt. or East	LINE	Rt. or West
2+45.0				4424		℄	bottom of channel
2+52.0				4529		℄	Top of bank
3+00				4535		℄	
				4544			35 Rt ground
				4526	33.5 Lt. Top of bank		
				4447	54.0 " bottom of channel		
				4436	68.0 " bottom of channel		
				4492	75.5 " Top of bank		
3+54.				4529		℄	Top of bank
3+71.5				4443		℄	bottom of channel
3+85.0				4444		℄	bottom of channel
3+91				4499		℄	Top of bank
4+00*				45007		℄	
				4500			19 Rt Top of bank

76L-298 CE 307 11-58

52.4 57.4

PLEASE RETURN TO
LOS ANGELES COUNTY ENGINEER
700 LOS ANGELES COUNTY ENGINEERING BLDG.

NOTE: ANY ADDITIONS OR CHANGES ON THIS SHEET MUST BE MADE OR CIRCLED IN RED INK, WITH DATE AND NAME OF PERSON MAKING CHANGE.

Do not extend notes this side of this line.

STATION	B.S.	H.I.	F.S.	ELEV.	Lt. or East	℄ Line Rt. or West
4+00				4445		26 Rt bottom of channel
				4445		37 " bottom of channel
				4552		57 " Top of bank
				4555		75 " ground
				4475	35 Lt ground	
				4497	70 Lt ground	
5+00				4495		℄
				4502		40 Rt ground
				4511		48 " Top of bank
				4455		52 " bottom of channel
				4455		65 " " " "
				4604		90 " Top of bank
				4609		105 " ground.
				4484	15 Lt. ground	
				4506	60 " ground	
5+15				4483		℄ ground
5+82.				4516		℄ Toe of cut bank
5+91				4561		℄ crest of cut bank

Profile Notes Red. No. Date
Plotted No. Date
Job No. 6012 Division No. 11
Survey of S.D. Project
Map No. Indexed C.J. GALLI Date MAY 10 '71
F.B. 336 Pg. 57

76L-295 CE 307 11-58 (460.07 T.P. PARKING LOT) 452.13 T.P.

PLEASE RETURN TO
LOS ANGELES COUNTY ENGINEER
700 LOS ANGELES COUNTY ENGINEERING BLDG.

NOTE: ANY ADDITIONS OR CHANGES ON THIS SHEET MUST BE MADE OR CIRCLED IN RED INK, WITH DATE AND NAME OF PERSON MAKING CHANGE.

Do not extend notes this side of this line.

F.B. 3369 Pg. 58
Job No. 6014.14 Division No. 11 Notes Red Plotted Profile
Survey of S.D. Project # 1214 Date 16 MAR. '71 Date No. X-Sec.
Survey by FEBrooks Notes FEB Notes Chkd. Checked
Indexed G.H. GALLI Date Date Date No.

STATION	B.S.	H.I.	F.S.	ELEV.	Lt. or East	↑ line	Rt. or West
6+00 *				45435		↑	
				4548			27. Rt. Top of bank
				4493			53 " bottom of channel
				4478			69 " " " "
				4585			82.2 " Top of bank
				4550	35 Lt ground		crest of cut bank
L+20				4566	70 Lt ground		
7+00				4549		↑	
				4550			15 Rt Top of bank
				4510			34 " bottom small ditch
				4535			49 " ground
				4492			64 " bottom of channel
				4492			74 " " " "
				4597			89 " Top of bank
				4556	35 Lt ground		
				4587	70 " ground		
7+85				45775			81 Rt end conc gutter
8+00 *				45678		↑	
				4565			1.0 Rt Top of bank

761-298 CE 307 11-58

PLEASE RETURN TO
LOS ANGELES COUNTY ENGINEER
70Q LOS ANGELES COUNTY ENGINEERING BLDG.

NOTE: ANY ADDITIONS OR CHANGES ON THIS SHEET MUST BE MADE OR CIRCLED IN RED INK, WITH DATE AND NAME OF PERSON MAKING CHANGE.

Do not extend notes this side of this line.

STATION	B.S.	H.I.	F.S.	ELEV.	Lt. or East	↑ LINE	Rt. or West
8+00				4521			20.0 Rt. bottom small ditch
				4541			40.0 " ground
				4491			47.0 " bottom of channel
				4491			58.0 " bottom of channel
				4523			60.0 " ground
				4538			70.0 " "
				4599			85.0 " Top of bank
				4571	35 Lt ground		
				4585	70 " "		
8+24				46142			77 Rt Top of conc retaining wall edge of parking lot
9+00*				45709		↑	
				4572			8.0 Rt Top of bank
				4536			16.0 " bottom of small ditch
				4534			26.0 " ground
				4490			36.0 " bottom of channel
				4490			45.0 " bottom of channel
				46150			58.5 " Top conc. retaining wall edge parking lot

Profile Notes Red ____ Plotted ____ Job No. 60124 Division No. 11
No. ____ Date ____ Date ____ Survey of S.D. Project # 1274
X-Sec. ____ Notes Chkd. ____ Checked ____ Surveyed by E.J. Brooks Notes by E.J. Brooks
No. ____ Date ____ Date ____ Map No. ____ Indexed ____ Date 10-7
F.B. 3369 PG. 58

76L-298 CE 307 11-58

PLEASE RETURN TO
LOS ANGELES COUNTY ENGINEER
700 Los Angeles County Engineering Bldg.

NOTE: ANY ADDITIONS OR CHANGES ON THIS SHEET MUST BE MADE OR CIRCLED IN RED INK, WITH DATE AND NAME OF PERSON MAKING CHANGE.

Do not extend notes this side of this line.

F.B. 3319 Pg. 60 | Job No. 6012.74 | Division No. | Notes Red | Plotted | Profile
Survey of S.D. Project #12744 | Date 17 MAR. '71 | No. | X-Sec.
Survey by EE Brady Notes EEB | Notes Chkd. | Checked | No.
Indexed [redacted] GALL | Date | Date | Date

STATION	B. S.	H. I.	F. S.	ELEV.	Lt or East	Line	Rt. or West
9+00				4589	35 Lt ground		
				4590	70 " "		
10+00 *				45698		℄	
				4548			3.0 Rt ground
				4507			4.0 " bottom of channel
				4520			18.5 " " " "
				4606			44.5 " Top of bank
				4626	8.0 Lt. Top of bank		
				4606	35.0 " ground		
				4602	70 " "		
10+29.7				45564			11.2 Rt. Top 84" C.M.P.
					Pipe = 455.64		
	Invert 84" C.M.P.			44864	dia = 7.00		
					Invert = 448.64		
10+99.60	*			46147		℄	inter. of Colima Rd.

76L-298 CE 307 11-58

462.94 B.m.

PLEASE RETURN TO
LOS ANGELES COUNTY ENGINEER
700 LOS ANGELES COUNTY ENGINEERING BLDG.

NOTE: ANY ADDITIONS OR CHANGES ON THIS SHEET MUST BE MADE OR CIRCLED IN RED INK, WITH DATE AND NAME OF PERSON MAKING CHANGE.

Do not extend notes this side of this line.

STATION	B. S.	H. I.	F. S.	ELEV.		
					West on Colima Rd	
					Lt. or South ℄	Rt or North
1+00				461 47		℄
				461 05		21.0 Rt. pvmt
				460 68		40.0 " gutter out
				460 27		42.0 " gutter in
				461 09		42.0 " Top cb.
				461 49	2.0 Lt gutter out	
				461 47	2.7 " gutter in	
				461 97	3.0 " Top cb.	
				461 87	7.3 " Top cb.	
				461 40	7.6 " gutter in	
				461 38	8.3 " gutter out	
				461 09	21.0" pvmt	
				460 66	40.0" gutter out	
				460 46	42.0 " gutter in	
				461 10	42.0 " Top cb.	
1+13.0				456 84		44.0 RT Invert 18" corr iron pipe @ C.B.
1+04.0 O.K.				456 46	50.0 Lt Invert 18" Corr iron pipe	
1+16.4				456 98	44.2 Lt Invert 18 corr iron pipe at C.B.	

Profile Notes Rel. Plotted Job No. 6012.84 Division No. 11
No. X-Sec. Notes Ckd. Date Survey of S.D. District # 12 F.B. 3369 PG. 61
No. Date Date Map No. Indexed O.J. GALM Date 4-10-84

76L-298 CE 307 11-58

PLEASE RETURN TO
LOS ANGELES COUNTY ENGINEER
700 LOS ANGELES COUNTY ENGINEERING BLDG.

NOTE: ANY ADDITIONS OR CHANGES ON THIS SHEET MUST BE MADE OR CIRCLED IN RED INK, WITH DATE AND NAME OF PERSON MAKING CHANGE.

Do not extend notes this side of this line.

F.B. 3369 Pg. 62 | Job No. 6012.74 Division No. 11 Notes Red. Plotted | Survey of S.D. Prelim #1274 Date 17 mar 71 No. Profile | Survey by FE Brooks Notes FEB Notes Chkd. Checked No. X-Sec. | Indexed [redacted] Date Date Date

STATION	B.S.	H.I.	F.S.	ELEV.	Lt. or South	℄	Rt. or North
2+00				461.41		℄	
				461.16			21.0 Rt pvmt
				460.79			40.0 " gutter out
				460.62			42.0 " gutter in
				460.73			42.0 " Top ab. (depressed)
				461.10	21.0 Lt pvmt		
				460.76	40.0 " gutter out		
				460.60	42.0 " gutter in		
				460.70	42.0 " Top depressed ab.		
2+75.5		Erim = 461.14 Wrim = 461.18		461.16	30.5 Lt. mean rim elev.		
					"Inlet N	"Inlet E	"Inlet S	"Outlet W
	Invert "Inlet N			446.47	Rim = 461.16	461.16	461.16	461.16
	" " " E			445.73	meas = 14.02	13.93	13.92	13.97
	" " " S			446.57	Top pipe = 447.14	447.23	447.24	447.19
	Outlet " " W			445.69	dia = 0.67	1.50	0.67	1.50
					invert = 446.47	445.73	446.57	445.69

76L-298 CE 307 11-58

PLEASE RETURN TO
LOS ANGELES COUNTY ENGINEER
700 Los Angeles County Engineering Bldg.

NOTE: ANY ADDITIONS OR CHANGES ON THIS SHEET MUST BE MADE OR CIRCLED IN RED INK, WITH DATE AND NAME OF PERSON MAKING CHANGE.

Do not extend notes this side of this line.

Profile Notes Red ____ Plotted ____ Job No. 6012.7 Division No. 11
No. ____ Date ____ Date ____ Survey of S.D. Project #12 pg 17
X-Sec. Notes Chkd ____ Date ____ Map No. ____ Indexed L.A. GALLI Date 10-1
No. ____ Date ____ Date ____ F.B. 3369 Pg. 63

STATION	B.S.	H.I.	F.S.	ELEV.		
					East on Colima Rd.	
					Lt. or North.	& Rt. or South
		N Rim 461.10				
1+97.4		E Rim 461.10		461 10		30.7 Rt. mean rim elev.
					"Inlet E	"outlet W
					Rim =	461.10 / 461.10
	Invert	"Inlet E		446 74	meas =	12.86 / 12.88
	"	"Outlet W.		446 72	Top pipe =	448.24 / 448.22
					dia =	1.50 / 1.50
					invert =	446.74 / 446.72
2+00						
				461 75		& gutter out
				461 72		0.7 " gutter in
				462 18		1.0 " Top ob
				462 10		5.3 " Top ob.
				461 65		5.6 gutter in
				461 62		6.3 " gutter out
				461 34		21.0 " pvmt
				460 89		40.0 " gutter out
				460 70		42.0 " gutter in
				461 37		42.0 " Top ob

76L-296 CE 307 11-58

PLEASE RETURN TO
LOS ANGELES COUNTY ENGINEER
700 LOS ANGELES COUNTY ENGINEERING BLDG.

NOTE: ANY ADDITIONS OR CHANGES ON THIS SHEET MUST BE MADE OR CIRCLED IN RED INK, WITH DATE AND NAME OF PERSON MAKING CHANGE.

Do not extend notes this side of this line.

F.B. 3749 Pg. 64 | Job No. 6012.74 Division No. 11 | Notes Red ____ Plotted ____ Profile
Survey of S.D. Proj. Sect # 11 Tab. | Date 17 MAR. 71 Date ____ No. ____ X-Sec.
Survey by E.E. Brown Notes EE Bm. | Notes Chkd. ____ Checked ____ No. ____
Indexed G. J. GALLI | Date ____ Date ____

STATION	B.S.	H.I.	F.S.	ELEV.	Lt. or North	& Rt. or South
2+00				461 28	21 Lt Pvmt	
				460 87	40 " gutter out	
				460 70	42 " gutter in	
				461 35	42 " Top ob.	
					SOUTH on ℄ LINE	
					Lt or EAST	℄ LINE Rt or WEST
11+52.4				461 29		℄ at headwall
				4519		℄ at bottom of headwall
				4 5731		5.0 Rt along headwall suffit of 84" CMP
	Invert of 84" C.M.P.			450 31	Suffit = 457.31	
					dia = 7.00	
					Invert = 450.31	
11+78.0				4527		℄ bottom of channel
11+84.0				4527		℄ bottom of channel

76L-298 CE 307 11-58

4639 TP

PLEASE RETURN TO
LOS ANGELES COUNTY ENGINEER
700 LOS ANGELES COUNTY ENGINEERING BLDG.

NOTE: ANY ADDITIONS OR CHANGES ON THIS SHEET MUST BE MADE OR CIRCLED IN RED INK, WITH DATE AND NAME OF PERSON MAKING CHANGE.

Do not extend notes this side of this line.

STATION	B. S.	H. I.	F. S.	ELEV.	Lt. or East	LINE	Rt. or West
12+00				4576			
				4630			8.0 Rt Top of bank
12+10.0				4630			Top of bank
12+19.56				46355			Apt. in parking lot
12+50				46433			
				4634	6.5 Lt Top of bank		
				4585	23.0" grounded		
				4522	29.0" bottom of channel		
				4522	" " " "		
				4614	70 " Top of bank		
13+00				46492			
				4643	6.0 Lt. Top of bank		
				4593	19.0" grounded		
				4596	26.0" "		
				4545	29" bottom of channel		
				4547	43" " " "		
				4622	53.5" Top of bank.		

Profile Noted Rod Plotted Job No. 6012.74 Division No. 11
No. X-Sec. Date Date Survey of S.D. Project No. 11 F.B. 3369 Pg. 65
No. Notes Chkd. Checked Surveyed by E. Buckhorn, F. Bonilla, J. Mc...
Date Date Map No. Indexed R. L. GALLI Date 10-7-74

76L-296 CE 307 11-58

46495 T.P.

46419 T.P.

PLEASE RETURN TO
LOS ANGELES COUNTY ENGINEER
700 Los Angeles County Engineering Bldg.

NOTE: ANY ADDITIONS OR CHANGES ON THIS SHEET MUST BE MADE OR CIRCLED IN RED INK, WITH DATE AND NAME OF PERSON MAKING CHANGE.

Do not extend notes this side of this line.

F.B. 3769 Pg. 66 | Job No. 6012.74 | Division No. 11 | Notes Red | Plotted | Profile
Survey of S.D. Project No 1274 | Date 12 mar. '71 | No. | X-Sec.
Survey by EEBlanks Notes EEB. | Checked | No.
Indexed G. A. GALLI | Date | Notes Chkd. | Date | Date

STATION	B.S.	H.I.	F.S.	ELEV.	Lt. or East	Line	Rt. or West
13+30.6				4641		T	Top of bank
13+63.0				4603		T	ground
13+96				4606		T	ground
14+00				4596		T	
				4609			3.0 Rt ground
				4609			17.0 " ground
				4645			20.0 " Top of bank
				4545	5.0 Lt bottom of channel		
				4545	14.5 " " " "		
				4634	25.5 " Top of bank		
14+09.0				4544		T	bottom of channel
14+25.5				4539		T	bottom of channel
14+44.5				4634		T	Top of bank
14+76.48				4613		T	4 pt.

76L-298 CE 307 11-58

(462.18 T.P.) 61.4

PLEASE RETURN TO
LOS ANGELES COUNTY ENGINEER
700 LOS ANGELES COUNTY ENGINEERING BLDG.

NOTE: ANY ADDITIONS OR CHANGES ON THIS SHEET MUST BE MADE OR CIRCLED IN RED INK, WITH DATE AND NAME OF PERSON MAKING CHANGE.

Do not extend notes this side of this line.

STATION	B.S.	H.I.	F.S.	ELEV.	Lt. or East	℄ LINE	Rt. or West
15+00				4638		℄	
				4635			11.0 Rt Top of bank
				4533			22.0 " bottom of channel
				4533			31.0 " " " "
				4607			38.0 " ground
				4610			46.6" ground
				4643			54.0 Top of bank
15+43.3				4639		℄	
16+00				4607		℄	
				4576			9.5 Rt bottom of channel
				4555			21.5 " " " "
				4592			29.5" GROUND
				4623			31.5" "
				4650			36.5" Top of bank
				4636	3.0 Lt Top of bank		
17+00				4641		℄	
17+01.5				4641		℄	

Profile Notes Red ____ Plotted ____ Job No. 60K1-14 Division No. 11
No. ____ Date ____ Date ____ Survey of S.D. Project #1 in Dry
X-Sec. ____ Notes Chkd. ____ Date ____ Chkd. ____ Date ____ Map No. ____ Indexed G. J. GALLI Date 10-71
No. ____ Date ____

F.B. 382 PG. 64

76L-266 CE 307 11-58

PLEASE RETURN TO
LOS ANGELES COUNTY ENGINEER
700 LOS ANGELES COUNTY ENGINEERING BLDG.

NOTE: ANY ADDITIONS OR CHANGES ON THIS SHEET MUST BE MADE OR CIRCLED IN RED INK, WITH DATE AND NAME OF PERSON MAKING CHANGE.

Do not extend notes this side of this line.

B.B. 3369 Pg. 68 | Job No. 6017.74 | Division No. 11 | Notes Red ____ Plotted ____ Profile
Survey of S.D. Project #12 Dr | Date 12 MAR. 71 | No. ____ X-Sec.
Survey by E.E. Black Notes F.E.B. | Notes Chkd. ____ Checked ____
Indexed -- J. GALLI | Date ____ Date ____ No.

STATION	B.S.	H.I.	F.S.	ELEV.	Lt or East	Time	Rt. or West
17+01.5	(edge of poor conc)			4640			4.0 Rt Top of channel
				4577			12.0" bottom of channel
				4579			22.5" " " "
				4621			28.5" Top of channel
17+21.5	(edge of good conc)			4641		T	
				46485			5.6 Rt Top of channel
				45756			13.6" bottom of channel
				45760			22.1" " " "
				46483			29.6" Top of channel
17+32.64				46419		T	
				46495			6.3 Rt Top of headwall
		4.00		46179			6.3 Rt Suffit
				45779			6.3 Rt Invert
		3.99		46176			16.3" Suffit
				45777			16.3" Invert
		4.01		46175			17.0" Suffit
				45774			17.0" Invert
		3.96		46174			27.0" Suffit
				45778			27.0" Invert

76L-298 CE 307 11-58

PLEASE RETURN TO
LOS ANGELES COUNTY ENGINEER
700 LOS ANGELES COUNTY ENGINEERING BLDG.

NOTE: ANY ADDITIONS OR CHANGES ON THIS SHEET MUST BE MADE OR CIRCLED IN RED INK, WITH DATE AND NAME OF PERSON MAKING CHANGE.

Do not extend notes this side of this line.

STATION	B.S.	H.I.	F.S.	ELEV.	Lt. or East	Line	Rt. or West
17+36.64				464.97			27.0 RT Top of headwall
BM S.D. 1253				464.21	BM S.D. 1253 Elev. 464.220 FB 3369-W Sellick Ave. and Sierra Leone Ave S.W. Cor. PK spk in lead. in N.E. Cor. of Catch basin 35± ft W. of curb return.		

Profile Notes Red No. Date Plotted Date Job No. 60121-94 Division No. 11 Survey of S.D. District No 1274 F.B. 3369 Pg. 69

Map No. Indexed G. J. GALEY Date 10-7

F. B. 3369 Pg. 70

Job No. Division No. Notes Red Plotted Profile

Survey of Date Date No.

Survey by Notes Notes Chkd. Checked X-Sec.

Indexed Date Date Date No.

STATION	B.S.	H.I.	F.S.	ELEV.	

761-268 CE 307 11-58

PLEASE RETURN TO

LOS ANGELES COUNTY ENGINEER

700 Los Angeles County Engineering Bldg.

Do not extend notes this side of this line.

NOTE: ANY ADDITIONS OR CHANGES ON THIS SHEET MUST BE MADE OR CIRCLED IN RED INK, WITH DATE AND NAME OF PERSON MAKING CHANGE.

Notes Ck'd by H. HOLMAN	Survey of [illegible] F.B. [illegible] Pg. 71
Map No.	JN 6012; [illegible] Tape [illegible] Std 68 °F
Office Work	Surveyed by FE Brooks
Checked	Notes FEB Date
Date	Indexed G. J. GALLO MAY 10 '71

SN 6012.74

STORM DRAIN PROJECT

No 1274

LINE B CENTERLINE

Note: Any Additions or Changes on This Sheet Must be Made or Circled in Red Ink With Date and Name of Person Making Change.

Do not extend this side of this line.

PLEASE RETURN TO
COUNTY OF LOS ANGELES
DEPARTMENT OF COUNTY ENGINEER
403 LOS ANGELES COUNTY ENGINEERING BLDG.

FE Brooks
GO Guizado
RA Moore
T Ohashi

76F3095 CE#310 3-68

X

F. B. 3369 PG. 72

S.D. PROJ. 1274
LINE "B"

VIDORA

VIVERO DR

ALLEY

QUENAJ DR

ALLEY

ALBERCA DR.

ALLEY

DR

ALLEY

℄ 73

78 Topog

79 Topog

80 Topog

81 Topog

℄ 74

82 Topog

℄ 75

83 Topog

84 Topog

DR

PADRES

ST.

LOS

℄ 76

85 Topog

FARJARDO

VIVERO DR

BATSON AVE

PLEASE RETURN TO
COUNTY OF LOS ANGELES
DEPARTMENT OF COUNTY ENGINEER
403 LOS ANGELES COUNTY ENGINEERING BLDG.

Note: Any Additions or Changes on This Sheet Must be Made or Circled in Red Ink With Date and Name of Person Making Change.

Do not extend this side of this line.

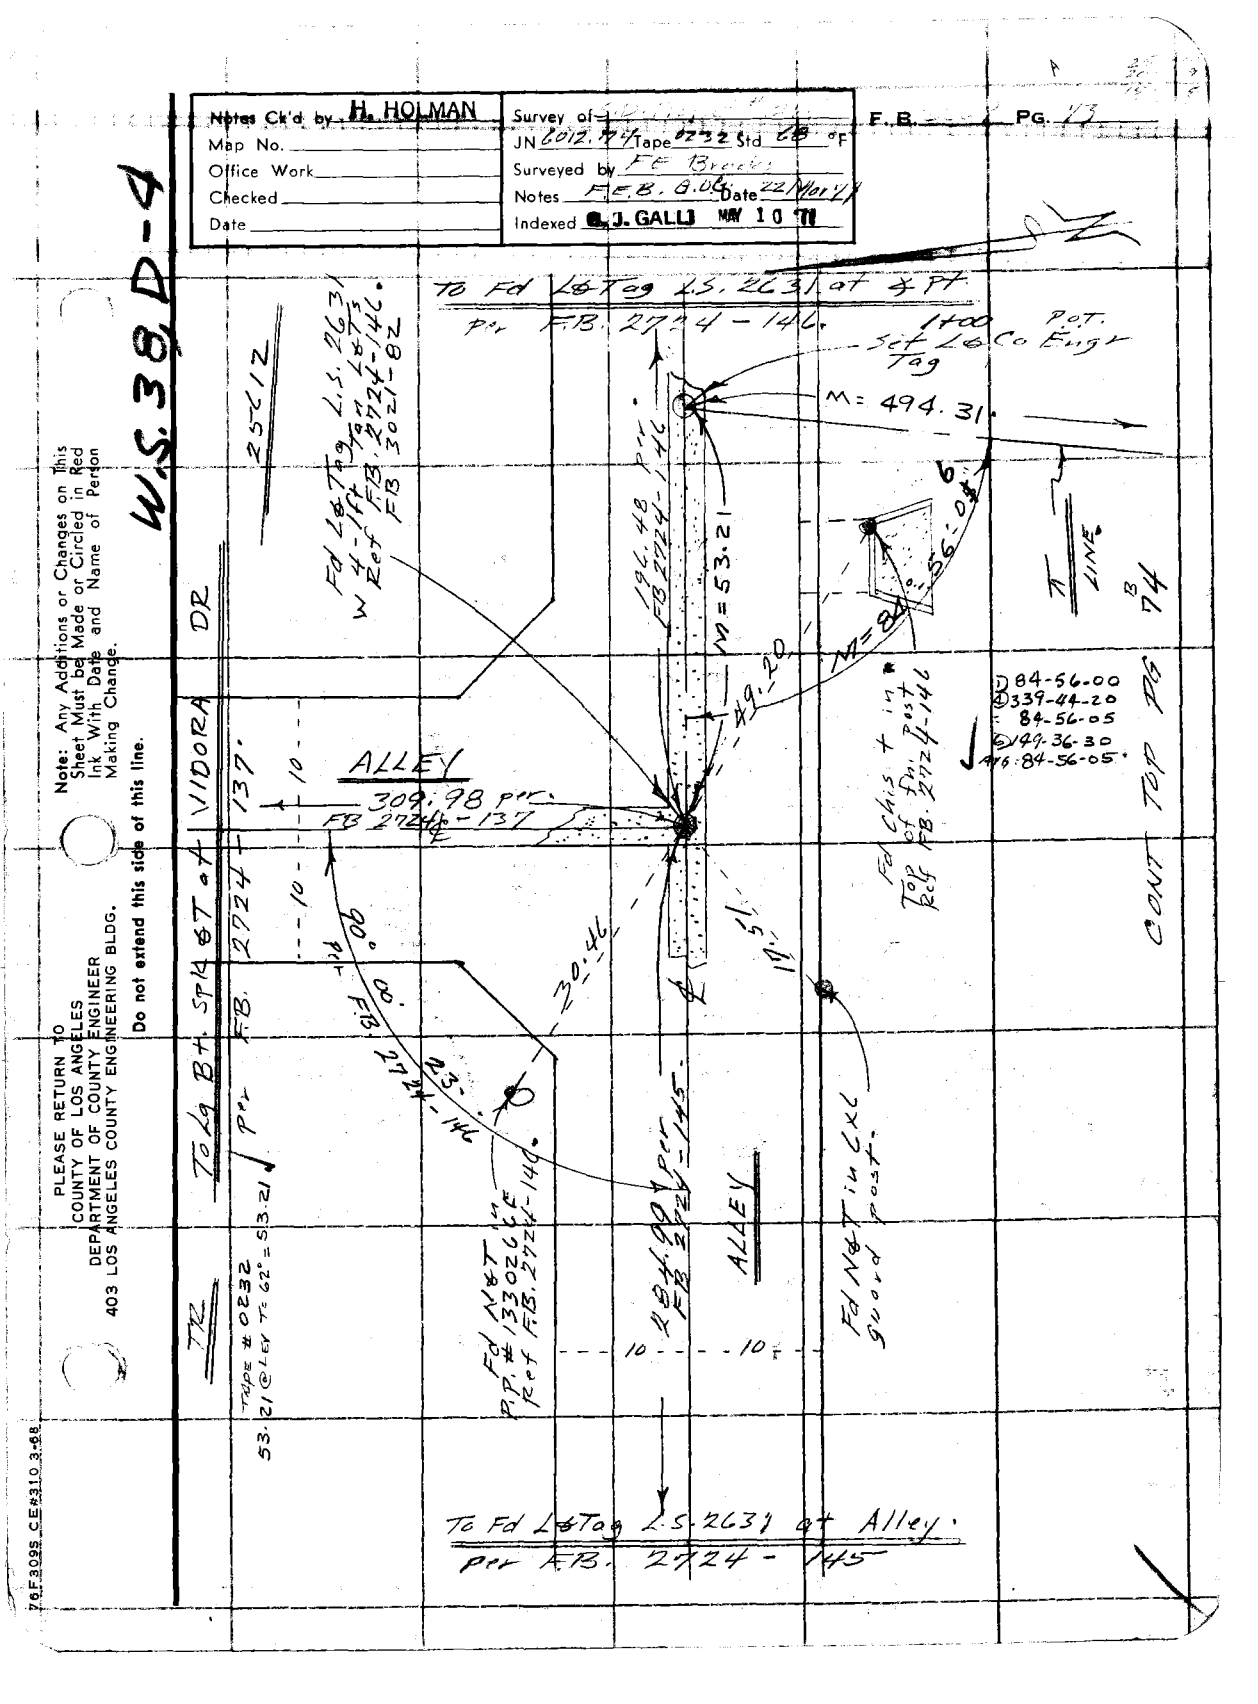
W.S. 38 D-4
Notes Ck'd by H. HOLMAN
Map No.
Office Work
Checked
Date
Survey of
JN 2012.74 Tape 0232 Std LB °F
Surveyed by FF Brooks
Notes F.E.B. 8.06 Date 22 Mar 74
Indexed G. J. GALLI MAY 10 '74
F.B. PG. 13
Note: Any Additions or Changes on This Sheet Must be Made or Circled in Red Ink With Date and Name of Person Making Change.
Do not extend this side of this line.
PLEASE RETURN TO
COUNTY OF LOS ANGELES
DEPARTMENT OF COUNTY ENGINEER
403 LOS ANGELES COUNTY ENGINEERING BLDG.
To Fd L&T og L.S. 2631 at ℄ PT.
per F.B. 2724 - 146.
Set L&Co Engr Tag
M = 494.31
Pot.
VIDORA DR
25CI2
Fd L&T og L.S. 2631 W 4-1/4" Ref F.B. 2724-146. F.B. 3021-82
196.48 per F.B. 2724-146
N = 53.21
N = 8
#9-20
0.1
0.6
0.4
℄ LINE
B
84
ALLEY
309.98 per F.B. 2724-137
10
10
137.
To Fd B.M. Spk & T VIDORA
F.B. 2724-137 per
TRE
TAPE # 0232
53.21 @ LEV TO 62° = 53.21
90° 00' 00"
Fd Chis + T in Top of Post Ref F.B. 2724-146
84-56-00
339-44-20
84-56-05
149.36.30
84-56-05
CONT TOP PG
30.46
23.
Fd NAIL in CXC
PP # 1330266
Ref F.B. 2724-146
194.99 per F.B. 2724-145
ALLEY
Fd NAIL in CXC Wood post
To Fd L&Tag L.S. 2631 at Alley.
per F.B. 2724 - 145
76F3095 CE#310 3-68

F. B. 3369 PG 74

CONT RT PG 73

TAPE # 0232

✓ 494.31 T=68°= 494.31

℄ = 494.31

5+94.31
℄ Pt. Set
1" F.P. Conc Plug
& Co Engr tag

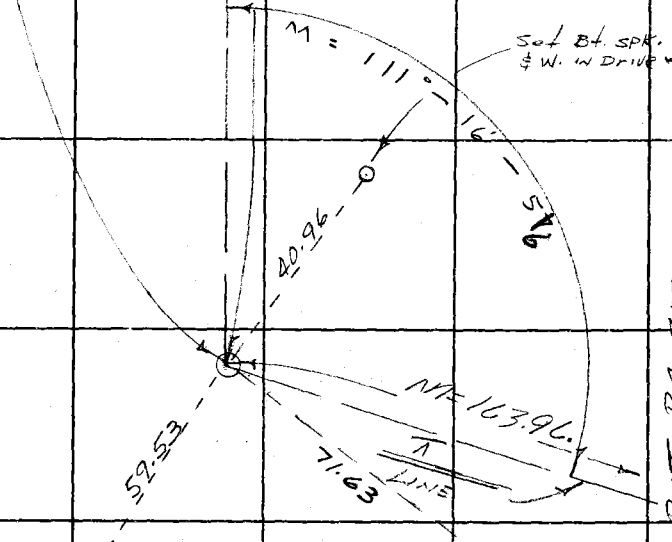

Set Punch Mark on Elbow of Drain Pipe

GARAGE

1) 111-16-55
2) 85-07-40
3) 111-16-55
4) 307-41-45
Avg: 111-16-57½

Set Lg. Bt. SPK & W. in Drive Way

CONT BOT PG 75

PLEASE RETURN TO
COUNTY OF LOS ANGELES
DEPARTMENT OF COUNTY ENGINEER
403 LOS ANGELES COUNTY ENGINEERING BLDG.

Do not extend this side of this line.

Note: Any Additions or Changes on This Sheet Must be Made or Circled in Red Ink With Date and Name of Person Making Change.

Notes Ck'd by H. HOLMAN	Survey of S.D. Pl. 4th Blk
Map No.	JN 6017.74 Tape 025E Std. 66 °F
Office Work	Surveyed by F.E. Brooks
Checked	Notes F.E.B. G.O.C. Date 22 Nov. 71
Date	Indexed C. J. GAN MAY 10 '72

F. B. 324 Pg. 25

Note: Any Additions or Changes on This Sheet Must be Made or Circled in Red Ink With Date and Name of Person Making Change.

Do not extend this side of this line.

PLEASE RETURN TO
COUNTY OF LOS ANGELES
DEPARTMENT OF COUNTY ENGINEER
403 LOS ANGELES COUNTY ENGINEERING BLDG.

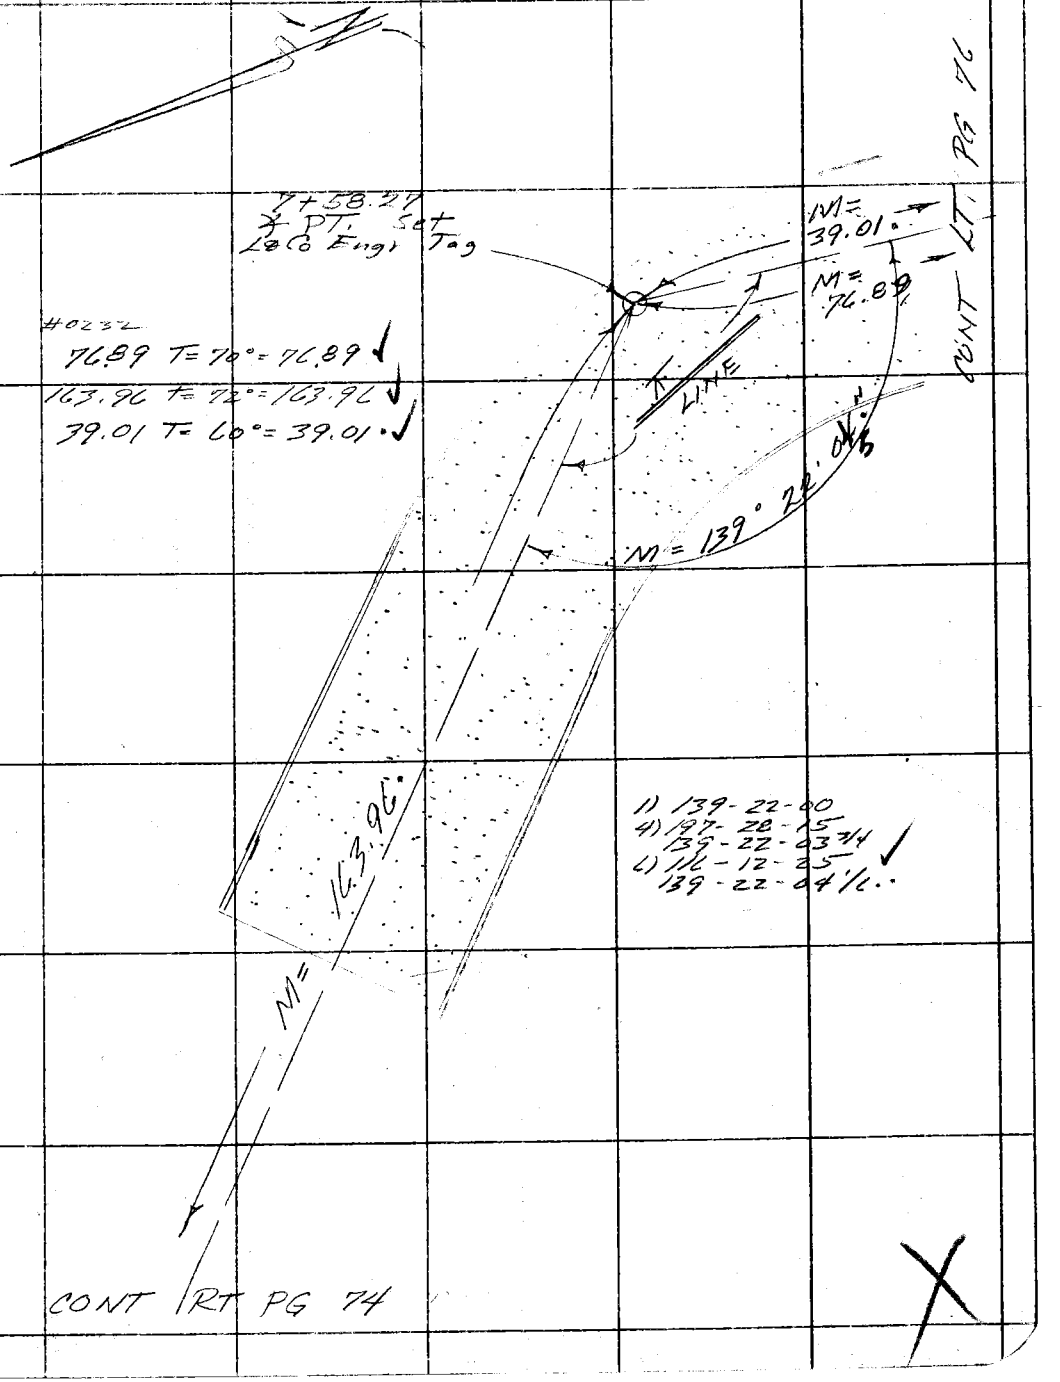

16F3095 C.E.#310 3-68

PLEASE RETURN TO
COUNTY OF LOS ANGELES
DEPARTMENT OF COUNTY ENGINEER
403 LOS ANGELES COUNTY ENGINEERING BLDG.

Note: Any Additions or Changes on This Sheet Must be Made or Circled in Red Ink With Date and Name of Person Making Change.

Do not extend this side of this line.

WS 39 D-4

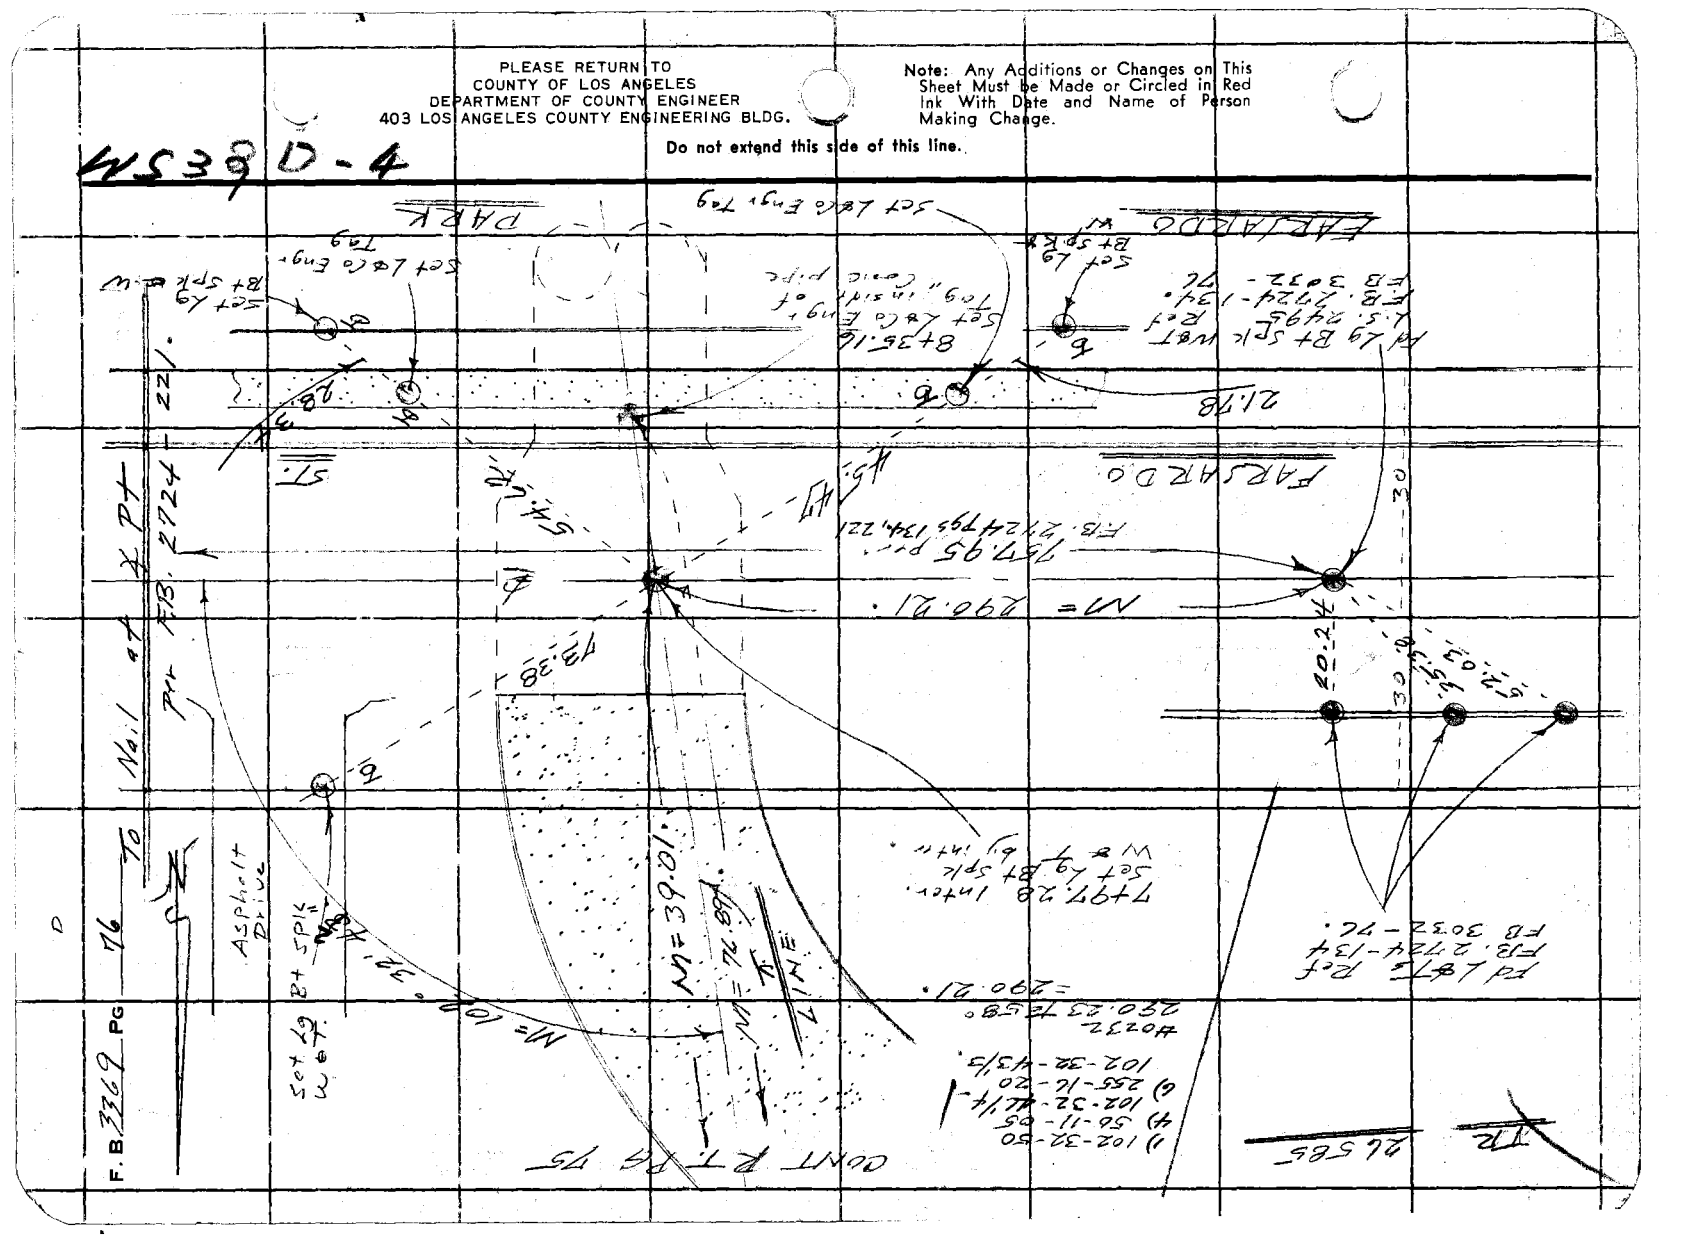
F.B. 3769 Pg
Asphalt Drive

Notes Ck'd by	Survey of S.D. Project #1254 F.B. 2204 Pg. 71
Map No.	JN 6012.74 Tape Std °F
Office Work	Surveyed by FE Brooks
Checked	Notes F.E.B. Date 23 Mar. 74
Date	Indexed G. J. GALLI MAY 10 '74

S.N. 6012.74

STORM DRAIN PROJECT

No 1254

LINE B

LOCATION OF IMPROVEMENTS

FE Brooks
GO Guizado
RA Moore
T Ohashi

Note: Any Additions or Changes on This Sheet Must be Made or Circled in Red Ink With Date and Name of Person Making Change.

Do not extend this side of this line.

PLEASE RETURN TO
COUNTY OF LOS ANGELES
DEPARTMENT OF COUNTY ENGINEER
403 LOS ANGELES COUNTY ENGINEERING BLDG.

76F309S CE#310 3-68

F. B. 3369 PG. 78

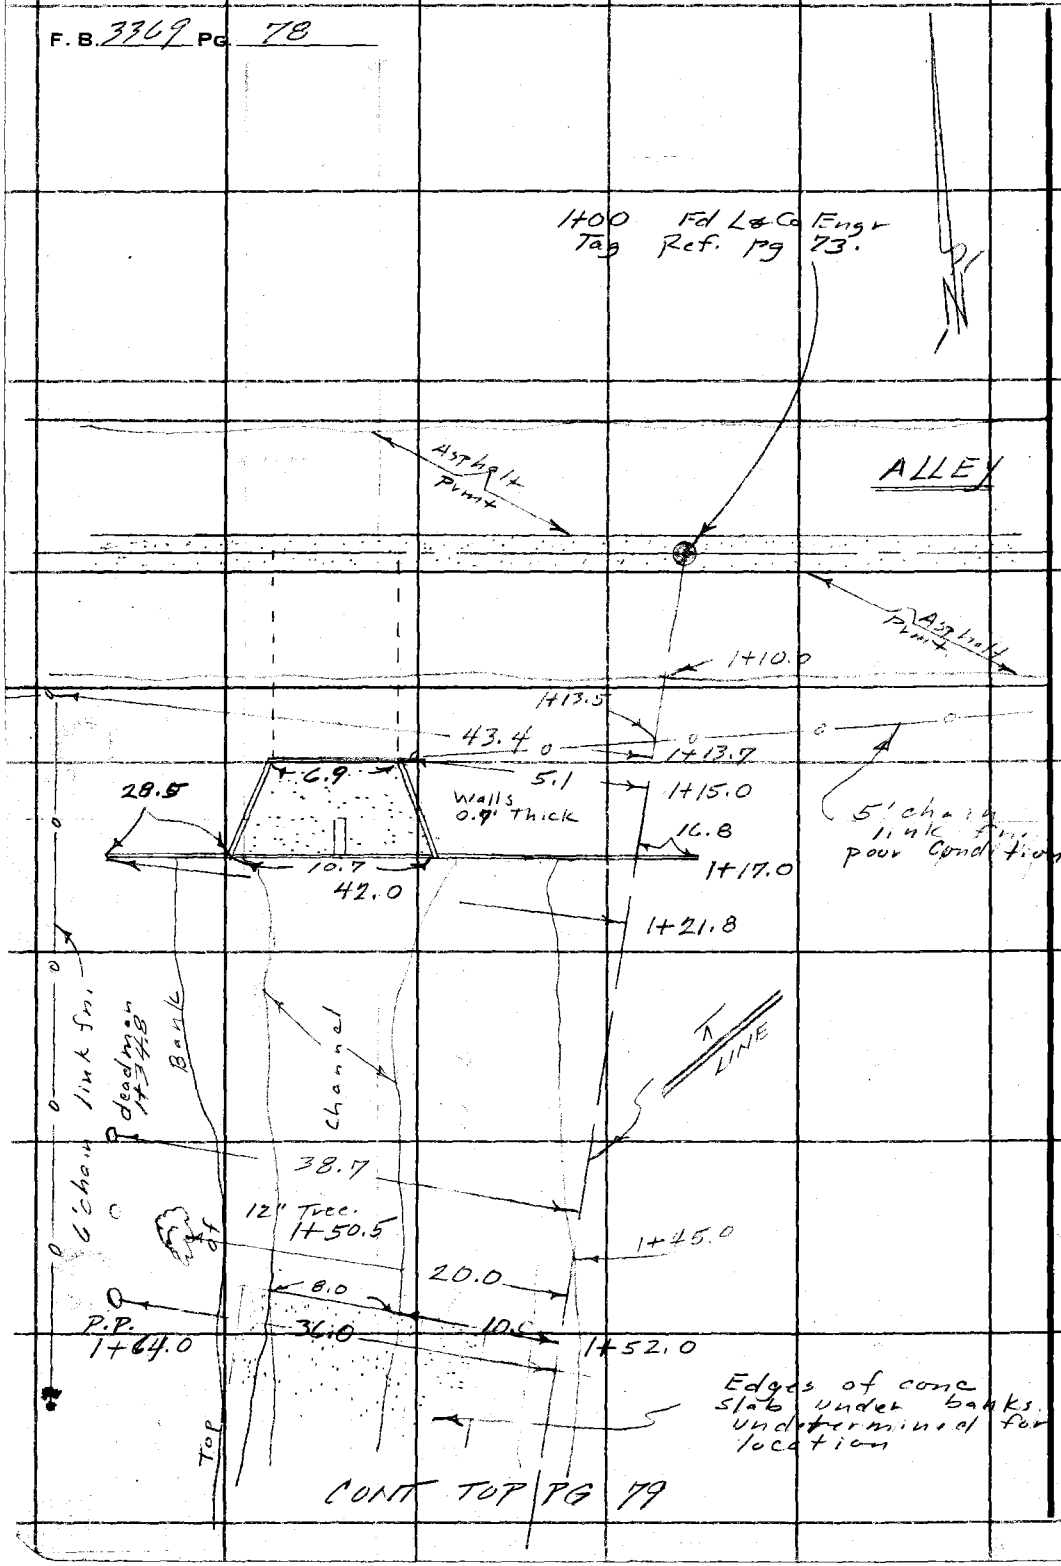

PLEASE RETURN TO
COUNTY OF LOS ANGELES
DEPARTMENT OF COUNTY ENGINEER
403 LOS ANGELES COUNTY ENGINEERING BLDG.

Do not extend this side of this line.

Note: Any Additions or Changes on This Sheet Must be Made or Circled in Red Ink With Date and Name of Person Making Change.

Notes C'd by
Map No.
Office Work
Checked
Date

Survey of Project
JN C012 77 Tape Std °F
Surveyed by F.F.Brooks
Notes F.F.B. Date 23 Nov 77
Indexed D. GALLI MAY 10 '77

F. B. 332 Pg. 77

CONT BOT PG 78

Wall 0.5 Wide

1+57.5

22.0

0.5

Edges of conc. slab and edge of the wall are unlevel. Laukes thru ave Undefined.

Toe with 6-2" Trunks 1+65.0

22.0

6.5 5.8 7.7 3.2

2+00

2+42.

C'l chain link fn.

Top of bank

Channel

Top of bank

LINE

24.0 2+51.6

35.8 2+53.7

Cont Slope

33.6 2+81.0

CONT TOP PG 80

Note: Any Additions or Changes on This Sheet Must be Made or Circled in Red Ink With Date and Name of Person Making Change.

Do not extend this side of this line.

PLEASE RETURN TO
COUNTY OF LOS ANGELES
DEPARTMENT OF COUNTY ENGINEER
403 LOS ANGELES COUNTY ENGINEERING BLDG.

76F3095 CE#310 3-68

F. B. 3369 Pg. 90

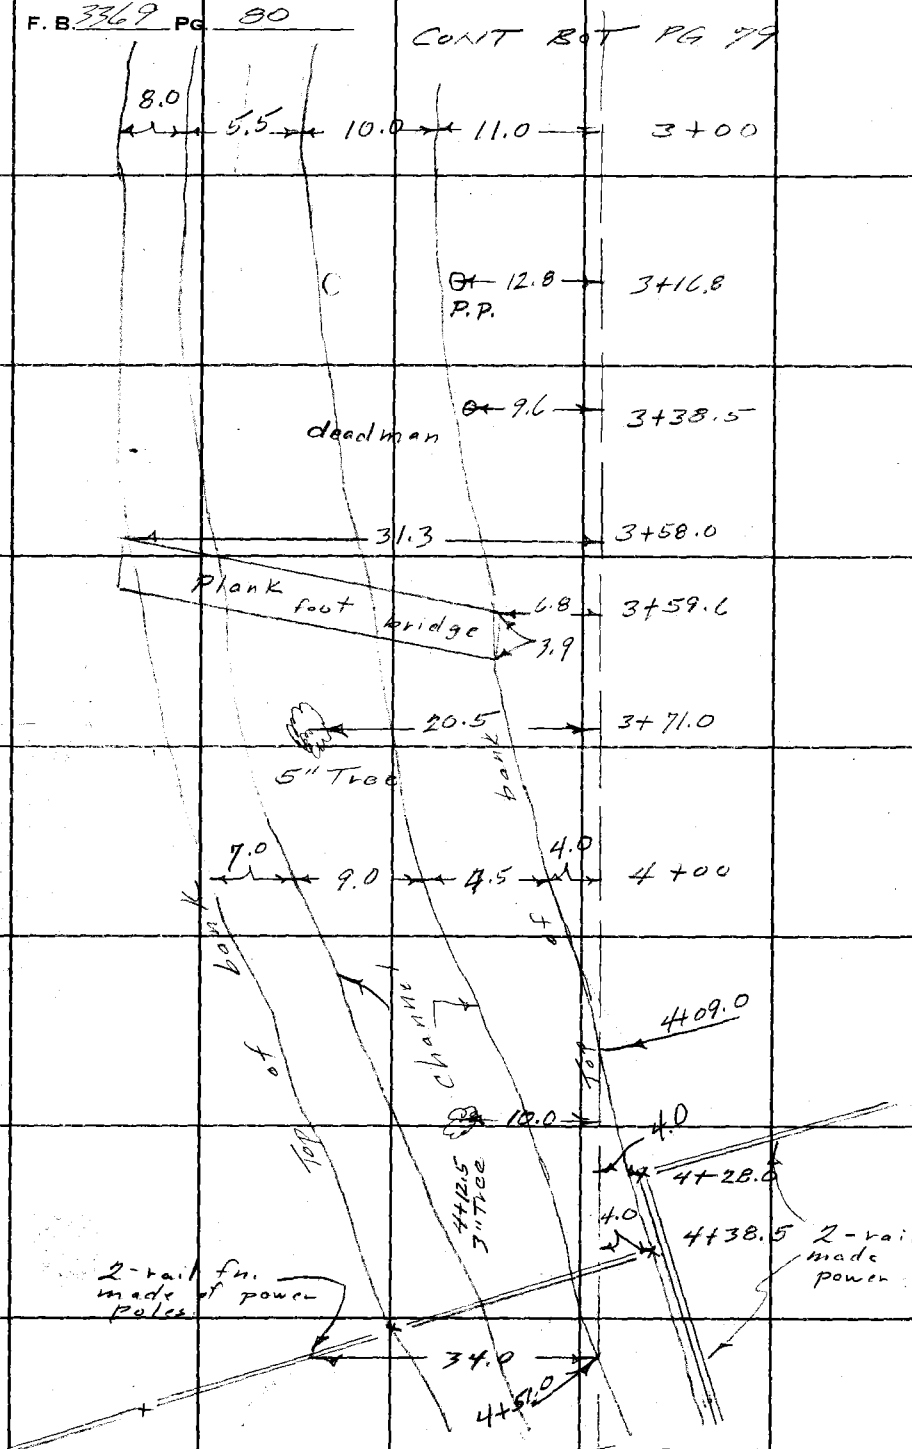

PLEASE RETURN TO
COUNTY OF LOS ANGELES
DEPARTMENT OF COUNTY ENGINEER
403 LOS ANGELES COUNTY ENGINEERING BLDG.

Do not extend this side of this line.

Note: Any Additions or Changes on This Sheet Must be Made or Circled in Red Ink With Date and Name of Person Making Change.

Notes Ck'd by	Survey of SD River F. B. PG.
Map No.	JN D17.94 Tape Std °F
Office Work	Surveyed by FE Brooks
Checked	Notes FE 13 Date 23 Nov 11
Date	Indexed J. GALLI MAY 10 '71

CONT BOT PG 80

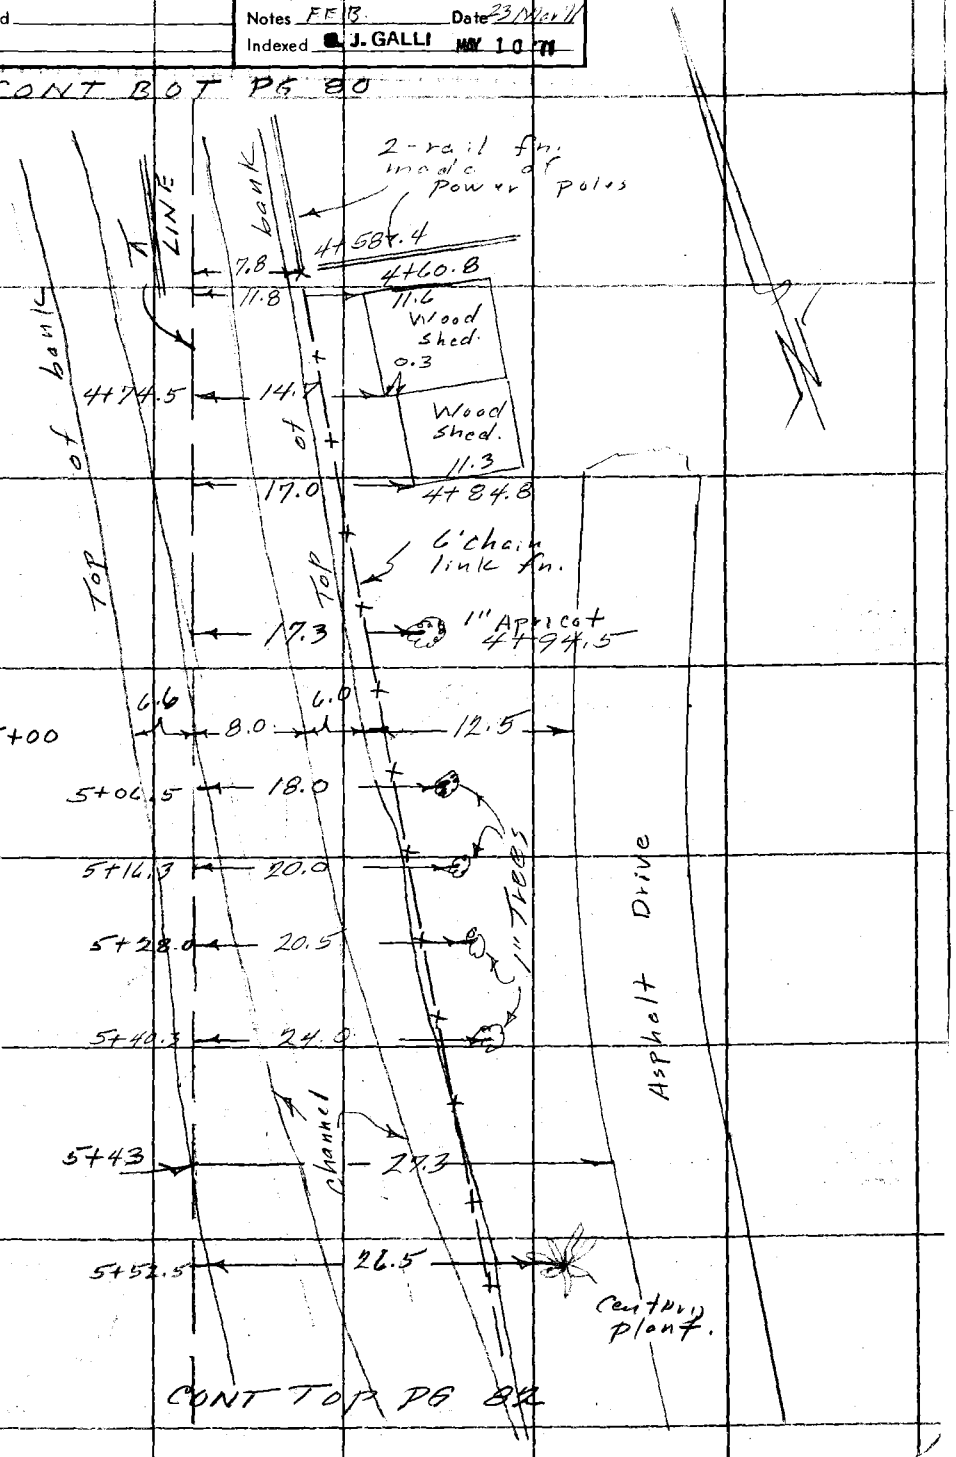

CONT TOP PG 82

Note: Any Additions or Changes on This Sheet Must be Made or Circled in Red Ink With Date and Name of Person Making Change.

PLEASE RETURN TO
COUNTY OF LOS ANGELES
DEPARTMENT OF COUNTY ENGINEER
403 LOS ANGELES COUNTY ENGINEERING BLDG.

Do not extend this side of this line.

76F309S CE#310 3-68

PLEASE RETURN TO
COUNTY OF LOS ANGELES
DEPARTMENT OF COUNTY ENGINEER
403 LOS ANGELES COUNTY ENGINEERING BLDG.

Note: Any Additions or Changes on This Sheet Must be Made or Circled in Red Ink With Date and Name of Person Making Change.

Do not extend this side of this line.

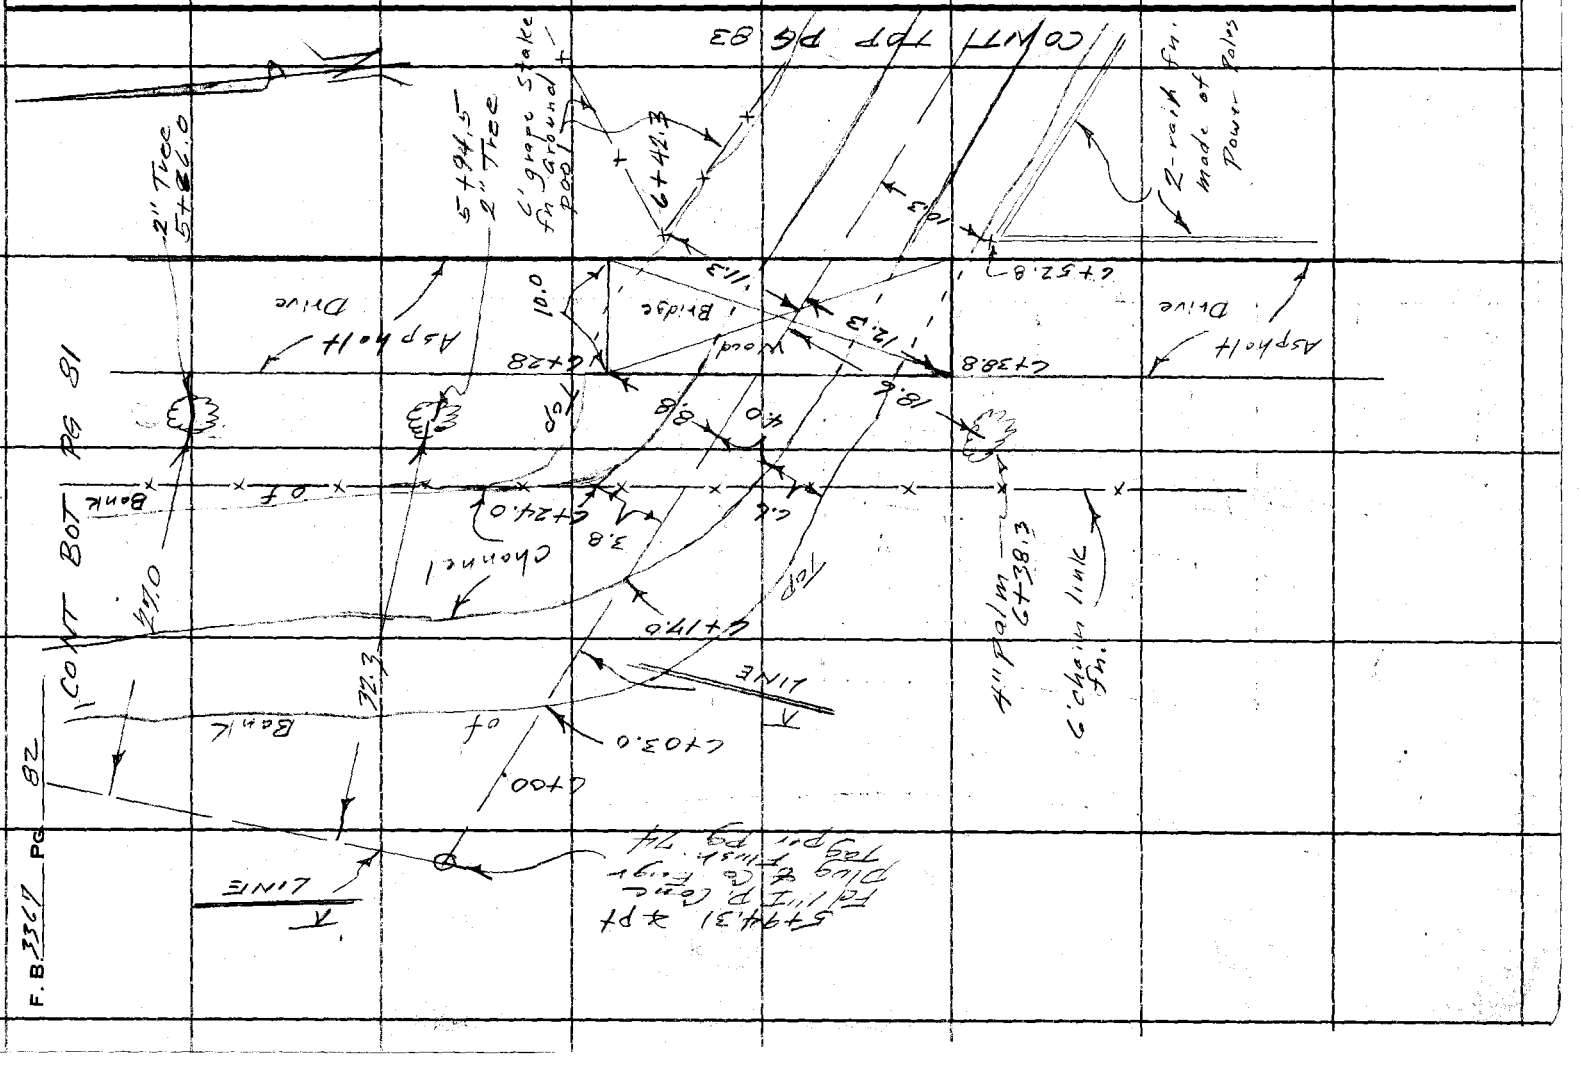

Notes Ckd by
Map No.
Office Work
Checked
Date

Survey of
JN 2012 Tape Std °F
Surveyed by FE Brooks
Notes FEB. Date 23 Nov 71
Indexed G. G. GALEN MAY 10 72

F. B. PG.

CONT RT PG 82

Top of bank

6+71.0

6' grape stake fm. around pool

Bank

6+84.0

Channel

9.5

2.5

3.0

7+06.0
21.0 OFF

7+02.0
16.0 OFF

7+02.0
8.0 OFF

7+03.0
5.2 OFF

7+18.5
9.0 OFF

4' CHAIN LINK FN.

2 - Rail fm. made of Power Poles

10.0

7+00

6+77.5

7+01.0
4.7 OFF

7+03.0
4.2 OFF

7+01.5
16.5 OFF

55

7+10.0

2 PRONG 10" TREE

4.0

4.7

7+45.0

CONT LT PG

Note: Any Additions or Changes on this Sheet Must be Made or Circled in Red Ink With Date and Name of Person Making Change.

Do not extend this side of this line.

PLEASE RETURN TO
COUNTY OF LOS ANGELES
DEPARTMENT OF COUNTY ENGINEER
403 LOS ANGELES COUNTY ENGINEERING BLDG.

76F309S CE#310 3-68

F. B. 3367 Pg. 84

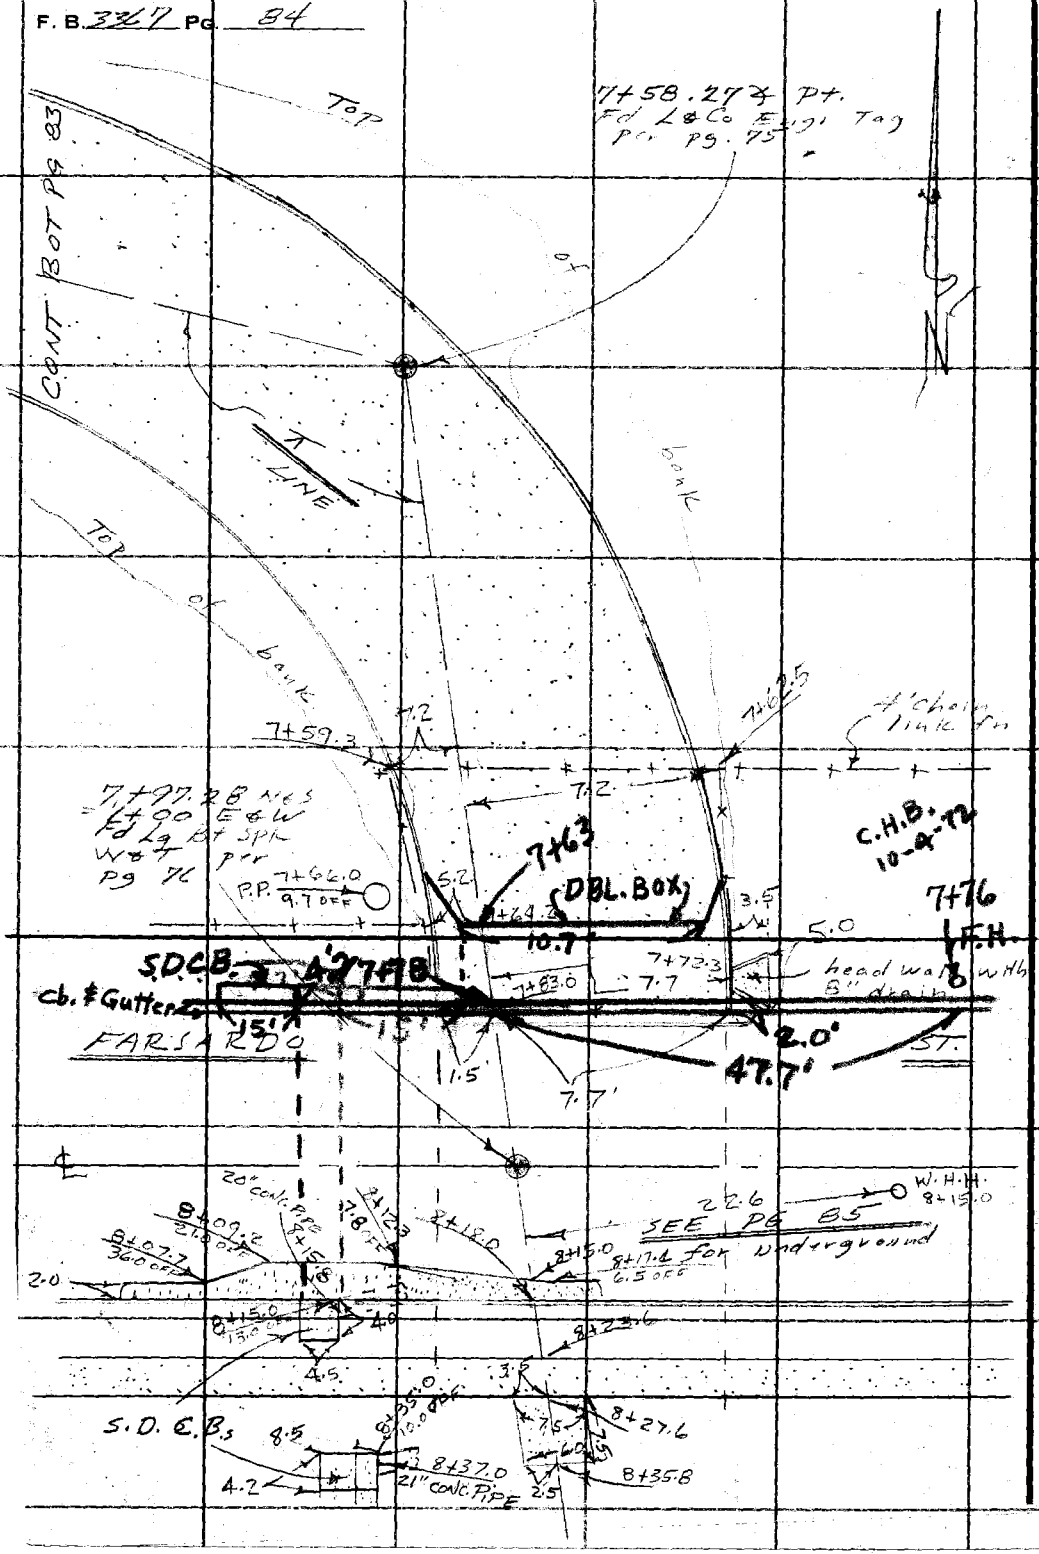

PLEASE RETURN TO
COUNTY OF LOS ANGELES
DEPARTMENT OF COUNTY ENGINEER
403 LOS ANGELES COUNTY ENGINEERING BLDG.

Do not extend this side of this line.

Note: Any Additions or Changes on This Sheet Must be Made or Circled in Red Ink With Date and Name of Person Making Change.

Notes C'k'd by	Survey of [illegible] F. B. [illegible] P.G.
Map No.	JN 6017 Tape Std °F
Office Work	Surveyed by F.E. Brooks
Checked	Notes G.O. Guizado Date 24 Mar. 71
Date	Indexed G. J. GALLI MAY 10 '71

INTERIOR OF BOX DRAIN AT FARSARDO ST.

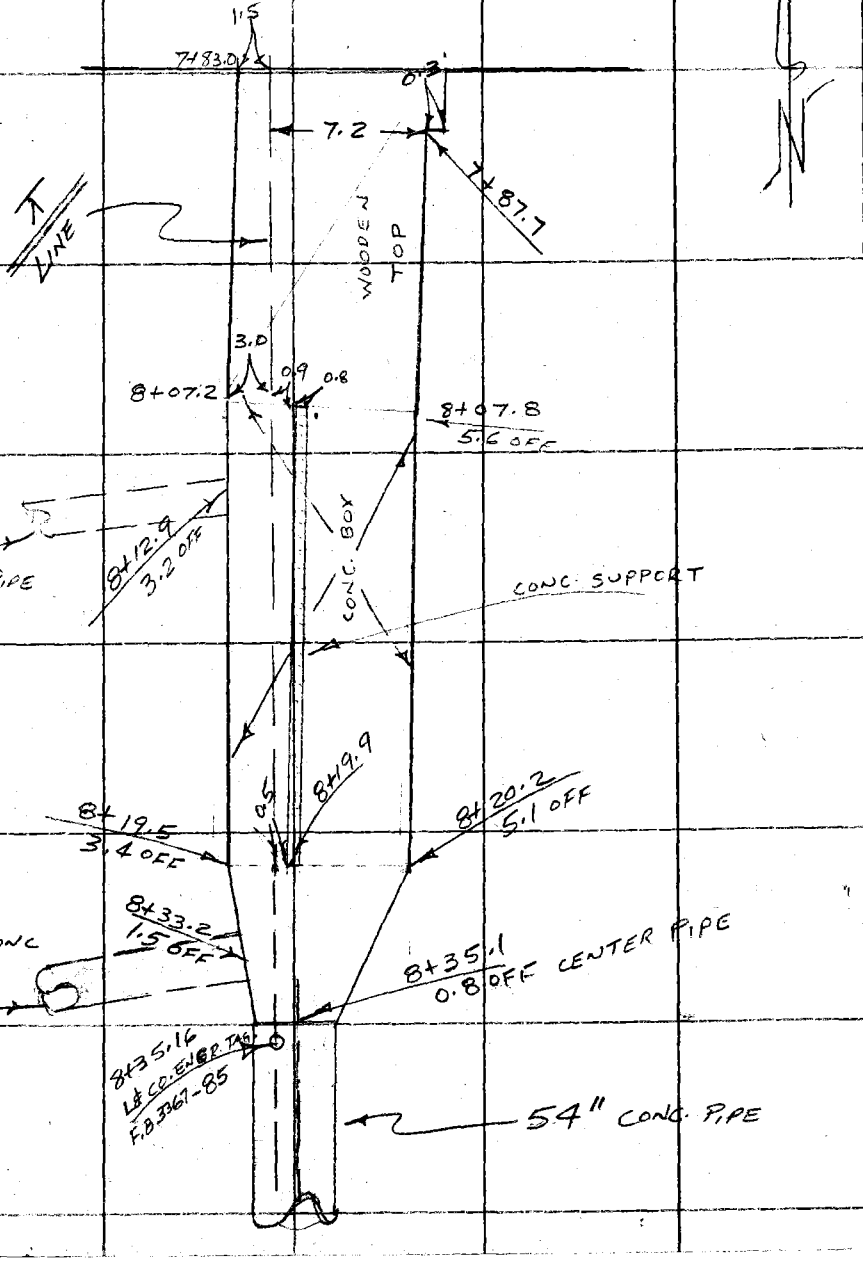

Note: Any Additions or Changes on this Sheet Must be Made or Circled in Red Ink With Date and Name of Person Making Change.

Do not extend this side of this line.

PLEASE RETURN TO
COUNTY OF LOS ANGELES
DEPARTMENT OF COUNTY ENGINEER
403 LOS ANGELES COUNTY ENGINEERING BLDG.

76F3095 CE#310 3-68

PLEASE RETURN TO
COUNTY OF LOS ANGELES
DEPARTMENT OF COUNTY ENGINEER
403 LOS ANGELES COUNTY ENGINEERING BLDG.

Note: Any Additions or Changes on This Sheet Must be Made or Circled in Red Ink With Date and Name of Person Making Change.

Do not extend this side of this line.

F. B. 3369 PG. 86

Profile No.____ Notes Red____ Date____ Plotted____ Date____ Job No. 6012.74 Division No. 11 Survey of S.D. Project # 1274

F. B. 3369 Pg. 87

X-Sec No.____ Notes Date____ Checked____ Date____ Map No.____ Indexed____ Date____

C.N. 6012.74

STORM DRAIN PROJECT

No 1274

LINE B

CROSS SECTIONS

STATION	B.S.	H.I.	F.S.	ELEV.

FE Brooks
G O Guizado
RA Moore
T Ohashi

NOTE: ANY ADDITIONS OR CHANGES ON THIS SHEET MUST BE MADE OR CIRCLED IN RED INK, WITH DATE AND NAME OF PERSON MAKING CHANGE.

Do not extend notes this side of this line.

PLEASE RETURN TO
LOS ANGELES COUNTY ENGINEER
700 Los Angeles County Engineering Bldg.

76L-296 CE 307 11-58

76L-298 CE 307 11-58

PLEASE RETURN TO
LOS ANGELES COUNTY ENGINEER
700 Los Angeles County Engineering Bldg.

NOTE: ANY ADDITIONS OR CHANGES ON THIS SHEET MUST BE MADE OR CIRCLED IN RED INK, WITH DATE AND NAME OF PERSON MAK.NG CHANGE

Do not extend notes this side of this line.

F.B. 3369 Pg. 88 | Job No. Col. 74 | Division No. 11 | Notes Red | Plotted | Profile No.
Survey of S.D. Project # 1254 | Date 24 MAR. '71 | Date | X-Sec. No.
Survey by F.F. Brooks | Notes F.B. | Notes Chkd. | Checked
Indexed O.L. (DATE) | Date | Date | Date

STATION	B. S.	H. I.	F S.	ELEV		
BM S.D. 1254					BM S.D. 1254 Elev. 484.518	FB 3369-13
					Alberca Dr. (cul de sac) W. side	
					140± ft. S. of Vidova	Dr. A. P.K. spk in
					lead in base of St. light std.	
					South on ℄ LINE	
					Lt. or East ℄ LINE	Rt. or West
1+00				487.09		℄ LINE of Alley
				487.30		53 Rt on ℄ of Alley
				487.49		100 " " " " "
				486.87	50 Lt. on ℄ of Alley	
				486.66	100 " " " " "	
1+10				487.02		℄ edge of pvmt
				487.84		100 Rt edge of pvmt
				486.89	100 Lt. edge of pvmt.	
1+15.0				486.37		5.1 Rt. Top of E. cor of headwall
				483.61		" " Soffit of S.D. E side
				476.71		" " Floor of S.D. E side

76L-298 CE 307 11-58

PLEASE RETURN TO
LOS ANGELES COUNTY ENGINEER
700 LOS ANGELES COUNTY ENGINEERING BLDG.

NOTE: ANY ADDITIONS OR CHANGES ON THIS SHEET MUST BE MADE OR CIRCLED IN RED INK, WITH DATE AND NAME OF PERSON MAKING CHANGE.

Do not extend notes this side of this line.

Profile Notes Red No. Date Plotted No. Date Job No. 6014.14 Division No. 11
Survey of S.D. Project - J H 1274
Map No. Indexed B.J. GALU Date 1-10-11
F.B. 3274 PG. 81

STATION	B.S.	H.I.	F.S.	ELEV.	Lt. or East	℄ LINE	Rt. or West
1+15.0							6.9' along head wall to Top of W. Cor.
				48361			" Suffit of S.D. W. side
				47671			" Floor of S.D. W. side
1+17.0				48627	16.8 Lt. Top of Wing Wall E. end.		
1+21.8				48666			42.0 Rt Top of Wing wall W. end
				48607			28.5' E. of W. end Cor. on wall
				48276			" " " " " Top of Wier
				47754			" " " " " Floor of S.D.
				47740			39.2' E of W end Floor of S.D.
				48282			" " " " " Top of Wier
				48599			" " " " " Cor. on Wall
1+45.0				4869		℄	Top of bank
1+52.0				4866		℄	Top of bank
				48295			10.0 Rt cone slab edge of channel
				48299			18.0 " cone slab edge of channel
1+57.5				4878		℄	
				48486			0.5 Rt. Top cone wall
				48307			" " cone slab bot. of wall

76L-266 CE 307 11-58

PLEASE RETURN TO
LOS ANGELES COUNTY ENGINEER
700 LOS ANGELES COUNTY ENGINEERING BLDG.

NOTE: ANY ADDITIONS OR CHANGES ON THIS SHEET MUST BE MADE OR CIRCLED IN RED INK, WITH DATE AND NAME OF PERSON MAKING CHANGE

Do not extend notes this side of this line.

F.B. 3169 Pg. 90 Job No. 6012.94 Division No. 11 Notes Red Plotted Profile
Survey of S.D. Project # 1294 Date 24 MAR 71 No. X-Sec.
Survey by FEBrooks Notes FEB Notes Chkd. Checked No.
Indexed G. J. GAEN Date Date Date

STATION	B. S.	H. I.	F S.	ELEV	Lt. or East	LINE	Rt. or West.
1+57.5				484 92		22.5 Rt Top conc wall	
				483 14		" " conc slab bot of wall	
2+00 *				489 73		T	
				4847		7.7 Rt. edge of channel	
				4849		13.5 " edge of channel	
				4877		20.0 " Top of bank	
				4917	6.3 Lt Top of bank		
2+42.0				491 6		T Top of bank	
2+53.7				489 16		35.8 Rt. Cor. Conc slab.	
2+81.0				489 50		33.6 Rt. Cor Conc. slab.	
3+00				494 0		T	
				493 7		11.0 RT Top of bank	
				4868		21.0 " edge of channel	
				4866		26.5 " edge of channel	
				4893		34.5 " Top of bank	

76L-298 CE 307 11-58

T.P. 49078

PLEASE RETURN TO
LOS ANGELES COUNTY ENGINEER
700 LOS ANGELES COUNTY ENGINEERING BLDG.

NOTE: ANY ADDITIONS OR CHANGES ON THIS SHEET MUST BE MADE OR CIRCLED IN RED INK, WITH DATE AND NAME OF PERSON MAKING CHANGE.

Do not extend notes this side of this line.

STATION	B.S.	H.I.	F.S.	ELEV.	Lt. or East	℄ Line	Rt. or West
4+00				4931		℄	
				4923			4.0 Rt Top of bank
				4884			8.5" edge of channel
				4880			17.5" edge of channel
				4910			24.5" Top of bank
4+09.0				4929		℄	Top of bank
4+51.0				4884		℄	edge of channel
5+00				4887		℄	edge of channel
				4921			C.C Rt. Top of bank
				4886	8.0 Lt edge of channel		
				4928	14.0" Top of bank		
5+43.0				4926		℄	Top of bank
5+94.31*				49284		℄	℄ pt.
6+00				4934		℄	

Profile Notes Red Plotted Job No. Division No. 11
No. Date Date Survey of S.D. Project
No. Date Date Map No. Indexed R.J. GALLI Date NOV 10 71
F.B. 3365 PG. 91

76L-298 CE 307 11-58

PLEASE RETURN TO
LOS ANGELES COUNTY ENGINEER
700 LOS ANGELES COUNTY ENGINEERING BLDG.

NOTE: ANY ADDITIONS OR CHANGES ON THIS SHEET MUST BE MADE OR CIRCLED IN RED INK, WITH DATE AND NAME OF PERSON MAKING CHANGE

Do not extend notes this side of this line.

F.B. 3369 Pg. 92 Job No. 6012.74 Division No. 11 Notes Red Plotted Profile
Survey of S.D. Project #.12 Date 24 MAR. '71 Date No. X-Sec.
Survey by FE Brooks Notes FE B Notes Chkd. Checked No.
Indexed B.T. GATES Date Date Date

STATION	B. S.	H. I.	F S.	ELEV	Lt. or East	℄ line	Rt. or West.
6+03.0				4937		℄	Top of bank
6+17.0				4896		℄	edge of channel
6+24.0				4887	3.8 Lt. edge of channel		bot.
				4931	" " " " "		Top.
6+28.0				4888		℄	
				4894			4.0 Rt. edge of channel bot
				4919			" " " " " Top.
				4936			10.6 " Top of bank
				4891	3.8 Lt. edge of channel		bot
				4931	" " " " "		Top.
				49477	6.8 Lt. N.W. Cor. of		wood bridge
				49528	10' E of N.W. Cor =		N.E. Cor. of bridge.
6+38.8				49455			12.3 Rt. S.W. Cor of wood bridge
				49469			10' E of S.W. Cor = SE Cor of bridge

76L-298 CE 307 11-58

PLEASE RETURN TO
LOS ANGELES COUNTY ENGINEER
700 LOS ANGELES COUNTY ENGINEERING BLDG.

NOTE: ANY ADDITIONS OR CHANGES ON THIS SHEET MUST BE MADE OR CIRCLED IN RED INK, WITH DATE AND NAME OF PERSON MAKING CHANGE.

P.P.S. T.P. = 493.58

Do not extend notes this side of this line.

STATION	B.S.	H.I.	F.S.	ELEV.	Lt. or East	℄ LINE	Rt. or West
6+84.0				4890		℄	
				4892		3.0 Rt. edge channel bot.	
				4920		" " " " Top	
				4938		8.0 " Top of bank	
				4894	2.5 Lt. edge channel bot		
				4928	" " " " Top		
				4953	10.0 " Top of bank.		
7+01.0				492 96		7.7 Rt & pt. in Wing wall	
7+01.5				492 52		16.5 Rt. end of wing wall	
7+02.0				493 59	8.0 Lt. & pt in wing wall		
7+02.0				493 87	18.0 " end of wing wall		
7+03.2				488 82		℄ edge conc channel	
				489 03		4.2 Rt bottom of channel	
7+03.2				492 96		" " Top of wall	
7+03.9 o.k				491 03			
7+03.2				493 4		15.0 " Top of bank	
7+03.2				489 02	5.2 Lt. bottom of channel		
7+03.2				493 43	" " Top of wall		
o.k 7+03.9				491 05			
7+03.2				495 3	17.0 " Top of bank		

Profile Notes Red No. ____ Date ____ Plotted ____ Date ____ Job No. 6012.74 Division No. 11 Survey of S.D. Dist. 5 in 1964 Map No. ____ Indexed G.R. GALLI Date 10-71

F.B. 3369 PG. 93

76L-298 CE 307 11-58

PLEASE RETURN TO
LOS ANGELES COUNTY ENGINEER
700 LOS ANGELES COUNTY ENGINEERING BLDG.

NOTE: ANY ADDITIONS OR CHANGES ON THIS SHEET MUST BE MADE OR CIRCLED IN RED INK, WITH DATE AND NAME OF PERSON MAKING CHANGE

489.71 T.P.

Do not extend notes this side of this line.

490.64

F.B. 3369 Pg. 94 Job No. 6012.74 Division No. 11 Notes Red Plotted Profile
Survey of S.D. Project #1274 Date 25 MAR. '71 Date No. X-Sec.
Survey by F.E. Brooks Notes F.B. Notes Chkd. Checked
Indexed E.E. GALLI Date Date Date No.

STATION	B.S.	H.I.	F.S.	ELEV	Lt. or East	℄ LINE	Rt. or West
7+45.0 B.C.				489 99		℄	
				489 96			4.0 Rt. bottom of channel
				492 07			" " Top of wall
				489 96	4.7 Lt bottom of channel		
				492 58	" " Top of wall		
7+58.27				490 26		℄	4 pt.
7+72.3				493 49	7.7 Lt. Invert of 8" drain.		
7+83.0				490 64		℄	bottom of channel
				493 35		℄	suffit of bridge
				494 88		℄	Floor of bridge
				490 63			1.5 Rt. bottom of channel
				492 67			1.5 RT. TOP OF WALL
				493 33			" " Suffit of bridge
				494 88			" " Floor of bridge
				490 18	7.7 Lt. bottom of channel		
				493 50	7.7 LT. TOP OF WALL		
				493 42	" " Suffit of bridge		
				495 03	" " Floor of bridge		
7+91.0				495 17		℄	print
7+97.28				495 31		℄	inter.

76L-298 CE 307 11-58

PLEASE RETURN TO
LOS ANGELES COUNTY ENGINEER
700 Los Angeles County Engineering Bldg.

NOTE: ANY ADDITIONS OR CHANGES ON THIS SHEET MUST BE MADE OR CIRCLED IN RED INK, WITH DATE AND NAME OF PERSON MAKING CHANGE.

Do not extend notes this side of this line.

STATION	B. S.	H. I.	F. S.	ELEV.		
					West on FARSARDO ST.	
					Lt. or South ℄	Rt. or North
1+50				495.35		℄
				495.24		6.2 Rt pvmt
				494.99		12.5 " edge pvmt
				494.6		30 " P/L
				495.21	10.1 Lt pvmt	
				494.83	18.4 " gutter out	
				494.57	20.2 " " in	
				495.19	20.2 " Top cb	
2+50				496.10		℄
				496.02		6.2 Rt pvmt
				495.88		12.5 " edge pvmt
				495.5		30 " P/L
				495.95	10.1 Lt pvmt	
				495.55	18.4 " gutter out	
				495.40	20.2 " gutter in	
				496.04	20.2 " Top cb.	

Profile Notes Red No. ___ Date ___ Plotted ___ Date ___ Job No. 6012.04 Division No. 11
Survey of S.D. Project #17-11
No. ___ Date ___ Date ___ Map No. ___ Indexed R.L. GALU Date 11-10-71
F.B. 3369 Pg. 95

76L-298 CE 307 11-58

PLEASE RETURN TO
LOS ANGELES COUNTY ENGINEER
700 LOS ANGELES COUNTY ENGINEERING BLDG.

NOTE: ANY ADDITIONS OR CHANGES ON THIS SHEET MUST BE MADE OR CIRCLED IN RED INK, WITH DATE AND NAME OF PERSON MAKING CHANGE

Do not extend notes this side of this line.

F. B. 3369 Pg. 96 | Job No. 4012.74 Division No. 11 Notes Red Plotted | Profile
Survey of S.D. Project # 12374 Date 25 MAR. '71 No. | X-Sec.
Survey by E.E. Brooks Notes E.B. Notes Chkd. Checked | No.
Indexed G. A. GALLI Date Date Date

STATION	B. S.	H. I.	F S.	ELEV		
					East on FARSARDO ST	
					Lt or North ℄	Rt. or South
1+50				495 90		℄
				495 71		10.1 Rt pvmt
				495 33		18.4" gutter out
				495 14		20.2" gutter in
				495 78		20.2" Top cb.
				495 84	6.2 Lt. pvmt	
				495 69	12.5" edge pvmt	
				496 03	30" P/L.	
2+50				498 35		℄
				498 08		10.1 Rt. pvmt
				497 48		18.4" gutter out
				497 36		20.2" gutter in
				497 96		20.2" Top cb.
				498 27	6.2 Lt. pvmt	
				498 05	12.5" edge pvmt	
				498 8	30" P/L.	

76L-296 CE 307 11-58

PLEASE RETURN TO
LOS ANGELES COUNTY ENGINEER
700 LOS ANGELES COUNTY ENGINEERING BLDG.

NOTE: ANY ADDITIONS OR CHANGES ON THIS SHEET MUST BE MADE OR CIRCLED IN RED INK, WITH DATE AND NAME OF PERSON MAKING CHANGE.

Do not extend notes this side of this line.

Profile Notes Rod No. Date Plotted Date Job No. Division No. 11
No. Date Survey of S.D. Date Map No. Indexed G.J. GALLI Date W 10-74
No. Date

F.B. 3769 Pg. 97

STATION	B. S.	H. I.	F. S.	ELEV.	
					South on ℄ LINE
					℄ Lt. or East ℄ line Rt. or West ℄
8+07.4				49525	℄ print.
8+15.0				49483	℄ gutter out
8+15.8				49515	13 Rt. Top S.D.C.B.
		dn.	3.04	49211	13 " Invert 20" drain
8+18.0				49464	℄ gutter in
				49524	℄ Top ch.
8+23.6				49579	℄ edge of walk
				49593	
8+27.6					℄ edge of walk
8+35.8				49677	℄ edge of conc. slab over drain
8+37.0				49884	10 Rt. Top S.D.C.B.
		dn	4.63	49421	10 " Invert 21" drain.

76L-298 CE 307 11-58

PLEASE RETURN TO
LOS ANGELES COUNTY ENGINEER
700 LOS ANGELES COUNTY ENGINEERING BLDG.

NOTE: ANY ADDITIONS OR CHANGES ON THIS SHEET MUST BE MADE OR CIRCLED IN RED INK, WITH DATE AND NAME OF PERSON MAKING CHANGE

Do not extend notes this side of this line.

F. B. 3369 Pg. 98 Job No. 6012.74 Division No. 11 Notes Red Plotted Profile
Survey of S.D. Project # 12.74 Date Date No. X-Sec.
Survey by FE Brooks Notes FEB Notes Chkd. Checked
Indexed C. T. CARLL Date Date Date No.

STATION	B. S.	H. I.	F S.	ELEV		
CROSS SECTION of INTERIOR of BOX DRAIN at FARSARDO ST.						
					South on ℄ LINE.	
					Lt. or East	℄ Rt. or West
7+83.0				490 64		℄ bottom of channel
				493 35		℄ suffit of wood bridge
				490 63		1.5 Rt bot. of channel
				492 67		1.5 " Top of wall
				493 33		" " suffit of wood bridge
				490 78	7.7 Lt bot. of channel	
				493 50	" " Top of wall	
				493 42	" " suffit of wood bridge	
7+87.7				490 81.	7.2 Lt. bot of channel	
				493 30.	" " suffit of wood bridge	
				490 81.	7.5 " bot. of channel	
				493 30.	" " suffit of wood bridge	
8+07.2				491 11.		℄
				491 16.		3.0 Rt. bot. of channel
				493 68.		" " suffit of Wood bridge
				493 68.		" " suffit of conc box

76L-296 CE 307 11-58

PLEASE RETURN TO
LOS ANGELES COUNTY ENGINEER
700 Los Angeles County Engineering Bldg.

NOTE: ANY ADDITIONS OR CHANGES ON THIS SHEET MUST BE MADE OR CIRCLED IN RED INK, WITH DATE AND NAME OF PERSON MAKING CHANGE.

Do not extend notes this side of this line.

STATION	B. S.	H. I.	F. S.	ELEV.	Lt. or East	Rt. or West
8+07.8				491 08.	5.6 Lt. bottom of channel	
				493 61.	" " soffit of wood bridge	
				493 61.	" " " " conc box	
8+12.9				491 34.		3.2 Rt Invert 20" conc pipe
8+19.5				491 20.		
				491 22.		3.4 Rt bot channel
				493 78.		" " soffit conc box
8+20.2				491 19.	5.1 Lt. bot of channel	
				493 75.	" " soffit of conc box	
8+33.2				492 38.		1.5 Rt. Invert 21" conc pipe
8+35.1				491 49.	0.8 Lt. Invert of 54" conc pipe	
BM S.D. 1255				495 17	BM S.D. 1255 Elev. 495.165 F.B. 3369-13 Farjardo St. S. curb. opposite house # 18525 Bench Nail in lead 1.2 ft. E of E edge of Catch basin.	

Profile Notes Red Plotted Job No. 6012.74 Division No. 11
No. Date Date Date Survey of S.D. Project #1255
No. Date Date Map No. Indexed B. J. GALA Date Date
F.B. 3369 Pg. 98

F.B. 3369 Pg. 100 Job No. 6012.74 Division No. 11 Notes Red Plotted Profile

Survey of S.D. Project # 1274 Date Date No.

Survey by F.E. Brooks Notes F.E.B. Notes Chkd. Checked X-Sec.

Indexed Date Date Date No.

STATION	B. S.	H. I.	F S.	ELEV

PLEASE RETURN TO
LOS ANGELES COUNTY ENGINEER
700 Los Angeles County Engineering Bldg.

Do not extend notes this side of this line.

NOTE: ANY ADDITIONS OR CHANGES ON THIS SHEET MUST BE MADE OR CIRCLED IN RED INK. WITH DATE AND NAME OF PERSON MAKING CHANGE

781-256 CE 507 11-58

Notes Ck'd by H. HOLMAN	Survey of SD Project #1274
Map No.	IN 6012.94 Tape Std °F
Office Work	Surveyed by FE Brooks
Checked	Notes FEB Guizado Date 29 May 71
Date	Indexed G. J. GALLI MAY 10 71

F. B. 2724 PG. 101

IN 6012.74

STORM DRAIN PROJECT

No 1274

LINE C

LINE D

LINE F

CENTERLINE

From Mescal st.

To Aguiro st.

NOTE F.B. 2724 pgs 169, 170, 175 show a T line and a ℄. The points shown on the notes will not line up with the proper offsets using the ℄. They will line up by using the T line. The T line was used for control in AGUIRO ST.

FE Brooks
60 Guizado
RA Moore
T Ohashi

Note: Any Additions or Changes on This Sheet Must be Made or Circled in Red Ink With Date and Name of Person Making Change.

Do not extend this side of this line.

PLEASE RETURN TO
COUNTY OF LOS ANGELES
DEPARTMENT OF COUNTY ENGINEER
403 LOS ANGELES COUNTY ENGINEERING BLDG.

76F3095 CE#310 3-68

F. B. 3369 PG 102

S.D. PROJ. 1274

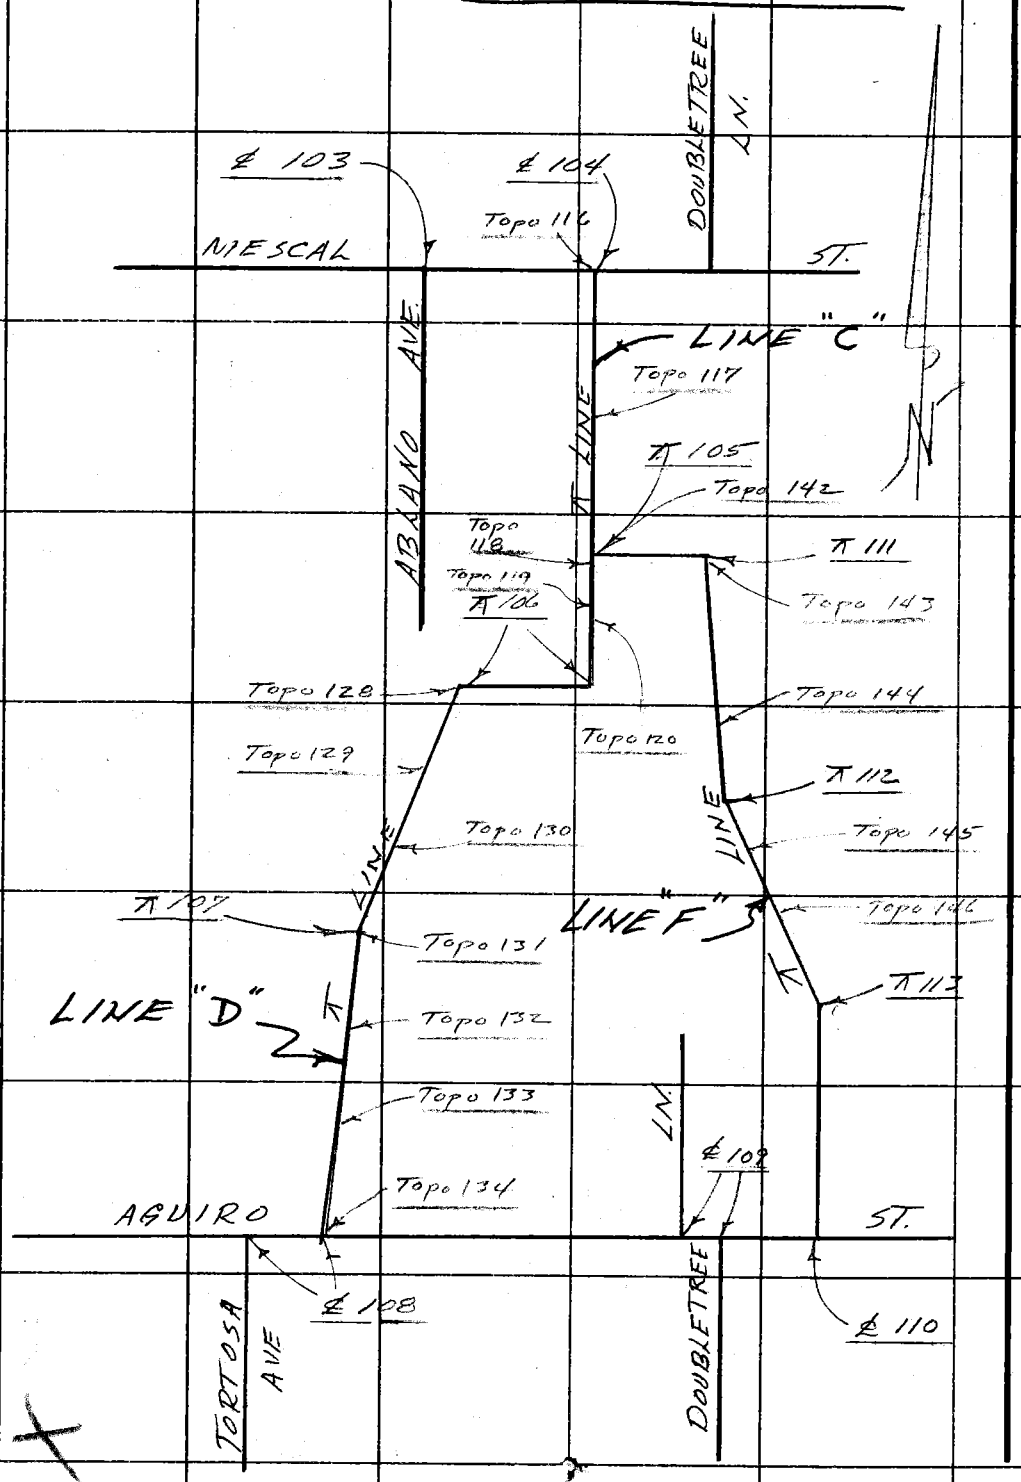

PLEASE RETURN TO
COUNTY OF LOS ANGELES
DEPARTMENT OF COUNTY ENGINEER
403 LOS ANGELES COUNTY ENGINEERING BLDG.

Do not extend this side of this line.

Note: Any Additions or Changes on This Sheet Must be Made or Circled in Red Ink With Date and Name of Person Making Change.

76F3095 CE#310 3-68

PLEASE RETURN TO
COUNTY OF LOS ANGELES
DEPARTMENT OF COUNTY ENGINEER
403 LOS ANGELES COUNTY ENGINEERING BLDG.

Note: Any Additions or Changes on This Sheet Must be Made or Circled in Red Ink With Date and Name of Person Making Change.

Do not extend this side of this line.

W.S 38D-4

Notes Ck'd by H. HOLMAN
Map No.
Office Work
Checked
Date

Survey of
Surveyed by F.E. Brooks
Notes F.B. Guides Date
Indexed J. GALLI NOV 10 71

F. B. PG.

Fd sq hd spk & T. 3" Sldr. Ref. F.B. 2724-237

30110

TR

CONT'D PG 104

MESCAL

0.04 E/W F.B. 2724-237

N1=266.85

ST.

17.0± E/W F.B. 2724-237

30

30

CONT'D TOP PG. R35

43.9'

44.30'

45.74'

N 17° 26' E

ABLANO AVE

Fd Nails & RCE. Tags No 12725 Ref F.B. 2724-237

IR

54

28704

F. B. 3369 PG 104

W.S. 38, D-4

PLEASE RETURN TO
COUNTY OF LOS ANGELES
DEPARTMENT OF COUNTY ENGINEER
403 LOS ANGELES COUNTY ENGINEERING BLDG.

Do not extend this side of this line.

Note: Any Additions or Changes on This Sheet Must be Made or Circled in Red Ink With Date and Name of Person Making Change.

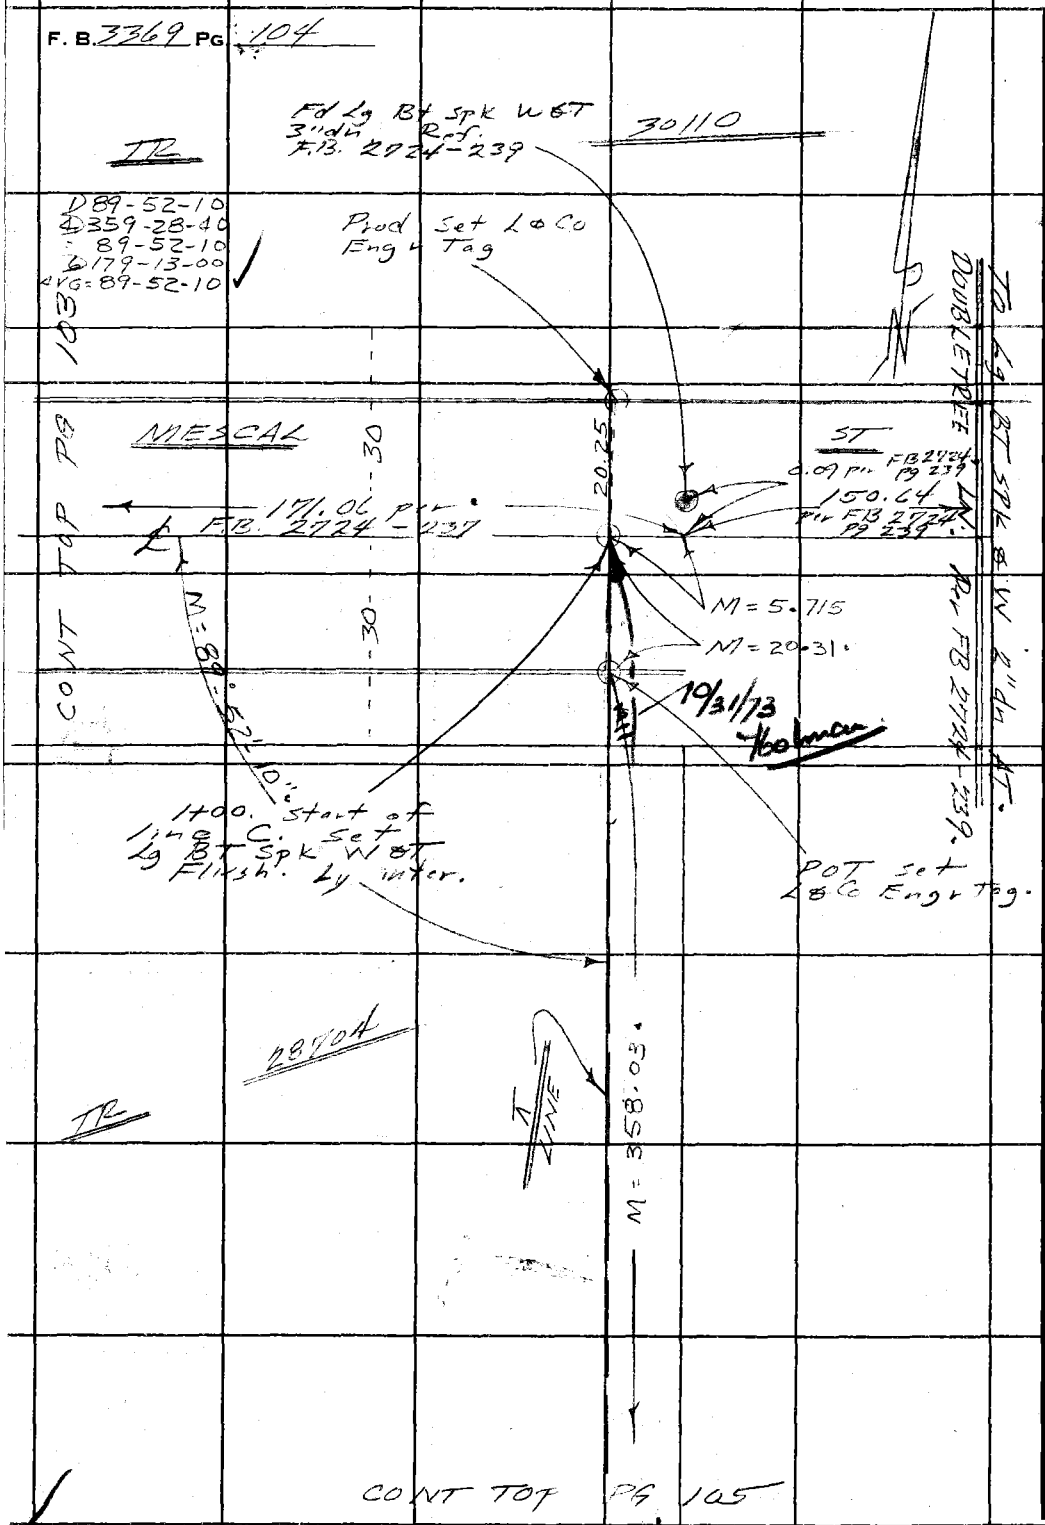

Notes Ck'd by H. HOLMAN	Survey of SD Project No. 1274 F. B. ____ Pg. ____
Map No.	JN 6012; Y Tape 0232 Std 60 °F
Office Work	Surveyed by F E Brooks
Checked	Notes FEB Gonzales Date 29 Nov 71
Date	Indexed B. J. GALLI MAY 10 '71

Note: Any Additions or Changes on this Sheet Must be Made or Circled in Red Ink With Date and Name of Person Making Change.

Do not extend this side of this line.

PLEASE RETURN TO
COUNTY OF LOS ANGELES
DEPARTMENT OF COUNTY ENGINEER
403 LOS ANGELES COUNTY ENGINEERING BLDG.

TAPE # 0232
358.03 L 6° 7' 66" = 358.03 ✓

CONT BOT PG 104

Δ LINE

D 94°-46'-40
Δ 19°-06'-20
= 04°-46'-35
D 208°-39'-45"
AVG: 94-46-37½ ✓

M = 358.03

M = 94°-46'-38"

CONT BOT PG 111

N 87°04' W

4+58.03 & 1.00 E'LY
SET 2" I.P. CONC. PLUG
& CO. ENGR. TAG FLUSH
P.O.T.

17.39

M = 135.40

RAIL RET. WALL

4.01

SET NAIL & TIN ON
TOP OF RAIL POST

12.51

Δ LINE

TAPE # 0232
135.40 T 70° = 135.40 ✓

M = 272.08

CONT LT PG 106

76F309S CE#310 3-68

F. B. 3369 PG 106

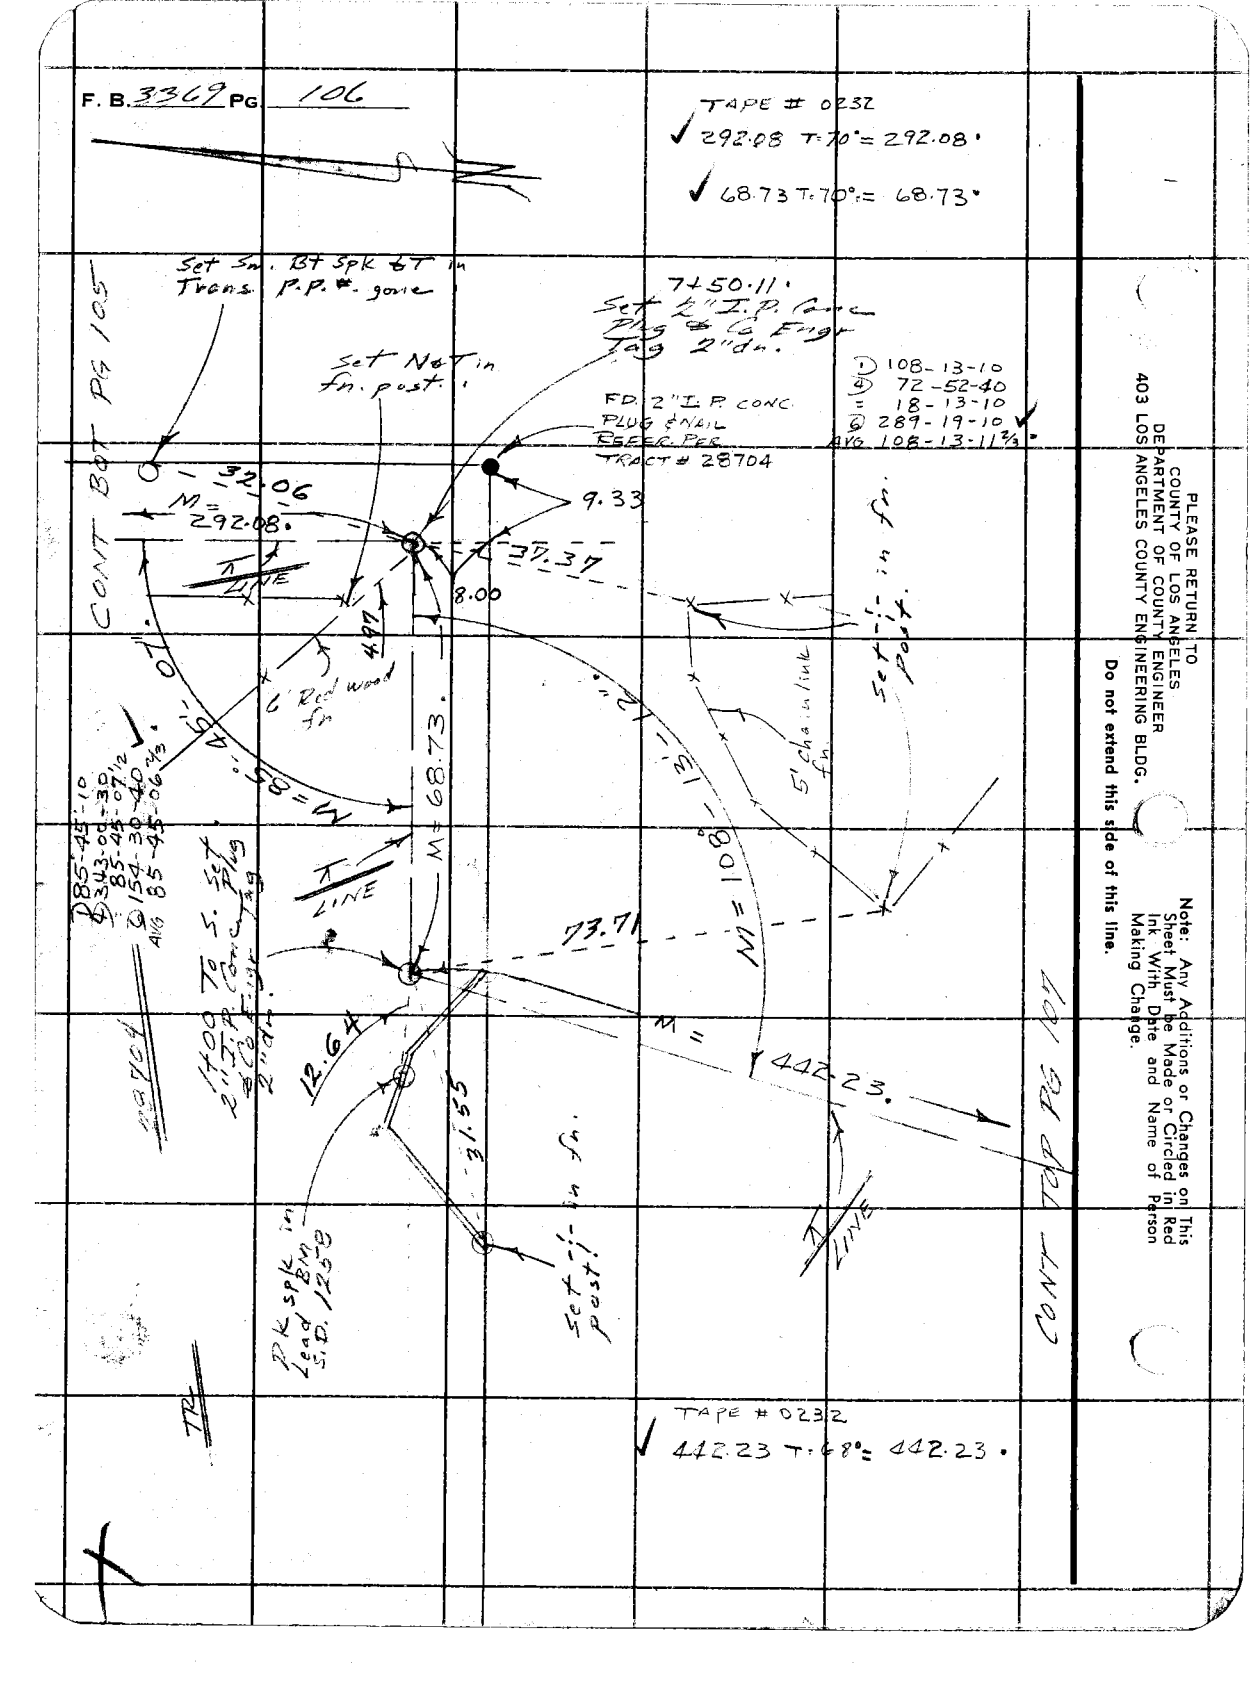

PLEASE RETURN TO
COUNTY OF LOS ANGELES
DEPARTMENT OF COUNTY ENGINEER
403 LOS ANGELES COUNTY ENGINEERING BLDG.

Do not extend this side of this line.

Note: Any Additions or Changes on This Sheet Must be Made or Circled in Red Ink With Date and Name of Person Making Change.

Notes Ck'd by H. HOLMAN	Survey of		F. B. PG.
Map No.	JN 1072 74	Tape 0232 Std 68 °F	
Office Work	Surveyed by F E Brooks		
Checked	Notes F E B Guiers	Date 29 Mar	
Date	Indexed G. J. GACH	MAY 10 71	

CONT RT PG 106

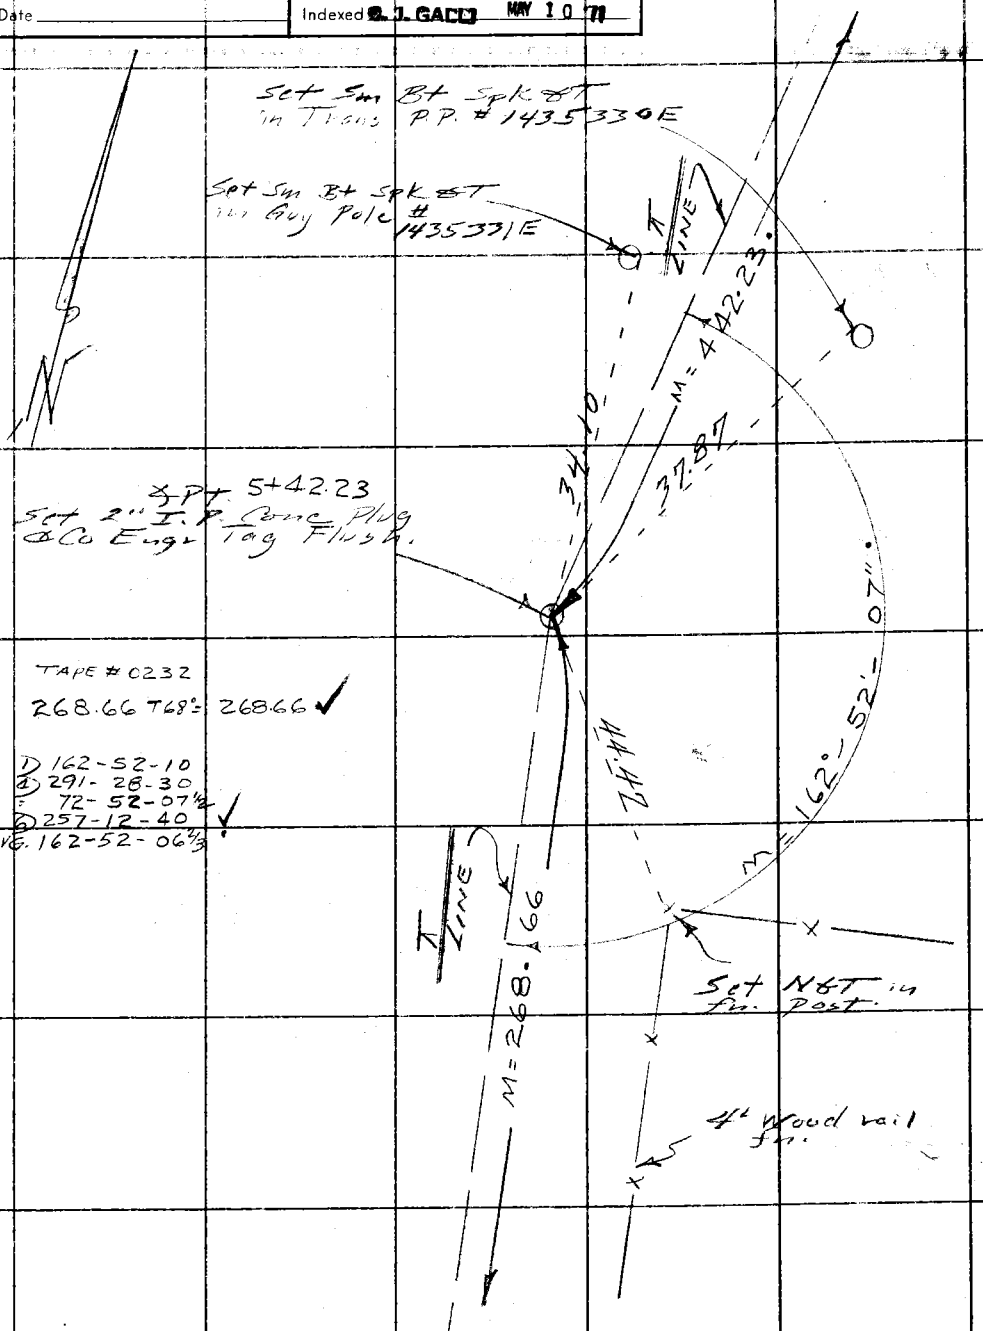

Note: Any Additions or Changes on This Sheet Must be Made or Circled in Red Ink With Date and Name of Person Making Change.

PLEASE RETURN TO
COUNTY OF LOS ANGELES
DEPARTMENT OF COUNTY ENGINEER
403 LOS ANGELES COUNTY ENGINEERING BLDG.

Do not extend this side of this line.

78F3095 CE#310 3-68

PLEASE RETURN TO
COUNTY OF LOS ANGELES
DEPARTMENT OF COUNTY ENGINEER
403 LOS ANGELES COUNTY ENGINEERING BLDG.

Note: Any Additions or Changes on This Sheet Must be Made or Circled in Red Ink With Date and Name of Person Making Change.

Do not extend this side of this line.

W.S. 38, D-5

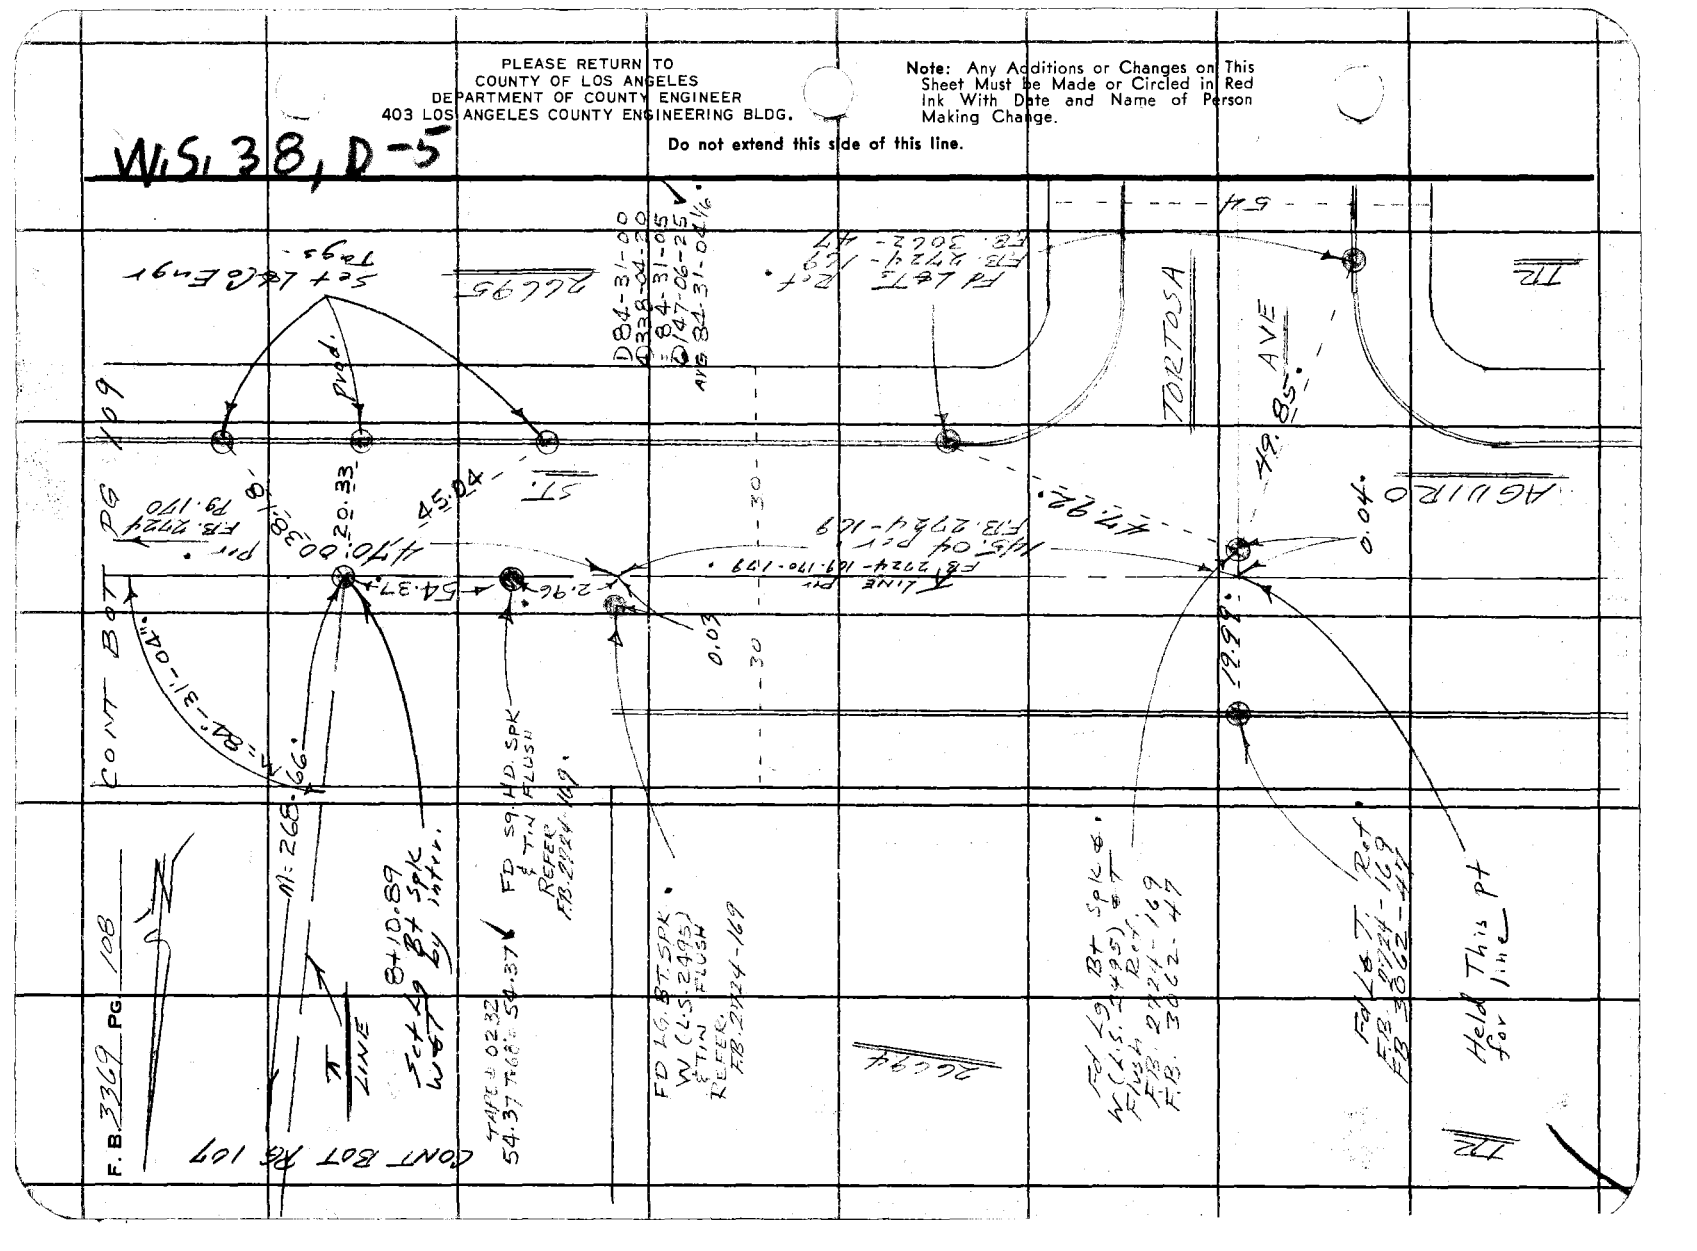
TORTOSA
AGUIRO
AVE
85'
169
108
F.B. 3369 Pg
CONT BOT
CONT BOT PG 107
LINE
Held This pt for 1:1
Held
Held
Held

Notes Ck'd by H. HOLMAN	Survey of S.D. Bd. of Hwds
Map No.	IN 6012, 44 Tape 0231 Std 6.6 °F
Office Work	Surveyed by F.E. Brooks
Checked	Notes F.E.B. Date
Date	Indexed O. J. GALLI MAY 10 '71


































Note: Any Additions or Changes on This Sheet Must be Made or Circled in Red Ink With Date and Name of Person Making Change.

Do not extend this side of this line.

PLEASE RETURN TO
COUNTY OF LOS ANGELES
DEPARTMENT OF COUNTY ENGINEER
403 LOS ANGELES COUNTY ENGINEERING BLDG.

78F3095 CE#310 3-68

PLEASE RETURN TO
COUNTY OF LOS ANGELES
DEPARTMENT OF COUNTY ENGINEER
403 LOS ANGELES COUNTY ENGINEERING BLDG.

Note: Any Additions or Changes on This Sheet Must be Made or Circled in Red Ink With Date and Name of Person Making Change.

Do not extend this side of this line.

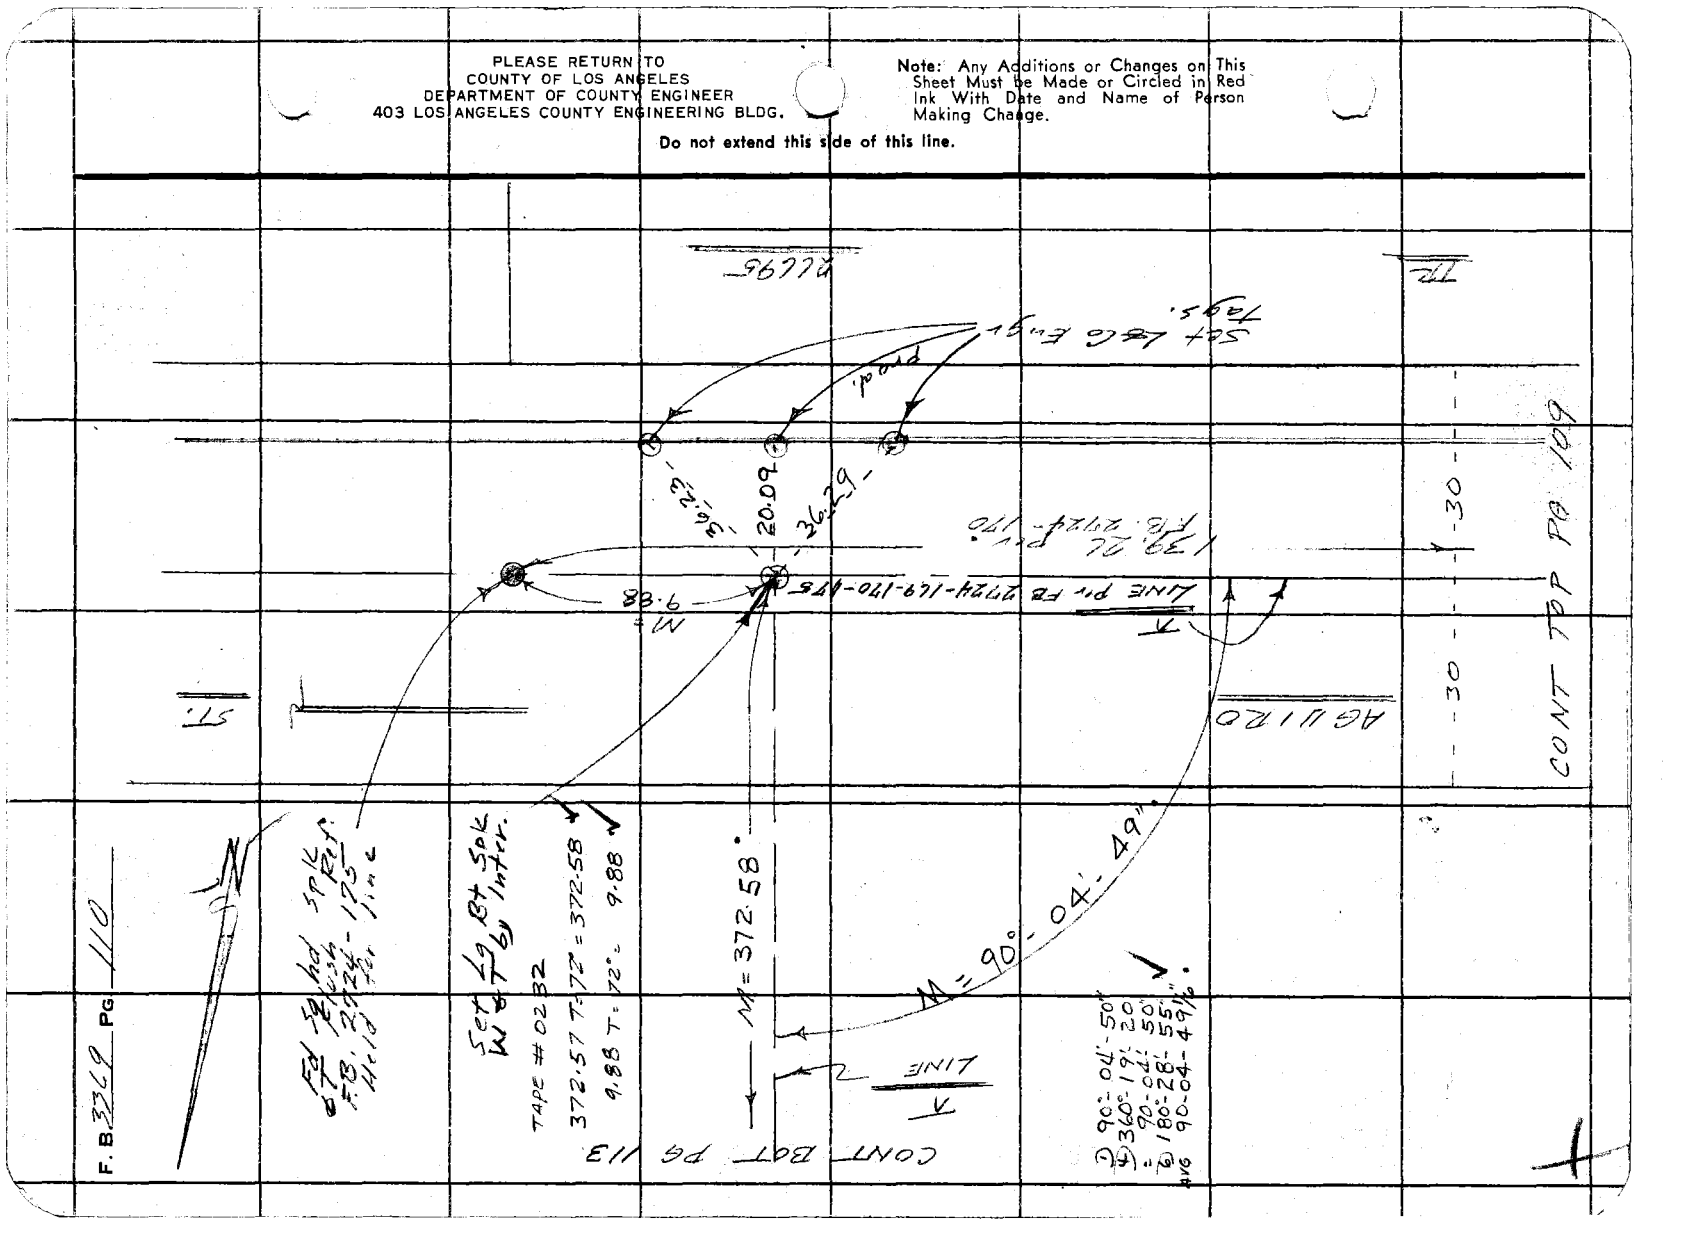

Notes Ck'd by H. HOLMAN	Survey of S.D. Project # 12 44
Map No.	JN 6012.14 Tape 0232 Std 60 °F
Office Work	Surveyed by FEB Books
Checked	Notes FEB Guided Date 30 Mar 71
Date	Indexed O. J. GALLI MAY 10 71

F. B. 2267 PG. 111

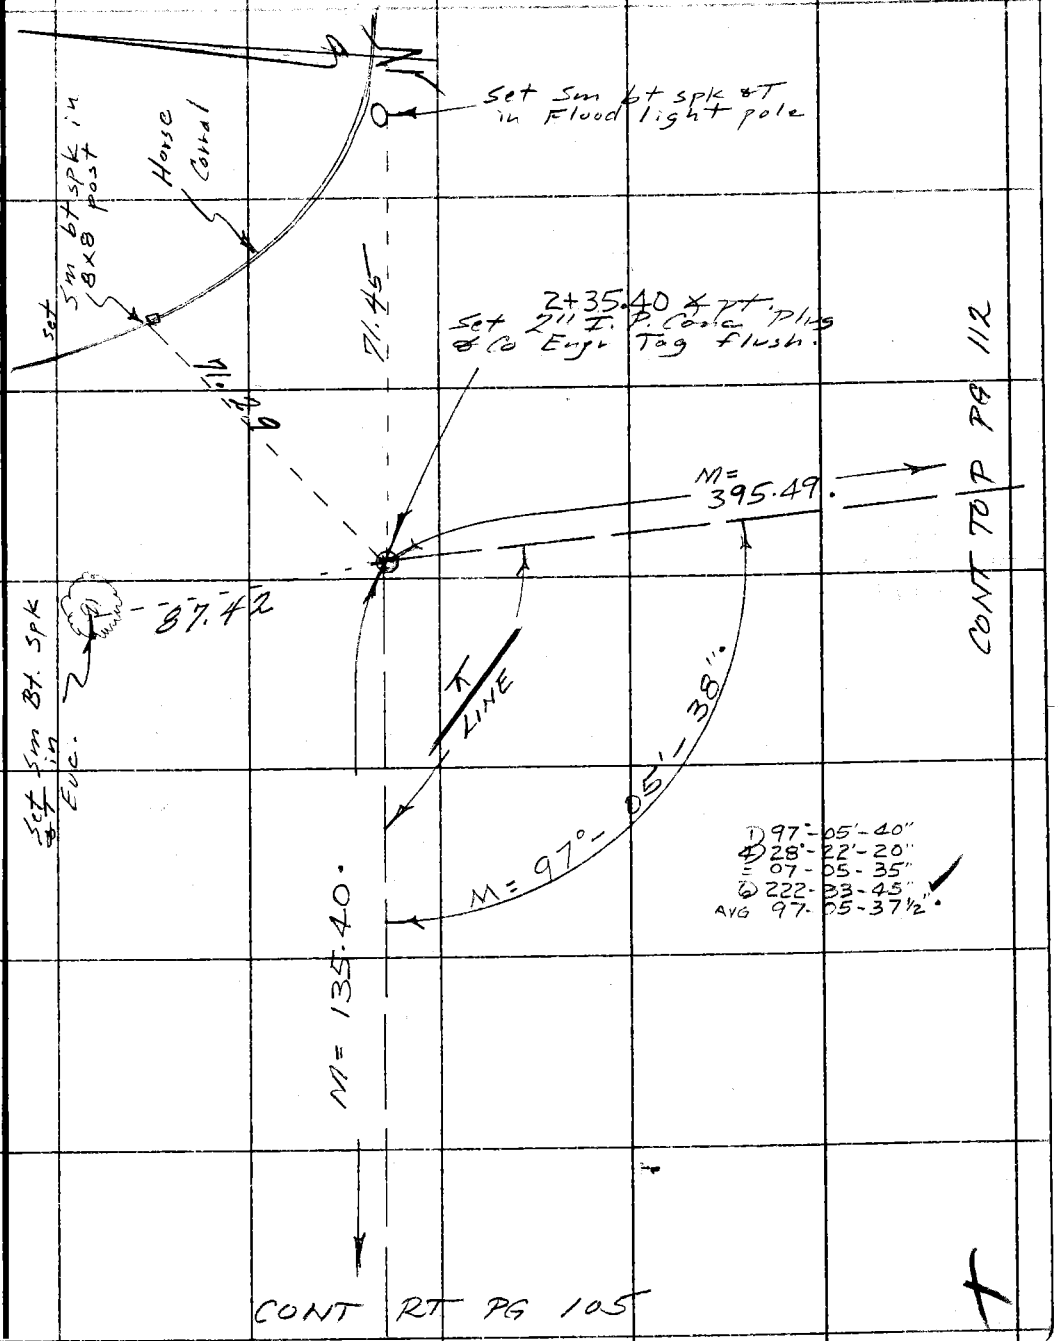

Note: Any Additions or Changes on This Sheet Must be Made or Circled in Red Ink With Date and Name of Person Making Change.

Do not extend this side of this line.

PLEASE RETURN TO
COUNTY OF LOS ANGELES
DEPARTMENT OF COUNTY ENGINEER
403 LOS ANGELES COUNTY ENGINEERING BLDG.

76F3095 CE#310 3-68

PLEASE RETURN TO
COUNTY OF LOS ANGELES
DEPARTMENT OF COUNTY ENGINEER
403 LOS ANGELES COUNTY ENGINEERING BLDG.

Note: Any Additions or Changes on This Sheet Must be Made or Circled in Red Ink With Date and Name of Person Making Change.

Do not extend this side of this line.

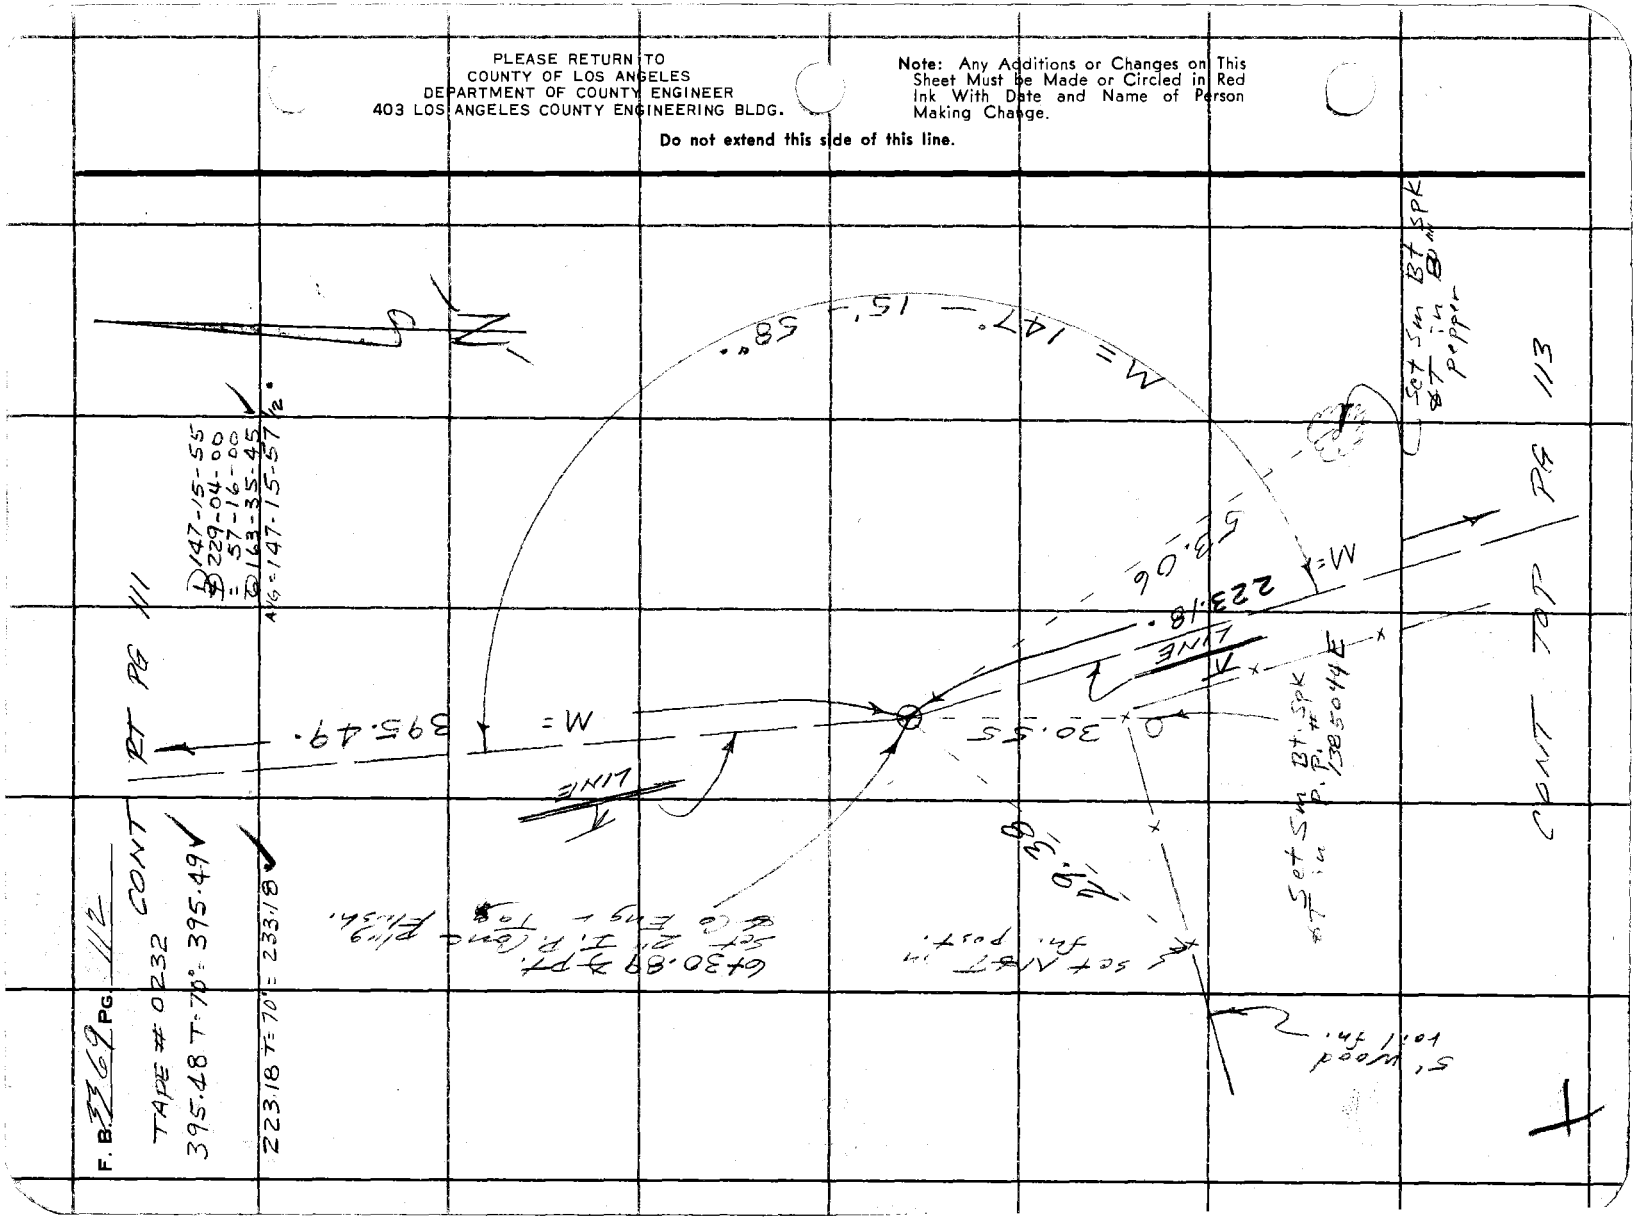

Notes Ck'd by H. HOLMAN	Survey of
Map No.	JN 2072 Tape 232 Std 68 °F
Office Work	Surveyed by FF Brooks
Checked	Notes FF/B Guizado Date 30/MAR/'11
Date	Indexed G. J. GALLI MAY 10 '11














Note: Any Additions or Changes on This Sheet Must be Made or Circled in Red Ink With Date and Name of Person Making Change.

Do not extend this side of this line.

PLEASE RETURN TO
COUNTY OF LOS ANGELES
DEPARTMENT OF COUNTY ENGINEER
403 LOS ANGELES COUNTY ENGINEERING BLDG.

76F309S CE #310 3-68

PLEASE RETURN TO
COUNTY OF LOS ANGELES
DEPARTMENT OF COUNTY ENGINEER
403 LOS ANGELES COUNTY ENGINEERING BLDG.

Note: Any Additions or Changes on This Sheet Must be Made or Circled in Red Ink With Date and Name of Person Making Change.

Do not extend this side of this line.

F. B. 3369 PG 114

Notes Ck'd by	Survey of
Map No.	JN 4012.74 Tape Std °F
Office Work	Surveyed by FE Brooks
Checked	Notes FEB GQuizado Date 31 Mar 71
Date	Indexed G. J. GALLI MAY 10 '71

F. B. [illegible] Pg. [illegible]

SN 4012.74

STORM DRAIN PROJECT

No 1274

LINE C

LOCATION OF IMPROVEMENTS.

From Existing drain near Mescal St.

To Existing drain near SE Cor TR 28704

FE Brooks
GQ Quizado
RA Moore
T Ohashi

Note: Any Additions or Changes on this Sheet Must be Made or Circled in Red Ink With Date and Name of Person Making Change.

PLEASE RETURN TO
COUNTY OF LOS ANGELES
DEPARTMENT OF COUNTY ENGINEER
403 LOS ANGELES COUNTY ENGINEERING BLDG.

Do not extend this side of this line.

76F309S CE#310.3-68

F. B. 3369 PG 116

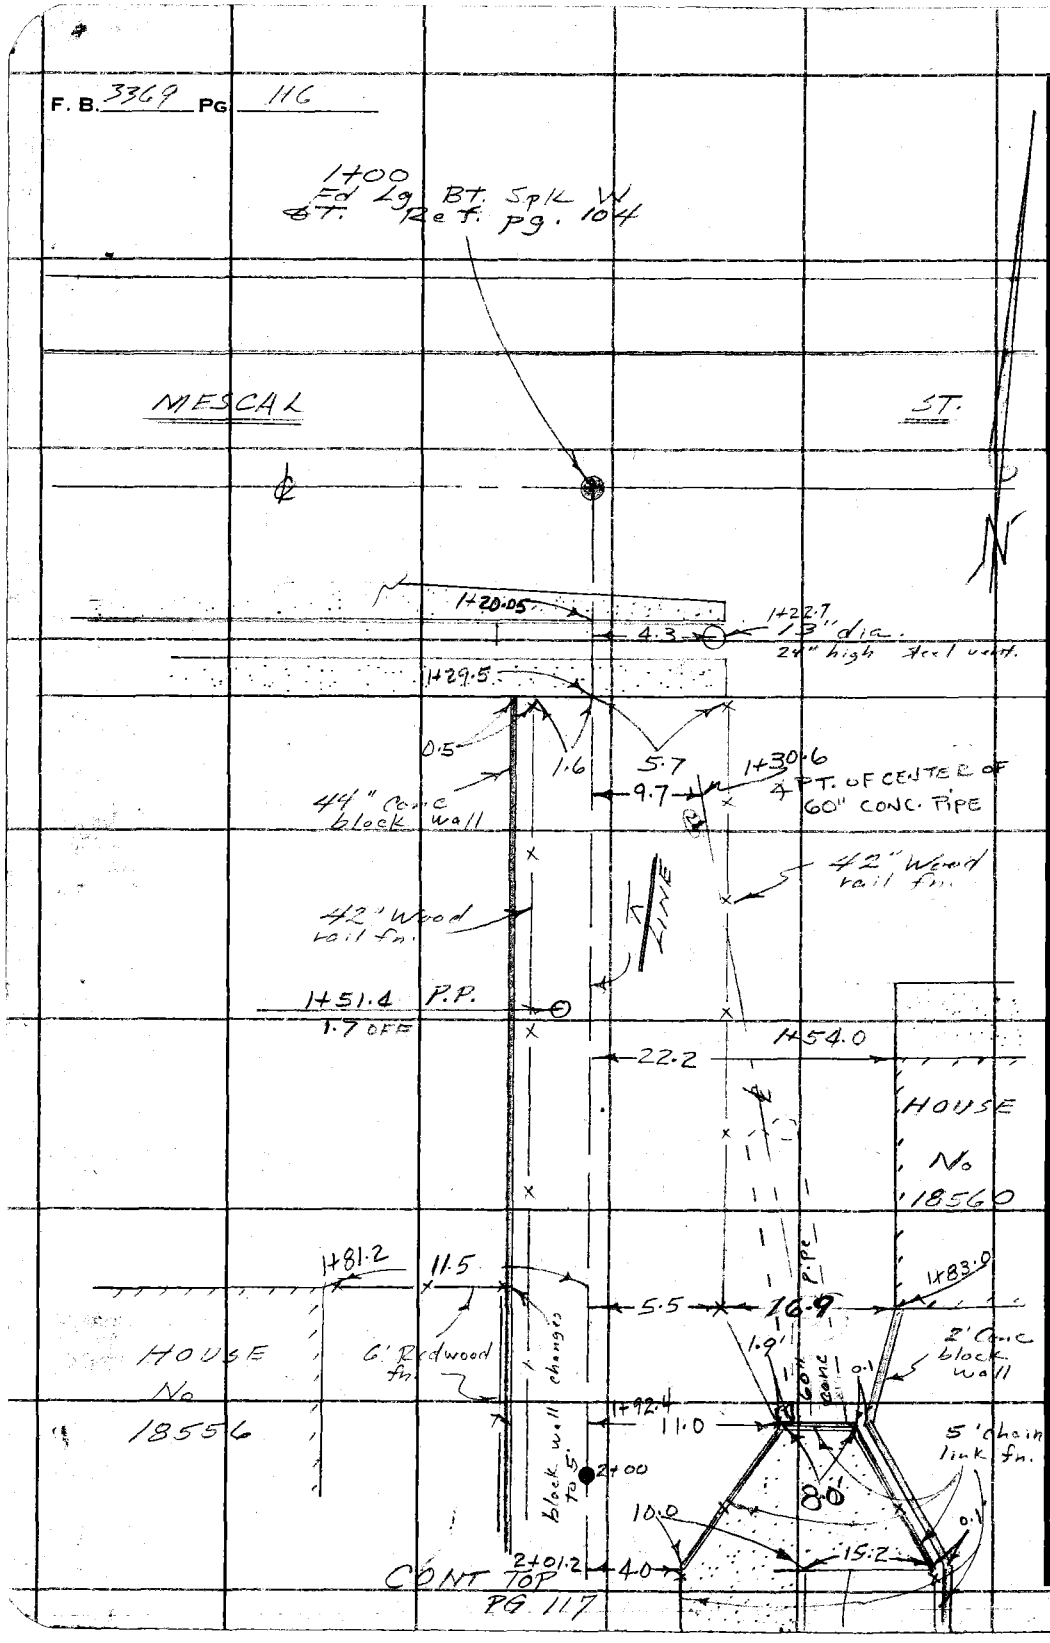

PLEASE RETURN TO
COUNTY OF LOS ANGELES
DEPARTMENT OF COUNTY ENGINEER
403 LOS ANGELES COUNTY ENGINEERING BLDG.

Do not extend this side of this line.

Note: Any Additions or Changes on This Sheet Must be Made or Circled in Red Ink With Date and Name of Person Making Change.

Notes Ch'd by _____
Map No. _____
Office Work _____
Checked _____
Date _____

Survey of Hydrology 12 XX
JN 102.74 Tape _____ Std _____ °F
Surveyed by FF Brooks
Notes FFB Guizado Date 31 Mar 71
Indexed G. J. GALLI MAY 10 '71



HOUSE No 18550

11.5' 2+07.7

6' Redwood fn
5' Conc. block wall
4' Wood rail fn

1.8 dead man 2x4 link fn

2+19.5 28.6
2+19.9 28.3

5' chain link fn.

5' chain link fn.

2+36.0 1.6 OFF
2+36.3 1.1 OFF
2+38.5 3.5 OFF

6' Redwood fn.

2.0

Trans. P.P. 2+40.7

6' chain link fn

6.5' 2+45.0

2+43.7

HORSE STALLS

LINE

Conc. b'rk 28.3 2+47.5

Channel

5.5' 2+64.0

3½' Pop'r pole retaining wall

Wood and T+G pp'r shed

6' Conc block wall

9.2

5.2' 3+00

1.0

3.8 12.0

3½' RR Tie retaining wall with 6' grape stake fn.

1.0'

CONT TOP PG 118

Note: Any Additions or Changes on This Sheet Must be Made or Circled in Red Ink With Date and Name of Person Making Change.

Do not extend this side of this line.

PLEASE RETURN TO
COUNTY OF LOS ANGELES
DEPARTMENT OF COUNTY ENGINEER
403 LOS ANGELES COUNTY ENGINEERING BLDG.

76F3095 CE#310 3-68

F. B. 3369 PG. 118

CONT BOT PG 117

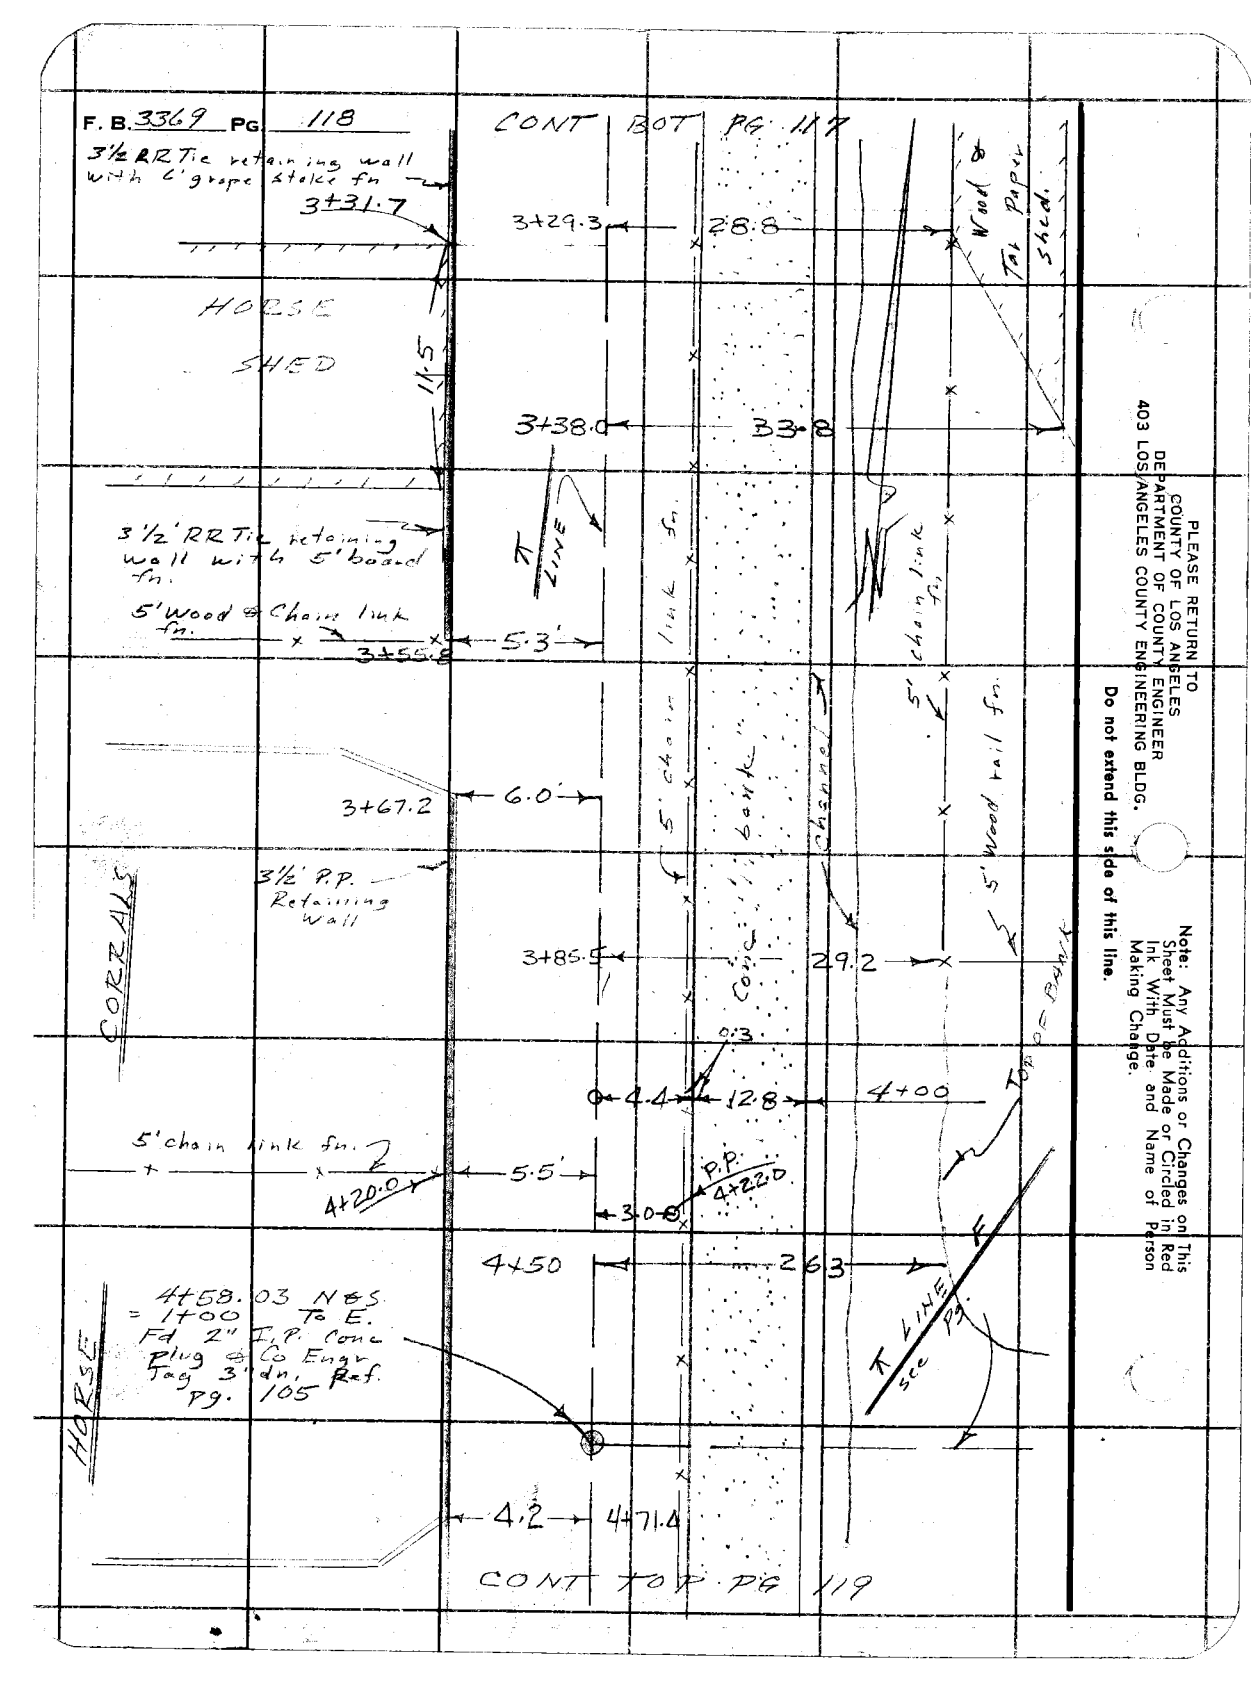

PLEASE RETURN TO
COUNTY OF LOS ANGELES
DEPARTMENT OF COUNTY ENGINEER
403 LOS ANGELES COUNTY ENGINEERING BLDG.

Do not extend this side of this line.

Note: Any Additions or Changes on This Sheet Must be Made or Circled in Red Ink With Date and Name of Person Making Change.

Notes Ck'd by	Survey of Whittier Narrows
Map No.	JN 1012.11 Tape Std °F
Office Work	Surveyed by FE Brooks
Checked	Notes FEB Quized Date 31 Mar. 71
Date	Indexed S. J. GALLI MAY 10 '71



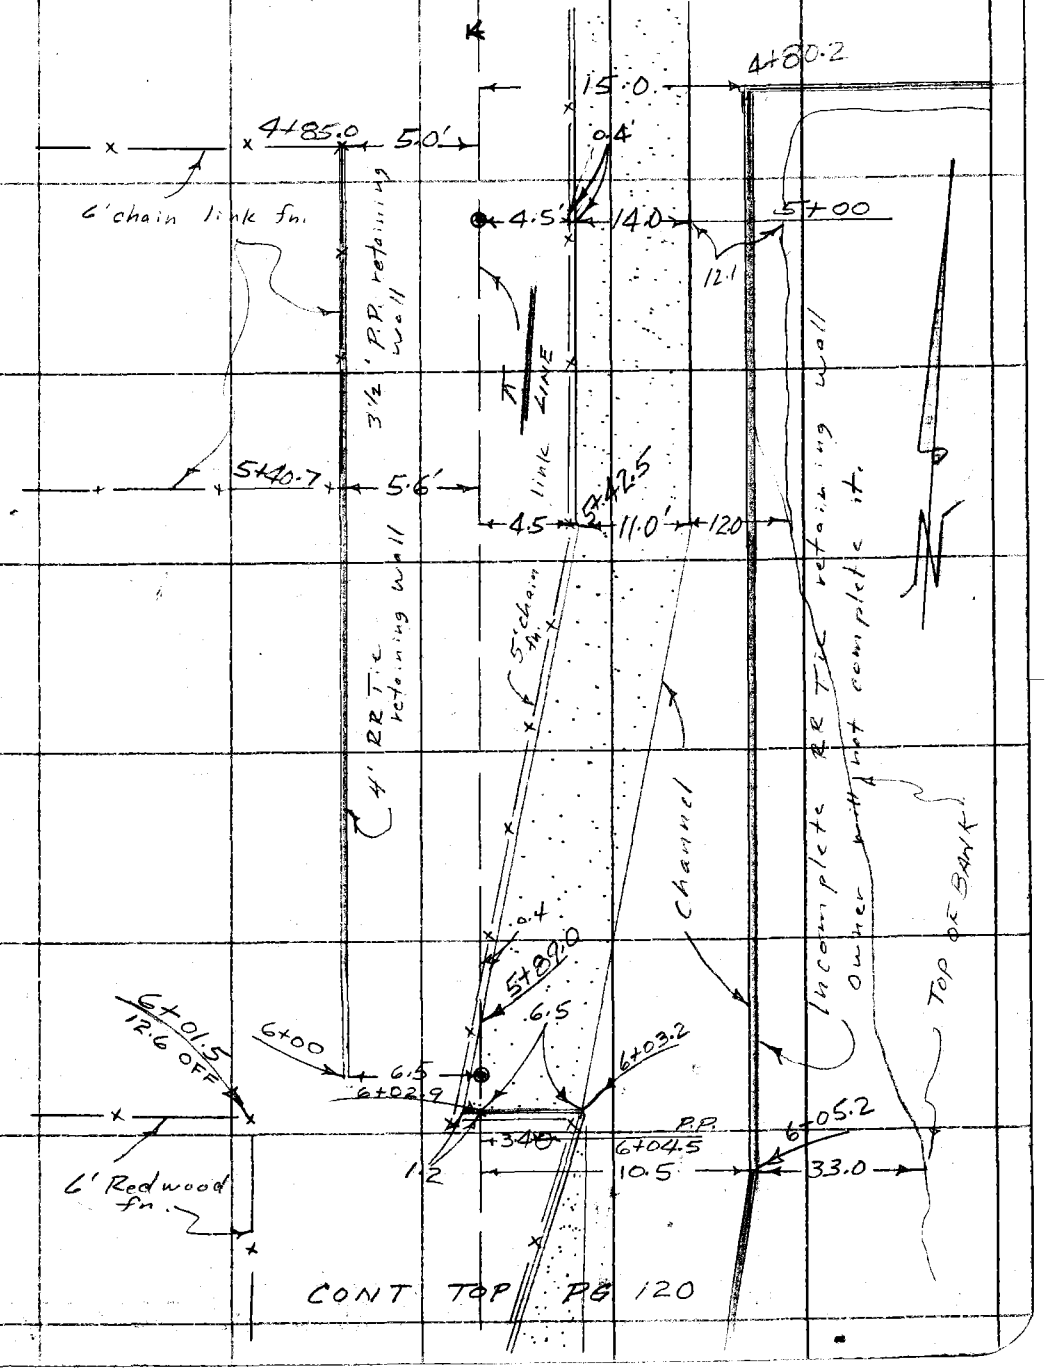

CONT TOP PG 120

Note: Any Additions or Changes on This Sheet Must be Made or Circled in Red Ink With Date and Name of Person Making Change.

Do not extend this side of this line.

PLEASE RETURN TO
COUNTY OF LOS ANGELES
DEPARTMENT OF COUNTY ENGINEER
403 LOS ANGELES COUNTY ENGINEERING BLDG.

76F3095 C.E.#310 3-68

F. B. 3369 PG 120

CONT BOT PG 119

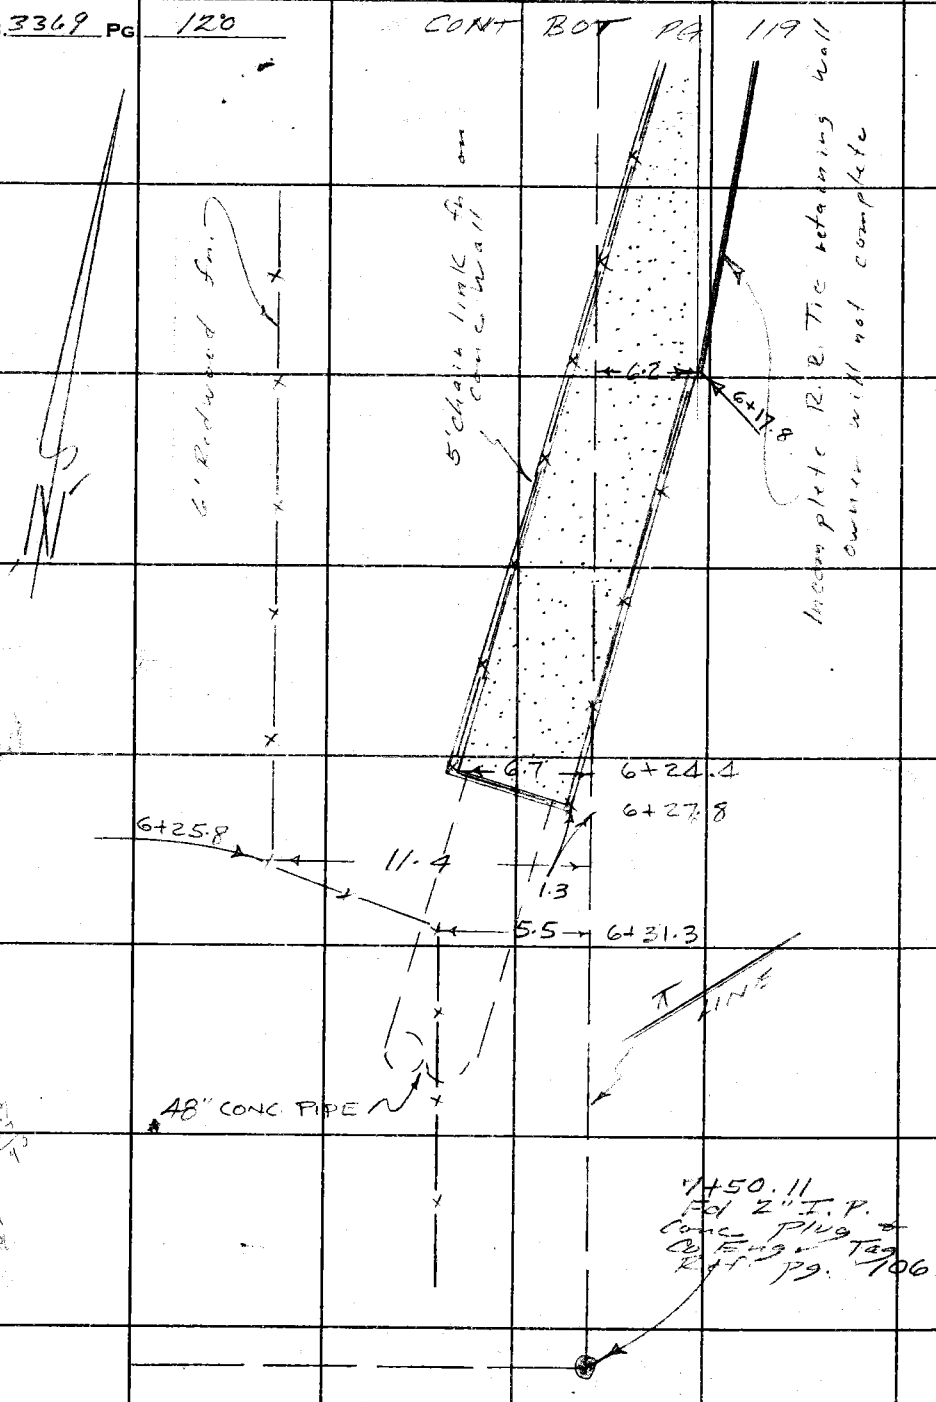

PLEASE RETURN TO
COUNTY OF LOS ANGELES
DEPARTMENT OF COUNTY ENGINEER
403 LOS ANGELES COUNTY ENGINEERING BLDG.

Do not extend this side of this line.

Note: Any Additions or Changes on This Sheet Must Be Made or Circled in Red Ink With Date and Name of Person Making Change.

Profile Notes Red Plotted Job No. 6012.14 Division No. 11 F. B. 3367 PG. 121

No. Date Date Survey of S.D. Project # 1274

No. Date Date Map No. Indexed C. J. GALLI Date 10-71

CN 6012.14

STORM DRAIN PROJECT

No 1274

LINE C

CROSS SECTIONS

From Existing drain near Mugeal st.

To Existing drain near S.E. Cor TR 28704

STATION	B.S.	H.I.	F.S.	ELEV.
		FE Bivelas GO Guizado RA Moore T Ohashi		

NOTE: ANY ADDITIONS OR CHANGES ON THIS SHEET MUST BE MADE OR CIRCLED IN RED INK, WITH DATE AND NAME OF PERSON MAKING CHANGE.

Do not extend notes this side of this line.

PLEASE RETURN TO
LOS ANGELES COUNTY ENGINEER
700 Los Angeles County Engineering Bldg.

761-298 CE 307 11-58

76L-298 CE 307 11-58

T.P. 522.67 P.K. 523.65 P.K. T.P.

PLEASE RETURN TO
LOS ANGELES COUNTY ENGINEER
700 LOS ANGELES COUNTY ENGINEERING BLDG.

NOTE: ANY ADDITIONS OR CHANGES ON THIS SHEET MUST BE MADE OR CIRCLED IN RED INK. WITH DATE AND NAME OF PERSON MAKING CHANGE.

Do not extend notes this side of this line.

F.B. 3369 Pg. 122 Job No. 6012.04 Division No. 11 Notes Red Date 1/12/71 Plotted Date
Survey of SD. Project #1204 Notes Chkd. Checked
Survey by FEB Brooks Notes FEB Guizado Date Date
Indexed [redacted] CALL! Date Date
Profile No. X-Sec. No.

STATION	B.S.	H.I.	F.S.	ELEV.		
BM S.D. 1256				522 75	BM SD 1256 Elev. 522.752 F.B. 3369-15 Mescal St. S. curb in front of house #18556 A P.K. Spk in lead in N.W. Cor. of S.D. Catch basin.	
					SOUTH on ℄ LINE	
					Lt. or East ℄ line RT or West.	
1+92.4				5239	℄	
				52321	11.0 Lt. Top of head wall	
				514 43	15.0 " Invert of 60" cone pipe.	
				52325	19.0 " Top of head wall	
2+01.2				5235	℄	
				52312	4.0 Lt. Top of wing wall	
				51594	13.0 " bottom of channel	
				515 98	18.0 " bottom of channel	
				52347	29.2 " Top of wing wall	
2+10				5233	℄	
				52306	4.0 Lt Top of cone bank	
				5156	16.0 " bottom of channel	

76L-298 CE 307 11-58

T.P. SPK (R.R TIE) 524.44

PLEASE RETURN TO
LOS ANGELES COUNTY ENGINEER
700 LOS ANGELES COUNTY ENGINEERING BLDG.

NOTE: ANY ADDITIONS OR CHANGES ON THIS SHEET MUST BE MADE OR CIRCLED IN RED INK, WITH DATE AND NAME OF PERSON MAKING CHANGE.

Do not extend notes this side of this line.

STATION	B.S.	HI.	F.S.	ELEV.	Lt. or East — ℄ LINE — Rt. or West	
2+10				5155	17.0 Lt bottom of channel	
				5226	29.0 " Top of bank.	
3+00				5249	℄	
				5218	4.0 Lt. Top of conc bank	
				5181	16.0 " bottom of channel	
				5183	17.0 " bottom of channel	
				5241	28.0 " Top of bank.	
4+00				5257	℄	
				5280	4.7 Lt. Top conc bank	
				5209	13.5 " bottom of channel	Rust
				5210	14.5 " bottom of channel	
				5250	28.5 " Top of bank	
5+00				5271	℄	
				52672	4.9 Lt. Top conc bank	
				5223	18.9 " bottom of channel	
				5246	31.0 " Top of bank	
5+42.5				5275	℄	

Profile Notes Red No. Date Plotted Date Job No. Division No. 11
No. Date Date Map No. Indexed R. L. GALLI Date JAN 10 19
Survey of L.D. F.B. 3262 PG. 123

76L-298 CE 307 11-58

PLEASE RETURN TO
LOS ANGELES COUNTY ENGINEER
700 LOS ANGELES COUNTY ENGINEERING BLDG.

NOTE: ANY ADDITIONS OR CHANGES ON THIS SHEET MUST BE MADE OR CIRCLED IN RED INK, WITH DATE AND NAME OF PERSON MAKING CHANGE.

Do not extend notes this side of this line.

F.B. 3369 PG. 124
Job No. 6012.04 Division No. 11 Notes Red Plotted Profile
Survey of S.D. Project # 1274 Date 1 APR. '71 Date No. X-Sec.
Survey by FEBrooks Notes FEB - Guizado Notes Chkd. Checked
Indexed B. L. GALLI Date Date Date No.

STATION	B.S.	H.I.	F.S.	ELEV.	Lt. or East	Rt. or West
5+42.5				527 50	4.9 Lt. Top conc bank	
				523 2	15.9 " bottom of channel	
				523 2	16.9 " bottom of Channel	
				525 6	27.9 " Top of bank	
5+89.0				52838		T Top of conc bank
6+02.9				52844		T Top of conc wall
				52855		1.2 Rt Top Conc bank
6+03.2				527 43	6.5 Lt. Top conc wall	
				524 17	6.5 " bottom of channel	
				524 35	10.5 " bottom of channel	
				5288	43.5 " Top of bank	
6+17.8				524 61	6.2 Lt. bottom of channel	
				526 95	6.2 " Top of conc wall	
6+24.4				53427		6.7 Rt. Top conc head wall
6+26.1				524 91		4.0 Rt Invert 48 Conc Pipe

76L-298 CE 307 11-58

529.45 T.P.

PLEASE RETURN TO
LOS ANGELES COUNTY ENGINEER
700 LOS ANGELES COUNTY ENGINEERING BLDG.

NOTE: ANY ADDITIONS OR CHANGES ON THIS SHEET MUST BE MADE OR CIRCLED IN RED INK, WITH DATE AND NAME OF PERSON MAKING CHANGE.

Do not extend notes this side of this line.

STATION	B. S.	H. I.	F. S.	ELEV.	Lt. or East	℄ LINE Rt. or West	
6+27.8				533.76		1.3 Rt. Top of conc. head wall	
S.D. BM 1257					BM S.D. 1257 Elev. 534.018 FB. 3369 - 15 Back lot line of house #2448 Ablano Ave. A P.K. spk in head of center of S.D. head wall		

Profile Notes Red Plotted Job No. 60[illegible]
No. X-Sec. Date Date Division No. 11
Notes Chkd. Checked Survey of S.D. Project #1227
Date Date Survey by [illegible] Notes [illegible] Date 1/[illegible]/71
Map No. Indexed Date F. B. 3369 Pg. 15

F. B. 3369 Pg. 126

Job No. _____ Division No. _____ Notes Red _____ Plotted _____ Profile

Survey of _____ Date _____ Date _____ No. _____

Survey by _____ Notes _____ Notes Chkd. _____ Checked _____ X-Sec.

Indexed _____ Date _____ Date _____ Date _____ No. _____

STATION	B.S.	H.I.	F.S.	ELEV.

76L-298 CE 307 11-58

PLEASE RETURN TO

LOS ANGELES COUNTY ENGINEER

700 LOS ANGELES COUNTY ENGINEERING BLDG.

NOTE: ANY ADDITIONS OR CHANGES ON THIS SHEET MUST BE MADE OR CIRCLED IN RED INK, WITH DATE AND NAME OF PERSON MAKING CHANGE.

Do not extend notes this side of this line.

Notes Ck'd by	Survey of
Map No.	JN 6012.74 Tape Std °F
Office Work	Surveyed by FE Brooks
Checked	Notes Date 1 APR 71
Date	Indexed J. GALLI MAY 10 71

F. B. Pg. 127

A

JN 6012.74

STORM DRAIN PROJECT

No 1274

LINE D

LOCATION OF IMPROVEMENTS

From Existing drain near S. line TR 28704

To Existing drain at A

FE Brooks
GO Guzado
RA Mauve
Foreign

Note: Any Additions or Changes on this Sheet Must be Made or Circled in Red Ink With Date and Name of Person Making Change.

Do not extend this side of this line.

PLEASE RETURN TO
COUNTY OF LOS ANGELES
DEPARTMENT OF COUNTY ENGINEER
403 LOS ANGELES COUNTY ENGINEERING BLDG.

76F3095 CE#3103-68

B

F. B. 3369 PG. 128

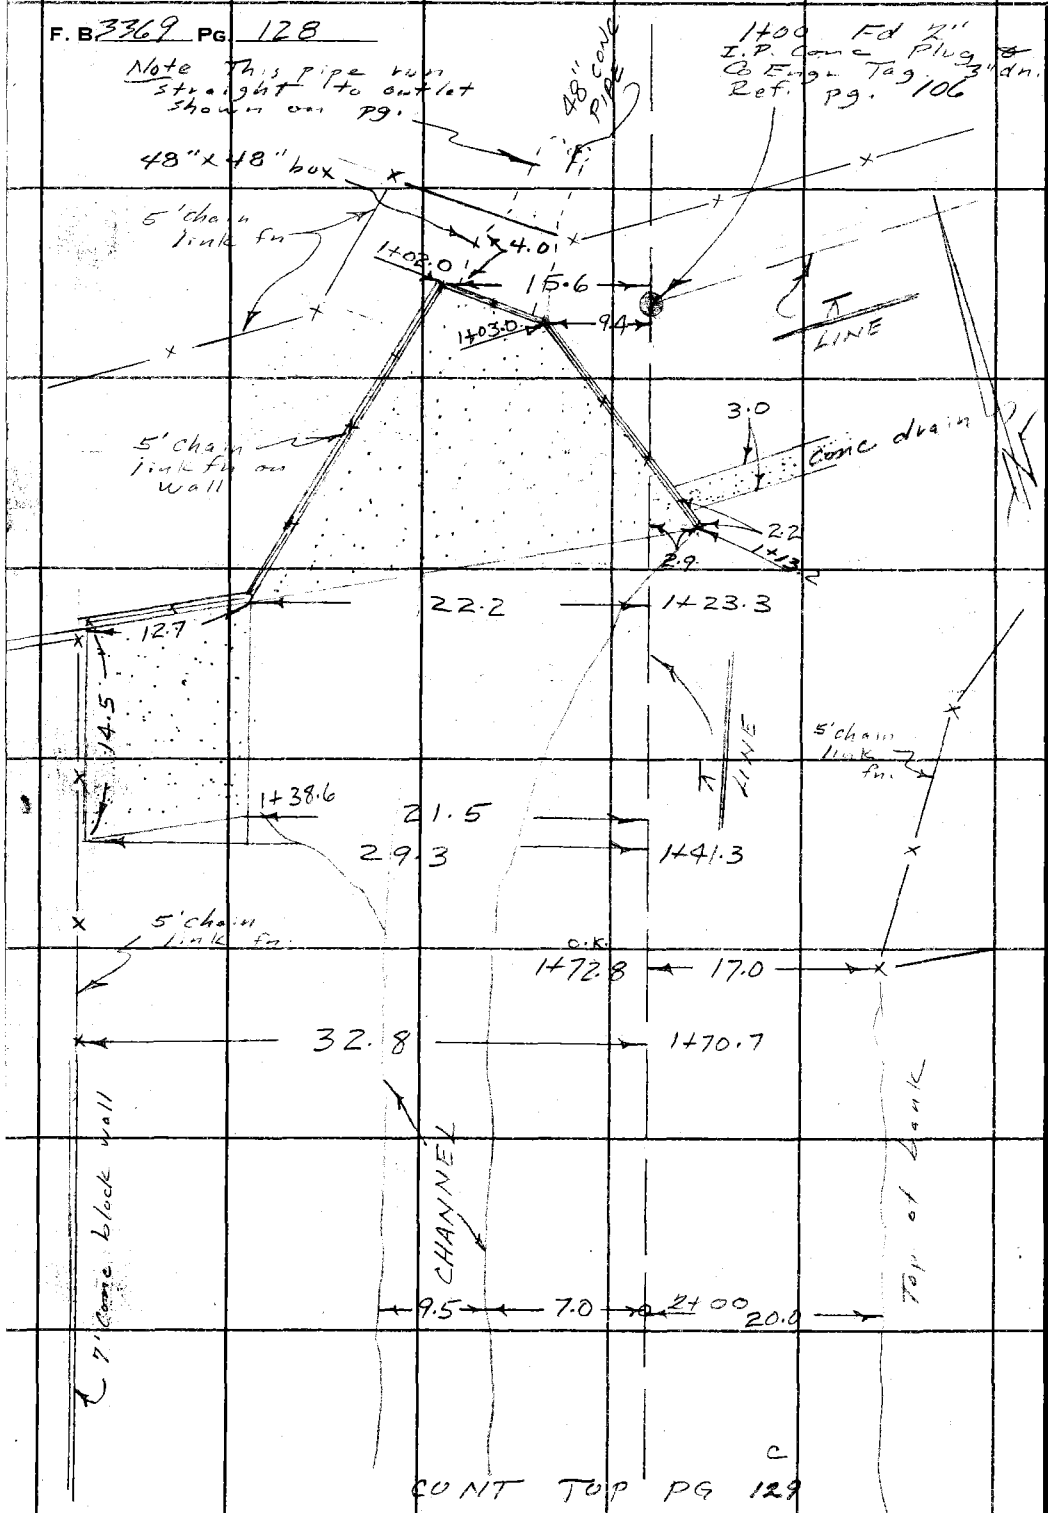

CONT TOP PG 129

PLEASE RETURN TO
COUNTY OF LOS ANGELES
DEPARTMENT OF COUNTY ENGINEER
403 LOS ANGELES COUNTY ENGINEERING BLDG.

Do not extend this side of this line.

Note: Any Additions or Changes on This Sheet Must be Made or Circled in Red Ink With Date and Name of Person Making Change.

Notes Ck'd by	Survey of [illegible]
Map No.	JN 6018, Tape Sht of
Office Work	Surveyed by F E Brooks
Checked	Notes F E B Guizado Date 14 DEC '71
Date	Indexed R. L. GALLI MAY 10 71

F. B. [illegible] PG. 122

C

CONT BOT PG 128

Note: Any Additions or Changes on This Sheet Must be Made or Circled in Red Ink With Date and Name of Person Making Change.

PLEASE RETURN TO
COUNTY OF LOS ANGELES
DEPARTMENT OF COUNTY ENGINEER
403 LOS ANGELES COUNTY ENGINEERING BLDG.

Do not extend this side of this line.

76F 3095 CE#310 3-68

4' Picket fn.
Block Wall
Stucco Garage
Horse Corral
Covered Patio
CHANNEL
Bank of
Top
LINE

32.0 — 2+24.8
11.3 — deadmen 2+34.7
12.0 — Trans. P.P. 2+52.0
7.0 — 4" Cedar 2+55.5
32.3 — 2+58.3
8.0
7.7
2+71.8
3" Cedar 2+67.0
8.3
36.0
5.7 — 2+73.7
6' chain link fn.
10.4 — 3" Apricot 2+82.0
Shrub. 2+90.5
7.0
2+94.0
35.0
10.1 — 2" Orange 2+92.4
10.0
10.0
10.0
12.5 — 3+00
9.9 — 1" Peach 3+04.7

CONT TOP PG 130

F. B. 3369 PG 130

CONT BOT Pg 129

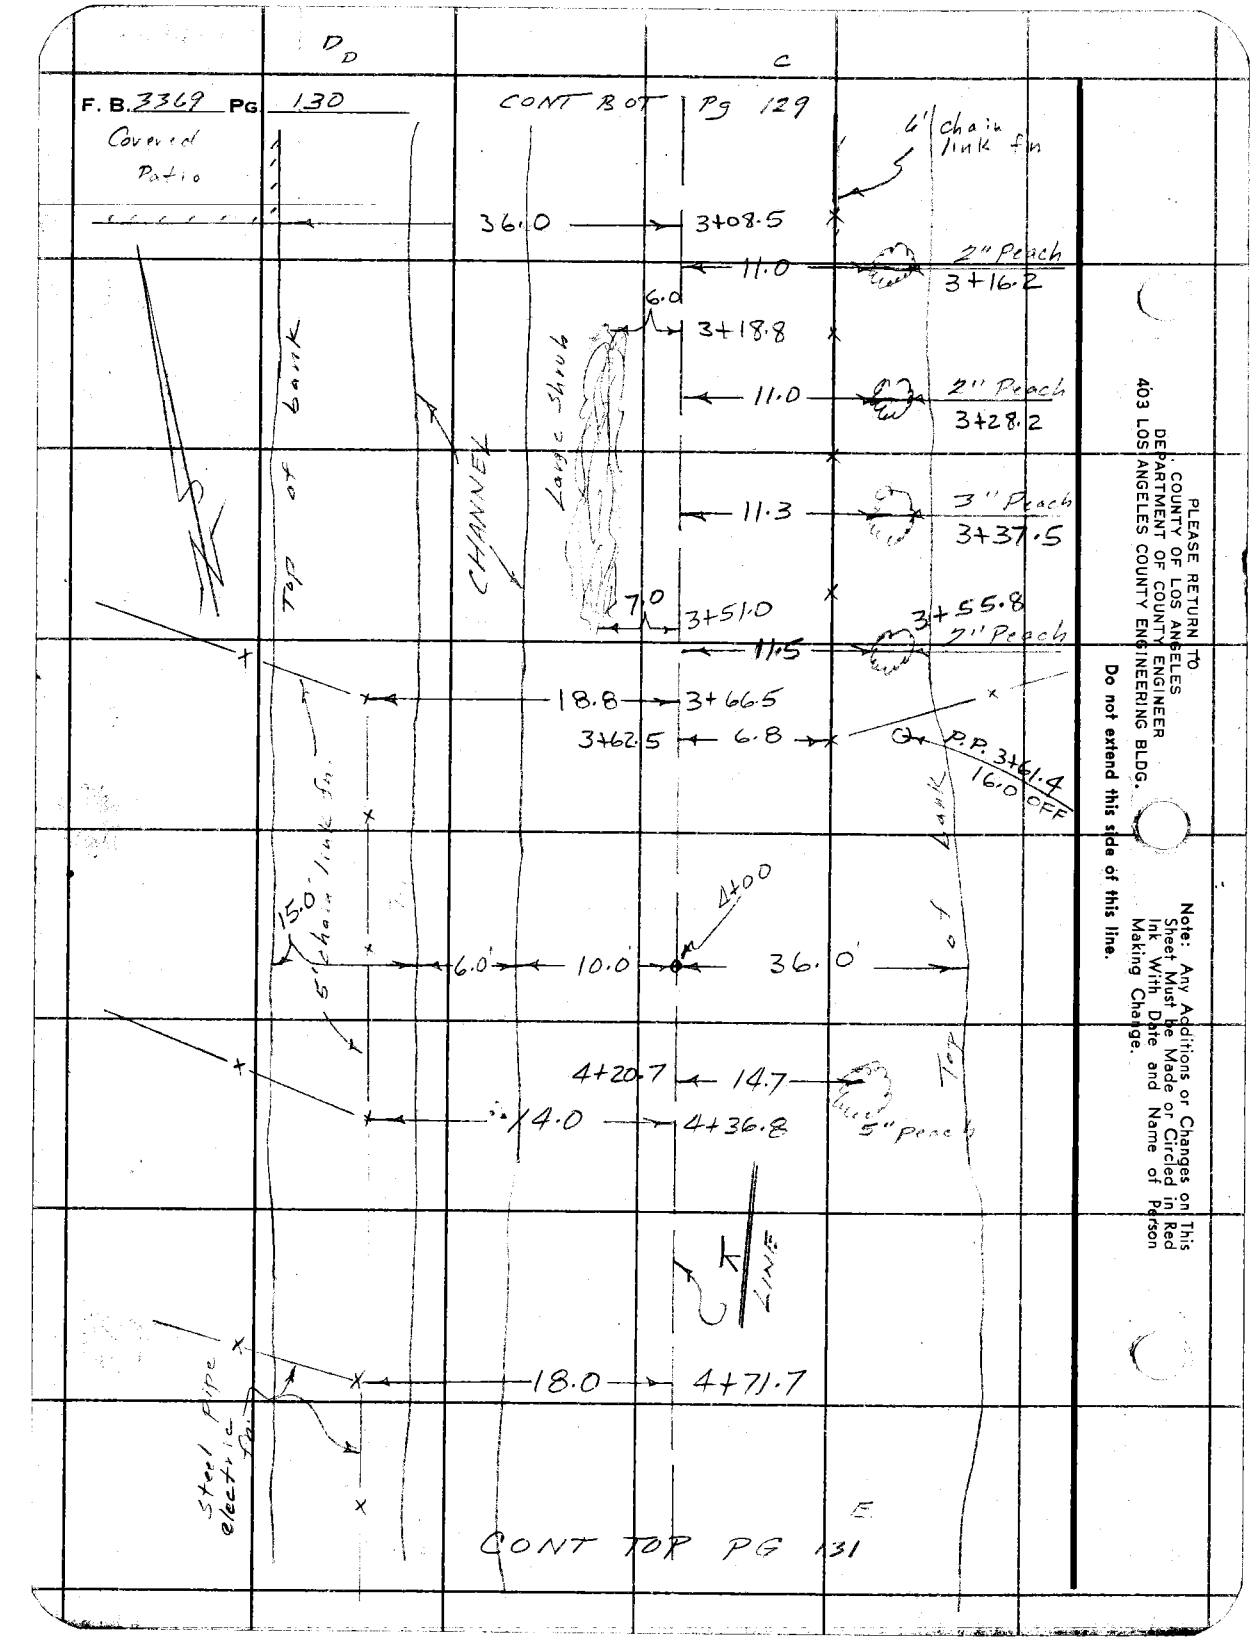

CONT TOP PG 131

PLEASE RETURN TO
COUNTY OF LOS ANGELES
DEPARTMENT OF COUNTY ENGINEER
403 LOS ANGELES COUNTY ENGINEERING BLDG.

Do not extend this side of this line.

Note: Any Additions or Changes on This Sheet Must be Made or Circled in Red Ink With Date and Name of Person Making Change.

Notes Ck'd by	Survey of S.D. Project H Mains
Map No.	INDEX, Tape, Std. °F.
Office Work	Surveyed by F.E. Brecht
Checked	Notes Date 1/20/71
Date	Indexed J. GALLI MAY 10 71

F. B. Pg. 131

D.

CONT LOT PG 130

1+10 — 6.0 — 10.0 — 5+00 — 26.5

Guy Pole — 5.6 — 5+08.8

21.0 — Trans P.P. 5+08.4

Bank of CHANNEL — 23.4 — 5+23.5

Top — 8.5 — 5+30.4

5+42.23 Pt. Fd 2" I.P. Conc Plug & Co. Engr. Tag Ref Pg. 109

1" pine — 22.8 — 5+39.0

5.5 — 5+41.7

4" Pine — 24.0 — 5+42.3

1" Tree — 5+46.5 — 27.4

3" Pine — 5+53.7 — 30.0

1" Tree — 5+55.0 — 21.6

2" Apricot — 5+60.0 — 27.5

2" Pine — 5+67.3 — 28.3

1" pine — 5+72.3 — 28.5

1" Peach — 5+81.0 — 22.0

3" Magnolia — 5+81.7 — 27.5

3" Pine — 5+86.4 — 22.3

1" Tree — 5+91.8 — 28.0

3" Pine — 5+93.0 — 21.5

2" Magnolia — 5+97.2 — 26.0

CONT TOP PG 132

2-Strand Barb Wire fn.

Bank of Top

10.0 — 5+85.4 — 2.5

4' Wood rail fn

HORSE CORRAL

F

Note: Any Additions or Changes on This Sheet Must be Made or Circled in Red Ink With Date and Name of Person Making Change.

Do not extend this side of this line.

PLEASE RETURN TO
COUNTY OF LOS ANGELES
DEPARTMENT OF COUNTY ENGINEER
403 LOS ANGELES COUNTY ENGINEERING BLDG.

F3095 CE#310 3-68

F. B. 3369 PG 132 CONT BOT PG 131

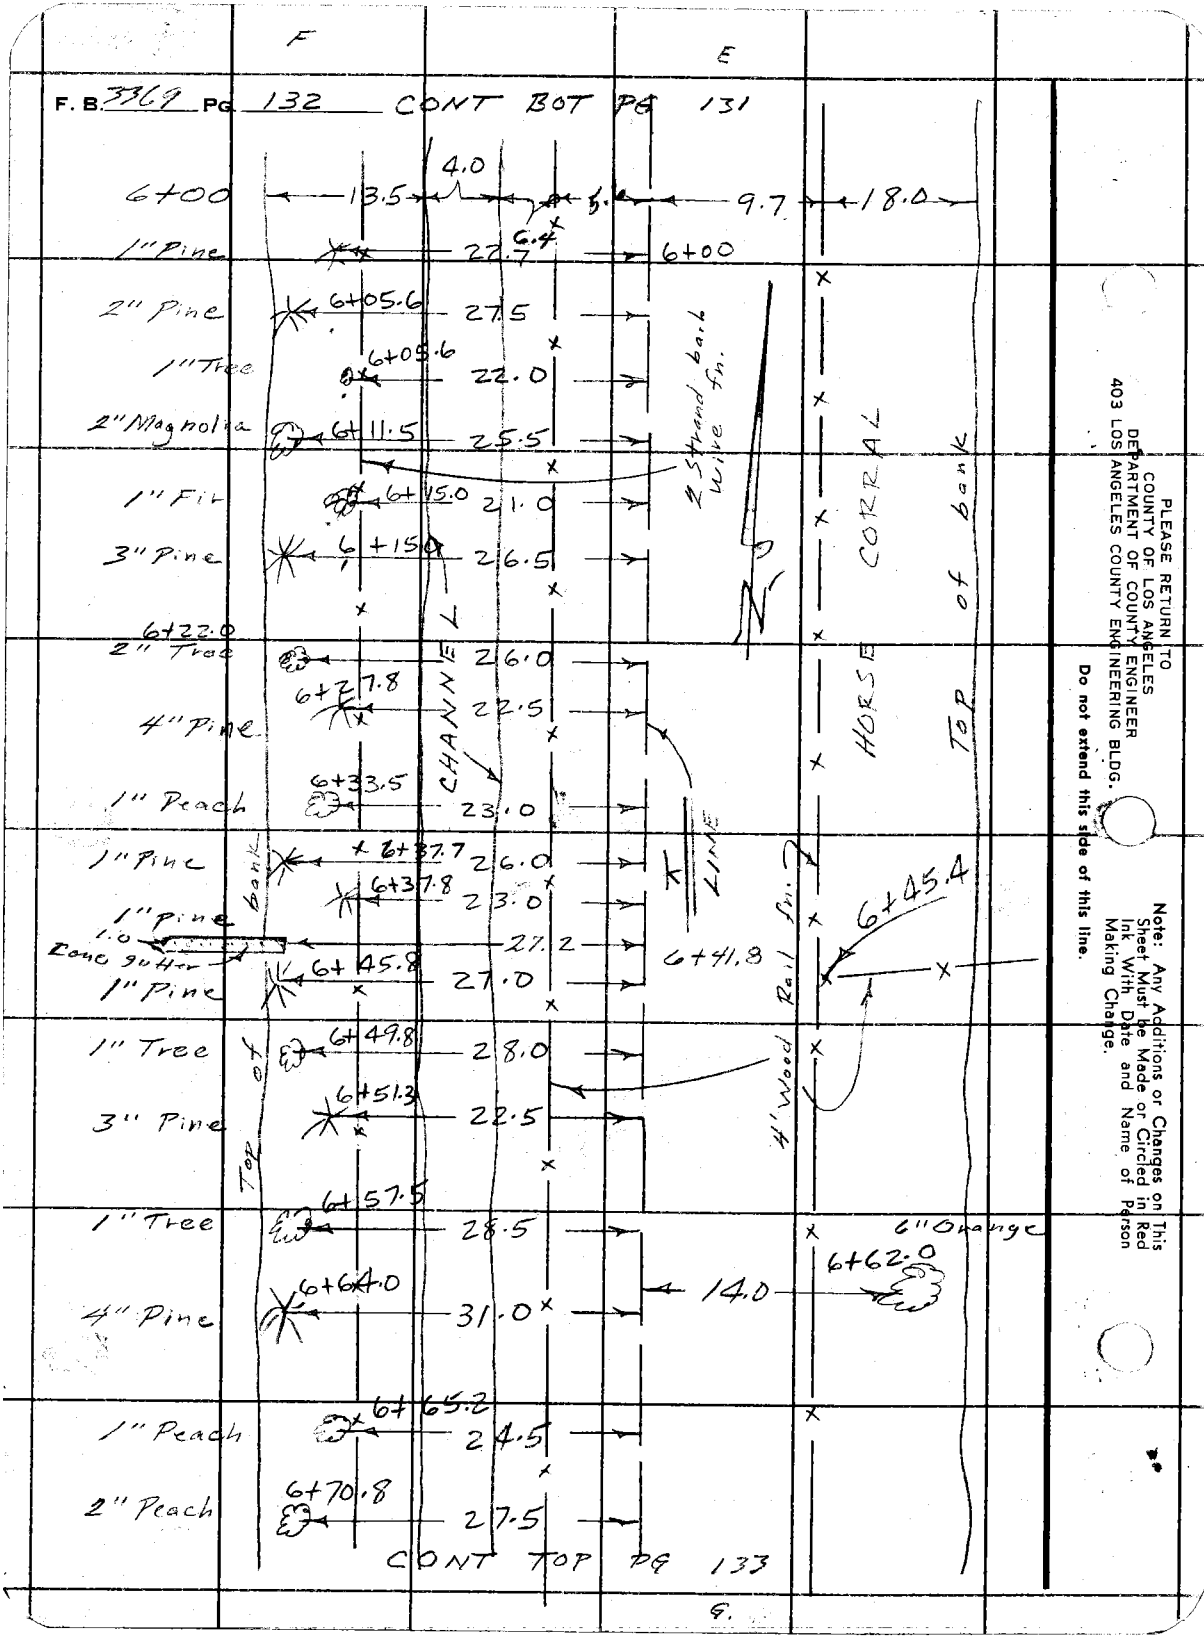

Notes Ck'd by	Survey of S.D. C.F.C.D.
Map No.	JN 6012.74 Tape Std. °F
Office Work	Surveyed by F.E. Brooks
Checked	Notes FEB Guizado Date 1 APR. '71
Date	Indexed G. J. GALLI MAY 10 71

F. B. 1110 PG. 133

CONT BOT PG 133

3" Pine 6+77.0 27.0

5.0

2" Pine 6+83.8 24.0

2" Plum

2" Pine 5.0 6+90.4 20.0

8.0

2" Peach

3" Acacia

Bank

Bank wire fn.

2-strand 16.0

7" Orange 6+86.3

2" Pine 30.0 6+94.5

1" Tree 7.0 26.0 7+00.5 O.K.

11.5 7.0 6.0 9.5 15.0

1" Pine 9.0 11.5 P.P. 7+02.0

7+00

3" Pine 32.0 7+06.5

2" Fir 25.5 7+08.0

1" Tree 7+13.0 32.0

LINE

Bank

2" Pine 26.5 7+15.0

Top of

3" Pine 28.5 7+20.0

CHANNEL

11.7 deadman 7+22.4

2" Peach 33.5 7+24.6

1" Pine 26.0 7+27.5

3" Pine 32.5 7+28.8

4' Wood rail fn.

Top of

1" Tree 24.5 7+34.2

1" Tree 33.0 7+35.8

1" Tree 28.5 7+38.0

CONT TOP PG 134

H

Note: Any Additions or Changes on This Sheet Must be Made or Circled in Red Ink With Date and Name of Person Making Change.

Do not extend this side of this line.

PLEASE RETURN TO
COUNTY OF LOS ANGELES
DEPARTMENT OF COUNTY ENGINEER
403 LOS ANGELES COUNTY ENGINEERING BLDG.

76F3095 C.E.#310 3-68

F. B. 3369 PG. 134 CONT BOT PG 133

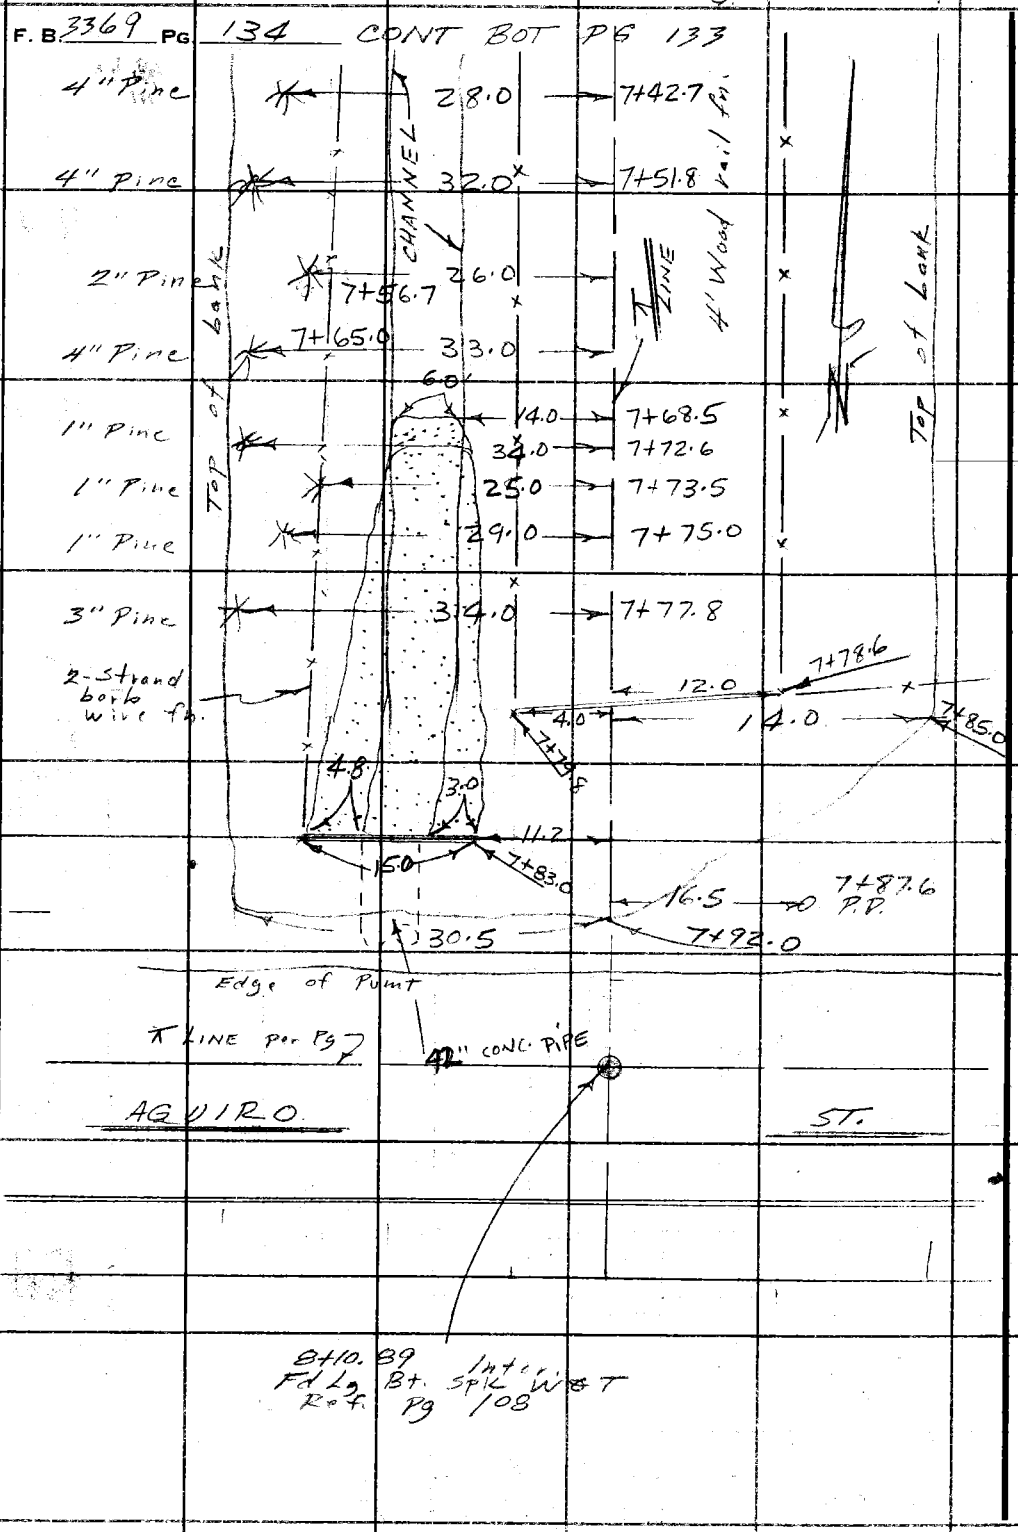

PLEASE RETURN TO
COUNTY OF LOS ANGELES
DEPARTMENT OF COUNTY ENGINEER
403 LOS ANGELES COUNTY ENGINEERING BLDG.

Do not extend this side of this line.

Note: Any Additions or Changes on This Sheet Must be Made or Circled in Red Ink With Date and Name of Person Making Change.

127

Profile No. | Notes Red | Plotted | Job No. 6012.74 | Division No. 11 | F.B. 5719 Pg. 135
X-Sec. No. | Date | Date | Survey of S.D. Project #1274
Notes Chkd. | Checked | Survey by FE Brooks | Notes FE B | Date 2 APR. 71
Date | Date | Map No. | Indexed | Date

J.N. 6012.74

STORM DRAIN PROJECT

No 1274

LINE D

CROSS SECTIONS

From Existing S.D. at S. end of TR 28704

To Existing S.D. at Aguilo St.

STATION	B.S.	H.I.	F.S.	ELEV.
		FE Brooks GO Guizado RA Moore T. Ohashi		

NOTE: ANY ADDITIONS OR CHANGES ON THIS SHEET MUST BE MADE OR CIRCLED IN RED INK, WITH DATE AND NAME OF PERSON MAKING CHANGE.

Do not extend notes this side of this line.

PLEASE RETURN TO
LOS ANGELES COUNTY ENGINEER
700 Los Angeles County Engineering Bldg.

761-226 CE 307 11-58

76L-298 CE 307 11-58

PLEASE RETURN TO
LOS ANGELES COUNTY ENGINEER
700 Los Angeles County Engineering Bldg.

NOTE: ANY ADDITIONS OR CHANGES ON THIS SHEET MUST BE MADE OR CIRCLED IN RED INK, WITH DATE AND NAME OF PERSON MAKING CHANGE.

Do not extend notes this side of this line.

F.B. 3369 Pg. 136 Profile
Job No. 6012.54 Division No. 11 Notes Red Plotted
Survey of S.D. Project # 12.74 Date 2 APR. 171 Date
Survey by FE Briggs Notes FEB. - Grid 4 10 Notes Chkd. Checked
Indexed O. J. GALU Date Date
No. X-Sec. No.

STATION	B. S.	H. I.	F. S.	ELEV.		
BM S.D. 1258					BM S.D. 1258 Elev. 536.870 F.B. 3369 - 15 Back lot line of house #2450 Ablano Ave. A. P.K. spk. in lead at center of S. D. head wall	
					SOUTH on T LINE	
					Lt. or East T LINE	Rt. or West
1+02.0				53686		15.6 Rt Top of headwall
1+02.5				52909		12.5 RT Invert of 48" box
1+03.0				53687		9.4 Rt Top of headwall
1+11.				53218	2.0 Lt Invert of 3' wide conc drain	
1+13.2				53065	2.9 Lt. bottom of channel	
				53333	2.9 " Top of wing wall	
				5356	13.0 " Top of Lank	
1+23.3				53056		22.2 Rt bottom of channel
				53662		22.2 " Top of Wing wall

76L-298 CE 307 11-58

2+00 535.21

PLEASE RETURN TO
LOS ANGELES COUNTY ENGINEER
700 LOS ANGELES COUNTY ENGINEERING BLDG.

NOTE: ANY ADDITIONS OR CHANGES ON THIS SHEET MUST BE MADE OR CIRCLED IN RED INK, WITH DATE AND NAME OF PERSON MAKING CHANGE.

Do not extend notes this side of this line.

STATION	B.S.	H.I.	F.S.	ELEV.	Lt or East	LINE	Rt or West
1+26.8				53656			34.7 Rt Top end of WingWall
1+30				53205			21.9 Rt edge conc s/ab
1+35				53555			34.7 Rt edge conc s/ab
1+38.6				53328			21.5 Rt edge conc s/ab
1+41.3				53644			29.3 Rt. edge conc s/ab.
2+00				5352			
				5329			7.0 Rt edge of channel
				5333			16.5 " edge of channel
				5395			32.0 " Top of bank
				5358	10.0 Lt ground		
				5388	20.0 " Top of bank		
3+00				5384			
				5385			2.5 Rt ground
				5344			10.0 Rt edge of channel
				5348			20.0 " edge of channel

Profile Notes Red. Plotted Job No. Division No. 11
No. Date Date Date Survey of S.D. Project
X-Sec. Notes Ckd. Checked Survey by Notes Ckd. Date
No. Date Date Map No. Indexed Date

F.B. 1361 Pg. 137

76L-298 CE 307 11-58

PLEASE RETURN TO
LOS ANGELES COUNTY ENGINEER
700 Los Angeles County Engineering Bldg.

NOTE: ANY ADDITIONS OR CHANGES ON THIS SHEET MUST BE MADE OR CIRCLED IN RED INK, WITH DATE AND NAME OF PERSON MAK.NG CHANGE.

Do not extend notes this side of this line.

B. 3419 Pg. 138

Survey of S.D. Project # 1879 Division No. 11 Notes Red Plotted Profile

Survey by E.E. Brooks Notes FEB - Grizado Date 2 APR 71 Notes Chkd. Checked No. X-Sec.

Indexed [illegible] Date Date Date No.

Job No. 6012.94

STATION	B.S.	H.I.	F.S.	ELEV.	Lt. or East	↑ LINE	Rt. or West
3+00				5418			35.0 Rt Top of bank
				5388	5.0 Lt ground		
				5430	12.5 " Top of bank		
4+00				5384			
				5369			10.0 Rt edge of channel
				5370			16.0 " edge of channel
				5444			31.0 " Top of bank
				5387	9.0 Lt ground		
				5398	15 " ground		
				5404	25 " ground		
				5465	36 " Top of bank		
5+00 *				54266			
				5409			10.0 Rt. edge channel
				5411			16.0 " edge channel
				5460			27.0 " Top of bank
				5432	15.0 Lt ground		
				5497	26.5 " Top of bank		
6+00 *				54515			

76L-298 CE 307 11-58

554.26

PLEASE RETURN TO
LOS ANGELES COUNTY ENGINEER
700 LOS ANGELES COUNTY ENGINEERING BLDG.

NOTE: ADDITIONS OR CHANGES ON SHEET MUST BE MADE OR CIRCLED IN INK, WITH DATE AND NAME OF PERSON MAKING CHANGE.

Do not extend notes this side of this line.

STATION	B.S.	H.I.	F.S.	ELEV.	Lt or East of Line	Rt. or West
6+08				544 5		12.0 Rt edge of channel
				544 4		16.0 " edge of channel
				551 2		29.5 " Top of bank
				545 8	9.7 Lt ground	
				551 0	27.7 " Top of bank	
6+41.8				546 87		27.2 Rt to Horn Conc gutter
7+00				548 89		T
				547 6		15.0 Rt edge of channel
				547 3		22.0 " edge of channel
				554 7		33.5 " Top of bank
				549 7	9.0 Lt ground	
				556 5	24.5 " Top of bank	
7+68.5				549 8		14.0 Rt Conc edge of channel
				551 1		20.0 " Conc edge of channel
7+83.0				566 2		T
				554 02		11.2 Rt Top of head wall
				548 87		18.7 " Invert of 48" CMP

Profile Notes Red Plotted Job No. 612.74 Division No. 11
No. Date Date Survey of S.D. Project # 1274
No. Date Date Map No. Indexed Date 10-10-74
F.B. 33 L.L. Pg. 139

76L-208 CE 307 11-58

55533 T.P.

PLEASE RETURN

LOS ANGELES COUNTY ENGINEER

700 LOS ANGELES COUNTY ENGINEERING BLDG.

NOTE: ANY ADDITIONS OR CHANGES ON THIS SHEET MUST BE MADE OR CIRCLED IN RED INK, WITH DATE AND NAME OF PERSON MAKING CHANGE

Do not extend notes this side of this line.

F.B. 3769 Pg. 140 Job No. 6012.74 Division No. 11 Notes Red Plotted Profile

Survey of S.D. Project # 1224 Date 2 APR 71 No. X-Sec.

Survey by FE Brooks Notes FEB — Guiz Notes Chkd. Checked No.

Indexed G. I. GALLI Date Date Date

STATION	B. S.	H. I.	F. S.	ELEV	Lt. or East of Line	Rt. or West of Line
7+83.0				554 01		26.2 Rt Top of headwall
7+85.0				5579	14.0 Lt Top of bank	
7+92.0				5578		T Top of bank
				5577		30.5 Rt Top of bank
BM S.D. 1260					BM S.D 1260 Elev. 558.500 FB 3369-17 Aguiro St. S. side at house # 18542 P.K. spk in lead in N.E. Cor. of S.D. catch basin.	

Notes Ck'd by	Survey of [illegible]
Map No.	JN 6012.74 Topo Std SF
Office Work	Surveyed by F.E. Brooks
Checked	Notes FEB Guizado Date APR '71
Date	Indexed S.J. GALEB MAY 10 '71

F. B. [illegible] Pg. 141

S.N. 6012.74

STORM DRAIN PROJECT

No 1274

LINE F

LOCATION OF IMPROVEMENTS

From LINE C

To Existing drain N. of Aguiro St.

FE Brooks
GO Guizado
RA Moore
T Ohashi

Note: Any Additions or Changes on This Sheet Must be Made or Circled in Red Ink With Date and Name of Person Making Change.

Do not extend this side of this line.

PLEASE RETURN TO
COUNTY OF LOS ANGELES
DEPARTMENT OF COUNTY ENGINEER
403 LOS ANGELES COUNTY ENGINEERING BLDG.

76F3085 CE#310 3-68

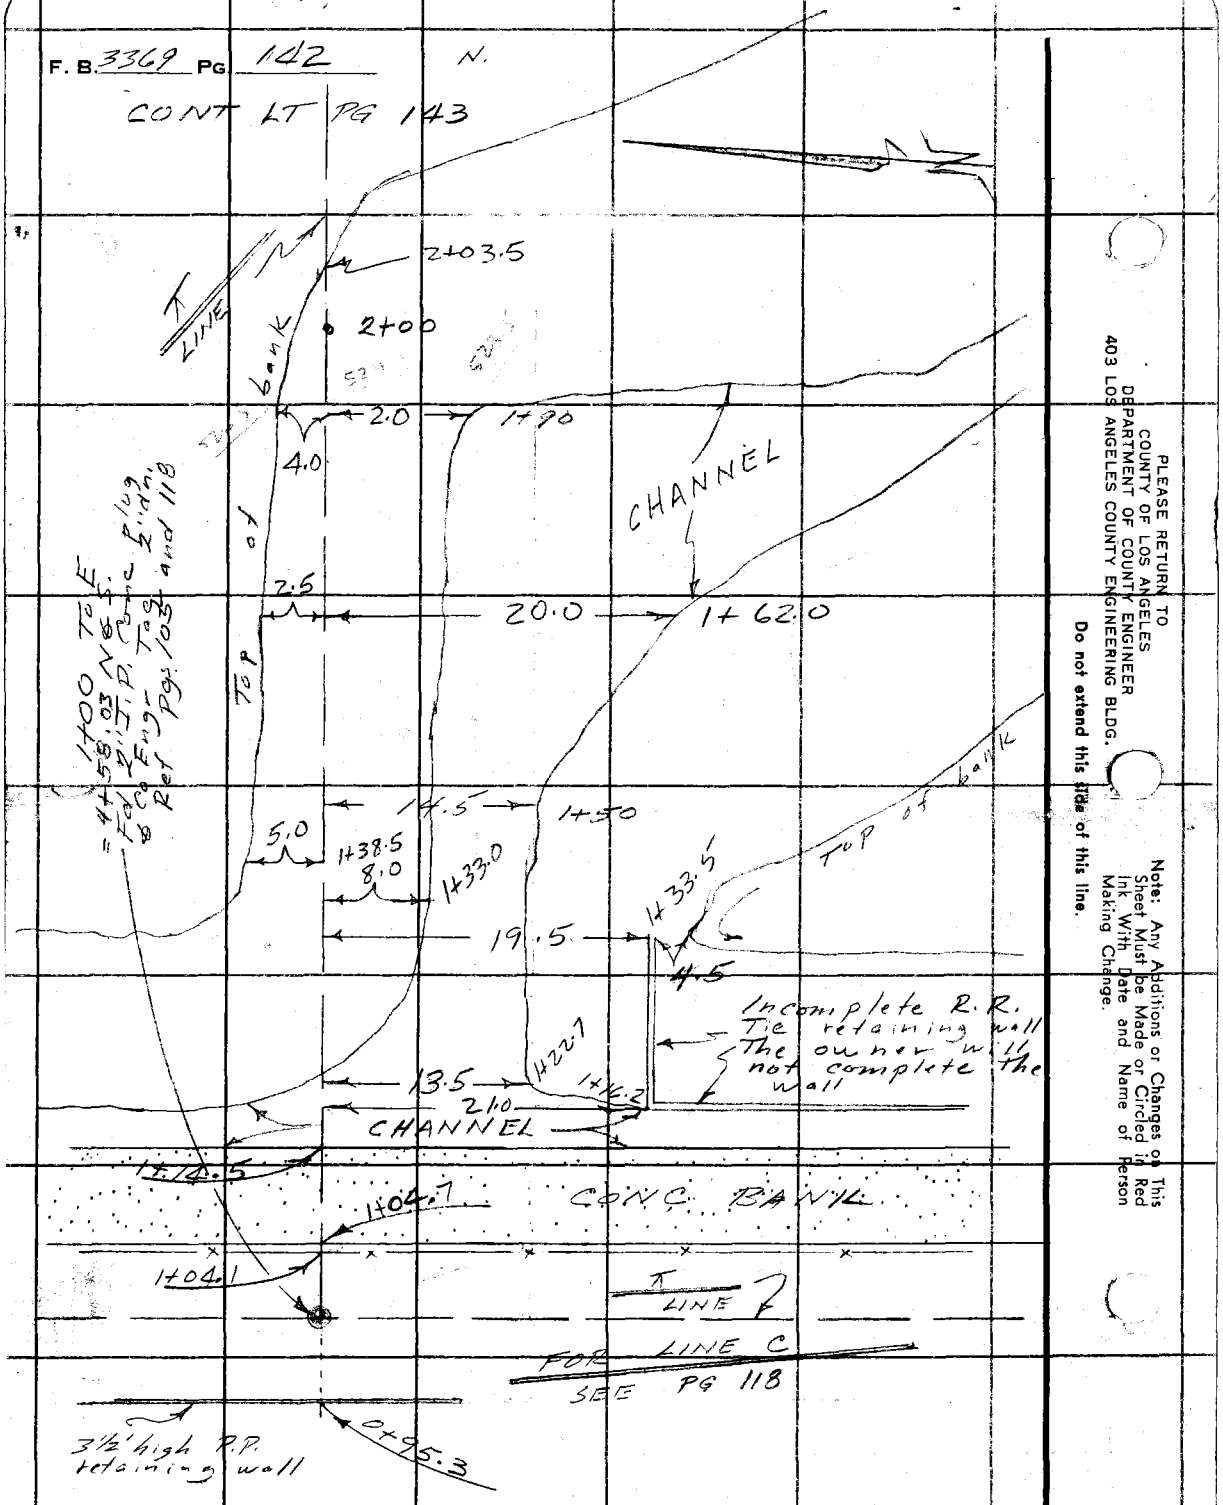

PLEASE RETURN TO
COUNTY OF LOS ANGELES
DEPARTMENT OF COUNTY ENGINEER
403 LOS ANGELES COUNTY ENGINEERING BLDG.

Do not extend this title of this line.

Note: Any Additions or Changes on This Sheet Must be Made or Circled in Red Ink With Date and Name of Person Making Change.

Notes Ck'd by
Map No.
Office Work
Checked
Date

Survey of S.D. Project #1274
JN [illegible] Tape Std °F
Indexed

F. B. 3369 PG. 143

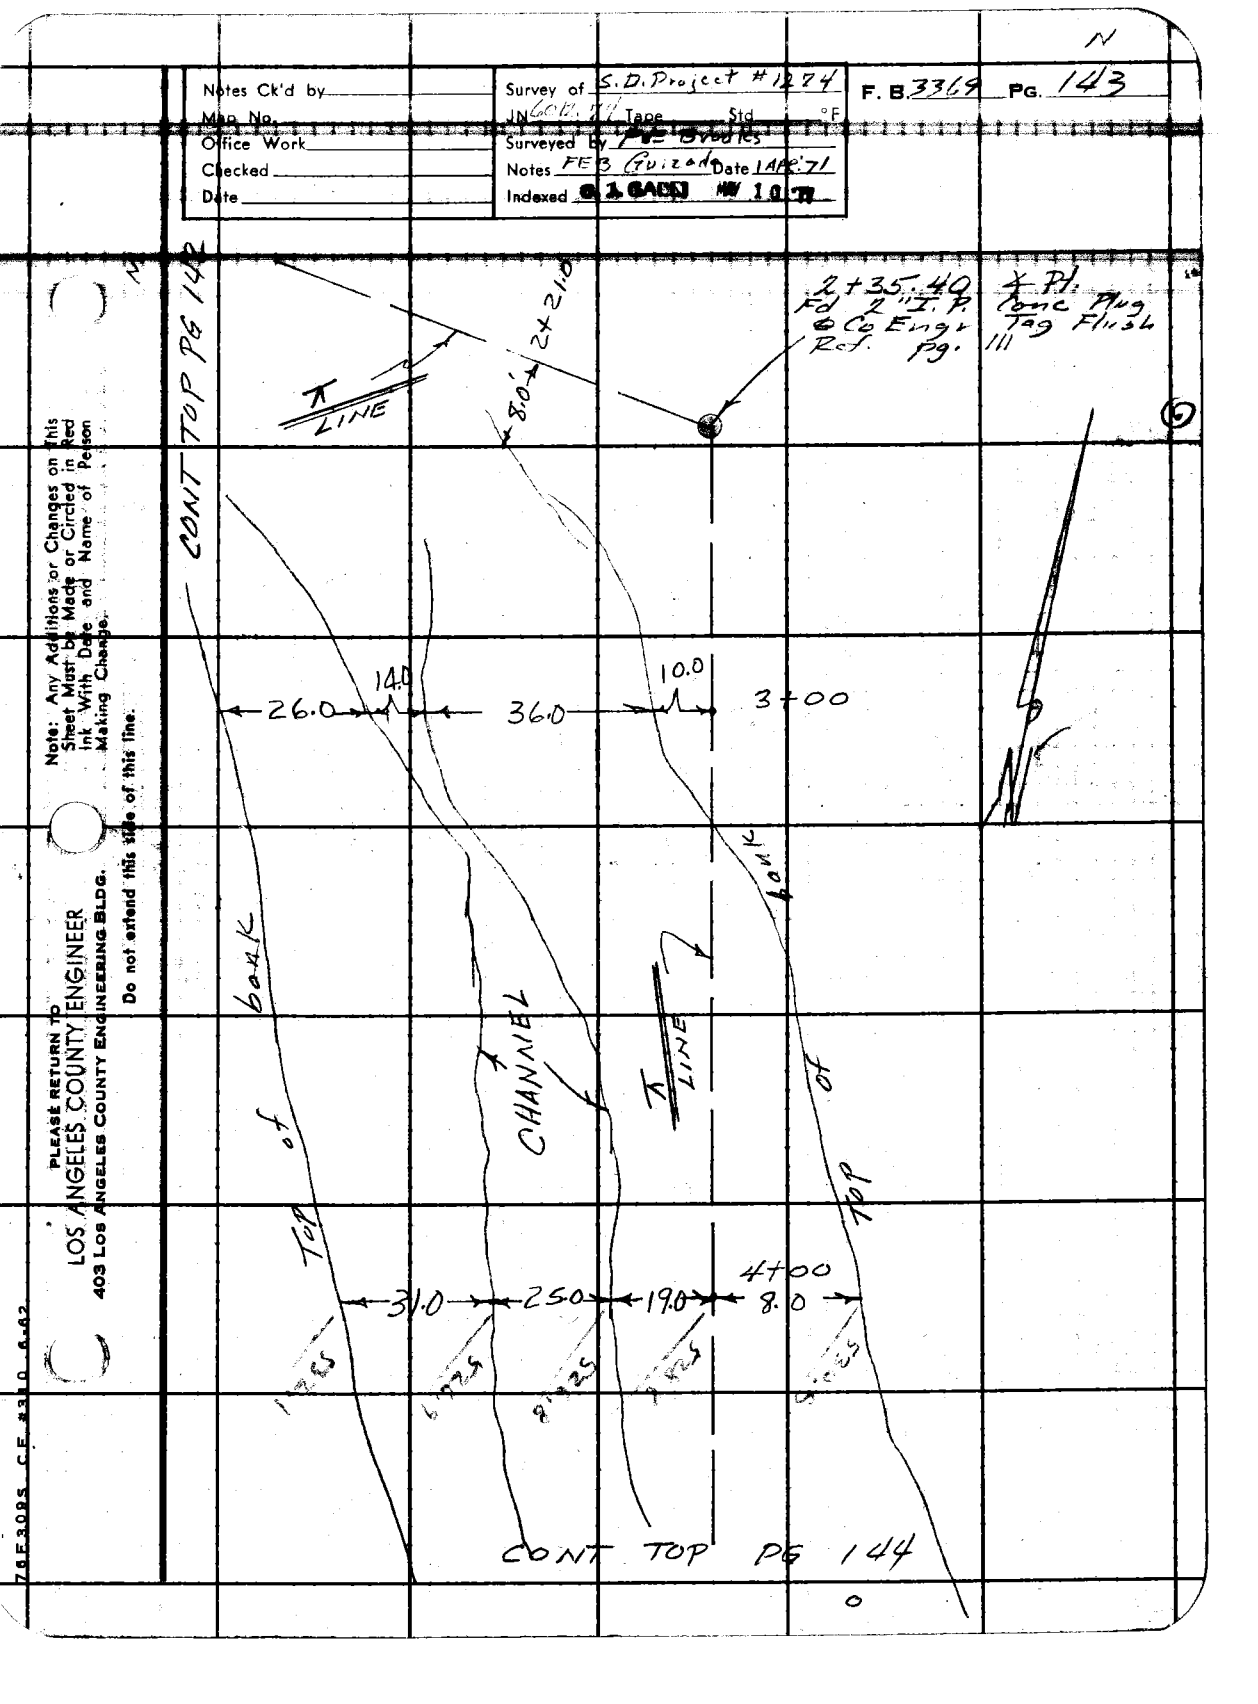

Note: Any Additions or Changes on this Sheet Must be Made or Circled in Red Ink With Date and Name of Person Making Change.

Do not extend this side of this line.

PLEASE RETURN TO
LOS ANGELES COUNTY ENGINEER
403 Los Angeles County Engineering Bldg.

78E308S C.E. #310 4-62

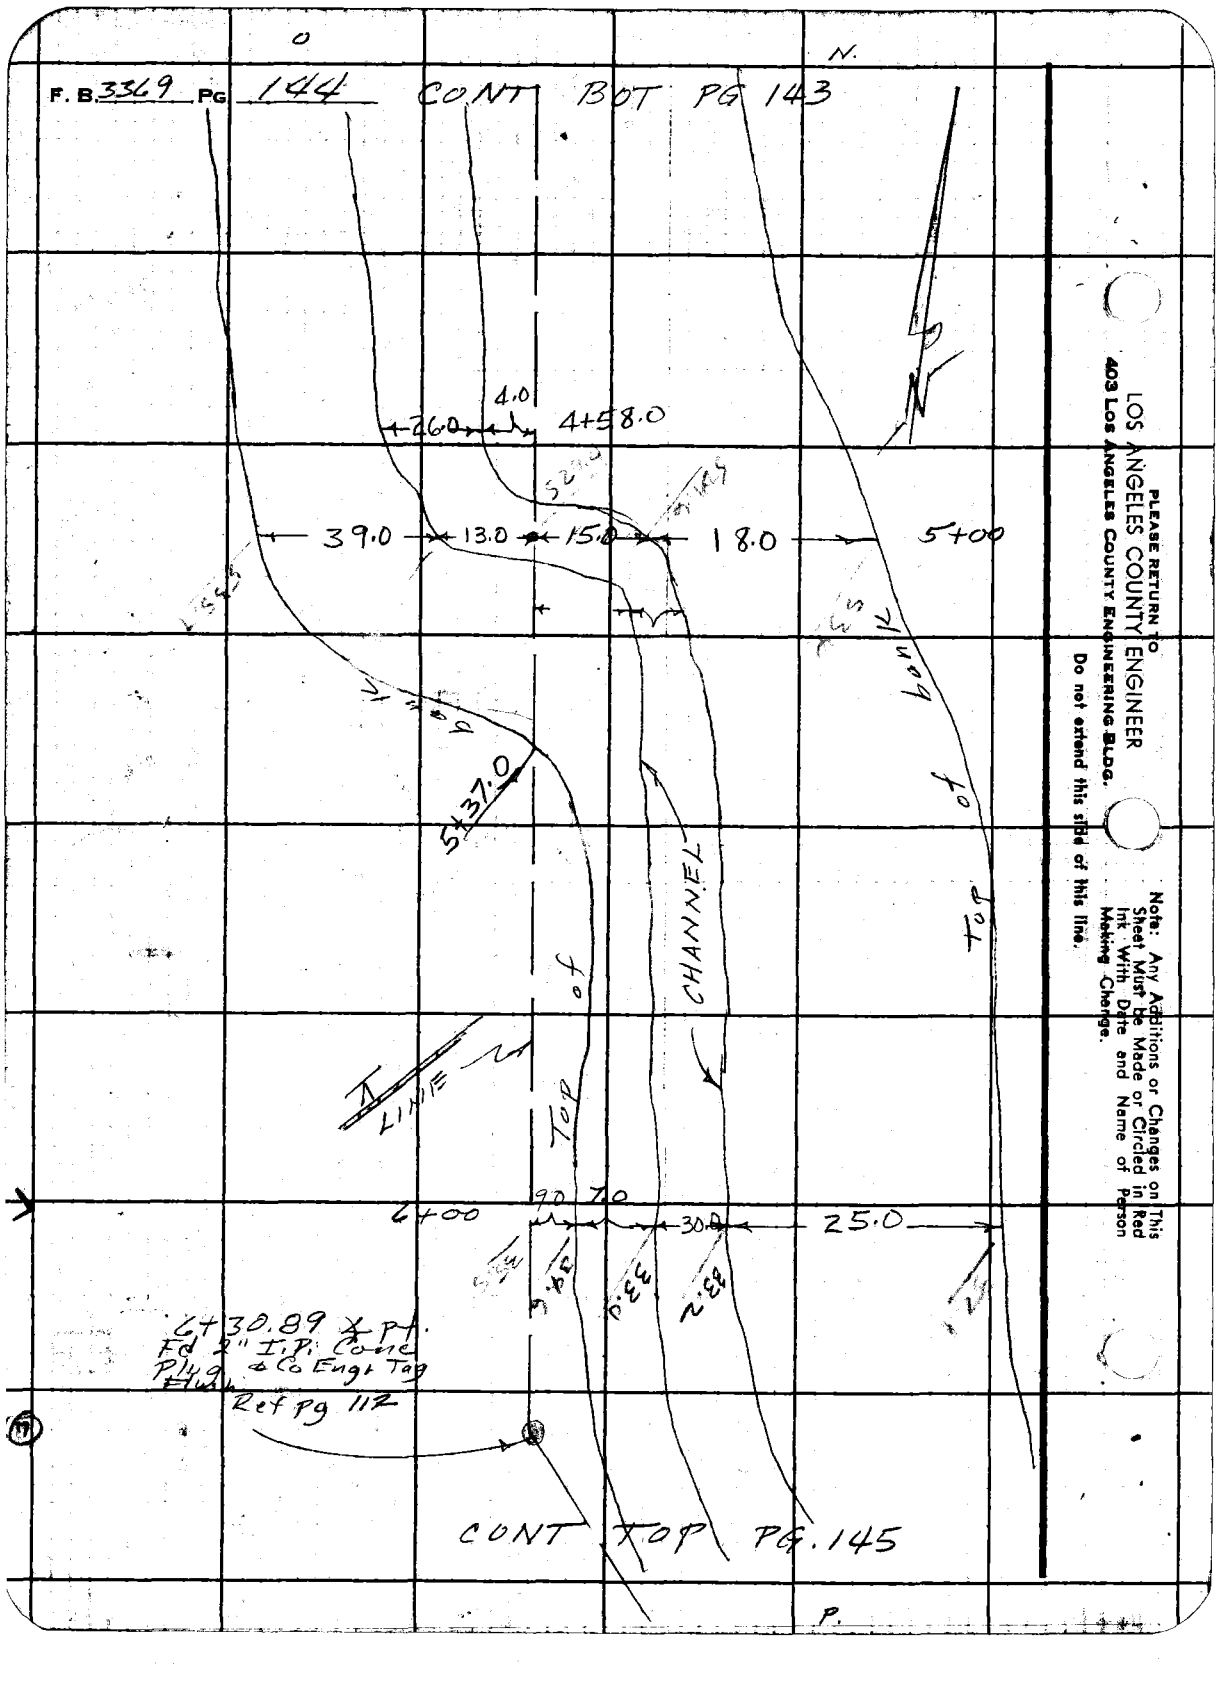

LOS ANGELES COUNTY ENGINEER
403 Los Angeles County Engineering Bldg.
PLEASE RETURN TO

Do not extend this side of this line.

Note: Any Additions or Changes on This Sheet Must be Made or Circled in Red Ink With Date and Name of Person Making Change.

Notes Ck'd by
Map No.
Office Work
Checked
Date

Survey of SDP. Acct #1294
JN Wk. Tape Sta °F
Surveyed by F.E. Brooks
Notes FEB Guizado Date
Indexed G. J. GALLI NOV 10 71

F. B. 3369 PG. 145

CONT. FROM PG. 144

Note: Any Additions or Changes on This Sheet Must be Made or Circled in Red Ink With Date and Name of Person Making Change.

PLEASE RETURN TO
LOS ANGELES COUNTY ENGINEER
403 Los Angeles County Engineering Bldg.

Do not extend this side of this line.

78F3095 CE #310 663

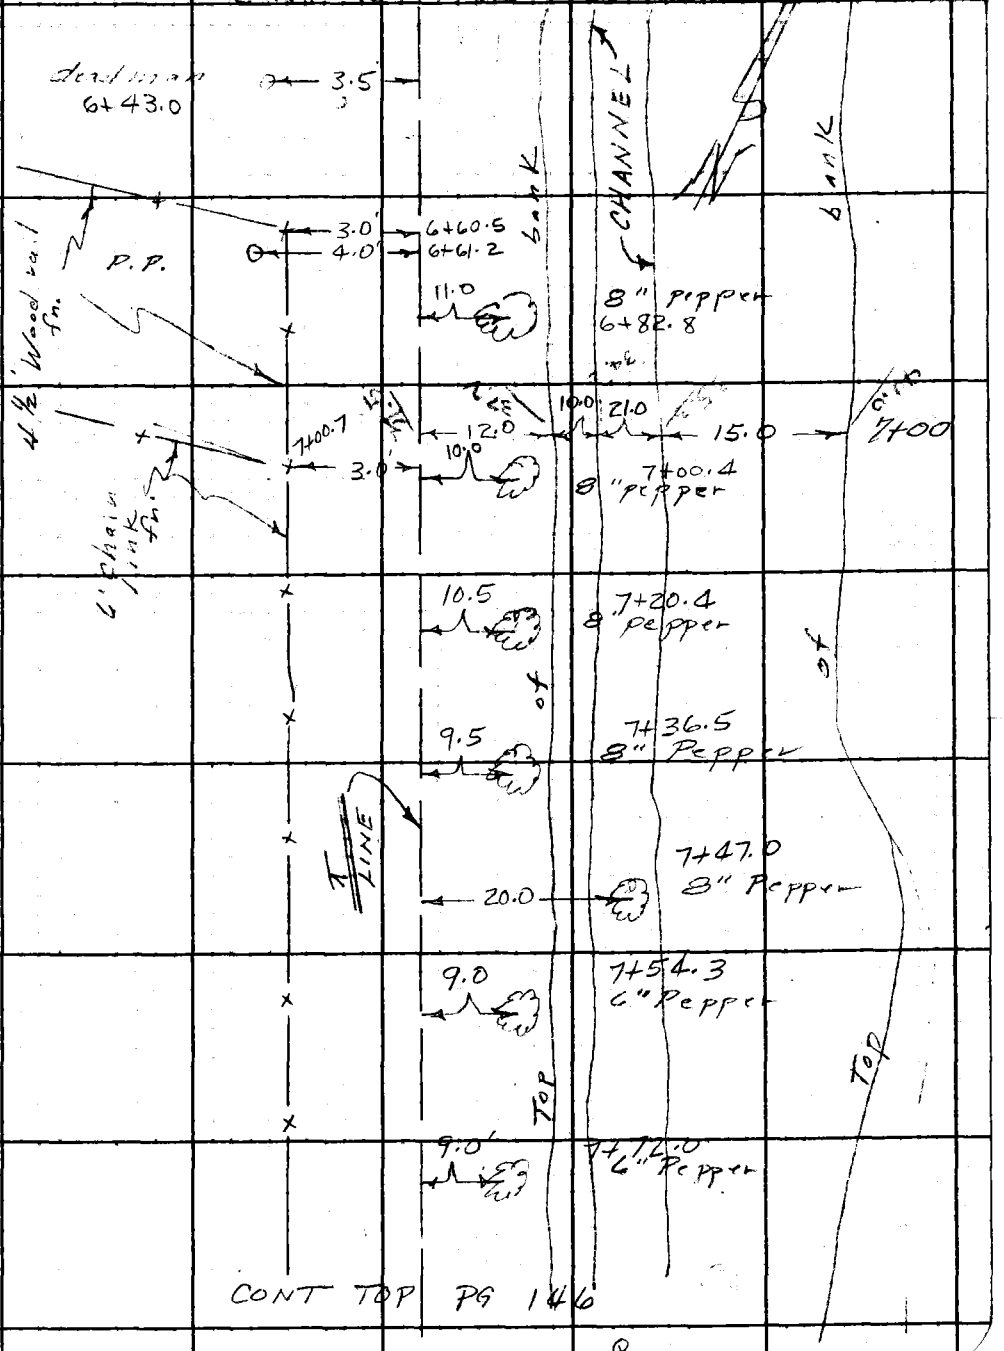

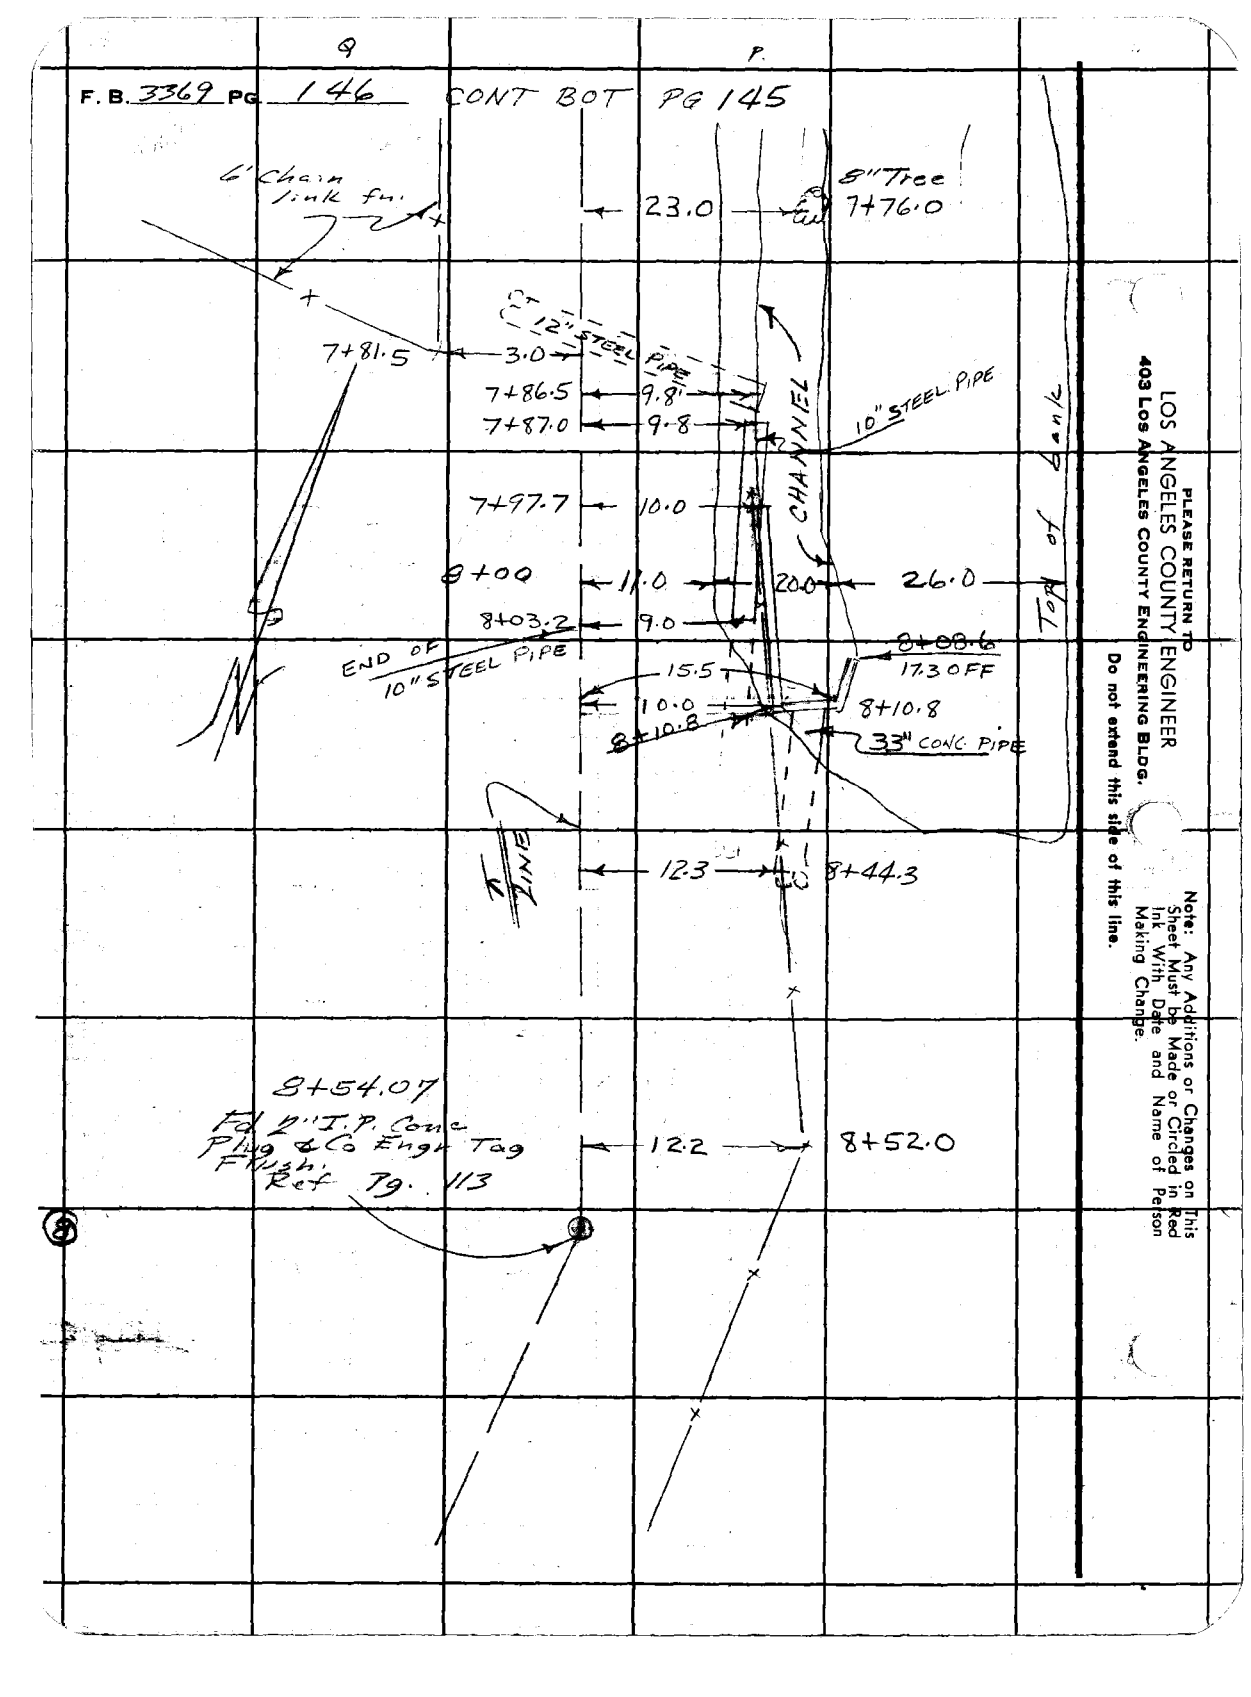
9
P.
F. B. 3369 PG. 146 CONT BOT PG 145
6' Chain link fn.
23.0
8" Tree
7+76.0
CT 12" STEEL PIPE
7+81.5
3.0
7+86.5
9.8'
7+87.0
9.8
10" STEEL PIPE
CHANNEL
Top of Bank
7+97.7
10.0
8+00
11.0
20.0
26.0
8+03.2
9.0
END OF 10" STEEL PIPE
8+08.6
17.3 OFF
15.5
10.0
8+10.8
8+10.8
33" CONC. PIPE
ENTRANCE
12.3
8+44.3
8+54.07
Fd 2" I.P. Conc Plug & Co Engr Tag Flush Ref Pg. 113
12.2
8+52.0
PLEASE RETURN TO
LOS ANGELES COUNTY ENGINEER
403 Los Angeles County Engineering Bldg.
Do not extend this side of this line.
Note: Any Additions or Changes on This Sheet Must be Made or Circled in Red Ink With Date and Name of Person Making Change.

Profile No. Notes Red Date Plotted Date Job No. 6012.74 Division No. 11
X-Sec. No. Notes Chkd Date Checked Date Survey of S.D. Project #1274
Map No. Indexed Date

F. B. 3369 Pg. 147

J N 6012.74

STORM DRAIN PROJECT

No 1274

LINE F

CROSS SECTIONS

From LINE C

To existing drain N. of Aguiro St.

STATION	B.S.	H.I.	F.S.	ELEV.

F E Brooks
G. O. Guizado
R A Moore
Tohoshi

NOTICE: ALTERATIONS OR CHANGES MUST BE MADE BY CIRCLING IN INK, WITH DATE AND NAME OF PERSON MAKING CHANGE.

PLEASE RETURN TO
LOS ANGELES COUNTY ENGINEER
700 LOS ANGELES COUNTY ENGINEERING BLDG.

Do not extend notes this side of this line.

76L-298 CE 307 11-58

76L-298 CE 307 11-58

PLEASE RETURN TO
LOS ANGELES COUNTY ENGINEER
700 LOS ANGELES COUNTY ENGINEERING BLDG.

NOTE: ANY ADDITIONS OR CHANGES ON THIS SHEET MUST BE MADE OR CIRCLED IN RED INK. WITH DATE AND NAME OF PERSON MAKING CHANGE

Do not extend notes this side of this line.

F.B. 3369 Po. 148 Job No. 6012.76 Division No. S.D. Project # 1234 Notes Red Date 2 APR '71 Plotted Date Profile No. X-Sec. No.
Survey of S.D. Project # 1234 Notes Chkd Checked
Survey by F.E. Bieck Notes FEB - Guzzardo Date Date
Indexed [redacted] Date Date

STATION	B. S.	H. I.	F S.	ELEV		
BM SD 1257				534.02	BM SD 1257 Elev. 534.018 F.B. 3369-15 Back lot line of house #2448 Alcano Ave. A P.K. spk in lead in center of S.D. head wall.	
					EAST on ℄ LINE	
					Lt. or NORTH	℄ LINE RT or South.
1+00				526.4		℄
				527.5		24 Rt
				526.3	7.0 Lt	
1+04.7				525.76		℄ Top cone bank
				526.30		24 Rt Top cone bank
				525.58	7.0 Lt Top cone bank	
1+14.5				521.3		℄ edge of channel
				521.4		24 Rt edge of channel
				521.5	7.0 Lt edge of channel	
1+22				521.7		℄ edge of channel

76L-298 CE 307 11-58

PLEASE RETURN TO
LOS ANGELES COUNTY ENGINEER
700 LOS ANGELES COUNTY ENGINEERING BLDG.

NOTE: ANY ADDITIONS OR CHANGES ON THIS SHEET MUST BE MADE OR CIRCLED IN RED INK, WITH DATE AND NAME OF PERSON MAKING CHANGE.

Do not extend notes this side of this line.

Profile No. Notes Red Plotted Job No. 6012.44 Division No. 11
X-Sec. No. Date Date Survey of S.D. Project # 12744
Notes Chkd. Date Checked Date Survey by [illegible] Notes [illegible] Date [illegible]
Map No. Indexed [illegible] Date [illegible]

F.B. 3369 PG. 149

STATION	B.S.	H.I.	F.S.	ELEV.	Lt. or North	℄ LINE	RT or South
1+33.5				5235		℄	
				5220			8.0 Rt edge of Channel
				5218			14.5 " edge of channel
				5237			24.0 " Top of bank
				5250	6.5 Lt Top of bank		
1+90				5247		℄	
				5235			20 Rt edge of channel
				5265	4.0 Lt Top of bank		
2+03.5				5265		℄	Top of bank
2+35.40				~~5265~~		℄	℄ ℄

SOUTH on ℄ LINE

					Lt or East	℄ LINE	RT or West
3+00				5274		℄	
				5271			10 Rt Top of bank
				5243			46 Rt edge of channel
				5241			50 " edge of channel
				5253			76 " Top of bank

76L-298 CE 307 11-58

T.P. 4400 528.91

PLEASE RETURN TO
LOS ANGELES COUNTY ENGINEER
700 LOS ANGELES COUNTY ENGINEERING BLDG.

NOTE: ANY ADDITIONS OR CHANGES ON THIS SHEET MUST BE MADE OR CIRCLED IN RED INK, WITH DATE AND NAME OF PERSON MAKING CHANGE

Do not extend notes this side of this line.

F.B. 3369 Pg. 150 Job No. LA12.74 Division No. 11 Notes Red Plotted Profile
Survey of S.D. Project #1274 Date 2 APR. 74 No. X-Sec.
Survey by F.E. Brooks Notes FE 13 - Glenada Notes Chkd. Checked
Indexed G.L. GALLI Date Date Date No.

STATION	B.S.	H.I.	F.S.	ELEV	Lt. or East	℄ LINE	Rt. or West
4+00				528 8		℄	
				526 8			19.0 Rt edge of channel
				526 9			44.0 " edge of channel
				532 1			75.0 " Top of bank
				530 5	8.0 Lt Top of bank		
5+00				529 4		℄	
				529 4			13.0 Rt edge of channel
				535 7			52.0 " Top of bank
				529 6	15.0 Lt edge of channel		
				534 0	33.0 " Top of bank		
5+37.0				534 6		℄	Top of bank
6+00*				535 49		℄	
				534 6	9.0 Lt Top of bank		
				533 0	16.0 " edge of channel		
				533 2	46.0 " edge of channel		
				537 1	71.0 " Top of bank		
7+00				537 5		℄	

76L-298 CE 307 11-58

PLEASE RETURN TO
LOS ANGELES COUNTY ENGINEER
700 LOS ANGELES COUNTY ENGINEERING BLDG.

NOTE: ANY ADDITIONS OR CHANGES ON THIS SHEET MUST BE MADE OR CIRCLED IN RED INK, WITH DATE AND NAME OF PERSON MAKING CHANGE.

Do not extend notes this side of this line.

STATION	B. S.	H. I.	F. S.	ELEV.	Lt. or East ℄ LINE Rt. or West
7+00				5372	12.0 Lt Top of bank
				5342	22.0 " edge of channel
				5353	43.0 " edge of channel
				5400	58.0 " Top of bank
7+86.5				53731	9.8 Lt Invert 12" steel drain pipe
7+97.7				53695	10.0 Lt Top of wing wall
				5365	10.0 " edge of channel
8+00 *				53985	℄
				5386	11.0 Lt Top of bank
				5373	31.0 " edge of channel
				5450	57.0 " Top of bank
8+08.6		5.5 27		5367	17.3 Lt edge of channel
				53747	17.3 " Top of wing wall
8+10.8				54007	10.0 Lt Top of head wall
				53583	12.7 " Invert 33" conc pipe
				54009	15.5 " Top of head wall

Profile Notes Red. Plotted Job No. 6012.14 Division No. 11
No. X-Sec. Date Date Survey of S.D. Project #1378
No. Note Chkd. Date Checked Surveyed by E.E.H. Notes Chkd. Date 7/11/
Date Map No. Indexed E.J.C. Date 10-10-74
F.B. 3364 Pg. 151

76L-298 CE 307 11-58

PLEASE RETURN TO
LOS ANGELES COUNTY ENGINEER
700 LOS ANGELES COUNTY ENGINEERING BLDG.

NOTE: ANY ADDITIONS OR CHANGES ON THIS SHEET MUST BE MADE OR CIRCLED IN RED INK, WITH DATE AND NAME OF PERSON MAKING CHANGE

Do not extend notes this side of this line.

F.B. 3369 Pg. 152 Job No. 6012.74 Division No. 11 Notes Red Plotted
Survey of S.D. Project #12.24 Date 2 APR. '71 Date
Survey by E.E. Brooks Notes FEB - Elizade Notes Chkd. Checked
Indexed B.J. BALL Date Date Date
Profile No. X-Sec. No.

STATION	B. S.	H. I.	F S.	ELEV	Lt. or East	TZone	Rt. or West
8+10.8				5380	15.5 Lt. ground		
				5375	38.7 " ground		
				5421	47.7 " ground		
				5446	" Top bank		
8+54.07 T.P.				54389			
BM S.D. 1259				54595	BM S.D. 1259 Elev. = 545.959 F.B. 3369-11 120ft ± E. of Doubletree Ln. and 345ft ± N of Aguiro St. A chis + in the N Rim of a S.D. M.H.		

Notes Ck'd by H. HOLMAN
Map No.
Office Work
Checked
Date

Survey of S.D. Project # 1274
JN 6012.74 Temp 0273 Sht 46 °F
Surveyed by FE Brooks
Notes FEB 606 Date 5 Apr 71
Indexed C.S. GALLI MW 10 71

F. B. 3819 PG. 153

JN 6012.74

STORM DRAIN PROJECT

No 1274

LINE E

CENTERLINE

From Aguiro St.

To Path finder Rd.

FE Brooks
GO Guizado
RA Moore
T Ohashi

Note: Any Additions or Changes on This Sheet Must be Made or Circled in Red Ink With Date and Name of Person Making Change.

Do not extend this side of this line.

PLEASE RETURN TO
LOS ANGELES COUNTY ENGINEER
403 Los Angeles County Engineering Bldg.

76F3095 CE # 310 3-61

F. B. 3369 Pg. 154

S. D. PROJ. # 1274
Line "E"

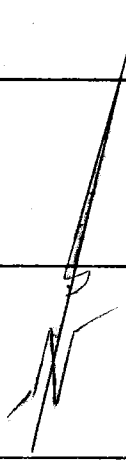

DEL BONITA ST.

℄ 155

AGUIRO ST.

GALLIO

℄ 156

HIDALGO ST

℄ 157

LINCROFT ST.

℄ 158

AVE.

RD.

PATHFINDER

℄ 159

PLEASE RETURN TO
LOS ANGELES COUNTY ENGINEER
403 Los Angeles County Engineering Bldg.

Do not extend this side of this line.

Note: Any Additions or Changes on This Sheet Must be Made or Circled in Red Ink With Date and Name of Person Making Change.

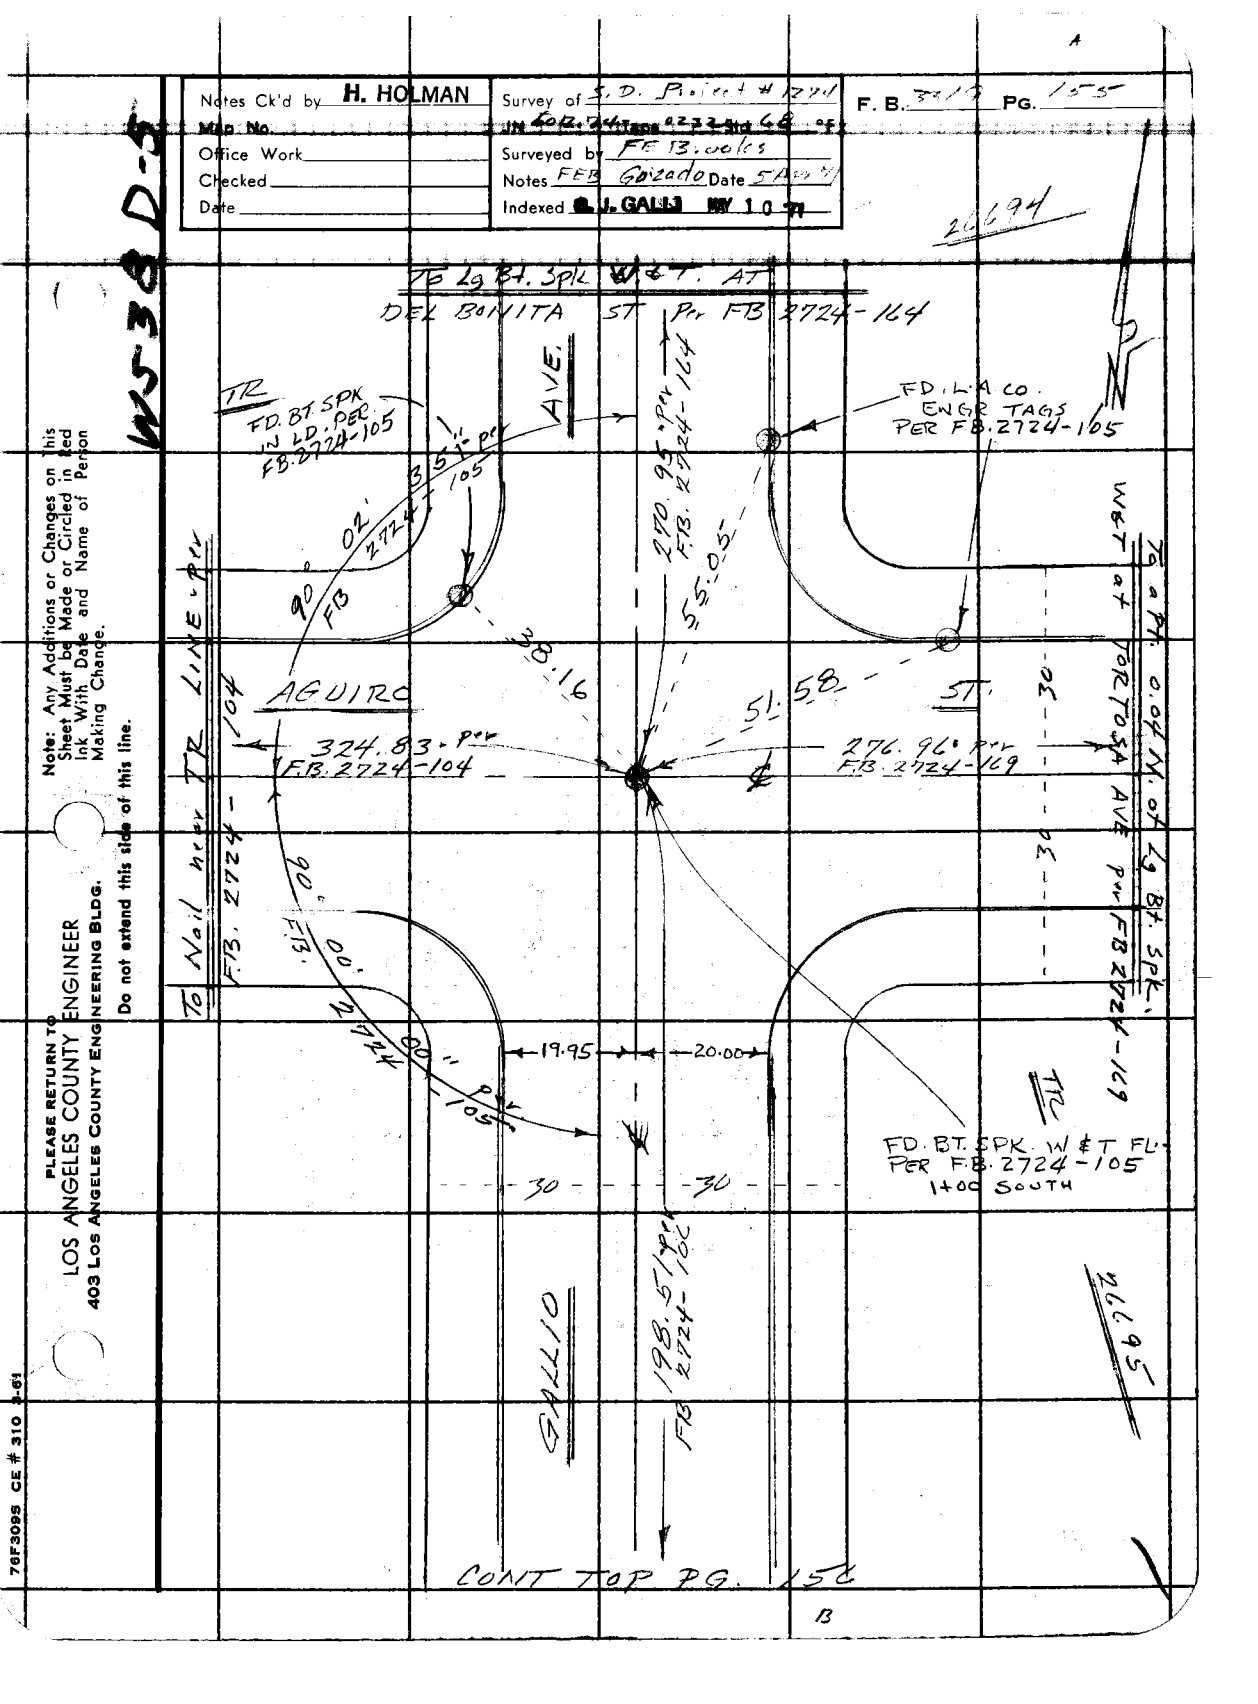
Notes Ck'd by H. HOLMAN
Map No.
Office Work
Checked
Date
Survey of S.D. Project #12741
JN 6012.244 Tape 0232 Bld 68 of
Surveyed by FF 13. coles
Notes FEB Gonzado Date 5 Aug 71
Indexed R. J. GALLO MAY 10 '71
F. B. 3013 PG. 155
WS 38 D-5
TR
FD. BT. SPK IN LD. PER F.B. 2724-105
AVE.
DEL BONITA ST
Per FB 2724-164
FD. L.A CO. ENGR TAGS PER F.B. 2724-165
324.83' P&r F.B. 2724-104
276.96' P&r F.B. 2724-169
270.95' P&r F.B. 2724-164
TO Nail near TR LINE P&r F.B. 2724-104
TO a Pt. 0.04' N. of Lg Bt. SPK. WEST at TORTOSA AVE P&r FB 2724-169
19.95
20.00
30
FD. BT. SPK. W & T FL. PER F.B. 2724-105 1+00 SOUTH
GALLIO
198.51' P&r F.B. 2724-164
CONT TOP PG. 156
Note: Any Additions or Changes on This Sheet Must be Made or Circled in Red Ink With Date and Name of Person Making Change.
Do not extend this side of this line.
PLEASE RETURN TO
LOS ANGELES COUNTY ENGINEER
403 Los Angeles County Engineering Bldg.
76F3095 CE # 310 3-61

PLEASE RETURN TO
LOS ANGELES COUNTY ENGINEER
403 LOS ANGELES COUNTY ENGINEERING BLDG.

Note: Any Additions or Changes on This Sheet Must be Made or Circled in Red Ink With Date and Name of Person Making Change.

Do not extend this side of this line.

F.B. 3369 Pg. 151

CONT 1ST PG 135

CONT 2ND PG 135

2+98.51
FD. 59. HD. SPK
PER F.B. 2724-106

198.51' PVT. FD. 2924+ AVE

171.93' PVT FD. 2924+ 10E

30

30

N 5°903

72

72

1

Notes Ck'd by H. HOLMAN
Map No.
Office Work
Checked
Date

Survey of S.D. Project #2002
IN 6412 Tape 0232 Dist. 66 °F
Surveyed by F.E. Brooks
Notes F.E. 15 906 Date 5 Apl. 71
Indexed G. J. GALLI NOV 10 71

F. B. 2724 Pg. 107

W.S. 38 E-5

25195

TR

4430.44 FD. BT. SPK W & T. FLUSH PER F.B. 2724-107 1+00 WEST

CONT FROM PG 107

30' GALLIO

AVE

131.93 P.T. F.B. 2724-106

49.97

19.91

45.32

100.00'

498.14 P.T. F.B. 2724-109

48.51

51.24

CONT FROM PG 108

L & T PER F.B. 2724-107

17.94

8.07

90° 00' F.B. 2724-109

90° 00' F.B. 2724-107

L & T PER F.B. 2724-107

TAPE # 0232

99.99 T=90°-1000

SET L.A.CO. ENGR. TAG

18.34

18.30

SET L.A.CO. ENGR TAG

30

30

25-903

FIDALGO ST.

SET LG. BT. SPK W & T. FLUSH

TR

TO P.M. ON WASHER 0.05 N. OF BT SPK W & T IN 3

4+ ABETO AVE PROJ

F.B. 2724-109

Note: Any Additions or Changes on This Sheet Must be Made or Circled in Red Ink With Date and Name of Person Making Change.

Do not extend this side of this line.

PLEASE RETURN TO
LOS ANGELES COUNTY ENGINEER
403 Los Angeles County Engineering Bldg.

76F3095 CE # 310 3-69

F. B. 3369 PG. 158

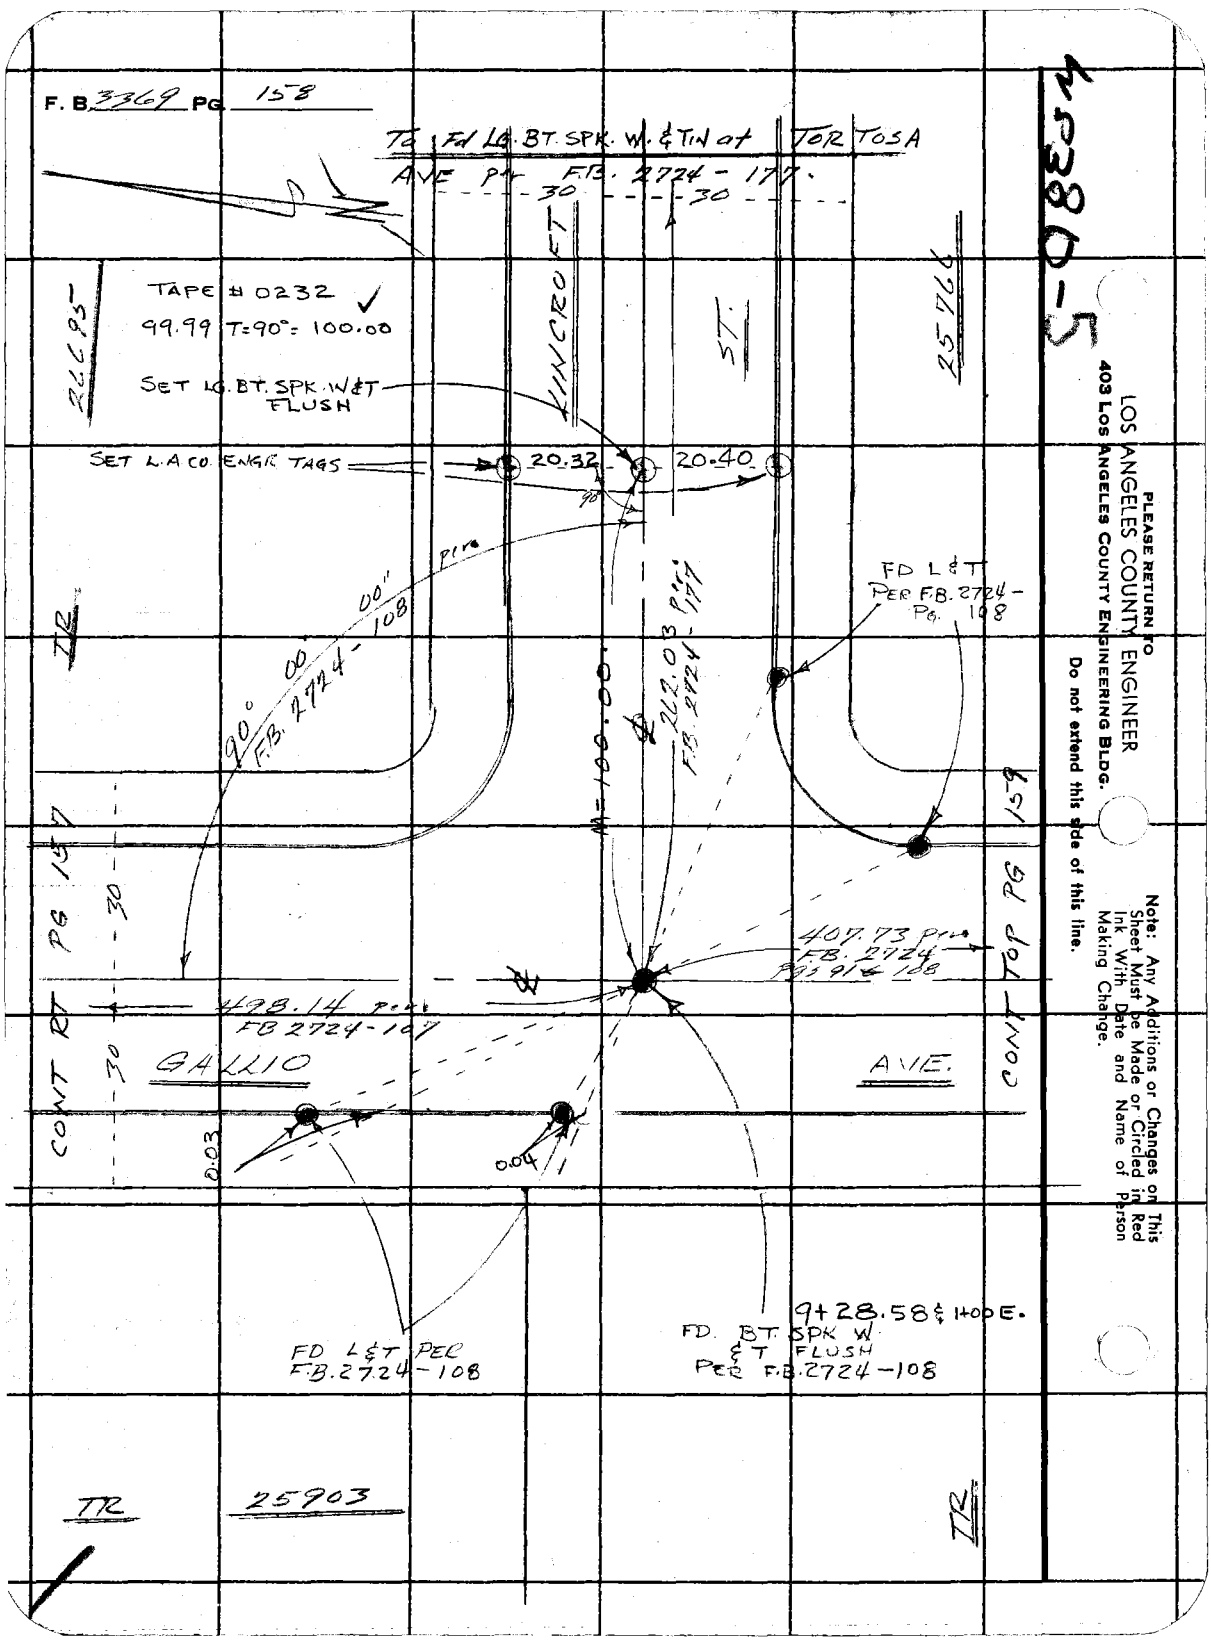

5-0834

LOS ANGELES COUNTY ENGINEER
403 Los Angeles County Engineering Bldg.

PLEASE RETURN TO

Do not extend this side of this line.

Note: Any Additions or Changes on This Sheet Must be Made or Circled in Red Ink With Date and Name of Person Making Change.

Notes Ck'd by H. HOLMAN	Survey of S.D. Project #1704	F. B. 2724	Pg. 159
Map No.	JN 60R-1704 Tape 4232 Rec 66		
Office Work	Surveyed by F.E. Brooks		
Checked	Notes FEB - Guizado Date		
Date	Indexed G.L. GALLI		

25R66

CONT RT PG 158

WR38, D-5

Note: Any Additions or Changes on this Sheet Must be Made or Circled in Red Ink With Date and Name of Person Making Change.

Do not extend this side of this line.

PLEASE RETURN TO
LOS ANGELES COUNTY ENGINEER
403 Los Angeles County Engineering Bldg.

GALLIO AVE

30 30

TR

HOM 73°P.L.S. 91 F.B. 2724 Pgs 108

13+36.31
•FD L.A CO. ENGR TAG IN CURB PER F.B. 2724-91

FD L.A CO. ENGR TAG PER F.B. 2724-91

13.4

14.63

FD. L.A CO. ENGR TAG IN WALL PER F.B. 2724-91

FD 2" I.P CONC. PLUG (TAG OUT) PER F.B. 2724-91

RD (Proposed)

83°49'30" F.B. 2724-91

TC, L.B.P.L.S. F.B. 2724 Pg. 91

15.00

10

56.15

PATHFINDER

Prop ℄

95

13+92.99
•FD 1" I.P. CONC. PLUG & L.A CO. ENGR. TAG PER F.B. 2724-91

FD. 2" I.P. CONC. PLUG & RCE TAG # 8244 PER F.B. 2724-91

76F3095 CE # 310 3-61

PLEASE RETURN TO
LOS ANGELES COUNTY ENGINEER
403 LOS ANGELES COUNTY ENGINEERING BLDG.

Note: Any Additions or Changes on This Sheet Must be Made or Circled in Red Ink With Date and Name of Person Making Change.

Do not extend this side of this line.

F. B. 3369 Pg. 160

Notes Ck'd by _____
Map No. _____
Office Work _____
Checked _____
Date _____

Survey of S.D. Project #1274
INCLUDING Tape _____ Std. _____ °F
Surveyed by F.E. Brooks
Notes FEB - G. Guizado Date 6 APR 71
Indexed S.D. GALLI MW 10 T

F. B. 331-K Pg. 161

SN 6012.74

STORM DRAIN PROJECT

No 1274

LINE E

LOCATION of IMPROVEMENTS

From Aguila St.

To Pathfinder Rd.

F E Brooks
G O Guizado
R A Moore
T Ohashi

Note: Any Additions or Changes on This Sheet Must be Made or Circled in Red Ink With Date and Name of Person Making Change.

Do not extend this side of this line.

PLEASE RETURN TO
LOS ANGELES COUNTY ENGINEER
403 LOS ANGELES COUNTY ENGINEERING BLDG.

76F3095 CE # 310 2-61

F. B. 3369 Pg. 162

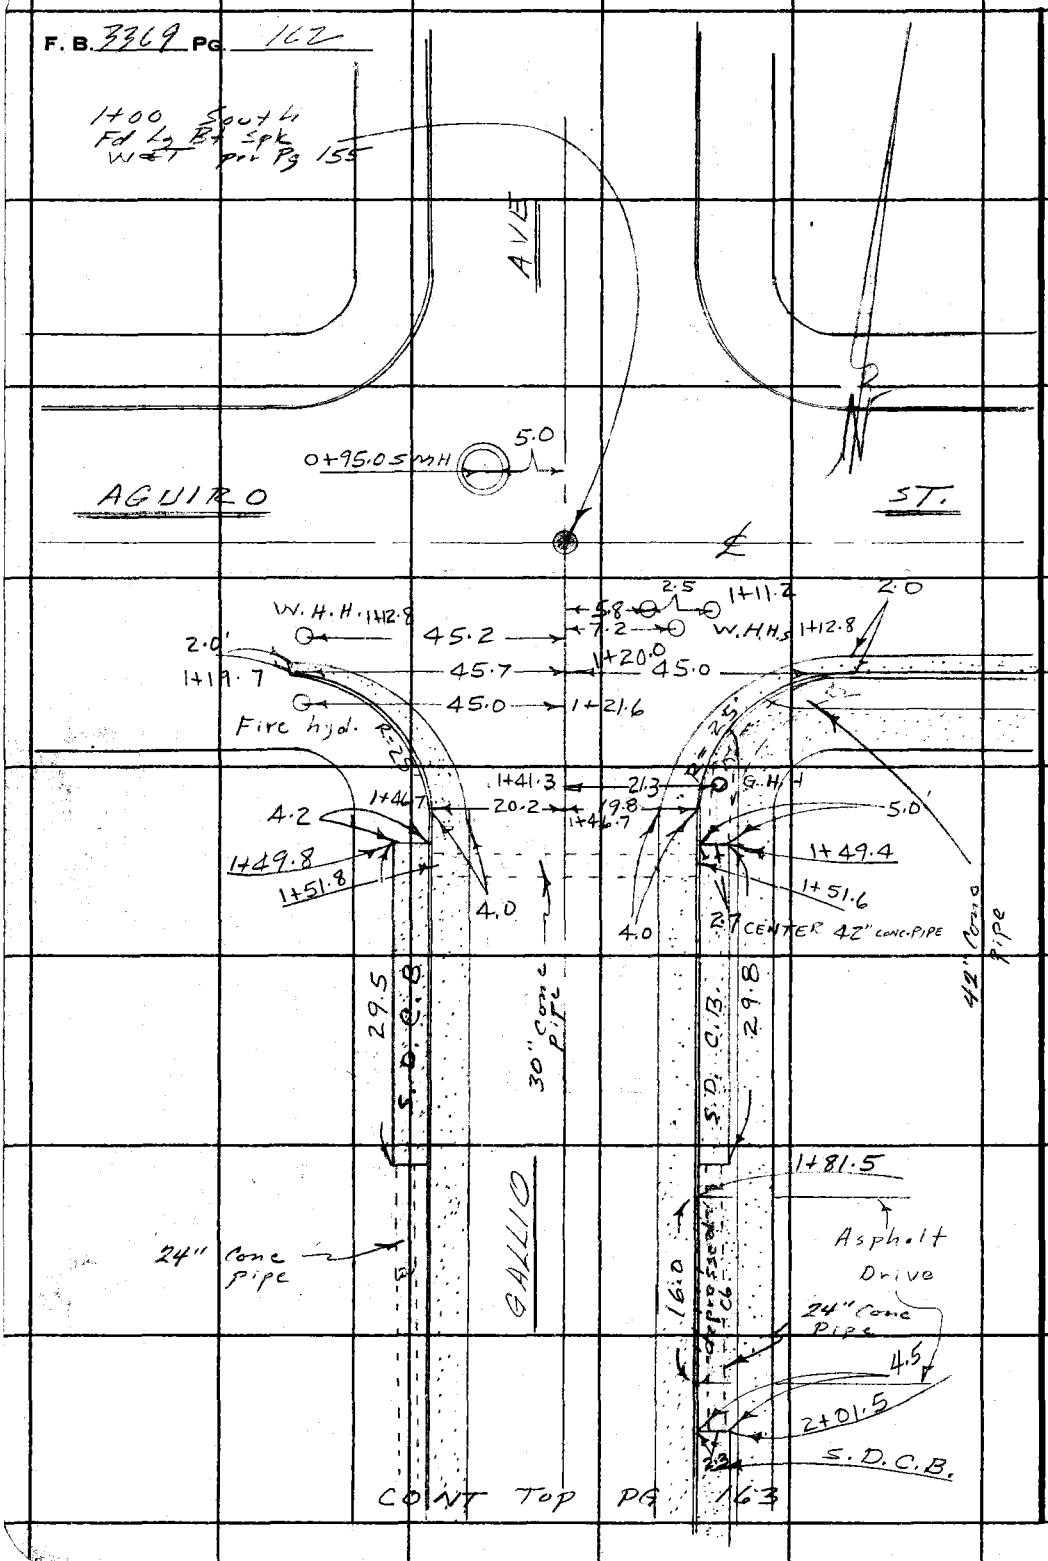

PLEASE RETURN TO
LOS ANGELES COUNTY ENGINEER
403 Los Angeles County Engineering Bldg.

Do not extend this side of this line.

Note: Any Additions or Changes on This Sheet Must be Made or Circled in Red Ink With Date and Name of Person Making Change.

Notes Ck'd by	Survey of S.D. Project 4 Proj.
Map No.	JN 5012.24 Tape Std.
Office Work	Surveyed by F.E. Brooks
Checked	Notes FEB-Guiz. Date 5 APR 71
Date	Indexed G. J. GALLI MAY 10 '71

F. B. ____ PG. 162

CONT BOT PG 162

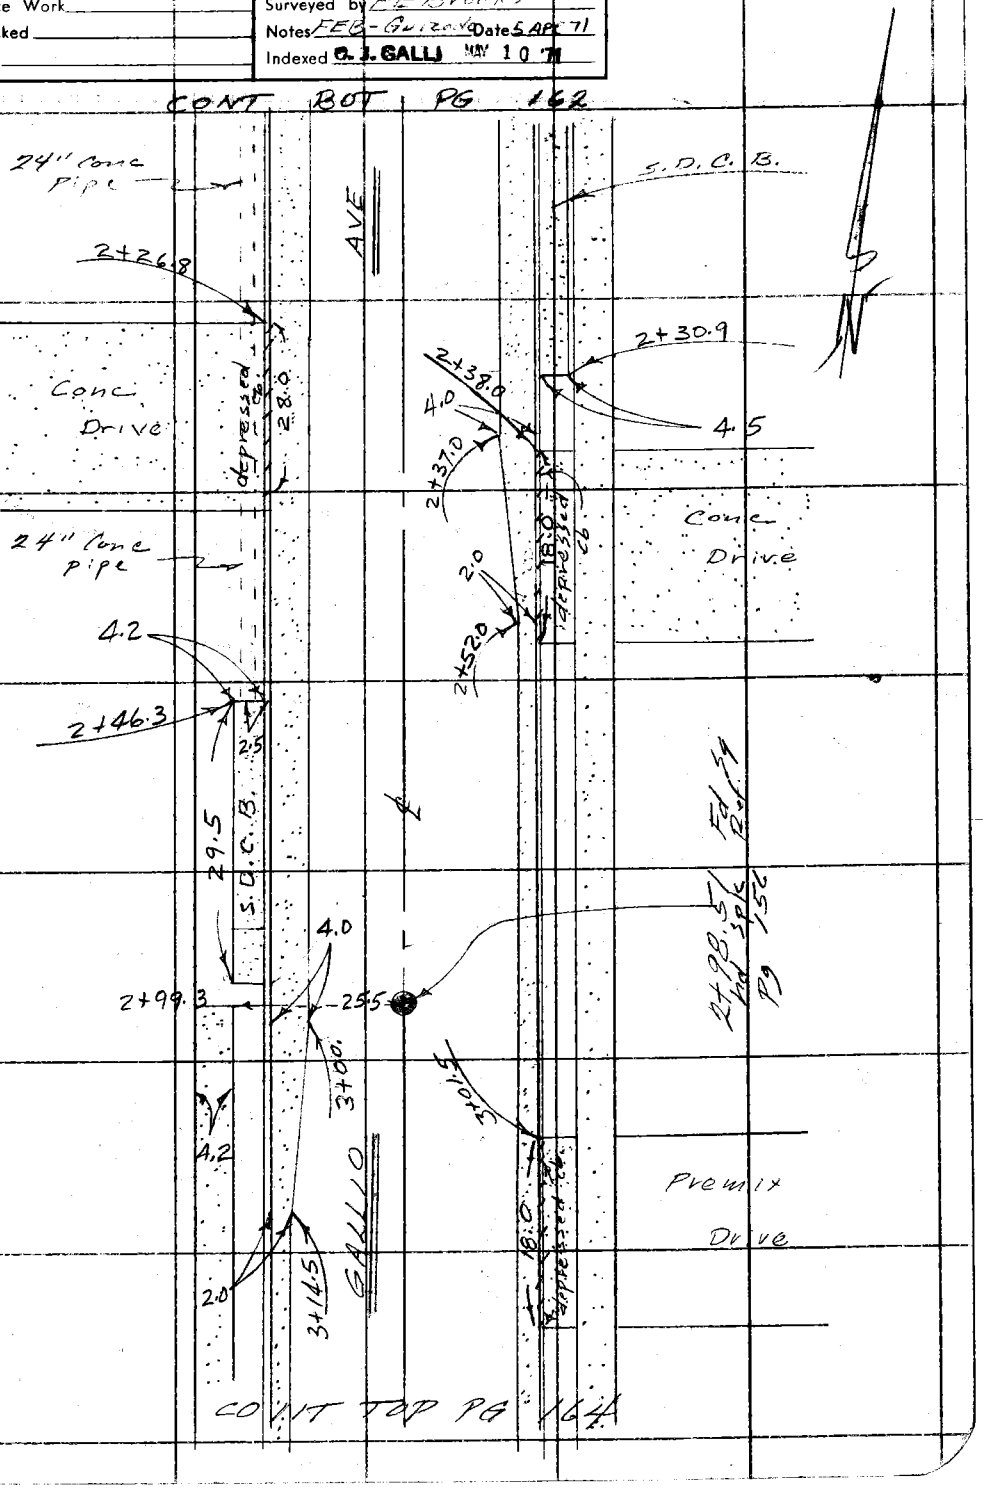

CONT TOP PG 164

PLEASE RETURN TO
COUNTY OF LOS ANGELES
DEPARTMENT OF COUNTY ENGINEER
403-LOS ANGELES COUNTY ENGINEERING BLDG.

Note: Any Additions or Changes on this Sheet Must be Made or Circled in Red Ink With Date and Name of Person Making Change.

Do not extend this side of this line.

76F3095 CE#310 3-68

F. B. 339 Pg. 164

CONT BOT PG 163

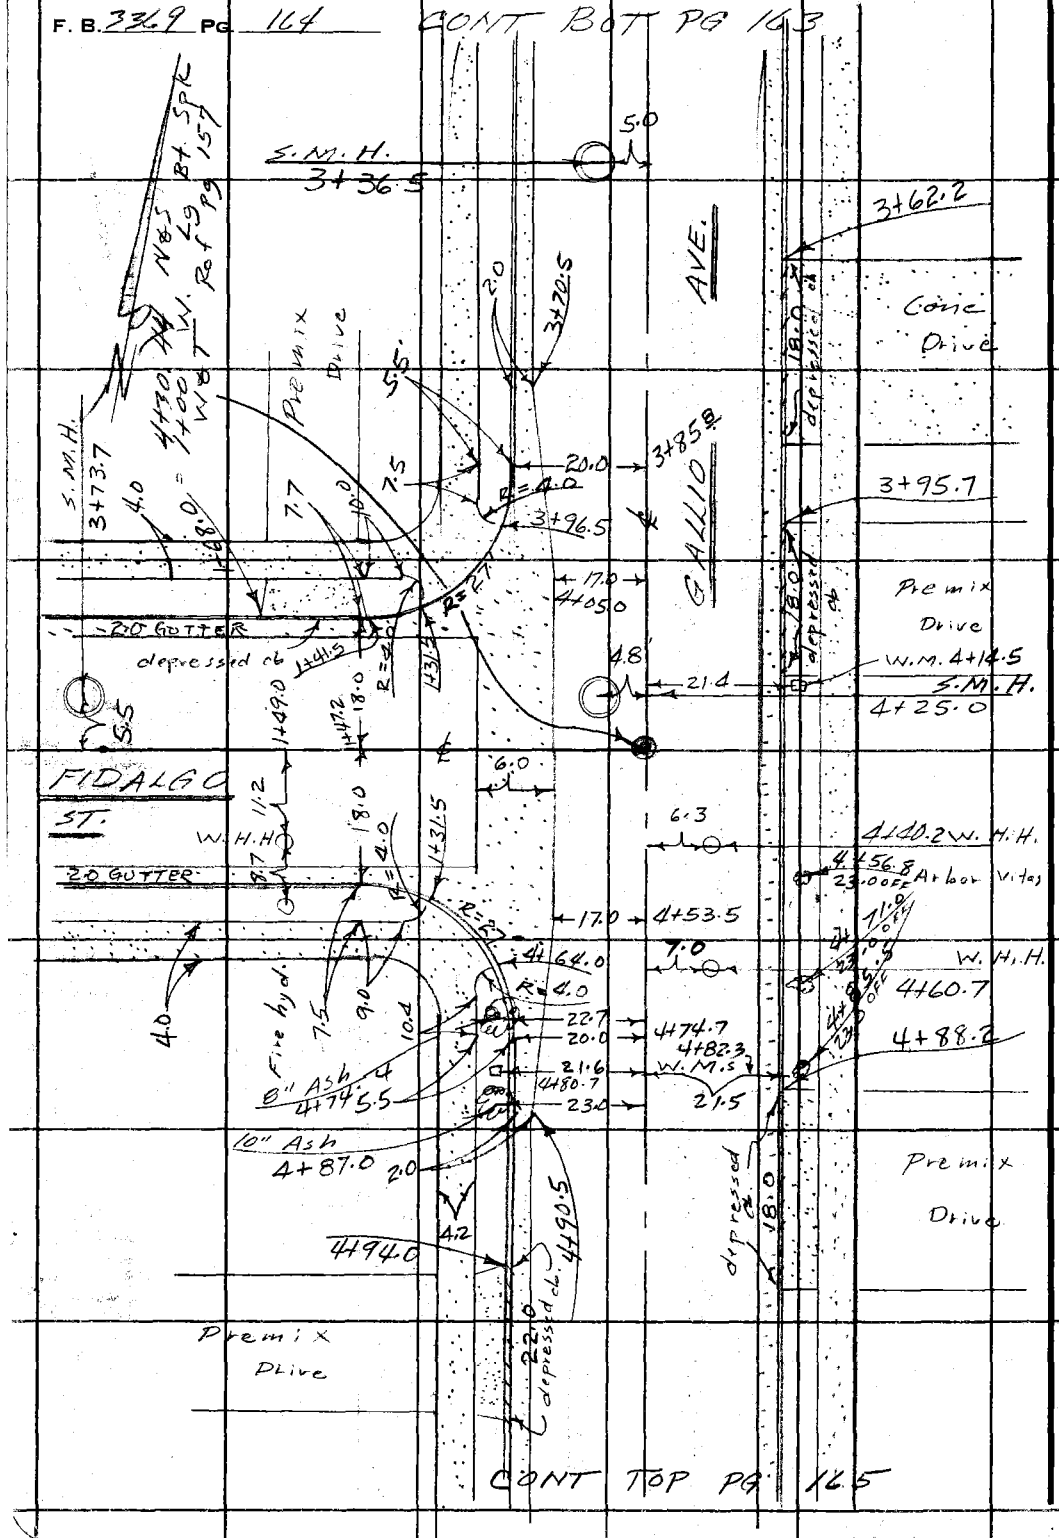

PLEASE RETURN TO
COUNTY OF LOS ANGELES
DEPARTMENT OF COUNTY ENGINEER
403 LOS ANGELES COUNTY ENGINEERING BLDG.

Do not extend this side of this line.

Note: Any Additions or Changes on This Sheet Must be Made or Circled in Red Ink With Date and Name of Person Making Change.

Notes Ck'd by	Survey of S.D. Project #12 74
Office Work	Surveyed by FT Brooks
Checked	Notes FEB Guizado Date 5 APR 71
Date	Indexed B. J. GALLI MAY 10 '71


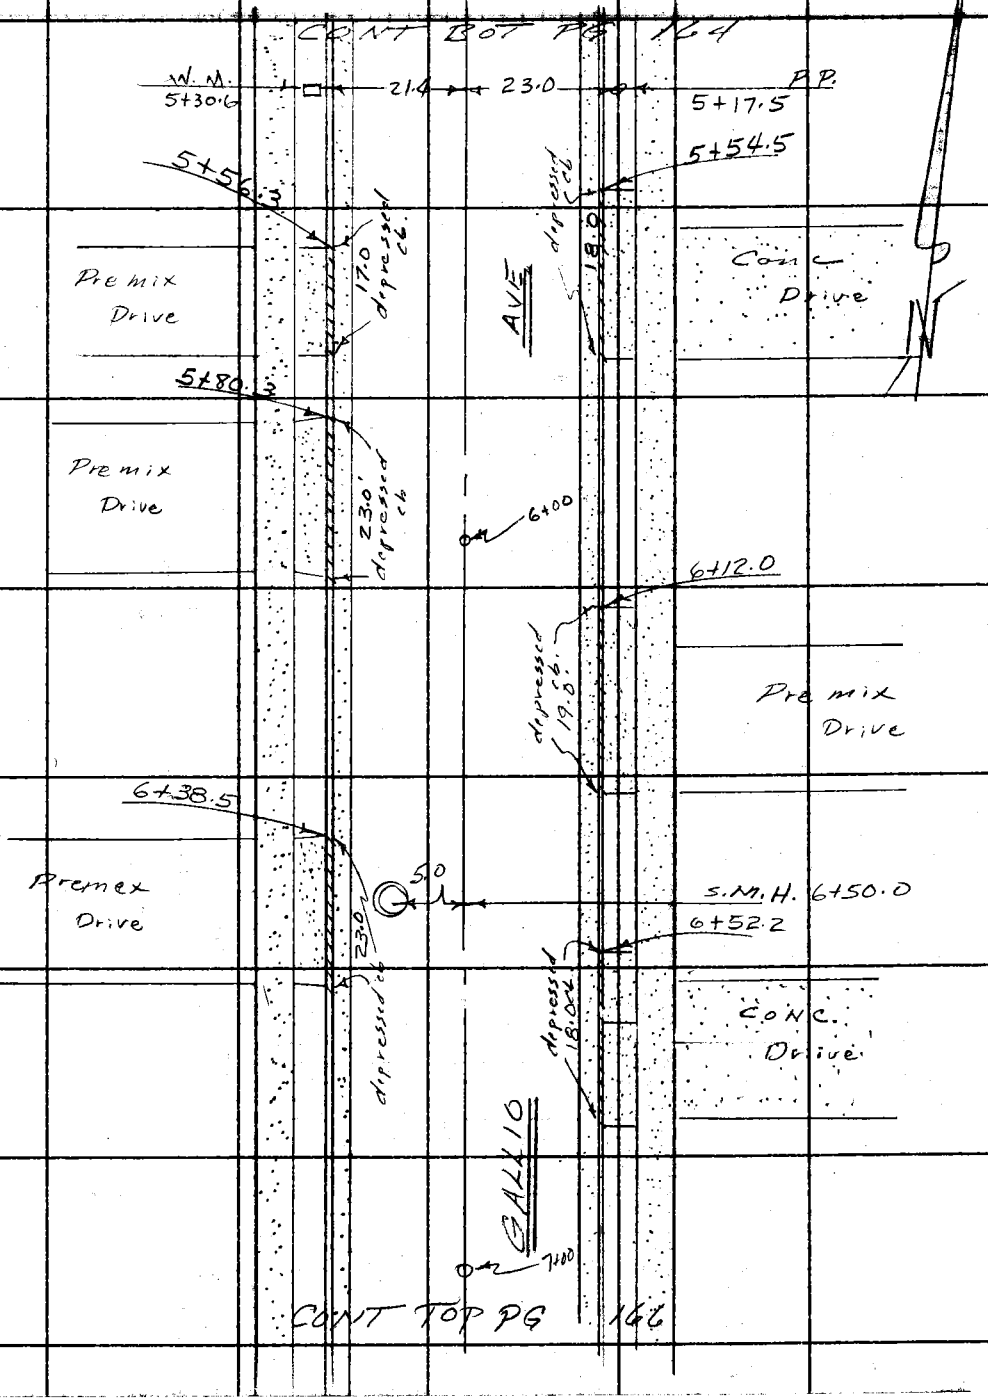

Note: Any Additions or Changes on this Sheet Must be Made or Circled in Red Ink With Date and Name of Person Making Change.

Do not extend this side of this line.

PLEASE RETURN TO
LOS ANGELES COUNTY ENGINEER
403 LOS ANGELES COUNTY ENGINEERING BLDG.

76F3095 CE # 310 2-61

F. B. 3369 Pg. 166 CONT BOT Pg 165

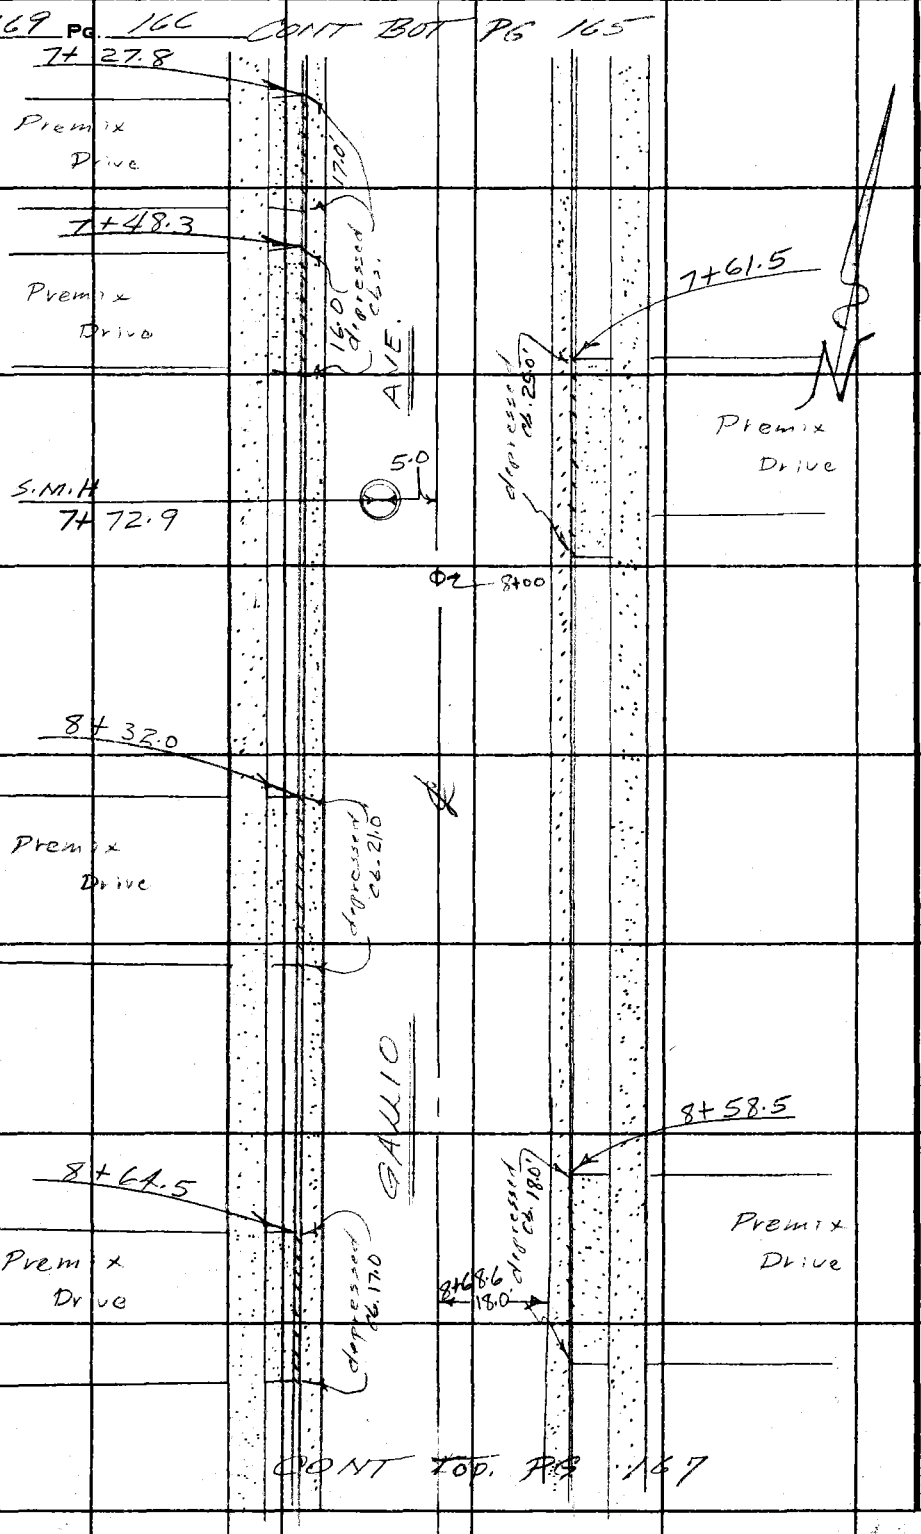

CONT TOP. Pg 167

PLEASE RETURN TO
LOS ANGELES COUNTY ENGINEER
403 Los Angeles County Engineering Bldg.

Do not extend this side of this line.

Note: Any Additions or Changes on This Sheet Must Be Made or Circled in Red Ink With Date and Name of Person Making Change.

Notes Ck'd by
Note No.
Office Work
Checked
Date

Survey of L D Dist # [illegible]
IN [illegible] Tape Std °F
Surveyed by FF Brooks
Notes FFB Glendora Date 6 APR '71
Indexed L.J. GALLI NW 10 '71

F. B. 33[illegible] Pg. 167

CONT BOT PG 166

9+28.58 N&S = 1100 E. Fd Lg Bt Spk W&T Ref. Pg 158

AVE

8+83.0
20.0
9+00
9+01.4
17.0
8+97.0
R=25
6.0
5.5
10.0'
R=4'
10.0'
5.5
4.0 WALK
2.0' GUTTER
S.M.H.
13+67.0
1+320
20.0
1+449
1+352
1+325.3
20.2
1+432.5
R=25
R=4.0
9+15.9
17.0
7.8 W.H.
9+58.3
9+61.5
9+74.2
9+74.5
22.8
20.2
9.0
10.0'
5.5
9+74.8
F.H.
5.5
4.0
9+83.5
Cone Planter
3' Tree
W.M.
9+90.4
21.7
9+97.8
10+00
2.0 GUT.
10+00.5
Premix
Drive
10+02.2
d/pressed cb.
18.0'
Premix
Drive
W.M.
10+23.0
21.5
CONT TOP PG 168

P.P. with capped 1½" conduit
0
22.4
9+18.5
dead man
9+28.6
21.5
S.M.H.
9+32.3
5.0
Premix
Drive
9+32.5
d/pressed cb
18.0
W.M.
9+55.0
9+67.4
21.5
Brick Planter
2" Tree
5.5

47
LINCROFT
ST.
2.0' GUTT.
4.0 WALK

PLEASE RETURN TO
LOS ANGELES COUNTY ENGINEER
403 Los Angeles County Engineering Bldg.

Note: Any Additions or Changes on This Sheet Must be Made or Circled in Red Ink With Date and Name of Person Making Change.

Do not extend this side of this line.

78F3095 CE # 310 3-61

F. B. 3369 PG. 168

CONT BOT PG 167

10+63.0

Premix Drive

10+76

Premix Drive

17.5' depressed

4.0' W'walk

11+00

AVE

11+23.0

Premix Drive

11+43.0

Premix Drive

17.0 depressed

11+59.8

11+76.0

11+83.8

11+81.6

GALLIO

Premix Drive

12+05.5

12+04.3

12+00.2

Drain under walk

5.0'

5.0

CONT TOP PG 168

depressed 18.0

5.0

Drain under walk

5.0

PLEASE RETURN TO
LOS ANGELES COUNTY ENGINEER
403 Los Angeles County Engineering Bldg.

Do not extend this side of this line.

Note: Any Additions or Changes on This Sheet Must be Made or Circled in Red Ink With Date and Name of Person Making Change.

Notes Ck'd by
Mtls. No.
Office Work
Checked
Date

Survey of S.D. Project #1205
Tape Std
Surveyed by F.E. Brooks
Notes FEB Quizeta Date 6 APR 71
Indexed J.J. GALLI MAY 10 '71

F. B. 3569 Pg. 119

Drain under walk

GRAT BAT PG. 1613

Drain under walk

12+13.8

Premix Drive

18.0 Depressed Ctr

AVE.

5.0

5.0'

0.5'

12+37.0

0.5

12+47.5

4.0

20.0' GUTTER

12+31.5

Premix Drive

Depressed Ctr 18.0

12+72.7

S.M.H. 12+85.0

12+84.3

5.0

Premix Drive

13+00

GALLI

Premix Drive

4.0

O.K 13+16.3

13+16.3 O.K

13+92.99 Fd 1" I.P. Conc. Plug & Co Engr Tag Ref Pg 159

13+11.0

20.0 20.0

13+12.4 9.0 IN. M.H.

13+11.6

22.2

13+13.5

5.5

5.5

R=20

Fire Hyd.

13+36.31 Fd 1" I.P. Co Engr Tag Ref Pg 159

18" Cast Iron Pipe

RD.

128.8

13+53.7

PATHFINDER

PLEASE RETURN TO
LOS ANGELES COUNTY ENGINEER
403 Los Angeles County Engineering Bldg.

Note: Any Additions or Changes on This Sheet Must be Made or Circled in Red Ink With Date and Name of Person Making Change.

Do not extend this side of this line.

76F3095 CE # 310 3-61

PLEASE RETURN TO
LOS ANGELES COUNTY ENGINEER
403 LOS ANGELES COUNTY ENGINEERING BLDG.

Note: Any Additions or Changes on This Sheet Must be Made or Circled in Red Ink With Date and Name of Person Making Change.

Do not extend this side of this line.

F. B. 3360 PG. 170

Profile No.____ Notes Red____ Date____ Plotted____ Date____ Job No. 6012.74 Division No. 11 Survey of S.D. Project #1274 F.B. 3369 PG. 171

X Sec. No.____ Notes Chkd____ Date____ Checked____ Date____ Computed FE Brooks 6-76 Date____

No.____ Date____ Date____ Map No.____ Indexed R. J. GALLI Date MAY 10 77

J. N. 6012.74

STORM DRAIN PROJECT

No 1274

LINE E

CROSS SECTIONS

From Aguiva St.

To Pathfinder Rd.

STATION	B.S.	H.I.	F.S.	ELEV.
		FE Brooks GO Giuzado RA Moore T. Ohashi		

NOTE: ANY ADDITIONS OR CHANGES ON THIS SHEET MUST BE MADE OR CIRCLED IN RED INK, WITH DATE AND NAME OF PERSON MAKING CHANGE.

Do not extend notes this side of this line.

PLEASE RETURN TO
LOS ANGELES COUNTY ENGINEER
700 LOS ANGELES COUNTY ENGINEERING BLDG.

76L-298 CE 307 11-58

76L-298 CE 307 11-58

PLEASE RETURN TO
LOS ANGELES COUNTY ENGINEER
700 LOS ANGELES COUNTY ENGINEERING BLDG.

NOTE: ANY ADDITIONS OR CHANGES ON THIS SHEET MUST BE MADE OR CIRCLED IN RED INK, WITH DATE AND NAME OF PERSON MAKING CHANGE

Do not extend notes this side of this line.

F.B. 3369 Pg. 172 | Job No. 6012.74 | Division No. LL | Notes Red | Plotted | Profile
Survey of S.D. Project #12 74 | Date 12 APRIL 1974 | No. | X-Sec.
Survey by E.E. Brooks Notes E.E.B. - Guizada | Notes Chkd. | Checked | No.
Indexed [redacted] GALLI | Date | Date

STATION	B. S.	H. I.	F. S.	ELEV			
BM SD 1261				563 74	BM S.D 1261 Elev. 563.741 F.B. 3369-17		
					Aguiro St. and Gallio Ave S.E. Cor.		
					PK spk in lead in S.W. Cor. of S.D.C.B.		
					SOUTH on GALLIO AVE		
					Lt. or East	℄	Rt. or West.
0+95.0		N Rim = 561.12 S.M.H. S Rim = 561.13		561.12			5.0 Rt Mean Rim elev.
						Inlet So.	Inlet E. outlet W
INVert		" Inlet SOUTH		546.53	Rim	561.12	561.12 561.12
"		" EAST		546.23	Meas	13.92	14.22 14.21
"		outlet WEST		545.24	dia	547.20	546.90 546.91
					Top pipe	0.67	0.67 0.67
					Invert.	546.53	546.23 545.24
1+46.9				562.27			℄
				562.22			10.1 Rt pvmt
				561.75			16.2 " gutter out
				561.52			20.2 " gutter in
				562.23			20.2 " Top cb.
				562.02	9.9 Lt pvmt		
				561.94	15.8 " gutter out		

76L-298 CE 307 11-58

PLEASE RETURN TO
LOS ANGELES COUNTY ENGINEER
700 LOS ANGELES COUNTY ENGINEERING BLDG.

NOTE: ANY ADDITIONS OR CHANGES ON THIS SHEET MUST BE MADE OR CIRCLED IN RED INK, WITH DATE AND NAME OF PERSON MAKING CHANGE.

Do not extend notes this side of this line.

Profile Notes Red ____ Plotted ____ Job No. 60-1178 Division No. 11
No. ____ Date ____ Date ____ Survey of S.D. Project #1 1974
X-Sec. Notes Chkd ____ Checked ____ Surveyed by ____ Notes ____ Date ____
No. ____ Date ____ Date ____ Map No. ____ Indexed ____ Date ____ Date 10-10-74

F.B. 236 Pg. 1173

STATION	B.S.	H.I.	F.S.	ELEV.	Lt. or East	℄ Rt. or West
1+46.7				56159	19.8 Lt gutter in	
				56235	19.8 " Top of cb.	
1+49.4				55971	22.5 Lt Invert of 42" outlet from C.B.	
1+51.6				55878	19.8 Lt Invert of 30" Inlet to C.B	
1+51.8				55955		20.2 Rt. Invert 30" outlet from C.B.
2+00				56456		℄
				56440		16.1 Rt pvmt
				56414		16.2 " gutter out
				56387		20.2 " gutter in
				56451		20.2 " Top of cb.
				56438	9.9 Lt pvmt	
				56418	15.8 " gutter out	
				56377	19.8 " gutter in	
				56462	19.8 " Top cb.	
2+01.5				56205	23.1 Lt. Invert of 24" outlet from C.B.	

76L-298 CE 307 11-58

PLEASE RETURN TO
LOS ANGELES COUNTY ENGINEER
700 Los Angeles County Engineering Bldg.

NOTE: ANY ADDITIONS OR CHANGES ON THIS SHEET MUST BE MADE OR CIRCLED IN RED INK, WITH DATE AND NAME OF PERSON MAKING CHANGE

Do not extend notes this side of this line.

F.B. 3369 Pg. 174 Job No. 6012.9 Division No. 11 Notes Red Plotted Profile
Survey of S.D. Project #12 54 Date 12 APRIL 171 Date No. X-Sec.
Survey by FE Brooks Notes FEB. - Guizado Notes Chkd. Checked
Indexed G. T. GAILI Date Date Date No.

STATION	B. S.	H. I.	F S.	ELEV	Lt or East	℄ Rt. or West.
2+37.0				565.71	15.8 Lt. ✗pt gutter out	
2+46.3				564.75		22.7 Rt. Invert of 24" drain out Lt.
2+52.0				566.28	17.8 Lt. ✗pt. gutter out.	
3+00 *				568.79		℄
				568.69		10.0 Rt. pvmt
				568.43		16.0 " ✗pt Gutter out
				568.21		20.0 " gutter in
				568.87		20.0 " Top cb.
				568.62	9.9 Lt pvmt	
				568.43	17.8 " gutter out	
				568.19	19.8 " " in	
				568.89	19.8 " Top cb.	
3+36.5	S.M.H.	N Rim = 570.33 S. Rim = 570.43		570.38		5.0 Rt Mean rim elev. 8" OUTLet NORTH
					Rim meas	570.38 7.53
	IN Vert 8" outlet North			562.18	Top pipe dia	562.85 0.67
					invert	562.18

76L-298 CE 307 11-58

PLEASE RETURN TO
LOS ANGELES COUNTY ENGINEER
700 LOS ANGELES COUNTY ENGINEERING BLDG.

NOTE: ANY ADDITIONS OR CHANGES ON THIS SHEET MUST BE MADE OR CIRCLED IN RED INK, WITH DATE AND NAME OF PERSON MAKING CHANGE.

Do not extend notes this side of this line.

Profile No. X-Sec. No. Notes Red Date Date Plotted Date Checked Job No. 4012.11 Survey of S.D. Project # 12774 Division No. 11 Surveyed by E.E. Brown Notes by E.E.B. Date 12-4-64 Indexed Date Map No. Date

F.B. 336 Pg. 175

STATION	B.S.	H.I.	F.S.	ELEV.	Lt. or East	℄	Rt. or West.
3+75.8				57210		℄	
				57194		10.0 Rt pvmt	
				57169		17.8 " gutter out	
				57150		20.0 " gutter in	
				57215		20.0 " Top cb.	
				57186	9.9 Lt. pvmt		
				57160	17.8" gutter out		
				57144	19.8" gutter in		
				57155	19.8" Top depressed cb.		
4+25.0	S.M.H.	N Rim = 57404 S Rim = 57411		57407		4.8 Rt Mean Rim Elev.	
		1 Vert 8" inlet S.		56587	8" inlet So.	8" outlet West	8" outlet No.
		1 8" outlet W		56558	Rim 574.07	574.07	574.07
		1 " " N.		56588	Meas 7.53	7.82	7.52
					Top pipe 566.54	566.25	566.55
					dia 0.67	0.67	0.67
					Invert 565.87	565.58	565.88
4+30.44				57436		℄ inter.	

76L-298 CE 307 11-58

PLEASE RETURN TO
LOS ANGELES COUNTY ENGINEER
700 LOS ANGELES COUNTY ENGINEERING BLDG.

NOTE: ANY ADDITIONS OR CHANGES ON THIS SHEET MUST BE MADE OR CIRCLED IN RED INK, WITH DATE AND NAME OF PERSON MAKING CHANGE

Do not extend notes this side of this line.

F.B. 3749 Pg. 176 | Job No. L012.7F | Division No. 11 | Notes Red | Plotted | Profile

Survey of S.D. Project # 12 94 | Date 12 APRIL 1971 | No. | X-Sec.

Survey by FEB Brooks Notes FEB - Guizado | Notes Chkd. | Checked

Indexed G. T. BALLI | Date | Date | No.

STATION	B. S.	H. I.	F S.	ELEV		
					WEST on FIDALGO ST.	
					Lt or South	& Rt. or North
1+57.2				575 00		℄
				574 61		9.0 Rt pvmt
				574 32		16.0 " gutter out
				574 13		18.0 " gutter in
				574 80		18.0 " Top ch
				575 18	9.0 Lt pvmt	
				575 24	16.0 " gutter out	
				575 08	18.0 " gutter in	
				575 74	18.0 " Top ch.	
1+97.2				575 05		℄
				575 81		9.0 Rt pvmt
				574 57		16.0 " gutter out
				574 40		18.0 " gutter in
				575 00		19.0 " Top ch.
				575 03	9.0 Lt pvmt	
				575 00	16.0 " gutter out	
				574 89	18.0 " gutter in	
				575 53	18.0 " Top ch.	

76L-298 CE 307 11-58

PLEASE RETURN TO
LOS ANGELES COUNTY ENGINEER
700 LOS ANGELES COUNTY ENGINEERING BLDG.

NOTE: ANY ADDITIONS OR CHANGES ON THIS SHEET MUST BE MADE OR CIRCLED IN RED INK, WITH DATE AND NAME OF PERSON MAKING CHANGE.

Do not extend notes this side of this line.

Profile Notes Red____ Plotted____ Job No. 6012.98 Division No. 11
No.____ Date____ Date____ Survey of S.D. Project # 17761
X-Sec. Notes Chkd. Date____ Checked____ Surveyed by [illegible] Notes [illegible] Data [illegible]
No.____ Date____ Date____ Map No.____ Indexed [illegible] Date [illegible]

F.B. 3361 Pg. 17

STATION	B.S.	H.I.	F.S.	ELEV.	Lt. or South	℄	Rt. or North.
2+99.2				571.73		℄	
				571.51			9.0 Rt prm+
				571.30			16.0" gutter out
				571.14			18.0" gutter in
				571.80			18.0" Top ob.
				571.52	9.0 Lt. prm+		
				571.34	16.0" gutter out		
				571.12	18.0" gutter in		
				571.76	18.0" Top ob.		
3+73.7	S.M.H	E Rim = 569.21 W Rim = 569.23		569.22			5.5 Rt mean Rim elev.
					8" inlet E		inlet S outlet W.
	Invert 8" inlet E			561.32	Rim	569.22	569.22 569.22
	" " " S			561.44	meas	7.23	7.11 7.37
	" 8" outlet W			561.18	Top pipe	561.99	562.11 561.85
					dia	0.67	0.67 0.67
					invert	561.32	561.44 561.18

76L-298 CE 307 11-58

PLEASE RETURN TO
LOS ANGELES COUNTY ENGINEER
700 LOS ANGELES COUNTY ENGINEERING BLDG.

NOTE: ANY ADDITIONS OR CHANGES ON THIS SHEET MUST BE MADE OR CIRCLED IN RED INK, WITH DATE AND NAME OF PERSON MAKING CHANGE

Do not extend notes this side of this line.

F.B. 3769 Pg. 178 Job No. 6027.74 Division No. 11 Notes Red Plotted Profile
Survey of S.D. Project #12746 Date 2 APRIL 1971 No. X-Sec.
Survey by FEBrooks Notes FEB - Guizado Notes Chkd. Checked
Indexed C.T. GALLI Date Date Date No.

STATION	B.S.	H.I.	F.S.	ELEV		
					South on GALLIO ST.	
					Lt or East ℄	Rt or West
4+84.7				57675		℄
				57654		10.0 Rt prmt
				57628		17.8 " gutter out
				57610		20.0 " gutter in
				57675		20.0 " Top ch.
				57657	9.9 Lt prmt	
				57629	17.8 " gutter out	
				57618	19.8 " gutter in	
				57673	19.8 " Top ch.	
5+24.7				57841		℄
				57825		10.0 Rt prmt
				57800		18.0 " gutter out
				57783		20.0 " gutter in
				57850		20.0 " Top ch.
				57823	9.9 Lt prmt	
				57796	17.8 " gutter out	
				57777	19.8 " gutter in	
				57842	19.8 " Top ch.	

76L-298 CE 307 11-58

PLEASE RETURN TO
LOS ANGELES COUNTY ENGINEER
700 LOS ANGELES COUNTY ENGINEERING BLDG.

NOTE: ANY ADDITIONS OR CHANGES ON THIS SHEET MUST BE MADE OR CIRCLED IN RED INK, WITH DATE AND NAME OF PERSON MAKING CHANGE.

6+00 TP = 581.84

Do not extend notes this side of this line.

Profile Notes Red No. ____ Date ____ Plotted ____ Date ____ Job No. 4012.26 Division No. 11
No. ____ Date ____ Checked ____ Date ____ Map No. ____ Indexed ____ Date ____

STATION	B.S.	H.I.	F.S.	ELEV.	Lt or East	℄	Rt. or West
4+24.7				583.17		℄	
				583.09			10.0 Rt prmt
				582.76			18.0 " gutter out
				582.59			20.0 " gutter in
				583.23			20.0 " Top cb.
				583.00	10.0 Lt prmt		
				582.72	18.0 " gutter out		
				582.58	20.0 " gutter in		
				582.66	20.0 " Top cb. (depressed)		
4+38.5	S.M.H.	N Rim = 584.43 S Rim = 584.57		584.50			5.0 Rt mean thickness
					8" inlet S.		out let N.
	1 INVert	8" inlet	South	576.48	Rim 584.50		584.50
	"	" outlet	North	576.24	meas 7.35		7.59
					Top pipe 577.15		576.91
					dia 0.67		0.67
					invert 576.48		576.24
7+00				587.39		℄	
				587.25			10.0 Rt prmt
				587.02			18.0 " gutter out

Survey of S. D. Project #12 74
Date 10-7-74
F.B. 3364 Pg. 179

76L-258 CE 307 11-58

PLEASE RETURN TO
LOS ANGELES COUNTY ENGINEER
700 LOS ANGELES COUNTY ENGINEERING BLDG.

NOTE: ANY ADDITIONS OR CHANGES ON THIS SHEET MUST BE MADE OR CIRCLED IN RED INK, WITH DATE AND NAME OF PERSON MAKING CHANGE

T.P.=591.06

Do not extend notes this side of this line.

F.B. 3369 Pg. 180 Job No. 6012.14 Division No. 11 Notes Red Plotted Profile
Survey of S. D. Project # 1274 Date 2 APR 1971 No. X-Sec.
Survey by F.E.Brooks Notes F.E.B - Guizado Notes Chkd. Checked
Indexed C.J. GALVAN Date Date No.

STATION	B. S.	H. I.	F S.	ELEV	Lt. or East	℄	Rt. or West
7+00				586 85			20.0 Rt. gutter in
				587 49			20.0 " Top cb.
				587 19	10.0 Lt prmt		
				587 03	18.0 " gutter out		
				586 88	20.0 " gutter in		
				587 53	20.0 " Top cb.		
7+72.9	S.M.H.	N. Rim = 591.57 S. Rim = 591.63		591 60			5.0 Rt Mean rim elev.
					8" inlet S		8" outlet N
		Invert 8" Inlet S.		583 50	Rim 591.60		591.60
		" " outlet N		583 29	Meas 7.43		7.64
					Top of pipe 584.17		583.96
					dia. 0.67		0.67
					Invert 583.50		583.29
8+00				593 25		℄	
				593 09			10. Rt prmt
				592 83			18.0 " gutter out
				592 69			20.0 " gutter in
				593 35			20.0 " Top cb.
				593 11	10.0 Lt prmt		

76L-298 CE 307 11-58

PLEASE RETURN TO
LOS ANGELES COUNTY ENGINEER
700 LOS ANGELES COUNTY ENGINEERING BLDG.

NOTE: ANY ADDITIONS OR CHANGES ON THIS SHEET MUST BE MADE OR CIRCLED IN RED INK, WITH DATE AND NAME OF PERSON MAKING CHANGE.

9400 - 599.03

Do not extend notes this side of this line.

STATION	B. S.	H. I.	F. S.	ELEV.	Lt or East	℄	Rt. or West
8+00				59299	18.0 Lt gutter out		
				59281	20.0 " gutter in		
				59342	20.0 " Top of cb.		
8+73.0				59745		℄	
				59726			10.0 Rt Prmt
				59713			18.0 " gutter out
				59694			20.0 " gutter in
				59703			20.0 " Top cb. depressed
				59736	10.0 Lt. prmt		
				59724	18.0 " gutter out		
				59705	20.0 " gutter in		
				59723	20.0 " Top cb. depressed		
9+28.58				60084		℄ Inter.	

East on LINCROFT ST.

					LT or North	℄	Rt. or South
1+54.9				60151		℄	
				60102	10.0 Lt. Prmt.		
				60050	18.0 " gutter out		

Profile Notes Red Plotted Job No. 6012.74 Division No. 11
No. X-Sec Date Date Survey of S.D. Project #12774
No. Date Date Map No. Indexed Date
F.B. 3369 Pg. 181

76L-298 CE 307 11-58

PLEASE RETURN TO
LOS ANGELES COUNTY ENGINEER
700 LOS ANGELES COUNTY ENGINEERING BLDG.

NOTE: ANY ADDITIONS OR CHANGES ON THIS SHEET MUST BE MADE OR CIRCLED IN RED INK, WITH DATE AND NAME OF PERSON MAKING CHANGE

Do not extend notes this side of this line.

F.B. 3369 Pg. 182 Job No. 6012.74 Division No. 11 Notes Red Plotted
Survey of S.D. Project #12.74 Date 12 APRIL 1971 Date X-Sec. No.
Survey by FEBrooks Notes FEB - Gutters Notes Chkd. Checked
Indexed A.T. GALU Date Date Date No.

STATION	B. S.	H. I.	F. S.	ELEV	Lt. or North	℄ Rt. or South
1+54.9				600 34	20.0 Lt gutter in	
				601 01	20.0 " Top cb.	
1+55.2				601 94		℄
				602 20		10.1 Rt print.
				602 11		18.2 " gutter out
				602 71		20.2 " gutter in
						20.2 " Top cb.
1+94.9				601 90		℄
				602 25		10.1 Rt print
				602 32		18.2 " gutter out
				602 17		20.2 " gutter in
				602 77		20.2 " Top cb.
				601 59	10.0 Lt print	
				601 22	18.0 " gutter out	
				601 07	20.0 " gutter in	
				601 70	20.0 " Top cb.	
2+94.9				599 72		℄
				599 90		10.1 Rt Print

76L-298 CE 307 11-58

PLEASE RETURN TO
LOS ANGELES COUNTY ENGINEER
700 LOS ANGELES COUNTY ENGINEERING BLDG.

NOTE: ANY ADDITIONS OR CHANGES ON THIS SHEET MUST BE MADE OR CIRCLED IN RED INK, WITH DATE AND NAME OF PERSON MAKING CHANGE.

Do not extend notes this side of this line.

Profile No. X Sec. No. | Notes Red Date Date Date | Plotted Survey of S.D. Project # 1274 | Job No. 6012 | Division No. 11 | F.B. 3361 Pg. 163

STATION	B.S.	H.I.	F.S.	ELEV.	Lt or North	Rt. or South
2+94.9				599.75		18.2 Rt gutter out
				599.63		20.2 " gutter in
				600.23		20.2 " Top slope
				599.40	10.0 Lt pvmt	
				599.05	18.0 " gutter out	
				598.91	20.0 " gutter in	
				599.56	20.0 " Top of slope	
3+67.0	SMH	MRim = 598.14 ERim = 598.12		598.13	4.7 Lt. Mean rim elev.	
					8" Inlet S.	8" Inlet E. / Outlet W.
	Invert 8" Inlet S.			585.69	Rim 598.13	598.13 / 598.13
	" " " E.			585.59	Meas 11.77	11.87 / 11.92
	" " Outlet W			585.54	Top Pipe 586.36	586.26 / 586.21
					dia 0.67	0.67 / 0.67
					invert 585.69	585.59 / 585.54

South on GALLIO ST.
Lt. or East | Rt. or West

76L-298 CE 307 11-58

PLEASE RETURN TO
LOS ANGELES COUNTY ENGINEER
700 LOS ANGELES COUNTY ENGINEERING BLDG.

NOTE: ANY ADDITIONS OR CHANGES ON THIS SHEET MUST BE MADE OR CIRCLED IN RED INK, WITH DATE AND NAME OF PERSON MAKING CHANGE

Do not extend notes this side of this line.

F.B. 3369 Pg. 184 Job No. 6012.74 Division No. 11 Notes Red Plotted Profile
Survey of S.D. Project #1274 Date 12 APRIL 1971 Date No. X-Sec.
Survey by FE Brooks Notes FEB - Guzado Notes Chkd. Checked No.
Indexed B.J. GALLI Date Date Date

STATION	B.S.	H.I.	F.S.	ELEV	Lt. or East	℄	Rt. or West
9+32.3 S. M.H		N Rim = 601.01 S. Rim = 601.11		601.06			5.0 Rt mean rim elev.
					8" Inlet S.	8" Inlet E	8" outlet N
INVert	8" Inlet S.			584.48	Rim 601.06	601.06	601.06
"	" " E			584.45	Mean 15.91	15.94	16.22
"	" outlet N			584.17	Top pipe 585.15	585.12	584.84
					dia 0.67	0.67	0.67
					Invert 584.48	584.45	584.17
9+84.5				604.09		℄	
				604.17		10.0 Rt Print	
				603.96		18.0 " gutter out	
				603.81		20.0 " gutter in	
				604.44		20.0 " Top ch.	
				604.19	10.0 Lt Print		
				603.94	18.0 " gutter out		
				603.78	20.0 " gutter in		
				604.31	20.0 " Top of ch.		
10+24.5				606.66		℄	
				606.53		10.0 Rt Print	
				606.37		18.0 gutter	

76L-298 CE 307 11-58

PLEASE RETURN TO
LOS ANGELES COUNTY ENGINEER
700 LOS ANGELES COUNTY ENGINEERING BLDG.

NOTE: ANY ADDITIONS OR CHANGES ON THIS SHEET MUST BE MADE OR CIRCLED IN RED INK, WITH DATE AND NAME OF PERSON MAKING CHANGE.

T.R
11+00 = 611.23

Do not extend notes this side of this line.

Profile Notes Red. ____ Plotted ____ Job No. 6012.04
No. ____ Date ____ Date ____ Survey of S. D. Project #12 pt
X-Sec. ____ Notes Chkd. ____ Checked ____ Survey by F. Bleecker Notes by ____ Date 12 April 61
No. ____ Date ____ Date ____ Map No. ____ Indexed [illegible] Date [illegible]

F. B. 3367 Pg. 125

STATION	B. S.	H. I.	F. S.	ELEV.	Lt or East	℄ Rt. or West
10+24.5				606 18		20.0 Rt gutter in
				606 80		20 " Top of cb.
				606 57	10.0 Lt prmt	
				606 35	18.0 " gutter out	
				606 23	20.0 " gutter in	
				606 83	20.0 " Top cb.	
11+24.5				61 265		℄
				61 252		10.0 Rt prmt
				61 235		18.0 " gutter out
				61 220		20.0 " gutter in
				61 283		20.0 " Top cb.
				61 252	10.0 Lt Prmt	
				61 234	18.0 " gutter out	
				61 217	20.0 " gutter in	
				61 270	20.0 " Top depressed cb.	
12+00				61 728		℄
				61 714		10. Rt. prmt
				61 683		18.0 " gutter out
				61 665		20.0 " gutter in

76L-298 CE 307 11-58

PLEASE RETURN TO
LOS ANGELES COUNTY ENGINEER
700 LOS ANGELES COUNTY ENGINEERING BLDG.

NOTE: ANY ADDITIONS OR CHANGES ON THIS SHEET MUST BE MADE OR CIRCLED IN RED INK, WITH DATE AND NAME OF PERSON MAKING CHANGE

617.29 TP. 12+00

Do not extend notes this side of this line.

F.B. 3369 Pg. 186 Job No. 6012.04 Division No. 11 Notes Red Plotted Profile No. X-Sec. No.
Survey of S.D. Project # 12.7 Date 12 APRIL 17 Date Checked Date
Survey by FEBrucko Notes FEB - Gizado Notes Chkd. Date
Indexed B. H. GALLE Date

STATION	B.S.	H.I.	F.S.	ELEV	Lt. or East	℄ Rt. or West.
12+00				61767		20.0 Rt Top cb.
				61715	10.0 Lt prmt	
				61692	18.0" gutter out	
				61665	20.0" gutter in	
				61734	20.0" Top cb.	
12+85.0 S.M.H.		N. Rim = 621.72 S. Rim = 621.80		62176		5.0 Rt mean rim elev.
					8" Inlet S.	8" OUTLET N.
	Invert	8" Inlet S.		61431	Rim 621.76	621.76
		" Outlet N		61407	meas 6.78	7.02
					top pipe 614.98	614.74
					dia 0.67	0.67
					invert 614.31	614.07
13+00				62242		℄
				62231		10.0 Rt prmt
				62209		18.0" gutter out
				62196		20.0" gutter in
				62235		20.0" Top of depressed cb.
				62228	10.0 Lt prmt	
				62207	18.0" gutter out	

76L-298 CE 307 11-58

PLEASE RETURN TO
LOS ANGELES COUNTY ENGINEER
700 LOS ANGELES COUNTY ENGINEERING BLDG.

NOTE: ANY ADDITIONS OR CHANGES ON THIS SHEET MUST BE MADE OR CIRCLED IN RED INK, WITH DATE AND NAME OF PERSON MAKING CHANGE.

Do not extend notes this side of this line.

STATION	B.S.	H.I.	F.S.	ELEV.	Lt. or East ℄	℄ Rt. or South
13+00				621.94	20.0 Lt gutter in	
				622.55	20.0 " Top cb.	
13+34.3				623.31		℄ gutter out
13+36.3				623.15		℄ gutter in
				623.81		℄ Top cb.
13+53.7				628.75		128.8 Rt. 18" Corr iron pipe drain
13+44.0				626.8		
13+70.0				627.8		
13+92.9				628.8		
BM S.D. 1265				622.94	BM S.D. 1265 Elev. 622.941 FB 3369-18 Gallio Ave W. curb. at house # 2751 Rd Dept Bkn Nail in lead.	

Profile Notes Red Plotted Job No. 6012.14 Division No. 11
No. Y Sec. Date Date Survey of L.D. Project # 1274
No. Date Date Map No. Indexed Date
F.B. 3369 Pg. 187

F.B. 3369 Pg. 188

Job No. Division No. Notes Red Plotted Profile

Survey of Date Date No.

Survey by Notes Notes Chkd. Checked X-Sec.

Indexed Date Date Date No.

STATION	B.S.	H.I.	F.S.	ELEV	

78L-200 C€ 507 11-58

PLEASE RETURN TO

LOS ANGELES COUNTY ENGINEER

700 Los Angeles County Engineering Bldg.

Do not extend notes this side of this line.

NOTE: ANY ADDITIONS OR CHANGES ON THIS SHEET MUST BE MADE OR CIRCLED IN RED INK. WITH DATE AND NAME OF PERSON MAKING CHANGE

Notes Ck'd by H. HOLMAN
Map No.
Office Work
Checked
Date

Survey of SD Pavement
J.N. 6012.74 Tape 223 Sht. 48
Surveyed by FE Brooks
Notes FEB - Gurzada Date
Indexed G. J. GALL MAY 10 '74

F. B. 2210 PG. 109

J. N. 6012. 74

STORM DRAIN PROJECT

No 1274

LINE G

CENTERLINE

From Existing drain in Fortjavdo St

To Pathfinder Rd.

Note

The Cross sections for this line are in F.B. 3380 From pg 5 To pg. 56

FE Brooks
GO Gurzada
RA Moore
T Ohashi.

Note: Any Additions or Changes on this Sheet Must be Made or Circled in Red Ink With Date and Name of Person Making Change.

Do not extend this side of this line.

PLEASE RETURN TO
LOS ANGELES COUNTY ENGINEER
403 Los Angeles County Engineering Bldg.

76F3095 CE # 310 3-61

F. B. 3369 PG. 190

S.D. PROJ. 1274

LINE "G"

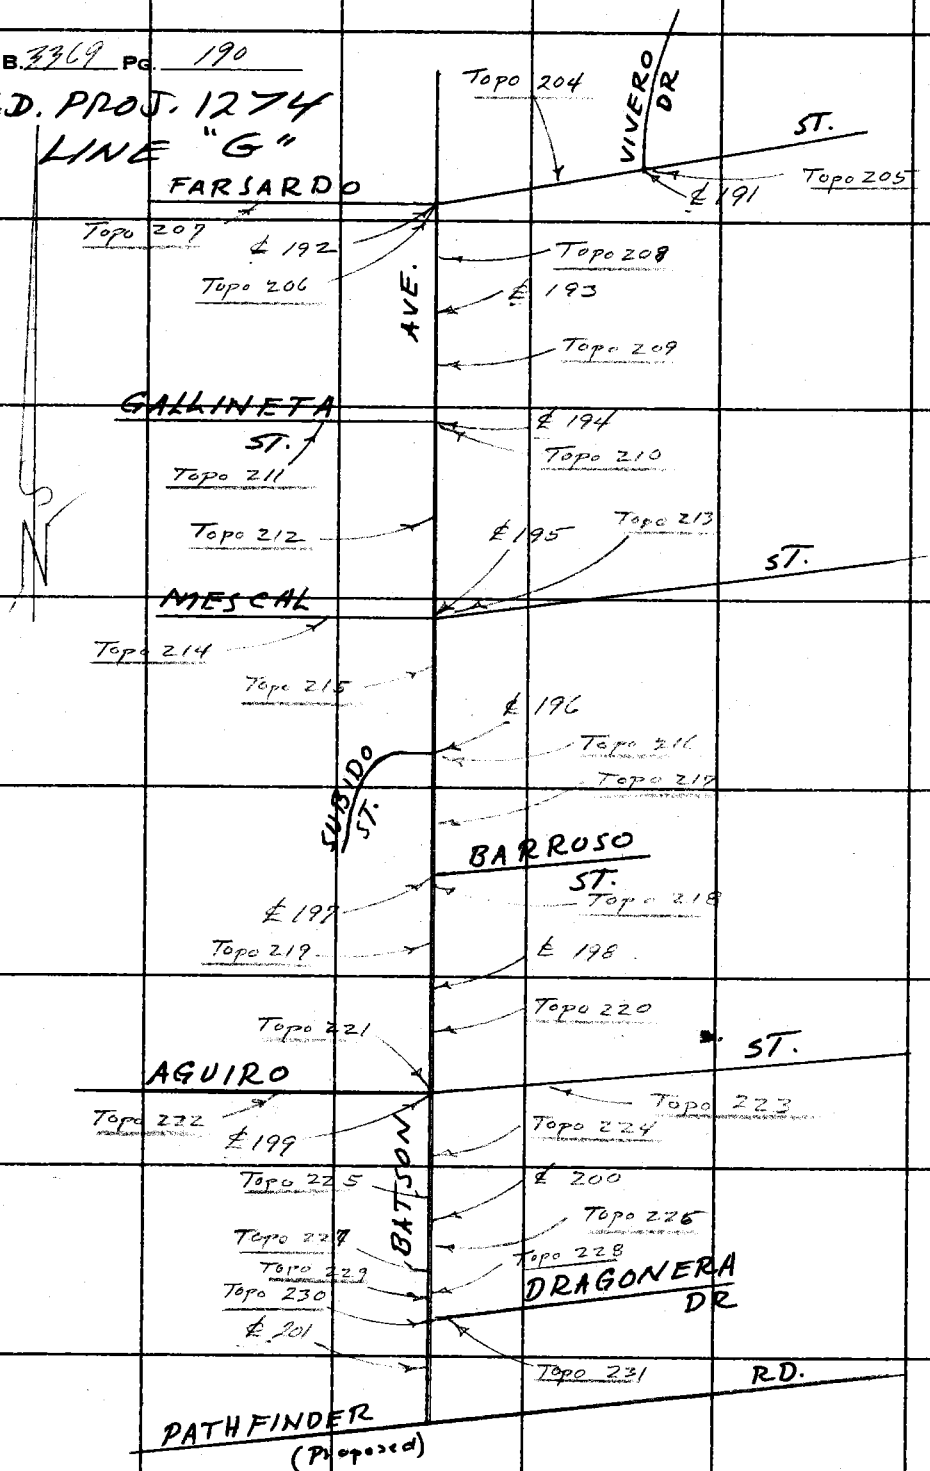

PLEASE RETURN TO
LOS ANGELES COUNTY ENGINEER
403 Los Angeles County Engineering Bldg.

Do not extend this side of this line.

Note: Any Additions or Changes on This Sheet Must be Made or Circled in Red Ink With Date and Name of Person Making Change.

Notes Ck'd by H. HOLMAN
Map No.
Office Work
Checked
Date

Survey of 3D Photo Hwy 1
IN [illegible]
Surveyed by Ft. Bragg
Notes F.I.=B Gurnard Date SEP 71
Indexed G.D. GALLI NOV 10 71

F. B. [illegible] PG. 31

W.S. 3BD-9

26.58S

FD L&T
PER F.B. 2724-134

VIVERO DR

HELD THIS POINT FOR LINE NOTHING SET

17.81

0.02 PER F.B. 2724-134

1+00
FD. LG BT SPK.
W. & TIN DN 2"
PER F.B. 2724-134

ST.

54

49.15

47.75

ED. L&T
PER F.B. 2724-134

30 30

FARSAR DU

FND. LS & T
F.B. 2724-134

N

CONT RT PG 192

B

Note: Any Additions or Changes on this Sheet Must be Made or Circled in red Ink With Date and Name of Person Making Change.

Do not extend this side of this line.

PLEASE RETURN TO
LOS ANGELES COUNTY ENGINEER
403 Los Angeles County Engineering Bldg.

75F3095 CE # 310 3-61

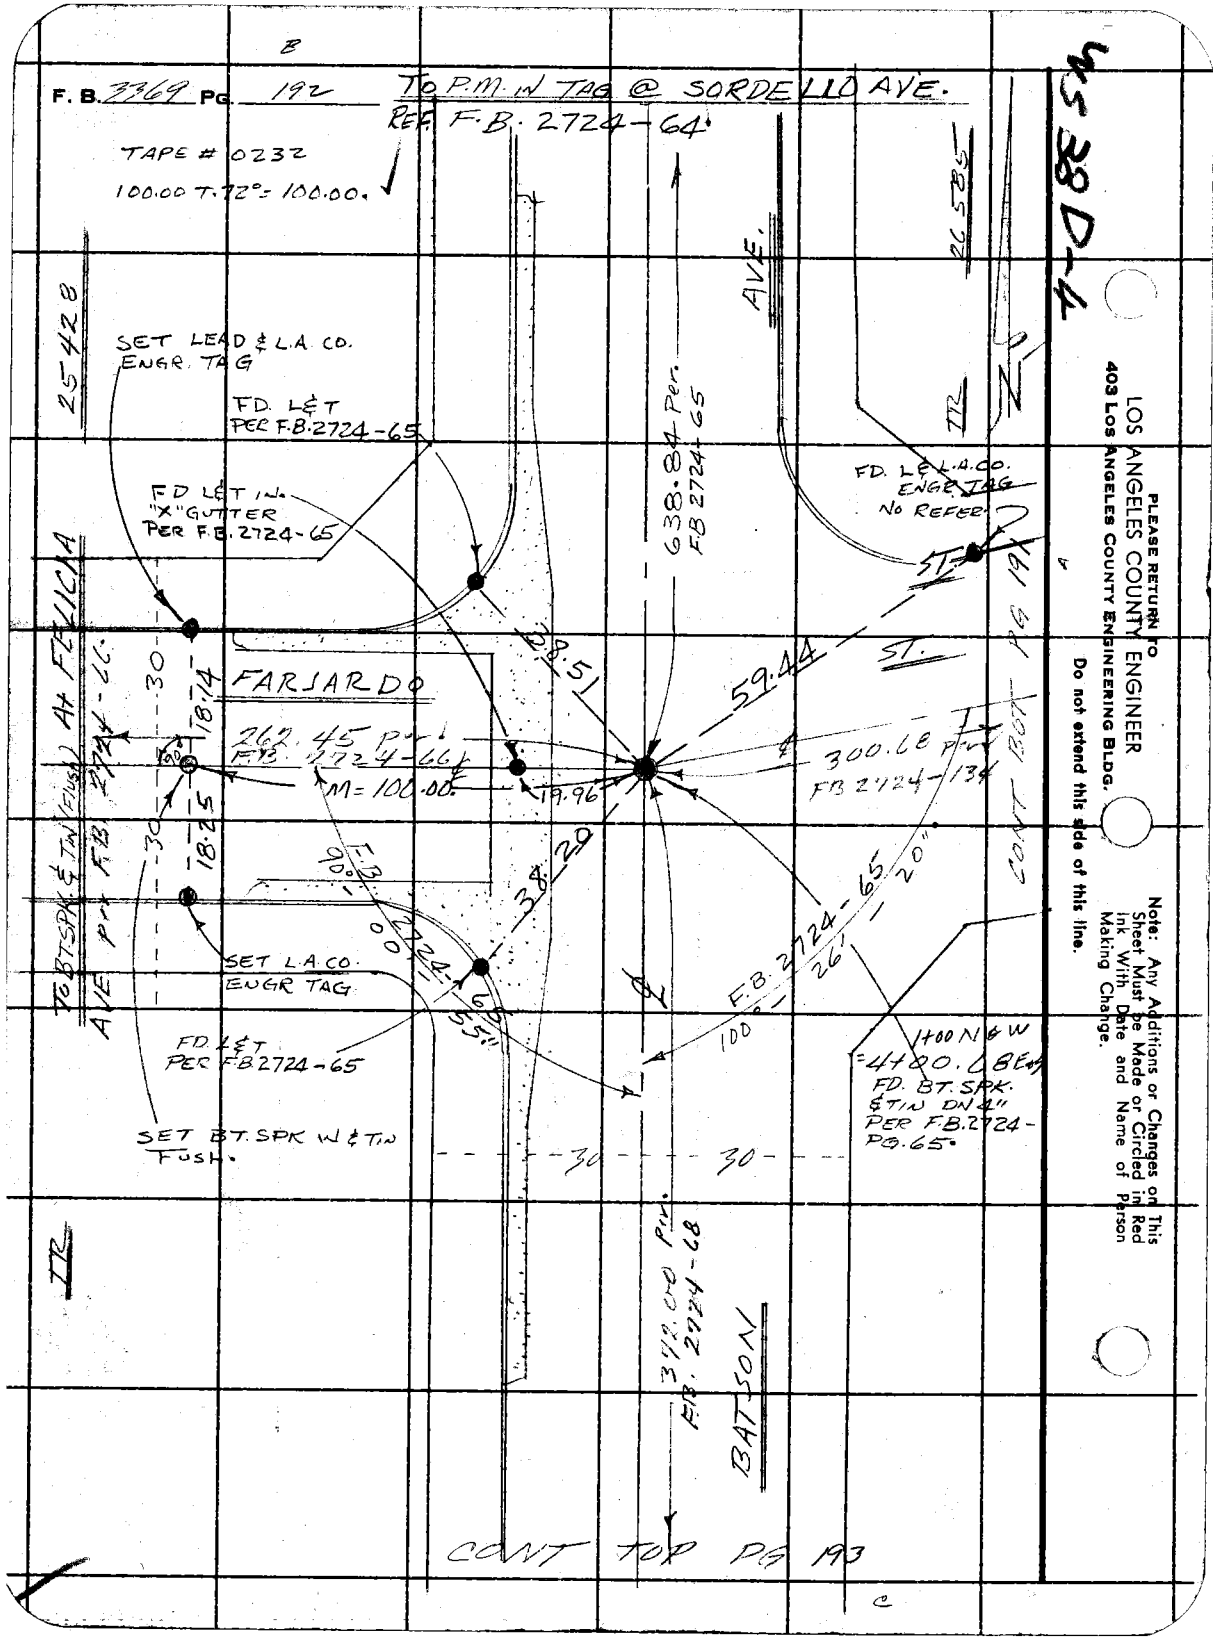
F. B. 3369 PG. 192
TO P.M. IN TAG @ SORDELLO AVE.
REF. F.B. 2724-64.
TAPE # 0232
100.00 T. 72° = 100.00.
25428
SET LEAD & L.A. CO. ENGR. TAG
FD. L&T PER F.B. 2724-65
FD L&T IN. "X" GUTTER PER F.B. 2724-65
638.84 Per. F.B. 2724-65
AVE.
FD. L&T. L.A.CO. ENGR. TAG NO REFER.
ST.
FARJARDO
262.45 P.M. F.B. 2724-66
M = 100.00.
59.44
300.66 P.M. F.B. 2724-134
CONT TOP PG 191
AT FELICIA
To BT SPK & TIN (illegible) AT FELICIA F.B. 2724-66
18.14
18.25
30
38.29
F.B. 2724-65
SET L.A.CO. ENGR TAG
FD. L&T PER F.B. 2724-65
SET BT. SPK W & TIN Fush.
1400 N 6 W = 4420.08 Ex.
FD. BT. SPK. & TIN DN 4" PER F.B. 2724-PG. 65.
3 1/2 O.D. P.M. F.B. 2724-68
BATSON
CONT TOP PG 193
PLEASE RETURN TO
LOS ANGELES COUNTY ENGINEER
403 Los Angeles County Engineering Bldg.
Do not extend this side of this line.
Note: Any Additions or Changes on This Sheet Must Be Made or Circled in Red Ink With Date and Name of Person Making Change.

Notes Ck'd by H. HOLMAN	Survey of S.D. Project #1274
Map No.	JN 66-12-144 Tape 0.9973 Std. 68 °F
Office Work	Surveyed by FE Brooks
Checked	Notes FEB Guizado Date 15 Apr 11
Date	Indexed J. GALLI NOV 10 11

F. B. 3215 PG. 193

CONT BOT PG 192

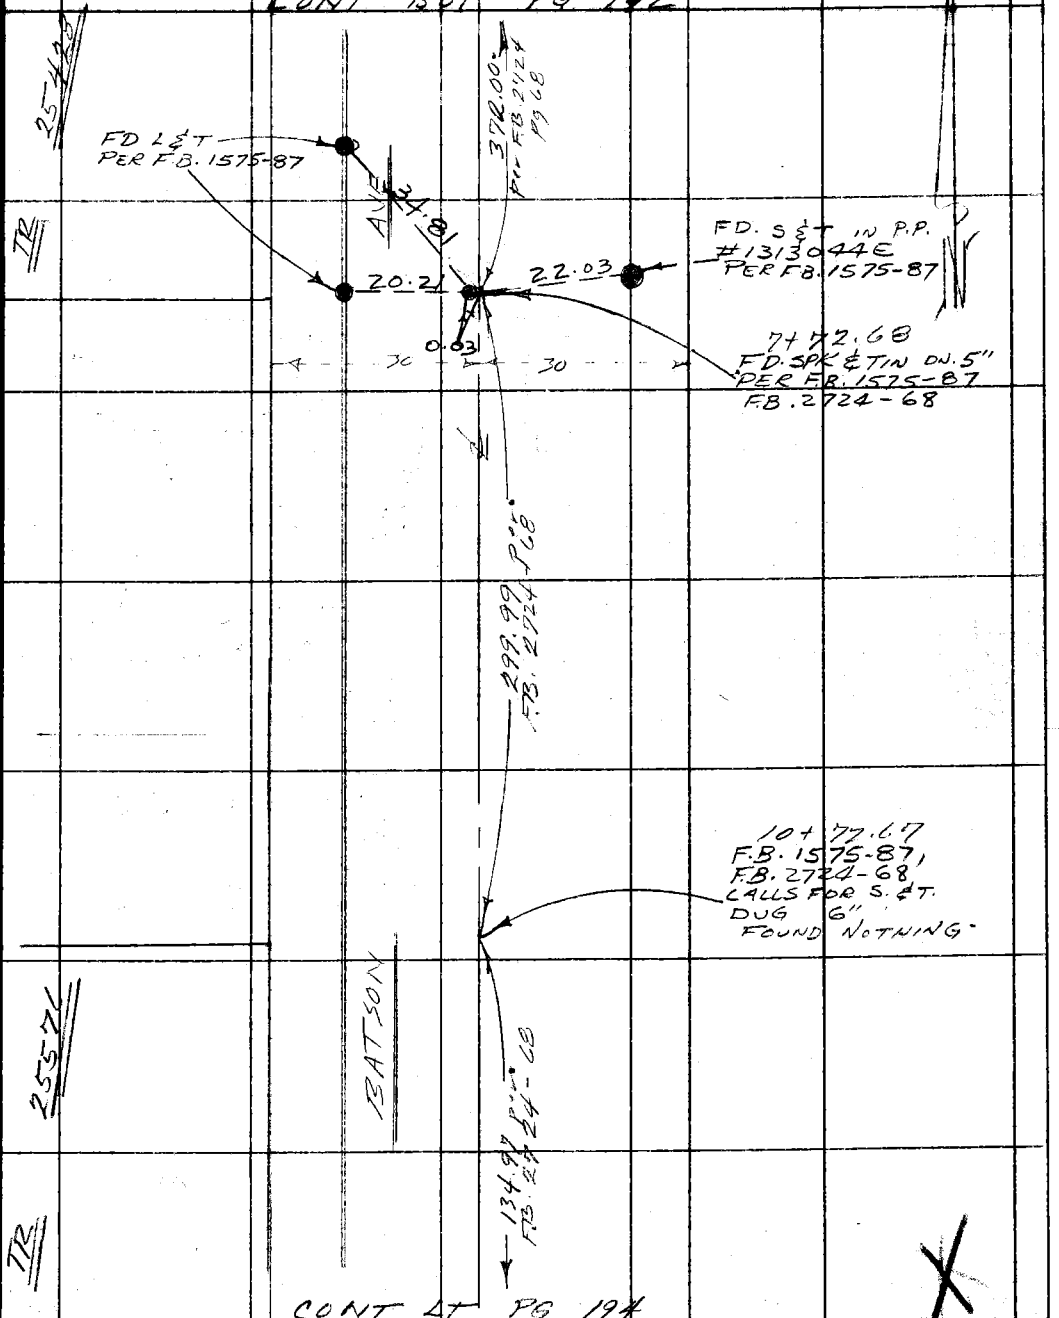

CONT AT PG 194

D

Note: Any Additions or Changes on this Sheet Must be Made or Circled in Red Ink With Date and Name of Person Making Change.

Do not extend this side of this line.

PLEASE RETURN TO
COUNTY OF LOS ANGELES
DEPARTMENT OF COUNTY ENGINEER
403 LOS ANGELES COUNTY ENGINEERING BLDG.

76F3095 CE#310 3-68

PLEASE RETURN TO
COUNTY OF LOS ANGELES
DEPARTMENT OF COUNTY ENGINEER
403 LOS ANGELES COUNTY ENGINEERING BLDG.

Do not extend this side of this line.

Note: Any Additions or Changes on This Sheet Must be Made or Circled in Red Ink With Date and Name of Person Making Change.

D.

F. B. 3369 PG. 194

WS 38 D-4.

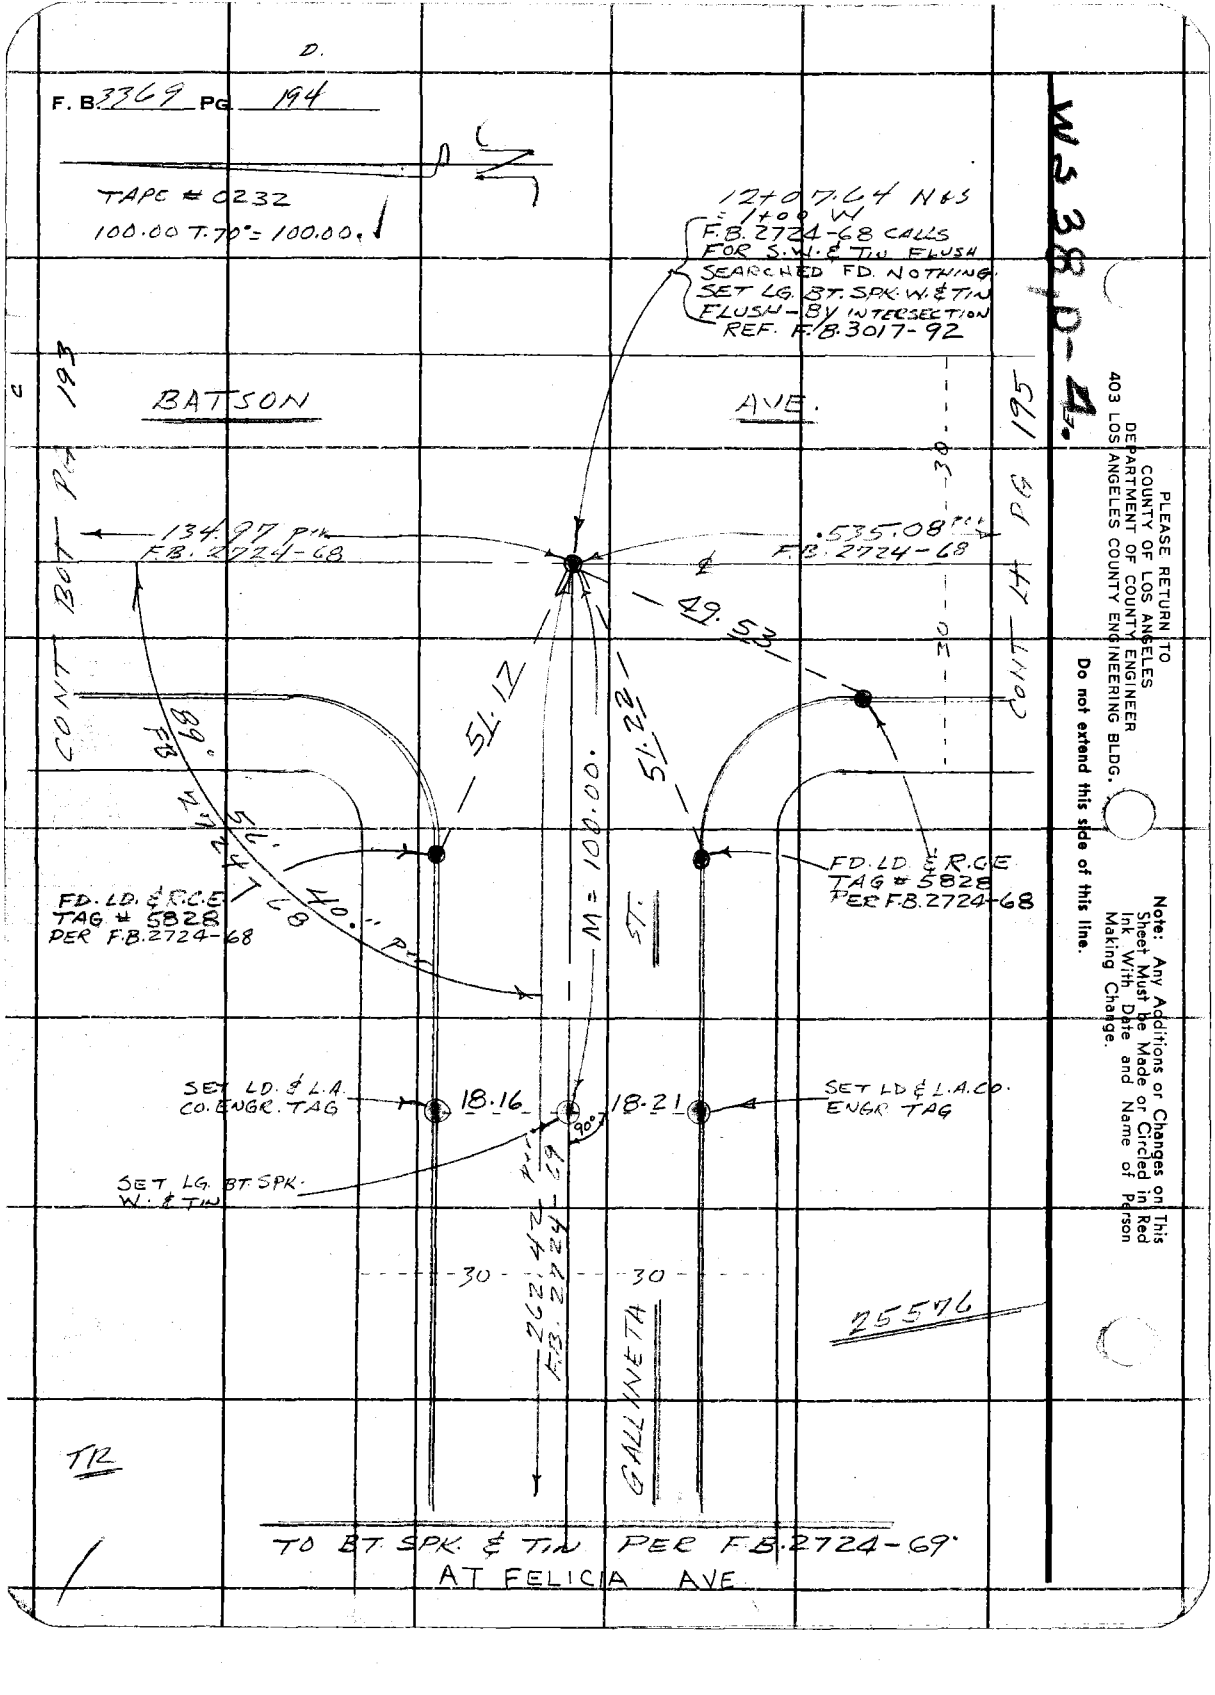

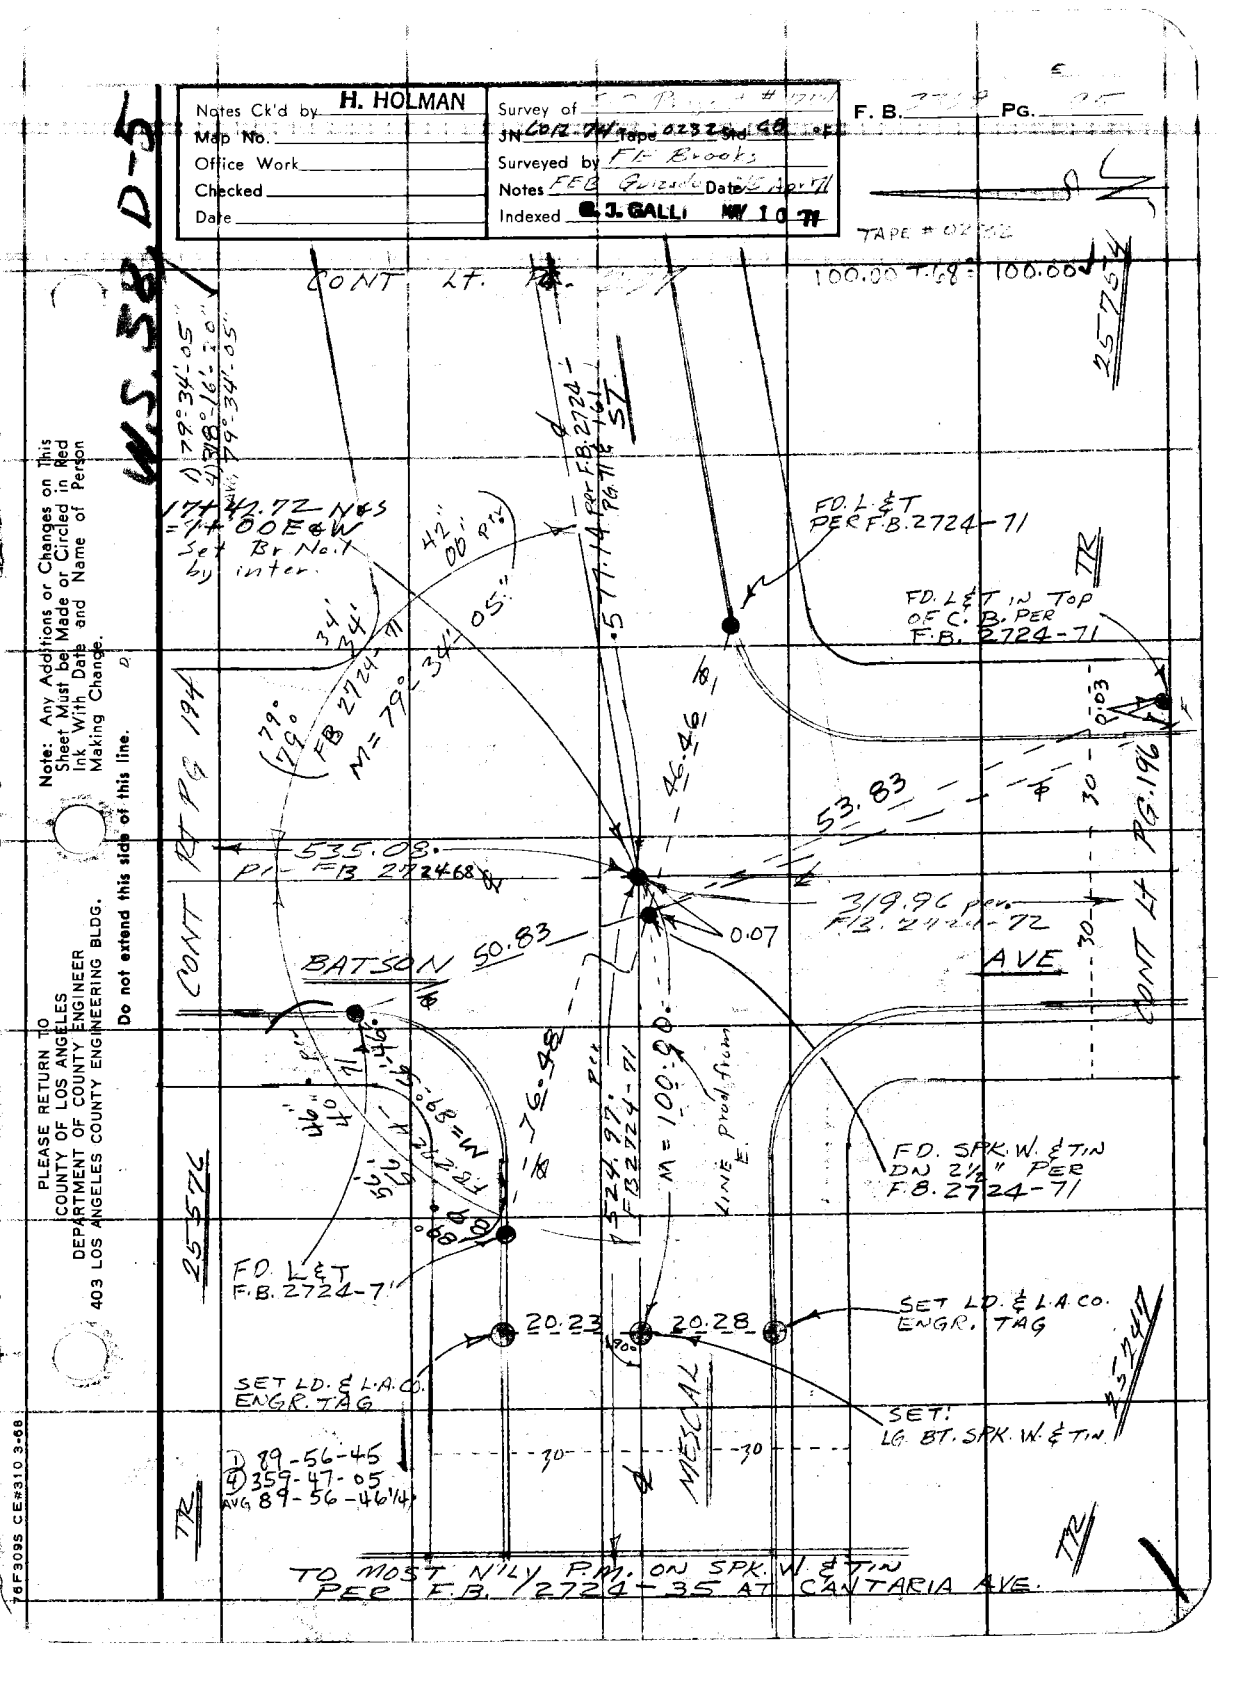
W.S. 58, D-5
Notes Ck'd by H. HOLMAN
Map No.
Office Work
Checked
Date
Survey of
JN CO12-7W Tape 0232 Std. 40
Surveyed by F.L. Brooks
Notes FEB Gutierrez Date 5 April 71
Indexed E. J. GALLI MAY 10 71
F. B. PG.
TAPE # 0232
CONT LT.
100.00 T.68 = 100.00
25 STG
Δ 79°34'05" Δ 79°34'05"
1744.72 N&S = 1744.00 E&W Set Br No. 1 by inter.
42.00 P.U.
FB 2724-71
M = 79°-34'-05"
79.00 79.00
34' 34'
FD. L & T PER F.B. 2724-71
FD. L & T IN TOP OF C. B. PER F.B. 2724-71
577.14 FR FB 2724-71 PG 161 ST.
46.46
53.83
P.O.B.
30
PG. 196
CONT LT PG 194
535.03 PK FB 2724-68
319.96 PER F.B. 2724-72
0.07
BATSON AVE
50.83
CONT LT
46" 40"
576.58
FD. SPK. W. & TIN DN 2½" PER F.B. 2724-71
M = 100.00
LINE PROJECTION
FD L & T F.B. 2724-71
20.23
20.28
SET LD. & L.A. CO. ENGR. TAG
SET! LG. BT. SPK. W. & TIN
SET LD. & L.A.CO. ENGR. TAG
1) 89-56-45
4) 359-47-05
AVG 89-56-46¼
MESCAL
30
TO MOST N'LY P.M. ON SPK. W. & TIN PER F.B. 2724-35 AT CANTARIA AVE.
PLEASE RETURN TO COUNTY OF LOS ANGELES DEPARTMENT OF COUNTY ENGINEER 403 LOS ANGELES COUNTY ENGINEERING BLDG.
Note: Any Additions or Changes on This Sheet Must be Made or Circled in Red Ink With Date and Name of Person Making Change.
Do not extend this side of this line.
76F3095 CE#310 3-68

PLEASE RETURN TO
COUNTY OF LOS ANGELES
DEPARTMENT OF COUNTY ENGINEER
403 LOS ANGELES COUNTY ENGINEERING BLDG.

Do not extend this side of this line.

Note: Any Additions or Changes on This Sheet Must be Made or Circled in Red Ink With Date and Name of Person Making Change.

F. B. 3369 PG. 196

25 75-4

M380-5

IR

1400 N
= 2062.68 N & S

NOTHING SET

FD. LD & R.C.E TAG #5828 PER F.B. 2724-72

FD. L&T ON ℄ PROD PER F.B. 2724-72

BATSON AVE.

30

30

PG 195

CONT RT

PG 47 M 47

29.51

20.09

338.82 P.T. F.B. 2724-72

0.03

319.96 P.T. F.B. 2724-72

47.96

48.43

60.00° PC F.B. 2724-153

00.00 F.B. 2724-153

N 0° 00' E

FD. LD & R.C.E TAG # 5828 PER F.B. 2724-72

FD. LD & R.C.E TAG # 5828 PER F.B. 2724-72

FD. SQ. HD. SPK & T. PER F.B. 2724-72 DN. 2"

21

21

SUBIDO

FD. LG. BT. SPK & TIN PER F.B. 2724-153

14.23

14.14

FD. LD & R.C.E. TAG NO. 5828 PER F.B. 2724-153

FD. LD. & R.C.E. TAG # 5828 PER F.B. 2724-153

IR

21.10

25-247

54.61

FD. LD. & T. PER F.B. 2724-153

Notes Ck'd by H. HOLMAN	Survey of
Map No.	JN 6082.77 Tape 0232 Sht 6 B. of F.
Office Work	Surveyed by FE Books
Checked	Notes FEB - Quized Date 6 April
Date	Indexed L GALLI MAY 10 71

F. B. PG.

W.S. 38 D-5

Note: Any Additions or Changes on This Sheet Must be Made or Circled in Red Ink With Date and Name of Person Making Change.

Do not extend this side of this line.

PLEASE RETURN TO
COUNTY OF LOS ANGELES
DEPARTMENT OF COUNTY ENGINEER
403 LOS ANGELES COUNTY ENGINEERING BLDG.

76F3095 CE#310 3-68

TO LG. ST. SPK. W. & TIN
PER F.B. 2724-155 AT RECINTO AVE.

Set Lg. ST. Spk. W & T flush.

Set L&C Engr. Tag

Set L&C Engr. Tag

18.28 ℄

18.25 ℄

1400 E
= 24701.50 N 65
nothing set.

25175-4

26945

ST

FD. R.C.E. TAG #5828 PER F.B. 2724-213

34'

2724-21

79°

F.B.

PIV

TR

105.38

M= 109.00 ℄

226.38 F.B. 2724-155

BARROSO

F.B. 2724-21 CALLS FOR S.W. & T. AND S. & T. DID NOT SEARCH FOR PTS.

58.87

338.82 PIV F.B. 2724-72 ℄

0.02

268.34 PIV F.B. 2724-20

30

AVE.

CONT TO PG 198

CONT RT PG 196

BATSON

FD. SPK. W. & TIN DN. 2" PER F.B. 2724-21

F.B.

PIV

F.B.

PIV

F.B.

42.20 2724-21

1.0 E 44°

#0232
100.00 E 64°
= 100.00.

25247

TR

F. B. 3369 PG. 198

CONT RT PG 197

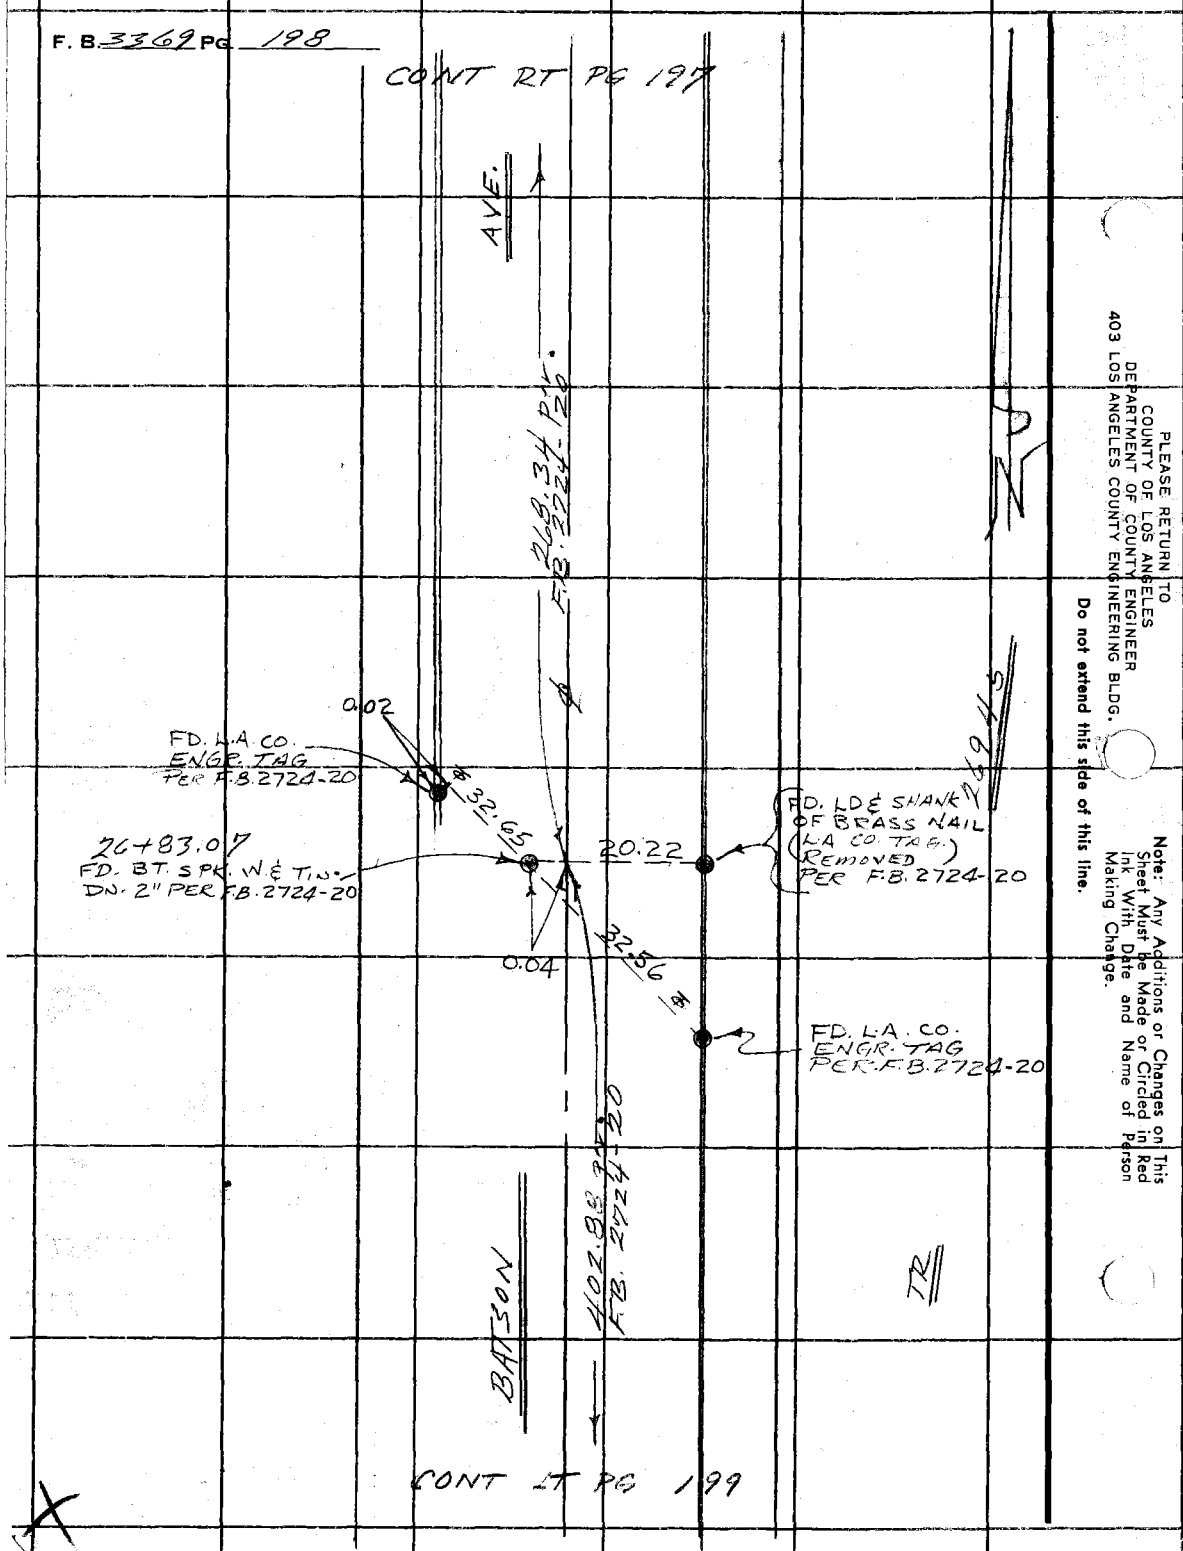

CONT LT PG 199

PLEASE RETURN TO
COUNTY OF LOS ANGELES
DEPARTMENT OF COUNTY ENGINEER
403 LOS ANGELES COUNTY ENGINEERING BLDG.

Do not extend this side of this line.

Note: Any Additions or Changes on This Sheet Must be Made or Circled in Red Ink With Date and Name of Person Making Change.

Notes Ck'd by H. HOLMAN
Map No.
Office Work
Checked
Date



W.S. 38 D-5

Note: Any Additions or Changes on This Sheet Must be Made or Circled in Red Ink With Date and Name of Person Making Change.
Do not extend this side of this line.

PLEASE RETURN TO
COUNTY OF LOS ANGELES
DEPARTMENT OF COUNTY ENGINEER
403 LOS ANGELES COUNTY ENGINEERING BLDG.

TO Nail R.O.T. Ref.
F.B. 2724-104
Fd L&Co. Engr. Tag
Tie Ref.
F.B. 2724-19
Set L&Co. Engr. Tag
Fd St. Spk. 1' N of R.O.T.
F.B. 2724-19
23.16
54"
50'
19
32'
79°
F.B.
TR
CONT BOT PG 198
63.07
431.45 P.I.R.
F.B. 2724-104
ST.
30+85.95 N&W
=1700 E
FD. 2" I.P. CMT. PLUG
& R.E. TAG # 1668 DPW
PER. F.B. 2724-19
Set L&Co Engr Tag
10.00 P.I.R.
F.B. 2724-19
159.22
Fd LETag L.S. 2408 Ref
F.B. 2724 Pg 19
30.50
402.88 P.I.R.
F.B. 2724-20
BATSON AVE
52.13
30
24'
415.91 P.I.R.
F.B. 2724-19
BATSON AVE
Pvt. 37.
CONT TO PG 200
42
Set L&Co Engr. Tag
30+95.95 E&S
=1700 W.
SEARCHED FOR P.K.
NAIL PER F.B. 2724-19
FD. NOTHING -
SET NAIL
89°
F.B. 2724-19
50'
20'
854.46 P.I.R.
F.B. 2724-18.19
HGWY 2
90° 04'
F.B. 2724
30
30
67.22
R.S.
TO A PT. 0.02 ± SOUTH OF A 2" I.R.
CONC. PLUG & TAG RE. 7668 @ NATIVE AVE PER
F.B. 2724-18.

76F3095 CE#310 3-68

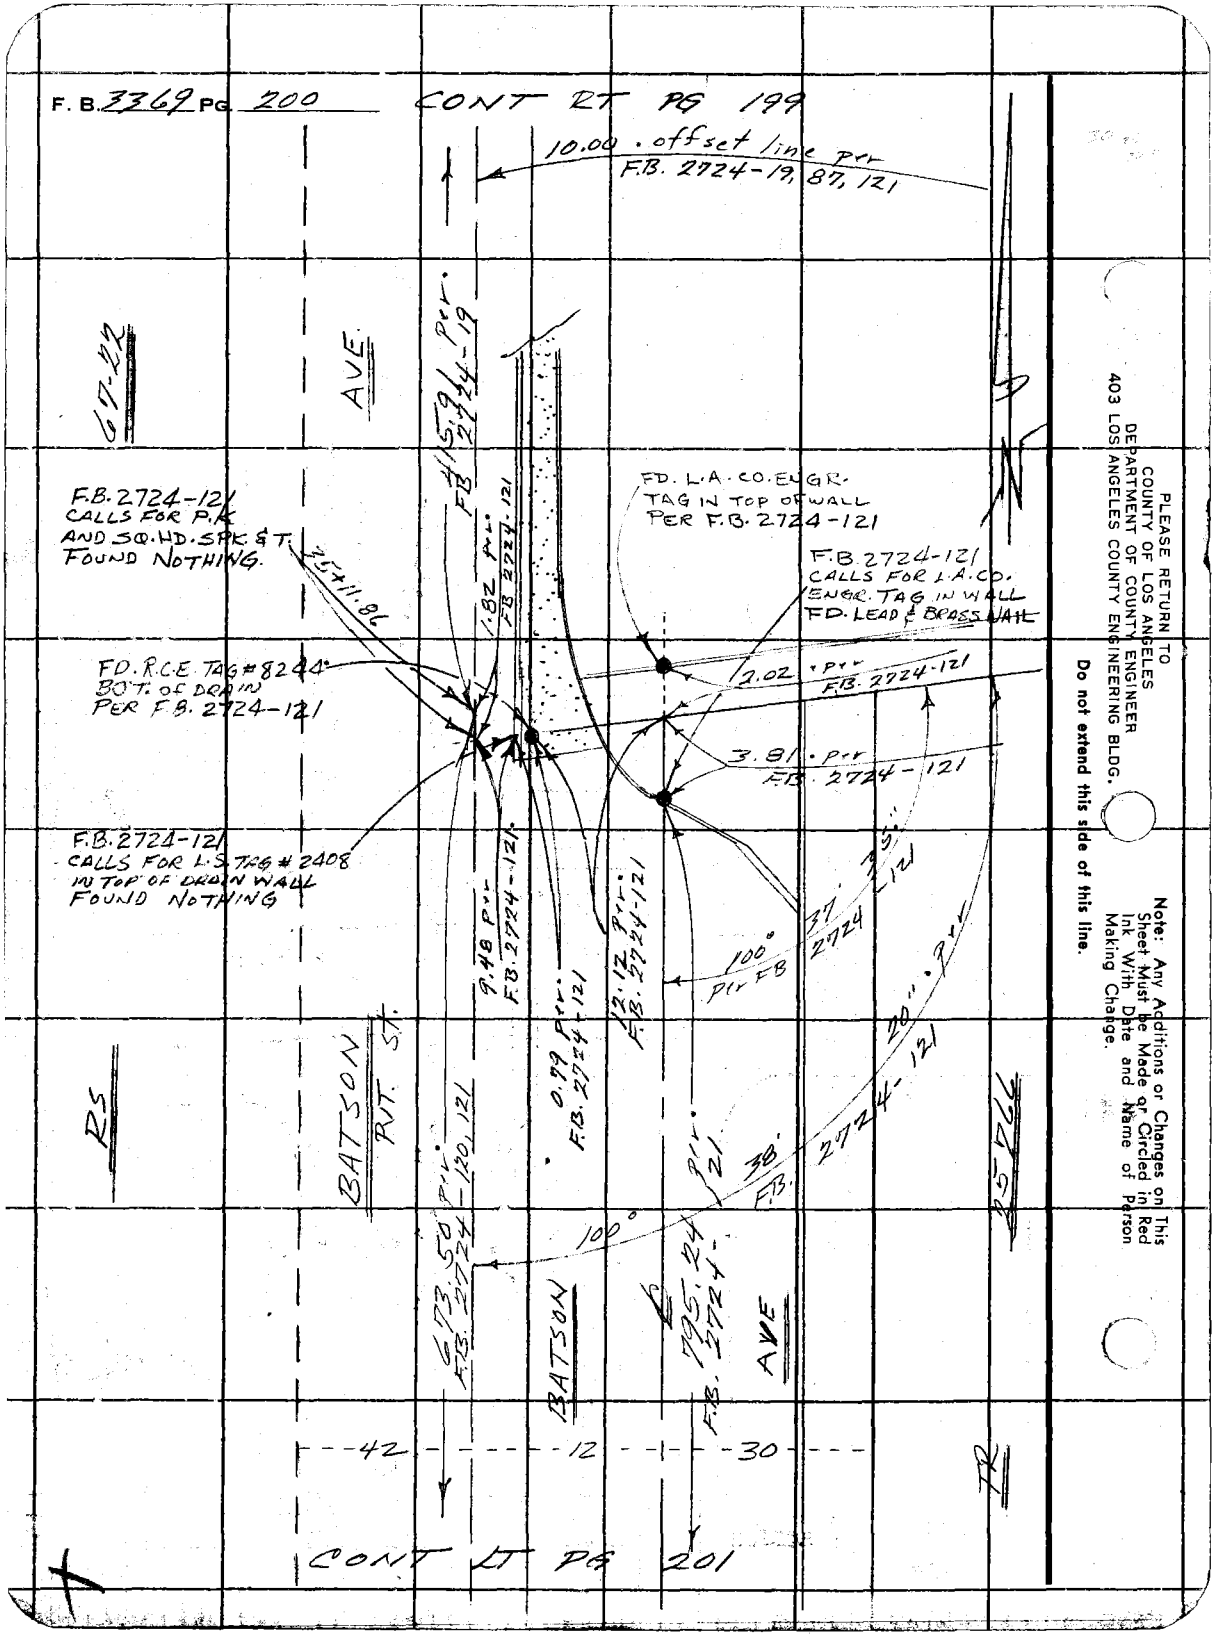

PLEASE RETURN TO
COUNTY OF LOS ANGELES
DEPARTMENT OF COUNTY ENGINEER
403 LOS ANGELES COUNTY ENGINEERING BLDG.

Do not extend this side of this line.

Note: Any Additions or Changes on This Sheet Must be Made or Circled in Red Ink With Date and Name of Person Making Change.

Notes Ck'd by H. HOLMAN	Survey of SD Proj. # 12174	F. B.	PG.
Map No.	JN 6028.04 Tape 0232 Sht 62		
Office Work	Surveyed by FF Brooks		
Checked	Notes FEB - Guizado Date 6 APRIL 71		
Date	Indexed L.J. GALLI NOV 10 71		

Note: Any Additions or Changes on This Sheet Must be Made or Circled in Red Ink With Date and Name of Person Making Change.

Do not extend this side of this line.

PLEASE RETURN TO
COUNTY OF LOS ANGELES
DEPARTMENT OF COUNTY ENGINEER
403 LOS ANGELES COUNTY ENGINEERING BLDG.

TO P.I. - NAIL FLUSH PER F.B. 2724-120

45-38 D-5

TR

45°-11'-46"

SEMI TAN

DR

DRAGOMERA

RD.

PATHFINDER

BOT PK

CONT.

FD. L & R.C.E. TAG #8244 PER F.B. 2724-120

90° 00' 35" F.B. 2724-120

21.15

65.30

00'

F.B. 2724-120

62.49

79.74 P.T.

F.B. 2724-121

90° P.T.

BATSON AVE

30

12

200

65.84 P.T. F.B. 2724-120

30

1+70.14

1+22.15

FD. BT. SPK. W. & TIN FLUSH PER F.B. 2724-120

38.61

69.96

47.99 P.T. F.B. 2724-120

53

61

21.95

FD. L & R.C.E. TAG #8244 PER F.B. 2724-120

50.24

55.80 P.T. F.B. 2724-89

FD. 3/4" I.P. & N. DN. 2" PER F.B. 2724-89

22.15 P.T. F.B. 2724-120

103.36 P.T. F.B. 2724-120

307.23 P.T. F.B. 2724-120

10.44 PER F.B. 2724-89

BATSON AVE (PVT)

42

50

L.T.B.

41+85.36 F.B. 2724-120 CALLS FOR SQ. HD. SPK & T. FLUSH FOUND NOTHING SET

1+00 E = 43+08.72 N & S SET 1X2 & N BY TIES (FLUSH) PER F.B. 2724-120

45+48.47 FD. 1X2 & NAIL FLUSH PER F.B. 2724-89

44+92.89 did not search for 1X2 P.T. F.B. 2724-89 corner in the way.

10.00 OFFSET LINE PER F.B. 2724-120

67-22

RS

F3095 CE#310 3-68

PLEASE RETURN TO
COUNTY OF LOS ANGELES
DEPARTMENT OF COUNTY ENGINEER
403 LOS ANGELES COUNTY ENGINEERING BLDG.

Note: Any Additions or Changes on This Sheet Must be Made or Circled in Red Ink With Date and Name of Person Making Change.

Do not extend this side of this line.

F. B. 3369 PG. 202

Notes Ck'd by
Map No.
Office Work
Checked
Date

Survey of [illegible]
JN [illegible] Tape [illegible] Std CB
Surveyed by FE Brooks
Notes FEB-Guizado Date 20 April 71
Indexed G. J. GALLI NOV 10 71

F. B. [illegible] PG.

S. N. 6012.74

STORM DRAIN PROSECT

No 1274

LINE G.

LOCATION OF IMPROVEMENTS

Note The Cross Sections for this line are in F.B. 3386 From pg 5 To pg. 56

FE Brooks
GO Guizado
RA Moore
T Ohashi

Note: Any Additions or Changes on This Sheet Must be Made or Circled in Red Ink With Date and Name of Person Making Change.

Do not extend this side of this line.

PLEASE RETURN TO
COUNTY OF LOS ANGELES
DEPARTMENT OF COUNTY ENGINEER
403 LOS ANGELES COUNTY ENGINEERING BLDG.

76F3095 CE#310 3-68

F. B. 3369 PG. 204

LOCATION OF EXISTING DRAIN IN FARJARDO ST.

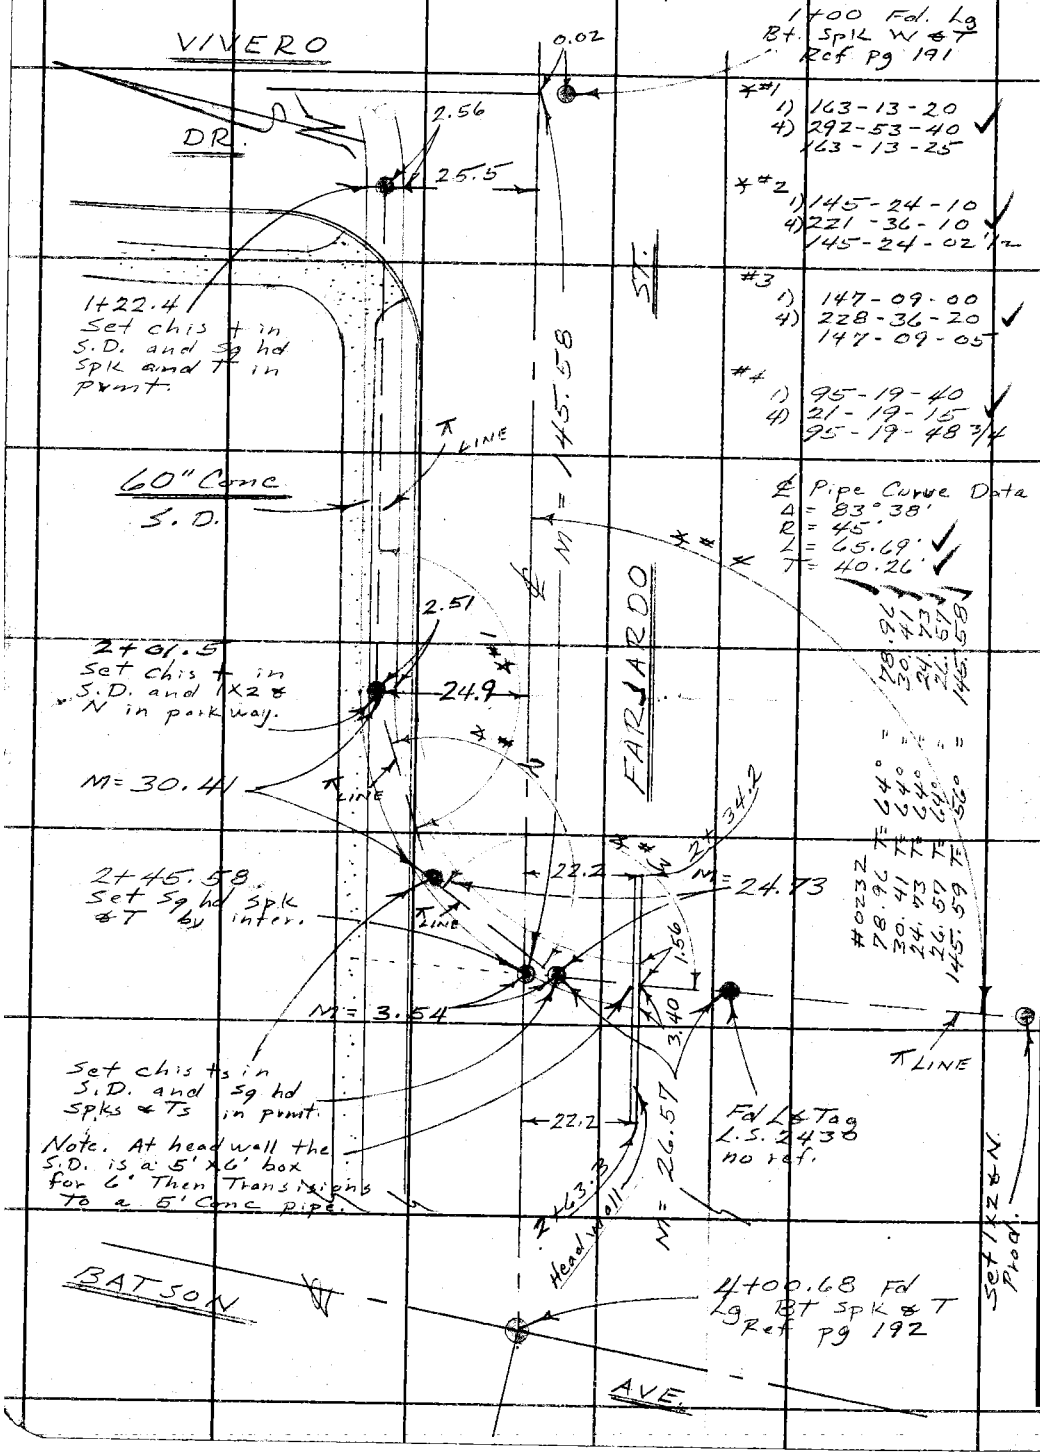

PLEASE RETURN TO
COUNTY OF LOS ANGELES
DEPARTMENT OF COUNTY ENGINEER
403 LOS ANGELES COUNTY ENGINEERING BLDG.

Do not extend this side of this line.

Note: Any Additions or Changes on This Sheet Must Be Made or Circled in Red Ink With Date and Name of Person Making Change.

Notes Ck'd by _____ | Survey of SDP 00-111 #12178
Office Work _____ | Surveyed by F.E. Brooks
Checked _____ | Notes APNS-(5) 2216 Date 2.0 APR 11
Date _____ | Indexed S.I. GAT 1 MW 1.0 PM

F.B. 221-9 Pg. 90-5

Notes: Any Additions or Changes on this Sheet Must be Made or Checked in Red Ink With Date and Name of Person Making Change.

Do not detach this side of this line.

PLEASE RETURN TO
LOS ANGELES COUNTY ENGINEER
403 LOS ANGELES COUNTY ENGINEERING BLDG.

Tapboard Ck #310 8-68

1400
Roadway Excl.

1700
Fd Lg Bar & Spk
W&T Ref
Pg 19.1

VIA VERDE

5-2

0+94.9 ENTH

11.0

0.02

11.5 W.H. W.H. 1417

13.0 W.H. W.H. 1422.7

JOR

20.0

20.0 Curb Face

5-4

4.0

Edge of Pvmt

11.0

1484.0

Premix Drive

2408.2

Premix Drive

2404.3

Depression Ea 23.0

FAIRIADO

2434.2 22.2

Headwall of storm drain. See Dwg for location of drain.

CONT TOP PG 206

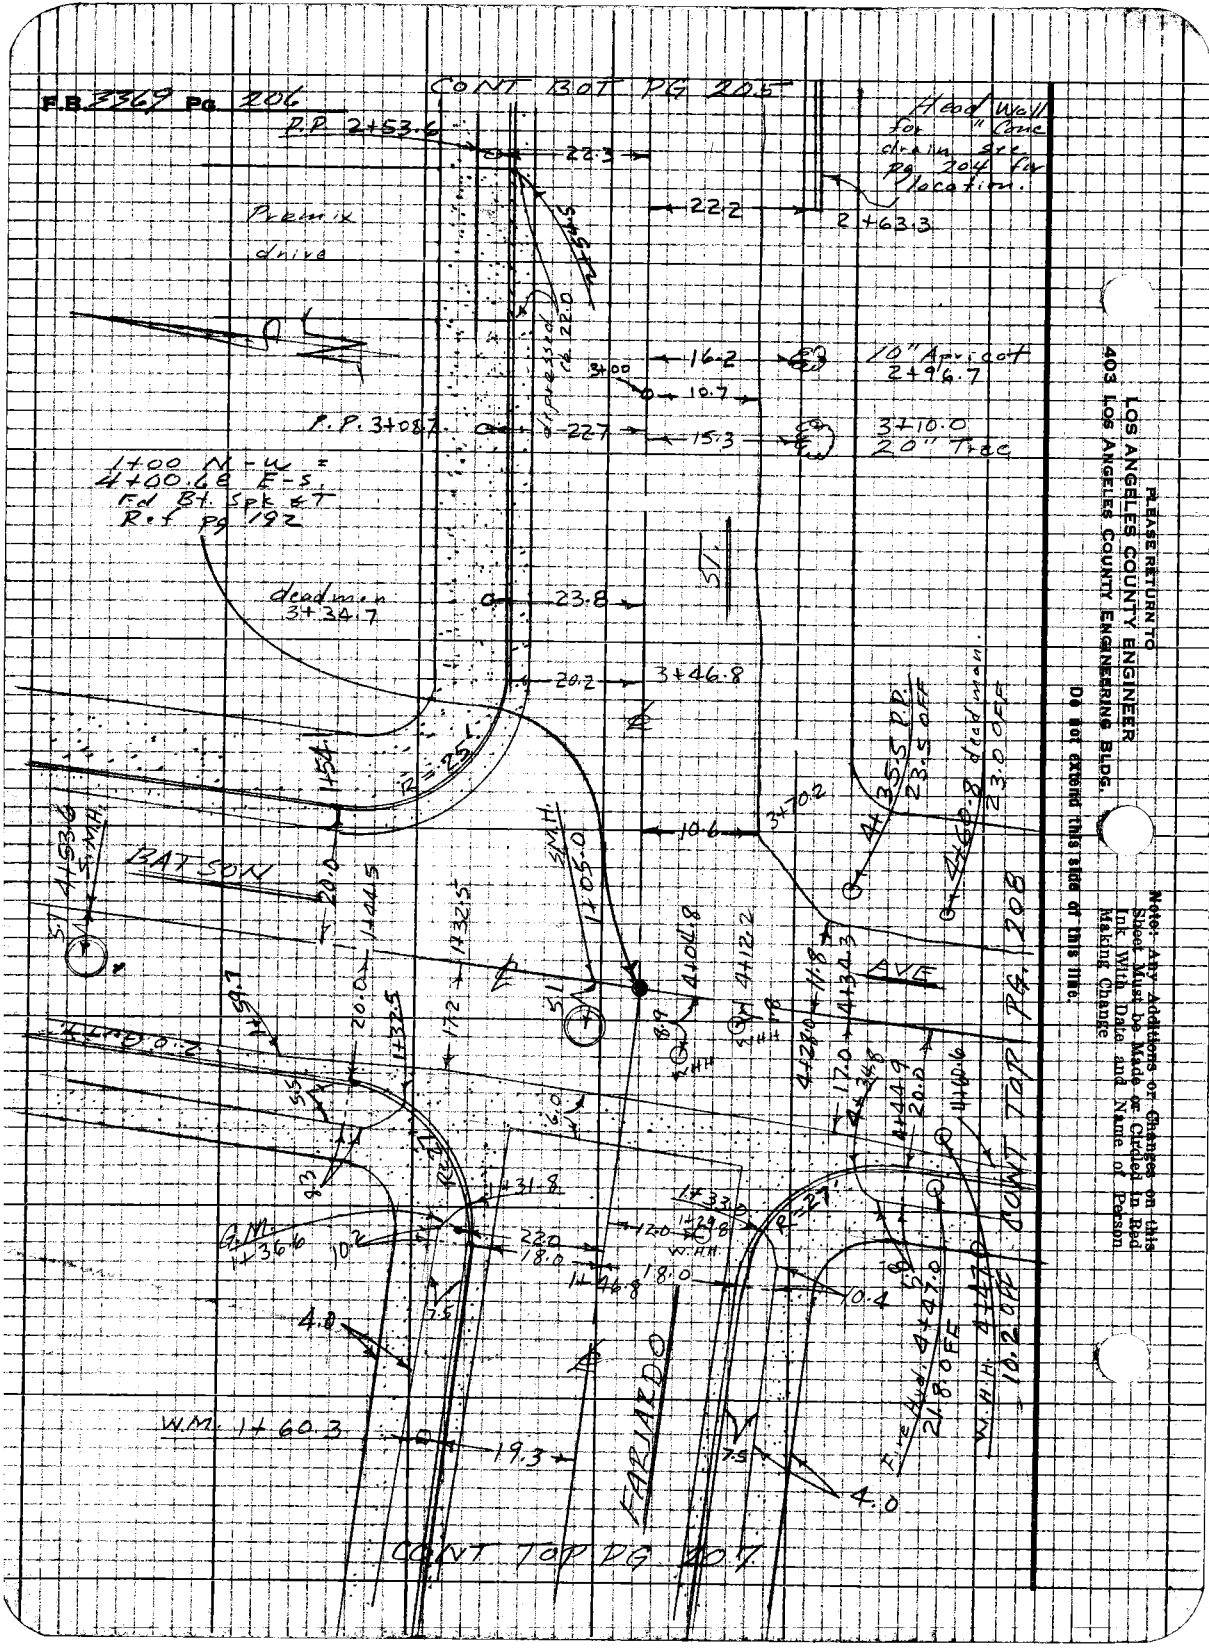
F.B. 2369 Pg. 206
CONT BOT PG 205
P.P. 2+53.6
Head Wall for 18" Conc. storm drain See Pg 204 for Location.
2+63.3
P.P. 3+08.7
1700 N-W = 4+00.68 E-S, Fd BT. Spk & T R.f Pg 192
deadman 3+34.7
3+46.8
35.5 P.D. 23.5 OFF
23.0 OFF
deadman
CONT TOP PG 208
W.M. 1+60.3
CONT TOP PG 207
Water Any Additions or Changes on this Sheet Must be Made or Circled in Red Ink With Date and Name of Person Making Change
PLEASE RETURN TO LOS ANGELES COUNTY ENGINEER 403 LOS ANGELES COUNTY ENGINEERING BLDG.
DO NOT CROSS THIS LINE OF THIS LINE.

Notes Ck'd by _____
Office Work _____
Checked _____
Date _____

Survey of S.D. Project #1274
Surveyed by FE Brooks
Notes FE Brooks Date 20 APR 71
Indexed [redacted] 10 71

F.B. 331 Pg. 207

CONT BOT PG. 206

1+73.0

Premix

drive

2+01.6

Conc

Drive

27.0

27.0

Depressed CL

ST

4.0

4.0

FAIRLAWN

37.50

50

Notes: Any Additions or Changes on this Sheet Must be Made or Checked in Red Ink With Date and Name of Person Making Change

Do not extend this area of this line.

PLEASE RETURN TO
LOS ANGELES COUNTY ENGINEER
403 LOS ANGELES COUNTY ENGINEERING BLDG.

Zephyr ck #310 8-68

F.B. 3369 Pg. 208

CONT RT PG 206

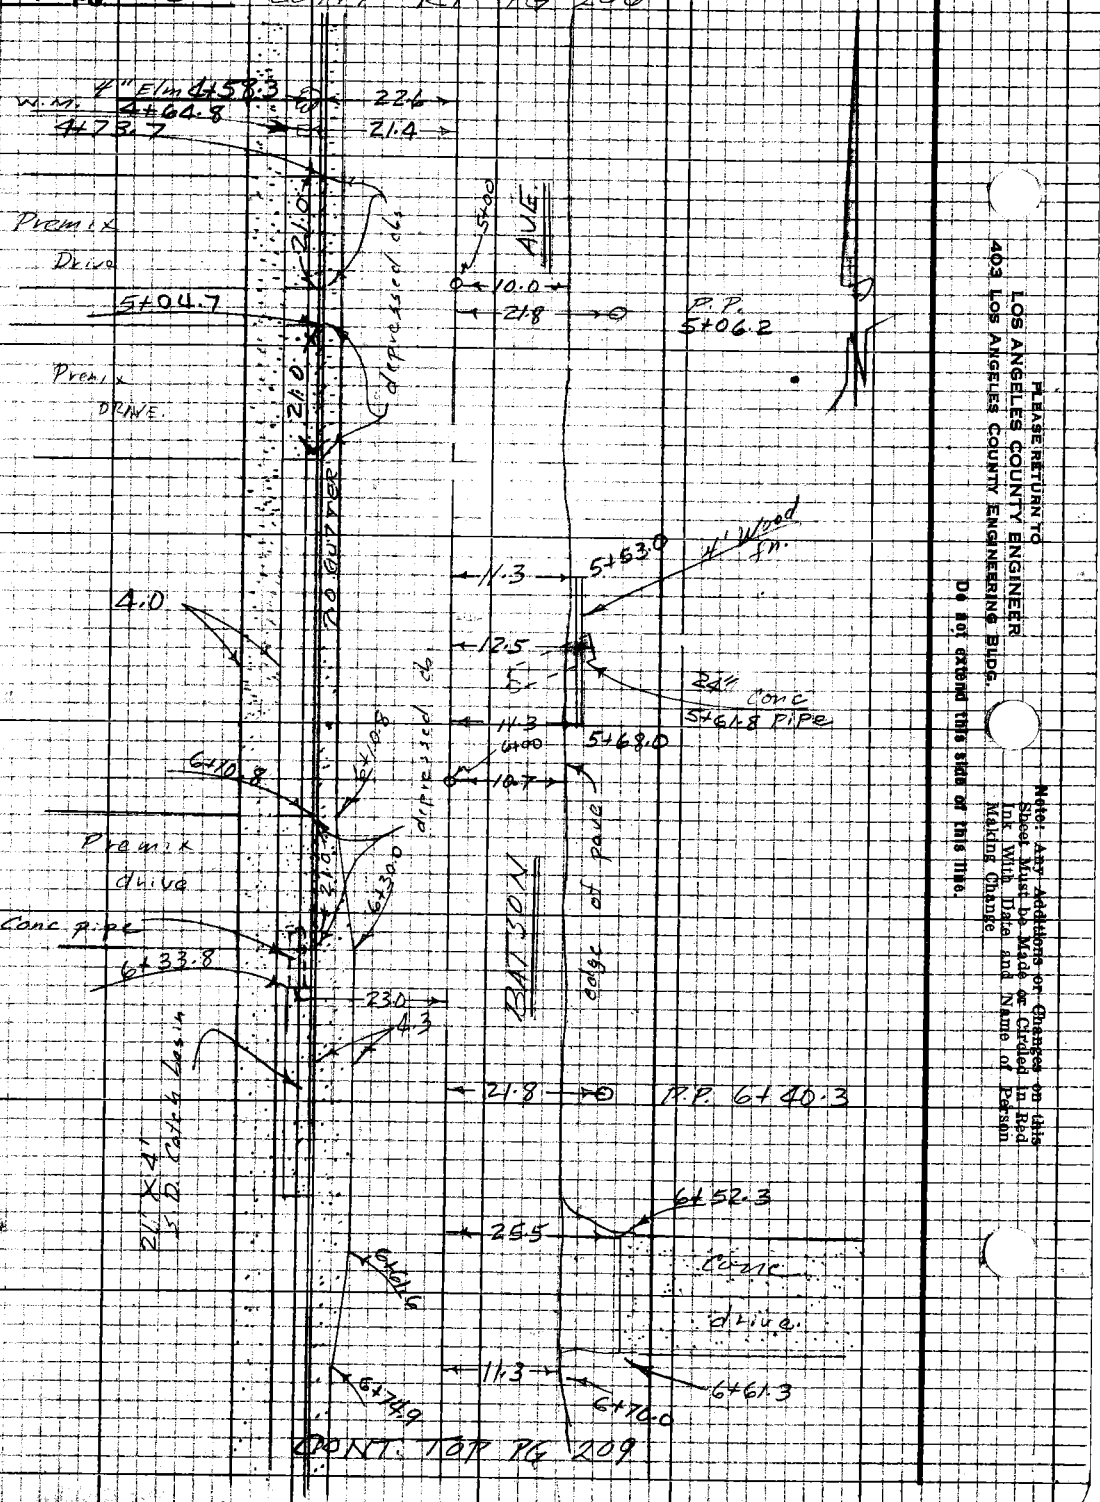

Note: Any Additions or Changes on this Sheet Must be Made or Circled in Red Ink With Date and Name of Person Making Change

PLEASE RETURN TO
LOS ANGELES COUNTY ENGINEER
403 LOS ANGELES COUNTY ENGINEERING BLDG.

DO NOT CROWD THIS SIDE OF THIS LINE.

Notes Ck'd by	Survey of S.D. Project #12.74
Office Work	Surveyed by FE Brooks
Checked	Notes FE's - Gu·zade Date 20 Dec. 71
Date	Indexed [illegible]

F. B. 3319 Pg. 209

CONT FROM PG 208

6+76.7

Premix Drive

dr. pass. 2.0 dia.

20.0

6+81.8

4.0

S.M.H. 7+46.6

o.k. 7+45.7

2.0 CUT

AVE.

depressed c&g.

7+80.3

Conc. Drive

26.5

5.0

Premix Drive

depressed 2.0 c&g.

2.0 CUTT

4.0

7+72.7

5.5

depressed c&g.

20.0

7+87.7

8+02.6

dirt drive

12.0

10.0

S.M.H. 8+83.0

5.1

8+91.4

dirt drive

23.0

depressed c&g.

9+00

BATTSON

100

edge of print

Trans P.P. 8+95.2

21.5 OFF

CONT TOP PG 210

Note: Any Additions or Changes on this Sheet Must be Made or Circled in Red Ink With Date and Name of Person Making Change.

Do not extend this side of this line.

PLEASE RETURN TO

LOS ANGELES COUNTY ENGINEER

700 Los Angeles County Engineering Bldg.

76F3098 SSE #247 11-68

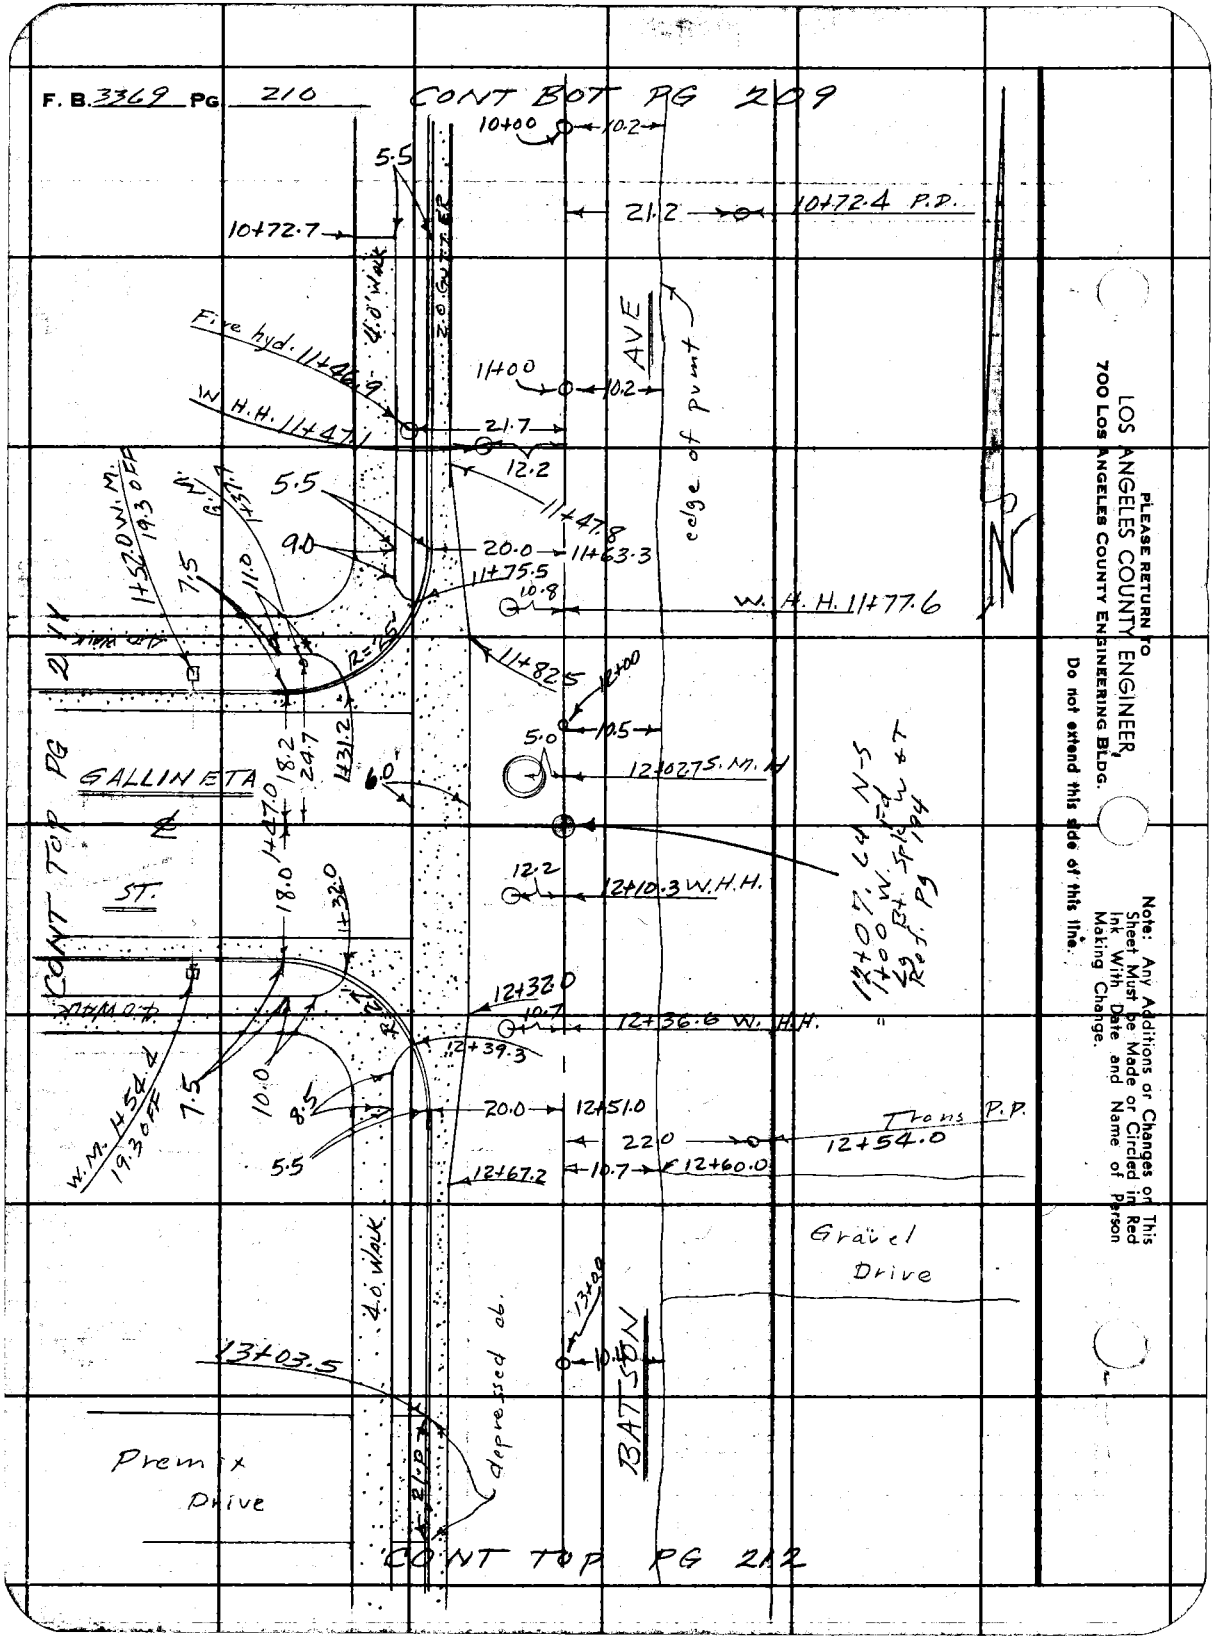
F. B. 3369 PG 210
CONT BOT PG 209
10+00
10.2
5.5
21.2
10+72.4 P.P.
10+72.7
Fire hyd. 11+46.9
4.0' Walk
AVE
edge of pvmt
11+00
10.2
21.7
12.2
11+47.8
11+57.0 W.M. 193.0 Eff
5.5
9.0
20.0
11+63.3
11+75.5
10.8
W. H. H. 11+77.6
7.5
11.0
11+82.5
12+00
10.5
5.0
12+02.5 M.M.
GALLINETA
CONT TOP PG
ST.
18.2
24.7
431.2
60'
18.0
12.2
12+10.3 W.H.H.
12+32.0
10.7
12+36.6 W. H.H.
12+39.3
W.M. 454.4
193.0 Eff
7.5
10.0
8.5
20.0
12+51.0
220
Trans P.P.
12+54.0
5.5
12+67.2
10.7
12+60.0
Gravel Drive
4.0 Walk
13+00
13+03.5
depressed ob.
BATSON
Premix Drive
CONT TOP PG 212
LOS ANGELES COUNTY ENGINEER,
700 Los Angeles County Engineering Bldg.
PLEASE RETURN TO
Do not extend this side of this line.
Note: Any Additions or Changes on This Sheet Must be Made or Circled in Red Ink With Date and Name of Person Making Change.

Notes Ck'd by

Office Work

Checked

Date

Survey of S. D. Project #1274

Surveyed by F E Brooks

Notes F E B - Gonzales Date

Indexed

F. B. 3369 Pg. 211

CONT FROM PG 210

1+74.8

Premix Drive

2+01.3

Premix Drive

depressed cls

ST.

depressed cls

2+06.1

Premix Drive

GALLINETA

2+41.5

Premix Drive

S.M.H. 3+68.2

5.1

Note: Any Additions or Changes on This Sheet Must be Made or Circled in Red Ink With Date and Name of Person Making Change.

Do not extend this side of this line.

PLEASE RETURN TO
LOS ANGELES COUNTY ENGINEER
700 Los Angeles County Engineering Bldg.

76F3098 SAE #247 11-68

F. B. 3369 PG 212

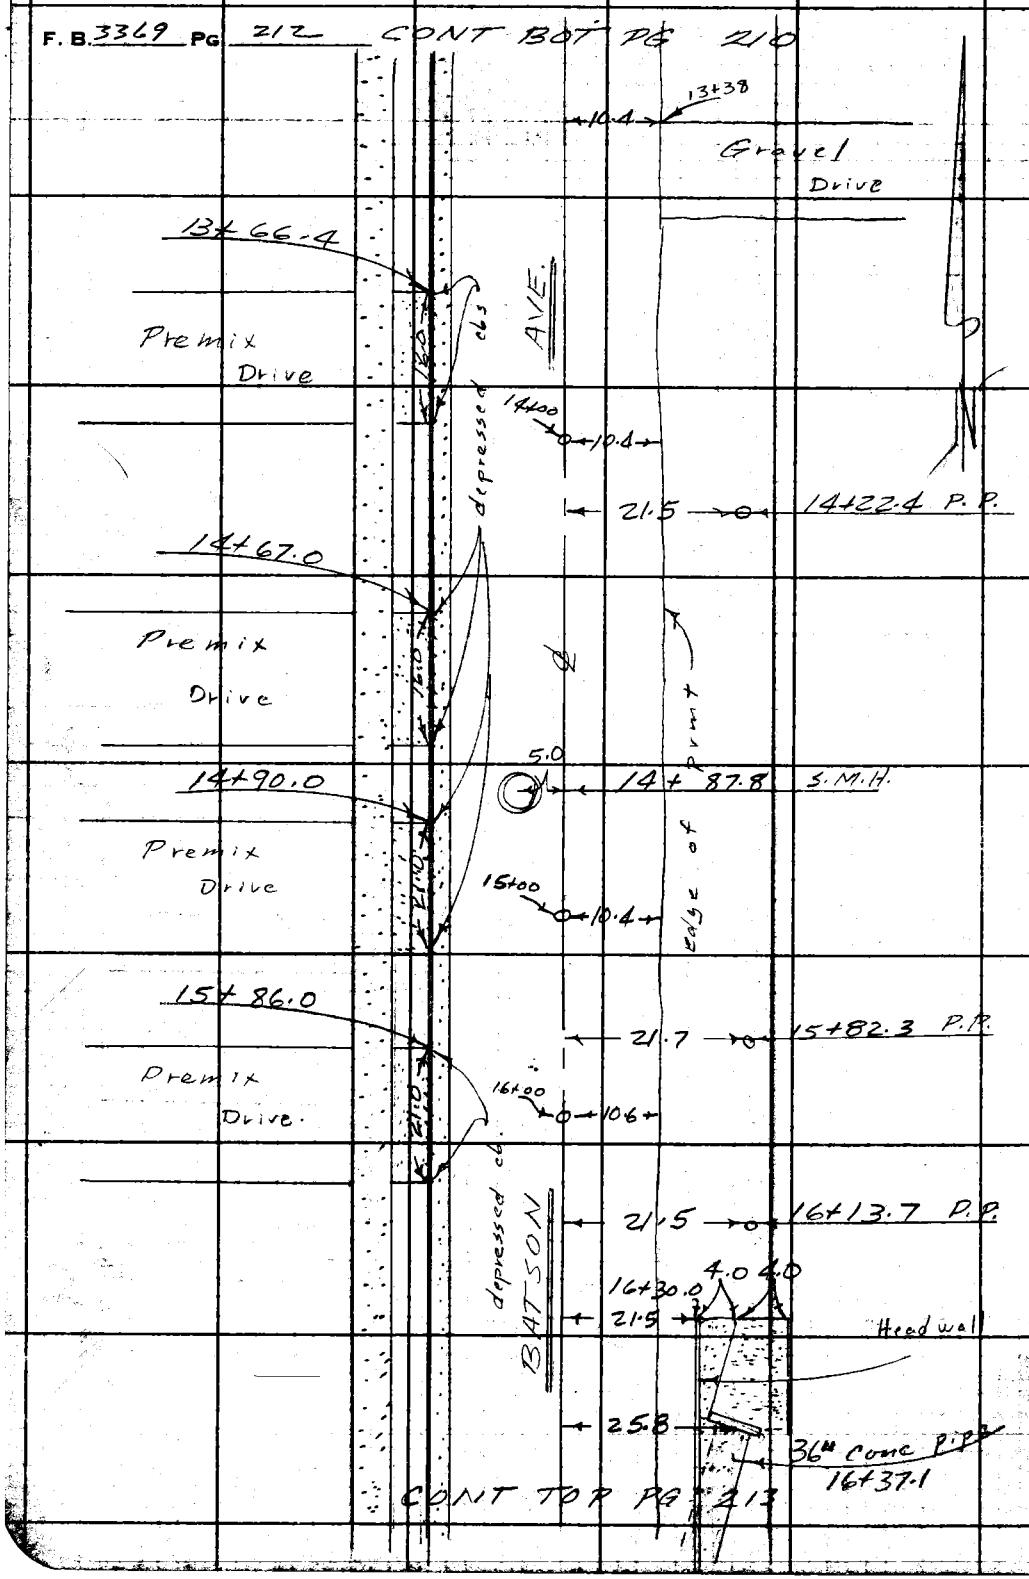

PLEASE RETURN TO
LOS ANGELES COUNTY ENGINEER
700 Los Angeles County Engineering Bldg.
Do not detach this side of this line.

Note: Any Additions or Changes on This Sheet Must be Made or Circled in Red Ink With Date and Name of Person Making Change.

Notes Ck'd by	Survey of S.D. Proj. and Hiway	F. B. 221-2 Pg. 213
Office Work	Surveyed by FE Brooks	
Checked	Notes FE & Guizada Date 21 APR 71	
Date	Indexed [illegible]	

Note: Any Additions or Changes on This Sheet Must be Made or Circled in Red Ink With Date and Name of Person Making Change.
Do not extend this title of this line.

PLEASE RETURN TO
LOS ANGELES COUNTY ENGINEER
900 Los Angeles County Engineering Bldg.

78F3088 SAE #247 $1.00

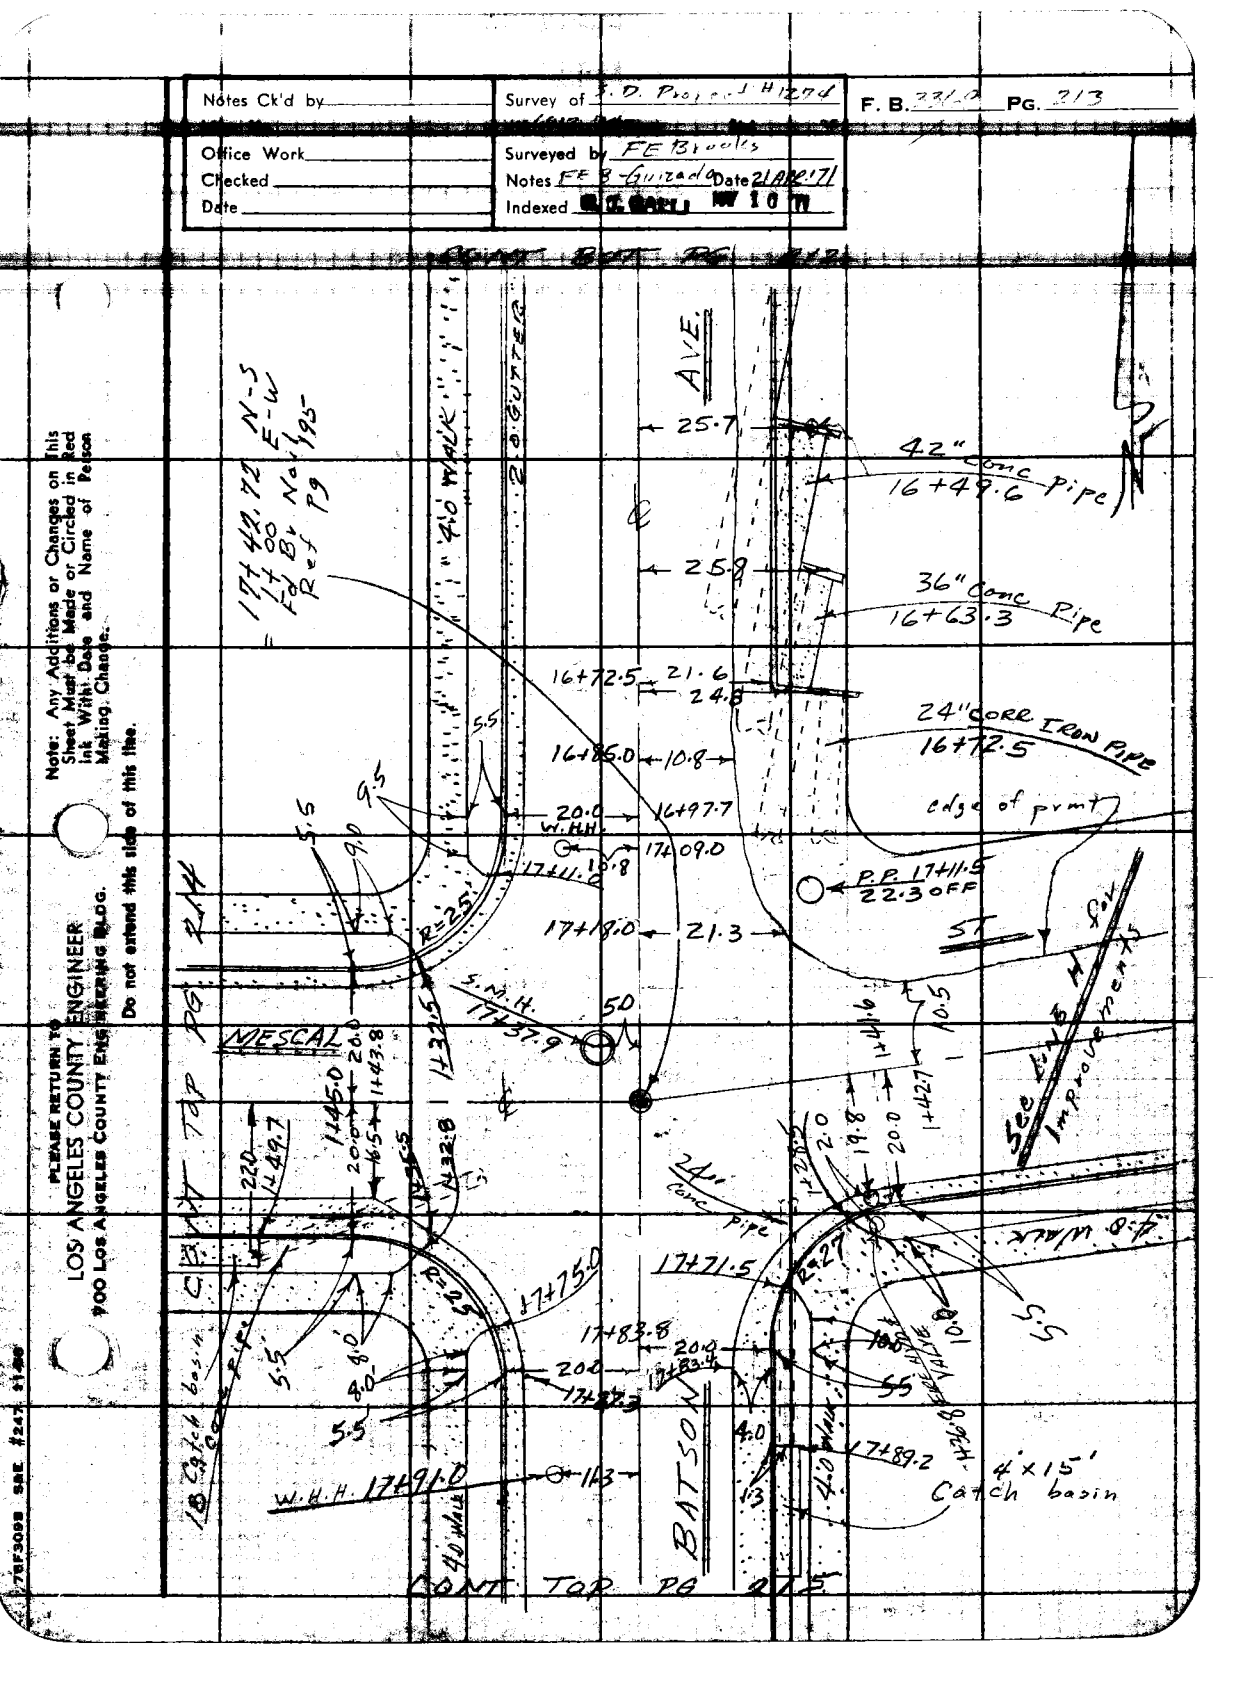

F. B. 3369 PG. 214

CONT LT PG 215

4.2' x 11.0'
CATCH BASIN

1+60.7

W.M. 1+62.2

21.4

1+65.0

4.0

1+73.0

1+81.0

14.1

1+82.4 W.H.H

Premix
Drive

2.0 GUTTER

ST.

2+35.3

Premix
Drive

2+40.7

Premix
Drive

depressed
CBs

2+65.5

Premix
Drive

MESCAL

S.M.H. 3+50.3

5.0

2.0 GUTTER

PLEASE RETURN TO
LOS ANGELES COUNTY ENGINEER
700 Los Angeles County Engineering Bldg.

Do not extend this side of this line.

Note: Any Additions or Changes on This Sheet Must be Made or Circled in Red Ink With Date and Name of Person Making Change.

Notes Ck'd by

Office Work

Checked

Date

Survey of S. D. Project #12 74

Surveyed by F E Brooks

Notes FPB-Guizado Date 21 APR '71

Indexed MAY 10


Cont. Rt. Pg. 212

Note: Any Additions or Changes on This Sheet Must be Made or Circled in Red Ink With Date and Name of Person Making Change.

Do not extend this line.

PLEASE RETURN TO LOS ANGELES COUNTY ENGINEER 700 Los Angeles County Engineering Bldg.

18+13.0

40

W.M. 18+17.3

21.8

18+25.8

18+35.0

Premix Drive

21.0

18+52.0

AVE.

2.0 GUTTER

18" conc Pipe

3.2

18+69.0

Catch 4'x15' basin

18+73.0

53.0

18+80.2

36" 36"

21 L.F.

18+89.9

52.8

depressed cl.

18+93.2

depressed cl.

(2) 36" ED 42" Cmd pipes

gate

18+94.2

18" conc pipe

19+08.6

Premix Drive

4'x15' Catch basin.

40

19+18.0

BATSON

19+29.4

Premix Drive

19+58.6

19+42.8

depressed cl.

Premix Drive

16.0

CONT LT PG 216

76F3098 SAE #247 11-86

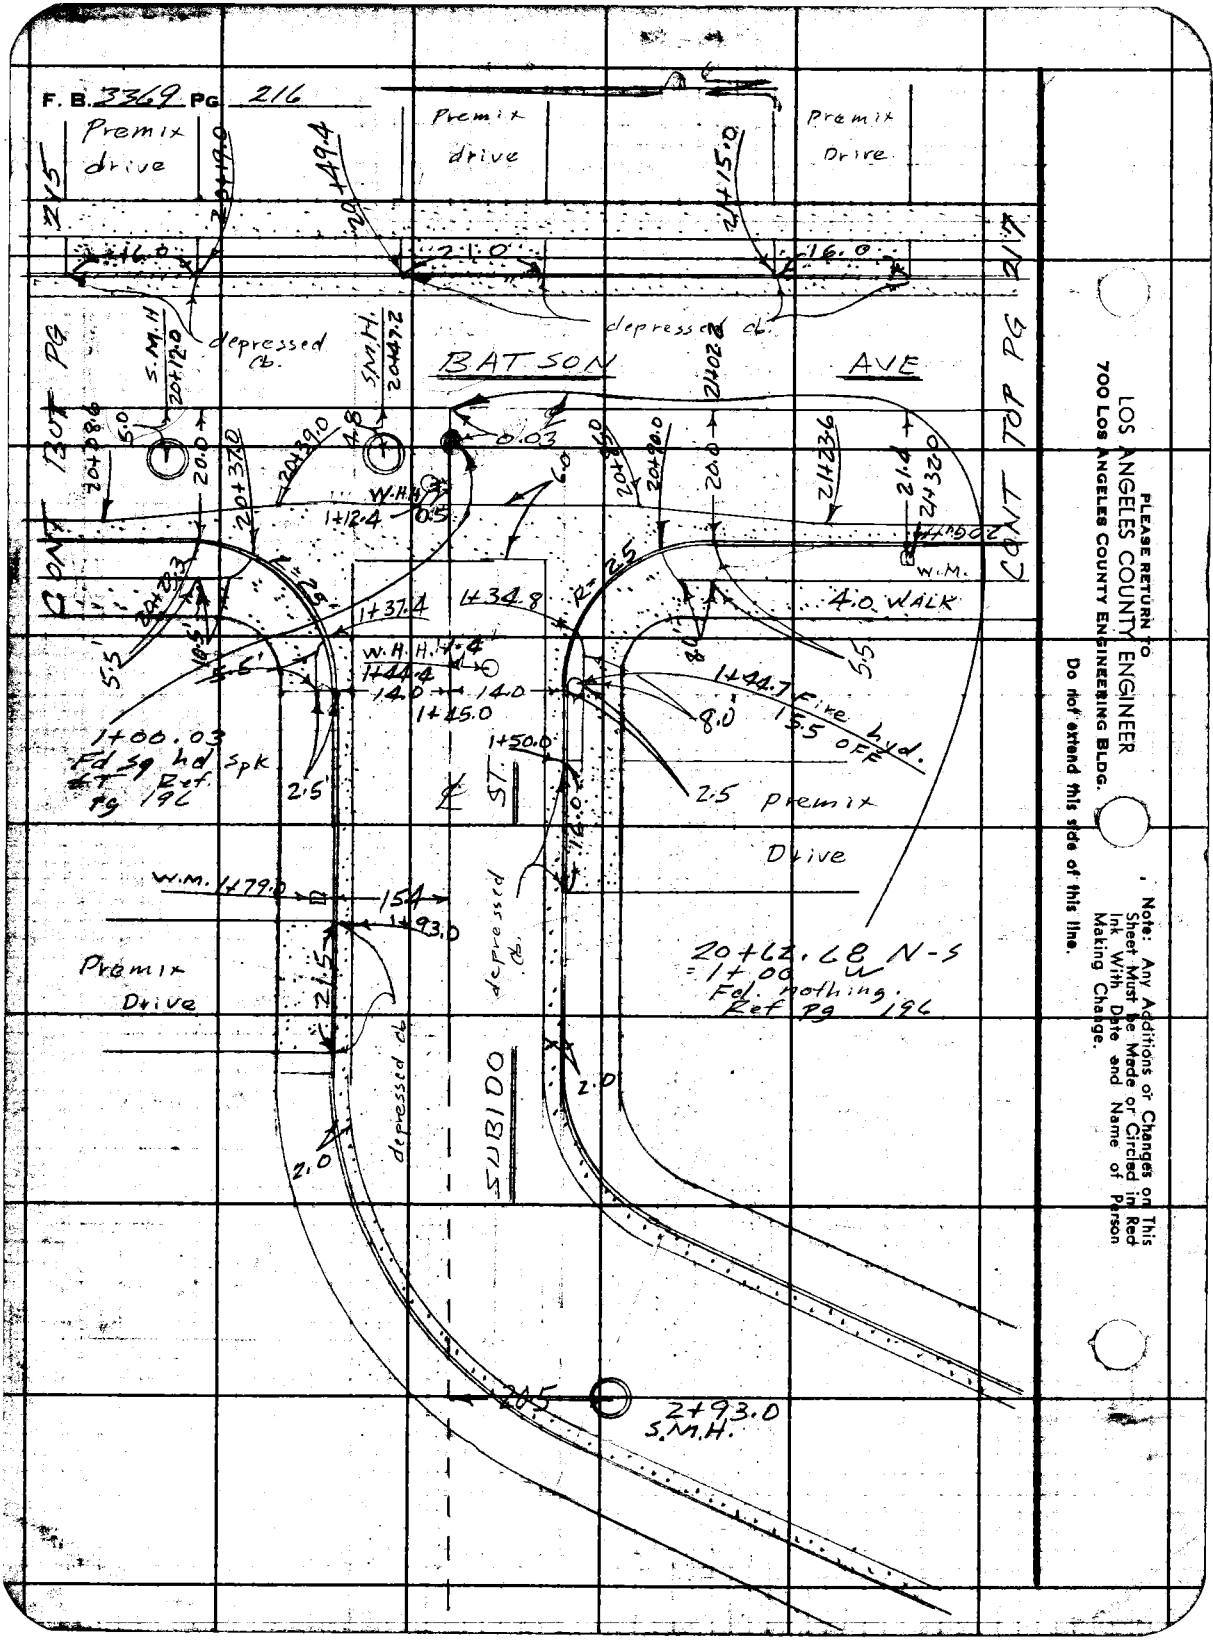
F. B. 3369 PG 216
Premix drive
Premix drive
Premix Drive
depressed ch.
depressed ch.
BATSON AVE
S.M.H.
W.H.H.
W.M.
4.0 WALK
1+00.03 Fd 59 hd spk Ref Pg 196
1+42.7 Fire hyd. 15.5 OFF
2.5 premix Drive
20+62.68 N-S = 1+00 W Fd nothing Ref Pg 196
Premix Drive
SUBIDO
2+93.0 S.M.H.
PLEASE RETURN TO
LOS ANGELES COUNTY ENGINEER
700 Los Angeles County Engineering Bldg.
Do not extend this side of this line.
Note: Any Additions or Changes on This Sheet Must be Made or Circled in Red Ink With Date and Name of Person Making Change.

Notes Ck'd by	Survey of S. D. Project # 12114
Map No.	UNG 67-4 Type Sht.
Office Work	Surveyed by FF Brooks
Checked	Notes FF B - Guirado Date 21 APR 71
Date	Indexed G. J. GALLI MW 10 m

F. B. 331.9 Pg. 217

CONT. RT. PG. 216

Note: Any Additions or Changes on this Sheet Must be Made or Circled in Red Ink With Date and Name of Person Making Change.

Do not extend this side of this line.

PLEASE RETURN TO
LOS ANGELES COUNTY ENGINEER
403 Los Angeles County Engineering Bldg.

21+69.4
Premix
Drive
16.0
depressed cb's
AVE.
21+99.5
Premix
Drive
16.0
depressed cb's
22+15.8
Premix
Drive
21.0
22+26.7
Premix
Drive
16.5
depressed cb's
22+82.5
Premix
Drive
16.0
depressed cb's
BATSON
S.M.H. 23+12.0
5.0
23+12.5
Premix
Drive
20.0
23+29.0
Premix
Drive
16.0
depressed cb's

CONT TOP PG 218

76F3095 CE # 310 2-67

F. B. 3369 Pg. 218

CONT BOT PG 217

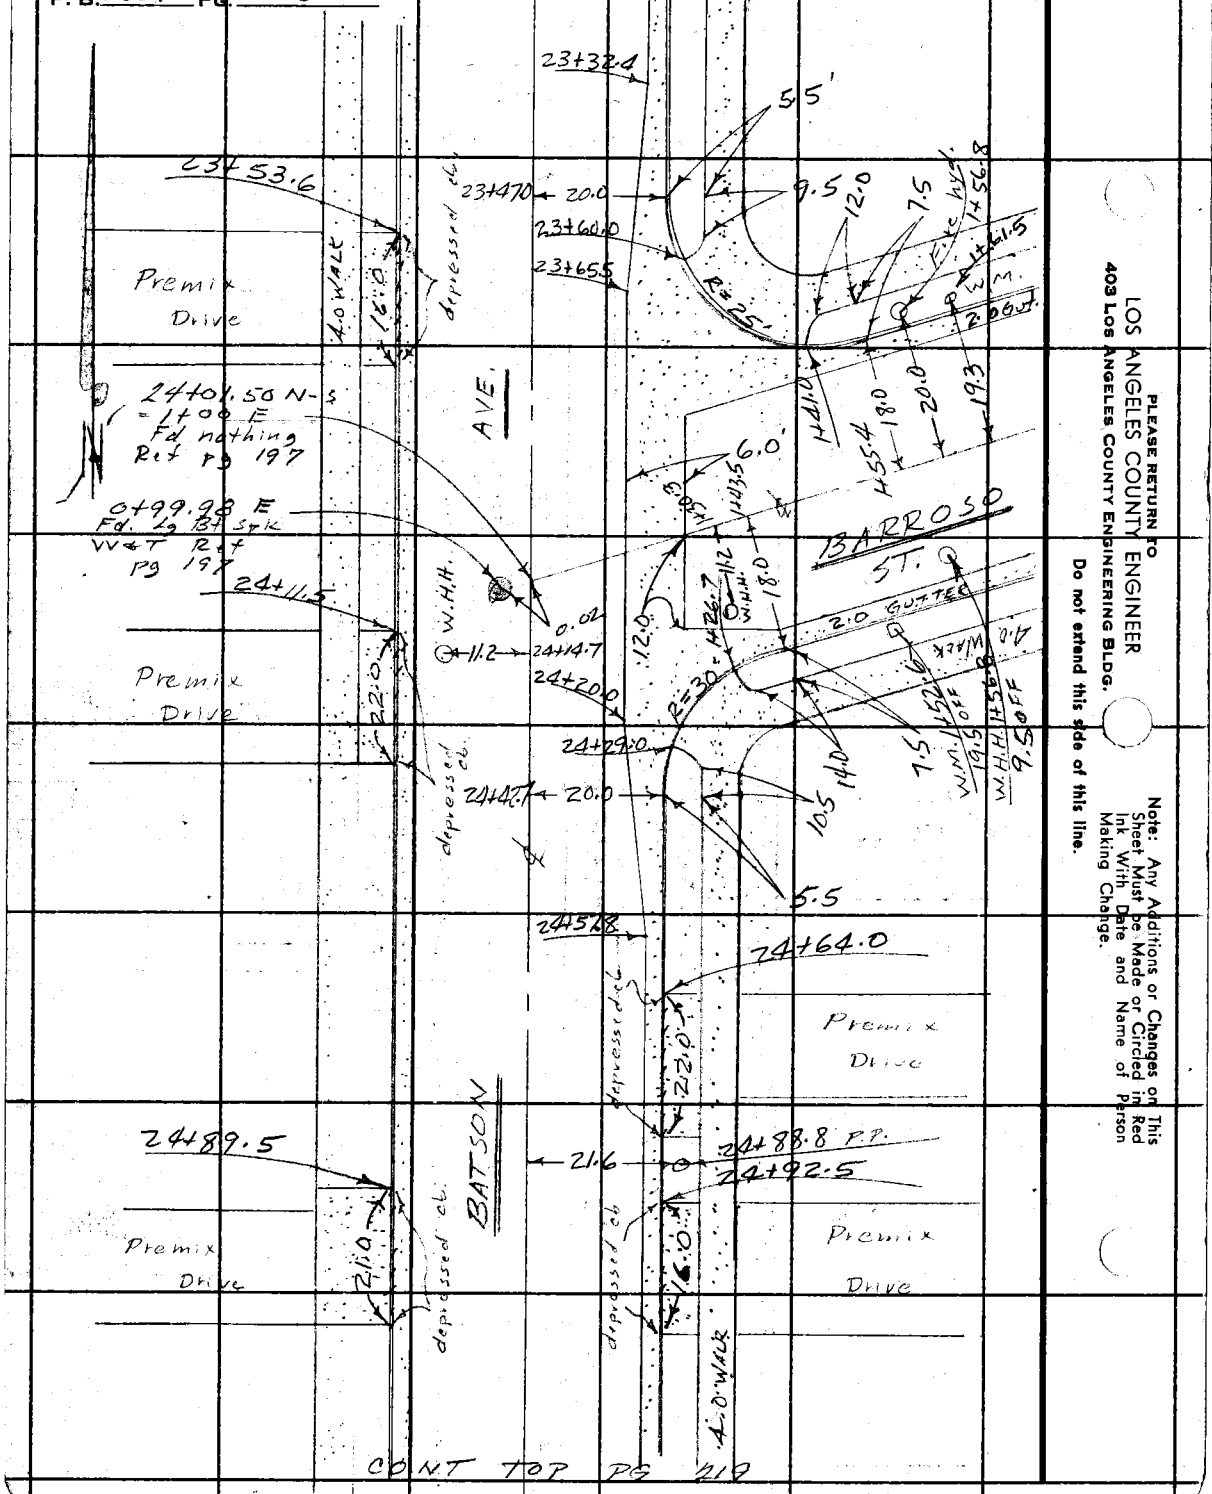

PLEASE RETURN TO
LOS ANGELES COUNTY ENGINEER
403 Los Angeles County Engineering Bldg.

Do not extend this side of this line.

Note: Any Additions or Changes on This Sheet Must be Made or Circled in Red Ink With Date and Name of Person Making Change.

Notes Ck'd by	Survey of S.D. Pipe Hydrant	F. B. Pg.
Map No.	UN 642.44 Tape Std.	
Office Work	Surveyed by F.I. Bucks	
Checked	Notes FEB Surveys Date 2/APR/71	
Date	Indexed R. J. BACLI NOV 10 71	

CONT. EOT PG. 210

S.M.H. 25+61.3

5.2

25+79.8

Premix Drive

25+96.0

Premix Drive

22.0

AVE.

depressed ct.

22.0

depressed ct.

26+10.0

Premix Drive

℄

26+70.0

Premix Dr.

BATTSON

depressed ct.

27+30.5

Conic Drive

23.0

depressed ct.

27+29.0

Premix Dr.

CONT. TOP PG. 220

Note: Any Additions or Changes on This Sheet Must be Made or Circled in Red Ink With Date and Name of Person Making Change.

Do not extend this side of this line.

PLEASE RETURN TO
LOS ANGELES COUNTY ENGINEER
403 Los Angeles County Engineering Bldg.

76F3095 CE # 310 3-61

F. B 3369 Pg. 220 CONT BOT Pg. 219

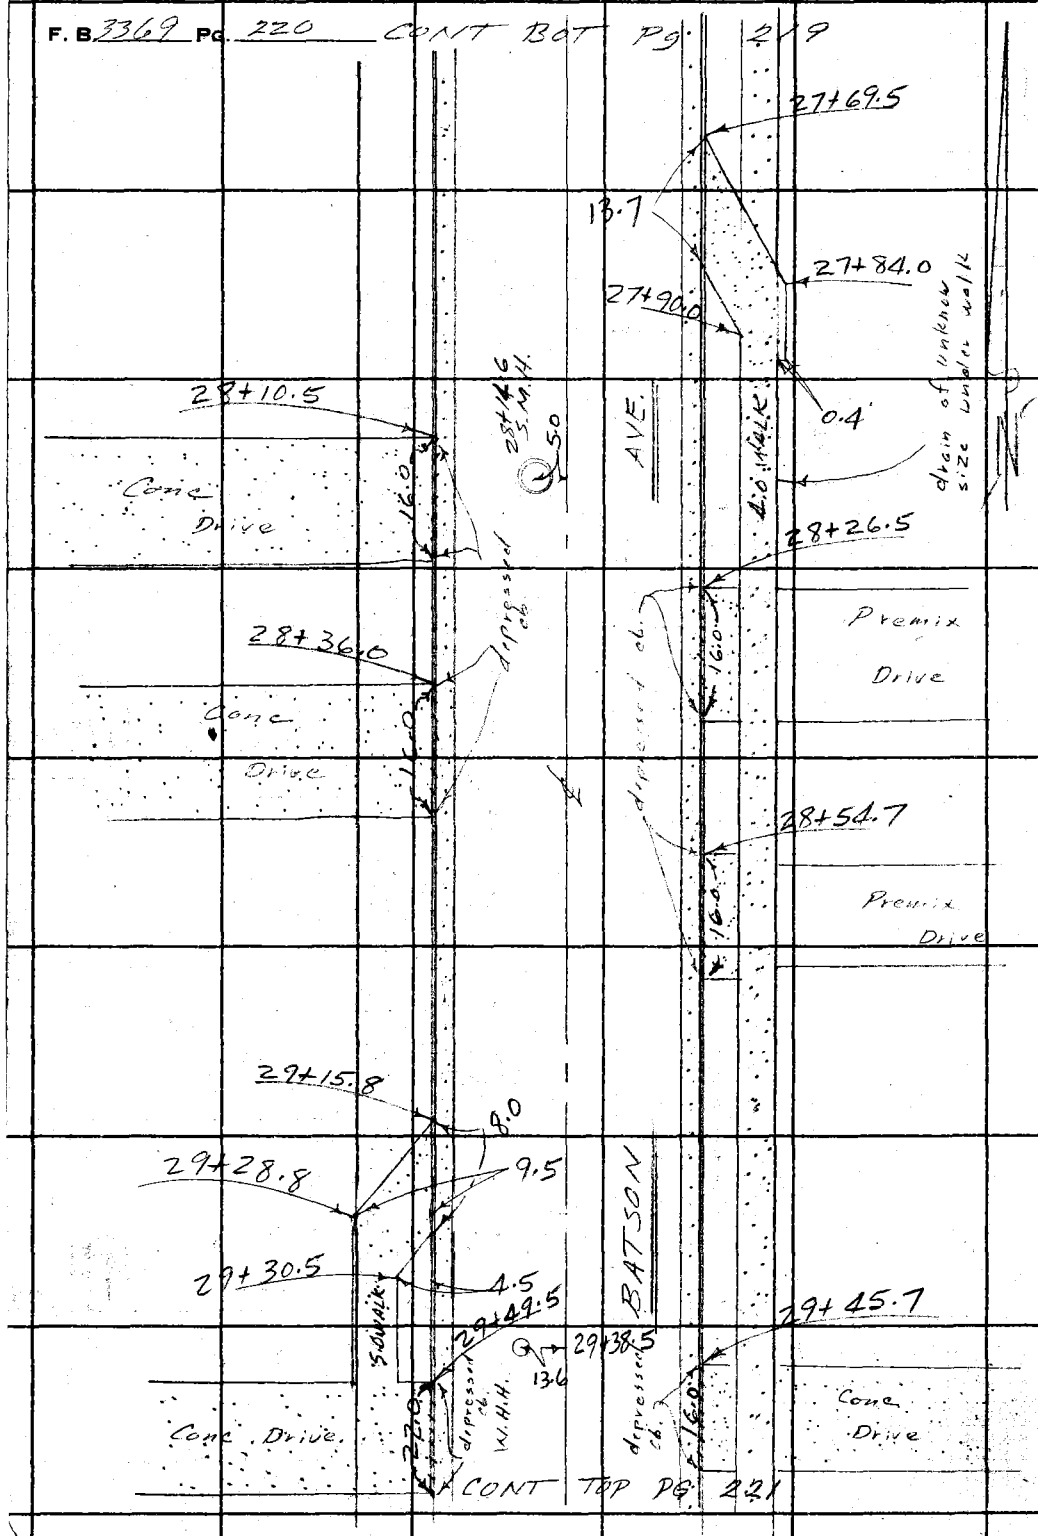

LOS ANGELES COUNTY ENGINEER
403 Los Angeles County Engineering Bldg.

PLEASE RETURN TO

Do not extend this side of this line.

Note: Any Additions or Changes on This Sheet Must Be Made or Circled in Red Ink With Date and Name of Person Making Change.

Notes Ck'd by _____ Survey of S.D. Project Hwy 94

Office Work _____ Surveyed by F E Brooks

Checked _____ Notes EEB - Gonzales Date 2 APR '71

Date _____ Indexed C. J. GALLI MAY 10 '71


CONT BOT PG 220

Conc box 4' wide 10" deep

29+78.7 S.D.M.H.

AVE

27.0

29+69.0

Conc Drive

30+85.95 N-W = 1+00 E Fd 2" I.P. conc Plug & Tag RE 16 LB Ref Pg 199

30+95.95 E-S = 1+00 W Fd conc N. Ref Pg 199

2.0' GUTTER

BATSON

21.5

29+93.5 P.P.

4.0'

21.7

30+26.3 dead man

30+31.0

20.0

30+38.8

20.0

7.0'

7.0'

5.5'

5.5'

P.P. 1+53.4

1+73.4

5.5'

30+41.5

2" 25'

1+73.6

1+60.3 W.M.

1+77.3

2.0' GUTTER

1+42.5

1+53.0

21.0

23.0

1+81.0

4 Pal

22.0

20.2

22

24.0

21.6

1+31.0

20.2

PS

CONT TOP

AGUIRO

9.0

22.5

W.H.H.

31+08.2

20.8

W.H.H.

31+10.0

11.7 OFF

11.7 OFF

1+02.5

1+05.8

1+21.5

1+30.7

1+35.4

20.0

20.8

20.8

S.M.H.

W.H.H.

Fire hyd.

ST.

16.0

Drive

1+74.3

Pavmt

CONT BOT PG 222

1+39.7 W.M.

12" Walnut

21.6

31+30.0

31+42.0

8.5

4.5

9.5

31+21.6

Drive

Fire hyd.

3" Pine

1+51.3 3" Palm

1+52.1 5" Palm

Pre m.t

Edge of Pavmt

DIRT DRIVE

10'0 Offset LINE

BATSON PVT.

8.0'

Prem

31+60.0

18.5

1st Tree of a row of 206 4" to 19" Eucalyptus

CONT TOP PG 224

Note: Any Additions or Changes on this Sheet Must be Made or Circled in Red Ink With Date and Name of Person Making Change.

Do not extend this side of this line.

PLEASE RETURN TO

LOS ANGELES COUNTY ENGINEER

403 LOS ANGELES COUNTY ENGINEERING BLDG.

75F309S CE # 310 3-61

F. B. 3369 Pg. 222

CONT LT PG 221

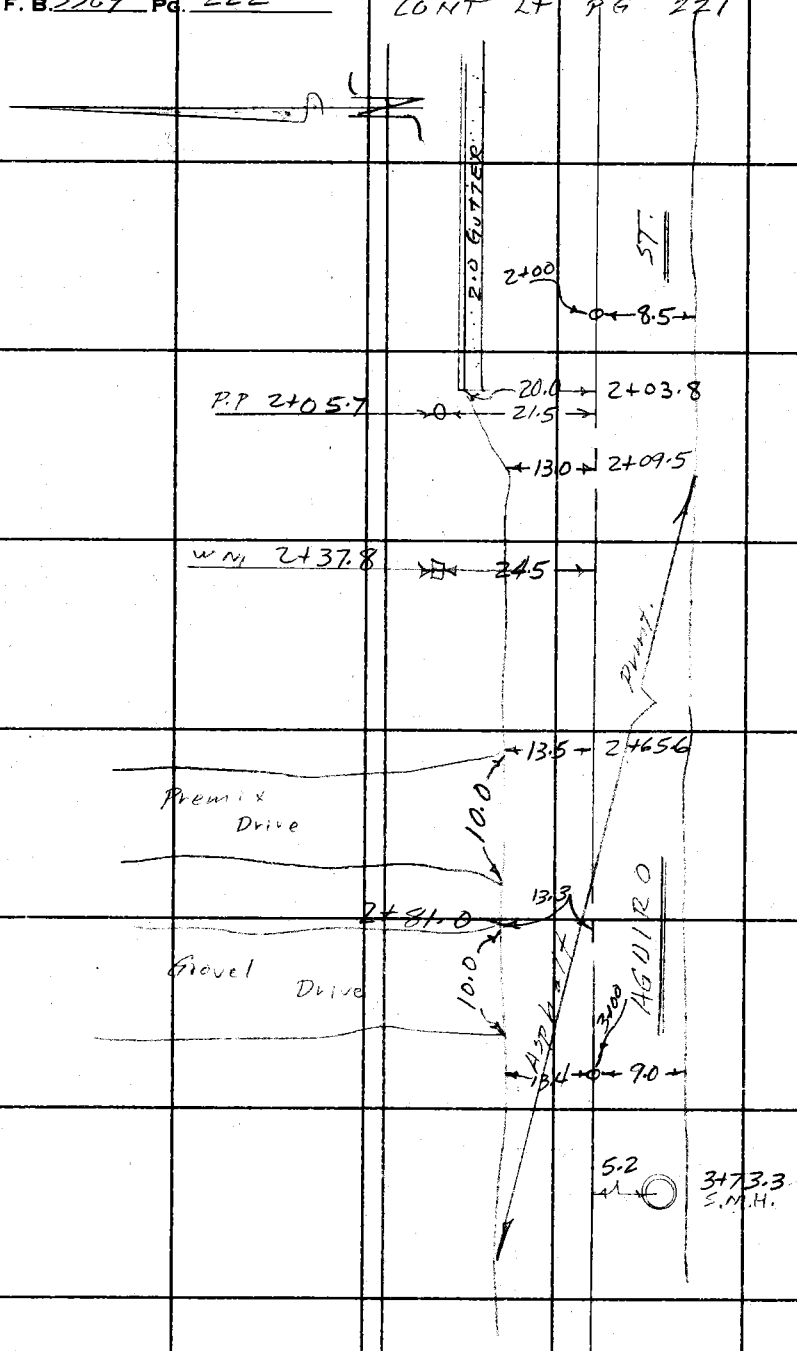

PLEASE RETURN TO
LOS ANGELES COUNTY ENGINEER
403 Los Angeles County Engineering Bldg.

Do not extend this side of this line.

Note: Any Additions or Changes on This Sheet Must be Made or Circled in Red Ink With Date and Name of Person Making Change.

Notes Ck'd by
Map No.
Office Work
Checked
Date

Survey of S.D. Project #1274
JN Tape Std °F
Surveyed by
Notes FEB-Guizado Date 2/28/71
Indexed

F. B. 3369 Pg. 223

Note: Any Additions or Changes on This Sheet Must be Made or Circled in Red Ink With Date and Name of Person Making Change.

Do not extend this side of this line.

PLEASE RETURN TO
LOS ANGELES COUNTY ENGINEER
403 Los Angeles County Engineering Bldg.

76F3085 CF #330 4-62

20.0
11.5
Premix Drive
16.0
depressed ct.
2+86.0
2+86.3
11.5
10.0
Conc Drive
2+82.2 S.M.H.
5.2
ST.
edge of pvmt
2.0 GUTTER
11.8
17.0
Conc Drive
2+22.0
20.7
4" Pine 2+02.0
2+00
12.0
ED. PAV.
20.5
5" Palm 1+95.0
AGUIRO
20.5
5" Palm 1+94.0
19.7
5" Palm 1+82.9
19.7
3" palm 1+81.4
CONT RT PG 221

F. B. 3369 PG 224

CONT BOT PG 221

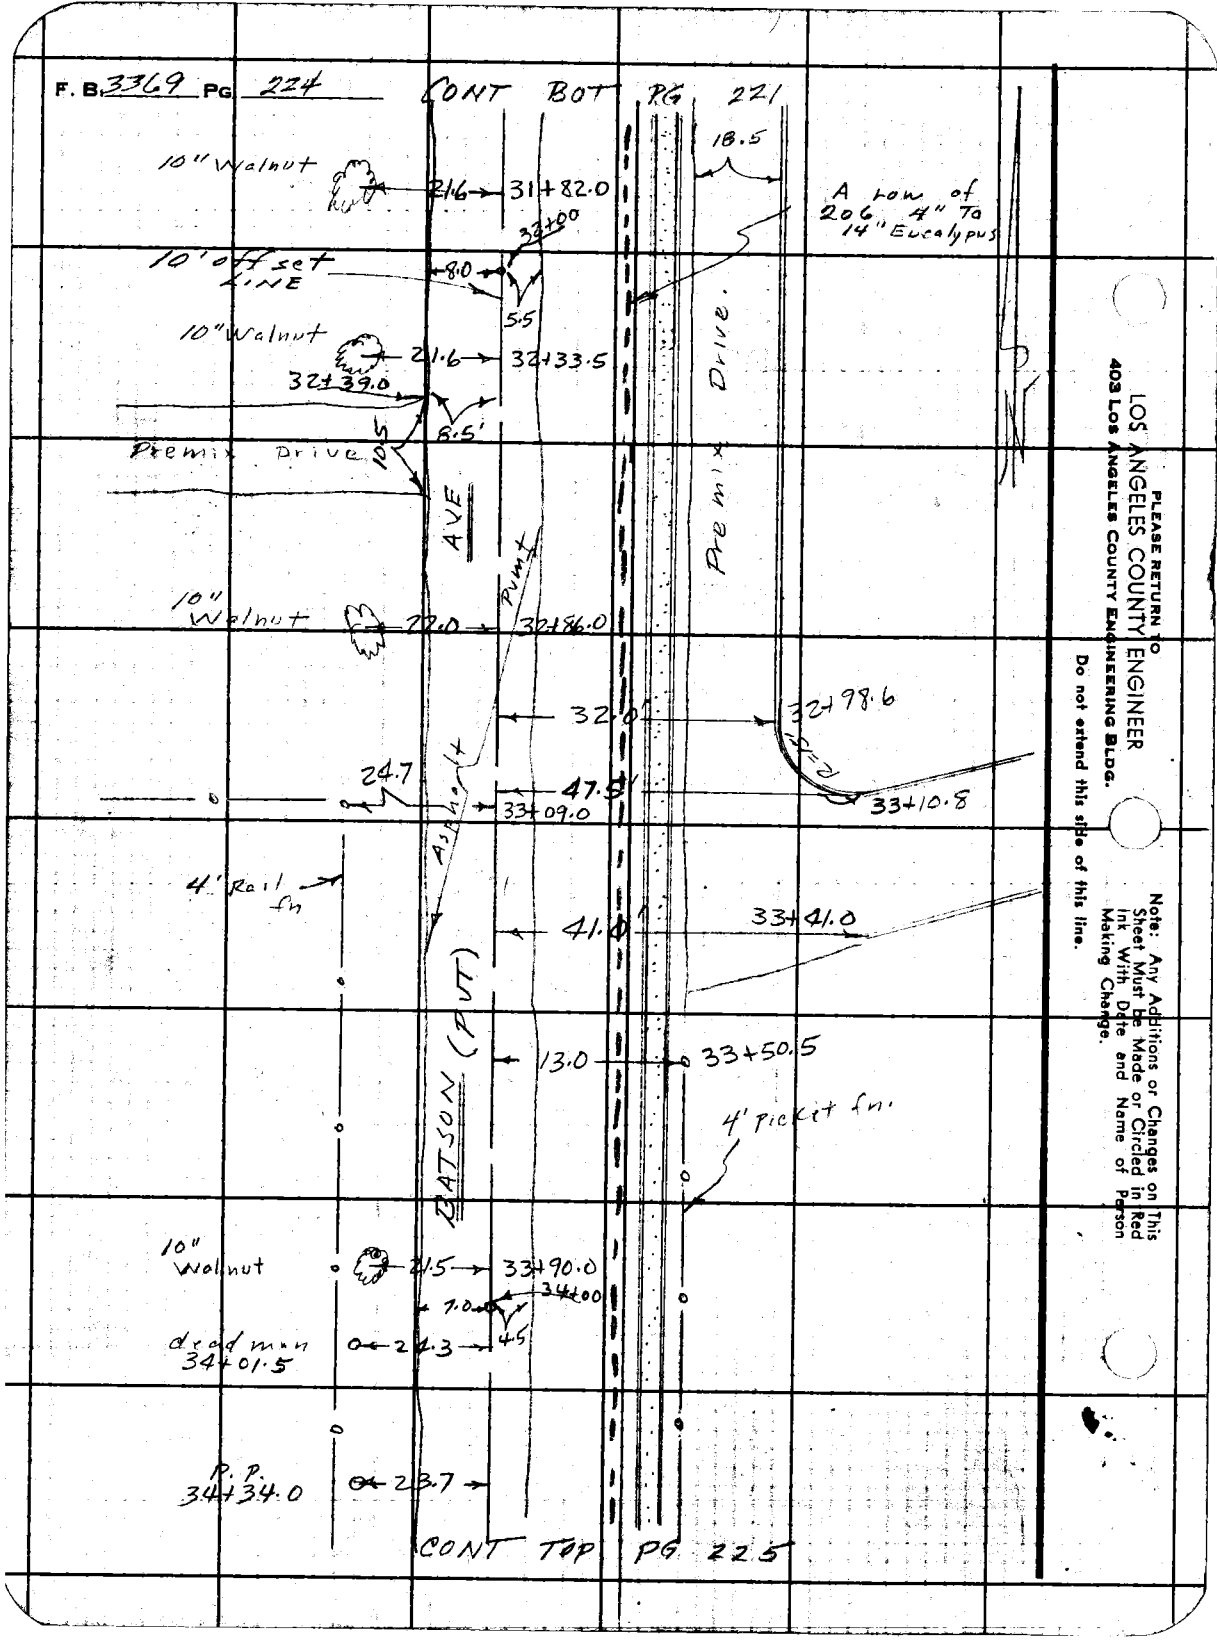

LOS ANGELES COUNTY ENGINEER
403 LOS ANGELES COUNTY ENGINEERING BLDG.
PLEASE RETURN TO

Do not extend this side of this line.

Note: Any Additions or Changes on This Sheet Must be Made or Circled in Red Ink With Date and Name of Person Making Change.

Notes Ck'd by
Mod. No.
Office Work
Checked
Date

Survey of S.D. Project #1284 JN 6012 Tape Std °F
Surveyed by P.E. BROWN
Notes FEB-Guizar Date 21 APR 71
Indexed G.L. GALLI MAY 10 71

F. B. 3369 PG. 225

CONT BOT PG 224

34+35.8
23.5
10" Walnut 34+41.7
21.2
Power
2 Story Frame house
34+64.0
A row of 206 4" to 14" Eucalypus
44 picket fn.
10' Offset Line
AVE
(PVT)
35+00
34+93.8
13.0'
12" JAC 35+02.6
41' fence
9.5
Asphalt
17.6'
35+07.8 16.5 OFF
35+10.8 20.0 OFF
35+09.5
16.0'
9.0
S.M.H.
35+12.6
27.7 OFF
35+22.0
32.0
42.0
35+31.0
35+32.2 42.0 OFF
BATSON
AVE
Edge of pvmt
Ditch
10" Walnut 35+45.4
21.6
37.0
W.M.H. 35+49.0
Premix Drive
35+59.0
21" Conc Pipe

CONT TOP PG 226

Note: Any Additions or Changes on This Sheet Must be Made or Circled in Red Ink With Date and Name of Person Making Change.

PLEASE RETURN TO
LOS ANGELES COUNTY ENGINEER
403 Los Angeles County Engineering Bldg.
Do not extend this side of this line.

7.8 R 30 S C.E. #310 0-62

F. B. 3369 PG 226

CONT BOT PG 225

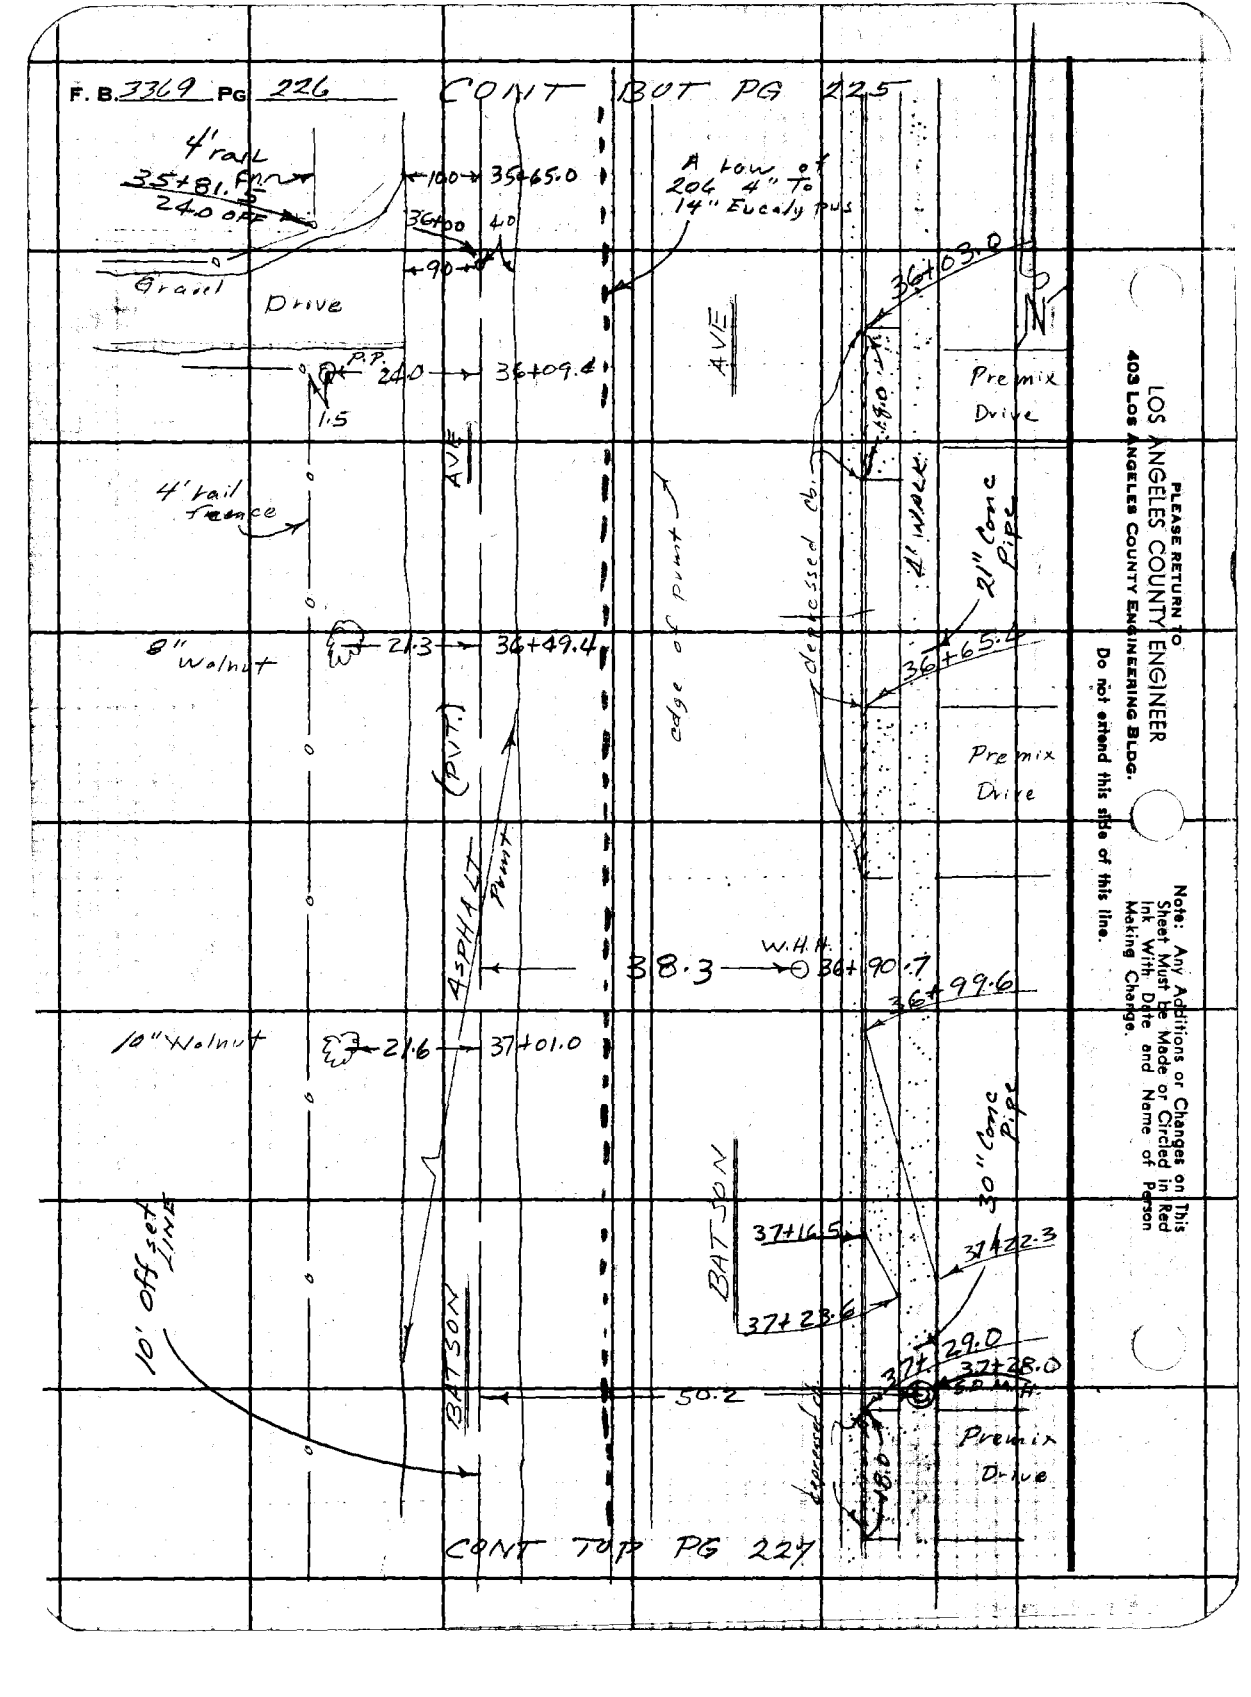

CONT TOP PG 227

PLEASE RETURN TO
LOS ANGELES COUNTY ENGINEER
403 Los Angeles County Engineering Bldg.
Do not extend this side of this line.

Note: Any Additions or Changes on This Sheet Must Be Made or Circled in Red Ink With Date and Name of Person Making Change.

Notes Ck'd by
Map No.
Office Work
Checked
Date

Survey of S.D. Project # 12-14
JN 6012 Tape Std °F
Surveyed by F.E. Brooks
Notes F.E.B.-Guizado Date 22 Apr. '71
Indexed F. E. BALL! NOV 10 '71

F. B. 3369 PG. 227

CONT. RT. PG 226

8" Walnut
4' Bank Ch
216 → 37+53.0
25.5 → 37+65.0
P.P. 24.5 → 37+66.5
37+69.0
A row of 4" to 20" 14" Eucalyptus
Asphalt Dr.
10.0
10.0
10.0
AVE
38+00
10.0
2.5
edge of pvmt
AVE
2'-0" GUTTER
3+90.0
Premix Dr.
10" Walnut
220 → 38+05.0
38+13.0
11.0
Dirt Drive
19.0
(PVT)
Pvmt
depressed
30" Conc Pipe
10" WALNUT
38+58.0
21.5
27.3
38+34.0
W.M. H.
28+53
depressed C.B.
18.3
Premix Dr.
10' Offset Line
Asphalt
BATSON
39+00
38+91.5
+75
40
8" Walnut
39+09.3
21.5
39+08.6
39+15.5
39+13.5
CONT TOP PG 228

Note: Any Additions or Changes on this Sheet Must be Made or Circled in Red Ink With Date and Name of Person Making Change.

PLEASE RETURN TO
LOS ANGELES COUNTY ENGINEER
403 Los Angeles County Engineering Bldg.
Do not extend this file of this line.

75E3085 C.E. #310 6-62

F. B. 3369 PG 228 CONT BOT PG 227

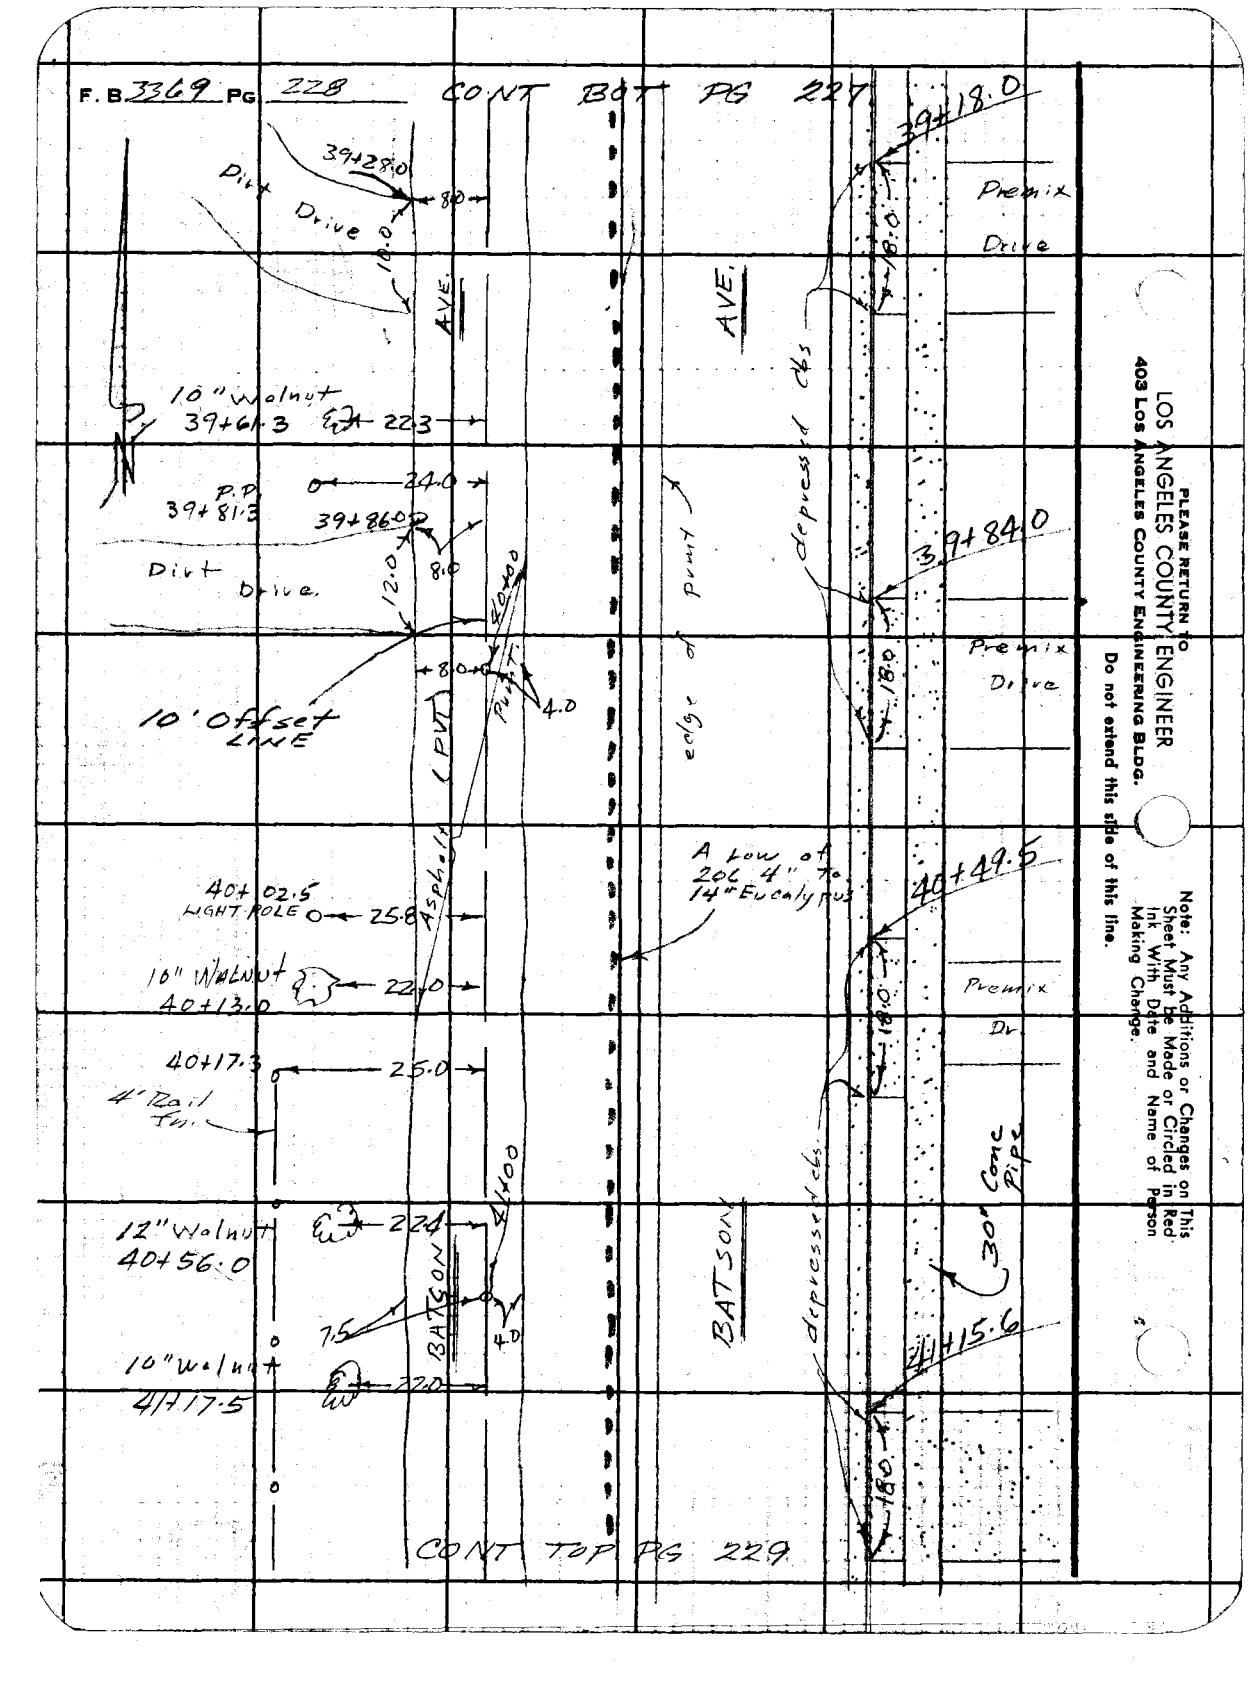

PLEASE RETURN TO
LOS ANGELES COUNTY ENGINEER
403 Los Angeles County Engineering Bldg.
Do not extend this side of this line.

Note: Any Additions or Changes on This Sheet Must be Made or Circled in Red Ink With Date and Name of Person Making Change.

Notes Ck'd by
Map No.
Office Work
Checked
Date

Survey of S.D. Project #1244
JN Tape Stg °F
Surveyed by F.E. Bybee
Notes Ft. Guijarro Date 22 APR '71
Indexed B. GALLA 10 TH


CONT. BOT. PG 228

4' Rail fn
12" Walnut
41+69.0
21.5
41+87.0
4' wire fn
41+87.5 P.P
26.0
24.3
22.0
41+93.5
4-10" Trees
22.0
41+98.0
22.0
42+01.5
22.0
42+05.0
4' Wire fn
42+17.3
25.8
8" Walnut
42+21.0
22.0
42+30.0
9.0 OFF
Premix Drive.
13.0
6" Ash
42+52.4
21.5
10' offset LINE
42.5
6" Walnut
42+73.0
22.0
37.7
41+45 S.N.H.
27.1
AVE.
Asphalt Pvmt
edge of pvmt
A row of 206 4" To 14" Eucalypus
BATSON
(PVT)
41+80.0
30" Conc Pipe
N
Premix Drive
19.0
4.0 WALK
depressed 6"
42+14.3
18.0
Premix Drive
42+33.0
5.5
42+50.5
46.5
50.5 OFF
42+57.3
6.0
4.5
39" RCP
R=375'
42+81.8
W.H.H.

CONT AT PG 230

Note: Any Additions or Changes on This Sheet Must be Made or Circled in Red Ink With Date and Name of Person Making Change.

PLEASE RETURN TO
LOS ANGELES COUNTY ENGINEER
403 Los Angeles County Engineering Bldg.
Do not extend this side of this line.

74F3085 C.E. #330 6-62

PLEASE RETURN TO
LOS ANGELES COUNTY ENGINEER
403 LOS ANGELES COUNTY ENGINEERING BLDG.

Note: Any Additions or Changes on This Sheet Must be Made or Circled in Red Ink With Date and Name of Person Making Change.

Do not extend this side of this line.

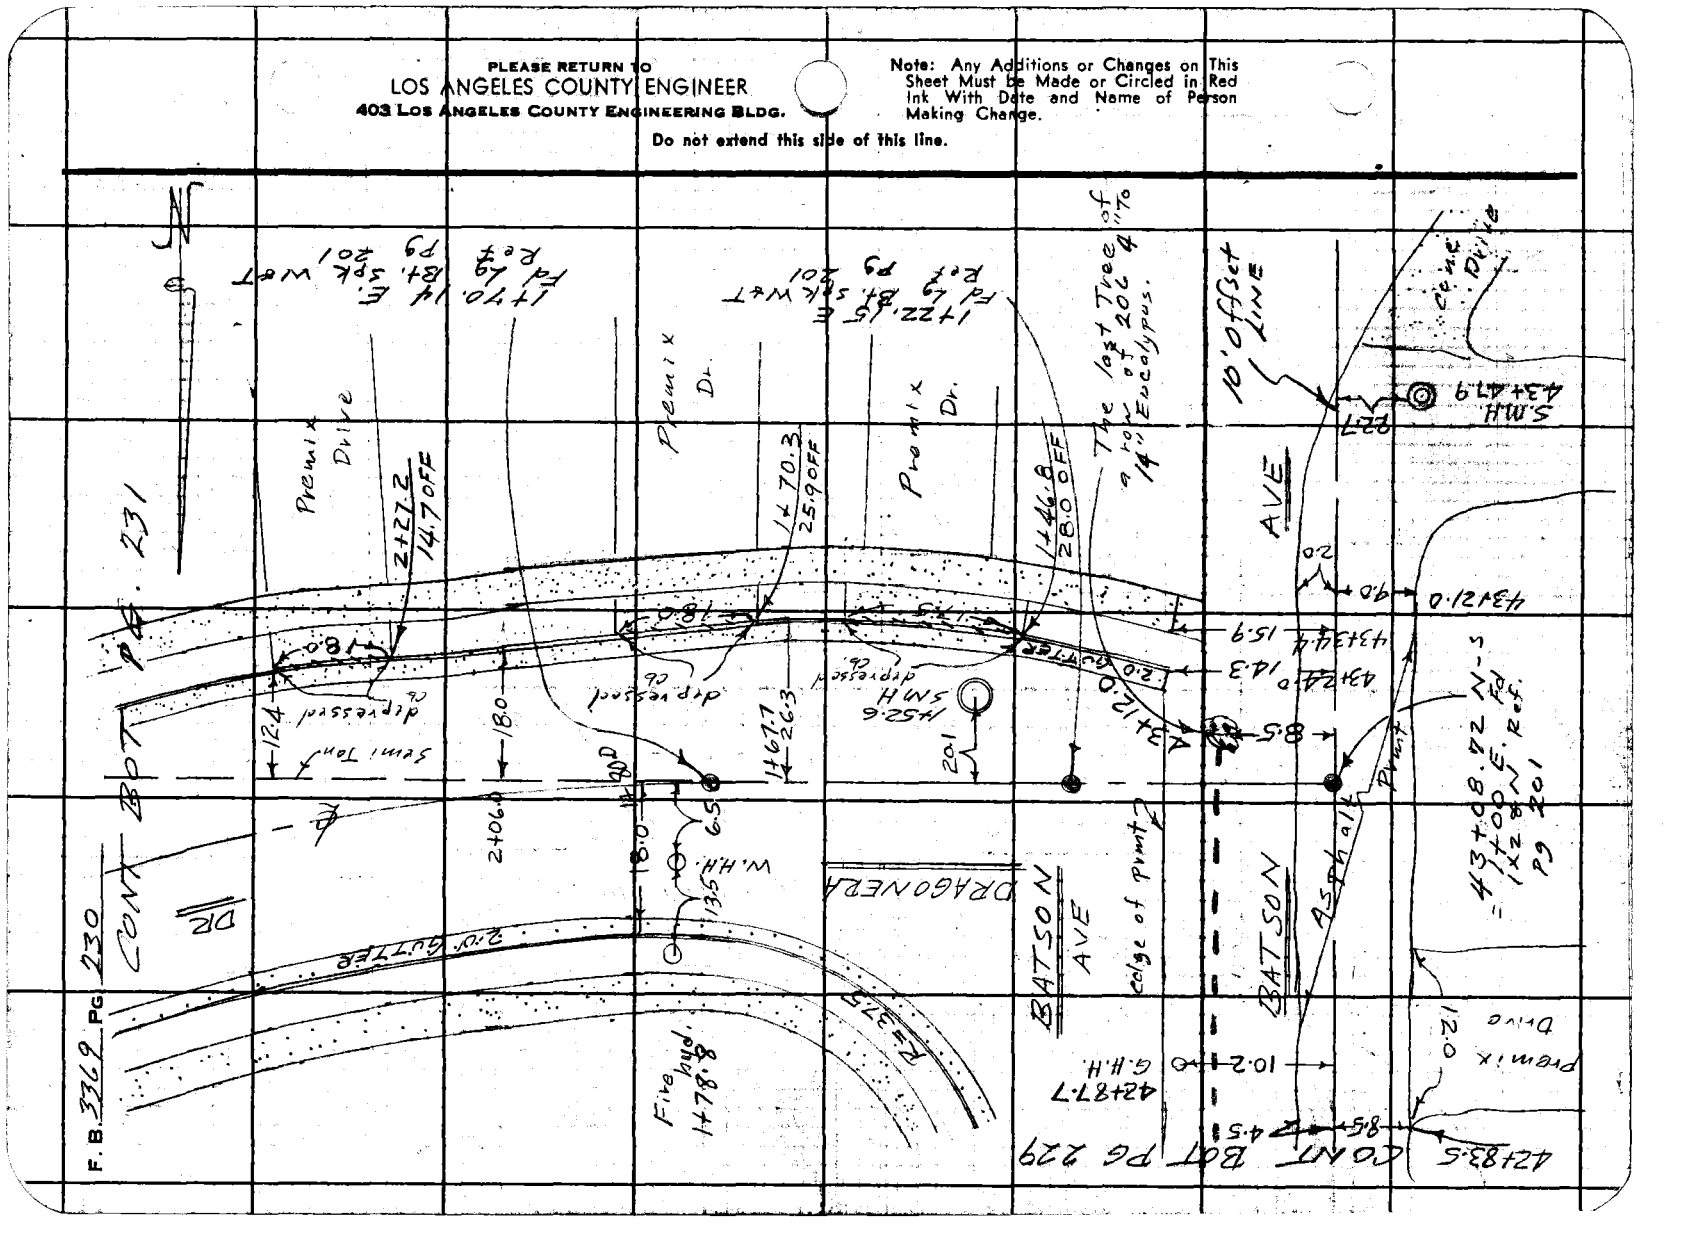

Notes Ck'd by _____
Map No. _____
Office Work _____
Checked _____
Date _____

Survey of _____
JN _____ Tape _____ Std. _____
Surveyed by F E Brooks
Notes F E B Grizado Date 22 Apr '71
Indexed G. T. GALLI NOV 10 71

F. B. _____ PG. _____

Note: Any Additions or Changes on This Sheet Must be Made or Circled in Red Ink With Date and Name of Person Making Change.

Do not extend this side of this line.

PLEASE RETURN TO
COUNTY OF LOS ANGELES
DEPARTMENT OF COUNTY ENGINEER
403 LOS ANGELES COUNTY ENGINEERING BLDG.

16F309S CE#310 3-69

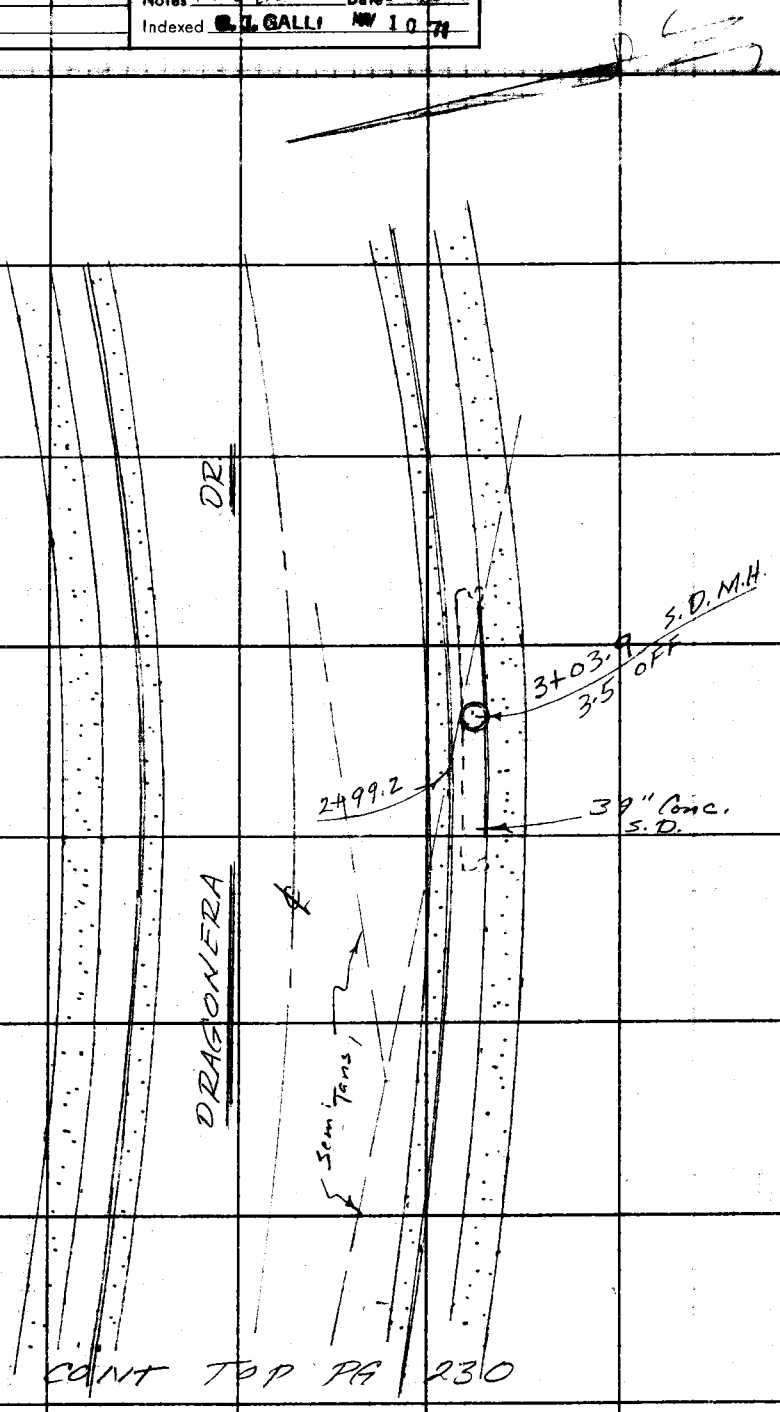

CONT TOP PG 230

PLEASE RETURN TO
COUNTY OF LOS ANGELES
DEPARTMENT OF COUNTY ENGINEER
403 LOS ANGELES COUNTY ENGINEERING BLDG.

Note: Any Additions or Changes on This Sheet Must be Made or Circled in Red Ink With Date and Name of Person Making Change.

Do not extend this side of this line.

F. B. 3369 PG 232

Notes Ck'd by H. HOLMAN	Survey of SD Project #1274	F. B. 3369 Pg. 233
Map No.	JN	Tape Std °F
Office Work	Surveyed By FE Brooks	
Checked	Notes FEB GOG Date 27 Apr 71	
Date	Indexed G. L. GALLI NW 1.0 71	

Note: Any Additions or Changes on This Sheet Must be Made or Circled in Red Ink With Date and Name of Person Making Change.

Do not extend this side of this line.

PLEASE RETURN TO
LOS ANGELES COUNTY ENGINEER
403 Los Angeles County Engineering Bldg.

76F3095 CE #3109 6-62

LN 03.03.00

STORM DRAIN PROJECT

No 1274

LINE H CENTERLINE

Note

CROSS SECTIONS are in
F.B. 3386 Pg 57 To Pg

FE Brooks
GO Guizado
RA Moore
T Ohashi

F. B. 3369 PG. 234

S.D. PROJ. 1274
Line "H"

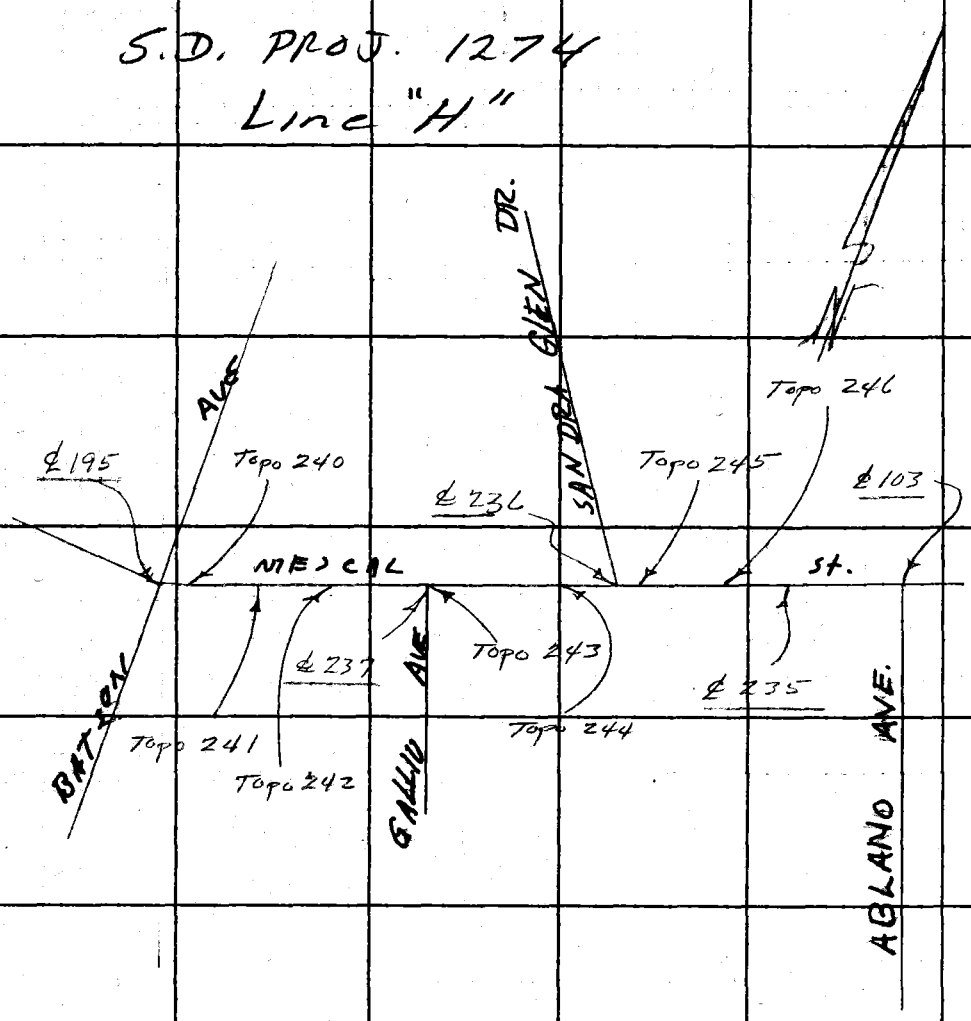

PLEASE RETURN TO
LOS ANGELES COUNTY ENGINEER
403 Los Angeles County Engineering Bldg.
Do not extend this side of this line.

Note: Any Additions or Changes on This Sheet Must Be Made or Circled in Red Ink With Date and Name of Person Making Change.

C

Notes Ck'd by H. HOLMAN
Map No.
Office Work
Checked
Date

Survey of SD Project #1274
JN Tape Sta °F
Surveyed by F.E. BYERS
Notes F-B-3306 Date 27 Apr 11
Indexed

F. B. 3368 PG. 235

CONT BOT PG 183

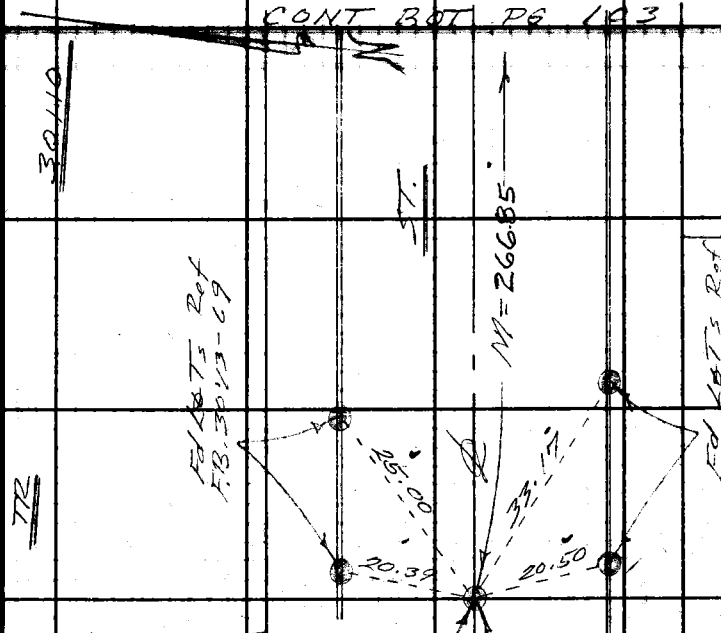

Note: Any Additions or Changes on This Sheet Must be Made or Circled in Red Ink With Date and Name of Person Making Change.

PLEASE RETURN TO
LOS ANGELES COUNTY ENGINEER
403 LOS ANGELES COUNTY ENGINEERING BLDG.

Do not extend this side of this line.

T#0232

266.85 T66°=266.85
160.06 T66°=160.06

CONT RT. PG. 236

D.

76F3095 C.F. #310 6-62

PLEASE RETURN TO
LOS ANGELES COUNTY ENGINEER
403 LOS ANGELES COUNTY ENGINEERING BLDG.

Note: Any Additions or Changes on This Sheet Must be Made or Circled in Red Ink With Date and Name of Person Making Change.

Do not extend this side of this line.

45380-4

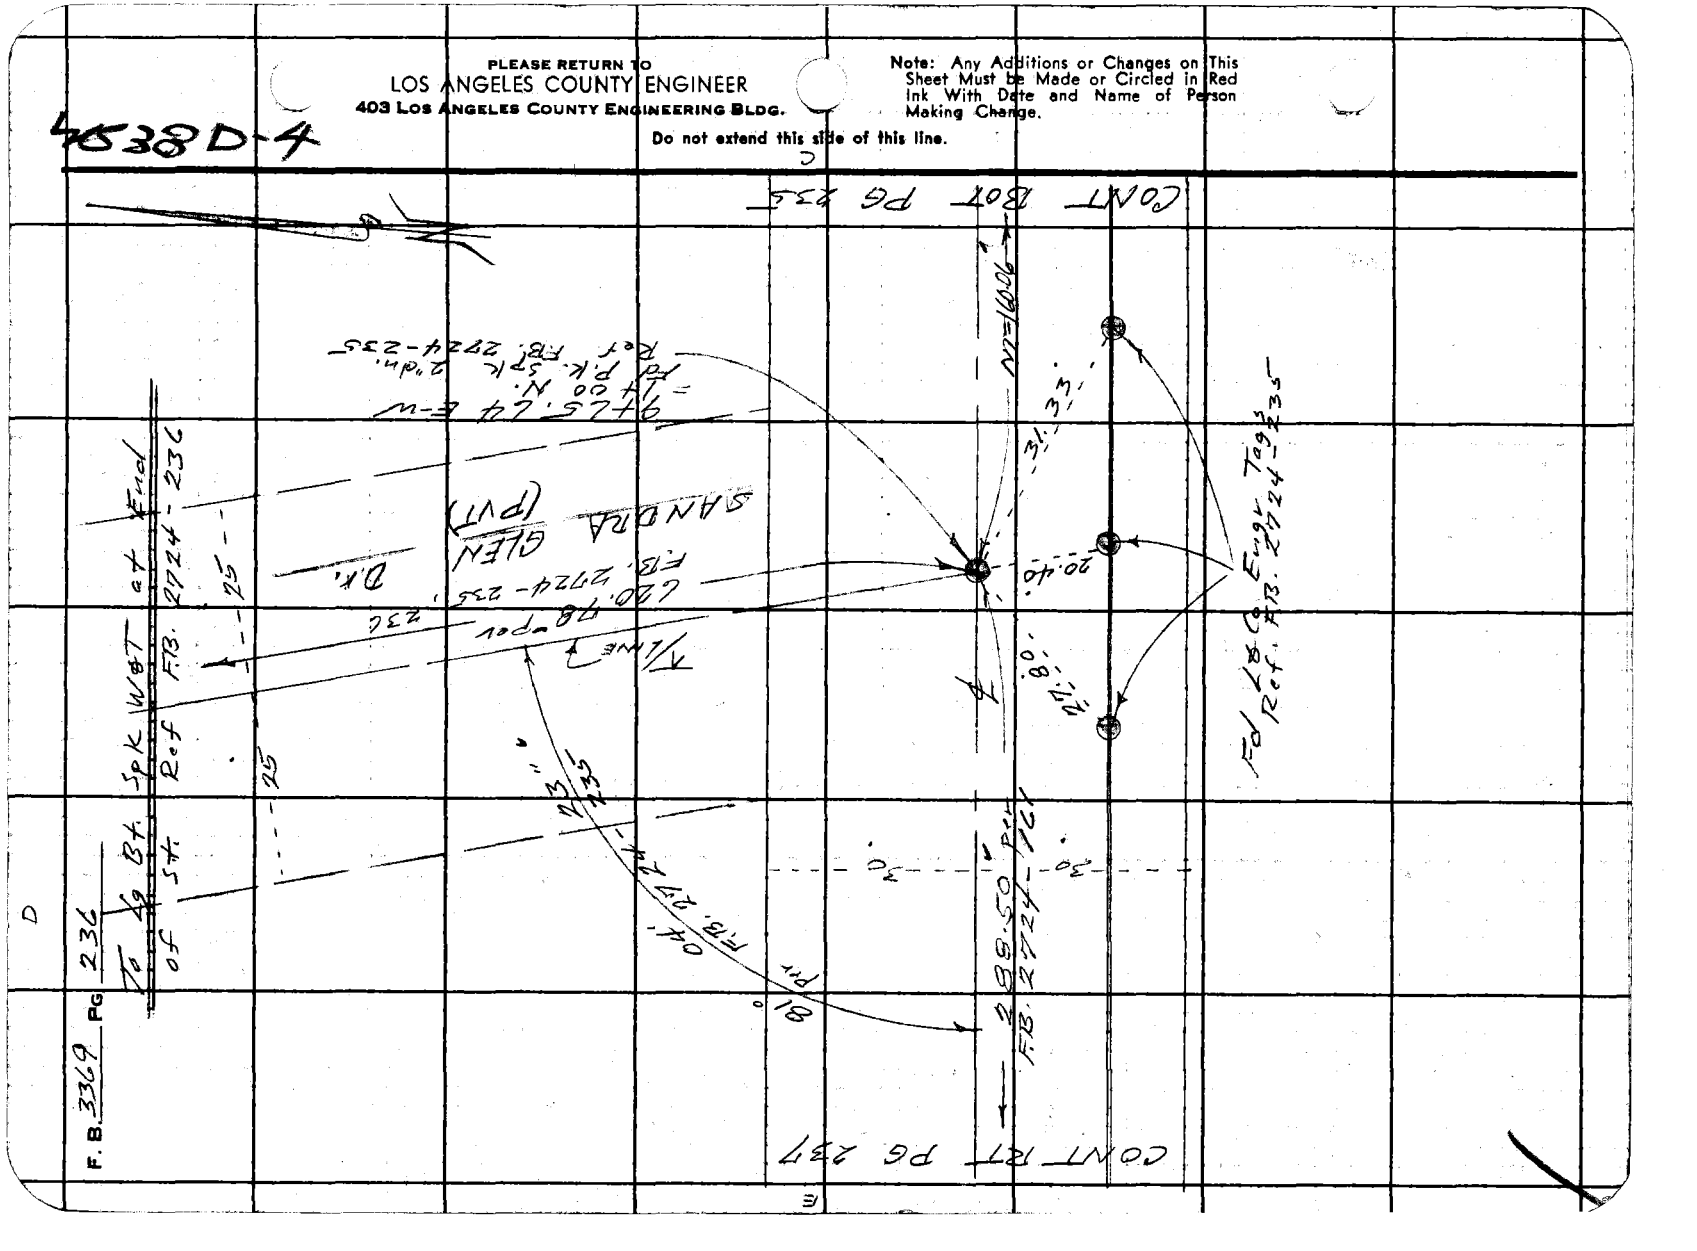

Notes Ck'd by H. HOLMAN
Map No.
Office Work
Checked
Date

Survey of S.D. Project #1274
INC. Tape Stg. °F
Surveyed by FE Brooks
Notes FE B - Guizado Date 24 Apr 74
Indexed

F. B. 3369 PG. 237

6771.14 E-W = 1400 S Nothing Fd or set.

TAPE # 0232

100.00 T68 = 100.00 ✓

W.S. 38.84

Fd Lg BT. SPK W&T Guida. Ref FB 2724 pg 161

MESCAL

ST.

0.03

577.14 Per

288.50 E&W

FB 2724- pgs 111, 161

FB. 2724- 161

50.75

50

30

COUNT Top PS 195

COUNT Pl 237

Fd L&Ts Ref FB 2724-161

Fd L&Ts Ref FB. 2724- 161

FB. 2724-161

20' AVE.

M&E 100.00

SET L.A CO. ENGR. TAG

18.18

18.20

SET LA. CO. ENGR. TAG

SET BT. SPK & TIN FLUSH

264.98 PK 158 FB. 2724-161

GALLIO

30 30

To Fd Lg BT. SPK W&T at LA GUARDIA ST Ref F.B. 2724-158

Note: Any Additions or Changes on this Sheet Must be Made or Circled in Red Ink With Date and Name of Person Making Change.

PLEASE RETURN TO
LOS ANGELES COUNTY ENGINEER
403 Los Angeles County Engineering Bldg.

Do not extend this side of this line.

76E3085 C.E. #310 6-62

PLEASE RETURN TO
LOS ANGELES COUNTY ENGINEER
403 LOS ANGELES COUNTY ENGINEERING BLDG.

Note: Any Additions or Changes on This Sheet Must be Made or Circled in Red Ink With Date and Name of Person Making Change.

Do not extend this side of this line.

F. B. 3349 PG 238

Notes Ck'd by	Survey of S.D. Project #1274
Map No.	Tape Std °F
Office Work	Surveyed by FE Brooks
Checked	Notes FE Brooks - Guizado Date 27 Apr 71
Date	Indexed E. GALLI MW 10 71

F. B. 3369 PG. 239

S M 6012.74

STORM DRAIN PROJECT

No. 1274 LINE H

Location of Improvements

Note

CROSS SECTIONS are in F.B. 3386 pg 57 To pg

FE Brooks
G O Guizado
R A Moore
T Tonoshi

Note: Any Additions or Changes on This Sheet Must be Made or Circled in Red Ink With Date and Name of Person Making Change.

PLEASE RETURN TO
LOS ANGELES COUNTY ENGINEER
403 Los Angeles County Engineering Bldg.

Do not extend this title of this line.

76F3095 C.E. #310 6-62

F. B. 3369 PG 240

CONT BOT PG 241

Premix Drive

27.0

10.4

1+97.5

Depressed cb.

16.0

Premix Drive

WM

25.3

1+89.4

1+91.0

Dirt Dr

13.0

15.3

W.H.H.

20.0 Centerline

22.0

Premix Drive

1+67.3

10.4

1+63.5

Fd. Ref. 1" = 5' N-S

1+00 E 1st 42.72 N 1st 43.43 N Pg 193

edge of Permit

1+54.4

+21.5

1+59.5

1+42.7

10.5

Curb

4.0 Curb

5.5

1+41.6

20.0

19.8

10.0

1+36.8

Fire Hyd.

2.0

H28.5

1+85.0

1+18.0

10.8

21.3

BAT 50 N

1+83.8

See LINE G Pg 213 for Improvements

AVE

MESCAL

LOS ANGELES COUNTY ENGINEER

403 Los Angeles County Engineering Bldg.

PLEASE RETURN TO

Do not extend this side of this line.

Note: Any Additions or Changes on This Sheet Must be Made or Circled in Red Ink With Date and Name of Person Making Change.

Notes Ck'd by	Survey of
Map No.	SN 6012-74 Tape Rod
Office Work	Surveyed by FE Brooks
Checked	Notes FEB Gonzales Date 27 Apr. 71
Date	Indexed E.Z. GALLI MAY 10 71

F. B. PG.

Note: Any Additions or Changes on This Sheet Must be Made or Circled in Red Ink With Date and Name of Person Making Change.

Do not extend this side of this line.

PLEASE RETURN TO
COUNTY OF LOS ANGELES
DEPARTMENT OF COUNTY ENGINEER
403 LOS ANGELES COUNTY ENGINEERING BLDG.

CONT BOT PG 242

10.1 → 0 ← 5+00

44+43 P.P.

25.2

Premix Dr

4+44.0

edge of pvmt

ST.

10.2

5+00

Depressed ch.

Premix Dr.

3+62.6

deadman 3+31.2

24.4

S.M.H. 3+22.5

5.0

3+17.0 P.P.

24.8

3+00

10.1

40.0 Walk

Premix Dr.

3+09.8

Premix Dr.

Dirt Drive

14.0

MESCAL

10.2

2+39.5

2+71.5

CONT TOP PG 240

16F309S CE#310 3-69

PLEASE RETURN TO
COUNTY OF LOS ANGELES
DEPARTMENT OF COUNTY ENGINEER
403 LOS ANGELES COUNTY ENGINEERING BLDG.

Do not extend this side of this line.

Note: Any Additions or Changes on This Sheet Must be Made or Circled in Red Ink With Date and Name of Person Making Change.

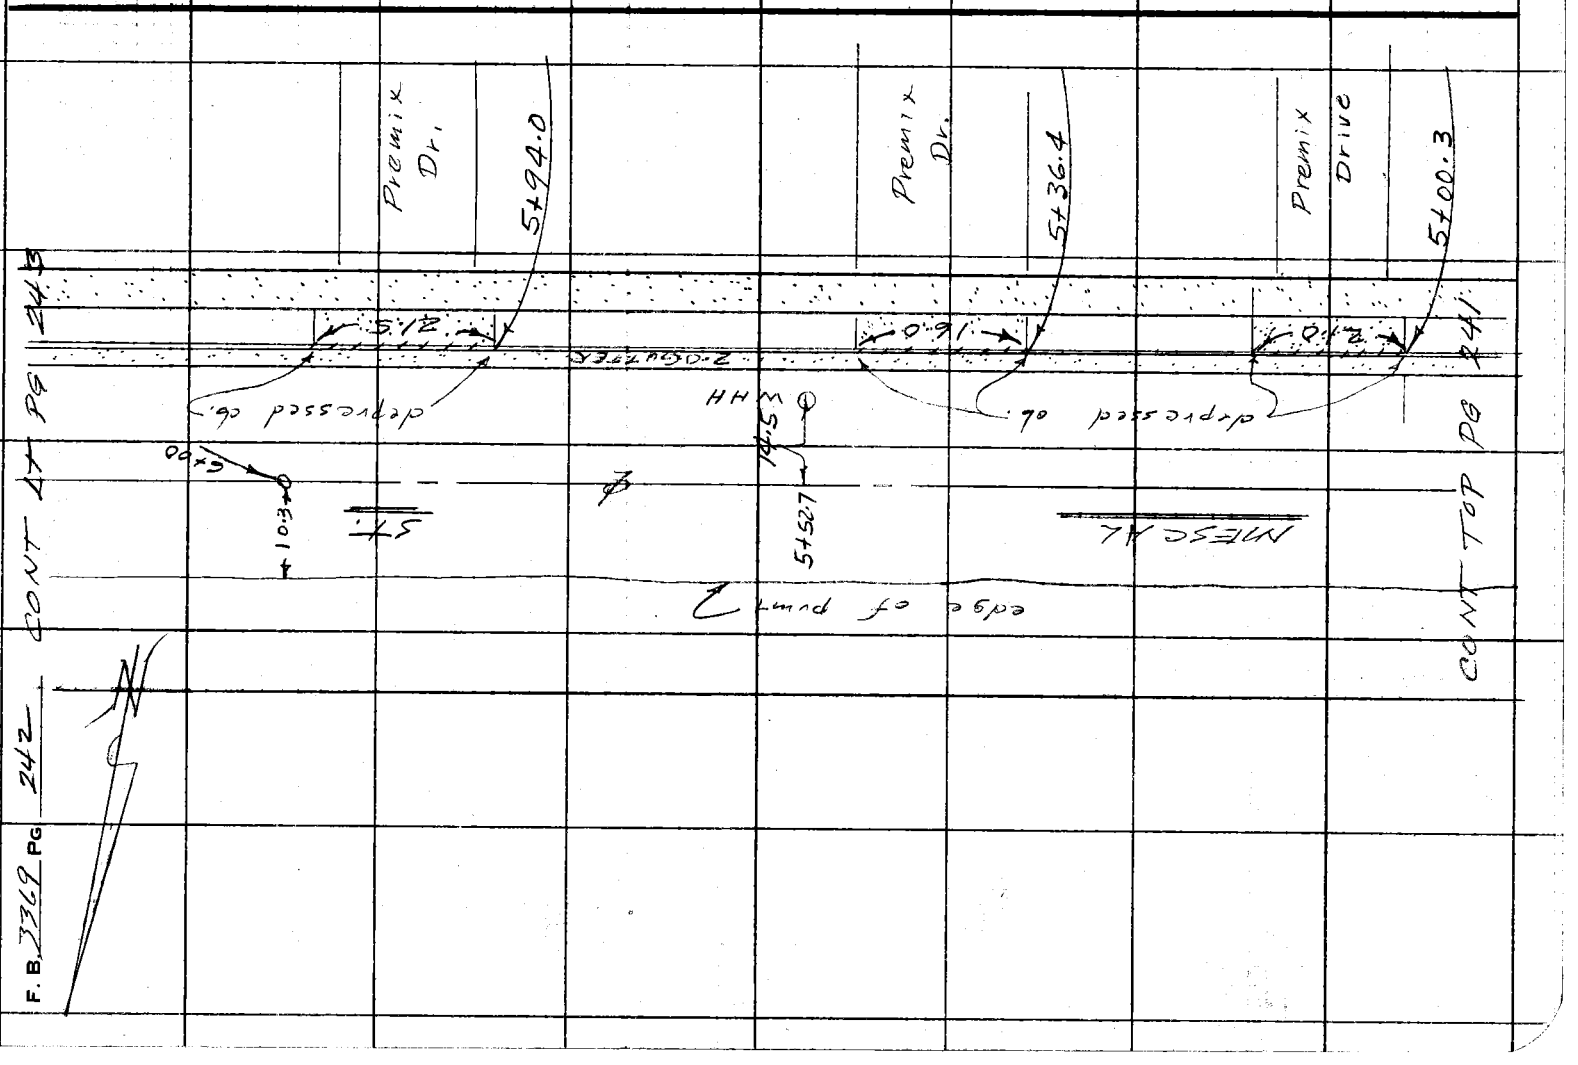

Notes Ck'd by	Survey of S. D. [illegible]
Map No.	JN 608.76 Topo Bk. PG.
Office Work	Surveyed by F.E. Brooks
Checked	Notes FEB - Gazette Date 28 Apr 71
Date	Indexed G. J. GALLI MAY 10 '71

F. B. 7212 PG. 9 12

Fd Lg Bt Spic W of Ref Pg 237

S.M.H. 6+72.0

2+77.14 E-W = 1+00 Fd nothing Ref pg 237

edge of pvmt

CONT TOP Pg 442

6+34.7 P.P.

24.4

MESCAL

6+32.3

20.1

6+44.4

6+63.7

5.0

0.03

10.3

7+00 ℄

1+22.0 ST.

20.0

CONT BOT Pg 444

2.0 Gutter

4.5 WALK

R=27.0

1+31.7

7+10.0

S.M.H.

5.5

8.5

6.3

W.M.H.

13.6

18.0

18.1

1+47.1

AVE.

Fire hyd. 1+47.6

10.5

7.5

4.0

1+51.2

1+51.3

30" Conc drain

40'X15.5'S. D. C.B.

1+58.7

24" Conc Pipe

4'X15.3'S. D. C.B.

1+58.8

1+72.0

1+73.4

GALLIO

1+88.5

1+88.8

4.0 Walk

2.0 Gutter

5.0

S.M.H.

3+70.5

Note: Any Additions or Changes on This Sheet Must be Made or Circled in Red Ink With Date and Name of Person Making Change.

Do not extend this side of this line.

PLEASE RETURN TO
COUNTY OF LOS ANGELES
DEPARTMENT OF COUNTY ENGINEER
403 LOS ANGELES COUNTY ENGINEERING BLDG.

76F309S CE#310 3-69

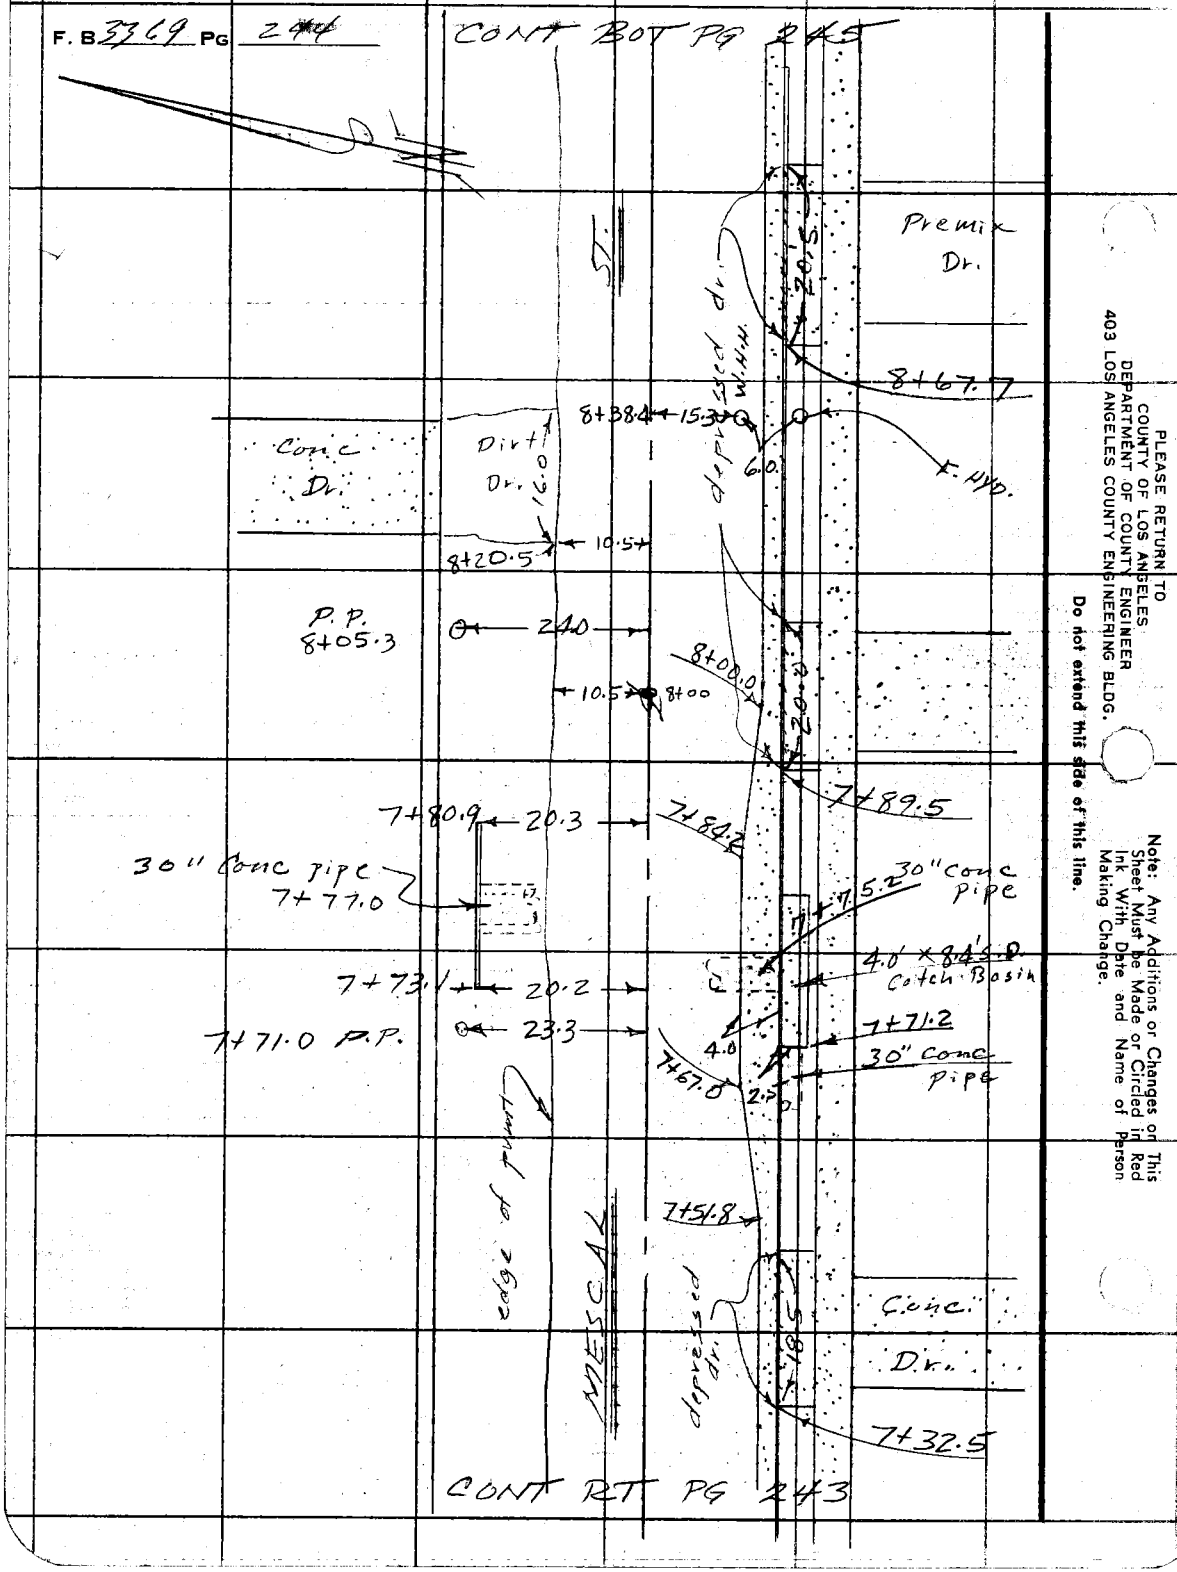
F. B. 3369 PG 244
Premix Dr.
8+67.7
8+38.4
15.3
6.0
Conc Dr.
Dirt Dr.
10.5
8+20.5
P.P. 8+05.3
24.0
10.5
8+00
8+00.0
7+89.5
7+84.2
7+80.9
20.3
30" Conc pipe 7+77.0
7+75.2
30" Conc pipe
4.0 x 8.4' S.D. Catch Basin
7+73.1
20.2
7+71.0 P.P.
23.3
7+71.2
30" Conc Pipe
7+67.0
2.5
4.0
7+51.8
Conc Dr.
7+32.5
CONT RT PG 243
PLEASE RETURN TO
COUNTY OF LOS ANGELES
DEPARTMENT OF COUNTY ENGINEER
403 LOS ANGELES COUNTY ENGINEERING BLDG.
Do not extend this side of this line.
Note: Any Additions or Changes or This Sheet Must be Made or Circled in Red Ink With Date and Name of Person Making Change.

Notes Ck'd by _____
Office Work _____
Checked _____
Date _____

Survey of D Division # [illegible]
Location [illegible] Rd.
Surveyed by F E Brooks
Notes F E B Guide Date 22 Apr. 71
Indexed [illegible]

F. B. _____ PG. 7

CONT BOT PG 2+46

9+45.5 14 E-W 1500 N Ref PK SPK 232

edge of pvmt

ST.

Premix Drive

10+11.0

10.5 → 0 ← 10.5

9+98.8 P.P.

0 ← 24.3

9+87.2 10.5 OFF

depressed cb.

GLEN

SANDRA DR.

15.0

2700

11.8

9+58.5 W.H.H. 9+57.3

PUT Rd.

9+26.0 ← 10.5

5.0

S.M.H. 9+20.7

10.5 9+00

MESCAL

depressed cb.

Premix Drive.

8+98.0

CONT TOP PG 2+44

Note: Any Additions or Changes on This Sheet Must be Made or Circled in Red Ink With Date and Name of Person Making Change.

Do not extend this side of this line.

PLEASE RETURN TO
COUNTY OF LOS ANGELES
DEPARTMENT OF COUNTY ENGINEER
403 LOS ANGELES COUNTY ENGINEERING BLDG.

16F309S CE#310 3-69
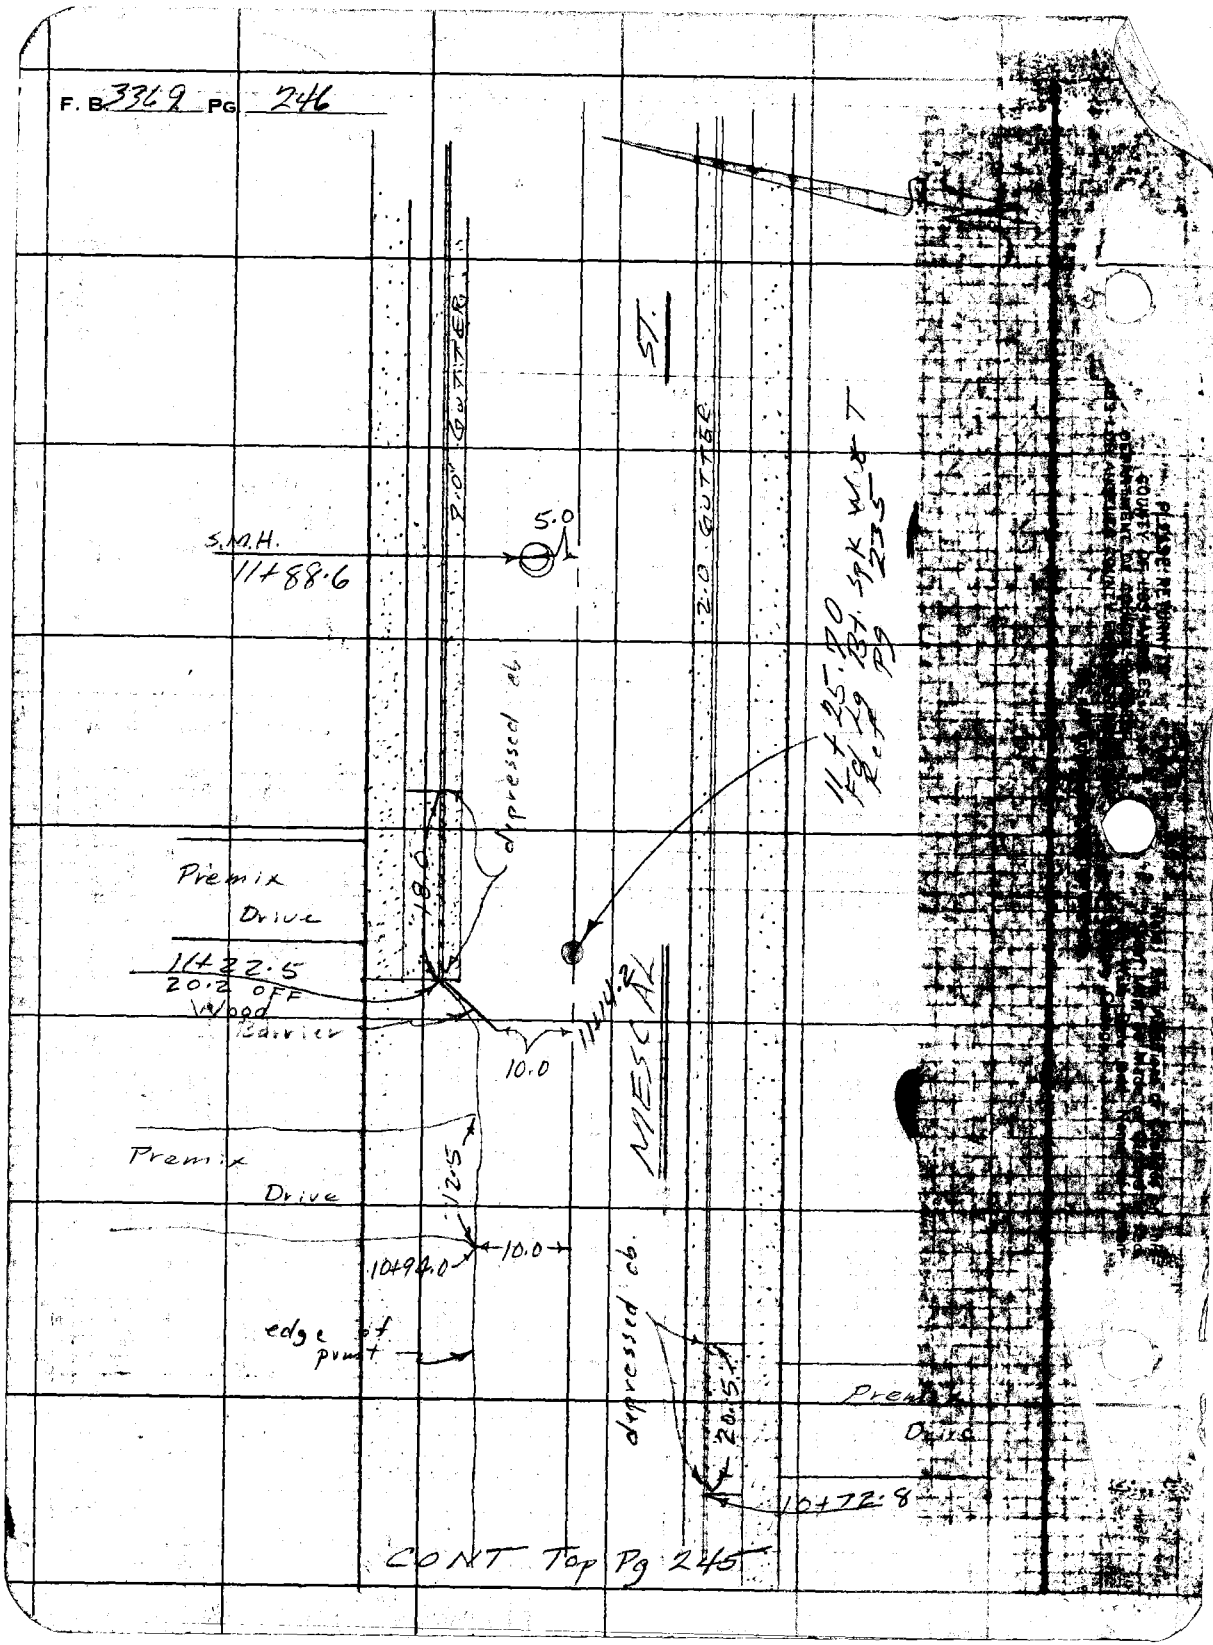
F. B. 3369 PG. 246