Notes Ck'd by | Survey of | 3417

Surveyed by

Notes | Date

Indexed

Description

PENNSYLVANIA AVE. 0097.25

Index

C.L. Survey fr. Montrose Ave to Foothill

Geo. Ties Penn. Ave. & Montrose Ave.

Index

C.L. Surv. fr. Foothill Blvd. to Orange Ave.

ORANGE AVE. 0097.28

Index

C.L. Sur. fr. La Crescenta Ave. to Penn.

Index PENNSYLVANIA AVE. 0097.25

C.L. C.L. survey from Montrose Ave. to Foothill Blvd.

Microfilmed March '87

E.W. file o.k. Aug '87

PLEASE RETURN TO
LOS ANGELES COUNTY ENGINEER
408 Los Angeles County Engineering Bldg.

Do not extend this side of this line.

If Any Additions or Changes on This Sheet Must be Made or Circled in Red Ink With Date and Name of Person Making Change.

F.B. PG.

PWFB 1921 2346

Notes Ck'd by W. EDMONDSON	Survey of Pennsylvania Ave	F. B. 3417 Pg. 5
Map No. B-5072	JN009725 Tape 202 Std. [illegible] °F	
Office Work H. H. F. [illegible]	Surveyed by [illegible]	
Checked	Notes [illegible] Date 1-9-67	
Date	Indexed E. J. GALLI NOV 17 67	

JN 009725

PENNSYLVANIA AVE.

℄

From - Montrose Ave
To - Foothill Blvd.

Geodetic Tie[illegible]

CK THIS BOOK AGAINST SCANS, IT LOOKS LIKE A LOT OF PAGES ~~[illegible]~~ ARE NOT IN THE FOLDER. SOME PAGES # IN ERROR (LOOKS LIKE A GOOD ONE FOR GREG ALVARADO)

PLEASE RETURN TO
LOS ANGELES COUNTY ENGINEER
403 LOS ANGELES COUNTY ENGINEERING BLDG.

Note: Any Additions or Changes on This Sheet Must be Made or Circled in Red Ink, With Date and Name of Person Making Change.

Do not extend this side of this line.

76F3093 CE#B1D 1-65

PWFB 1921

2347

F. B. 3417 Pg 6

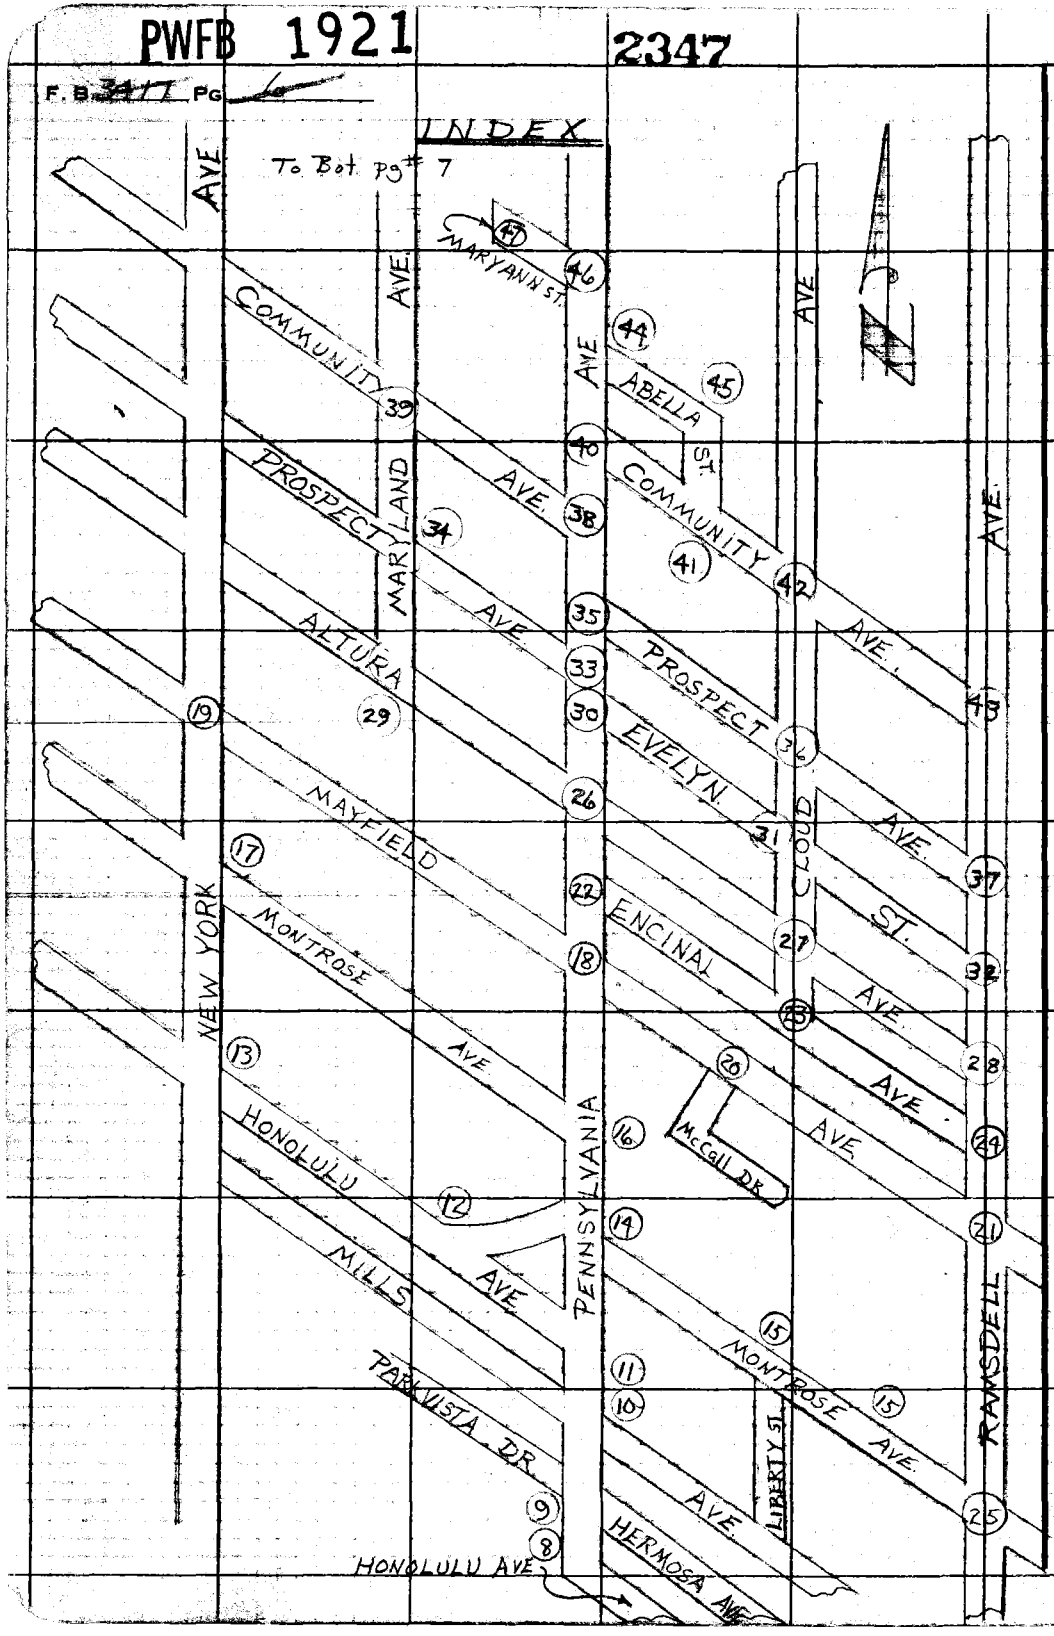

PWFB 1921

2348

Notes Ck'd by W. EDMONDSON	Survey of Pennsylvania Ave	F. B. 3417 Pg. 7
Map No. B-5072	IN009(2) Tape 01 Std 68 °F	
Office Work H. H. F. DONG	Surveyed by Burkholder	
Checked	Notes D.L.B. Date 1-67	
Date	Indexed C. J. GALLI	

INDEX

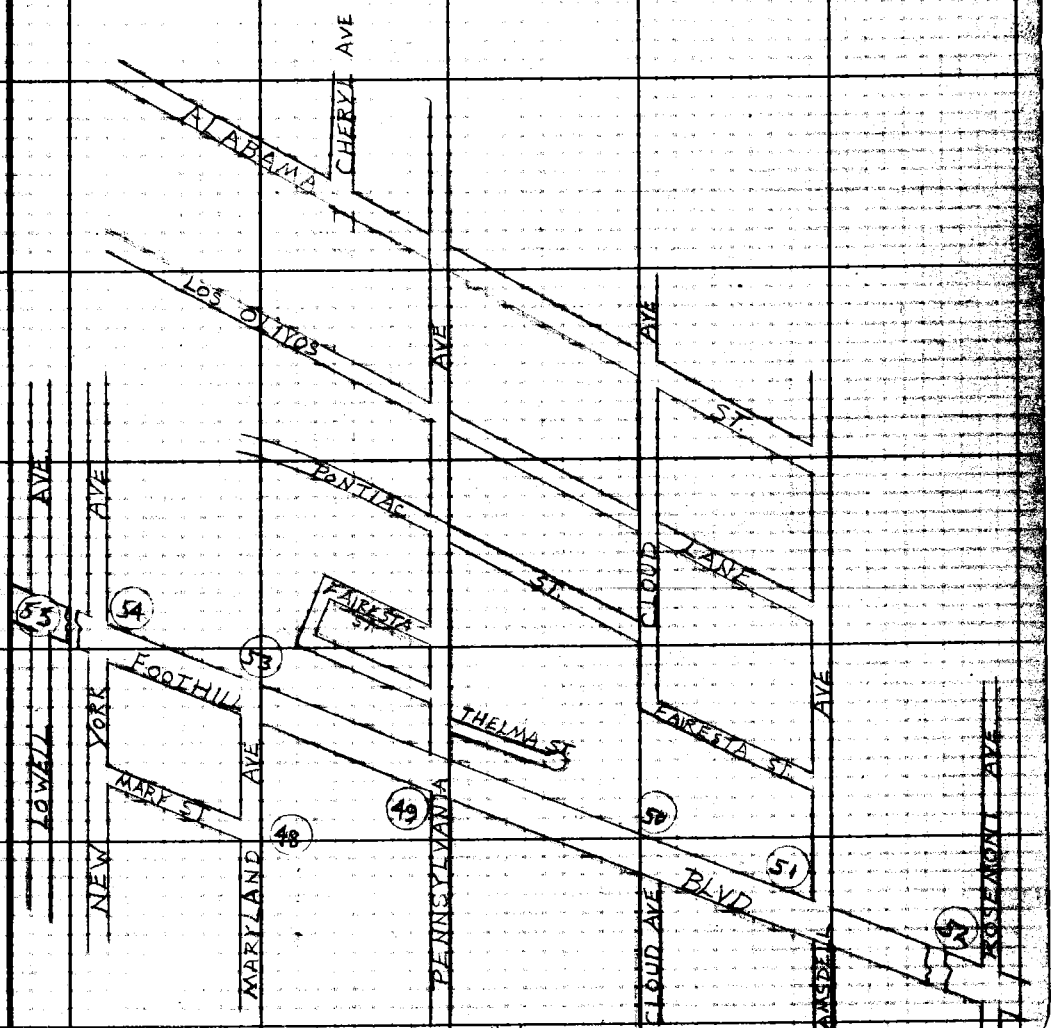

To Top Pg # 6

Note: Any Additions or Changes on this Sheet Must be Made or Circled in Red Ink With Date and Name of Person Making Change.

PLEASE RETURN TO
LOS ANGELES COUNTY ENGINEER
403 LOS ANGELES COUNTY ENGINEERING BLDG.
Do not extend this side of this line.

76F309S CE#310 1-65

PWFB 1921

2349

F. B. ~~3417~~ PG ~~8~~

To Bgt. Pg #9

See Pg #221 for ℄ Penn Ave

S 51 B-5

℄ Line

AVE.

290.02

Set Ld. & C.F. Tag in Dep. Cb. @ Dwy to Hse #3800

Fd. L & T No Ref.

Set Ch-1-in M.H. Rim

59.48

PENNSYLVANIA

61.82 Lev. T-68° = 61.82

51.96

61.82

Fd. L & T No Ref

Set Conc. Nail on 2' offset Line for wiggle pt. @ Honolulu Ave.

24.71

2.00

70.30

Fd. Cut Spk in Conc. 50" dn. Per F.B. 1198-224 R.D. F.B. F.T. 51-7 Reset 2x2 & City of Glendale brass Tag, Flush, over Cut spk, Per City of Glendale F.B. 103-15

See C.S. 8949-1 (Spk in Conc. is replacement of 2x2 ~~Per C.S. 8949-1, R.D. F.B. 51-7~~) See

Fd. Ld & T. No Ref.

LOS ANGELES COUNTY ENGINEER
403 LOS ANGELES COUNTY ENGINEERING BLDG.

PLEASE RETURN TO

Do not extend this side of this line.

Note: Any Additions or Changes on This Sheet Must be Made or Circled in Red Ink With Date and Name of Person Making Change.

PWFB 1921 2350

Notes Ck'd by W. EDMONDSON	Survey of Pennsylvania Ave	F. B. 3417 Pg. 9
Map No. B-5072	JN 009728 Tape 0124 Sta 68 °F	
Office Work H. H. F. DONG	Surveyed by Burkhalder	
Checked	Notes D.L.B. Date 1-67	
Date	Indexed C. J. GALLI NOV 1 7 '67	

W.S. 51, B-5

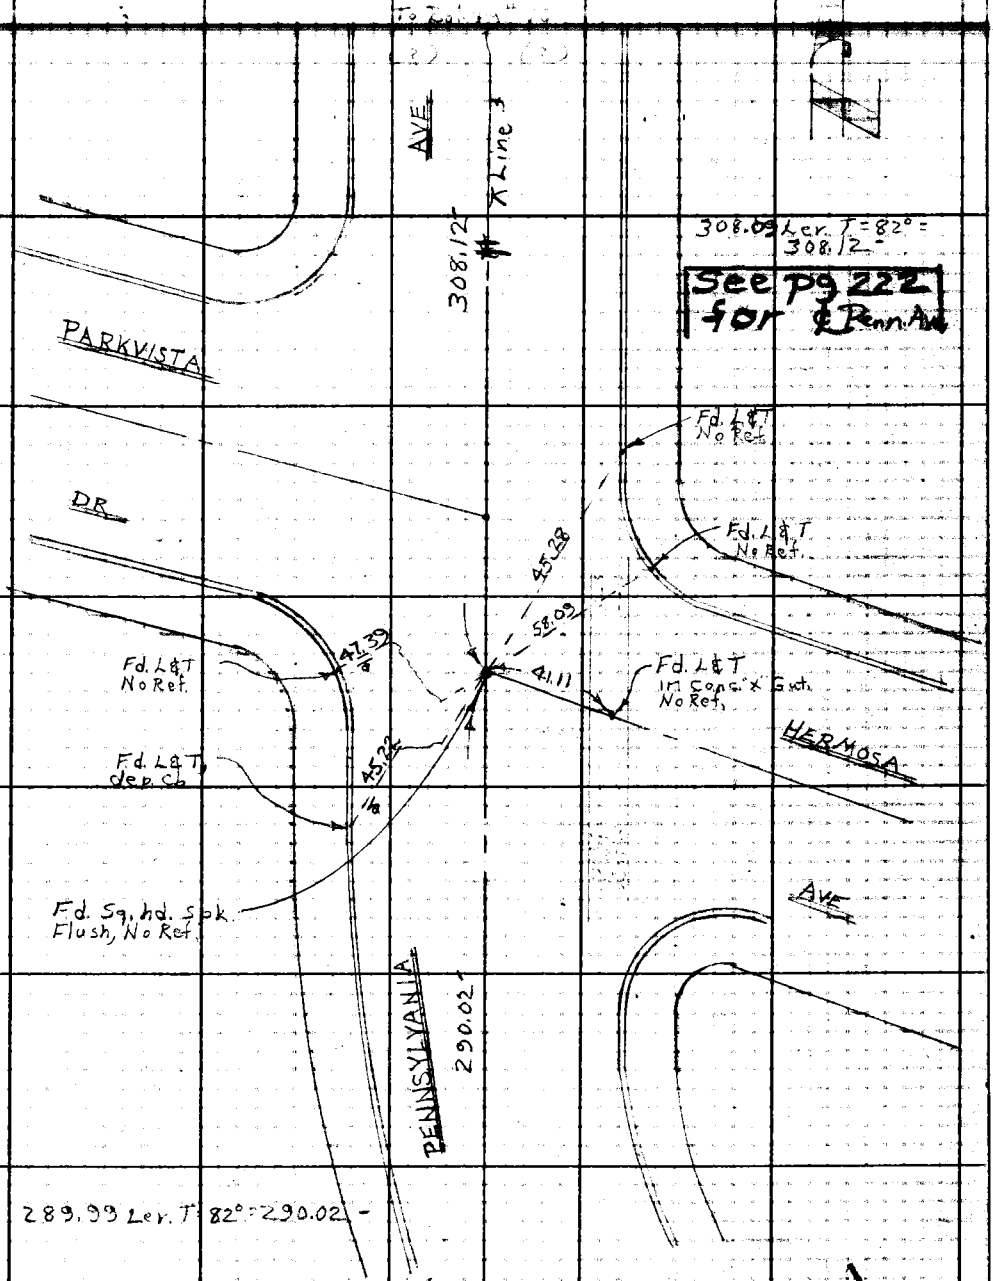

Contd. top Pg. 8

Note: Any Additions or Changes on this Sheet Must be Made or Circled in Red Ink With Date and Name of Person Making Change.

Do not extend this side of this line.

PLEASE RETURN TO
LOS ANGELES COUNTY ENGINEER
403 LOS ANGELES COUNTY ENGINEERING BLDG.

76F309S CE#310 1-65

PWFB 1921 2351

F. B. ~~2417~~ PG. 10

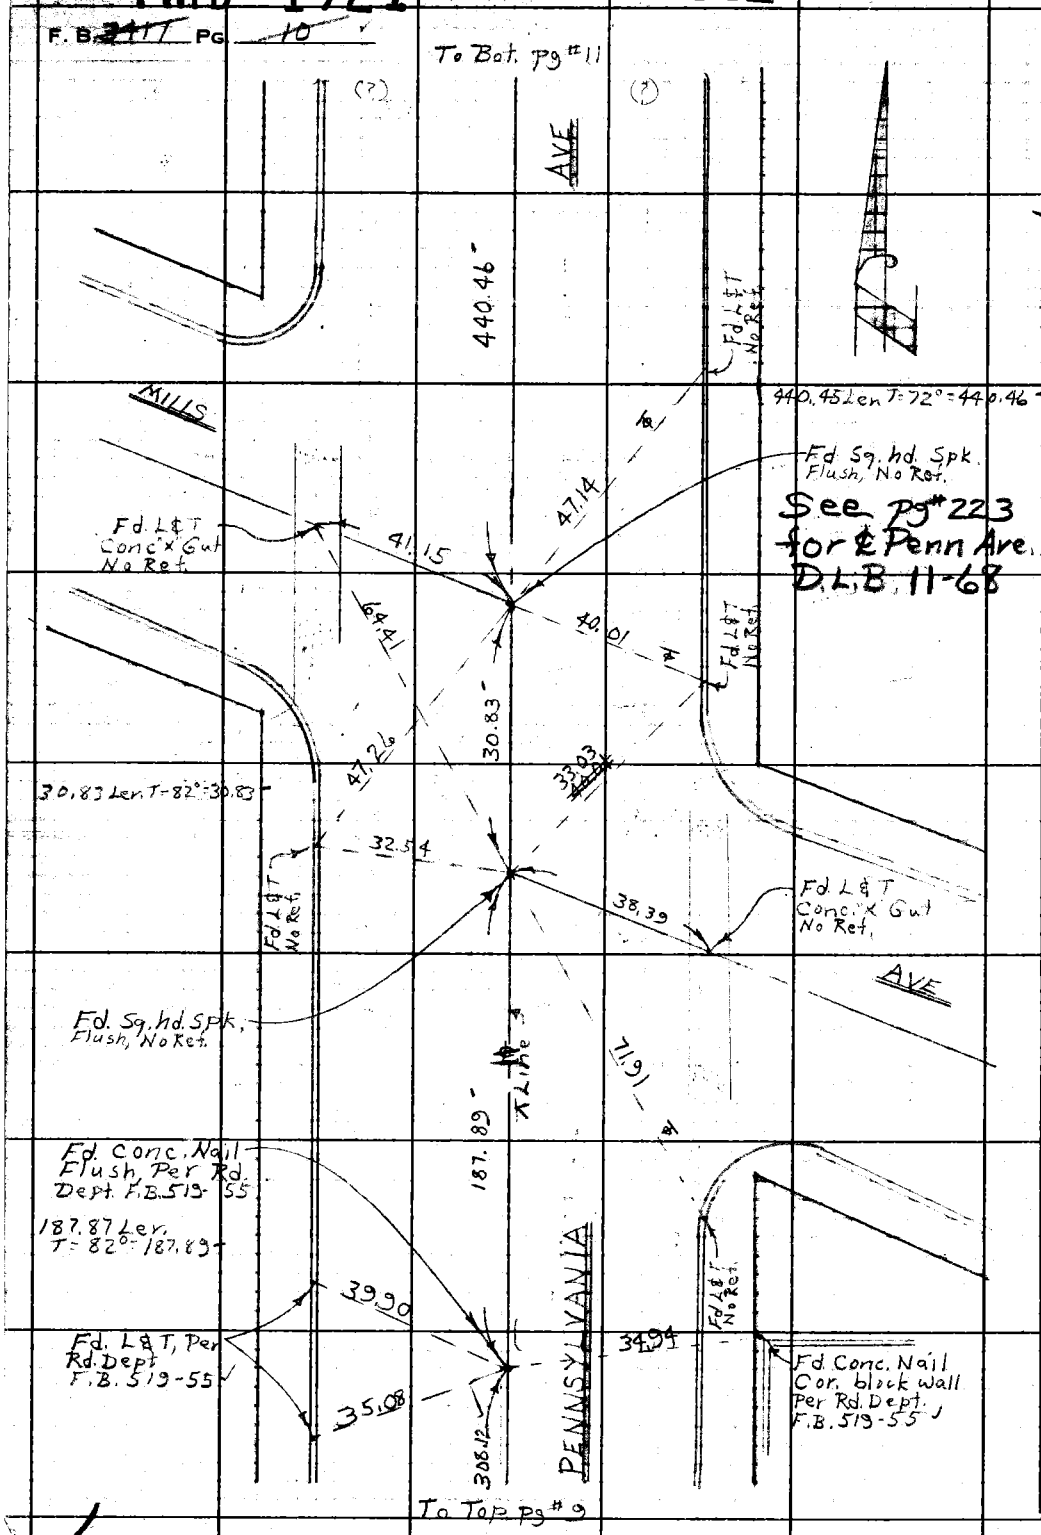

W.S. 51, B-4

PLEASE RETURN TO
LOS ANGELES COUNTY ENGINEER
403 LOS ANGELES COUNTY ENGINEERING BLDG.

Do not extend this side of this line.

Note: Any Additions or Changes on This Sheet Must be Made or Circled in Red Ink With Date and Name of Person Making Change.

PWFB 1921 2352

Notes Ck'd by W. EDMONDSON	Survey of Pennsylvania Ave	F. B. 3417 Pg. 11
Mat. No. B-5072	Jn 403 Sec 40 Sheet	
Office Work H. H. F. DONG	Surveyed by Burkhalter	
Checked	Notes	Date 1-67
Date	Indexed F. J. GALLI	

To Bot. Pg# 11

36.65 for T=78°= 36.65 -
23.66 for T=78°= 23.66 -
34.43 for T=78°= 34.43 -

TRACT 5547

(33) (33)

AVE 215.47

P.O.T Set Ld & C.E. Tag (Signals on Island on ℄ Line) Rem.

Set Ld & C.E. Removed

HONOLULU

To Top Pg# 12

524.01

AVE

35°14'

126°18'30"

47.78

70.80

Fd. L & T in conc. Spillway Per FQ 498-15

Conc. Wall

Set Ld. & C.E. Tag in Fd. Ch't top Wall Per F.B. 524-186 FQ 498-15

D 126°-18'-30"-
A 145-14-00
C 37-51-00-
126-18-30-

PENNSYLVANIA

℄ Line

440.46

To Top Pg# 10

2.00

Set ch't "Wiggle Pt. on 2' offset Line Removed

34.43

Set ch't on 2' offset Line Removed

Fd. Sq. hd. spk & W. & Eagle Channel Per Rd. Dept. F.B. 519-55

23.66

2.00

0.016

Set Ld & C.E. Tag Removed.

Int. Set Bt. Spk w&T Flush, by 1qt. Removed 11-68 D.L.B. See pg# 224 for ℄ Penn. Ave.

36.65

58°41'

Fd. Sq. hd. Spk. & W.

10.0

23.66

0.045

Fd. Sq. hd. Spk. Flush Per Rd. Dept. F.B. 519-55 (Used for Line w'ly)

40.04

Fd. L&T & Prod. Per Rd. Dept. F.B. 519-55 (Used for Line w'ly)

55.50

Fd L&T Per Rd. Dept. F.B. 519-55

Note: Any Additions or Changes on this Sheet Must be Made or Circled in Red Ink With Date and Name of Person Making Change.

Do not extend this tie of this line.

PLEASE RETURN TO
LOS ANGELES COUNTY ENGINEER
403 LOS ANGELES COUNTY ENGINEERING BLDG.

W 51, B 4

TBF 309S CE#310 1-65

PWFB 1921 2353, 2354

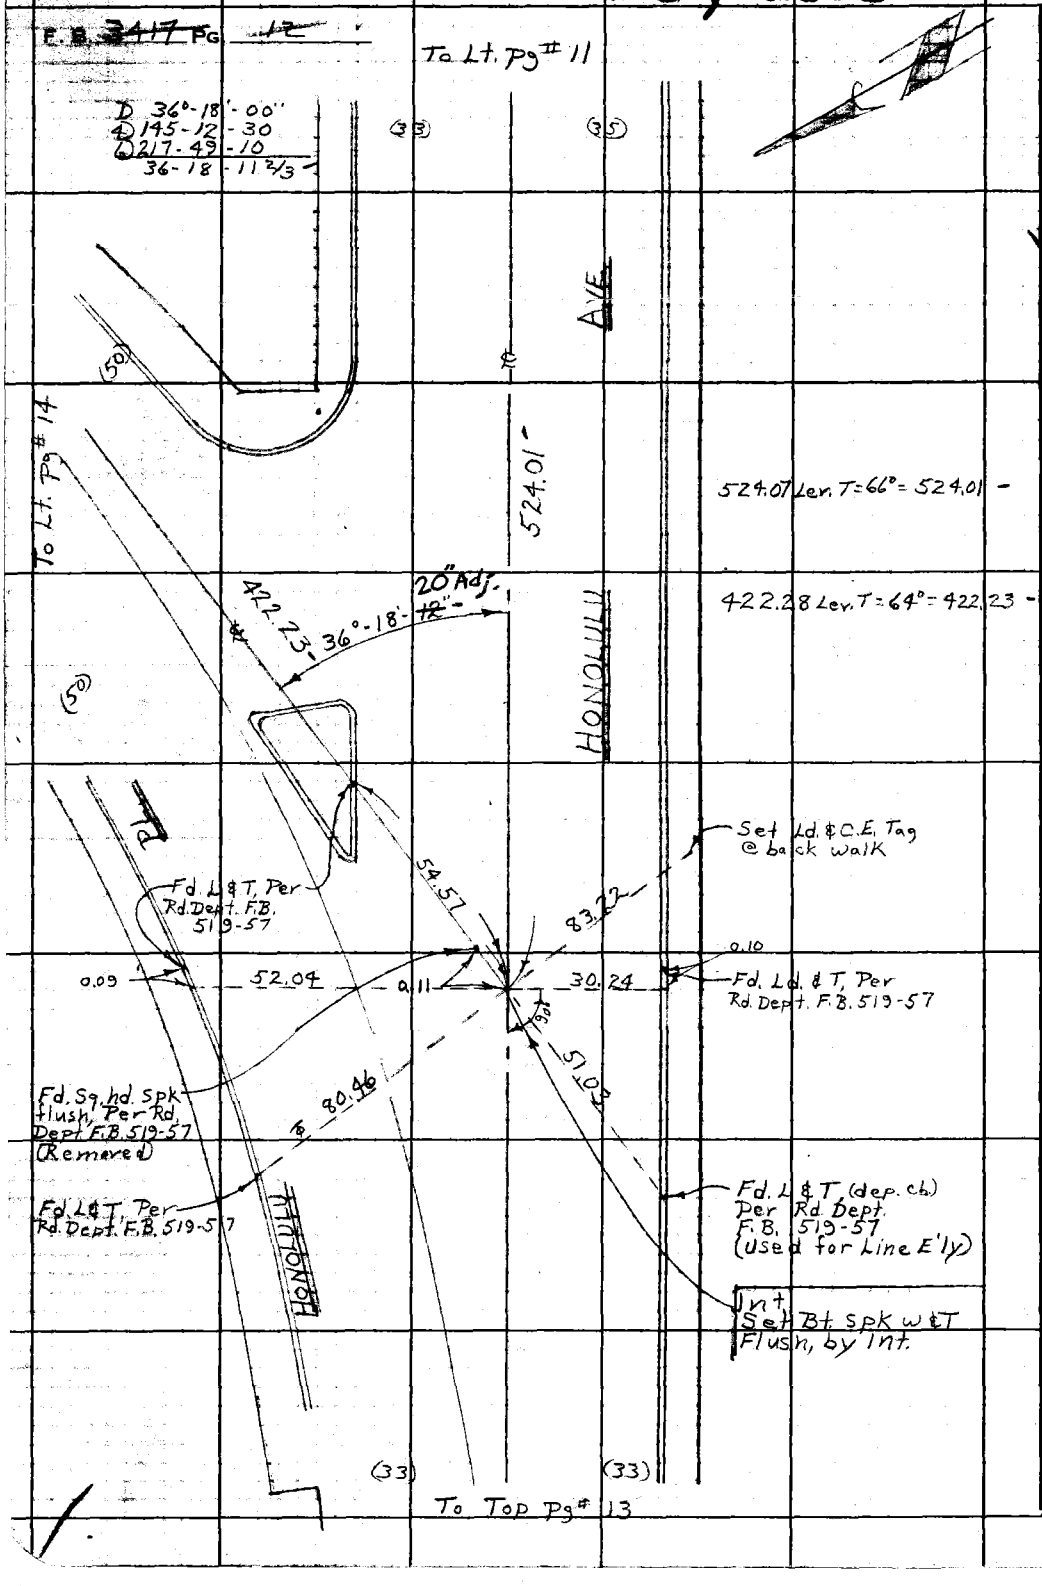

W.S. 51, B-4

PLEASE RETURN TO
LOS ANGELES COUNTY ENGINEER
403 LOS ANGELES COUNTY ENGINEERING BLDG.
Do not extend this side of this line.

Note: Any Additions or Changes on This Sheet Must be Made or Circled in Red Ink With Date and Name of Person Making Change.

76F309S CE#310 1-65

PLEASE RETURN TO
LOS ANGELES COUNTY ENGINEER
403 LOS ANGELES COUNTY ENGINEERING BLDG.

Note: Any Additions or Changes on This Sheet Must be Made or Circled in Red Ink With Date and Name of Person Making Change.

Do not extend this side of this line.

W.S. 57, B-4

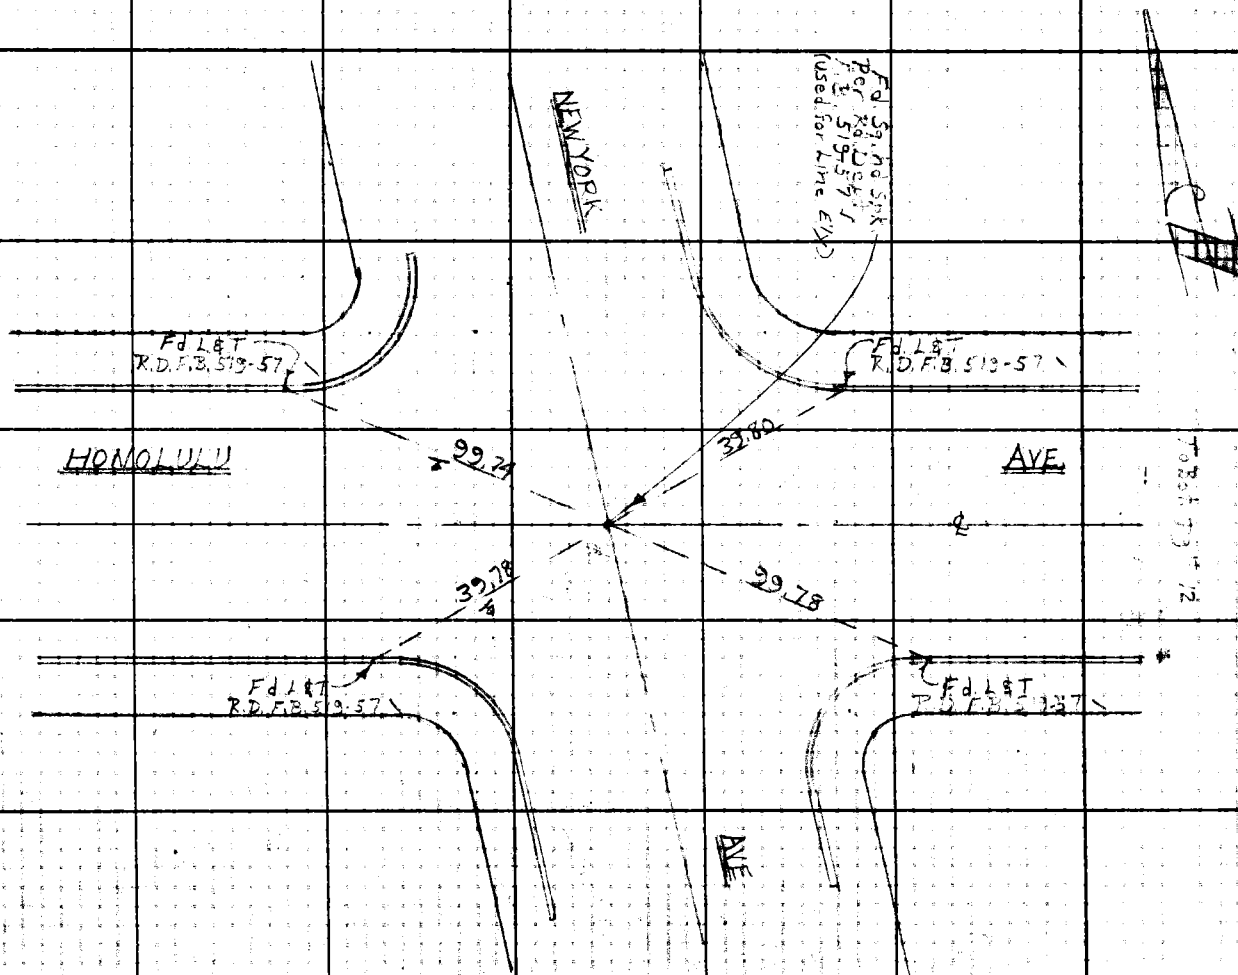

PWFB 1921

2355

Notes Ck'd W. EDMONDSON
Office Work H. H. F. DONG
Checked
Date

Survey of
Surveyed by
Notes
Indexed G. J. GALLI

F. B. 347 PG. 12

PWFB 1921 2356, 2357

PG 14

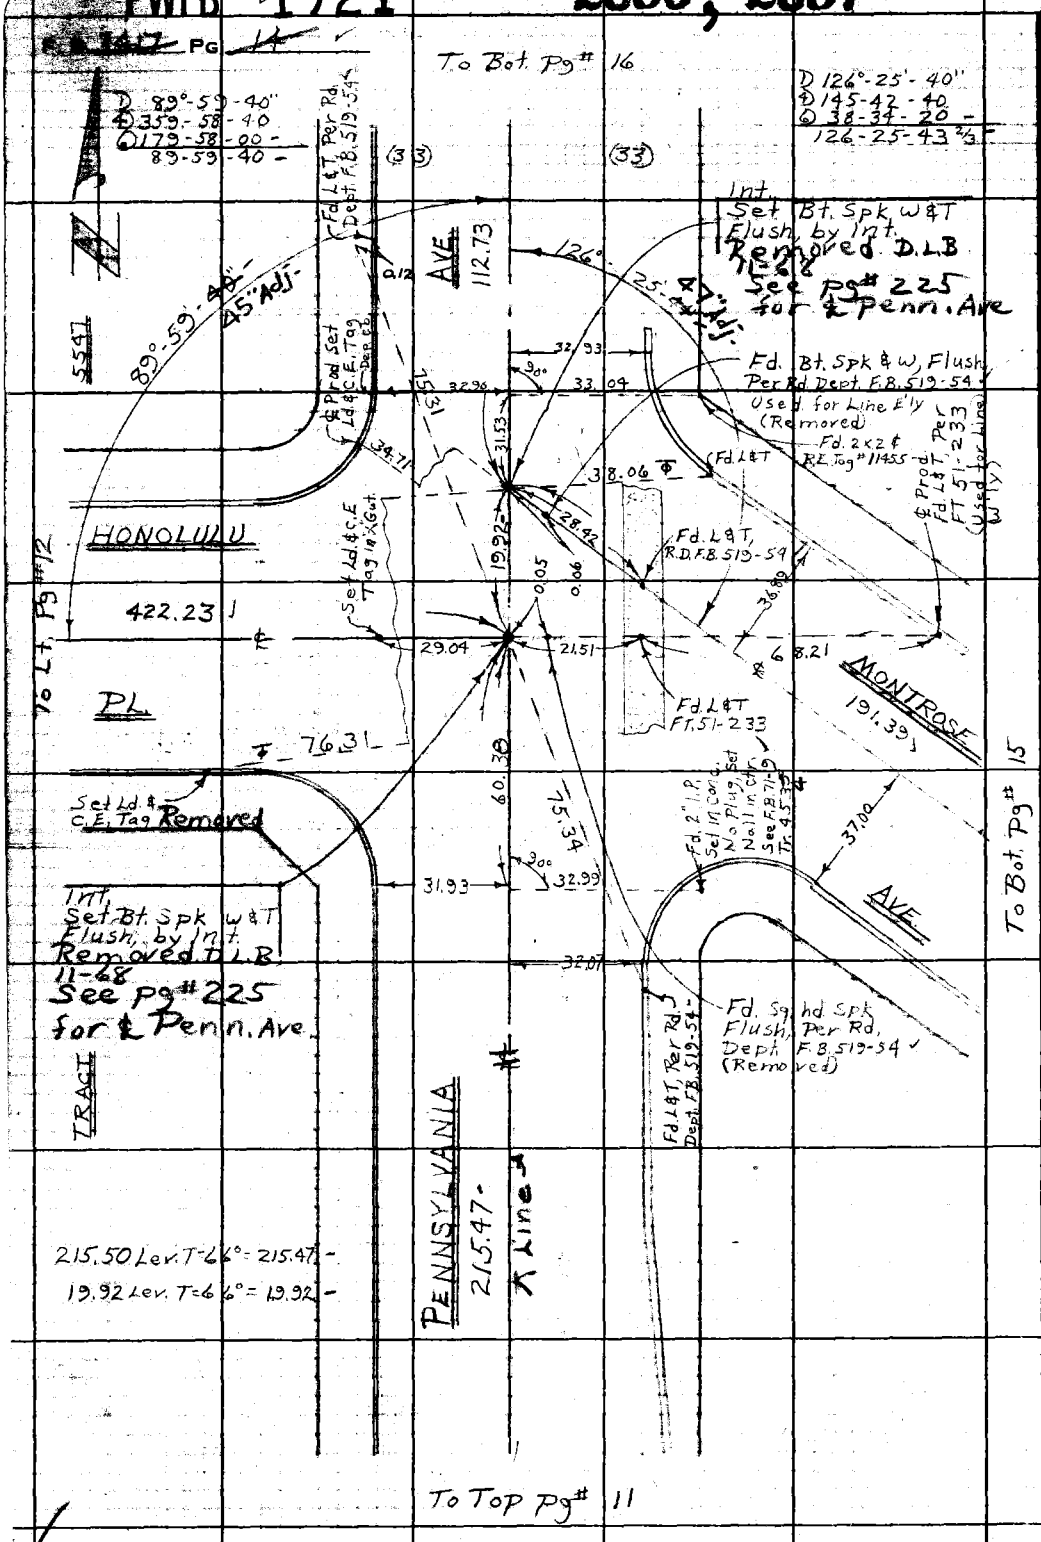

PLEASE RETURN TO
LOS ANGELES COUNTY ENGINEER
403 LOS ANGELES COUNTY ENGINEERING BLDG.
Do not extend this side of this line.

Note: Any Additions or Changes on This Sheet Must be Made or Circled in Red Ink With Date and Name of Person Making Change.

PWEB 1921 2358

Notes Ck'd By W. EDMONDSON	Survey of	F. B. 417	Pg. 15
Office Work H. H. F. DONG	Surveyed by		
Checked	Notes D. A. B. Date 2-67		
Date	Indexed G. J. GALLI		

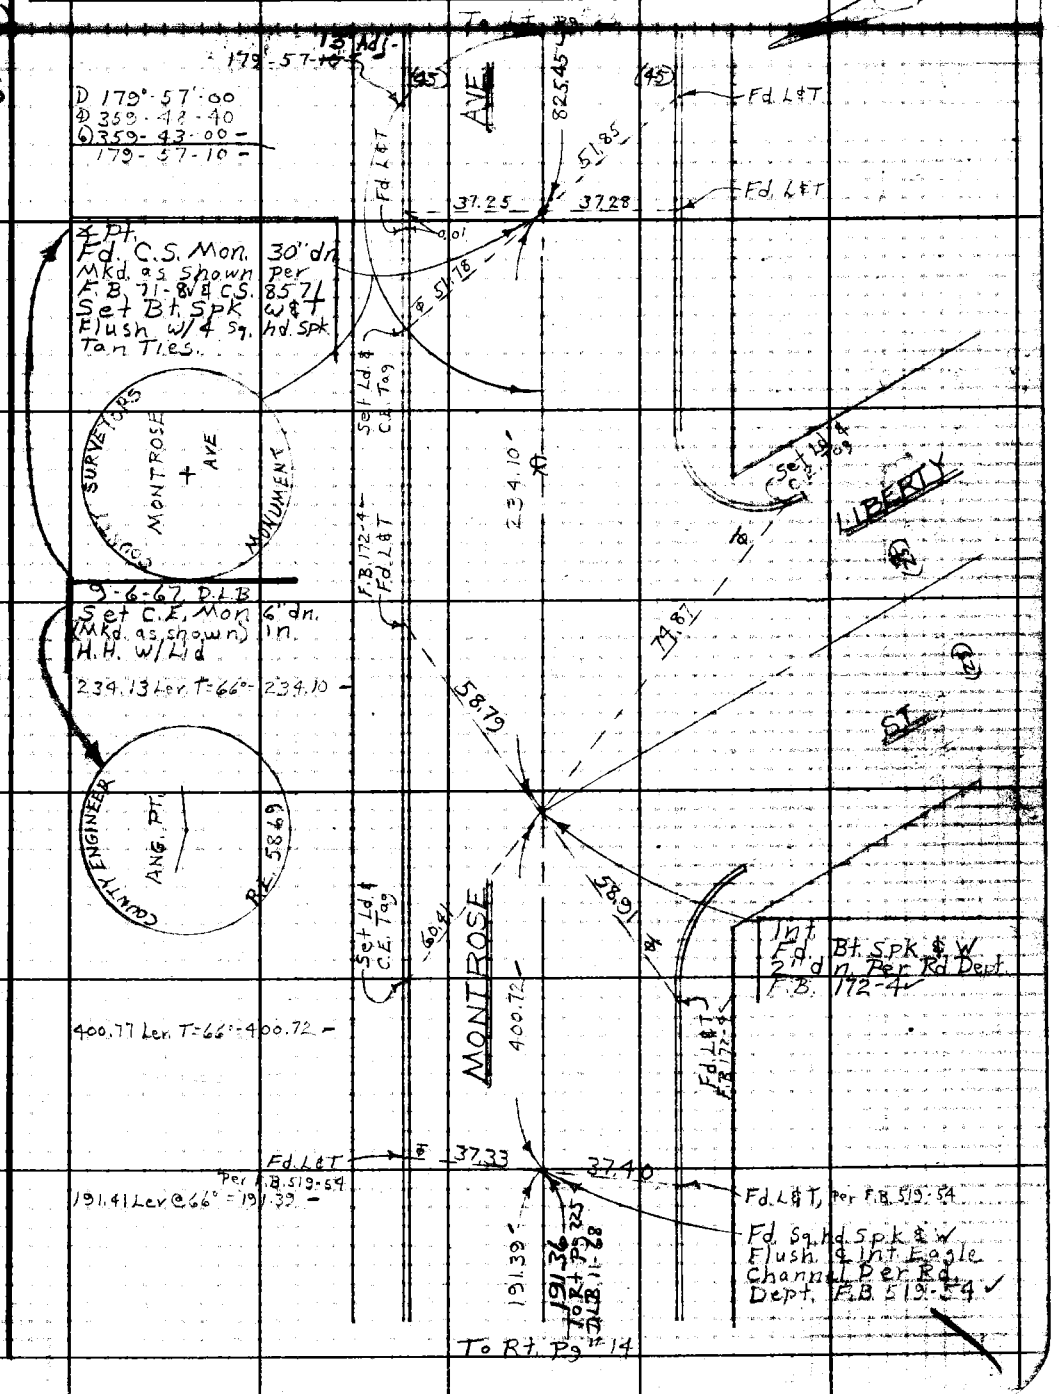

Note: Any Additions or Changes on This Sheet Must be Made or Circled in Red Ink With Date and Name of Person Making Change.

Do not extend this side of this line.

PLEASE RETURN TO
LOS ANGELES COUNTY ENGINEER
403 LOS ANGELES COUNTY ENGINEERING BLDG.

76F309S CE#310 1-65

PWFB 1921

2359

F.B. ~~3417~~ PG ~~16~~

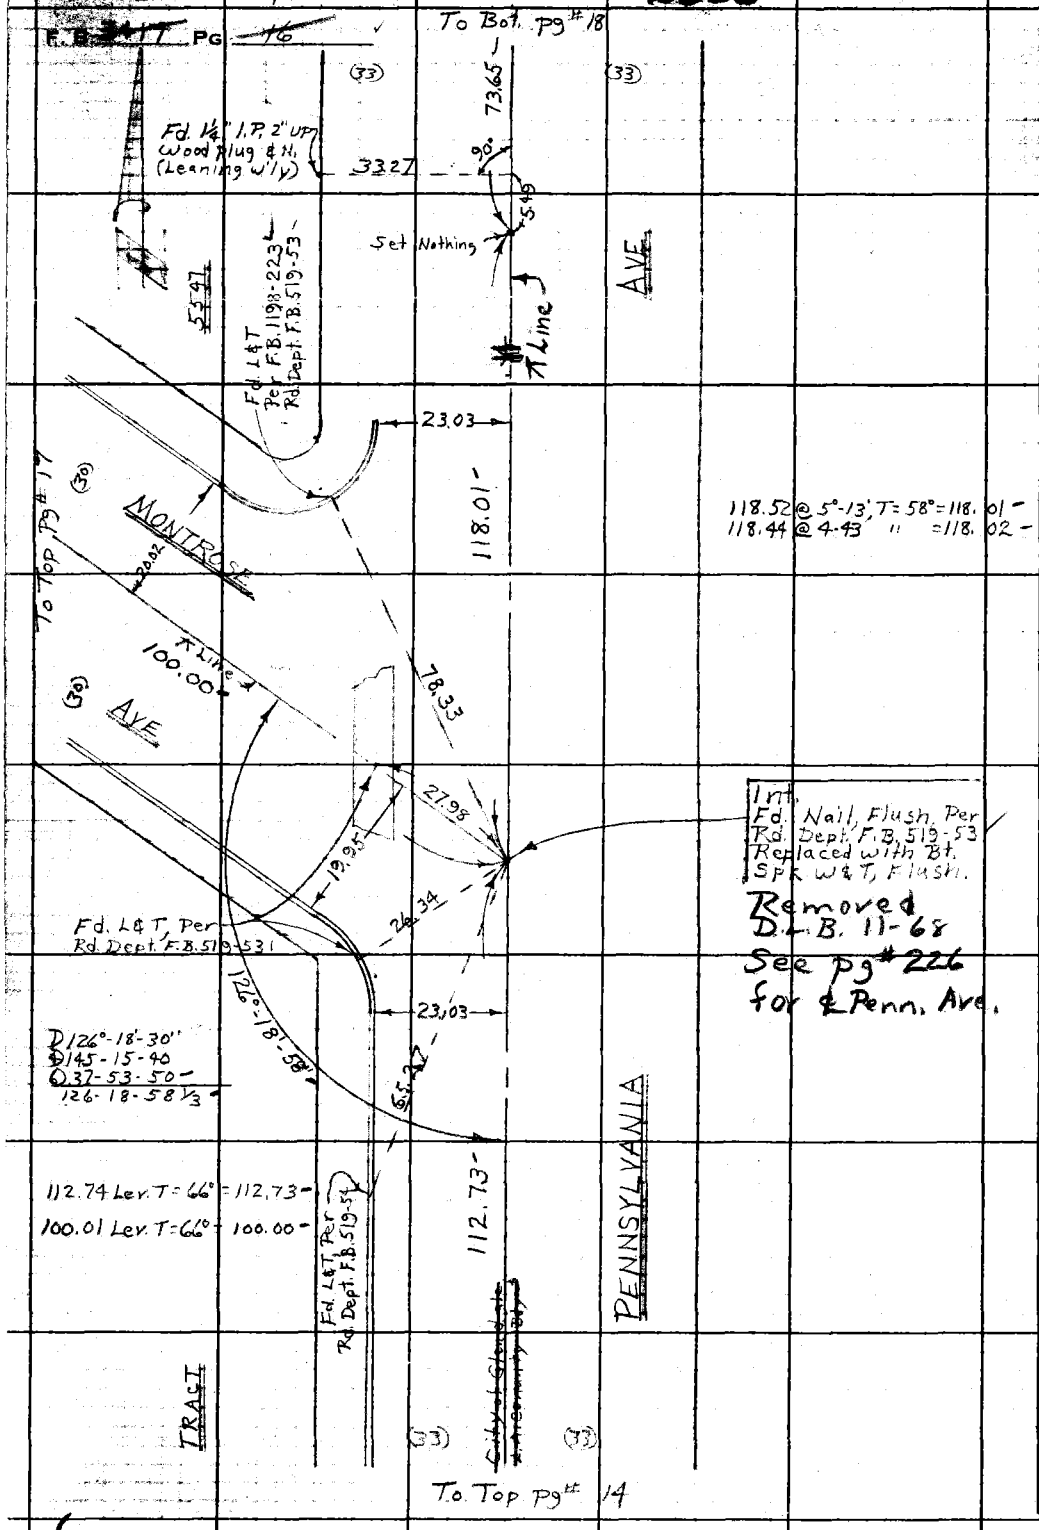

WS 51-B4

PLEASE RETURN TO
LOS ANGELES COUNTY ENGINEER
403 LOS ANGELES COUNTY ENGINEERING BLDG.

Do not extend this side of this line.

Note: Any Additions or Changes on This Sheet Must be Made or Circled in Red Ink With Date and Name of Person Making Change.

PWFB 1921 2360

Notes Ck'd by W. EDMONDSON	Survey of Pennsylvania Ave	F. B. 3417 Pg. 17
Map No. B-5072	[illegible]	
Office Work H. H. F. DONG	Surveyed by Burkholder	
Checked	Notes [illegible] Date [illegible]	
Date	Indexed E. J. GALLI	

W.S. 51 B-7

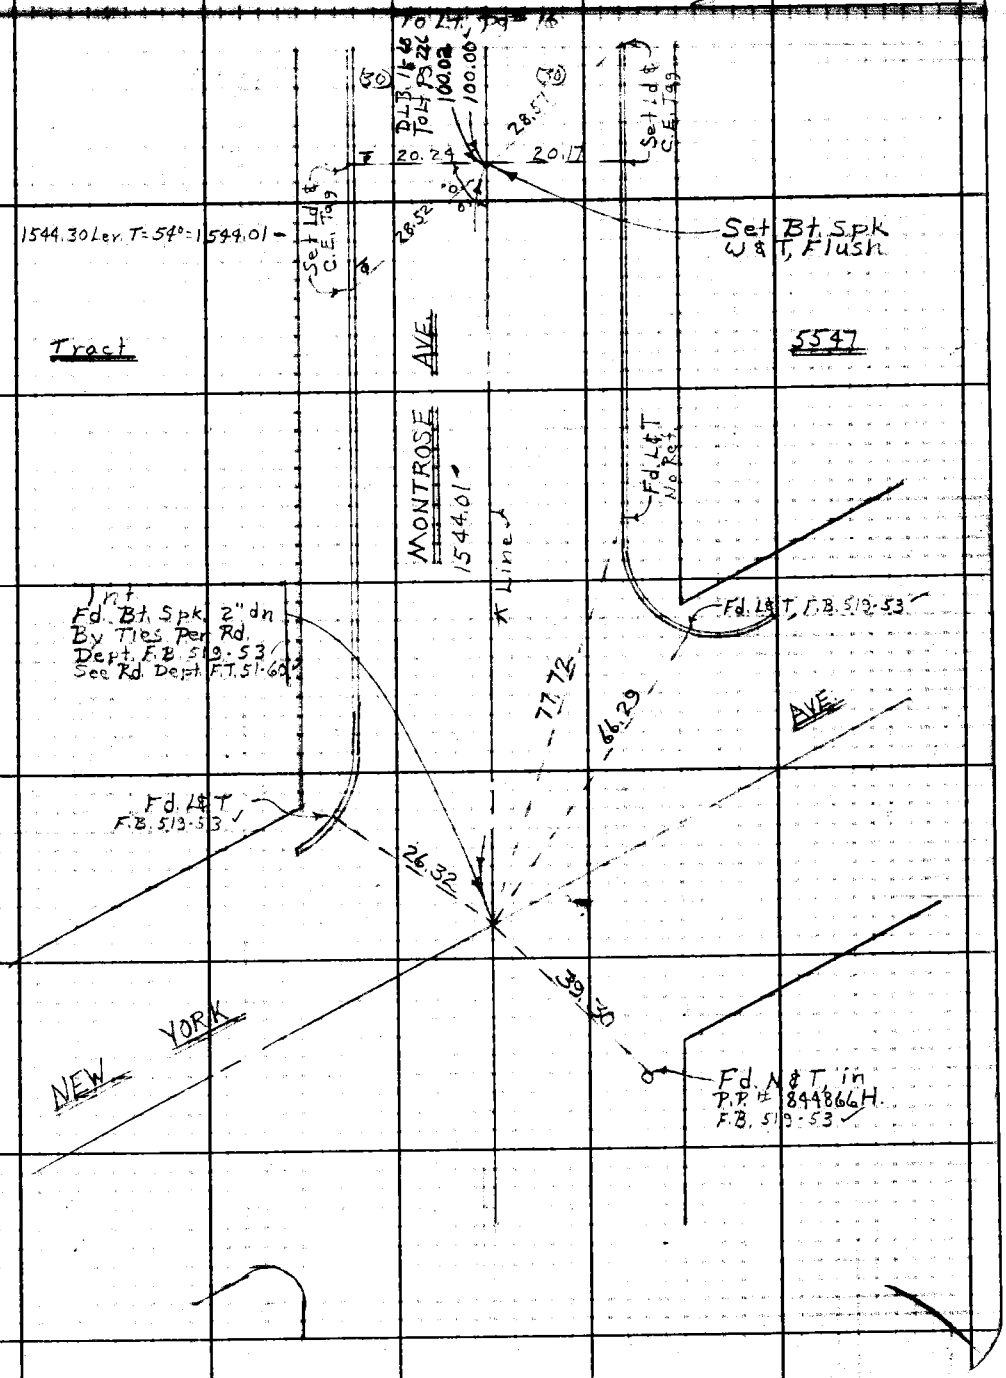

Note: Any Additions or Changes on This Sheet Must be Made or Circled in Red Ink With Date and Name of Person Making Change.

Do not extend this side of this line.

PLEASE RETURN TO
LOS ANGELES COUNTY ENGINEER
403 LOS ANGELES COUNTY ENGINEERING BLDG.

76F309S CE#310 1-65

PWFB 1921 2361

F.B. 1467 PG 18

To Bot. Pg# 22

Fd. North.

Fd. L&T F.B. 519-52

To Top Pg#19

19.94

53°-41'-18"

Line J

100.00

MAYFIELD

Set Ld & C.E. Tag

Fd. L&T

Fd. L&T F.B. 519-52

Fd. Nothing 24" dn

Int. & Pt. E&W Set Bt. Spk w&T Flush, by Int. Removed

6.21 Lev. T=66°=6.21

25.43 Lev. T-66°=25.43

See Pg# 221 for Penn Ave. D.L.B. 1168

5547

TRACI

AVE

PENNSYLVANIA

299.86 @ 3°-27', T=66°=299.28 .27

299.91 @ 3-40, " =299.29 .26

29.56 Lev. " = 29.56

328.85

.83

24.53 Lev T=60°=24.53

73.66 Lev. T=60°=73.65

331.16

78.21

22.97

0.05

6.21

34.37

46.27

30.18

19.37

26.30

25.43

22.80

0.05

Fd. Sq. hd. Spk & W. F.B. 519-52

Rem. Set Ld & C.E. Tag & bk. w/k.

Fd. Bt. Spk w/T Flush. Per Rd. Dept. F.B. 519-52

D 126°-25'-00"
A 145-40-20
C 38-30-30
126-25-05

D 53°-41-30"
A 214-45-10
C 322-07-50
53-41-18½

126°-25'-05"

07"

20.00

27.85

Set Ld & C.E. Tag

40.21

Fd. Sq. hd. Spk & W.

0.03

100.00

20.03

23.12

Rem. Set Ld & C.E. Tag & bk. w/k.

Fd. Sq. hd Spk & W. Flush, Per Rd. Dept. F.B. 519-52 (Removed Used for Line w'ly)

0.05

Fd. Sq. hd. Spk. Flush. No ref.

24.53

90°

33.12

Fd. Nothing

73.65

Set 1" Gpipe 24" on Bdy.

Fd 1" I.P. Wood Plug & Nail Flush. See In 23688

TRACI 23688

To Bot. Pg# 20

To Top. Pg# 16

(33) (33) (30) (30) (40) (40) (30) (30) (33) (33)

LOS ANGELES COUNTY ENGINEER
403 LOS ANGELES COUNTY ENGINEERING BLDG.

PLEASE RETURN TO

Do not extend this side of this line.

Note: Any Additions or Changes on This Sheet Must be Made or Circled in Red Ink With Date and Name of Person Making Change.

4-8-19 SM

PWFB 1921 2362

Notes Ck'd by W. EDMONDSON	Survey of [illegible] Ave	F. B. 3417 PG. 19
[illegible]	[illegible]	
Office Work H. H. F. DONO	Surveyed by [illegible]	
Checked	Notes D.L.B. Date 2-67	
Date	Indexed C. J. GALLI	

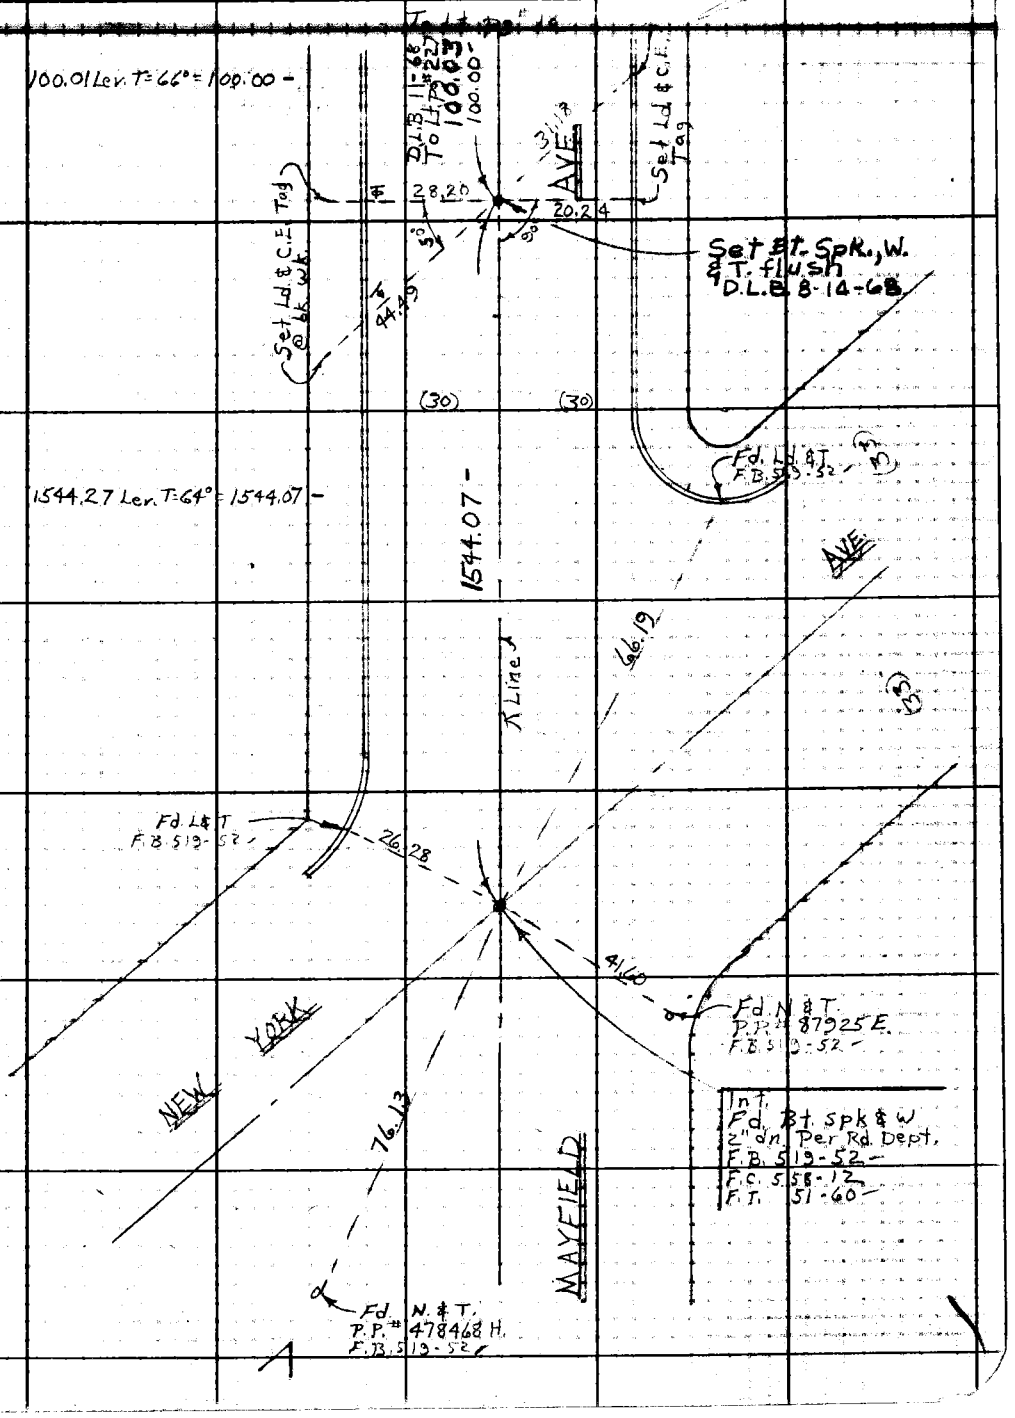

Note: Any Additions or Changes on this Sheet Must be Made or Circled in Red Ink With Date and Name of Person Making Change.

Do not extend this side of this line.

PLEASE RETURN TO
LOS ANGELES COUNTY ENGINEER
403 LOS ANGELES COUNTY ENGINEERING BLDG.

76F309S CE#310 1-65

PWFB 1921 2363

F.B. 2417 PG. 20

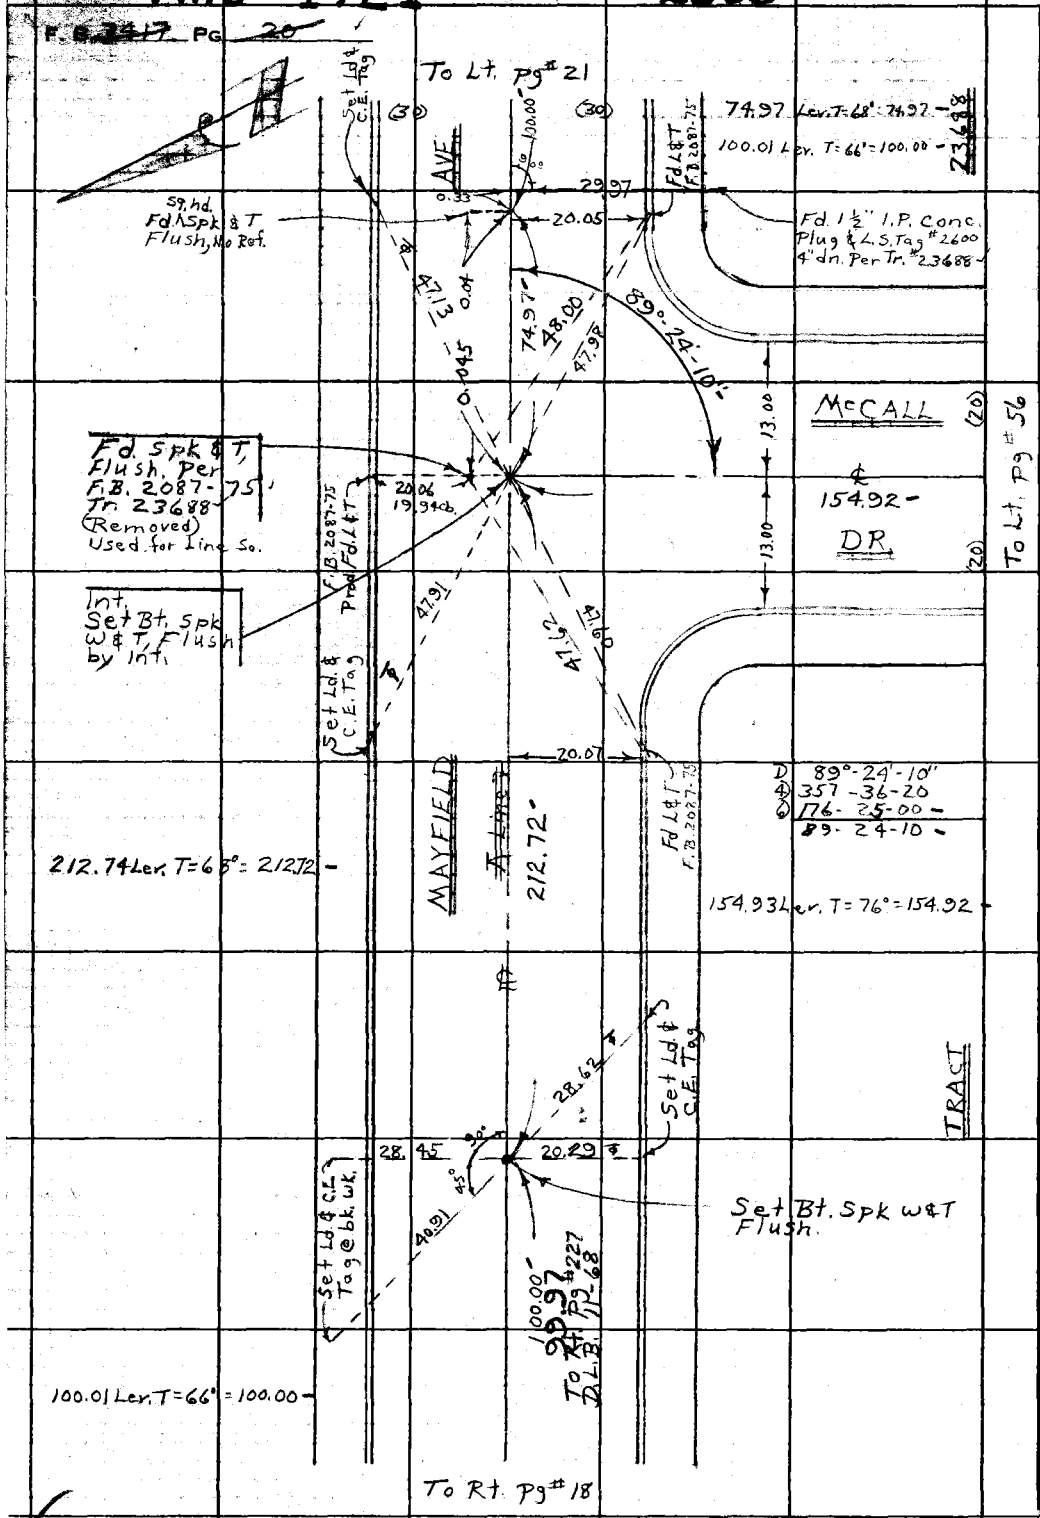

PLEASE RETURN TO
LOS ANGELES COUNTY ENGINEER
403 LOS ANGELES COUNTY ENGINEERING BLDG.

Do not extend this side of this line.

Note: Any Additions or Changes on This Sheet Must be Made or Circled in Red Ink With Date and Name of Person Making Change.

PWFB 1921 2364

Notes Ck'd. W. EDMONDSON	Survey of	F. B. 3417 PG. 21
Map No. B-5012	JN0097.2 Tape Std	
Office Work H. H. F. DONG	Surveyed by	
Checked	Notes D.L.B. Date 5-67	
Date	Indexed E. J. GALLI	

Note: Any Additions or Changes on This Sheet Must be Made or Circled in Red Ink With Date and Name of Person Making Change.

Do not extend this side of this line.

PLEASE RETURN TO
LOS ANGELES COUNTY ENGINEER
403 LOS ANGELES COUNTY ENGINEERING BLDG.

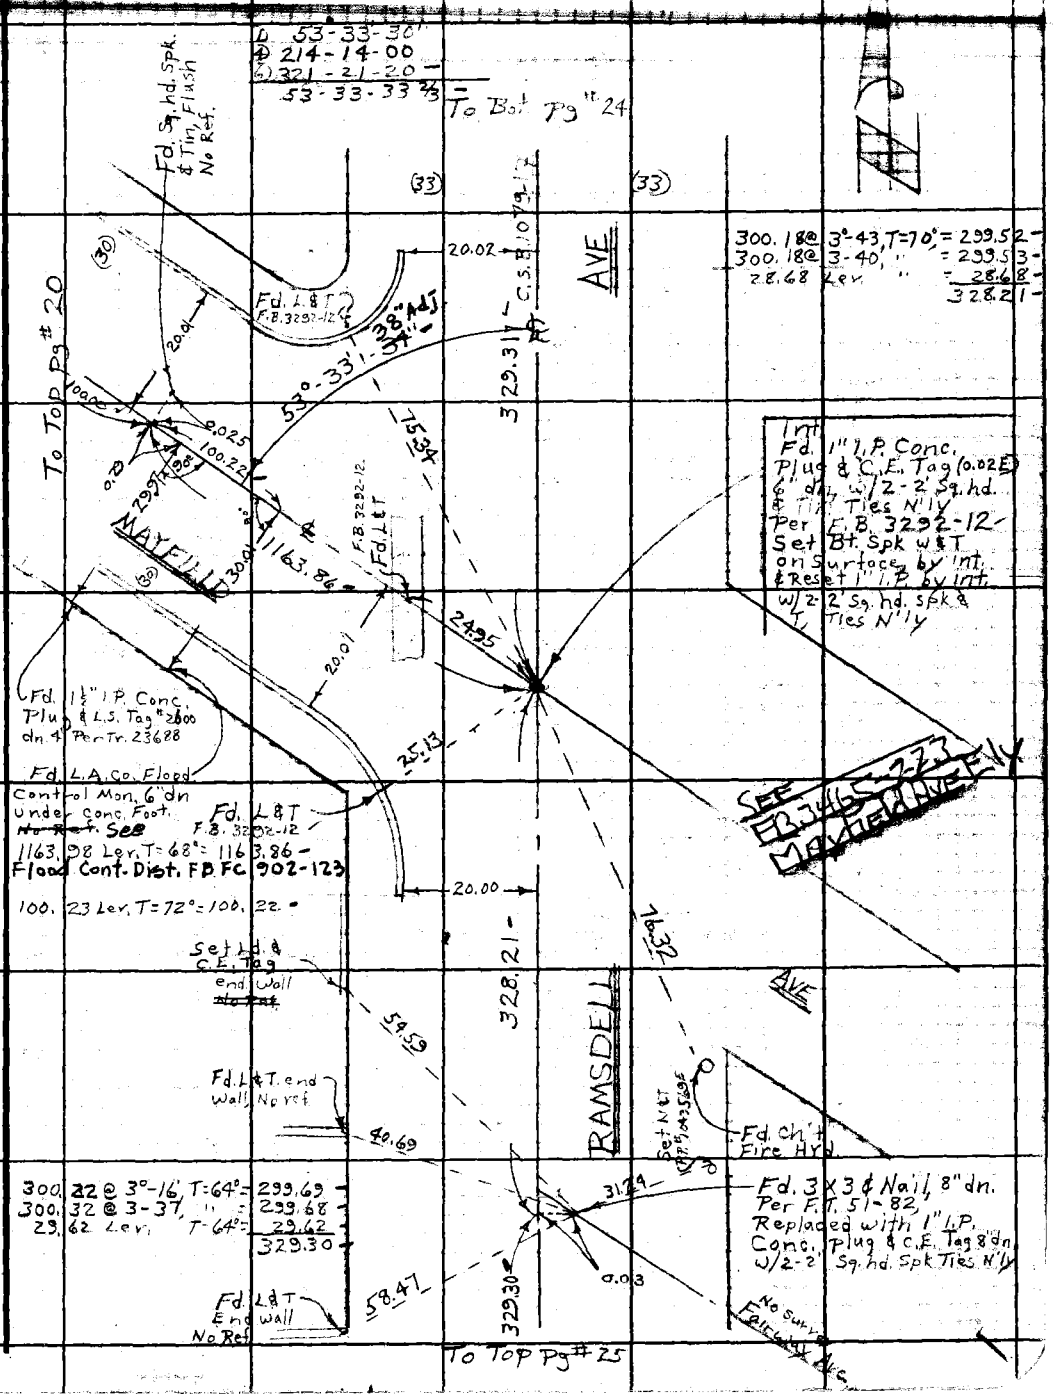

78F309S CE#310 1-65

PWFB 1921 2365, 2366

F.B. ~~2417~~ PG. ~~22~~

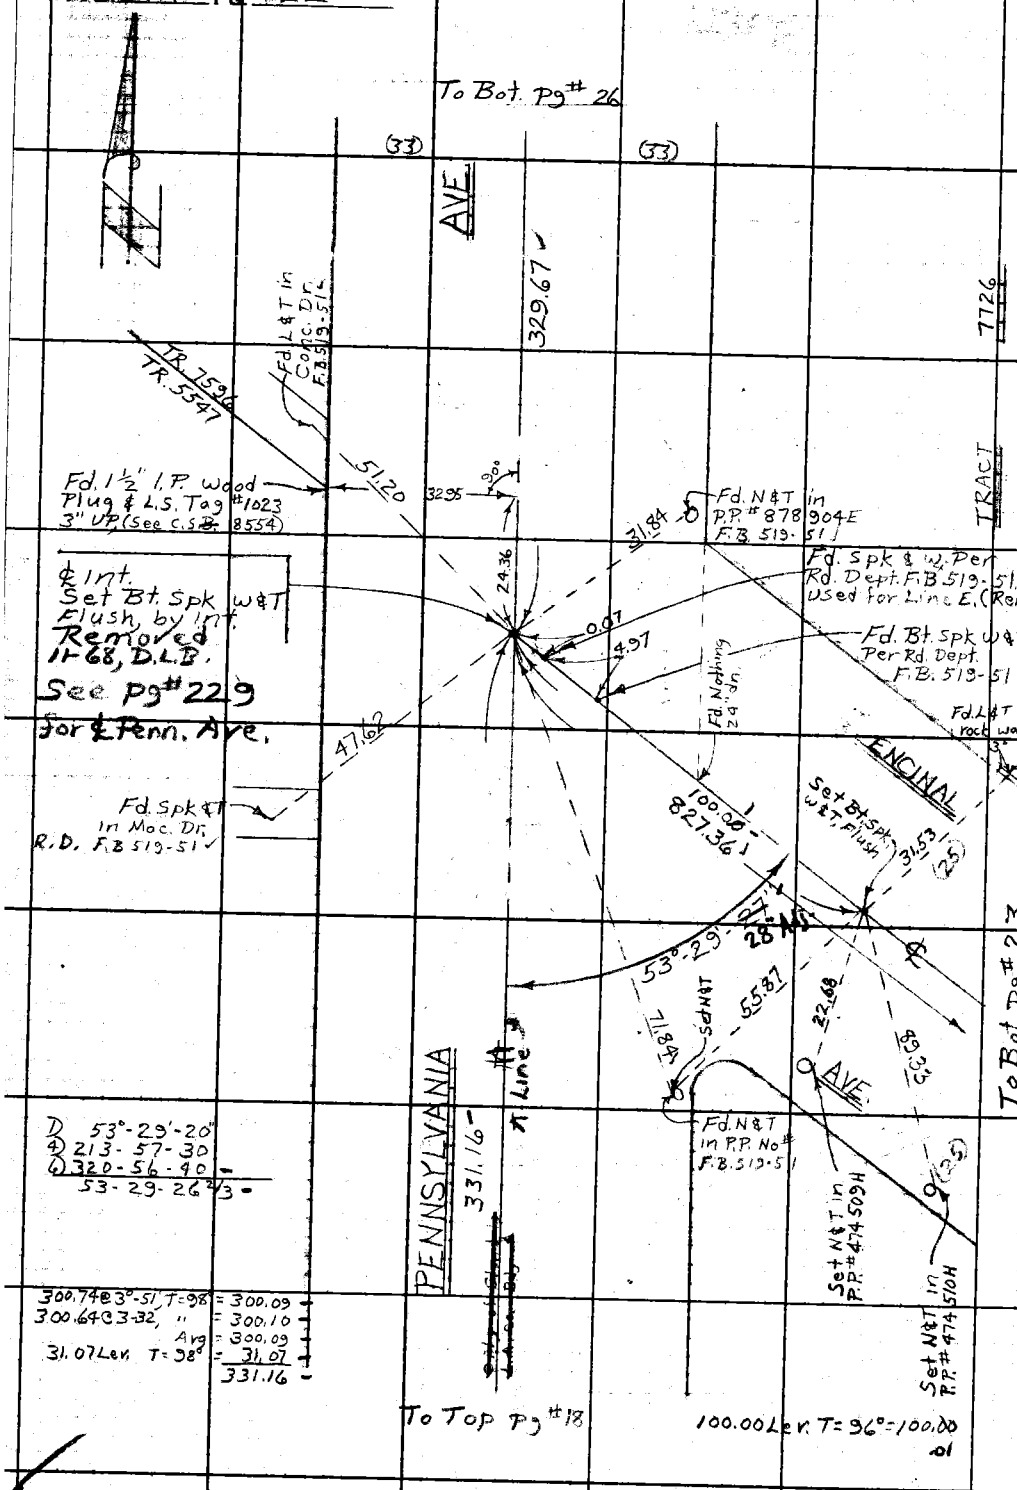

WS 51 B-4

PLEASE RETURN TO
LOS ANGELES COUNTY ENGINEER
403 LOS ANGELES COUNTY ENGINEERING BLDG.

Do not extend this side of this line.

Note: Any Additions or Changes on This Sheet Must be Made or Circled in Red Ink With Date and Name of Person Making Change.

PWFB 1921 2367

Notes Ck'd by W. EDMONDSON	Survey of [illegible] Ave.	F. B. 3417 Pg. 25
Map No. [illegible]	[illegible]	
Office Work H. H. F. DONG	Surveyed by Burkholder	
Checked	Notes D.L.B. Date 5-67	
Date	Indexed E. J. GALLI	

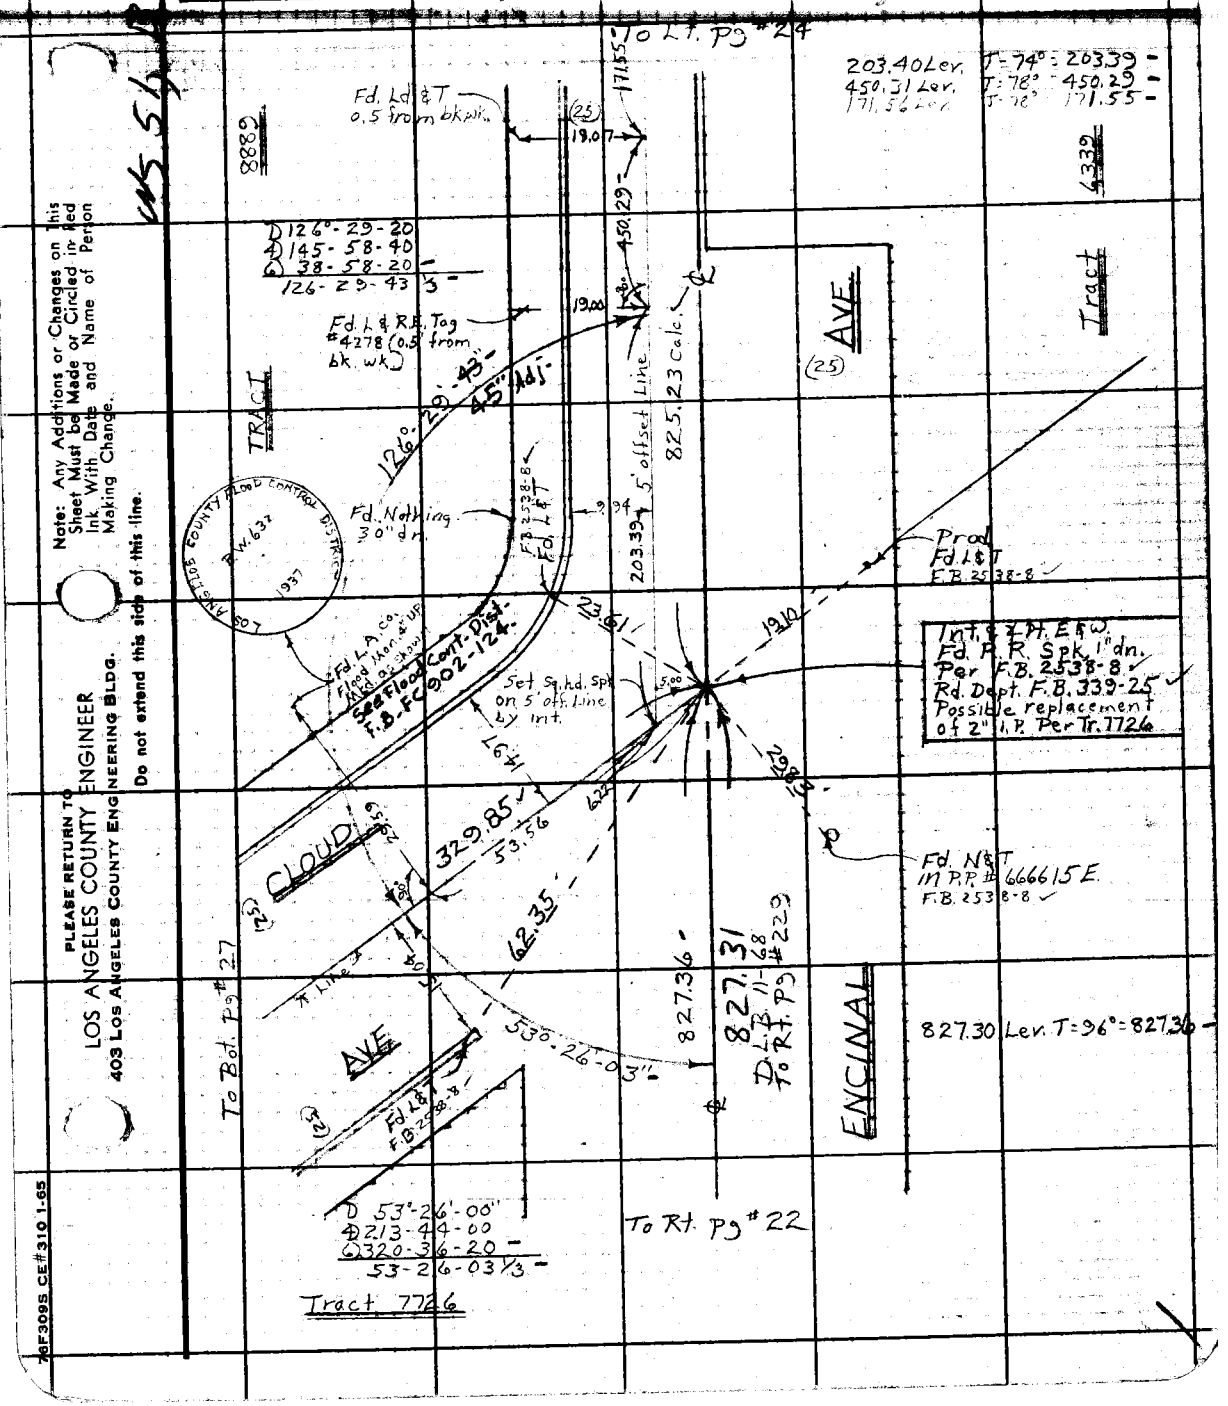

Note: Any Additions or Changes on This Sheet Must be Made or Circled in Red Ink With Date and Name of Person Making Change.

Do not extend this side of this line.

PLEASE RETURN TO
LOS ANGELES COUNTY ENGINEER
403 Los Angeles County Engineering Bldg.

76F309S CE#310 1-65

PWFB 1921 2368

F.B. 3417 PG. 24

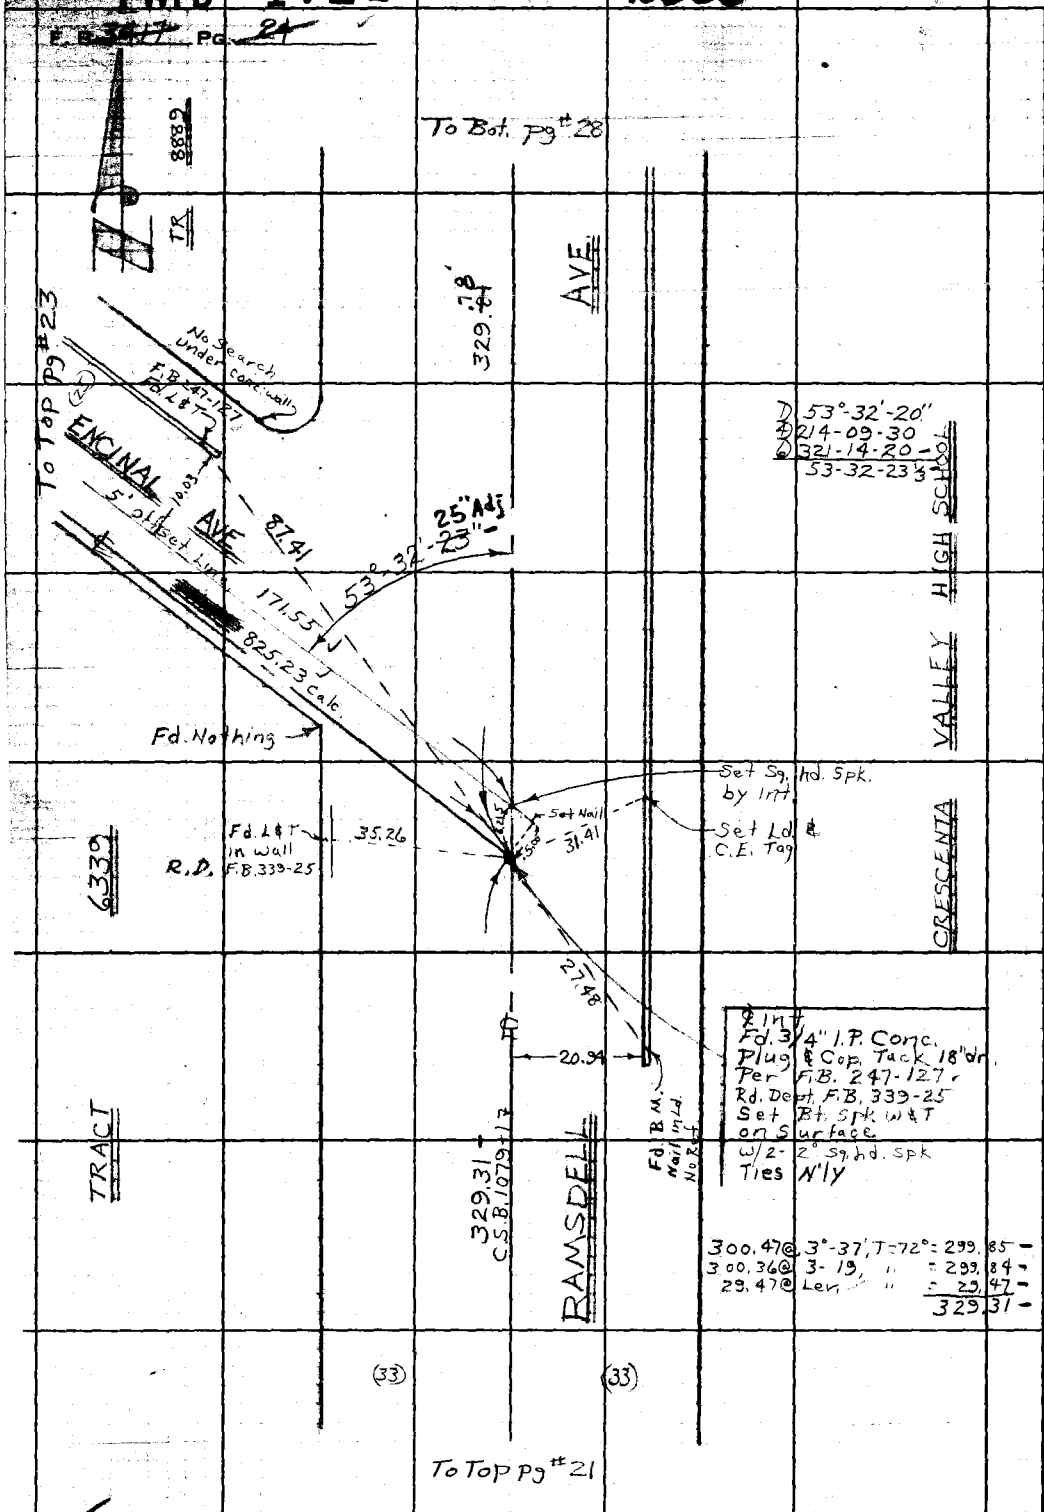

PLEASE RETURN TO
LOS ANGELES COUNTY ENGINEER
403 LOS ANGELES COUNTY ENGINEERING BLDG.

Do not extend this side of this line.

Note: Any Additions or Changes on This Sheet Must be Made or Circled in Red Ink With Date and Name of Person Making Change.

WS 51-B-4

PWFB 1921 2369

Notes Ck'd by W. EDMONDSON	Survey of [illegible]	F. B. 3417 PG. 25
Map No. B-5072	JN [illegible] Tape [illegible] Std [illegible]	
Office Work H. H. F. DONG	Surveyed by [illegible]	
Checked	Notes D.L.B. Date 5-67	
Date	Indexed E. J. GALLI	

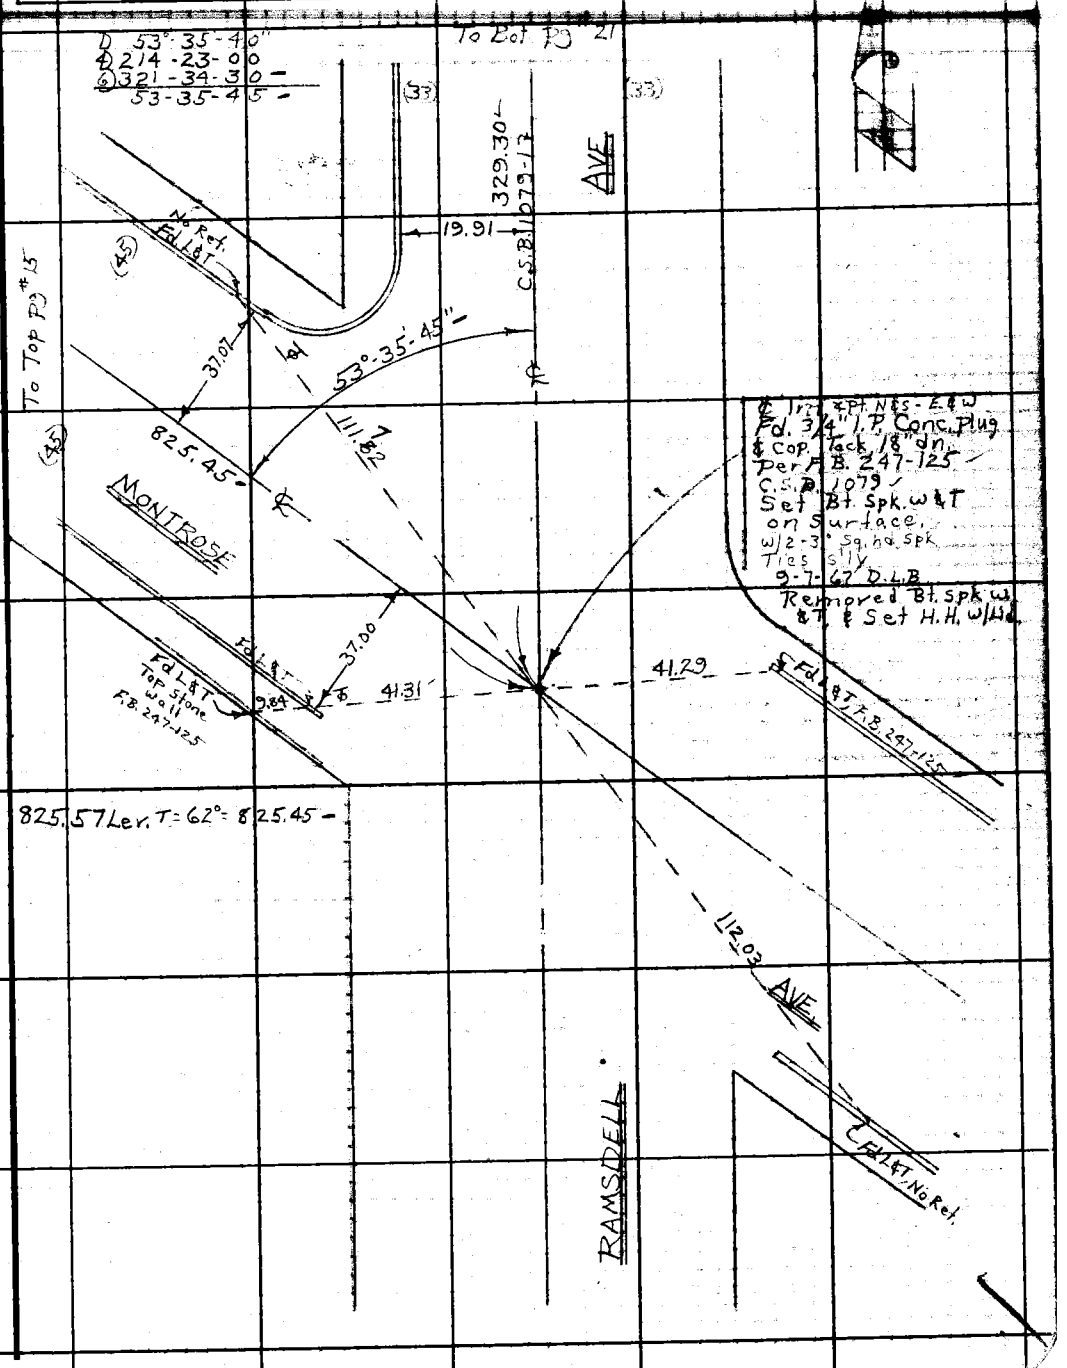

Note: Any Additions or Changes on This Sheet Must be Made or Circled in Red Ink With Date and Name of Person Making Change.

Do not extend this side of this line.

PLEASE RETURN TO
LOS ANGELES COUNTY ENGINEER
403 LOS ANGELES COUNTY ENGINEERING BLDG.

76F309S CE#310 1-65

PWFB 1921 2370

F.B. ~~3417~~ PG. ~~26~~

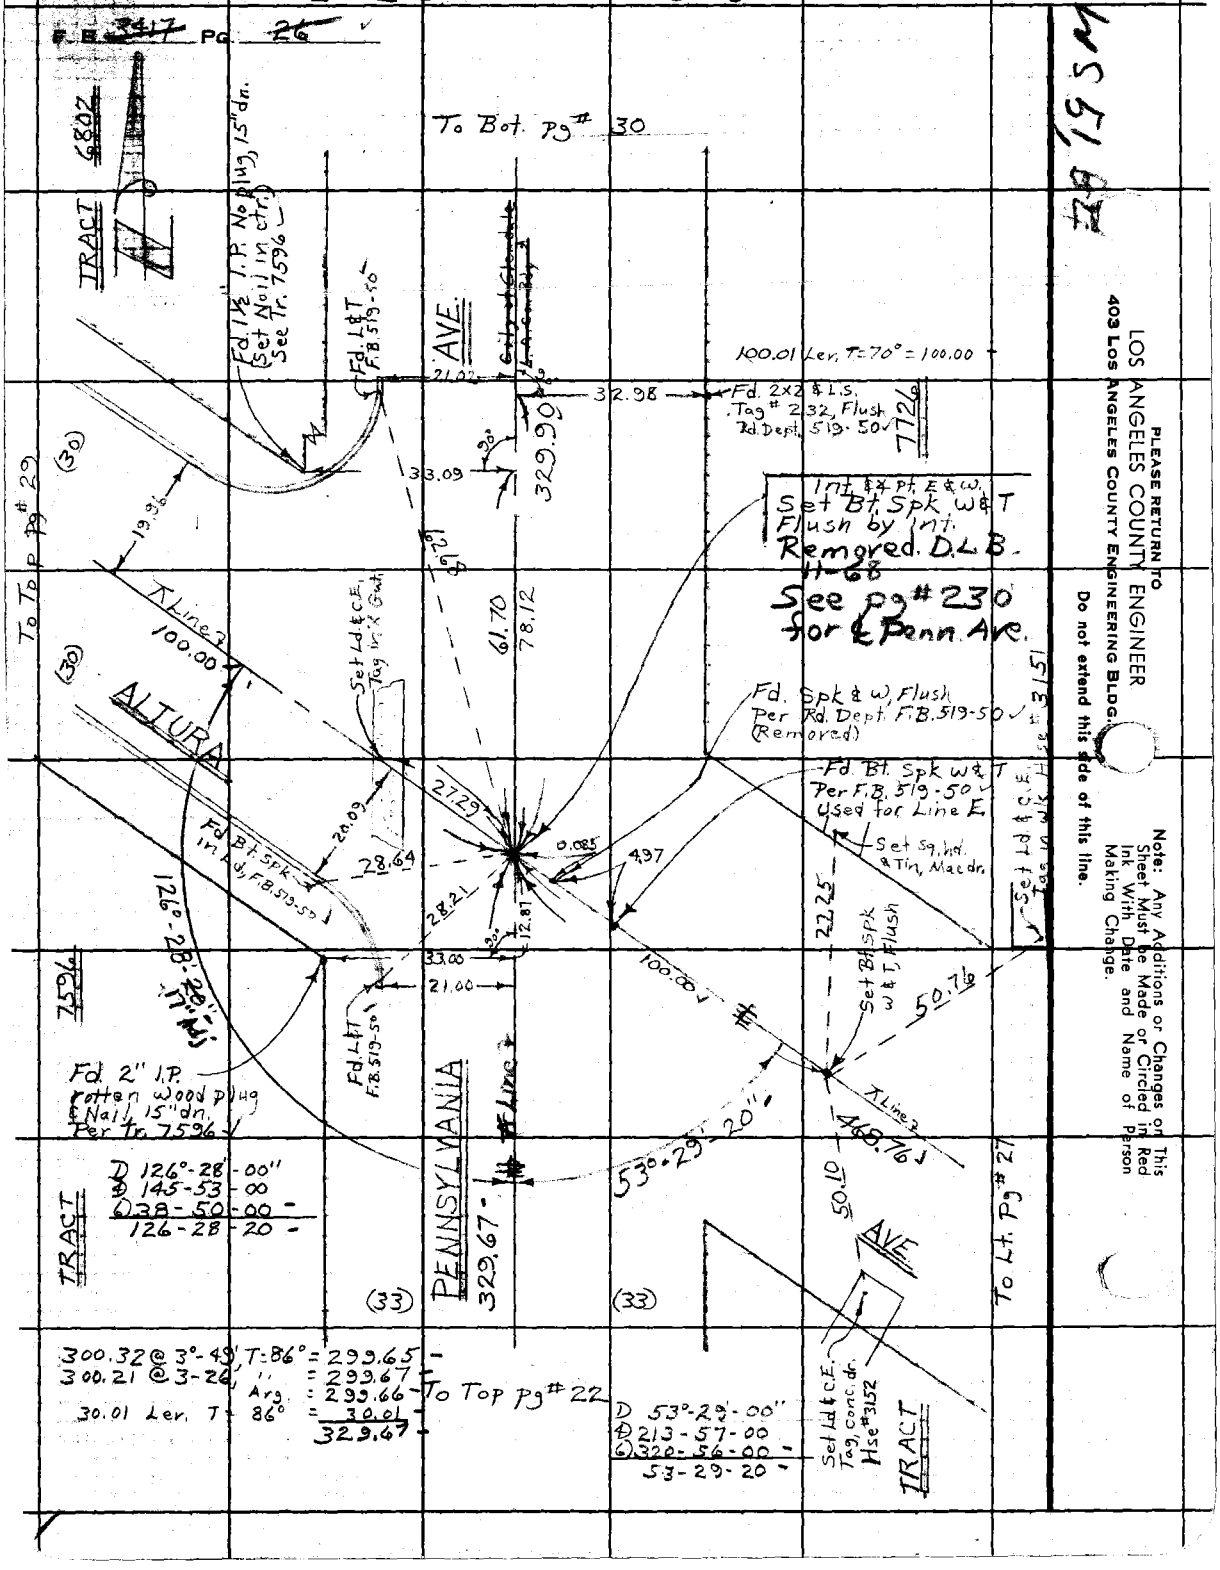

PLEASE RETURN TO
LOS ANGELES COUNTY ENGINEER
403 LOS ANGELES COUNTY ENGINEERING BLDG.
Do not extend this side of this line.

Note: Any Additions or Changes on This Sheet Must be Made or Circled in Red Ink With Date and Name of Person Making Change.

PWFB 1921

2371

Notes Ck'd by W. EDMONDSON	Survey of [illegible]
Map No. B-5072	JN0097.25 Tape 202 Std [illegible]
Office Work H. H. F. DONG	Surveyed by Burkholder
Checked	Notes D.L.B. Date 5-67
Date	Indexed [illegible] GALLI

F. B. 3417 PG. 27

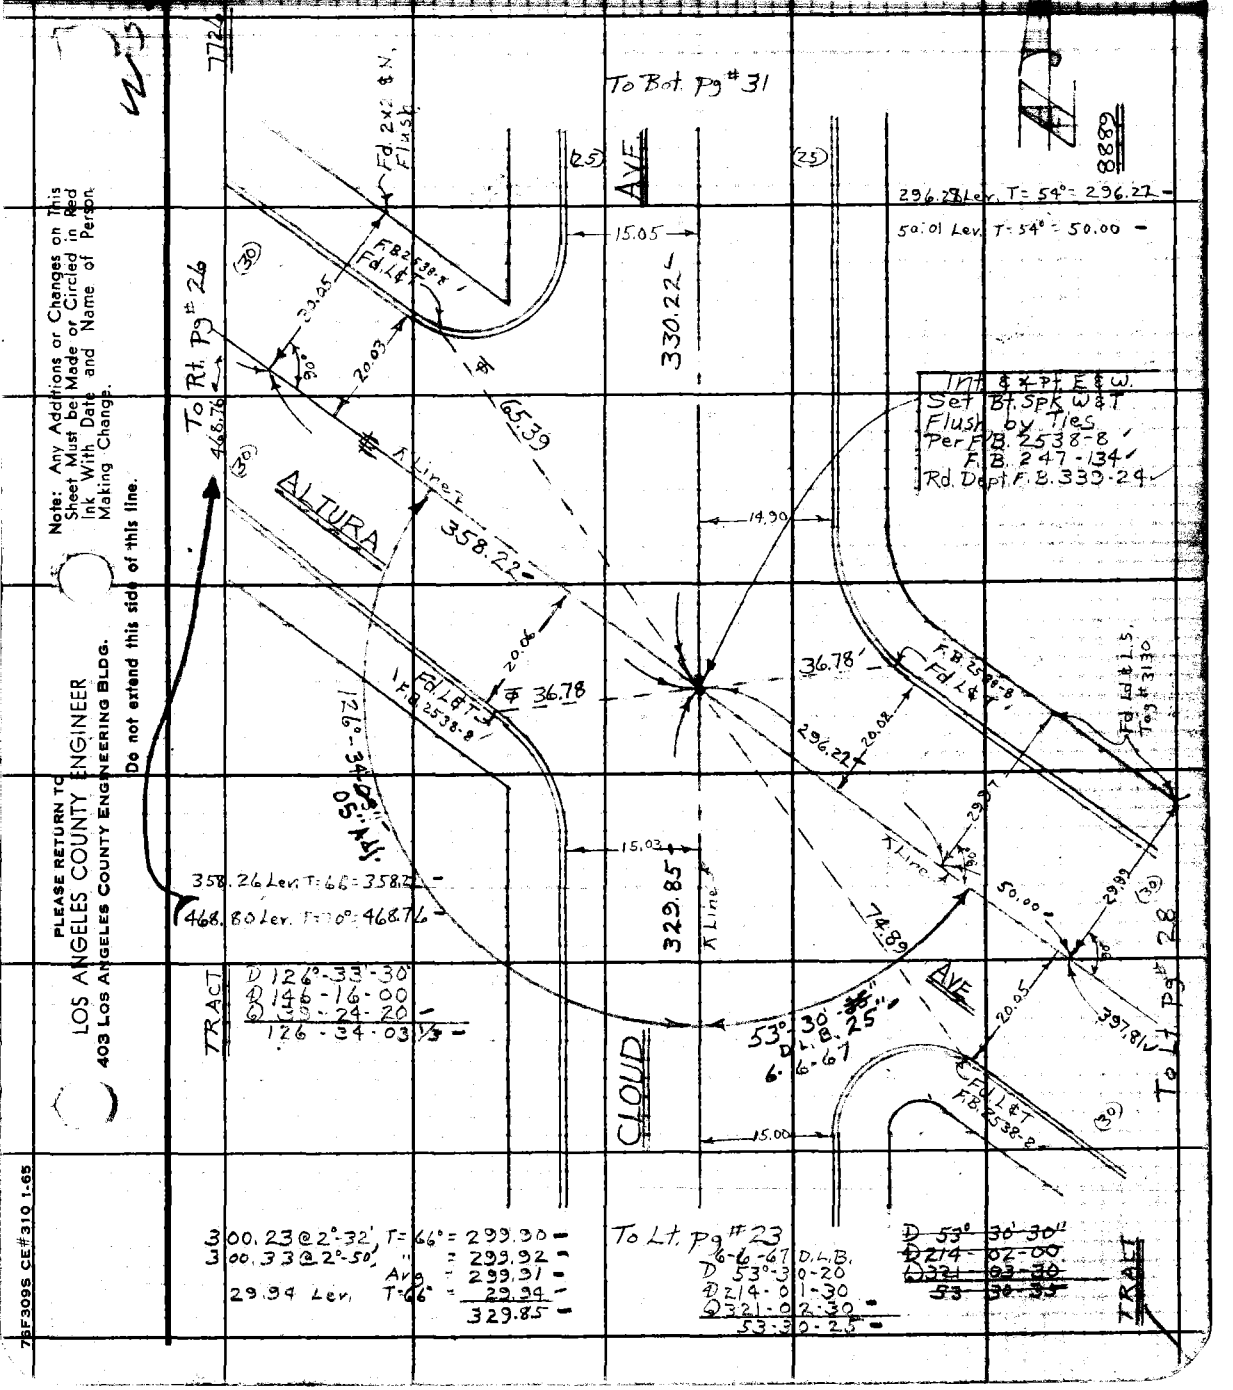

Note: Any Additions or Changes on This Sheet Must be Made or Circled in Red Ink With Date and Name of Person Making Change.

Do not extend this side of this line.

PLEASE RETURN TO
LOS ANGELES COUNTY ENGINEER
403 LOS ANGELES COUNTY ENGINEERING BLDG.

76F309S CE#310 1-65

PWFB 1921 2372

F.B. 3417 Pg. 28

WS 51.B-4

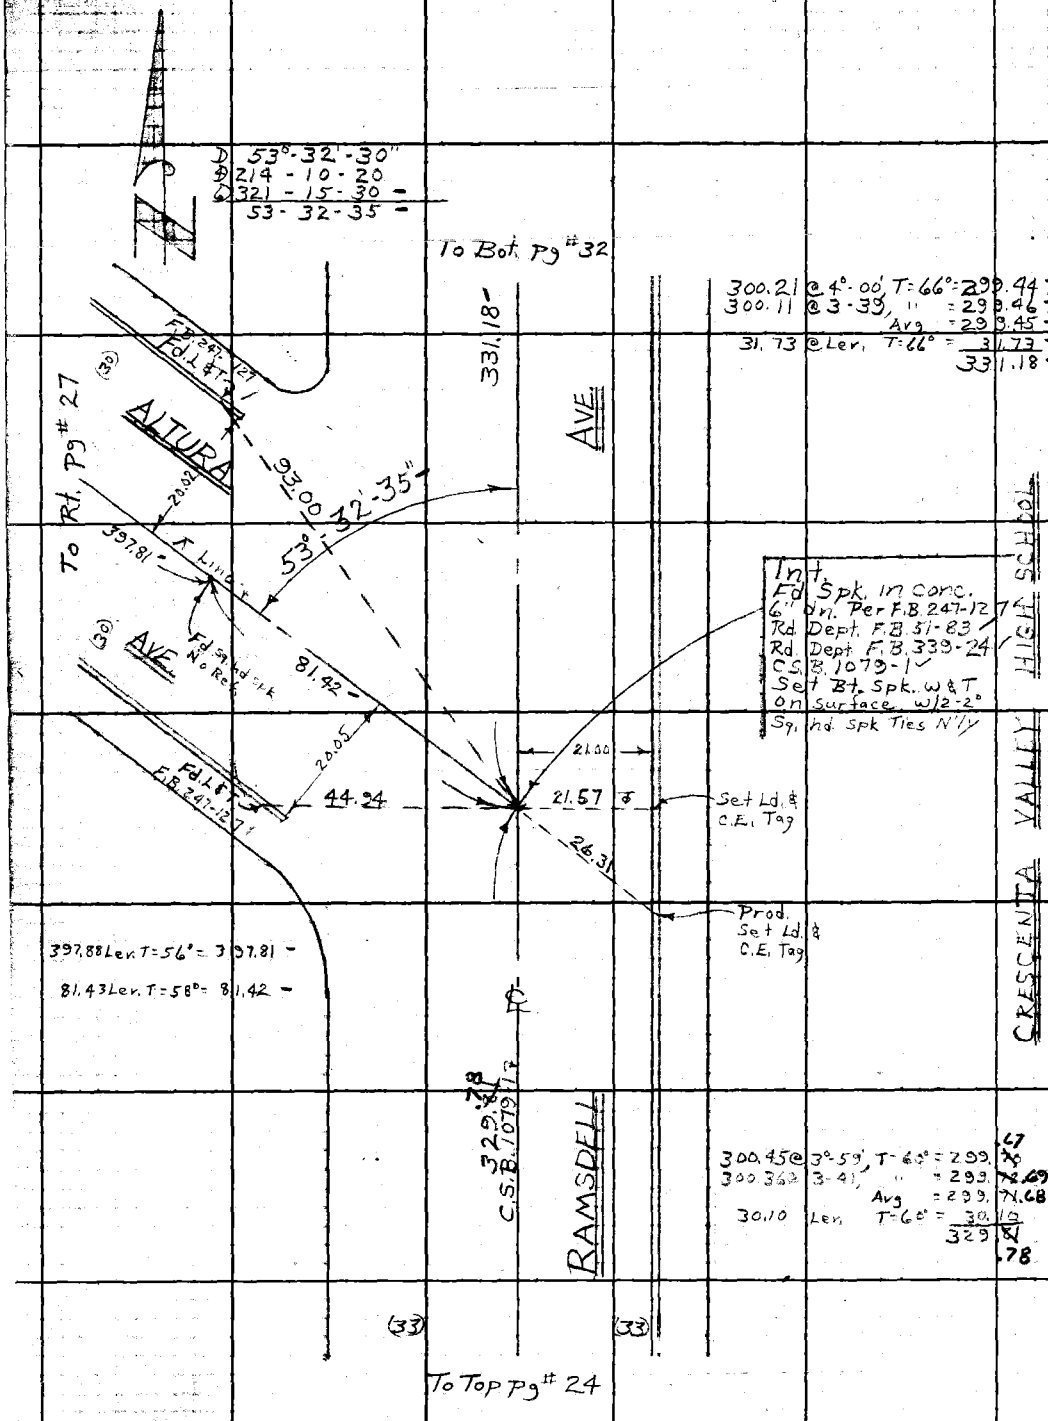

PLEASE RETURN TO
LOS ANGELES COUNTY ENGINEER
403 LOS ANGELES COUNTY ENGINEERING BLDG.

Do not extend this side of this line.

Note: Any Additions or Changes on This Sheet Must be Made or Circled in Red Ink With Date and Name of Person Making Change.

PWFB 1921 2373

Notes Ck'd by W. EDMONDSON
Map No. B-5672
Office Work H. H. F. DONG
Checked
Date

Survey of
JN
Surveyed by
Notes D.L.B. Date 5-67
Indexed

F. B. PG.

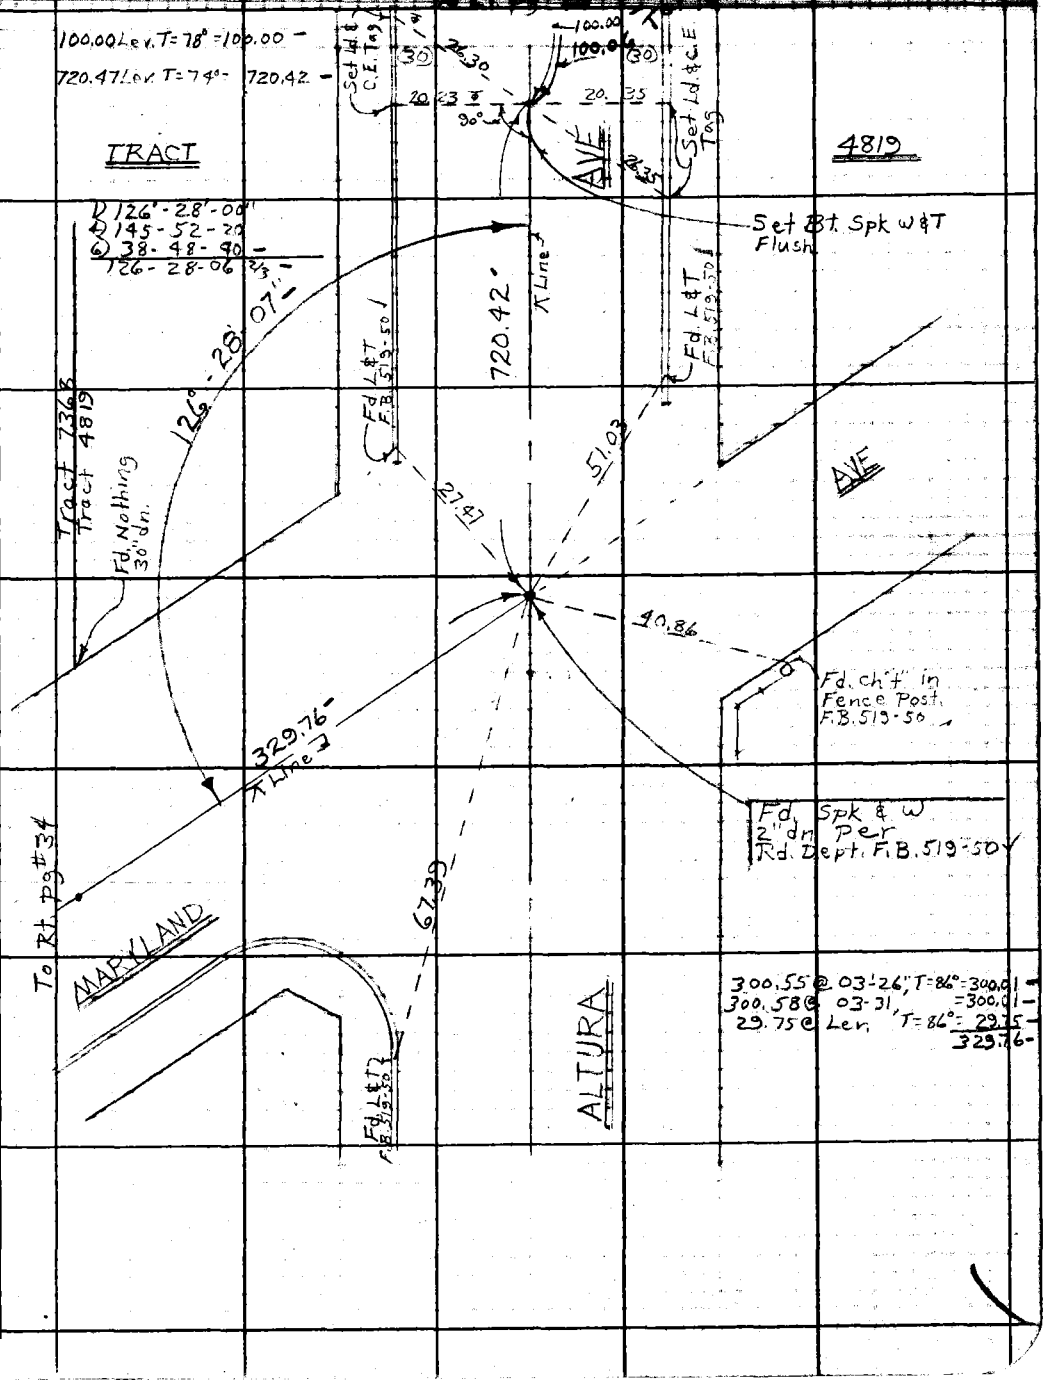

Note: Any Additions or Changes on This Sheet Must be Made or Circled in Red Ink With Date and Name of Person Making Change.

Do not extend this side of this line.

PLEASE RETURN TO
LOS ANGELES COUNTY ENGINEER
403 LOS ANGELES COUNTY ENGINEERING BLDG.

75F309S CE#310 1-65

PWFB 1921 2374

F.B. ~~3417~~ PG. ~~30~~

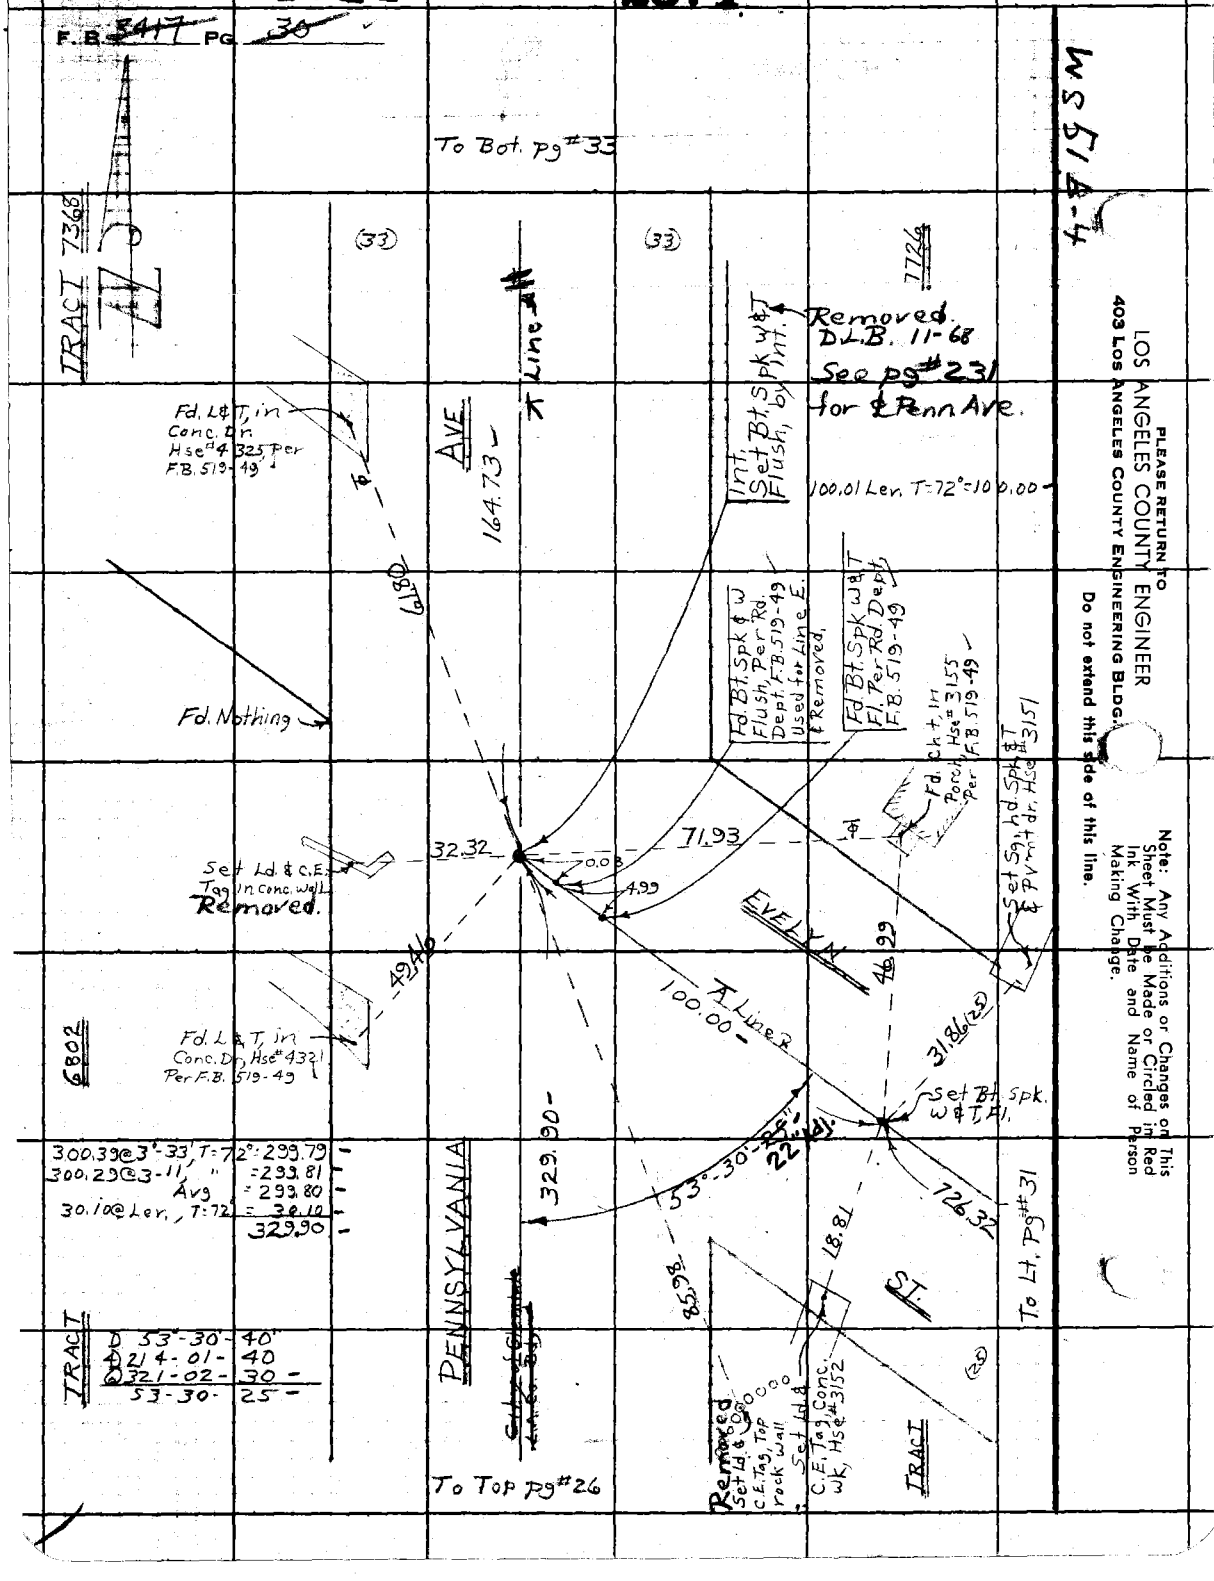

4-8 15 SM

PLEASE RETURN TO
LOS ANGELES COUNTY ENGINEER
403 LOS ANGELES COUNTY ENGINEERING BLDG.

Do not extend this side of this line.

Note: Any Additions or Changes on This Sheet Must be Made or Circled in Red Ink With Date and Name of Person Making Change.

PWFB 1921

2375

Checked	Notes D-6-8 Date 6-67
Date	Indexed G. J. GALLI

F. B. 3412 PG. 31

D 126° 18' 00"
D 141-12-12
Q 37-01-10 -
126-10-112/3 -

To Book Pg # 19

To Rt Pg # 30

726.36 Lev. T=76° = 726.32 -

32" Adj.

53°-42'-26 -

(25)

AVE

14.82

EVELYN

Fd. L&T F.B. 2538-10

14.97

59.82

60.00

Set Ld. & C.E. Tag in X Cut

328.62

Int. to west.
Fd. Cut spk w&T
Flush, Per Rd. Dept.
F.C. 869-8
F.B. 247-134 -
F.B. 2538-10 -
See Rd. Dept. F.T. 51-70

7843

℄ Line

726.32

126-18-00

10" Adj.

TRACT

15.01

Fd. L&T F.B. 2538-10

35.30

15.09

35.91

0.23 -

No Search under conc.

35.45

Fd. L&T F.B. 2538-10

15.03

56.50

Set Ld. & C.E. Tag "X" Cut

Set Ld. & C.E. Tag in wk.

D 53°-42'-30"
Q 214-49-40
Q 322-14-40 -
53-42-26 2/3 -

℄ Pt. & Int. to East
Set Sq. hd. Spk & T.
Flush, on Line Prod.
from No. & Rec. dist.
from Int. to West
Per Rd. Dept. F.T. 51-70
Fd. Nothing 6.20 So.
of this pt. (36" dn)
Per Tract # 7726
℄ Tract # 8889
℄ Tract # 7843

14.95

℄ Line

19.36

70.29

190.24

824.98

ST

D 53°-39'-00"
Q 214-17-00
Q 321-25-30 -
53-34-15 -

TRACT

330.22

53°-39-15" = 14

15.07

15.00

Fd. L&T F.B. 2538-10

Fd. Nothing 24" dn

Set Ld. & C.E. Tag in wk.

To Lt. Pg # 32

300.69 @ 3°-15', T=60°	=	300.16
300.62 @ 3-01, "	=	300.15
30.07 @ Lev., T=60°	=	30.07
		330.22
0.23 @ Lev. T=60°	=	0.23 -

℄ Line

TRACT 8889

To Top Pg # 27

Note: Any Additions or Changes on This Sheet Must be Made or Circled in Red Ink With Date and Name of Person Making Change.

Do not extend this side of this line.

PLEASE RETURN TO
LOS ANGELES COUNTY ENGINEER
403 LOS ANGELES COUNTY ENGINEERING BLDG.

76F309S CE#310 1-65

PWFB 1921 2376

F.B. 3417 PG 32

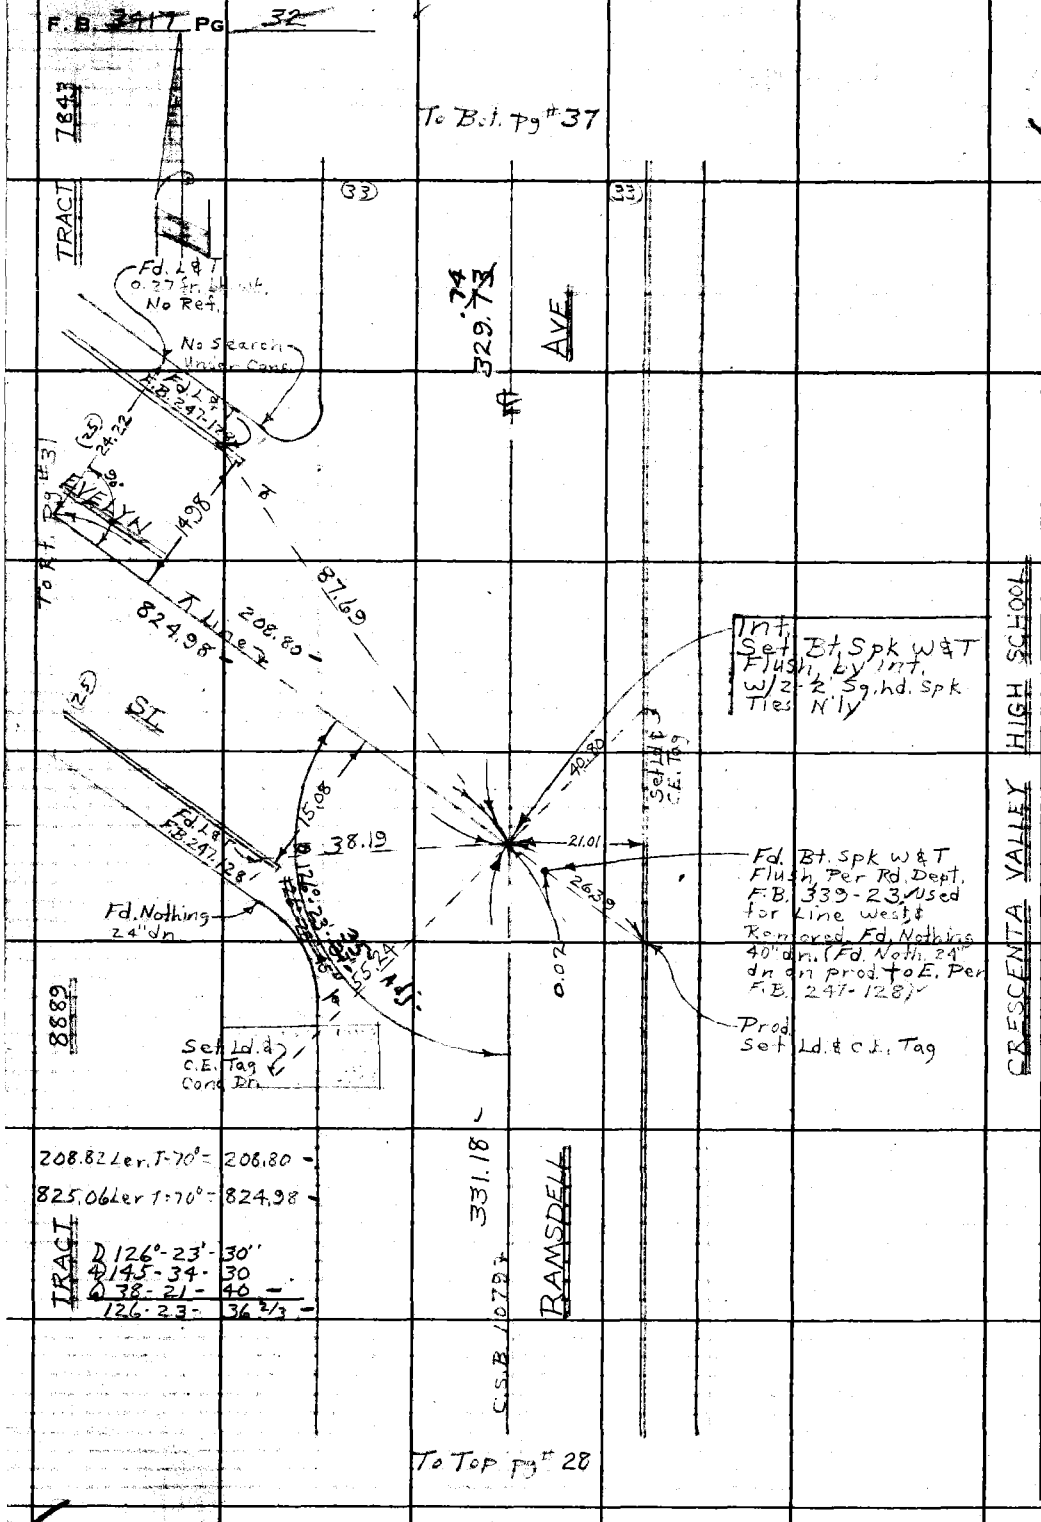

208.82 Ler. T-70° = 208.80

825.06 Ler T-70° = 824.98

TRACT

①	126°-23'-	30"
④	145-34-	30
⑥	38-21-	40
	126-23-	36 2/3

WS 51, B4

PLEASE RETURN TO
LOS ANGELES COUNTY ENGINEER
403 LOS ANGELES COUNTY ENGINEERING BLDG.

Do not extend this side of this line.

Note: Any Additions or Changes on This Sheet Must Be Made or Circled in Red Ink With Date and Name of Person Making Change.

PWFB 1921 2377

Notes Ck'd by W. EDMONDSON	Survey of Pennsylvania Ave	F. B. 3417 PG. 33
Map No. B-5072	JN 009 420 Tape 202 Std 84 °F	
Office Work H. H. F. DONG	Surveyed by Burkhalter	
Checked	Notes [illegible] Date [illegible]	
Date	Indexed C. J. GALL	

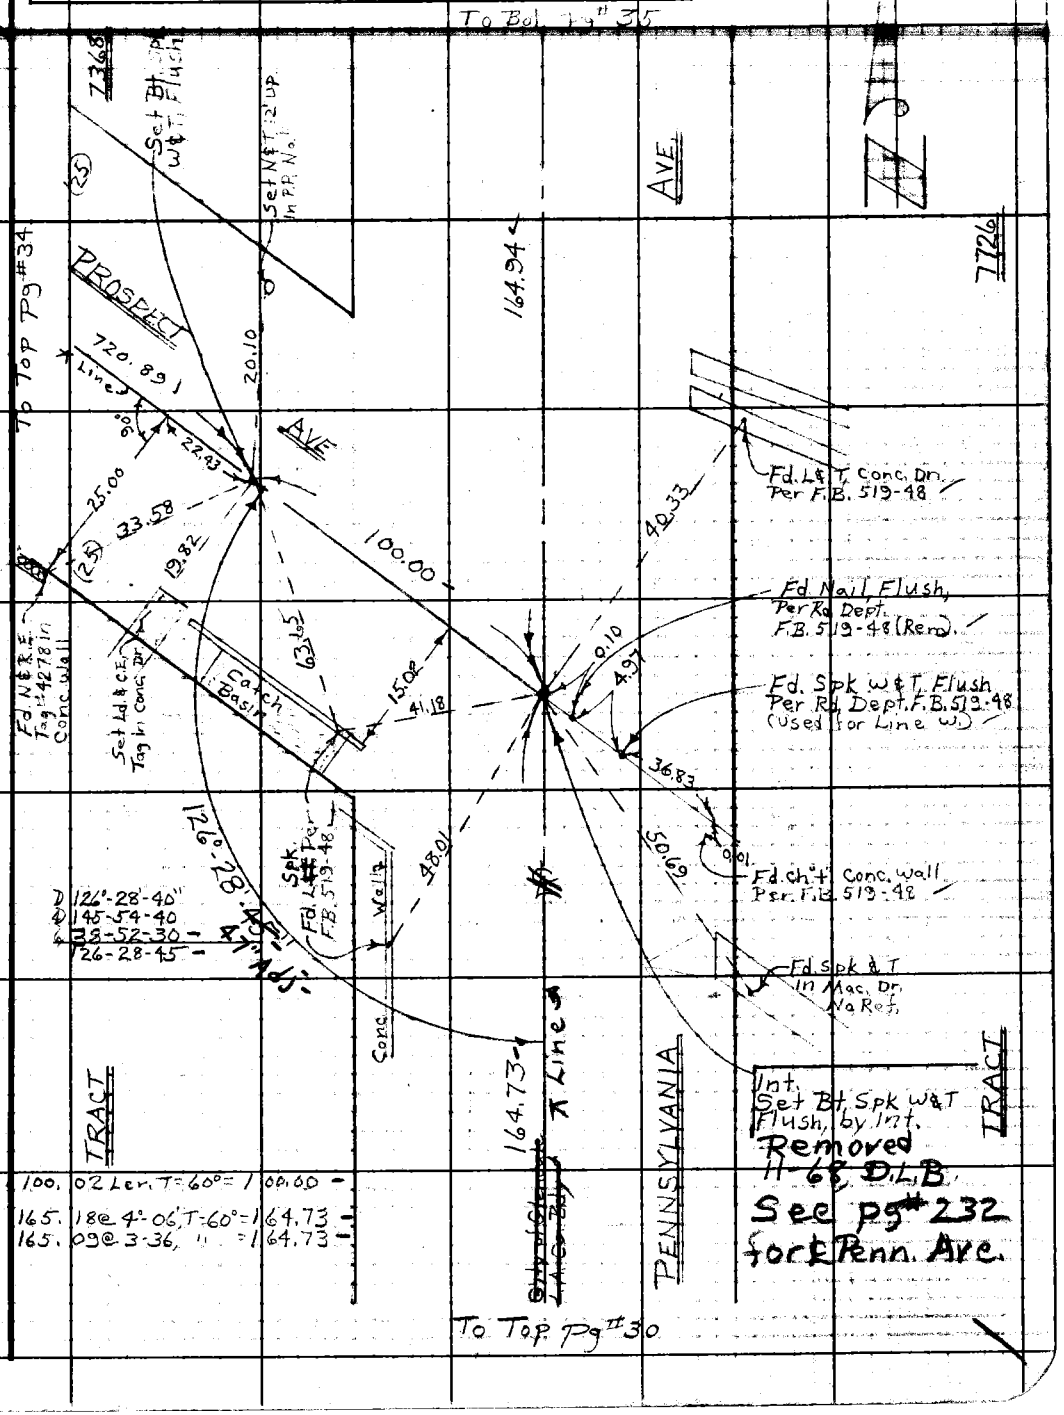

Note: Any Additions or Changes on This Sheet Must be Made or Circled in Red Ink With Date and Name of Person Making Change.

Do not extend this side of this line.

PLEASE RETURN TO
LOS ANGELES COUNTY ENGINEER
403 Los Angeles County Engineering Bldg.

76F309S CE#310 1-65

PWFB 1921 2378

F. B. 3417 PG 34

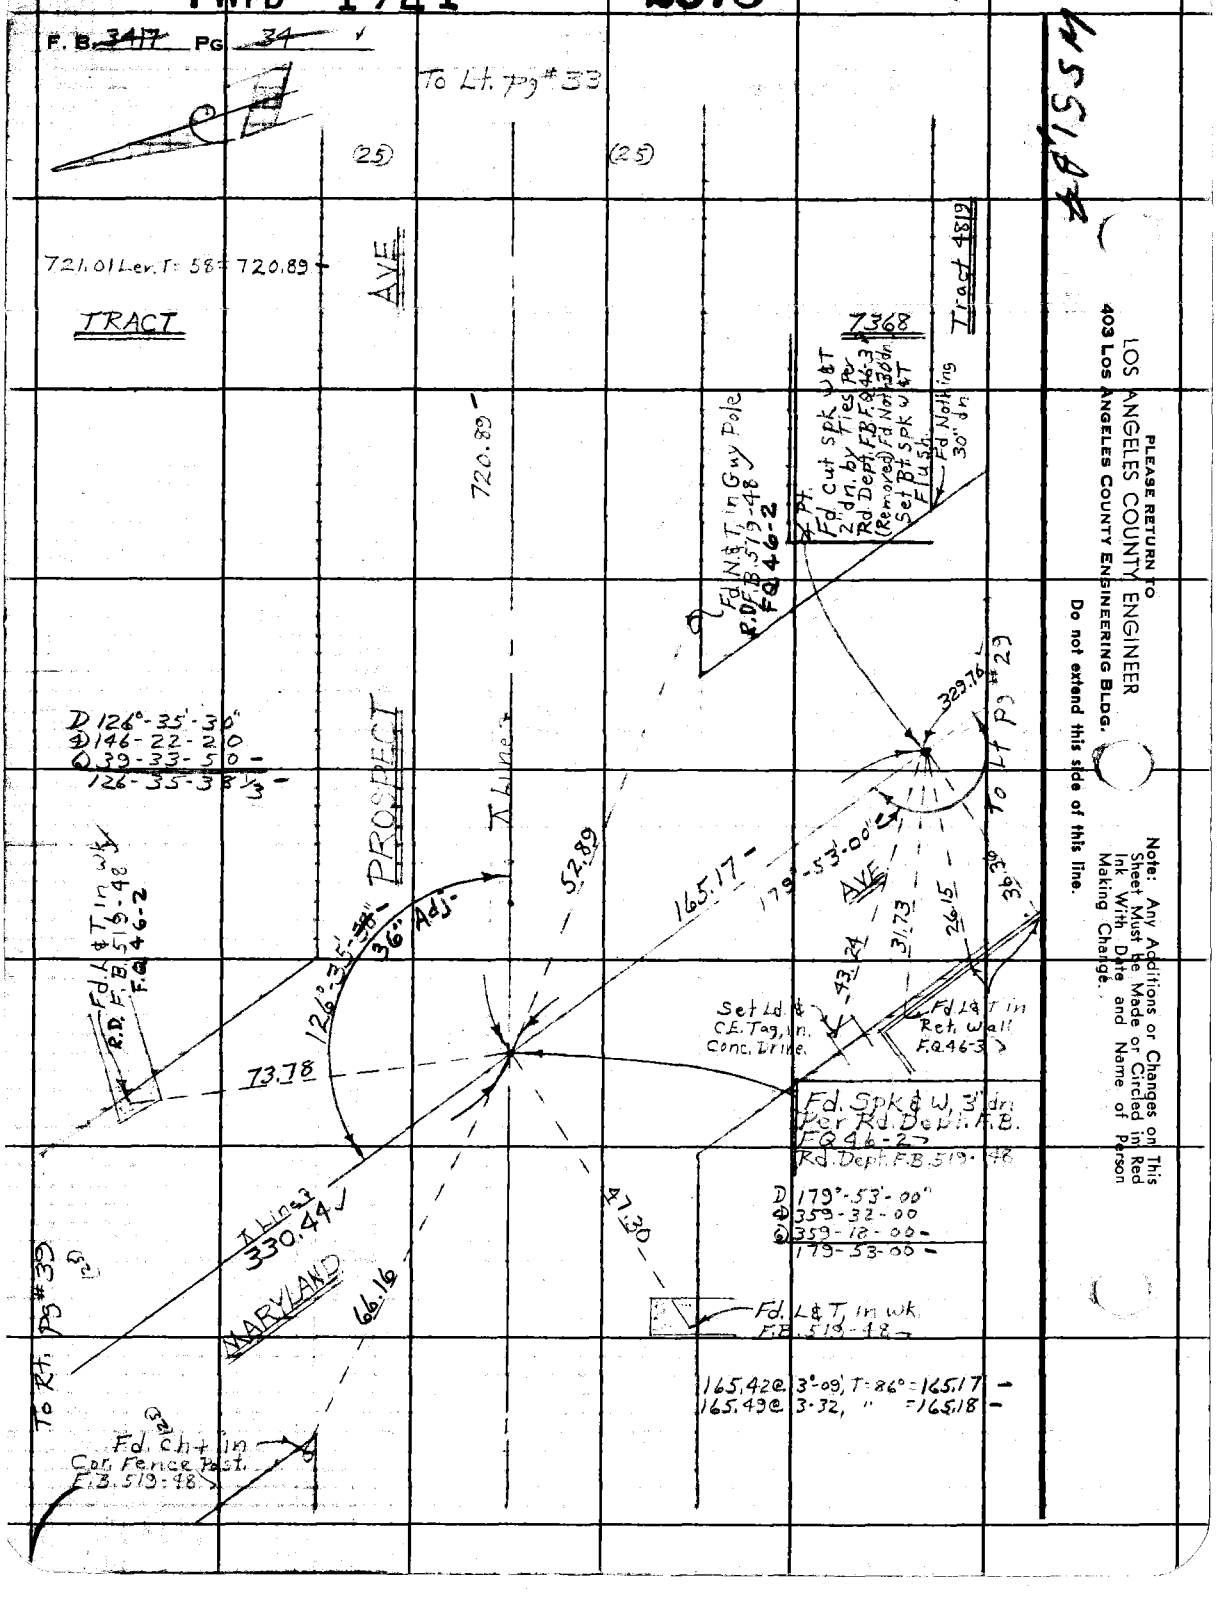

PLEASE RETURN TO
LOS ANGELES COUNTY ENGINEER
403 LOS ANGELES COUNTY ENGINEERING BLDG.

Do not extend this side of this line.

Note: Any Additions or Changes on This Sheet Must be Made or Circled in Red Ink With Date and Name of Person Making Change.

PWFB 1921 2379

Notes Ck'd by W. EDMONDSON	Survey of Pennsylvania Ave	F. B. 3417 PG. 35
Map No. B-5072	JN 909236 Topo 202 Elev 86 °F	
Office Work H. H. F. DONG	Surveyed by Bank Holder	
Checked	Notes D.L.B. Date 6-6-6	
Date	Indexed C. J. GALLI	

W.S. 31, B-9

To Top Pg # 38

164.87 Lev. T=82° = 164.87

100.01 Lev. T=62° = 100.00

16.10 Lev. T=62° = 16.10

727.91 Lev. T=90° = 727.94

AVE

7368

164.87

Prod. Fd. Ld. & L.A. Co. Flood Control Tag In Conc. Dr. Per F.B. 519-48

44.00

Fd. L & T, Conc. Step Per F.B. 519-48

Fd. Bt. Spk & W Flush, Per Rd. Dept. F.B. 519-48 (Rem.)

Fd. Bt. Spk W & T Flush, Per Rd. Dept. F.B. 519-48 (Used for Line E)

Set Bt. Spk W & T Flush, by Int.

Removed 11-68, D.L.B. See Pg # 233 for ℄ Penn. Ave.

42.56

0.09

4.98

Set N & T P.P. 544858H

Set Ld. & C.E. Tag Top rock wall

65.23

22.19

36.19

PROSPECT

100.00 ⊼ Line 2

Fd. N & T P.P. # 793 285E F.B. 519-48

61.91

16.10

727.94

To Lt Pg # 36

76.57

25.56

165.58 @ 5°-01', T=62° = 164.93

165.42 @ 4°-14', " = 164.95

Avg = 164.94

PENNSYLVANIA

164.94

⊼ Line 4

Set Ld. & C.E. Tag in C.B.

AVE

53°-29'-50" 40" Adj

TRACT

1) 53°-30'-00"

4) 213-59-20

6) 320-59-00

53-29-50

Set Bt. Spk W & T, Flush

TRACT

To Top Pg # 33

Note: Any Additions or Changes on This Sheet Must be Made or Circled in Red Ink With Date and Name of Person Making Change.

Do not extend this side of this line.

PLEASE RETURN TO LOS ANGELES COUNTY ENGINEER 403 LOS ANGELES COUNTY ENGINEERING BLDG.

76F309S CE#310 1-65

PWFB 1921 2380

F. B. ~~3417~~ Pg ~~36~~

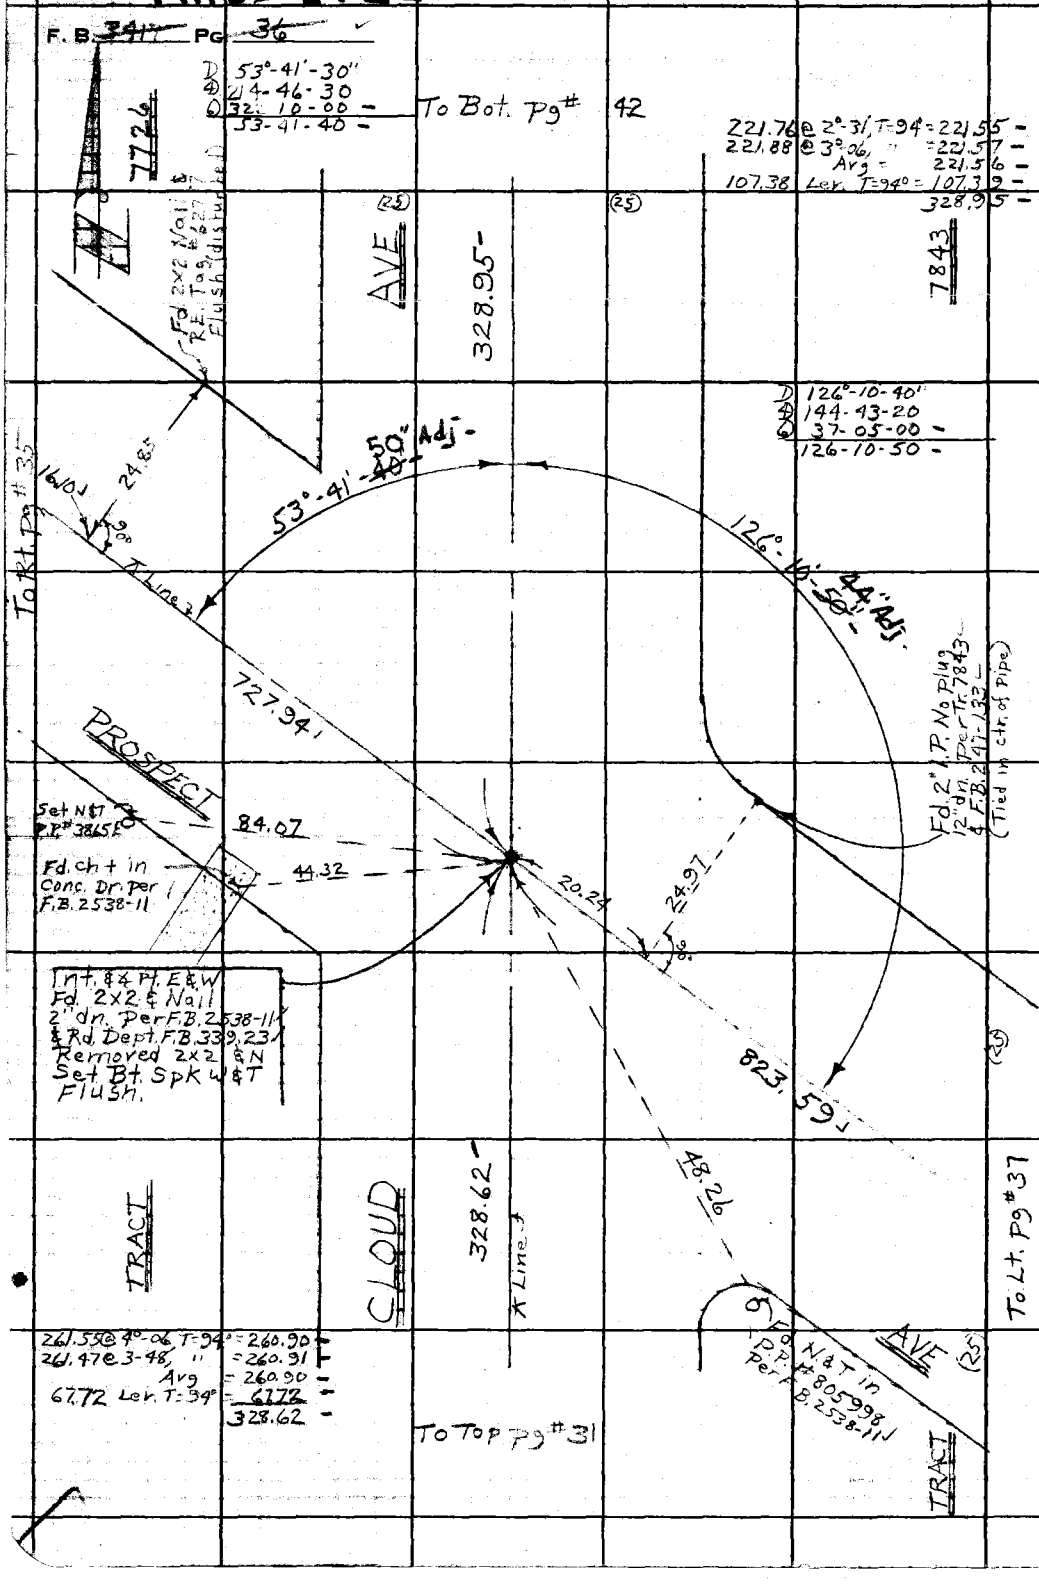

W.S. 51, B-4

PLEASE RETURN TO
LOS ANGELES COUNTY ENGINEER
403 LOS ANGELES COUNTY ENGINEERING BLDG.

Do not extend this side of this line.

Note: Any Additions or Changes on This Sheet Must be Made or Circled in Red Ink With Date and Name of Person Making Change.

PWFB 1921

2381

Notes Ck'd by W. EDMONDSON	Survey of [illegible] Ave
Map No. B-5072	[illegible]
Office Work H. H. F. DONG	Surveyed by [illegible]
Checked	Notes D. L. B. Date 7-67
Date	Indexed C. J. GALL

F. B. 3417 PG. 37

W.S. 1, B-4

To Bot. pg 43

PROSPECT AVE

Fd. Nothing

To Rt. Pg #36

T Line 2
823.59

329.60

246.80 @ 2°-45', T=90° = 246.53
246.92 @ 3-15, " = 246.53
83.07 @ Lev. T=90° = 83.07
329.60

Fd. L&T in Conc. Wk. Rd. Dept. F.B. 339-23

49.42

Fd. L&T, in Conc. Wk. Rd. Dept. F.B. 339-23

CRESCENTA VALLEY HIGH SCHOOL

AVE

94.34

41.34

52.64

21.02

7843

Fd. L&T Top rock wall F.B. 247-128

58.53

26.38

43.03

Prod. Set Ld & C.E. Tag

Fd. Ch't" in conc Step, Hse #4367 F.B. 247-128 R.D. F.B. 339-23

126°-24'-09" Adj.

Prod. Fd. 3/4" I.P. Conc. Plug & T, 12" dn. Per Rd. Dept. F.B. 339-23

D 126°-23'-50"
4 145-36-00
6 38-24-30
126-24-05

Int. Fd. Bt. Spk W&T 1" dn. Per Rd. Dept. F.B. 339-23

823.53 Lev, T=96° = 823.59

329.74

RAMSDELL

247.49 @ 4°-05', T=94° = 246.88
247.44 @ 3-57, " = 246.87
82.86 @ Lev. T=94° = 82.87
329.73

= 82.87
Sum = 329.74

TRACT

To Top pg #32

Note: Any Additions or Changes on This Sheet Must be Made or Circled in Red Ink With Date and Name of Person Making Change.

Do not extend this side of this line.

PLEASE RETURN TO
LOS ANGELES COUNTY ENGINEER
403 LOS ANGELES COUNTY ENGINEERING BLDG.

76F309S CE#310 1-65

PWFB 1921 2382

F. B. 3477 PG 38

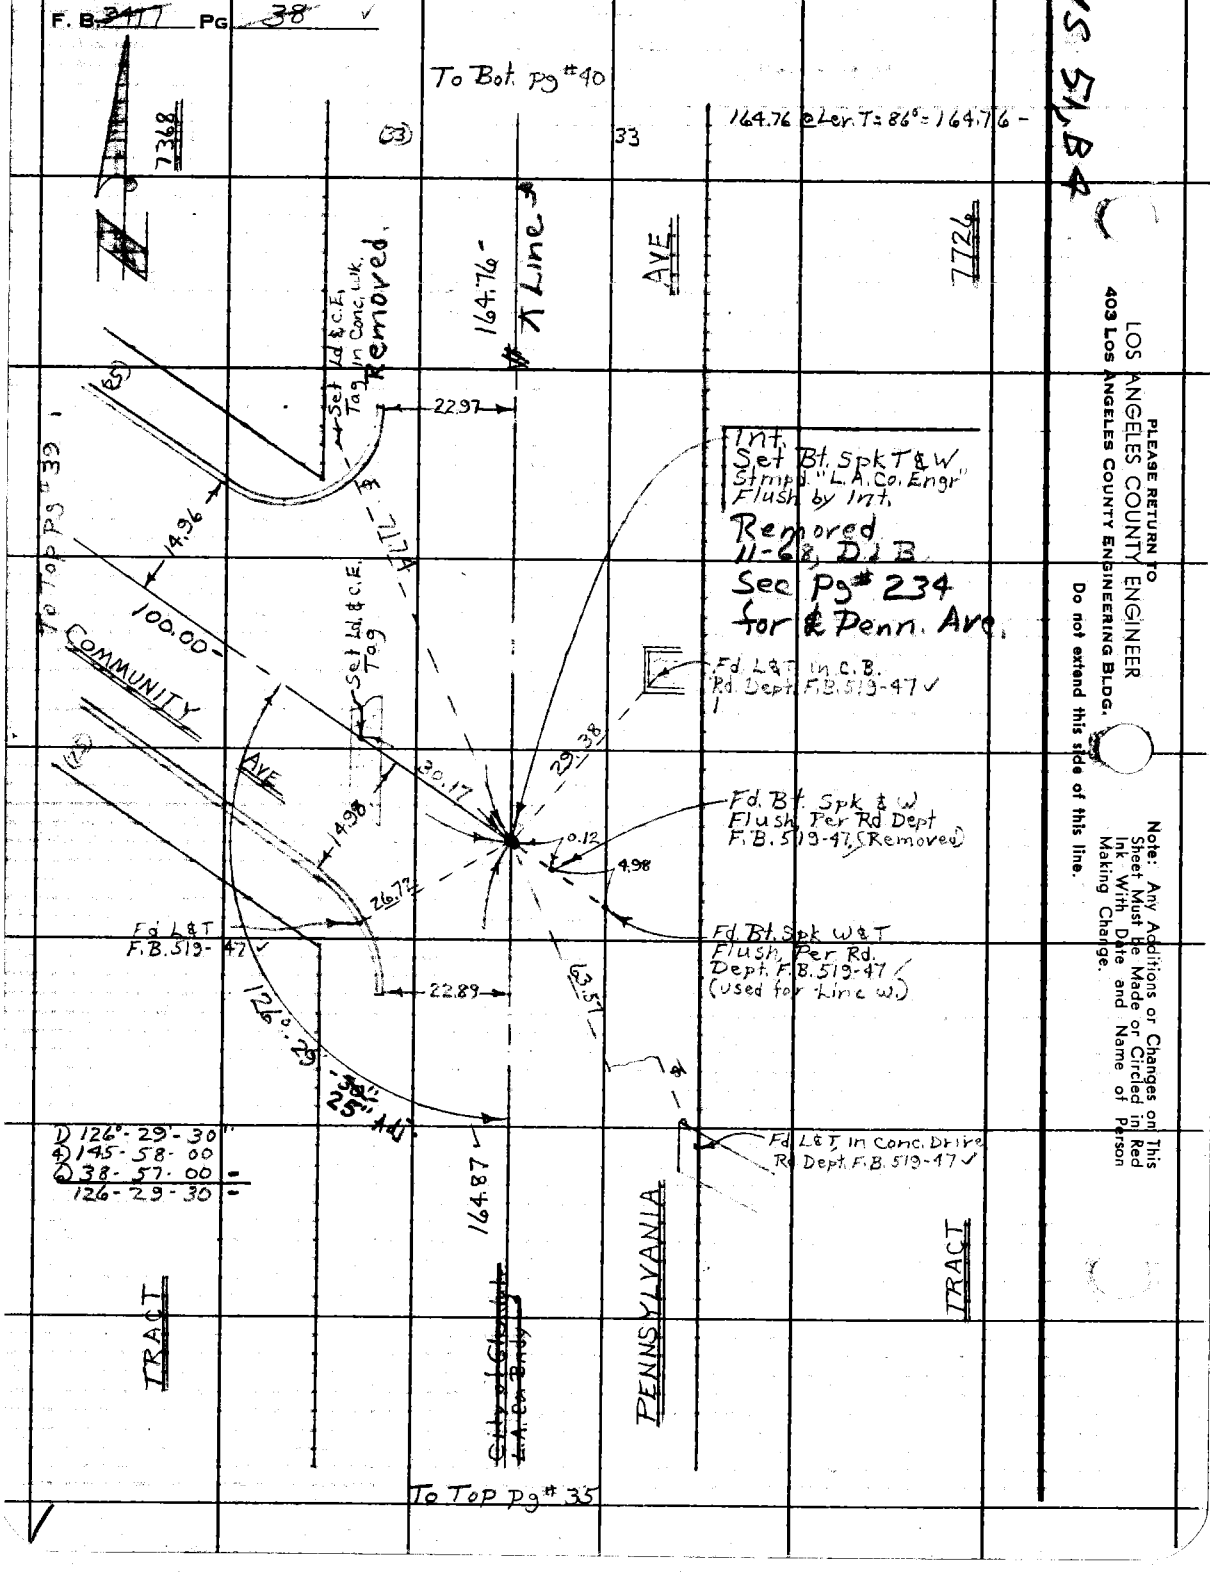

WS 51, B4

PLEASE RETURN TO
LOS ANGELES COUNTY ENGINEER
403 LOS ANGELES COUNTY ENGINEERING BLDG.

Do not extend this side of this line.

Note: Any Additions or Changes on This Sheet Must be Made or Circled in Red Ink With Date and Name of Person Making Change.

PWFB 1921 2383

Notes Ck'd by W. EDMONDSON	Survey of Pennsylvania Ave.	F. B. ~~3417~~ Pg. ~~39~~
Map No. [illegible]	[illegible]	
Office Work H. H. F. DONG	Surveyed by Burkholder	
Checked	Notes D.L.B. Date 2-67	
Date	Indexed C. J. GALL	

W.S. 51, B. 4

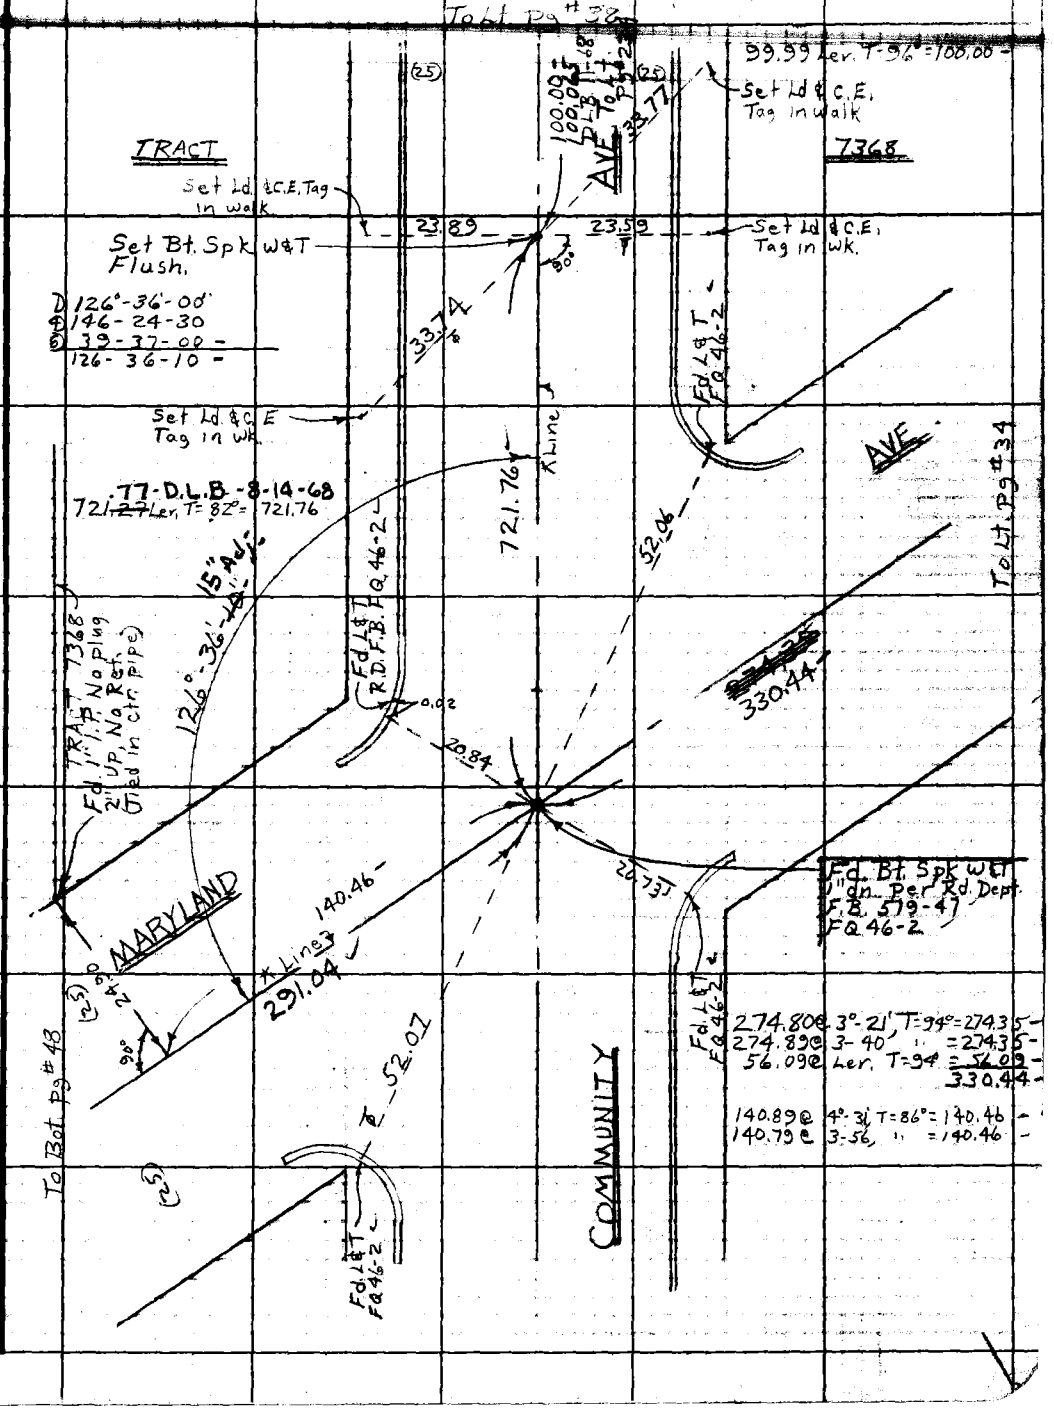

Note: Any Additions or Changes on This Sheet Must be Made or Circled in Red Ink With Date and Name of Person Making Change.

PLEASE RETURN TO
LOS ANGELES COUNTY ENGINEER
403 LOS ANGELES COUNTY ENGINEERING BLDG.

Do not extend this side of this line.

76F309S CE#310 1-65

PWFB 1921 2384

F.B. ~~34~~ PG ~~40~~ ✓

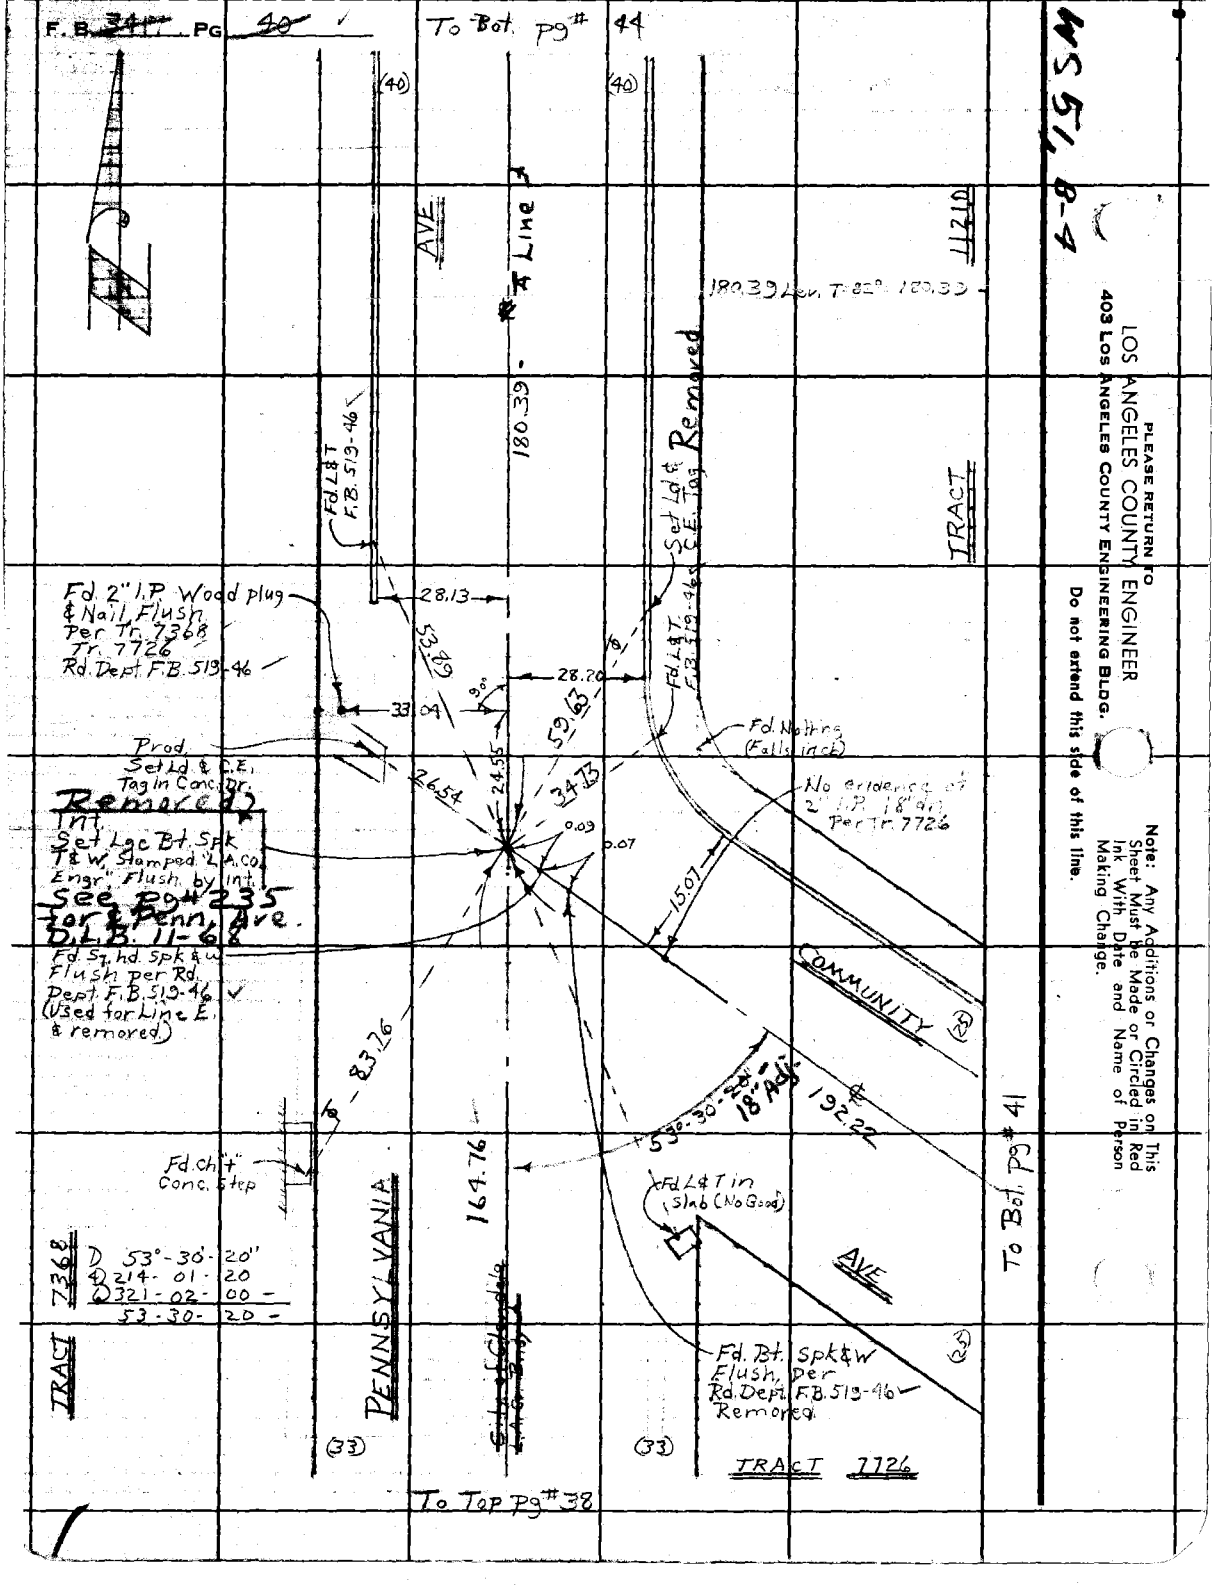

WS 51, B-4

PLEASE RETURN TO
LOS ANGELES COUNTY ENGINEER
403 LOS ANGELES COUNTY ENGINEERING BLDG.

Do not extend this side of this line.

Note: Any Additions or Changes on This Sheet Must be Made or Circled in Red Ink With Date and Name of Person Making Change.

PWFB 1921 2385

Notes Ck'd by W. EDMONDSON	Survey of [illegible] Ave	F. B. 3417 Pg. 41
Map No. [illegible]	[illegible] Tape 203 Std. 84 °F	
Office Work H. H. F. DONG	Surveyed by Burkholder	
Checked	Notes D.L.B. Date 7-67	
Date	Indexed C. J. GALLI	

W.S. 51, B-4

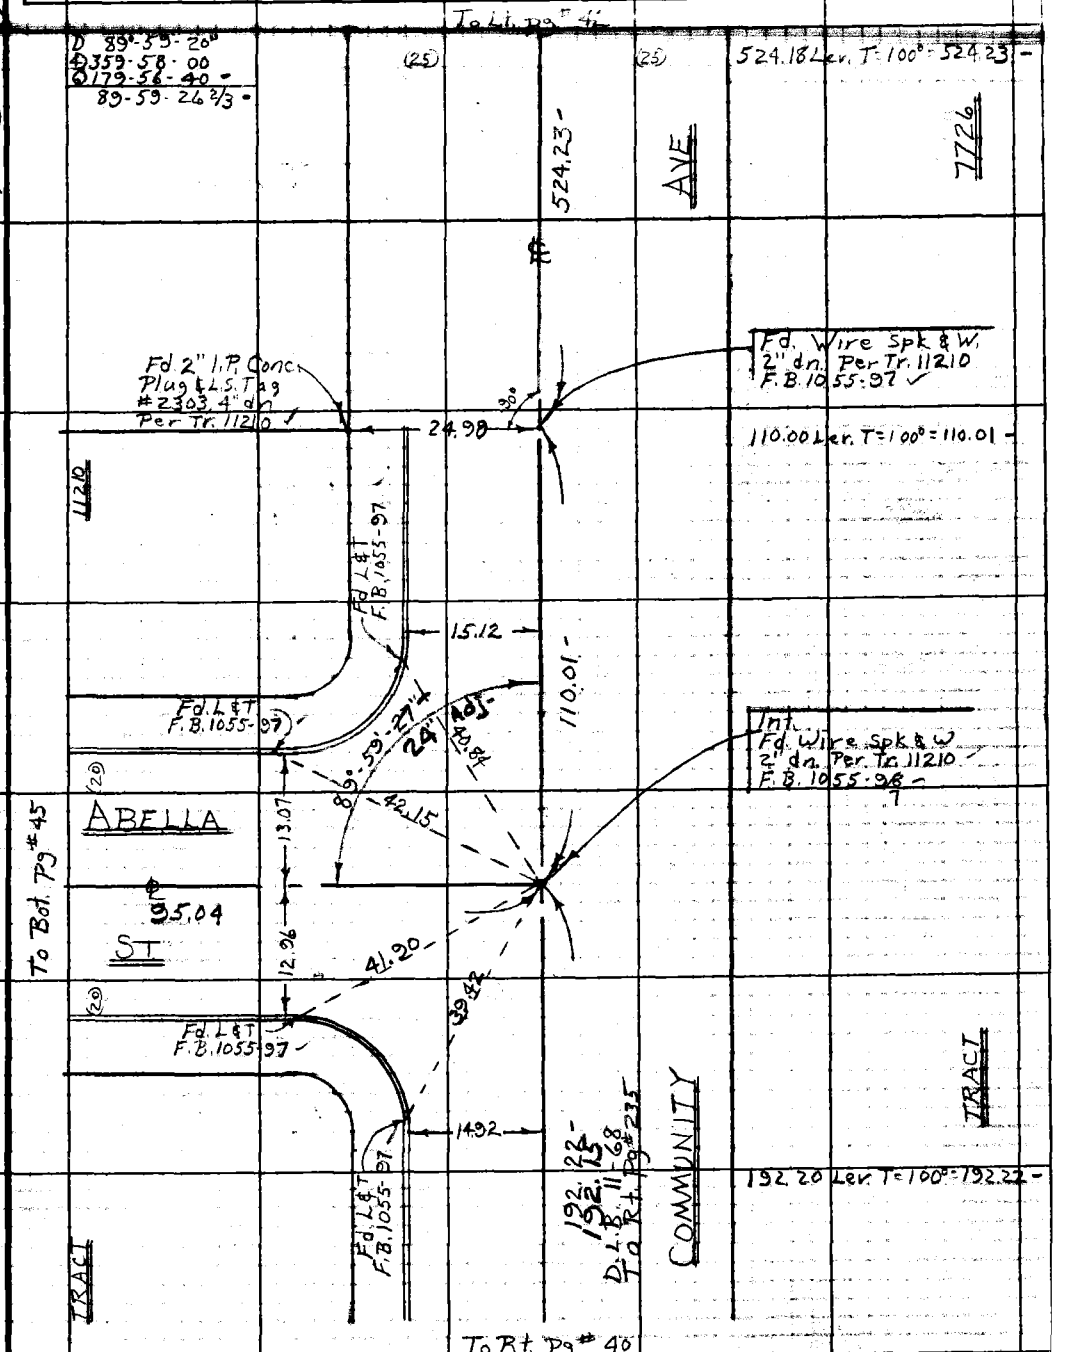

Note: Any Additions or Changes on This Sheet Must be Made or Circled in Red Ink With Date and Name of Person Making Change.

PLEASE RETURN TO
LOS ANGELES COUNTY ENGINEER
403 LOS ANGELES COUNTY ENGINEERING BLDG.
Do not extend this side of this line.

76F309S CE#310 1-65

PWFB 1921

2386

F.B. 3417 PG 42

To Rt. Pg #50

D 53°-29-20"
Δ 213-55-40
Δ 320-53-30 -
53-28-55 -

(25)

(25)

298.11 @ 2°-32', T=90° = 297.83 -
298.25 @ 3-02, " = 297.84 -
Avg = 297.84 -
171.77 @ 2° 39' T=98° = 171.61 -
171.88 @ 3-23 " = 171.60 -
Avg = 171.60 -
297.84
49.90 Lev. T=98° = 49.90 -
519.34 -

142.68 @ 5°-47', T=90° = 141.96 -
142.54 @ 5-17, " = 141.96 -

Fd. L & T. Top wall Rd. Dept. F.B. 519-37

Stmp'd "Br. Disc. Survey L.S. 2249" 2" UP No Ref.

Fd. 1" I.P. & 2" Br. Disc.

519.34 -

℄ Line

AVE

Fd. 2" I.P. Conc. plug & R.E. Tag #4278 Flush Per Tr. 18479 (Appears to be disturbed)

29.58

2.86 Lev. T=96° = 2.86 -

Tr. 18479

Fd. L & T. Top Wall Rd. Dept. F.B. 519-37

Fd. 2" I.P. Conc. Plug & Nail 6" dn. Per Tr. 18479

TRACT 18479

To Top Pg # 41

24.85

90°

"Adj" -55

530-28

141.96 -

524.23

55.82

58.93

COMMUNITY

44.54 Lev. T=100° = 44.54 -
184.00 Lev. " = 184.02 -
24.02 Lev. T=102° = 24.02 -

25.00

44.54

2.86

126°-17'-32"

357.75

184.02

℄ Line

Int.
Fd. Sq. hd. Spk, Flush Per Rd. Dept. F.B. 519-37

7726

Fd. L & T. Top rock wall, Rd. Dept. F.B. 519-37

Int. ℄ & Pt. L & W
Fd. Bt. Spk T & W Stpmd "L.A. Co. Rd. Dept." Flush Per Rd. Dept. F.B. 519-37

D 126°-17'-40"
Δ 145-10-00
Δ 37-45-10 -
126-17-31 2/3 -

127.81

"Adj" -27

53°-48'

24.96

24.02

To Lt. Pg #43

AVE

Fd 2x2 & Nail, Flush

328.95

℄ Line

CLOUD

Fd. L & T, conc. wk Rd. Dept. F.B. 519-37

TRACT 7843

TRACT

D 53°-48'-20"
Δ 215-13-20
Δ 322-50-30 -
53-48-25 -

55.81 Lev. T=100° = 55.82 -

To Top Pg #36

LOS ANGELES COUNTY ENGINEER
403 LOS ANGELES COUNTY ENGINEERING BLDG.

PLEASE RETURN TO

Do not extend this side of this line.

Note: Any Additions or Changes on This Sheet Must be Made or Circled in Red Ink With Date and Name of Person Making Change.

1.5 SM

PWFB 1921 2387

Notes Ck'd by W. EDMONDSON	Survey of Pennsylvania Ave	F. B. 3417 Pg. 45
Map No. B-5073	[illegible]	
Office Work H. H. F. DONG	Surveyed by Burkhalter	
Checked	Notes D.L.B. Date 7-67	
Date	Indexed C. J. GALLI	

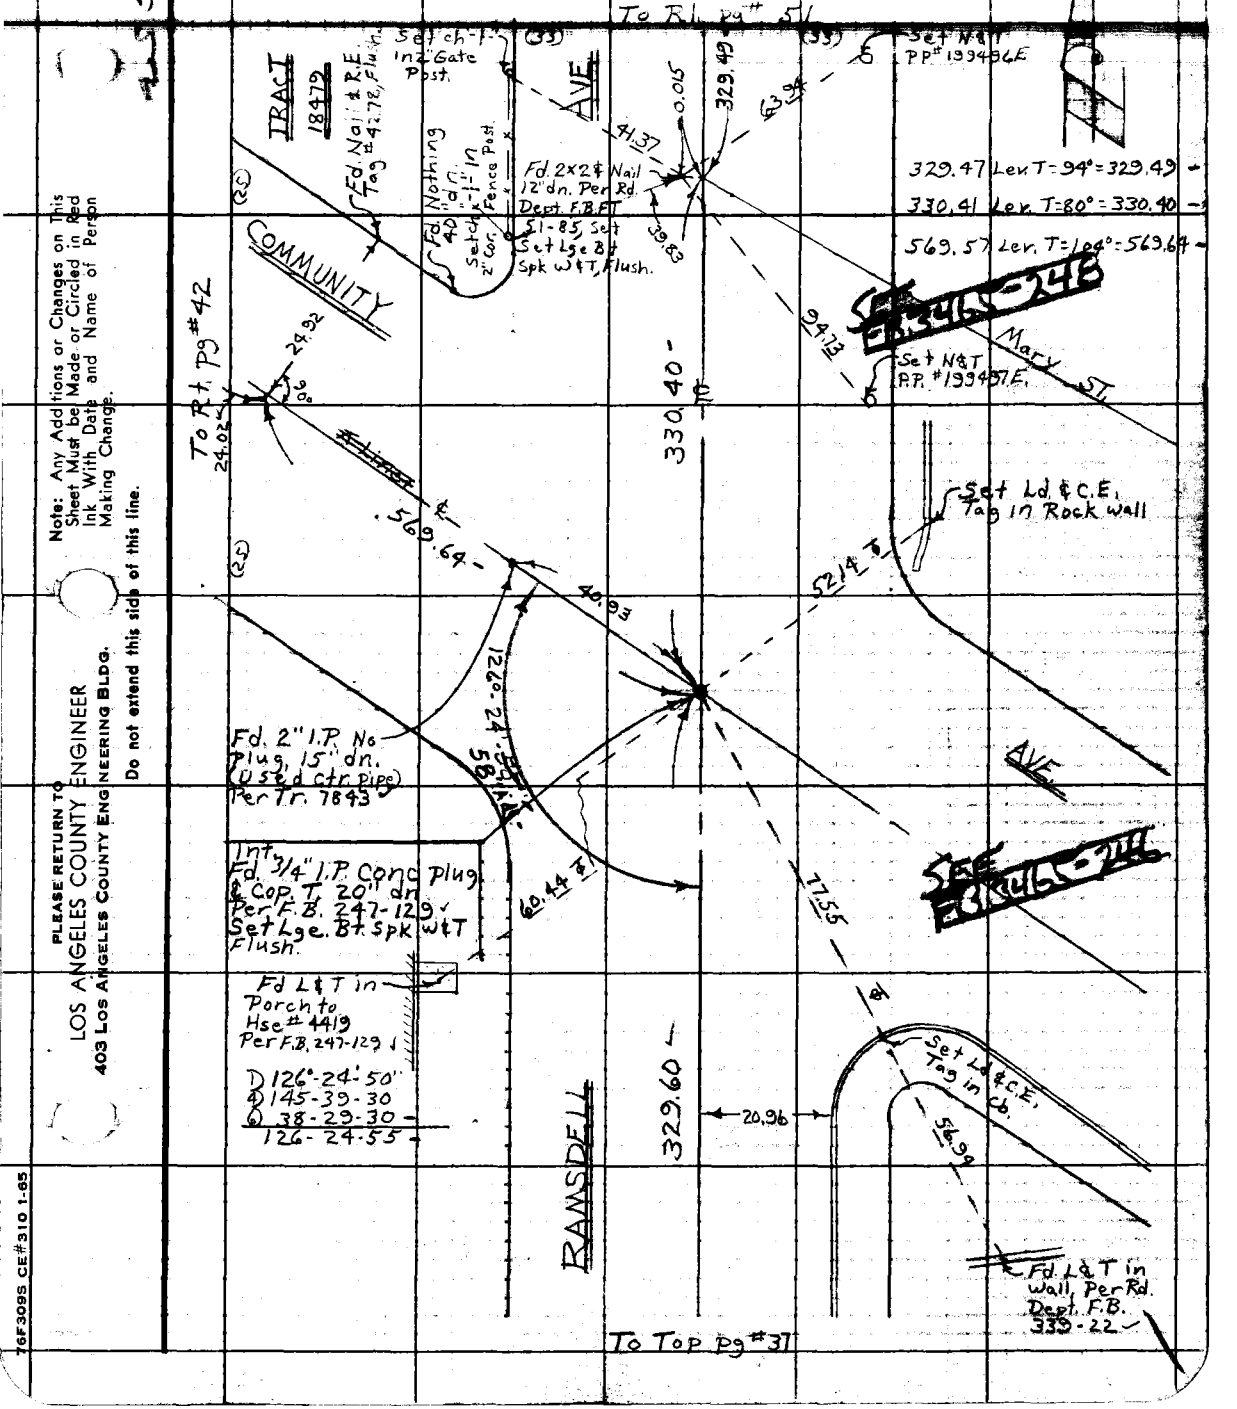

Note: Any Additions or Changes on This Sheet Must be Made or Circled in Red Ink With Date and Name of Person Making Change.

Do not extend this side of this line.

PLEASE RETURN TO
LOS ANGELES COUNTY ENGINEER
403 LOS ANGELES COUNTY ENGINEERING BLDG.

76F309S CE#310 1-65

PWFB 1921 2388

F.B. ~~3417~~ PG. ~~44~~

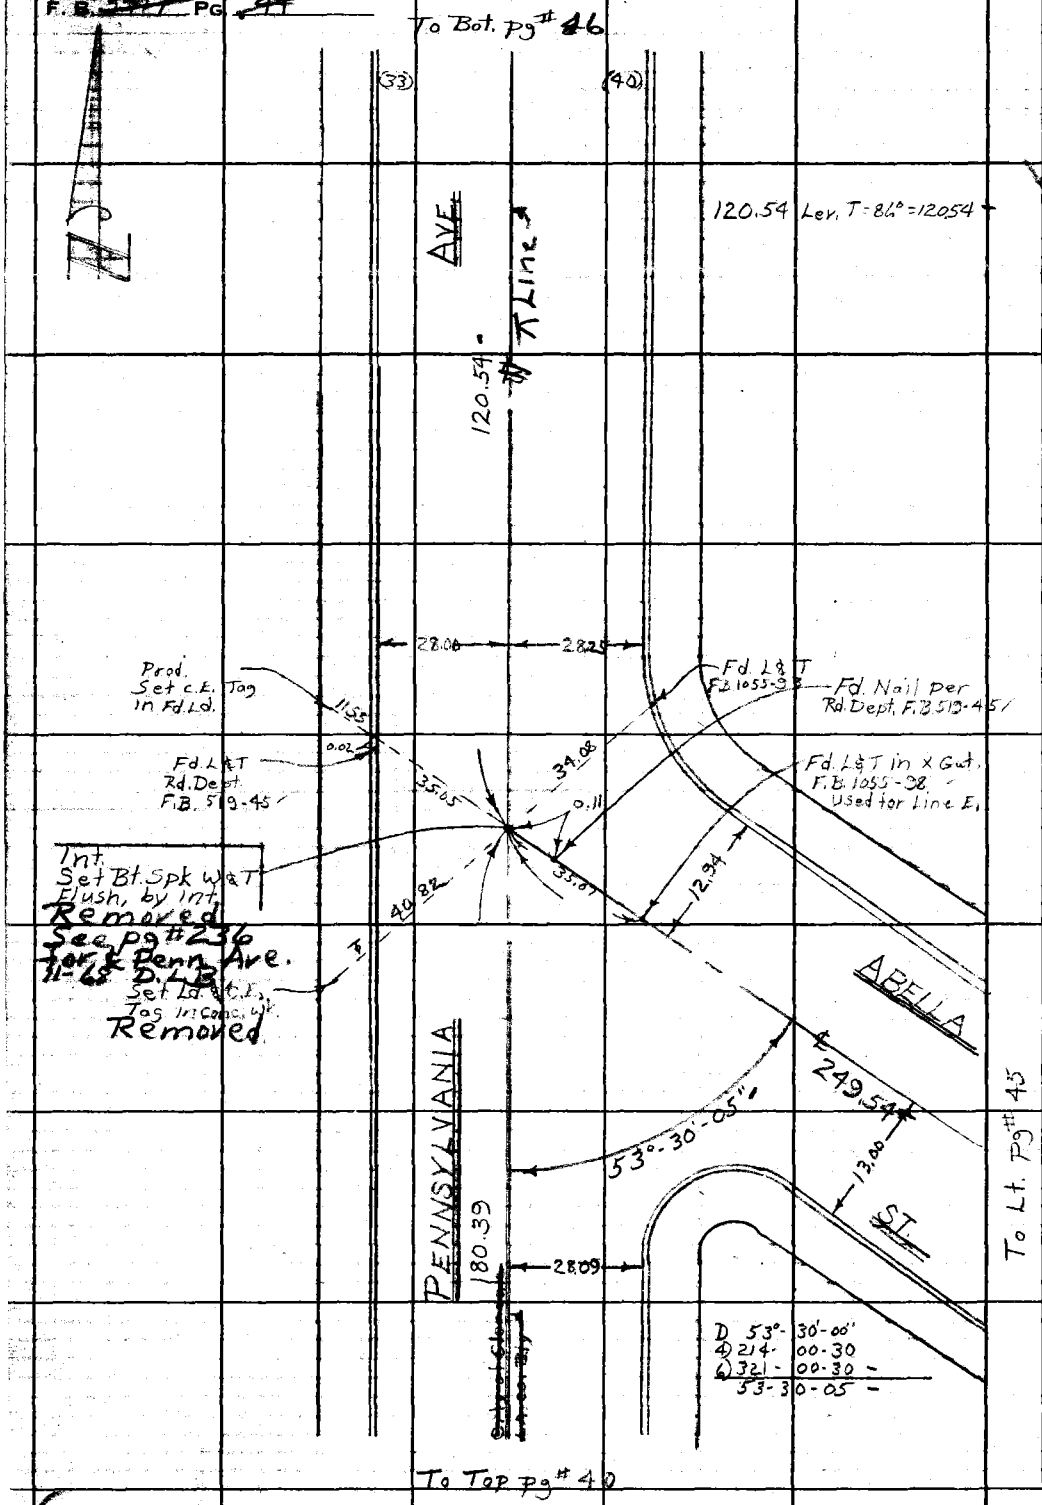

PLEASE RETURN TO
LOS ANGELES COUNTY ENGINEER
403 LOS ANGELES COUNTY ENGINEERING BLDG.
Do not extend this side of this line.

Note: Any Additions or Changes on This Sheet Must be Made or Circled in Red Ink With Date and Name of Person Making Change.

PWFB 1921 2389

Notes Ck'd by W. EDMONDSON	Survey of Pennsylvania Ave.
Map No. B-5032	JN 0087-25 Page 2 of 2
Office Work H. H. F. DONG	Surveyed by Burkhalter
Checked	Notes D.L.B. Date 7-67
Date	Indexed C. J. GALLI

F. B. 3417 PG. 45

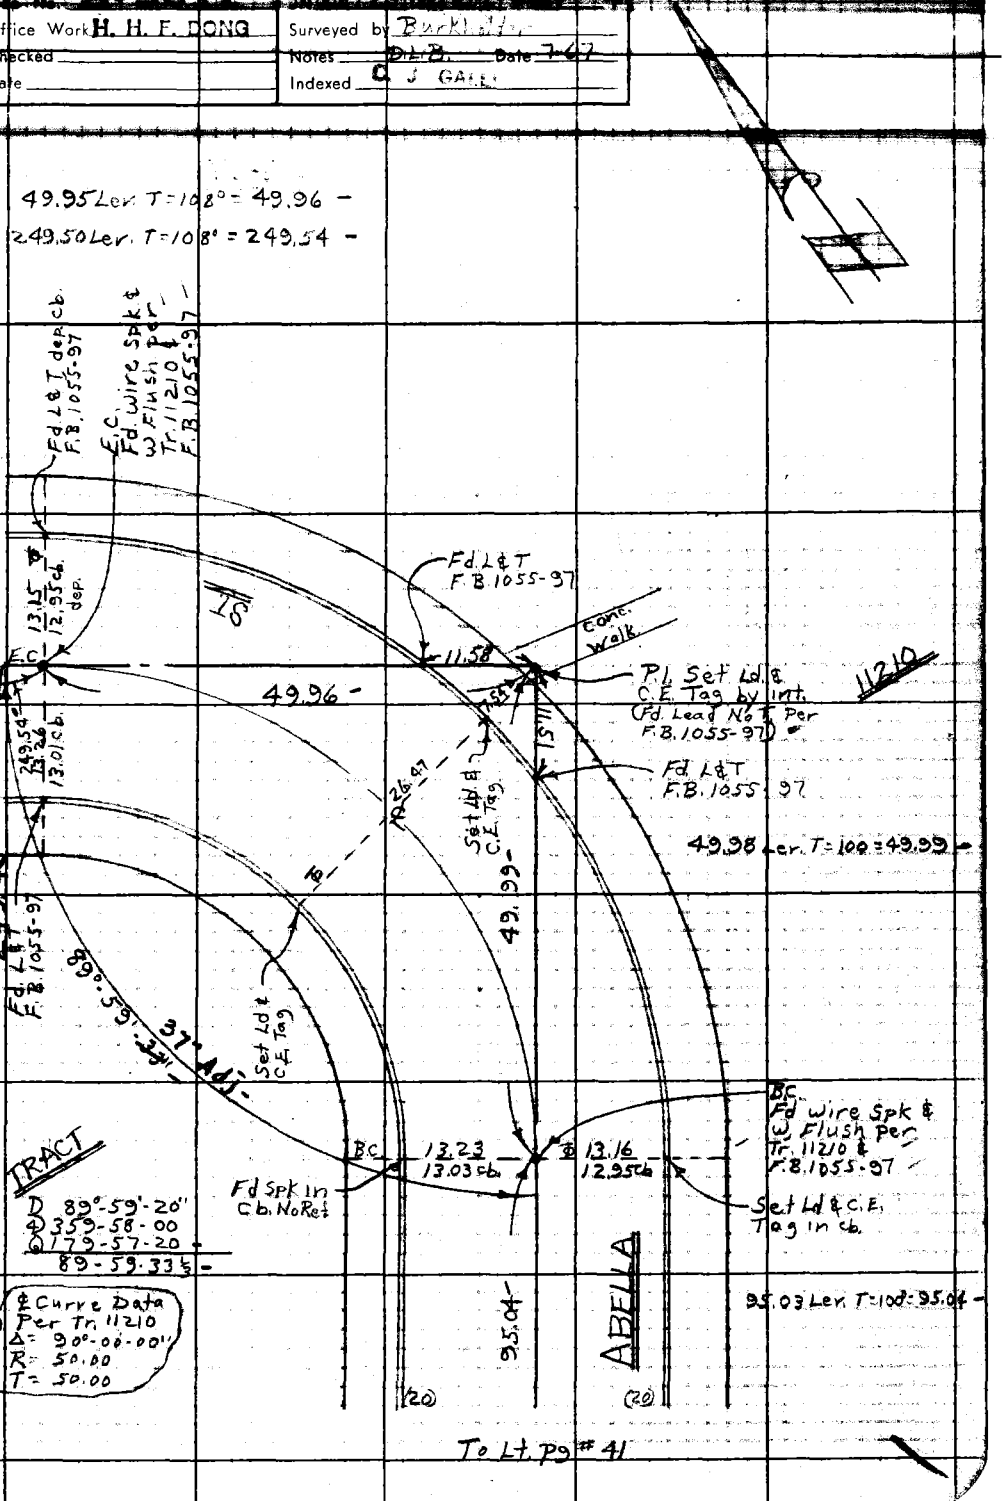

Note: Any Additions or Changes on This Sheet Must be Made or Circled in Red Ink With Date and Name of Person Making Change.

Do not extend this side of this line.

PLEASE RETURN TO
LOS ANGELES COUNTY ENGINEER
403 LOS ANGELES COUNTY ENGINEERING BLDG.

76F309S CE#310 1-65

PWFB 1921 2390

F. B. ~~3417~~ PG ~~46~~

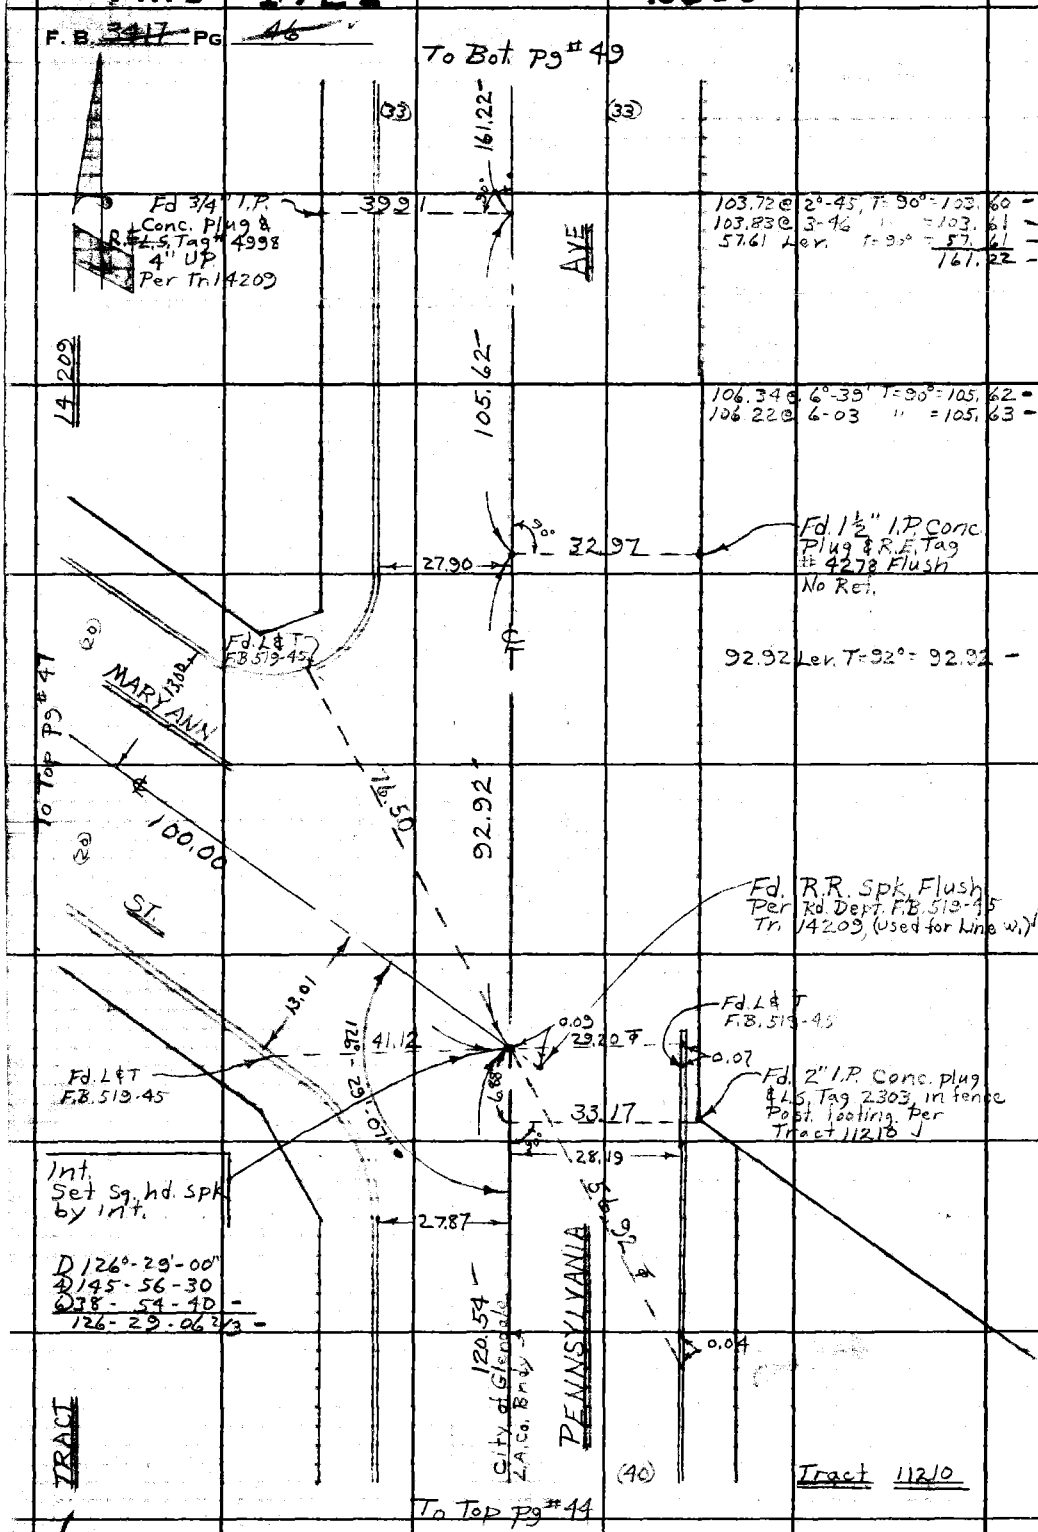

MS 51 B-4

PLEASE RETURN TO
LOS ANGELES COUNTY ENGINEER
403 LOS ANGELES COUNTY ENGINEERING BLDG.

Do not extend this side of this line.

Note: Any Additions or Changes on This Sheet Must Be Made or Circled in Red Ink With Date and Name of Person Making Change.

PWFB 1921 2391

Notes Ck'd by W. EDMONDSON	Survey of [illegible]	F. B. [illegible] Pg. 47
Map No. [illegible]	[illegible]	
Office Work H. H. F. DONG	Surveyed by [illegible]	
Checked	Notes [illegible] Date 8-6-[illegible]	
Date	Indexed C. J. GALL	

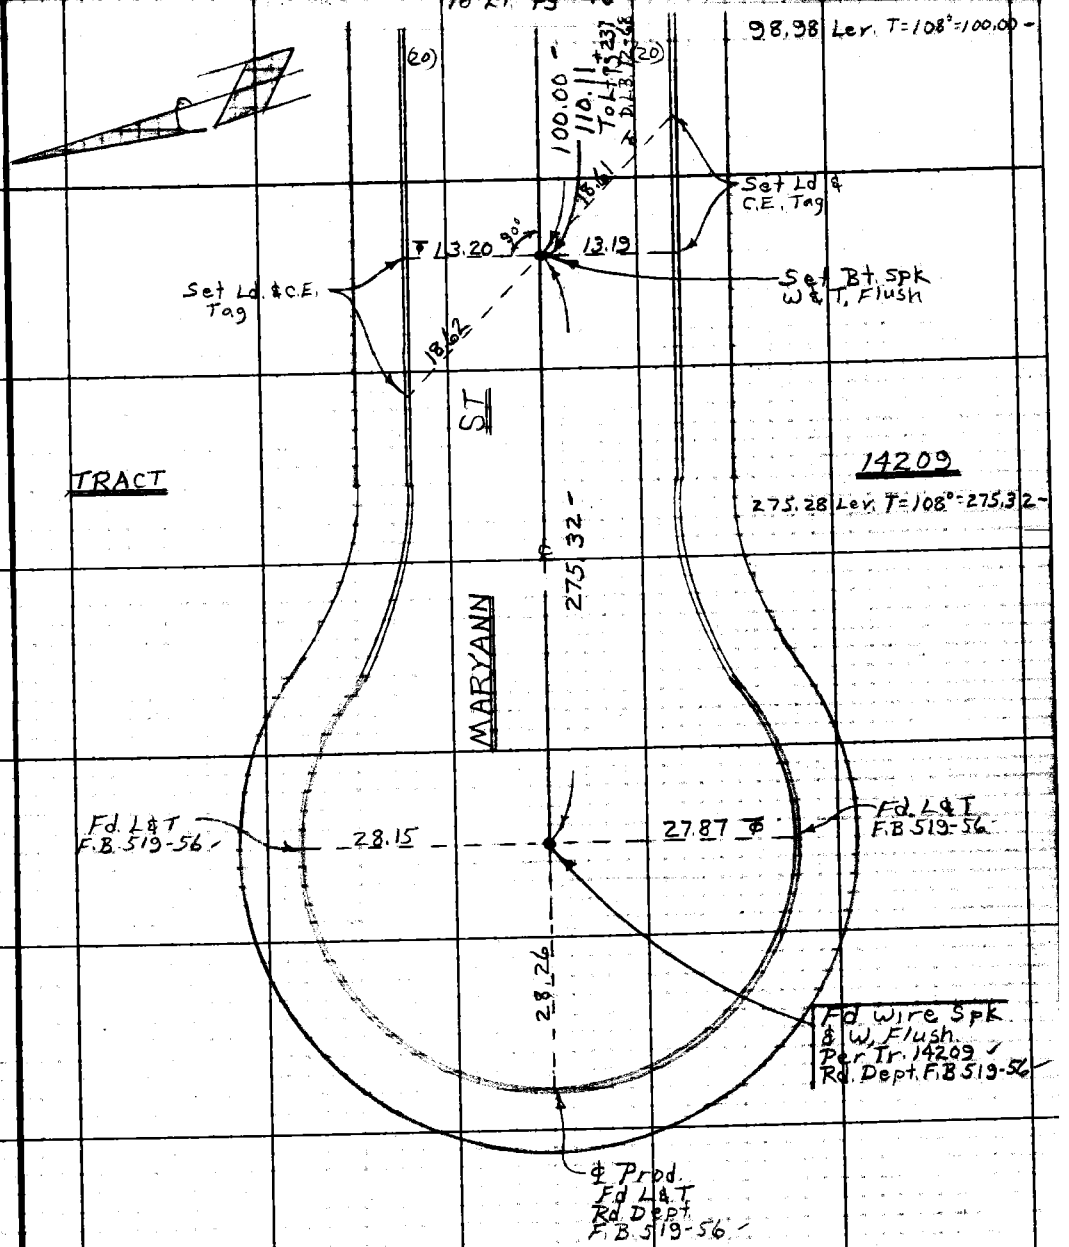

Note: Any Additions or Changes on This Sheet Must be Made or Circled in Red Ink With Date and Name of Person Making Change.

Do not extend this side of this line.

PLEASE RETURN TO
LOS ANGELES COUNTY ENGINEER
403 LOS ANGELES COUNTY ENGINEERING BLDG.

76F309S CE#310 1-65

PWFB 1921 2392, 2393

F. B. ~~3417~~ PG ~~48~~

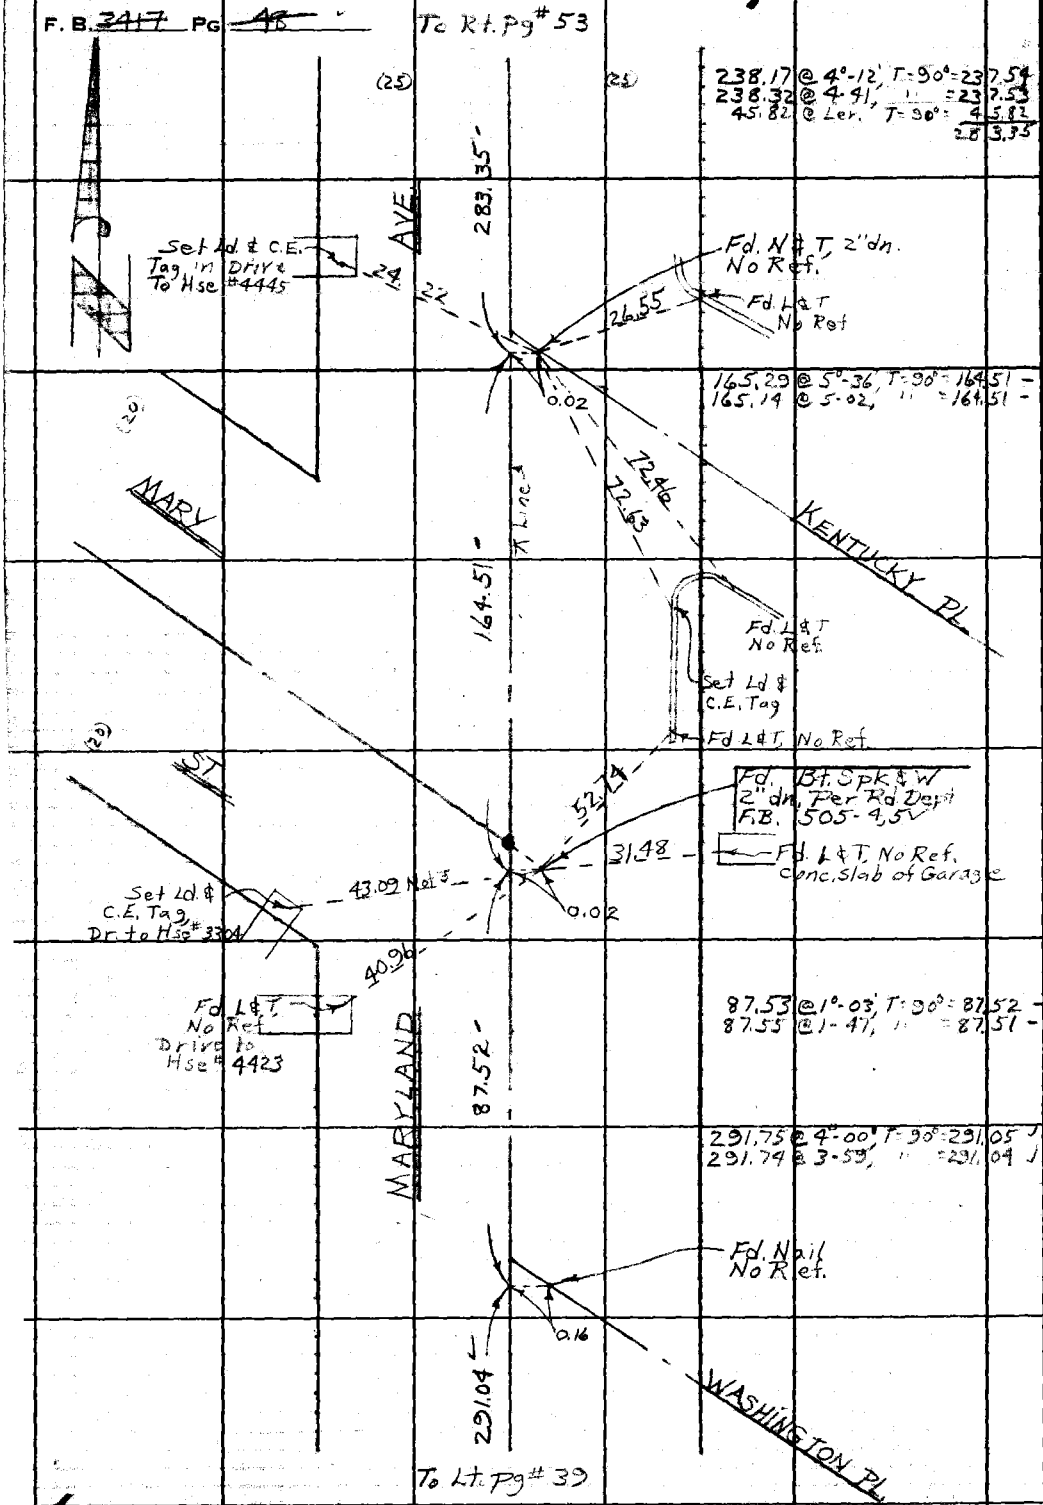

W.S.51 B4

PLEASE RETURN TO
LOS ANGELES COUNTY ENGINEER
403 LOS ANGELES COUNTY ENGINEERING BLDG.

Do not extend this side of this line.

Note: Any Additions or Changes on This Sheet Must be Made or Circled in Red Ink With Date and Name of Person Making Change.

PWFB 1921 2394, 2395

Notes Ck'd by W. EDMONDSON	Survey of [illegible]	F. B. 3417 PG. 49
Map No. B-5672	JN [illegible] Tape [illegible]	
Office Work H. H. F. DONG	Surveyed by Bur-Kholder	
Checked	Notes D.L.B. Date 5-67	
Date	Indexed C. J. GALLI	

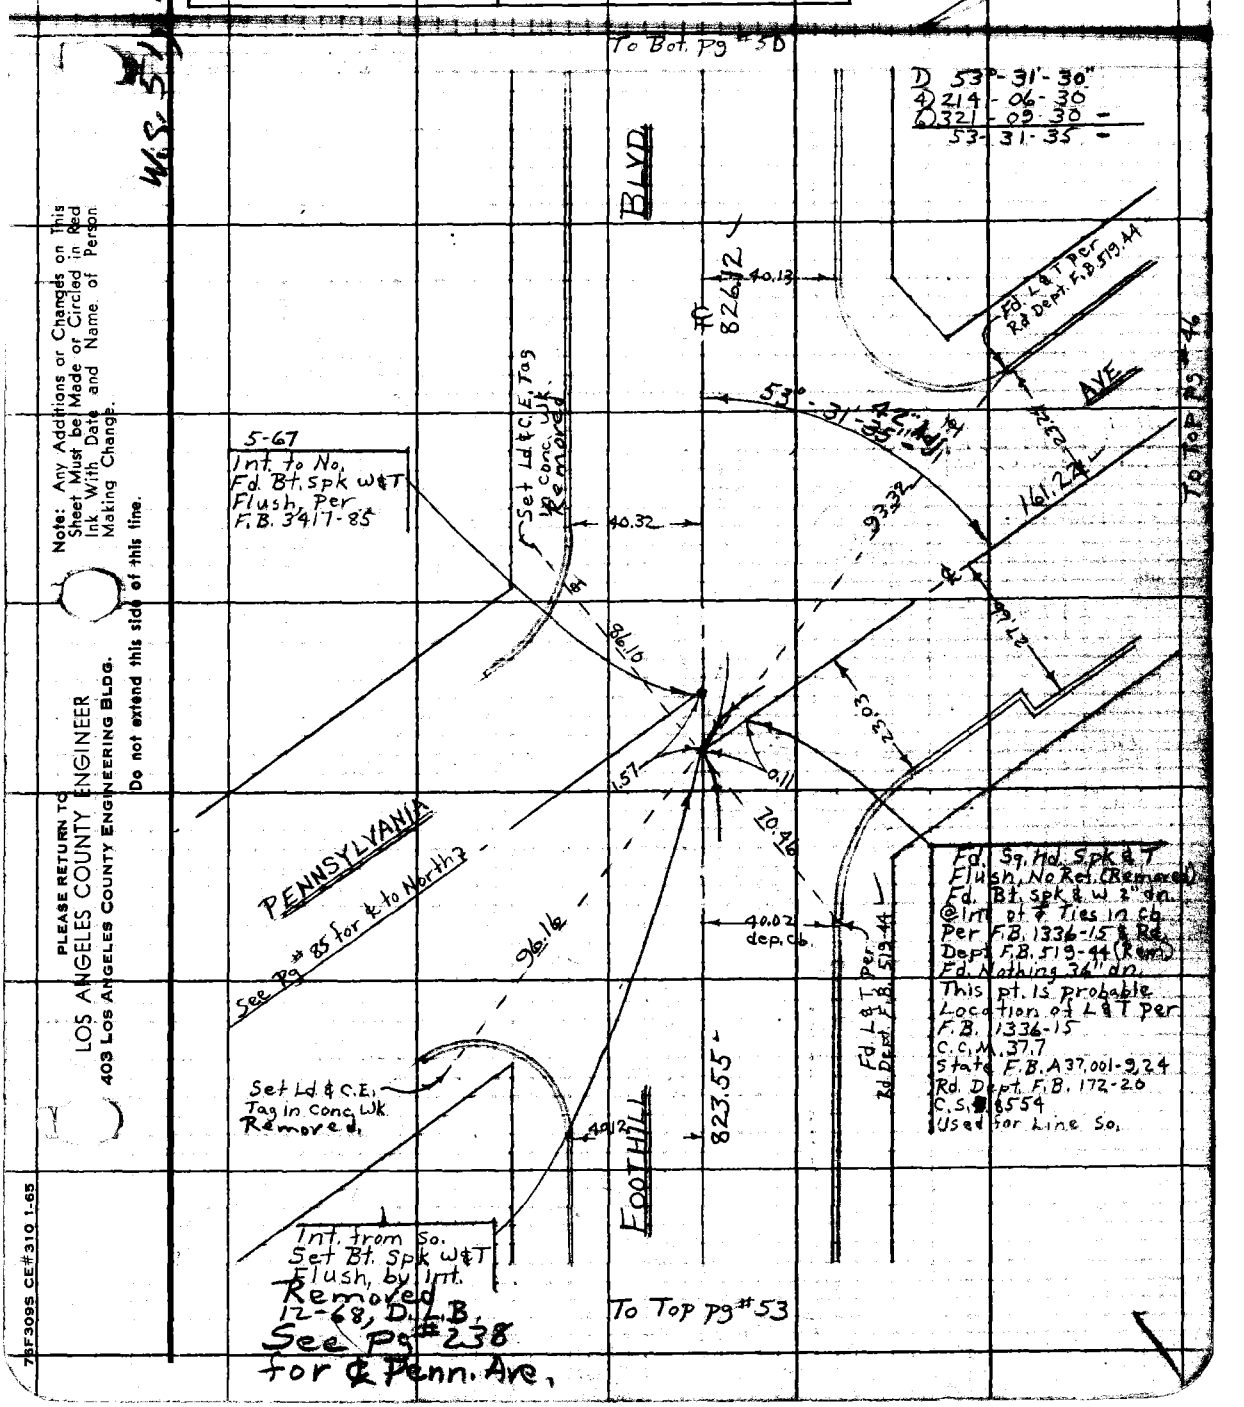

Note: Any Additions or Changes on This Sheet Must be Made or Circled in Red Ink With Date and Name of Person Making Change.

Do not extend this side of this line.

PLEASE RETURN TO
LOS ANGELES COUNTY ENGINEER
403 LOS ANGELES COUNTY ENGINEERING BLDG.

75F309S CE#310 1-65

PWFB 1921 2396

F.B. 3917 PG 50

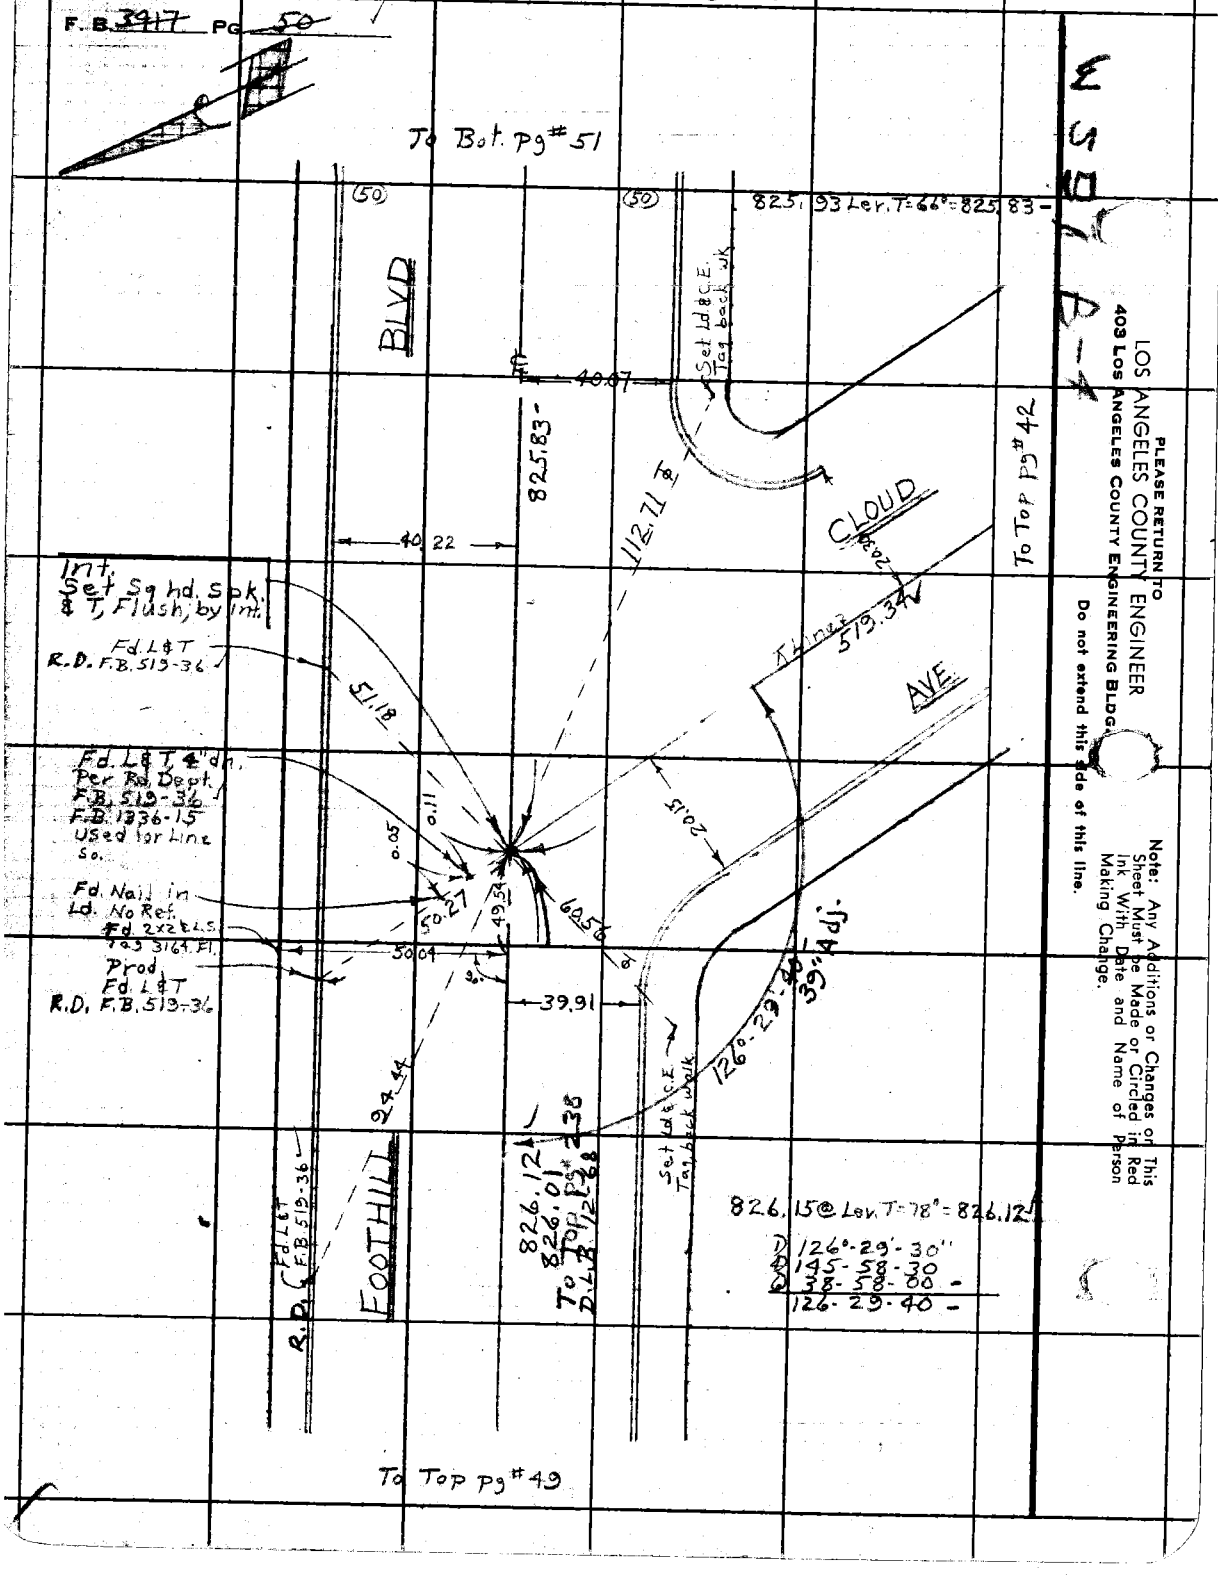

PLEASE RETURN TO
LOS ANGELES COUNTY ENGINEER
403 LOS ANGELES COUNTY ENGINEERING BLDG.

Do not extend this side of this line.

Note: Any Additions or Changes on This Sheet Must be Made or Circled in Red Ink With Date and Name of Person Making Change.

PWFB 1921

2397 , 2398

Notes Ck'd by W. EDMONDSON	Survey of [illegible]	F. B. [illegible]	Pg. 54
Map No. B-5012	JN [illegible] Tape [illegible] Std [illegible]		
Office Work H. H. F. DONG	Surveyed by Burkholder		
Checked	Notes D.L.B. Date 5-67		
Date	Indexed C. J. GA[illegible]		

W.S. 5 B-4

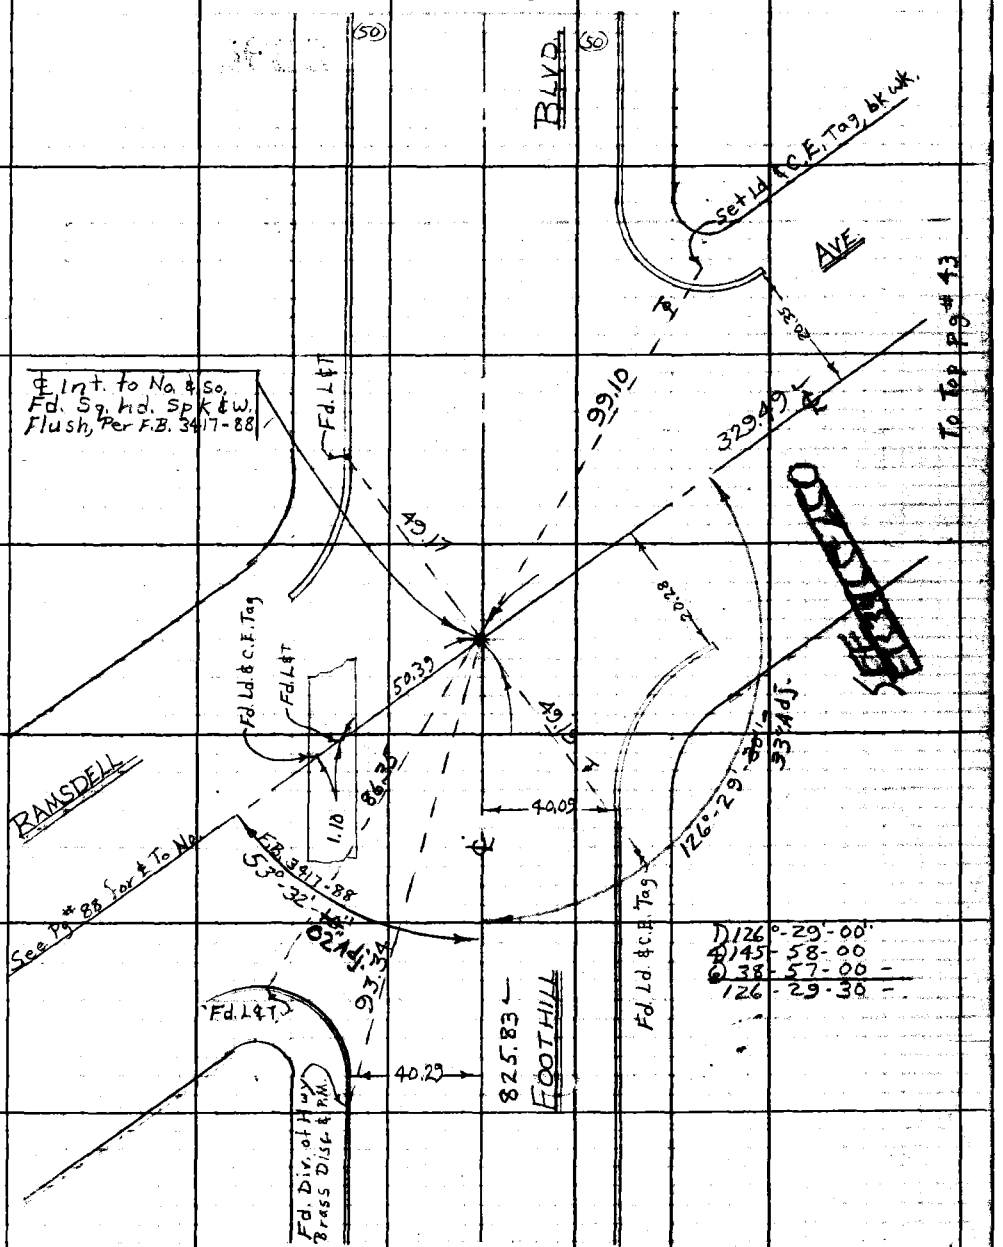

Note: Any Additions or Changes on This Sheet Must be Made or Circled in Red Ink With Date and Name of Person Making Change.

Do not extend this side of this line.

PLEASE RETURN TO
LOS ANGELES COUNTY ENGINEER
403 LOS ANGELES COUNTY ENGINEERING BLDG.

76F309S CE#310 1-65

PWFB 1921 2399

F. B. ~~3417~~ Pg. ~~52~~

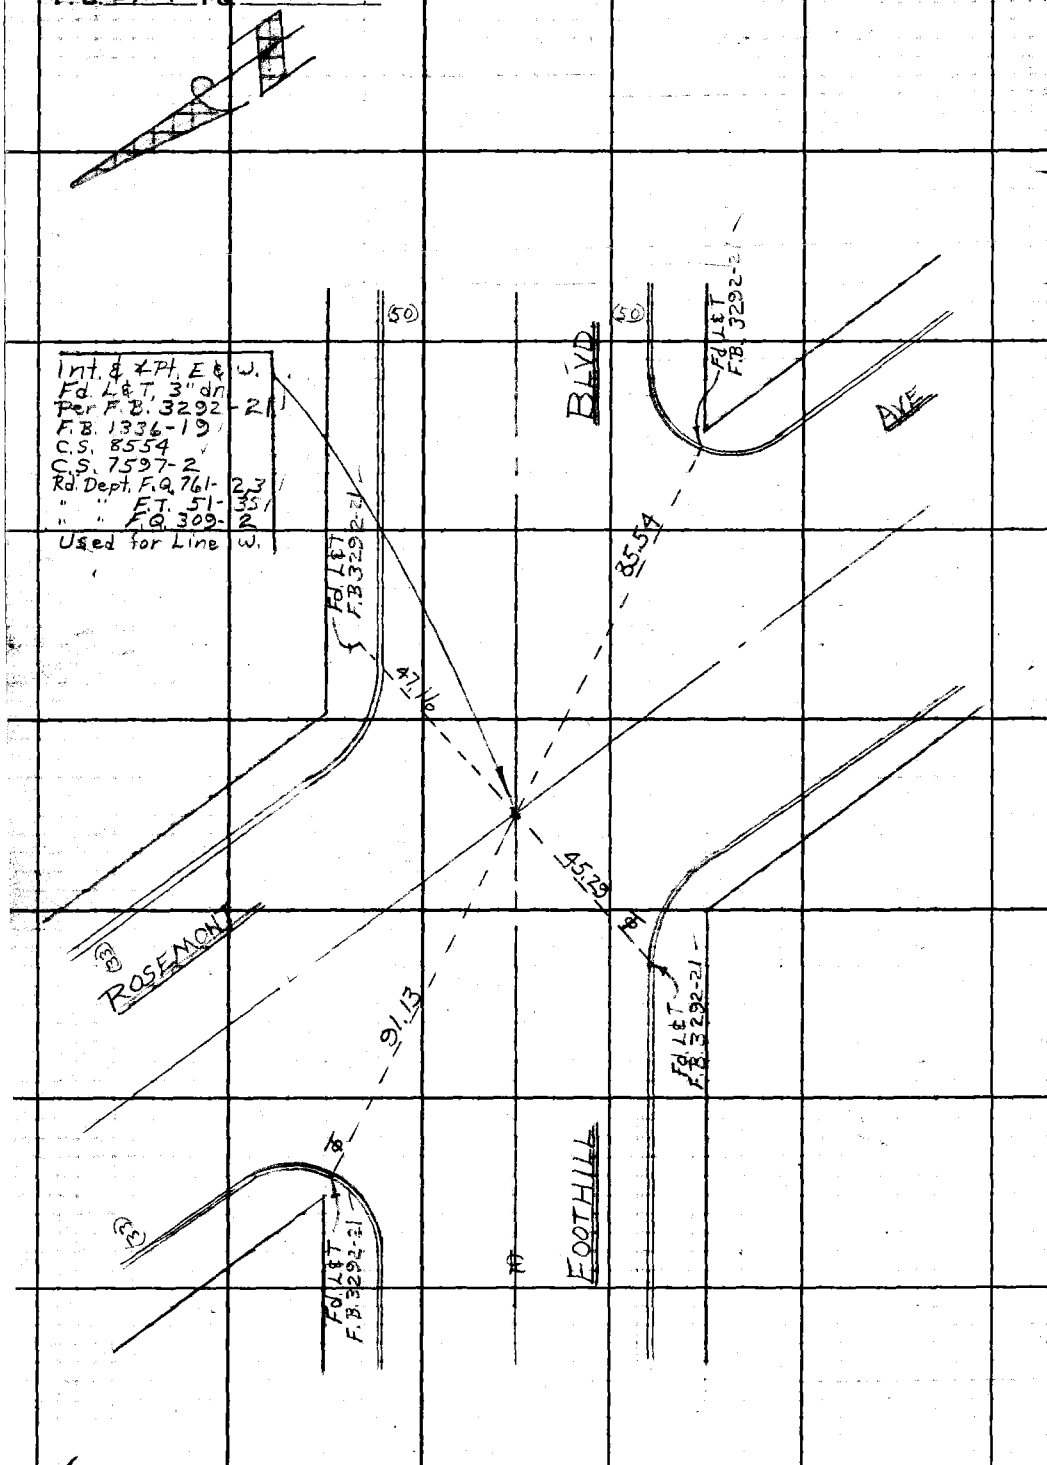

PLEASE RETURN TO
LOS ANGELES COUNTY ENGINEER
403 LOS ANGELES COUNTY ENGINEERING BLDG.

Do not extend this side of this line.

Note: Any Additions or Changes on This Sheet Must be Made or Circled in Red Ink With Date and Name of Person Making Change.

H-B 15.54

PWFB 1921 2403

Notes Ck'd by W. EDMONDSON	Survey of [illegible]
Map No. B-5072	IN 4497.35 Topo 1163 Std. X4 °F
Office Work H. H. F. DONG	Surveyed by [illegible]
Checked	Notes [illegible] Date 3-19-67
Date	Indexed C. J. GALLI

F. B. 3417 PG. 57

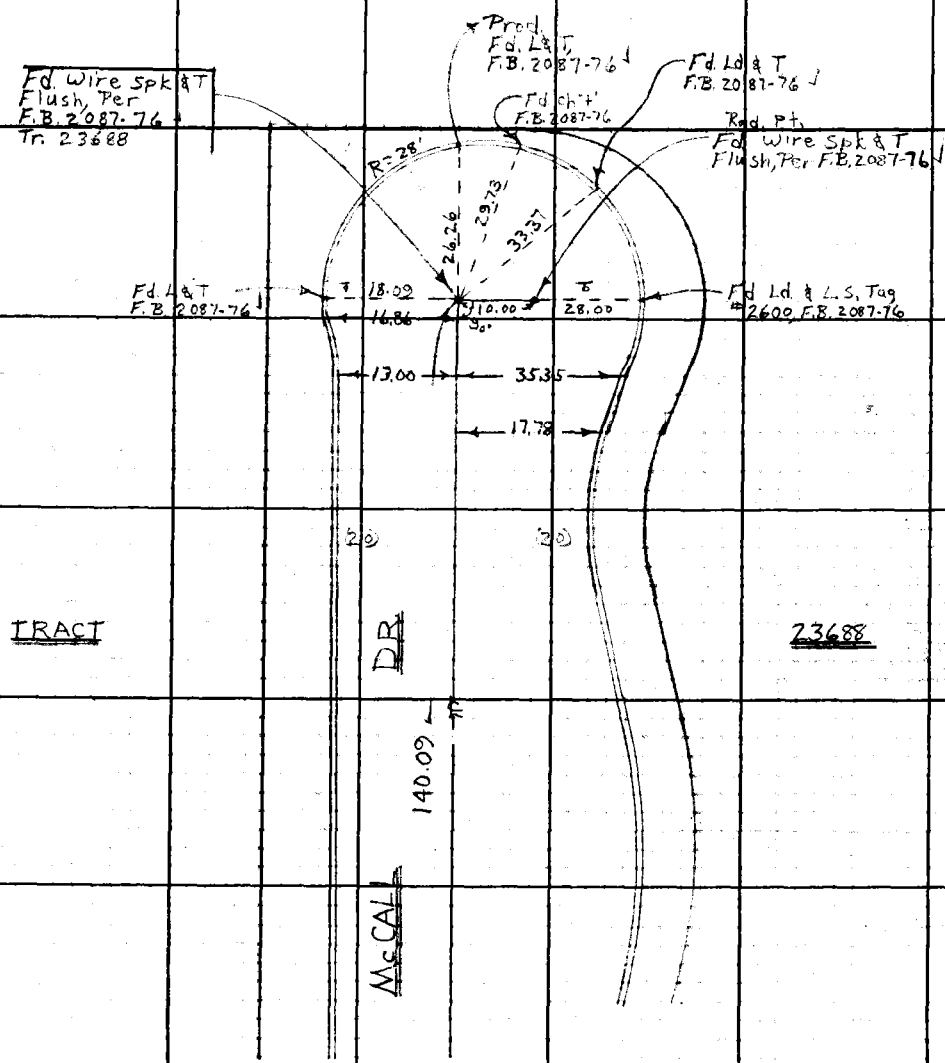

To Top pg # 56

Note: Any Additions or Changes on This Sheet Must be Made or Circled in Red Ink With Date and Name of Person Making Change.

Do not extend this side of this line.

PLEASE RETURN TO
LOS ANGELES COUNTY ENGINEER
403 LOS ANGELES COUNTY ENGINEERING BLDG.

76F309S CE#310 1-65

F. B. 3417 PG 58

PLEASE RETURN TO
LOS ANGELES COUNTY ENGINEER
403 LOS ANGELES COUNTY ENGINEERING BLDG.

Do not extend this side of this line.

Note: Any Additions or Changes on This Sheet Must be Made or Circled in Red Ink With Date and Name of Person Making Change.

PWFB 1921 2400

Notes Ck'd by W. EDMONDSON	Survey of Pennsylvania Ave.	F. B. 3417	PG. 53
Map No. B-5073	[illegible]		
Office Work H. H. F. DONG	Surveyed by Burkholder		
Checked	Notes D.L.K. Date 1-6-7		
Date	Indexed C. J. GALLI		

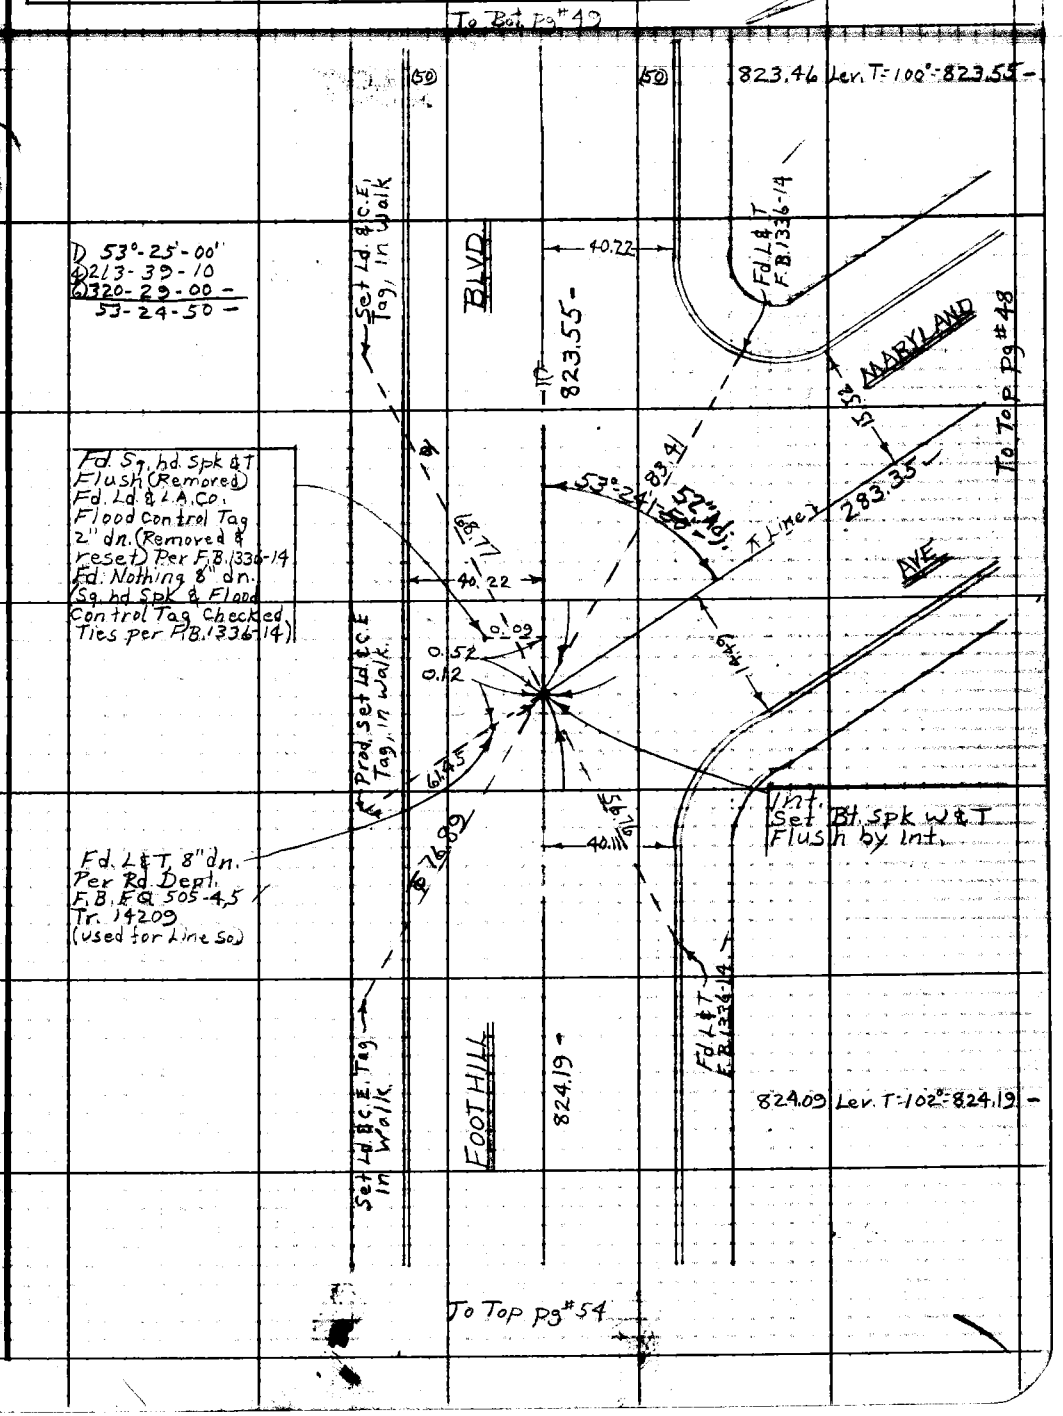

W 551, 15.4

Note: Any Additions or Changes on This Sheet Must be Made or Circled in Red Ink With Date and Name of Person Making Change.

Do not extend this side of this line.

PLEASE RETURN TO
LOS ANGELES COUNTY ENGINEER
403 LOS ANGELES COUNTY ENGINEERING BLDG.

76F309S CE#310 1-65

PWFB 1921 2401

F. B. ~~3417~~ PG. ~~54~~ ✓

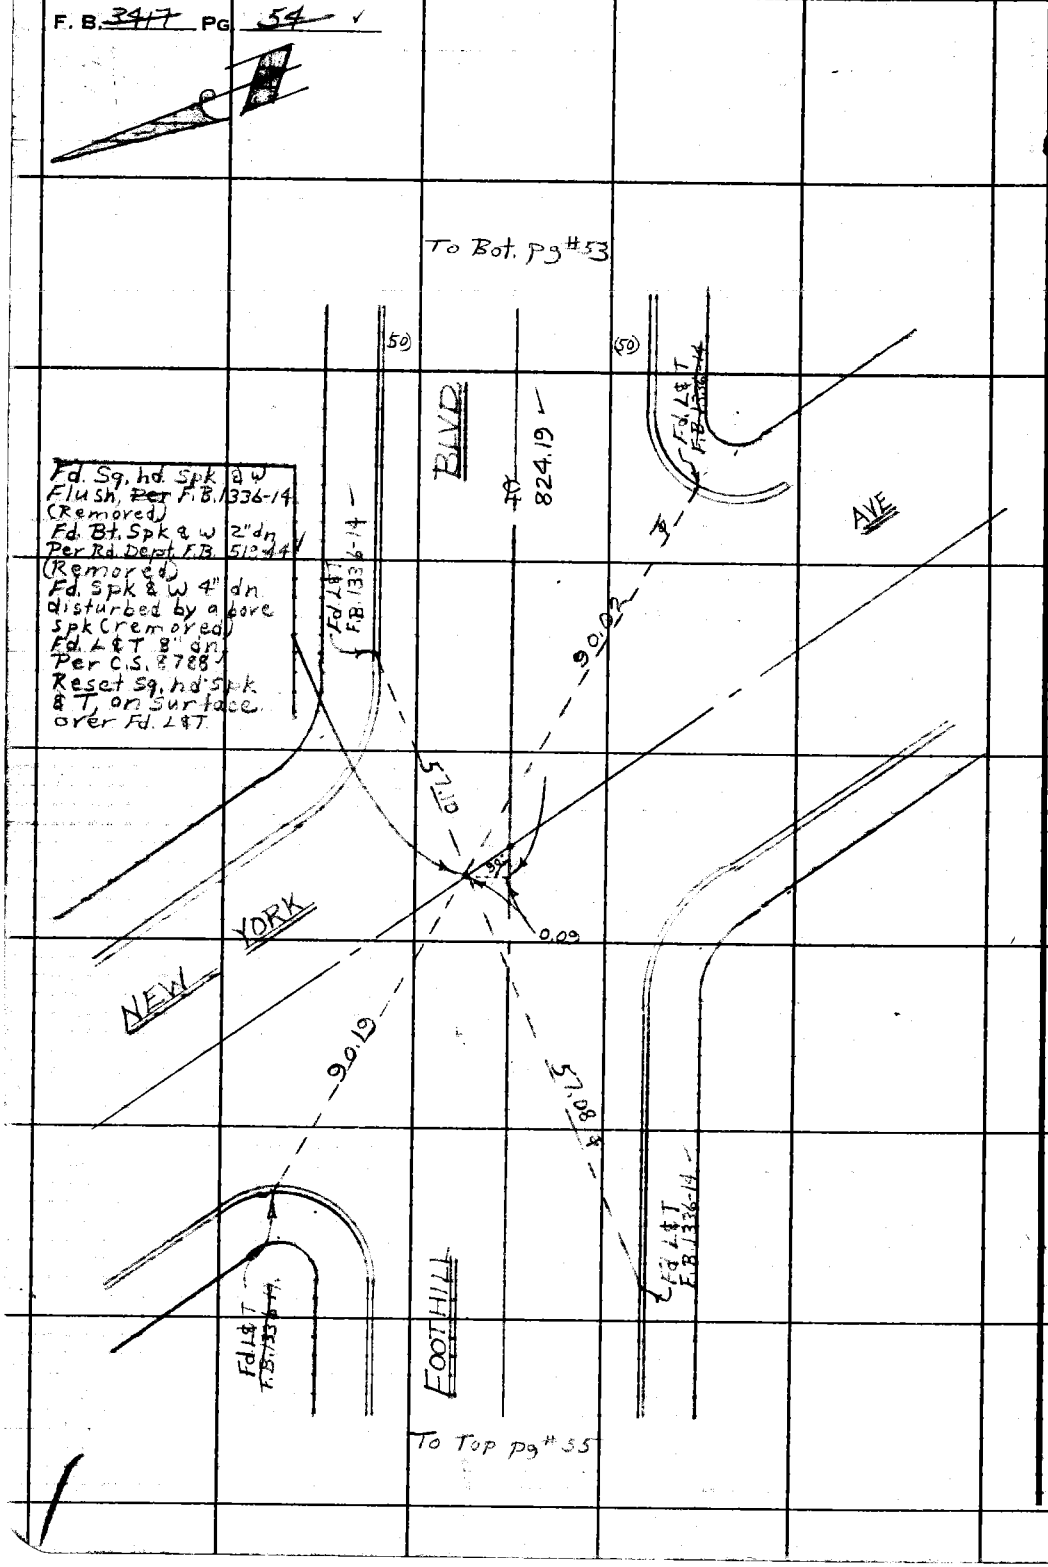

WS 51 A 4

PLEASE RETURN TO
LOS ANGELES COUNTY ENGINEER
403 LOS ANGELES COUNTY ENGINEERING BLDG.

Do not extend this side of this line.

Note: Any Additions or Changes on This Sheet Must be Made or Circled in Red Ink With Date and Name of Person Making Change.

PWFB 1920

98

Notes Ck'd by W. EDMONDSON	Survey of [illegible]	F. B. 3417 Pg. 55
Map No. [illegible]	TM 00972 5 Tape 202 Sht 84 °F	
Office Work H. H. F. DONG	Surveyed by [illegible]	
Checked	Notes [illegible] Date [illegible]	
Date	Indexed C. J. GALLI	

W 3 1 A-3

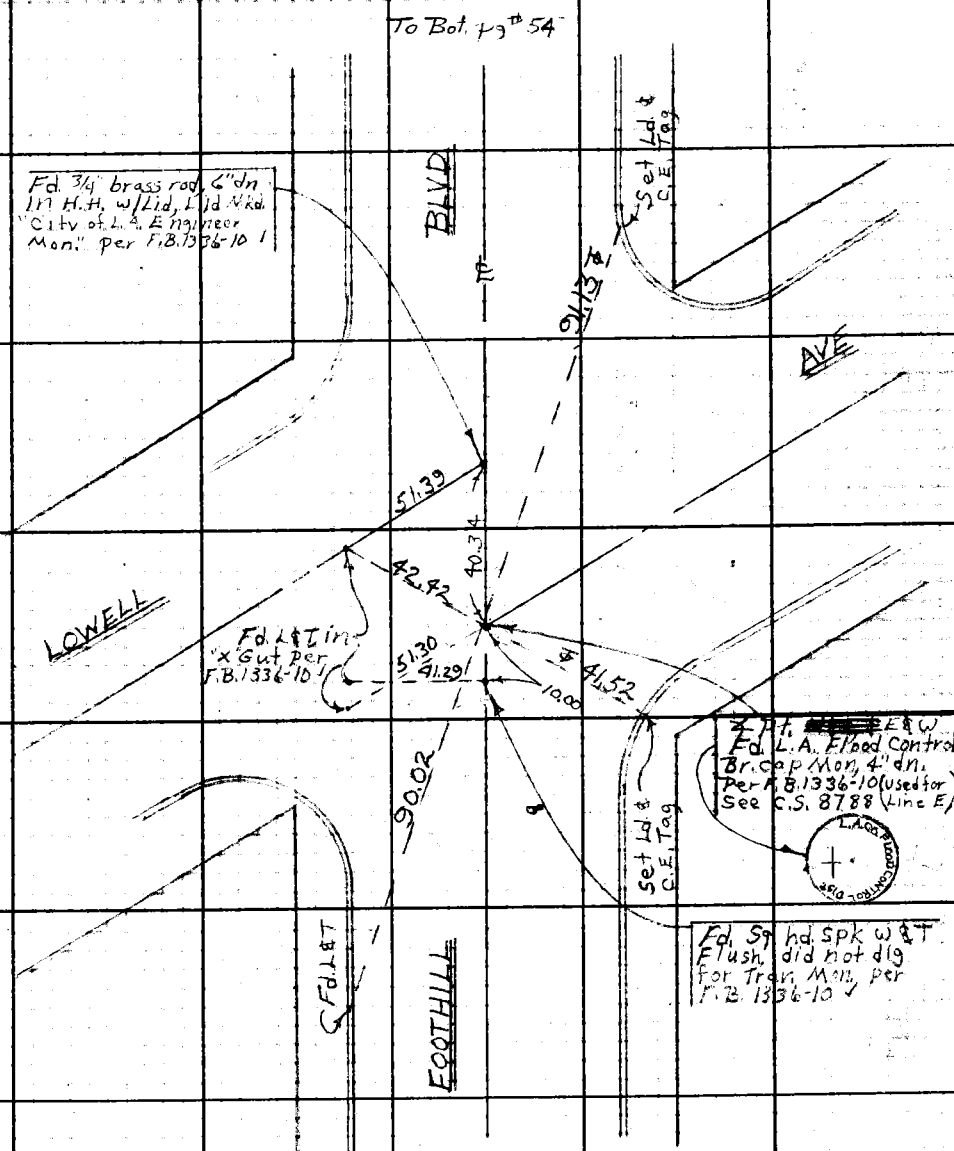

Note: Any Additions or Changes on This Sheet Must be Made or Circled in Red Ink With Date and Name of Person Making Change.

Do not extend this side of this line.

PLEASE RETURN TO
LOS ANGELES COUNTY ENGINEER
403 LOS ANGELES COUNTY ENGINEERING BLDG.

76F309S CE#310 1-65

F. B. ~~2417~~ PG. ~~56~~

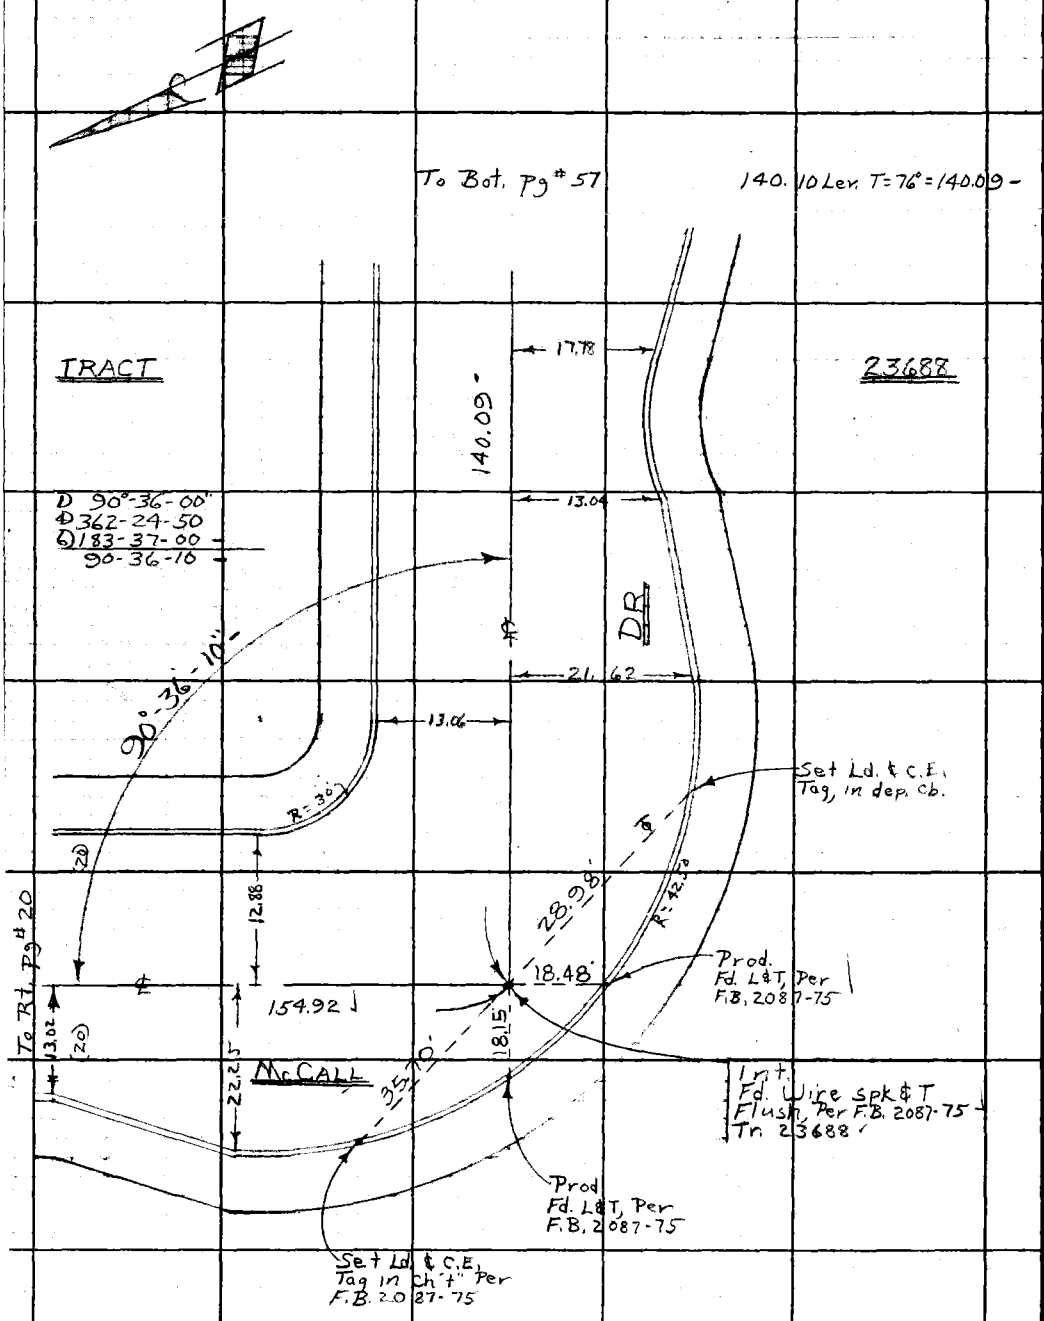

PLEASE RETURN TO
LOS ANGELES COUNTY ENGINEER
403 LOS ANGELES COUNTY ENGINEERING BLDG.
Do not extend this side of this line.
Note: Any Additions or Changes on This Sheet Must be Made or Circled in Red Ink With Date and Name of Person Making Change.

PWFB 1921

2404

Notes Ck'd by W. EDMONDSON	Survey of Pennsylvania Ave	F. B. 2404 PG. 59
Map No. B-5072	JN009725 Type 0117 Std 68 °F	
Office Work H. H. F. DONG	Surveyed by Burkholder	
Checked	Notes D.L.B. Date 9-8-67	
Date	Indexed C. J. GALLI NOV 17 '67	

J.N 009725

PENNSYLVANIA AVE.

GEODETIC TIES

@ Pennsylvania Ave & Montrose Ave

Burkholder
Newman
Moore

Note: Any Additions or Changes on This Sheet Must be Made or Circled in Red Ink With Date and Name of Person Making Change.

Do not extend this side of this line.

PLEASE RETURN TO
LOS ANGELES COUNTY ENGINEER
403 LOS ANGELES COUNTY ENGINEERING BLDG.

76F309S CE#310 1-65

PWFB 1921 2405, 2406, 2407, 2408

F. B. ~~3417~~ PG ~~60~~

INDEX

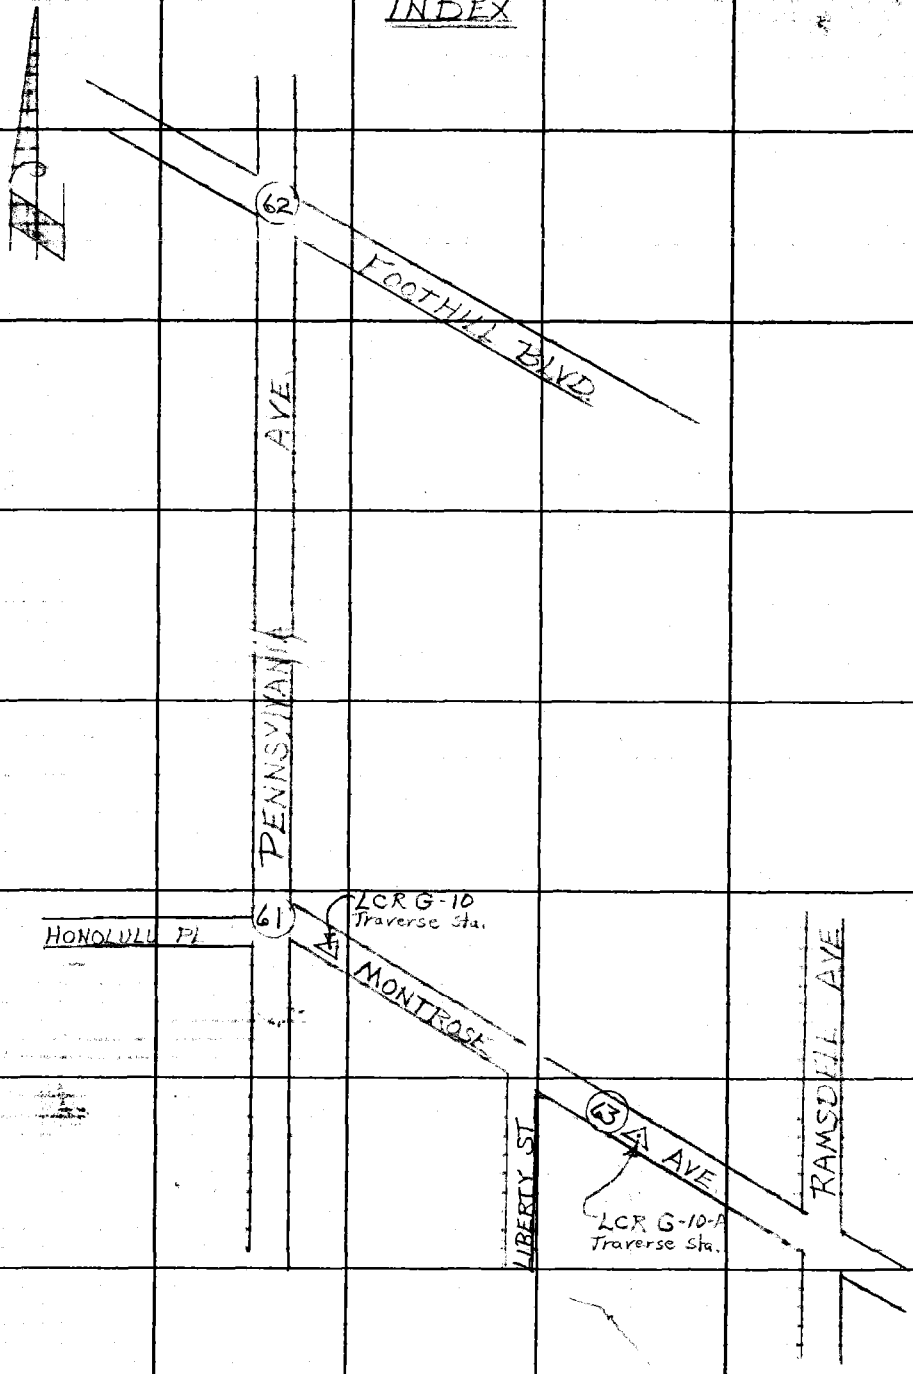

PLEASE RETURN TO
LOS ANGELES COUNTY ENGINEER
403 LOS ANGELES COUNTY ENGINEERING BLDG.
Do not extend this side of this line.

Note: Any Additions or Changes on This Sheet Must be Made or Circled in Red Ink With Date and Name of Person Making Change.

PWFB 1921 2409, 2410

Notes Ck'd By W. EDMONDSON	Survey of [illegible]
Map No. 8-5072	[illegible]
Office Work H. H. F. DONG	Surveyed by [illegible]
Checked	Notes D.J.B. Date 9-8-67
Date	Indexed C. J. GALLI

F. B. 7417 PG. 61

W.S. 51, B-4

To Bot. pg #62

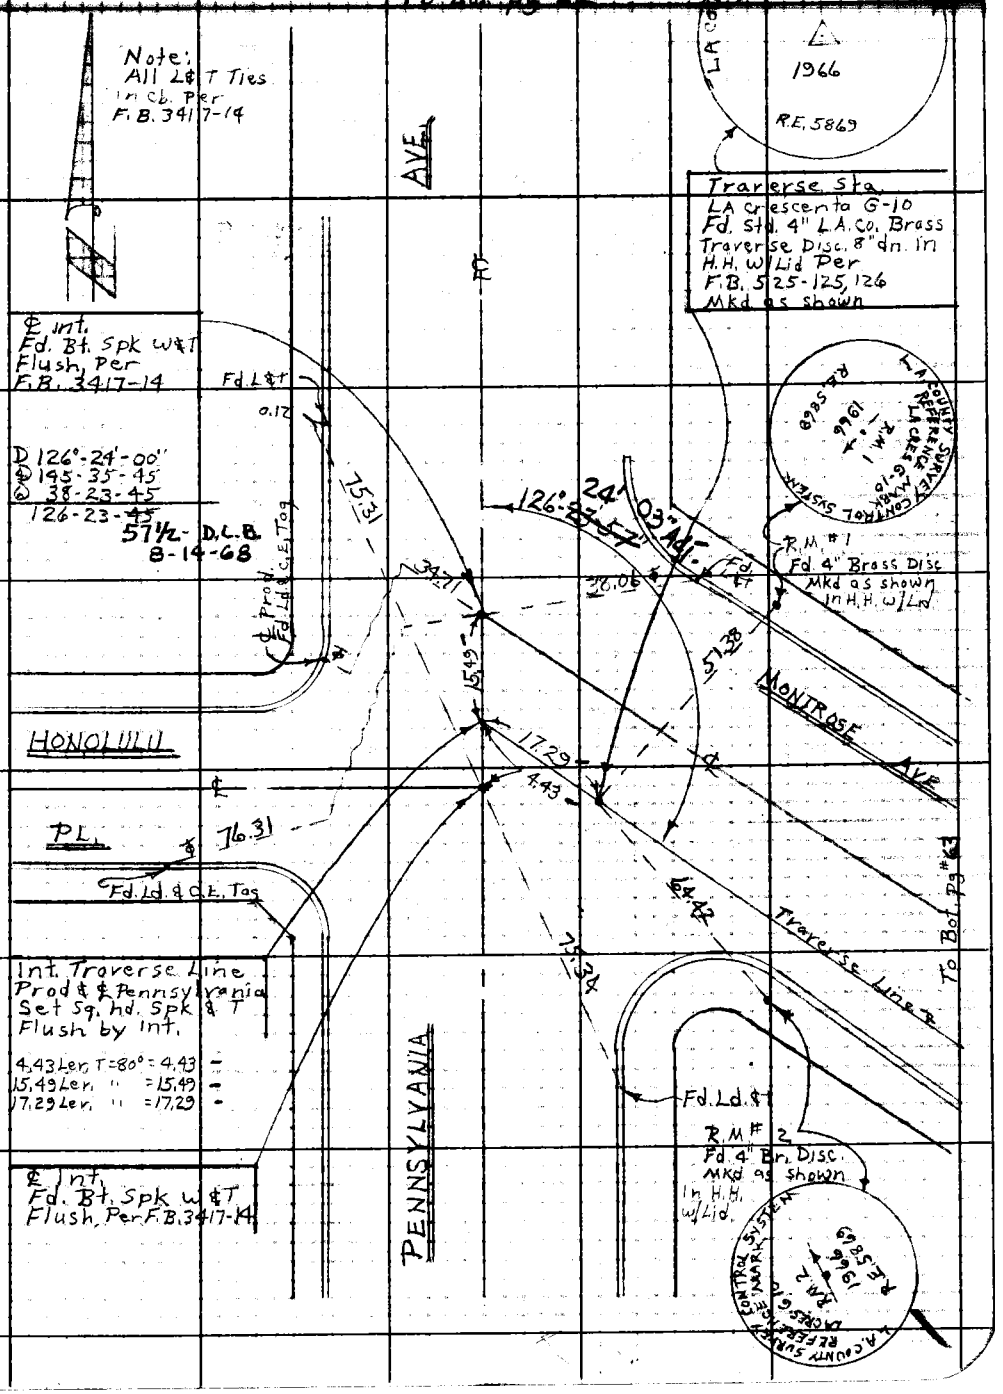

Note: Any Additions or Changes on This Sheet Must be Made or Circled in Red Ink With Date and Name of Person Making Change.

Do not extend this side of this line.

PLEASE RETURN TO
LOS ANGELES COUNTY ENGINEER
403 LOS ANGELES COUNTY ENGINEERING BLDG.

76F309S CE#310 1-65

PWFB 1921 2411, 2412

F. B. ~~3417~~ PG ~~62~~ 1

AVE.

Fd. Id. & C.E. Tag F.B. 3417-19

96.10

Int. to No. Fd. Bt. Spk W&T Flush, Per F.B. 3417-85

FOOTHILL

Fd. Id. & C.E. Tag F.B. 3417-49

86.10

70.46

Fd. L&T F.B. 3417-49

157

Int. to So. Fd. Bt. Spk W&T Flush Per F.B. 3417-49 (used for Line So)

PENNSYLVANIA

BLVD.

93.32

Fd. L&T F.B. 3417-49

To Top pg #61

WS 51-54

LOS ANGELES COUNTY ENGINEER

PLEASE RETURN TO 403 Los Angeles County Engineering Bldg.

Do not extend this side of this line.

Note: Any Additions or Changes on This Sheet Must Be Made or Circled in Red Ink With Date and Name of Person Making Change.

PWFB 1921

2413

Notes Ck'd by W. EDMONDSON	Survey of	F. B. 3417	Pg. 63
Map No. B-5872			
Office Work H. H. F. DONG	Surveyed by		
Checked	Notes DLB Date 9-8-67		
Date	Indexed C. J. GA		

Note: Any Additions or Changes on This Sheet Must be Made or Circled in Red Ink With Date and Name of Person Making Change.

PLEASE RETURN TO
LOS ANGELES COUNTY ENGINEER
403 LOS ANGELES COUNTY ENGINEERING BLDG.

Do not extend this side of this line.

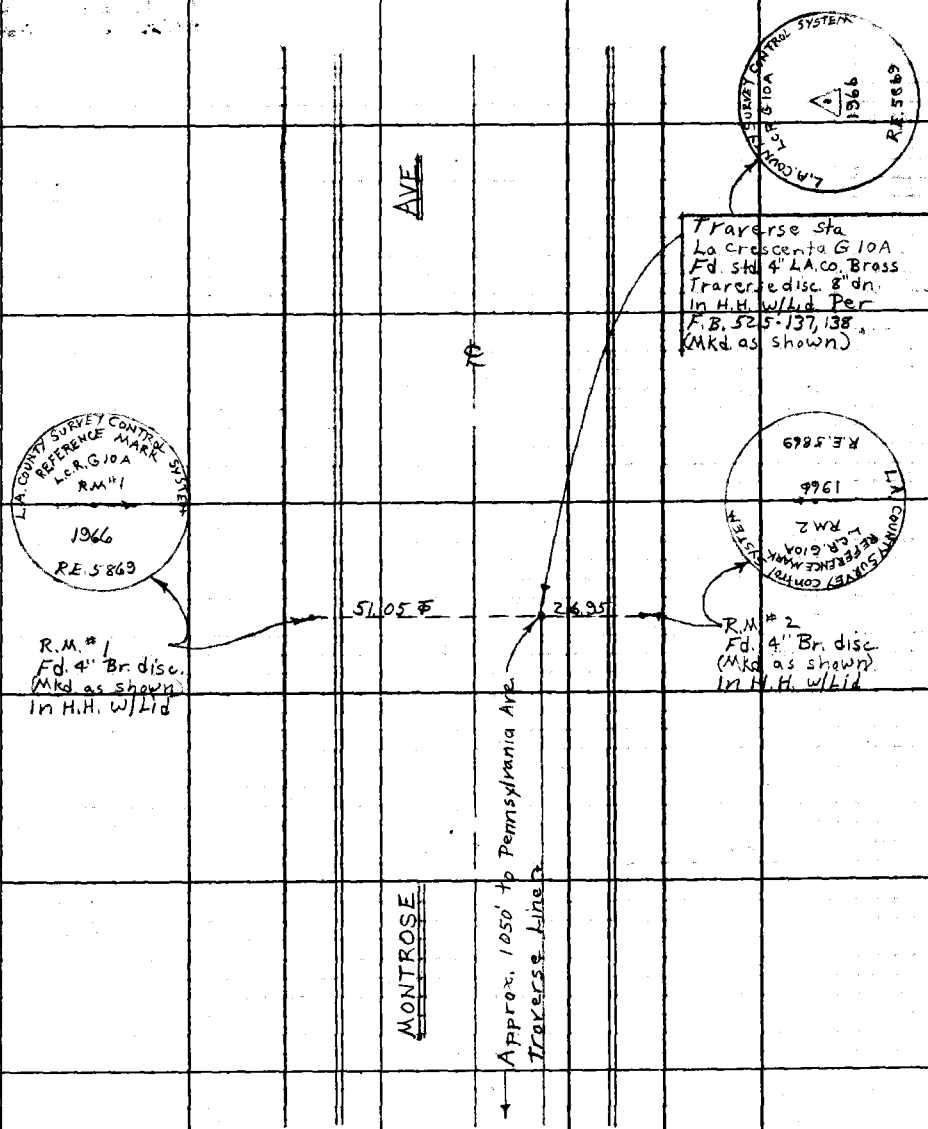

76F309S CE#310 1-65

F. B. 3417 PG. 64

PLEASE RETURN TO
LOS ANGELES COUNTY ENGINEER
403 LOS ANGELES COUNTY ENGINEERING BLDG.

Do not extend this side of this line.

Note: Any Additions or Changes of This Sheet Must be Made or Circled in Red Ink With Date and Name of Person Making Change.

PWFB 1921 2414, 2415

Notes Ck'd by	Survey of Penn. Ave	F. B. 3417 Pg. 81
Office Work	Surveyed by H H Spriggs	
Checked	Notes HHS Date 4-17-67	
Date	Indexed C. J. GALLI NOV 17 '67	

JN 0097.25

PENNSYLVANIA AVENUE

CENTERLINE

(Foothill Blvd to Orange Ave)
(Line & Dist. only Nly to Ro. Line)

Index Pg. 83-84

Pg's 132-150 = 1st Portion of JN 0097.28

Orange Ave ℄

REFERENCE:

FB 3292
FB 2005
1336
2005
1061
1192
1080
2087
2001
2025
2538
2009
1057
525

CS 8554
CS 8788 2

City of Glendale
98-90
91-91

RDFB 172-
FQ 851
339
772

FCFB-2535
2427
2536
2283

H H Spriggs
M A Walsh
H E Fronk
A R Workman
P. L. Beasley
G. Valdez
E. Goshorn
G. Merino

Note: Any Additions or Changes on This Sheet Must be Made or Circled in Red Ink With Date and Name of Person Making Change.

Do not extend this side of this line.

PLEASE RETURN TO
LOS ANGELES COUNTY ENGINEER
403 Los Angeles County Engineering Bldg.

76F309S CE#310 1-65

F. B. 3417 PG 82

PLEASE RETURN TO
LOS ANGELES COUNTY ENGINEER
403 LOS ANGELES COUNTY ENGINEERING BLDG.

Do not extend this side of this line.

Note: Any Additions or Changes on This Sheet Must be Made or Circled in Red Ink With Date and Name of Person Making Change.

ZONE 7 E

PENNSYLVANIA AVE.

BLANK

PWFB 1921 2416

Notes Ck'd by R. P. SHORT	Survey of Penn Ave
Map No. B-5072	F. B. 3417 Pg. 82
Office Work H. H. F. DONG	Surveyed by HH
Checked W. EDMONDSON	Notes Walsh Date 4-12-67
Date NOV 21 '69	Indexed C. J. GALL

INDEX MAP
IN 009725
PENN AVE

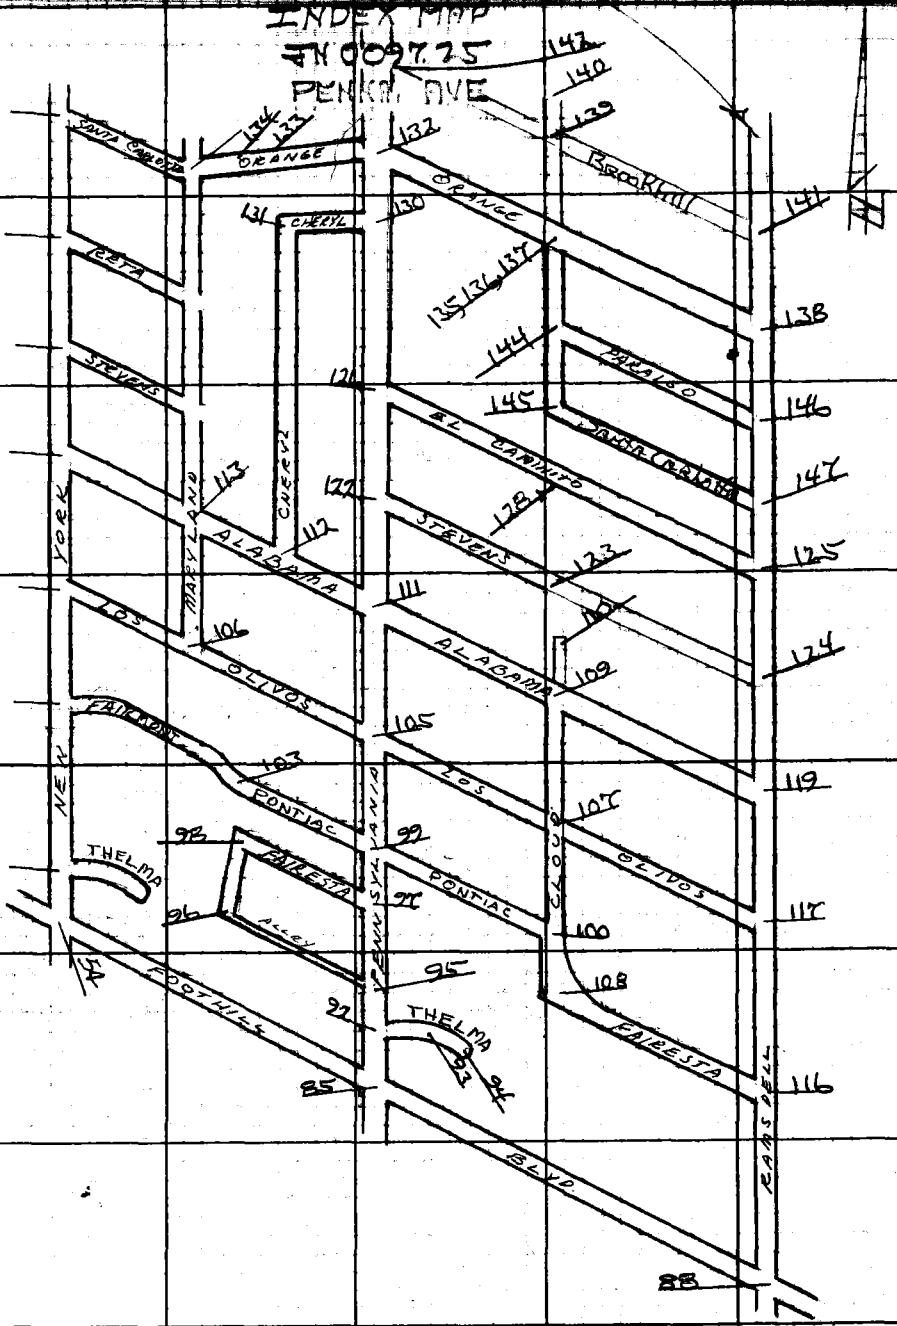

Note: Any Additions or Changes on This Sheet Must be Made or Circled in Red Ink With Date and Name of Person Making Change.

Do not extend this side of this line.

PLEASE RETURN TO
LOS ANGELES COUNTY ENGINEER
403 Los Angeles County Engineering Bldg.

76F3095 CE#310 1-65

F. B. 3417 PG. 84

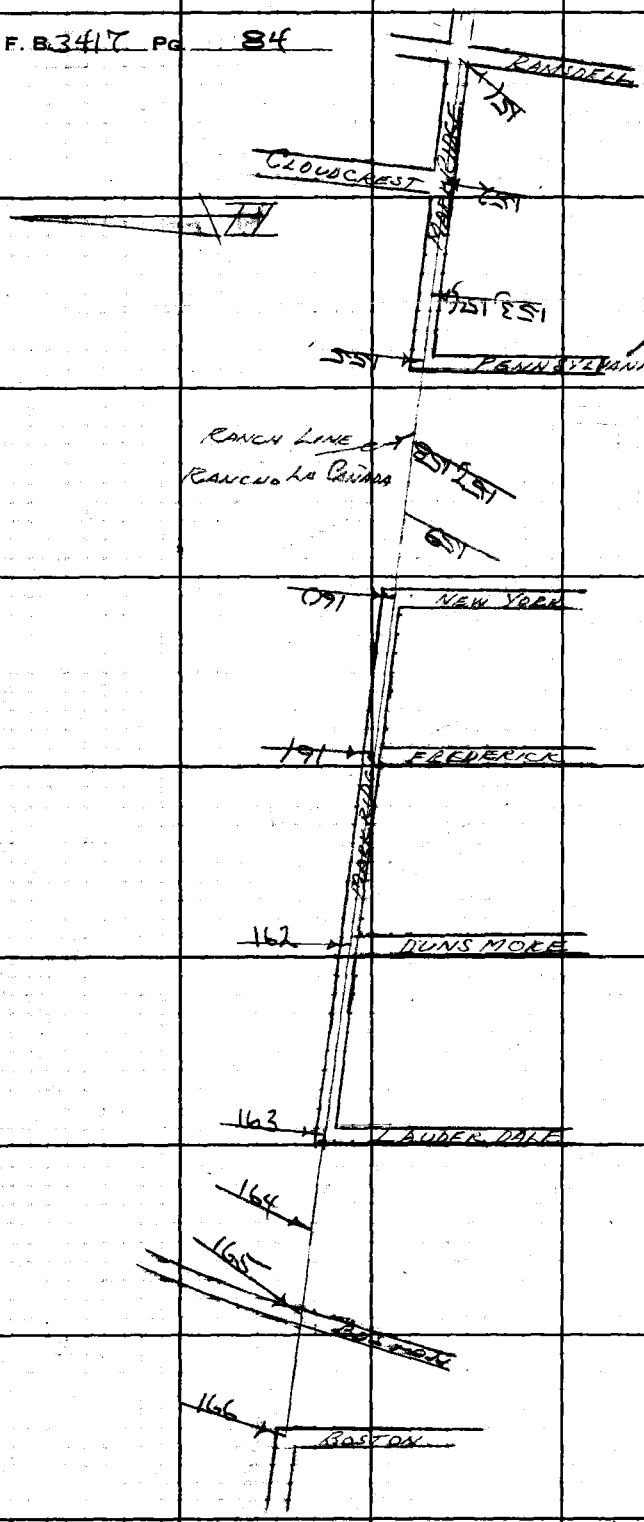

PLEASE RETURN TO
LOS ANGELES COUNTY ENGINEER
403 LOS ANGELES COUNTY ENGINEERING BLDG.

Do not extend this side of this line.

Note: Any Additions or Changes of This Sheet Must be Made or Circled in Red Ink With Date and Name of Person Making Change.

PWFB 1921 **2417, 2418**

Notes Ck'd by R. P. SHORT — Survey of [illegible] — F. B. 3417 Pg. [illegible]

Office Work H. H. F. DONG — Surveyed by SPRIGGS

Checked W. EDMONDSON — Notes [illegible] Date [illegible]

Date NOV 21 '69 — Indexed C. J. GALL

Note: Any Additions or Changes on This Sheet Must be Made or Circled in Red Ink With Date and Name of Person Making Change.

Do not extend this side of this line.

PLEASE RETURN TO
LOS ANGELES COUNTY ENGINEER
403 Los Angeles County Engineering Bldg.

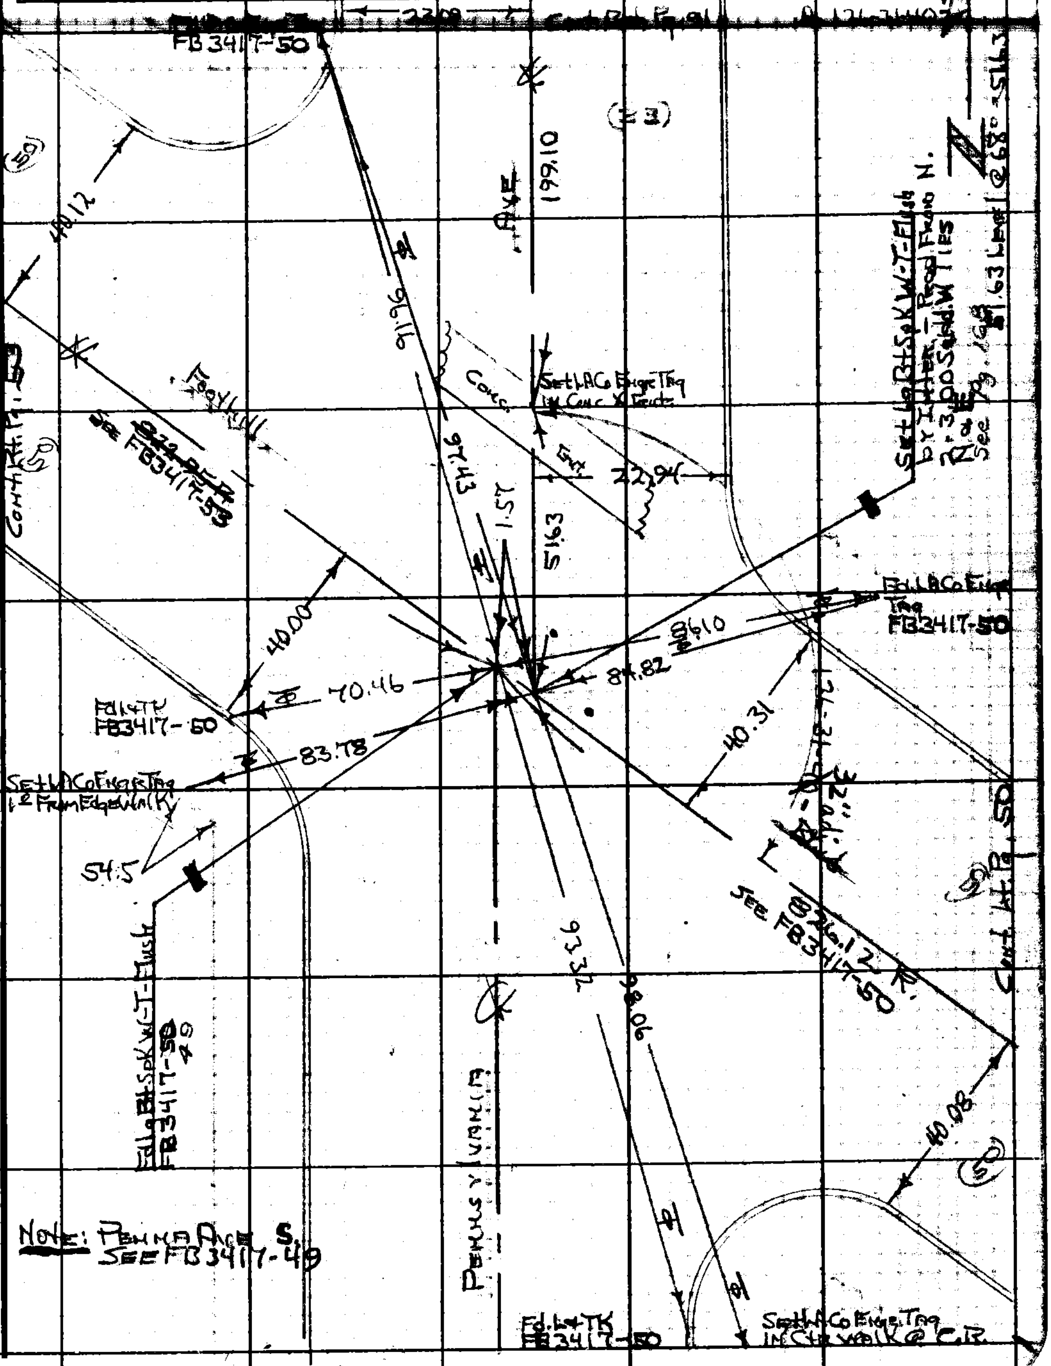

Note: Penna Ave S. See FB3417-49

76F309S CE#310 1-65

Blank

F. B. ~~3792 Pg 86~~

PLEASE RETURN TO
LOS ANGELES COUNTY ENGINEER
403 LOS ANGELES COUNTY ENGINEERING BLDG.

Do not extend this side of this line.

Note: Any Additions or Changes on This Sheet Must be Made or Circled in Red Ink With Date and Name of Person Making Change.

Notes Ck'd by	Survey of Penna Ave	F. B. 3417 Pg. 87
Map No.	[illegible]	
Office Work	Surveyed by HHSpriggs	
Checked	Notes HHS Date [illegible]	
Date	Indexed C. J. GALL	

Note: Any Additions or Changes on This Sheet Must be Made or Circled in Red Ink With Date and Name of Person Making Change.

PLEASE RETURN TO
[illegible]GELES COUNTY ENGINEER
[illegible]GELES COUNTY ENGINEERING BLDG.

Do not extend this side of this line.

76F309S CE#310 1-65

PWFB 1921 2419, 2420

F. B. ~~3417~~ PG. ~~88~~

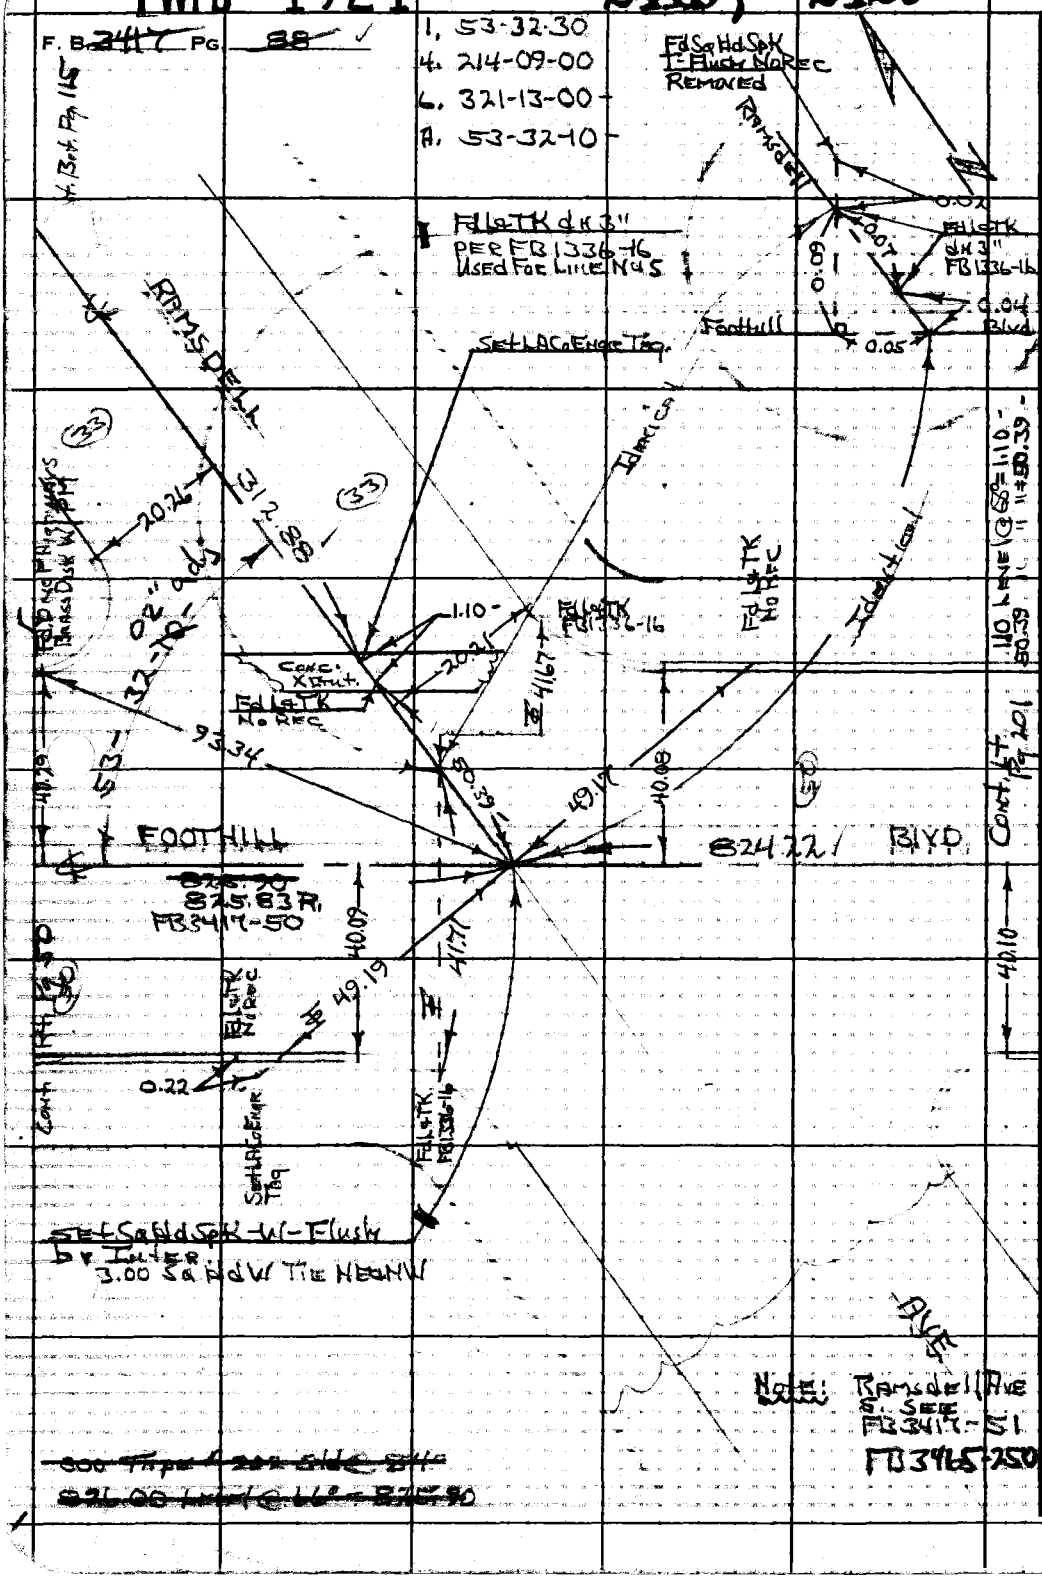

W.S. 51, 8.4

PLEASE RETURN TO
LOS ANGELES COUNTY ENGINEER
403 LOS ANGELES COUNTY ENGINEERING BLDG.
Do not extend this side of this line.

Note: Any Additions or Changes on This Sheet Must be Made or Circled in Red Ink With Date and Name of Person Making Change.

Notes Ck'd by R. P. SHORT	Survey of [illegible]
~~Map No.~~	~~[illegible]~~
Office Work	Surveyed by [illegible]
~~Checked~~	~~Notes~~ ~~[illegible]~~ ~~Date~~
Date	Indexed C. J. GALLI

F. B. 3417 PG. 59

Note: Any Additions or Changes on This Sheet Must be Made or Circled in Red Ink With Date and Name of Person Making Change.

Do not extend this side of this line.

PLEASE RETURN TO
LOS ANGELES COUNTY ENGINEER
403 LOS ANGELES COUNTY ENGINEERING BLDG.

76F309S CE#310 1-65

BLANK

F. B. 3417 PG. 90

PLEASE RETURN TO
LOS ANGELES COUNTY ENGINEER
403 LOS ANGELES COUNTY ENGINEERING BLDG.

Do not extend this side of this line.

Note: Any Additions or Changes on This Sheet Must be Made or Circled in Red Ink With Date and Name of Person Making Change.

PWFB 1921

2421

Notes Ck'd by R. P. SHORT	Survey of [illegible]	F. B. 3417 PG. 91
Map No. B-5072	[illegible]	
Office Work H. H. F. DONG	Surveyed by [illegible]	
Checked W. EDMONDSON	Notes [illegible] Date [illegible]	
Date NOV 21 '69	Indexed C. J. GALLI	

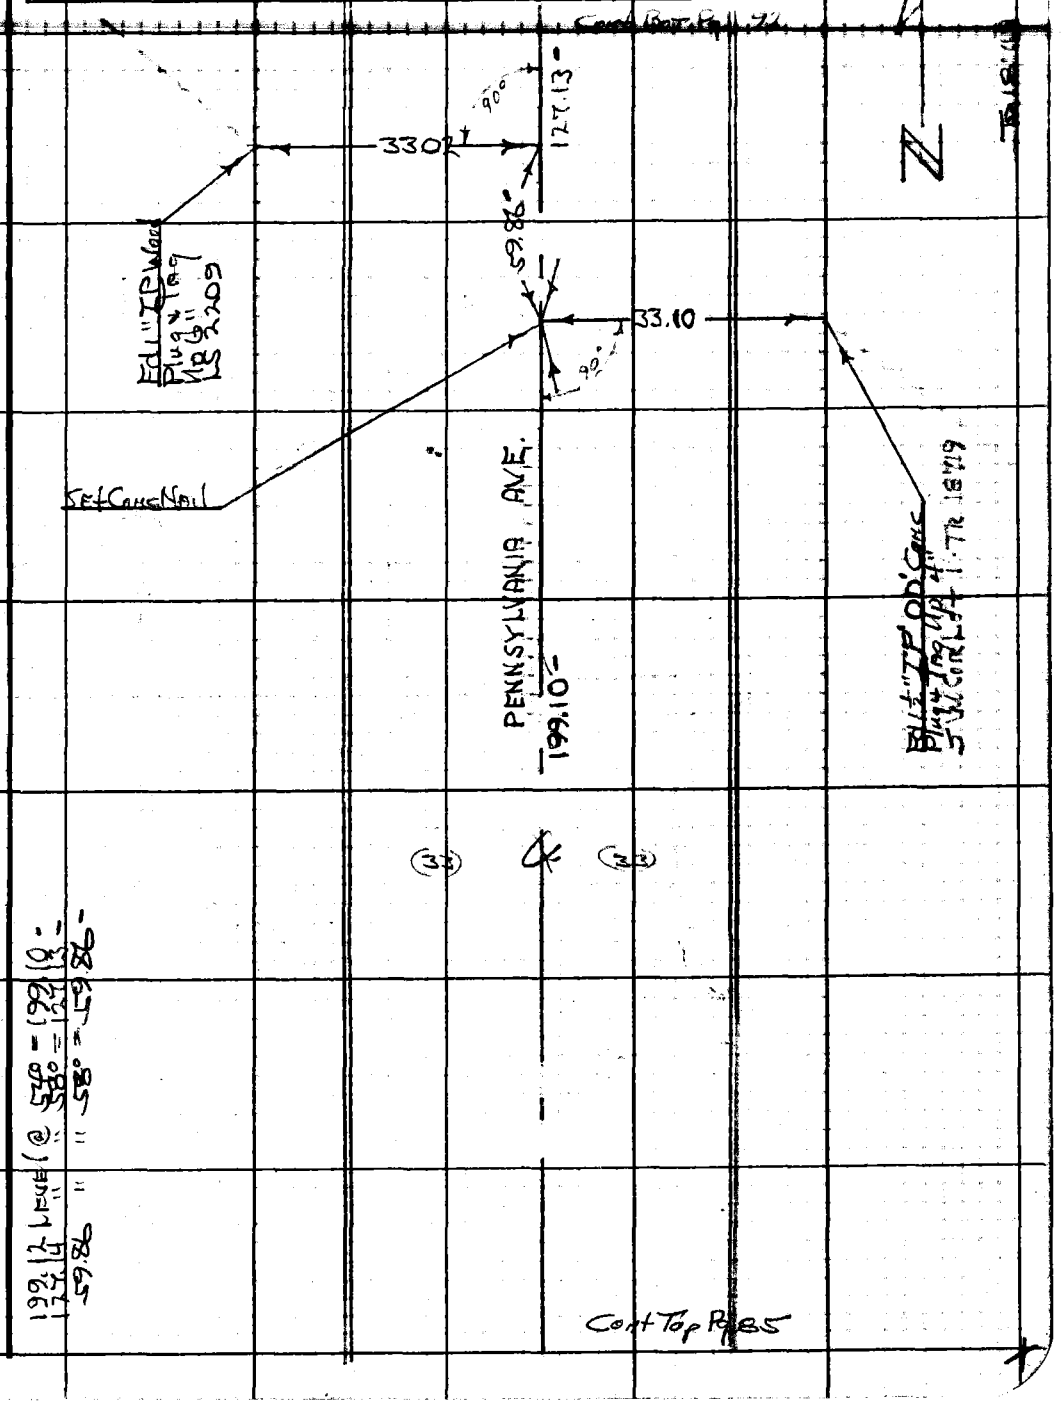

Note: Any Additions or Changes on This Sheet Must be Made or Circled in Red Ink With Date and Name of Person Making Change.

PLEASE RETURN TO
LOS ANGELES COUNTY ENGINEER
403 LOS ANGELES COUNTY ENGINEERING BLDG.

Do not extend this side of this line.

26F309S CE#310 1-65

PWFB 1921 2422

F. B. 3417 PG. 92

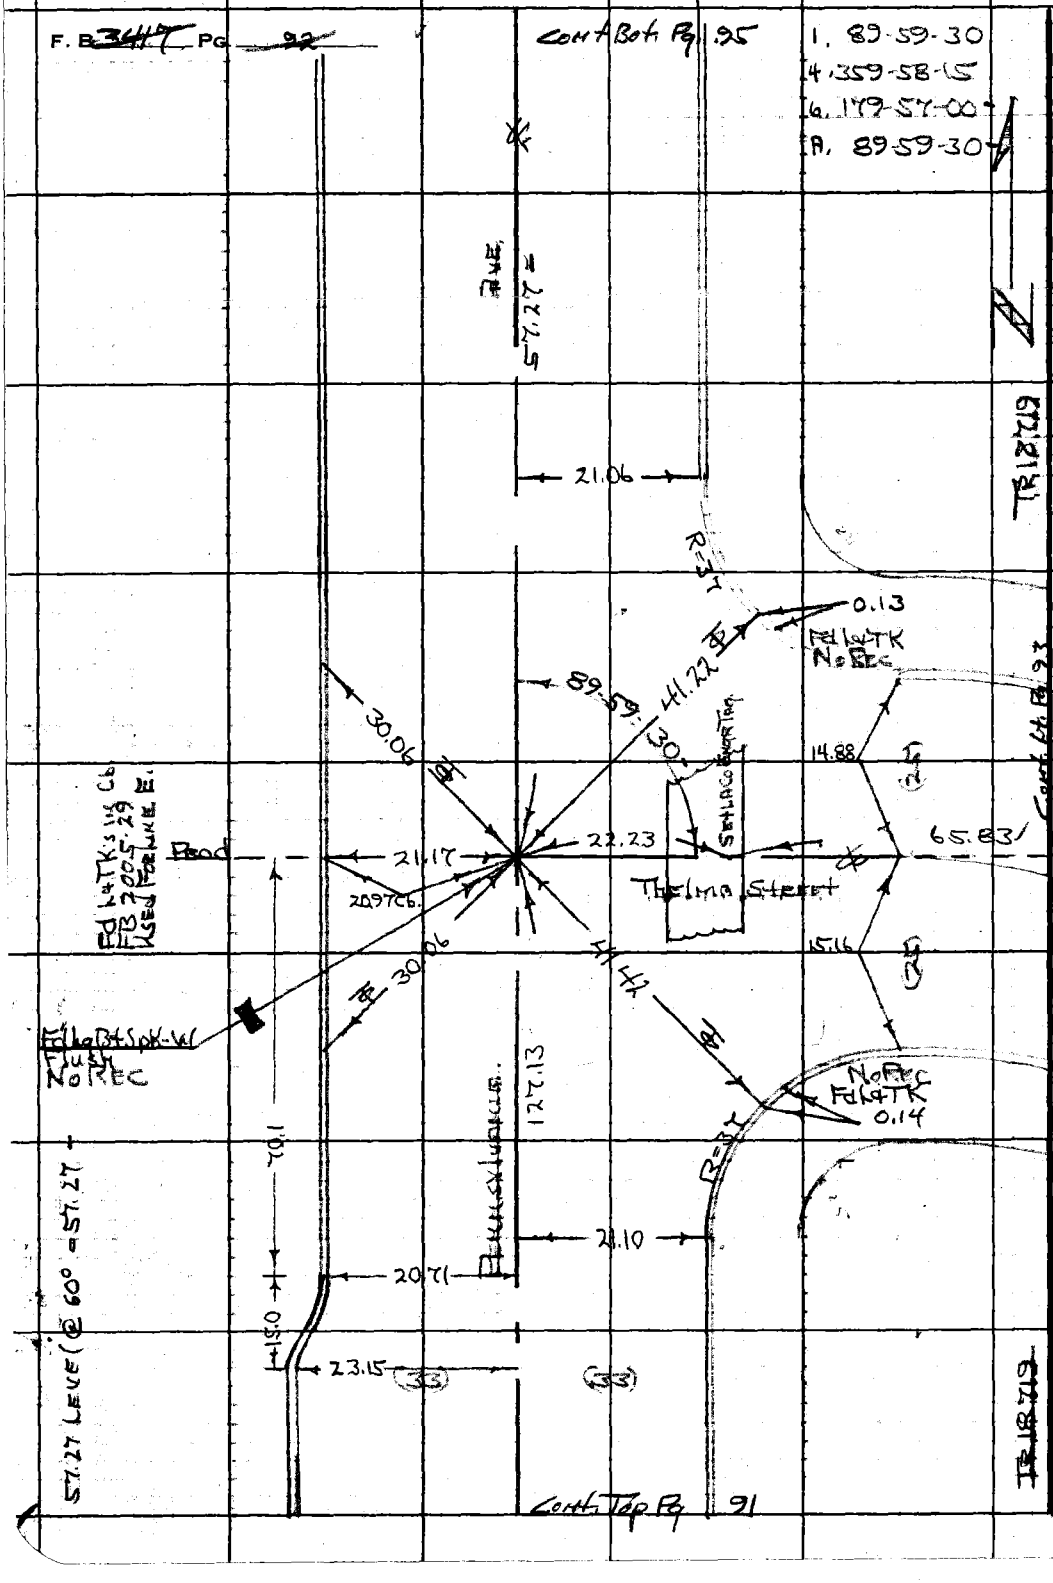

PLEASE RETURN TO
LOS ANGELES COUNTY ENGINEER
403 LOS ANGELES COUNTY ENGINEERING BLDG.

Do not extend this side of this line.

Note: Any Additions or Changes on This Sheet Must be Made or Circled in Red Ink With Date and Name of Person Making Change.

PWFB 1921 2423

Notes Ck'd by R. P. SHORT	Survey of [illegible]	F. B. 3417 PG. 33
Map No. [illegible]	[illegible]	
Office Work H. H. F. DONG	Surveyed by [illegible]	
Checked	Notes [illegible] Date 4-14-67	
Date	Indexed [illegible]	

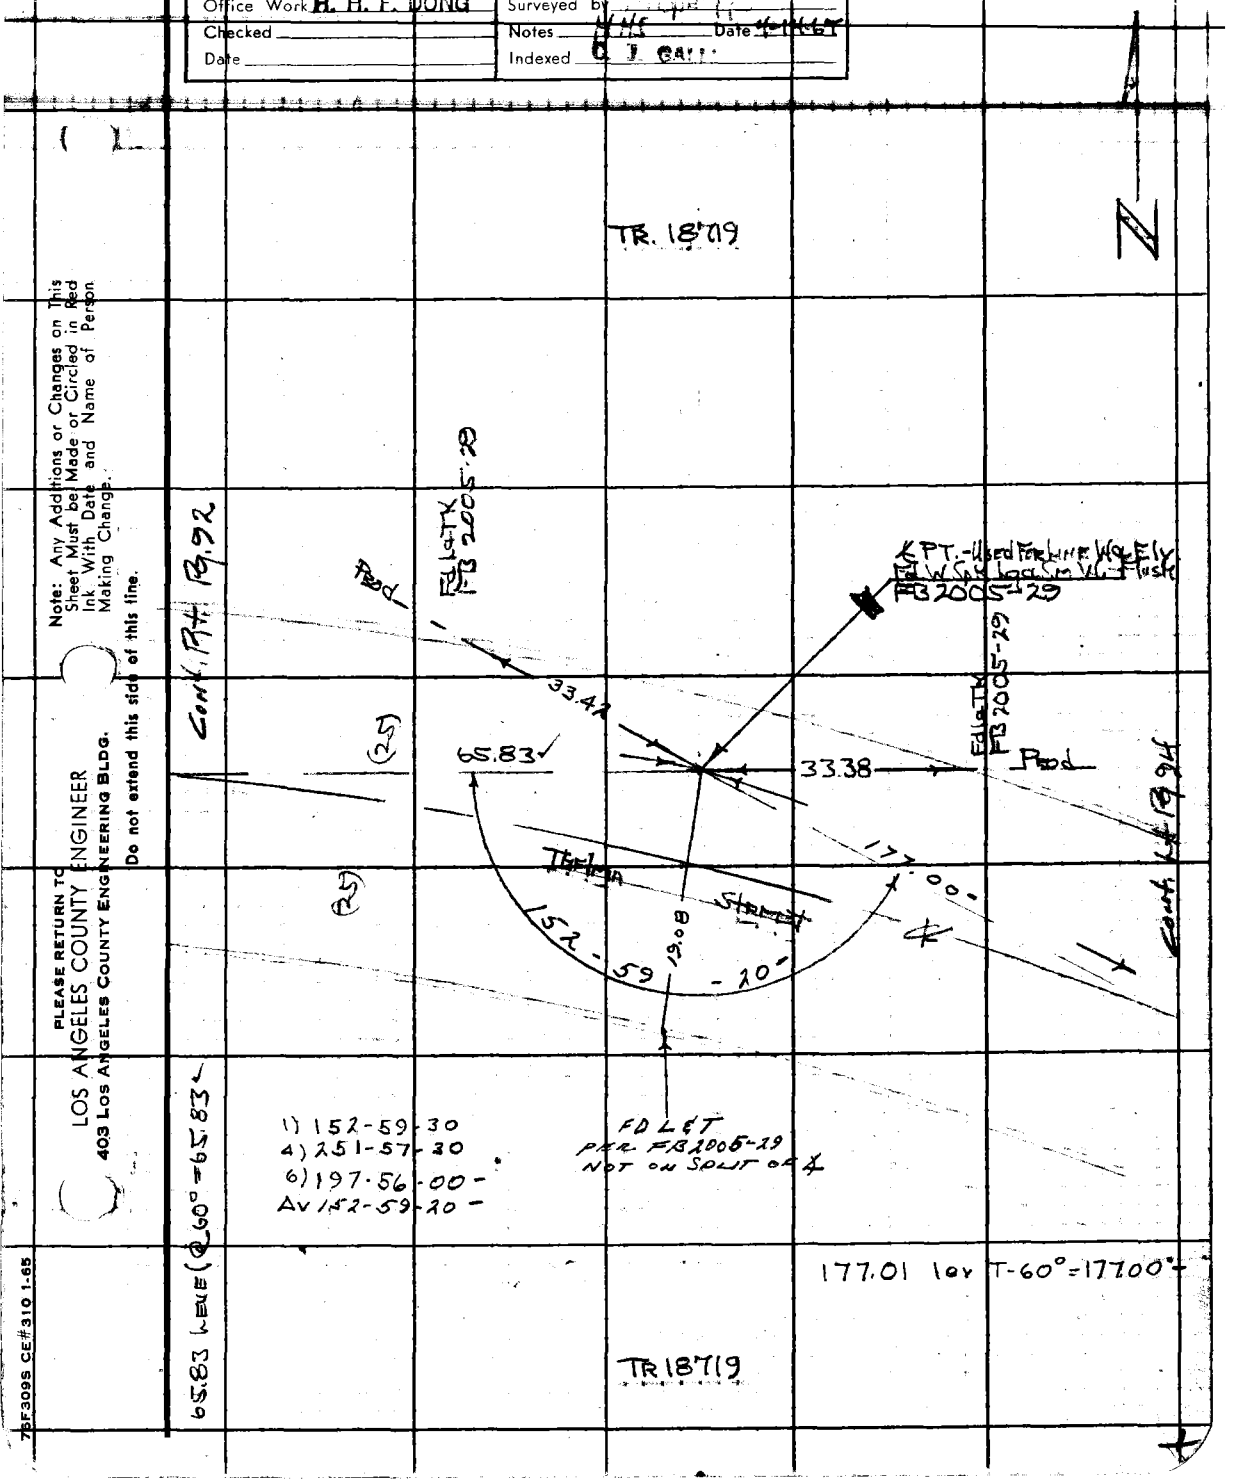

Note: Any Additions or Changes on This Sheet Must be Made or Circled in Red Ink With Date and Name of Person Making Change.

Do not extend this side of this line.

PLEASE RETURN TO
LOS ANGELES COUNTY ENGINEER
403 LOS ANGELES COUNTY ENGINEERING BLDG.

75F309S CE#310 1-65

PWFB 1921 2424

F. B. ~~3417~~ PG. ~~94~~

W.S. 51, B-4

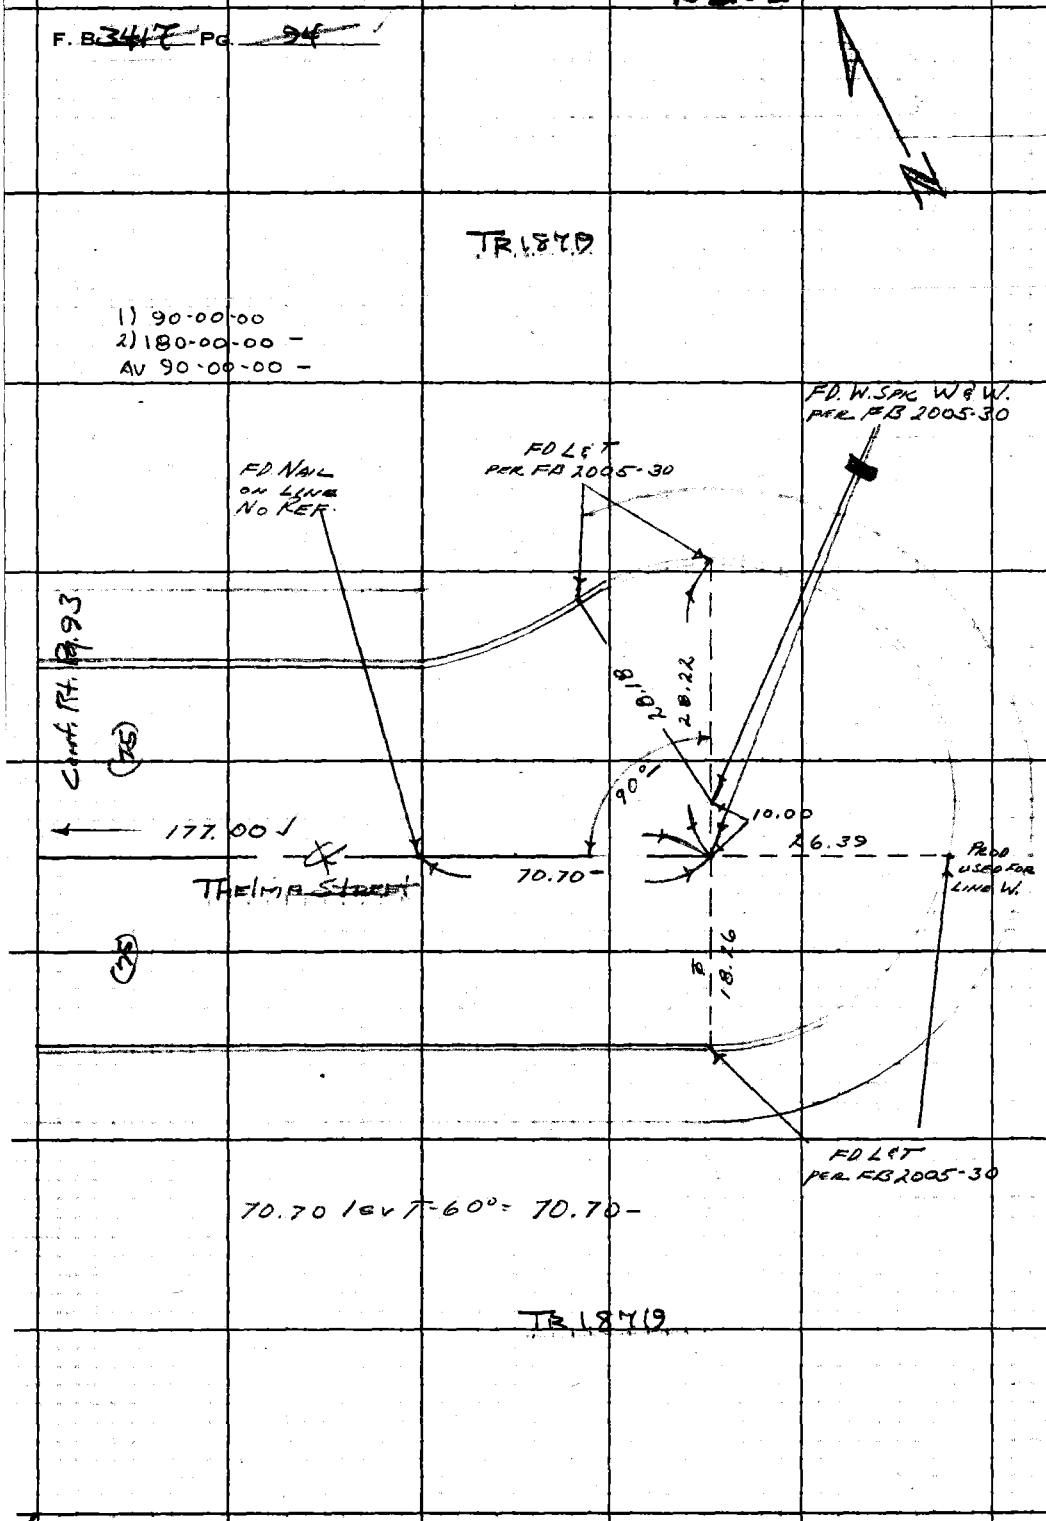

PLEASE RETURN TO
LOS ANGELES COUNTY ENGINEER
403 LOS ANGELES COUNTY ENGINEERING BLDG.

Do not extend this side of this line.

Note: Any Additions or Changes on This Sheet Must be Made or Circled in Red Ink With Date and Name of Person Making Change.

PWFB 1921

2425

Notes Ck'd by R. P. SHORT	Survey of [illegible]
Map No. B-5072	JN 0097[illegible]
Office Wo H. H. F. DONG	Surveyed by [illegible]
Checked W. EDMONDSON	Notes [illegible] Date 4-14-67
Date NOV 21 '69	Indexed C. J. GALI

F. B. 3417 PG. 95

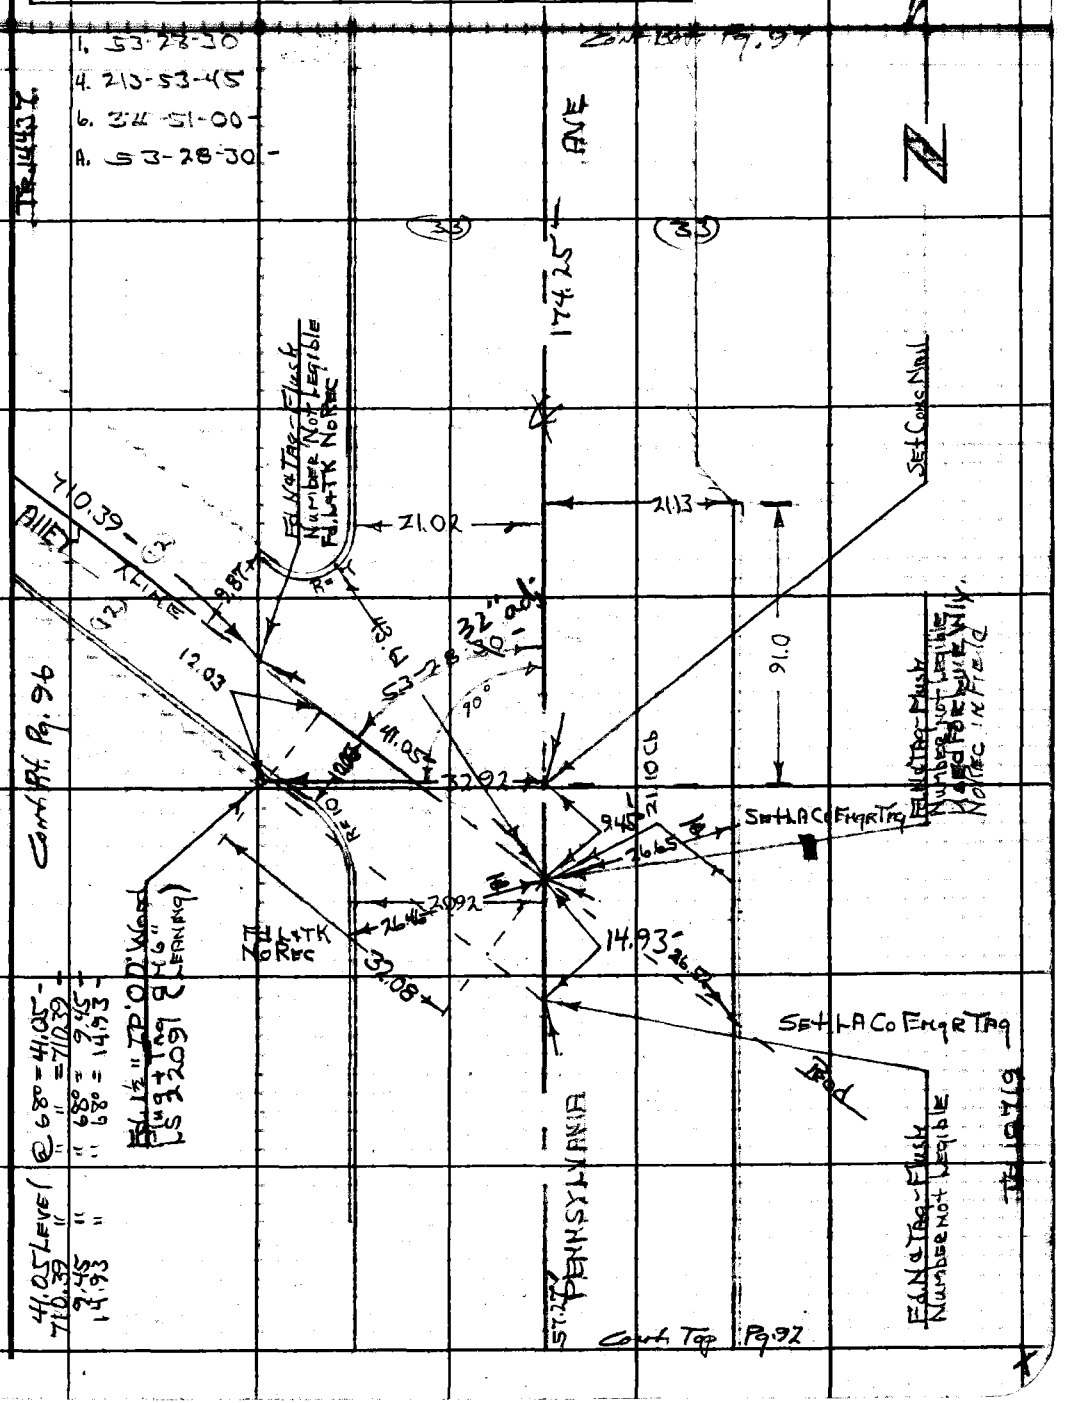

Note: Any Additions or Changes on This Sheet Must be Made or Circled in Red Ink With Date and Name of Person Making Change.

Do not extend this side of this line.

PLEASE RETURN TO
LOS ANGELES COUNTY ENGINEER
403 LOS ANGELES COUNTY ENGINEERING BLDG.

75F309S CE#310 1-65

PWFB 1921 2426, 2427

F. B. 3417 PG. 96

Cont. Bot. Pg. 98

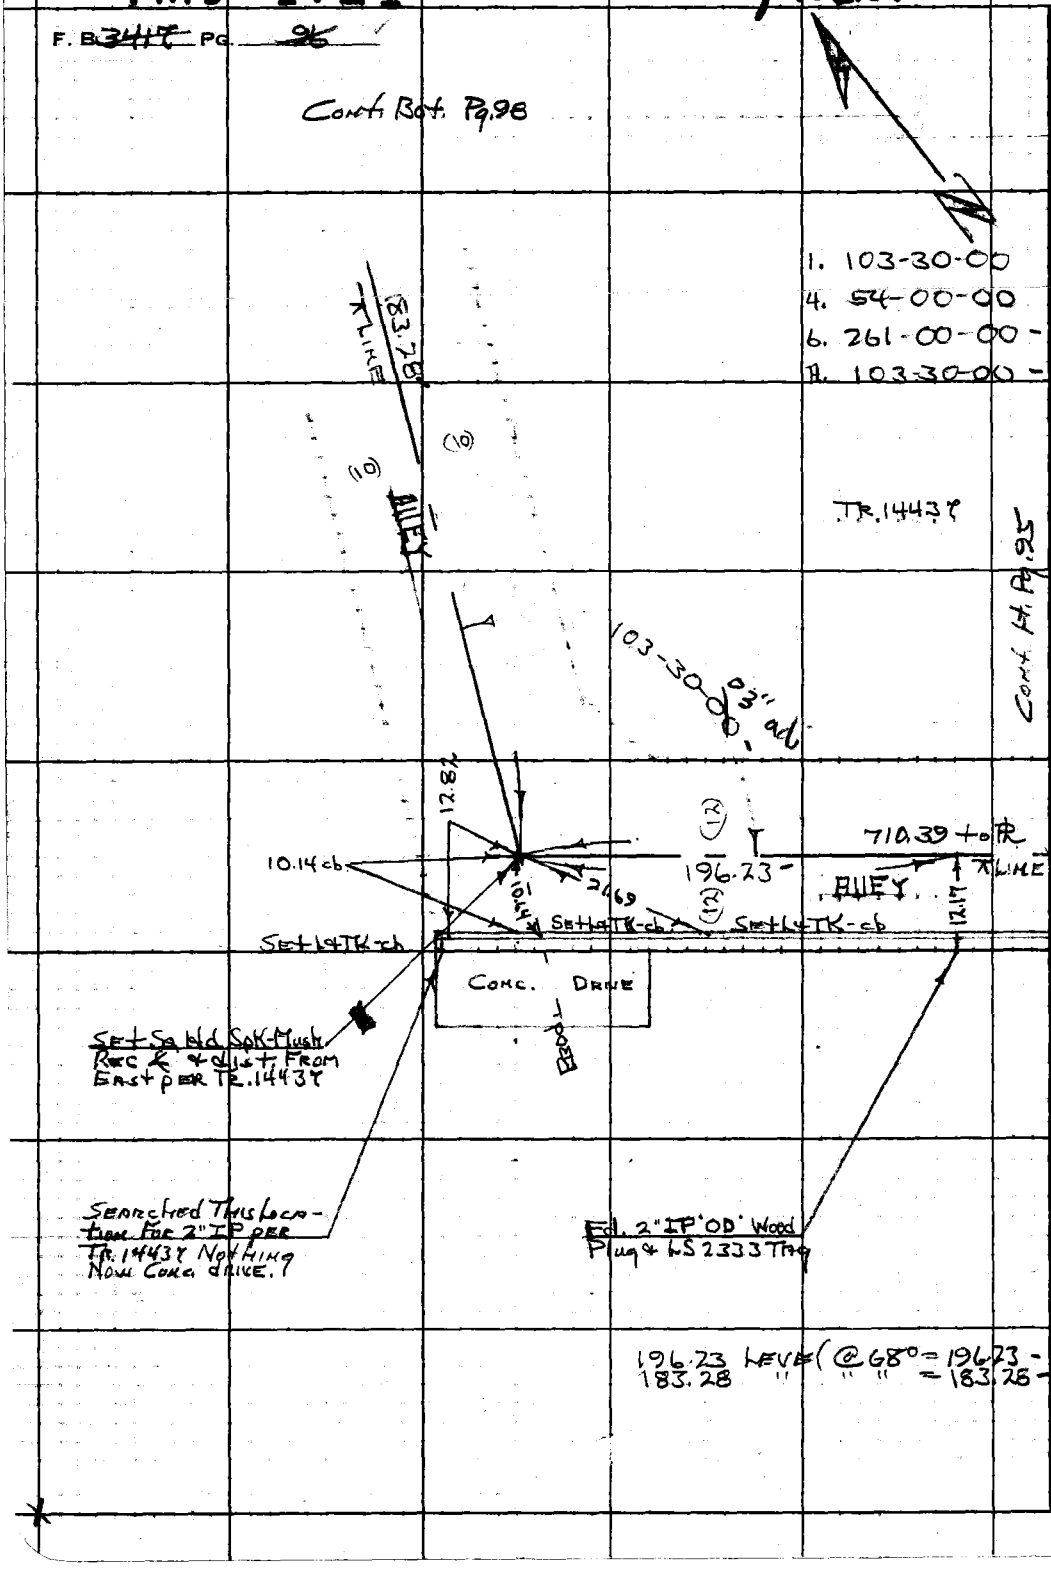

PLEASE RETURN TO
LOS ANGELES COUNTY ENGINEER
403 LOS ANGELES COUNTY ENGINEERING BLDG.

Do not extend this side of this line.

Note: Any Additions or Changes on This Sheet Must be Made or Circled in Red Ink With Date and Name of Person Making Change.

PWFB 1921 2428

Notes Ck'd by R. P. SHORT	Survey of [illegible]
Map No. B-5072	SN [illegible] Tape [illegible] Std [illegible]
Office Work H. H. F. DONG	Surveyed by [illegible]
Checked W. EDMONDSON	Notes [illegible] Date [illegible]
Date NOV 21 '69	Indexed C. J. GALLI

F. B. [illegible] PG. [illegible]

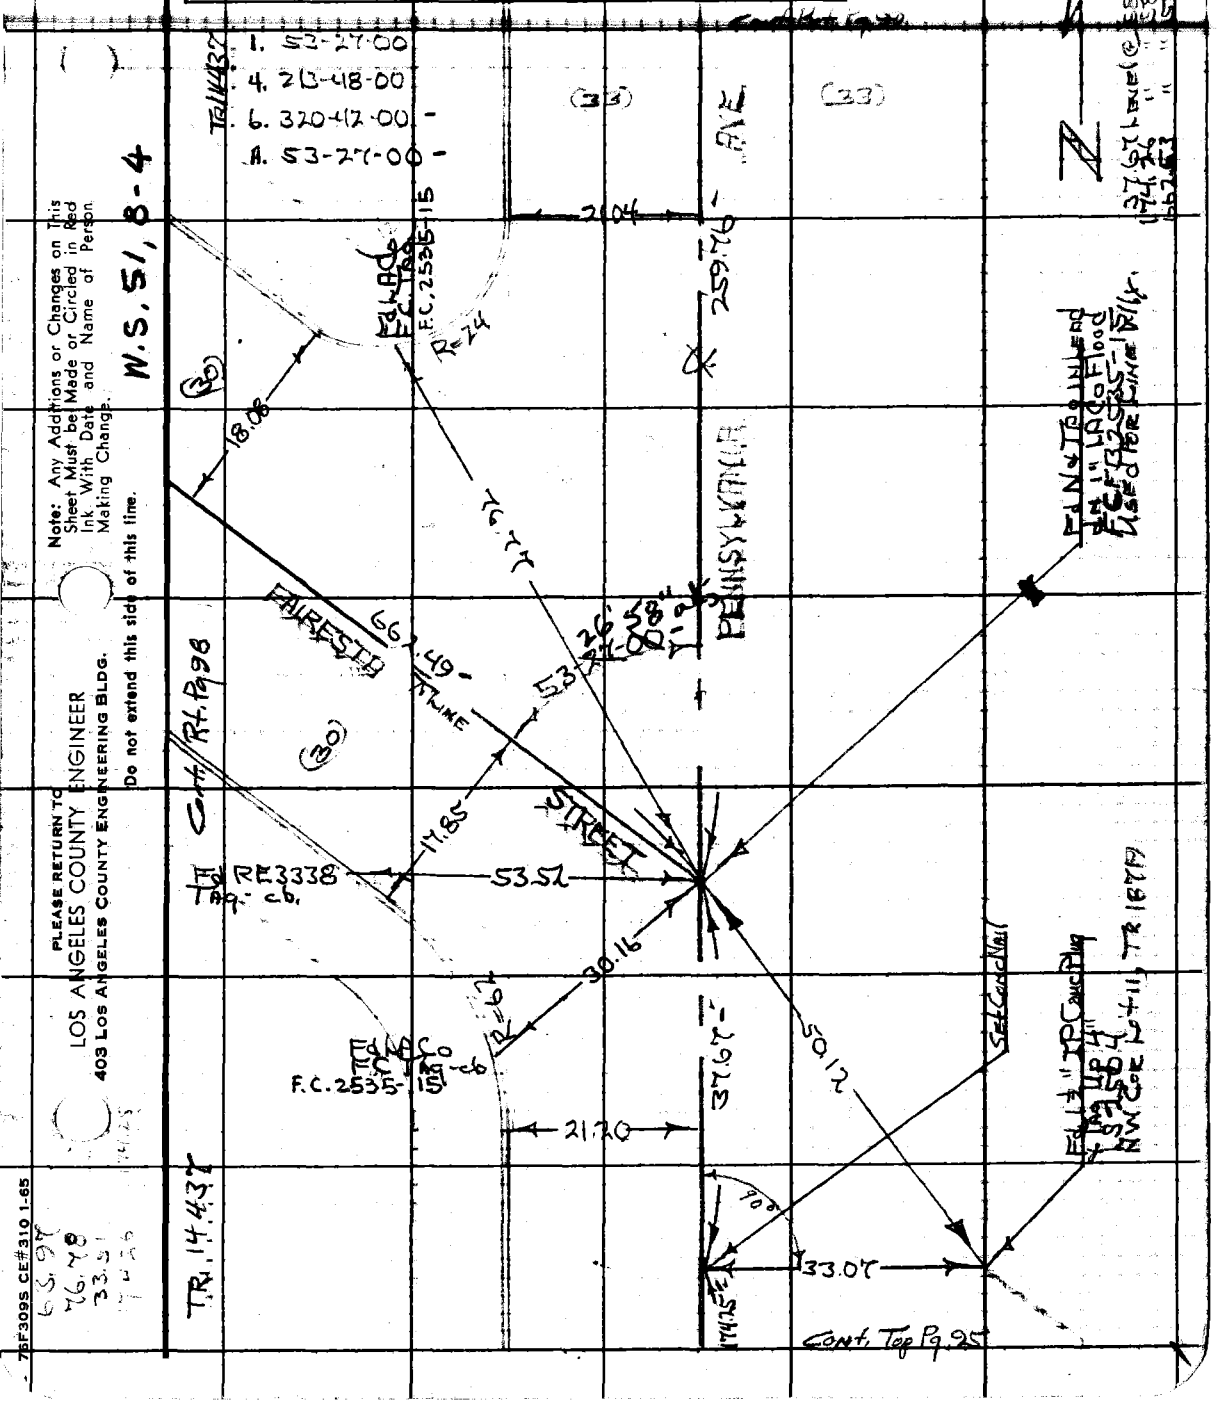

76F309S CE#310 1-65

PWFB 1921 2429

F. B 3417 Pg 98

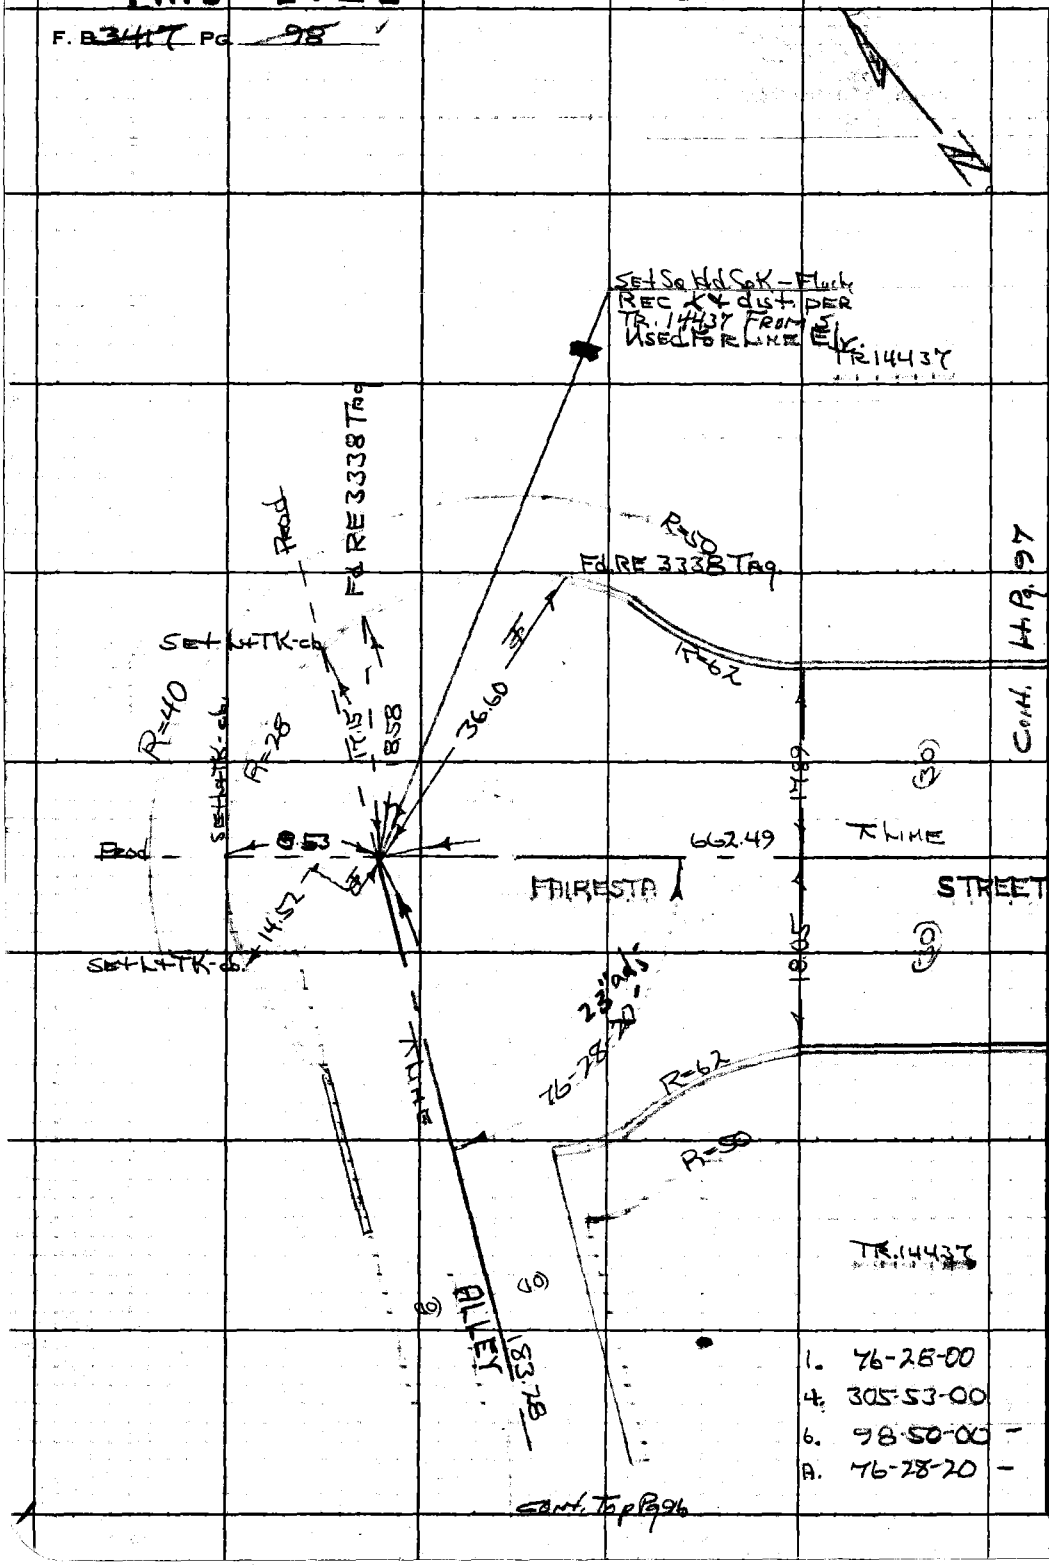

1. 76-28-00
4. 305-53-00
6. 98-50-00 -
A. 76-28-20 -

W.S. 51, B-4

PLEASE RETURN TO
LOS ANGELES COUNTY ENGINEER
403 LOS ANGELES COUNTY ENGINEERING BLDG.
Do not extend this side of this line.

Note: Any Additions or Changes on This Sheet Must be Made or Circled in Red Ink With Date and Name of Person Making Change.

PWFB 1921 2430, 2431

Notes Ck'd by R. P. SHORT	Survey of Penna Ave
Map No. [illegible]	[illegible]
Office Work H. H. F. DONG	Surveyed by [illegible]
Checked W. EDMONDSON	Notes NHS Date [illegible]
Date NOV 2 1 '69	Indexed C. J. GALLI

F. B. 2414 Pg. 99

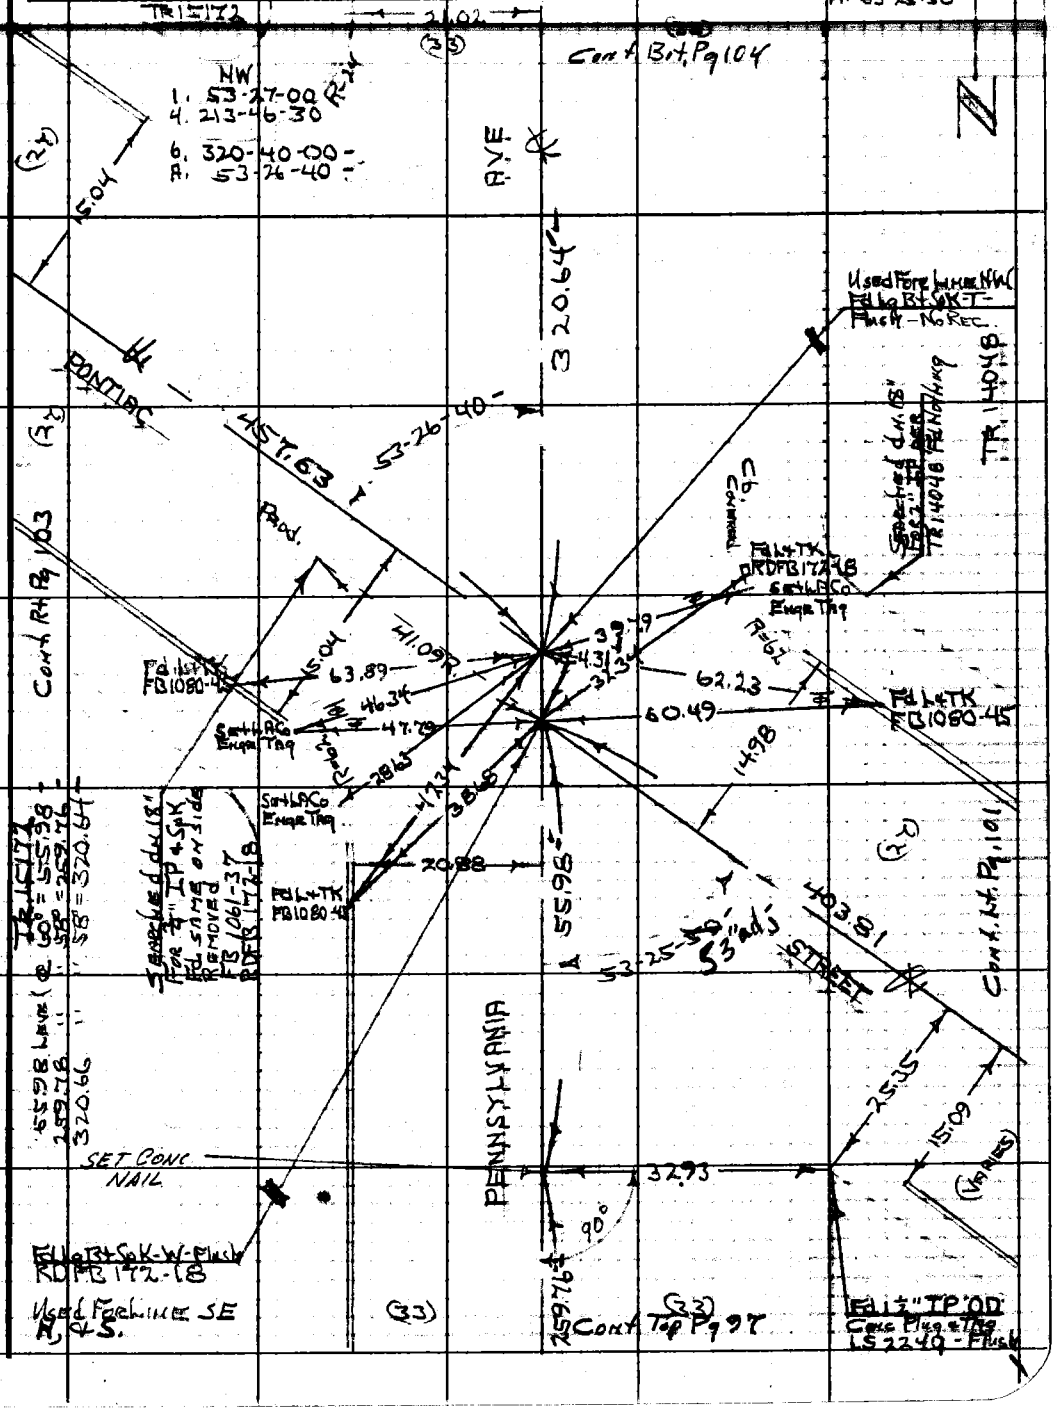

W.S. 51, B-4

Note: Any Additions or Changes on This Sheet Must be Made or Circled in Red Ink With Date and Name of Person Making Change.

Do not extend this side of this line.

PLEASE RETURN TO
LOS ANGELES COUNTY ENGINEER
403 LOS ANGELES COUNTY ENGINEERING BLDG.

76F309S CE#310 1-65

PWFB 1921 2432

F. B. ~~2417~~ PG. ~~100~~

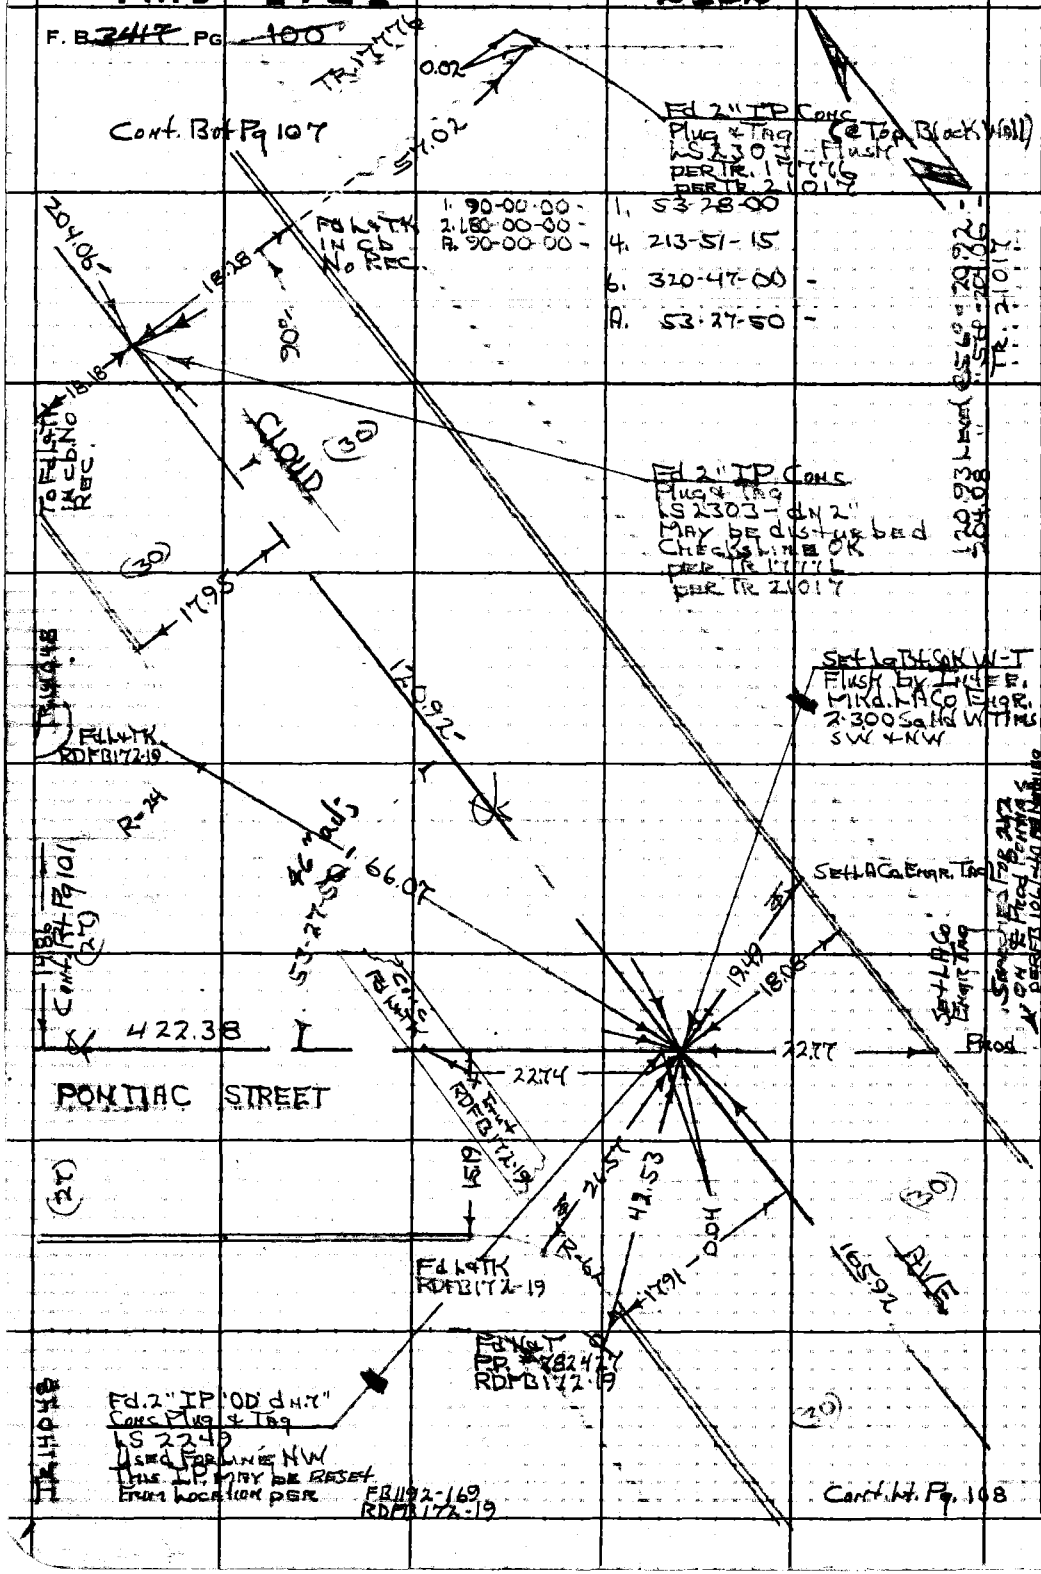

W.S. 51, P-4

PLEASE RETURN TO
LOS ANGELES COUNTY ENGINEER
403 LOS ANGELES COUNTY ENGINEERING BLDG.

Do not extend this side of this line.

Note: Any Additions or Changes on This Sheet Must be Made or Circled in Red Ink With Date and Name of Person Making Change.

PWFB 1921 2433

Notes Ck'd by R. P. SHORT	Survey of Pening Ave
Map No. B-5072	JN [illegible]
Office Work H. H. F. DONG	Surveyed by [illegible]
Checked	Notes [illegible] Date 4-17-67
Date	Indexed C. J. GALLI

F. B. 3417 PG. 101

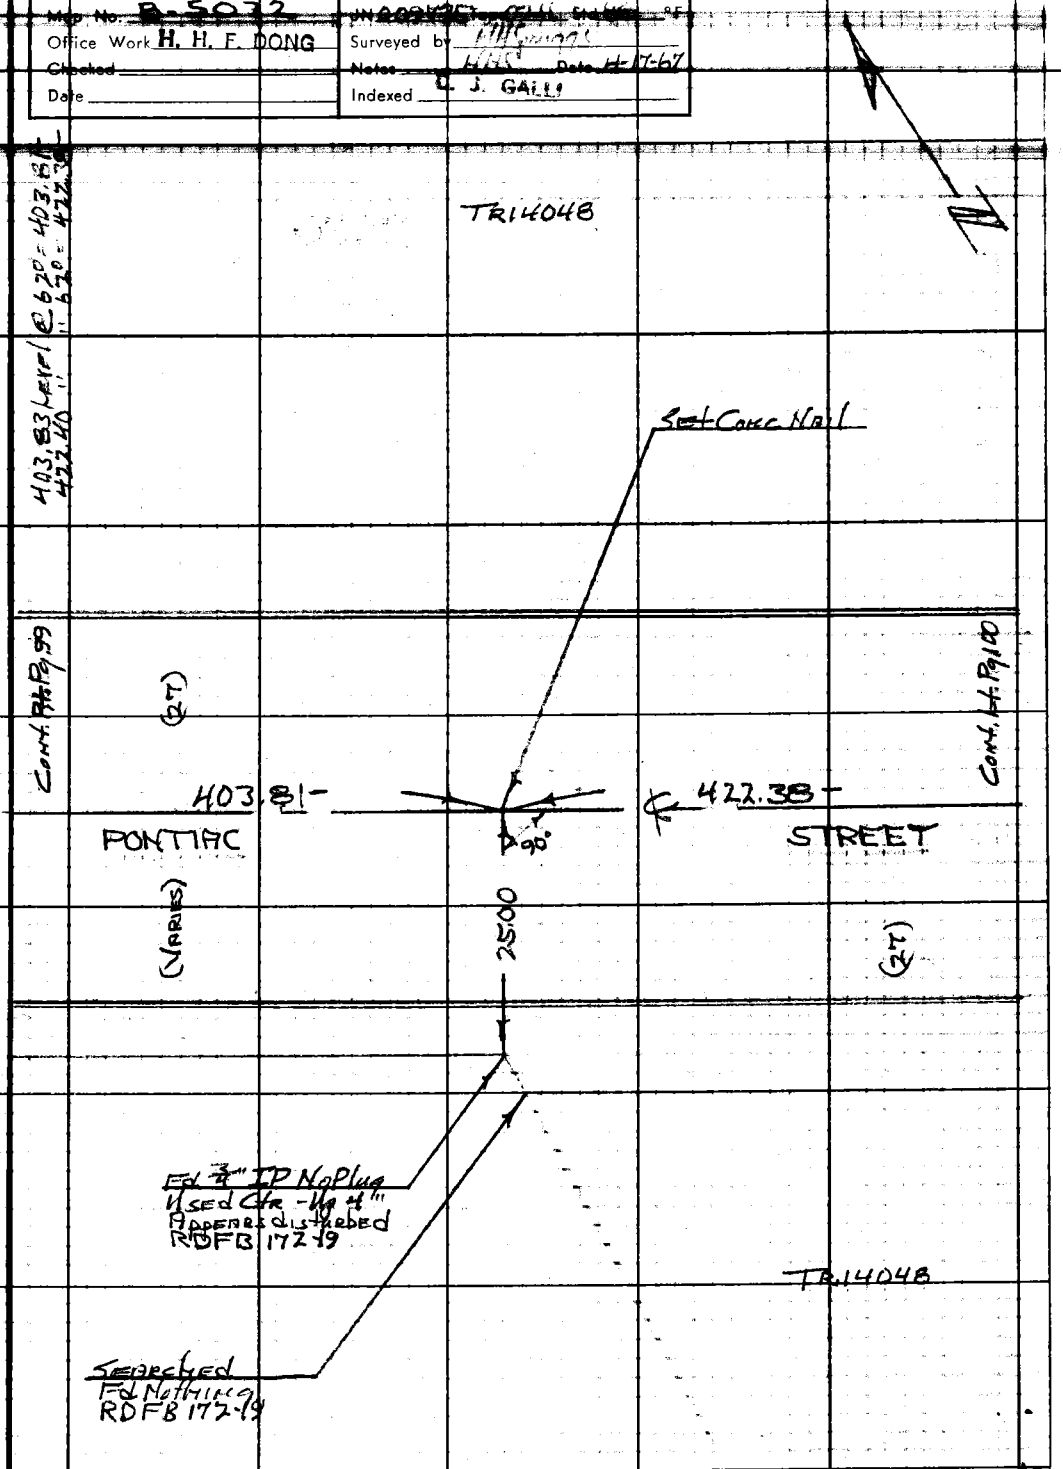

Note: Any Additions or Changes on This Sheet Must be Made or Circled in Red Ink With Date and Name of Person Making Change.

Do not extend this side of this line.

PLEASE RETURN TO
LOS ANGELES COUNTY ENGINEER
403 LOS ANGELES COUNTY ENGINEERING BLDG.

76F309S CE#310 1-65

PWFB 1921 2434

F. B. ~~3417~~ PG ~~102~~

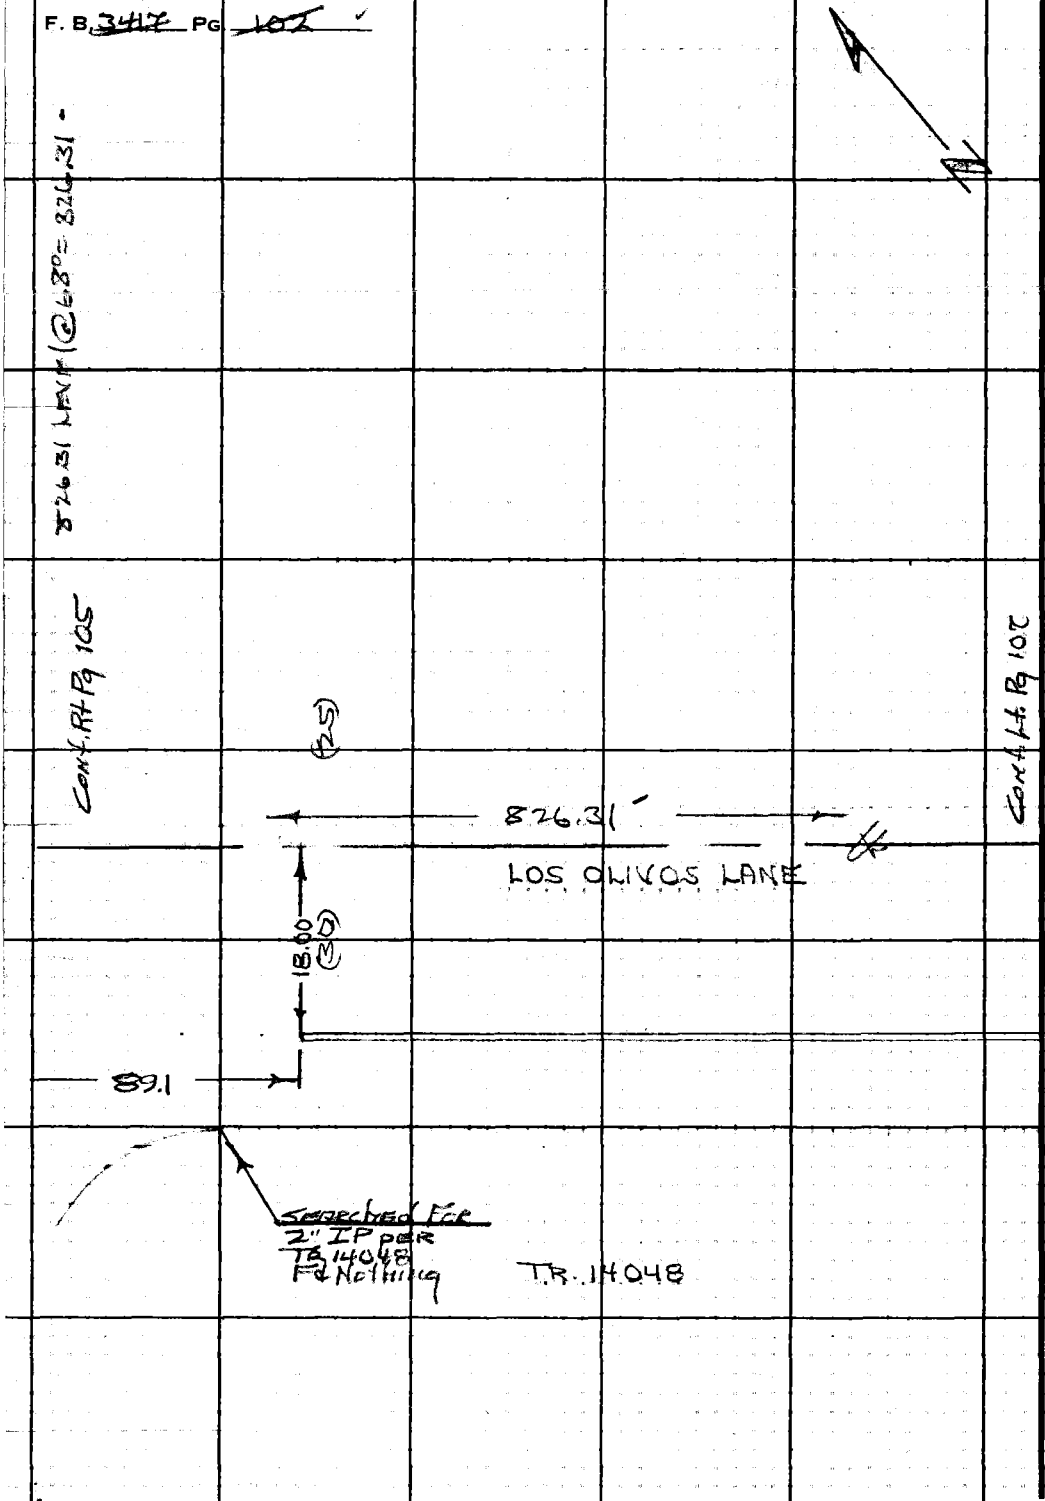

PLEASE RETURN TO
LOS ANGELES COUNTY ENGINEER
403 LOS ANGELES COUNTY ENGINEERING BLDG.

Do not extend this side of this line.

Note: Any Additions or Changes on This Sheet Must be Made or Circled in Red Ink With Date and Name of Person Making Change.

PWFB 1921 2435

Notes Ck'd by R. P. SHORT	Survey of Person Ave	F. B. [illegible] Pg. [illegible]
Map No. [illegible]	[illegible]	
Office Work H. H. F. DONG	Surveyed by [illegible]	
Checked	Notes HHS Date [illegible]	
Date	Indexed C. J. GALLI	

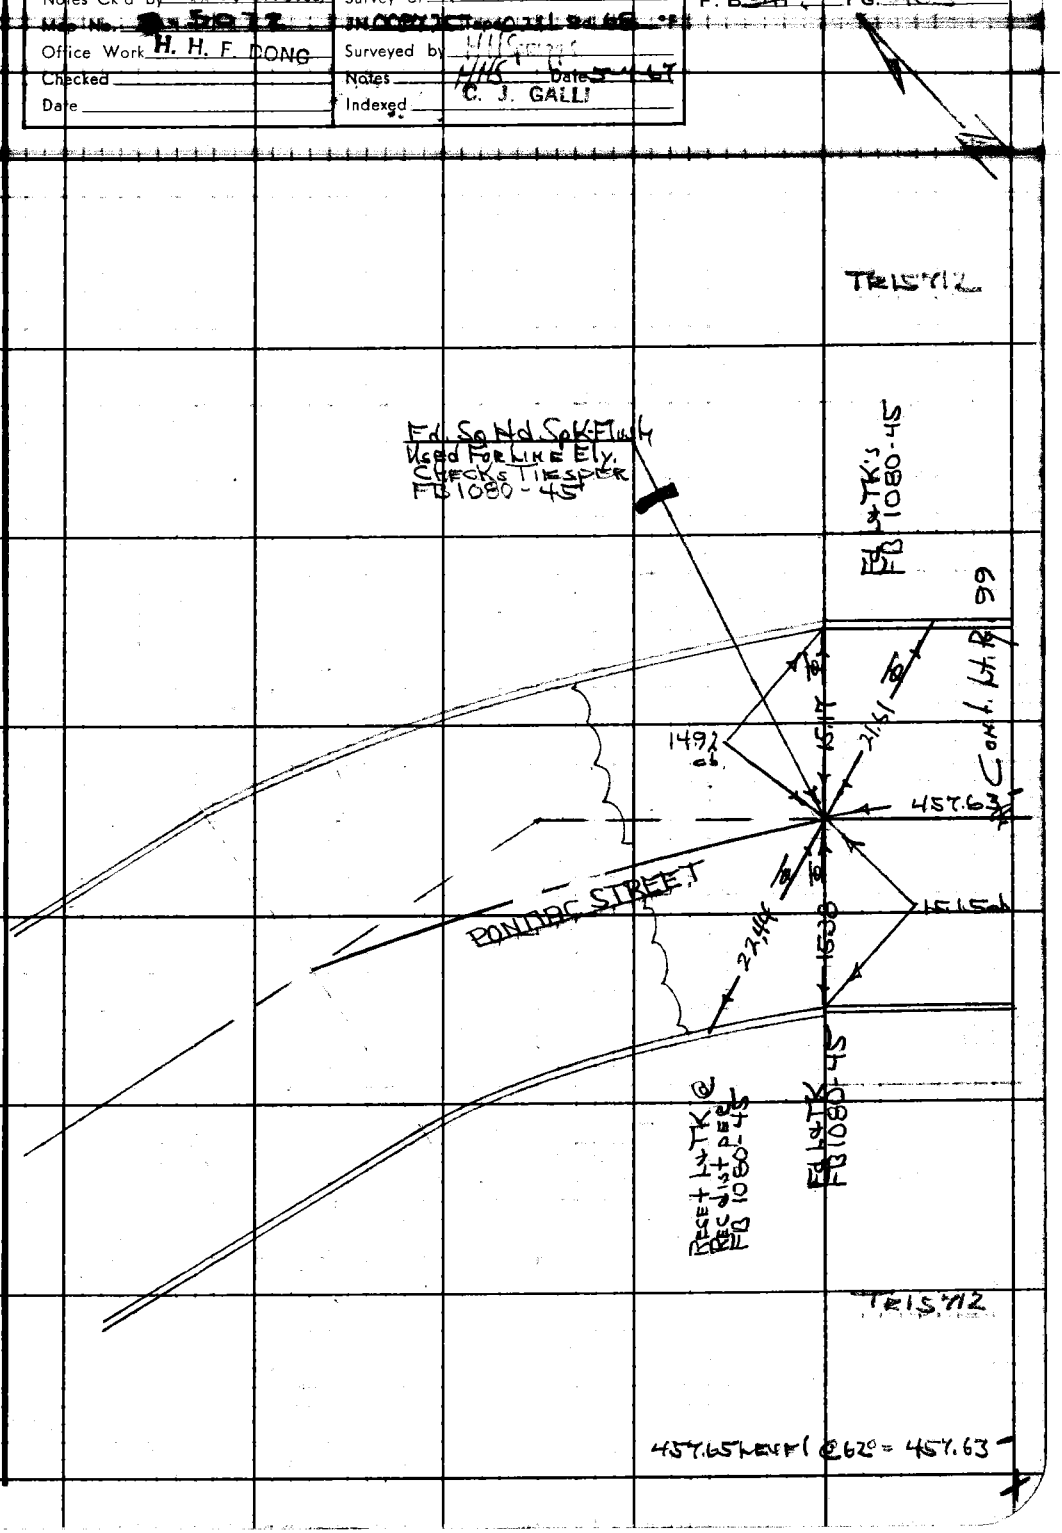

Note: Any Additions or Changes on This Sheet Must be Made or Circled in Red Ink With Date and Name of Person Making Change.

PLEASE RETURN TO
LOS ANGELES COUNTY ENGINEER
403 LOS ANGELES COUNTY ENGINEERING BLDG.
Do not extend this side of this line.

76F309S CE#310 1-65

PWFB 1921 2436

F. B. ~~3444~~ PG. ~~104~~ ✓

Cont. Bot Pg. 105

PLEASE RETURN TO
LOS ANGELES COUNTY ENGINEER
403 Los Angeles County Engineering Bldg.
Do not extend this side of this line.

Note: Any Additions or Changes on This Sheet Must be Made or Circled in Red Ink With Date and Name of Person Making Change.

PWFB 1921 2437

Notes Ck'd by R. P. SHORT	Survey of [illegible]
Map No. B-5072	JN [illegible]
Office Work CHECKED W. EDMONDSON	Surveyed by HHS [illegible]
Checked H. H. F. DONG	Notes HHS Date
Date NOV 2 1 '69	Indexed C. J. GALLI

F. B. [illegible] PG. [illegible]

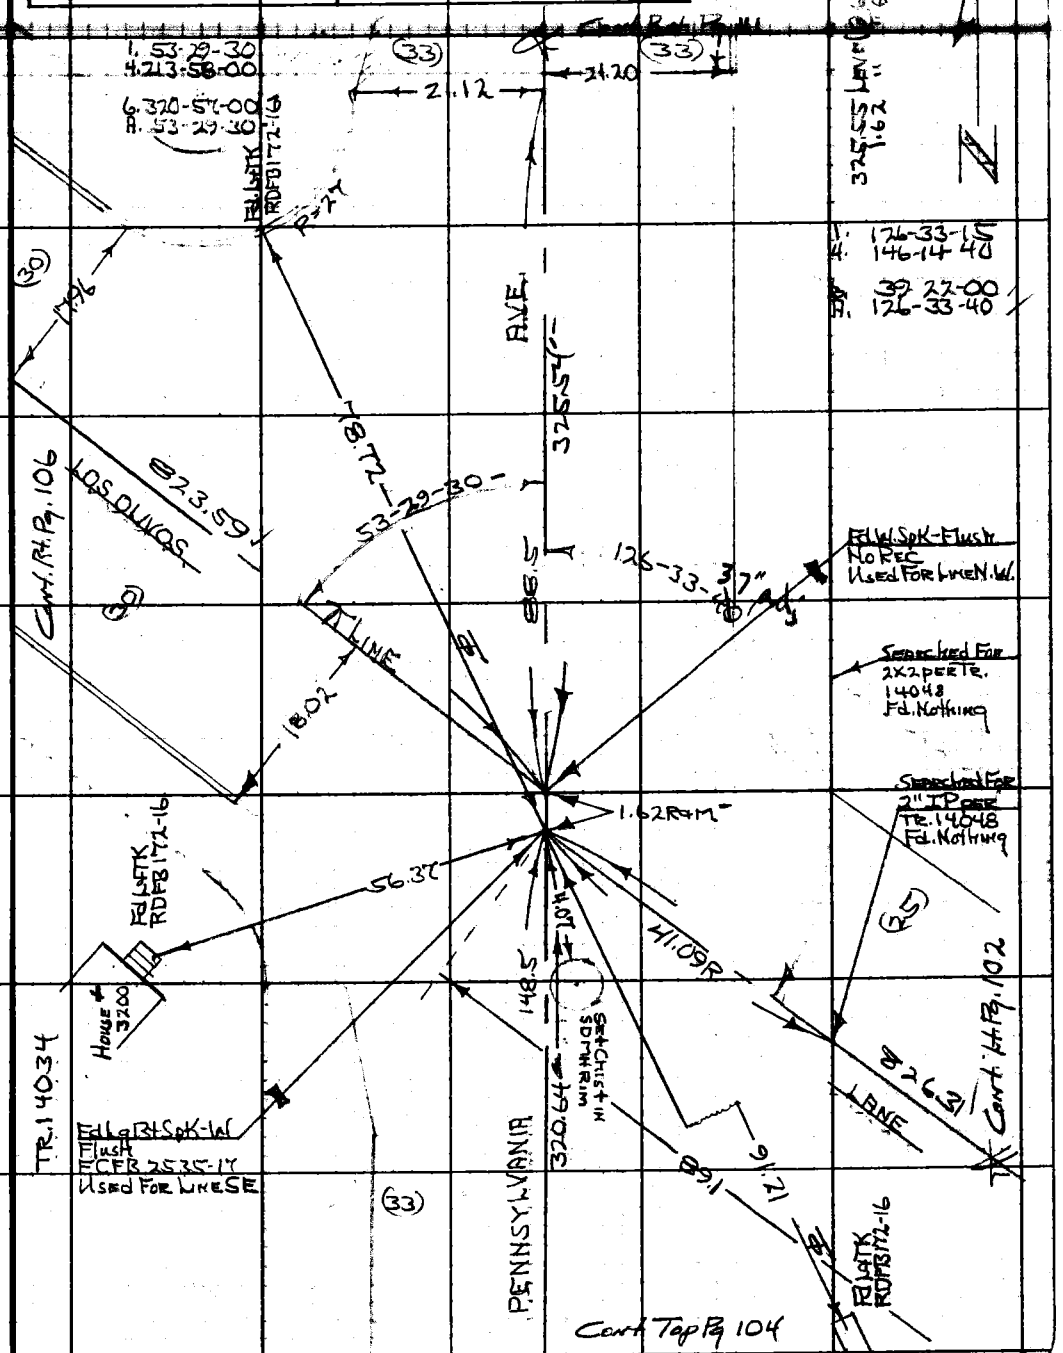

W.S. 51, B-4

Note: Any Additions or Changes on This Sheet Must be Made or Circled in Red Ink With Date and Name of Person Making Change.

Do not extend this side of this line.

PLEASE RETURN TO
LOS ANGELES COUNTY ENGINEER
403 LOS ANGELES COUNTY ENGINEERING BLDG.

76F309S CE#310 1-65

PWFB 1921 2438

F. B. 3417 PG. 106

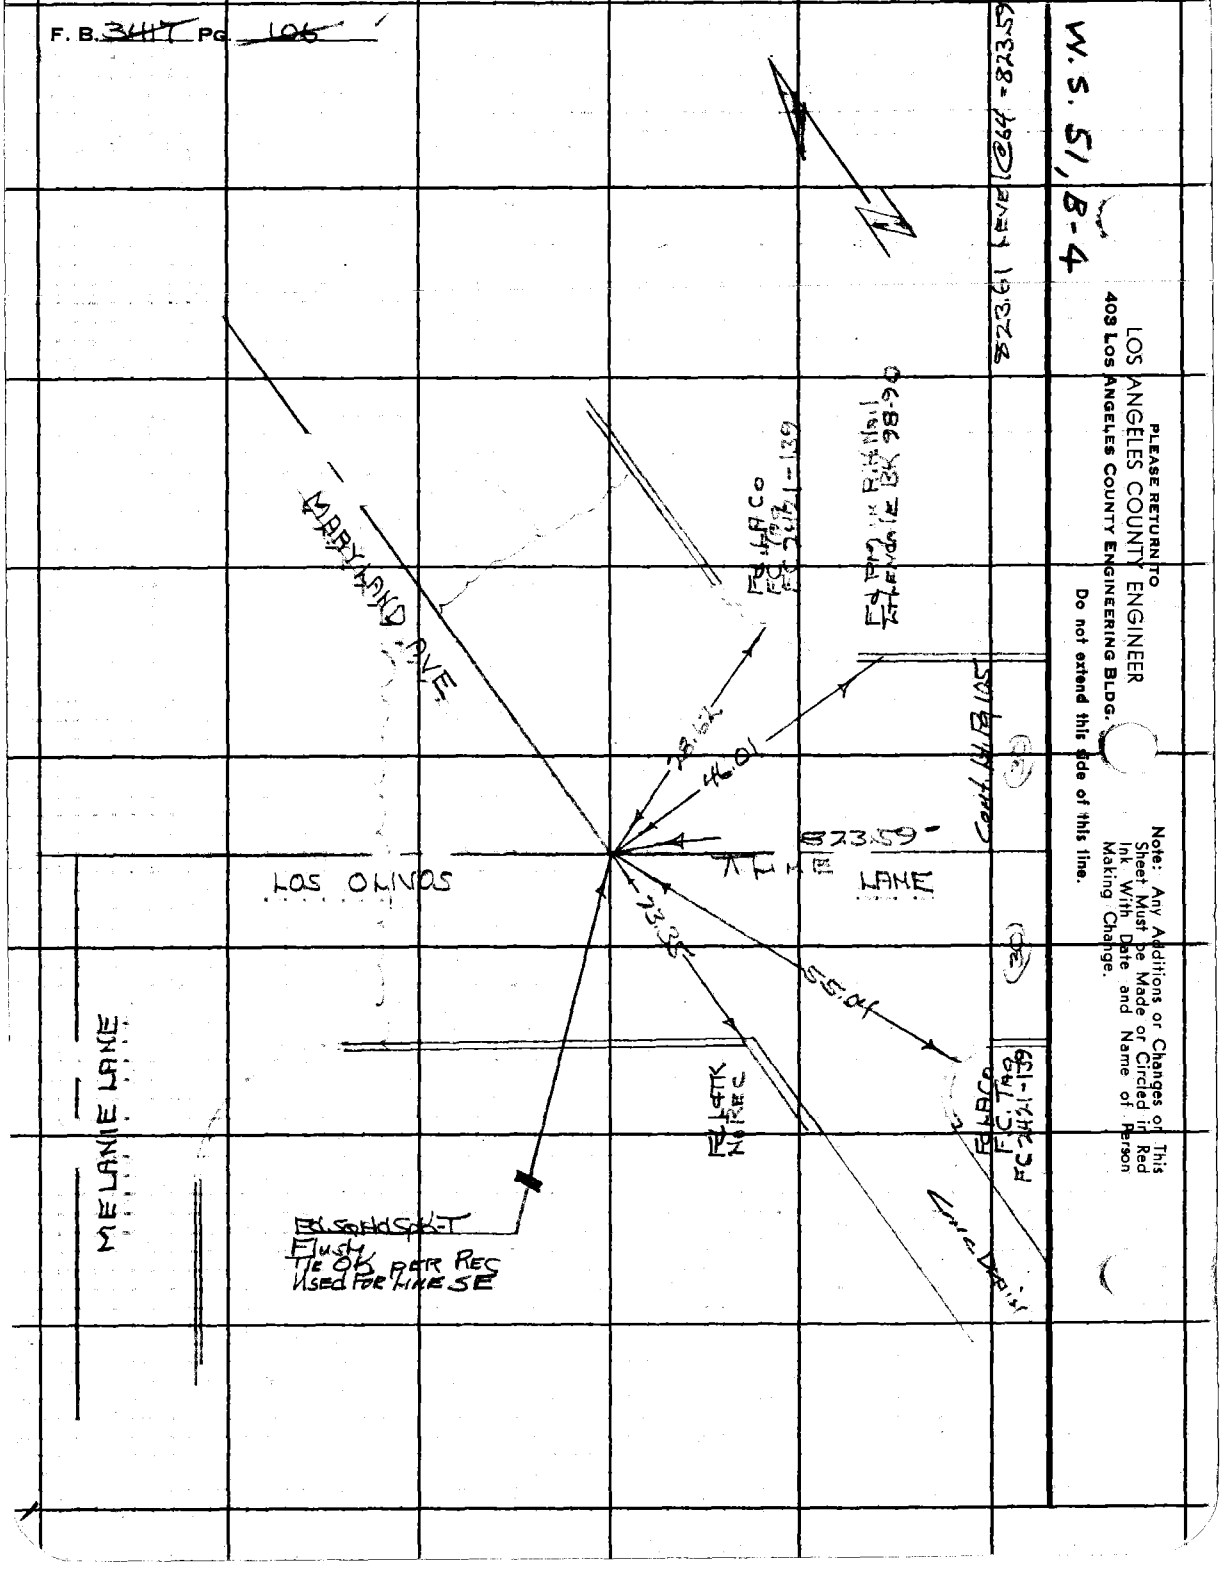

PWFB 1921 2439

Notes Ck'd by R. P. SHORT	Survey of	F. B.	Pg.
Office Work H. H. F. DONG	Surveyed by		
Date	Indexed C. J. GALLI		

PLEASE RETURN TO LOS ANGELES COUNTY ENGINEER
403 Los Angeles County Engineering Bldg.

Note: Any Additions or Changes on This Sheet Must be Made or Circled in Red Ink With Date and Name of Person Making Change.

Do not extend this side of this line.

W.S. 51, B-4

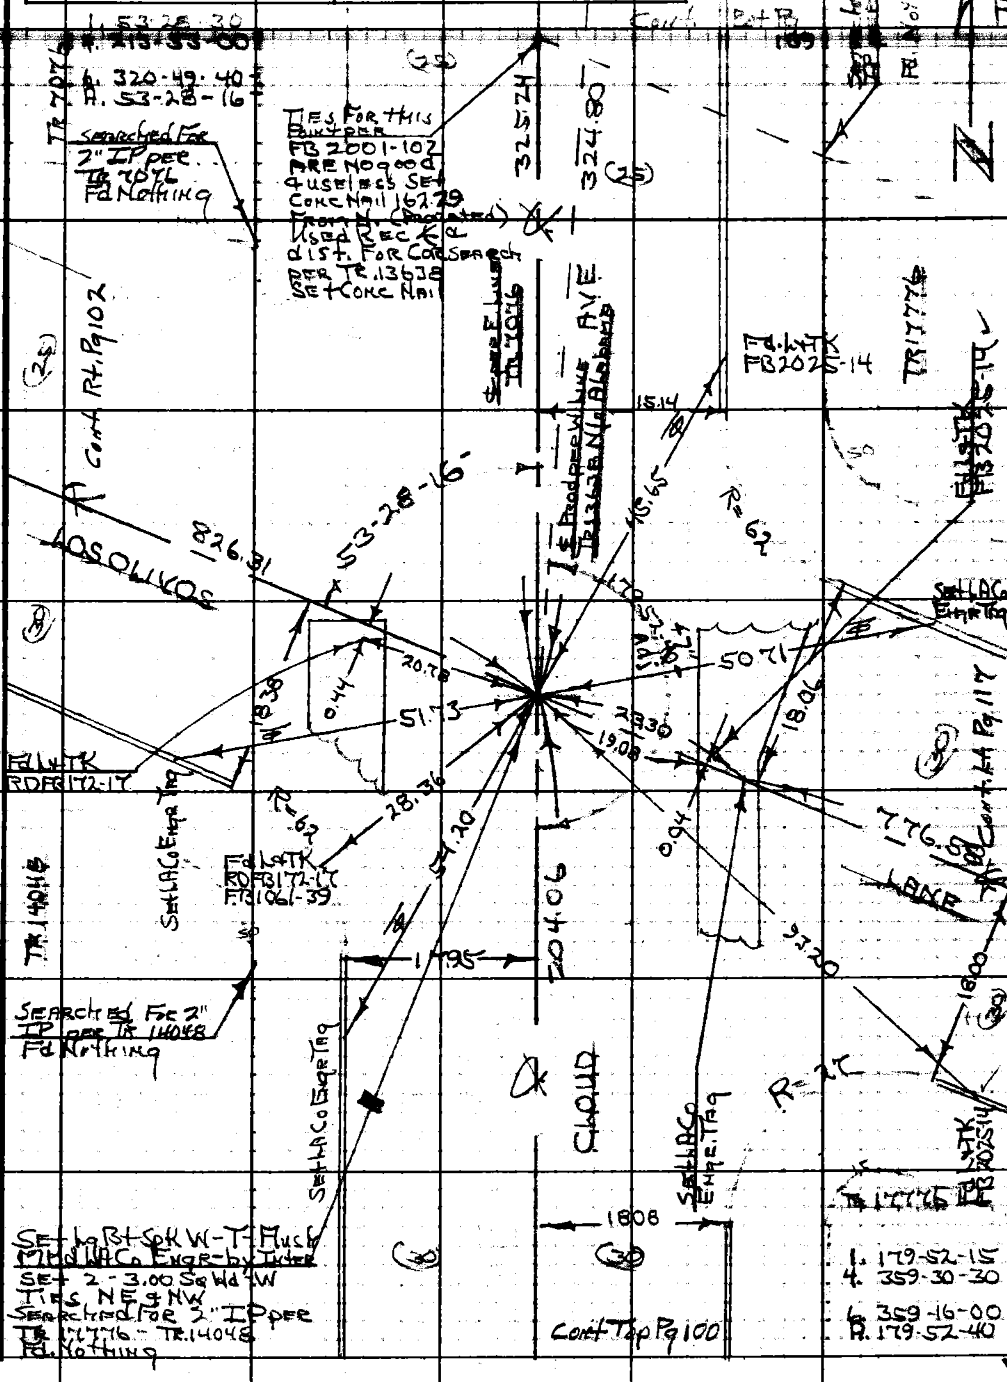

76F3095 CE#310 1-65

PWFB 1921 2440

F. B. ~~3417~~ PG ~~108~~

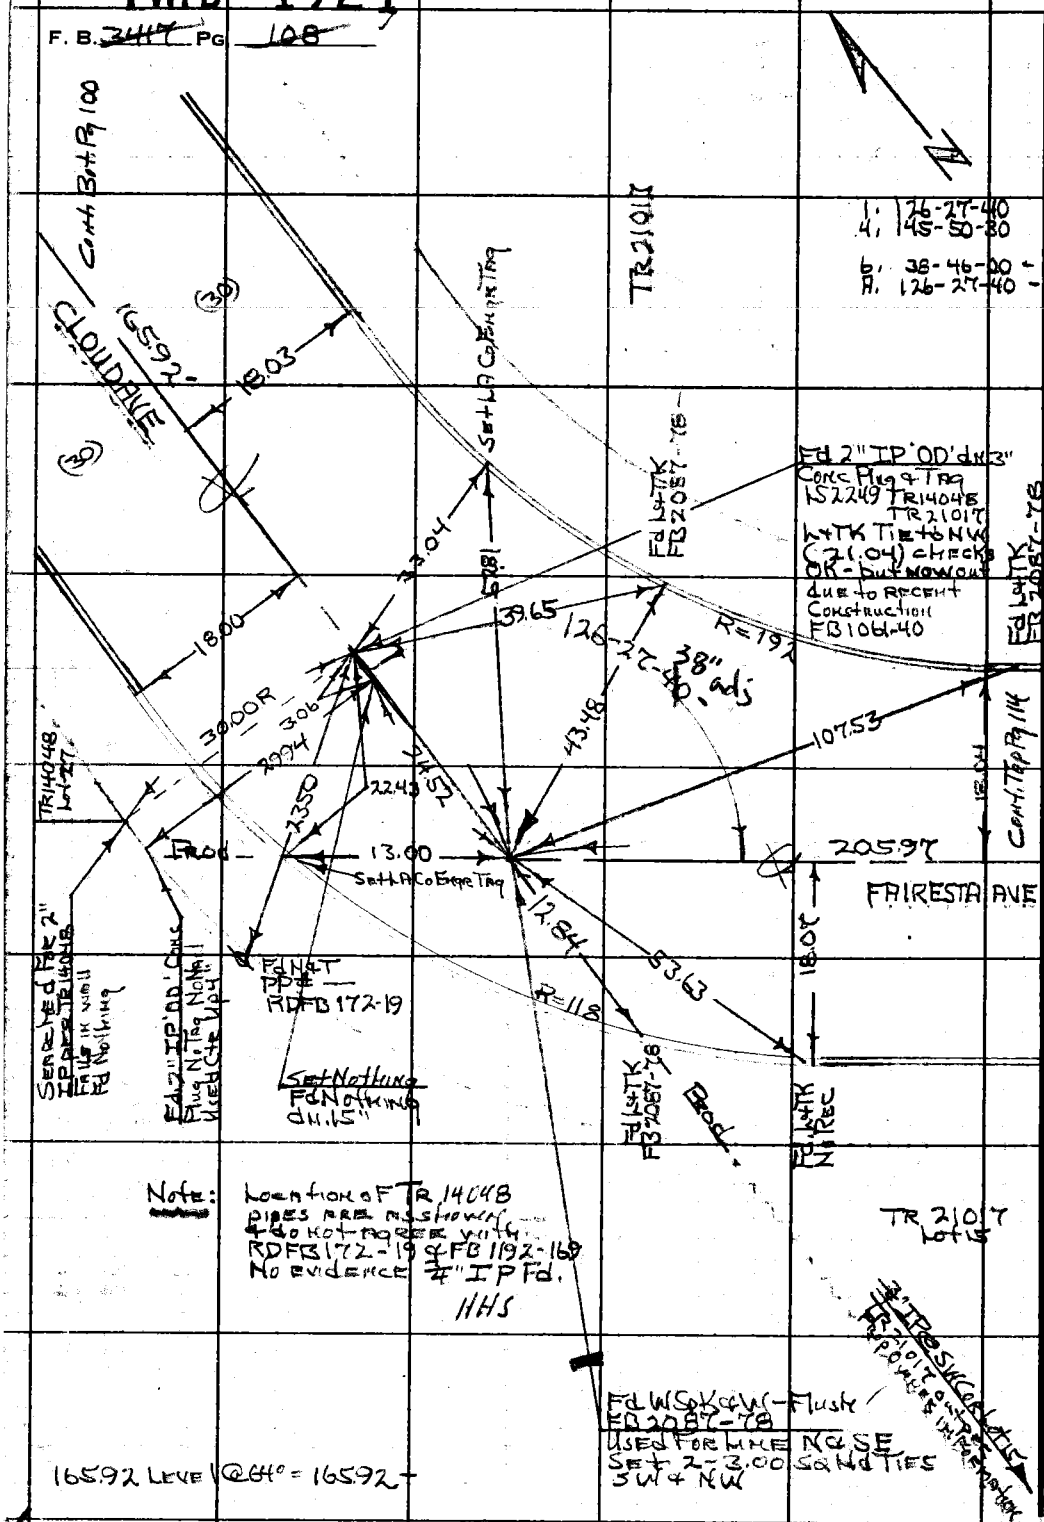

W.S. 51, B-4

1. 126-27-40
4. 145-50-30
6. 38-46-00
A. 126-27-40

PLEASE RETURN TO
LOS ANGELES COUNTY ENGINEER
403 LOS ANGELES COUNTY ENGINEERING BLDG.

Do not extend this side of this line.

Note: Any Additions or Changes on This Sheet Must be Made or Circled in Red Ink With Date and Name of Person Making Change.

PWFB 1921 2441

Date	Indexed C. J. GALLI		

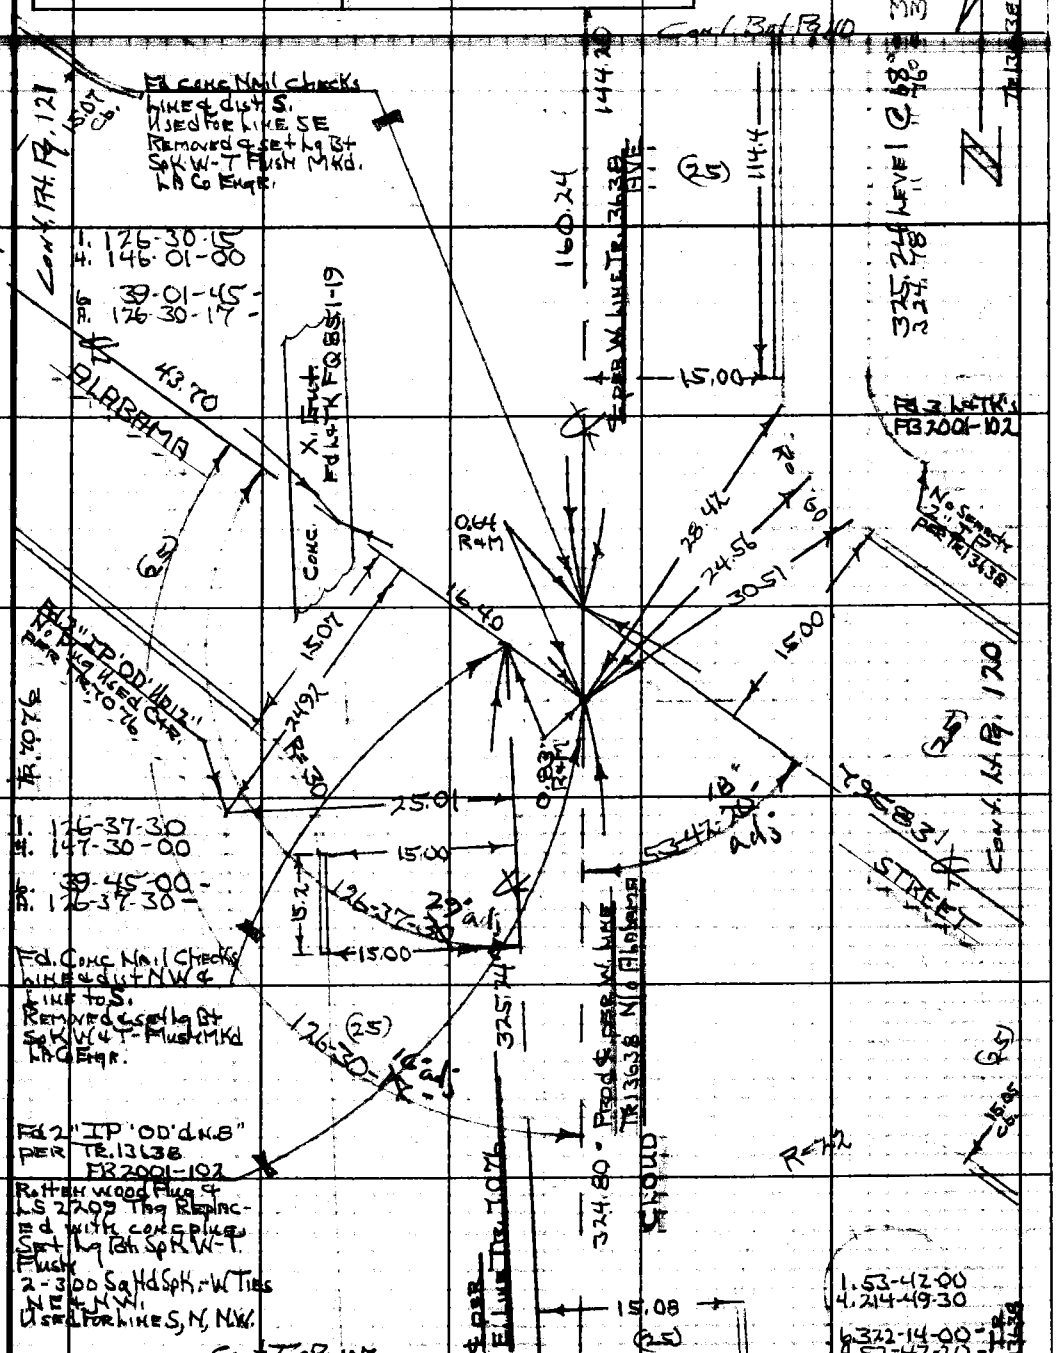

W.S. 51, 8-4

Note: Any Additions or Changes on This Sheet Must be Made or Circled in Red Ink With Date and Name of Person Making Change.

Do not extend this side of this line.

PLEASE RETURN TO
LOS ANGELES COUNTY ENGINEER
403 LOS ANGELES COUNTY ENGINEERING BLDG.

76F309S CE#310 1-65

PWFB 1921 2442

F. B 3417 PG 110 ✓

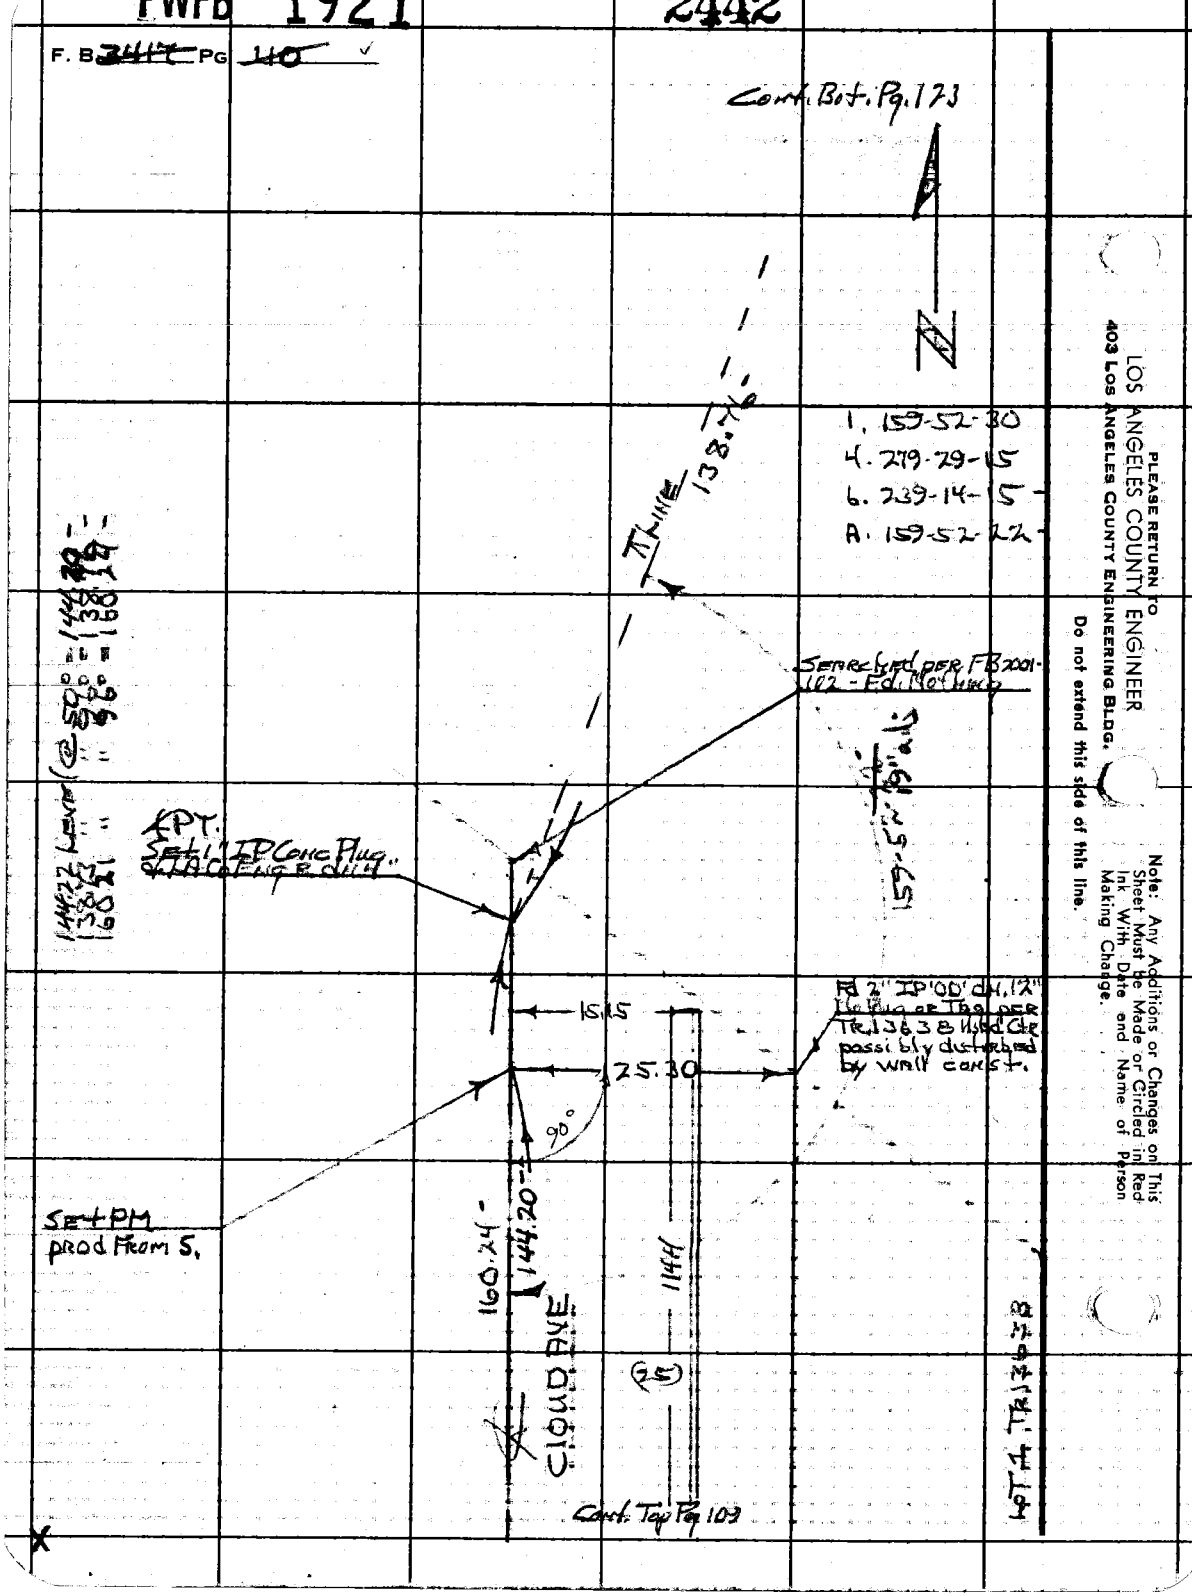

PWFB 1921 2443

Notes Ck'd by R. P. SHORT	Survey of	F. B.	Pg.
Map No. B-5072			
Office Work H. H. F. DONG	Surveyed by		
Checked W. EDMONDSON	Notes		
Date NOV 21 '69	Indexed C. J. GALLI		

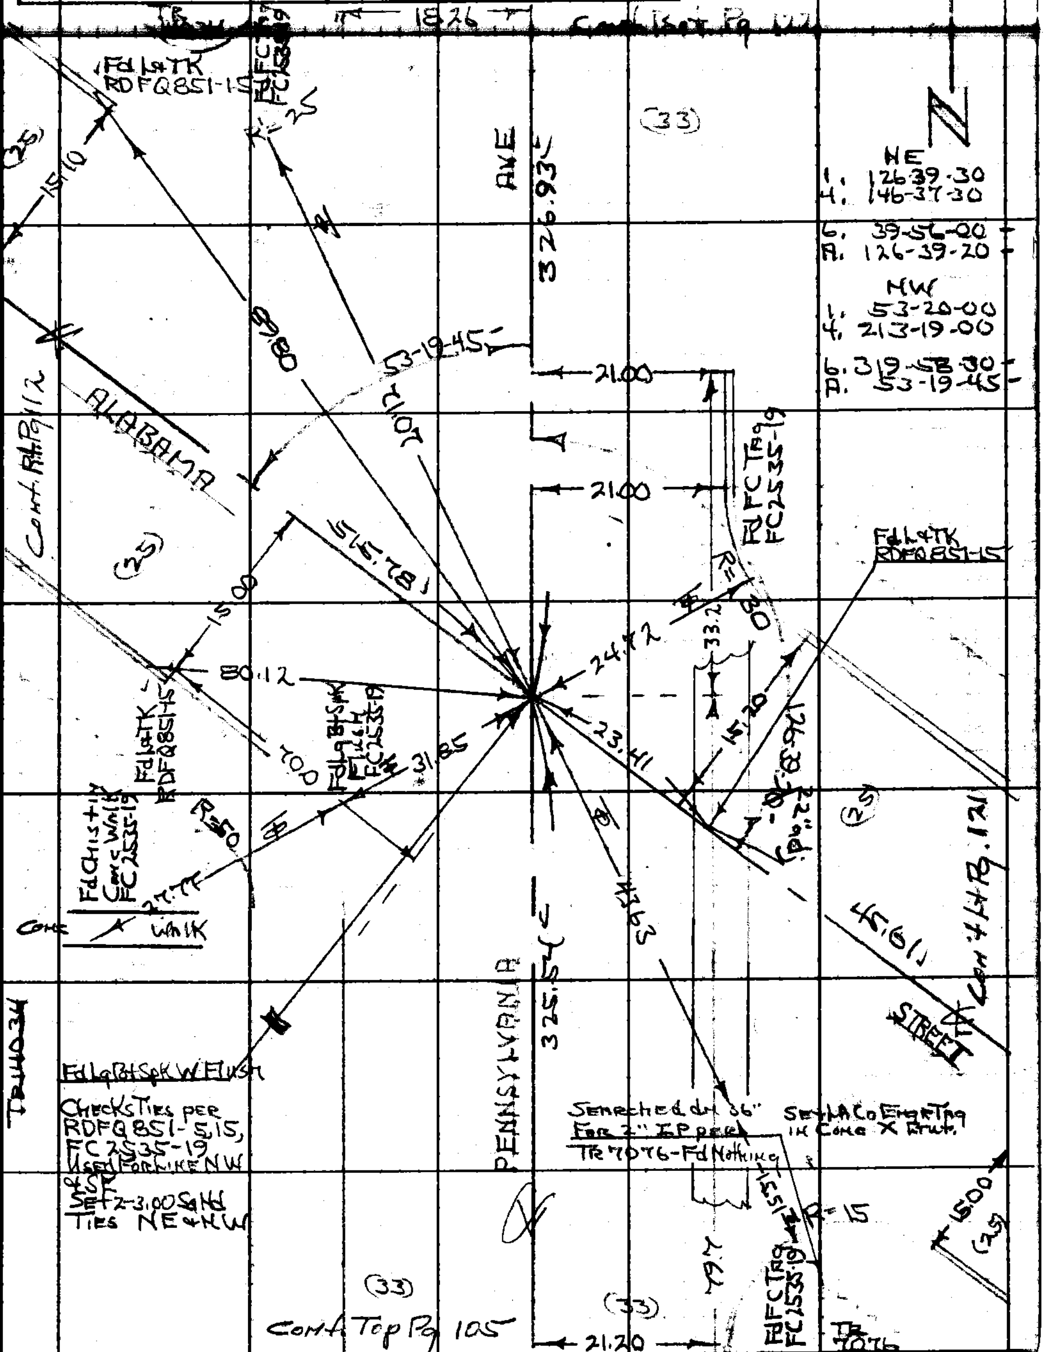

Note: Any Additions or Changes on This Sheet Must be Made or Circled in Red Ink With Date and Name of Person Making Change.

Do not extend this side of this line.

PLEASE RETURN TO
LOS ANGELES COUNTY ENGINEER
403 Los Angeles County Engineering Bldg.

76F3095 CE#310 1-65

PWFB 1921

2444

F. B. ~~3417~~ Pg. ~~112~~

W.S. 51, 8-4

LOS ANGELES COUNTY ENGINEER
403 Los Angeles County Engineering Bldg.

PLEASE RETURN TO

Do not extend this side of this line.

Note: Any Additions or Changes on This Sheet Must be Made or Circled in Red Ink With Date and Name of Person Making Change.

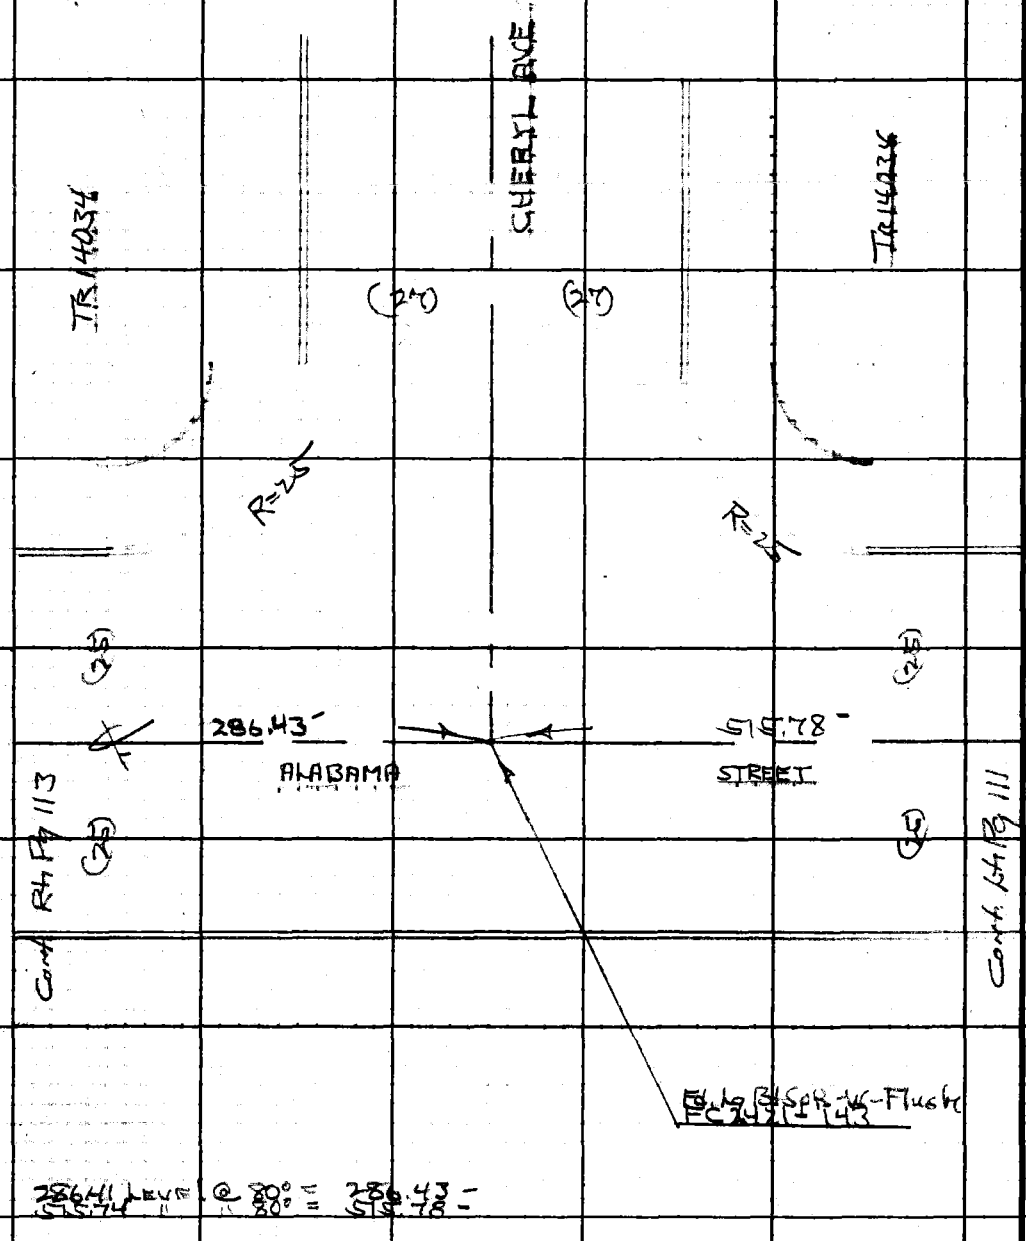

PWFB 1921

2445

Notes Ck'd by R. P. SHORT	Survey of [illegible]
Map No. [illegible] 5072	[illegible]
Office Work H. H. F. DONG	Surveyed by [illegible]
Checked	Notes [illegible] Date 6-15-67
Date	Indexed C. J. GALLI

F. B. [illegible] PG. 113

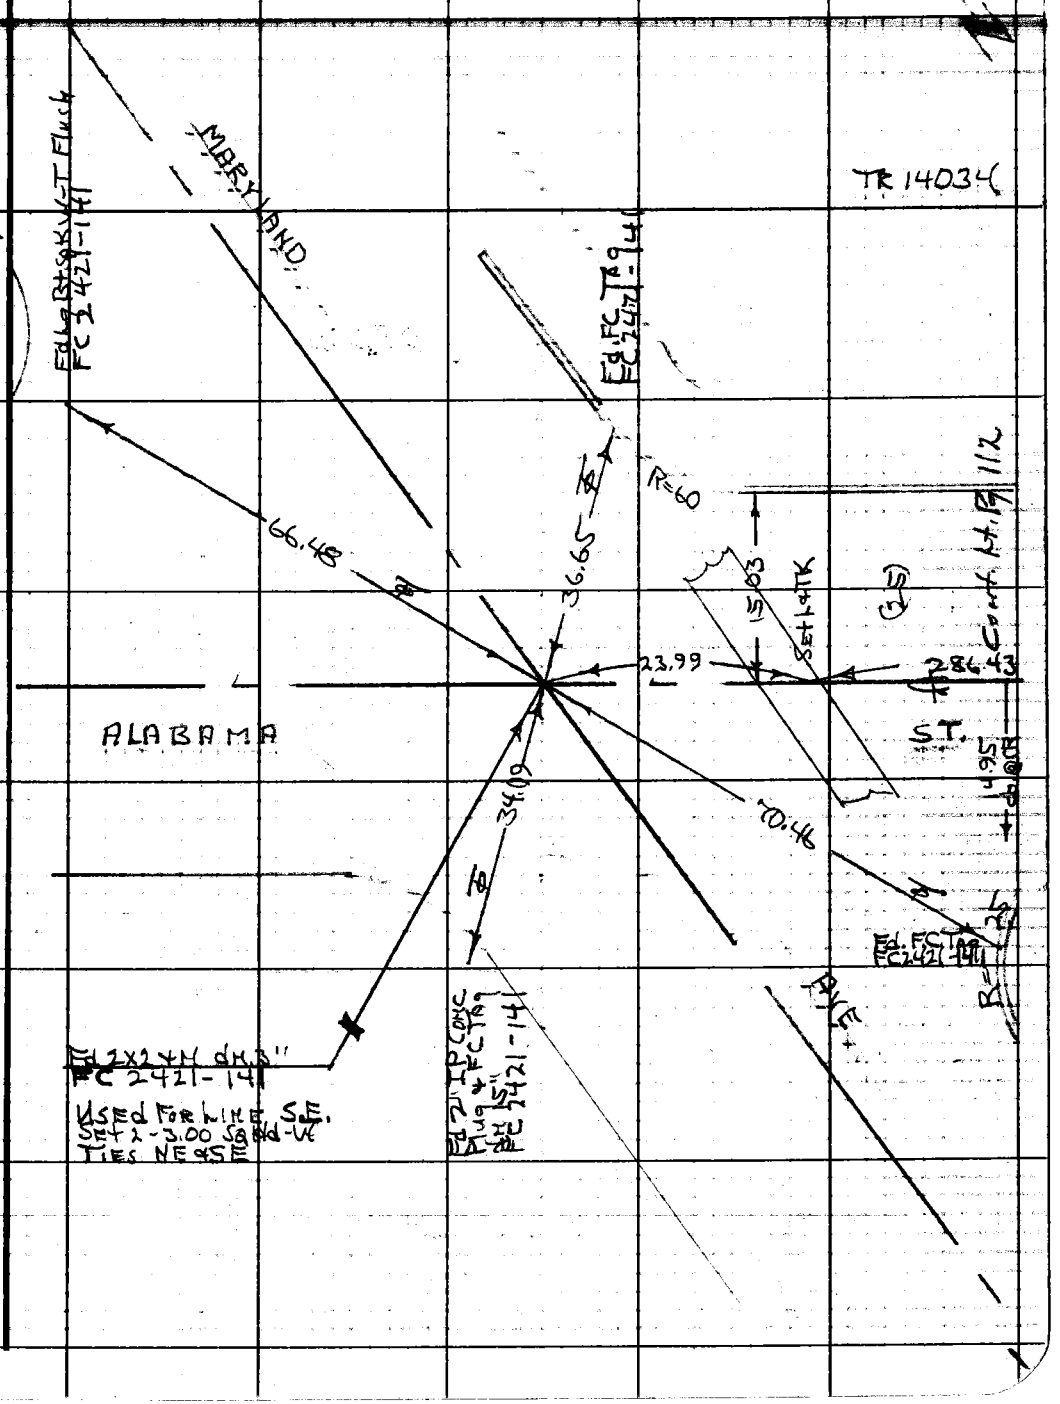

Note: Any Additions or Changes on This Sheet Must be Made or Circled in Red Ink With Date and Name of Person Making Change.

Do not extend this side of this line.

PLEASE RETURN TO
LOS ANGELES COUNTY ENGINEER
403 LOS ANGELES COUNTY ENGINEERING BLDG.

76F309S CE#310 1-65

PWFB 1921 2446

F. B. 3417 PG 114

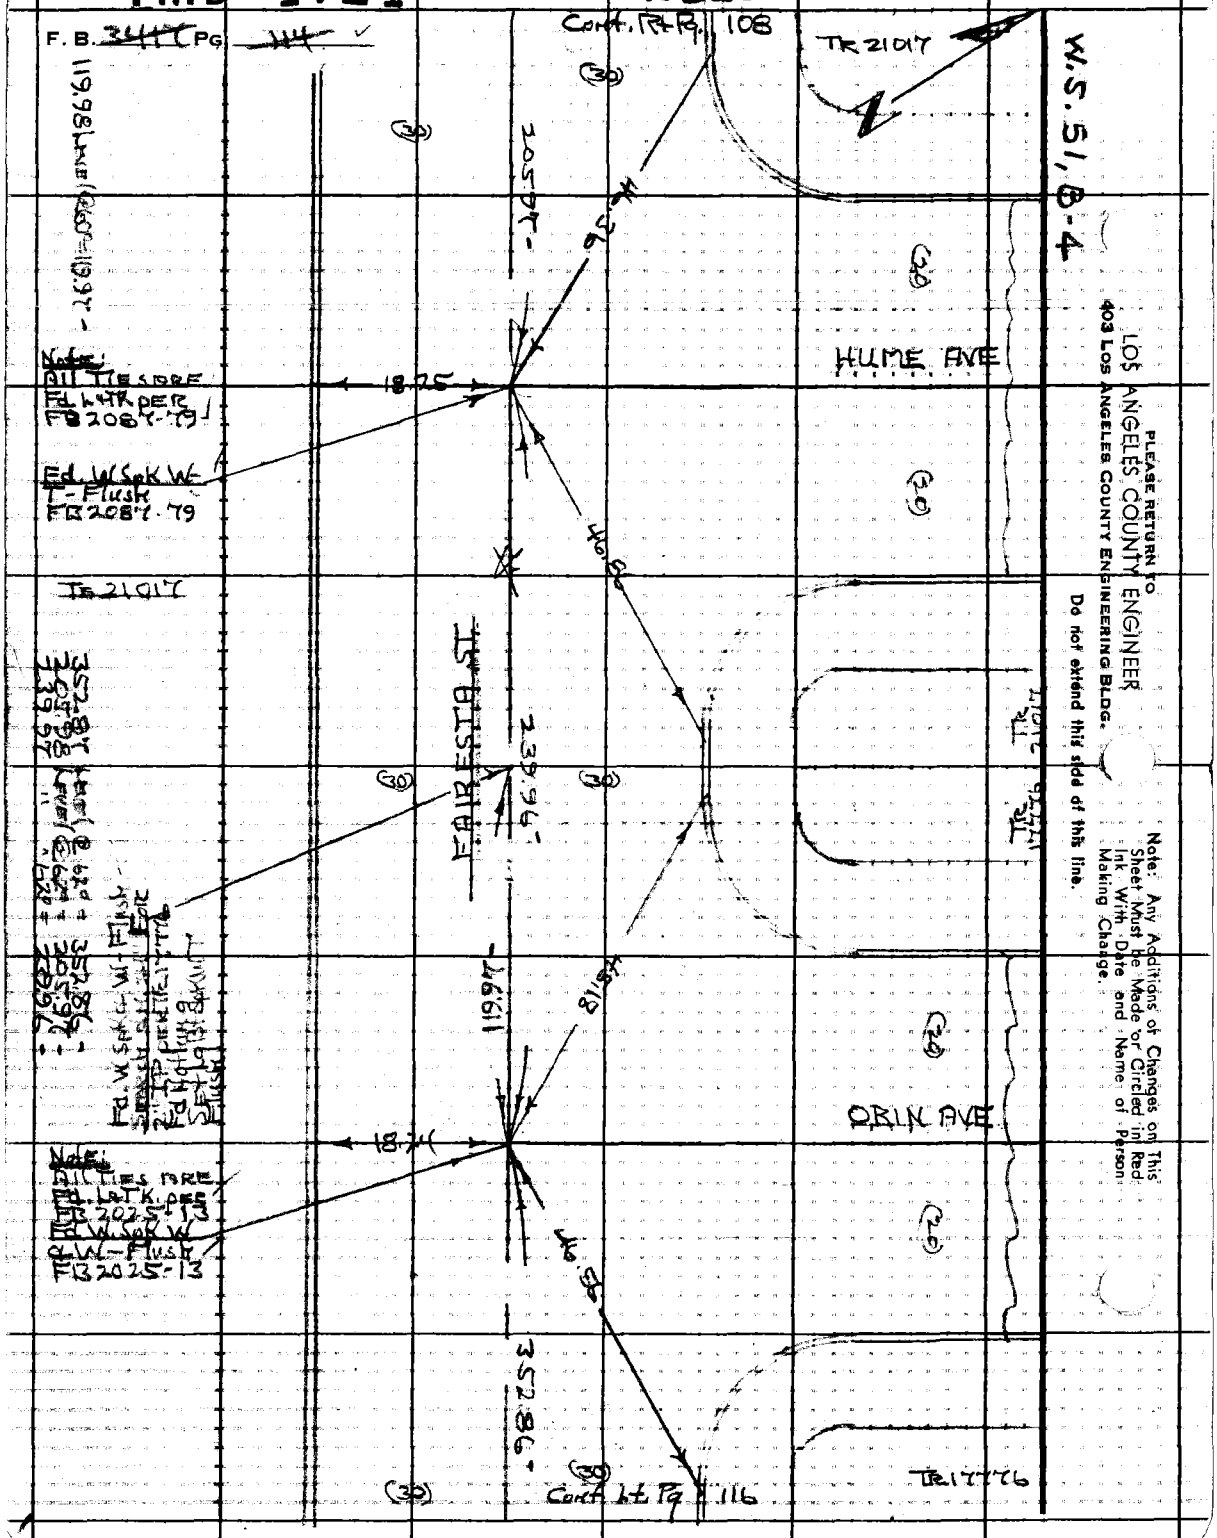

PLEASE RETURN TO
LOS ANGELES COUNTY ENGINEER
403 LOS ANGELES COUNTY ENGINEERING BLDG.

Do not extend this side of this line.

Note: Any Additions or Changes on This Sheet Must be Made or Circled in Red Ink With Date and Name of Person Making Change.

PWFB 1921

2447

Notes Ck'd by R. P. SHORT	Survey of [illegible]
Map No. B-5072	[illegible]
Office Work H. H. F. DONG	Surveyed by [illegible]
Checked	Notes [illegible] Date [illegible]
Date	Indexed C. J. GALLI

F. B. [illegible] PG. 115

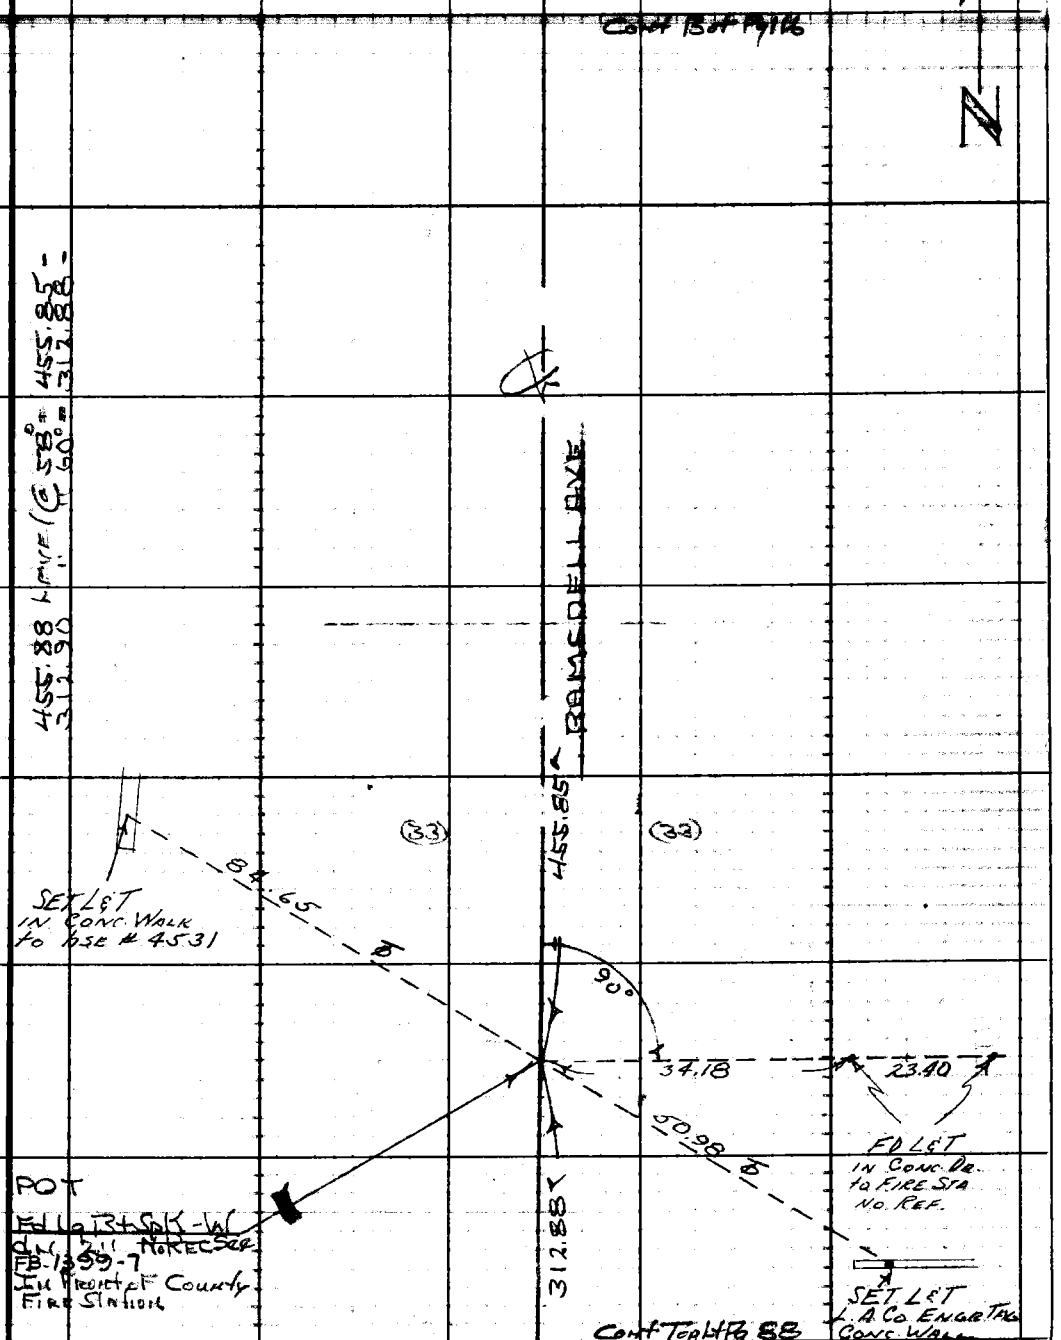

Note: Any Additions or Changes on This Sheet Must be Made or Circled in Red Ink With Date and Name of Person Making Change.

Do not extend this side of this line.

PLEASE RETURN TO
LOS ANGELES COUNTY ENGINEER
403 LOS ANGELES COUNTY ENGINEERING BLDG.

76F309S CE#310 1-65

PWFB 1921

2448

3025-11

LOS ANGELES COUNTY ENGINEER
403 Los Angeles County Engineering Bldg.

PLEASE RETURN TO

Do not extend this side of this line.

Note: Any Additions or Changes on This Sheet Must Be Made or Circled in Red Ink With Date and Name of Person Making Change.

PWFB 1921 2449

Notes Ck'd by R. P. SHORT	Survey of [illegible]
Map No. B-5072	[illegible]
Office Work H. H. F. DONG	Surveyed by [illegible]
Checked	Notes [illegible] Date 6-13-67
Date	Indexed C. J. GALLI

F. B. 2417 PG. 117

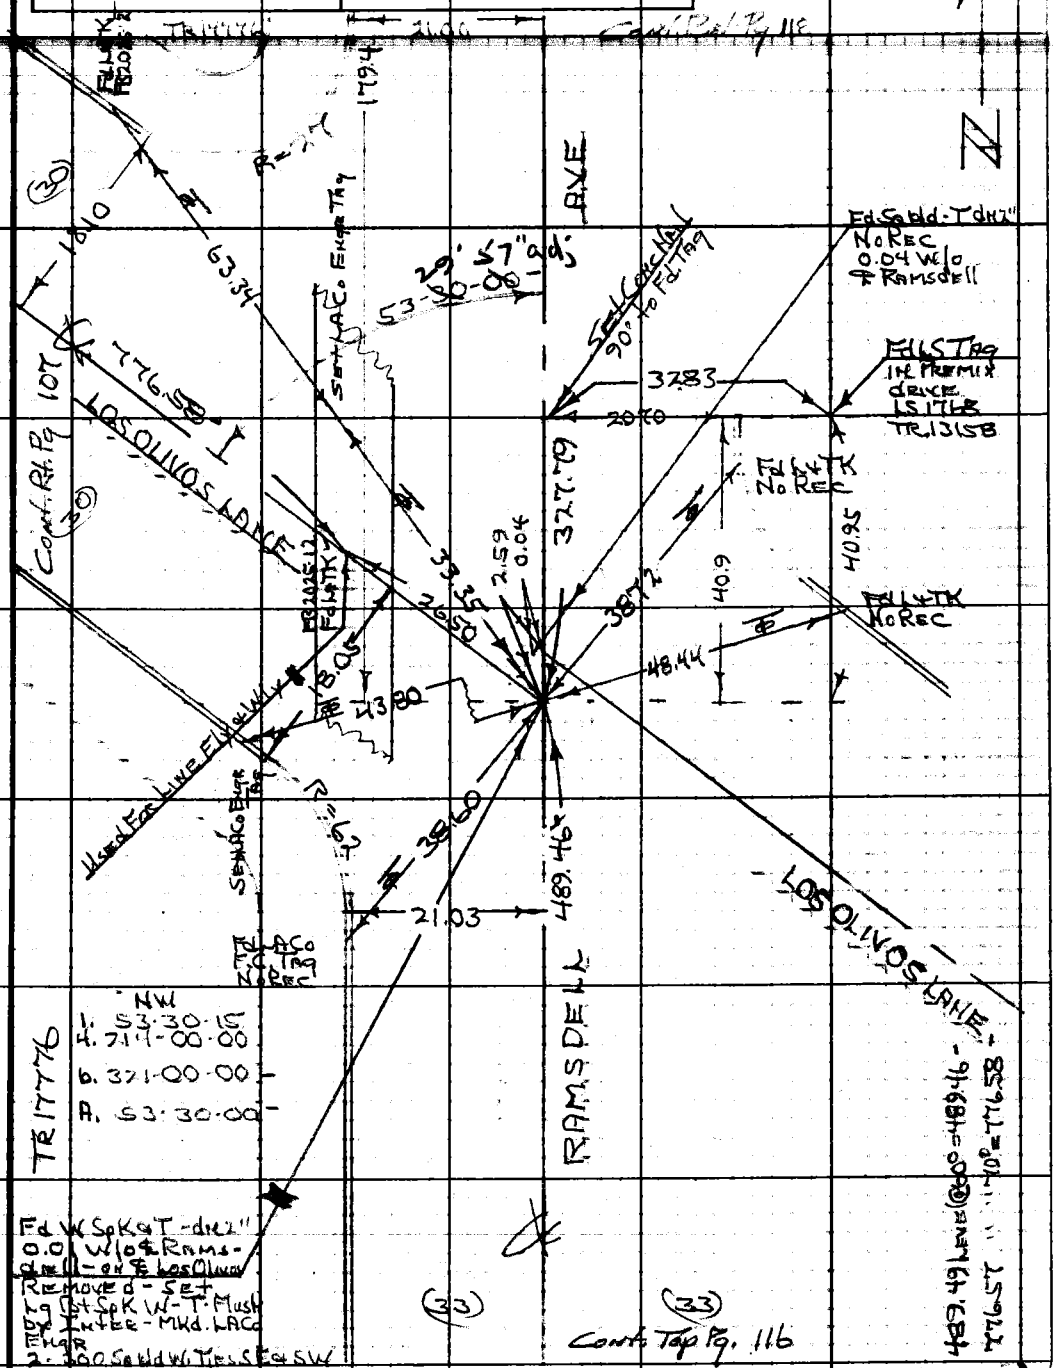

Note: Any Additions or Changes on This Sheet Must be Made or Circled in Red Ink With Date and Name of Person Making Change.

W.S. 51, 8-4

Do not extend this side of this line.

PLEASE RETURN TO
LOS ANGELES COUNTY ENGINEER
403 LOS ANGELES COUNTY ENGINEERING BLDG.

76F309S CE#310 1-65

PWFB 1921 2450

F. B. 3417 PG 118

Cont. Bot. Pg 119

327.79 LEVEL @ 70° = 327.79

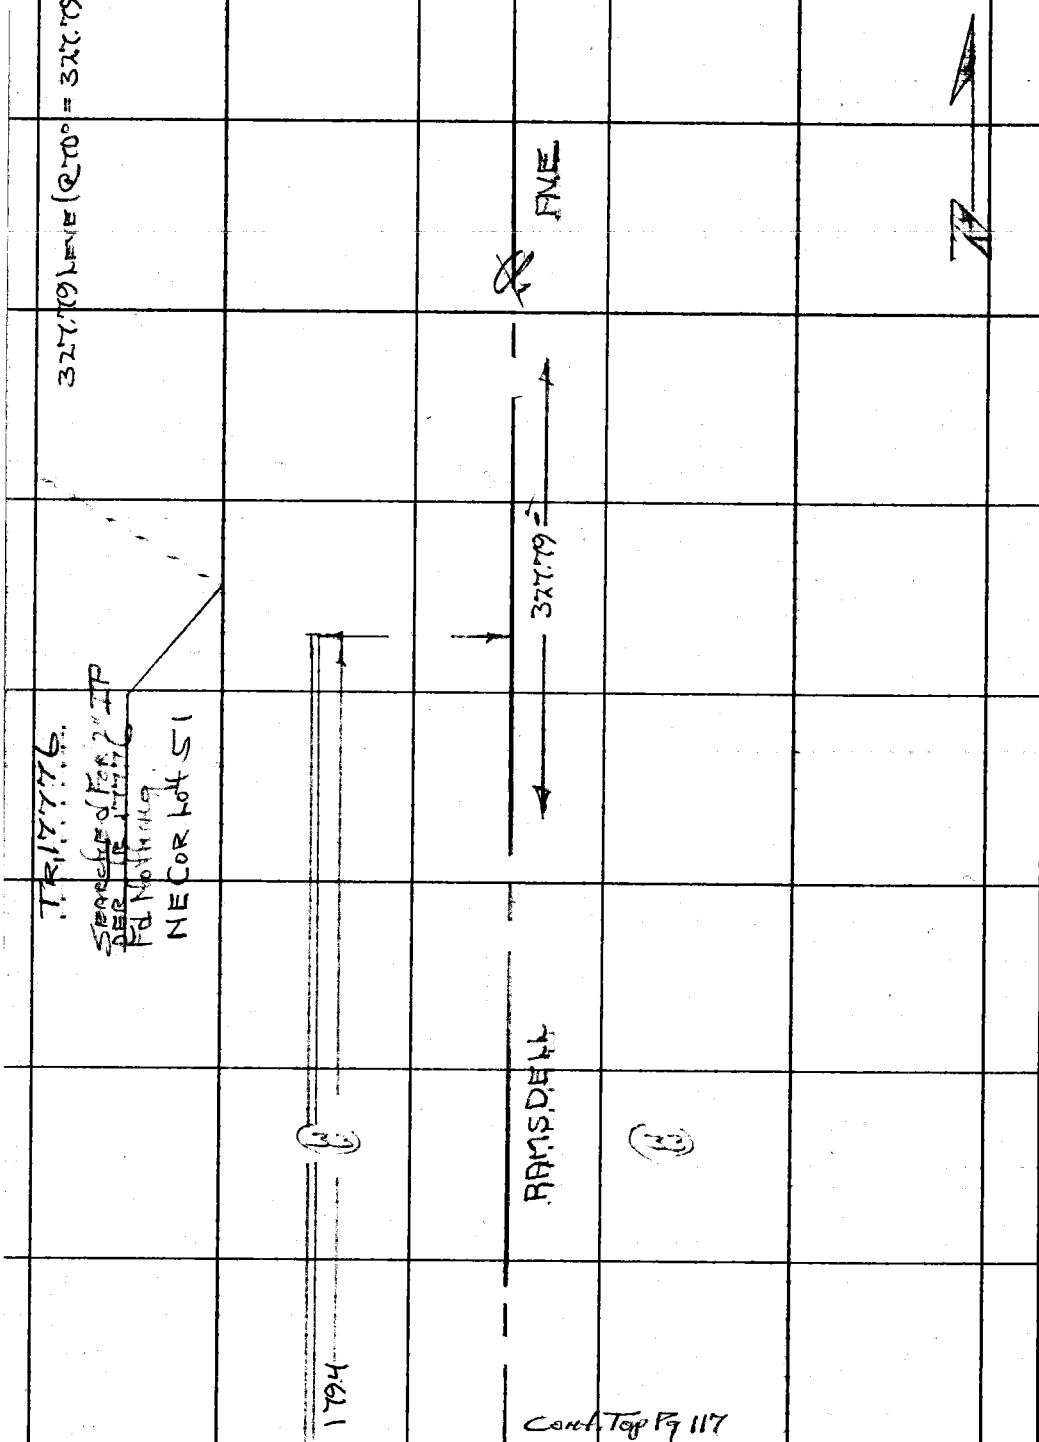

Cont. Top Pg 117

PLEASE RETURN TO
LOS ANGELES COUNTY ENGINEER
403 LOS ANGELES COUNTY ENGINEERING BLDG.

Do not extend this side of this line.

Note: Any Additions or Changes on This Sheet Must be Made or Circled in Red Ink With Date and Name of Person Making Change.

PWFB 1921 2451

Notes Ck'd by R. P. SHORT	Survey of Perkins Ave
Map No. B-5972	[illegible]
Office Work H. H. F. DONG	Surveyed by [illegible]
Checked	Notes [illegible] Date [illegible]
Date	Indexed C. J. GALLI

F. B. 3417 PG. 119

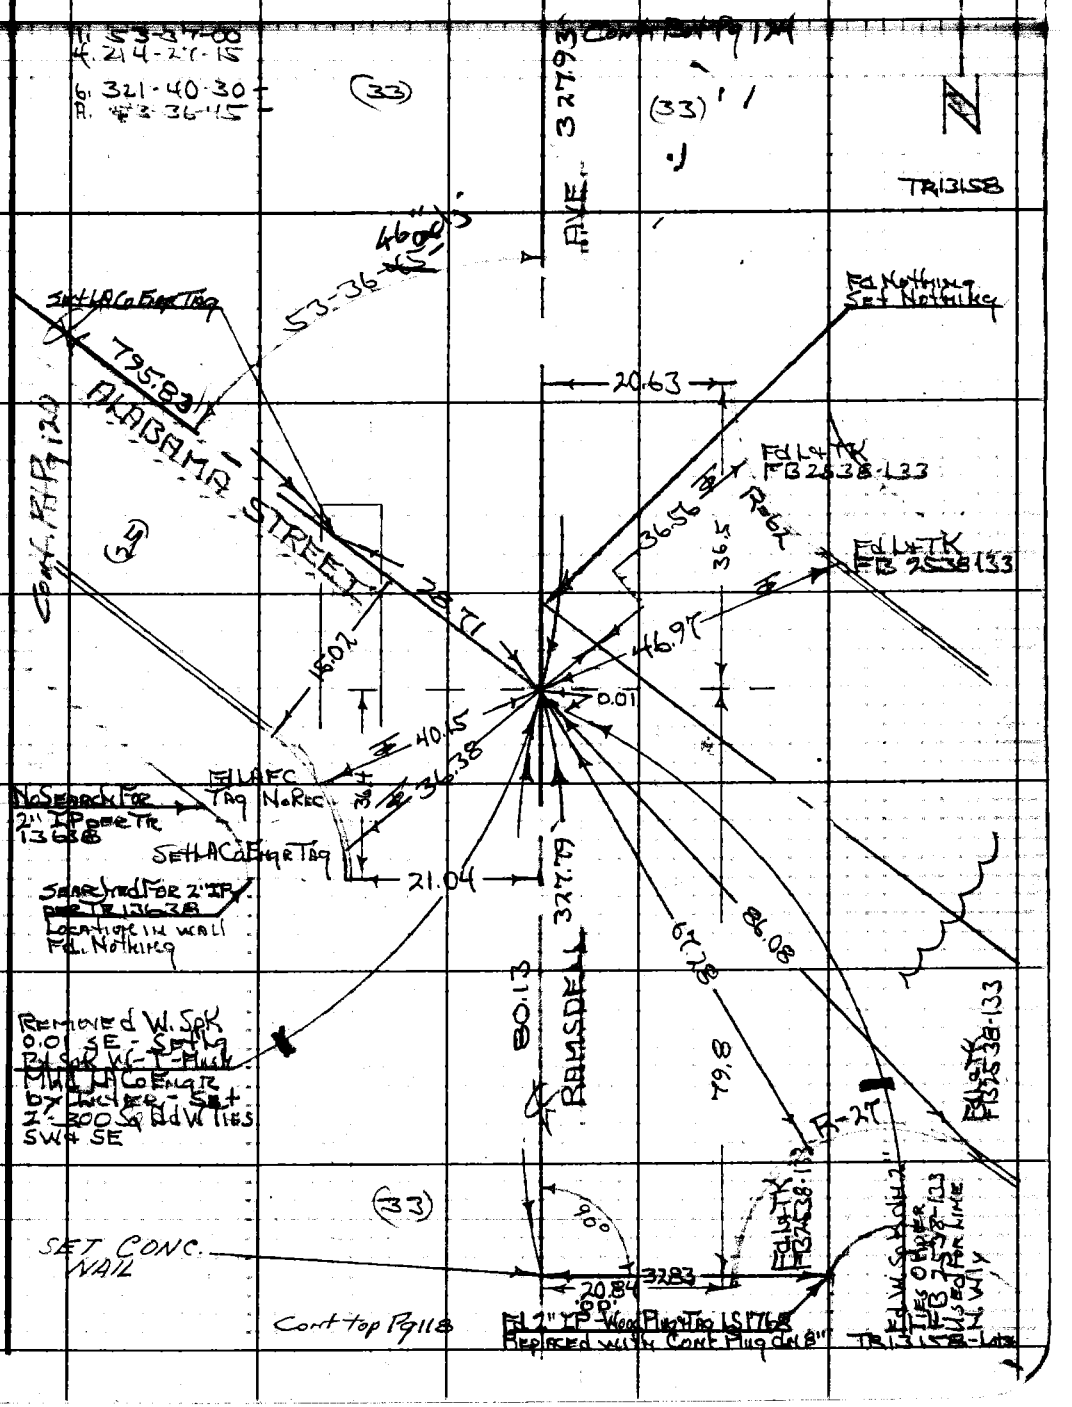

W.S. 51, B-4

Note: Any Additions or Changes on This Sheet Must be Made or Circled in Red Ink With Date and Name of Person Making Change.

Do not extend this side of this line.

PLEASE RETURN TO
LOS ANGELES COUNTY ENGINEER
403 LOS ANGELES COUNTY ENGINEERING BLDG.

76F309S CE#310 1-65

PWFB 1921 2452

F. B. 3417 PG 120

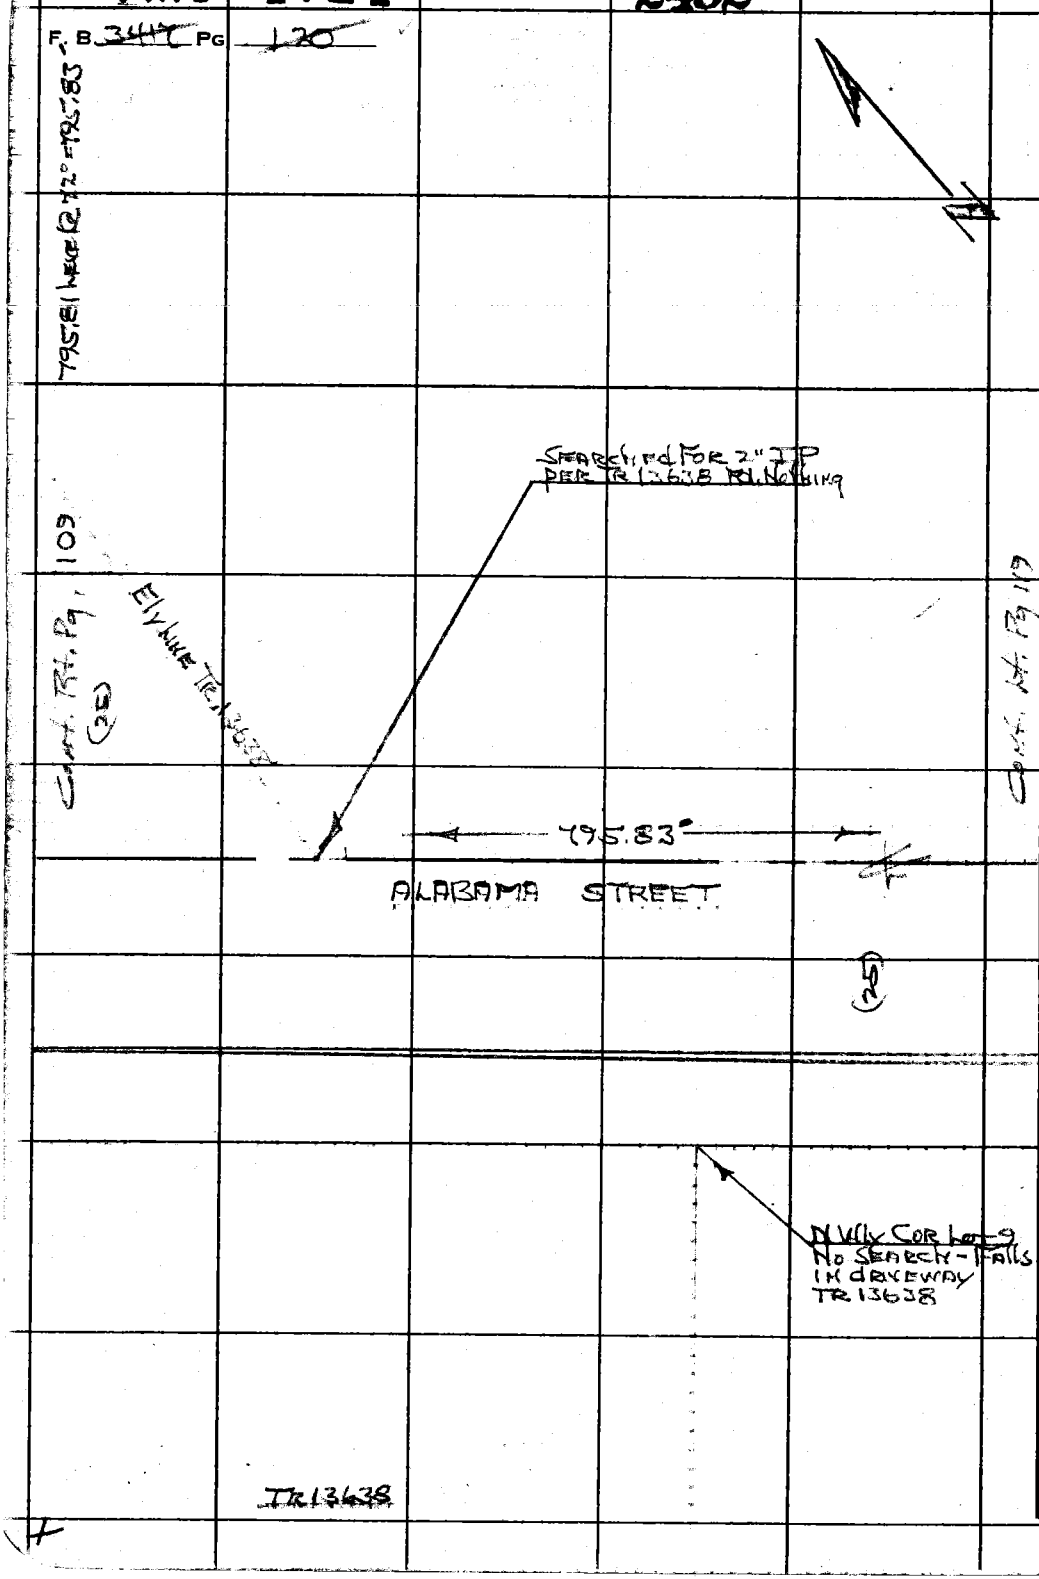

PLEASE RETURN TO
LOS ANGELES COUNTY ENGINEER
403 LOS ANGELES COUNTY ENGINEERING BLDG.

Do not extend this side of this line.

Note: Any Additions or Changes on This Sheet Must Be Made or Circled in Red Ink With Date and Name of Person Making Change.

PWFB 1921

2453

Notes Ck'd by R. P. SHORT
Map No. [illegible]
Office Work H. H. F. DONG
Checked
Date

Survey of [illegible]
Surveyed by [illegible]
Notes [illegible] Date 6-14-67
Indexed C. J. GALLI

F. B. [illegible] Pg. [illegible]

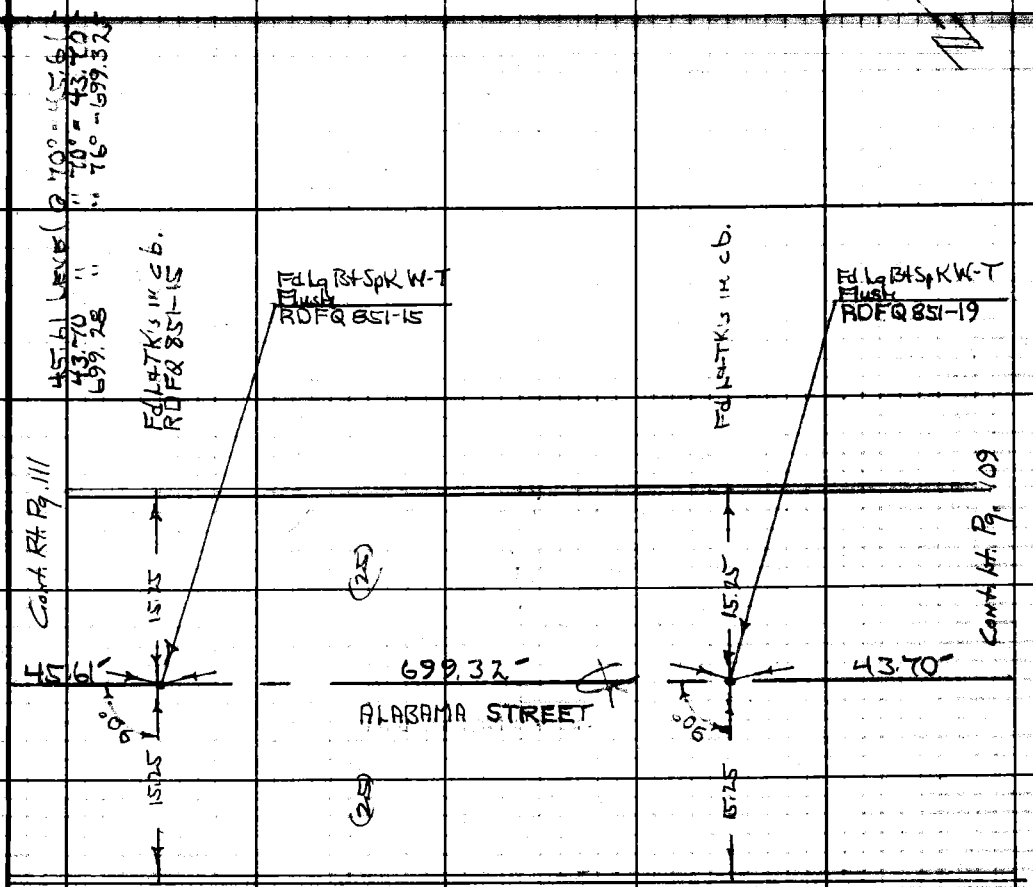

Note: Any Additions or Changes on This Sheet Must be Made or Circled in Red Ink With Date and Name of Person Making Change.

Do not extend this side of this line.

PLEASE RETURN TO
LOS ANGELES COUNTY ENGINEER
403 LOS ANGELES COUNTY ENGINEERING BLDG.

76F309S CE#310 1-65

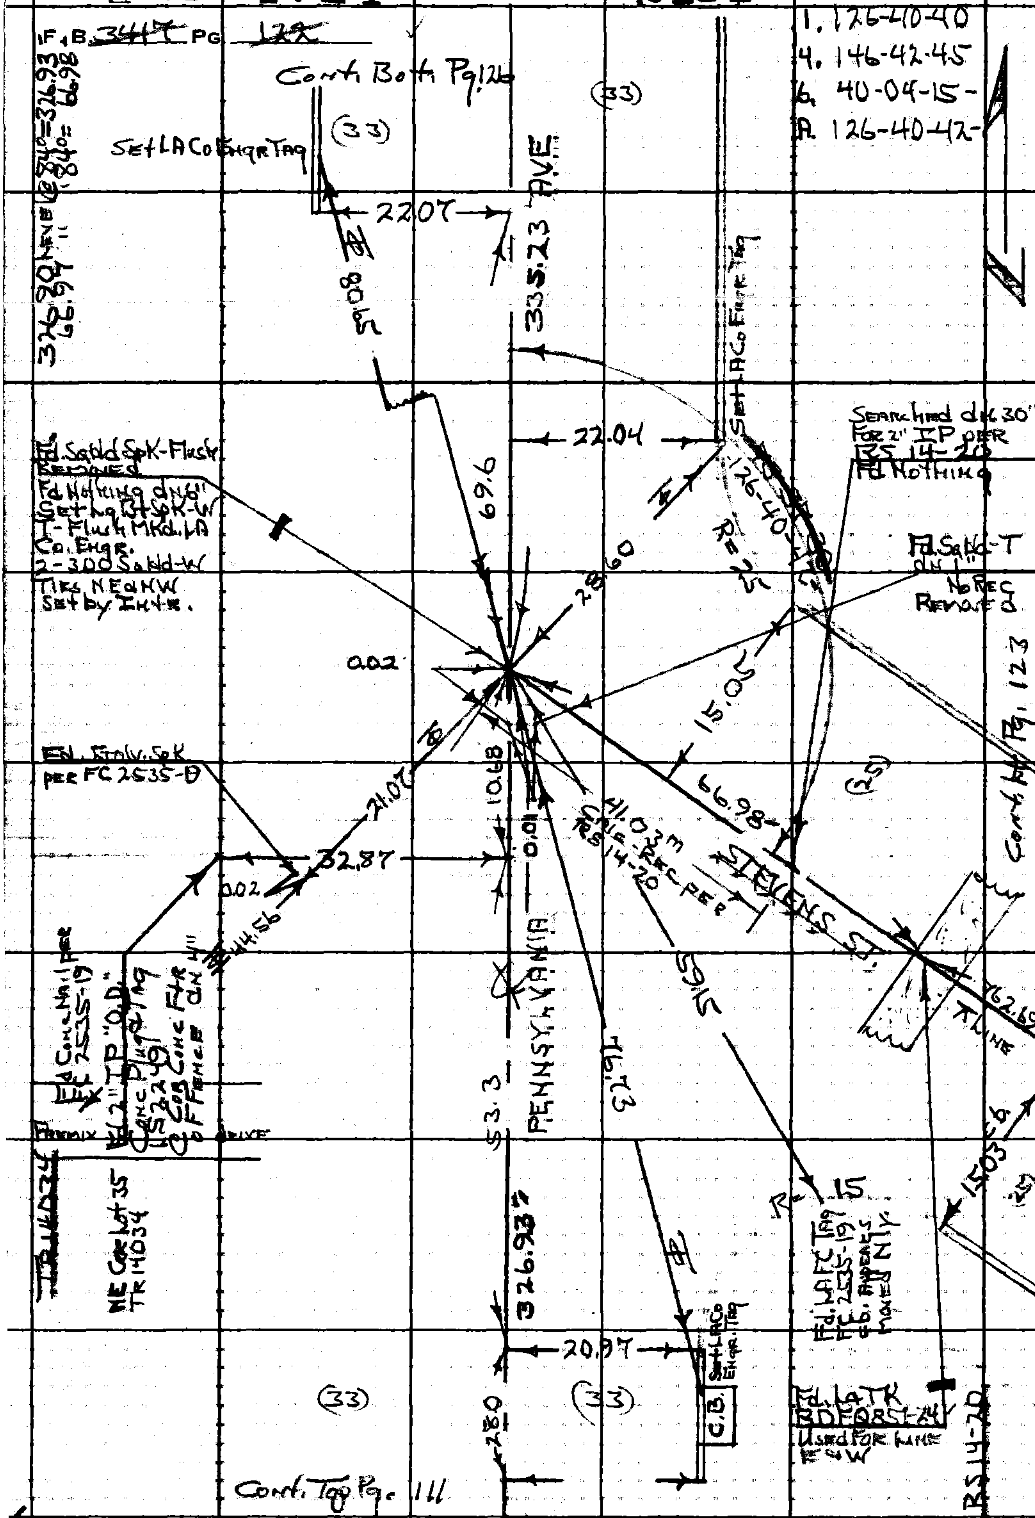

PLEASE RETURN TO
LOS ANGELES COUNTY ENGINEER
403 LOS ANGELES COUNTY ENGINEERING BLDG.

Do not extend this side of this line.

Note: Any Additions or Changes on This Sheet Must be Made or Circled in Red Ink With Date and Name of Person Making Change.

PWFB 1921 2455

Notes Ck'd by R. P. SHORT	Survey of Pound Ave	F.B. 3417	Pg. 122-A
[illegible]	[illegible]		
Office Work H. H. F. DONG	Surveyed by HHSpriggs		
Checked	Notes HHS Date 7-27-67		
Date	Indexed C. J. GALLI		

Note concerning FB 3417-123 - Stevens Street

℄ PT. - 2" Std. brass cap Mon per LACoRD - set to replace Fd. 2" IP FQ 851-3, 25,
Above Pt. accepted as SWCor TR 4126 by LA Co RD & TR. 13638

Surveys concerning this area by date - Maps.
TR 4126 May 1923 - Area N & E to Ramsdell
RS 14-20 Aug 1923 Area
TR 7076 Jan 1924 Area E, W, & S.
TR 13638 1919 Area E & S

Searched entire area 2.93 Wly of Fd. Mon @ TrCor for RS 14-20 for 2" IP - ℄ PT dn 36" Fd.
Nothing falls in water main ditch.

True line to S. (160' N/o Alabama Pg. 110) blocked - see cut off line

True line to N. (El Caminito) blocked - see TR 4126 & LACoRD FQ 851-3, 4, Etc

Line which is ℄ of Cloud has been perpetuated by sections - S. to Fairesta & N. to Santa Carlotta.

HHSpriggs

Note: Any Additions or Changes on this Sheet Must be Made or Circled in Red Ink With Date and Name of Person Making Change

Do not extend this side of this line.

PLEASE RETURN TO
LOS ANGELES COUNTY ENGINEER
403 Los Angeles County Engineering Bldg.

76P3098 CK #310 8-66

BLANK

F.B. _____ Pg. _____

PLEASE RETURN TO
LOS ANGELES COUNTY ENGINEER
403 LOS ANGELES COUNTY ENGINEERING BLDG.

Do not extend this side of the line.

Note: Any Additions or Changes on this Sheet Must be Made or Circled in Red Ink With Date and Name of Person Making Change

PWFB 1921 2456

Notes Ck'd by R. P. SHORT	Survey of [illegible]	F.B. [illegible]	Pg. 123
[illegible]	[illegible]		
Office Work H. H. F. DONG	Surveyed by [illegible]		
Checked	Notes [illegible]	Date [illegible]	
Date	Indexed C. J. GALLI		

Notes Sum Pg. 122-A

1. 179-38-40
4. 358-34-30
6. 357-52-00
A. 179-38-40

762.64 Level @ 78° = 762.69
59.20 Line @ 96° = 59.21
822.57 Level @ 92° = 822.65

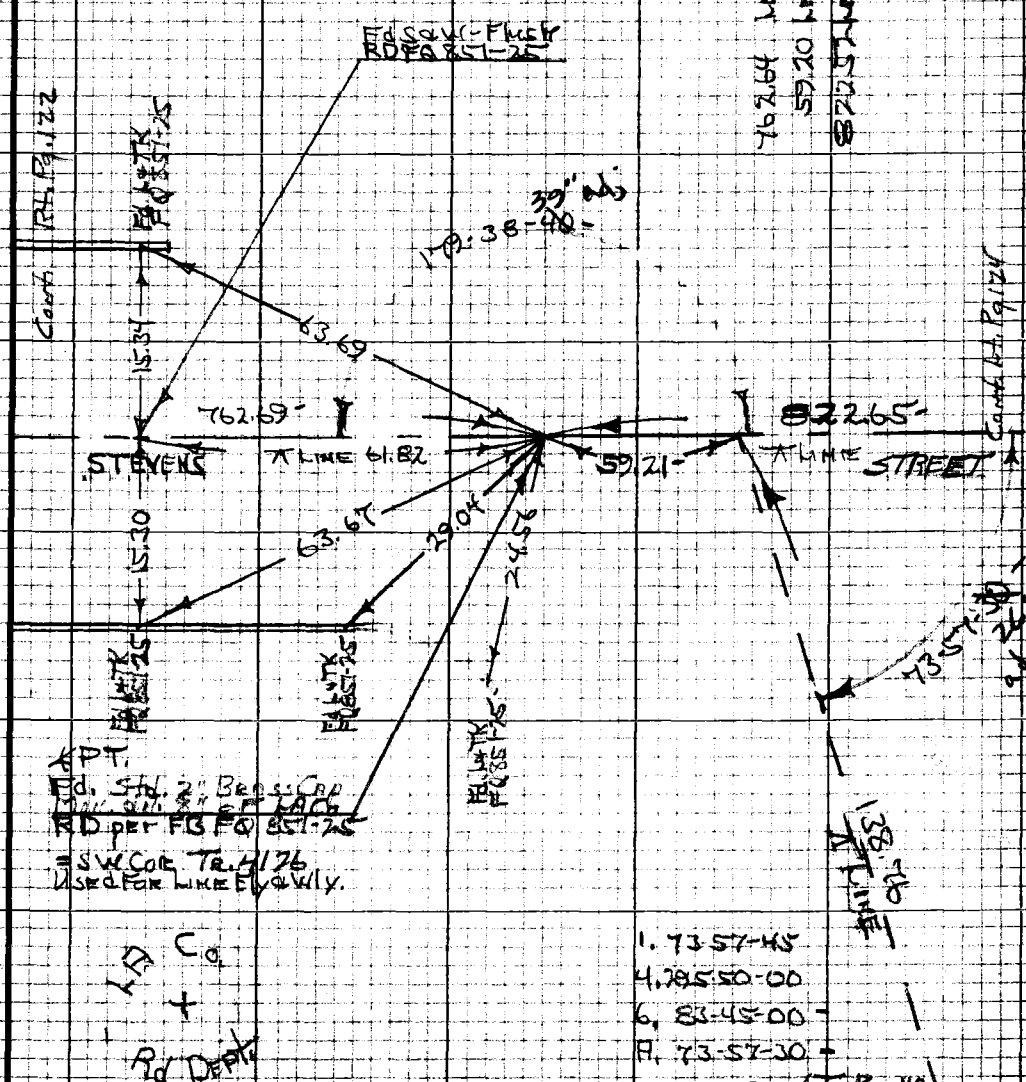

1. 73-57-45
4. 295-50-00
6. 83-45-00
A. 73-57-30

Cont. Top Pg. 110

Note: Any Additions or Changes on this Sheet Must be Made or Circled in Red Ink With Date and Name of Person Making Change

W.S. 51, B-4

Do not extend this side of this line.

PLEASE RETURN TO
LOS ANGELES COUNTY ENGINEER
403 LOS ANGELES COUNTY ENGINEERING BLDG.

76P3098 CE #310 5-66

PWFB 1921 2457, 2458

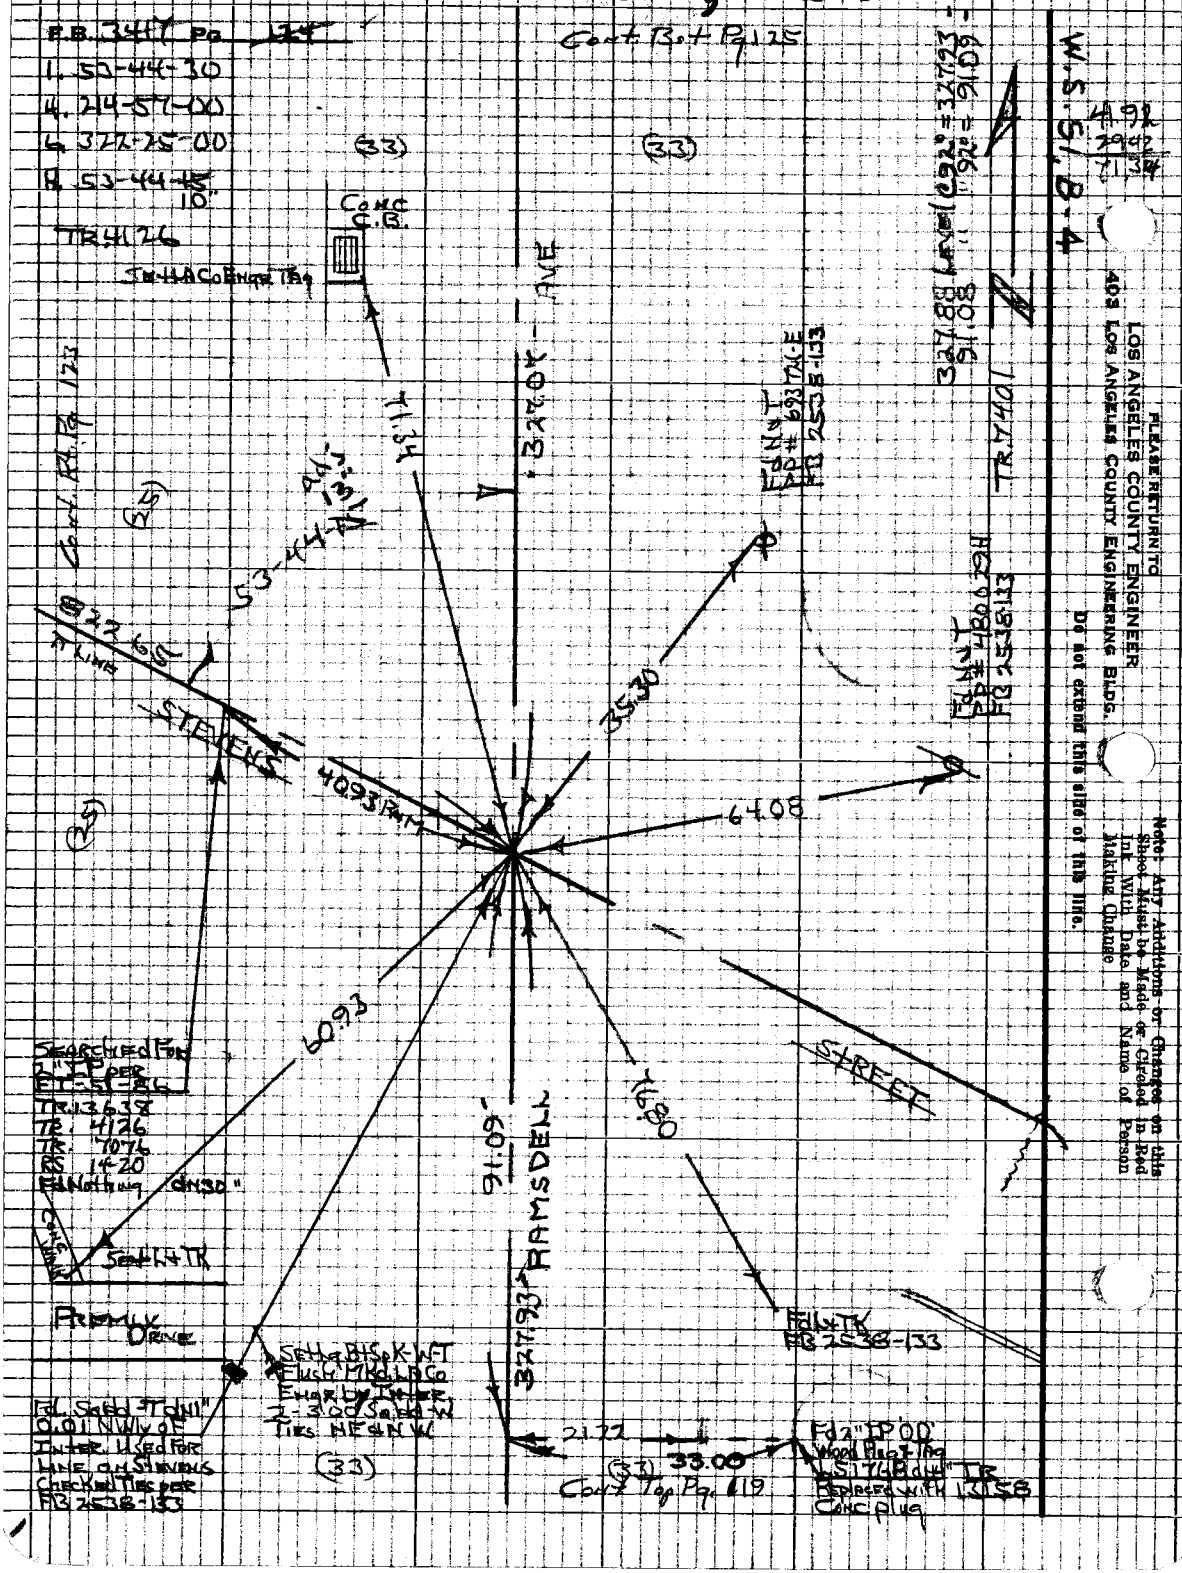

PLEASE RETURN TO
LOS ANGELES COUNTY ENGINEER
403 LOS ANGELES COUNTY ENGINEERING BLDG.
Do not extend this side of this line.

Note: Any Additions or Changes on this Sheet Must be Made or Circled in Red Ink With Date and Name of Person Making Change

PWFB 1921 2459

Notes Ck'd by R. P. SHORT	Survey of PENNA. AVE	F.B. 3417	Pg. 125
[illegible]	[illegible]		
Office Work H. H. F. DONG	Surveyed by HH Springs		
Checked	Notes HHS Date 7-25-68		
Date	Indexed C. J. GALLI		

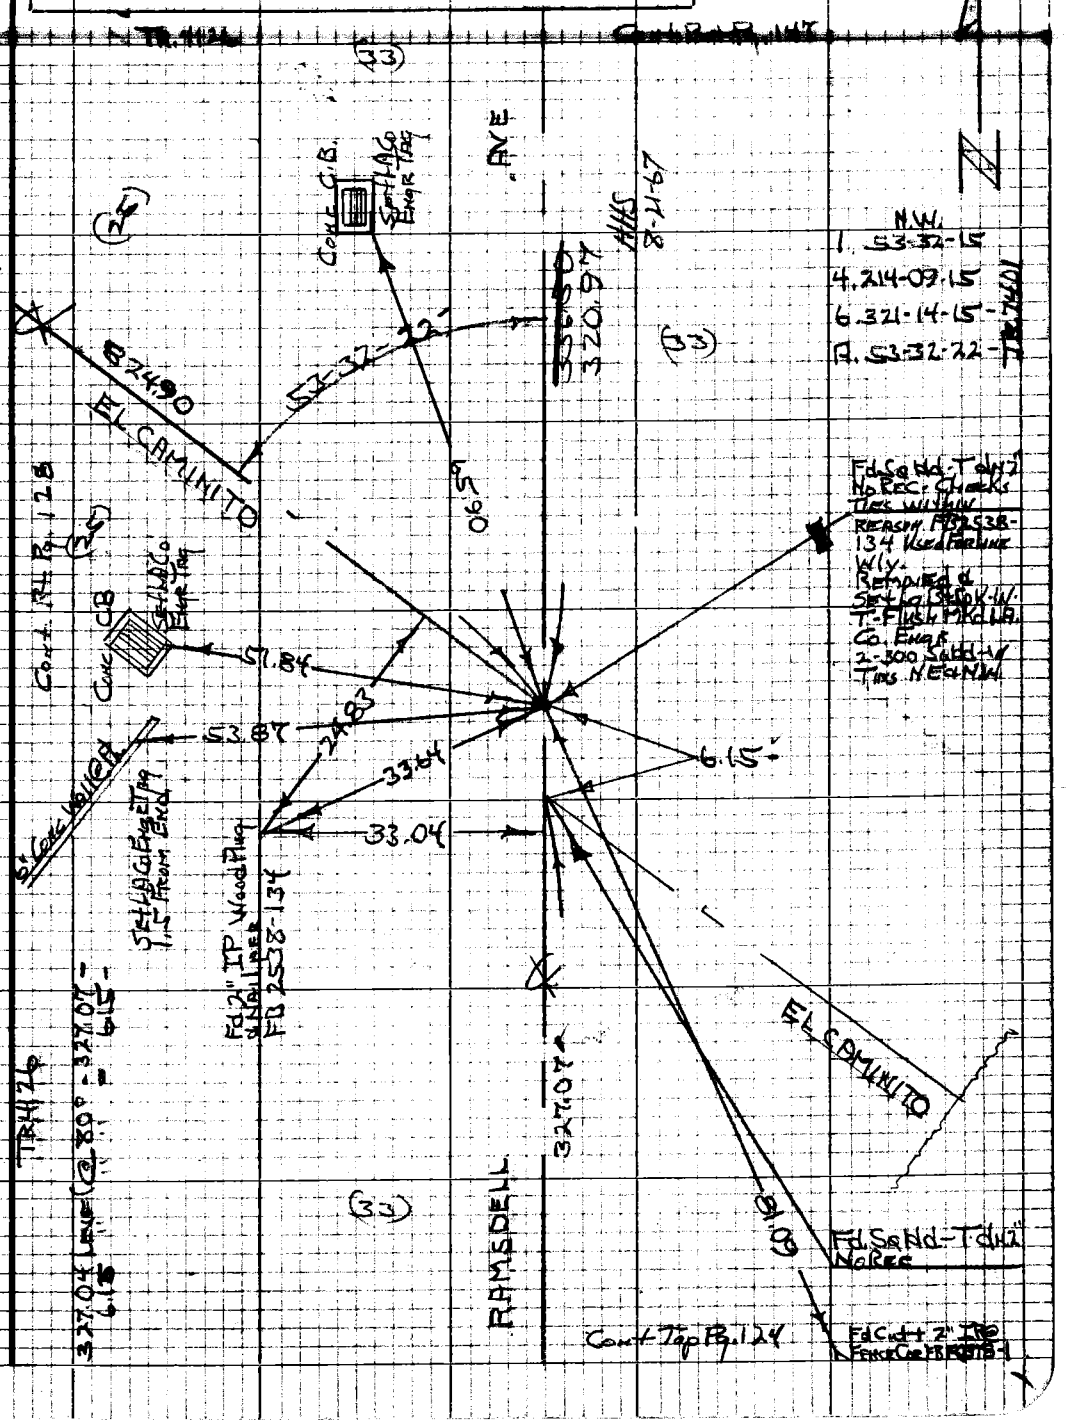

Note: Any Additions or Changes on this Sheet Must be Made or Circled in Red Ink With Date and Name of Person Making Change

Do not extend this side of this line.

PLEASE RETURN TO
LOS ANGELES COUNTY ENGINEER
403 LOS ANGELES COUNTY ENGINEERING BLDG.

76P2098 CE #310 5-66

PWFB 1921

2460

F.B. 3417 Pg. 126

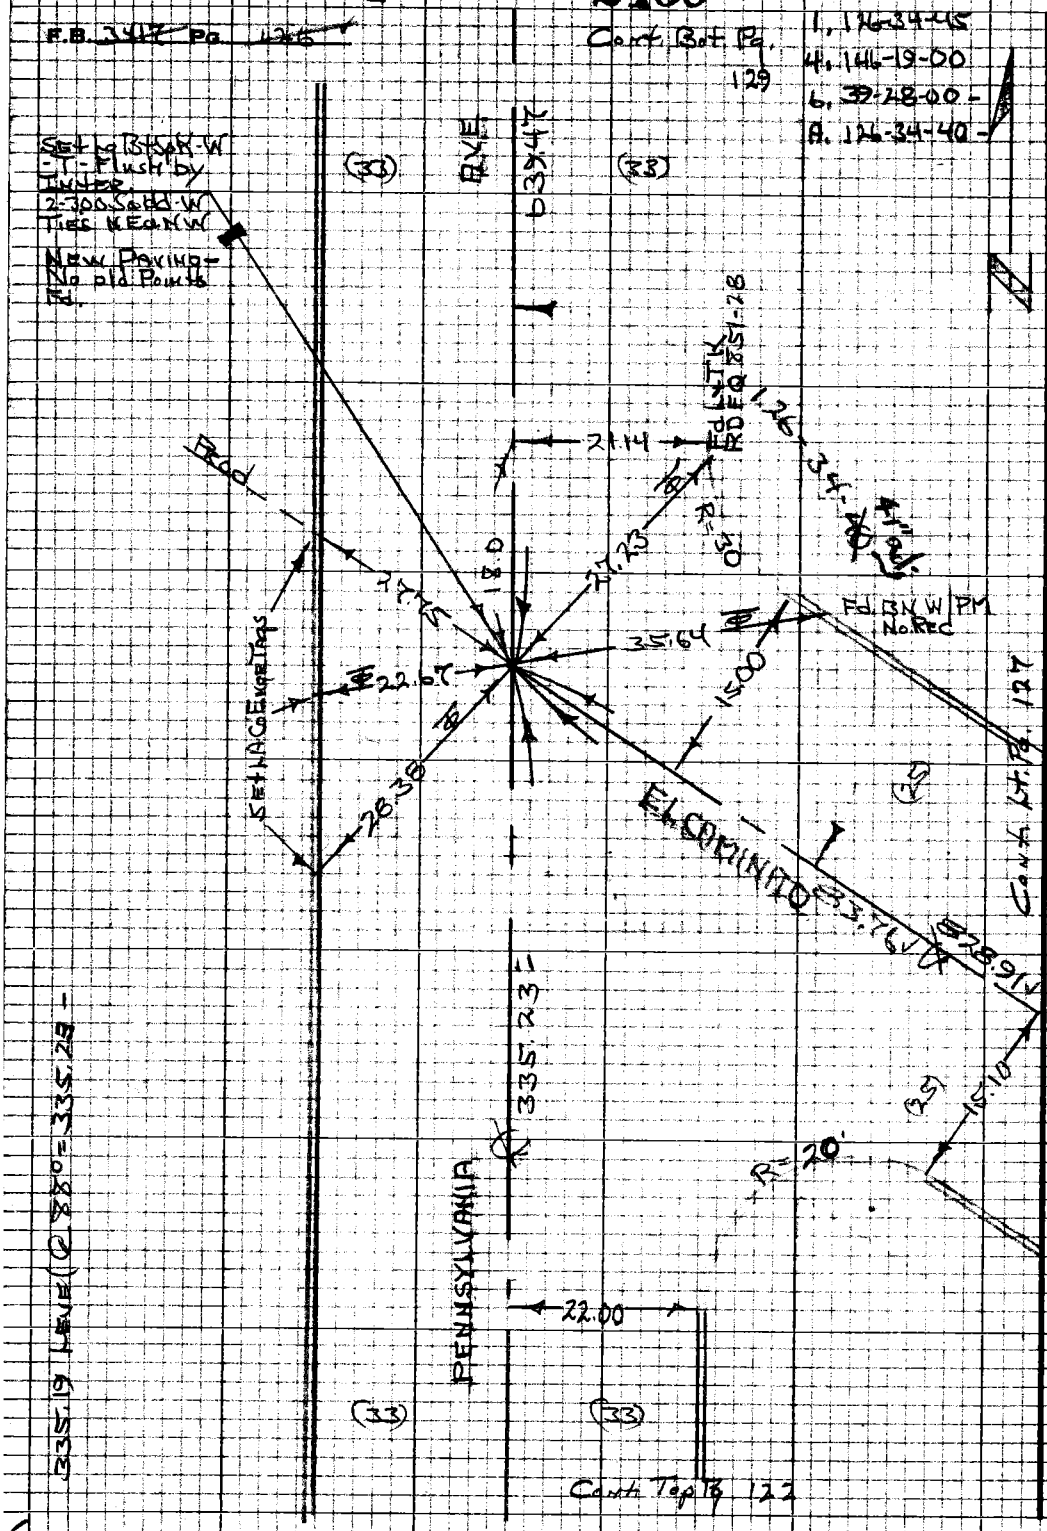

PLEASE RETURN TO
LOS ANGELES COUNTY ENGINEER
403 LOS ANGELES COUNTY ENGINEERING BLDG.

Do not extend this side of this line.

Note: Any Additions or Changes on this Sheet Must be Made or Circled in Red Ink With Date and Name of Person Making Change

PWFB 1921 2461

Notes Ck'd by R. P. SHORT	Survey of PENNA AVE	F.B. 3417	Pg. 127
Map No. [illegible]	[illegible]		
Office Work H. H. F. DONG	Surveyed by HHS		
Checked	Notes HHS	Date 7-25-[illegible]	
Date	Indexed C. J. GALLI		

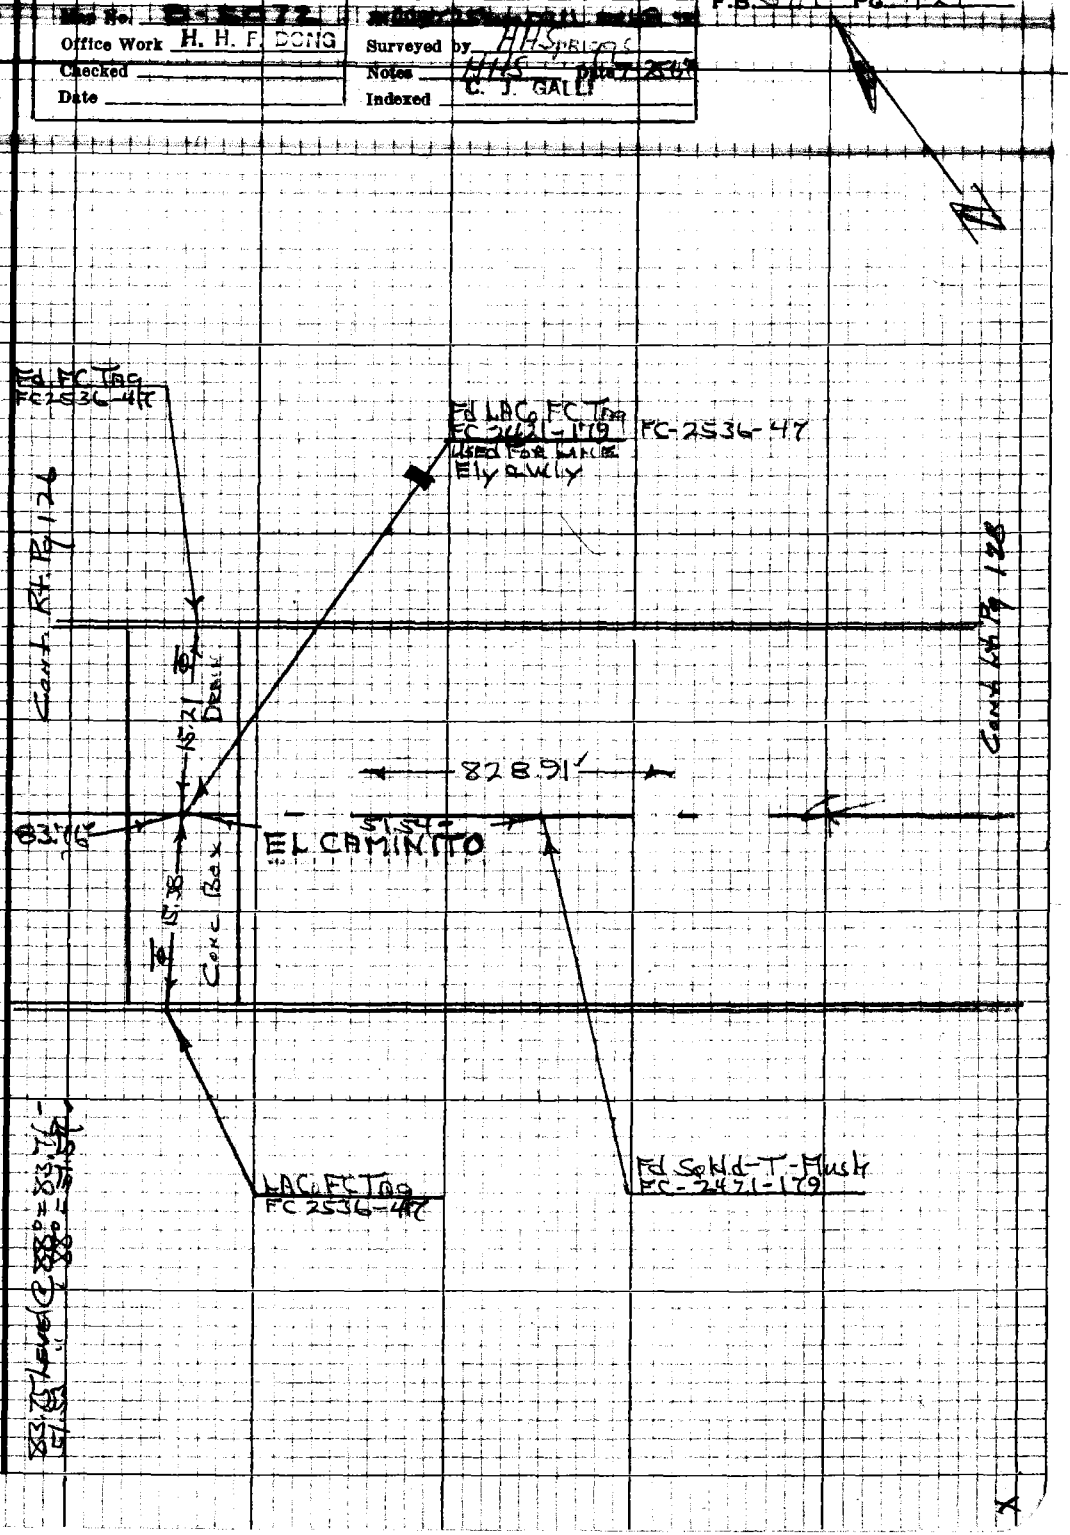

Note: Any Additions or Changes on this Sheet Must be Made or Circled in Red Ink With Date and Name of Person Making Change

Do not extend this side of this line.

PLEASE RETURN TO
LOS ANGELES COUNTY ENGINEER
403 LOS ANGELES COUNTY ENGINEERING BLDG.

76P3098 CE #310 8-66

PWFB 1921 2462

F.B. 3447 Pg. 128

W.S. 57 B.4

LOS ANGELES COUNTY ENGINEER
403 LOS ANGELES COUNTY ENGINEERING BLDG.

PLEASE RETURN TO

Do not extend this side of this line.

Note: Any Additions or Changes on this Sheet Must be Made or Circled in Red Ink With Date and Name of Person Making Change

1. 179-56-30
4. 359-46-00
6. 359-39-00
A. 179-56-30

S 828.19 LEVEL (C 90°-828.91)

S03.52 LEVEL (C 90°-S08.59)
S21.78 " (C 82°-S24.31)
Tot. 84.90

WH LINE

TR 4126

Searched d=30' for 2" IP per RDFQ472-17 Fd. Nothing

Cont. Rt. Pg. 127

Cont. Rt. Pg. 125

Fd. & TK RDFQ851-29

11.5

17.63

0.44

S78.91'

S24.90'

EL CAMINITO

7.91

Fd. & TK RDFQ851-29

Set 1A Coe Marking

Conc. Porch

KPT
Fd. L.S. Spikes - dia. 2"
RDFQ851-4
Used for line w/ Clay
Remove and Reset after
2" IP Search
Set 2-3.00 Sq. Id & w/ties

Fd. & TK in Porch
RDFQ851-29

TR 4126

Fd. L.S. Spikes - dia. 2"
RDFQ851-4

PWFB 1921

2463

Notes Ck'd by R. P. SHORT	Survey of PENNA AVE	F.B 3417	Pg 129
[illegible] B-5072	[illegible]		
Office Work H. H. F. DONG	Surveyed by HH George		
Checked W. EDMONDSON	Notes [illegible]	Date 7-25-67	
Date NOV 2 1 '69	Indexed C. J. GALLI		

Cont. Bot Pg. 120

N

Note: Any Additions or Changes on this Sheet Must be Made or Circled in Red Ink With Date and Name of Person Making Change

Do not extend this side of this line.

PLEASE RETURN TO
LOS ANGELES COUNTY ENGINEER
403 LOS ANGELES COUNTY ENGINEERING BLDG.

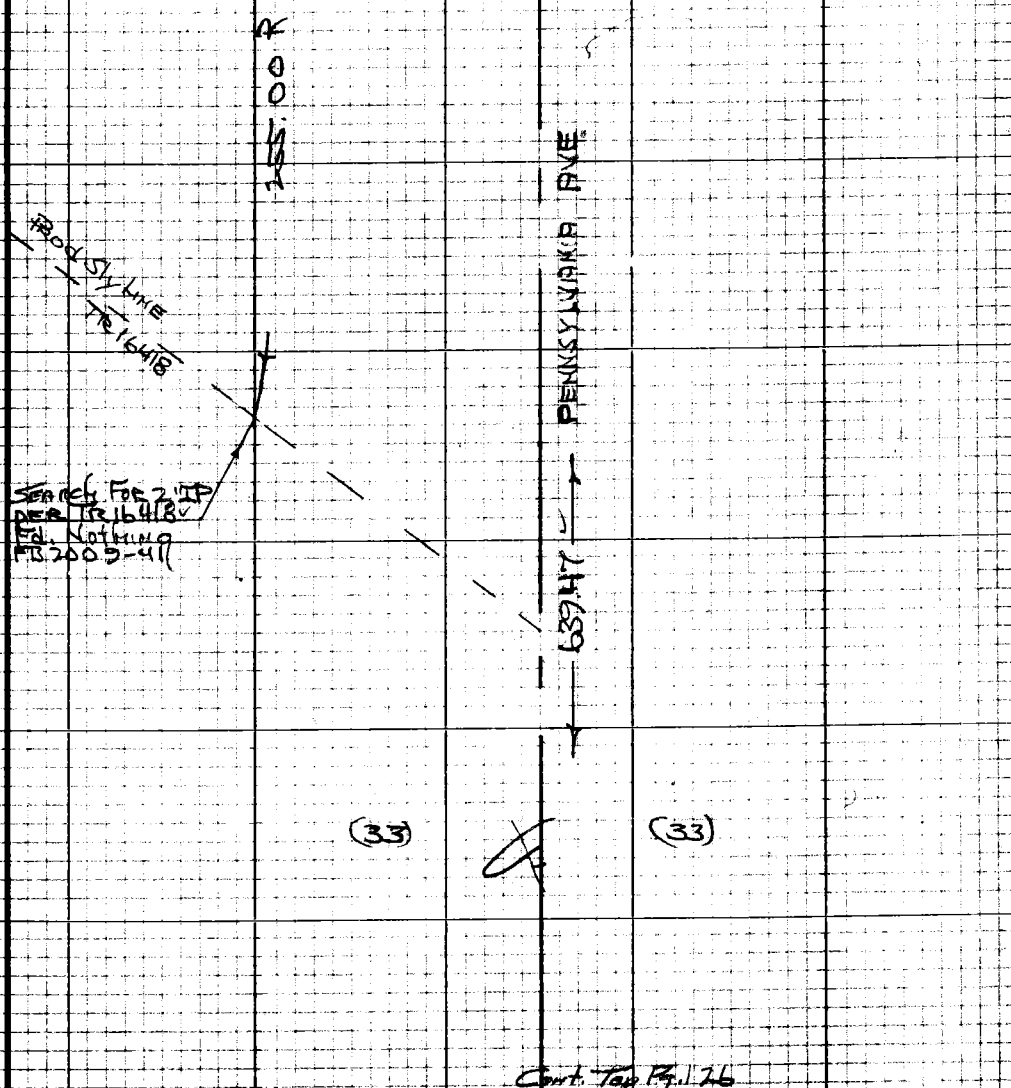

Cont. Top Pg. 126

76P3098 CE #310 5-66

PWFB 1921 2464

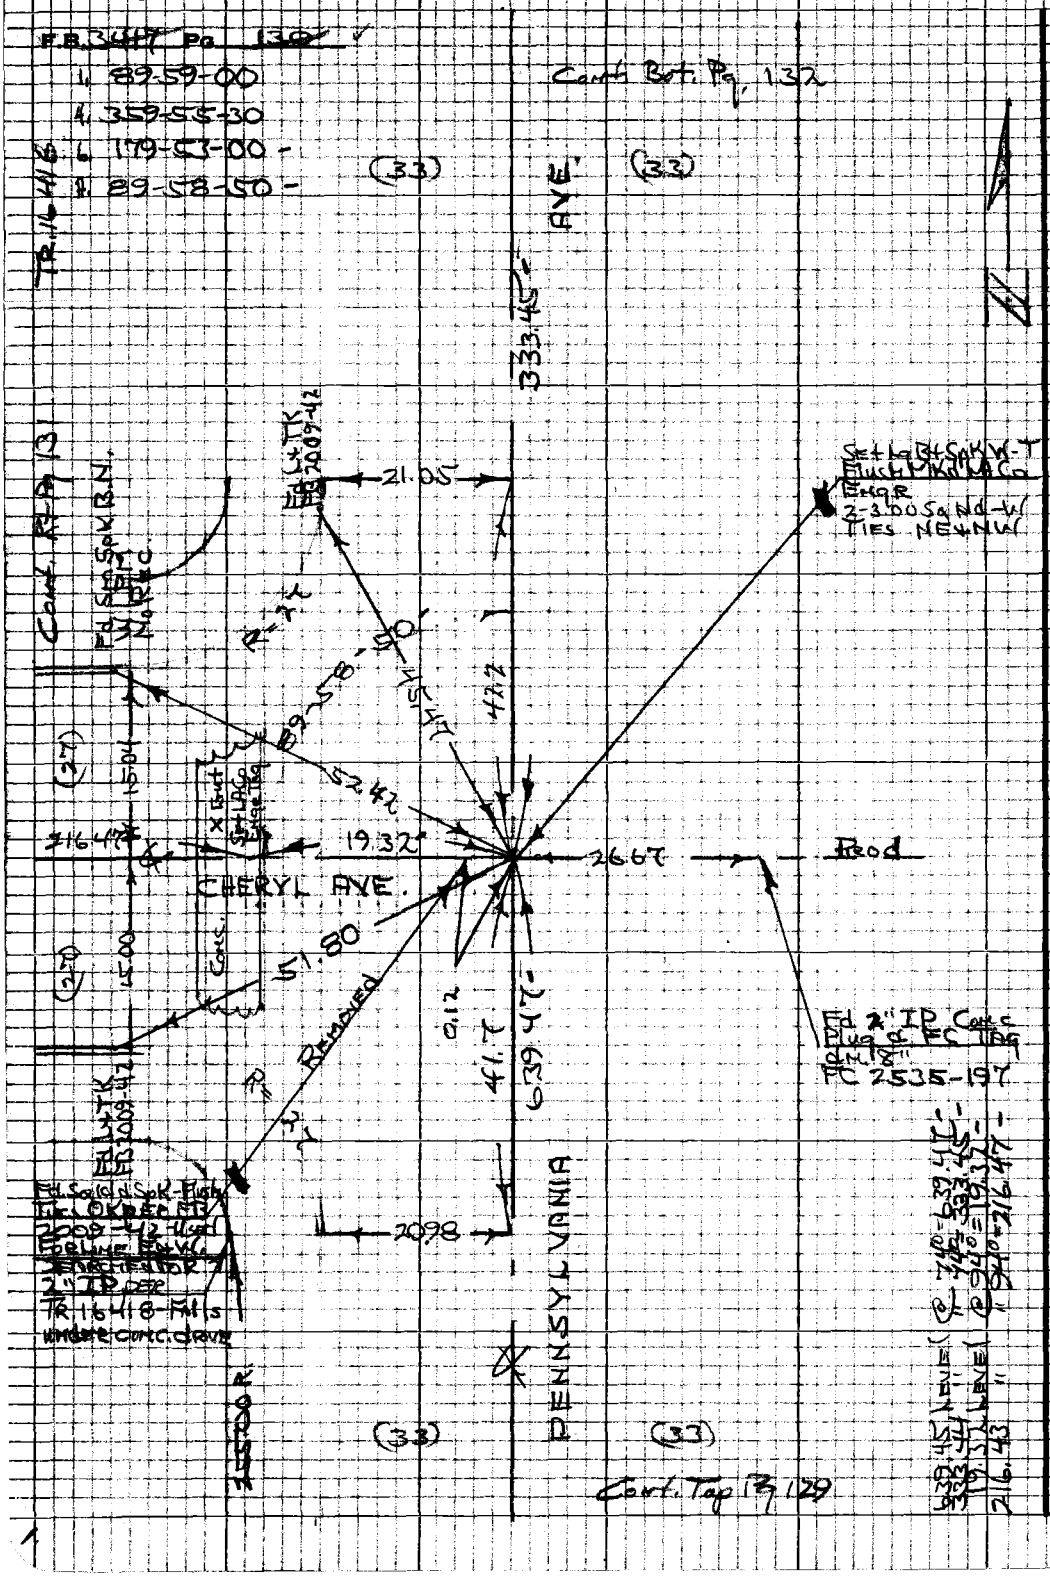

PLEASE RETURN TO
LOS ANGELES COUNTY ENGINEER
403 LOS ANGELES COUNTY ENGINEERING BLDG.

Do not extend this side of this line.

Note: Any Additions or Changes on this Sheet Must be Made or Circled in Red Ink With Date and Name of Person Making Change

PWFB 1921

2465

Notes Ck'd by R. P. SHORT	Survey of PENNA AVE	F.B. [illegible]	Pg. 131
[illegible] B-3072	[illegible]		
Office Work H. H. F. DONG	Surveyed by HHSpriggs		
Checked	Notes HHS Date [illegible]		
Date	Indexed C. J. GALLI		

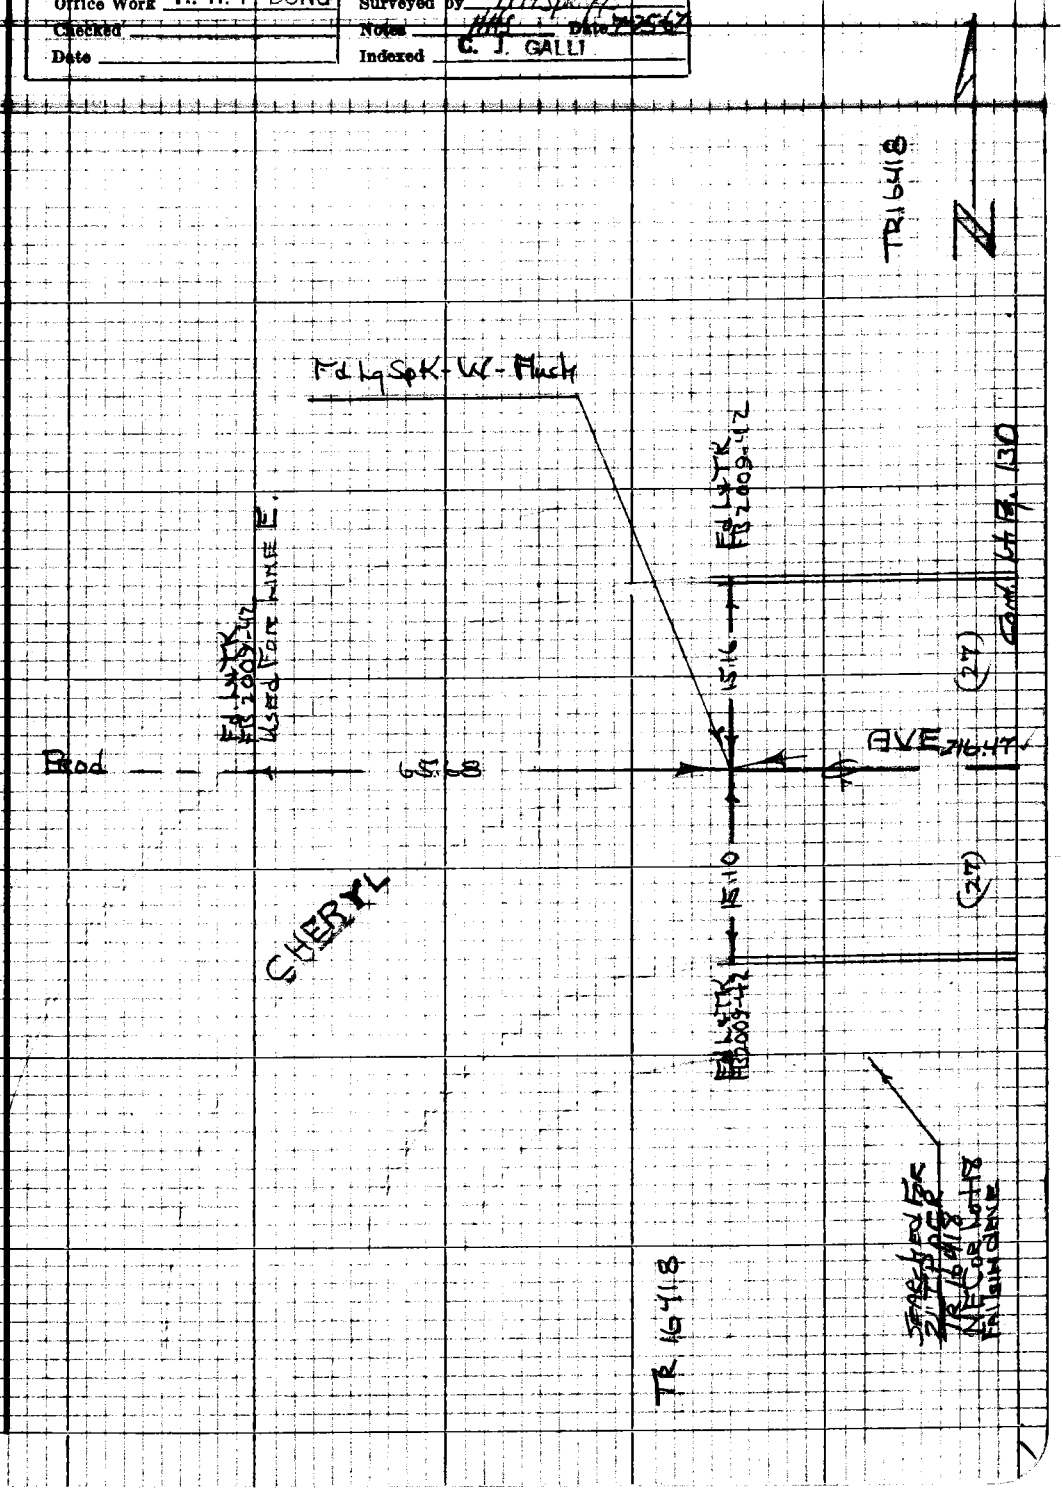

Note: Any Additions or Changes on this Sheet Must be Made or Circled in Red Ink With Date and Name of Person Making Change

Do not extend this side of this line.

PLEASE RETURN TO
LOS ANGELES COUNTY ENGINEER
403 LOS ANGELES COUNTY ENGINEERING BLDG.

76P3098 CE #310 8-66

PWFB 1921

2466

W.S. 51, B-3

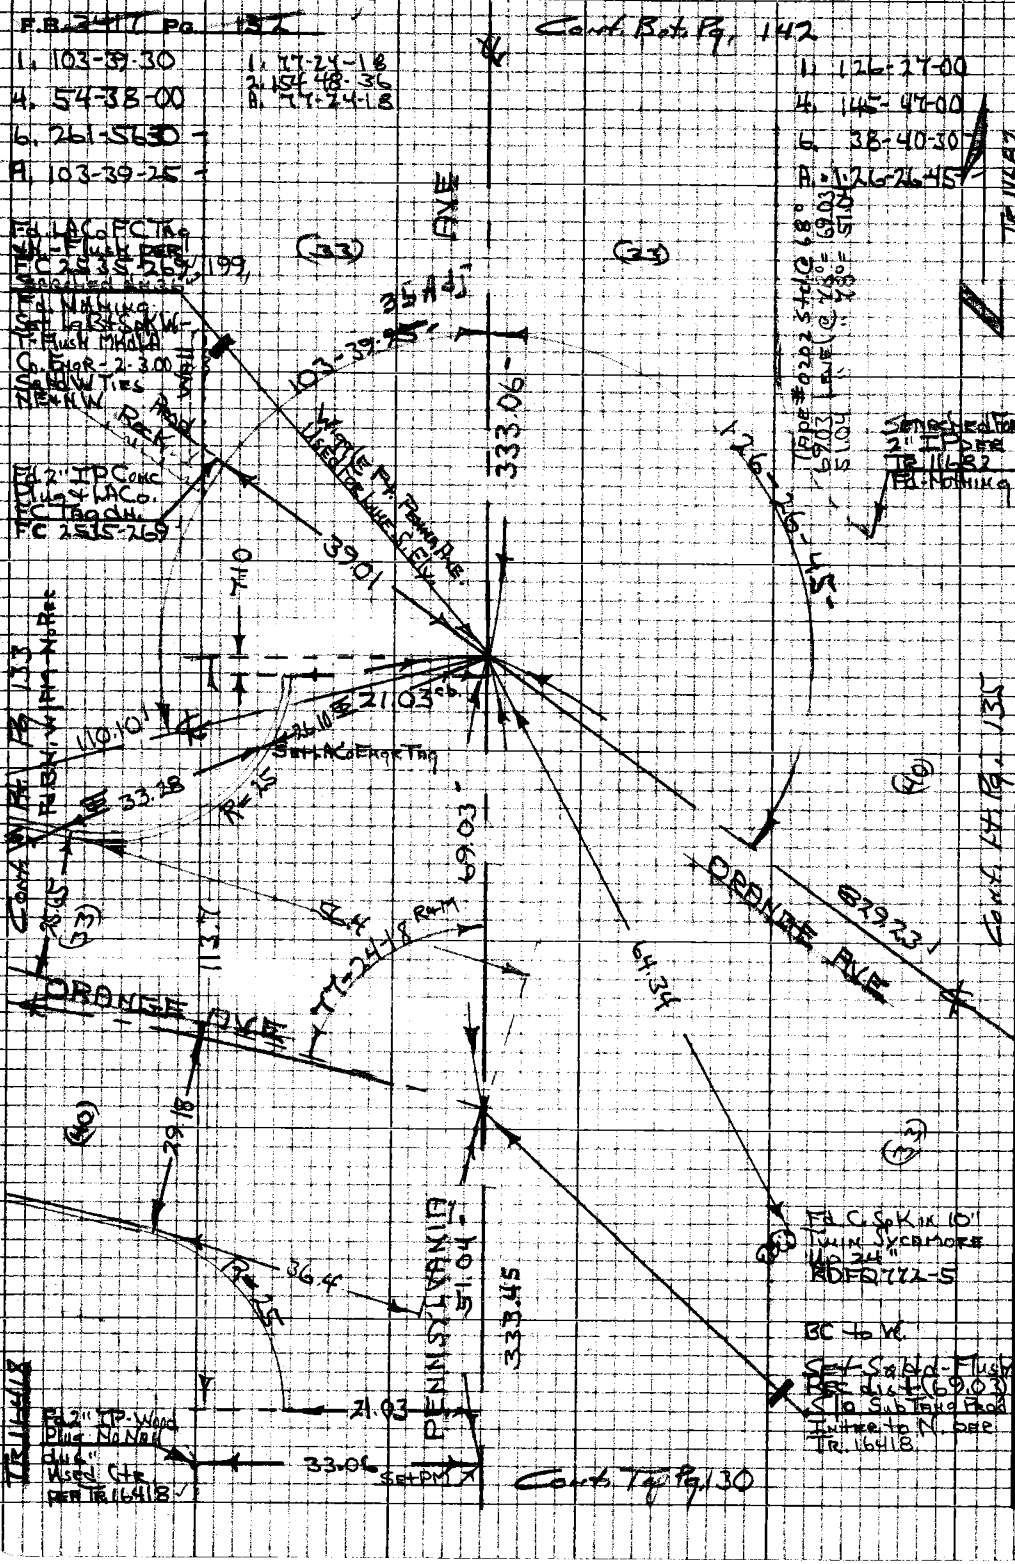

PLEASE RETURN TO
LOS ANGELES COUNTY ENGINEER
409 LOS ANGELES COUNTY ENGINEERING BLDG.

Do not extend this side of this line.

Note: Any Additions or Changes on this Sheet Must be Made or Circled in Red Ink With Date and Name of Person Making Change

PWFB 1921

2467

Notes Ck'd by R. P. SHORT	Survey of [illegible] AVE	F.B. [illegible]	Pg. 132
[illegible]	[illegible]		
Office Work H. H. F. DONG	Surveyed by HHSpriggs		
Checked	Notes HHS Date		
Date	Indexed C. J. GALLI		

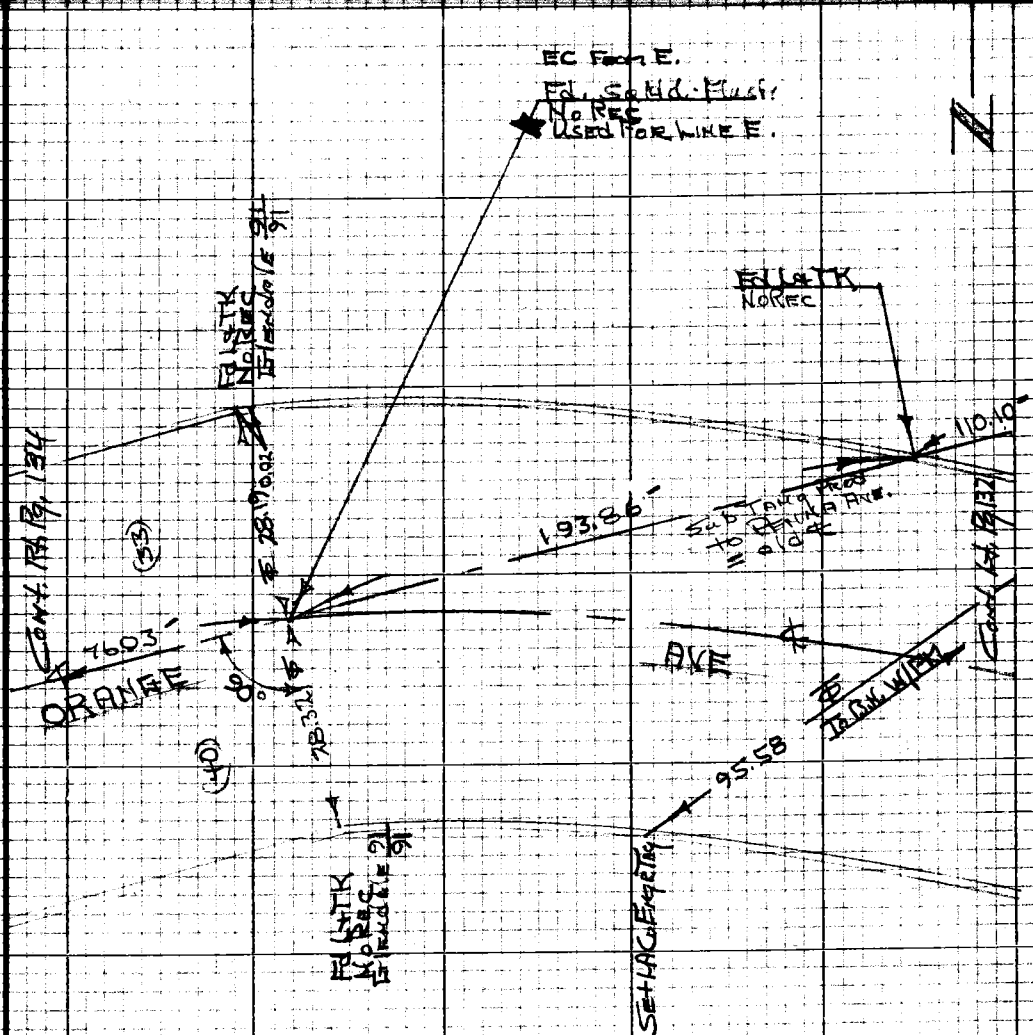

110.08 Level @ 90° = 110.10 -
193.83 " " 90° = 193.86 -
76.02 " " 90° = 76.03 -

TR16418

Note: Any Additions or Changes on this Sheet Must be Made or Circled in Red Ink With Date and Name of Person Making Change

Do not extend this side of this line.

PLEASE RETURN TO
LOS ANGELES COUNTY ENGINEER
403 Los Angeles County Engineering Bldg.

76P3098 CK #310 5-66

PWFB 1921 2468, 2469

F.B. 3417 Pg. 134

194.21 Level @ 90° = 194.24 -

TR 16418

PWFB 1921

2470

Notes Ck'd by R. P. SHORT	Survey of [illegible]	F.B. [illegible]	Pg. 135
Map No. B-5072	[illegible]	Cont.	[illegible]
Office Work H. H. F. DONG	Surveyed by [illegible]		
Checked	Notes [illegible] Date [illegible]		
Date	Indexed C. J. GALLI		

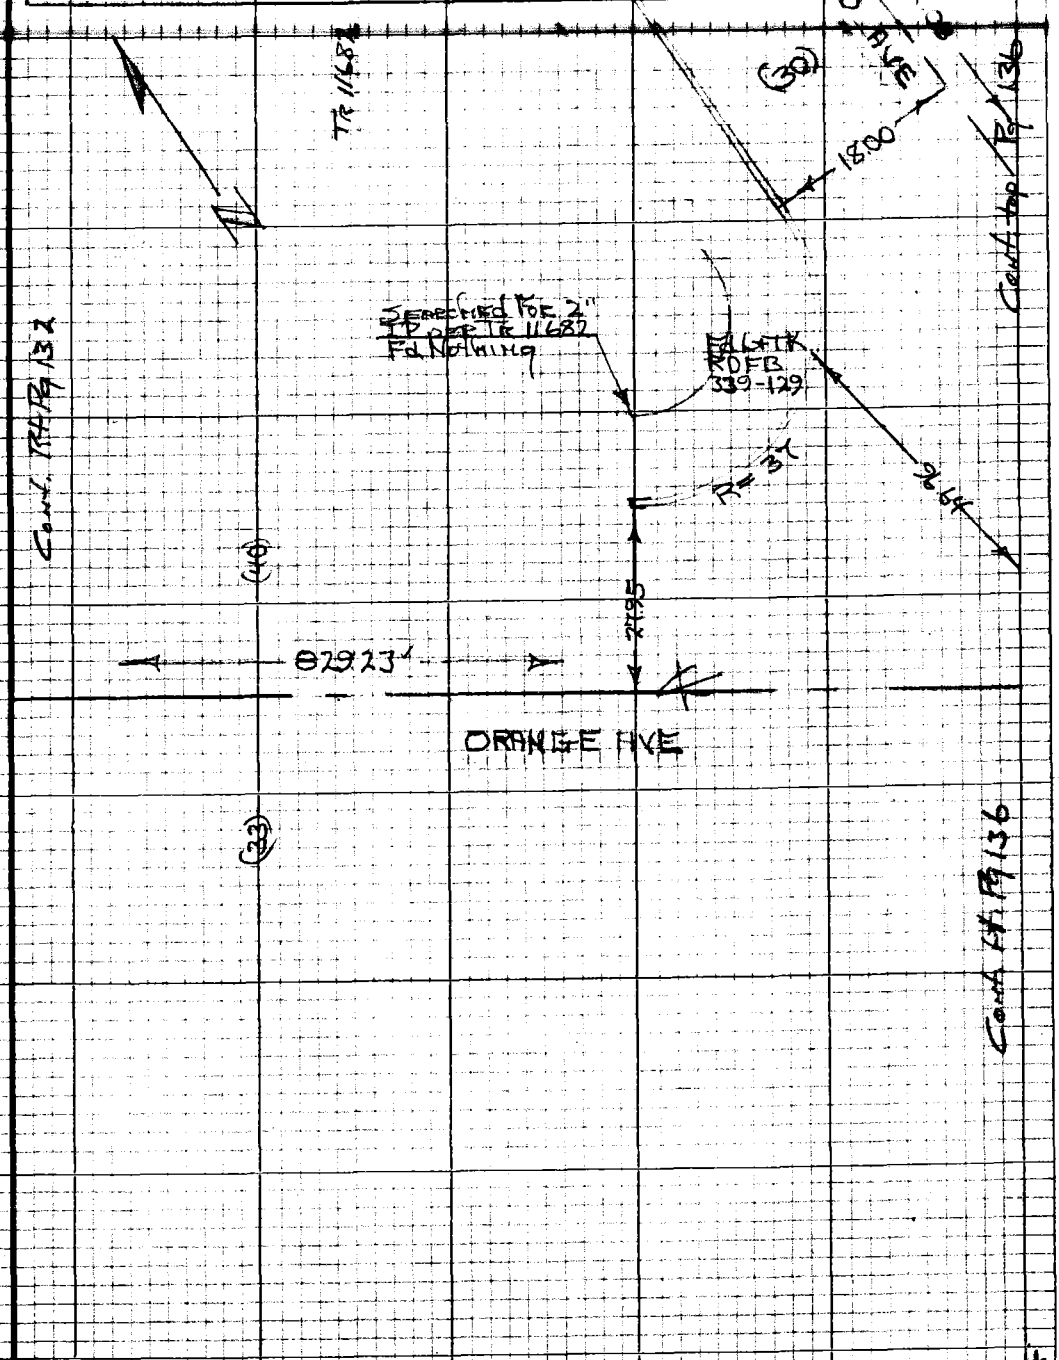

Note: Any Additions or Changes on this Sheet Must be Made or Circled in Red Ink With Date and Name of Person Making Change

Do not extend this side of this line.

PLEASE RETURN TO
LOS ANGELES COUNTY ENGINEER
403 LOS ANGELES COUNTY ENGINEERING BLDG.

76P3098 CE #310 8-66

PWFB 1921 2471

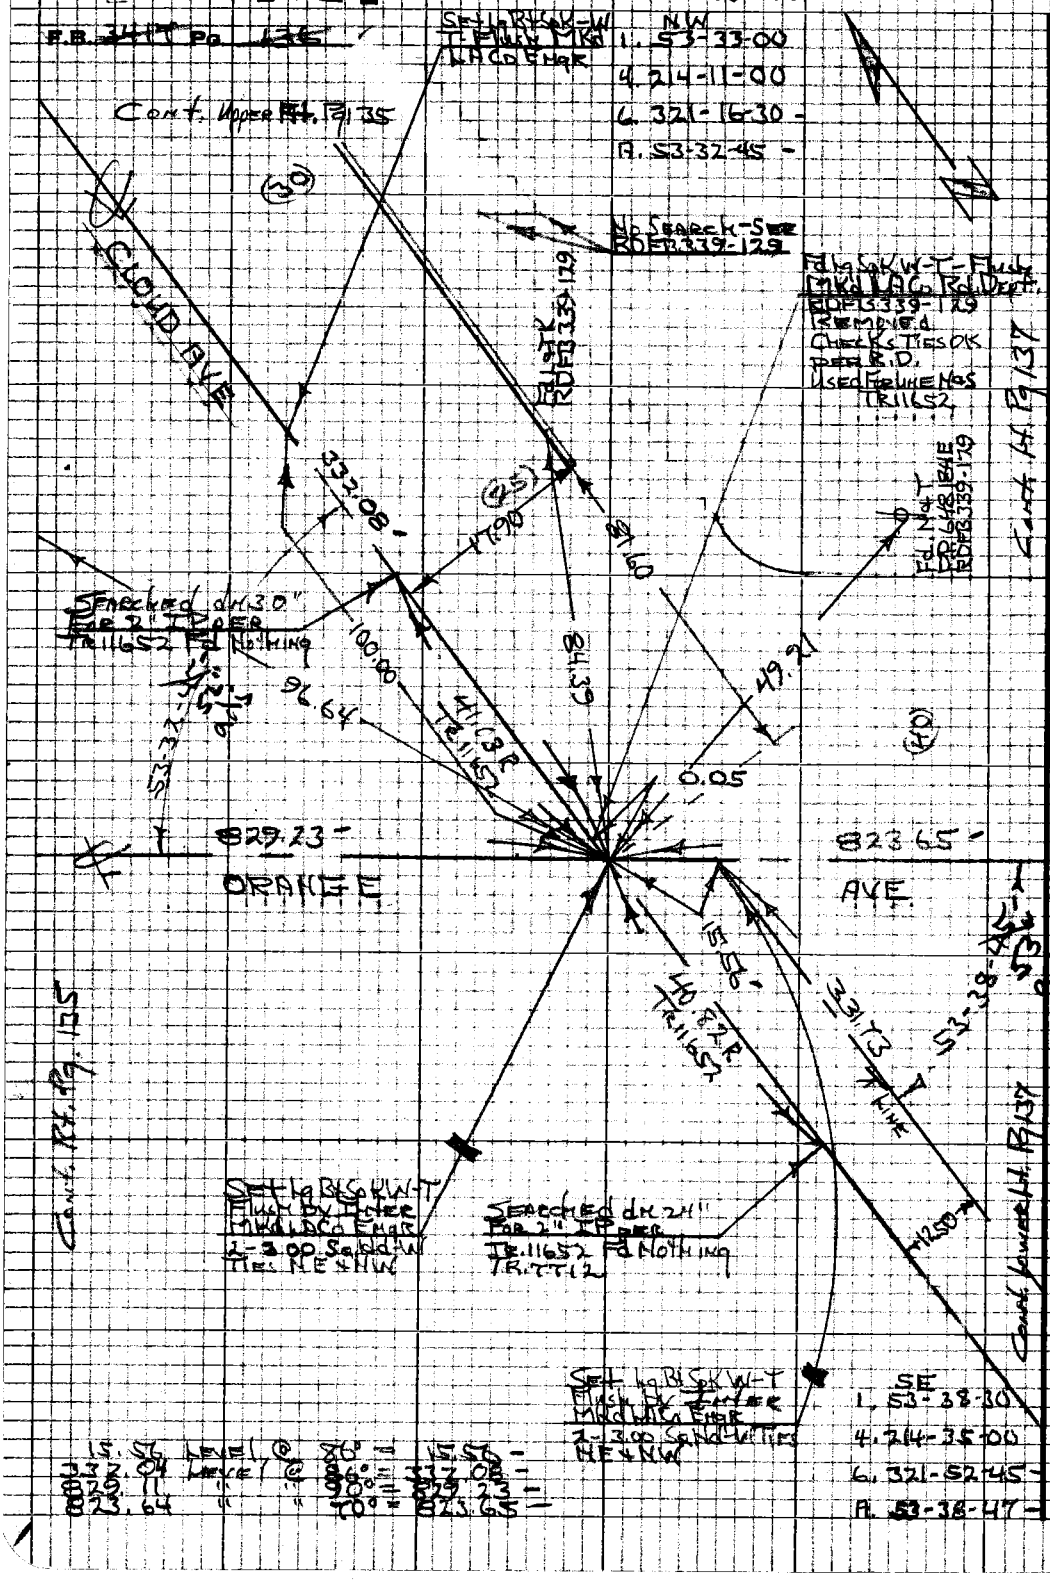

W.S. 51, B-4

PLEASE RETURN TO
LOS ANGELES COUNTY ENGINEER
403 LOS ANGELES COUNTY ENGINEERING BLDG.

Do not extend this side of this line.

Note: Any Additions or Changes on this Sheet Must be Made or Circled in Red Ink With Date and Name of Person Making Change

PWFB 1921

2472

Notes Ck'd by R. P. SHORT	Survey of [illegible]	F.B. 347 Pg. 13	
Office Work H. H. F. DONG	Surveyed by [illegible]		
Checked	Notes [illegible]		
Date	Indexed C. J. GALLI		

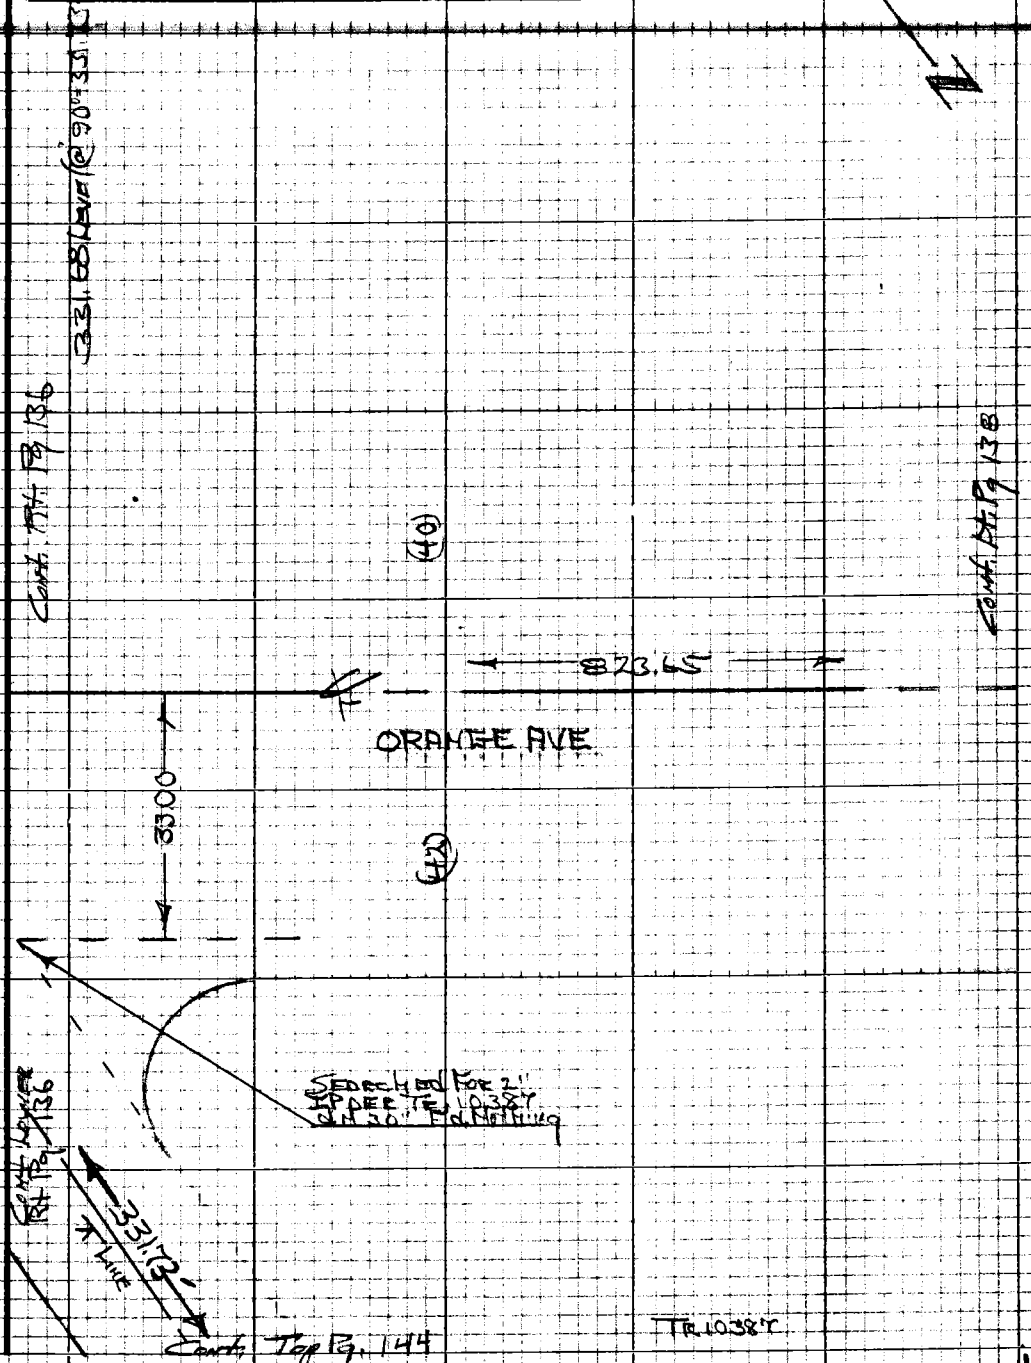

Note: Any Additions or Changes on this Sheet Must be Made or Circled in Red. Ink With Date and Name of Person Making Change

Do not extend this side of this line.

PLEASE RETURN TO
LOS ANGELES COUNTY ENGINEER
403 LOS ANGELES COUNTY ENGINEERING BLDG.

762-2035 CE #310 8-66

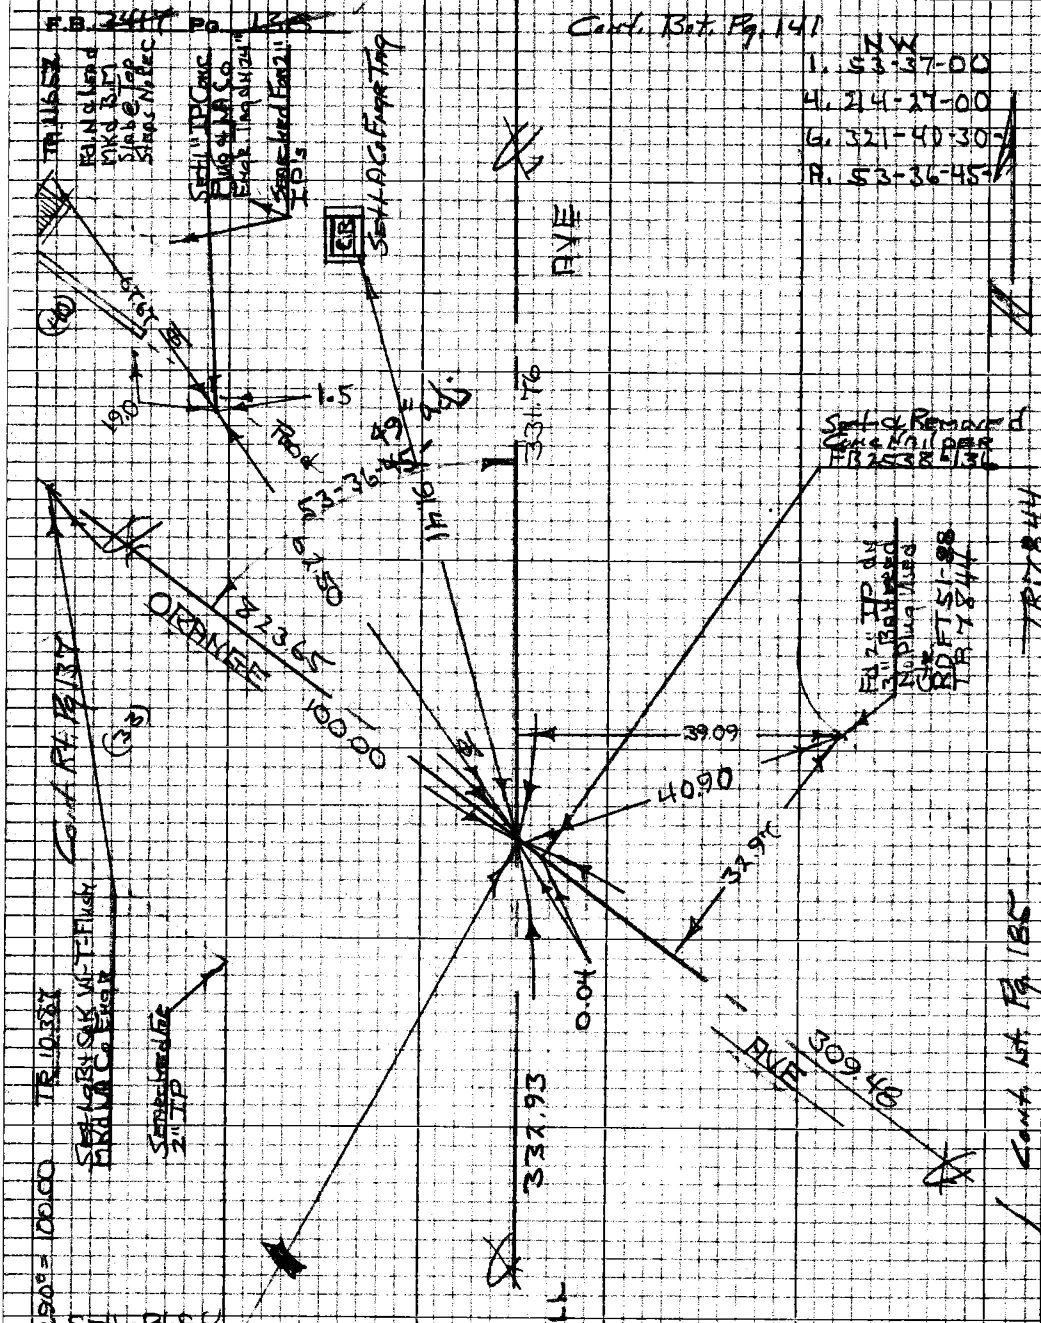

PLEASE RETURN TO
LOS ANGELES COUNTY ENGINEER
403 LOS ANGELES COUNTY ENGINEERING BLDG.

Do not extend this side of this line.

Note: Any Additions or Changes on this Sheet Must be Made or Circled in Red Ink With Date and Name of Person Making Change

PWFB 1921

2474, 2475

Notes Ck'd by R. P. SHORT	Survey of
Office Work H. H. F. DONG	Surveyed by
Checked	Notes / Date
Date	Indexed C. T. GALLI

F.B. ____ Pg. ____

Note: Any Additions or Changes on this Sheet Must be Made or Circled in Red Ink With Date and Name of Person Making Change

Do not extend this side of this line.

PLEASE RETURN TO LOS ANGELES COUNTY ENGINEER 403 LOS ANGELES COUNTY ENGINEERING BLDG.

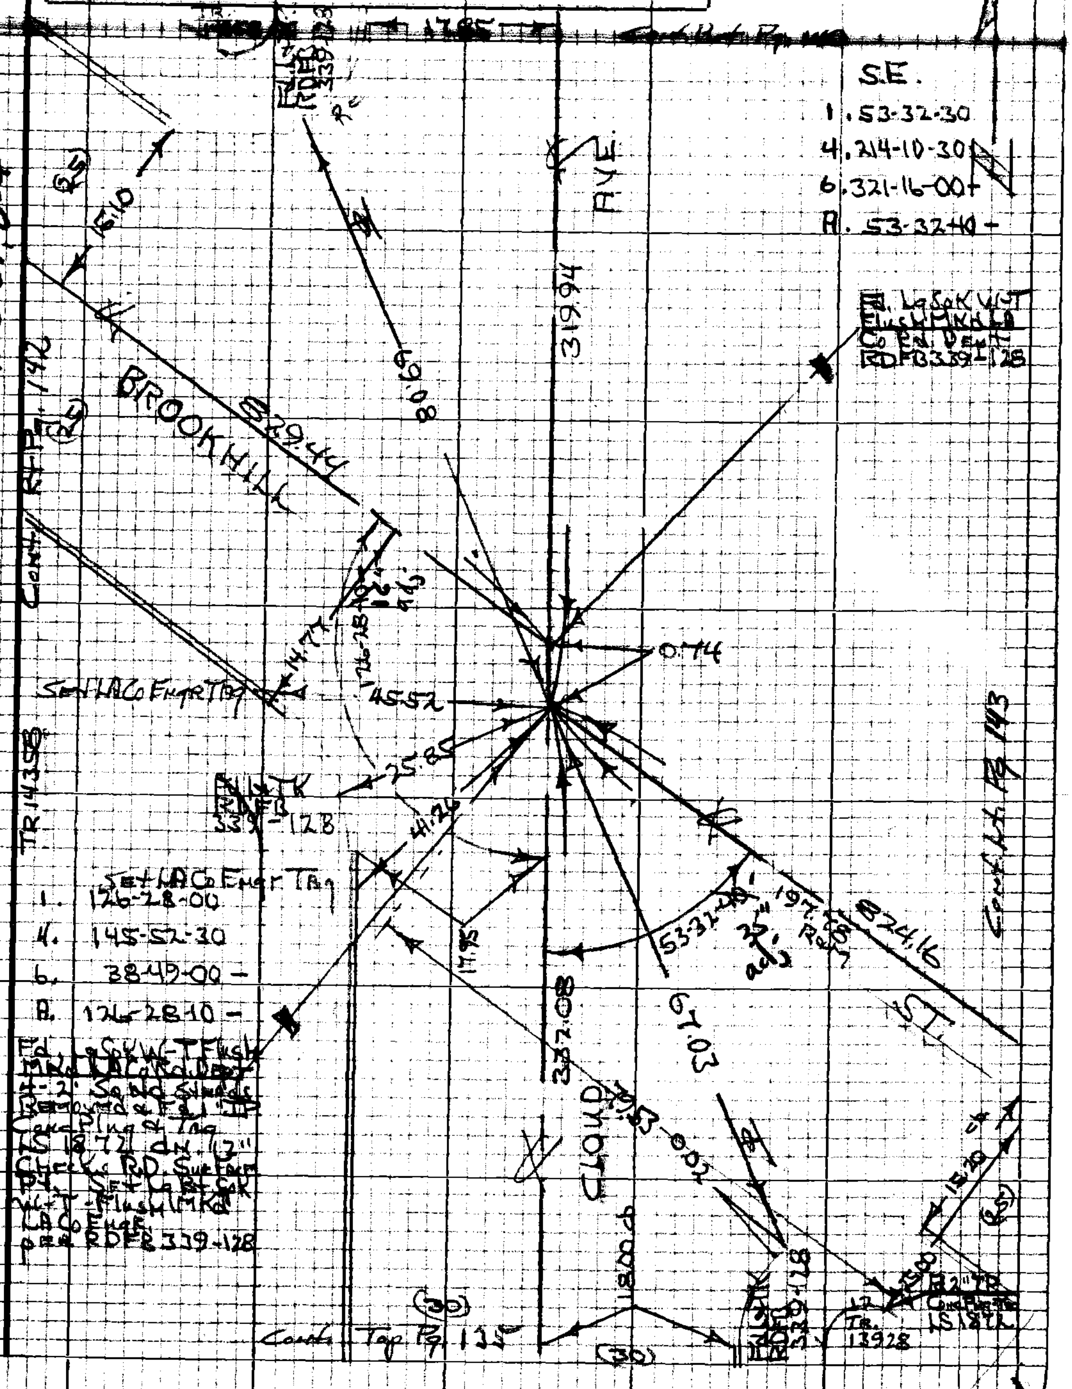

76P3098 CK #310 8-46

PWFB 1921 2476

F.B. 3447 Pg 140

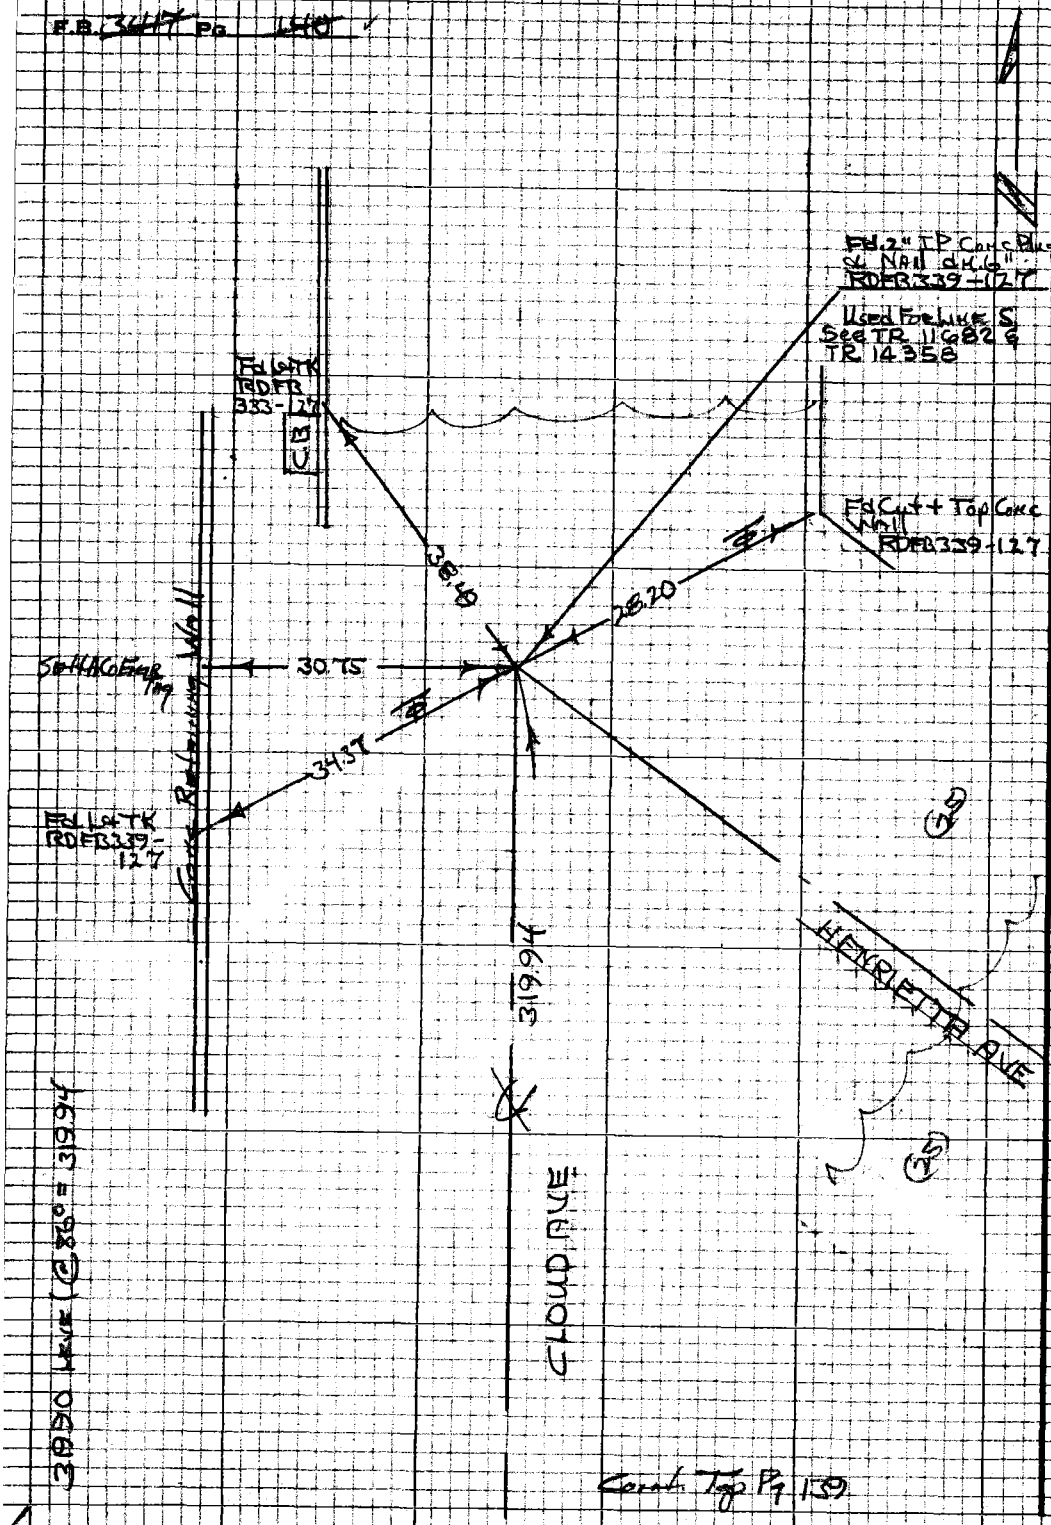

Cont. Top Pg 139

W.S. 51, B-3

PLEASE RETURN TO
LOS ANGELES COUNTY ENGINEER
403 LOS ANGELES COUNTY ENGINEERING BLDG.

Do not extend this side of this line.

Note: Any Additions or Changes on this Sheet Must be Made or Circled in Red Ink With Date and Name of Person Making Change

PWFB 1921 2477

Notes Ck'd by R. P. SHORT	Survey of [illegible]	F.B. [illegible]	Pg. 141
[illegible]	[illegible]		
Office Work H. H. F. DONG	Surveyed by [illegible]		
Checked	Notes [illegible]	Date [illegible]	
Date	Indexed C. J. GALLI		

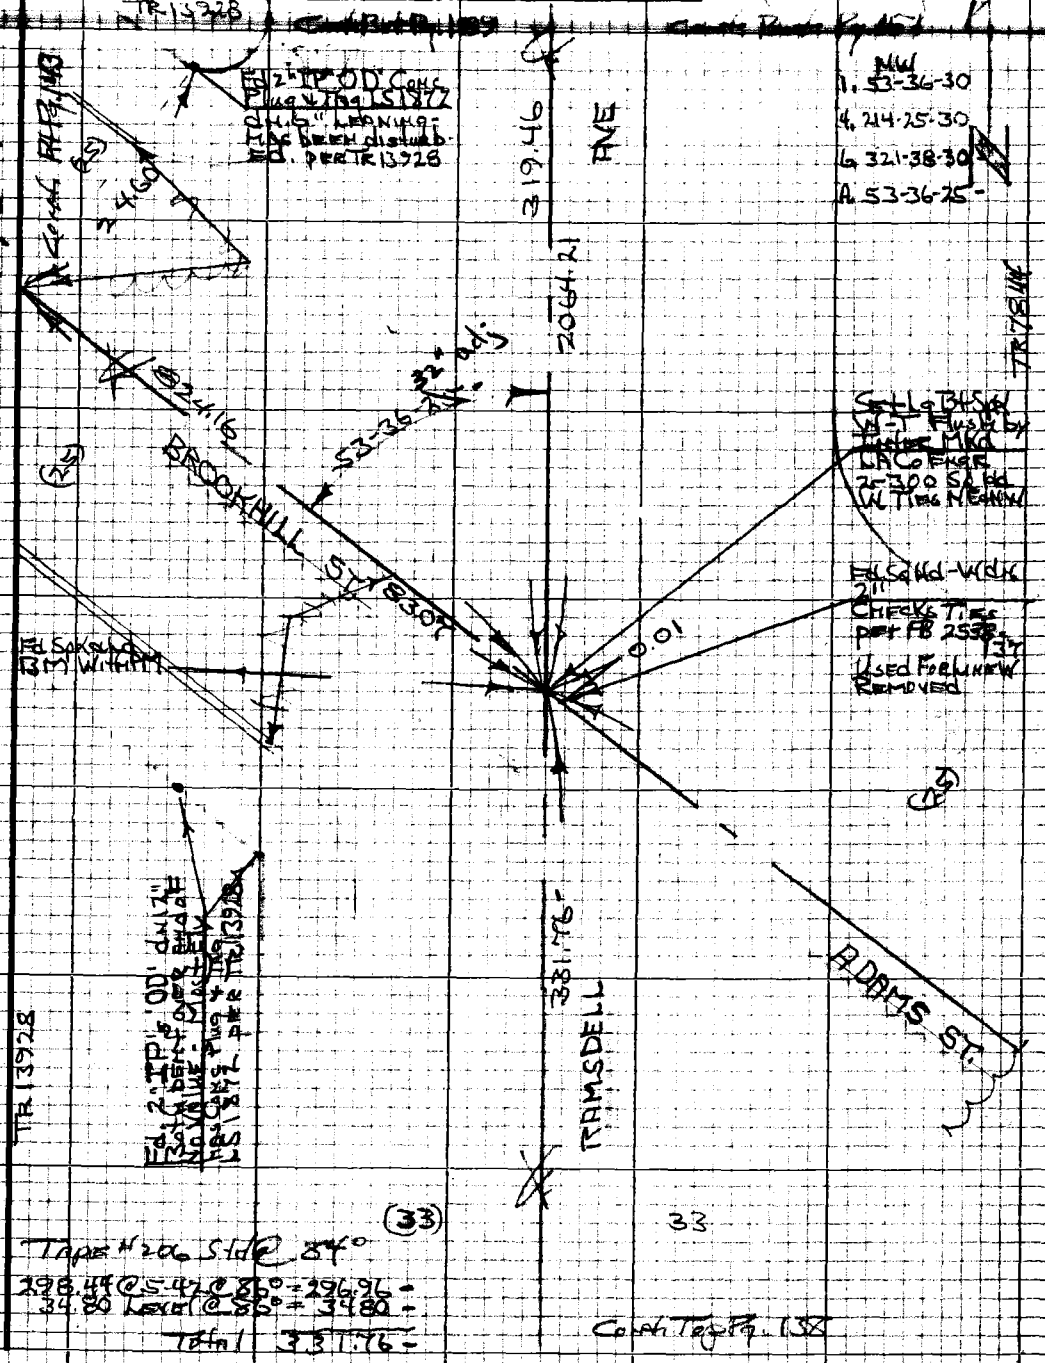

Note: Any Additions or Changes on this Sheet Must be Made or Circled in Red Ink With Date and Name of Person Making Change

Do not extend this side of this line.

PLEASE RETURN TO
LOS ANGELES COUNTY ENGINEER
403 LOS ANGELES COUNTY ENGINEERING BLDG.

76P3098 CK #310 5-66

PWFB 1921 2478

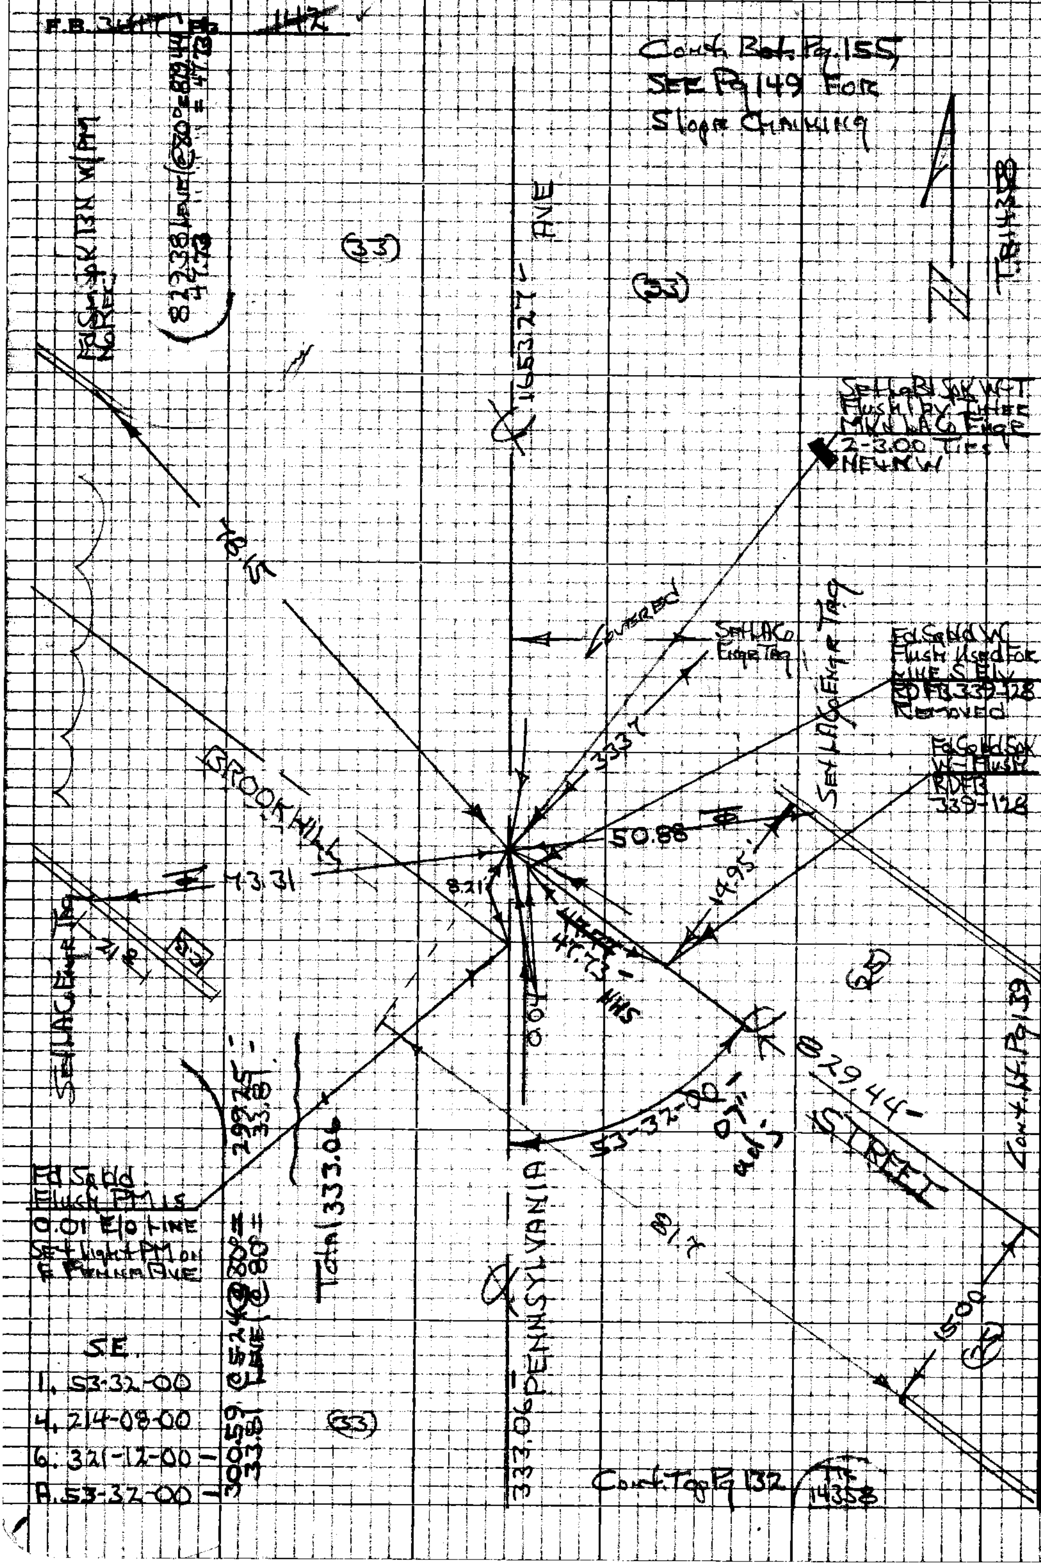

W.S. 51, B-3

PLEASE RETURN TO
LOS ANGELES COUNTY ENGINEER
403 LOS ANGELES COUNTY ENGINEERING BLDG.

Do not extend this side of this line.

Note: Any Additions or Changes on this Sheet Must be Made or Circled in Red Ink With Date and Name of Person Making Change

PWFB 1921

2479

Notes Ck'd by R. P. SHORT	Survey of [illegible]	F.B. 3417	Pg. 143
[illegible]	[illegible]		
Office Work H. H. F. DONG	Surveyed by [illegible]		
Checked	Notes [illegible] Date [illegible]		
Date	Indexed C. J. GALLI		

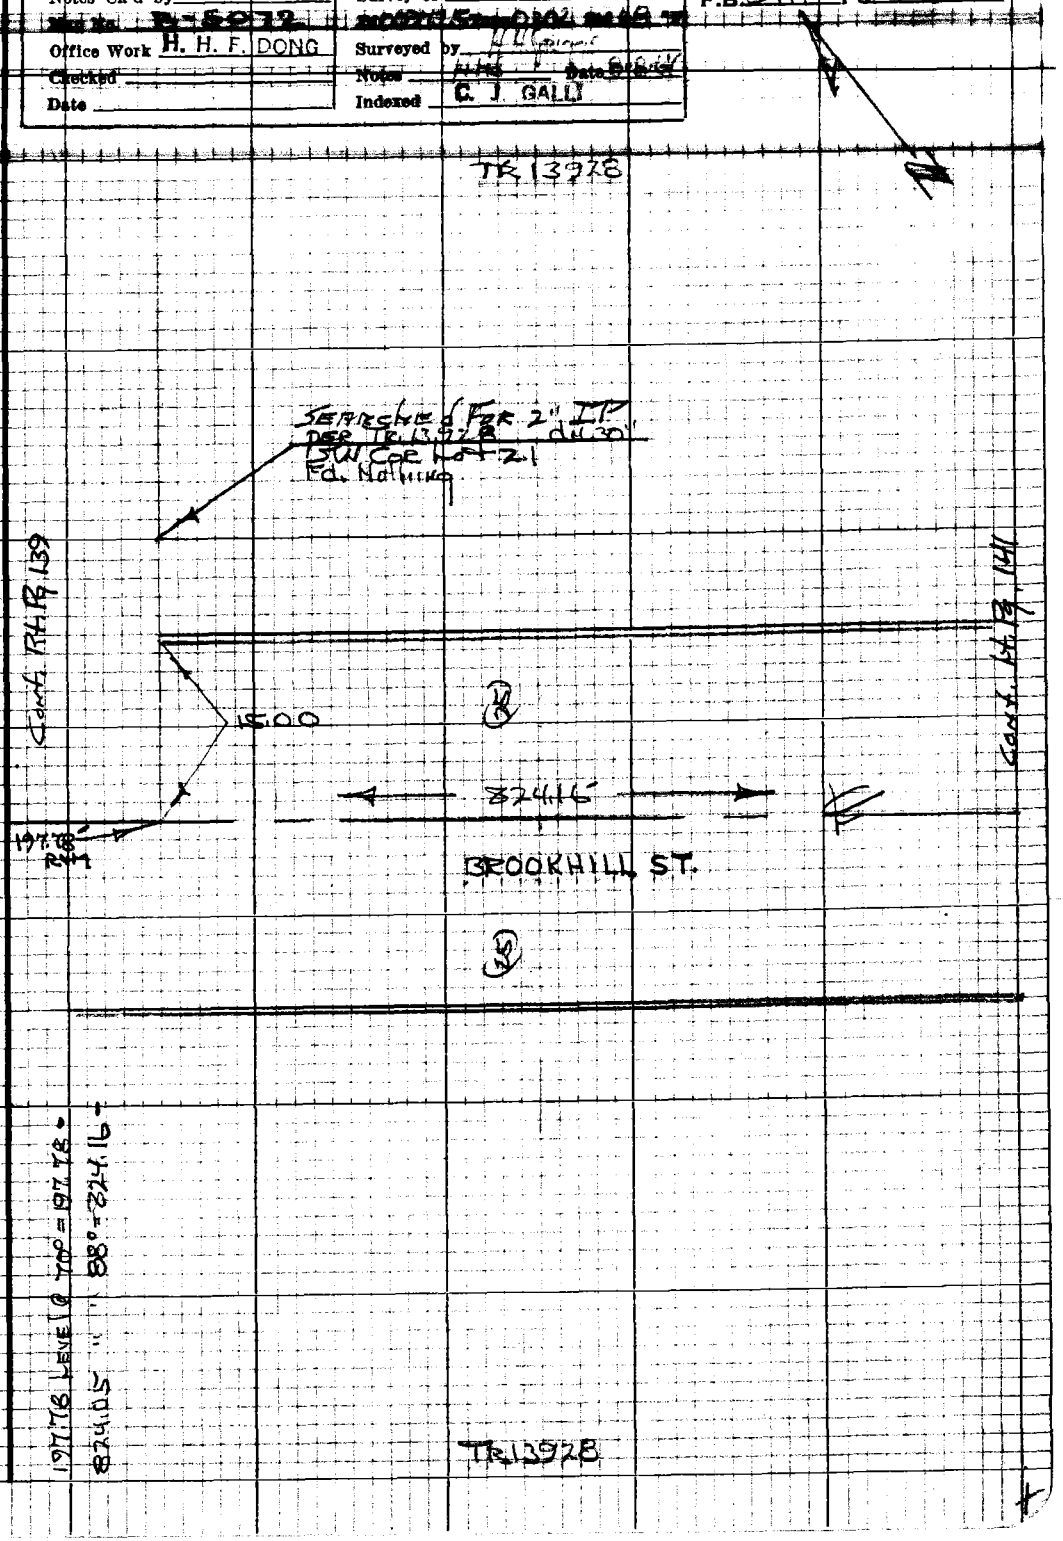

Note: Any Additions or Changes on this Sheet Must be Made or Circled in Red Ink With Date and Name of Person Making Change

Do not extend this side of this line.

PLEASE RETURN TO
LOS ANGELES COUNTY ENGINEER
403 LOS ANGELES COUNTY ENGINEERING BLDG.

76P3098 CE #310 5-66

PWFB 1921 2480

F.B. 2417 Pg. 144

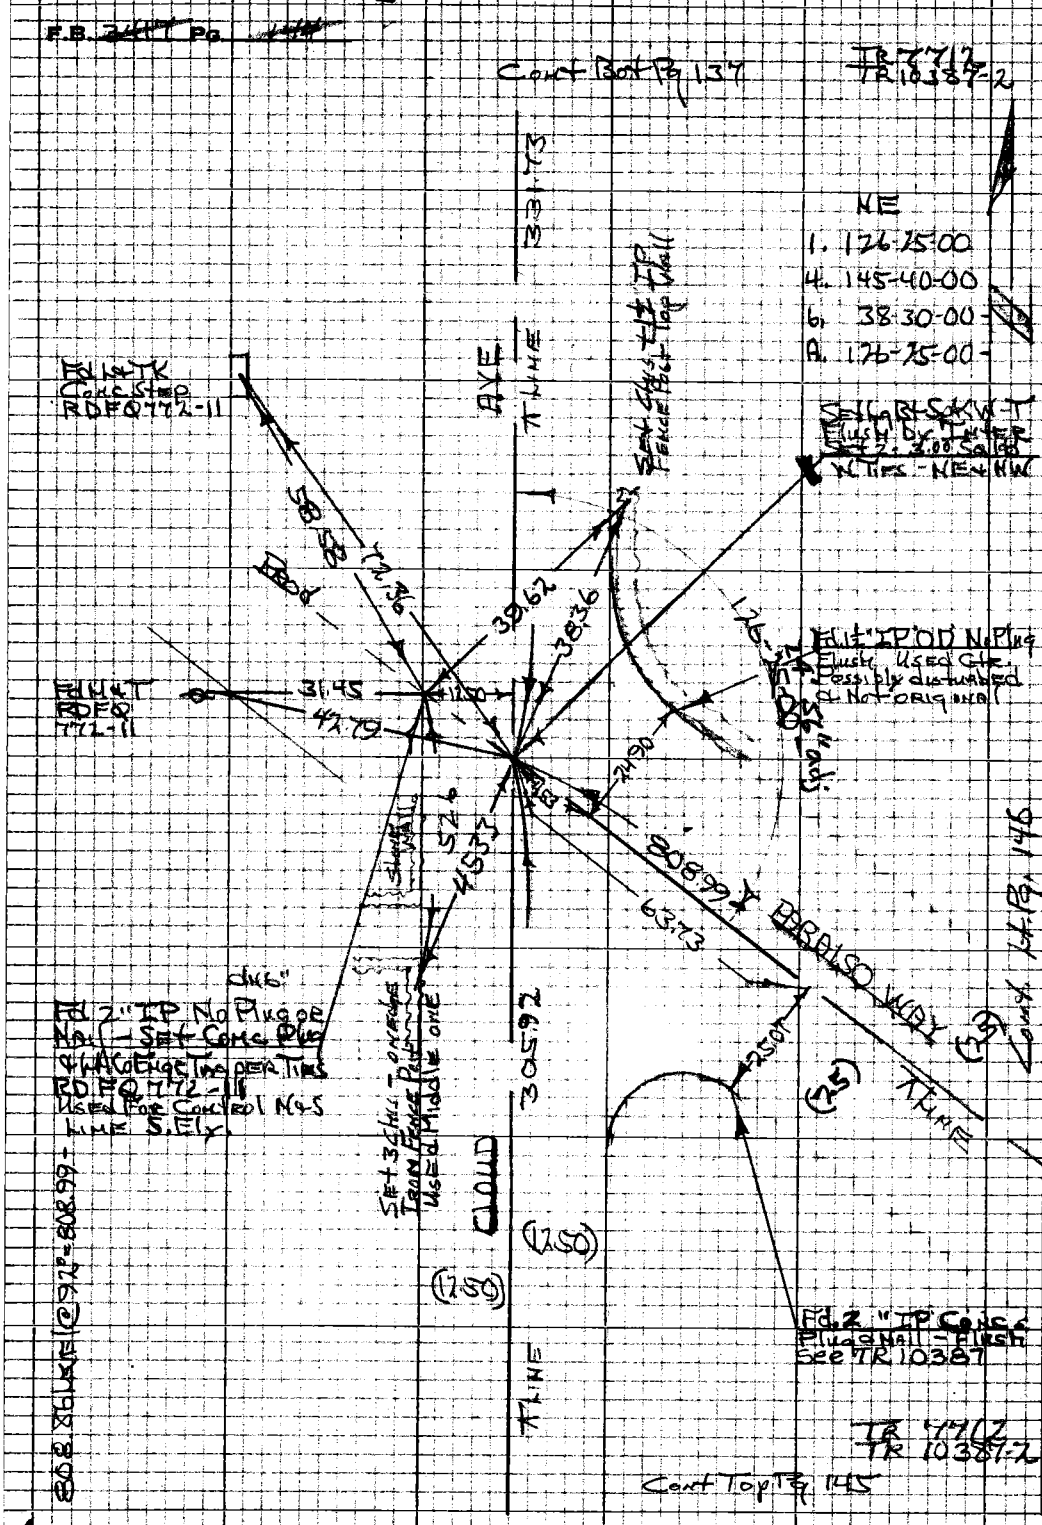

PLEASE RETURN TO
LOS ANGELES COUNTY ENGINEER
403 LOS ANGELES COUNTY ENGINEERING BLDG.

Do not extend this side of this line.

Note: Any Additions or Changes on this Sheet Must be Made or Circled in Red Ink With Date and Name of Person Making Change

PWFB 1921

2481

Notes Ck'd by R. P. SHORT

Survey of

Office Work H. H. F. DONG

Surveyed by

Checked

Notes

Date

Indexed C. J. GALLI

F.B. Pg.

Note: Any Additions or Changes on this Sheet Must be Made or Circled in Red Ink With Date and Name of Person Making Change

Do not extend this side of this line.

PLEASE RETURN TO
LOS ANGELES COUNTY ENGINEER
403 LOS ANGELES COUNTY ENGINEERING BLDG.

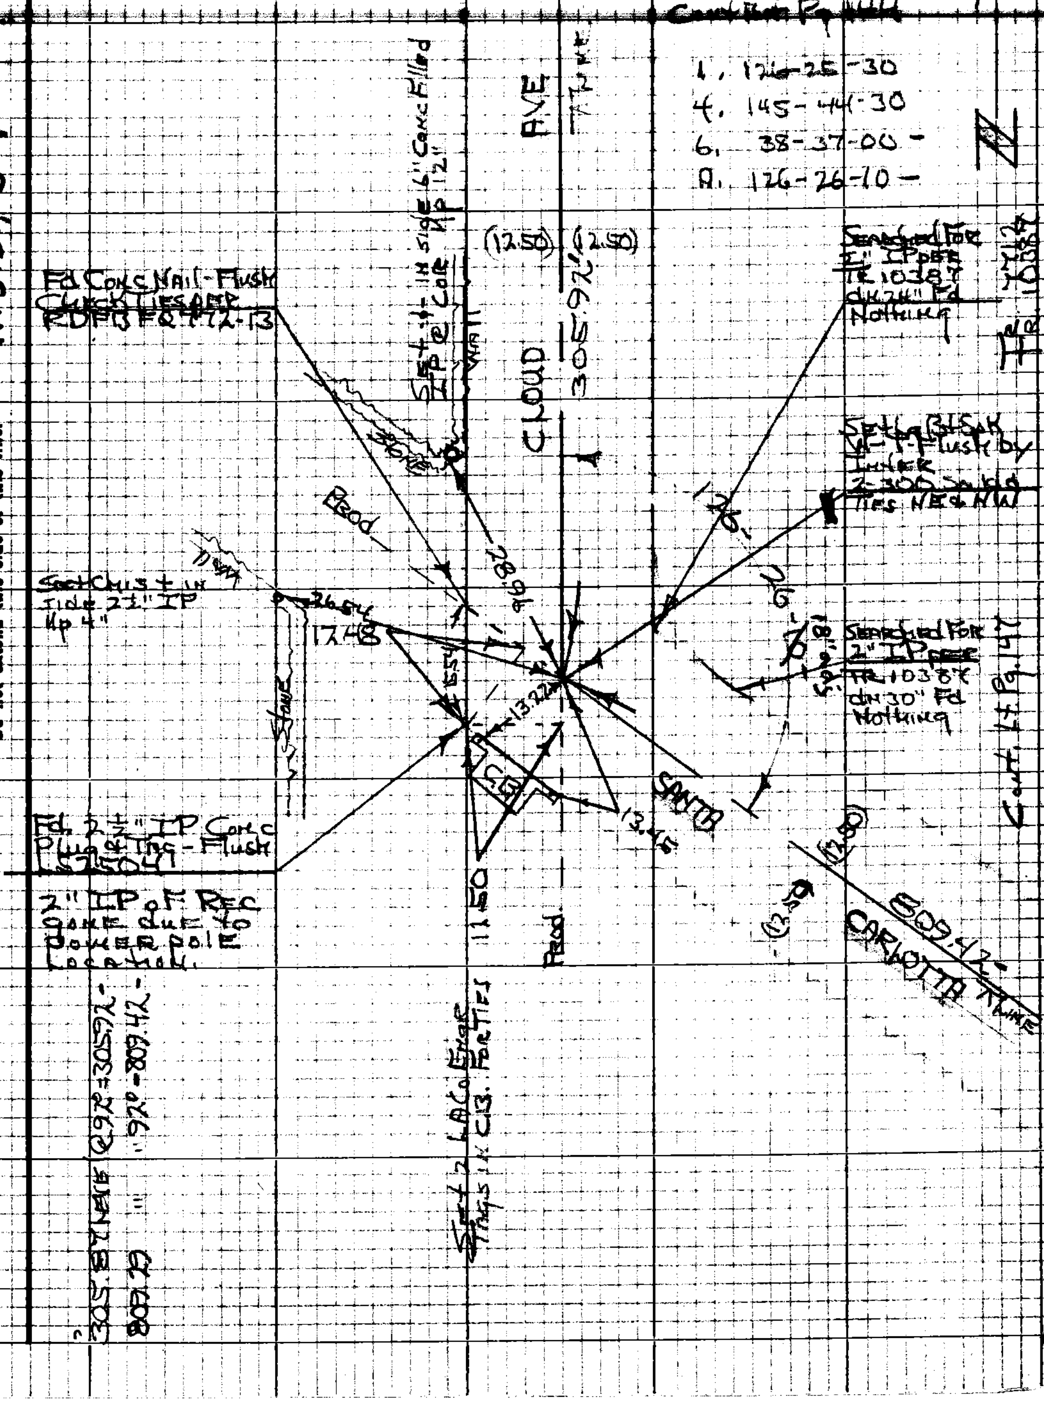

76P3098 CK #310 5-66

PWFB 1921 2482

F.B. 3417 Pg. 176

Cont. Bot. Pg. 138

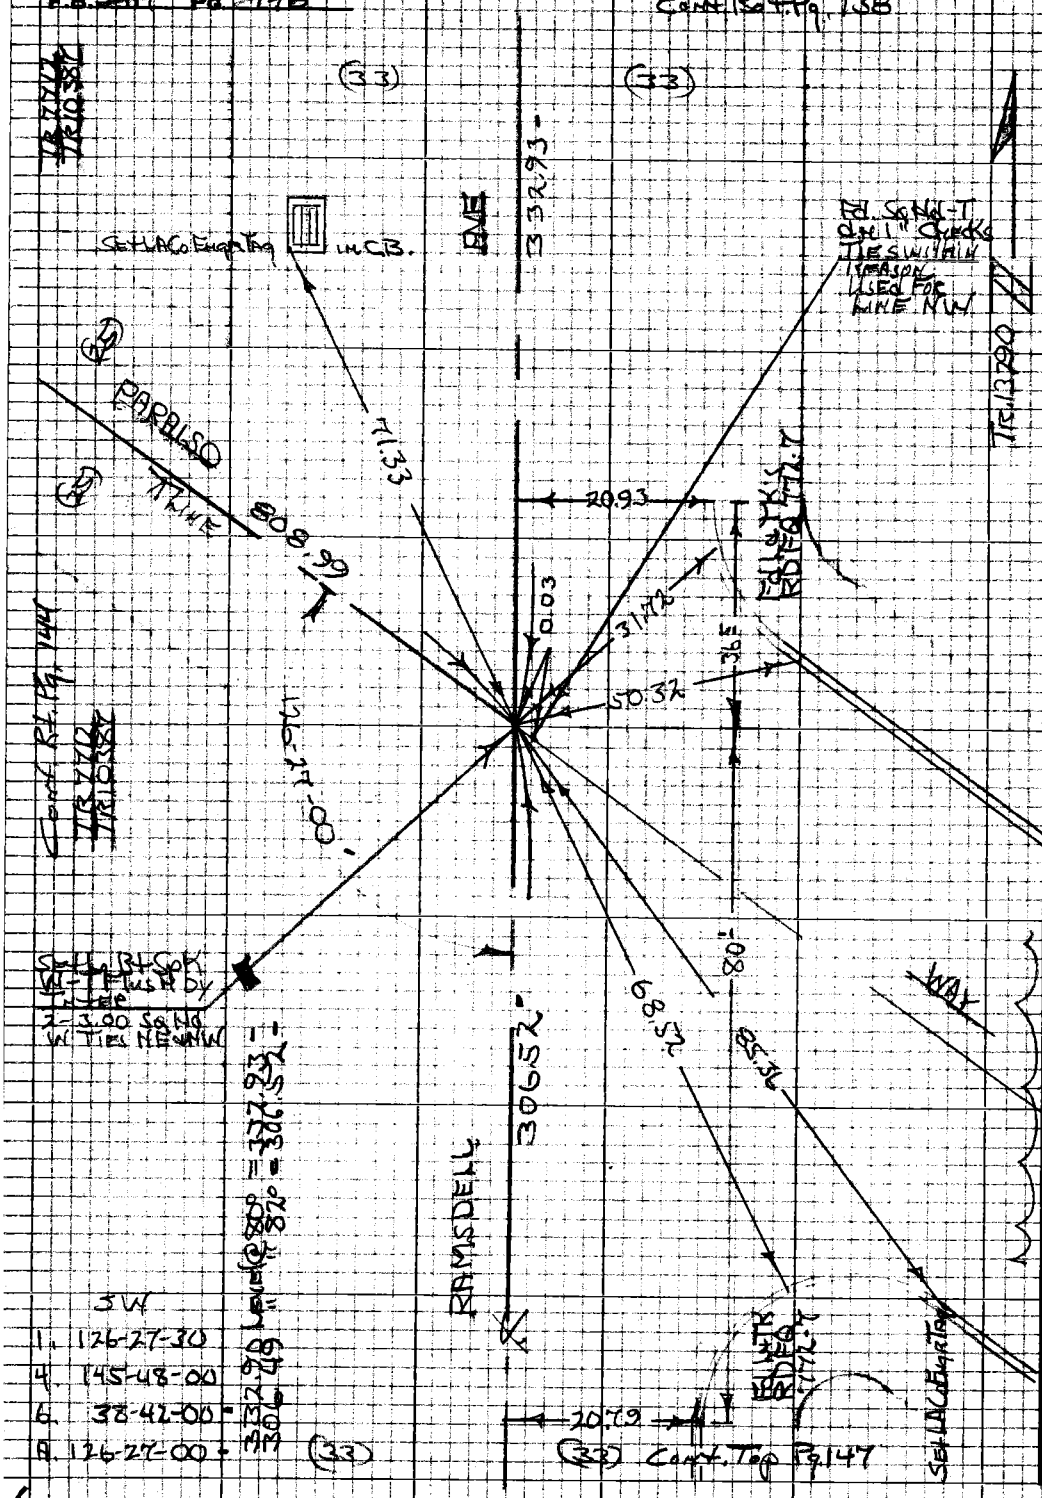

SW
1. 126-27-30
4. 145-48-00
6. 38-42-00
A. 126-27-00

332.93 Level @ 80° = 332.93
306.49 " " 82° = 306.52

W.S. 51, B-4

PLEASE RETURN TO
LOS ANGELES COUNTY ENGINEER
403 LOS ANGELES COUNTY ENGINEERING BLDG.

Do not extend this side of this line.

Note: Any Additions or Changes on this Sheet Must be Made or Circled in Red Ink With Date and Name of Person Making Change

PWFB 1921 2483

Notes Ck'd by R. P. SHORT	Survey of PENHA AVE	F.B. 3417 Pg. [illegible]
[illegible]	[illegible]	
Office Work H. H. F. DONG	Surveyed by [illegible]	
Checked	Notes [illegible] Date [illegible]	
Date	Indexed C. J. GALLI	

Cont. Bot Pg 146

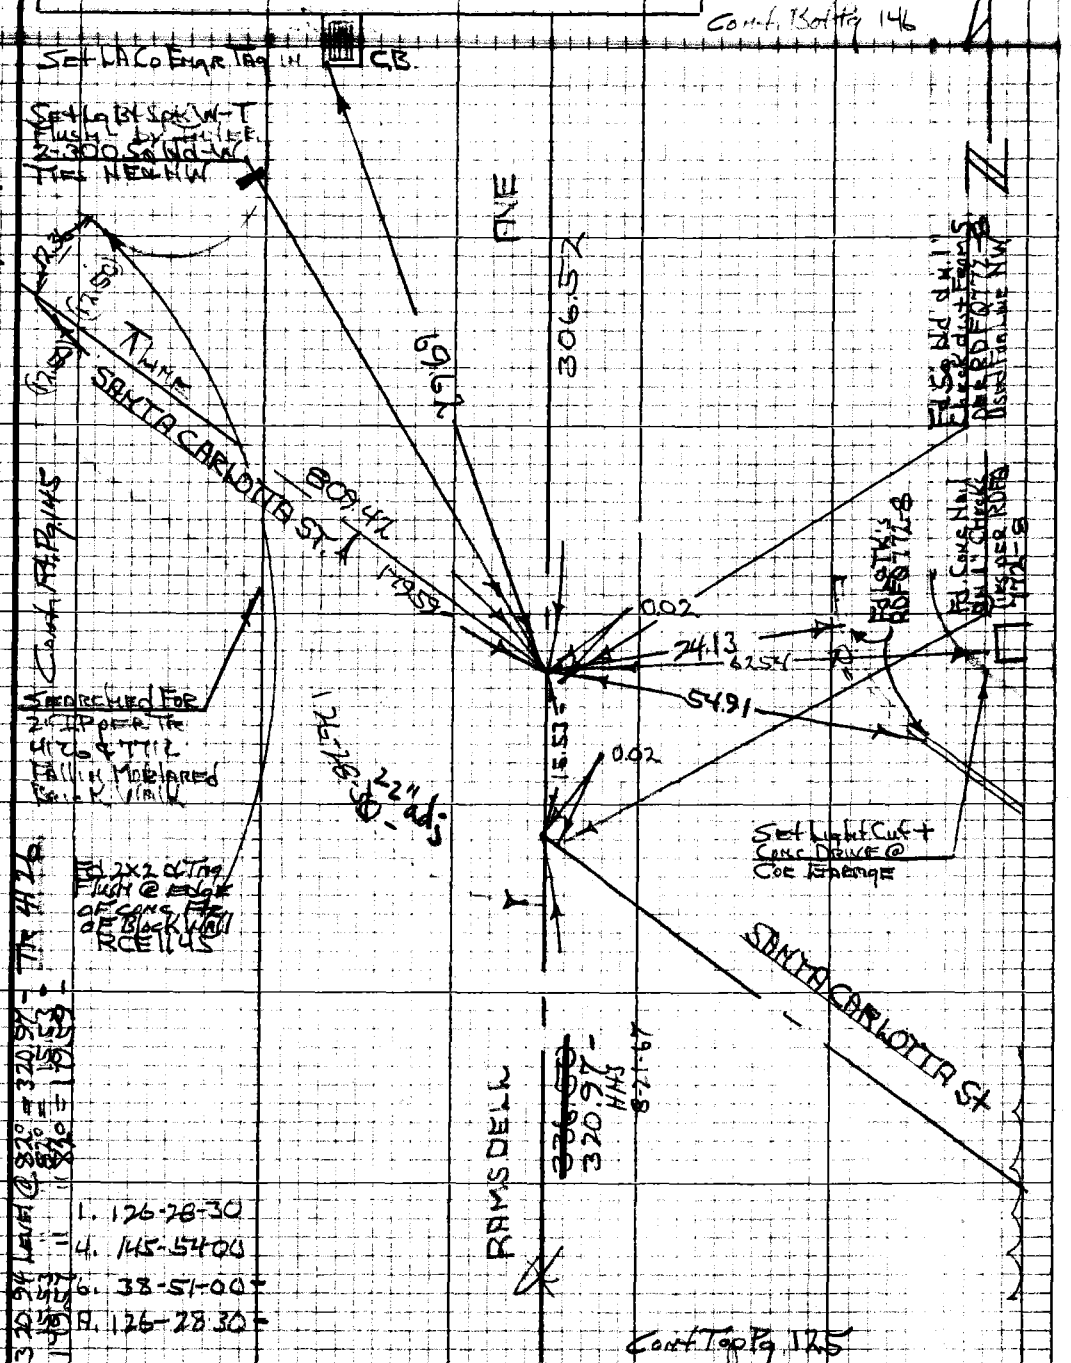

Note: Any Additions or Changes on this Sheet Must be Made or Circled in Red Ink With Date and Name of Person Making Change

Do not extend this side of this line.

PLEASE RETURN TO
LOS ANGELES COUNTY ENGINEER
403 LOS ANGELES COUNTY ENGINEERING BLDG.

76P3095 CE #310 8-66

PLEASE RETURN TO
LOS ANGELES COUNTY ENGINEER
403 LOS ANGELES COUNTY ENGINEERING BLDG.

Note: Any Additions or Changes on this Sheet Must be Made or Circled in Red Ink With Date and Name of Person Making Change

Do not extend this side of this line.

F.B. 3417 Pg. 148

PWFB 1921

2484

Notes Ck'd by R. P. SHORT	Survey of [illegible]	F.B. [illegible] Pg. 149
[illegible]	[illegible]	
Office Work H. H. F. DONG	Surveyed by [illegible]	
Checked	Notes [illegible] Date 8-8-67	
Date	Indexed C. J. GALLI	

300' Tape #206 Std @ 84°

SEE Bot Pg 155

300.87 @ 6.35 @ 72° = 298.87 -
300.04 @ 5.15 @ 76° = 298.76 -
301.00 @ 5.55 @ 78° = 299.39 -
300.45 @ 4.58 @ 78° = 299.31 -
300.67 @ 5.53 @ 80° = 299.08 -
158.27 @ 3.57 @ 80° = 157.86 -

Total 1653.27 -

PENNSYLVANIA AVE
1653.27 -

SEE top Pg 142

Note: Any Additions or Changes on this Sheet Must be Made or Circled in Red Ink With Date and Name of Person Making Change

Do not extend this side of this line.

PLEASE RETURN TO
LOS ANGELES COUNTY ENGINEER
403 LOS ANGELES COUNTY ENGINEERING BLDG.

76P3098 CE #310 5-66

PWFB 1921 2485

F.B. ~~3417~~ Pg. ~~150~~

300' Tape #206 Std @ 84°

SEE Bot Pg. 151

236.53	@ 7-03	@ 86° =	234.74	-
300.15	@ 5-47	@ 86° =	298.62	-
300.52	@ 4-53	@ 86° =	299.43	-
300.20	@ 5-28	@ 86° =	298.83	-
287.42	@ 5-13	@ 86° =	286.23	-
229.25	@ 4-14	@ 86° =	228.62	-
239.02	@ 5-00	@ 86° =	238.11	-
180.63	@ 6-01	@ 86° =	179.63	-
		Total	2064.21	-

RAMSDELL AVE

2064.21

SEE Top Pg. 141

PLEASE RETURN TO
LOS ANGELES COUNTY ENGINEER
403 Los Angeles County Engineering Bldg.

Note: Any Additions or Changes on this Sheet Must be Made or Circled in Red Ink With Date and Name of Person Making Change.

Do not extend this side of this line.

PWFB 2021

Notes Ck'd by R. P. SHORT	Survey of	F.B.	Pg. 151
Office Work H. H. F. DONG	Surveyed by		
Checked	Notes	Date	
Date	Indexed C. I. GALLI		

Note: Any Additions or Changes on this Sheet Must be Made or Circled in Red Ink With Date and Name of Person Making Change

Do not extend this side of this line.

W.S. 51, B-3

PLEASE RETURN TO
LOS ANGELES COUNTY ENGINEER
403 Los Angeles County Engineering Bldg.

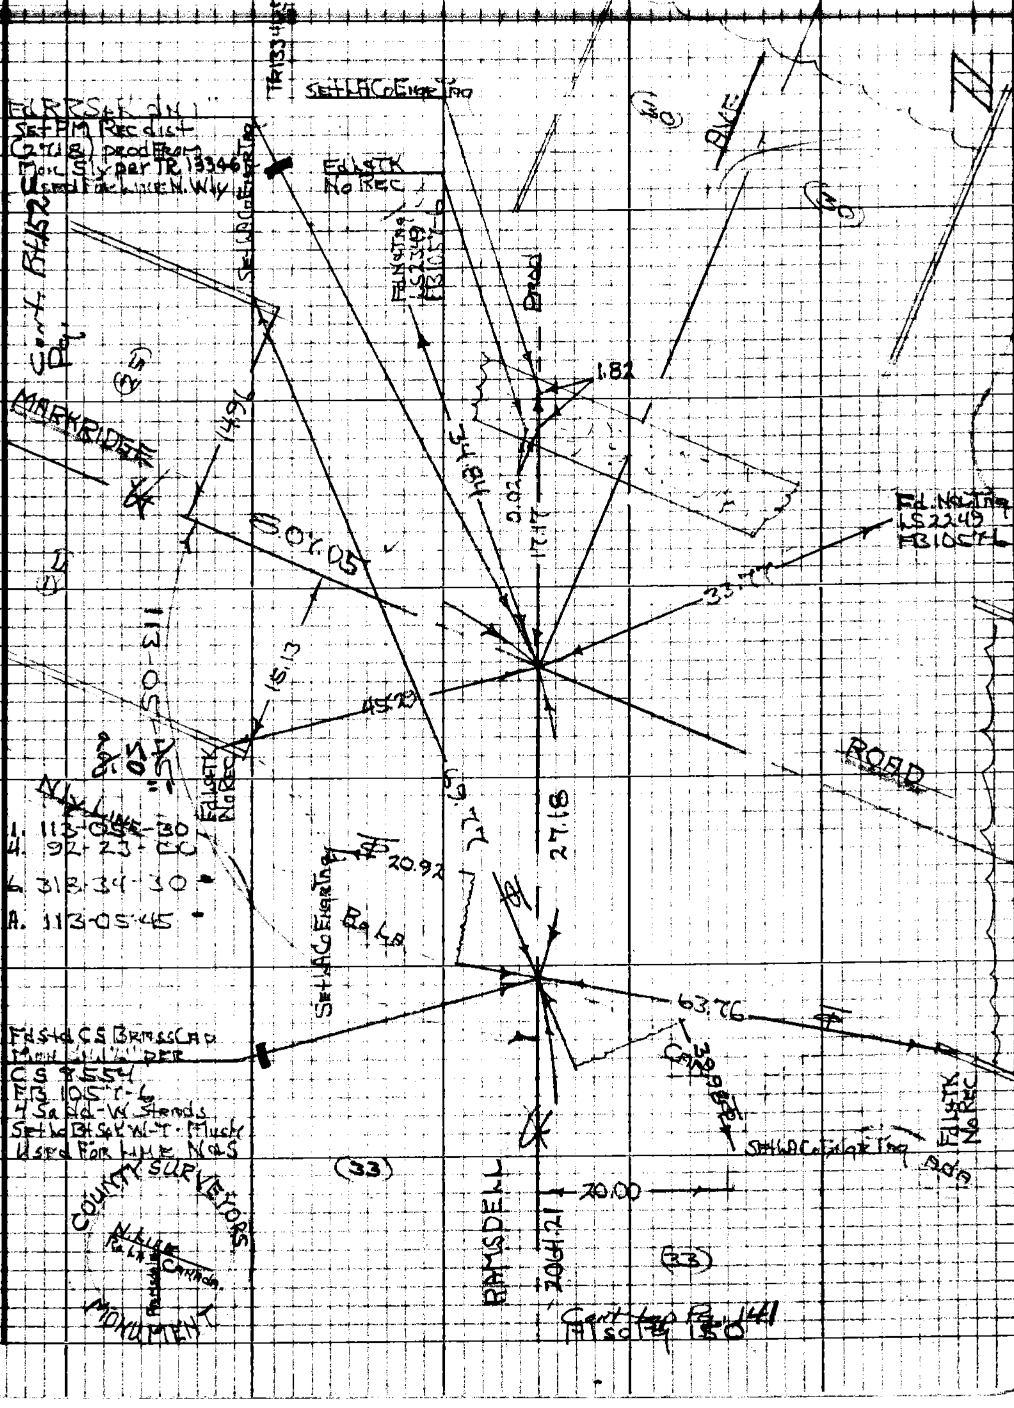

PWFB 2021

100

F.B. 3417 Pg. 152

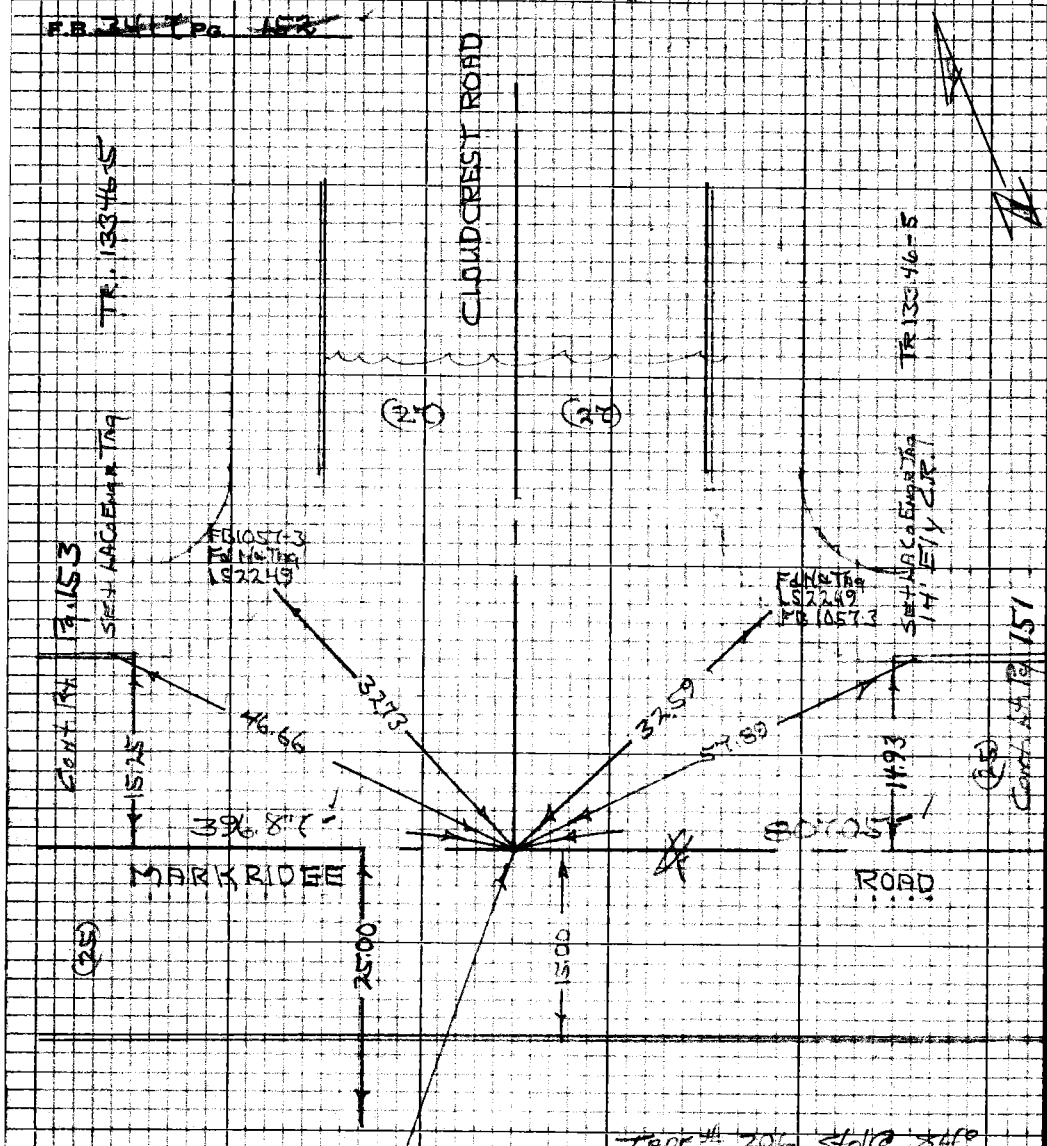

Tape # 206 Std @ 84°
209.51 @ 3-51 @ 60° = 209.41
299.45 @ 2-04 @ 62° = 299.22
23.78 @ 1-44 @ 66° = 23.78
274.79 @ 1-44 @ 66° = 274.64

Total 807.05

211.63 Level @ 66° = 211.61
116.50 " " 66° = 116.49
68.78 " " 66° = 68.77

Total 396.87

W.S. 51, B-3

PLEASE RETURN TO
LOS ANGELES COUNTY ENGINEER
403 LOS ANGELES COUNTY ENGINEERING BLDG.

Do not extend this side of this line.

Note: Any Additions or Changes on this Sheet Must be Made or Circled in Red Ink With Date and Name of Person Making Change

PWFB 2021

101

(3)

Notes Ck'd by R. P. SHORT	Survey of Penna Ave	F. B. [illegible] PG. 153
Map No. [illegible]	[illegible]	
Office Work H. H. F. DONG	Surveyed by HHS Briggs	1. 112-58-30
Checked	Notes HHS Date 6-20-67	4. 91-54-00
Date	Indexed C. J. GALLI	L. 317-50-45
		R. 112-58-27

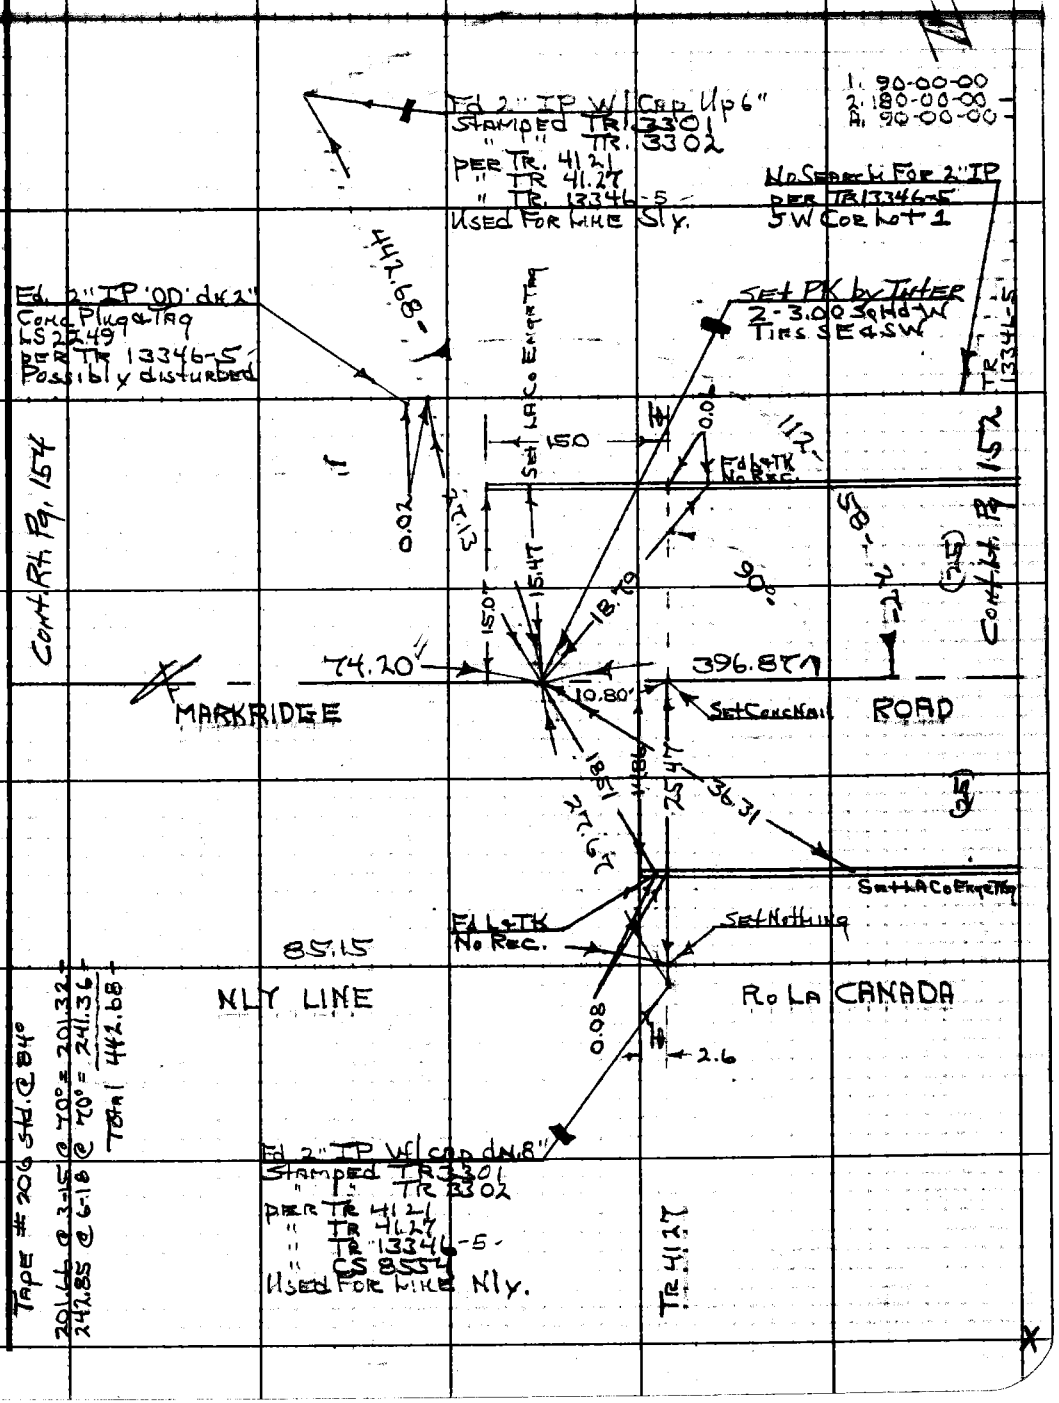

Note: Any Additions or Changes on This Sheet Must be Made or Circled in Red Ink With Date and Name of Person Making Change.

Do not extend this side of this line.

PLEASE RETURN TO
LOS ANGELES COUNTY ENGINEER
403 LOS ANGELES COUNTY ENGINEERING BLDG.

76F309S CE#310 1-65

PWFB 2021 102

F. B. ~~2417~~ PG ~~154~~

~~1. 179-13-20~~
~~4. 356-52-30~~
~~6. 355-19-00~~
~~A. 179-13-10~~
HHS 8-8-67

1. 90-23-30 -
2. 180-47-00 -
A. 90-23-30 -

1. 179-13-00
4. 356-52-00
6. 355-17-30 -
A. 179-12-55 -

W.S. 51, B-3

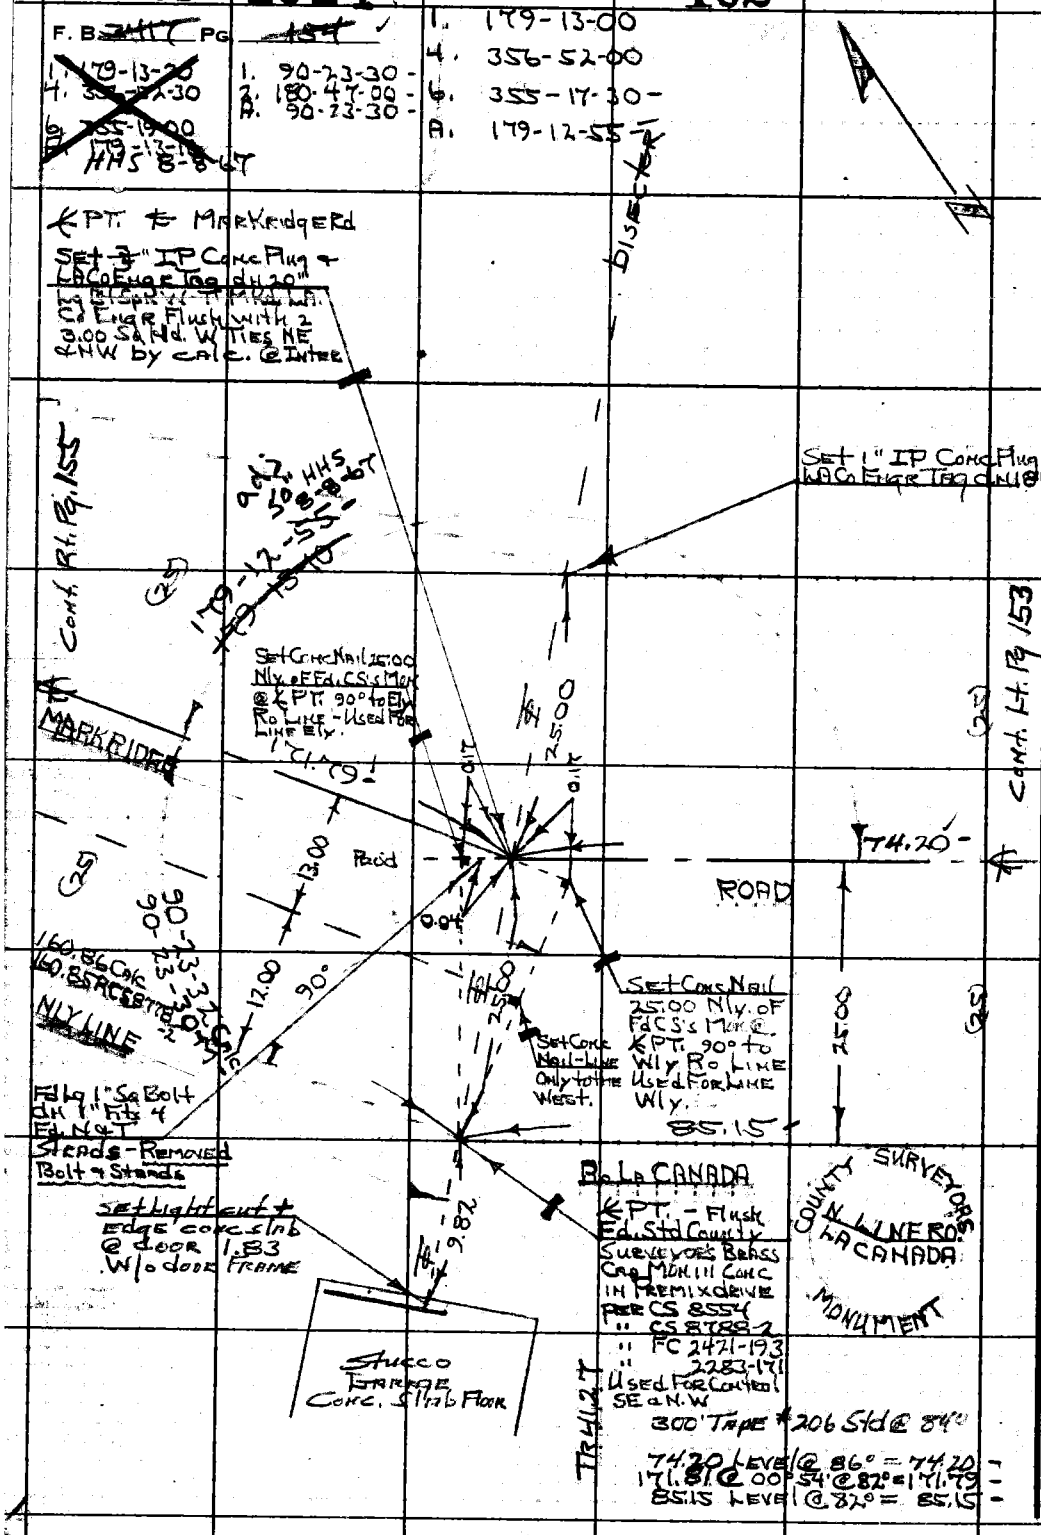

PLEASE RETURN TO
LOS ANGELES COUNTY ENGINEER
403 LOS ANGELES COUNTY ENGINEERING BLDG.
Do not extend this side of this line.

Note: Any Additions or Changes on This Sheet Must be Made or Circled in Red Ink With Date and Name of Person Making Change.

PWFB 2021

103

Notes Ck'd by R. P. SHORT	Survey of Penna Dur	F. B. 3417	PG. 155
Map No. [illegible]	[illegible]		
Office Work H. H. F. DONG	Surveyed by HH Spengs		
Checked	Notes HHS Date 6-22-64		
Date	Indexed C. J. GALLI		

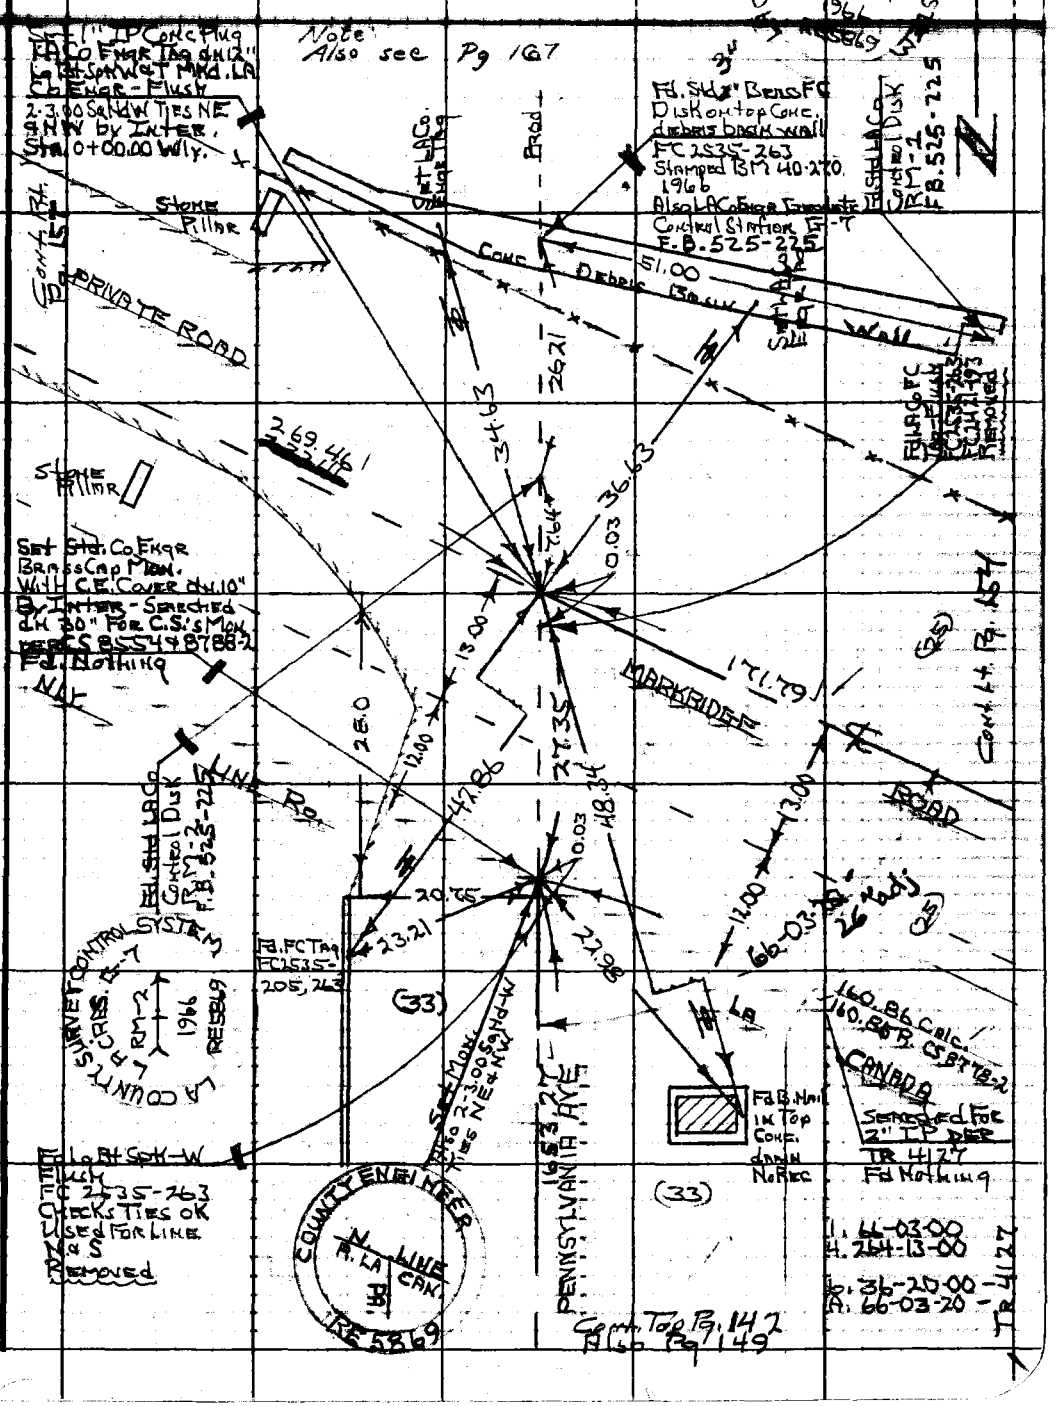

Note: Any Additions or Changes on This Sheet Must be Made or Circled in Red Ink. With Date and Name of Person Making Change.

Do not extend this side of this line.

PLEASE RETURN TO
LOS ANGELES COUNTY ENGINEER
403 LOS ANGELES COUNTY ENGINEERING BLDG.

76F309S CE#310 1-65

	6	BLANK			
F. B3417 PG 156					

LOS ANGELES COUNTY ENGINEER

PLEASE RETURN TO
403 LOS ANGELES COUNTY ENGINEERING BLDG.

Do not extend this side of this line.

Note: Any Additions or Changes on This Sheet Must be Made or Circled in Red Ink With Date and Name of Person Making Change.

PWFB 2021

104

Notes Ck'd by R. P. SHORT	Survey of Penna Ave
Map No. [illegible]	JN [illegible]
Office Work H. H. F. DONG	Surveyed by HHSpriggs
Checked	Notes HHS Date 6-27-67
Date	Indexed C. I. GALLI

F. B. [illegible] PG. 157

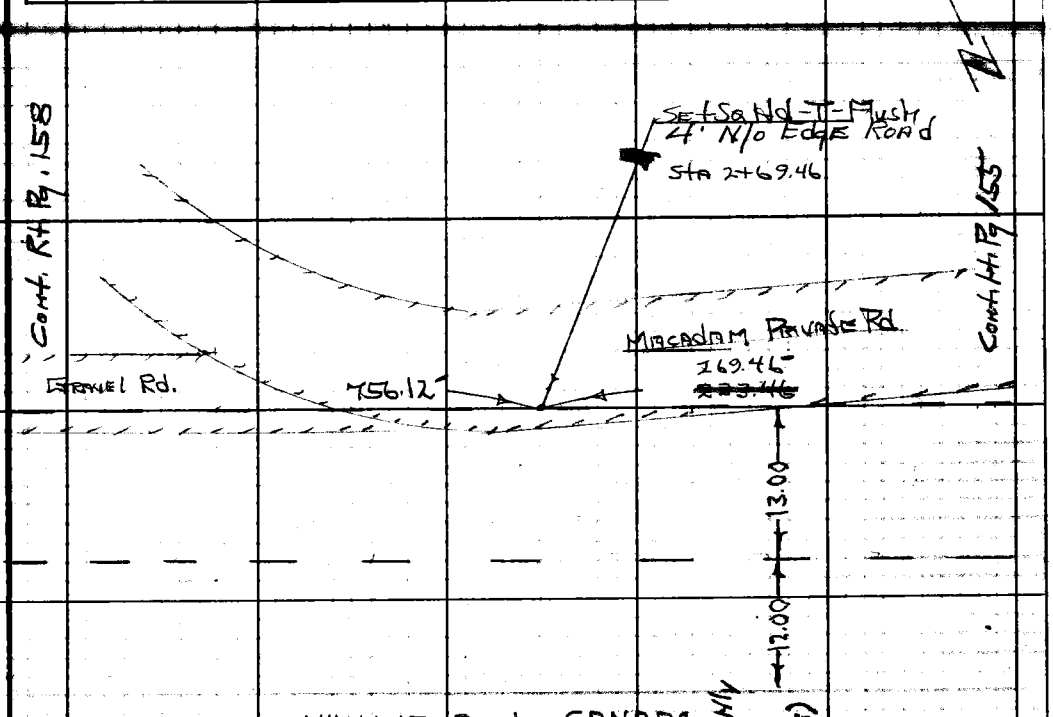

152.00 @ 5-35 @ 78° = 151.27
118.60 @ 4-47 @ 80° = 118.79
Total 269.46

300.43 @ 2-51 @ 80° = 300.05
279.39 @ 7-19 @ 84° = 277.12
180.52 @ 7-33 @ 82° = 178.95
Total 756.12

Note:

Rancho Line Chaining

℄ PT. E/o Penna Ave. to ℄ Penna Ave 2500 offset N/y
= ℄ Markridge Ave

Sta 00+00.00 (℄ Penna Ave) W/y to
Sta. 10+25.58 (Flood Control Pl) 25.00 offset N/y

Sta. 10+25.58 (Flood Control Pl) W/y to
Sta. 15+01.45 (Dunsmuir Canyon Channel) 12.00 offset N/y

Sta. 15+01.45 (Dunsmuir Canyon Channel) W/y to
Sta. 40+68.68 (County Surveyor's Mon. E/o Boston Ave)
Chained on true Rancho Line

Note: Any Additions or Changes on This Sheet Must be Made or Circled in Red Ink With Date and Name of Person Making Change.

PLEASE RETURN TO
LOS ANGELES COUNTY ENGINEER
403 LOS ANGELES COUNTY ENGINEERING BLDG.

Do not extend this side of this line.

76F309S CE#310 1-65

PWFB 2021

105

F. B. ~~3417~~ PG ~~158~~

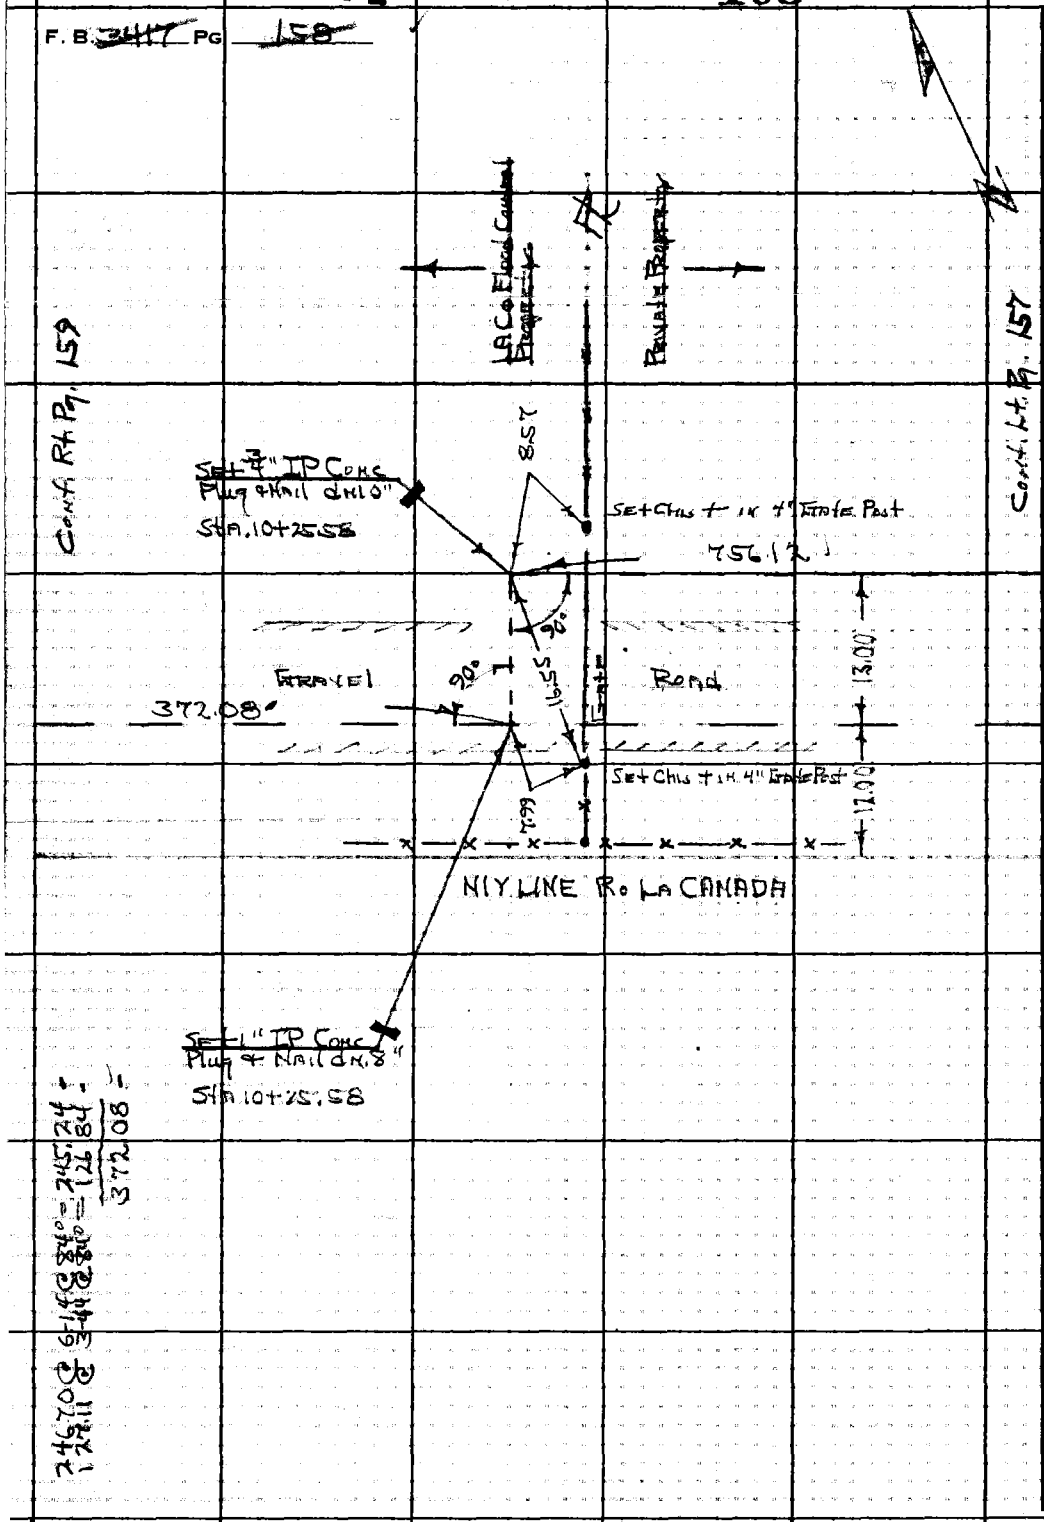

24670 @ 6-14 @ 84° = 245.24
127.11 @ 3-44 @ 84° = 126.84
372.08

PLEASE RETURN TO
LOS ANGELES COUNTY ENGINEER
403 LOS ANGELES COUNTY ENGINEERING BLDG.

Do not extend this side of this line.

Note: Any Additions or Changes on This Sheet Must be Made or Circled in Red Ink With Date and Name of Person Making Change.

PWFB 2021

106

Map No. B-3072	JN [illegible] Topo 206 Std 84
Office Work H. H. F. DONG	Surveyed by HHSpriggs
Checked	Notes HHS Date 6-27-67
Date	Indexed C. J. GALLI

F. B. 3417 PG. 159

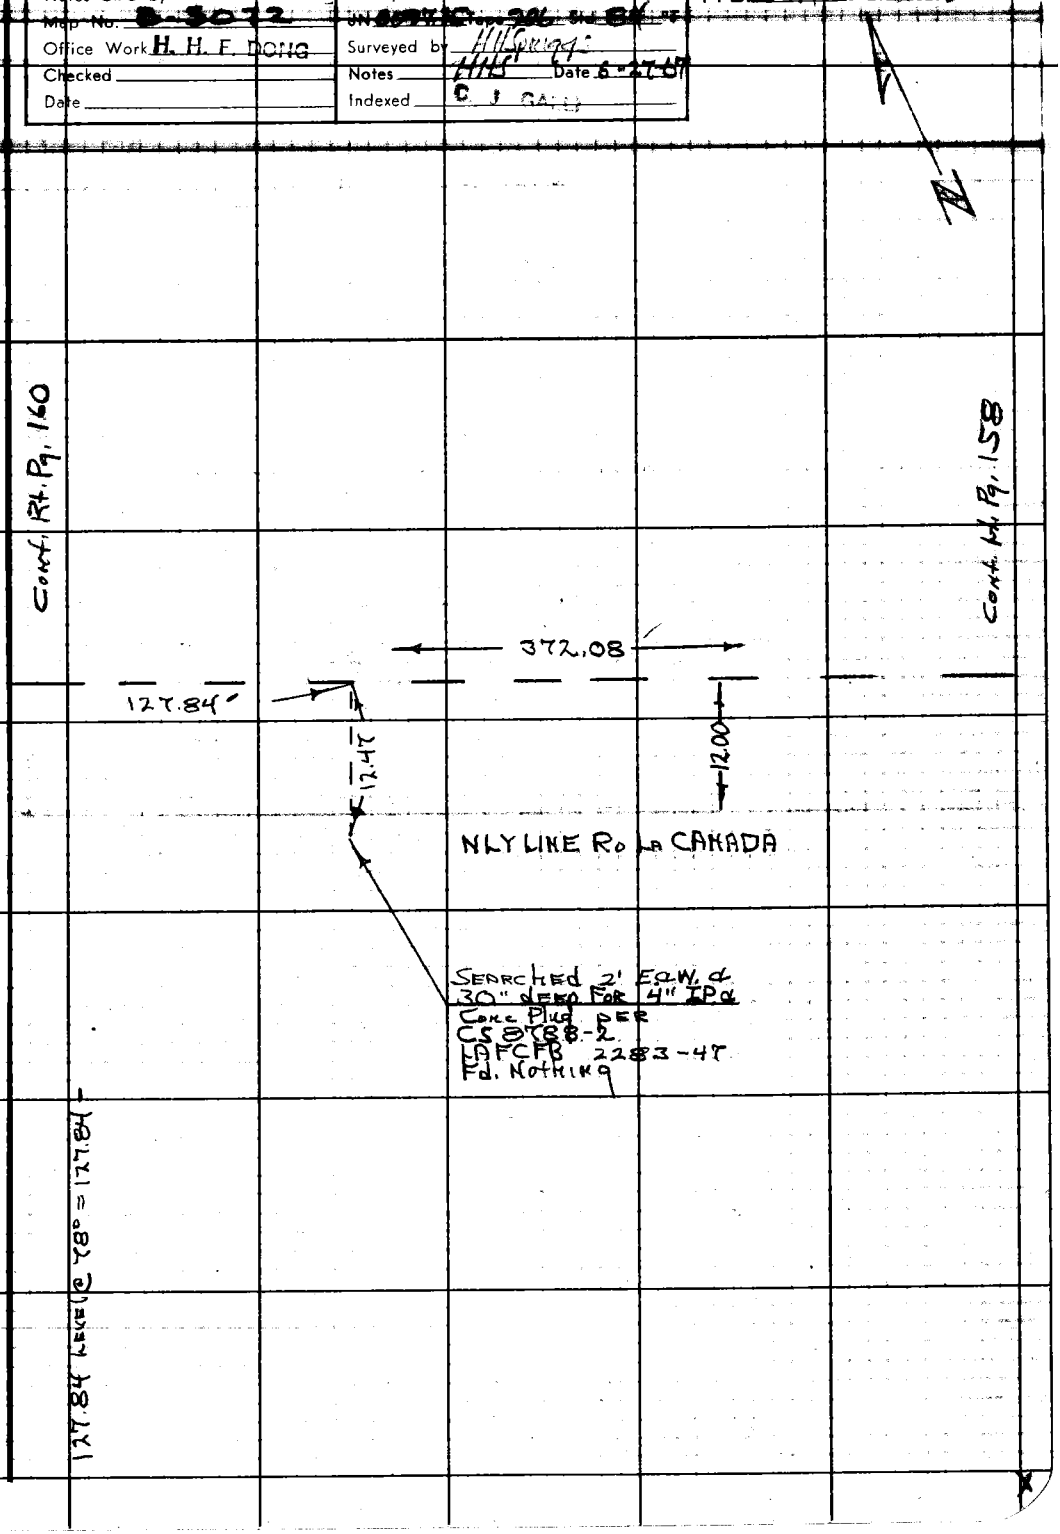

Note: Any Additions or Changes on This Sheet Must be Made or Circled in Red Ink With Date and Name of Person Making Change.

Do not extend this side of this line.

PLEASE RETURN TO
LOS ANGELES COUNTY ENGINEER
403 LOS ANGELES COUNTY ENGINEERING BLDG.

76F309S CE#310 1-65

PWFB 2021 107

F. B. 3417 PG 160

W.S. 51, B-3

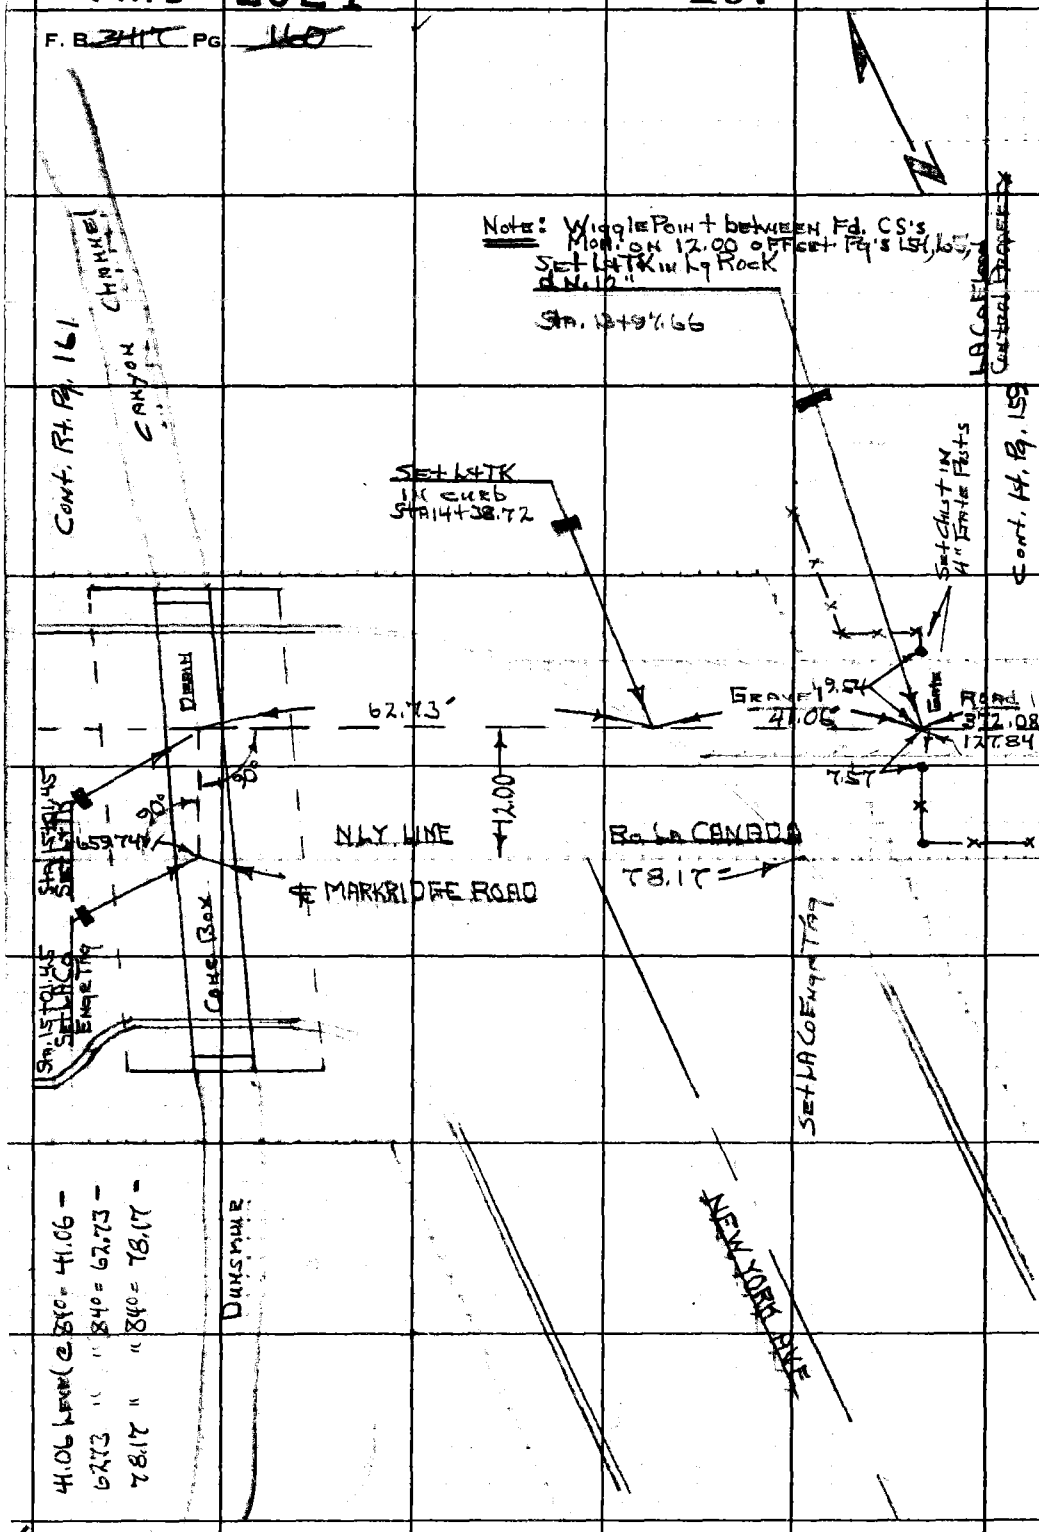

PLEASE RETURN TO
LOS ANGELES COUNTY ENGINEER
403 LOS ANGELES COUNTY ENGINEERING BLDG.

Do not extend this side of this line.

Note: Any Additions or Changes on This Sheet Must be Made or Circled in Red Ink With Date and Name of Person Making Change.

PWFB 2021

108

Notes Ck'd by R. P. SHORT	Survey of PENNA AVE	F. B. 3417	PG. 161
Map No. B-5072	JN0097.25 Topo 201 Sta 840		
Office Work H. H. F. DONG	Surveyed by [illegible]		
Checked	Notes [illegible] Date 6-27-67		
Date	Indexed C. I. GALLI		

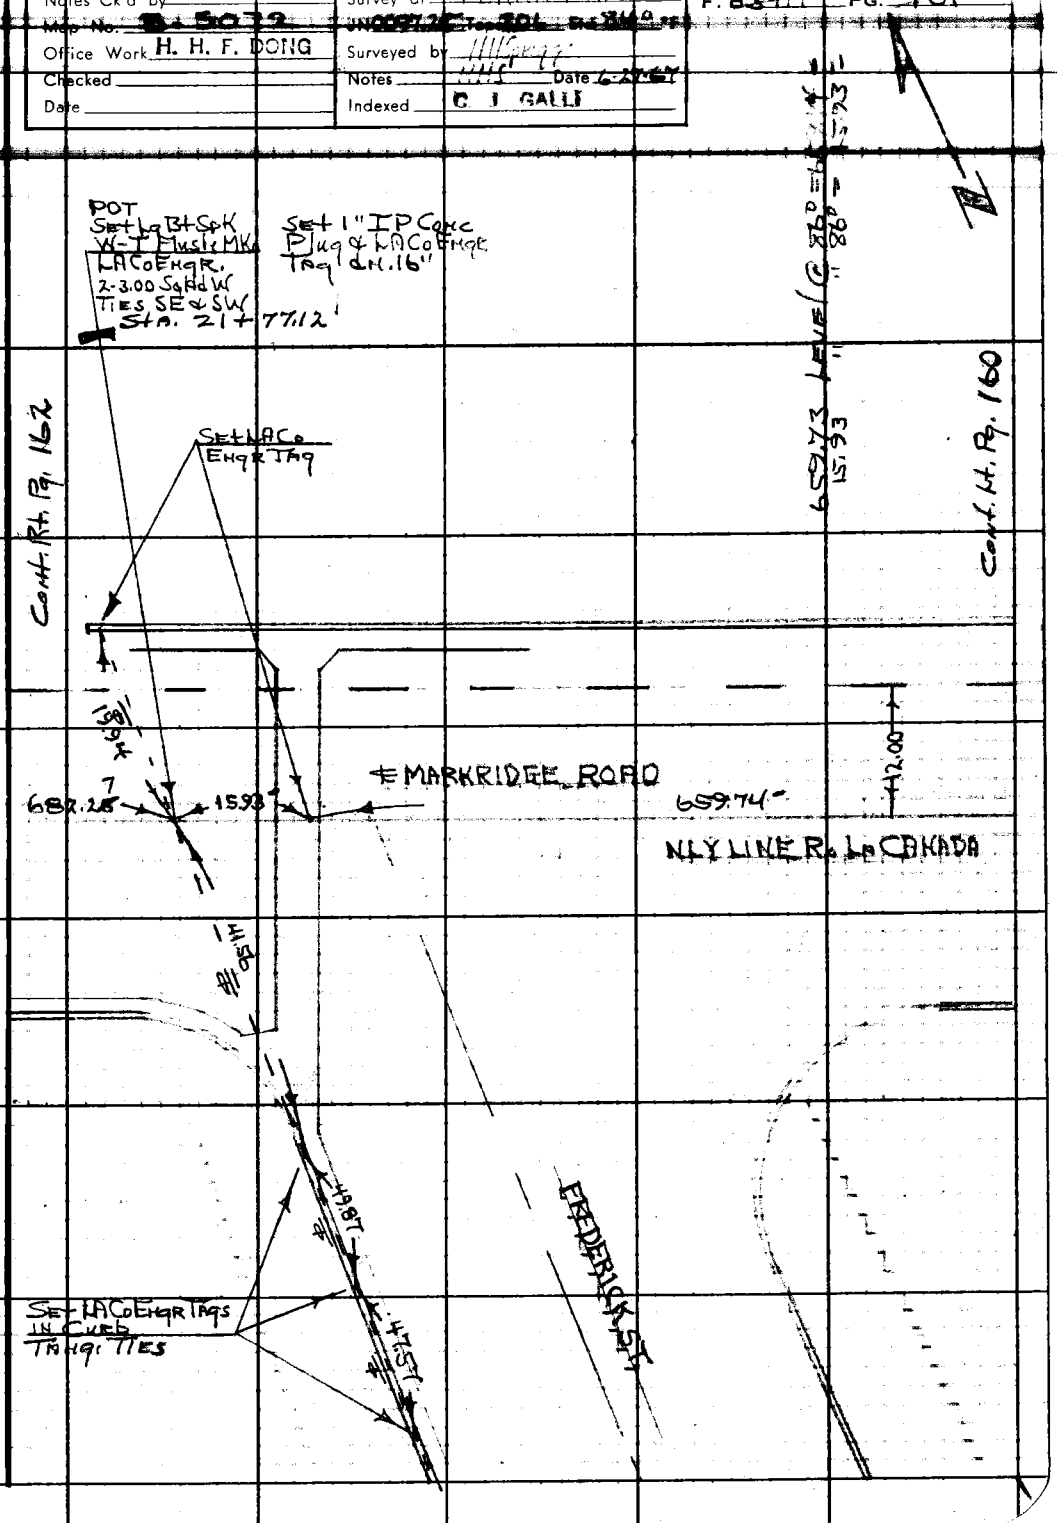

W.S. 51, A-3

Note: Any Additions or Changes on This Sheet Must be Made or Circled in Red Ink With Date and Name of Person Making Change.

Do not extend this side of this line.

PLEASE RETURN TO
LOS ANGELES COUNTY ENGINEER
403 Los Angeles County Engineering Bldg.

76F309S CE#310 1-65

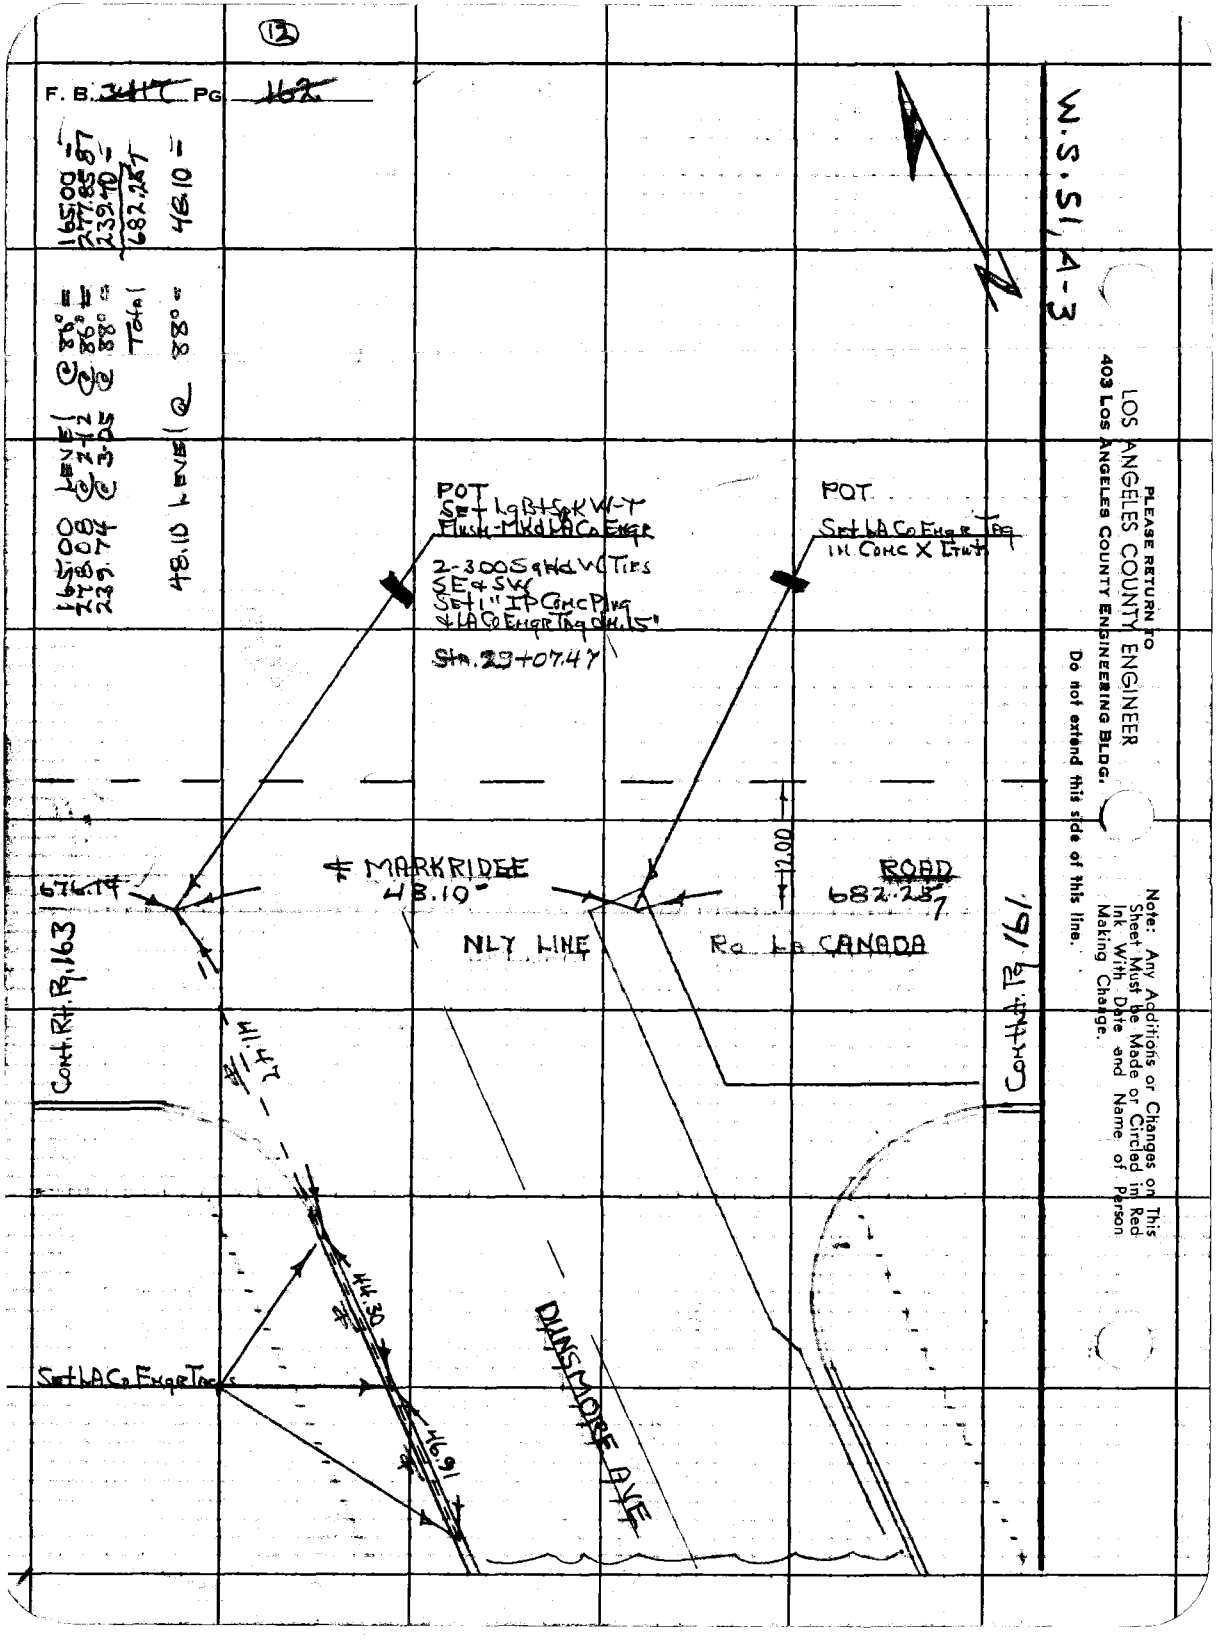

12
F. B. 3417 PG 162
165.00 LEVEL @ 86° = 165.00
278.08 @ 2-12 @ 86° = 277.85
239.74 @ 3-25 @ 88° = 239.40
Total 682.25
48.10 LEVEL @ 88° = 48.10
POT
Set LgBtSpKW-T
Flush-MKd LA Co Engr
2-300 SgHd W Ties
SE & SW
Set 1" IP Conc Plug
& LA Co Engr Tag dn. 15"
Sta. 29+07.47
POT
Set LA Co Engr Tag
in Conc X Lt wt
12.00
676.14
℄ MARKRIDGE
48.10
ROAD
682.25
NLY LINE
Ro La CANADA
Cont. Rt. Pg. 163
Cont. Rt. Pg. 161
44.47
44.30
46.91
DUNSMORE AVE
Set LA Co Engr Tacks
W.S. 51, A-3
PLEASE RETURN TO
LOS ANGELES COUNTY ENGINEER
403 LOS ANGELES COUNTY ENGINEERING BLDG.
Do not extend this side of this line.
Note: Any Additions or Changes on This Sheet Must be Made or Circled in Red Ink With Date and Name of Person Making Change.

PWFB 2020

68

(13)

Notes Ck'd by R. P. SHORT	Survey of [illegible]
Map No. B-5073	JN [illegible]
Office Work H. H. F. DONG	Surveyed by H H Spriggs
Checked	Notes HHS Date 6-28-68
Date	Indexed C. J. GALLI

F. B. 3417 PG. 163

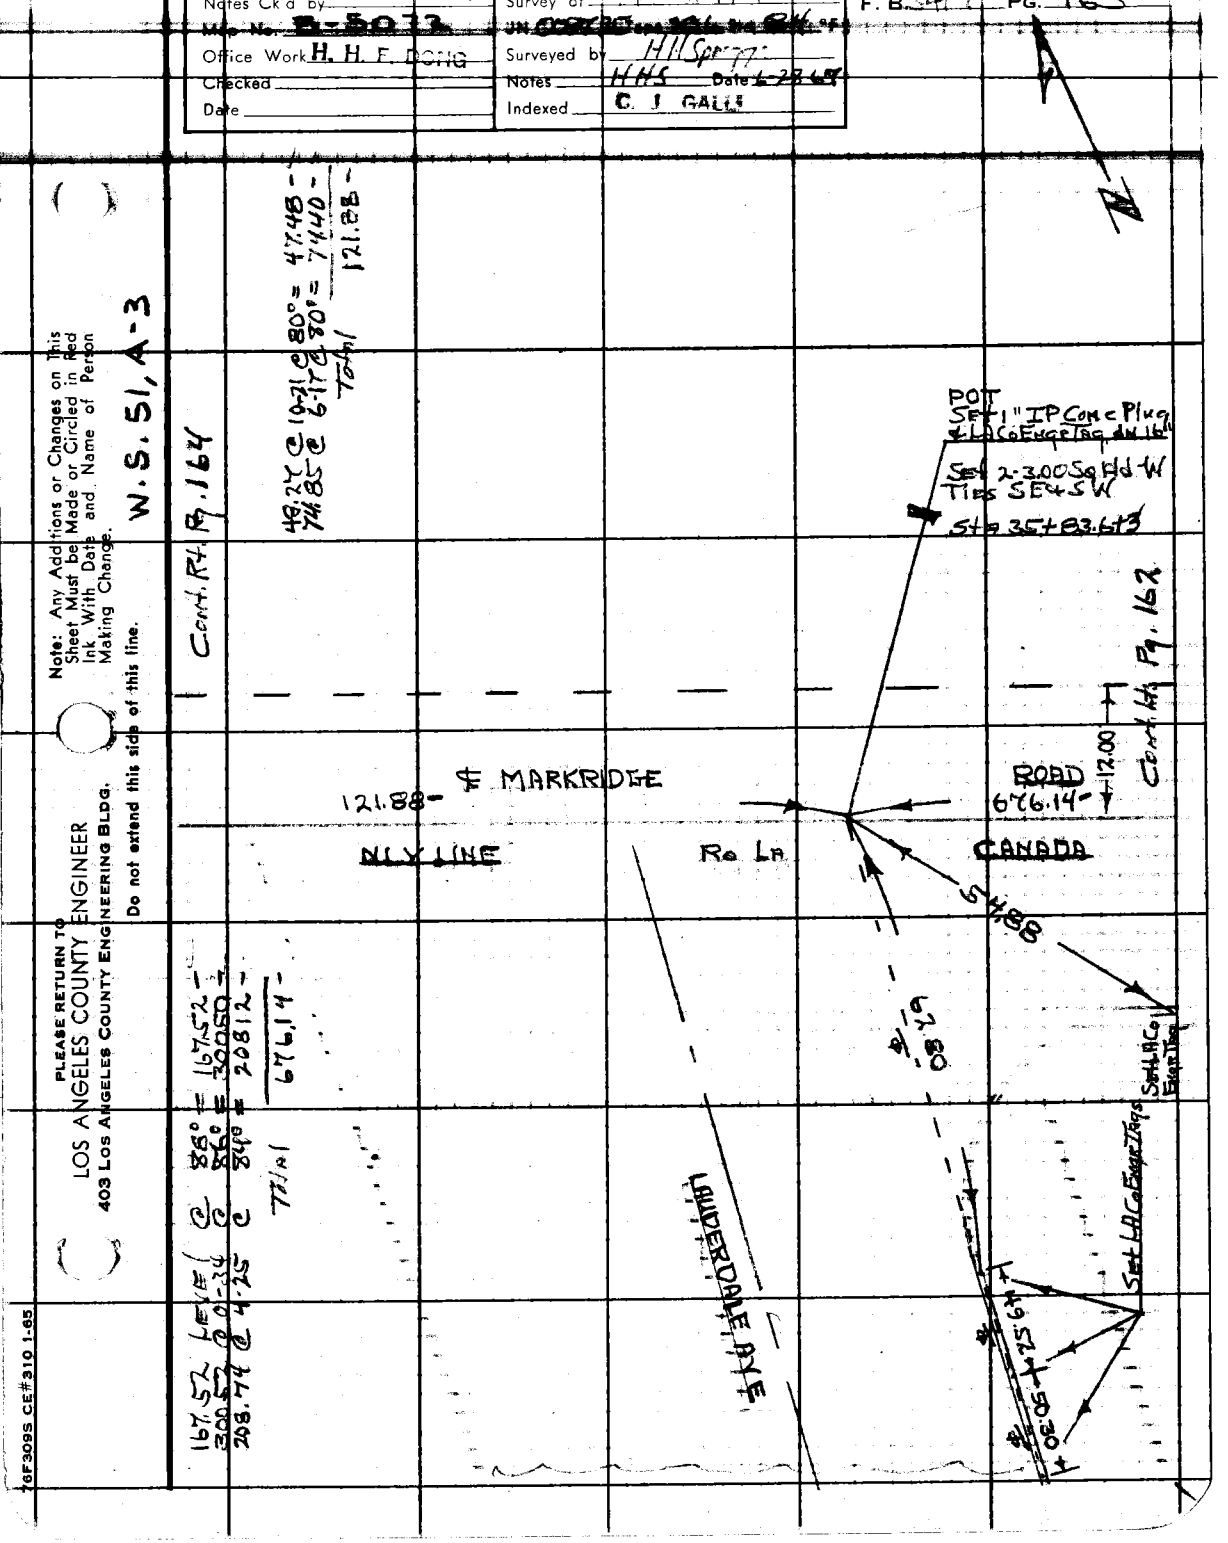

Note: Any Additions or Changes on This Sheet Must be Made or Circled in Red Ink With Date and Name of Person Making Change.

Do not extend this side of this line.

PLEASE RETURN TO
LOS ANGELES COUNTY ENGINEER
403 Los Angeles County Engineering Bldg.

76F309S CE#310 1-65

PWFB 2020 69, 70

F. B. ~~3417~~ PG ~~164~~

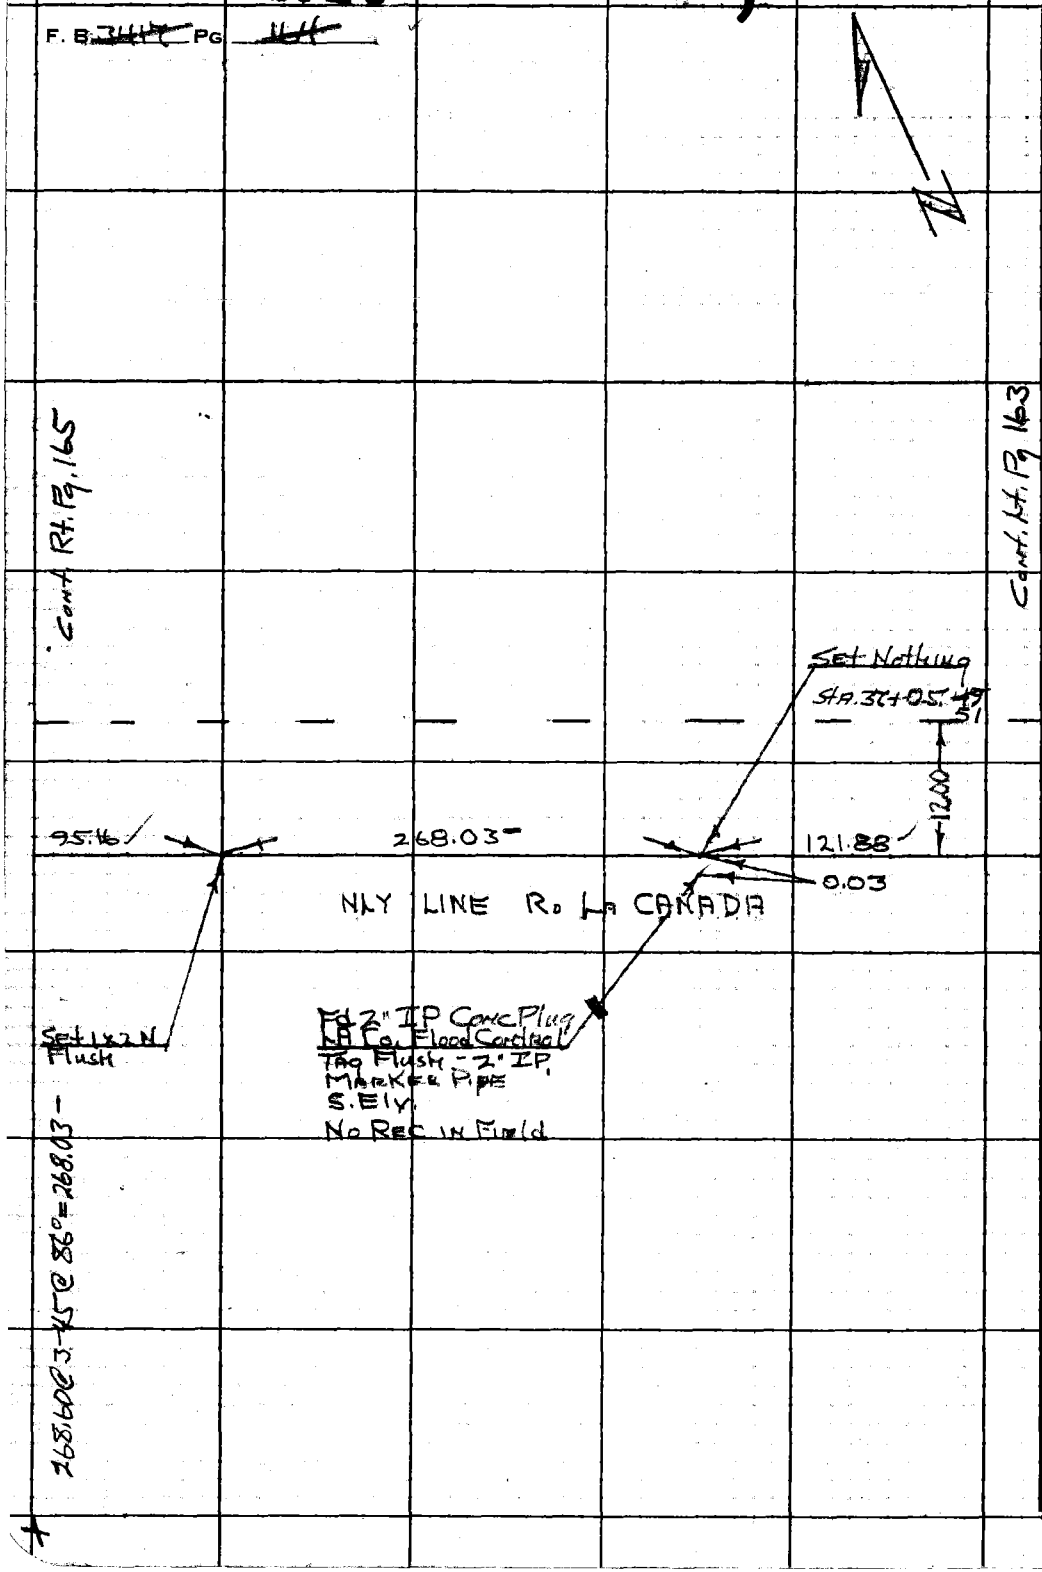

PLEASE RETURN TO
LOS ANGELES COUNTY ENGINEER
403 LOS ANGELES COUNTY ENGINEERING BLDG.

Do not extend this side of this line.

Note: Any Additions or Changes on This Sheet Must be Made or Circled in Red Ink With Date and Name of Person Making Change.

PWFB 2020

71

(15)

Notes Ck'd by R. P. SHORT	Survey of Pennel Ave
Map No. B-5072	[illegible]
Office Work H. H. F. DONG	Surveyed by HHS
Checked	Notes HHS Date 6-13-67
Date	Indexed C. J. GALLI

F. B. 3417 PG. 165

W. S. 51, A-3

75.25 Level @ 86° = 75.25
33.28 " 86° = 33.28
188.15 @ 2-5 @ 86° = 187.91
22.04 Level @ 86° = 22.04
Total 318.48

Note: Any Additions or Changes on This Sheet Must be Made or Circled in Red Ink With Date and Name of Person Making Change.

Do not extend this side of this line.

PLEASE RETURN TO
LOS ANGELES COUNTY ENGINEER
403 LOS ANGELES COUNTY ENGINEERING BLDG.

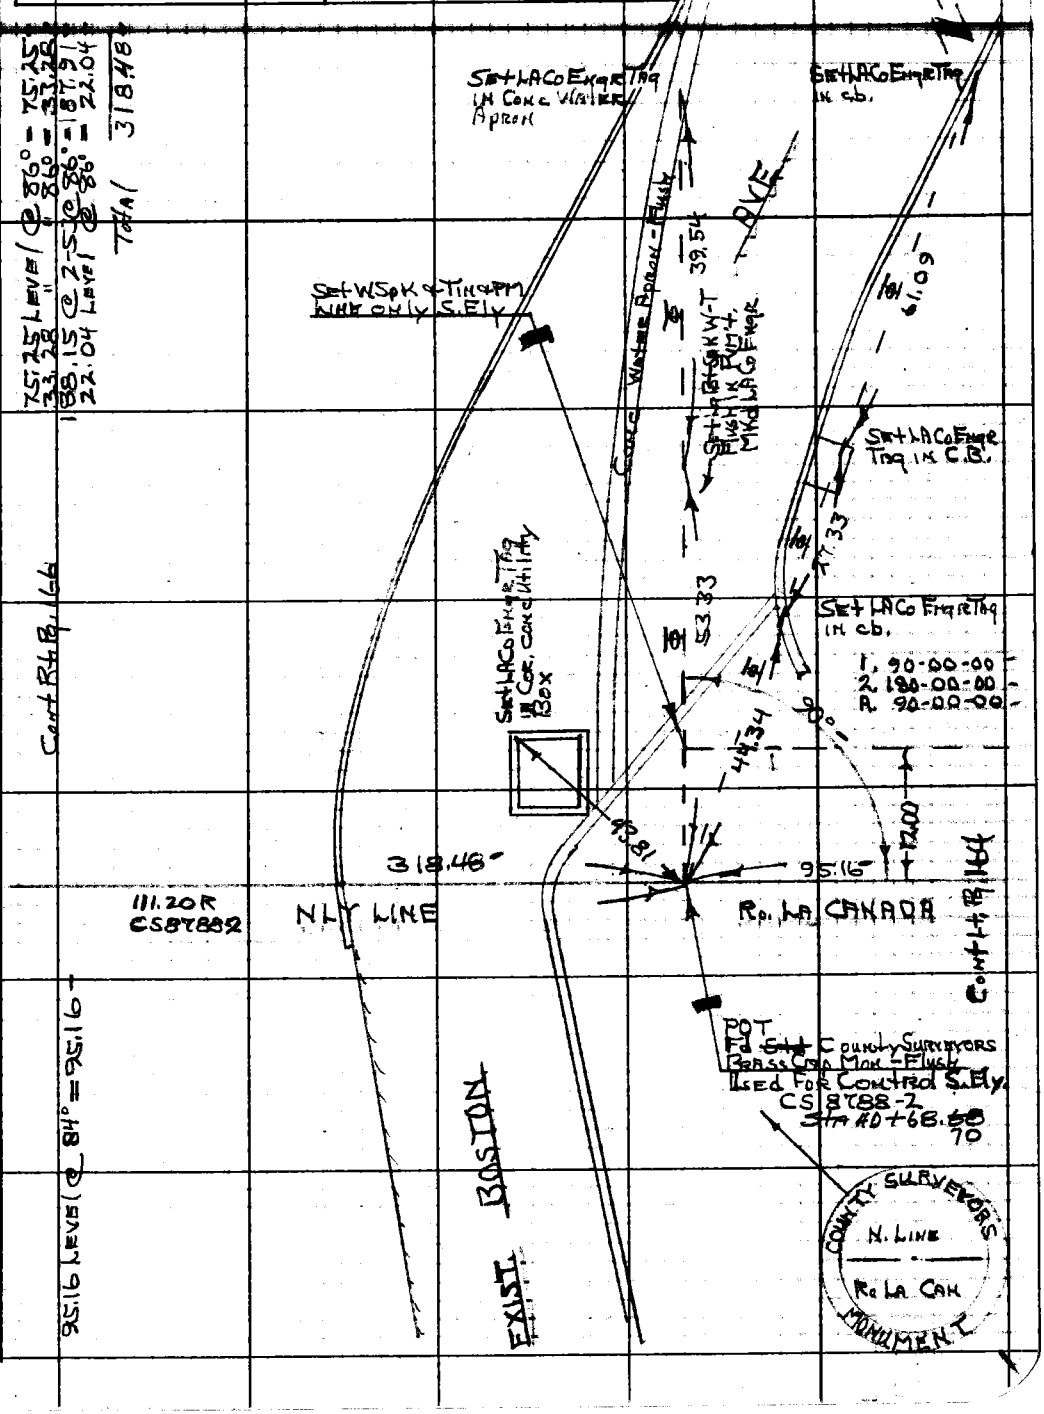

76F309S CE#310 1-65

PWFB 2020 72

F. B. ~~3417~~ Pg ~~166~~

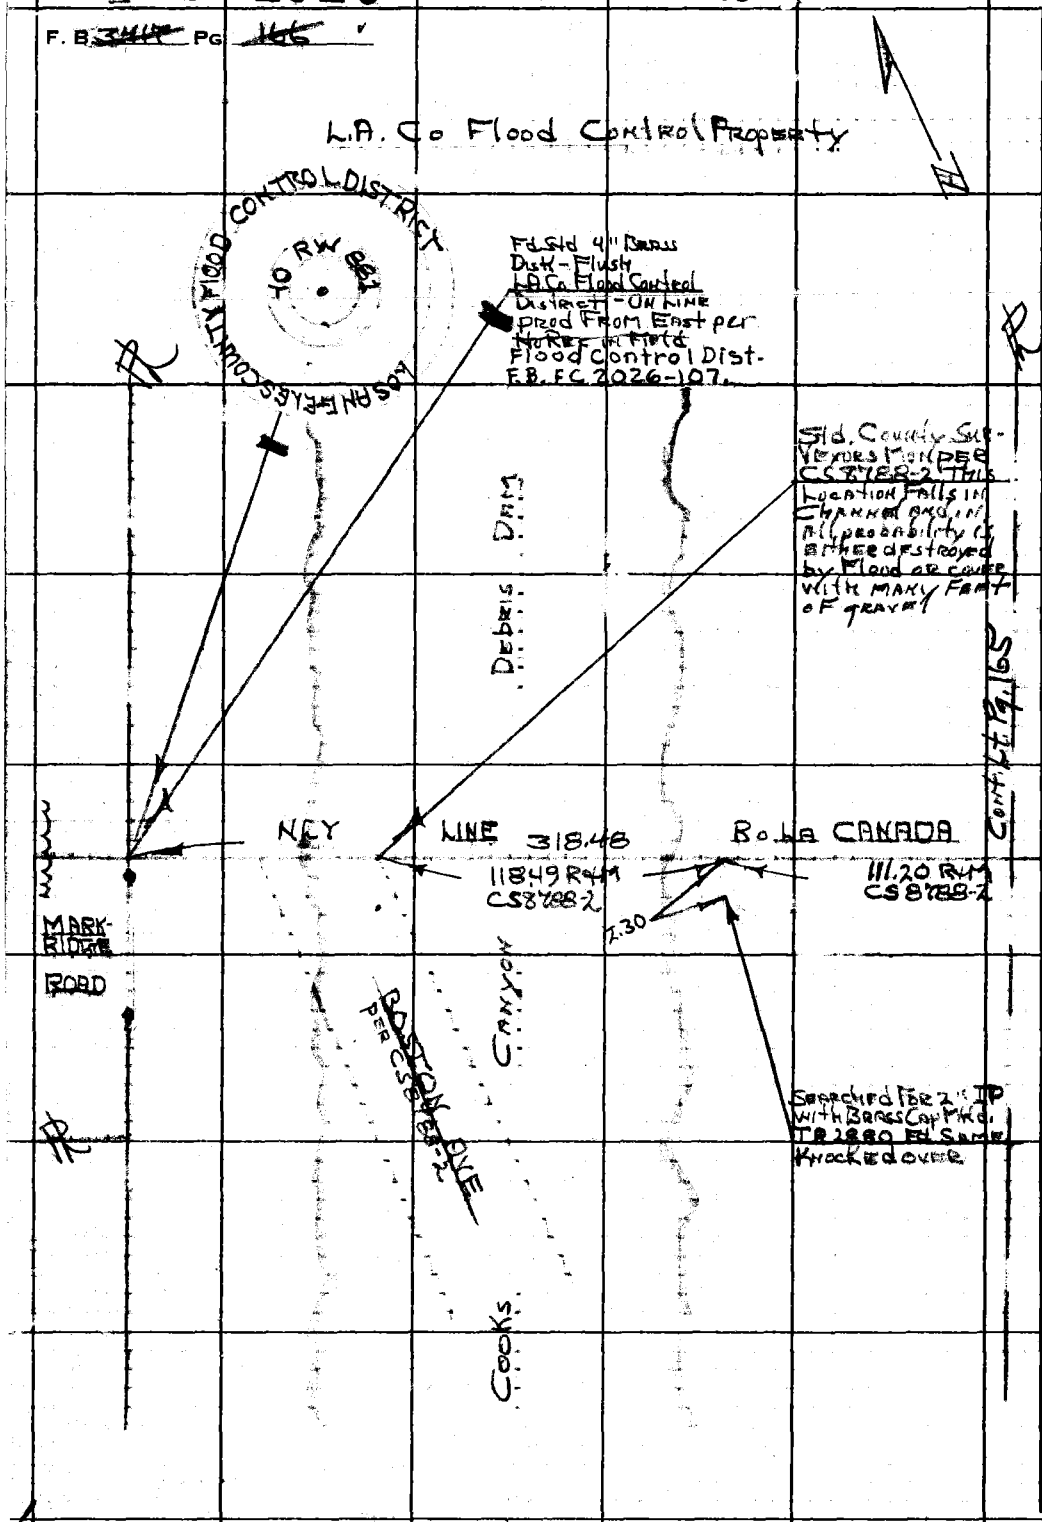

W.S. 51, A-3

PLEASE RETURN TO
LOS ANGELES COUNTY ENGINEER
403 LOS ANGELES COUNTY ENGINEERING BLDG.

Do not extend this side of this line.

Note: Any Additions or Changes on This Sheet Must be Made or Circled in Red Ink With Date and Name of Person Making Change.

PWFB 2021

109

Notes Ck'd by R. P. SHORT	Survey of Penna Ave	F.B. 3417	Pg. 167
[illegible]	[illegible]		
Office Work H. H. F. DONG	Surveyed by HHS		
Checked	Notes HHS Date 7-28-67		
Date	Indexed C. J. GALLI		

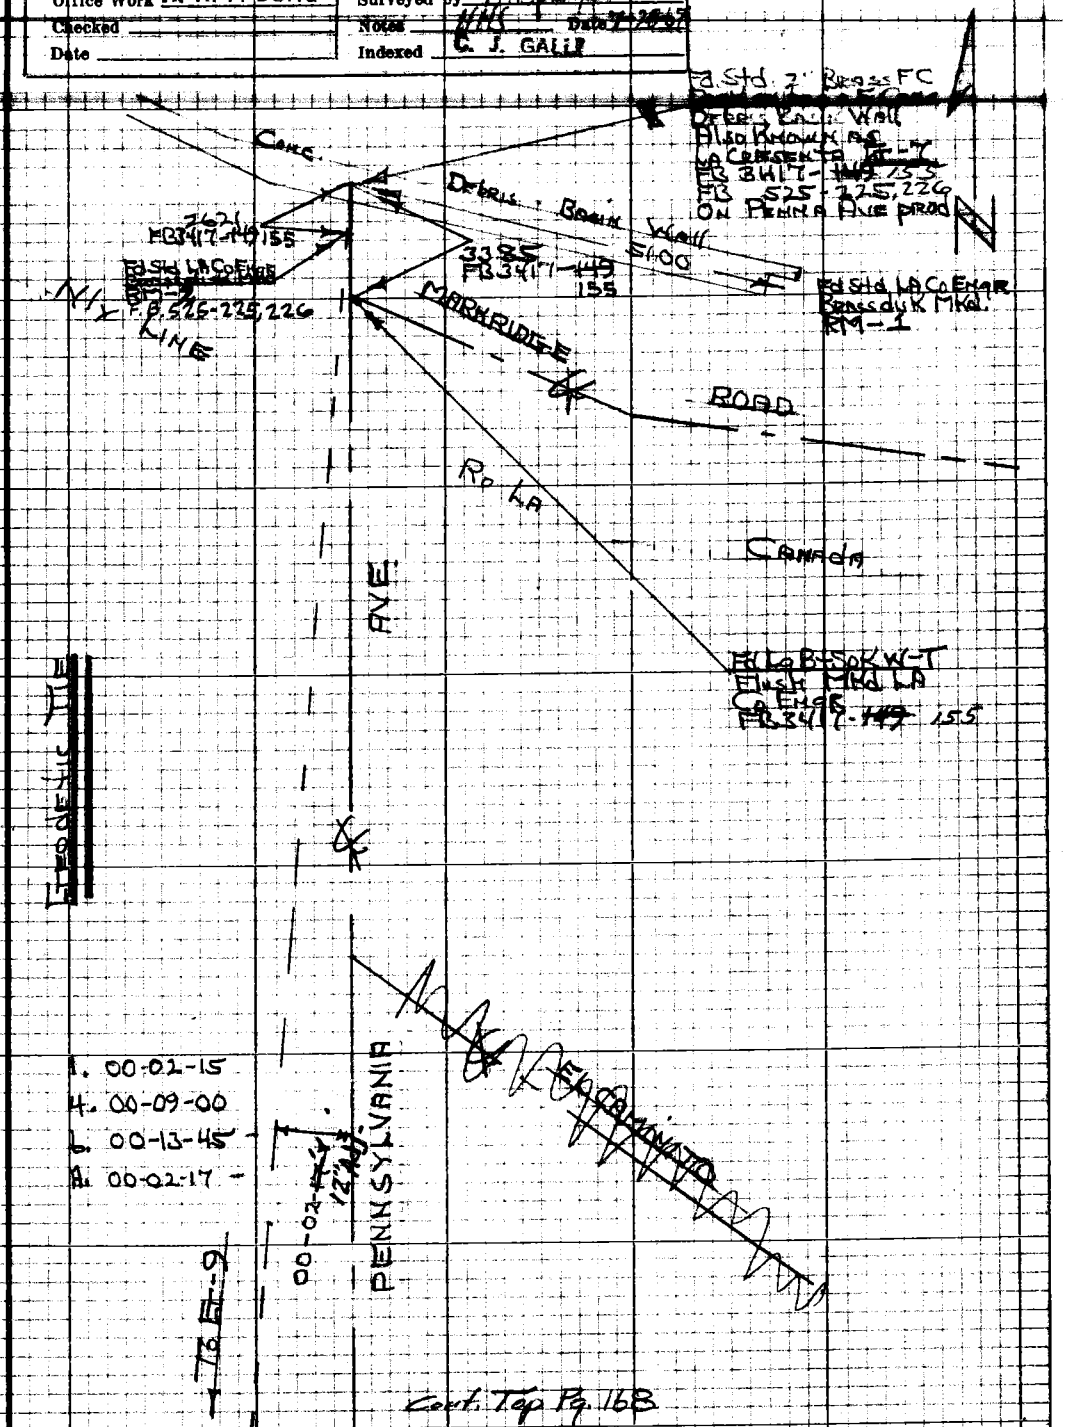

Cont. Top Pg. 168

Note: Any Additions or Changes on this Sheet Must be Made or Circled in Red Ink With Date and Name of Person Making Change

W.S. 51, B-3

Do not extend this side of this line.

PLEASE RETURN TO
LOS ANGELES COUNTY ENGINEER
403 LOS ANGELES COUNTY ENGINEERING BLDG.

76P3098 CE #310 5-66

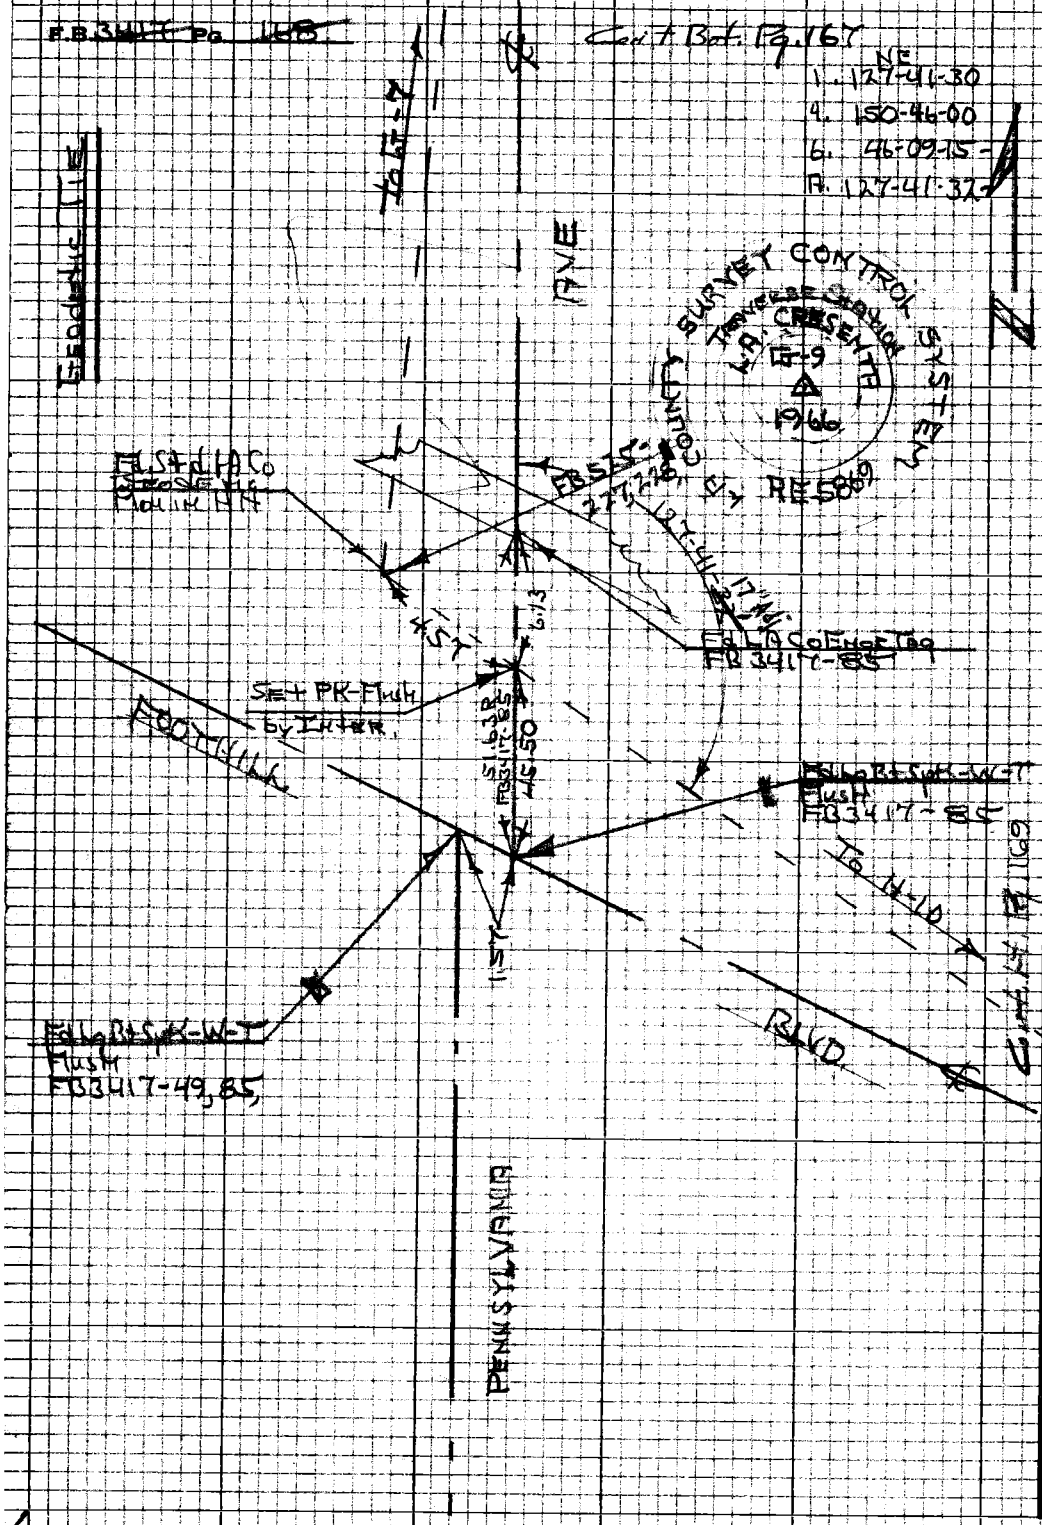

PLEASE RETURN TO
LOS ANGELES COUNTY ENGINEER
403 LOS ANGELES COUNTY ENGINEERING BLDG.

Do not extend this side of this line.

Note: Any Additions or Changes on this Sheet Must be Made or Circled in Red Ink With Date and Name of Person Making Change

PWFB 1921 2488

Notes Ck'd by R. P. SHORT	Survey of PENNS AVE	F.B. [illegible]	Pg. 169
[illegible]	[illegible]		
Office Work H. H. F. DONG	Surveyed by [illegible]		
Checked	Notes HHS Date 7-16-67		
Date	Indexed C. J. GALLI		

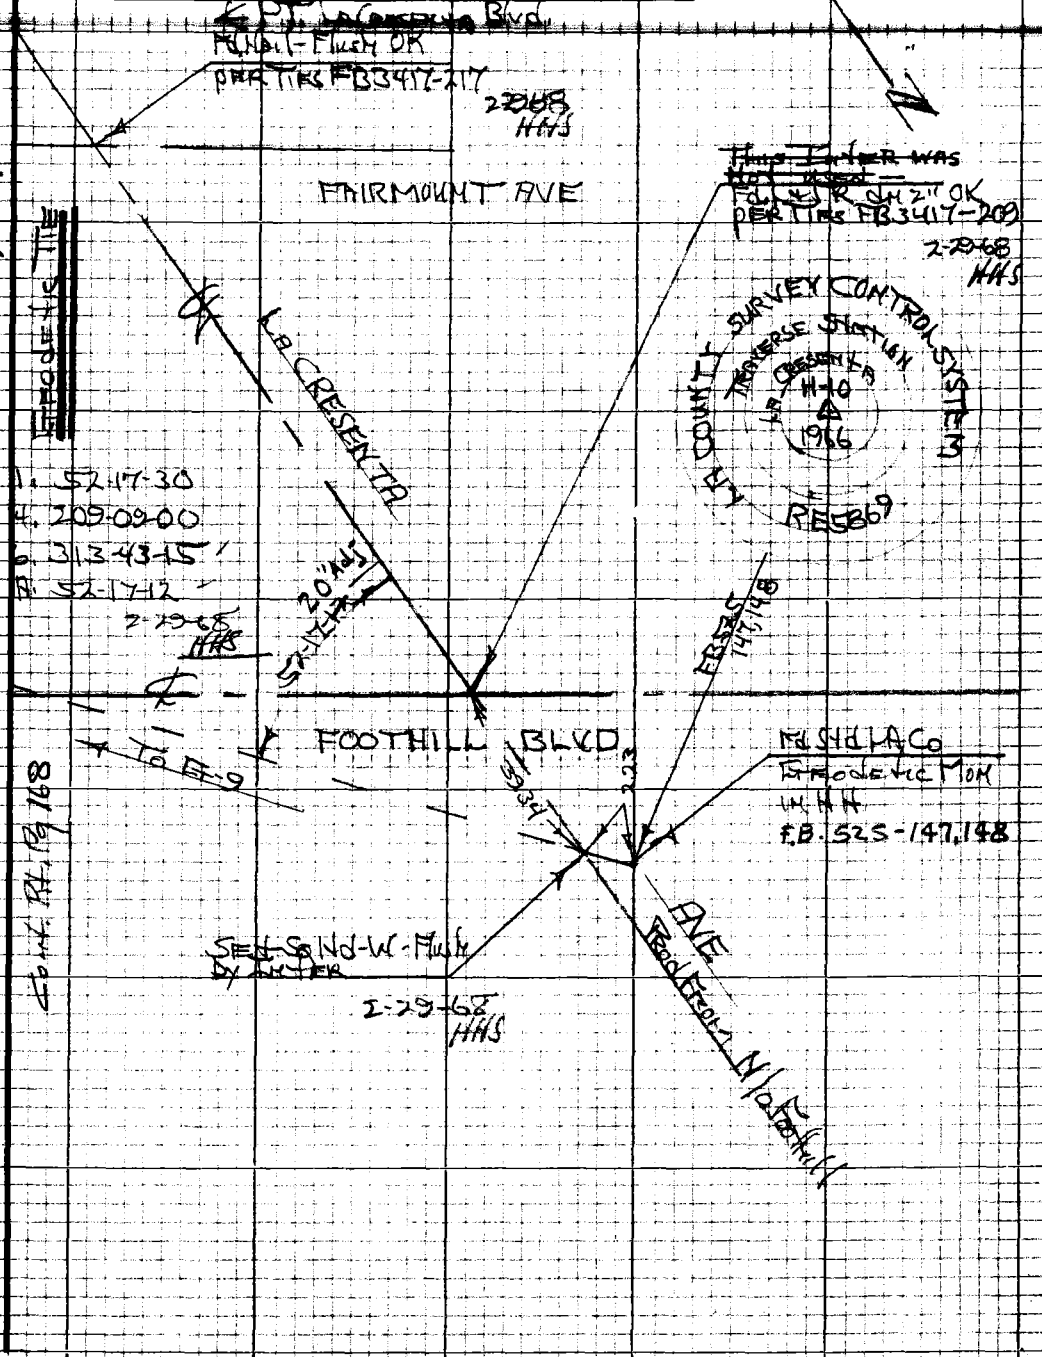

Note: Any Additions or Changes on this Sheet Must be Made or Circled in Red Ink With Date and Name of Person Making Change

Do not extend this side of this line.

PLEASE RETURN TO
LOS ANGELES COUNTY ENGINEER
403 Los Angeles County Engineering Bldg.

76P3098 CK #310 8-66

PLEASE RETURN TO
LOS ANGELES COUNTY ENGINEER
403 LOS ANGELES COUNTY ENGINEERING BLDG.

Note: Any Additions or Changes on this Sheet Must be Made or Circled in Red Ink With Date and Name of Person Making Change

Do not extend this side of this line.

F B 32/17 Pg. 170

PWFB 1921

2489

Notes Ck'd by W. EDMONDSON	Survey of ORANGE AVE	F.B. [illegible]	Pg. 181
[illegible]	[illegible]		
Office Work M. HAMASU	Surveyed by H.H. Spriggs		
Checked W. EDMONDSON	Notes HHS Date 9-67		
Date SEP 25 '68	Indexed L. J. GALLI NOV 17 '67		

JN 009728

ORANGE AVE

(PENNA AVE. S. Ely to LA CRESCENTA AVE)
(LINE ONLY to ROSEMONT)

INDEX Pg. 183, 184,

FB3417-132-150 JN 009725 PENNA AVE
℄ = 1st portion of this ℄ survey.

Index: Pg. 183, 184

REFERENCE:

CS 8554
CS 8486

FB 3292
" 3417 - 132-150
" 2538
" 1399
" 49
" 1336
" 524
" 3072
" 47
" 2059
" 1896

H.H. Spriggs
M.A. Walsh
H.E. Fronk
J.L. Lybrand
P.L. Beasley
E. Valdez
E. Merino

RDZ 357-
RDFQ 145-
RDZ 52-
RDFQ 378
RDFT 51-

FC 2421

Note: Any Additions or Changes on this Sheet Must be Made or Circled in Red Ink With Date and Name of Person Making Change

PLEASE RETURN TO
LOS ANGELES COUNTY ENGINEER
403 LOS ANGELES COUNTY ENGINEERING BLDG.

Do not extend this side of this line.

76P3098 CE #310 8-66

PLEASE RETURN TO
LOS ANGELES COUNTY ENGINEER
403 LOS ANGELES COUNTY ENGINEERING BLDG.

Note: Any Additions or Changes on this Sheet Must be Made or Circled in Red Ink With Date and Name of Person Making Change

Do not extend this side of this line.

F.B. 3417 Pg. 127

PWFB 1921

2490

Notes Ck'd by W. EDMONDSON	Survey of [illegible]	F.B. [illegible]	Pg. [illegible]
Map No. [illegible]	[illegible]		
Office Work M. HAMASU	Surveyed by [illegible]		
Checked W. EDMONDSON	Notes [illegible]	Date 7-6-[illegible]	
Date SEP 2 5 '68	Indexed L. J. GALLI		

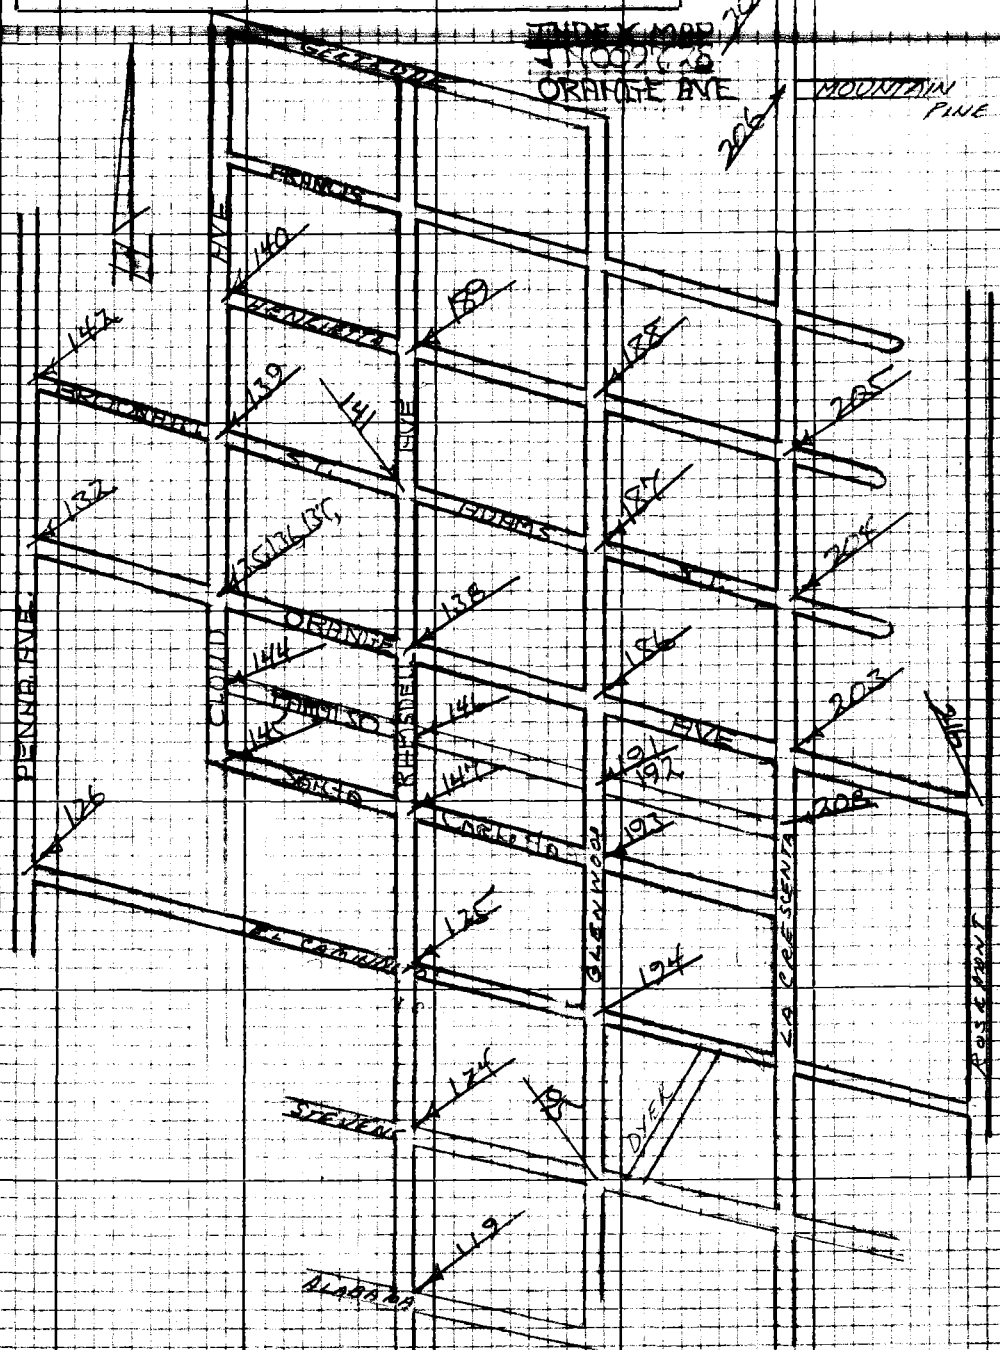

CONT TO PG. 184

Notice: Any Additions or Changes on this Sheet Must be Made or Circled in Red Ink With Date and Name of Person Making Change.

Do not extend this side of this line.

PLEASE RETURN TO
LOS ANGELES COUNTY ENGINEER
403 LOS ANGELES COUNTY ENGINEERING BLDG.

78P208 CE #310 5-68

PWFB 1921 2491

F.B. 3417 Pg. 184

CONT. BOT. PG. 183

INDEX MAP
4N 0097.28
ORANGE AVE

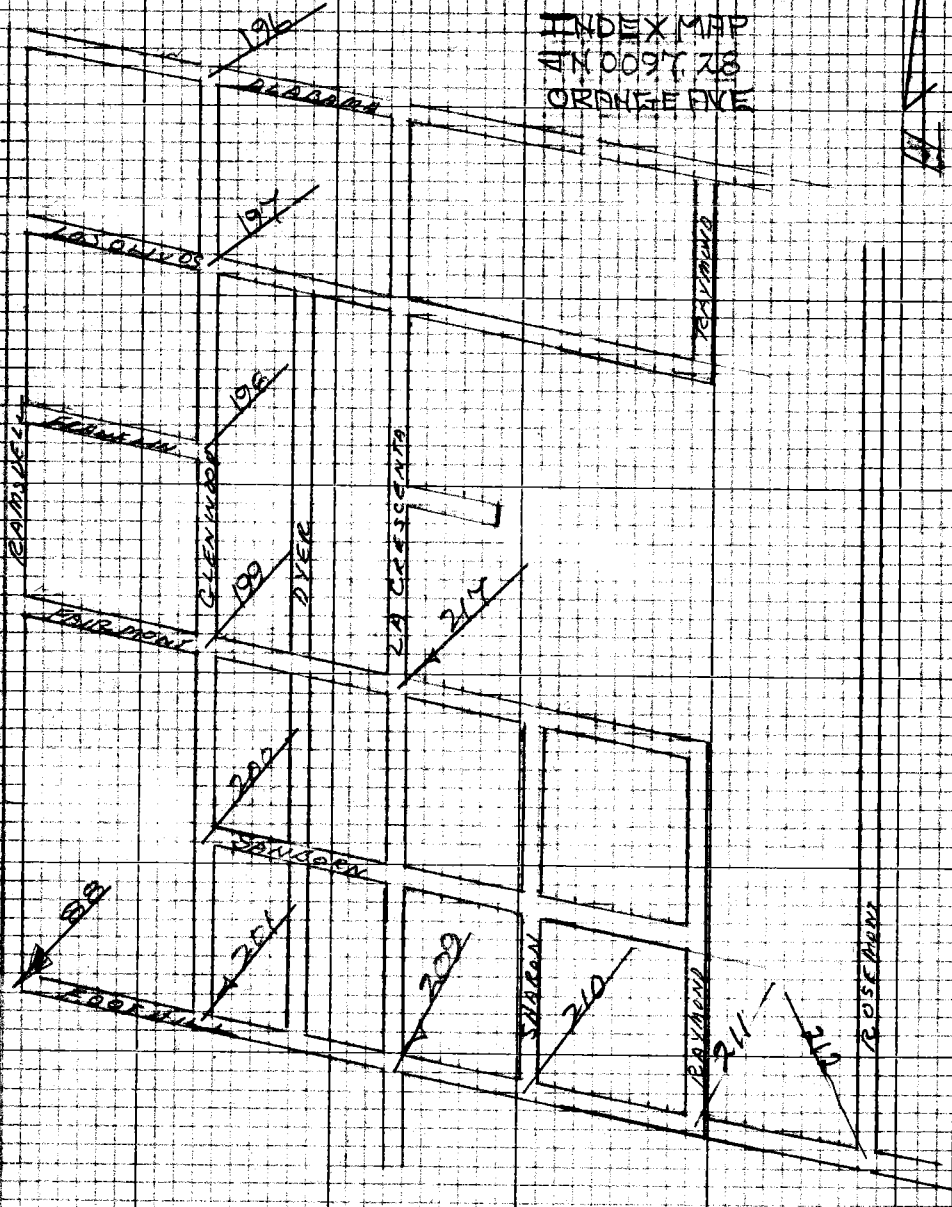

PLEASE RETURN TO
LOS ANGELES COUNTY ENGINEER
403 LOS ANGELES COUNTY ENGINEERING BLDG.

Do not extend this side of this line.

Note: Any Additions or Changes on this Sheet Must be Made or Circled in Red Ink With Date and Name of Person Making Change.

PWFB 1921

2492

Notes Ck'd by W. EDMONDSON		Survey of Orange Ave	F.B. [illegible] Pg. [illegible]
[illegible]		[illegible]	
Office Work M. HAMASU		Surveyed by HH Spriggs	
Checked W. EDMONDSON		Notes HH Date 9-67	
Date SEP 25 [illegible]		Indexed C. J. GALLI	

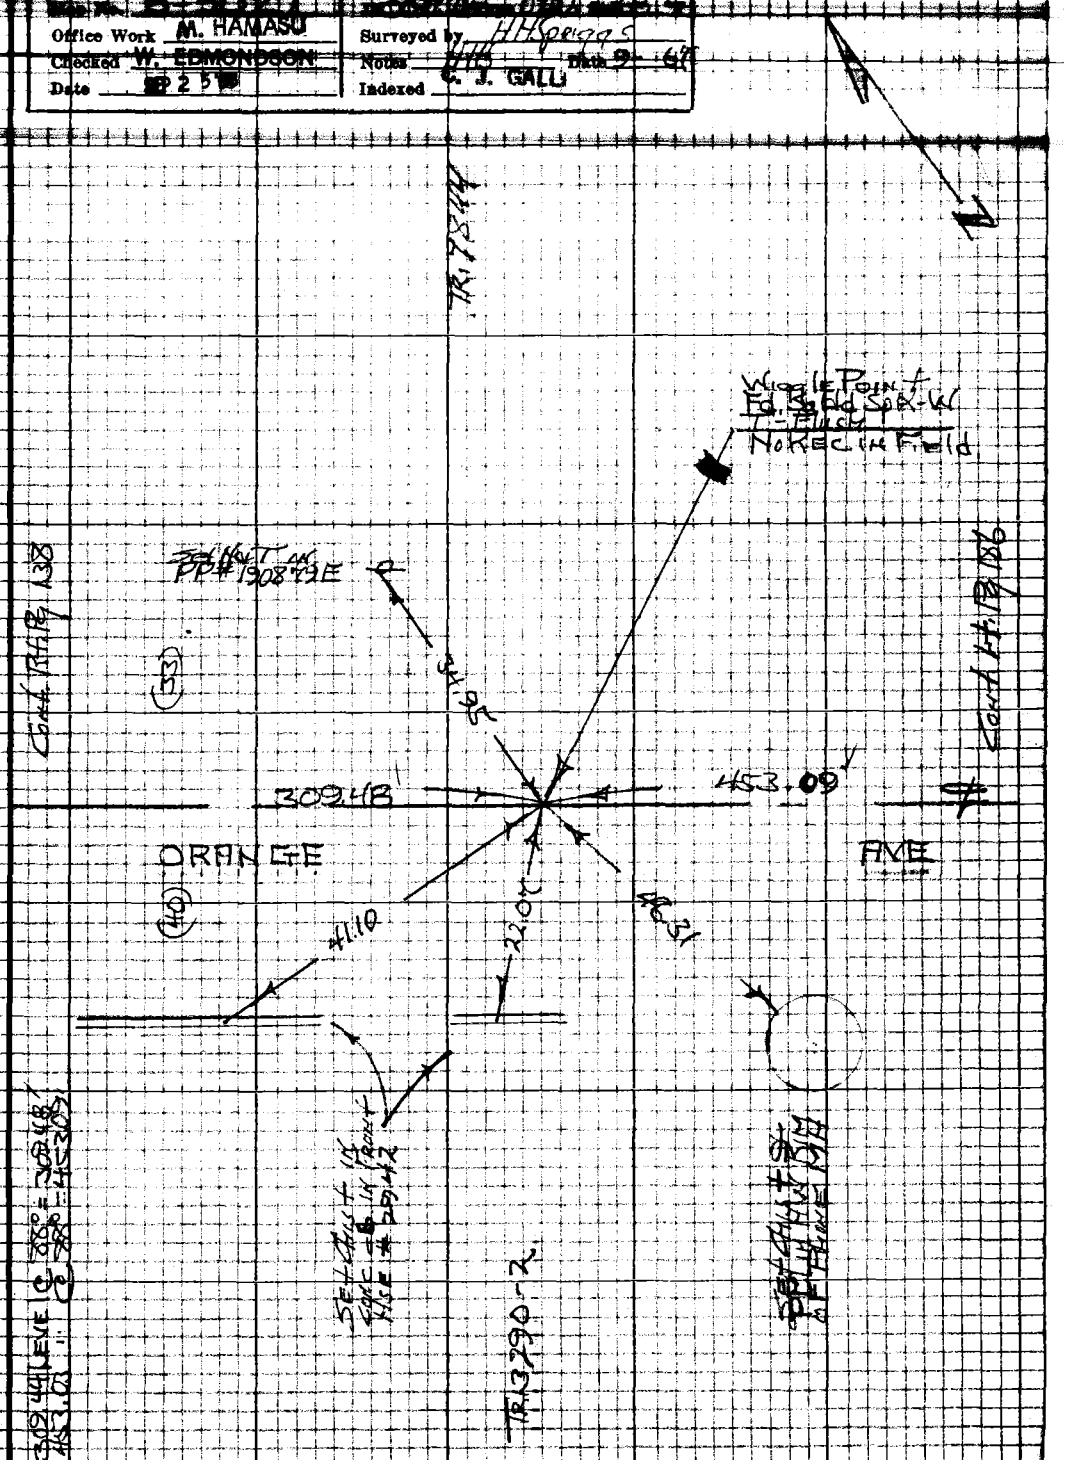

Note: Any Additions or Changes on this Sheet Must be Made or Circled in Red Ink With Date and Name of Person Making Change

Do not extend this side of this line.

PLEASE RETURN TO
LOS ANGELES COUNTY ENGINEER
403 LOS ANGELES COUNTY ENGINEERING BLDG.

76P3098 CK #310 5-66

PWFB 1921

2493

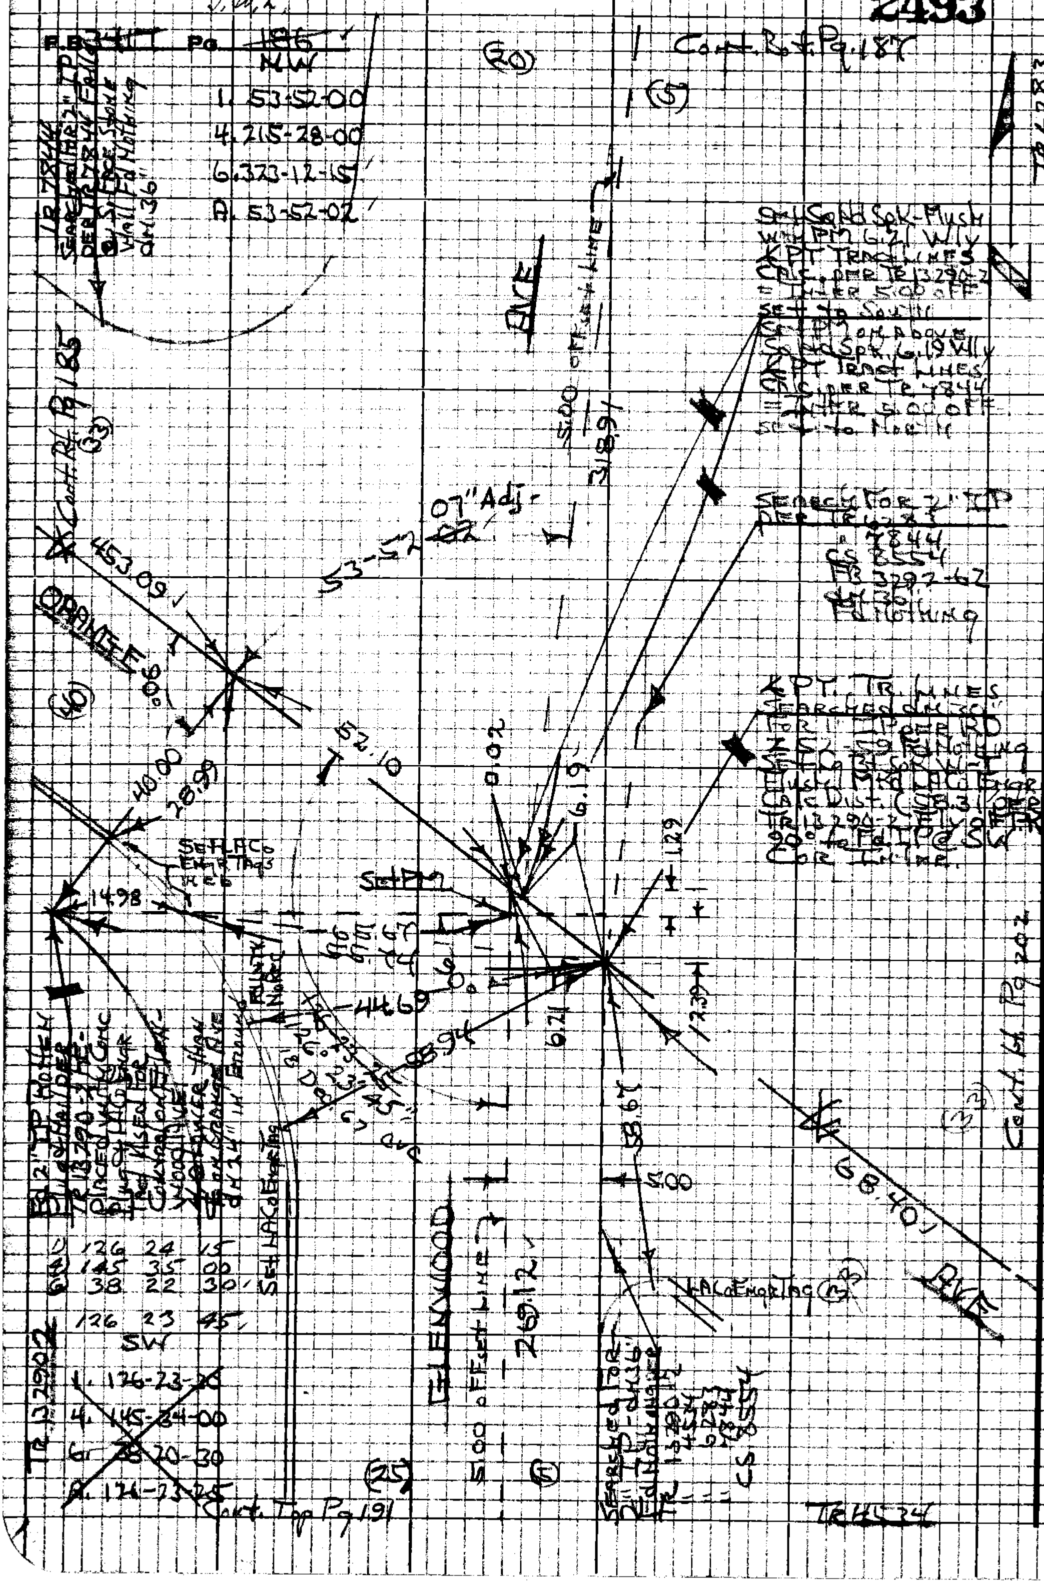

PLEASE RETURN TO
LOS ANGELES COUNTY ENGINEER
403 LOS ANGELES COUNTY ENGINEERING BLDG.

Do not extend this side of this line.

Note: Any Additions or Changes on this Sheet Must be Made or Circled in Red Ink With Date and Name of Person Making Change

PWFB 1921 2494

Notes Ck'd by W. EDMONDSON		Survey of [illegible]	F.B. [illegible] Pg. 18[illegible]
[illegible]		[illegible]	
Office Work M. HAMASU		Surveyed by HH Spiggs	
Checked W. EDMONDSON		Notes HHS Date 9-3-67	
Date SEP 2 5 '68		Indexed C. J. GALLI	

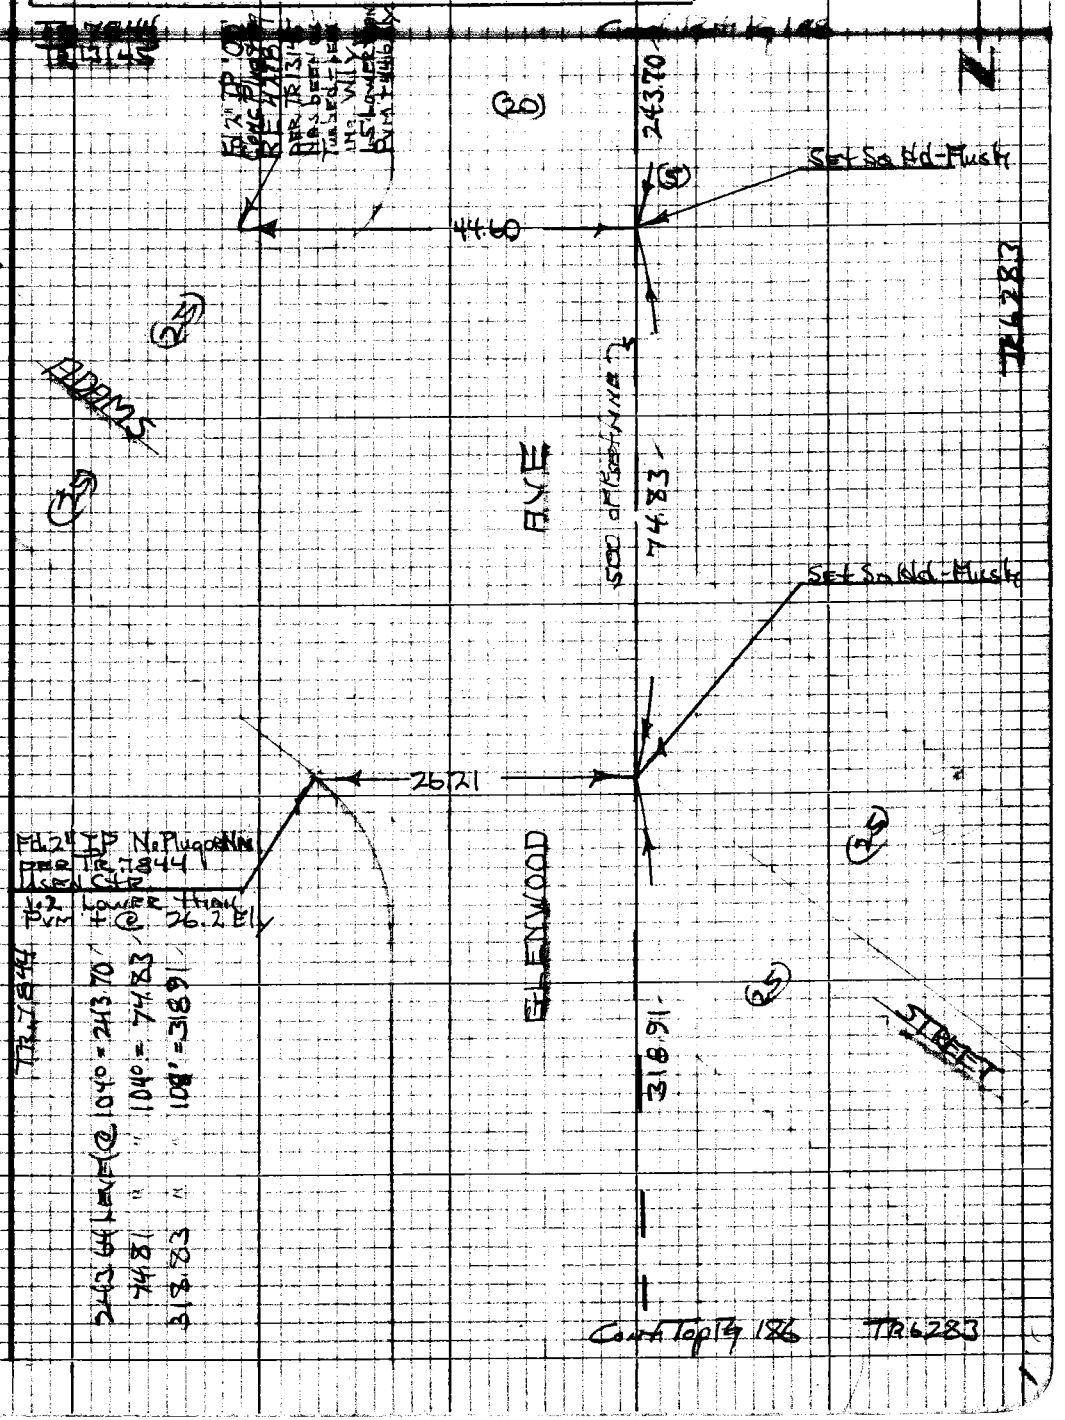

Note: Any Additions or Changes on this Sheet Must be Made or Circled in Red Ink With Date and Name of Person Making Change

Do not extend this side of this line.

PLEASE RETURN TO
LOS ANGELES COUNTY ENGINEER
403 LOS ANGELES COUNTY ENGINEERING BLDG.

W.S. 51, 8-4

76P3098 CK #310 5-66

PWEB 1921 2495

F.B. 244 Pg. 188

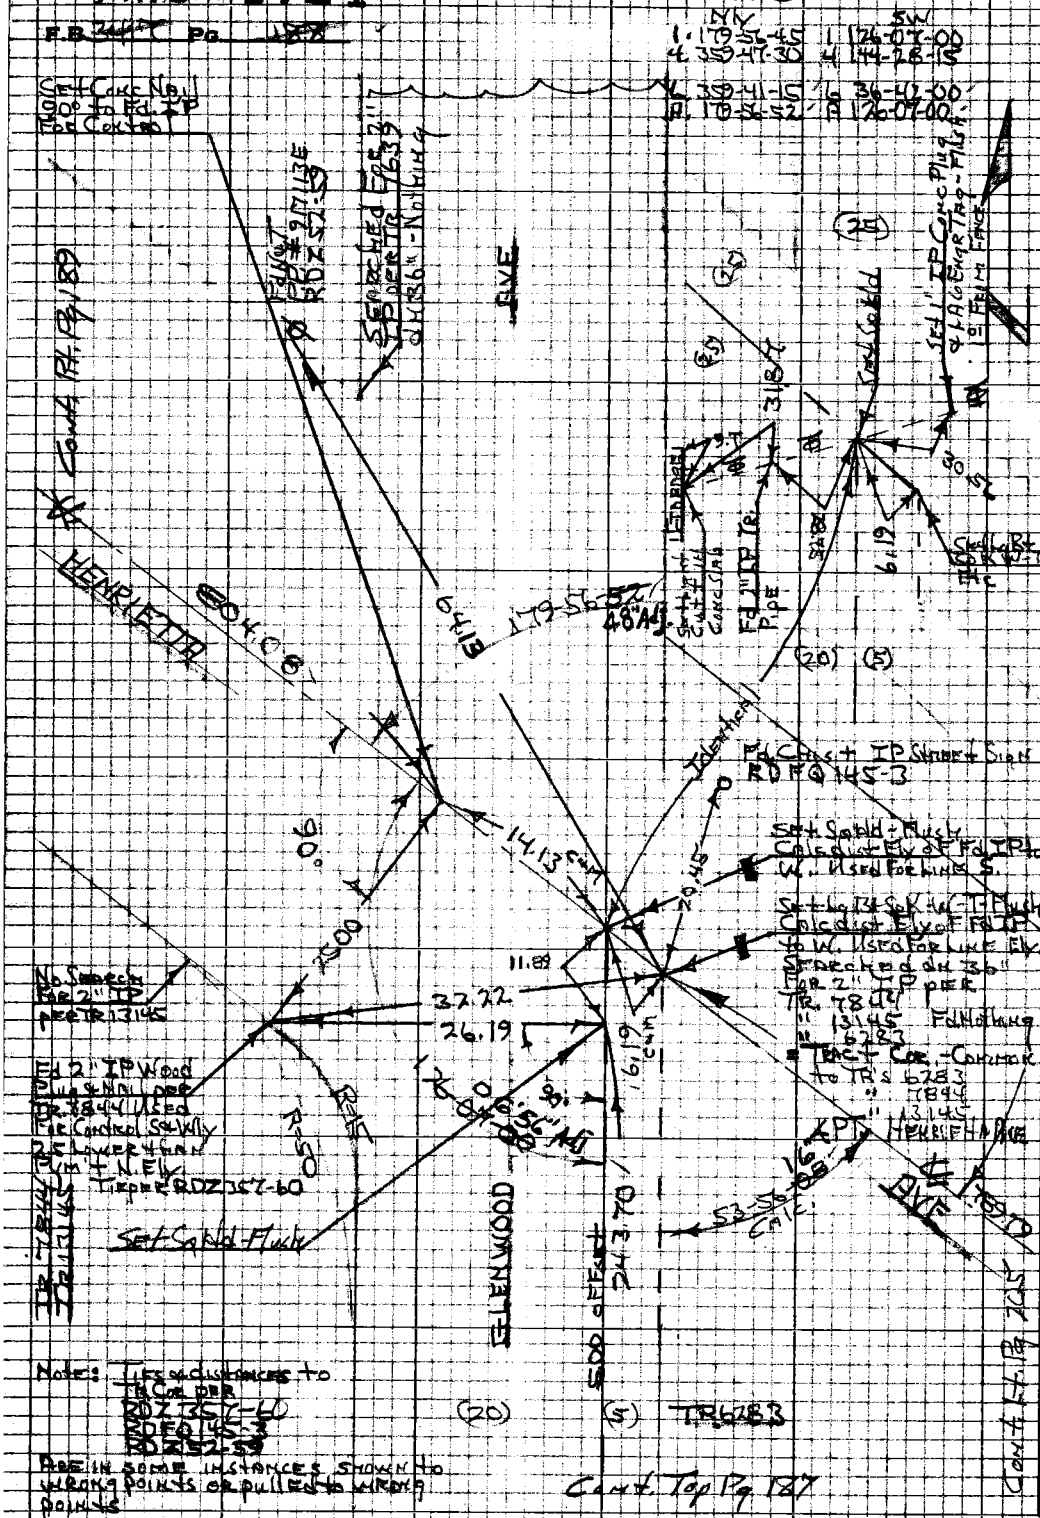

W.S. 51, B-4

PLEASE RETURN TO
LOS ANGELES COUNTY ENGINEER
403 LOS ANGELES COUNTY ENGINEERING BLDG.

Do not extend this side of this line.

Note: Any Additions or Changes on this Sheet Must be Made or Circled in Red Ink With Date and Name of Person Making Change

PWFB 1921

2496

Notes Ck'd by W. EDMONDSON	Survey of [illegible]
[illegible] 8-5027	[illegible]
Office Work M. HAMASU	Surveyed by [illegible]
Checked W. EDMONDSON	Notes [illegible] Date 2-67
Date SEP 2 5 '68	Indexed C. J. GALLI

F.B. [illegible] Pg. 189

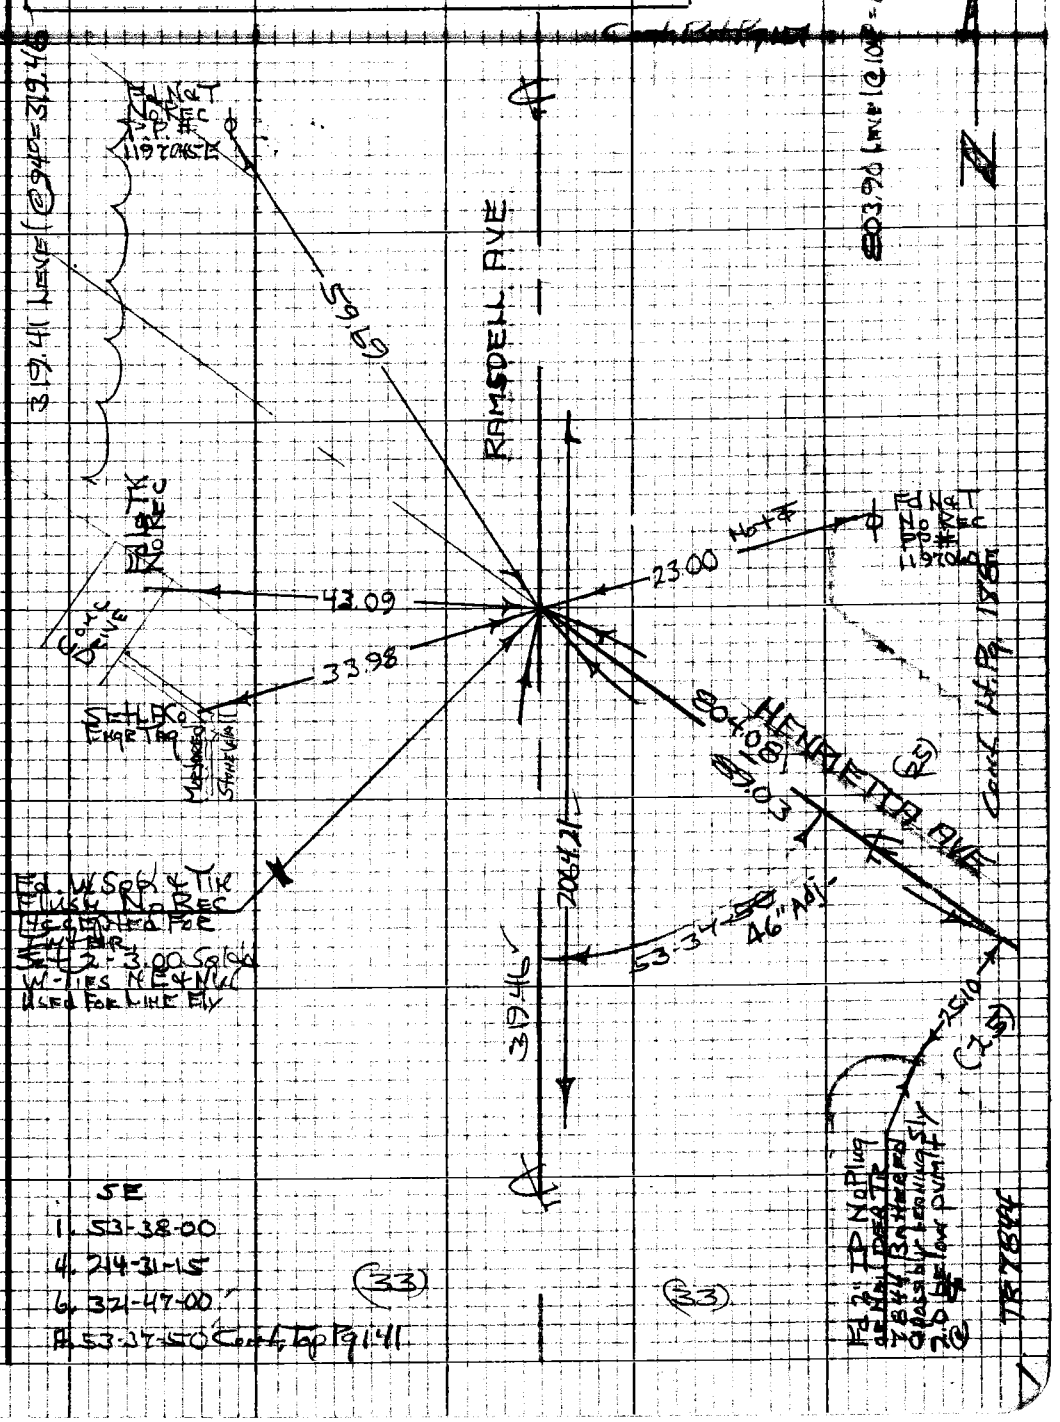

SE
1. 53-38-00
4. 214-31-15
6. 321-47-00
A. 53-37-50 Conf. Top Pg 141

Note: Any Additions or Changes on this Sheet Must be Made or Circled in Red Ink With Date and Name of Person Making Change

Do not extend this side of this line.

PLEASE RETURN TO
LOS ANGELES COUNTY ENGINEER
403 LOS ANGELES COUNTY ENGINEERING BLDG.

76P3098 CK #310 8-66

F.B. 3407 Pg. 190

PLEASE RETURN TO
LOS ANGELES COUNTY ENGINEER
403 LOS ANGELES COUNTY ENGINEERING BLDG.

Do not extend this side of this line.

Note: Any Additions or Changes on this Sheet Must be Made or Circled in Red Ink With Date and Name of Person Making Change

PWFB 1921 2497

Notes Ck'd W. EDMONDSON	Survey of Orange Ave
[illegible] B-5027	[illegible]
Office Work M. HAMASU	Surveyed by [illegible]
Checked W. EDMONDSON	Notes [illegible] Date [illegible]
Date SEP 2 5 '68	Indexed C. J. GALLI

F.B. [illegible] Pg. 195

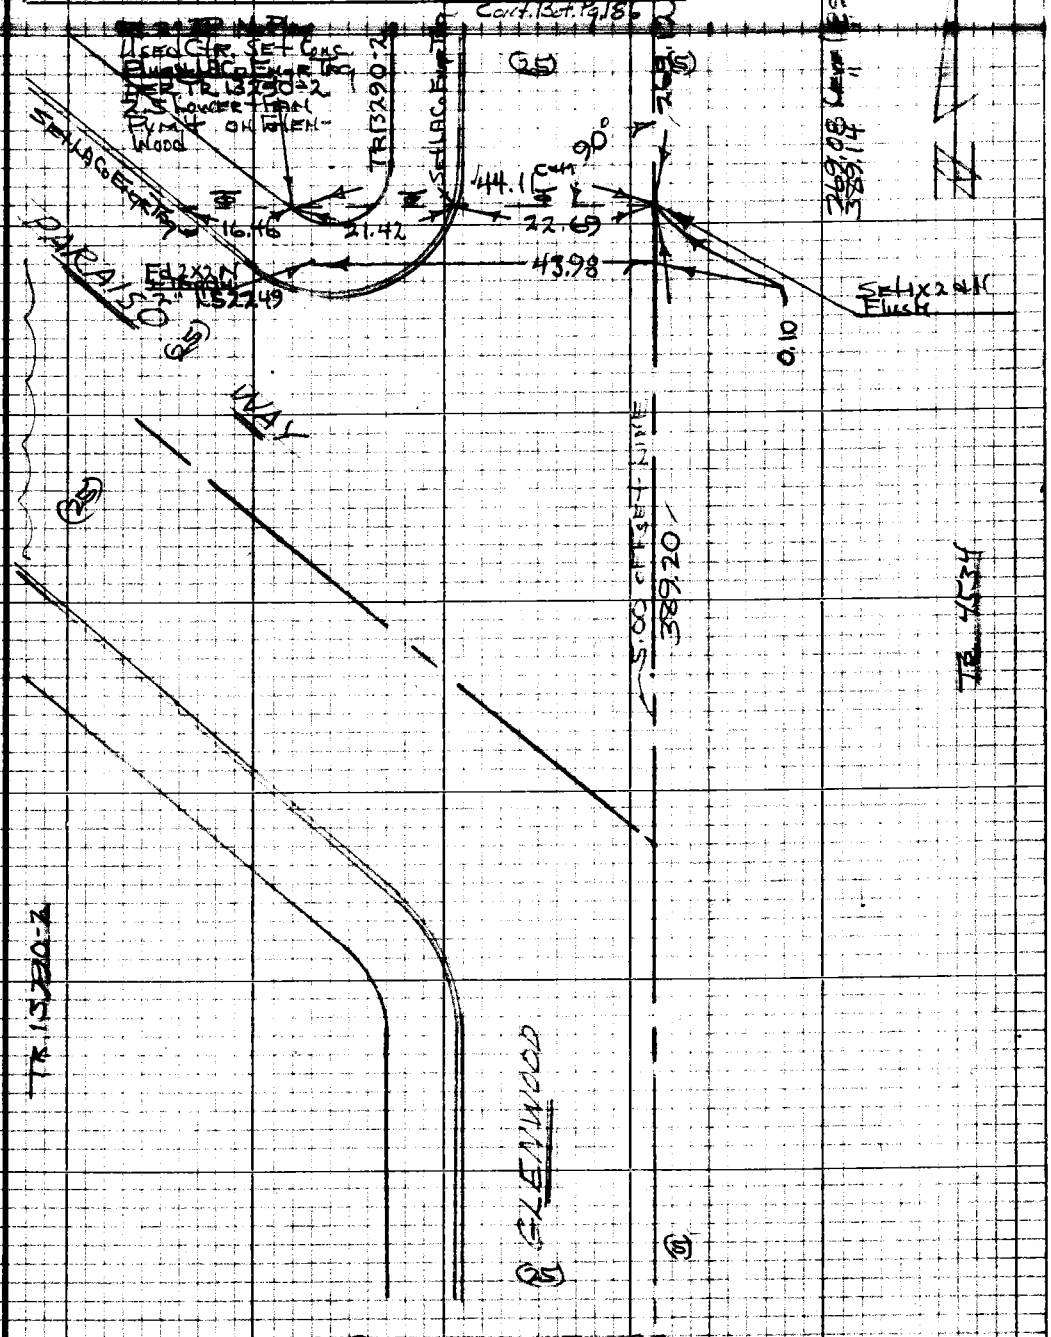

Cont. To Pg 192

Note: Any Additions or Changes on this Sheet Must be Made or Circled in Red Ink With Date and Name of Person Making Change

W.S. 51, B-4

PLEASE RETURN TO
LOS ANGELES COUNTY ENGINEER
403 LOS ANGELES COUNTY ENGINEERING BLDG.

Do not extend this side of this line.

76P3095 CE #310 5-66

PWFB 1921 2498

F.B. ~~3487~~ Pg. ~~192~~

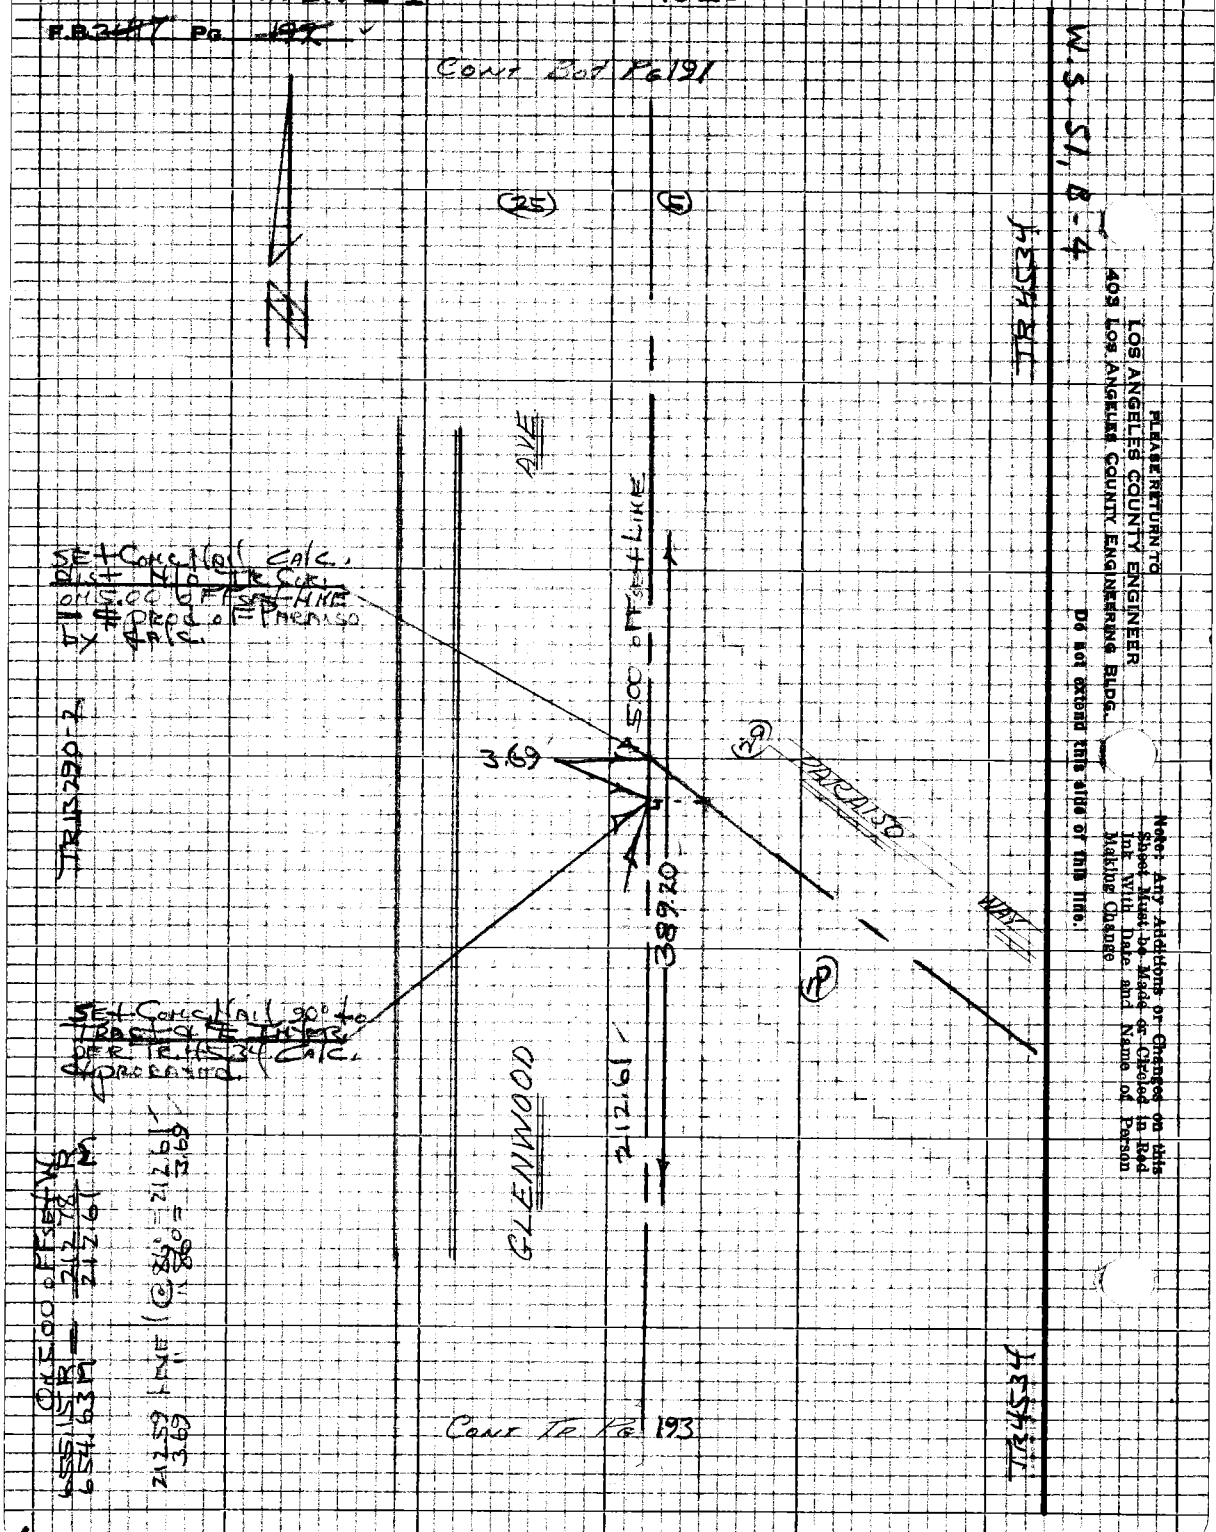

PLEASE RETURN TO
LOS ANGELES COUNTY ENGINEER
403 LOS ANGELES COUNTY ENGINEERING BLDG.

Do not extend this side of this line.

Note: Any Additions or Changes on this Sheet Must be Made or Circled in Red Ink With Date and Name of Person Making Change

PWFB 1921

2499

Notes Ck'd By W. EDMONDSON		Survey of	F.B. Pg. 193
Office Work M. HAWASU		Surveyed by	
Checked W. EDMONDSON		Notes	Date
Date 2 5 '68		Indexed C. I. GALLI	

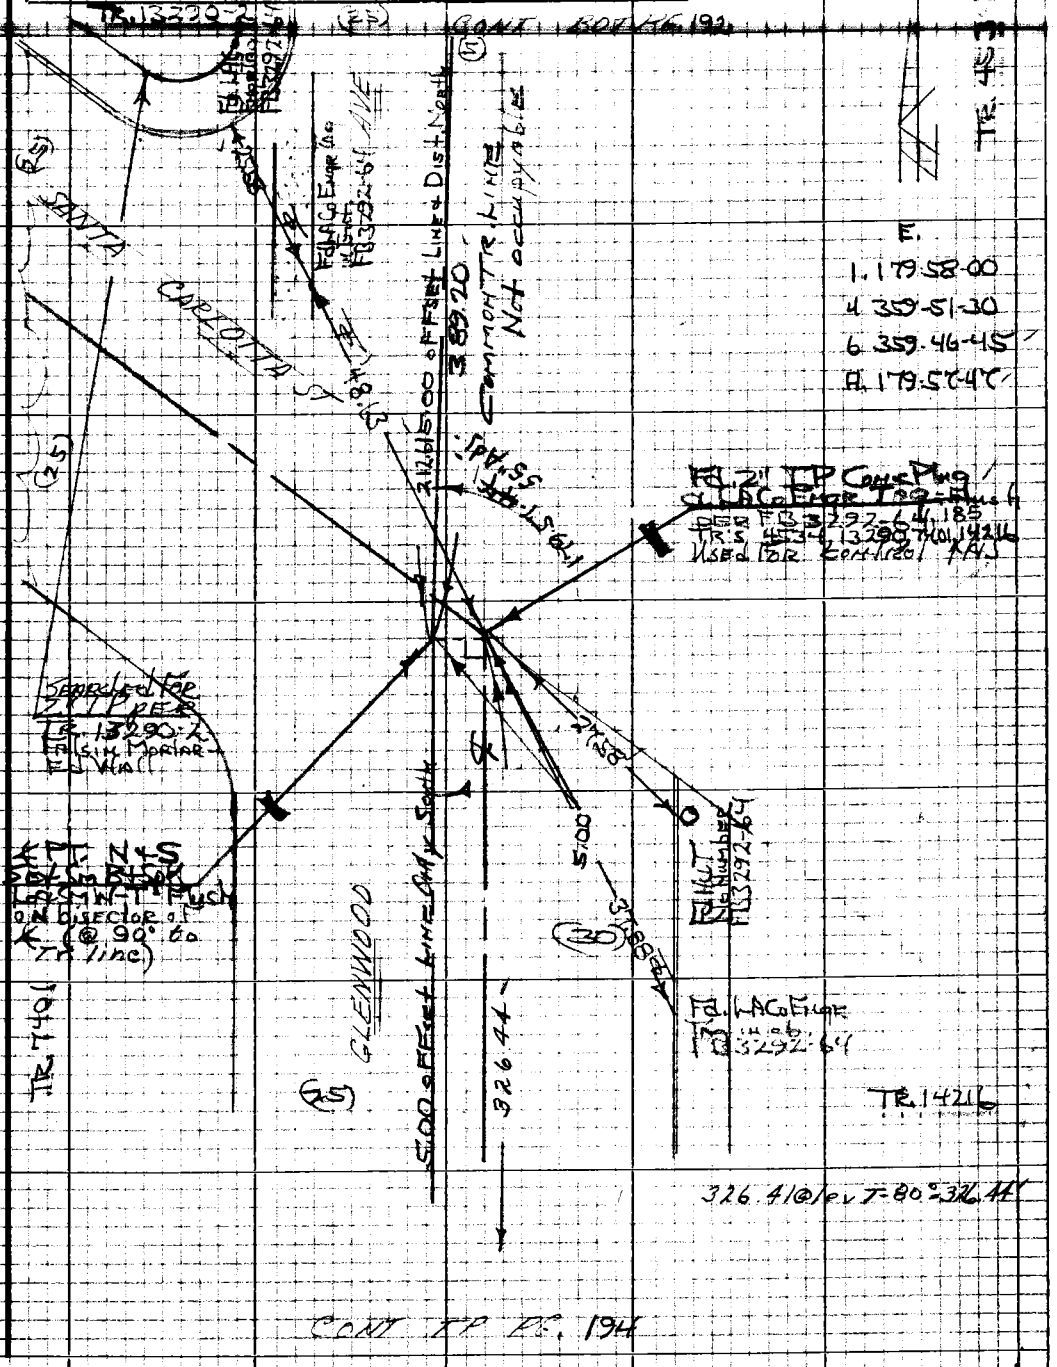

Note: Any Additions or Changes on this Sheet Must be Made or Circled in Red Ink With Date and Name of Person Making Change

Do not extend this side of this line.

PLEASE RETURN TO
LOS ANGELES COUNTY ENGINEER
403 LOS ANGELES COUNTY ENGINEERING BLDG.

76P3058 CE #310 8-66

PWFB 1921 2500

F.B. 3417 Pg 194

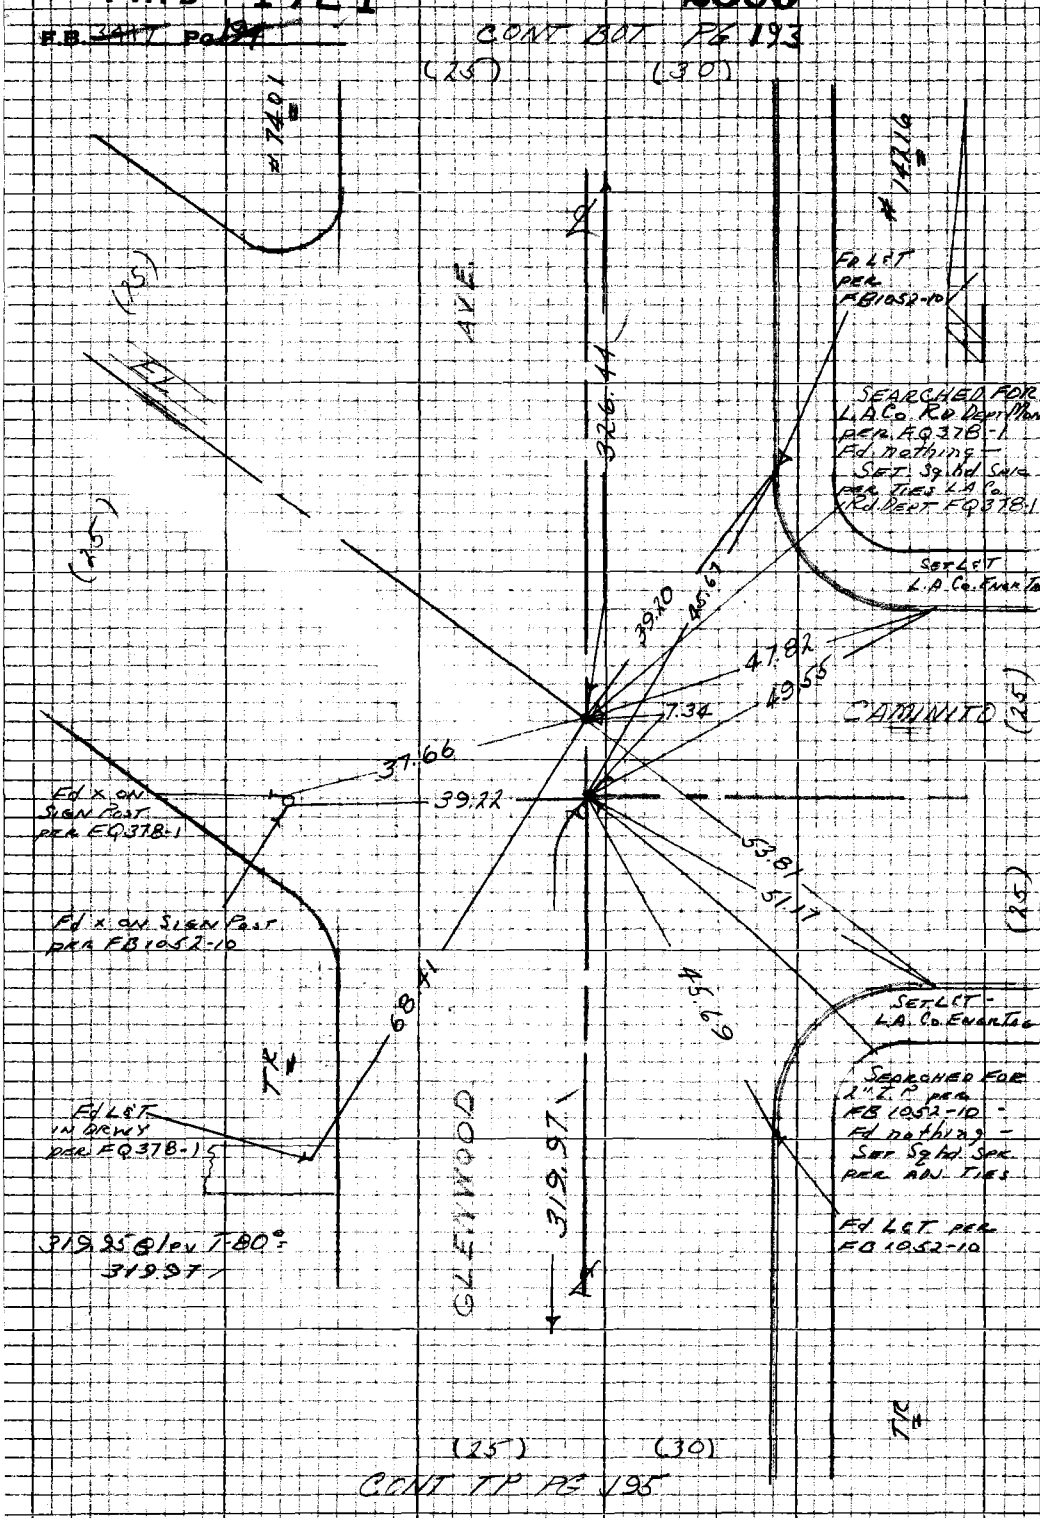

W.S.51, B-4

PLEASE RETURN TO
LOS ANGELES COUNTY ENGINEER
403 LOS ANGELES COUNTY ENGINEERING BLDG.

Do not extend this side of this line.

Note: Any Additions or Changes on this Sheet Must be Made or Circled in Red Ink With Date and Name of Person Making Change

PWFB 1921 2501

Notes Ck'd by W. EDMONDSON	Survey of OPANGE AVE	F.B. 3417	Pg. 125
Map No. 6-5027	[illegible]		
Office Work M. HAMASU	Surveyed by SPRIGGS		
Checked W. EDMONDSON	Notes M. [illegible] Date 8-47		
Date SEP 2 5 '68	Indexed C. J. GALLI		

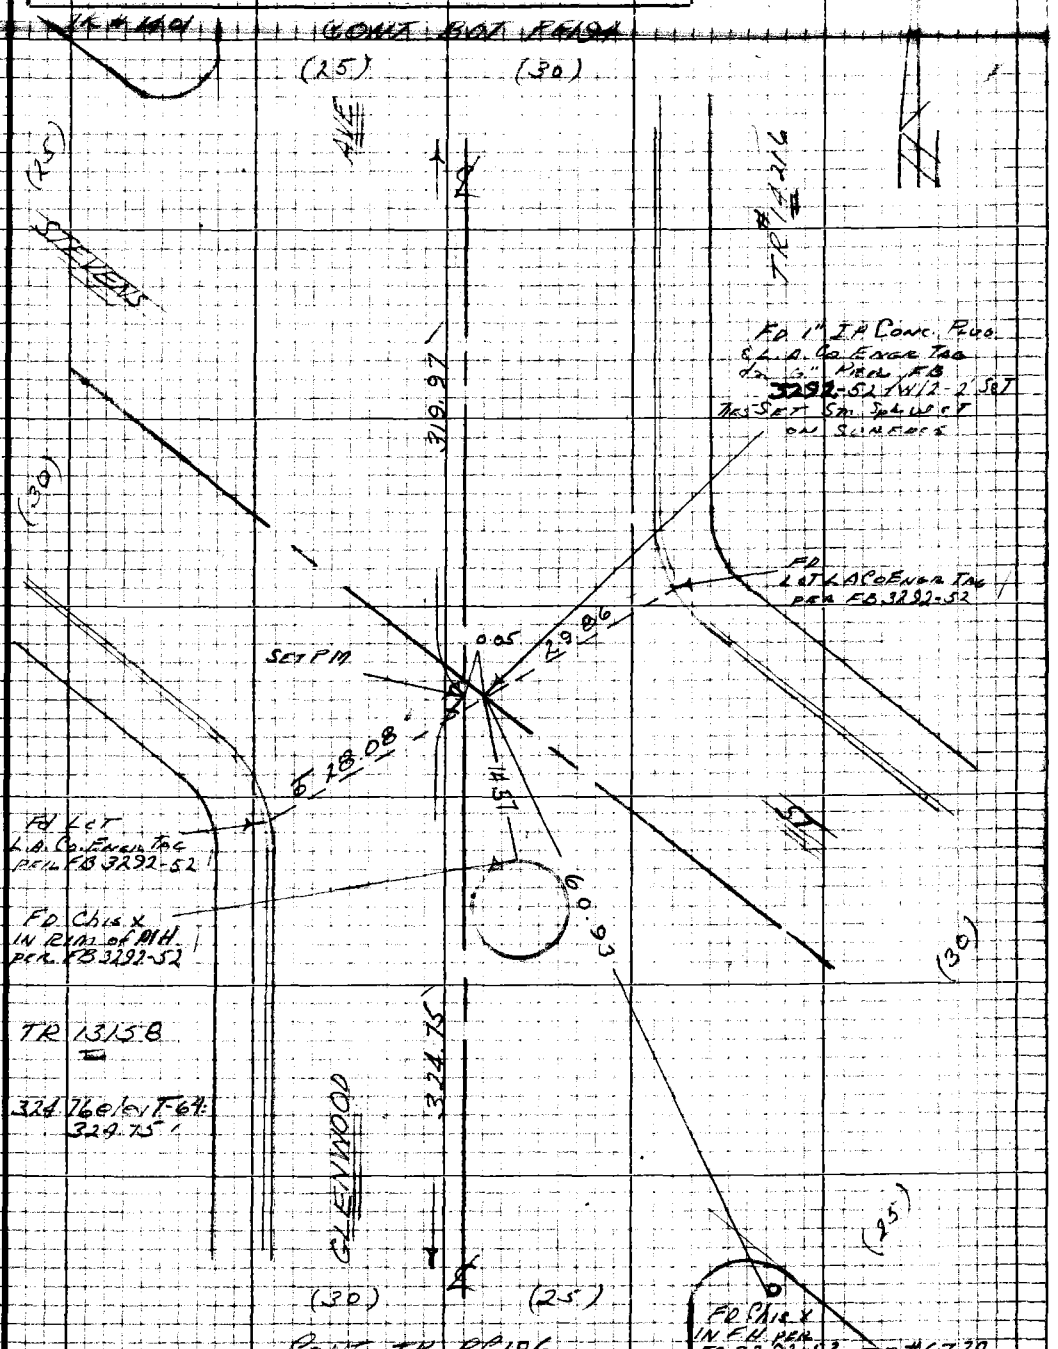

Note: Any Additions or Changes on this Sheet Must be Made or Circled in Red Ink With Date and Name of Person Making Change

Do not extend this side of this line.

W.S. S1, B-4

PLEASE RETURN TO
LOS ANGELES COUNTY ENGINEER
403 LOS ANGELES COUNTY ENGINEERING BLDG.

76P3098 CK #310 8-66

PWFB 1921 2502

F.B. 347 Pg. 196

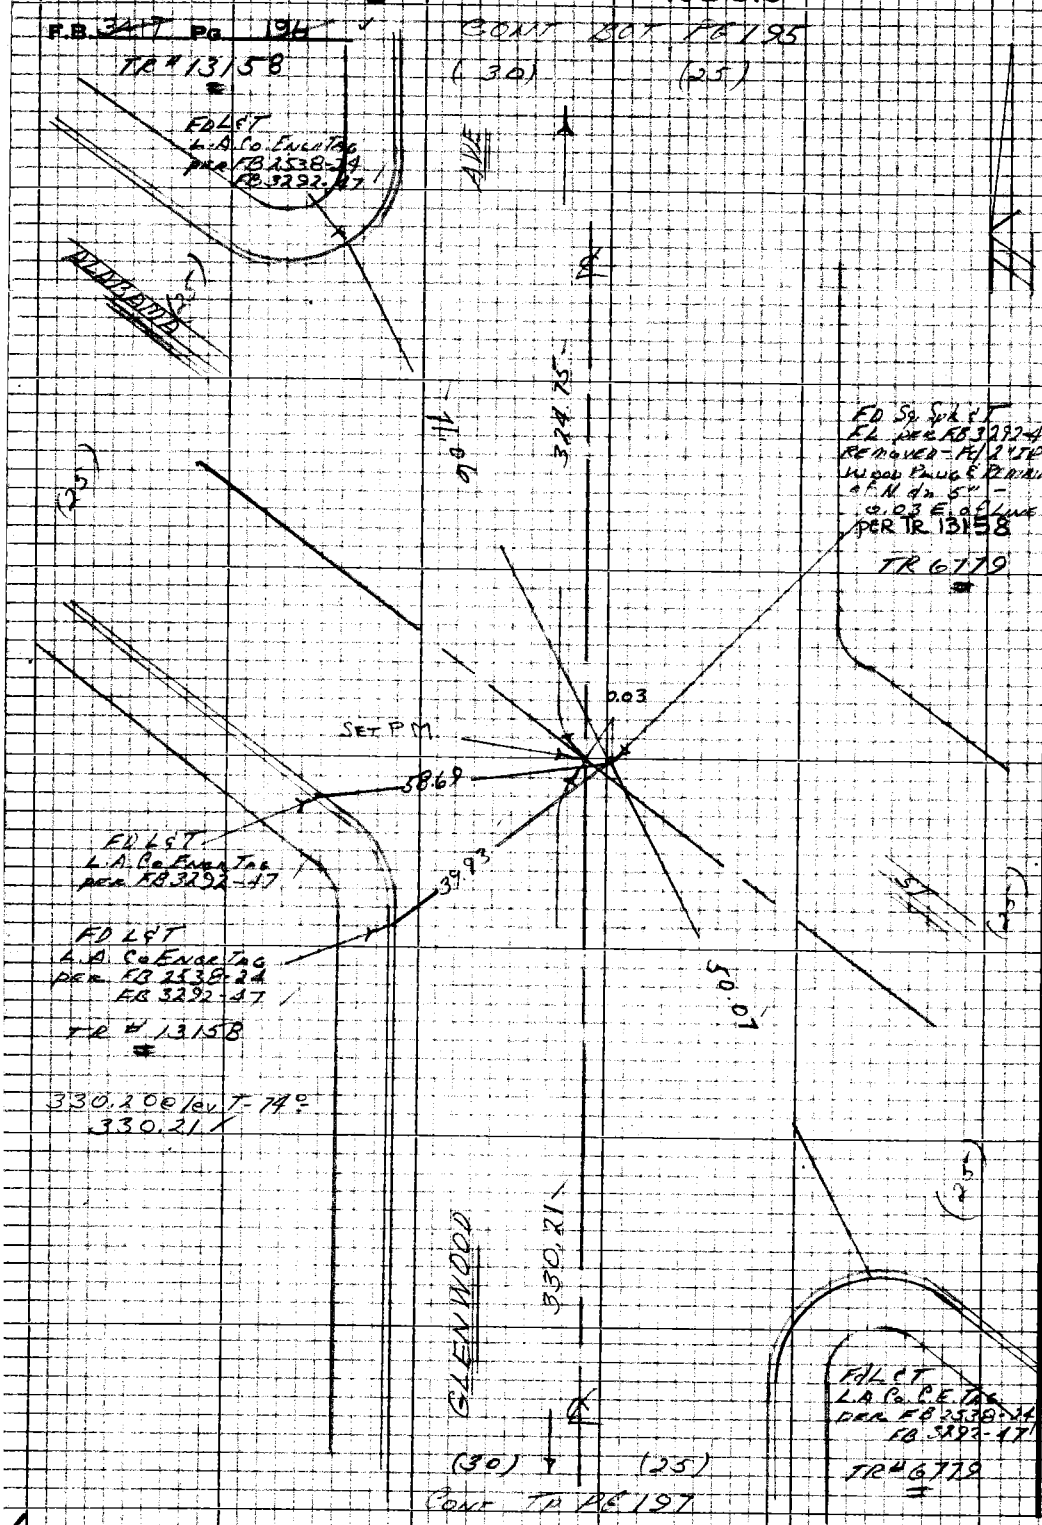

W.S. 51, B-4

PLEASE RETURN TO
LOS ANGELES COUNTY ENGINEER
403 LOS ANGELES COUNTY ENGINEERING BLDG.

Do not extend this side of this line.

Note: Any Additions or Changes on this Sheet Must be Made or Circled in Red Ink With Date and Name of Person Making Change

PWFB 1921 2503

Notes Ck'd by W. EDMONDSON	Survey of ORANGE AVE
Map No. B-5027	[illegible]
Office Work M. HAMASU	Surveyed by SPRIGGS
Checked W. EDMONDSON	Notes [illegible] Date [illegible]
Date SEP 2 5 '68	Indexed C. J. GALLI

F.B. [illegible] Pg. 197

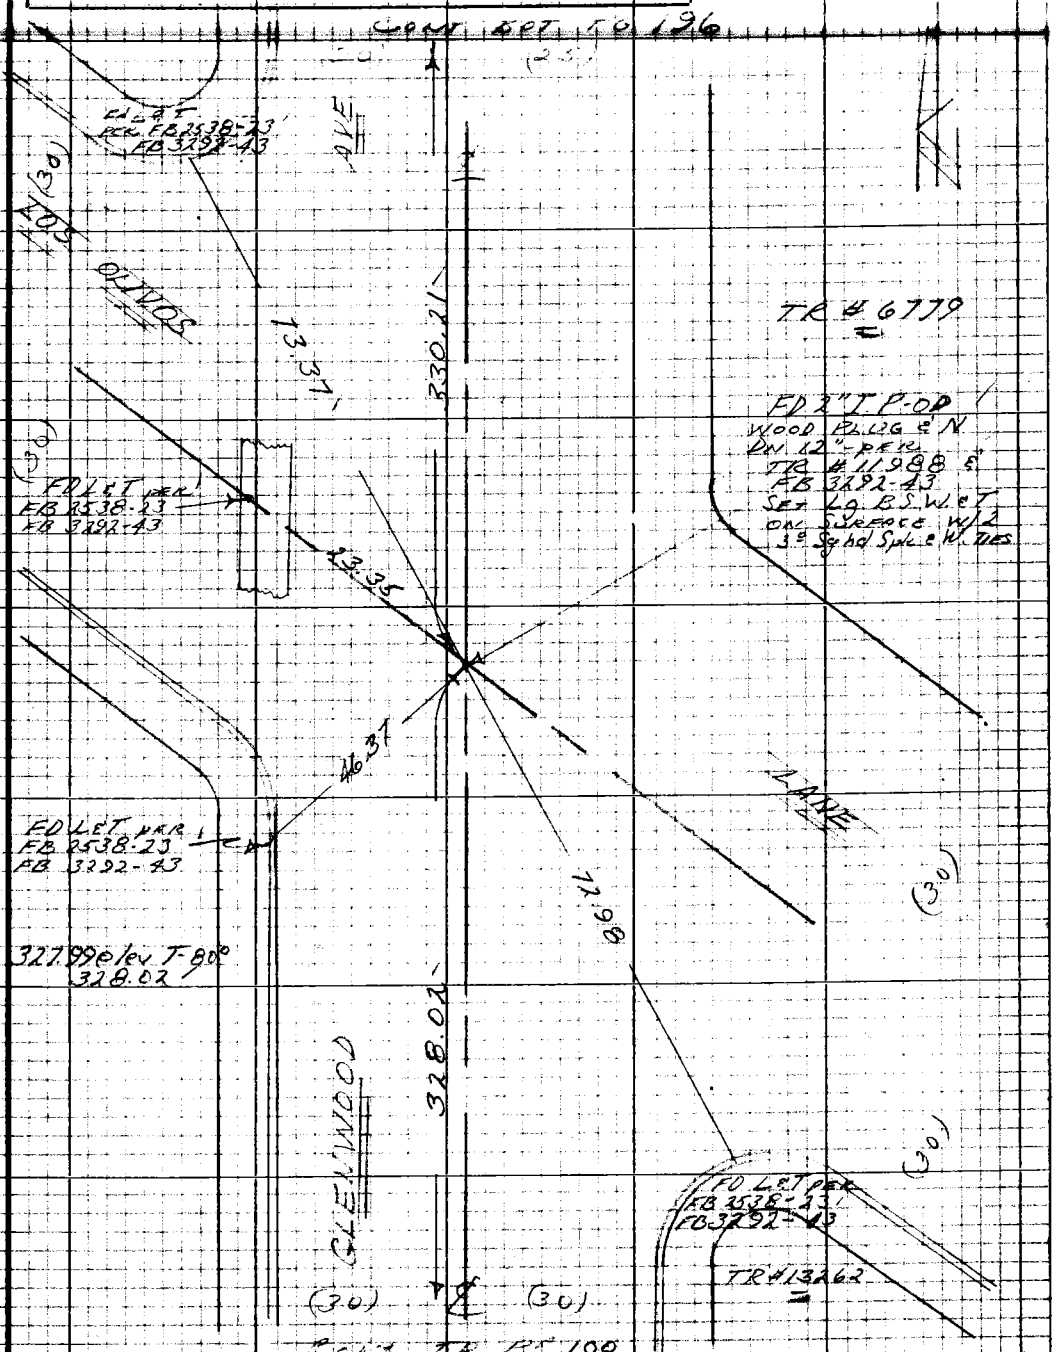

Note: Any Additions or Changes on this Sheet Must be Made or Circled in Red Ink With Date and Name of Person Making Change

W.S. 51, B-4

Do not extend this side of this line.

PLEASE RETURN TO
LOS ANGELES COUNTY ENGINEER
403 LOS ANGELES COUNTY ENGINEERING BLDG.

76P3058 CK #310 5-66

PWFB 1921 2504

F.B. 3417 Pg. 198 CONT DOT PG197

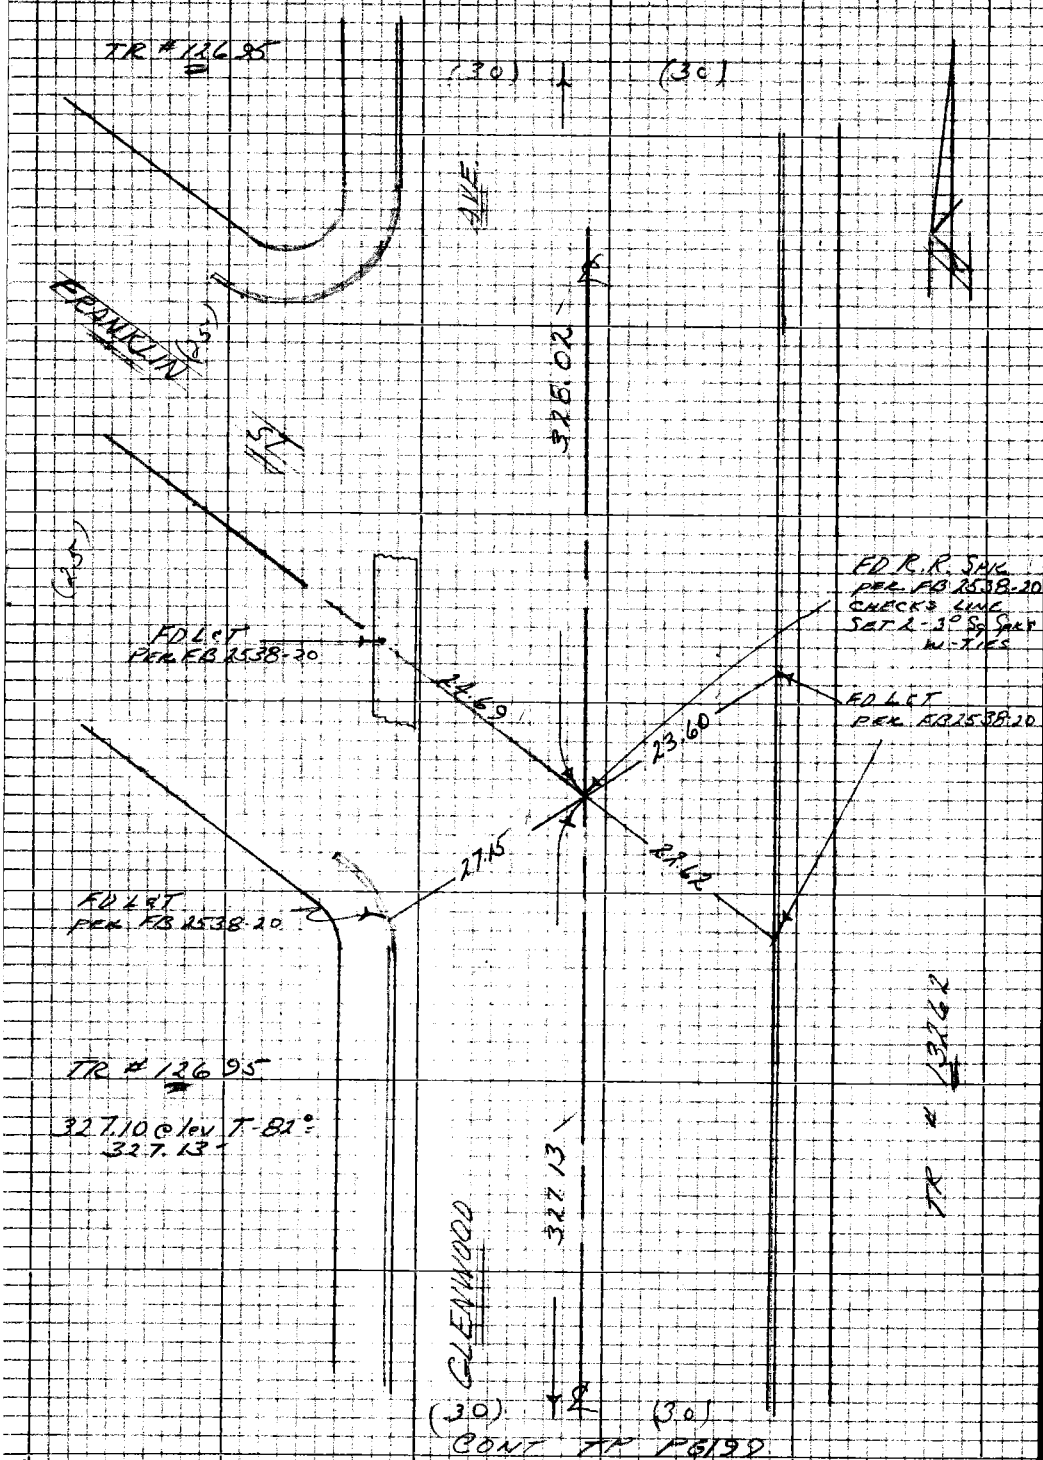

CONT TP PG199

W.S. 51, B-4

PLEASE RETURN TO
LOS ANGELES COUNTY ENGINEER
403 LOS ANGELES COUNTY ENGINEERING BLDG.

Do not extend this side of this line.

Note: Any Additions or Changes on this Sheet Must be Made or Circled in Red Ink With Date and Name of Person Making Change

PWFB 1921

2505

Notes Ck'd by W. EDMONDSON	Survey of ORANGE AVE	F.B. 3447	Pg. 199
[illegible] B-5027	[illegible]		
Office Work M. HAMASU	Surveyed by SPRIGGS		
Checked W. EDMONDSON	Notes [illegible] Date [illegible]		
Date SEP 2 5 '68	Indexed [illegible] J. GALLI		

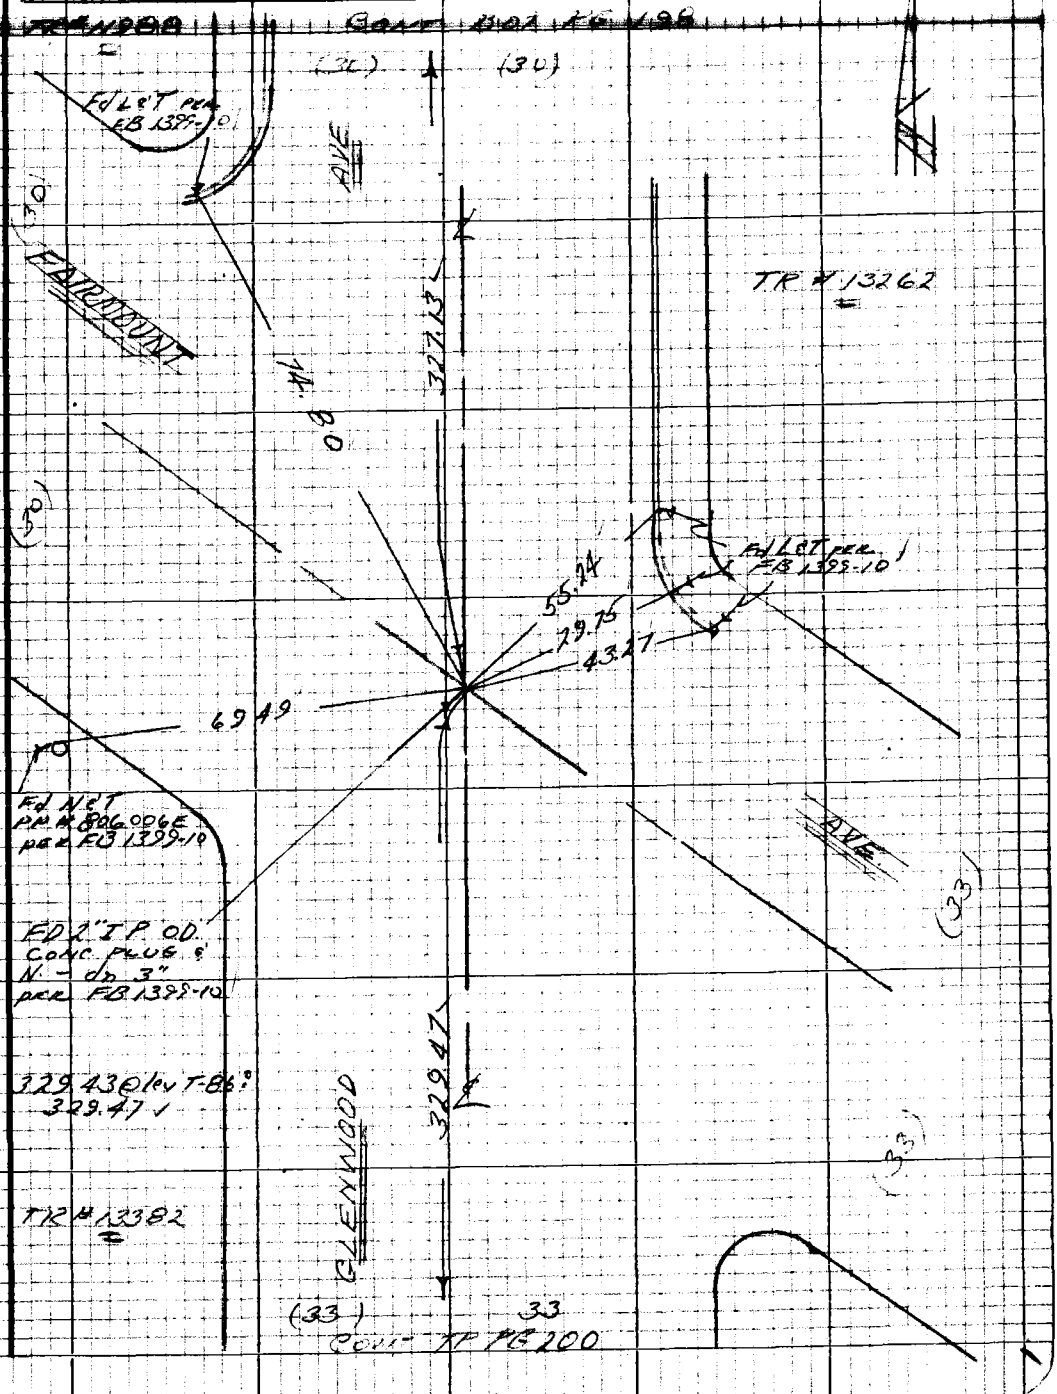

Note: Any Additions or Changes on this Sheet Must be Made or Circled in Red Ink With Date and Name of Person Making Change

PLEASE RETURN TO
LOS ANGELES COUNTY ENGINEER
403 LOS ANGELES COUNTY ENGINEERING BLDG.

Do not extend this side of this line.

76P3098 CE #310 8-66

PWFB 1921

2506

F.B. ~~2417~~ Pg. ~~200~~

CONT BOT PG 199

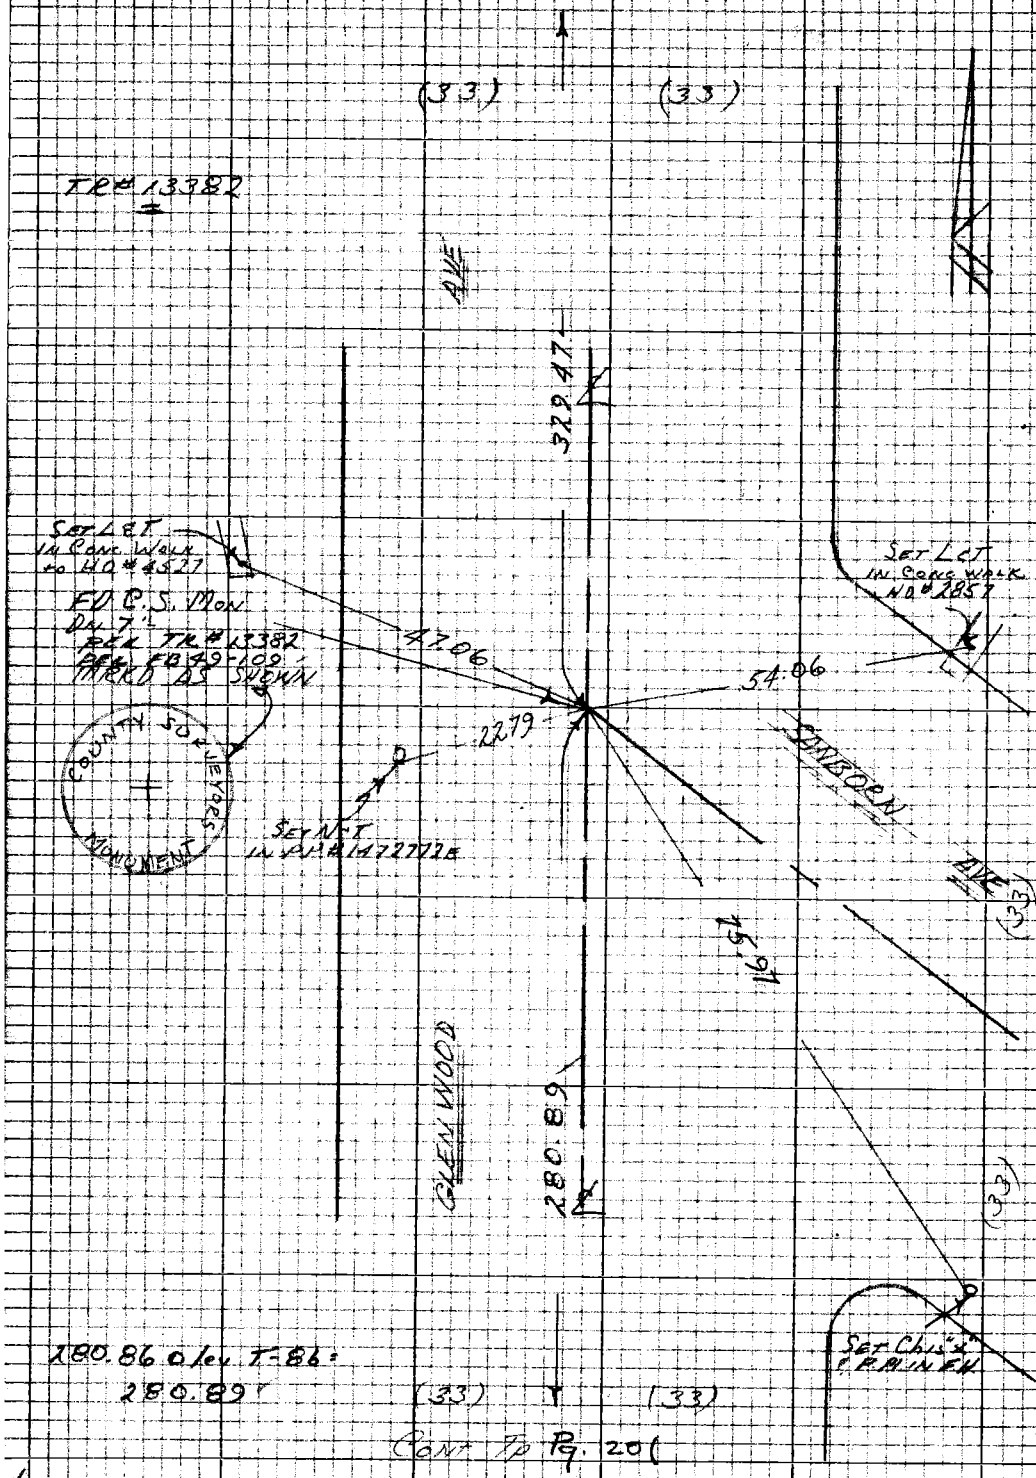

CONT TO PG. 201

W. S. 51, B-4

PLEASE RETURN TO
LOS ANGELES COUNTY ENGINEER
403 LOS ANGELES COUNTY ENGINEERING BLDG.

Do not extend this side of this line.

Note: Any Additions or Changes on this Sheet Must be Made or Circled in Red Ink With Date and Name of Person Making Change

PWFB 1921 2507

Notes Ck'd by W. EDMONDSON

Survey of

F.B. Pg. 201

Office Work M. HAMASU

Checked W. EDMONDSON

Date SEP 25 '68

Surveyed by

Notes

Indexed L. J. GALLI

Note: Any Additions or Changes on this Sheet Must be Made or Circled in Red Ink With Date and Name of Person Making Change

W. S. 51, 8-4

Do not extend this side of this line.

PLEASE RETURN TO
LOS ANGELES COUNTY ENGINEER
403 Los Angeles County Engineering Bldg.

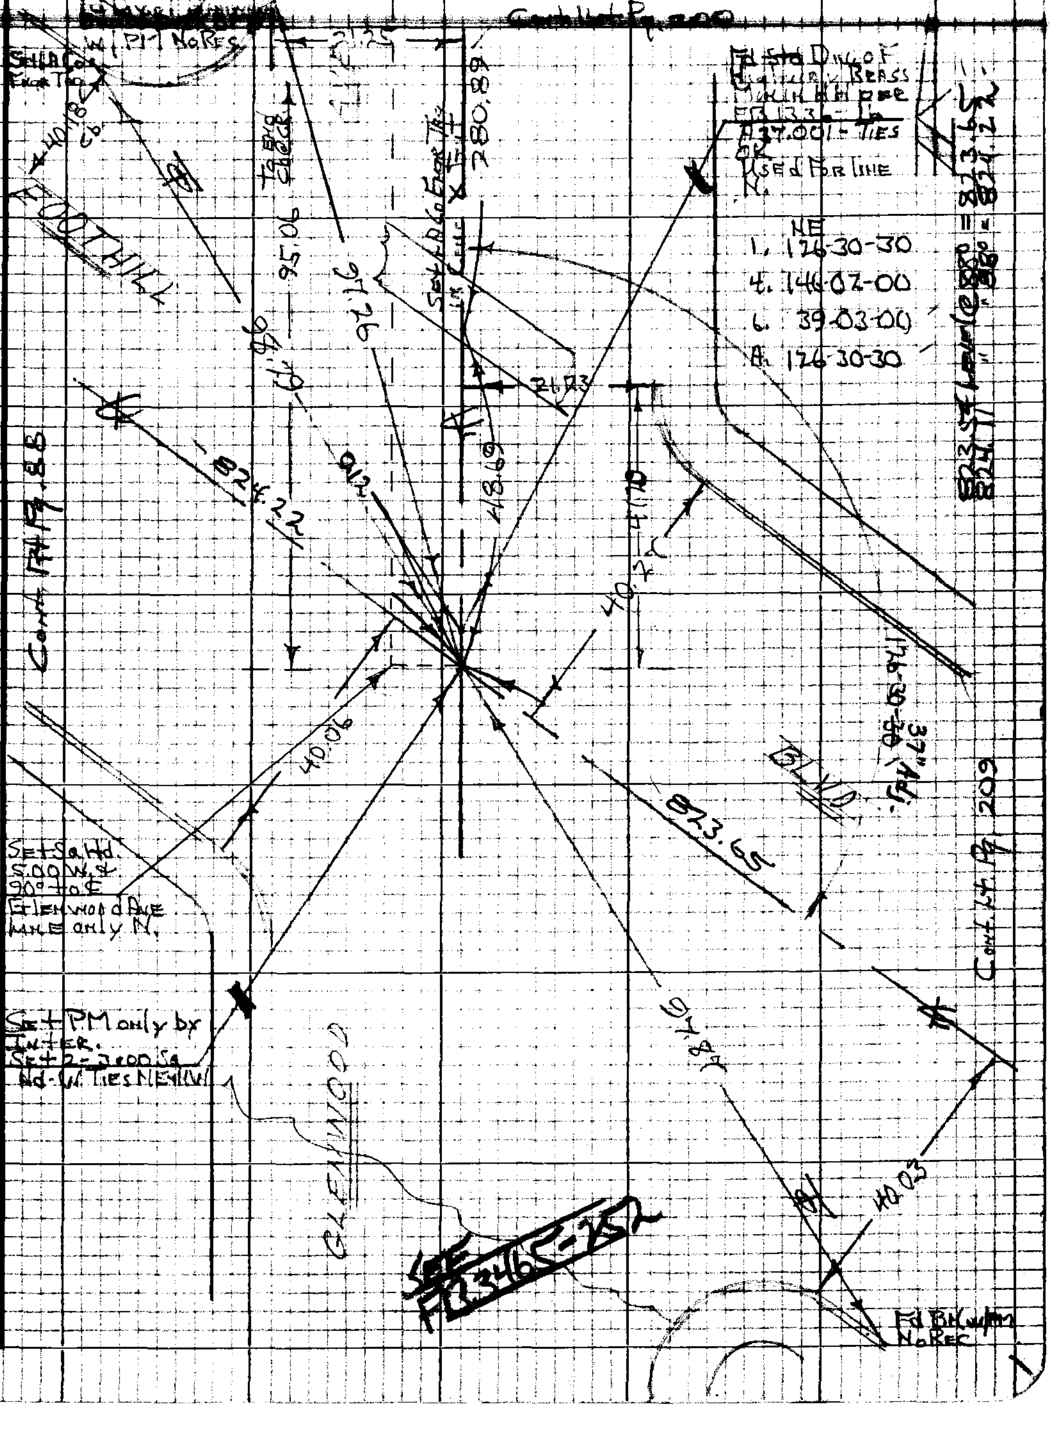

76P3093 CK #310 5-66

PWFB 1921 2508

F.B. 3467 Pg. 202

PWFB 1921 2509

Notes Ck'd by W. EDMONDSON	Survey of [illegible]	F.B. [illegible] Pg. 202
[illegible] 8-5027	[illegible]	
Office Work M. HAMASU	Surveyed by [illegible]	
Checked W. EDMONDSON	Notes [illegible] Date 9-1-67	
Date SEP 2 5 '68	Indexed C. J. GALLI	

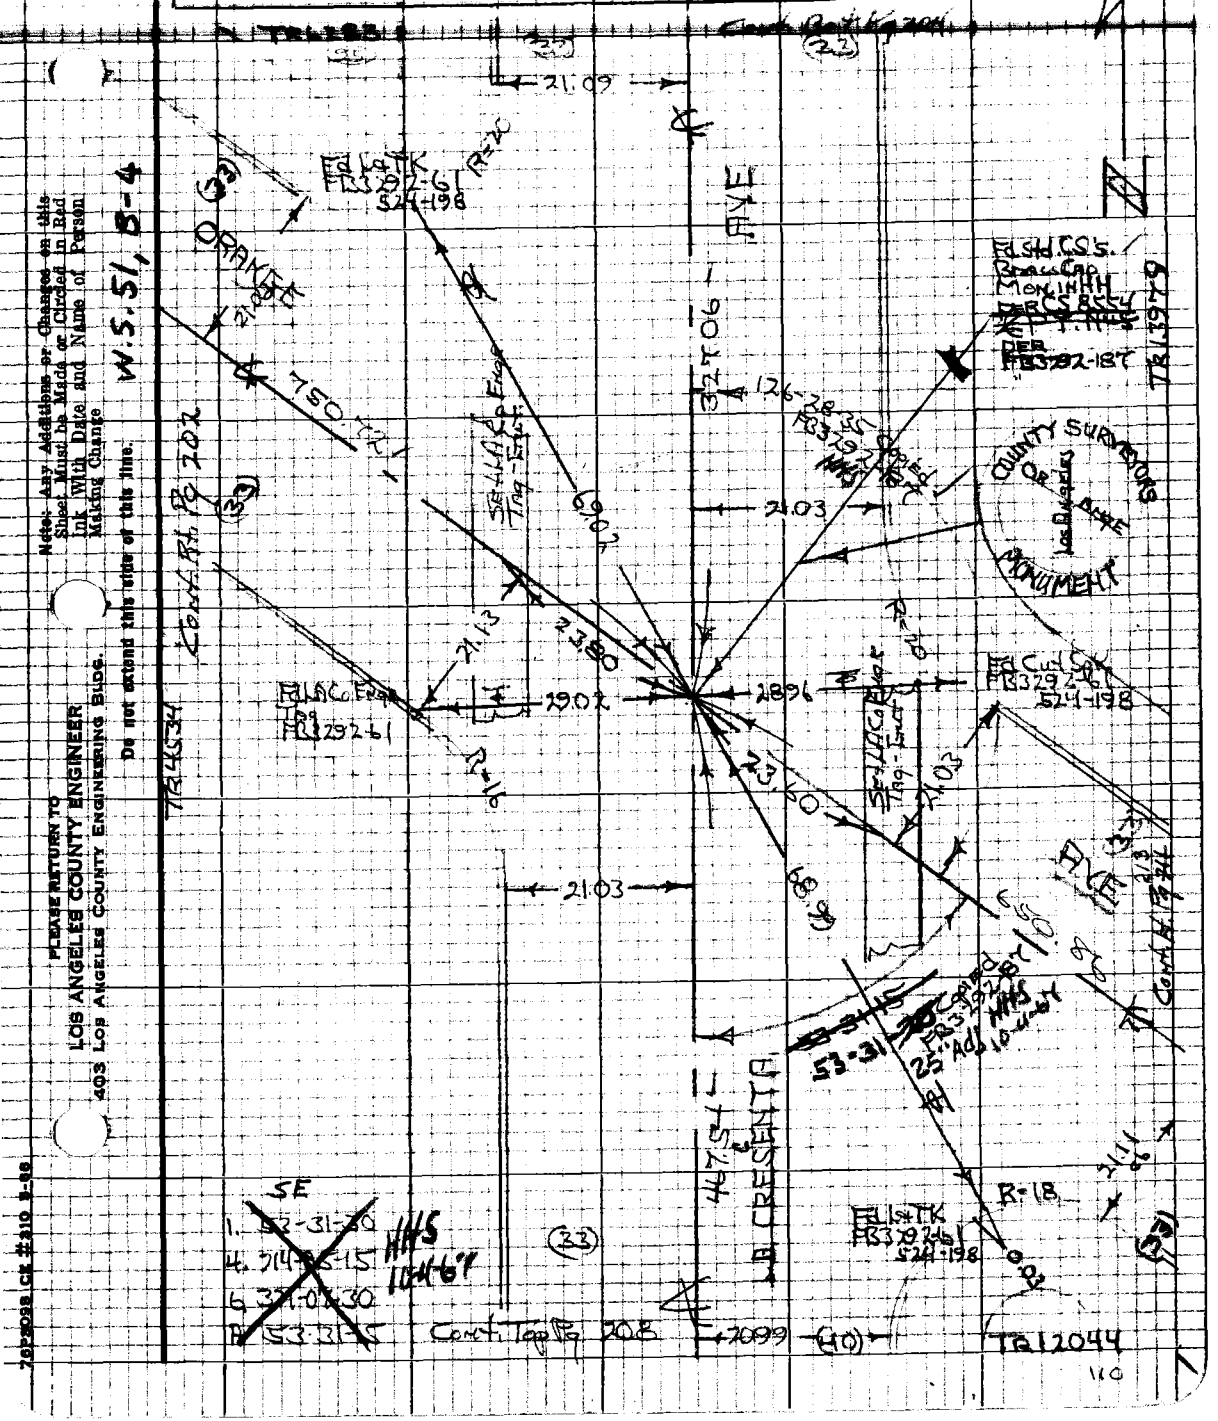

Note: Any Additions or Changes on this Sheet Must be Made or Circled in Red Ink With Date and Name of Person Making Change

Do not extend this side of this line.

PLEASE RETURN TO
LOS ANGELES COUNTY ENGINEER
403 Los Angeles County Engineering Bldg.

76P2098 CE #310 8-66

PWFB 1921

2510

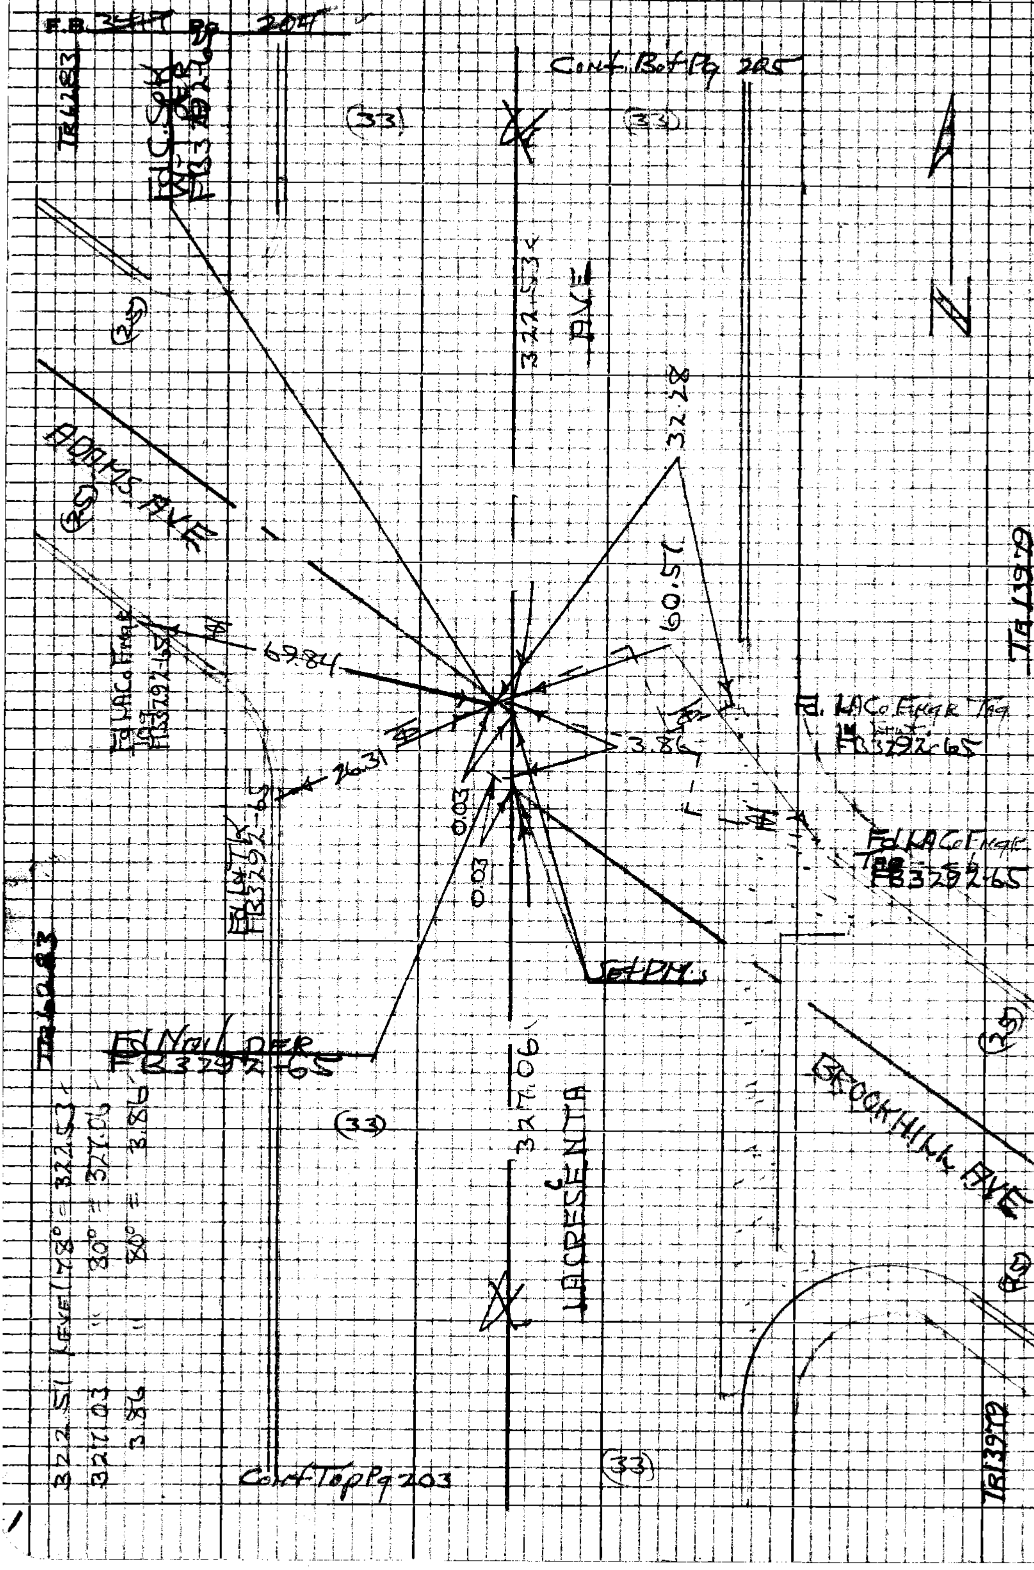

W.S. 51, B-4

PLEASE RETURN TO
LOS ANGELES COUNTY ENGINEER
403 LOS ANGELES COUNTY ENGINEERING BLDG.

Do not extend this side of this line.

Note: Any Additions or Changes on this Sheet Must be Made or Circled in Red Ink With Date and Name of Person Making Change

PWFB 1921 2511, 2512

Notes Ck'd by W. EDMONDSON	Survey of [illegible]	F.B. [illegible]	Pg. [illegible]
[illegible]	[illegible]		
Office Work M. HAMASU	Surveyed by [illegible]		
Checked W. EDMONDSON	Notes [illegible] Date [illegible]		
Date SEP 2 5 '88	Indexed C. J. GALLI		

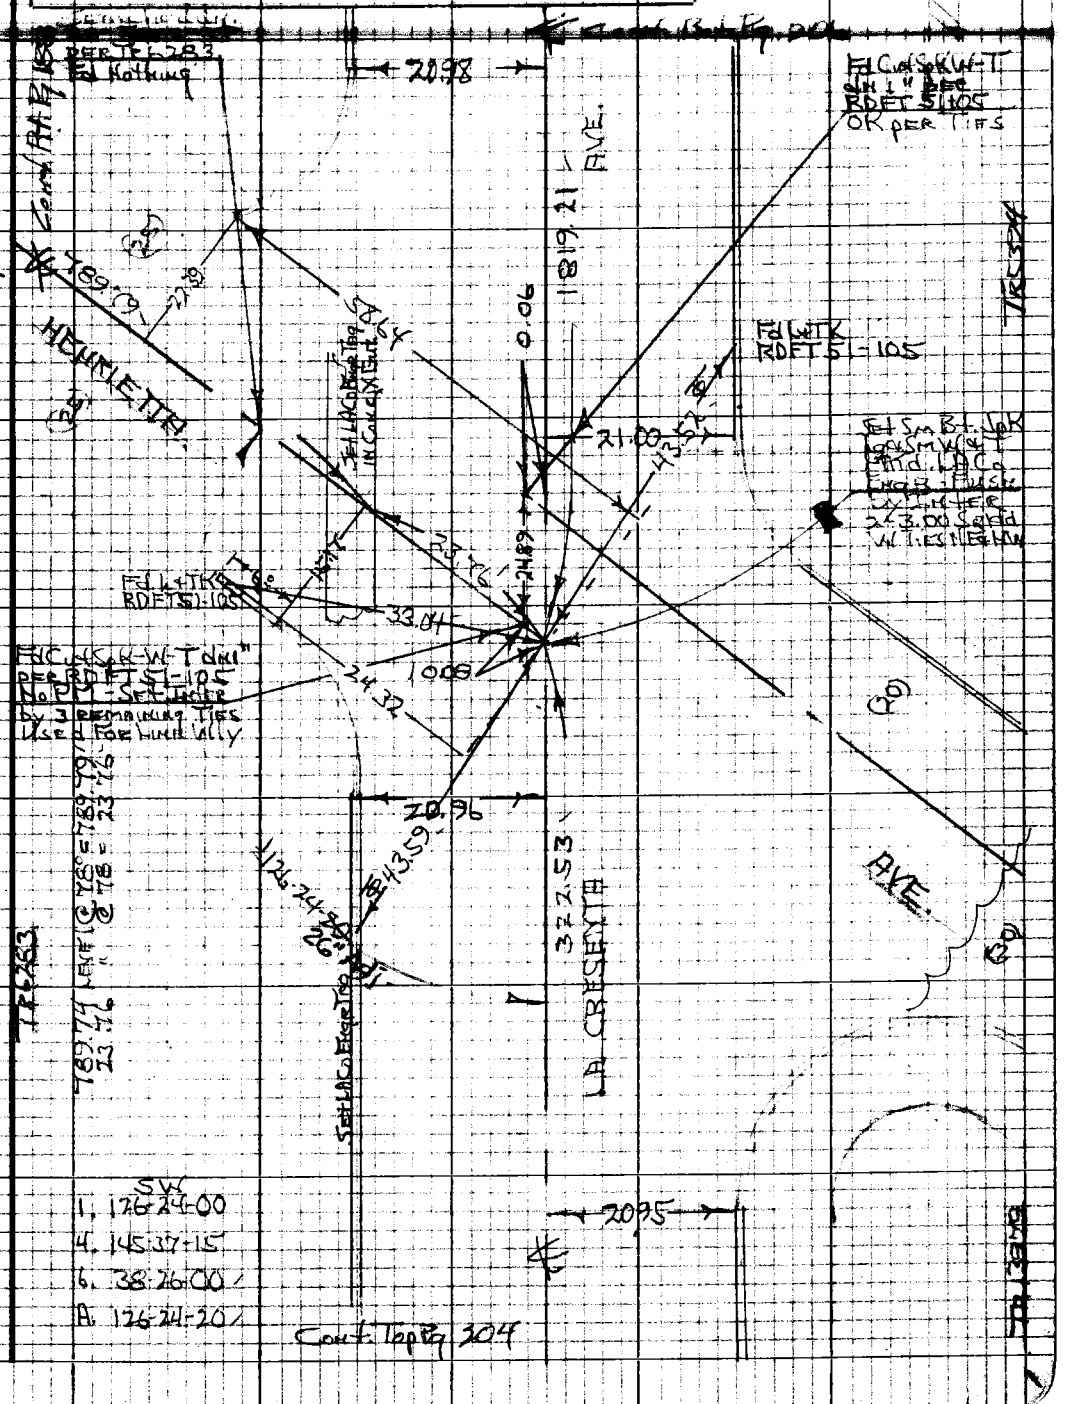

W.S. 51, B-4

Note: Any Additions or Changes on this Sheet Must be Made or Circled in Red Ink With Date and Name of Person Making Change

Do not extend this side of this line.

PLEASE RETURN TO
LOS ANGELES COUNTY ENGINEER
403 LOS ANGELES COUNTY ENGINEERING BLDG.

76P3098 CE #310 8-66

PWFB 1921

2513

F.B. 341 Pg 206

Cont. Bot Pg 207

PWFB 1921

2514

Notes Ck'd by W. EDMONDSON	Survey of ORANGE AVE	F.B. [illegible]	Pg. [illegible]
Map No. B-5027	[illegible]		
Office Work M. HAMASU	Surveyed by [illegible]		
Checked W. EDMONDSON	Notes [illegible]	Date [illegible]	
Date SEP 2 5 '68	Indexed E. J. GALLI		

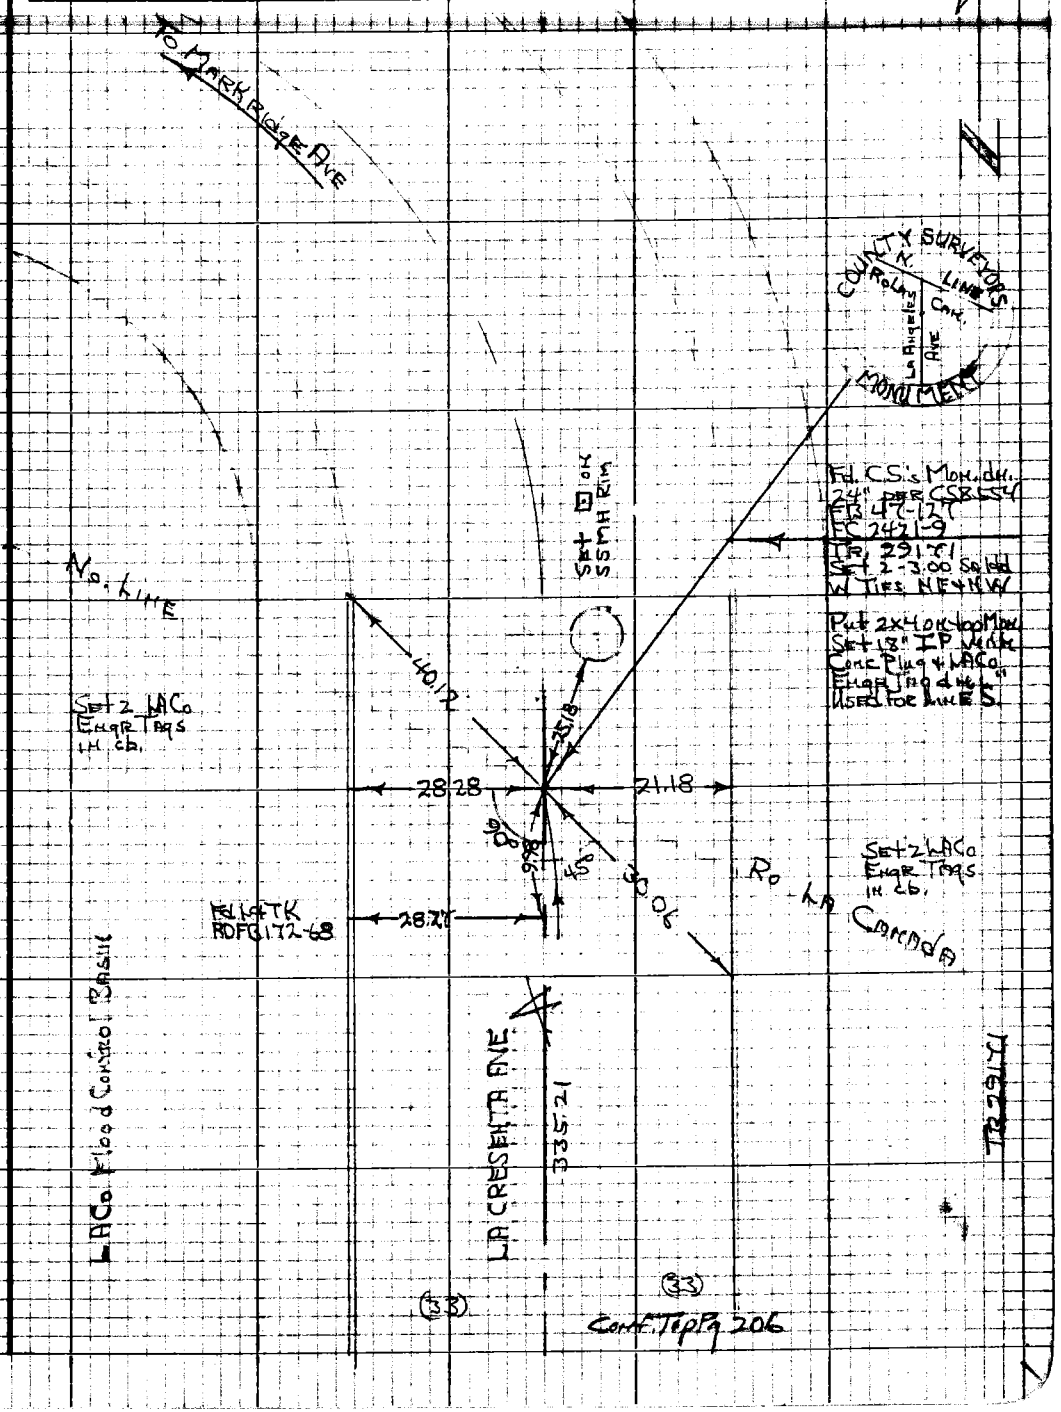

Note: Any Additions or Changes on this Sheet Must be Made or Circled in Red Ink With Date and Name of Person Making Change

W.S. 51, B-3

Do not extend this side of this line.

PLEASE RETURN TO
LOS ANGELES COUNTY ENGINEER
403 LOS ANGELES COUNTY ENGINEERING BLDG.

76P3095 CE #310 5-66

PWFB 1921 2515

F.B. 3417 Pg. 208

Cont. Bot. Pg. 203

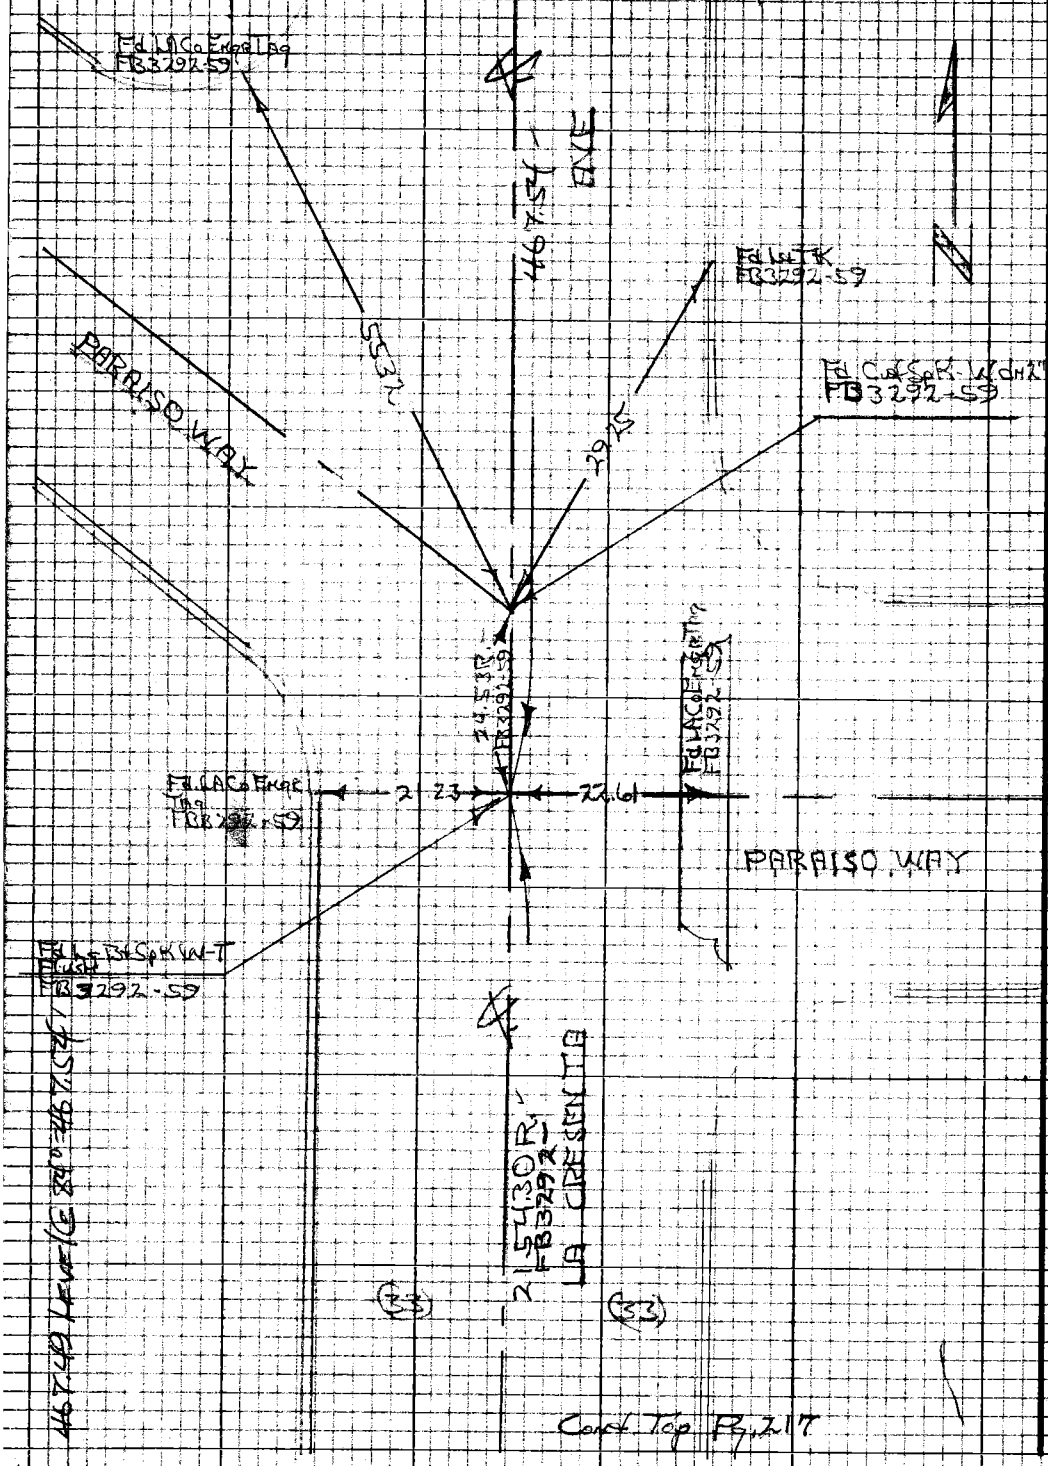

Cont. Top Pg. 217

W.S. 51, B-4

PLEASE RETURN TO
LOS ANGELES COUNTY ENGINEER
403 LOS ANGELES COUNTY ENGINEERING BLDG.

Do not extend this side of this line.

Note: Any Additions or Changes on this Sheet Must be Made or Circled in Red Ink With Date and Name of Person Making Change

PWFB 1921

2516

Notes Ck'd by W. EDMONDSON	Survey of [illegible]	F.B. [illegible]	Pg. [illegible]
[illegible]	[illegible]		
Office Work M. HAMASU	Surveyed by [illegible]		
Checked W. EDMONDSON	Notes HHS Date 9-12-67		
Date SEP 2 5 '68	Indexed E. J. GALLI		

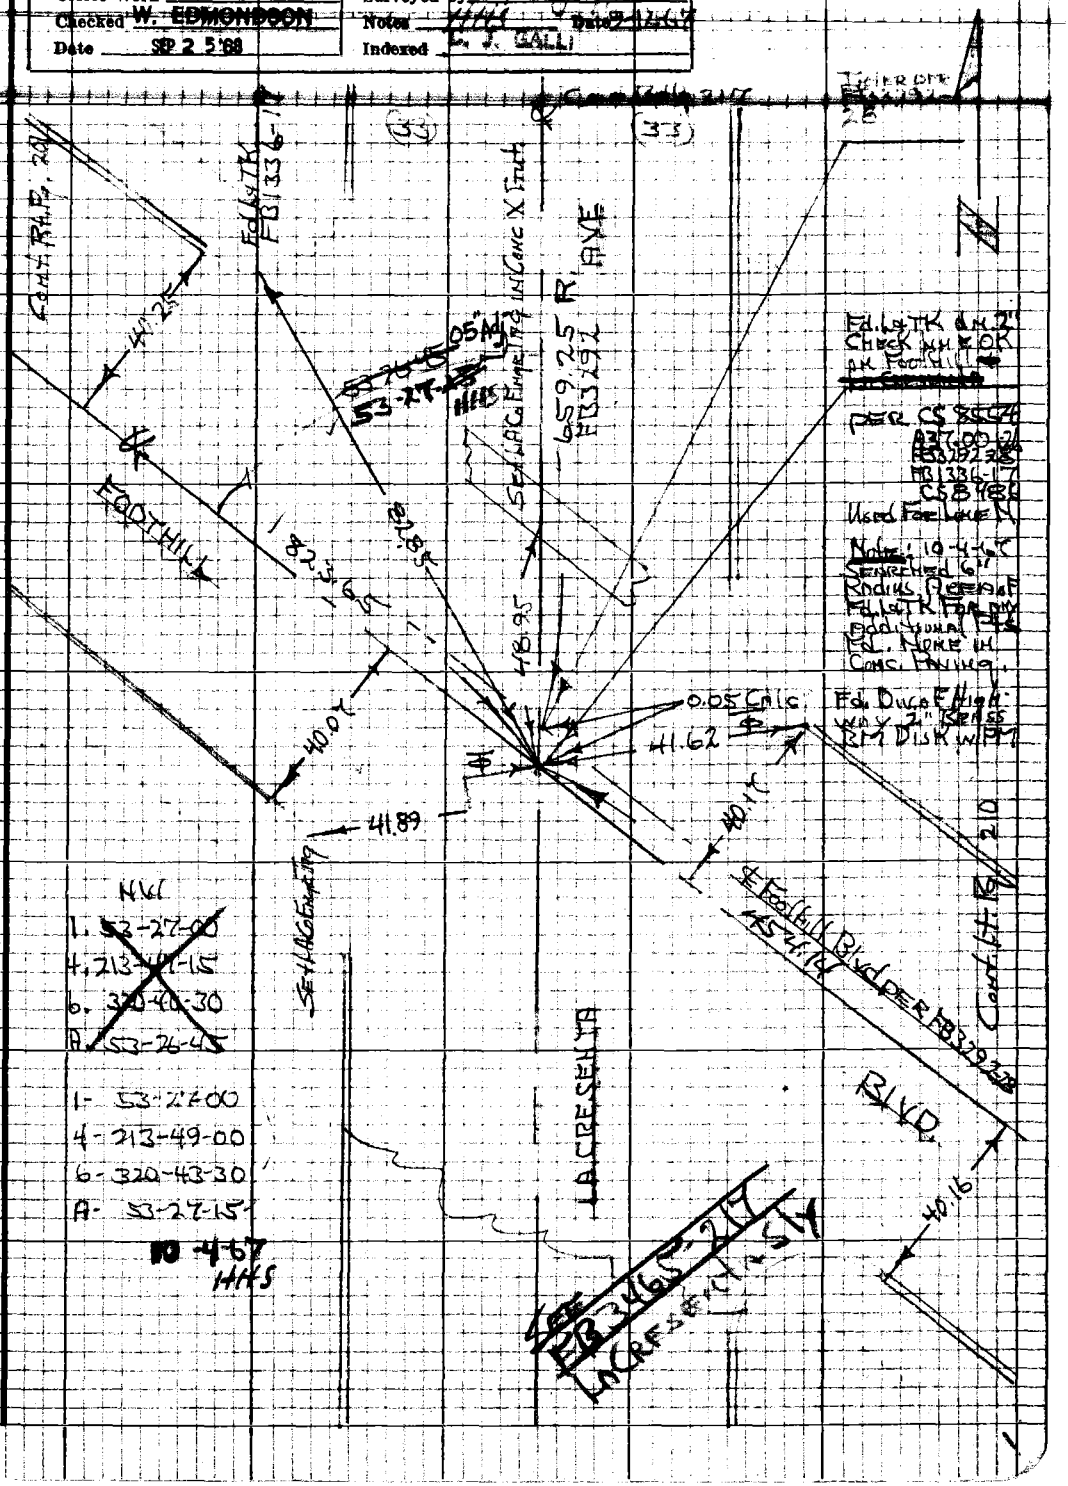

Note: Any Additions or Changes on this Sheet Must be Made or Circled in Red Ink With Date and Name of Person Making Change

Do not extend this side of this line.

PLEASE RETURN TO
LOS ANGELES COUNTY ENGINEER
403 LOS ANGELES COUNTY ENGINEERING BLDG.

76P2068 CK #310 8-66

PWFB 1921 2517

F.B. 3417 Pg. 210

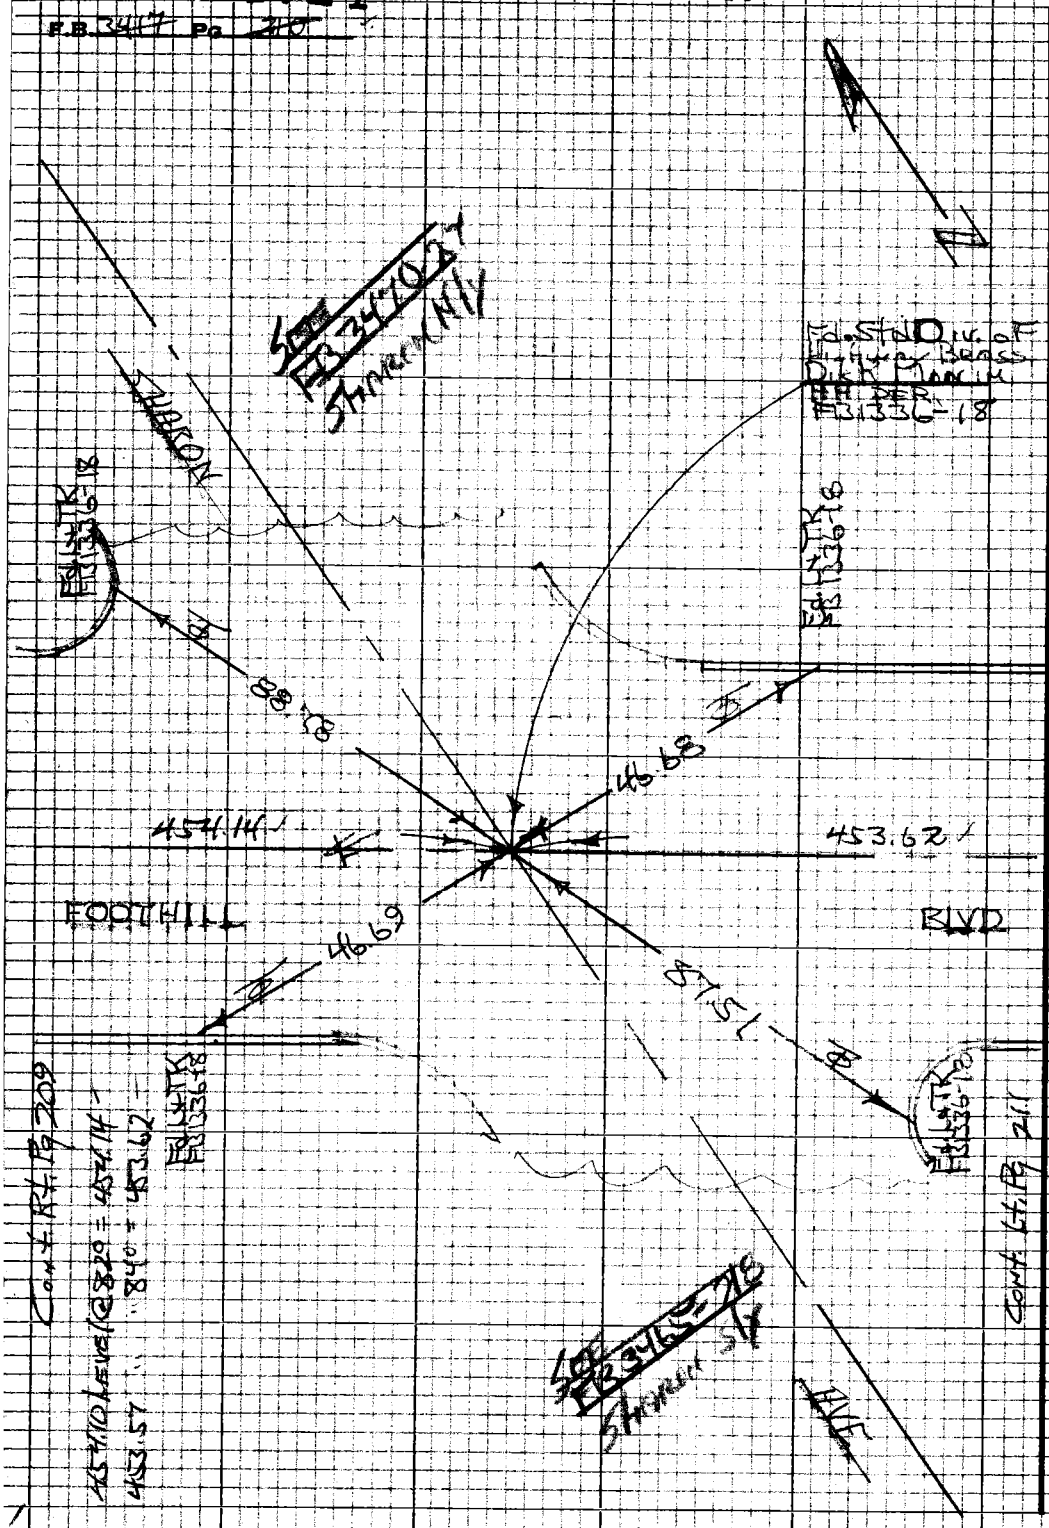

PLEASE RETURN TO
LOS ANGELES COUNTY ENGINEER
403 LOS ANGELES COUNTY ENGINEERING BLDG.

Do not extend this side of this line.

Note: Any Additions or Changes on this Sheet Must be Made or Circled in Red Ink With Date and Name of Person Making Change

76F3095 CE#319 1-65

PLEASE RETURN TO
LOS ANGELES COUNTY ENGINEER
403 LOS ANGELES COUNTY ENGINEERING BLDG.

Do not extend this side of this line.

Note: Any Additions or Changes on This Sheet Must be Made or Circled in Red Ink With Date and Name of Person Making Change.

W.S. 51, 3-4

PWFB 1921

2518

Notes Ck'd W. EDMONDSON
Map No. [redacted]
Office Work M. HAMASU
Checked W. EDMONDSON
Date SEP 2 5 '68

Survey of [redacted]
Surveyed by [redacted]
Notes [redacted]
Indexed R. J. GALLI

F. B. [redacted] Pg. [redacted]

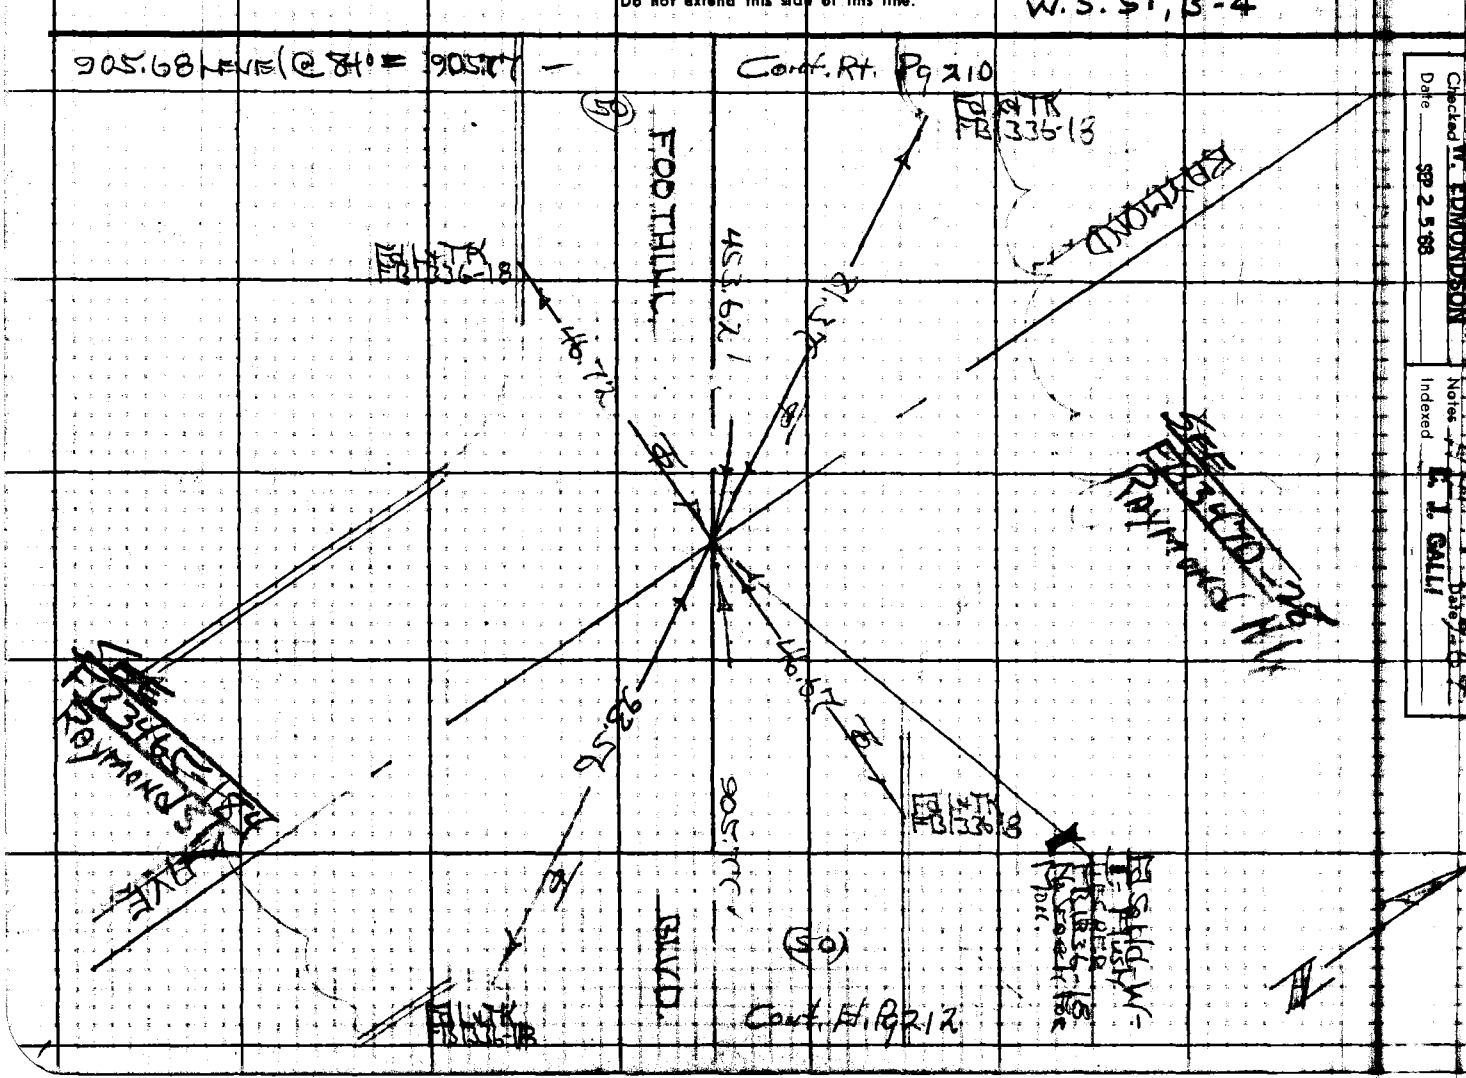

PWFB 1921 2519, 2520

F. B. 3417 PG. 212

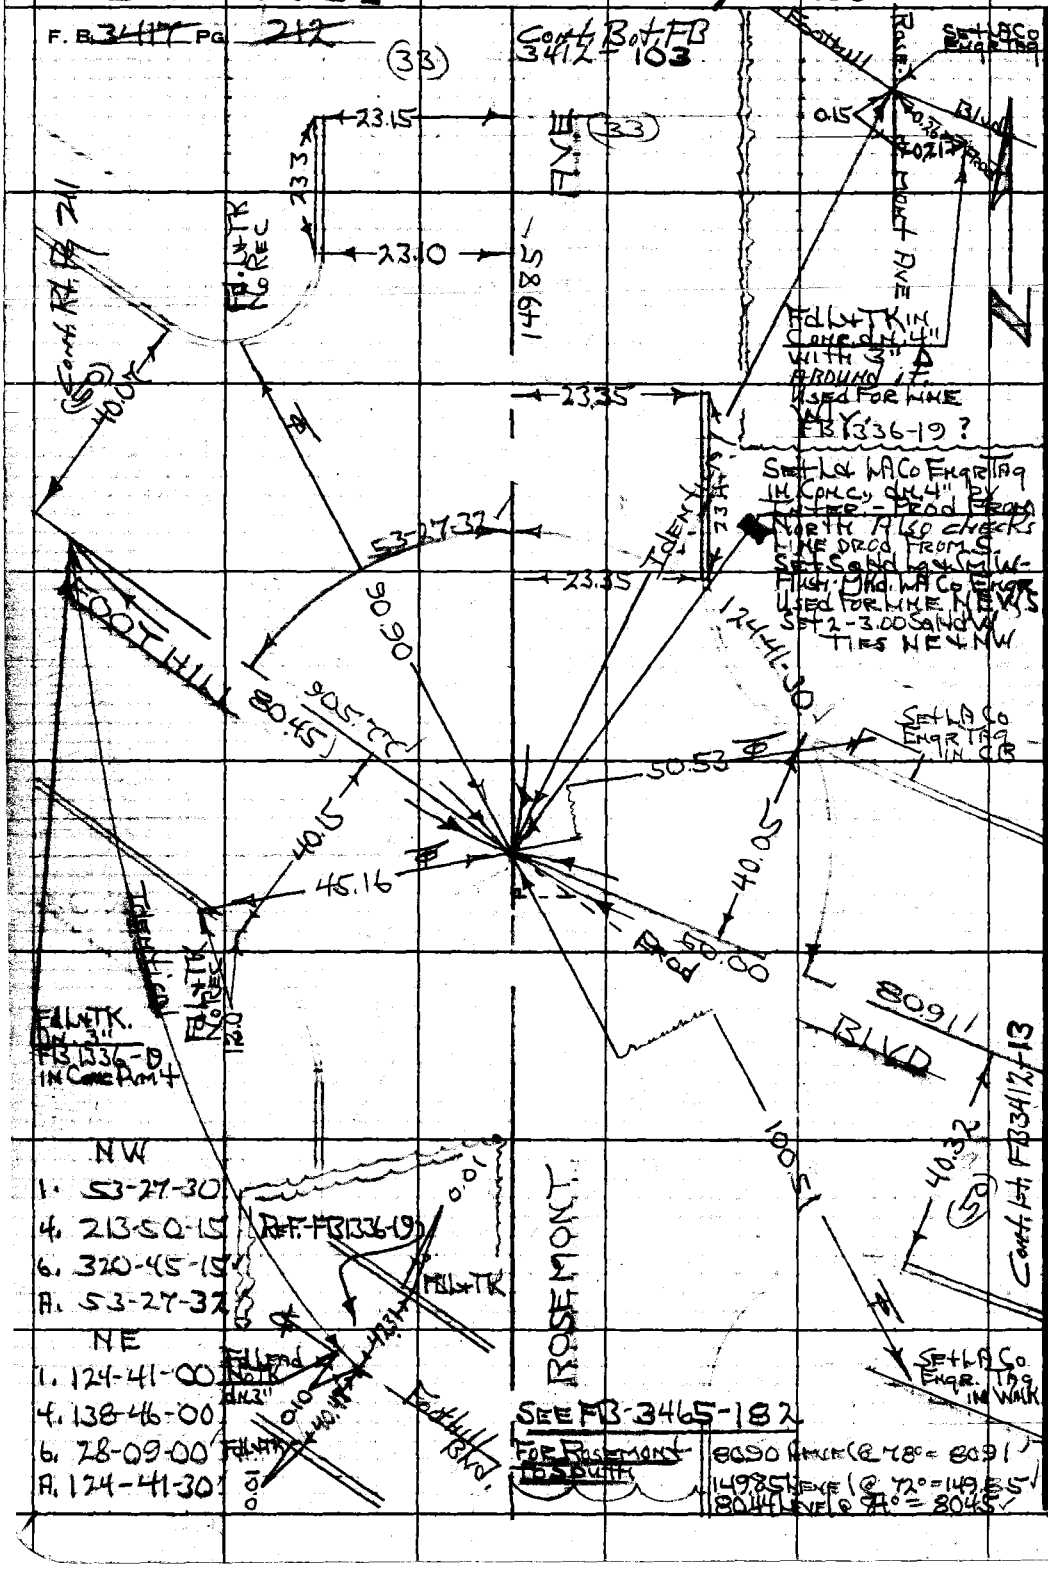

W.S. 51, B-4

PLEASE RETURN TO
LOS ANGELES COUNTY ENGINEER
403 LOS ANGELES COUNTY ENGINEERING BLDG.

Do not extend this side of this line.

Note: Any Additions or Changes on This Sheet Must be Made or Circled in Red Ink With Date and Name of Person Making Change.

PWFB 1921

2521

Notes Ck'd by W. EDMONDSON	Survey of [illegible]	F.B. [illegible]	Pg. 213
Office Work M. HAMASU	Surveyed by [illegible]		
Checked W. EDMONDSON	Notes [illegible]	Date [illegible]	
Date SEP 2 5 '68	Indexed C. J. GALLI		

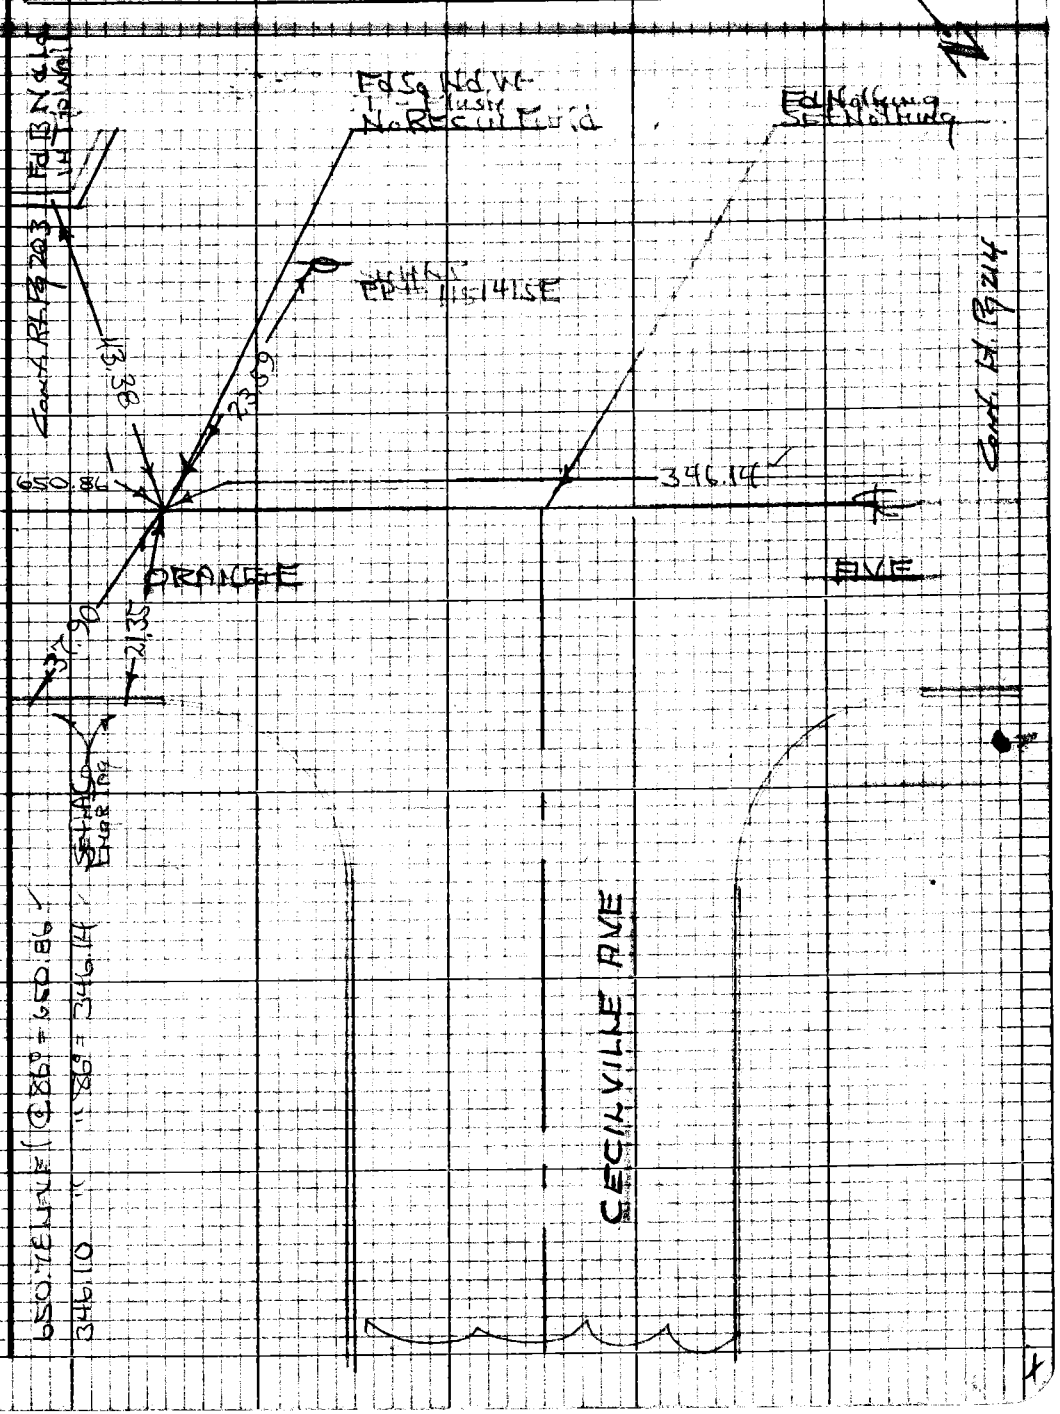

Note: Any Additions or Changes on this Sheet Must be Made or Circled in Red Ink With Date and Name of Person Making Change

Do not extend this side of this line.

PLEASE RETURN TO
LOS ANGELES COUNTY ENGINEER
403 Los Angeles County Engineering Bldg.

76P3098 CE #310 8-66

PWFB 1921 2522

F.B. 344 Pg. 244

PLEASE RETURN TO
LOS ANGELES COUNTY ENGINEER
403 LOS ANGELES COUNTY ENGINEERING BLDG.

DO NOT EXTEND THIS SIDE OF THE LINE.

Note: Any Additions or Changes on this Sheet Must be Made or Checked in Red Ink With Date and Name of Person Making Change

PWFB 1921 2523

Notes Ck'd by W. EDMONDSON	Survey of Orange Ave	F.B. [illegible]	Pg. [illegible]
Map No. B-5027	[illegible]		
Office Work M. HAMASU	Surveyed by [illegible]		
Checked W. EDMONDSON	Notes [illegible]	Date [illegible]	
Date SEP 2 5 '88	Indexed C. J. GALLI		

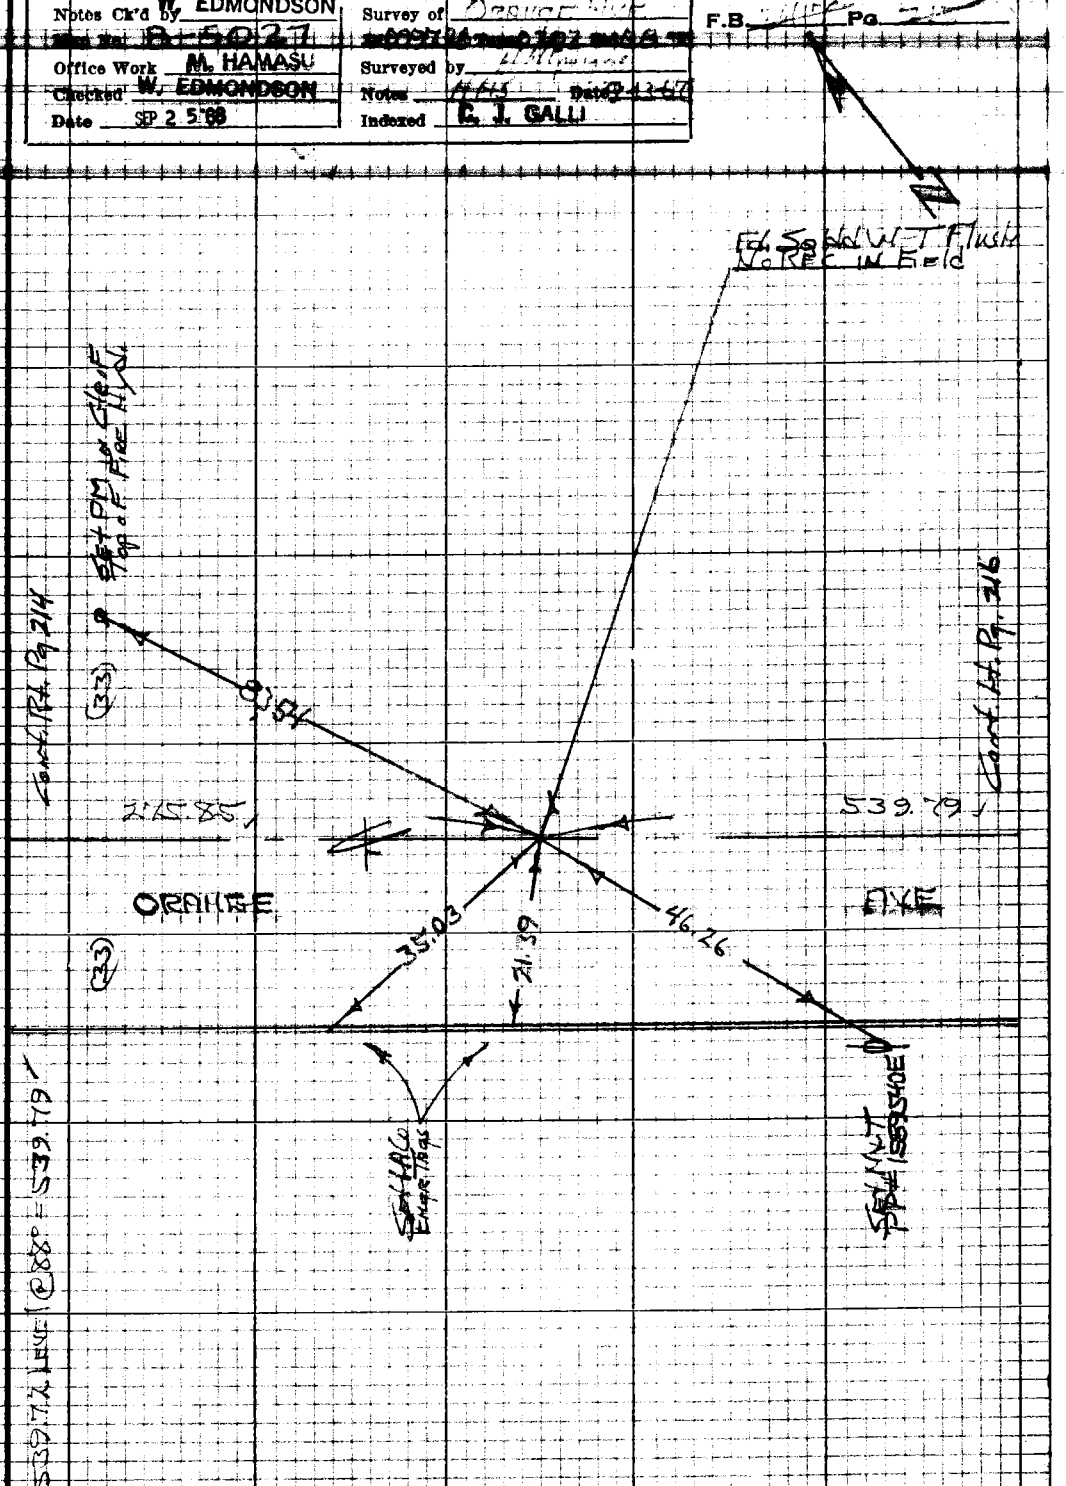

Note: Any Additions or Changes on this Sheet Must be Made or Circled in Red Ink With Date and Name of Person Making Change

Do not extend this side of this line.

PLEASE RETURN TO
LOS ANGELES COUNTY ENGINEER
403 LOS ANGELES COUNTY ENGINEERING BLDG.

76P2098 CE #310 5-66

PWFB 1921 2524

F.B. 3417 Pg. 215

TR 13376

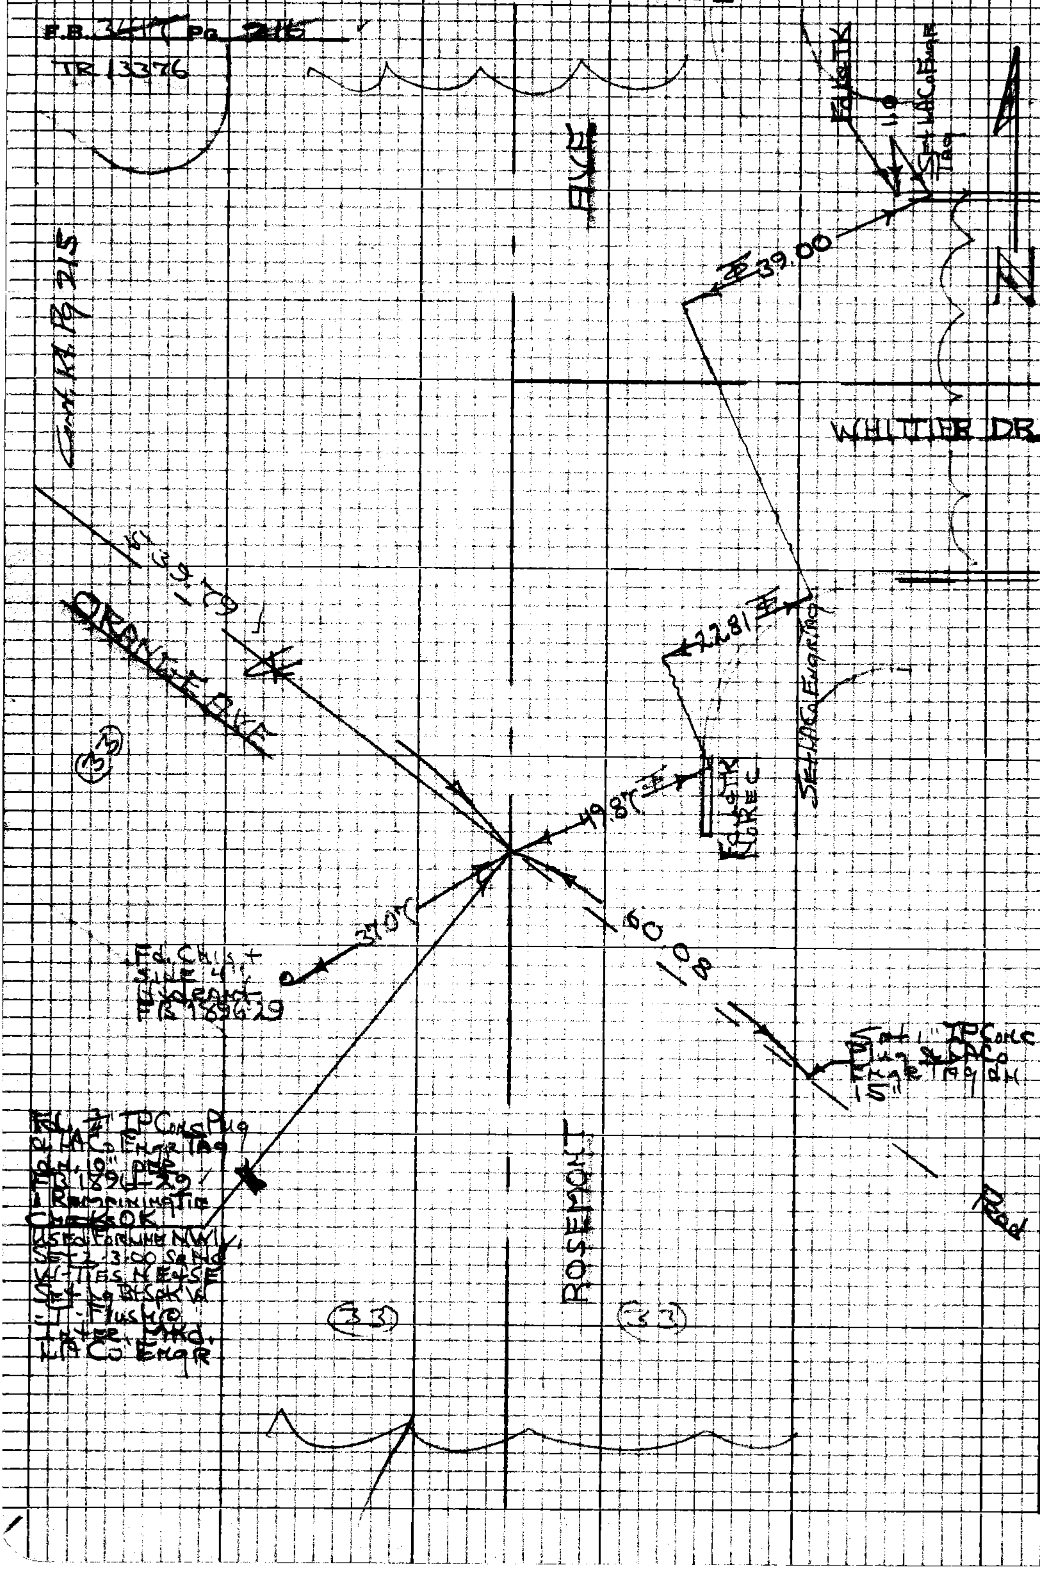

PLEASE RETURN TO
LOS ANGELES COUNTY ENGINEER
405 LOS ANGELES COUNTY ENGINEERING BLDG.

Do not extend this side of this line.

Note: Any Additions or Changes on this Sheet Must be Made or Circled in Red Ink With Date and Name of Person Making Change.

76P2098 CK #210 8-66

PLEASE RETURN TO
LOS ANGELES COUNTY ENGINEER
403 LOS ANGELES COUNTY ENGINEERING BLDG.

Note: Any Additions or Changes on this Sheet Must be Made or Circled in Red Ink With Date and Name of Person Making Change

Do not extend this side of this line. W.S. 51, 8-4

PWFB 1921

2525

Notes Ck'd W. EDMONDSON

Office Work M. HAMASU

Checked W. EDMONDSON

Date SEP 2 5 1968

Survey of

Surveyed by

Noted

Indexed

F.B. Pg.

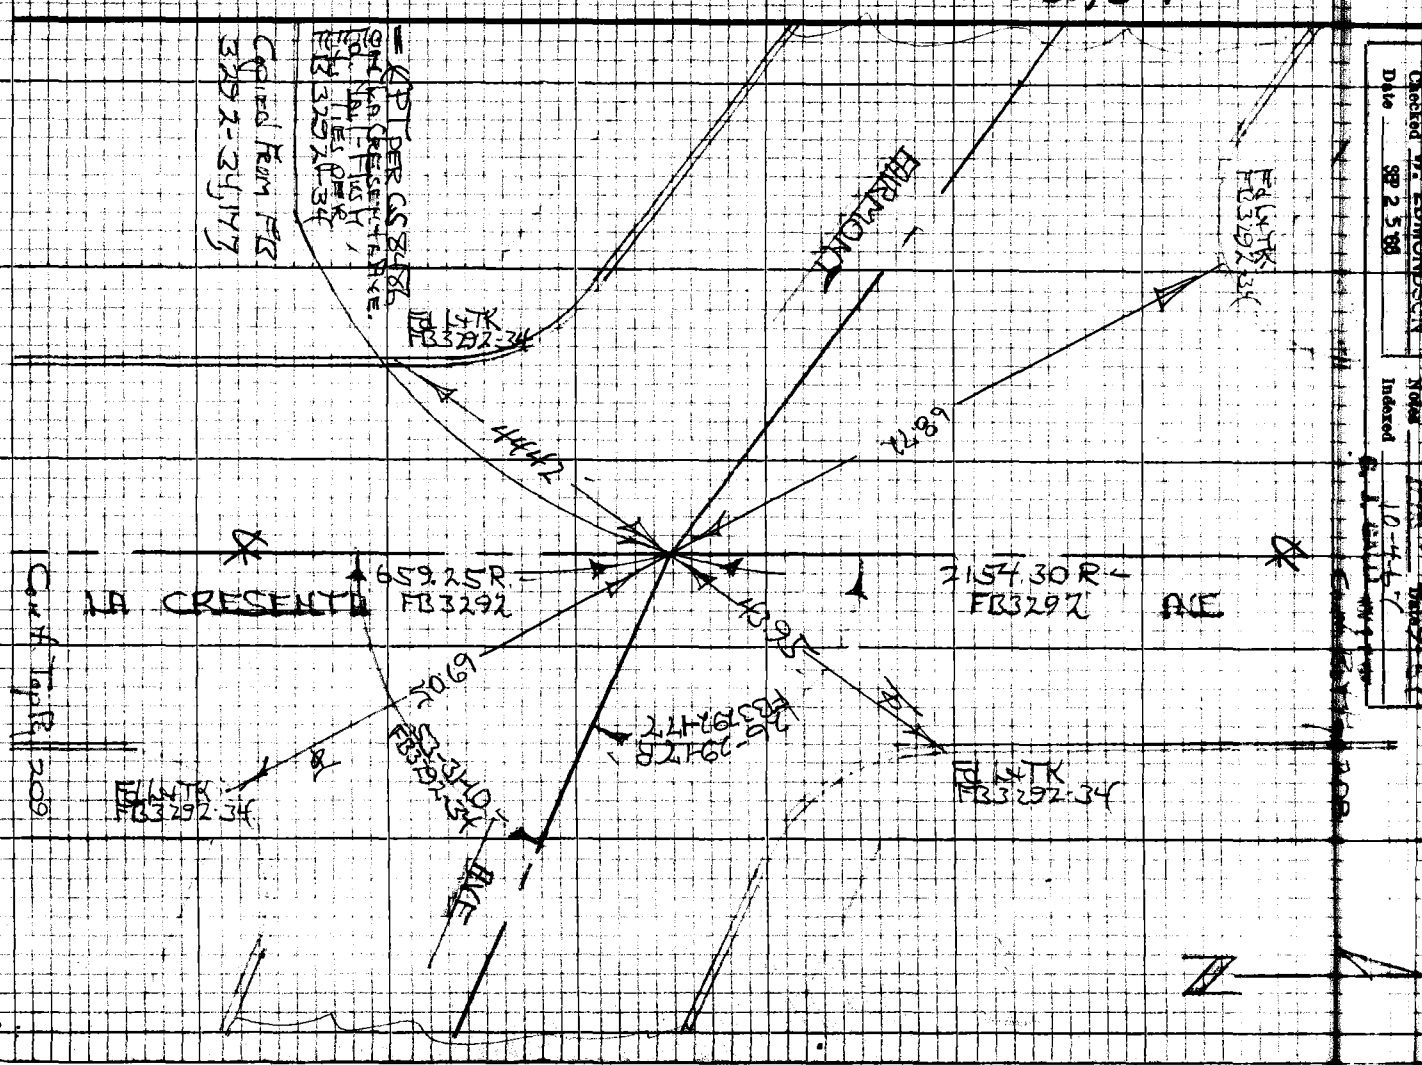

F.B. 341 Pg. 218

PLEASE RETURN TO
LOS ANGELES COUNTY ENGINEER
403 LOS ANGELES COUNTY ENGINEERING BLDG.

Note: Any Additions or Changes on this Sheet Must be Made or Circled in Red Ink With Date and Name of Person Making Change

Do not extend this side of this line.

PWFB 1921 2526

Notes Ck'd by W. EDMONDSON	Survey of Pennsylvania Ave.
Map No. B-5072	JN 0097.25 Tape 139 Std 24
Office Work H. H. F. DONG	Surveyed by [illegible]
Checked W. EDMONDSON	Notes D.I.B. Date 11-68
Date NOV 2 1 '69	Indexed E. L. GALLI DEC 10 '69

F. B. 3417 PG. 2[illegible]

J.N. 0097.25

PENNSYLVANIA AVE.

℄

From: Montrose Ave
To: Foothill Blvd.

Burkholder
Newman
Martinez
Creason

Note: Any Additions or Changes on This Sheet Must be Made or Circled in Red Ink With Date and Name of Person Making Change.

Do not extend this side of this line.

PLEASE RETURN TO
COUNTY OF LOS ANGELES
DEPARTMENT OF COUNTY ENGINEER
403 LOS ANGELES COUNTY ENGINEERING BLDG.

76F309S CE#310 3-68

PWFB 1921 [redacted] 2527

F. B. 3417 PG 220

INDEX

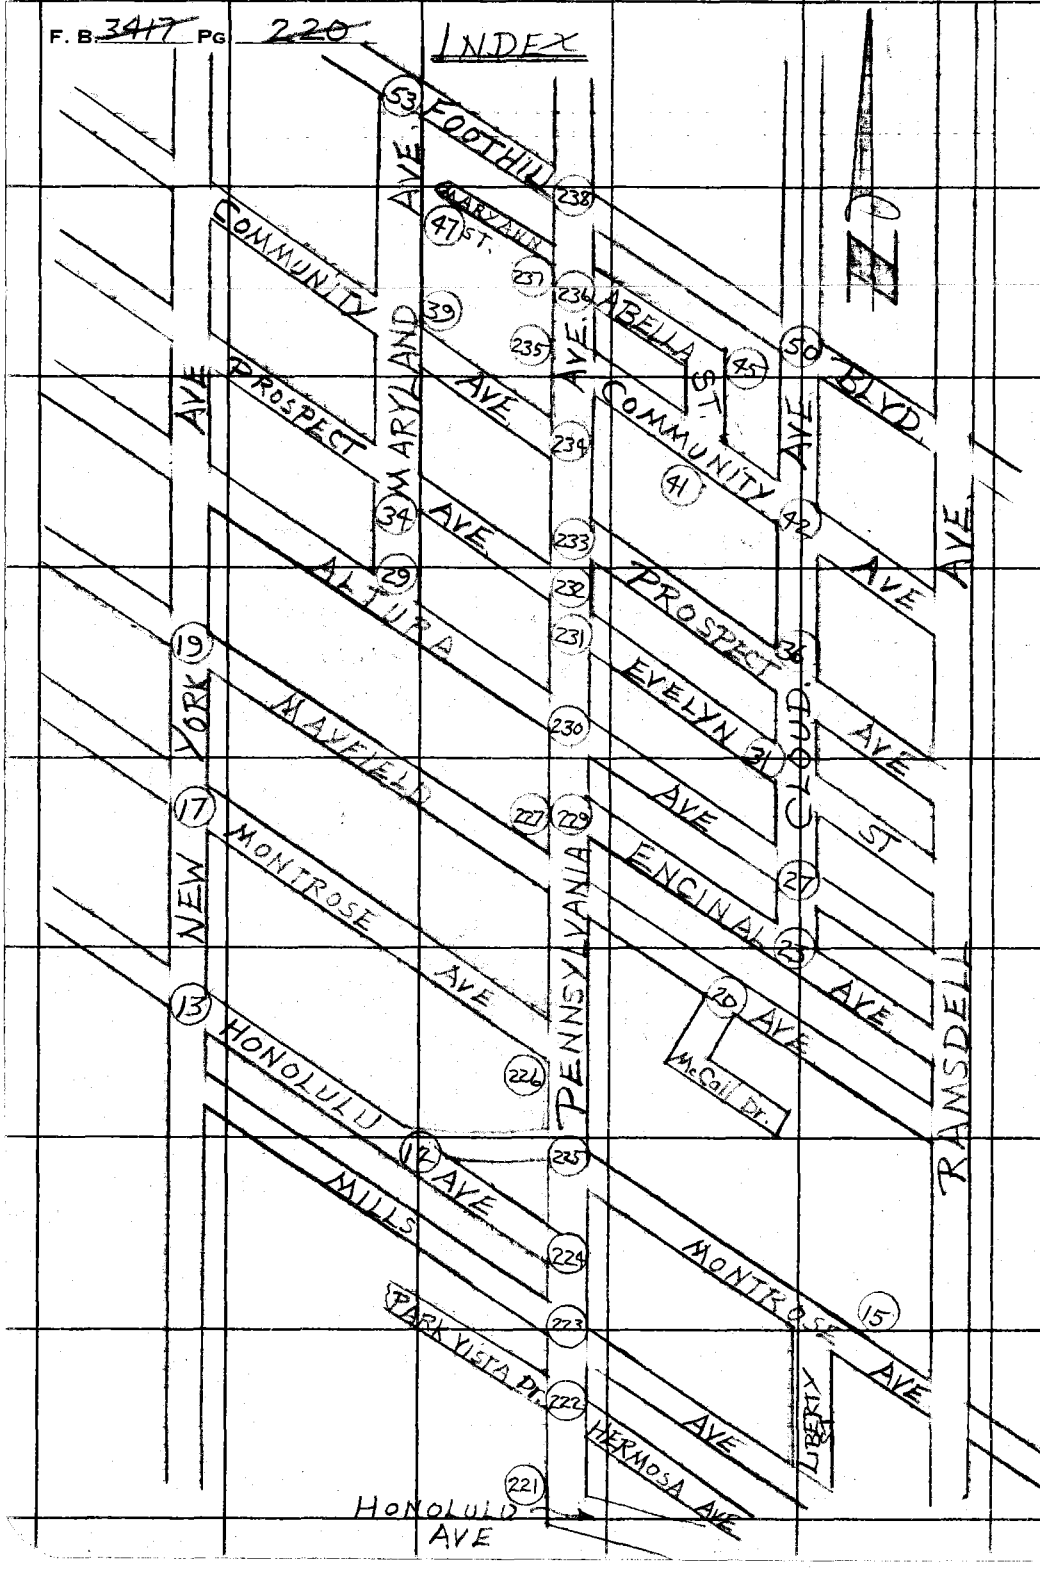

PLEASE RETURN TO
COUNTY OF LOS ANGELES
DEPARTMENT OF COUNTY ENGINEER
403 LOS ANGELES COUNTY ENGINEERING BLDG.

Do not extend this side of this line.

Note: Any Additions or Changes on This Sheet Must be Made or Circled in Red Ink With Date and Name of Person Making Change.

PWFB 1921 2528

Notes Ck'd by W. EDMONDSON	Survey of [illegible]
Map No. B-5072	JN009725 Tape 139 Std [illegible]
Office Work H. H. F. DONG	Surveyed by Barkholder
Checked W. EDMONDSON	Notes D.L.B. Date 11-68
Date NOV 2 1 '69	Indexed [illegible] GALI [illegible]

F. B. 3417 PG. 221

W.S. 51 B-5

To Bot. Pg 222

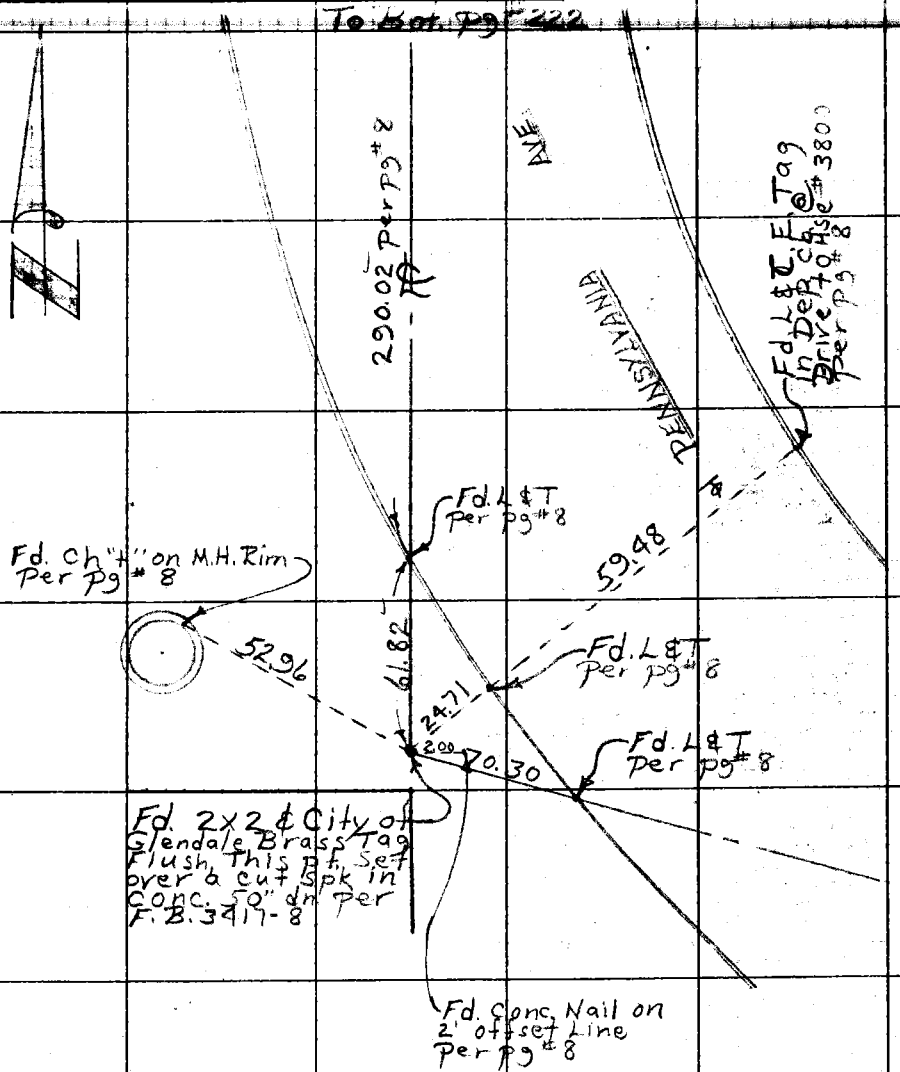

Note: Any Additions or Changes on This Sheet Must be Made or Circled in Red Ink With Date and Name of Person Making Change.

Do not extend this side of this line.

PLEASE RETURN TO
COUNTY OF LOS ANGELES
DEPARTMENT OF COUNTY ENGINEER
403 LOS ANGELES COUNTY ENGINEERING BLDG.

76F309S CE#310 3-68

PWFB 1921 2529

F. B. 3417 PG 222

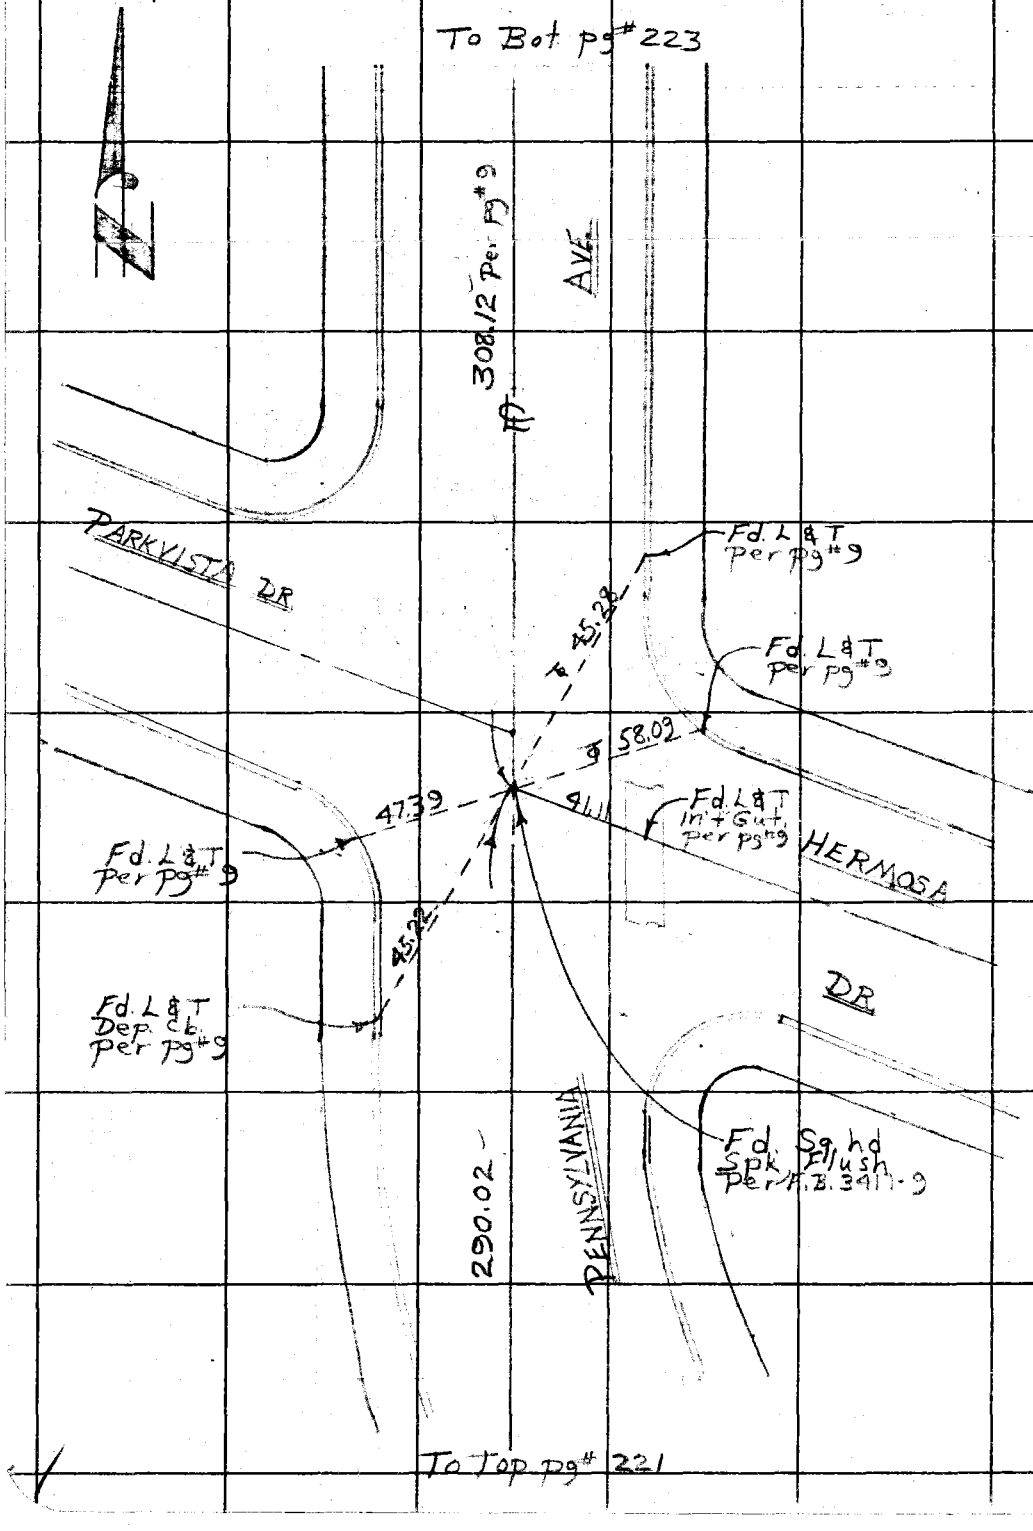

WS 5/1, B-5

PLEASE RETURN TO
COUNTY OF LOS ANGELES
DEPARTMENT OF COUNTY ENGINEER
403 LOS ANGELES COUNTY ENGINEERING BLDG.

Do not extend this side of this line.

Note: Any Additions or Changes on This Sheet Must be Made or Circled in Red Ink With Date and Name of Person Making Change.

PWFB 1921

2530

Notes Ck'd by W. EDMONDSON	Survey of
Map No. B-5072	JN 0097/25 Tape 139 Sid 84
Office Work H. H. F. DONG	Surveyed by
Checked W. EDMONDSON	Notes D.L.B. Date 11-68
Date NOV 2 1 '69	Indexed B.L. GALLI

F. B. 3417 PG. 22

B-4

W 5 5 1

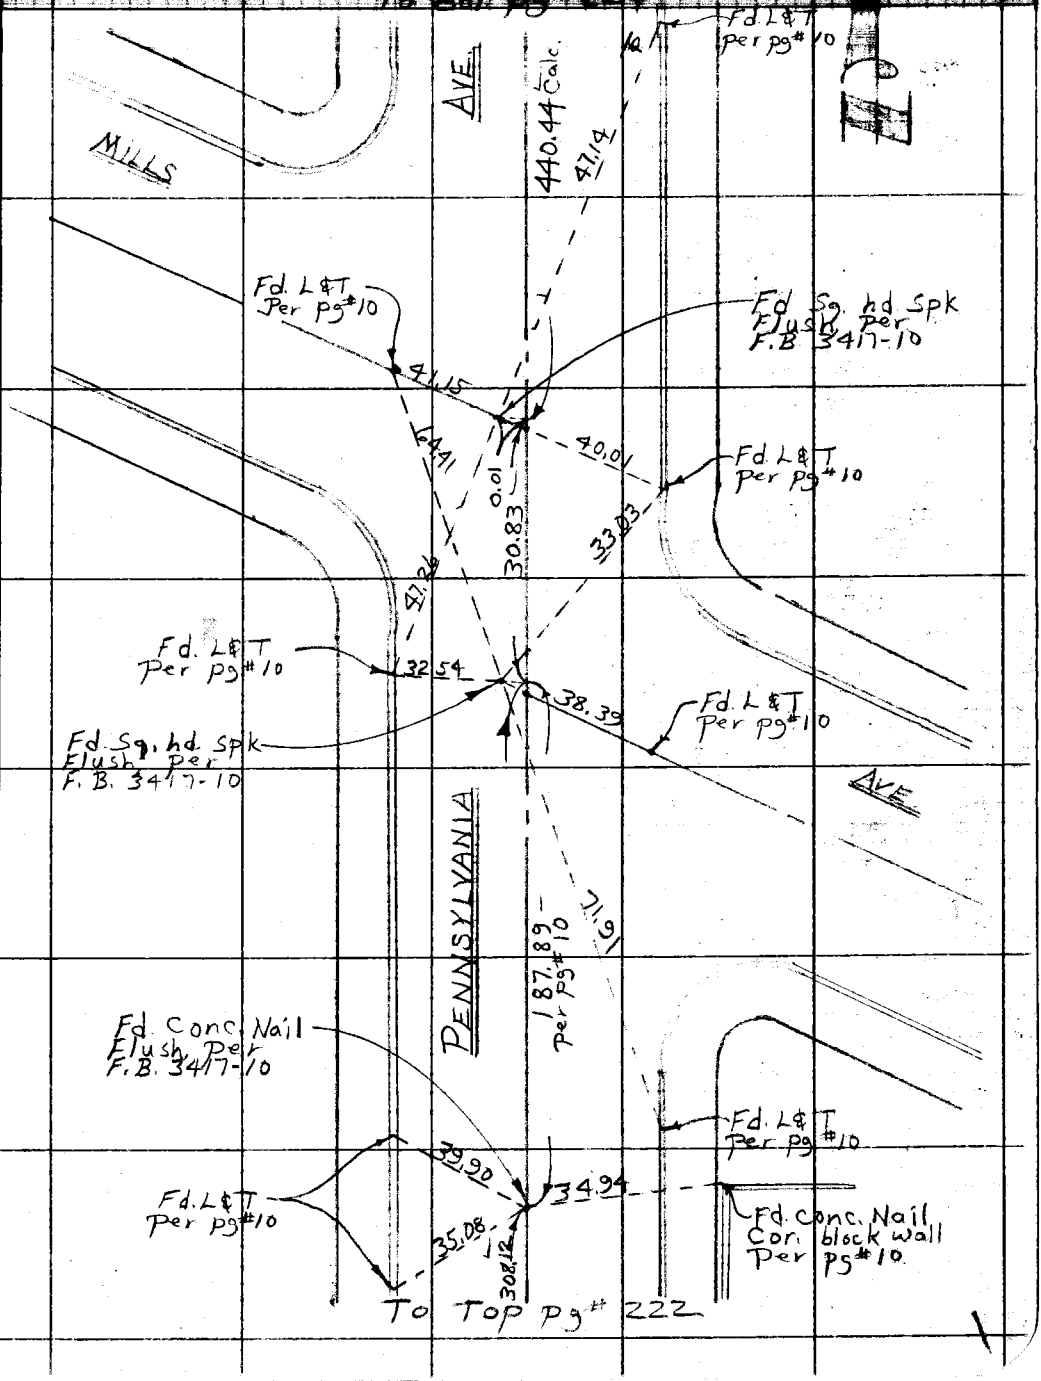

Note: Any Additions or Changes on This Sheet Must be Made or Circled in Red Ink With Date and Name of Person Making Change.

Do not extend this side of this line.

PLEASE RETURN TO
COUNTY OF LOS ANGELES
DEPARTMENT OF COUNTY ENGINEER
403 LOS ANGELES COUNTY ENGINEERING BLDG.

76F309S CE#310 3-68

PWFB 1921 2531

F. B. ~~3417~~ PG. ~~224~~

To Bot pg #225

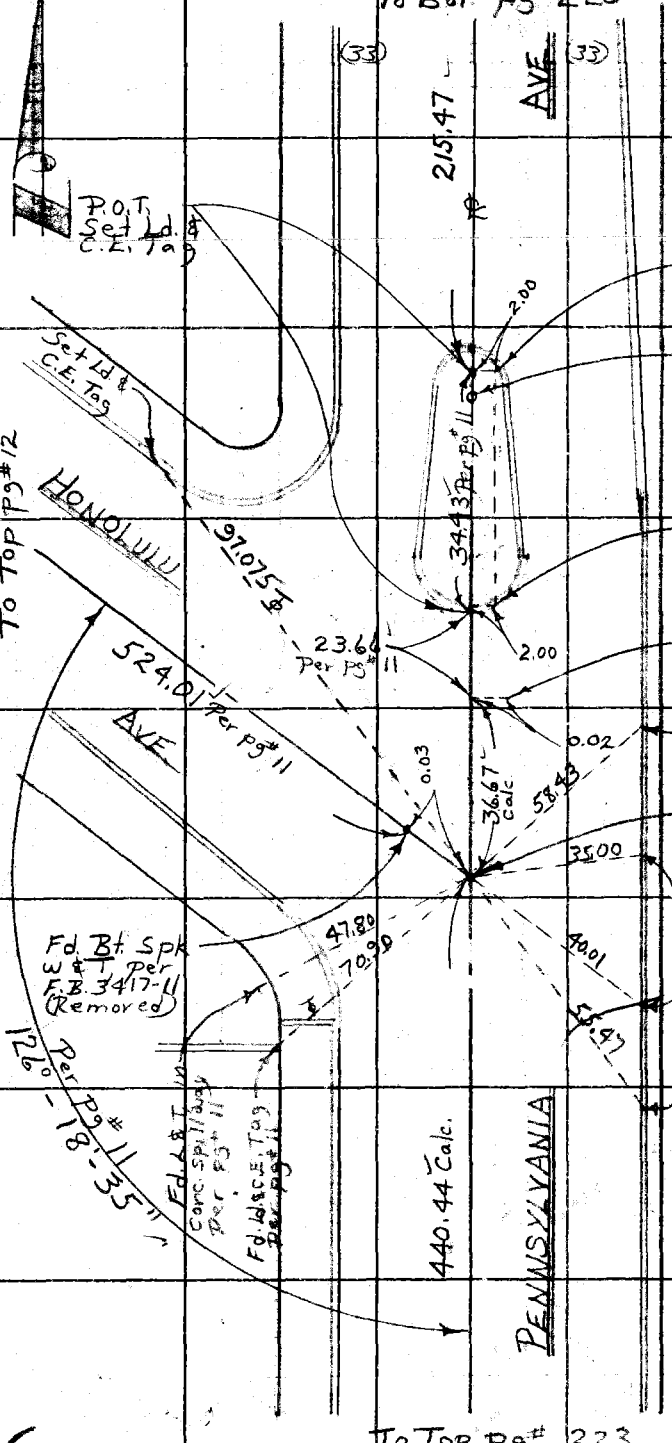

PLEASE RETURN TO
COUNTY OF LOS ANGELES
DEPARTMENT OF COUNTY ENGINEER
403 LOS ANGELES COUNTY ENGINEERING BLDG.

Do not extend this side of this line.

Note: Any Additions or Changes on This Sheet Must be Made or Circled in Red Ink With Date and Name of Person Making Change.

PWFB 1921

2532, 2533

Notes Ck'd By W. EDMONDSON	Survey of Pa. Ave.
Map No. B-5072	JN 403324 Tape 1733 Wd 24 SF
Office Work H. H. F. DONG	Surveyed by Bar Khadder
Checked W. EDMONDSON	Notes D.L.B Date 11-68
Date NOV 21 '69	Indexed [redacted] GALLI

F. B. 3417 PG. 225

To Bot. pg # 226

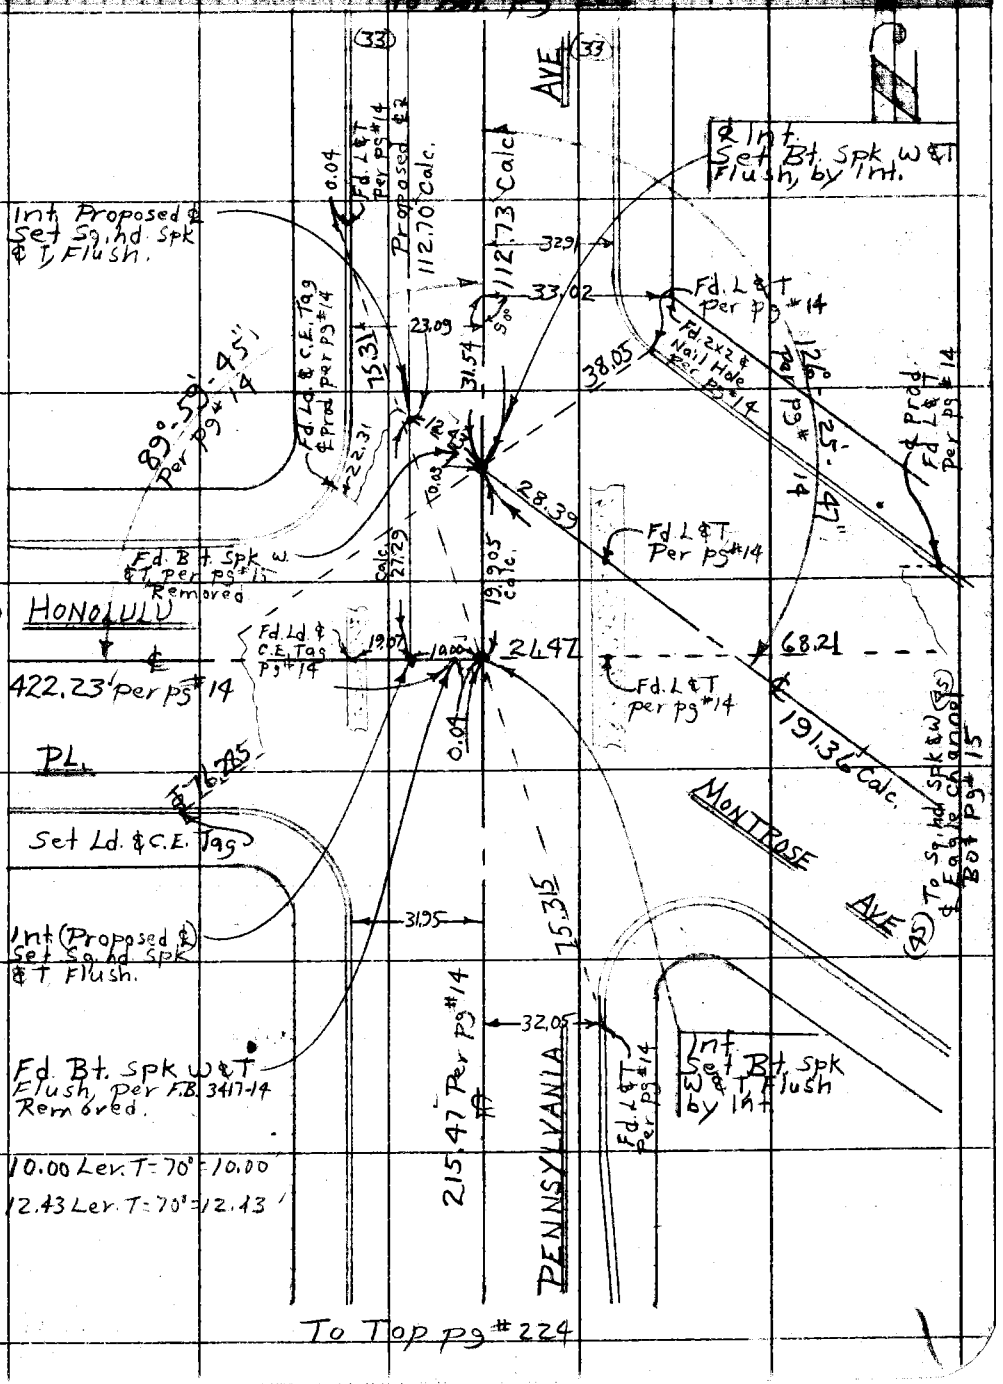

Note: Any Additions or Changes on this Sheet Must be Made or Circled in Red Ink With Date and Name of Person Making Change.

Do not extend this side of this line.

PLEASE RETURN TO
COUNTY OF LOS ANGELES
DEPARTMENT OF COUNTY ENGINEER
403 LOS ANGELES COUNTY ENGINEERING BLDG.

76F3095 CE#310.3-68

PWFB 1921 2534

F. B. 3417 PG. 226

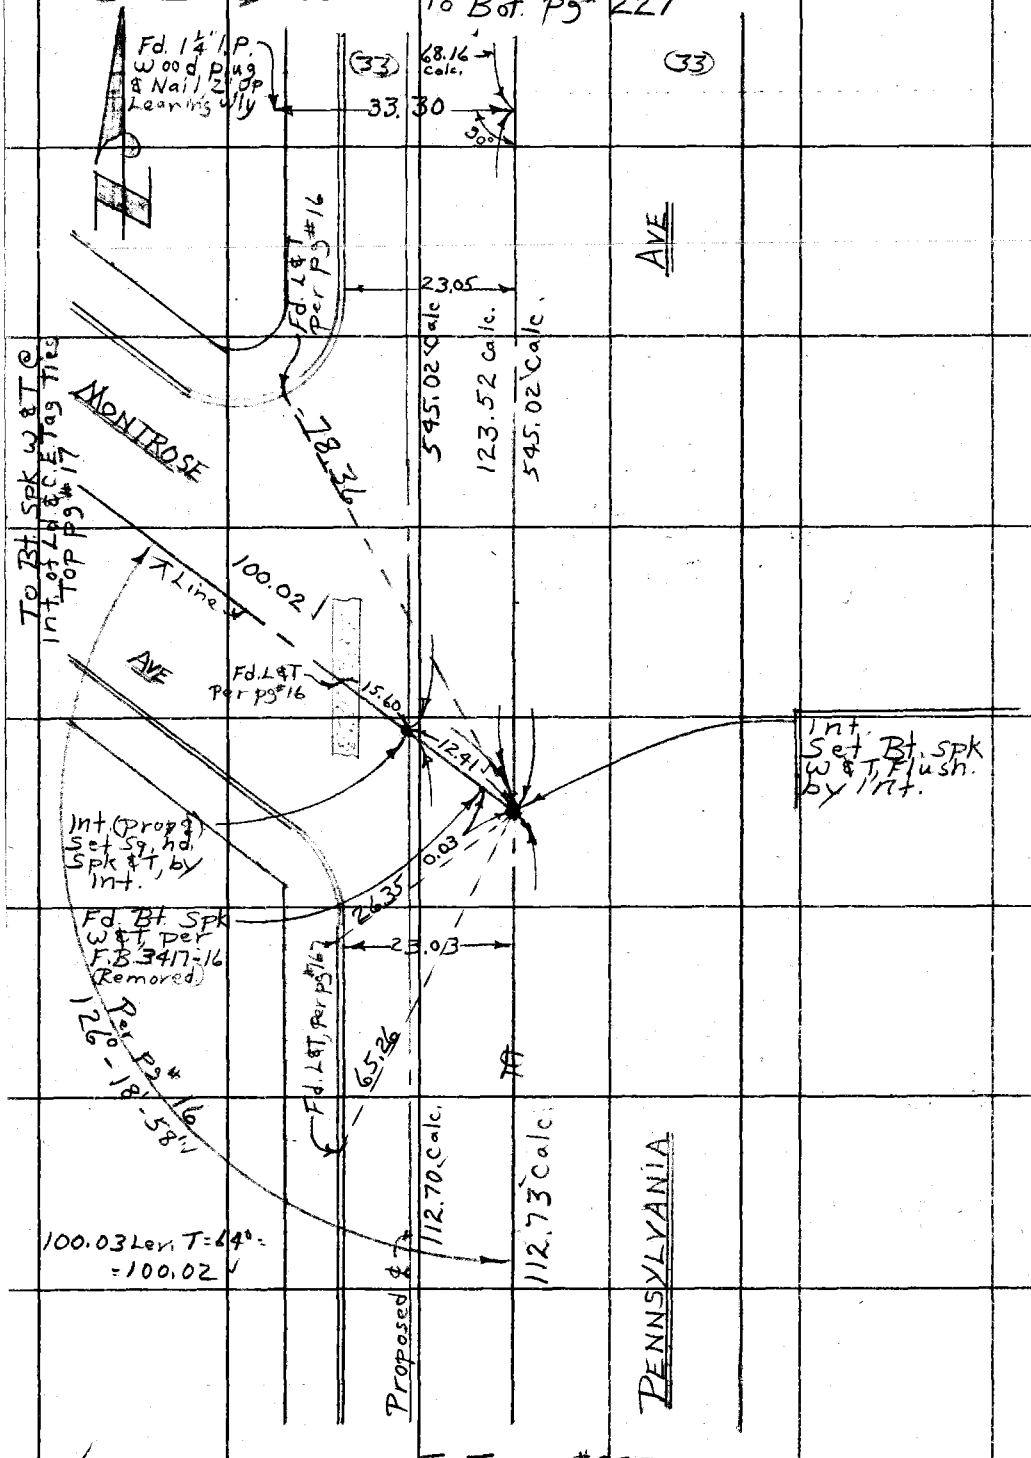

PLEASE RETURN TO
COUNTY OF LOS ANGELES
DEPARTMENT OF COUNTY ENGINEER
403 LOS ANGELES COUNTY ENGINEERING BLDG.

Do not extend this side of this line.

Note: Any Additions or Changes on This Sheet Must be Made or Circled in Red Ink With Date and Name of Person Making Change.

51 B.4

PWFB 1921 2535

Notes Ck'd by W. EDMONDSON	Survey of [illegible]
Map No. B-5072	JN009725 Tape 139 [illegible]
Office Work H. H. F. DONG	Surveyed by Burkholder
Checked W. EDMONDSON	Notes D.L.B. Date 11-68
Date NOV 21 '69	Indexed [illegible]

F. B. 3417 PG. 227

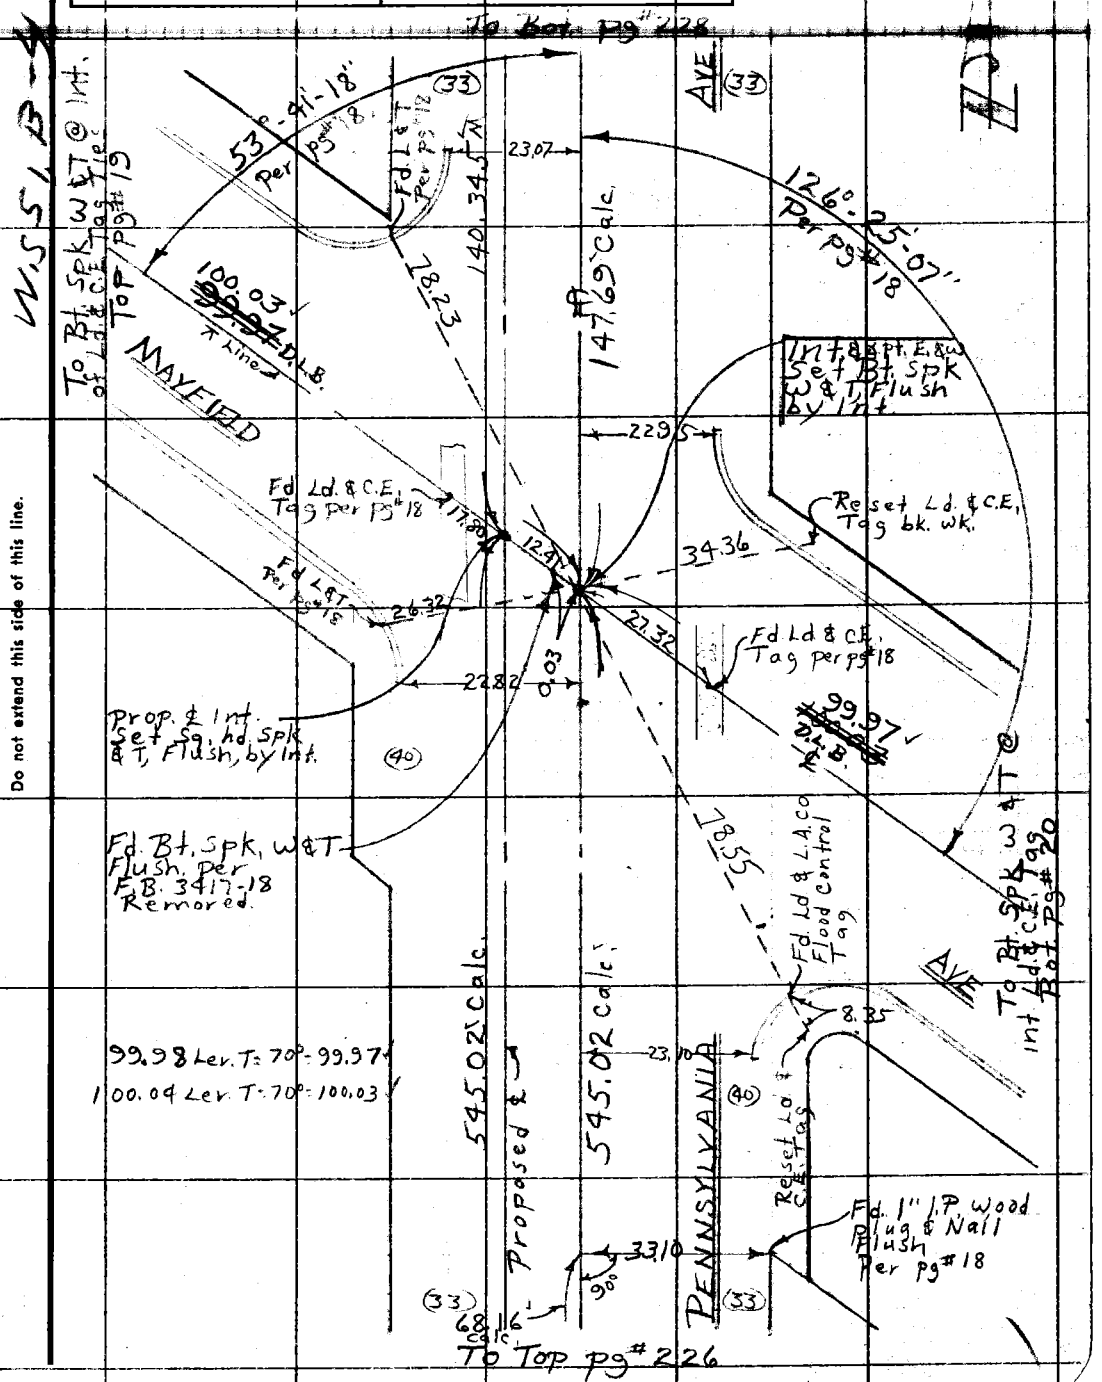

Note: Any Additions or Changes on This Sheet Must be Made or Circled in Red Ink With Date and Name of Person Making Change.

Do not extend this side of this line.

PLEASE RETURN TO
COUNTY OF LOS ANGELES
DEPARTMENT OF COUNTY ENGINEER
403 LOS ANGELES COUNTY ENGINEERING BLDG.

76F309S CE#310 3-68

PWFB 1921 2536

F. B. ~~3417~~ PG. ~~228~~

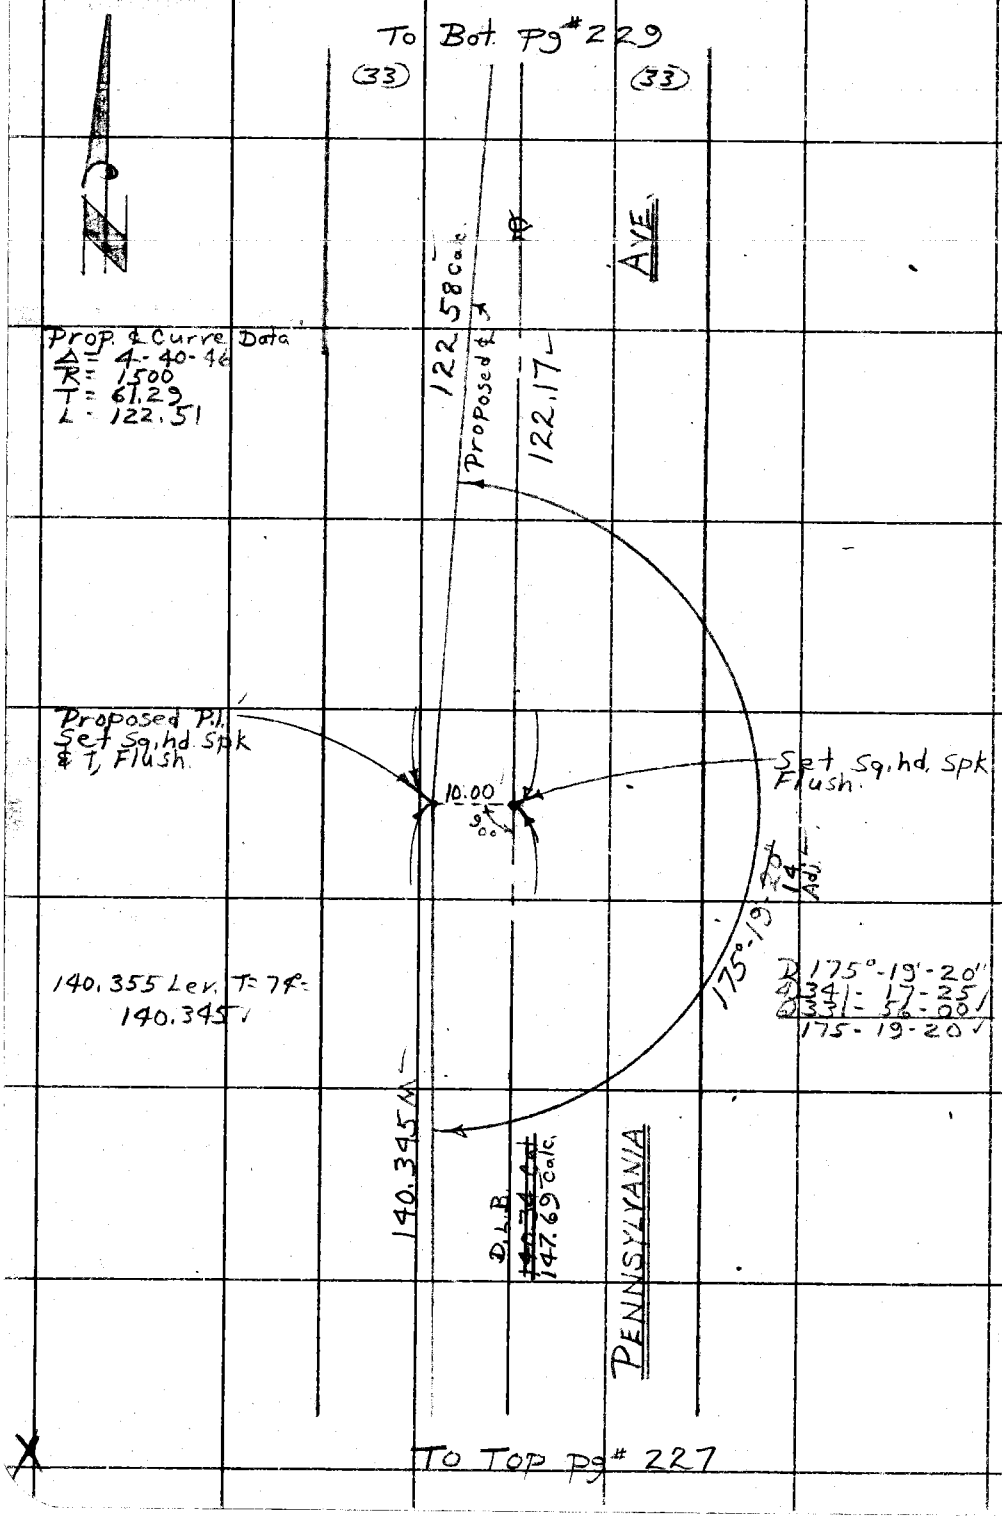

PLEASE RETURN TO
COUNTY OF LOS ANGELES
DEPARTMENT OF COUNTY ENGINEER
403 LOS ANGELES COUNTY ENGINEERING BLDG.

Do not extend this side of this line.

Note: Any Additions or Changes on This Sheet Must be Made or Circled in Red Ink With Date and Name of Person Making Change.

PWFB 1921 2537, 2538

Notes Ck'd by W. EDMONDSON	Survey of [illegible]
Map No. B-5072	[illegible] Tops 139 Sta 84
Office Work H. H. F. DONG	Surveyed by Burkholder
Checked W. EDMONDSON	Notes D.L.B. Date 11-68
Date NOV 21 '69	Indexed [illegible] BALLI

F. B. 3417 PG. 229

W.S. 51, B-9

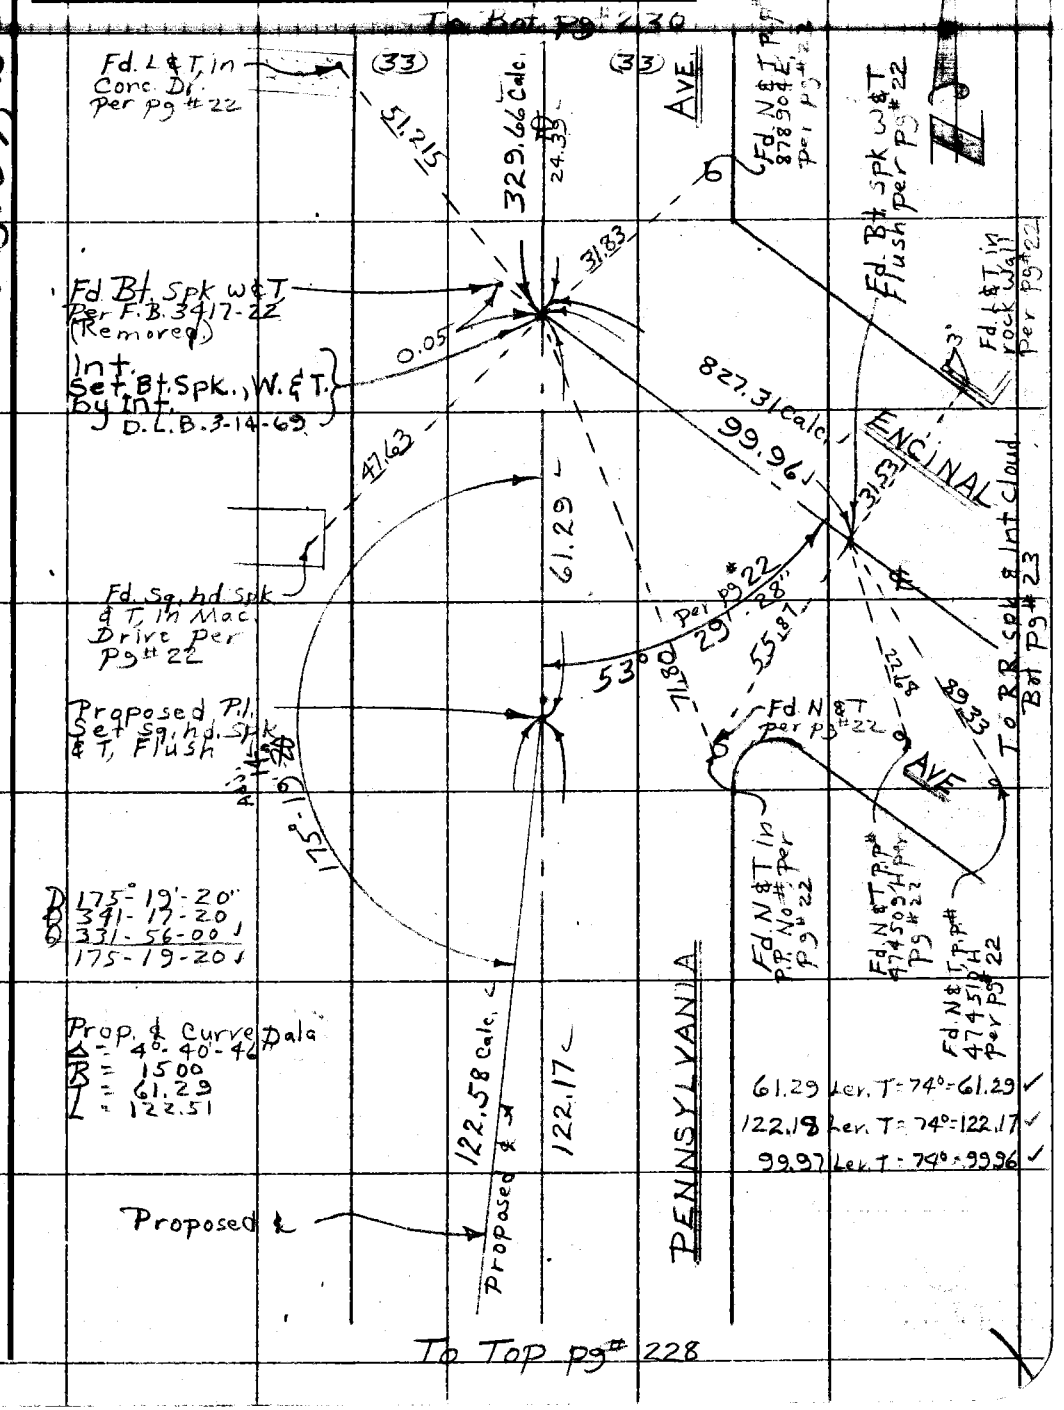

Note: Any Additions or Changes on This Sheet Must be Made or Circled in Red Ink With Date and Name of Person Making Change.

Do not extend this side of this line.

PLEASE RETURN TO
COUNTY OF LOS ANGELES
DEPARTMENT OF COUNTY ENGINEER
403 LOS ANGELES COUNTY ENGINEERING BLDG.

76F309S CE#310 3-68

PWFB 1921 2539

F. B. 3417 PG. 230

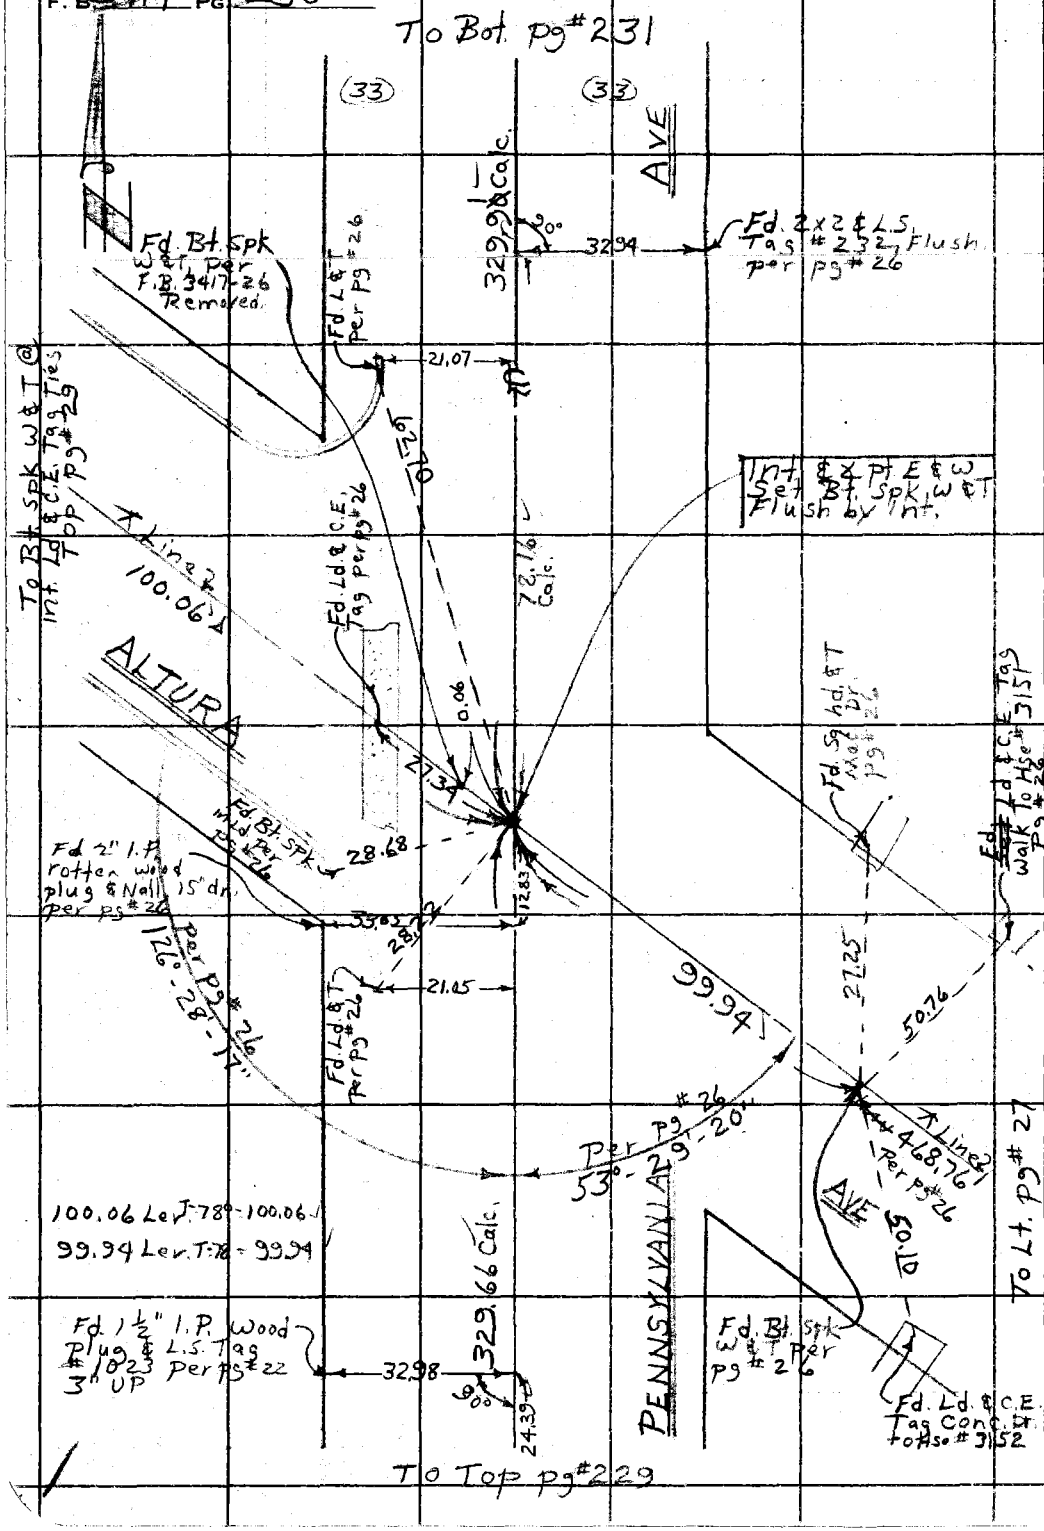

PLEASE RETURN TO
COUNTY OF LOS ANGELES
DEPARTMENT OF COUNTY ENGINEER
403 LOS ANGELES COUNTY ENGINEERING BLDG.

Do not extend this side of this line.

Note: Any Additions or Changes on This Sheet Must be Made or Circled in Red Ink With Date and Name of Person Making Change.

W551-84

PWFB 1921 2540

Notes Ck'd by W. EDMONDSON	Survey of [illegible]
Map No. B-5072	[illegible]
Office Work H. H. F. DONG	Surveyed by [illegible]
Checked W. EDMONDSON	Notes D.L.B. Date 11-68
Date NOV 21 '69	Indexed [illegible] GALLI

F. B. 3417 PG. 235

WS 57 B-4

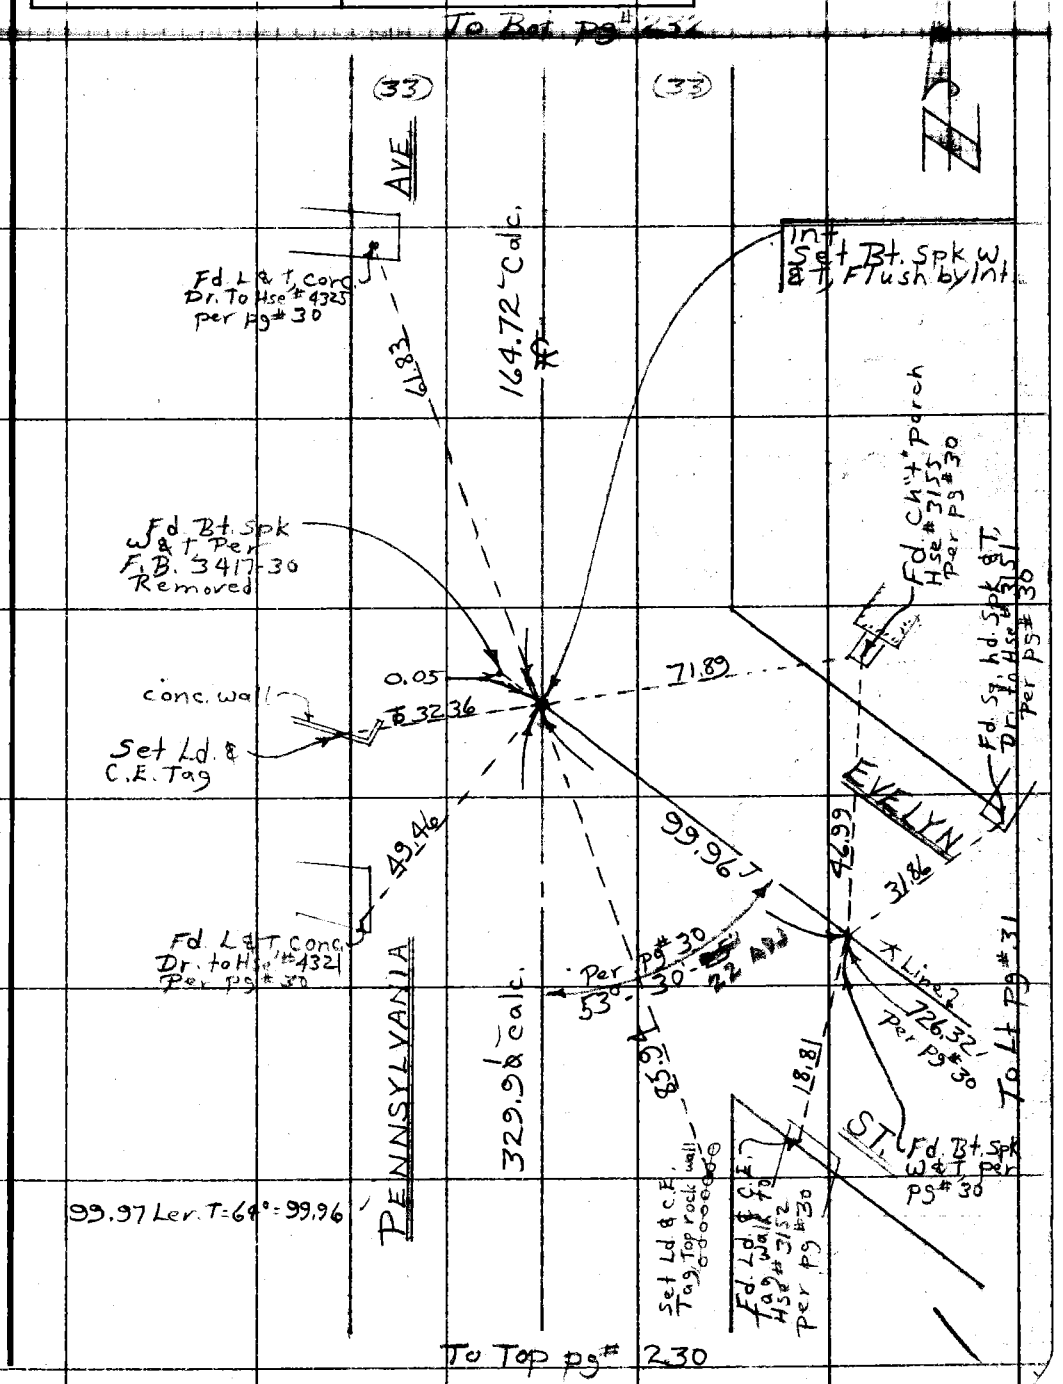

Note: Any Additions or Changes on This Sheet Must be Made or Circled in Red Ink With Date and Name of Person Making Change.

Do not extend this side of this line.

PLEASE RETURN TO
COUNTY OF LOS ANGELES
DEPARTMENT OF COUNTY ENGINEER
403 LOS ANGELES COUNTY ENGINEERING BLDG.

76F309S CE#310 3-68

PWFB 1921 2541

F. B. ~~3417~~ PG. ~~232~~

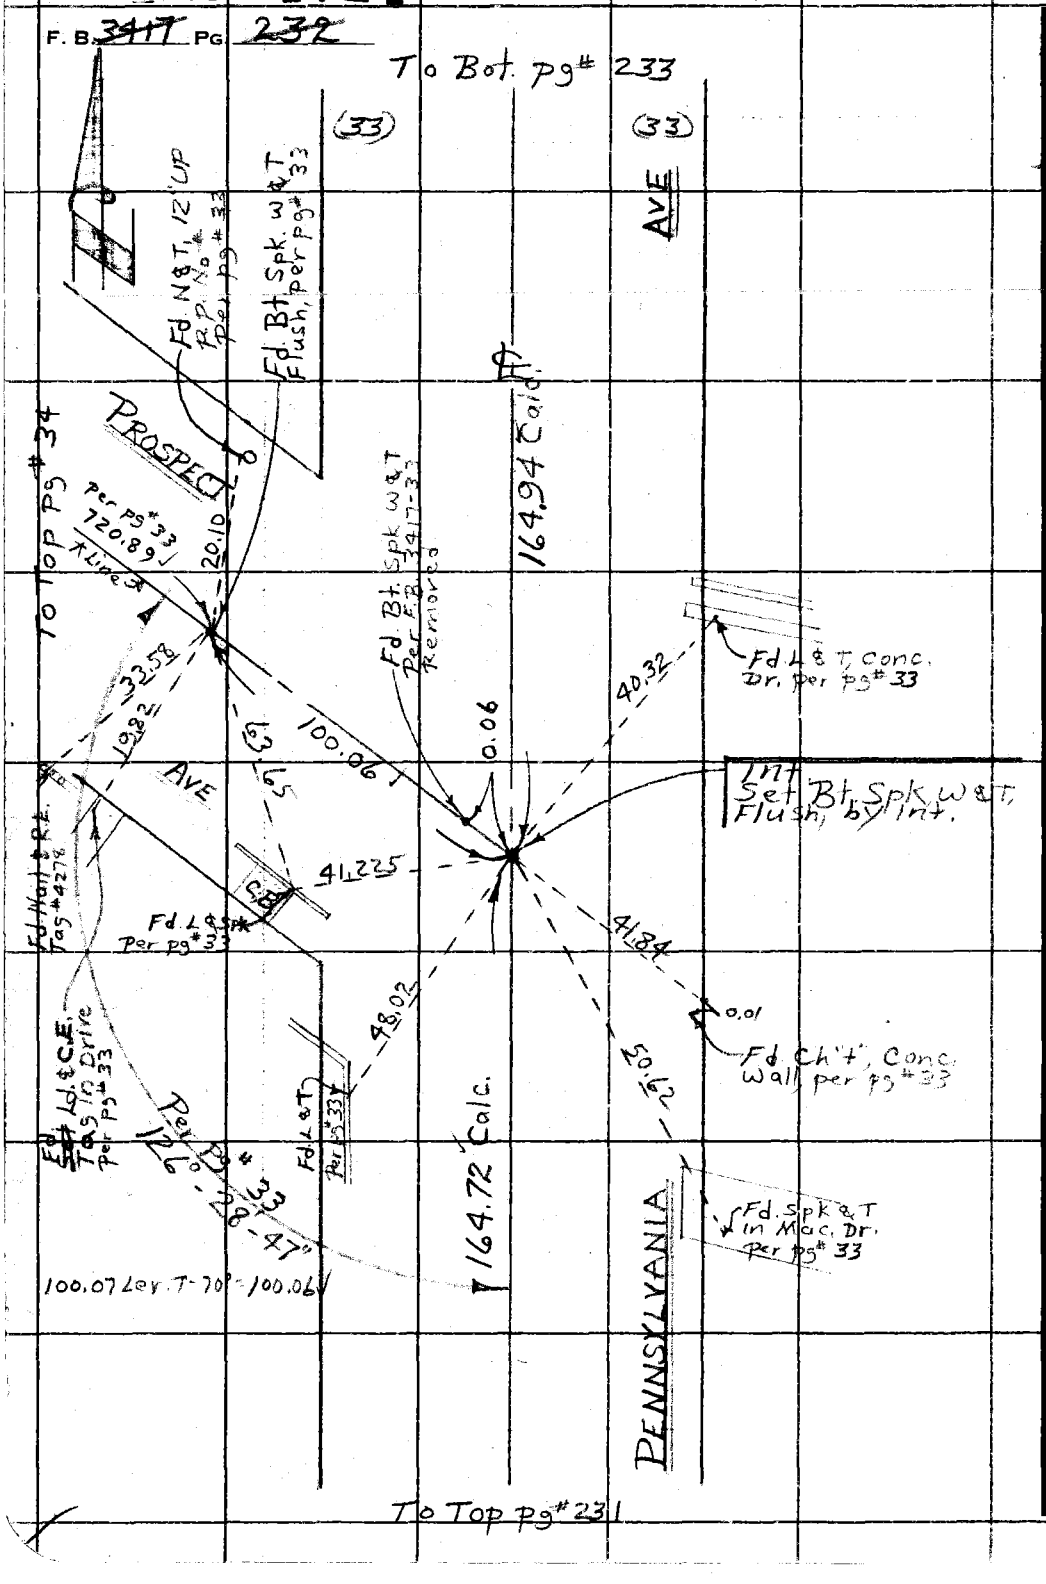

WS 51, B-4

PLEASE RETURN TO
COUNTY OF LOS ANGELES
DEPARTMENT OF COUNTY ENGINEER
403 LOS ANGELES COUNTY ENGINEERING BLDG.

Do not extend this side of this line.

Note: Any Additions or Changes on This Sheet Must be Made or Circled in Red Ink With Date and Name of Person Making Change.

PWFB 1921

2542

Notes Ck'd by W. EDMONDSON	Survey of [illegible]
Map No. B-5072	JN 099725 Tape 139, Std 24 °F
Office Work H. H. F. DONG	Surveyed by [illegible]
Checked W. EDMONDSON	Notes [illegible] Date 11-68
Date NOV 2 1 '69	Indexed [illegible] GALLI

F. B. 3417 PG. 23

W 551 B-4

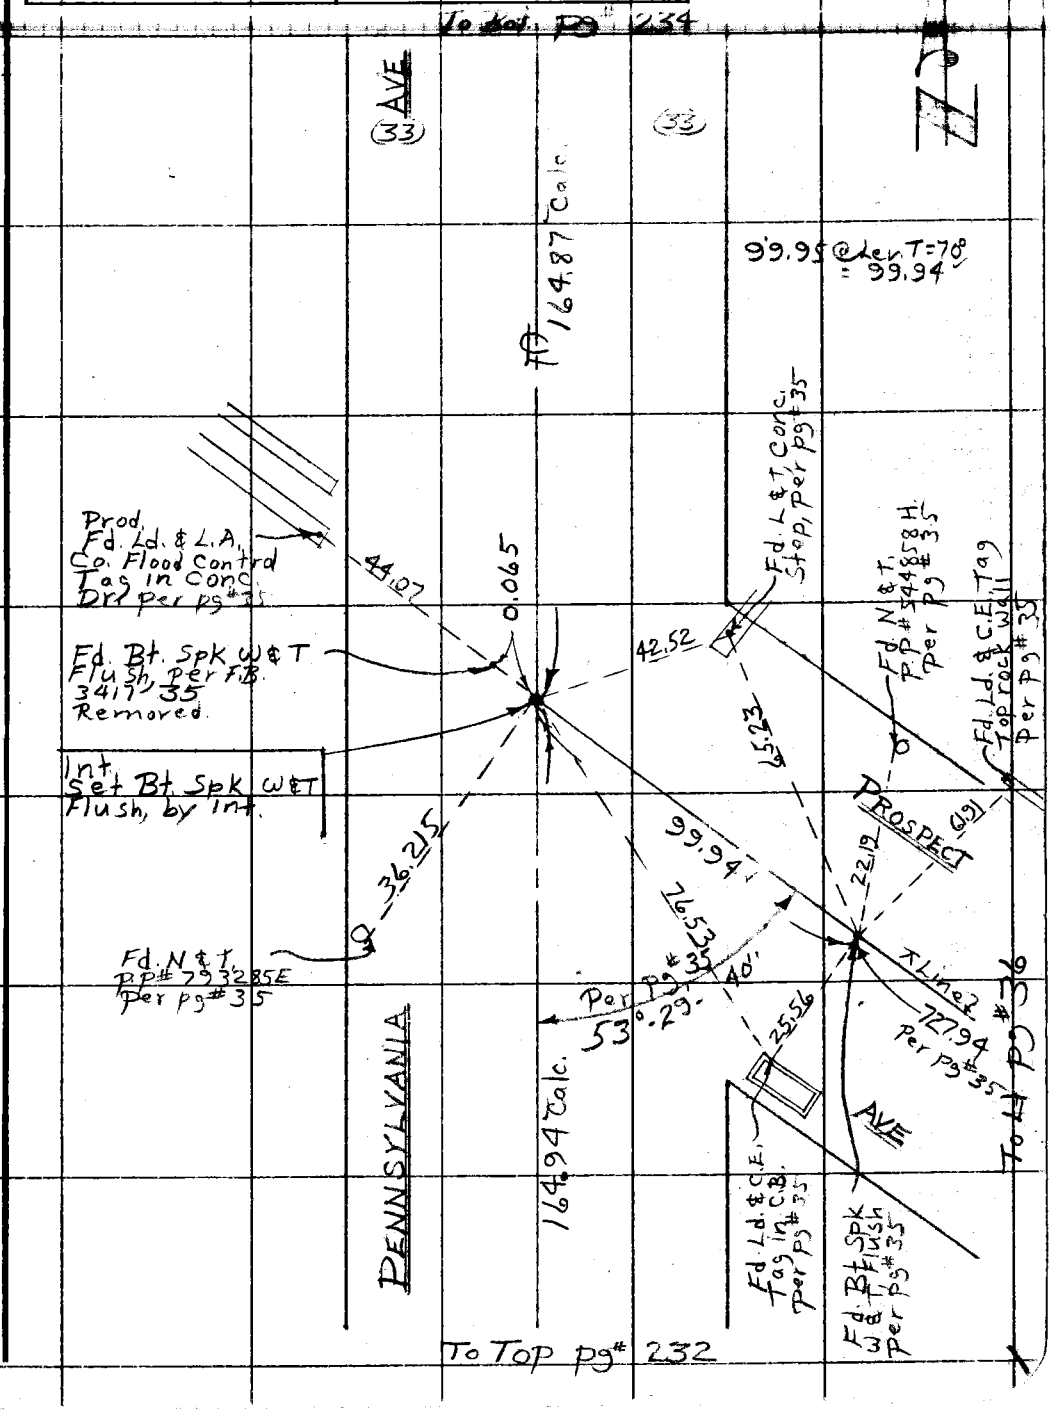

Note: Any Additions or Changes on This Sheet Must be Made or Circled in Red Ink With Date and Name of Person Making Change.

Do not extend this side of this line.

PLEASE RETURN TO
COUNTY OF LOS ANGELES
DEPARTMENT OF COUNTY ENGINEER
403 LOS ANGELES COUNTY ENGINEERING BLDG.

76F309S CE#310 3-68

PWFB 1921 2543

F. B. 3417 PG. 234

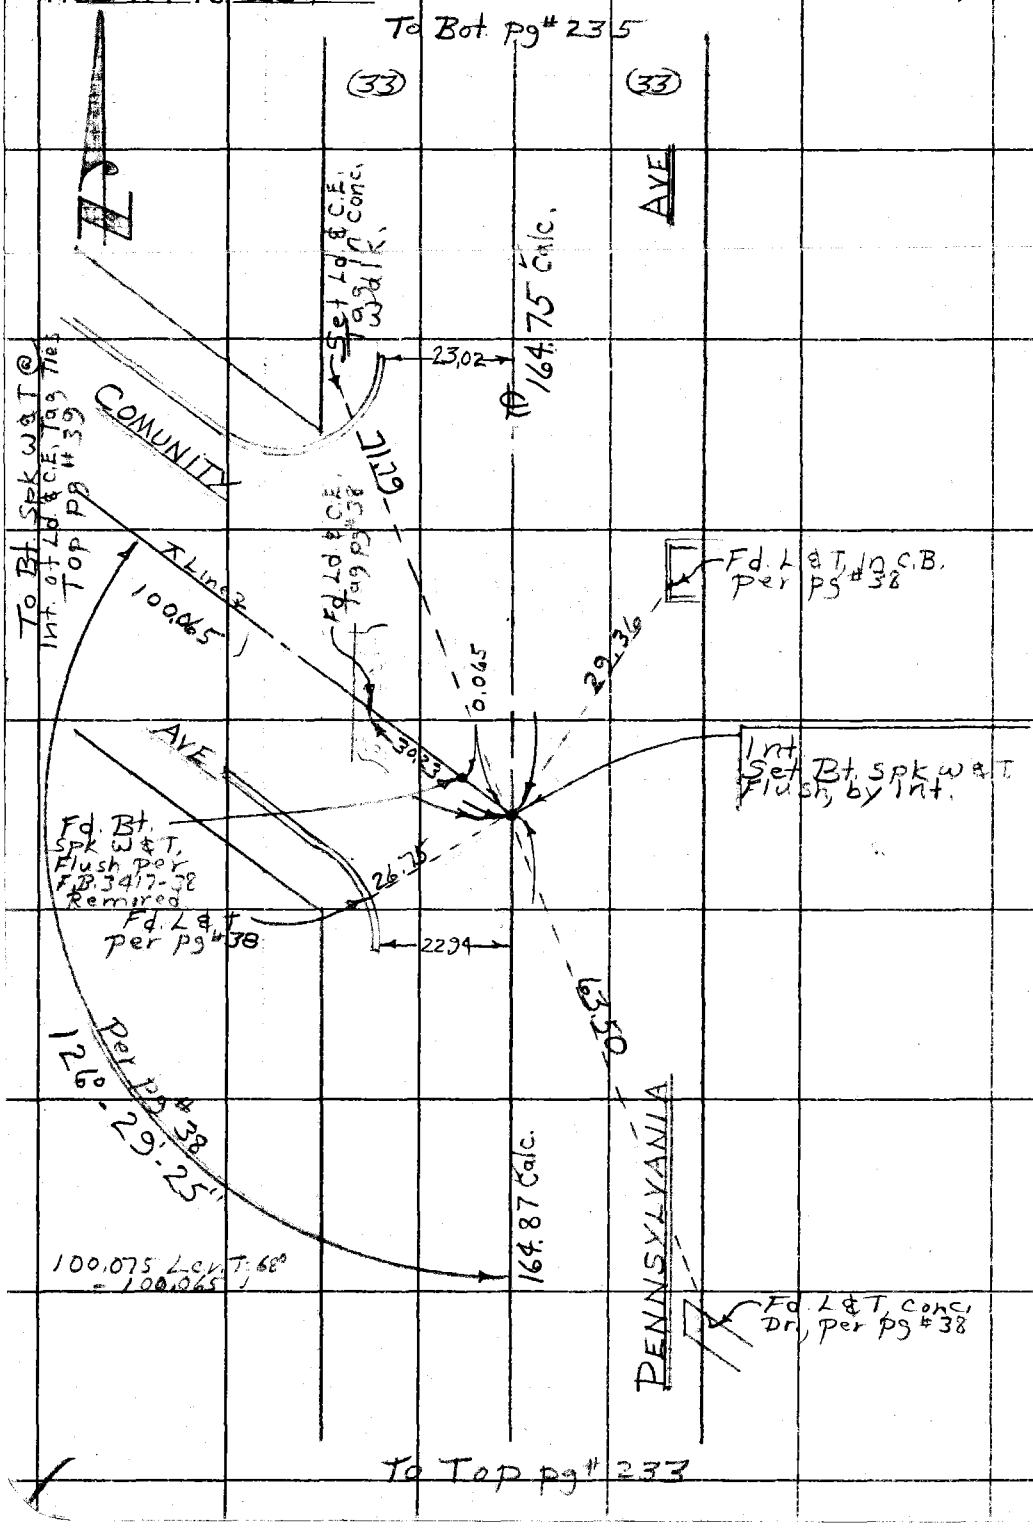

WS 51 B-4

PLEASE RETURN TO
COUNTY OF LOS ANGELES
DEPARTMENT OF COUNTY ENGINEER
403 LOS ANGELES COUNTY ENGINEERING BLDG.

Do not extend this side of this line.

Note: Any Additions or Changes on This Sheet Must be Made or Circled in Red Ink With Date and Name of Person Making Change.

PWFB 1921 2544

Notes Ck'd by W. EDMONDSON	Survey of [illegible]
Map No. B-5072	JN 0097.25 Tbpa 139 Sta 84 °F
Office Work H. H. F. DONO	Surveyed by [illegible]
Checked W. EDMONDSON	Notes D.L.B. Date 11-68
Date NOV 2 1 '69	Indexed R.L. GALLI

F. B. 3417 PG. 235

W.S. 51, 8-4

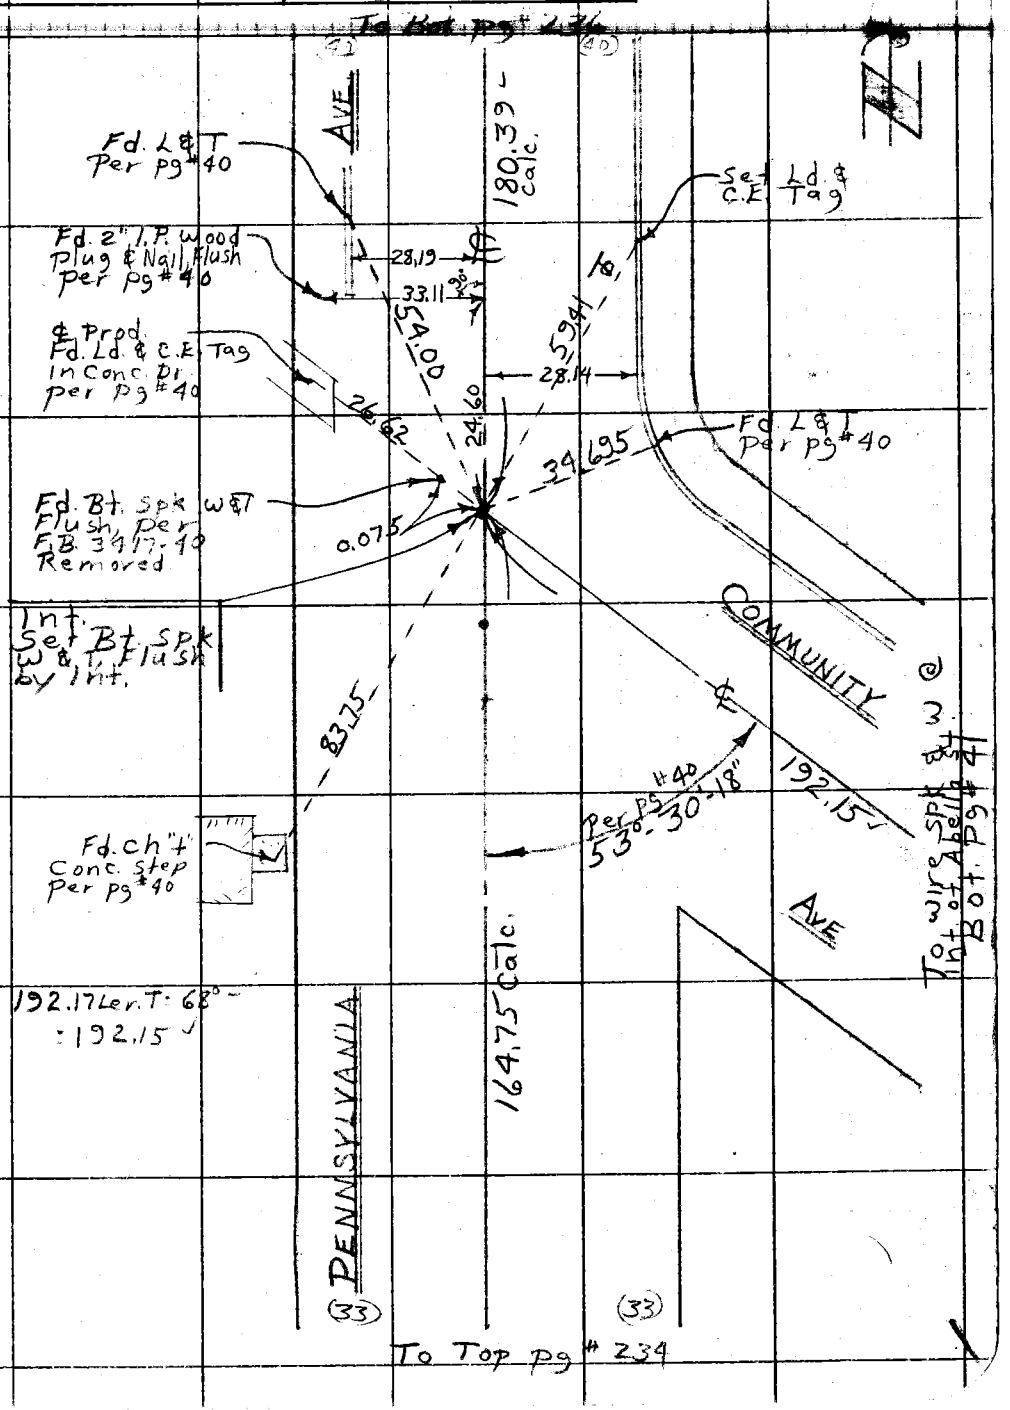

Note: Any Additions or Changes on This Sheet Must be Made or Circled in Red Ink With Date and Name of Person Making Change.

Do not extend this side of this line.

PLEASE RETURN TO
COUNTY OF LOS ANGELES
DEPARTMENT OF COUNTY ENGINEER
403 LOS ANGELES COUNTY ENGINEERING BLDG.

76F3095 CE#310 3-68

PWFB 1921 2545

F. B. 3417 PG. 236

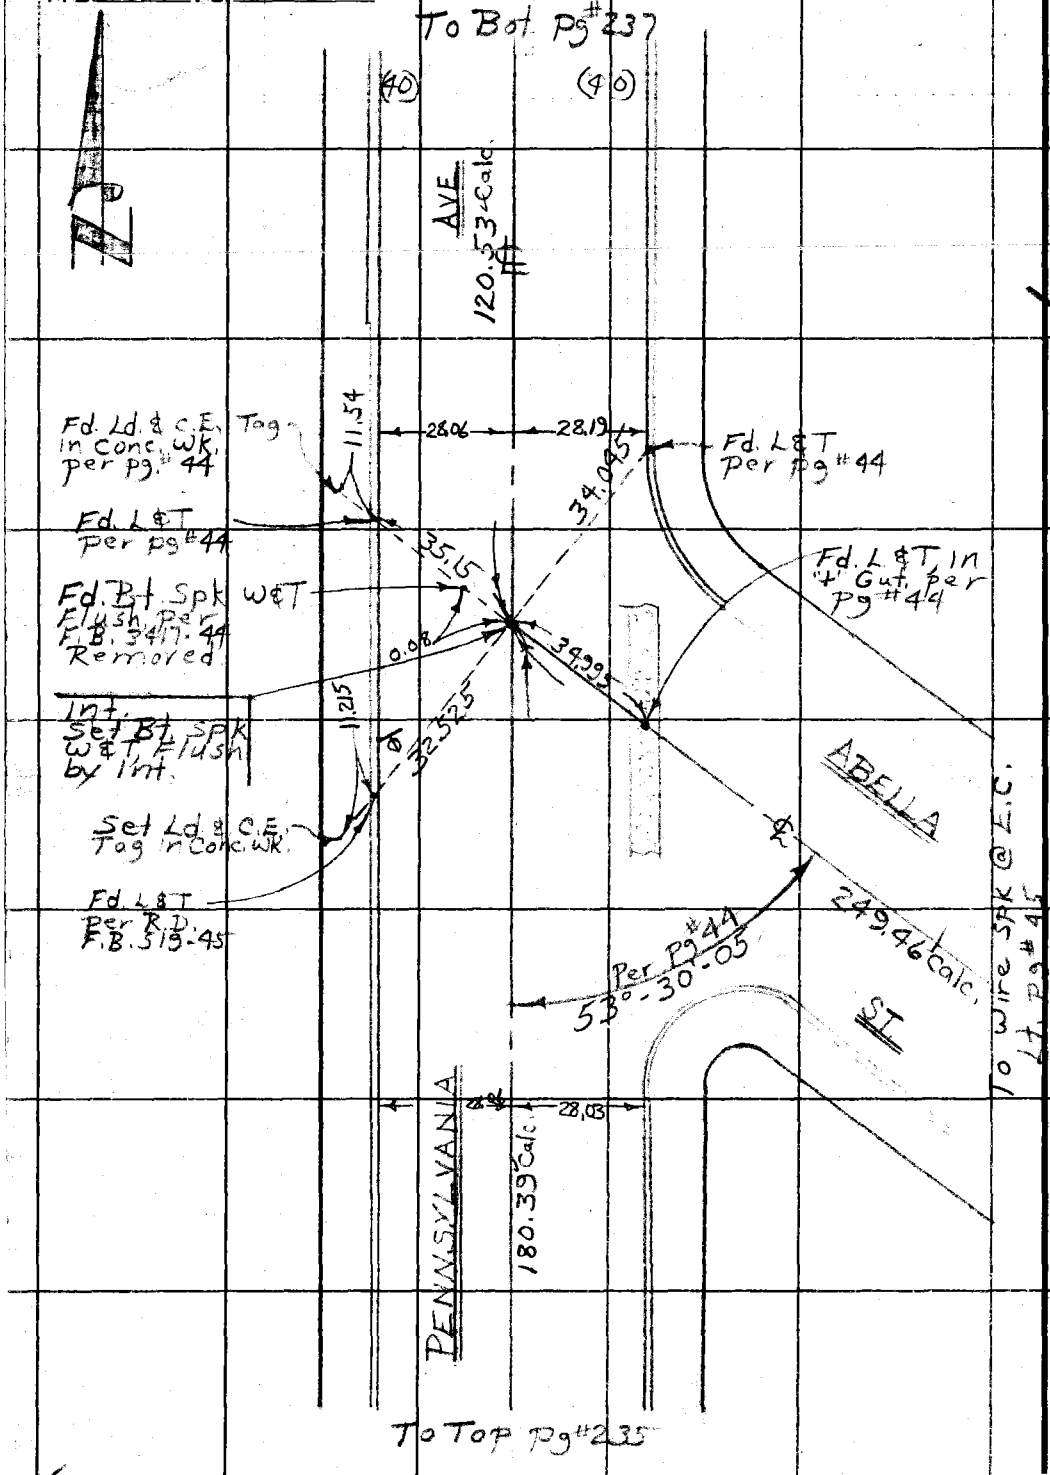

MS 51, B-4

PLEASE RETURN TO
COUNTY OF LOS ANGELES
DEPARTMENT OF COUNTY ENGINEER
403 LOS ANGELES COUNTY ENGINEERING BLDG.

Do not extend this side of this line.

Note: Any Additions or Changes on This Sheet Must be Made or Circled in Red Ink With Date and Name of Person Making Change.

PWFB 1921 2546

Notes Ck'd W. EDMONDSON	Survey of Pennsylvania Ave.
Map No. B-5072	UN 009725 Tape 139, Std 84 °F
Office Work H. H. F. DONG	Surveyed by Burkholder
Checked W. EDMONDSON	Notes D.L.B. Date 12-68
Date NOV 21 '69	Indexed R.R. GALLI

F. B. 3417 PG. 237

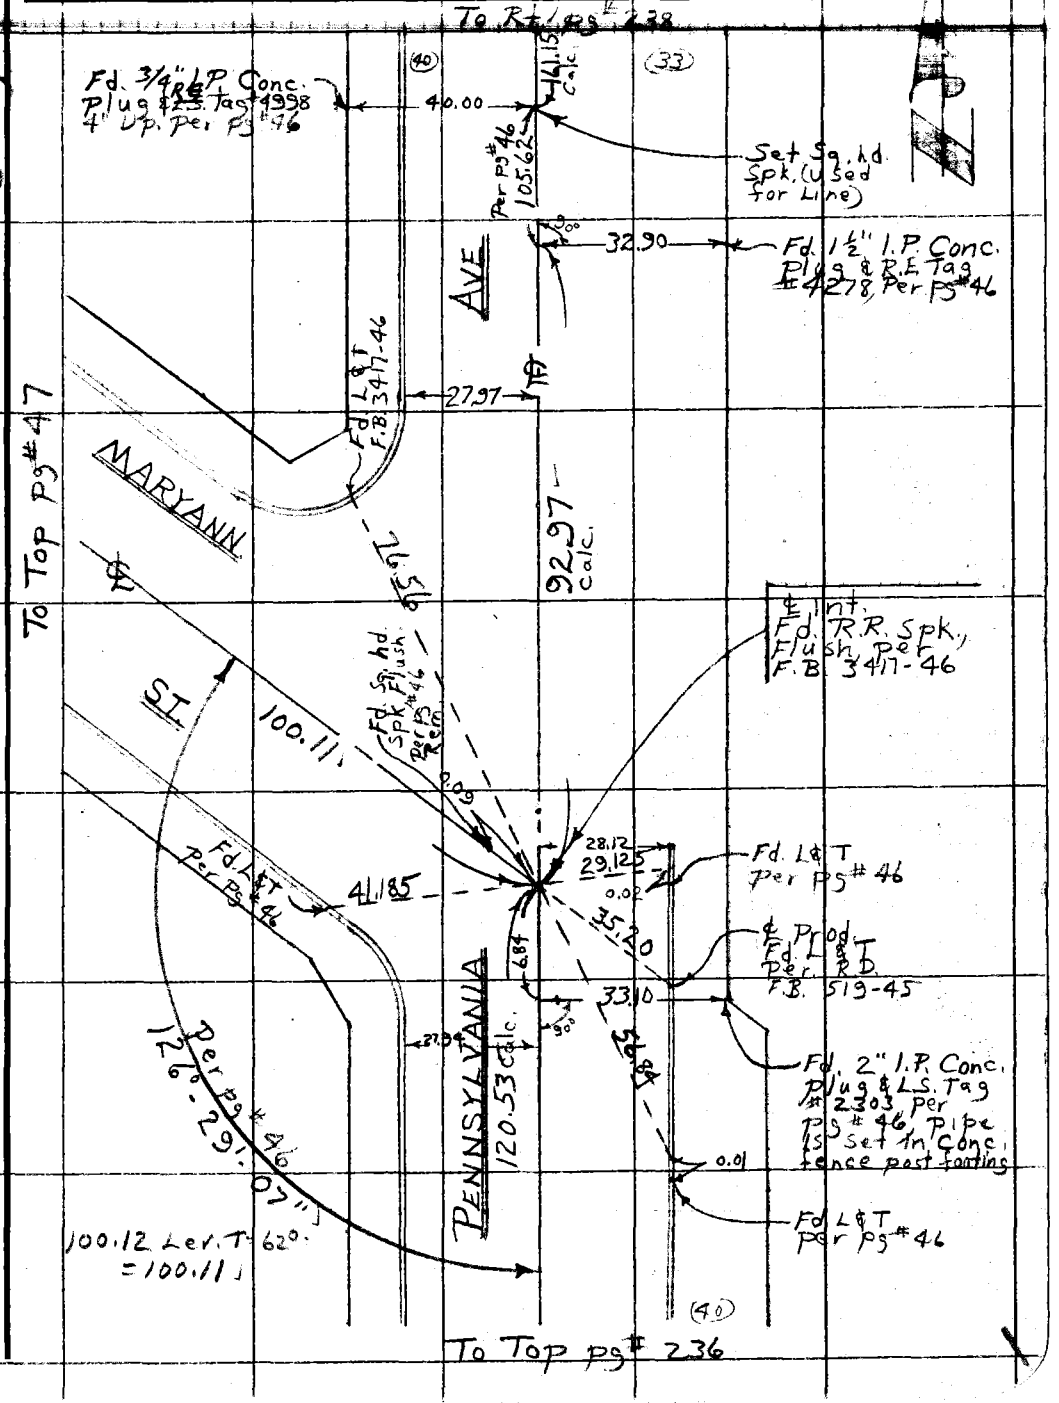

W.S. 51, B-9

Note: Any Additions or Changes on This Sheet Must be Made or Circled in Red Ink With Date and Name of Person Making Change.

Do not extend this side of this line.

PLEASE RETURN TO
COUNTY OF LOS ANGELES
DEPARTMENT OF COUNTY ENGINEER
403 LOS ANGELES COUNTY ENGINEERING BLDG.

76F309S CE#310 3-68

PWFB 1921 To Bot pg #50 2547, 2548

F. B. 3417 PG 238

To sq. hd. spk & T @ Int. Cloud Ave.

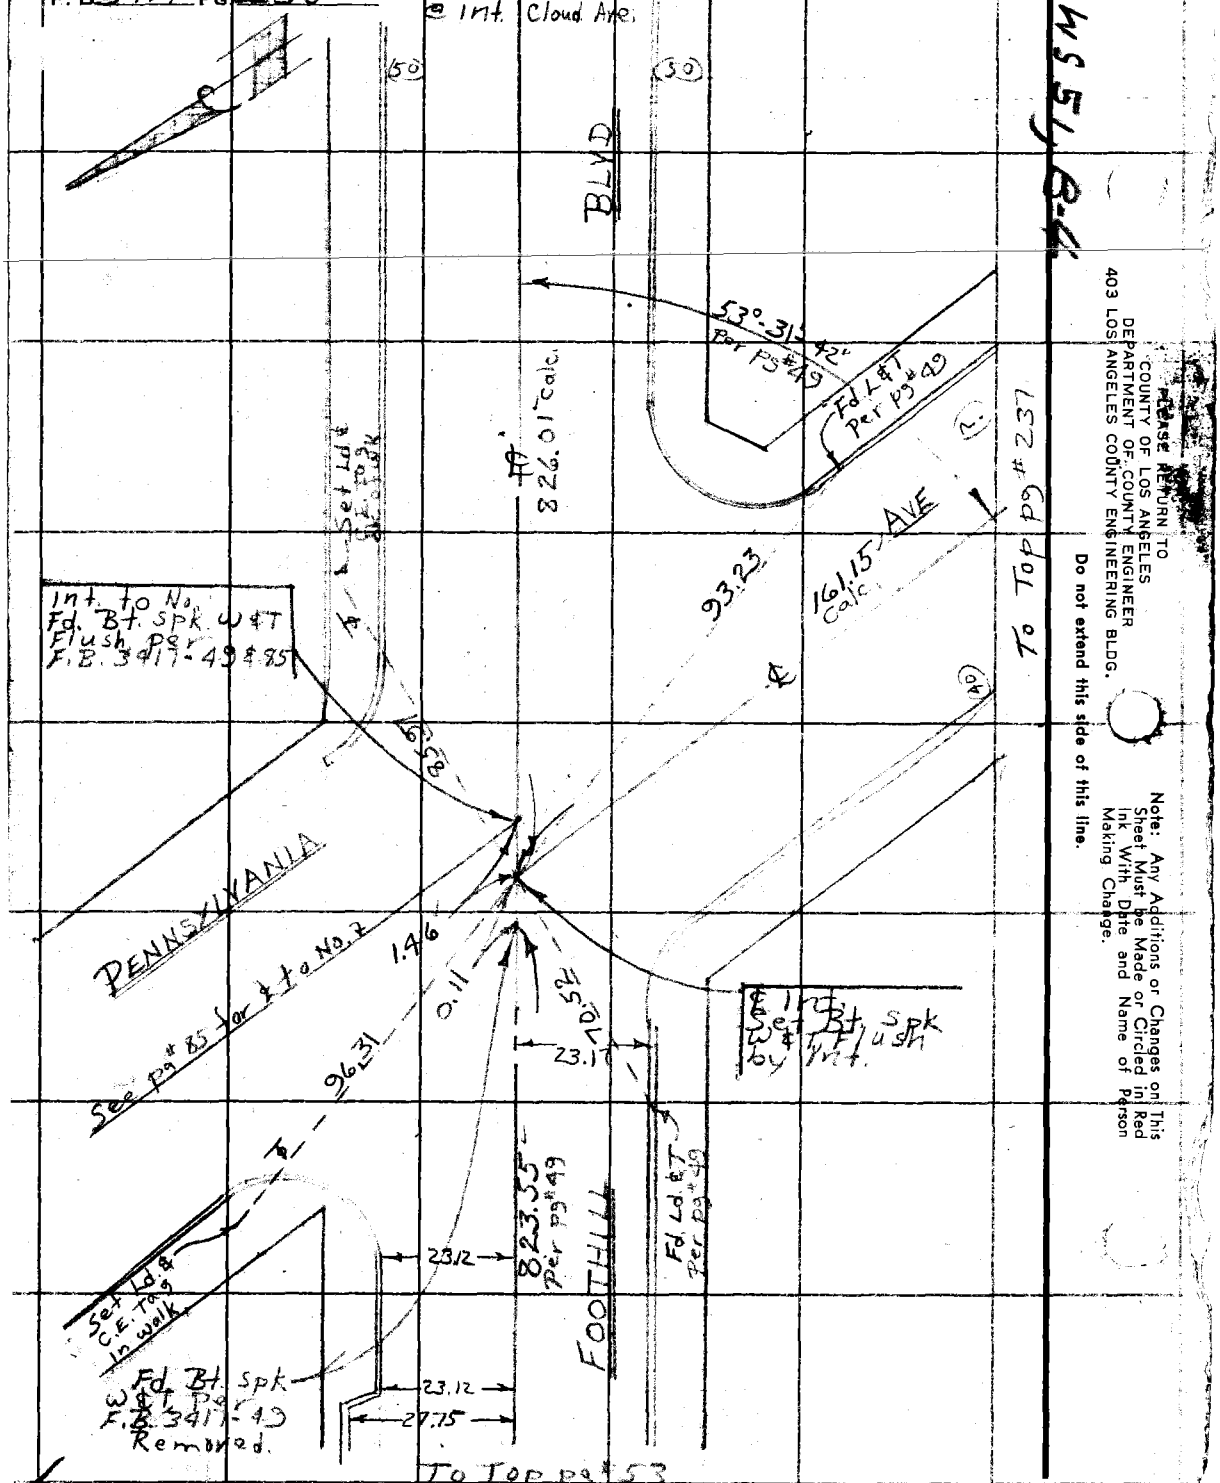

PLEASE RETURN TO
COUNTY OF LOS ANGELES
DEPARTMENT OF COUNTY ENGINEER
403 LOS ANGELES COUNTY ENGINEERING BLDG.

Do not extend this side of this line.

Note: Any Additions or Changes on This Sheet Must be Made or Circled in Red Ink With Date and Name of Person Making Change.