Notes Ck'd by _____ Survey of _____ F.B. 3442 Pg. _____

Office Work _____ Surveyed by _____

Notes _____ Date _____

Date _____ Indexed _____

Job	Description
	JEFFERSON BLVD. 0097.56
Index	
[illegible]1	C.L. Proposed realignment fr. Culver Blvd & Vista Del Mar Lane to Lincoln Blvd.
[illegible]7	Topo. Loc. of existing Fill & Ditch & Oil Well.

Microfilmed Jan '85

D.P.W. file o.k. Dec '87

PLEASE RETURN TO
LOS ANGELES COUNTY ENGINEER
403 LOS ANGELES COUNTY ENGINEERING BLDG.

Note: Any Additions or Changes on this Sheet Must be Made or Circled in Red Ink With Date and Name of Person Making Change

Do not extend this side of this line.

E.B. _____ PG.

PWFB 0915

129

Notes Ck'd by A. E. DART	Survey of JEFFERSON BLVD
Map No. [illegible]	JN [illegible] Page [illegible]
Office Work R. R. SHEAN	Surveyed by
Checked A. E. DART	Notes G. E. DEALER Date 11-67
Date APR 26 71	Indexed

F. B. 2447 PG. 6

JOB NO. 0097.56

JEFFERSON BLVD.

PROPOSED REALIGNMENT FROM CULVER BLVD AND VISTA DEL MAR TO LINCOLN BLVD.

DREYER
WILKS
SIEMANN
McKNIGHT

Note: Any Additions or Changes on this Sheet Must be Made or Circled in Red Ink With Date and Name of Person Making Change.

Do not extend this side of this line.

PLEASE RETURN TO
LOS ANGELES COUNTY ENGINEER
403 Los Angeles County Engineering Bldg.

76F309S CE # 310 3-61

PWFB 0915 INDEX SKETCH 130

F. B. 2442 PG. 6

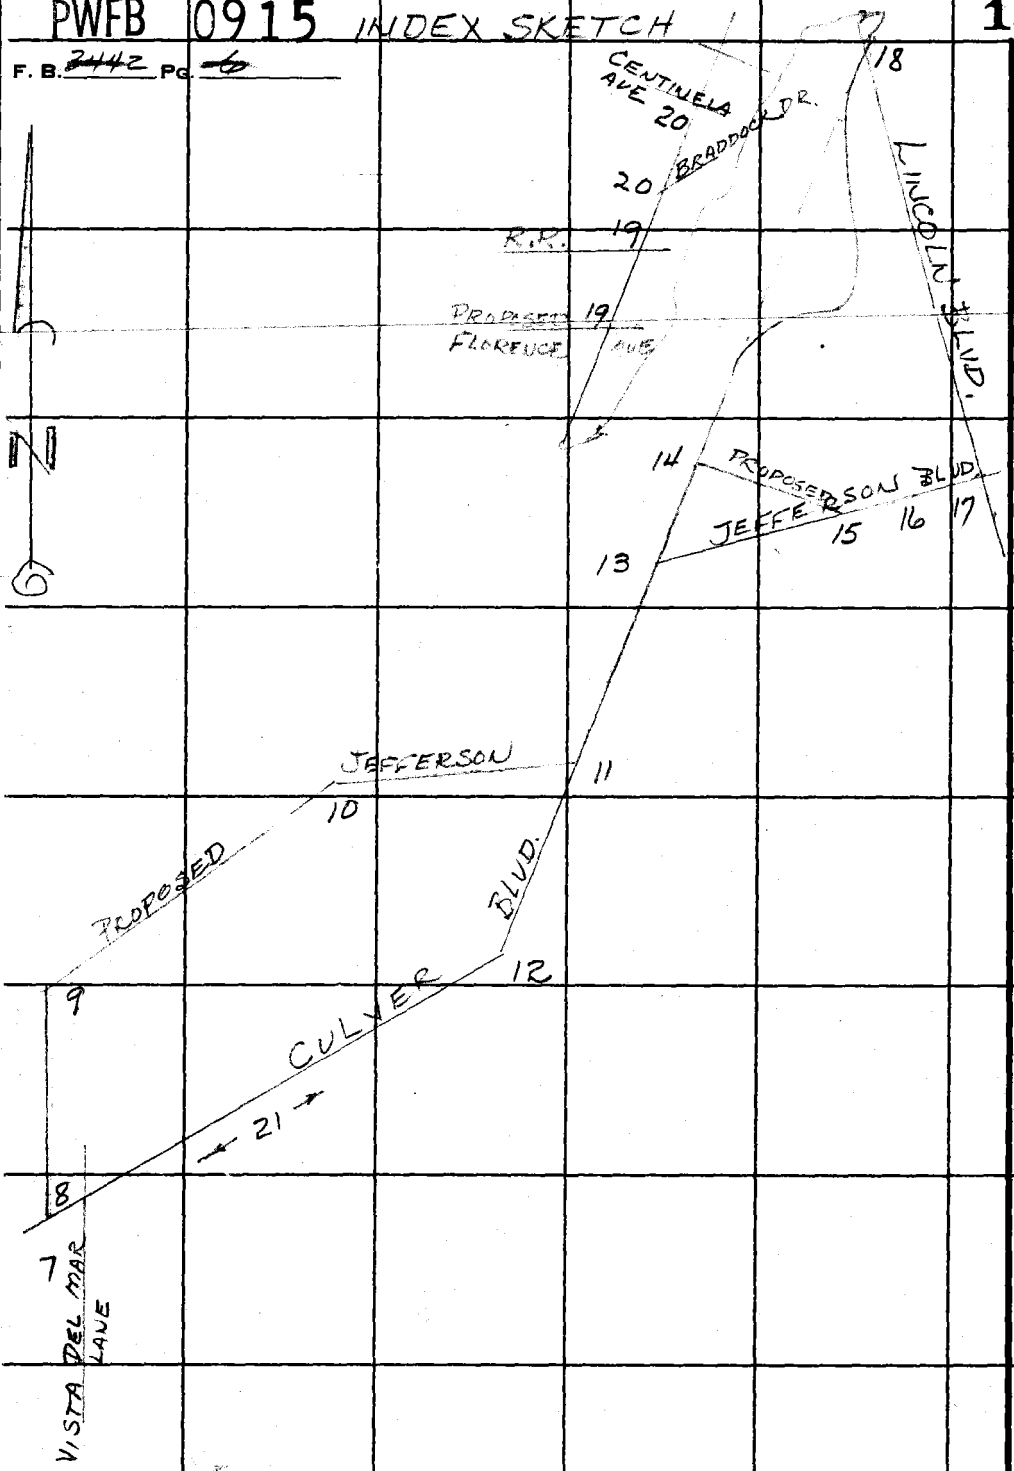

PLEASE RETURN TO
LOS ANGELES COUNTY ENGINEER
403 Los Angeles County Engineering Bldg.

Do not extend this side of this line.

Note: Any Additions or Changes on This Sheet Must be Made or Circled in Red Ink With Date and Name of Person Making Change.

PWFB 0915

131

Notes Ck'd by [illegible]	Survey of TEGGERSON BLVD.
Map No. [illegible]	JN 0007.56 Temp 0185 [illegible] °F
Office Work R. R. SHEAN	Surveyed by [illegible]
Checked A. E. DART	Notes G. E. DREIER Date 11-19-67
Date APR 26 '71	Indexed [illegible]

F. B. 2447 PG. 7

CONT. BOT. PAGE 8

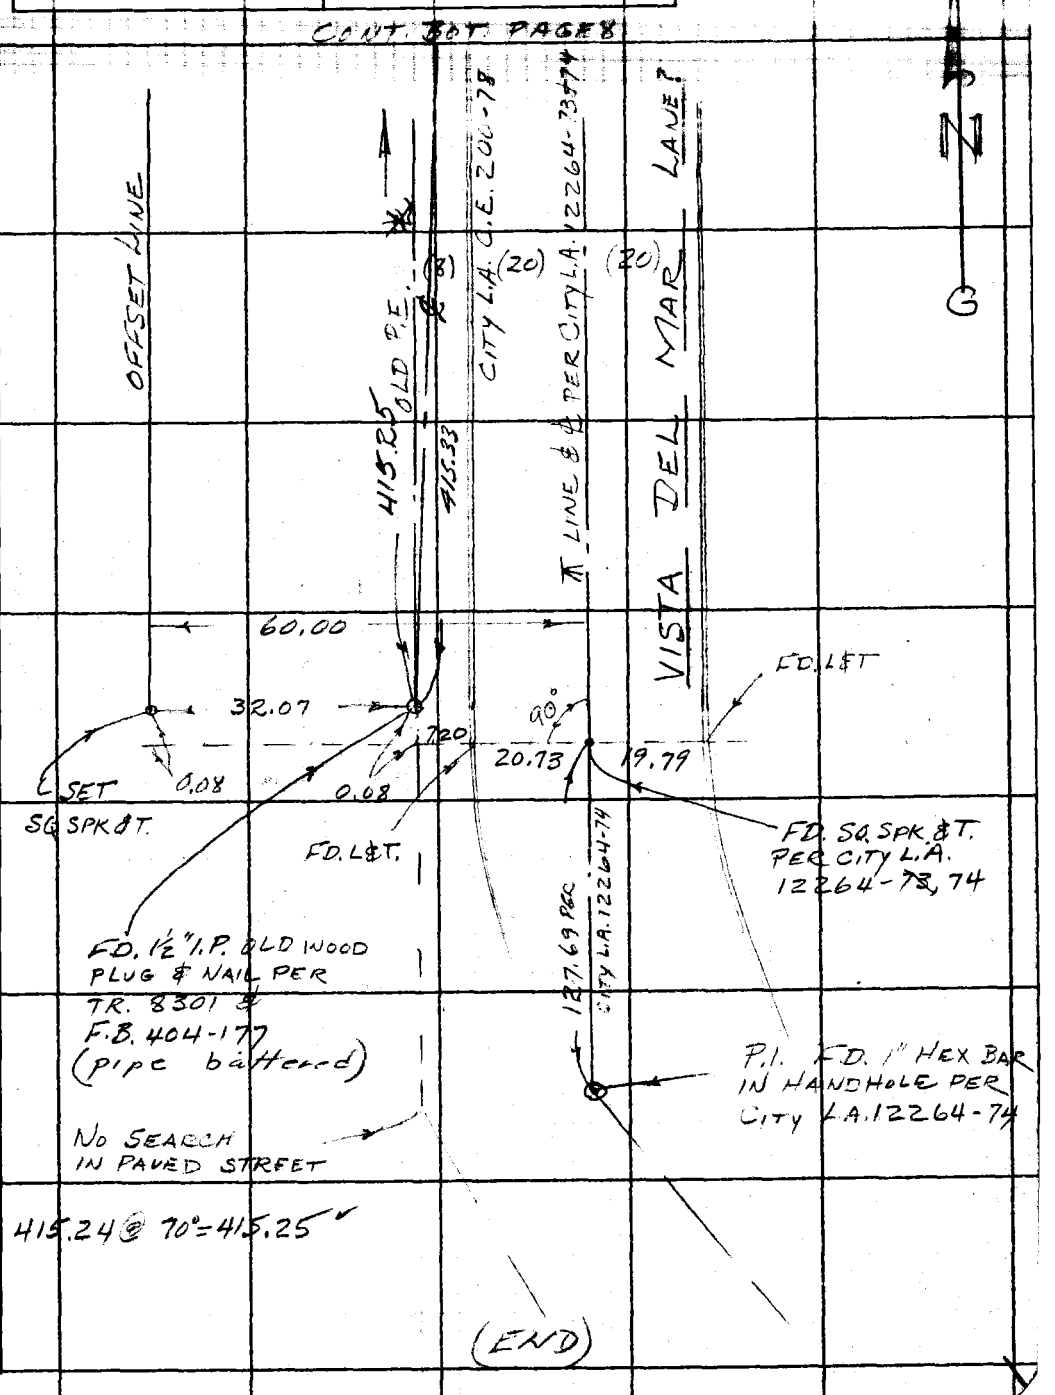

W.S. 23, B-4

Note: Any Additions or Changes on this Sheet Must be Made or Circled in Red Ink With Date and Name of Person Making Change.

Do not extend this side of this line.

PLEASE RETURN TO
LOS ANGELES COUNTY ENGINEER
403 LOS ANGELES COUNTY ENGINEERING BLDG.

76F309S CE # 310 3-61

CONT. ON BOT PAGE 9

F. B. ~~3442~~ Pg. ~~8~~

W.S. 23, 8-4

LOS ANGELES COUNTY ENGINEER
403 Los Angeles County Engineering Bldg.

PLEASE RETURN TO

Do not extend this side of this line.

Note: Any Additions or Changes on This Sheet Must be Made or Circled in Red Ink With Date and Name of Person Making Change.

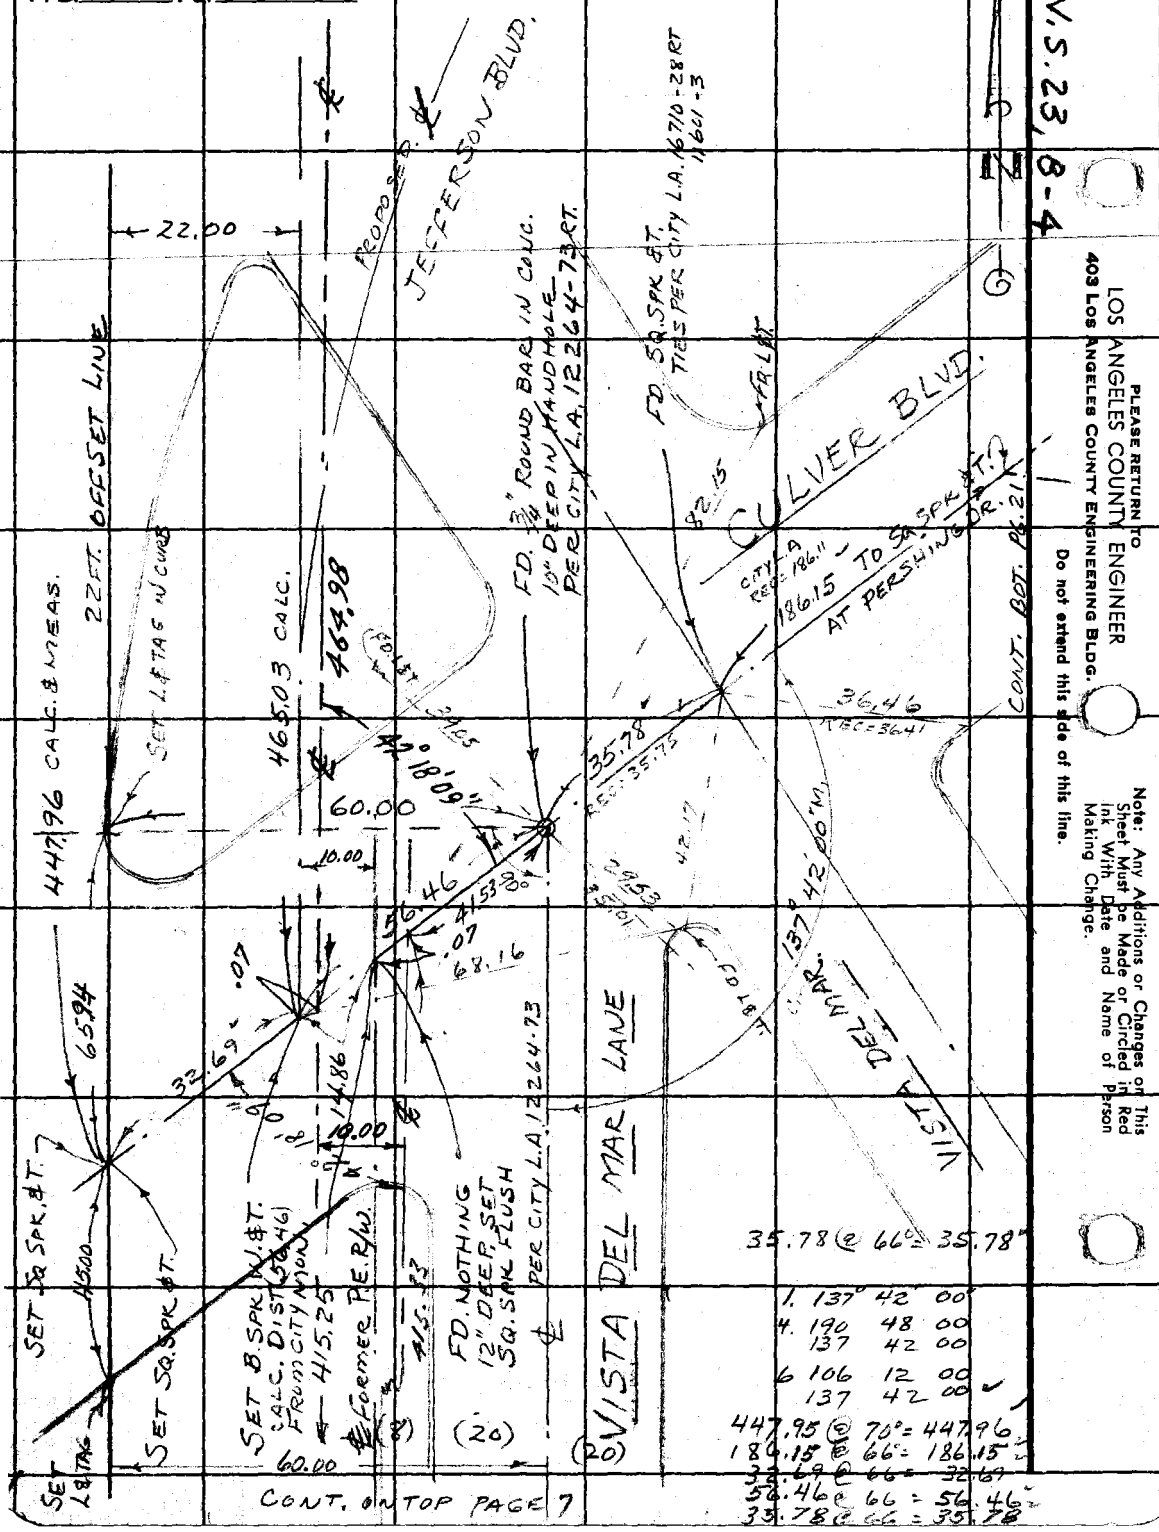

CONT. ON TOP PAGE 7

Notes Ck'd by	Survey of
Map No.	JN Tape Std
Office Work R. R. SHEAN	Surveyed by
Checked A. F. DART	Notes G.E. DREIER Date 11-22-67
Date APR 26 71	Indexed

F. B. Pg.

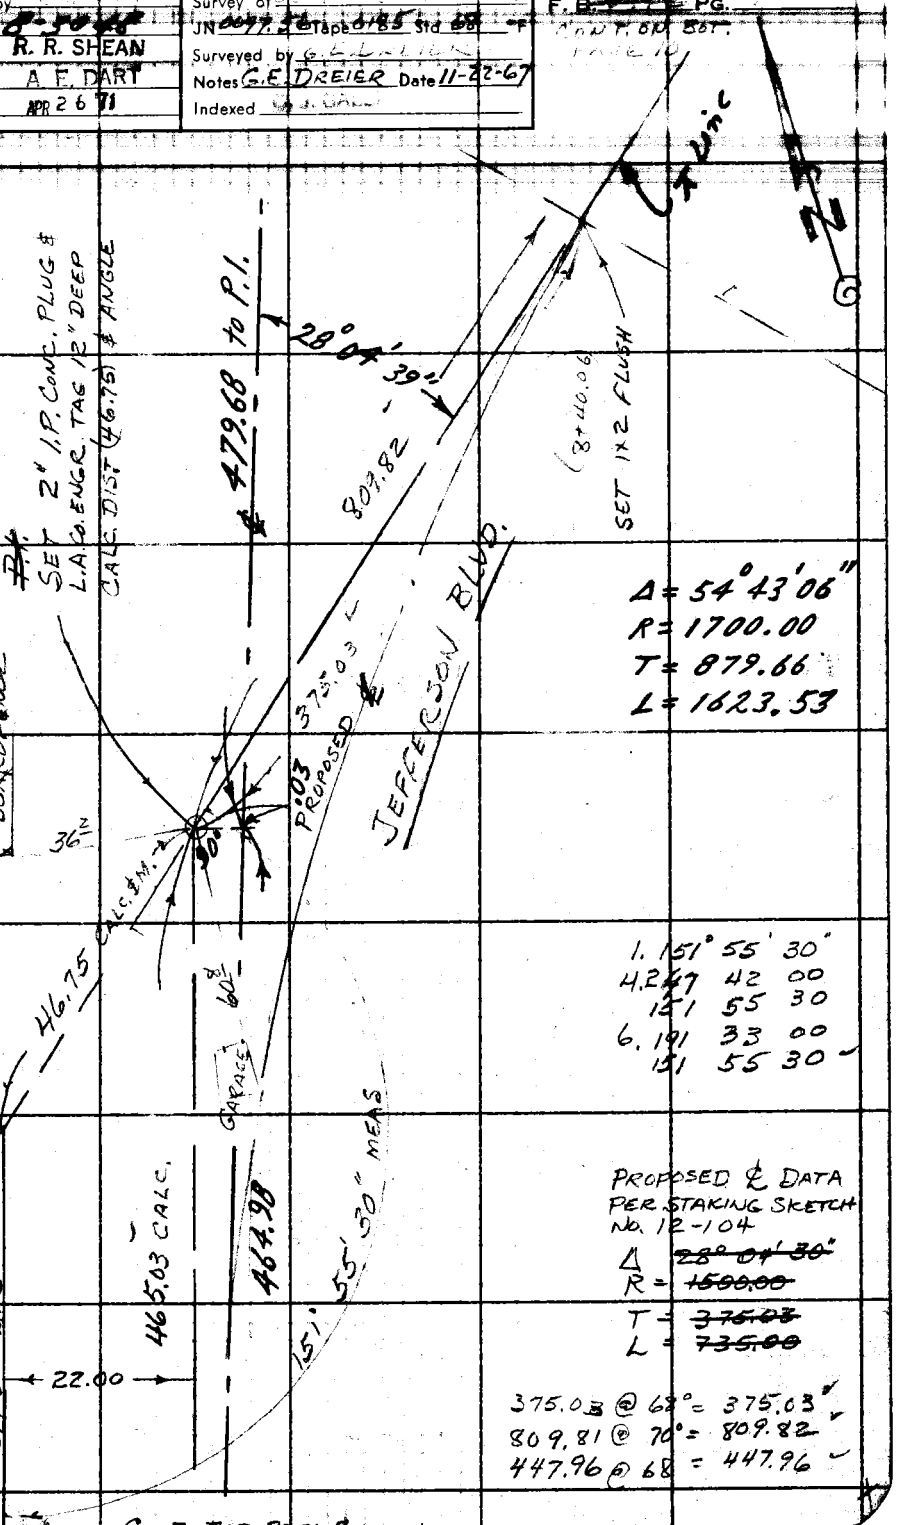

Note: Any Additions or Changes on This Sheet Must be Made or Circled in Red Ink With Date and Name of Person Making Change.

Do not extend this side of this line.

PLEASE RETURN TO
LOS ANGELES COUNTY ENGINEER
403 LOS ANGELES COUNTY ENGINEERING BLDG.

76F3009 CE # 310 3-61

CONT. TOP PAGE 8

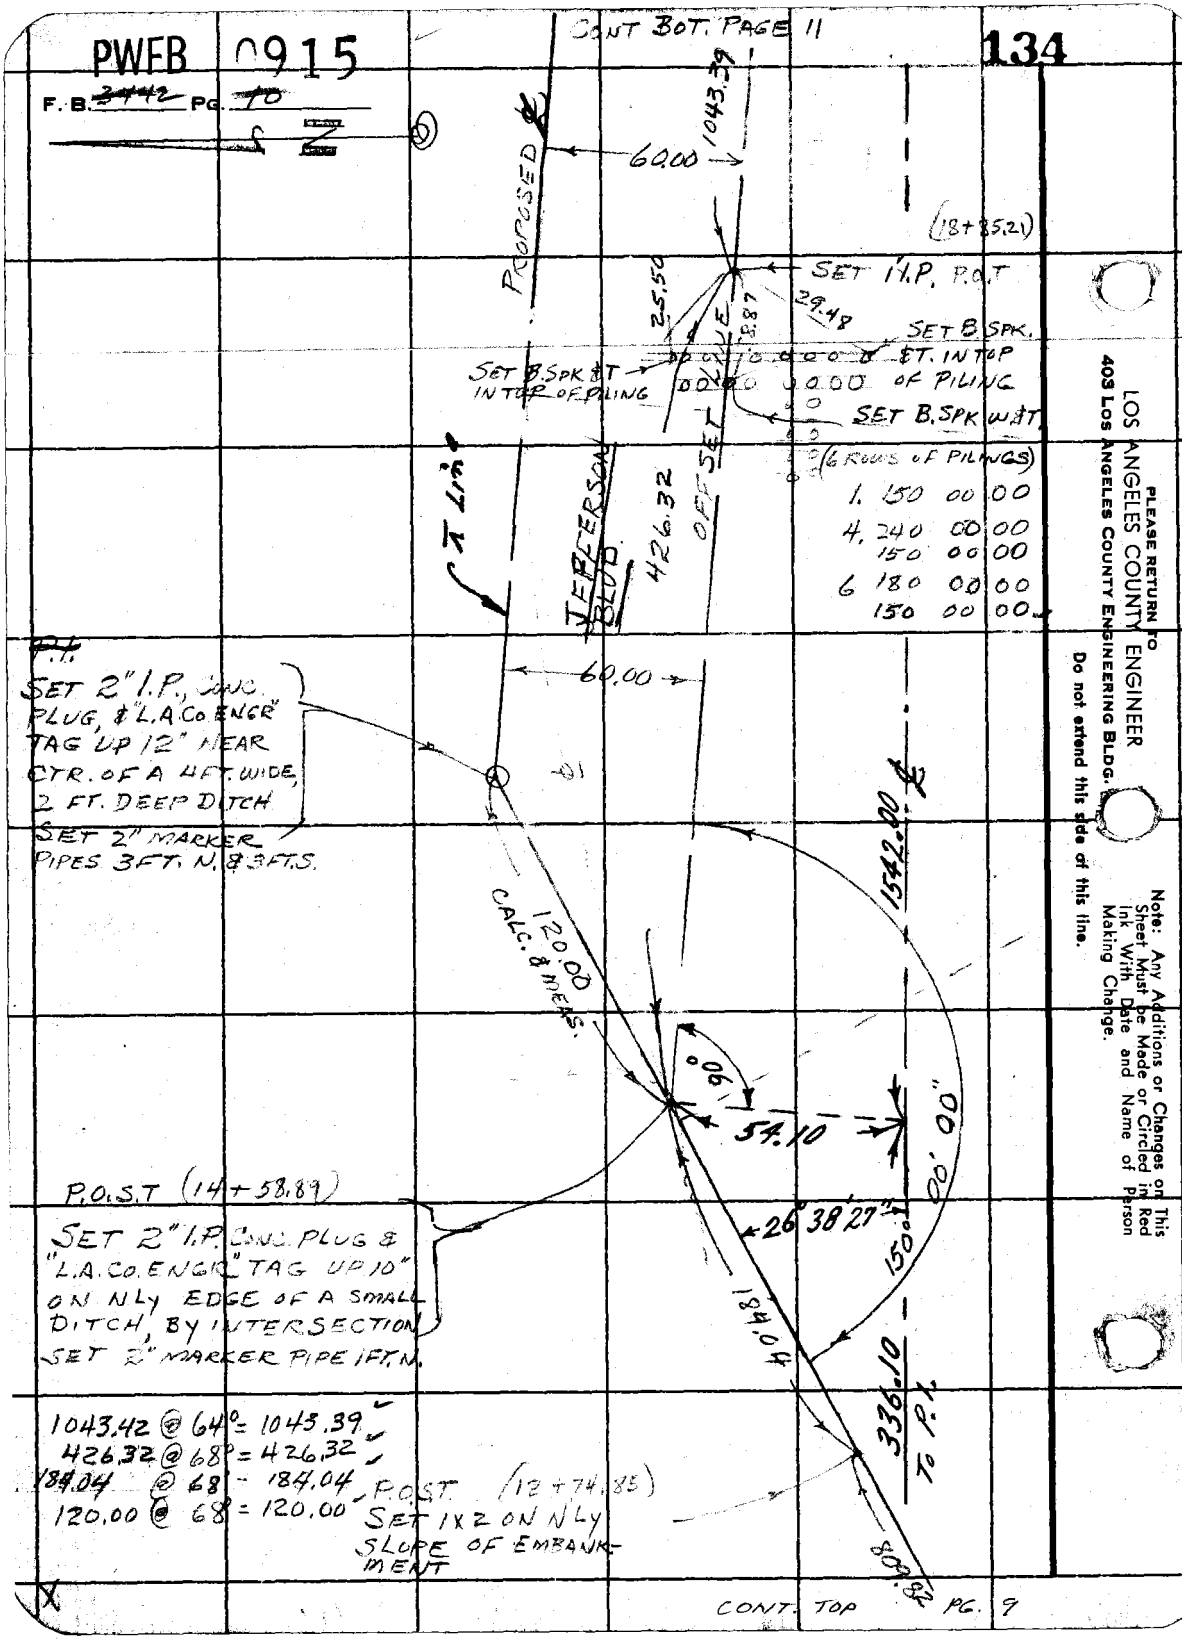

PLEASE RETURN TO
LOS ANGELES COUNTY ENGINEER
403 Los Angeles County Engineering Bldg.
Do not extend this side of this line.
Note: Any Additions or Changes on This Sheet Must be Made or Circled in Red Ink With Date and Name of Person Making Change.

Notes Ck'd by
Map No.
Office Work R. R. SHEAN
Checked A. E. DART
Date APR 26 '71

Survey of
JN Tape Std
Surveyed by
Notes G.E. DREIER Date 1-19-68
Indexed

F.B. Pg.

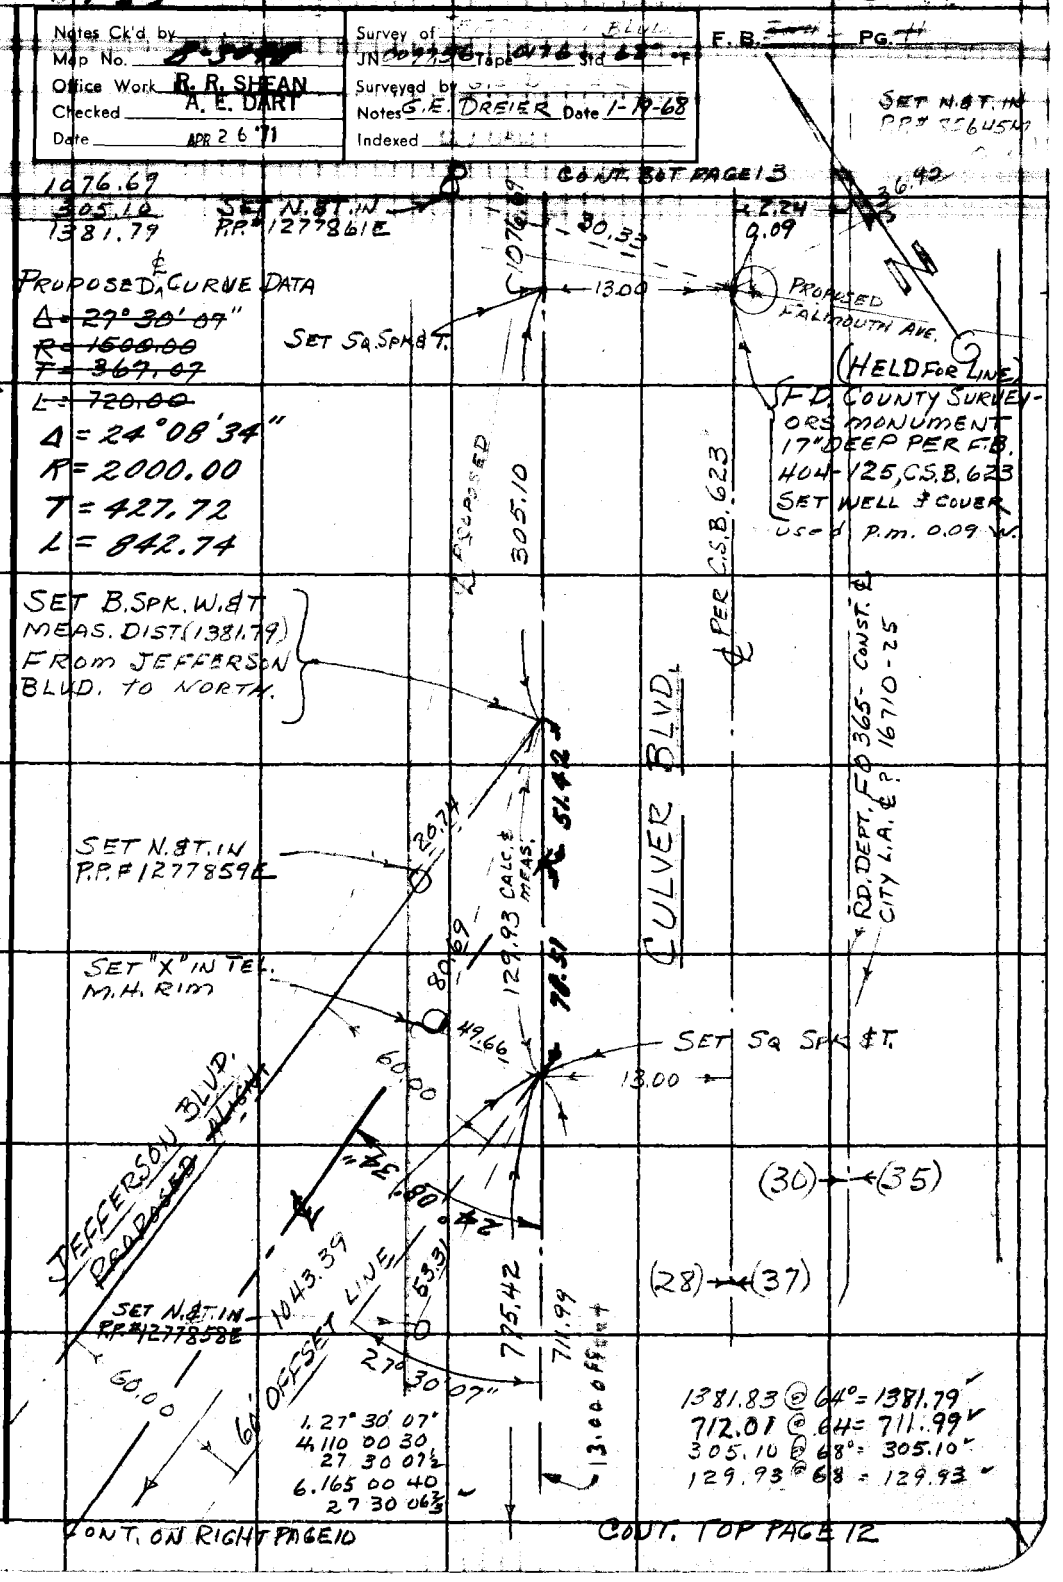

W.S. 23, B-4

Note: Any Additions or Changes on this Sheet Must be Made or Circled in Red Ink With Date and Name of Person Making Change.

Do not extend this side of this line.

PLEASE RETURN TO
LOS ANGELES COUNTY ENGINEER
403 Los Angeles County Engineering Bldg.

76F309S CE # 310 3-61

PWFB 0915

CONT. ON BOT. PAGE 11

136,137

F. B. ~~3442~~ PG. ~~12~~

1. 168° 16' 10"
4. 313 04 40
168 16 18
6 289 36 50
168 16 08½

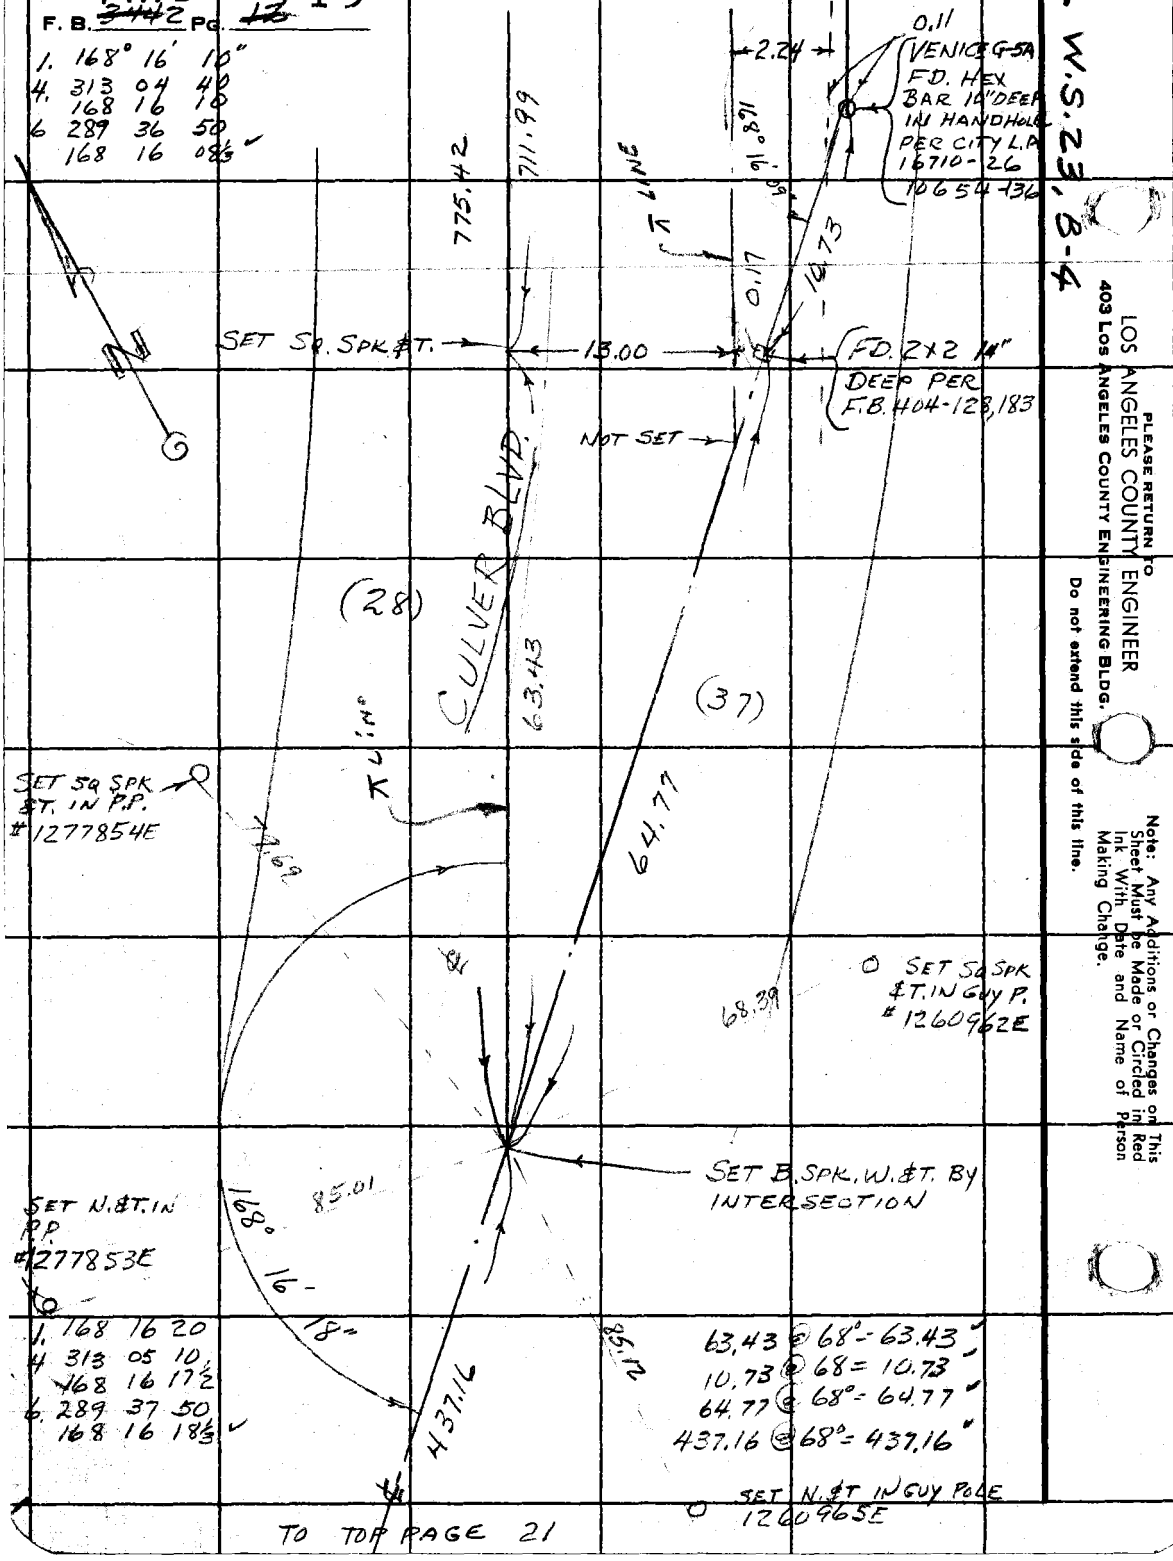

TO TOP PAGE 21

W.S. 23, B-4

LOS ANGELES COUNTY ENGINEER
403 Los Angeles County Engineering Bldg.

PLEASE RETURN TO

Do not extend this side of this line.

Note: Any Additions or Changes on This Sheet Must be Made or Circled in Red Ink With Date and Name of Person Making Change.

PWFB 1015

638

Notes Ck'd by	Survey of JEFFERSON BLVD
Map No.	0176 W 68 °F
Office Work R. R. SHEAN	Surveyed by G.E. DREIER
Checked A. E. DART	Notes G.E. DREIER Date 1-16-68
Date APR 26 '71	Indexed

F. B. PG. 18

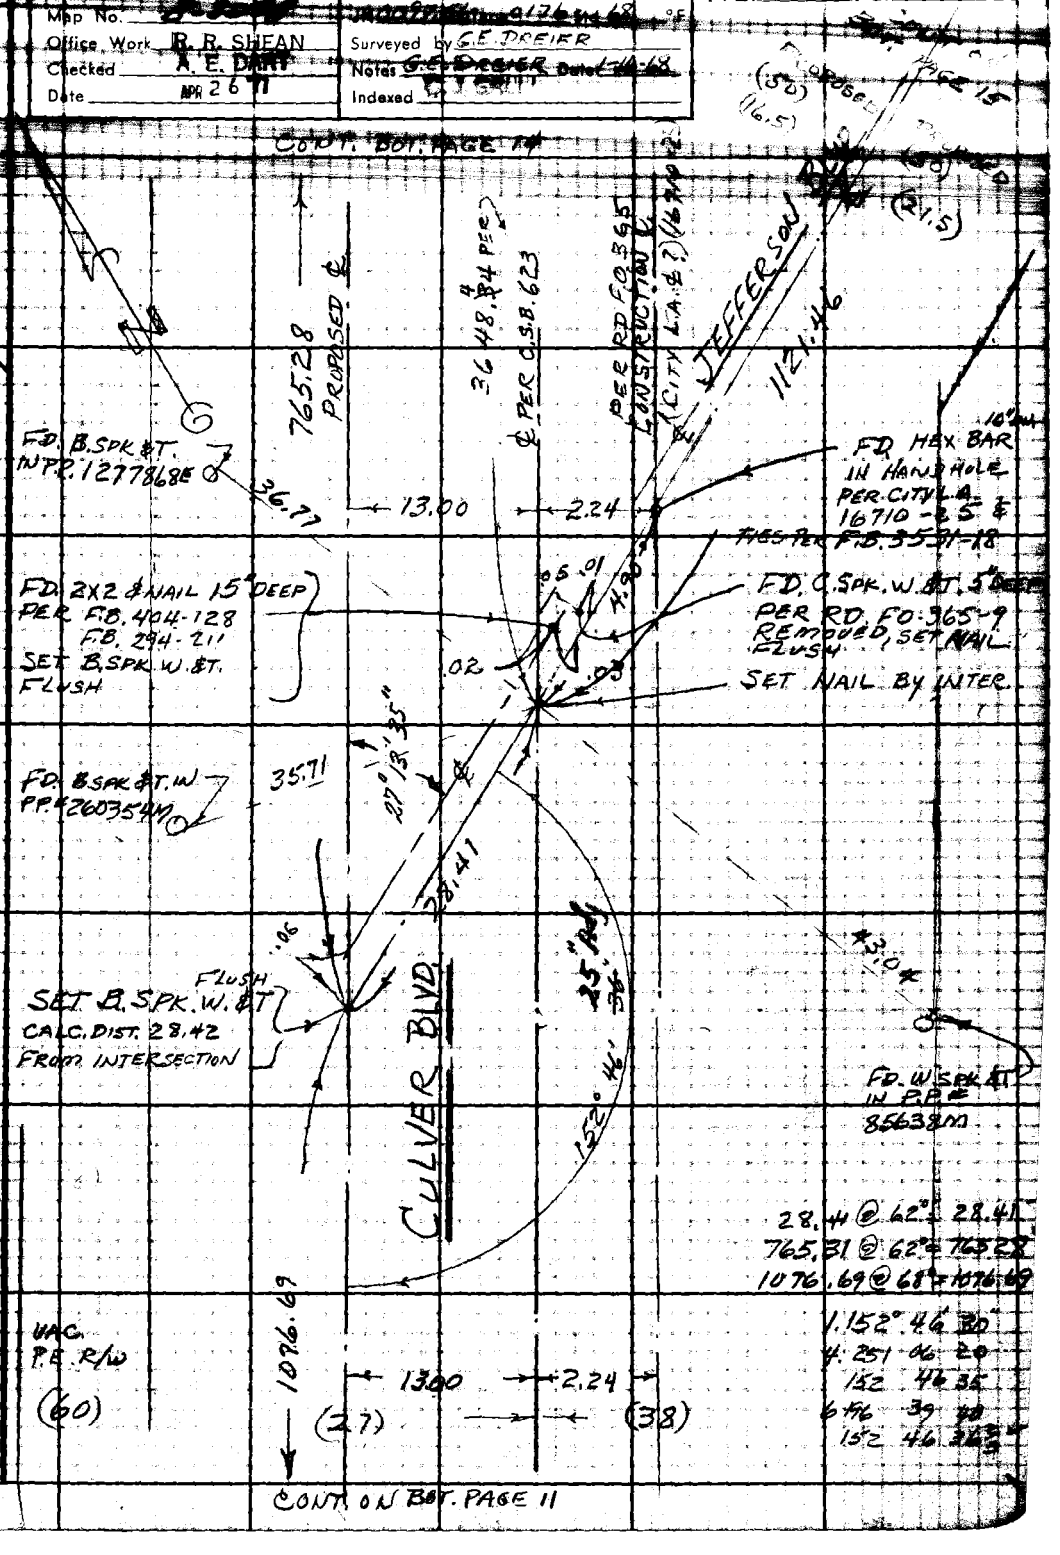

Note: Any Additions or Changes on This Sheet Must be Made or Circled in Red Ink With Date and Name of Person Making Change.

Do not extend this side of this line.

PLEASE RETURN TO LOS ANGELES COUNTY ENGINEER 403 LOS ANGELES COUNTY ENGINEERING BLDG.

76F3095 C.E. #310 6-62

PWFB 1015 CONT. ON BOT. PAGE 18 639

F. B. ~~3442~~ PG ~~44~~

W.S. 23, B-3

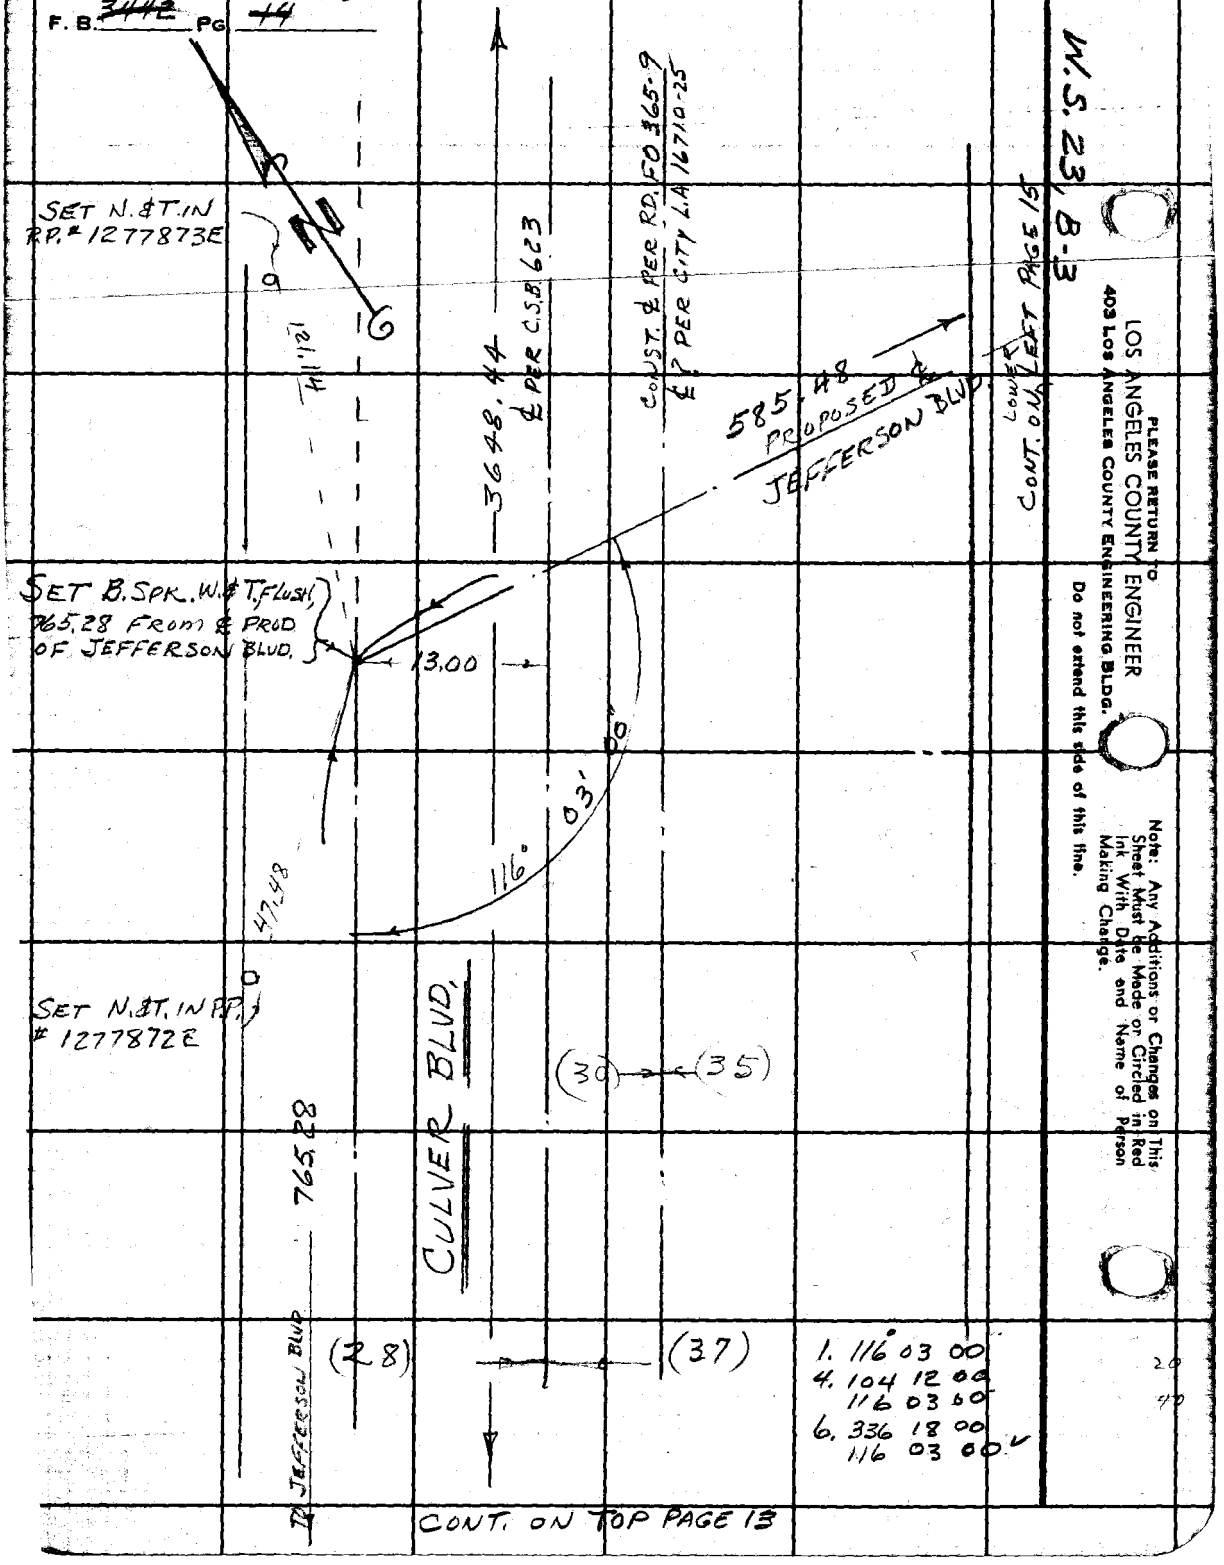

1. 116 03 00
4. 104 12 00
116 03 00
6. 336 18 00
116 03 00 ✓

20
40

CONT. ON TOP PAGE 13

LOS ANGELES COUNTY ENGINEER
403 Los Angeles County Engineering Bldg.
PLEASE RETURN TO
Do not extend this side of this line.

Note: Any Additions or Changes on This Sheet Must Be Made or Circled in Red Ink With Date and Name of Person Making Change.

PWFB 1015

640

Notes Ck'd by	Survey of [illegible]
Map No. [illegible]	JN 0097.56 Tape 0185 Std 68 °F
Office Work R. R. SHEAN	Surveyed by [illegible]
Checked A. E. DART	Notes G.E. DREIER Date 11-24-67
Date APR 26 '71	Indexed [illegible]

F. B. [illegible] PG. [illegible]

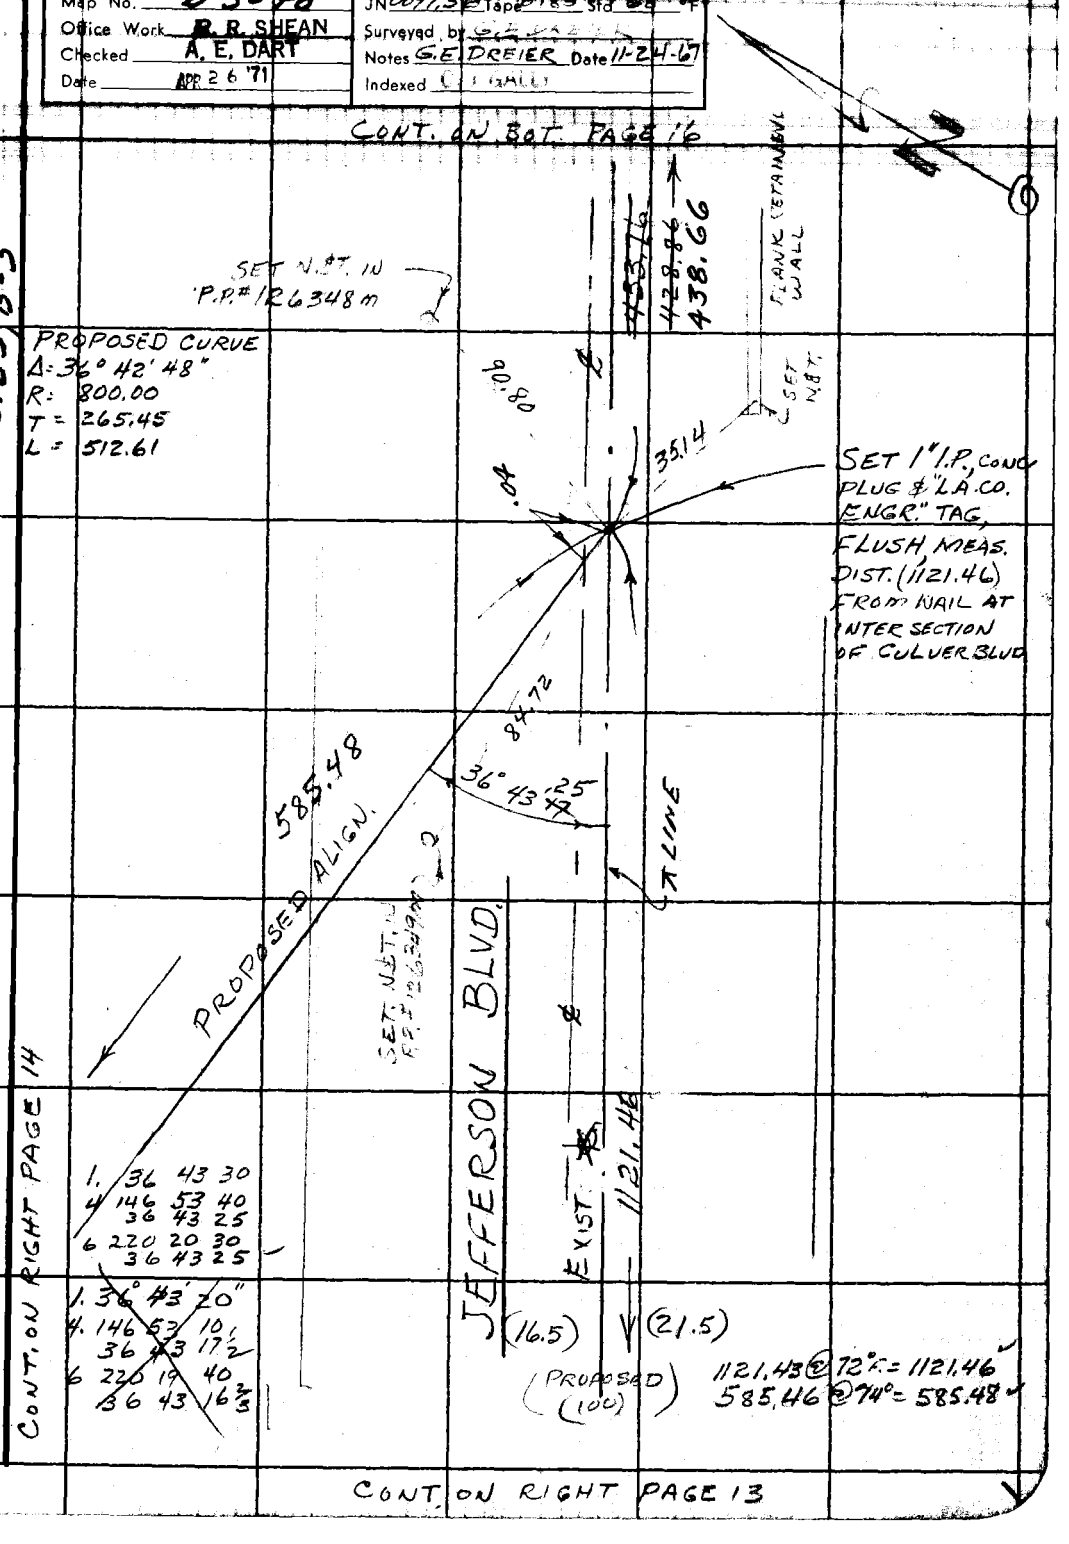

Note: Any Additions or Changes on this Sheet Must be Made or Circled in Red Ink With Date and Name of Person Making Change.

Do not extend this side of this line.

PLEASE RETURN TO
LOS ANGELES COUNTY ENGINEER
403 LOS ANGELES COUNTY ENGINEERING BLDG.

76F309S CE # 310 3-61

PWFB 1015 CONT. BOT PAGE 17 641

F. B. ~~3442~~ PG. 46

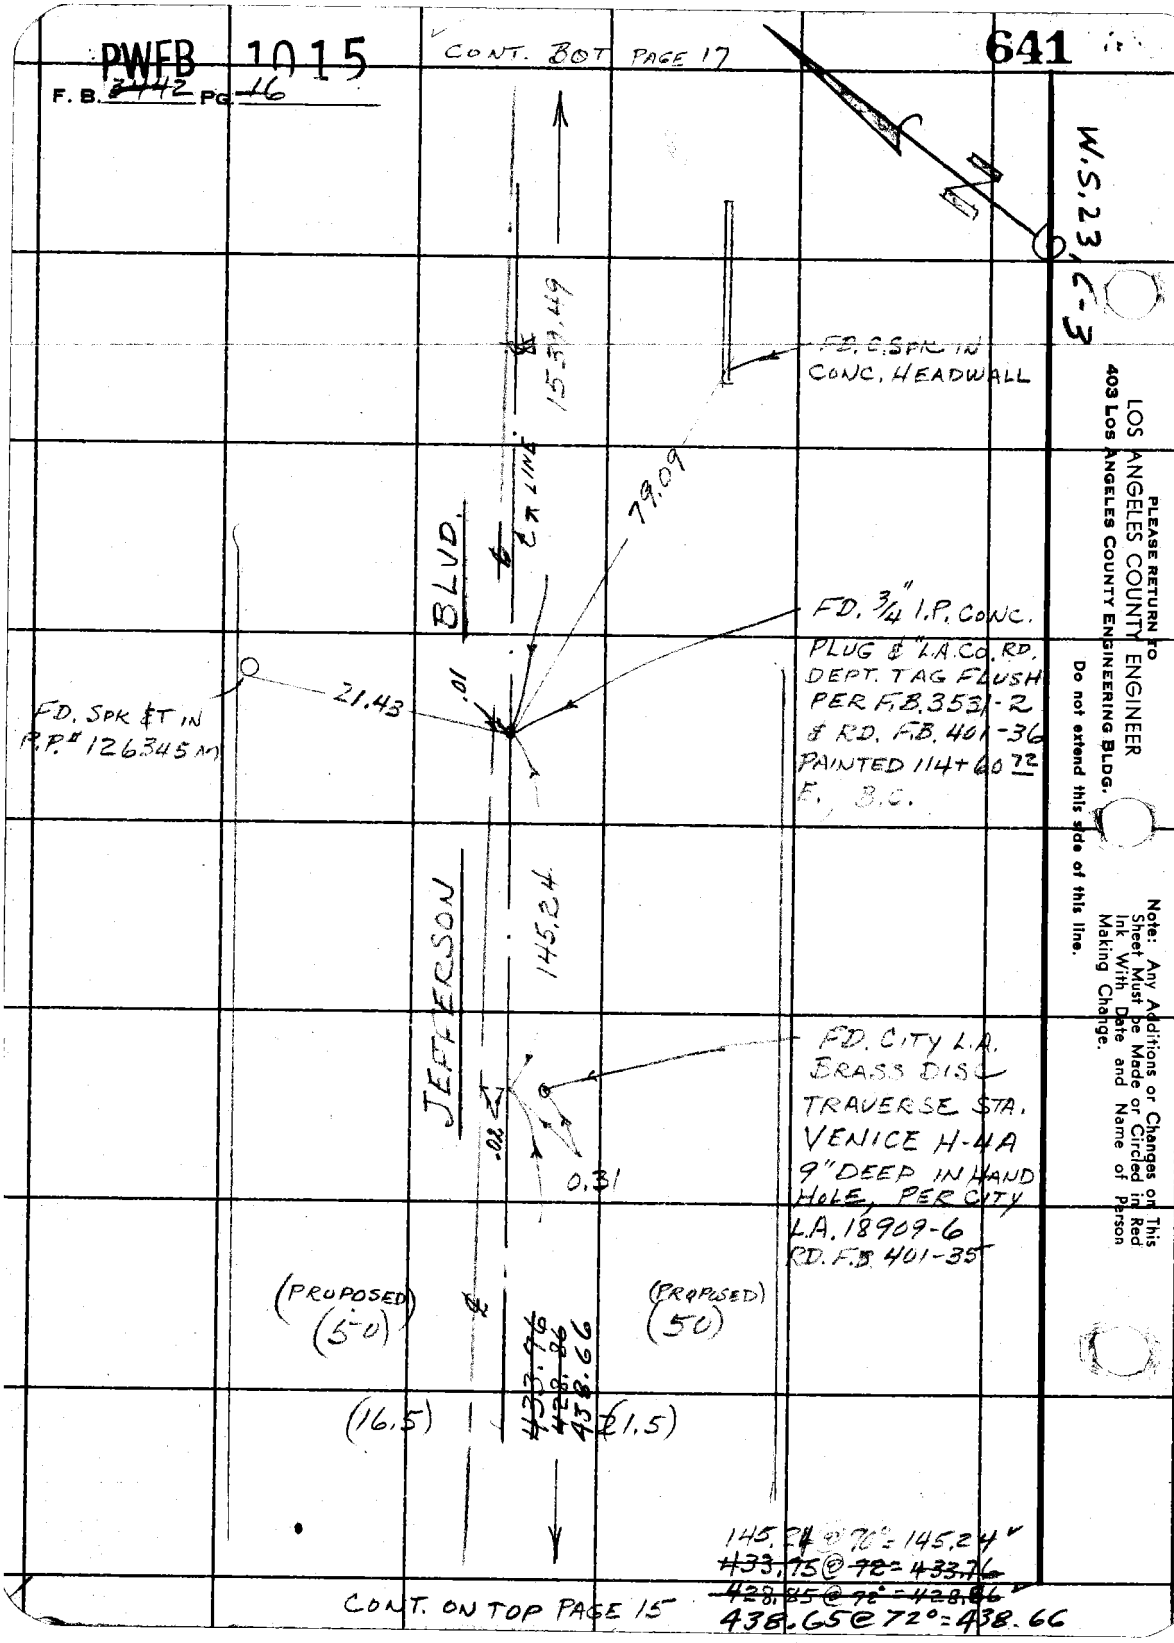

CONT. ON TOP PAGE 15

PLEASE RETURN TO
LOS ANGELES COUNTY ENGINEER
403 LOS ANGELES COUNTY ENGINEERING BLDG.
Do not extend this side of this line.
Note: Any Additions or Changes on This Sheet Must be Made or Circled in Red Ink With Date and Name of Person Making Change.

PWFB 1015

642

Notes Ck'd by A. E. DART	Survey of
Map No. 5-3048	JN 0097-6 Tape 185 Std 68 °F
Office Work R. R. SHEAN	Surveyed by G. E. DREIER
Checked A. E. DART	Notes G.E. DREIER Date 11-29-67
Date APR 26 '71	Indexed

F. B. ____ PG. ____

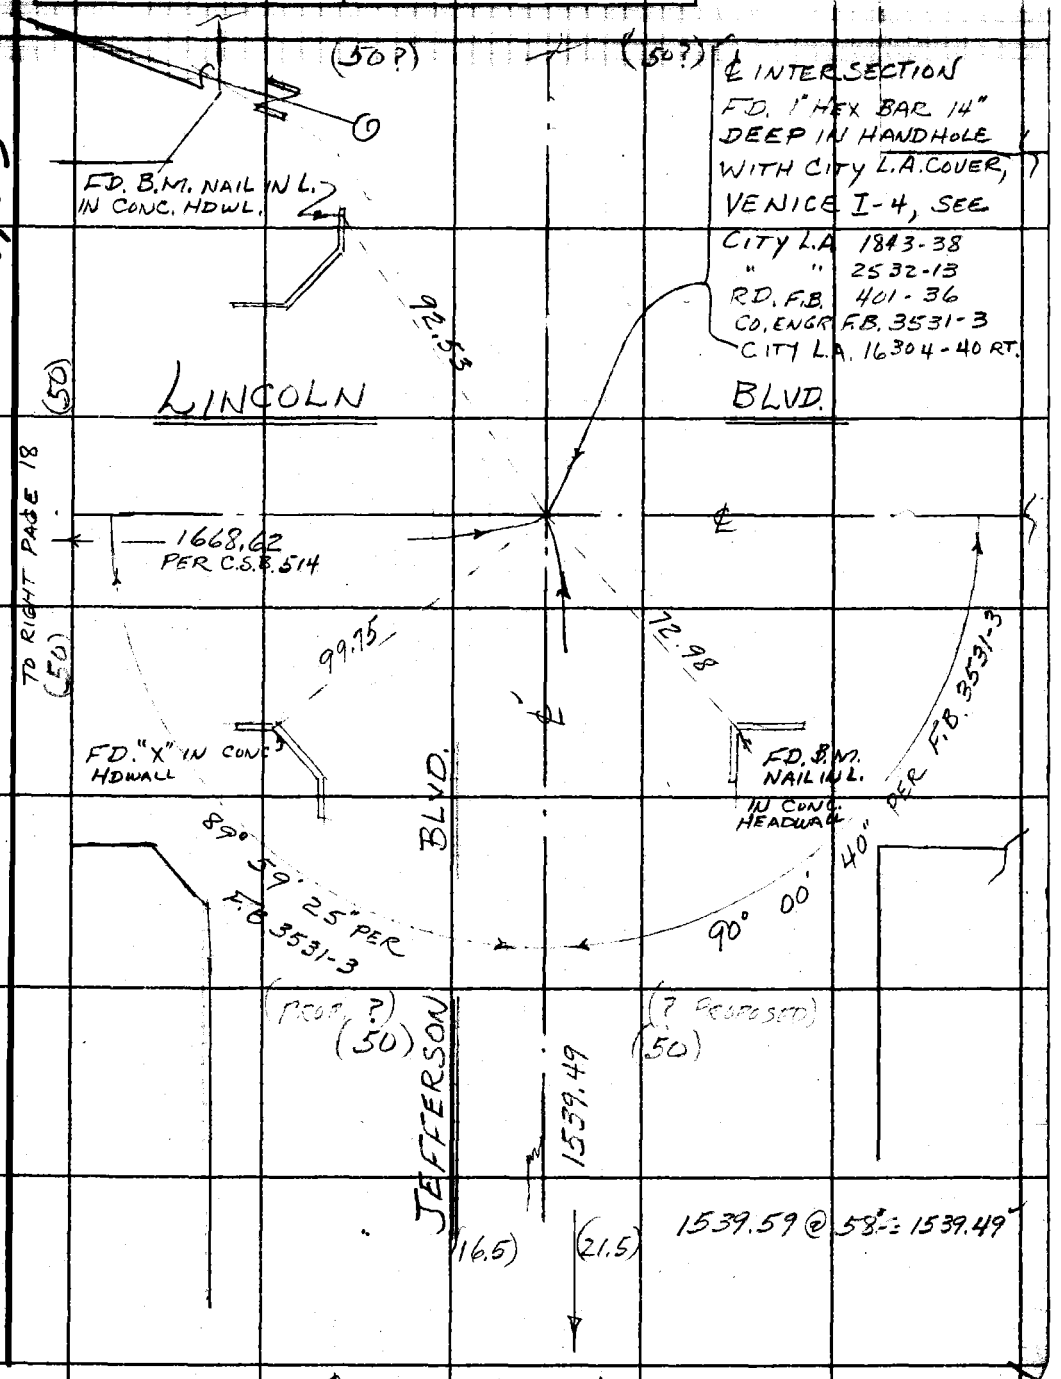

CONT. TOP PAGE 16

W.S. 23, C-3

Note: Any Additions or Changes on This Sheet Must be Made or Circled in Red Ink With Date and Name of Person Making Change.

Do not extend this side of this line.

PLEASE RETURN TO
LOS ANGELES COUNTY ENGINEER
403 LOS ANGELES COUNTY ENGINEERING BLDG.

76F3095 CE # 310 3-61

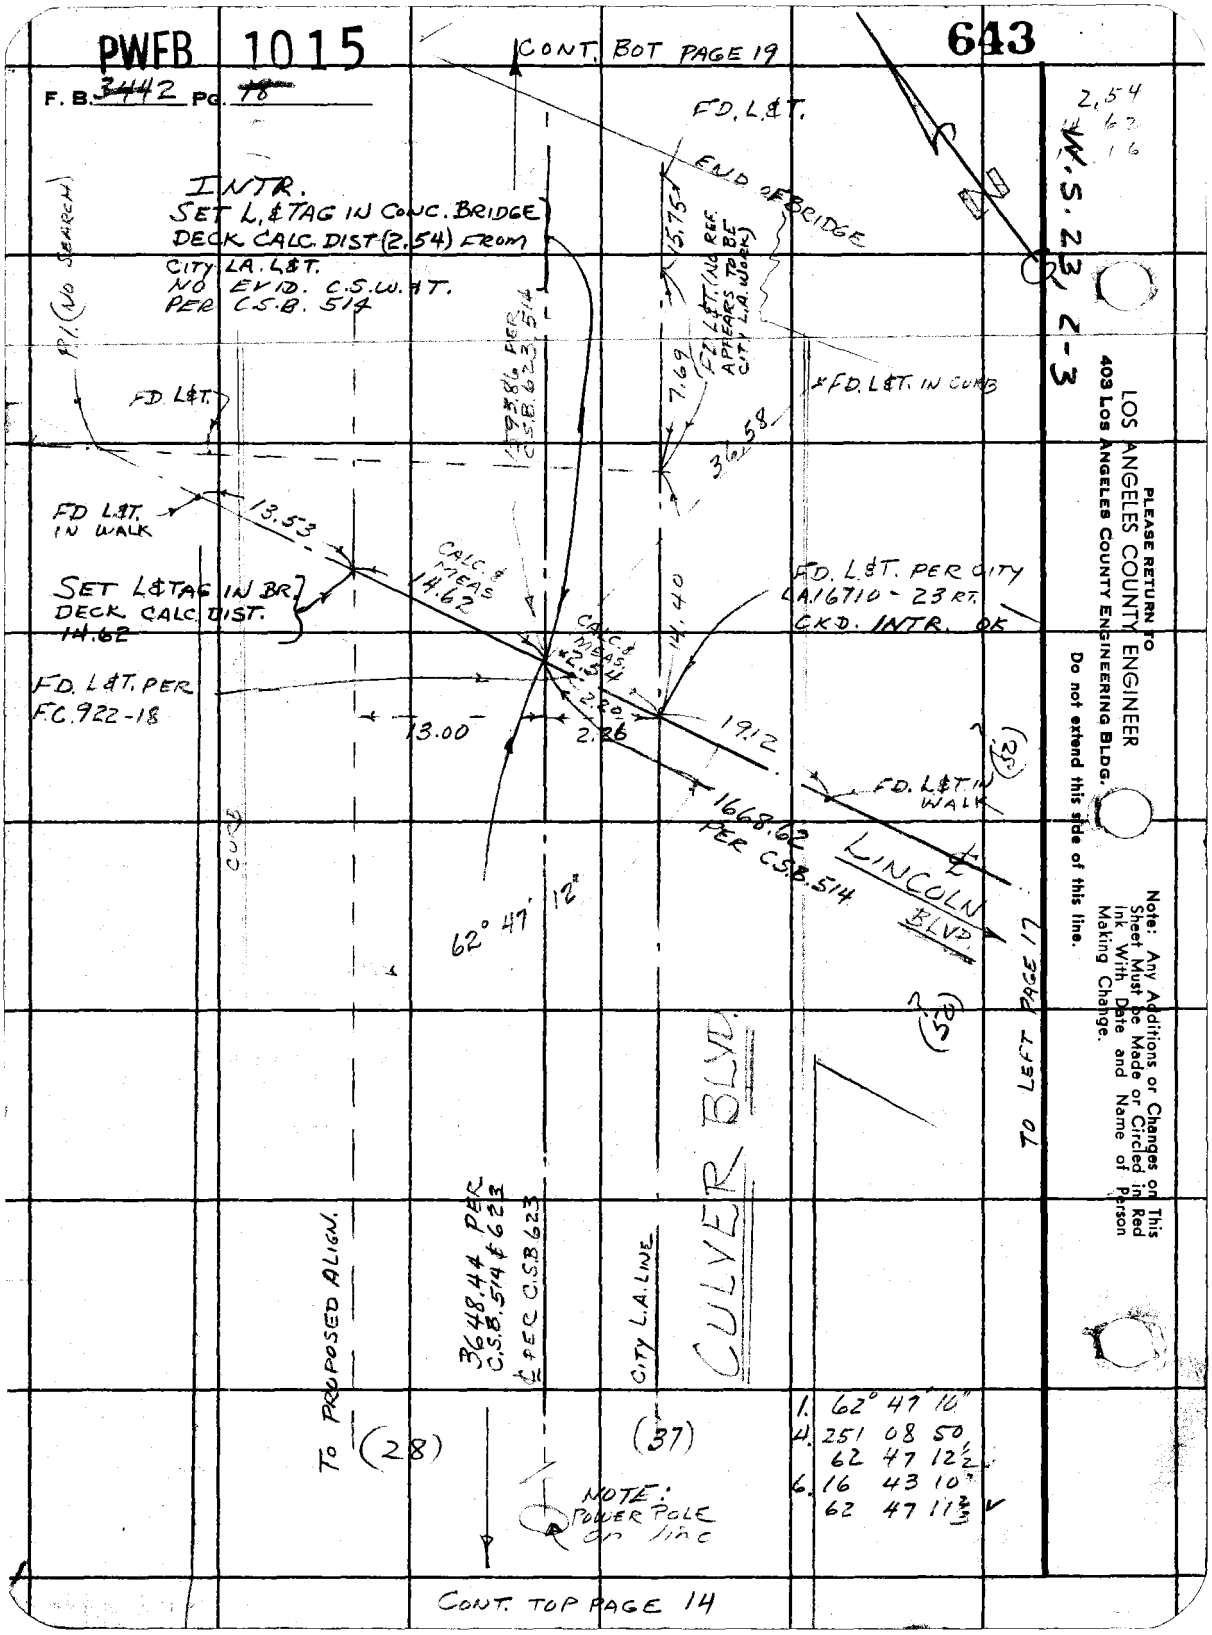
PWFB 1015
643
F. B. 3442 PG. 18
CONT. BOT PAGE 19
FD. L&T.
END OF BRIDGE
INTR.
SET L.&TAG IN CONC. BRIDGE
DECK CALC. DIST (2.54) FROM
CITY LA. L&T.
NO EVID. C.S.W. & T.
PER C.S.B. 514
15.75
FD. L&T. (NO REF. APPEARS TO BE CITY L.A. WORK)
7.69
FD. L&T. IN CURB
36.58
FD. L&T.
FD. L&T. IN WALK
13.53
CALC. & MEAS. 14.62
SET L&TAG IN BR.
DECK CALC. DIST.
14.62
FD. L&T. PER CITY
LA.16710 - 23 RT.
CKD. INTR. OK
14.40
CALC. & MEAS. 2.54
2.20
2.26
FD. L&T. PER
F.C. 922-18
13.00
19.12
FD. L&T. IN WALK
1668.62
PER C.S.B. 514
LINCOLN BLVD.
62° 47' 12"
CURB
TO LEFT PAGE 17
CULVER BLVD.
3648.44 PER C.S.B. 514 & 623
℄ PER C.S.B. 623
CITY L.A. LINE
TO PROPOSED ALIGN.
(28)
(37)
NOTE: POWER POLE on line
1. 62° 47' 10"
4. 251 08 50
62 47 12½
6. 16 43 10"
62 47 11⅔
CONT. TOP PAGE 14
W.S. 23, 2-3
2.54
62
16
PLEASE RETURN TO
LOS ANGELES COUNTY ENGINEER
403 LOS ANGELES COUNTY ENGINEERING BLDG.
Do not extend this side of this line.
Note: Any Additions or Changes on This Sheet Must be Made or Circled in Red Ink With Date and Name of Person Making Change.

PWFB 1015

644, 645

Notes Ck'd by A. E. DART	Survey of JEFF
Map No. [illegible]	[illegible] Tone 0176 Std 68 °F
Office Work R. R. SHEAN	Surveyed by G. E. DREIER
Checked A. E. DART	Notes G. E. DREIER Date 1-22-68
Date APR 26 '71	Indexed C. L. GAULT

F. B. 3442 PG. 79

CONT. BOT. PG. 60

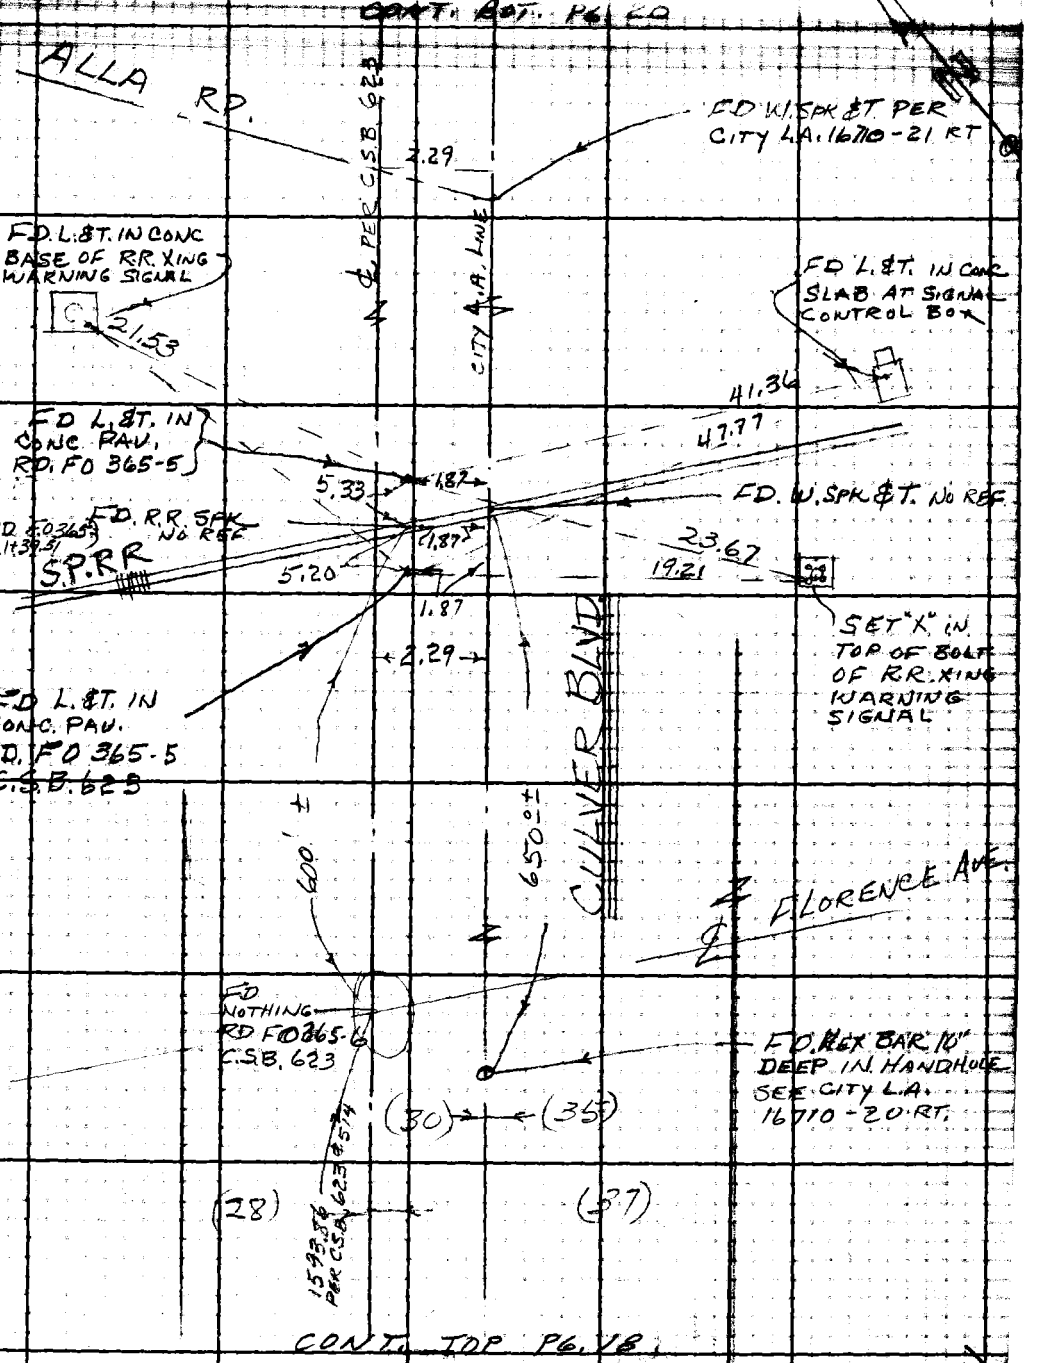

CONT. TOP PG. 78

W.S. 23, C-3

Note: Any Additions or Changes on This Sheet Must be Made or Circled in Red Ink With Date and Name of Person Making Change.

Do not extend this side of this line.

PLEASE RETURN TO LOS ANGELES COUNTY ENGINEER 403 LOS ANGELES COUNTY ENGINEERING BLDG.

76F3095 CE #310 6-62

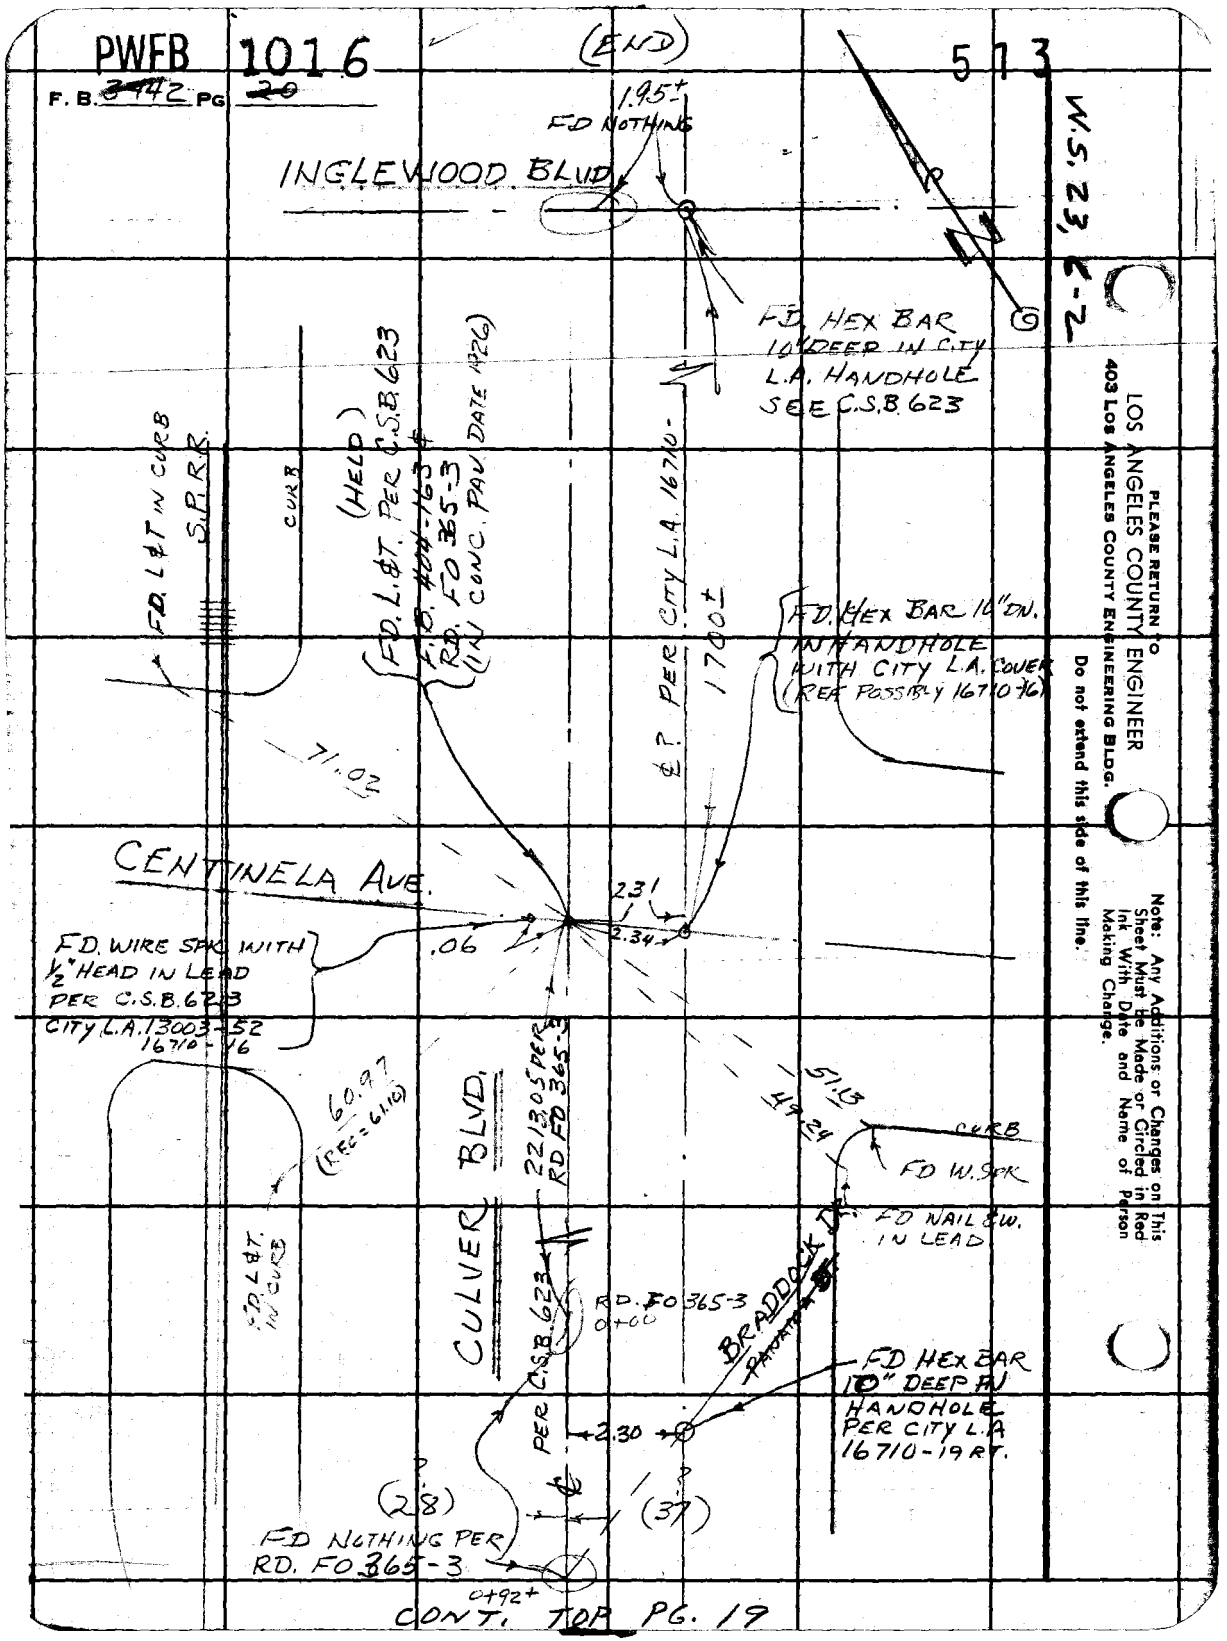
PWFB 1016
F. B. 3442 PG 20
(END)
513
W.S. 23, K-2
1.95±
FD NOTHING
INGLEWOOD BLVD
FD. HEX BAR
10" DEEP IN CITY
L.A. HANDHOLE
SEE C.S.B. 623
FD. L&T IN CURB
S.P.R.R.
CURB
(HELD)
FD. L.&T. PER C.S.B. 623
F.B. 404-163
RD. FO 365-3
(IN CONC. PAV. DATE 1926)
℄? PER CITY L.A. 16710-
1700±
FD. HEX BAR 10" DN.
IN HANDHOLE
WITH CITY L.A. COVER
(REF POSSIBLY 16710-16)
71.02
CENTINELA AVE.
2.31
2.34
.06
FD. WIRE SPK WITH
1/2" HEAD IN LEAD
PER C.S.B. 623
CITY L.A. 13003-52
16710-16
60.97
(REC=61.10)
CULVER BLVD.
2213.05 PER
RD FO 365-3
51.13
49.24
CURB
FD W. SPK
FD NAIL & W.
IN LEAD
FD. L&T.
IN CURB
PER C.S.B. 623
RD. FO 365-3
0+00
BRADDOCK DR.
FD HEX BAR
10" DEEP IN
HANDHOLE
PER CITY L.A.
16710-19 RT.
2.30
(28)
(37)
FD NOTHING PER
RD. FO 365-3
0+92+
CONT. TOP PG. 19
PLEASE RETURN TO
LOS ANGELES COUNTY ENGINEER
403 LOS ANGELES COUNTY ENGINEERING BLDG.
Do not extend this side of this line.
Note: Any Additions or Changes on This Sheet Must be Made or Circled in Red Ink With Date and Name of Person Making Change.

PWFB 0915

138,139,140,141

Notes Ck'd by		Survey of	JEFFERSON BLVD
Map No.	[illegible]		
Office Work	R. R. SHEAN	Surveyed by	G.E. DREIER
Checked	A. E. DART	Notes	G.E. DREIER Date 1-19-60
Date	APR 26 '71	Indexed	

F.B. 2442 Pg. 21

TO EAT PAGE 12

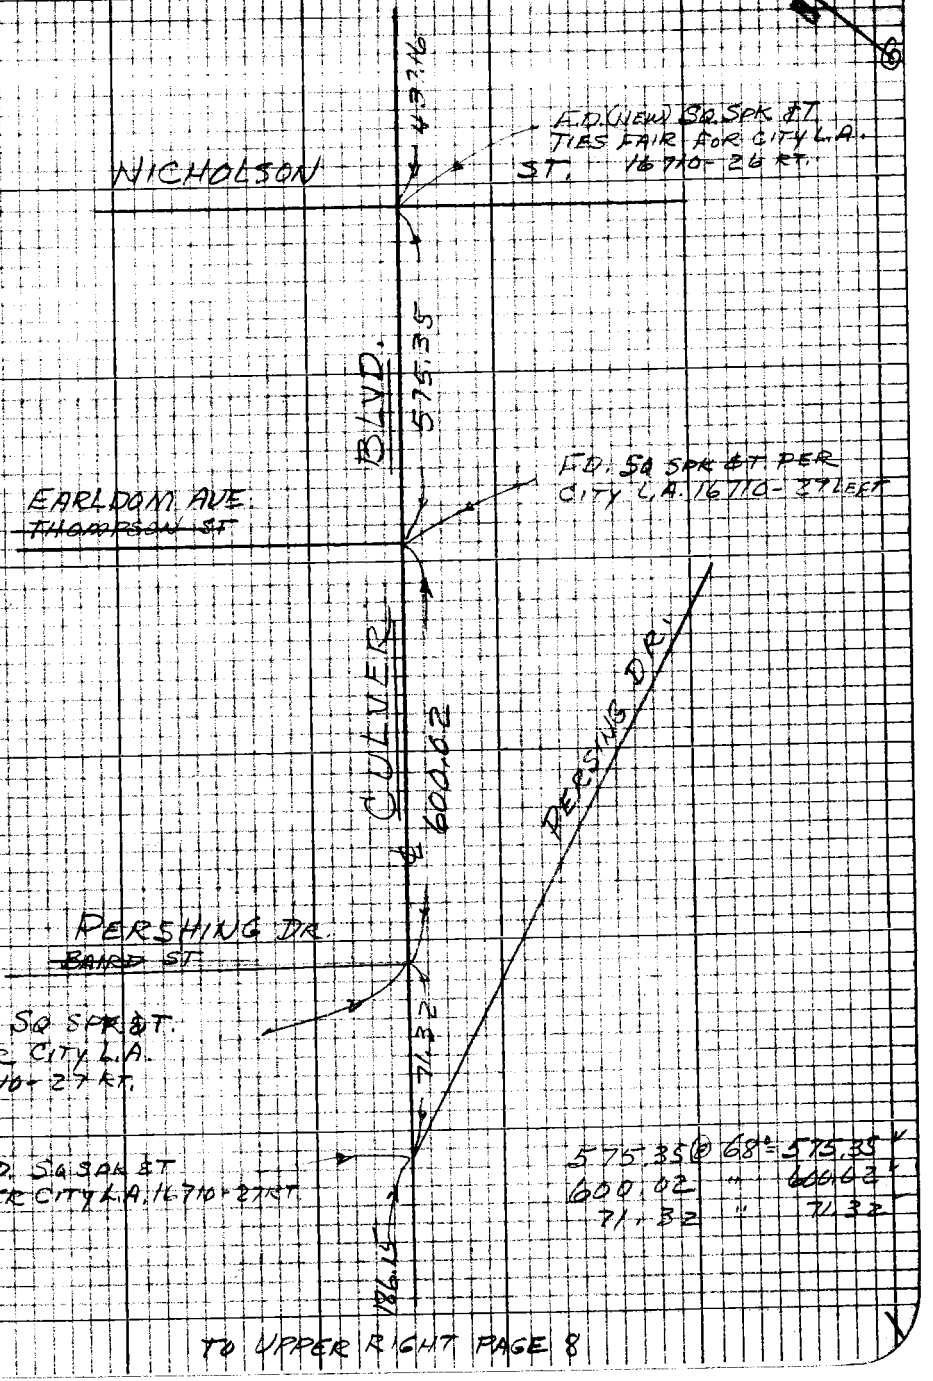

575.35 @ 68° = 575.35
600.02 " 600.02
71.32 " 71.32

TO UPPER RIGHT PAGE 8

W.S. 23, 8-4

Note: Any Additions or Changes on this Sheet Must be Made or Circled in Red Ink With Date and Name of Person Making Change

Do not extend this side of this line.

PLEASE RETURN TO
LOS ANGELES COUNTY ENGINEER
403 LOS ANGELES COUNTY ENGINEERING BLDG.

76P3098 CE #310 8-66

F.B. 3442 Pg. 22

PLEASE RETURN TO
LOS ANGELES COUNTY ENGINEER
403 LOS ANGELES COUNTY ENGINEERING BLDG.

Do not extend this side of this line.

Note: Any Additions or Changes on this Sheet Must be Made or Circled in Red Ink With Date and Name of Person Making Change

Notes Ck'd. by	Survey of
Map No. B-3048	JN 0097.56 Tape Std °F
Office Work R. B. SHEAN	Surveyed by
Checked A. E. DART	Notes Date 11- 67
Date APR 26 '71	Indexed

F. B. PG.

JEFFERSON BLVD.

JOB NO. 0097.56

LOCATION OF EXISTING FILL & DITCH, PAGE 24 & 25

LOCATION OF OIL WELL PAGE 27

Note: Any Additions or Changes on This Sheet Must be Made or Circled in Red Ink With Date and Name of Person Making Change.

PLEASE RETURN TO
LOS ANGELES COUNTY ENGINEER
403 LOS ANGELES COUNTY ENGINEERING BLDG.

Do not extend this side of this line.

76F309S CE # 310 3-61

CONT BOT PAGE 25

F. B. 3442 PG. 24

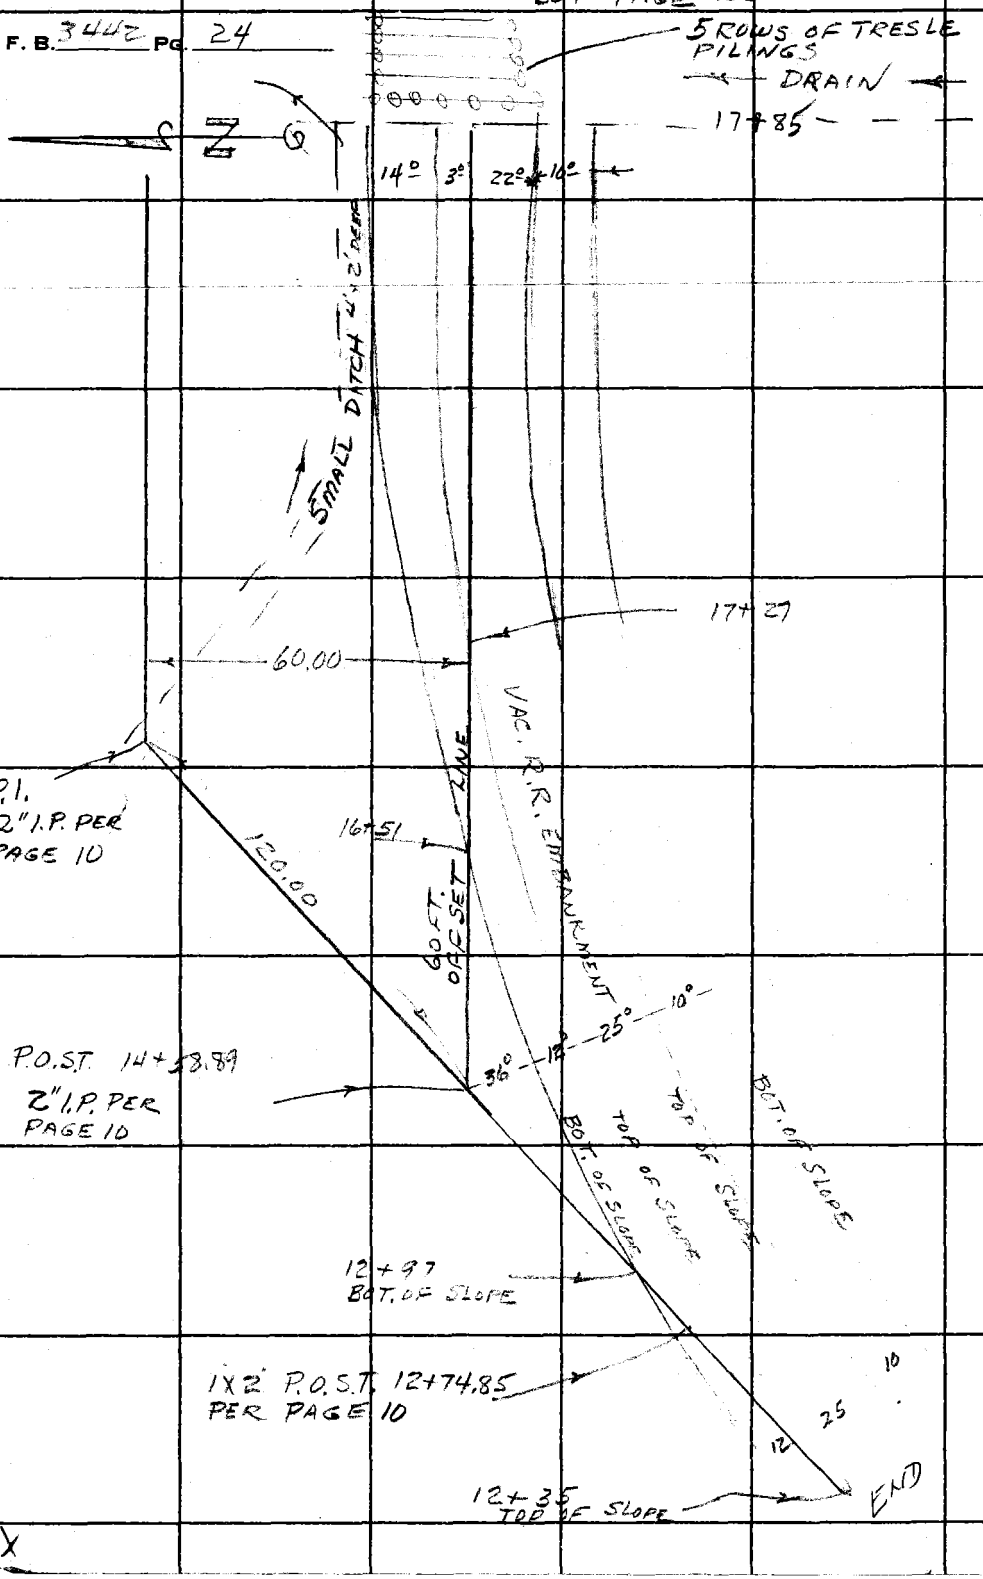

PLEASE RETURN TO
LOS ANGELES COUNTY ENGINEER
403 LOS ANGELES COUNTY ENGINEERING BLDG.
Do not extend this side of this line.
Note: Any Additions or Changes on This Sheet Must be Made or Circled in Red Ink With Date and Name of Person Making Change.

Notes Ck'd by	Survey of	F. B. PG.
Map No. B-3048	JN [illegible] Tape Std °F	
Office Work R. R. SHEAN	Surveyed by [illegible]	
Checked A. E. DART	Notes G. E. DREIER Date 11-29-67	
Date APR 26 '71	Indexed	

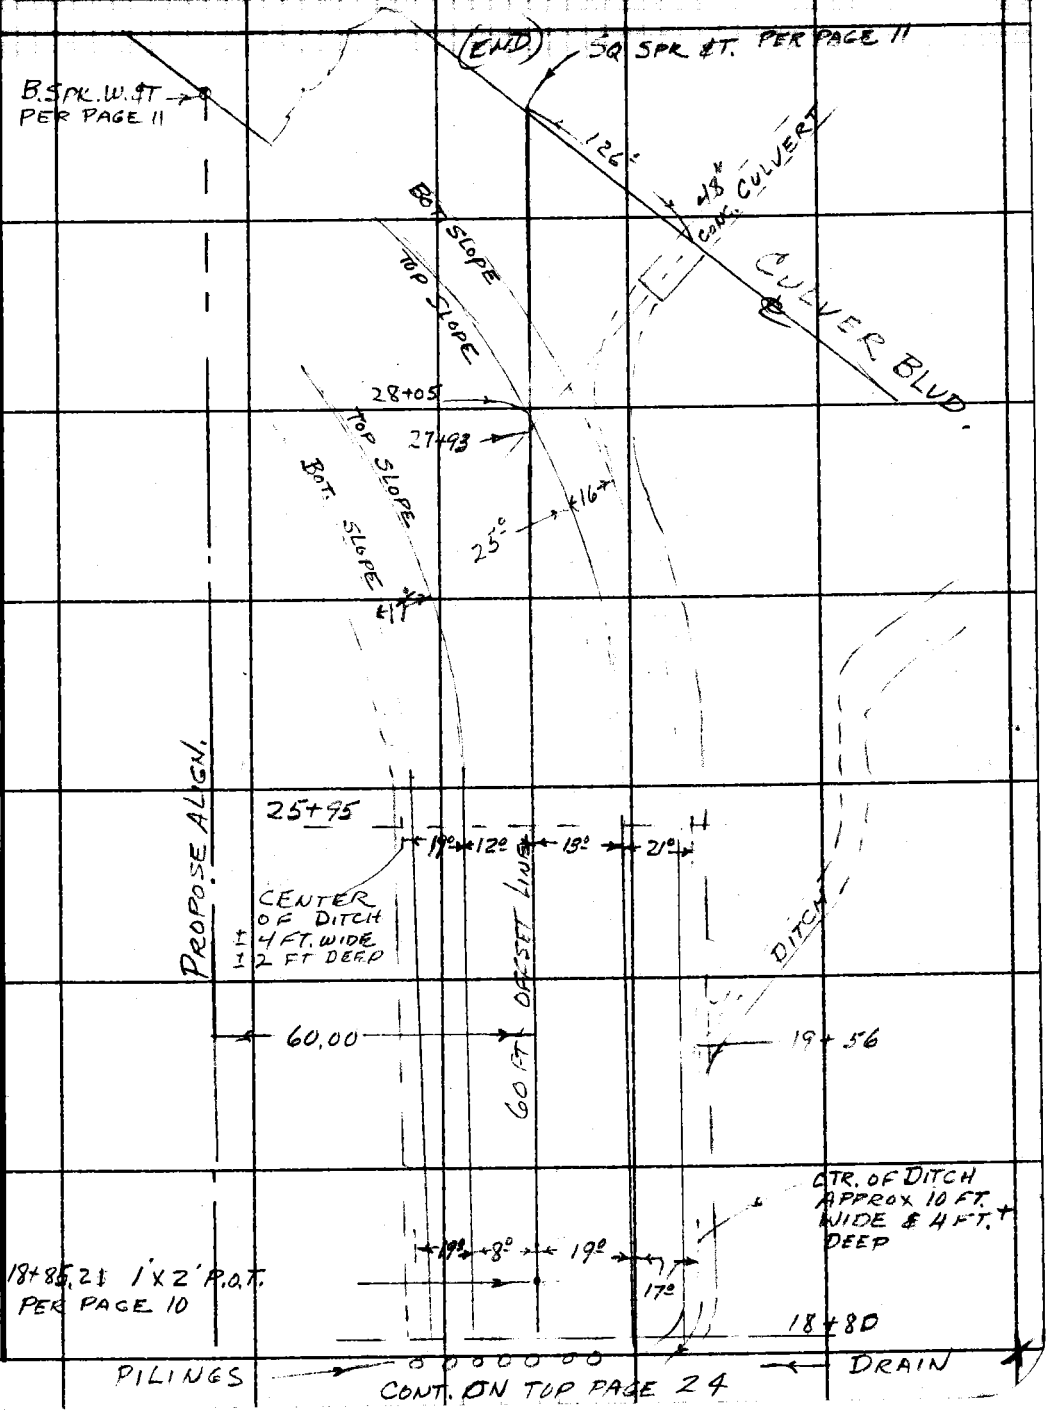

CONT. ON TOP PAGE 24

Note: Any Additions or Changes on This Sheet Must be Made or Circled in Red Ink With Date and Name of Person Making Change.

Do not extend this side of this line.

PLEASE RETURN TO
LOS ANGELES COUNTY ENGINEER
403 LOS ANGELES COUNTY ENGINEERING BLDG.

76F309S CE # 310 3-61

F. B. 3442 PG. 26

PLEASE RETURN TO
LOS ANGELES COUNTY ENGINEER
403 Los Angeles County Engineering Bldg.

Do not extend this side of this line.

Note: Any Additions or Changes on This Sheet Must be Made or Circled in Red Ink With Date and Name of Person Making Change.

Notes Ck'd. by	Survey of
Map No. B-3048	JN 0097.56 Tape Std °F
Office Work R. R. SHEAN	Surveyed by
Checked A. E. DART	Notes G. E. DREIER Date 11-24-67
Date APR 26 '71	Indexed MAP

F. B. PG.

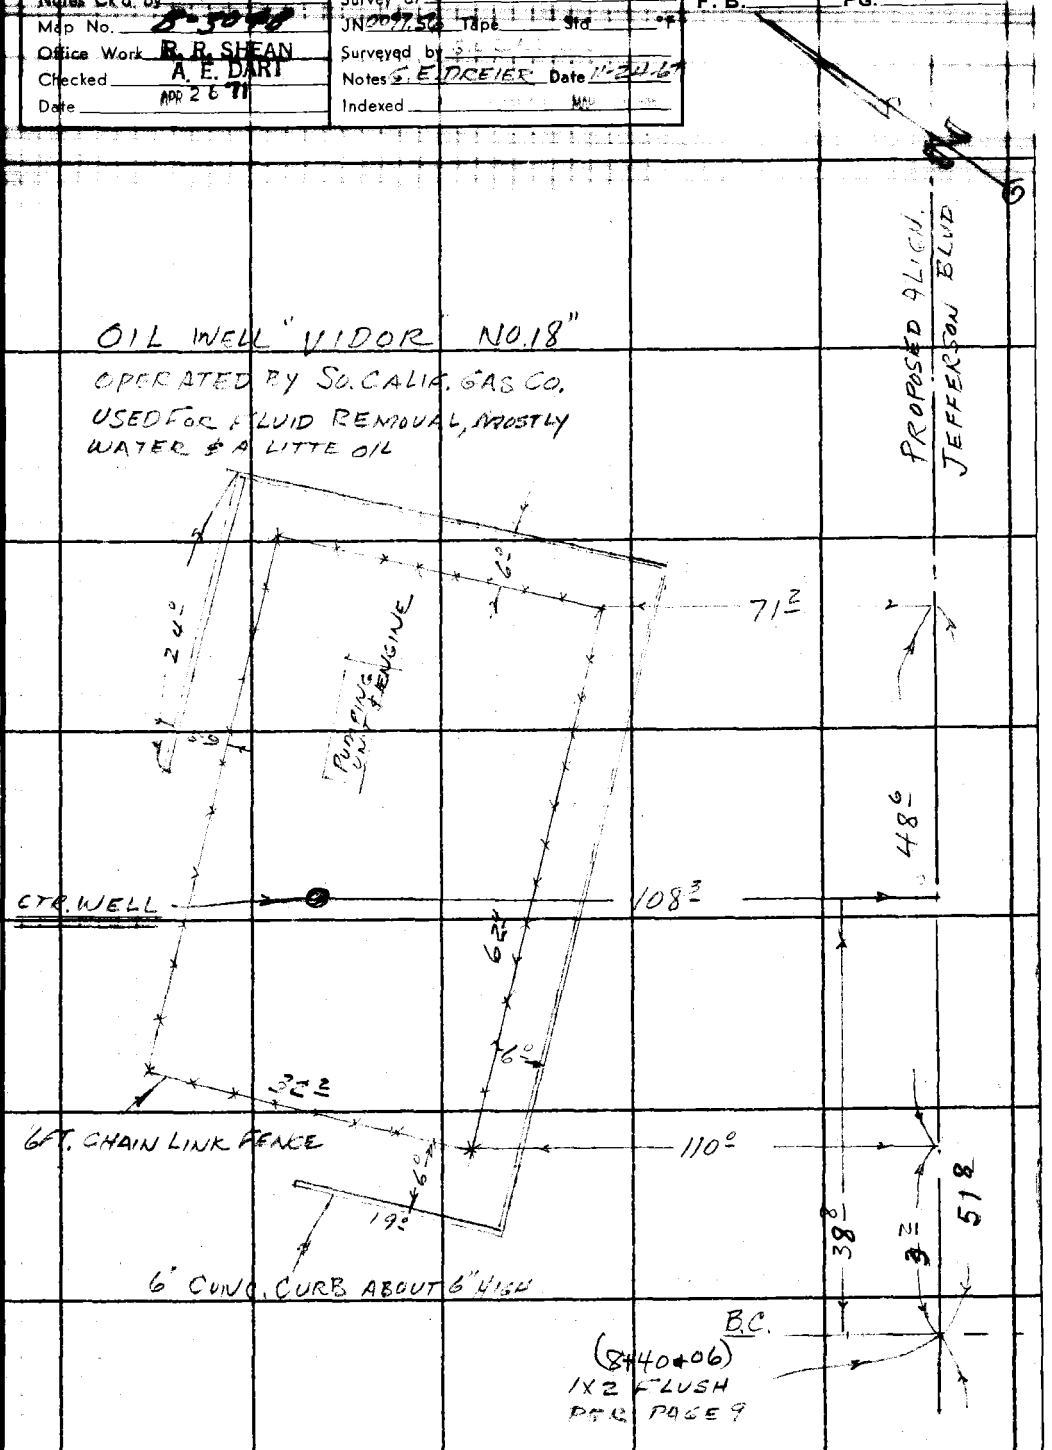

Note: Any Additions or Changes on This Sheet Must be Made or Circled in Red Ink With Date and Name of Person Making Change.

Do not extend this side of this line.

PLEASE RETURN TO
LOS ANGELES COUNTY ENGINEER
403 LOS ANGELES COUNTY ENGINEERING BLDG.

76F309S CE # 310 3-61

PLEASE RETURN TO
LOS ANGELES COUNTY ENGINEER
403 LOS ANGELES COUNTY ENGINEERING BLDG.

Note: Any Additions or Changes on This Sheet Must be Made or Circled in Red Ink With Date and Name of Person Making Change.

Do not extend this side of this line.

F. B. 3442 PG. 28