Notes Ck'd by _____
Map No. _____
Office Work _____
Checked _____
Date _____

Survey of Sections in T5N/R15W
JN 0302.01 Tape EAST Std 82°F
Surveyed by FE Brooks
Notes AEB Date 6-11-02
Indexed C. J. GALL APR 14 '03

F.B. 3497 Pg. 3

SN 0302.01

SECTIONS IN T 5 N R 15 W

ROUQUET CANYON AREA

FE Brooks
N Smith
G Quizada
R Moore
T. Ohashi
C. Johnson
T. Miyahira

Note: Any Additions or Changes as this Sheet Must be Made or Checked In Ink With Date and Name of Person Making Change.

Do not unbind ... of this Map.

RETURN TO
LOS ANGELES COUNTY ENGINEER
900 Los Angeles County Engineering Bld.

PLEASE RETURN TO
LOS ANGELES COUNTY ENGINEER
409 Los Angeles County Engineering Bldg.

Note: Any Additions or Changes on this Sheet Must be Made or Circled in Red Ink With Date and Name of Person Making Change.

Do not extend ... of this line.

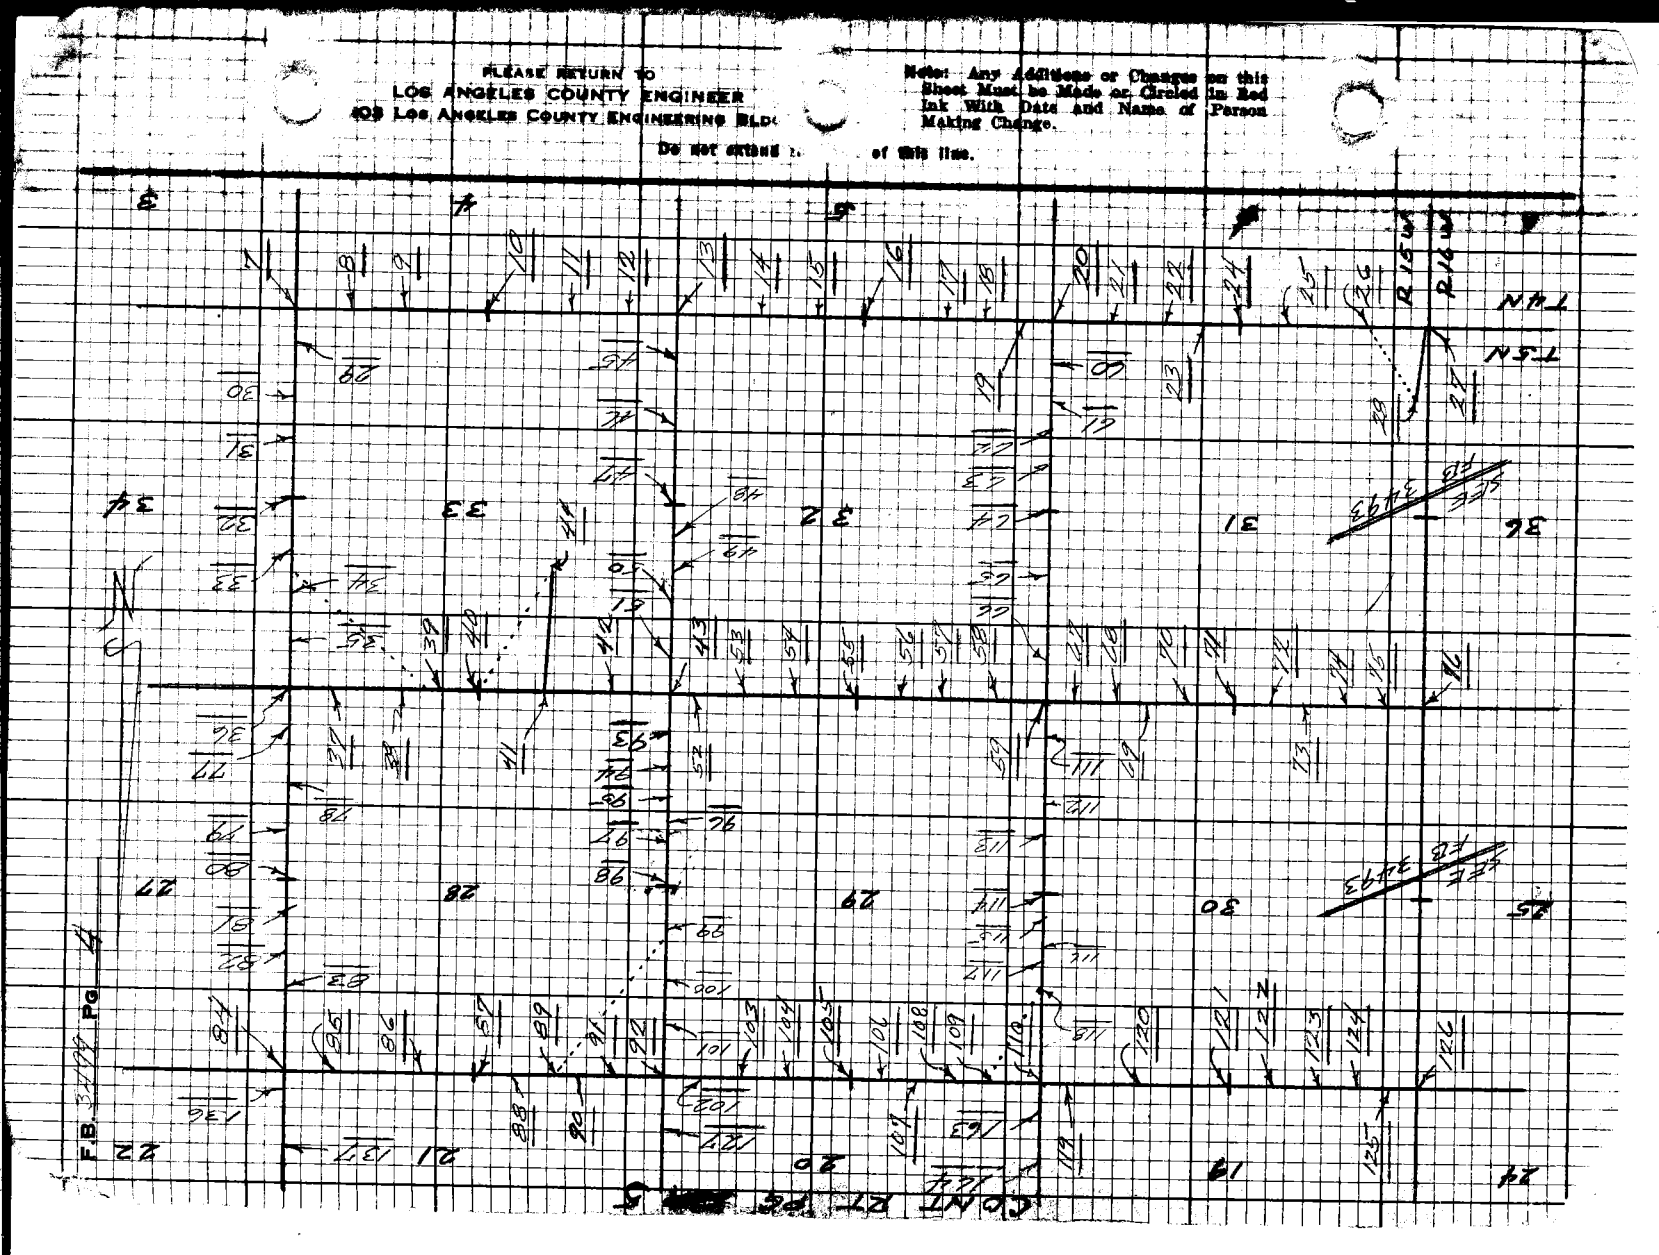

78F3098 CE# 310

PLEASE RETURN TO
LOS ANGELES COUNTY ENGINEER
3 LOS ANGELES COUNTY ENGINEERING B

Note: Any Additions or Changes on this Sheet Must be Made or Circled in Red Ink With Date and Name of Person Making Change.

Do not extend this side of this line.

CO RT RT PG 6

Notes Ck'd by
Map No.
Office Work
Checked
Date

Survey of Section 12 T2S R11W
Surveyed by FEB & Crews
Notes
Indexed FEB J. GALLI Date 4/14/72

F.B. 3490 Pg. 65

RIGHT

FB 3490

SEE FB 3493

SEE FB 3490

SEE FB 3493

SEE FB 3490

SEE FB 3493

COAST RT PG 4

PLEASE RETURN TO
LOS ANGELES COUNTY ENGINEER
[illegible] LOS ANGELES COUNTY ENGINEERING B[illegible]

Note: Any Additions or Changes on this Sheet Must be Made or Circled in Red Ink With Date and Name of Person Making Change.

Do not extend this side of this line.

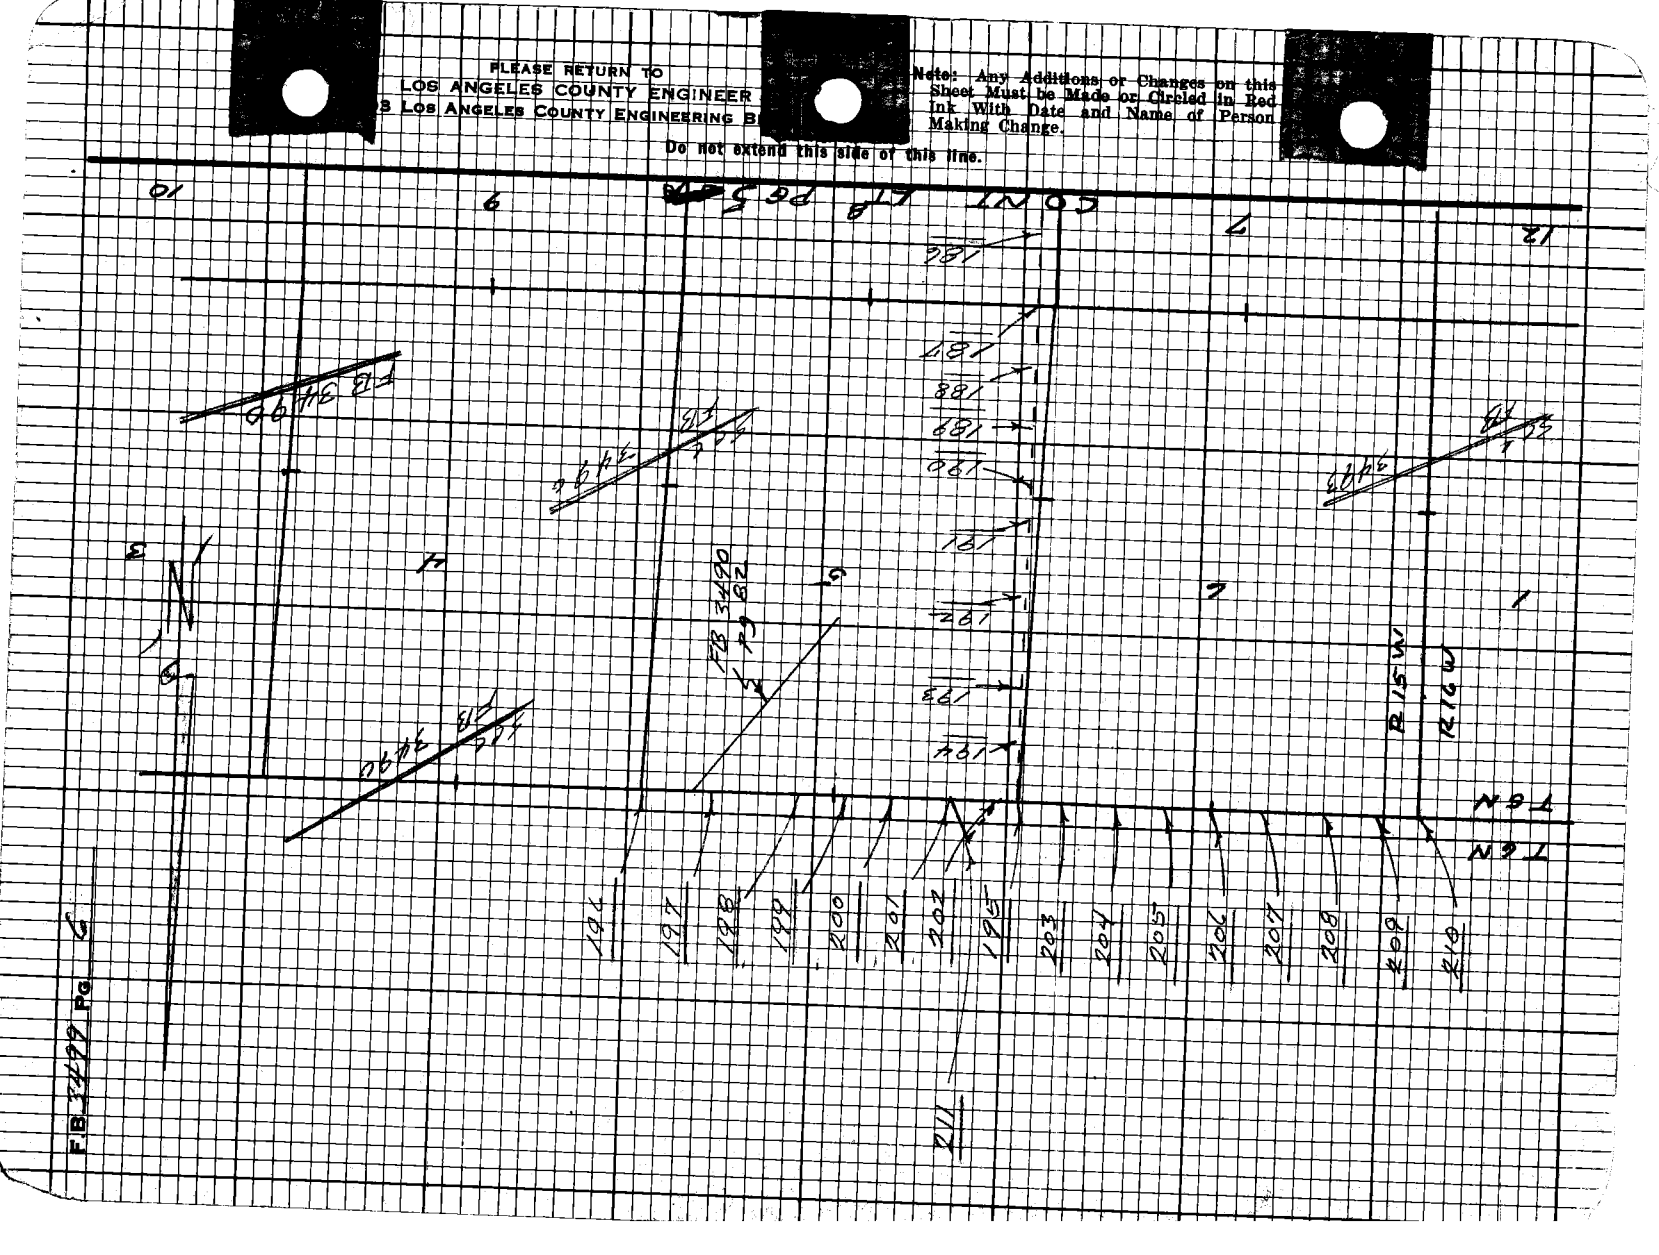

76F309S CE#310 3-68

PLEASE RETURN TO
COUNTY OF LOS ANGELES
DEPARTMENT OF COUNTY ENGINEER
403 LOS ANGELES COUNTY ENGINEERING BLDG.

Do not extend this side of this line.

Note: Any Additions or Changes on This Sheet Must be Made or Circled in Red Ink With Date and Name of Person Making Change.

Gls. 78, A-6

Notes Ck'd by
Mbp No.
Office Work
Checked
Date

Survey of Sections in T5N
JN 0302 P/Tape 215 Std 54 °F
Surveyed by F.E. Brooks
Notes
F.E.B. Date 8/4-5/49
Indexed C. J. GALLI APR 14 '72

F. B. 3499 PG. 1

T5N
R15W

SEC 33

SEC 34

CONT BOT PG. 29

#215 T=70°
291.70 (291.69) @ 5°30' = 290.328'
291.60 (291.57) @ 5°19' = 290.316'
M = 290.32
Level = 9.90
Total = 300.22'

30"

CTR Traveled dirt Rd.

51'

N 91° W

N 135 E

300.22'

SECTION LINE

COUNTY SURVEYOR'S T5N R15W 33 34 4 3 SEC. COR'S T4N MONUMENT

Fd Co. Surveyor's Mon
2" H.P. R.&.P.
L.S. 80-2
C.S.B. 428-1
C.S.B. 900-1
2" marker pipe
5' N.

Flat Aver

1) 91-51-30
4) 347-26-00
91-51-30
6) 191-09-00
91-51-30.

CONT Top

M = 806.89'

Station LINE

Top of Slope

PG. 8

#215 T=90°
203.20 (203.21) @ 1°33' = 203.112'
203.23 (203.24) @ 1°41' = 203.122'
Level 215.09 T=94 = 215.09'

M = 203.12'

T=94° 214.88 (214.89) @ 0°16' = 214.890'
214.89 (214.90) @ 0°04' = 214.900'
Level 113.78 T=94° = 113.79'
Total = 806.89'

M = 214.89'

T4N
SEC 4

SEC 3

PLEASE RETURN TO
COUNTY OF LOS ANGELES
DEPARTMENT OF COUNTY ENGINEER
403 LOS ANGELES COUNTY ENGINEERING BLDG.

Note: Any Additions or Changes on This Sheet Must be Made or Circled in Red Ink With Date and Name of Person Making Change.

Do not extend this side of this line.

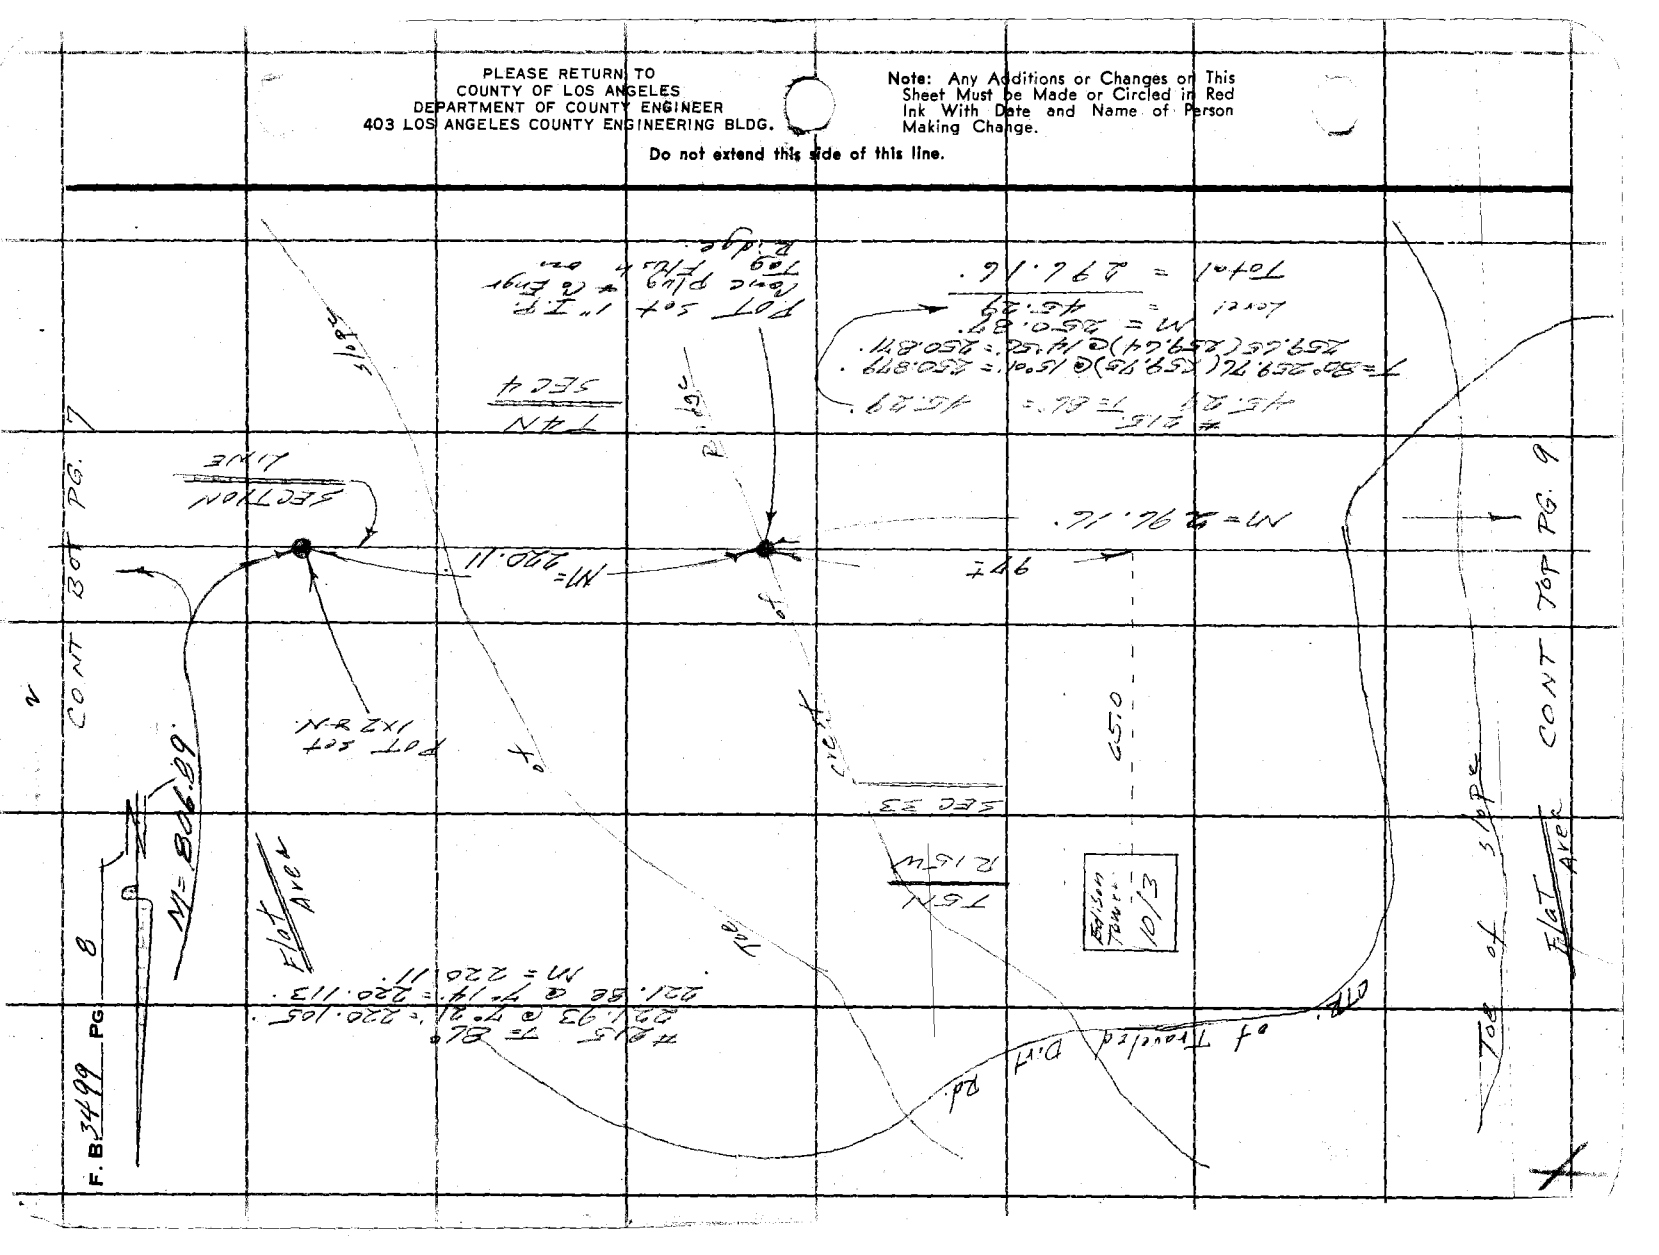

76F309S CE#310 3-68

PLEASE RETURN TO
COUNTY OF LOS ANGELES
DEPARTMENT OF COUNTY ENGINEER
403 LOS ANGELES COUNTY ENGINEERING BLDG.

Note: Any Additions or Changes on This Sheet Must be Made or Circled in Red Ink With Date and Name of Person Making Change.

Do not extend this side of this line.

Notes Ck'd by
Mpp No.
Office Work
Checked
Date

Survey of Sections in T5N R15W
JN 1302.01 Tape 215 Std 60 °F
Surveyed by FEB
Notes
Indexed FEB Date 2/29/72
C.J. GALLI APR 14 72

F. B. 3499 PG. 9

#215
T=90° 136.67 (136.68) @ 3° 20' = 136.449'
136.69 (136.70) @ 3° 32' = 136.449' M = 136.44'
Level 238.60 T = 92° = 238.61'
T=92° 299.65 (299.67) @ 5° 37' = 298.231'
299.73 (299.75) @ 5° 44' = 298.251' M1 = 298.24'
T=96° 59.00 (59.01) @ 26° 38' 00" = 52.739'
58.76 (58.77) @ 26° 09' 00" = 52.754'. M = 52.75'
Total = 726.04'

T5N
R15W
SEC 33

CONT TO PG 8

CONT TO PG 10

CTR. of Traveled

SECTION LINE

M = 726.04'

M = 296.16'

PAT 5.4 1X28 N.S.

Flat Ave

Dirt Rd.

T4N
SEC 4

3

PLEASE RETURN TO
COUNTY OF LOS ANGELES
DEPARTMENT OF COUNTY ENGINEER
403 LOS ANGELES COUNTY ENGINEERING BLDG.

Note: Any Additions or Changes on This Sheet Must be Made or Circled in Red Ink With Date and Name of Person Making Change.

Do not extend this side of this line.

WS-78, A-6

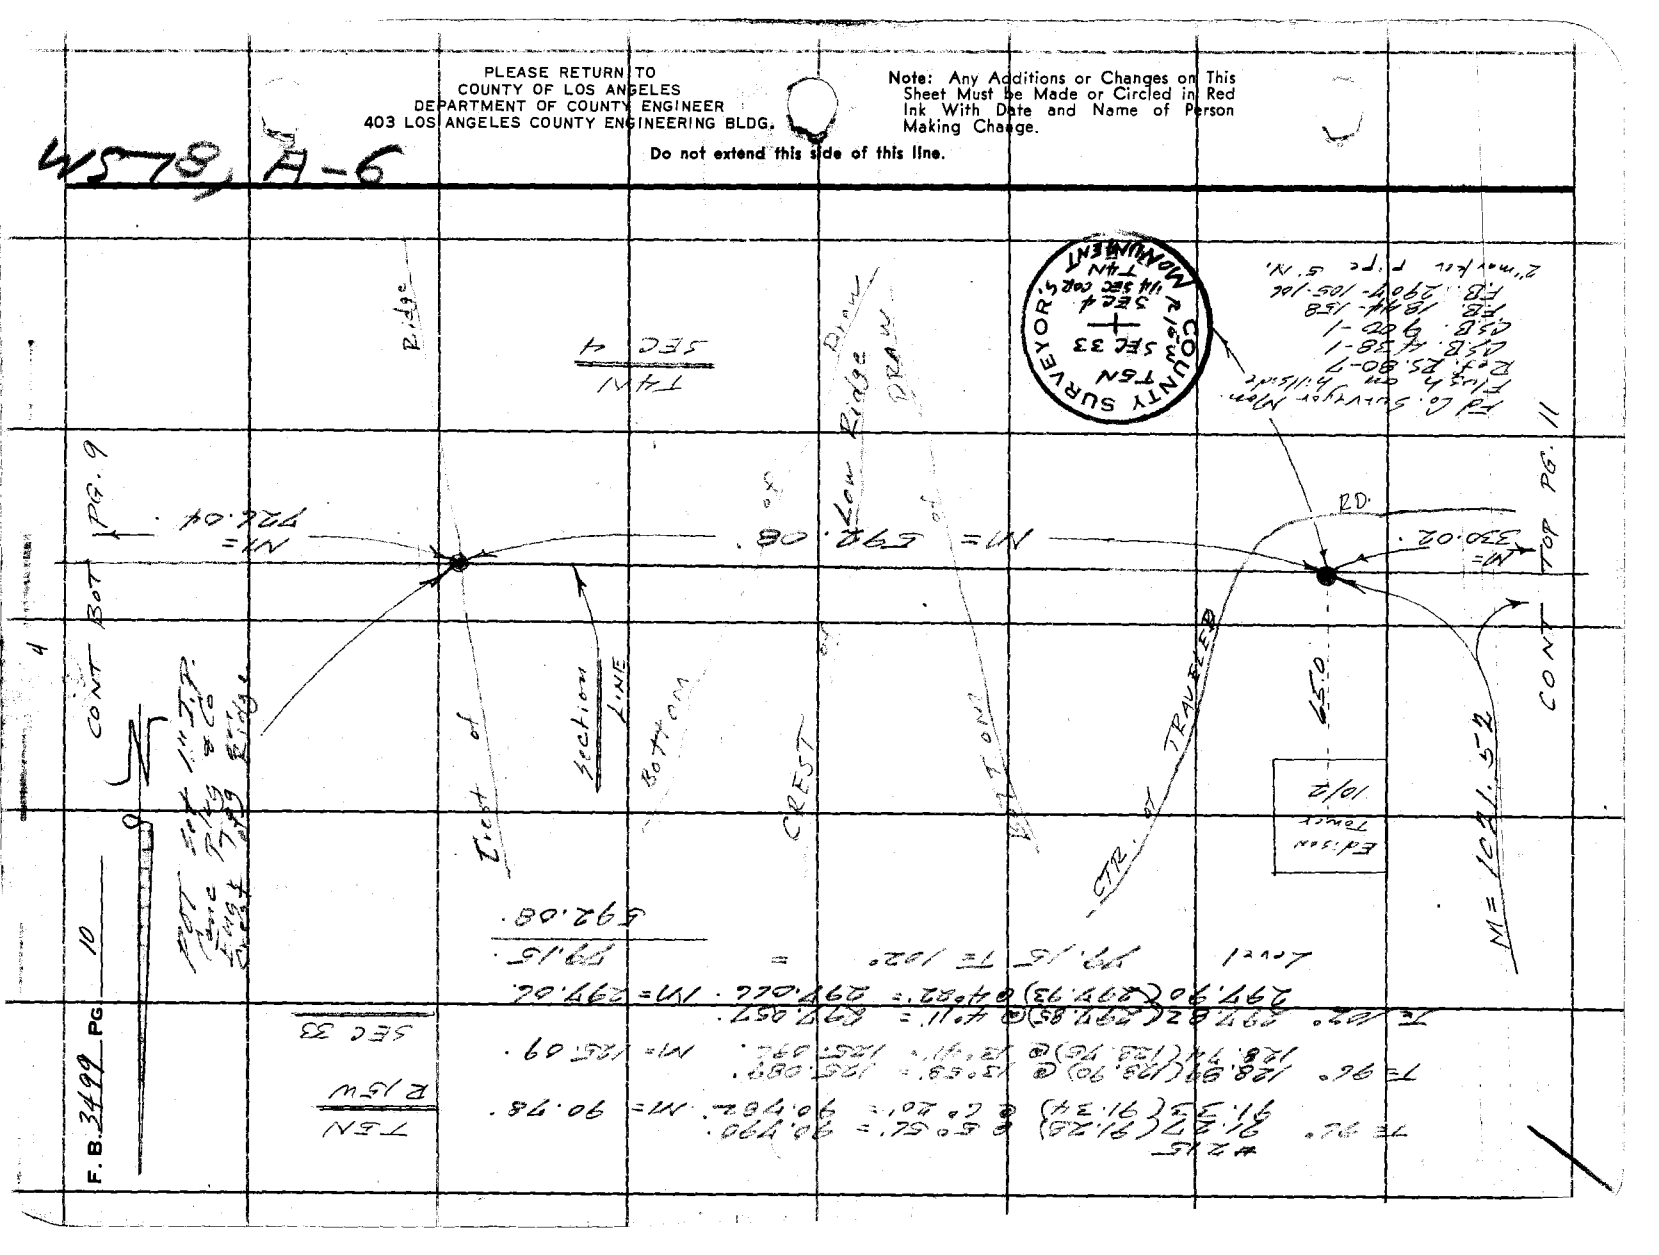

76F3095 CE#310 3-68

PLEASE RETURN TO
COUNTY OF LOS ANGELES
DEPARTMENT OF COUNTY ENGINEER
403 LOS ANGELES COUNTY ENGINEERING BLDG.

Note: Any Additions or Changes on This Sheet Must be Made or Circled in Red Ink With Date and Name of Person Making Change.

Do not extend this side of this line.

Notes Ck'd by
Map No.
Office Work
Checked
Date

Survey of sections in T5N R15W
JN 63242 Tape 215' Std 68° F
Surveyed by F.E. Brooks
Notes
Indexed by D.J. CALLI Date 29 Sept 72
APR 14 '72

F. B. 3499 PG. 11

#215
T= 102° 299.41 (299.45) @ 1°42' = 296.772 ·
297.30 (297.34) @ 1°34' = 296.768 · M = 296.77 ·

T5N
R15W

T= 102° 222.69 (222.72) @ 2°37' = 222.488 ·
222.65 (222.68) @ 2°22' = 222.490 · M = 222.49 ·

Line 1 78.19 T= 102° = 78.20 ·

SEC 33

T= 106° 230.01 (230.04) @ 2°57' = 229.734 ·
229.98 (230.01) @ 2°44' = 229.747 · M = 229.74 ·

T= 106° 194.42 (194.45) @ 2°09' = 194.313 ·
194.41 (194.44) @ 1°57' = 194.327 · M = 194.32 ·

Total = 1021.52 ·

CONT

POT set 1x2 N on edge of Rd.

Fd 2" I.P. Conc plug & Tag RE 4823 Flush Ref F.B. 1844-158 ground Cracked pipe loose.

CONT

M = 711.97 ·

M = 1021.52 ·

0.13

Traveled Dirt

SECTION LINE

CTR

10.0' OF

STOPC

Flat Area

T4N

SEC 4

#216
330.00 T= 92° = 330.02

POT PG 12

M = 330.02 ·

5

10

F. B. 3499 PG. 12

CONT BOT PG. 11

PLEASE RETURN TO
COUNTY OF LOS ANGELES
DEPARTMENT OF COUNTY ENGINEER
403 LOS ANGELES COUNTY ENGINEERING BLDG.

Note: Any Additions or Changes on This Sheet Must be Made or Circled in Red Ink With Date and Name of Person Making Change.

Do not extend this side of this line.

T 4 N
SEC 4

= 0.80 = 1 mile

T = 100.0 = 80.00
" = 100.0 = 80.00
R = 100.0 = 239.52
" = 100.0 = 239.52

Notes Ck'd by	Survey of Sections in T5N R15W
Map No.	JN 0302.01 Tape [illegible] Std 0° °F
Office Work	Surveyed by FE Brooks
Checked	Notes FEB Date 2-24-69
Date	Indexed E. J. GALLI 1 4 72

F. B. 3499 PG. 13

CONT BOT PG 12

WS 7B A-5

SEC 33

T 5 N
R 15 W
SEC 32

T 4 N
R 15 W
SEC 5

T 4 N
SEC 6

1) 89-30-00
2) 358-00-25
3) 89-30-05
4) 179-00-35
5) 89-30-05

N = 908.80'

N = 89° 30' 06"

N = 445.98'

06' 36"

179°

N = 3°22'40"

T = 44.42'

Δ 1) 3°22'40" = 192.02'
Δ 2) 3°00' = 191.09'
Δ 3) N1° = 191.09'
Δ 4) 3°22'40" = 192.02'
Δ 5) N1° = 191.09'
Δ 6) 3°22'40" = 192.02'
Total = 1149.40'

1149.40 T=44.42'

T=1148.96' 191.41 (191.41')

DIRT RD TRAVELED

DIRT

SLOPE

SECTION LINES

FD 4" S. N10°W 15.10' ON EDGE OF ROAD 1955 FEB

FD 4" S. N10°W 15.10' ON EDGE OF ROAD 1955 FEB

Marks PT of S. of Mon.

COUNTY SURVEYOR
T 5 N
R 15 W
SEC 32 33
5 4
SEC COR
T 4 N 3
R. E. 03

CONT TOP PG. 14

FLAT AREA

STR OF

T&C

Note: Any Additions or Changes on This Sheet Must be Made or Circled in Red Ink With Date and Name of Person Making Change.

Do not extend this side of this line.

PLEASE RETURN TO
COUNTY OF LOS ANGELES
DEPARTMENT OF COUNTY ENGINEER
403 LOS ANGELES COUNTY ENGINEERING BLDG.

16F3095 C.E.#310 3-68

F. B. 3499 PG. 14

P.O.T. Fd 1" IP
Cenic Plug & CB.
Edge Tag Wiggle
PT Ref
F.B. 3760-75

CONT BOT PG. 13

N = 372.40

R.D.

DIRT SLOPE

SECTION LINE

Tel

TEA VELED

CTR.

N = 16 55. 57.

CONT TOP PG. 15

T= 58° 39.99.
T= 82° 215.99
T= 82° 1332.48 @ 13°48'11" = 1328.913' N= 128.91.
1332.48 @ 12°48'48" = 1328.925' N=
T= 82° 1173.80 @ 10°52'00" = 1173.277 N= 173.77.
1173.80 @ 10°52'00" = 1173.277 N=
T=80° 1610.20 @ 2°11'53" = 169.885' N= 169.88.
1610.20 @ 2°11'53" = 169.885' N=
T=84° 1605.47 @ 1°31'47" = 2135.326' N= 195.33.
1605.47 @ 1°31'47" = 2135.326' N=
T= 82° 208.81 @ 1°44'53" = 208.709' N= 208.71.
208.83 @ 1°44'53" = 208.709' N=
T= 81° 210.74 @ 2°18'13" = 210.598' N= 210.59.
210.80 @ 2°30'52" = 210.552' N= 210.54.
322.37 T=82° = 322.36.
Total = 16 55. 57.

Ed. 8.14 Tonet 9/3

Note: Any Additions or Changes on This Sheet Must be Made or Circled in Red Ink With Date and Name of Person Making Change.

PLEASE RETURN TO
COUNTY OF LOS ANGELES
DEPARTMENT OF COUNTY ENGINEER
403 LOS ANGELES COUNTY ENGINEERING BLDG.

Do not extend this side of this line.

Notes Ck'd by	Survey of Sections in T5N R15W
Map No.	JN 03072-91 Tape 215 Std 64 °F
Office Work	Surveyed by F.E. Brooks
Checked	Notes F.E. 13. Date 30-Jul-69
Date	Indexed C. J. GALLI AUG 14 72

F. B. 3499 PG. 15

CONT BDY PG. 14

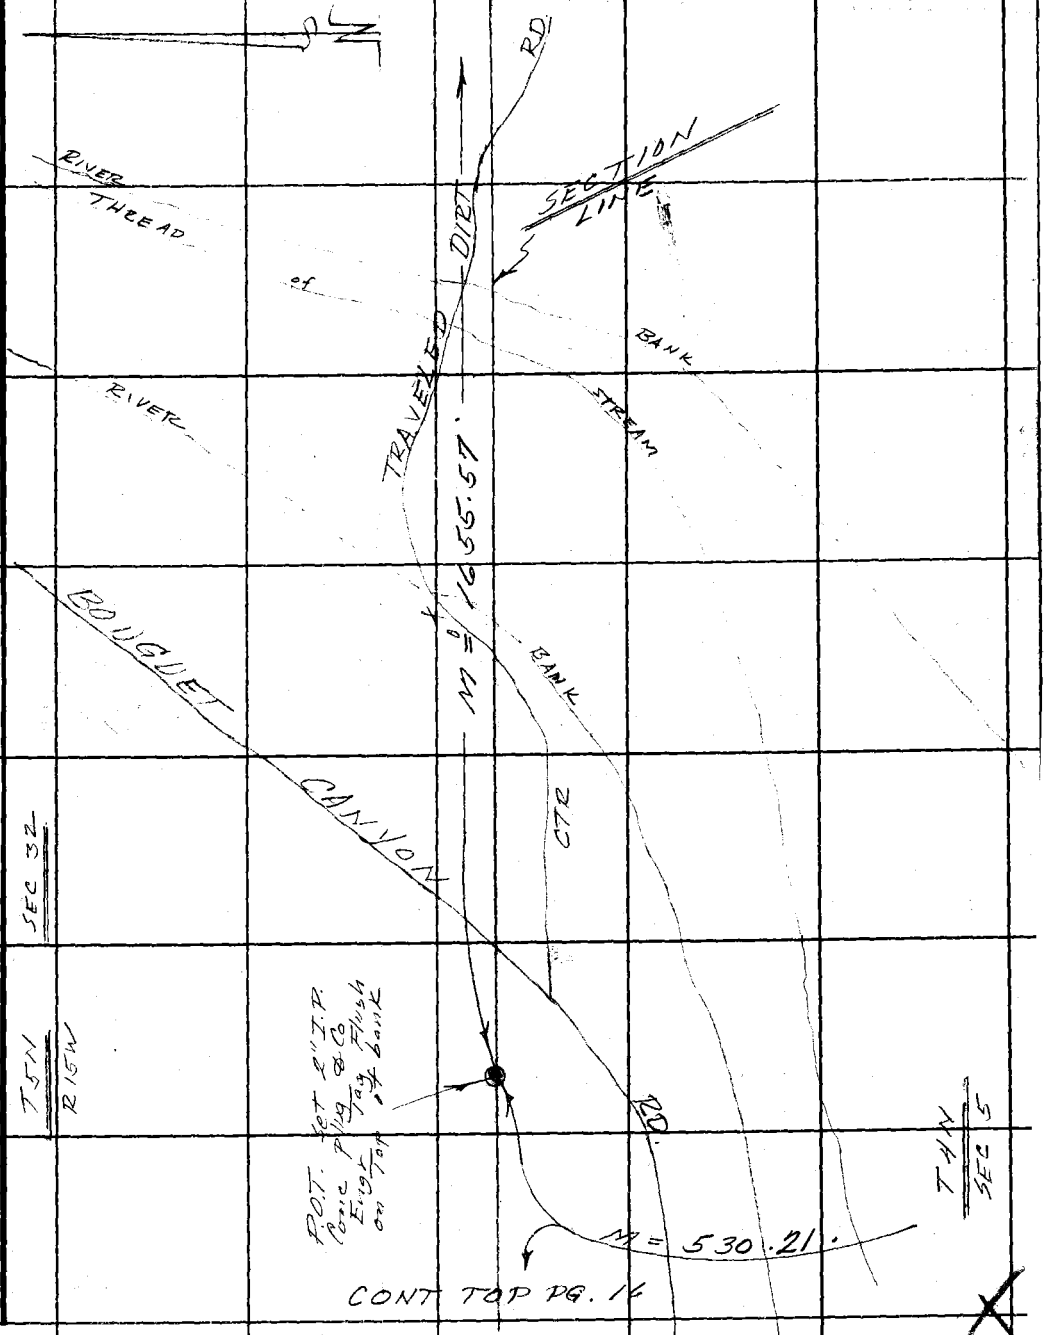

Note: Any Additions or Changes on This Sheet Must be Made or Circled in Red Ink With Date and Name of Person Making Change.

Do not extend this side of this line.

PLEASE RETURN TO
COUNTY OF LOS ANGELES
DEPARTMENT OF COUNTY ENGINEER
403 LOS ANGELES COUNTY ENGINEERING BLDG.

16F3095 CE#310 3-68

F. B. 3499 PG 16

10

CONT BOT PG 15

Toe of slope

= 198.79
= 109.00
= 222.46 @ 12°24'46" : 222.46 N= 222.42
= 231.51 @ 109°: 222.46 E= 222.42

Total = 530.21

Edison Tower 9/2

d.ft. = 113.04

#2/5
198.80 T= 60°
109.00 T= 60°
222.81 @ 10°30' = 253.842 : N= 253.84
231.51 @ 10°38' = 253.835 : N= 253.84

#2/5
258.20 (258.18)
258.29 (258.27)

T= 74° 140.803 @ 42°42' = 140.812 : N= 140.80
T= 74° 140.81 (141.16) @ 40°01' = 140.812 : E= 140.80

N= 113.04

Toe of slope

Co. Surveyor

SECTION LINE

T 4N
SEC 5

N= 612.92

1/4 Cor. Fd Co. Flush
N10E. Ref: RS. 60-6
CSB 428-1
CSB 900-1
FB 3160-213
FB 1455-249
FB 1844-151

SURVEYOR'S DEPARTMENT COUNTY OF LOS ANGELES SEC 32 SEC 5 T 4N R 15W

T 5N R 15W
SEC 32

T= 80°

dirt Rd.

CONT TOP PG. 17

Fd So Calif Edison Brass Ref. RS 60-6 FB 3160-13

SOUTHERN CALIFORNIA EDISON COMPANY RECTIFIER

crest of hill

9-D 27

PLEASE RETURN TO
COUNTY OF LOS ANGELES
DEPARTMENT OF COUNTY ENGINEER
403 LOS ANGELES COUNTY ENGINEERING BLDG.

Do not extend this side of this line.

Note: Any Additions or Changes on This Sheet Must Be Made or Circled in Red Ink With Date and Name of Person Making Change.

76F309S CE#310 3-68

PLEASE RETURN TO
COUNTY OF LOS ANGELES
DEPARTMENT OF COUNTY ENGINEER
403 LOS ANGELES COUNTY ENGINEERING BLDG.

Note: Any Additions or Changes on This Sheet Must be Made or Circled in Red Ink With Date and Name of Person Making Change.

Do not extend this side of this line.

Notes Ck'd by
Map No.
Office Work
Checked
Date

Survey of Sections in T6N R15W
JN 0302.01 Tape 215 Std 84 °F
Surveyed by F.E.B. Books
Notes
Indexed C. J. GALLI Date Added 1972

F. B. 3422 PG. 17

11

T= 74° # 215
140.97 (140.96) @ 2°42' = 140.803'
141.17 (141.16) @ 4°01' = 140.812' M = 140.80'

T= 76° 278.70 (278.68) @ 4°55' = 277.654'
278.58 (278.56) @ 4°35' = 277.668' M = 277.66'

T= 82° 210.77 @ 22°47' = 194.325'
210.59 @ 22°40' = 194.324' M = 194.32'

T= 82° 237.98 @ 0°49' = 237.958'
237.96 @ 0°38' = 237.945' M = 237.95'

12.19 T= 82° = 12.19'

Total = 862.92'

DIRT

T5N R15W

SEC 32

CONT TOP

M= 1433.38'

271.0

PG 18

POT set
1" I.P. cone plug
& Lo Engr Tag
Flush.

Edison Tower 9/1

T 69.0

R 1.

CONT BOT PG 16

T 2

of

M= 862.92'

CREST of 2 SEC

BOTTOM of DRAW

SECTION LINE

CREST of Ridge

S1/4 pc

T4N

SEC 5

PLEASE RETURN TO
COUNTY OF LOS ANGELES
DEPARTMENT OF COUNTY ENGINEER
403 LOS ANGELES COUNTY ENGINEERING BLDG.

Note: Any Additions or Changes on This Sheet Must be Made or Circled in Red Ink With Date and Name of Person Making Change.

Do not extend this side of this line.

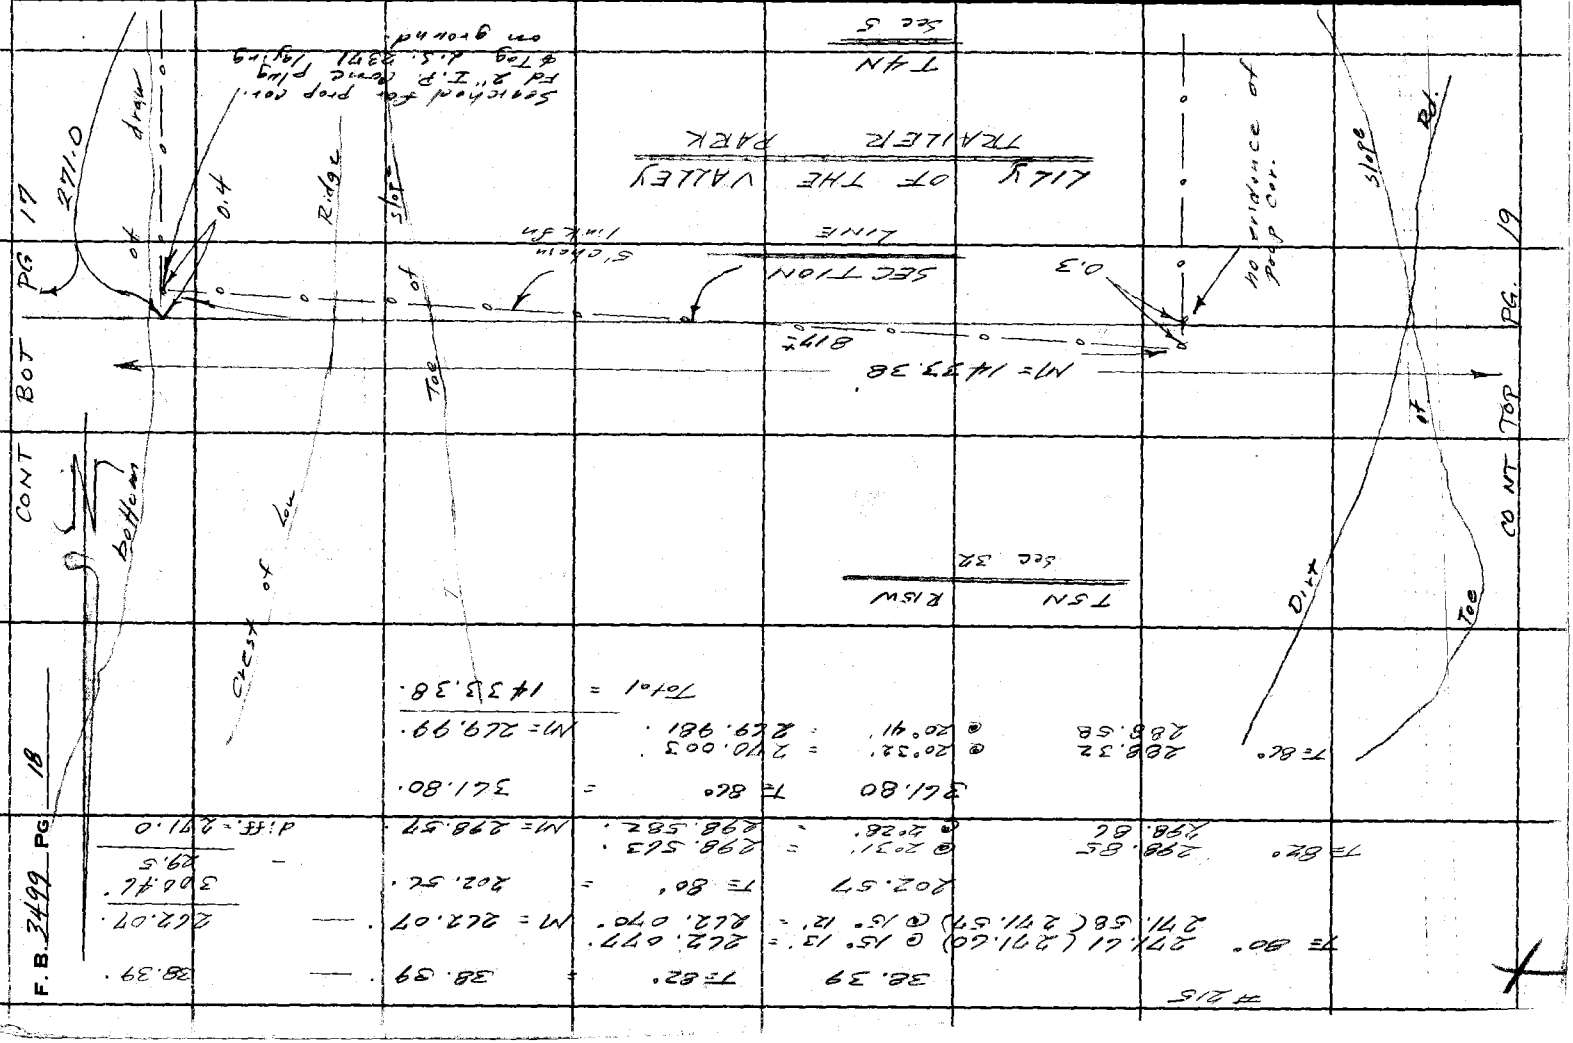

76F309S CE#310 3-68

PLEASE RETURN TO
COUNTY OF LOS ANGELES
DEPARTMENT OF COUNTY ENGINEER
403 LOS ANGELES COUNTY ENGINEERING BLDG.

Note: Any Additions or Changes on This Sheet Must be Made or Circled in Red Ink With Date and Name of Person Making Change.

Do not extend this side of this line.

Notes Ck'd by
Map No.
Office Work
Checked
Date

Survey of Sections in T4N R15W
JN 02302 #1 Tape 815 Std 68 °F
Surveyed by F.F. Brooks
Notes
Indexed D. J. GALLI Date 6 Oct 72

F. B. 3492 PG. 19

#215 T=82°
41.85 @ 15°10' = 40.392'
42.20 @ 16°50' = 40.391'
M = 40.39'

#215
T=86° 136.19 @ 15°07' = 131.477'
135.99 @ 14°49' = 131.468' M = 131.47'

T=88° 208.62 (208.63) @ 13°46' = 202.636'
208.31 (208.32) @ 13°25' = 202.634' M = 202.63'
Total = 334.10'

T5N R15W
Sec 32

THN
Sec 5

DIRT RD

N 14° 33.38' E

CONT BOT PG. 18

CONT TOP PG. 20

Edison Tower 814

CREST

25.0

M = 40.39'

M = 334.10'

0.07

0.10

0.1

Fd 2" I.P. cone plug #709 L.S. 2371 w.o.f. 1" up.

Fd 3/4" galv. pipe Brass Cap RCE 7211 Flush 80-2

SECTION LINE

old fn line

Bottom

Down

Ridge

SOUTHERN CALIFORNIA EDISON COMPANY

RCE 7211

13

PLEASE RETURN TO
COUNTY OF LOS ANGELES
DEPARTMENT OF COUNTY ENGINEER
403 LOS ANGELES COUNTY ENGINEERING BLDG.

Note: Any Additions or Changes on This Sheet Must be Made or Circled in Red Ink With Date and Name of Person Making Change.

Do not extend this side of this line.

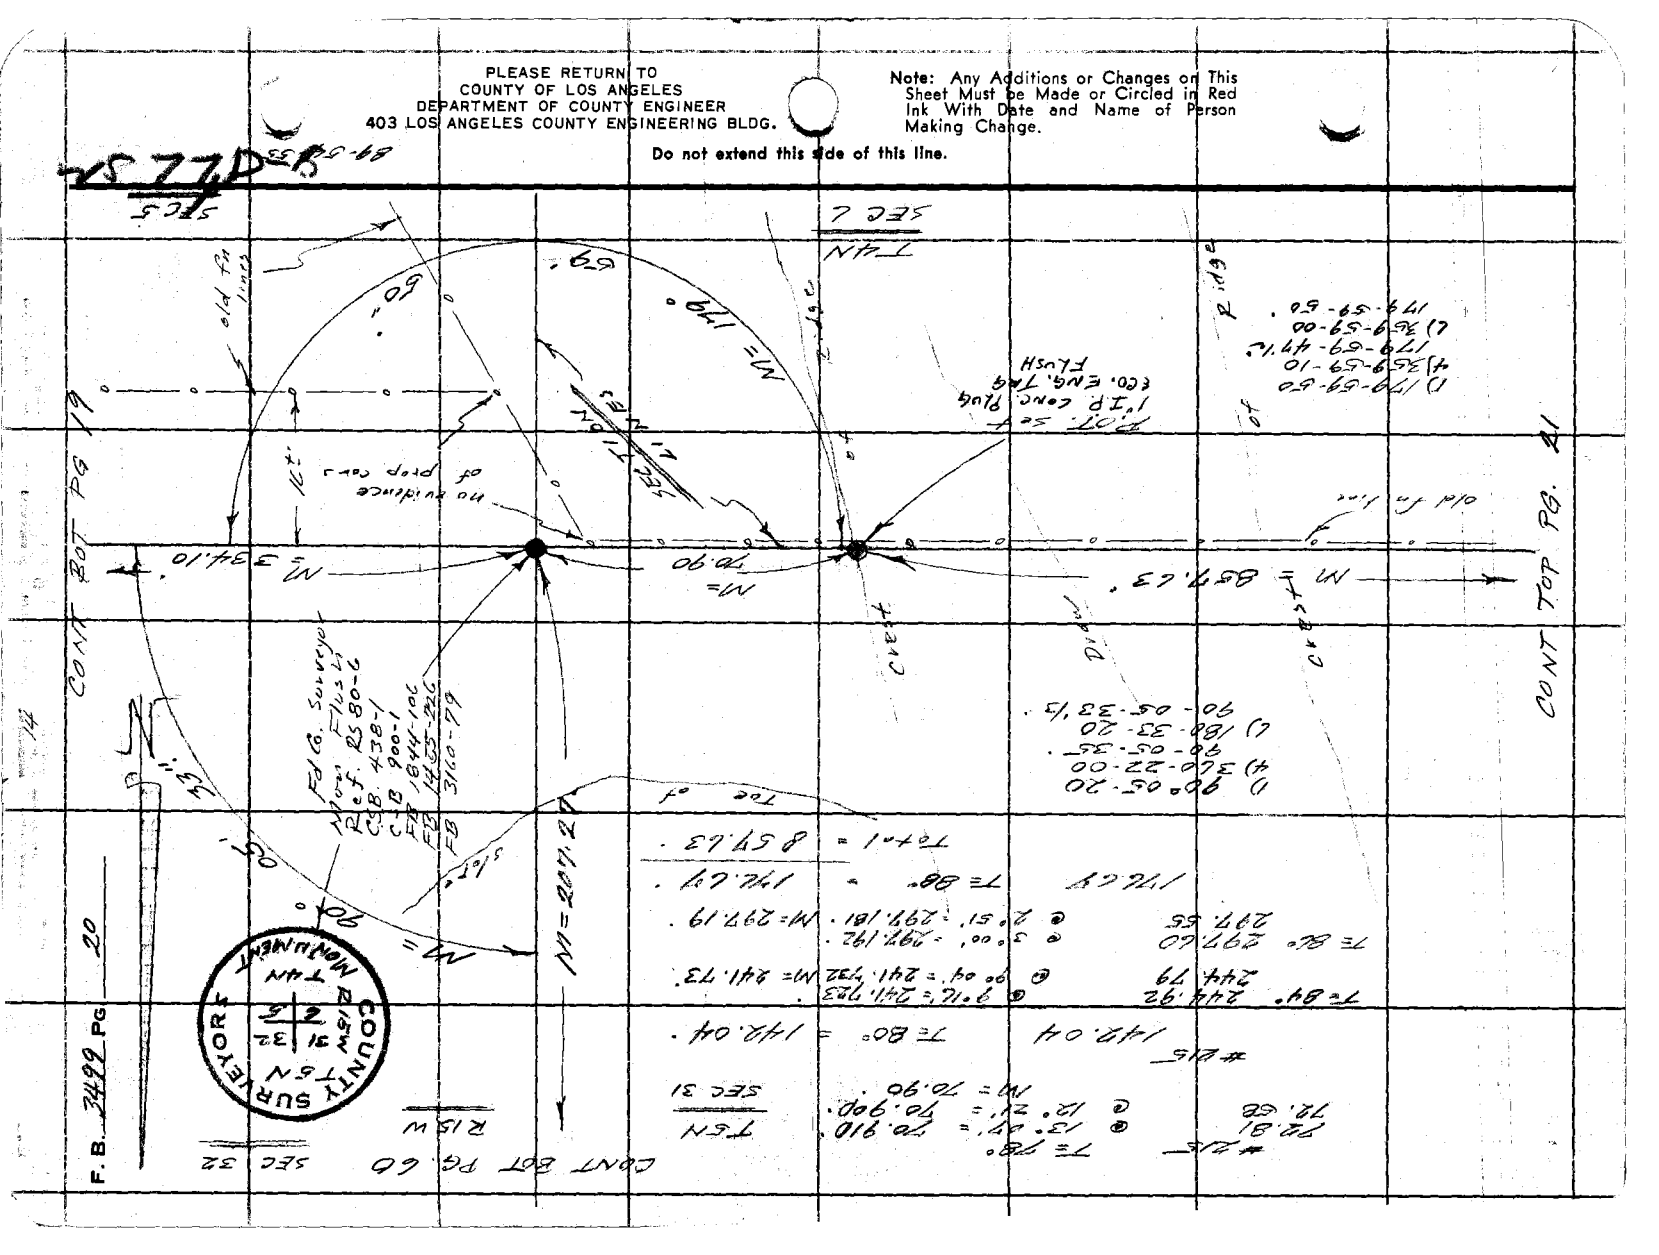
SEC 3
SEC 2
T4N
R15W
CONT BOT PG 19
CONT TOP PG. 41
CONT BOT PG. 60
SEC 32
SEC 31
T5N
R15W
F.B. 3499 PG 20
COUNTY SURVEYOR
MONUMENT
T4N
R15W
31
32
2
5
N2 34.10'
N= 70.90
N= 887.23'
Tee of
Old fn line
No evidence of prop cors
1" IP conc. Plug & Tag Flush
Fd Co. Survey Mon. Fd 1½ LC
P.O.T. 80-6
C.B. 438-1
C.B. 900-1
F.B. 1844-106
F.B. 1435-126
F.B. 3160-79
1) 90° 05' 20"
2) 360° 22' 00"
3) 90° 05' 33"
4) 180° 33' 20"
5) 90° 05' 33"
1) 179° 59' 50"
2) 359° 59' 00"
3) 179° 59' 47"
4) 359° 59' 10"
5) 179° 59' 50"
T= 887.23'
1/2 CV
T= 80° = 192.04'

15

Notes Ck'd by	Survey of Sections in T6N R15W
Map No.	JN 0302.01 Tape 215 Std 8' °F
Office Work	Surveyed by FE Brooks
Checked	Notes FFB Date 7oct69
Date	Indexed C. J. GALLI APR 14 72

F. B. 3499 PG. 21

CONT FOT PG. 20

old fn. line

RD.

DIRT

Toe of slope

DIRT

Dirt Rd.

DIRT

N = 857.13

POT set 1x2 BN

SECTION LINE

T5N R15W SEC 31

T6N SEC 6

#215

T=70° 278.42 (278.43) @ 11°35' = 272.758'
278.67 (278.58) @ 11°43' = 272.774' N = 272.77'

T=70° 269.38 (269.89) @ 21°42" = 150.162'
269.71 (269.72) @ 21°31" = 150.480' N = 150.77'

Total = 543.54'

N = 523.54'

Toe of slope

Crest of Ridge

CONT TOP PG. 22

PLEASE RETURN TO
COUNTY OF LOS ANGELES
DEPARTMENT OF COUNTY ENGINEER
403 LOS ANGELES COUNTY ENGINEERING BLDG.

Note: Any Additions or Changes on This Sheet Must be Made or Circled in Red Ink With Date and Name of Person Making Change.

Do not extend this side of this line.

76F3095 CE#310 3-68

PLEASE RETURN TO
COUNTY OF LOS ANGELES
DEPARTMENT OF COUNTY ENGINEER
403 LOS ANGELES COUNTY ENGINEERING BLDG.

Note: Any Additions or Changes on This Sheet Must be Made or Circled in Red Ink With Date and Name of Person Making Change.

Do not extend this side of this line.

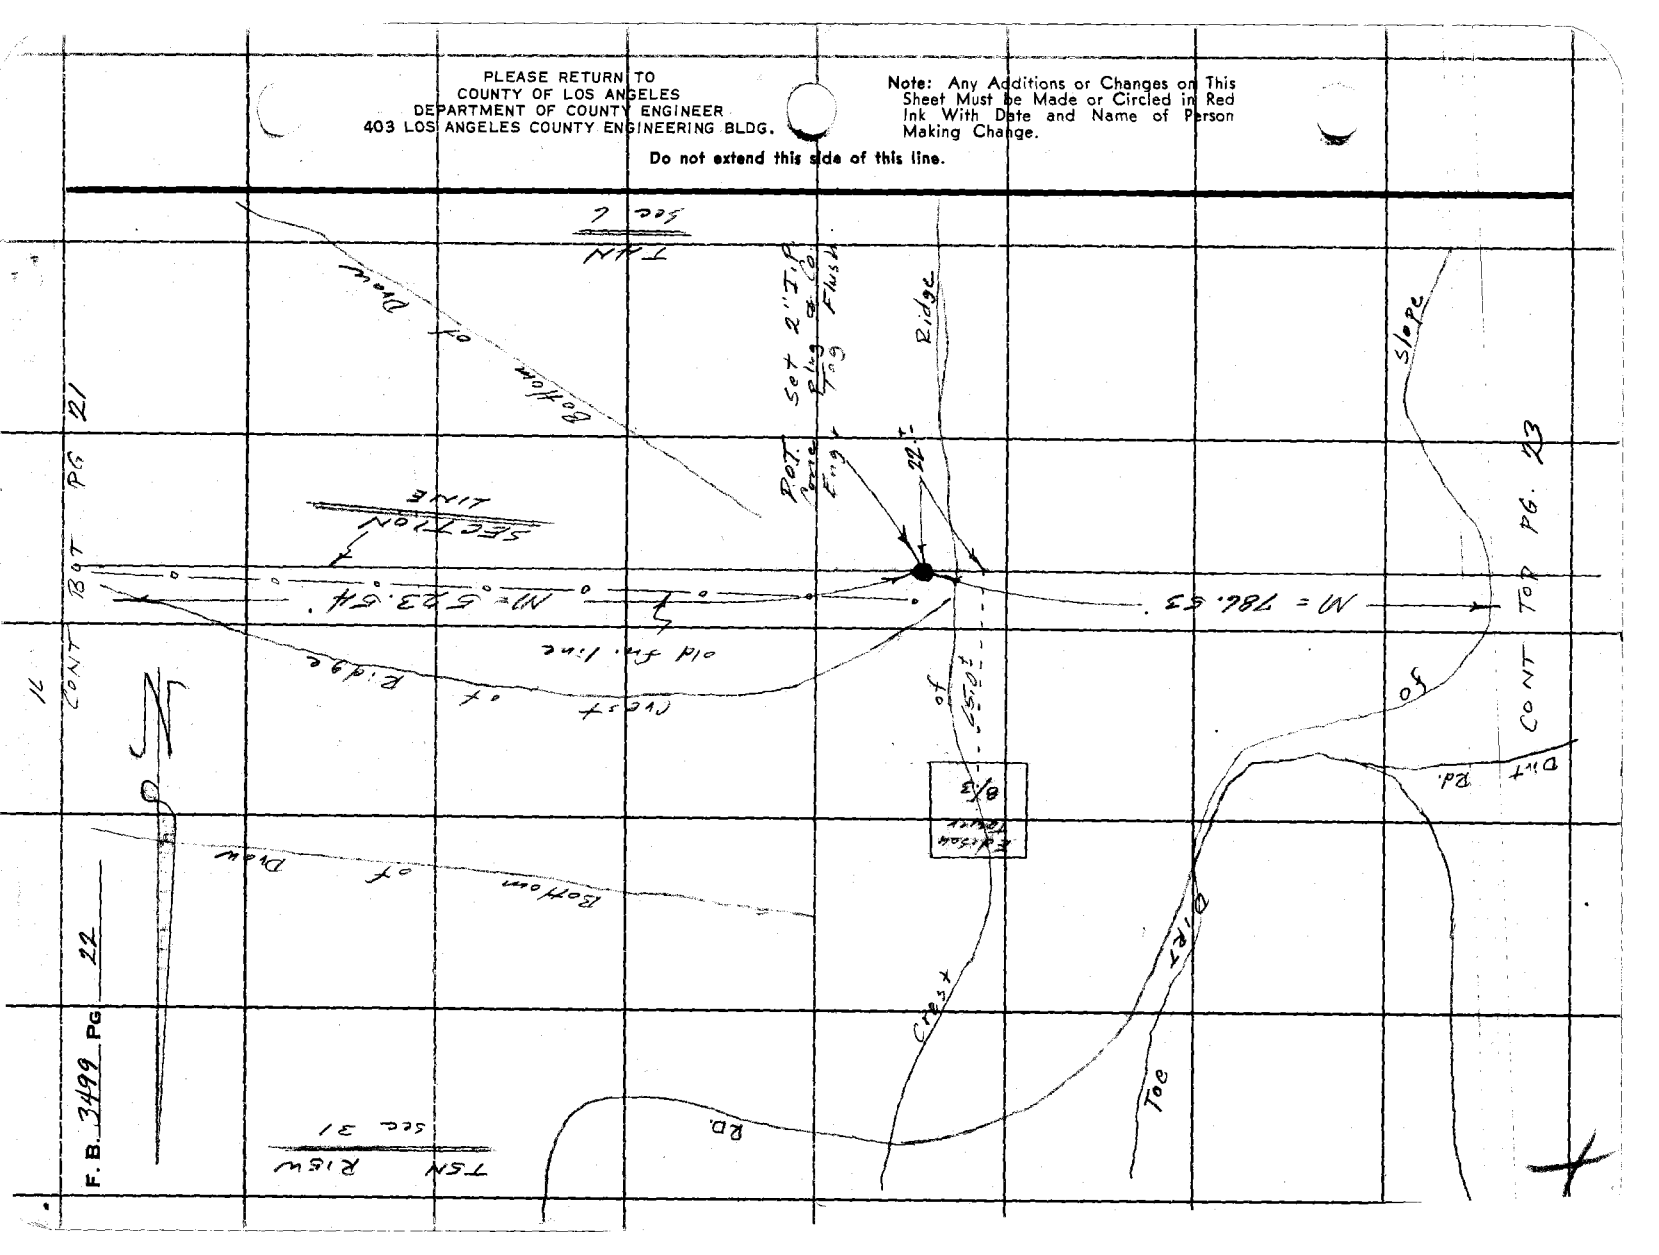

76F3095 CE#310 3-68

PLEASE RETURN TO
COUNTY OF LOS ANGELES
DEPARTMENT OF COUNTY ENGINEER
403 LOS ANGELES COUNTY ENGINEERING BLDG.

Note: Any Additions or Changes on This Sheet Must be Made or Circled in Red Ink With Date and Name of Person Making Change.

Do not extend this side of this line.

#215

19.73 T=94° = 19.73'

T=100° 285.90 (285.93) @ 25°36' = 257.810'
285.56 (285.59) @ 25°26' = 257.842' M = 257.85'

T=96° 233.89 (233.91) @ 4°41' = 233.128'
233.84 (233.86) @ 4°32' = 233.128' M = 233.13'

T=96° 295.21 (295.23) @ 24°43' = 268.183'
295.61 (295.63) @ 24°56' = 268.184' M = 268.18'

7.64 T=96° = 7.64'
Total = 786.53'

T5N R15W
Sec 31

Edison Tower B/2

M = 432.40'

M = 786.53'

Dont Top Pg. 24

Section Line

Toe of Slope

Crest of Ridge

Fnd So. Calif Edison Brass Disc Flush Rcf. R.S. 80-6

Southern California Edison Company

Rcf 72-11

Dirt Road

Dont Top Pg. 22

T4N
Sec 6

Notes Ck'd by
Map No.
Office Work
Checked
Date

Survey of Sections in T5N R15W
JN 6702.4 Tape 215 Std @ 68°F
Surveyed by F.E.B. Date 10/6/72
Notes
Indexed R.N. CALLI APR 14 73

F.B. 3492 PG. 23

17

PLEASE RETURN TO
COUNTY OF LOS ANGELES
DEPARTMENT OF COUNTY ENGINEER
403 LOS ANGELES COUNTY ENGINEERING BLDG.

Note: Any Additions or Changes on This Sheet Must be Made or Circled in Red Ink With Date and Name of Person Making Change.

Do not extend this side of this line.

LS 77 D-6

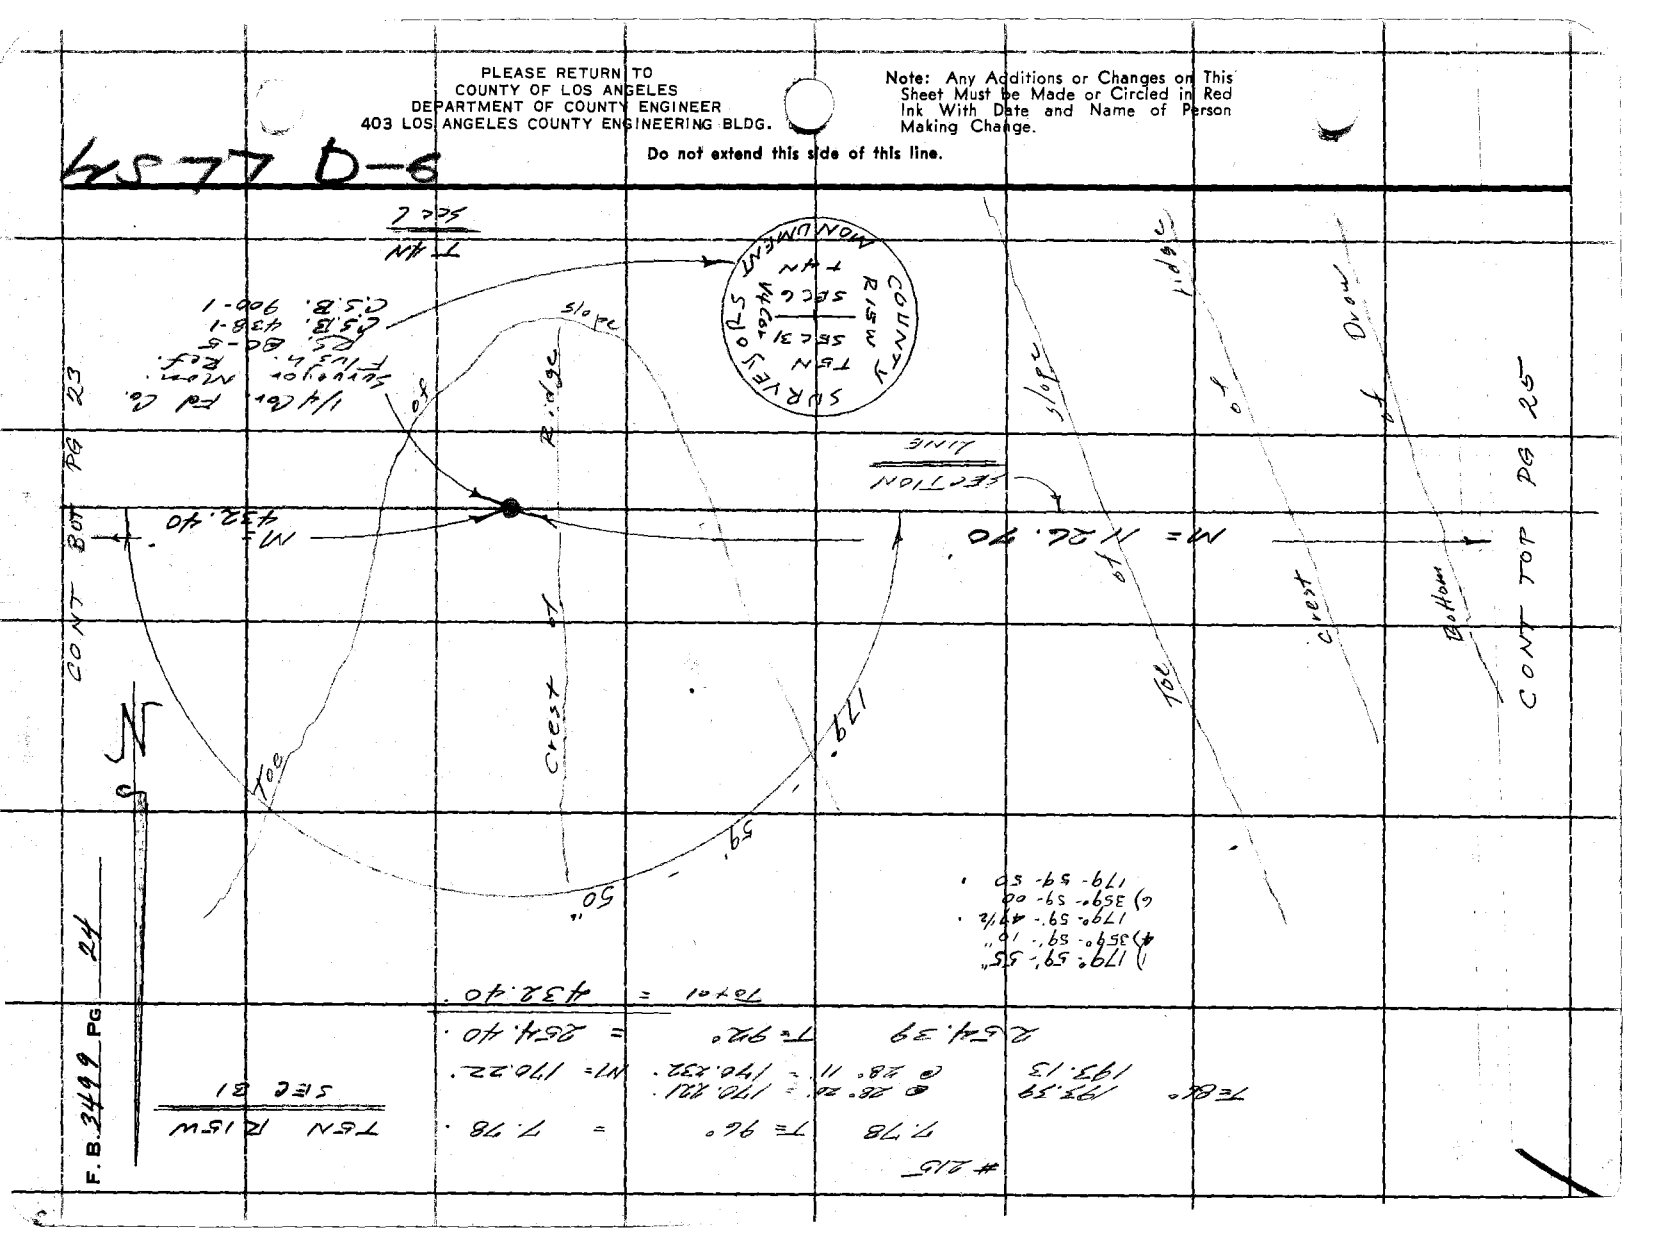

76F3095 CE#310 3-68

PLEASE RETURN TO
COUNTY OF LOS ANGELES
DEPARTMENT OF COUNTY ENGINEER
403 LOS ANGELES COUNTY ENGINEERING BLDG.

Note: Any Additions or Changes on This Sheet Must be Made or Circled in Red Ink With Date and Name of Person Making Change.

Do not extend this side of this line.

Notes Ck'd by
Map No.
Office Work
Checked
Date

Survey of Sections in T5N R15W
JN 0302.101 Tape 215 Std. 64 °F
Surveyed by F.E. Brooks
Notes
Indexed C.J. GALLI Date 8 OCT 69
APR 14 '72

F.B. 3412 PG. 25

#215

T= 92°	275.86 (275.81)	@ 5°43'	= 274.498	M = 244.49
	275.91 (275.92)	@ 5°50'	= 274.490	
T= 92°	291.00 (291.02)	@ 7°51'	= 288.293	M = 288.29
	291.04 (291.06)	@ 7°55'	= 288.286	
T= 94°	57.11	@ 4°39'	= 56.922	M = 56.92
	57.16	@ 5°18'	= 56.915	
T= 94°	114.41 (114.42)	@ 18°00'	= 108.820	M = 108.83
	114.17 (114.16)	@ 17°36'	= 108.835	
T= 96°	276.94 (276.96)	@ 37°23'30"	= 220.044	M = 220.03
	276.64 (276.66)	@ 37°18'50"	= 220.033	
T= 90°	104.61 (104.62)	@ 21°53'30"	= 97.086	M = 97.09
	104.84 (104.85)	@ 22°10'40"	= 97.092	
T= 90°	138.91 (138.92)	@ 28°21'15"	= 122.253	M = 122.26
	138.59 (138.60)	@ 28°06'	= 122.263	
			Total	1167.91
T= 86°	45.18	@ 24°11'16"	= 41.213	M = - 41.21
	45.57	@ 25°13'40"	= 41.223	
			Diff.	= 1126.70

POINT TOP PS

T 5N R 15W
Sec 31

M = 1126.70'

POINT BOT PS

Dr'J

Creek

13. Horn

Stor

SECTION LINE

T 4N
Sec 6

Ridge

PLEASE RETURN TO
COUNTY OF LOS ANGELES
DEPARTMENT OF COUNTY ENGINEER
403 LOS ANGELES COUNTY ENGINEERING BLDG.

Note: Any Additions or Changes on This Sheet Must be Made or Circled in Red Ink With Date and Name of Person Making Change.

Do not extend this side of this line.

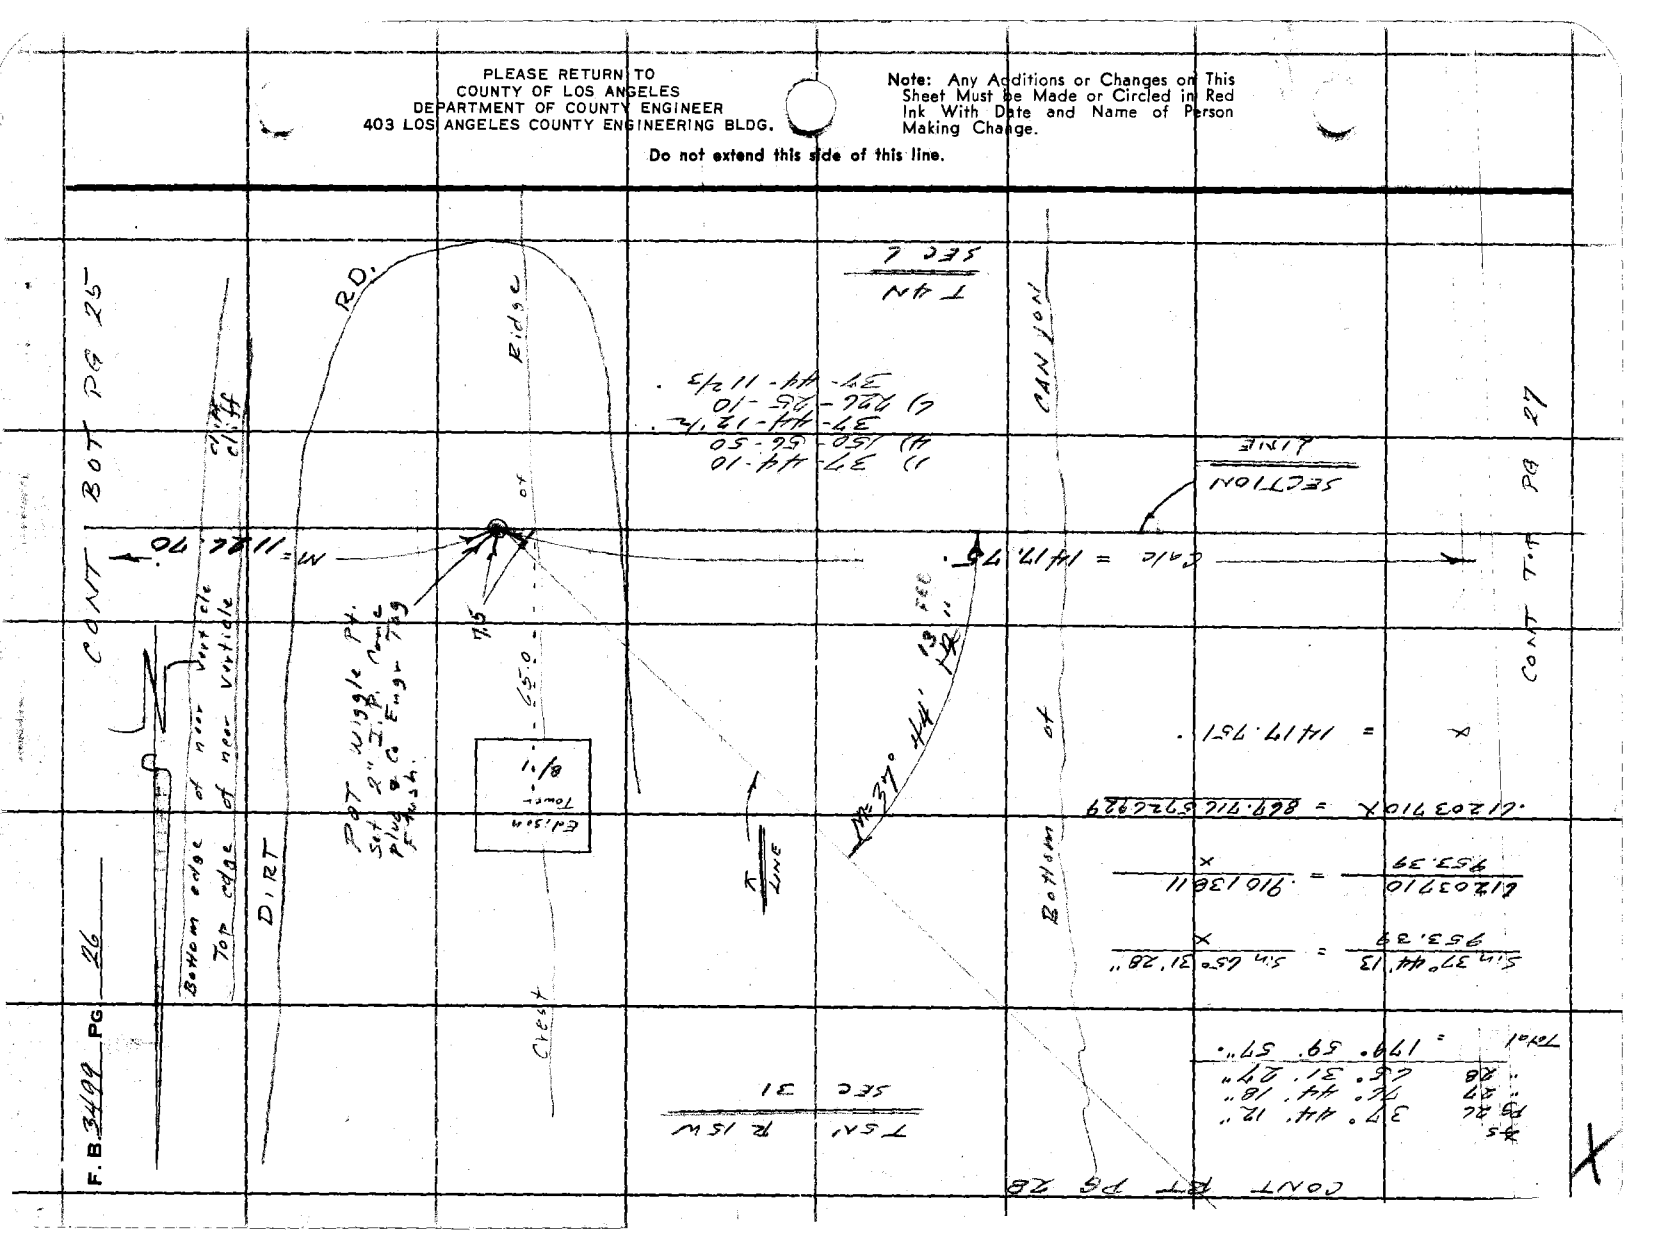

76F3095 CE#310 3-68

PLEASE RETURN TO
COUNTY OF LOS ANGELES
DEPARTMENT OF COUNTY ENGINEER
403 LOS ANGELES COUNTY ENGINEERING BLDG.

Note: Any Additions or Changes on This Sheet Must be Made or Circled in Red Ink With Date and Name of Person Making Change.

Do not extend this side of this line.

W.S. 77 D-6

D CONT BOT // PG 28

T5N R16W SEC 36

T5N R15W SEC 31

BASE LINE

CREST

RD

N 20° 00' 30" W 2653.93'

N 76° 44' 20" W 1417.75'

Calc = 1417.75'

CONT BOT PG 26

19 FEB

25.0

5.0

SECTION LINES

Ridge

1) 76° 44' 20"
2) 306° 59' 20"
3) 76° 44' 20"
4) 100° 25' 45"
76° 44' 17½"

COUNTY SURVEYORS MAP

T5N

R16W	36	31
	1	6

TWP COR T4N MONUMENT

F.B. Co. Sur. Mon 3" IP Ref. RS. 80-3"
CSB 438-1
CSB 900-1
F.B. 1844-138

T4N SEC 1

T4N SEC 6

Survey of Sections in T6N R15W
JN 0502.4 Tape 215 Std. B 1/4 °F
Surveyed by F.E. Brooks
Notes F.E.B. Date 4/24/72
Indexed by D. J. GALLI APR 14 72

F.B. 3499 Pg. 22

PLEASE RETURN TO
COUNTY OF LOS ANGELES
DEPARTMENT OF COUNTY ENGINEER
403 LOS ANGELES COUNTY ENGINEERING BLDG.

Note: Any Additions or Changes on This Sheet Must be Made or Circled in Red Ink With Date and Name of Person Making Change.

Do not extend this side of this line.

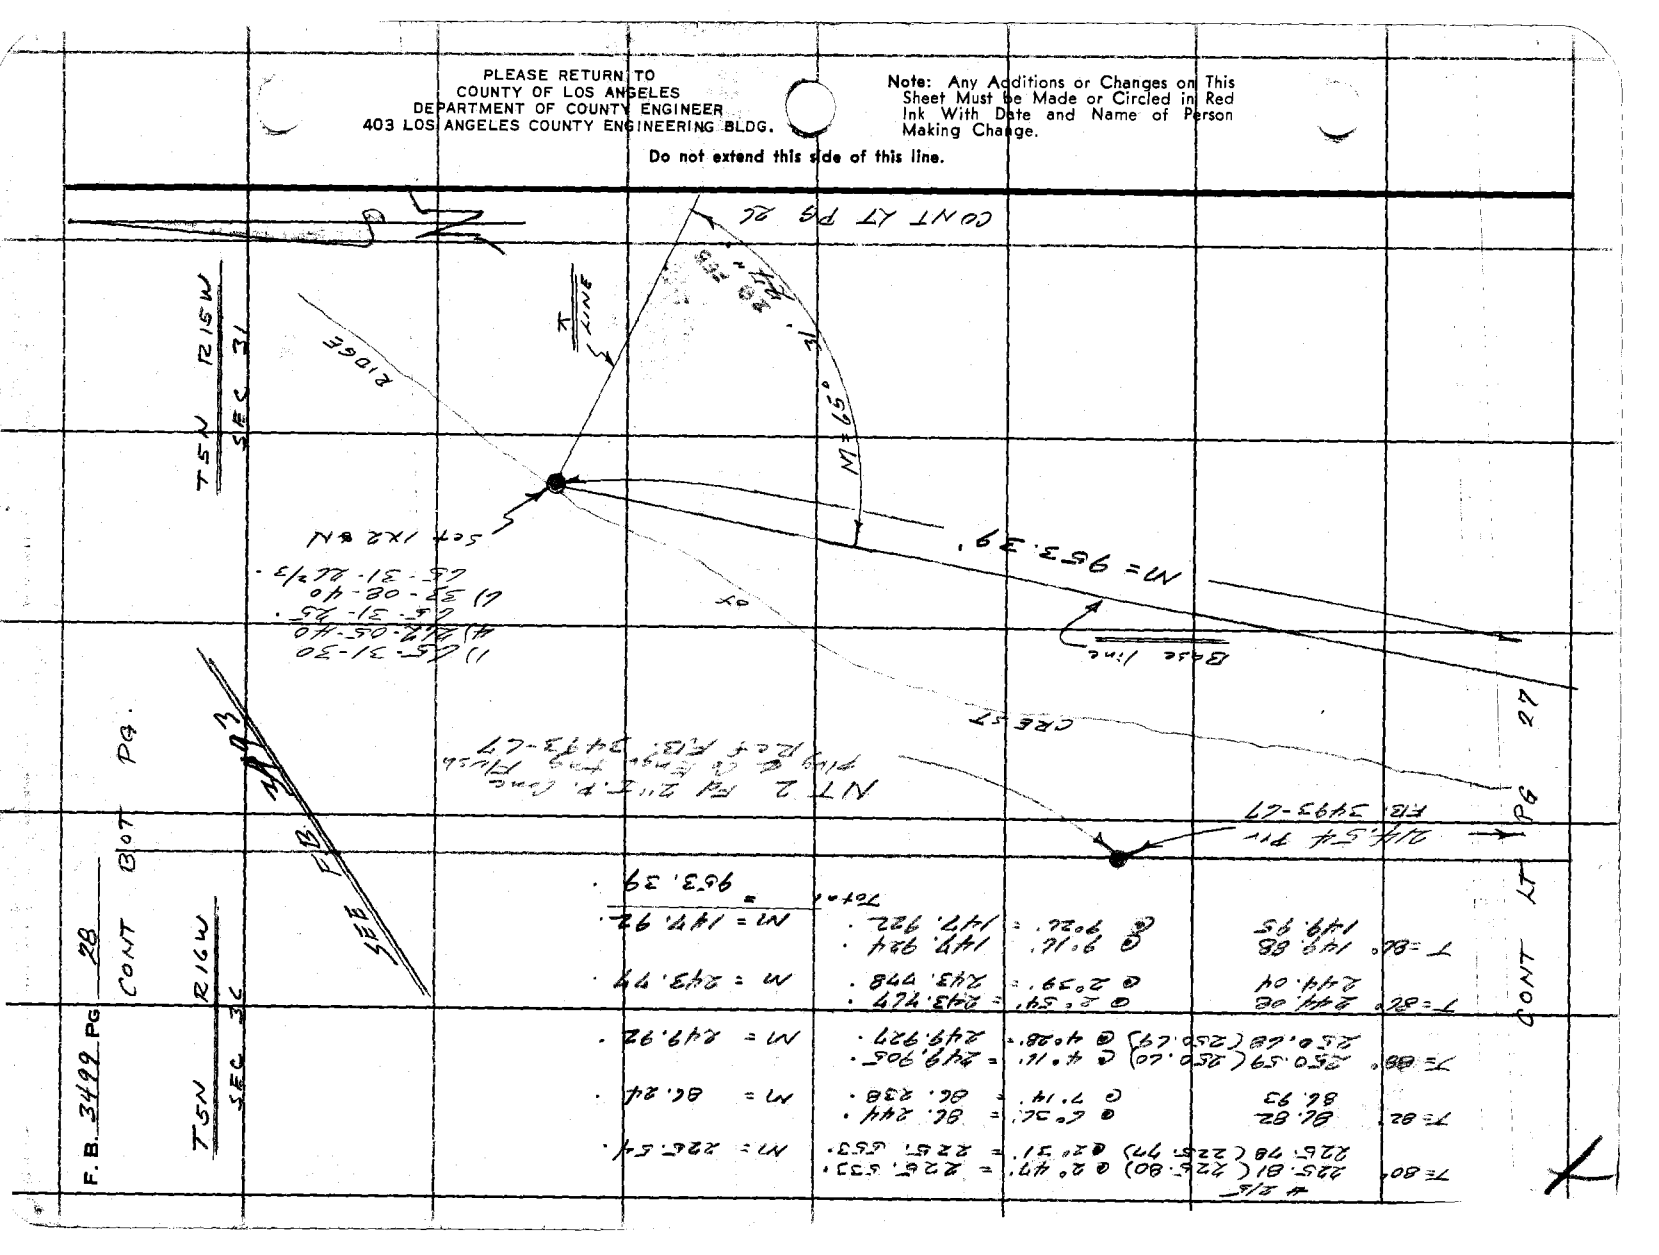

Notes Ck'd by	Survey of Sections in T5N R15W
Map No.	JN 0302.01 Tape 215 Std 5' °F
Office Work	Surveyed by FE Brooks
Checked	Notes FEB Date 2 Oct 69
Date	Indexed C. J. GALLI APR 14 72

F. B. 3499 PG. 29

CONT BOT PG 30

T5N
SEC 33

R15W
SEC 34

Edge of Bank

N1 = 209.83

POT set 2" I.P. conc Plug & Co Engr Tag Flush. wiggle pt

Ridge

N

of Crest

SECTION LINE

RCE 7211

SOUTHERN CALIFORNIA EDISON COMPANY

N1 = 244.04

Ed So. Calif Edison Brass Disc in 2" I.P. 3" NT. Ref. RS 80-7

#215 T= 80°
247.58 (247.57) @ 9°40'30" = 244.04'
N1 = 244.04'

0.13

Tow

CTR of Dry Wash

Slope

N1 = 300.22

CONT LT PG 7

Note: Any Additions or Changes on This Sheet Must be Made or Circled in Red Ink With Date and Name of Person Making Change.

Do not extend this side of this line.

PLEASE RETURN TO
COUNTY OF LOS ANGELES
DEPARTMENT OF COUNTY ENGINEER
403 LOS ANGELES COUNTY ENGINEERING BLDG.

16F3095 CE#310 3-68

PLEASE RETURN TO
COUNTY OF LOS ANGELES
DEPARTMENT OF COUNTY ENGINEER
403 LOS ANGELES COUNTY ENGINEERING BLDG.

Note: Any Additions or Changes on This Sheet Must be Made or Circled in Red Ink With Date and Name of Person Making Change.

Do not extend this side of this line.

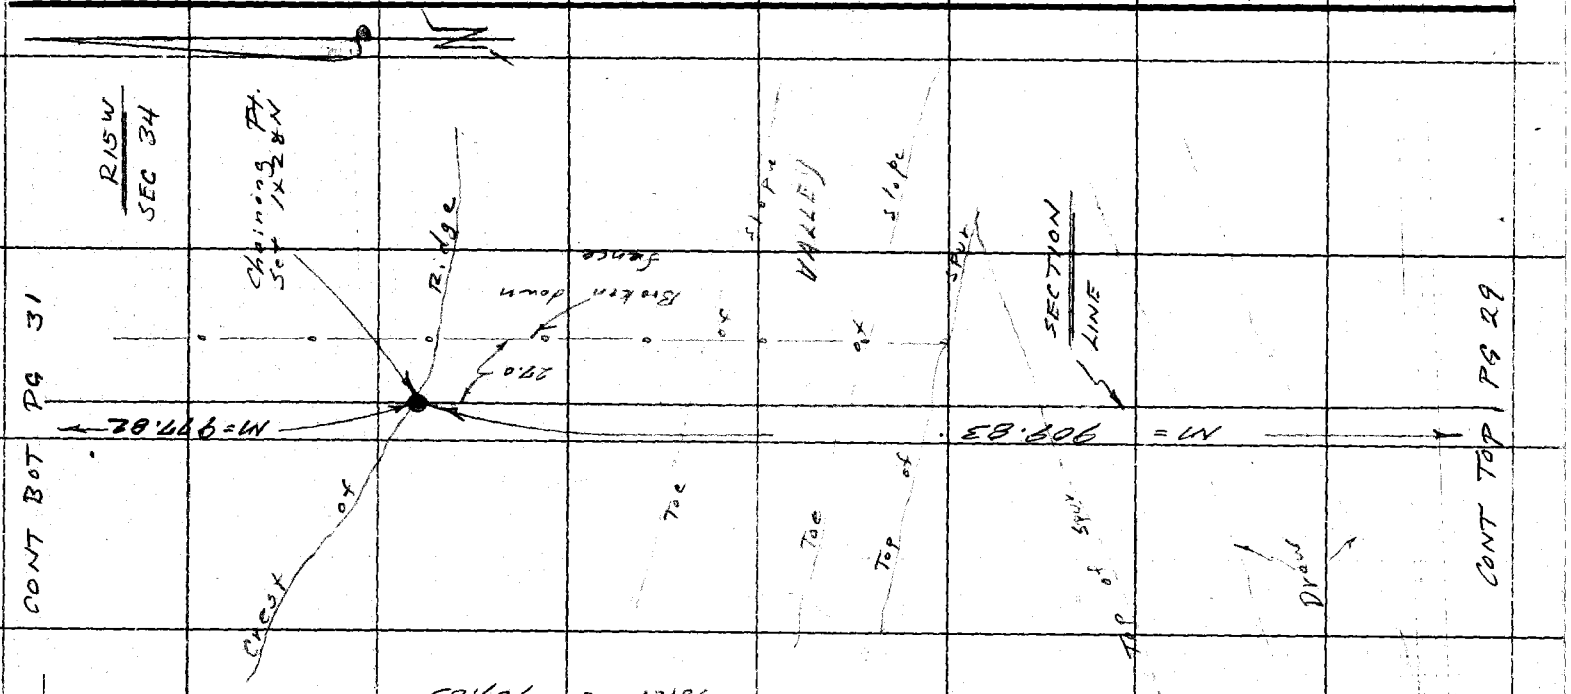

N1 = 977.82

N = 908.83

Total = 909.83

T = 78° 229.04 (229.03) @ 16° 15' = 219.880 . N1 = 219.87 .
228.35 (228.94) @ 16° 11' = 219.867 .

T = 78° 199.75 (199.94) @ 22° 12' = 181.229 . N2 = 181.22 .
199.39 (199.38) @ 21° 57' = 181.216 .

T = 94° 148.35 (148.34) @ 14° 45' = 143.452 . N1 = 143.45 .
148.19 (148.18) @ 14° 31' = 143.448 .

T = 78° 217.97 (217.96) @ 90° 29' = 214.980 . N2 = 214.98 .
217.86 (217.85) @ 90° 19' = 214.972 .

T = 80° 150.37 @ 1° 37' = 150.309 . N1 = 150.31 .
150.35 @ 1° 12' = 150.313 .

Notes Ck'd by
Map No.
Office Work
Checked
Date

Survey of Sections in T5N R15W F.B 3499 Pg. 31
JN 9312-01 Tape 215 Std 8' F
Surveyed by F E Boots
Notes F E B
Indexed GAL Date 2/20/69 1" = 72'

CONT BOT PG 32

T5N / SEC 33

R15W / SEC 34

ME 206.70'

POT Set R" E.B. Rebar & Cap Even with Flush

Edge of Bank

Edge of Bank

Bldg

Bldg

Top

Top

Top

Top

Top

Top

Toe

Toe

Toe

PLEASE RETURN TO
LOS ANGELES COUNTY ENGINEER
403 LOS ANGELES COUNTY ENGINEERING BLDG.

Note: Any Additions or Changes on this Sheet Must be Made or Circled in Red Ink With Date and Name of Person Making Change.

Do not extend this side of this line.

W.S. 78, A-6

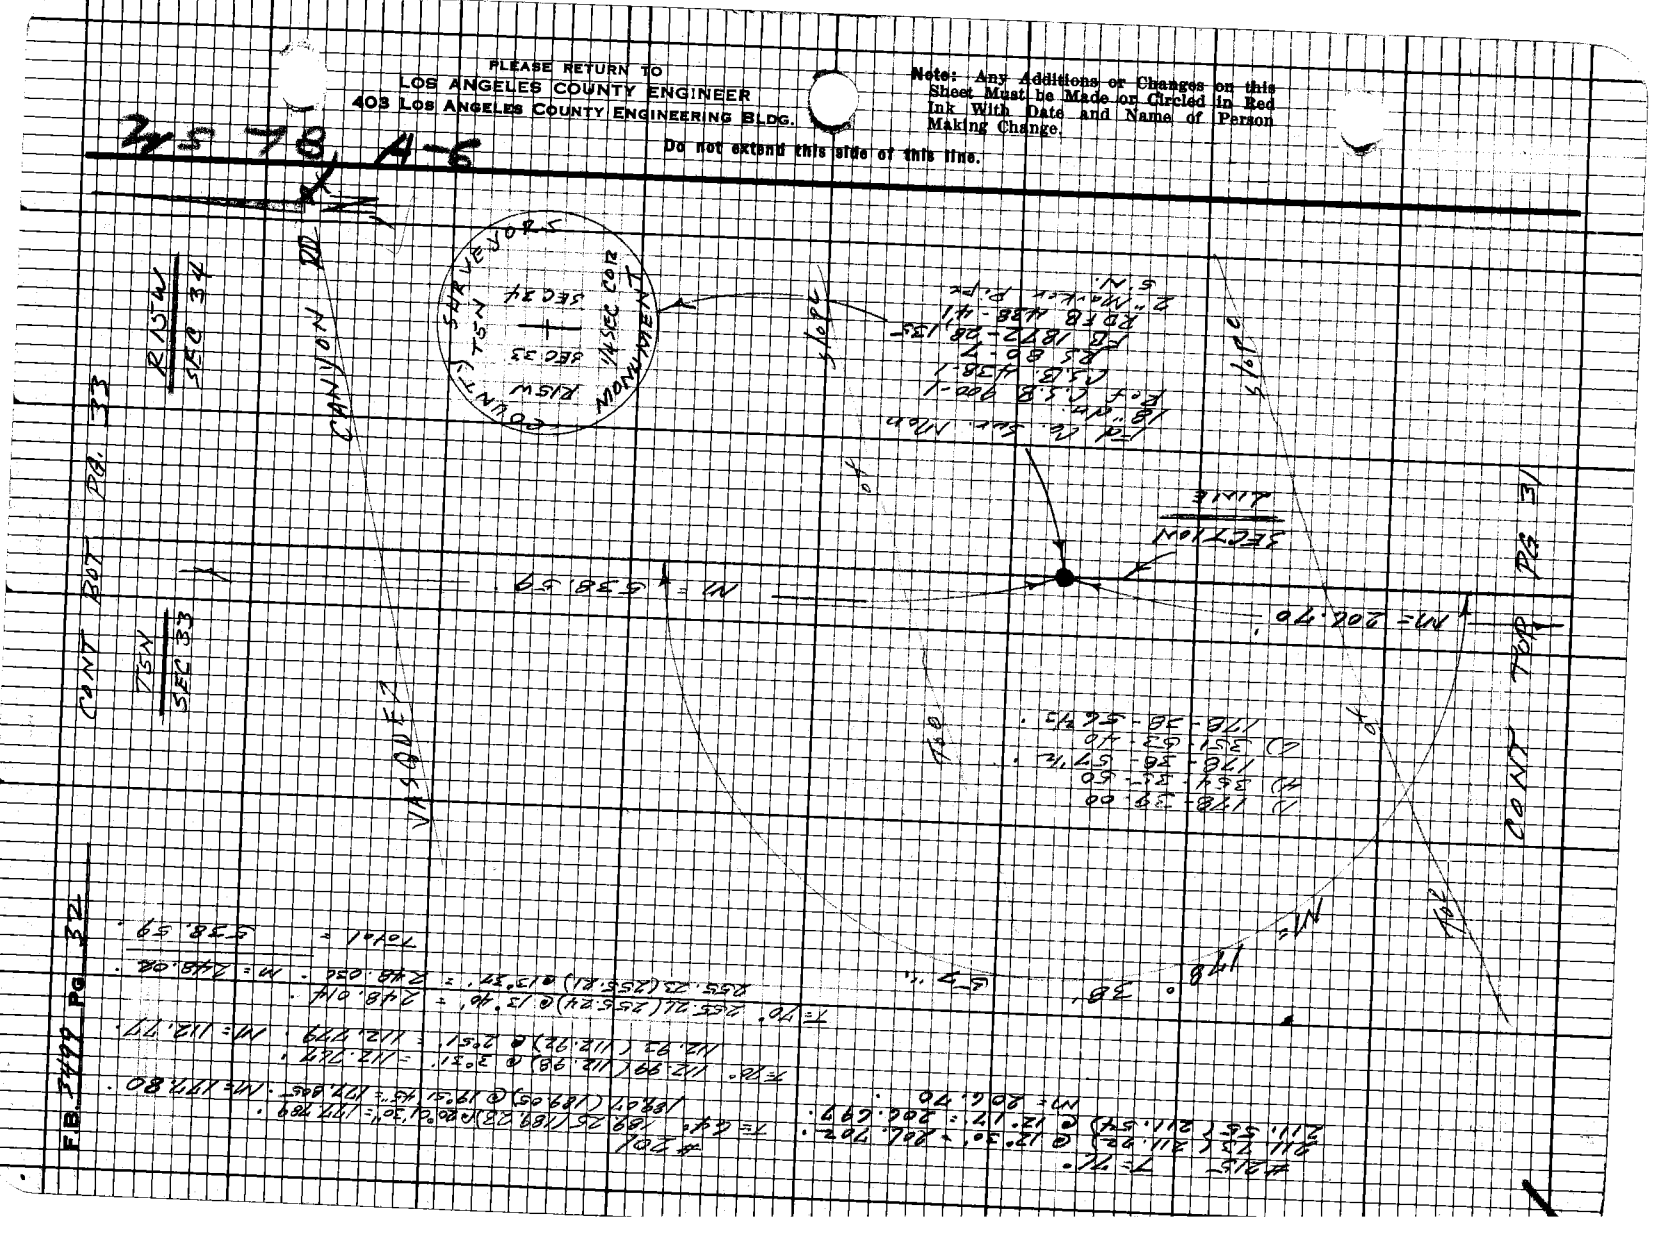
RISW
SEC 34
T5N
SEC 33
CANYON
VASQUEZ
CONT EAST
CONT THIS
POINT
SECTION
LINE
N1 = 638.59'
N1 = 206.70'
N1 = 112.77'

Notes Ck'd by
Map No.
Office Work
Checked
Date

Survey of Sections in T5N R14W
Inspector of Tape 215 Std 84°F
Surveyed by FE B. Inks
Notes FE B. Date 2 Feb 72
Indexed D. J. GALLI MAR 14 '72



T5N / SEC 33

R15W / SEC 34

Note: Any Additions or Changes on this Sheet Must be Made or Circled in Red Ink With Date and Name of Person Making Change.

PLEASE RETURN TO
LOS ANGELES COUNTY ENGINEER
403 Los Angeles County Engineering Bldg.

Do not extend this side of this line.


















PLEASE RETURN TO
LOS ANGELES COUNTY ENGINEER
403 Los Angeles County Engineering Bldg.

Do not extend this side of this line.

Note: Any Additions or Changes on this Sheet Must be Made or Circled in Red Ink With Date and Name of Person Making Change.

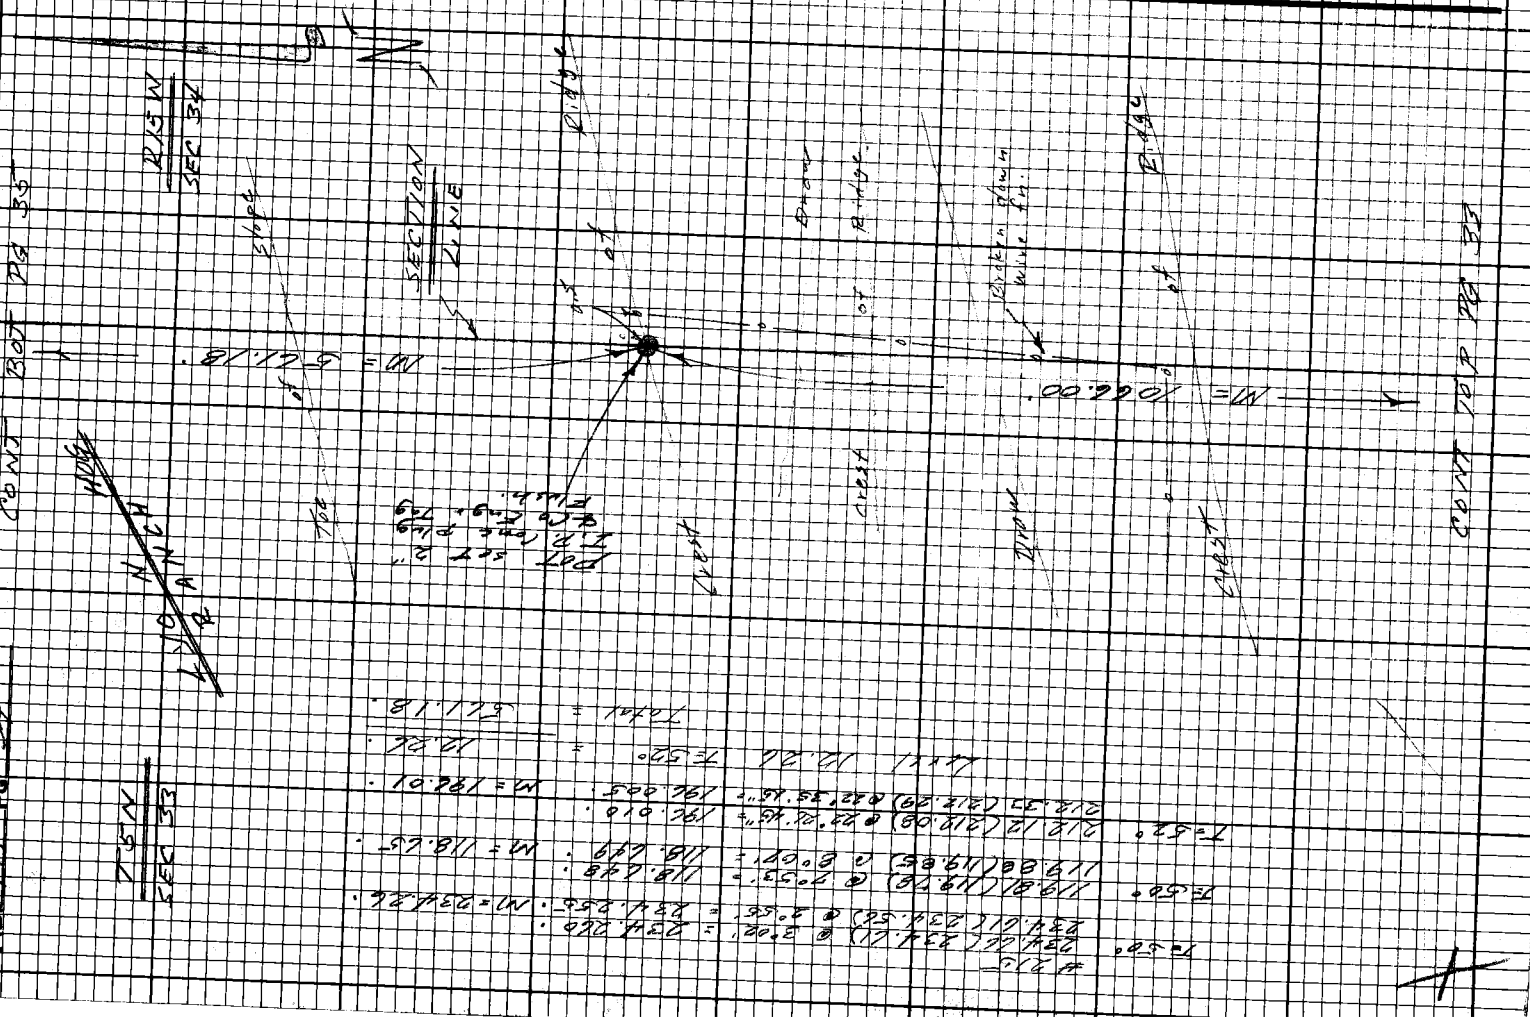

Notes Ck'd by
Map No.
Office Work
Checked
Date

Survey of SECTIONS 34 T5N R15W
Jn 42-01 Tape 25' Std 64°F
Surveyed by F.E. BLOOR
Notes F.E.B. Date 8-4-69
Indexed by D. J. GALLI APR 14 72

F.B. 3499 Pg. 35

Note: Any Additions or Changes on this Sheet Must be Made or Circled in Red Ink With Date and Name of Person Making Change.

PLEASE RETURN TO
LOS ANGELES COUNTY ENGINEER
409 LOS ANGELES COUNTY ENGINEERING BLDG.

Do not extend this side of this line.

16F3098 (EE#310) 9.67

R 15 W
SEC 34

CONT EAST

T5N
SEC 33

3' Board fence

HUGO RANCH

Good Dirt Road

SECTION LINE

Weed

SHEDS

Wash

Dry

F.O.T. set 1" I.P. Cond. Plug & Tag Engr. Flash

10.0

Road

Paved

5.0

370' To Locked Gate

CONT TOP OF 34

F.B. 3177 Pg. 36

CONT FROM PG 37

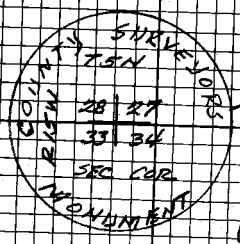

Set 60 Sq. Nail 18" on, in a Conc. Well in edge of Hog Barn, Well extend 4" above ground. Ref. CSB 900-1, CSB 438-1, FB 412-10, FB 725-38

SEC 28

SEC 27

N 88° W 1185. M

10°

10°

10°

10°

N 1°

N 1°

N 1

Notes Ck'd by
Map No.
Office Work
Checked
Date

Survey of Sec 1, 2, 11 & 12 T5N R15W F.B 3499 Pg 38
JN 4372 #1 Tape 2/5 Std 8'4"F
Surveyed by F E B & Crews
Notes F E B Date Oct 69
Indexed D. J. GAILI 11-1-72

Note: Any Additions or Changes on this Sheet Must be Made in Red Ink With Date and Name of Person Making Change.

PLEASE RETURN TO
LOS ANGELES COUNTY ENGINEER
403 Los Angeles County Engineering Bldg.

Do not extend this side of this line.

7RESOBA (REV. 8-67)

CONT FR PG 39

HOG BARN

3' Barb Fence

RD.

DIRT

Cor's = 1383.78'

Cone

Loading Dock

SECTION LINE

3' Barb Fence

BARN

DIRT

T5N

R15W

SEC 1

SEC 12

CONT TOP PG 38

PLEASE RETURN TO
LOS ANGELES COUNTY ENGINEER
403 LOS ANGELES COUNTY ENGINEERING BLDG.

Note: Any Additions or Changes on this Sheet Must be Made or Circled in Red Ink With Date and Name of Person Making Change.

Do not extend this side of this line.

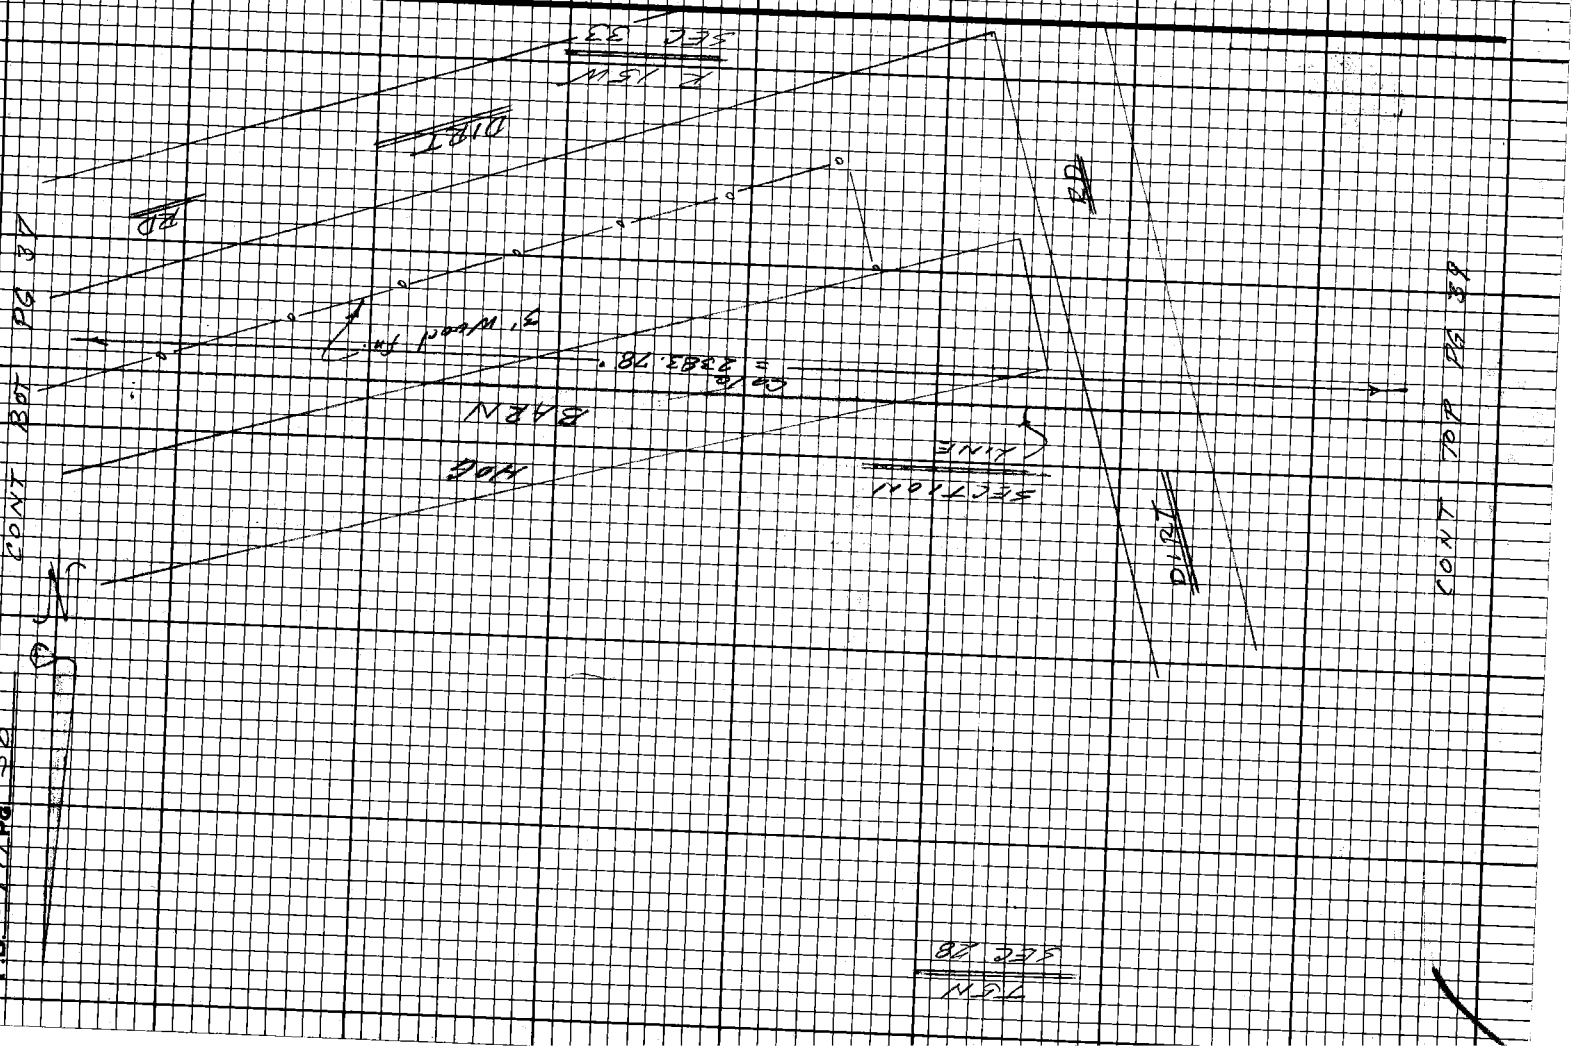

Notes Ck'd by
Map No.
Office Work
Checked
Date

Survey of Sections in T5N R15W
JN 030701 Tape 0198 Std 66 °F
Surveyed by FEBrooks
Notes FEB. Date 27 Oct 69
Indexed C. J. GALLI

F. B. 3499 PG. 39

CONT BOT PG 38

Toe of slope

CREST of Ridge

DRAW

Crest of Ridge

Draw

SEC LINE

T 5N SEC 28

R15W SEC 33

CONT LT PG 33

CONT TOP PG 40

CONT. TOP PG. 44

P.O.T. Wiggle Pt. Set 1" I.P. Conc Plug & Co Engr Tag Flush. Pipe mound of Rock.

POT Set 1X28N

1) 41-49-50
4) 166-59-30
41-44-52½ .
6) 250-29-20
41-44-53⅓ .

1) 35-27-40
4) 141-50-54½ .
35-27-46-00 .
6) 212-46-00
35-27-40

0198
37.69 T = 40° = 37.69.

N=37.69°

Calc = 1771.45°

N=35° 27' 40" .
38' FEB.

Calc = 2383.78 .

N = 44°

44.

33' FEB.

LINE

LINE

Note: Any Additions or Changes on This Sheet Must be Made or Circled in Red Ink With Date and Name of Person Making Change.

PLEASE RETURN TO
COUNTY OF LOS ANGELES
DEPARTMENT OF COUNTY ENGINEER
403 LOS ANGELES COUNTY ENGINEERING BLDG.

Do not extend this side of this line.

16F3095 CE#310 3-68

F. B. 3499 PG. 40

CONT BOT PG 39

PLEASE RETURN TO
COUNTY OF LOS ANGELES
DEPARTMENT OF COUNTY ENGINEER
403 LOS ANGELES COUNTY ENGINEERING BLDG.

Do not extend this side of this line.

Note: Any Additions or Changes on This Sheet Must be Made or Circled in Red Ink With Date and Name of Person Making Change.

SURVEY

SECTION LINE

1.45

COUNTY SURVEYORS
T 5 N
R 15 W
SEC 28
SEC 33
MONUMENT
1/4 SEC COR

Bottom of Canyon

Total = N 65° E 1.14'

#106 T=86° 298.72 / 298.14 @ 0°39' = 298.732 / @ 0°52' = 298.701 ; N = 298.72 / 64.19 ; 64.19 T=86° = 257.553 / 257.541 ; IN = 257.53

T=84° 238.75 / 240.13 @ 20°13' = 224.979 / @ 20°27'30" = 224.985 ; N = 224.98

#106 T=86° 258.08 / 259.05 @ 3°46' = 224.088 / @ 3°32' = 224.071 ; IN = 224.08

T=86° 59.69 / 59.69 @ 12°46' = 87.436 / @ 12°17' = 87.436 ; IN = 87.44

For old 2x2 Flush Post

CREST of Ridge

Draw

CL = 1871.45'

N = 320.26'

8.13

For Co. Sur. Mon. on Ridge. Mon. has mound. N. Ties To

For mound of rock. Ref. C.S.B. 900-1 FD 2915-267

New weld Tag Flush in mound of rock. W.P. 10 ft. W. of 1/4 Cor. mound located on a ridge.

Set 1x1x4 N by 2 double sight.

SEC 33

R 15 W

LINE Prod from W

0.39

CREST

T 5 N
SEC 28

#106
#3.12
T=86° 191.13 @ 110°14" = 187.550
160.85 = 162.543 ; N = 182.56'

#3.12 T = 87° = 43.12'

T=90° 154.03 (154.04) @ 7°51' = 154.570'
154.20 (154.21) @ 8°10' = 154.560'

T=90° 154.560 / 162.543 / 23.12'

N = 154.56'

Total = 320.22'

Set 2" IP. Iron Pipe #6 Flush in mound of Rock.

N = 1157.14'

Toe of Slope

CONT TOP PG 41

76F309S CE#310 1-65

D.38

PLEASE RETURN TO
LOS ANGELES COUNTY ENGINEER
403 LOS ANGELES COUNTY ENGINEERING BLDG.

Note: Any Additions or Changes on This Sheet Must be Made or Circled in Red Ink With Date and Name of Person Making Change.

Do not extend this side of this line.

T5N
SEC 28

1) 99-45-00
4) 39-00-20
99-45-05
6) 238-30-35
99-45-05 S/L.

Set Tag B.T.
Spk & T. in
24" Sycamore.

134'

4' chain link F.

Fd 2½" I.P. Conc. plug
& Lead Control Tag
12" dia. Ref.
P.C. 2915+22.7

Set Sq. hd
Spk B.T.

2 Strand
Barb Wire
Fence

Dirt Rd

Wood Bridge

CALC = 1771.45

M = 1150.1'

Dirt Rd

P.C. Set 1½"
I.P. at 90° to
Fd. pipe

Fd N&T
in Trans
P.P. #

4' chain link F.

Line Post
from W

BASE LINE

Set Tag B.T. in
24" Sycamore

M = 99°

R15W
SEC 33

Notes Ck'd by
Map No.
Office Work
Checked
Date

Survey of Sec 28 Thru 33 T5N R15W
UN Area of Tapia Park Std Q.Q. °F
Surveyed by F.E.B. Date 3-24-72
Notes
Indexed by D. GALLI Date 4-14-72

F. B. 72-11 PG. 1-11

PLEASE RETURN TO
LOS ANGELES COUNTY ENGINEER
403 LOS ANGELES COUNTY ENGINEERING BLDG.

Note: Any Additions or Changes on This Sheet Must be Made or Circled in Red Ink With Date and Name of Person Making Change.

Do not extend this side of this line.

WS 78, A-6

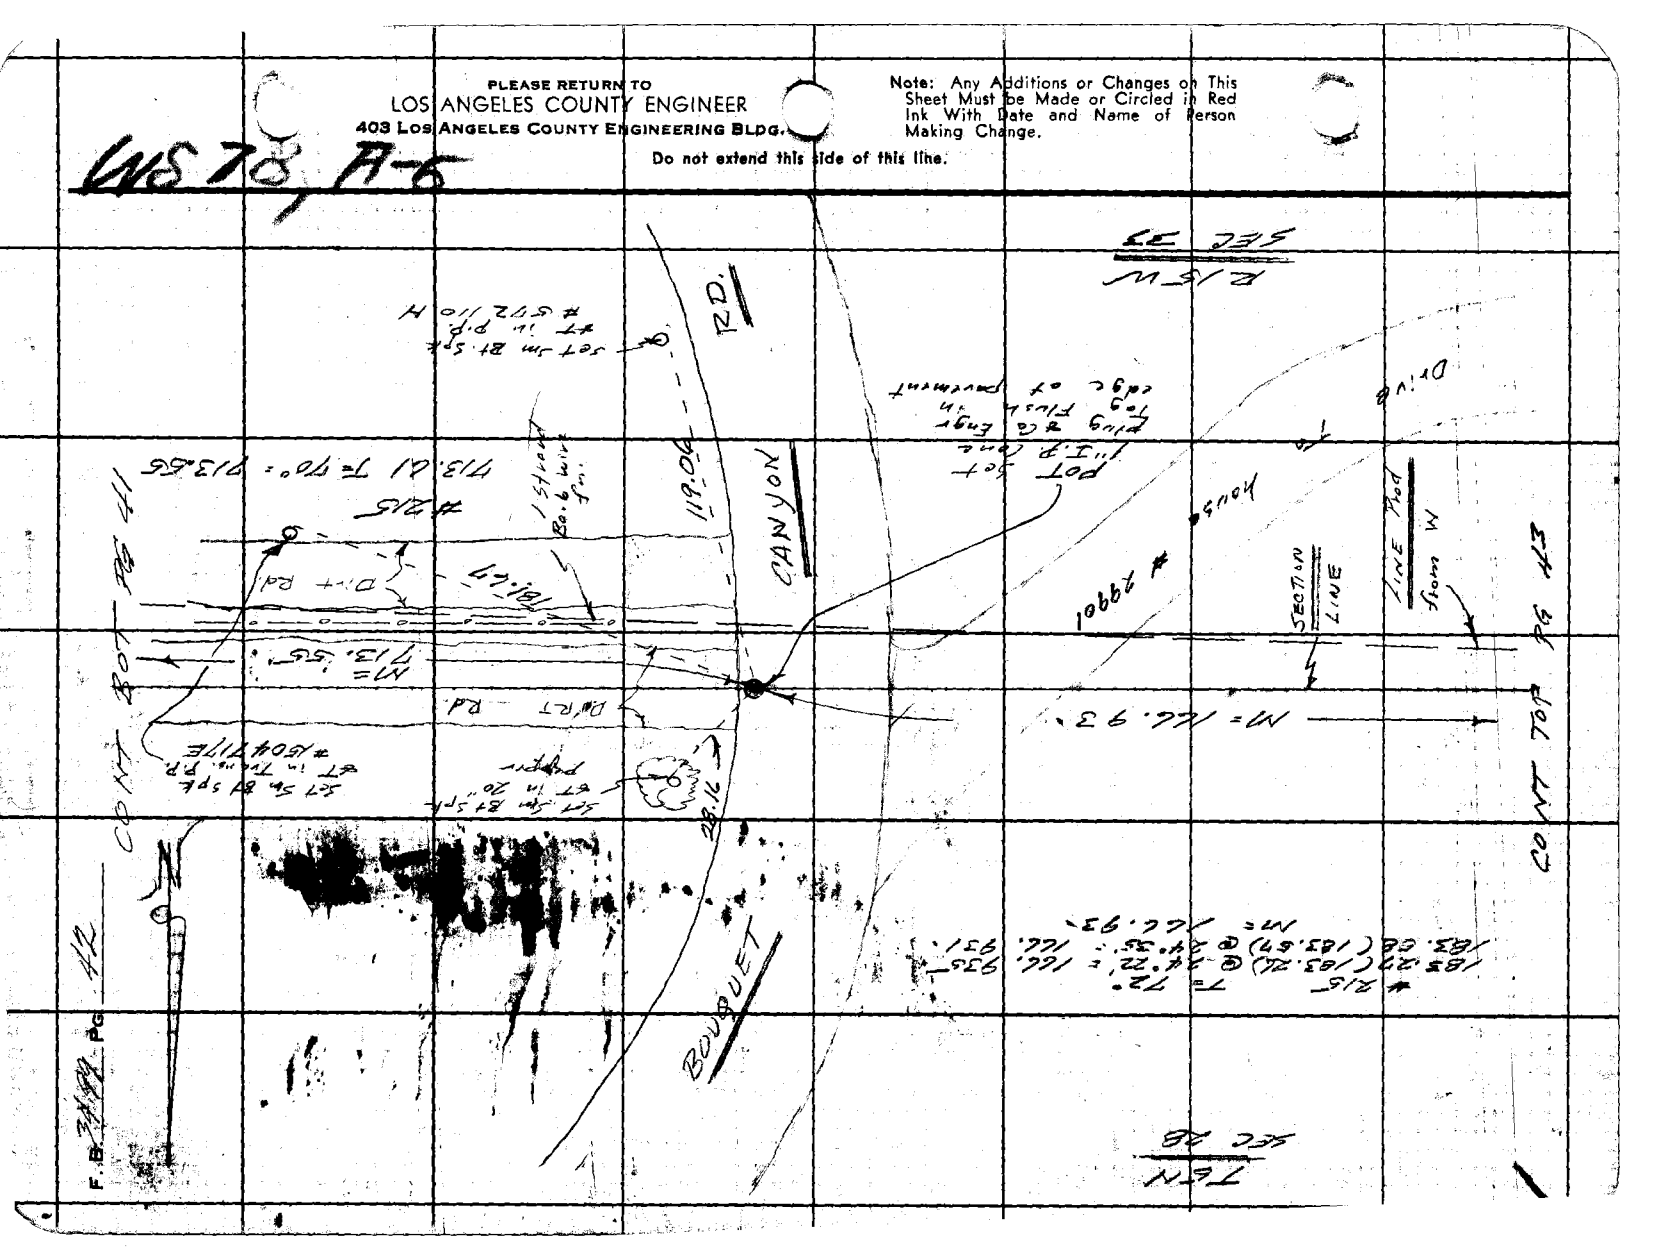

16F309S CE#310 1-65

PLEASE RETURN TO
LOS ANGELES COUNTY ENGINEER
403 LOS ANGELES COUNTY ENGINEERING BLDG.

Note: Any Additions or Changes on This Sheet Must be Made or Circled in Red Ink With Date and Name of Person Making Change.

Do not extend this side of this line.

90-15-45

W.S. 78 & A-6

Notes Ck'd by
Map No.
Office Work
Checked
Date

Survey of Sections in T5N R15W
JN 0262 Tape #15 + Std #2 °F
Surveyed by F.E. Brooks
Notes
Indexed F.E. Date 2-14-69
F.B. 3222 PG 1

CONT BOT PG. 93

SEC 29

T5N

SEC 28

1) 0-58-35
4) 3-54-20
0-58-35.
4) 5-51-20 1/3
0-58-33 1/3.

245 T= 84°

243.30 @ 1° 22' = 243.304.
243.35 @ 1° 11' = 243.298 1
M= 243.30

T=84
47.42 @ 8° 40' = 46.878.
47.33 @ 7° 54' = 46.888.
M= 46.88. 243.30 / 46.88

Total = 290.18.
Level ± 16.01 T=84° = -16.01
dist = 274.17.

M= 112.02

Drive

SECTION LINES

M= 0° 58' 33".

To

Fd 1/2" I.P.
R.S. FC 2915-287

M= 274.17.

M= 246.93.

CONT BOT PG. 94

1) 90-16-00
4) 361-04-10
90-16-02 1/2
6) 181-36-20
90-16-03 1/3

M= 192.64.

Bo Horn

CONT TOP PG 52

M= 90° 16' 03".

Fd Nail

Line Post

Line Post N.

M= 246.93

Fd Nail

M= 46.88

Fd Nail

Chain link fence

#29901

Fd. Co. Surv. Mon
Flush to ground
C.S.B.
F.C. 2915-287
2" Monument
set 5' E of
mon.

COUNTY SURVEYORS
T5N
R15W
29 | 28
32 | 33
SEC COR
MONUMENT

SEC 32

CONT TOP PG. 51

R 15 W
SEC 33

F.B. 3499 PG. 44 CONT BOT PG 39

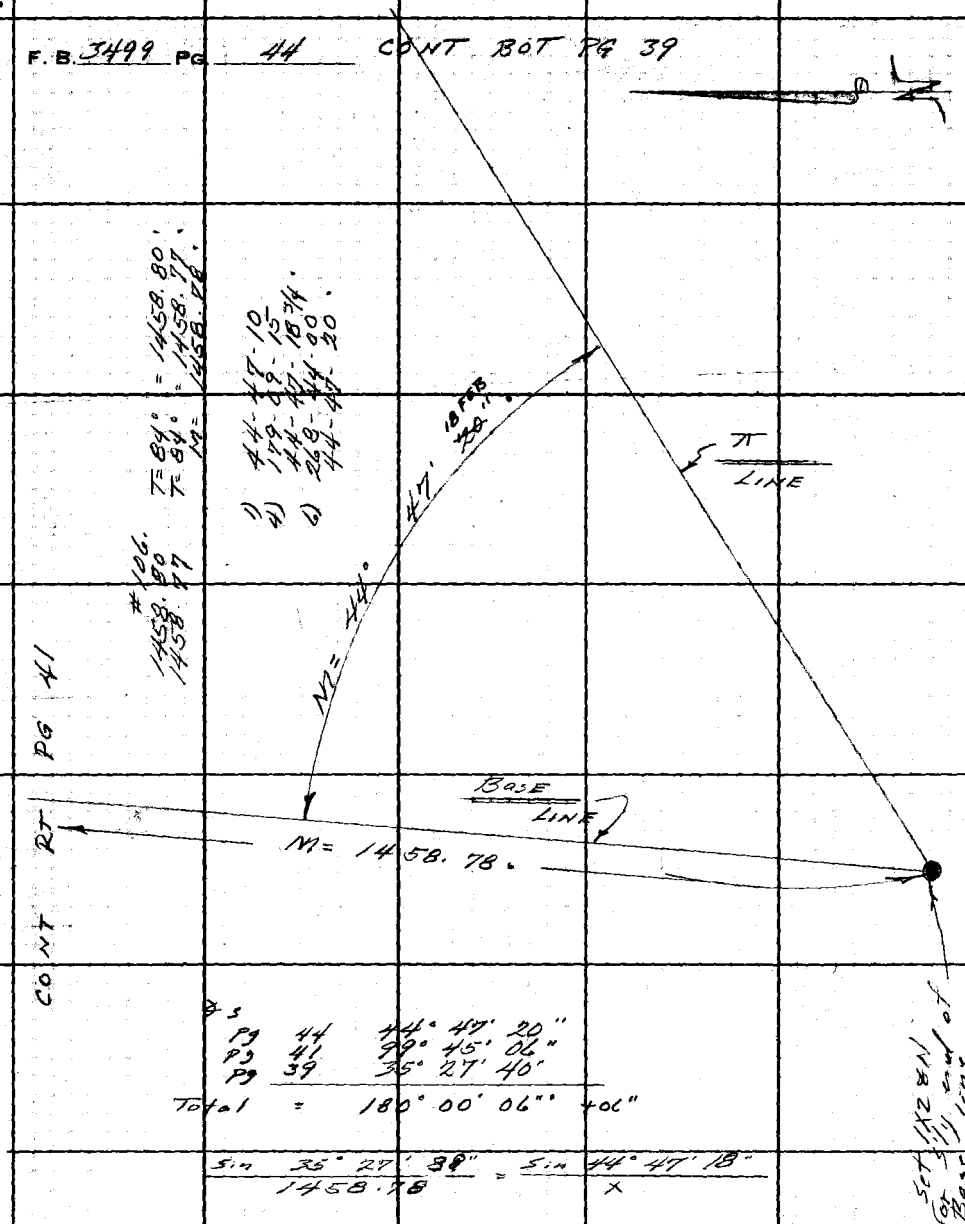

#106. 1458.80'
#80 T= 84° = 1458.77'
#77 T= 84° = 1458.78'
M=

1) 44-48-10
2) 179-59-15
3) 268-44-00
4) 44-47-20

P3	44	44° 47' 20"
P3	41	99° 45' 02"
P3	39	35° 27' 40"
Total =		180° 00' 06" +06"

$$\frac{\sin 35^\circ 27' 38''}{1458.78} = \frac{\sin 44^\circ 47' 18''}{X}$$

$$\frac{.58014235}{1458.78} = \frac{.70148971}{X}$$

$$.58014235\,X = 1027.695499153 8$$

$$X = 1771.454'$$

PLEASE RETURN TO
LOS ANGELES COUNTY ENGINEER
403 LOS ANGELES COUNTY ENGINEERING BLDG.
Do not extend this side of this line.

Note: Any Additions or Changes on This Sheet Must be Made or Circled in Red Ink With Date and Name of Person Making Change.

76F3098 CE#310 9.67

PLEASE RETURN TO
LOS ANGELES COUNTY ENGINEER
409 LOS ANGELES COUNTY ENGINEERING BLDG.

Note: Any Additions or Changes on this Sheet Must be Made or Circled in Red Ink With Date and Name of Person Making Change.

Do not extend this slug of this line.

Notes Ck'd by
Map No.
Office Work
Checked
Date

Survey of Portion of Tract No. 19201 as per Map Recorded in Book 201 Page 5 et seq. of Maps, in the Office of the County Recorder of said County.
Surveyed by F.E.B. Dated 6-67
Notes
Indexed by M. Gatti Jan 1 '72

FB 3098 PG. 43

T 5 N
SEC 32

201.
446.03
446.03

T = 68° = 445.98
T = 68° = 445.98

M = 445.98 ·

594.98
625.01

T = 850 = 594.93
T = 72° = 594.94

M = 594.94 ·

374.18
374.13

T = 76° = 374.16
T = 76° = 374.13

M = 374.14 ·

SECTION LINE

M = 445.98 ·

M = 594.94 ·

M = 374.14 ·

POINT NOT IN TRACT

POINT NOT IN TRACT

CONT. IN FB 13

R 13 W
SEC 33

F.B. 3499 PG. 46

CONT FROM PG 47

CONT TO PG 45

PLEASE RETURN TO
LOS ANGELES COUNTY ENGINEER
403 Los Angeles County Engineering Bldg.

Note: Any additions or Changes on this Sheet Must be Made or Ruled in Red Ink With Date and Name of Person Making Change.

Do not extend this side of this line.

POT 1X2IN

POT 1X2IN

POT 1X2IN

WASH

DS

SECTION LINE

N 89° 55' 22" E 2,632.44'



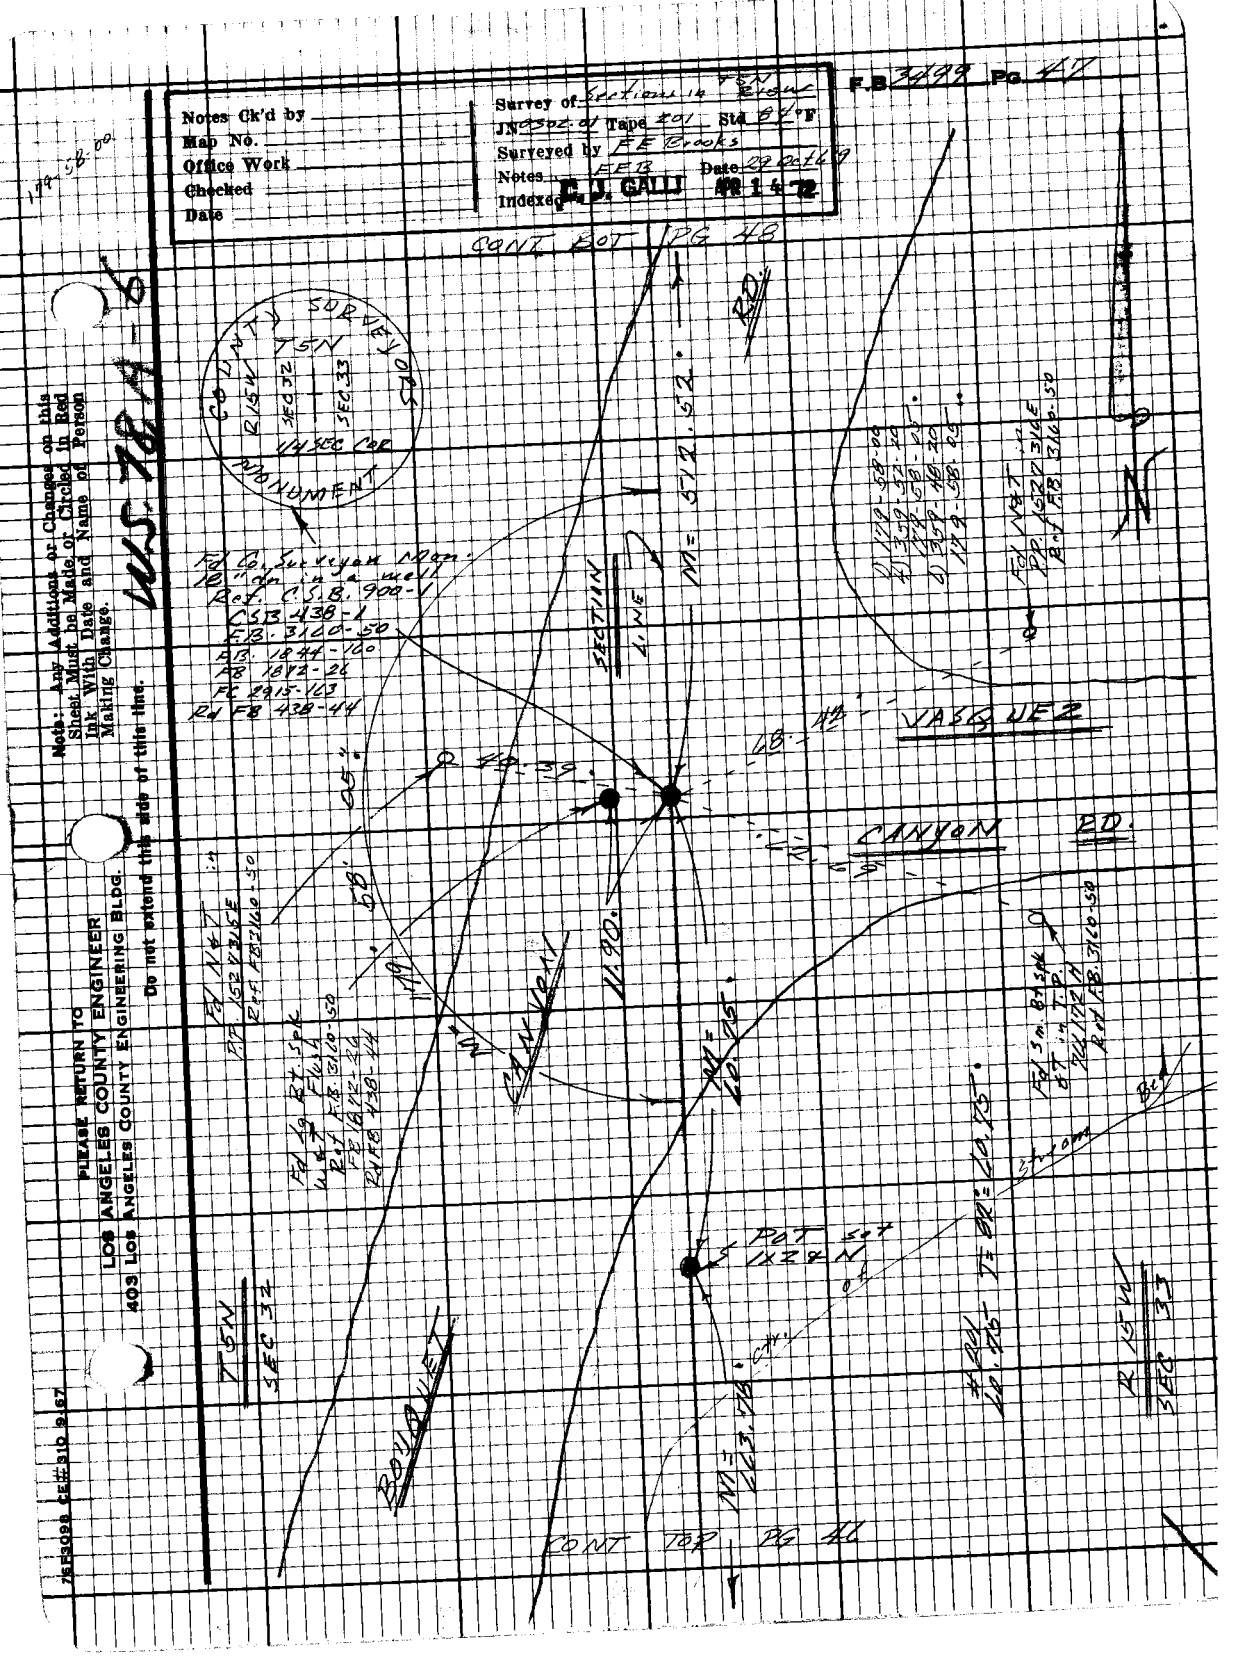
Notes Ck'd by
Map No.
Office Work
Checked
Date
Indexed by F. J. GALLI 4/14/72
CONT EOT PG 48
COUNTY ROAD SURVEY
T 5 N R 14 W
SEC 32
SEC 33
1/4 SEC COR
MONUMENT
Fd Col. Surveyors Mon.
10" dia in a well
Ref. C.S.B. 900-V
C.S.B. 438-1
C.S.B. 3100-50
A.B. 1841-100
F.B. 1892-26
F.C. 8915-163
Rd F.B. 138-44
Fd 1/2" I.P.
P.P. 152 E 3.45 S
2.0 F.B. 3140-50
Fd 1/2" I.P.
P.P. 152 E 3.45 S
2.0 F.B. 3140-50
Fd Tag RT. Spk
West F.B. 3140-50
2.0 F.B. 3140-44
F.B. 1892-44
F.B. 138-44

PLEASE RETURN TO
LOS ANGELES COUNTY ENGINEER
403 LOS ANGELES COUNTY ENGINEERING BLDG.

Do not extend this side of this line.

Note: Any Additions or Changes on this Sheet Must be Made or Circled in Red Ink With Date and Name of Person Making Change.

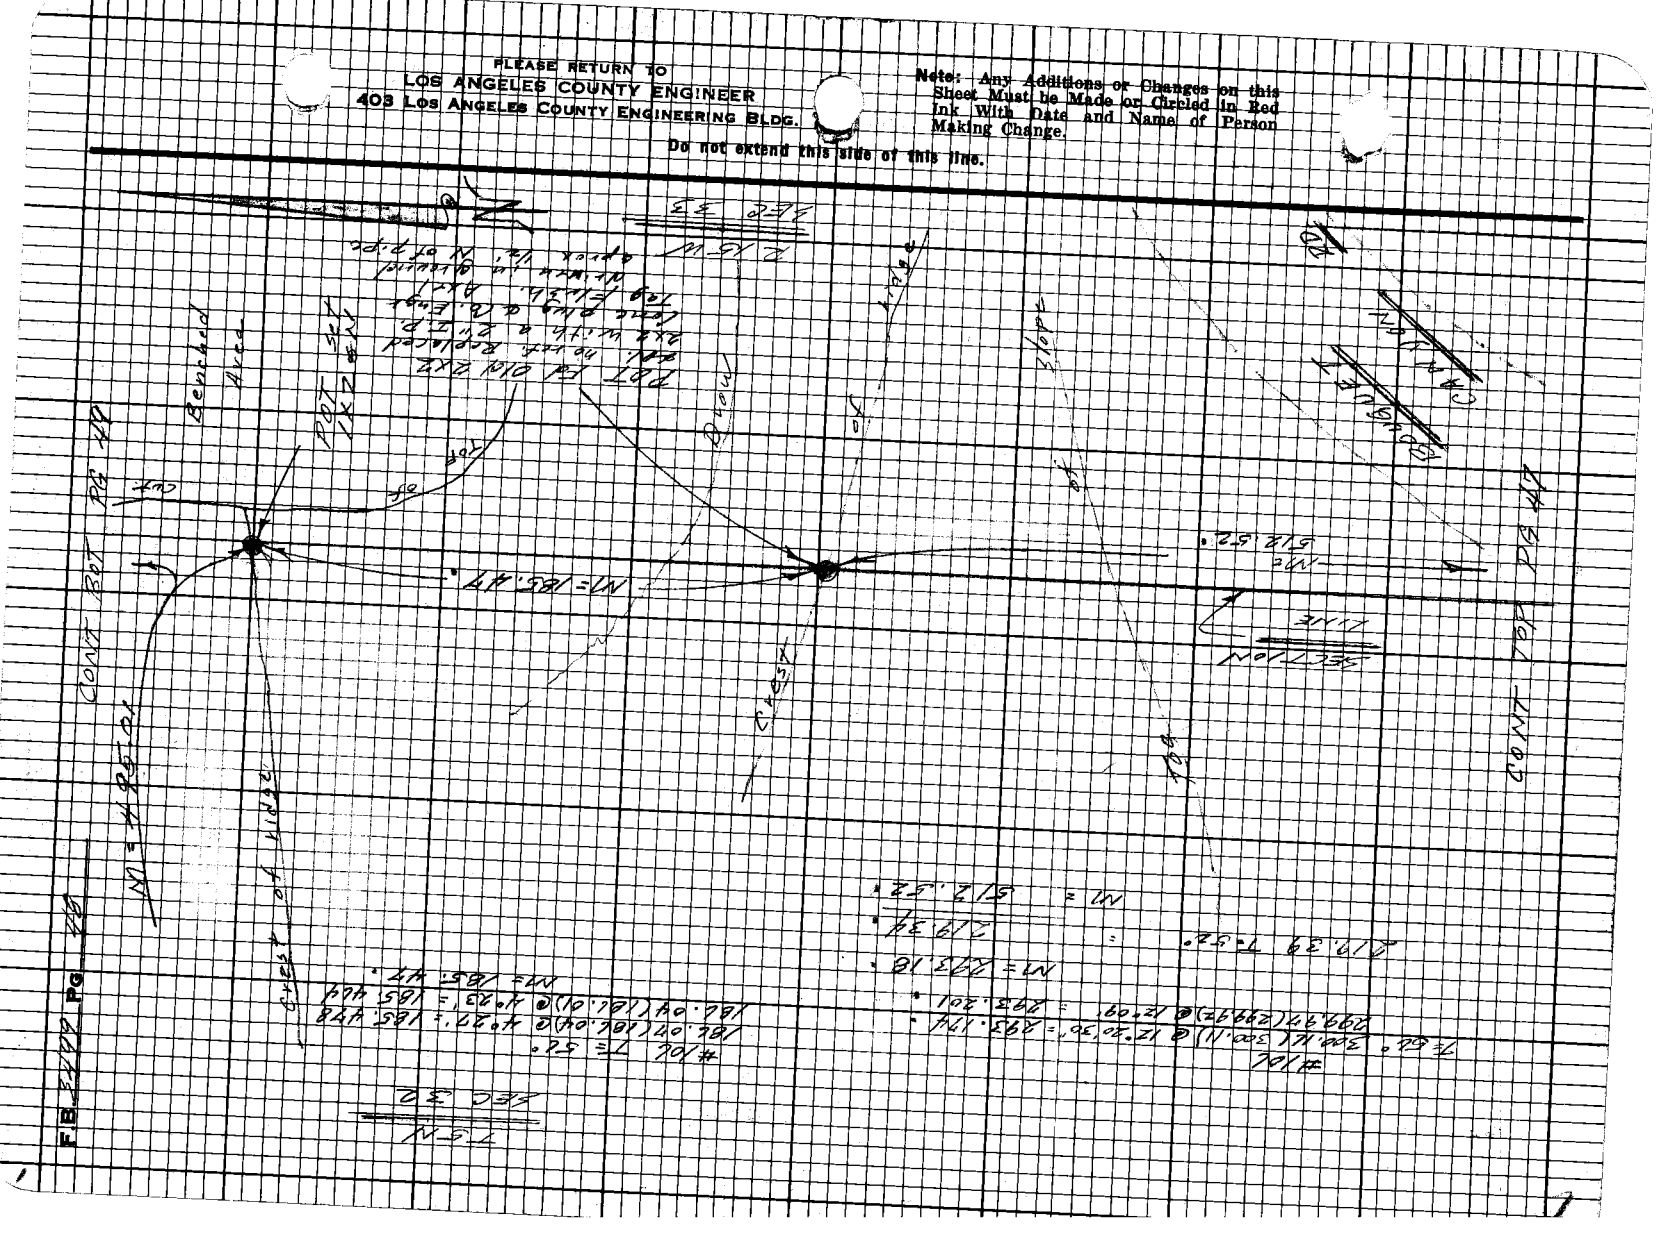

Notes Ck'd by _____
Map No. _____
Office Work _____
Checked _____
Date _____

Survey of Sections 14 T5N R16W
JN 0392.01 Tape 100' Std 8.4'F
Surveyed by FEB Books
Notes FEB Date 6 Nov 69
Indexed C. J. GALLI RE 1 & 72

FB 3499 Pg 49

CONT BOT PG 50

24" Pepper Tree 5149

Found 2" I.P. wood Plug & Tag RE 917 no tick

30" Euc

Found Nail

Calc 5149

STR 13+20.1 1/4 1/4 SOL

Painted on wall of 5149

0.55

24.48

N 1°

122.74

N0°

POT set NAIL & TAG

10.79

0.38

For axel driven into the ground in a rock mound.

T5N R16W SEC 33

SECTION LINE

Cone w Tank

N = 426.01'

T5N SEC 32

TE 38° #106 (RS 3:34) @ 12° 01' = 93.24'
SET POT @ 13° 23' 30" = 93.34'
N1 = 93.24'

TE 58° 157.12 (RS 157.12) @ 5° 21' = 150.44'
157.09 (RS 157.09) @ 5° 00' = 150.48'
N = 150.46'

TE 38° #57.80 (RS 57.46) @ 150' = 251.31'
#57.54 (RS 57.50) @ 2°12' = 247.13'
Total = N1 = RST 31'
#95.01'

CONT TOP PG 48

Jackson ce #310 9-67

PLEASE RETURN TO
LOS ANGELES COUNTY ENGINEER
403 LOS ANGELES COUNTY ENGINEERING BLDG.

Do not extend this side of this line.

Note: Any Additions or Changes on this Sheet Must be Made or Circled in Red Ink With Date and Name of Person Making Change.

PLEASE RETURN TO
LOS ANGELES COUNTY ENGINEER
403 LOS ANGELES COUNTY ENGINEERING BLDG.

Note: Any Additions or Changes on this Sheet Must be Made or Circled in Red Ink With Date and Name of Person Making Change.

Do not extend this side of this line.

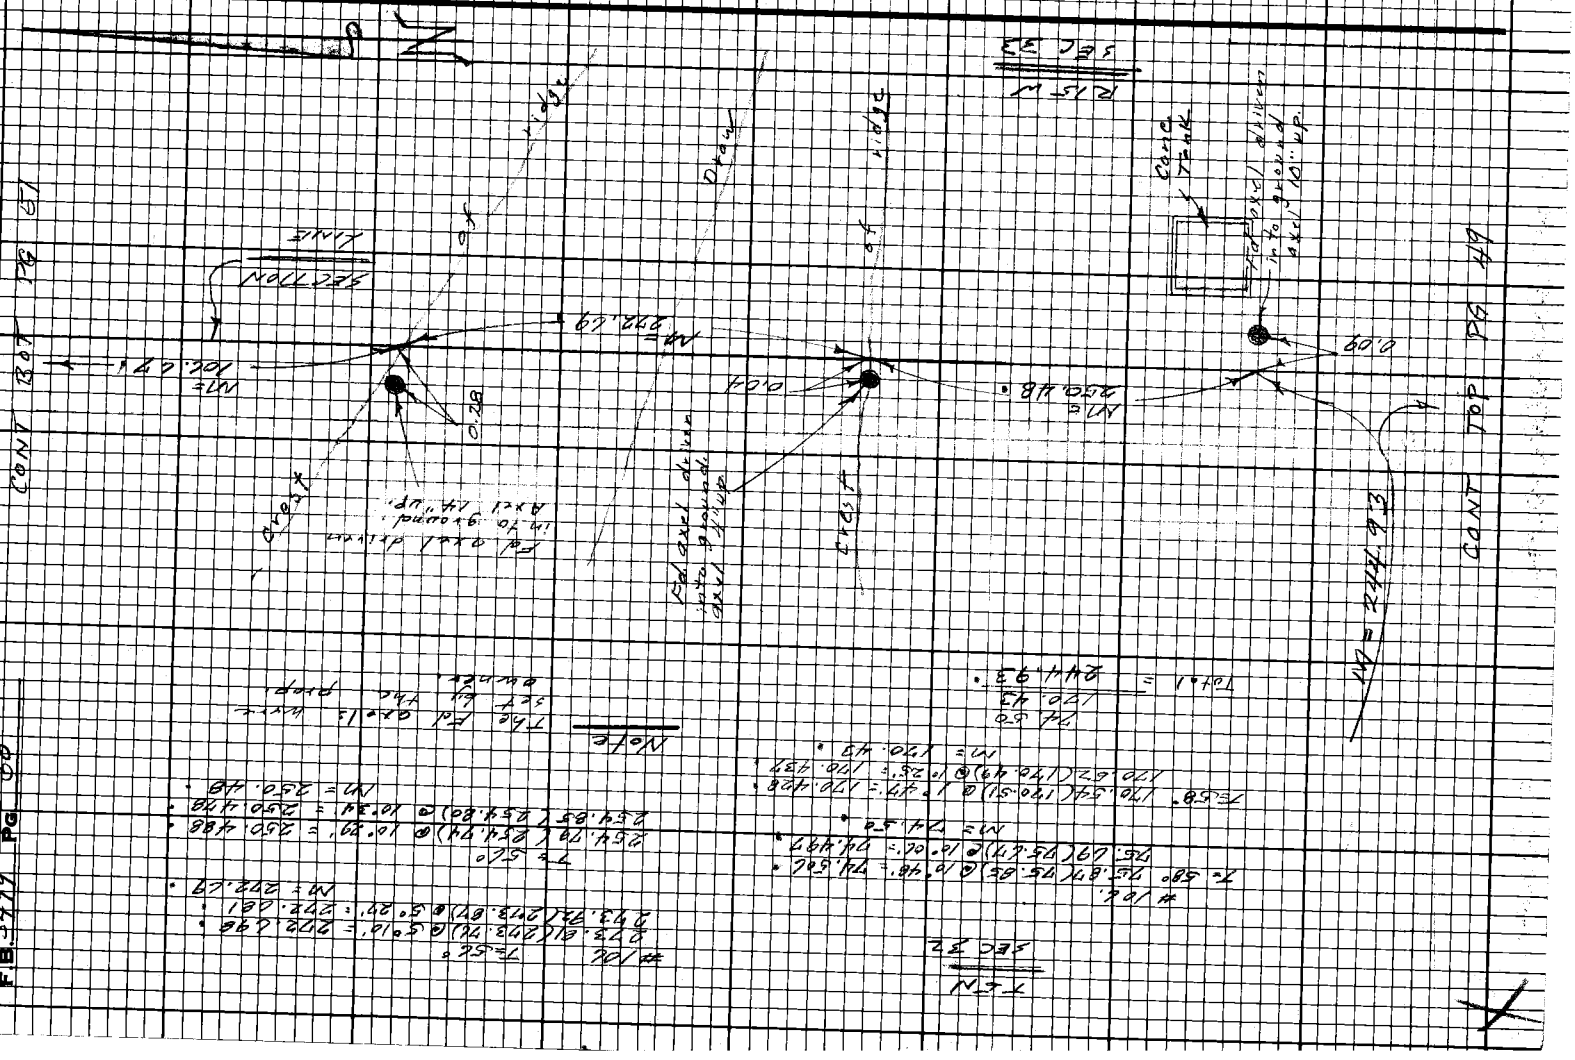
CONT

Notes Ck'd by
Map No.
Office Work
Checked
Date

Survey of Sections in T4N R14W
JN 03272 Tape 100' Std 84°F
Surveyed by FE Bowers
Notes FEB Date 4 Nov 72
Indexed G. J. GALLI

F.B. 3498 Pg. 51

Note: Any Additions or Changes on this Sheet Must be Made or Circled in Red Ink With Date and Name of Person Making Change.

Do not extend this side of this line.

PLEASE RETURN TO
LOS ANGELES COUNTY ENGINEER
403 Los Angeles County Engineering Bldg.

COMM RP RG 43

SECTION LINE

T6N
SEC 32

FE 20.0 #1/4 1971 (CE) @ 1.00' E & 0.00' N
FE 20.0

PLEASE RETURN TO
LOS ANGELES COUNTY ENGINEER
403 Los Angeles County Engineering Bldg.

Note: Any Additions or Changes on this Sheet Must be Made or Circled in Red Ink With Date and Name of Person Making Change.

Do not extend this side of this line.

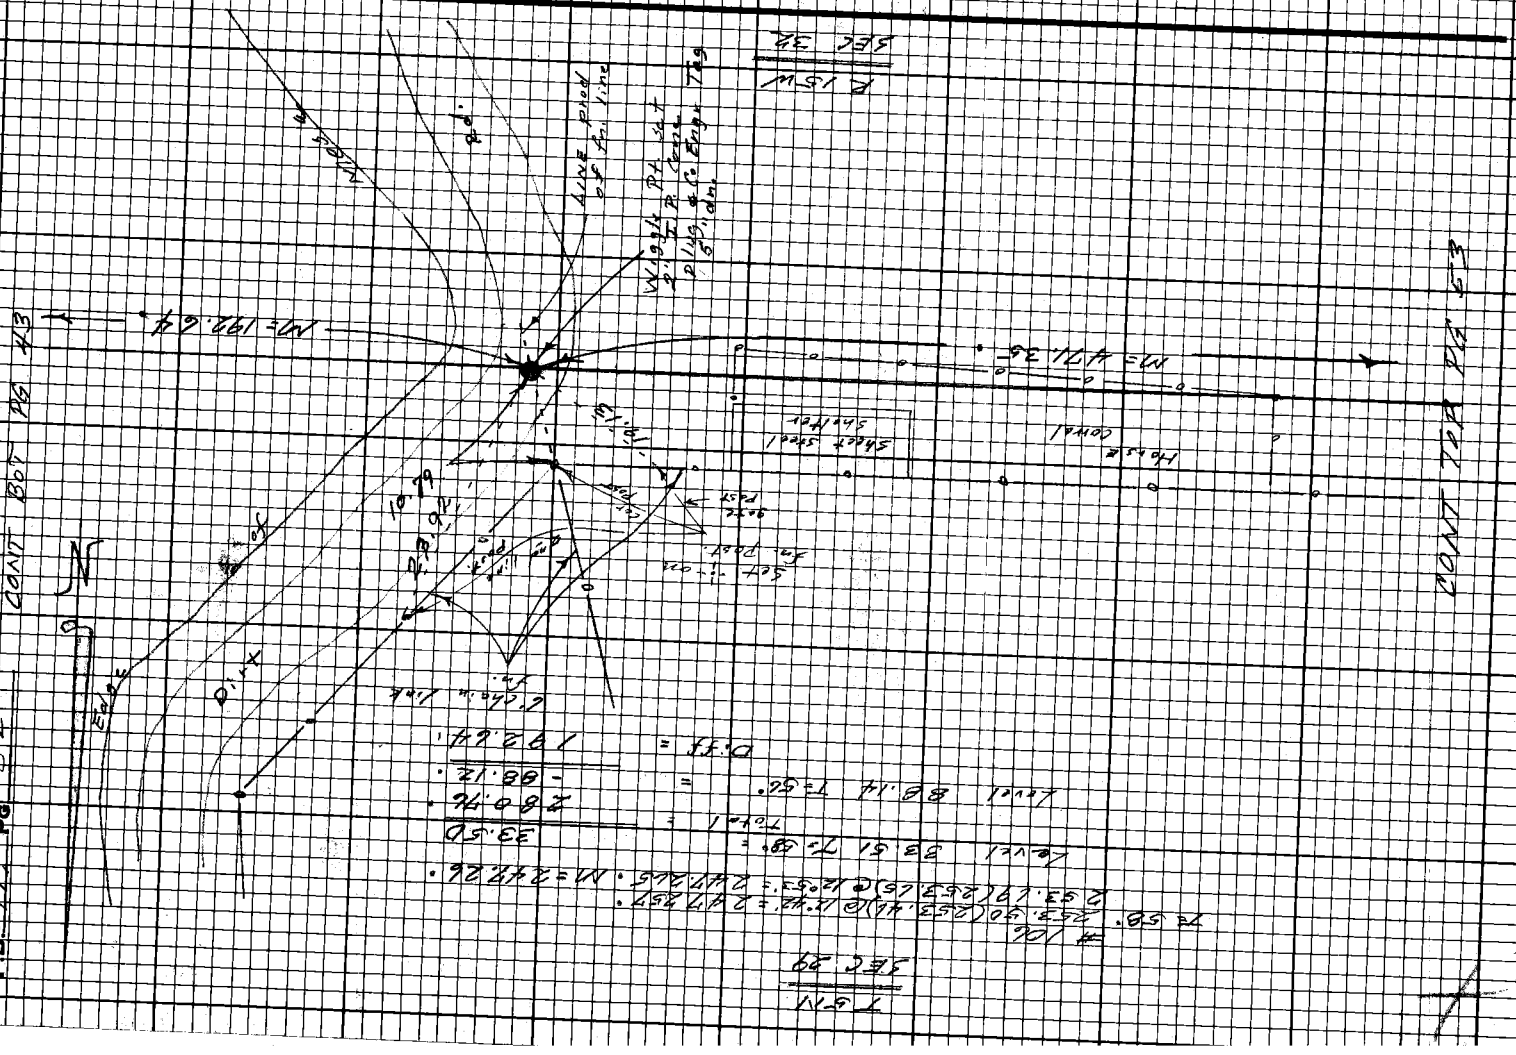
CONT BOT PG 43
CONT TOP PG 43
Edge
Wash
Edge
Edge
Edge

76F3098 CE#310 9-67

PLEASE RETURN TO
LOS ANGELES COUNTY ENGINEER
403 LOS ANGELES COUNTY ENGINEERING BLDG.

Note: Any Additions or Changes on this Sheet Must be Made or Circled in Red Ink With Date and Name of Person Making Change.

Do not extend this side of this line.

Notes Ck'd by
Map No.
Office Work
Checked
Date

Survey of Centerline, Misc. R/S
JN 43901 of T4N6 10 E. Sta 64 "T"
Surveyed by FEB 11-17
Notes
Indexed by A. Calli Date Nov 1 12

F.B. 3498 Pg. 53

T 5 N

SEC 29

#106

T=44° 197.32 (197.32) @ 3°03' = 197.039
197.41 (197.32) @ 3°22' = 197.048 M = 197.04'

T=44° 274.68 (274.65) @ 2°52' = 274.306
274.65 (274.62) @ 2°44' = 274.306 M = 274.31'

Tot = 471.35'

F.I. T.P. Wood
Alig = Tg RE 917
3" up in rock mound
no wit.

6' chain link fence

CONT. BOT PS 52

Roll

Dirt

0.0'

CONT TOP PS 54

M = 254.73'

M = 471.35'

See Plan

#106

T = 44° 5' 55"

254.13 (254.10) @ 5° 46' = 254.734'
254.05 (254.02) @ 5° 46' = 254.724'
M = 254.73'

R 15 W

SEC 32

F.B. 3499 Pg 54

CONT FROM Pg 53

PLEASE RETURN TO
LOS ANGELES COUNTY ENGINEER
403 Los Angeles County Engineering Bldg.

Note: Any Additions or Changes on this Sheet Must be Made or Circled in Red Ink With Date and Name of Person Making Change.

Do not extend this line at this time.

T 3-N
SEC 29
385.96

T= 70° 191.82 (191.65) @ 2° 05' = 191.600
191.82 (191.60) @ 3° 08' = 191.614
NW = 191.61'

T= 68° 245.71 (245.44) @ 1° 11' = 245.528
245.71 (245.43) @ 1° 12' = 245.653
NW = 245.66'

298.80 T= 74° 298.78'

T= 82° 172.82 (172.91) @ 7° 00' = 170.480
172.14 (172.13) @ 7° 43' = 170.203
NW = 170.68'

T= 82° 299.35 (299.33) @ 9° 09' = 295.422
299.46 (299.44) @ 9° 18' = 295.605
NW = 295.51'

T= 72° 62.65 @ 18° 54' 45" = 59.268
62.48 @ 19° 07' = 59.266
NW = 59.24'

T= 72° 92.84 (92.73) @ 10° 35' = 90.459
92.71 (92.70) @ 11° 44' = 90.162
NW = 90.16'

Total = 1352.28'

Wiggle Pt. Set Iron Pin & Cap Flush Pipe set in rock mound.

Ed.

NW = 254.13'

Point of Intersection

NW = 380.71'

24.60

0.35

2.86

Fd 1" Pipe, Bent, Flush with ground

R 15 W

SEC 32

DIRT

SECTION LINE

Fd Wood Hub & Post Painted W.K.H. & 2' S.W.
RANCHO EX MEX NO 8
COR S 5 Ext on W. face
N 1/8 NE 32 Ext on W. face.

CONT TOP Pg 55

7SF3098 CE#310 9-67

PLEASE RETURN TO
LOS ANGELES COUNTY ENGINEER
403 LOS ANGELES COUNTY ENGINEERING BLDG.

Do not extend this side of this line.

Note: Any Additions or Changes on this Sheet Must be Made or Circled in Red Ink With Date and Name of Person Making Change.

45 27 D-6

Notes Ck'd by
Map No.
Office Work
Checked
Date

Survey of Sections in TOWNSHIP
JN 9702 of Tract 106 Std B.F.
Surveyed by F.E.B. & Crews
Notes
Date 10/11/72
Indexed F. B. GALLI RS 1442

F.B. 344 B Pg. 55

T5N
SEC 29

#106 TE 90°
129.13 (129.12) @ 0°2' = 127.751'
129.16 (129.15) @ 0°2.5' = 127.768'
M = 127.76'

SURVEY MONUMENT
T5N
S. 29
S. 32
1/4 COR

N 11°00' W
M = 129.76'
N 11°00' W
129.76'

1/4 Cor. Fd. Co. Surv.
Mon. & Tag
R.F. C.S.B. 900-1
F.B. 14 pc - 1971
A #4 rebar Set Tag
mark - marked
N 34°A set 25' E

SECTION LINE

Dirt Rd

M = 1352.28'

1) 179 - 59 - 45
2) 359 - 59 - 25
179 - 59 - 51 1/4'
3) 359 - 59 - 40
179 - 59 - 50'

M & Ties Subsequent to Establishment of Monument C.S.B. 900-1

CONT TOP PG 54

CONT TOP PG 54

R15W
SEC 32

PLEASE RETURN TO
LOS ANGELES COUNTY ENGINEER
403 Los Angeles County Engineering Bldg.

Do not extend this side of this line.

Note: Any Additions or Changes on this Sheet Must be Made or Circled in Red Ink With Date and Name of Person Making Change.

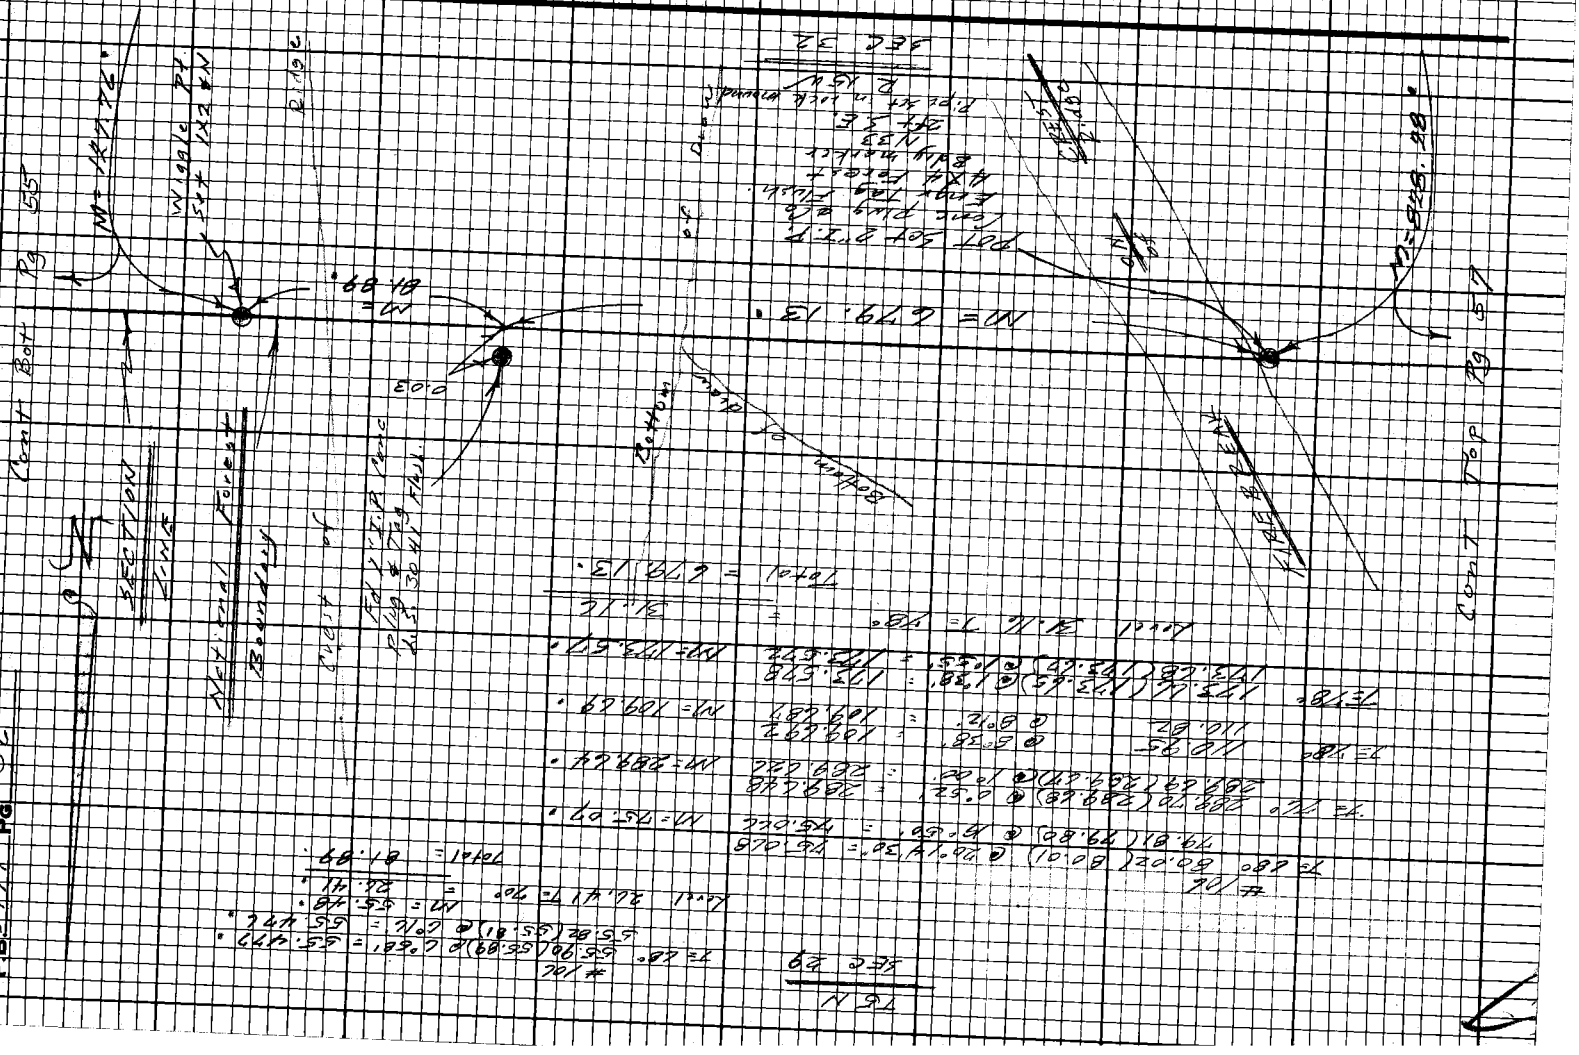

Notes Ck'd by		Survey of Sections in T5N R15W	F.B. 3499 Pg. 57
Map No.		JN 03172.01 Tape 10C Sta 64 °F	
Office Work		Surveyed by F.E. Brooks	
Checked		Notes F.E.B. Date 10 Nov 69	
Date		Indexed L. J. GALLI 1-4-72	

Note: Any Additions or Changes on this Sheet Must be Made or Circled in Red Ink With Date and Name of Person Making Change.

PLEASE RETURN TO
LOS ANGELES COUNTY ENGINEER
403 LOS ANGELES COUNTY ENGINEERING BLDG.

Do not extend this side of this line.

CONT ROT PG 56

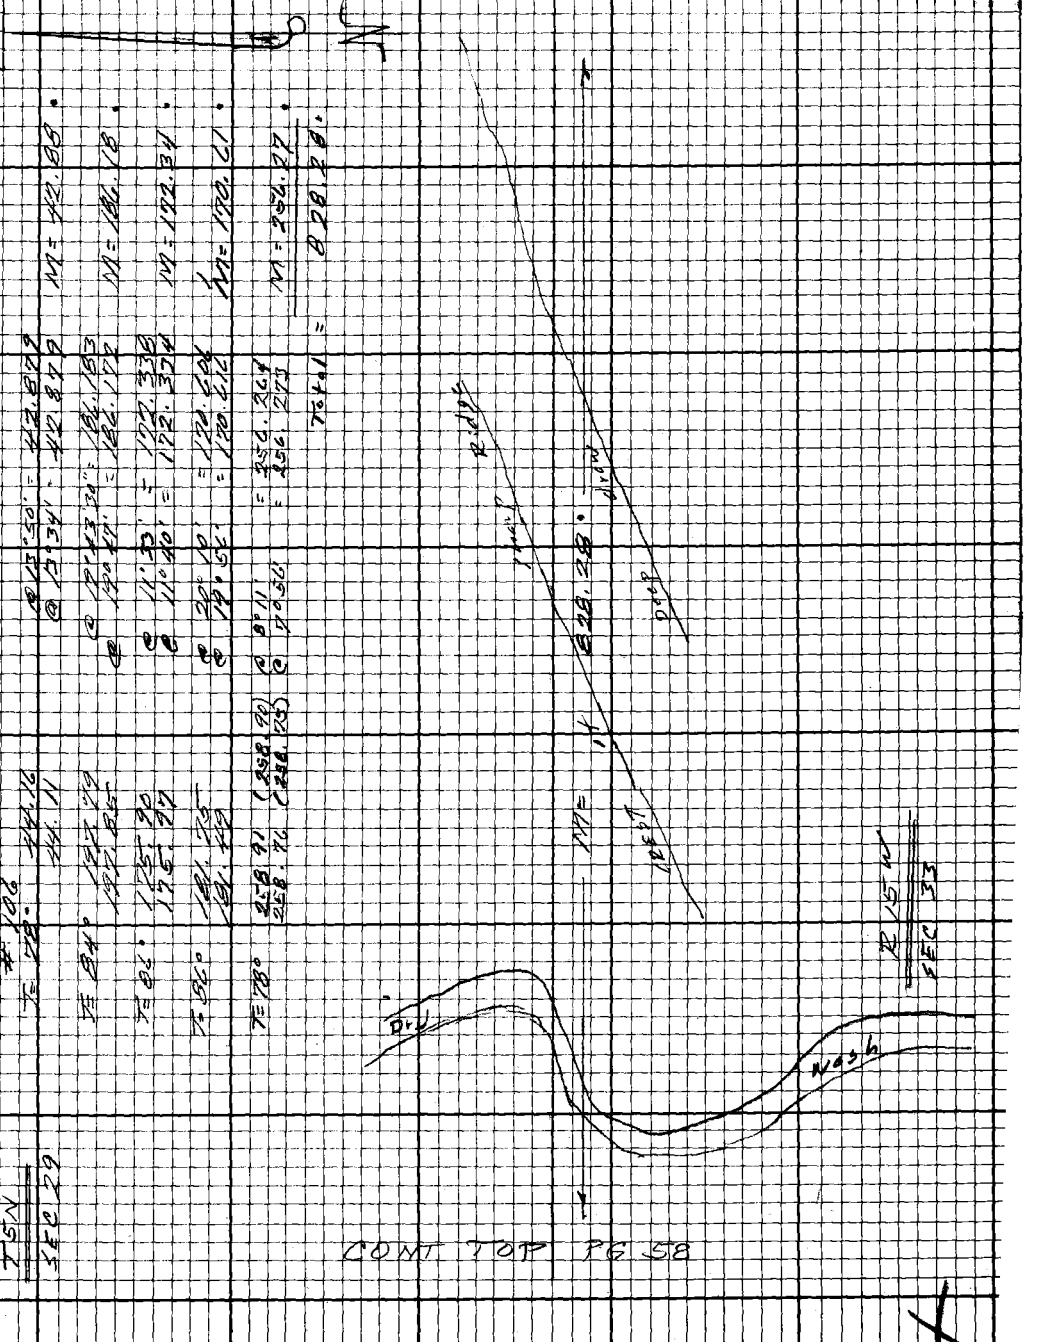

PLEASE RETURN TO
LOS ANGELES COUNTY ENGINEER
403 LOS ANGELES COUNTY ENGINEERING BLDG.

Note: Any Additions or Changes on this Sheet Must be Made or Circled in Red Ink With Date and Name of Person Making Change.

Do not extend this side of this line.

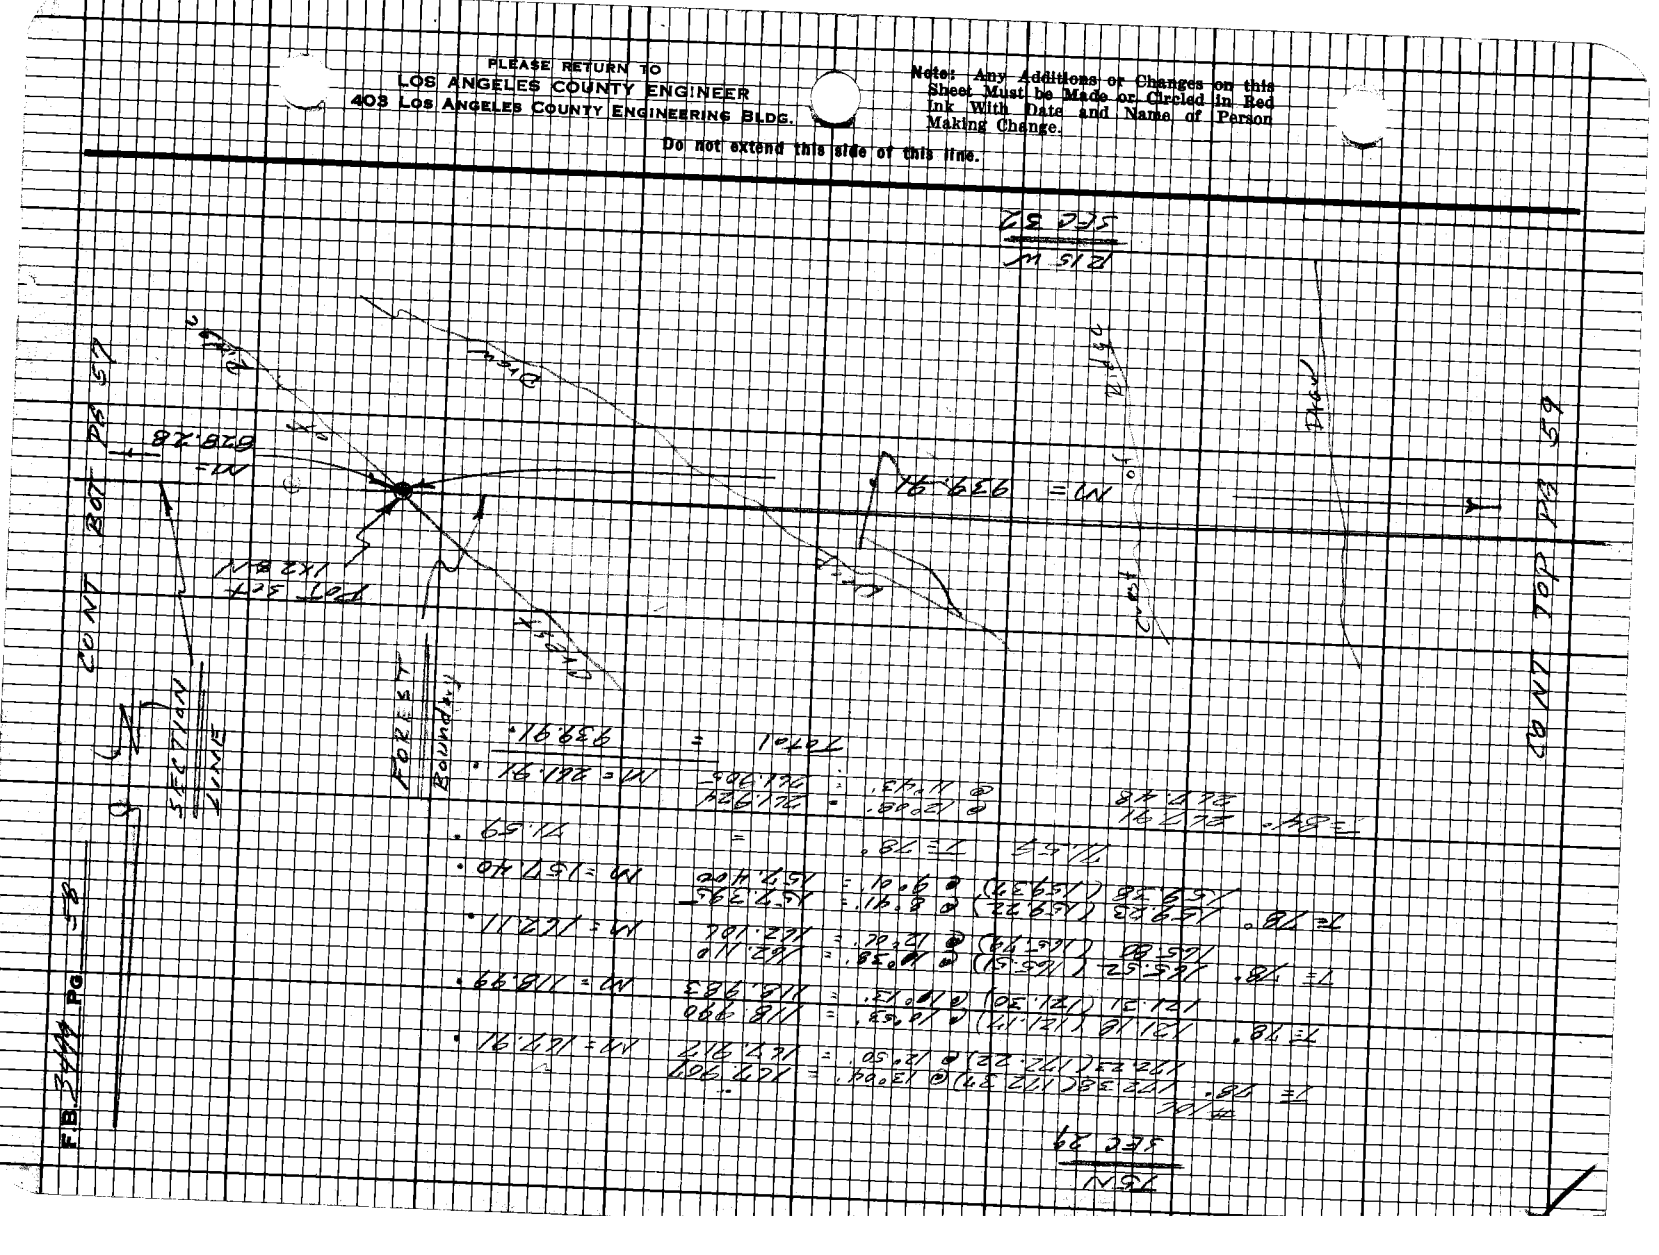

Notes Ck'd by
Map No.
Office Work
Checked
Date

Survey of Sections 4, T5N R15W
JN 1302.4 Tape 10L Std 6A °F
Surveyed by FEB. 00143
Notes FB 13 Date 14 Nov 69
Indexed T. J. GALLI 1-4-72

FB 3499 Pg. 59

W 5477 D-6

Note: Any Additions or Changes on this Sheet Must be Made or Circled in Red Ink With Date and Name of Person Making Change.

PLEASE RETURN TO
LOS ANGELES COUNTY ENGINEER
403 LOS ANGELES COUNTY ENGINEERING BLDG.
Do not extend this side of this fmn.

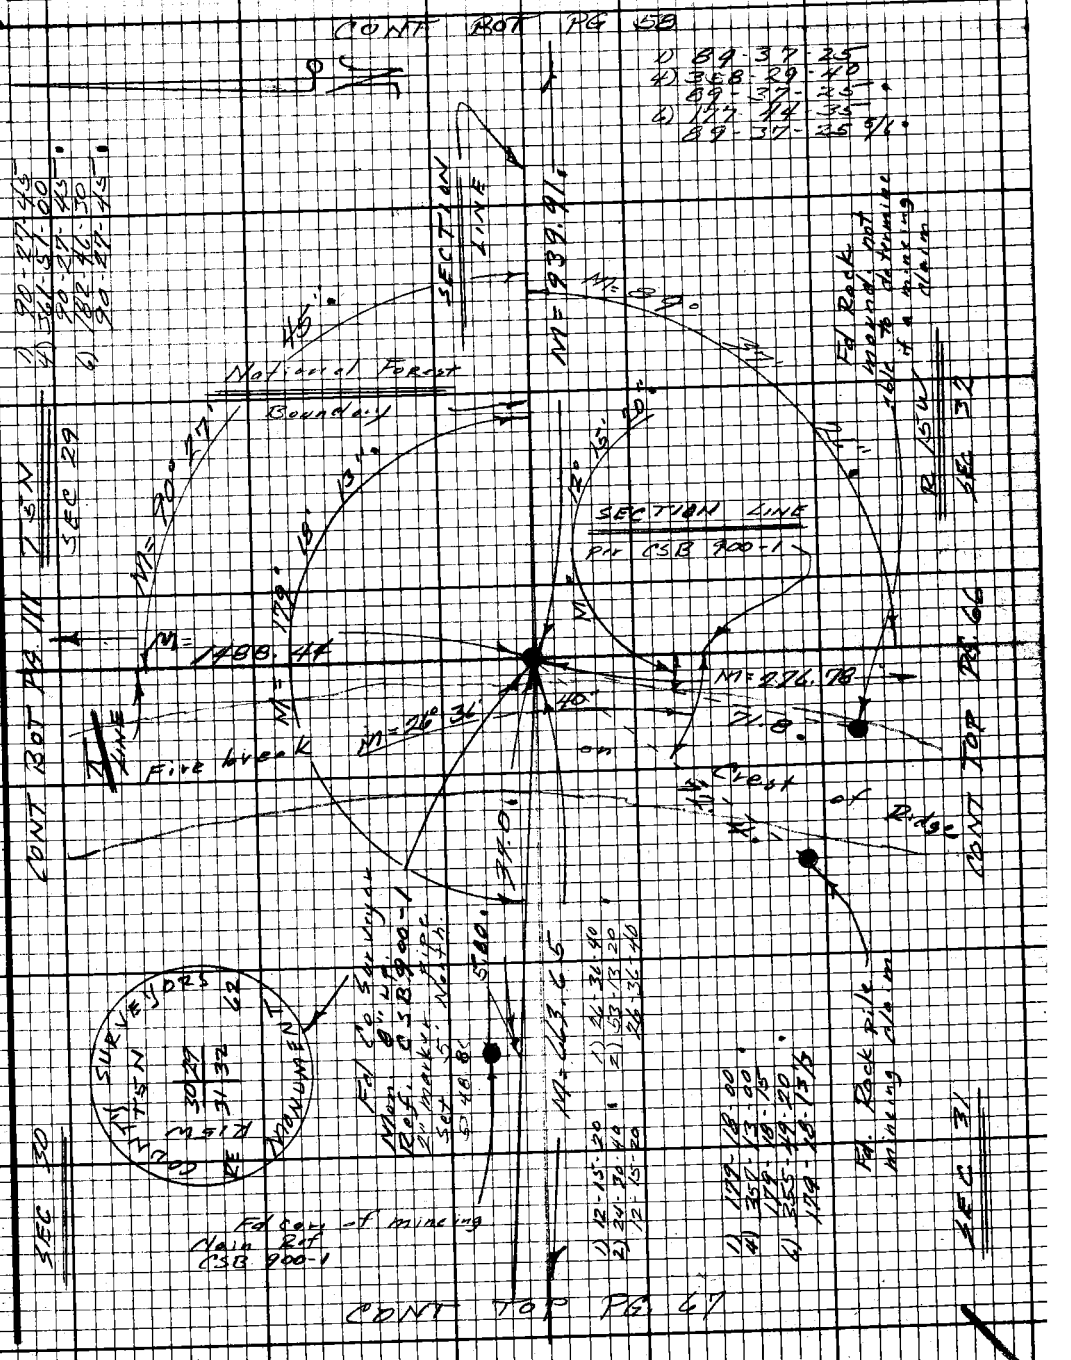

PLEASE RETURN TO
LOS ANGELES COUNTY ENGINEER
403 LOS ANGELES COUNTY ENGINEERING BLDG.

Note: Any Additions or Changes on this Sheet Must be Made or Circled in Red Ink With Date and Name of Person Making Change.

Do not extend this side of this line.

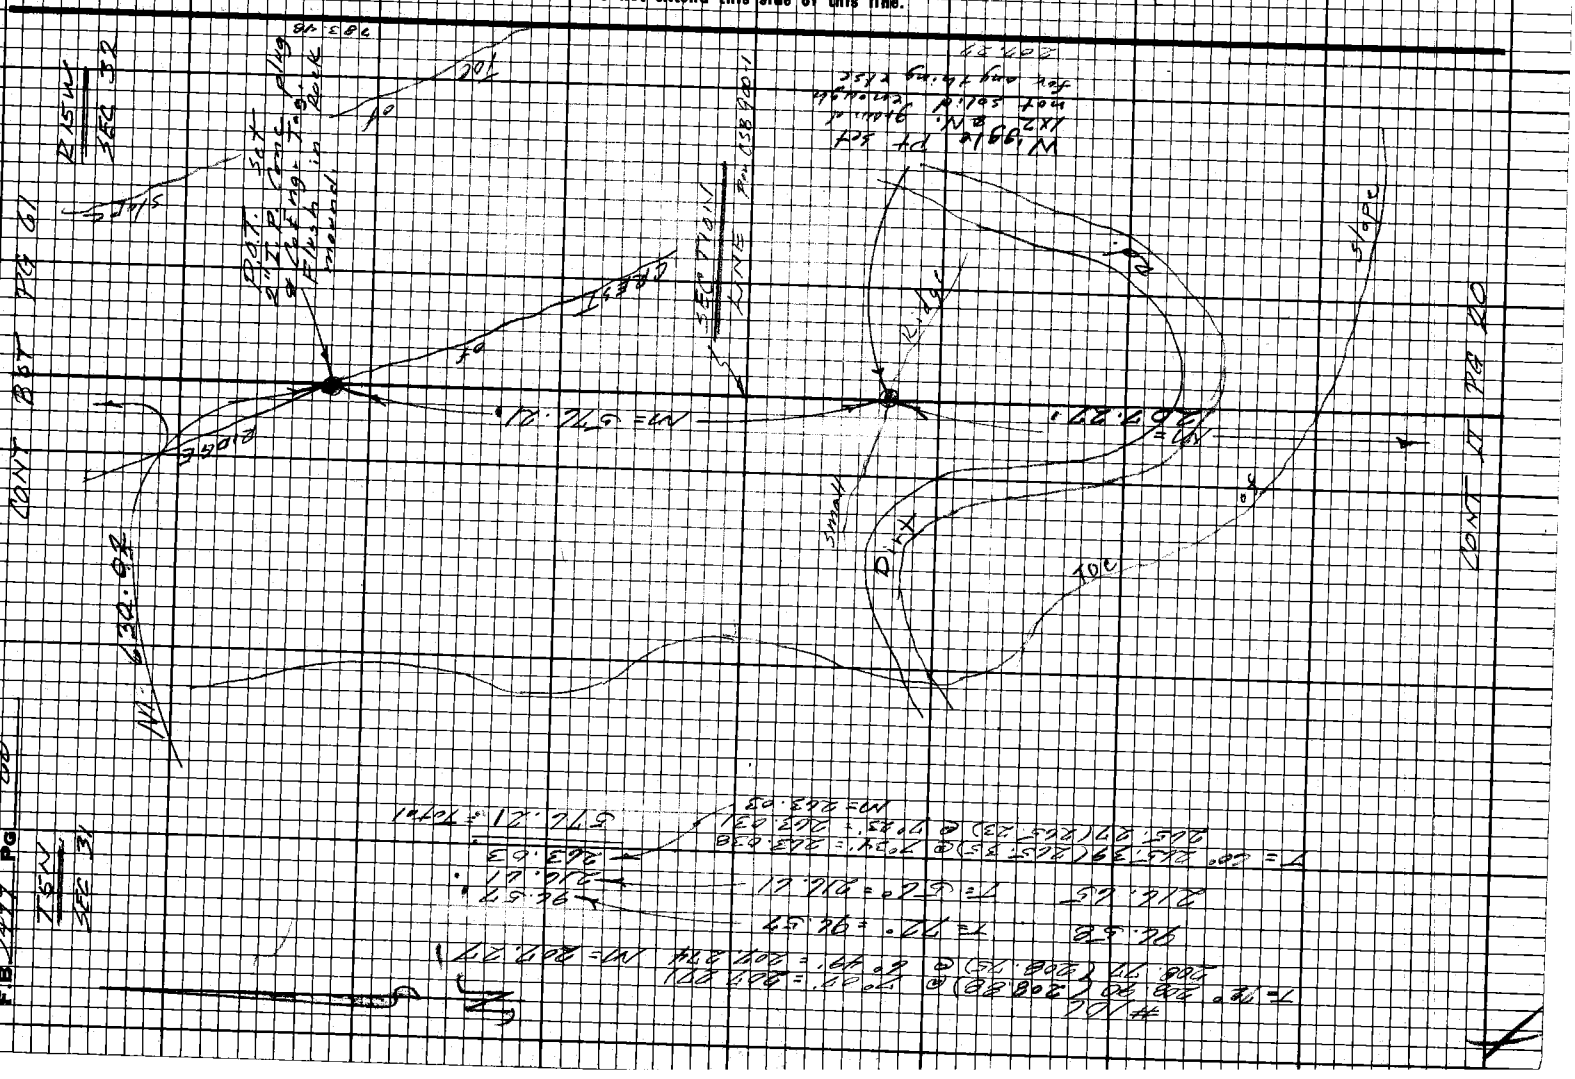

76F3028 CE#310 9/67

PLEASE RETURN TO
LOS ANGELES COUNTY ENGINEER
403 LOS ANGELES COUNTY ENGINEERING BLDG.

Do not extend this side of this line.

Note: Any Additions or Changes on this Sheet Must be Made or Circled in Red Ink With Date and Name of Person Making Change.

Notes Ck'd by
Map No.
Office Work
Checked
Date

Survey of Sect. Mill Tow Right
JN 8344 Tape 106 Sta 0+00 to 7+00
Surveyed by [illegible] Date May 69
Notes
Indexed [illegible] Date MAY 14 72

F.B. 7417 Pg. 41

Δ = 40° 56.85 (56.94) @ 7°12' = 56.490
56.82 (56.91) @ 6°02' = 56.495 M = 56.49 ✓

Δ = 40° 220.25 (220.2) @ 13°45' = 214.789
220.54 (220.5) @ 13°03' = 214.814 M = 214.80 ✓

Δ = 62° 135.42 (135.40) @ 30°25' = 135.158
135.34 (135.32) @ 21°46' = 135.141 M = 135.16 ✓

Δ = 57° 225.61 (225.58) @ 7°46' = 223.563
225.66 (225.63) @ 7°45' = 223.609 M = 223.58 ✓

Total = 630.021

M = 630.02 ✓

SECTION
LINE P.O.C. 0.58 900-1

SEC 31 T5N

CONT. 8.07 Pg 42

SEC 32

Dirt Top Pg 40

Dirt

Rd.

Dirted

Dirt

Rock

112 chain PK 1413 53

Fence

Fence

PLEASE RETURN TO
LOS ANGELES COUNTY ENGINEER
403 Los Angeles County Engineering Bldg.

Do not extend this side of this line.

Note: Any Additions or Changes on this Sheet Must be Made or Circled in Red Ink With Date and Name of Person Making Change.

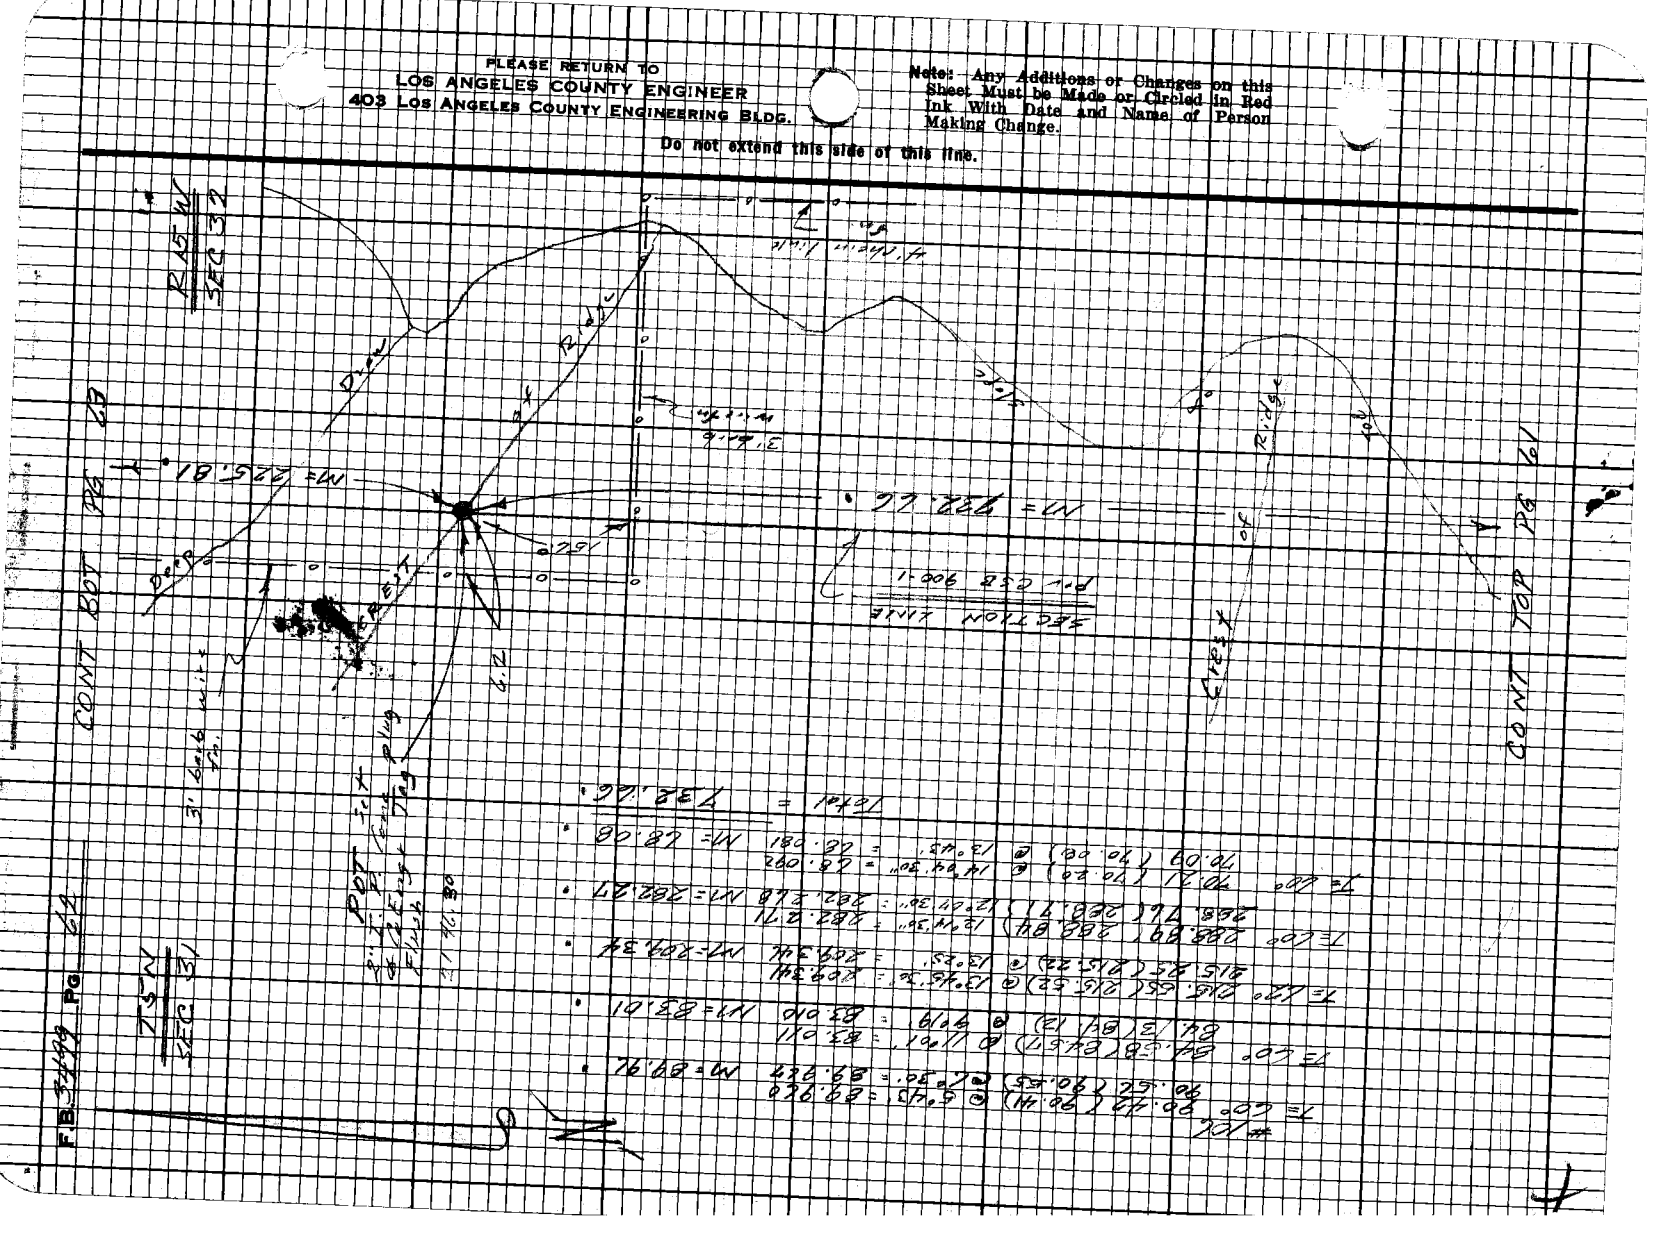
CONT BOT PG 23
CONT TOP PG 101
SECTION LINE
SEC 33
SEC 32
T 5 N
R 15 W
POT
POT
POT

76F3098 CE#310 8-67

PLEASE RETURN TO
LOS ANGELES COUNTY ENGINEER
403 LOS ANGELES COUNTY ENGINEERING BLDG.

Note: Any Additions or Changes on this Sheet Must be Made or Circled in Red Ink With Date and Name of Person Making Change.

Do not extend this side of this line.

Notes Ck'd by
Map No.
Office Work
Checked
Date

Survey of Section in T2S R14W
JN 23-20 / Tape / Loc. Std. 84-7
Surveyed by F.E.B. Brooks
Notes
Indexed F.E.B. CALD Date 11-1-72

FB 3499 Pg. 43

T=58° #104 226.03 (225.99) @ 2° 26' = 225.802
226.10 (226.06) @ 2° 30' = 225.820 M = 225.81'

#104 T = 62°
126.36 (126.34) @ 22°18' = 116.891'
126.21 (126.19) @ 22°08' = 116.904'
M = 116.91'

24.85 T = 62° = 24.85'

#104
T = 62° 24.09 @ 15°48'30" = 23.092'
24.14 @ 17°00'30" = 23.084' M = 23.09'

T = 62° 263.65 (263.61) @ 18°13'30" = 250.387
263.41 (263.37) @ 18°04'30" = 250.375 M = 250.38'
Total = 273.47'

CONT TOP PG 42

#392.80
Pot set 1x2
in N.

SECTION LINE
Pt. 2518 300-1

M = 273.47'

M = 225.81'

M = 24.85'

Pot set 1x2 D
w/c plug & 12 Elgar Tag
on ridge
34 96.85

1) 52-43-00
2) 105-00-50
157-43-50 1/2

Fd. Iron Rock mound on crest of Ridge. Appx. 6" high and 4' dia. Rock mound appears to be grading into ground. Appx. 6" Fd iron stringer at head post dia. 12". Probably not Nelson's YV Cor. probably a old mine log claim.

3" Brass Wire Fn.

CONT EAST PG 44

SEC. 31

SEC. 32

PLEASE RETURN TO
LOS ANGELES COUNTY ENGINEER
403 LOS ANGELES COUNTY ENGINEERING BLDG.

Do not extend this side of this line.

Note: Any Additions or Changes on this Sheet Must be Made or Circled in Red Ink With Date and Name of Person Making Change.

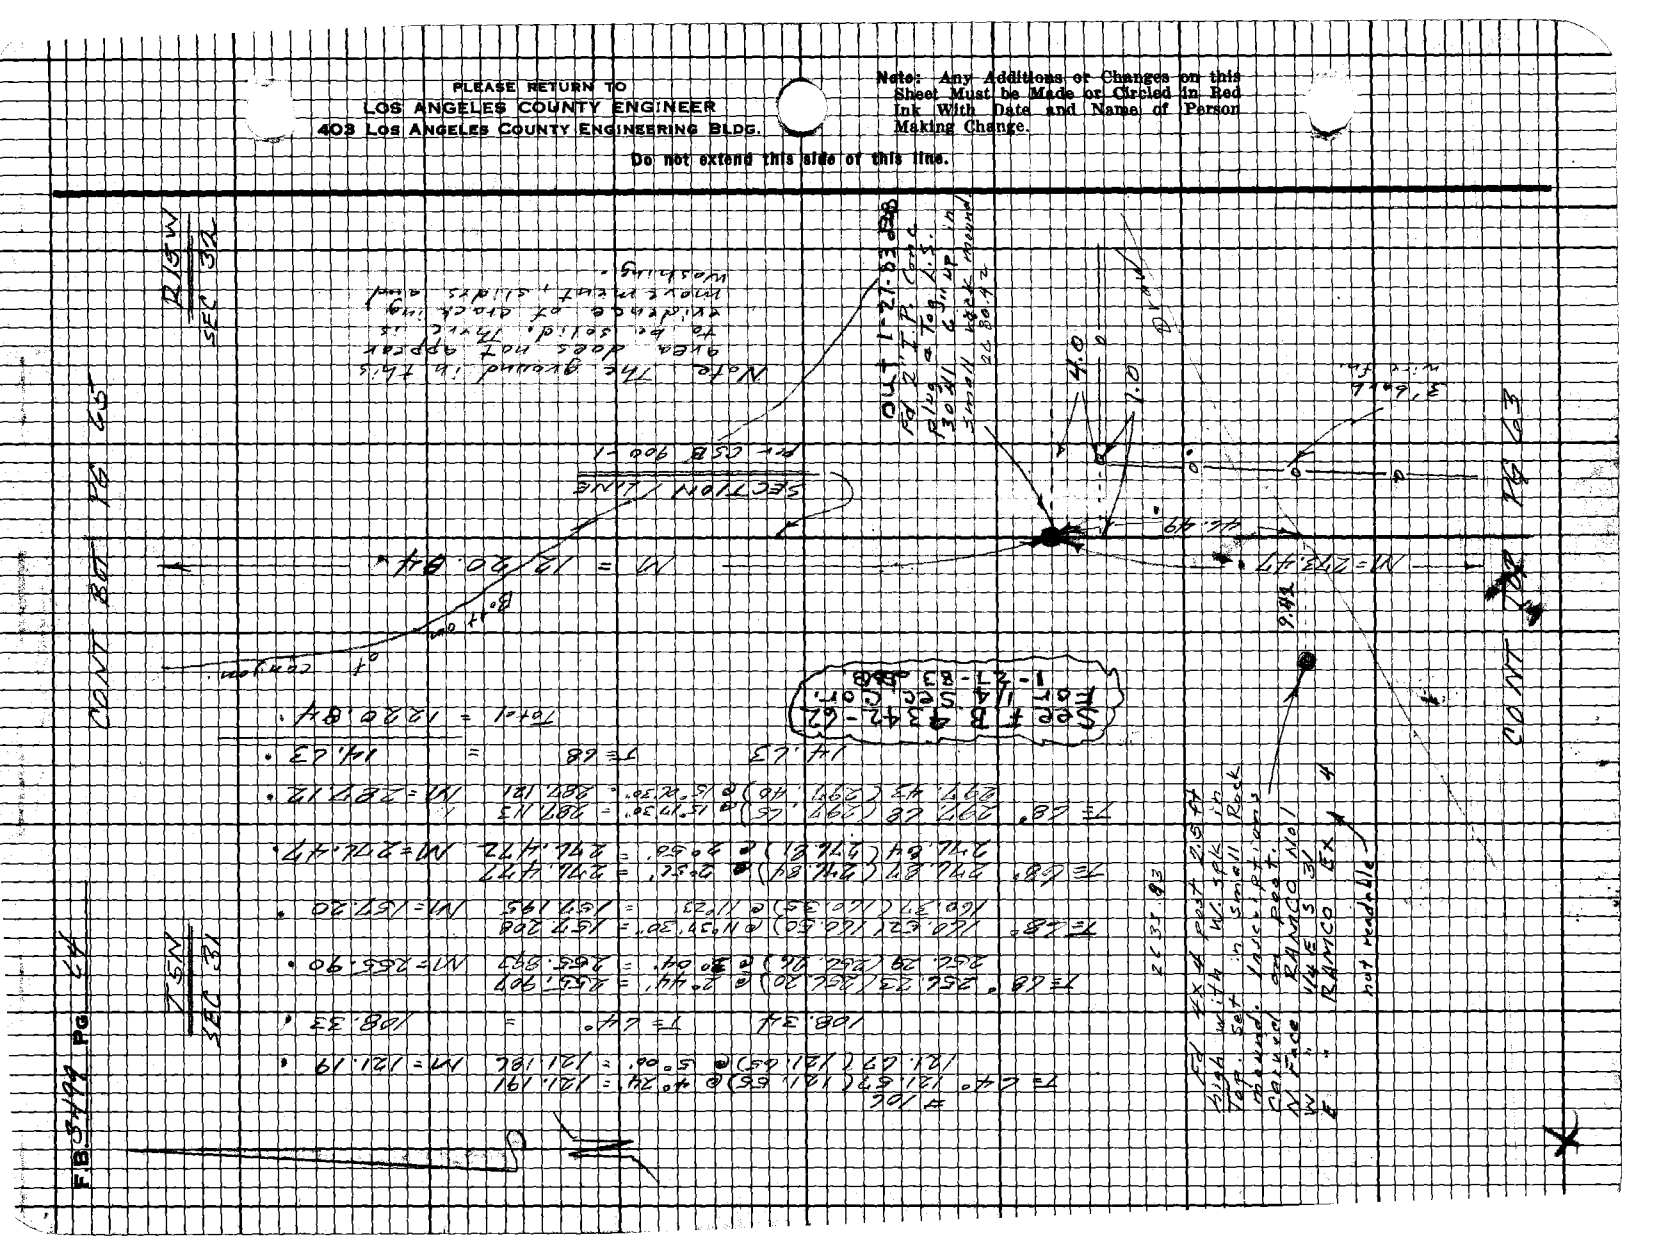
SECTION LINE
Ave. CSB 900-1
Note: The ground in this area does not appear to be solid. This will require protection, slides, and washouts.

76F3098 CE 310 9-67

PLEASE RETURN TO
LOS ANGELES COUNTY ENGINEER
403 LOS ANGELES COUNTY ENGINEERING BLDG.

Note: Any Additions or Changes on this Sheet Must be Made or Circled in Red Ink With Date and Name of Person Making Change.

Do not extend this side of this line.

Notes Ck'd by
Map No.
Office Work
Checked
Date

Survey of Sect. 1 in T3N R12W
JN 03202 Compd. by SJC Std. 8/67
Surveyed by FEB Date 2/24/72
Notes
Indexed by [illegible] Date 3/14/72

FB 3299 Pg. 45

#106 10.62 T = 28°

10.62

T = 66° 53.50 (53.49) @ 21°49' = 49.881
53.28 (53.27) @ 20°32' = 49.884 M = 49.89

T = 66° 198.99 (198.97) @ 2°04' = 198.880
198.95 (198.93) @ 1°37' = 198.850 M = 198.84

T = 60° 257.02 (256.98) @ 7°29' = 254.790
256.74 (256.70) @ 7°01' = 254.717 M = 254.78

T = 70° 97.50 (97.49) @ 16°14' = 93.603
97.87 (97.86) @ 16°59'30" = 93.621 M = 93.60

T = 44° 43.20 (43.19) @ 4°41' = 43.979
43.14 (43.13) @ 5°0'57" = 43.979 M = 43.98

T = 68° 251.97 (251.94) @ 12°03'30" = 240.867
251.70 (251.67) @ 12°31'30" = 240.855 M = 240.86

Total = 911.57

M = 911.57

M = 1200.84

75N 12E 31

CONT TOP PG 44

CONT BOT PG 46

CANYON

SECTION LINE

R/S 4W 3R

Apx CSB 900-1

Apx 1/2 Fence plus 3.0 Ft. Inside Fence


PLEASE RETURN TO
LOS ANGELES COUNTY ENGINEER
403 LOS ANGELES COUNTY ENGINEERING BLDG.

Note: Any Additions or Changes on this Sheet Must be Made or Circled in Red Ink With Date and Name of Person Making Change.

Do not extend this side of this line.

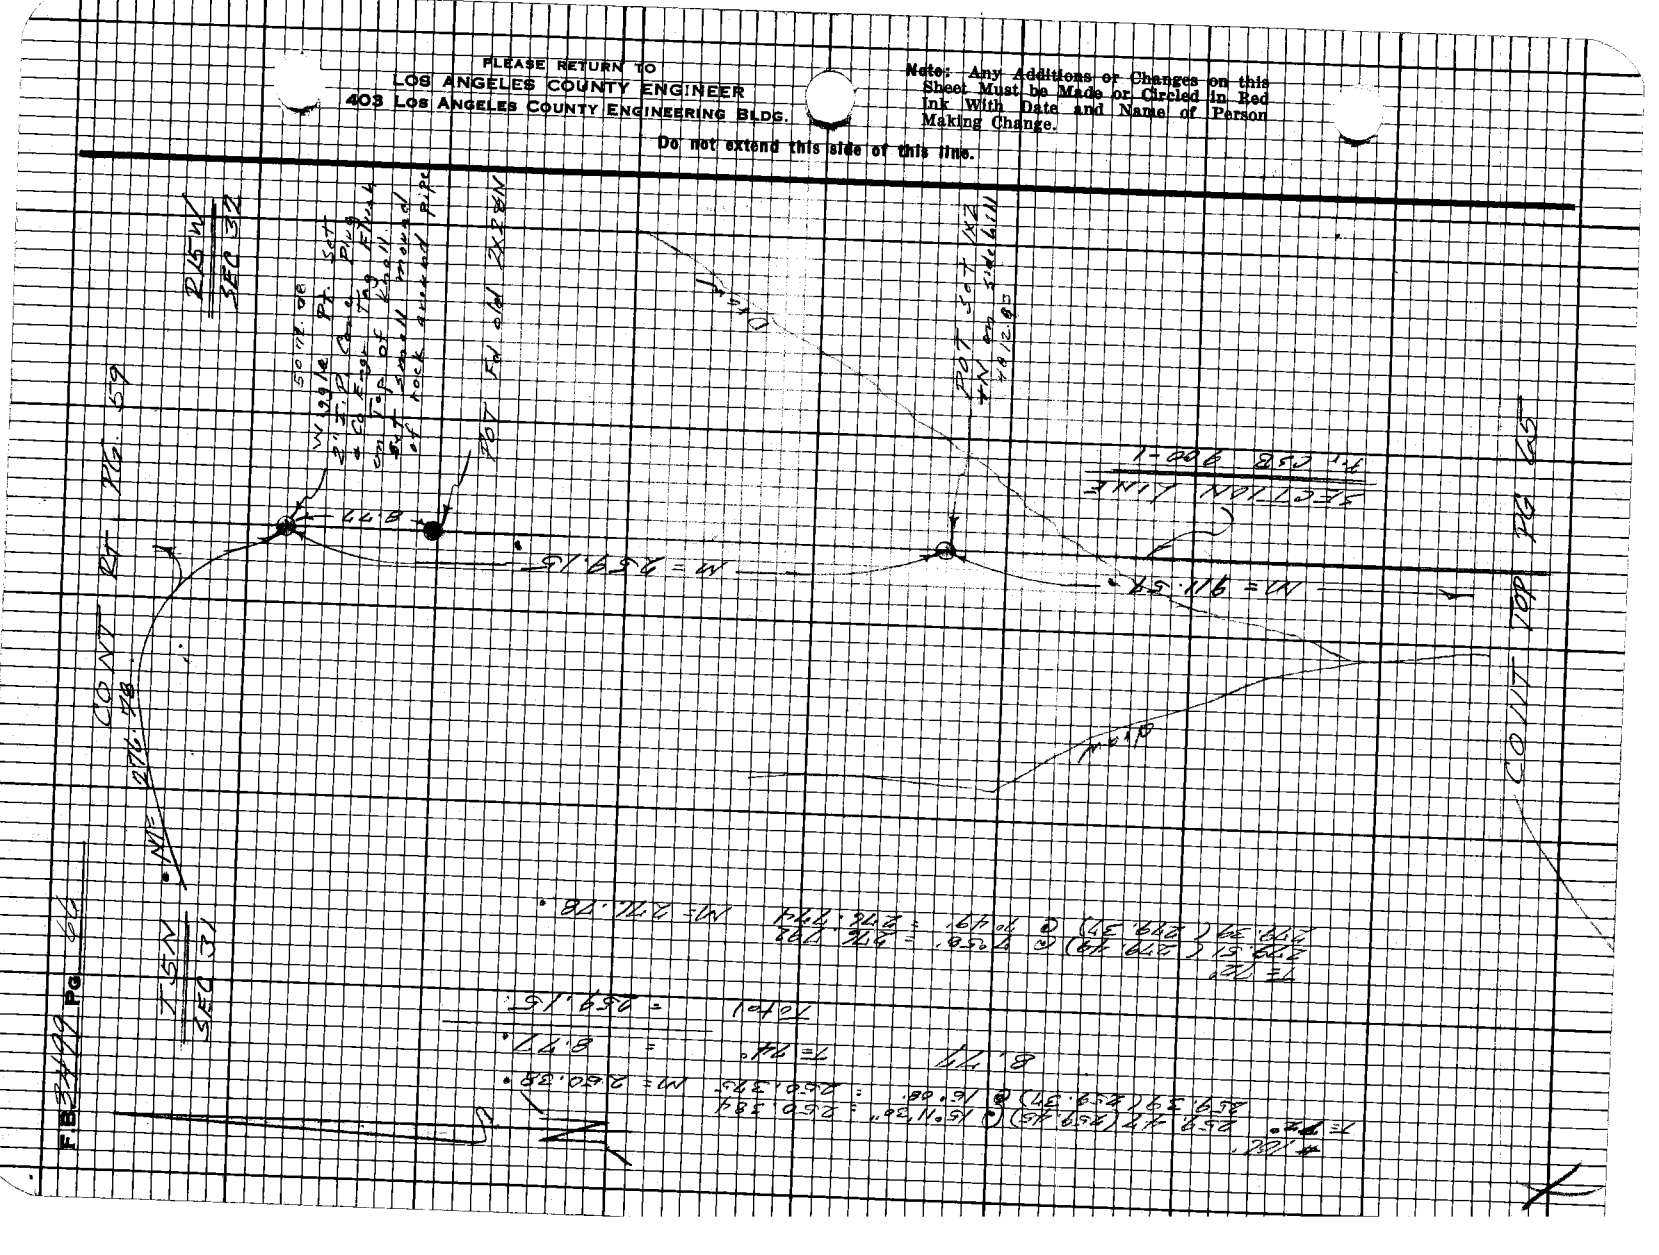

75F3098 CE#310 9/67

PLEASE RETURN TO
LOS ANGELES COUNTY ENGINEER
403 Los Angeles County Engineering Bldg.

Note: Any Additions or Changes on this Sheet Must be Made or Circled in Red Ink With Date and Name of Person Making Change.

Do not extend this side of this line.

Notes Ck'd by
Map No.
Office Work
Checked
Date




















SEC 31

PLEASE RETURN TO
LOS ANGELES COUNTY ENGINEER
403 LOS ANGELES COUNTY ENGINEERING BLDG.

Note: Any Additions or Changes on this Sheet Must be Made or Circled in Red Ink With Date and Name of Person Making Change.

Do not extend this side of this line.

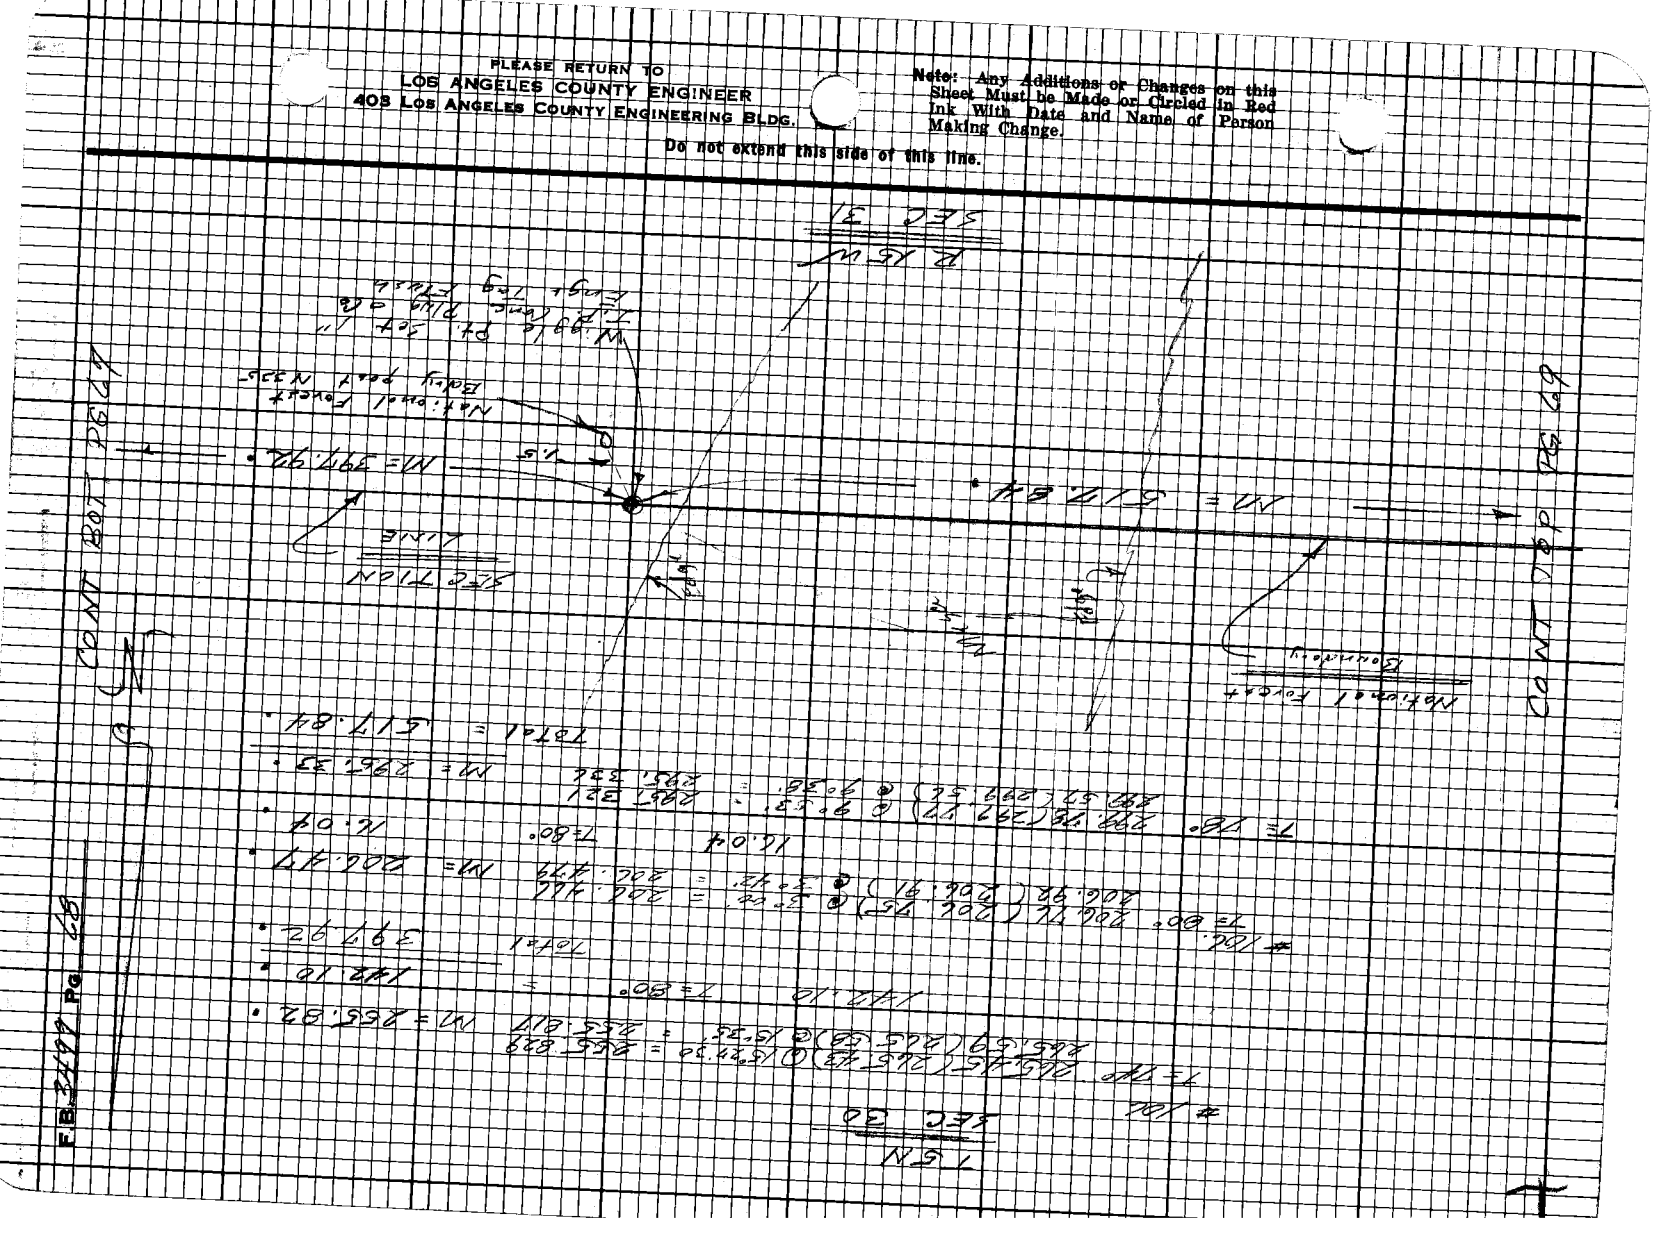
T 5 N
R 15 W
SEC 30
SEC 31

75F3098 CE#310 2-67

PLEASE RETURN TO
LOS ANGELES COUNTY ENGINEER
403 Los Angeles County Engineering Bldg.

Do not extend this side of this line.

Note: Any Additions or Changes on this Sheet Must be Made or Circled in Red Ink With Date and Name of Person Making Change.

Notes Ckd by
Mod No.
Office Work
Checked
Date


















R 15 W
SEC 31

PLEASE RETURN TO
LOS ANGELES COUNTY ENGINEER
403 Los Angeles County Engineering Bldg.

Note: Any Additions or Changes on this Sheet Must be Made or Circled in Red Ink With Date and Name of Person Making Change.

Do not extend this side of this line.

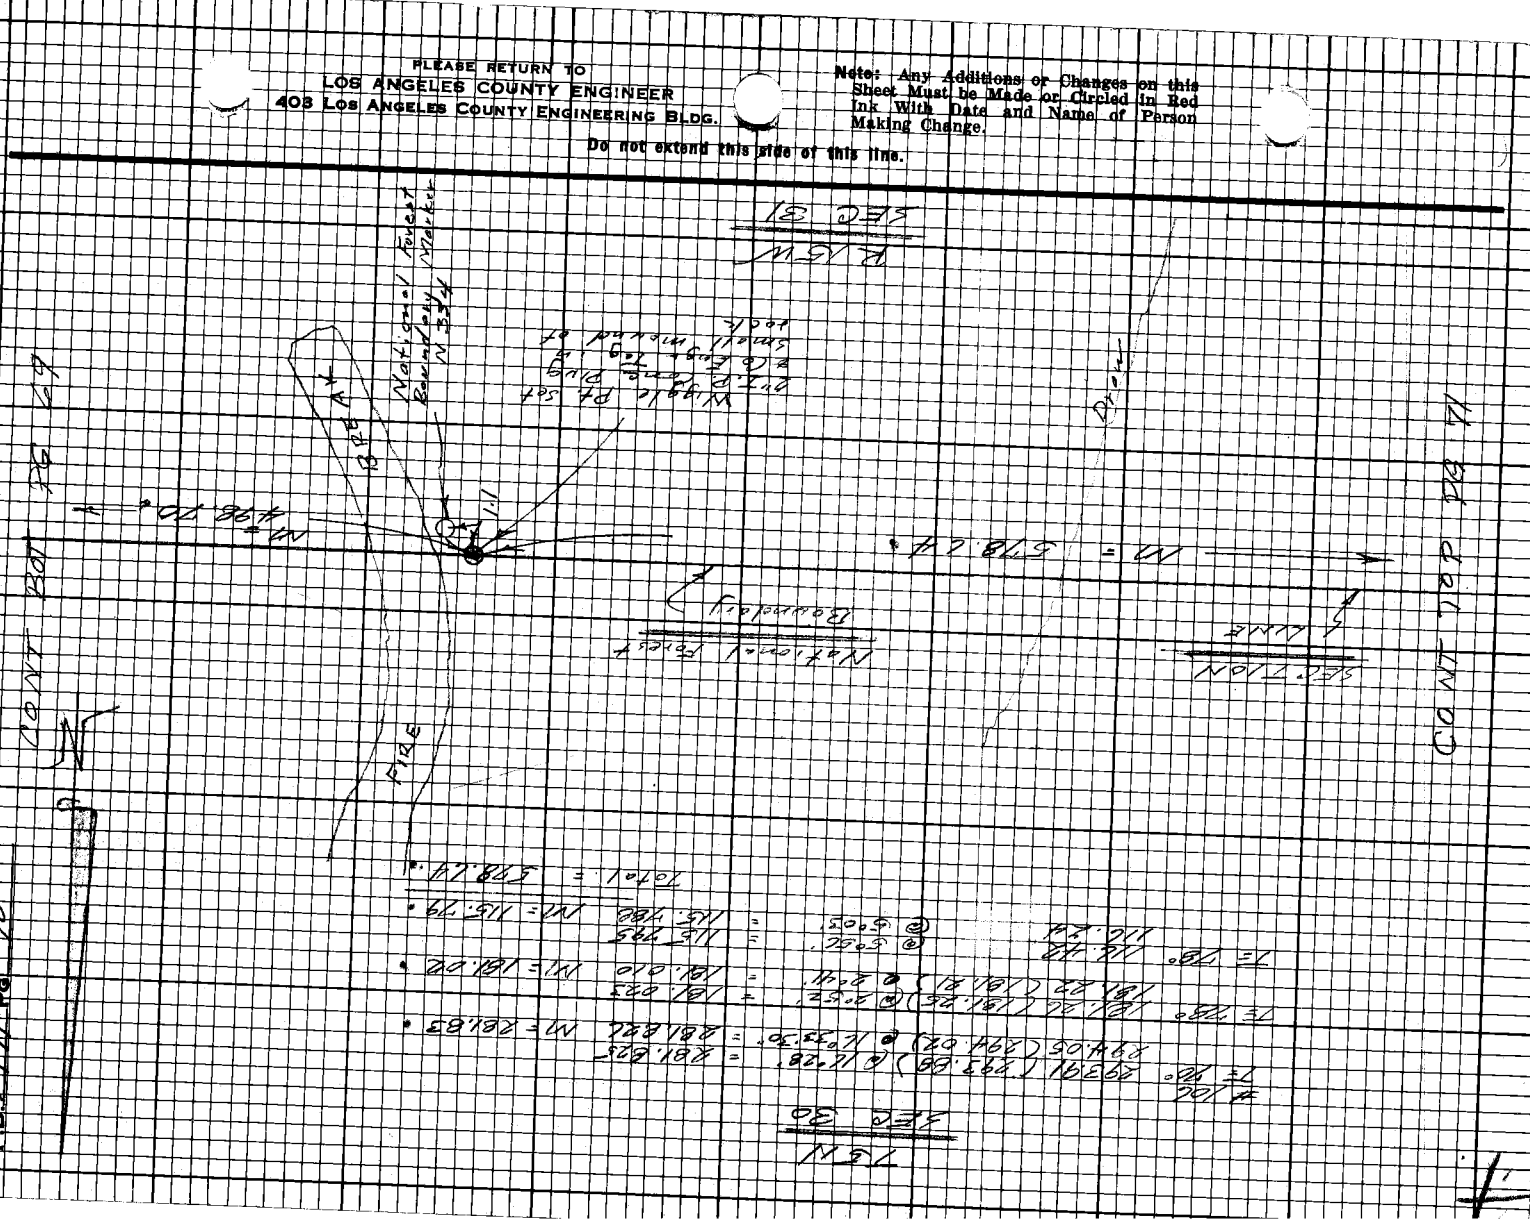

76F3098 CE#310 9-67

PLEASE RETURN TO
LOS ANGELES COUNTY ENGINEER
403 LOS ANGELES COUNTY ENGINEERING BLDG.

Do not extend this side of this line.

Note: Any Additions or Changes on this Sheet Must be Made or Circled in Red Ink With Date and Name of Person Making Change.























R 15 W
SEC 31

PLEASE RETURN TO
LOS ANGELES COUNTY ENGINEER
403 Los Angeles County Engineering Bldg.

Do not extend this side of this line.

Note: Any Additions or Changes on this Sheet Must be Made or Circled in Red Ink With Date and Name of Person Making Change.

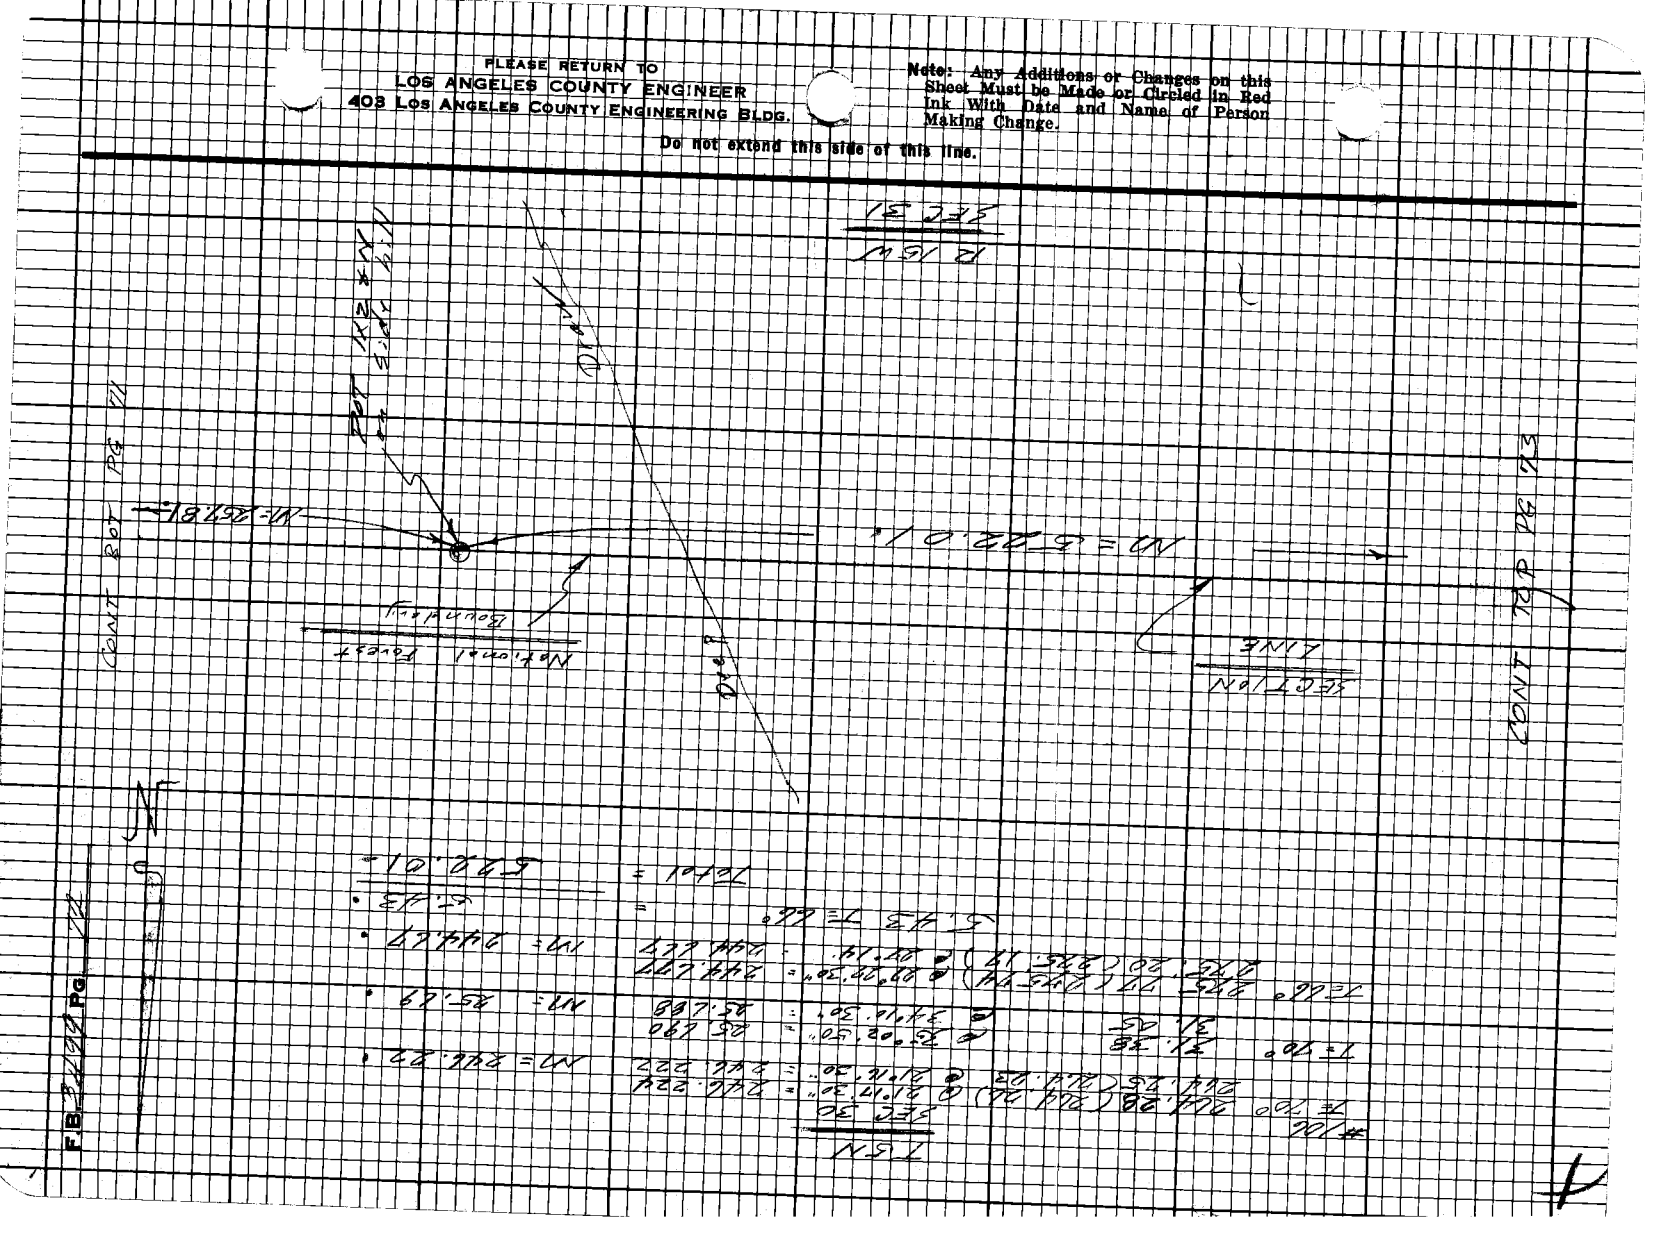

76F3098 CE#310 9-67

PLEASE RETURN TO
LOS ANGELES COUNTY ENGINEER
403 LOS ANGELES COUNTY ENGINEERING BLDG.

Note: Any Additions or Changes on this Sheet Must be Made or Circled in Red Ink With Date and Name of Person Making Change.

Do not extend this side of this line.

Notes Ckd by _____
Map No. _____
Office Work _____
Checked _____
Date _____



















National Forest Boundary

N1 = 522.01'

CONT BOT P6 P2

Witness Pt. Scribed "+" on rock 0.4' plug & tag

Original Forest Boundary N.E. 1/4 Sec 31

R 15 W

SEC 31

PLEASE RETURN TO
LOS ANGELES COUNTY ENGINEER
403 Los Angeles County Engineering Bldg.

Do not extend this side of this line.

Note: Any Additions or Changes on this Sheet Must be Made or Circled in Red Ink With Date and Name of Person Making Change.

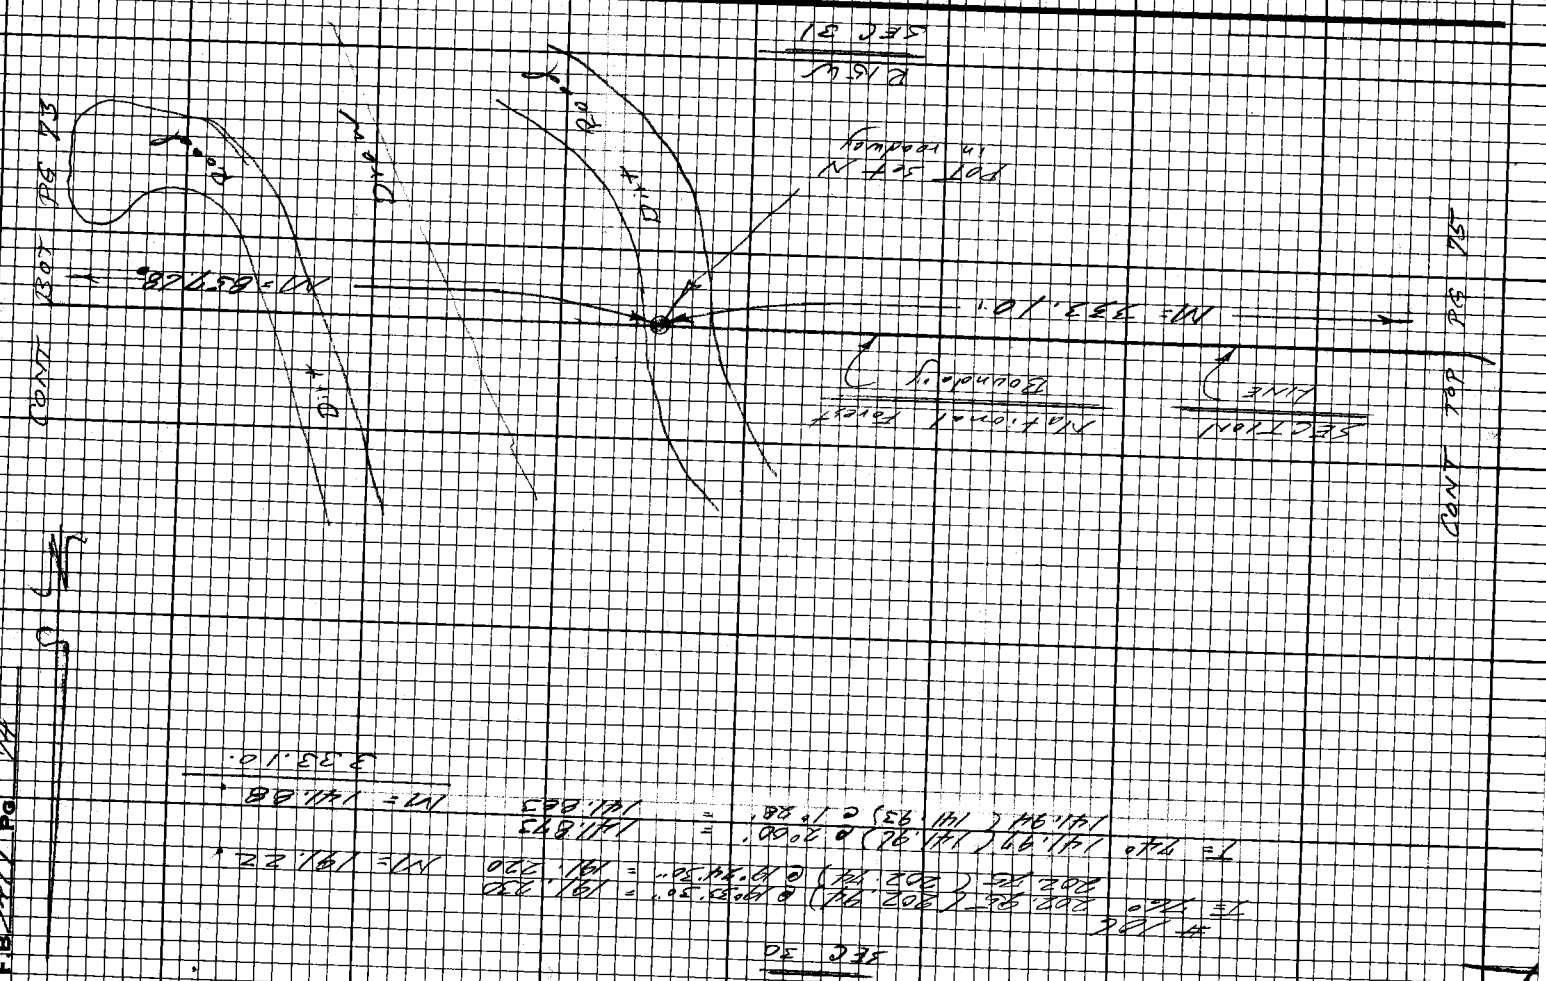

FB
Pg

76H3098 CE#310 9:67

PLEASE RETURN TO
LOS ANGELES COUNTY ENGINEER
403 LOS ANGELES COUNTY ENGINEERING BLDG.

Note: Any Additions or Changes on this Sheet Must be Made or Circled in Red Ink With Date and Name of Person Making Change.

Do not extend this side of this line.

Notes Ck'd by _____
Map No. _____
Office Work _____
Checked _____
Date _____

Notes
Indexed R. L. GALLI Aug 14 '72

FB 3298 PG 123

#106
I= 76° 298.51 (298.29) @ 28°03' = 1013.252
298.64 (298.42) @ 20°08' = 1013.243

I= 84° 267.72
267.92

@ 14°00' = 259.807
@ 13°30' = 259.800

I= 84° 60.12
60.01

@ 10°01' = 57.484
@ 12°11' = 57.484

70101 =

N1 = 463.25 '
N1 = 259.80 '
N = 57.49 '
580.54'

T 5 N
SEC 30


N 0°11' E 2641.70'

N1 = 580.54'

#13

Fire

Nat. onal Forest
Boundary

SECTION
LINE

N1 = 333.10'

Bou

Bro

Nat. onal Forest
Boundary N 328


R 15W
SEC 31

PLEASE RETURN TO
LOS ANGELES COUNTY ENGINEER
403 Los Angeles County Engineering Bldg.

Note: Any Additions or Changes on this Sheet Must be Made or Circled in Red Ink With Date and Name of Person Making Change.

Do not extend this side of this line.

WS 71, B-6

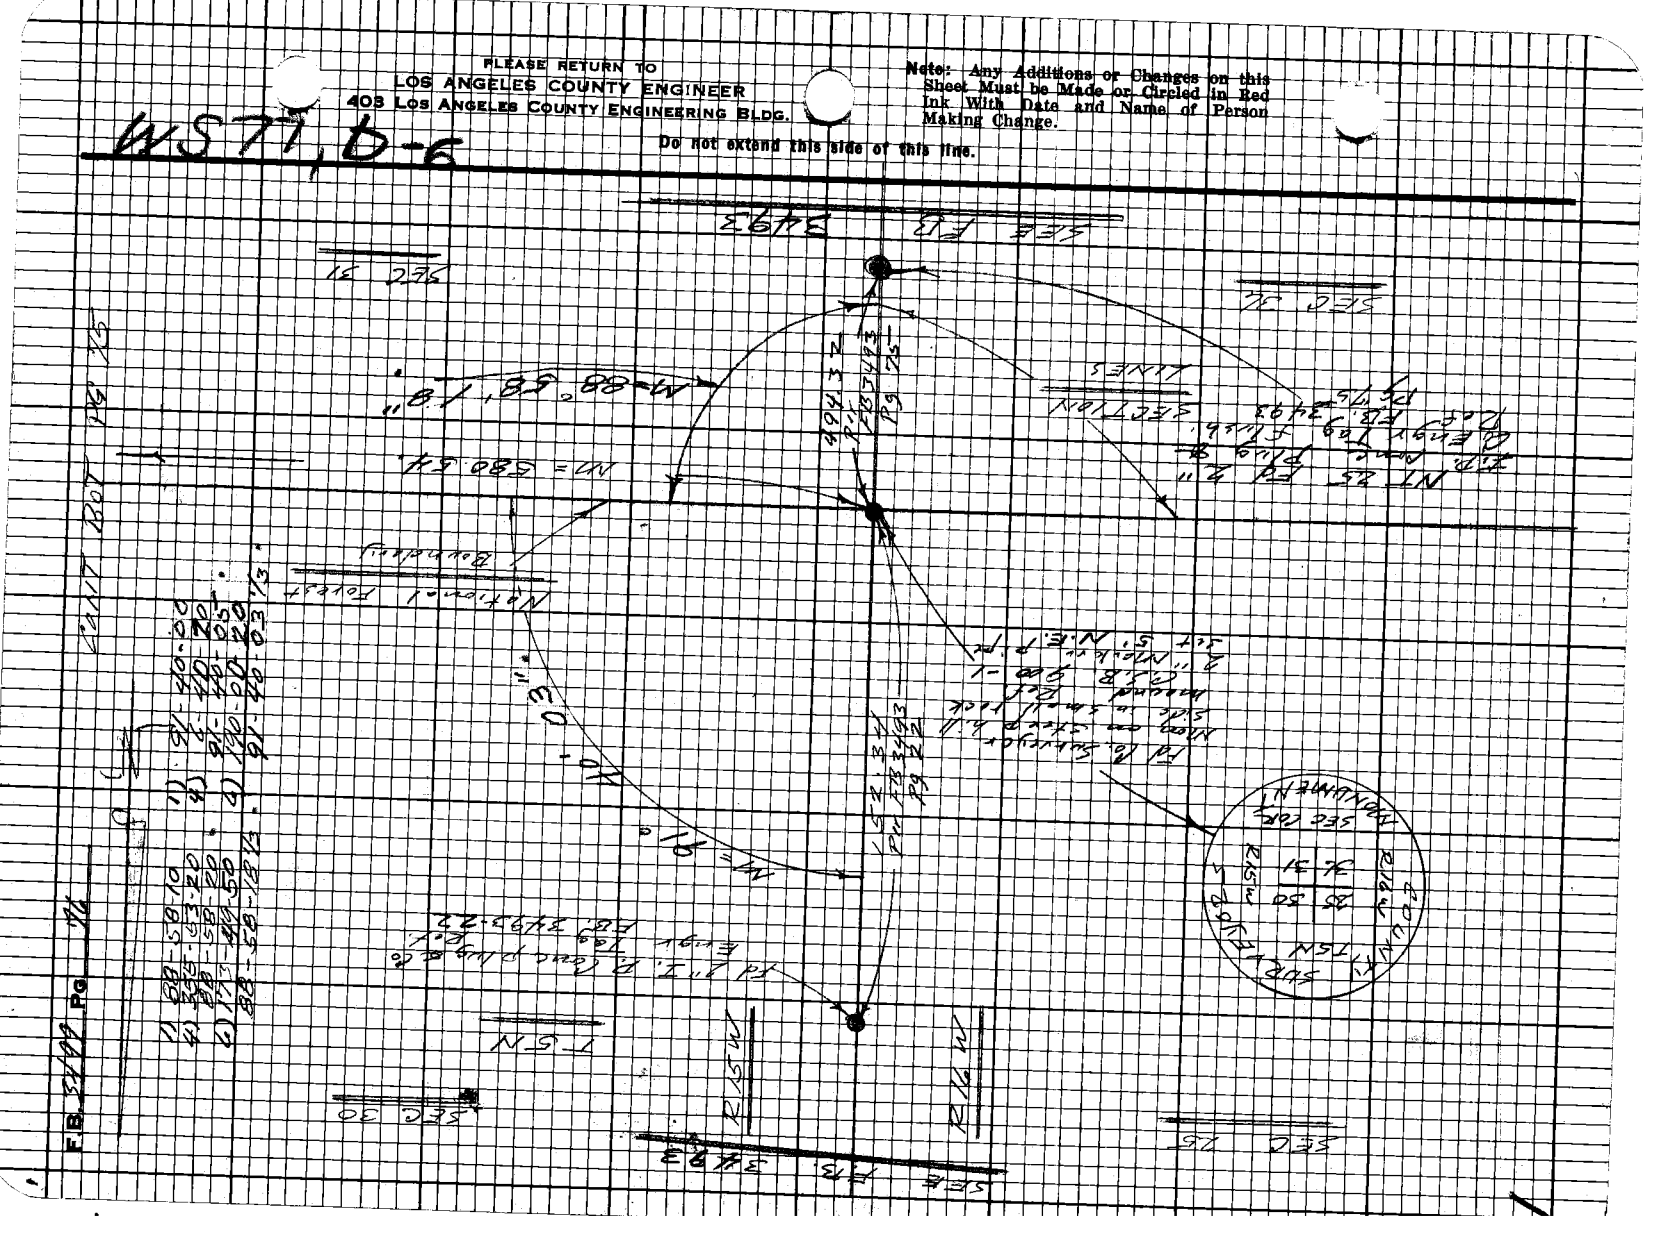

Notes Ck'd by
Map No.
Office Work
Checked
Date

Survey of Sections in T5N R15W
JN 03202 Tape 100' Std 81° F
Surveyed by FEB
Notes FEB Date 5/26/67
Indexed D.J. GALLI

FB 3499 Pg 17

CONT BOT PG 28

T5N
SEC 28

R15W
SEC 27

HOG SHED

HOG SHED

HOG SHED

HOG RANCH

DIRT

HOG

R.R.

SHED

N 44° 51' W

R.R.

SECTION LINE

DIRT

CONT TOP PG 36

Note: Any Additions or Changes on this Sheet Must be Made or Circled in Red Ink With Date and Name of Person Making Change.

Do not extend this side of this line.

PLEASE RETURN TO
LOS ANGELES COUNTY ENGINEER
403 Los Angeles County Engineering Bldg.

7653GBA (4-66) 10 6/67

PLEASE RETURN TO
LOS ANGELES COUNTY ENGINEER
403 LOS ANGELES COUNTY ENGINEERING BLDG.

Note: Any Additions or Changes on this Sheet Must be Made or Circled in Red Ink With Date and Name of Person Making Change.

Do not extend this side of this line.

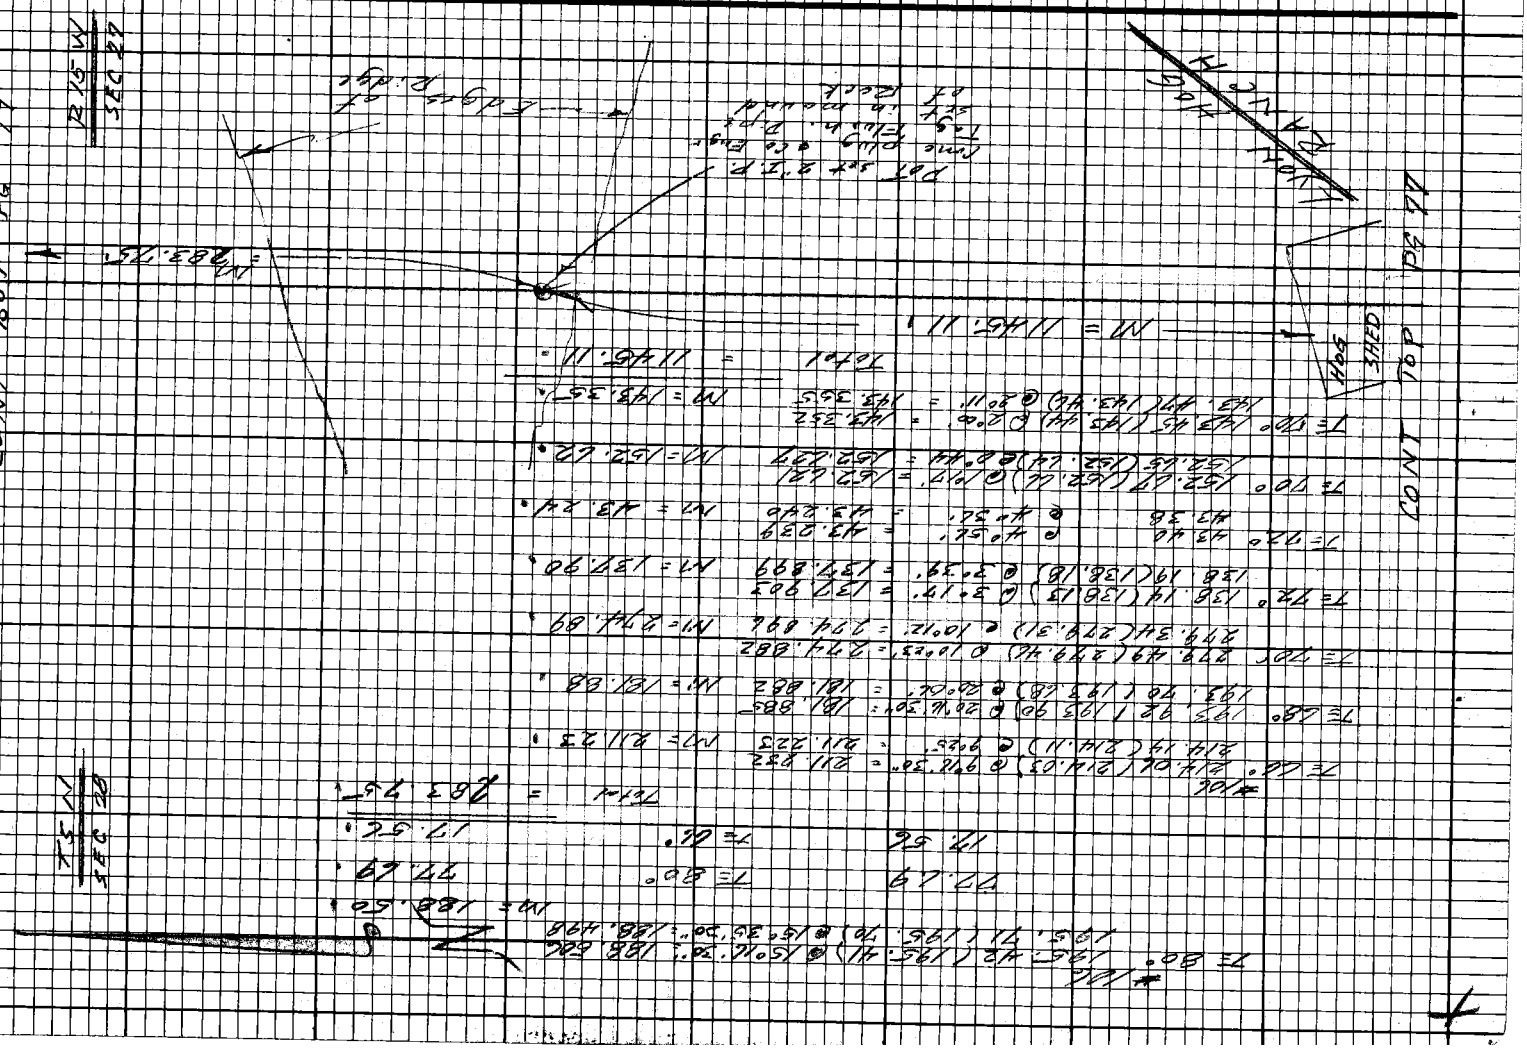
CONT BOT PG 79
CONT TOP PG 81
SOUTH SIDE
N 283.75'
N 1145.11
N 1145.11

76F3095 CE#310 1-65

PLEASE RETURN TO
LOS ANGELES COUNTY ENGINEER
403 LOS ANGELES COUNTY ENGINEERING BLDG.

Note: Any Additions or Changes on This Sheet Must be Made or Circled in Red Ink, With Date and Name of Person Making Change.

Do not extend this side of this line.

Notes Ck'd by
Map No.
Office Work
Checked
Date

Notes
Indexed by D. T. GALLI MR 1 '72

#106

27.34 T= 64° = 27.34'

T= 74° 80.97 (80.96) @ 13°16' = 78.799
80.63 (80.82) @ 12°49' = 78.695 M= 78.80'

T= 78° 116.94 @ 27°24' = 103.821
116.69 @ 27°12' = 103.516 M= 103.82'

T= 78° 197.95 (193.94) @ 29°16' = 169.183
193.60 (193.79) @ 29°21'30" = 169.196 M= 169.18'

T= 76° 176.81 (176.80) @ 17°33' = 168.414
176.48 (176.47) @ 17°23' = 168.410 M= 168.41'

T= 78° 197.98 (197.91) @ 16°16' = 189.887
197.79 (197.78) @ 16°07'30" = 189.997 M= 189.99'

148.06 T= 84° = 148.06'

T= 82° 184.58 @ 12°56' = 179.897
184.68 @ 13°05'30" = 179.880 M=179.89'

Total = 1065.49'

M = 1046.48'

M = 283.75'

T5N
SEC 28

Ridges
side

CONT TOP PG 78

Chg. in Bdy. Sec. 1/2

Bdry. on Canyon

SECTION LINE

CONT. BDY. PG. 80

R 15 W.
SEC. 27

PLEASE RETURN TO
LOS ANGELES COUNTY ENGINEER
403 LOS ANGELES COUNTY ENGINEERING BLDG.

Note: Any Additions or Changes on This Sheet Must be Made or Circled in Red Ink With Date and Name of Person Making Change.

Do not extend this side of this line.

W578, A5

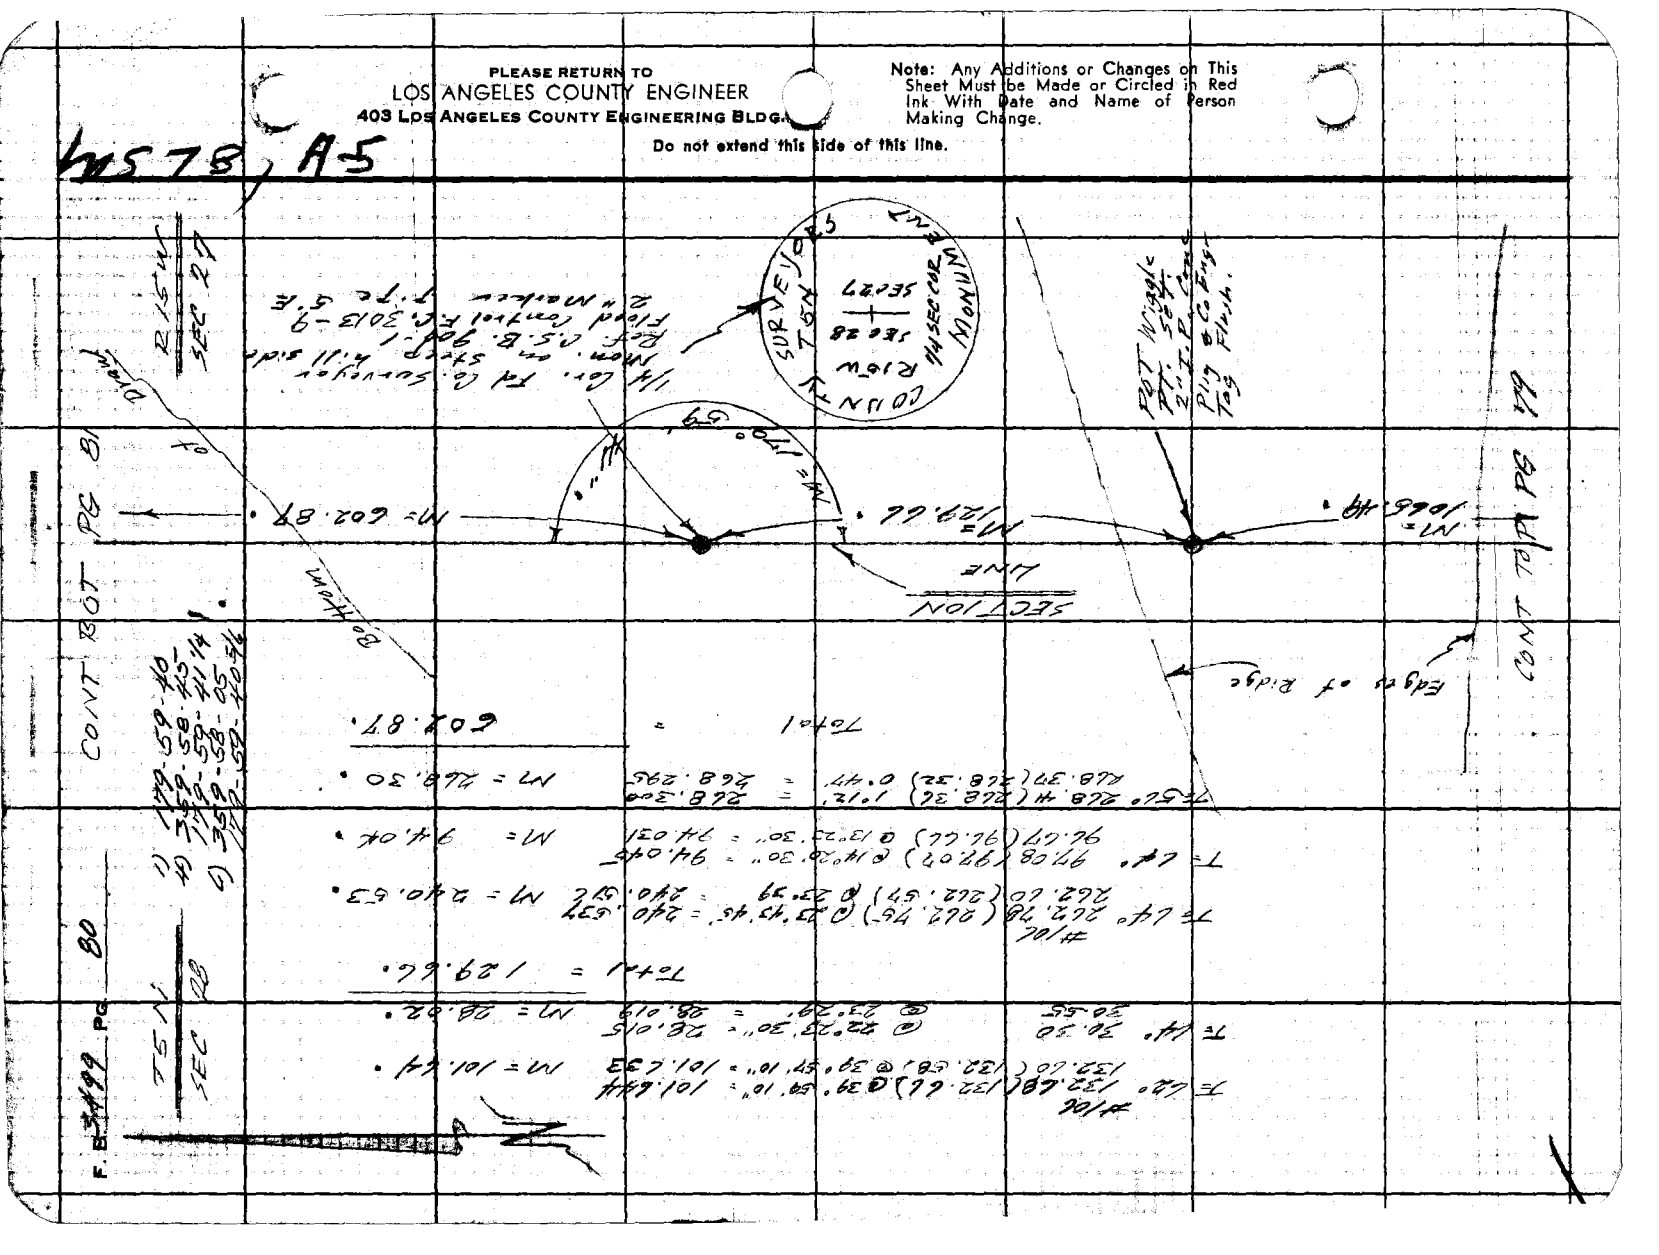

Total = 602.87'







1) 1159-58-410-14
2) 1159-58-411-14
3) 1159-58-405-16
4) 1159-58-410-16

Ref. Mon. Set
Ref. Mon. Set

Notes Ck'd by _____
Map No. _____
Office Work _____
Checked _____
Date _____

Survey of Sections in T6N R15W F.B. 3499 Pg. 81
JN 4302.01 Tape 196 Sur. BY "E"
Surveyed by F E B. and Ks
Notes F E B Date 8 Dec 49
Indexed by D. J. GALLI 1-14-72

CONT BOT PG 82

T6N / SEC 28

R15W / SEC 27

N 1° E 40.02 = 2640.02

N 89° 30' 30" E 2641.82

N 0° 30' 30" E 2641.80 N'= 2641.81

Total = 303.83'

N'= 303.83'

Edge of Bldg

W. 3 gic Set Nail & Tag

SECTION LINE

Rohan

of Road

N'= 602.87'

Ridge of Crest

CONT TOP PG 80

Note: Any Additions or Changes on this Sheet Must be Made or Checked in Red Ink With Date and Name of Person Making Change.

Do not extend this side of this line.

PLEASE RETURN TO
LOS ANGELES COUNTY ENGINEER
403 LOS ANGELES COUNTY ENGINEERING BLDG.

102

E 42.0 295.04 (295.02)
294.71 (294.69)

REPRODUCED BY PHOTOSTAT

PLEASE RETURN TO
LOS ANGELES COUNTY ENGINEER
403 LOS ANGELES COUNTY ENGINEERING BLDG.

Note: Any Additions or Changes on this Sheet Must be Made or Circled in Red Ink With Date and Name of Person Making Change.

Do not extend this side of this line.

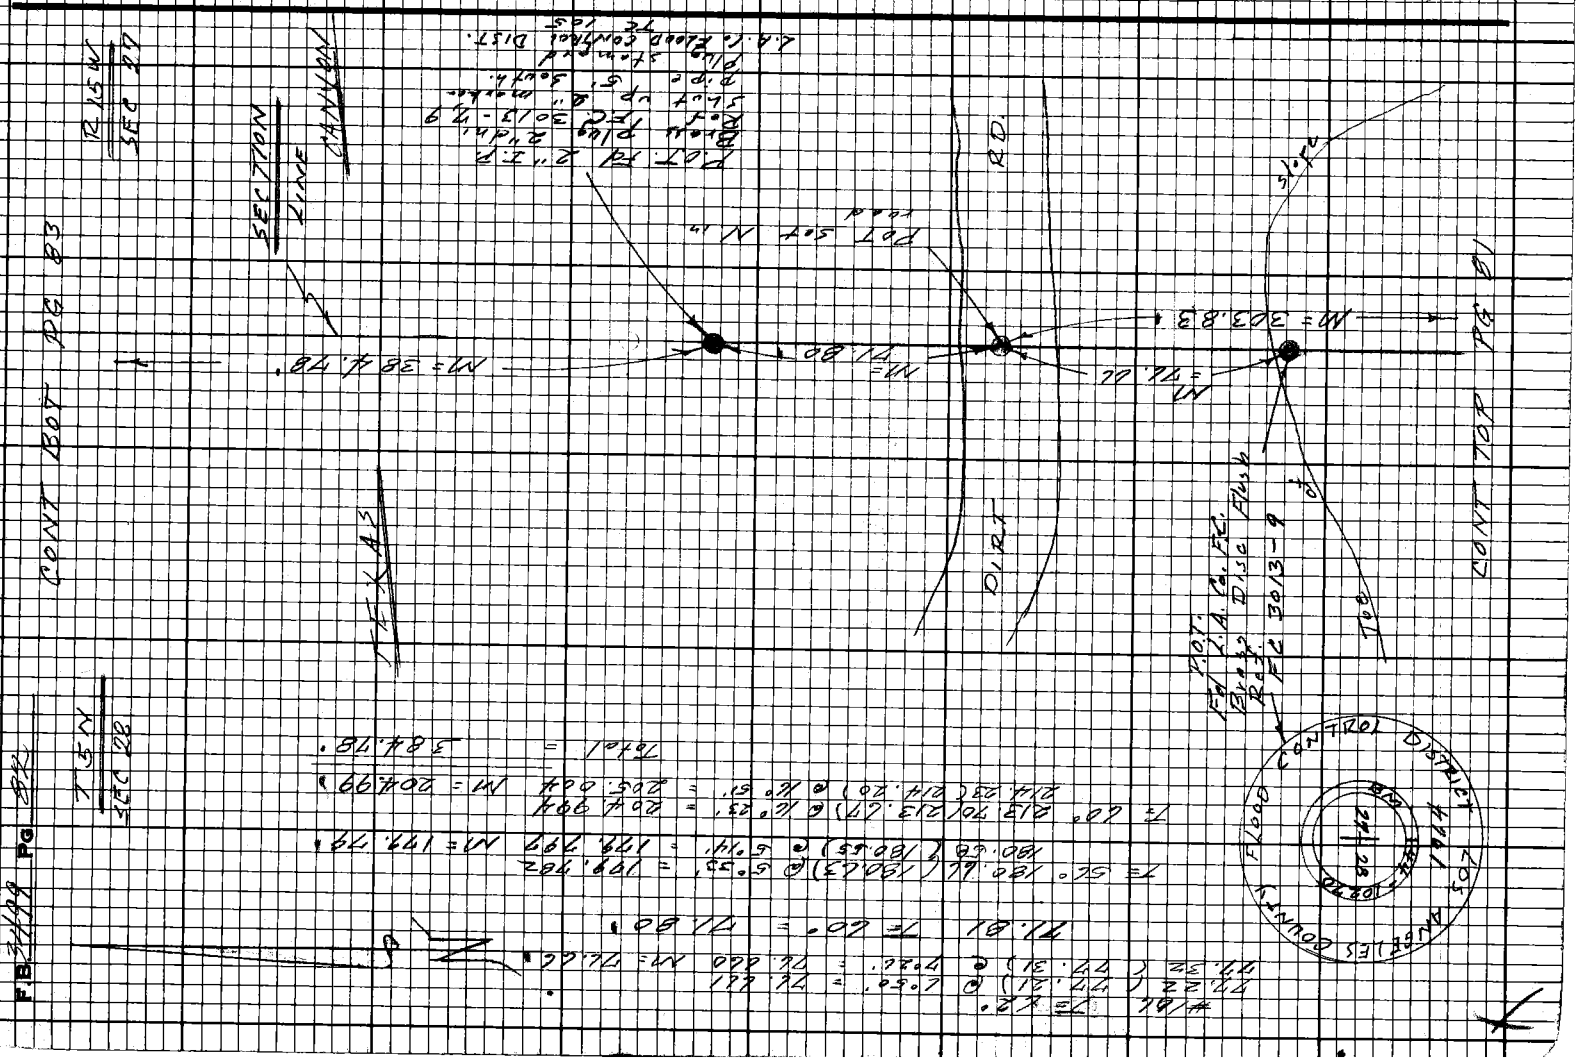

Notes Ck'd by
Map No.
Office Work
Checked
Date

Survey of Sections in T5N R15W F.B. 34999 Pg. 63
JN 6302.01 Tape 100' Sta 84 "F"
Surveyed by F.E. Brooks
Notes FET Date 8 Dec 71
Indexed D. J. GALLI APR 14 72

CONT BOT PG 84

T5N SEC 28

R15W SEC 27

SECTION LINE

N = 810.50'

Top of Ridge

Ridge

CO. FLOOD CONTROL

Stamping on Br. plug

Set 2" I.P. Brass Plug 2" dn Shot up Pipe 6" S. marker

Ridge

Top of Ridge

N = 384.76'

CANYON

TEXAS







CONT TOP PG 82

PLEASE RETURN TO
LOS ANGELES COUNTY ENGINEER
403 Los Angeles County Engineering Bldg.

Note: Any Additions or Changes on this Sheet Must be Made or Cked in Red Ink With Date and Name of Person Making Change.

Do not extend this side of this line.

Jetscan CE #310 9-67

PLEASE RETURN TO
LOS ANGELES COUNTY ENGINEER
403 LOS ANGELES COUNTY ENGINEERING BLDG.

Note: Any Additions or Changes on this Sheet Must be Made or Circled in Red Ink With Date and Name of Person Making Change.

Do not extend this side of this line.

LWS 78A-5

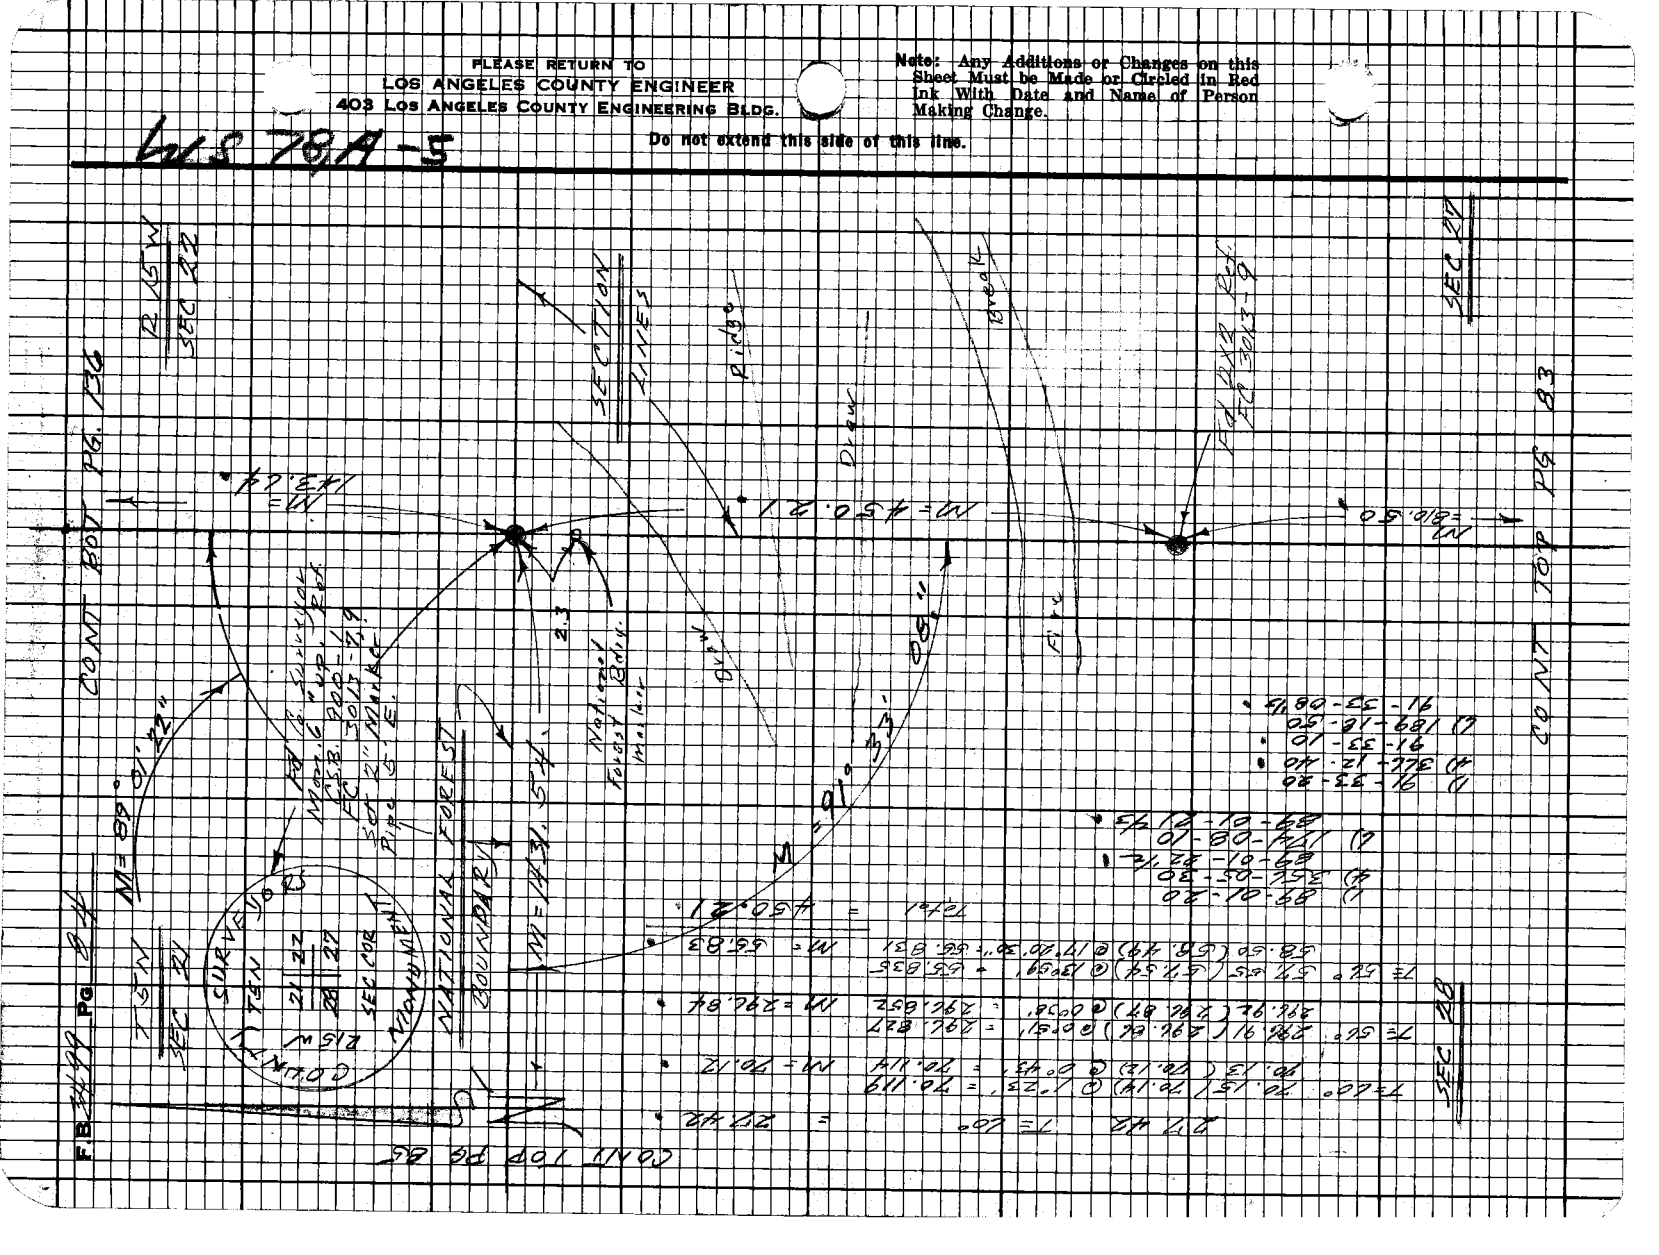

76E3098 CE#31D 9-67

PLEASE RETURN TO
LOS ANGELES COUNTY ENGINEER
403 LOS ANGELES COUNTY ENGINEERING BLDG.

Note: Any Additions or Changes on this Sheet Must be Made or Circled in Red Ink With Date and Name of Person Making Change.

Do not extend this side of this line.

T 5N
SEC 21

#186
T= 62° 122.56 (122.54) @ 5°15' = 122.025
122.46 (122.43) @ 4°39' = 122.027 M = 122.03 '

T= 62° 297.19 (297.15) @ 4°25' = 296.367
297.34 (297.30) @ 4°49' = 296.250 M = 296.26 '

T= 62° 134.92 (134.90) @ 7°23' = 133.781
134.73 (134.71) @ 6°41' = 133.783 M = 133.79 '

94.26 T = 62° = 94.25 '

T= 62° 294.57 (294.53) @ 5°23' = 293.231
294.47 (294.43) @ 5°36' = 293.224 M = 293.23 '

T= 60° 296.11 (296.06) @ 1°56' = 295.891
296.09 (296.03) @ 1°44' = 295.893 M = 295.89 '

T= 60° 196.21 (196.18) @ 1°50' = 196.079
196.14 (196.23) @ 2°09' = 196.092 M = 196.09 '

Total = 1431.54'

CONT TO T5N R5W SEC 34

National Forest Boundary

Section Line

M = 1431.54 '

CONT TO T5N R5W SEC 22

Drop

Shaw

R15W
SEC 28

X

Notes Ck'd by
Map No.
Office Work
Checked
Date

Survey of Sec 1 and 12 T5N R15W
JN 4322-01 Tape 104 Std 6" T
Surveyed by F.F. Brooks
Notes
Indexed by D. J. Gallup Date 2 Feb 72

F.B. 3449 Pg 85

PLEASE RETURN TO
LOS ANGELES COUNTY ENGINEER
403 LOS ANGELES COUNTY ENGINEERING BLDG.

Note: Any Additions or Changes on this Sheet Must be Made or Circled in Red Ink With Date and Name of Person Making Change.

Do not extend this side of this line.

F.B. [illegible] Pg [illegible]

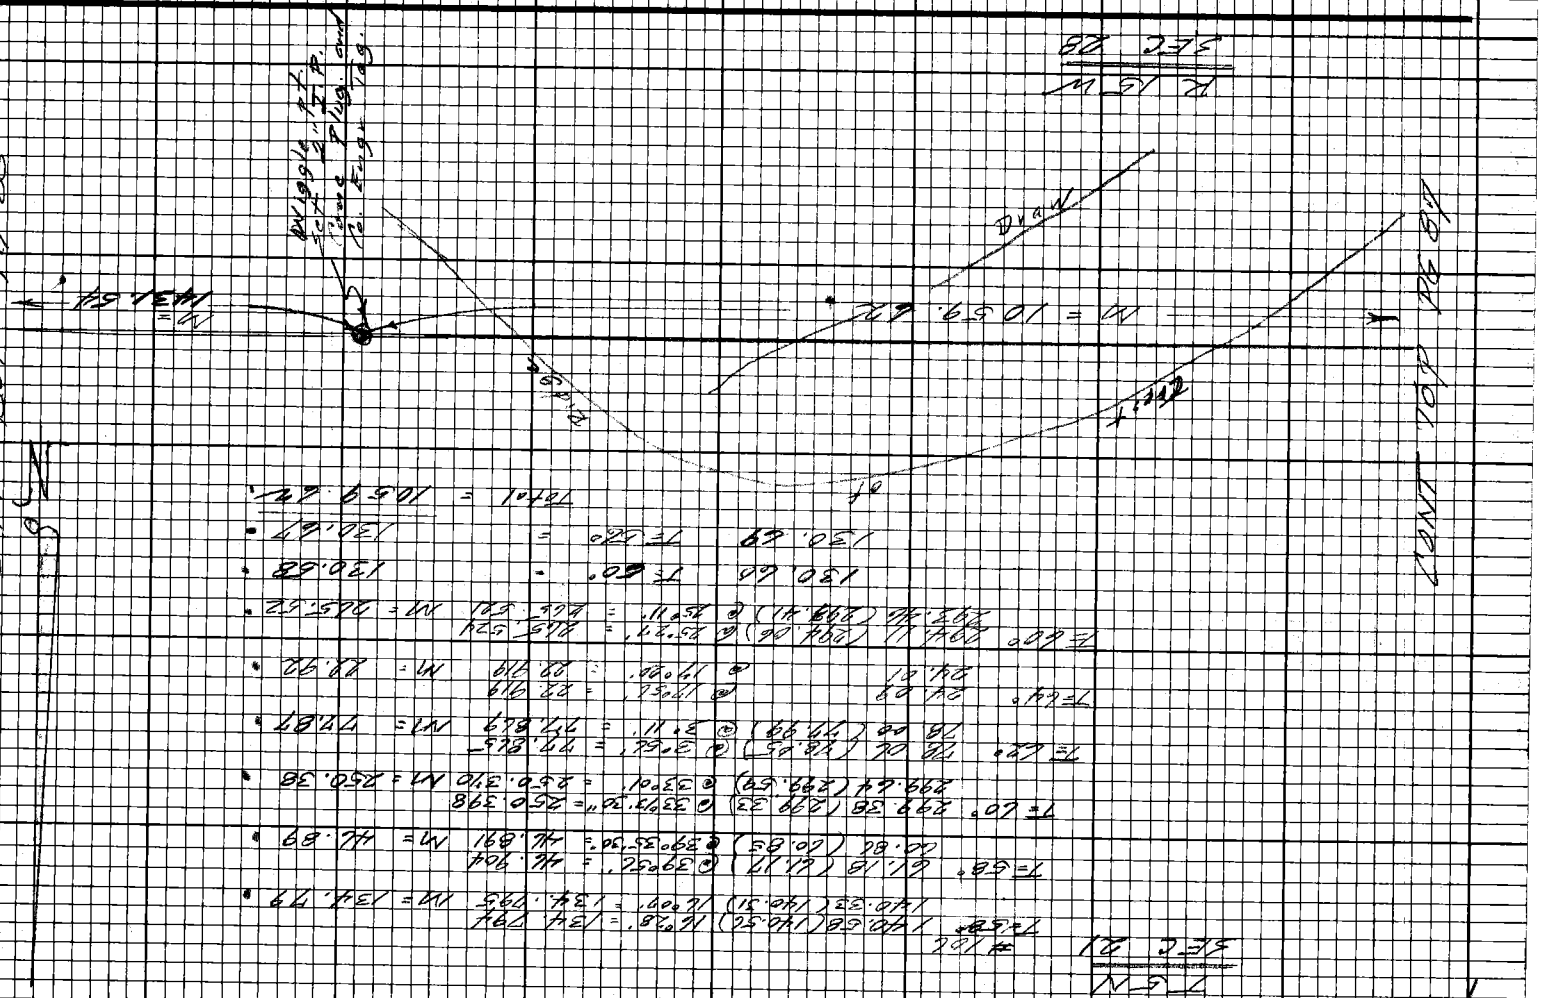
Cont. Rt. 55
Cont. Rt. 55
Dual
Dual
Dual

Notes Ck'd by
Map No.
Office Work
Checked
Date

Survey of Sections in T5N R15W F.B. 321 Pg. 87
JN 2302 Tape 186 Sta 84+E
Surveyed by F.E. Brooks
Notes F.E.B. Date 12 Dec 68
Indexed by S. GALLI 1972

WS 78 A-5

Note: Any Additions or Changes on this Sheet Must be Made or Circled in Red Ink With Date and Name of Person Making Change.

Do not extend this side of this line.

PLEASE RETURN TO
LOS ANGELES COUNTY ENGINEER
403 LOS ANGELES COUNTY ENGINEERING BLDG.

CONT BOT PG 86

SECTION LINE

N 31° 40' 10" E

Creek

channel

NATIONAL FOREST BDRY

2 large cabin roads

Line Road

Shows W

Bouquet

CANYON

RD

Witness 1/4 Cor. For Co Surv. Mon. 18" dia. Ref. R3B 900-1 FC 2915-275 2" Marker pipe 5' S.E. N = 77.90

Fd 3/4 Ld Spk & Tag Flush Ref. FC 2915-275

Set 1/2" Iron pipe 3.5' high

Set 1/2" Iron pipe flush

SURVEYORS MONUMENT

T 5 N R 15 W SEC 21 SEC 28

Light Pole For Co. Surv. Mon. Elbow on hillside Ref. R3B 900-1 FC 2915-275 2" Marker Pipe 5' N.W.

Searched for Spk in 2" Wood Post F.B. 323 Pg 23 Found nothing 32" dia

CONT TOP PG 88

reissue ce#310 9.67

PLEASE RETURN TO
LOS ANGELES COUNTY ENGINEER
403 LOS ANGELES COUNTY ENGINEERING BLDG.

Note: Any Additions or Changes on this Sheet Must be Made or Circled in Red Ink With Date and Name of Person Making Change.

Do not extend this side of this line.

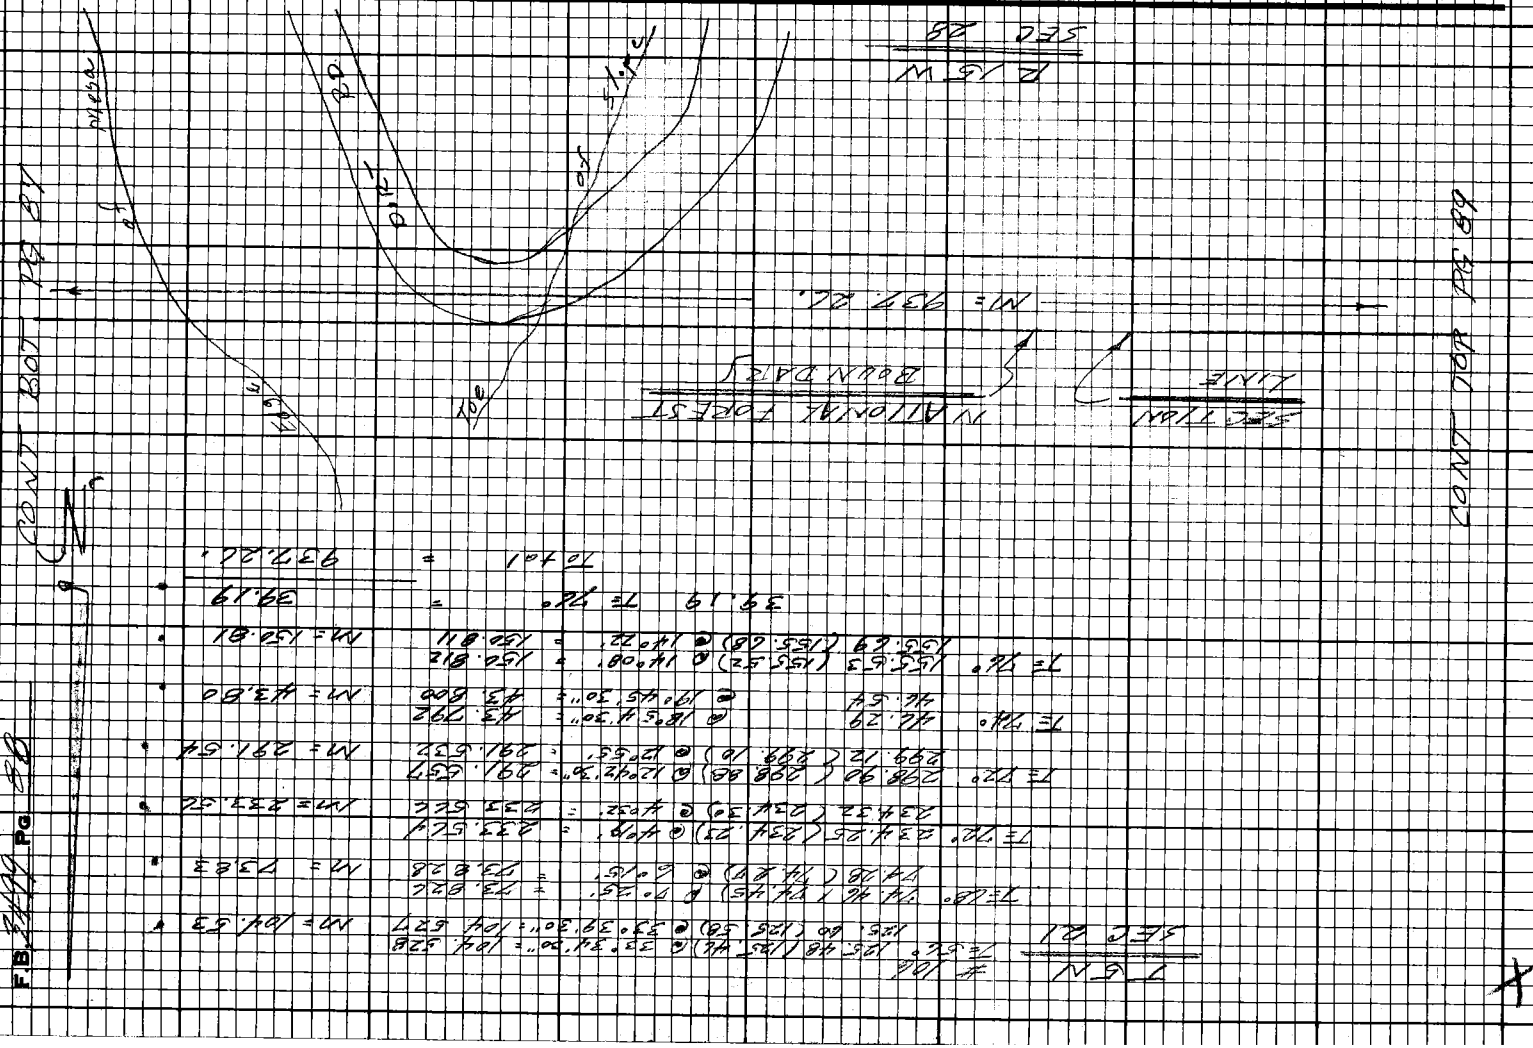

76F3098 CE#310 1-65

PLEASE RETURN TO
LOS ANGELES COUNTY ENGINEER
403 LOS ANGELES COUNTY ENGINEERING BLDG.

Note: Any Additions or Changes on This Sheet Must be Made or Circled in Red Ink, With Date and Name of Person Making Change.

Do not extend this side of this line.

Notes Ck'd by
Map No.
Office Work
Checked
Date

Survey of Sections 21 & 28 T5N R15W
Surveyed by F.E. Brooks Date 12 Dec 64
Notes F.E.B.
Indexed D.J. GALLI M 1 72

F. B. 3498 PG. 99

T5N
SEC 21

#106
T= 78° 241.19 (241.18) @ 6°17' = 239.730
241.27 (241.26) @ 6°30' = 239.708 M = 239.72 .

T= 78° 136.36 (136.35) @ 7°16' = 135.255
136.26 (136.25) @ 6°50' = 135.254 M = 135.25 .

12.36 T= 78° = 12.36 .

Total = 387.33 .

13.77 T= 78° = - 13.72 .

diff. = 373.61 A

1) 131-00-50
4) 134-03-40
5) 131-00-65
6) 66-05-20
131-00-53 1/3 .

CONT. TOP PG 98

SECTION LINE

Calc = 1732.43 .

M= 373.56 .

M= 937.26 .

NATIONAL FOREST BOUNDARY

Calc M= 48° 54'

POT SET IN HOLE

T LINE

M= 131° 00'

SLOPE

R15W
SEC 28

CONT RT PG 99

F. B. 3499 PG. 90

CONT BOT PG 89

PLEASE RETURN TO
LOS ANGELES COUNTY ENGINEER
403 Los Angeles County Engineering Bldg.

Do not extend this side of this line.

Note: Any Additions or Changes on This Sheet Must be Made or Circled in Red Ink With Date and Name of Person Making Change.

CREST

For Mound of 2' dia. x 1.2' high rock, small trees in center of mound

3.6

N1 = 379.51'

RIDGE

of

W. pg. & pt. set 2" I.P. conc. Tag 799 stg. Fd. & Plug

N1 = 23.44'

3.0

Northerly Boundary of Forest Land

68° 34' 40" 1732.43'

Calc. = 1732.43'

FOREST

NATIONAL

BOUNDARY

Fd 1½ I.P. Brass Plug & Tag L.S. 3691 flush

"I.P. Brass L.S. 3691 flush

R 15 W

SEC. 28

DRAW

SECTION LINE

#1967 23.44' = 80.

1) 68-34-30
2) 112-09-20
68-34-40

CONT TOP PG 91

T 5 N
SEC 21

	40° 59' 00"	
1992	40° 44' 40"	
1993	40° 30' 53"	

1991 = 179° 59' 47" - 18"

	40° 59' 11"	40° 15' 58"
	20224.49	15533.58
	.75455531	.26445788
	X	X
	1307.21331	411.2742

X = 1732.432'

Notes Ck'd by
Map No.
Office Work
Checked
Date

Survey of Sections in T3N, R10W
JN #304-01 Tape 106 Std 84°F
Surveyed by FE Brooks
Notes FEB Date 4 Dec 84
Indexed C. J. GALLI

F.B. 3499 Pg. 91

CONT BOT PG 90

CREST

CREST

SECTION LINE

N 43° W 1338.43'

CALC

NATIONAL FOREST BOUNDARY

N 45° W 1338.43'

SEC 21

R 10 W

SEC 28

CONT TOP PG 92

Note: Any Additions or Changes on this Sheet Must be Made or Circled in Red Ink With Date and Name of Person Making Change.

Do not extend this dtp of this line.

PLEASE RETURN TO
LOS ANGELES COUNTY ENGINEER
403 Los Angeles County Engineering Bldg.

7858098 FE #310 9-67

PLEASE RETURN TO
LOS ANGELES COUNTY ENGINEER
403 Los Angeles County Engineering Bldg.

Do not extend this side of this line.

Note: Any Additions or Changes on this Sheet Must be Made or Circled in Red Ink With Date and Name of Person Making Change.

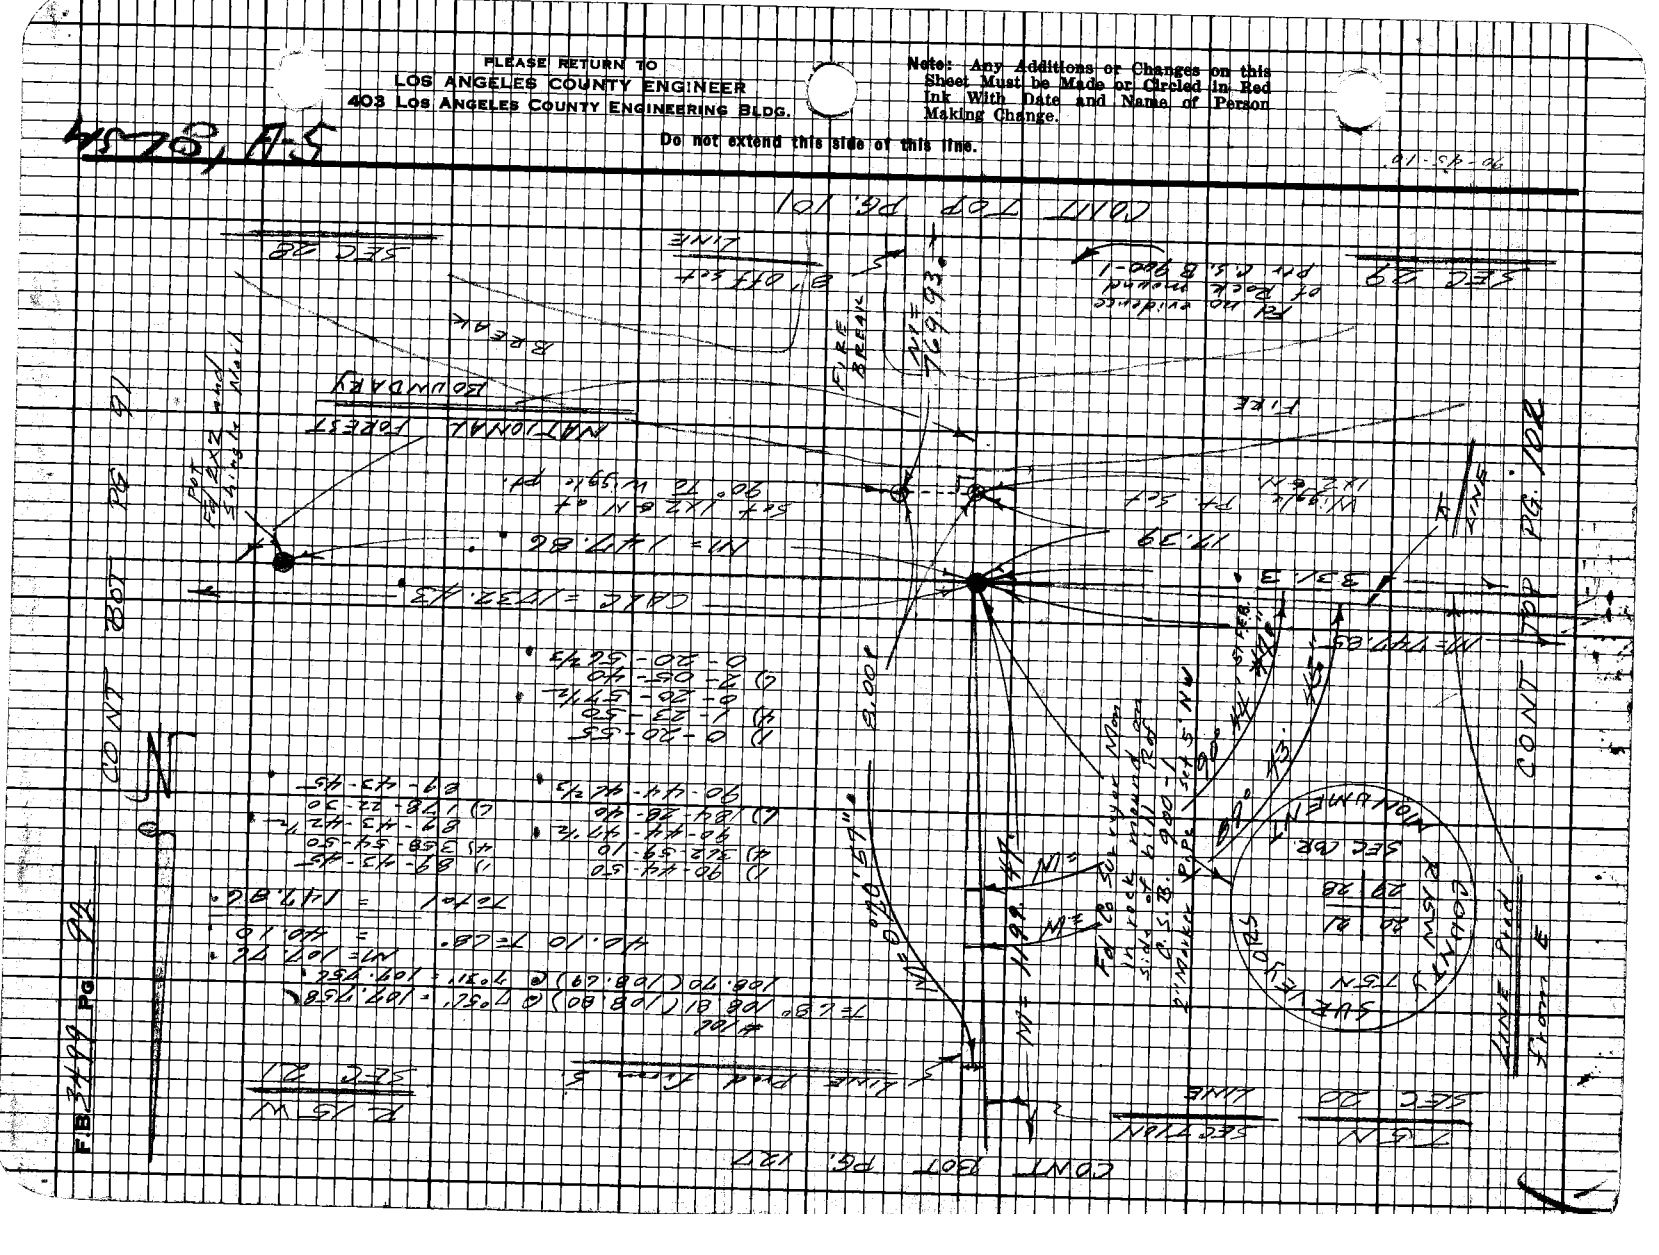

Notes Ck'd by
Map No.
Office Work
Checked
Date

Survey of Sections in T5N R15W F.B. 3488 Pg. 93
JN 0202-07 Tape 100' Std 8 1/2"F
Surveyed by F.E. Brooks
Notes F.E.B. Date 5 Dec 72
Indexed E. J. GALLI APR 14 '72

CONT 307 PG 94

T5N
SEC 29

M=768.55'

R15W
SEC 28

Note: Any Additions or Changes on this Sheet Must be Made or Circled in Red Ink With Date and Name of Person Making Change.

Do not extend this side of this fine.

PLEASE RETURN TO
LOS ANGELES COUNTY ENGINEER
403 LOS ANGELES COUNTY ENGINEERING BLDG.

16.1

Bank

CONT LT PG 43

7R3098 (REV 9-70) 9-67

PLEASE RETURN TO
LOS ANGELES COUNTY ENGINEER
403 LOS ANGELES COUNTY ENGINEERING BLDG.

Do not extend this side of this line.

Note: Any Additions or Changes on this Sheet Must be Made or Circled in Red Ink With Date and Name of Person Making Change.

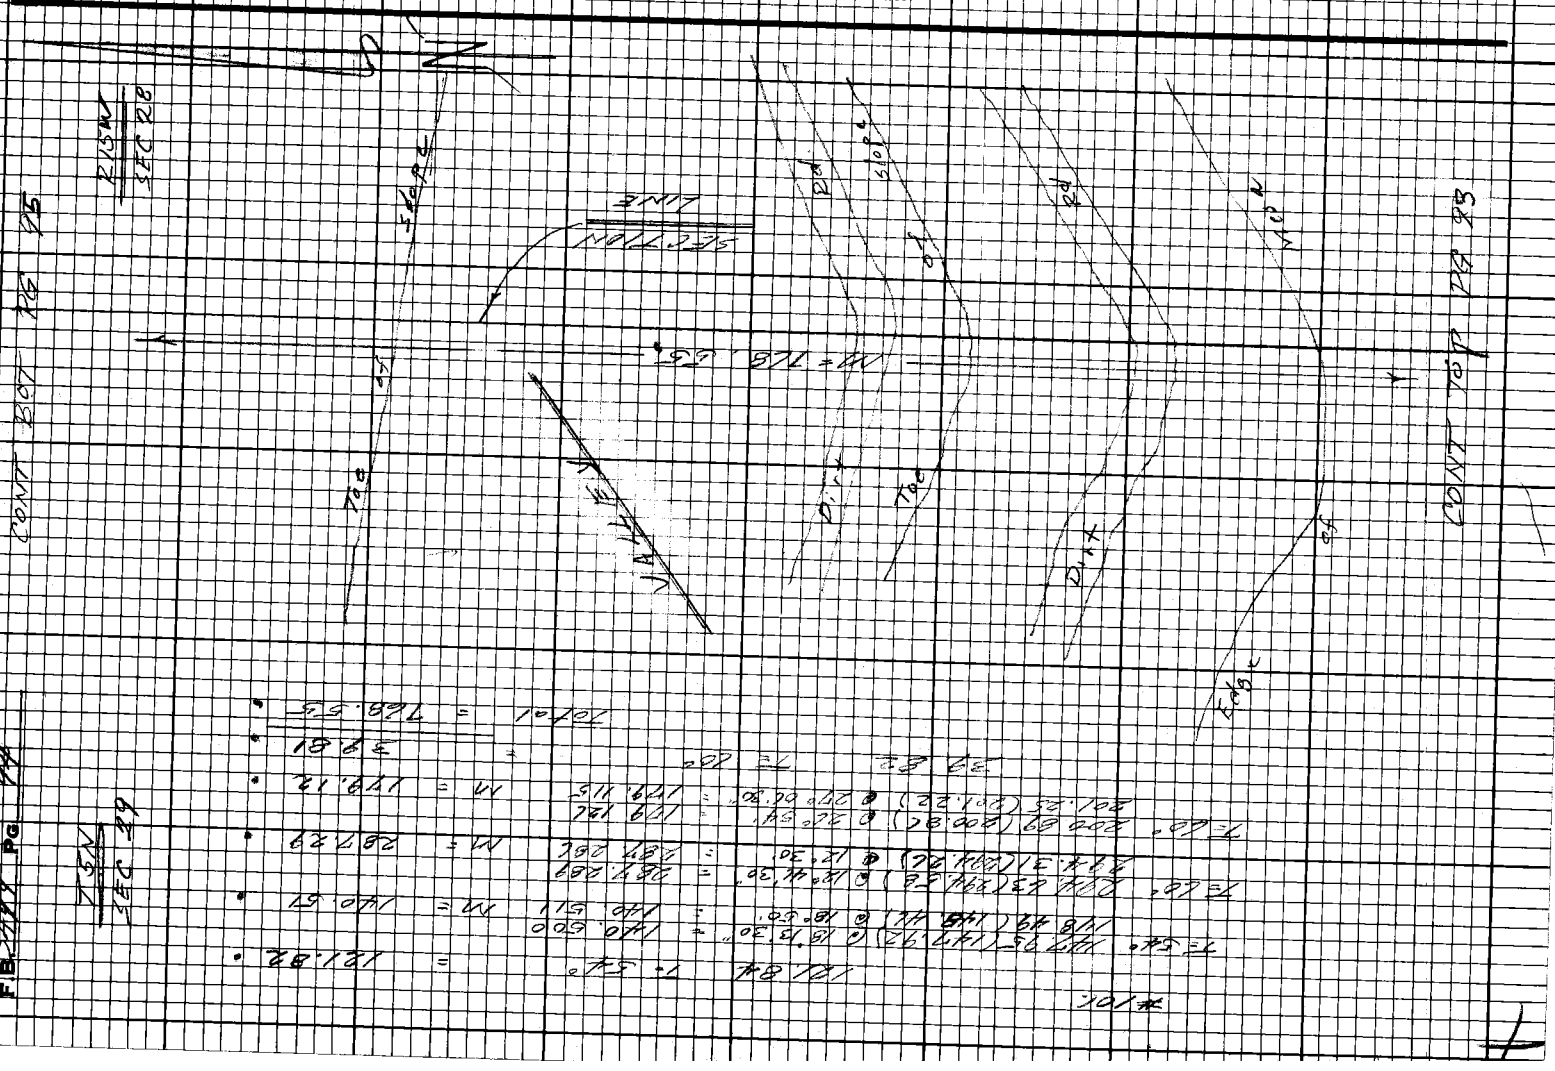

Notes Ck'd by
Map No.
Office Work
Checked
Date


Note: Any Additions or Changes on this Sheet Must be Made or Circled in Red Ink With Date and Name of Person Making Change.

Do not extend this side of this line.

PLEASE RETURN TO
LOS ANGELES COUNTY ENGINEER
403 Los Angeles County Engineering Bldg.

7E5698 CE#310 9-67

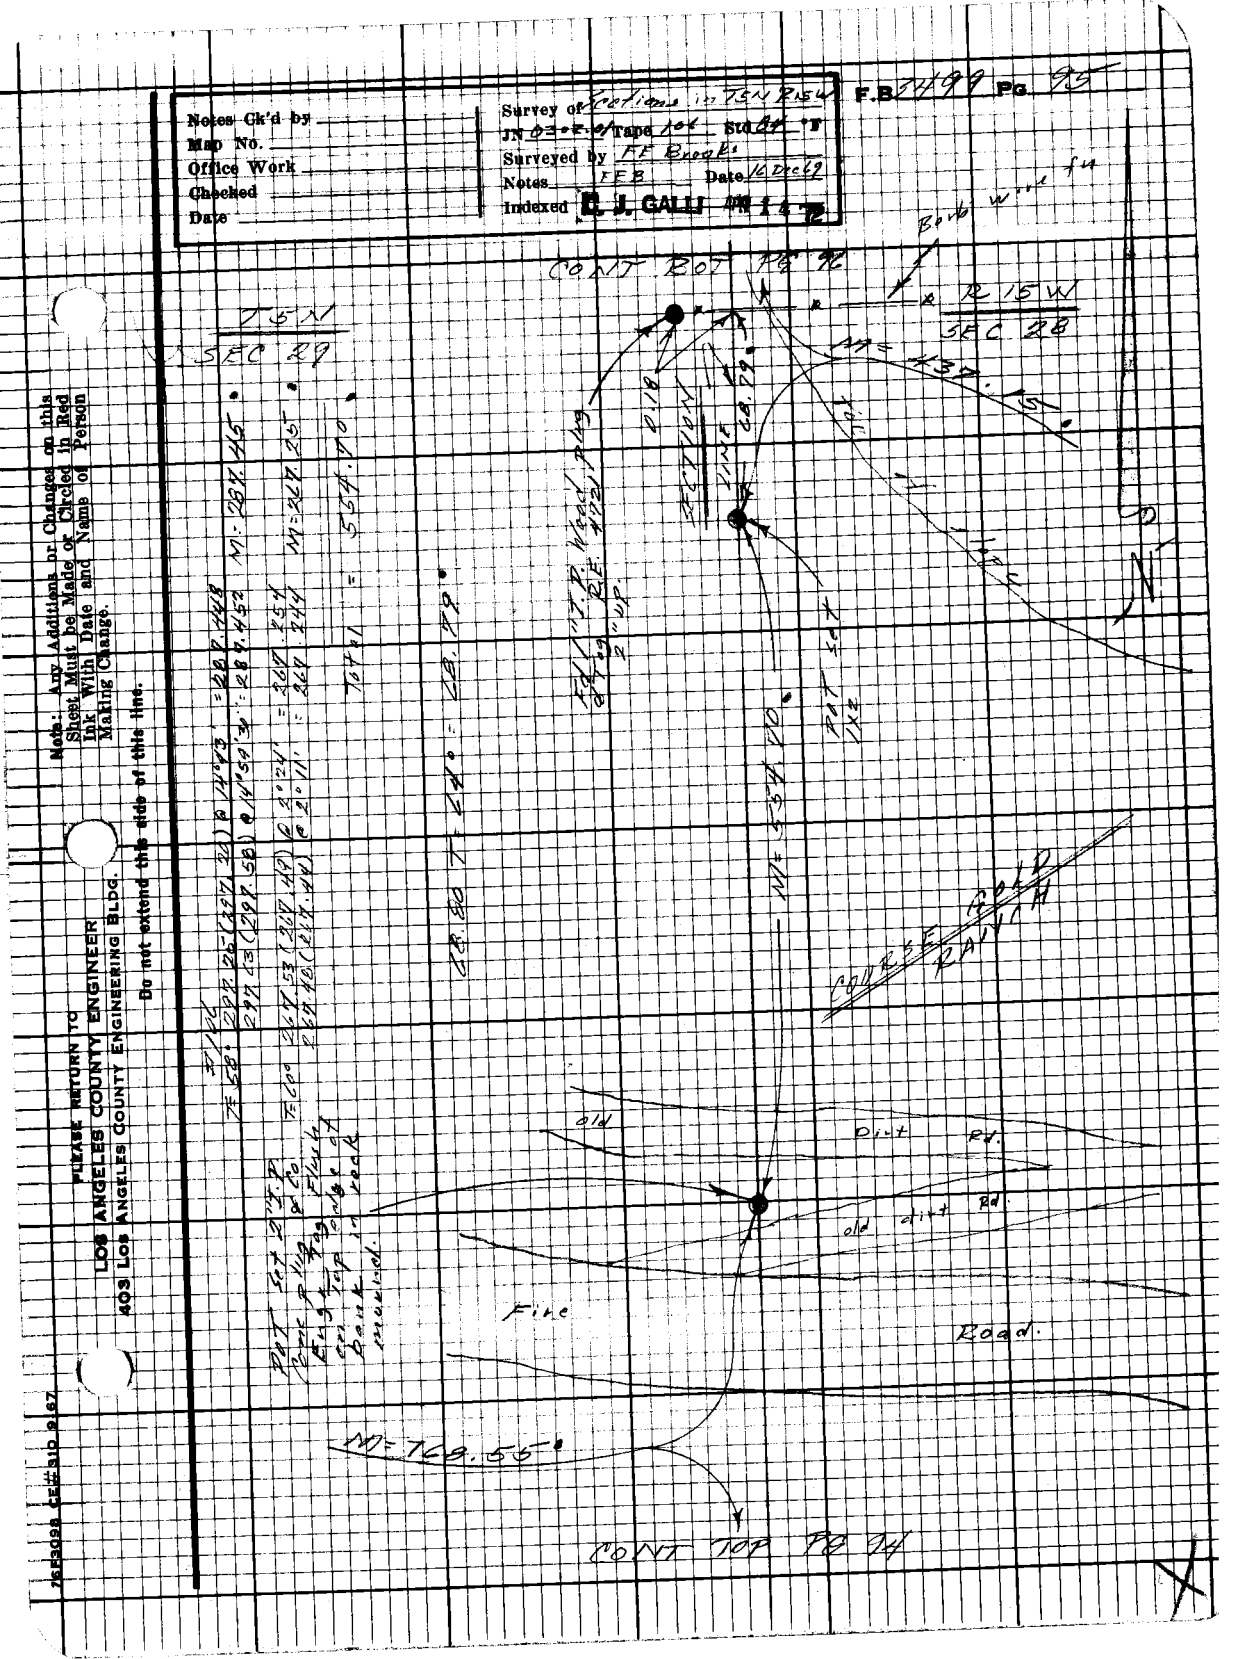

PLEASE RETURN TO
LOS ANGELES COUNTY ENGINEER
403 LOS ANGELES COUNTY ENGINEERING BLDG.

Note: Any Additions or Changes on this Sheet Must be Made or Circled in Red Ink With Date and Name of Person Making Change.

Do not extend this side of this line.

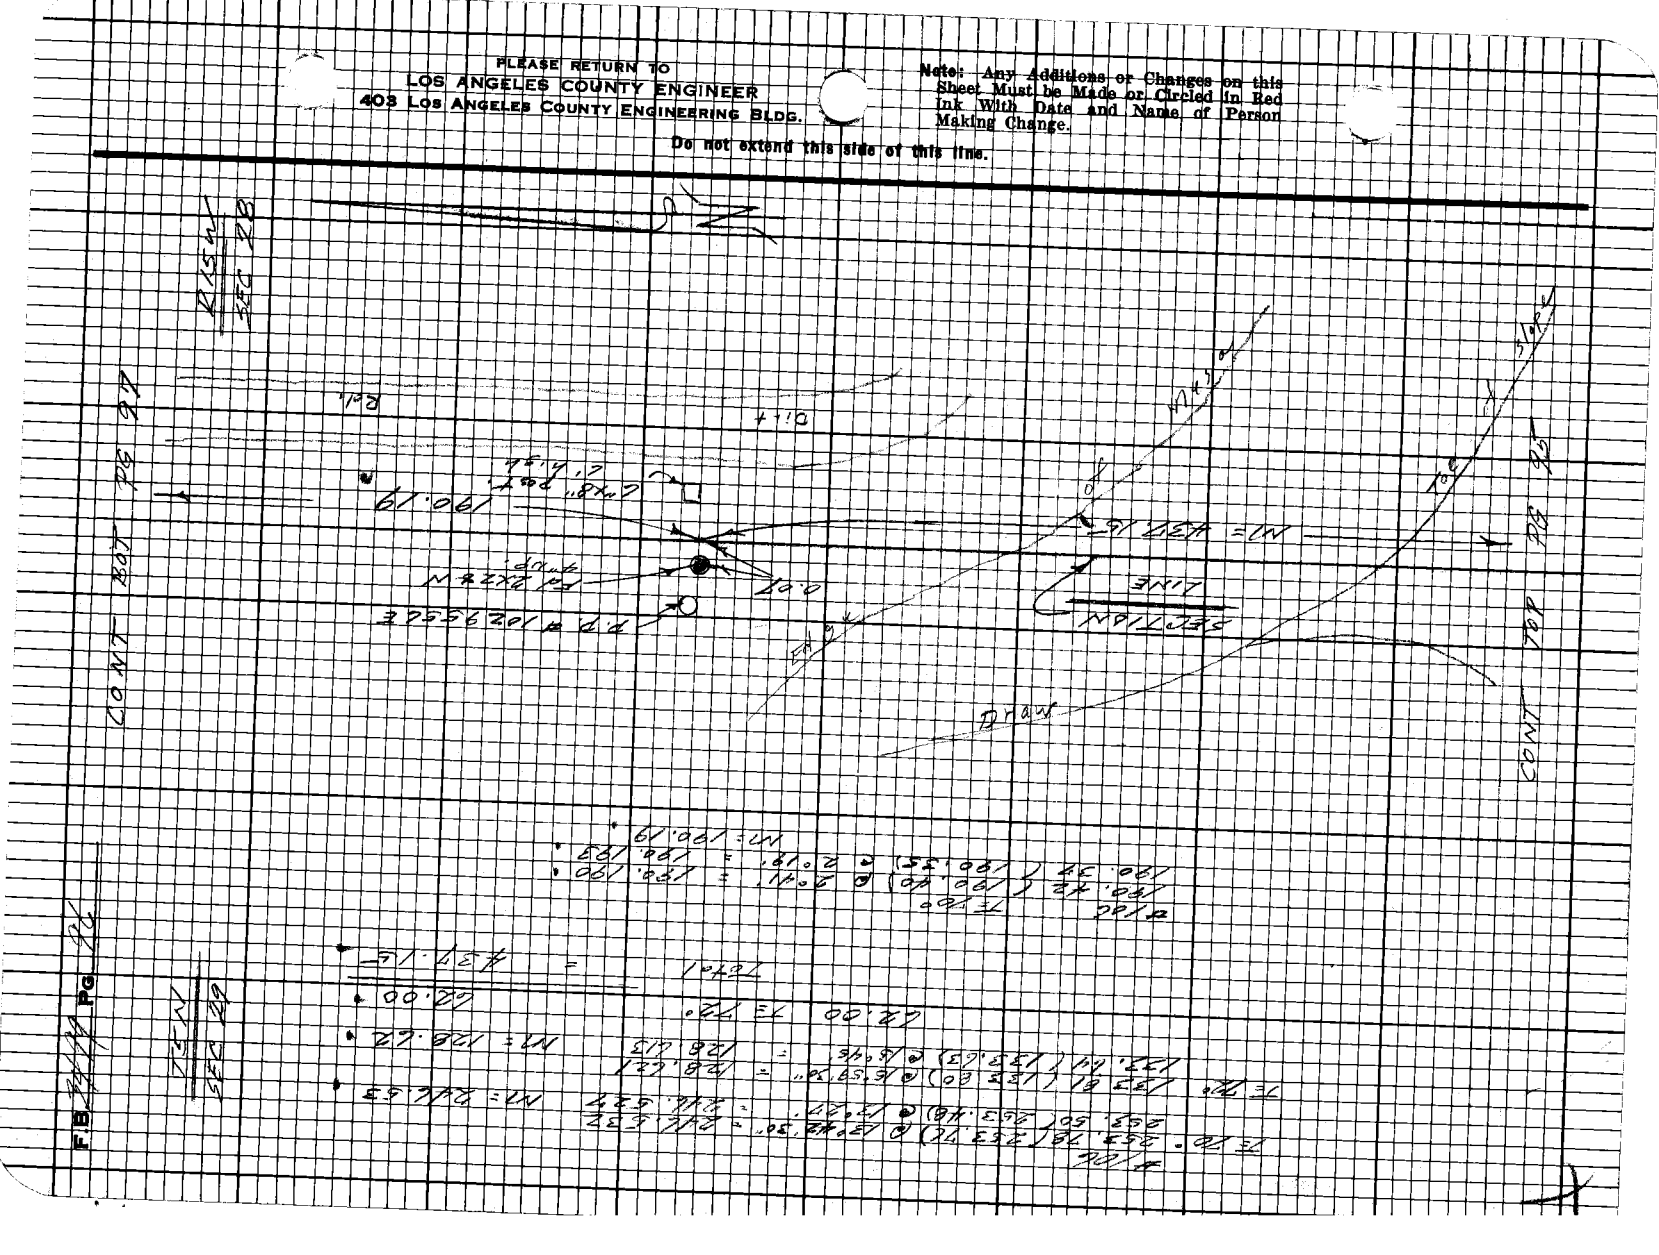

76ES098 CE # 310 9/67

PLEASE RETURN TO
LOS ANGELES COUNTY ENGINEER
403 Los Angeles County Engineering Bldg.

Do not extend this side of this line.

Note: Any Additions or Changes on this Sheet Must be Made or Circled in Red Ink With Date and Name of Person Making Change.

Notes Ck'd by
Map No.
Office Work
Checked
Date
















4 1/2" x 8" post
4' in ground

Dirt

Rd.


R15W

PLEASE RETURN TO
LOS ANGELES COUNTY ENGINEER
403 LOS ANGELES COUNTY ENGINEERING BLDG.

Note: Any Additions or Changes on this Sheet Must be Made or Circled in Red Ink With Date and Name of Person Making Change.

Do not extend this side of this line.

WS 78,435

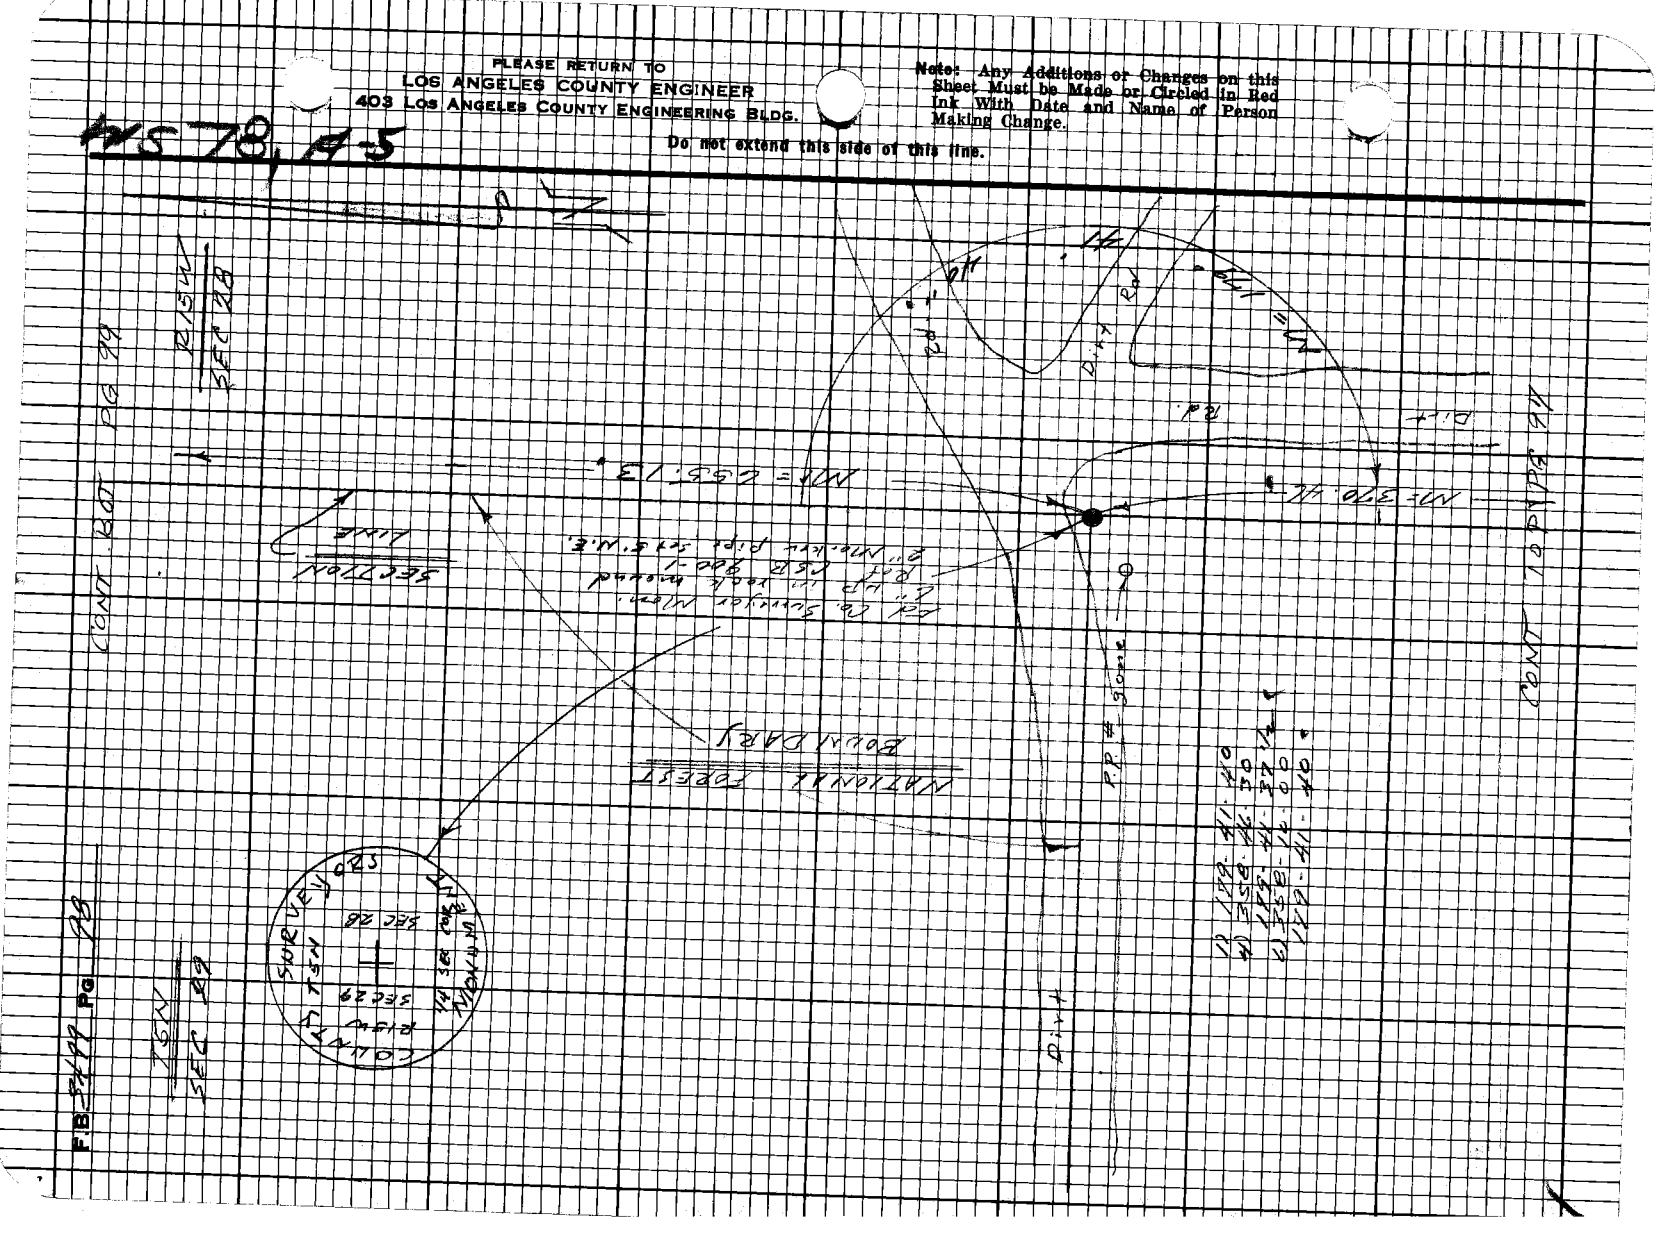


75F3098 CE# 310 9-67

PLEASE RETURN TO
LOS ANGELES COUNTY ENGINEER
403 LOS ANGELES COUNTY ENGINEERING BLDG.

Do not extend this side of this line.

Note: Any Additions or Changes on this Sheet Must be Made or Circled in Red Ink With Date and Name of Person Making Change.

Notes Ckd by _____
Map No. _____
Office Work _____
Checked _____
Date _____



N= 185.88'

T= 20° 38' 15" (298.12) Δ 5°16' = 297.934
(298.53) (298.50) Δ 5°25' = 297.944
116.69 T= 20° = 116.68
N= 297.94'
T=1 = 655.13'

1) 40-15-50
2) 141-03-30
40-15-32½
3) 241-35-20
40-15-53½


NATIONAL FOREST BOUNDARY

N= 655.13'

PUT SCH 1X2 #W

8.00'

SCH 1X2 #7 PW 207

SECTION LINE

POINT BOT REC 100

N=1235.17'

N= 40.

SECTION LINE

POINT RT PG. 99

PLEASE RETURN TO
LOS ANGELES COUNTY ENGINEER
403 LOS ANGELES COUNTY ENGINEERING BLDG.

Note: Any Additions or Changes on this Sheet Must be Made or Circled in Red Ink With Date and Name of Person Making Change.

Do not extend this side of this line.

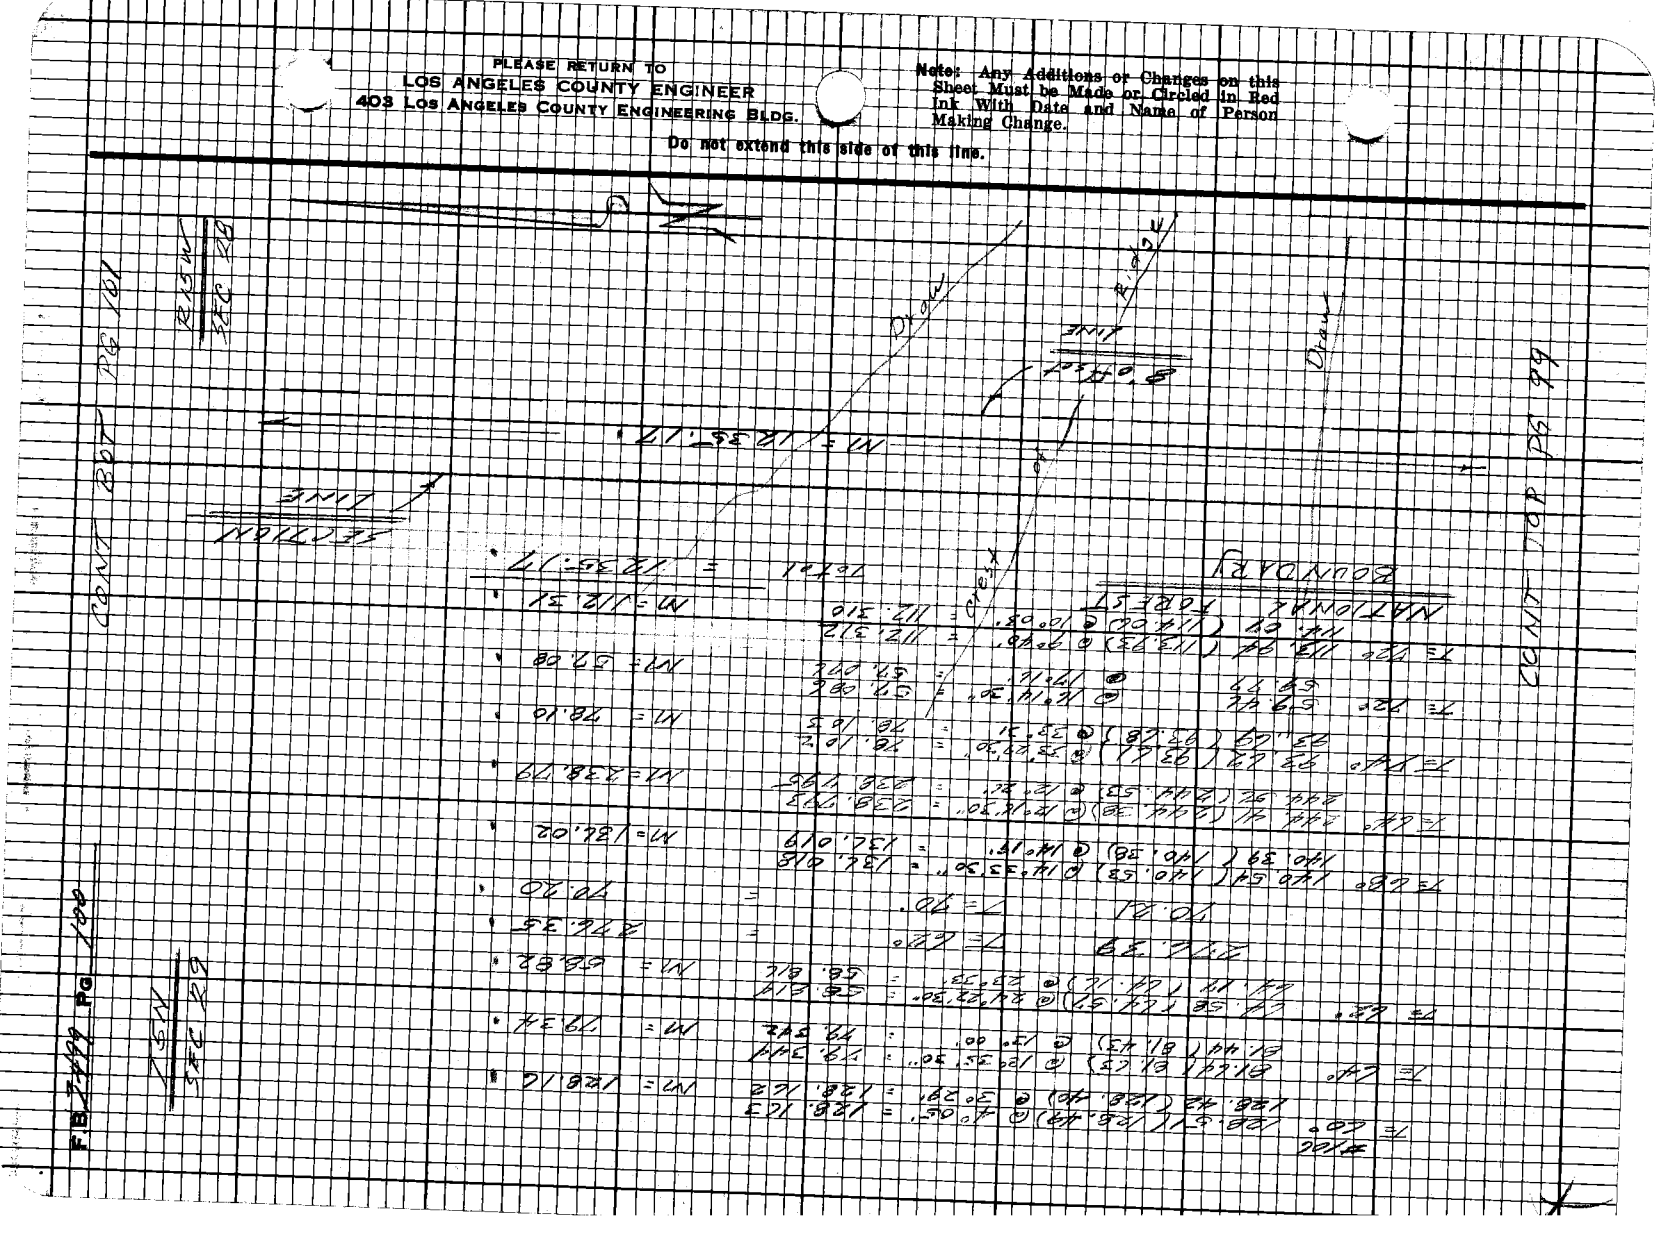

75F3098 CE#310 8/67

PLEASE RETURN TO
LOS ANGELES COUNTY ENGINEER
403 Los Angeles County Engineering Bldg.

Do not extend this side of this line.

Note: Any Additions or Changes on this Sheet Must be Made or Circled in Red Ink With Date and Name of Person Making Change.

Notes Ck'd by
Map No.
Office Work
Checked
Date

Survey of Sect'd. in T5S R15W JN Tract of Trade Tract Sta. 0+00
Surveyed by F.E.B. Date 7/1967
Notes F.E.B. Date 7/1967
Indexed F.E.B. Date 7/1967

F.B. 14447 Pg. 101

106 222.98 T= 74° = 222.97

T= 74° 72.03 @ 21°30'30" = 67.572
72.72 @ 21°42' = 67.564 M= 67.57 '

T= 74° 298.31 (298.29) @ 6°30' = 294.975
298.43 (298.41) @ 6°44' = 294.951 M= 294.96 '
34.46 T= 74° = 34.46 '

T= 74° 75.38 @ 14°30' = 72.979
75.21 @ 14°0' = 72.970 = 72.97 '
TOTAL 769.93 '

T5S R15W SEC 28

CONT ON PG 102

CONT FROM PG 100

SECTION LINE

3213'

0024

N 1235.17'

NE 769.93'

E. 1/4 SEC

BLOCK

S. 1/4 COR

X=5300

Y=1,1,1,1,1,2

T5S R15W SEC 28

PLEASE RETURN TO
LOS ANGELES COUNTY ENGINEER
403 LOS ANGELES COUNTY ENGINEERING BLDG.

Note: Any Additions or Changes on this Sheet Must be Made or Circled in Red Ink With Date and Name of Person Making Change.

Do not extend this side of this line.

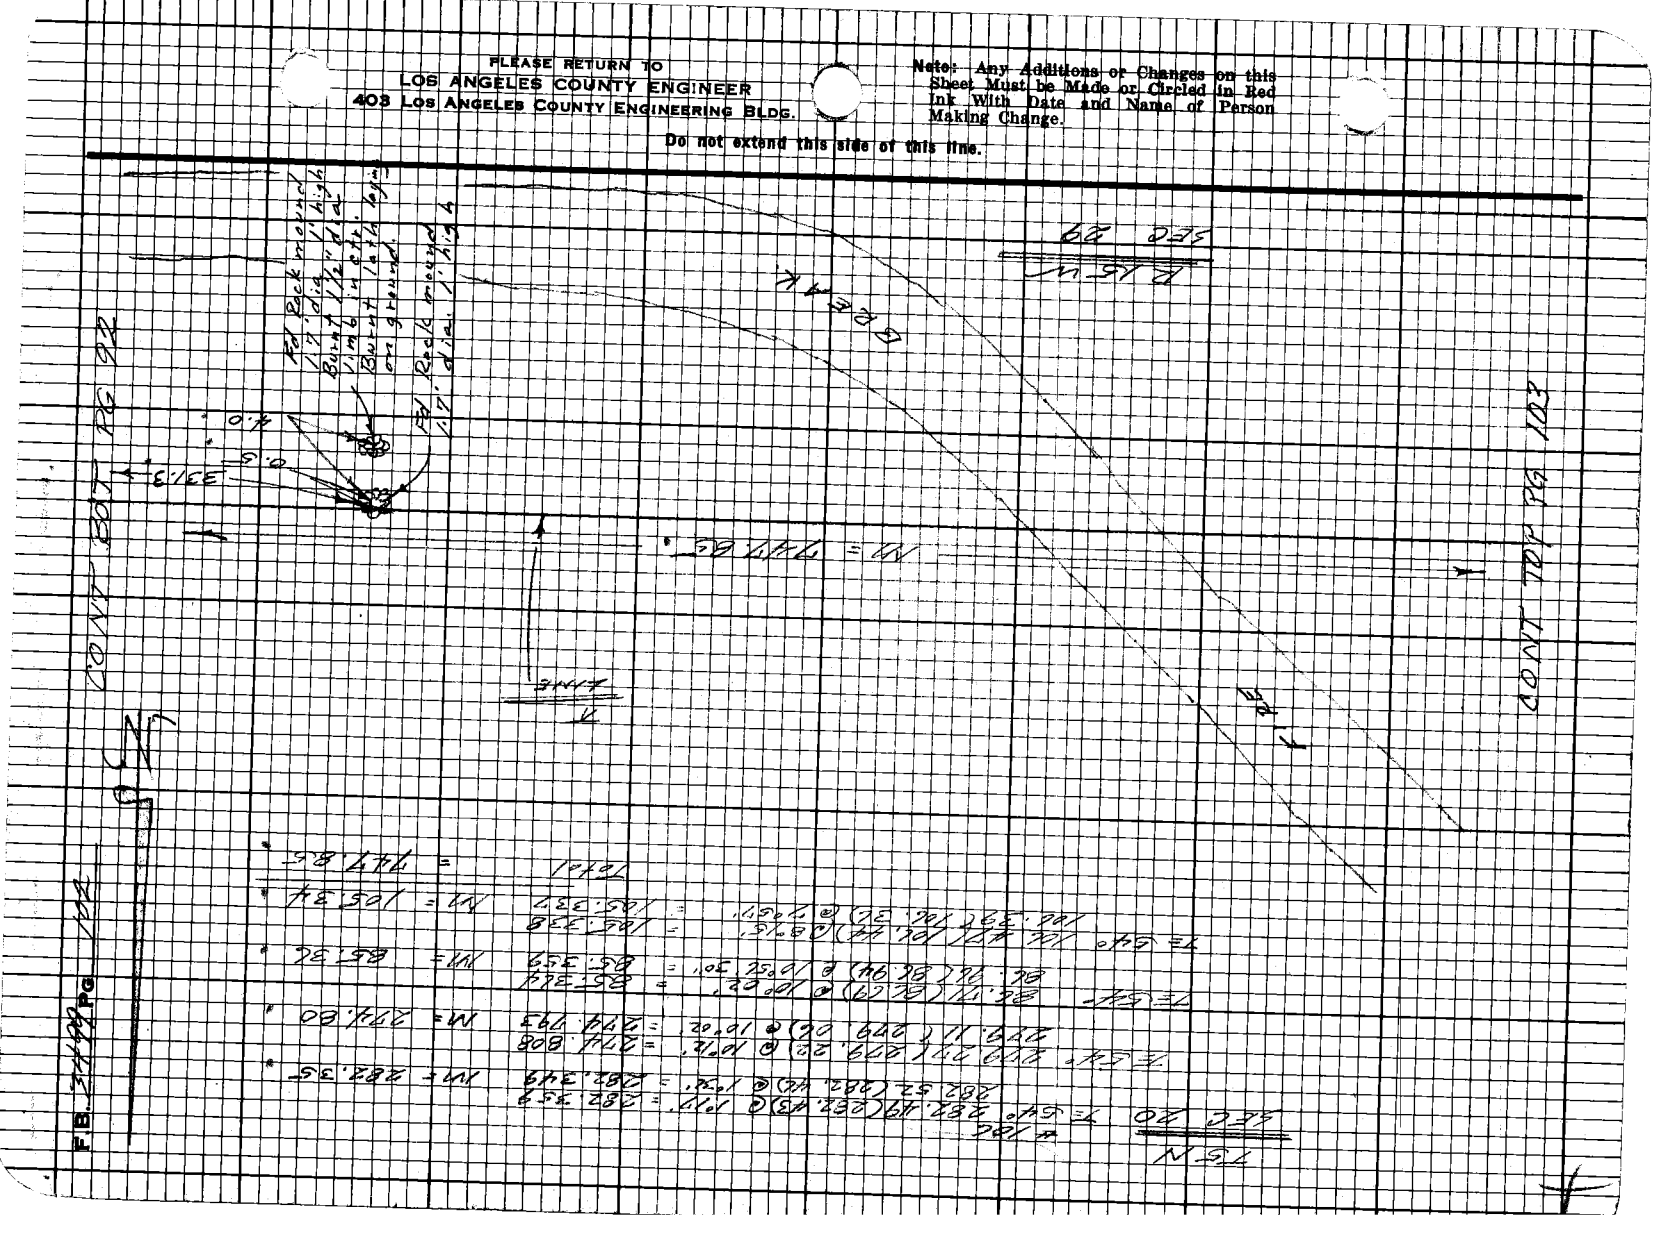

Notes Ck'd by
Map No.
Office Work
Checked
Date

Survey of Rock mound in 35N R13W
JN 03161 Tape 100' Std 68 °F
Surveyed by FE Brooks
Notes FEB
Indexed D. J. GALLI MAY 1 '72

F.B. 3499 Pg. 103

Note: Any Additions or Changes on this Sheet Must be Made or Circled in Red Ink With Date and Name of Person Making Change.

Do not extend this side of this line.

PLEASE RETURN TO
LOS ANGELES COUNTY ENGINEER
403 LOS ANGELES COUNTY ENGINEERING BLDG.

7825029 CE# 310 8167

CONT FROM PG 102

Fd. Rock Mound 2½" dia 6" high

Fd. Rock Mound 2½" dia 6" high w/ 2x4 batter board 4' out on line & 1' off line

Fd. Rock Mound 2" dia 1' high

Fd. Rock Mound 2" dia 1' high

Set 1x2 6N with Double Replaced 1x2 6N with 4" I.P. Long Plug & Tag Flush in a rock mound 22" in 1970

Fd. Rock Mound 2" dia 1' high with remains of 1x2 in

CONT TOP PG 104

PLEASE RETURN TO
LOS ANGELES COUNTY ENGINEER
403 LOS ANGELES COUNTY ENGINEERING BLDG.

Note: Any Additions or Changes on this Sheet Must be Made or Circled in Red Ink With Date and Name of Person Making Change.

Do not extend this side of this line.

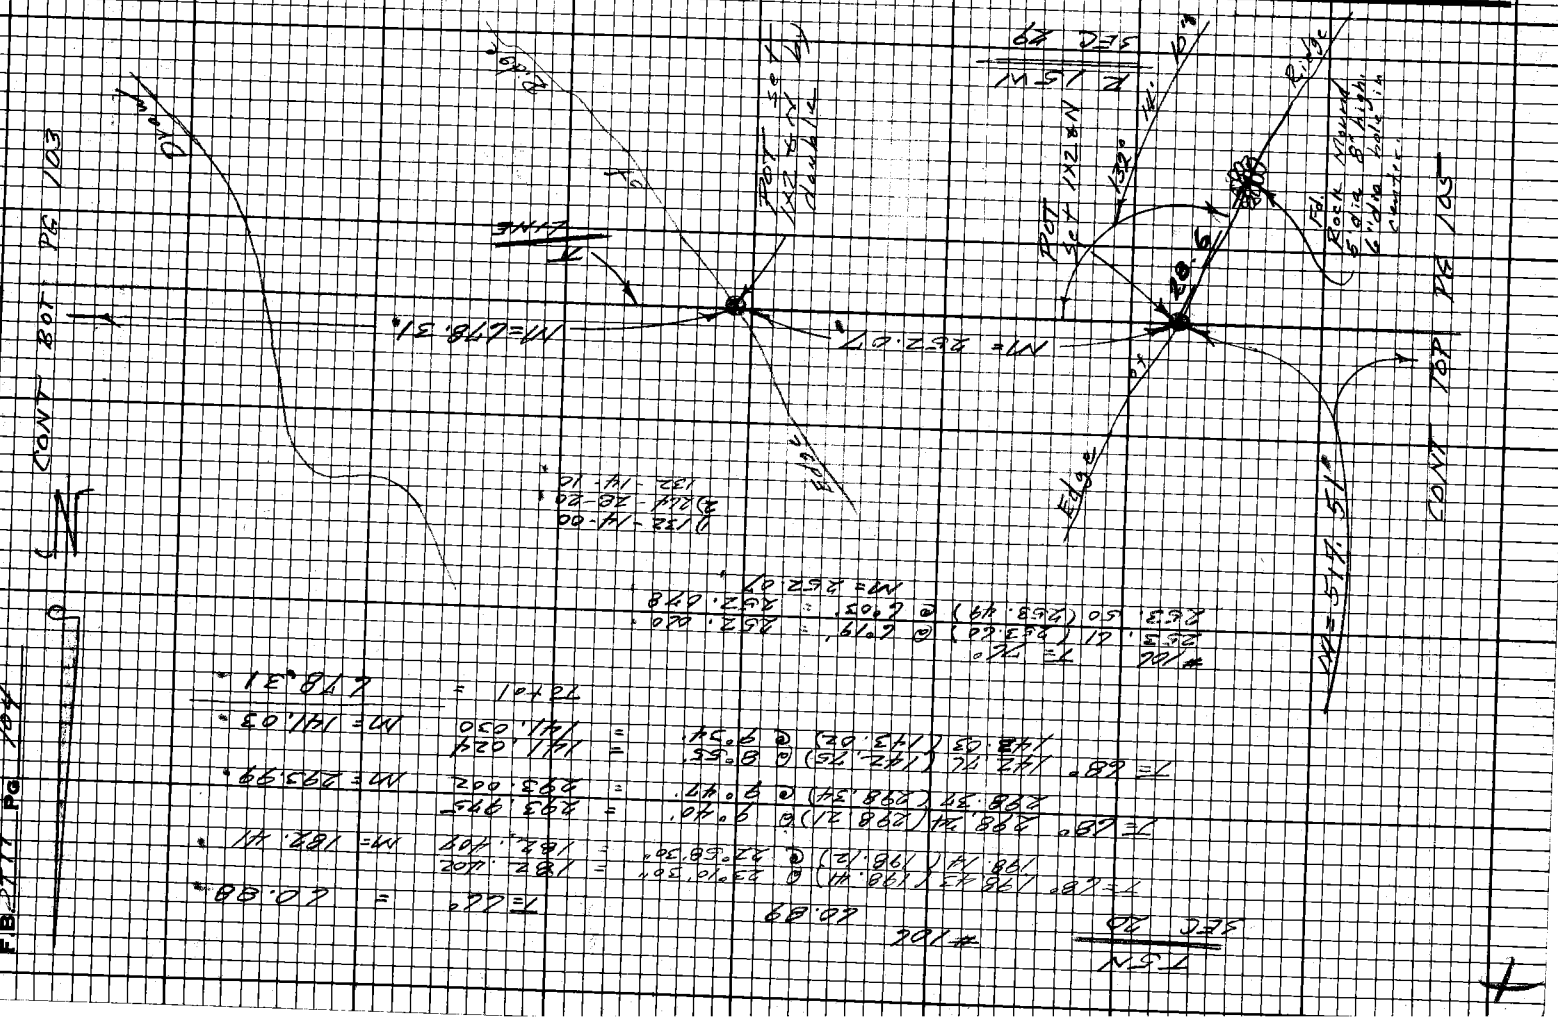
CONT TOP PG 103
CONT TOP PG 105
CONT TOP PG 105
N
FB 3444 PG 1401
Edge
Edge
Edge

76F3058 CE#310 9-67

PLEASE RETURN TO
LOS ANGELES COUNTY ENGINEER
403 LOS ANGELES COUNTY ENGINEERING BLDG.

Do not extend this side of this line.

Note: Any Additions or Changes on this Sheet Must be Made or Circled in Red Ink With Date and Name of Person Making Change.

WS 177, D-5

Notes Ck'd by
Map No.
Office Work
Checked
Date

Surveyed by FE Brock Date 22 Dec 69
Notes
Indexed by D.L. GALLI Date 1-14-70

T5N
SEC 20

#106

FB 7787 Pg 105

FE 76° 40.94
41.15

@ 12°37' = 39.951
@ 13°56' = 39.942 M = 39.94'

T=54° 71.31 (71.30) @ 22°28'30" = 45.884'
70.83 (70.82) @ 23°31'30" = 45.881 M = 45.88'

T=66° 42.34 (42.33) @ 10°39' = 41.540'
42.56 (42.55) @ 12°09'30" = 41.552' M = 41.60'

T=72° 115.86 (115.85) @ 9°08' = 114.381
115.77 (115.76) @ 9°50' = 114.387' M = 114.38'

T=54° 257.09 (257.04) @ 5°60' = 255.708'
256.94 (256.89) @ 5°29' = 255.713' M = 255.71'

Total = 517.51'

Searched area for 1X4 Cor. per government notes G.L.O. 9101-15 for the elevation of called for rock mound.

M = 517.51'

Line

Cont. to POB

Cont. to POB

Cont. FB 787 Pg 106

Set P.K. in 3½" dia. Aluminum Cap Stamped with the letters LSIZE, Flush to Grade at Point of Intersection

16.0

M = 821.92'

POB Set 1X2 FN
Replaced 1X2 FN with Rebar & P.K. Nail Plug & Tag Flush in Rock Mound 22 Dec 1970

See F.B. 4342-66 for 1X4 Sec. Cor. 2-83, D.L.G.

1/4 Cor

R15W
SEC 29

PLEASE RETURN TO
LOS ANGELES COUNTY ENGINEER
403 LOS ANGELES COUNTY ENGINEERING BLDG.

Note: Any Additions or Changes on this Sheet Must be Made or Circled in Red Ink With Date and Name of Person Making Change.

Do not extend this side of this line.

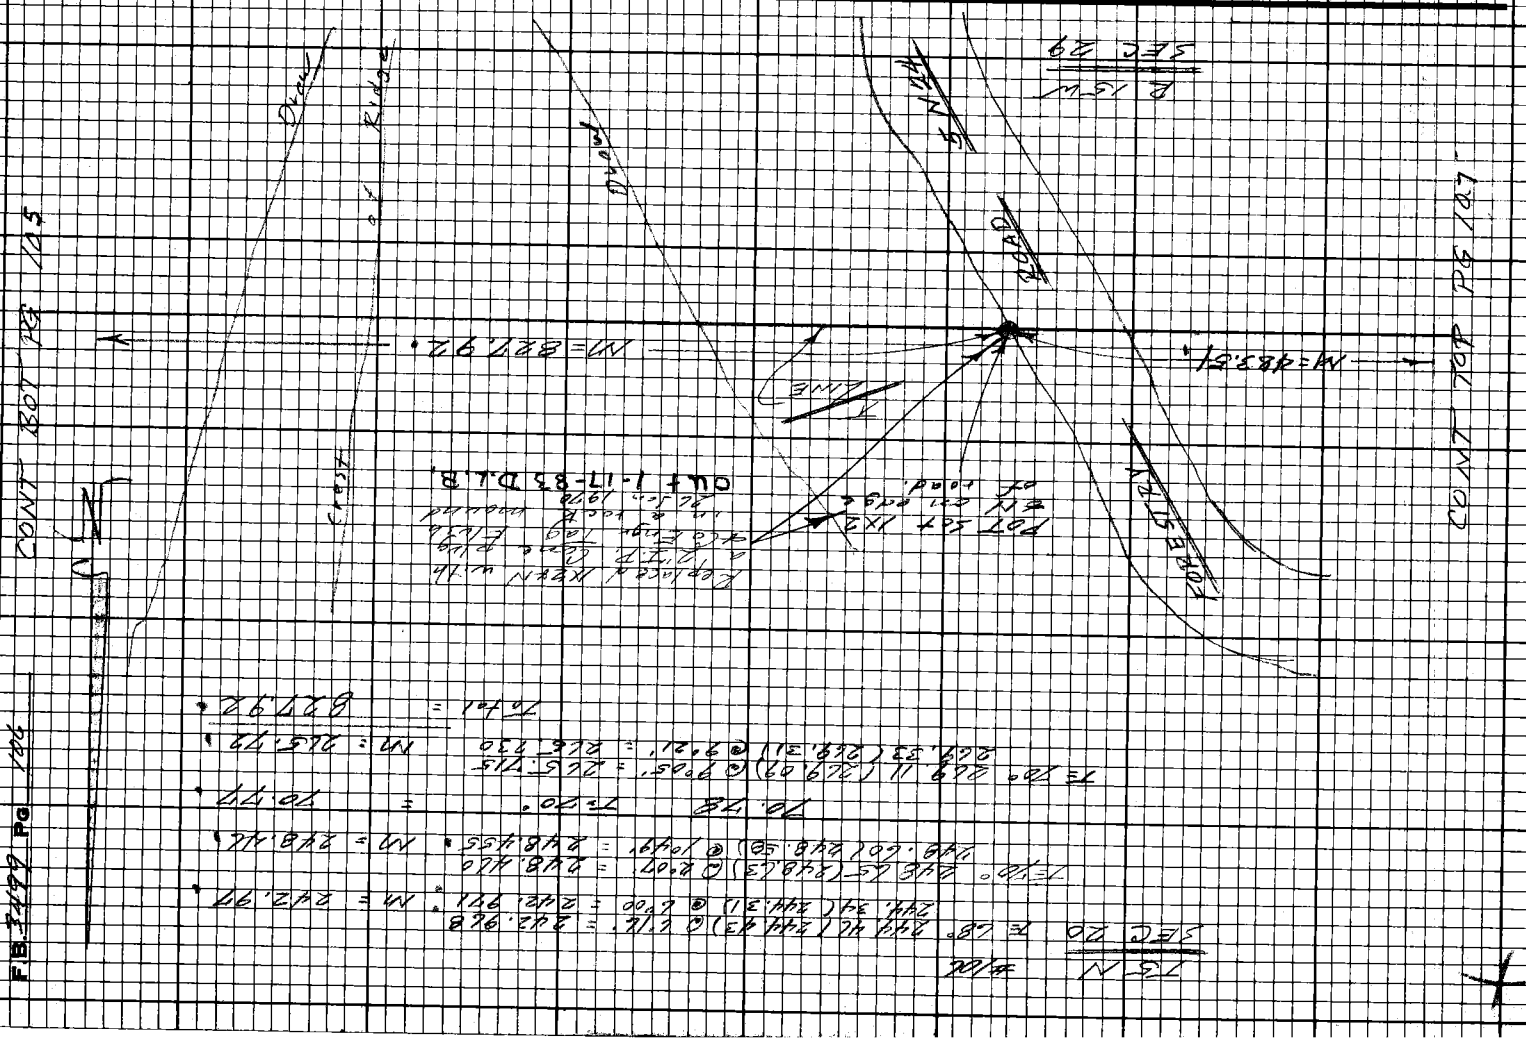
Draw
Ridge
CONT BOT PK 105
CONT TOP PK 107
N = 827.92'
N = 483.51'

76F3098 CE 310 9-67

PLEASE RETURN TO
LOS ANGELES COUNTY ENGINEER
403 LOS ANGELES COUNTY ENGINEERING BLDG.

Note: Any Additions or Changes on this Sheet Must be Made or Circled in Red Ink With Date and Name of Person Making Change.

Do not extend this side of this line.

Notes Ck'd by
Map No.
Office Work
Checked
Date

Notes
Indexed
Plotted
Deputy Surveyor
E. J. GALLI

Pg. 1047

#106

T 5 N
R 10 W
SEC 20

T= 46° 169.84 (169.82) @ 13°47' = 164.929
170.00 (169.98) @ 14°00' = 164.951 M = 164.93.

T= 68° 299.45 (299.42) @ 6°59' = 299.402
299.43 (299.40) @ 6°59' = 299.397 M = 299.40.

19.18 T= 48° = 19.18.

Total = 483.51.

#106 T= 52°
211.66 (211.62) @ 16°24'30" = 203.158
211.63 (211.59) @ 16°14' = 203.153
M = 203.16

Replaced 1X2 with a 2" I.P. One plug & Co Engr tag Flush in a hole mound 23 Jan 1970

Post Set 1X2 ON by double

M = 203.16.

M = 483.51.

25.695

Set 1X2 ON by double Replaced 1X2 with a 2" I.P. One plug & Co Engr Tag Flush in Hole mound 23 Jan 1970





LINE

BREAK

CURVE

PLEASE RETURN TO
LOS ANGELES COUNTY ENGINEER
403 LOS ANGELES COUNTY ENGINEERING BLDG.

Do not extend this side of this line.

Note: Any Additions or Changes on this Sheet Must be Made or Circled in Red Ink With Date and Name of Person Making Change.

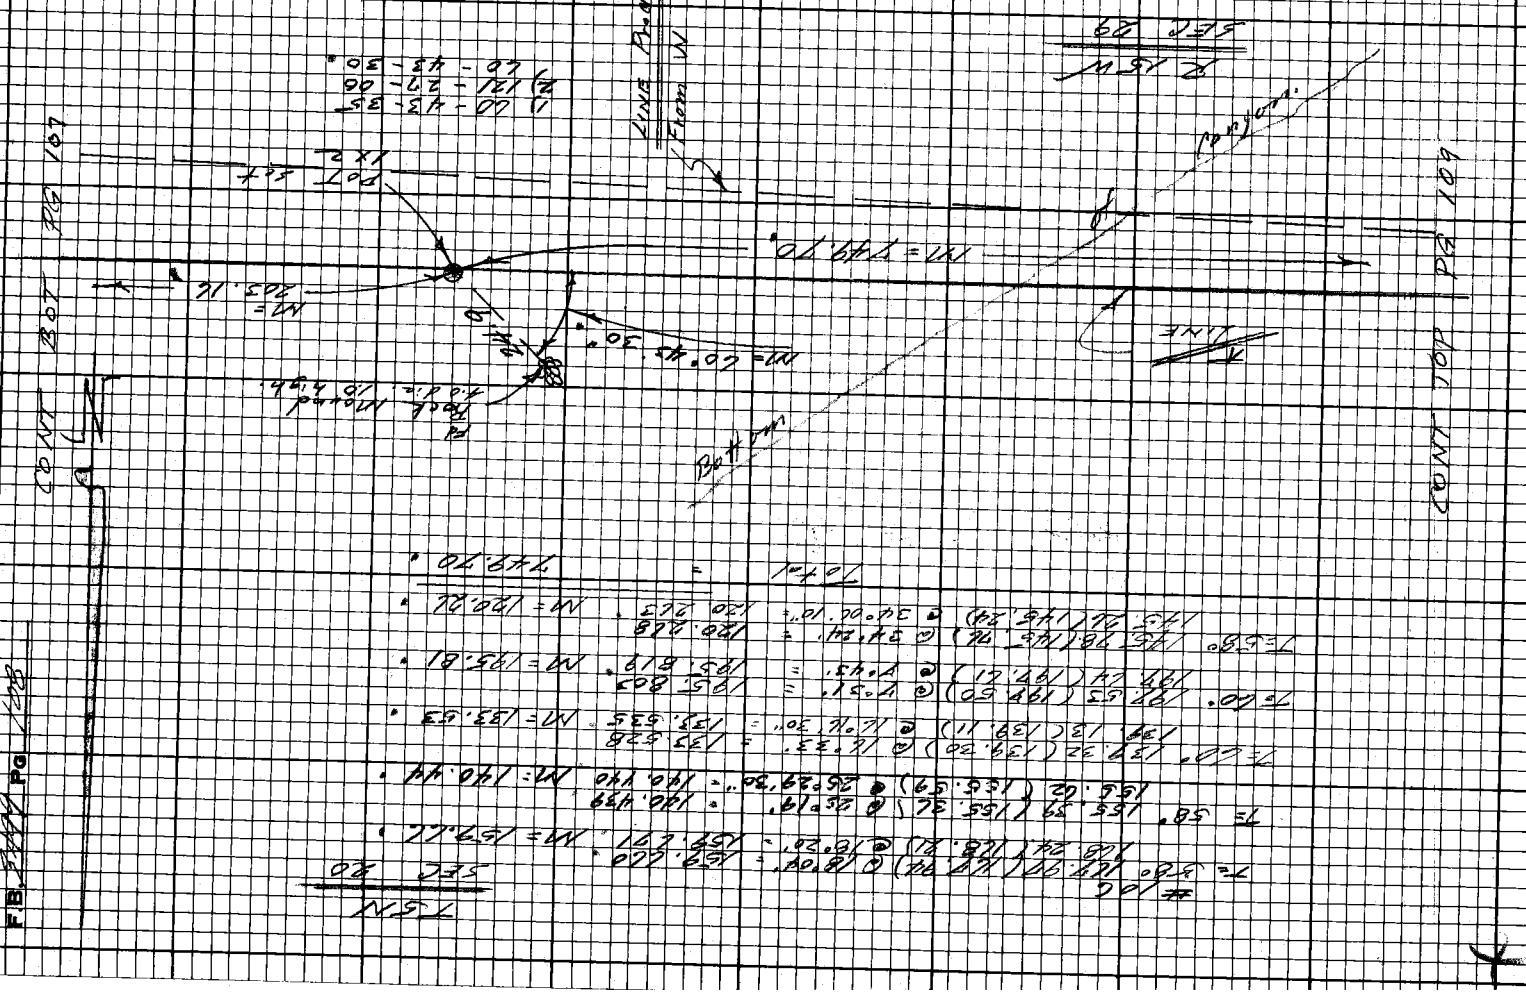

76F3098 CE #310 9-67

PLEASE RETURN TO
LOS ANGELES COUNTY ENGINEER
403 LOS ANGELES COUNTY ENGINEERING BLDG.

Note: Any Additions or Changes on this Sheet Must be Made or Circled in Red Ink With Date and Name of Person Making Change.

Do not extend this side of this line.

T 5N
SEC 20



1) 119-17-50
2) 119-11-10
3) 119-18-40 1/2"
4) 355-42-00
5) 119-17-50

Survey of Tract No. 7594 Lot 1 and Lot 2
Surveyed by F.E. Brooks Date 3-24-67
Notes F.E.B. Indexed [illegible]
Map No. Book 84 Page 17
Office Work
Checked
Date

Notes Ck'd by

FB 7222 Pg 107

CONT TAP PG 110

N 25° E

T LINE

M = 204.93'

M = 136.98'

M = 749.70'

CONT TAP PG 109

R 15 W
SEC 29

CONT RT PG 118

PLEASE RETURN TO
LOS ANGELES COUNTY ENGINEER
403 LOS ANGELES COUNTY ENGINEERING BLDG.

Do not extend this side of this line.

Note: Any Additions or Changes on this Sheet Must be Made or Circled in Red Ink With Date and Name of Person Making Change.

W 577 D-5

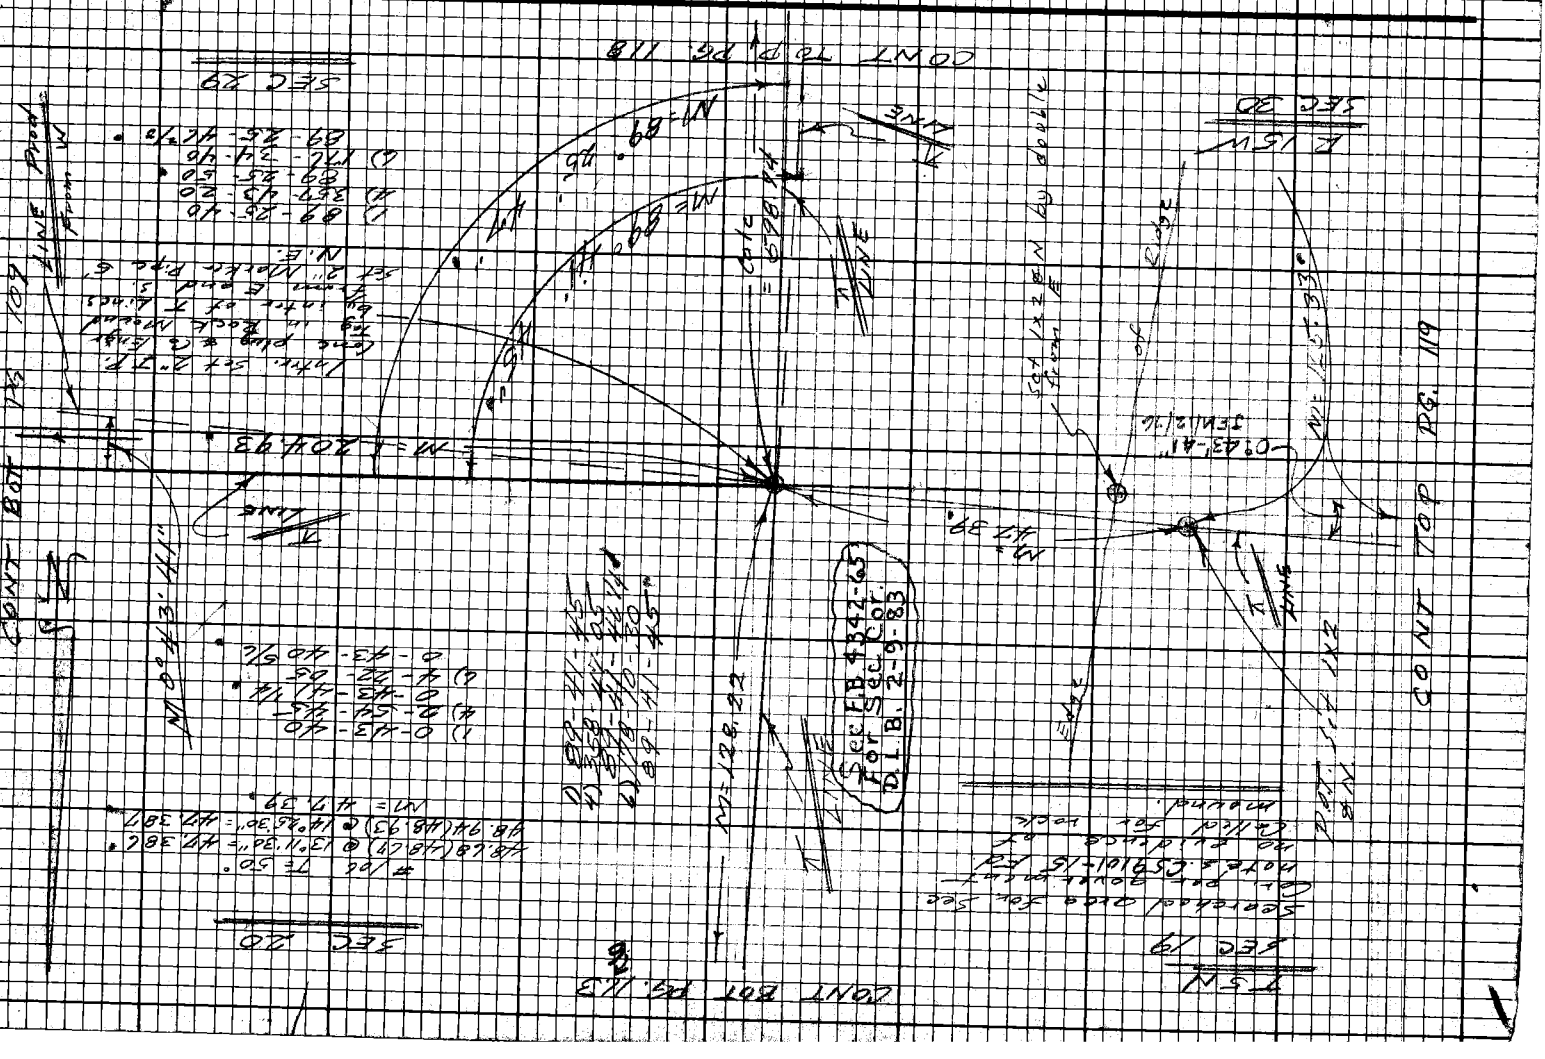
SEC 29
SEC 30
SEC 19
SEC 20
COUNT BOT PG. 118
COUNT TOP PG. 119
N1°43'E 2044.93'
N1°43'E
N1°43'E
N1°43'E

76F3098 CE#310 9-67

PLEASE RETURN TO
LOS ANGELES COUNTY ENGINEER
403 Los Angeles County Engineering Bldg.

Note: Any Additions or Changes on this Sheet Must be Made or Circled in Red Ink With Date and Name of Person Making Change.

Do not extend this side of this line.

Noted Ck'd by
Map No.
Office Work
Checked
Date

Survey of Sections in T5N R15W SBB&M
JN 43004 Type 1196 Std B-1-5
Surveyed by F.E.B. Wells
Notes
Indexed by F. J. GALLI Date 10 Dec 69

FB 3499 Pg 111

T 5 N

SEC 30













LINE

NT = 1468.44

CONN T-7

SEC 30

RIVER

BR EAK

R15W

SEC 25

PLEASE RETURN TO
LOS ANGELES COUNTY ENGINEER
403 LOS ANGELES COUNTY ENGINEERING BLDG.

Do not extend this side of this line.

Note: Any Additions or Changes on this Sheet Must be Made or Circled in Red Ink With Date and Name of Person Making Change.

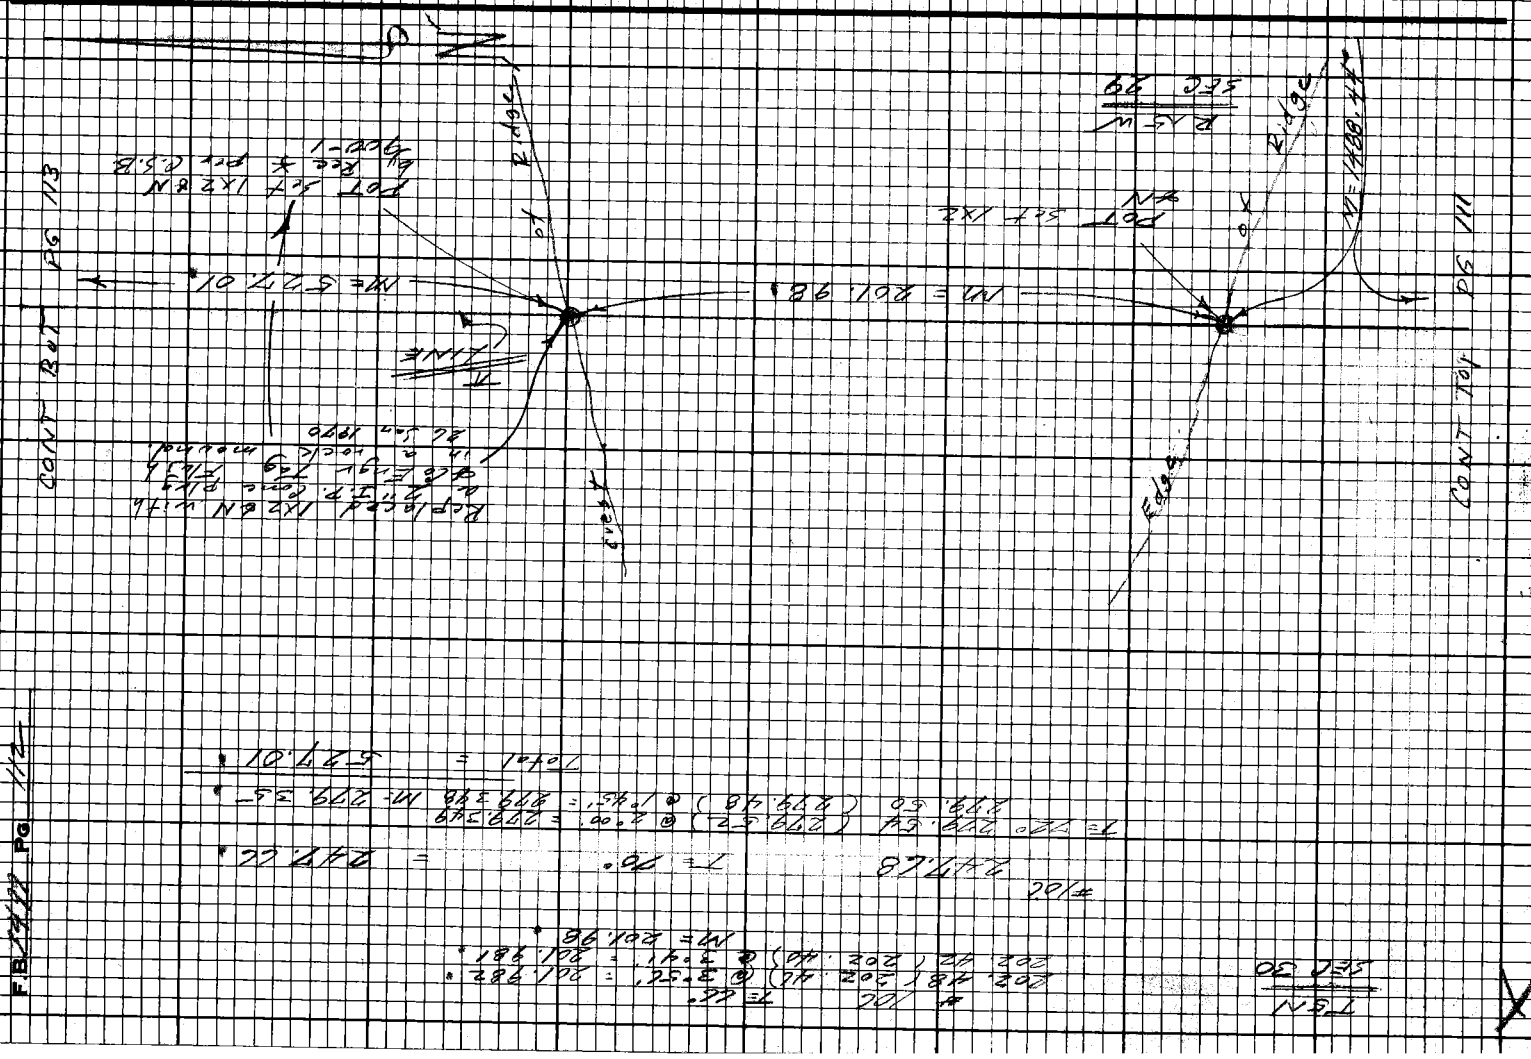

F.B. 1444 Pg 112

Notes Ck'd by	Survey of Topo. Line to T5N R15W F.B. 3499 PG. 113
Map No.	JN 7302 W Tape 146 Scale 1"
Office Work	Surveyed by F.E. Brown
Checked	Notes F.E.B. Date 10-26-68
Date	Indexed B. J. GALLI 4-9-72

Note: Any Additions or Changes on this Sheet Must be Made or Circled in Red Ink With Date and Name of Person Making Change.

Do not extend this side of this line.

PLEASE RETURN TO
LOS ANGELES COUNTY ENGINEER
403 LOS ANGELES COUNTY ENGINEERING BLDG.

CONT BOT PG 114

T5N
SEC 30



CREST of RIDGE

POT SCH 1X2"N

N 227.01 to Creek

T5N R15W SEC 25

Ridge of Hill

CONT TOP PG 112

2653098 CE-310 9-67

PLEASE RETURN TO
LOS ANGELES COUNTY ENGINEER
403 LOS ANGELES COUNTY ENGINEERING BLDG.

Do not extend this side of this line.

Note: Any Additions or Changes on this Sheet Must be Made or Circled in Red Ink With Date and Name of Person Making Change.

F.B. 3966 PG. 114

CONT BOT FR PG 115

CONT TOP PG 113

See F.B. 4342-63 for T/4 Sec. Cor 2-83, D.T.B.

TANGENT LINE

M = 446.05

M = 289.22

T 45N R 15W SEC 29

T 45N SEC 30

T = 68° 29' 47" (299.42) R 250.00' = 299.32'
299.50 (299.42) R 1°25' = 299.32'
R 1°31' = 299.32' M = 299.33'

T = 55° 27' 00" (89.28) @ 17°41' 30" = 82.89'
R 16°03' 30" = 82.89' M = 83.82'

T = 28° 19' 51" (19.50) R 70.03' = 19.88'
R 16°22' = 19.88' M = 19.90'

TOTAL = 446.05'

76F3098 CE#310 9-67

PLEASE RETURN TO
LOS ANGELES COUNTY ENGINEER
403 LOS ANGELES COUNTY ENGINEERING BLDG.

Note: Any Additions or Changes on this Sheet Must be Made or Circled in Red Ink With Date and Name of Person Making Change.

Do not extend this side of this line.

Notes Ck'd by
Map No.
Office Work
Checked
Date

Survey of Sections in T5N R15W
JN 4202 46 Tape 104 Sta 0+00
Surveyed by F.E. Brooks
Notes F.E.B.
Indexed by J. GALLO Date MAY 1 1972

F.B. 3492 Pg. 118

T 5 N
SEC 30

#NE
T= 54° 56.04 (56.03) @ 14°15'30" = 54.304
56.24 (56.23) @ 13°09' = 54.306 M = 54.31

T= 50° 49.03 (49.01) @ 21°53'30" = 44.033
40.21 (40.19) @ 21°12'30" = 44.037 M = 44.04

T= 44° 291.14 (291.06) @ 1°46' = 290.920
291.13 (291.05) @ 1°51' = 290.896 M = 290.91

109.05 T= 50° = 109.03

T= 50° 177.96 (177.92) @ 6°50' = 176.456
178.14 (178.10) @ 7°20' = 176.843 M 176.65

Total = 694.94

M = 694.94

M = 402.05

CONT TO P.G. 118

CONT FROM P.G. 118

FIRE

℄ LINE

BREAK

Plot #N

Set 1X2

Replaced 1X2 #N w/ 1/2 2" I.P. Cc.= Plug & Co Engr Tag FN 1 A in a rock mound. 20 Jan 1970 Out 2-15-83, D.L.B.

R 15 W
SEC 29

PLEASE RETURN TO
LOS ANGELES COUNTY ENGINEER
403 Los Angeles County Engineering Bldg.

Note: Any Additions or Changes on this Sheet Must be Made or Circled in Red Ink With Date and Name of Person Making Change.

Do not extend this side of this line.

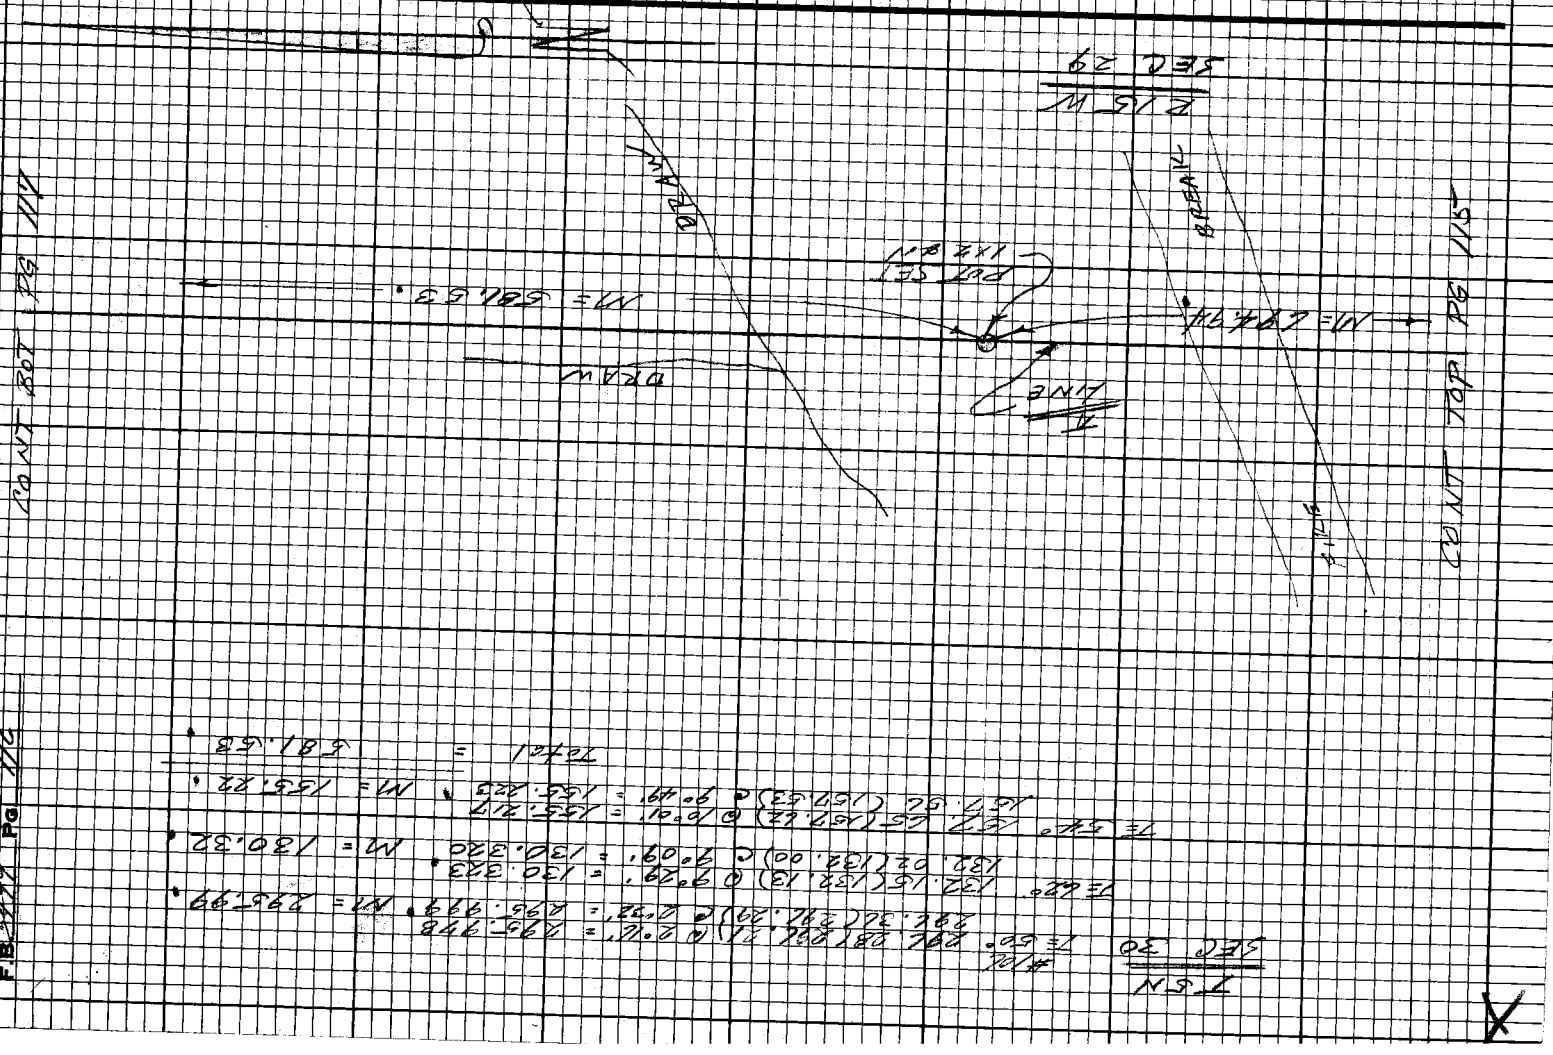

zsf3098 CE 310 9.67

PLEASE RETURN TO
LOS ANGELES COUNTY ENGINEER
403 Los Angeles County Engineering Bldg.

Note: Any Additions or Changes on this Sheet Must be Made or Circled in Red Ink With Date and Name of Person Making Change.

Do not extend this side of this line.

T5N
R15W
SEC 30






Set 1" I.P. Conc. Plug
Co. Engr Tag Flush
in rock Mound
by Calc from C.S. 900-1

T LINE

M = 496.03

M = 581.53

POT

POT Set 1x3 Double
#N. W. Replaced 1x2 BM with
2" I.P. Conc Plug
Co. Engr Tag Flush
in rock mound
RL Son 1980

R 15 W
SEC 29

Notes
Indexed Date


PLEASE RETURN TO
LOS ANGELES COUNTY ENGINEER
403 LOS ANGELES COUNTY ENGINEERING BLDG.

Note: Any Additions or Changes on this Sheet Must be Made or Circled in Red Ink With Date and Name of Person Making Change.

Do not extend this side of this line.

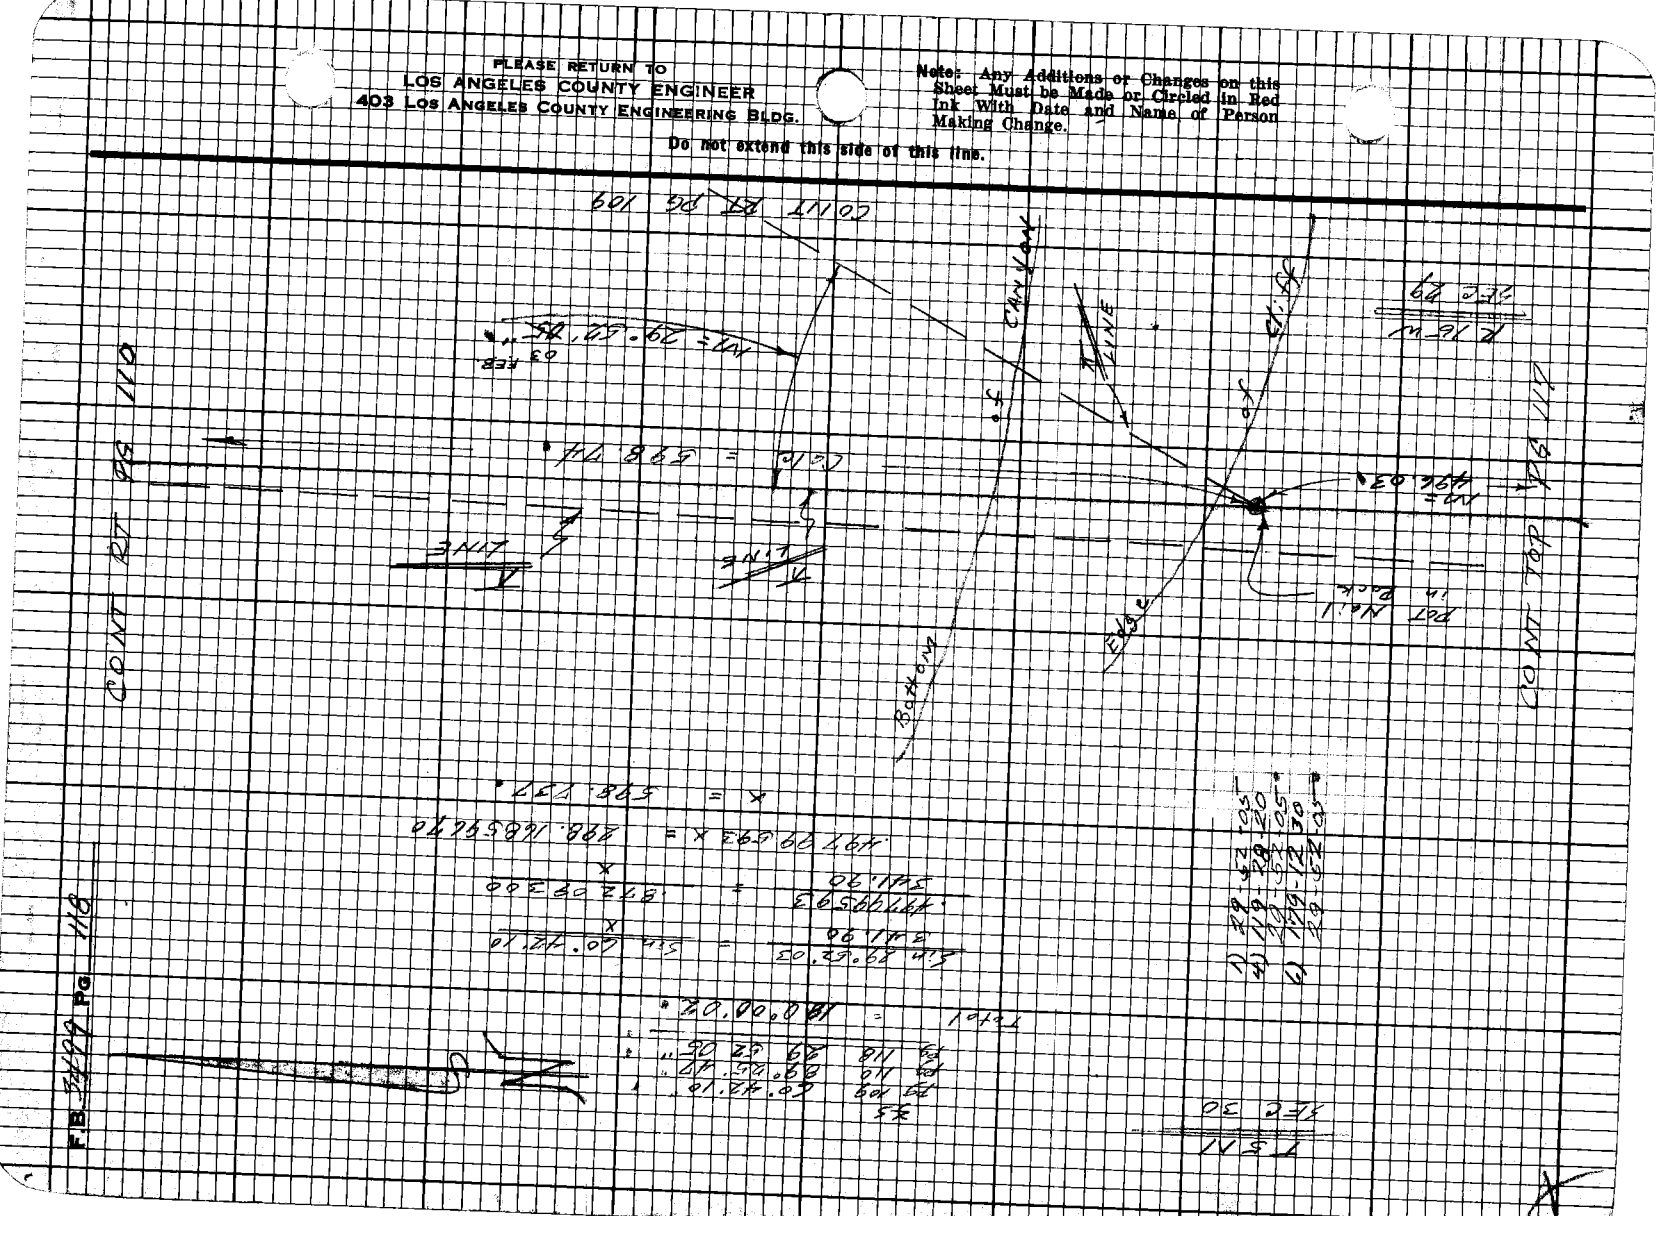

78F3098 CE#310 9-67

PLEASE RETURN TO
LOS ANGELES COUNTY ENGINEER
403 Los Angeles County Engineering Bldg.

Note: Any Additions or Changes on this Sheet Must be Made or Circled in Red Ink With Date and Name of Person Making Change.

Do not extend this side of this line.

T 5 N
SEC 19

#106

















Replaced 1/2" ø N with a 2" I.P. Conc plug & Co. Engr. Tag. Flush in a Tuck found. 26 Jun 1970

P.T. 1/2" ø N

R 15 W
SEC 30

Notes (Ord by)
Map No.
Office Work
Checked
Date

Surrey of Section 19 T5N R15W
JN 0382 47 Triad/ACE Sht 044
Surveyed by E.C. Brandt Date 4/1/70
Notes
Indexed E. J. Galli Date 4/1/72

F.B. 3228 Pg 119

PLEASE RETURN TO
LOS ANGELES COUNTY ENGINEER
403 LOS ANGELES COUNTY ENGINEERING BLDG.

Note: Any Additions or Changes on this Sheet Must be Made or Circled in Red Ink With Date and Name of Person Making Change.

Do not extend this side of this line.

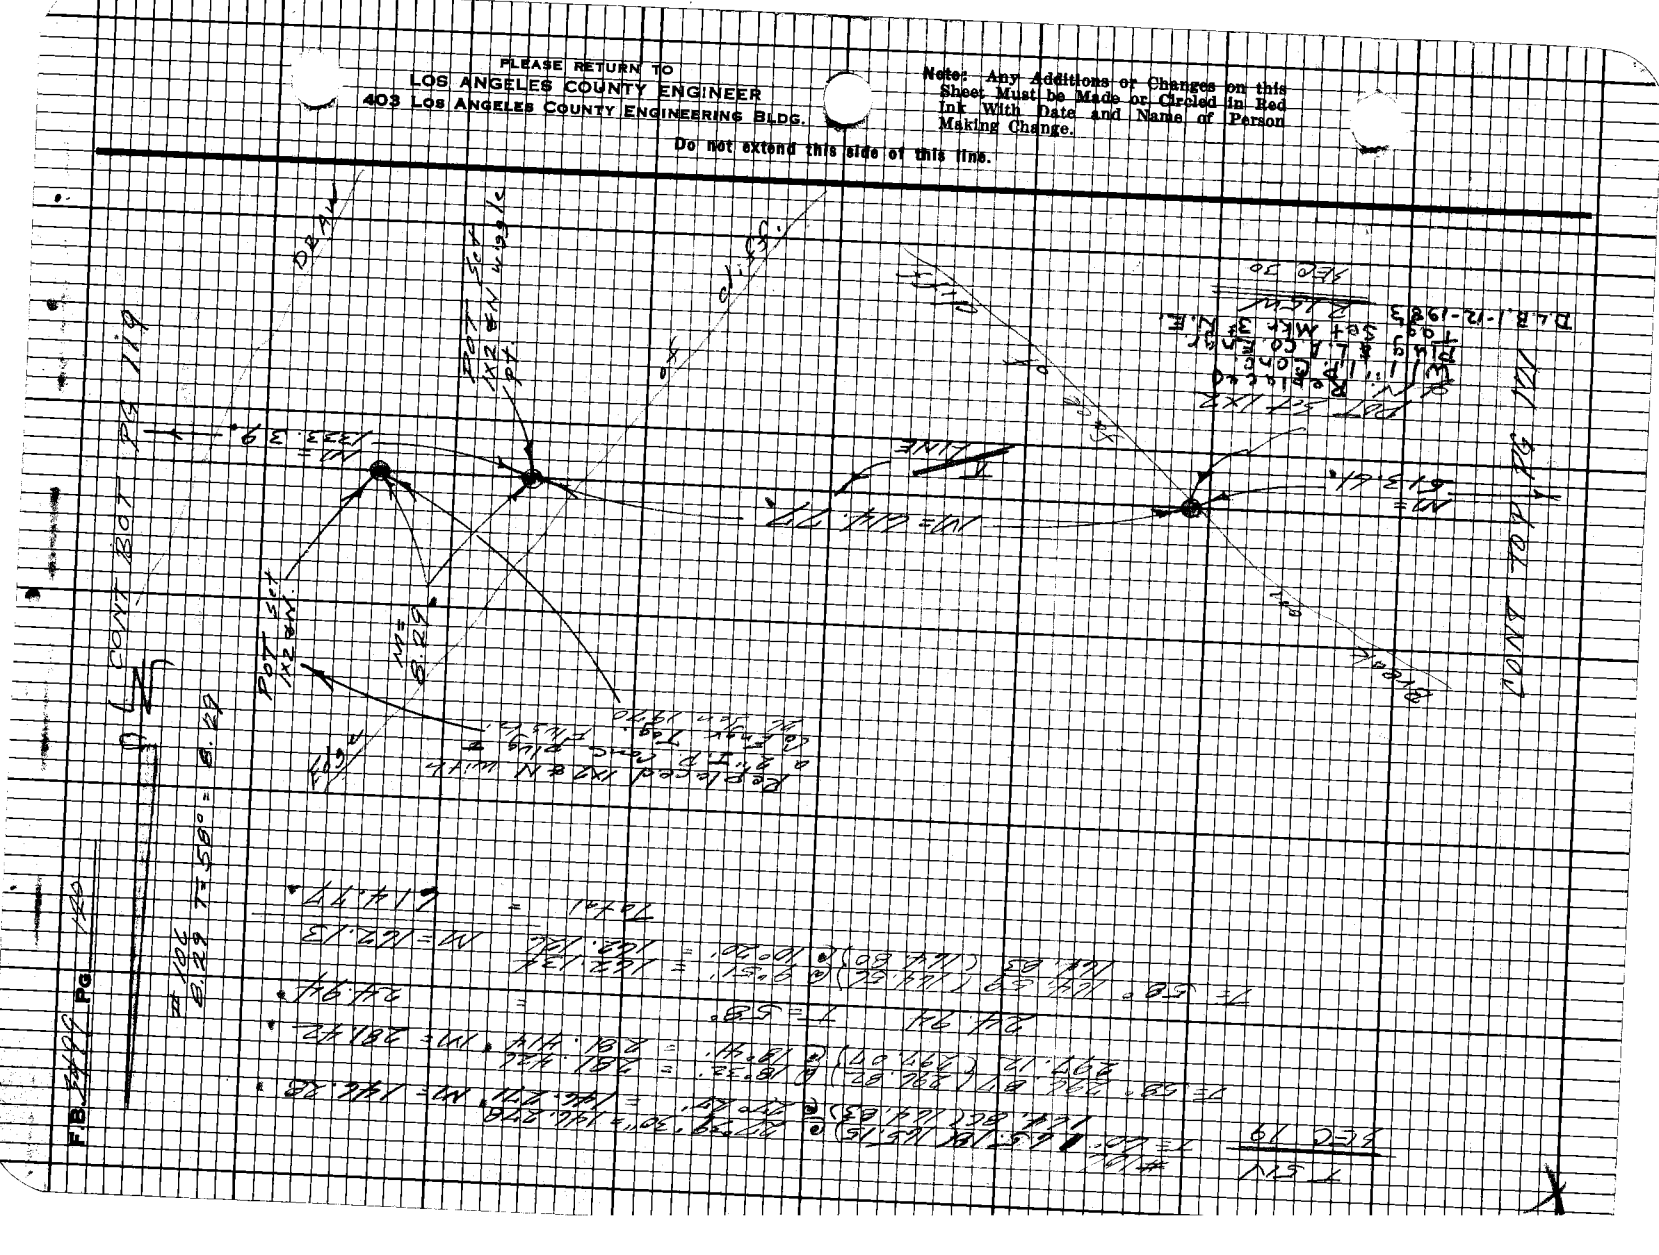

Notes Ck'd by
Map No.
Office Work
Checked
Date

Survey of SECTIONS in T5N R13W F.B. 3499 Pg. 121
JN 8302.0 Trape 146 Sta 84+00
Surveyed by FE 13 Yrs R3
Notes FE.B. Date 8-Jun-70
Indexed C. J. GALLI APR 14 72

CONT BOT PG 120

Note: Any Additions or Changes on this Sheet Must be Made or Circled In Red Ink With Date and Name of Person Making Change.

Do not extend this side of this line.

PLEASE RETURN TO
LOS ANGELES COUNTY ENGINEER
403 LOS ANGELES COUNTY ENGINEERING BLDG.






PLEASE RETURN TO
LOS ANGELES COUNTY ENGINEER
403 LOS ANGELES COUNTY ENGINEERING BLDG.

Note: Any Additions or Changes on this Sheet Must be Made or Circled in Red Ink With Date and Name of Person Making Change.

Do not extend this side of this line.

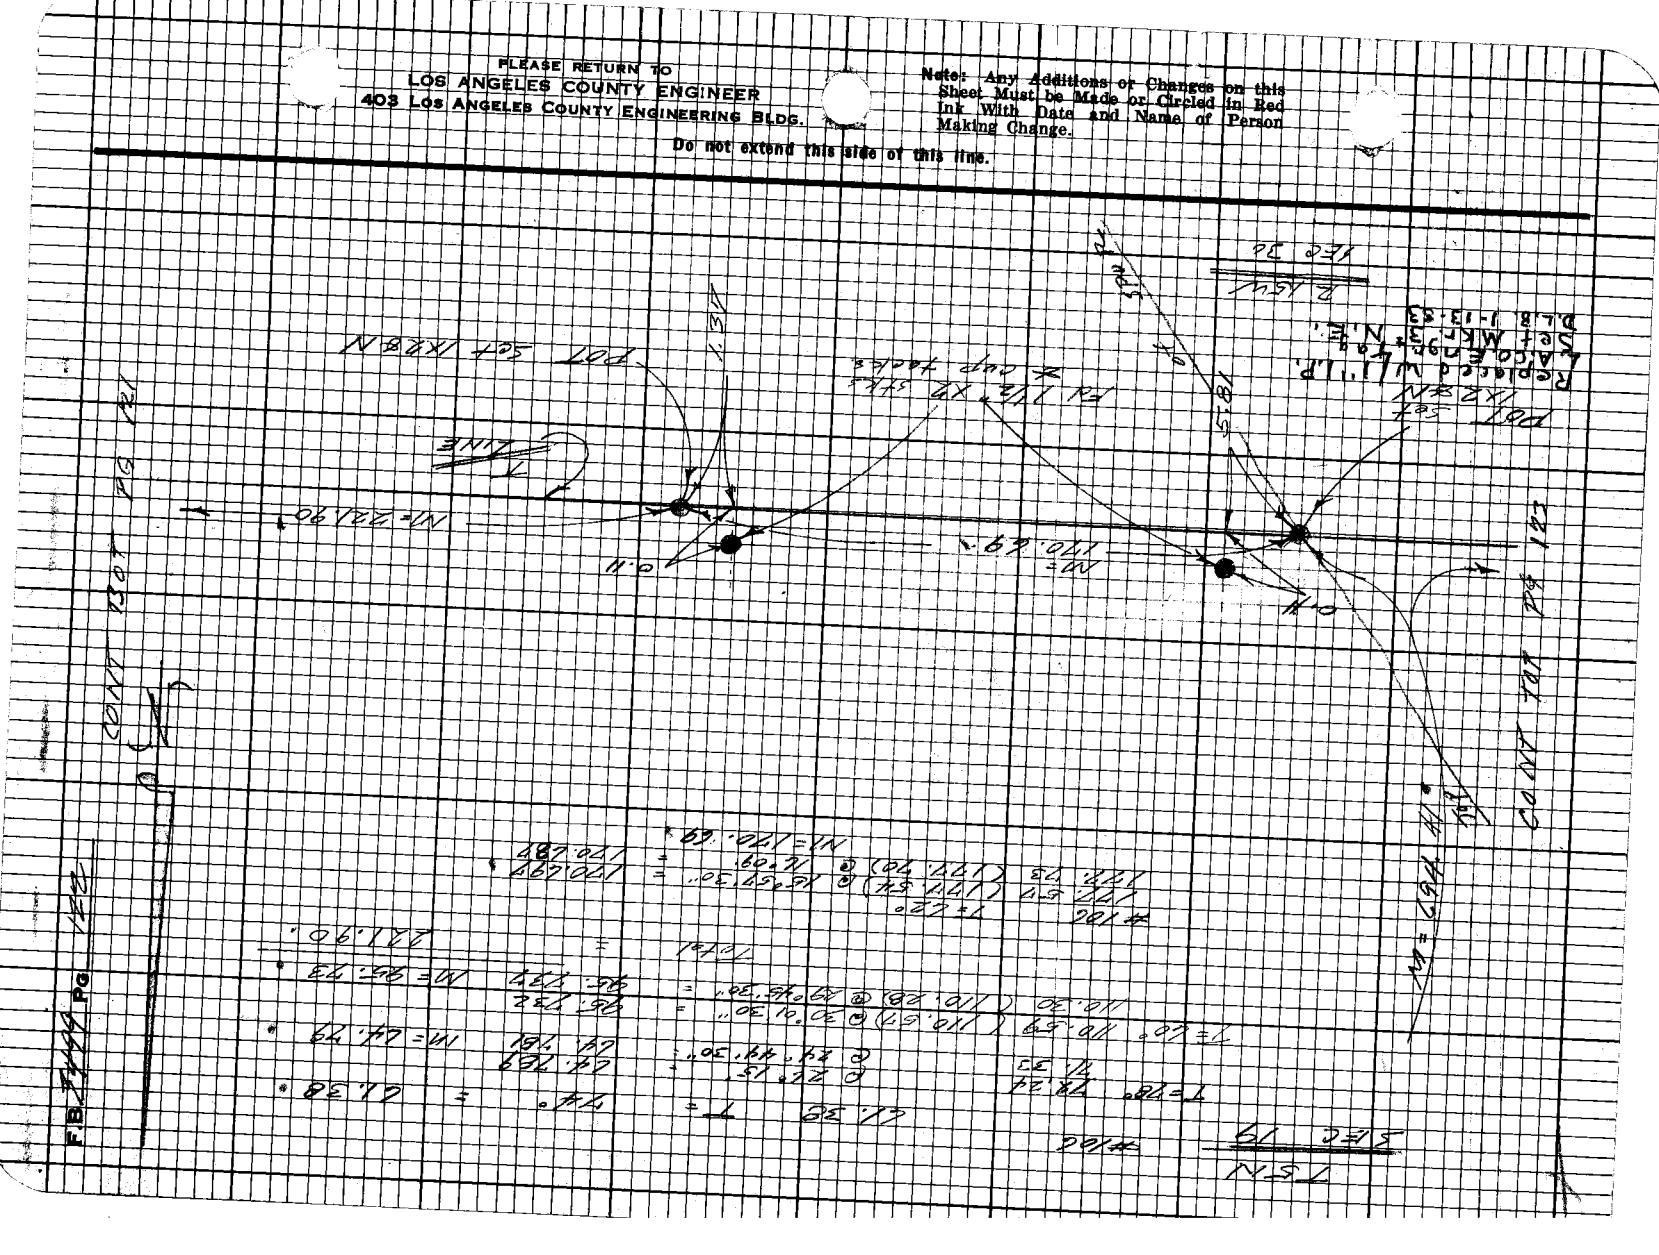

75F3098 CE#310 9-67

PLEASE RETURN TO
LOS ANGELES COUNTY ENGINEER
403 Los Angeles County Engineering Bldg.

Note: Any Additions or Changes on this Sheet Must be Made or Circled in Red Ink With Date and Name of Person Making Change.

Do not extend this side of this line.

Notes Ck'd by _____
Map No. _____
Office Work _____
Checked _____
Date _____

Survey of Sections T5N R15W & T6N R15W SBB&M
Surveyed by FEE Brooks Date 8/67
Notes FEE J. GALLI Date 9/67
Indexed

T5N














R 15 W
SEC 30

PLEASE RETURN TO
LOS ANGELES COUNTY ENGINEER
403 LOS ANGELES COUNTY ENGINEERING BLDG.

Note: Any Additions or Changes on this Sheet Must be Made or Circled in Red Ink With Date and Name of Person Making Change.

Do not extend this side of this line.

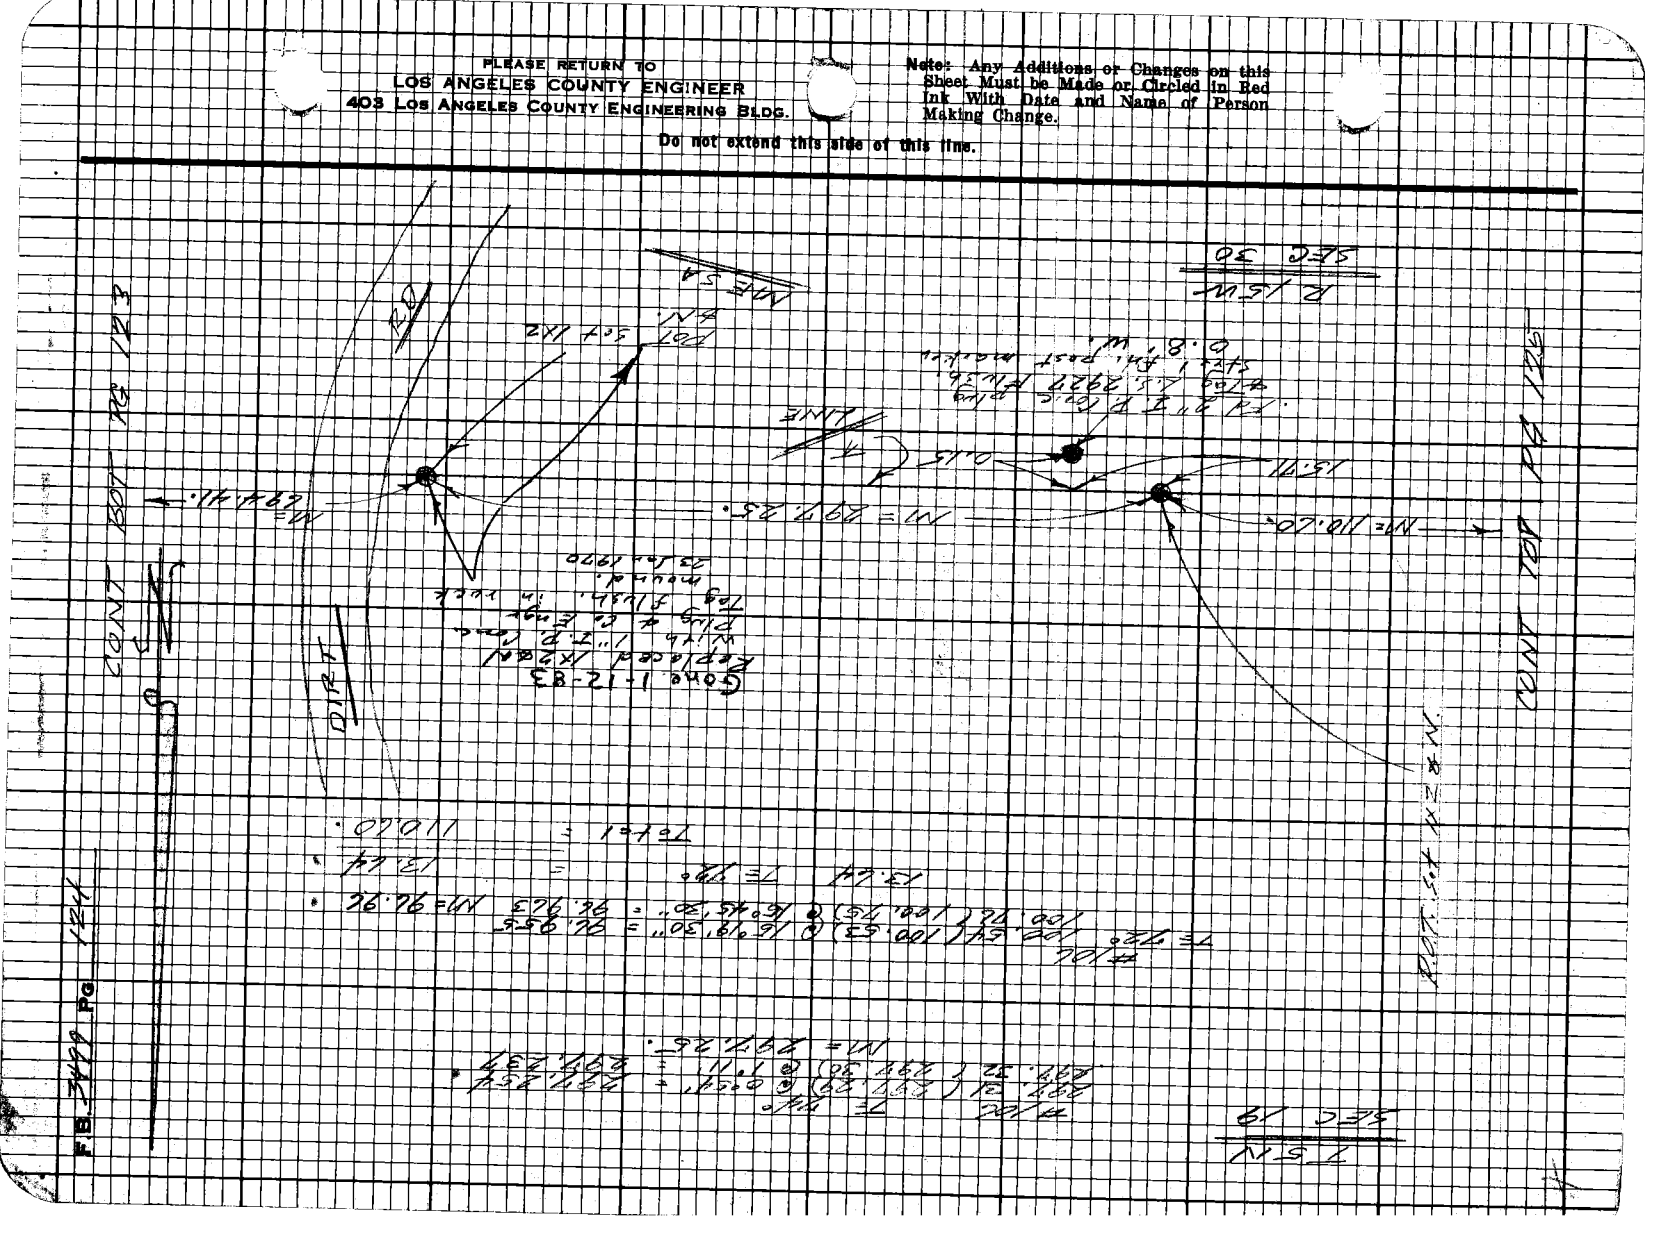

76F3098 CE#31D 9/67

PLEASE RETURN TO
LOS ANGELES COUNTY ENGINEER
403 LOS ANGELES COUNTY ENGINEERING BLDG.

Do not extend this side of this line.

Note: Any Additions or Changes on this Sheet Must be Made or Circled in Red Ink With Date and Name of Person Making Change.

Notes Cl'd by
M&P No.
Office Work
Checked
Date

Survey of Sec. 19, T5N, R15W, SBB&M
Surveyed by F.E. [illegible] Date May 71
Notes
Indexed by E. J. CALLI Date MAR 1 8 72

Book 125 Page 125

T5N
R15W
SEC 19
SEC 30






Replaced 1x2 x N
with a 2" I.D. Copper
Plug & Cap Engr. Tag
flush in rock mound.
23 Jan 1980
Set Mkr. 3' N.E.
W. 99/4 Pt. Set
1x2 x N.

M= 788.50'

M= 110.60'









PLEASE RETURN TO
LOS ANGELES COUNTY ENGINEER
403 LOS ANGELES COUNTY ENGINEERING BLDG.

Do not extend this side of this line.

Note: Any Additions or Changes on this Sheet Must be Made or Circled in Red Ink With Date and Name of Person Making Change.

WS 77D-5

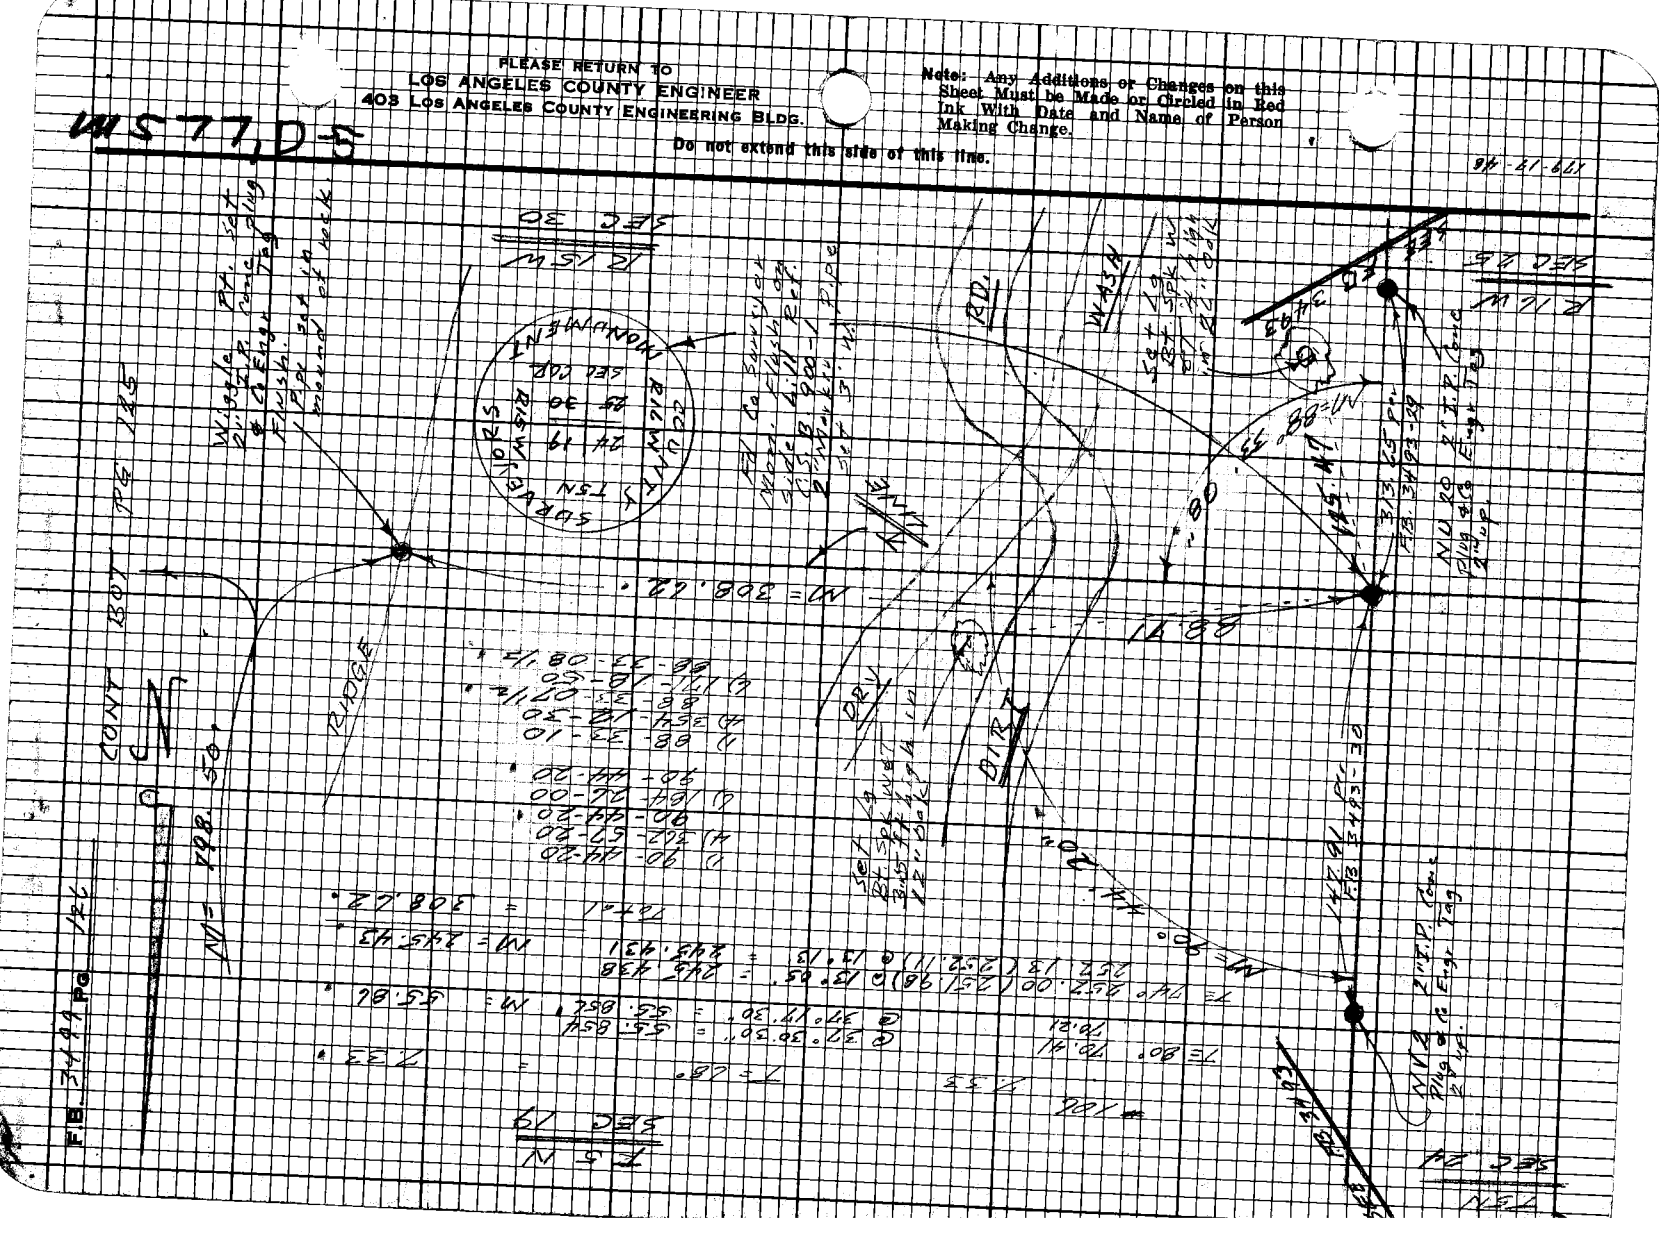
SEC 30
SEC 19
SEC 24
SEC 25

16F3098 CE#310 9-67

PLEASE RETURN TO
LOS ANGELES COUNTY ENGINEER
403 LOS ANGELES COUNTY ENGINEERING BLDG.

Note: Any Additions or Changes on this Sheet Must be Made or Circled in Red Ink With Date and Name of Person Making Change.

Do not extend this side of this line.

Noes Ck'd by _____
Map No. _____
Office Work _____
Checked _____
Date _____

Survey of Sec 21, 22, 27, 28 T5N R15W
JN 4222-21 Tape 164 Std 64 'B'
Surveyed by EE Bowker Date 3/14 to 7/9
Notes EE
Indexed by L. J. GALLI 10 14 72

F.B. 2499 Pg. 182

T5N
SEC 22









POINT NOT AT PROPERTY LINE

DRAW

SECTION LINE

POINT AT PROPERTY LINE

DRAW

R15W
SEC 21

PLEASE RETURN TO
LOS ANGELES COUNTY ENGINEER
403 LOS ANGELES COUNTY ENGINEERING BLDG.

Note: Any Additions or Changes on this Sheet Must be Made or Circled in Red Ink With Date and Name of Person Making Change.

Do not extend this side of this line.

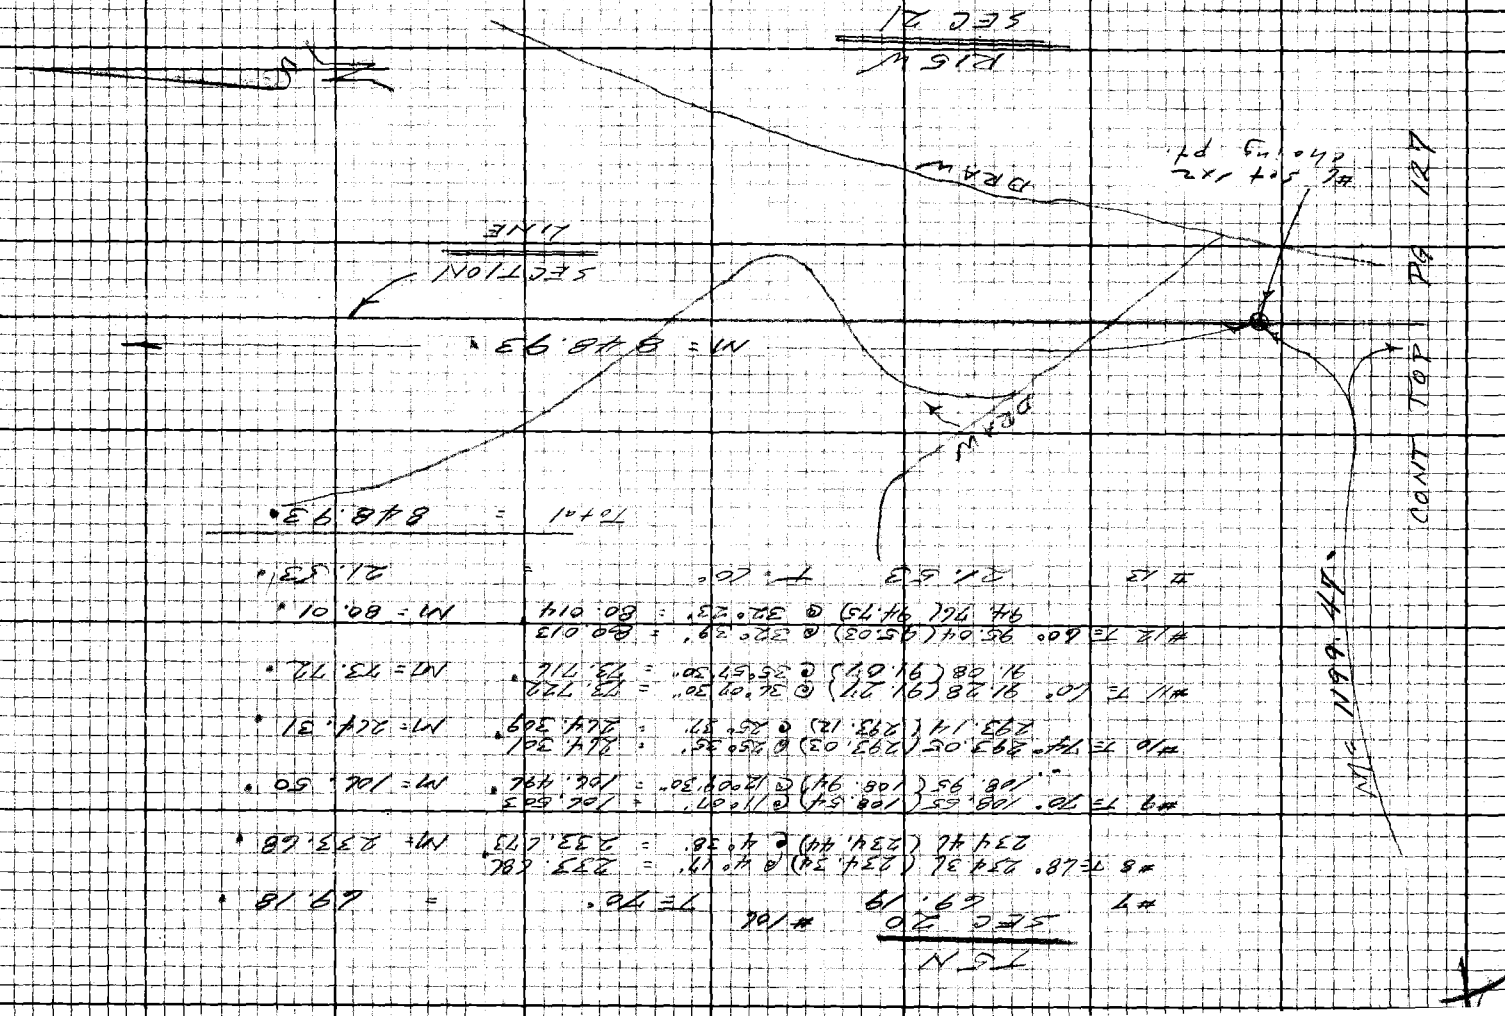

F.B. 3499 Pg 125

16F3098 CE#310 8-67

PLEASE RETURN TO
LOS ANGELES COUNTY ENGINEER
403 LOS ANGELES COUNTY ENGINEERING BLDG.

Note: Any Additions or Changes on this Sheet Must be Made or Circled in Red Ink With Date and Name of Person Making Change.

Do not extend this side of this line.

Notes Cksd by
Map No.
Office Work
Checked
Date

Survey of Sections in T5N R15W
JN 2122.01 Maps 1 of — Std 84 "F"
Surveyed by FE 13 Date 7-24-76
Notes FEB
Indexed by J. GALLI Date 8-11-76

FB 3447 Pg 129

T 5 N
SEC 20

#14 T= 64° 61.41 (61.40) @ 5°39' = 61.052 · M = 61.05 ·
61.54 (61.53) @ 5°18' = 61.049 ·

#15 T= 64° 298.74 (298.70) @ 1°56' = 296.916 · M = 296.52 ·
298.66 (298.62) @ 1°47' = 296.523 ·

#16 20.91 T= 64° = 20.91 ·

#17 T=64° 115.93 (115.91) @ 2°14' = 115.224 · M = 115.23 ·
115.86 (115.84) @ 5°51' = 115.236 ·

#18 T=66° 104.89 (104.87) @ 21°30' = 97.573 · M = 97.57 ·
104.68 (104.66) @ 21°14' = 97.563 ·

Total = 591.28 ·

CONT TO PG 128

CONT FROM PG 130

SECTION LINE

M = 848.93 ·

M = 591.28 ·

#13 P.O.T. 60# Plug
2" I.P. Conc Tag
and Cu Engr
Finish in a rock
mound.

DRAW

T 5 N
R 15 W
SEC 21

PLEASE RETURN TO
LOS ANGELES COUNTY ENGINEER
403 LOS ANGELES COUNTY ENGINEERING BLDG.

Note: Any Additions or Changes on this Sheet Must be Made or Circled in Red Ink With Date and Name of Person Making Change.

Do not extend this side of this line.

WS 28, A-5

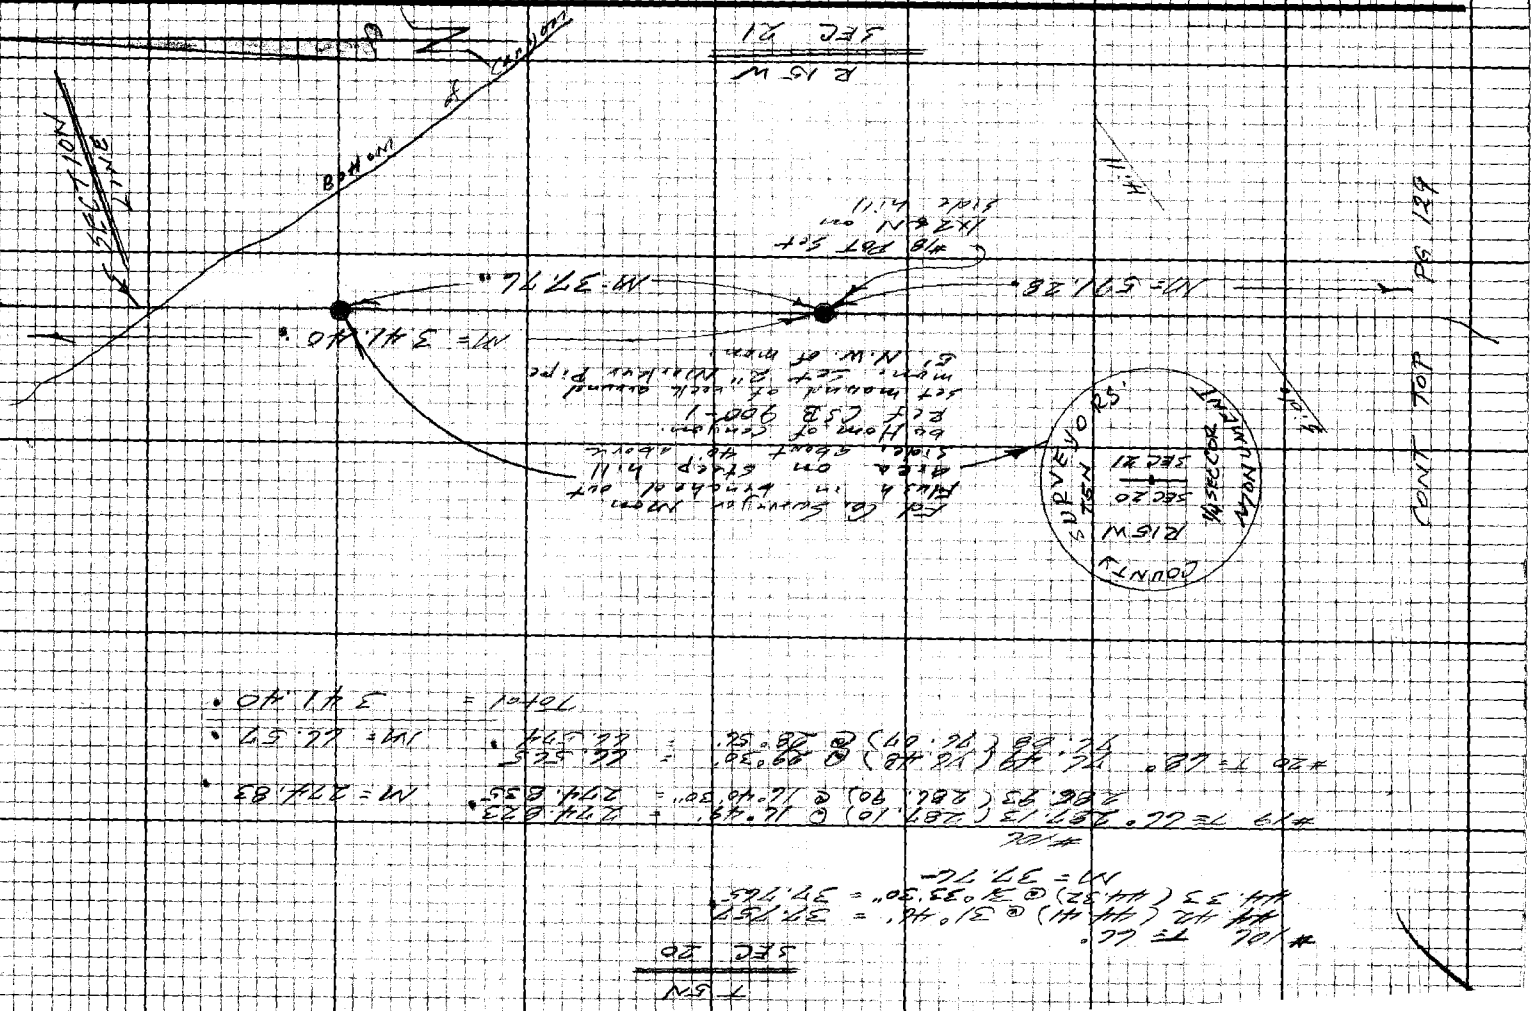

FB 3499 PG 130

Notes Ck'd by
Map No.
Office Work
Checked
Date

Survey of Sections in T6N R15W F.B 3449 Pg 13
JN 3202.1 Tape 106 Std 64 °F
Surveyed by FE Brooks
Notes F&B Date 3 Feb 70
Indexed C. J. GALLI FEB 14 '72

CONT BOT PG 132

Note: Any Additions or Changes on this Sheet Must be Made or Circled in Red Ink With Date and Name of Person Making Change.

Do not extend this side of this line.

PLEASE RETURN TO
LOS ANGELES COUNTY ENGINEER
403 Los Angeles County Engineering Bldg.

Jefferson CE#310 9-67

T6N
SEC 20























CONT TOP PG 130

PLEASE RETURN TO
LOS ANGELES COUNTY ENGINEER
403 Los Angeles County Engineering Bldg.

Note: Any Additions or Changes on this Sheet Must be Made or Circled in Red Ink With Date and Name of Person Making Change.

Do not extend this side of this line.

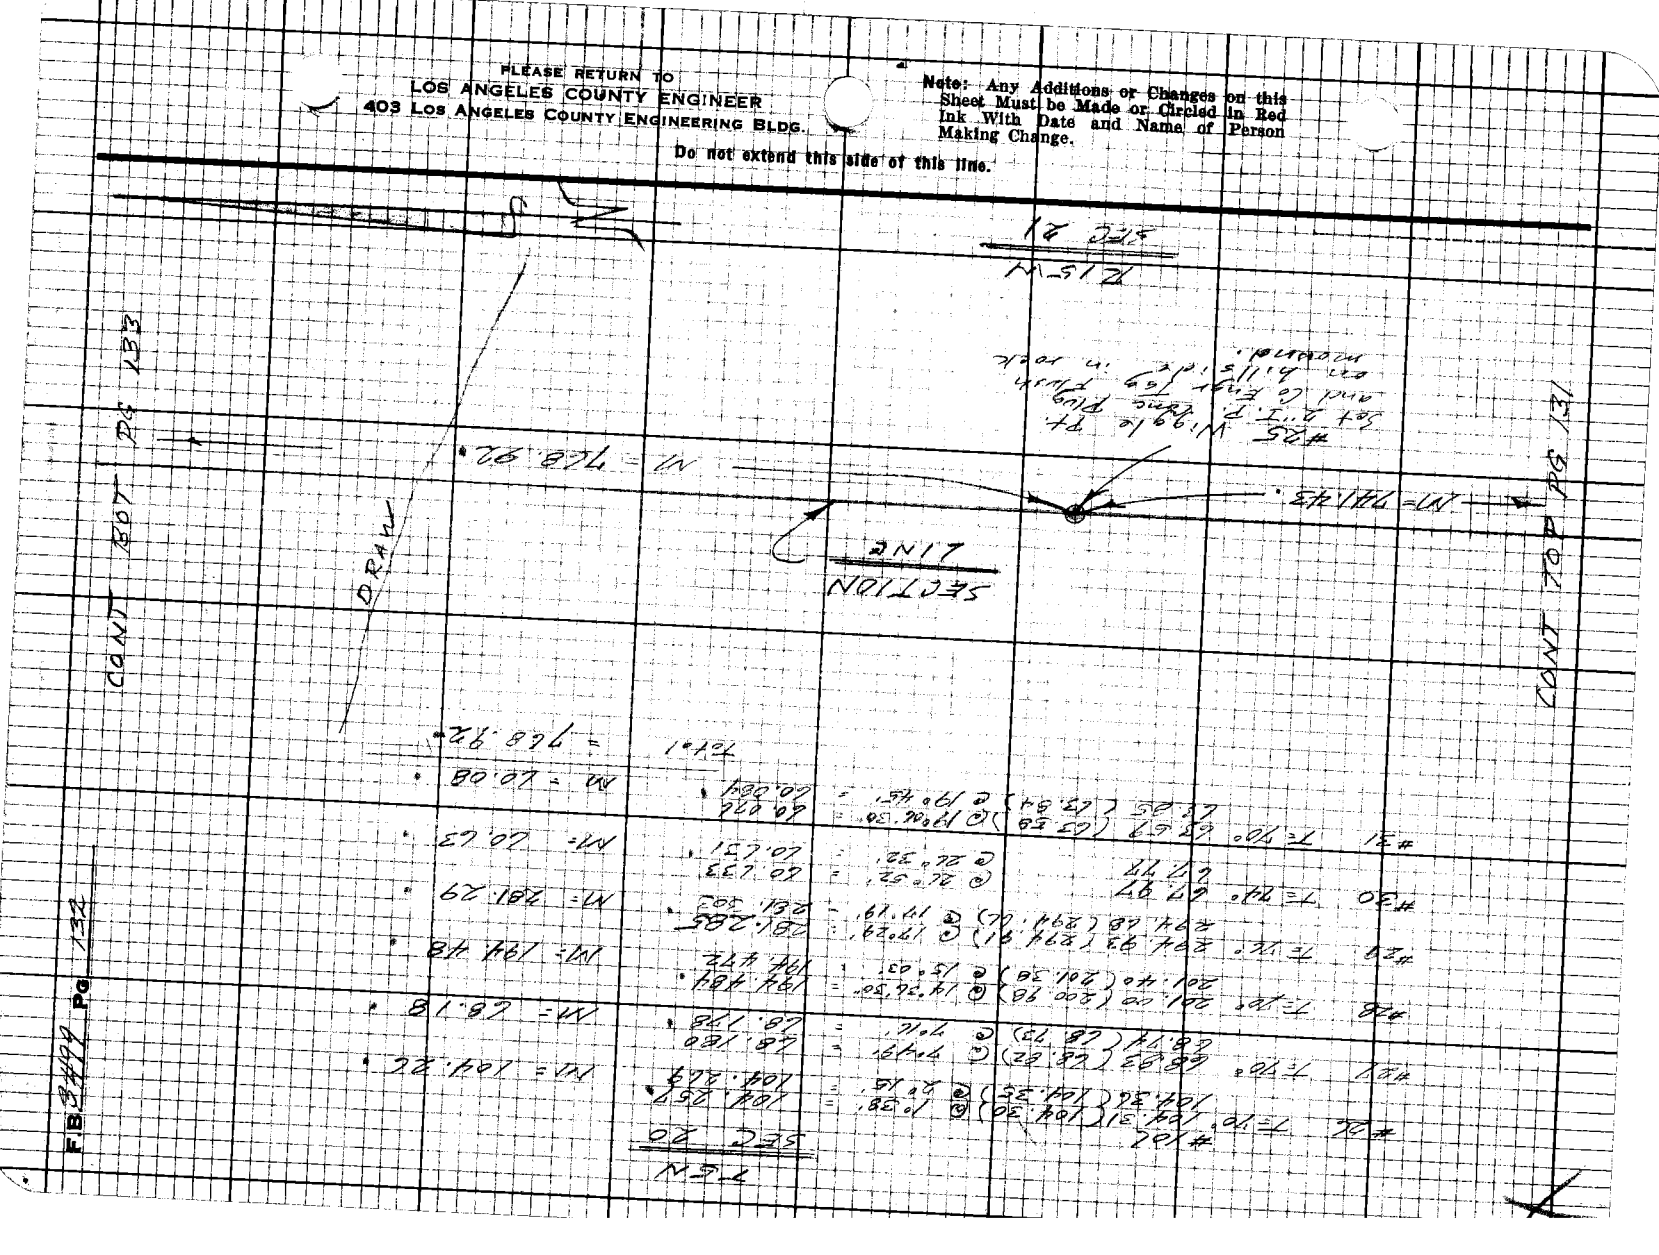

1SF3098 CE#310 9-67

PLEASE RETURN TO
LOS ANGELES COUNTY ENGINEER
403 LOS ANGELES COUNTY ENGINEERING BLDG.

Note: Any Additions or Changes on this Sheet Must be Made or Circled in Red Ink With Date and Name of Person Making Change.

Do not extend this side of this line.

T5N
SEC 20

CONT RT PG 152






M = 768.92

CONT TOP PG 152

SECTION LINE






#31 POT Set
2" I.P. conc plug
& Co Engr Tag
Flush in rock
mound.

BRG

R 15 W
SEC 21

Notes Ck'd by _____
Map No. _____
Office Work _____
Checked _____
Date _____

Survey of Sections in T5N R15W
JN 4502.01 Tape 146 Std. Ft
Surveyed by FEB 1972
Notes FEB
Indexed R. M. GALLI Date APR 14 72

FB 3422 PG 133

PLEASE RETURN TO
LOS ANGELES COUNTY ENGINEER
403 LOS ANGELES COUNTY ENGINEERING BLDG.

Note: Any Additions or Changes on this Sheet Must be Made or Circled in Red Ink With Date and Name of Person Making Change.

Do not extend this side of this line.

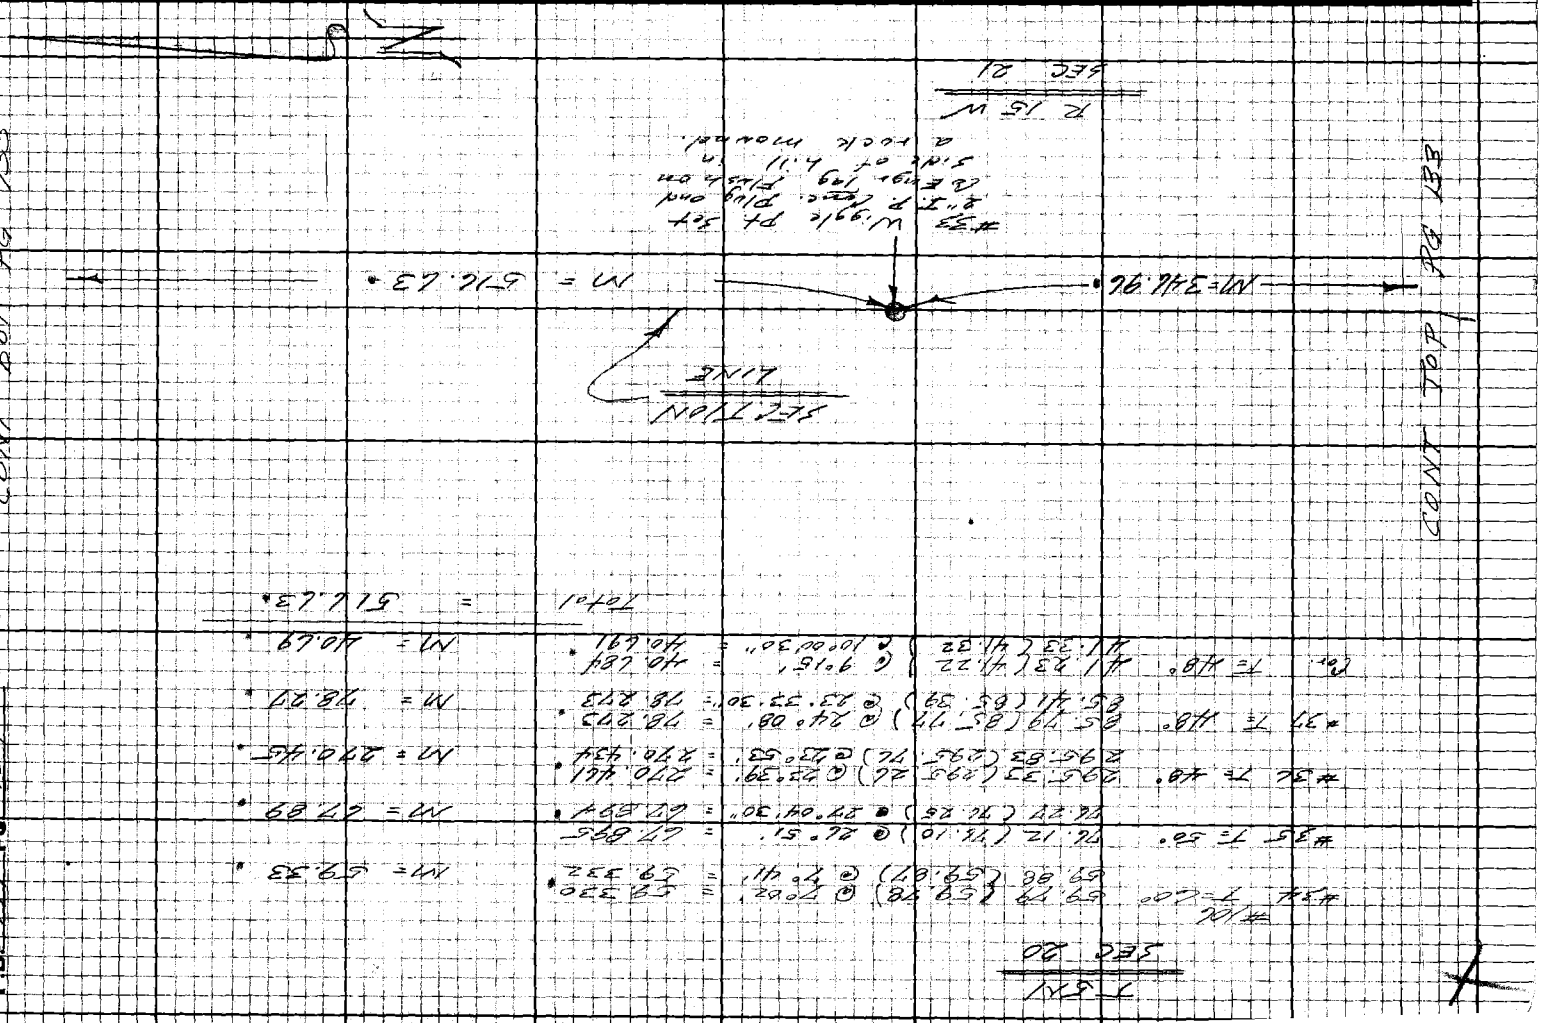

Notes Ck'd by
Map No.
Office Work
Checked
Date

Survey of Sec 1, 2 & 11 T5N R15W F.B. 34490 Pg. 1 & 5
JN 3392.01 Tape 100 Std 64°F
Surveyed by F E Brooks
Notes by F E B Date 9-24-70
Indexed by C. J. GALLI #142

Note: Any Additions or Changes on this Sheet Must be Made or Circled in Red Ink With Date and Name of Person Making Change.

PLEASE RETURN TO
LOS ANGELES COUNTY ENGINEER
403 LOS ANGELES COUNTY ENGINEERING BLDG.

Do not extend this side of this line.

1st Copy 12-67 REF #310 9-67

W 5278.4-5

CONT BOT PG.

SEC 11

F.B. 34490-70

SEE

SEC 14

T 5 N

R 16 W

CONT BOT PG 134

CONT TOP PG 135

Calc = 1451.28

N = Grid. N.

LINE

Ed Lowe Survey #1
Found 4" dia. conc. monument with nail & tag on 5x5 conc. post
Set 3/4" iron pipe with plug & tack in Rock mound.

N 89° 43' 40" W 2673.43'

SECTION LINE

CONT TOP PG 134

1) 89-43-40
2) 358-54-40
3) 89-43-40
4) 178-22-00
89-43-40

DRAW

1) 90-22-05
2) 271-40-30
3) 90-22-05
4) 182-42-30
90-22-05

COUNTY SURVEY MONUMENT

T5N R15W
T5N R16W
SEC 11 14
SEC 2 1

SEC COR

PLEASE RETURN TO
LOS ANGELES COUNTY ENGINEER
403 LOS ANGELES COUNTY ENGINEERING BLDG.

Note: Any Additions or Changes on this Sheet Must be Made or Circled in Red Ink With Date and Name of Person Making Change.

Do not extend this side of this line.

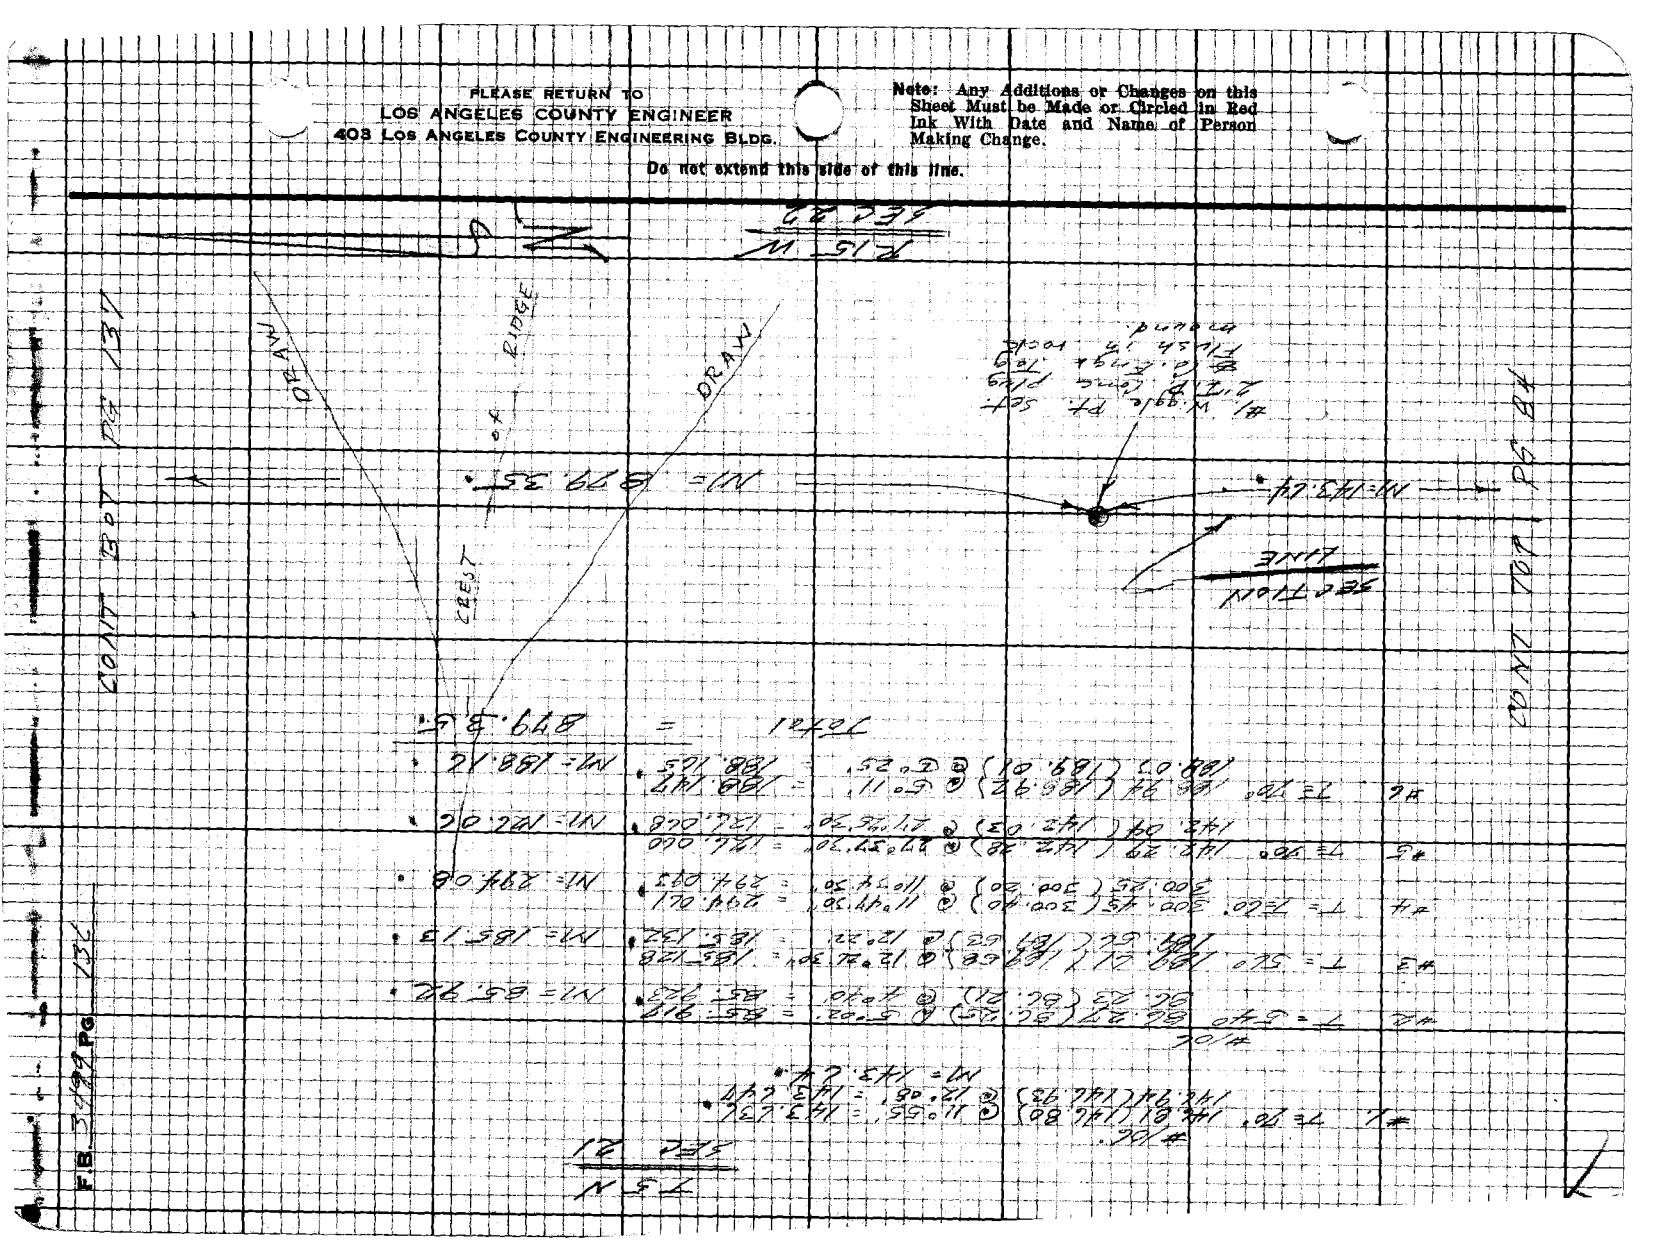

FB 3499 Pg 137

Notes Ck'd by
Map No.
Office Work
Checked
Date

Survey of Sections in T5N R15W FB 3499 Pg 1-37
JN 2302.01 Tape 100 Std 64 °F
Surveyed by F E Brooks
Notes FB 3499 Date 1972 10
Indexed

R. J. GALLI APR 14 '72

COUNTY SURVEY PG 138

Note: Any Additions or Changes on this Sheet Must Be Made or Circled in Red Ink With Date and Name of Person Making Change.

Do not extend this strip of this line.

PLEASE RETURN TO
LOS ANGELES COUNTY ENGINEER
403 Los Angeles County Engineering Bldg.

T 5 N
SEC. 21

DRAW


PLEASE RETURN TO
LOS ANGELES COUNTY ENGINEER
403 LOS ANGELES COUNTY ENGINEERING BLDG.

Note: Any Additions or Changes on this Sheet Must be Made or Circled in Red Ink With Date and Name of Person Making Change.

Do not extend this side of this line.

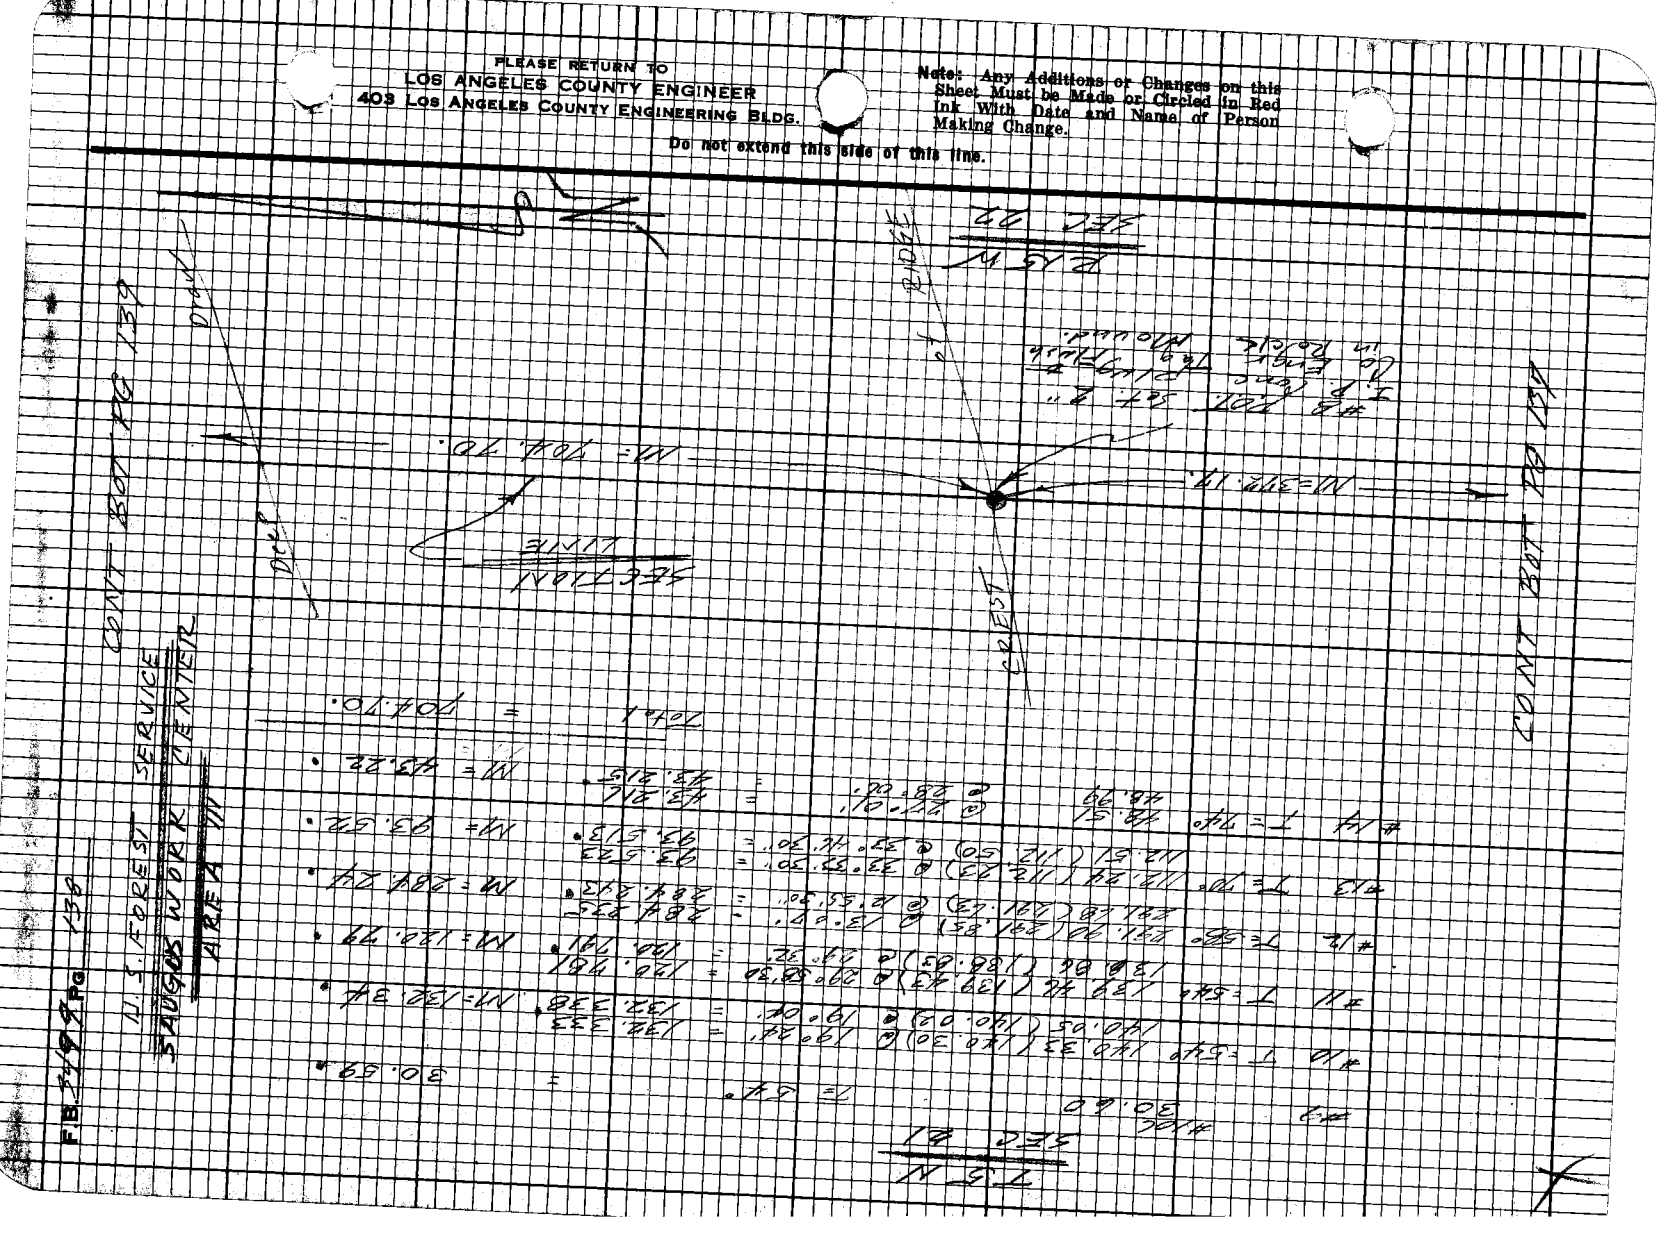

Notes Ck'd by
Map No.
Office Work
Checked
Date

Survey of Section in T5N R15W F.B. 3499 Pg. 139
JN 4302.14 Tape 146 Std 64 °F
Surveyed by EE Brooks
Notes EE
Indexed by E. T. GALLI APR 14 72

CONT BOT PG 140

N = 275.33'

#515 POT Set 2½" I.P. Force Plug & Engr Tag Flush in Rock Mound.

CREST of RIDGE

DRAW

T 5 N
R 15 W
SEC 27

U.S. FOREST SERVICE
AREA




SECTION LINE

N = 448.11'

SHARP RIDGE

CREST

N = TOWER TO #515 = 1149.19'

#515 POT

CONT TOP PG 138

PLEASE RETURN TO
LOS ANGELES COUNTY ENGINEER
403 LOS ANGELES COUNTY ENGINEERING BLDG.

Do not extend this side of this line.

Note: Any Additions or Changes on this Sheet Must be Made or Circled in Red Ink With Date and Name of Person Making Change.

16F3098 CE#310 9-67

PLEASE RETURN TO
LOS ANGELES COUNTY ENGINEER
403 LOS ANGELES COUNTY ENGINEERING BLDG.

Note: Any Additions or Changes on this Sheet Must be Made or Circled in Red Ink With Date and Name of Person Making Change.

Do not extend this side of this line.

2578 A 5

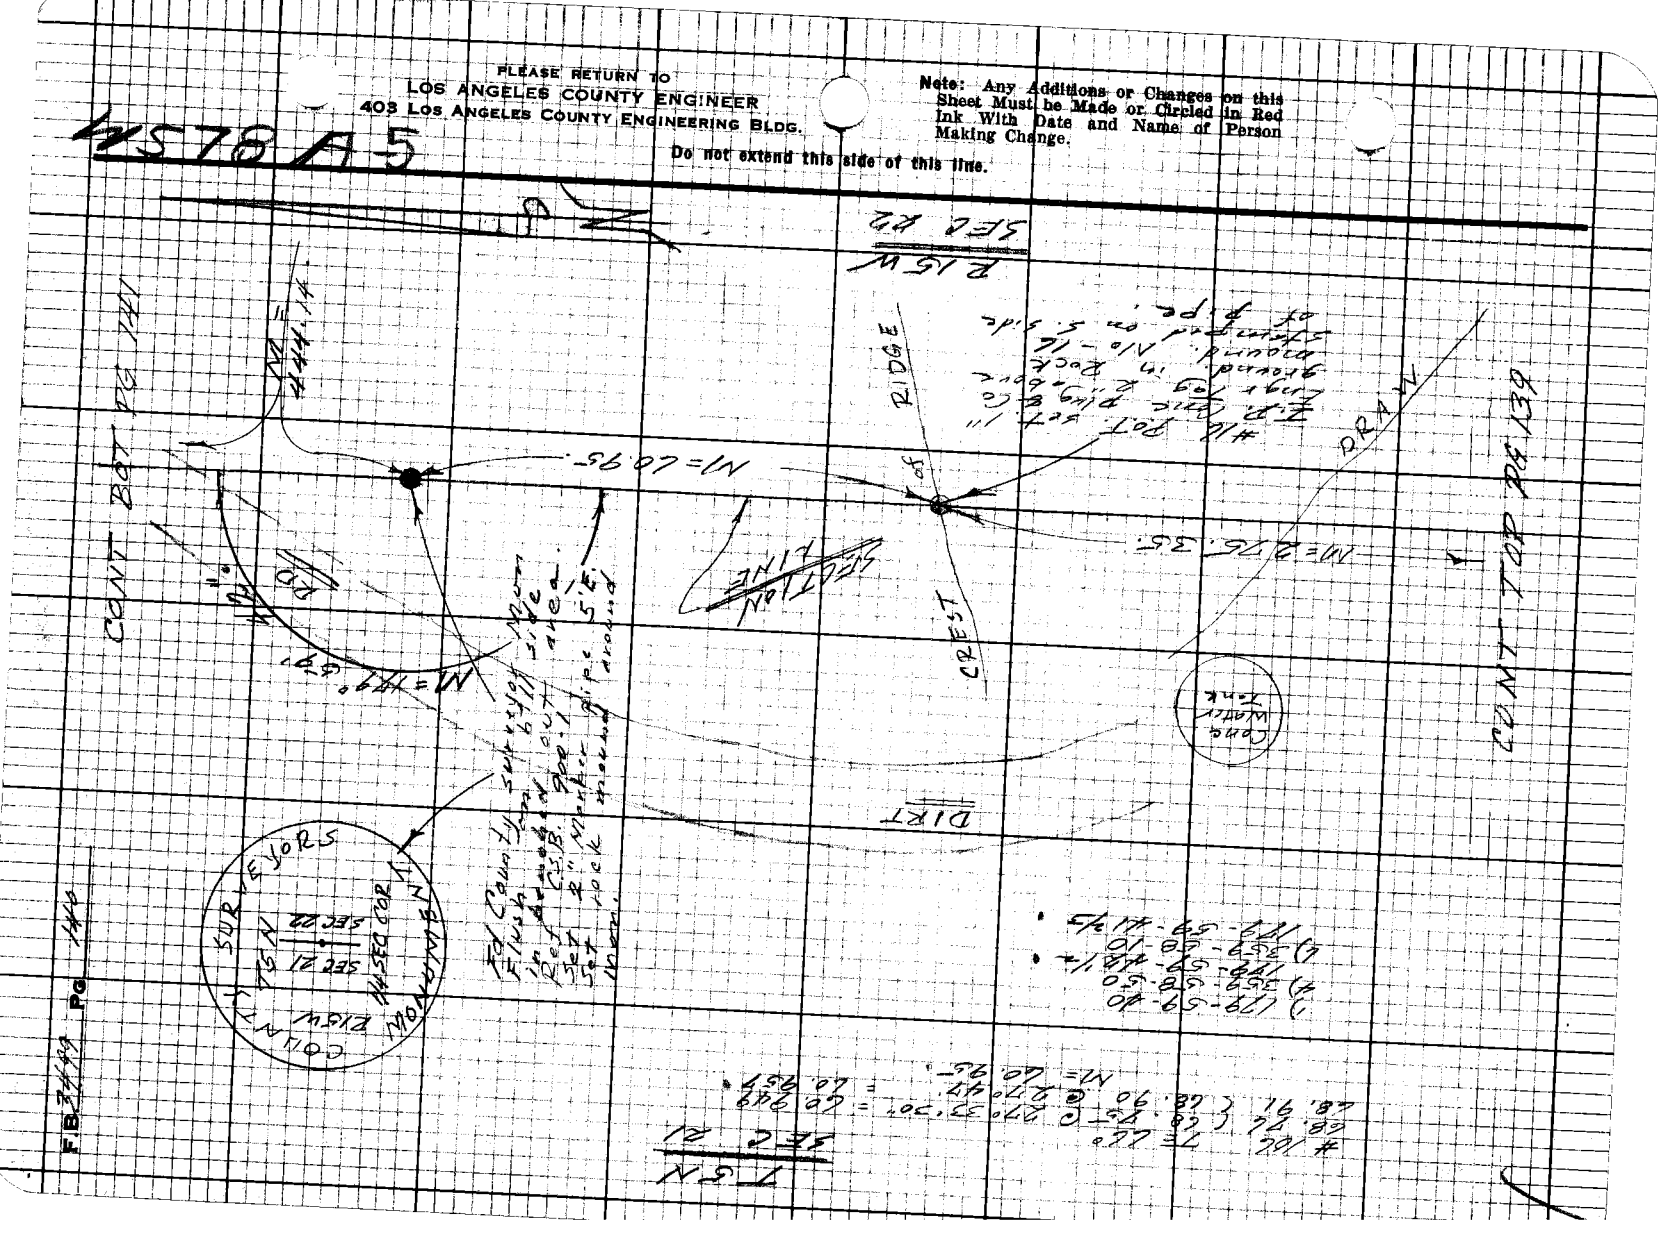

Notes Ck'd by
Map No.
Office Work
Checked
Date

Survey of Sections in T5NR15W F.B. 3499 Pg. 141
JN 83104 Tape 100 Std 68 °F
Surveyed by FE Brooks
Notes FEB Date 24 Feb 70
Indexed by J. GALL APR 14 72

CONT BOT PG 142

N = 250.14'

CREST of very sharp Ridge

N

Note: Any Additions or Changes on this Sheet Must be Made or Circled in Red Ink With Date and Name of Person Making Change.

PLEASE RETURN TO
LOS ANGELES COUNTY ENGINEER
405 LOS ANGELES COUNTY ENGINEERING BLDG.
Do not extend this tie of this line.

T5N
SEC 21

#11 158.44 (158.09) @ 128°17'30" = 153.852
158.02 (158.08) @ 128°05' = 153.852
2.10
Ø 44' =
#12 299.78 (299.95) @ 28°18' = 295.932
299.53 (299.53) @ 28°21' = 295.932
#13 T= 32° 07' 30" = 64.410
@ 32° 03' 30" = 64.410
#20 T=76° 28.62 28.87

N = 153.85'
2.10'
N = 24.24'
N = 295.94'
444.14'
Total

SECTION LINE

80.00'

N = 444.14'

POT Set #20 rebar, Tag illegible

R 15 W

CONT TOP PG 140

DIRT

26FR028 CE#310 9.67

F.B. 3499 Pg. 142

CONT BOT PG 143

PLEASE RETURN TO
LOS ANGELES COUNTY ENGINEER
403 Los Angeles County Engineering Bldg.

Note: Any Additions or Changes on this Sheet Must be Made or Checked in Red Ink With Date and Name of Person Making Change.

Do not extend this side of this line.

SECTION LINE

#2 1/2" I.P. 0.2' Above Ground

#2A 2" Dia Post 1.2' Above Ground

#3

#4

Notes Ck'd by
Map No.
Office Work
Checked
Date

Survey of Sections in 7SN R15W F.B. 3499 Pg. 143
JN 4272 of Tape 100' Std 68 °F
Surveyed by DE Brooks
Notes FE B Date 25 Feb 72
Indexed D. J. GALL APR 14 72

Note: Any Additions or Changes on this Sheet Must be Made or Circled in Red Ink With Date and Name of Person Making Change.

PLEASE RETURN TO
LOS ANGELES COUNTY ENGINEER
403 Los Angeles County Engineering Bldg.

Do not extend this side of this line.

Cont Top PG 144

CANYON

DIRT RD

Toe of slope

N = 1125.28'

7SN
SEC 21

SECTION LINE

Total = 1125.28'

N = 220.24'
220.242'
146.154'
146.154'
152.251'
152.251'
109.918'
109.918'
225.432'
225.432'
251.199'
251.199'


CREST of RIDGE

N = 1125.28'

DRAW

CREST of RIDGE

CONT TOP PG 142

R15W SEC 22

X

PLEASE RETURN TO
LOS ANGELES COUNTY ENGINEER
403 Los Angeles County Engineering Bldg.

Note: Any Additions or Changes on this Sheet Must be Made or Circled in Red Ink With Date and Name of Person Making Change.

Do not extend this side of this line.

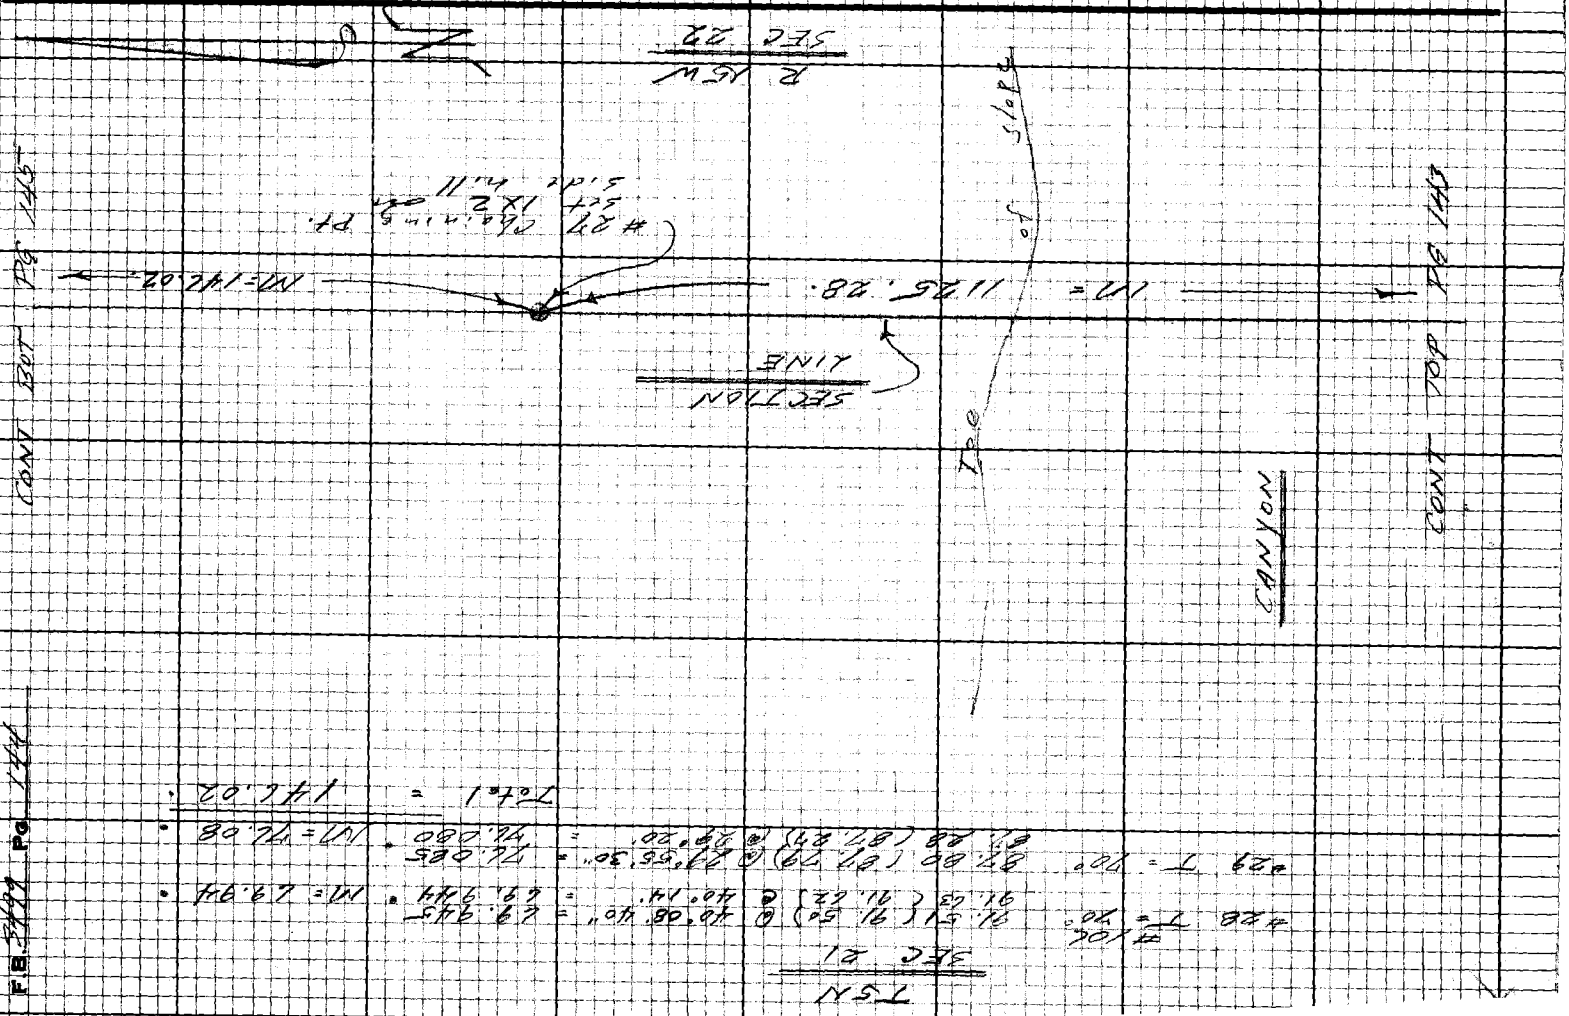

16F3098 CE#310 9-67

PLEASE RETURN TO
LOS ANGELES COUNTY ENGINEER
403 LOS ANGELES COUNTY ENGINEERING BLDG.

Note: Any Additions or Changes on this Sheet Must be Made or Circled in Red Ink With Date and Name of Person Making Change.

Do not extend this side of this line.

T5N

SEC 21








Notes Ck'd by _____
Map No. _____
Office Work _____
Checked _____
Date _____

Survey of See #1 Map #106 T5N R15W Sec 21
JN 23424 Page 106 Std 24"x36"
Surveyed by FEB 1972 Date 2-15-72
Notes
Indexed by G. J. GALLI APR 14 72

CENT TOP PC 1441

CREST

SECTION LINE

M = 146.02




R 15W
SEC 22

CENT TOP PC 1441

F.B. 3499 Pg 144

CONT BOT PG.

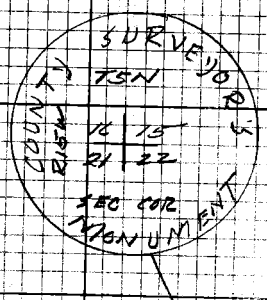

For Co. Survey Mon.
Flush on Stake, hill
side in Excluded Out
Area Ref C.S.B. 900-1

SEE FB. 3490-1

T5N R15W SEC 14

SEC 13

SEC 22

SEC 21

CONT TOP PG. 144

N = 417.75.

DRAW

SECTION LINE

1) 89-59-20
2) 359-59-30
89-59-22½
3) N 0-00-20 E
89-59-23½

N = 89° 59' E 2318.81'

CREST of RIDGE

U.S. FOREST SERVICE
TEXAS CANYON STATION

CONT TOP PG 145

PLEASE RETURN TO
LOS ANGELES COUNTY ENGINEER
403 Los Angeles County Engineering Bldg.

Note: Any Additions or Changes on this Sheet Must be Made on Original in Red Ink With Date and Name of Person Making Change.

Do not extend this side of this line.

16F3023 CE#310 9-67

PLEASE RETURN TO
LOS ANGELES COUNTY ENGINEER
403 LOS ANGELES COUNTY ENGINEERING BLDG.

Do not extend this side of this line.

Note: Any Additions or Changes on this Sheet Must be Made or Circled in Red Ink With Date and Name of Person Making Change.

Notes Ck'd by
Map No.
Office Work
Checked
Date

Survey of Tract 4422 Std B F F
Surveyed by FEB Date 4/28/1972
Notes
Indexed by D.J. GALLI APR 14 72

F.B. 1422 Pg. 1-17

#1 T=72° 112.72 112.70 @ 32°24' = 95.214
113.21 113.20 @ 32°44'30" = 95.214 NM=95.22 ' SEC 16 T5N

#2 T=82° 107.61 @ 30°09' = 162.228
107.95 @ 30°20' = 162.219 NM=162.22 '

#3 T=82° 124.23 @ 29°23'30" = 108.677
124.29 @ 29°26' = 108.683 NM=108.68 '

#4 T=84° 129.00 @ 24°11' = 117.478
129.26 @ 24°26'30" = 117.666 NM=117.67 '

#5 T=84° 80.62 @ 18°55' = 76.181
80.37 @ 18°32' = 76.192 NM=76.17 '

#6 54.75 T=80° = 64.75 '

Total = 614.71 '

CENT. ASST. PS 1443

NM=614.71 '

NM=908.34 '

#6 P.O.T. Set
2" I.P.S.W. Conc. Mkg. &
Co. Engr. Tag in Rock Mound

FIRE

SEC LINE

32 ACRE

R 15W
SEC 21

PLEASE RETURN TO
LOS ANGELES COUNTY ENGINEER
403 LOS ANGELES COUNTY ENGINEERING BLDG.

Note: Any Additions or Changes on this Sheet Must be Made or Circled in Red Ink With Date and Name of Person Making Change.

Do not extend this side of this line.

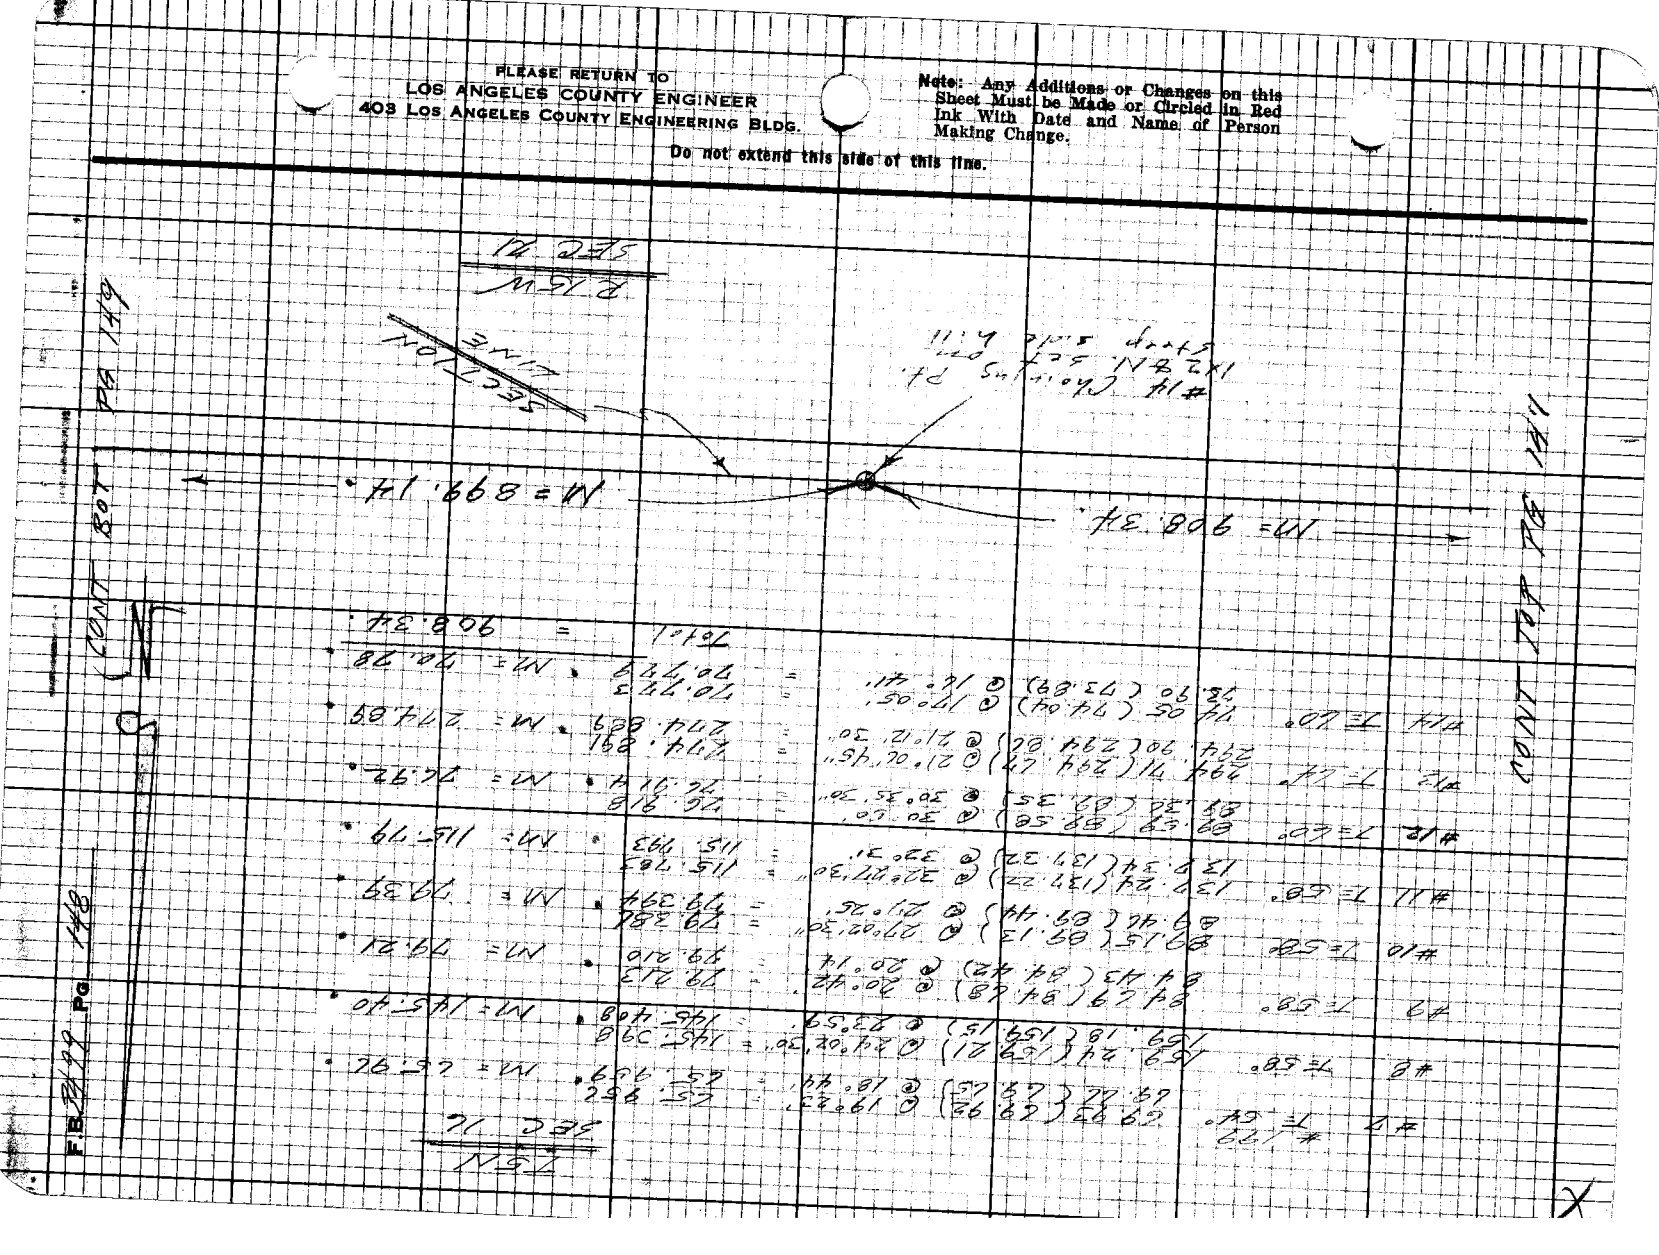

76F3098 CE#310 9-67

PLEASE RETURN TO
LOS ANGELES COUNTY ENGINEER
403 LOS ANGELES COUNTY ENGINEERING BLDG.

Do not extend this side of this line.

Note: Any Additions or Changes on this Sheet Must be Made or Circled in Red Ink With Date and Name of Person Making Change.

Notes Ck'd by _____
Map No. _____
Office Work _____
Checked _____
Date _____

Survey of Sect. 22 in T 3 S R 15 W
JN 4202 dated Tape 1/42 Std Ch 66'
Surveyed by F.C.B. Date 6/64
Notes Blocks
Indexed by R. J. GALLI JAN 14 '72

F.B. 3499 Pg. 142

7 S N
SEC 15


COUNTY ROAD SURVEY BOOK PG. 150

DRAW

M = 899.14

DRAW

M = 242.78

#20 Chain 1+79 Pt. on 1+24-17 ahd. Steep hill side

DRAW

SECTION LINE

COUNTY ROAD SURVEY BOOK PG. 148

R 16 W
SEC 21

PLEASE RETURN TO
LOS ANGELES COUNTY ENGINEER
403 LOS ANGELES COUNTY ENGINEERING BLDG.

Do not extend this side of this line.

Note: Any Additions or Changes on this Sheet Must be Made or Circled in Red Ink With Date and Name of Person Making Change.

WS 78, A 5

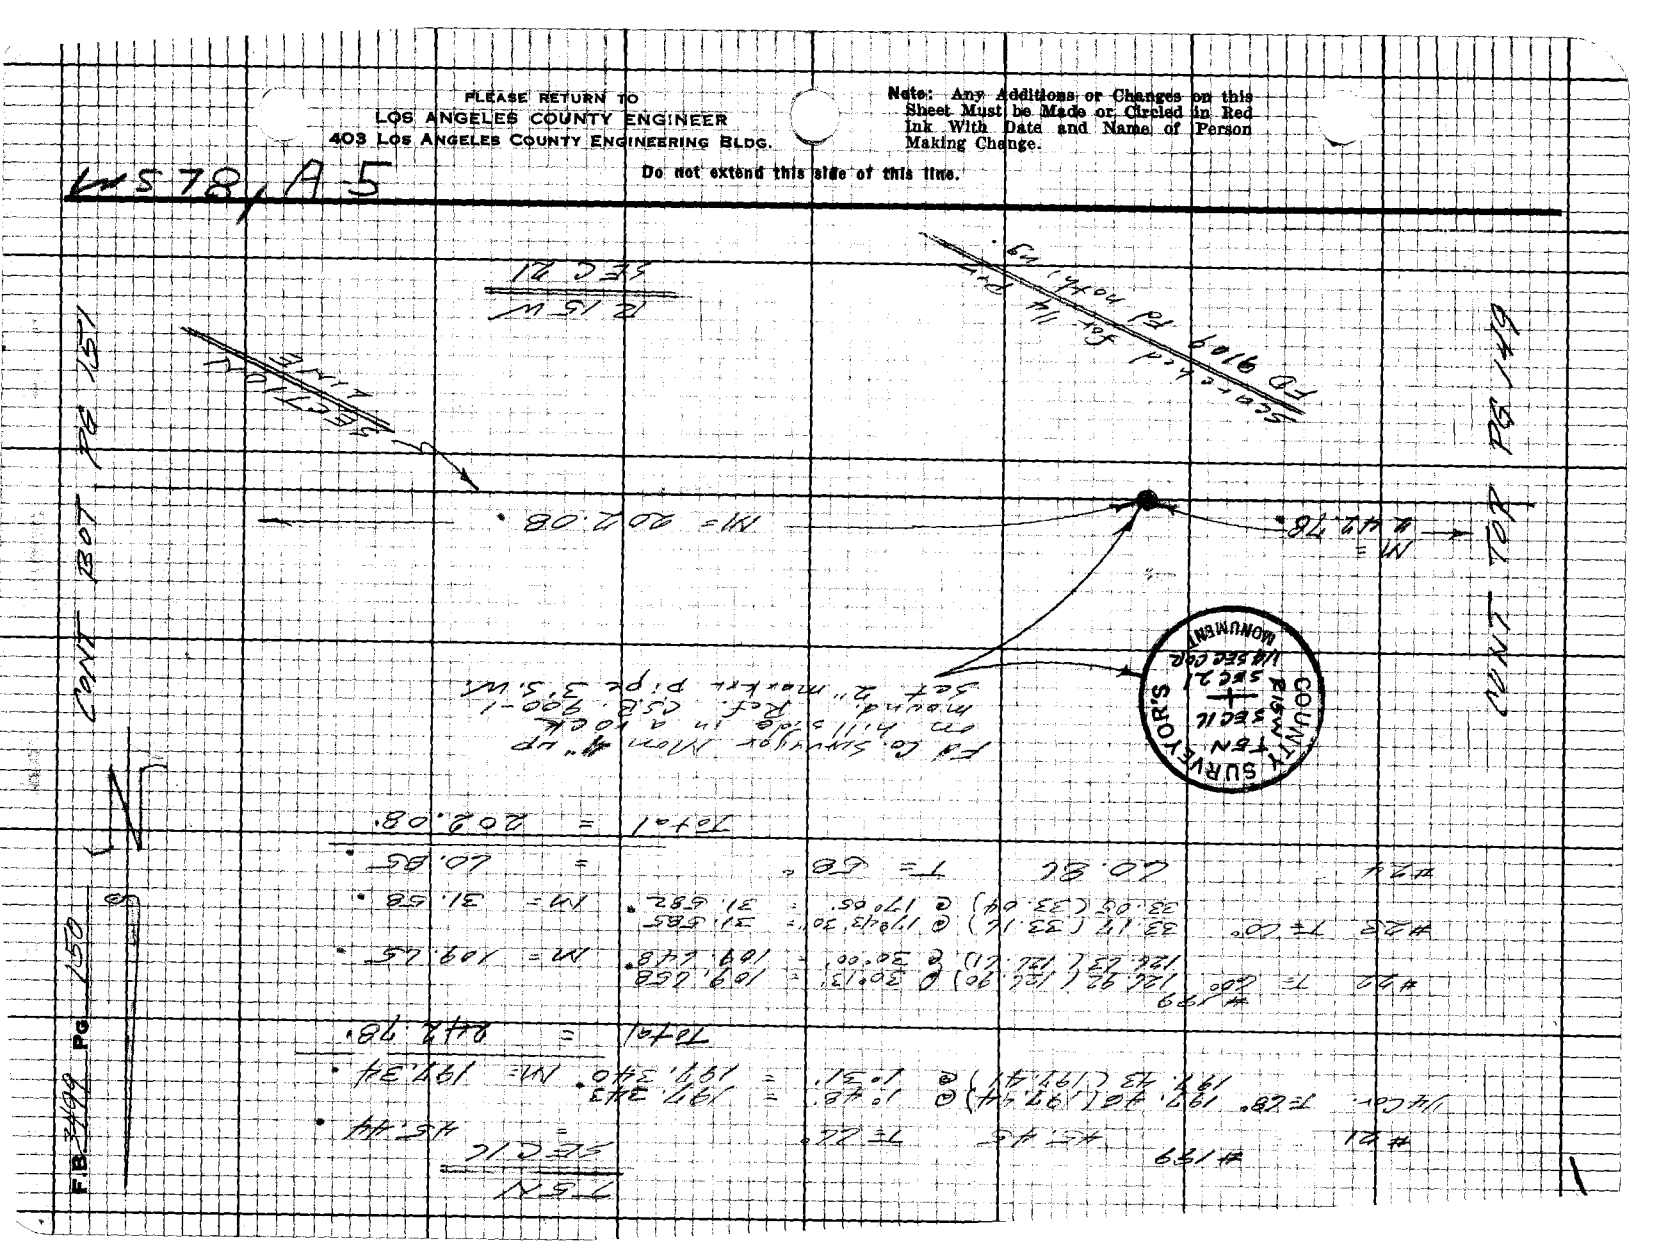
SURVEYOR'S MONUMENT
COUNTY
T 5N
R 15W
SEC 21
SEC 16
SEC 20
SEC 21

Notes Ck'd by
Map No.
Office Work
Checked
Date

Survey of Sections in T5N R15W F.B. 3499 Pg. 151
JN 4302.01 Tape 199 Std 64°F
Surveyed by FE Brooks
Notes FEB Date 4 April 70
Indexed C. J. GALLI APR 1 4 '70

CONT FROM PG 152

T5N
R15W


PLEASE RETURN TO
LOS ANGELES COUNTY ENGINEER
403 LOS ANGELES COUNTY ENGINEERING BLDG.

Note: Any Additions or Changes on this Sheet Must be Made or Circled in Red Ink With Date and Name of Person Making Change.

Do not extend this side of this line.

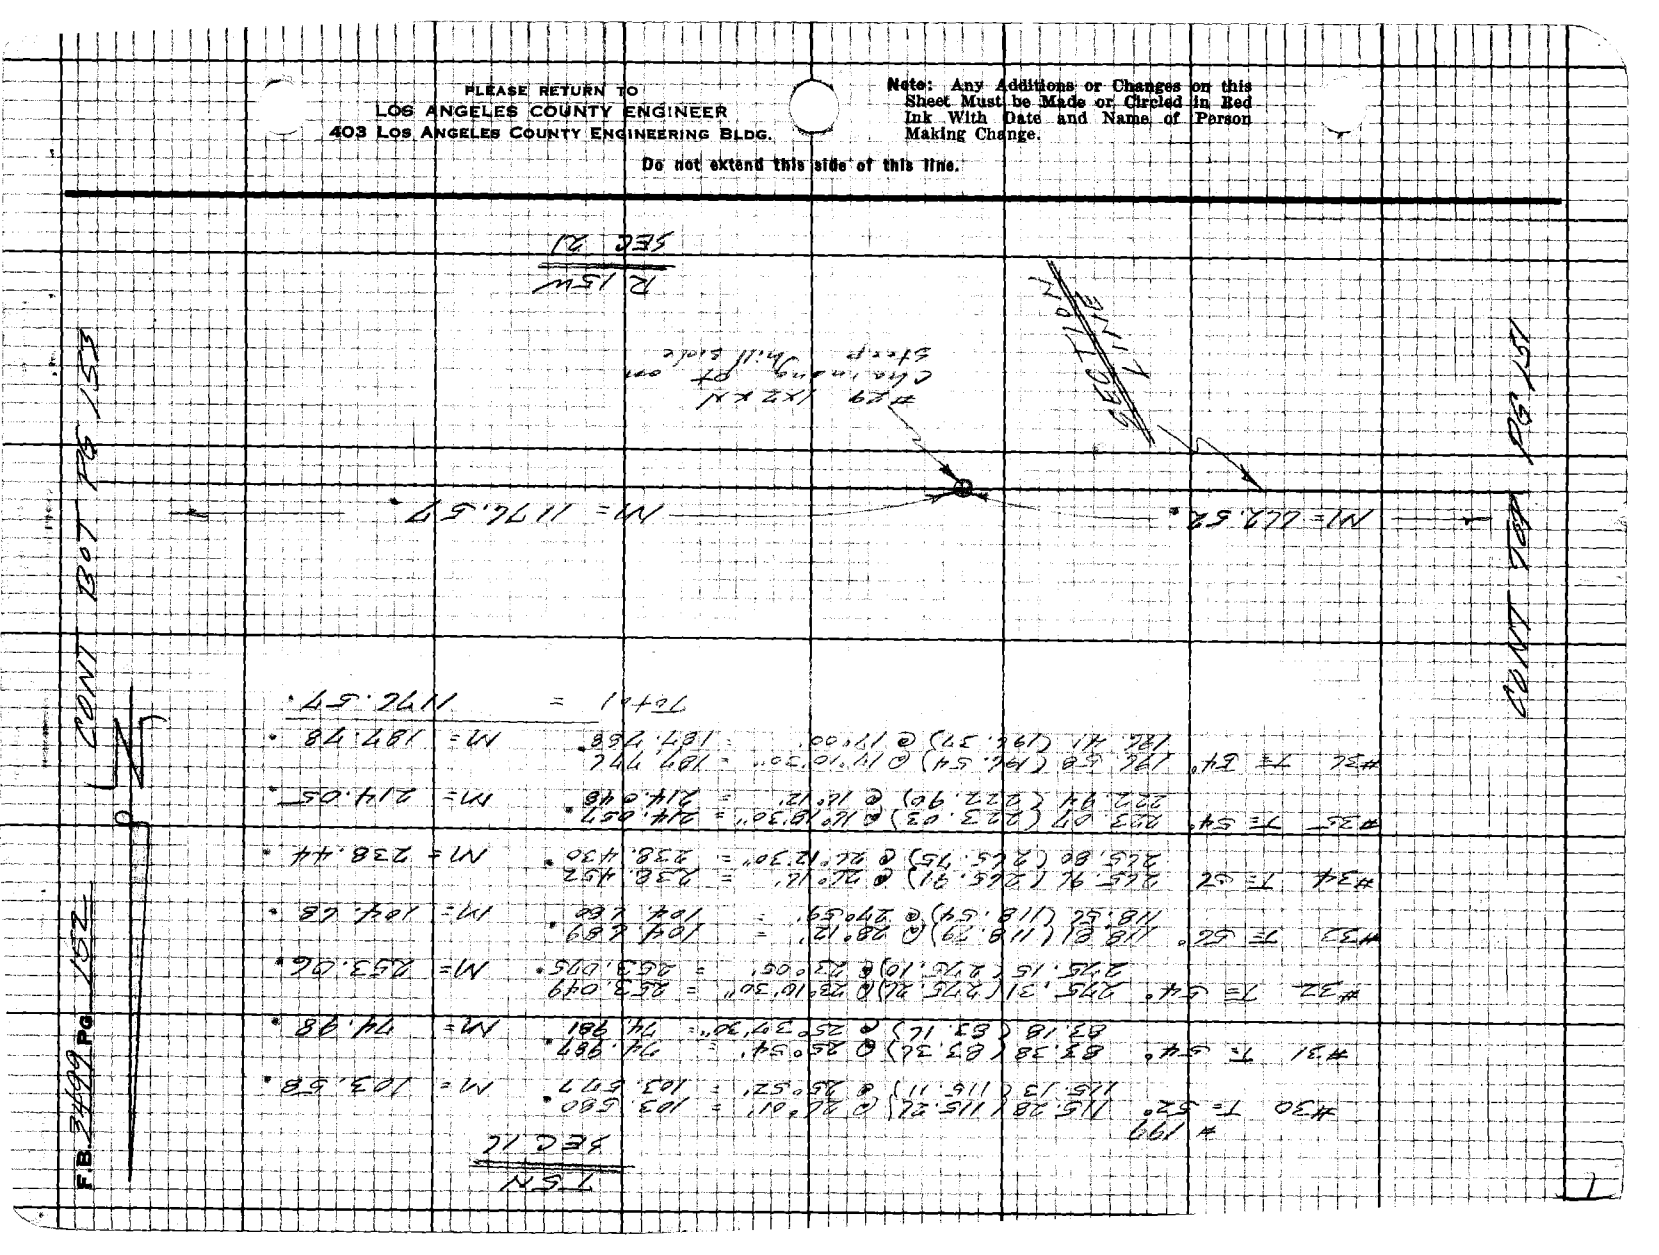

Notes Ck'd by
Map No.
Office Work
Checked
Date

Survey of Sections in T3S R15W
JN 0302.01 Tape 199 Std @ 64 °F
Surveyed by F.E. Brooks
Notes F.E.B. Date 17 Apr. 1970
Indexed D. J. GALLI APR 1 4 '72

F.B. 3499 Pg. 153

Note: Any Additions or Changes on this Sheet Must be Made or Circled in Red Ink With Date and Name of Person Making Change.

Do not extend this side of this line.

PLEASE RETURN TO
LOS ANGELES COUNTY ENGINEER
409 LOS ANGELES COUNTY ENGINEERING BLDG.

1665088 CE#310 9-67

CONT FROM PG 154

N 1= 417.75

Rock wall

Set L&LCo Engr Tags

14" pine

38.59

19.61

10" pine

13.75

Set Br. N. in E-W mortar Conc. Top

U.S. FOREST SERVICE TEXAS

Conc. block wall

Low Sta.

R 15 W

SEC. 21

T 3 S

SEC. 21 T3S R15W N1= 131.77 E0= 131.77 E1= 20577.30 N0= 131.77 E0= 20577.30

EQUINOX

CANYON

#38 P.O.T. set 2" I.P. Conc. Plug & Co. Engr. Tag Flush in a rock mound.

N 0 = 20575.94

SECTION LINE

CREEK

#37 T=S1°45'(151.75)(151.75) @ 69°44'30" 70 @ 69°44'30" T= 53 PA 22

#38

Crest of

Sharp ridge

#38 P.O.T. set 2" I.P. Conc. Plug & Co. Engr. Tag Flush in a rock mound.

N = 1176.52

Draw

CONT TO PG 152

PLEASE RETURN TO
LOS ANGELES COUNTY ENGINEER
403 LOS ANGELES COUNTY ENGINEERING BLDG.

Do not extend this side of this line.

Note: Any Additions or Changes on this Sheet Must be Made or Circled in Red Ink With Date and Name of Person Making Change.

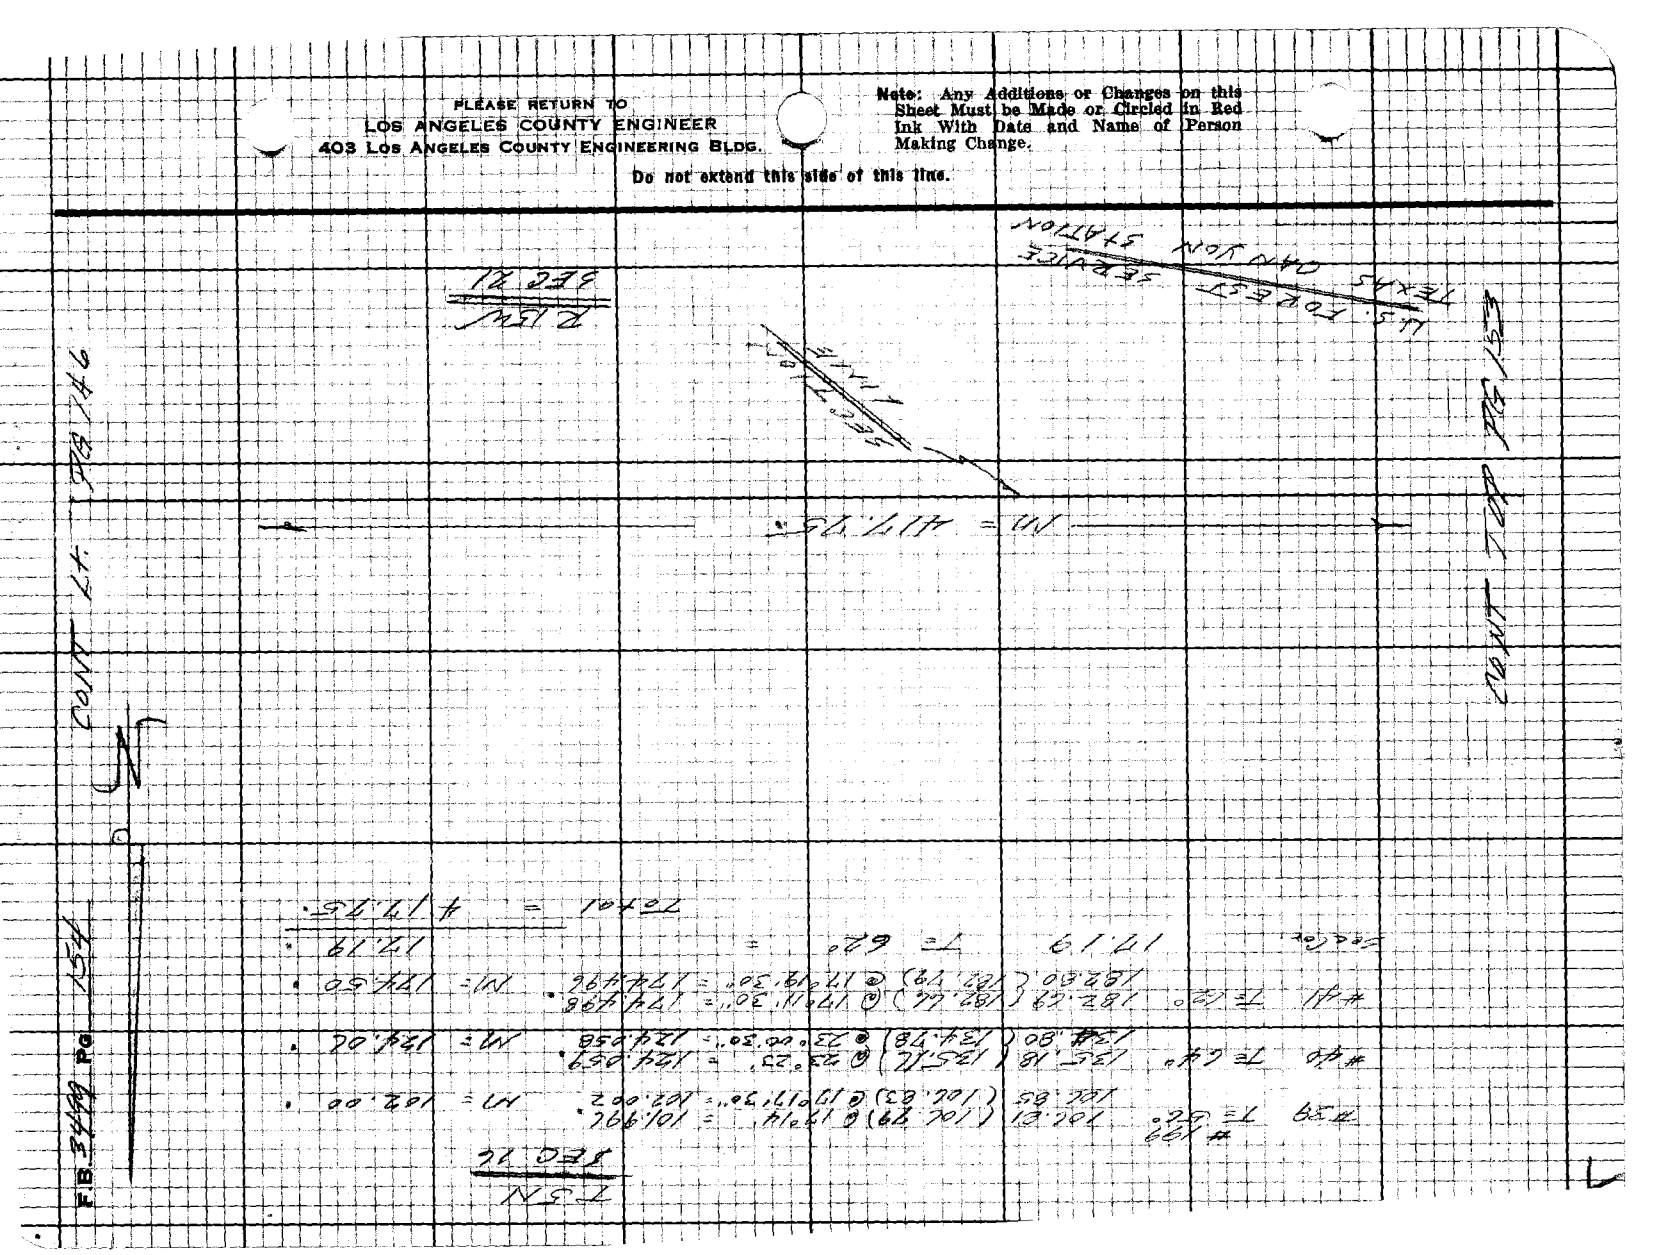

Notes Ck'd by
Map No.
Office Work
Checked
Date

Survey of Sections in T5N R15W
JN 0302.01 Tape 199 Std 84°F
Surveyed by F E B + books
Notes F E B Date 27 April 70
Indexed C. J. GALLI APR 14 72

F.B. 3499 Pg. 155

CONT AT PG 135

N

CANYON

Calc = 1651.28'

1651.281' x .883252440 = 1457.761199011160

1457.76 x 1.132492 = 1651.28'

863.59 x 1.132492 = 977.76

863.59
30.41
30.00
179° 59' 51"
Sin 179° 59' 51" = .883252440
Tan 179° 59' 51" = -1132492.61

Tan 179° 59' 51" = -1132492.61
Sin 179° 59' 51" = .883252440
Cos 179° 59' 51" = -1.000000000

179° 59' 51"
90° 00' 30"
90° 00' 09"
359° 59' 30"

T5N
R15W
SEC. 17

CONT TOP PG 156

PLEASE RETURN TO
LOS ANGELES COUNTY ENGINEER
409 Los Angeles County Engineering Bldg.

Do not extend this side of this line.

Note: Any Additions or Changes on this Sheet Must be Made or Circled in Red Ink With Date and Name of Person Making Change.

1st 3008 LE #330 9-67

PLEASE RETURN TO
LOS ANGELES COUNTY ENGINEER
403 LOS ANGELES COUNTY ENGINEERING BLDG.

Note: Any Additions or Changes on this Sheet Must be Made or Circled in Red Ink With Date and Name of Person Making Change.

Do not extend this side of this line.

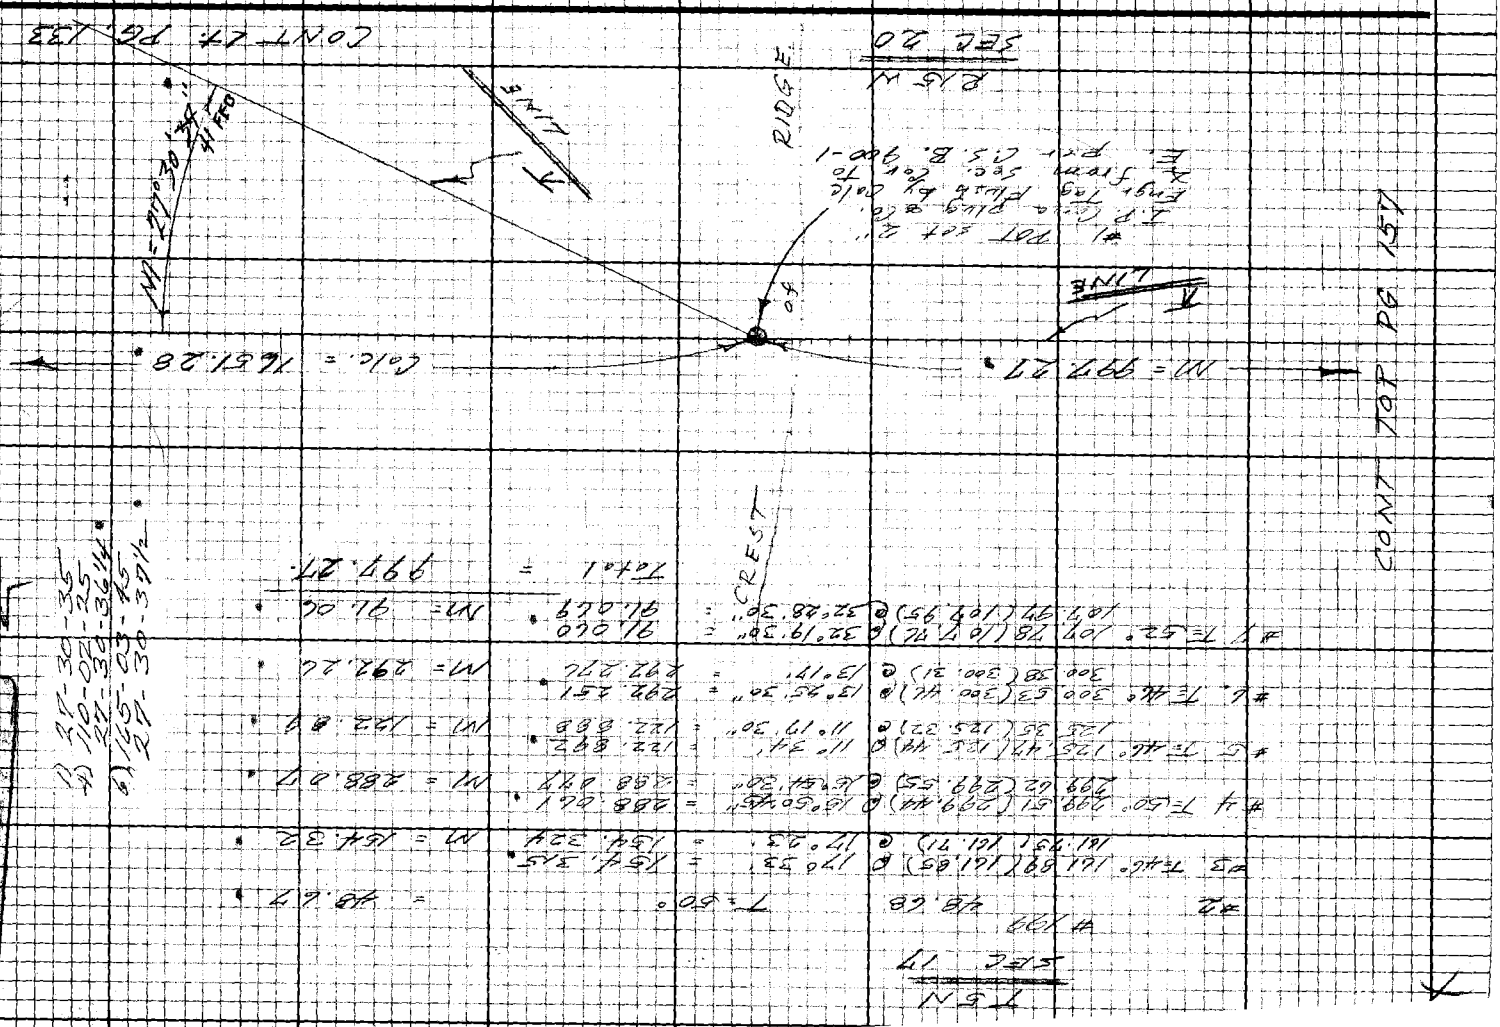
CONT TOP PG 157
CONT BOT PG 157
SEC 20
R15W
RIDGE LINE
CREST
LINE
N1 = 997.27'
Calc. = 1681.28'
N2 = 91.06'
91.060
997.27'
1681.28'
N3 = 1454.32
N4 = 288.07
N5 = 292.26
N6 = 123.89
N7 = 99.47
T = 50°
#1 T = 52° 10' (10 V 12) @ 32°19'30" = 91.060
#2 T = 44° 53' (300. 31) @ 13°95'30" = 292.451
#3 T = 73°46' 189 89 (189. 71) @ 170°53' = 1454.325
#4 T = 50° 1999.51 (2299.44) @ 16°50'45" = 288.071
2299.62 (2227.55) @ 16°51'30" = 288.077
#5 T = 44° 125. 43 (125. 44) @ 11°34' = 122.892
125. 35 (125. 32) @ 11°19'30" = 122.889

Notes Ck'd by
Map No.
Office Work
Checked
Date

Survey of Sections in T5N R15W
JN 0302.01 Tape 199 Std 84 °F
Surveyed by F E Blacks
Notes FEB Date 27 Apr 70
Indexed E. J. GALLI MAR 14 '72

F.B. 4342 Pg. 157

CONT BOT PG 156

See F.B. 4342-70 For 1/4 Sec. Cor. 2-83, D.L.B.

#7 Pot. set 1" I.P. 10" Deep Tag illegible Stamp illegible Found: Removed 2-83, DLB.

CANYON

#8 T = 52°

#9 T = 58°

#10

T5N R15W SEC 20

SEC 21

CONT TOP PG 158

Note: Any Additions or Changes on this Sheet Must be Made or Circled in Red Ink With Date and Name of Person Making Change.

Do not extend this side of this line.

PLEASE RETURN TO
LOS ANGELES COUNTY ENGINEER
403 Los Angeles County Engineering Bldg.

JEFFCOR CE#310 9-67

PLEASE RETURN TO
LOS ANGELES COUNTY ENGINEER
403 LOS ANGELES COUNTY ENGINEERING BLDG.

Note: Any Additions or Changes on this Sheet Must be Made or Circled in Red Ink With Date and Name of Person Making Change.

Do not extend this side of this line.

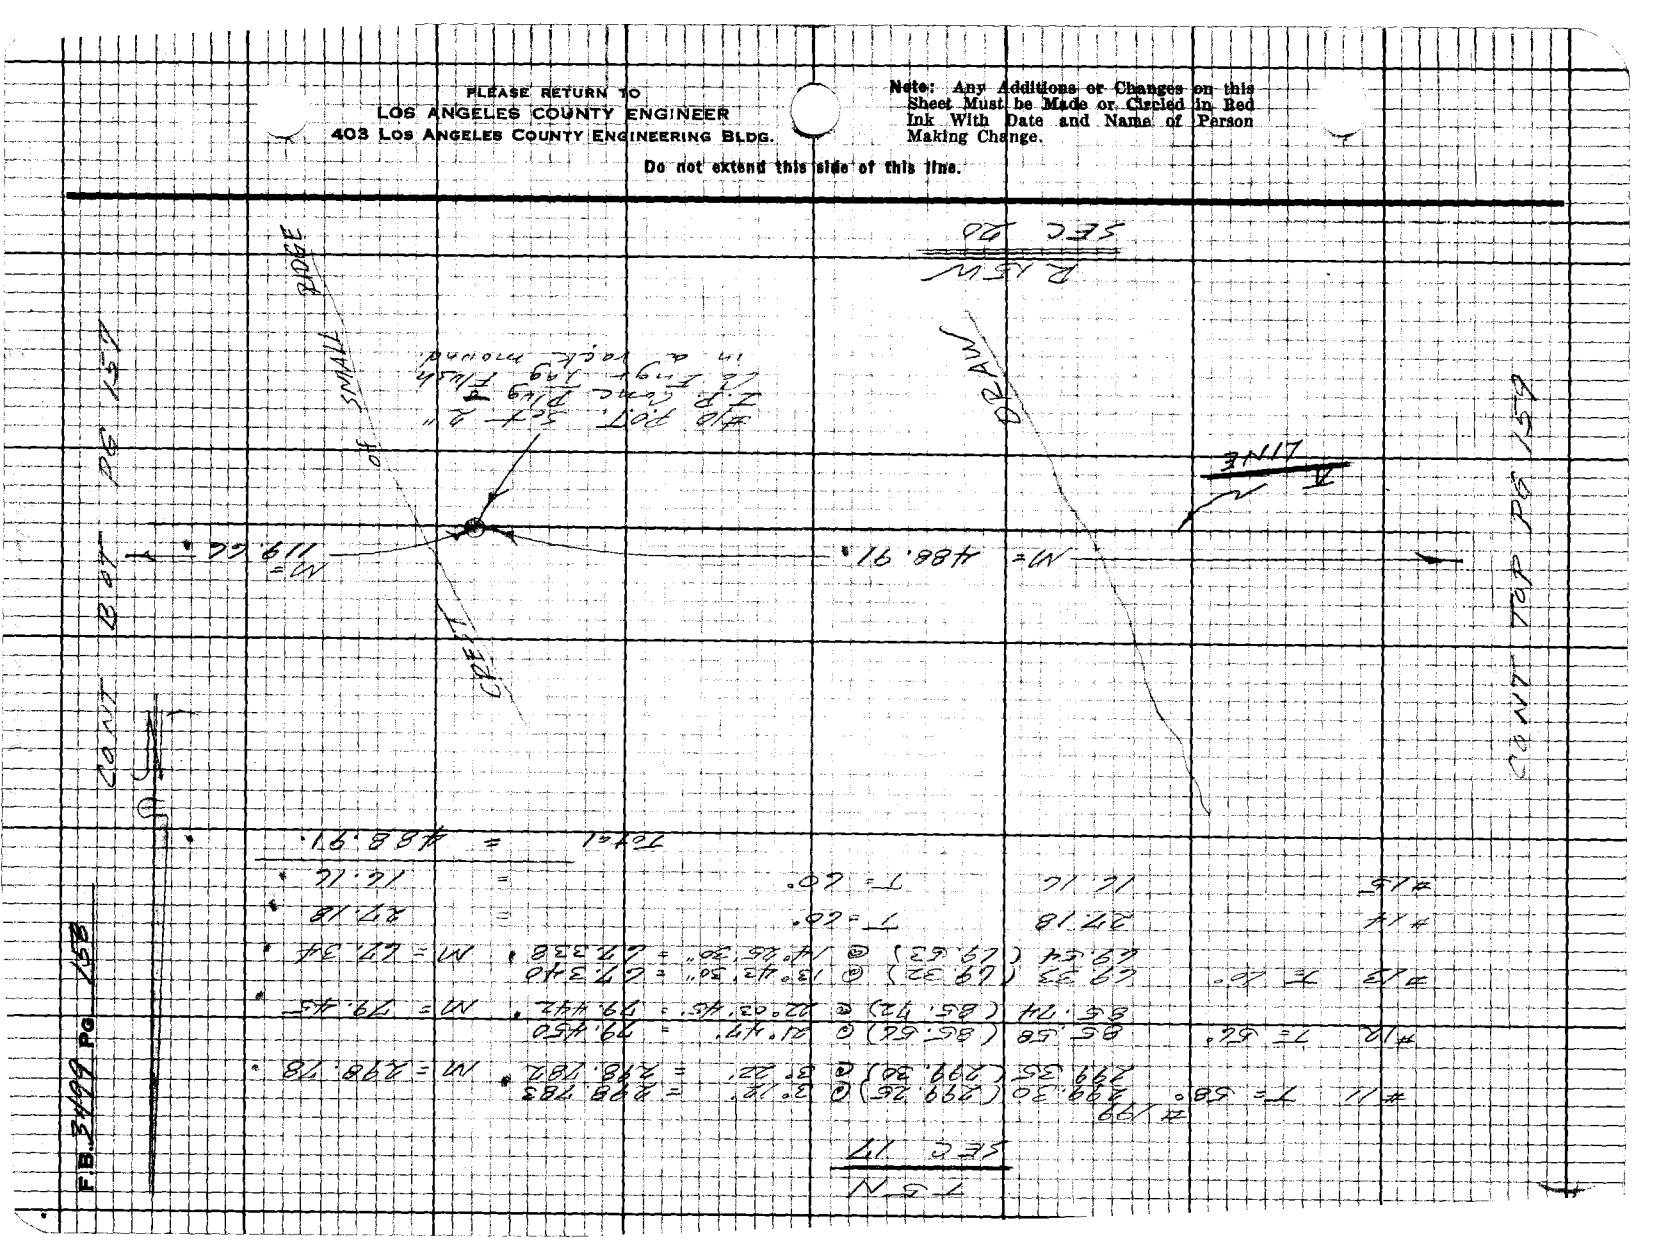
SEC 20
R 15 W

76F3098 CE#910 9-67

PLEASE RETURN TO
LOS ANGELES COUNTY ENGINEER
403 LOS ANGELES COUNTY ENGINEERING BLDG.

Note: Any Additions or Changes on this Sheet Must be Made or Circled in Red Ink With Date and Name of Person Making Change.

Do not extend this side of this line.

Notes Ck'd by
Map No.
Office Work
Checked
Date



T5N
SEC 17

#199
#16 T=56° 250.12 (250.07) @ 11°54' = 244.195 M=244.68
249.90 (249.85) @ 11°41' = 244.673
#17 T=58° 154.16 (154.13) @ 3°41' = 153.810 M=153.81
154.12 (154.09) @ 3°29' = 153.804
#18 197.79 T=57° = 197.75
#19 T=68° 183.21 (183.19) @ 11°32'30" = 179.485 M=179.49
183.13 (183.11) @ 11°23'30" = 179.502
#20 T=66° 58.53 (58.52) @ 5°31' = 58.257 M=58.26
58.64 (58.63) @ 6°25' = 58.262
Total = 833.99

COUNTY TOP PT 1.60

DEL SOR ROAD

M=833.99

M=488.91

COUNTY BOTT PT 1528

A LINE

FIBRE BREAK

#15 P.B. 7 Pg. 54 x
#2 Fence Post
Fills & Ties
Reset
Gone 4-26-83 JSB

U.S. FOREST SERVICE

R15W
SEC 20

PLEASE RETURN TO
LOS ANGELES COUNTY ENGINEER
403 LOS ANGELES COUNTY ENGINEERING BLDG.

Note: Any Additions or Changes on this Sheet Must be Made or Circled in Red Ink With Date and Name of Person Making Change.

Do not extend this side of this line.

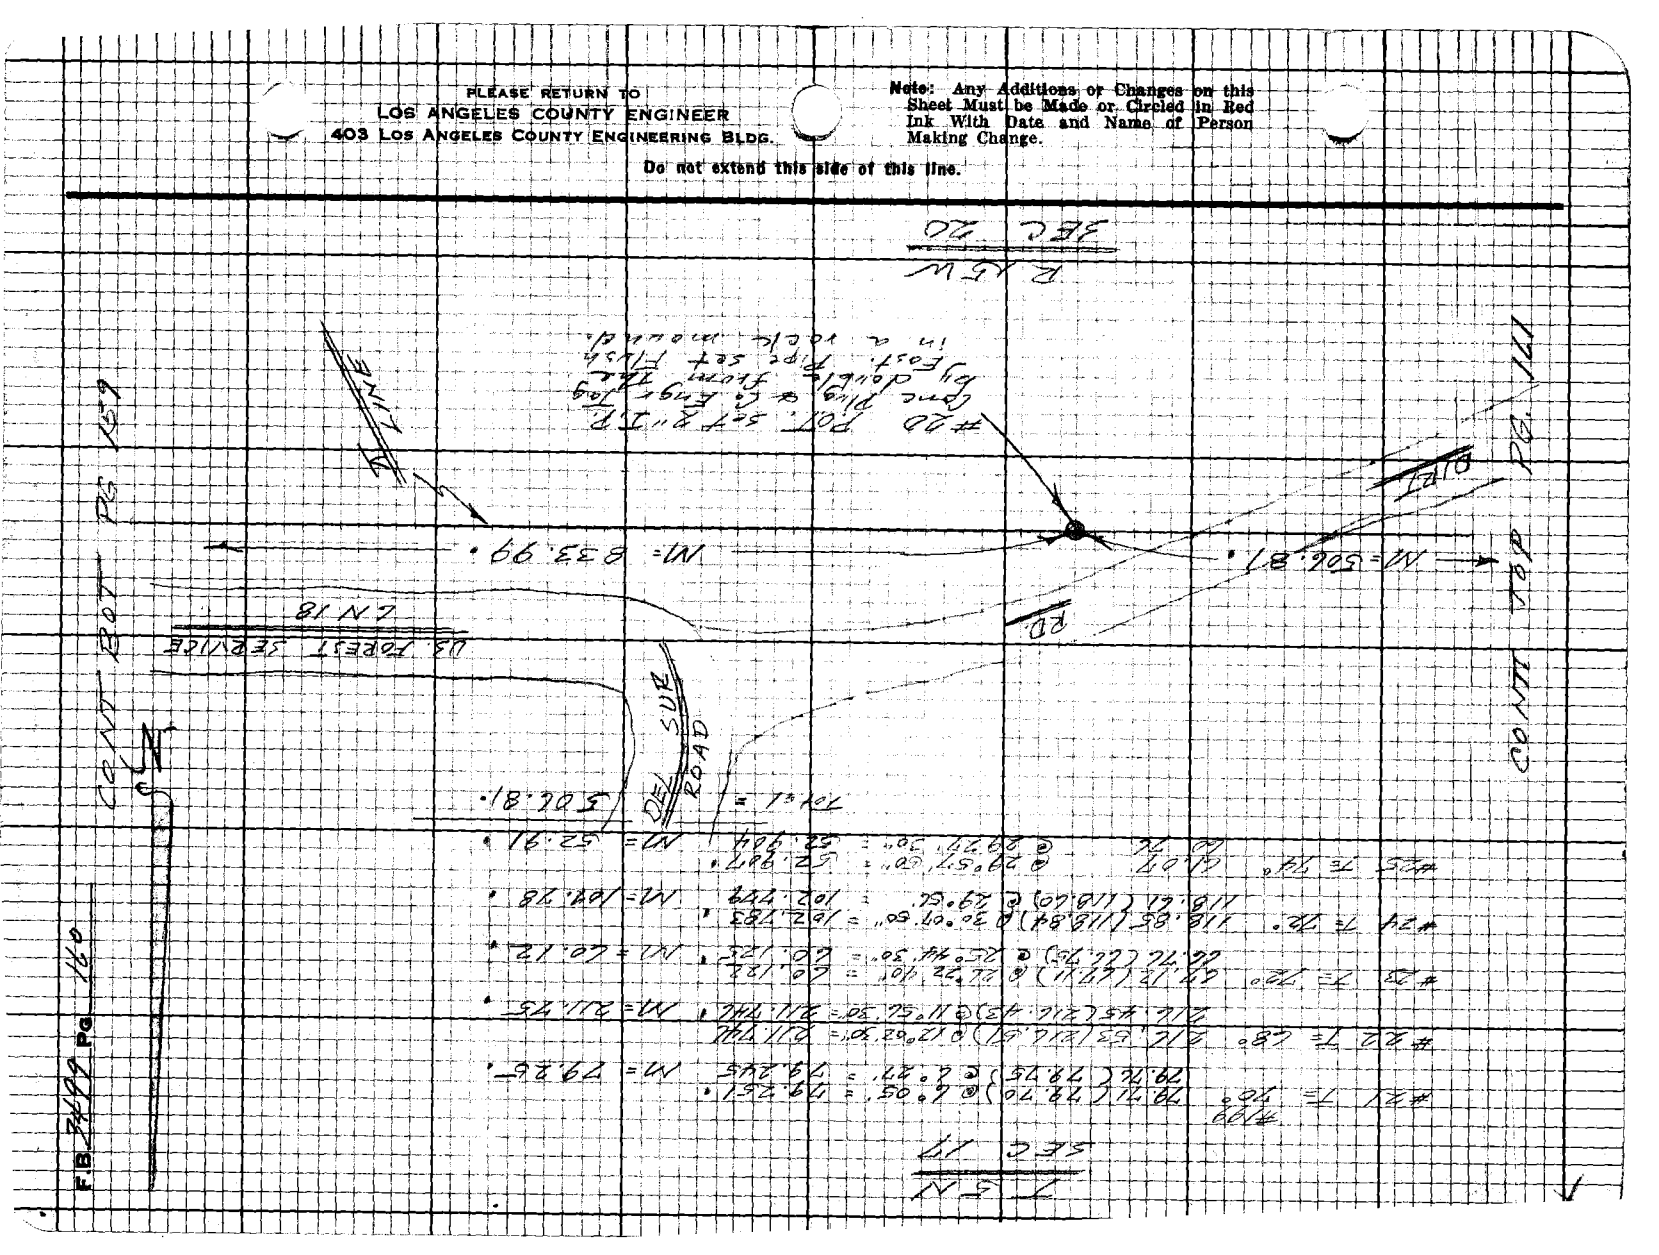

Notes Ck'd by
Map No.
Office Work
Checked
Date



CONT BAT PG 160

LIME

DRAW











Note: Any Additions or Changes on this Sheet Must be Made or Circled in Red Ink With Date and Name of Person Making Change.

PLEASE RETURN TO
LOS ANGELES COUNTY ENGINEER
403 LOS ANGELES COUNTY ENGINEERING BLDG.
Do not extend this side of this line.

Jackson CE #310 (8-67)

PLEASE RETURN TO
LOS ANGELES COUNTY ENGINEER
403 LOS ANGELES COUNTY ENGINEERING BLDG.

Note: Any Additions or Changes on this Sheet Must be Made or Circled in Red Ink With Date and Name of Person Making Change.

Do not extend this side of this line.

W 577 D-5

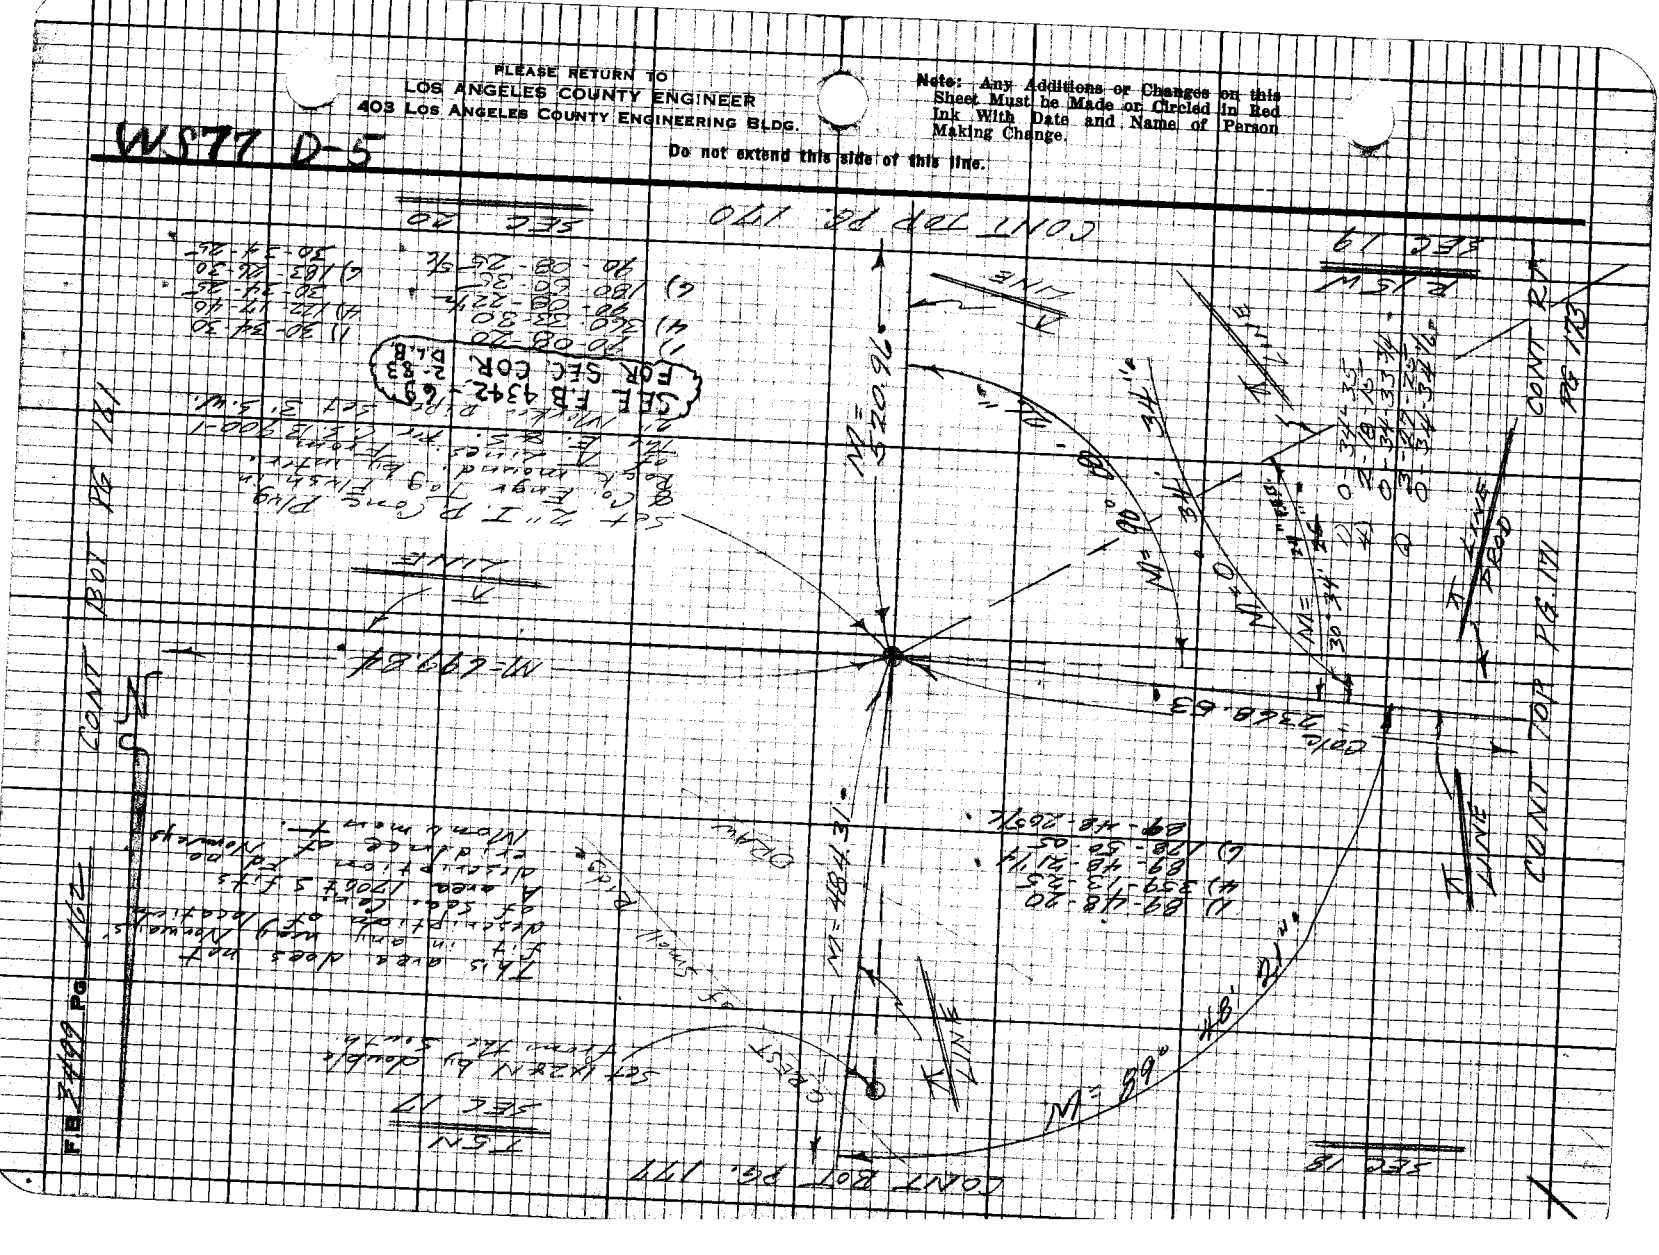

76F3093 CE#310 9-67

PLEASE RETURN TO
LOS ANGELES COUNTY ENGINEER
403 LOS ANGELES COUNTY ENGINEERING BLDG.

Note: Any Additions or Changes on this Sheet Must be Made or Circled in Red Ink With Date and Name of Person Making Change.

Do not extend this side of this line.

Notes Ck'd by _____
Map No. _____
Office Work _____
Checked _____
Date _____

Survey of Set found in 1957
JM 392 ; Tape 66 ; Std @ 68°F
Surveyed by FE & Bros
Notes Drawn by
Indexed by R. L. CALL MAR 14 '72

T5N
SEC 19













#2 Pat Set 2" I.P.
Disc Plug & Tag
Tag Flush by double
From the South.

EAST

T5N
SEC 20

POINT OF BEGINNING

F.B. 1570 Pg. 102

PLEASE RETURN TO
LOS ANGELES COUNTY ENGINEER
403 LOS ANGELES COUNTY ENGINEERING BLDG.

Note: Any Additions or Changes on this Sheet Must be Made or Circled in Red Ink With Date and Name of Person Making Change.

Do not extend this side of this line.

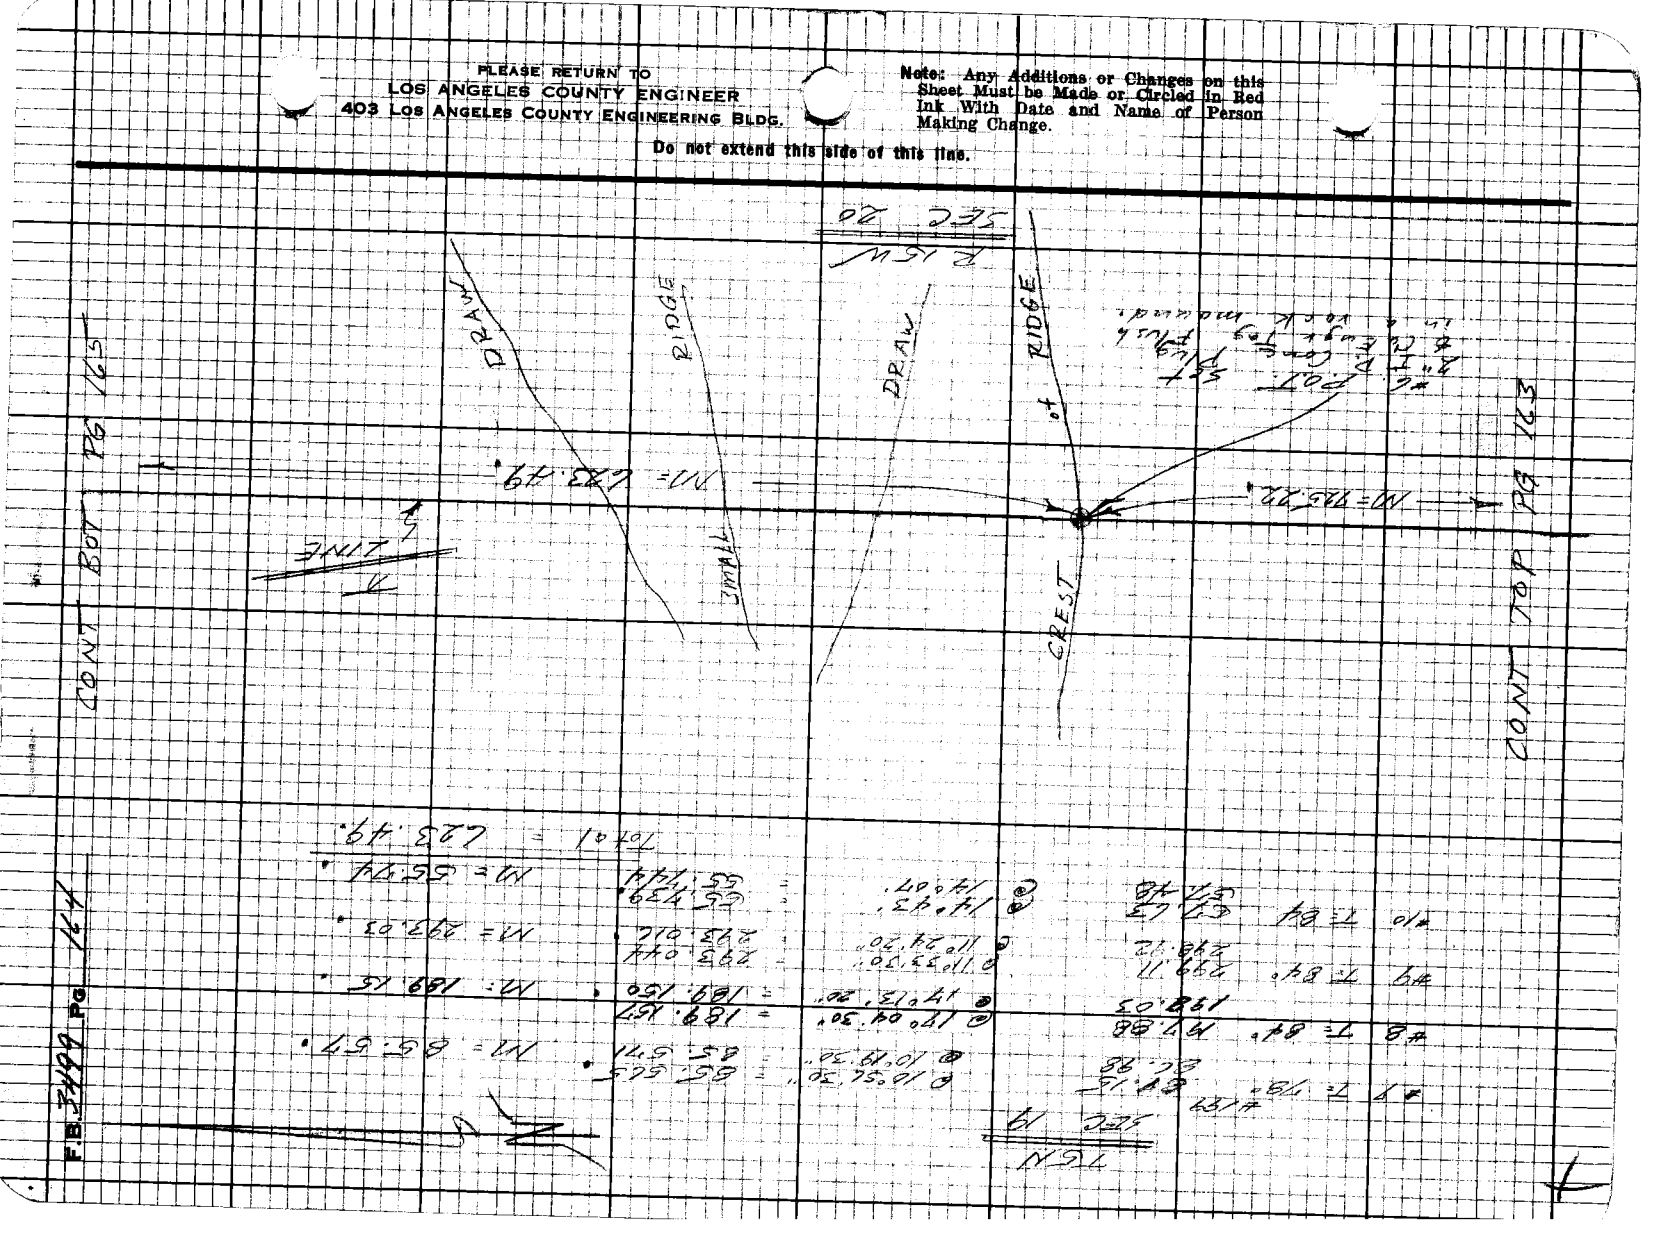

Notes Ck'd by
Map No.
Office Work
Checked
Date

Survey of Sections in T5N R15W
JN 2542-01 Tape 149 Std 64 °F
Surveyed by FEB, RJ
Notes FEB Date MAY 70
Indexed C. J. GALLI APR 14 72

F.B. 3499 Pg. 165

Note: Any Additions or Changes on this Sheet Must be Made in Red Ink With Date and Name of Person Making Change.

Do not extend this line of this line.

PLEASE RETURN TO
LOS ANGELES COUNTY ENGINEER
403 Los Angeles County Engineering Bldg.

CONT BOT PG 166

DRAW

DRAW

DRAW














PLEASE RETURN TO
LOS ANGELES COUNTY ENGINEER
403 LOS ANGELES COUNTY ENGINEERING BLDG.

Note: Any Additions or Changes on this Sheet Must be Made or Circled in Red Ink With Date and Name of Person Making Change.

Do not extend this side of this line.

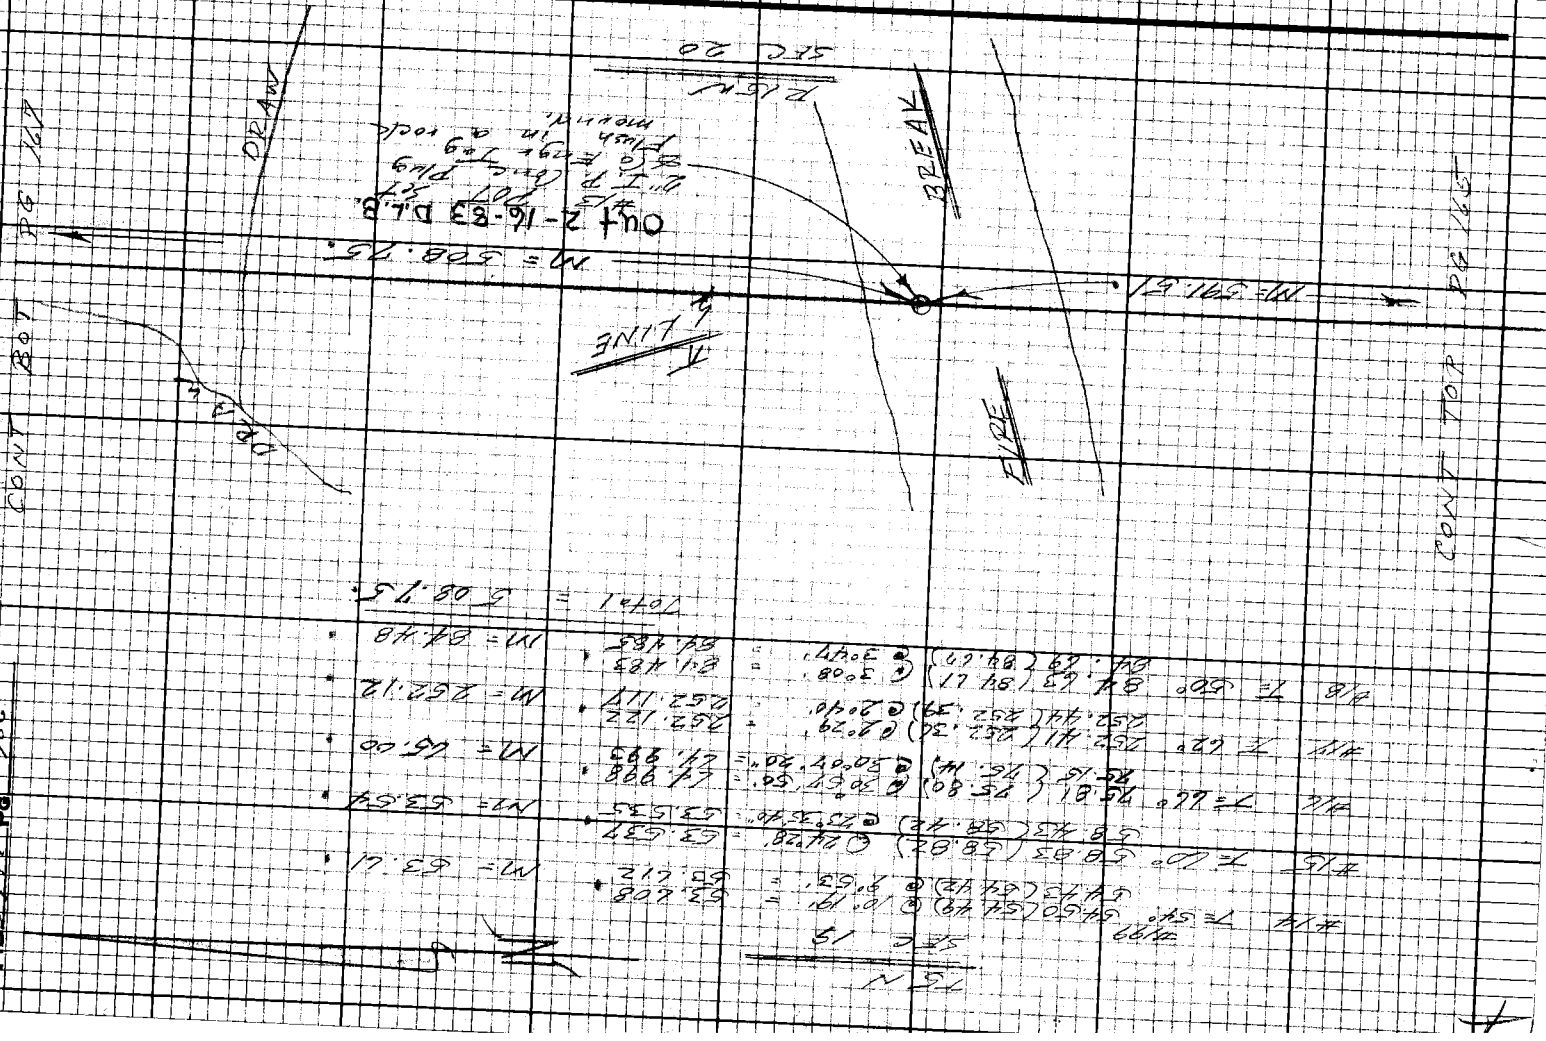

78F3098 CE#310 9-67

PLEASE RETURN TO
LOS ANGELES COUNTY ENGINEER
403 LOS ANGELES COUNTY ENGINEERING BLDG.

Note: Any Additions or Changes on this Sheet Must be Made or Circled in Red Ink With Date and Name of Person Making Change.

Do not extend this side of this line.

Notes Ck'd by
Map No.
Office Work
Checked
Date

Survey of JN 0752 Tract 1426 Std Bk. P.
Surveyed by F.B. 13
Notes Indexed C. J. GALLI R.C.E. 14742

F.B. 4342 Pg. 167

T 5 N

SEC 19










CONT TO 4th

CONT BOT

LINE

M 598.75 ·

#18 POT Set 2" I.P. Cone Flush w/ Ground Mag Nail & Washer Stamped LS 4342

Removed 2-17-83 D.L.B.
See F.B. 4342-67

See F.B. 4342-67 for 1/4 Sec Cor. 2-17-83 D.L.B.

C.S. Sec Cor.

DRIVE

This is S.E. Corner of Lot 4

Lot 4

R 15 W

SEC 20

PLEASE RETURN TO
LOS ANGELES COUNTY ENGINEER
403 LOS ANGELES COUNTY ENGINEERING BLDG.

Note: Any Additions or Changes on this Sheet Must be Made or Circled in Red Ink With Date and Name of Person Making Change.

Do not extend this side of this line.

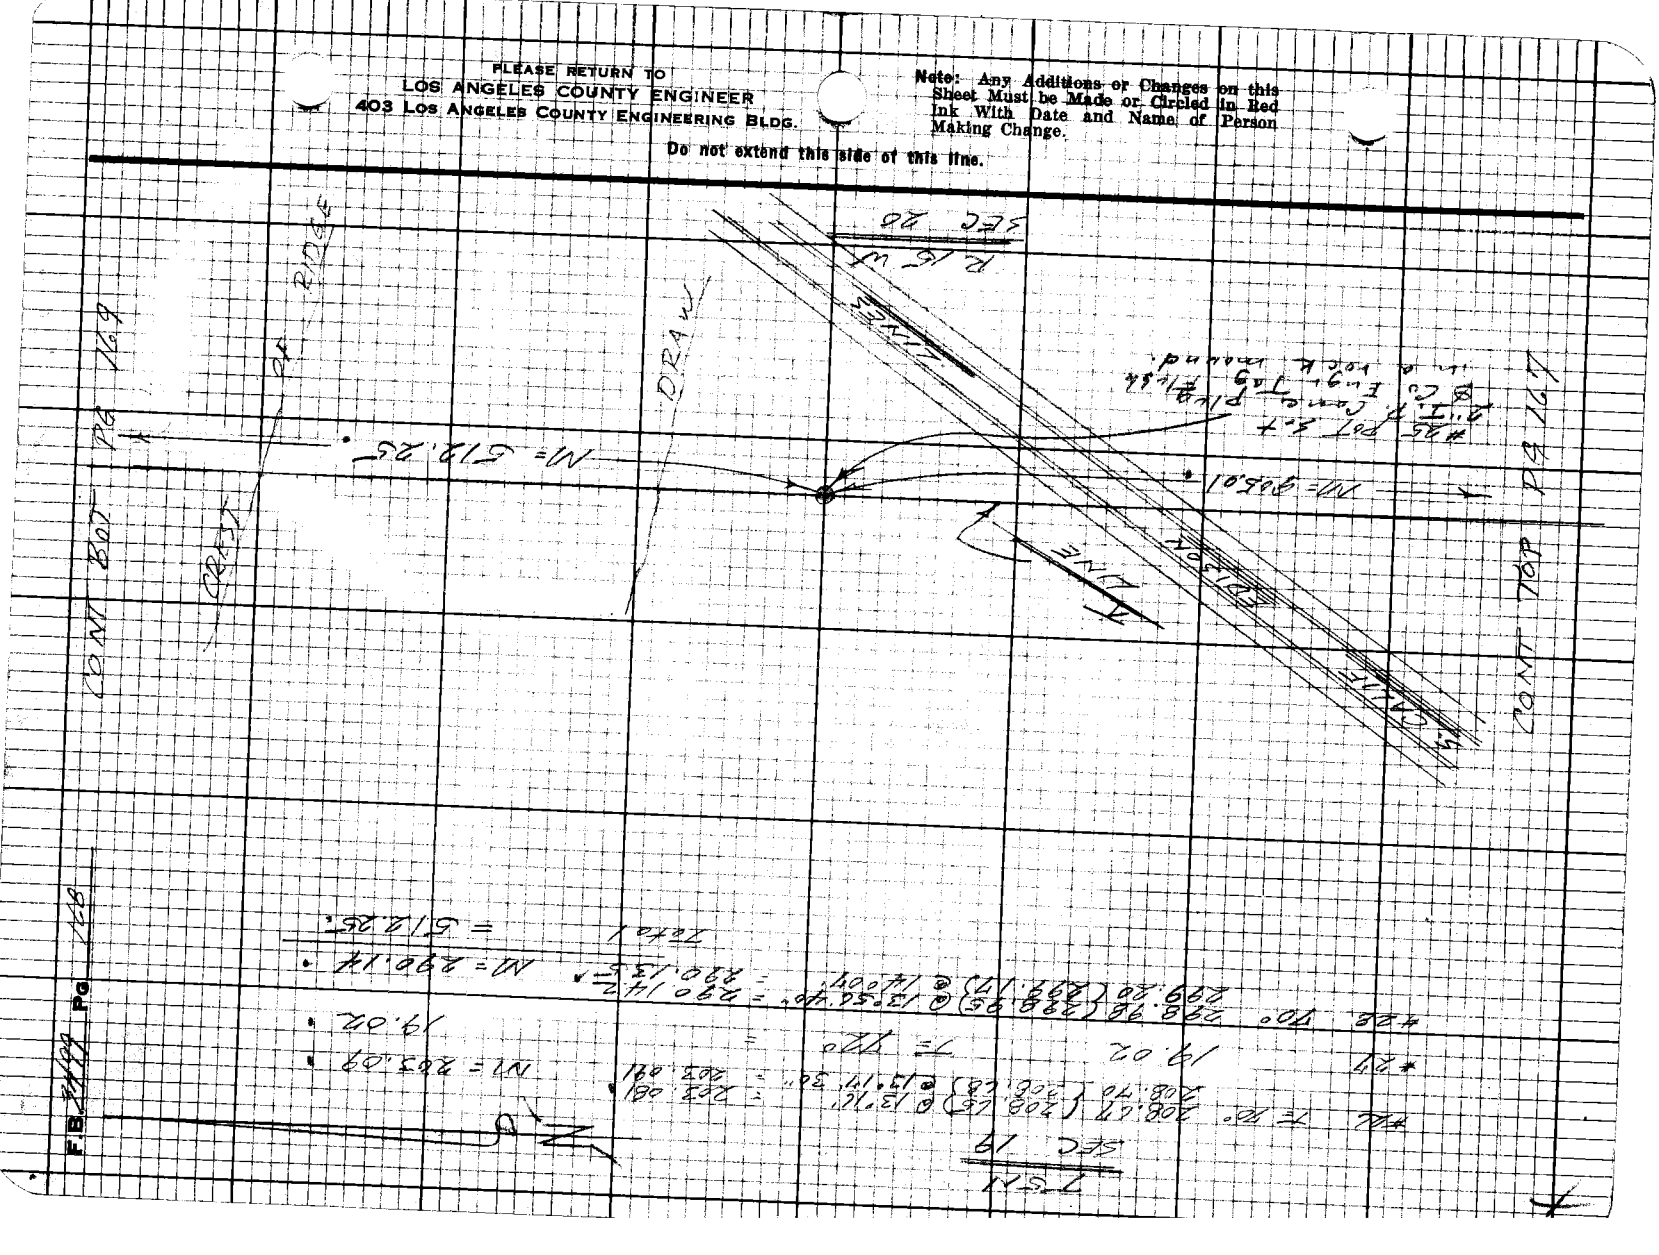

16F3093 CE#310 9-67

PLEASE RETURN TO
LOS ANGELES COUNTY ENGINEER
403 Los Angeles County Engineering Bldg.

Do not extend this side of this line.

Note: Any Additions or Changes on this Sheet Must be Made or Circled in Red Ink With Date and Name of Person Making Change.

T5N
SEC 19



Notes Ck'd by _____
Map No. _____
Office Work _____
Checked _____
Date _____

Survey of Sec 19, T5N, R15W
JN 23-2-01 Tape 122 Sheet 5
Surveyed by F.B. 3199 Pg 122
Notes F.B. 3199 Pg 122
Indexed by M. CALLI Date 8/4/67

CONT TOP PG 168

CONT BOT PG 170

LINE

M = 512.25'

M = 627.85'

#28 POT SET
2" I.P. Chis Dig
Co Engr Tag Flag
in a rock mound.

R15W
SEC 20

PLEASE RETURN TO
LOS ANGELES COUNTY ENGINEER
403 LOS ANGELES COUNTY ENGINEERING BLDG.

Note: Any Additions or Changes on this Sheet Must be Made or Circled in Red Ink With Date and Name of Person Making Change.

Do not extend this side of this line.

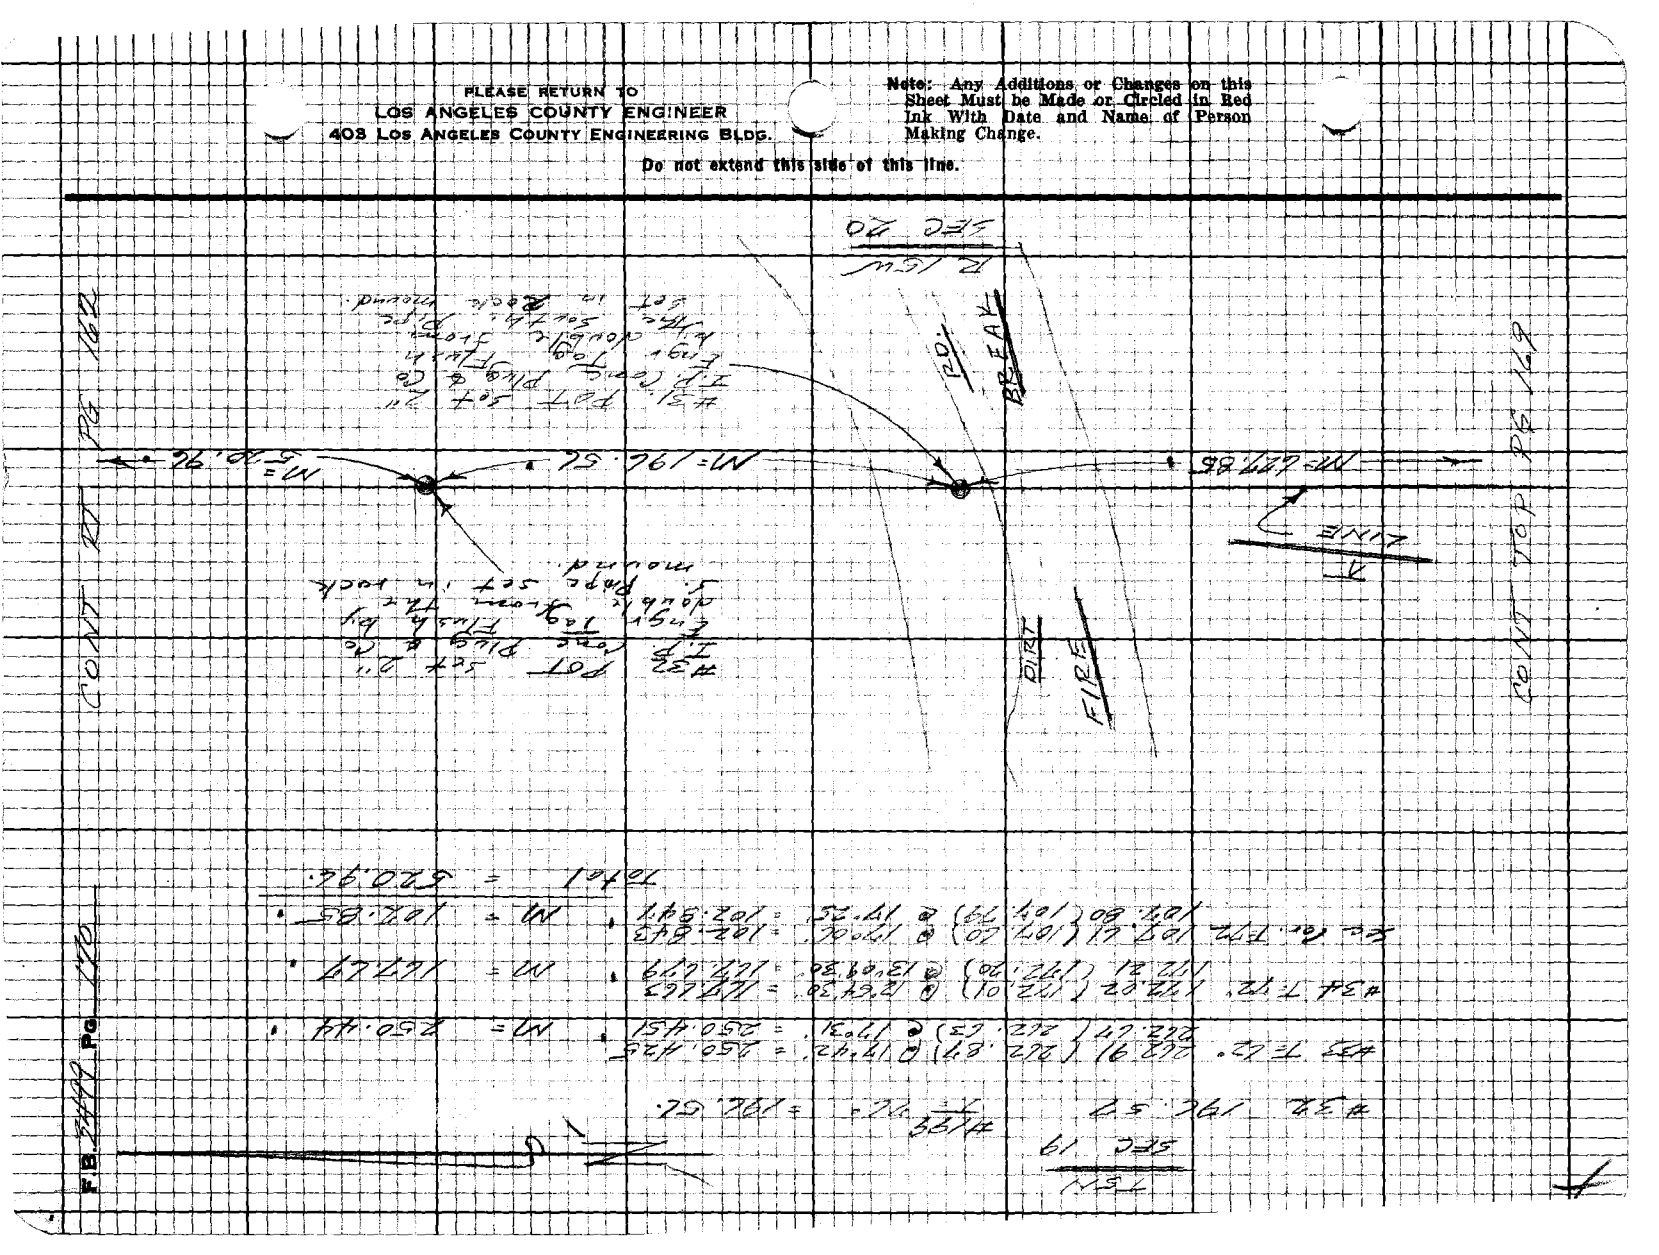

FB 2999 Pg 110

16F309B CE 310 9-67

PLEASE RETURN TO
LOS ANGELES COUNTY ENGINEER
403 LOS ANGELES COUNTY ENGINEERING BLDG.

Note: Any Additions or Changes on this Sheet Must be Made or Circled in Red Ink With Date and Name of Person Making Change.

Do not extend this side of this line.

T 5 N
SEC 18

P3	172	901.13
"	173	975.83
Total		1876.96 ' Base line

P3	172	30-34-43 "
"	172	109-29-48 "
"	173	39-55-48 "
Total	=	180-00-01 "

S.in 30-34-24 = S.in 39-55-48

1876.96 x

.50864075 = 1641.95123

1876.96 x

.50864075 x = 1204.72908446408

x = 2368.526 '

CONT RT PG 172

CANAL

Calc = 2368.53 '

CONT LEFT PG 172

℄ LINE

℄ LINE PROD

R 15 W
SEC 19

Notes Ck'd by _____
Map No. _____
Office Work _____
Checked _____
Date _____

Survey of Sec 4, on, in T2N R15W
JN 0352 Tape 172 Std 66'
Surveyed by FE Books
Notes FEB
Indexed by J. GALLI Date MAR 14 '72

FB 3499 Pg 172

F.B. 3499 Pg 172

T 5 N

SEC 18

"A" T = 80° #188
211.91 [211.90] @ 2° 50' = 211.041'
211.96 [211.95] @ 3° 10' = 211.125' M = 211.03'

"B" T = 86° 186.34
186.36
@ 90° 11' = 186.323'
@ 90° 59' = 186.332' M = 186.33'

"C" T = 86° 245.03
244.82
@ 3° 21' = 244.610'
@ 3° 00' = 244.602' M = 244.61'

"D" T = 86° 241.68
241.49
@ 5° 52' = 258.552'
@ 8° 30' = 258.563' M = 258.56'

Total = 901.13'

See F.B. 4342-68 For 1/4 Sec. Cor. 6-85, D.L.B.

POT #1 Set 2" I.P. Conc. Plug & Co Engr. Tag Flush in a rock mound
Removed 5-85, D.L.B.

BREAK

T LINE

Calc. = 2848.23'

Calc. 2745

Calc. = 2368.63'

26.64'

Prod from P.O.T. #1 2" I.P. Conc. Plug & Co Engr. Tag Flush in a rock mound.

T LINE PROD

CONT TOP PG 171

CONT BOT PG 171

N = 40.

M = 109° 29'

BASE LINE

M = 901.13'

1) 109-29-50
2) 70-30-10
3) 109-29-47 1/2
4) 70-30-12 1/2
5) 109-29-48 1/2

1/4

R 15 W

SEC 19

CONT TOP PG 173

PLEASE RETURN TO
LOS ANGELES COUNTY ENGINEER
403 Los Angeles County Engineering Bldg.

Do not extend this side of this line.

Note: Any Additions or Changes on this Sheet Must be Made or Checked in Red Ink With Date and Name of Person Making Change.

78F399S CE#310 1-65

PLEASE RETURN TO
LOS ANGELES COUNTY ENGINEER
403 LOS ANGELES COUNTY ENGINEERING BLDG.

Note: Any Additions or Changes on This Sheet Must be Made or Circled in Red Ink, With Date and Name of Person Making Change.

Do not extend this side of this line.

Notes Ck'd. by
Map No.
Office Work
Checked
Date

Survey of Sec. Lines in T5SN R15W
JN 57021 Tape 177 Std. E.K. °F
Surveyed by E.E. Brooks
Notes F.E.B. 1-14-72
Indexed D. J. GALLI 1-17-72

F. B. 3109 PG. 173

CONT. FR. PG. 176

#199

E' T=90° 267.29 (267.28) @ 7°56' = 264.722
267.39 (267.38) @ 8°05' = 264.746 M = 264.73

'F' T=90° 121.01 @ 8°37' = 119.536
121.12 @ 9°15' = 119.545 M = 119.54

'G' T=80° 294.14 @ 8°03' = 294.213
294.30 @ 8°14' = 294.234 M = 294.22

'H' T=86° 294.09 @ 14°00'36" = 285.327
294.33 @ 14°12'40" = 285.323 M = 285.33

FEB 12.01 T=86° = 12.01

Total = 975.83

T5SN R15W SEC 19.

T LINE

N = 70.52 W 12.01 FEB.

FIRE

N = 975.83

BREAK

BASE LINE

N 84 59 W

T LINE

Claims 50 ft 1 x 2 PT 0.

1) 70-52-15
4) 283-29-00
6) 70-52-15
L5-13-20 1/3
70-52-14 1/3

1) 39-55-50
4) 159-43-20
39-55-50
6) 239-34-50
39-55-49 1/3

Set 1" I.P. Tagged RCE 5128 Flush with ground at Fence Corner 3.55 Feet Southerly and 0.28 Feet Westerly of Point Indicated.

CONT. BOT. PG. 162

PLEASE RETURN TO
LOS ANGELES COUNTY ENGINEER
403 LOS ANGELES COUNTY ENGINEERING BLDG.

Note: Any Additions or Changes on This Sheet Must be Made or Circled in Red Ink With Date and Name of Person Making Change.

Do not extend this side of this line.

HS 77, D-5

R 15 W
SEC 19

CONT ON PG 172

Cale. 291.5

Cale. = 2840.73

CANYON LINE

CONT FROM PG 175

Cale. location is on a very steep hillside. does not affect description by NOR WAY. Pad Nothing.

T 3N
SEC 18

F.B. 3499 Pg 141

76F309S CE#310 1-65

PLEASE RETURN TO
LOS ANGELES COUNTY ENGINEER
403 LOS ANGELES COUNTY ENGINEERING BLDG.

Note: Any Additions or Changes on This Sheet Must be Made or Circled in Red Ink With Date and Name of Person Making Change.

Do not extend this side of this line.

T3N
SEC 18

B's			
Pg 172	70-30-12	Pg 172	901.13
" 173	70-52-13	" 173	975.83
" 186	38-37-37	Total	1876.96 Base line
Total	= 180-00-02		

Sin 38-37-37 = Sin 70-52-12
1876.96 X
.62424327 = .94477745
1876.96 X
.62424327X = 1773.309482552O
X = 2840.734

Calc = 2840.73

CONT. RT. PG. 172

RIDGE

DRAW

CONT. LEFT PG. 174

X LINE

RIDGE

R15W
SEC 13

Notes Ck'd by
Map No.
Office Work
Checked
Date

Survey of Sections in T3N R15W
JN 0262 Bitterwater Quad
Surveyed by FEC Brooks Date 8 AUG 72
Notes
Indexed by D. J. GALLI Date 8 AUG 72

F. B. 3497 PG. 175

F.B. 3499 Pg. 176

T 5N
SEC 13 | SEC 18

SEE F.B. 3493

COUNTY SURVEYOR'S MONUMENT
T6N
R16W 13 | 18
24 | 19
SEC COR

Fd B. Sur. Mon
2" IP. in rock mound
Ref F.B. 3493 - 39
C.S.B. 900-1
2" Marker Pipe - Set
3' W.

Calc
= 2840.73

T LINE

N 89° 34' 40" E
1) 89 34 40
4) 358-17-19.12
6) 180-25-40.73
89 34 16 73

N = 89° 34' 17"

P.I. 37.39

T LINE

RANGE LINE

1230.13'
F.B. 3493

N 38° 37' 14" E
1) 38-37-40
4) 154-30-35.14
6) 231-45-40.73
38-37-36.73

N.V. 22 Fd 2" I.P.
Tone Plug & Co Engr
Tag Flush in rock
Mound Ref
F.B. 3493 - 37
2" Marker Pipe
3' W.

SEE F.B. 3493

R16W
SEC 24

R15W
SEC 19

PLEASE RETURN TO
LOS ANGELES COUNTY ENGINEER
403 LOS ANGELES COUNTY ENGINEERING BLDG.

Do not extend this tide of this line.

Note: Any Additions or Changes on This Sheet Must be Made or Circled in Red Ink With Date and Name of Person Making Change.

76F309S CE#310 3-68

PLEASE RETURN TO
COUNTY OF LOS ANGELES
DEPARTMENT OF COUNTY ENGINEER
403 LOS ANGELES COUNTY ENGINEERING BLDG.

Note: Any Additions or Changes on This Sheet Must be Made or Circled in Red Ink With Date and Name of Person Making Change.

Do not extend this side of this line.

Notes Ck'd by
Map No.
Office Work
Checked
Date

Survey of Sections in T5N R15W
JN 0192 by Tape 1999 Std. 8V °F
Surveyed by FE Brooks
Notes F.B. 8
Indexed R. J. GALLI Date MAR 14 72

F. B. 3499 PG. 177

#199

A-1	T = 72°	159.81 (159.80) @ 8°32' 158.68 (158.67) @ 8°12'	= 158.031 = 158.038	M = 158.03
A-2	T = 80°	299.98 (299.97) @ 12°47' 299.76 (299.75) @ 12°36'	= 292.533 = 292.532	M = 292.53
A-3	T = 84°	37.59 39.45	@ 26°07'20" = 33.750 @ 25°46'45" = 33.751	M = 33.75 Total = 484.31

#199

A-4	T = 90°	33.48 33.16	@ 18-12 = 31.804 @ 16-24-30 = 31.809	M = 31.81
A-5	T = 88°	65.84 65.27	@ 34-12 = 64.454 @ 33-27-30 = 64.454	M = 54.45
A-6	T = 86°	110.65 110.33	@ 38-38-40 = 86.422 @ 39-04-30 = 86.427	M = 86.42
A-7	T = 84°	275.10 275.02	@ 5°47' = 273.699 @ 5°35' = 273.716	M = 273.71 Total = 446.39

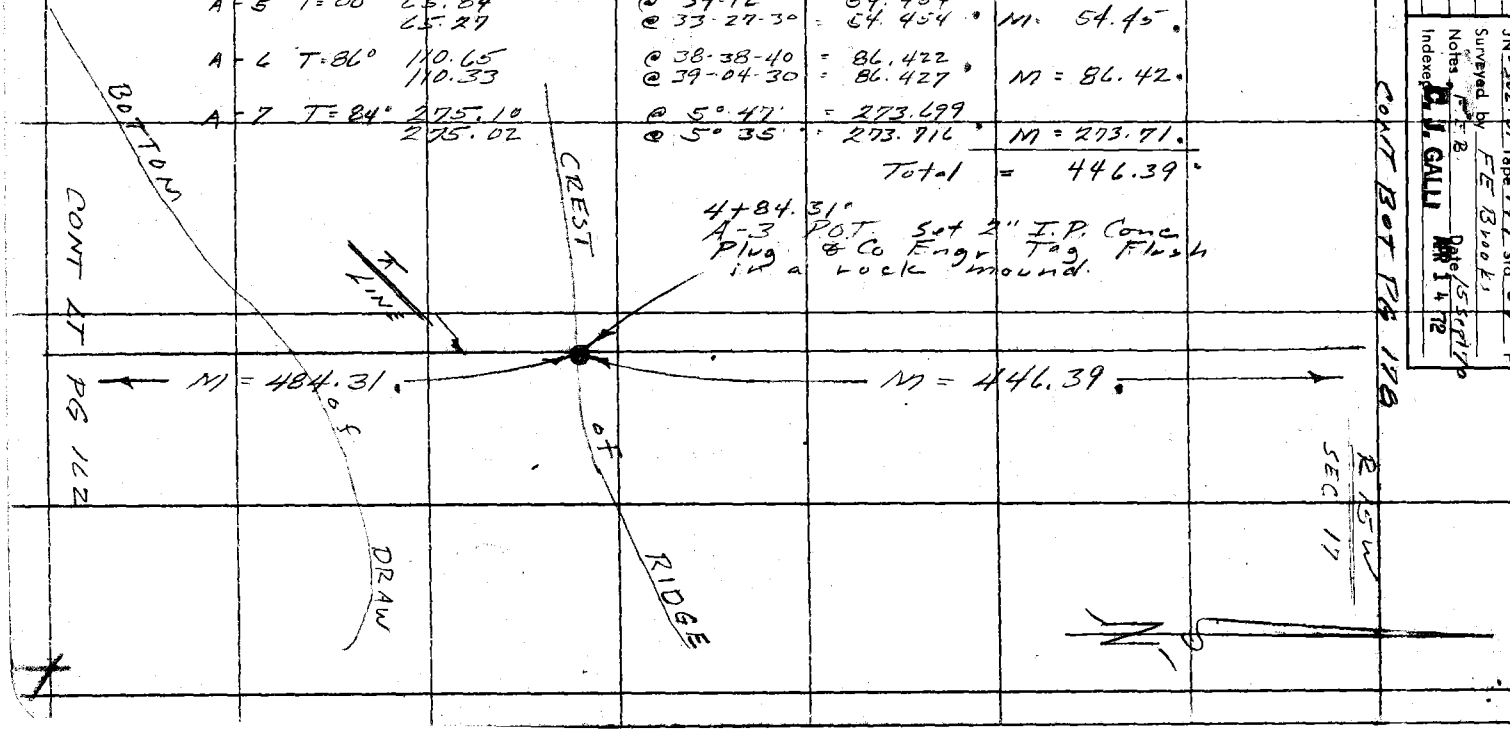

PLEASE RETURN TO
COUNTY OF LOS ANGELES
DEPARTMENT OF COUNTY ENGINEER
403 LOS ANGELES COUNTY ENGINEERING BLDG.

Note: Any Additions or Changes on This Sheet Must be Made or Circled in Red Ink With Date and Name of Person Making Change.

Do not extend this side of this line.

F.B. 3449 PG 178

T 5 N
SEC 18

R 15 W
SEC 17

CONT BOT PG 179

CONT TOP PG 179

DRAW

CANYON

HASKELL

A LINE

N = 1662.96'

N = 1446.39'

9+30.70 = 4-7 Chain pt. 5+ 1X2

199 A-8	T= 94°	160.19 (160.20)	@ 28-14-45	=	141.121	N = 141.12
		160.01 (160.02)	@ 28-07-45	=	141.121	
A-9	T= 98°	53.51	@ 19-04-20	=	50.672	N = 50.67
		53.47	@ 19-33-	=	50.645	
A-10	T= 94°	150.72 (150.73)	@ 4°13'	=	150.321	N = 150.32
		150.74 (150.77)	@ 4°21'	=	150.319	
A-11	T= 104°	127.44 (127.45)	@ 6°19'	=	124.138	N = 124.13
		127.34 (127.33)	@ 7°52'	=	124.131	
A-12	T= 102°	294.53 (294.24)	@ 2-02-40	=	270.778	N = 270.77
		294.32 (293.95)	@ 2-44-40	=	270.760	
A-13	T= 100°	50.55 (50.54)	@ 20-40-30	=	43.185	N = 43.19
		50.53 (50.54)	@ 20-39	=	43.179	
A-14	T= 100	222.19 (222.21)	@ 19-00-20	=	210.097	N = 210.09
		222.06 (222.04)	@ 18-53-10	=	210.069	
A-15	T= 96°	94.45 (94.46)	@ 16-42-30	=	90.462	N = 90.49
		94.32 (94.33)	@ 16-42-40	=	90.470	

T 0 T A L = 1068.75'

76F3095 CE#310 3-68

PLEASE RETURN TO
COUNTY OF LOS ANGELES
DEPARTMENT OF COUNTY ENGINEER
403 LOS ANGELES COUNTY ENGINEERING BLDG.

Note: Any Additions or Changes on This Sheet Must be Made or Circled in Red Ink With Date and Name of Person Making Change.

Do not extend this side of this line.

T5N
SEC 18

A-1C T= 98° #199 248.00 Level

A-1D T= 100° 169.77 (169.79) @ 12-01-45 = 166.063'
169.50 (169.52) @ 11-36-40 = 166.057'

A-1B T= 84° 193.37 Level

N= 248.02'.

N= 166.06'.

N= 193.37'.

TOTAL = 607.45'.

See F.B. 4342-71 For 1/4 Sec. Cor. D.L.B.

CONT TOP PG 178

CONT BOT PG 180

26+17.10'
A-1BA POT Set 2" I.P. Conc Plug & Co Engr Tag Flush in rock mound on side hill.

4.00

℄ LINE

N= 1082.95'

N= 607.45'

N= 2128.96'

20+13.65'
A-1E P.O.T. Set 2" I.P. Conc Plug & Co Engr Tag Flush in rock mound. Pipe set on side hill.

26+21.10.
A-1B no permanent pt. set.

R15W
SEC 17

Notes Ck'd by
Map No.
Office Work
Checked
Date

Survey of Sections in T6N R15W
JN 2302. by Tape 199 Std 81 °F
Surveyed by FF Brooks
Notes FF B3 Date 11-27-72
Indexed by D.J. GALLI MR 14 72

F. B. 3499 PG. 179

PLEASE RETURN TO
COUNTY OF LOS ANGELES
DEPARTMENT OF COUNTY ENGINEER
403 LOS ANGELES COUNTY ENGINEERING BLDG.

Note: Any Additions or Changes on This Sheet Must be Made or Circled in Red Ink With Date and Name of Person Making Change.

Do not extend this side of this line.

F.B. 34499 PG 180

T 5 N
SEC 18

CONT BOT PG 181

CONT TOP PG 179

FIRE BREAK

R 5 W
SEC 13

M = 128.96'

M1 = S29.94'

47+50.06
A-29 R=0.7
SET 2"I.P. CONC.
PLUG & CO. SURV. TWO
FLUSH IN ROCK MOUND
ON SIDE HILL

128.96'

M1 = 180.71'

A-19	T=88°	199	300.48 (300.49)	@ 5°11' = 299.220	M = 299.25'
			300.55 (300.55)	@ 5°21' = 299.249	
A-20	T=82°		205.43	@ 10-53 = 201.930	M = 201.92'
			205.43	@ 11-04-30 = 201.918	
A-21	T=84°		185.08	@ 3°13' = 185.198	M = 185.19'
			185.08	@ 3°03' = 185.098	
A-22	T=82°		237.80	@ 7°21' = 235.802	M = 235.80'
			237.80	@ 7°21' = 235.795	
A-23	T=92°		226.75 (226.76)	@ 14°21'48" = 219.676	M = 219.67'
			226.93 (226.92)	@ 14°32'26" = 219.678	
A-24	T=90°		290.68 (290.69)	@ 16-32-40 = 278.452	M = 278.24'
			290.50 (290.51)	@ 16-26-30 = 278.237	
A-25	T=90°		300.15 (300.16)	@ 14-09-20 = 291.047	M = 291.04'
			299.29 (299.30)	@ 13-48-50 = 291.032	
A-26	T=92°		75.25'	@ 17-55-10 = 71.980	M = 71.98'
			75.48	@ 17-32 = 71.973	
A-27	T=94°		88.25 (88.96)	@ 13-21-50 = 86.551	M = 86.52'
			89.12 (89.13)	@ 13-47-20 = 86.520	
A-28	T=96°		92.38 (92.39)	@ 8-27 = 71.603	M = 71.60'
			92.51 (92.52)	@ 9-06 = 71.606	
A-29	T=76°		187.26 (187.25)	@ 4°20' = 186.714	M = 180.71'
			187.20 (187.19)	@ 4°05' = 186.714	

CONT BOT PG 181

CONT TOP PG 179

76F3095 CE#310 3-68

PLEASE RETURN TO
COUNTY OF LOS ANGELES
DEPARTMENT OF COUNTY ENGINEER
403 LOS ANGELES COUNTY ENGINEERING BLDG.

Note: Any Additions or Changes on This Sheet Must be Made or Circled in Red Ink With Date and Name of Person Making Change.

Do not extend this side of this line.

Notes Ck'd by
Map No.
Office Work
Checked
Date

Survey of Sections in T5N R15W
JN 03 02 Octave 19 Q Std. 64 °F.
Surveyed by F.E. Brooks
Notes F.B.
Indexed L.J. GALLI Date APR 14 72

F.B. 3498 PG. 181

SEC 18

T5N

SEC 7

#199

A-30 T= 76° 139.10 @ LEVEL M= 139.09 .

A-31 T=90° 298.44 (298.45) @ 5°23' = 297.133
298.34 (298.35) @ 5°08' = 297.153 M= 297.14 .

A-32 T=90° 49.29 @ 14°29' = 47.723
49.19 @ 14°02'30" = 47.720 M= 47.72 .

A-33 T= 96° 45.99 Level M= 45.99 .

Total = 529.94 .

See F.B. 4342-73 for Sec. Cor. 6-85, D.L.B.

CONT TOP OF PG 180

℄ LINE See F.B. 3490-60

For Intcr. F.B. 3490-60

60.55

M=529.94 .

M= 622.67 .

CONT BOT OF PG 182

℄ LINE

P.O.T. 52+80.00 A-33
Set 2" I.P.E. CO. TAG IN CONC. PLUG. PIPE FLUSH WITH GROUND ON SIDE HILL IN ROCK MOUND.

R15W

SEC 8

SEC 17

F. B. 7499 PG. 182

CONT. BOT. OF PG. 193

B-1	#199 T= 82°	(58.30') @ 24°50'20" = 52.906		
		(57.99') @ 24°10'50" = 52.901	M = 52.90	T 5N / SEC 7
B-2	T= 64°	225.76 (225.73) @ 19°04'15" = 213.339		
		225.40 (225.37) @ 18°48'35" = 213.337	M = 213.34	
B-3	T=70°	282.91 (282.88) @ 19°22'50" = 266.852		
		282.63 (282.60) @ 19°13'10" = 266.850	M = 266.85	
B-4	T=70°	92.52 (92.51) @ 14°22'10" = 89.582		
		92.39 (92.38) @ 14°07'25" = 89.587	M = 89.58	
			TOTAL = 622.67'	

CONT. TOP OF PG 181

M = 622.67'

M = 878.31'

LINE

59+02.67 B-4

P.O.T. SET 2" I.P. CONC. PLUG & CO. ENGR. TAG FLUSH IN ROCK MOUND ON RIDGE

R 15 W / SEC 8

PLEASE RETURN TO
COUNTY OF LOS ANGELES
DEPARTMENT OF COUNTY ENGINEER
403 LOS ANGELES COUNTY ENGINEERING BLDG.

Note: Any Additions or Changes on This Sheet Must Be Made or Circled in Red Ink With Date and Name of Person Making Change.

Do not extend this side of this line.

76F309S CE#310 3-68

PLEASE RETURN TO
COUNTY OF LOS ANGELES
DEPARTMENT OF COUNTY ENGINEER
403 LOS ANGELES COUNTY ENGINEERING BLDG.

Note: Any Additions or Changes on This Sheet Must be Made or Circled in Red Ink With Date and Name of Person Making Change.

Do not extend this side of this line.

TAPE #199

T5N
SEC 7

B-5	T=72°	47.32 @ LEV.		M= 47.32
B-6	T=74°	263.40 (263.38) @ 3°-36'-00" = 262.861 263.48 (263.46) @ 3°-53'-00" = 262.854		M= 262.86
B-7	T=74°	109.39 (109.38) @ 18°-23'-30" = 103.793 109.67 (109.66) @ 18°-56'-00" = 103.788		M= 103.79
B-8	T=80°	101.30 @ 16°-44'-00" = 97.010 101.14 @ 16°-25'-40" = 97.011		M= 97.01
B-9	T=76°	244.41 (244.40) @ 7°-49'-00" = 242.129 244.46 (244.45) @ 7°-55'-00" = 242.120		M= 242.12
B-10	T=76°	127.08 (127.07) @ 9°-48'-00" = 125.216 126.94 (126.93) @ 9°-27'-30" = 125.205		M= 125.21
			TOTAL =	878.31

Notes Ck'd by
Map No.
Office Work
Checked
Date

Survey of Sections in T5N R15W
JN 023 a.o. Tape 199 Std. 8 4° F
Surveyed by FE Brooks
Notes by G.G. Izard Date 10-8-70
Indexed by D.J. GALLI 11 4 72

F. B. 3499 PG. 183

CONT TOP OF RIDGE

M = 878.31

RIDGE LINE

M= 1275.88

CONT BOT OF RIDGE

67+80.98 B-10
P.O.T. SET 2" I.P. CONC. PLUG & CO. TAG. FLUSH IN ROCK MOUND ON RIDGE

R 15 W
SEC 8

PLEASE RETURN TO
COUNTY OF LOS ANGELES
DEPARTMENT OF COUNTY ENGINEER
403 LOS ANGELES COUNTY ENGINEERING BLDG.

Note: Any Additions or Changes on This Sheet Must be Made or Circled in Red Ink With Date and Name of Person Making Change.

Do not extend this side of this line.

F.B. 3499 PG 184

CONT BOT OF PG 185

CONT TOP OF PG 182

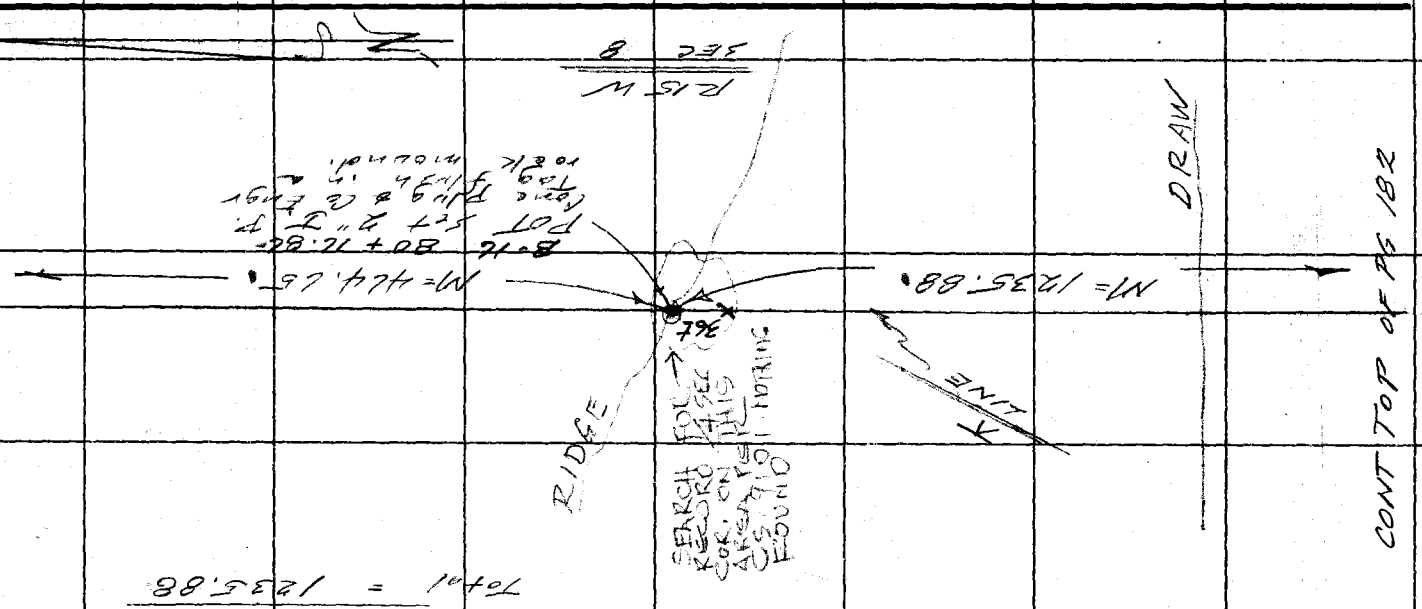

B-11	T= 84°	21.49	Level	=	21.49
		193.36	@ 3°37'	= 192.975	N1= 192.97
B-12	T= 84°	193.36	43 2.6		
B-13	T= 64°	209.30 (209.27)	@ 1°07'	= 209.230	N1= 109.24
		209.32 (209.29)	@ 1°16'	= 209.239	
B-14	T= 74°	300.92 (300.90)	@ 1°01'	= 300.848	N1= 300.85
		300.95 (300.93)	@ 1°14'	= 300.820	
B-15	T= 74°	233.25 (233.22)	@ 1°45'	= 233.157	N1= 237.16
		233.22 (233.20)	@ 1°08'	= 233.153	
B-16	T= 820	279.78	@ 60°10'	= 279.160	N1= 278.17
		279.91	@ 60°22'	= 279.182	

Total = 1235.88

76F309S CE#310 3-68

PLEASE RETURN TO
COUNTY OF LOS ANGELES
DEPARTMENT OF COUNTY ENGINEER
403 LOS ANGELES COUNTY ENGINEERING BLDG.

Note: Any Additions or Changes on This Sheet Must be Made or Circled in Red Ink With Date and Name of Person Making Change.

Do not extend this side of this line.

T 5 N
SEC. 7

B-17 #193	Δ=78°	254.04 (254.03) @ 7°27'	= 251.885	M = 251.89
		253.92 (253.92) @ 7°15'	= 251.888	
B-18	T=72°	102.96 (102.95) @ 22°00'30"	= 95.448	M = 95.45
		102.65 (102.64) @ 21°34'30"	= 95.449	
B-19	T=72°	120.14 (120.13) @ 12°26'	= 117.312	M = 117.31
		120.34 (120.33) @ 12°51'30"	= 117.313	
			Total =	464.65
B-20	T=76	33.25	Level =	33.25

Survey of Sections in T 5 N R 15 W
JN 03 02 - 01 Tape 1997 Std. 8 1/4 °F
Surveyed by F.E.B. Date 13 Oct 70
Notes
Indexed C. J. CALLI APR 14 72

Notes Ck'd by
Map No.
Office Work
Checked
Date

F. B. 34199 PG. 185

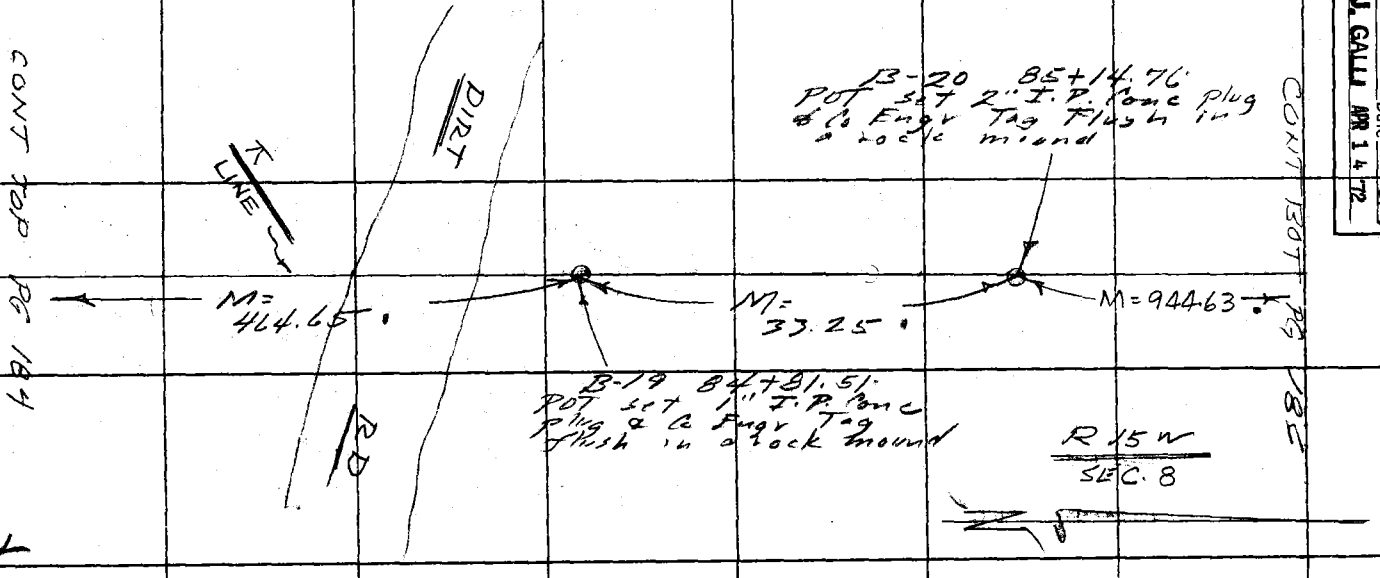

F.B. 3492 PG. 186

T 5N
SEC. 7

#199

B-21 T=62° 106.83 (106.81) @ 15°40'00" = 102.842
106.69 (106.67) @ 15°23'00" = 102.848
M = 102.85

B-22 T=62° 109.01 (108.99) @ 20°09'20" = 102.315
108.78 (108.76) @ 19°48'10" = 102.327
M = 102.32

B-23 T=62° 138.95 (138.93) @ 22°33'20" = 128.303
138.69 (138.67) @ 22°17'20" = 128.308
M = 128.31

B-24 T=66° 249.95 (249.92) @ 4°34'00" = 249.127
249.83 (249.80) @ 4°15'00" = 249.113
M = 249.12

B-25 T=54° 274.61 (274.56) @ 3°41'00" = 274.123
274.57 (274.52) @ 3°20'00" = 274.138
M = 274.13

B-26 T=60° 87.91 @ LEVEL
M = 87.90

TOTAL = 944.63

CONT. TO PG 185

M = 944.63

B-26 94+59.39
P.O.T. SET 2" I.P.
CONC. PLUG & COENGR
TAG. FLUSH IN A
ROCK MOUND ON
SIDE OF HILL

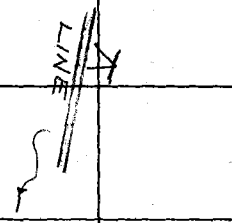

M = 957.71

CONT. FROM PG 187

R 15 W
SEC. 8

Do not extend this side of this line.

PLEASE RETURN TO
COUNTY OF LOS ANGELES
DEPARTMENT OF COUNTY ENGINEER
403 LOS ANGELES COUNTY ENGINEERING BLDG.

Note: Any Additions or Changes on This Sheet Must be Made or Circled in Red Ink With Date and Name of Person Making Change.

76F3095 CE#310 3-68

PLEASE RETURN TO
COUNTY OF LOS ANGELES
DEPARTMENT OF COUNTY ENGINEER
403 LOS ANGELES COUNTY ENGINEERING BLDG.

Note: Any Additions or Changes on This Sheet Must be Made or Circled in Red Ink With Date and Name of Person Making Change.

Do not extend this side of this line.

T5N
SEC. 7

#199

B-27 T=68° 103.49 (103.48) @ 10°16'30" = 101.820
103.46 (103.45) @ 10°09'30" = 101.827
M = 101.82

B-28 T=52° 276.48 (276.42) @ 5°53'00" = 274.971
276.58 (276.52) @ 6°01'00" = 274.996
M = 274.98

B-29 T=54° 225.87 (225.83) @ 1°43'00" = 225.728
225.91 (225.87) @ 1°56'00" = 225.741
M = 225.73

B-30 T=60° 297.89 (297.84) @ 6°51'00" = 295.713
297.79 (297.74) @ 6°43'00" = 295.697
M = 295.70

B-31 T=68° 59.49 @ LEVEL = 59.48
M = 59.48

TOTAL = 957.71

B-33 T=58° 149.53 (149.50) @ 14°35'00" = 144.683
149.30 (149.27) @ 14°14'30" = 144.682
M = 144.68

B-32 T=60° 1.78 @ LEVEL
M = 1.78

CONT FROM PG 186

T LINE

M = 144.68

B-33 105+61.78
SET 1X2" NAIL
P.O.T. FLUSH ON
SIDE HILL

M = 957.71

142.90 CALC.

M = 551.83

1.78

B-32 105+60.00
P.O.T. SET 2" I.P.
CONC. PLUG & CO. TAG
FLUSH IN A ROCK
MOUND ON SIDE HILL

B-31 104+17.10
P.O.T. SET 2" I.P.
CONC. PLUG & CO. TAG
FLUSH IN A ROCK
MOUND ON SIDE HILL

CONT TO PG 188

R15W
SEC 8

Notes Ck'd by
Map No.
Office Work
Checked
Date

Survey of Sections in T5N R15W
JN 03302.01 Tape 119 Std 4 °F
Surveyed by [illegible]
Notes by G. Guizado Date 2-2-70
Indexed by D. J. GALLI APR 1 '72

F.B. 3499 PG. 187

TAPE # 199

C-1	T=60°	219.33 (219.30) @ 10°-30'-30" =	215.622	
		219.18 (219.15) @ 10°-17'-30" =	215.626	M = 215.62
C-2	T=58°	271.33 (271.28) @ 16°-08'-30" =	260.586	
		271.18 (271.13) @ 16°-02'-40" =	260.569	M = 260.58
C-3	T=60°	76.28 (76.27) @ 7°-23'-30" =	75.636	
		76.18 (76.17) @ 6°-48'-00" =	75.634	M = 75.63
			TOTAL =	551.83

T 5N 1
SEC 6

F. B. 3499 PG 186

CONT BOT PG 189

C-3 111+13.61
P.O.T. SET 2" I.P
CONC. PLUG & CO. TAG
FLUSH IN A ROCK
MOUND ON TOP OF
WIDE RIDGE.

CENT TRIP REF. 1911

493'±
~~867'±~~

M = 551.83

M = 838.93

RIDGE

SEARCHED FOR RECORD
SEC. COR. ON THIS AREA
PER C.S. 9101 NOTHING
FOUND

R 15 W
SEC. 5

PLEASE RETURN TO
COUNTY OF LOS ANGELES
DEPARTMENT OF COUNTY ENGINEER
403 LOS ANGELES COUNTY ENGINEERING BLDG.

Note: Any Additions or Changes on This Sheet Must Be Made or Circled in Red Ink With Date and Name of Person Making Change.

Do not extend this side of this line.

76F3095 CE#310 1-65

PLEASE RETURN TO
LOS ANGELES COUNTY ENGINEER
403 LOS ANGELES COUNTY ENGINEERING BLDG.

Note: Any Additions or Changes on This Sheet Must be Made or Circled in Red Ink. With Date and Name of Person Making Change.

Do not extend this side of this line.

TAPE #199

T5N
SEC. 6

C-4	T= 66°	172.10 (172.08) @ 6°-52'-30" = 170.842	M = 170.84	
		172.01 (171.99) @ 6°-37'-30" = 170.842		
C-5	T= 68°	169.16 (169.14) @ 8°-52'-30" = 167.115	M = 167.12	
		169.00 (168.98) @ 8°-30'-30" = 167.121		
C-6	T= 72°	100.12 (100.11) @ 19°-04'-15" = 94.614	M = 94.61	
		99.84 (99.83) @ 18°-37'-00" = 94.606		
C-7	T= 66°	134.77 (134.75) @ 22°-42'-25" = 124.305	M = 124.30	
		134.61 (134.59) @ 22°-33'-16" = 124.297		
C-8	T= 64°	250.50 (250.47) @ 9°-05'-00" = 247.329	M = 247.33	
		250.62 (250.59) @ 9°-14'-30" = 247.337		
C-9	T= 76°	22.90 @ LEV. = 22.90	M = 34.73	
		11.83 @ LEV. = 11.83		
		34.73		
			TOTAL = 838.93	

Notes Ck'd by
Map No.
Office Work
Checked
Date

Survey of Sections in T5N R15W
JN0302-01 Topo 193 Std. 314 °F
Surveyed by F.E. Brooks
Notes Compiled Date 2/6/67
Indexed R.M. GALLI M1A 72

CONT TOP PG. 188

M = 838.93'

C-9 119+52.54'
P.O.T. SET 2" I.P.
CONC. PLUG & CO. TAG.
FLUSH IN A ROCK
MOUND

LINE 1 2

M = 1176.21'

CONT BOT PG. 190

R15W
SEC. 5

F.B. 3199 PG. 189

TAPE #199

C-10 T=68° 95.85 (95.84) @ 15°-27'-45" = 92.371
96.04 (96.04) @ 15°-52'-00" = 92.380
M = 92.38

C-11 T=68° 218.04 (218.02) @ 20°-41'-20" = 203.959
218.15 (218.13) @ 20°-45'-55" = 203.958
M = 203.96

C-12 T=70° 177.63 (177.61) @ 15°-15'-50" = 171.343
177.47 (177.45) @ 15°-04'-40" = 171.340
M = 171.34

C-13 T=70° 194.08 (194.06) @ 15°-11'-30" = 187.279
194.37 (194.35) @ 15°-30'-35" = 187.271
M = 187.27

C-14 T=78° 105.50 (—) @ 9°-02'-00" = 104.191
105.61 (—) @ 9°-24'-00" = 104.191
M = 104.19

C-15 T=78° 91.64 (—) @ 14°-18'-10" = 88.218
90.94 (—) @ 14°-02'-15" = 88.223
M = 88.22

C-16 T=78° 283.11 (283.10) @ 3°-08'-00" = 282.678
283.16 (283.15) @ 3°-24'-00" = 282.665
M = 282.67

C-17 T=78° 34.30 @ LEV = 34.30
M = 34.30

C-17A T=78° 11.88 @ LEV = 11.88
M = 11.88

TOTAL = 1176.21

T4S R5W SEC 6

LE 8-34-79 PG 190

C-17A 131+28.75' P.O.T. SET 2" I.P. CONC. PLUG & CO TAG FLUSH IN A ROCK MOUND

CONT TOP PG. 189

M = 1176.21

M = 11.88

197±

M = 1076.16

CONT BOT PG. 191

C-17 131+16.87' SET 1/2" I.P. FLUSH

SEARCHED FOR RECORD 1/4 SEC. WITNESS COR PER C.S. 9101 NOTHING FD

R15W SEC. 5

PLEASE RETURN TO
LOS ANGELES COUNTY ENGINEER
403 LOS ANGELES COUNTY ENGINEERING BLDG.

Do not extend this side of this line.

Note: Any Additions or Changes on This Sheet Must be Made or Circled in Red Ink With Date and Name of Person Making Change.

76F3098 CE#310 1-65

PLEASE RETURN TO
LOS ANGELES COUNTY ENGINEER
403 LOS ANGELES COUNTY ENGINEERING BLDG.

Note: Any Additions or Changes on This Sheet Must be Made or Circled in Red Ink With Date and Name of Person Making Change.

Do not extend this side of this line.

TAPE # 199

T5N
R15W
SEC. 6

C-18	T= 78°	60.10 (—) @ 9°14'00" = 59.321 60.30 (—) @ 10°20'00" = 59.321	M=	59.32
C-19	T= 86°	121.61 (—) @ 14°56'40" = 117.495 121.43 (—) @ 14°37'10" = 117.499	M=	117.50
C-20	T= 78°	265.22 (265.21) @ 8°43'00" = 262.146 265.12 (265.11) @ 8°33'00" = 262.164	M=	262.15
C-21	T= 78°	33.06 @ LEV = 33.06	M=	33.06
C-22	T= 78°	300.16 (300.15) @ 12°37'00" = 292.901 299.95 (299.94) @ 12°26'15" = 292.900	M=	292.90
C-23	T= 82°	129.90 (—) @ 3°20'30" = 129.679 130.00 (—) @ 3°57'30" = 129.689	M=	129.68
C-24	T= 88°	181.55 @ LEV =		181.55
			TOTAL =	1076.16

Notes Ck'd by
Map No.
Office Work
Checked
Date

Survey of SECTIONS IN T5N R15W
JN 03302 dl tape 199 Std. 24 °F
Surveyed by F.C. BROOKS
Notes COGGINS & GALLI
Indexed by M.J. GALLI 2L Date 24 Nov 70

F.B. 3499 PG. 47

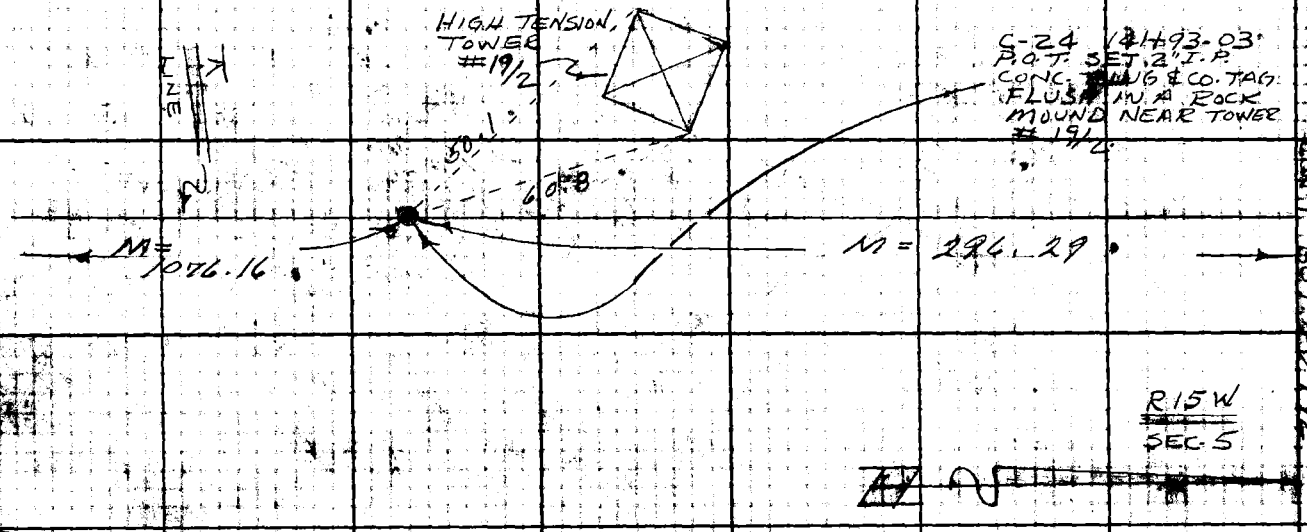

R15W
SEC. 5

PLEASE RETURN TO
LOS ANGELES COUNTY ENGINEER
403 LOS ANGELES COUNTY ENGINEERING BLDG.

Note: Any Additions or Changes on This Sheet Must be Made or Circled in Red Ink With Date and Name of Person Making Change.

Do not extend this side of this line.

F.B. 3499 Pg. 122

T5N
R15W
SEC. 6

CONT. BOT. PG. 193

CONT. TOP PG. 191

HIGHLINE ROAD

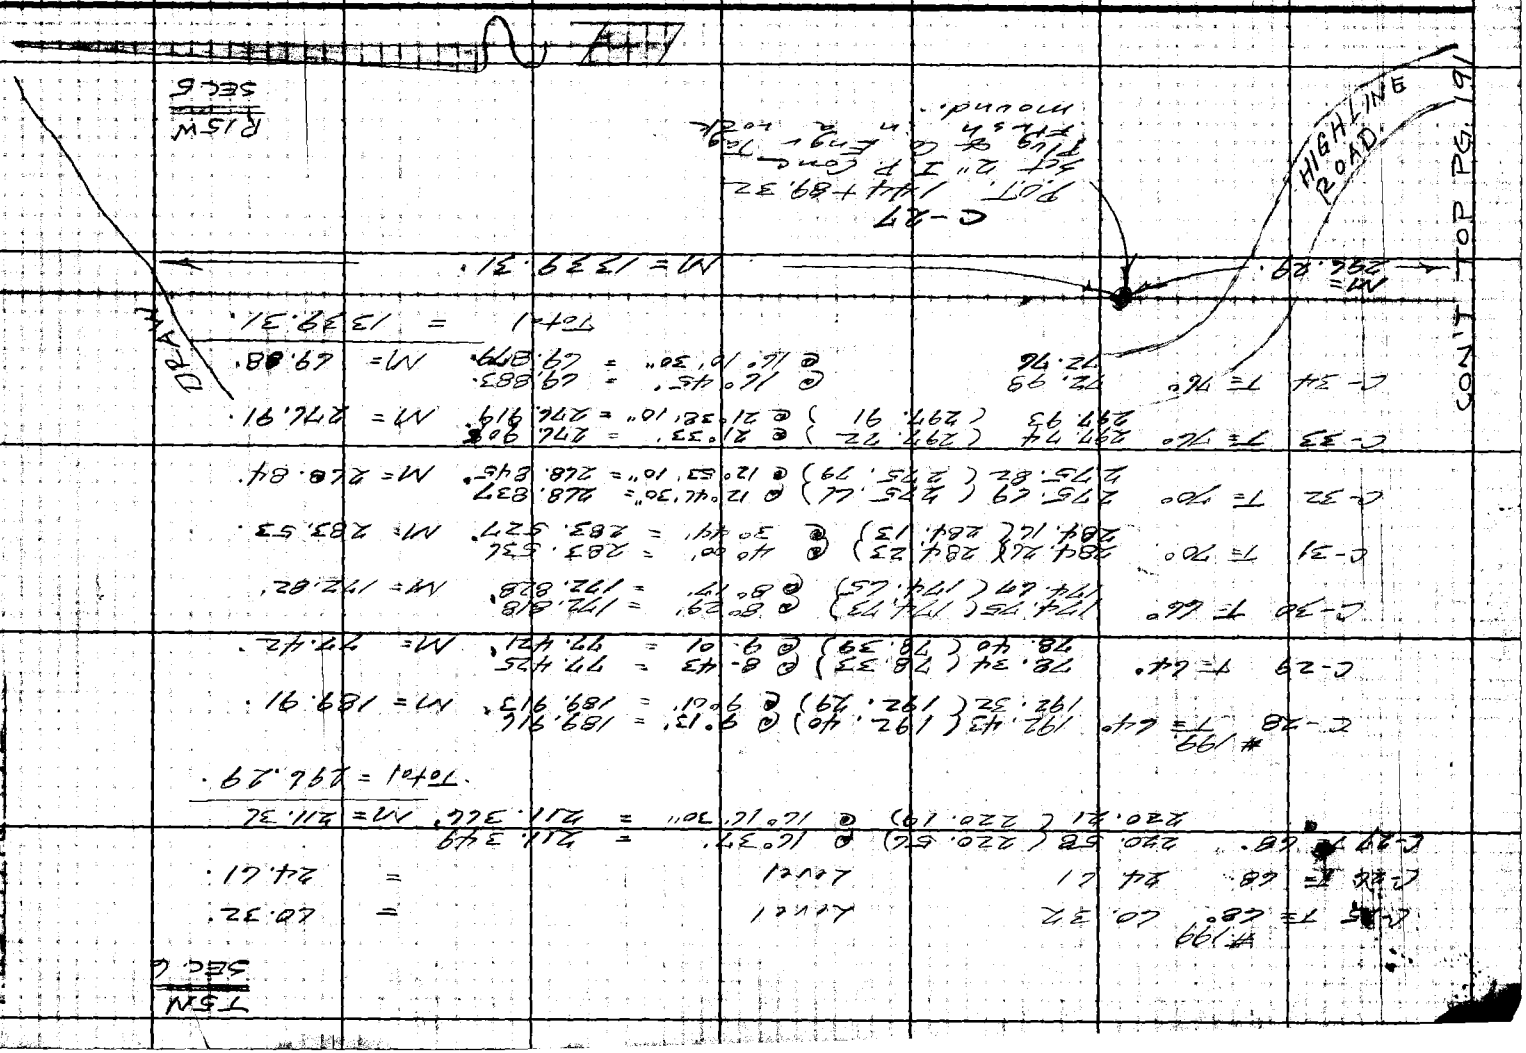
C-27
POT. 1444+89.32
PI 2+12.4 Elev. 7629.
Mound.
M = 1329.31
M = 1329.31
C-34 Δ 76° 72.99 @ 16°45' = 69.883 @ 16°30" = 69.879 M = 69.88
C-33 Δ 76° 299.74 (297.72) @ 21°33' = 274.90 (297.91) @ 21°32'10" = 274.919 M = 274.91
C-32 Δ 70° 275.29 (275.44) @ 12°41'30" = 268.837 (275.82) @ 12°53'10" = 268.894 M = 268.84
C-31 Δ 70° 284.45 (284.23) @ 40°00' = 283.531 (284.12) @ 39°44' = 283.527 M = 283.53
C-30 Δ 66° 174.75 (174.73) @ 8°29' = 172.818 (174.47) (174.25) @ 8°17' = 172.828 M = 172.82
C-29 Δ 64° 78.34 (78.33) @ 8.43 = 79.475 78.40 (78.39) @ 9.01 = 79.421 M = 79.42
C-28 Δ 64° #192 192.43 (192.40) @ 9°13' = 189.915 192.32 (192.29) @ 9°01' = 189.913 M = 189.91
Total = 296.29
C-27 Δ 68° 220.52 (220.62) @ 16°37' = 214.349 220.21 (220.19) @ 16°16'30" = 214.346 M = 214.34
C-26 Δ 68° 44.61 = 24.61
C-25 Δ 68° 44.61 = 46.32
T5N
SEC. 6

76F3095 CE#310 3-68

PLEASE RETURN TO
COUNTY OF LOS ANGELES
DEPARTMENT OF COUNTY ENGINEER
403 LOS ANGELES COUNTY ENGINEERING BLDG.

Note: Any Additions or Changes on This Sheet Must be Made or Circled in Red Ink With Date and Name of Person Making Change.

Do not extend this side of this line.

#199

C-35 T= 76° 95.89 @ 14°08' = 92.987.
95.75 @ 13°48' = 92.985 M= 92.99.

C-36 T= 60° 276.91 (276.87) @ 19°47'40" = 260.512.
T= 66° 276.95 (276.92) @ 19°50' = 260.493 M= 260.50.

C-37 T= 70° 225.69 (225.67) @ 2°25' = 225.469.
225.73 (225.711) @ 2°32' = 225.488 M= 225.48.

C-38 T= 70° 129.50 (129.49) @ 3°21' = 129.268
129.47 (129.46) @ 3°02' = 129.278 M= 129.27.

Total = 708.24.

T5N
SEC 6

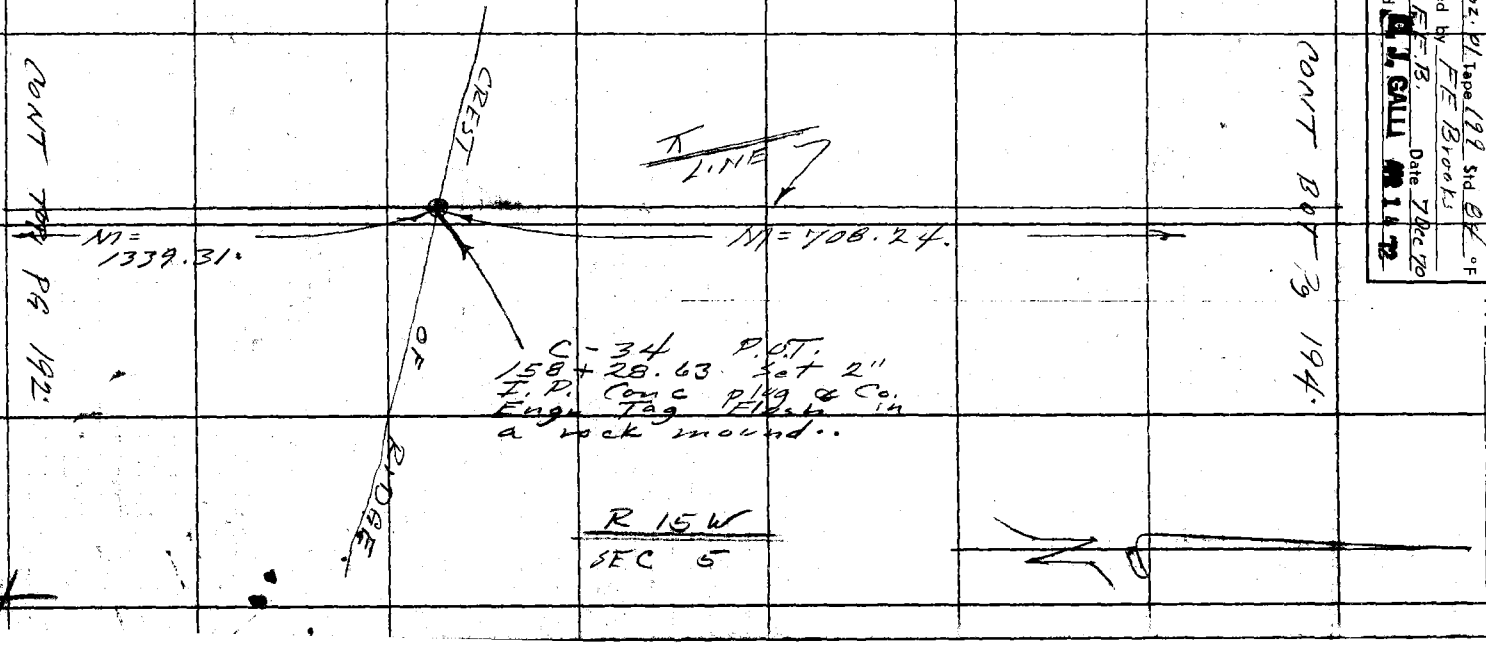

Notes Ck'd by
Map No.
Office Work
Checked
Date

Survey of Sections in T5N R15W
JN 0302. Pl. Tape 191 Std. 8K °F
Surveyed by FE Bronks
Notes FE B. Date 7 Dec 70
Indexed by L. J. CALLI MAR 14 72

F. B. 3499 PG. 193

F.B. 2482 PG. 194

T5N
SEC 6

#199

C-39	T=66°	95.84 (95.83)	@	15°46'	= 92.224.	M = 92.23.
		95.98 (95.97)	@	16°03'	= 92.229	
C-40	T=50°	115.00 (114.97)	@	19°20'	= 108.486.	M = 108.48.
		114.83 (114.80)	@	19°05'40"	= 108.483	
C-41	T=50°	86.88 (86.86)	@	21°07'	= 81.027.	M = 81.03.
		86.94 (86.92)	@	21°13'	= 81.028	
C-42	T=52°	214.74 (214.70)	@	19°45'	= 202.071.	M = 202.08.
		214.62 (214.58)	@	19°39'	= 202.082	
C-43	T=56°	77.91 (77.90)	@	26°45'40"	= 69.556.	M = 69.56.
		77.68 (77.69)	@	26°25'20"	= 69.555	
C-44	T=54°	98.45 (98.43)	@	26°52'20"	= 87.801	M = 87.80.
		98.24 (98.24)	@	26°39'40"	= 87.802	
C-45	T=50°	198.74 (198.70)	@	19°24'	= 187.417.	M = 187.42.
		198.00 (198.96)	@	19°36'40"	= 139.420	
C-46	T=50°	128.63 (128.60)	@	17°26'20"	= 122.689.	M = 122.69.
		128.75 (128.72)	@	17°36'	= 122.694	
Sec Cor.	T=52°	97.95 (97.93)	@	27°29'10"	= 86.876.	M = 86.87.
		97.76 (97.74)	@	27°16'40"	= 86.876.	

Total = 1038.16.

CONT FROM PG 193.

CONT TO PG 195.

N LINE

CREST

RIDGE

M = 708.24

M = 1038.16.

C-38 POT Set 2" I.P. 165+36.87 Brass plug & Tag Flush in rock mound.

R 15 W
SEC 5

PLEASE RETURN TO
COUNTY OF LOS ANGELES
DEPARTMENT OF COUNTY ENGINEER
403 LOS ANGELES COUNTY ENGINEERING BLDG.

Note: Any Additions or Changes on This Sheet Must Be Made and Name of Person Making Change.

Do not extend this side of this line.

Notes Ck'd by	Survey of Sections in T5N R15W
Map No.	JN 0302.04 Tape 199 Std 84 °F
Office Work	Surveyed by FE Brooks
Checked	Notes FEB Date 11 Dec 70
Date	Indexed

F. B. 3499 PG. 195

WS 77, D-3

CONT BUT PG. 202

SEC 5
T5N R15W

SEC 32
T6N R15W

RD.

DIRT

SEC LINE

N = 254.10.

N = 1038.16

LINE

N = 685.73.

N 89° 04' 39" E

2754.10 E & W = 1375.03 from S. COR. Fd 4 County Survey or Adopted

a hill 1.1 SW in a small rock mound set 2" marker pipe 2.6 Ref. pt. S.E. 800. mon.

COUNTY SURVEYOR'S MONUMENT T6N R15W SEC 6 SEC 5 T5N

CONT TOP PG 194.

CONT TOP PG 203.

SEC 6
T5 N.

Note: Any Additions or Changes on This Sheet Must be Made or Circled in Red Ink With Date and Name of Person Making Change.

Do not extend this side of this line.

PLEASE RETURN TO
COUNTY OF LOS ANGELES
DEPARTMENT OF COUNTY ENGINEER
403 LOS ANGELES COUNTY ENGINEERING BLDG.

70F3095 CE#310 3-68

PLEASE RETURN TO
COUNTY OF LOS ANGELES
DEPARTMENT OF COUNTY ENGINEER
403 LOS ANGELES COUNTY ENGINEERING BLDG.

Note: Any Additions or Changes on This Sheet Must be Made or Circled in Red Ink With Date and Name of Person Making Change.

Do not extend this side of this line.

WS 78, A-3

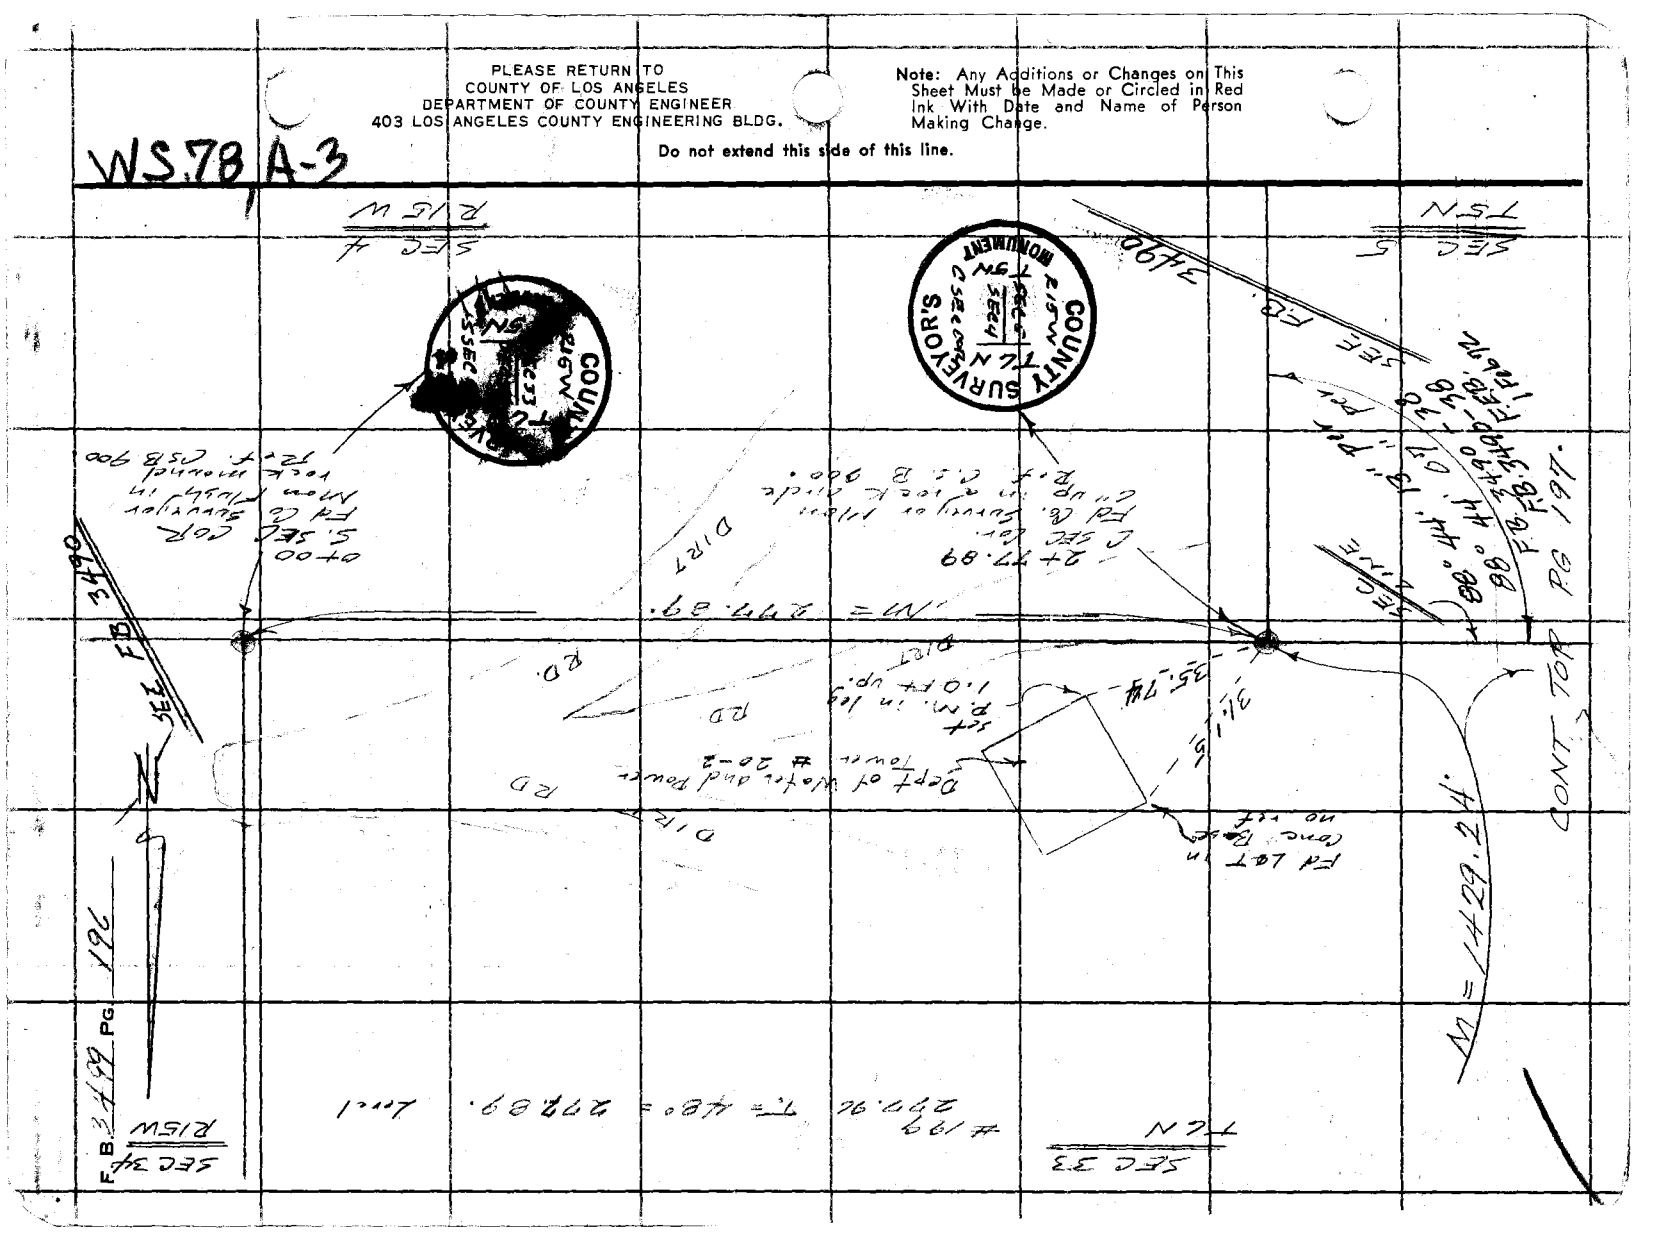
SEC 4
T5N
R16W
SEC 5
T5N
R15W
SEC 34
T6N
R15W
SEC 33
T6N
COUNTY SURVEYOR'S MONUMENT
SEC 4 T5N R16W
SEC 5 T5N R15W
SEC 33 T6N R15W
SEC 34 T6N R15W

76F3095 CE#310 3-68

PLEASE RETURN TO
COUNTY OF LOS ANGELES
DEPARTMENT OF COUNTY ENGINEER
403 LOS ANGELES COUNTY ENGINEERING BLDG.

Note: Any Additions or Changes on This Sheet Must be Made or Circled in Red Ink With Date and Name of Person Making Change.

Do not extend this side of this line.

Notes Ck'd by
Map No.
Office Work
Checked
Date

Survey of Sec in T5N R15W
JN 0302.01 Tape/99 Std ± °F
Surveyed by F.E. Brooks
Notes F.B.
Indexed D. J. GALLI Date 23 FEB 72

F. B. 3499 PG. 197

SEC 33
T5N R15W

#1	T= 52°	#199 14.38	Level		M= 14.38.
#2	T= 54°	292.50 (292.44) @ 26°46'30"		= 291.085	
		291.90 (291.84) @ 26°32'10"		= 291.095	M= 291.09.
#3	T= 56°	292.30 (292.25) @ 5°46'		= 290.771	
		292.13 (292.08) @ 5°27'		= 290.759	M= 290.76.
#4	T= 54°	127.53 (127.51) @ 21-46-10		= 118.416	
		127.81 (127.79) @ 22-04-20		= 118.424	M= 118.42.
#5	T= 62°	67.73 (67.72) @ 12°10' =		66.198	
		67.83 (67.82) @ 12°34' =		66.195	M= 66.20.
#6	T= 60°	218.10	Level	= 218.07	M= 218.07
#7	T= 64°	206.15 (206.12) @ 16°54'30" =		197.212	
		206.28 (206.25) @ 17°01-40" =		197.208	M= 197.21.
#8	T= 72°	77.51 (77.50) @ 18-17-40 =		73.582	
		77.61 (77.60) @ 18-31 =		73.582	M= 73.58.
#9	T= 60°	167.16 (167.13) @ 12°28'30"		163.184	
		167.44 (167.41) @ 12°53'40" =		163.188	M= 163.19.
#10	T= 60°	26.34	Level		M= 26.34.
				Total =	429.24.
				M=	429.24.

CONT TOP PG 198.

CONT BOT PG 196.

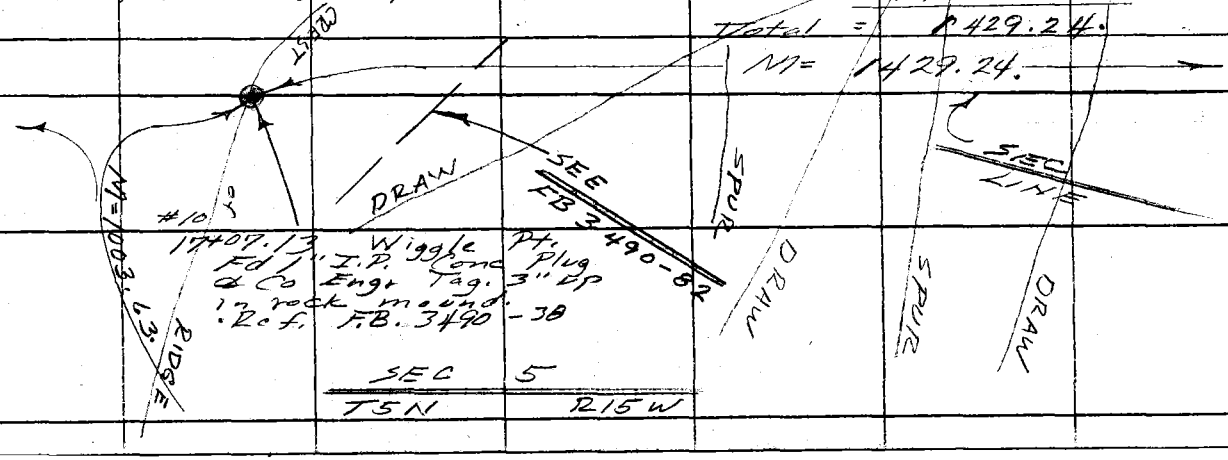

PLEASE RETURN TO
COUNTY OF LOS ANGELES
DEPARTMENT OF COUNTY ENGINEER
403 LOS ANGELES COUNTY ENGINEERING BLDG.

Note: Any Additions or Changes on This Sheet Must be Made or Circled in Red Ink With Date and Name of Person Making Change.

Do not extend this side of this line.

MS77, D-3

F.B. 3449 PG 198

SEC 33 T2N R15W

#1 199 T= 58° 35.22 Levrl = 35.22.

#12 T= 50° 270.00 (270.92) @ 11°23' 40" = 259.903 Δ 70.00 (270.64) @ 11°09' 40" = 259.893. M = 259.90.

#13 T= 49° 184.29 (184.25) @ 11°14' = 180.720. Δ 103.97 (183.93) @ 10°44' 30" = 180.709 M= 180.71.

#14 T= 54° 290.00 (290.00) @ 1°53' = 289.843 Δ 290.07 (290.01) @ 1°58' = 289.839. M= 289.84.

#15 T= 52° 214.93 (214.89) @ 2°12' = 214.094 214.91 (214.87) @ 2°12' = 214.910. M= 214.90.

5 1/4 Cir T=42° 21.27 Levrl = 21.22

Total = 1003.23.

#16 T= 46° 164.40 (164.37) @ 25°59' = 147.952 Δ 164.80 (164.76) @ 22°15' 30" = 147.757. M= 147.76.

C 1/4 Cir T= 60° 140.29 (140.25) @ 32°43' = 116.220 Δ 139.33 (139.30) @ 31°54' 30" = 118.251. M= 118.22.

Total = 266.00.

M= 1799.58' 55"

Δ 700 To W = 279.10.76 E 1/4 sec Cor.

Ref Cor. Surv. Mon. Pt. Rock Cut 8" DBL L
Pt. 3490-38
2" Meter Pipe
4.5 ft. N. of LINE

M1 = 1497.99

M = 2266.02.

M = 1003.23.

Cont Top Pg 199.

M = 489.40

Cont Bot Pg 197.

1) 179-68-40
2) 359-55-40
3) 179-58-55
4) 359-53-30
5) 179-68-55

SURVEYOR'S 1/4 SEC MONUMENTS
T2N R15W
SEC 33
COUNTY SURVEY

DRAW
SPUR
DRAW
SPUR
DRAW
SPUR

Notes Ck'd by
Map No.
Office Work
Checked
Date

Survey of Sec 14 T5N R15W
JN 43e:01 Tape 199 Std BY "F"
Surveyed by F E Brooks
Notes F.B. Date 2-24-67
Indexed D. J. GALL MAY 1 '72

F.B. 3499 Pg. 199

Note: Any Additions or Changes on this Sheet Must be Made or Circled in Red Ink With Date and Name of Person Making Change.

Do not extend this dip of this line.

PLEASE RETURN TO
LOS ANGELES COUNTY ENGINEER
403 Los Angeles County Engineering Bldg.

CONT BOT PG 198

DRAW













N = 453.89

First

of

Ridge

CONT TOP PG 200

Jetsada Cr #310 9-67

PLEASE RETURN TO
LOS ANGELES COUNTY ENGINEER
403 Los Angeles County Engineering Bldg.

Note: Any Additions or Changes on this Sheet Must be Made or Circled in Red Ink With Date and Name of Person Making Change.

Do not extend this side of this line.

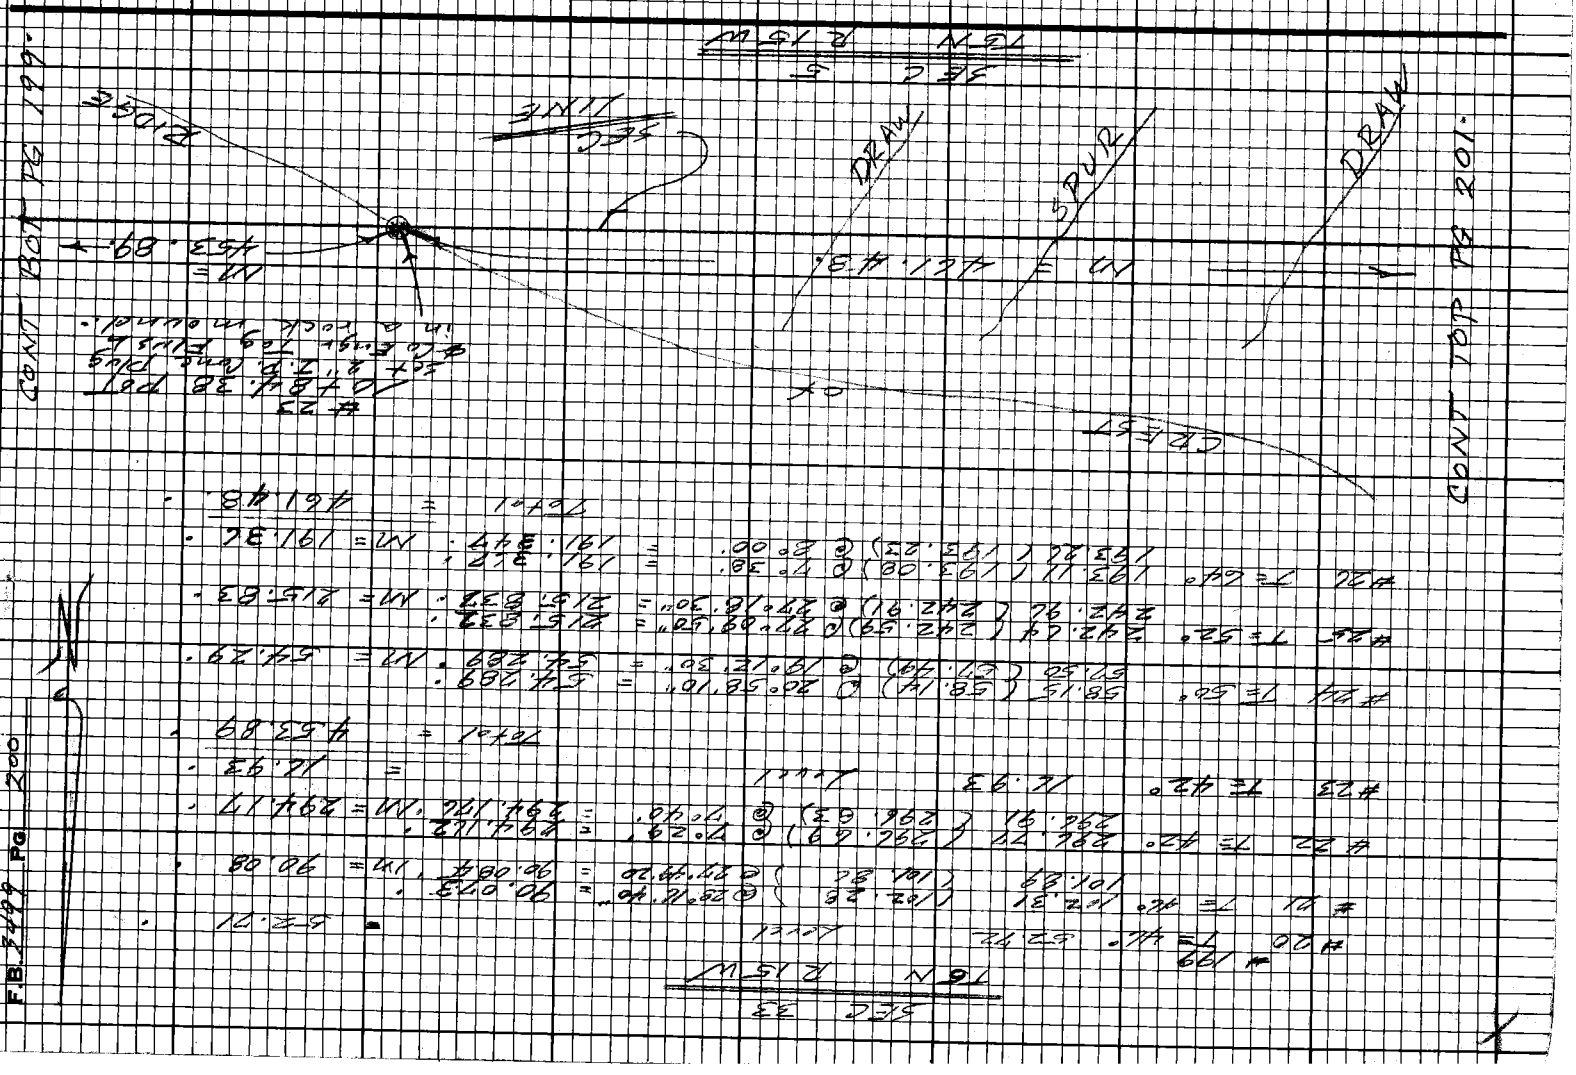

76F3095 CE#310 1-65

PLEASE RETURN TO
LOS ANGELES COUNTY ENGINEER
403 LOS ANGELES COUNTY ENGINEERING BLDG.

Note: Any Additions or Changes on This Sheet Must be Made or Circled in Red Ink, With Date and Name of Person Making Change.

Do not extend this side of this line.

Notes Ck'd by
Map No.
Office Work
Checked
Date

Survey of Sec. 33 T5N R15W
JN 42382 Stop 192 Std. 84 of
Surveyed by FE Brooks
Notes
Indexed R.D. SALL Date MAY 1 72

F. B. 3419 PG. 201

SEC 33
T5N R15W

#27 T= CC° 28.34 Level = 28.34 °

#28 T= CC° 200.35 (200.33) @ 32°46'55" = 169.695 °
199.70 (199.67) @ 31°48'10" = 169.682 ° M= 169.68 °

#29 T= CC° 294.21 (294.18) @ 29°27'10" = 256.160 °
294.05 (294.02) @ 29°24'15" = 256.144 ° M= 256.15 °

#30 T= 68° 125.27 (125.24) @ 17°43'35" = 118.312
125.55 (125.54) @ 18°06'40" = 119.320 ° M= 119.32 °

#31 T=68° 7.32 Level = 7.32 °

Total = 580.81 °

#154

12.78 T= 42° = 12.78 °

192.74 T= 42° = 192.69 °

1) 44-48-20
4) 179-13-30 1/2
44-48-22 1/2
4) 268-50-25
44-48-24 1/2 °

Baseline Cont. Top Pg 211

N1 = 192.69

CANYON

N1 = 12.78.

N = 580.81.

N = 461.48 →

Calc = 406.84 °

SEC LINE

15+45.86
#26 Chain Pt.
set 1x2 aN on
stump mill's olc

21+26.67
#33 I.P.
BR N. Conc Plug
Chain Pt.

21+79.45 P.O.T.
#31A Set 1x2 aN.

CONT. Bot. Pg 202.

SEC 5
T5N R15W

PLEASE RETURN TO
LOS ANGELES COUNTY ENGINEER
403 LOS ANGELES COUNTY ENGINEERING BLDG.

Note: Any Additions or Changes on This Sheet Must be Made or Circled in Red Ink With Date and Name of Person Making Change.

Do not extend this side of this line.

4577, D-3

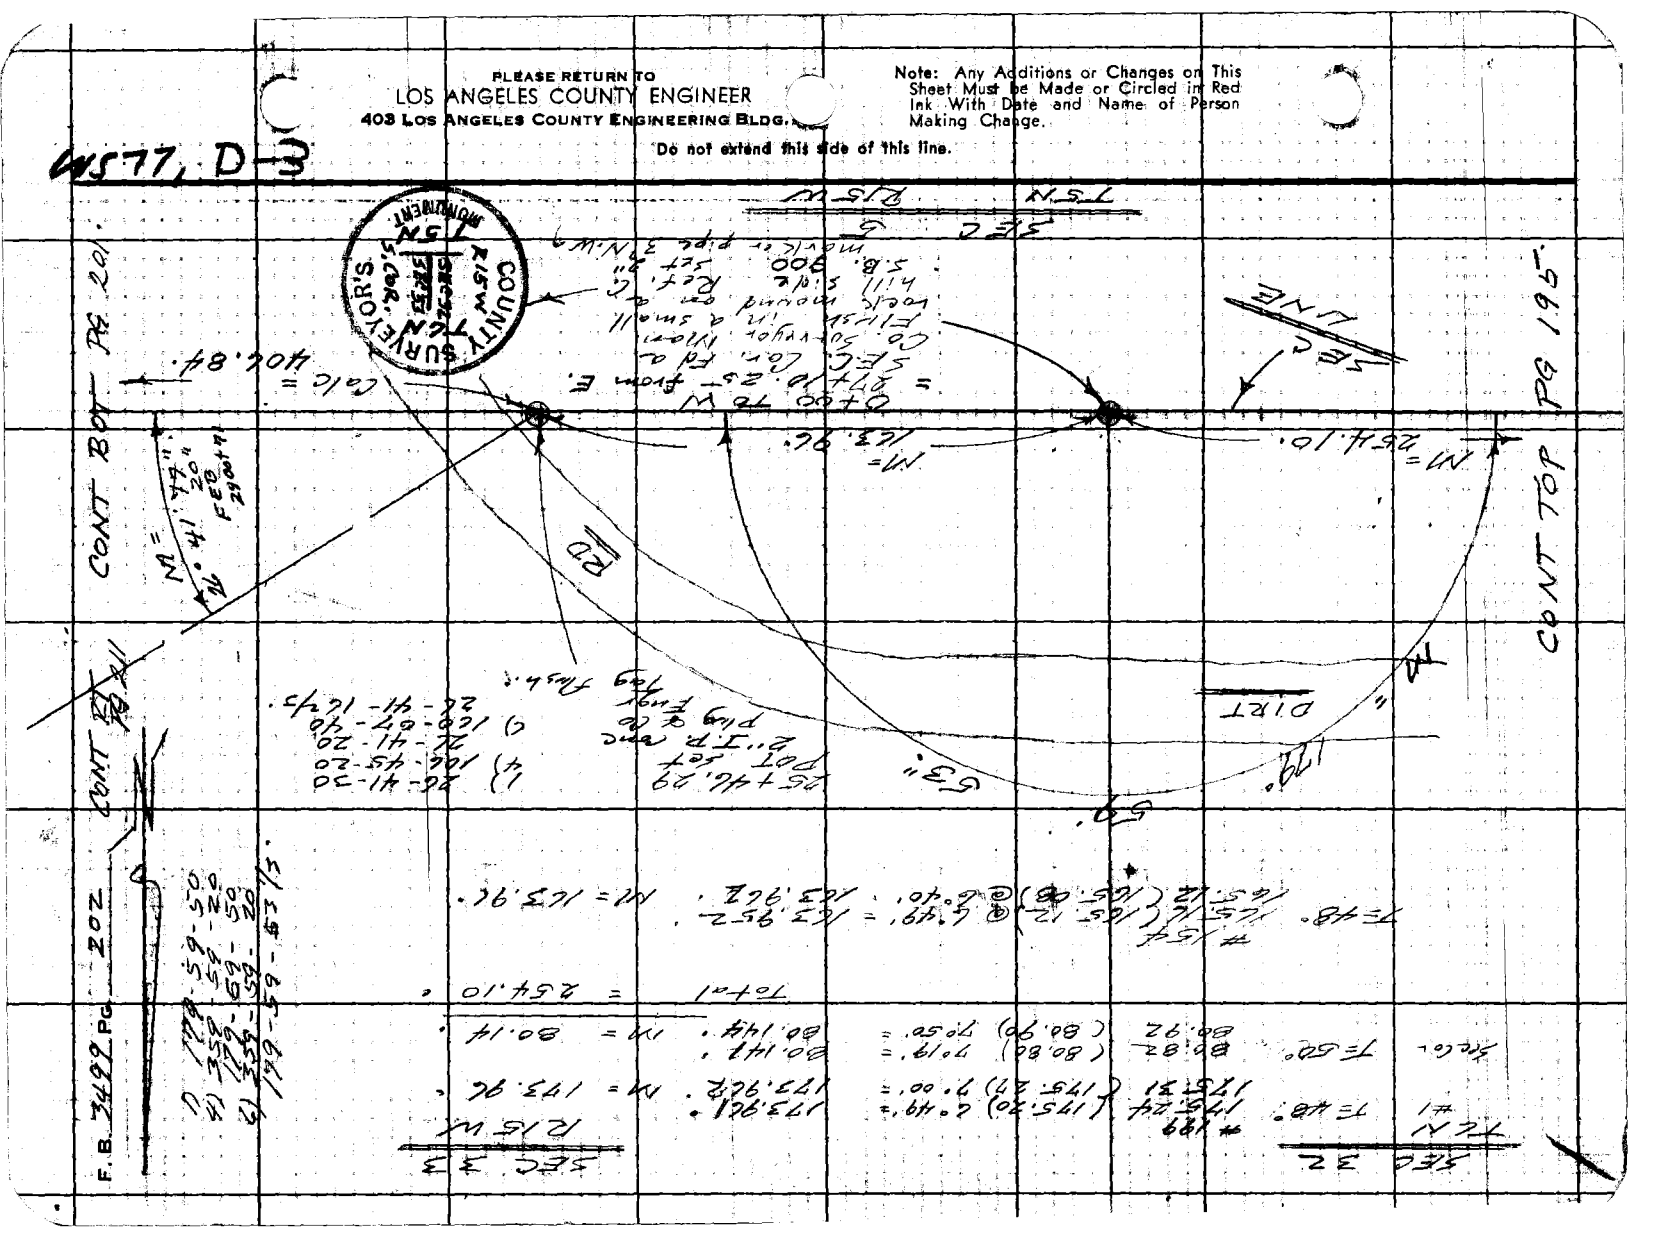

RCF3098 CE 310 9-67

PLEASE RETURN TO
LOS ANGELES COUNTY ENGINEER
403 LOS ANGELES COUNTY ENGINEERING BLDG.

Note: Any Additions or Changes on this Sheet Must be Made or Circled in Red Ink With Date and Name of Person Making Change.

Do not extend this side of this line.

SEC 32
T5N R15W

#1					
#2	T= 54°	60.39 (60.38)	@ 45° 22'	= 58.222	M= 58.22'
		60.28 (60.27)	@ 14° 58'	= 58.226	
#3	T= 60°	284.11 (284.07)	@ 3° 53'	= 277.868	M= 279.87'
		283.98 (283.94)	@ 9° 43'	= 277.847	
#4	T= 60°	105.64 (105.62)	@ 5° 03'	= 105.210	M= 105.21'
		105.73 (105.71)	@ 5° 36'	= 105.205	
#5	T= 60°	193.76 (193.73)	@ 9° 44'	= 190.949	M= 190.94'
		193.64 (193.61)	@ 9° 32'	= 190.936	
#6	T= 60°	56.03 (56.02)	@ 23° 12'	= 51.190	M= 51.49'
		56.00 (55.99)	@ 23° 09"	= 51.188	
			Total	= 685.73'	

Notes Ck'd by ____
Map No. ____
Office Work ____
Checked ____
Date ____

Survey of Sec. 32 T5N R15W
JN 6764-41 Tape 1/2" Sta 0+00 to 7+00
Surveyed by F.E.B. Date 8/21/69
Notes F.E.B.
Indexed F.E.B. Date 10-14-72

F.B. 3299 Pg. 203

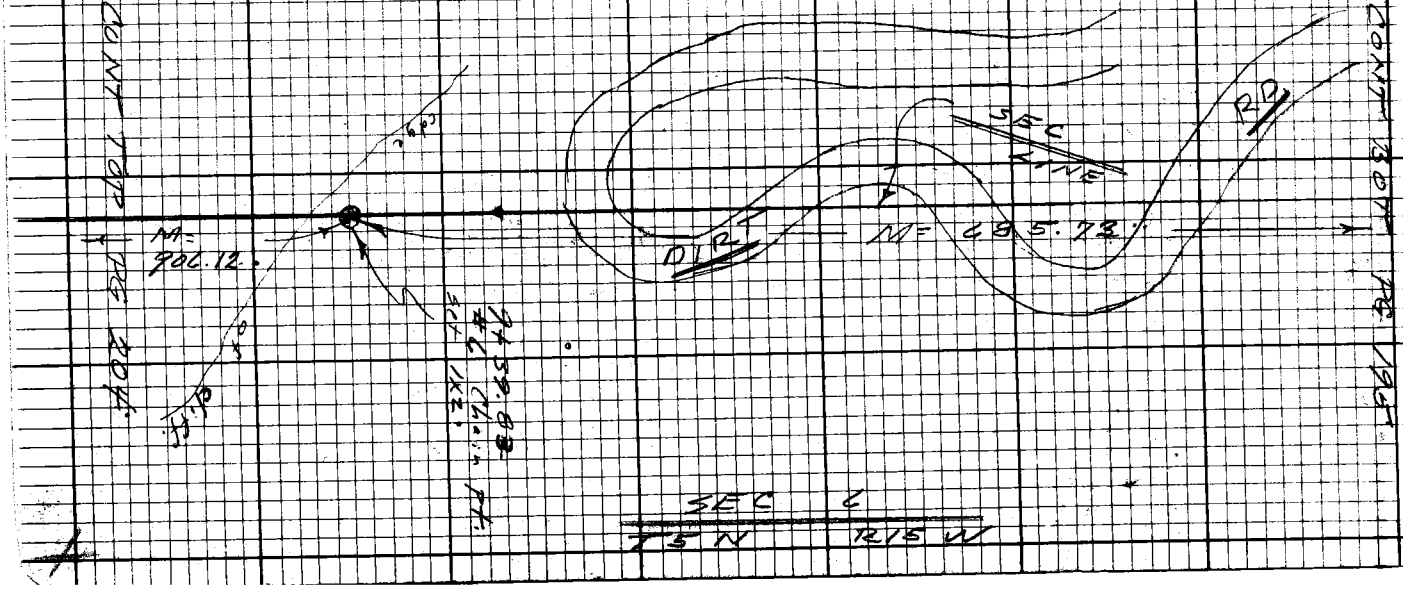

PLEASE RETURN TO
LOS ANGELES COUNTY ENGINEER
403 LOS ANGELES COUNTY ENGINEERING BLDG.

Note: Any Additions or Changes on this Sheet Must be Made or Circled in Red Ink With Date and Name of Person Making Change.

Do not extend this side of this line.

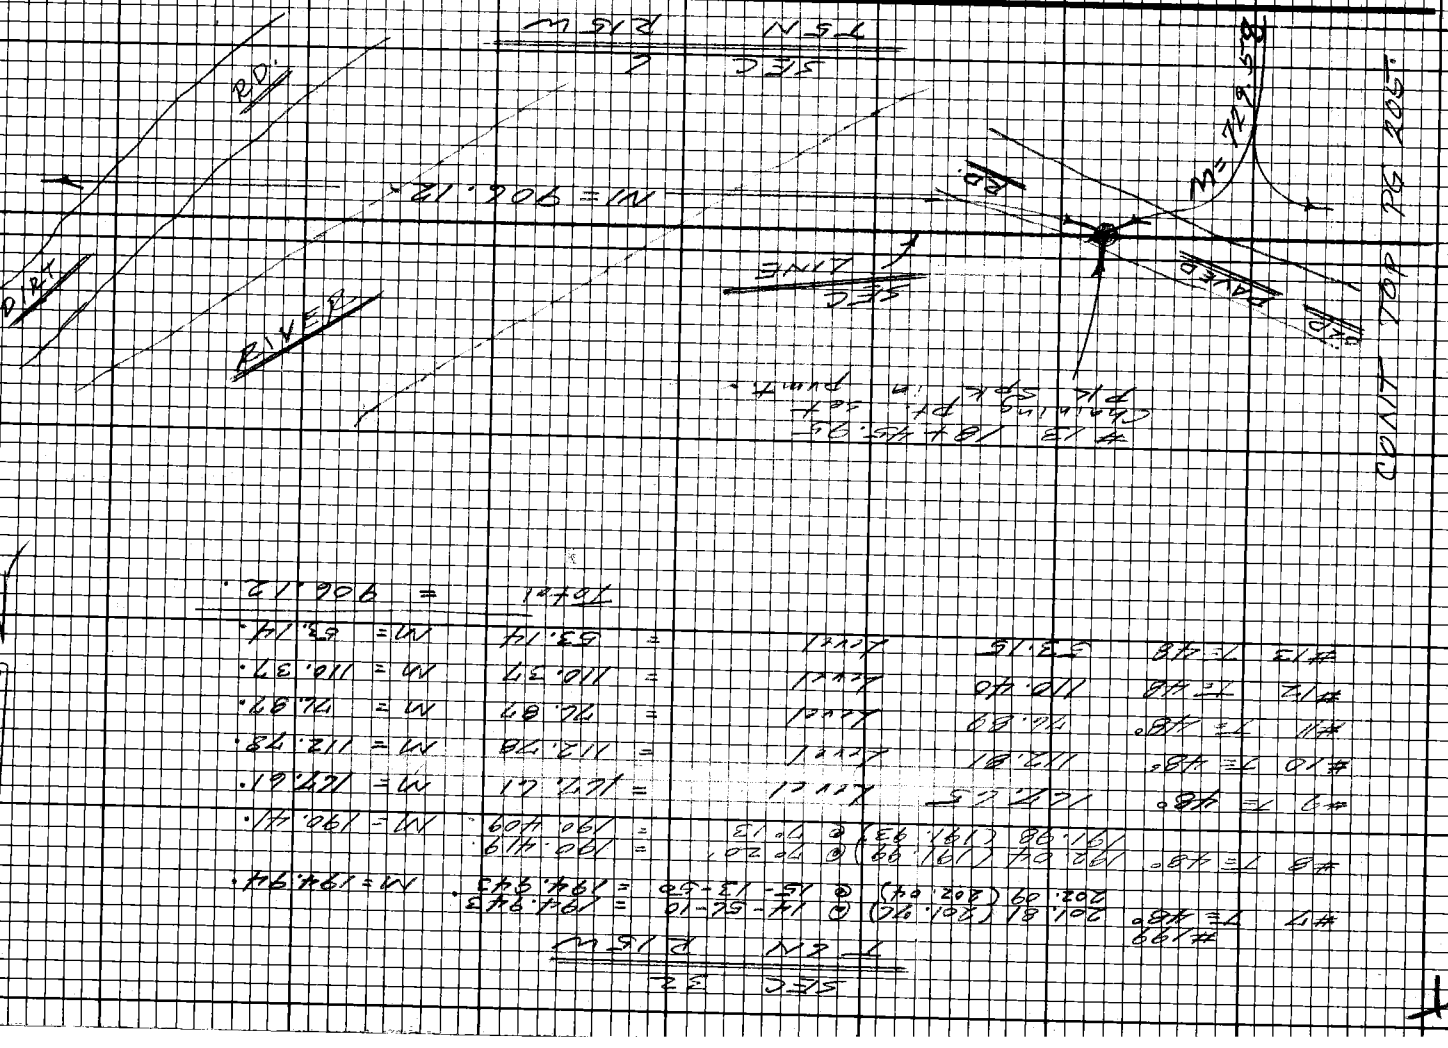

76F3098 CE#310 9-67

PLEASE RETURN TO
LOS ANGELES COUNTY ENGINEER
403 LOS ANGELES COUNTY ENGINEERING BLDG.

Note: Any Additions or Changes on this Sheet Must be Made or Circled in Red Ink With Date and Name of Person Making Change.

Do not extend this side of this line.

Notes Ck'd by _____
Map No. _____
Office Work _____
Checked _____
Date _____

Survey of Sec. 32, T2N, R15W
JN 43201 Tape 197 Sta 0+00
Surveyed by F.E. Brooks
Notes F.E.B. Date 2-22-67
Indexed F.E.B. Date 2-24-67

F.B. 2109 Pg. 2-03

SEC 32
T2N R15W

#199
#14 T=58° 271.18 (271.13) @ 10°34' = 266.533 M=266.53'.
271.21 (271.16) @ 10°36' = 266.633
#15 T=58° 75.25 (75.24) @ 4°53' = 74.966 M= 74.96'.
75.28 (75.27) @ 5°12' = 74.962
#16 T=58° 265.11 (265.01) @ 1°12' = 265.002 M= 265.00'.
265.14 (265.09) @ 1°28' = 265.002
N T=58° 127.11 (127.09) @ 1°25' = 123.088 M= 123.09'.
127.44 (127.45) @ 1°02' = 123.087
Total = 729.55'.
#17 T=60° 14.90 Level = 14.90 M= 14.90'.
#14 Sec Cor T=64° 135.01 (134.99) @ 27°18' = 119.936 M= 119.93'.
135.24 (135.22) @ 27°30'30" = 119.937
Total = 134.83'.

COUNTY ROAD

SEC LINE

M = 134.83'

25+70.58
WESTSIDE P.I.
SEC 32, T2N, R15W
BWG N'ly Co Engr
N=9°

M = 729.55'

CREST of RIDGE

DRAW

COUNTY ROAD

SEC 5
T1N R15W

PLEASE RETURN TO
LOS ANGELES COUNTY ENGINEER
403 LOS ANGELES COUNTY ENGINEERING BLDG.

Note: Any Additions or Changes on this Sheet Must be Made or Circled in Red Ink With Date and Name of Person Making Change.

Do not extend this side of this line.

LOS. 77, D-3

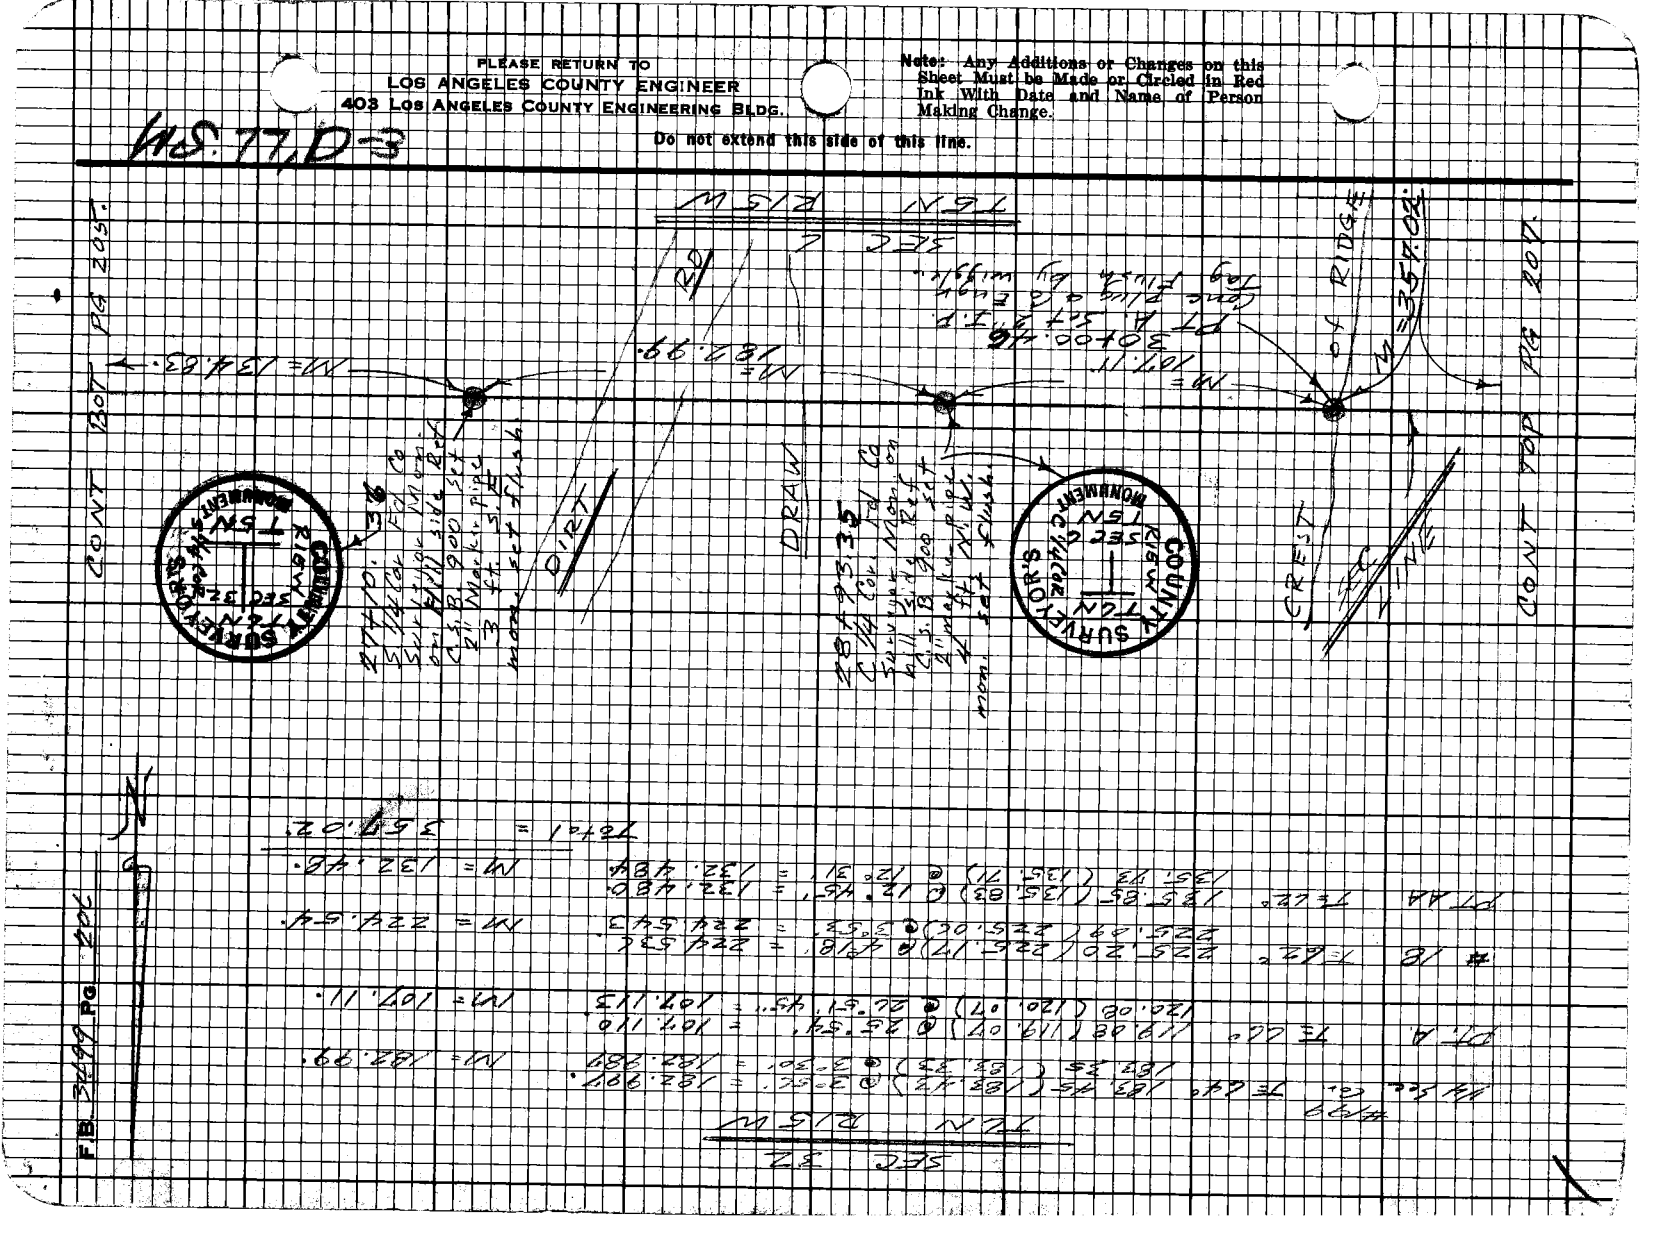

F.B. 3499 PG 102

76F3095 CE # 310 3-61

PLEASE RETURN TO
LOS ANGELES COUNTY ENGINEER
403 LOS ANGELES COUNTY ENGINEERING BLDG.

Note: Any Additions or Changes on This Sheet Must be Made or Circled in Red Ink With Date and Name of Person Making Change.

Do not extend this side of this line.

Notes Ck'd by
Map No.
Office Work
Checked
Date

Survey of Sec. in T5N R15W
JN 03202 Tape 199 Std 84 °F
Surveyed by FE Brooks
Notes FB 8 Date 2-25-47
Indexed D. J. CALLI AB 14 72

F. B. 3409 PG. 207

SEC 32
T 6N R 15W

#15 & #19 Δ = 80° 276.03 (276.02) @ 7°21' = 274.346
276.56 (276.55) @ 7°16' = 274.329 M = 274.34

#20 Δ = 76° 97.01 @ 18°32' = 91.979
96.56 @ 17°43'40" = 91.774 M = 91.98

#18 Δ = 76° 117.81 (117.80) @ 3°56' = 117.522
117.87 (117.86) @ 4°20' = 119.523 M = 117.52

Total = 483.84'

CREEK

DRAIN

CONT TOP PG 208.

38+41.38
PT. B. POT
Set 2" I.P. Conc Plug
& Co Engr Tag
Flush in rock mound

M = 483.84.

SEC LINE

CREST of ROAD

CONT

CONT TOP PG 206.

CNTY. RD.

M = 357.02.

33+57.48
PT. A.A. POT.
Set 2" I.P. Conc
Plug & Co Engr Tag
Flush in rock mound.

SAN FRANCISQUITO

NE

467.30.

R.P. 5E

SEC 6
T5N R15W

F. B. 3499 Pg. 208

CONT BOT PG 207

LOS ANGELES COUNTY ENGINEER
403 Los Angeles County Engineering Bldg.

PLEASE RETURN TO

Note: Any Additions or Changes on This Sheet Must be Made or Circled in Red Ink With Date and Name of Person Making Change.

Do not extend this side of this line.

SEC 32
T5N R15W

@ 14°47'50" = 22.203. N = 72.40.
@ 40°13' = 22.198.
@ 10°48' = 296.713
@ 20°03' = 296.799. N = 296.79.

@ 12°24'30" = 98.308.
@ 11°54'30" = 98.315. N = 98.31.
Total = 407.30.

@ 177°33'30" = 165.722. N = 165.72.
@ 17°23'10" = 165.725.

@ 7°55' = 257.502.
@ 7°44' = 257.484. N = 257.49.

@ 13°51' = 177.257. N = 177.25.
@ 14°11' = 177.250.

@ 25°27'50" = 160.618. N = 160.62.
@ 25°40'10" = 160.612.

T = 84° 12.71. 12.71.

Total = 793.99.

SEC. LINE

N = 467.30.

CONT TOP PG 209.

#21	T = 74°	74.48		
		74.48		
#22	T = 82°	296.92		
		296.99		
PT. 'C'	Δ = 90°	100.66		
		100.48		
#23	T = 82°	173.81		
		173.66		
#24	T = 81°	259.98		
		259.88		
#25	T = 82°	182.56		
		182.83		
#26	T = 84°	177.90		
		178.30		
PT. 'D'		12.71		

76F3095 CE # 310 3-61

PLEASE RETURN TO
LOS ANGELES COUNTY ENGINEER
403 LOS ANGELES COUNTY ENGINEERING BLDG.

Note: Any Additions or Changes on This Sheet Must be Made or Circled in Red Ink With Date and Name of Person Making Change.

Do not extend this side of this line.

Notes Ck'd by
Map No.
Office Work
Checked
Date

Survey of Sec. in T5N R15W
JN 0202.04 Tape 154 Std 84 °F
Surveyed by F.E. Brooks
Notes FKB Date 22 Oct 71
Indexed E.N. CALL APR 14 72

SEC 32
R15W

#154
PT 'E' T= 88° 191.71 @ L°38' = 190.426.
191.62 @ L°21' = 190.444.
M = 190.44.

#27 T=88° 24.08 Level
M = 24.08.

Std. Co. T= 92° 129.09 (129.10) @ 16°44' = 123.633.
129.31 (129.32) @ 17°02' = 123.647.
M = 123.64.

Total = 147.72'

52+72.85
PT 'E'
2" I.P. Conc Plug & Co Engr Tag Flush in rock Mound.

SEC LINE

M = 147.72.

M = 190.44.

50+82.44
PT 'D' Set 2" I.P. Conc Plug & Co Engr Tag Flush in rock Mound.

M = 173.79.

SEC 6
T5N R15W

CENT BOT PG 208.

F. B. 342 PG. 208

CONT TOP PG 210.

PLEASE RETURN TO
LOS ANGELES COUNTY ENGINEER
403 LOS ANGELES COUNTY ENGINEERING BLDG.

Note: Any Additions or Changes on This Sheet Must be Made or Circled in Red Ink With Date and Name of Person Making Change.

Do not extend this side of this line.

W.S.T.D-3

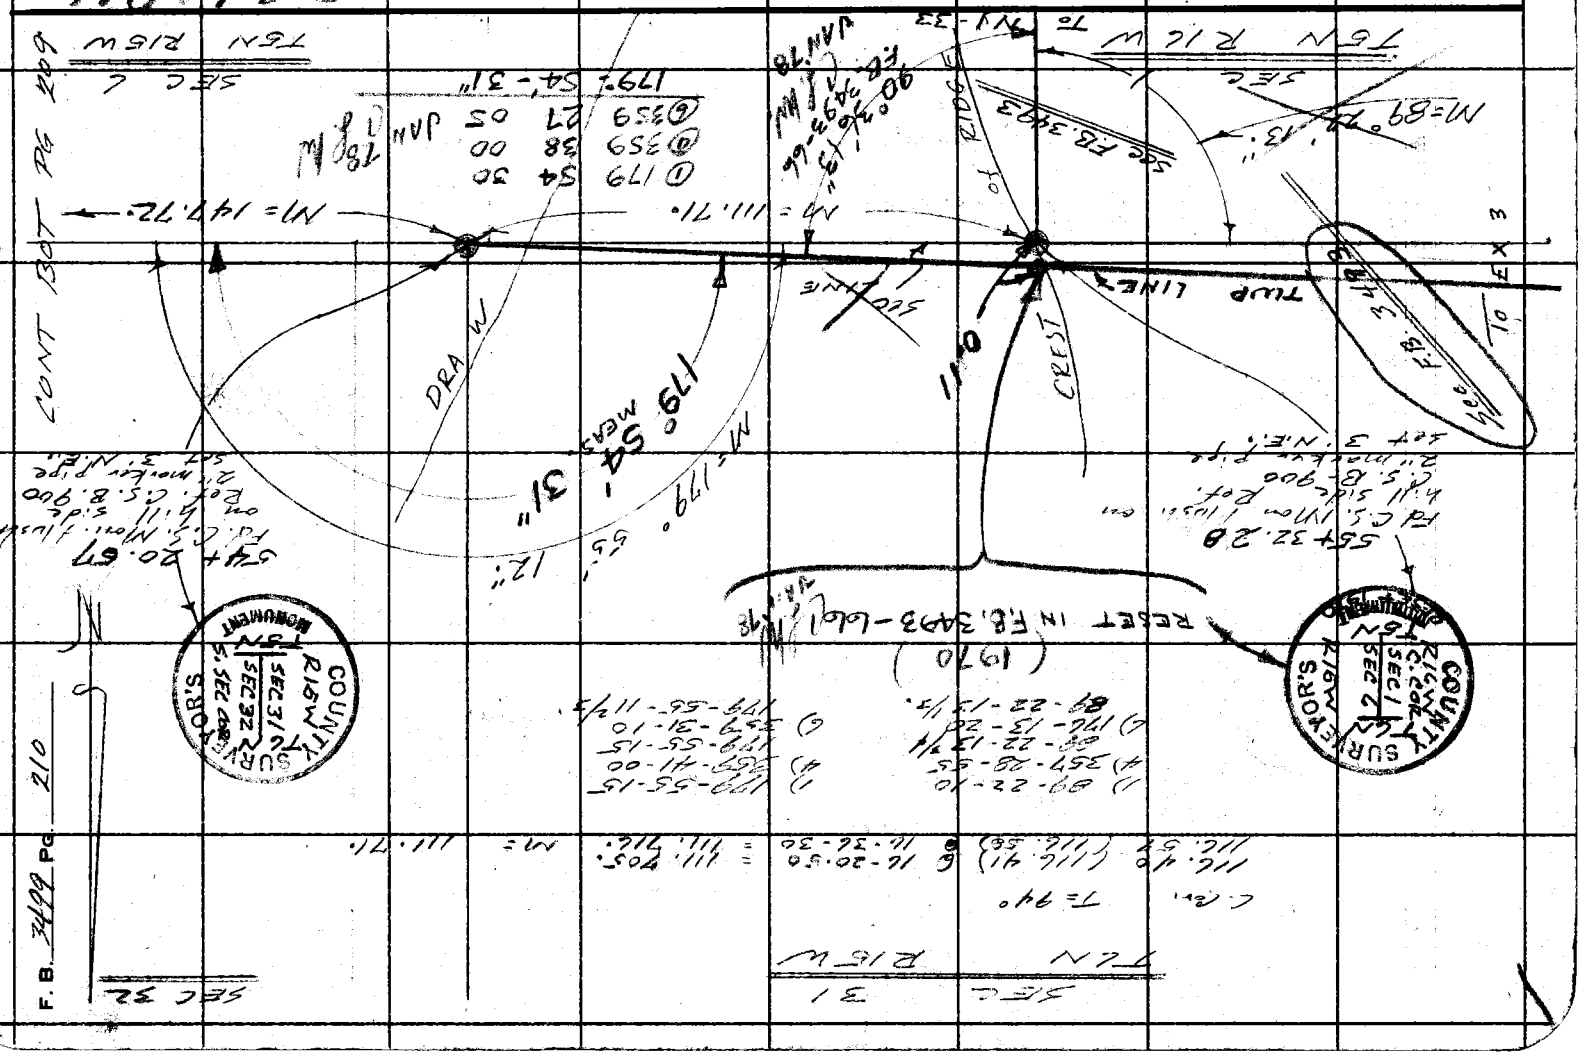

Survey of Sec. in T5N R15W F. B. 3499 Pg. 211
JN 8302.01 Tape 154 Std. 84 °F
Surveyed by F E Brooks
Notes LCR Date 28 Oct 71
Indexed L. J. GALLI Apr 1 72

Set IXZ & N hillside

108-30-20
84-00-40
120-30-10
35-01-10
108-30-11½

N = 192.69.

Base LINE

FEB 29 W 151.14'

CONT BOT PG 211

T LINE

N = 108.30.

Bottom of Canyon

Top of Canyon





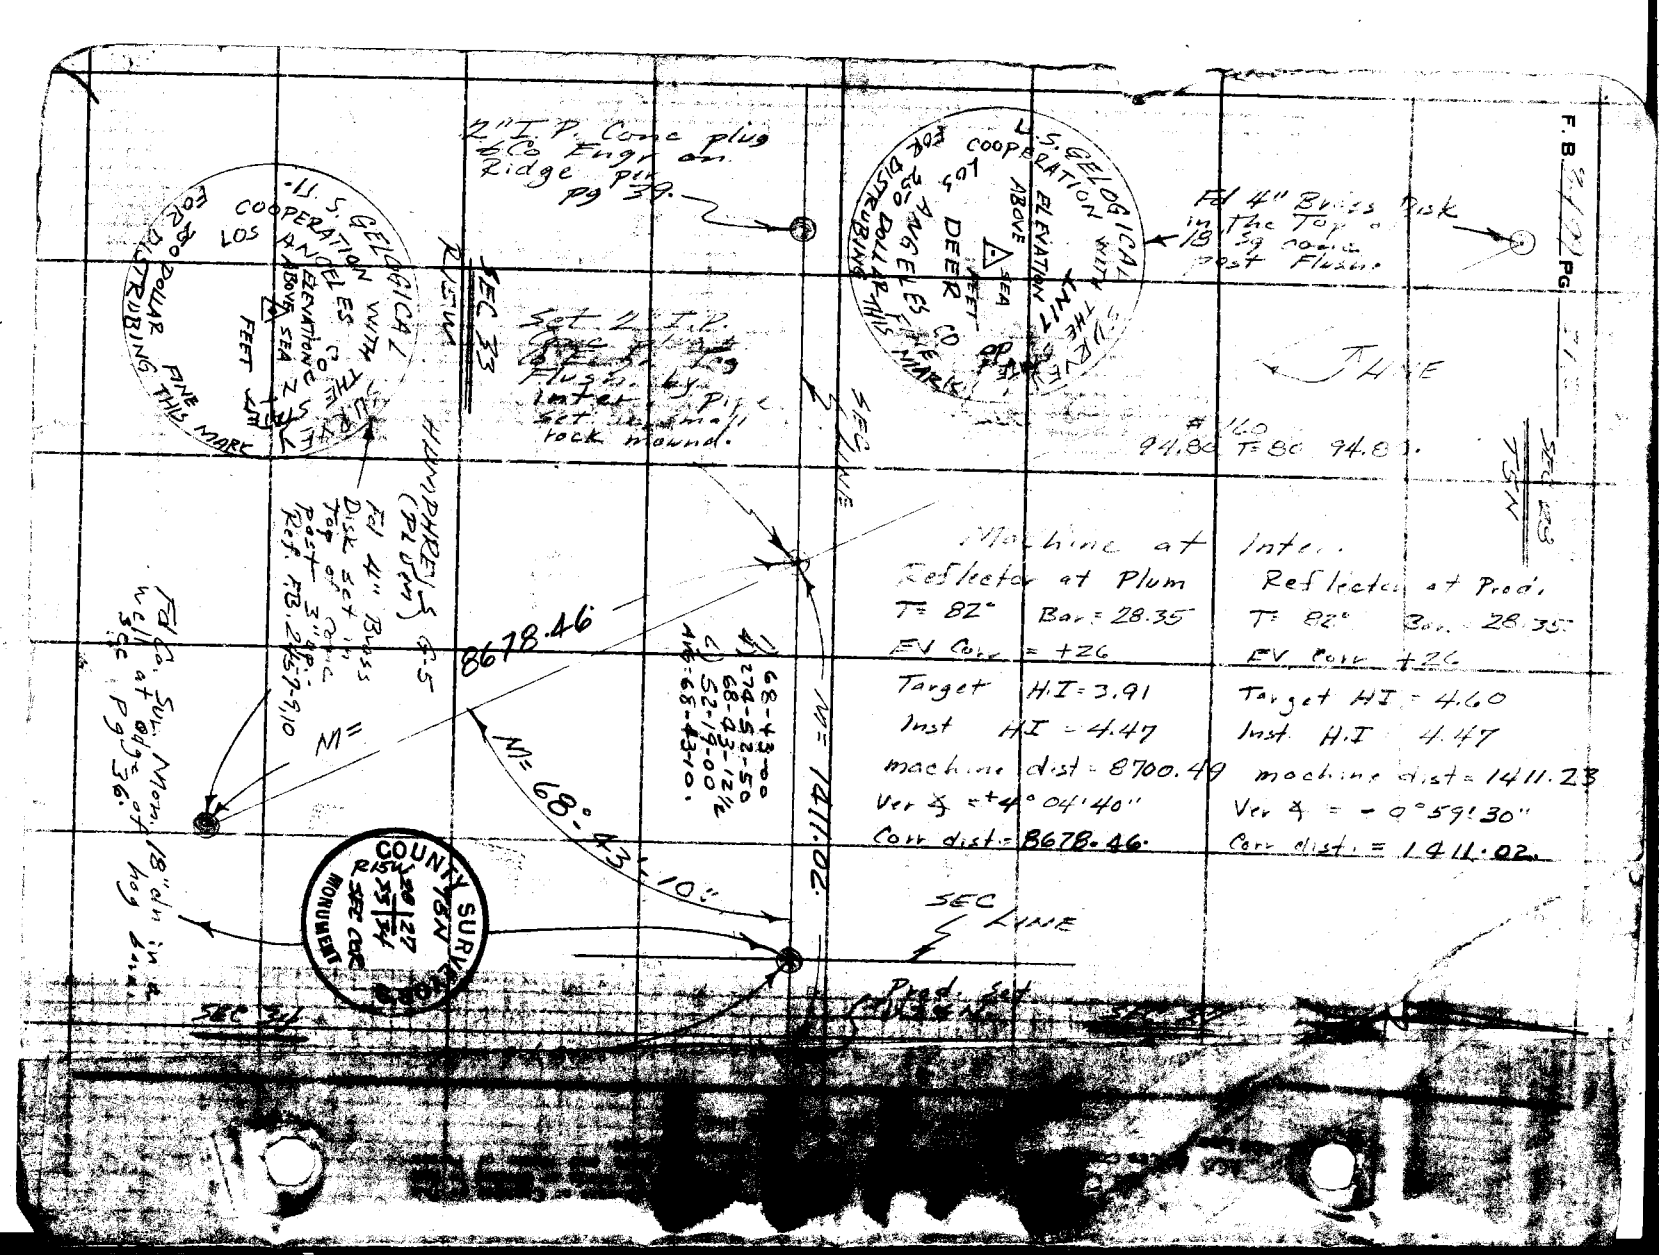
F.B. PG
U.S. GEOLOGICAL SURVEY COOPERATION WITH THE LOS ANGELES COUNTY FLOOD CONTROL DISTRICT
ELEVATION ABOVE SEA LEVEL 2250 FEET
DEER PINE 1917
U.S. GEOLOGICAL SURVEY COOPERATION WITH THE LOS ANGELES COUNTY FLOOD CONTROL DISTRICT
ELEVATIONS ABOVE SEA LEVEL 2250 FEET
DOLLAR PINE 1917
2" I.P. Cone plug in Co. Engr. on Ridge pin pg 59.
Fd 4" Bross Disk in the Top of 18" sq. conc. post Flush
LINE
SEC LINE
SEC 33
T3N
R5W
HUMPHREYS (PL 0mm) 4.5
Fd 4" Bross Disk set in Top of conc. Post 3" Above Ref. RB. 2.5-7-1/10
Set 2" I.P. Cone & Tag Engr. Ltr. Pipe set in small rock mound.
Machine at Reflector at Plum
T= 82° Bar.= 28.35
EV Corr = +26
Target H.I = 3.91
Inst H.I = 4.47
machine dist = 8700.49
Ver ∠ = +4° 04' 40"
Corr dist = 8678.46
Machine at Reflector at Prod.
T= 82° Bar. 28.35
EV Corr +26
Target H.I = 4.60
Inst H.I 4.47
machine dist = 1411.23
Ver ∠ = - 0° 59' 30"
Corr dist. = 1411.02
8678.46
N= 68°-43'-10"
N= 1411.02
68-43-10
274-52-50
68-43-00
52-19-00
N=
Fd Cr. Surv. Mound 18" o/u in Hog 4.4' W of Sec. Pg 56.
COUNTY SURVEY
RISE 1.27
SET 1.24
SEC COR
MONUMENT
Prod. Set
SEC LINE
SEC 34