F.B. 3555 Con't.

L.A. CO. FLOOD CONTROL DISTRICT

| | |
|---|---|
| NORWALK AREA | Pages 67-79 |
| Centerline ties | |
| WEST LA PUENTE AREA | Pages 80-97 |
| Centerline ties | |
| TURNBULL CANYON ROAD | Pages 98-111 |
| Centerline ties from Palm Ave. n'ly. to Clark Ave. | |
| EAST AZUSA AREA | Pages 112-131 |
| Centerline ties | |
| TORRANCE-LOMITA AREA | Pages 132-152 |
| Centerline ties | |
| NARBONNE AVENUE | Pages 153-156 |
| Centerline ties | |
| HAWTHORNE AREA | Pages 157-158 |
| Centerline ties | |
| LYNWOOD AREA | Page 159 |
| Monument ties | |
| TORRANCE-LOMITA AREA | Pages 160-180 |
| Centerline ties | |

3555

L.A. CO. FLOOD CONTROL DISTR.

FD PTS PER
FCSD 1227-79

V = FD AFTER CONST.
5-9-72 JH

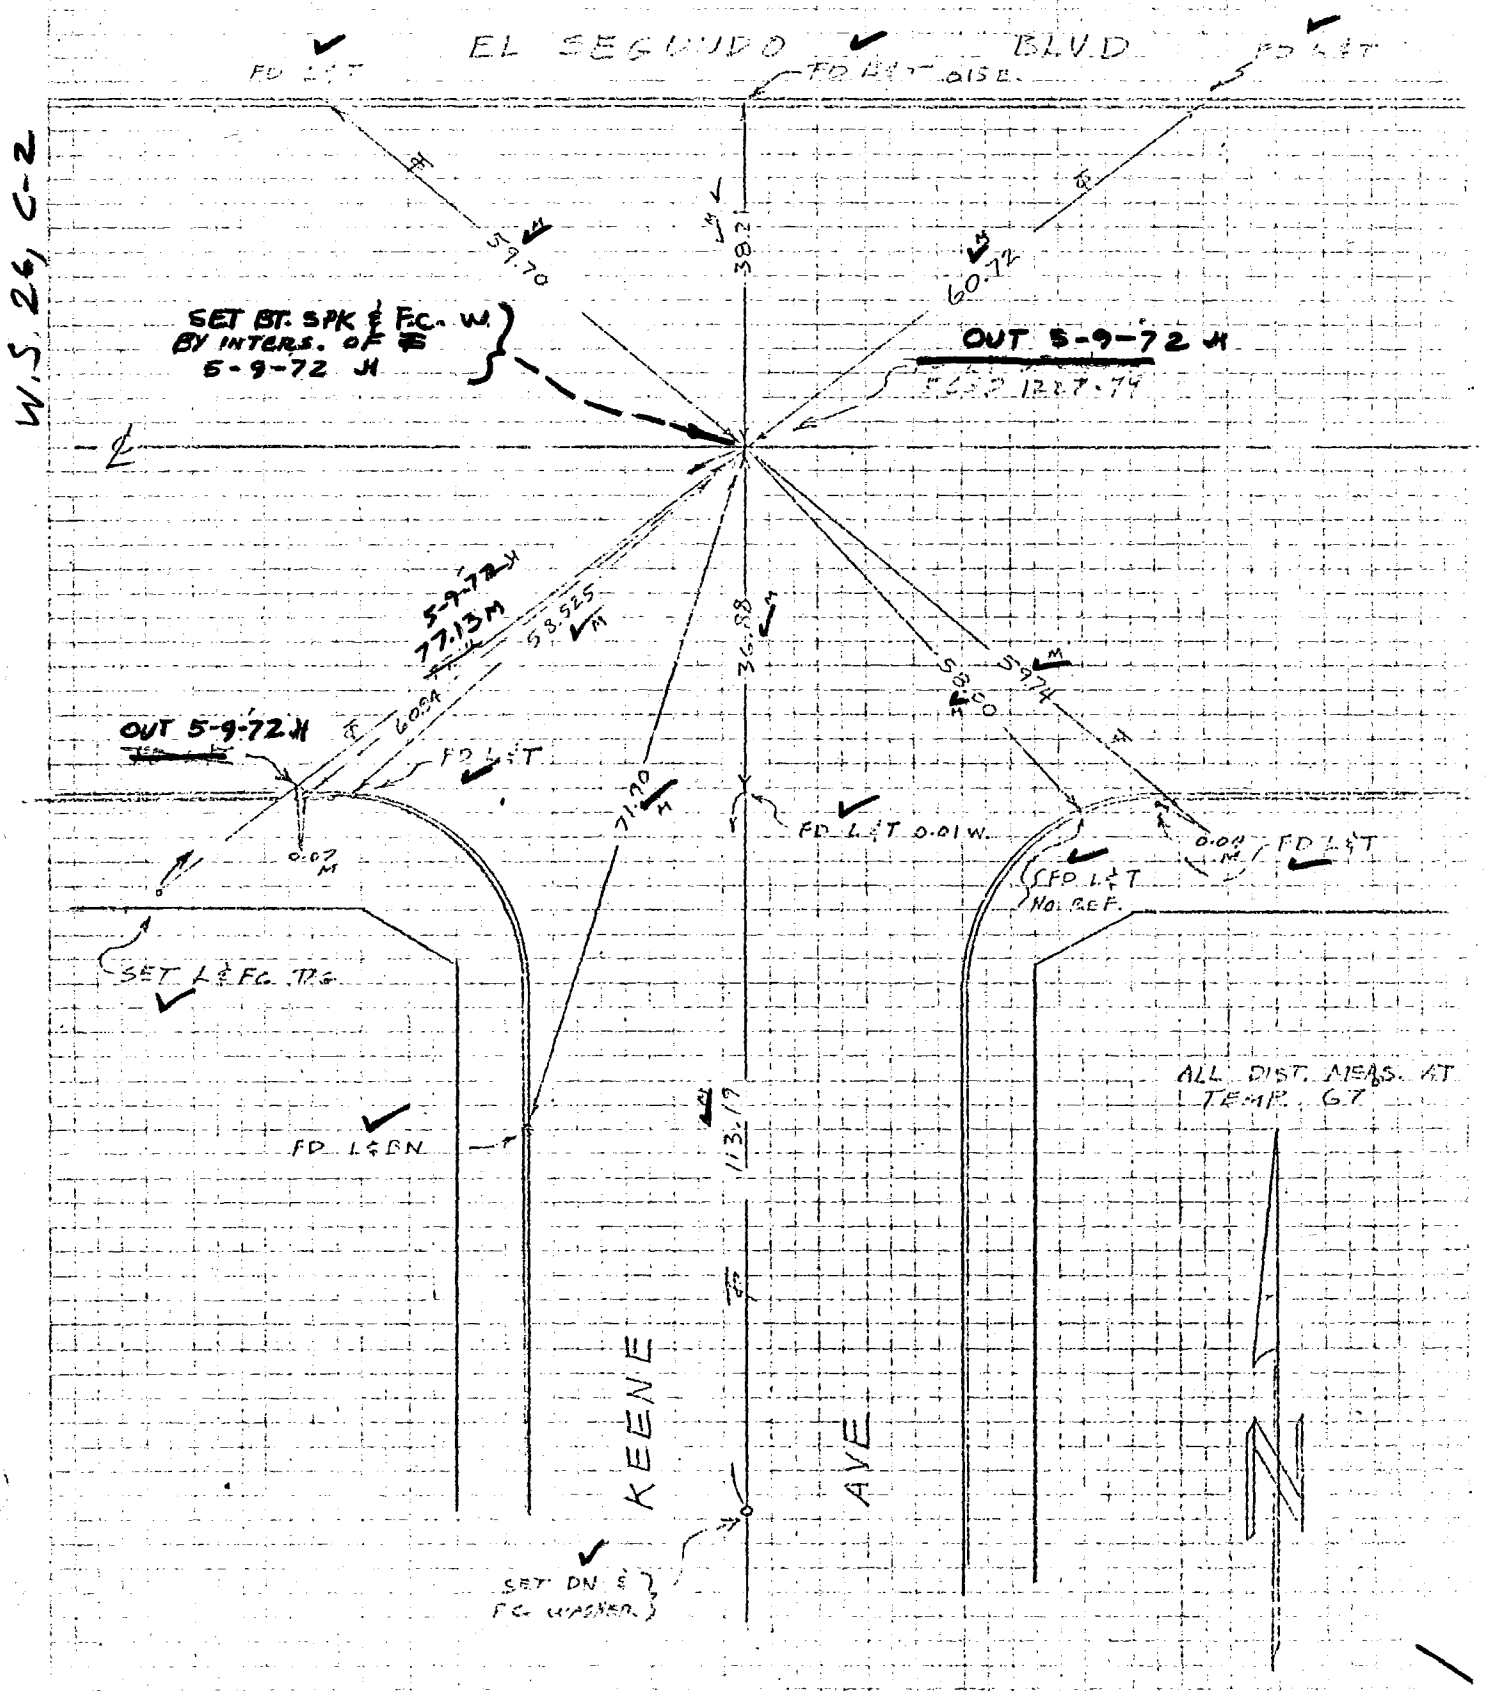

PROJECT 1256 U-2 Sup. County Design INDEX R&R-5

SURVEY BY [illegible] DATE 1-13-72

REVIEWED BY [illegible] DATE

[illegible] 7-17-72

LOS ANGELES COUNTY FLOOD CONTROL DISTRICT

✓ = FD AFTER CONST. 5-9-72 JH. TEMP. = 75°

ALL FD PTS. PER FCSD 1227-83

W.S. 26 C.2

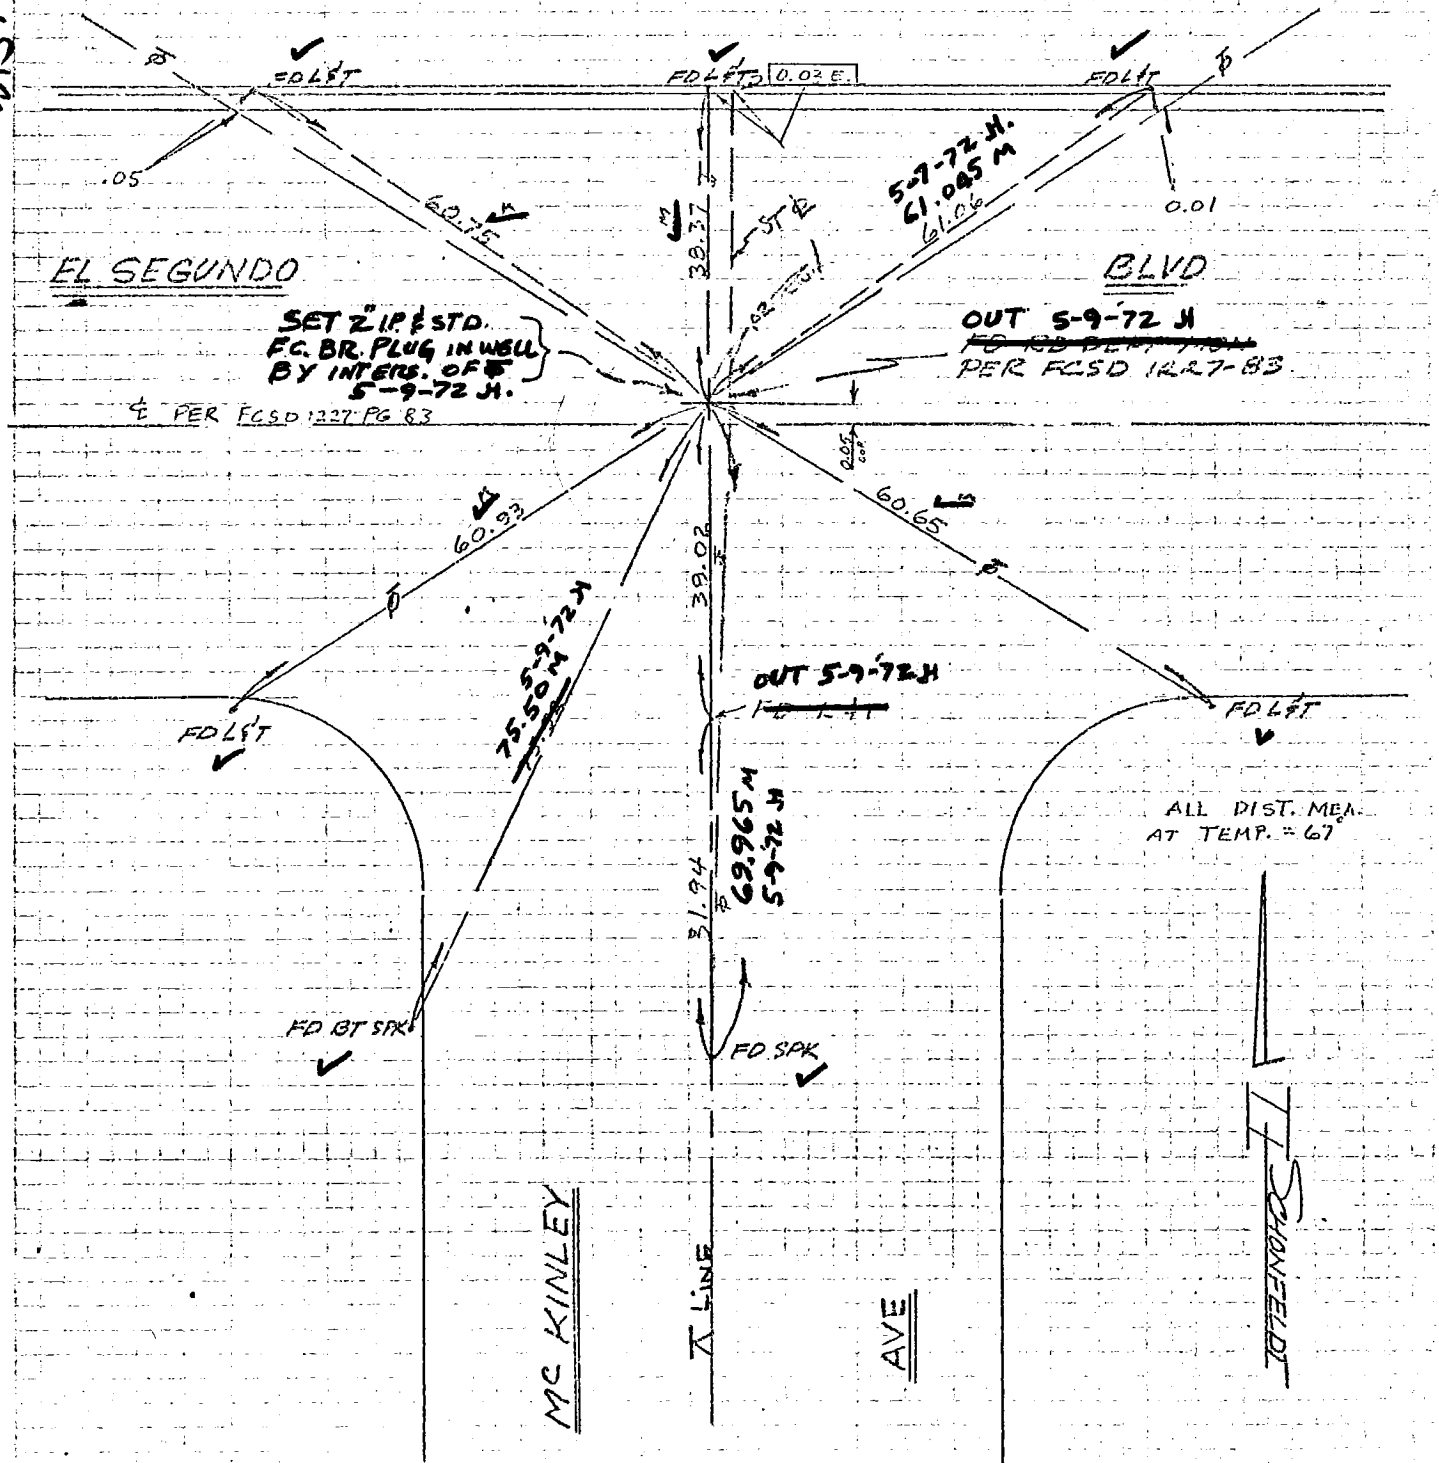

768911– Cdb 3-69

Co. Engr. F.B. 3555: 7

PROJECT 1256 D-7 S.L.A. County

INDEX FCSD1256 17

SURVEY BY CAH DATE 1-18-72

REVIEWED BY RJL 7-17-74 DATE

R&R-7

LOS ANGELES COUNTY FLOOD CONTROL DISTRICT

✓ = FD AFTER CONST. 5-9-72 JH

TEMP 72°

FD PTS. PER FCSD 1227-85

ALL DIST. MEA AT TEMP 68°

W,S,26, C-2

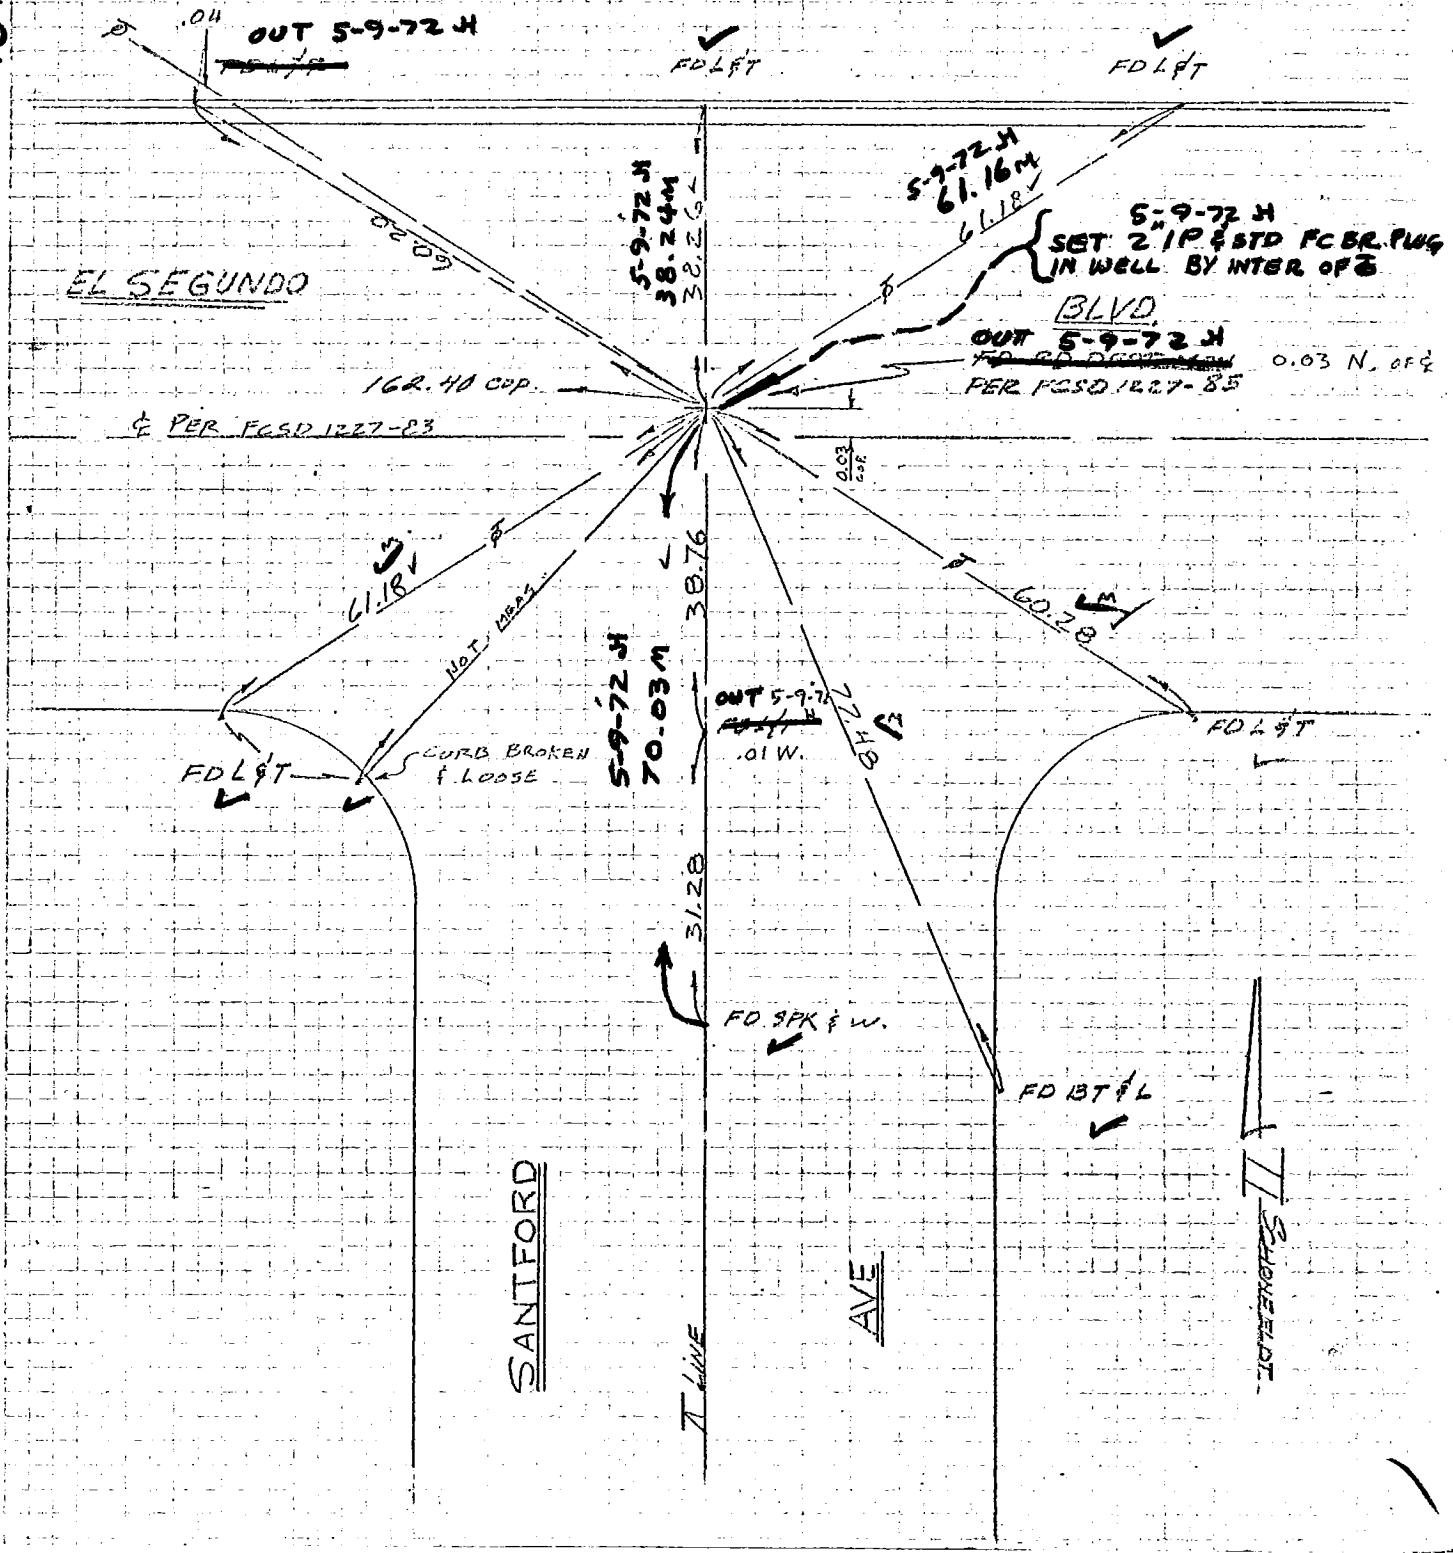

7858911– Cdb 3-69

Co. Engr. F.B. 3555: 8

PROJECT L.A. 56 C-2 S.M. County Drain

INDEX FCSD1256 9

SURVEY BY CPH DATE 1-13-72

REVIEWED BY CPH 1-17-72 DATE

LOS ANGELES COUNTY FLOOD CONTROL DISTRICT

W.S. 26, C-2

✓ = FD AFTER CONST. 5-18-72 JH.

TEMP. 68°

FD PTS. PER FCSD 1227-87

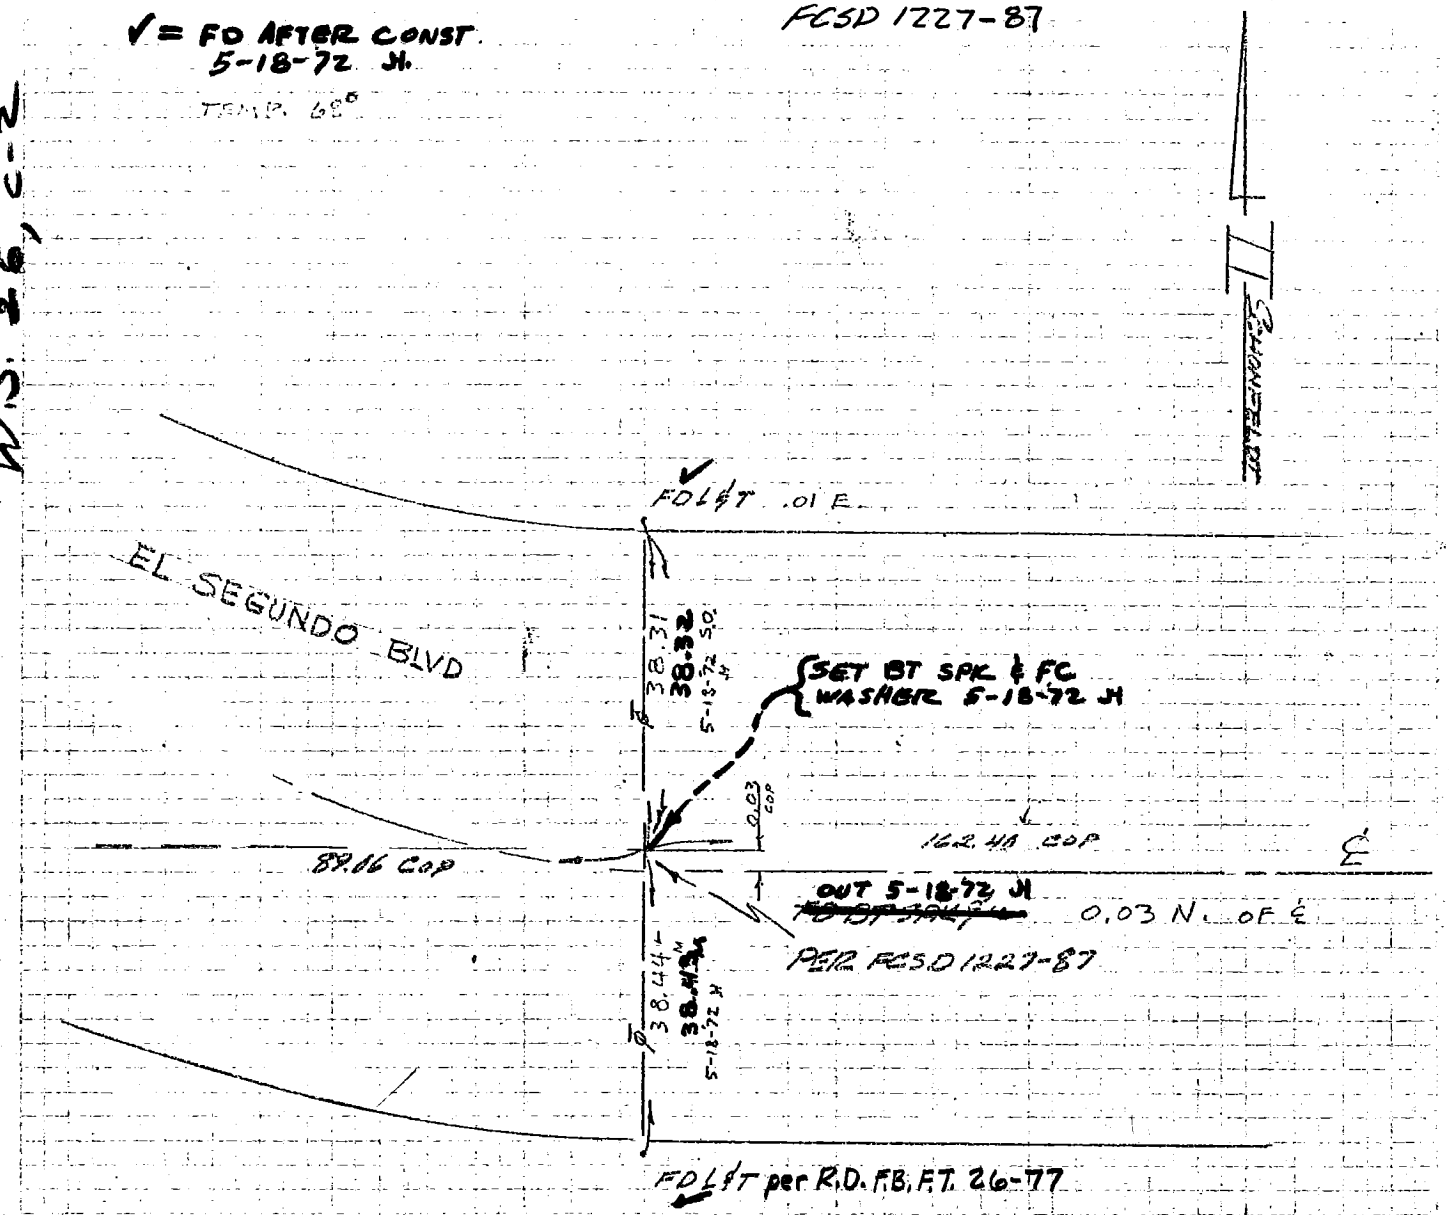

768911- Cdb 3-69

PROJECT 1256 O-T Sub County Drain

SURVEY BY CH DATE 1-12-72

REVIEWED BY DATE

Co. Engr. F.B. 3555: 9 INDEX FCSD1256 11

R&R-11

LOS ANGELES COUNTY FLOOD CONTROL DISTRICT

✓ = FD AFTER CONST.
5-18-72 JK
TF-11: 69

FD PTS. PER
FCSD 1227-89

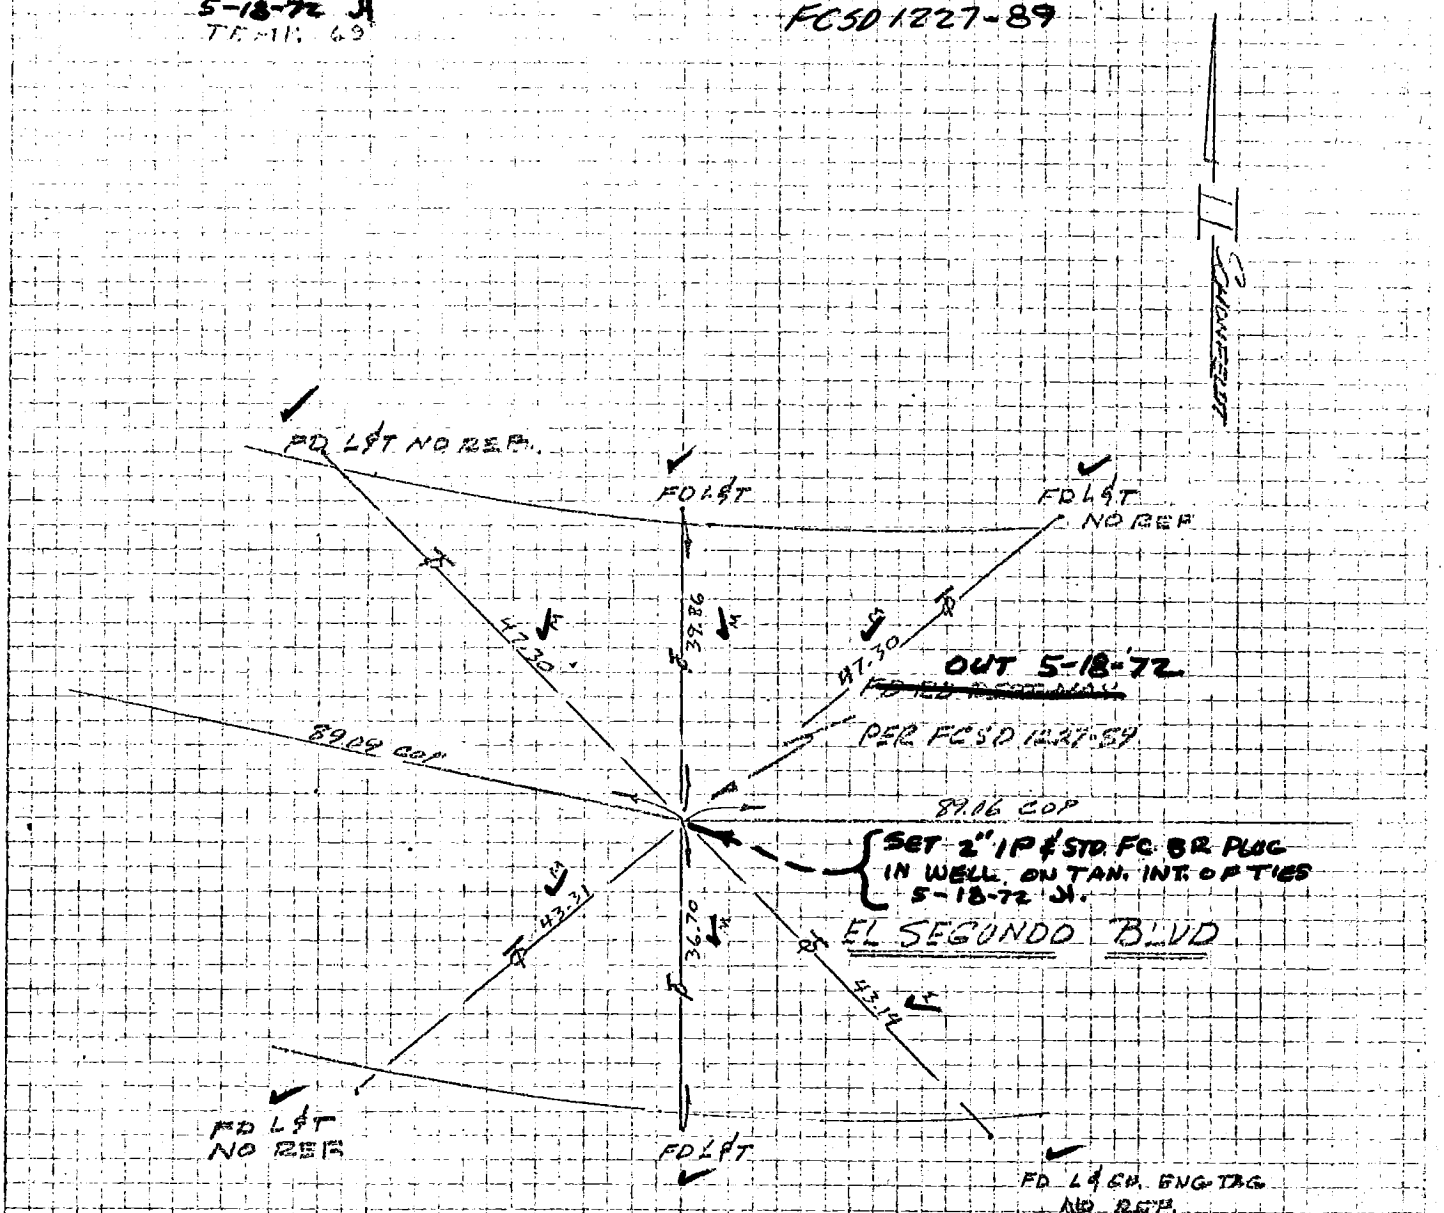

BS911- Cdb 3-69

PROJECT Los County Drain # 12.5 Co. Engr. F.B. 3555: 10 INDEX FCSD1256 13

SURVEY BY [illegible] DATE 5-18-72

REVIEWED BY [illegible] DATE 7-17-72

R&D-13

LOS ANGELES COUNTY FLOOD CONTROL DISTRICT

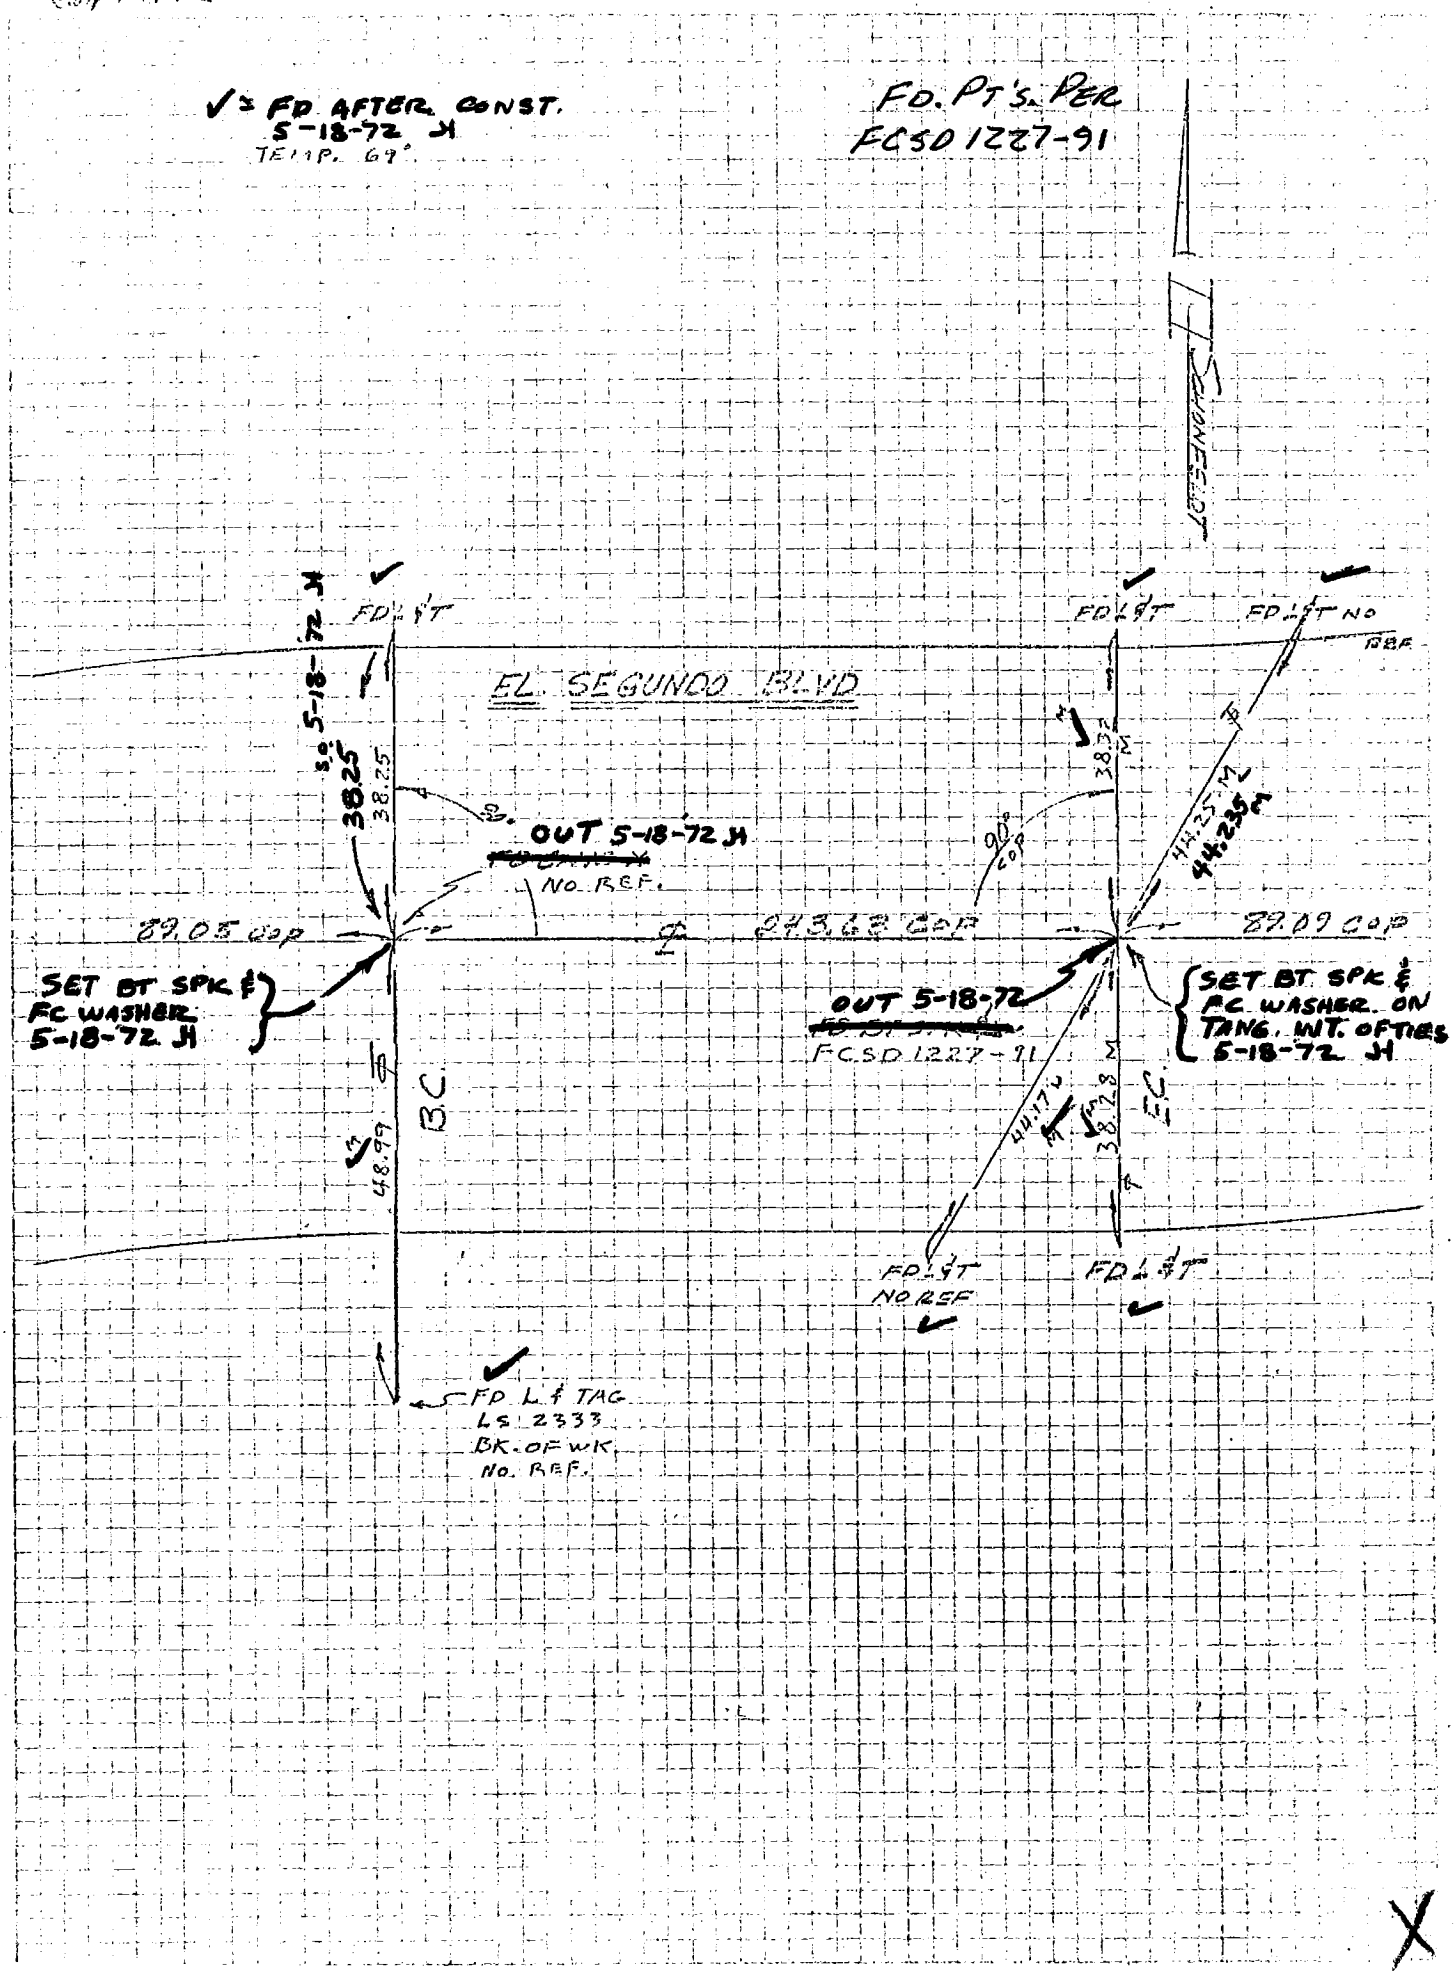

PROJECT Los Angeles County Storm Drain & Misc. Co. Engr. F.B. 3555-11 FCSD1256 15

SURVEY BY CM DATE 7-17-72

REVIEWED BY DATE

Surv 7-17-72

RD 0-15

LOS ANGELES COUNTY FLOOD CONTROL DISTRICT

WM. 26 C-2

✓ = FD AFTER CONST. 5-18-72 JH

TEMP. 70°

FD PT'S PER FCSD 1227-93

N

FD L&T .05 W.

FD L&T

AVALON BLVD.

39.30 SD. 5-18-72 JH

39.32 M

SET BT. SPK & FC. WASHER 5-18-72 JH

89.08 COP

153.88 COP

89.08 SUB.

64.83 COP

OUT 5-18-72 JH

FCSD 1227-95

39.29 M 5-18-72 JH

39.31 M

36.60 M

36.59 SD. 5-18-72 JH

SET 2" IP & STD. F.C. BR. PLUG IN WELL 5-18-72 JH

OUT 5-18-72 JH

PER FCSD 1227-93

89.05 COP

40.02 M 5-18-72 JH

EL SEGUNDO BLVD

70

FD L&T .22

FD L&T FCSD 1227-91

FD L&T & CO ENG TAG.

Co. Engr. F.B. 3555: 12

#2050 BELL GARDENS LINE "A"
WRE DATE 12-30-71
42 DATE 1-6-72

INDEX FCSD2050 49
R&R-3
LOS ANGELES COUNTY FLOOD CONTROL DISTRICT

NOTE
1 = Fd. L&T., No Ref.
RDEB 1023-128, 129
RDFB 1024-516

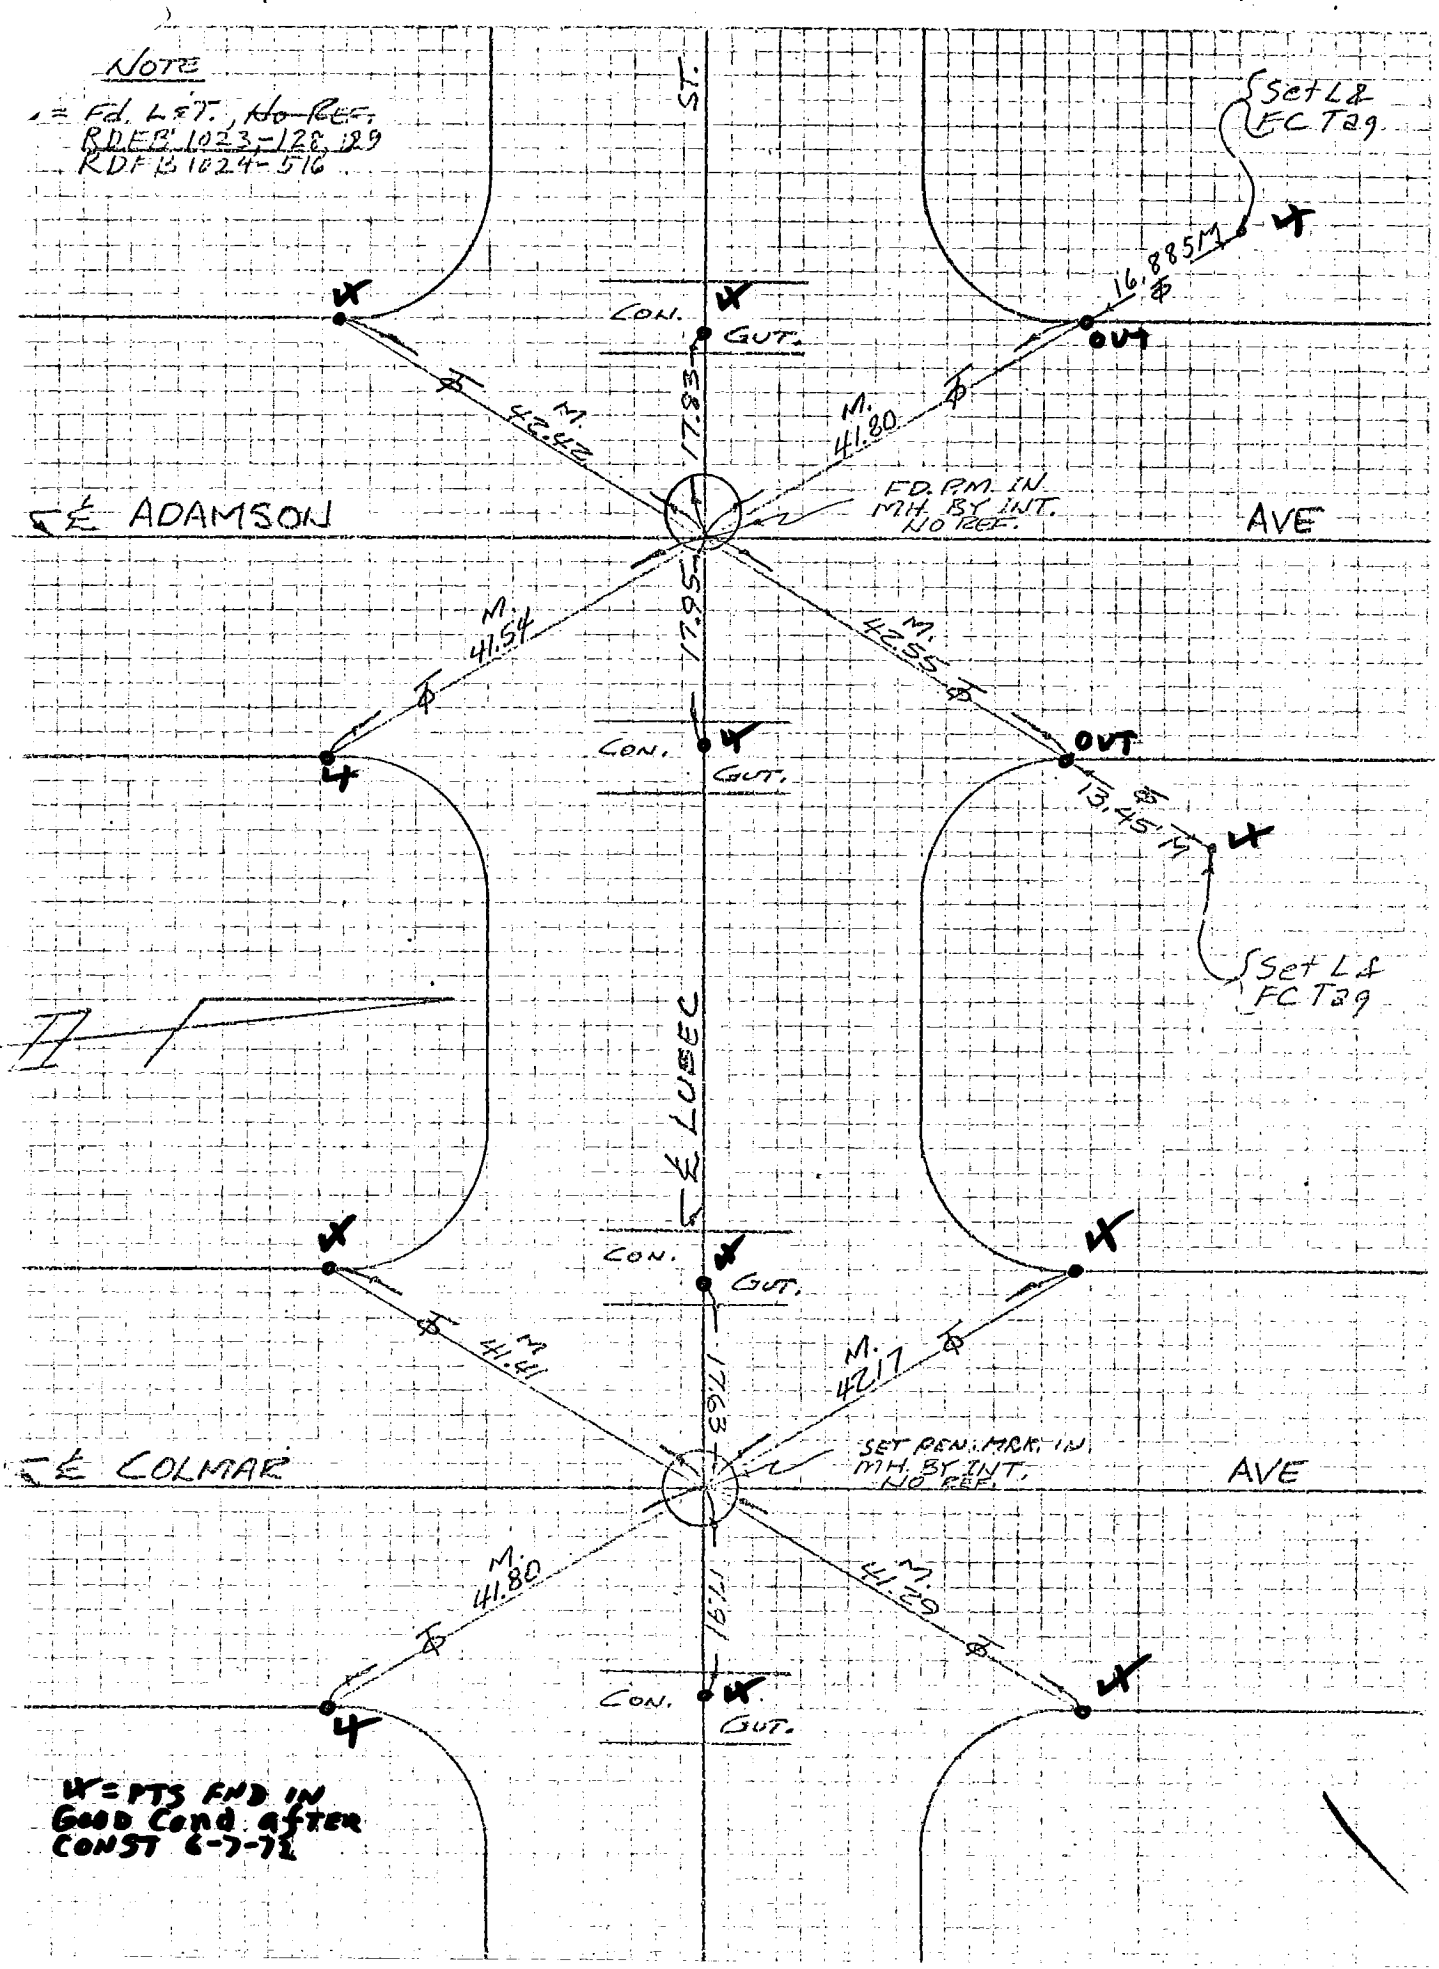


W = PTS FND IN GOOD Cond after CONST 6-7-72

76S911— Cdb, 3-69

Co., Engr. F.B. 3555 pg 13

PROJECT #7050 BELL GARDENS LINE A

INDEX FCSD2050 51

SURVEY BY WRE DATE 12-30-71

REVIEWED BY DATE 1-6-72

R & R - 5

LOS ANGELES COUNTY FLOOD CONTROL DISTRICT

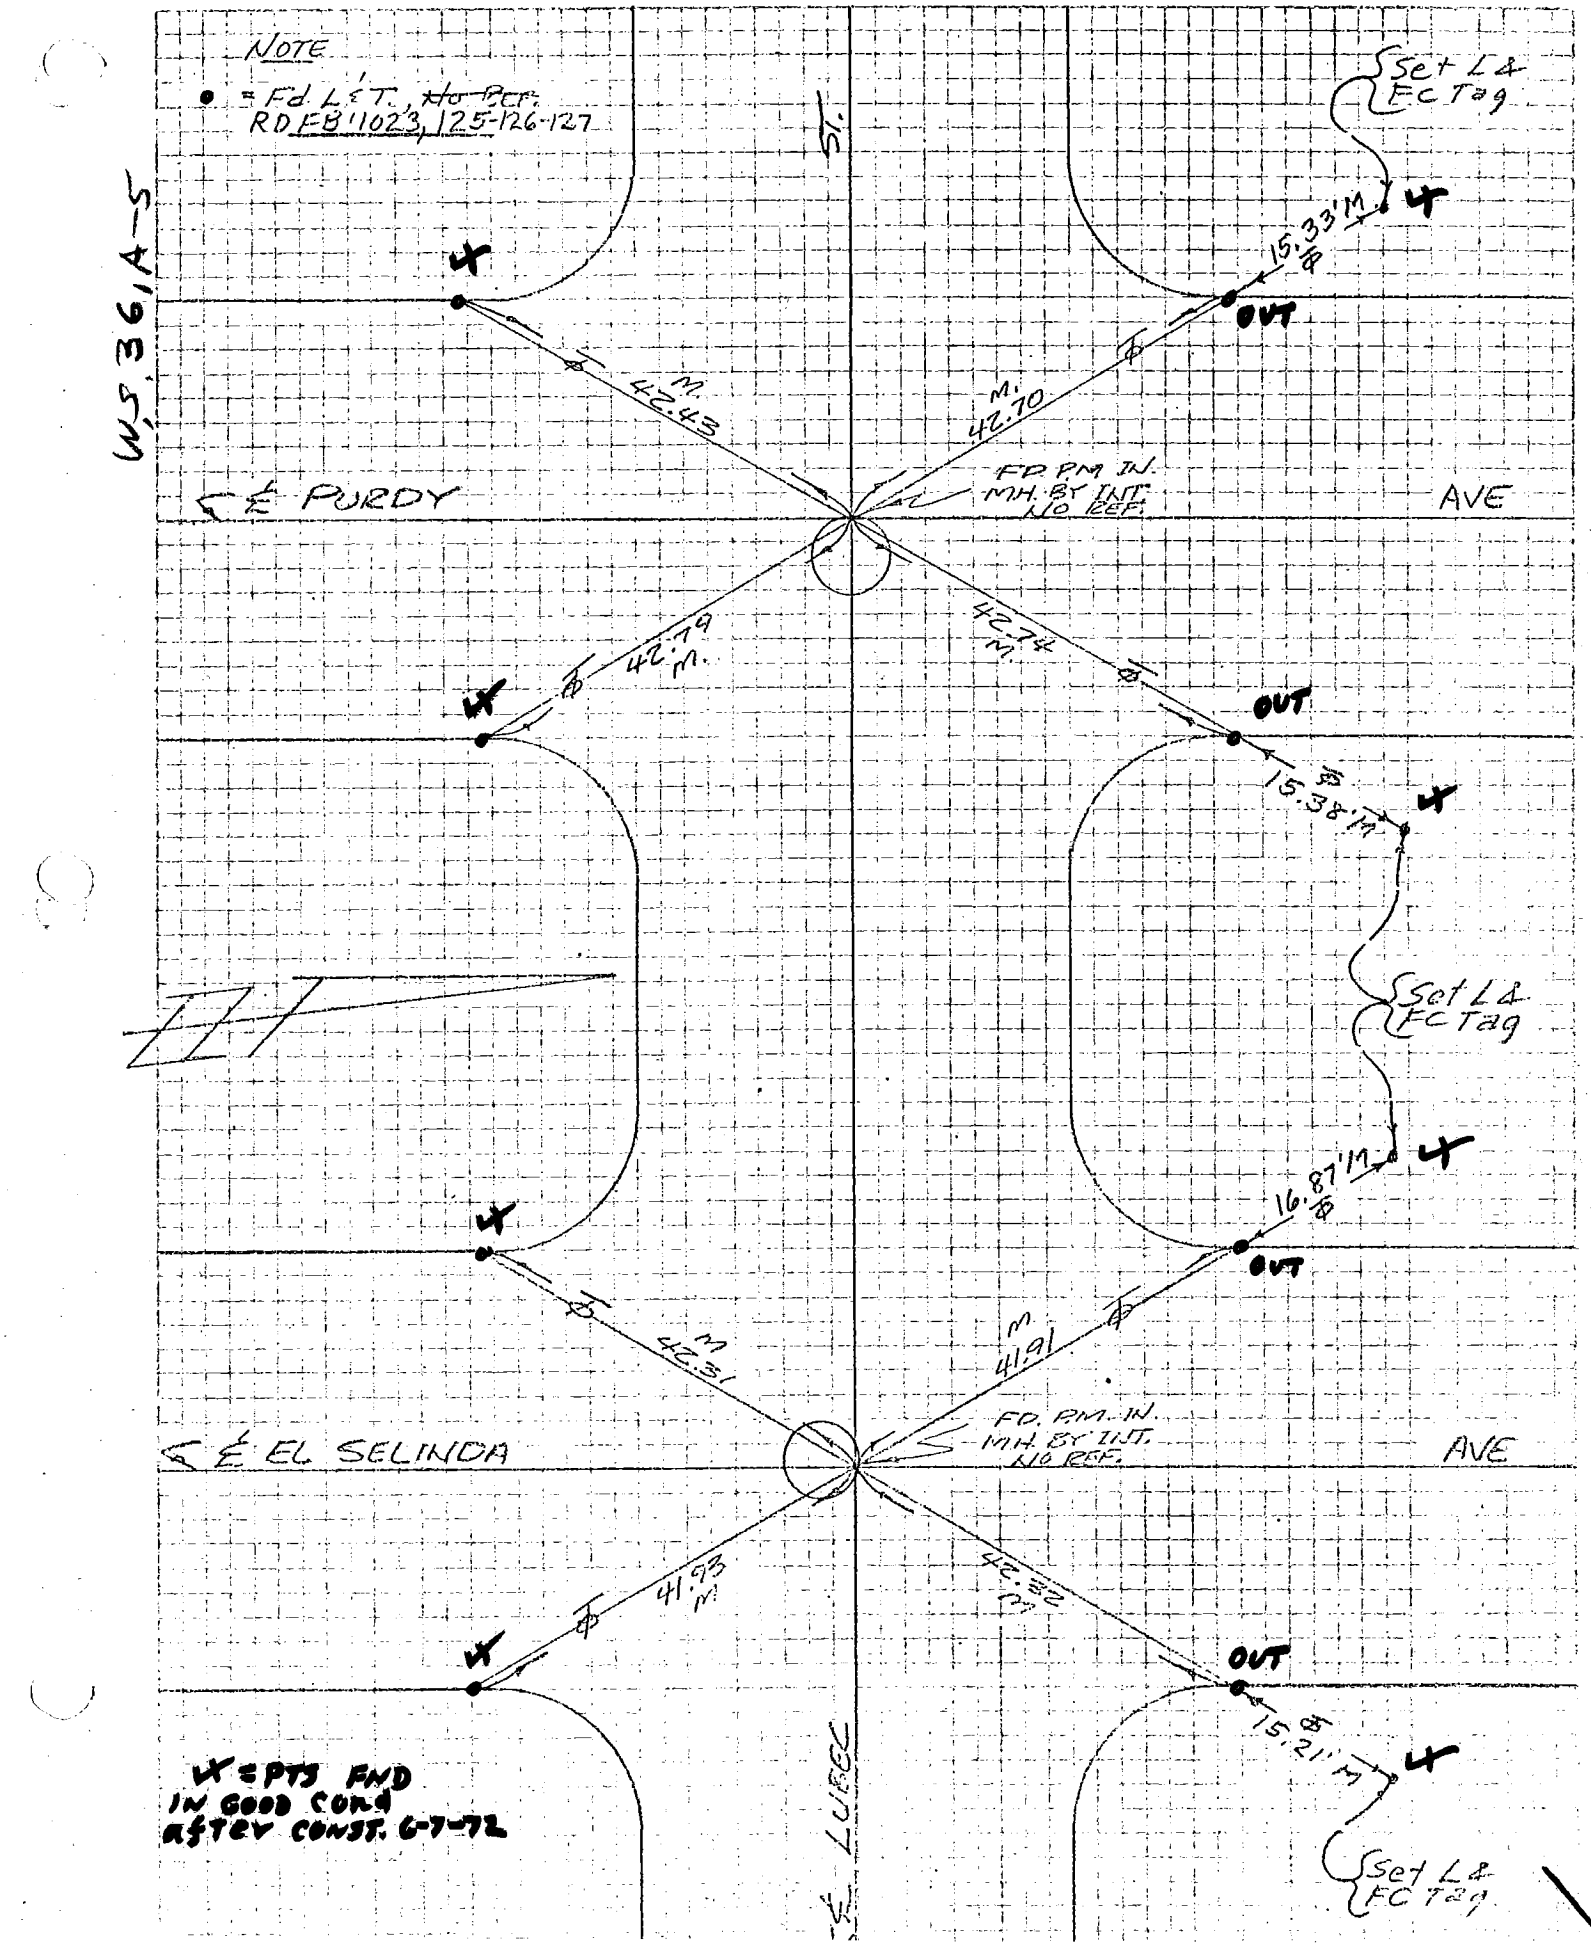

-69

NO. 2050 Bell Gardens Line "A"

B.P.B. DATE 1-6-72

DATE

Co. Engr. F.B. 3555: 14

INDEX FCSD2050 53

R&R 7

LOS ANGELES COUNTY FLOOD CONTROL DISTRICT

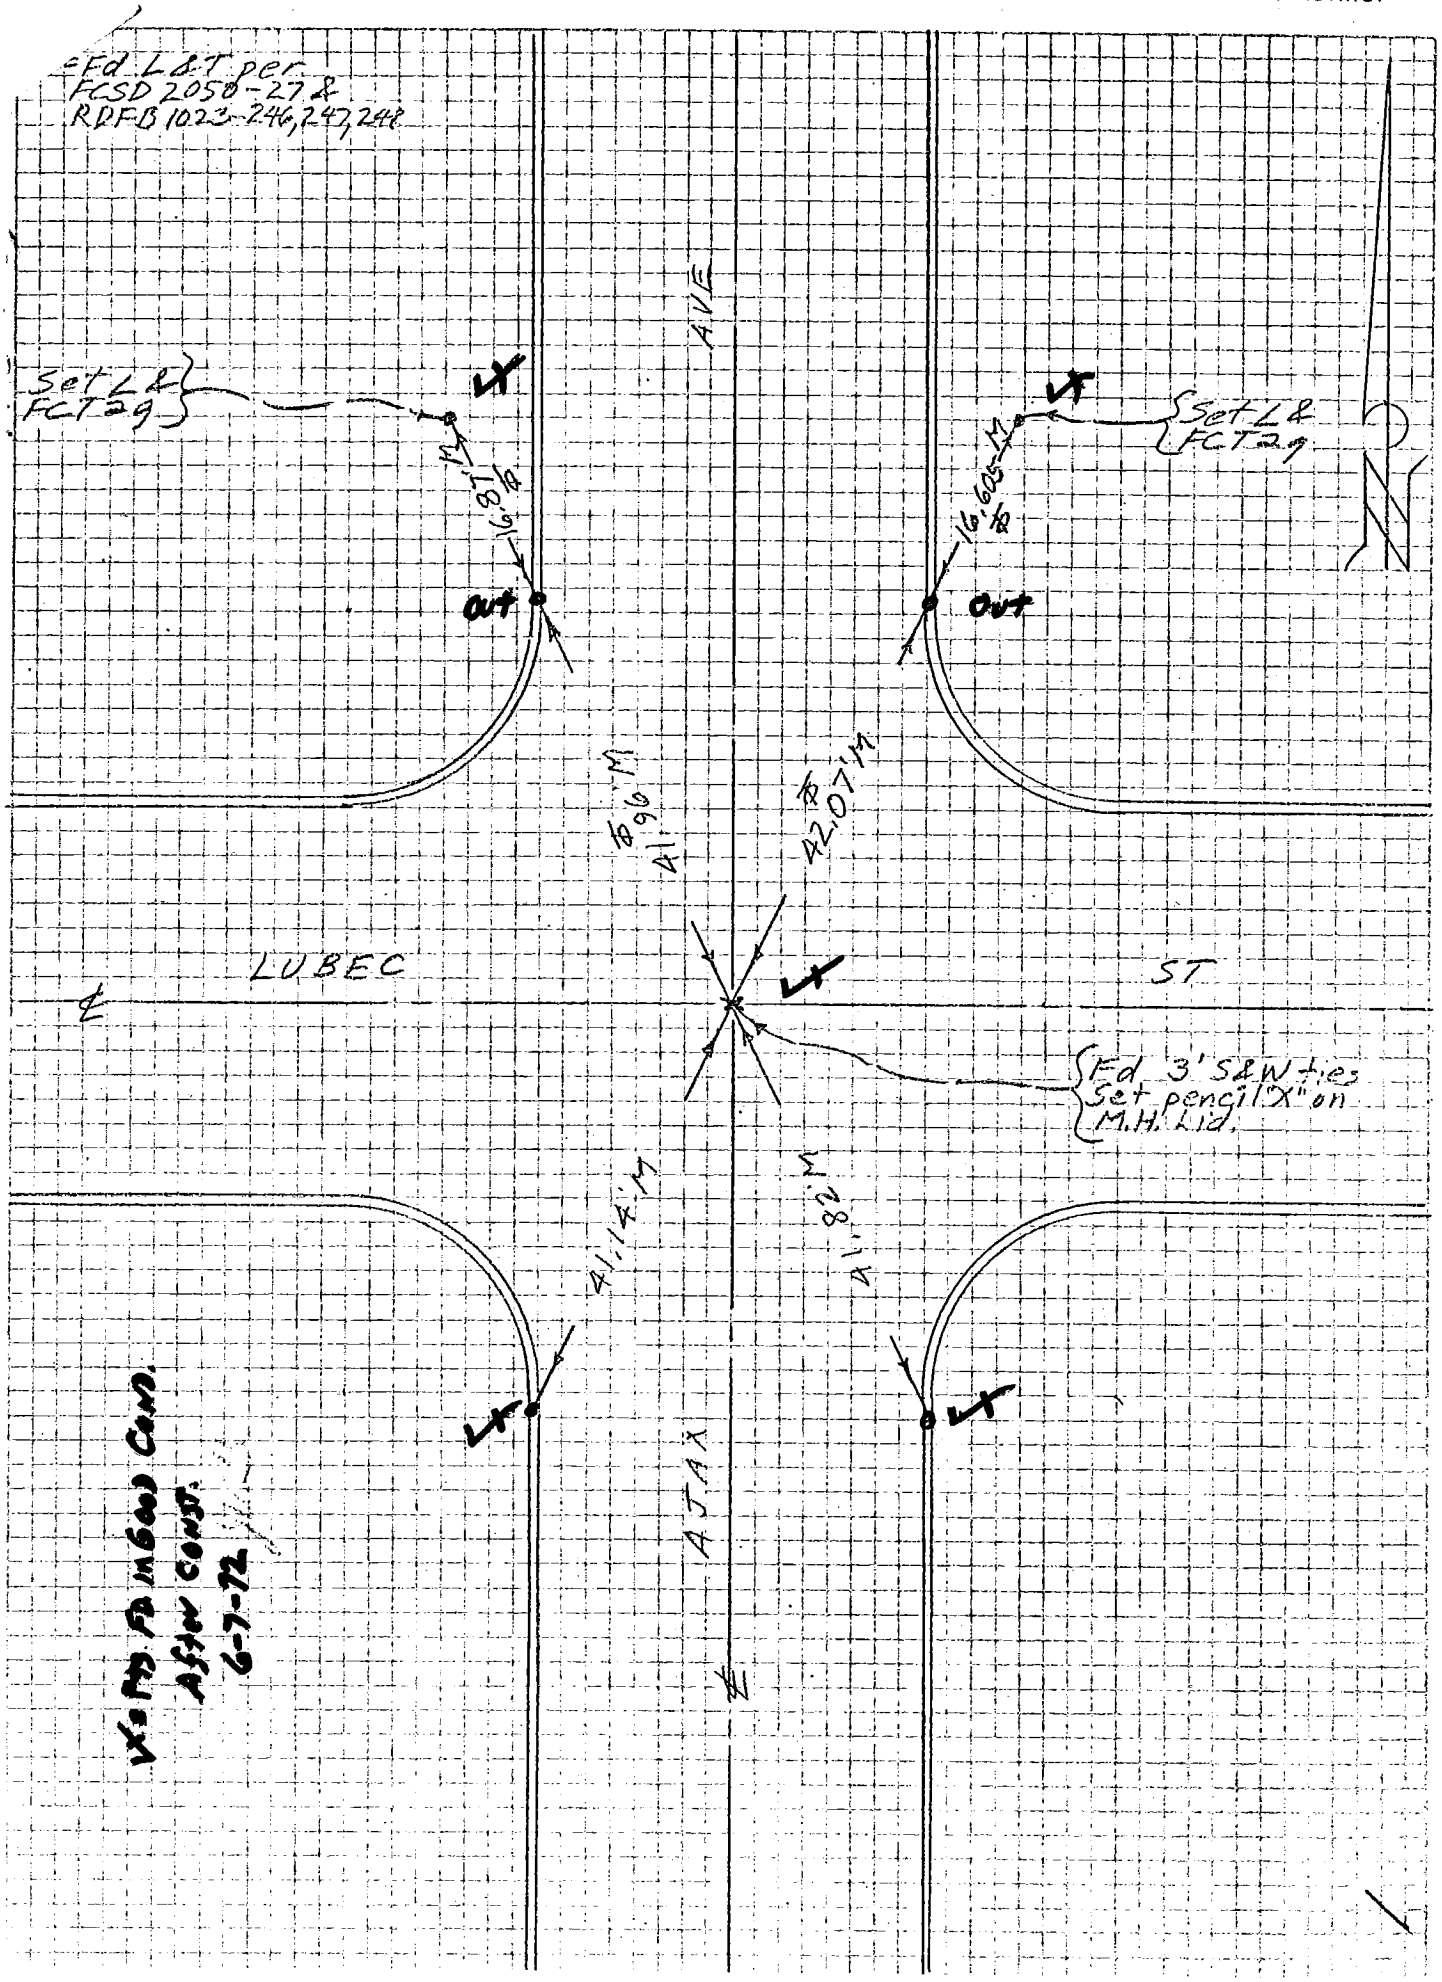

Co. Engr. F.B. 3555: 15

BELL GARDENS S.D. #2050 LINE "A"

C.O.S. DATE 12-31-71

DATE

INDEX FCSD2050 55

E&R-9

LOS ANGELES COUNTY FLOOD CONTROL DISTRICT

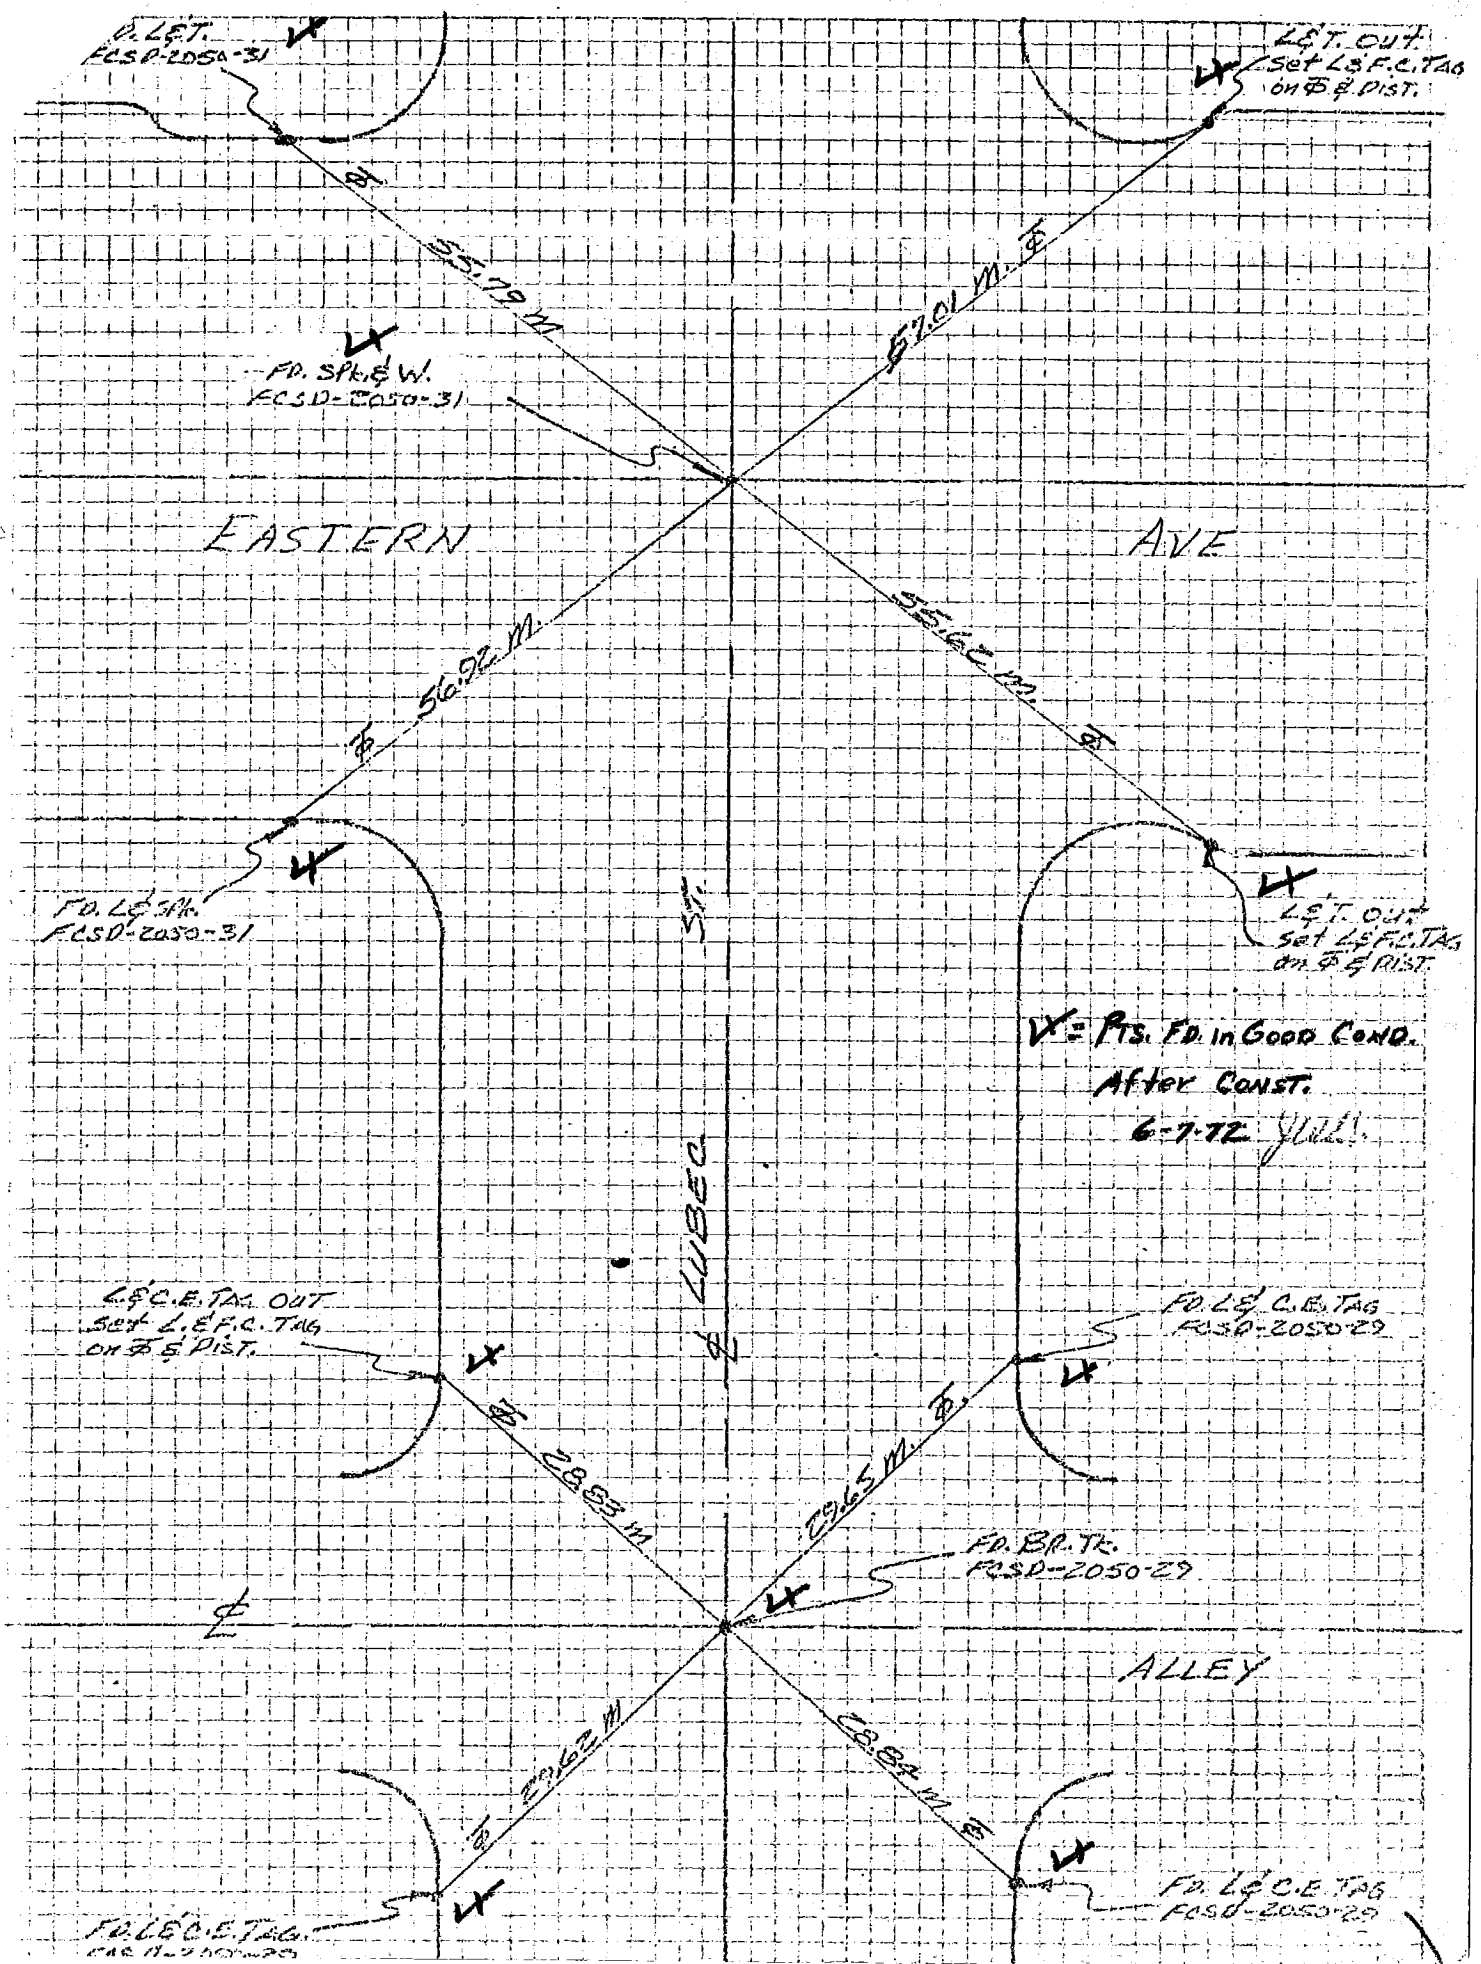


V = PTS. FD. IN GOOD COND. AFTER CONST. 6-7-72 JWL

76S911– Cdb 3-69

PROJECT BELL GARDENS SD-2050 LINE "B" Co. Engr. F.B. 3555:16 INDEX FCSD2050 61

SURVEY BY WRE DATE 1-6-72

REVIEWED BY [illegible] DATE 1-12-72

R&R 15

LOS ANGELES COUNTY FLOOD CONTROL DISTRICT

16

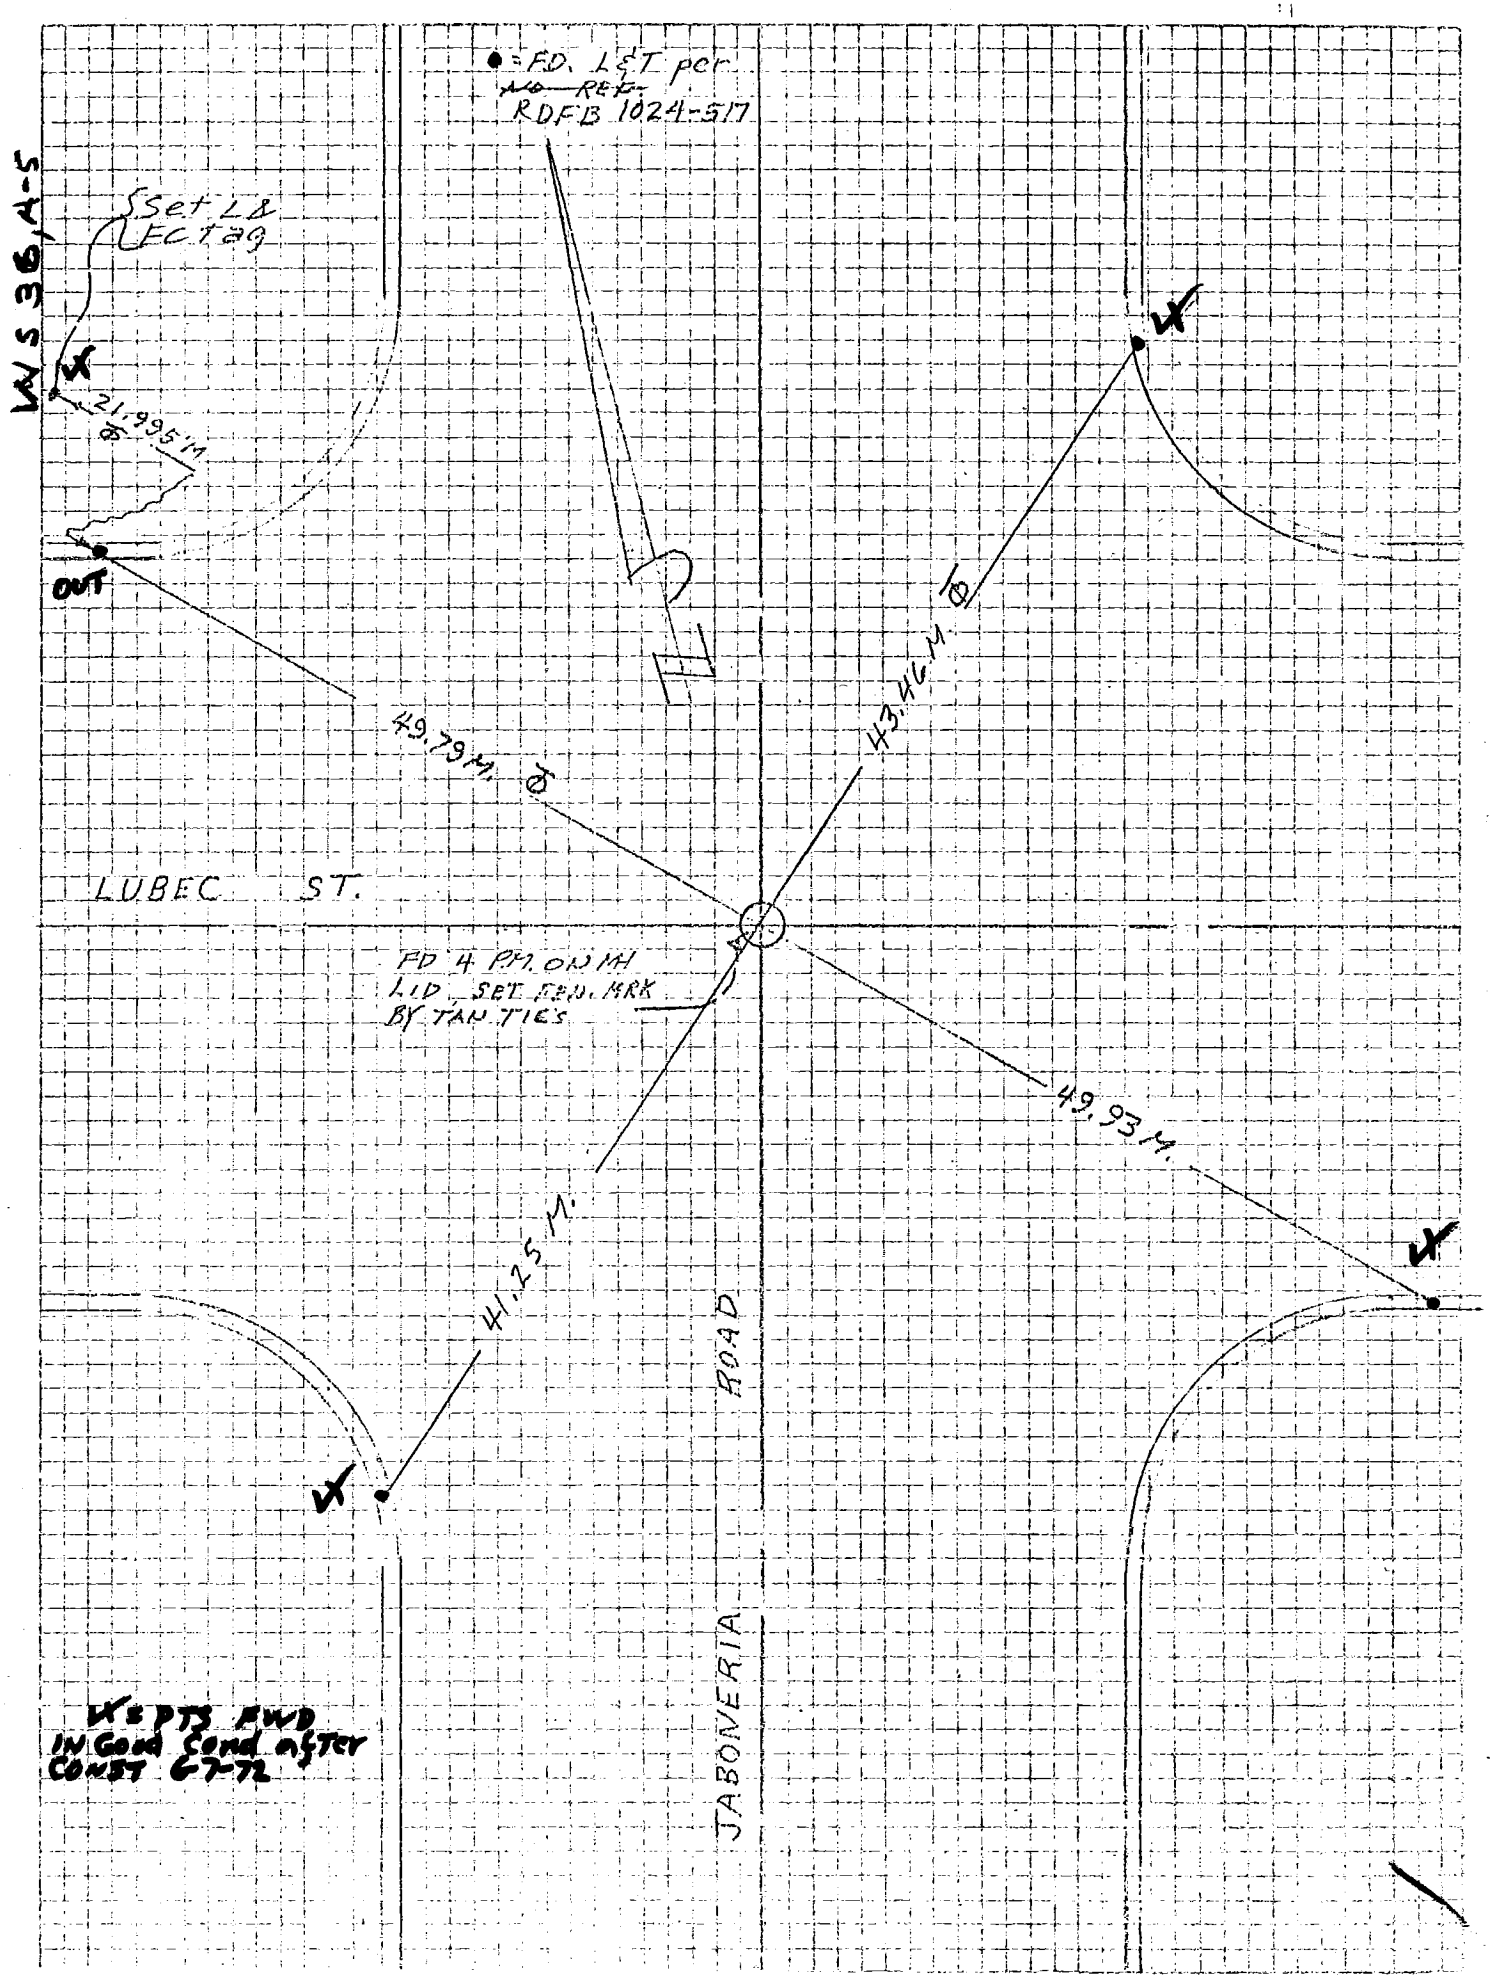

F. B. 2592 PG. 142

3555 - 17

3555 " 17

W.S. 25-13

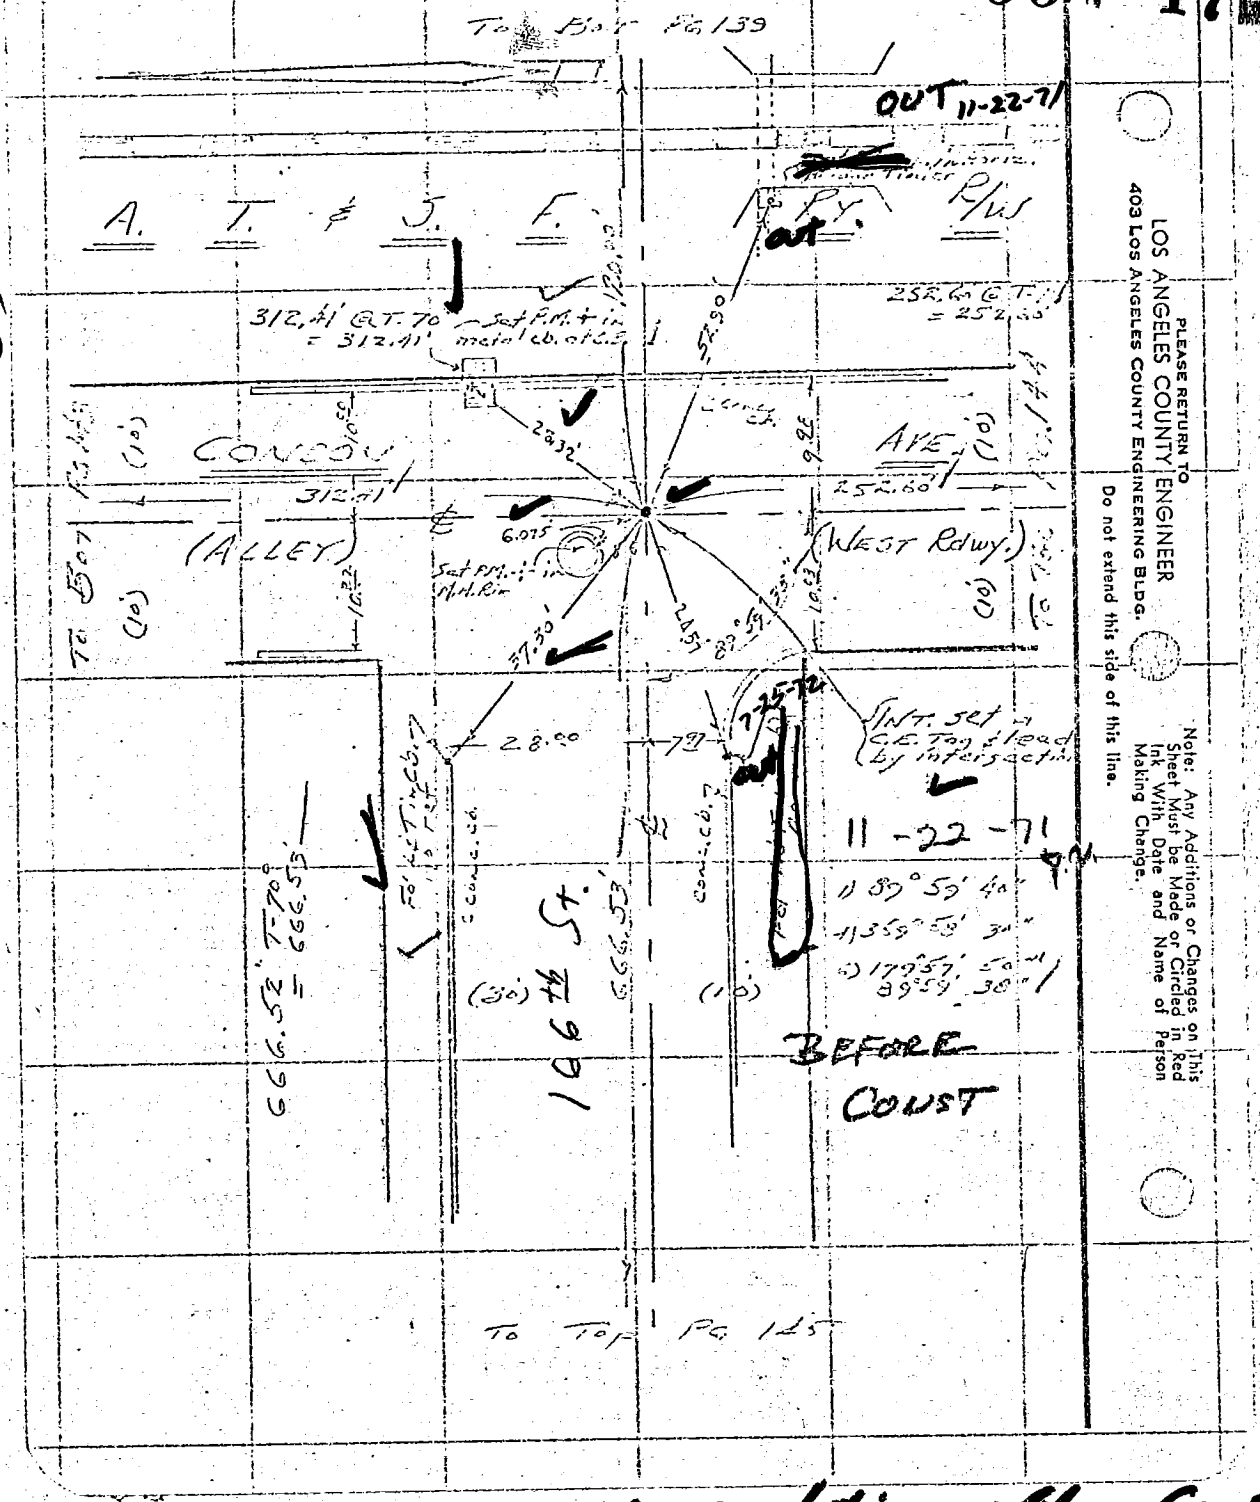


LOS ANGELES COUNTY ENGINEER
403 Los Angeles County Engineering Bldg.
PLEASE RETURN TO
Do not extend this side of this line.

Note: Any Additions or Changes on This Sheet Must be Made or Circled in Red Ink With Date and Name of Person Making Change.

V = Fd in good Condition after Const. 7-25-72. DMA

See R&R 7 for additional Ties

NEW TIES SEE FCSD 5050-F

OR C.S. F.B. 3555-20

AWNDALE SD 5050
J. VOGE DATE 12-16-71
DATE

Co. Engr. F.B. 3555: 18
INDEX FCSD5050 3
B&B-3
LOS ANGELES COUNTY FLOOD CONTROL DISTRICT

3555 18

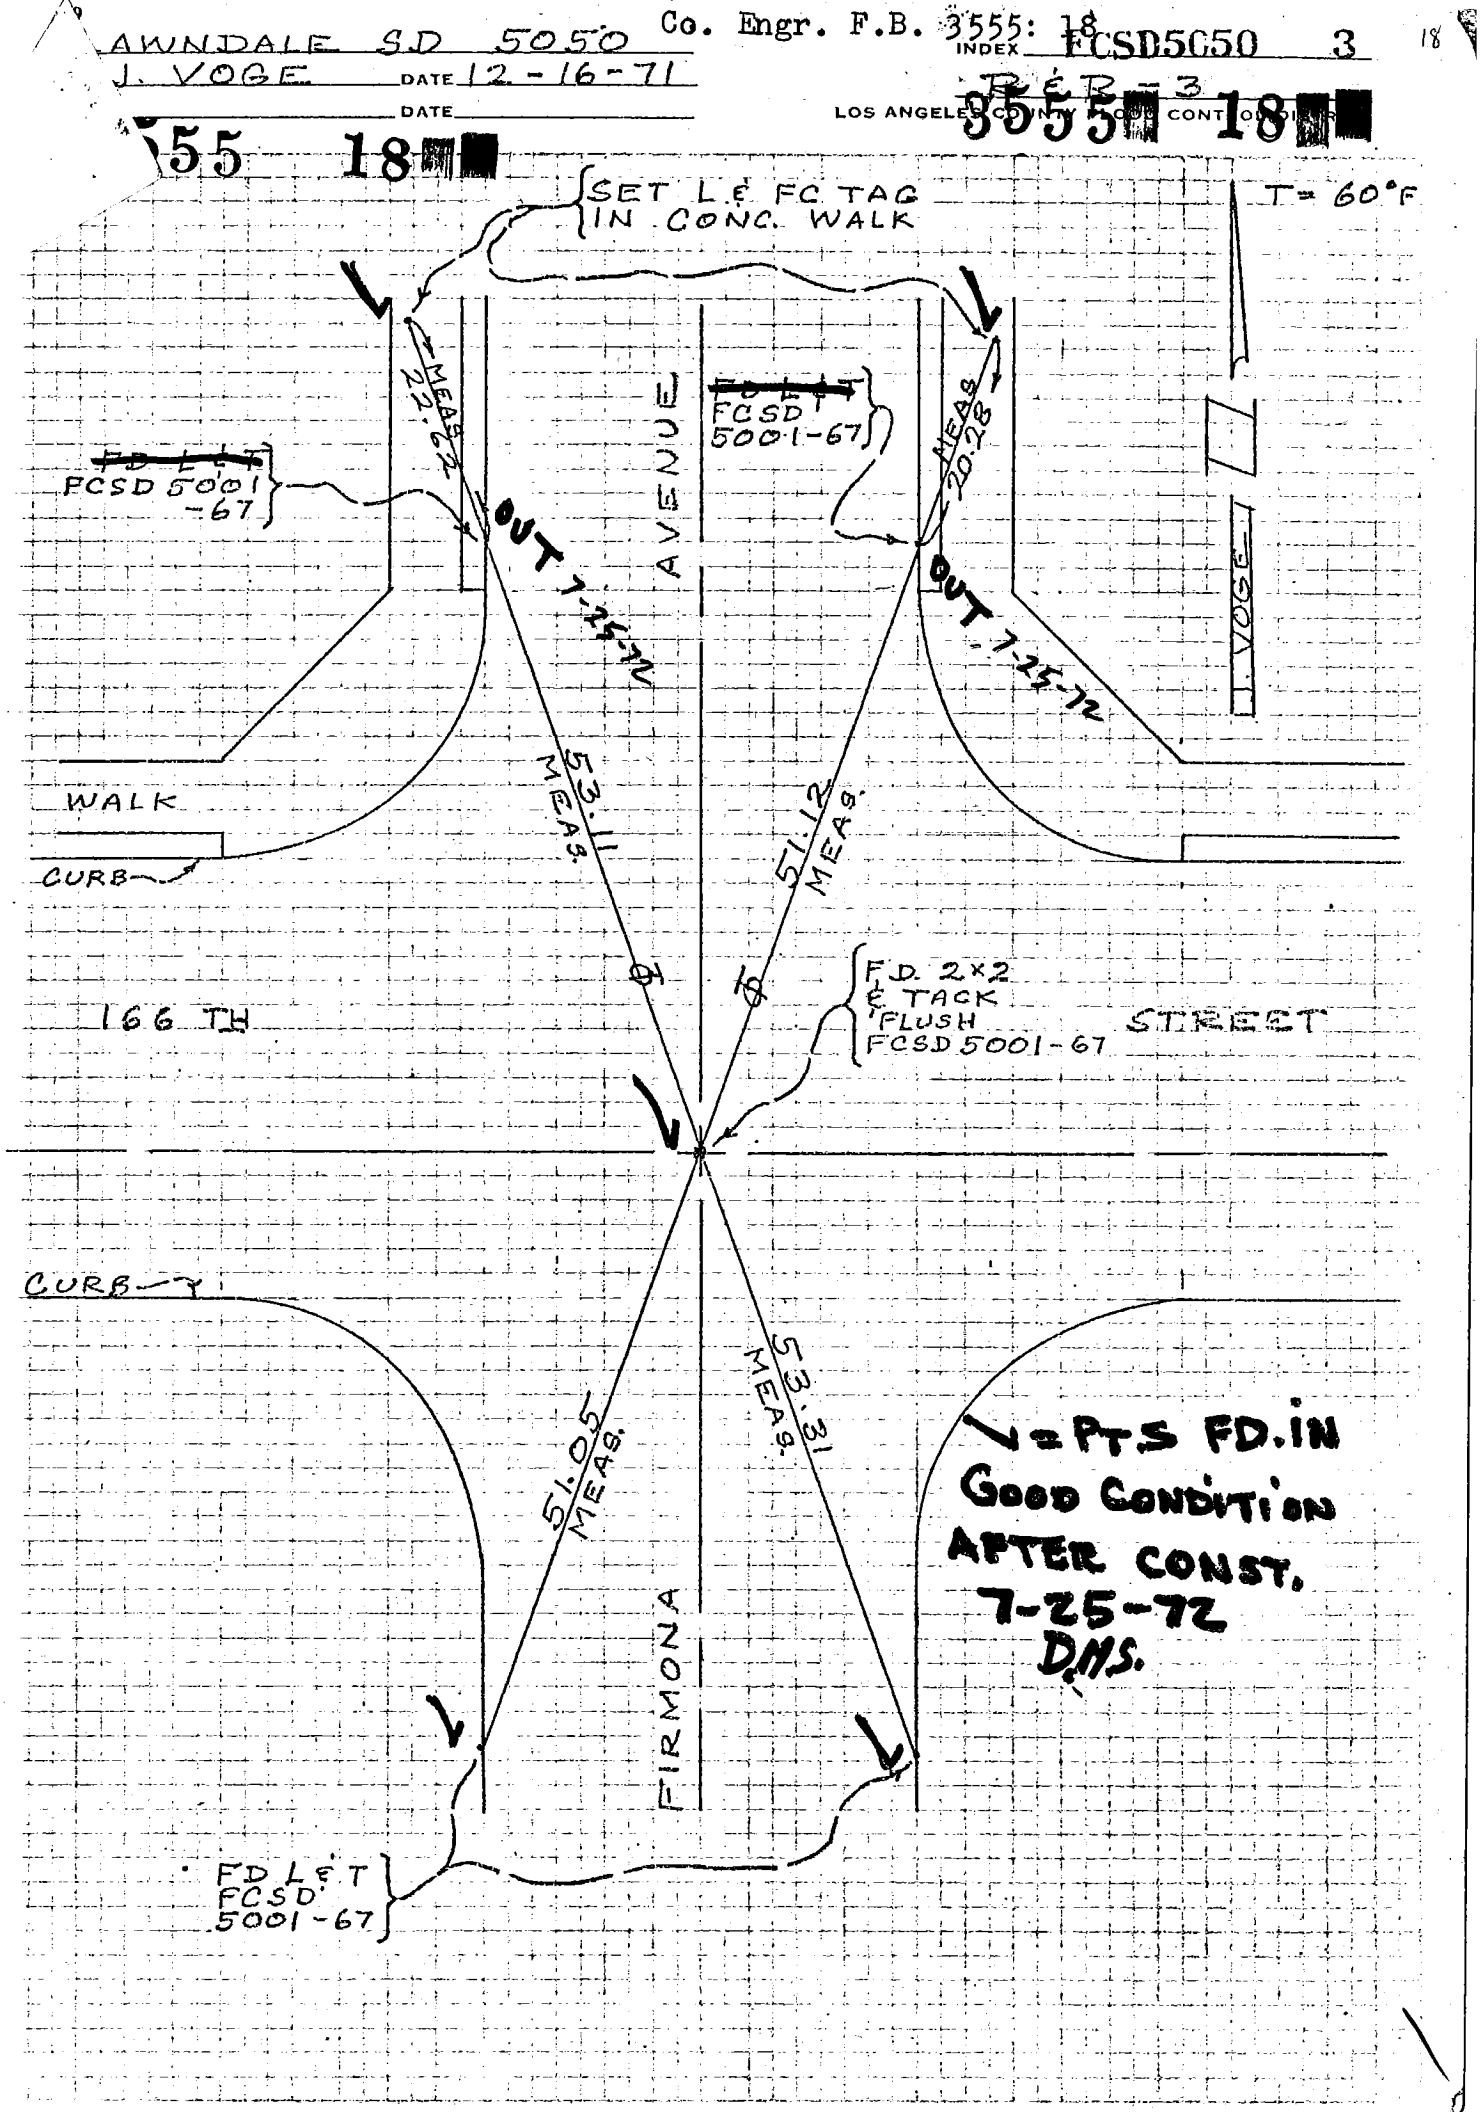

PROJECT 3555 19[redacted] 5050 Co. Engr. F.B. 3555; FCSD5050 5

SURVEY BY J. VOGE DATE 12-23-71 INDEX 19

REVIEWED BY DATE R & R - 5

LOS ANGELES COUNTY FLOOD CONTROL DISTRICT

19[redacted] 3555 19[redacted]

T = 65° F

W.S. 25 C-3

CONC WALK

FD L & T
FCSD
5001-71

SET L & FC
TAG

CONC CURB

21.73
MEAS

25.42
MEAS

AVENUE

J. VOGE

SET
DN

165 TH STREET

14.11
MEAS

FD BT SPK
FCSD
5001-71

FD L & T
IN CURB
FCSD
5001-71

25.02
MEAS

12.64
MEAS

CONC CURB

13.89

CONC WALK

SET L & FC
TAG

CONCRETE

A C CURB

FD L & T IN
HEADWALL
FCSD 5001
-71

✓ = Fd in good Condition after Const.
7-25-72 D.M.S.

76S911– C66 3-69

PROJECT LAWNDALE SD-5050 Co. Engr. F.B. 3555:20 INDEX FCSD5050 7 20

SURVEY BY DMS DATE 7-25-72 R/R P.1

REVIEWED BY 20 DATE LOS ANGELES COUNTY ROAD CONTROL DISTR

3555 20 3555 20

7-25-72 = after Const.

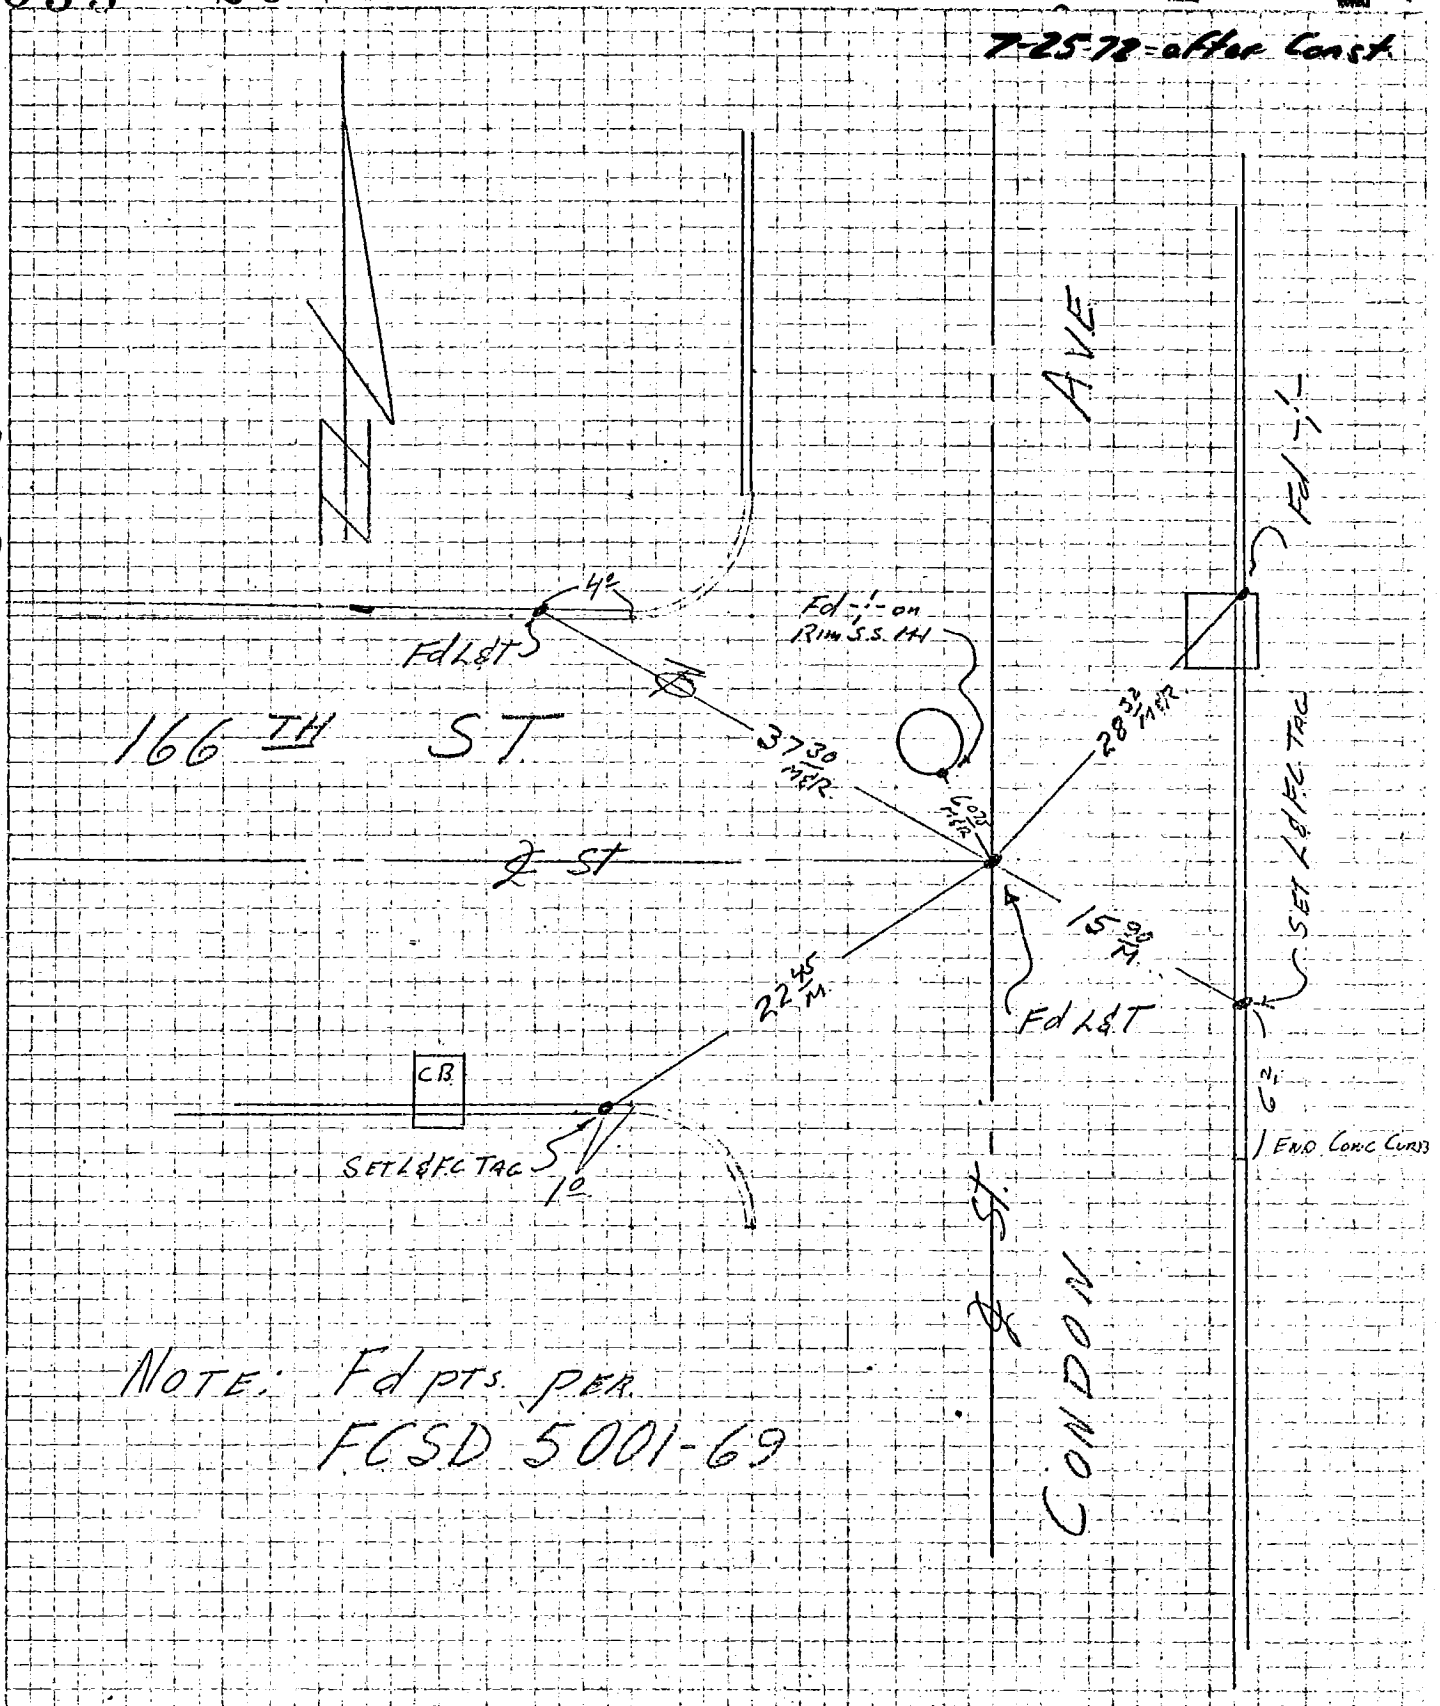


NOTE: Fd PTS. PER FCSD 5001-69

PROJECT LAWNDALE 9840 UNIT Co. Engr. F.B. 3555 FCSD 9840, 27
SURVEY BY J. VOGE DATE 12-1-71
REVIEWED BY DATE
INDEX 21
R & R - 3
LOS ANGELES COUNTY FLOOD CONTROL DISTRICT

3555 21

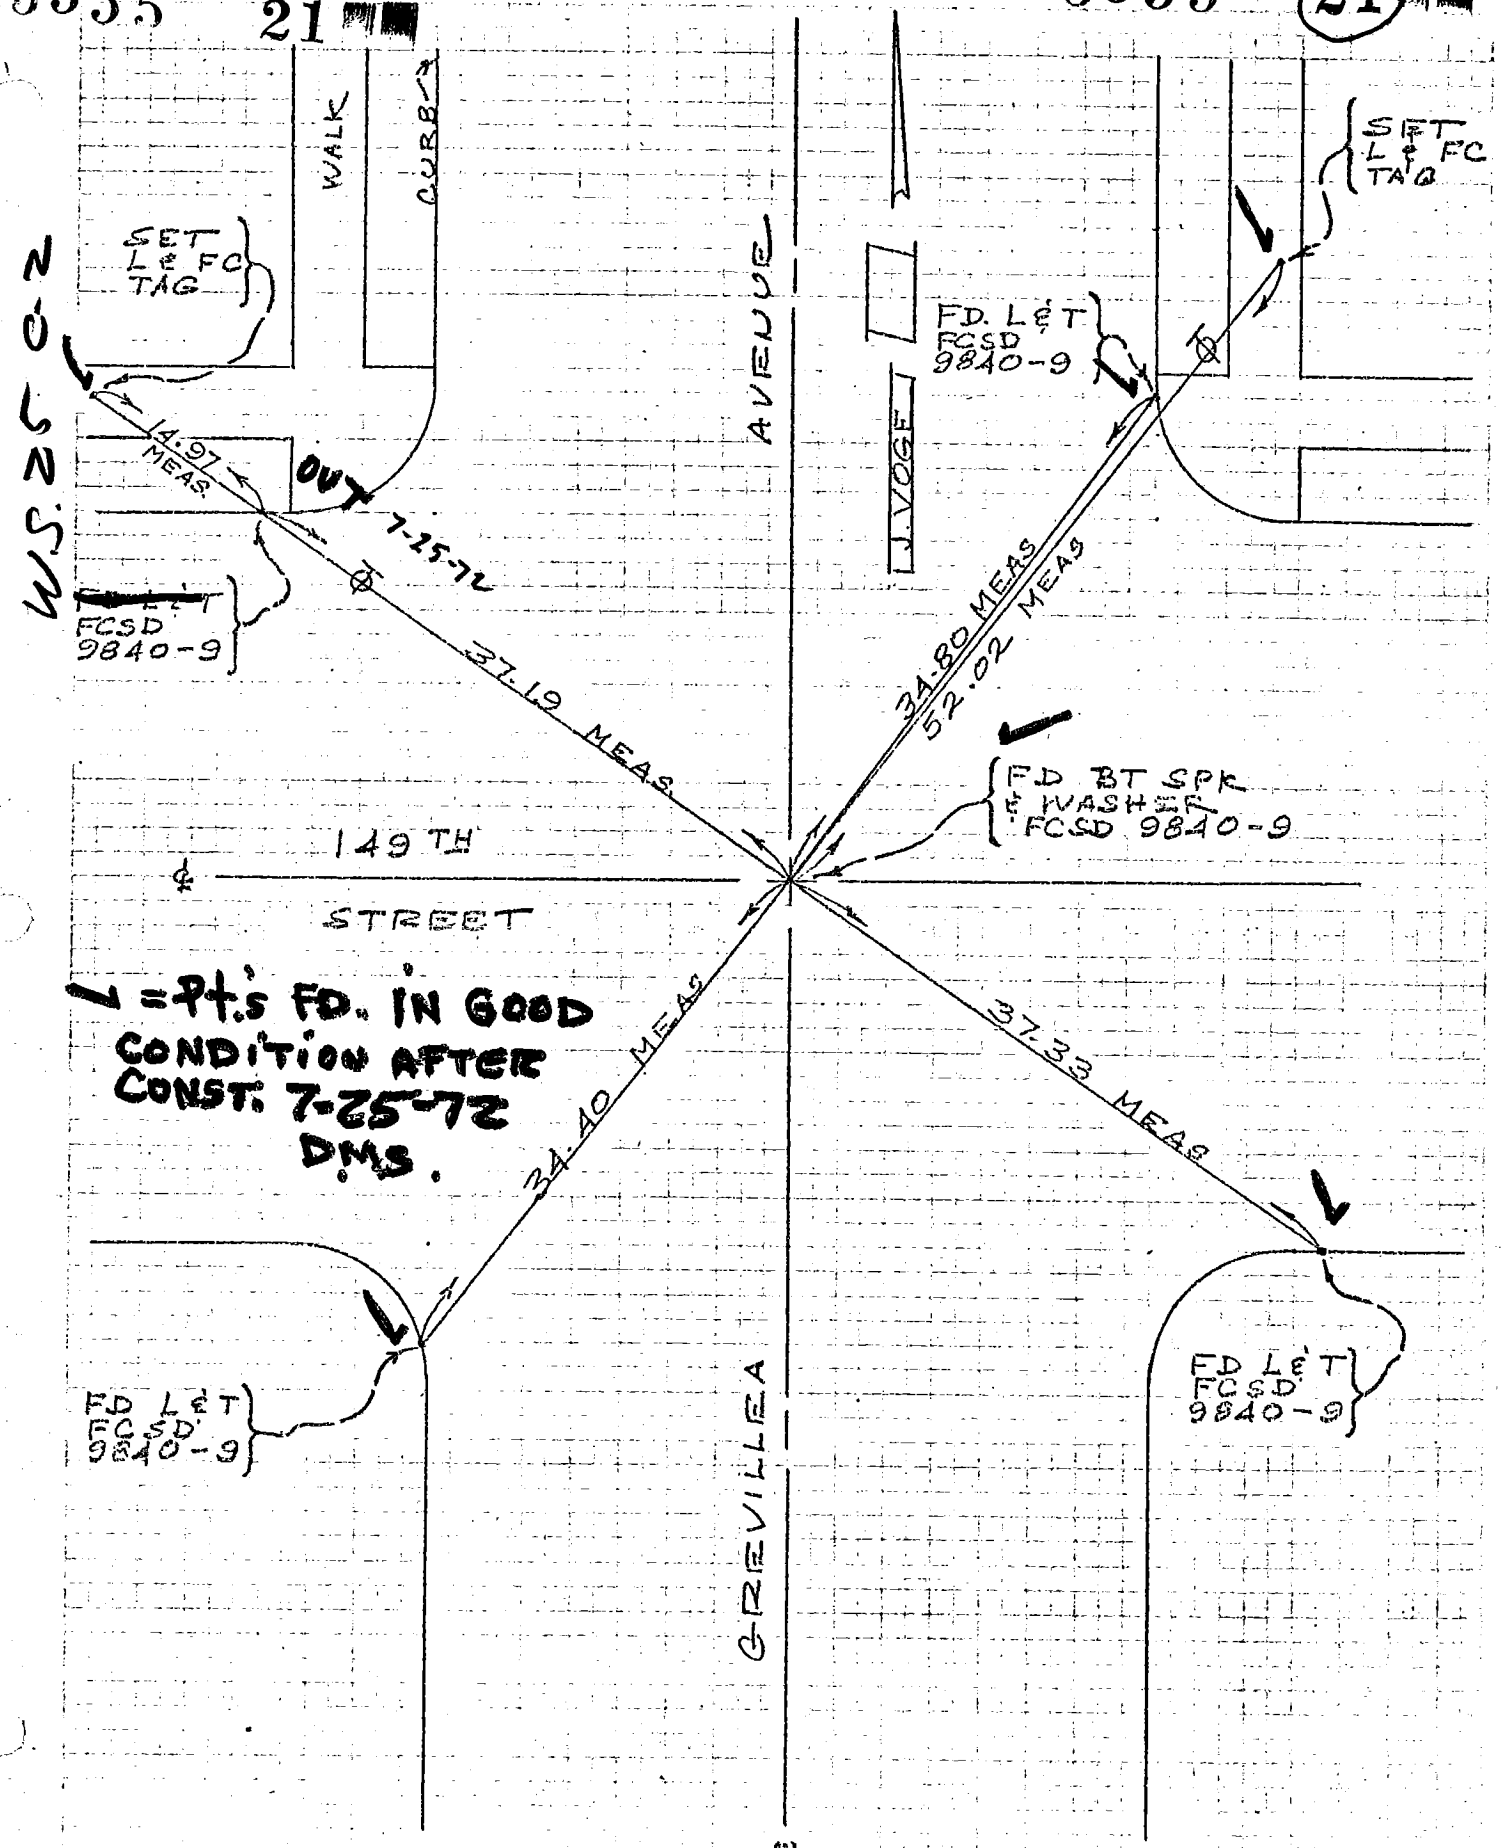

6S911– Cdb 3-69

Co. Engr. F.B. 3555: 22

PROJECT REDONDO BEACH 6550 UNIT 1

INDEX FCSD6550 31

SURVEY BY J. VOGE DATE 11-23-71

REVIEWED BY DATE

3555 : 22

R & R B. 22

LOS ANGELES COUNTY FLOOD CONTROL DISTRICT

T = 65° F

W.S. 25, C-3

V = Fd in Good Condition AFTER Comm 7-24-72 Dms.

FD. L & FC TAG FCSD 6550-23

SET L & FC TAG

CURB

33.50 MEAS.

LANE

SET L & FC TAG

40.95 MEAS.

FD 4-PM'S IN MH RIM, USED INTER FCSD 6550 -23

40.16 MEAS.

RUHLAND

AVENUE

℄

40.37 MEAS.

40.80 MEAS.

J. VOGE

28.95 MEAS.

32.43 MEAS.

CURB

SET L & FC TAG

OUT. 7-24-72. FD L & FC TAG FCSD 6550-23

OUT-7-24-72. FD L & FC TAG FCSD 6550-23

MAC KAY

OUT-7-24-72. FD. CHIS X FCSD 6550-23

SET L & FC TAG

SET L & FC TAG

37.78 MEAS.

CONC. WALK

CURB

28.72 MEAS.

43.82 MEAS.

NELSON

AVENUE

℄

FD 4-PM'S IN MH RIM, USED INTER FCSD 6550 -23

29.16 MEAS.

FD. CHIS X FCSD 6550-23

61.70 MEAS.

26.40 MEAS.

50.41 MEAS.

SET L & FC TAG IN CURB

FD. CHIS X, FCSD 6550-23

SET L & FC TAG

S911- Cdb 3-69

Co. Engr. F.B. 3555: 23 FCSD6550 33 23

PROJECT REDONDO BEACH 6550 UNIT I INDEX R & R - 5

SURVEY BY J. VOGE DATE 11-29-71

REVIEWED BY DATE

LOS ANGELES COUNTY FLOOD CONTROL DISTRICT

3555 23

3555 23

W.S. 25 B-3

L = FD. IN GOOD CONDITION AFTER CONST. 7-24-72.

FD. CHIS X FCSD 6550 - 25

CURB →

29.63 MEAS.

NELSON ℄

AVENUE

SET L & FC TAG

24.31 MEAS

FD. BT. SPK & W. FCSD 6550 - 23

AVENUE

SET L & FC TAG

24.21 MEAS.

28.72 MEAS.

OUT-7-24-72. FD. CHIS X FCSD 6550 - 23

OUT-7-24-72. FD. CHIS X FCSD 6550 - 23

CURB

J. VOGE

27.08 MEAS.

42.21 MEAS.

SET L & FC TAG

VAIL LANE ℄

FD CHIS X FCSD 6550 - 25

FD CHIS X FCSD 6550 - 25

SET L & FC TAG

29.15M MEAS.

28.57M MEAS.

28.89M MEAS.

NELSON ℄

AVENUE

OUT FD. BT. CUT ℄ W FCSD 6550 - 125

SET S & EC W. by T MEAS @ 68°

29.15M MEAS

28.58M MEAS.

SET L & FC TAG

29.90 MEAS

BLOSSOM

OUT-7-24-72. FD. CHIS X FCSD 6550 - 25

FD CHIS X FCSD 6550 - 25

S911 – Cdb 3-69

Co. Engr. F.B. 3555: 24

PROJECT REDONDO BEACH SD 6550 UNIT 1 INDEX FCSD6550 35

SURVEY BY R.E. BREWER DATE 11-30-71

REVIEWED BY DATE

R&R-7

LOS ANGELES COUNTY FLOOD CONTROL DISTRICT

3555 : 24

3555 : 24

W 25-B-3

= 2 Rd in Good Condition after Const. 7-24-72 ORG.

PTS. FD. PER FCSD 6550-25

LANE

MATHEWS AVE

RINGE

SET CH.+ TOP 25" HIGH CONC BLK WALL

1.62 M

SET L & FC TAG

OUT 7-24-72

12"

1"

29.00'

41.39' M

FD. CH.+

1"

29.21' M

FD. C.N.

28.87' M

41.72 M

28.96'

1"

SET L & FC TAG

SET L & FC TAG

SET CH.+ TOP 4" HIGH CONC BLK WALL

4"

6.45 M

OUT 7-24-72

Co. Engr. F.B. 3555: 25 FCSD4001 67

BY Whitcomb, Greggo DATE 4/19/65 SUBJECT ℄ Control Line # SHEET NO. OF

CHKD BY DATE JOB NO. Mt Hermosa Beach 4001

3555 : 25

3555 : 25

Note: All ties chisel crosses in curbs unless otherwise noted. All angles & dist mea.

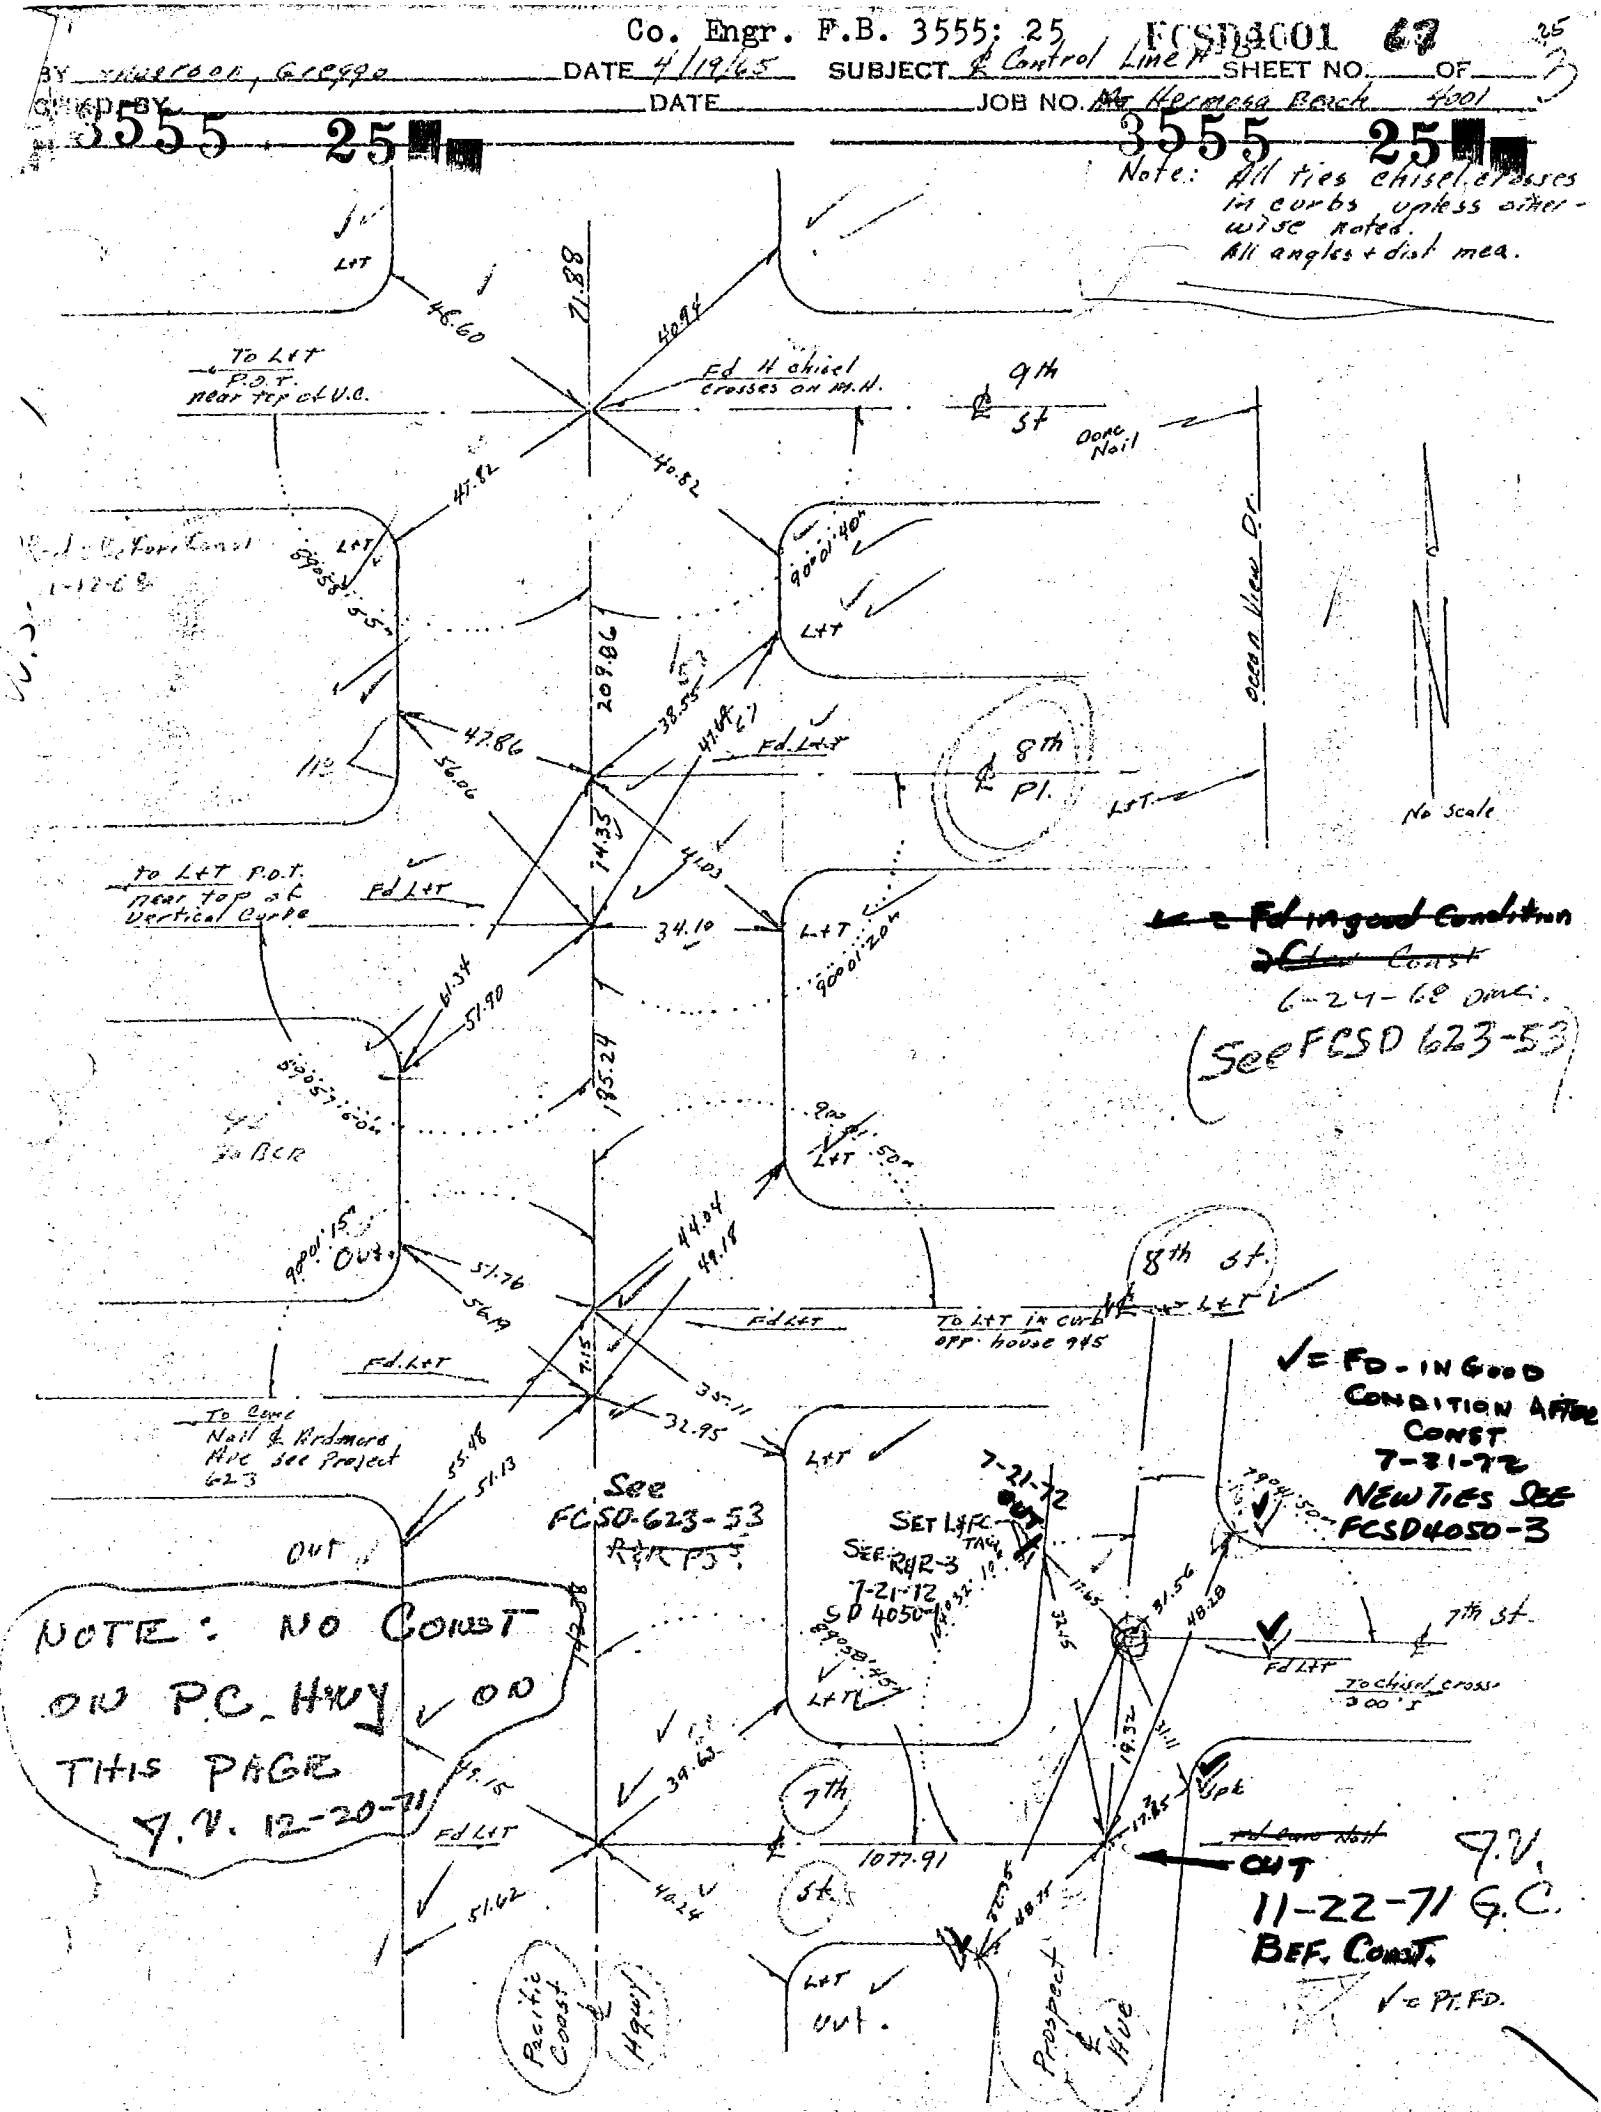

/S911– Cdb 3-69

Co. Engr. F.B. 3555: 26

PROJECT HERMOSA BEACH SD4050 UNIT-1

SURVEY BY R.E. BREWER DATE 7-21-72

REVIEWED BY [redacted] DATE

INDEX [redacted] 8

R&R 3555 26

LOS ANGELES COUNTY FLOOD CONTROL DISTRICT

FCSD 4050 3

3555 26 1

W.S. 25, B-4

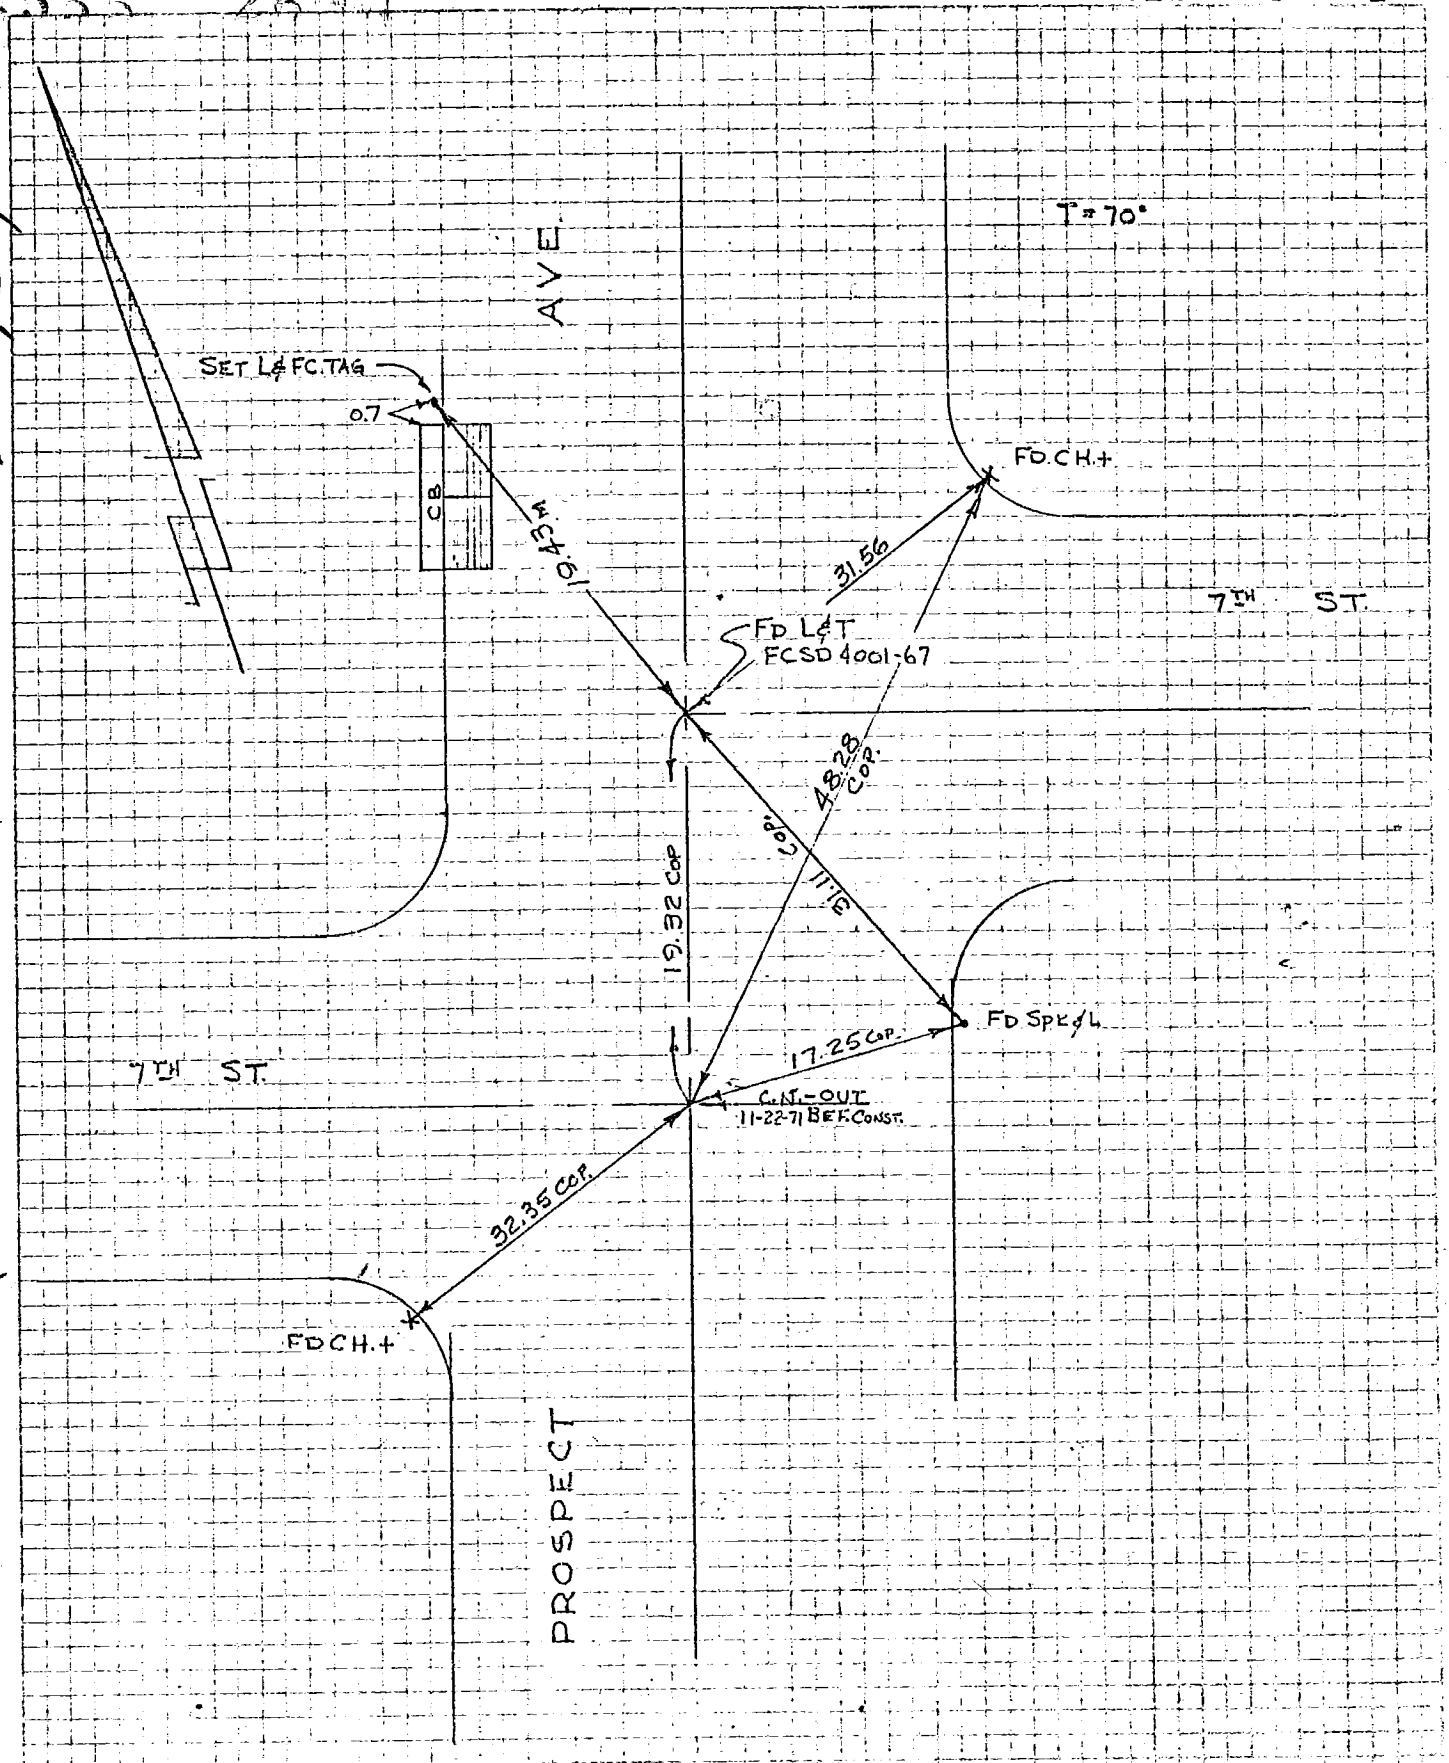

78S911– Cdb 3-69

Co. Engr. F.B. 3555: 27

PROJECT HERMOSA BEACH SD 4050 UNIT-1

SURVEY BY R E BREWER DATE 7-21-72

REVIEWED BY 3555 27 DATE

INDEX R&R-5 FCSD 4050 5

LOS ANGELES COUNTY FLOOD CONTROL DISTRICT

3555 1 27

W.S. 25-B-4

T = 78°

FD CH +

54.34 Cor.

HWY

SET L & FC TAG

40.55 M

4TH ST

FD L&T
FC SD 623-13

65.82 Cor.

10.79 M

FD CH +

PACIFIC COAST

26"

SET L & FC TAG

75.47 Cor.

68.00 M

3RD ST

FD L&T
FC SD 623-11

For Orig Ties See
FCSD 623-13

88.41 Cor.

FD CH +

Co. Engr. F.B. 3555: 28

PROJECT No. 2650, Unit 1, Line E

INDEX FCSD8650 21

SURVEY BY R.P.B. DATE 11-12-71

REVIEWED BY 3555 : 28 7-31-72

R&R 3

LOS ANGELES COUNTY FLOOD CONTROL DISTRICT

3555 28

28

Vs Fd. in good condition after const. 7-21-72 WNE

WS 28 C-2

Fd L&LACE Tag per FCSD 690-47

Fd L&LACE Tag per FCSD 690-47

34.96'M

14.20'M

24.23'M

29.23'M

Out 7-21-72 WNE

Set L&LC Tag

34.59'M

Fd S W&T per FCSD 690-47 (under dirt fill)

Fd L&LACE Tag per FCSD 690-47

℄ PANAMA

Fd L&LACE Tag per FCSD 690-45

Fd L&LACE Tag per FCSD 690-45

28.80M

28.805'M

14.20'M

℄ LINE

70.66'M

39.58 Meas.

WNE

Out 7-21-72

Fd DN&T No Ref.

Set S&W

BONDS ST (VACATED)

29.535'M

19.15'M

Set 2" I.P. & F.C. Brass Plug - flush & Prod

Fd L&LACE Tag per FCSD 690-45

Dirt fill - dug 2' Fd. Nothing

PROJECT No. 8650, Unit 1, Line "E" Co. Engr. F.B. 3555: 29 INDEX FCSD8650 23 29

SURVEY BY B.P.C. DATE 11-15-71

REVIEWED BY DATE 7-31-72

R&R 5

LOS ANGELES COUNTY FLOOD CONTROL DISTRICT

3555 29

3555 29

WS-286-2

Fd L & LACEng Tag per FCSD 690-51

28.57'M

4.095'M

24.32'M

4.14'M

ALLEY

Fd L&LA Co. Eng. Tag per FCSD 690-51

Fd S W L T per FCSD 690-51

31.25'M

Set 2" I.P. & Std F.C. Br. Plug, fl.

PANAMA AVE

Fd L & LACE Tag per FCSD 690-49

28.83'M

4.10'M

35.14'M

7-21-72 WHB

out

PACIFIC ST

24.975'M

No Tag

Fd L & ~~LACE~~ Tag per FCSD 690-49 0.01S, of Tan.

Set S & FC Washer

28.49'M

Set pencil 'X' on M.H. Lid by Tan P.M. on M.H. rim per FCSD 690-49

(M.H. Raised)

7-21-72 WHB

Fd L&LACE Tag per FCSD 690-49

√ = Fd. in good condition after const.

7-21-72 WHB

76S911– Cdb 3-69

Co. Engr. F.B. 3555: 30

INDEX FCSD8650 25

30

PROJECT No. 8650 Unit 1, Line E

SURVEY BY B.P.B. DATE 11-16-71

REVIEWED BY DATE 7-31-72

R & R 7

LOS ANGELES COUNTY FLOOD CONTROL DISTRICT

3555 30

3555 30

V=Fd in good condition after const 7-21-72 WNB

WS 28 C-N

Fd S.W.&T. per FCSD 690-55 (under dirt fill)

Fd L&LACE Tag per FCSD 690-55

#4.20'M

24.375'M

out 7-21-72 WNB

ALLEY

Set L & FC Tag

30.85'M.

19.92'M.

31.425'M

Fd L&LACE Tag per FCSD 690-55

ALLEY

24.30'M

#4.15'M

37.48'M.

Fd nothing, Set nail by int. of ties & ℄ St. (under dirt) fill

Set S & FC.W.

(No Tag) Fd L&LACE Tag per FCSD 690-53

℄ PANAMA AVE

Set S & FC. Washer

34.04'M

LINCOLN

#4.45'M

35.095'M

25.94'M

(No Tag) Fd L&LACE Tag per FCSD 690-53

out 7-21-72 WNB

ST

31.21'M

Set pencil 'X' on M.H. Lid by Tan P.M.'s on M.H. Ring per FCSD 690-53 (M.H. Raised) 7-21-72 WNB

Fd L&LACE Tag per FCSD 690-53

765911— Cad 3-69

PROJECT No. 8650, Unit 1, Line "E" Co. Engr. F.B. 3555:31 UNDER FCSD8650 27 31

SURVEY BY B. P.B. DATE 11-15-71

REVISED BY DATE 7-31-72

R 8 R 9

LOS ANGELES COUNTY FLOOD CONTROL DISTRICT

3555 31

3555 31

W.S. 28, C-2

V.C. F.D. AFTER CONST

6-14-72 WLE

7-21-72 WHB

Fd L&T per FCSD 690-59

36.84'M

36.88'M

Fd L&T per FCSD 690-59

238TH

℄

PL.

36.925'M

36.85'M

Set penci / "X" on M.H. Lid by Tan P.M.'s on M.H. ring per FCSD 690-59

Fd L&T per FCSD 690-59

Fd L&T per FCSD 690-59

PANAMA AVE

℄

Set L&T FC Tag

8.815'M

℄

Set L&T FC Tag

℄

12.795'M

~~Fd L&T per FCSD 690-57~~

out 7-21-72

Fd L&T per FCSD 690-57

60.68'M

54.96'M

54.96 M.

SEPULVEDA

BLVD

℄

out-7-21-72

~~Fd SWET per FCSD 690-57~~

Reset bt. Spk. & FC Washer

50.54'M

5.0'

60.65'M

5.0'

Fd L&T per FCSD 690-57

Fd L&T per FCSD 690-57

768911– Cdb 3-69

PROJECT No 8650, Unit 1, Line E Co. Engr. F.B. 3555: 32 INDEX 32 FCSD8650 29 32

SURVEY BY B.P.B. DATE 11-15-71

REVIEWED BY DATE 7-31-72 R4R 11

LOS ANGELES COUNTY FLOOD CONTROL DISTRICT

3555 32

3555 32

V.C. Fd in good condition after const. 7-19-72 WMB

W.S. 28 C-2

Fd L&T per FCSD 690-61

Fd L&T per FCSD 690-61

Fd L&T No ref.

238 TH

27.69 M

9.235

28.675 M

48.80' M.

ST.

Fd L&T No Ref.

~~Fd L&T per FCSD 690-61~~

out - Set pt. spk & fc. washer 7-19-72 WMB

30.965 M

39.855' M

Fd L&T per FCSD 690-61 0.01' NW of Tan.

Fd L&T per FCSD 690-61

PANAMA AVE

FD. DATUM ℄ NAIL

18.235' M

18.39' M

Fd L&T No Ref.

Fd L&T 0.01' So. of Tan. No Ref.

47.63' M

47.74' M

6601' M. to 238 TH PL

Fd L&T per FCSD 690-59

Fd L&T per FCSD 690-59

Survey Div

Co. Engr. F.B. 3555: 33

LARSEN, TULLY & SMITH
COMPTON & PARAMOUNT

15 MAR 71

FCSD 6150 11

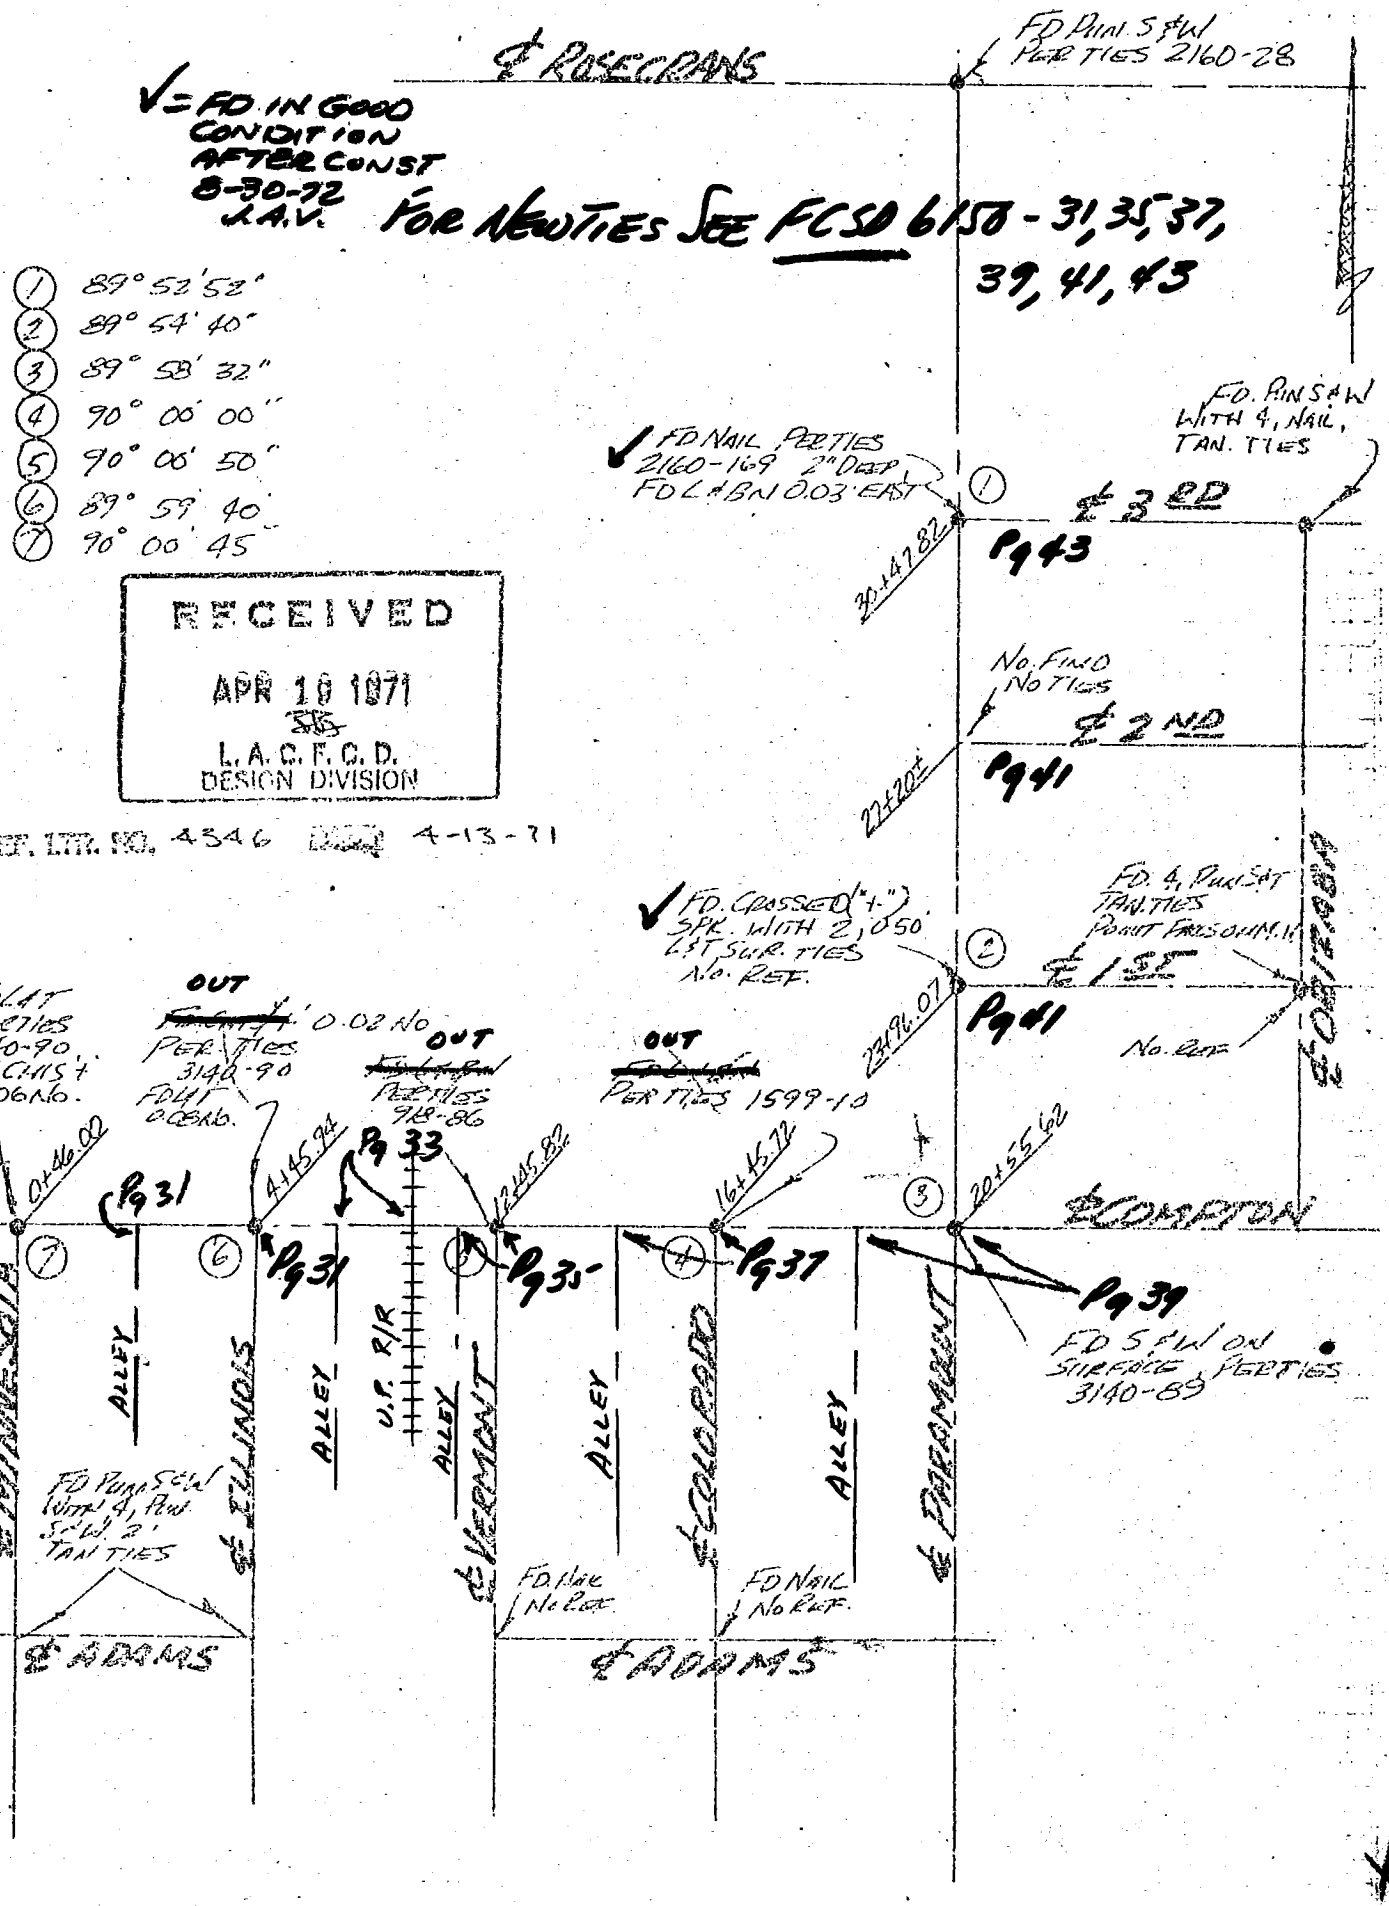

Co. Engr. F.B. 3555, 34

FCSD 6150 15

(84)

W.S. 32, C-4

# FOR NEW TIES SEE FCSD 6150-31, 33

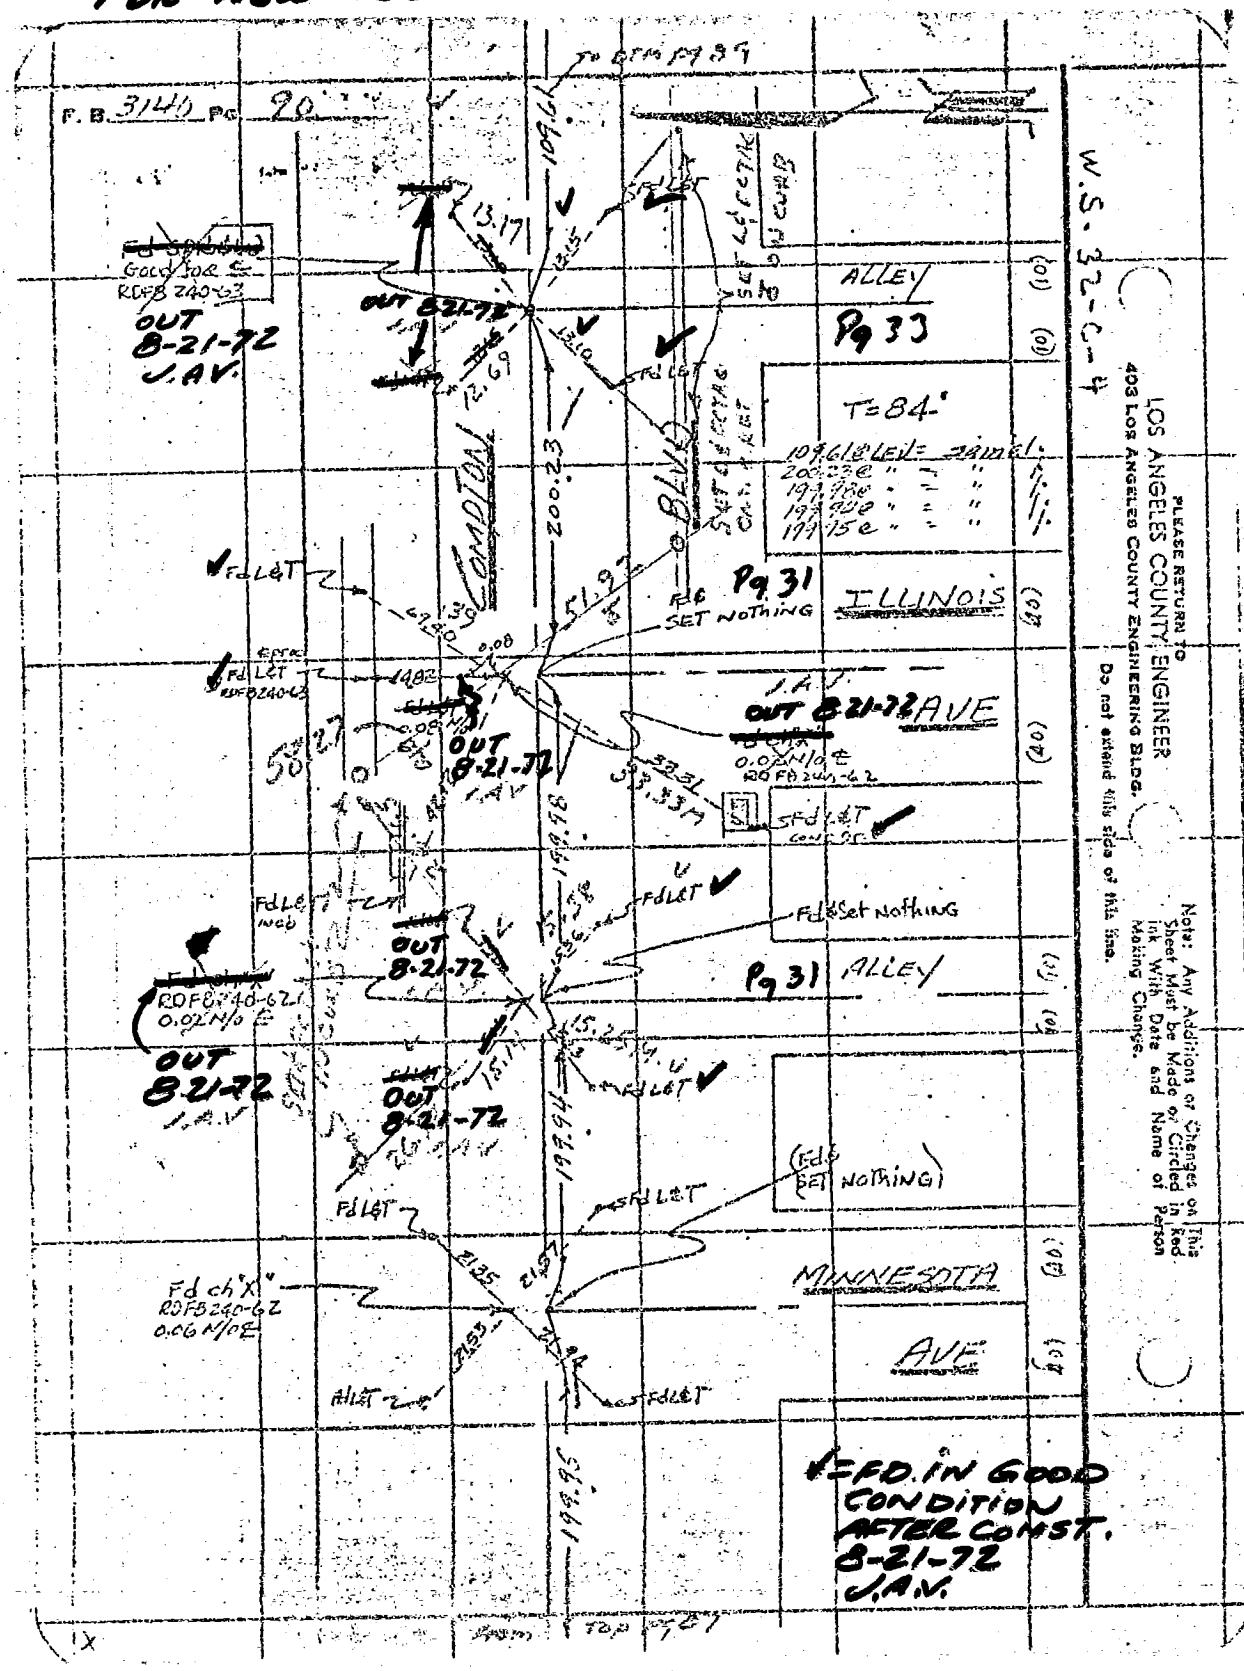
F.B. 3140 Pg 20
To Grn Pg 33
109.61
13.17
12.69
Fd Spindle
Good for ⊆
RDFB 240-62
OUT 8-21-72
J.A.V.
Fd LEAD & TACK
SET L&T FOR
W CURB
ALLEY
Pg 33
T=84°
109.61 @ LEVEL = signal
200.23 @ " = "
199.98 @ " = "
199.92 @ " = "
199.75 @ " = "
200.23
BLVD
SET L&T ON C.L. PLUG
Fd L&T
Pg 31
ILLINOIS
51.97
Fd SET NOTHING
Fd L&T
RDFB 240-62
0.00
1402
OUT 8-21-72
J.A.V.
50.27
J.A.V.
OUT 8-21-72
AVE
0.02 N/O ⊆
RDFB 240-62
32.34
33.33
Sfd L&T
Fd L&T
Fd L&T
Fd & Set Nothing
Pg 31
ALLEY
Fd L&T
N&B
OUT 8-21-72
RDFB 240-62
0.02 N/O ⊆
OUT 8-21-72
J.A.V.
OUT 8-21-72
199.94
Fd L&T
(Fd & SET NOTHING)
Fd L&T
Fd ch "X"
RDFB 240-62
0.06 N/O ⊆
21.35
21.37
MINNESOTA
AVE
Fd L&T
Fd L&T
199.87
Fd L&T
Fd L&T
Fd L&T

W.S. 32, C-4

FOR NEW TIES SEE FC SD 6150-35, 37

F.B. 918 Pg. 86

V=FD. IN GOOD CONDITION AFTER CONSTR
8-29-72
J.A.V.

W.S. 32-C-4

J.A.V.
OUT 8-29-72

COMPTON BLVD.

OUT 8-29-72 J.A.V.

OUT 8-29-72 J.A.V.

FB L+T. 4 tong L+Ts.
FB 479-212
RD E 0-210-18
RD Z-122-35

199.99'

199.99 T=72

199.95'

199.94 T=72

.035

.075

199.95

199.94 T=72

TO PG 87

FROM PG. 85

FD "X" + 4 tong L+Ts.
FB 479-214

SET SPIKE & TAG

(1) 90°-00'-15"
(2) 360-00-45"
(3) 180-01-00
30°+00'-10"

(40)

(40)

(40)

VERMONT AVE.

ALLEY

10 (10)

(50)

FD L+T. & 4 tong L+Ts.
FB 479-212
RD Z-122-334
RD Z-104-20

CENTER STREET

RETURN TO
LOS ANGELES COUNTY SURVEYOR
700 HALL OF RECORDS

Do not extend notes this side of this line.

Note: Any Additions or Changes on This Sheet Must be Made or Circled in Red Ink With Date and Name of Person Making Change.

Co. Engr. F.B. 3555: 36

(36)

FCSD 6150 21

For New Ties See FCSD 6150-37, 39

W.S. 32, C-4

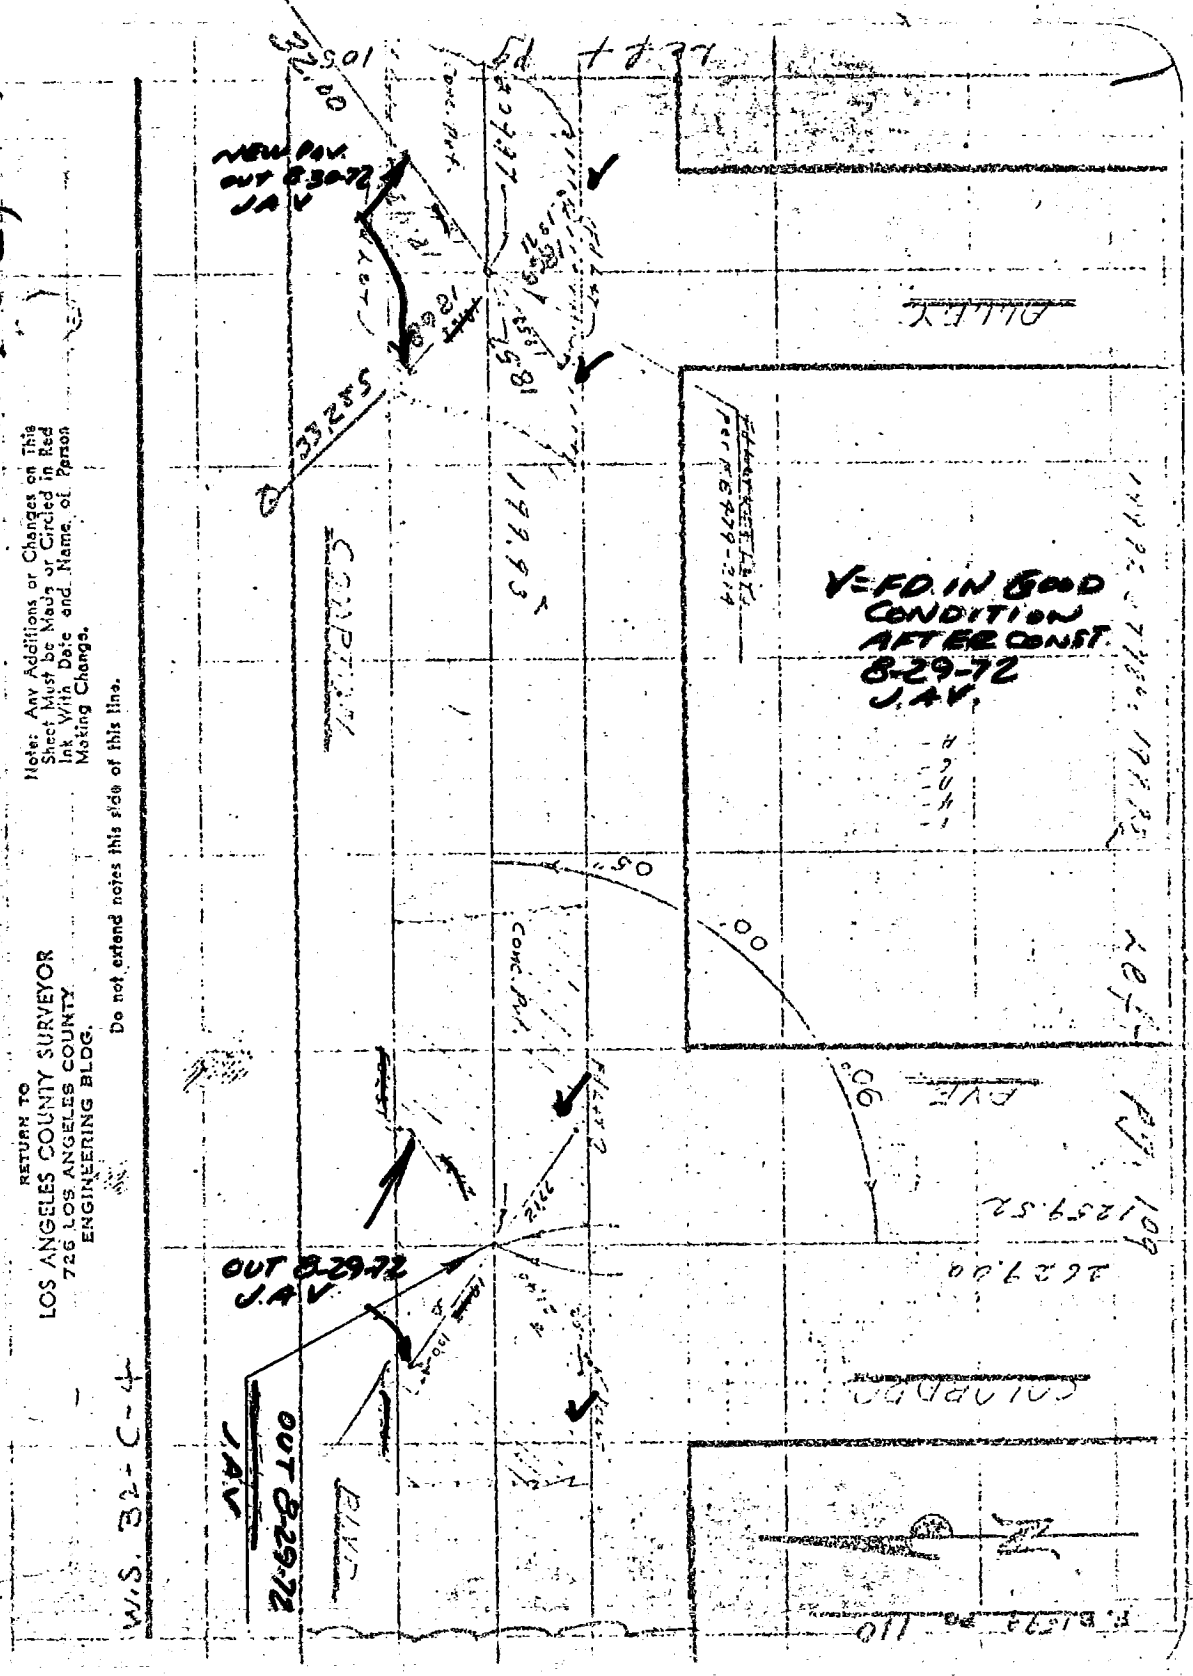


RETURN TO
LOS ANGELES COUNTY SURVEYOR
726 LOS ANGELES COUNTY
ENGINEERING BLDG.

Do not extend notes this side of this line.

Note: Any Additions or Changes on This Sheet Must be Made or Circled in Red Ink With Date and Name of Person Making Change.

Co. Engr. F.B. 3555: 37
FGSD 6150/23

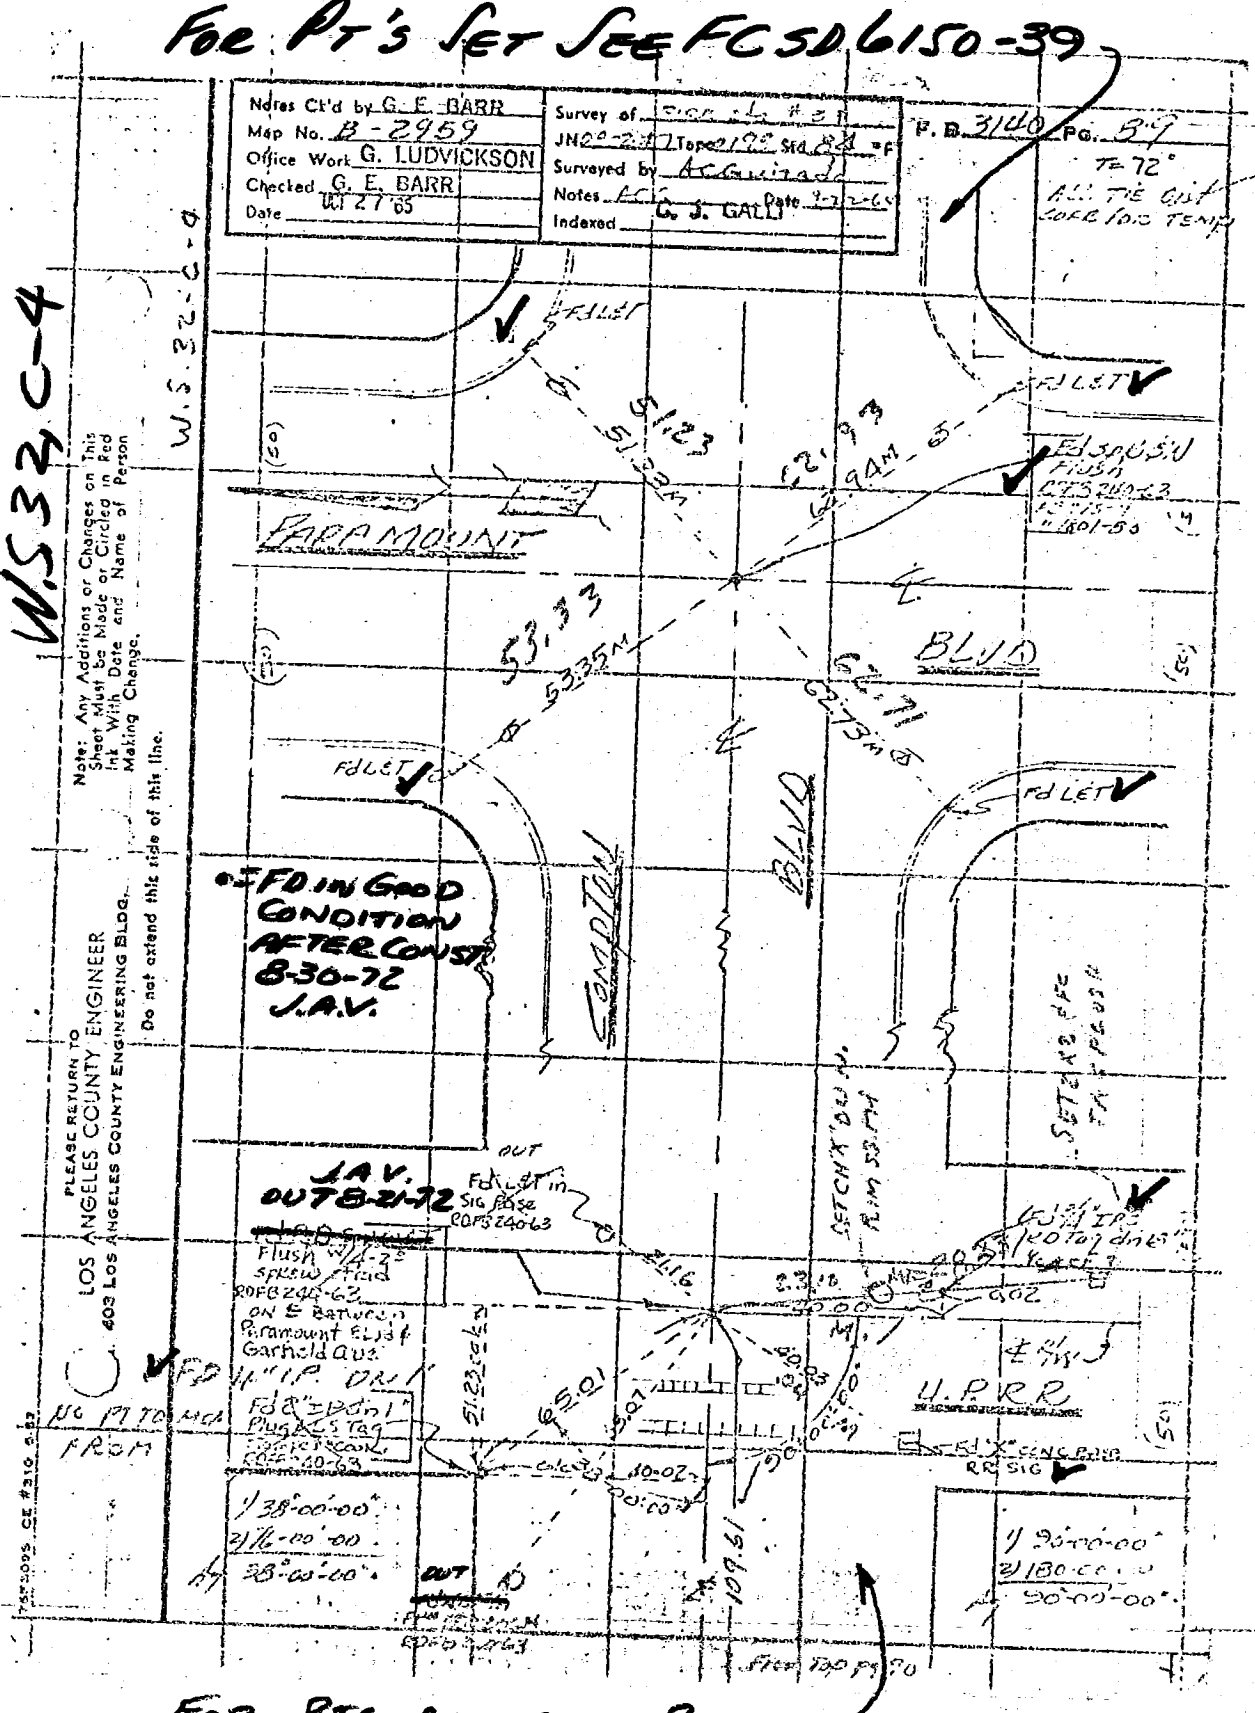

Co. Engr. F.B. 3555: 38

FCSD 6150 25

For New Ties See FCSD 6150-43

W.S. 32, C-4

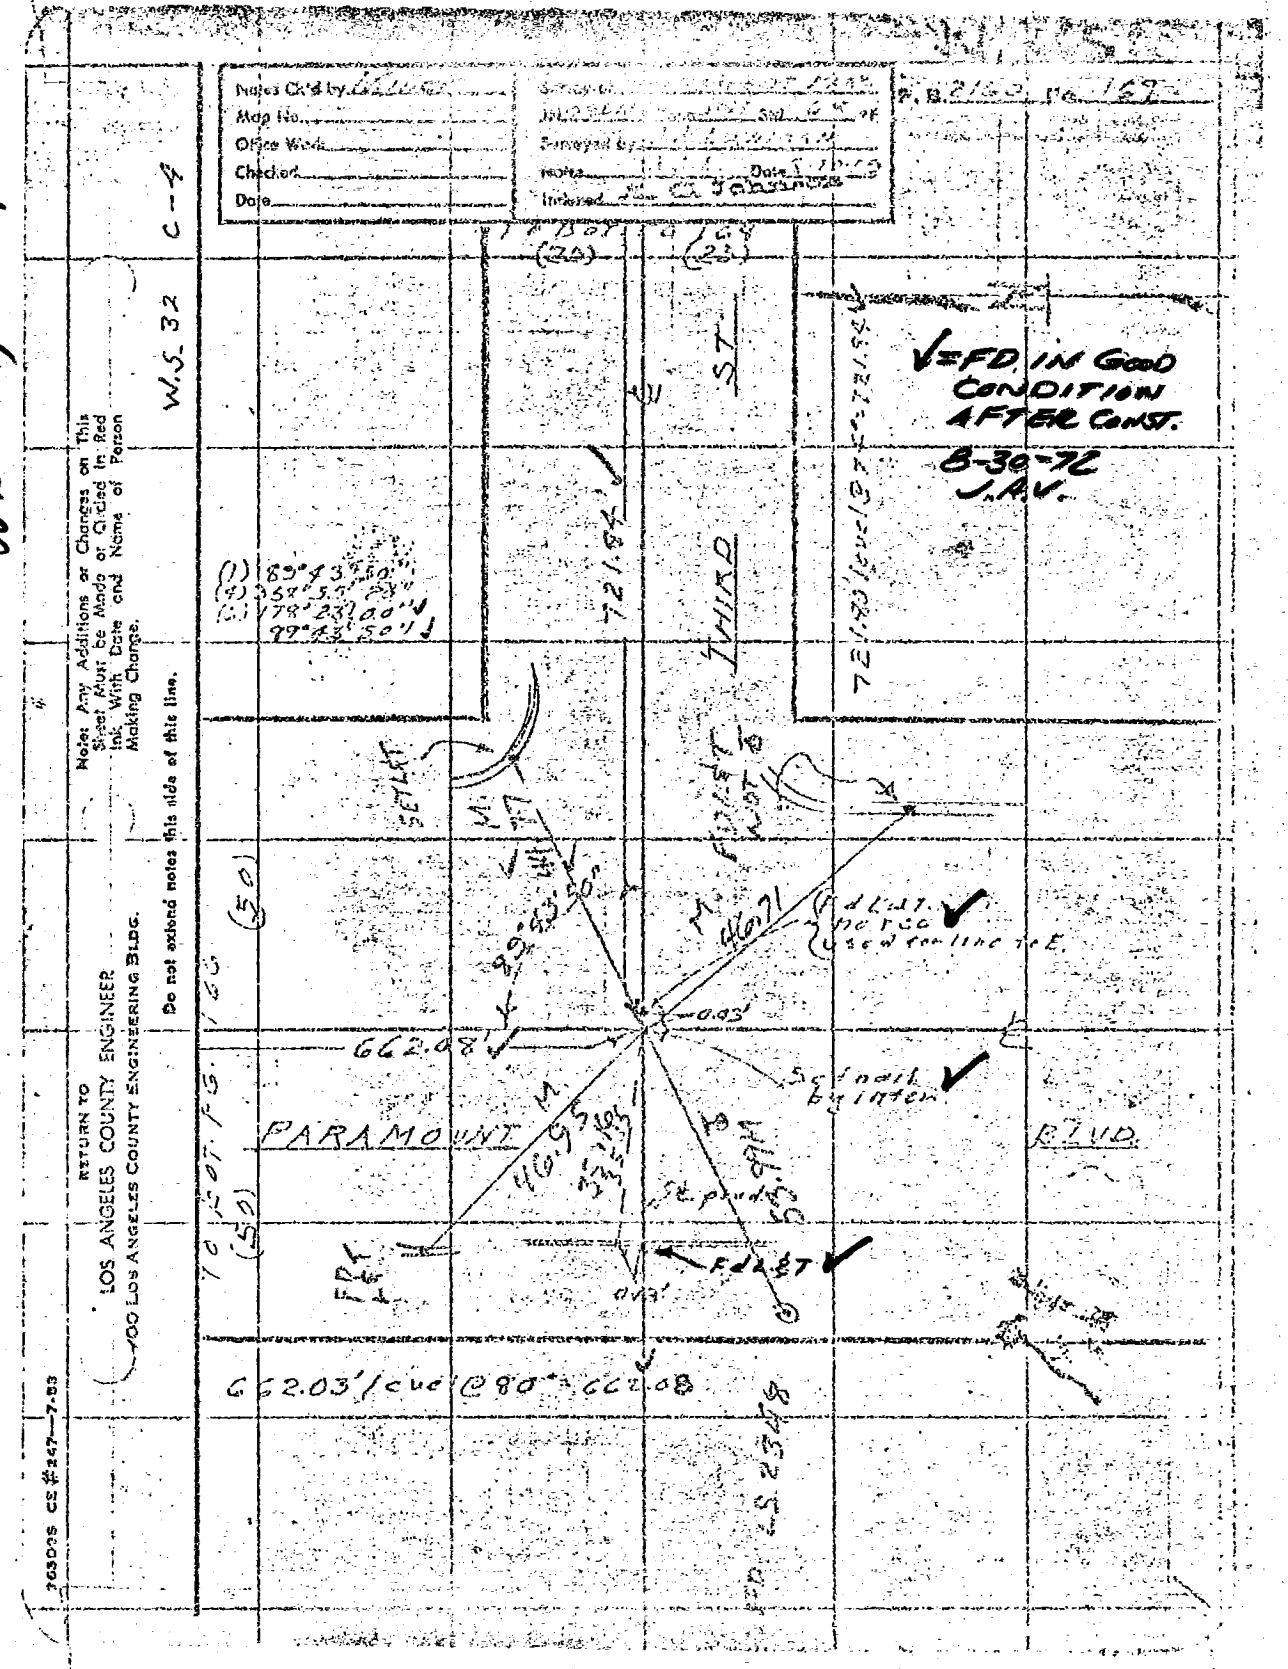

768911– Cdb 3-69

PROJECT Paramount Proj. No. 6150

SURVEY BY C.C.C. DATE 3-13-72

REVIEWED BY DIVISION DATE 4-26-72

Co. Engr. F.B. 2555: 39

INDEX FCSD6150 31

R & R 3

LOS ANGELES COUNTY FLOOD CONTROL DISTRICT

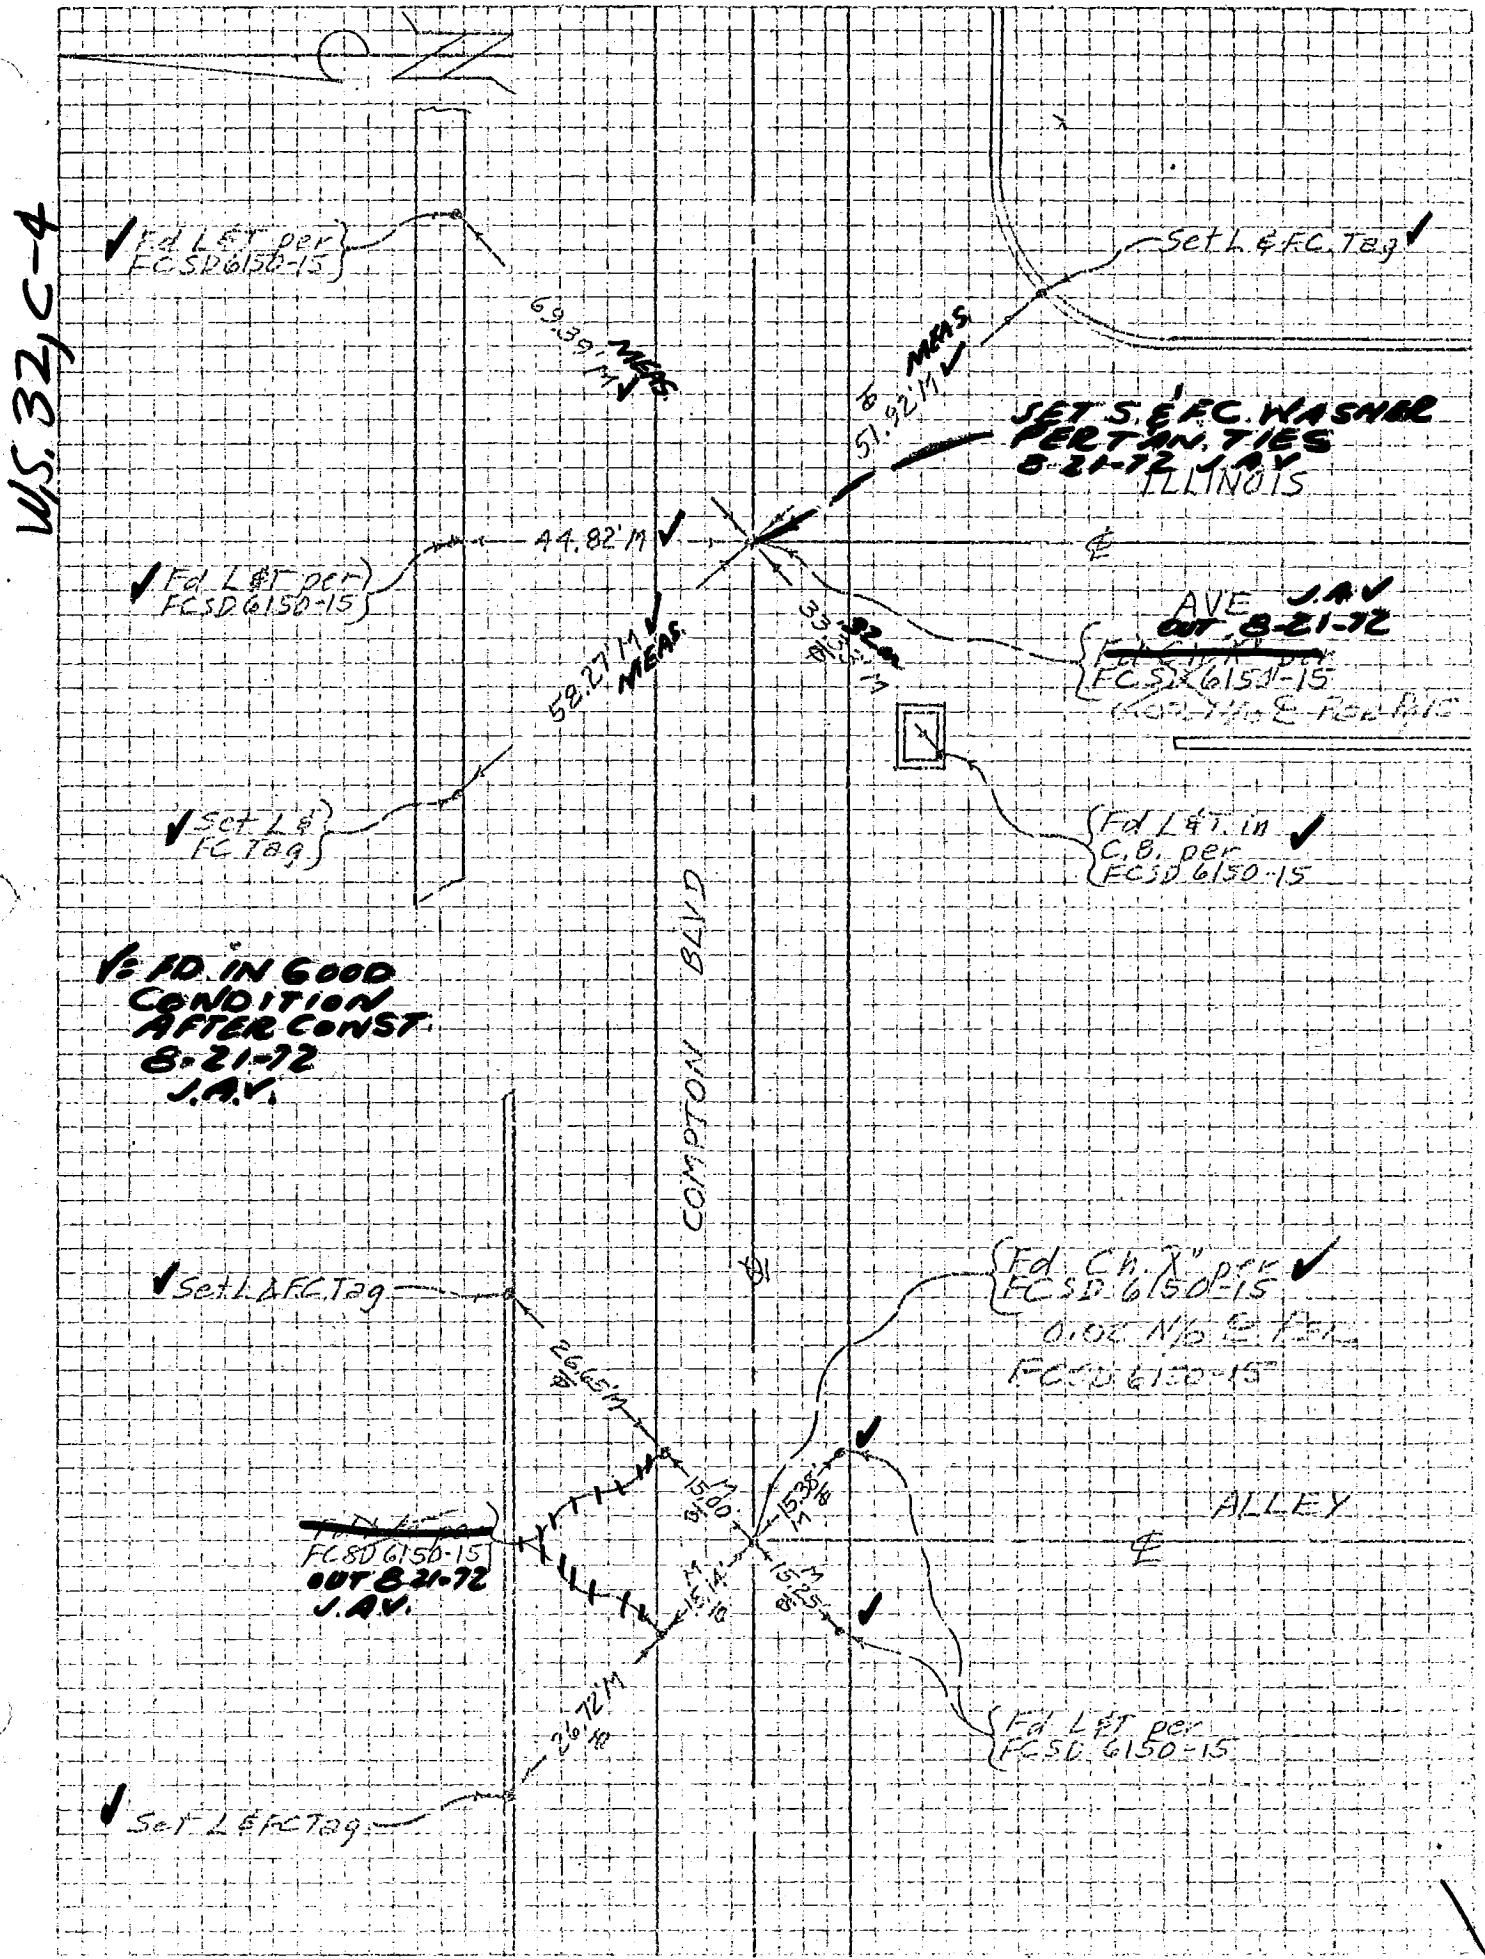

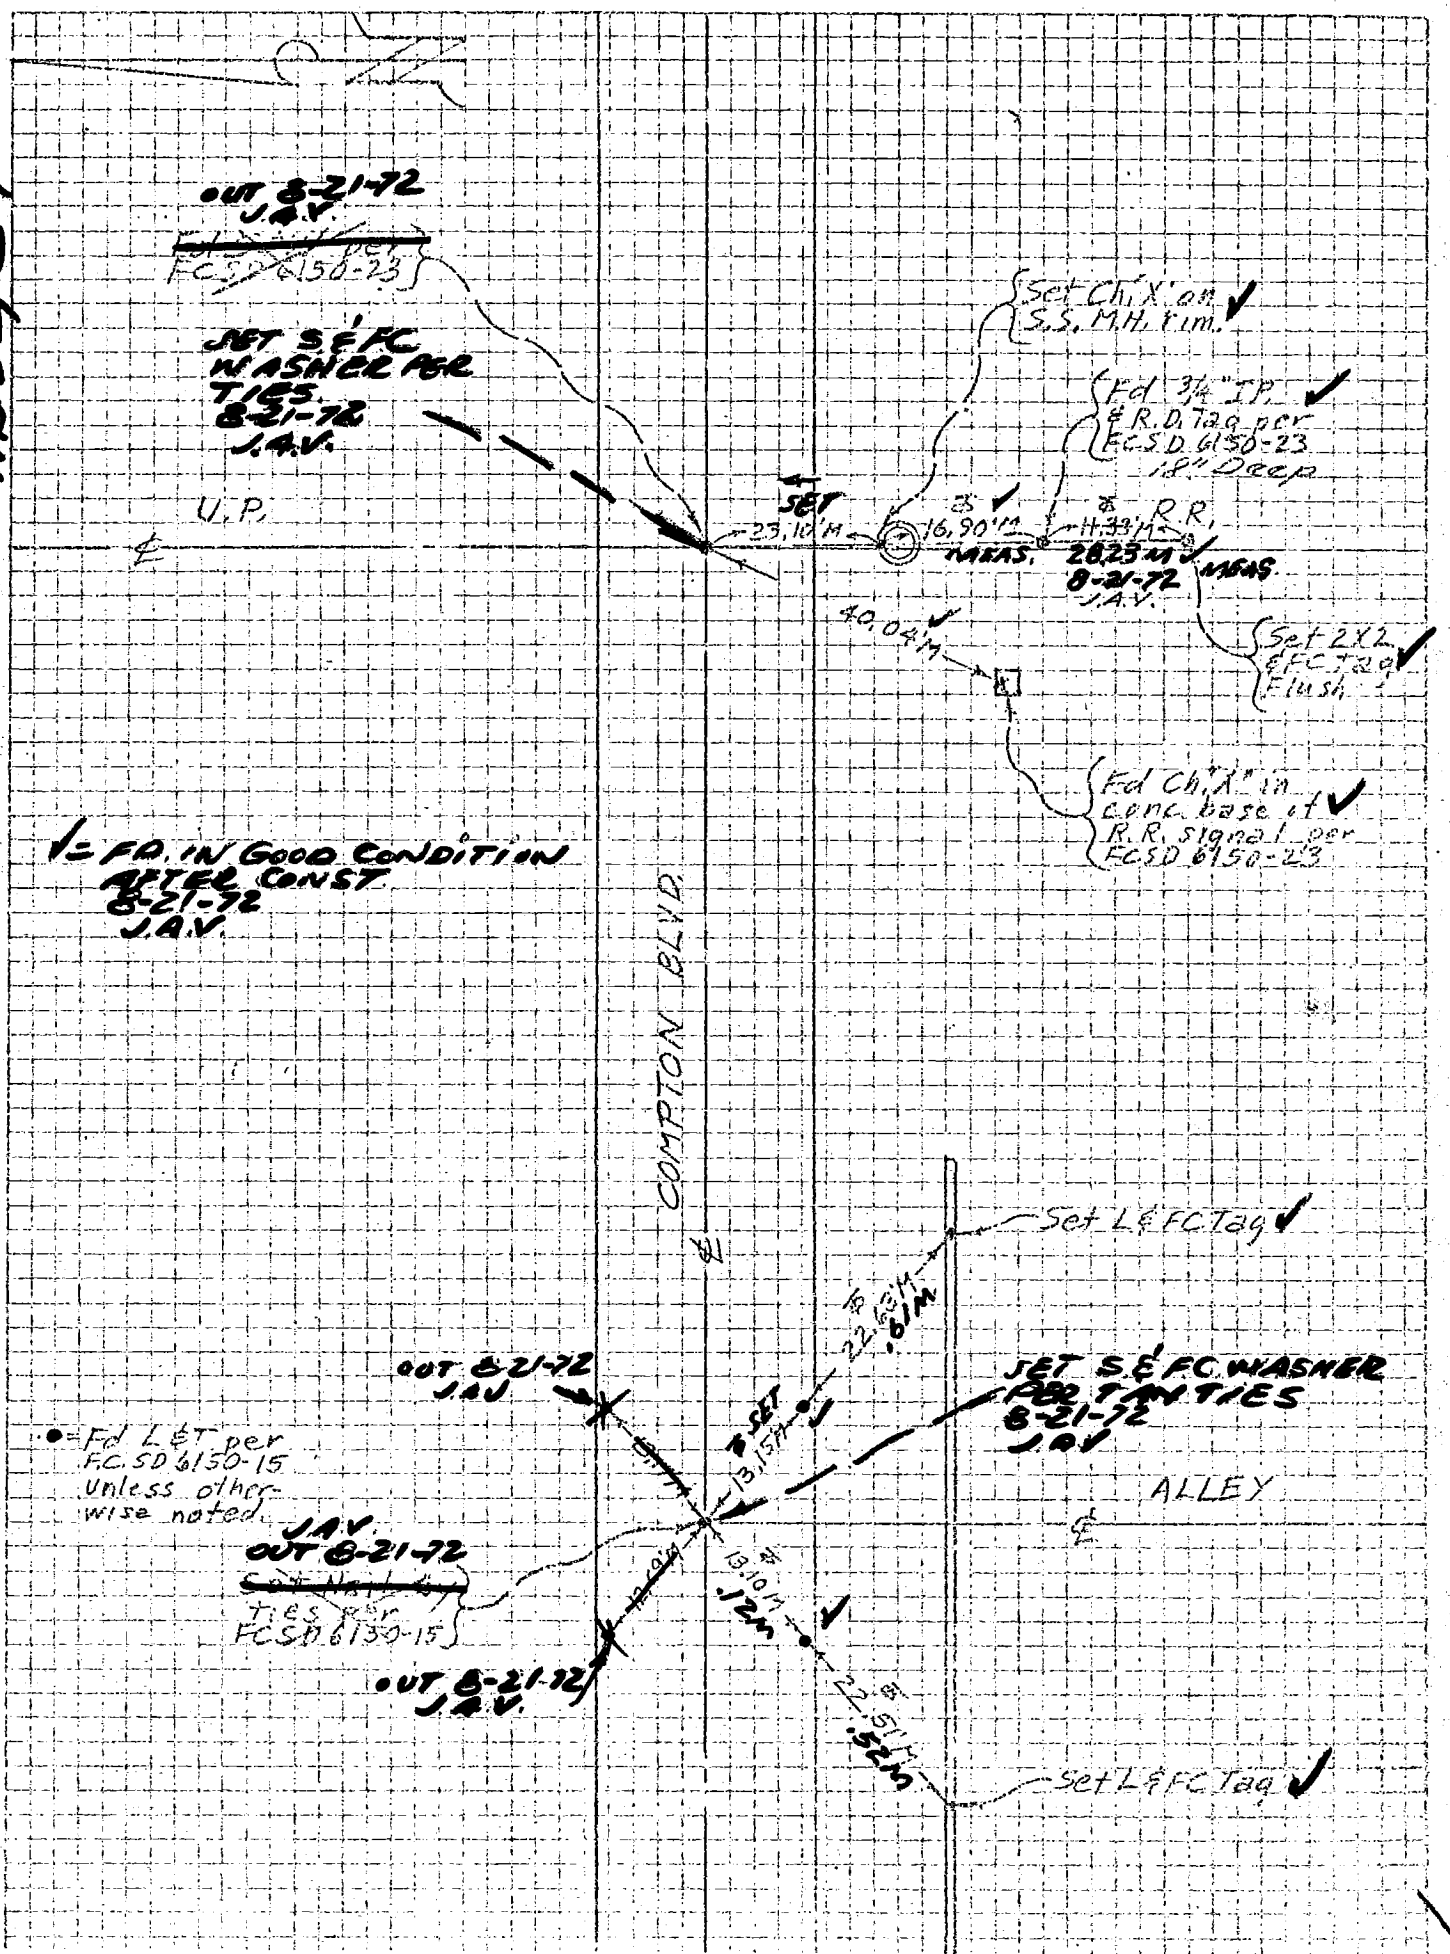
WS 32 C-R
OUT 8-21-72 J.A.V.
Set per FCSD 6150-23
SET S&FC WASHER AGR TIES 8-21-72 J.A.V.
U.P.
℄
Set Ch."X" on S.S. M.H. Rim.
Fd 3/4" IP. & R.D. Tag per FCSD 6150-23 18" Deep
SET
-23.10'M
16.90'M
R.R.
11.33'M
MEAS.
28.23 M
8-21-72 J.A.V.
MEAS.
Set 2X2 EFC Tag Flush
40.04'M
Fd Ch."X" in conc. base of R.R. Signal per FCSD 6150-23
√= FD. IN GOOD CONDITION AFTER CONST 8-21-72 J.A.V.
COMPTON BLVD.
Set L&FC Tag
22.63'M
1.61'M
OUT 8-21-72 J.A.V.
SET S&FC WASHER AGR TIES 8-21-72 J.A.V.
13.15'M
ALLEY
●=Fd L&T per F.C.S.D. 6150-15 Unless otherwise noted.
J.A.V. OUT 8-21-72
TIES per FCSD 6150-15
13.10'M
OUT 8-21-72 J.A.V.
22.51'M
Set L&FC Tag

7689 11-- Cdb 3-69

PROJECT Paramount Proj. No 6150

SURVEY BY E.F.B. DATE 3-14-72

REVIEWED BY Dalton DATE 4-7-72

Co. Eng. F.B. 3555: 41

INDEX FCSD6150 35

R&R 7

LOS ANGELES COUNTY FLOOD CONTROL DISTRICT

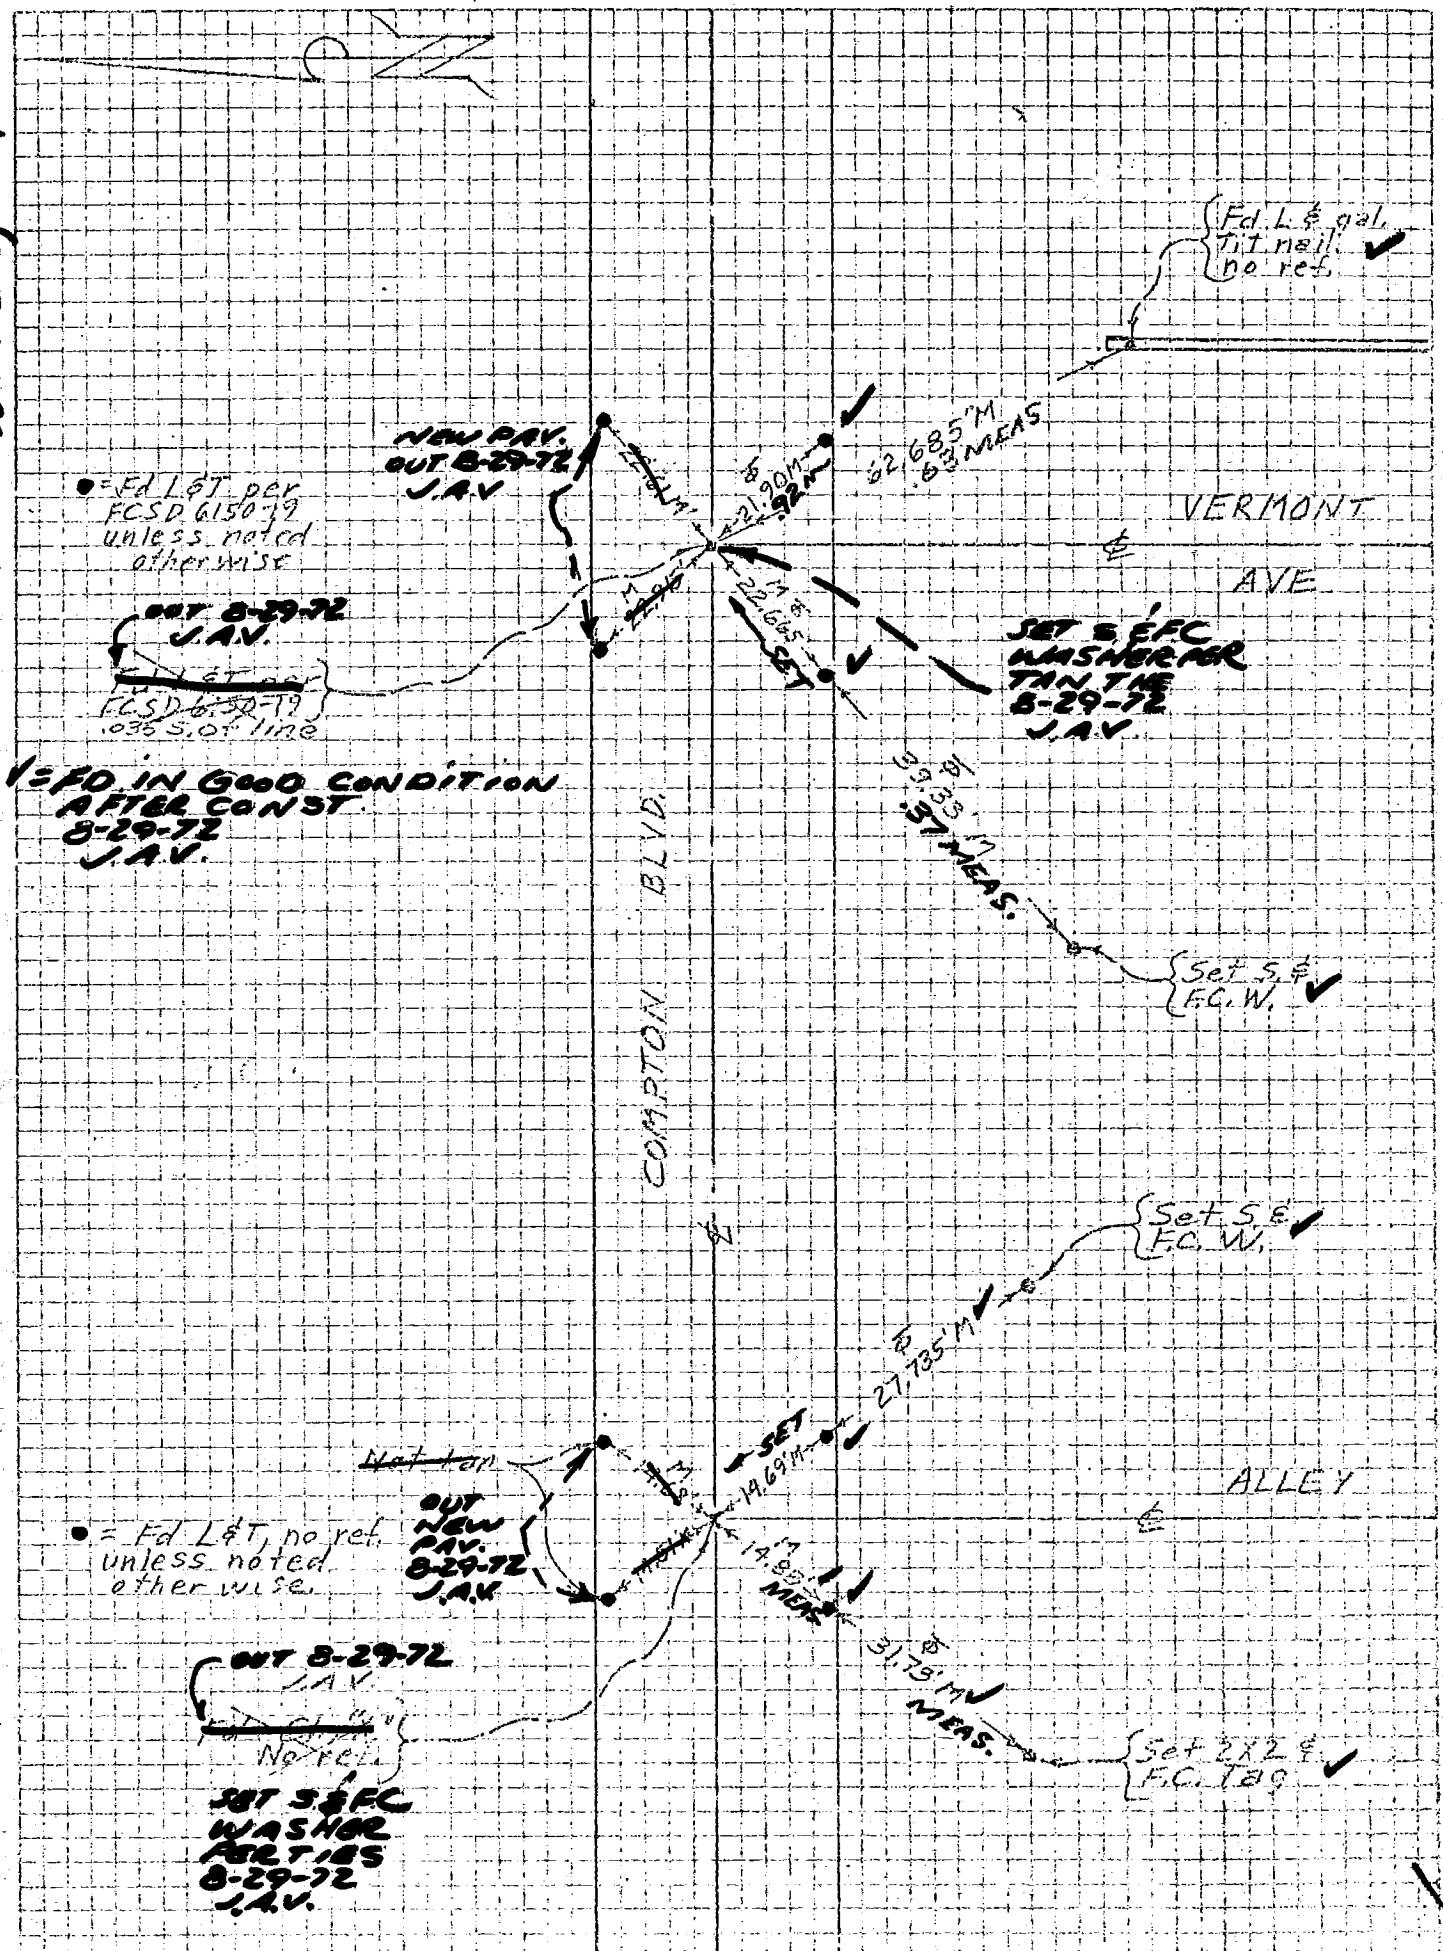

7689 11- Cdb 3-69

PROJECT Paramount Proj. No. 6150

SURVEY BY F.P.C. DATE 3-14-72

REVIEWED BY [illegible] DATE [illegible]

Co. Eng. F.B. 3555: 42

INDEX FCSD6150 37

R&R 9

LOS ANGELES COUNTY FLOOD CONTROL DISTRICT

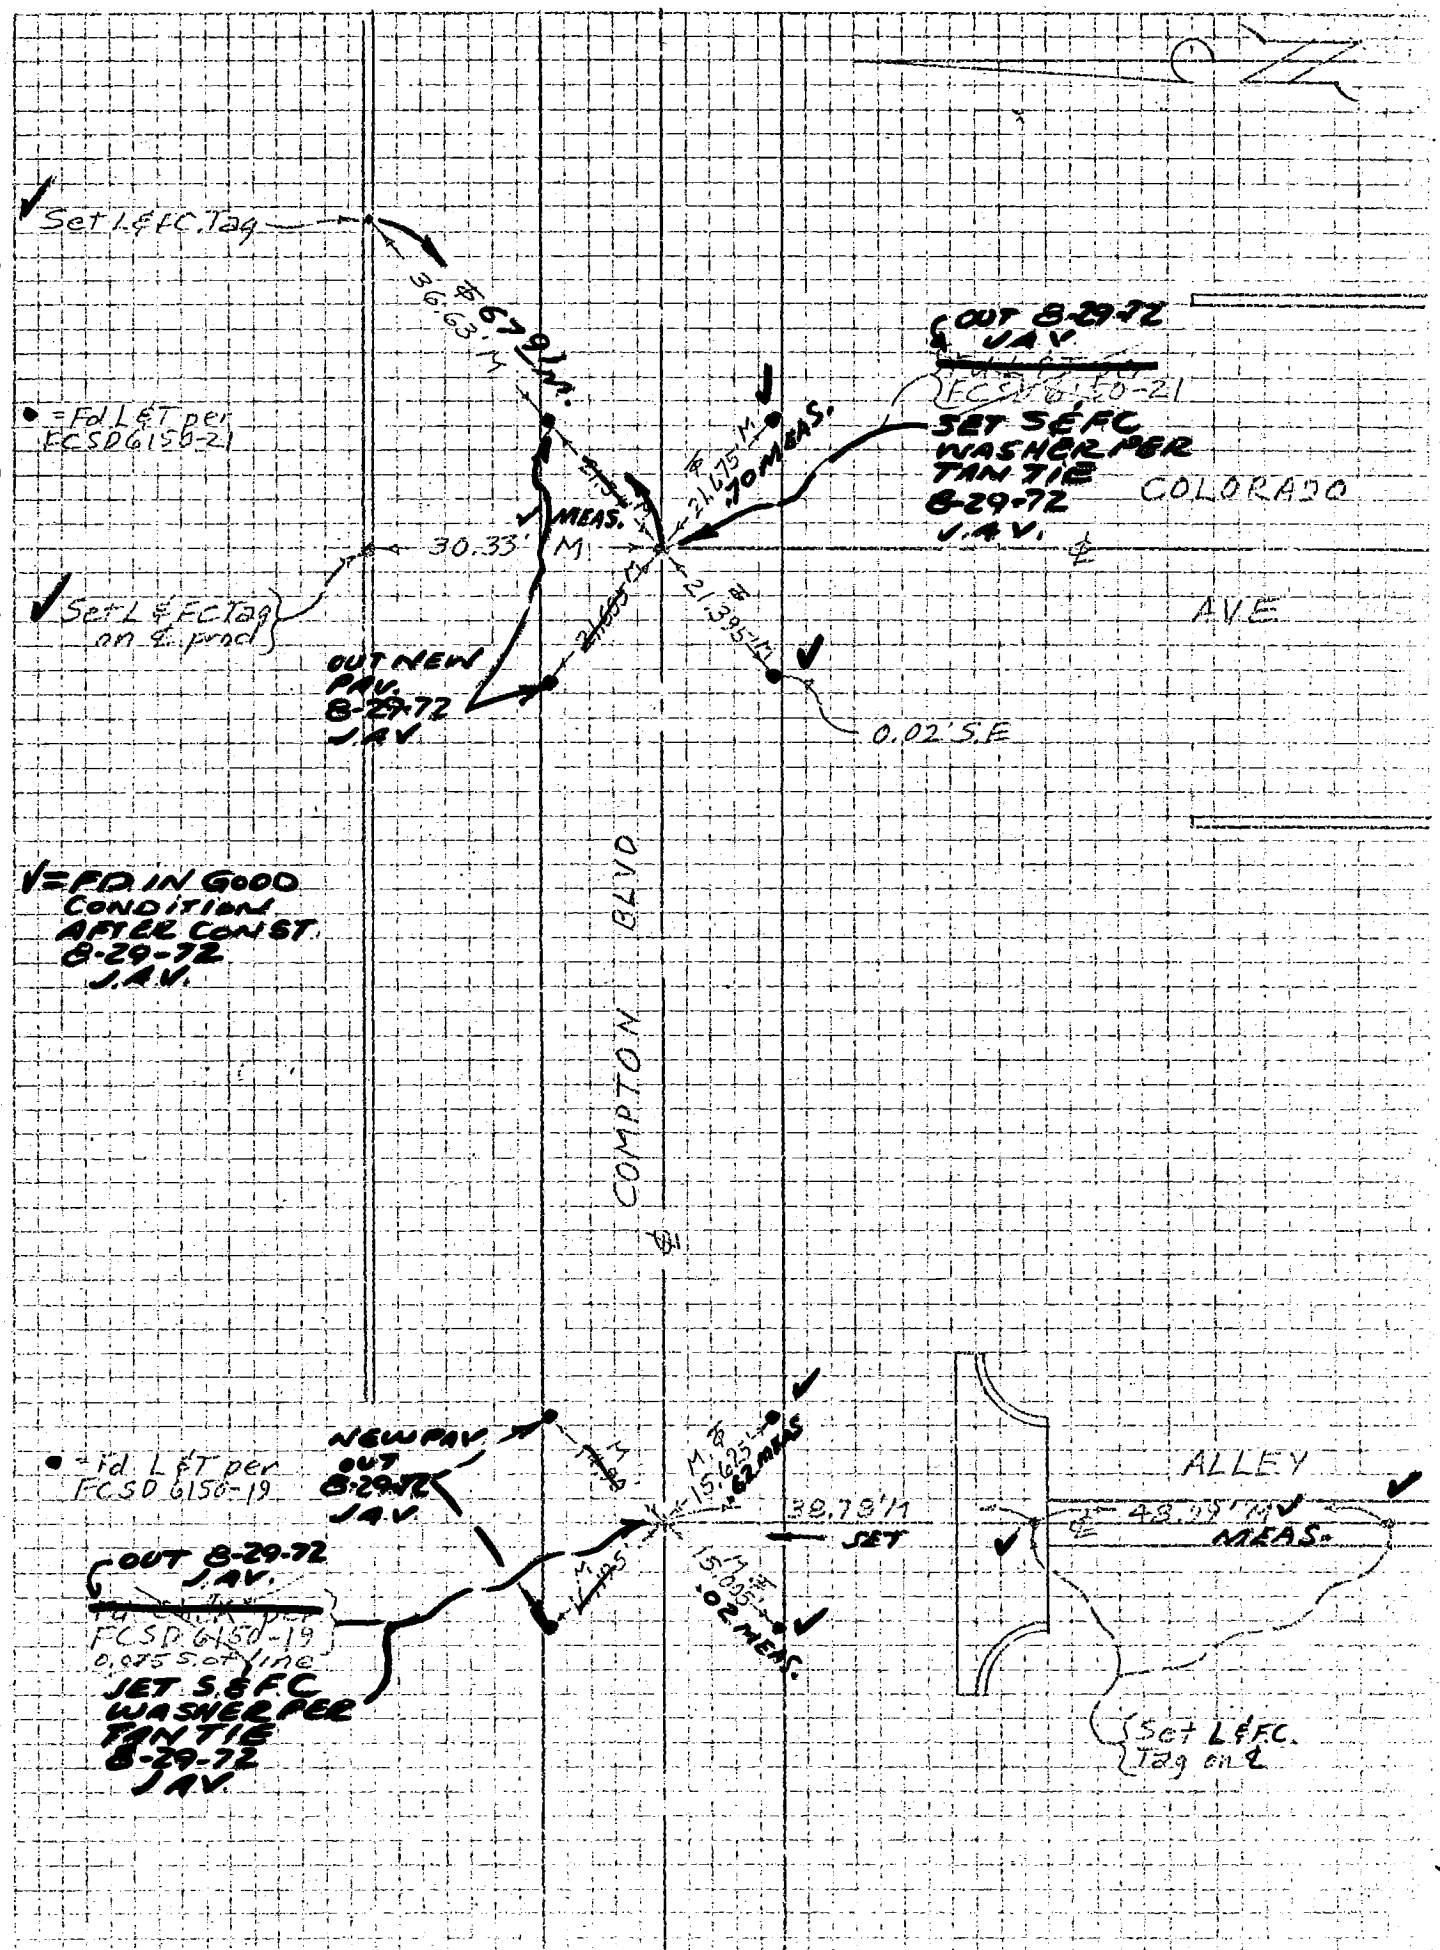

765911– Cdb 3-69

Co. Eng. F.B. 3555: 43

PROJECT Paramount Proj. No. 6150

INDEX FCSD6150 39

SURVEY BY B.F.B. DATE 3-14-72

REVIEWED BY DAWSON DATE 4-26-72

RER 11

LOS ANGELES COUNTY FLOOD CONTROL DISTRICT

W.S. 32, C-4

✓Fd L&T per FCSD 6150-23

✓Fd L&T per FCSD 6150-23

✓EFO. IN GOOD CONDITION AFTER CONST. 8-30-72 J.A.V.

51 23'M

62.93'M

PARAMOUNT BLVD

✓Fd L&T per FCSD 6150-23

53.33'M

62.11'M

COMPTON BLVD.

✓Fd L&T per FCSD 6150-23

✓Fd L&T per FCSD 6150-23 0.03'S.W.

•=Fd L&T per FCSD 6150-21

✓Set L&T FC Tag

32.60'M

SQ 49 MEAS

NEW A&V OUT 8-30-72 J.A.V.

18.69'M

30M

ALLEY

OUT 8-30-72 J.A.V.

Set L&T FC Ties per FCSD 6150-21

SET L&T FC TAG PER TAN TIES 8-30-72 J.A.V.

13.52'M

58 MEAS

33.29'M

51 91 MEAS

✓Set L&T FC Tag

768911– Cdb 3-69

PROJECT Paramount No. 6150

SURVEY BY B.P.B. DATE 3-14-72

REVIEWED BY Dewitt DATE 4-[illegible]-72

Co. Engr. F.B. 3555: 44

INDEX FCSD6150 41

R&R 13

LOS ANGELES COUNTY FLOOD CONTROL DISTRICT

W.S. 33, C-4

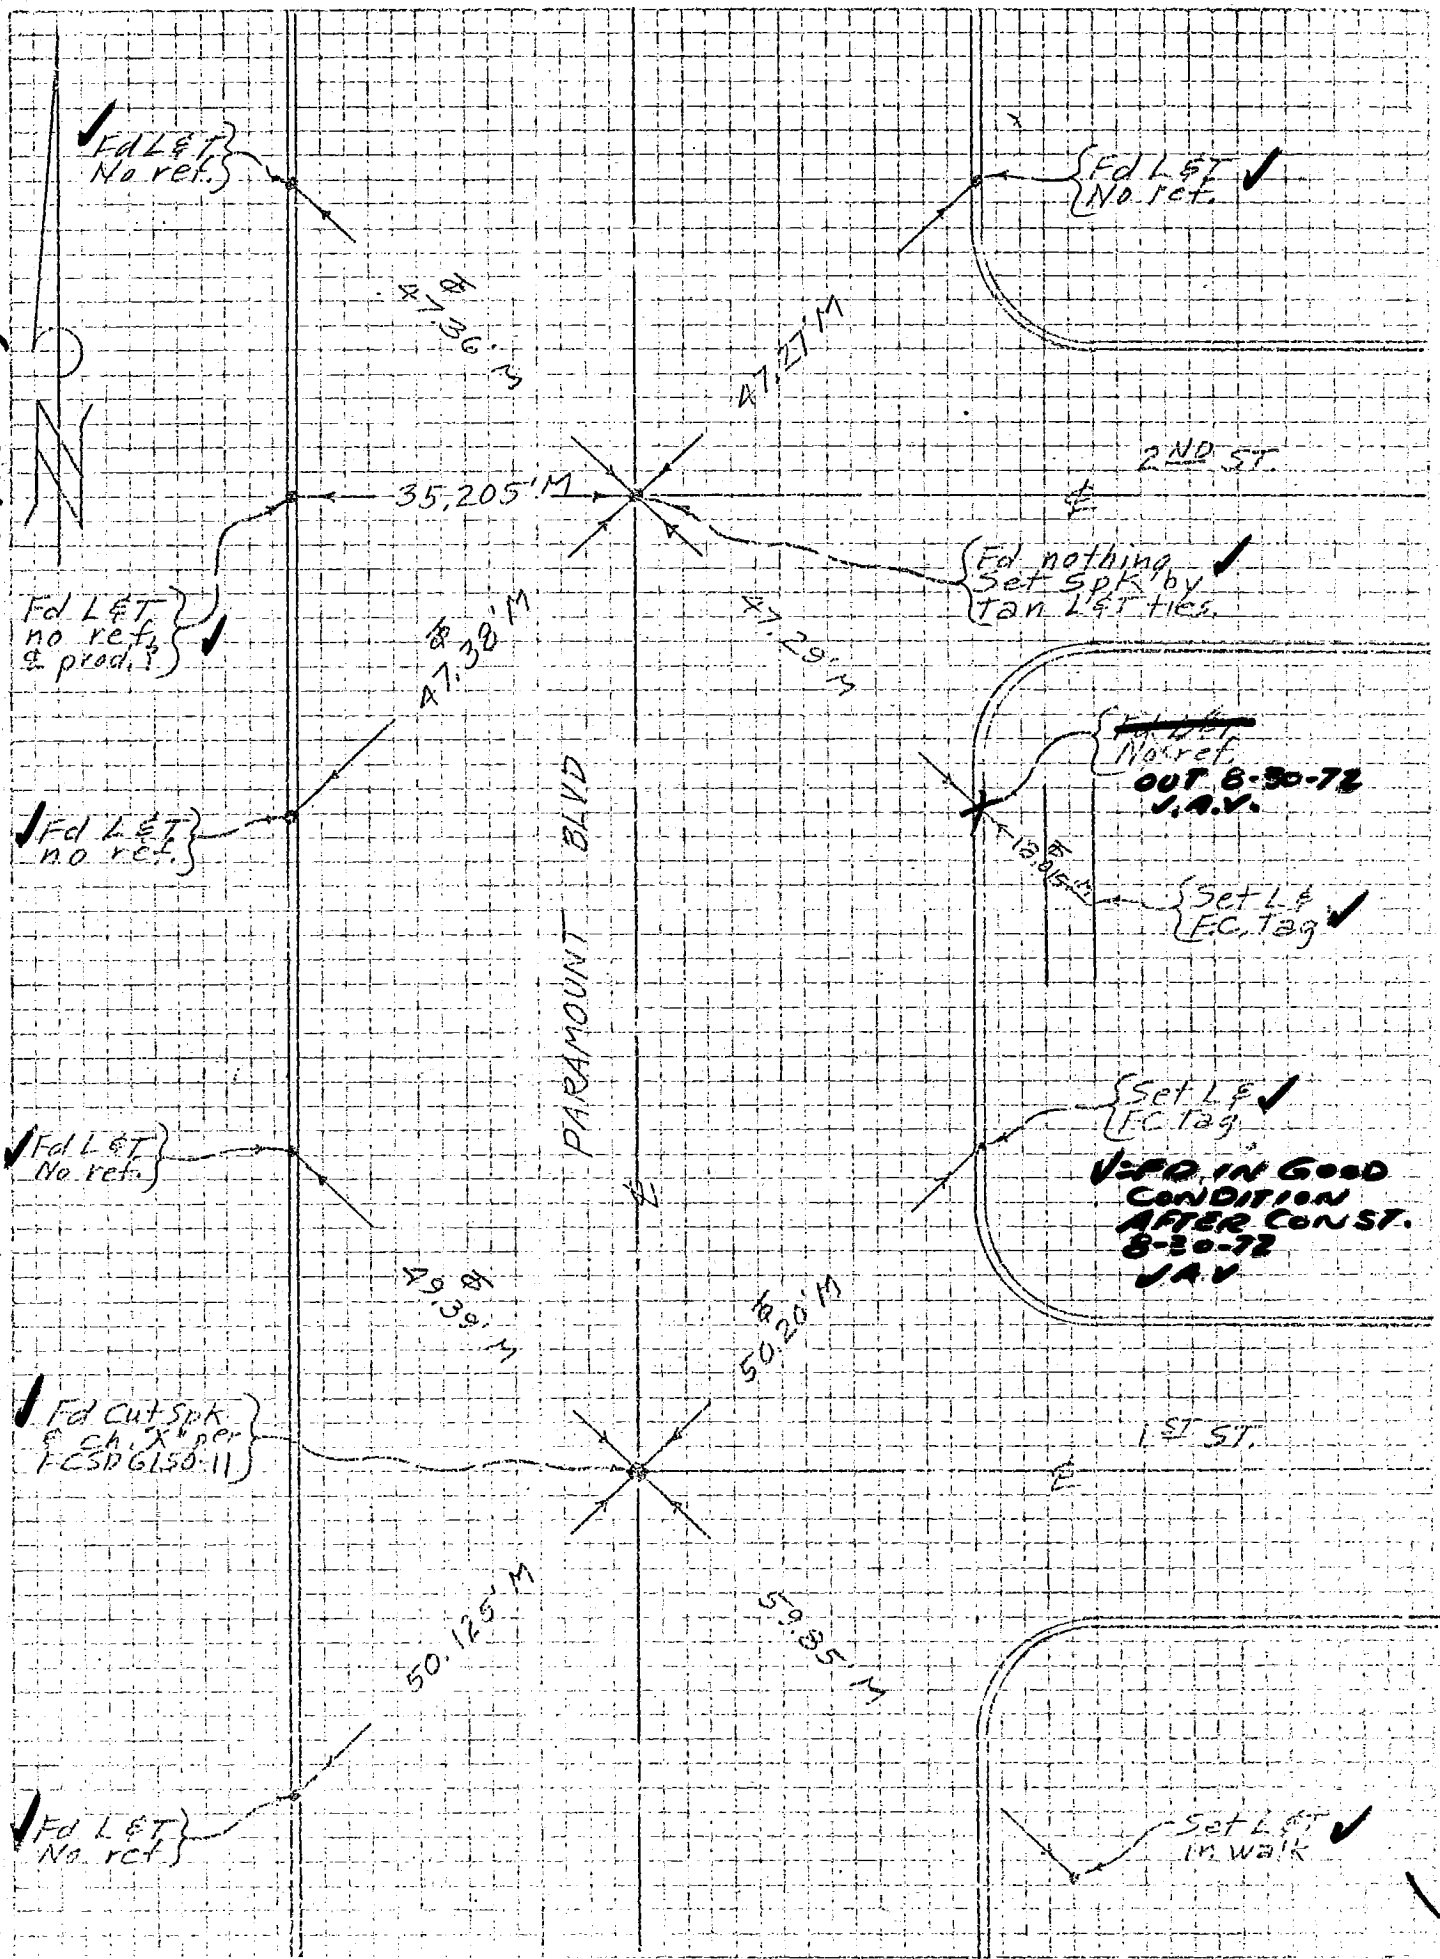

76S911– Cdb 3-69

PROJECT Paramount No. 6150

SURVEY BY B.R.E. DATE 3-14-72

REVIEWED BY [illegible] DATE [illegible]

Co. Engr. F.B. 3555: 45

INDEX FCSD6150 43

R&R 15

LOS ANGELES COUNTY FLOOD CONTROL DISTRICT

W.O. 3211-A

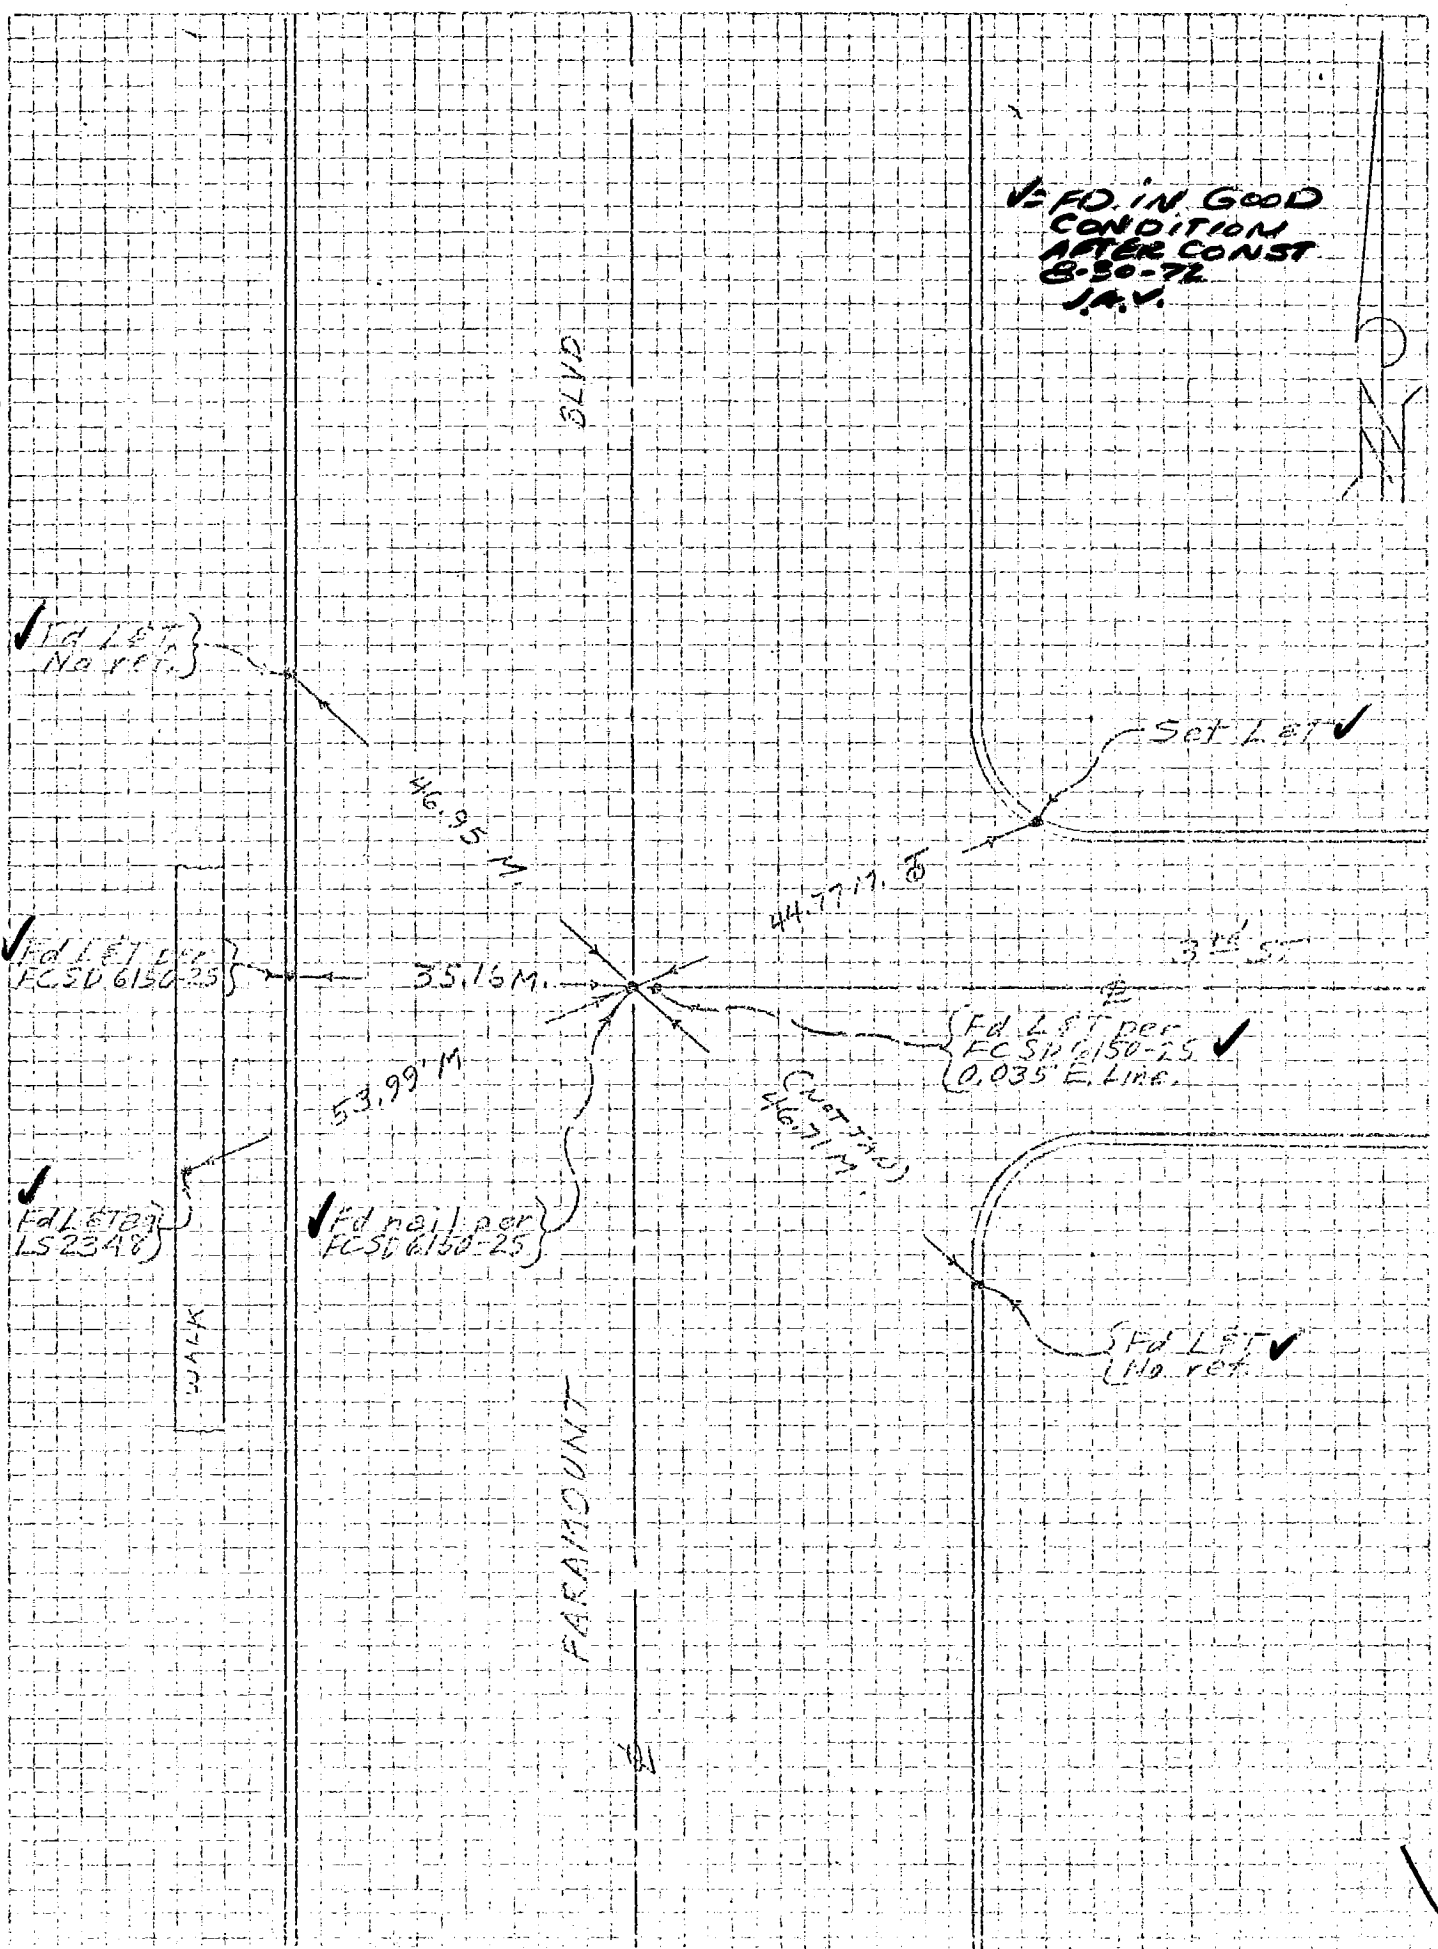

78S911– Cdb 3-69

Co. Engr. F.B. 3555: 46 FCSD1225 297

PROJECT #1225 UNIT 2 INDEX

SURVEY BY MULLIN DATE 1-15-71

REVIEWED BY DATE -- -71

R&R-3

LOS ANGELES COUNTY FLOOD CONTROL DISTRICT

WS 36 D-2

VILLA PARK DRIVE

GLEN ROSE AVENUE

ARROYO DRIVE

✓ FD. SPK. & T. TR. 24918

100' TAPE #252.

TEMP. 1-15-71 = 72°

✓ = F.D. IN GOOD CONDITION AFTER CONST.

✓ FD. L. & T. NO. REF.

9-13-71

TEMP = 109°

30.51 M. + 0.01
31.51 M. + 0.01
36.965 M. + 0.02
20.72 M. + 0.02

76.41 76.40 M

60.78 60.77 M

36.965 M

31.52 31.51 M

31.52 31.51 M

TR. 24918

OUT - SET F.C. TAG IN LEAD - D.N. PER OF TIES - 9-15-71 R.E.M.

✓ FD. L. & T. NO REF.

✓ FD. L. & T. 0.01 W.LY. NO. REF.

✓ SET LEAD & F.C. TAG & PROD.

✓ FD. L. & T. 0.01 W.LY. NO. REF.

76S911- Cdb 3-69

Co. Engr. F.B. 3555: 47

PROJECT #1225 UNIT-2

SURVEY BY MULLIN DATE 1-26-71

REVIEWED BY [illegible] DATE [illegible]

INDEX FCSD1225 305

R&R-11

LOS ANGELES COUNTY FLOOD CONTROL DISTRICT

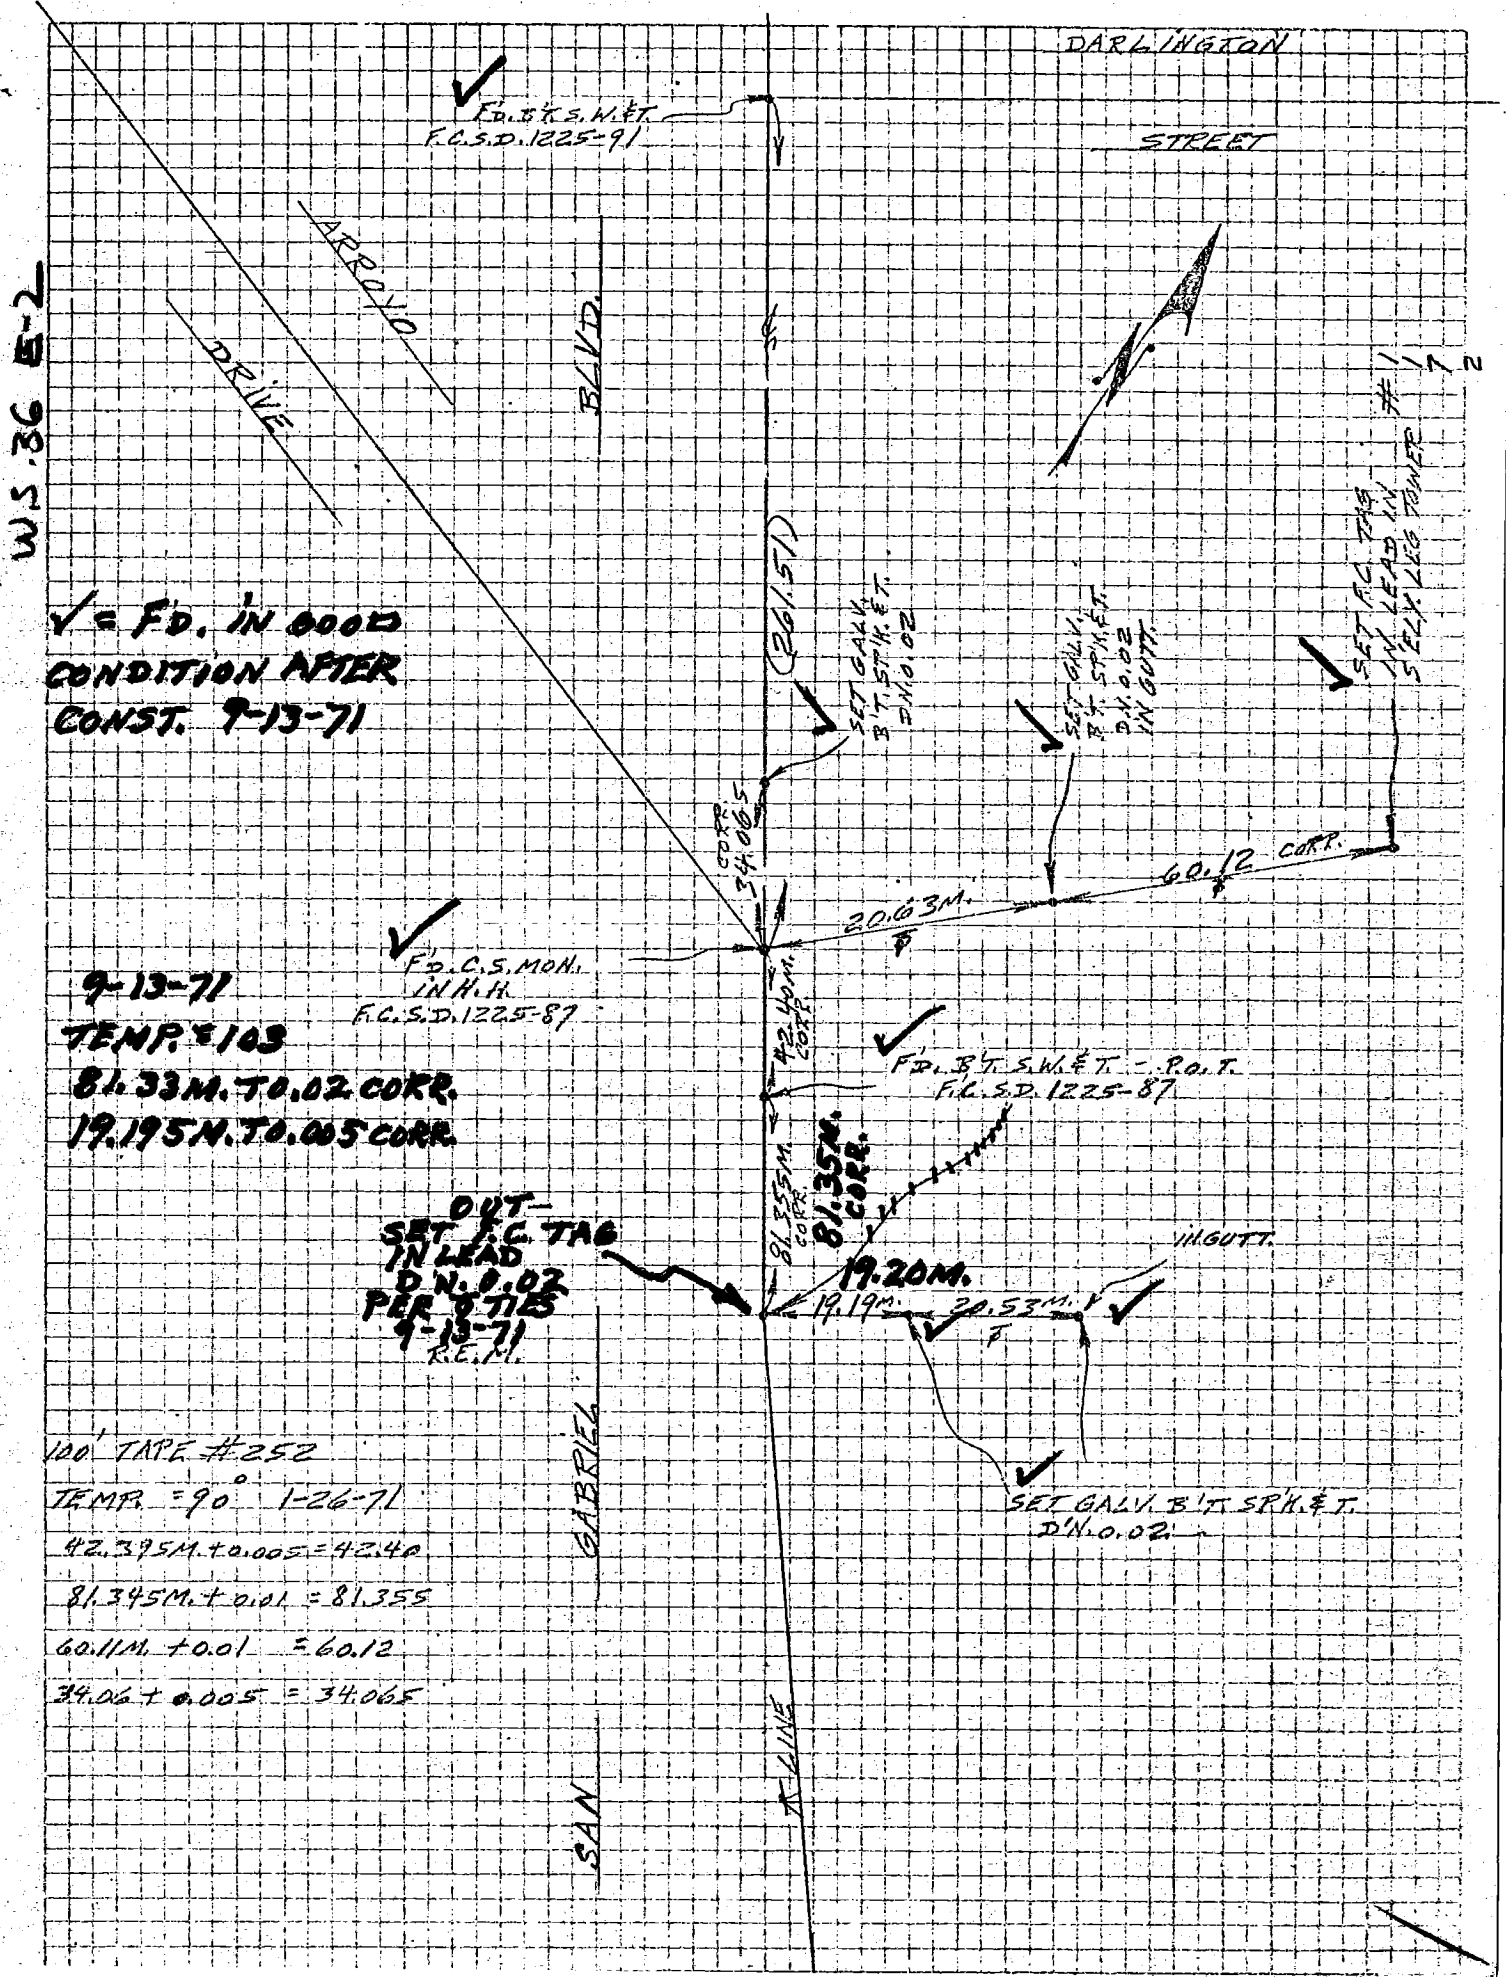


✓ = FD. IN GOOD CONDITION AFTER CONST. 9-13-71

9-13-71
TEMP. = 103
81.33M. T 0.02 CORR.
19.195M. T 0.005 CORR.

SET OUT - SET F.C. TAG IN LEAD D.N. 0.02 PER 2 TIES 9-13-71 R.E.L.

100' TAPE #252
TEMP. = 90° 1-26-71
42.395M. + 0.005 = 42.40
81.345M. + 0.01 = 81.355
60.11M. + 0.01 = 60.12
34.06 + 0.005 = 34.065

PROJECT SD # 1601

SURVEY BY DEWBERRY DATE 2-4-70

REVIEWED BY SASSE DATE 3-6-72

Co. Engr. F.B. 3555:48

INDEX FCSD1601 121

RR-19

LOS ANGELES COUNTY FLOOD CONTROL DISTRICT

WS 47, C-1

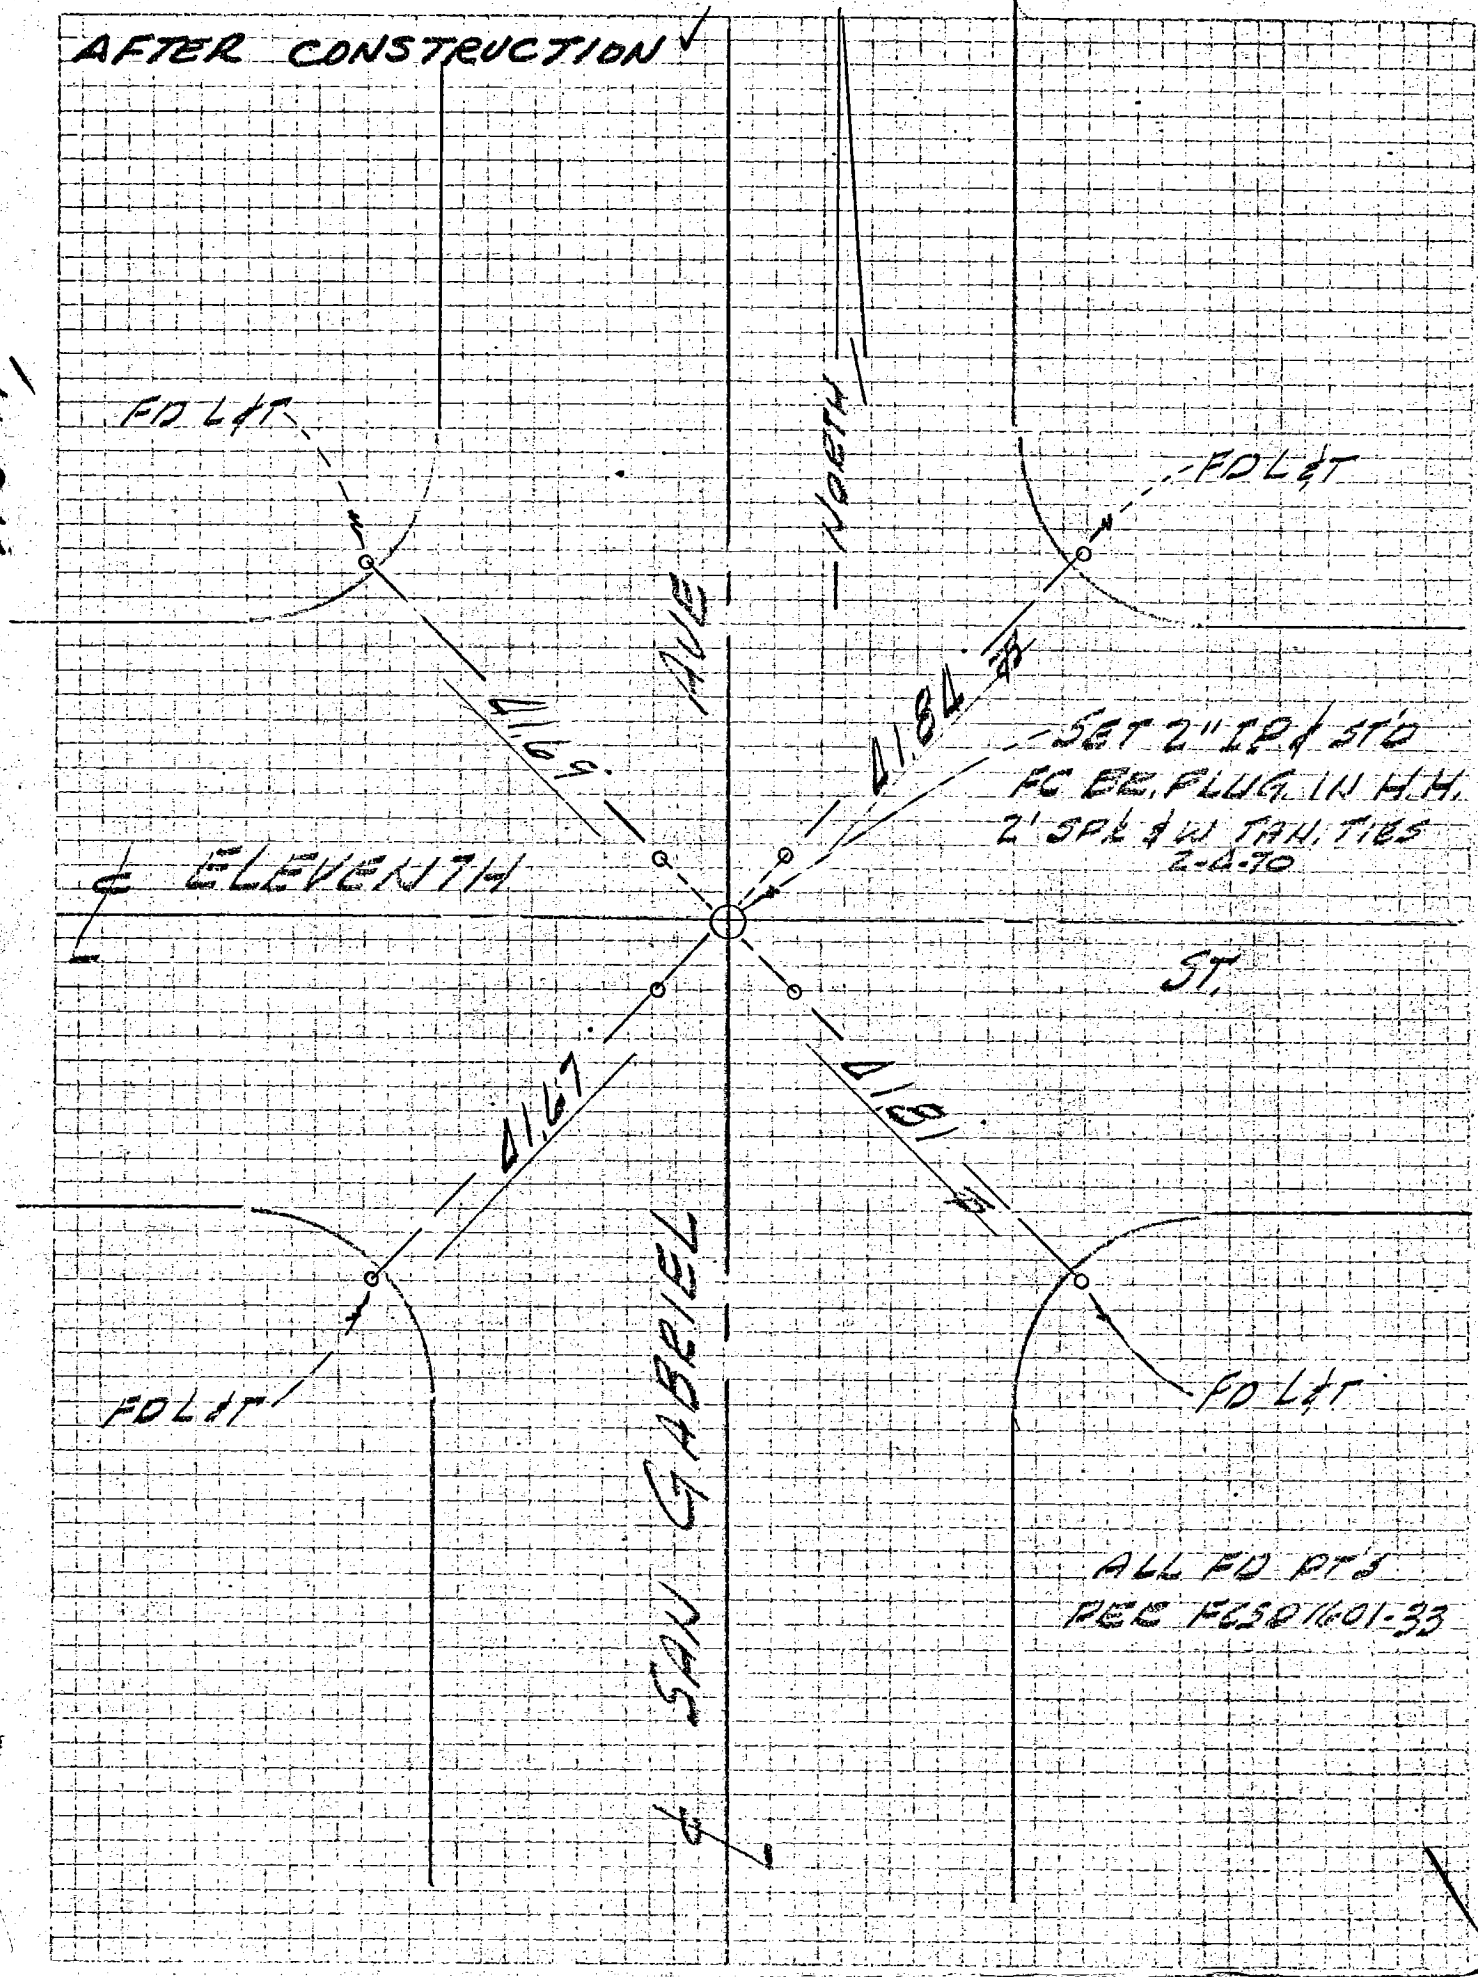

Co. Engr. F.B. 3555: 49

FCSD 1228 79

WS 47 #3

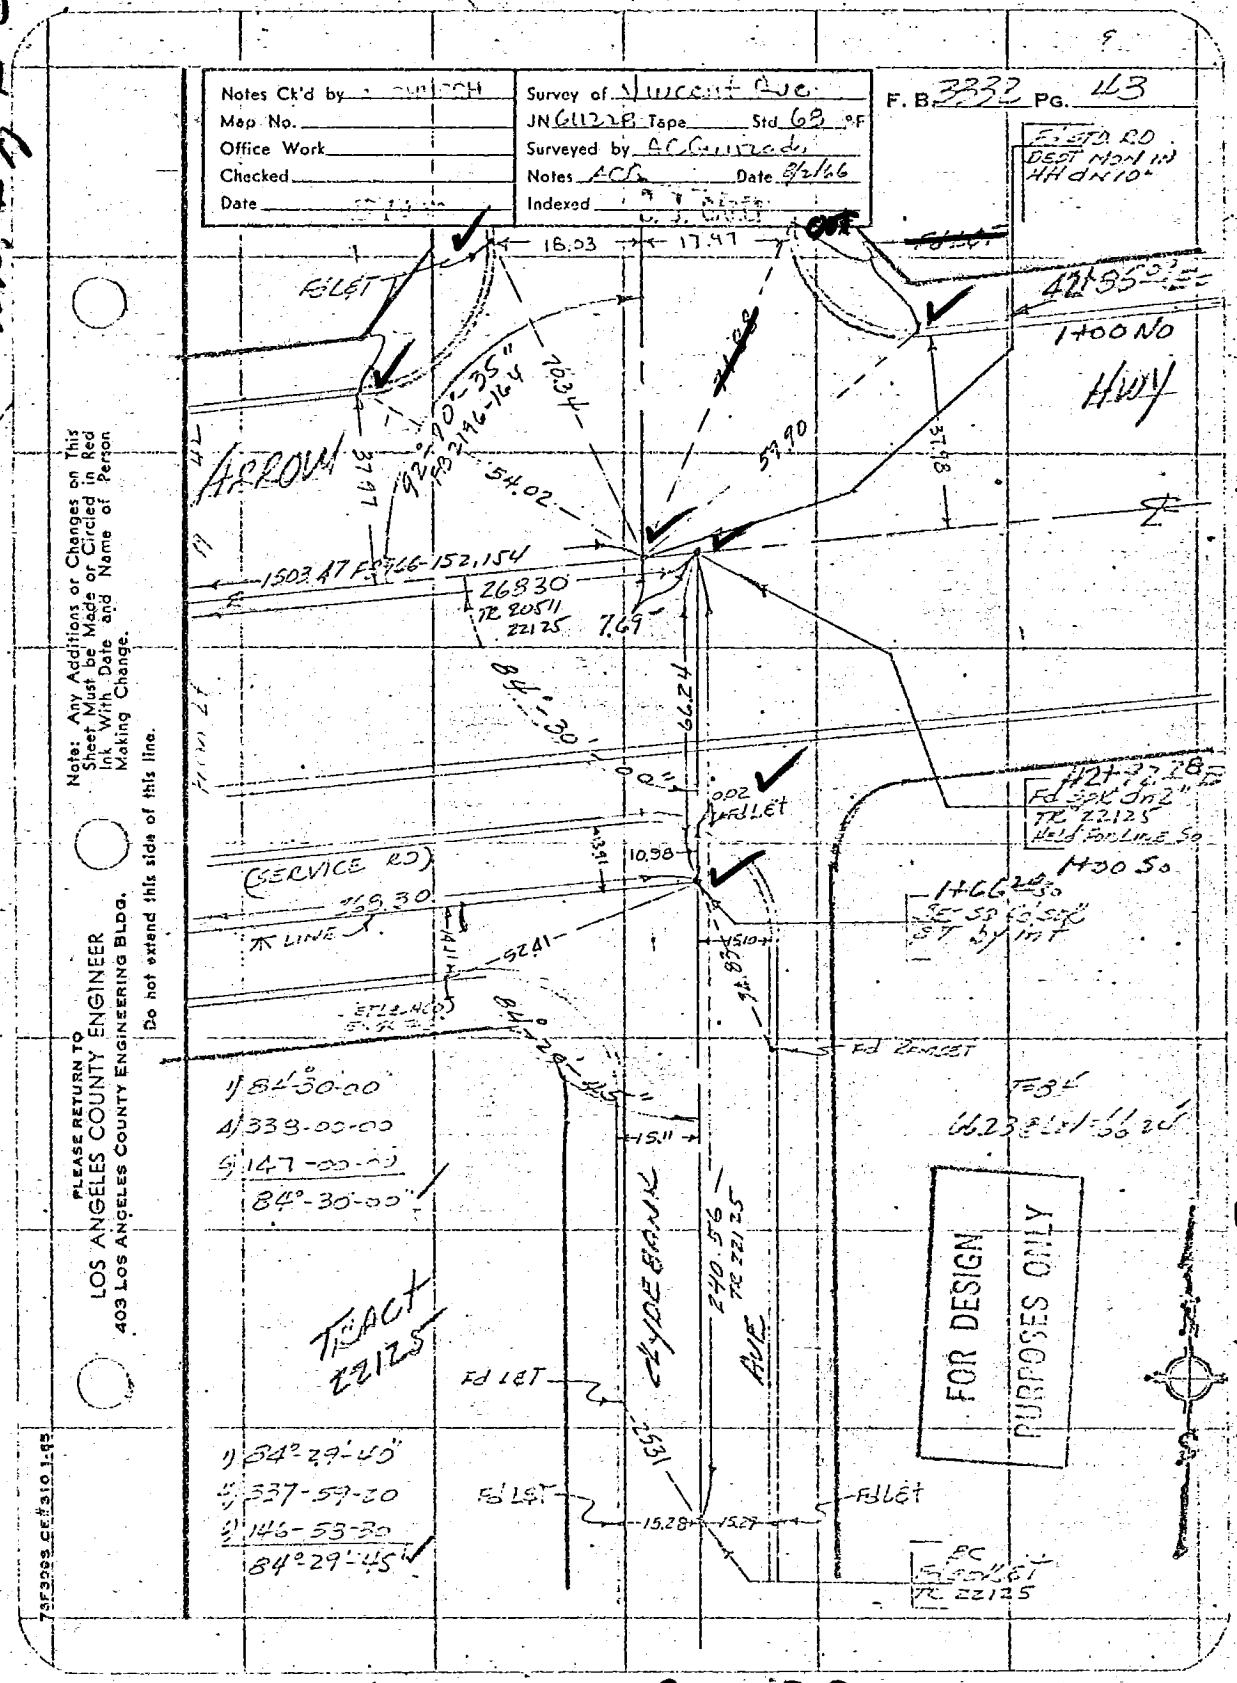


SEE FCSD 1228-133
FOR NEW PTS SET

Co. Engr. F.B. 3555: 50

FCSD 1228 91

See Pg. M-5

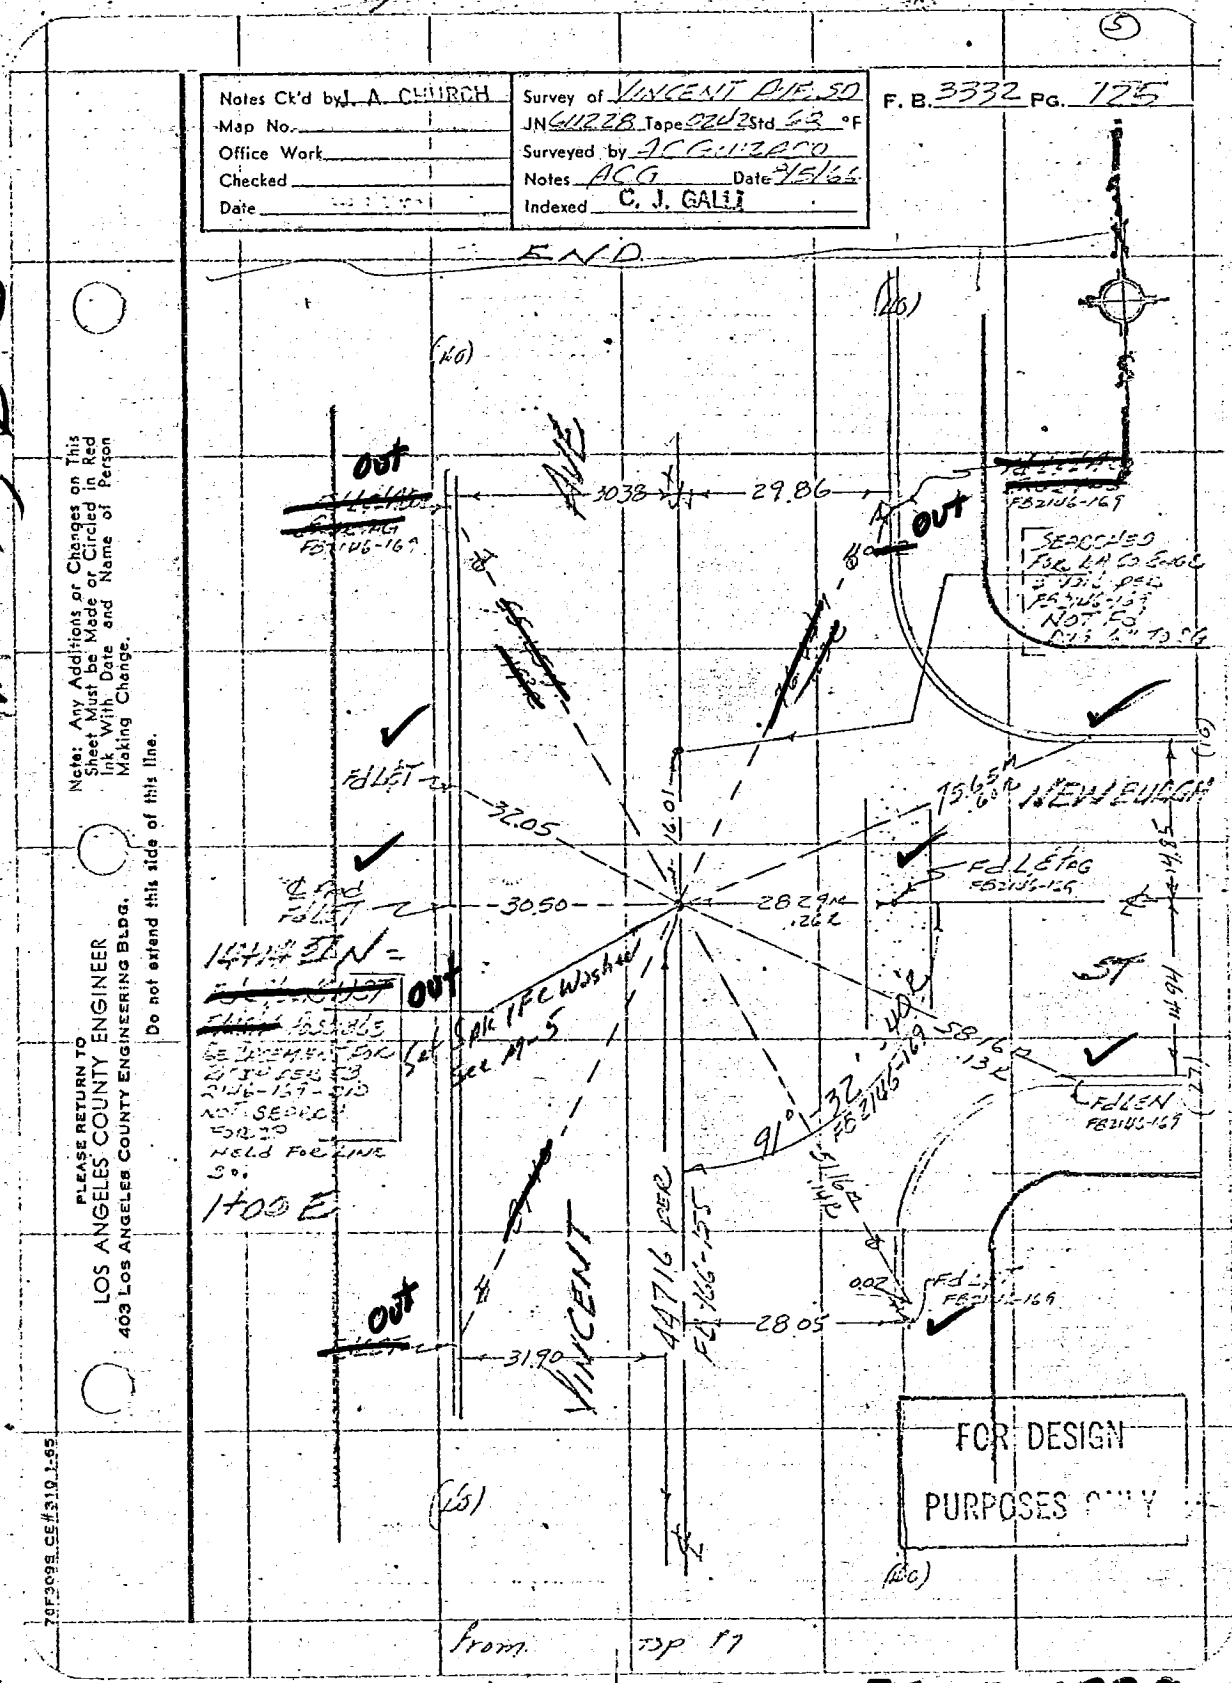
Notes Ck'd by J. A. CHURCH
Map No.
Office Work
Checked
Date
Survey of VINCENT DIF. 50
JN 61228 Tape 02U2 Std 62 °F
Surveyed by JC GUZZETTA
Notes ACG Date 2/5/66
Indexed C. J. GALLI
F. B. 3332 PG. 125
Note: Any Additions or Changes on This Sheet Must be Made or Circled in Red Ink With Date and Name of Person Making Change.
Do not extend this line.
PLEASE RETURN TO
LOS ANGELES COUNTY ENGINEER
403 Los Angeles County Engineering Bldg.
END
(40)
OUT
30.38
29.86
FB 2146-169
SEARCHED FOR L&T TO SAVE 2 TACK SET FB 2146-169 NOT FD 1/2" TO SW
FD LET
32.05
16.01
30.50
28.29 NE
.26 E
FD LET FB 2146-169
1.47' SW
OUT
SET SPK TACK Wash
See M-5
58.16
.13 E
FD LEN FB 2146-169
91° 32'
FD 2146-169
14.71 SW
VINCENT
44716 FBE
FD 2146-155
28.05
.00 E
FD FB 2146-169
31.90
FOR DESIGN PURPOSES ONLY
(45)
(20)
from Sp 17
(40)
(16)
(40)
(40)
(40

Co. Engr. F.B. 3555: 51
FCSD 1228 95

W.S. 47 B-4

Get latest Ties

Notes Ck'd by M. OSHITA
Map No.
Office Work
Checked
Date

Survey of VINCENT AVE S.D.
JN 6112.28 Tape 217 Std 84 °F
Surveyed by A.C. GONZADO
Notes E. LANDE Date 9.66
Indexed C. J. GALLI OCT 31 68

F. B. 3332 Pg. 157

Note: Any Additions or Changes on This Sheet Must be Made or Circled in Red Ink With Date and Name of Person Making Change.

Do not extend this side of this line.

PLEASE RETURN TO
LOS ANGELES COUNTY ENGINEER
403 Los Angeles County Engineering Bldg.

76F3095 CE# 319 1-65

CONT TO B&M 158

IRWINDALE AVE

BADILLO ST

HOOKEW C. MAC CO.

ENTER 1" I.P. ED. DEPT. TOC ON S. SET CI. SOIL W. ET FLUSH 1+00 N PER F.B. 2505-33

ST. FLOW

FND L&T

OUT

FND L&T

SET L&T TO BE FOR

FND L&T

SET L.G.C.E. TAG S.N.

FND L.G.C.E. TAG S.N.

SET L.G.C.E. TAG S.N.

FND L.G.C.E. TAG S.N.

FND 2" I.P. CAP PLUG L & T DN 2.0 PER F.B. 2747-13

FOR DESIGN PURPOSES ONLY

START OF SURVEY

1+64.00 SET N.

S 38.13 E 2747.13

67.00

86.53

87.39

90°00'00"

72.48

81.99

10.81

S 21°-08'-10" E 3505.33

82.70

80.02

92.18

92.18

55.14

52.11

RED = FND 4-18-69 BEFORE CONST
FOUND = L 2/18/70

SEE FCSD 1228-143 FOR NEW PTS SET

FCSD1228 103

LINE "C"

Notes Ck'd by M. OSHITA
Map No.
Office Work
Checked
Date

Survey of VINCENT AVE SD
JN 411223 Tape 217 Std 9.4 °F
Surveyed by A.C. Gurado
Notes ACG Date 9-27-66
Indexed C. J. GALLI

F. B. 3332 PG. 161

Note: Any Additions or Changes on This Sheet Must be Made or Circled in Red Ink With Date and Name of Person Making Change.

PLEASE RETURN TO
LOS ANGELES COUNTY ENGINEER
403 Los Angeles County Engineering Bldg.
Do not extend this side of this line.

7 of 3095 CE/310 1-65

Found 2/18/70

SEE FCSD 1228-141
FOR NEW PTS SET

Co. Engr. F.B. 3555: 53 FCSD 1228 125

RDFB 1432

SURVEY OF BE[illegible] INDEX PAGE 16

JOB NO. 28481 SURVEY NOTES 3

LOS ANGELES COUNTY ROAD DEPARTMENT
Room 144 - 1540 Alcazar Street
Los Angeles, Calif. 90033

SURVEY BY _____ DATE 9-12-68

CHECKED BY Bauer DATE 9-12-68

To P.S. 65

Tape std @ 74°
138.70 @ 78°:
138.70 corr.
268.00 @ 77°:
268.00 corr.

1) 90° 22' 36"
4) 01° 31' 00" =
90° 22' 45"
Tract # 18264:
90° 23' 00".

(27) (27)

ST.

To S.E.T. & B.C. Tract # 18264

BELLBROOK

276.94' M. & Tract # 18264

VFD 3-21-69

Fd. L&T in CB. No Ref

45" M

22'

90°

66.71M

(40) (40)

268.00M

138.70M

To 5/8" R.S. & T. Per: Tract # 18264

BARRANCA ST.

(40)

PROP R/W

28.32M

Fd. C E Tag on 4 Prod in CB. No Ref

31 + 96.56 So = 0+00 E Fd S E T Per TR # 18264

To 2" I.P. Flush Per RDFB 420-60

(40)

V = FOUND 2-2-70

SEE FCSD 1228-147 FOR NEW PTS SET

S910R-RD 125-1 Rev. 1-67

SURVEY OF COVINA BLVD. INDEX RDFB 420-
JOB NO. 53214 Pcl #162928 SURVEY NOTES RDFB 1432 P. 204, 205
Co. Engr. F.B. 3555 54

LOS ANGELES COUNTY ROAD DEPARTMENT
ROOM 130 — 1540 HENRY STREET
LOS ANGELES
WS47 D-4

SURVEY BY _____ DATE _____
CHECKED BY _____ DATE 7-20-64

TO RDFB 420-95

TO RDFB 520 — 84.140

TRACT

TRACT
Nº 18264.

TRACT Nº 15973:
Fd. Std. Survey Control RM Mon. Mrkd R.M. #1 Covina C-1 (Flush) Per CSFB 2106-113

COVINA AVE

COVINA BLVD.

BARRANCA

Nº 21489.

FOR ADD'L CENTERLINE
FB 1432-65-66
SEE.....

To C.S. Mon in H.H. CSD1228 131
@ ℄ CYPRESS AVE.
Per CSFB 2540-51.

Fd. 2"x2" dn 4" w/Tag ⌖ RE 8638 No Ref.

Fd. 2" I.P. Flush w/Conc. Pl. & Tag RE 8396 0.01' W. of ℄ Per Tr. #18264 & 21489

Fd. 2" I.P. dn 14" w/Conc. Pl. & Tag RE 8396 Per Tr. # 21489 & 18264.

Proposed R/W

ANGLE Pt.
26+60.04 E.
26+47.58 S.
Fd. Std. L.A. Co. Survey Control Mon. in H.H. Mrkd "COVINA C-1" Per CSFB 2106-113 Ctr. Sec. 12: T1S - R10W Per Tr. # 21489 & 18264

(2) 179°14'50" = 89°37'25"
(4) 358°29'30" = 89°37'21½"
89°37'10" CSFB 632-24

(2) 180°46'12" = 90°23'06"
(4) 1°32'35" = 90°23'09"
90°23'30" CSFB 632-24

(2) 180°45'20" = 90°22'40"
(4) 1°36'55" = 90°22'44"

89°37'20" M.
90°23'10" M.
90°22'50" Per CSFB 632-24
89°36'40" Per CSFB 632-24 & 2106-113

Fd. L&T C.E. Tag CSFB 2106-113
Fd. L&T CSFB 2106-113
Fd. L&T in Gutter RDFB 322-84
Fd. L&T CSFB 2106-112
Set L&T in Cb.
Set L&T in Ch.
Set L&T in Cb.
Set L&T in Cb.
Set L&T in Cb

7689 11– Cdb 3-69

PROJECT West Covina S.D. 1228 Line X A

SURVEY BY W.V.H. DATE 6/9/72

REVIEWED BY [illegible] DATE 11-16-72

Co. Engr. F.B. 3555: 55

INDEX PCSD1228 133

VAM-3

LOS ANGELES COUNTY FLOOD CONTROL DISTRICT

W.S. 4783

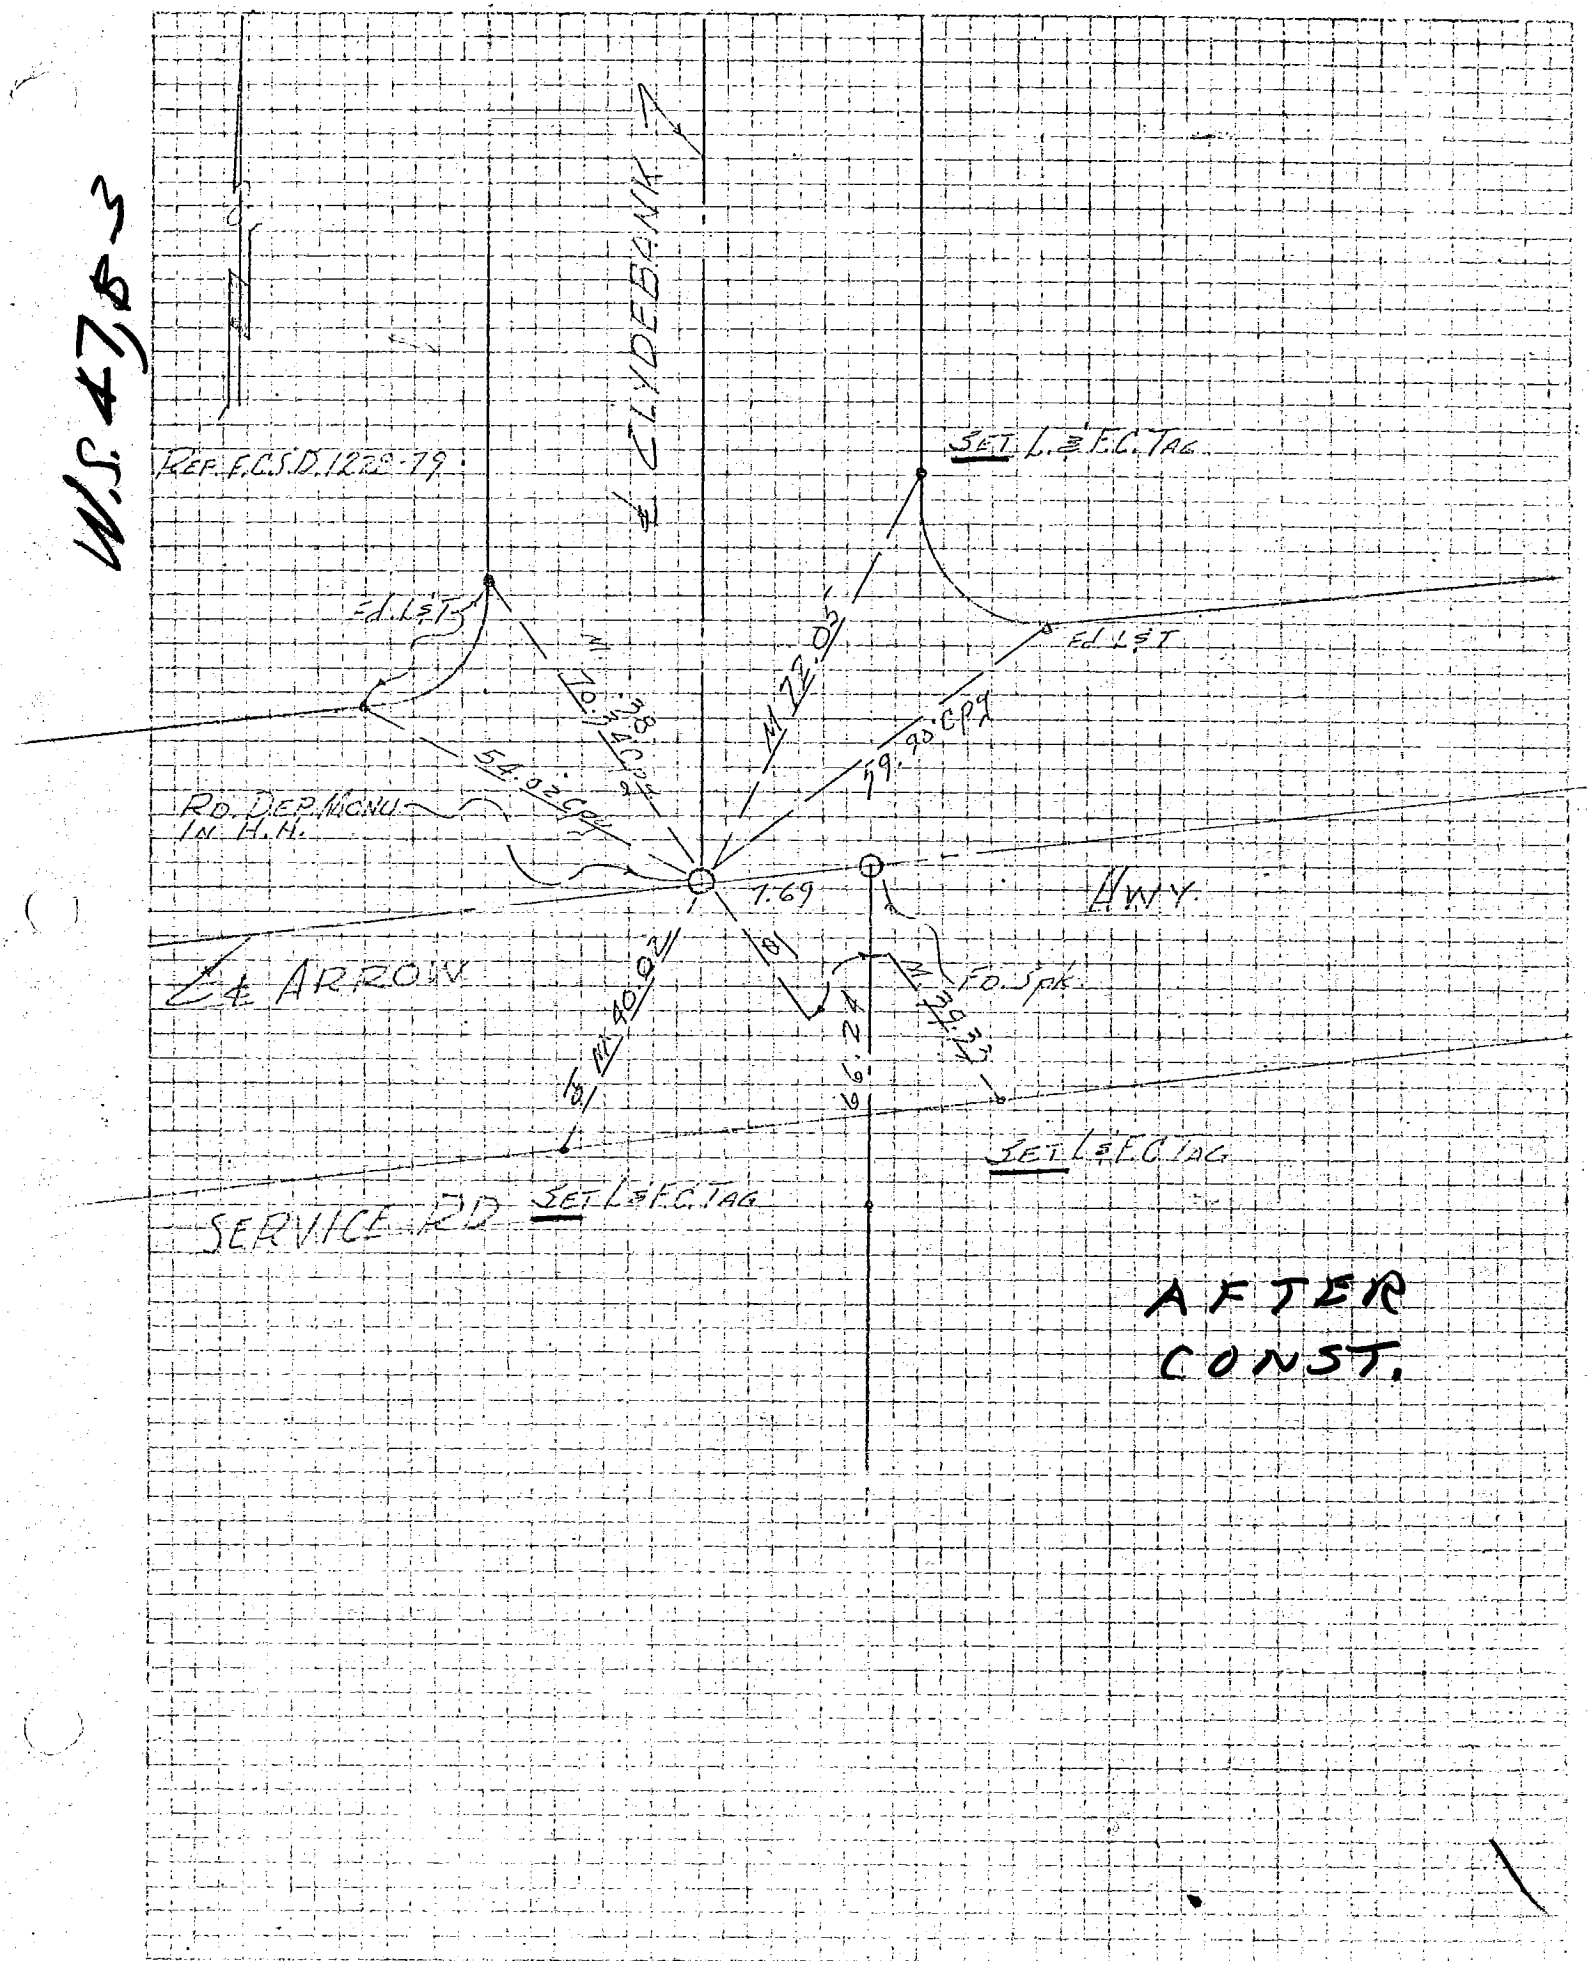

76S911– Cdb 1-68

Co. Engr. FB 3555: 56 FCSD1228 1.37

PROJECT 1228 LINE "B"

INDEX

SURVEY BY McGEHEE DATE 4-25-69

REVIEWED BY DATE 4-25-69 2-25-70

BM-5

LOS ANGELES COUNTY FLOOD CONTROL DISTRICT

W.S. 47B-3

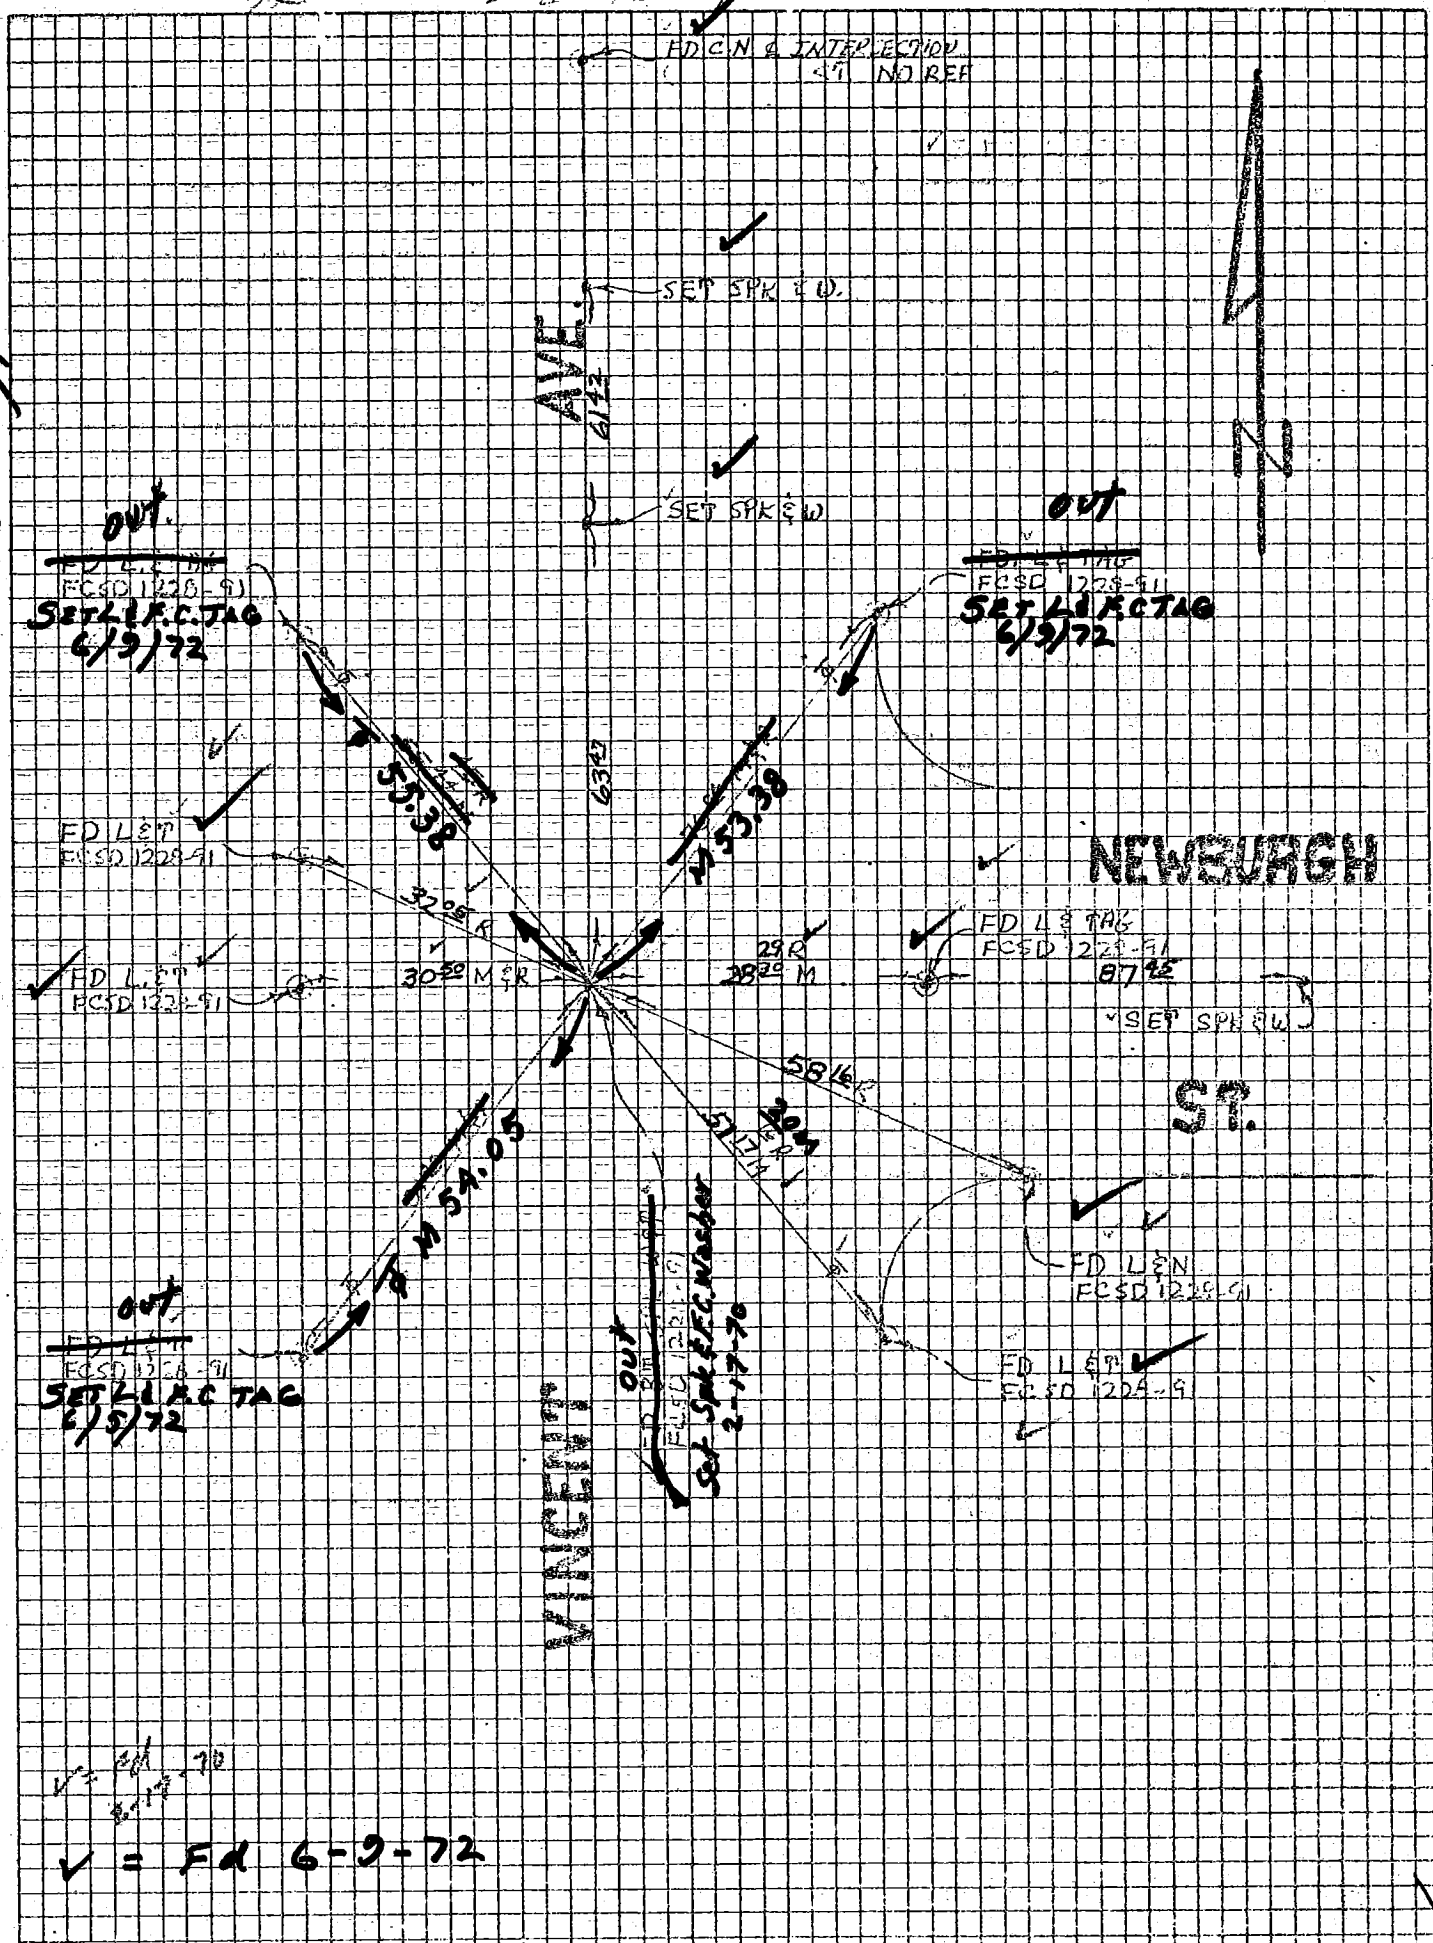

76S911– Cdb 3-69

PROJECT I.D. 1228 LINE C

SURVEY BY L.V.H. DATE 6/9/72

REVIEWED BY [illegible] DATE 11-16-72

Co. Engr. F.B. 3555: 57

INDEX FCSD1228 141

C M - 3

LOS ANGELES COUNTY FLOOD CONTROL DISTRICT

WS 47B-4

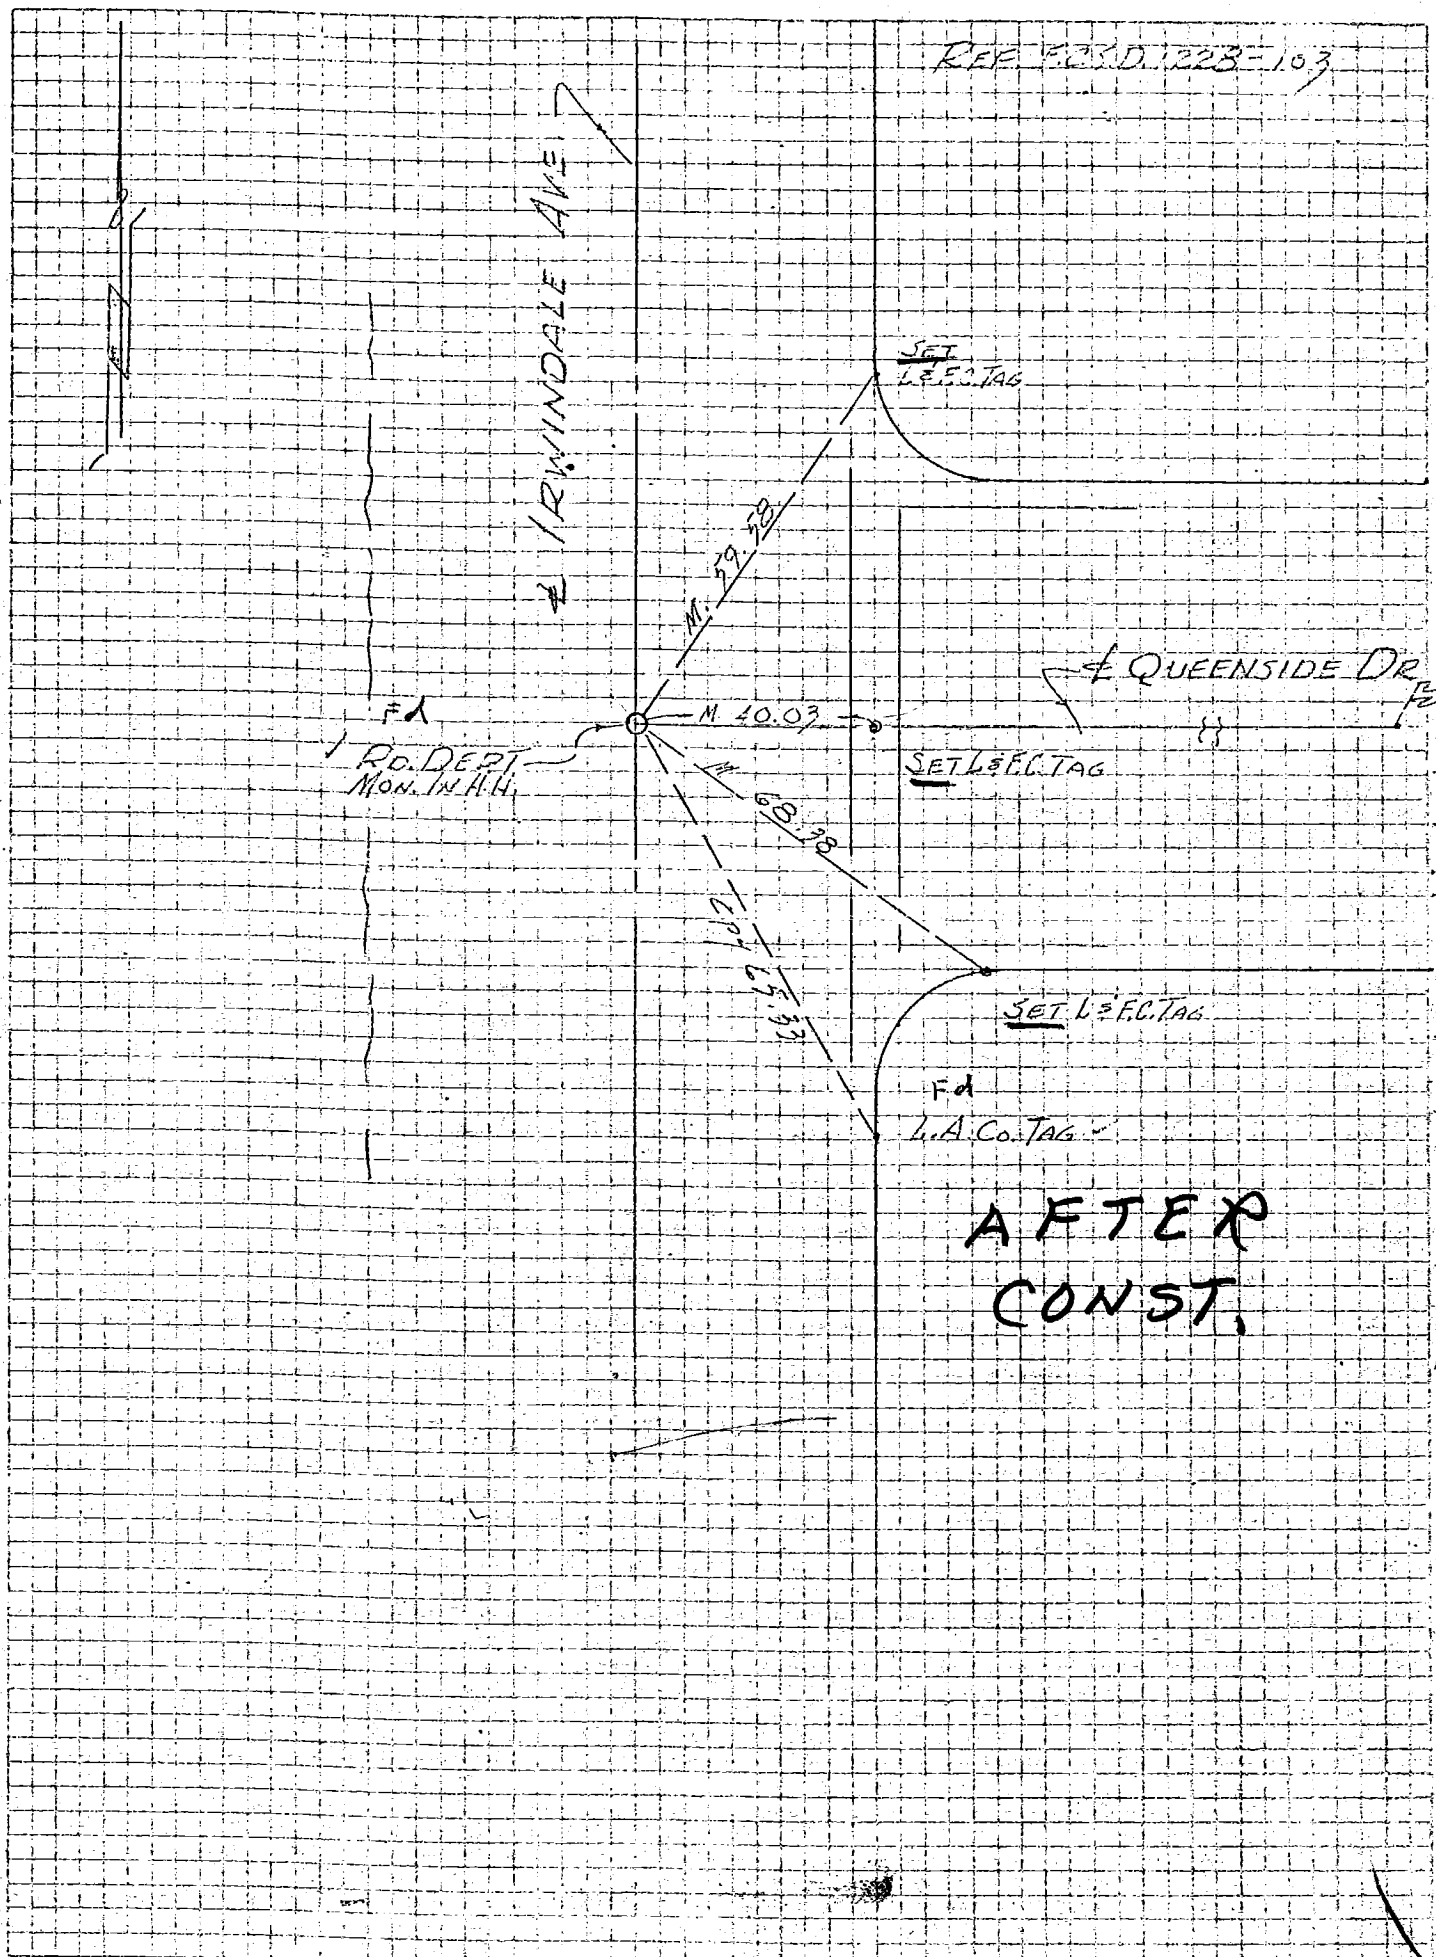

76S911– Cdb 1-68

PROJECT 1228 Lynwood

SURVEY BY McGehee DATE 4-18-69

REVIEWED BY (F) DATE 4-23-69 2-25-70

Co. Engr. F.B. INDEX 3555:58228 143

C11-5

LOS ANGELES COUNTY FLOOD CONTROL DISTRICT

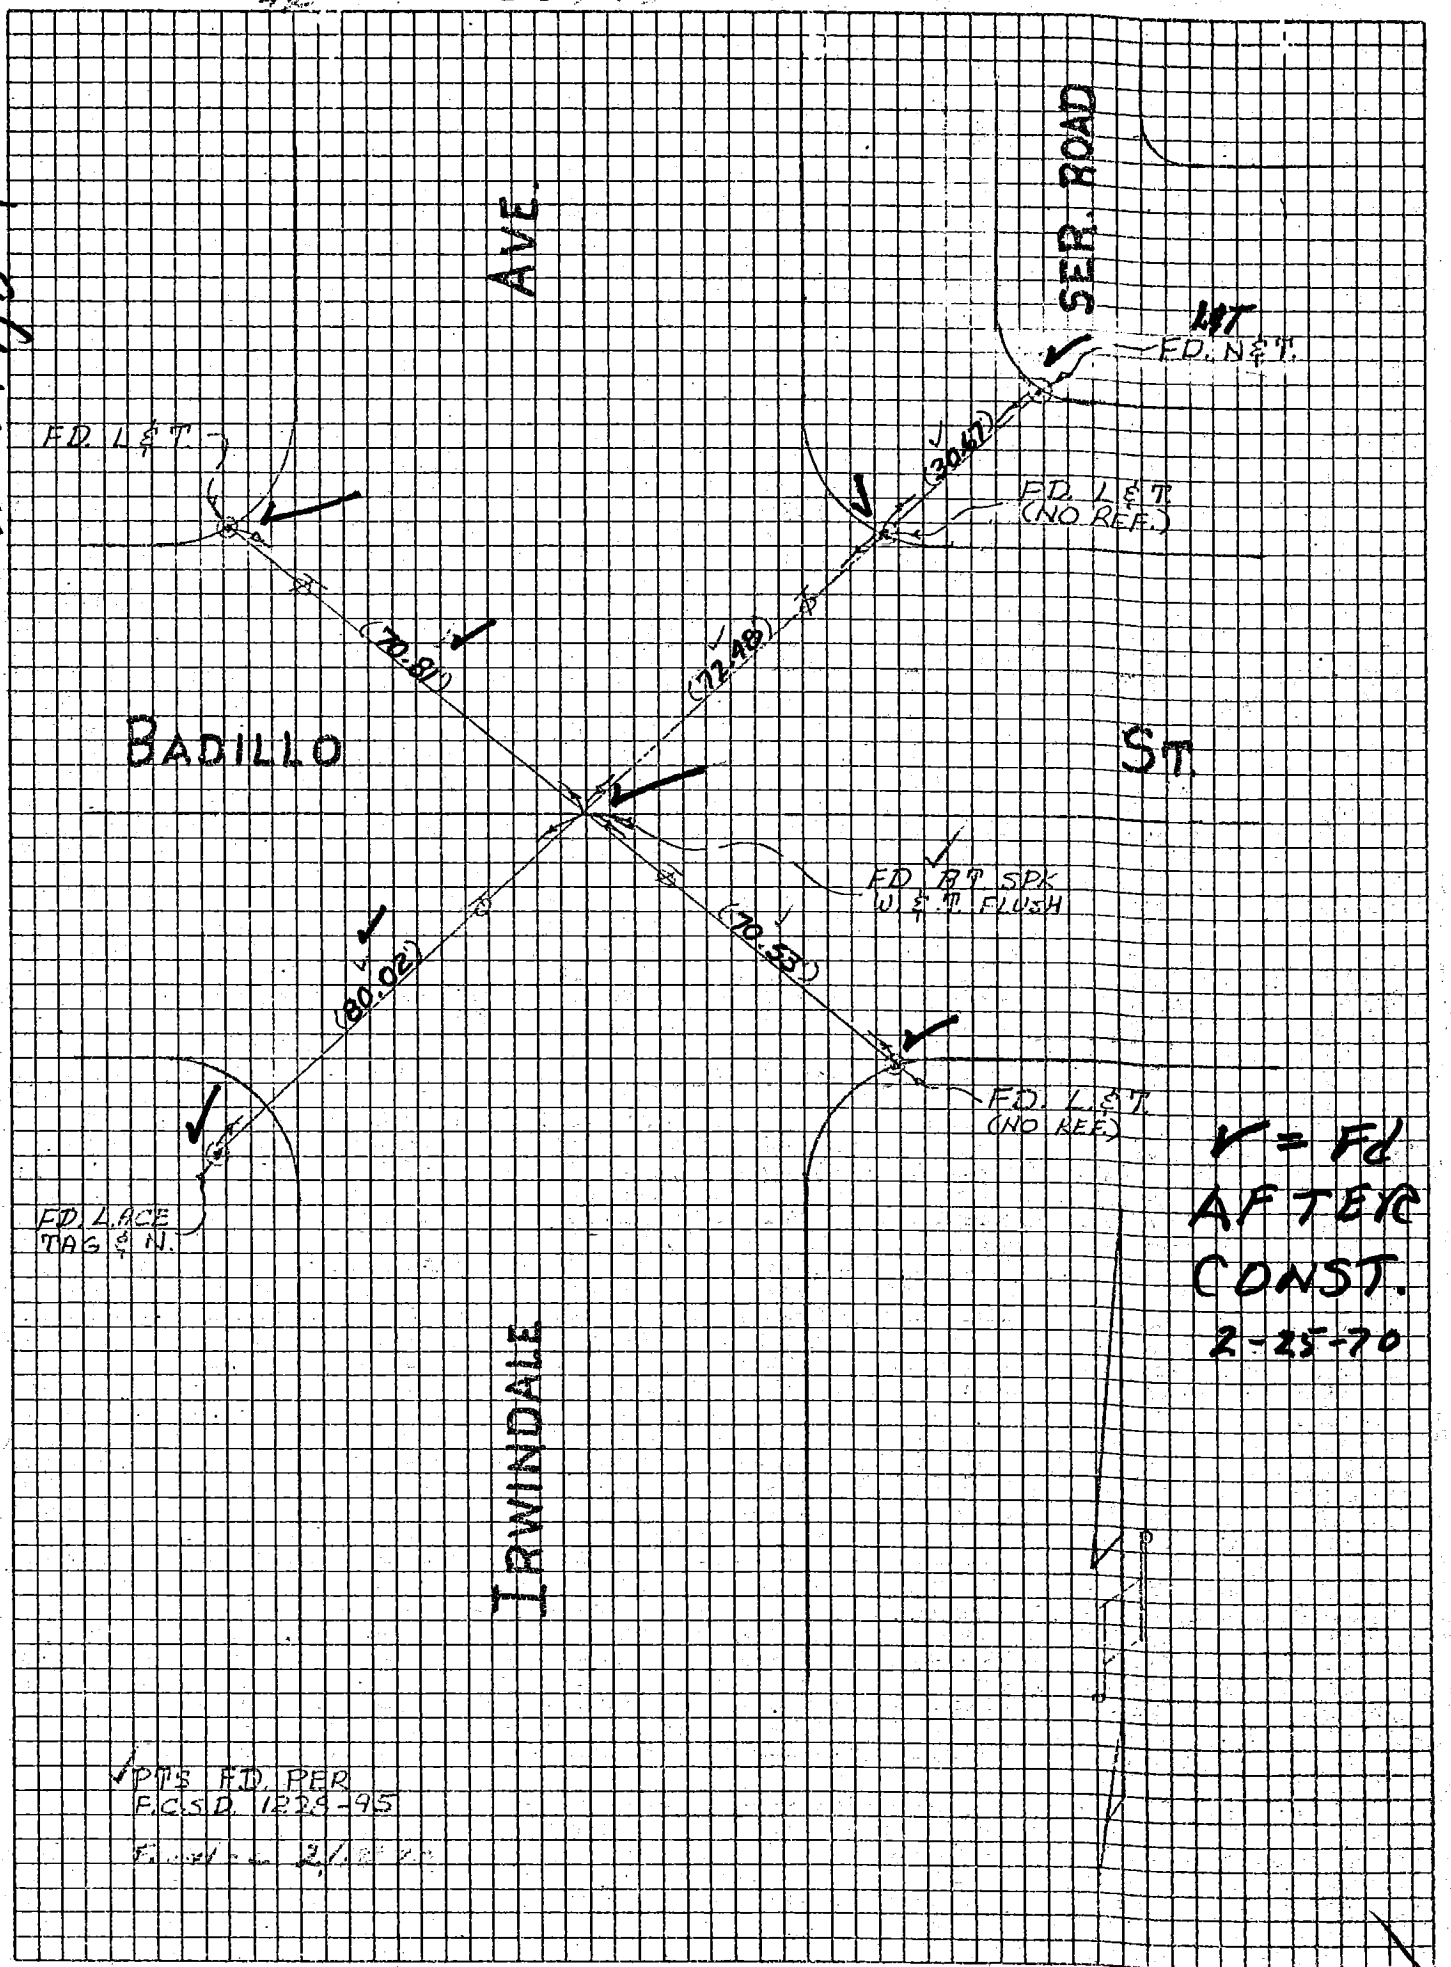

76S911– Cdb 3-69

Co. Engr. F.B. 3555: 59

PROJECT SD 1228 LINE P

SURVEY BY W.V.H. DATE 6/9/72

REVIEWED BY — DATE 11-16-72

INDEX FCSD1228 147

JM-9

LOS ANGELES COUNTY FLOOD CONTROL DISTRICT

W 47 D-4

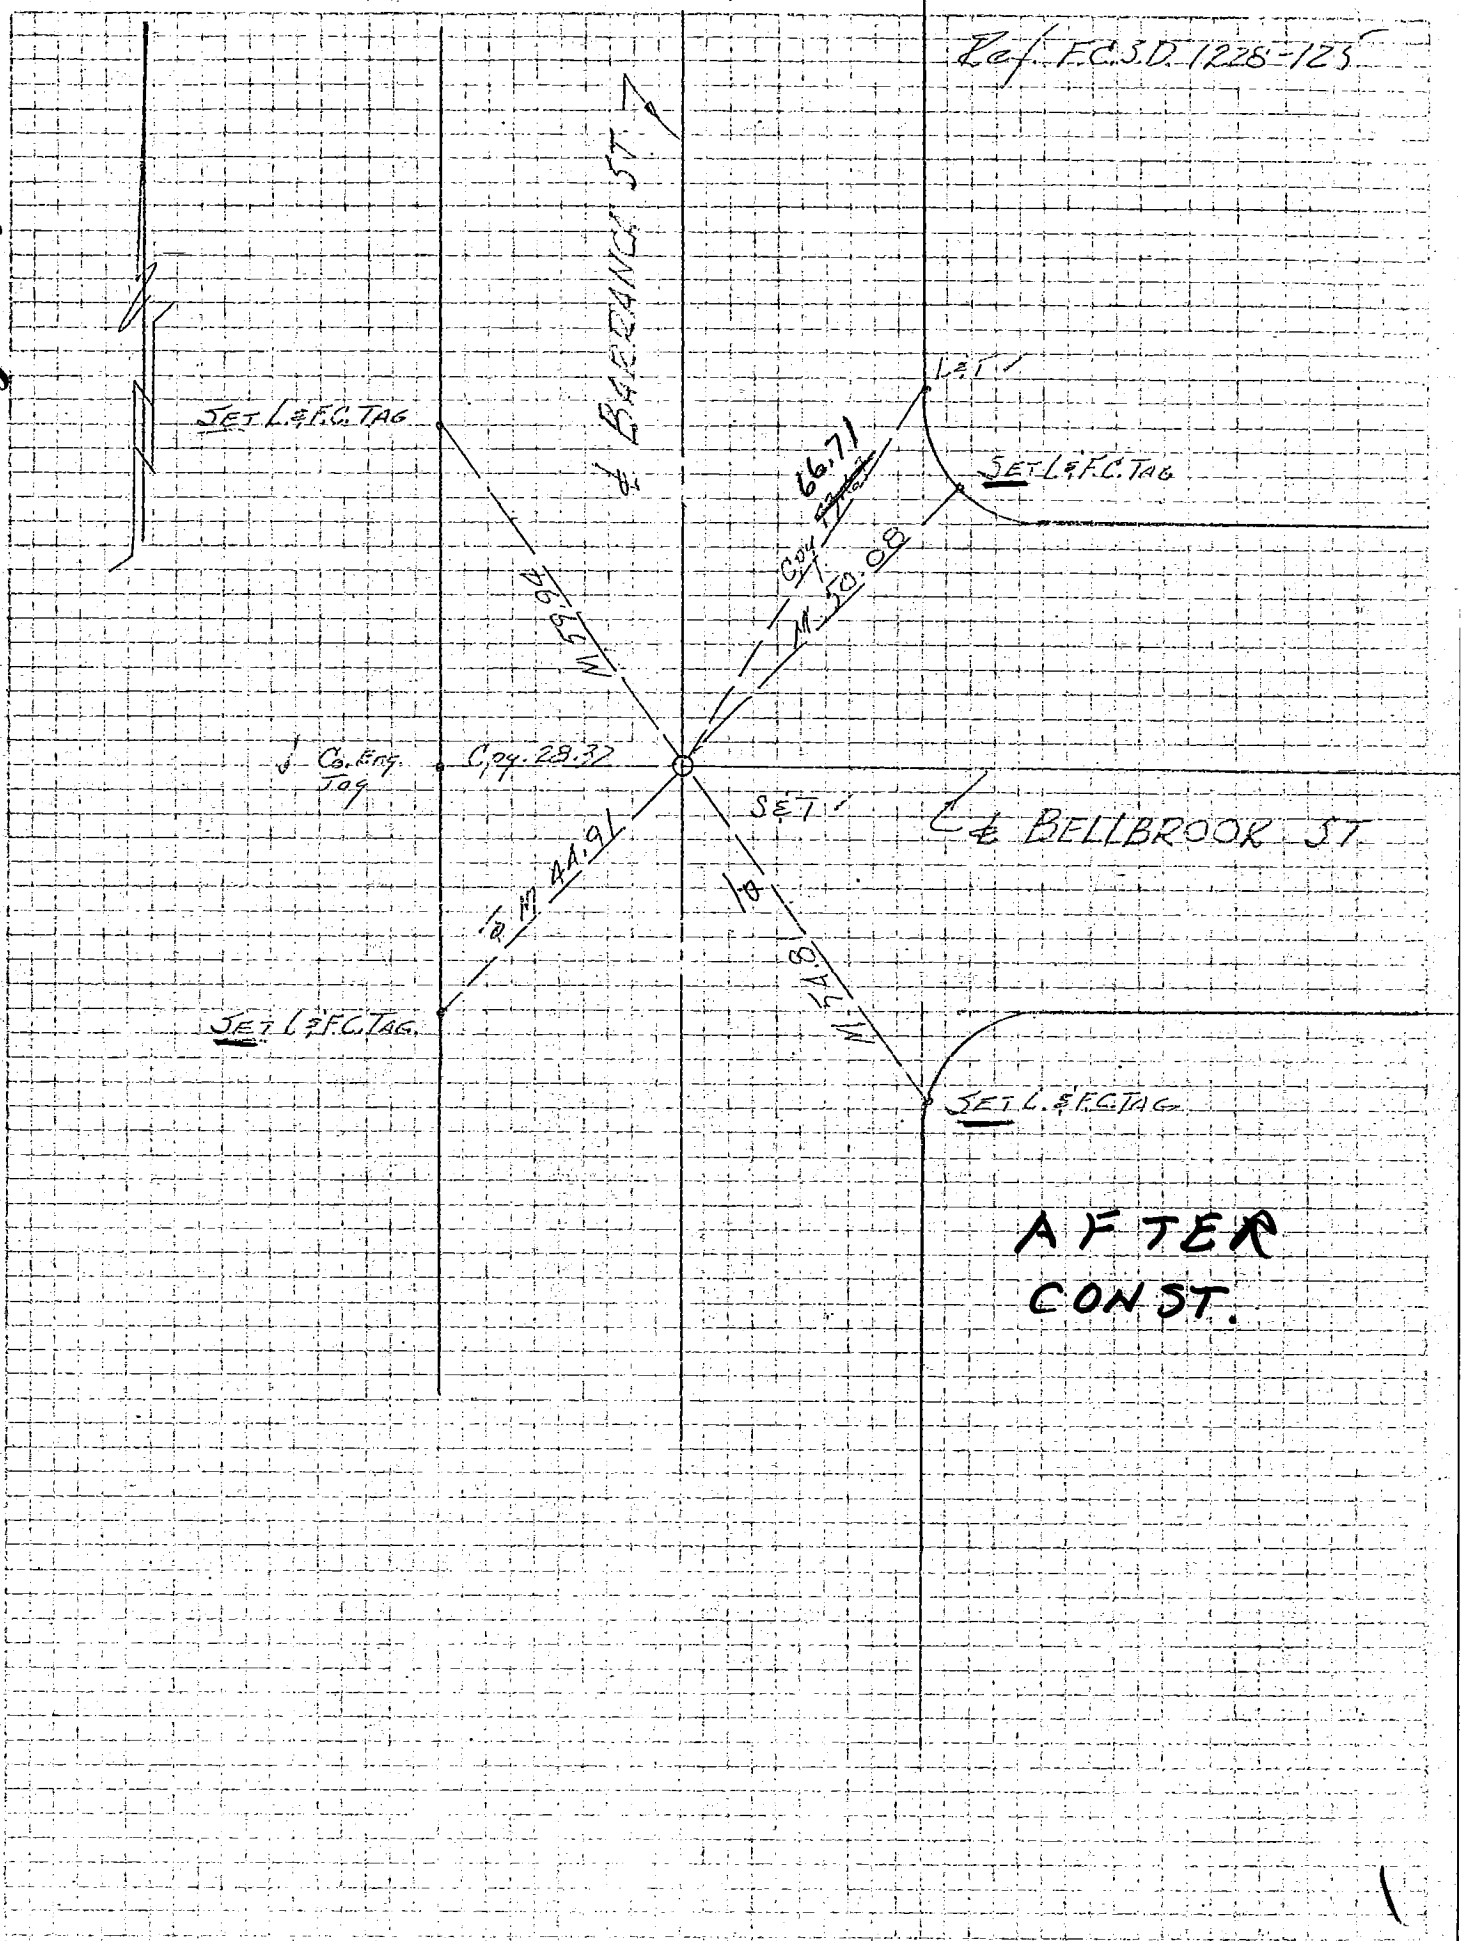

76S911-- Cdb 3-69

PROJECT 1228 Lucie D

SURVEY BY Nixon DATE 11/13/72

REVIEWED BY [illegible] DATE 11-16-72

Co. Engr. F.B. 3555 60

INDEX FCSD1228 149

DM-11

LOS ANGELES COUNTY FLOOD CONTROL DISTRICT

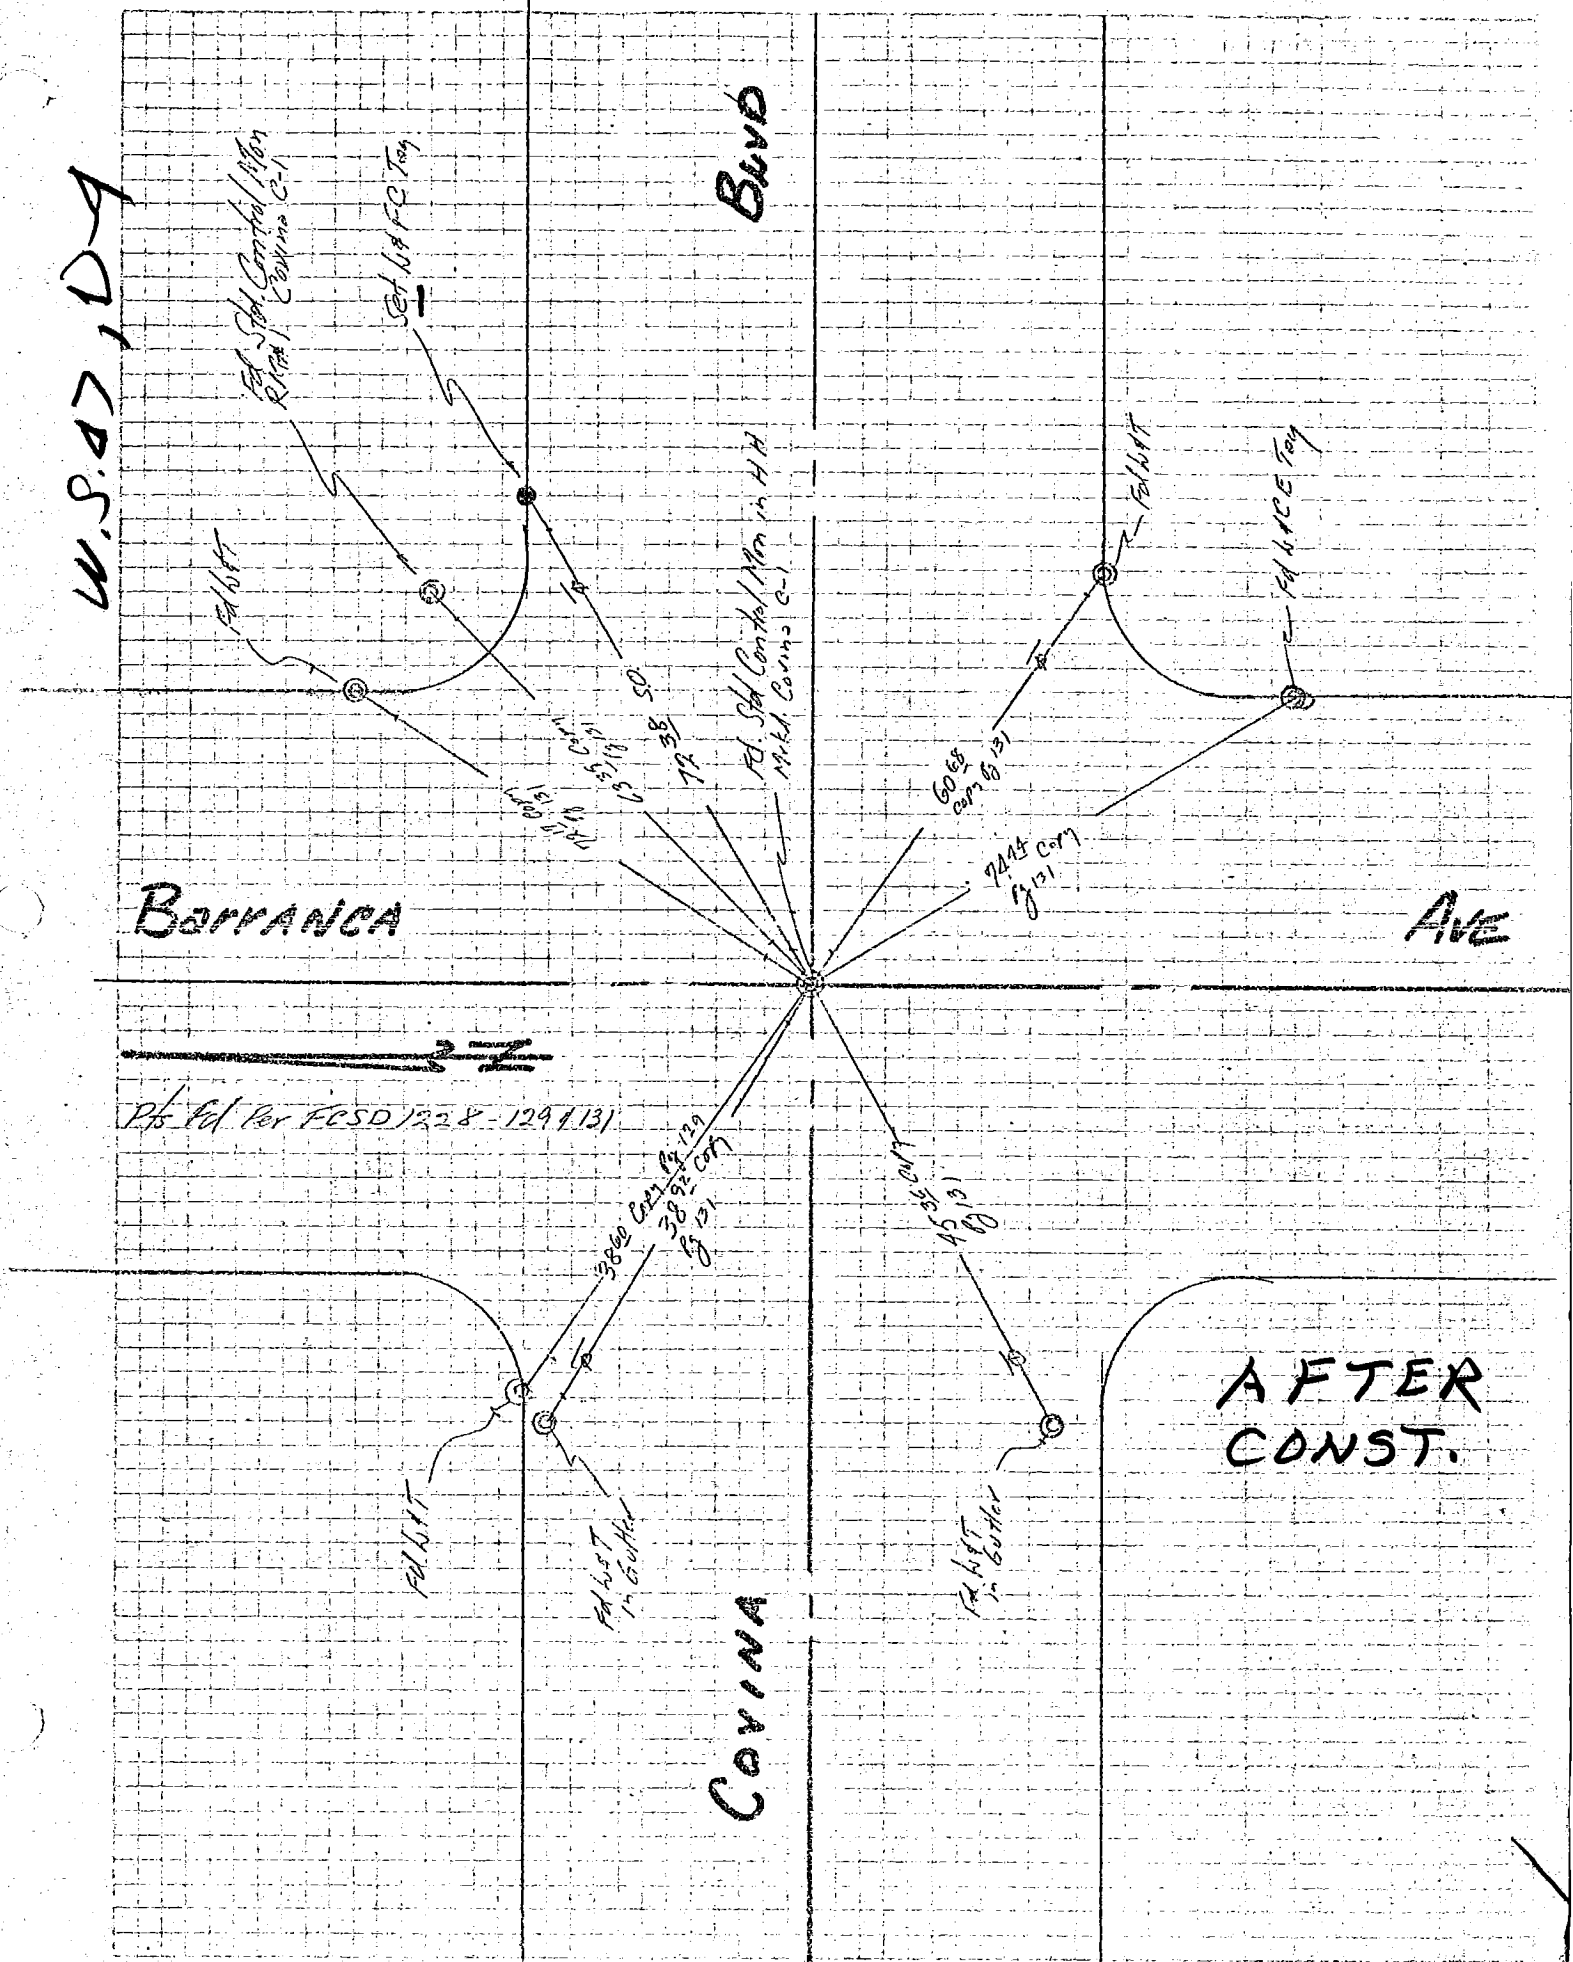
W.S.&T. DA
Blvd
Barranca
Ave
Covina
Pal Sta Conc Mon
Sol Sta Conc Tag

PROJECT COUNTY S.D. #1206 UNIT 3 LINE A
SURVEY BY J. W. Greenfield DATE 7-13-67
REVIEWED BY [illegible] DATE 7-27-67
INDEX P&R-3
LOS ANGELES COUNTY FLOOD CONTROL DISTRICT

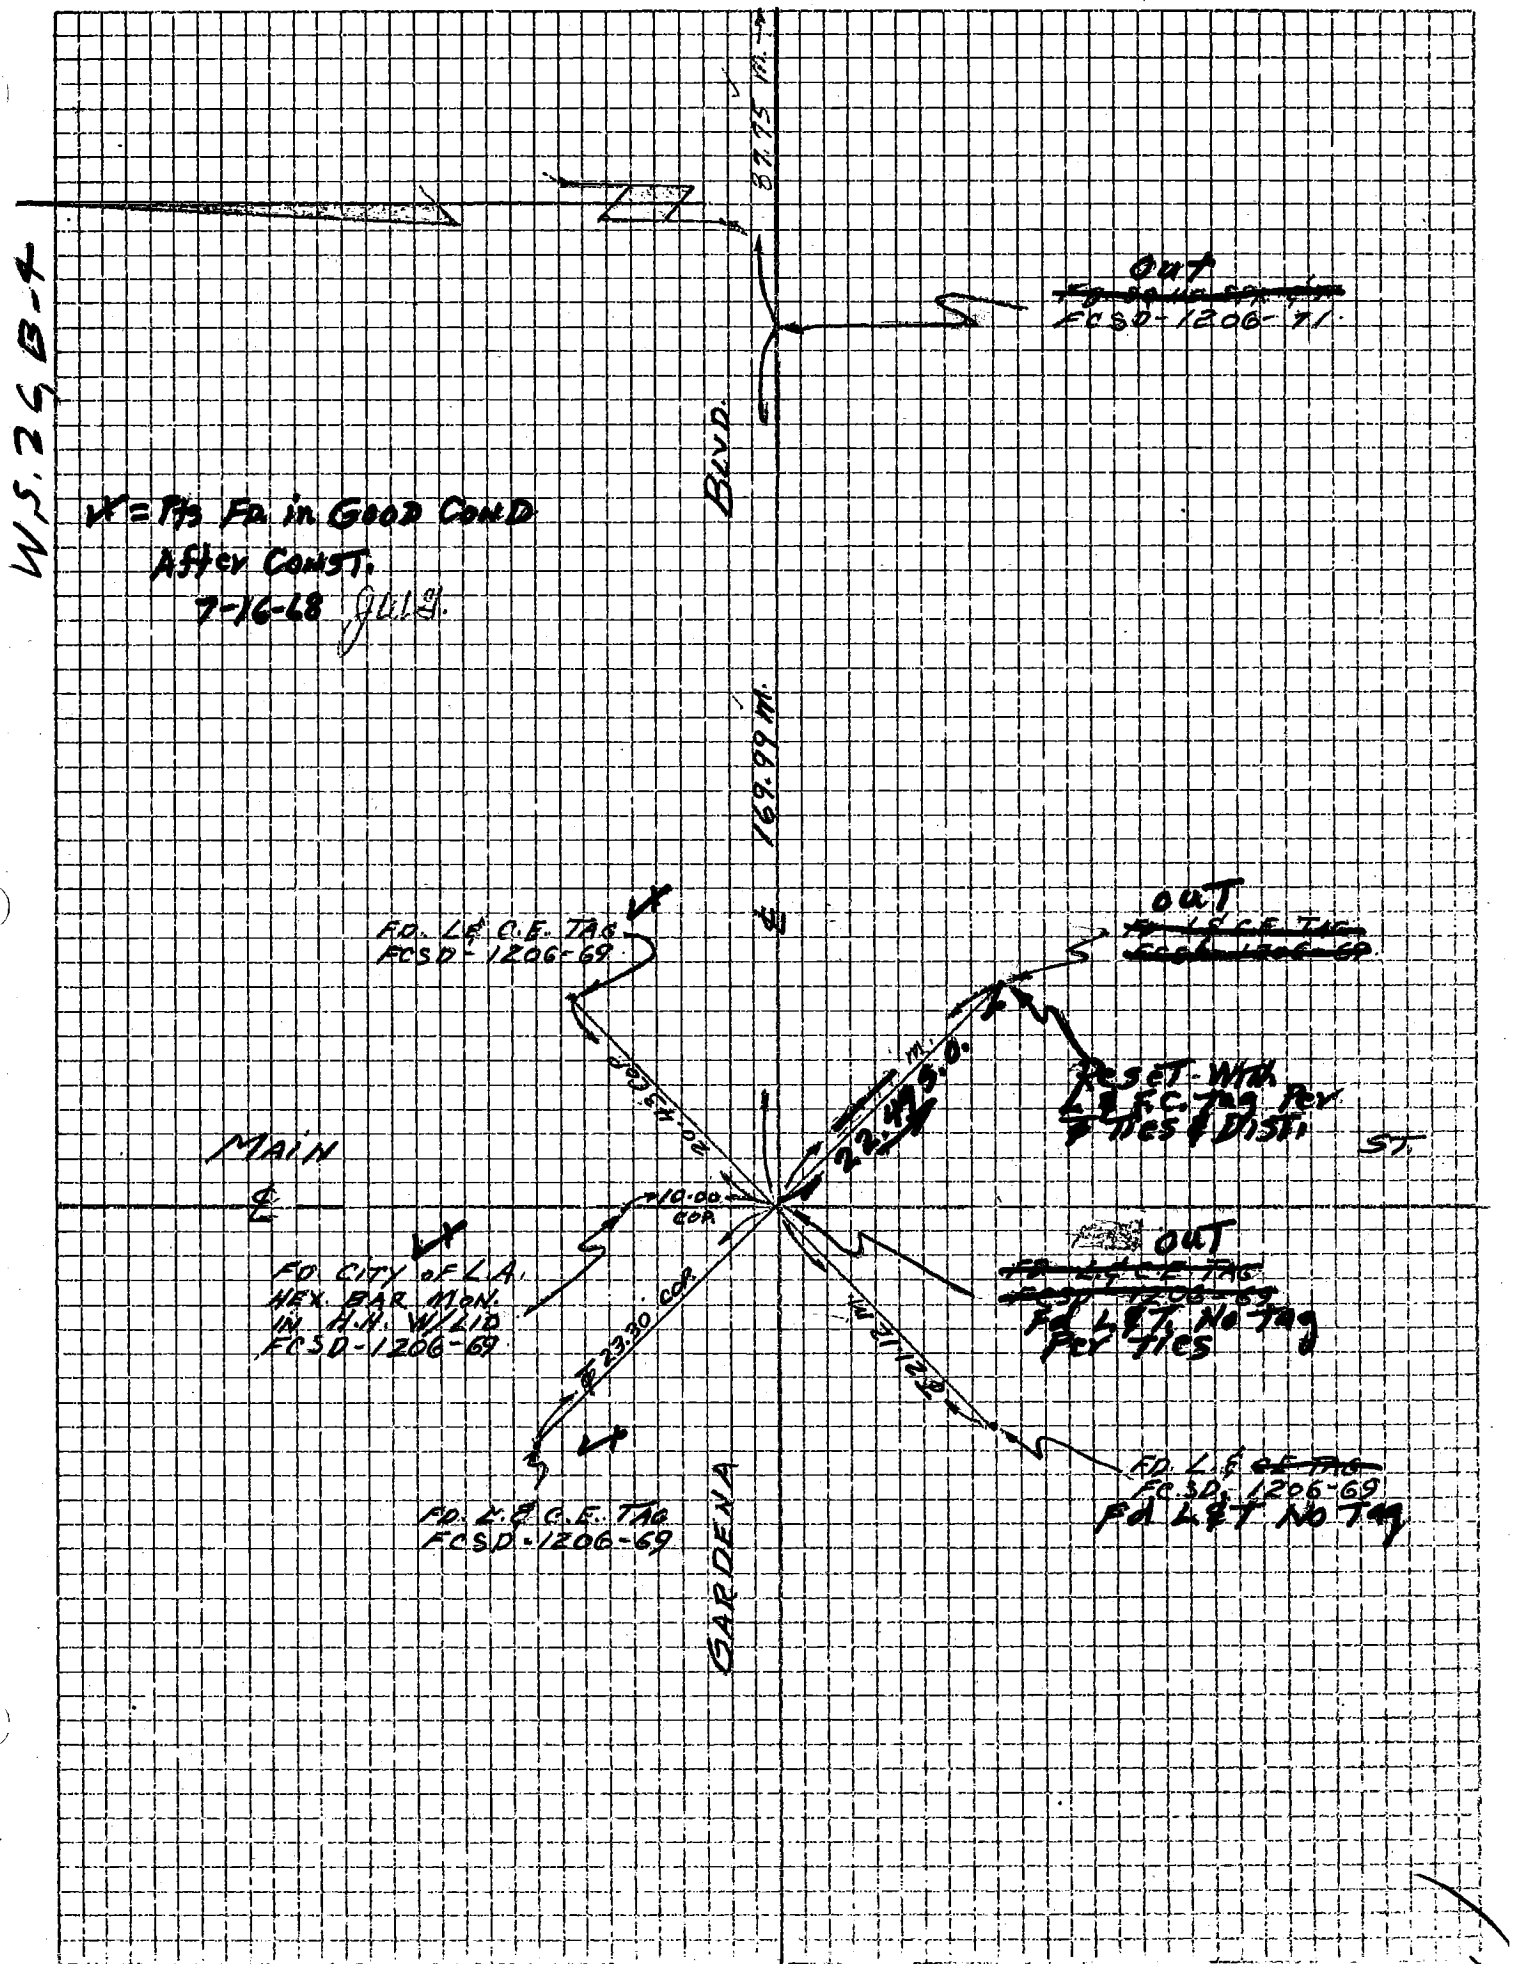

73S91 Cdb 8-66

PROJECT COUNTY S.D. #1206 UNIT 3 LINE A "Co. Engr. F.B. 3555 FCSD1206 123

SURVEY BY J. W. Eisenfield DATE 7-13-67 INDEX 62

REVIEWED BY _____ DATE 7-27-67 EDR-7

LOS ANGELES COUNTY FLOOD CONTROL DISTRICT

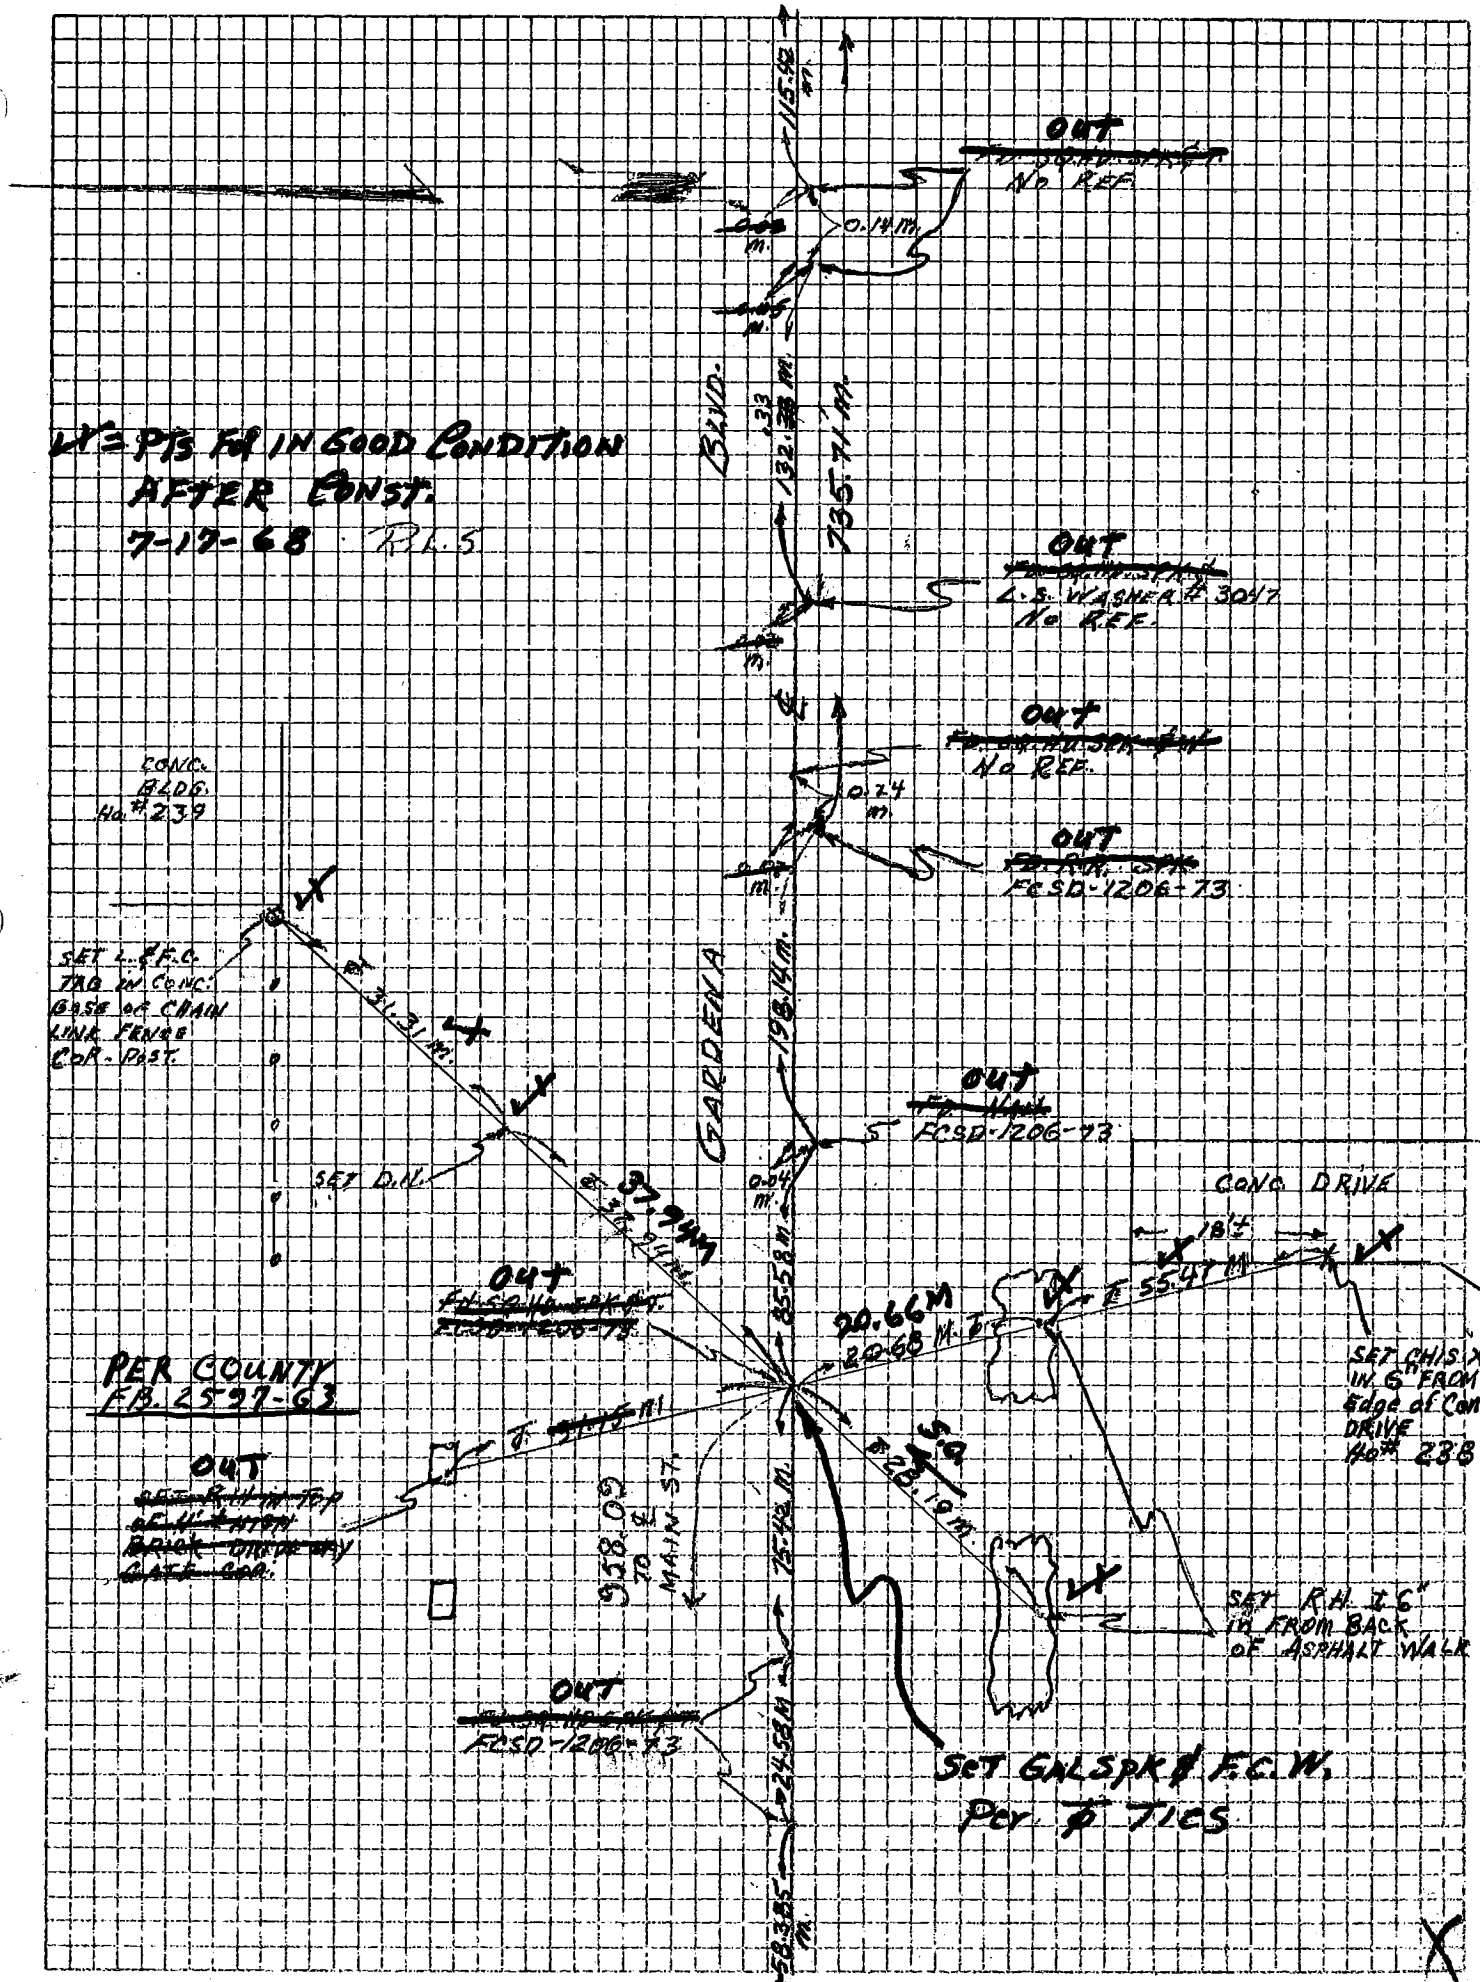

PROJECT COUNTY S.D. # 1206 UNIT 3 LINE A  Co. Engr. F.B. 3555: 63  INDEX FCSD1206 125

SURVEY BY L. W. Greenfield  DATE 7-12-67  REF-9

REVIEWED BY [illegible]  DATE 7-22-67

LOS ANGELES COUNTY FLOOD CONTROL DISTRICT

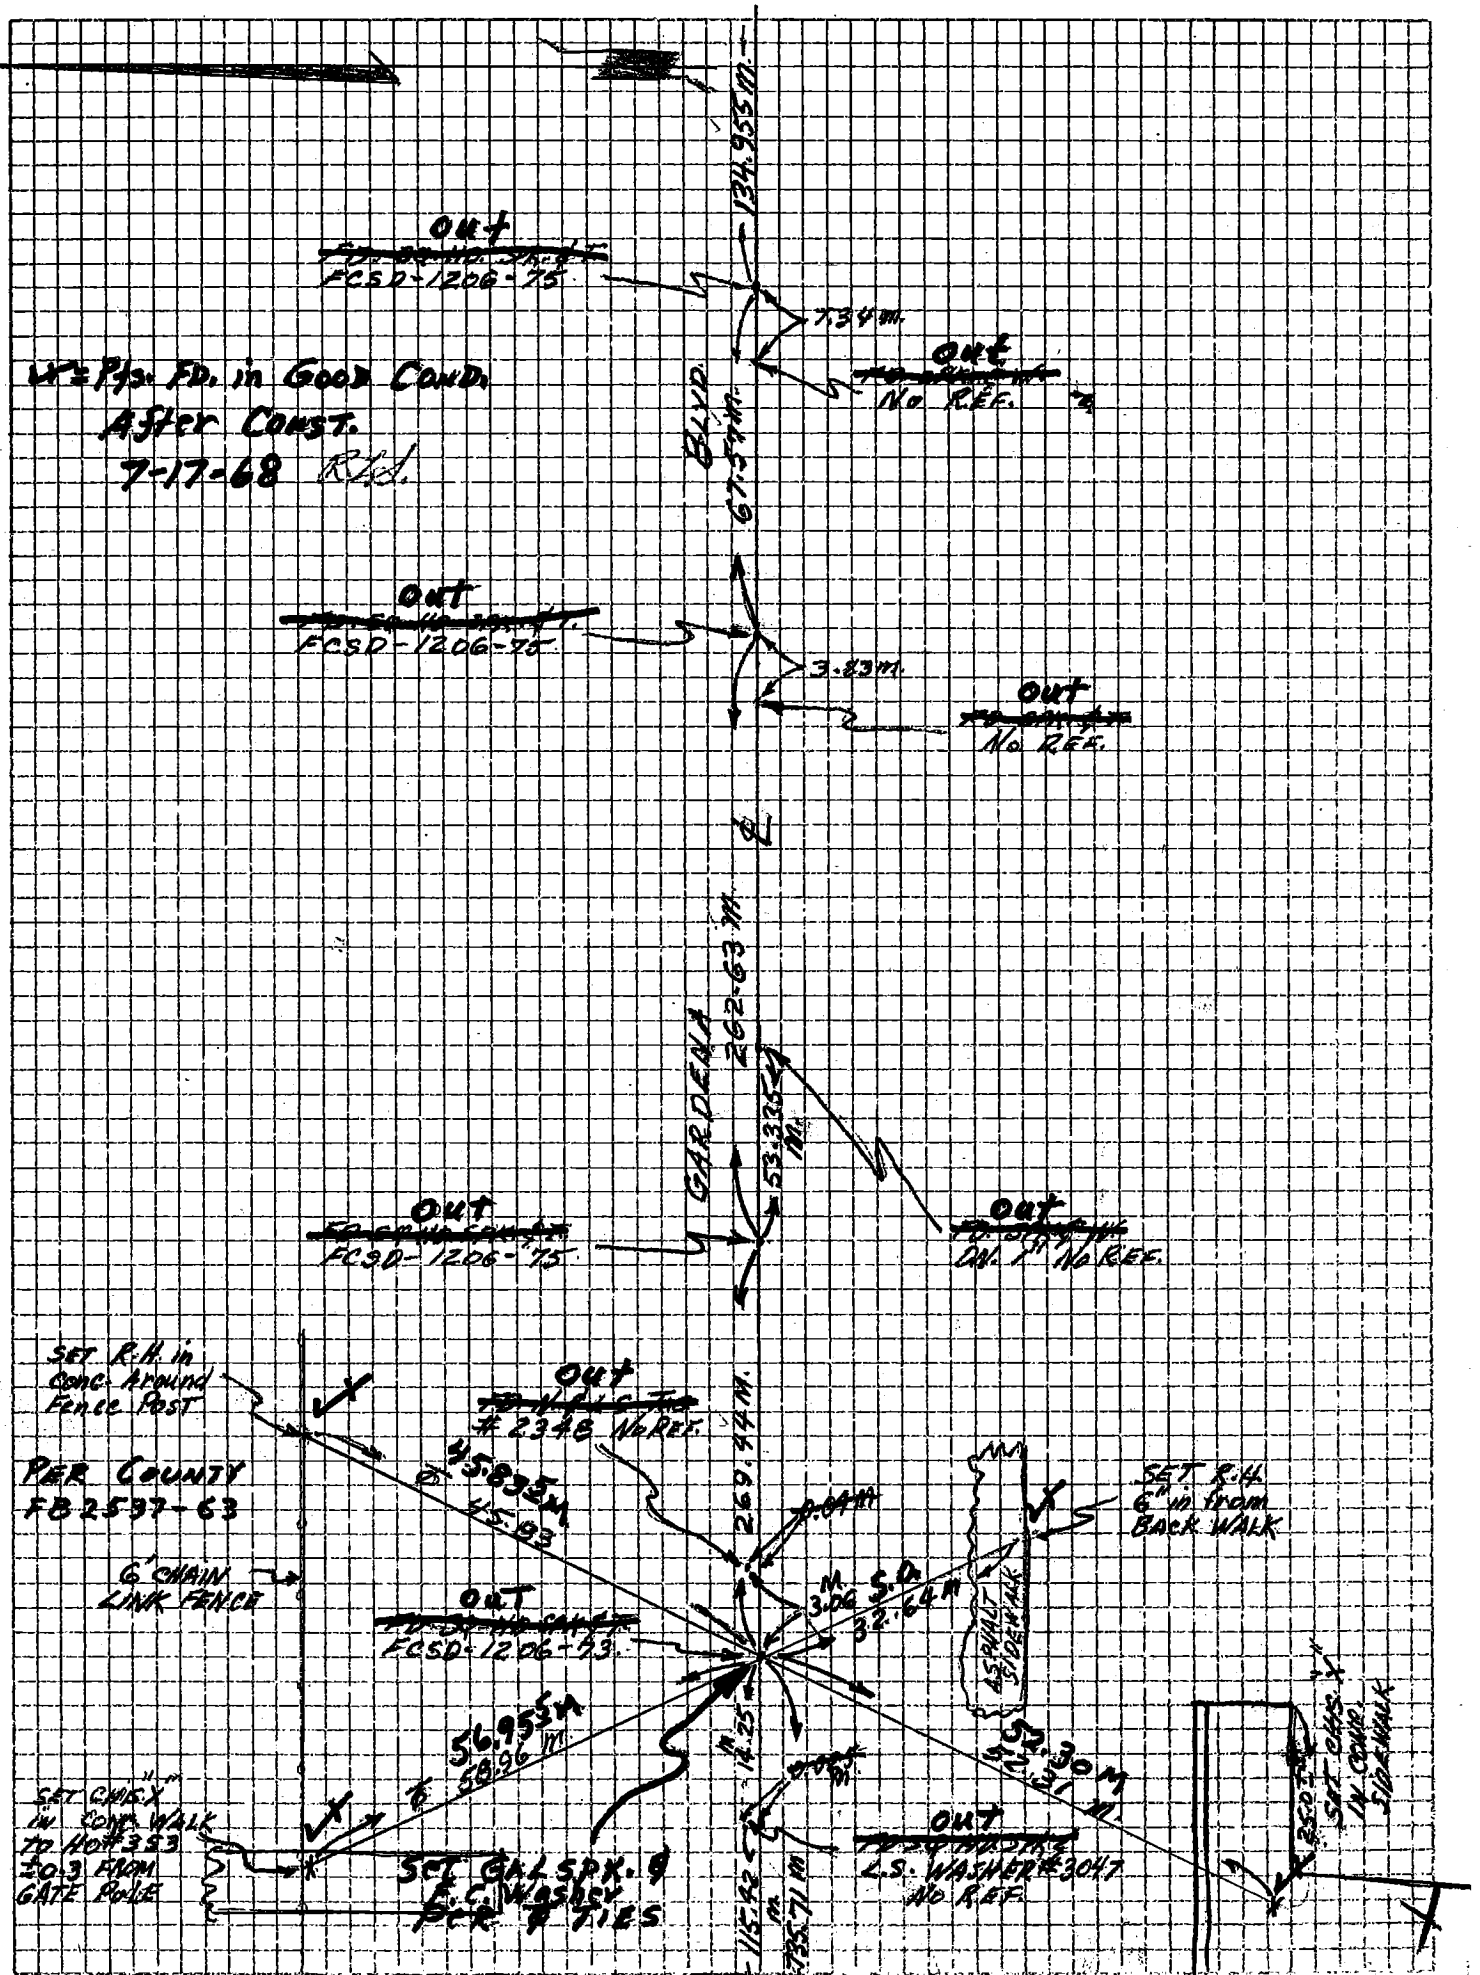

PROJECT COUNTY S.D. #1206 UNIT 3 LINE A Co. Engr. F.B. 3555: 104 INDEX FCSD1206 127

SURVEY BY J. W. Greenfield DATE 7-11-67 R&R--11

REVIEWED BY [illegible] DATE 7-27-67

LOS ANGELES COUNTY FLOOD CONTROL DISTRICT

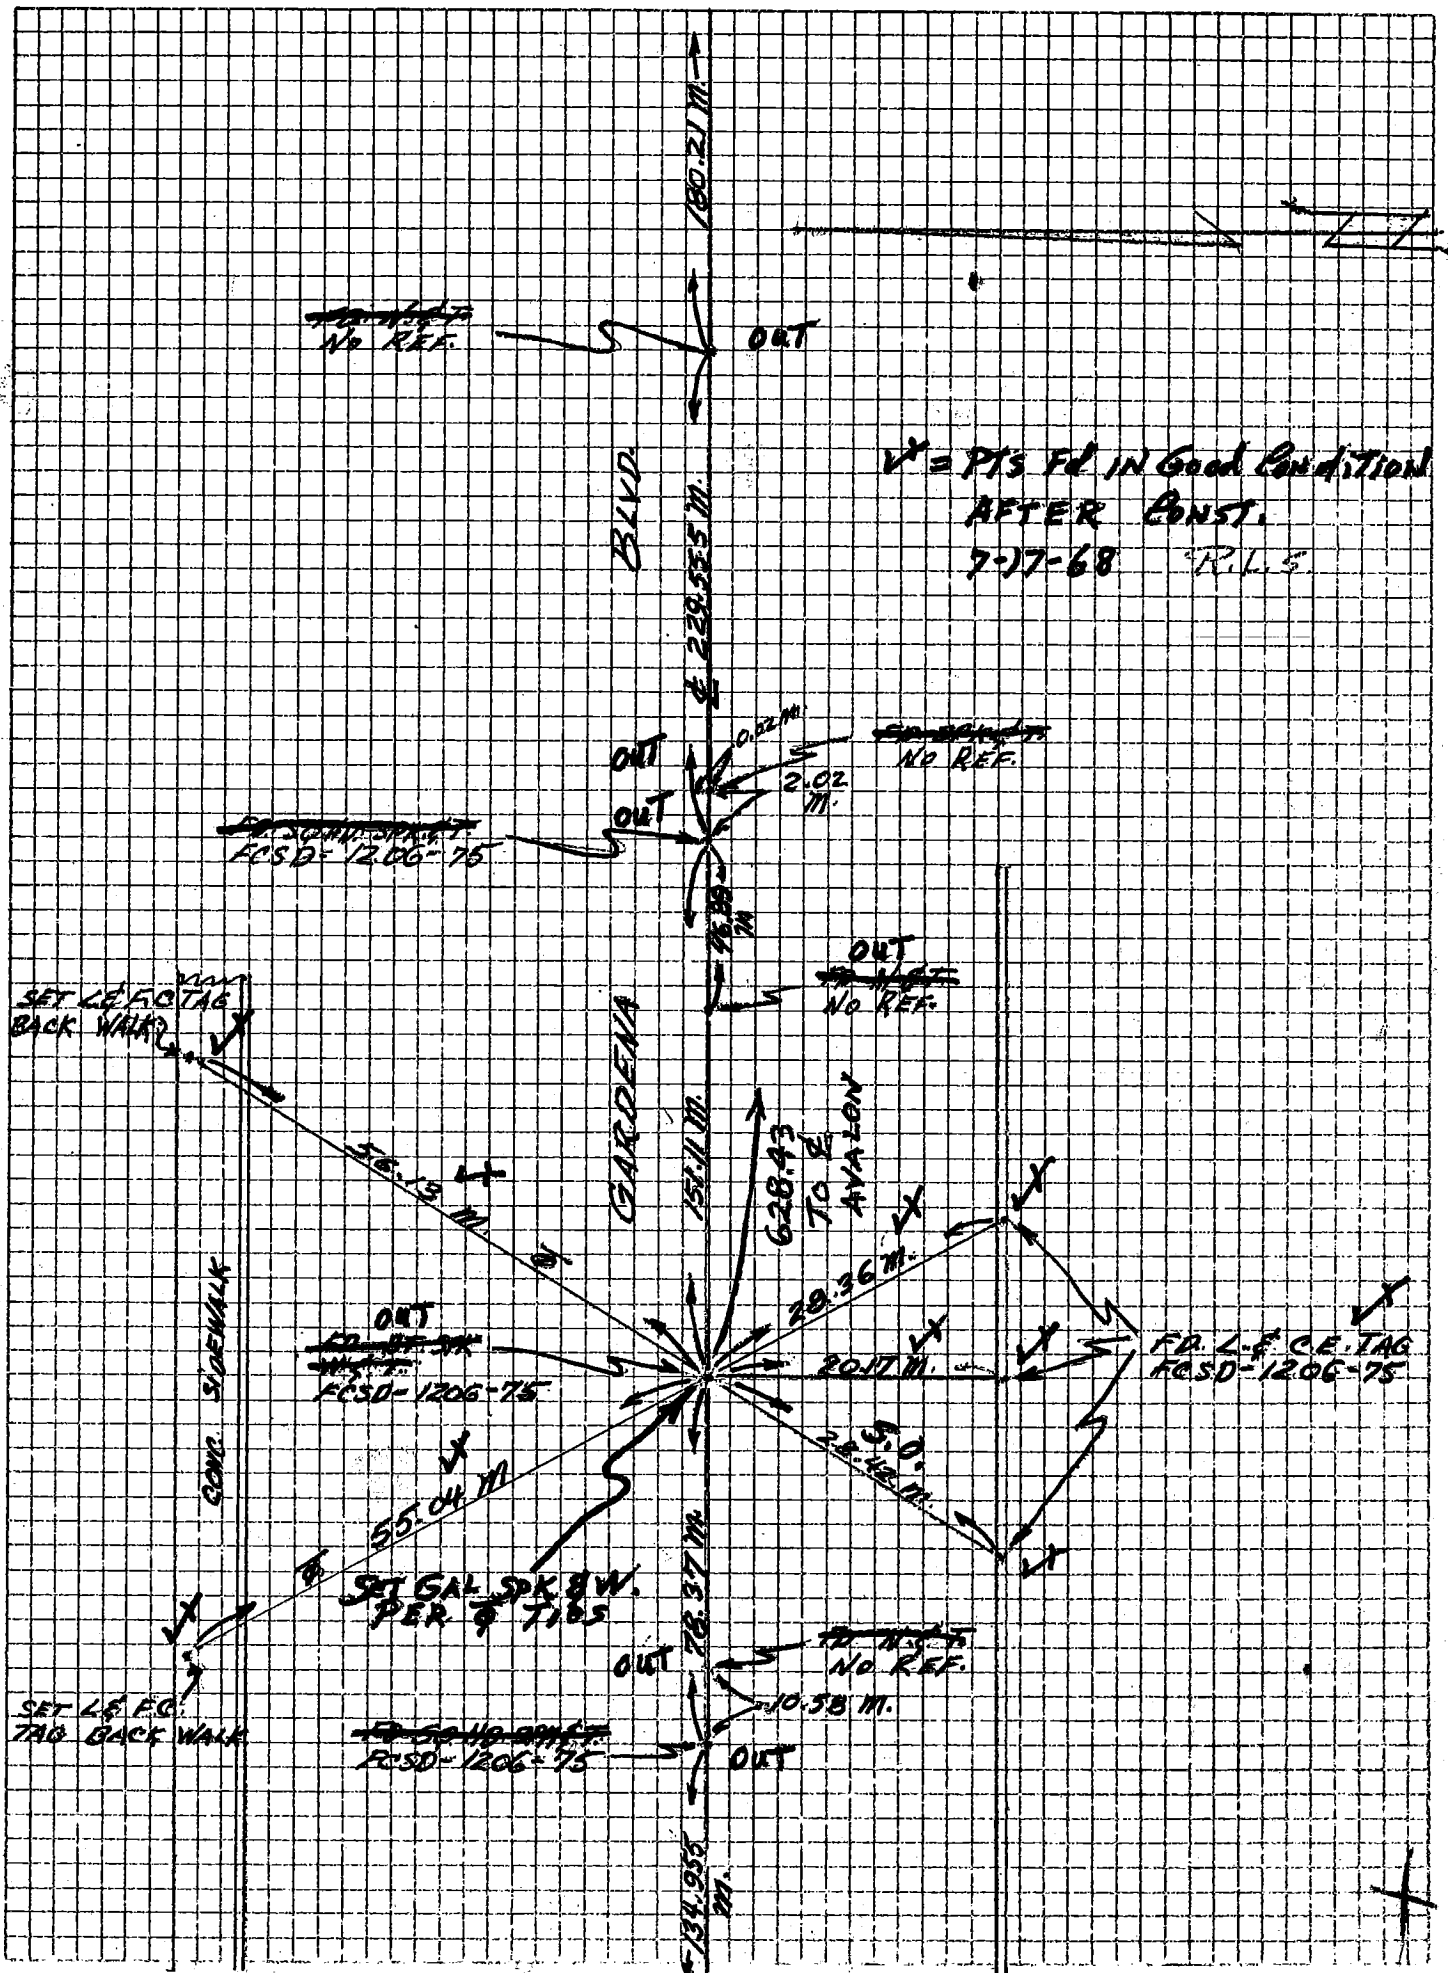

76S011—Cdb 5-66

PROJECT County Project 1206 UNIT 3 — LINE "F" RFR-15 — INDEX FCSD1206 131

SURVEY BY STRAUMEYER DATE 8-3-67 — Co. Engr. F.B. 3555: 65

REVIEWED BY [illegible] DATE 8-11-67

LOS ANGELES COUNTY FLOOD CONTROL DISTRICT

W.S. 26, C4

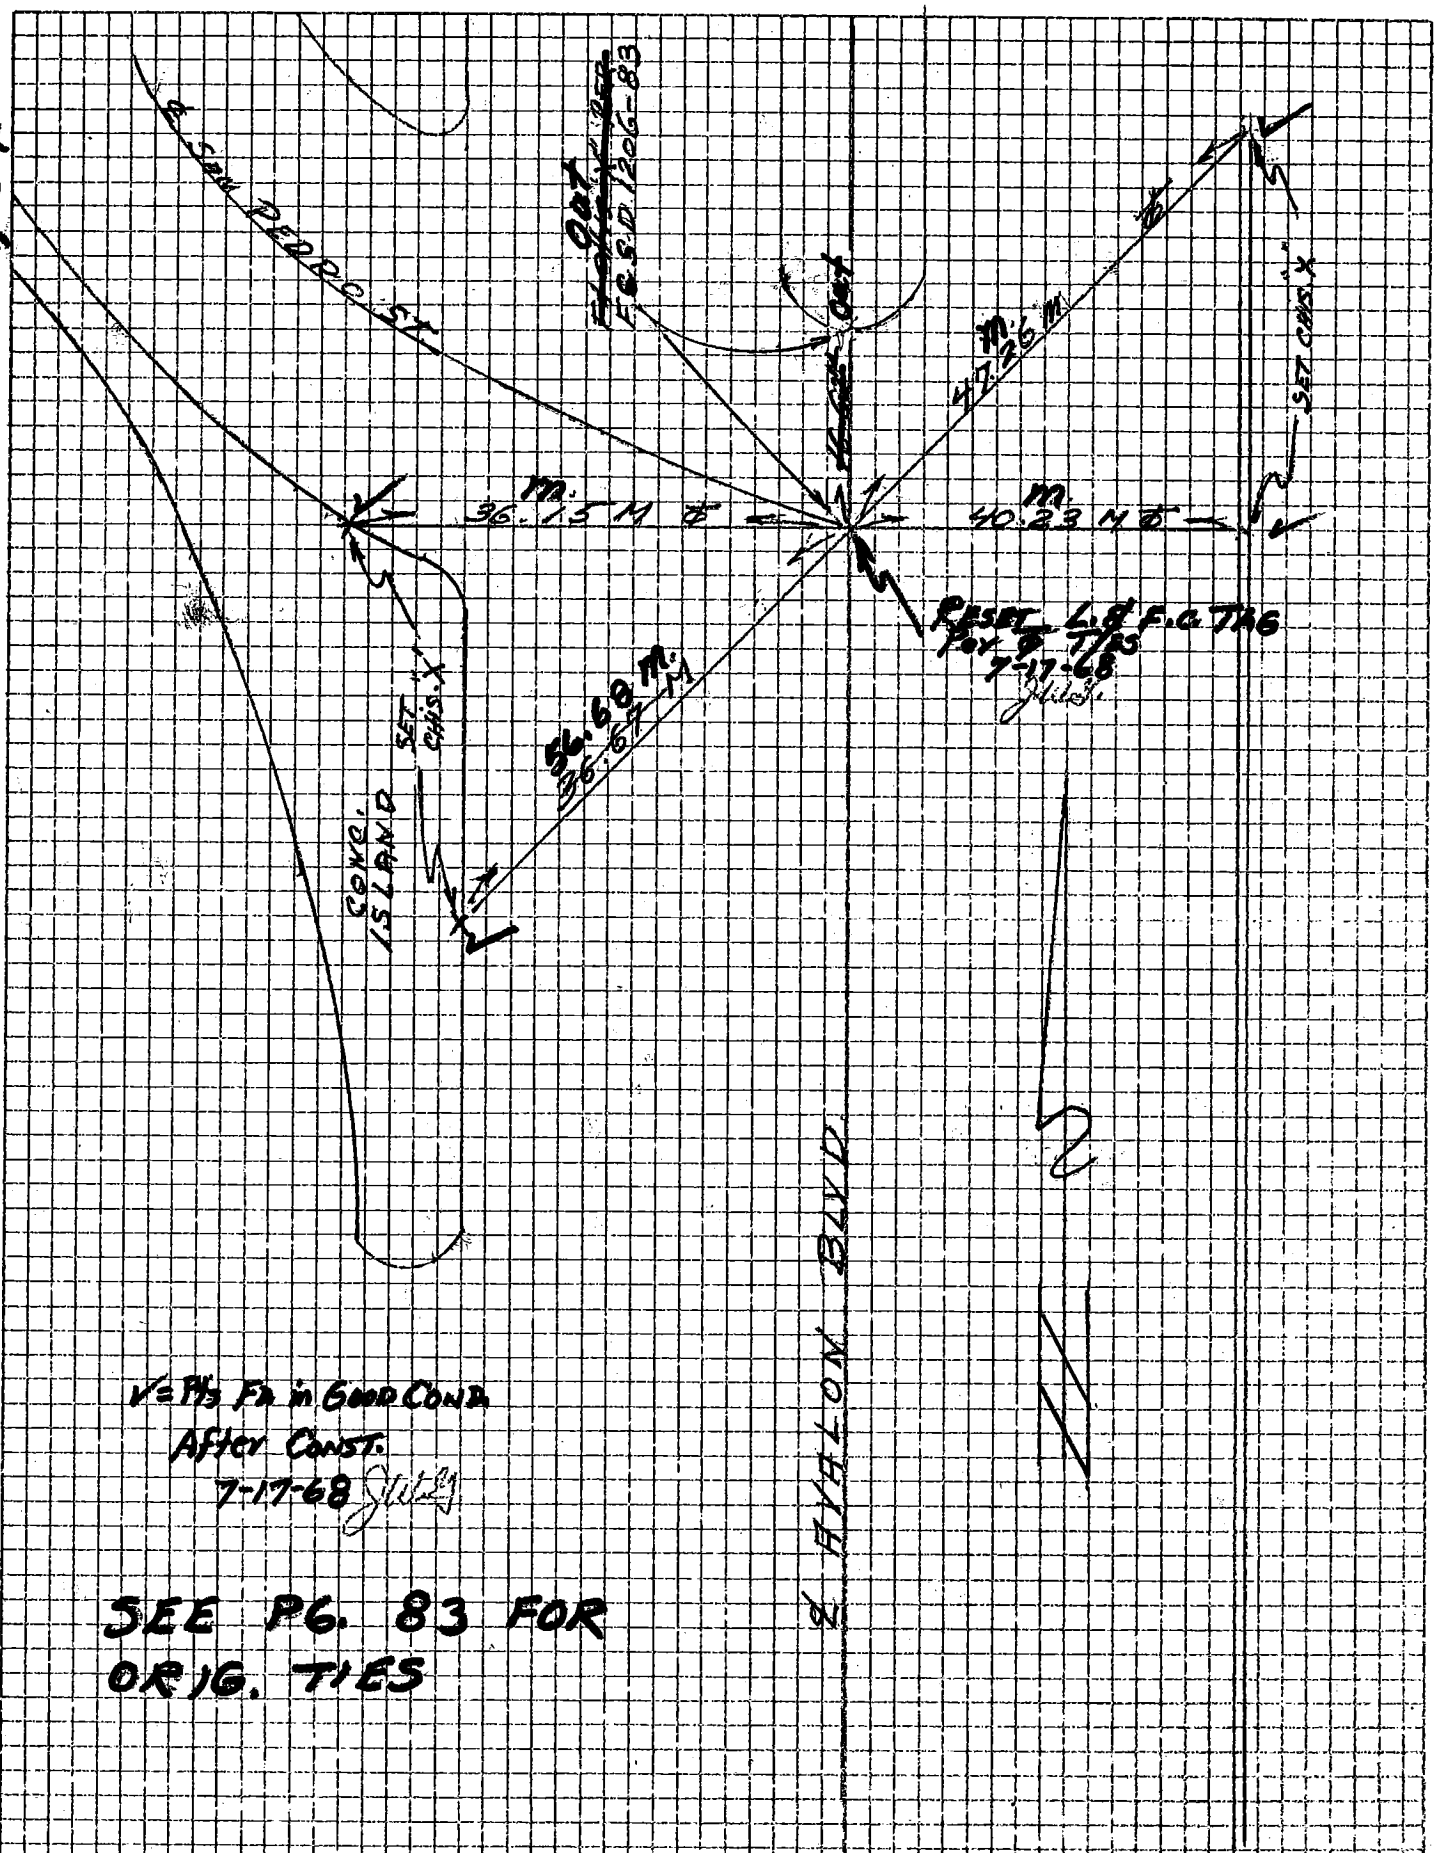


V = Pits Fa in Good Cond. After Const. 7-17-68 Stud.

SEE PG. 83 FOR ORIG. TIES

78S911—Cdb 5-66

PROJECT COUNTY PROJECT # 1206 UNIT 3
SURVEY BY J. W. Greenfield DATE 7-6-67
REVIEWED BY _____ DATE 8-11-67

CAE-17

INDEX FCSD1206 133
Co. Engr. F.B. 3555: 66

LOS ANGELES COUNTY FLOOD CONTROL DISTRICT

W.S. 26, C-4

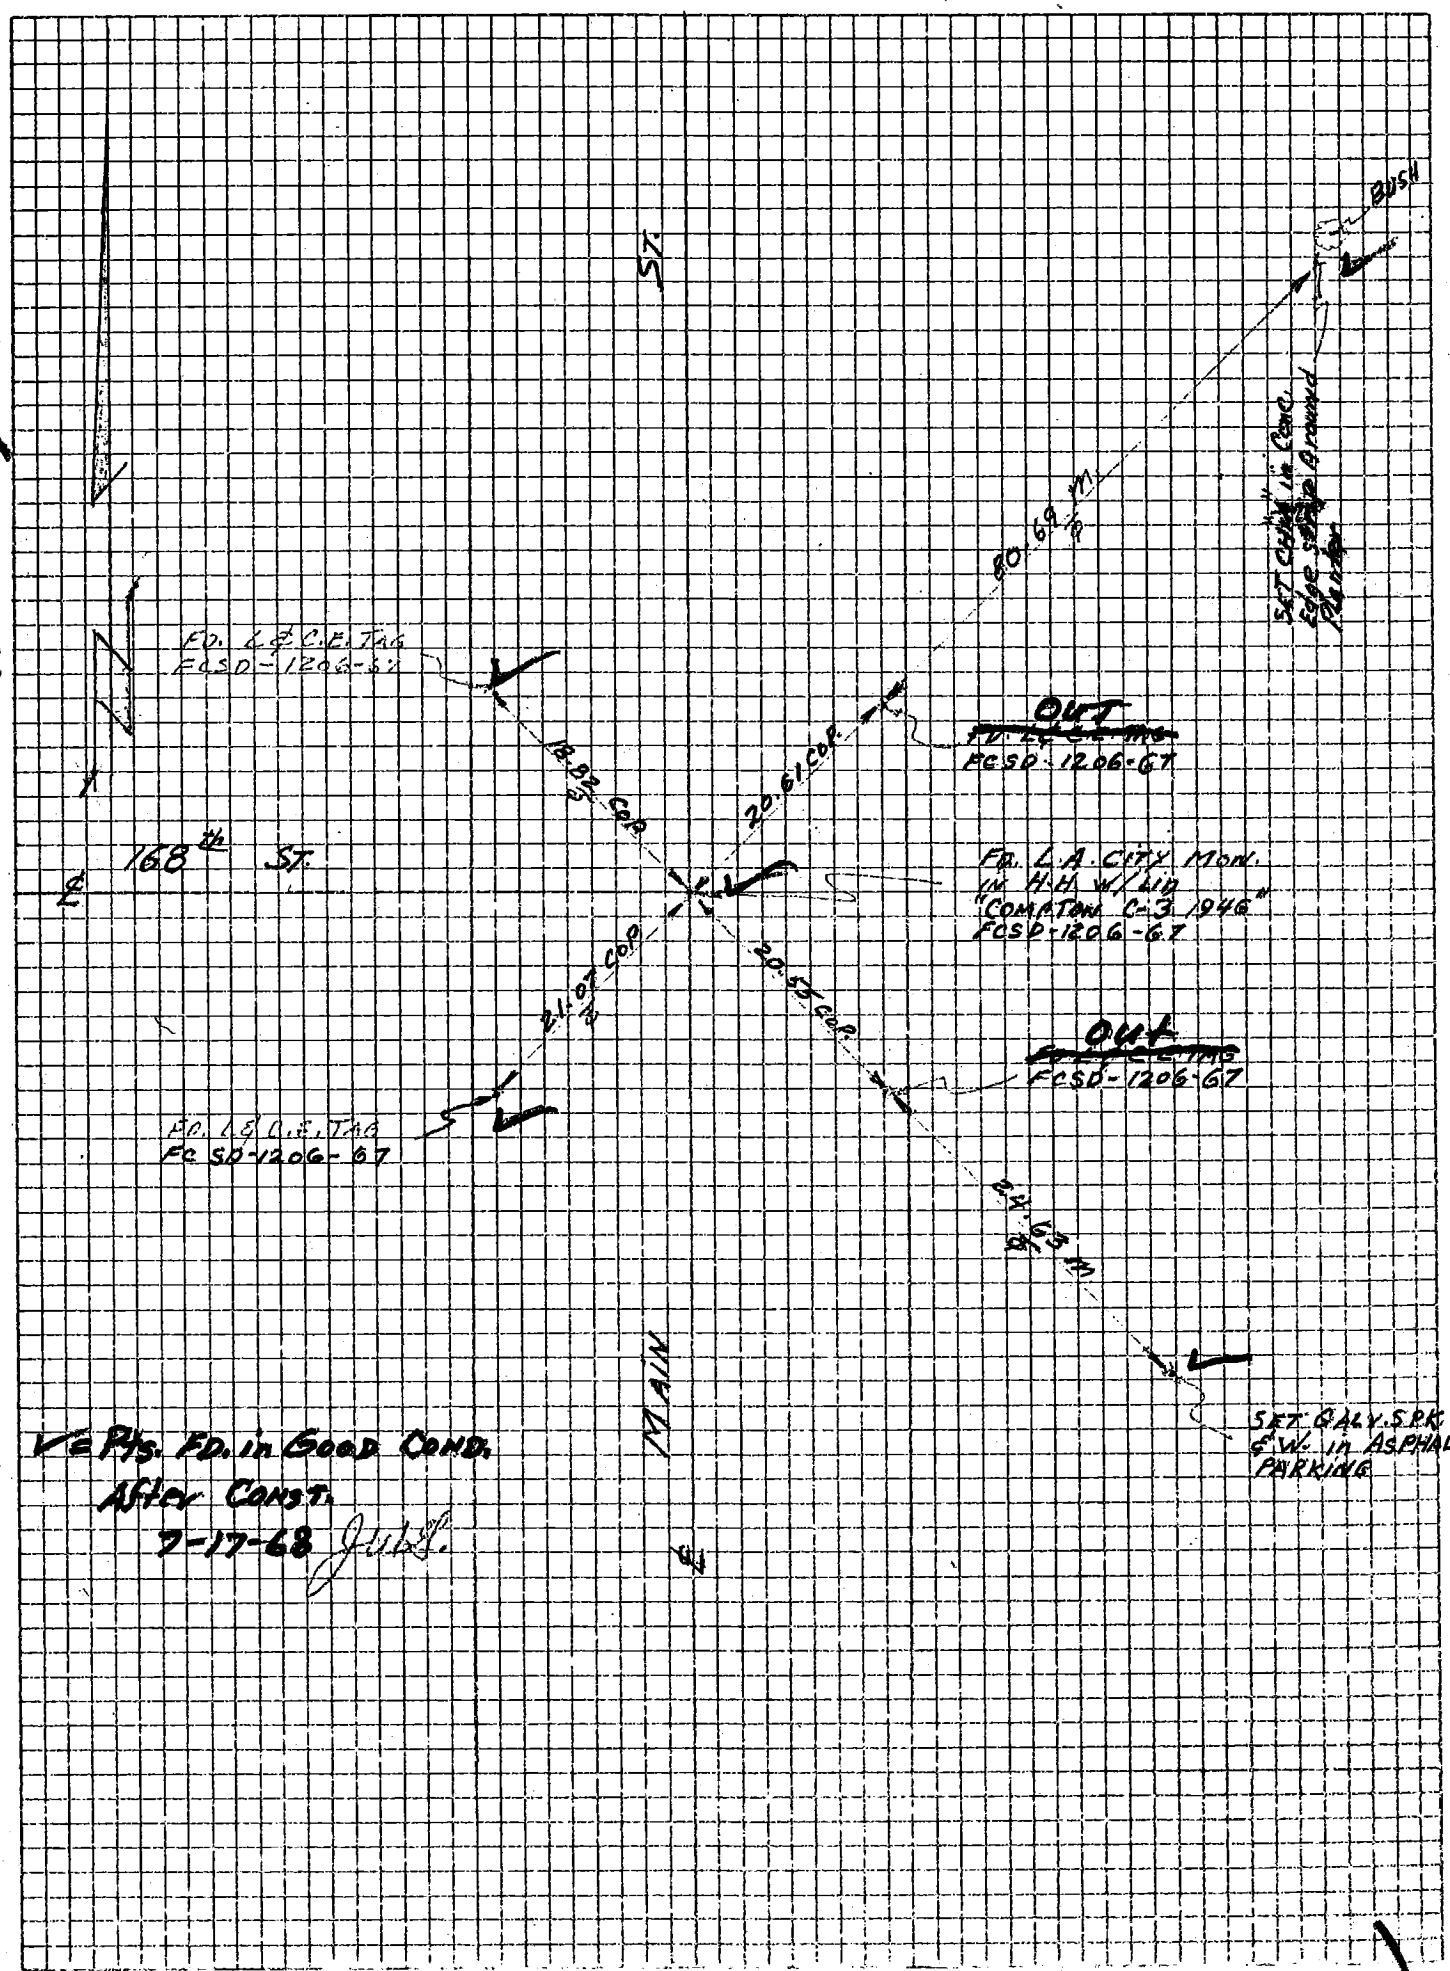


V = Pts. FD. in Good Cond. After Const.
7-17-68 J.W.G.

76S911- Cdb 5-71

PROJECT NORWALK S.D. 5950 LINE "A" Co. Engr. F.B. 3555: 67 INDEX FCSD5950 73

SURVEY BY J.A.V. DATE 11-13-72

REVIEWED BY [illegible] DATE 11-22-72

R.E.R.-1A

LOS ANGELES COUNTY FLOOD CONTROL DISTRICT

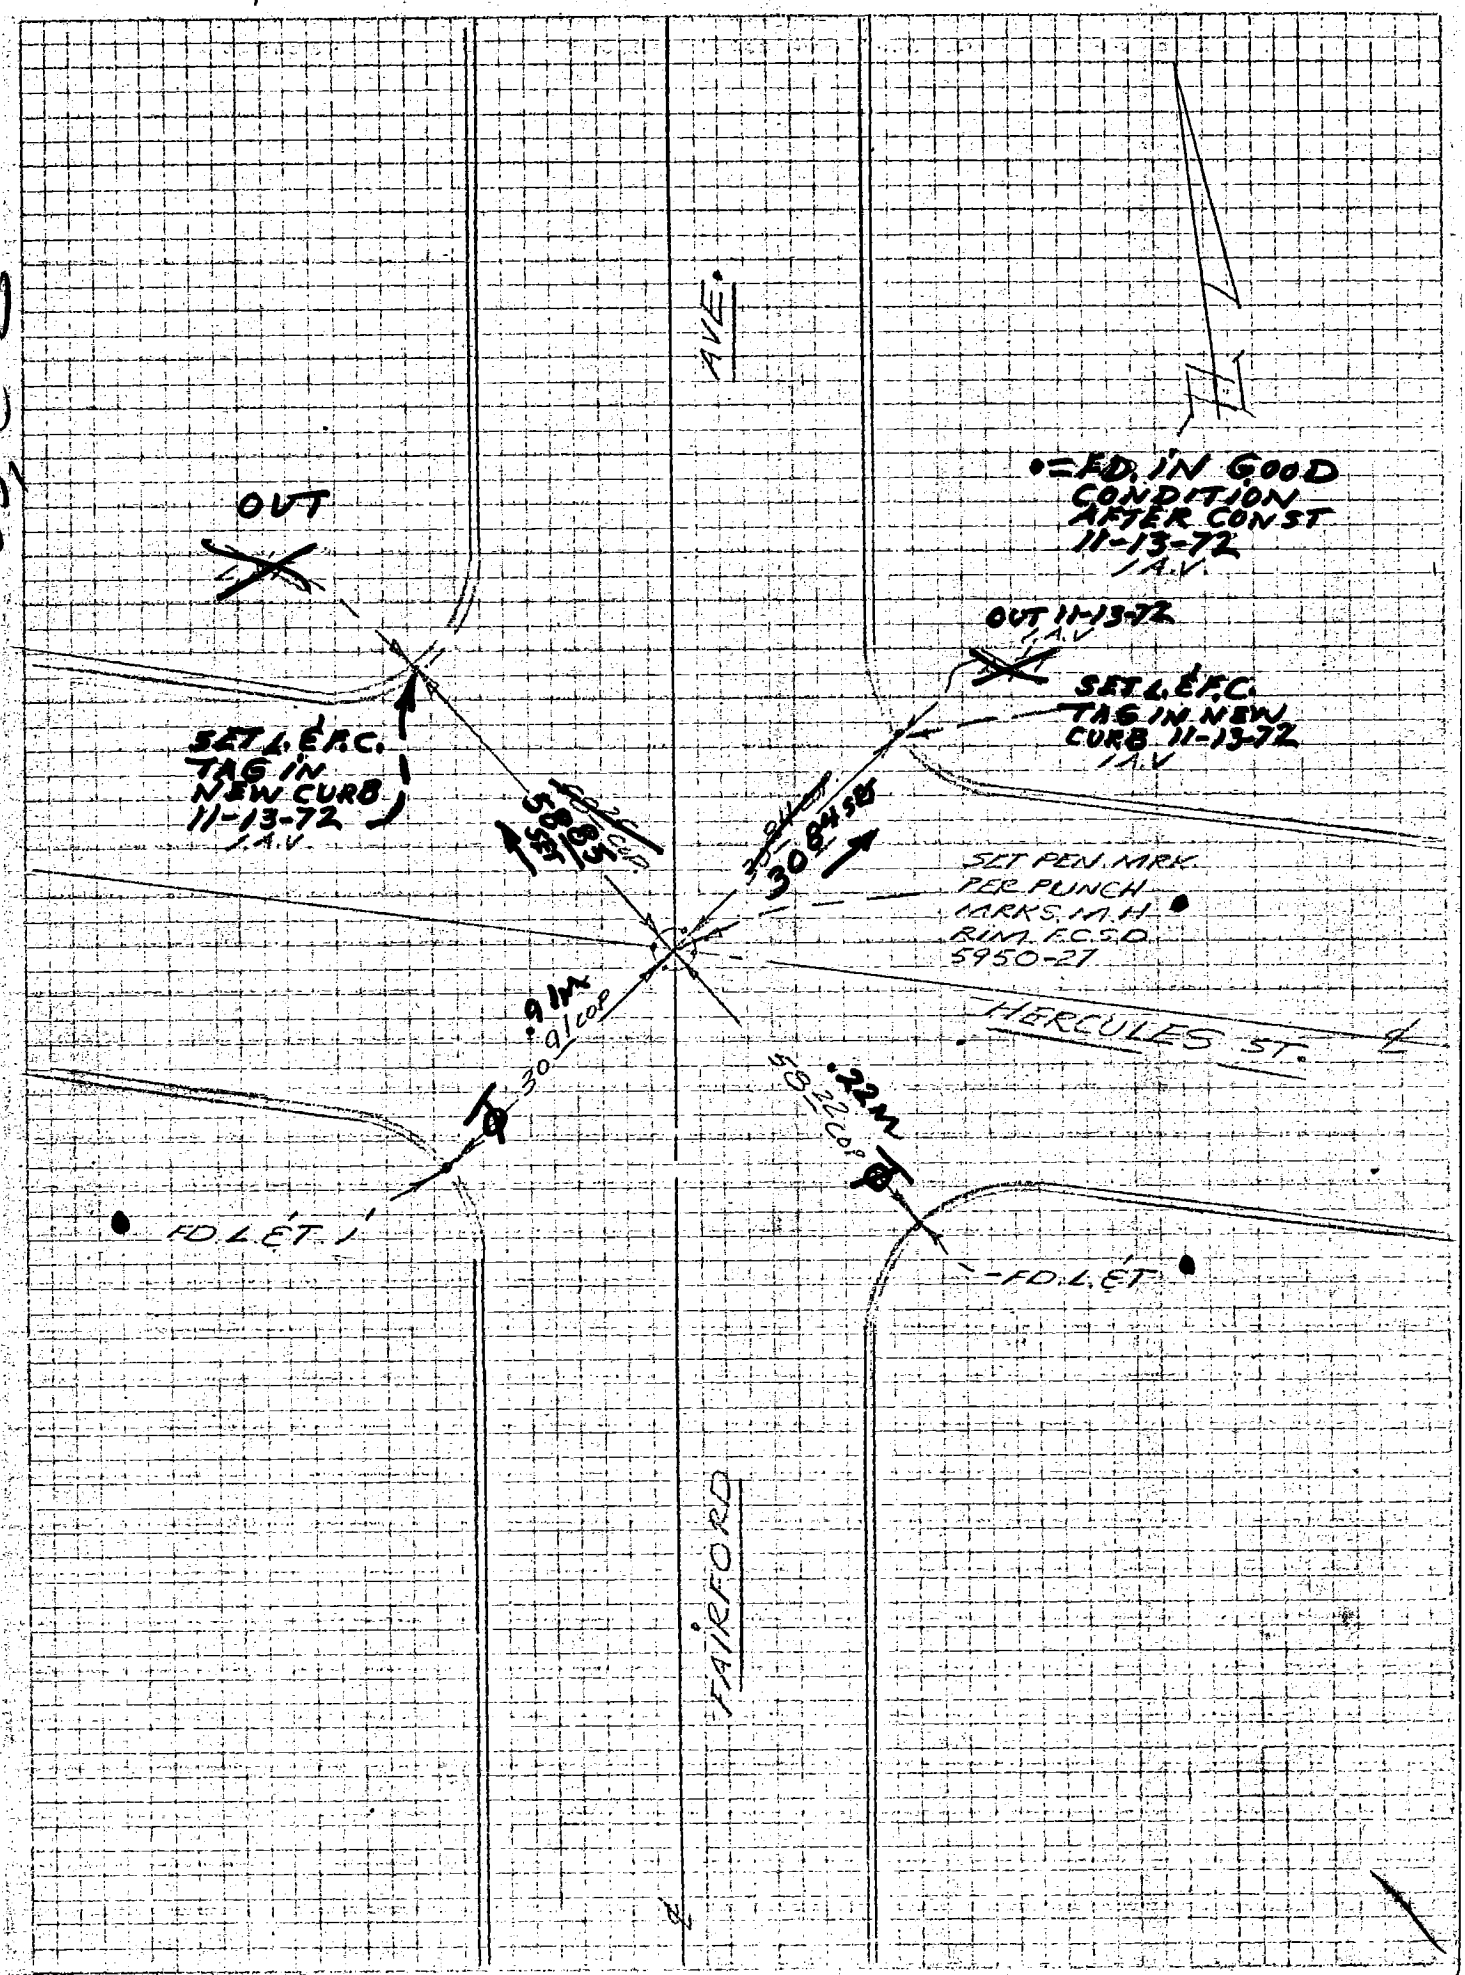

78S911— Cdb 3-69

PROJECT NORWALK S.D. #5950 LINE "A"

SURVEY BY L.A.V. DATE 4-3-72

REVIEWED BY [signature] DATE 4-11-72

Co. Engr. F.B. 3555: 68

INDEX FCSD5950 '75

R, ÉR-3

LOS ANGELES COUNTY FLOOD CONTROL DISTRICT

W. S. 3 C-2

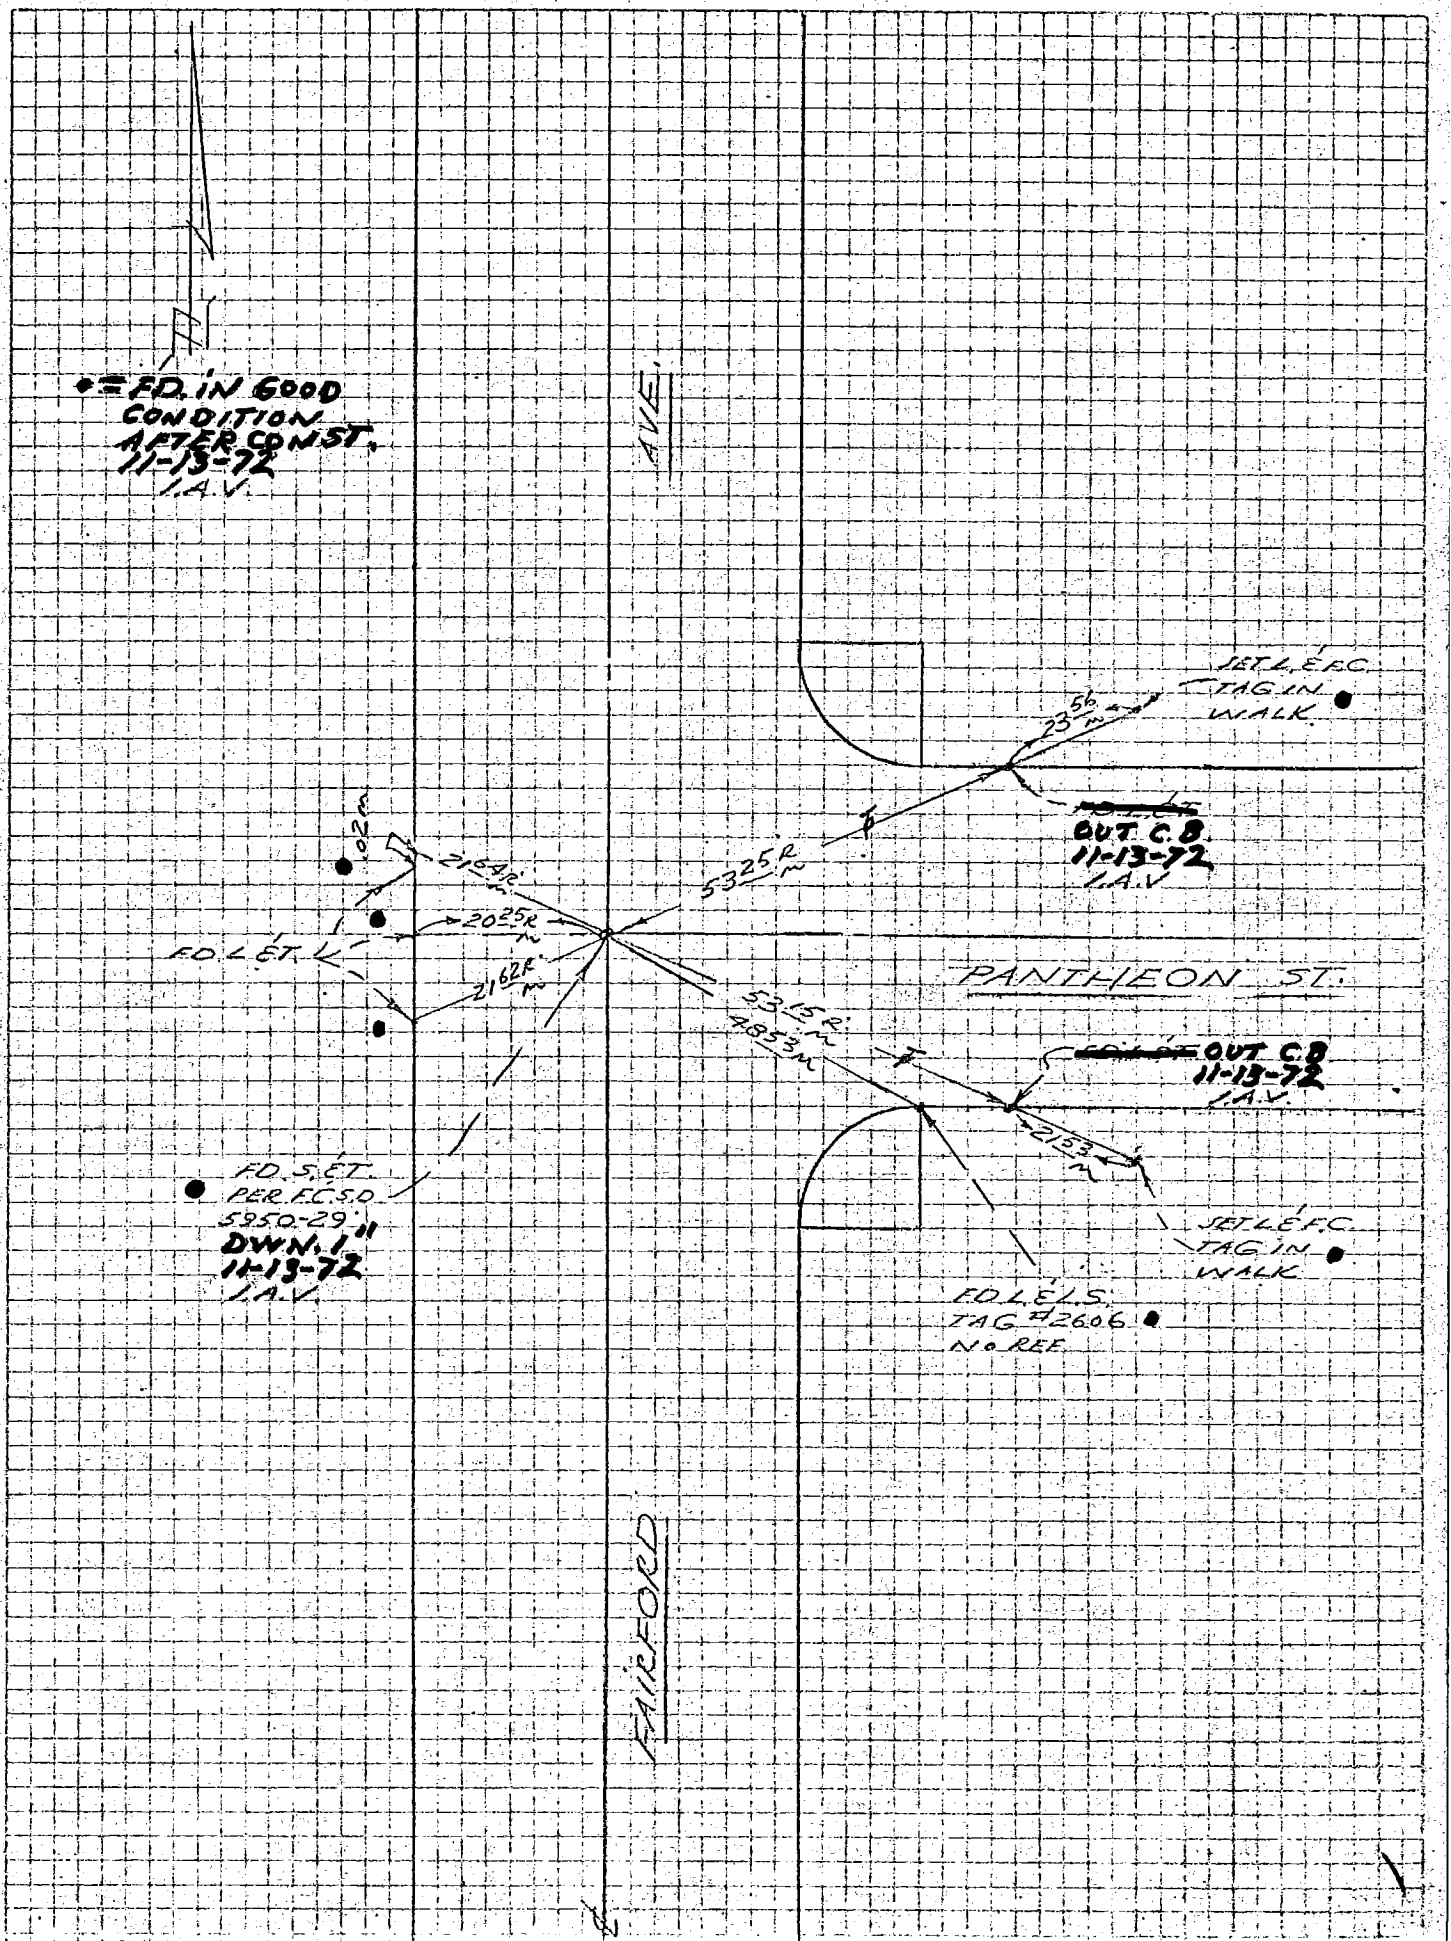

76S911– Cdb 5–71

Co. Engr. F.B. 3555: 69

PROJECT NORWALK S.D. #5950 LINE "A"

INDEX FCSD5350 '77

SURVEY BY I.A.V. DATE 11-13-72

REVIEWED BY [illegible] DATE 11-22-72

R.E.R. 3A

LOS ANGELES COUNTY FLOOD CONTROL DISTRICT

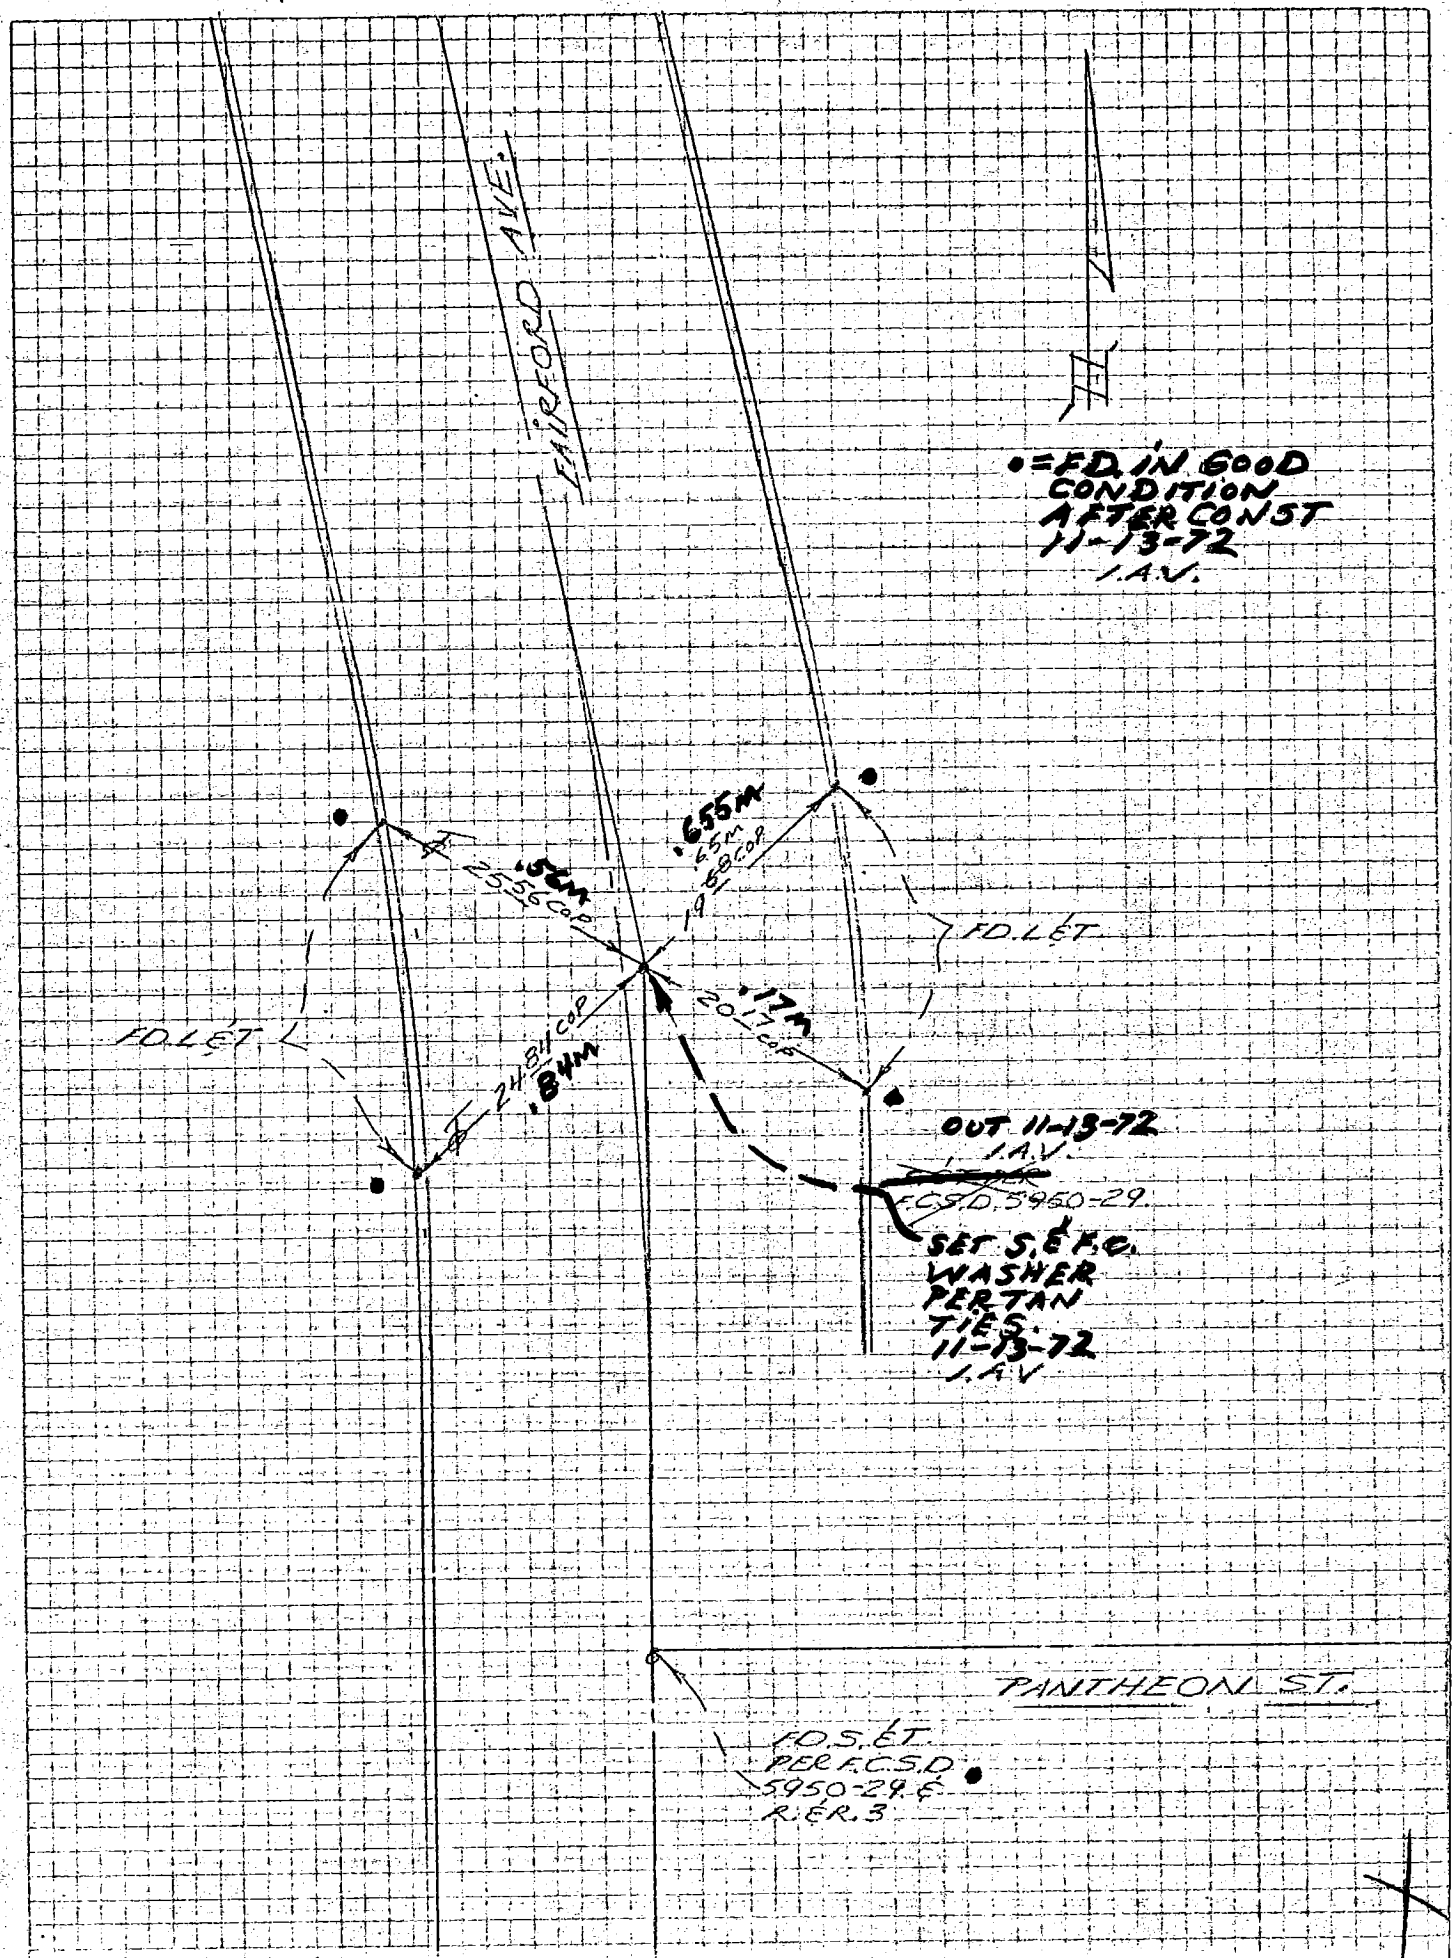

768911-- Cdb 3-69

PROJECT NORWALK S.D. #5950 LINE "A" Co. Engr. F.B. 3555: 70 INDEX FCSD5950 '79

SURVEY BY I.A.V. DATE 4-3-72

REVIEWED BY [signature] DATE 7-11-72

R.E.R-5

LOS ANGELES COUNTY FLOOD CONTROL DISTRICT

W.5331, C-2

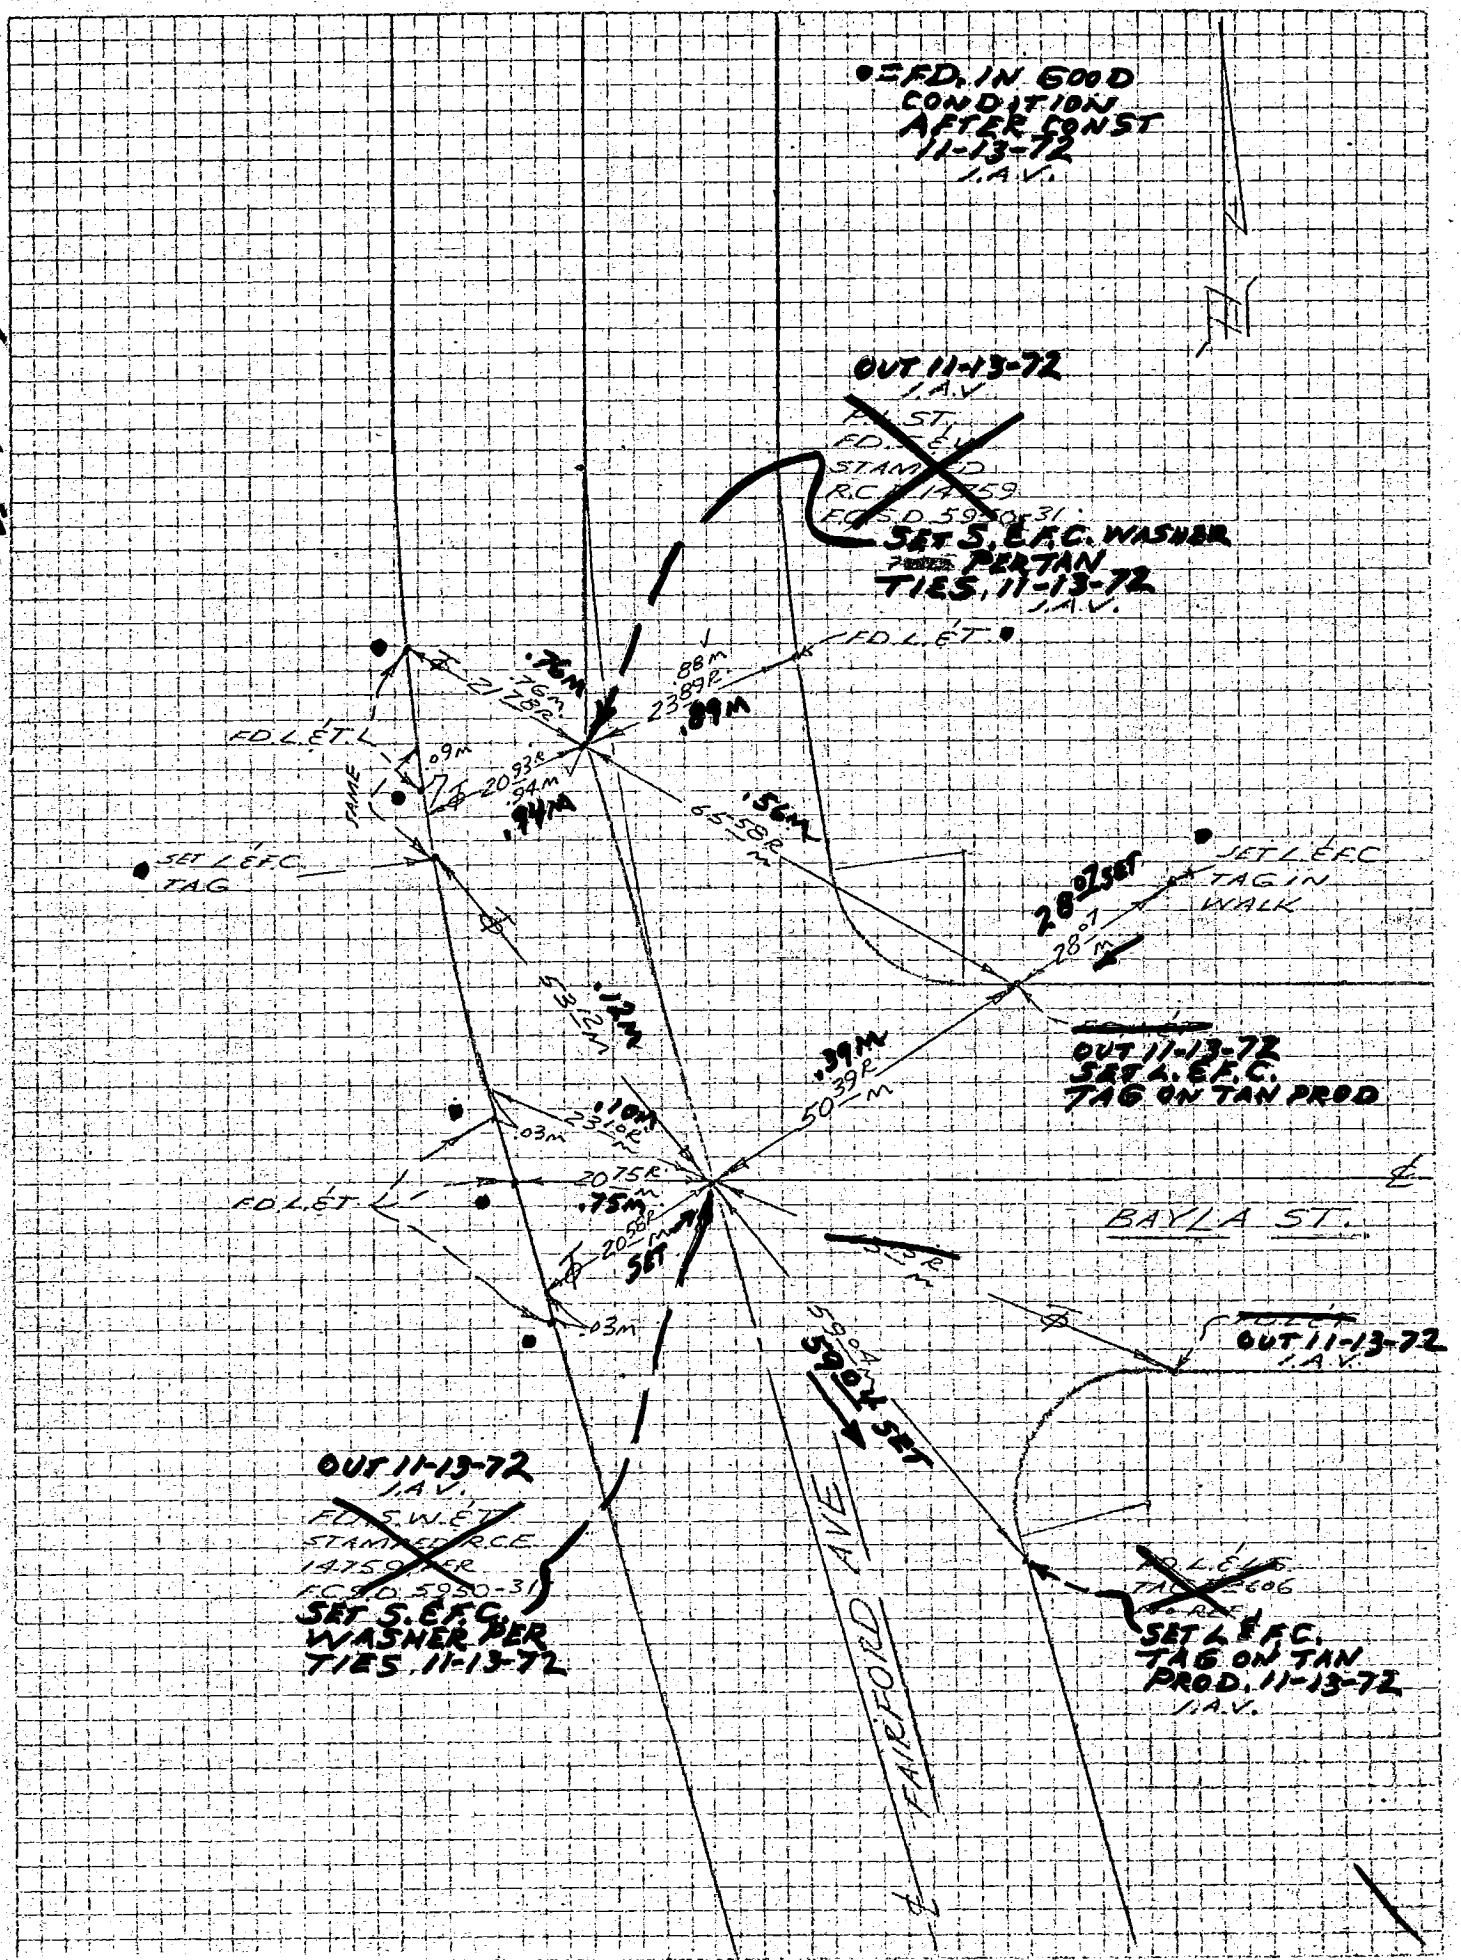

76S911– Cdb 3-69

Co. Engr. F.B. 3555: 71

PROJECT NORWALK S.D. #5950 LINE "A"

INDEX FCSD5950 81

SURVEY BY J.A.V. DATE 4-3-72

REVIEWED BY DATE 4-11-72

R, E R-7

LOS ANGELES COUNTY FLOOD CONTROL DISTRICT

W.S. 33 C-2

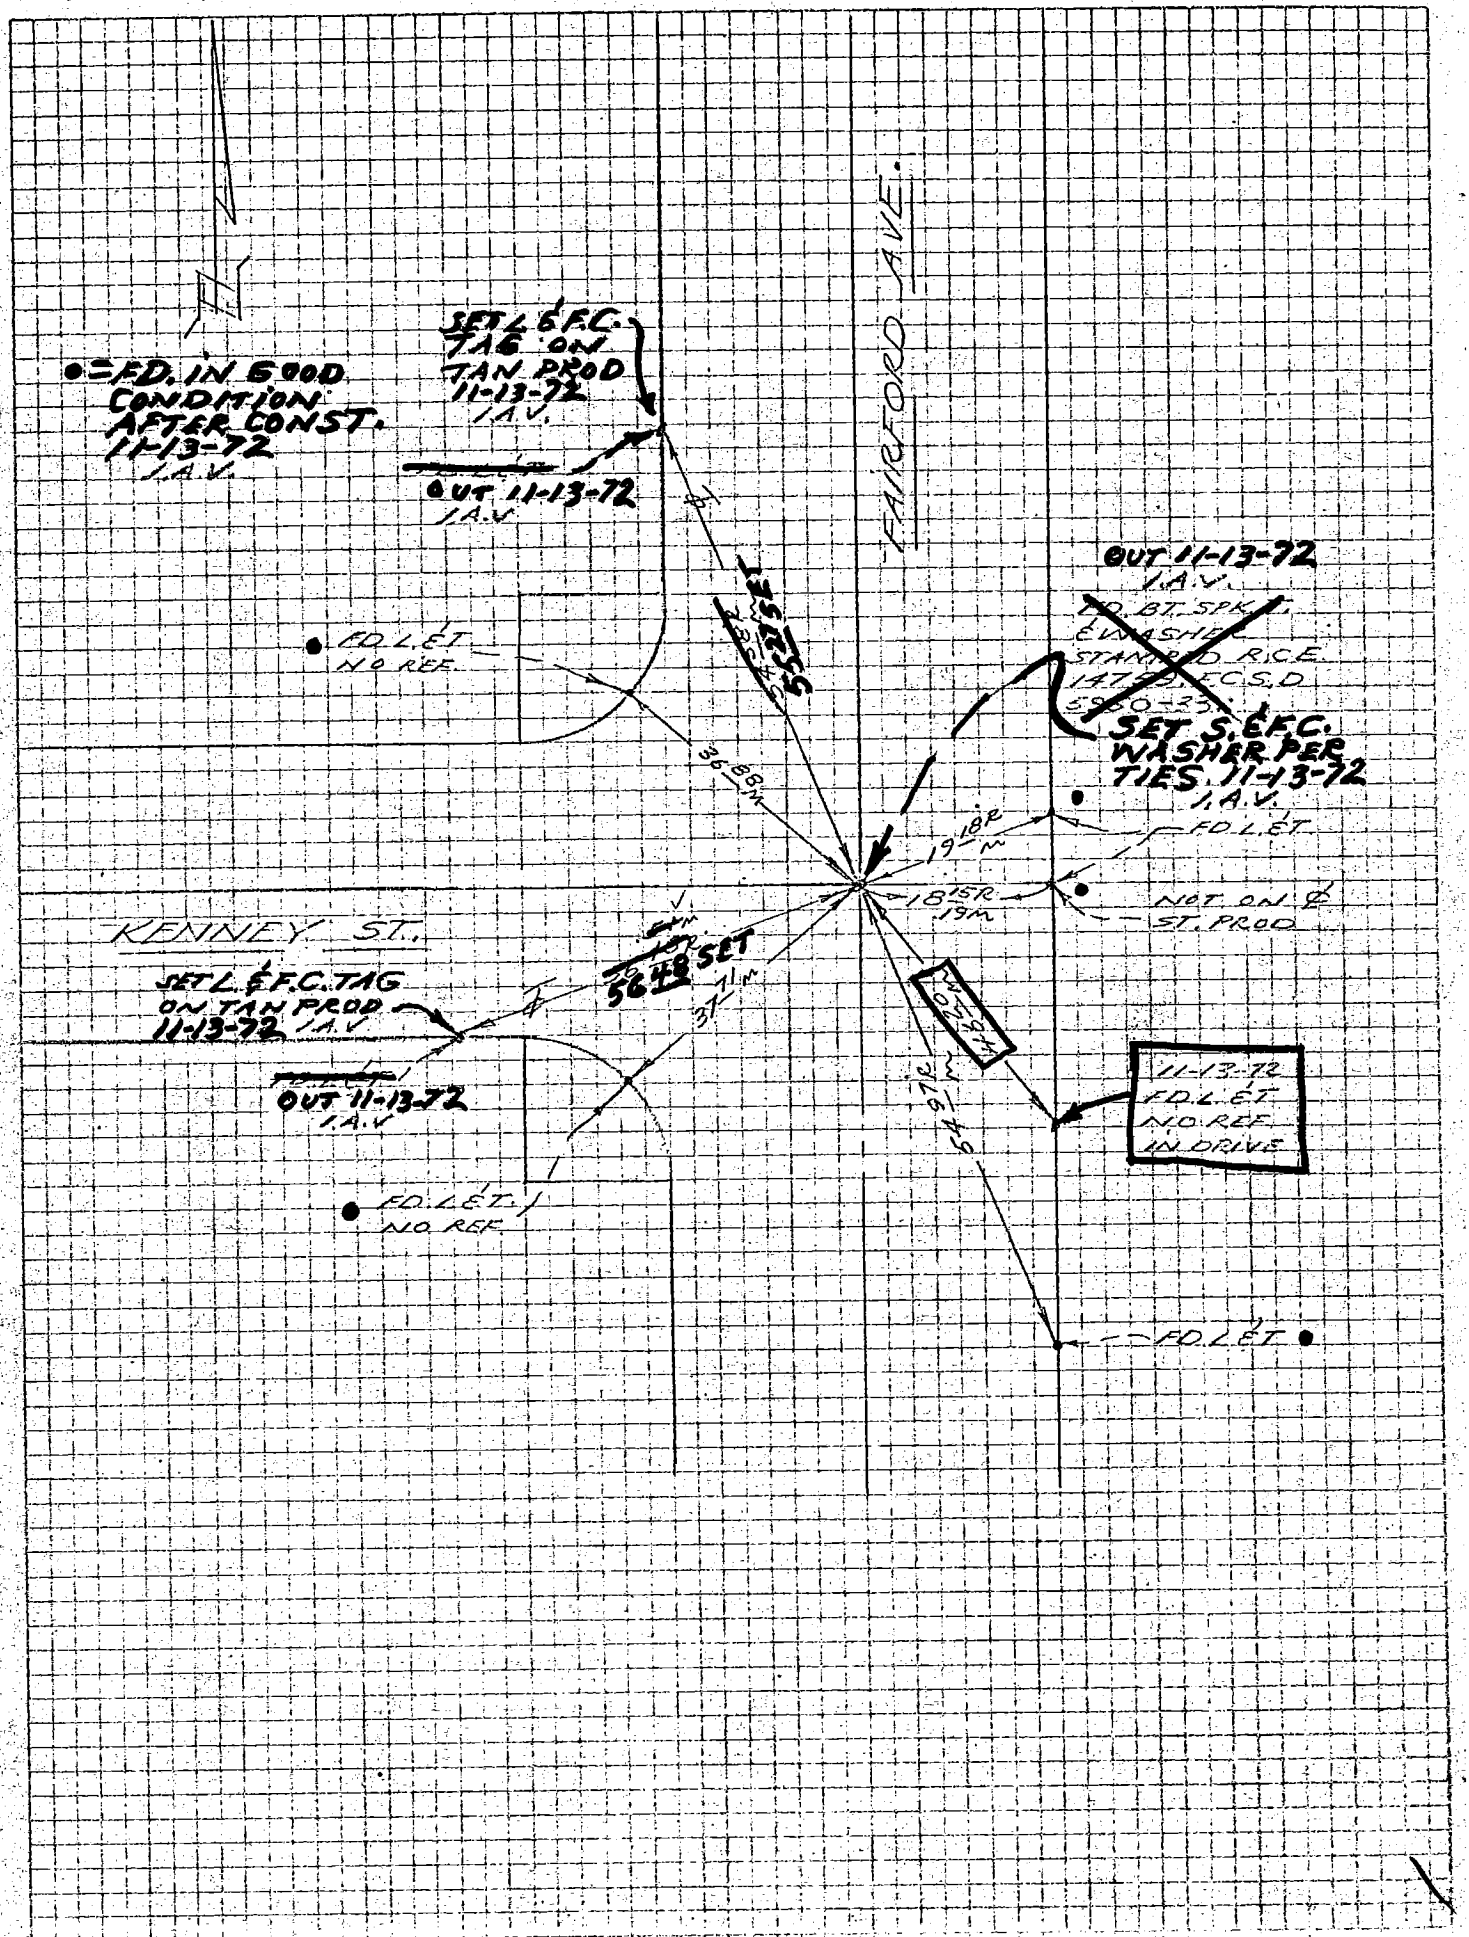

76S911- Cdb 5-71

Co. Engr. F.B. 3555: 72

PROJECT NORWALK SD #5950 LINE "A"

INDEX FCSD5950 83

SURVEY BY G.A.V. DATE 11-13-72

REVIEWED BY AD DATE 11-22-72

R.E.R-7A

LOS ANGELES COUNTY FLOOD CONTROL DISTRICT

MS.35 C-2

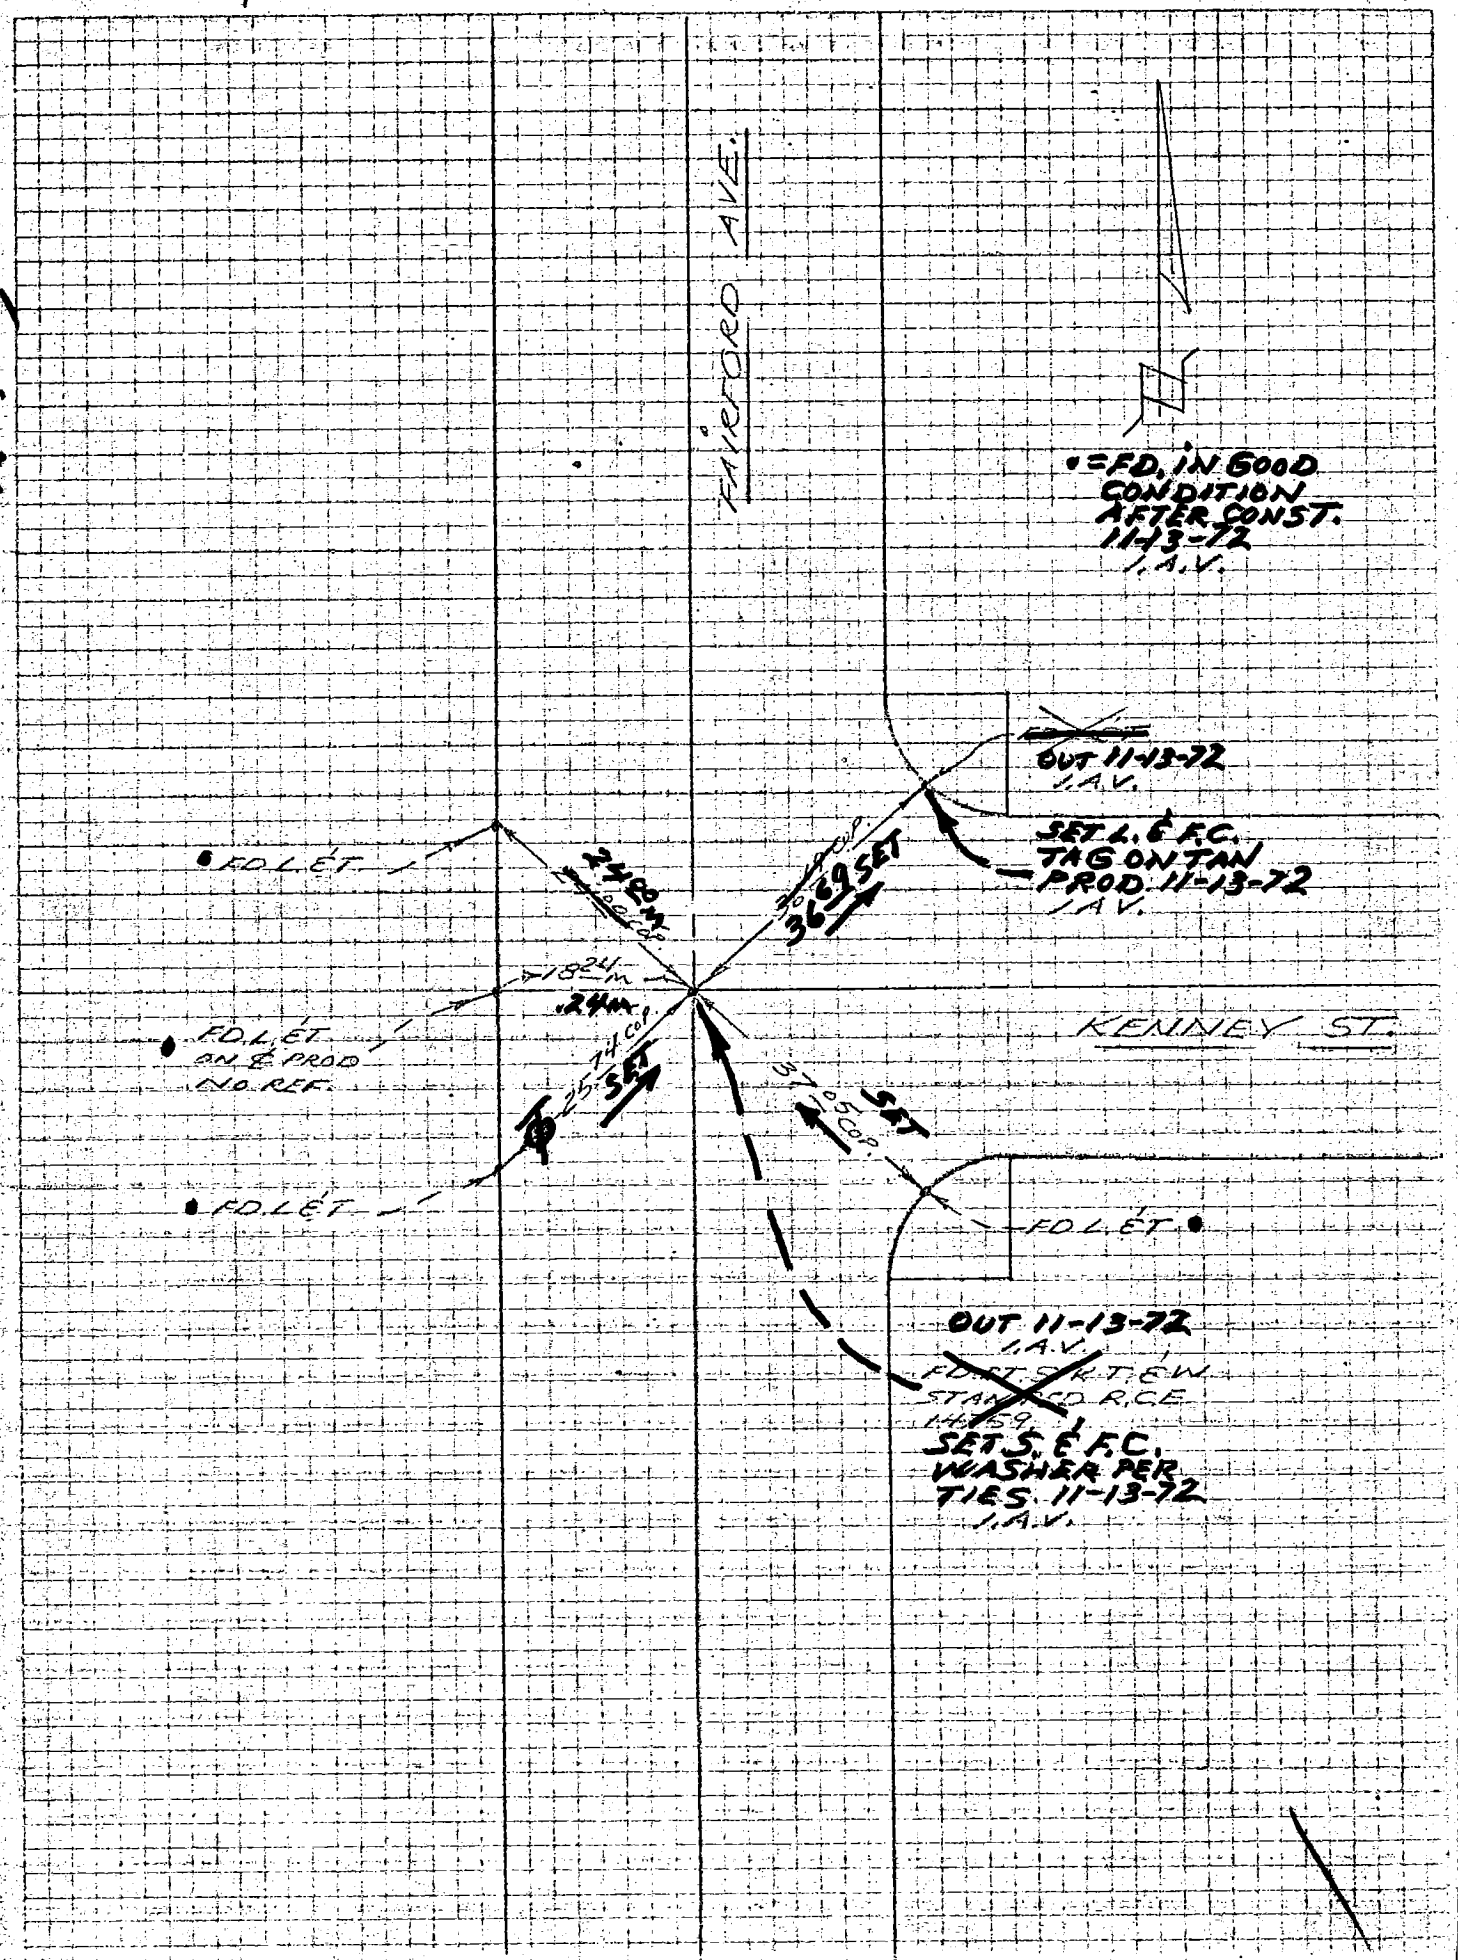

76S911– Cdb 5-71

PROJECT NORWALK SD #5950 LINE "A"

SURVEY BY IAV DATE 11-13-72

REVIEWED BY AD DATE 11-22-72

Co. Engr. F.B. 3555: 73

INDEX FCSD5950 85

R.ER 7B

LOS ANGELES COUNTY FLOOD CONTROL DISTRICT

W 5,33, C-2

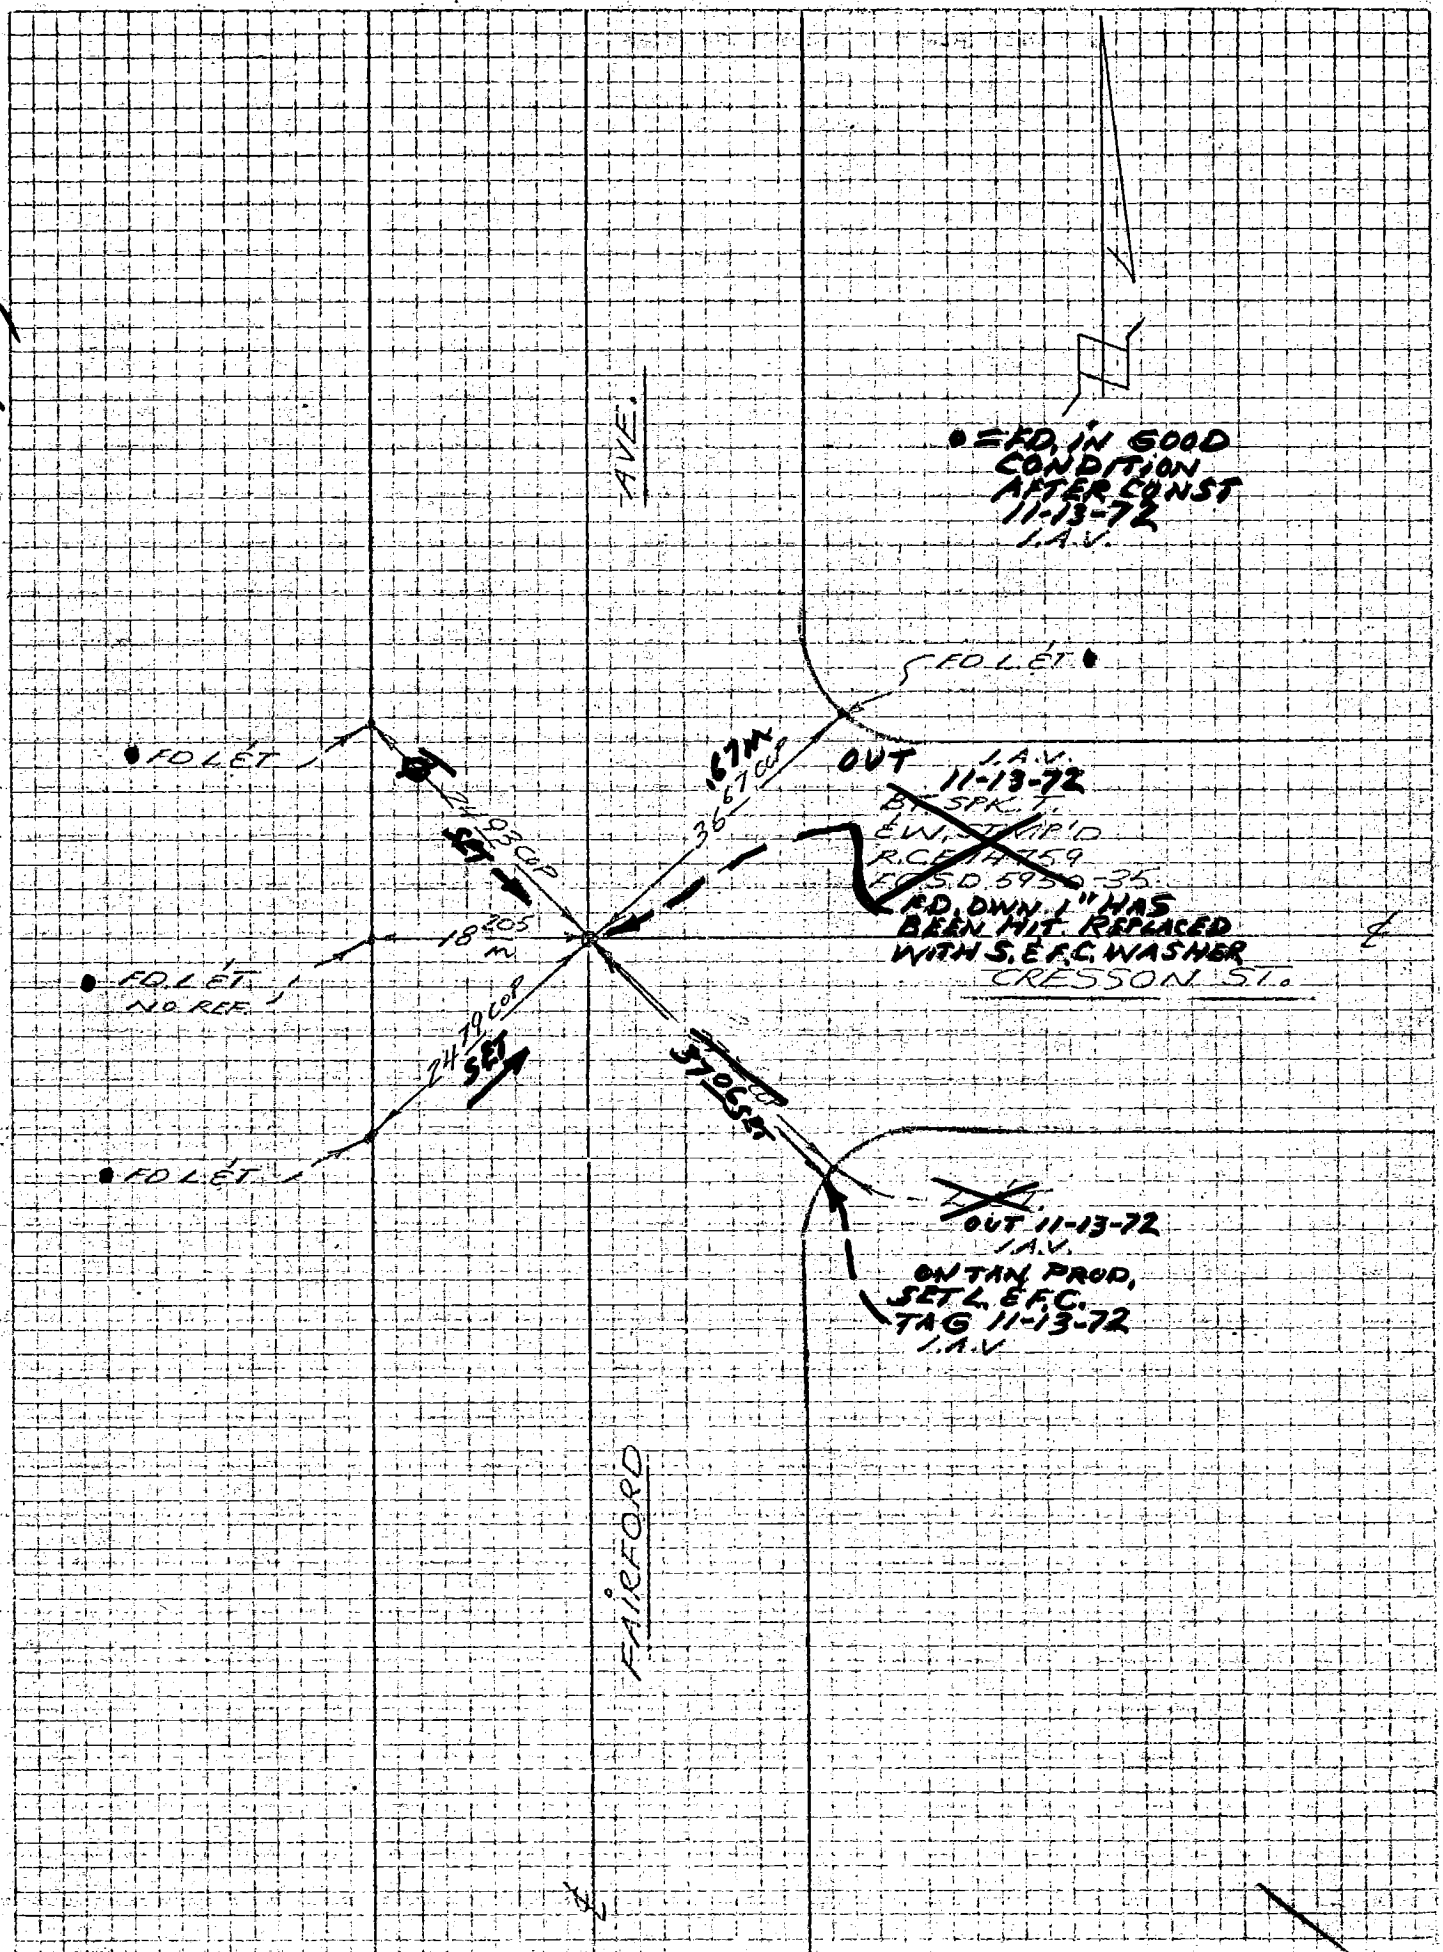

76S911– Cdb 3-69

PROJECT NORWALK SD #5950 LINE "A" Co. Engr. F.B. 3555: 74 INDEX FCSD5950 87

SURVEY BY LAV DATE 4-4-72

REVIEWED BY AJ DATE 4-11-72

R.E&R-9

LOS ANGELES COUNTY FLOOD CONTROL DISTRICT

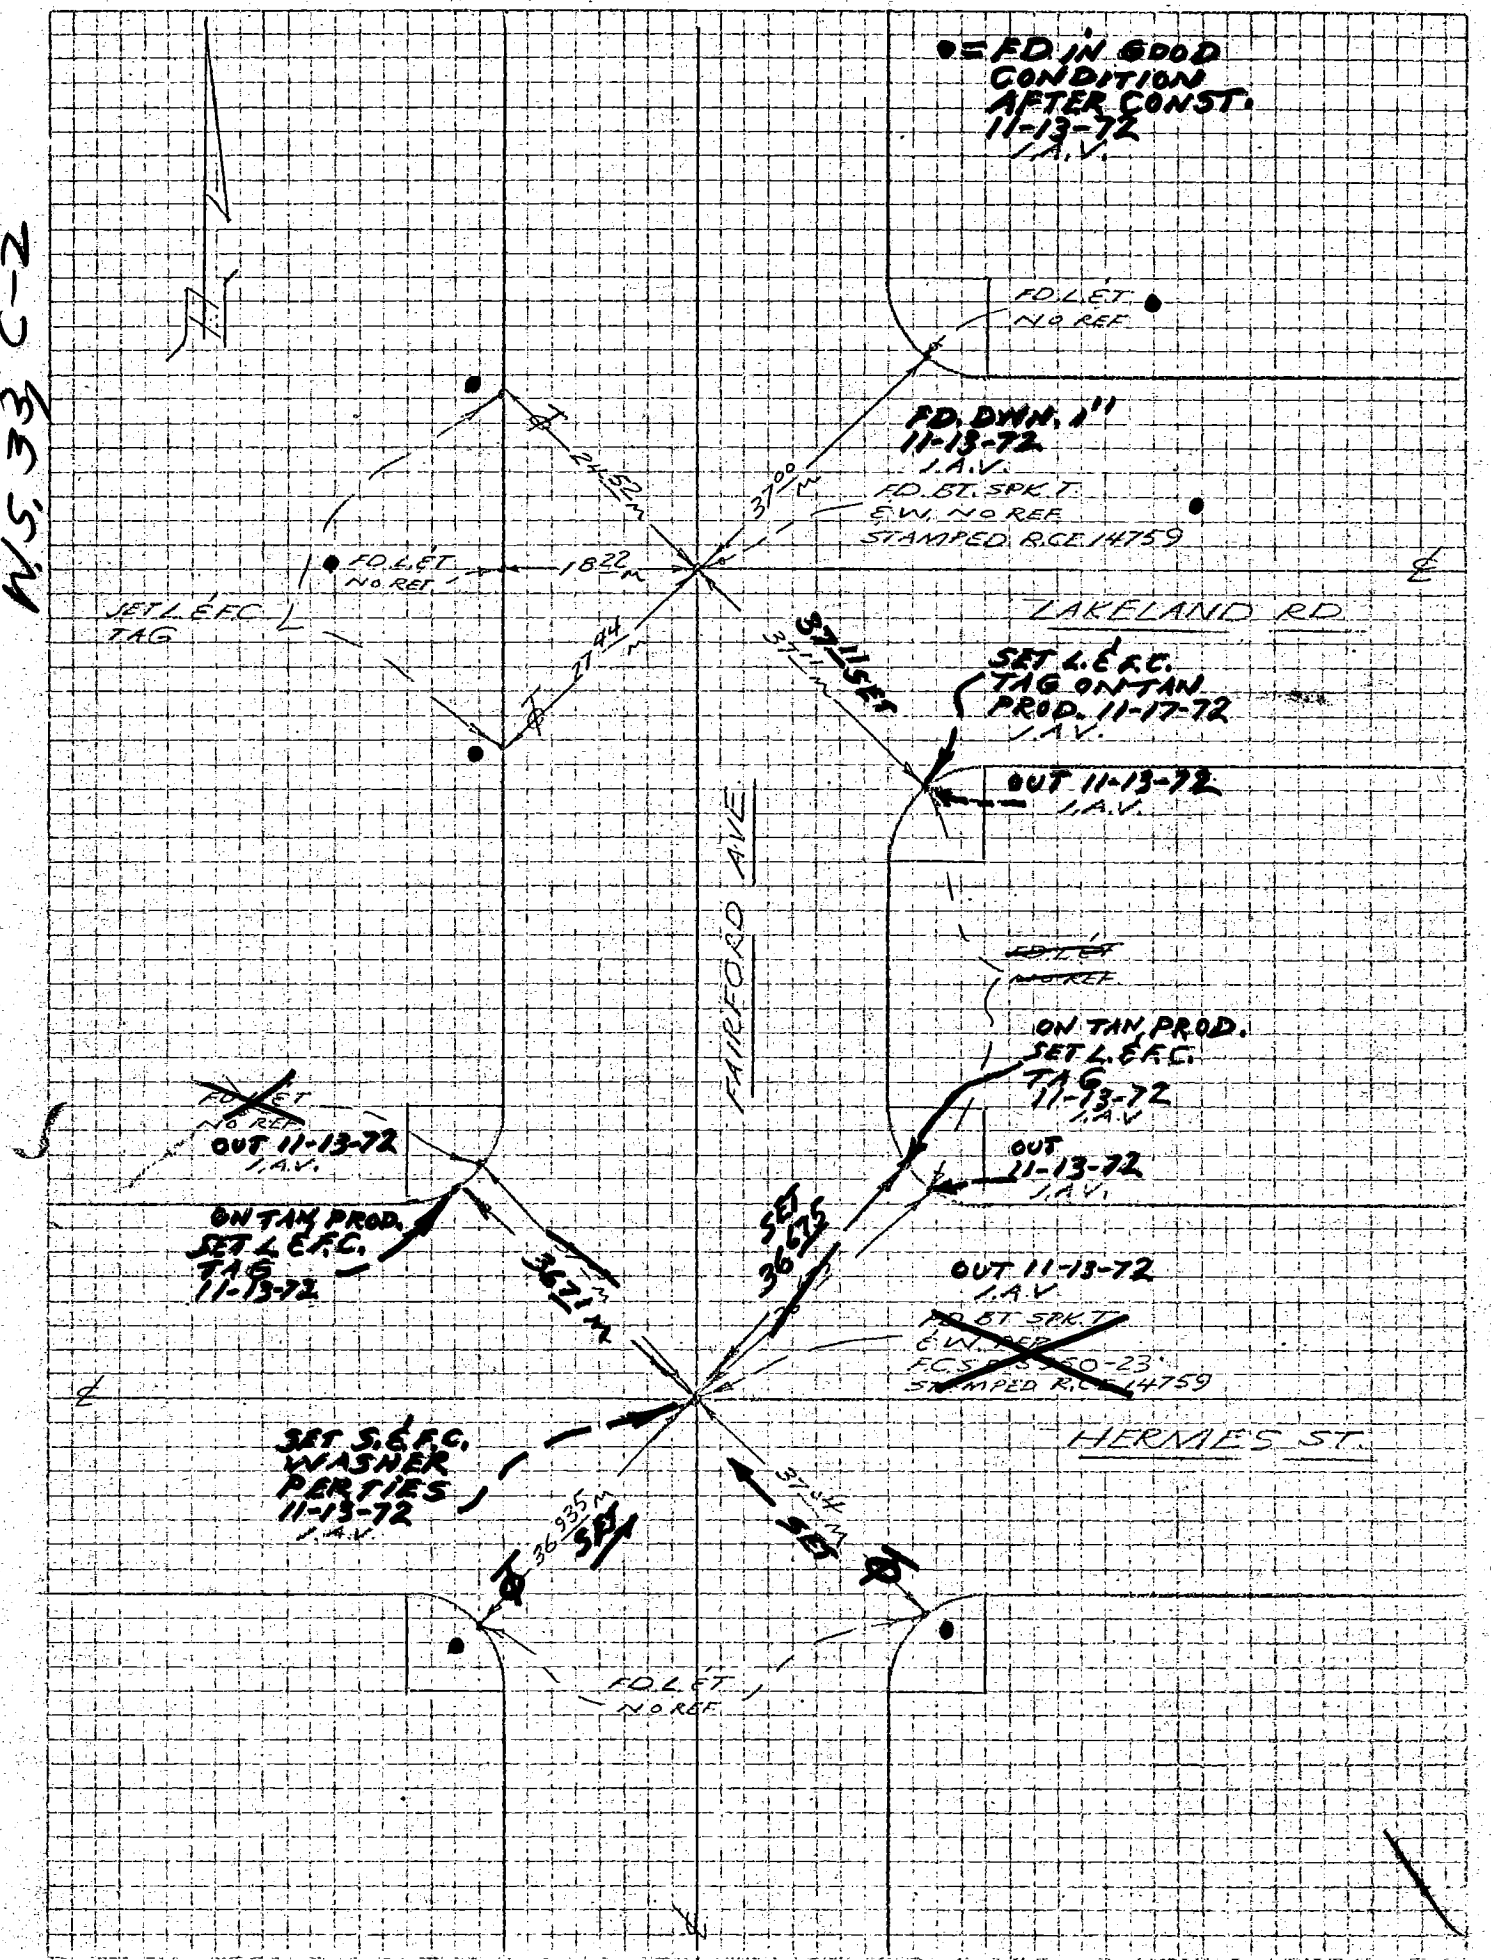

76S911- Cdb 3-69

PROJECT NORWALK S.D #5950 LINE "A" Co. Engr. F.B. 3555: 75 INDEX FCSD5950 89

SURVEY BY J.A.V. DATE 4-4-72

REVIEWED BY [illegible] DATE 4-11-72

R.E.R-11

LOS ANGELES COUNTY FLOOD CONTROL DISTRICT

WP 33, C-2

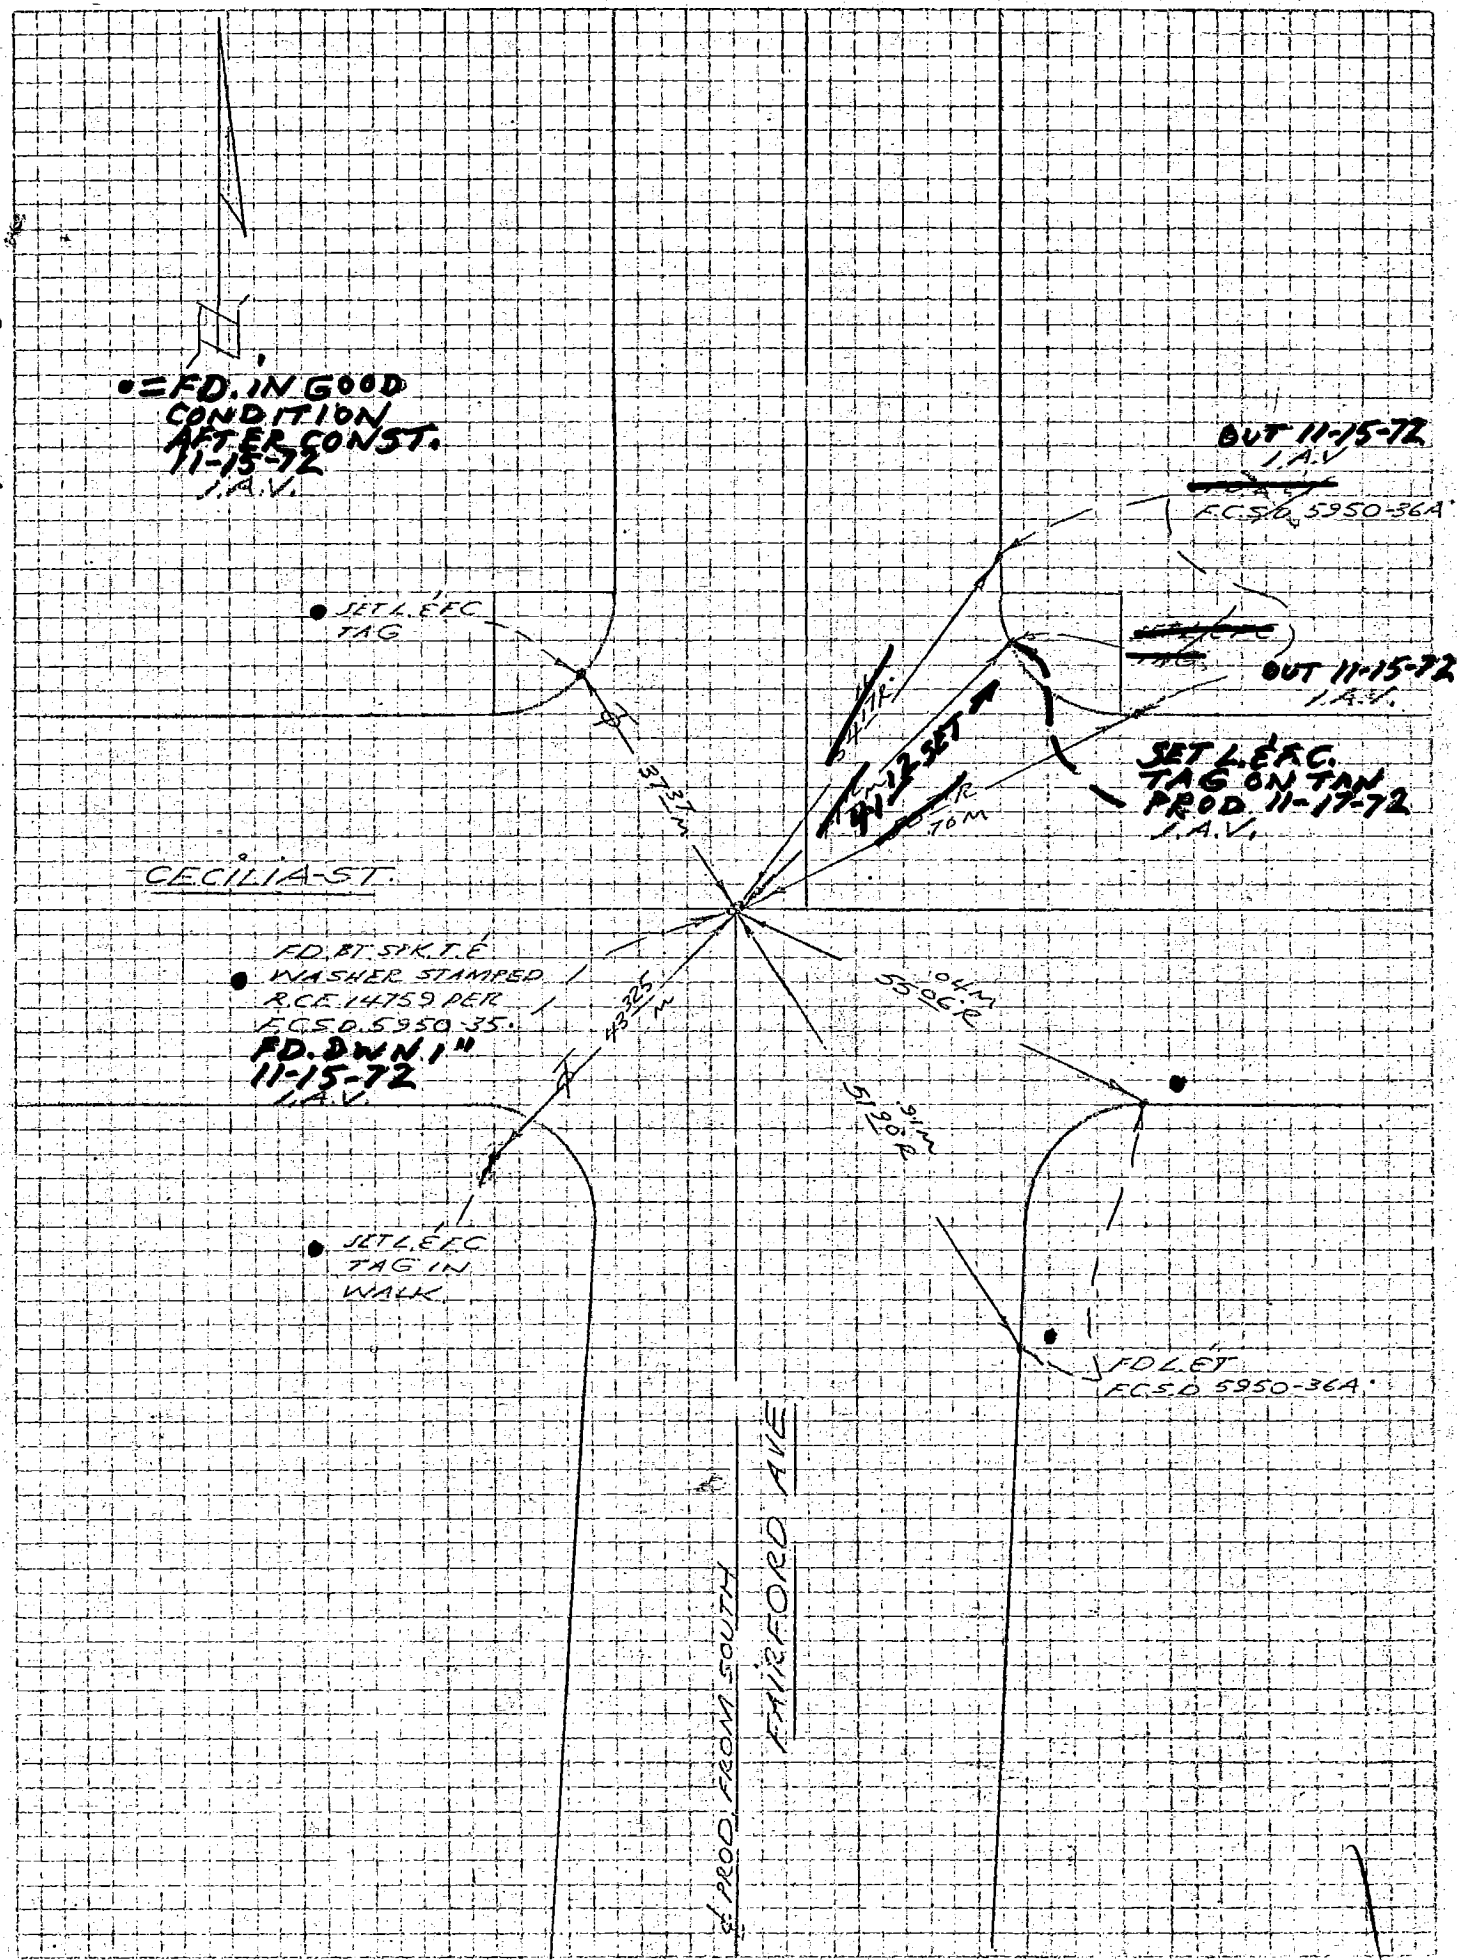

76S911– Cdb 5–71

PROJECT NORWALK SD #5950 LINE "B" Co. Engr. F.B. 3555: 76 INDEX FCSD5950 93

SURVEY BY J.A.V. DATE 11-13-72 R.E.R. 3

REVIEWED BY [illegible] DATE 11-22-72

LOS ANGELES COUNTY FLOOD CONTROL DISTRICT

WS 31 04

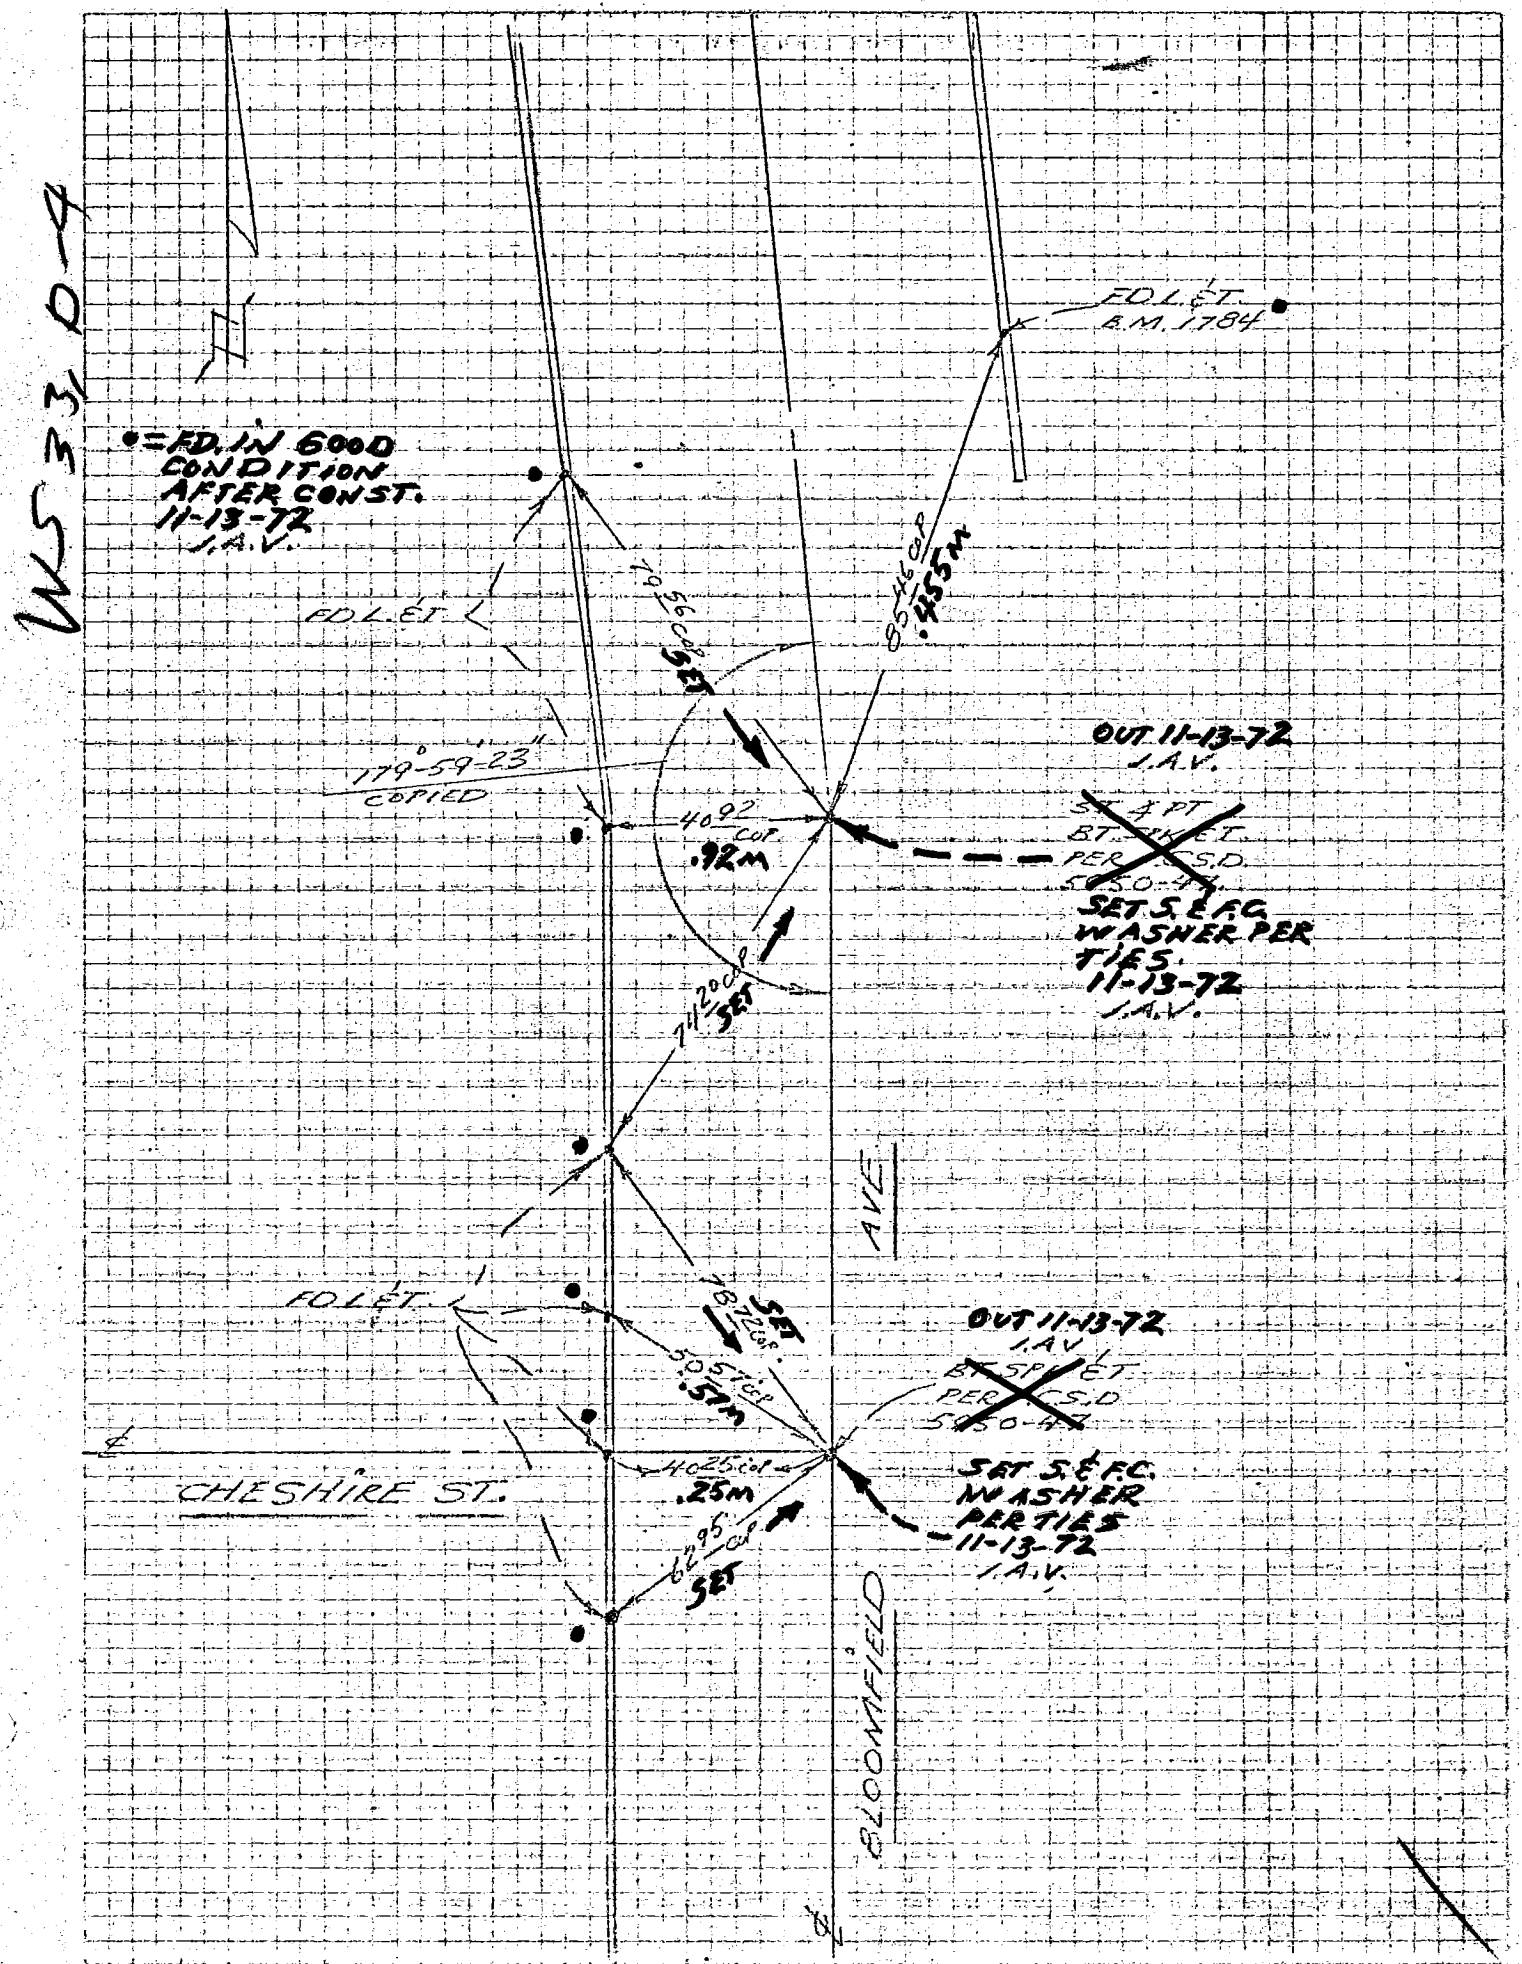

76S911– Cdb 5–71

Co. Engr. F.B. 3555: 77
FCSD5950 '97

PROJECT NORWALK S.D #5950 LINE "B"
INDEX R.E.R.-7

SURVEY BY J.A.V. DATE 11-13-72

REVIEWED BY [illegible] DATE 11-22-72

LOS ANGELES COUNTY FLOOD CONTROL DISTRICT

WS33 31 D-4

•=FD. IN GOOD CONDITION AFTER CONST. 11-13-72 J.A.V.

AVE.

• FD L&T — J.A.V.

OUT 11-13-72 PER F.C.S.D. 5950-49.

SET 5/8" REG. WASHER PER TIES 11-13-72 J.A.V.







BLOOMFIELD

768911– Cdb 3-69

Co. Engr. F.B. 3555: 78

PROJECT NORWALK S.D. #5950 LINE "C"

INDEX FCSD5950 101

SURVEY BY J.A.V. DATE 4-11-72

REVIEWED BY [signature] DATE 4-13-72

R.E.R.-3

LOS ANGELES COUNTY FLOOD CONTROL DISTRICT

WS 33, B-3

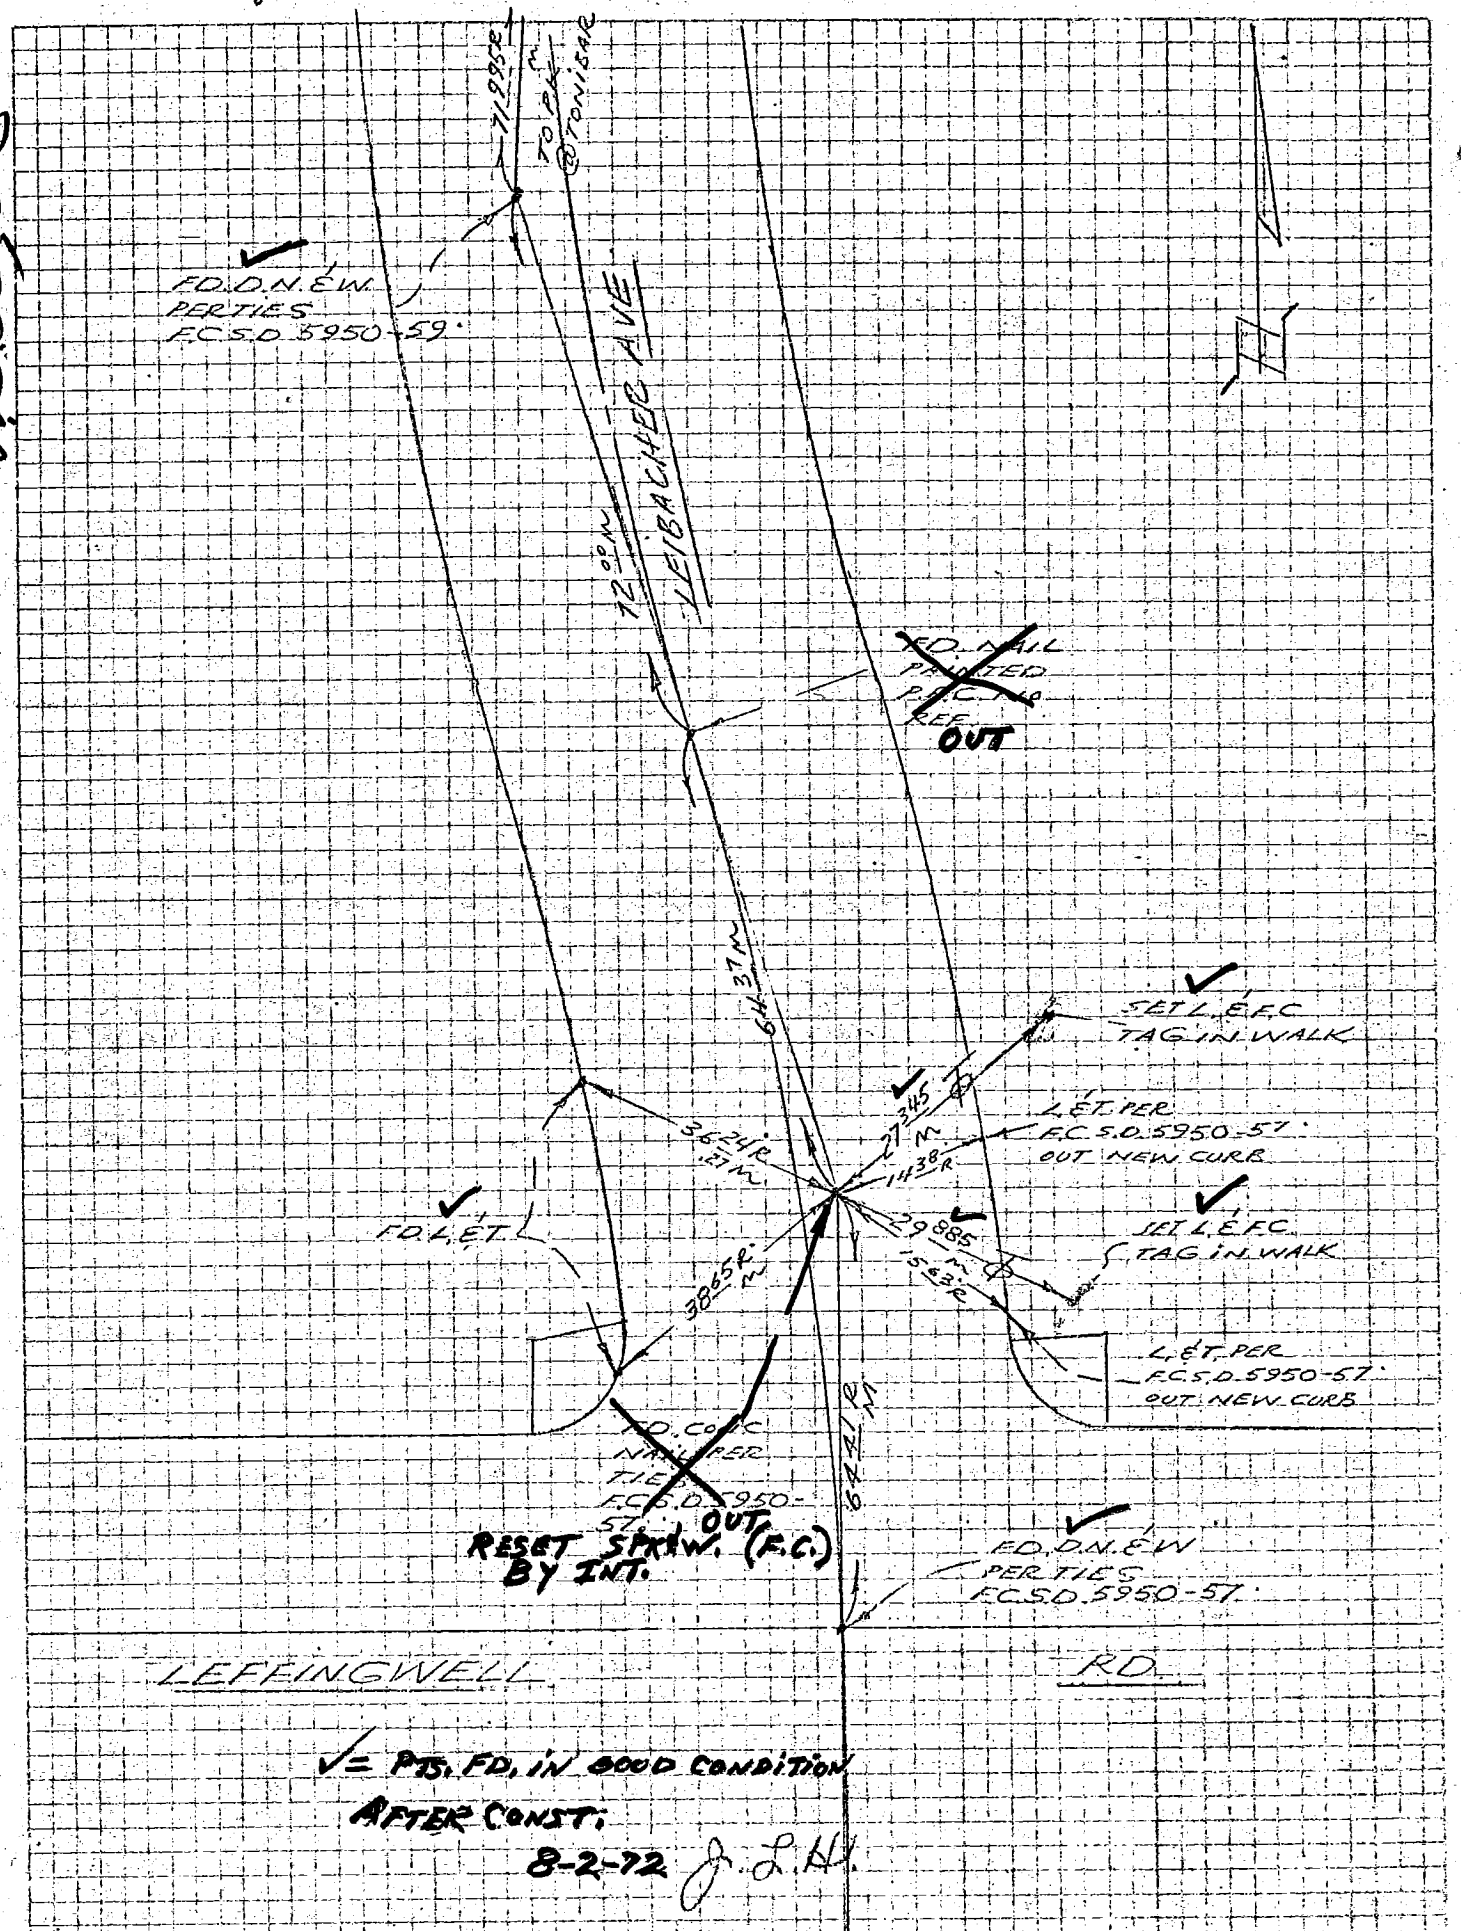


✓ = PTS. FD. IN GOOD CONDITION AFTER CONST.

8-2-72 J.A.V.

76S911- Cdb 5-71

PROJECT NORWALK S.D. #5950 LINE "C" Co. Engr. F.B. 3555: 79 INDEX FCSD5950 103

SURVEY BY LAV DATE 11-28-72

REVIEWED BY [illegible] DATE 12-4-72

R.ÉR-5

LOS ANGELES COUNTY FLOOD CONTROL DISTRICT

WS 33, B-3

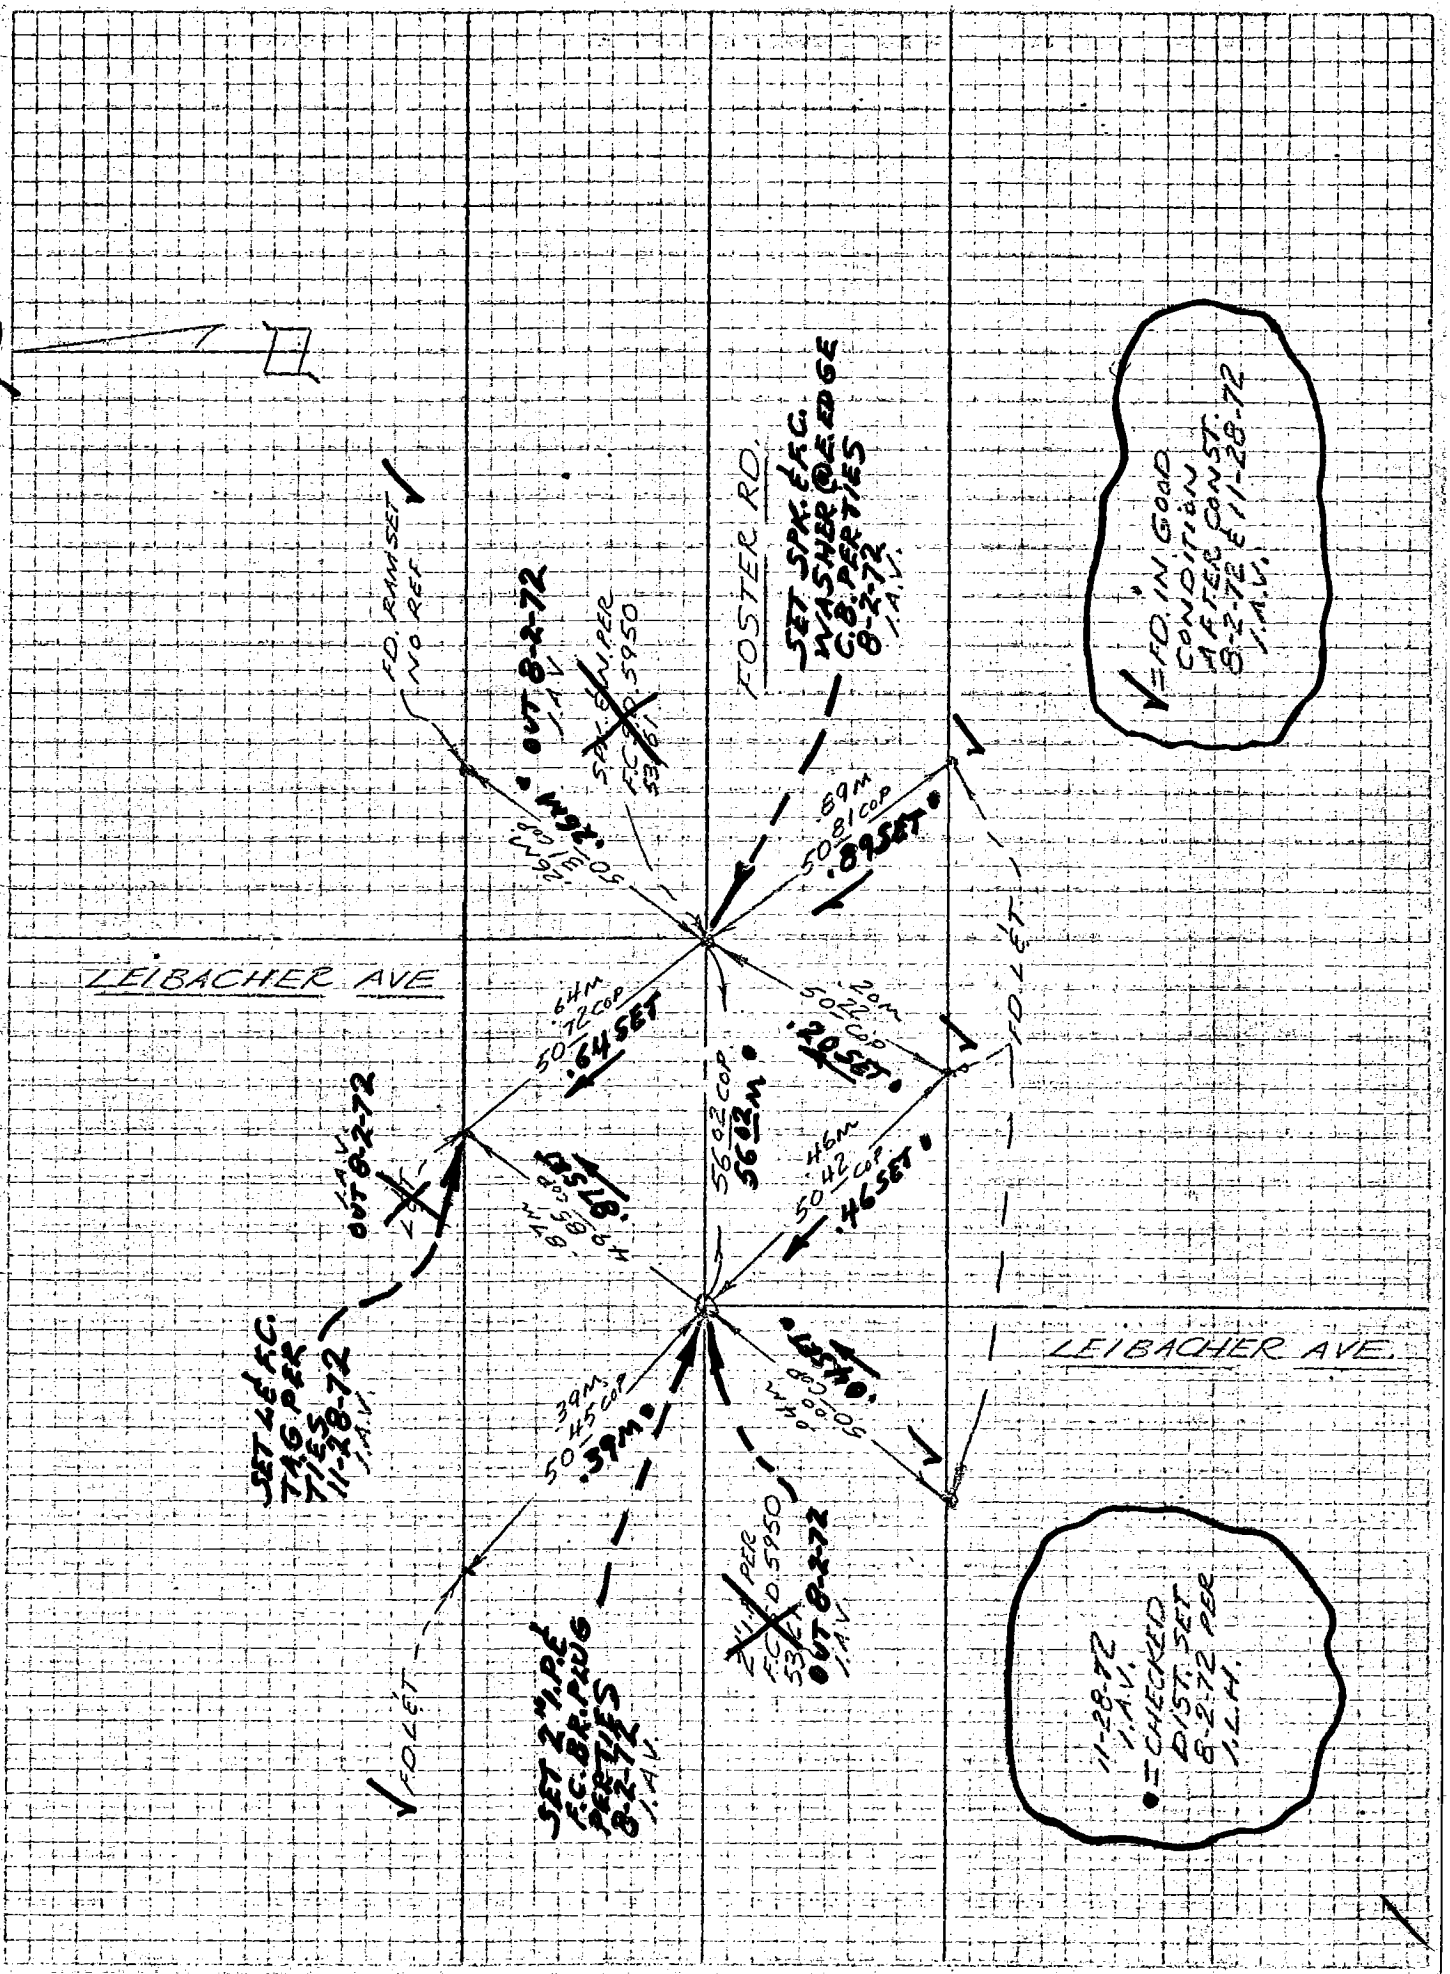

Co. Engr. F.B. 3555: 80
FCSD1221 41

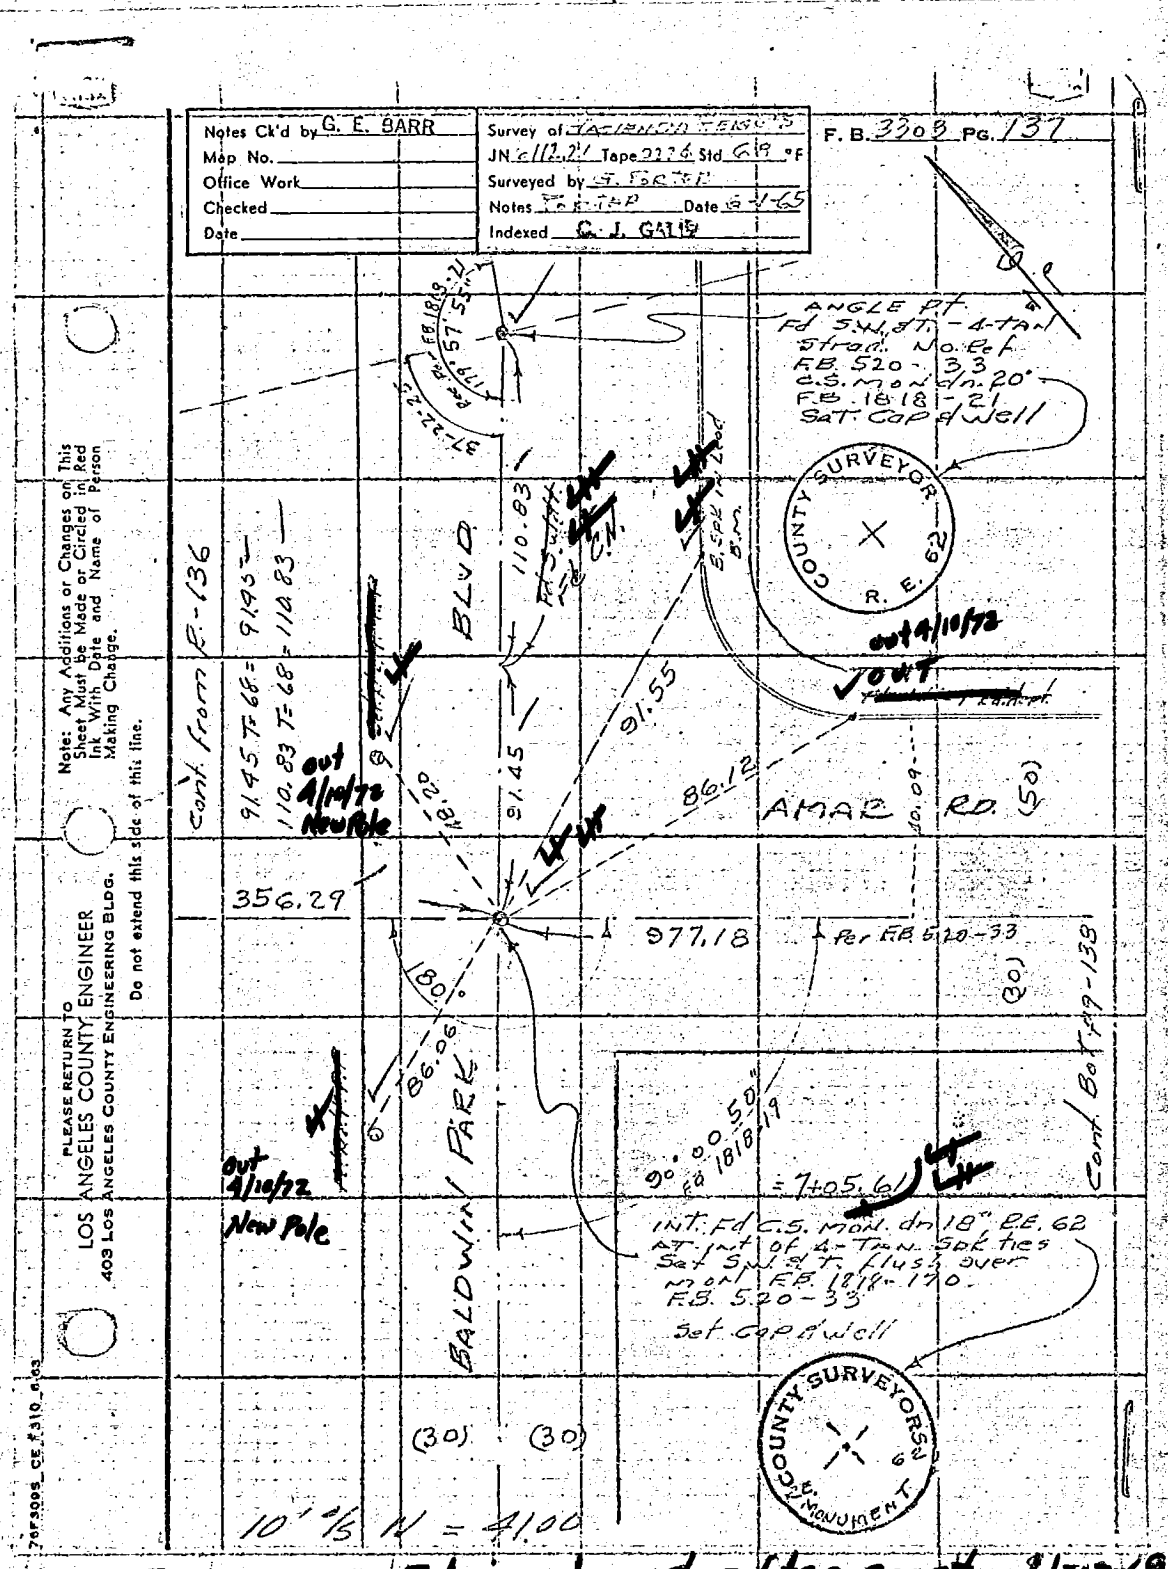


W.S. 46 C.S.

LT = Fd in gd cond. after const. 8-13-69

LT = Fd After const 4-10-72 ETN

1 = Fd. 5/8" 6-68 ETN

SEE Pg 113 FOR PTS RESET

Co. Engr. F.B. 3555: 81
FCSD1221 43

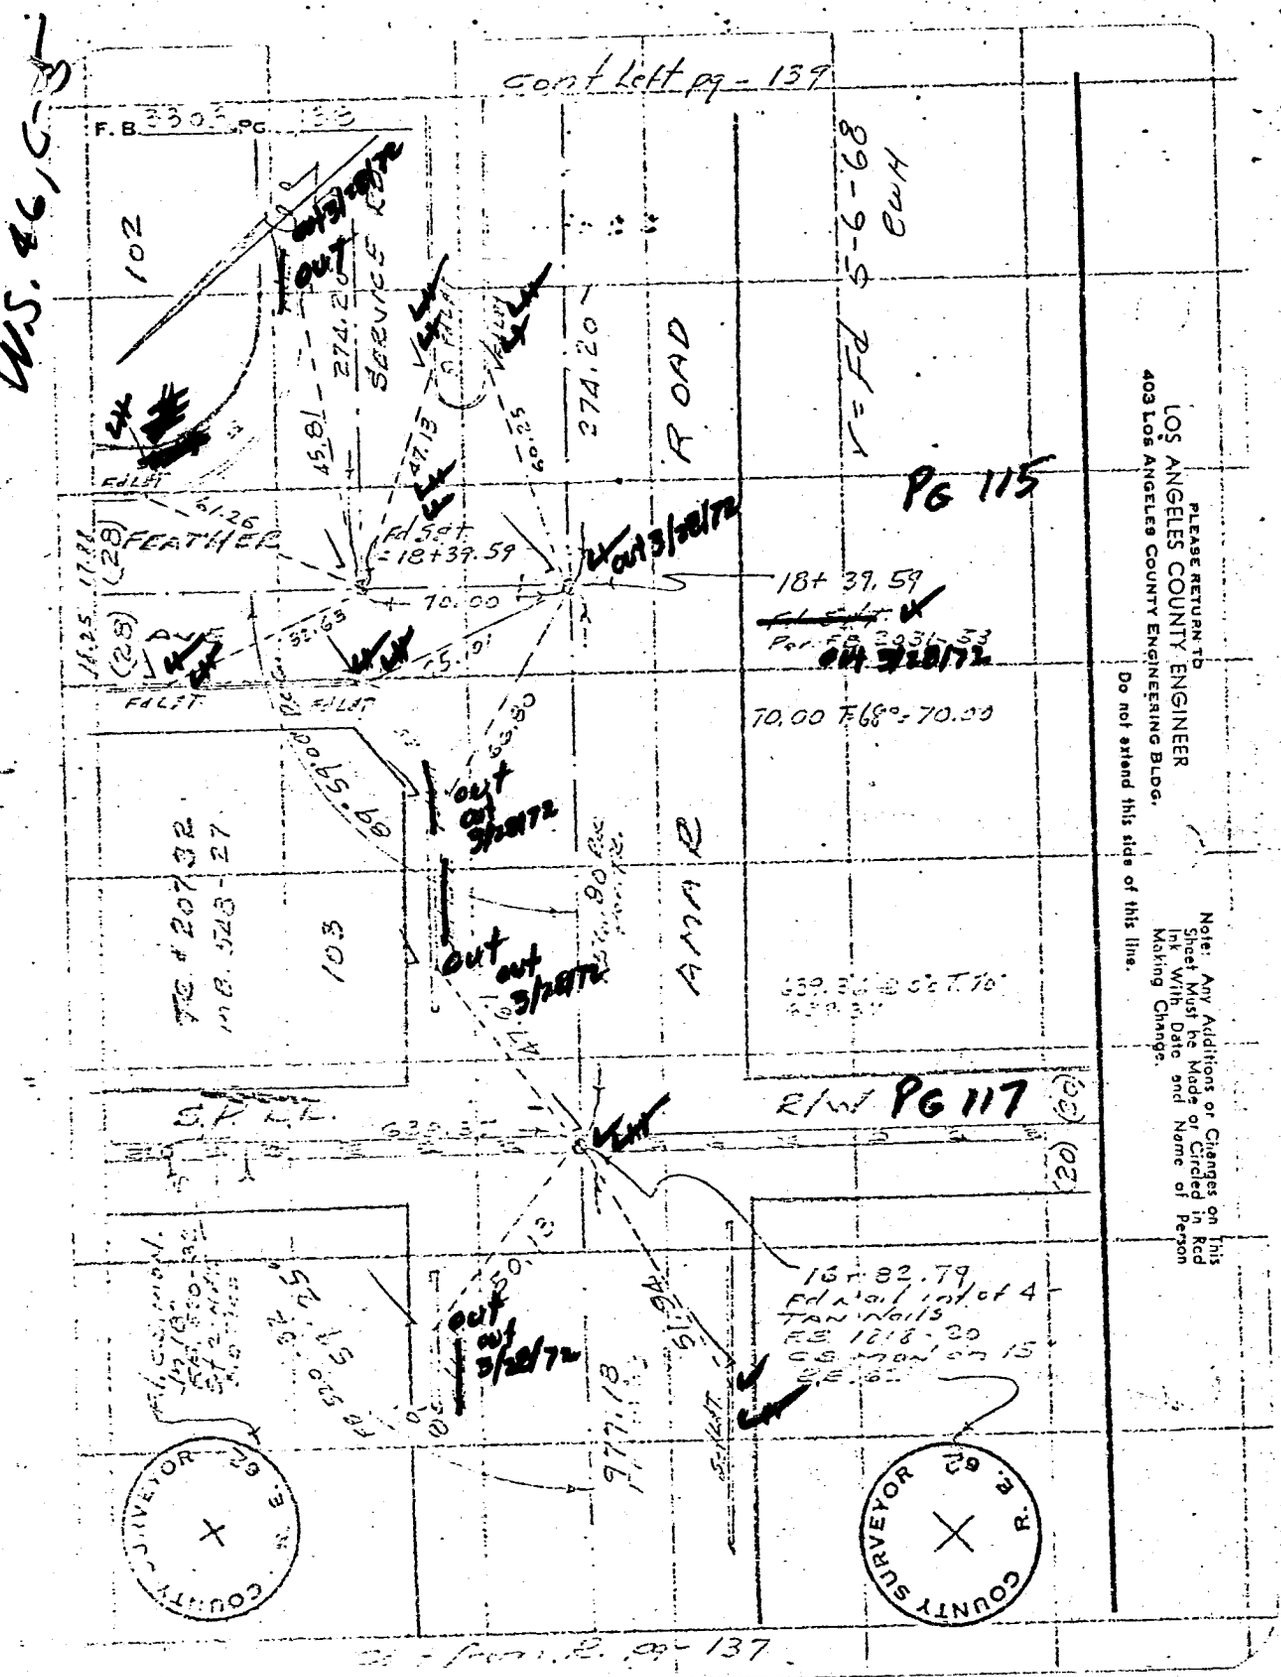


W = Fd in gd. cond 11-13-69 B.P.B.

AFTER CONST.
LW Fd 3/28/72 ETN

SEE PG 117 & 115 FOR PTS RESET

Co. Engr. F.B. 3555:82
FCSD1221 47

W.S. 46 C-5

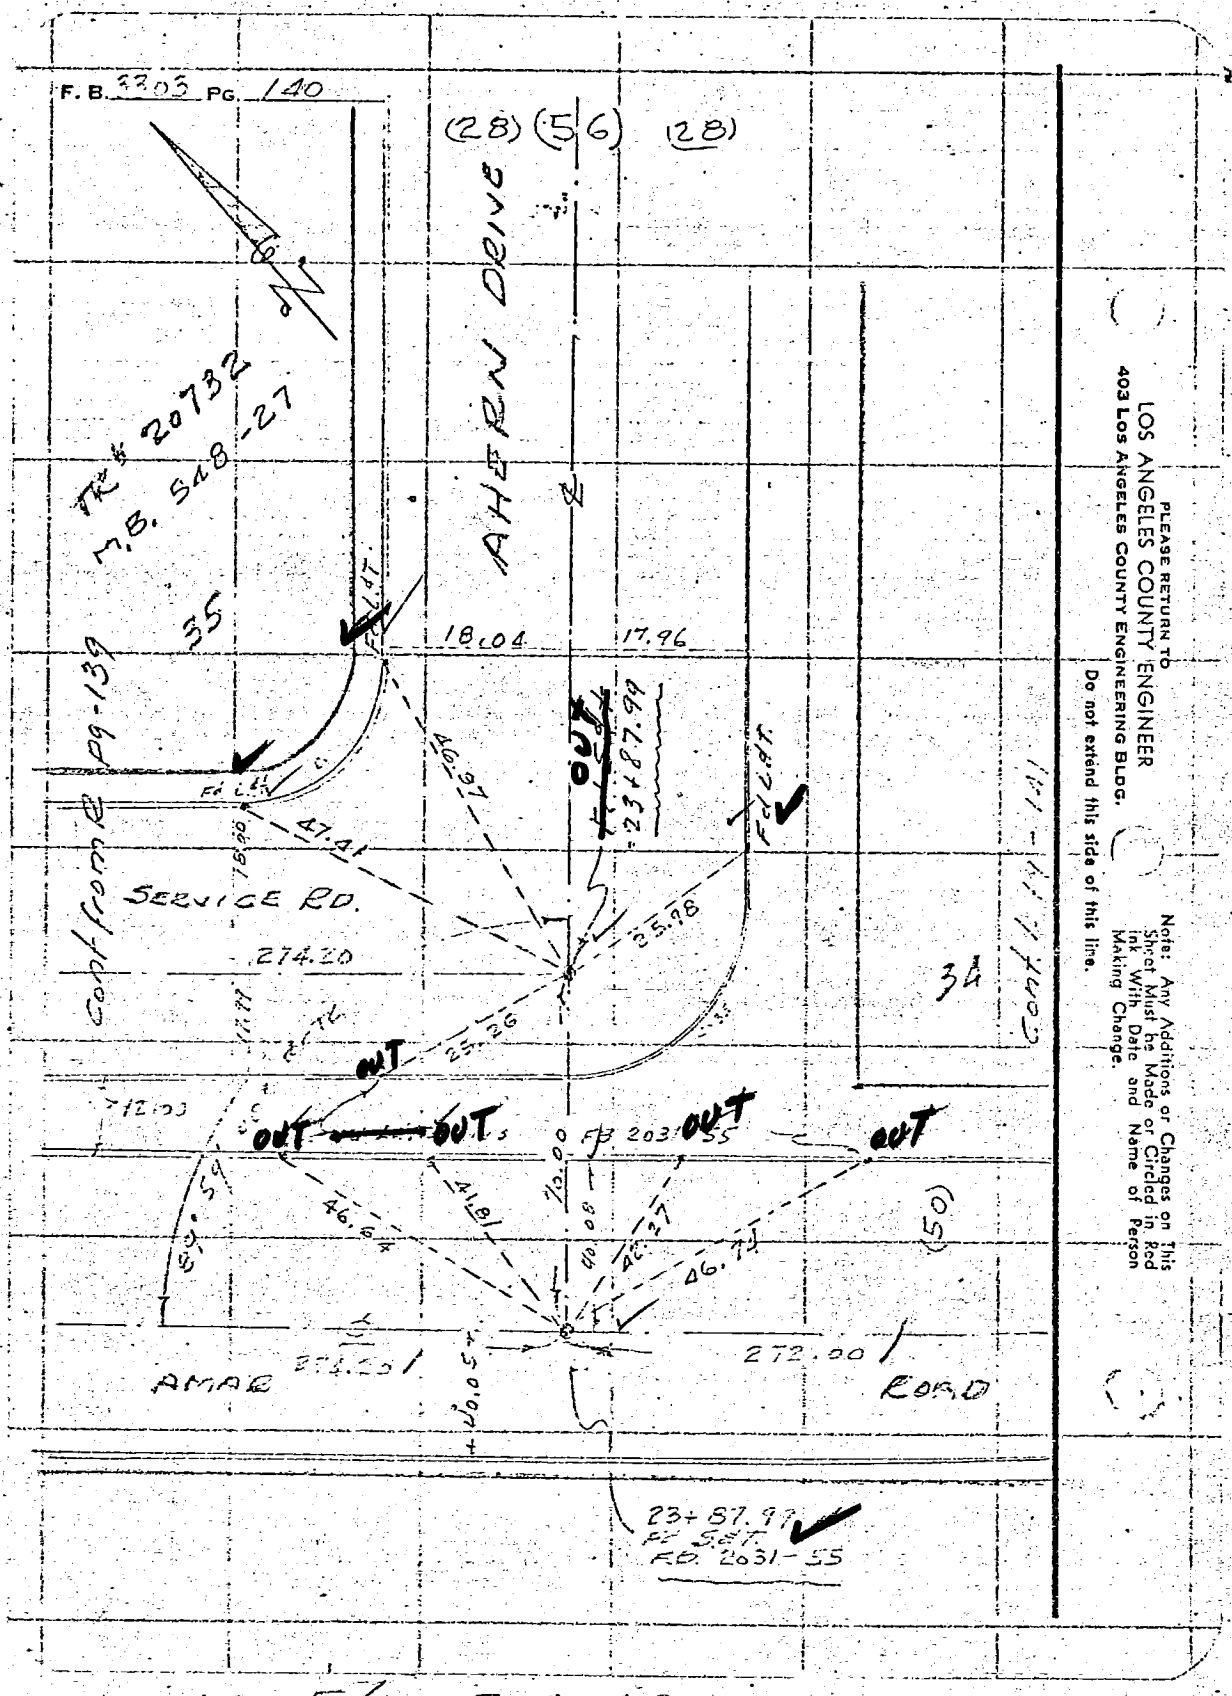


PLEASE RETURN TO
LOS ANGELES COUNTY ENGINEER
403 Los Angeles County Engineering Bldg.
Do not extend this side of this line.

Note: Any Additions or Changes on This Sheet Must be Made or Circled in Red Ink With Date and Name of Person Making Change.

✓ = Fd 5-6-68

✓ = Fd in gd cond - 11-13-69 R.P.B.

AFTER CONST.

SEE PG 117
FOR PTS RESET

Co. Engr. F.B. 3555: 83
FCSD1221 51

W.S. 4, C-5

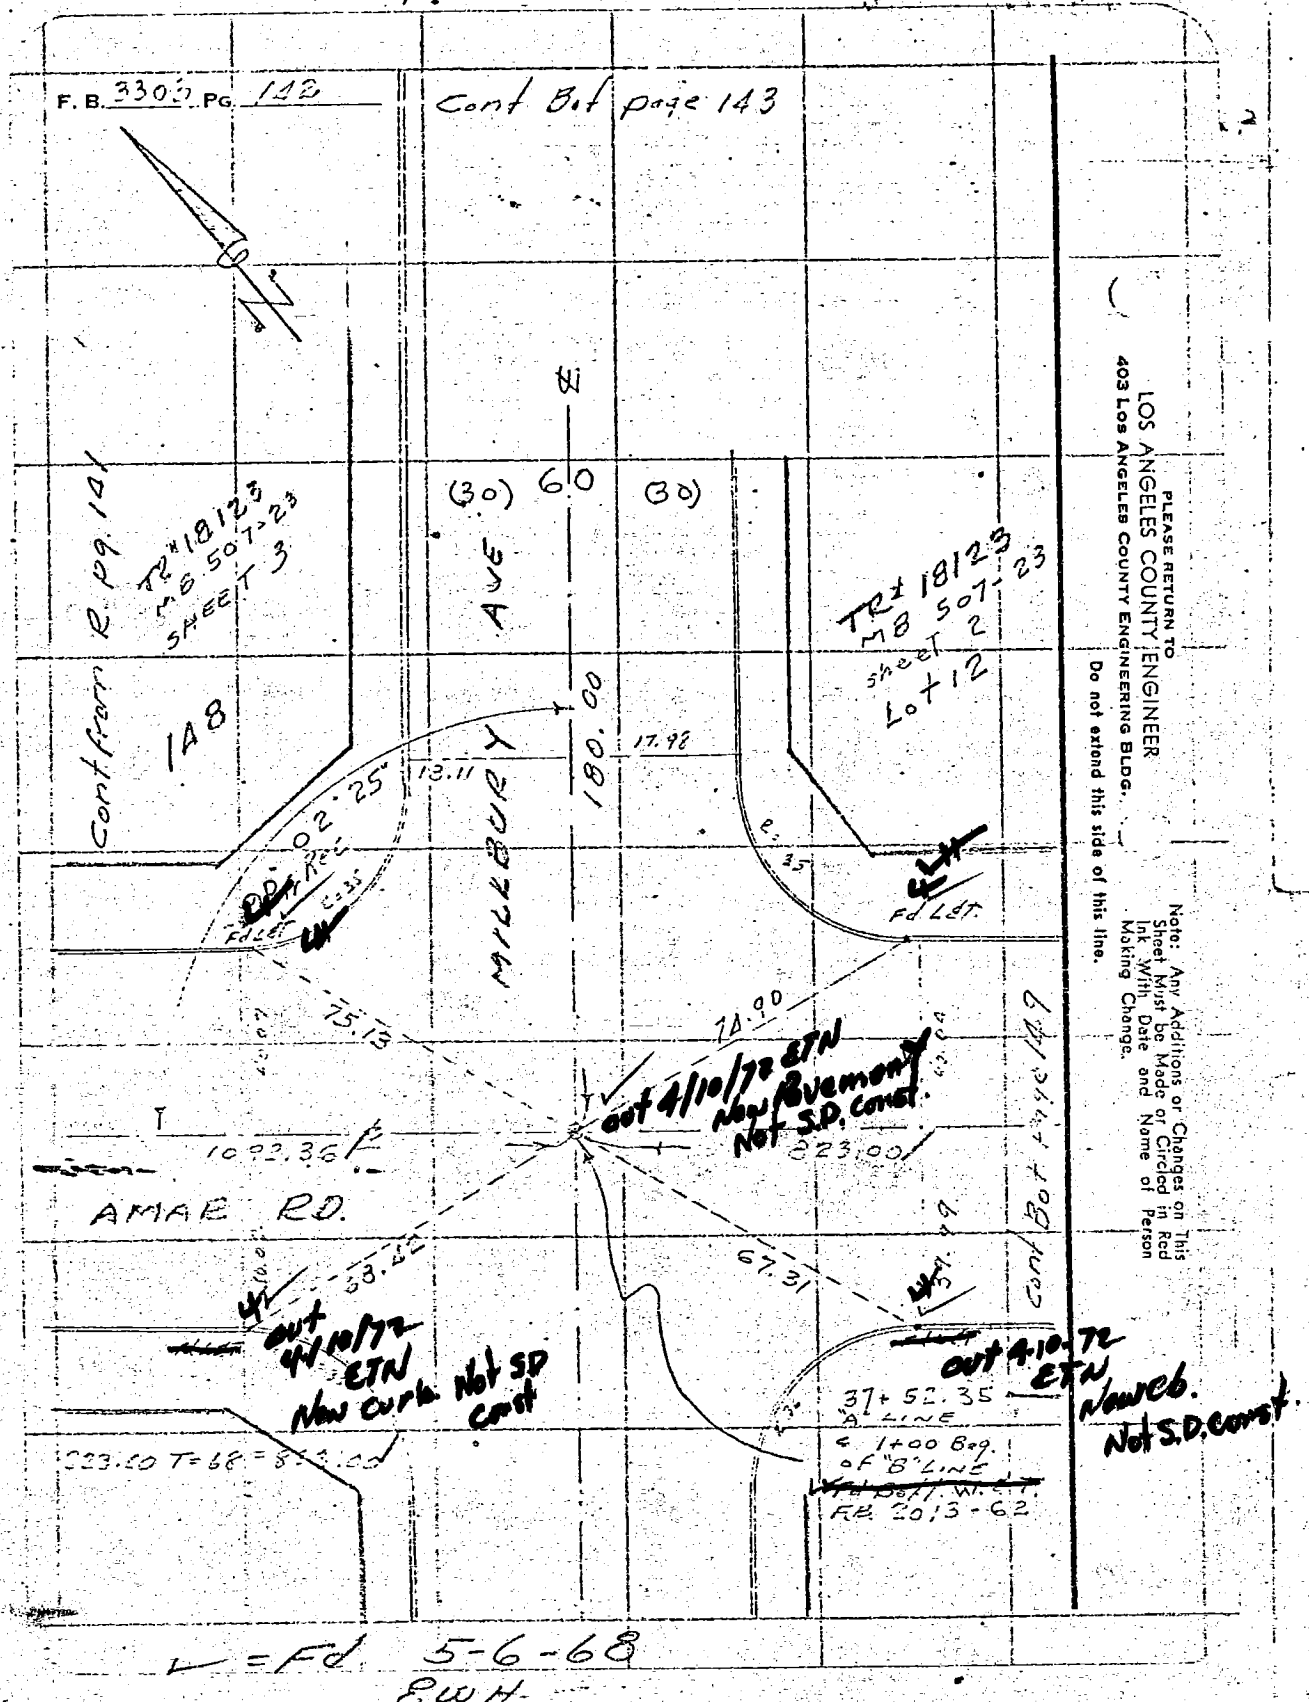


L = Fd 5-6-68
EWH

4 = Fd in gd cond. 11-14-69 B.P.B.
AFTER CONST.
4 = Fd 4/10/72 ETN

SEE PG 119
FOR PTS RESET

Co. Engr. F.B. 3555: 84

FCSD1221 55

W.S. 46, C-5

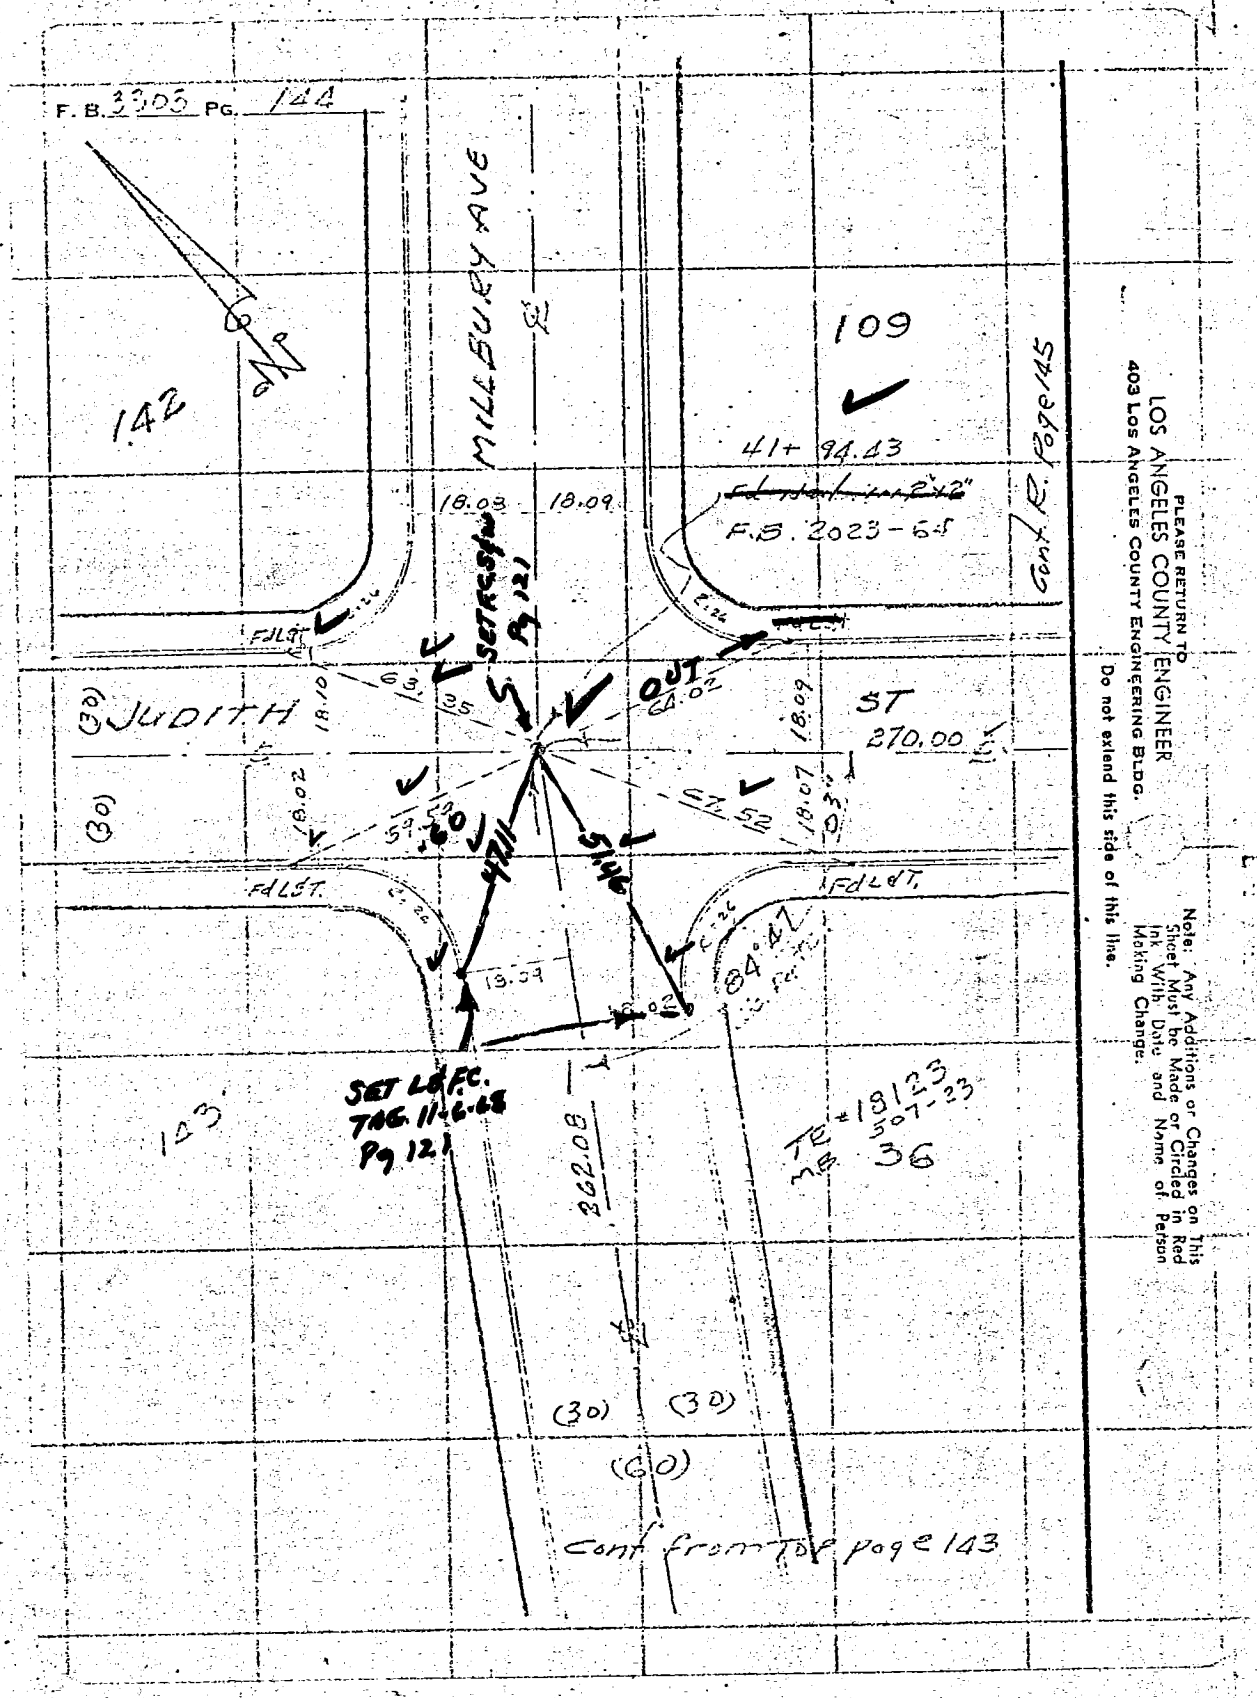


V = FD 5-6-68 ELW

V = FD IN GOOD CONDT BEFORE CONST BPB

V = FD IN GOOD CONDT AFTER CONST

SEE PG 121 FOR PTS RESET

PLEASE RETURN TO
LOS ANGELES COUNTY ENGINEER
403 Los Angeles County Engineering Bldg.

Do not extend this side of this line.

Note: Any Additions or Changes on This Sheet Must be Made or Circled in Red Ink With Date and Name of Person Making Change.

Co. Engr. F.B. 3555: 85
FCSD1221 87

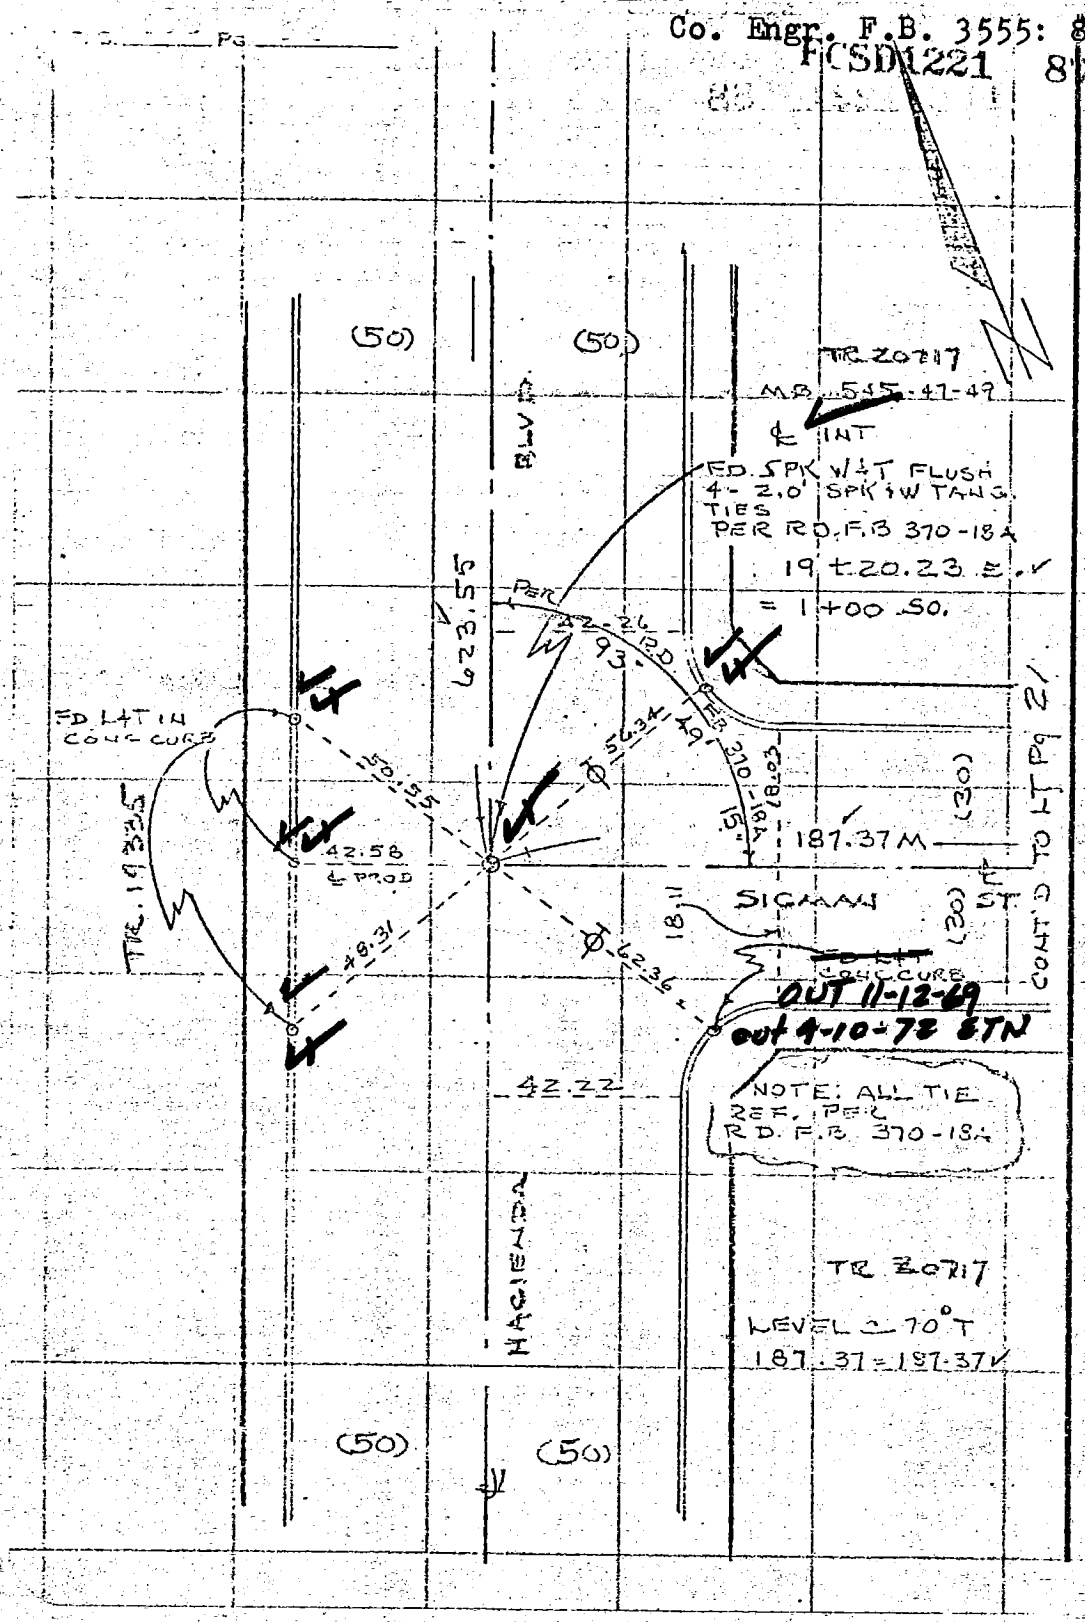


✓ = FD AFTER CONST.
11-17-69

℄ = Fd 4/10/72 ETN

SEE PG 127
FOR PTS RESET

PLEASE RETURN TO
LOS ANGELES COUNTY ENGINEER
403 LOS ANGELES COUNTY ENGINEERING BLDG.

Do not extend this side of this line.

Note: Any Additions or Changes on This Sheet Must be Made or Circled in Red Ink With Date and Name of Person Making Change.

Co. Engr. F.B. 3555:86 CSD1221 93

W.S. 099-297 A-1

| | |
|---|---|
| Notes Ck'd by | Survey of HACIENDA HEIGHTS S.D. |
| Map No. | JN 113.2 Tape 223-4 Std 68 °F |
| Office Work | Surveyed by G. PORTER |
| Checked | Notes R. SMITH Date 5-4-65 |
| Date | Indexed G. J. GALLI |

F. B. 3323 Pg. 23

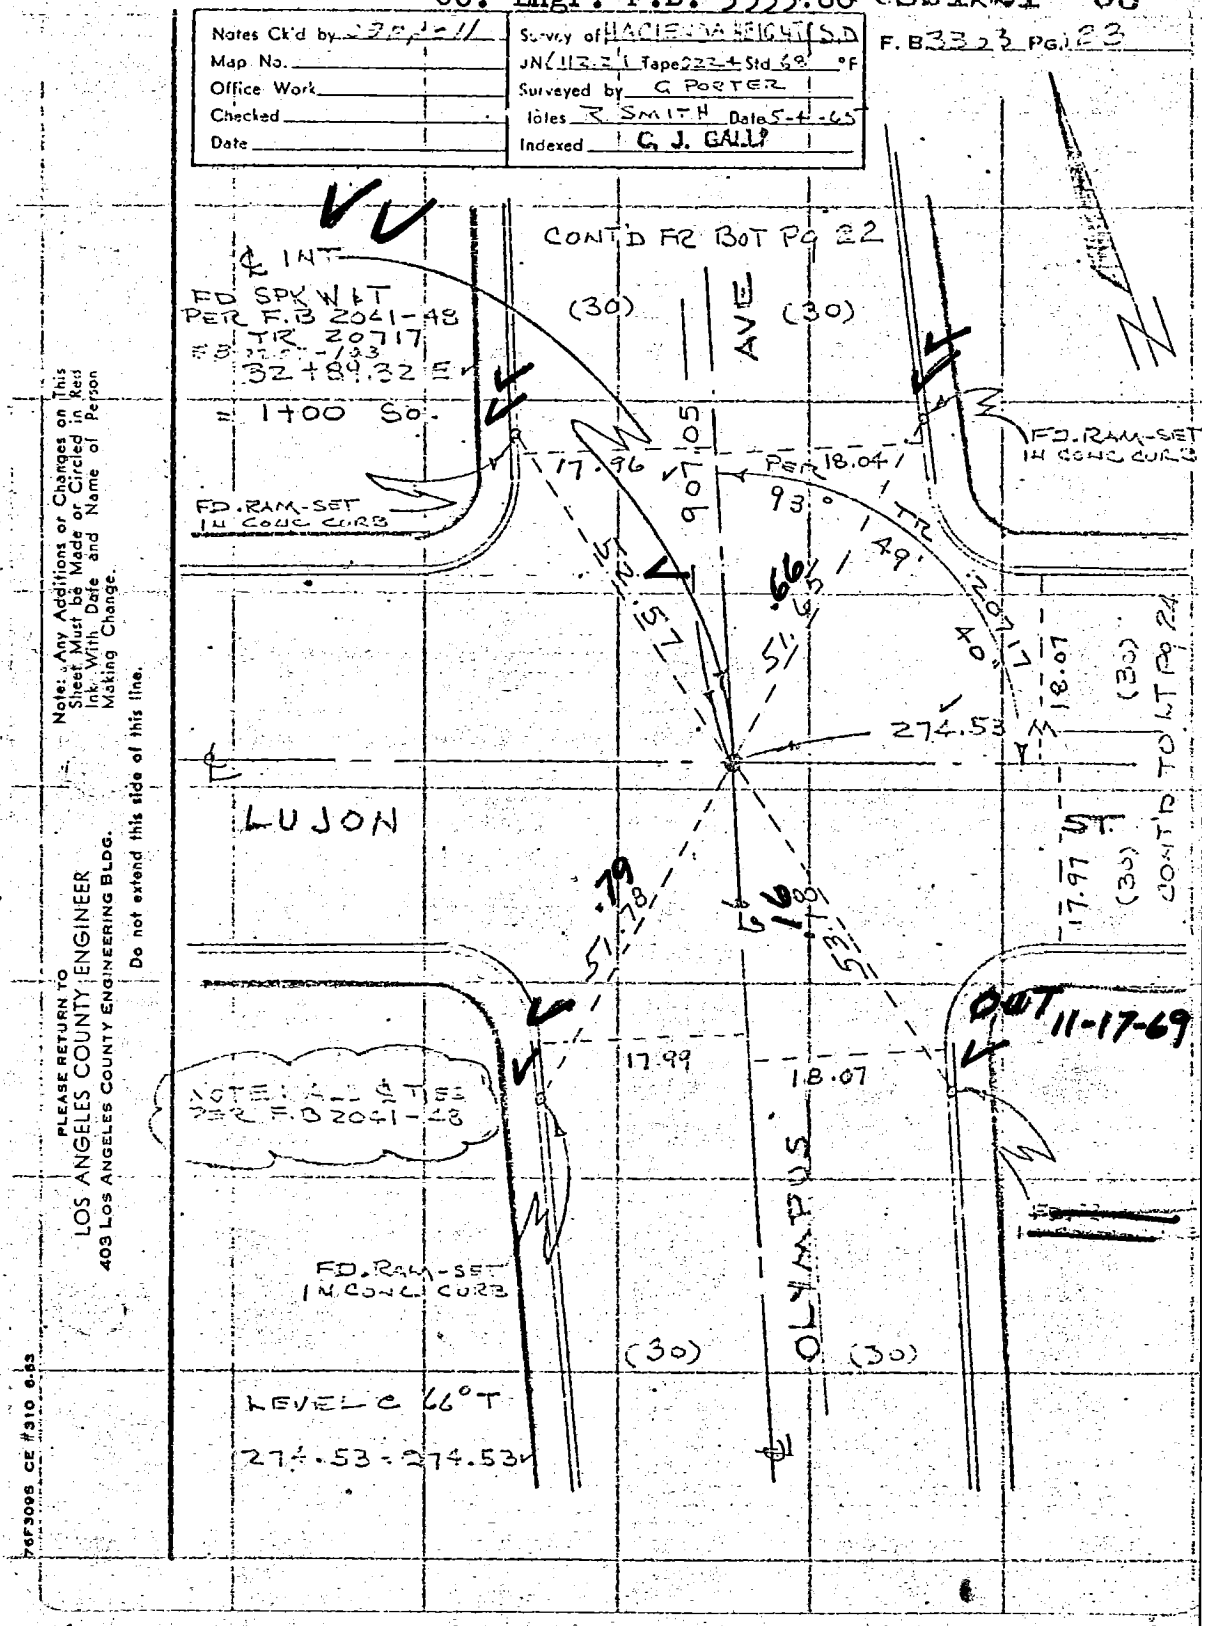


PLEASE RETURN TO
LOS ANGELES COUNTY ENGINEER
403 Los Angeles County Engineering Bldg.

Note: Any Additions or Changes on This Sheet Must be Made or Circled in Red Ink With Date and Name of Person Making Change.

Do not extend this side of this line.

765-3095 CE #310 6-65

V = FD IN GOOD CONDITION BEFORE CONST.
V = " " " " " AFTER CONST 11-17-69

SEE PG 129
FOR PTS RESET

Co. Engr. F.B. 3555: 87
FCSD1221 109

FOR LATER TIES SEE F.C.S.D. 1221-131

W.S. 37, E-4

Notes Ck'd by M. ASHLEY
Map No.
Office Work
Checked
Date

Survey of HAZELTON HEIGHTS S.D.
JN 6112.21 Tape 020' Std 61 °F
Surveyed by D.E. HOLMES
Notes MOODY Date 12-1-5
Indexed C. J. GALLI

F. B. 3222 Pg. 137

Cont. From Bot. Pg. 136

FD. BT. SPK. & 1-1/2" I.P. FLUSH. TIES IN CONC. PUNT. FB 2193-60 FB 1573-175 FOR & 1-1/2" I.P. FLUSH TIES. (NO ZERO FOR BT. SPK.)

CL HWY. RD.

FD. LEAD & TACK

FD. LET ON PROD.

out 4/10/72

TO BULL

158.93 FB 2193-60 & FB 1458-227

TO PT #33

51.87

39.65M

37-20 FB 2193-60 FB 1458-227

FD. LET

FD. LET ON PROD.

Fd 4/10/72 ETN

614.71 FB 2193-60 FB 1573-26

60.82

60.80M

35

S 27° 05' E FB 2193-60 FB 1458-227

out 4/10/72

N 27° 05' E TO

N 10° 18' E FB 2193-60 FB 1458-227

TO PT #1

S 30° 41' E

DR.

Note: Any Additions or Changes on This Sheet Must be Made or Circled in Red Ink With Date and Name of Person Making Change.

Do not extend this side of this line.

PLEASE RETURN TO
LOS ANGELES COUNTY ENGINEER
403 Los Angeles County Engineering Bldg.

75F3085_CE # 310_3-61

V = FOUND 6-20-68

V = Fd 4-10/72 ETN

Cdb 3-69

PROJECT 1221 Unit 1 Line A

SURVEY BY Nixon DATE 3/28/72

REVIEWED BY _____ DATE _____

Co. Engr. F.B. 3555: 88

INDEX FCSD1221 113

R4K-1A

LOS ANGELES COUNTY FLOOD CONTROL DISTRICT

W 546, C-5

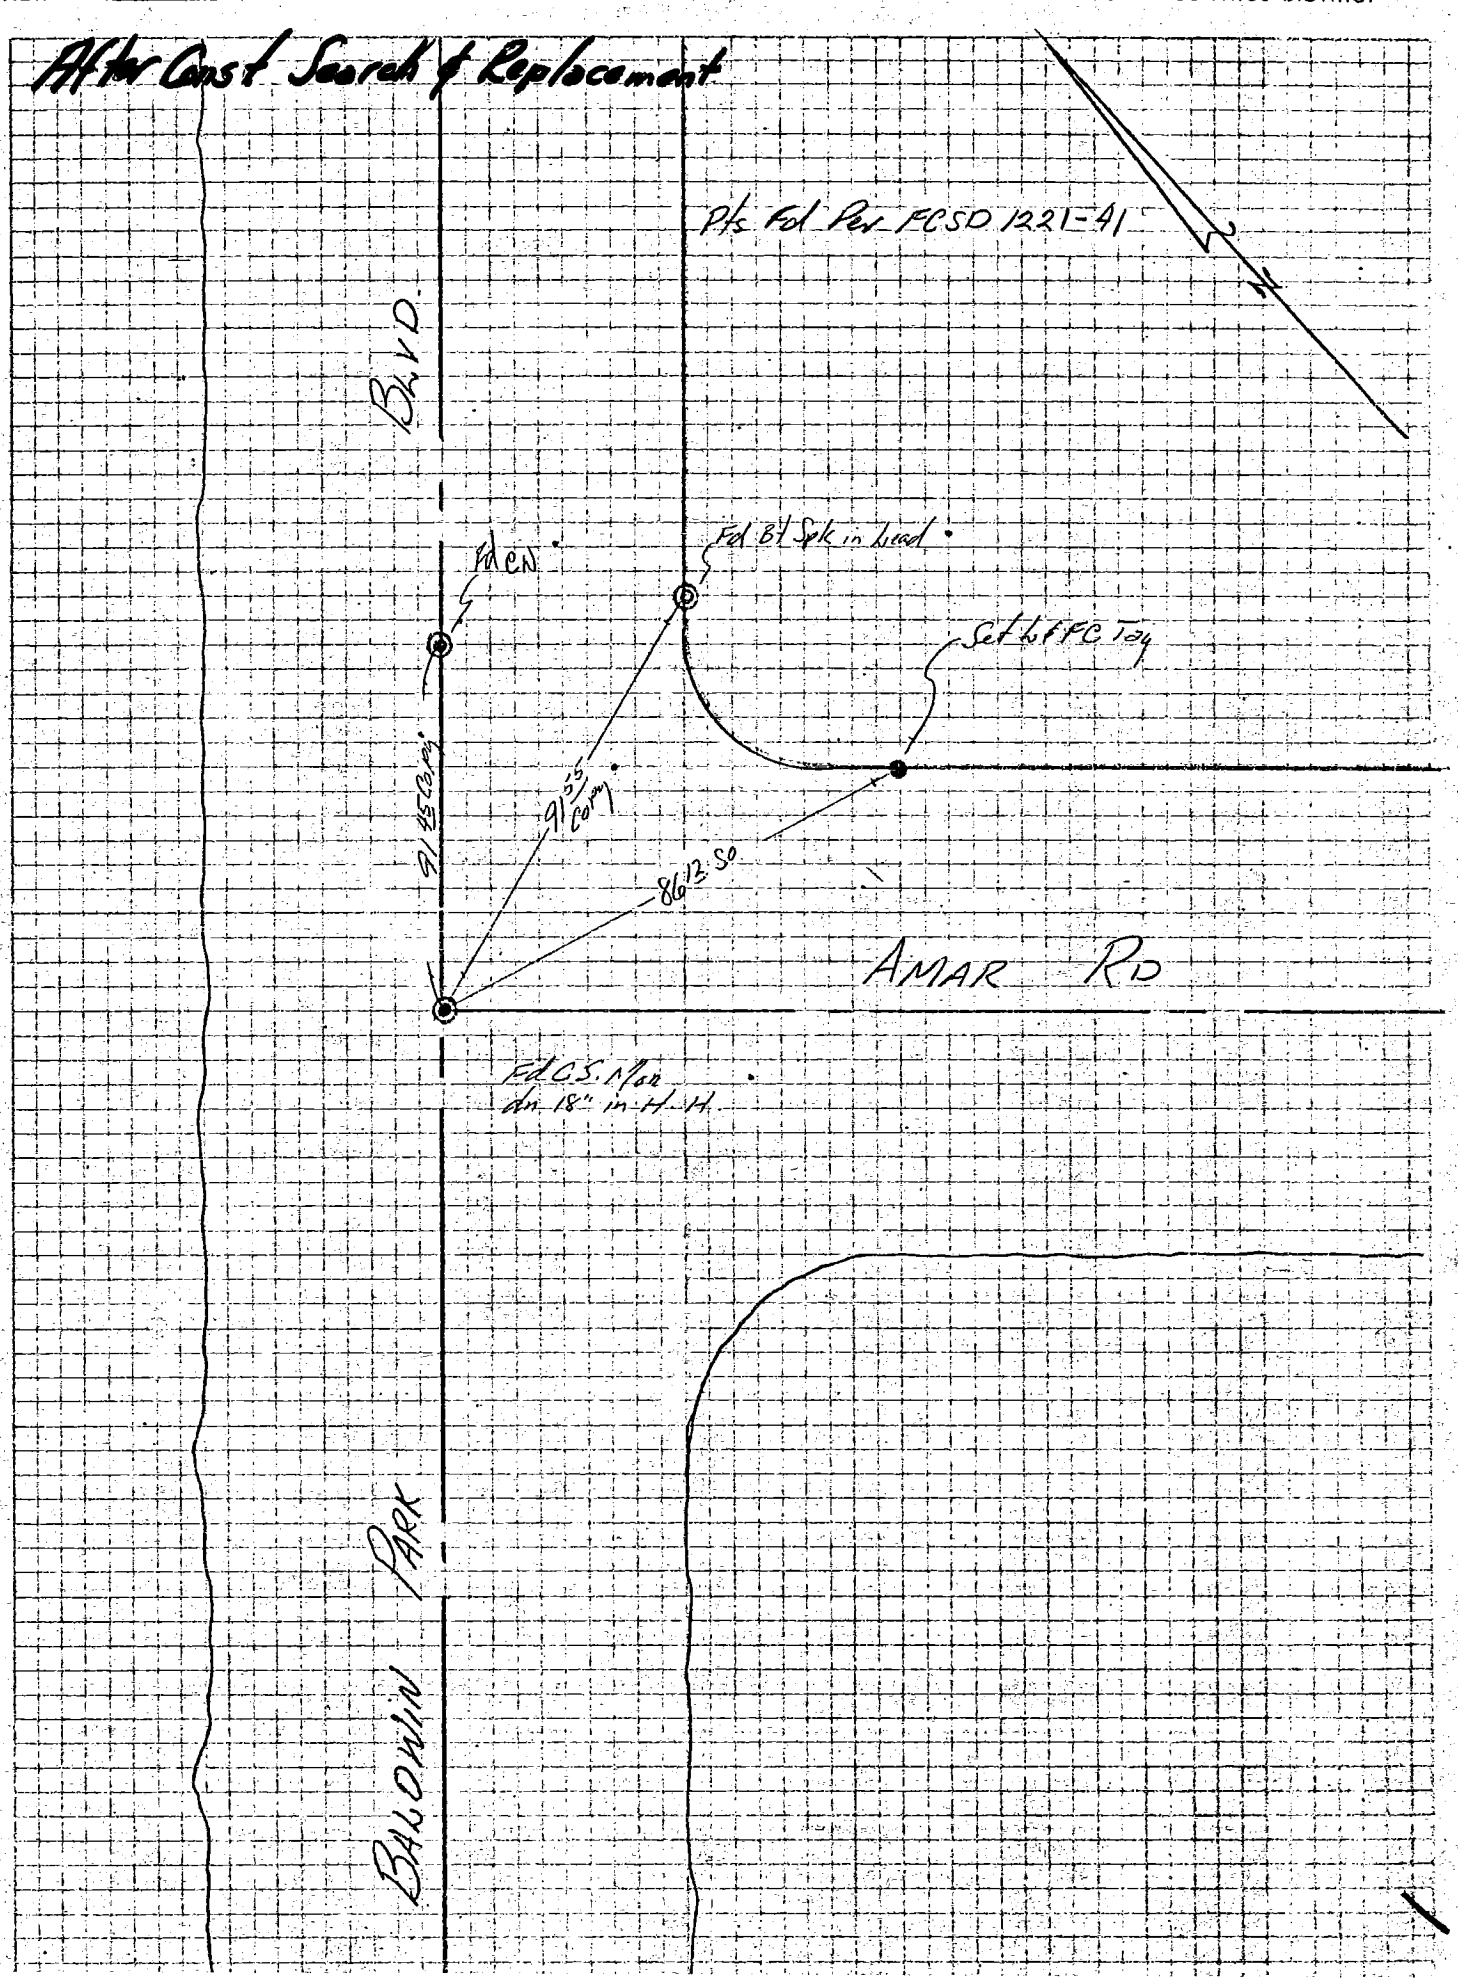

Cdb 3-69

PROJECT 1221 Unit 1 Line A Co. Engr. F.B. 3555:89 INDEX CSD1221 115

SURVEY BY NIXON DATE 3/28/72 R&R-18

REVIEWED BY DATE LOS ANGELES COUNTY FLOOD CONTROL DISTRICT

45, 46 C-5

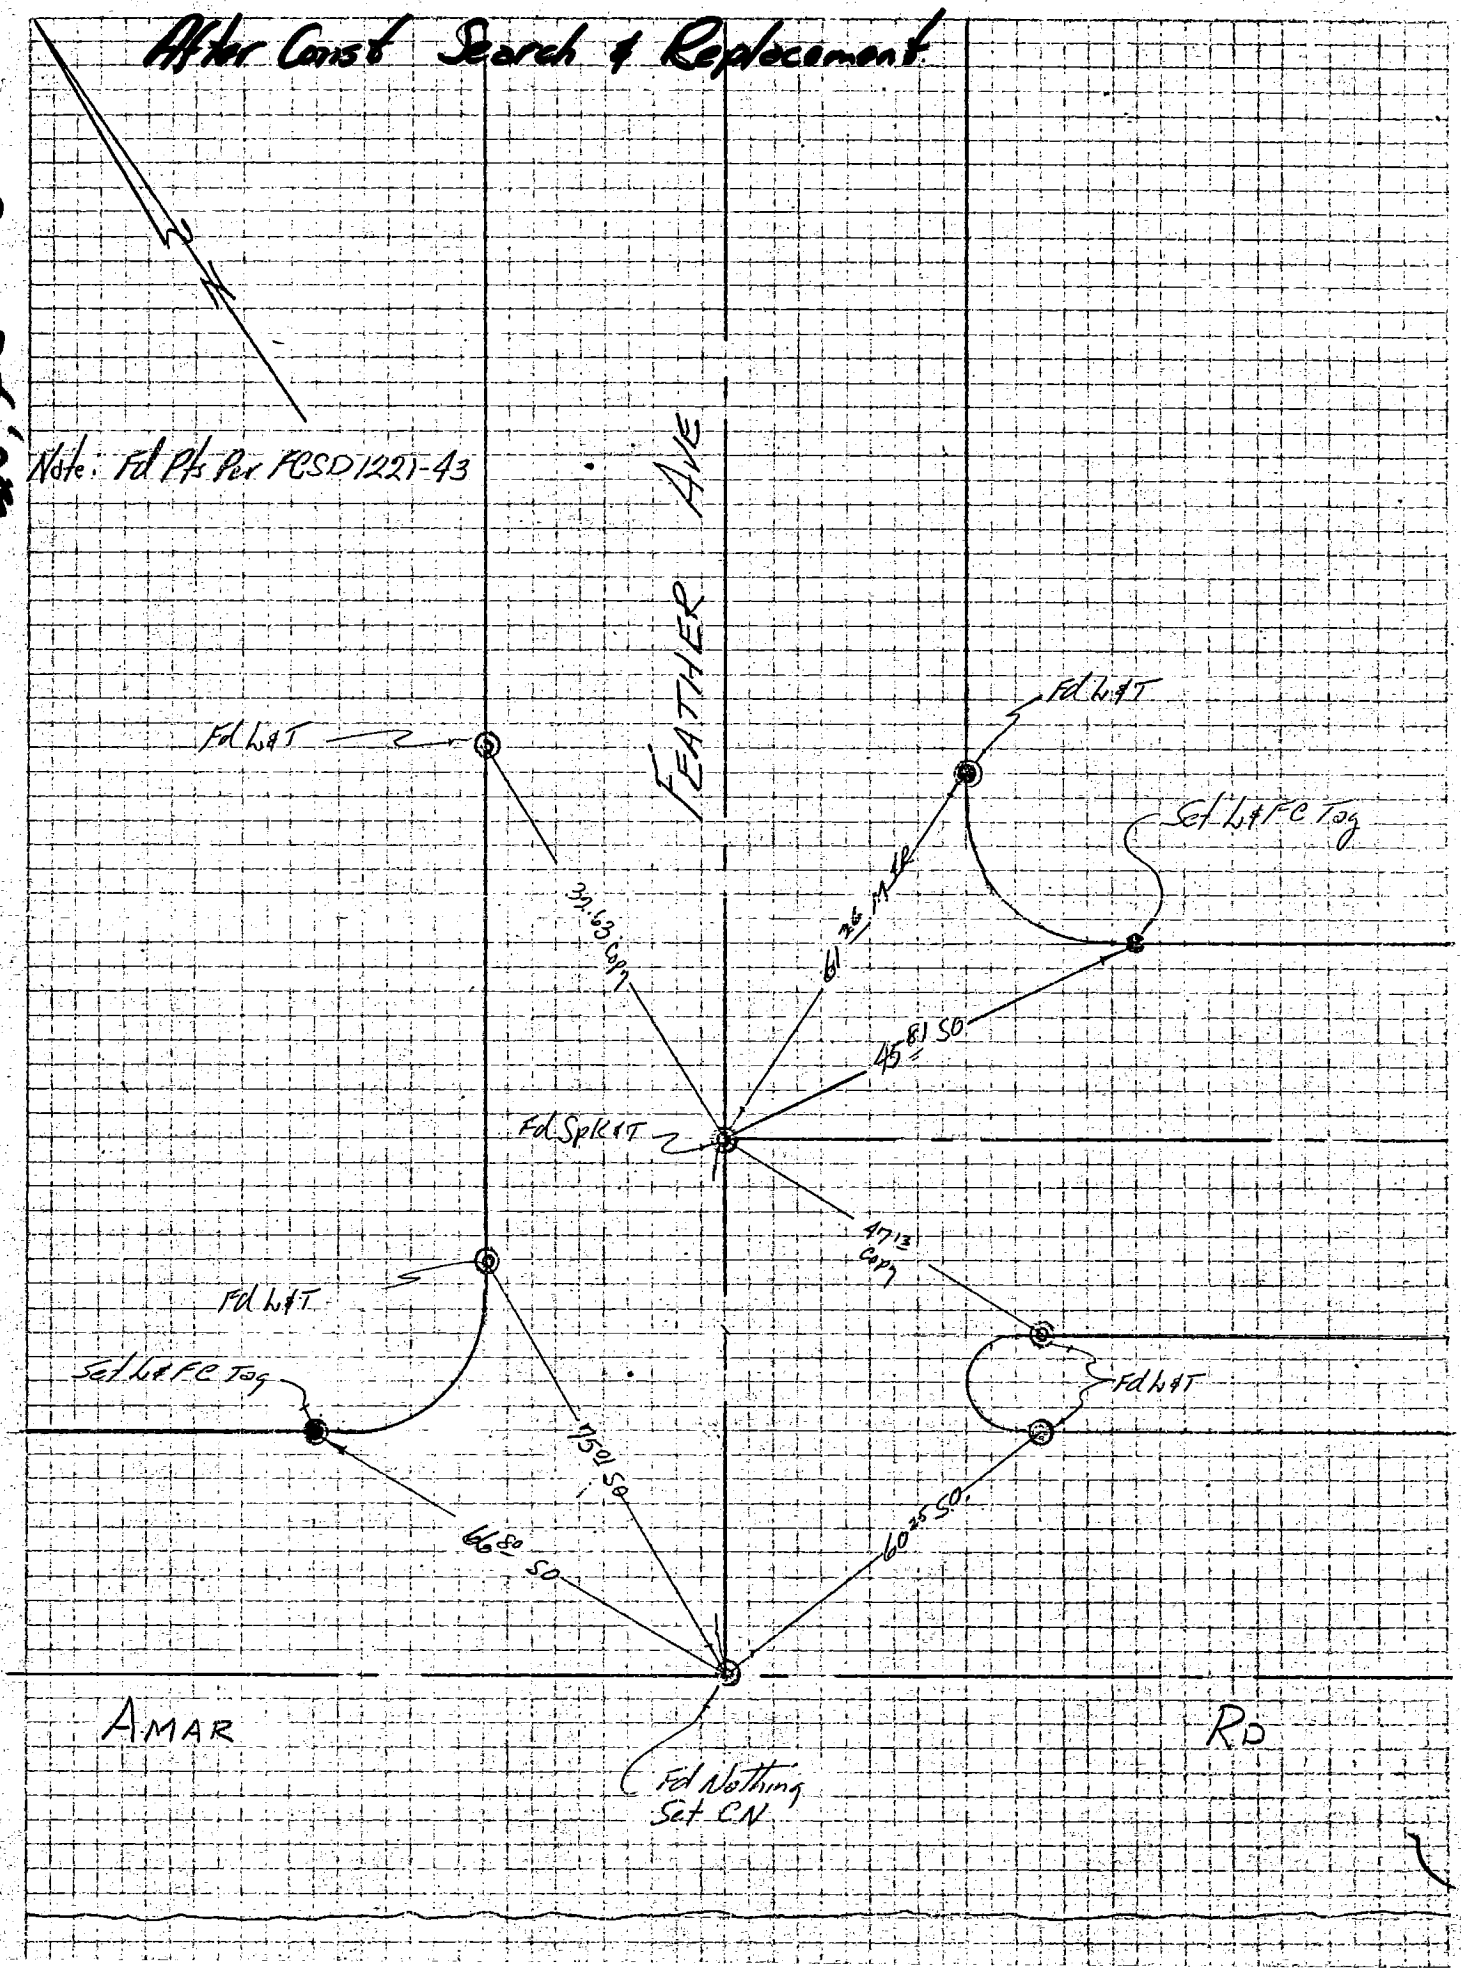

Cdb 1-68

Co. Engr. F.B. 3555: 90

T NO. 1221 UNIT 1 LINE "A"

INDEX FCSD1221 117

EY BY R.P.B. DATE 11-14-69

VIEWED BY [illegible] DATE 11-21-69

R & P 3

LOS ANGELES COUNTY FLOOD CONTROL DISTRICT

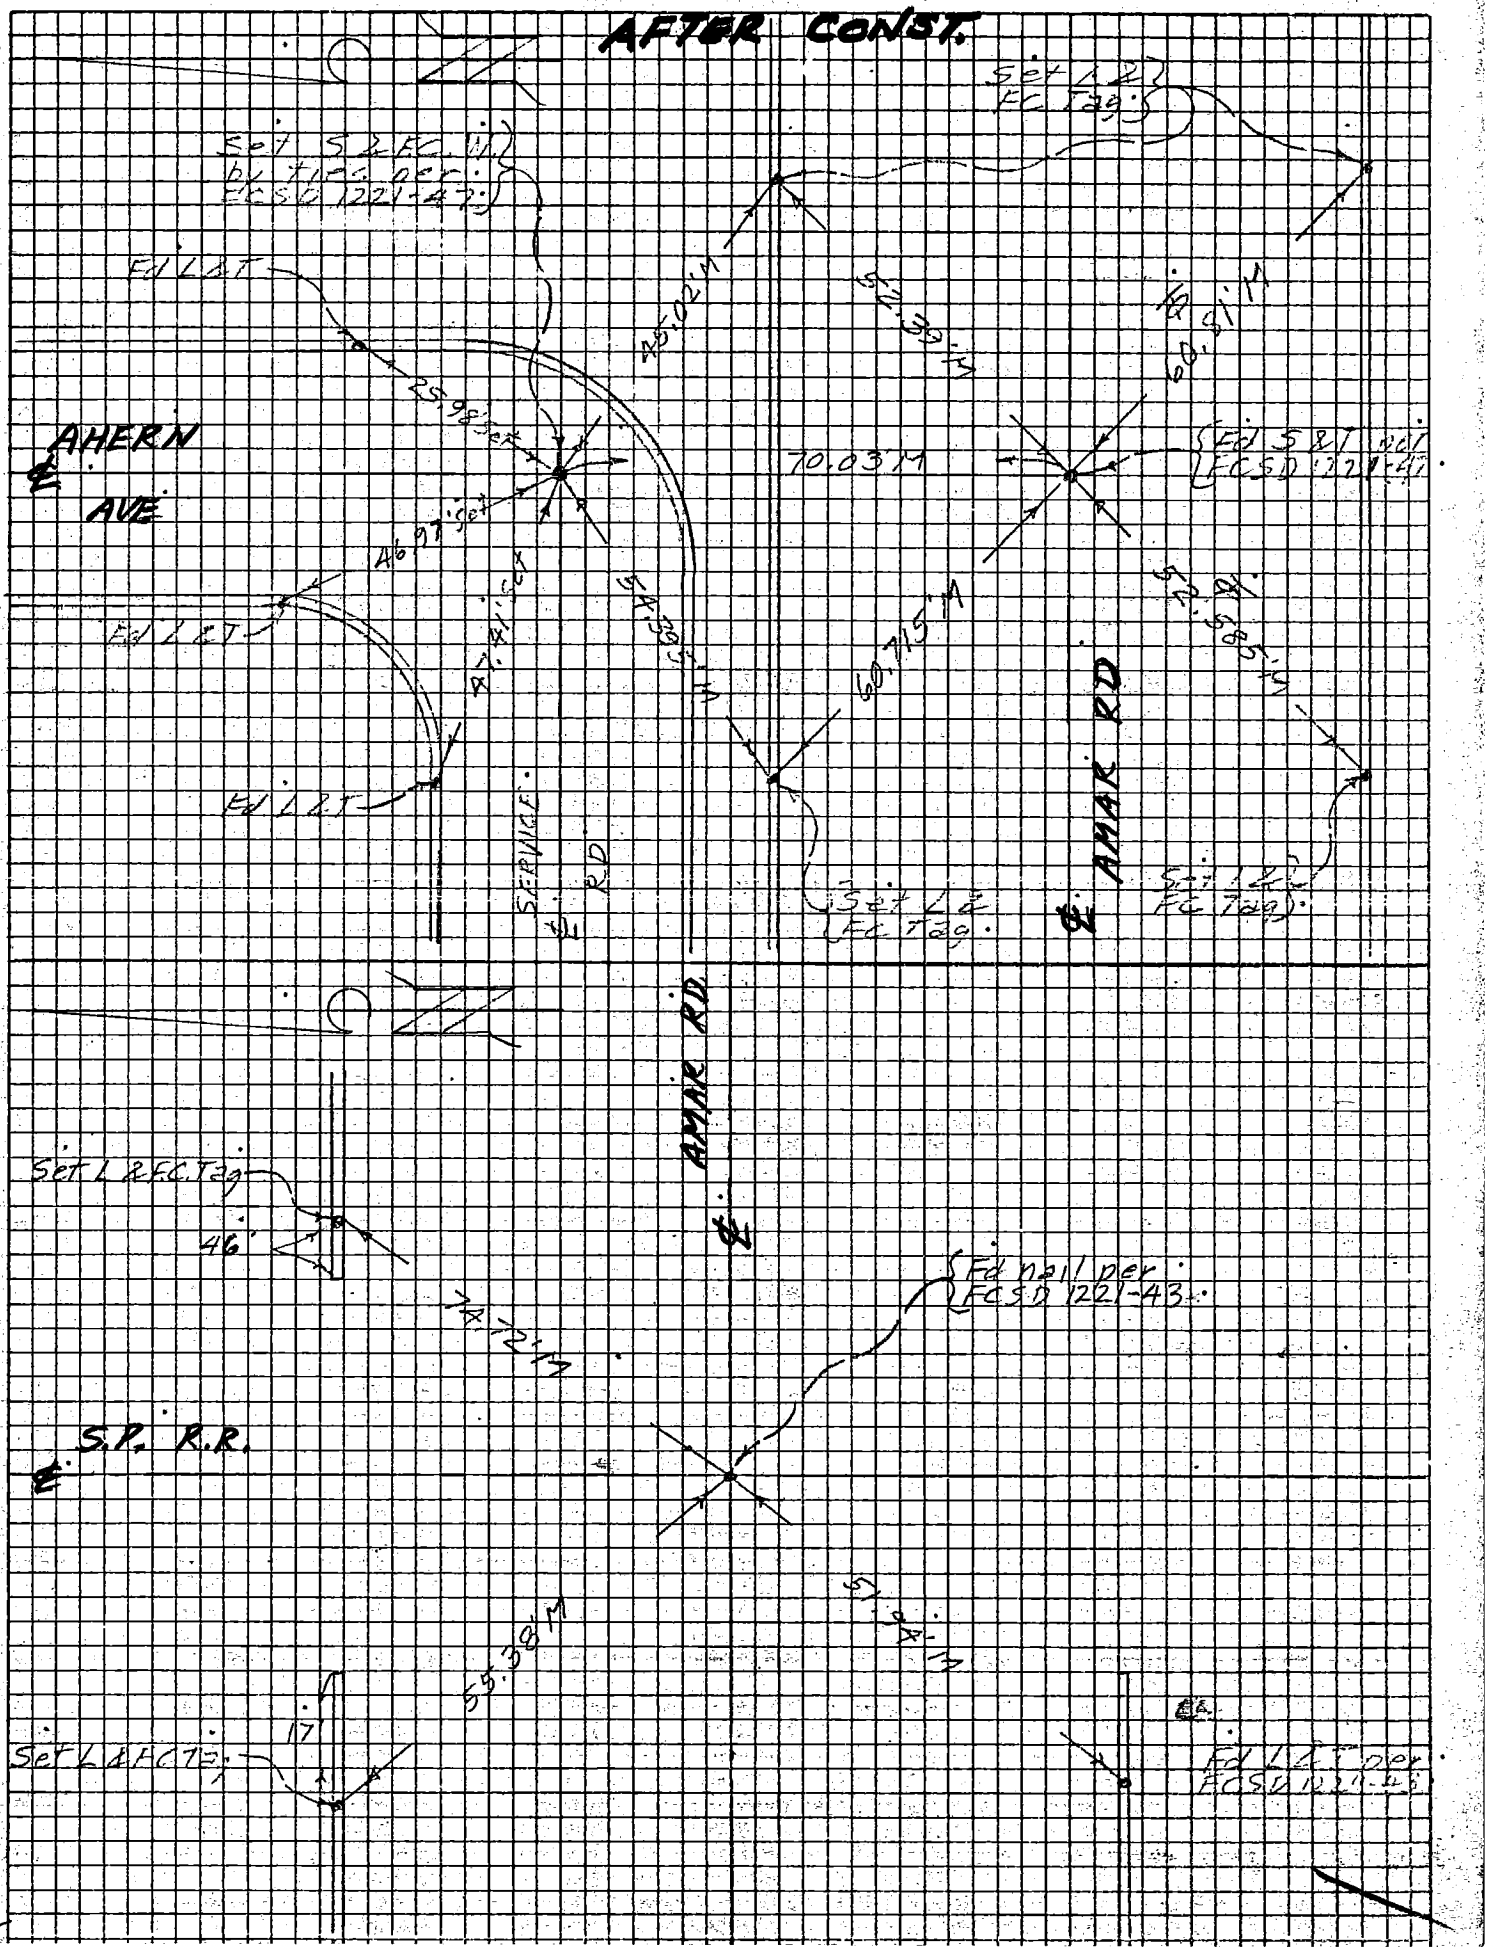

PROJECT No. 1221 UNIT I LINE A" Co. Engr. F.B. 3555 INDEX FCSD1221 119

SURVEY BY B.P.B. DATE 11-14-69

REVIEWED BY [signature] DATE 11-21-69

R & R 5

LOS ANGELES COUNTY FLOOD CONTROL DISTRICT

W.S. 46, C-5





















11– Cdb 1-68

PROJECT No. 1221 INIT. LINE "A" Co. Engr. F.B. 3555: 92 INDEX FCSD1221 121

SURVEY BY B.R.B. DATE 11-6-68 R & R. 7

REVIEWED BY _____ DATE _____ LOS ANGELES COUNTY FLOOD CONTROL DISTRICT

AFTER CONST.

W.5.46 C-5

11-21-69

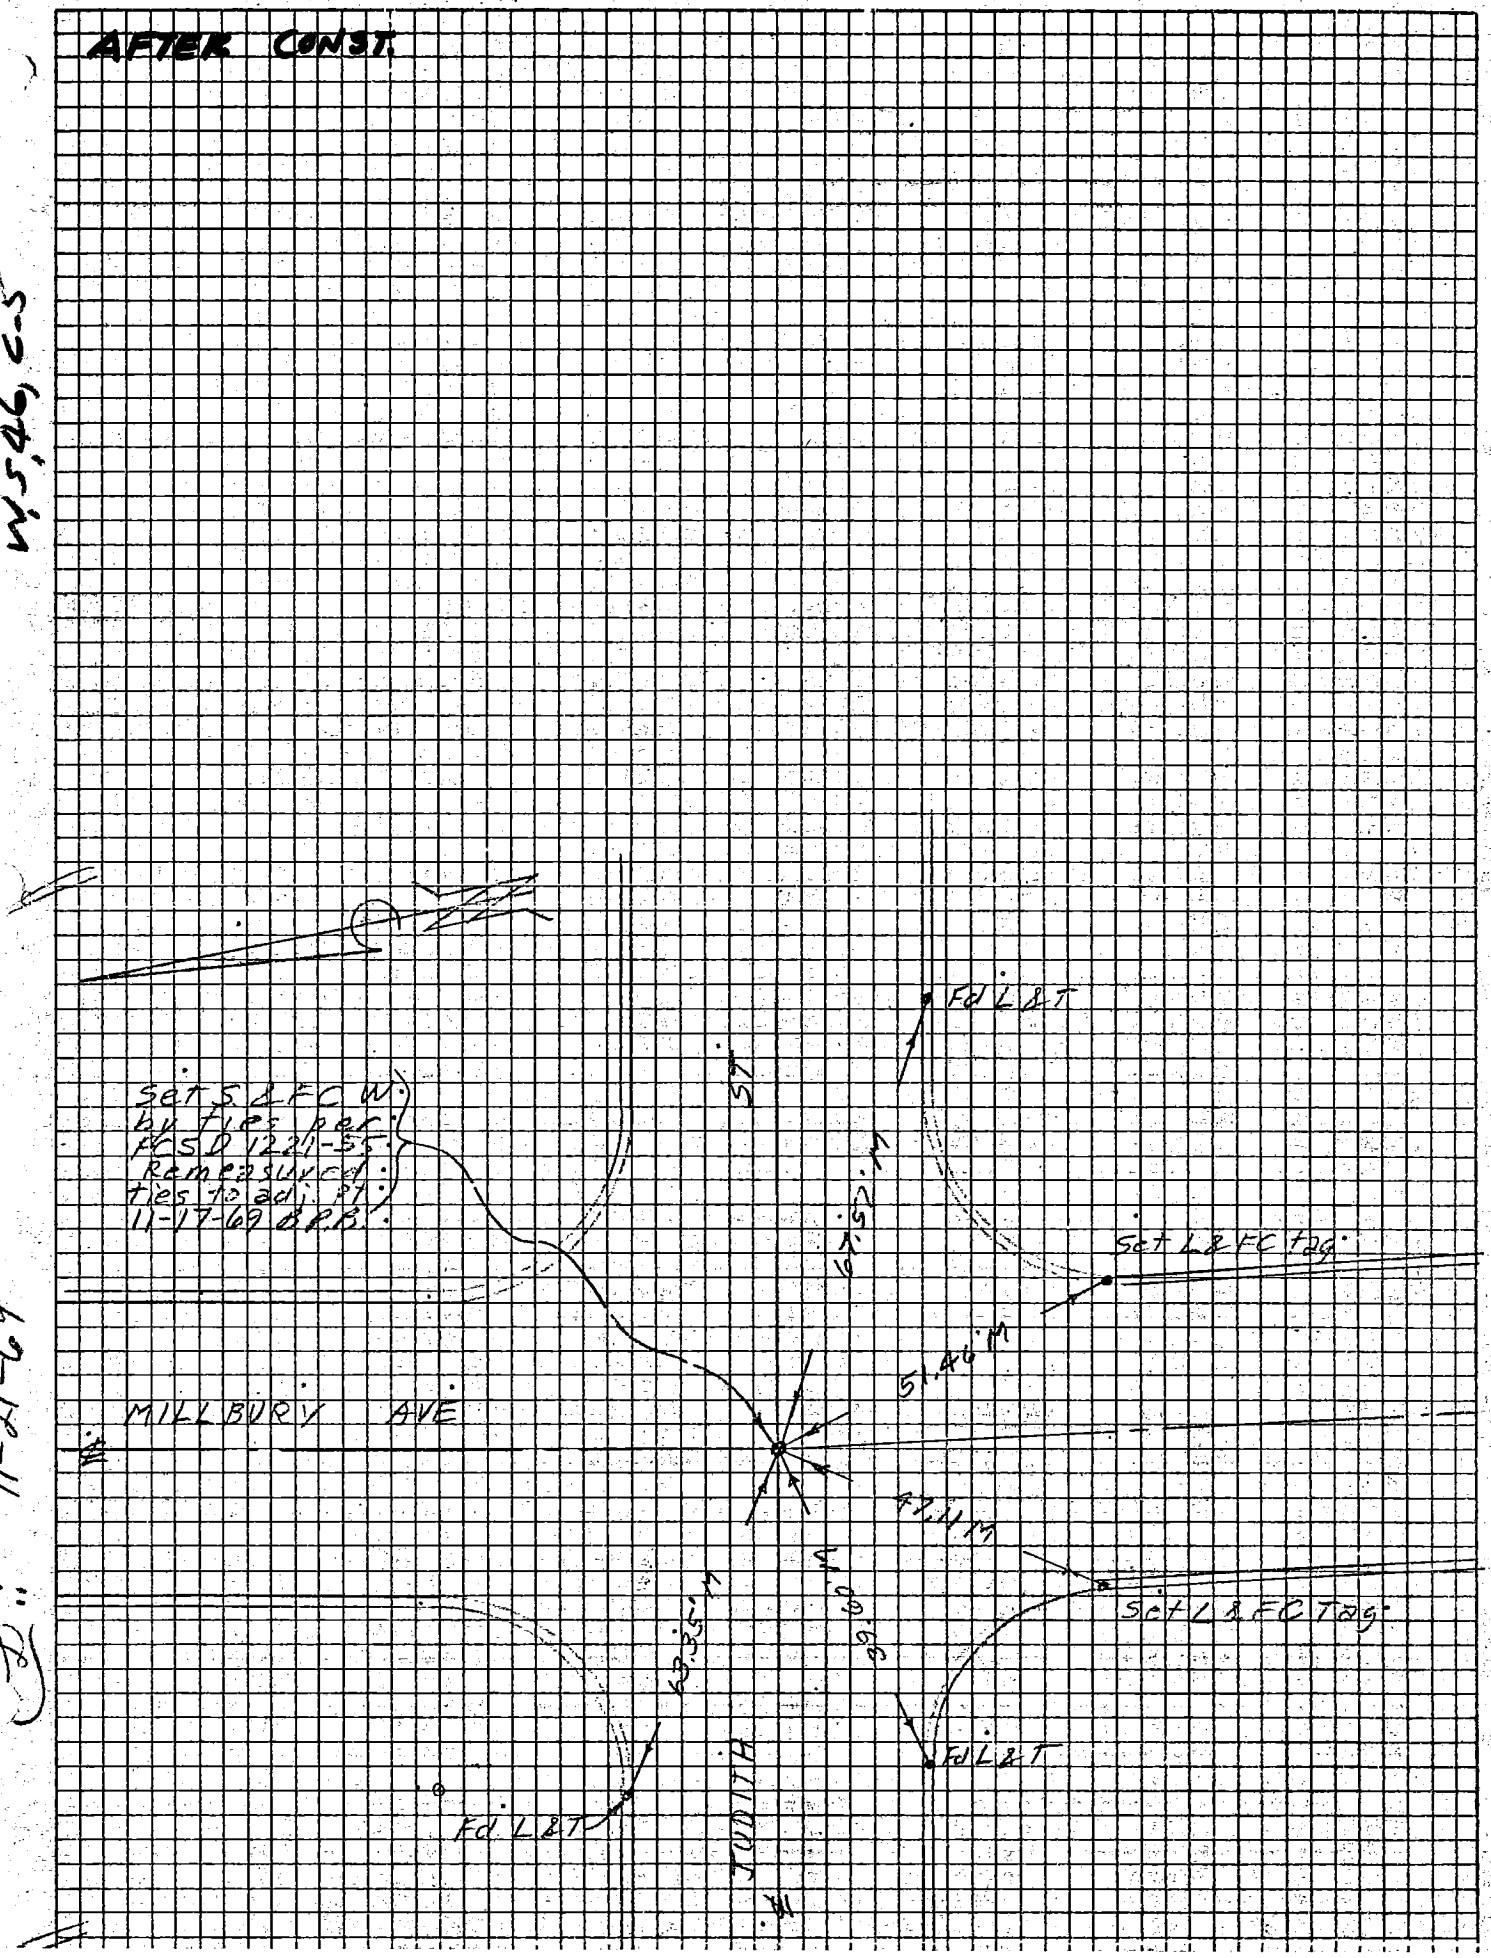

11-- Cdb 3-69

PROJECT 1221 Unit 1 Line A

SURVEY BY Nixon DATE 4-10-72

REVIEWED BY DATE

Co. Engr. F.B. 3555: 93

INDEX FCSD1221 123

R&R 7A

LOS ANGELES COUNTY FLOOD CONTROL DISTRICT

W546-5

Pks Fd Por FCSD 1221-61

**AFTER CONSTRUCTION**

AVE

Fd L&T
11/7/68 B.P.B.
Out 11/17/69
After Const BPB.
**Out** 4/10/72 ETN

Fd L&T
11/7/68 BPB
Out 11/17/69
After Const - BPB
**Out** 4/10/72 ETN

Set L&T FC Tag
11/7/68 BPB
Fd After Const 11/17/69 BPB
Fd 4/10/72 ETN

49.19 M.

63.93 Calc

63.89 Calc

SAUDER

Fd 2x2
11/7/68 BPB
11/17/69 BPB
4/10/72 ETN

AVE.

Fd Nail 11/7/68 BPB
11/17/69 BPB
4/10/72 ETN

0.14 Calc

49.11 M.

62.97 Calc

(49.01)

Set L&T FC Tag
11/7/68 BPB
Fd After Const 11/17/69 BPB
Fd 4/10/72 ETN

Fd L&T
11/7/68 BPB
11/17/69 BPB
4/10/72 ETN

Fd L&T
11/7/68 BPB
11/17/69 BPB
4/10/72 ETN

VAN NUYS

89.11— Cdb 1-68

PROJECT No. 1221 UNIT 1 LINE "C" Co. Engr. F.B. 3555: 94 INDEX FCSD1221 125

SURVEY BY B.P.B. DATE 11-17-69

REVIEWED BY DATE 11-21-69

R & R 9

LOS ANGELES COUNTY FLOOD CONTROL DISTRICT

W.S. 38 A 3

AFTER CONSTRUCTION

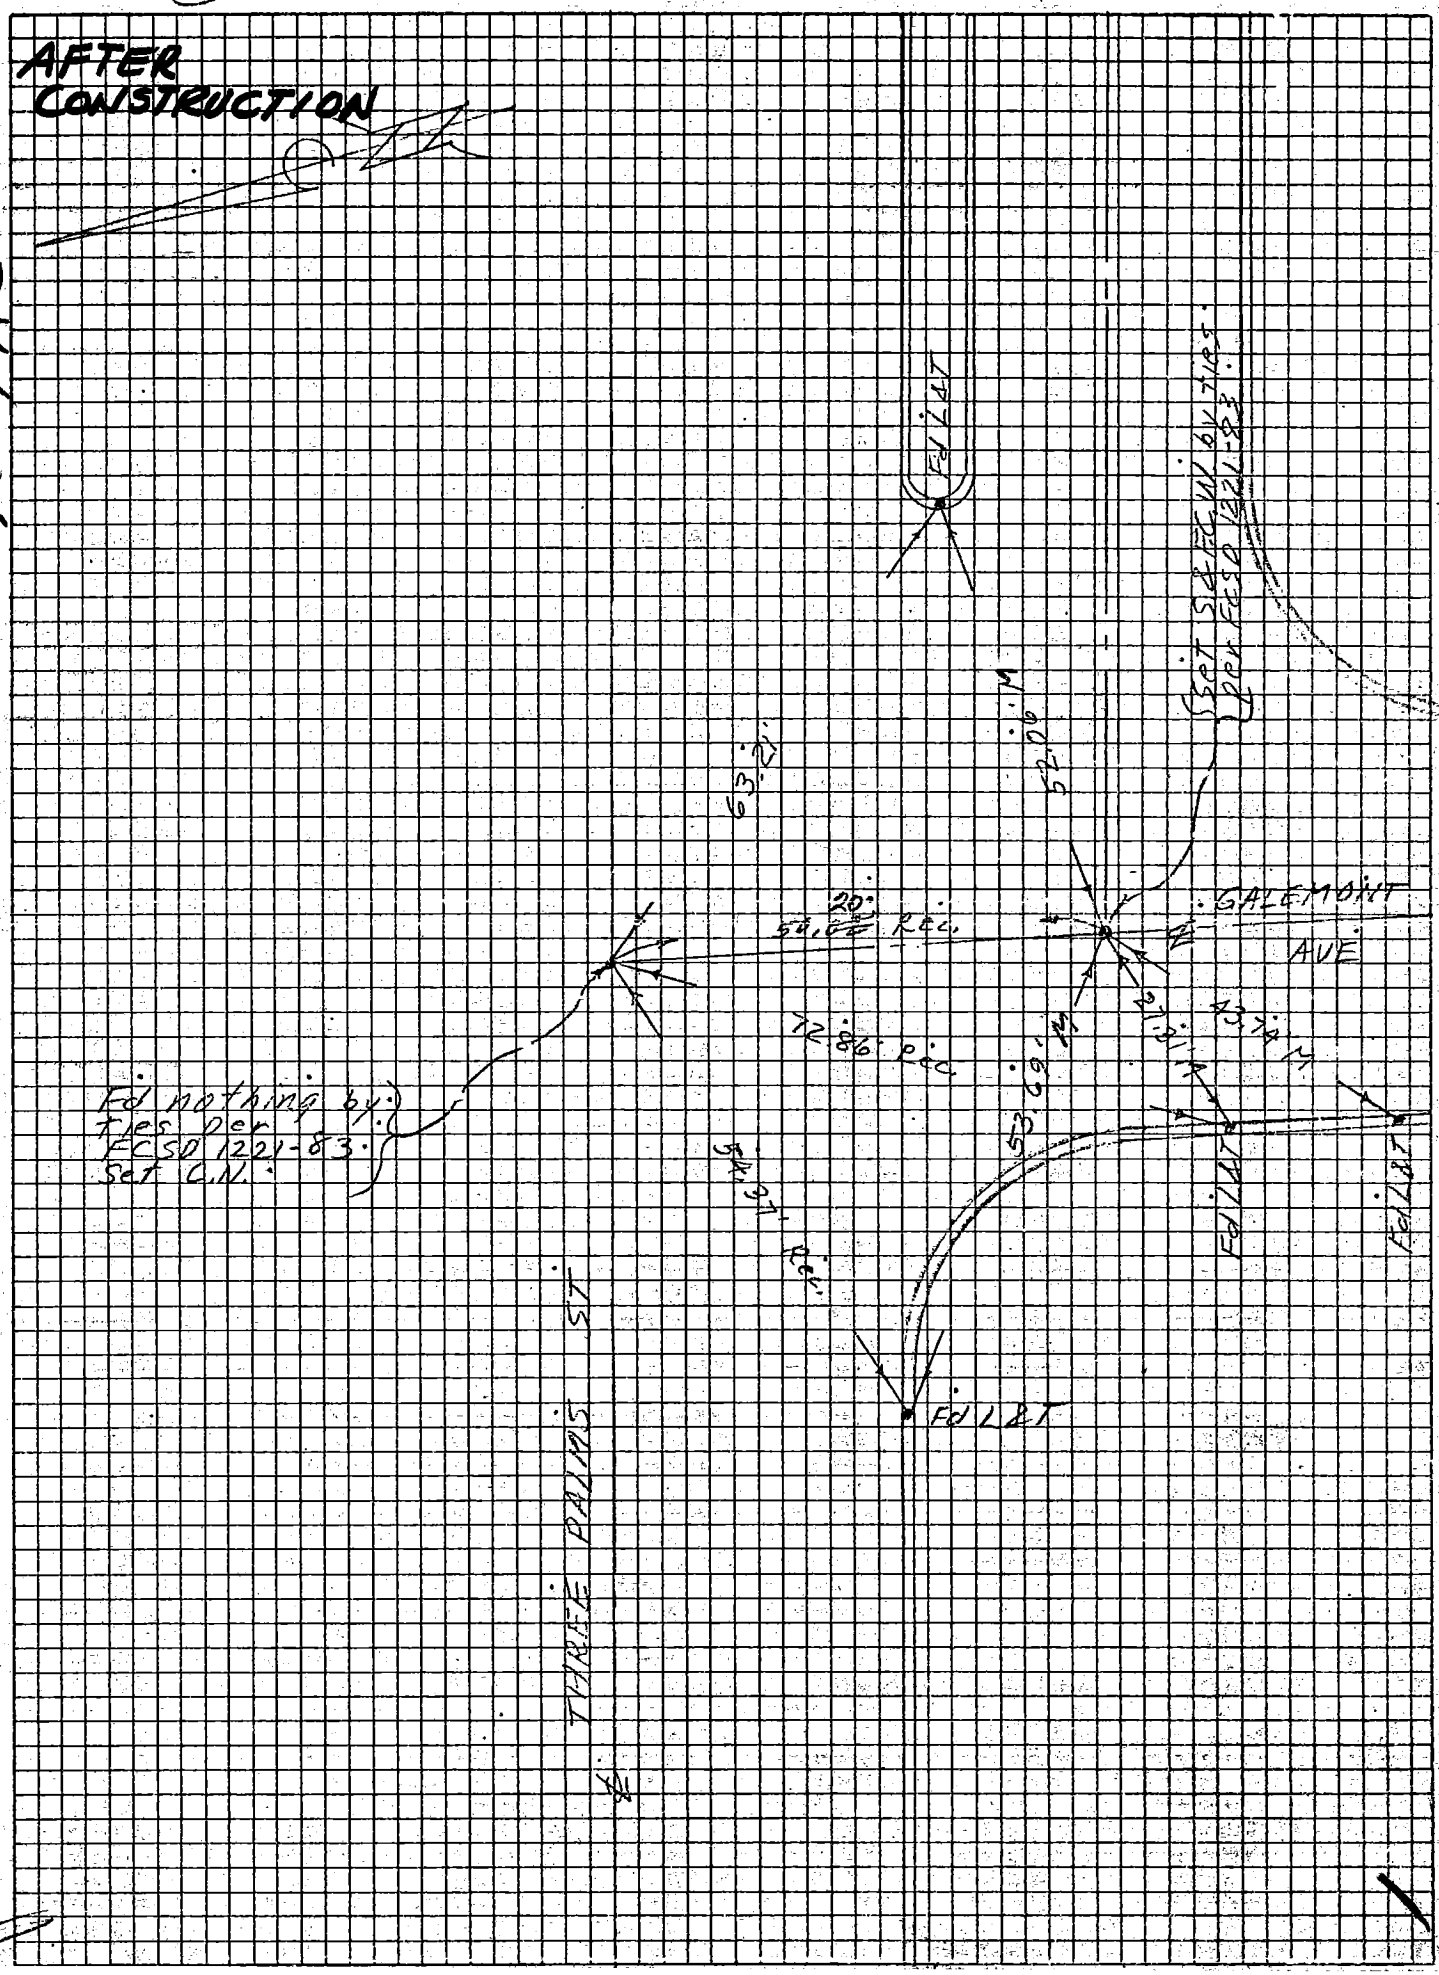

76S911— Cdb 3-69

PROJECT 1221 Unit 1 Line C Co. Engr. F.B. 3555: 95 INDEX FCSD1221 127

SURVEY BY NIXON DATE 4-10-92 R#R-11

REVIEWED BY DATE LOS ANGELES COUNTY FLOOD CONTROL DISTRICT

All Fd Pts Per FCSD 1221-87

**AFTER CONSTRUCTION**

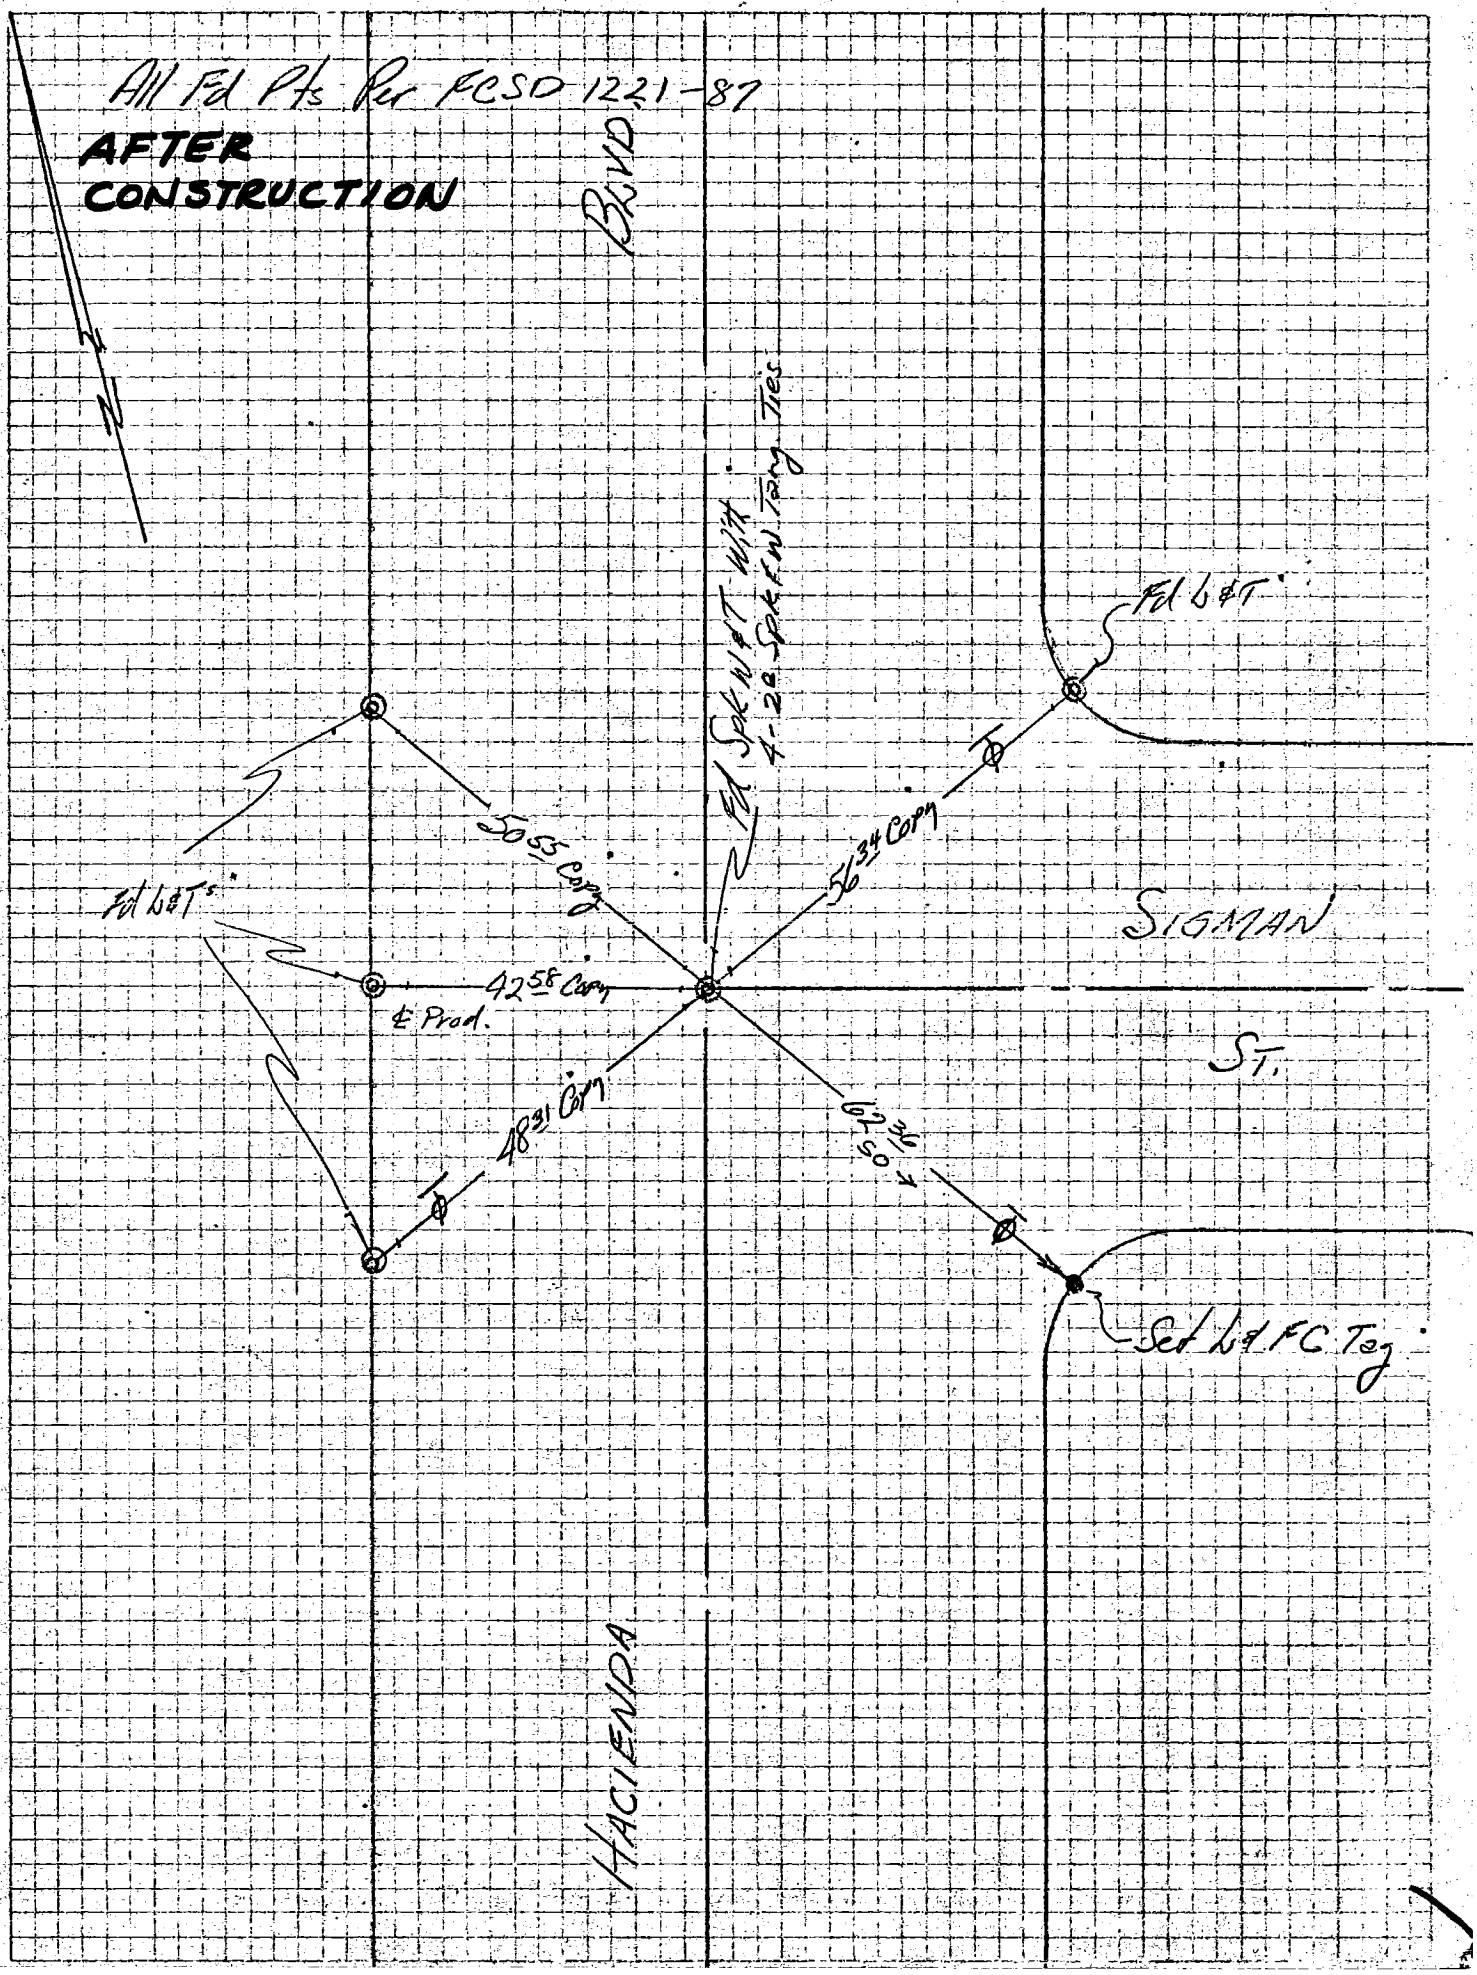


WS09-297, 14-1

Cdb 3-69

SUBJECT 1221 Unit 1 Line C

SURVEY BY Nixon DATE 4-10-72

REVIEWED BY [illegible] DATE

Co. Engr. F.B. 3555:96

INDEX FCSD1221 129

R&R-13

LOS ANGELES COUNTY FLOOD CONTROL DISTRICT

(96)


AFTER CONSTRUCTION

N




Fd Spk W.A.T.

Set Lead FC Tag









76S911--Cdb 5-66

PROJECT 1221 - Unit Line D  Co. Engr. F.B. 3555: 97  INDEX FCSD1221 131

SURVEY BY NIXON  DATE 6-28-68  M-3.

REVIEWED BY  DATE

LOS ANGELES COUNTY FLOOD CONTROL DISTRICT

W.S. 37, E-4

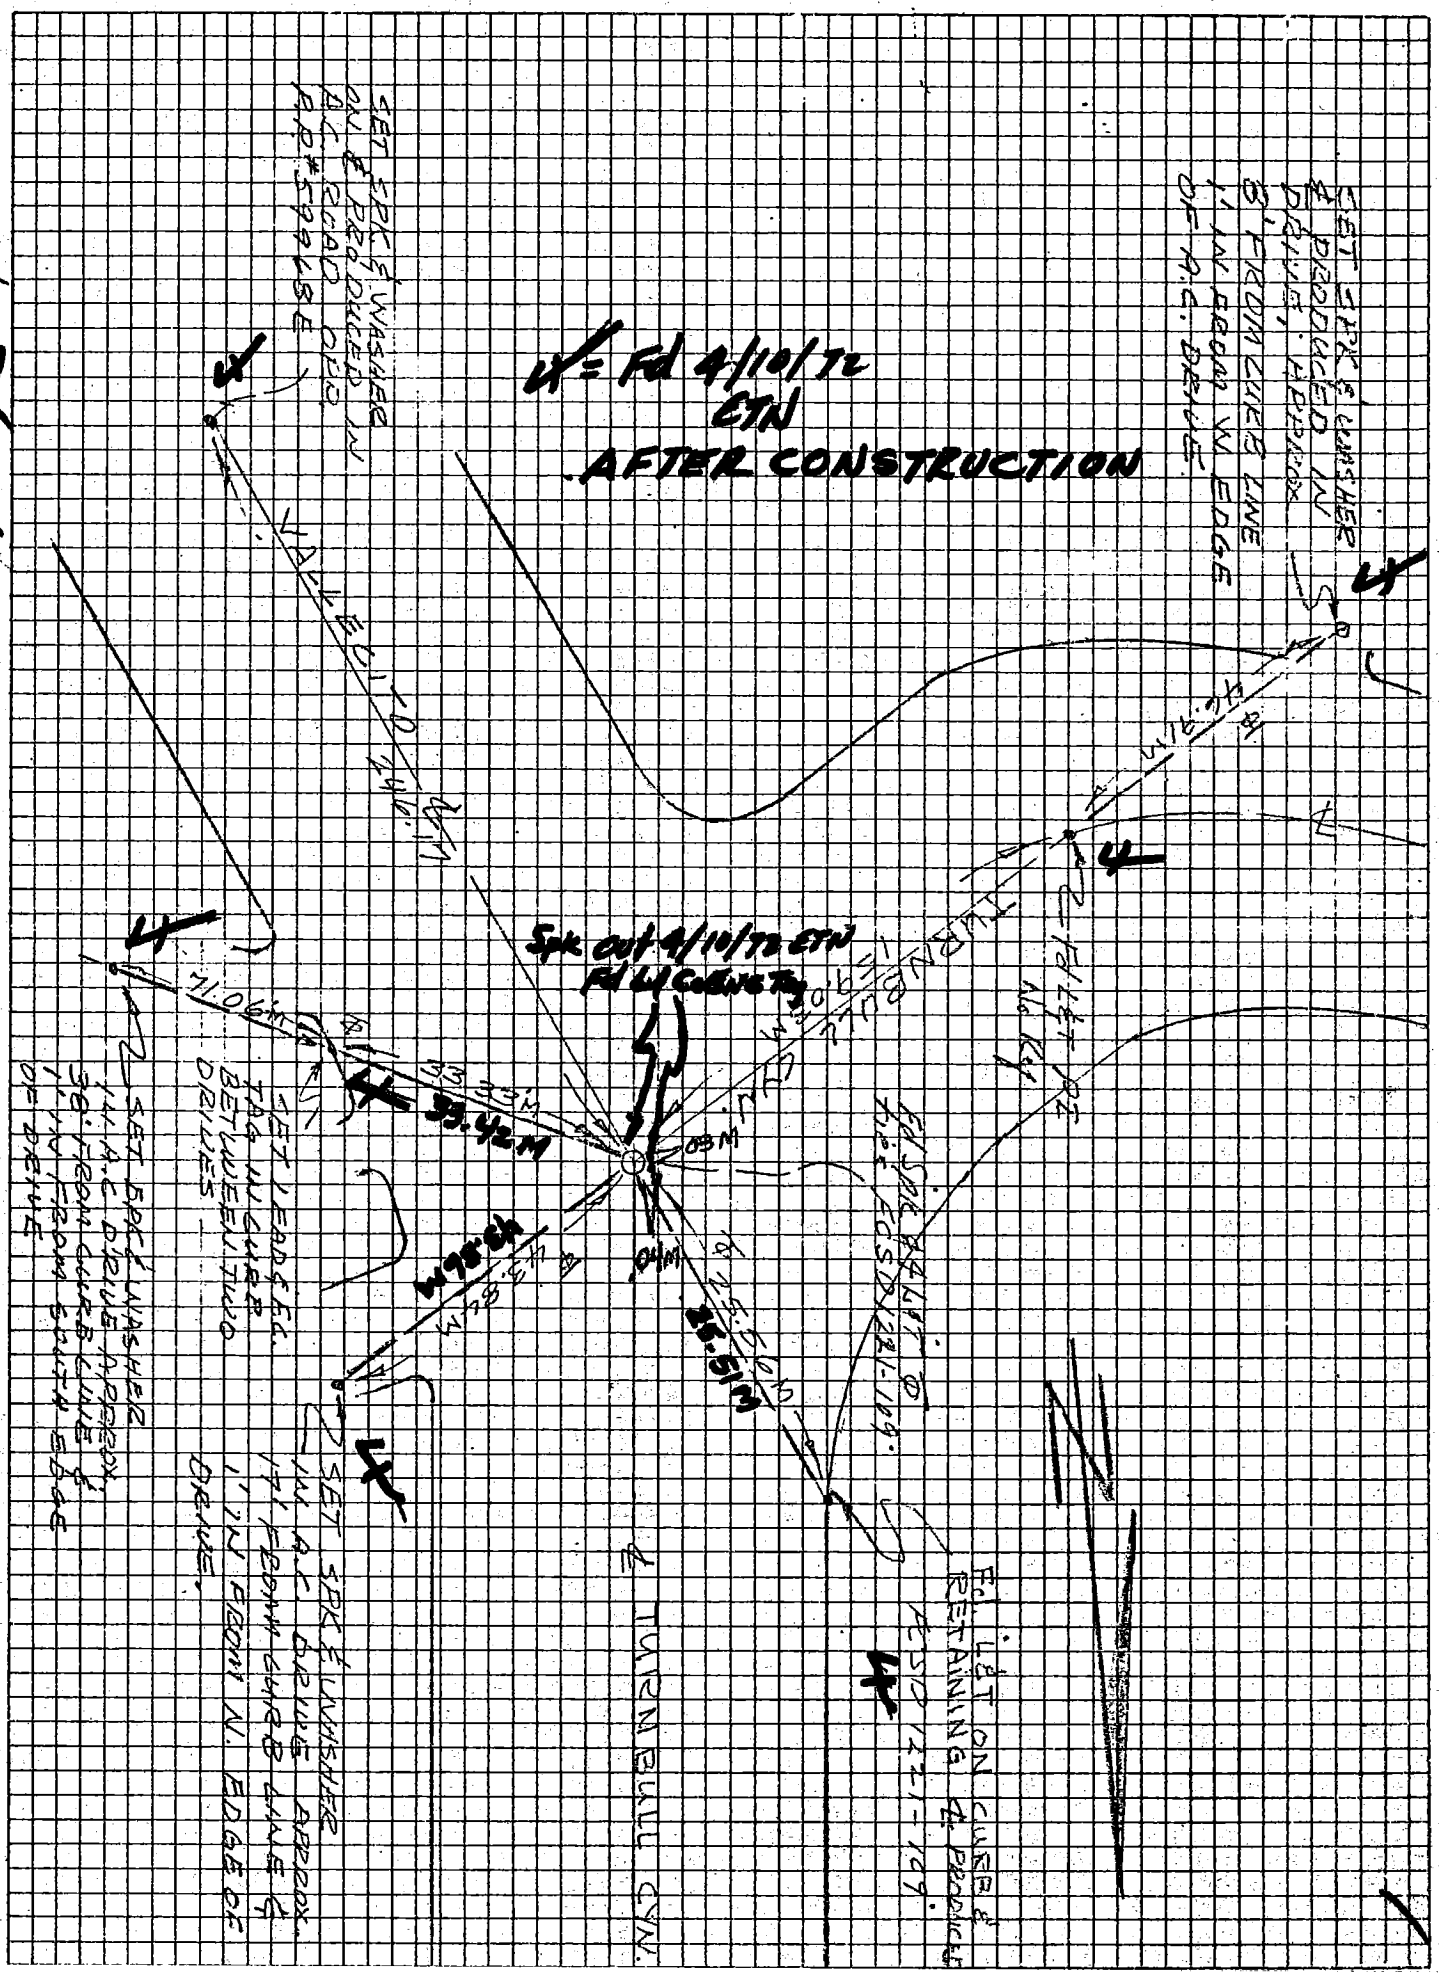

Co. Engr. F.B. 3555: 98

(98)

FCSD 703 45

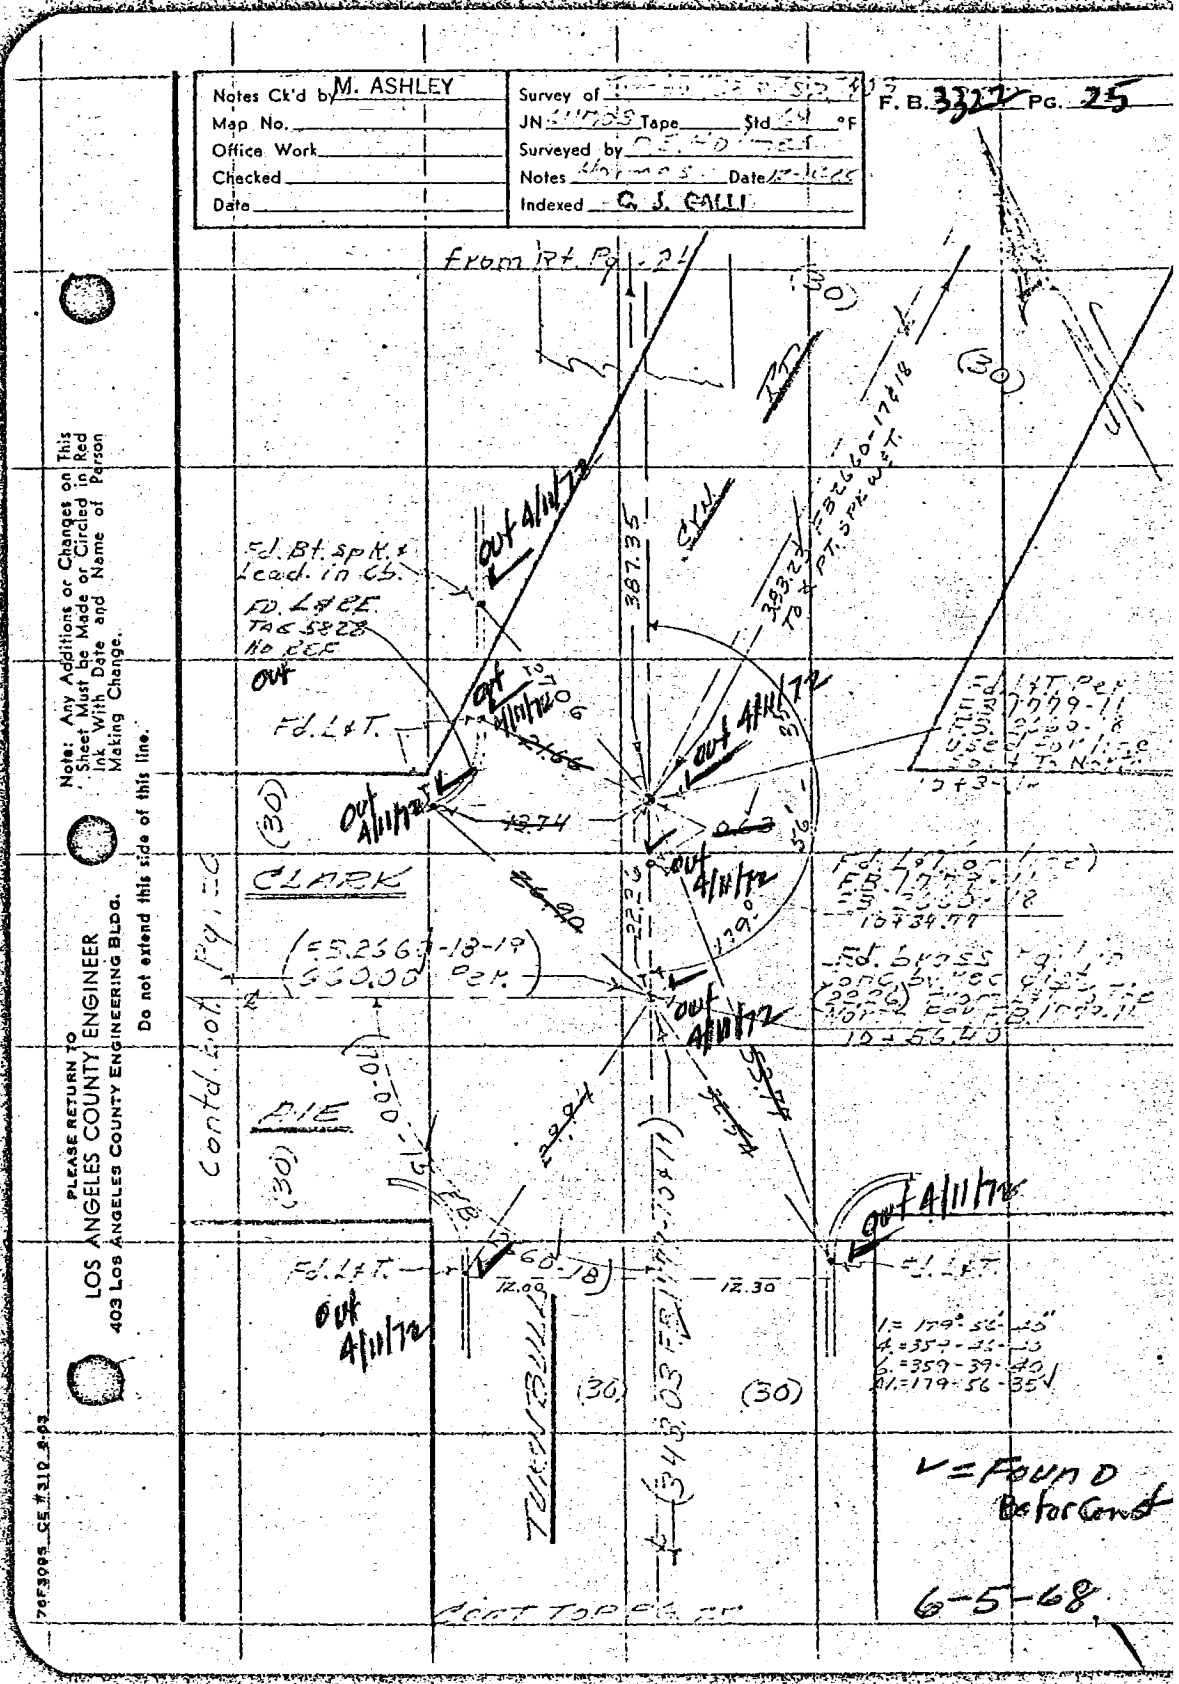


All Mts Destroyed due to Street Widening By Others 4/11/72 GSG

V = Fd. L & T. - 5.20' N & E of Pt.

W. 538 A-2

FOR LATER TIES SEE F.C.S.D. 703-109

Co. Engr. F.B. 3555: 99 (99)

FCSD 703 : 51

FOR LATER TIES SEE F.C.S.D. 703- PG 111

W.S. 28 4-2

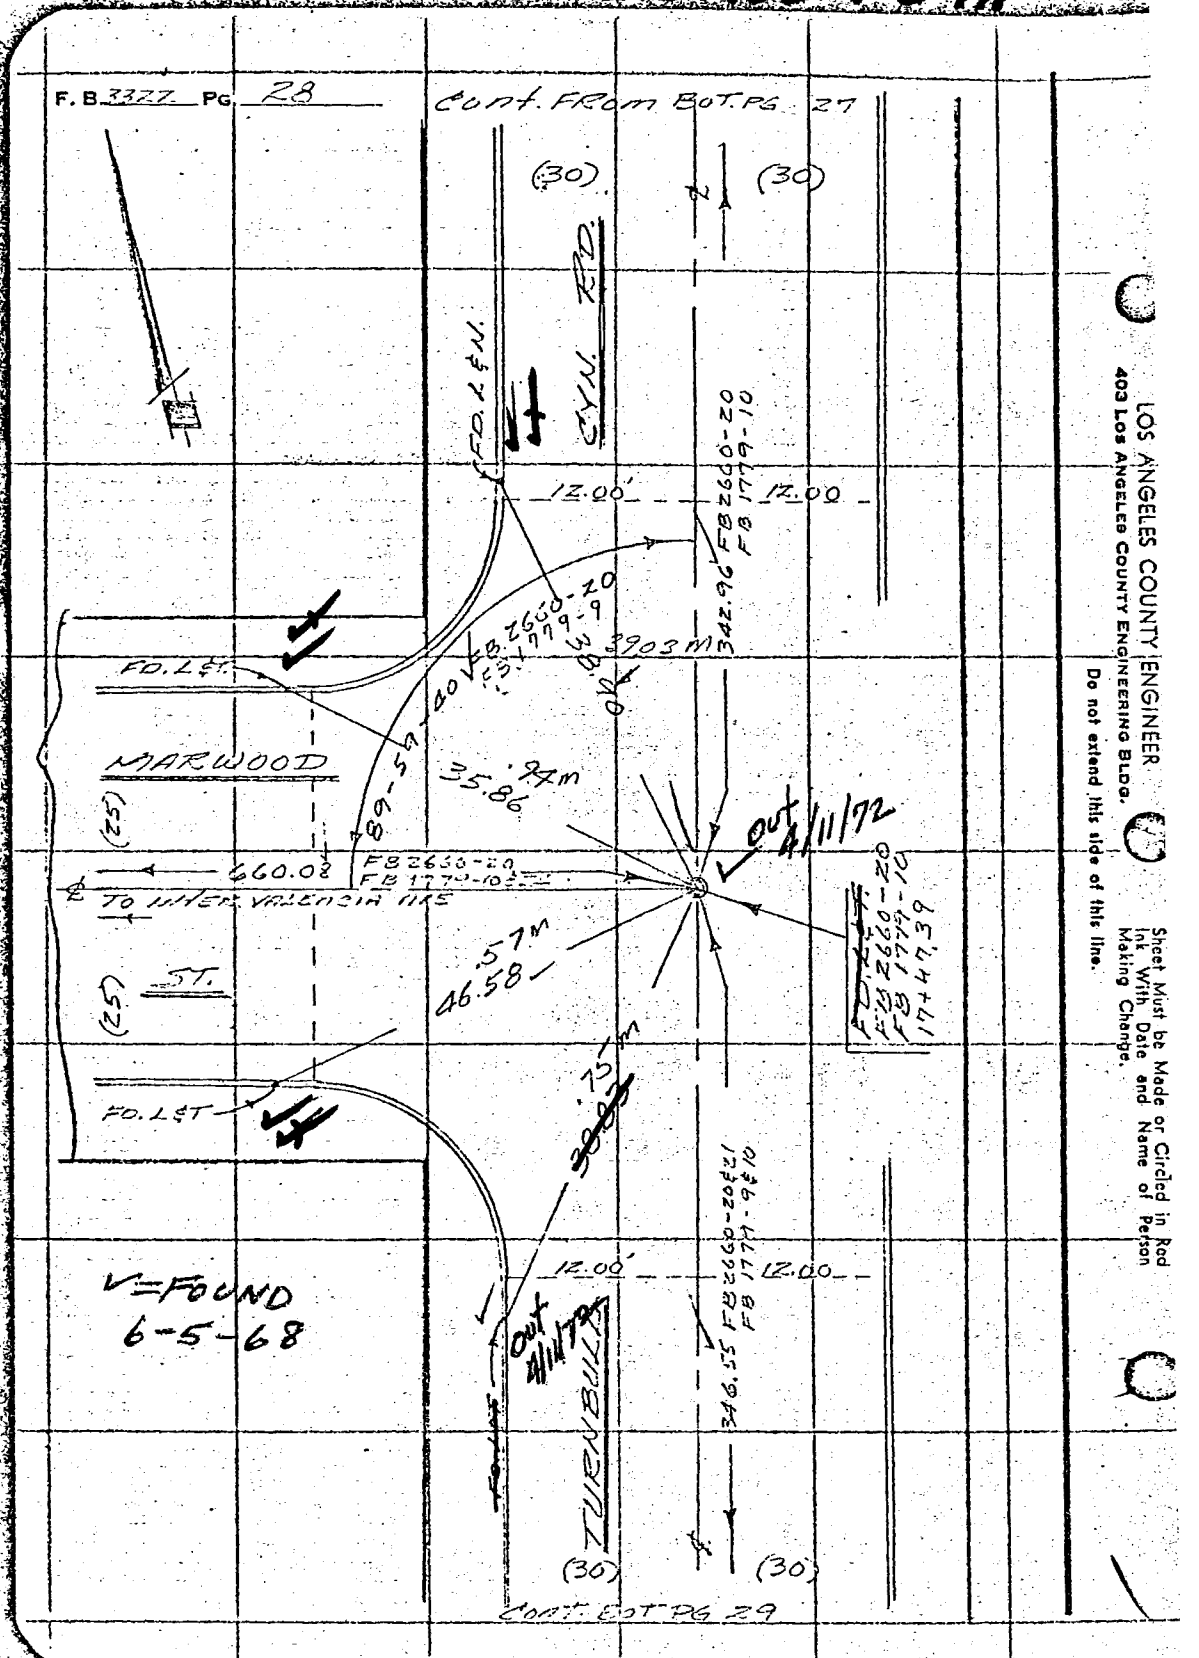


V = FD. 6-5-68 Cont. Set 4/11/72 ETN

LOS ANGELES COUNTY ENGINEER
403 Los Angeles County Engineering Bldg.
Do not extend this side of this line.

Sheet Must be Made or Circled in Red Ink With Date and Name of Person Making Change.

Co. Engr. F.B. 3555: 100 (100)

FCSD 703 53

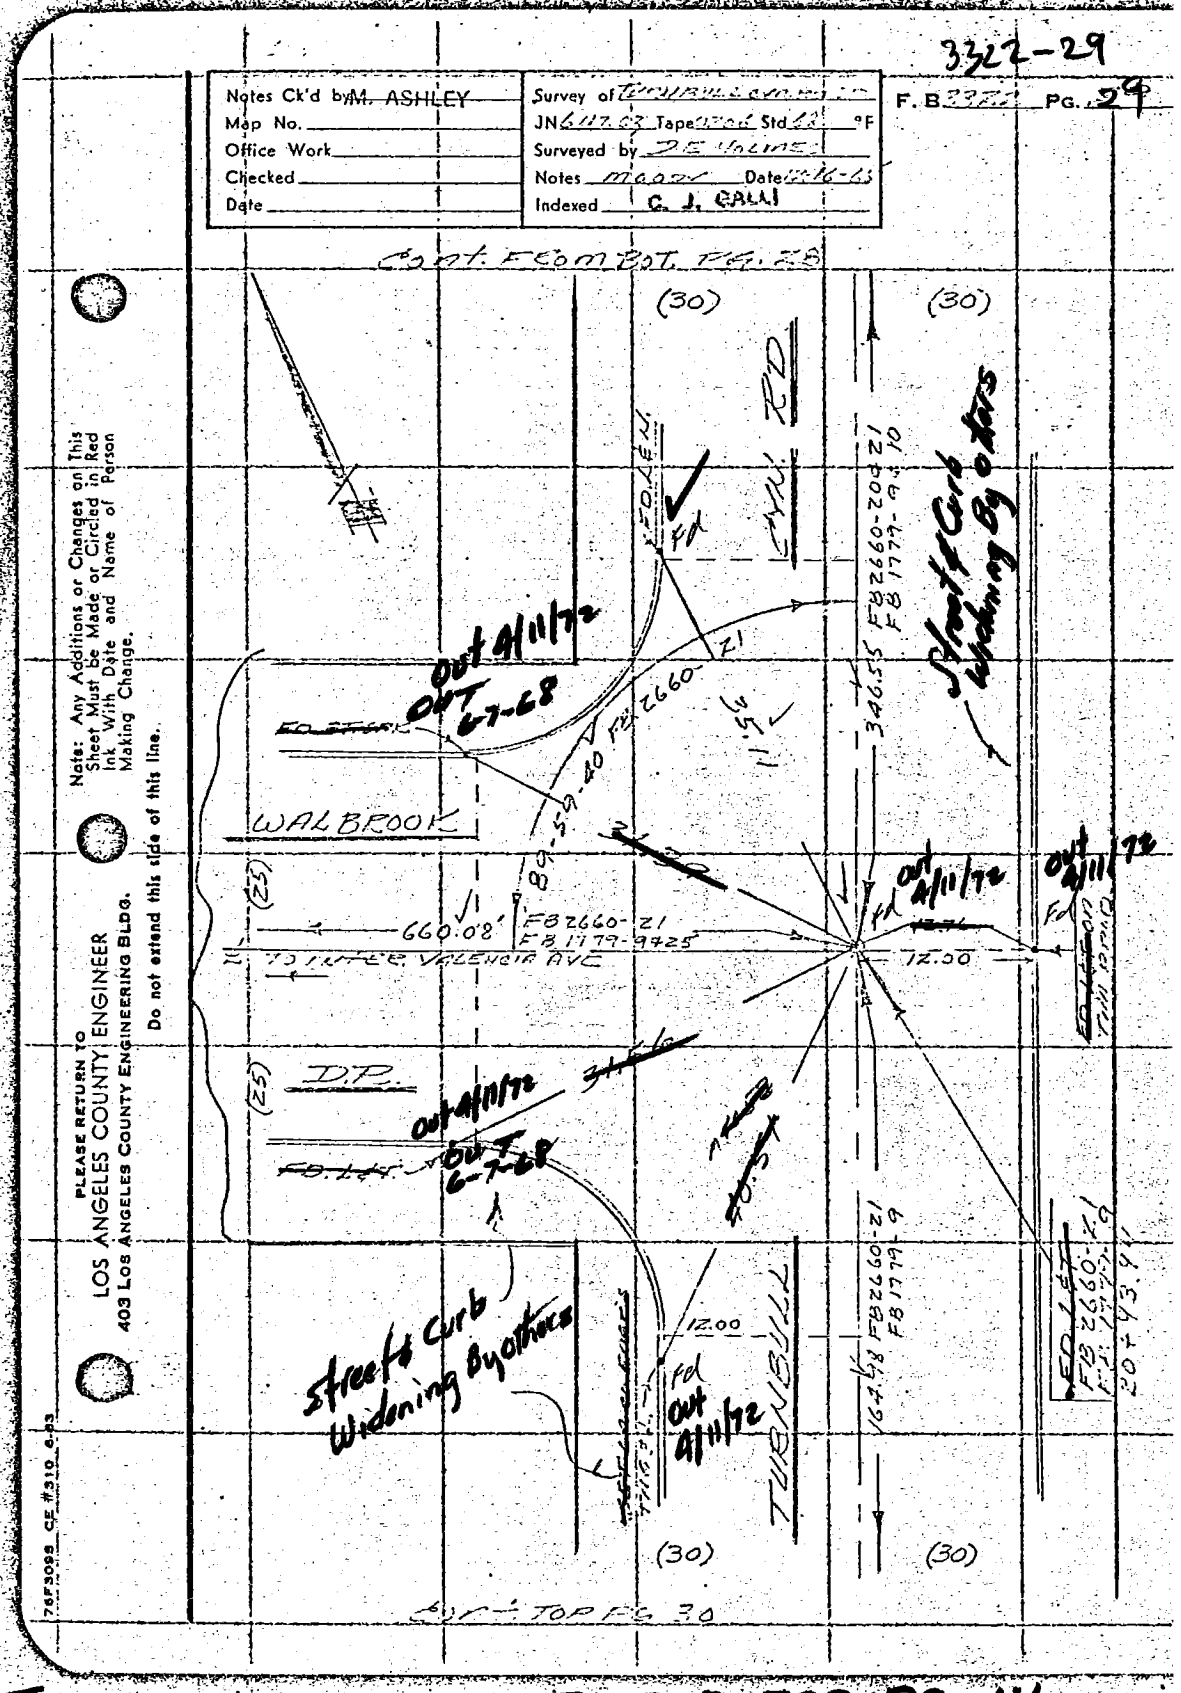


W.S. 38, A-3

Fd. = Fd Bolt found 4/11/72 ETN

V = Fd Bolt-Chest 4-11-72 ETN

FOR LATER TIES SEE F.C.S.D. 703 PG-111

Co. Engr. F.B. 3555: 101 (101)
FCSD 703 55

FOR LATER TIES SEE F.C.S.D. 703 PG 113

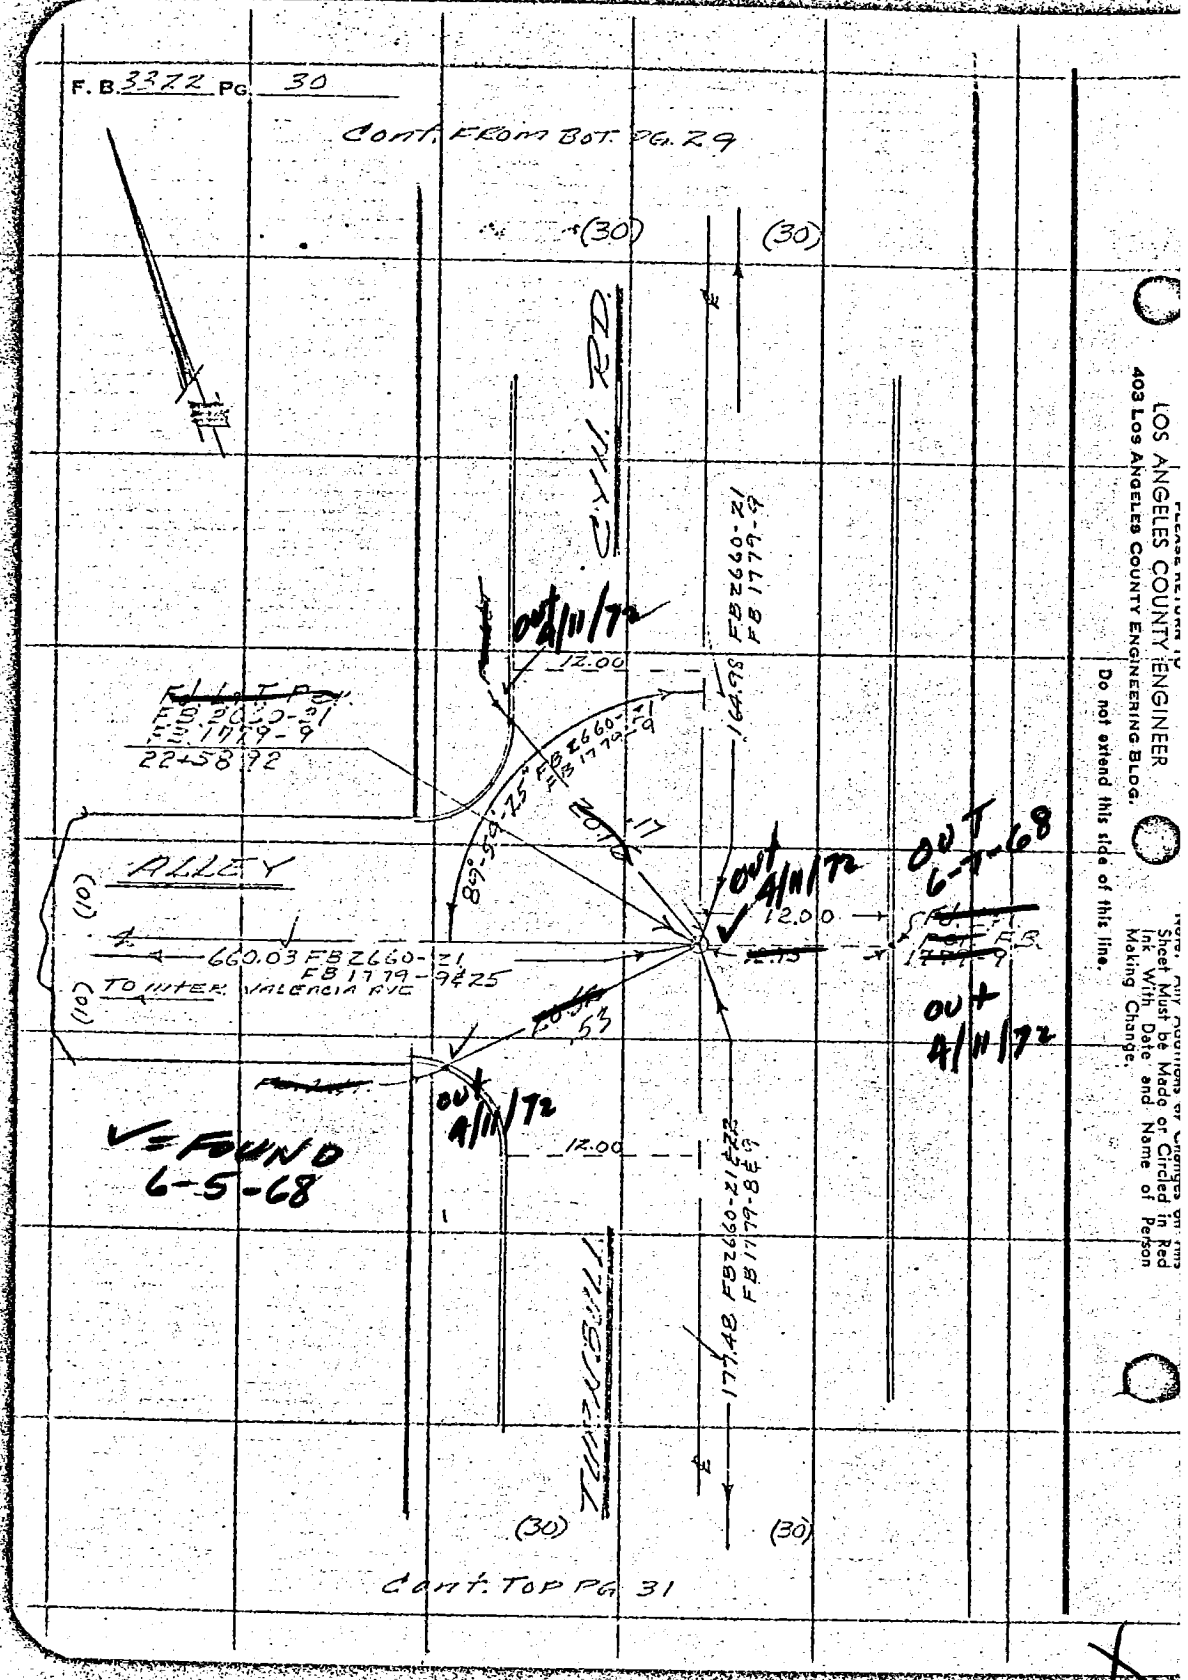


All R/S Sou 4/11/72 ETM
due to Street & Curb widening By others

LOS ANGELES COUNTY ENGINEER
403 Los Angeles County Engineering Bldg.
Do not extend this side of this line.

Sheet. Any Additions or Changes on this Ink With Date and Name of Person Making Change.

Co. Engr. F.B. 3555: 102 (102)

FCSD 703 59

FOR LATER TIES SEE F.C.S.D. 703 PG 115

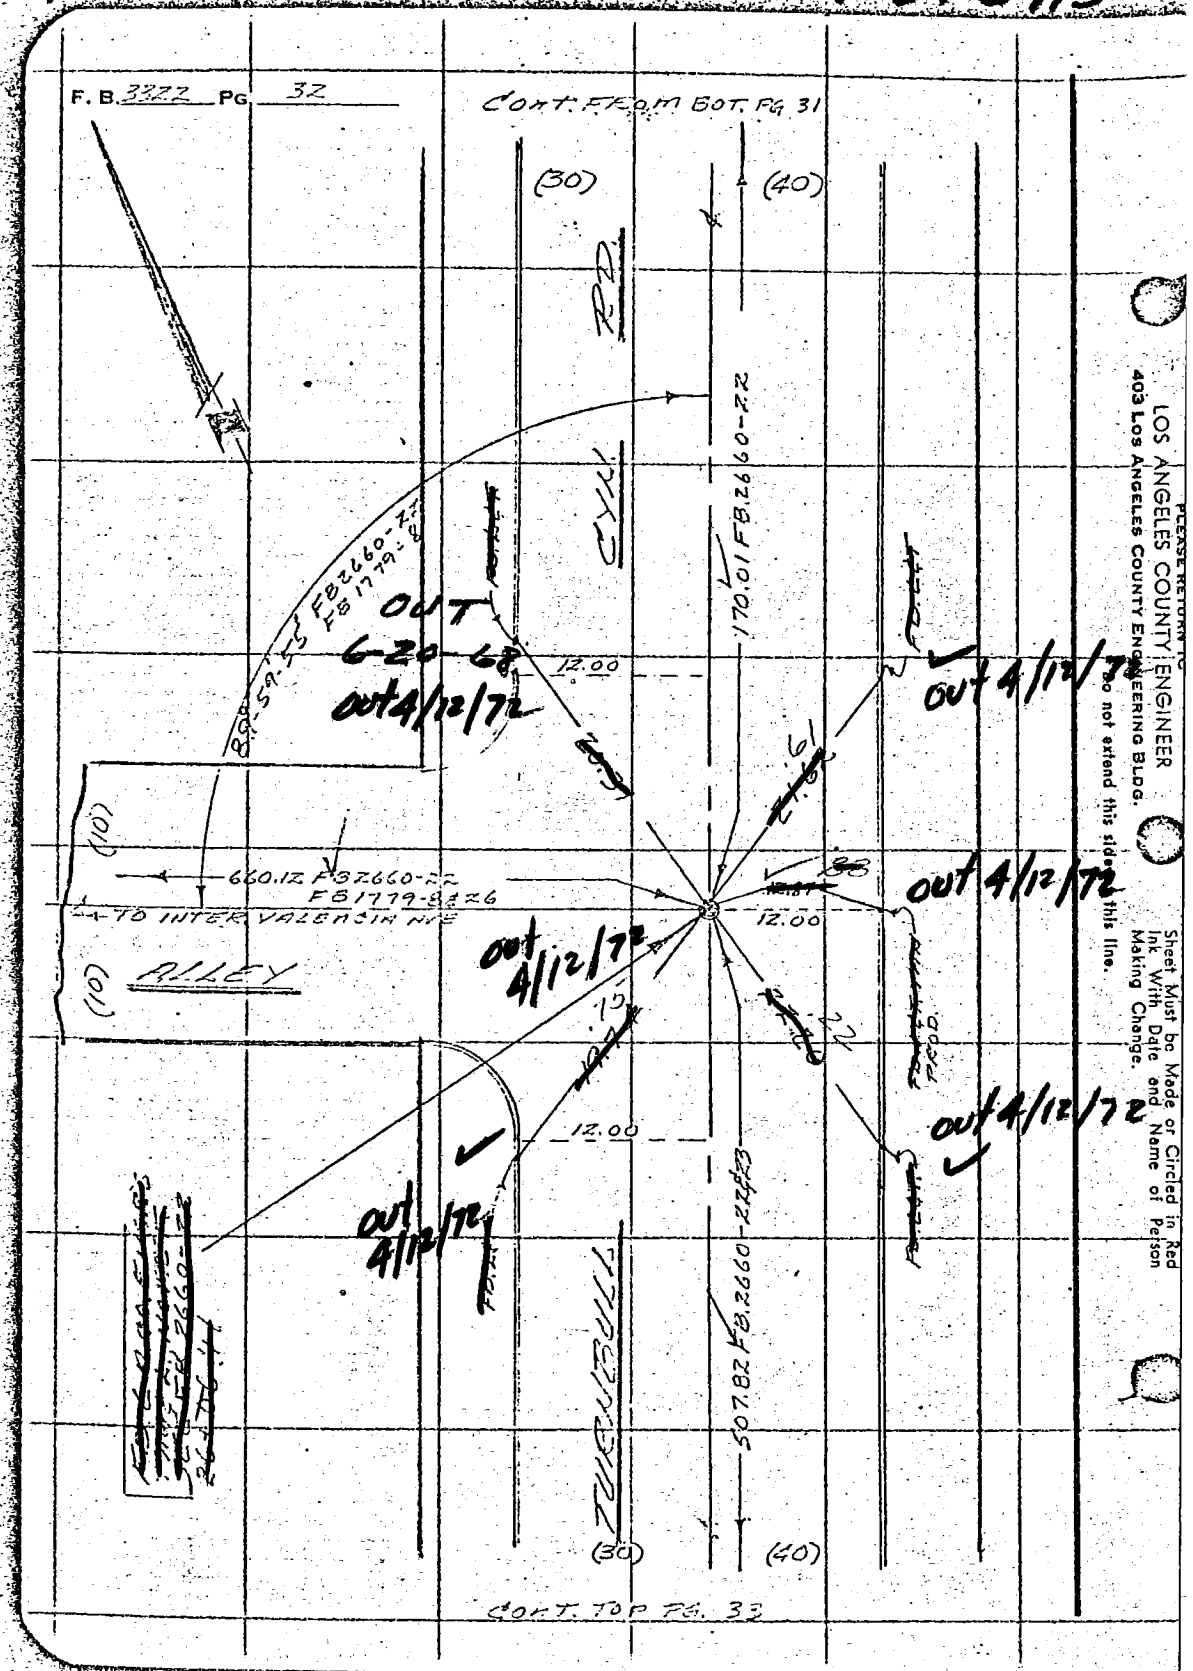




LOS ANGELES COUNTY ENGINEER
403 Los Angeles County Engineering Bldg.
Please Return To
Do not extend this side of this line.
Sheet Must be Made or Circled in Red Ink With Date and Name of Person Making Change.

X

Co. Engr. F.B. 3555: 103 (103)

FCSD 703 61

FOR LATER TIES SEE F.C.S.D. 703 P6 117

W.S. #8, A-3

3322-33

F. B. 3372 Pg. 33

| | |
|---|---|
| Notes Ck'd by M. ASHLEY | Survey of TOWN & EXT. STA. ED. S.D. |
| Map No. | JN 611703 Tape 25' Std. 68 °F |
| Office Work | Surveyed by D. E. Holmes |
| Checked | Notes Hwy 60 Date 2-17-68 |
| Date | Indexed C. J. GALLI |

Note: Any Additions or Changes on This Sheet Must be Made or Circled in Red Ink With Date and Name of Person Making Change.

PLEASE RETURN TO LOS ANGELES COUNTY ENGINEER 403 Los Angeles County Engineering Bldg.

Do not extend this side of this line.

70F3065 CE # 312 3-61

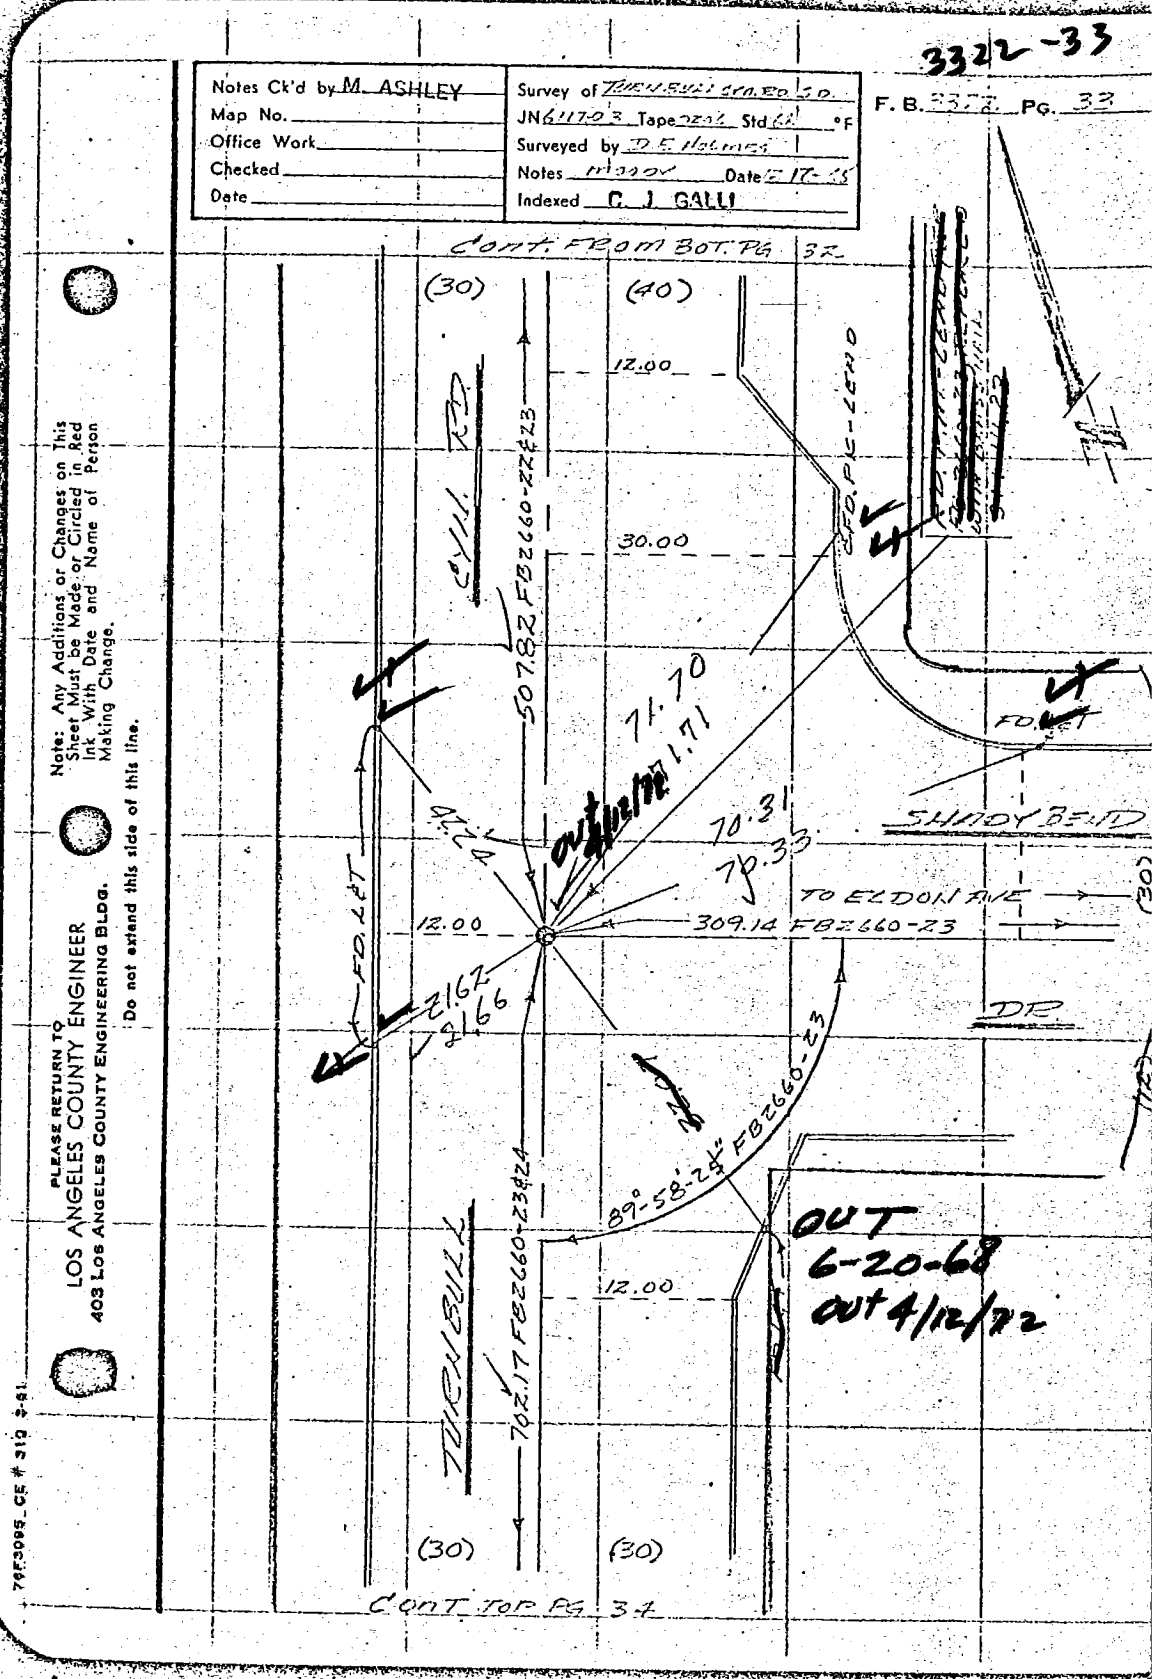


LV = Fd. After Const 4/12/72 ETN

FOR LATER TIES SEE F.C.S.D. 703 P6 119

W.S. 38 A-3

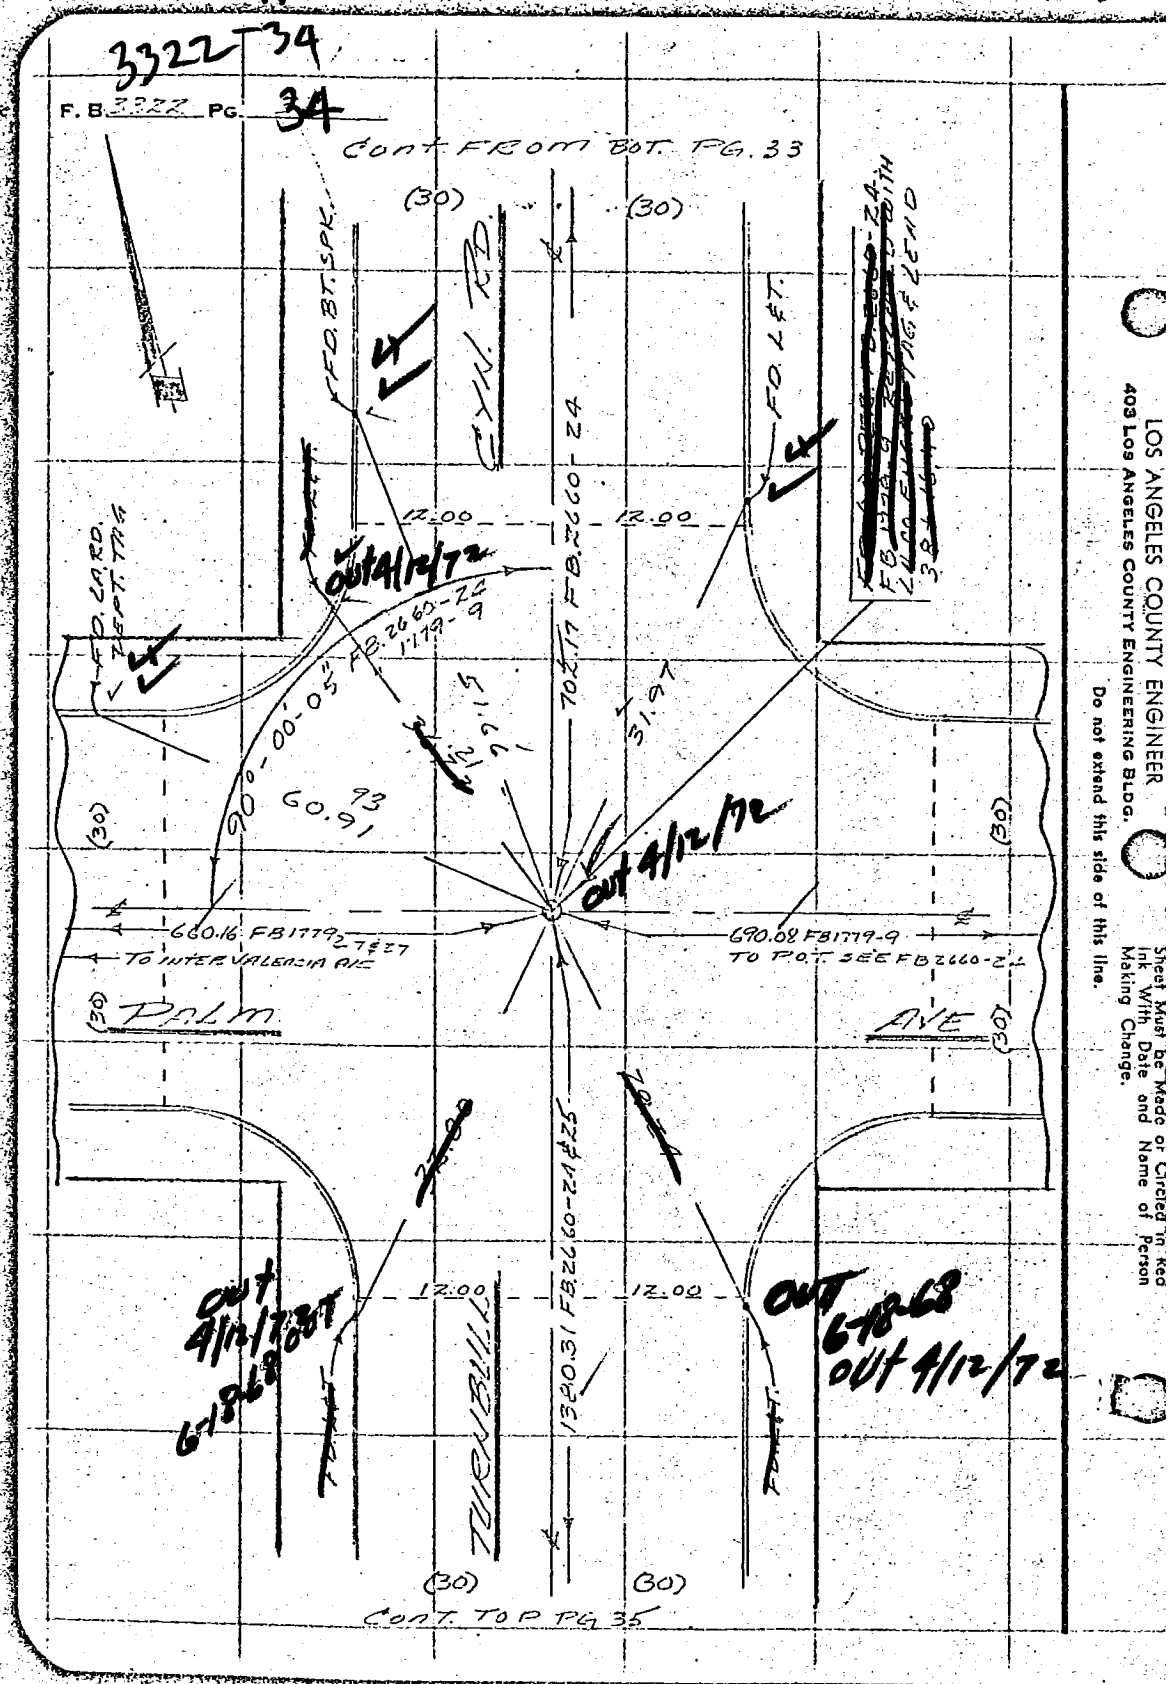


Sheet Must Be Made or Circled in Red Ink With Date and Name of Person Making Change.

LOS ANGELES COUNTY ENGINEER
403 Los Angeles County Engineering Bldg.
Do not extend this side of this line.

LT = Rd 4/12/72 ETN

PROJECT SD. 703, Unit 2

SURVEY BY Hyfinch DATE 6-5-68

REVIEWED BY PHK DATE 6/25/68

INDEX FCSD 703.109-3 (105)

Co. Engr. F.B. 3555: 105

LOS ANGELES COUNTY FLOOD CONTROL DISTRICT

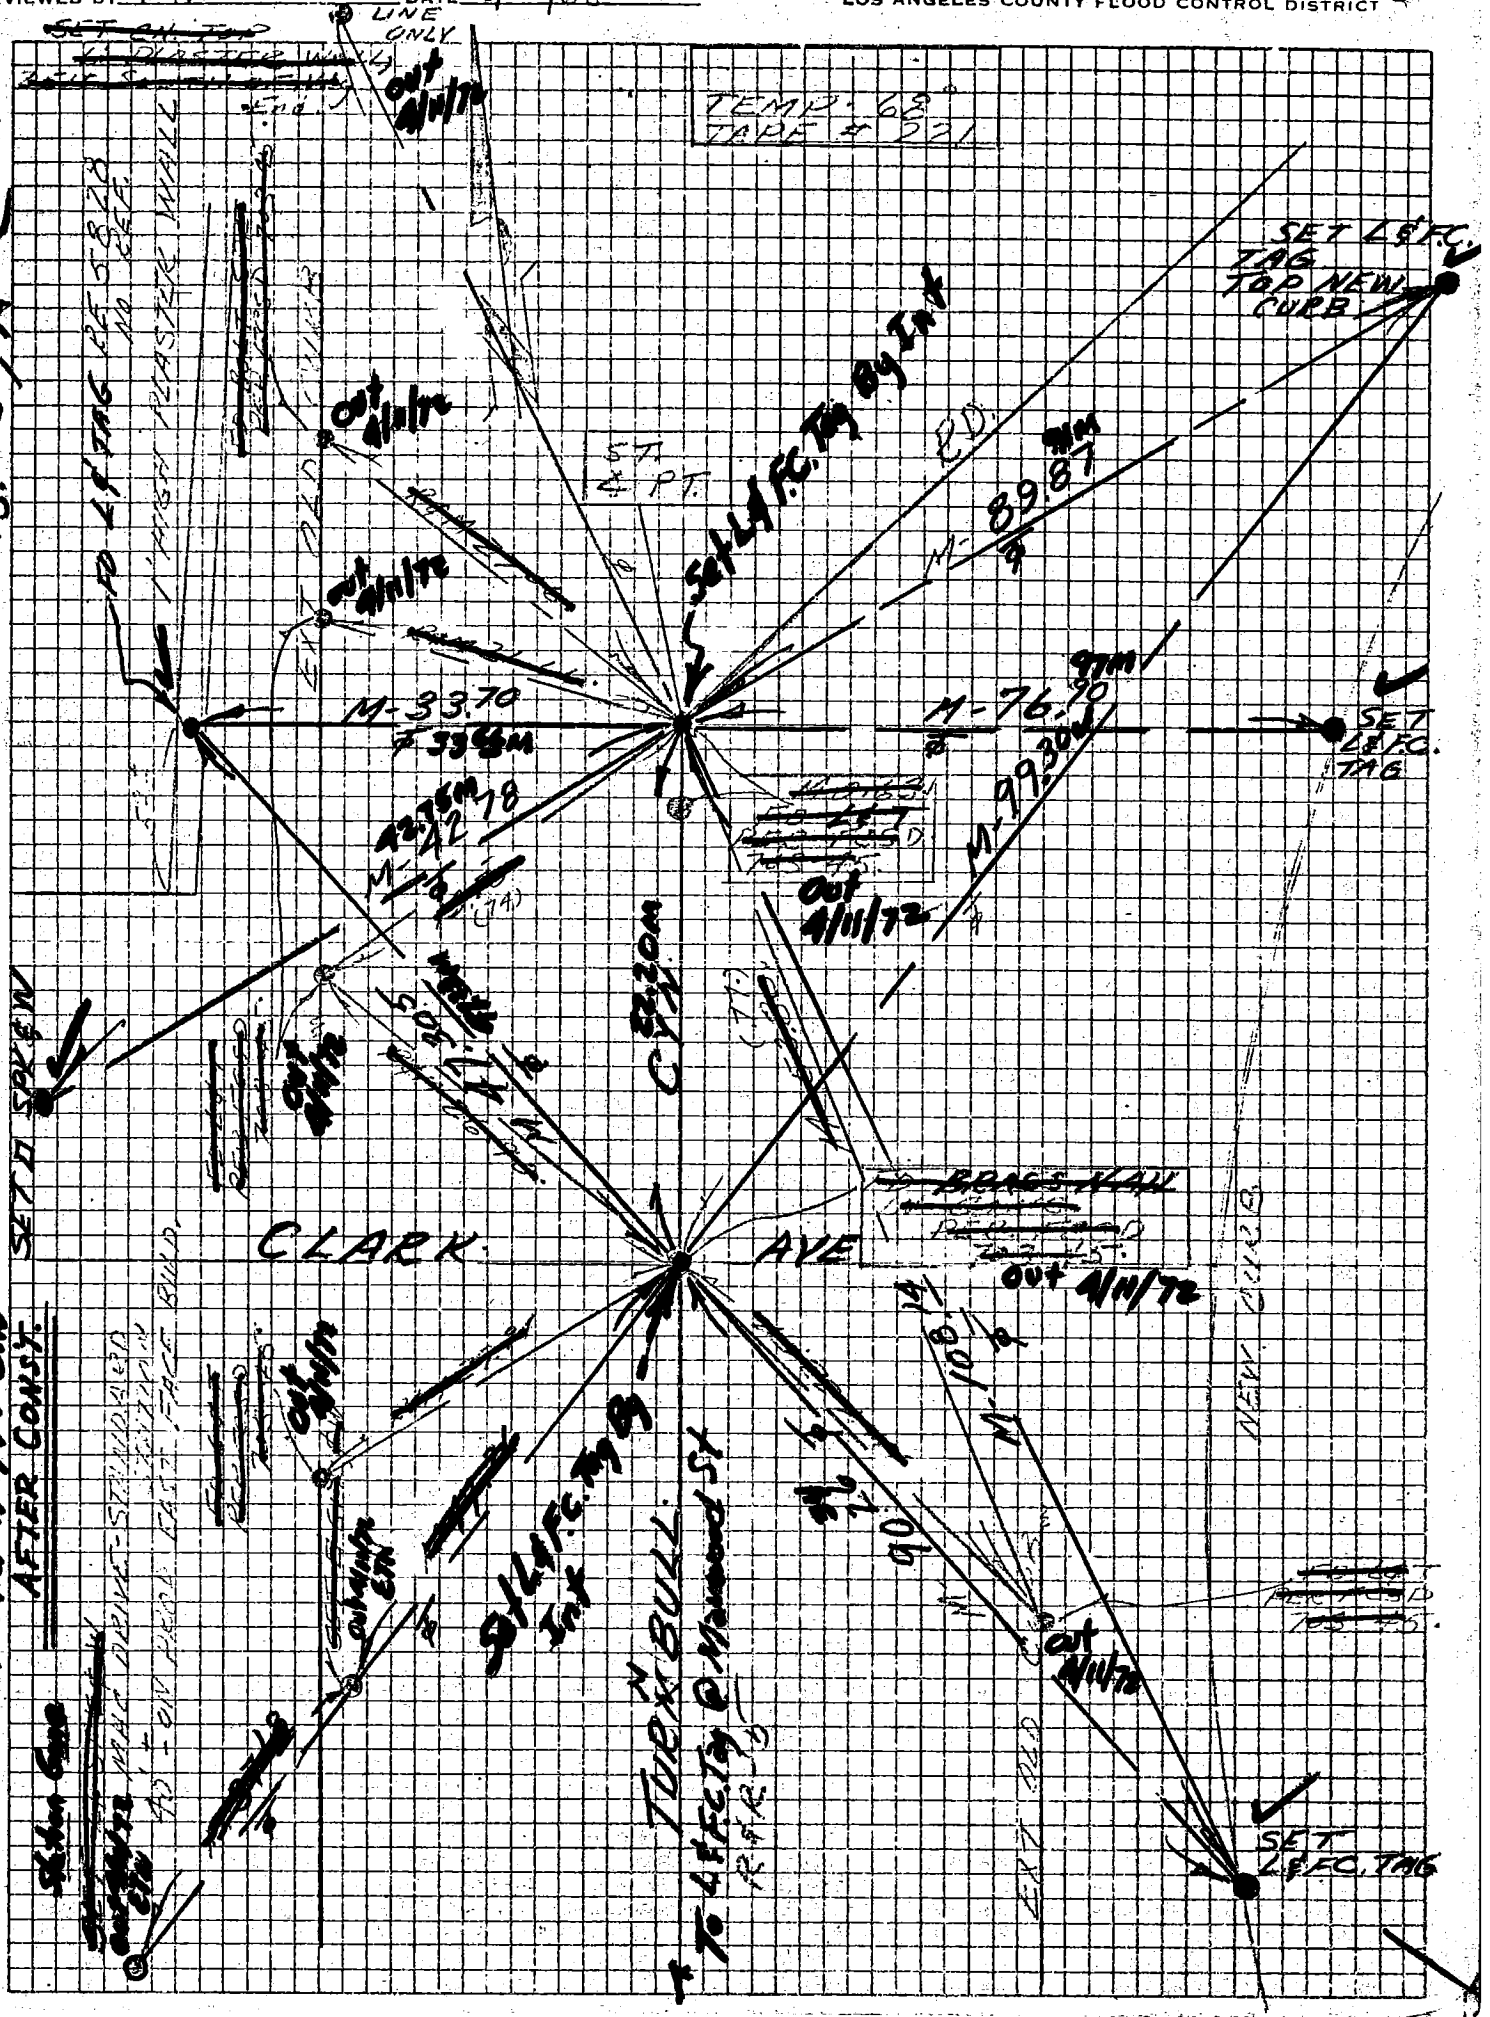
W.S. 38, A-2
SET CHISEL TOP
LINE ONLY
out 4/11/72
TEMP: 68°
SET L&F.C. TAG TOP NEW CURB
SET L&F.C. TAG
SET 1/2" PIPE
M-33.70
M-76.90
M-89.87
M-99.30
out 4/11/72
SET SPIKE & WASHER
CLARK AVE
SET L&F.C. TAG
SET L&F.C. TAG
SET L&F.C. TAG

76S911— Cdb 1-68

PROJECT SD. 703 UNIT II

SURVEY BY Hoffman DATE 6-7-68

REVIEWED BY DHK DATE 6/25/68

Co. Engr. F.B. 3555: 106 RR-5

INDEX FCSD 703 111

LOS ANGELES COUNTY FLOOD CONTROL DISTRICT

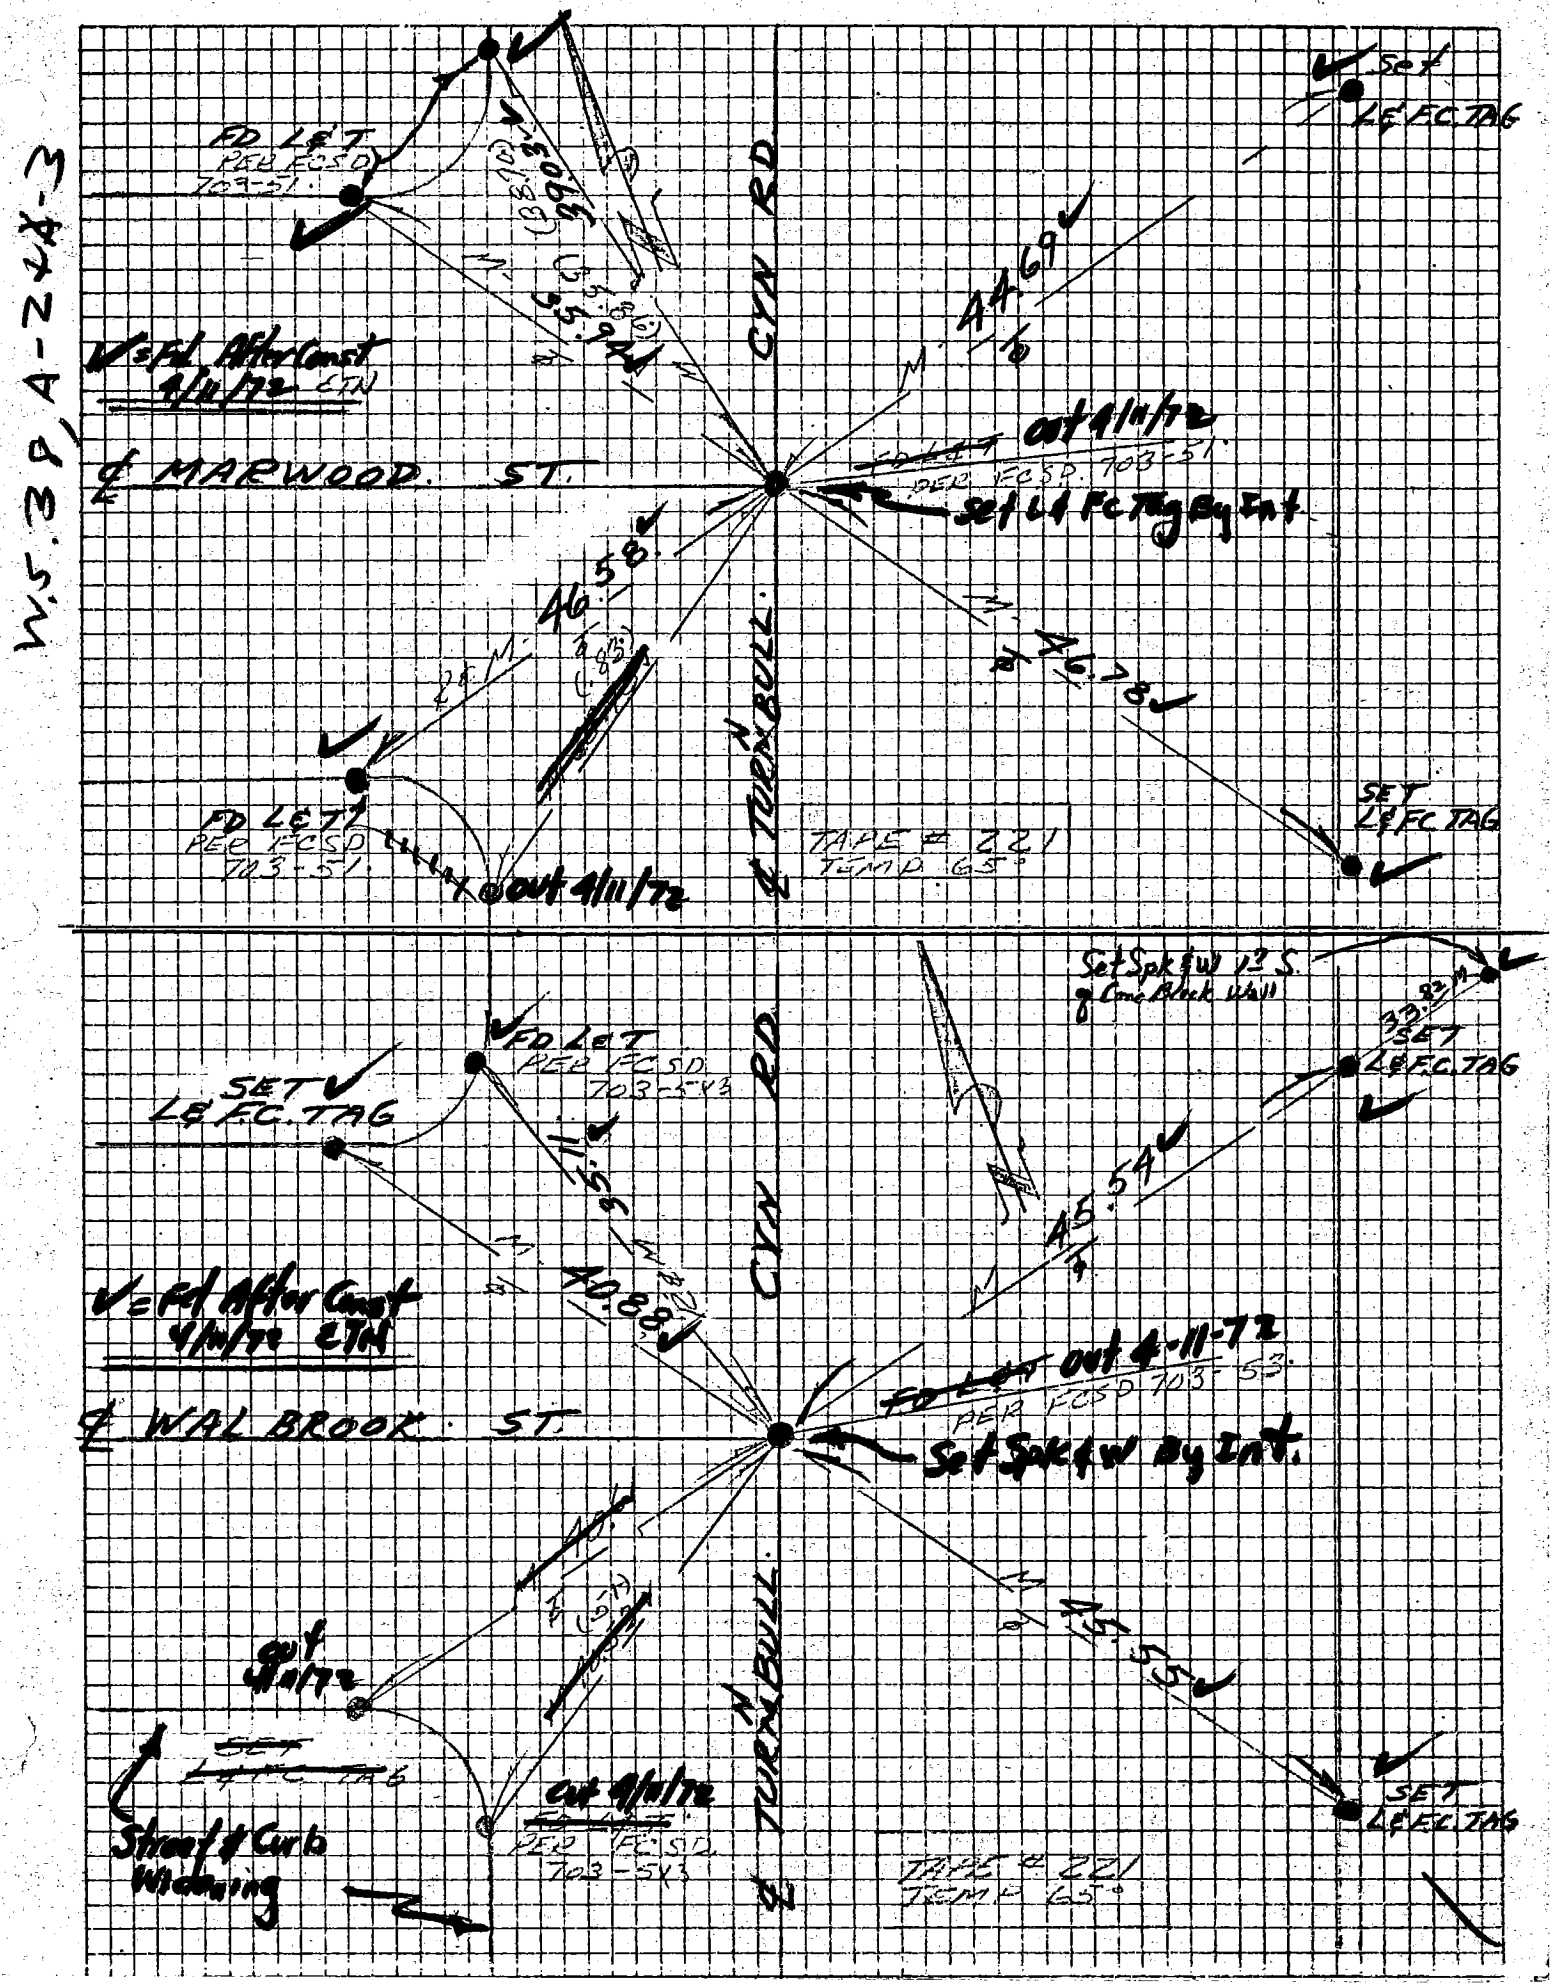

76S911– Cdb 1-68

PROJECT SD. 703 UNIT-2

SURVEY BY Hufnick DATE 6-7-68

REVIEWED BY PWK DATE 6/25/68

Co. Engr. F.B. 3555: 107 SHT 7 (107)

INDEX FCSD 703 113

LOS ANGELES COUNTY FLOOD CONTROL DISTRICT

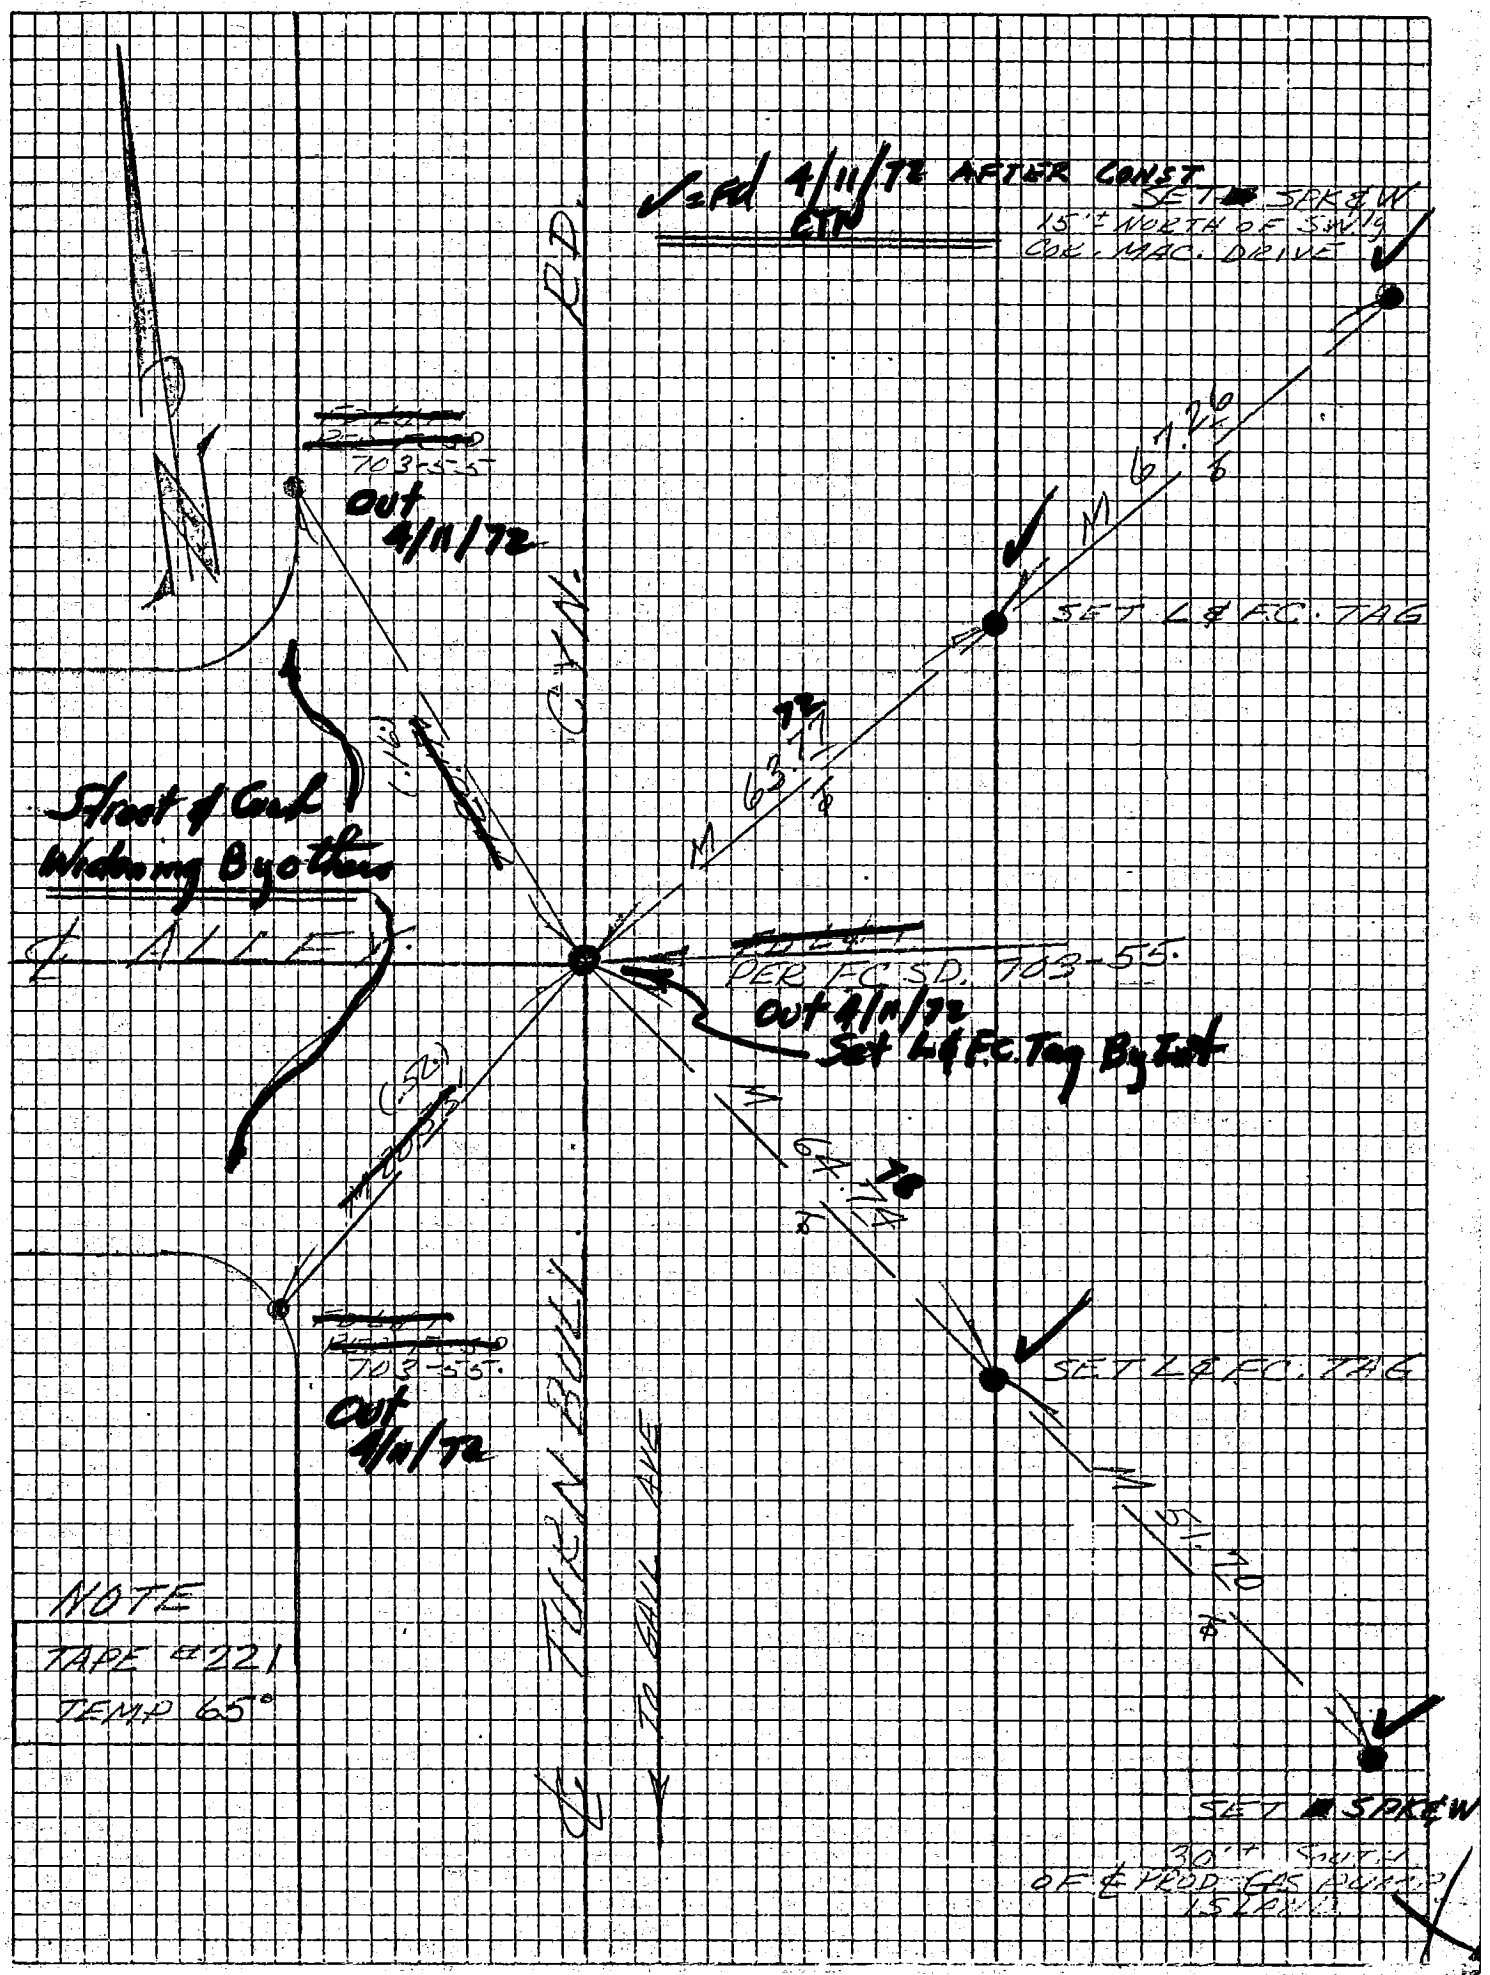

76S911– Cdb 1-68

PROJECT 703 Unit 2 — Co. Engr. F.B. 3555: 108 — INDEX FCSD 703 115 (108)

SURVEY BY Dixon — DATE 6-13-68 — R&K-9

REVIEWED BY PHK — DATE 6/25/68 — LOS ANGELES COUNTY FLOOD CONTROL DISTRICT

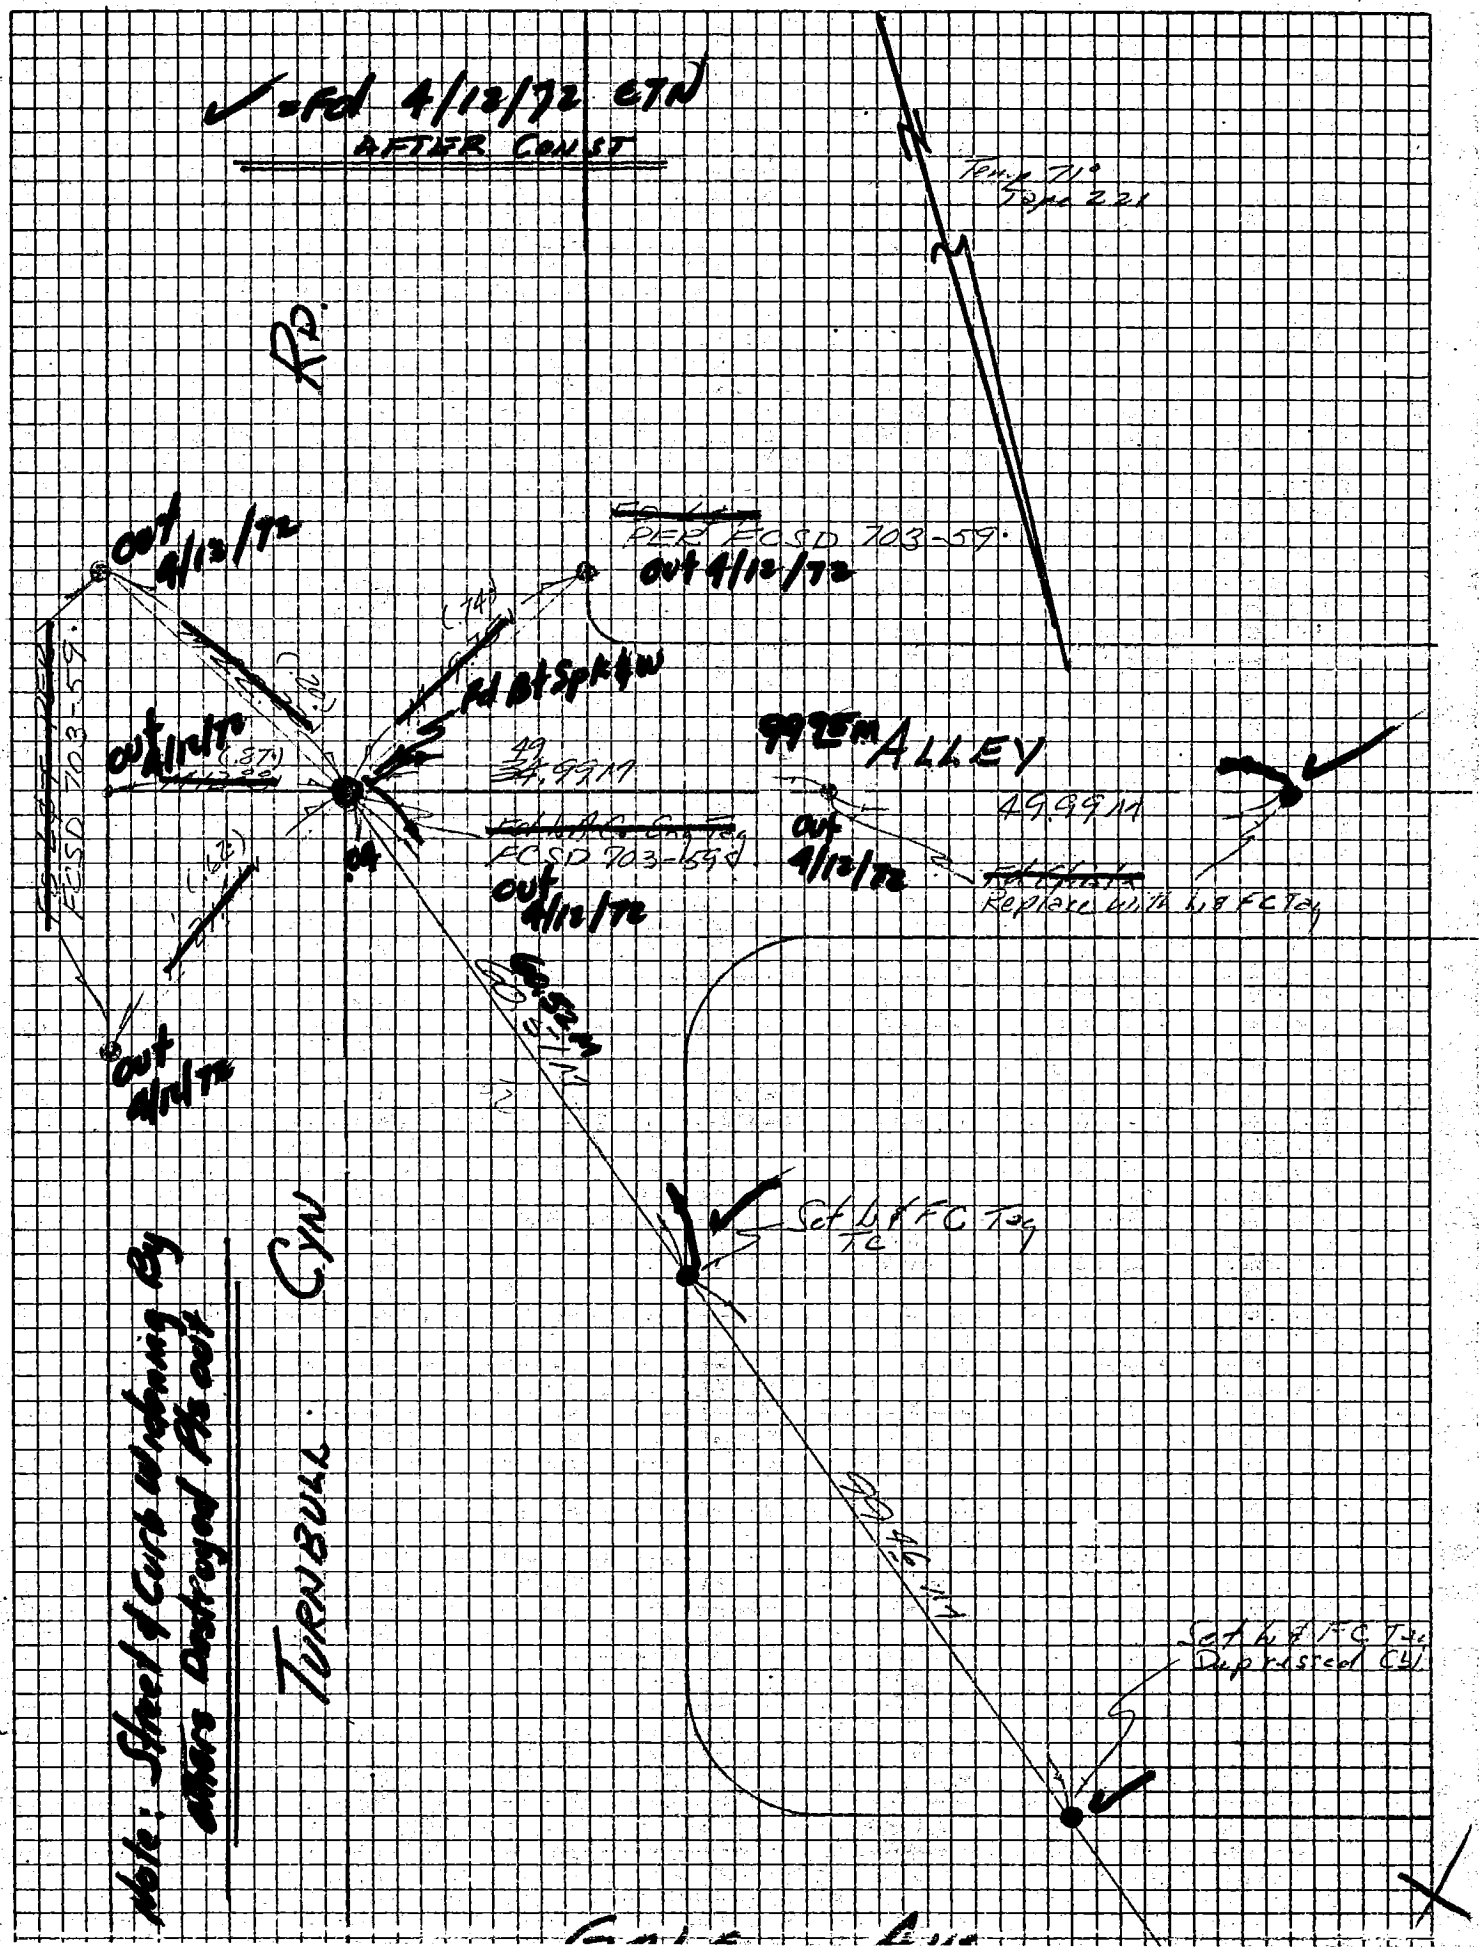

11– Cdb 1-68

PROJECT SD 703

SURVEY BY Hitchcock DATE 6-20-68

REVIEWED BY THK DATE 6/25/68

Co. Engr. F.B. 3555:109 INDEX FCSD 703 117

LOS ANGELES COUNTY FLOOD CONTROL DISTRICT

W.S. 38, A-3

TAPE 7821
TEMP 80°

Fd 4/12/72
ETJ AFTER CONST

SET 1½" IPCP
703-61.

FD PKNAIL
PER 703-61.

Fd ½" IP
FCSD 703-61.

SET 1½" IPCP
703-61.

(.71')
70'
M 71.1'

M 50.76

(.33')
10.31'
M 10.63'

SET ½ REC
TAG CONC
CURB

℄ STUDY BEND DR.

SET ½ REC TAG

SET 1½" IPCP
FCSD 703-61.

Fd 1½" IPCP
703-61.

SET ½ REC
TAG CONC
CURB

Fd 1½" IPCP
703-61.

Fd 4/12/72
FALLON ENG
TAG

Cdb 1-68

PROJECT 703 , Co. Engr. F.B. 3555:110 INDEX FCSD 703 119 (110)

SURVEY BY Eastlick DATE 6-20-68

REVIEWED BY PHK DATE 6/25/68

LOS ANGELES COUNTY FLOOD CONTROL DISTRICT

WS 38 A-3

✓ = Fd 4/12/72 AFTER CONST STN

TARE 221'
TEMP 80°

FD L&TAG PER 703-63.

SET L&TAG

FD L&TAG PER 703-63.

SET L&TAG

FD L&TAG PER 703-63.

SET L&TAG

Cdb 1-68

PROJECT 703 Unit 2 Sale Plat Co. Engr. F.B. 3555: ~~FCSD 703 185~~ 111

SURVEY BY Wixom DATE 7-12-68

REVIEWED BY [illegible] DATE 7-17-68

INDEX M-4

LOS ANGELES COUNTY FLOOD CONTROL DISTRICT

All of Intersection has been widened & changed ~~by~~ by others

Temp = 105°  Tape 221

| | | |
|---|---|---|
| 36.93 | +.81 = | 36.44 |
| 23.12 | +.005 | 23.125 |
| 174.75 | +.02 | 24.77 |
| 75.25 | +.02 | 75.27 |

RD

Fd L.S.T.& Co Eng Tag 10' Rt.

10' Rt

~~Fd L.S.T.~~ RE Tag 5828 No Rd

out 4/12/72

4'

Set Tag

~~Fd L.S.T.~~ FCSD 703-95

out 4/12/72

~~Fd L.S.T.~~ FCSD 703-97

out 4/12/72 CTW

Fd L.S. Rd Lgt Tag 1.04 N of Line

out 4/12/72

~~Set CTW~~ S.M.H. Rim

GALE

AVE.

CYN

TORREBILL

Set L.S.F.C. Tag

Fd 4-12-72 CTW AFTER CONST

Co. Engr. F.B. 3555: 112 (112)

FCSD 1217 31

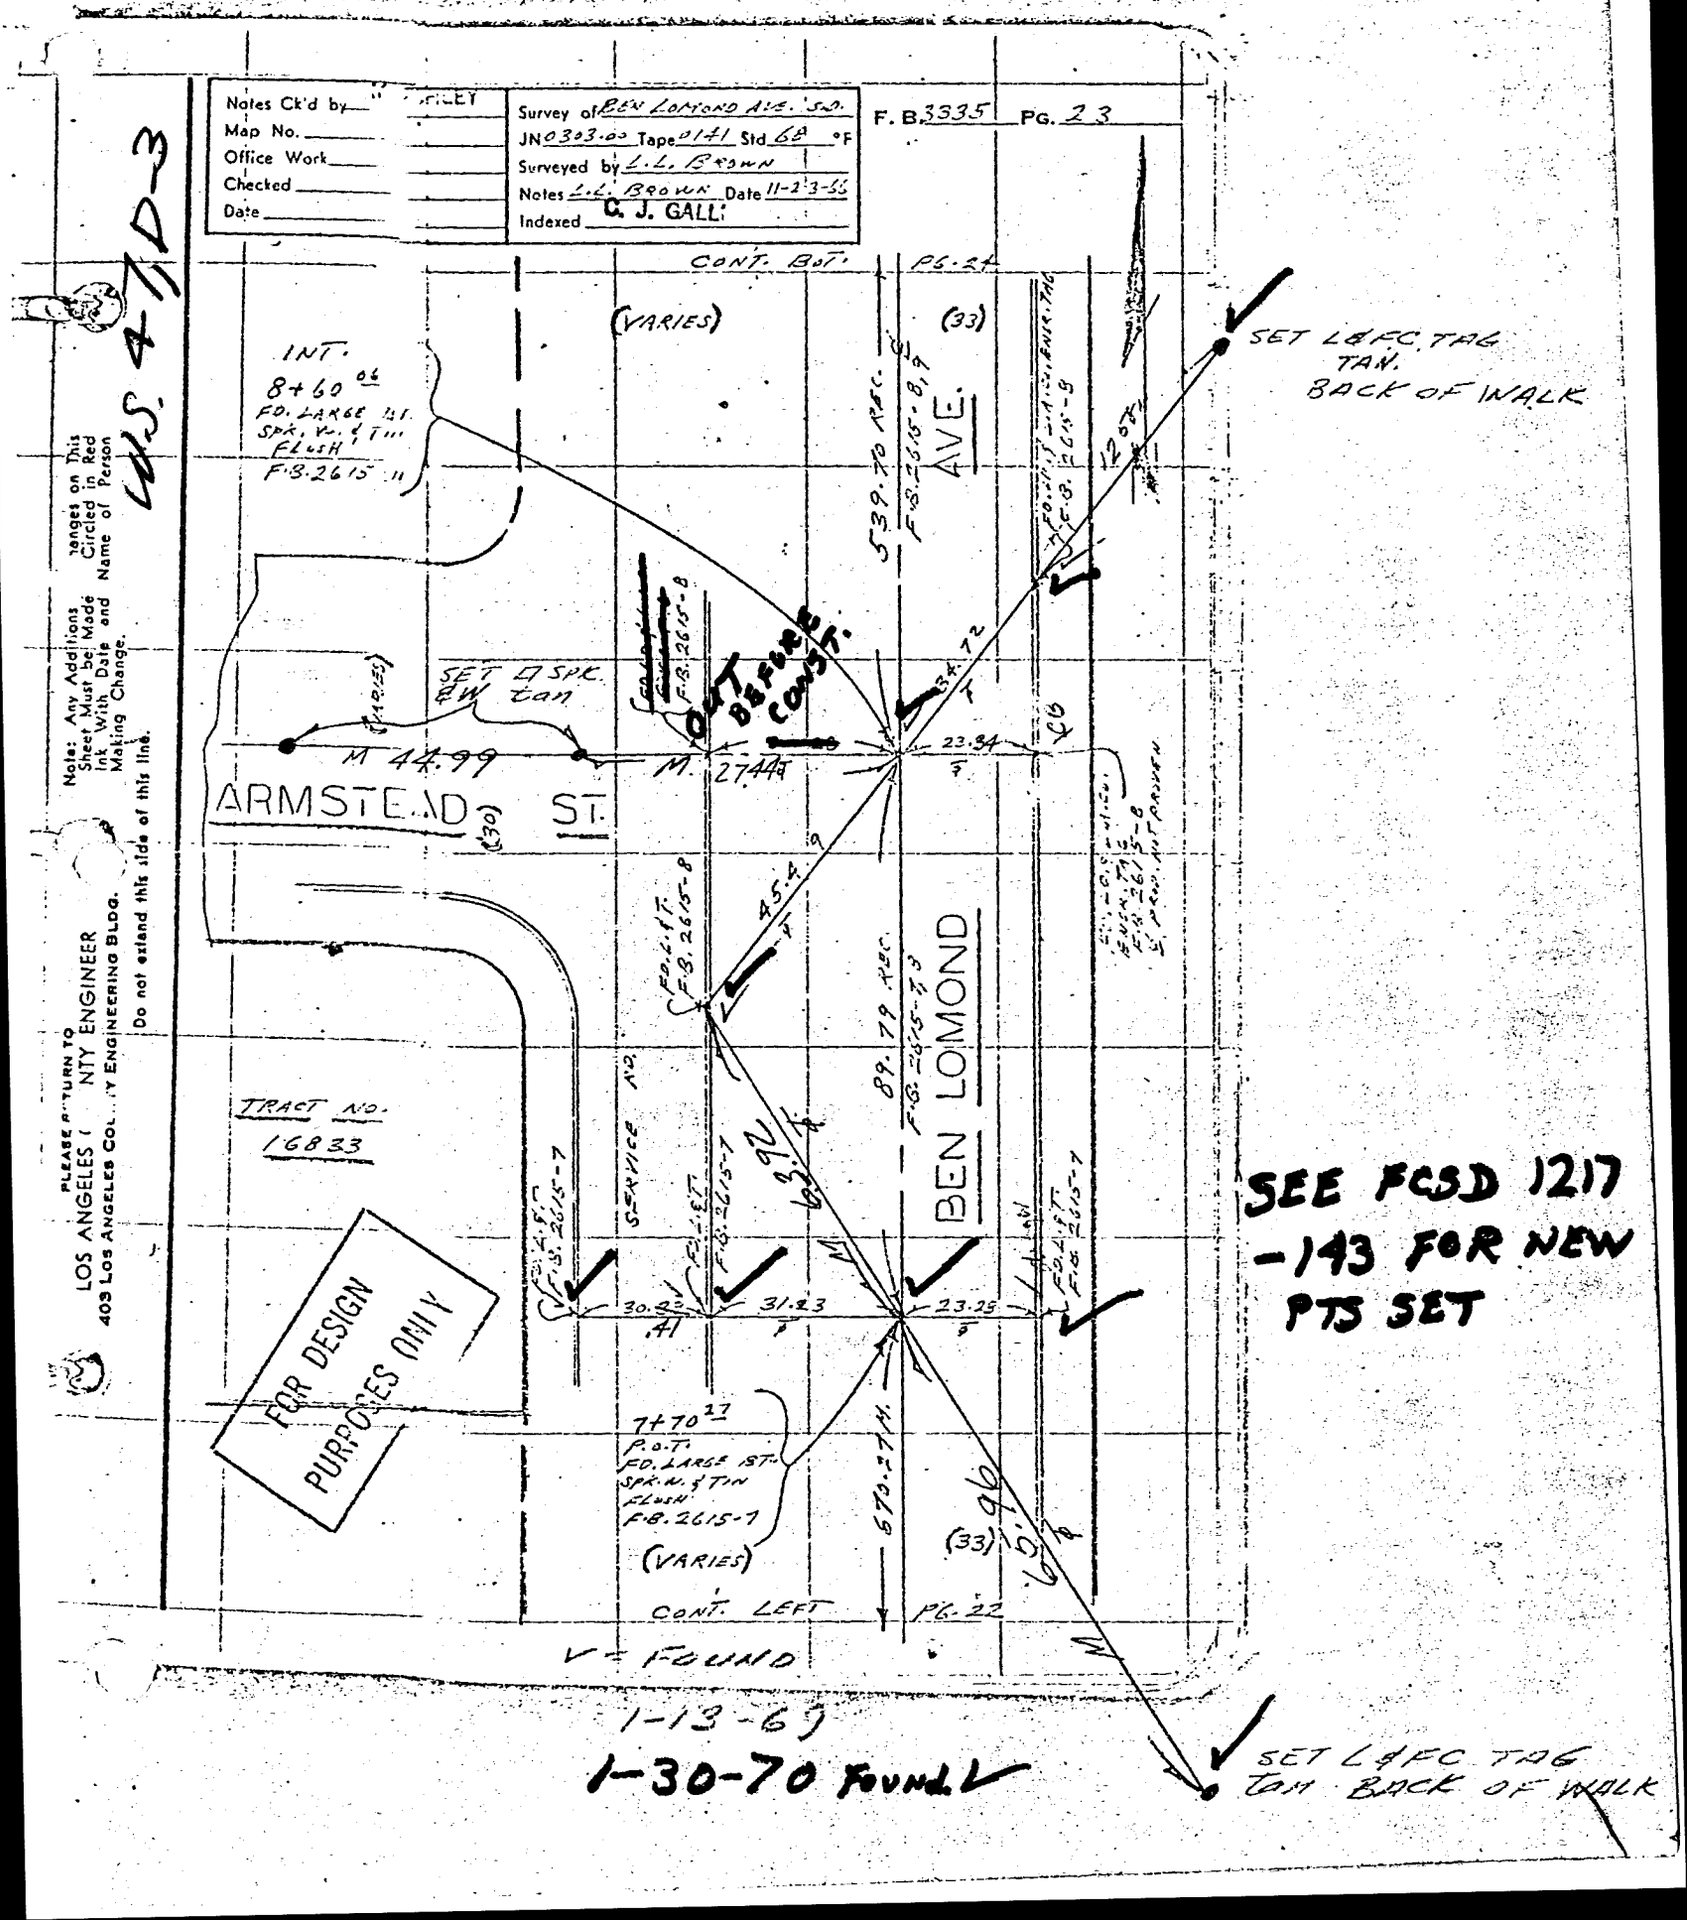

Co. Engr. F.B. 3555: 113 (113)

FCSD 1217 33

W.S. 47 D-3

First

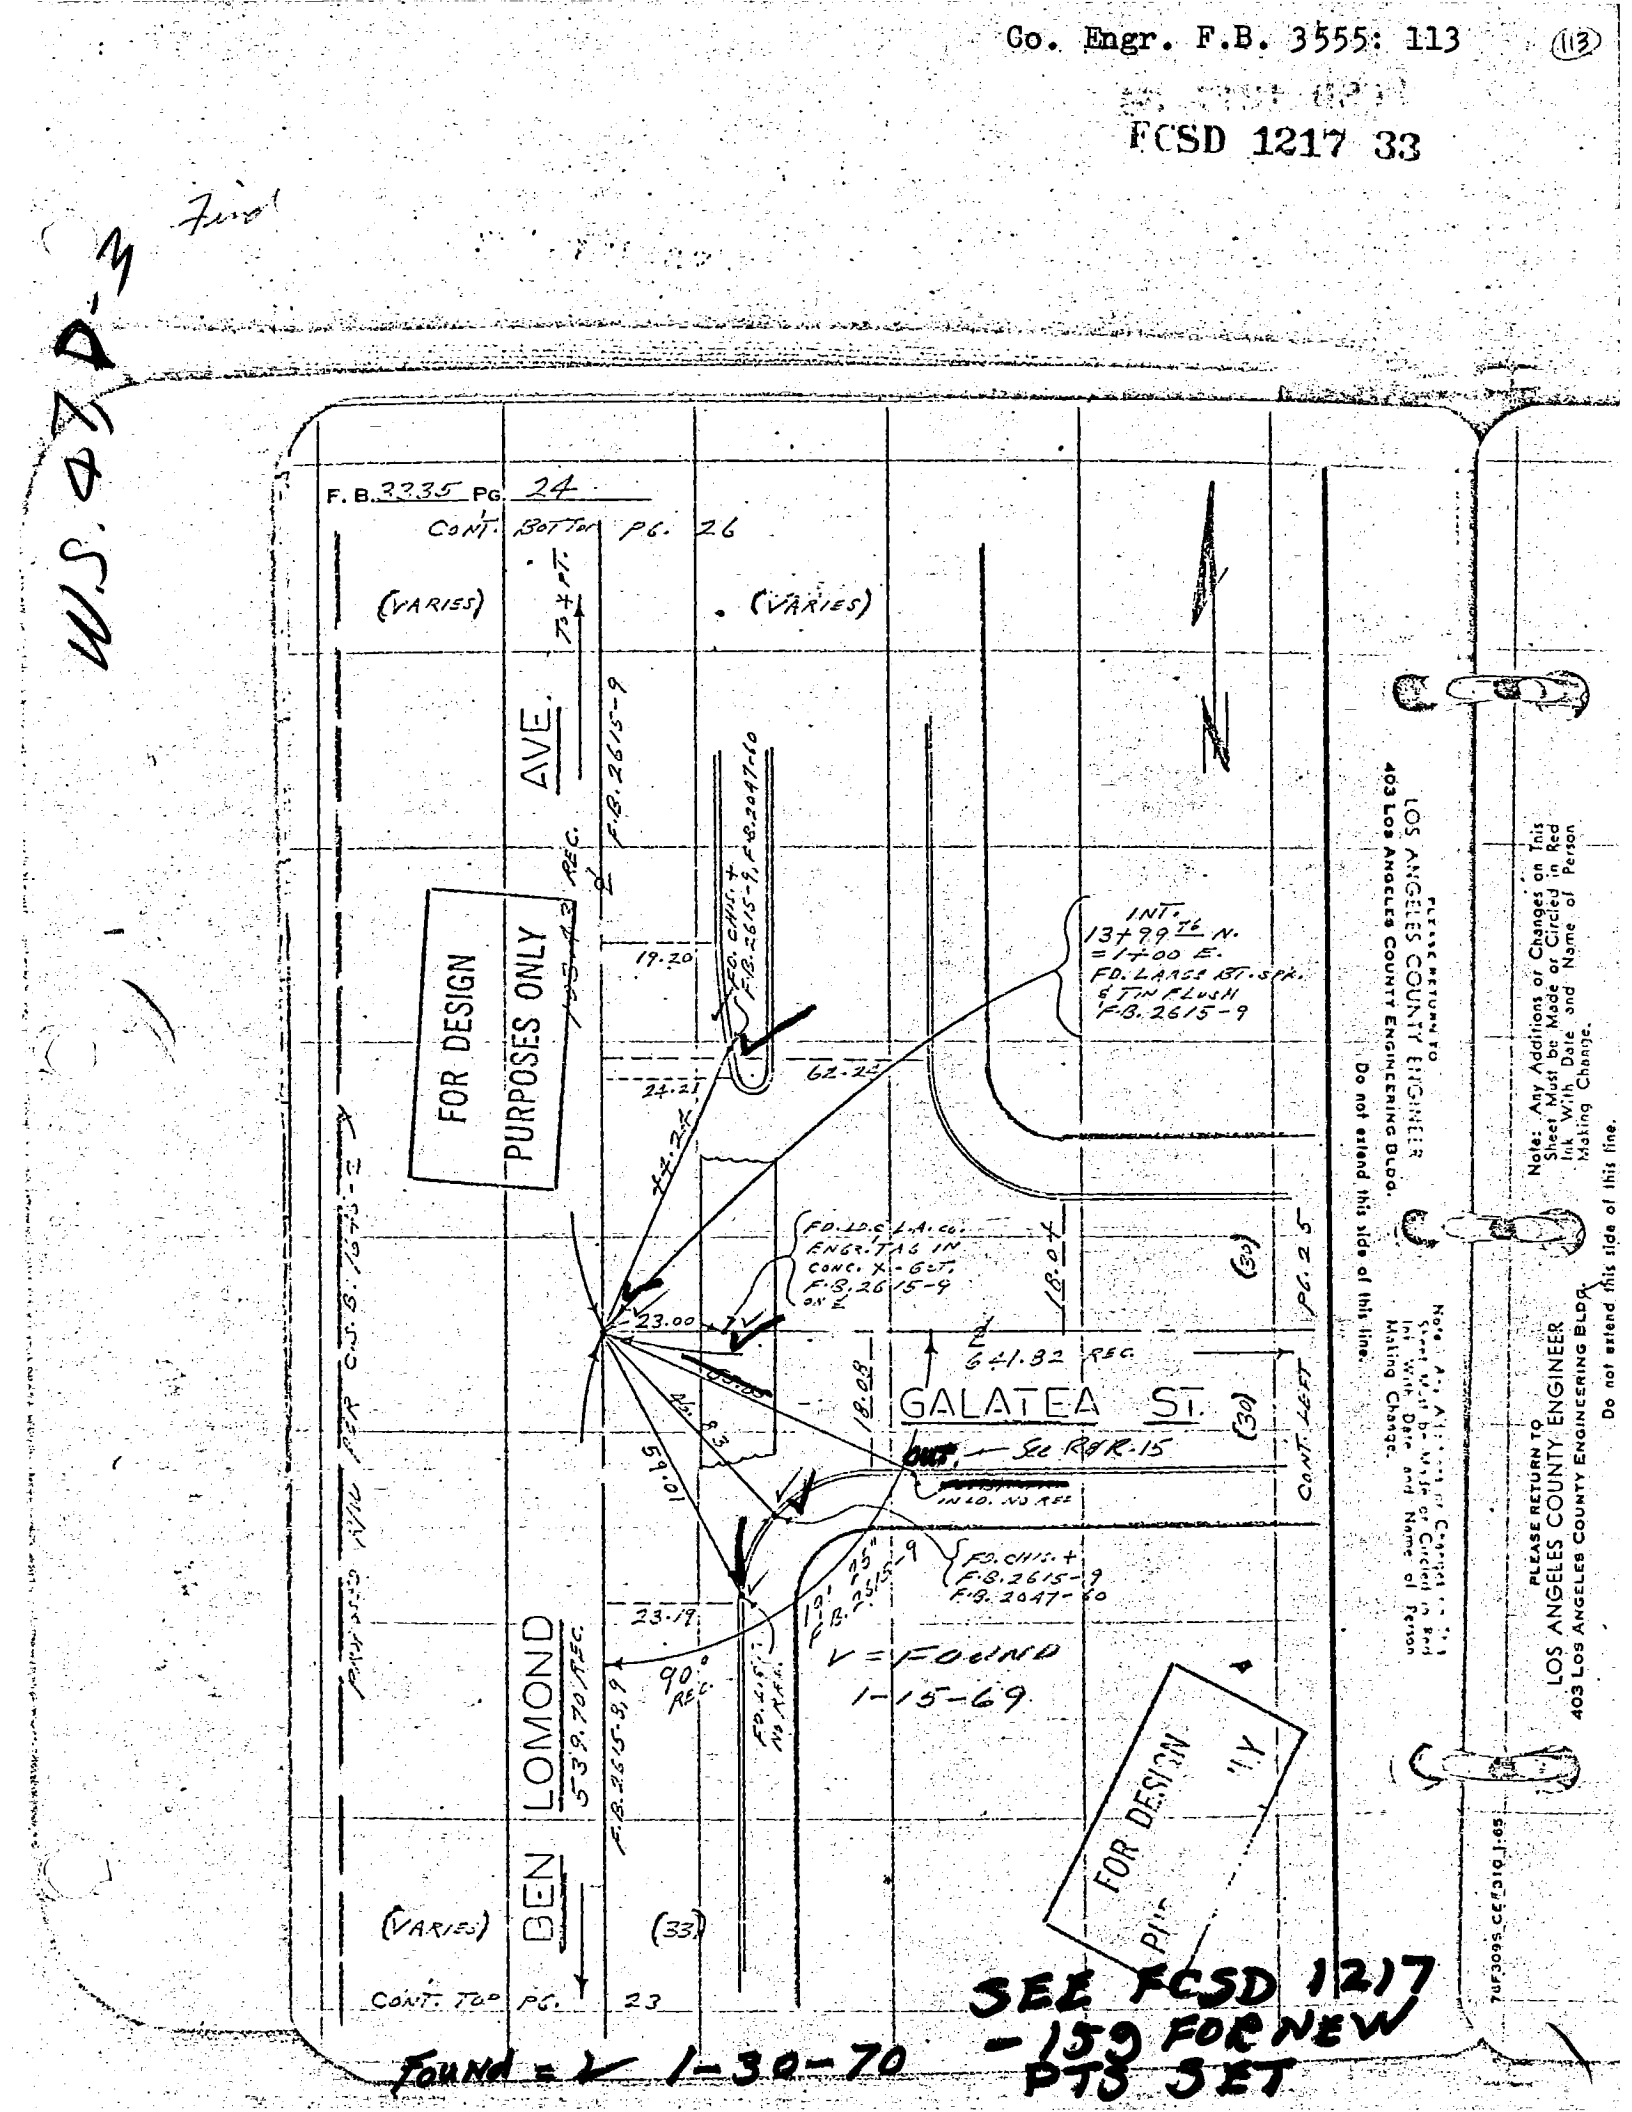


SEE FCSD 1217 -159 FOR NEW PTS SET

Found = V 1-30-70

Co. Engr. F.B. 3555: 114

(114)

FCSD 1217-47

W.S. 47 D-2

Notes Ck'd by M. ASHLEY
Map No.
Office Work
Checked
Date

Survey of BEN LOMOND AVE. S.D.
JN 2333.01 Tape 0141 Std 68 °F
Surveyed by L.L. BROWN
Notes L.L. BROWN Date 11-28-66
Indexed G. J. GALLI

F. B. 3335 Pg. 31

CONT. BST. PG. 34

FOR DESIGN PURPOSES ONLY

AVE.

(20) (20)

(40)

FD. L & TT. F.B. 2615-12

652.58 REC. F.B. 2119-7/12

INT. 48 20+74 = 17+00 E. FD. LARGE BT. SPK. & TIN FLUSH F.B. 2615-12

30.09

55' REC.

89.43' REC. F.B. 2119-7

NO REC.

OUT

02' 21'19-1

67.68

M 83.75

14.54

10.00 REC.

27.93

(40)

P.C. 33

(40)

M 43.37

20.07

330.23 REC.

F.B. 2615-12 (2) 16

M 92.30

397.40 REC.

BASELINE

RD.

M 98.53

SET L&FC TAG TOP 18" IN HILL TO FREEWAY FENCE TAW

20.27

(40)

90° 00' 00" 10.00 R

M 77.24

OUT

OUT BEFORE CONST

INT. 20+84.43 FD. LARGE BT. SPK. W.S. TIN FLUSH F.B. 2615-12

412.02 REC. 163.07 REC. PER F.W. 30925

19.48

F.B. 2615-12

SET L&FC TAG CURB OF NEW BRIDGE TAW

BEN LOMOND

(VARIES) (VARIES)

CONT. TOP PG. 29

FOUND = ✓ 1-30-70

SEE FCSD 1217-147 FOR NEW PTS SET

Note: Any Additions or Changes on This Sheet Must be Made or Circled in Red with Date and Name of Person Making Change.

Do not extend this side of this.

PLEASE RETURN TO LOS ANGELES COUNTY ENGINEER 403 Los Angeles County Engineering Bldg.

Co. Engr. F.B. 3555: 115

(115)

FCSD 1217 57

Found Check tie agrees w/ F.B. Prod in Nearby

Notes Ck'd by M. ASHLEY
Map No.
Office Work
Checked
Date

Survey of SEVILLANO AVE. S.D.
JN 2333.10 Tape 2141 Std 63 °F
Surveyed by L. L. BROWN
Notes L. L. BROWN Date 11-29-66
Indexed C. J. GALLI

F. B. 3335 PG. 37

CONT. BOTTOM PG. 39

(31) (34)

DR.

VECINO

865.03 REC. F.B. 2115-143, 151

FOR DESIGN PURPOSES ONLY

Note: Any Additions or Changes on This Sheet Must be Made or Circled in Red Ink With Date and Name of Person Making Change.

Do not extend this side of this line.

PLEASE RETURN TO LOS ANGELES COUNTY ENGINEER. 403 Los Angeles County Engineering Bldg.

95 CE/310.1-65

OUT REC. 22.10 22.02

FD. L. ST. F.B. 2115-148

FD. L. ST. F.B. 2115-145

OUT

90° F.B. 211 20.08 65.06

1320.32 REC.

270.87 REC. F.B. 2115-143, 149

20.03

(30) PG. 38

MAUNALOA AVE.

40.05

FD. 3/4" I.P. FD. CK. TAG F.B. 2115-149

.05 SOUTH M 155

10.02 EAST M 155

F.B. 2115-129

OUT

M 77.2

NNT. 47+29.20 = 1400. E. FD. CUT SQR. N. & TIN ON 2" F.B. 2115-143

S 80.85

SET L & FC TAG BACK OF WALK

FD C.S. MON ORG. CON TIES DO NOT FIT

2-3' SPK W/ TT PULL TIES

Set L & FC tag Back of Walk

✓ = FOUND 1-16-69

✓ = Fd 1-30-70

SEE FCSD 1217-155 FOR NEW PTS SET

Co. Engr. F.B. 3555: FCSD 1217 67 (116)
116

Final

WSEA 17-2

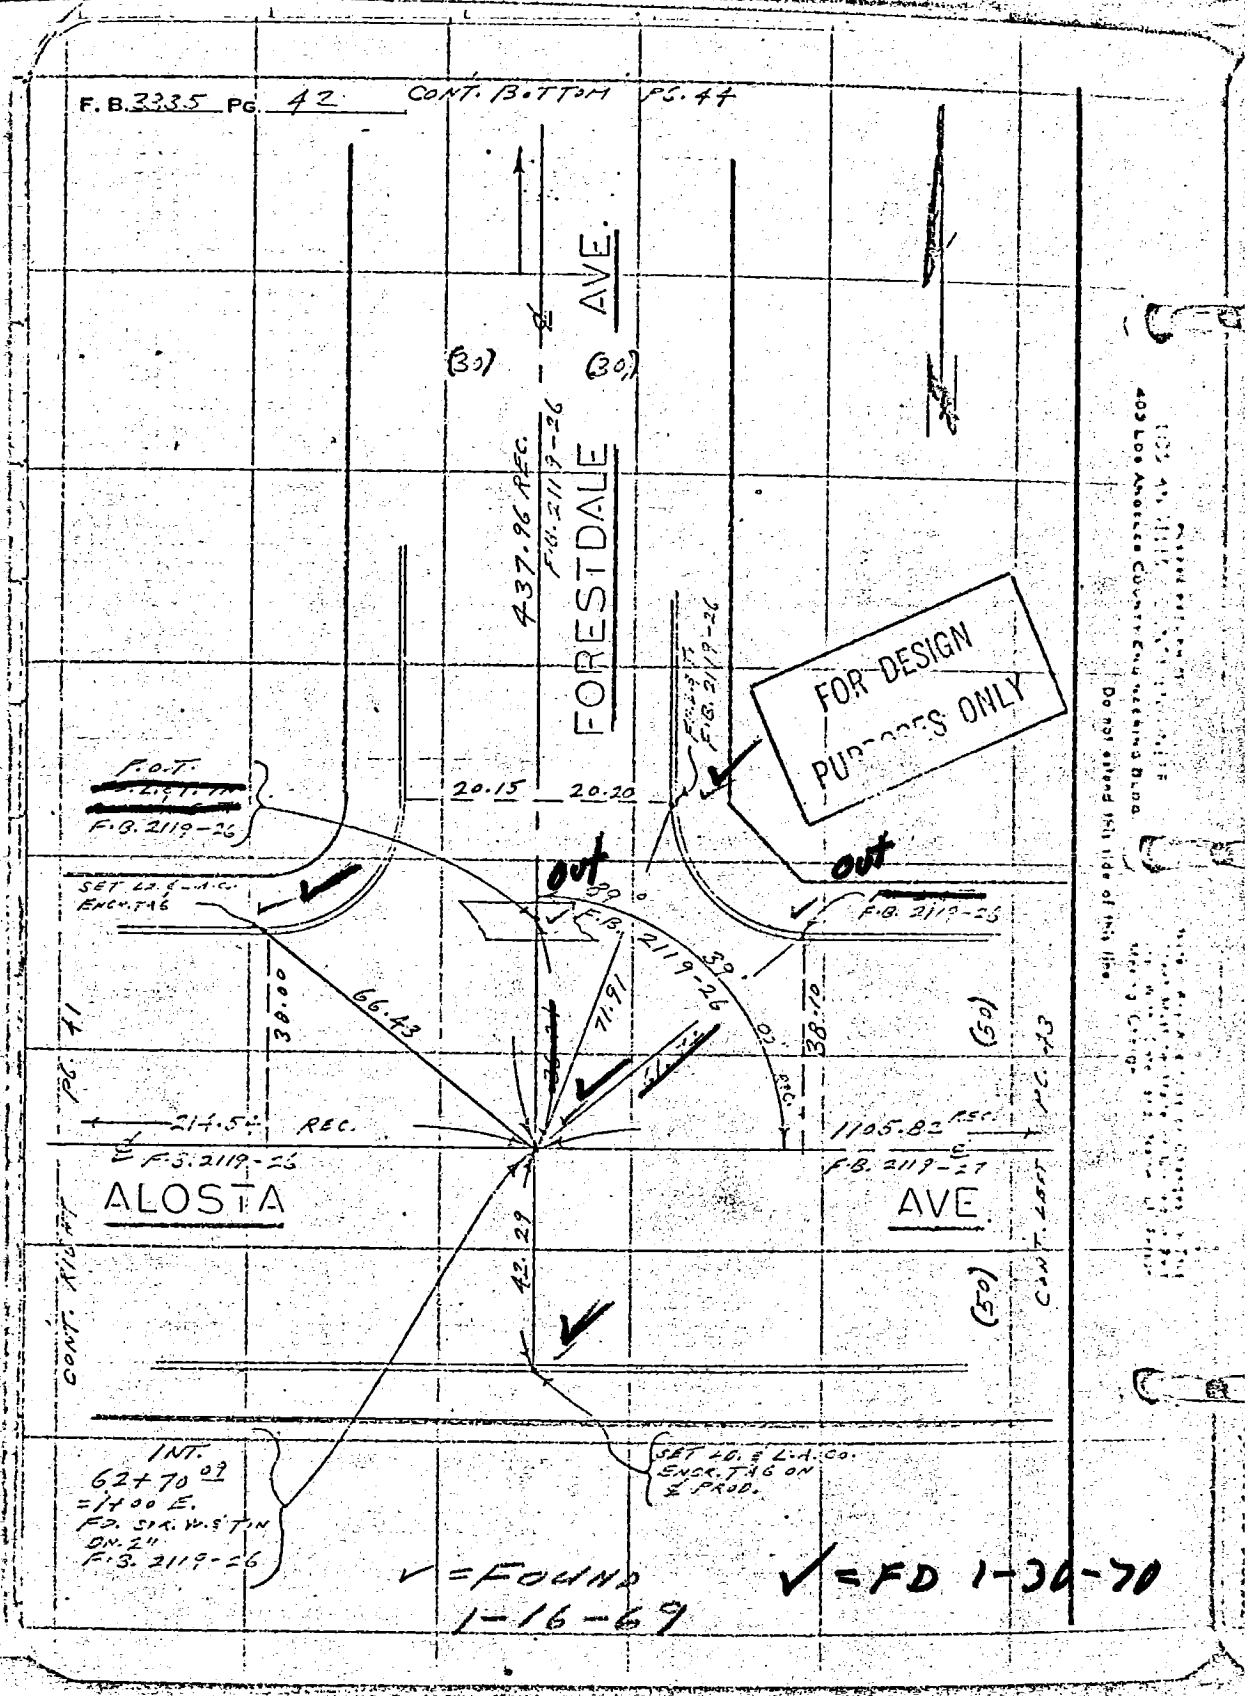


SEE FCSD 1217-161
FOR NEW PTS SET

Co. Engr. F.B. 3555: 117 (117)

Find FCSD 1217 71

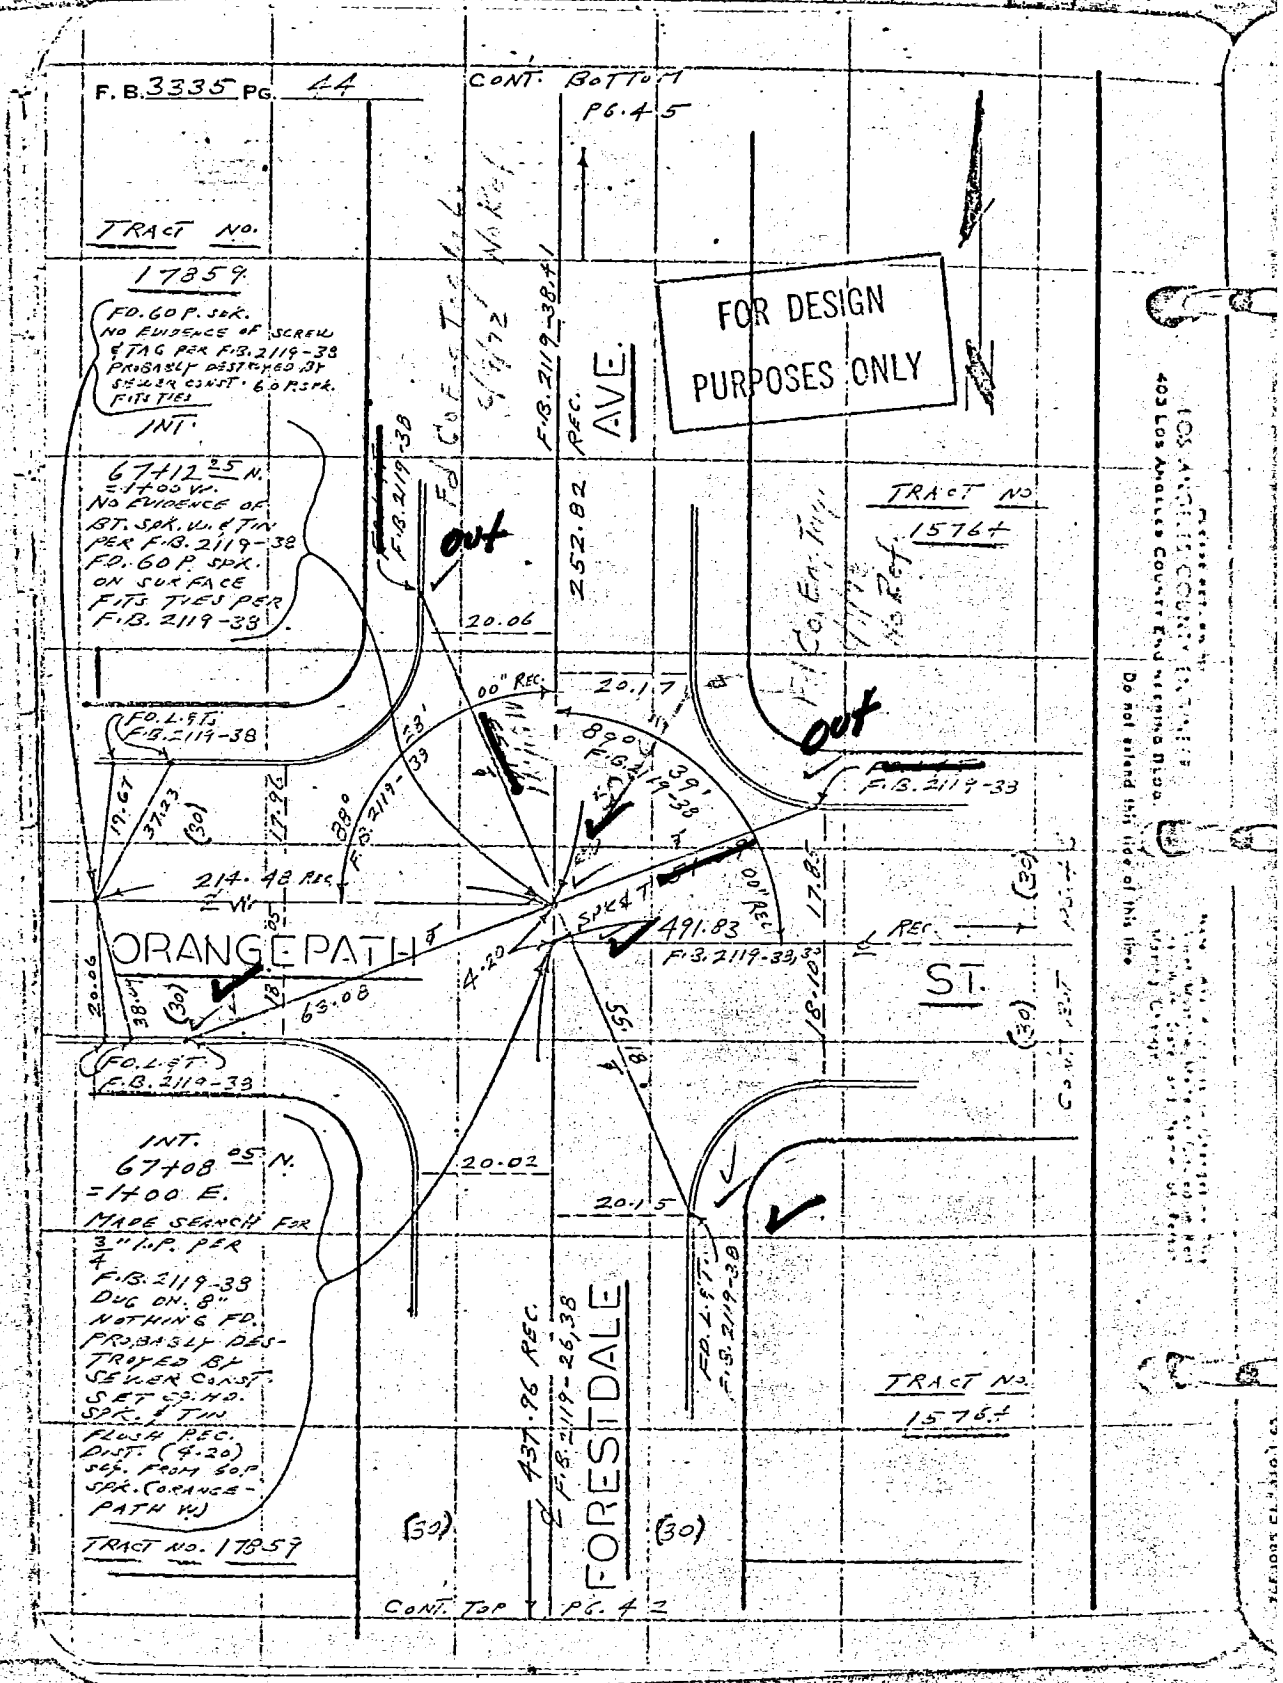


2-D 178 S.M.

V = FOUND 1-16-69

V = Fd 1-30-70

SEE FCSD 1217-163 FOR NEW PTS SET

Co. Engr. F.B. 3555: 118 (118)

FCSD1217 123

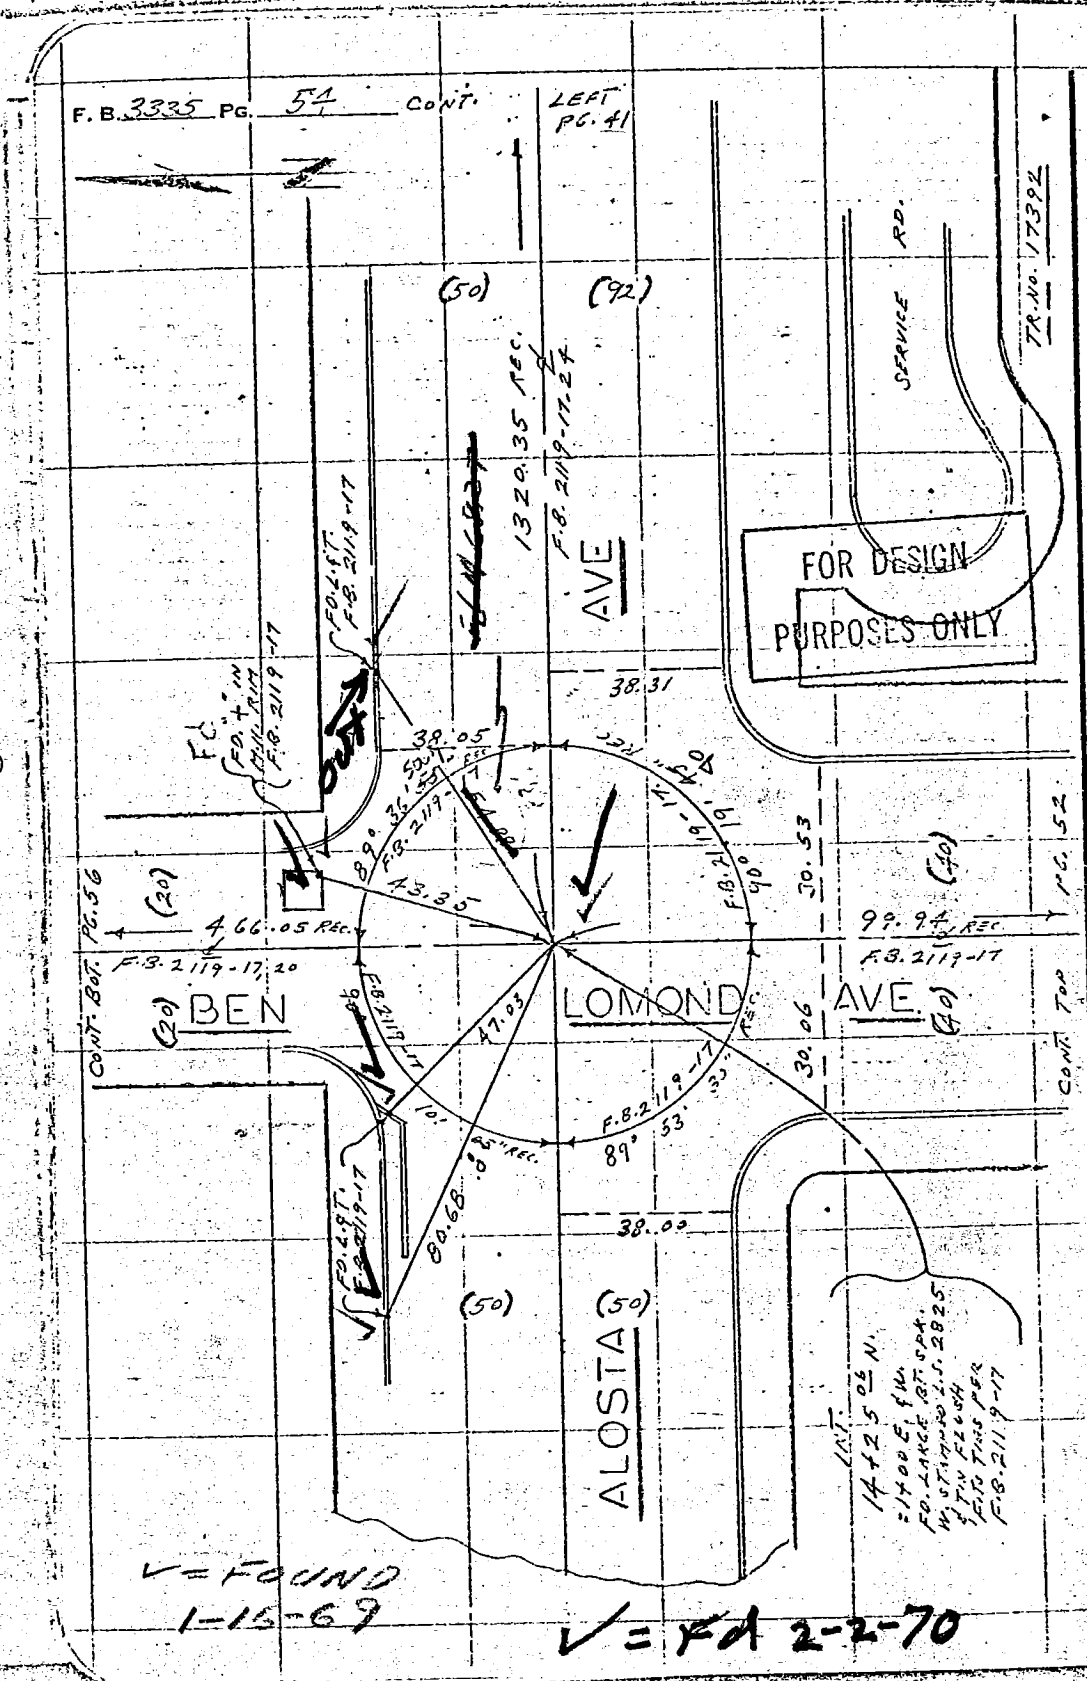


LOS ANGELES COUNTY ENGINEER
403 LOS ANGELES COUNTY ENGINEERING BLDG.
PLEASE RETURN TO

Note: Any Additions or Changes on This Sheet Must be Made or Circled in Red Ink With Date and Name of Person Making Changes.

Do not extend this side of this line.

Note: Any Additions or Changes on This Sheet Must be Made or Circled in Red Ink With Date and Name of Person Making Changes.

PLEASE RETURN TO
LOS ANGELES COUNTY ENGINEER

7 OF 2005 CE F 310 1-65

V = FOUND
1-15-69

V = FD 2-2-70

SEE FCSD 1217-165
FOR NEW TIE

Co. Engr. F.B. 3555:119

FCSD1217 125

W.S.#7 D-2

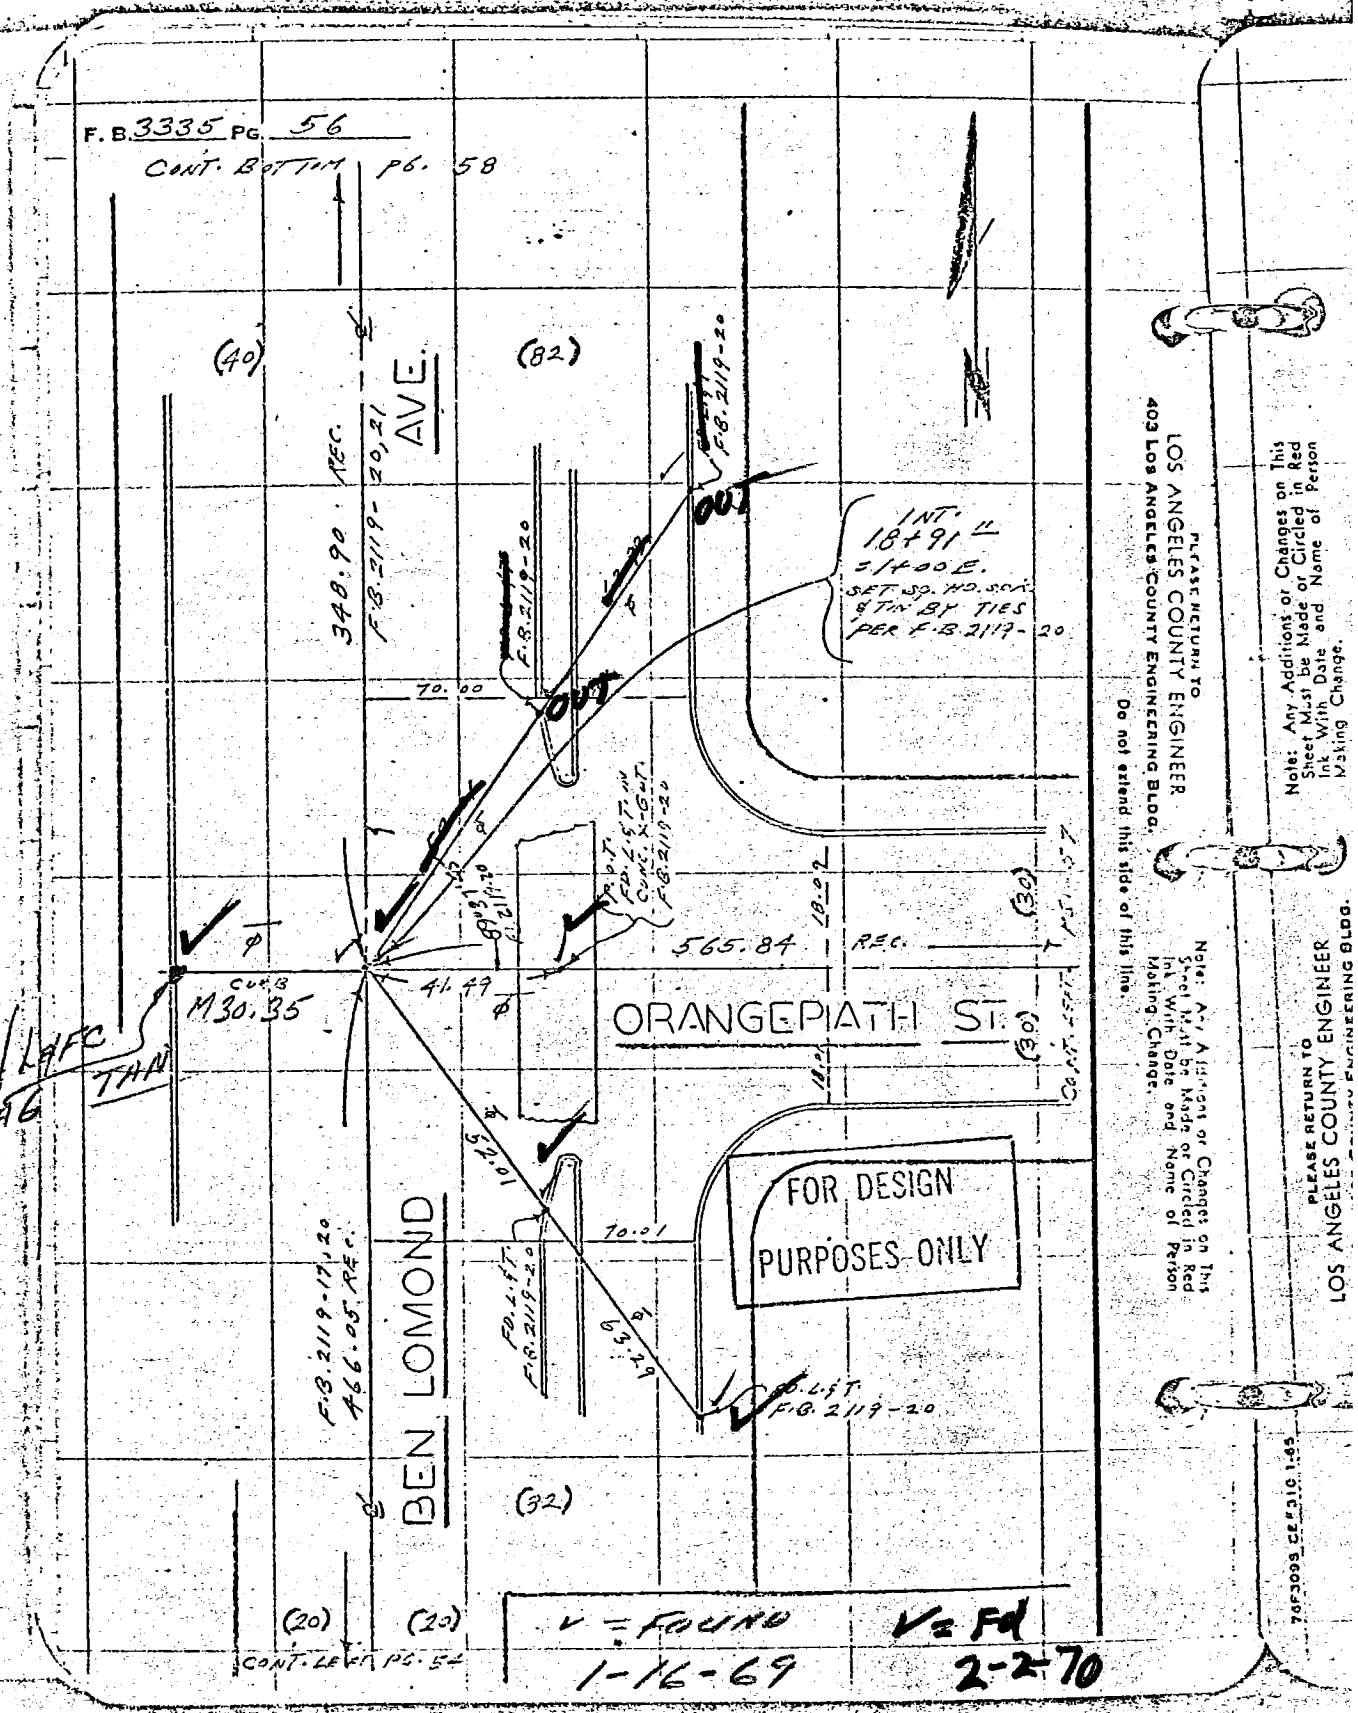


SEE FCSD 1217-167
FOR NEW PTS SET

76S911– Cdb 1-68

PROJECT 1217 Unit 2 Line A Co. Engr. F.B. 3555: FCSD1217 143

SURVEY BY Nixon DATE 1-13-69 120

REVIEWED BY (E) DATE 2-28-69 2-6-70

INDEX R&R-1

LOS ANGELES COUNTY FLOOD CONTROL DISTRICT

(120)

W.S. 11 D-3

Pts Fd Per FCSD1217-31

Set L&T FC Tag BK, NK

Line

Fd L&T FC Tag

ARMISTEAD ST.

Set Spk dw

Fd L&T Co. Eng Tag

44.99 M

2744 M

2334

Fd Spk W&T

Fd L&T

6252 M

Fd Spk W&T

3044 M

3123

2328

Fd L&T

Fd L&T

Fd L&T

6294 M

Barranca

Set L&T FC Tag BK, NK

Found 1-30-70

PROJECT 1217 Unit 2 Line A Co. Engr. F.B. 3555: 121 INDEX FCSD1217 145 (121)

SURVEY BY Nixon DATE 1-15-69 R&R-3

REVIEWED BY (E) DATE 2-28-69 2-6-70

LOS ANGELES COUNTY FLOOD CONTROL DISTRICT

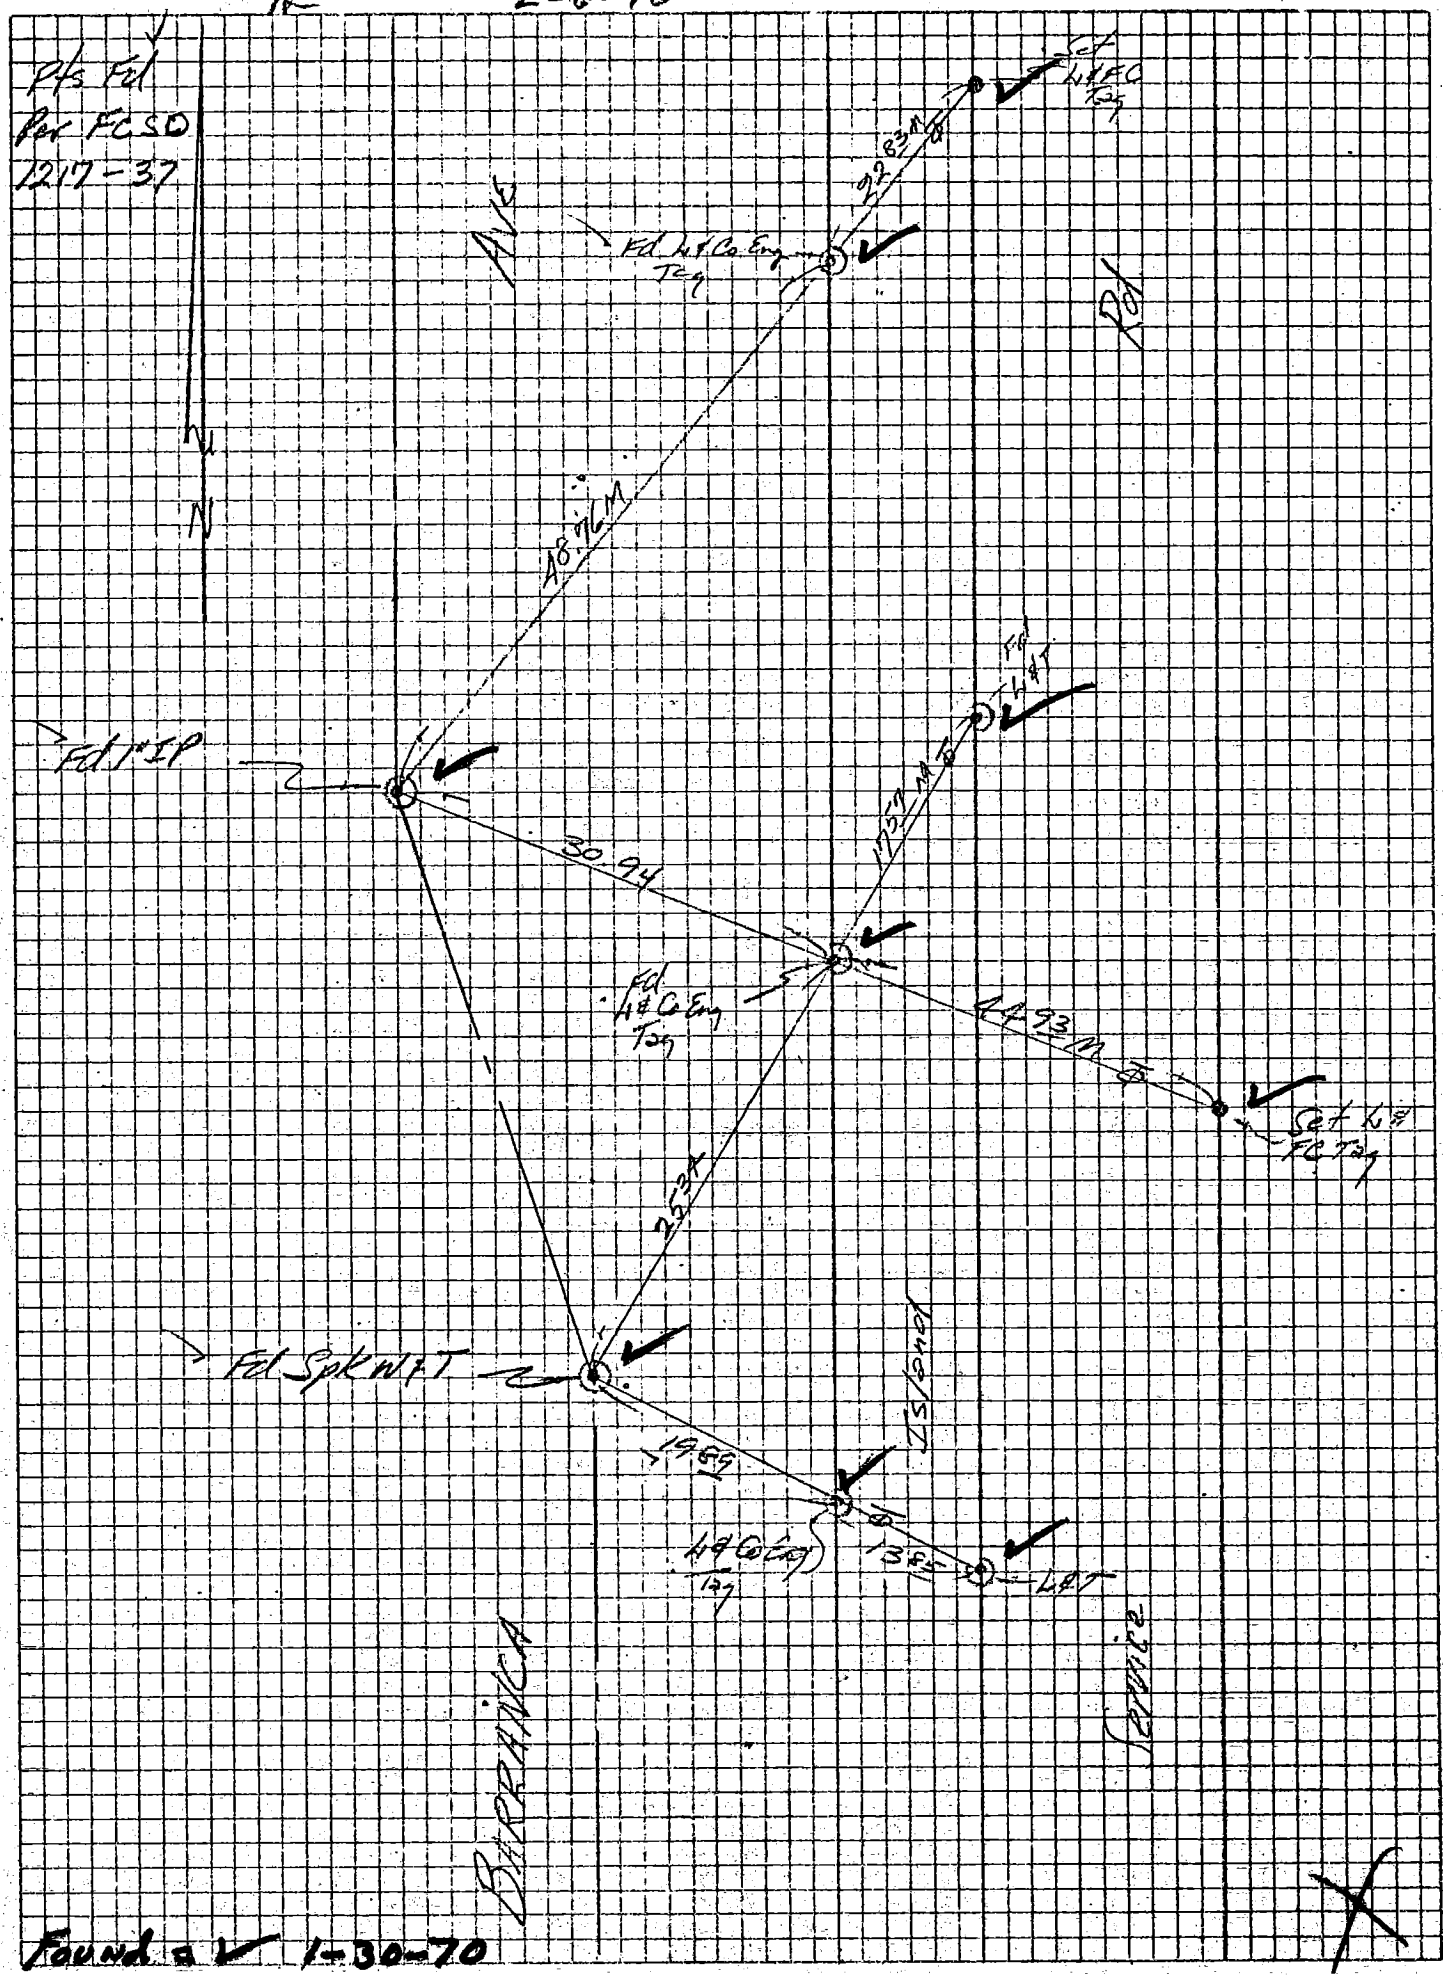


Found ✓ 1-30-70

76S911—Cdb 5-66

Co. Engr. F.B. 3555: 122

(122)

PROJECT 1217 Unit 2 Line A

INDEX FCSD 217 147

R&R 5

SURVEY BY Nixon DATE 2-14-69

REVIEWED BY (F) DATE 2-28-69 2-6-70

LOS ANGELES COUNTY FLOOD CONTROL DISTRICT

W.P. 97, D-2

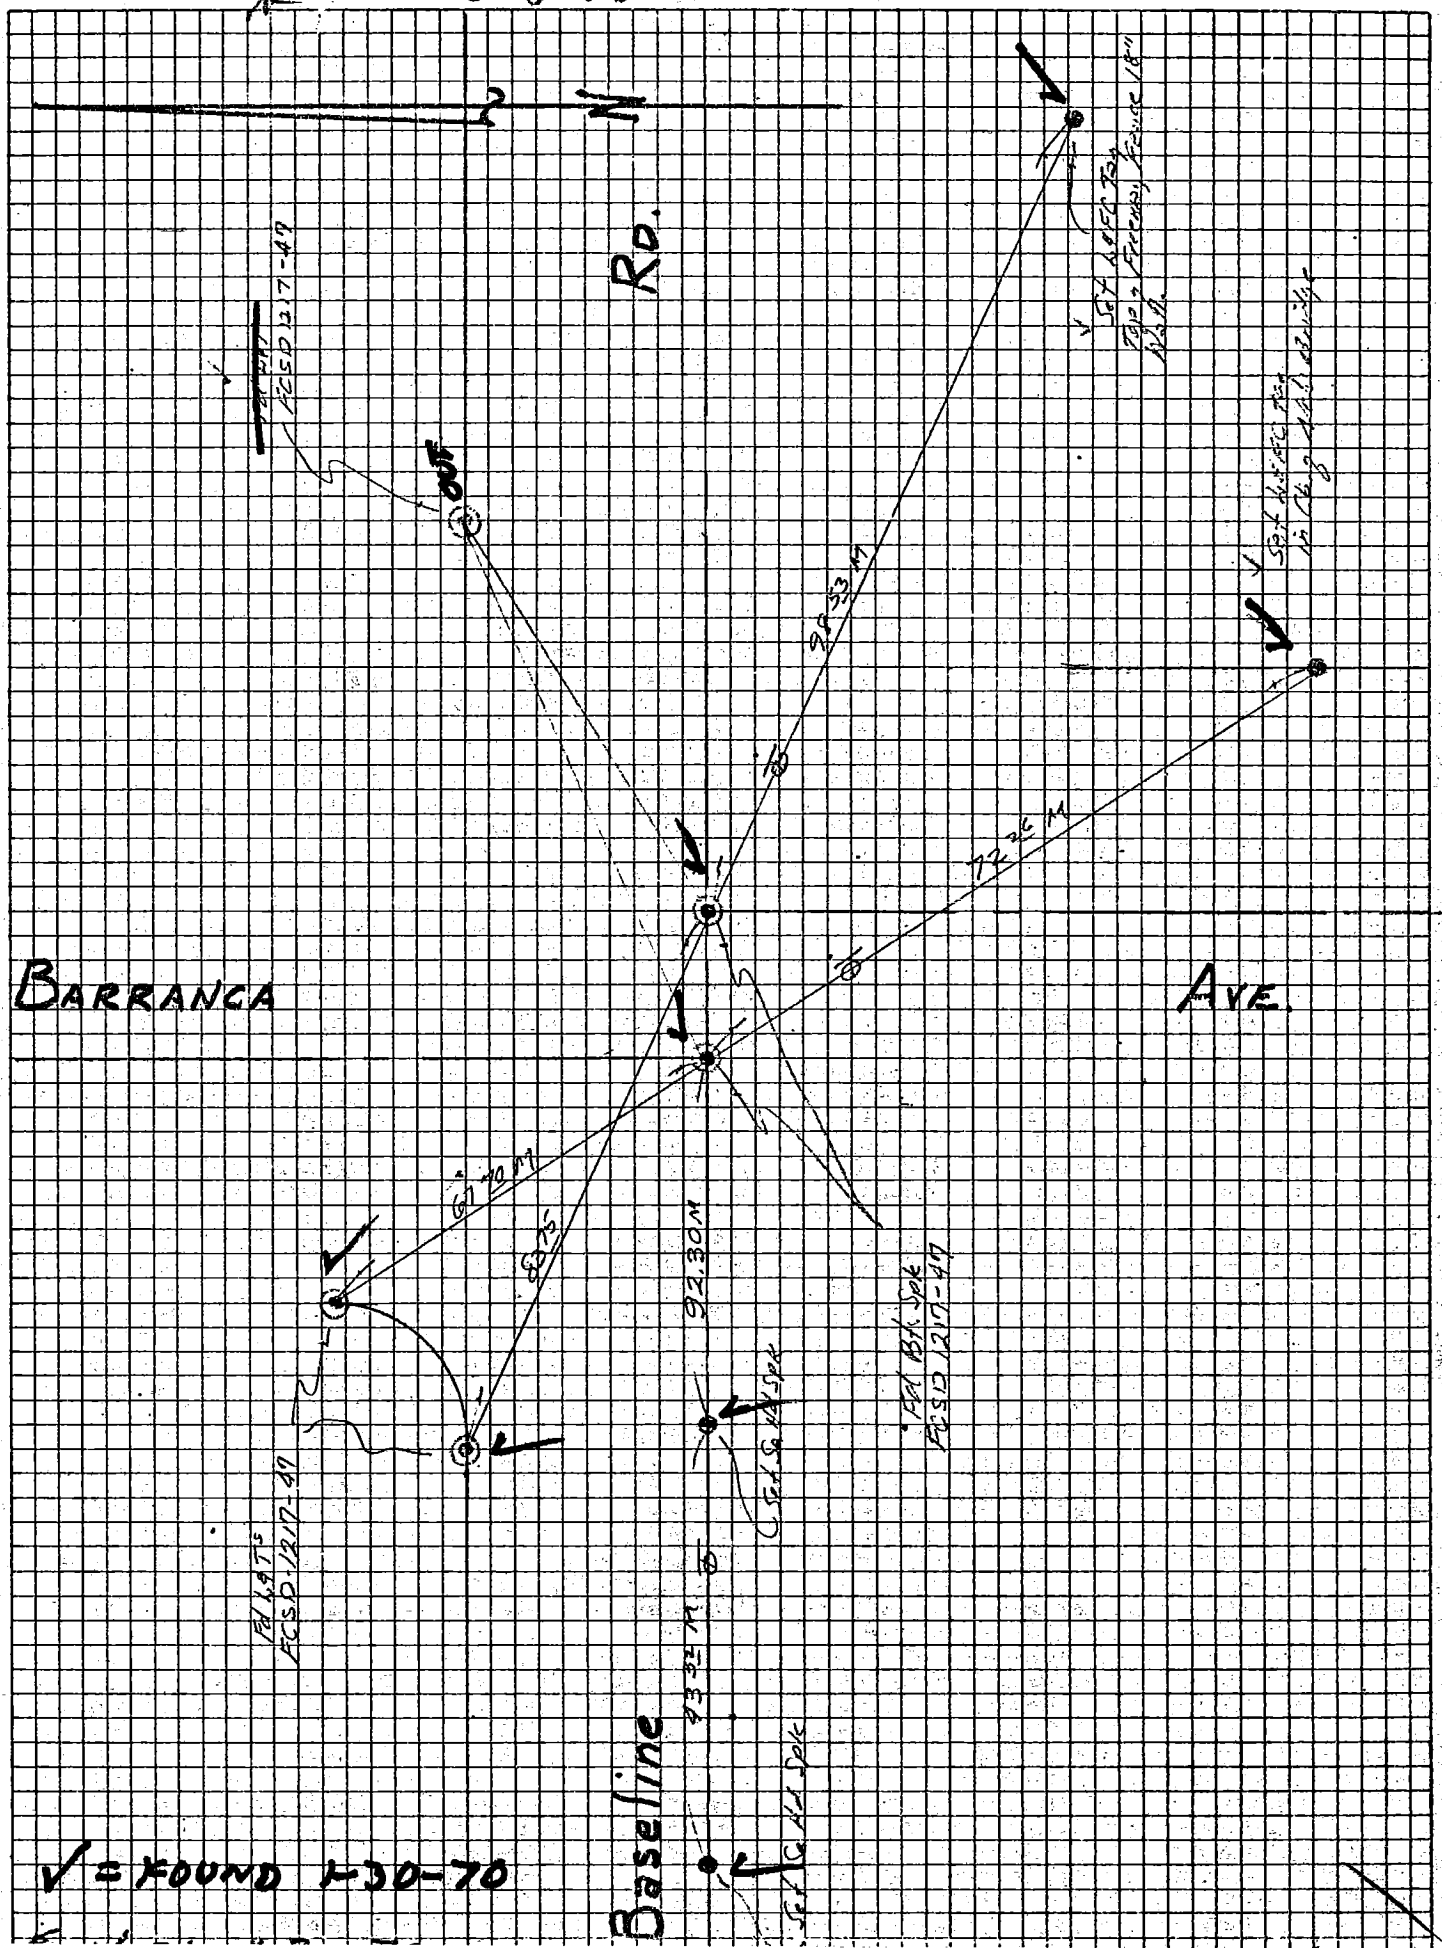
N
Rd.
BARRANCA
AVE.
Baseline

PROJECT 1217 Unit 2 Line A Co. Engr. F.B. 3555: 123 INDEX FCSD1217 149

SURVEY BY Nixon DATE 2-14-69

REVIEWED BY (F) DATE 2-28-69 2-6-70

LOS ANGELES COUNTY FLOOD CONTROL DISTRICT

(123)

R&R.7

W.S.47 D-2

✓ = FD 6-3-72

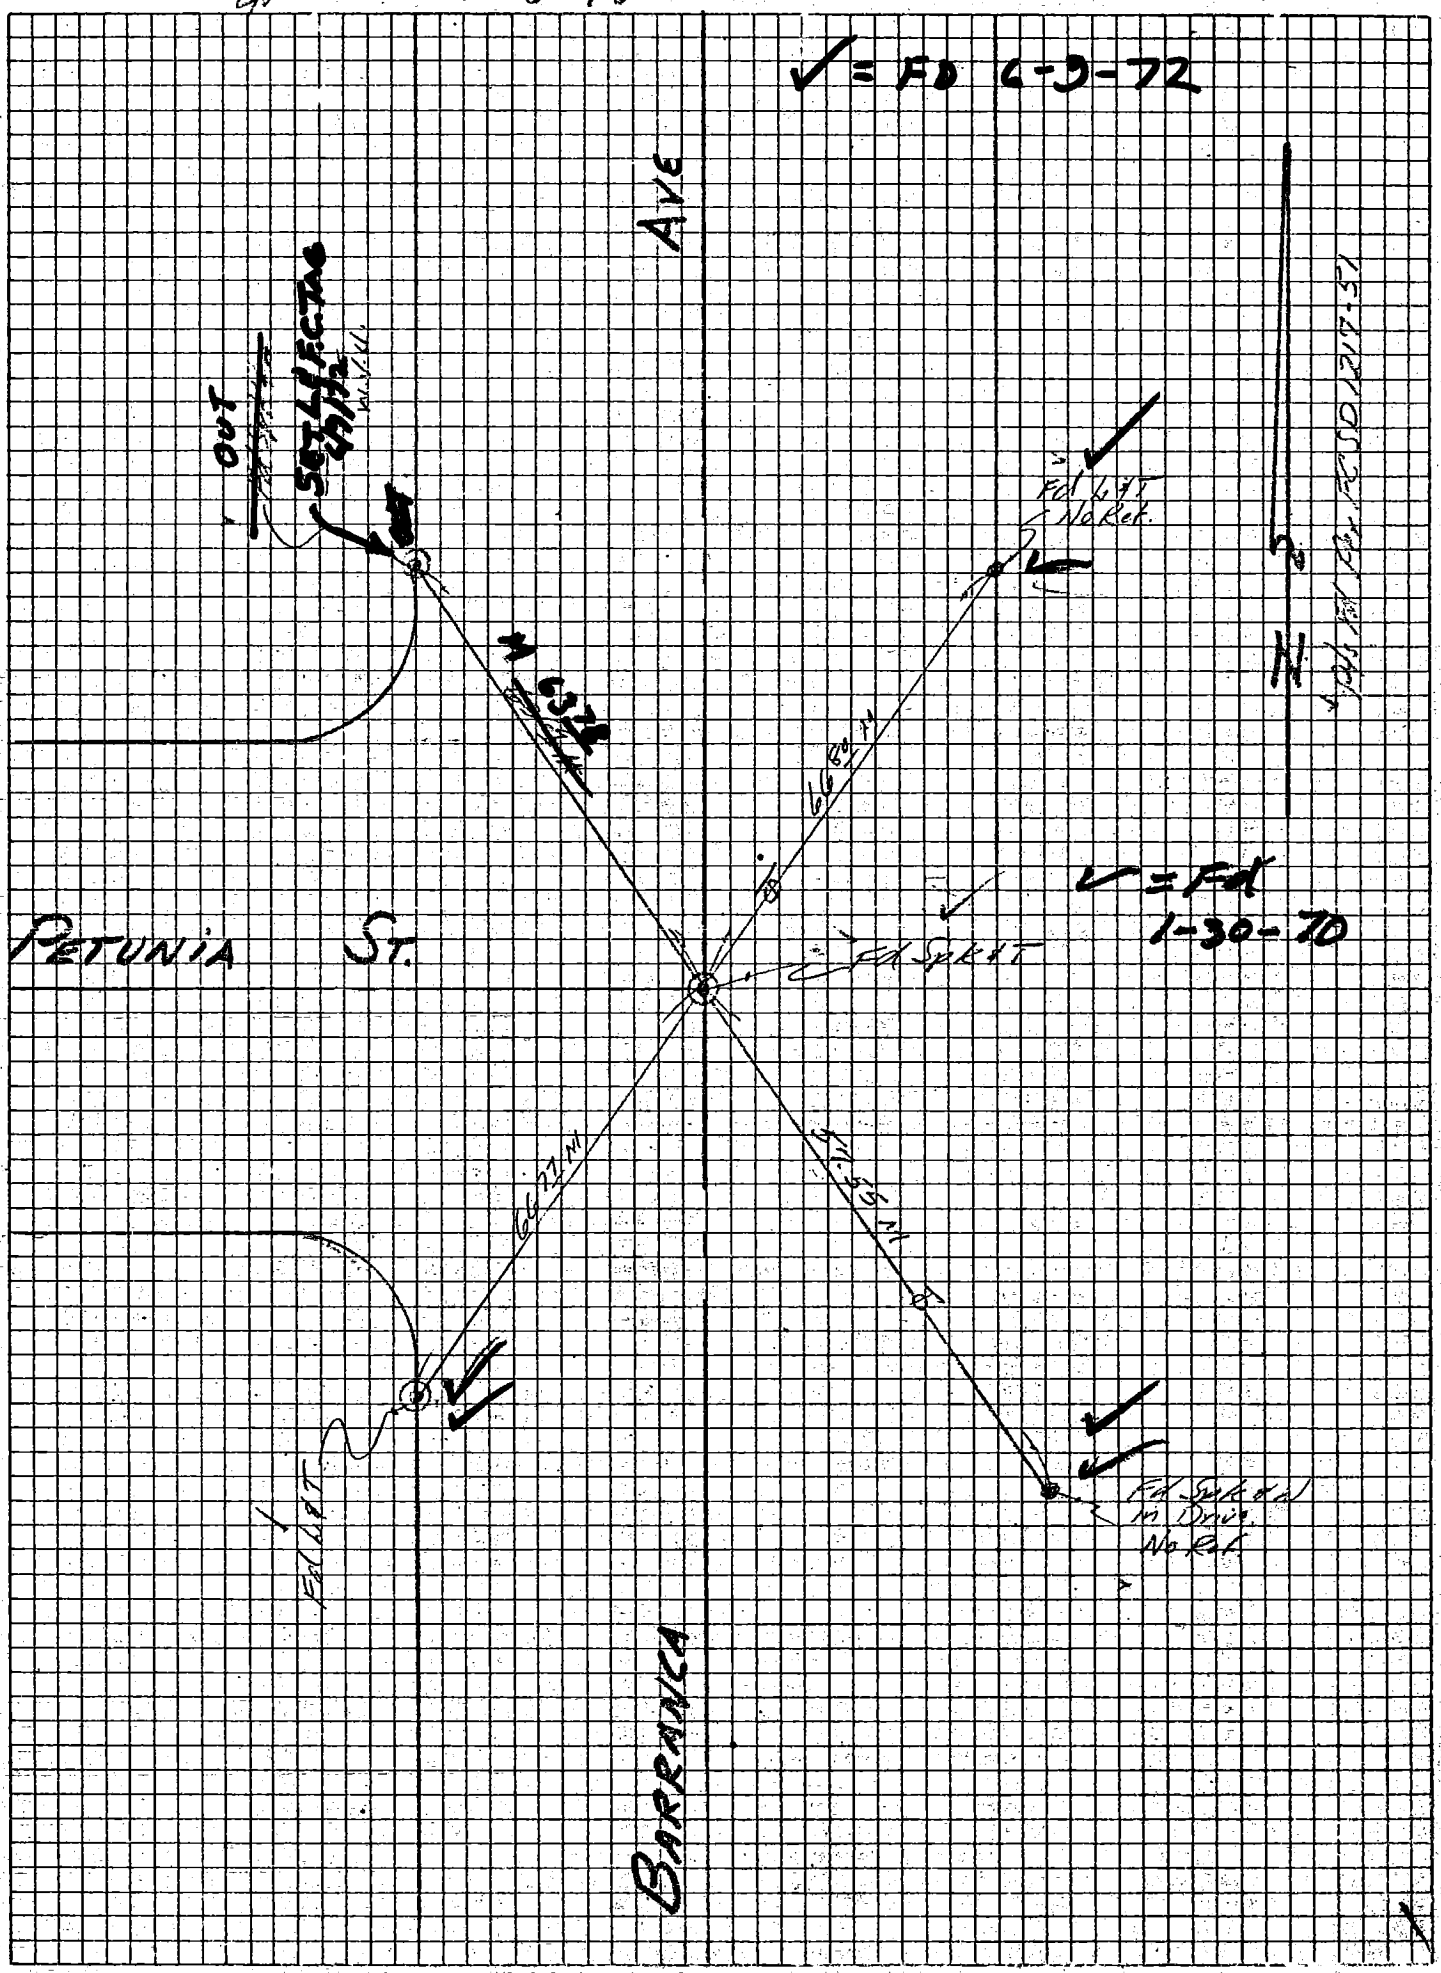

PROJECT 1217 Unit 2 Line A Co. Engr. F.B. 3555:124 INDEX FCSD1217 151 (124)

SURVEY BY Nixon DATE 2-29-69

REVIEWED BY (13) GR DATE 2-28-69 2-6-70

RAR-9

LOS ANGELES COUNTY FLOOD CONTROL DISTRICT

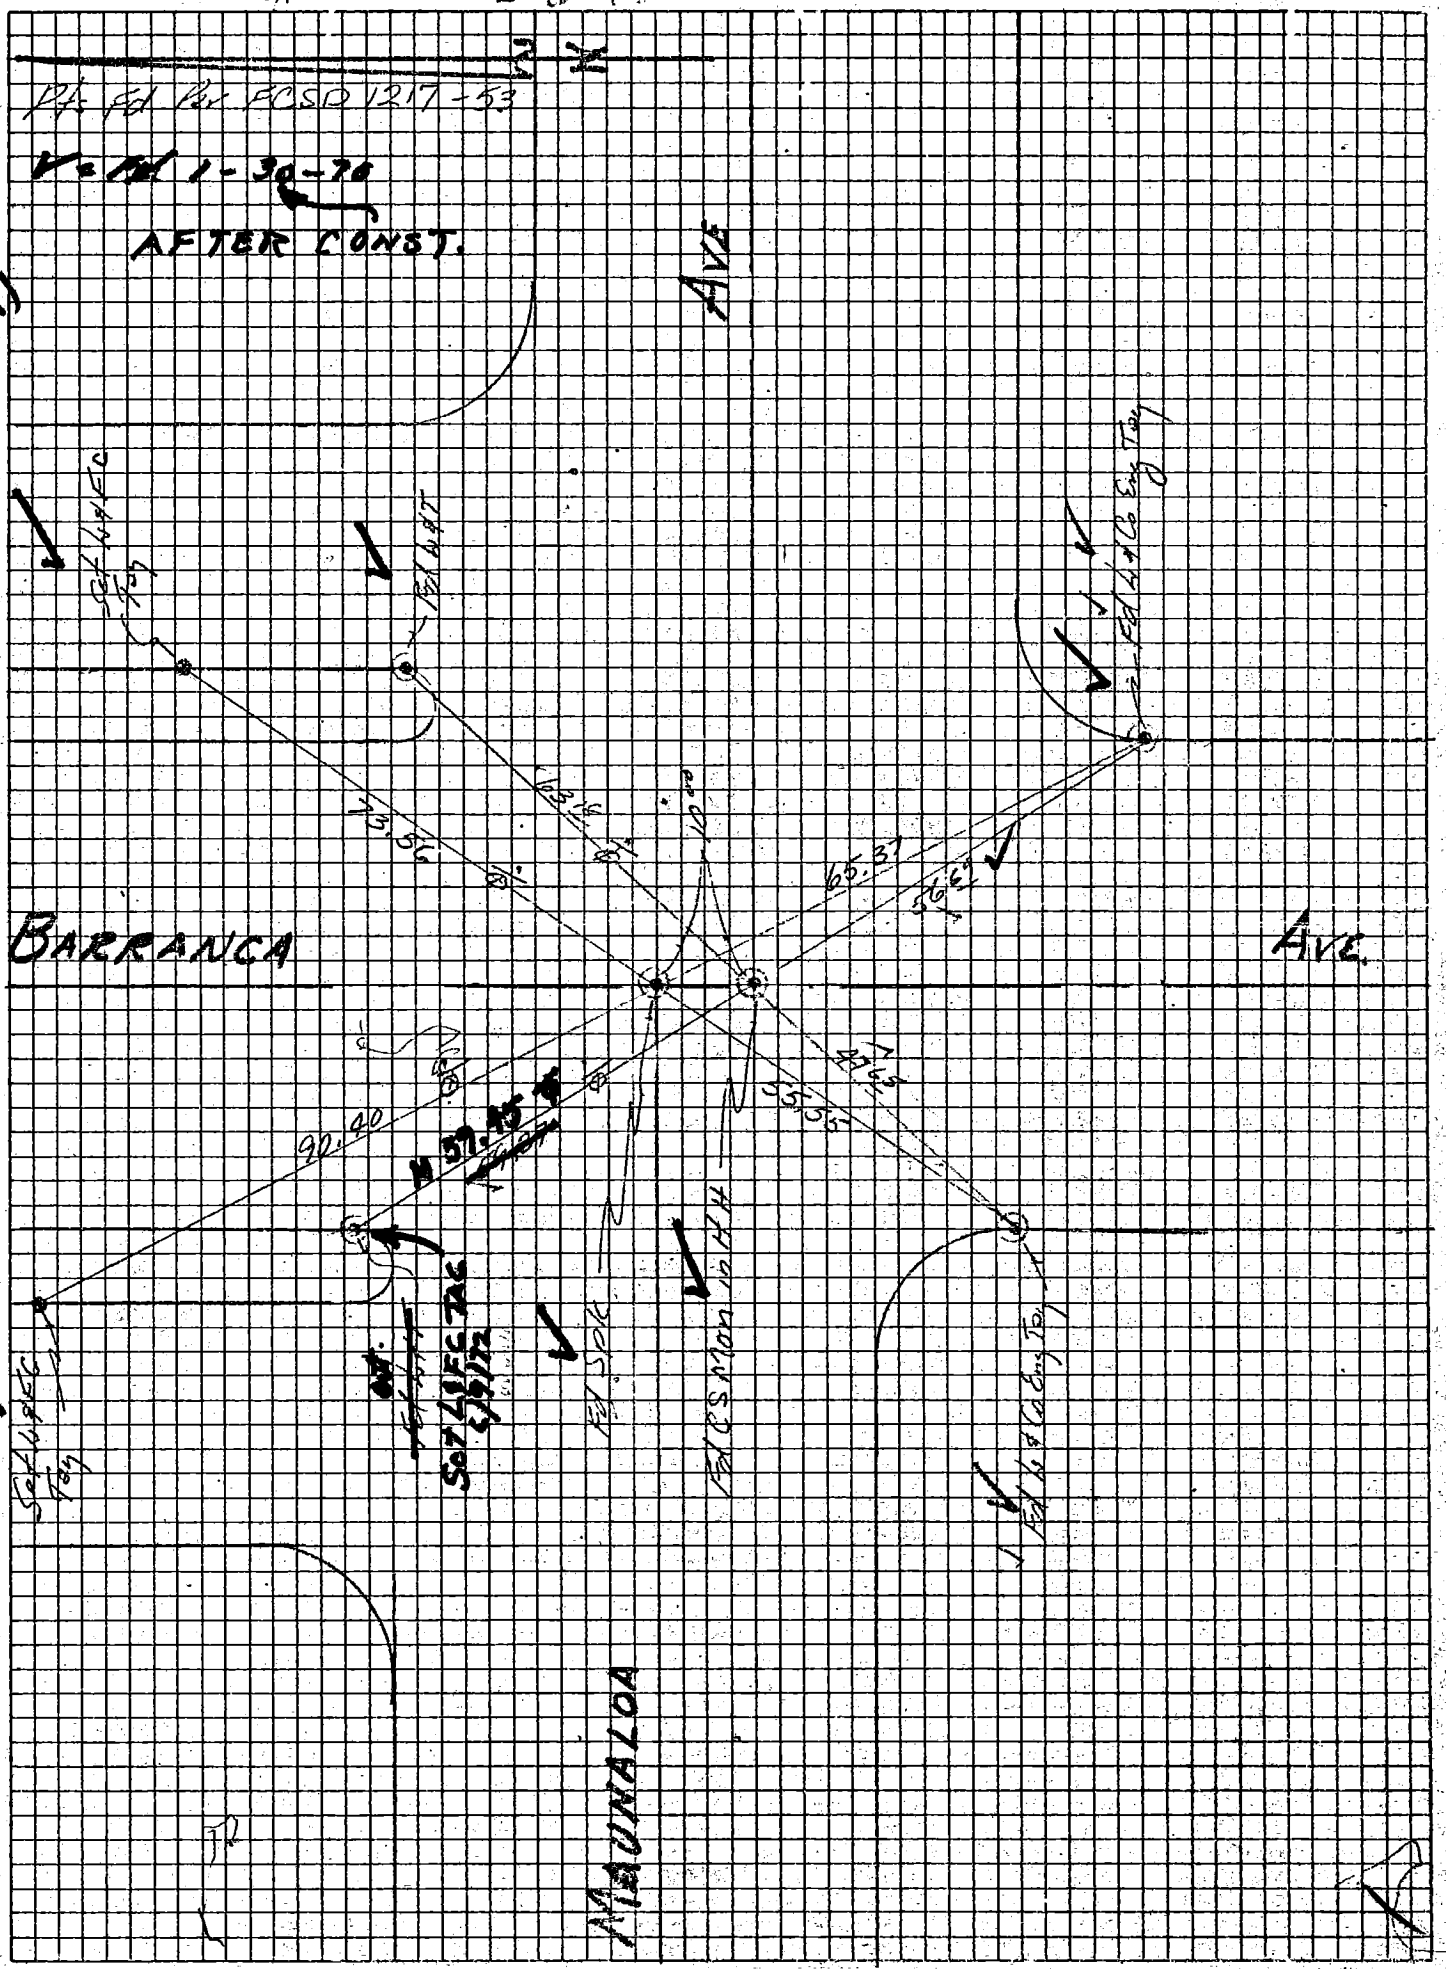
Rt. Fd Cr. FCSD 1217-53
V=Rt 1-30-70
AFTER CONST.
VAC 47, D-2
AVE
BARRANCA
AVE.
MAUNALOA
Sat Elec Tag
Sat Elec Tag
Sat Elec Tag

76S911— Cdb 1-68

PROJECT 1217 Unit 2 Line A

SURVEY BY Nixon DATE 2-26-69

REVIEWED BY (JS) DATE 2-28-69 2-6-70

Co. Engr. F.B. 3555: 125

INDEX FCSD1217 155 (125)

R & R-11

LOS ANGELES COUNTY FLOOD CONTROL DISTRICT

WS, 47, D-2

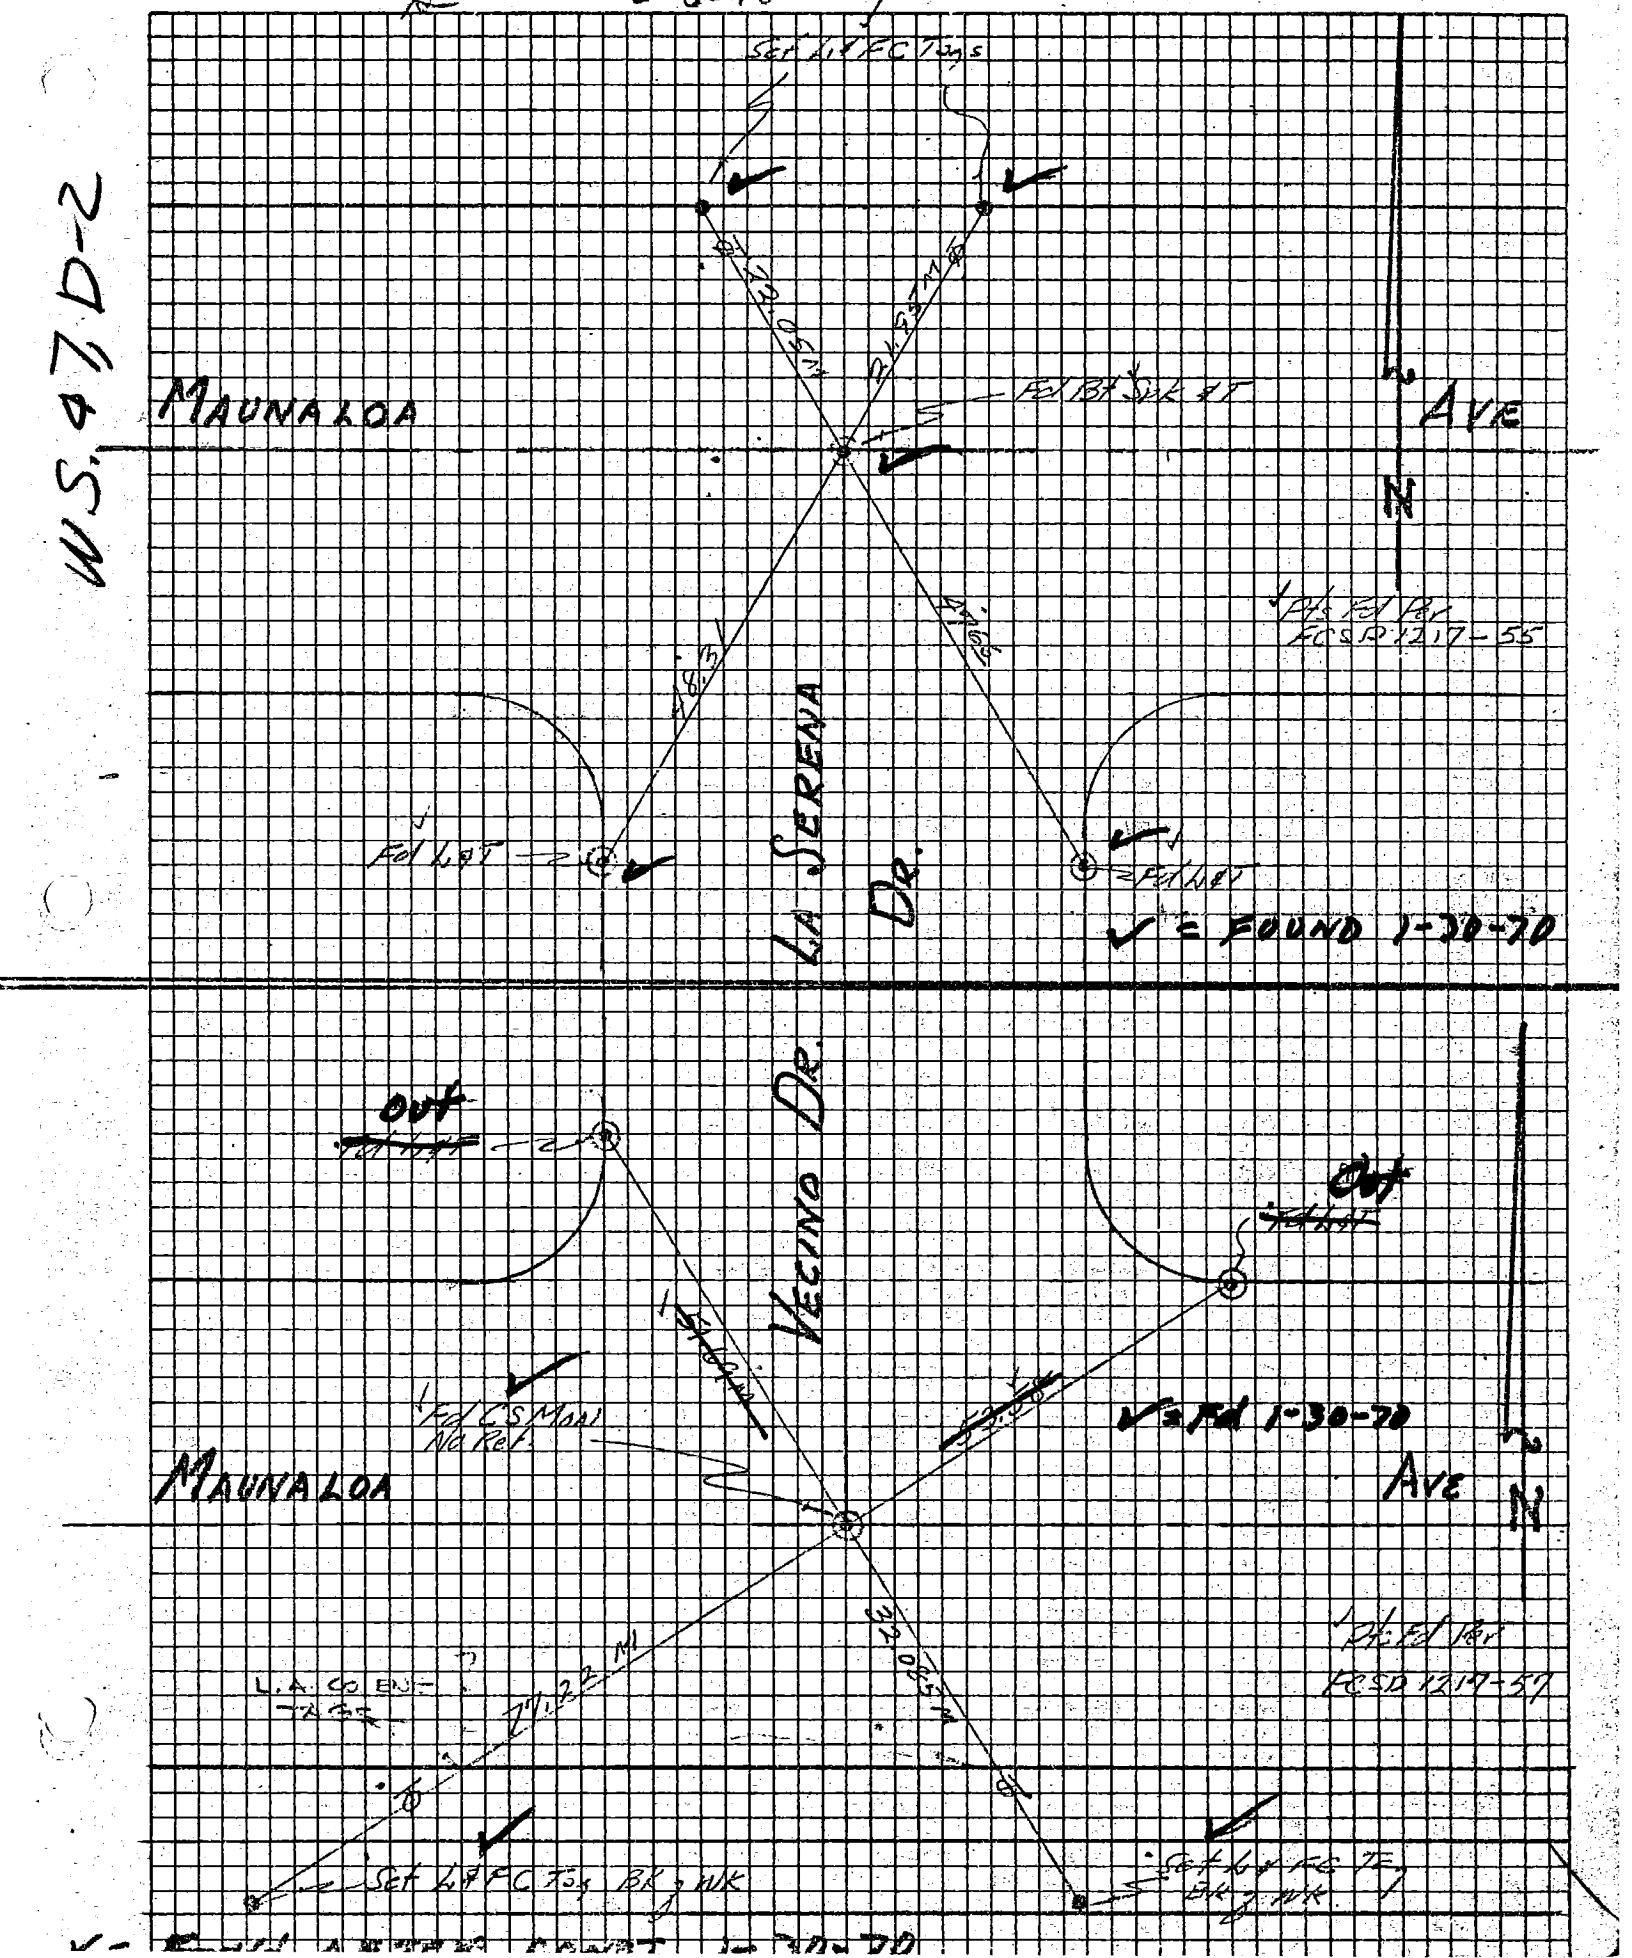

Cdb 1-68

PROJECT 1217 Unit 2 Line A Co. Engr. F.B. 3555: 126 INDEX FCSD121H 157

SURVEY BY NIXON DATE 2-26-69

REVIEWED BY [illegible] DATE 2-28-69 2-6-70

LOS ANGELES COUNTY FLOOD CONTROL DISTRICT

(126)

R&R-13

W.S. 47, D-2

N

Set Sq Hd Spike & Pad @ House #17203 E. Bway

V=FM 130-70 ETN

Set Sq Hd Spike & Tag in Wall

BAGNALL ST.

Set Sq Hd Spike & Tag in Wall

VECINO DR.

Set Sq Hd Spike & W in Misc Parking lot Luna Cnty

76S911- Cdb 5-71

PROJECT 1217 Unit 2 Line A

SURVEY BY Nixon

REVIEWED BY

DATE 11/10/72

DATE 11-16-72

Co. Engr. F.B. 3555: 127

INDEX FCSD1217 159

(127)

R.P. - 15

LOS ANGELES COUNTY FLOOD CONTROL DISTRICT

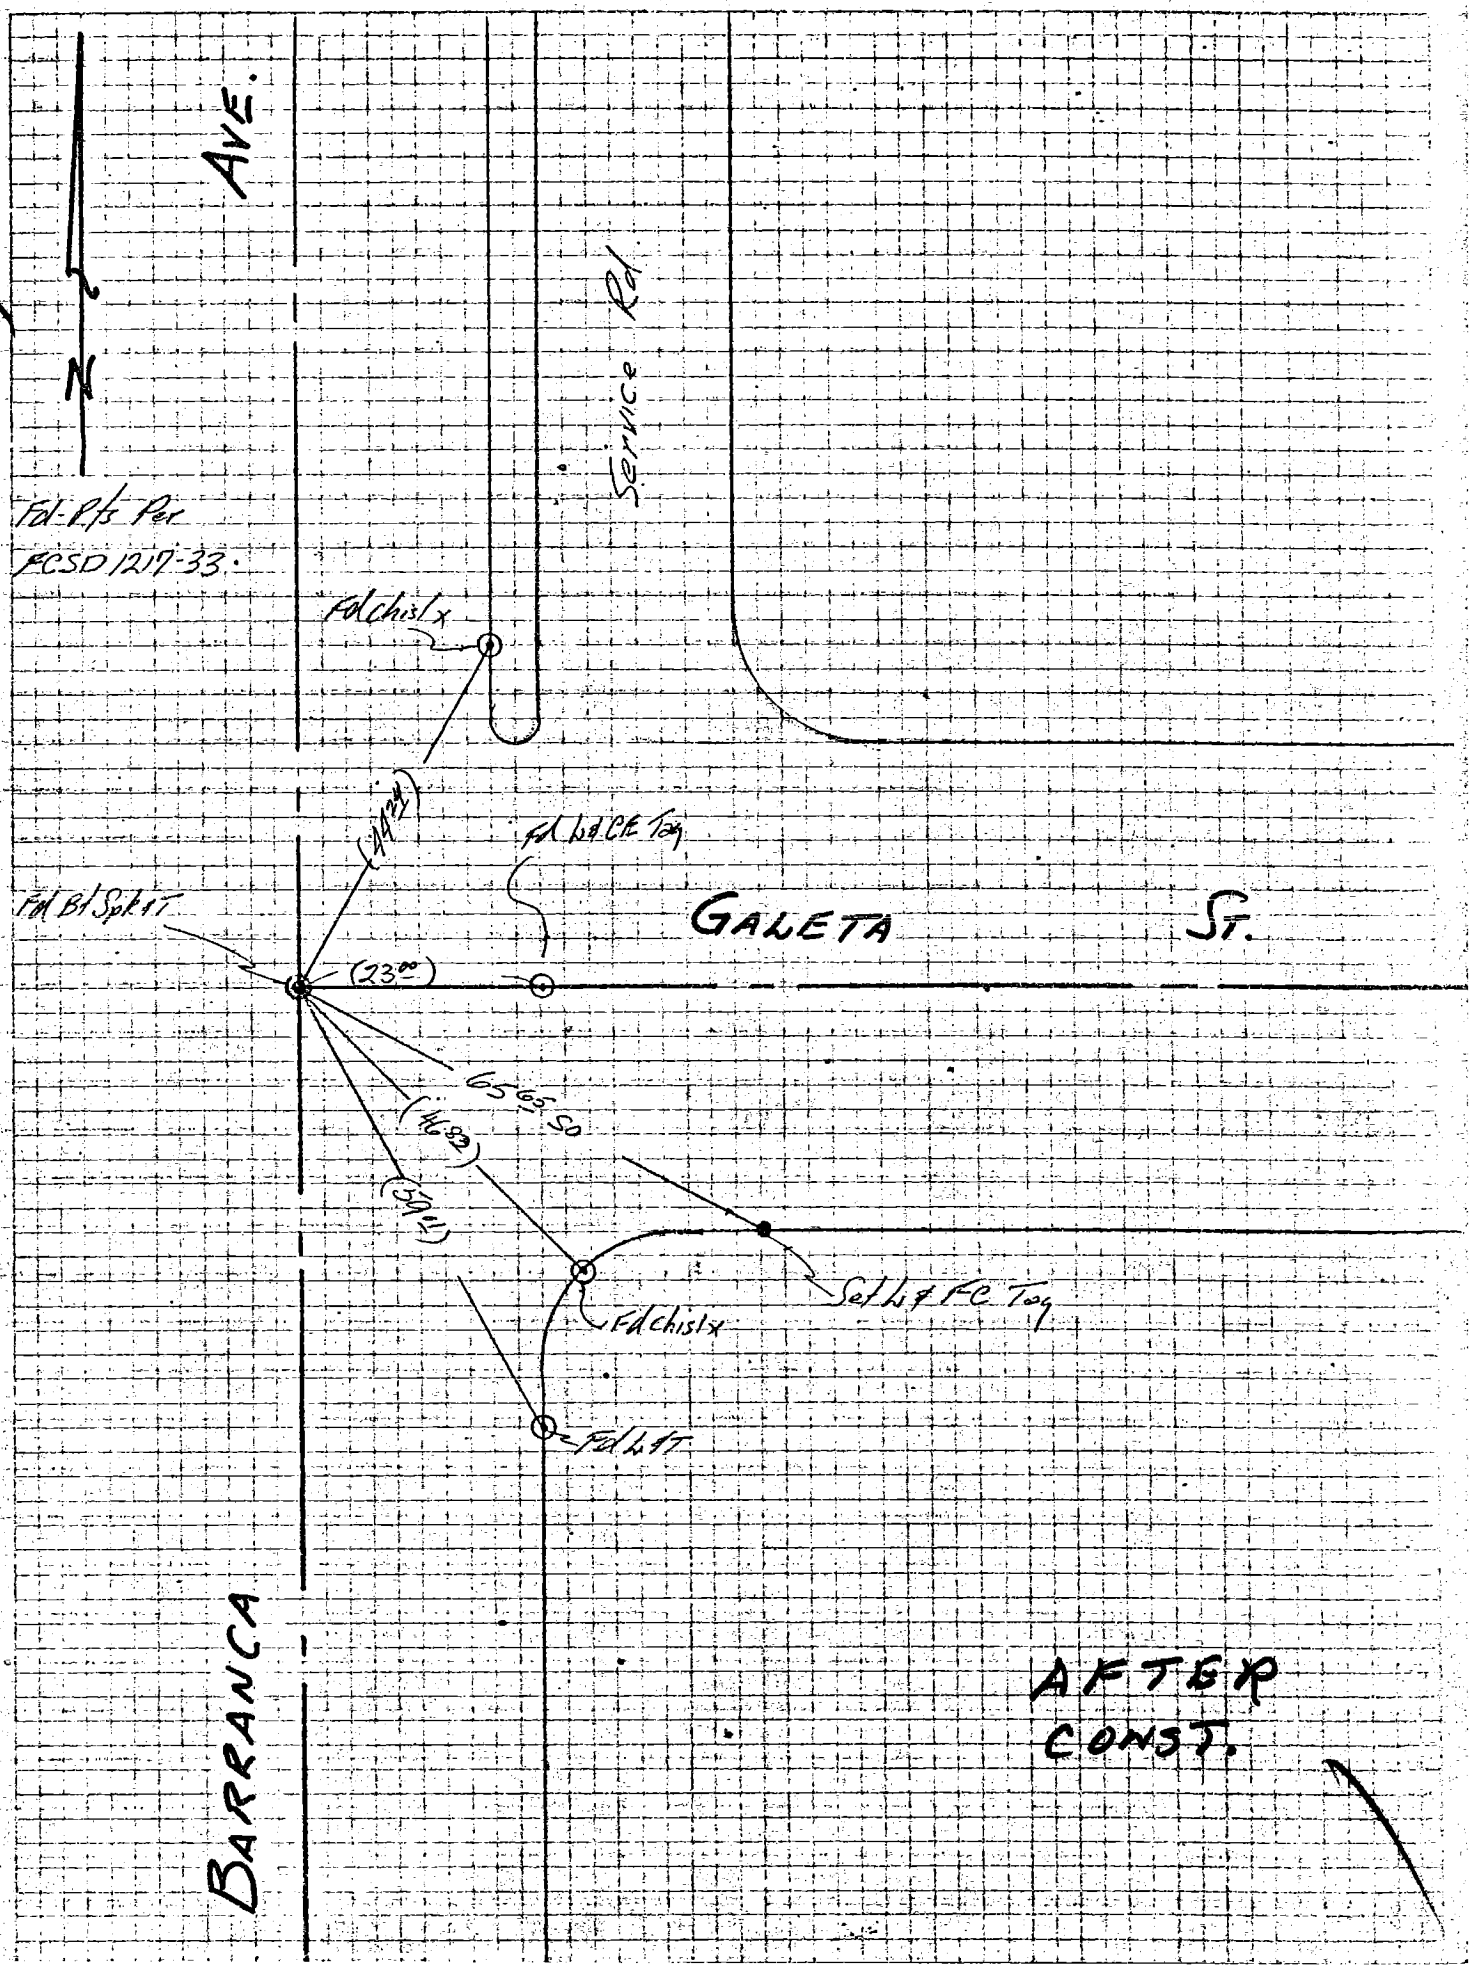

PROJECT S.D 1217 LINE A

SURVEY BY W.V.H. DATE 6/9/72

REVIEWED BY [illegible] DATE 11-16-72

Co. Engr. F.B. 3555: 128

INDEX FCSD1217 161

R&R-17

(129)

LOS ANGELES COUNTY FLOOD CONTROL DISTRICT

MAP # D-2

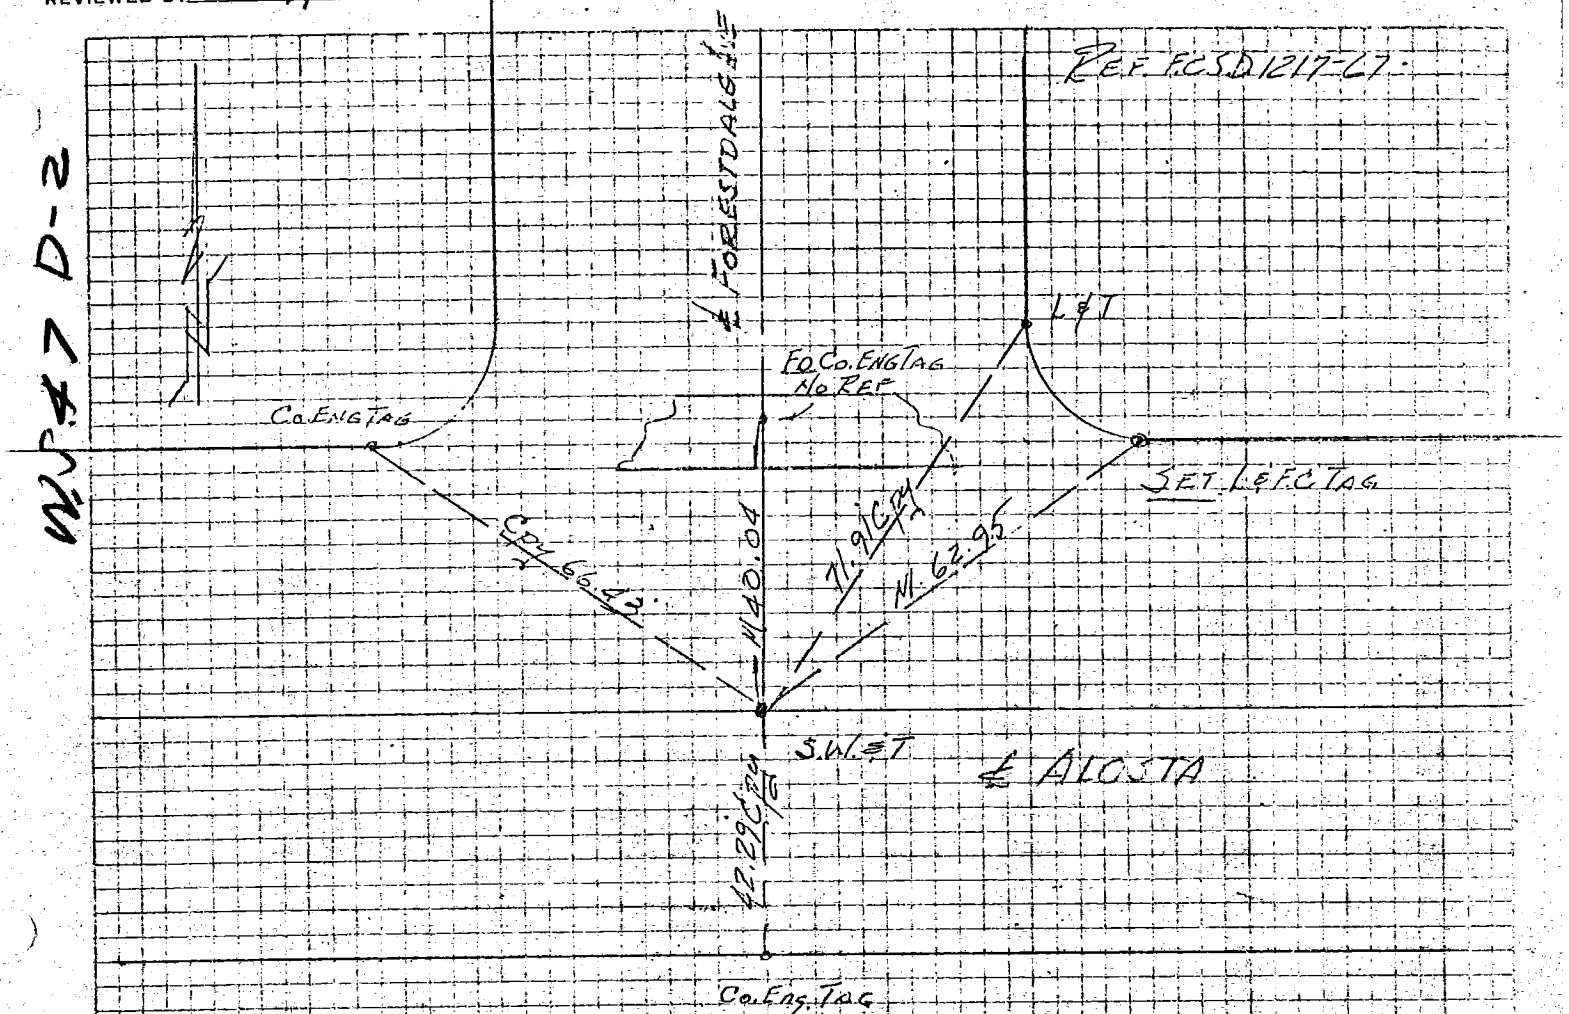


AFTER CONST.

76S911– Cdb 3-69

PROJECT 1217 Unit 2 Line A Co. Engr. F.B. 3555: 129 INDEX FCSD1217 163

SURVEY BY NIXON DATE 11/10/72

REVIEWED BY [illegal] DATE 11-16-72

R&R - 19

LOS ANGELES COUNTY FLOOD CONTROL DISTRICT

(129)

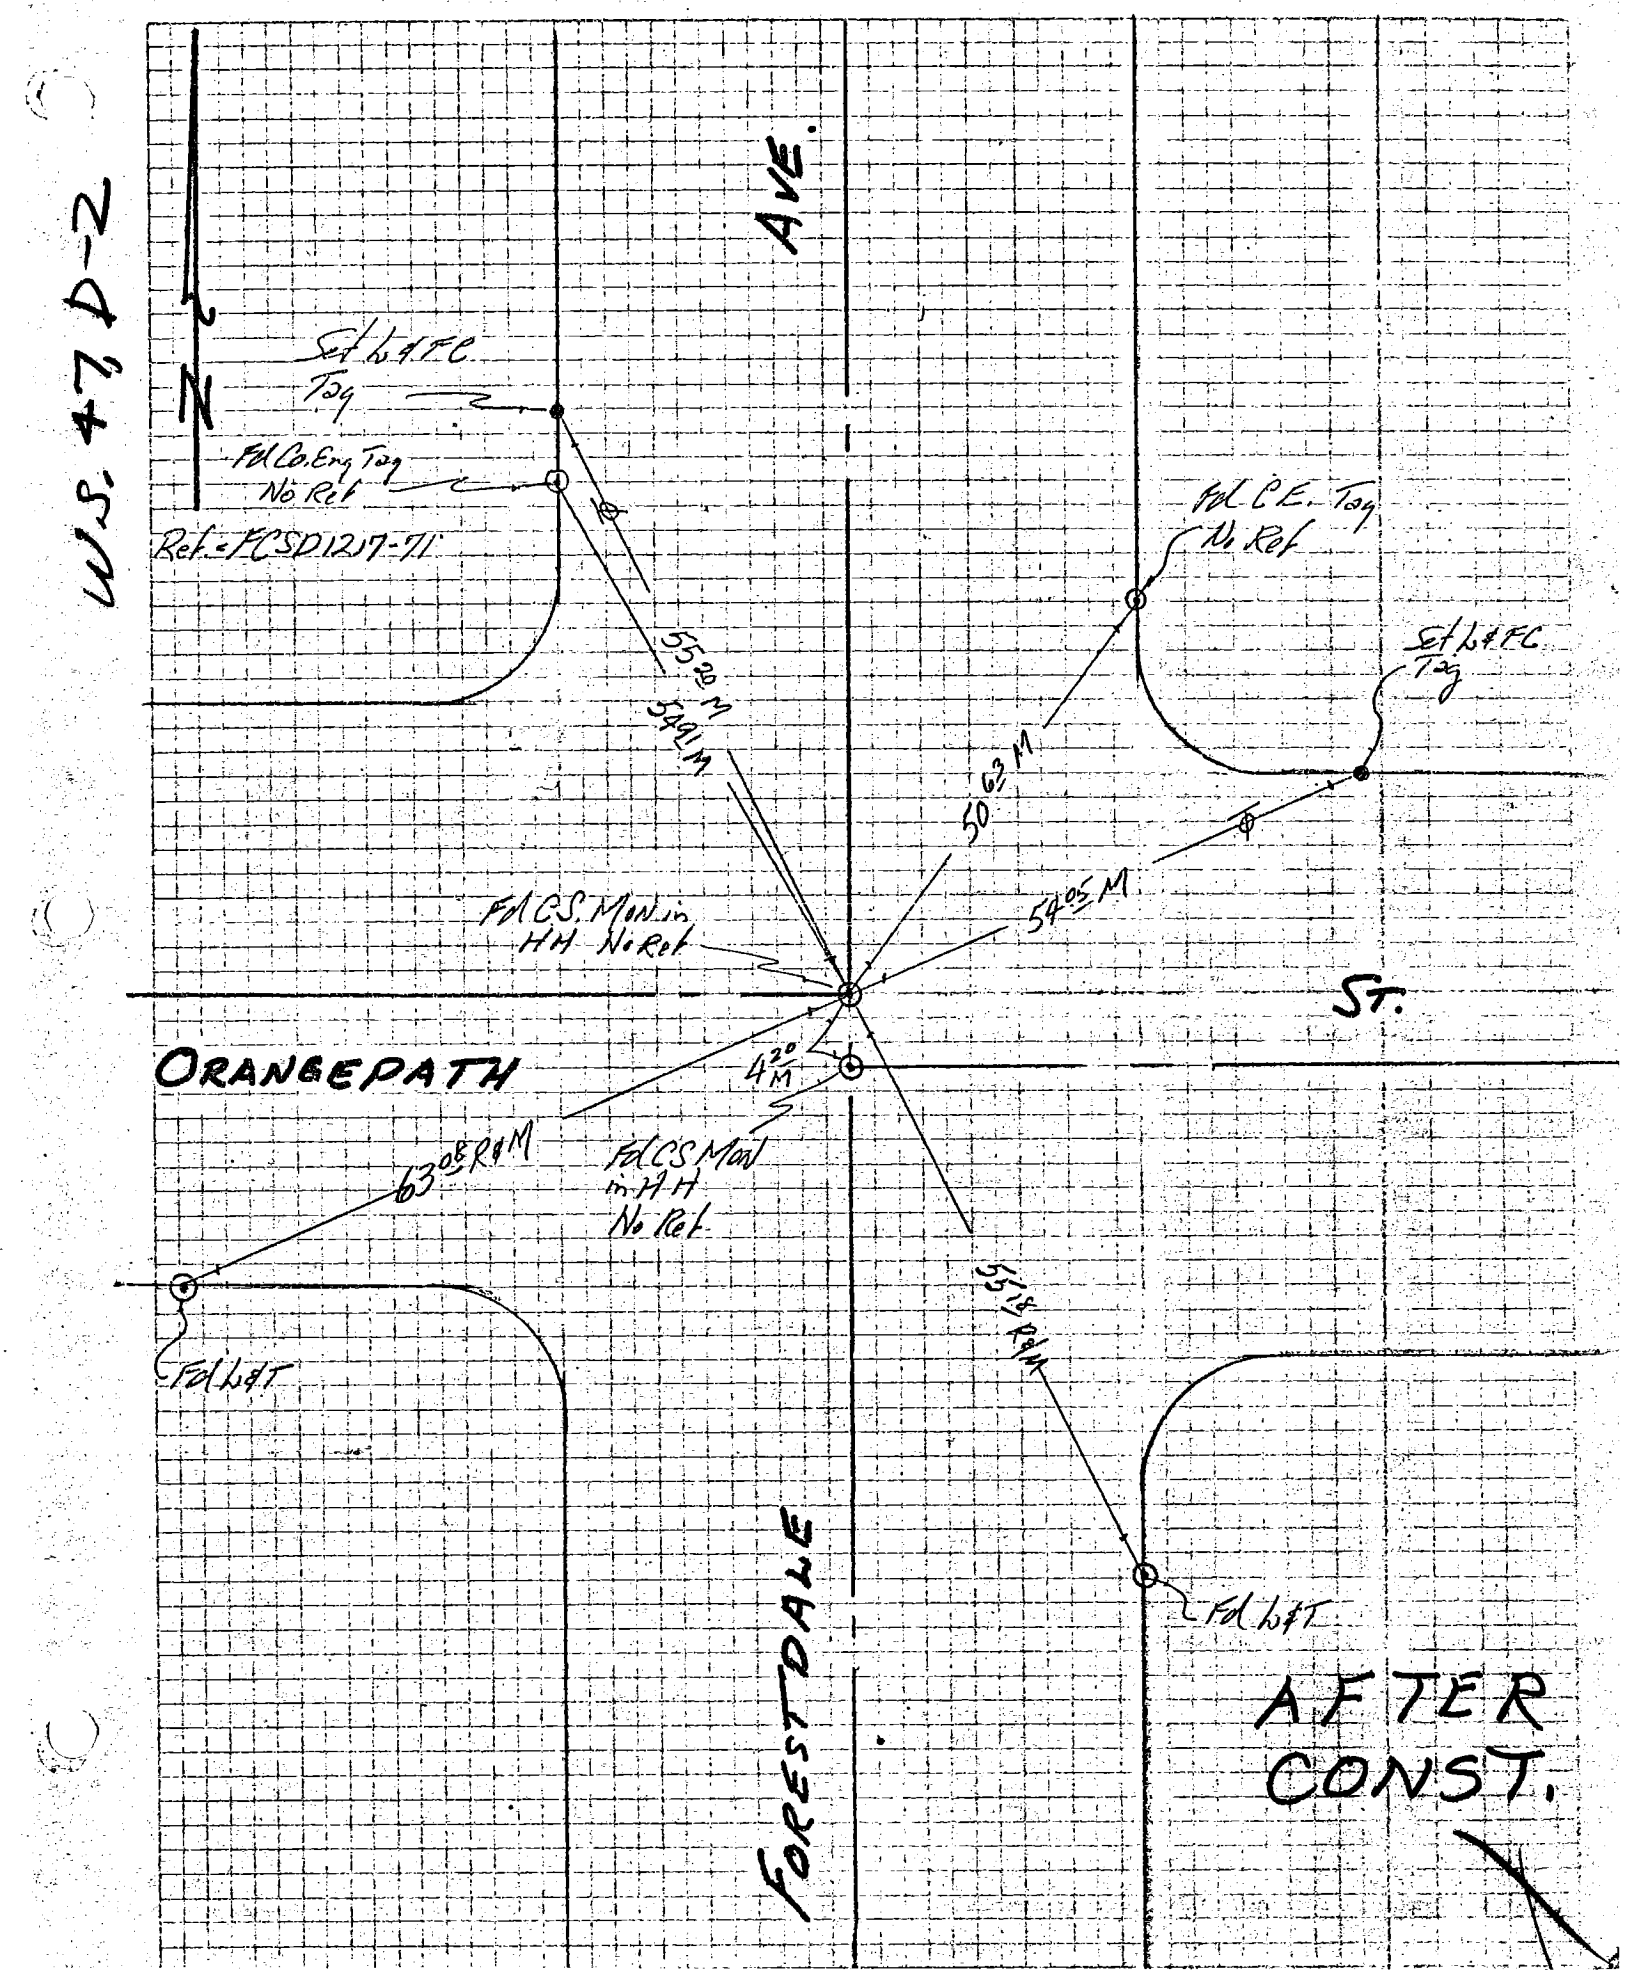

768911– Cdb 3-69

Co. Engr. F.B. 3555: FCSD 1217 185 (130)
130

PROJECT S.D. 1217 Line B — INDEX RAR-21

SURVEY BY W.V.N. — DATE 6/9/72

REVIEWED BY [illegible] — DATE 11-16-72

LOS ANGELES COUNTY FLOOD CONTROL DISTRICT

W547, D-2

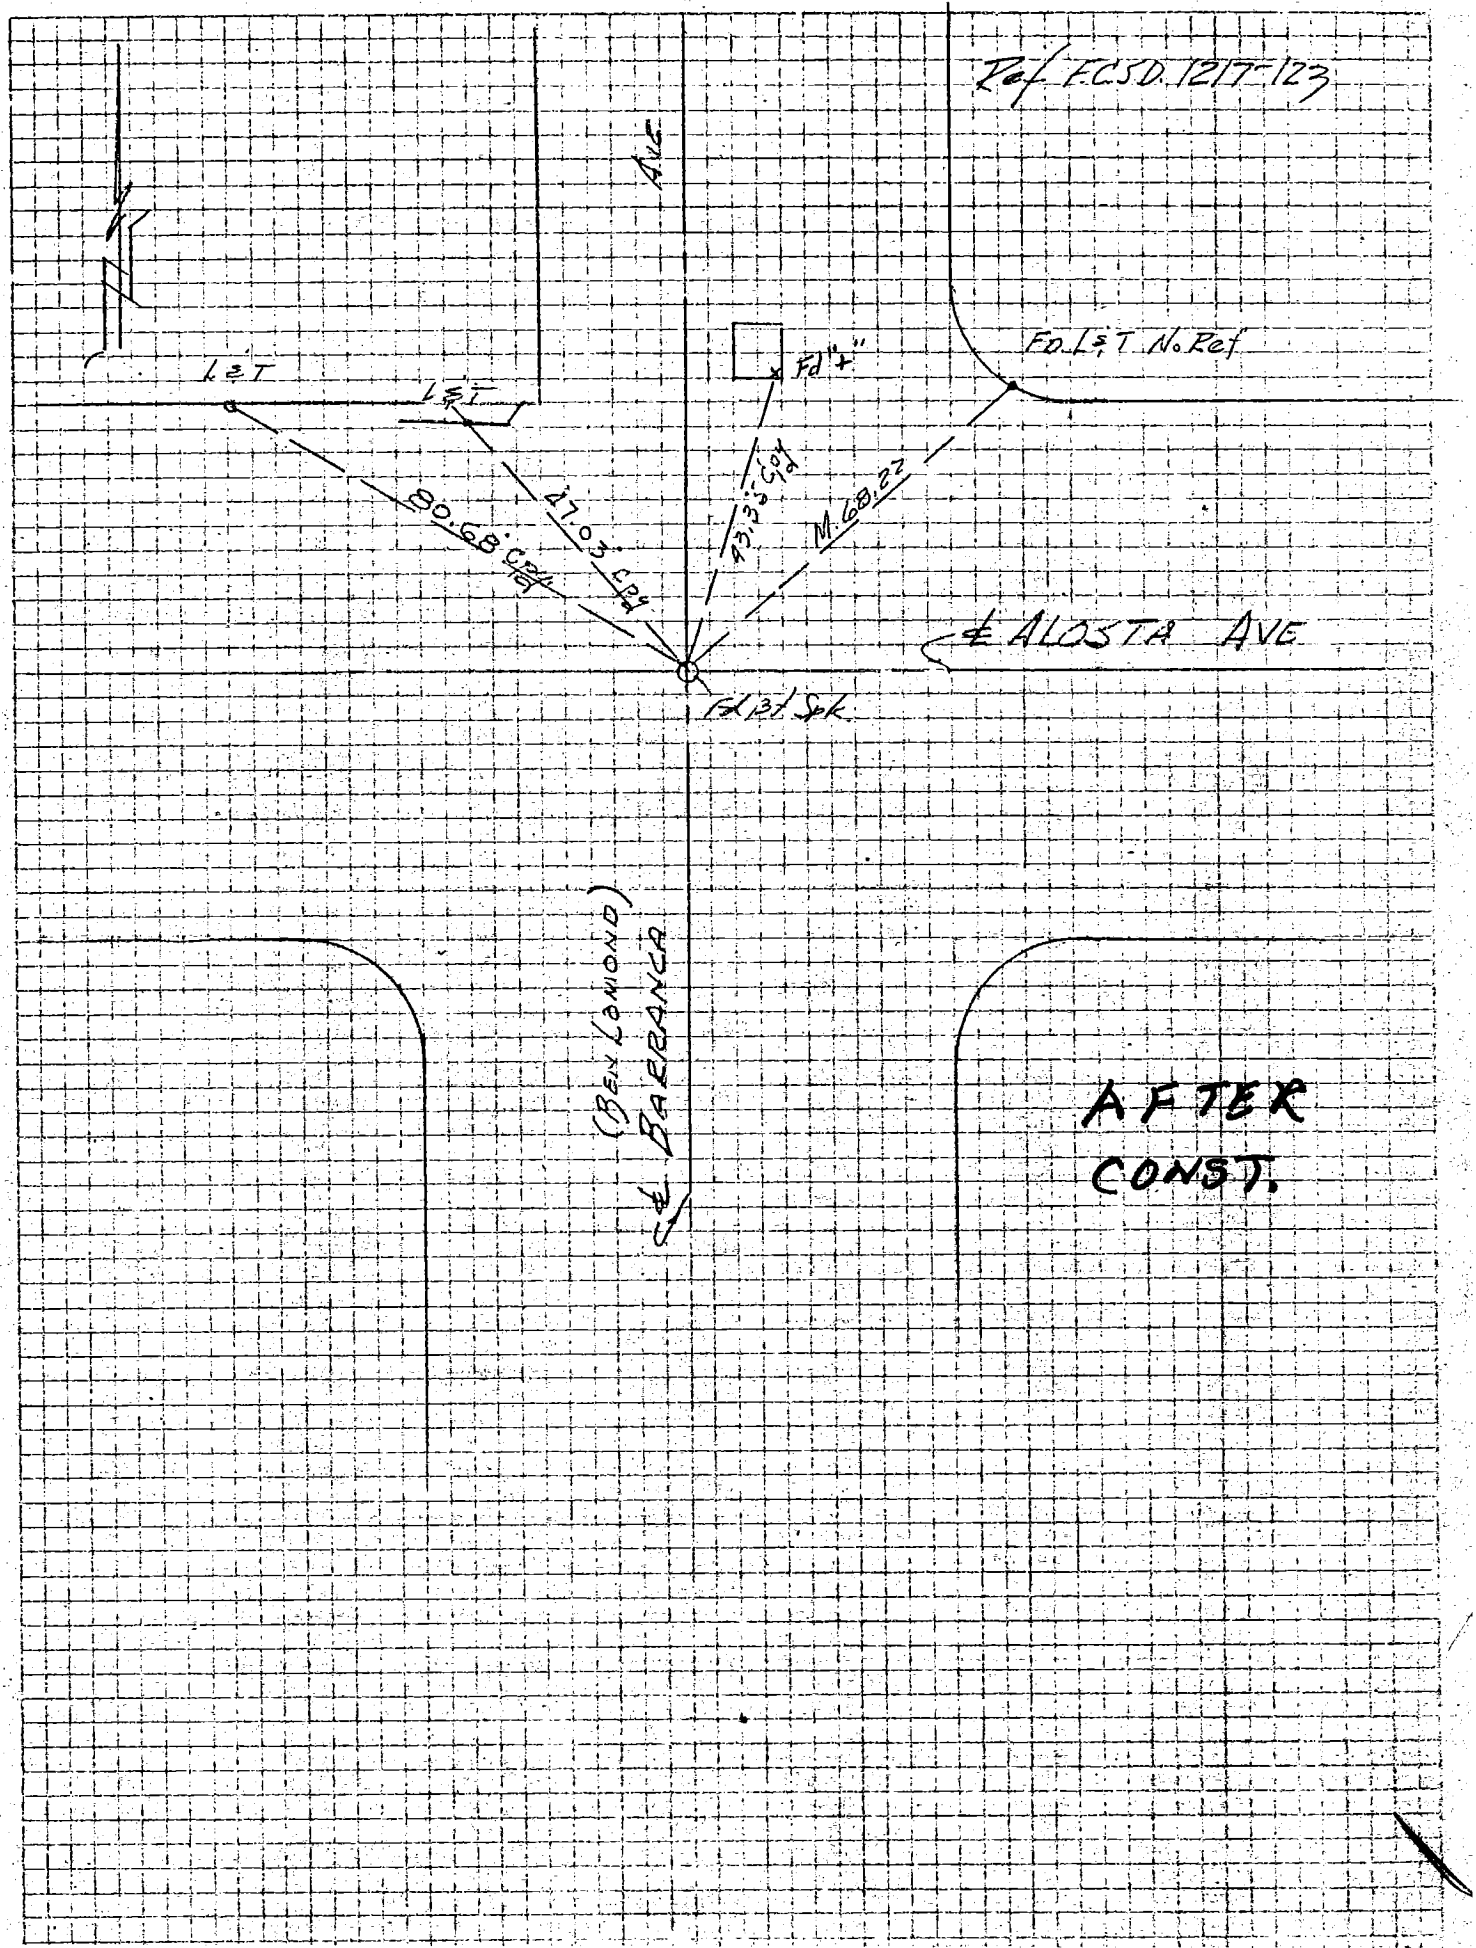

7859 11– Cdb 3-69

PROJECT S.D. 1217-12.5 Line B

SURVEY BY W.V.H. DATE 6/30/72

REVIEWED BY [illegible] DATE 11-16-72

Co. Engr. F.B. 3555: FCSD1217 167
131

INDEX R4R-23

(131)

LOS ANGELES COUNTY FLOOD CONTROL DISTRICT

W.S. 47D-2

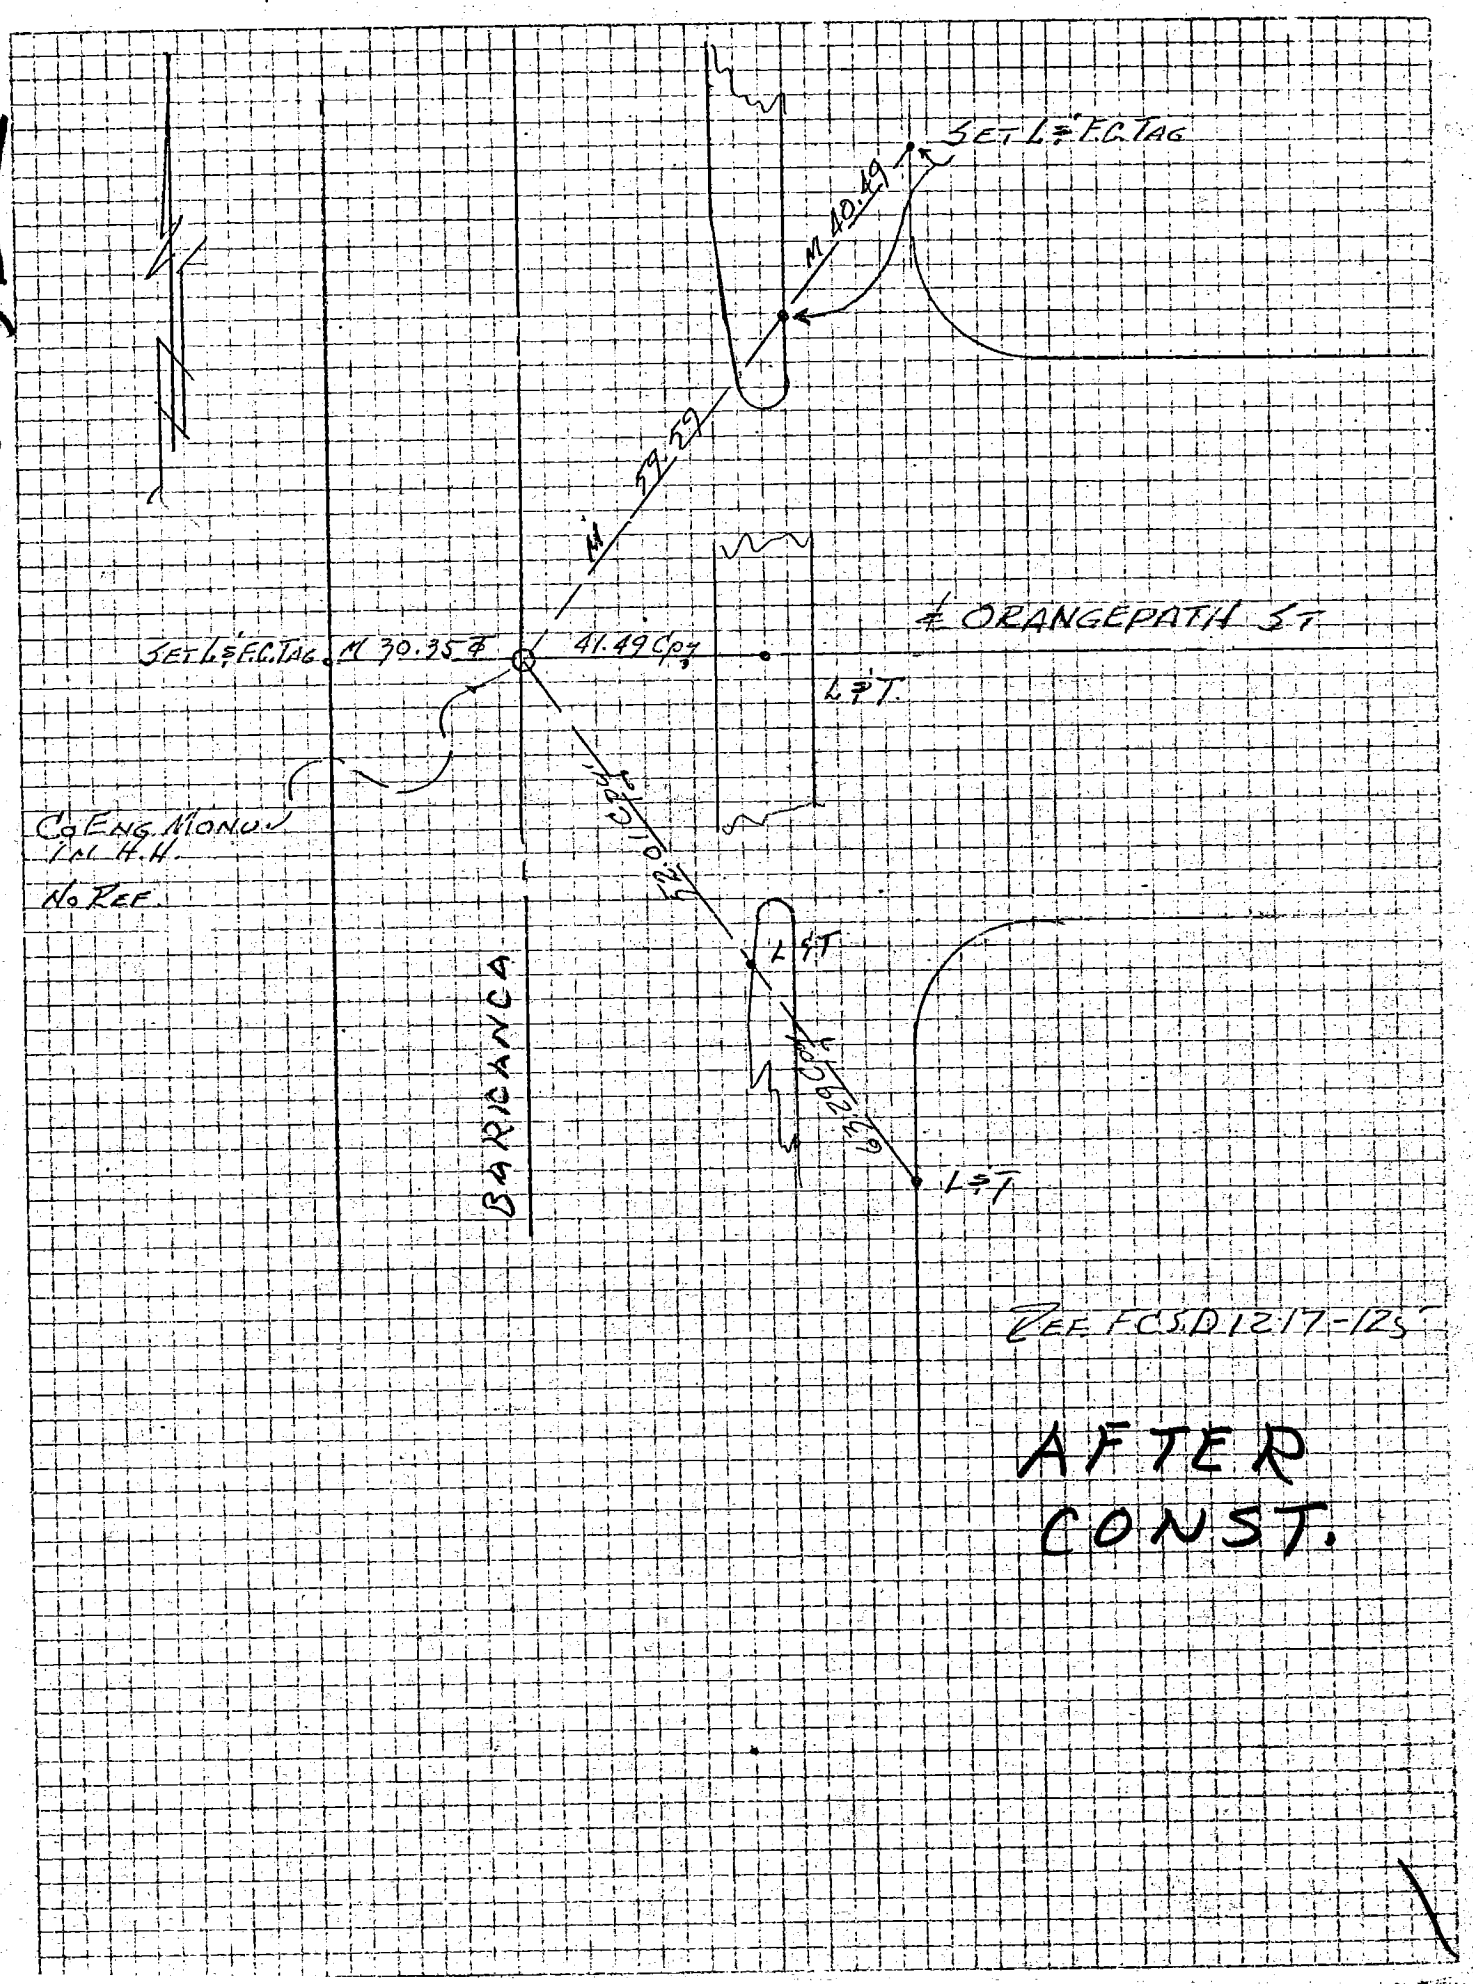

Co. Engr. F.B. 3555: 132 SD 688 27 (32)

W.S. 28, A-3

| | |
|---|---|
| Notes Ck'd by: | Survey of: |
| Map No. | JN: Tape: Std: °F |
| Office Work | Surveyed by: |
| Checked | Notes: Date: |
| Date | Indexed: R. J. GALLI |

F. B. 2588 PG. 25

V=Fd in good cond. after const. 4-14-71 BRB.

FROM BOTT PG 20

NOTE: SEE FCSD 1104-207 FOR ST. TIES. AFTER CONSTR.

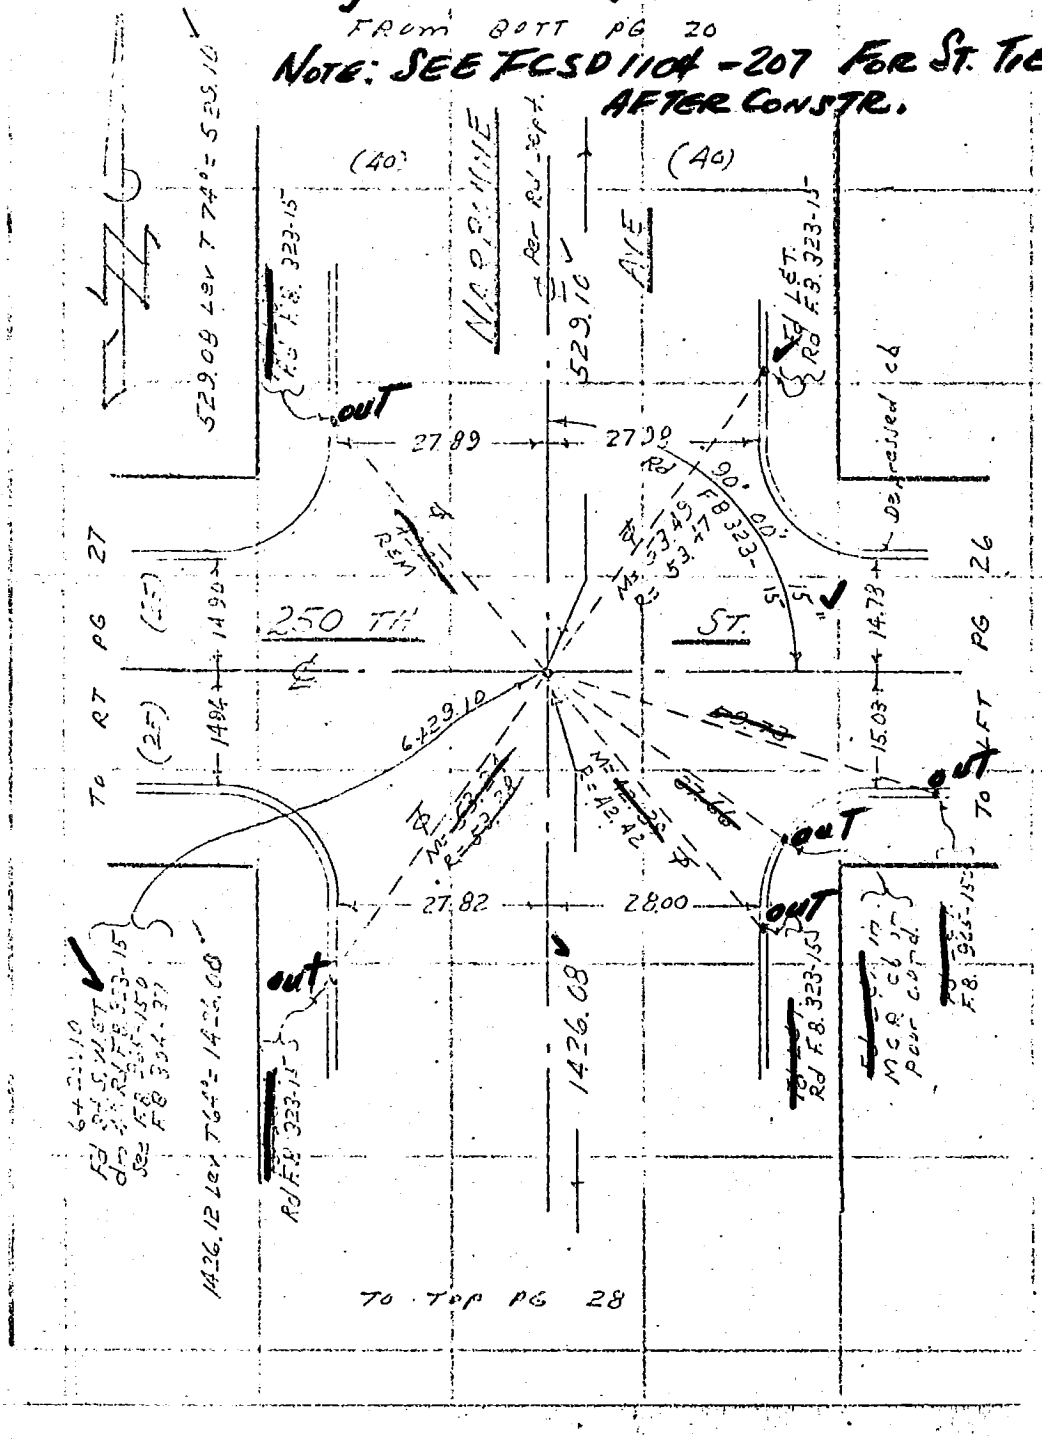
(40)
(40)
529.09 Rad 7 24'= S 25.10
529.10
MADRONE AVE
Rad
Rad
Rad

Co. Engr. F.B. 3555-133

FCSD 1104-83

(133)

F.B. 3321 Pg. 138

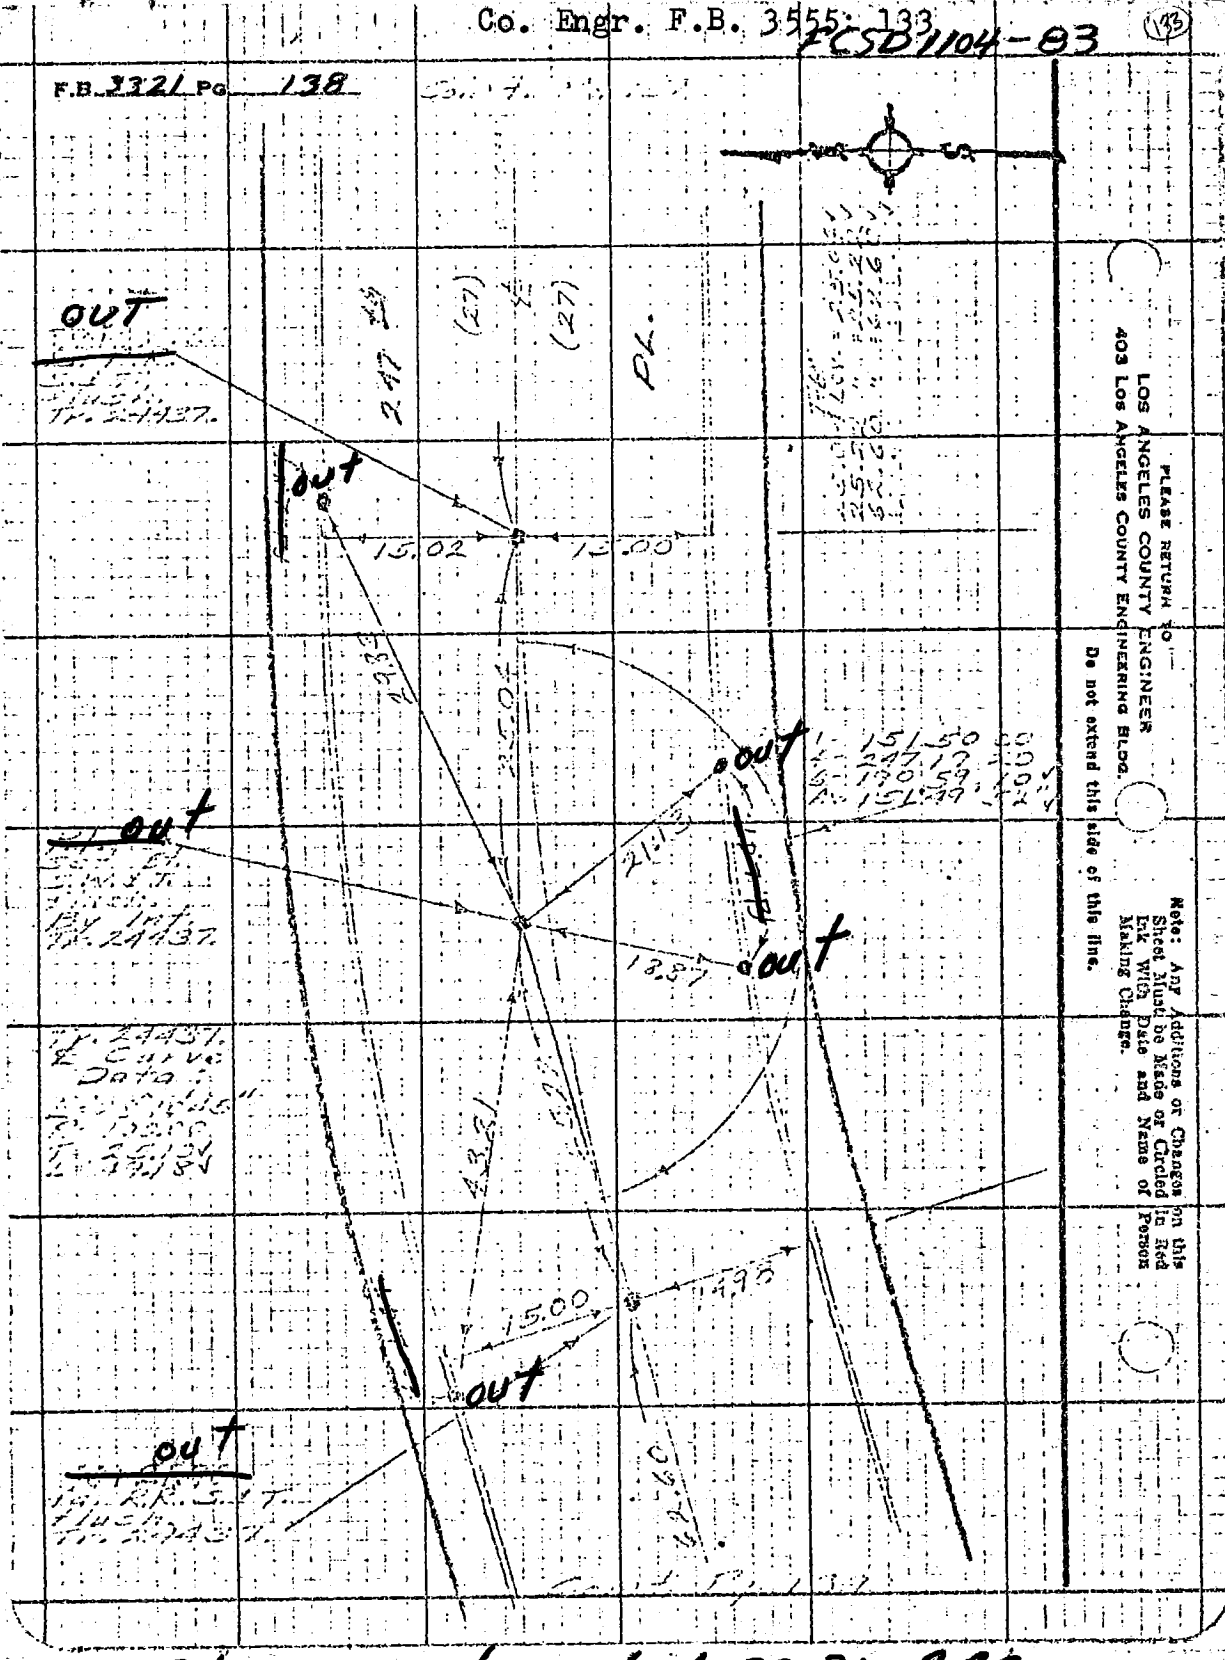


v = Fd in good cond. 4-28-71 - BPB

For Pt's Set See FCSD 1104-197

Co. Engr. F.B. 3555: 134

FCSD 1104-83A

(134)

F.B. 3321 Pg. 139

| | |
|---|---|
| Notes Ck'd by J. C. | Survey of |
| Map No. | JN ____ Tape ____ Std ____ "F |
| Office Work | Surveyed by |
| Checked | Notes S ____ Date ____ |
| Date | Indexed CALL |

W.S. 2814-3

Note: Any Additions or Changes on this Sheet Must be Made or Circled in Red Ink With Date and Name of Person Making Change.

Do not extend this side of this line.

PLEASE RETURN TO
LOS ANGELES COUNTY ENGINEER
403 Los Angeles County Engineering Bldg.

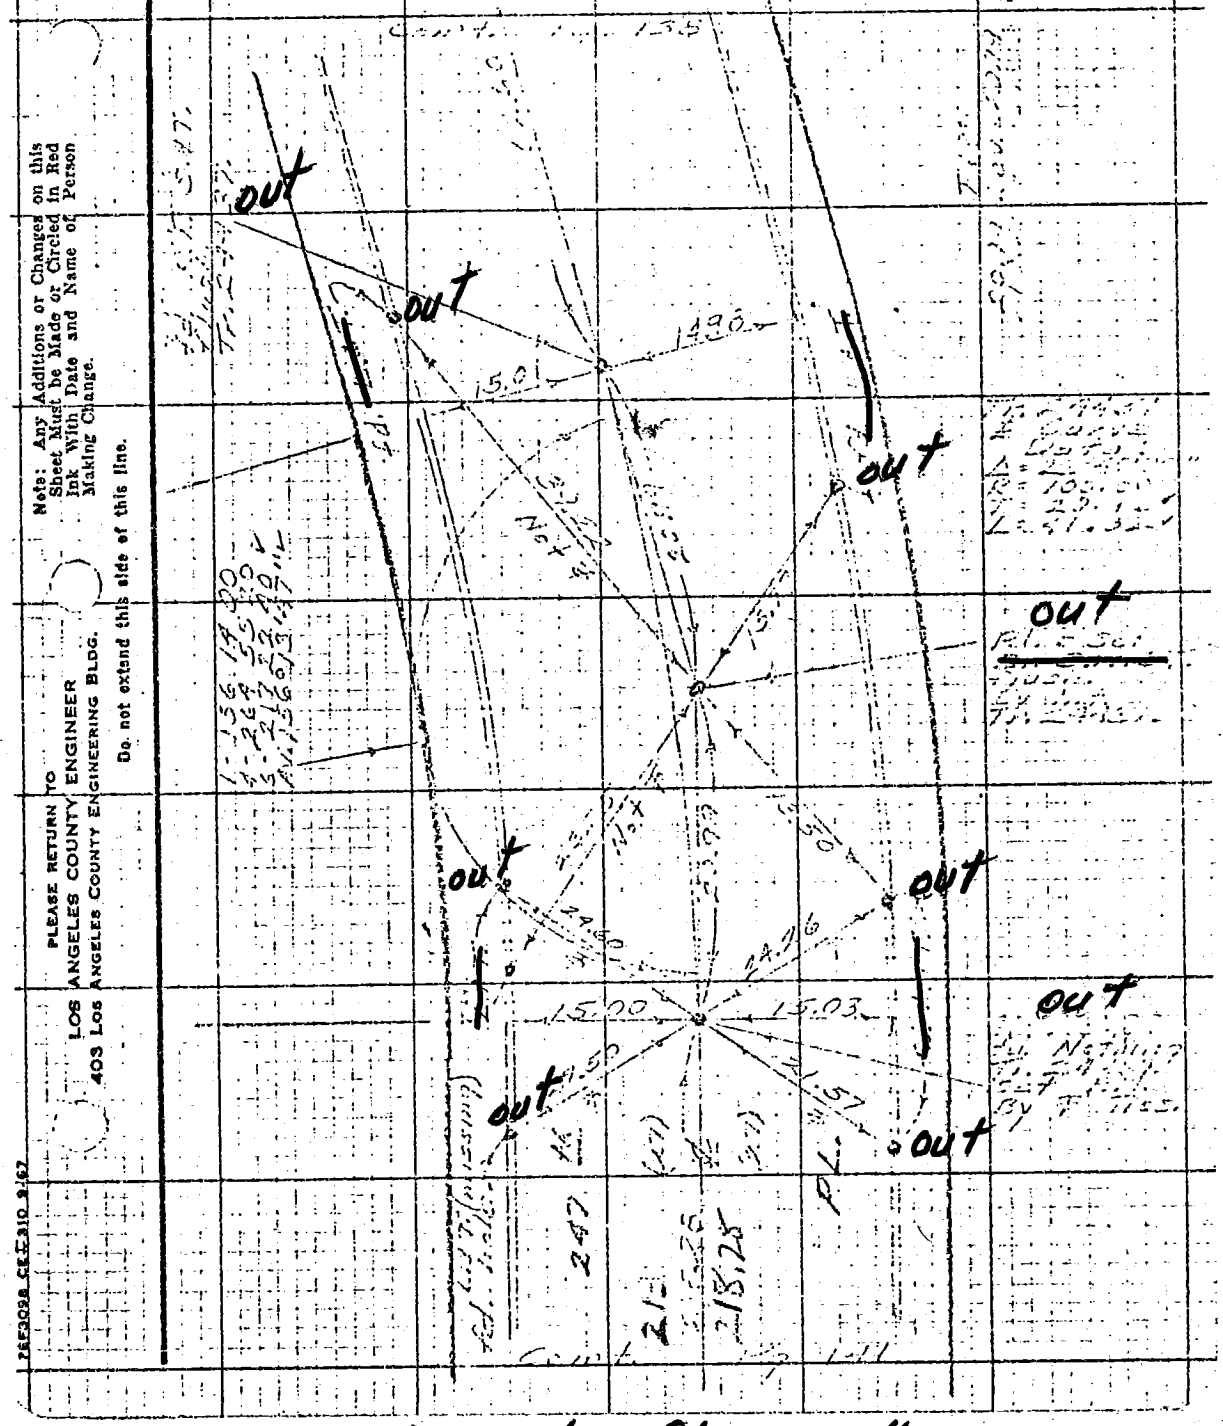
out
out
out
out
out
out
out
out
out
1496
1501
1500
1503

Co. Engr. F.B. 3555:135 FCSD 1104-85

(135)

| | |
|---|---|
| Notes Ck'd by J. Carlisle | Survey of |
| Map No. | JN Tape Std °F |
| Office Work | Surveyed by |
| Checked | Notes Date |
| Date | Indexed J.D. CALLI |

F.B 3321 PG. 141

Note: Any Additions or Changes on this Sheet Must be Made or Circled in Red Ink With Date and Name of Person Making Change.

Do not extend this side of this line.

PLEASE RETURN TO LOS ANGELES COUNTY ENGINEER 403 Los Angeles County Engineering Bldg.

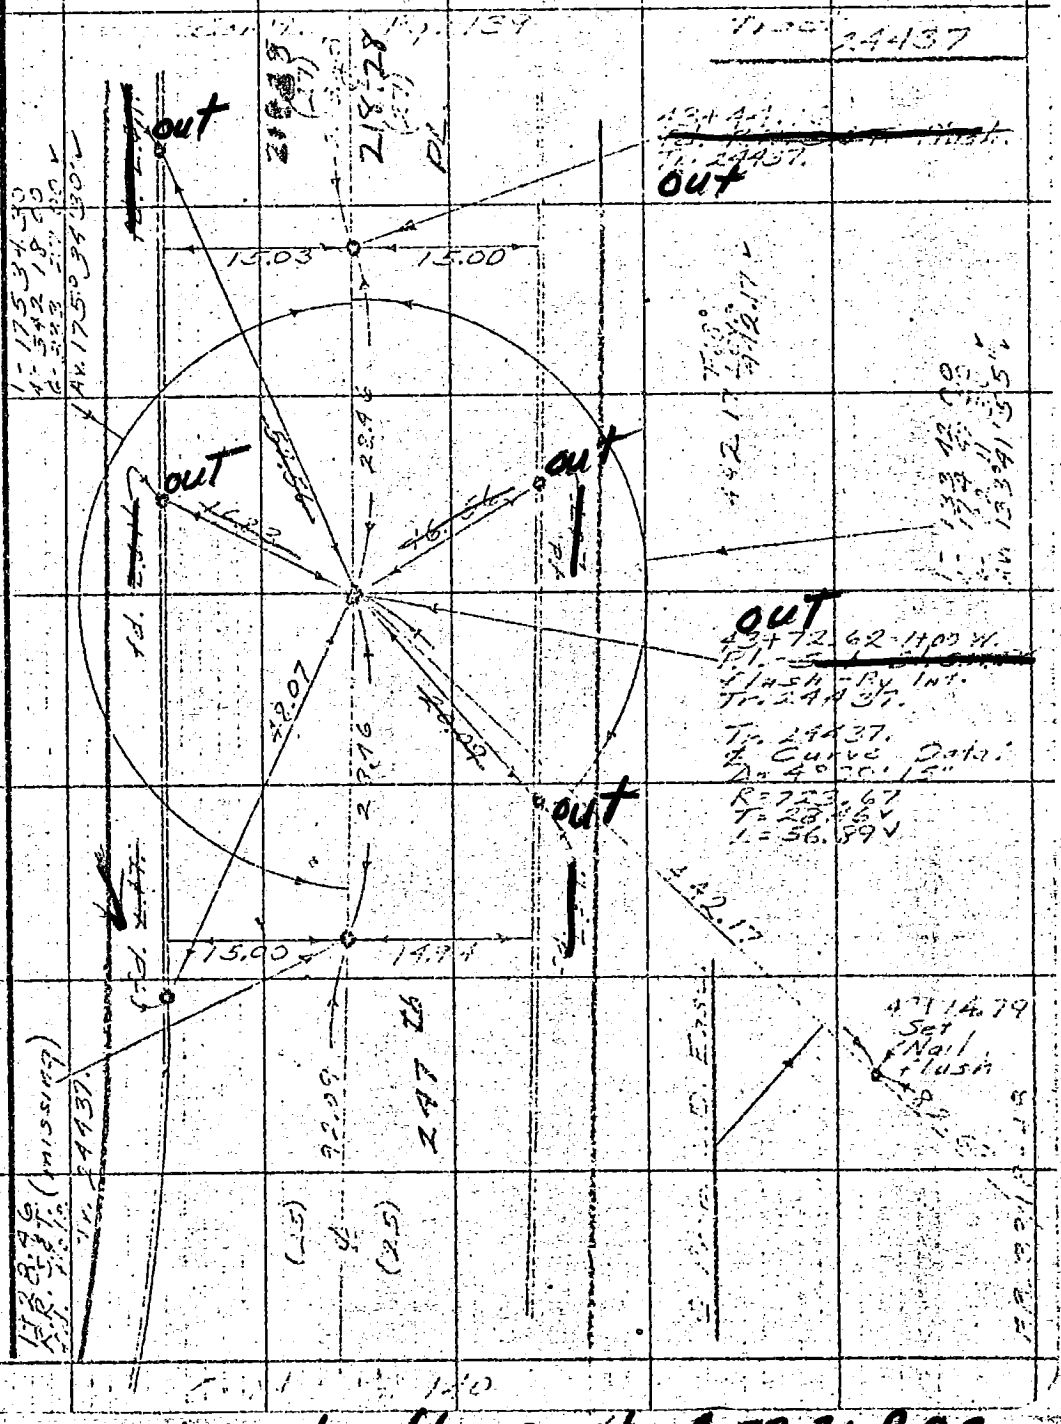


V=Fd in good cond after Const. 4-28-71 D.P.D.

FOR PT'S SET SEE FCSD 1104-199

Co. Engr. F.B. 3555: FCSD 1104-85A

(36)

F.B. 3521 Pg. 140

Cont. Pg. 136 (137)

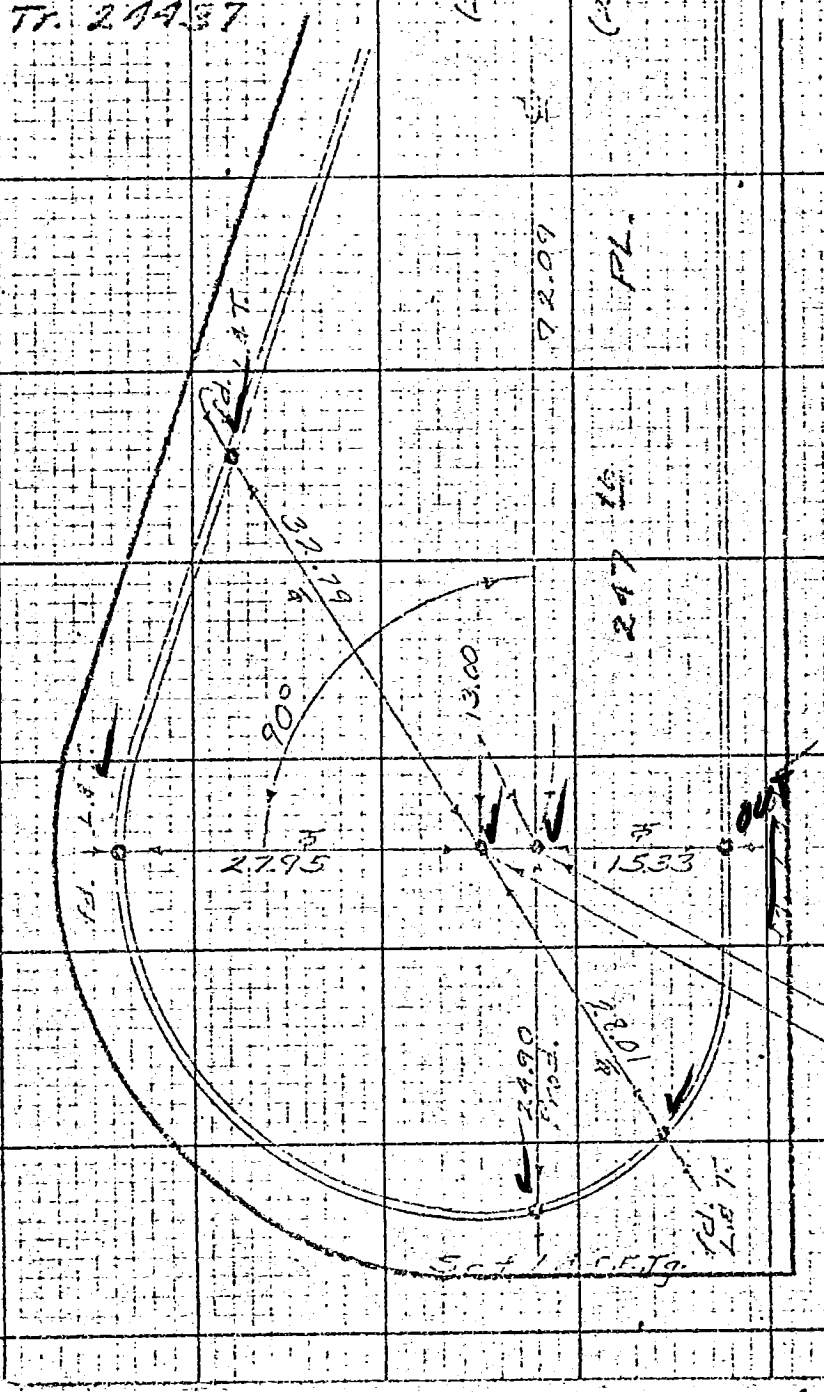


W.S. 28 4-3

Please Return to Los Angeles County Engineer 403 Los Angeles County Engineering Bldg.

Do not extend this side of this line.

Note: Any Additions or Changes on this Sheet Must be Made or Circled in Red Ink with Date and Name of Person Making Changes.

√ = Fd in good cond. after const 4-28-71 B.F.B.

FOR TIES SET SEE FCSD 1104-199

FCSD1104 87
Co. Engr. F.B. 3555: 137

(137)

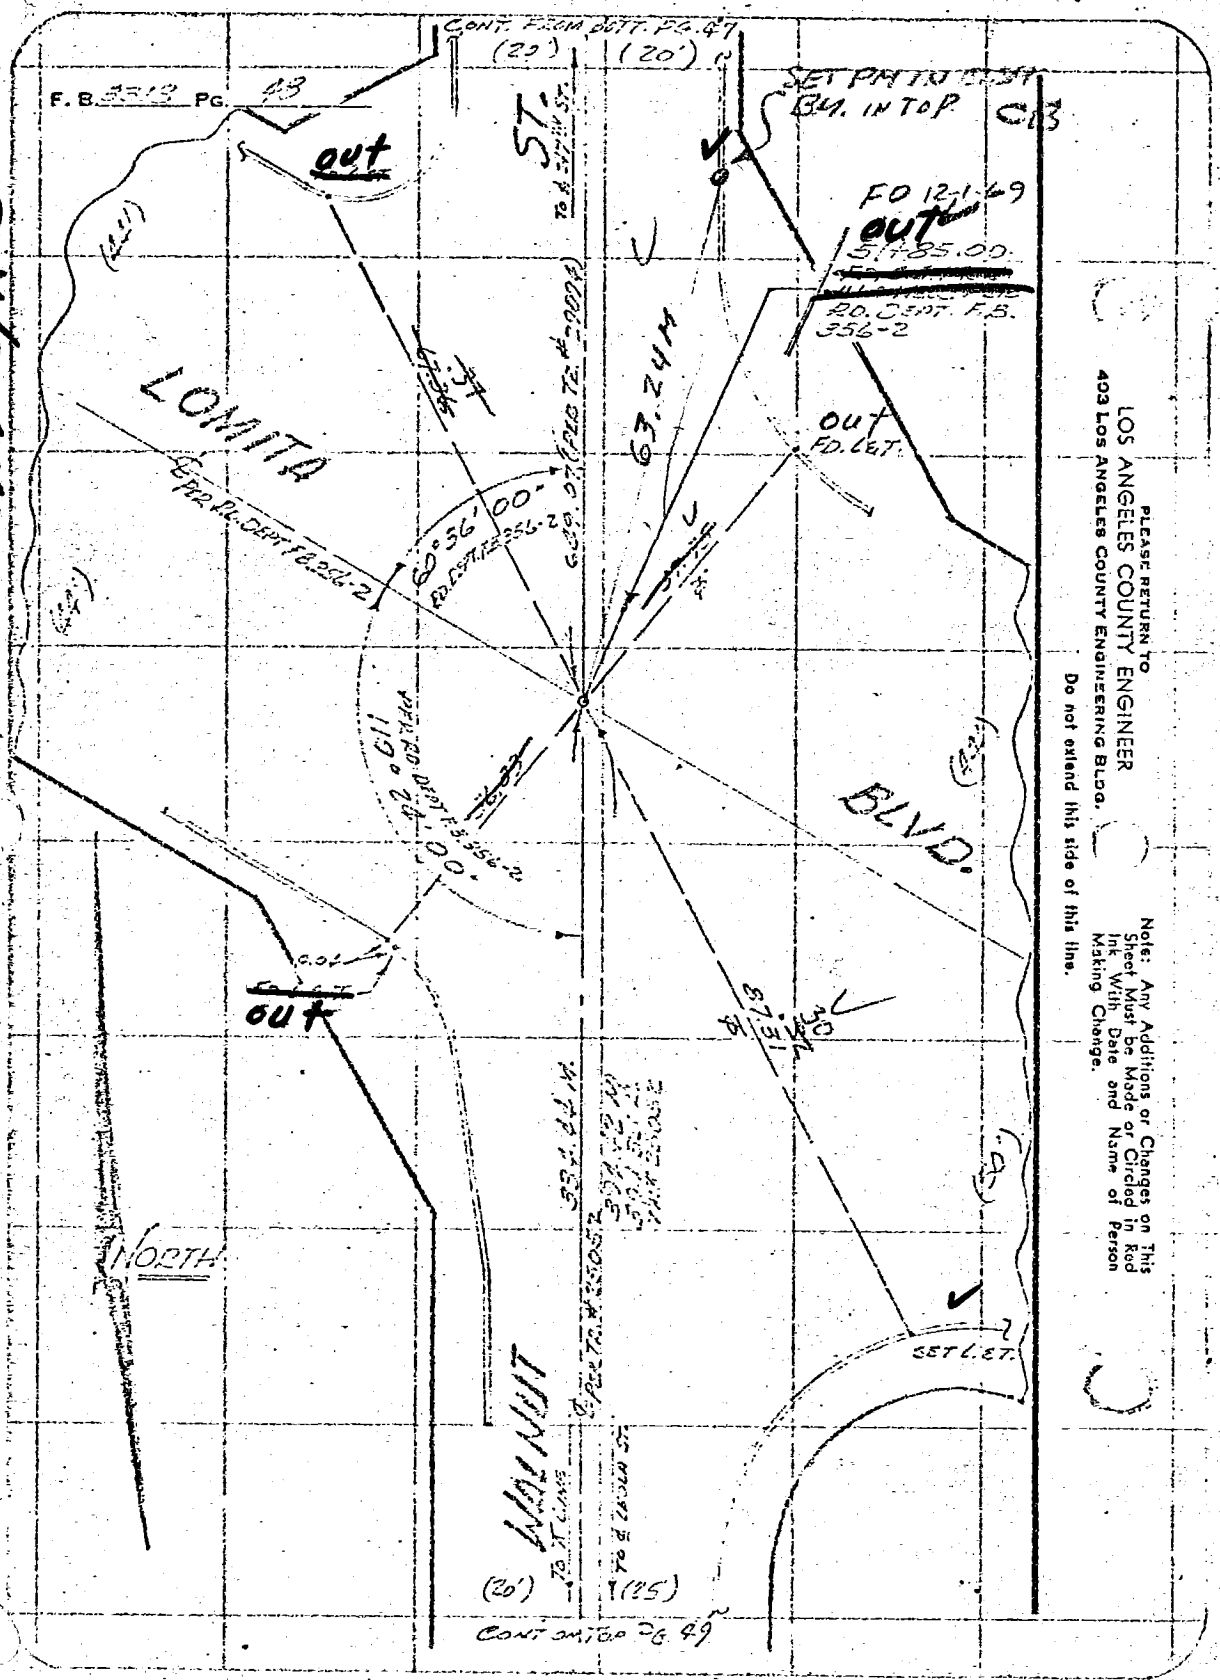


WS 28, A-3

V = FD IN GOOD CONDT 12-1-69 For Pt's Set See FCSD1104-185

V = 2-19-70

V = Fd in Good Condition after const. 4-28-71 - D.R.B.

Co. Engr. F.B. 3555: 138

FCSD1104 91

(138)

V=Fd in good cond. after const 4-30-71 B.P.B.

For PT's Set See FCSD1104-201

W.S.28A-5

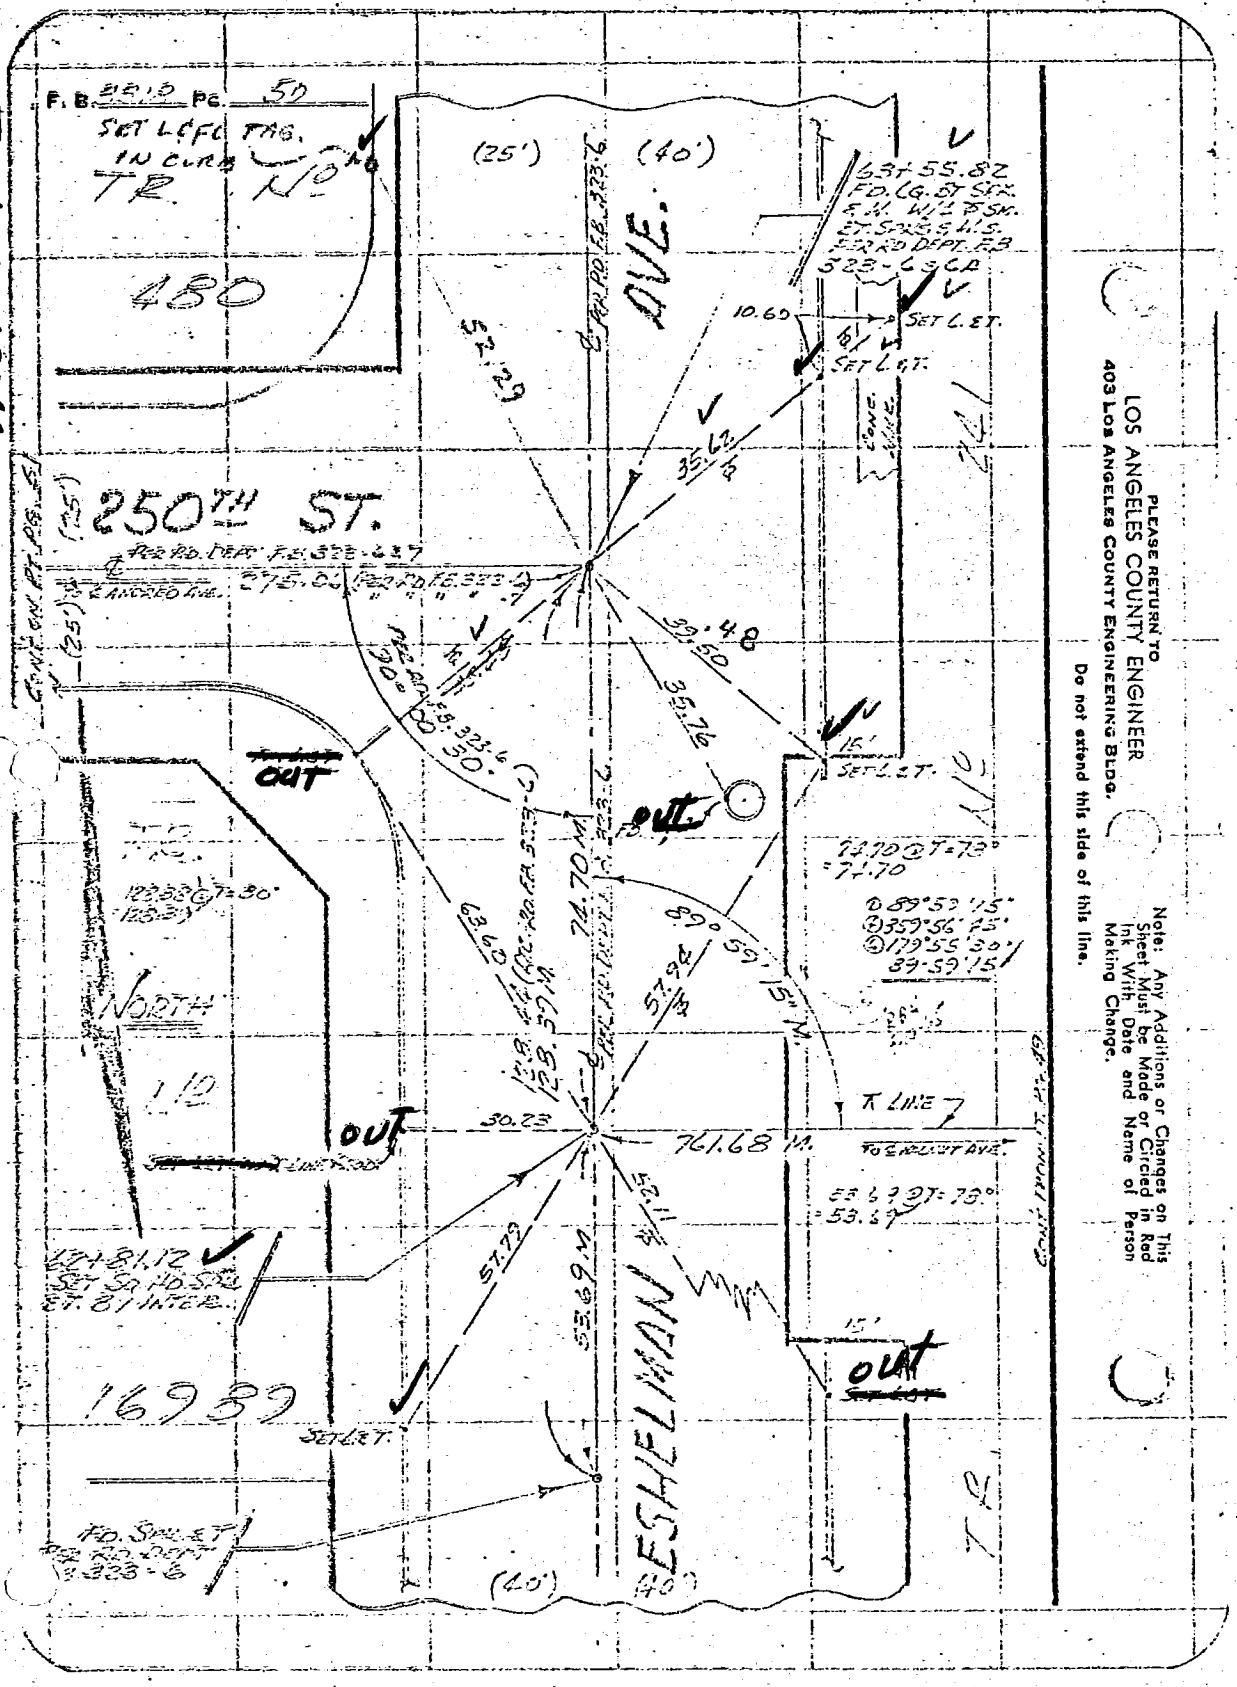


= V: FD IN GOOD COND
2-19-70

2

Co. Engr. F.B. 3555: 139
FCSD1104 93 (179)

W.S.28 A-3

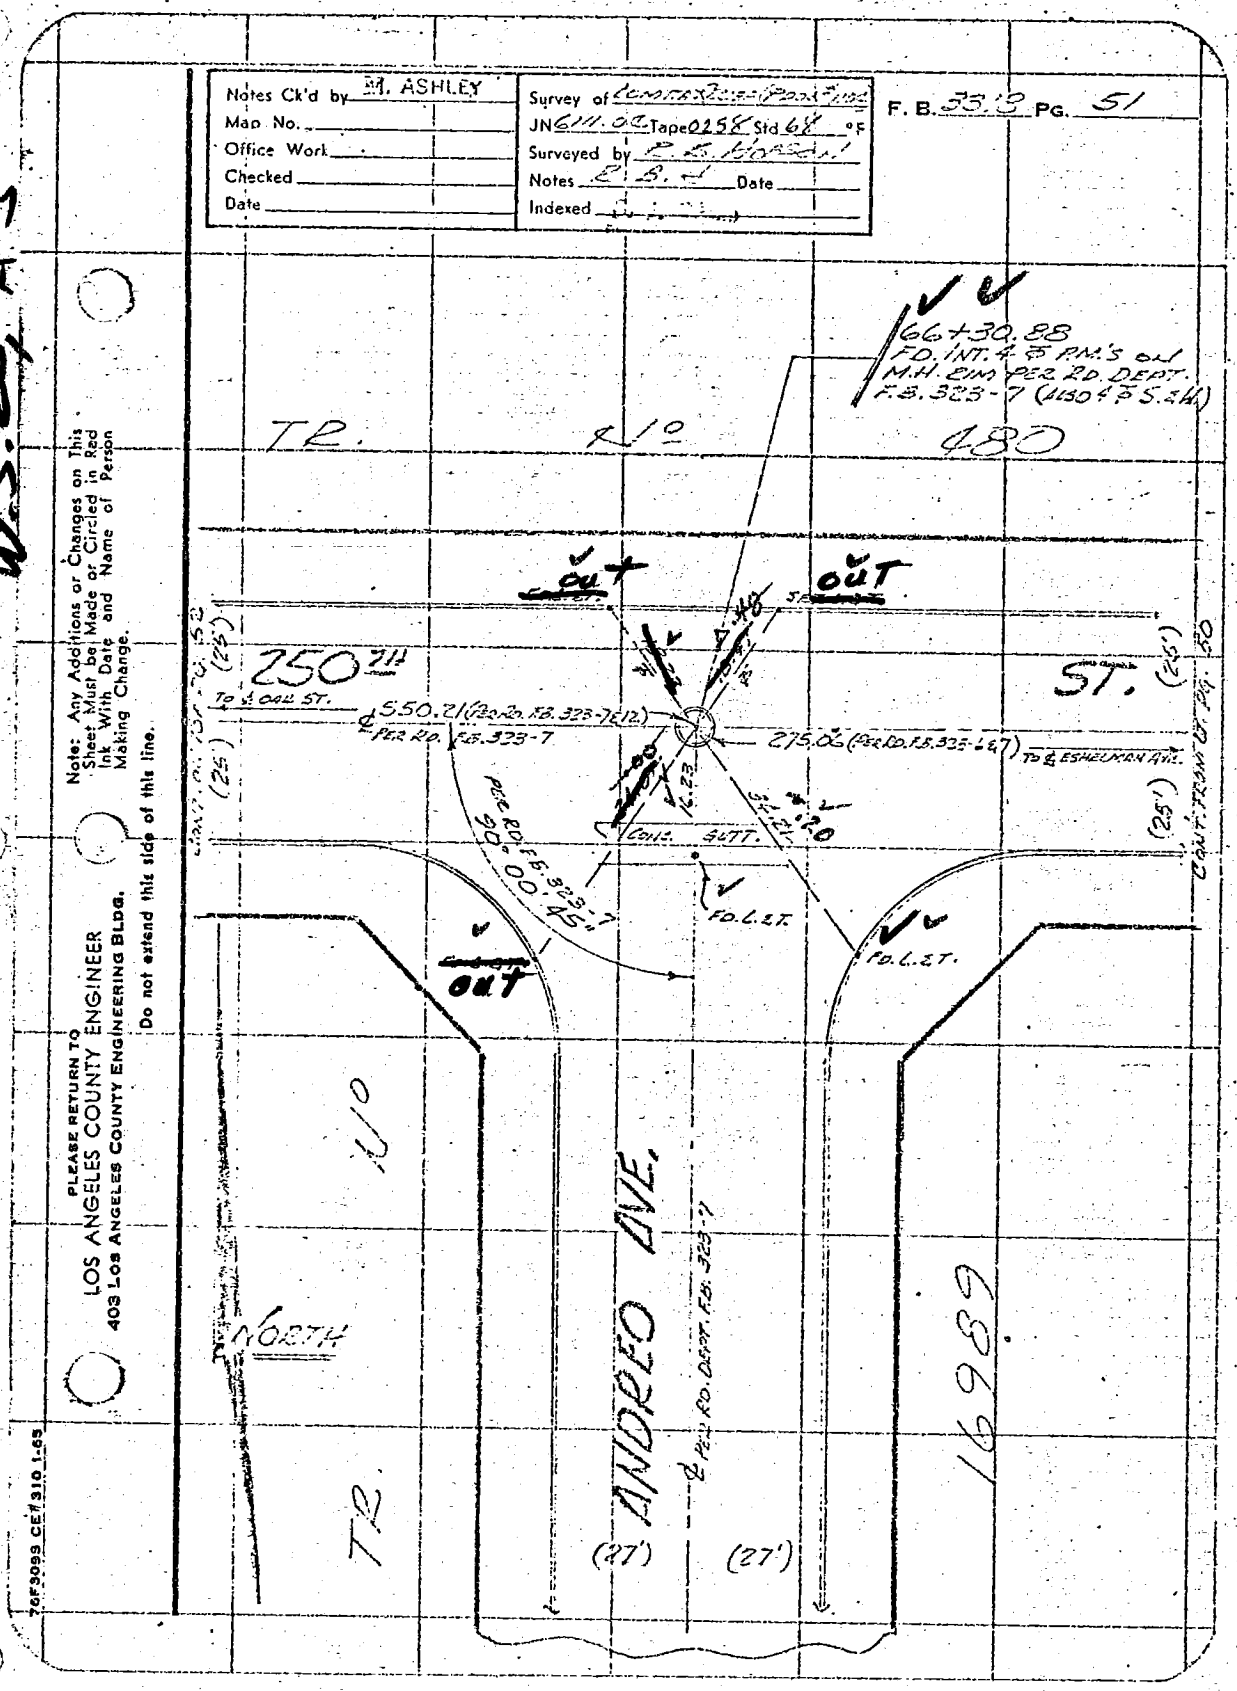


V = FD. IN GOOD CONDITION 2-19-70
V = Fd in good cond. after const 4-30-71 B.P.B.
FOR PT's SET SEE FCSD 1104-201

25

Co. Engr. F.B. 3555: 140
FCSD1104 : 95

V = FD. IN GOOD CONDT. AFTER CONSTR.
2-19-70
FOR PT's SET SEE FCSD1104-203

W.S. 28,4-3

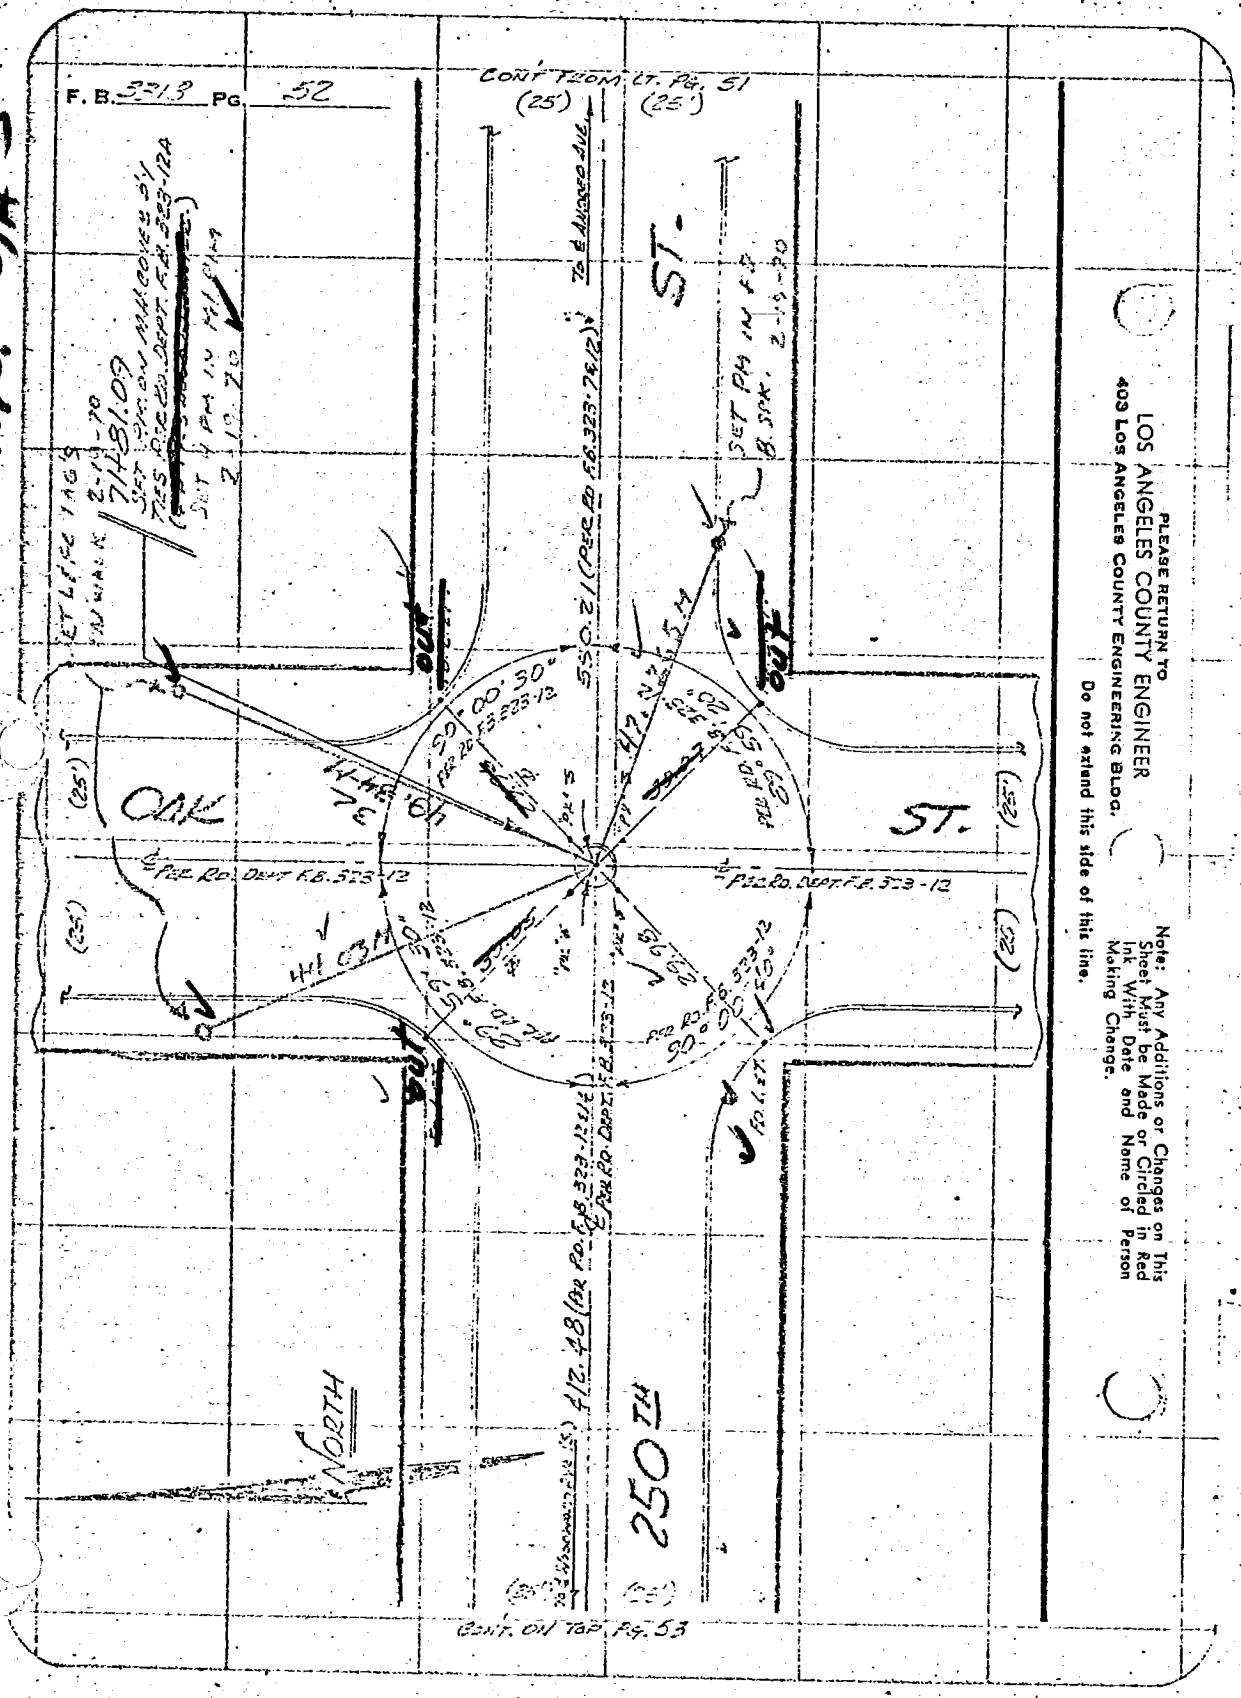


PLEASE RETURN TO
LOS ANGELES COUNTY ENGINEER
403 Los Angeles County Engineering Bldg.

Note: Any Additions or Changes on This Sheet Must be Made or Circled in Red Ink With Date and Name of Person Making Change.

Do not extend this side of this line.

26

Co. Engr. F.B. 3555: 141

FCSD1104 97

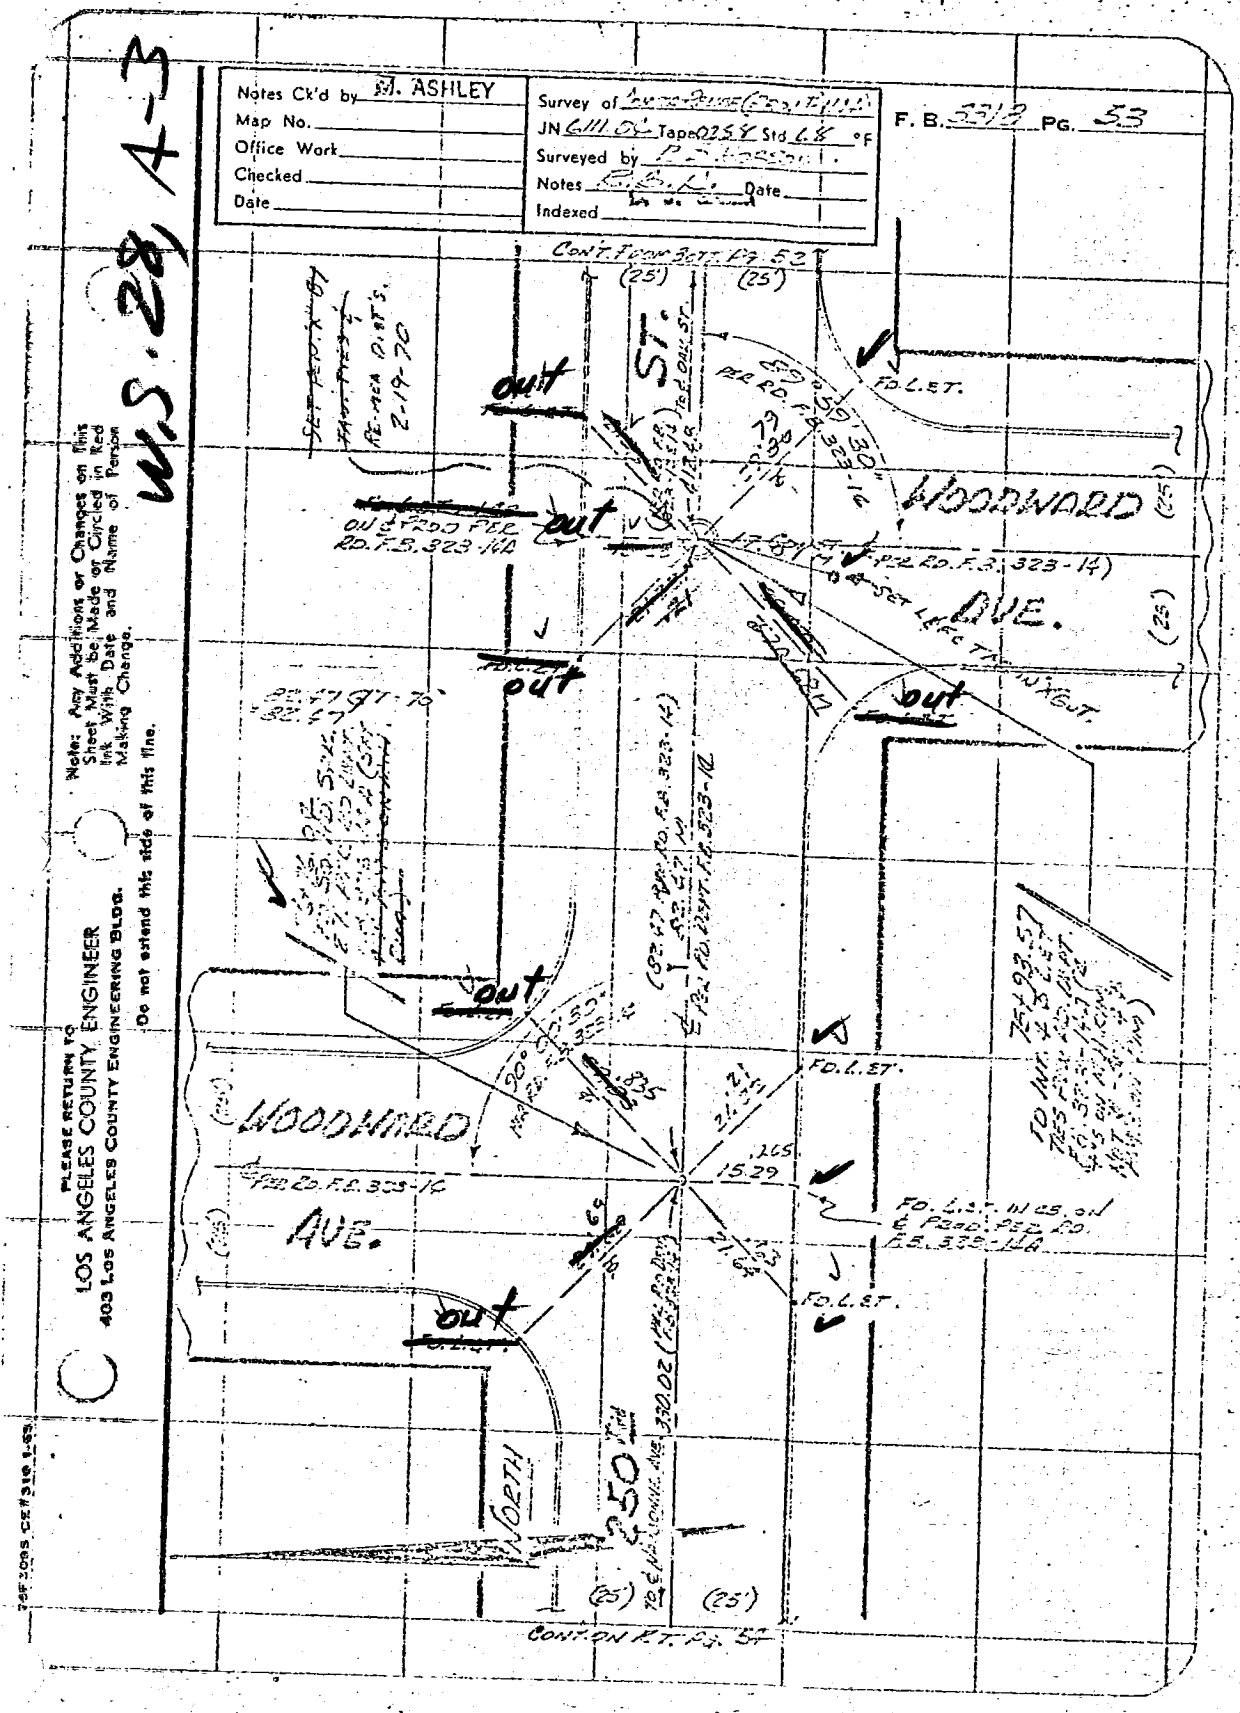


V=FD. IN GOOD CONDT.
2-19-70

V=fd in good cond. after const 4-30-71 B.P.D.
For Pt's Set See FCSD 1104-205

Co. Engr. F.B. 3555: 142

FCSD1104 39

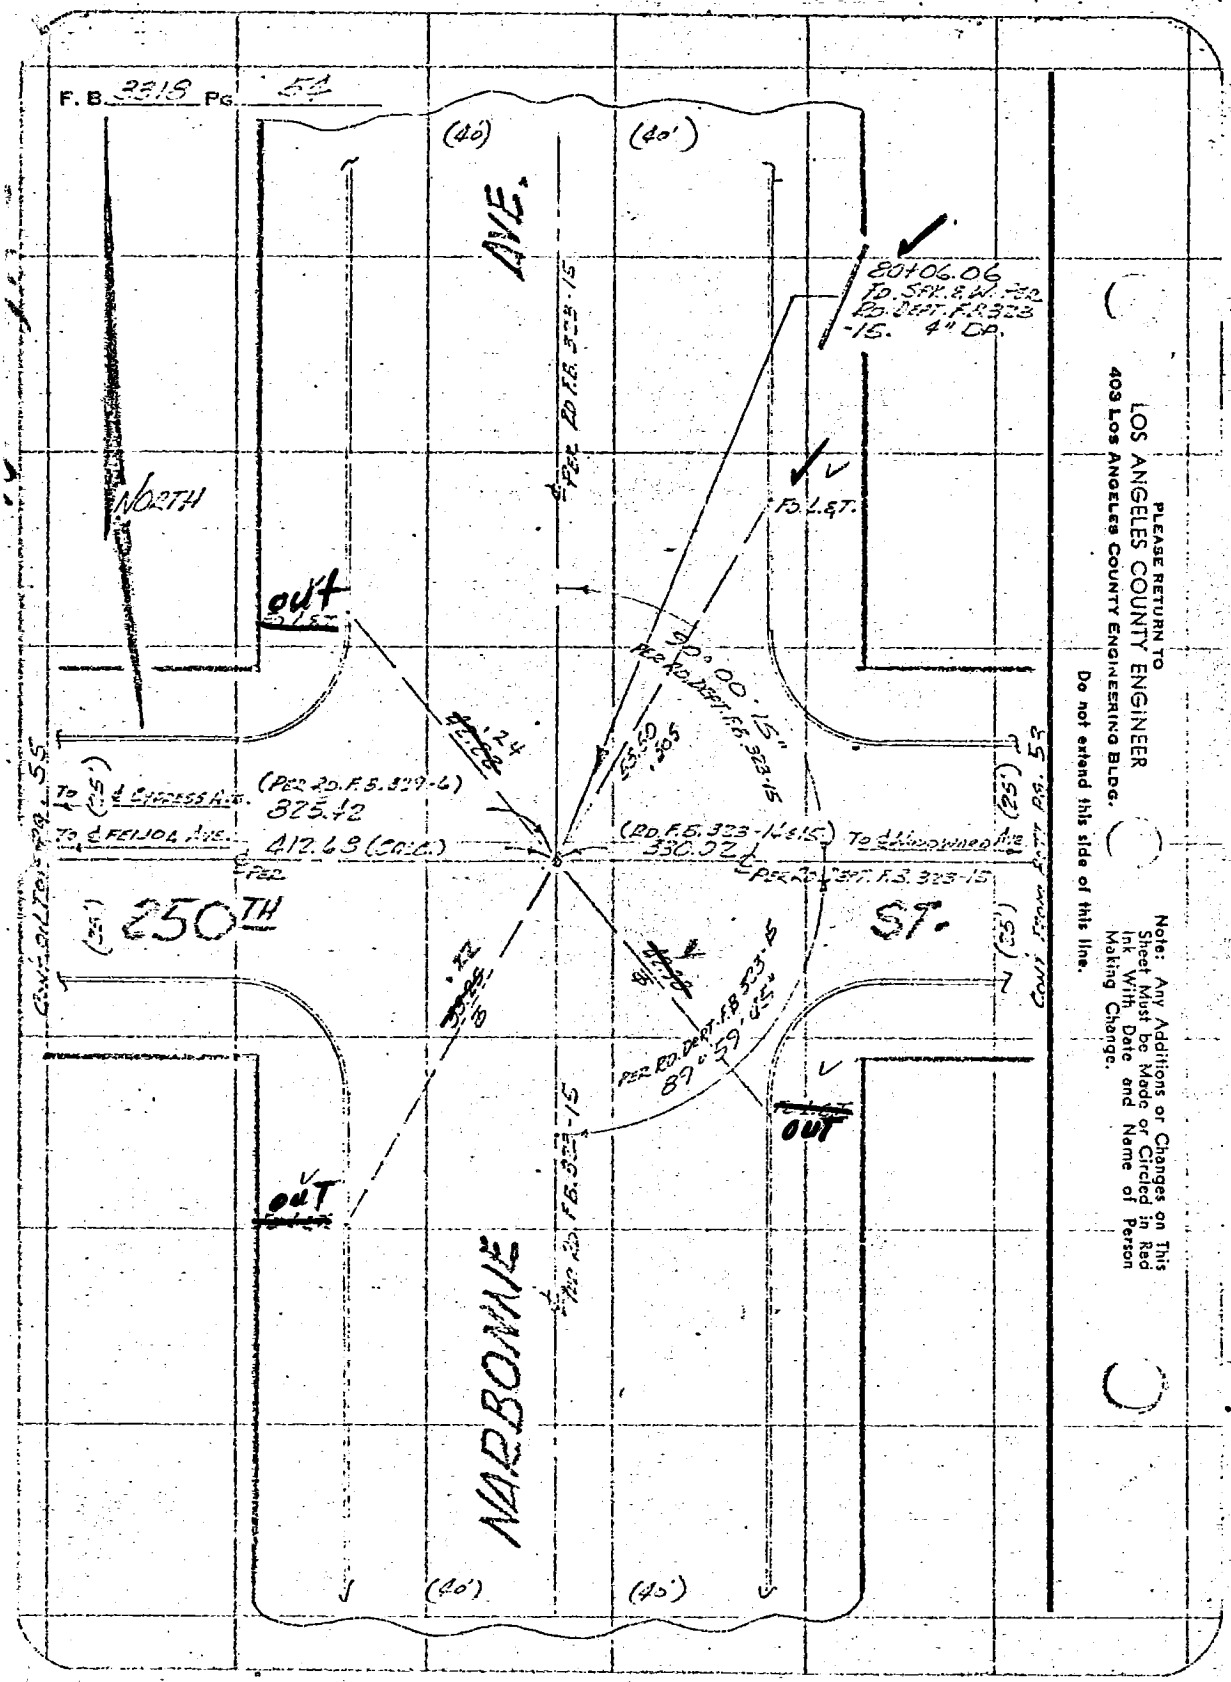


PLEASE RETURN TO
LOS ANGELES COUNTY ENGINEER
403 Los Angeles County Engineering Bldg.
Do not extend this side of this line.

Note: Any Additions or Changes on This Sheet Must be Made or Circled in Red Ink With Date and Name of Person Making Change.

V= FD. IN GOOD COND'T.
2-19-70

V=Fd in good cond after const 4-14-71 BRB.
For Ties Set See FCSD1104-207

28

Co. Engr. F.B. 3555:143 (143)
FCSD1104 101

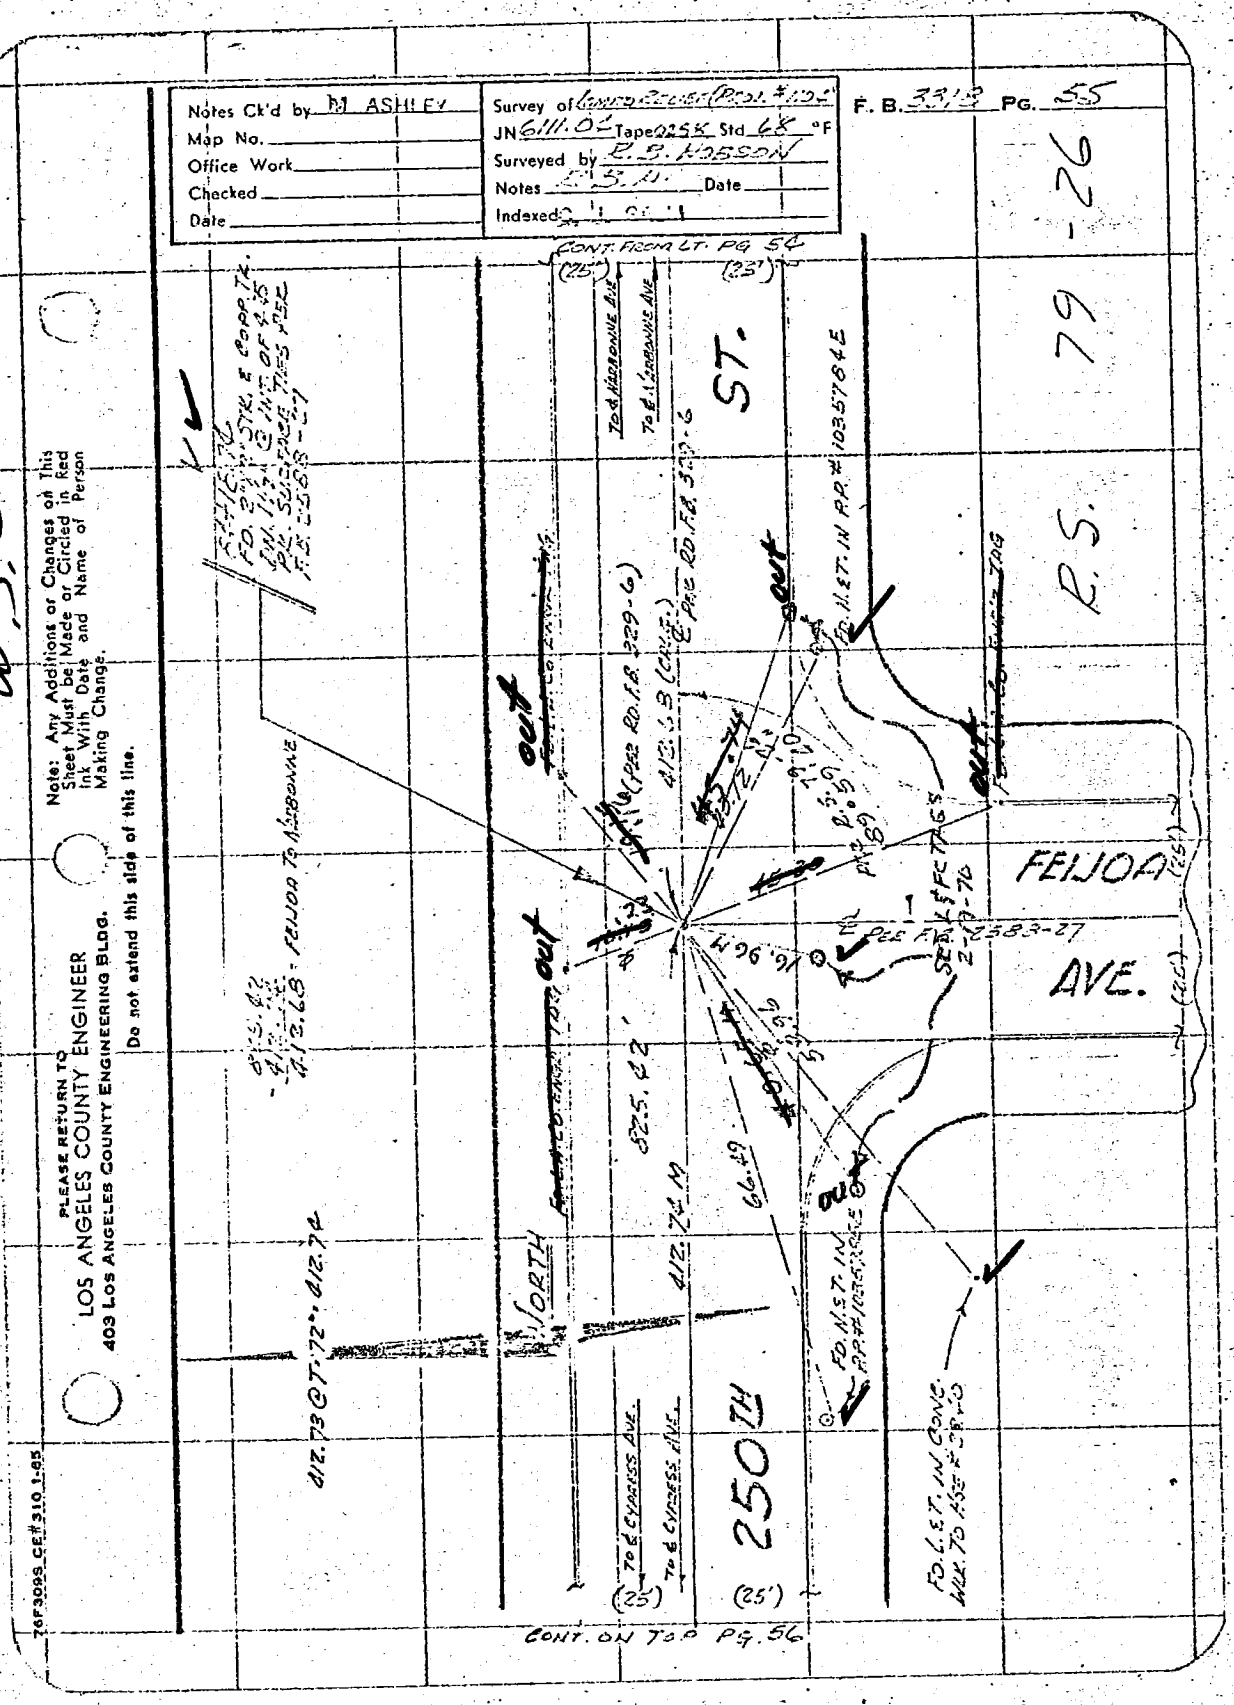


W.S. 2814-3

V = FD IN Good cond Before cons't,
2-19-70

V = Fd in good cond after cons't - 4-14-71 B.B.

FOR PT'S SET SEE FCSD 1104-209

29

Co. Engr. F.B. 3555: 144
FCSD1104 103

For Pt's Set See FCSD1104-209

V = Fd in good cond. after const. 4-14-71 B.P.B.

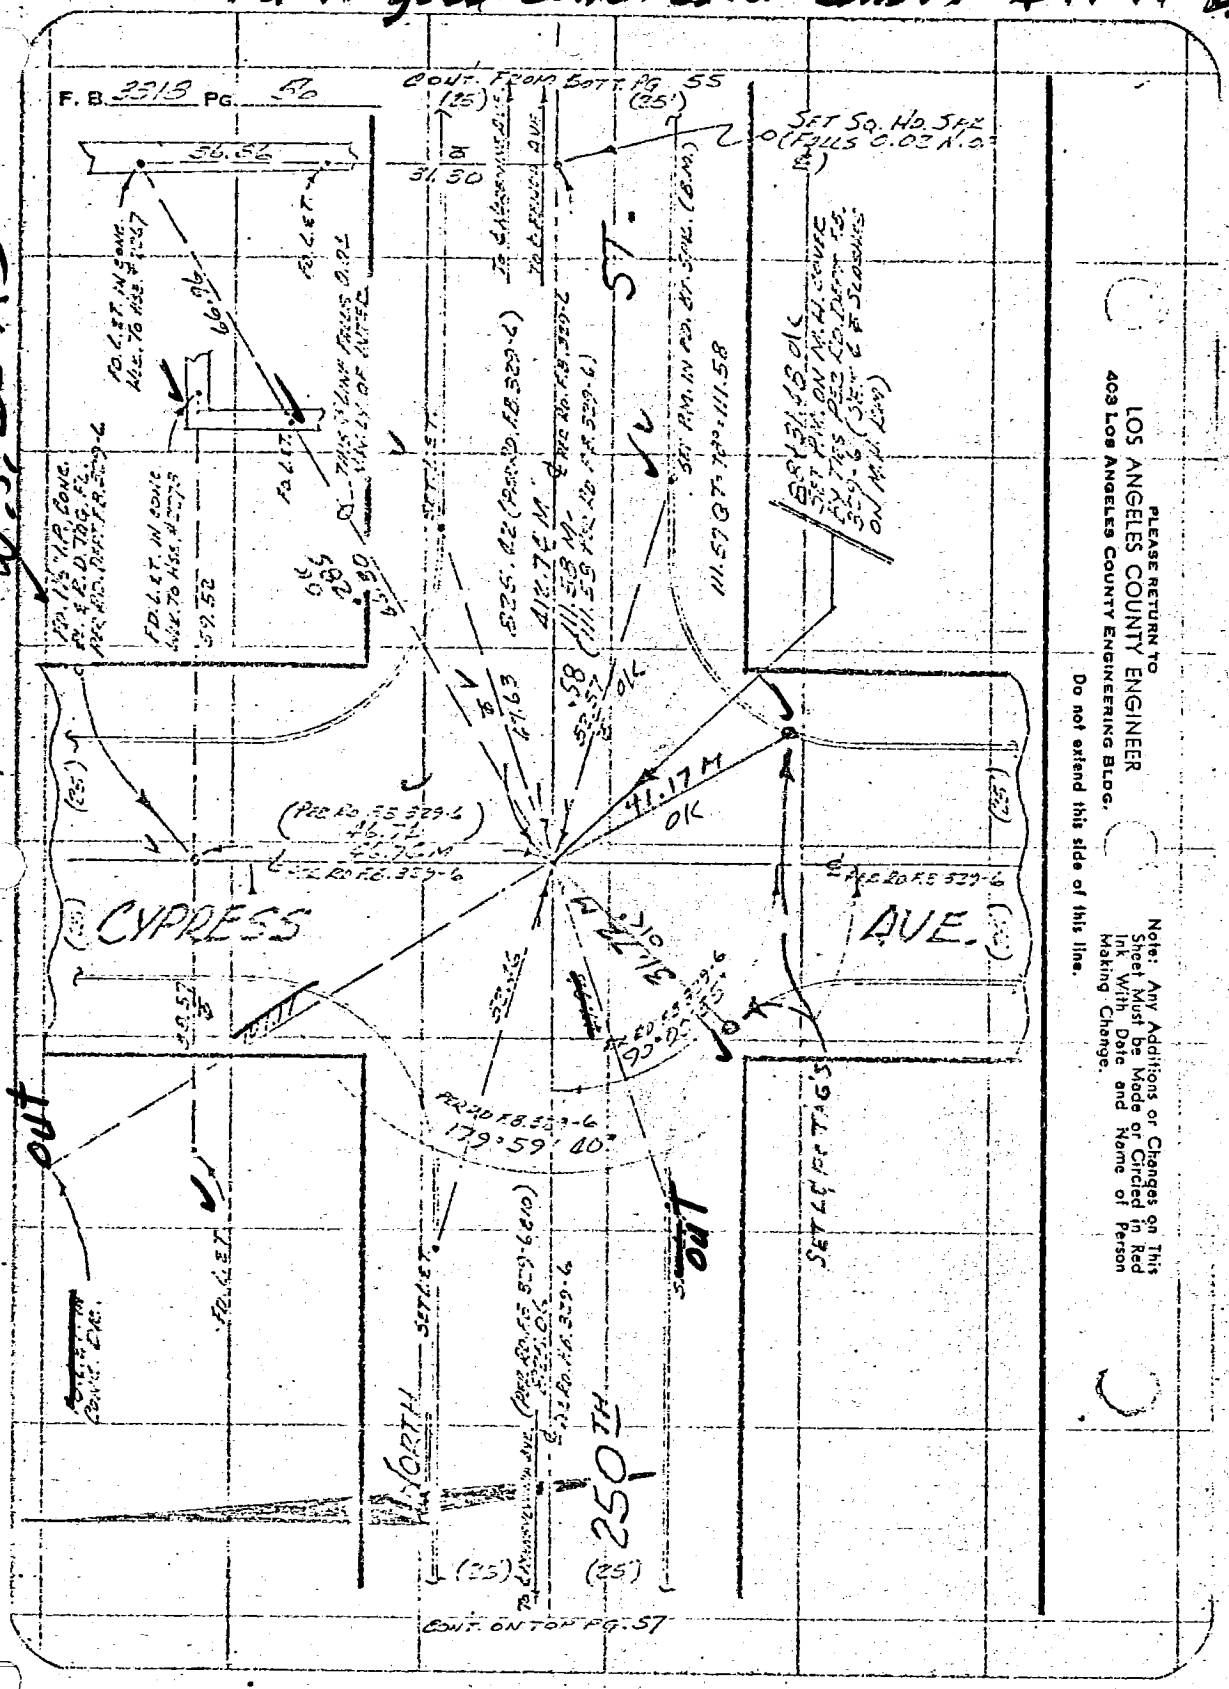


V = FD IN GOOD CONDT
2-17-70. BEFORE CONST.

W.S.28A-3

20

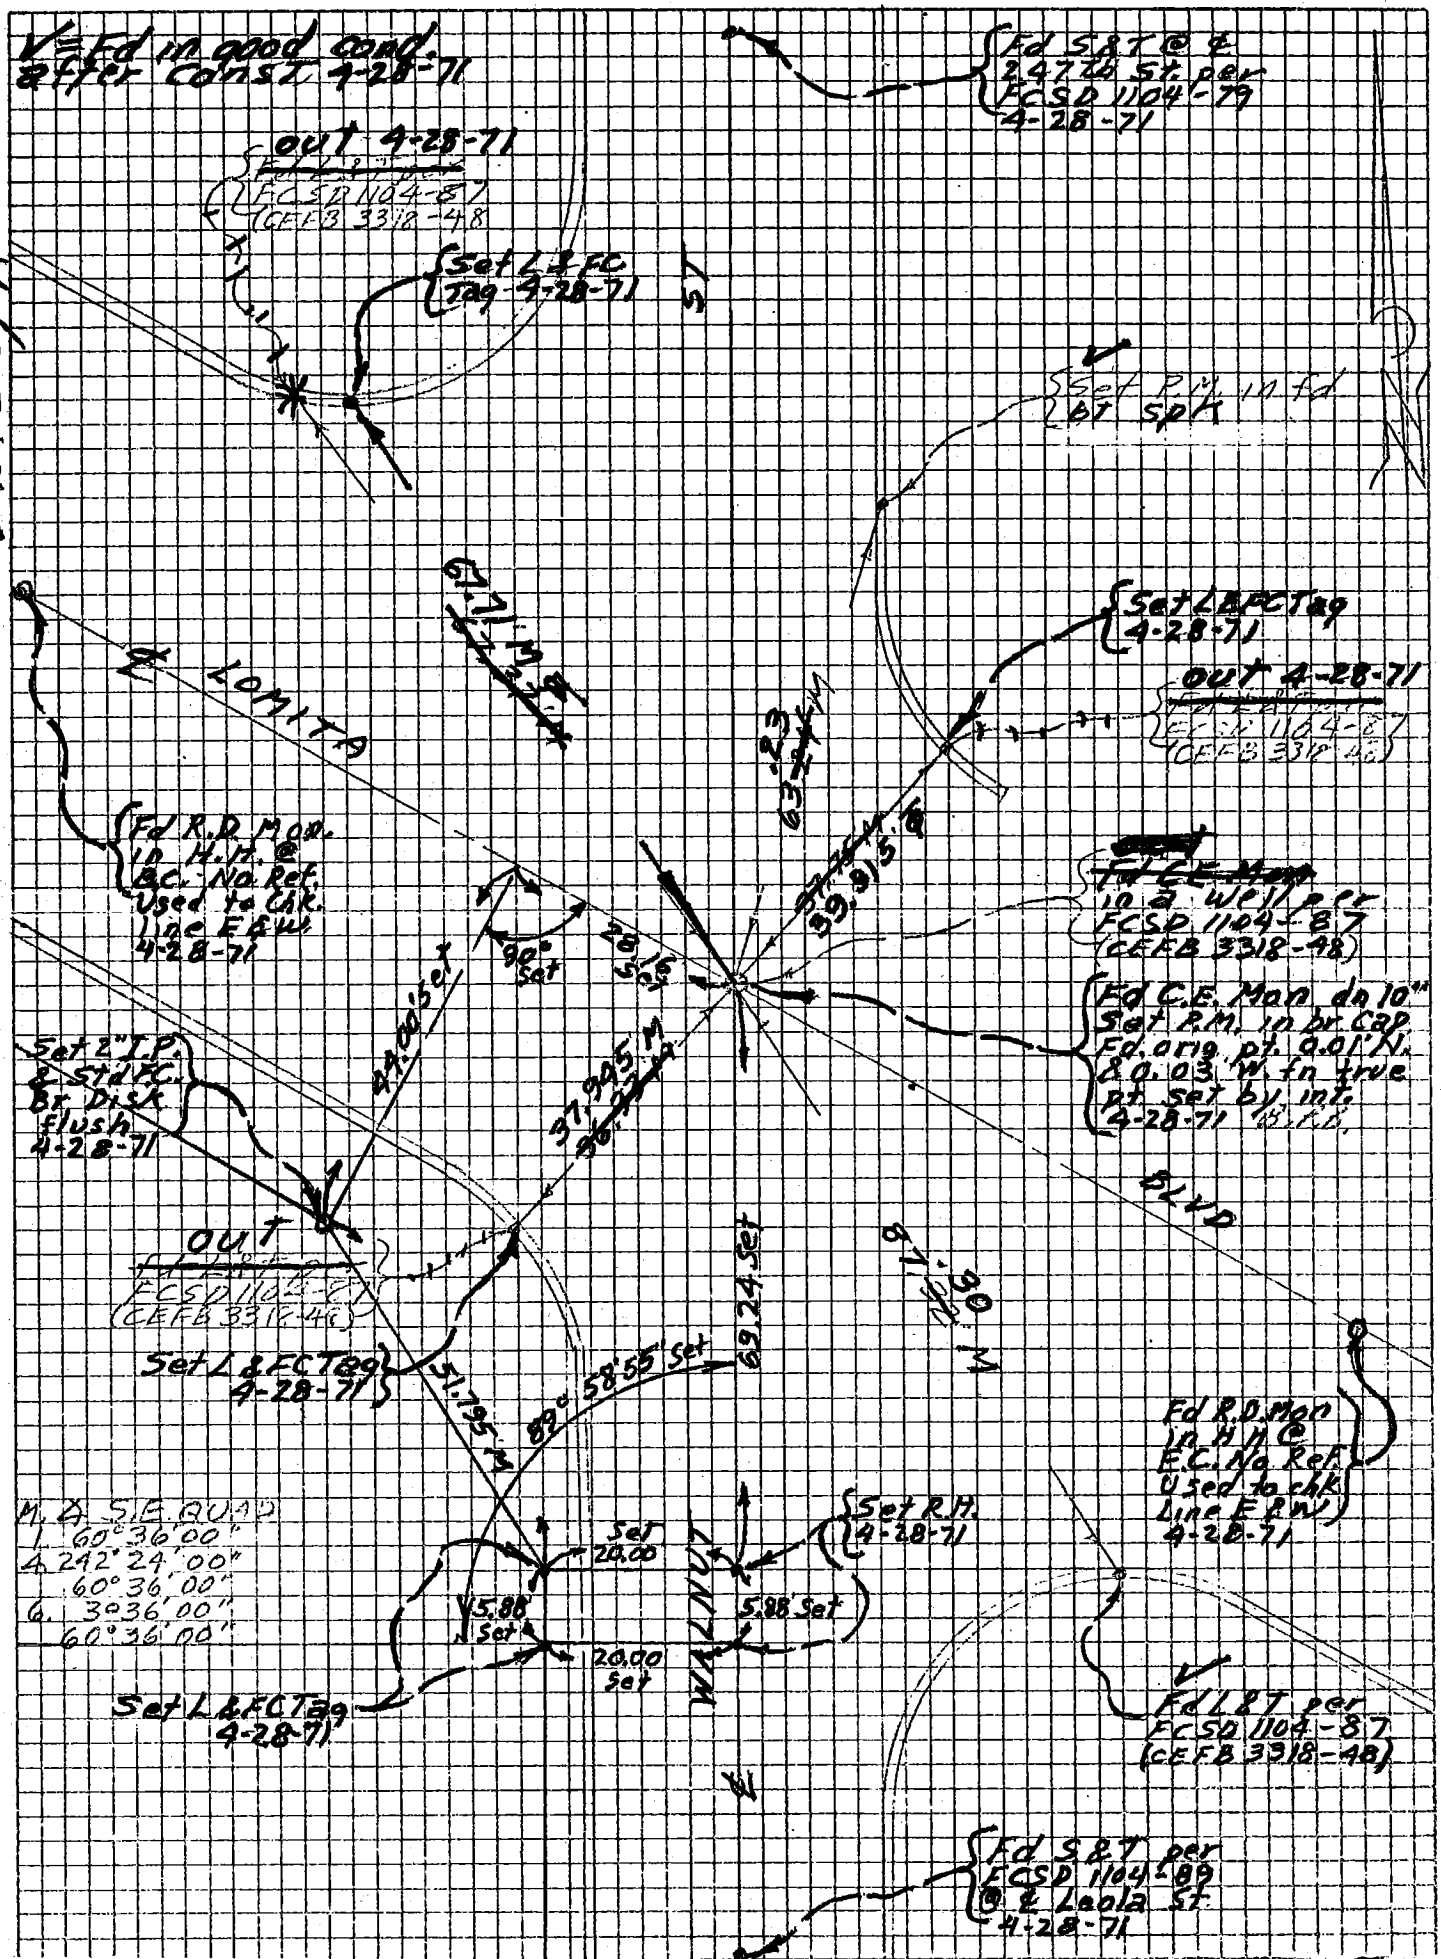
W.S. 28, 4-3
V=Fd in good cond. Effec Const. 4-28-71
Fd S&T @ ℄ 24" RCP St. per FCSD 1104-79 4-28-71
out 4-28-71 (FCSD 1104-87) (CEFB 3318-48)
Set L & FC Tag 4-28-71
Set PK in fd bit spot
Set L&FC Tag 4-28-71
out 4-28-71 (FCSD 1104-87) (CEFB 3318-48)
Fd R.R. Mon. in M.H. @ E.C. No Ref. Used to Chk. Line E&W 4-28-71
Fd C.E. Mon. in 2 WC's per FCSD 1104-87 (CEFB 3318-48)
Fd C.E. Mon. dn 10" Set P.K. in br cap Fd. orig. pt. 0.01' N. & 0.03' W. fm true pt. set by int. 4-28-71
Set 2" I.P. & Std F.C. Br. Disk flush 4-28-71
out (FCSD 1104-87) (CEFB 3318-48)
Set L & FC Tag 4-28-71
Set R.M. 4-28-71
Fd R.R. Mon in M.H. @ E.C. No Ref. Used to chk Line E&W 4-28-71
Fd L&T per FCSD 1104-87 (CEFB 3318-48)
Set L&FC Tag 4-28-71
Fd S&T per FCSD 1104-89 @ ℄ Loola St. 4-28-71
M & SE QUAD
1. 60°36'00"
4. 242°24'00"
60°36'00"
6. 300°36'00"
60°36'00"
69.24 Set
58.55' Set
20.00 Set
5.88 Set
20.00 Set
5.88 Set
89°
90°
90°
90°

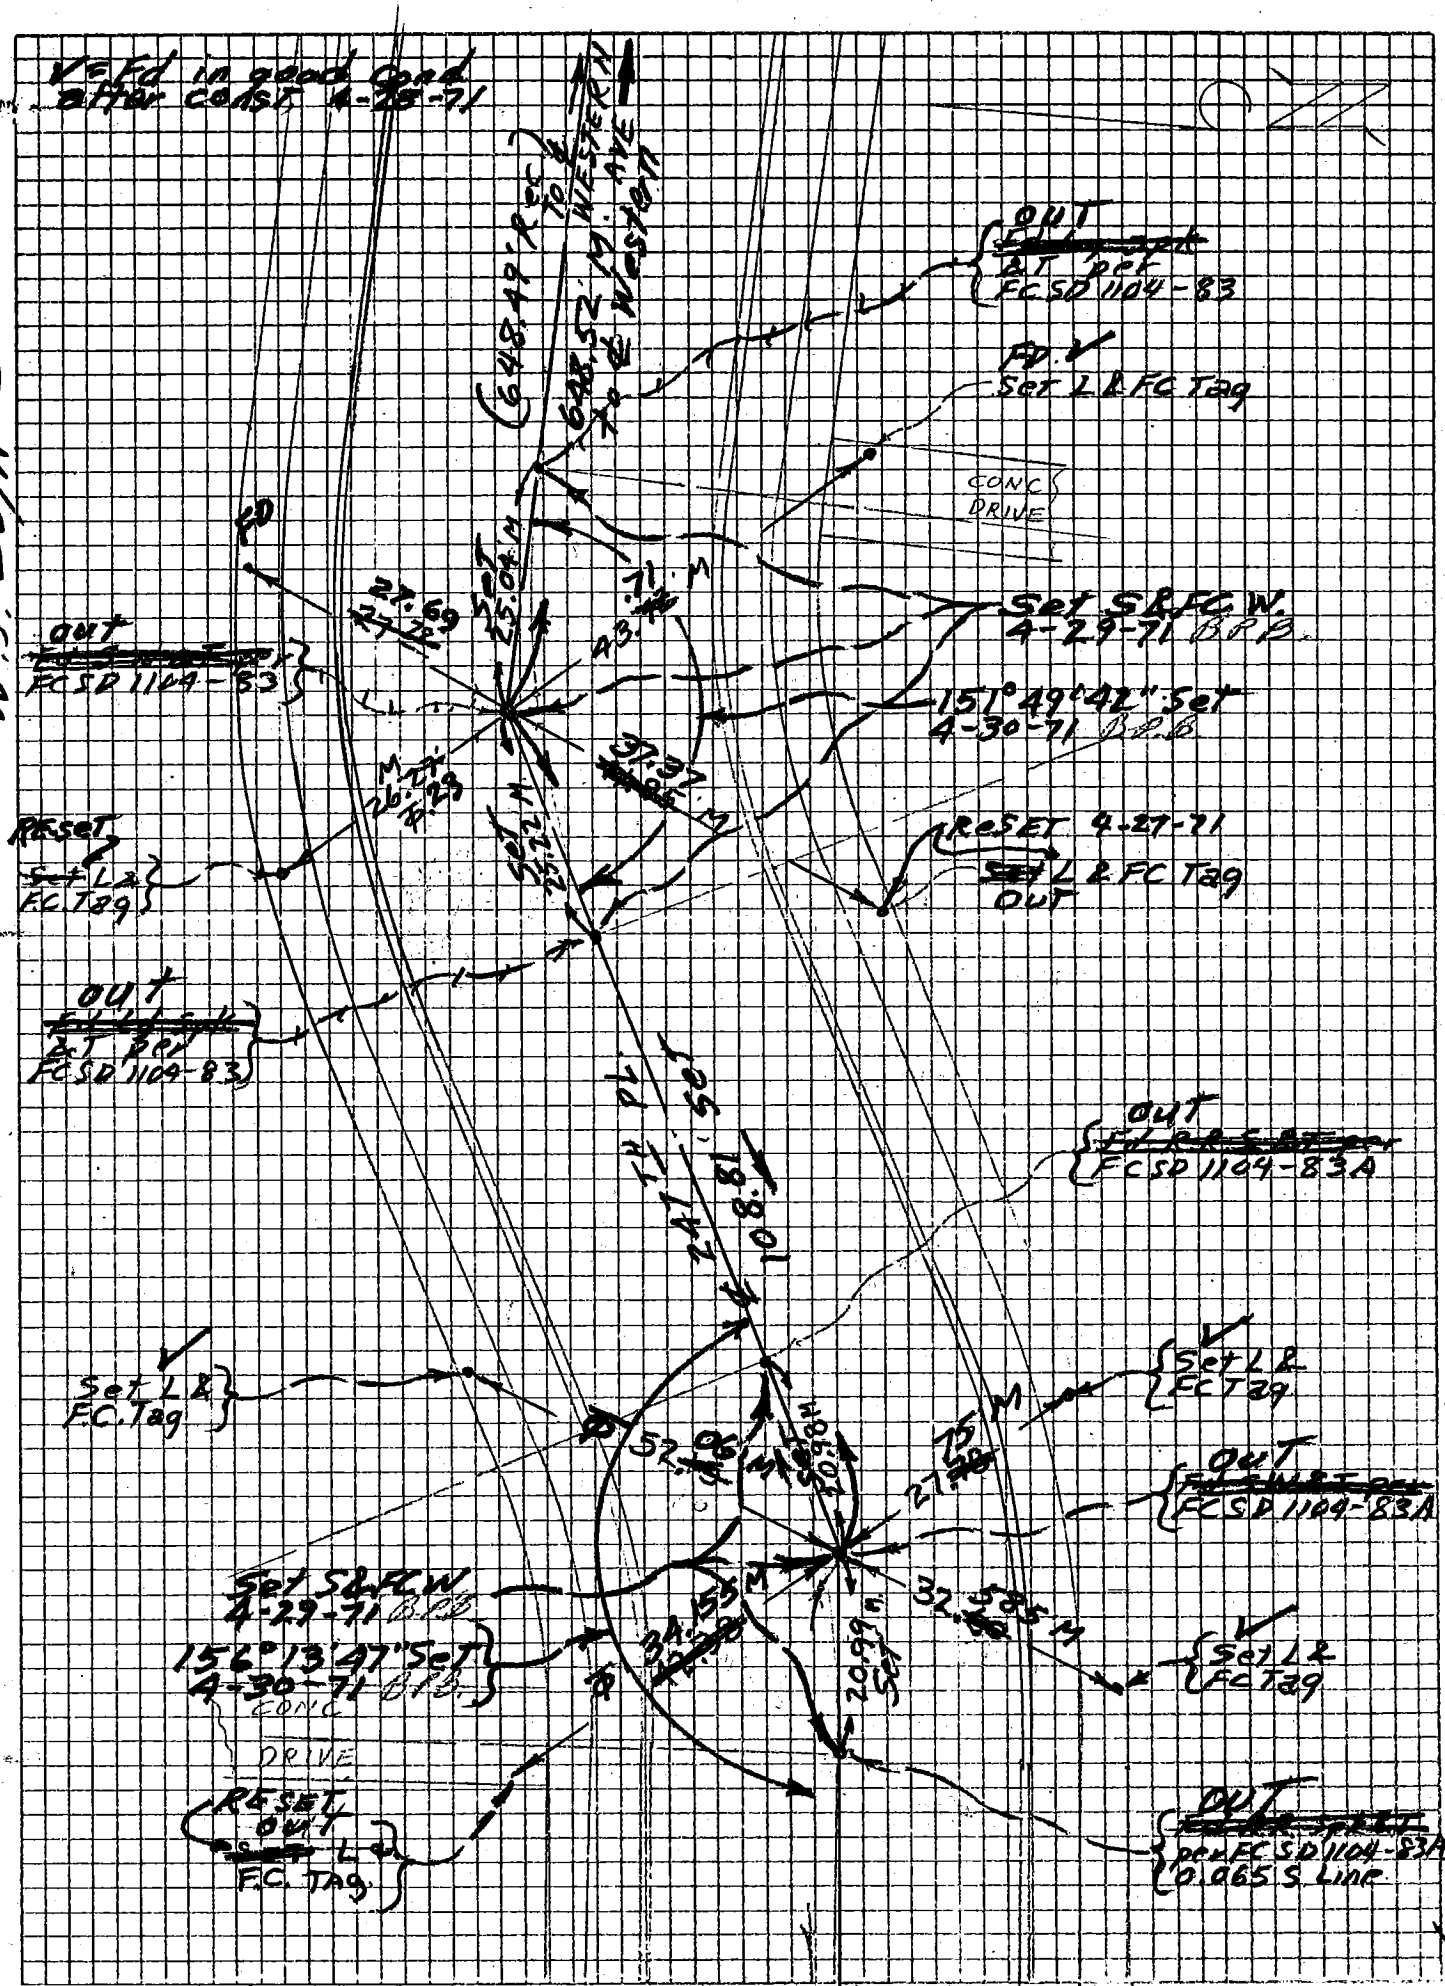
W.S. 28-14-3
Refd in good road after const 4-26-71
649.49' P.C. TO 648.52' P.T. WESTERN AVE
OUT
Set L & FC Tag
FD.
CONC DRIVE
Set S & FC W. 4-29-71 B&B
151°49'42" Set 4-30-71 B&B
RESET 4-27-71
Set L & FC Tag
OUT
FCSD 1104-83A
Set L & FC Tag
RESET OUT L & F.C. TAG
OUT per FCSD 1104-83A 0.065 S Line

WSP 28A-3

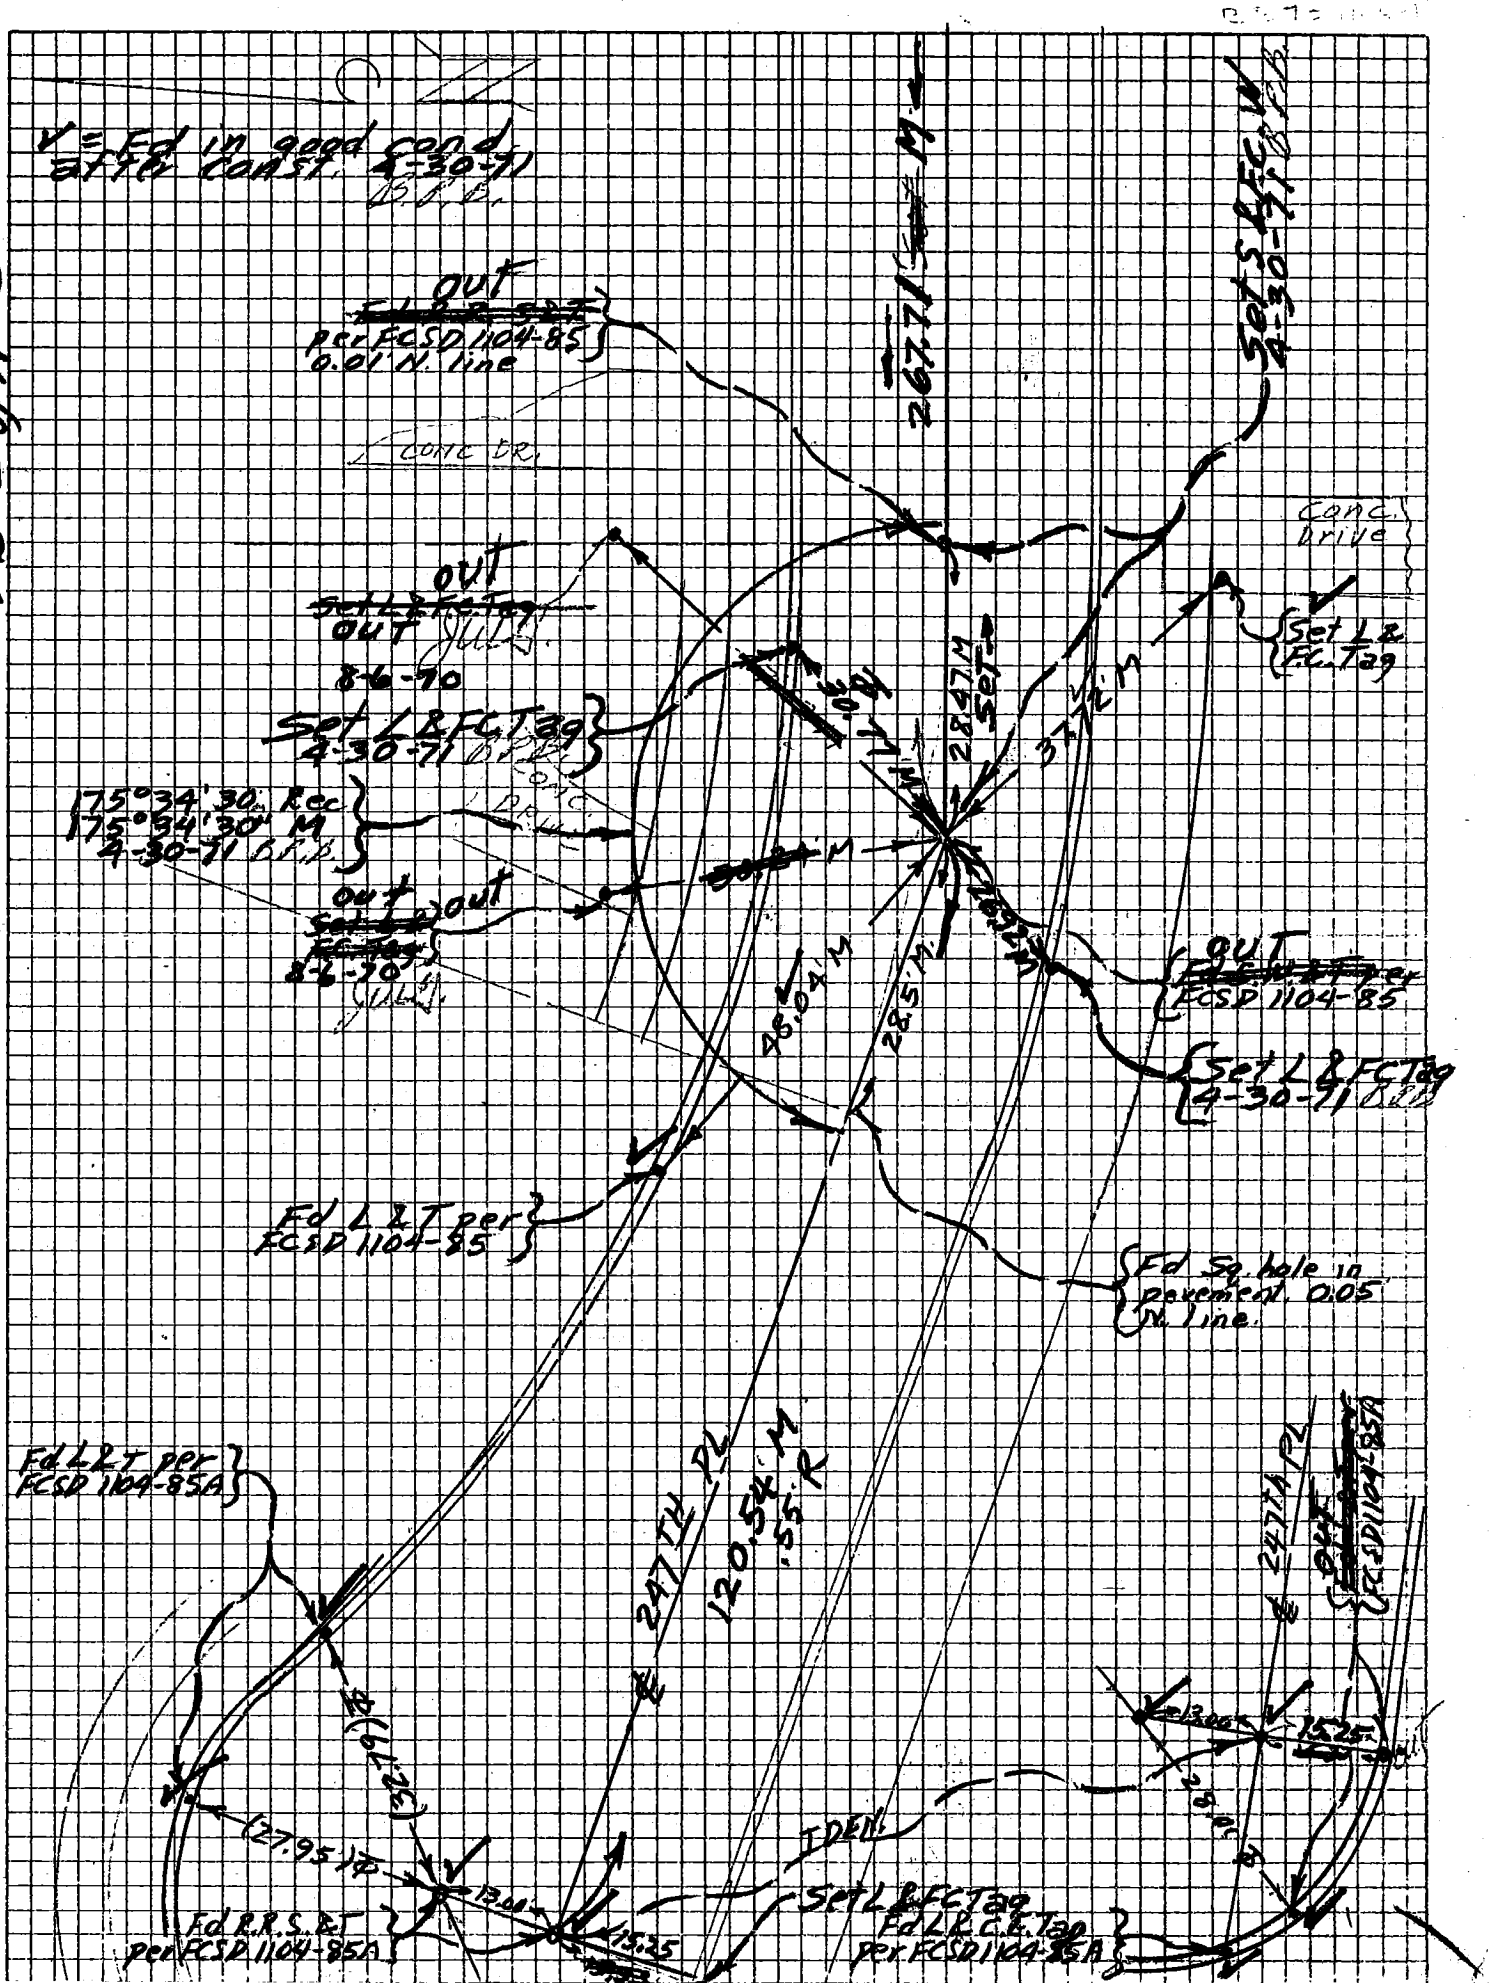
V = Fd in good cond. after const. 4-30-71 B.F.B.
OUT
Rec FCSD 1104-85 0.01' N. line
CONC. DR.
OUT
8-6-70
Set L & FC Tag 4-30-71 B.F.B.
175°34'30" Rec
175°34'30" M
4-30-71 B.F.B.
OUT
8-6-70
Set L & FC Tag
Set 3-4 FC in M 4-30-71 B.F.B.
267.71' M
Conc. Drive
Set L & FC Tag
28.47' M
Set
30.71' M
3' N
OUT
FCSD 1104-85
Set L & FC Tag 4-30-71 B.F.B.
46.04' M
28.5' M
Fd L & T per FCSD 1104-85
Fd Sq. hole in Perpendicular 0.05 W. Line
Fd L & T per FCSD 1104-85A
247 TH PL
120.54' M
5.5' R
247TH PL
OUT
FCSD 1104-85A
(27.95' M)
(27.79' M)
Fd R.R.S. & T per FCSD 1104-85A
15.01
15.25
IDEM
Set L & FC Tag
Fd L & C.E. Tag per FCSD 1104-85A
15.25
3 pc

Co. Engr. F.B. 3555: 148

PROJECT No. 1104 UNIT 1 INDEX FCSD1104 201 (148)

SURVEY BY B.C.B. DATE 2-19-70 R.&.R. 9

REVIEWED BY DATE LOS ANGELES COUNTY FLOOD CONTROL DISTRICT

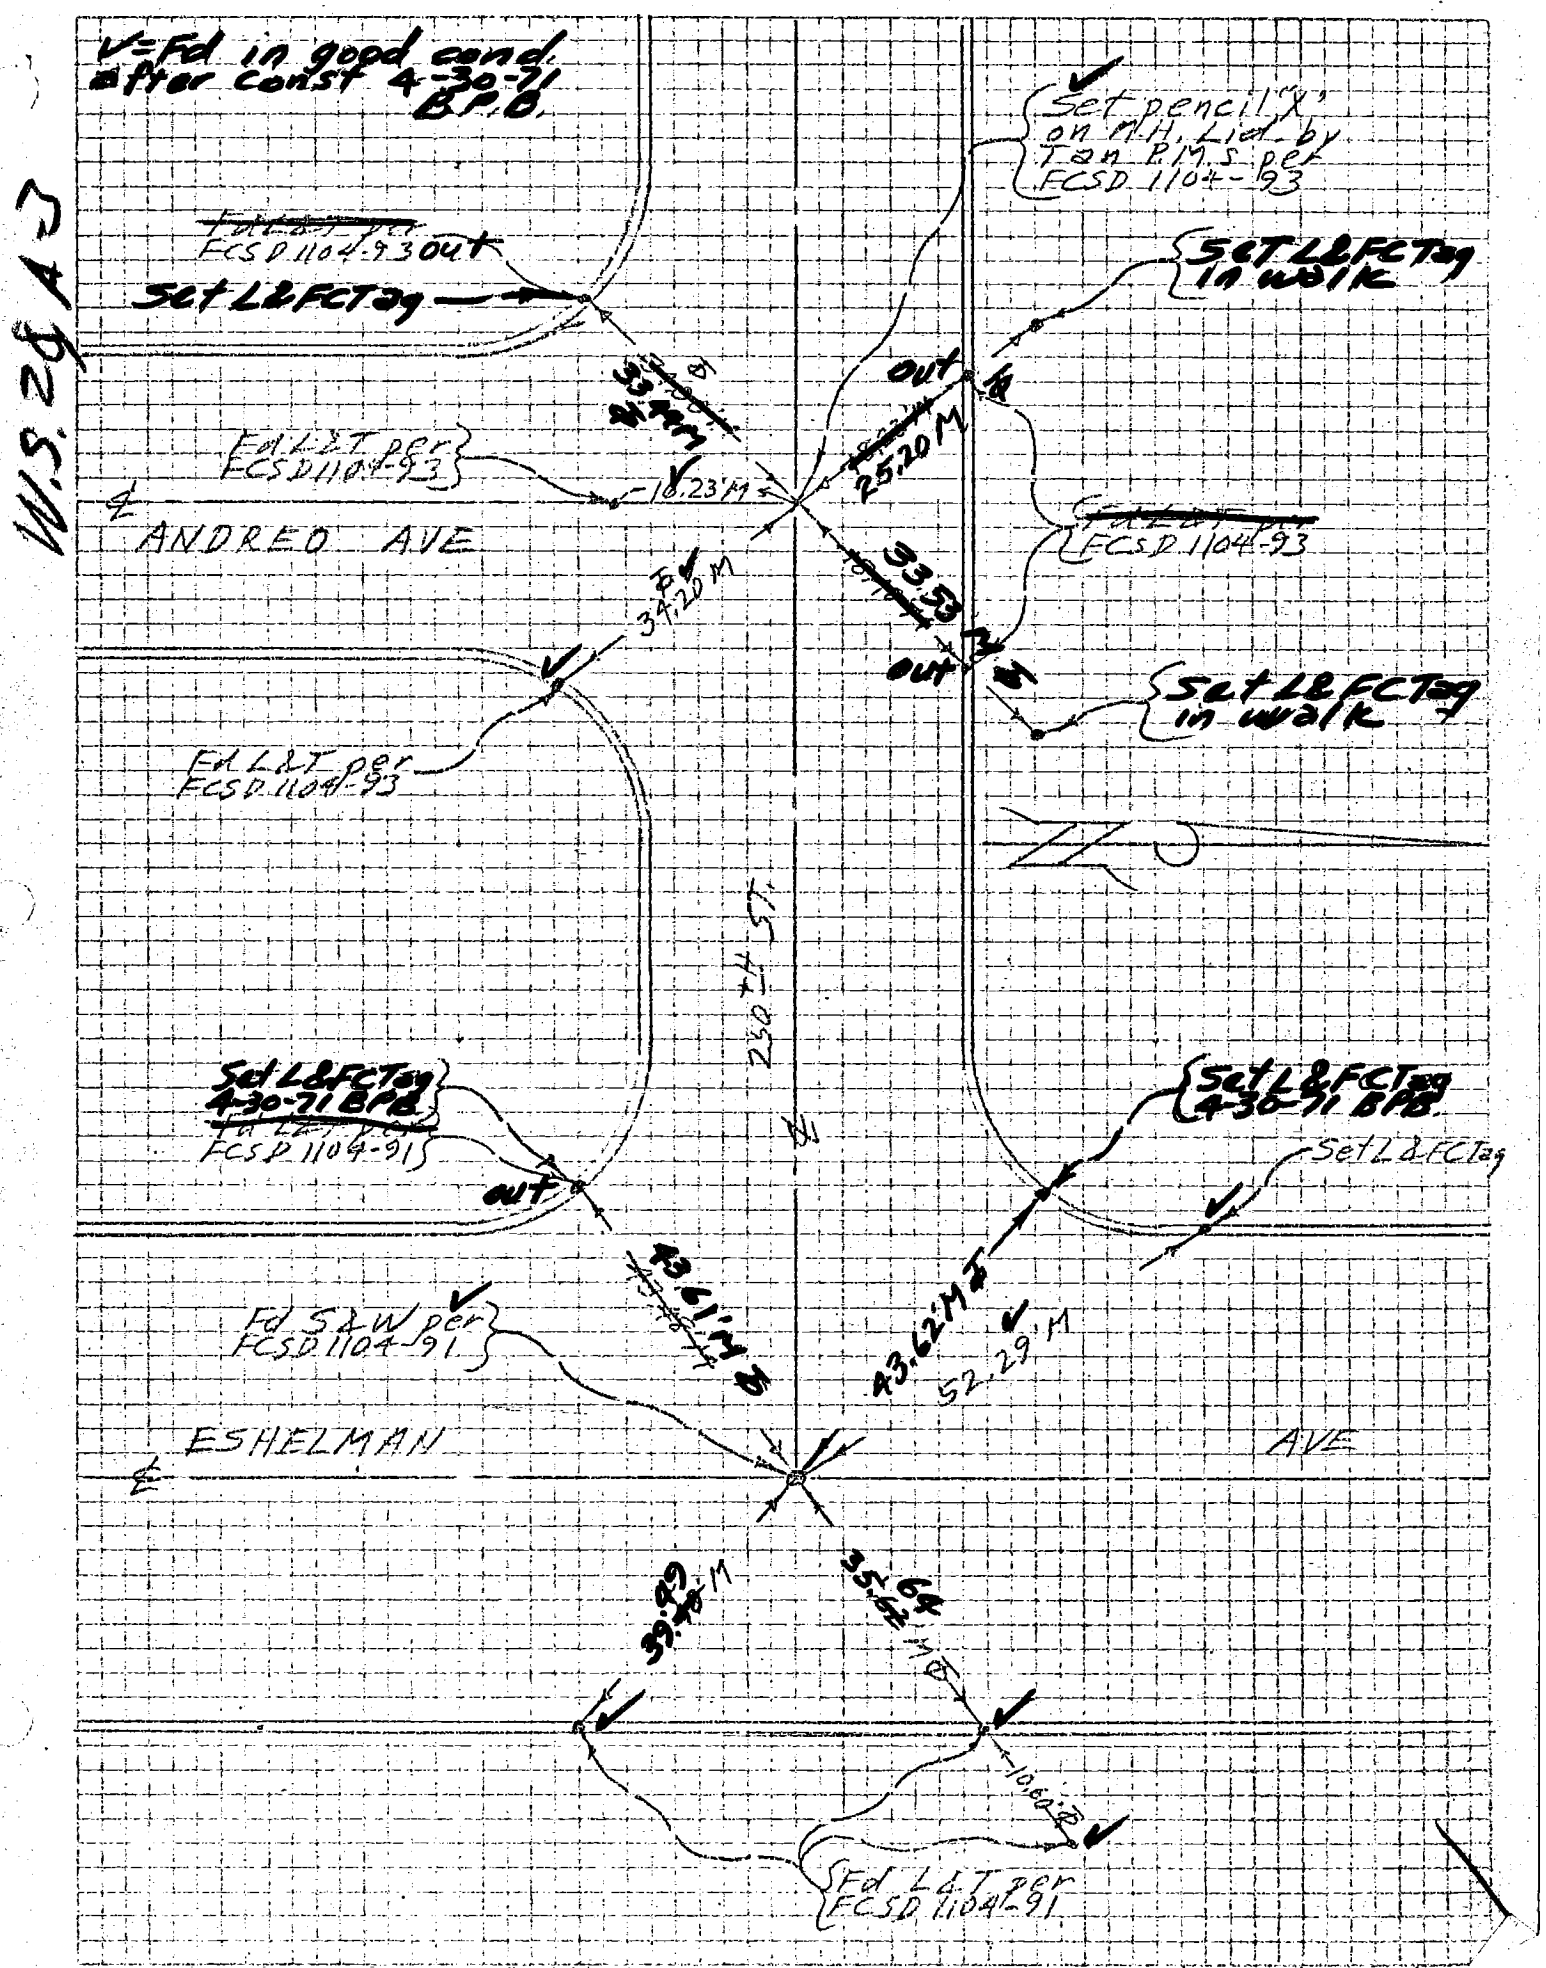

W.S. 28, A-3

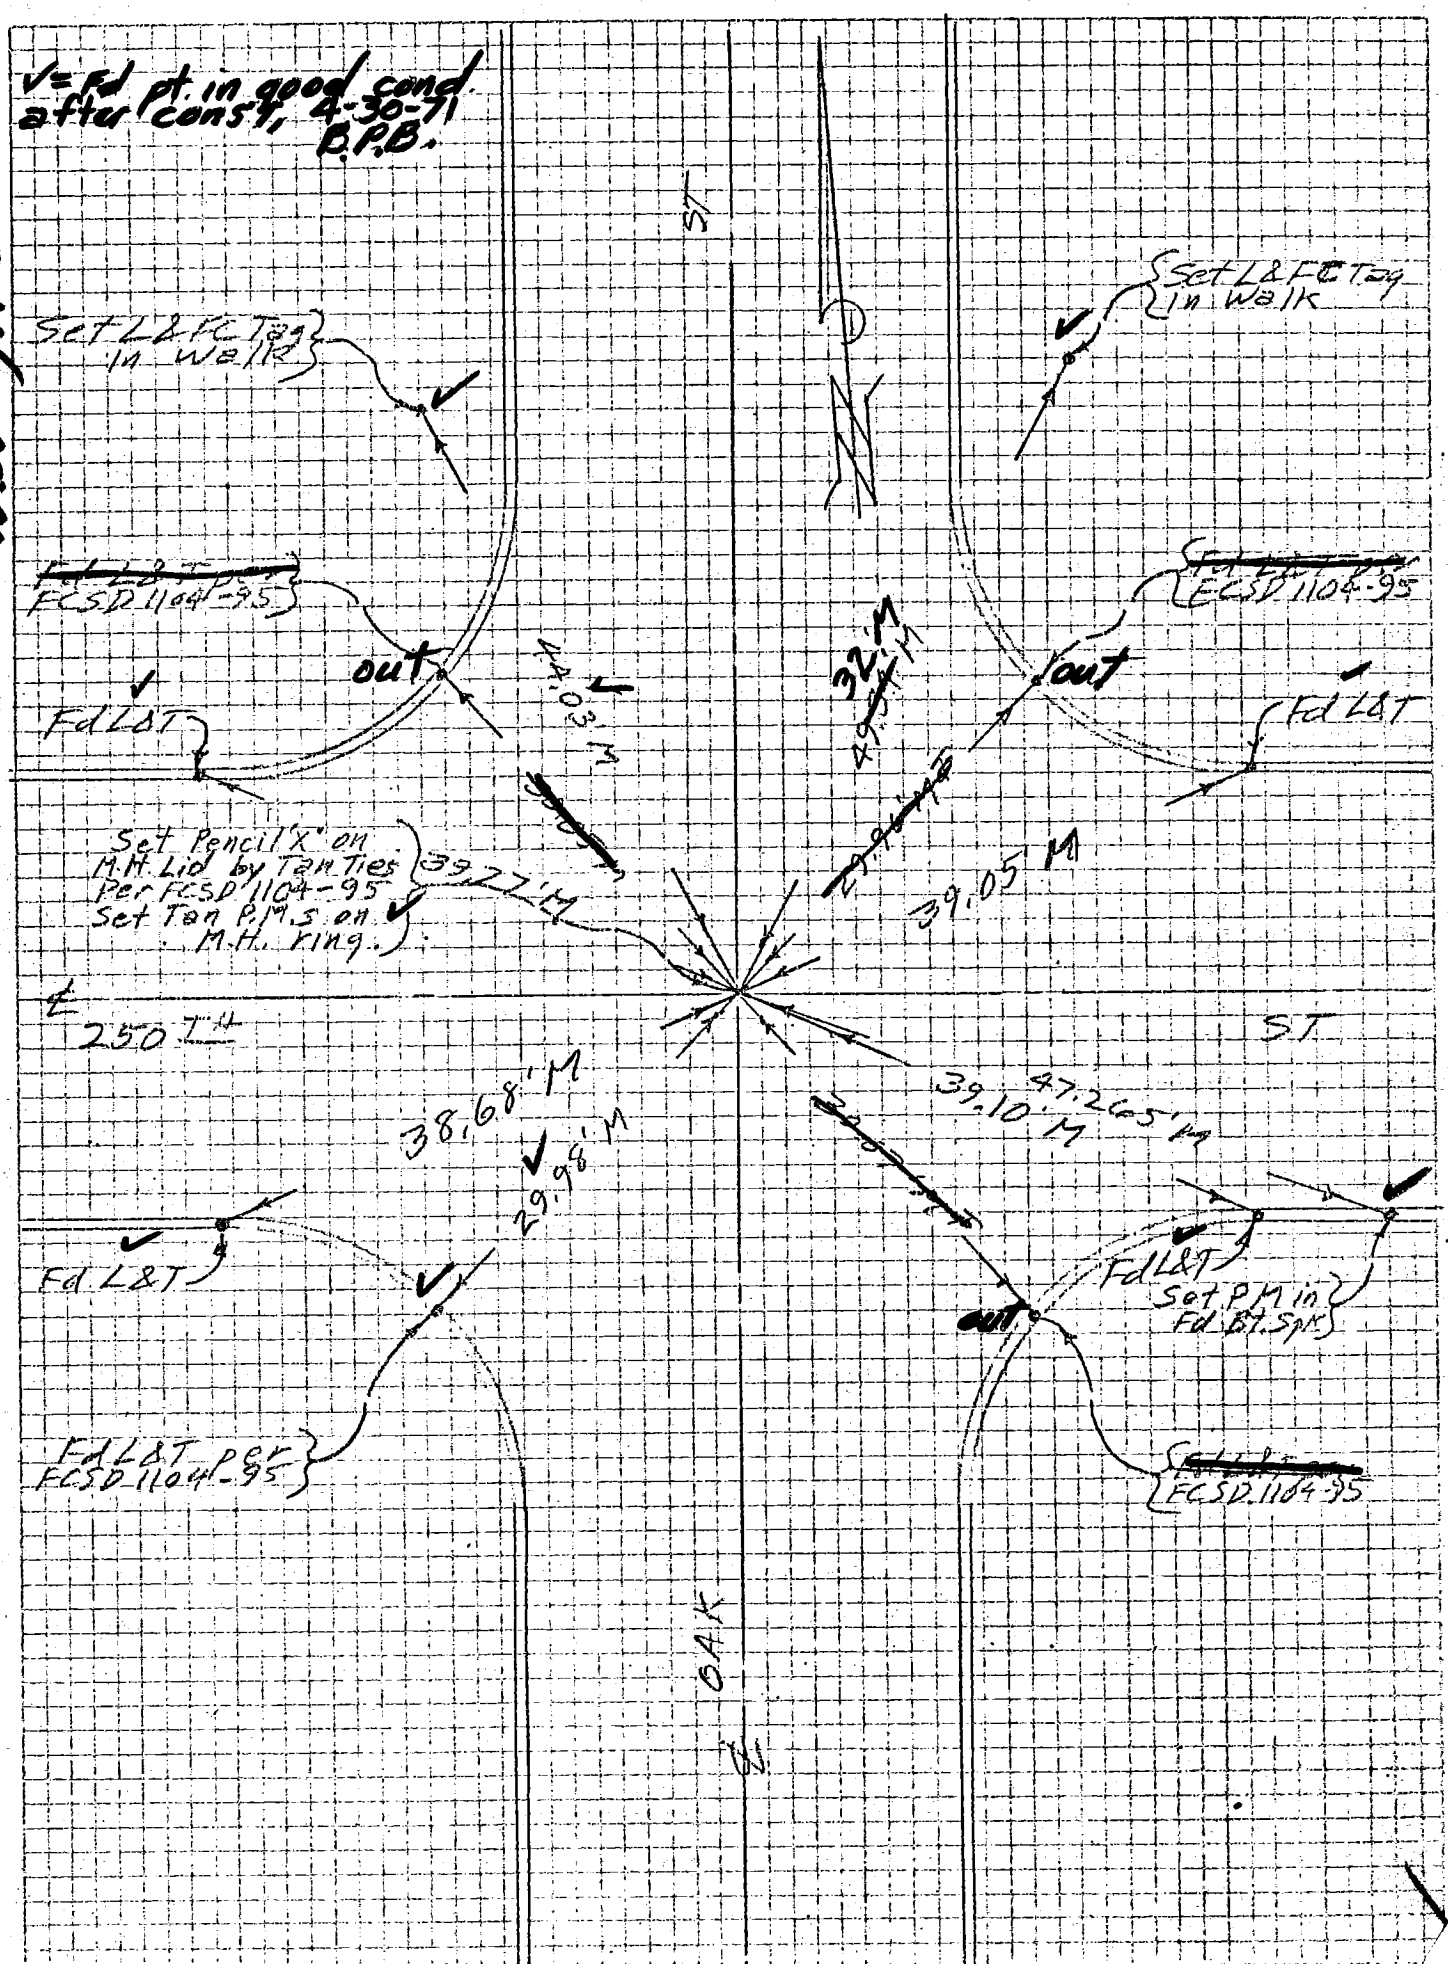
V=Fd pt. in good cond after const., 4-30-71 B.P.B.
Set L&FC Tag in Walk
Set L&FC Tag in Walk
FCSD 1104-95
FCSD 1104-95
out
out
Fd L&T
Fd L&T
Set Pencil 'X' on M.H. Lid by Tan Ties Per FCSD 1104-95 Set Tan P.K.S. on M.H. Ring.
39.27' M
39.05' M
39.10' M
47.26 Calc'd
38.68' M
39.98' M
Fd L&T
Fd L&T
Set P.M. in Fd. 67.5 P.M.
Fd L&T Per FCSD 1104-95
FCSD 1104-95
OAK
ST
ST

768911– Cdb 3-69

PROJECT No. 1104 Unit 1

SURVEY BY B.P.B. DATE 4-30-71

REVIEWED BY _____ DATE _____

Co. Engr. F.B. 355: 150

INDEX FCSD1104 205 (150)

R&R 13

LOS ANGELES COUNTY FLOOD CONTROL DISTRICT

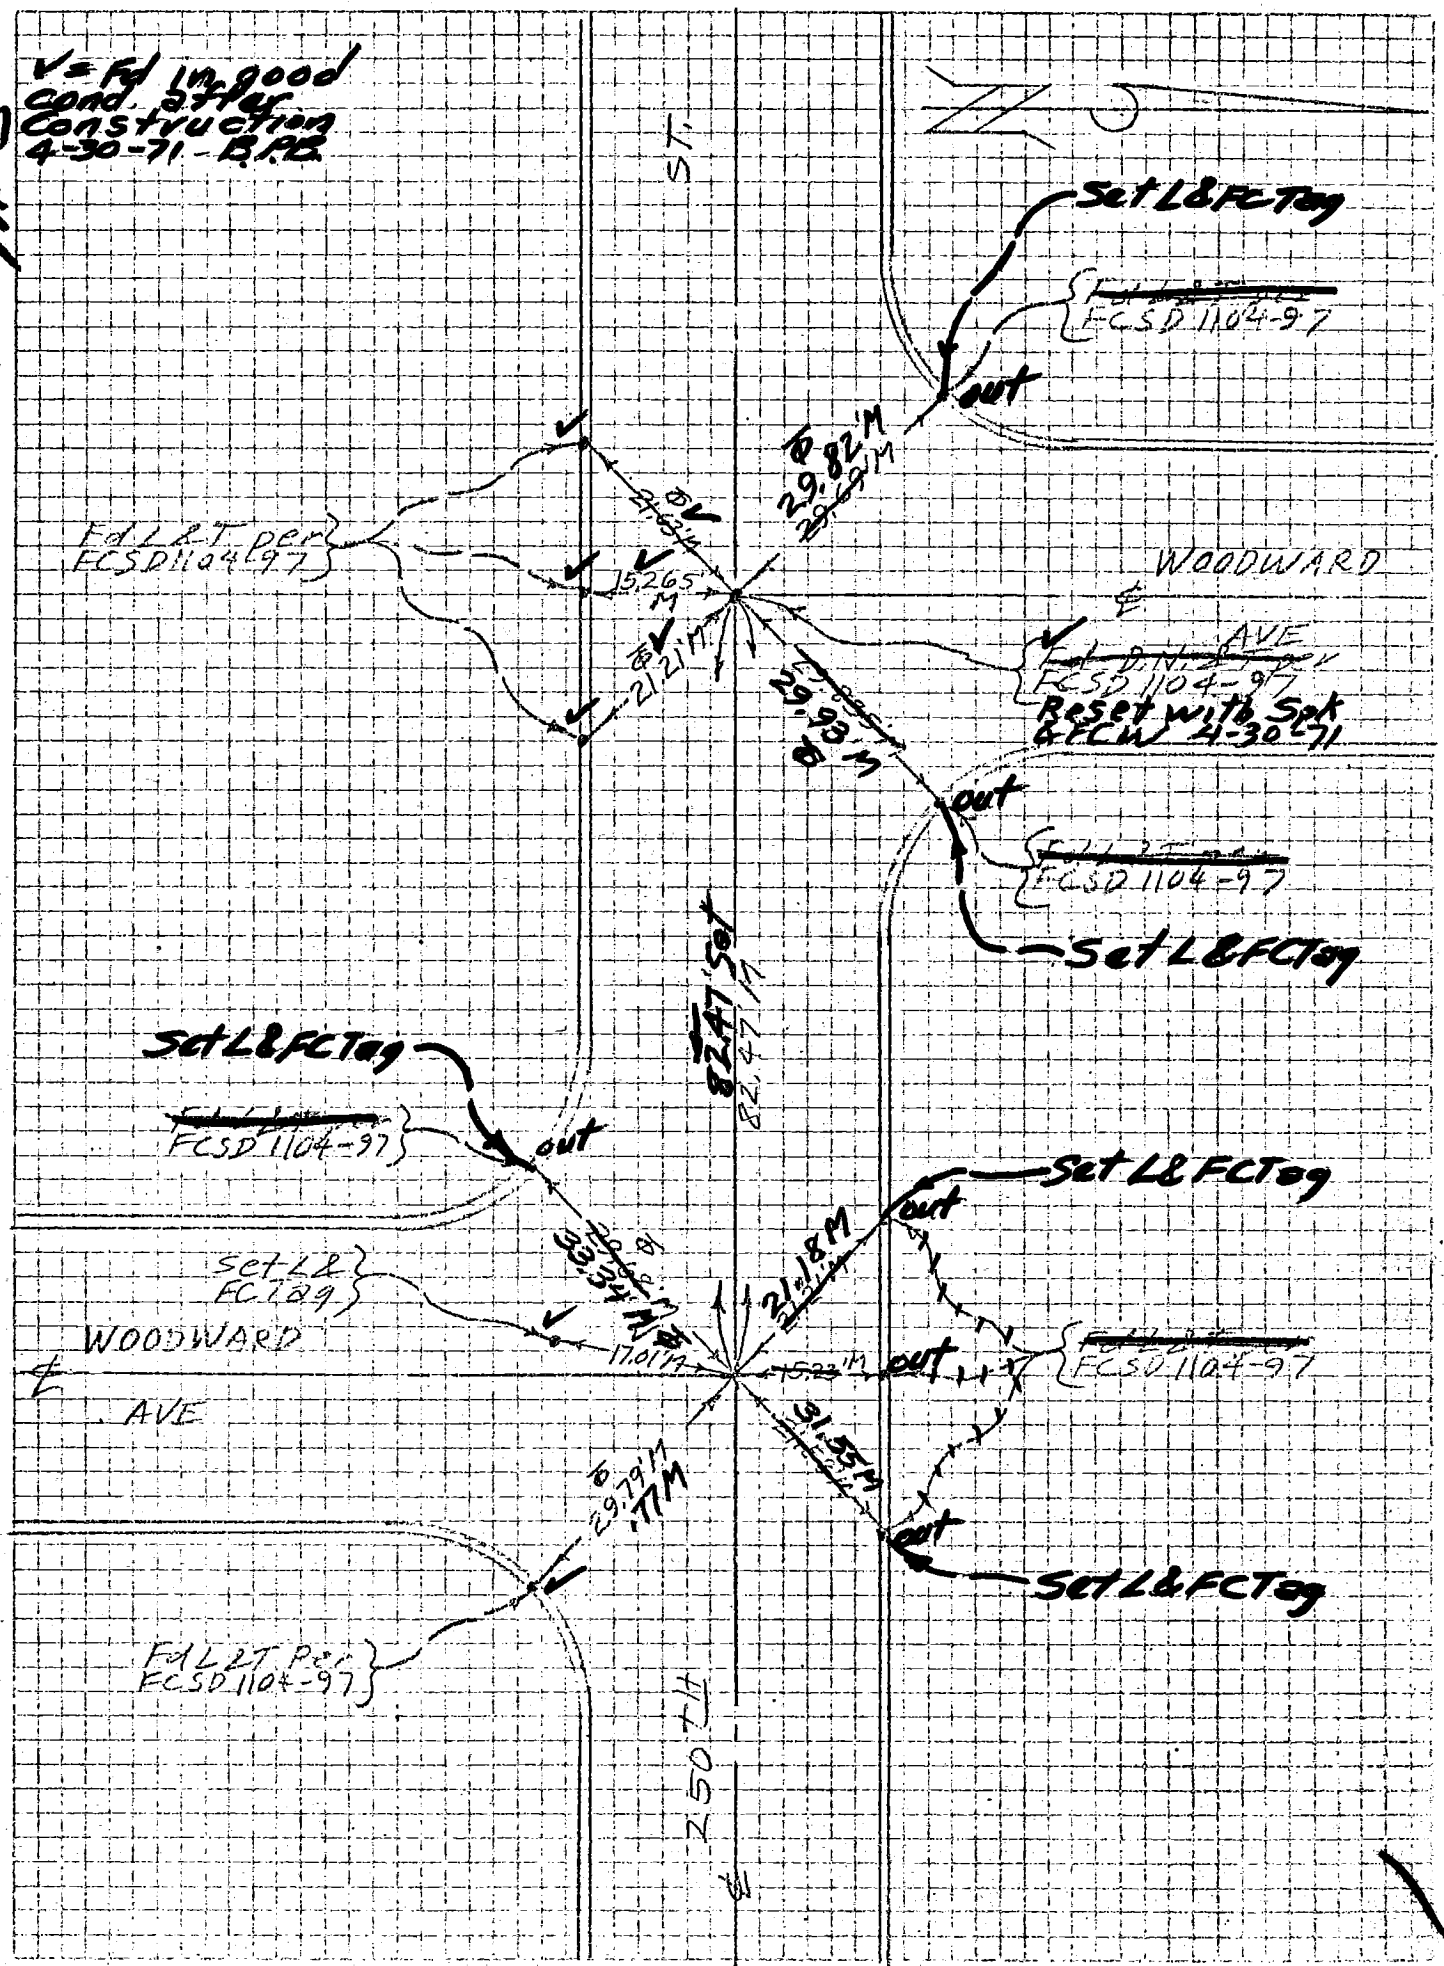
V=Fd in good cond. after construction 4-30-71 - B.P.B.
WS 28,4-7
ST.
Set L&FC Tag
FCSD 1104-97
out
Fd L&T per FCSD 1104-97
WOODWARD
AVE
Reset with Spk & FCW 4-30-71
Set L&FC Tag
Set L&FC Tag
Set L&FC Tag

W.S. 2843

V=Fd in good cond after const. 4-14-71 DPB

Set L&T 4-14-71

~~Ed L&T per FCSD 1104-99~~ OUT

ST

Set L&T 4-19-71

~~Ed L&T per FCSD 1104-99~~ OUT

53.33' M

37.59' M

NARBONNE

AVE

Ed S&W per FCSD 1104-99

53.505' M

36.88' M

~~Ed L&T~~ OUT ~~per FCSD 1104-99~~

Set L&T 4-14-71

25TH

Ed L&T per FCSD 1104-99

76S911– Cdb 3-69

PROJECT No. 1104 Unit 1

SURVEY BY R.P.B. DATE 2-19-70

REVIEWED BY _____ DATE _____

Co. Engr. F.B. 3555: 152

INDEX FCSD1104 209 (152)

R&R 17

LOS ANGELES COUNTY FLOOD CONTROL DISTRICT

W.S. 24-3

V = Fd in good cond. after const 4-14-71 B.P.O.

out
FCSD 1104-103

Set L&FC Tag

91.72'M
Set 4-14-71

CYPRESS AVE

Set Penci / "X"

41.40'M

96.75'M

Fd Nail "T.P. per FCSD 1104-103

out
FCSD 1104-103

Set L&FC Tag 4-14-71

41.17'M
Set 4-14-71

Set L&FC Tag

31.85'M

66.28'M

Set L&FC Tag 4-14-71

Fd 1 R.T. per FCSD 1104-103

Fd B+ Sp K+RM per FCSD 1104-103

Fd N&T in P.P. per FCSD 1104-101

Fd L&T in conc W 3/4" per FCSD 1104-101

250TH ST

58.96'M

15.09'M

Set L&F.C. Tag

FEIJOA AVE

16.96'M

16.30'M

out
Set L&T. 4-14-71

49.83'M

Set L&FC Tag 4-14-71

19.26'M

Fd L&T per FCSD 1104-101
Removed & set S&FC W.F.

74'M

out
per FCSD 1104-101

out
Set L&T. 4-14-71

Fd N&T in P.P. per FCSD 1104-101

F.B. 2588 PG. 30

FROM B&TT PG 28

V = Fd. in good cond. after const. 4-13-71 BPB

FOR PT's SET SEE FCSD 688 - 45

W.S. 28+43

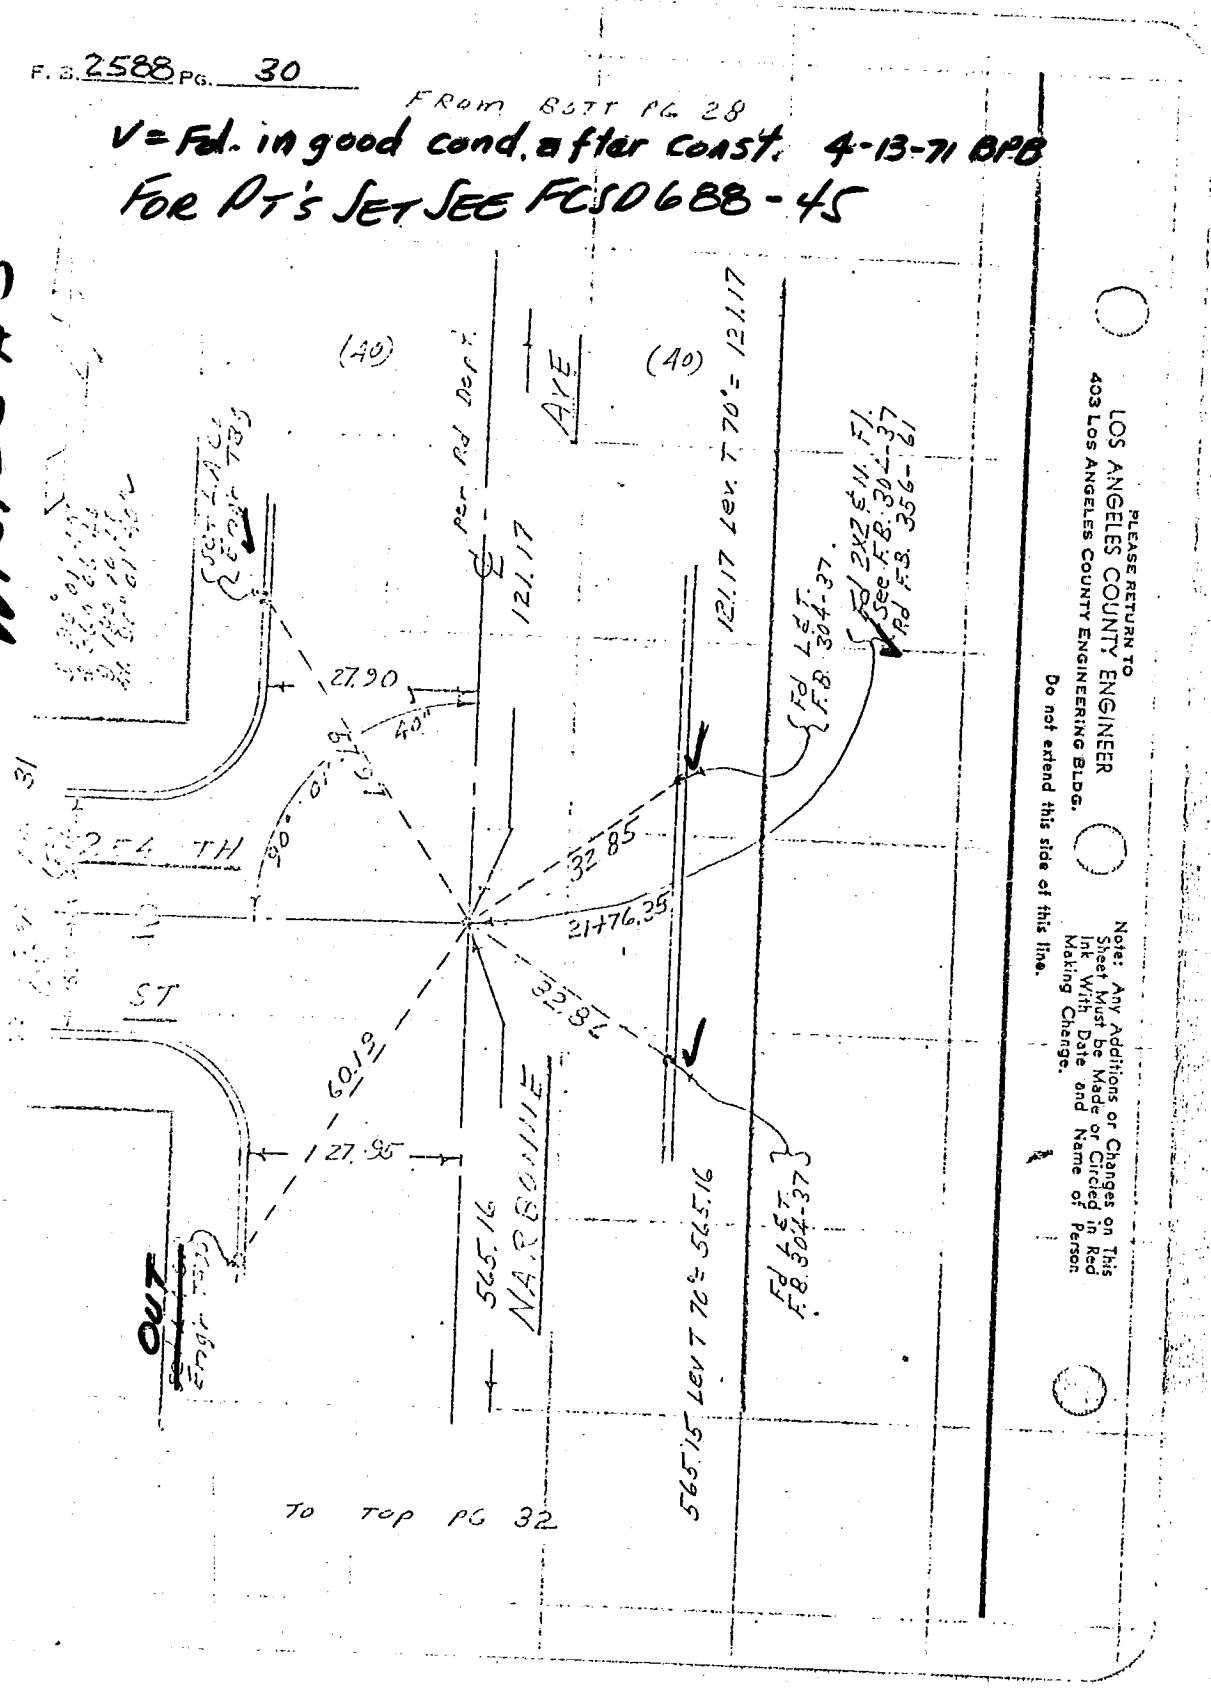


PLEASE RETURN TO
LOS ANGELES COUNTY ENGINEER
403 Los Angeles County Engineering Bldg.

Do not extend this side of this line.

Note: Any Additions or Changes on This Sheet Must be Made or Circled in Red Ink With Date and Name of Person Making Change.

✓ = Fd. in good cond. after const. 4-13-71 BPB

FOR PT'S SET SEE FCSD 688-43

W.S. 28/A-3

F. B. 2588 PG. 32

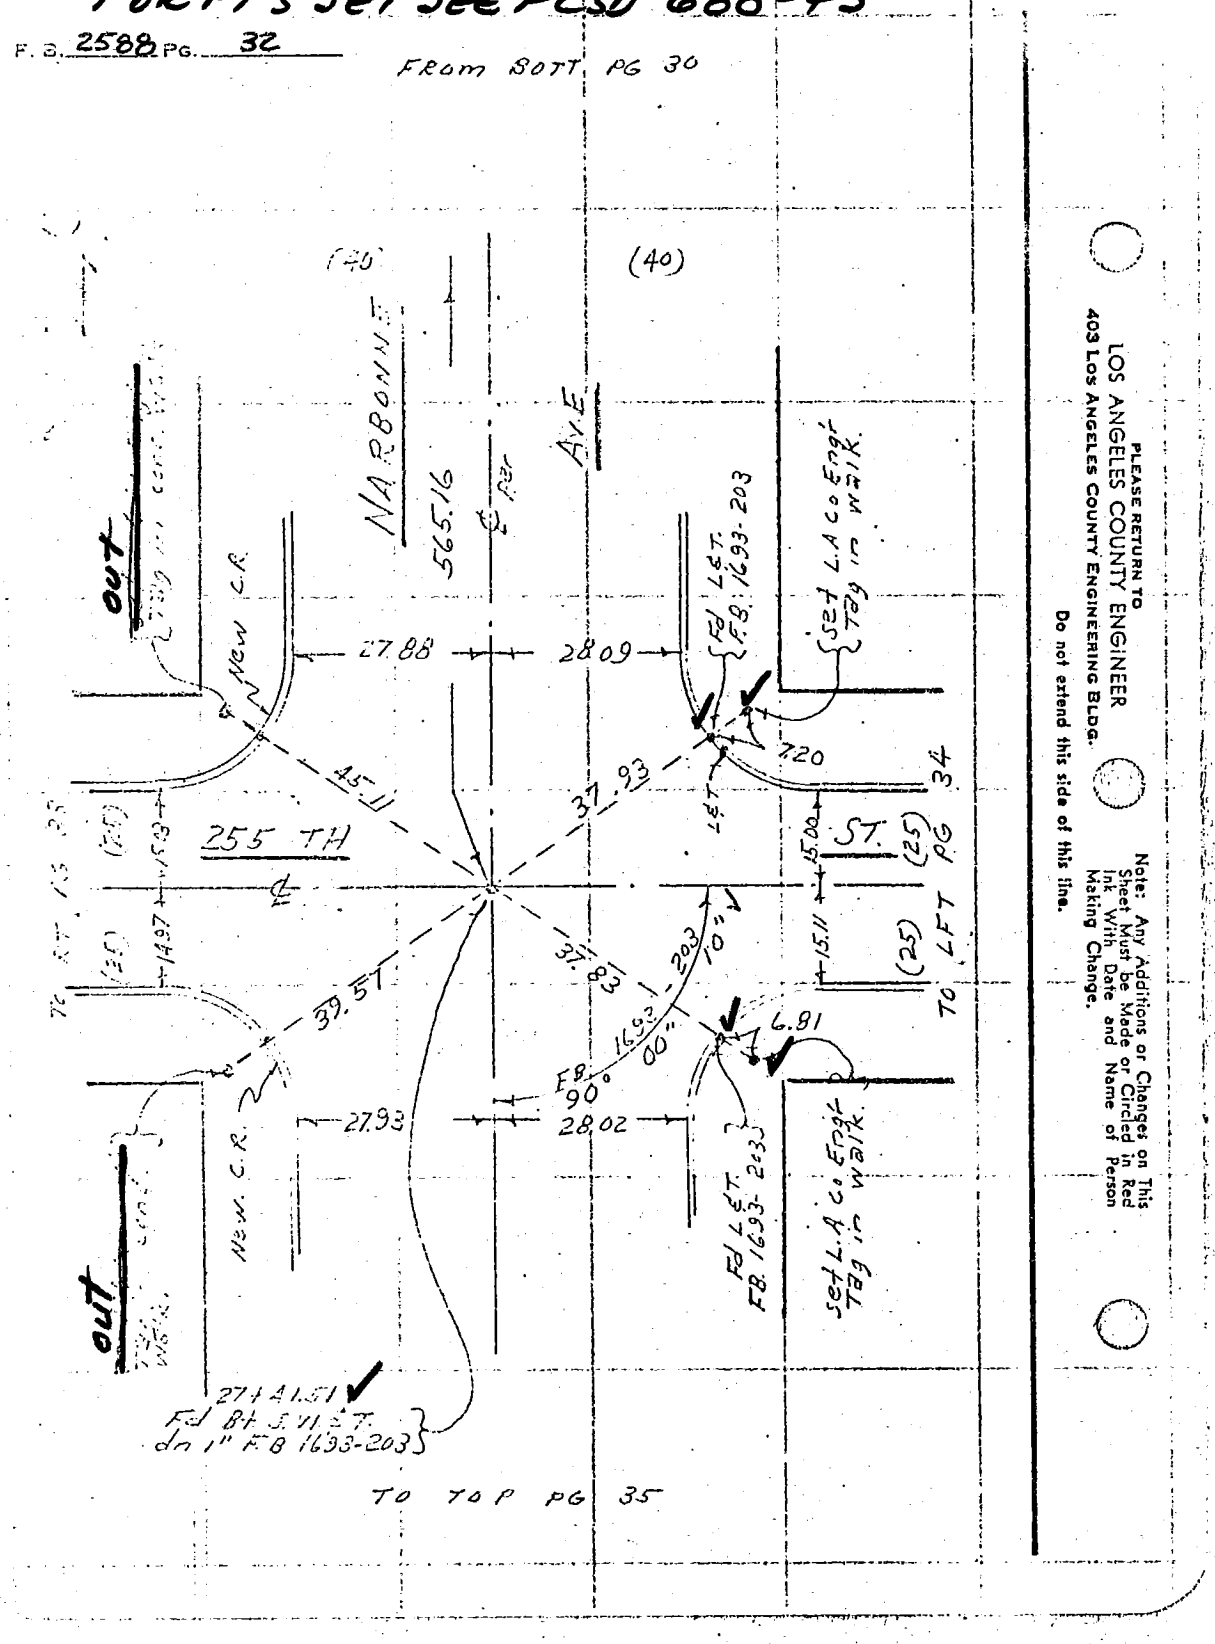

Co. Engr. F.B. 3555: 155

(186)

7-69911-- Cdb 3-69

PROJECT No. 688 - Narbonne Ave.

INDEX FCSD 688 43

SURVEY BY B.P.B. DATE 4-13-71

2485

REVIEWED BY DATE

LOS ANGELES COUNTY FLOOD CONTROL DISTRICT

W.S. 284-3

REF. FCSD 688-33 (ORIG TIES)

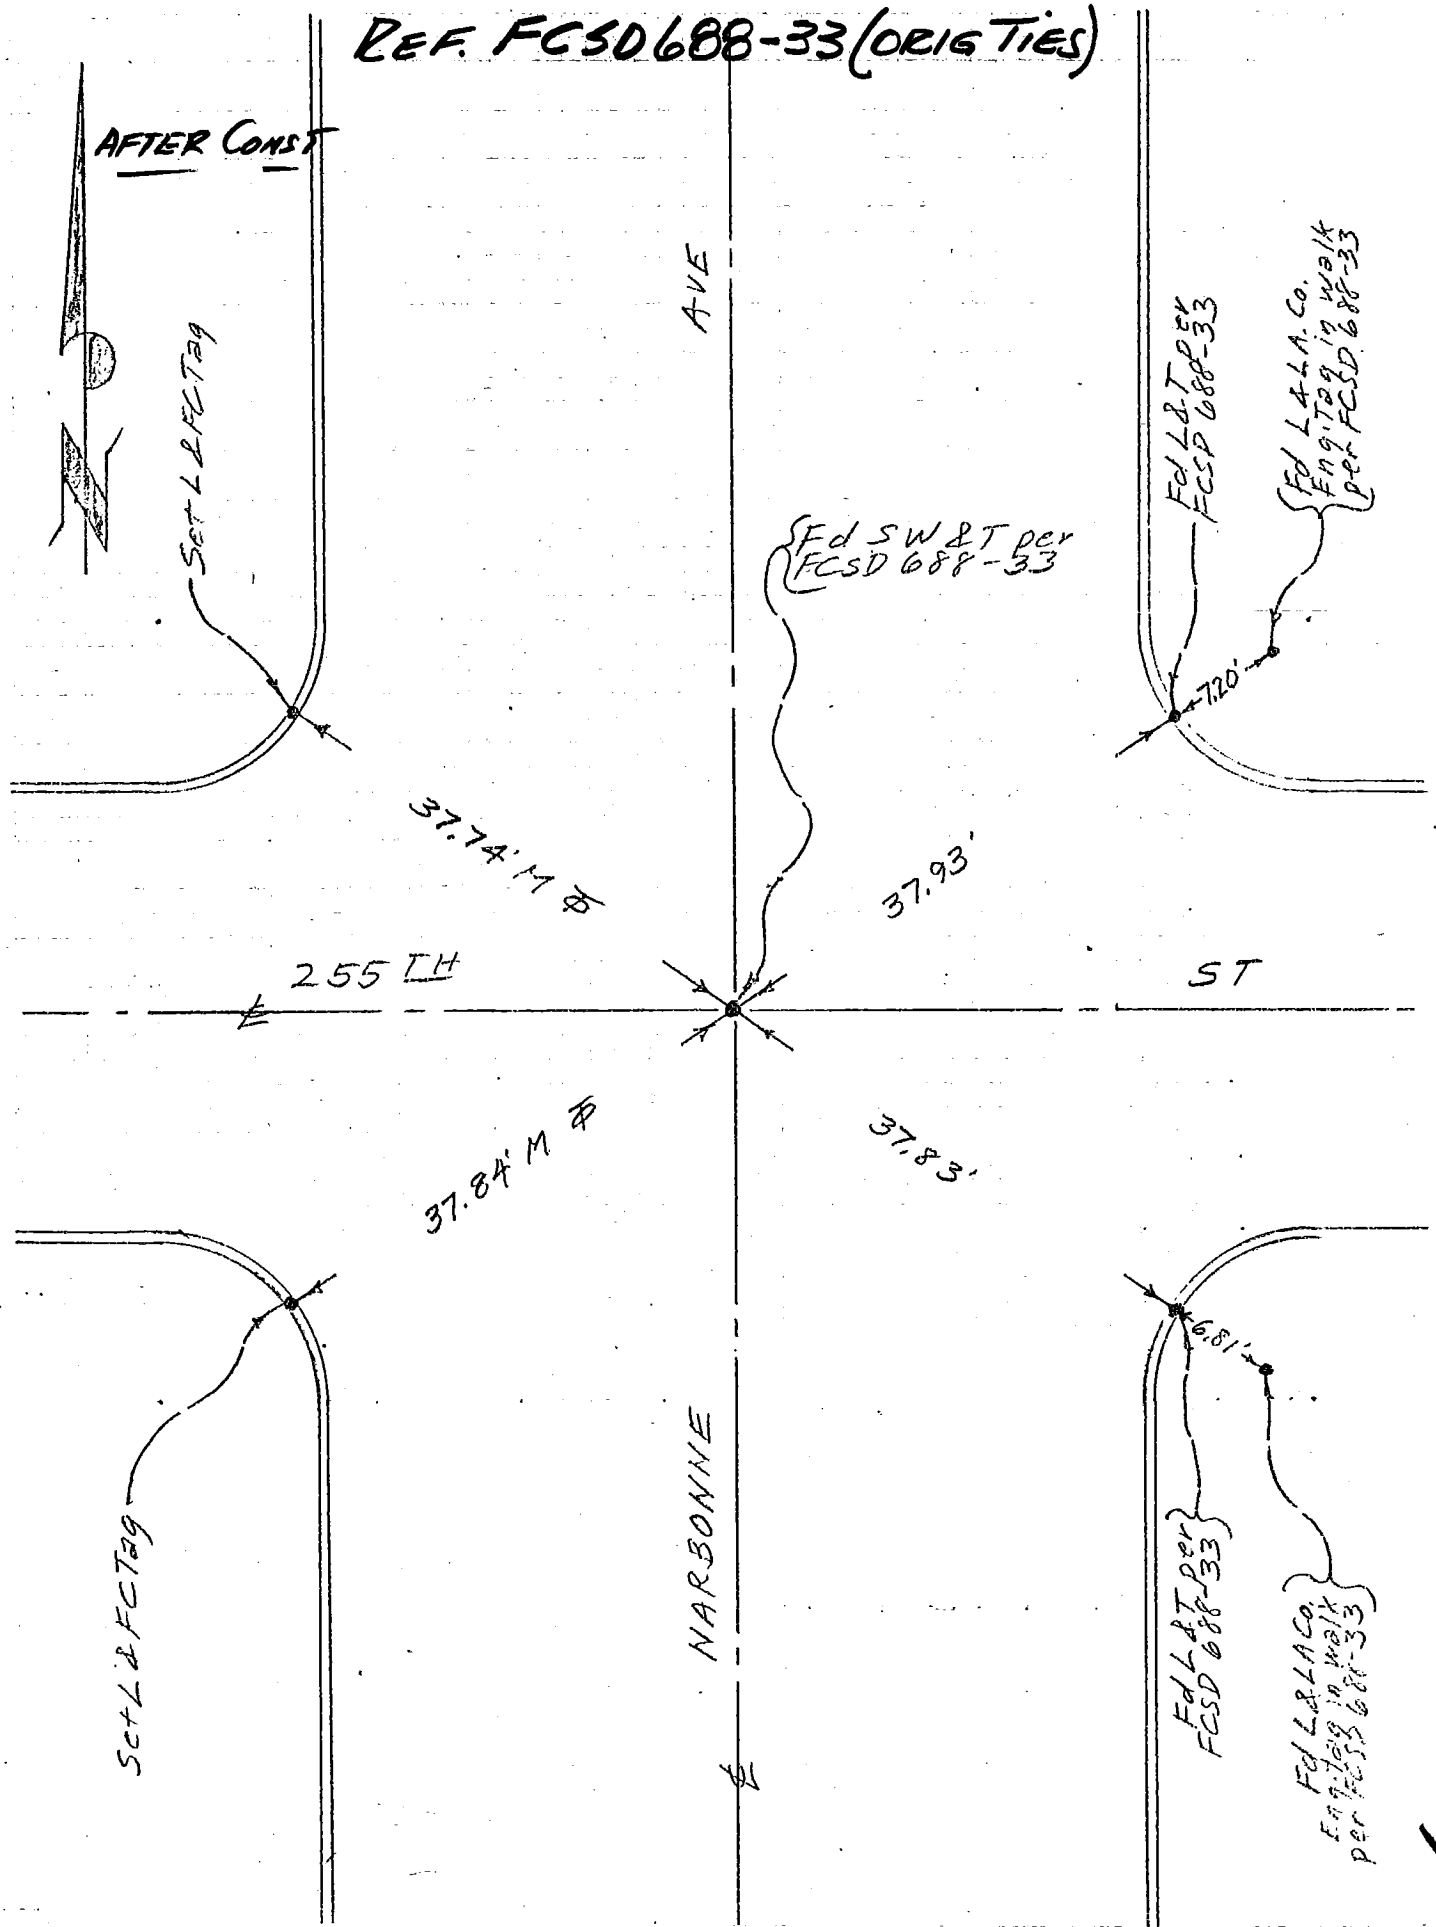

Co. Engr. F.B. 3555: 156
FCSD 688 45
(156)

76S911-- Cdb 3-69

PROJECT No. 688 Harbonne Ave.

SURVEY BY B.P.B. DATE 4-14-71

REVIEWED BY DATE

INDEX R&R3

LOS ANGELES COUNTY FLOOD CONTROL DISTRICT

AFTER CONST

REF FCSD 688-31 (ORIG TIES)

W.S. 28, A3

Fd L.A. Co Eng Tag per FCSD 688-31

AVE

S 71.97' M

254th ST

32.85' Set

Fd L & T GPIPE FCSD 688-31

32.86' Set

38.12' M

Set L & T.C. Tag

Set 2 x 2 F.C. Tag, Fl.

NARBONNE

76S911– Cdb 3-69

Co. Engr. F.B. 3555: 157

INDEX FCSD3950 117 (157)

PROJECT HAWTHORNE SD 3950

SURVEY BY DMS DATE 4-14-72.

REVIEWED BY WM DATE 4-19-72

SASSE 8-14-72

R&R P525

LOS ANGELES COUNTY FLOOD CONTROL DISTRICT

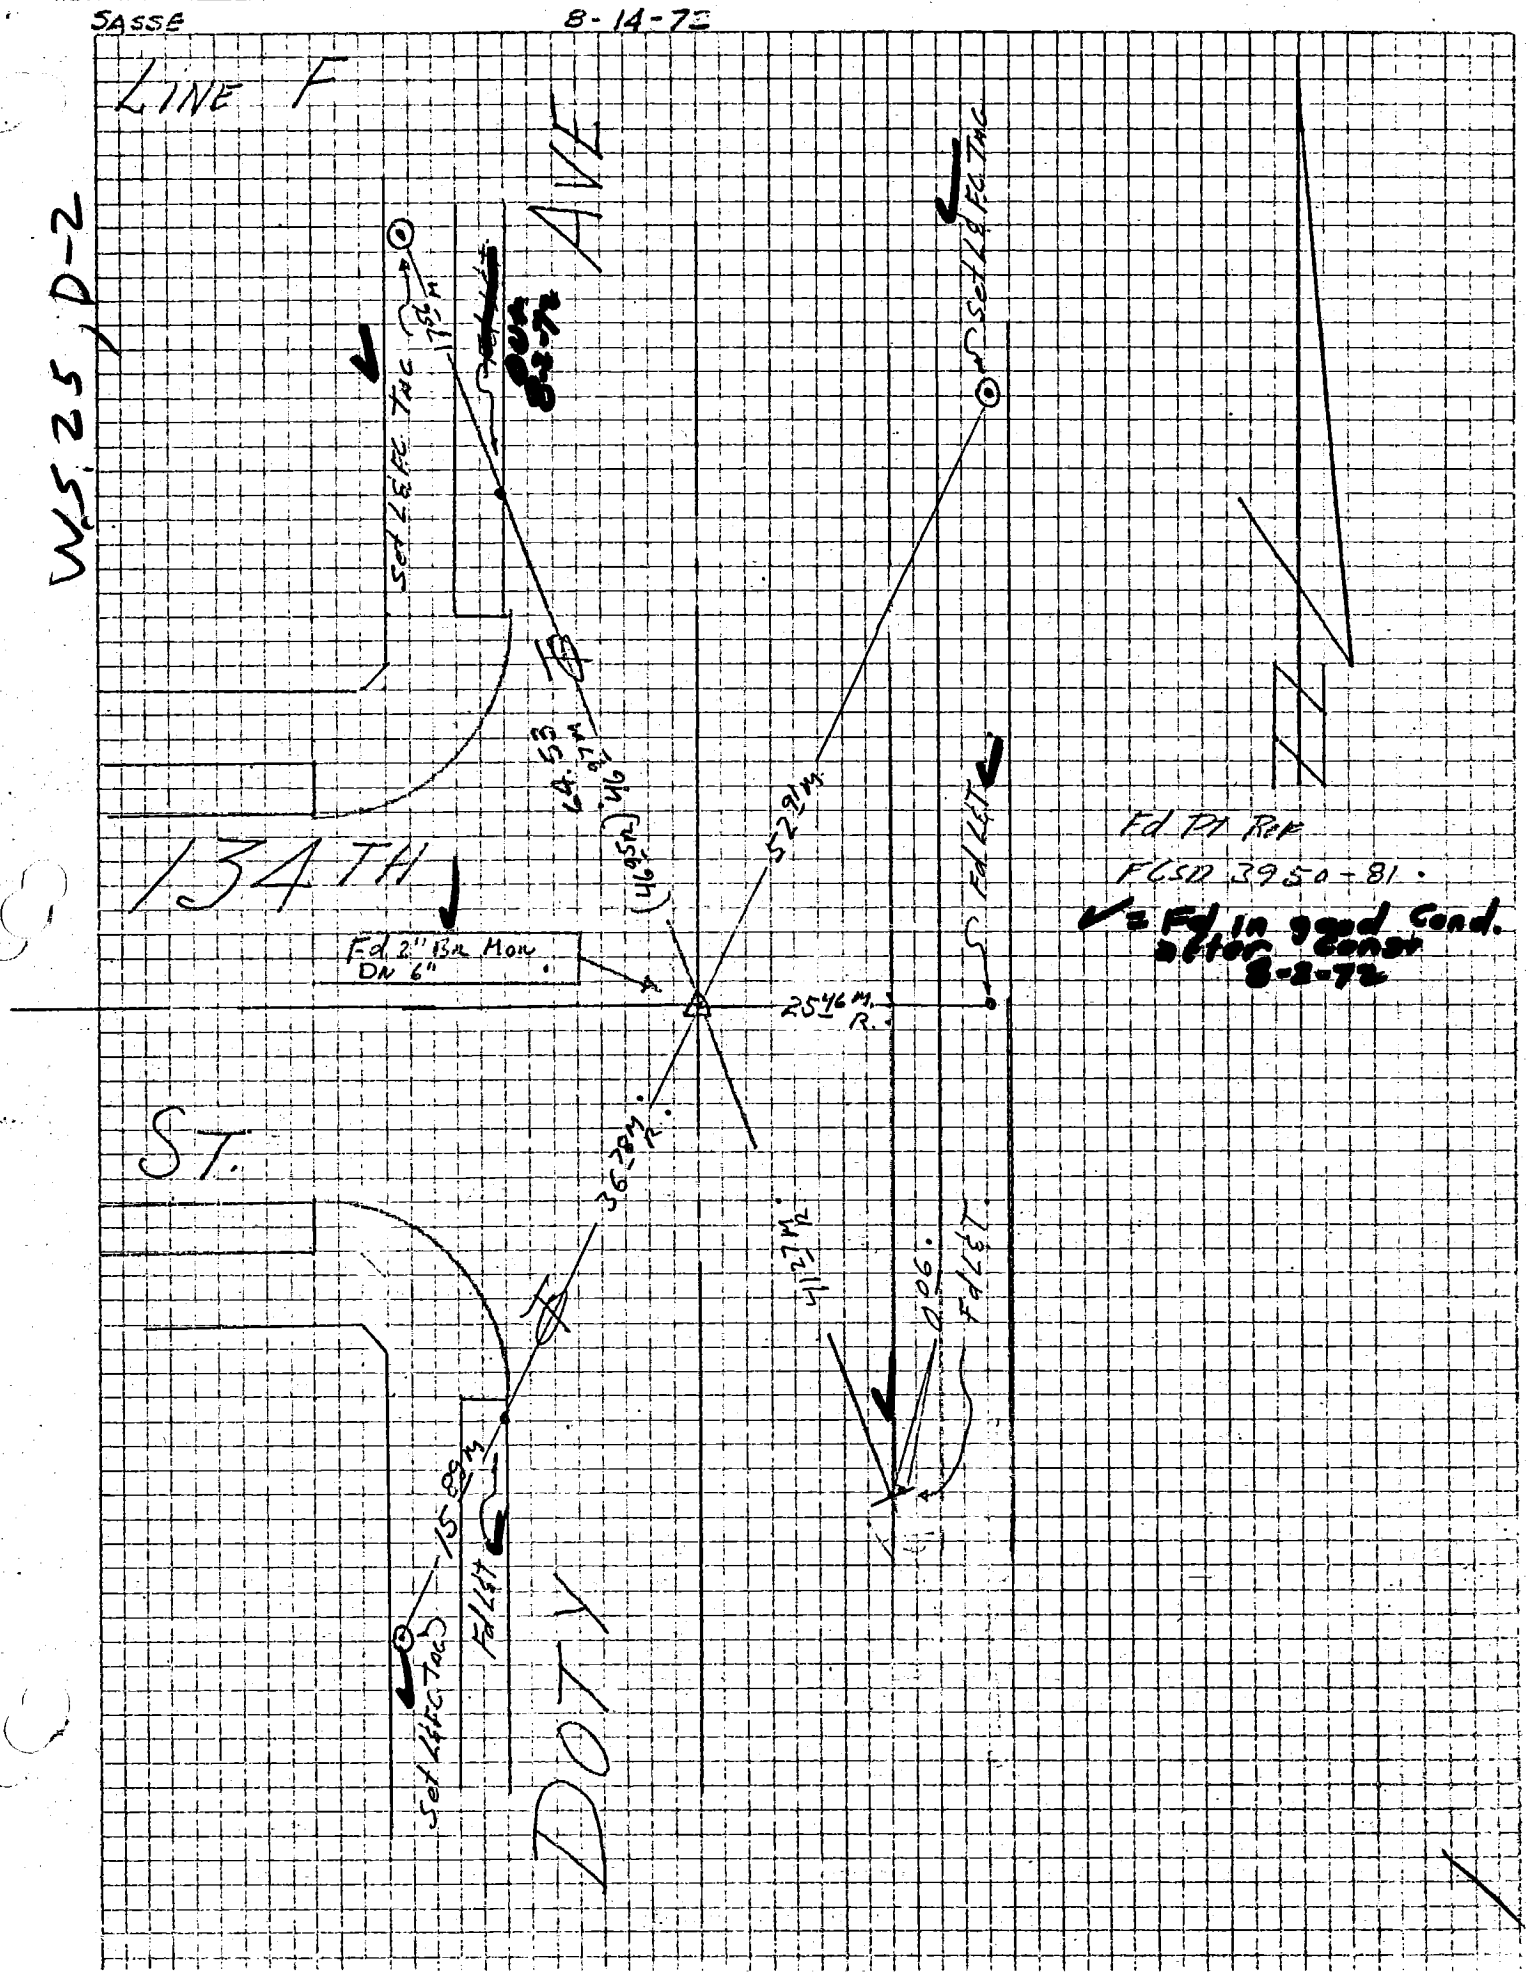
LINE F
W.S. 25, D-2
DOTY AVE
Set Lead & Tack
Fd 2" Brs Mon DN 6"
Fd Lead
Fd Tack
Fd Lead & Tack
Set Lead & Tack

PROJECT Hawthorne SD 3950 — Co. Engr. F.B. 3555: 158 — INDEX FCSD3950 119 (158)

SURVEY BY DMS — DATE 4-17-72 — PS RER-27

REVIEWED BY WM — DATE 4-19-72

LOS ANGELES COUNTY FLOOD CONTROL DISTRICT

SASSE 8-14-72

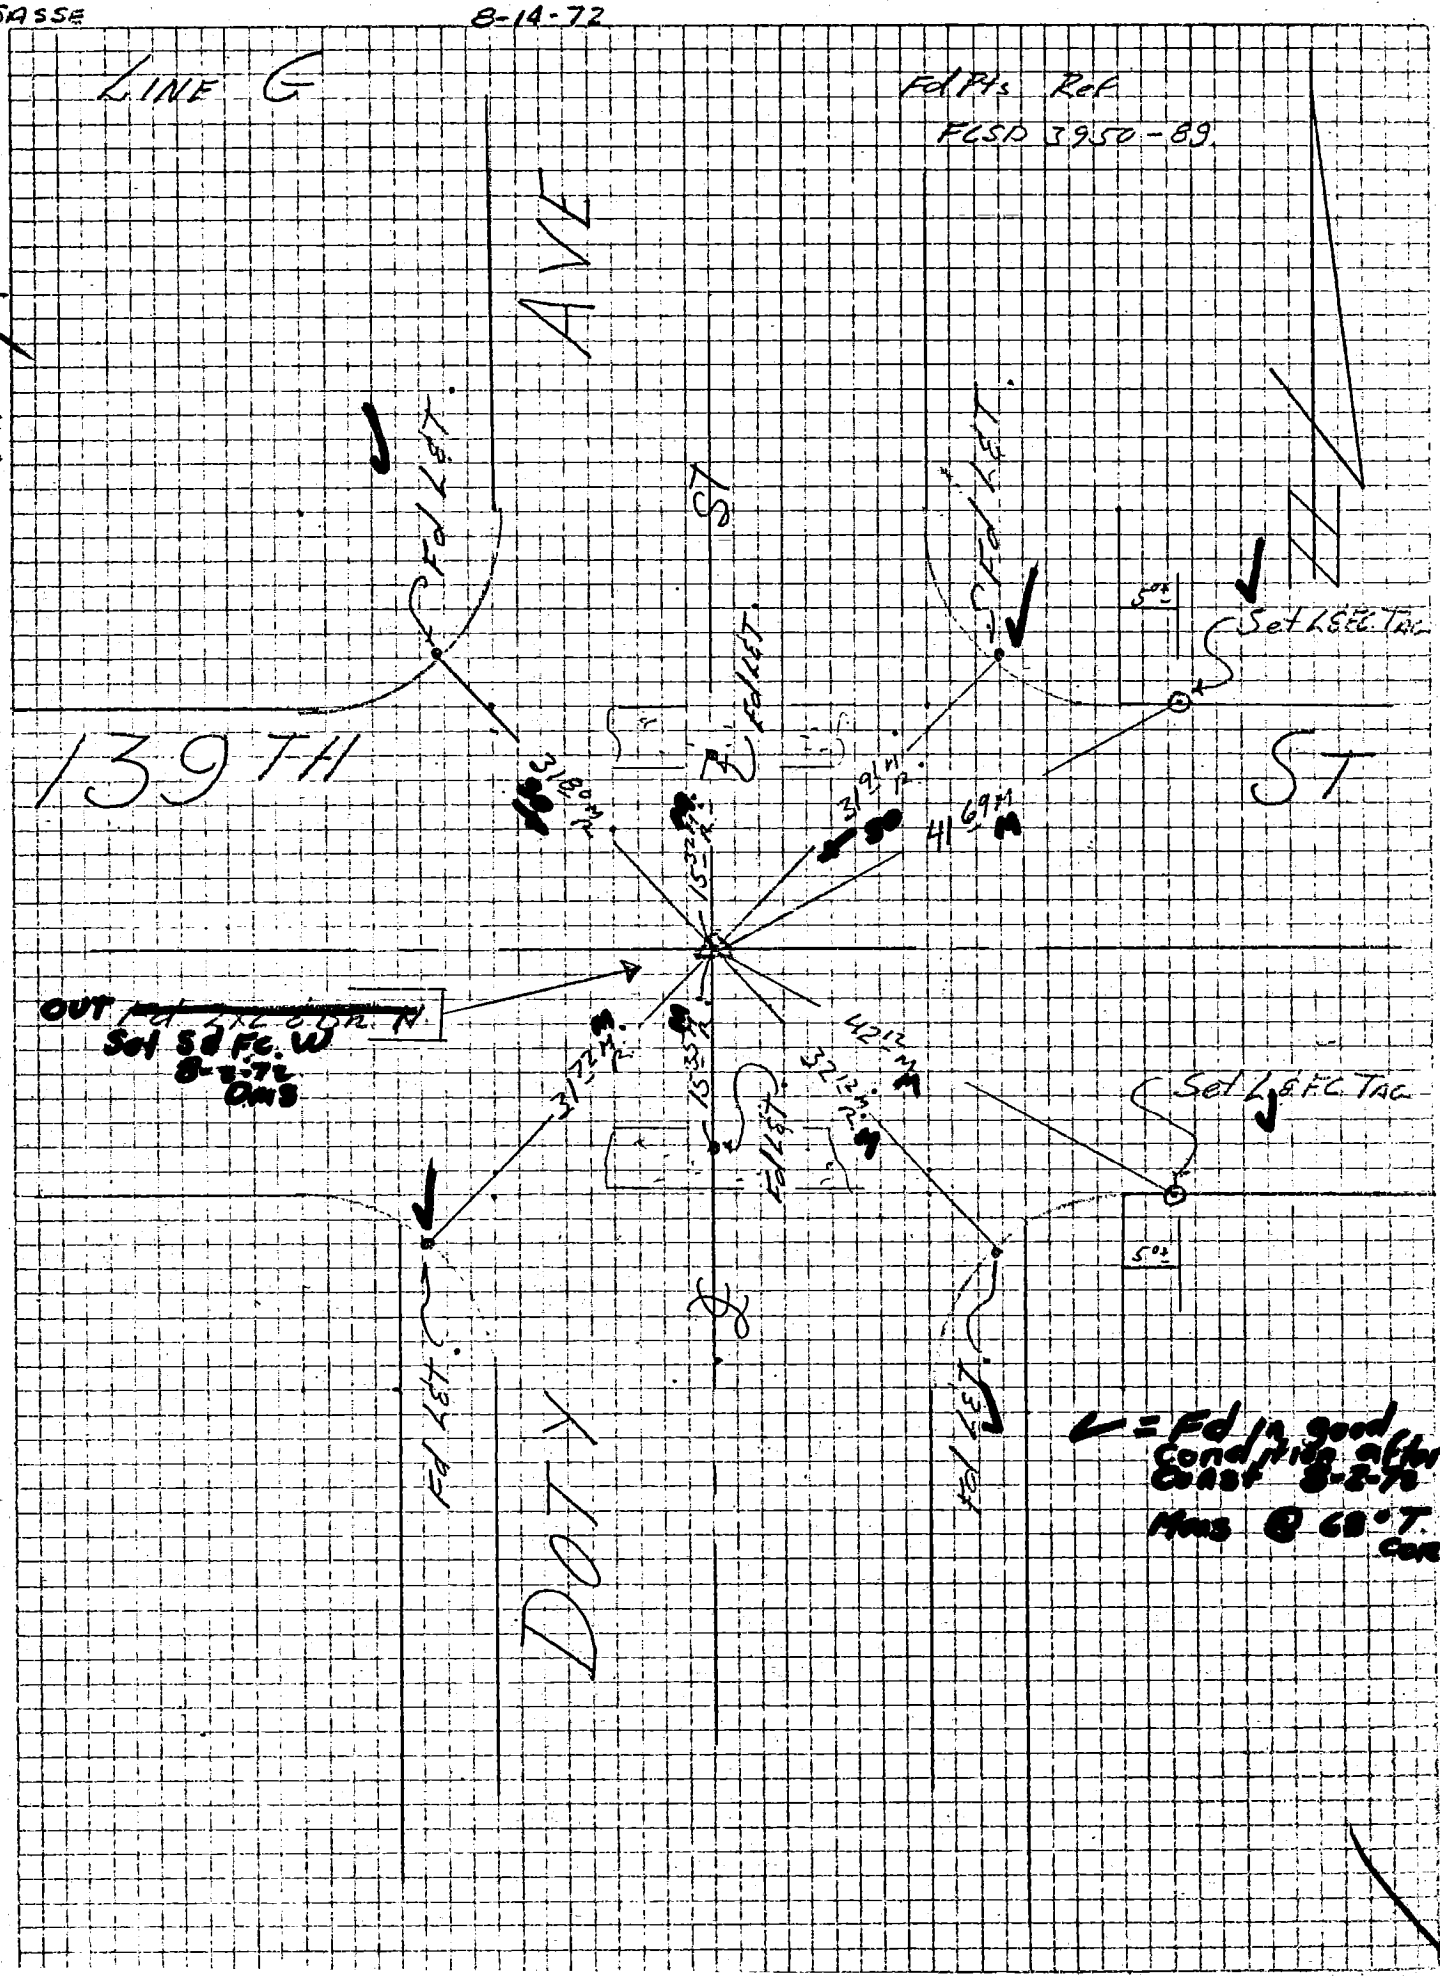
LINE G
FdPts Ref
FCSD 3950-89
W.25, D-2
139TH ST
Set L&FC Tac
Set L&FC Tac
OUT
Set Sd Fc. W
8-2-72
OMS
Fd L&FC
Fd L&FC
Fd L&FC
Fd L&FC
DOT
Fd L&FC
Fd L&FC
Fd L&FC
Fd L&FC

76S911– Cdb 3-69

PROJECT LYNWOOD I.O. 5350-2 LINE "A" Co. Engr. F.B. 3555: 159 INDEX FCSD5350 51

SURVEY BY B.P.D. DATE 3-16-72

REVIEWED BY [illegible] DATE 4-7-72

RER 3

(159)

LOS ANGELES COUNTY FLOOD CONTROL DISTRICT

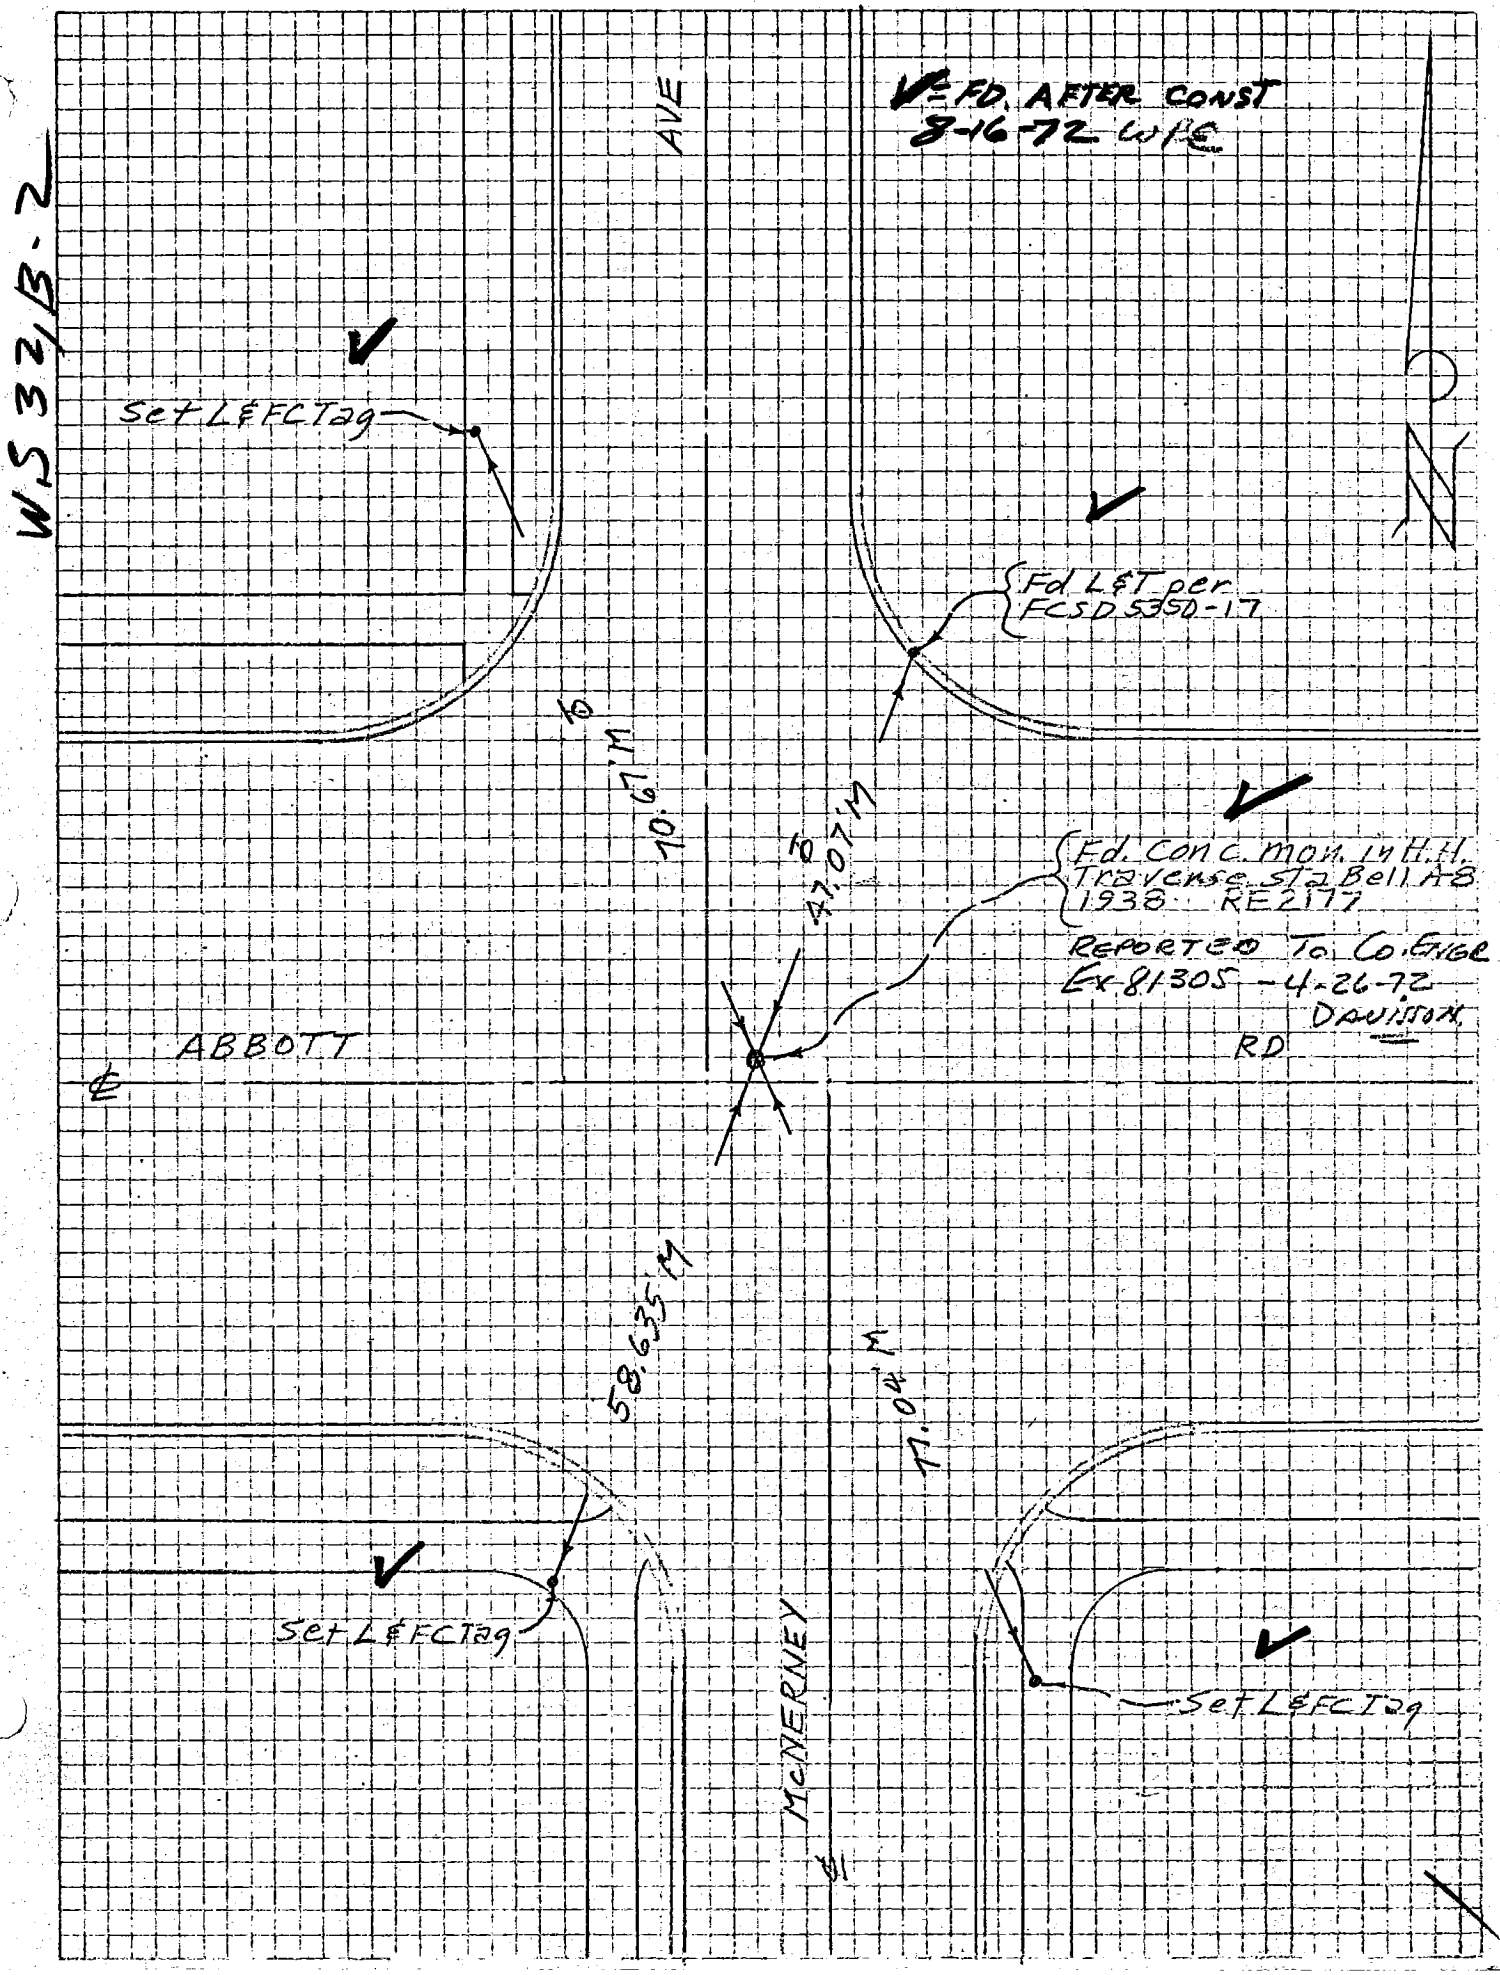

Co. Engr. F.B. 3555:160SD 688 27 (160)

W.S. 28, A-3

| | |
|---|---|
| Notes Cmd by: | Survey of: |
| Map No. | JN: Tape: Std: °F |
| Office Work | Surveyed by: |
| Checked | Notes: Date: |
| Date | Indexed: F.B. 3555 |

F. B. 2588 PG. 25

V=Fd in good cond. after const. 4-14-71 BRB

From BOTT PG 20

NOTE: SEE FCSD 1104-207 FOR ST. TIES. AFTER CONSTR.

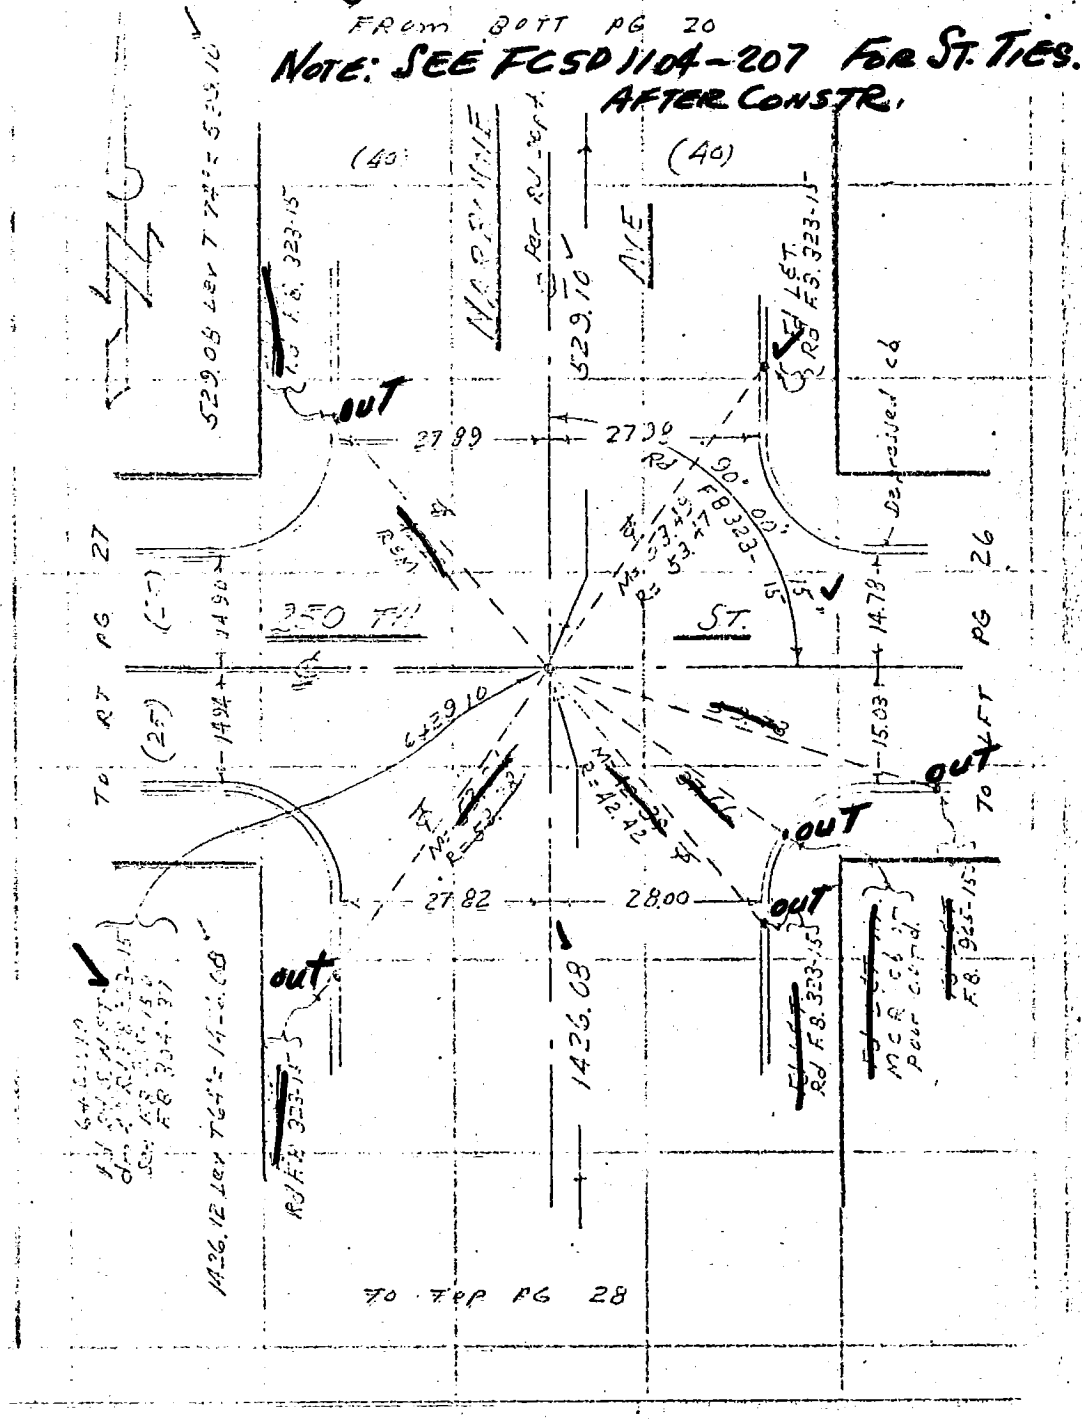
(40)
(40)
AVE
ST.
OUT
OUT
OUT
OUT
27.99
27.99
27.82
28.00
14.90
14.78
14.94
15.03
1426.08
1426.12
529.05
529.10
90° 00'
R=53.47
R=42.42
To Rt PG 27
To Lft PG 26
To Rt
To Lft
To Rep PG 28
R/W 323-15
R/W 323-15
R/W 323-15
R/W 323-15
Rel R/W
Rel R/W
Rel R/W

Co. Engr. F.B. 3555; 161

FCSD 1104-83

F.B. 3321 PG. 138

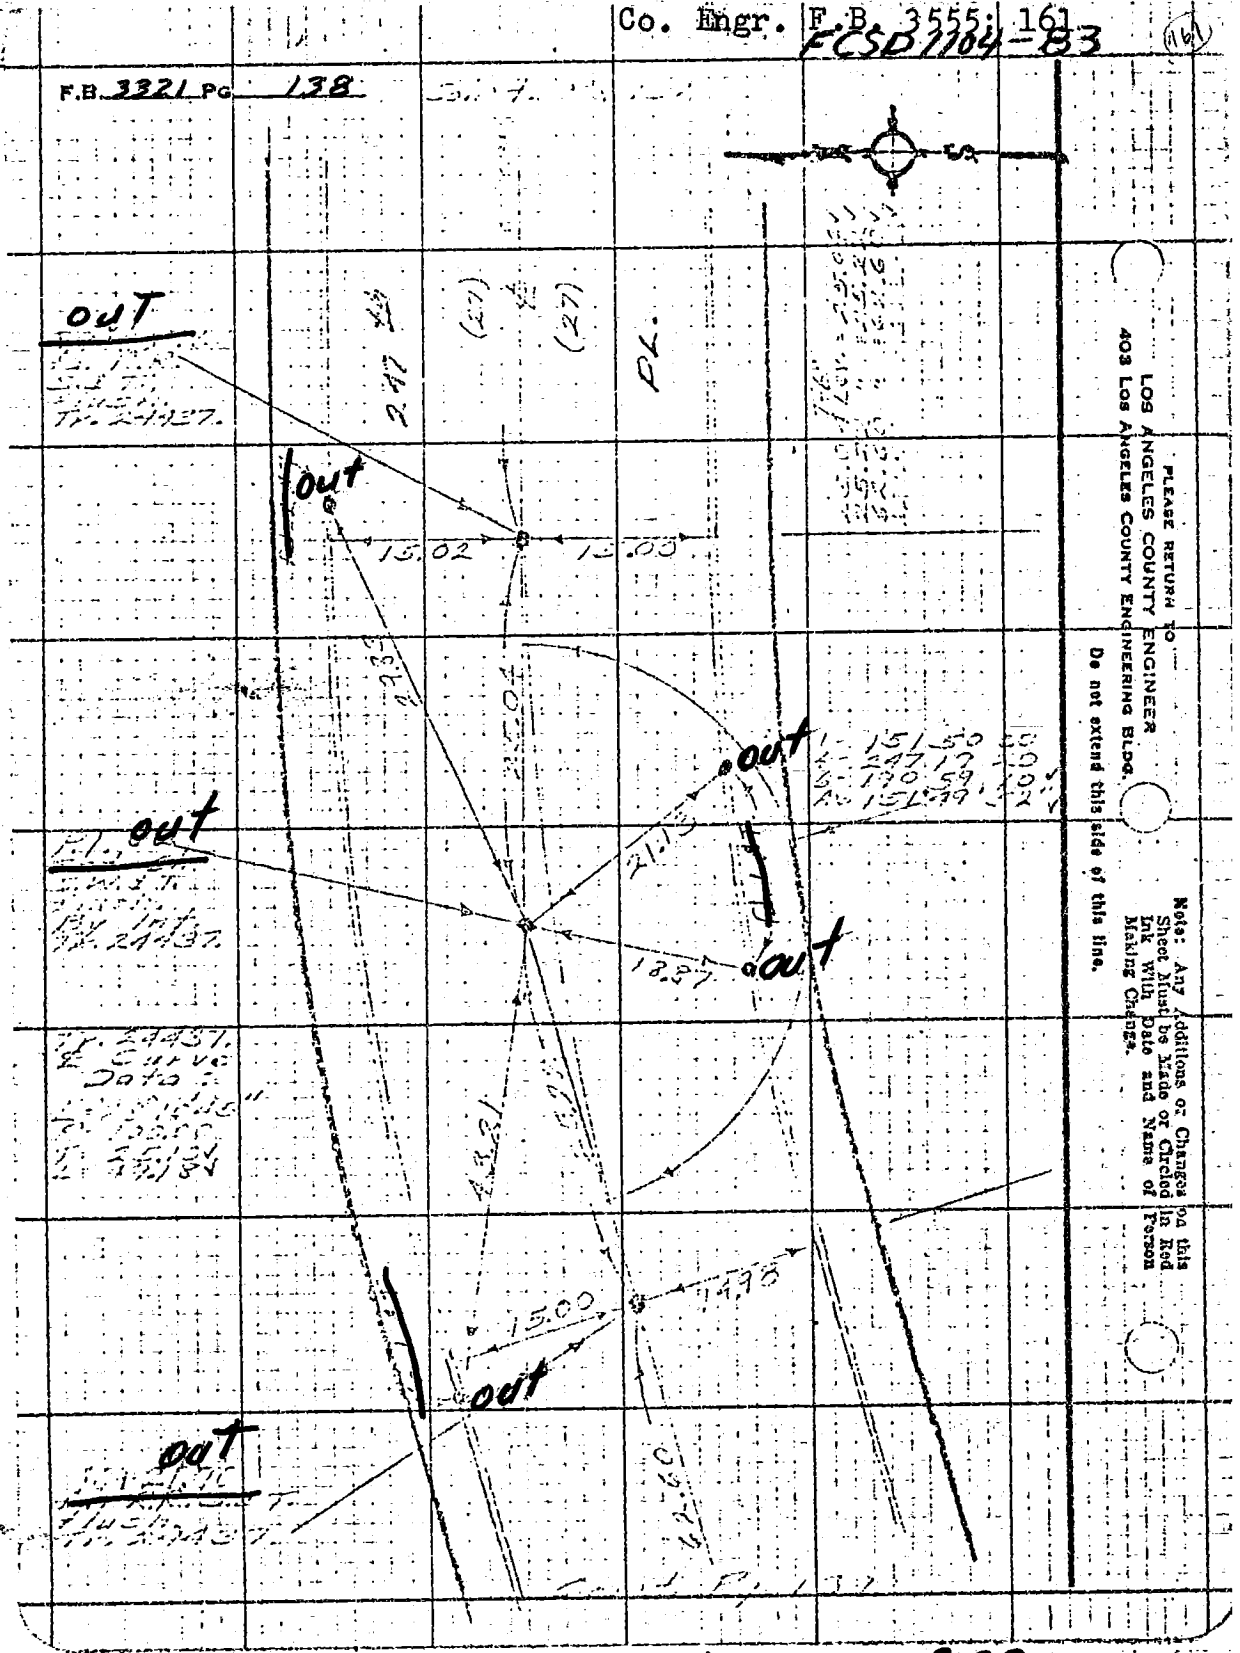


LOS ANGELES COUNTY ENGINEER
403 Los Angeles County Engineering Bldg.

PLEASE RETURN TO

Do not extend this side of this line.

Note: Any Additions or Changes on this Sheet Must be Made or Circled in Red Ink With Date and Name of Person Making Change.

V = Fd in good Cond. 4-28-71 - BPB

For Pt's Set See FCSD 1104-197

Co. Engr. F.B. 3555: 162

FCSD 1104-83A

(162)

F.B. 3321 Pg. 139

Notes Ck'd by _____
Map No. _____
Office Work _____
Checked _____
Date _____

Survey of _____
JN _____ Tape _____ Std. _____ °F
Surveyed by _____
Notes _____ Date _____
Indexed _____

Note: Any Additions or Changes on this Sheet Must be Made or Circled in Red Ink With Date and Name of Person Making Change.

Do not extend this side of this line.

PLEASE RETURN TO
LOS ANGELES COUNTY ENGINEER
403 Los Angeles County Engineering Bldg.

out

out

out

Co. Engr. F.B. 3555: FCSD 1104-85

163

F.B 3321 Pg. 141

Notes Ck'd by T. Cantrio
Map No.
Office Work
Checked
Date

Survey of
JN Tape Std °F
Surveyed by
Notes Date
Indexed B.T. CALL

Note: Any Additions or Changes on this Sheet Must be Made or Circled in Red Ink With Date and Name of Person Making Change.

Do not extend this side of this line.

PLEASE RETURN TO
LOS ANGELES COUNTY ENGINEER
403 Los Angeles County Engineering Bldg.

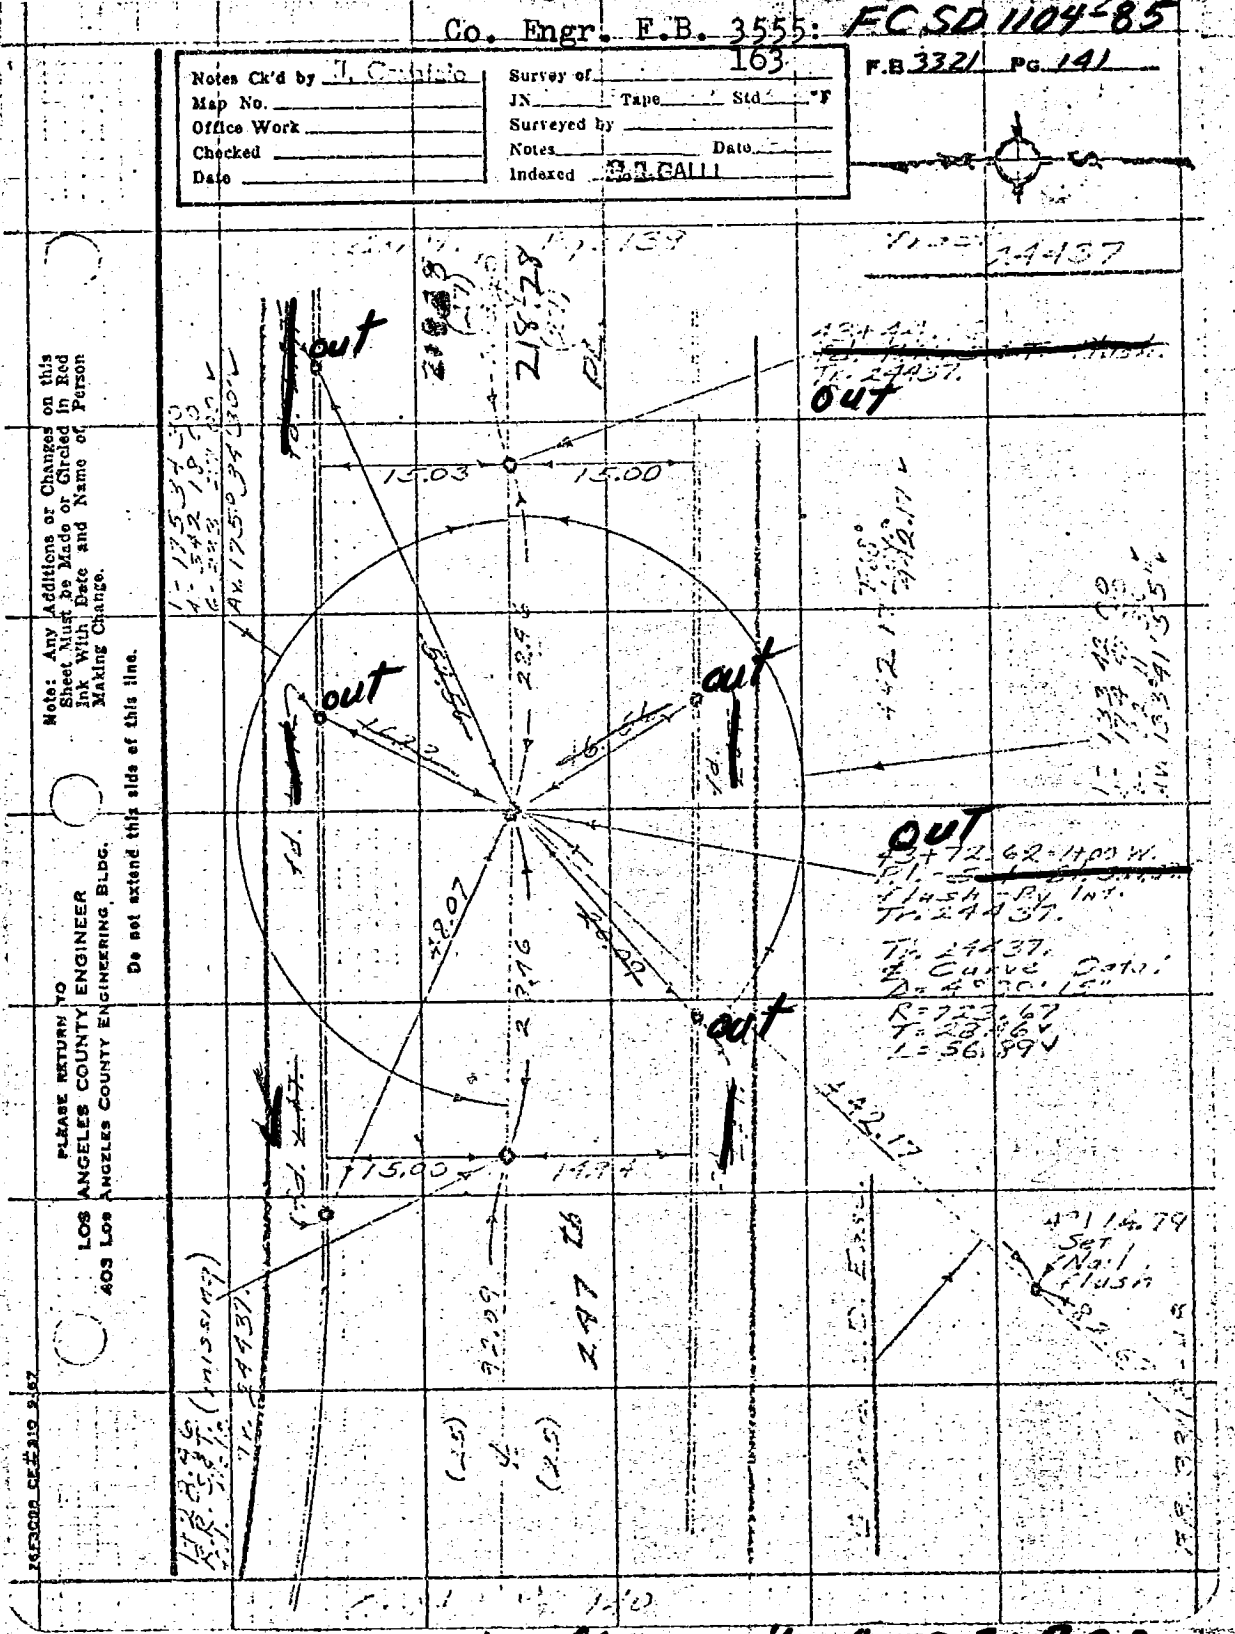

W.S. 2843

Co. Engr. F.B. 3555: 164

FCSD 1104-85A

F.B. 3241 Pg. 140

Cont. 19-41

(164)

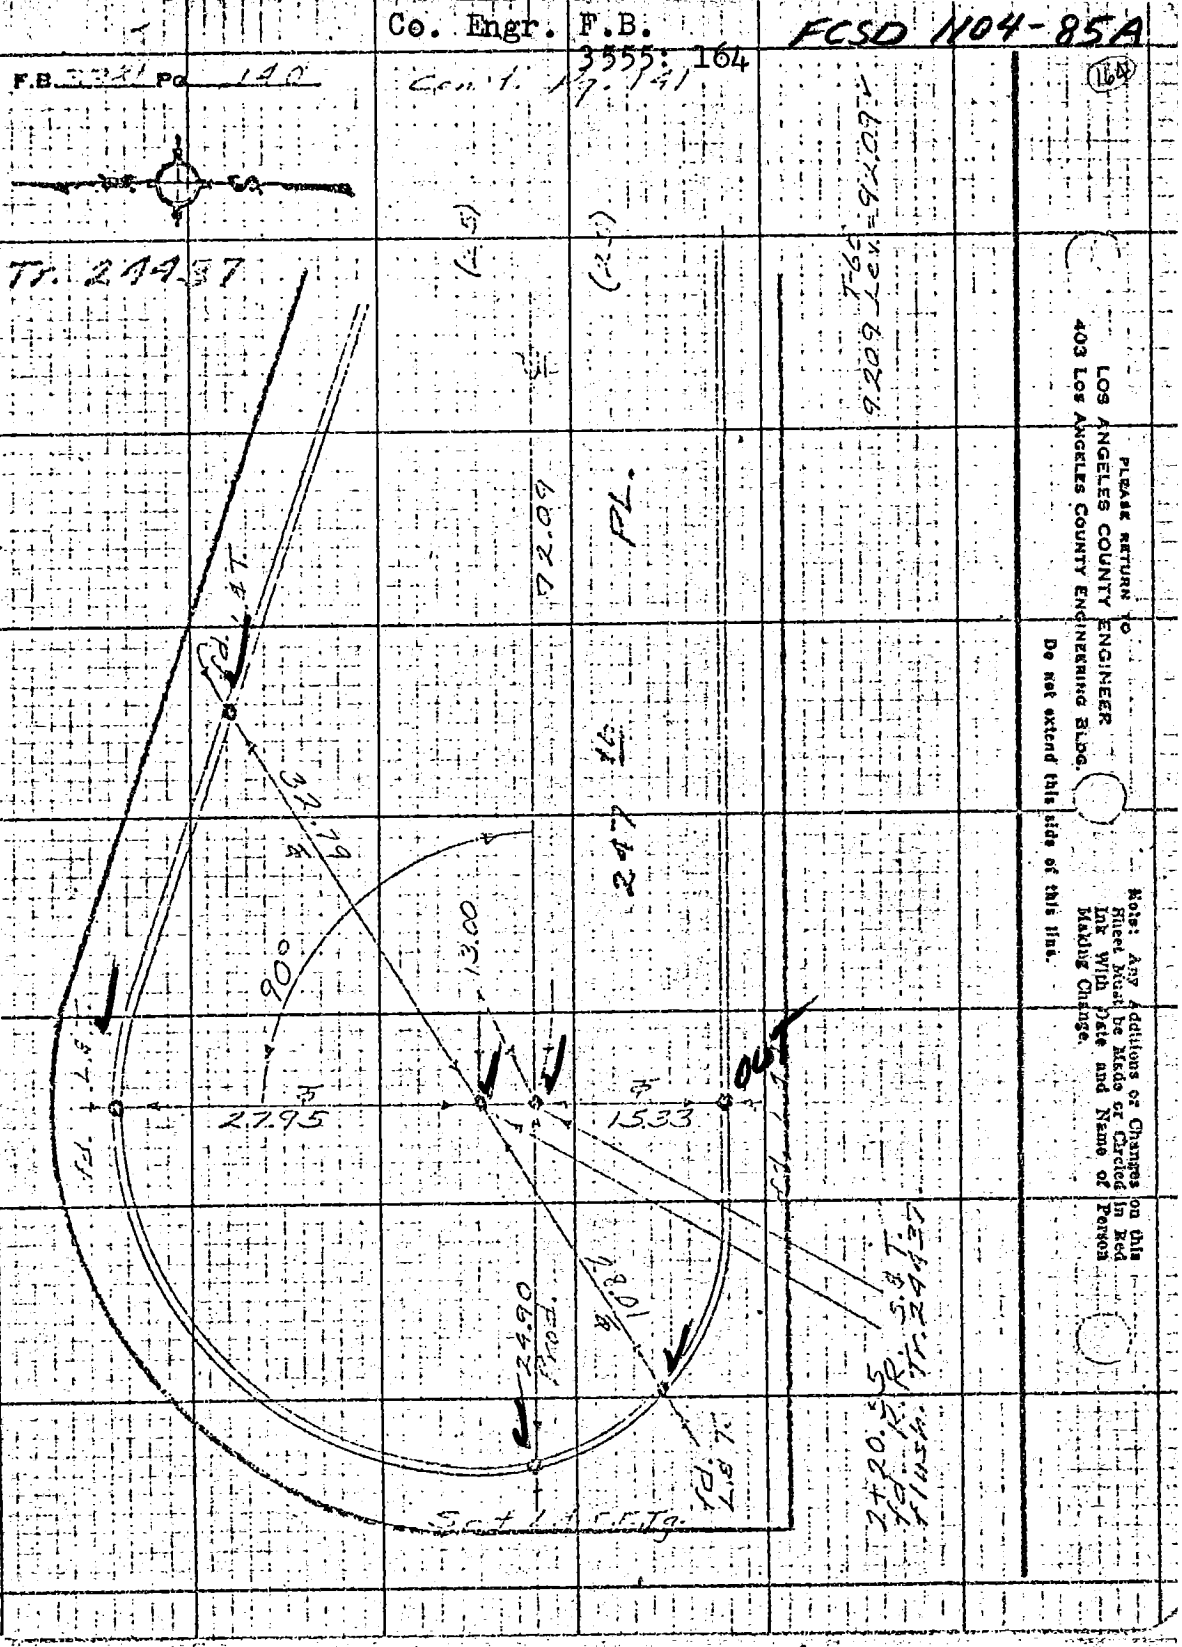


PLEASE RETURN TO
LOS ANGELES COUNTY ENGINEER
403 Los Angeles County Engineering Bldg.

Do not extend this side of this line.

Note: Any Additions or Changes on this Sheet must be Made or Circled in Red Ink With Date and Name of Person Making Change.

V=Fd in good cond. after const 4-28-71 B.P.B.

FOR TIES SET SEE FCSD 1104-199

FCSD1104 87
Co. Engr. F.B. 3555: 165

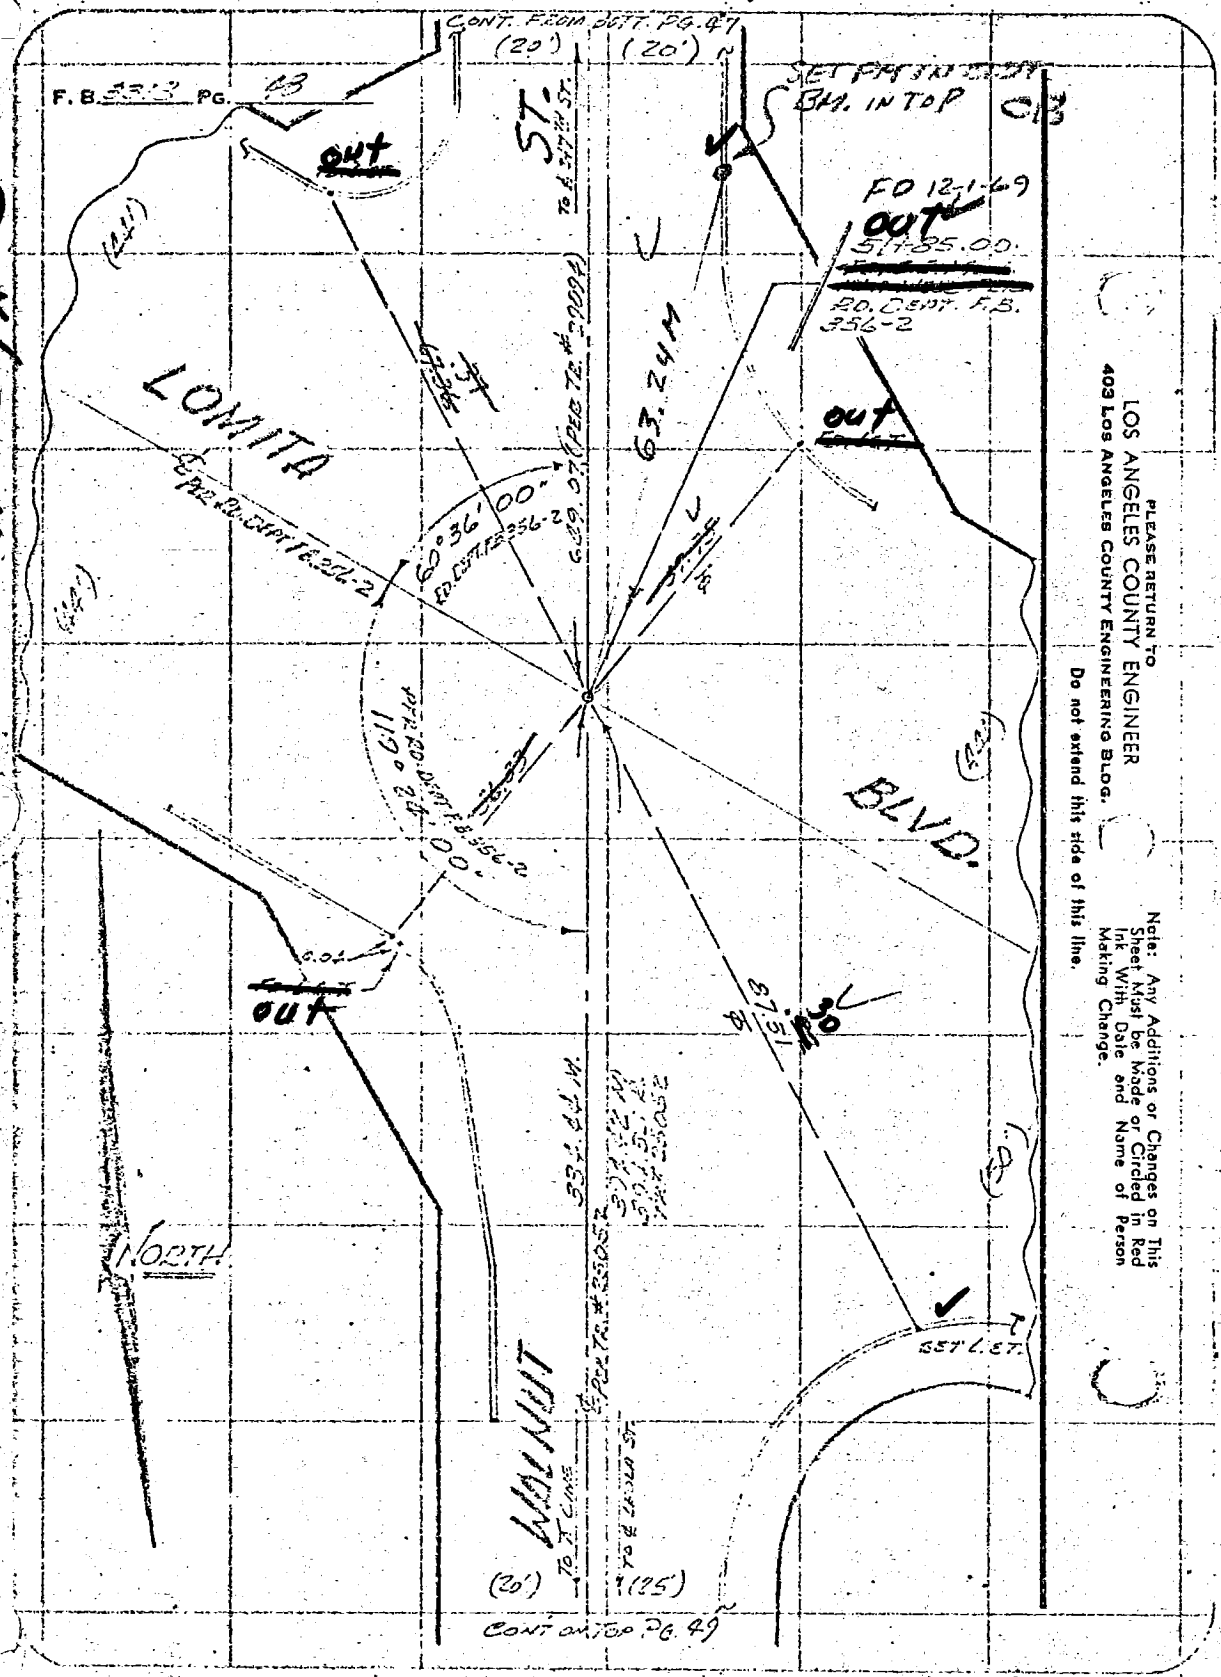


W 2814-3

✓ = FD IN GOOD CONDT 12-1-69

For PT's Set See FCSD1104-185

V = 2-19-70

V = Fd in good condt after const 4-28-71 - B.P.B.

22

V=Fd in good cond. after const 4-30-71 B.P.B.
For Pt's Set See FCSD 1104-201

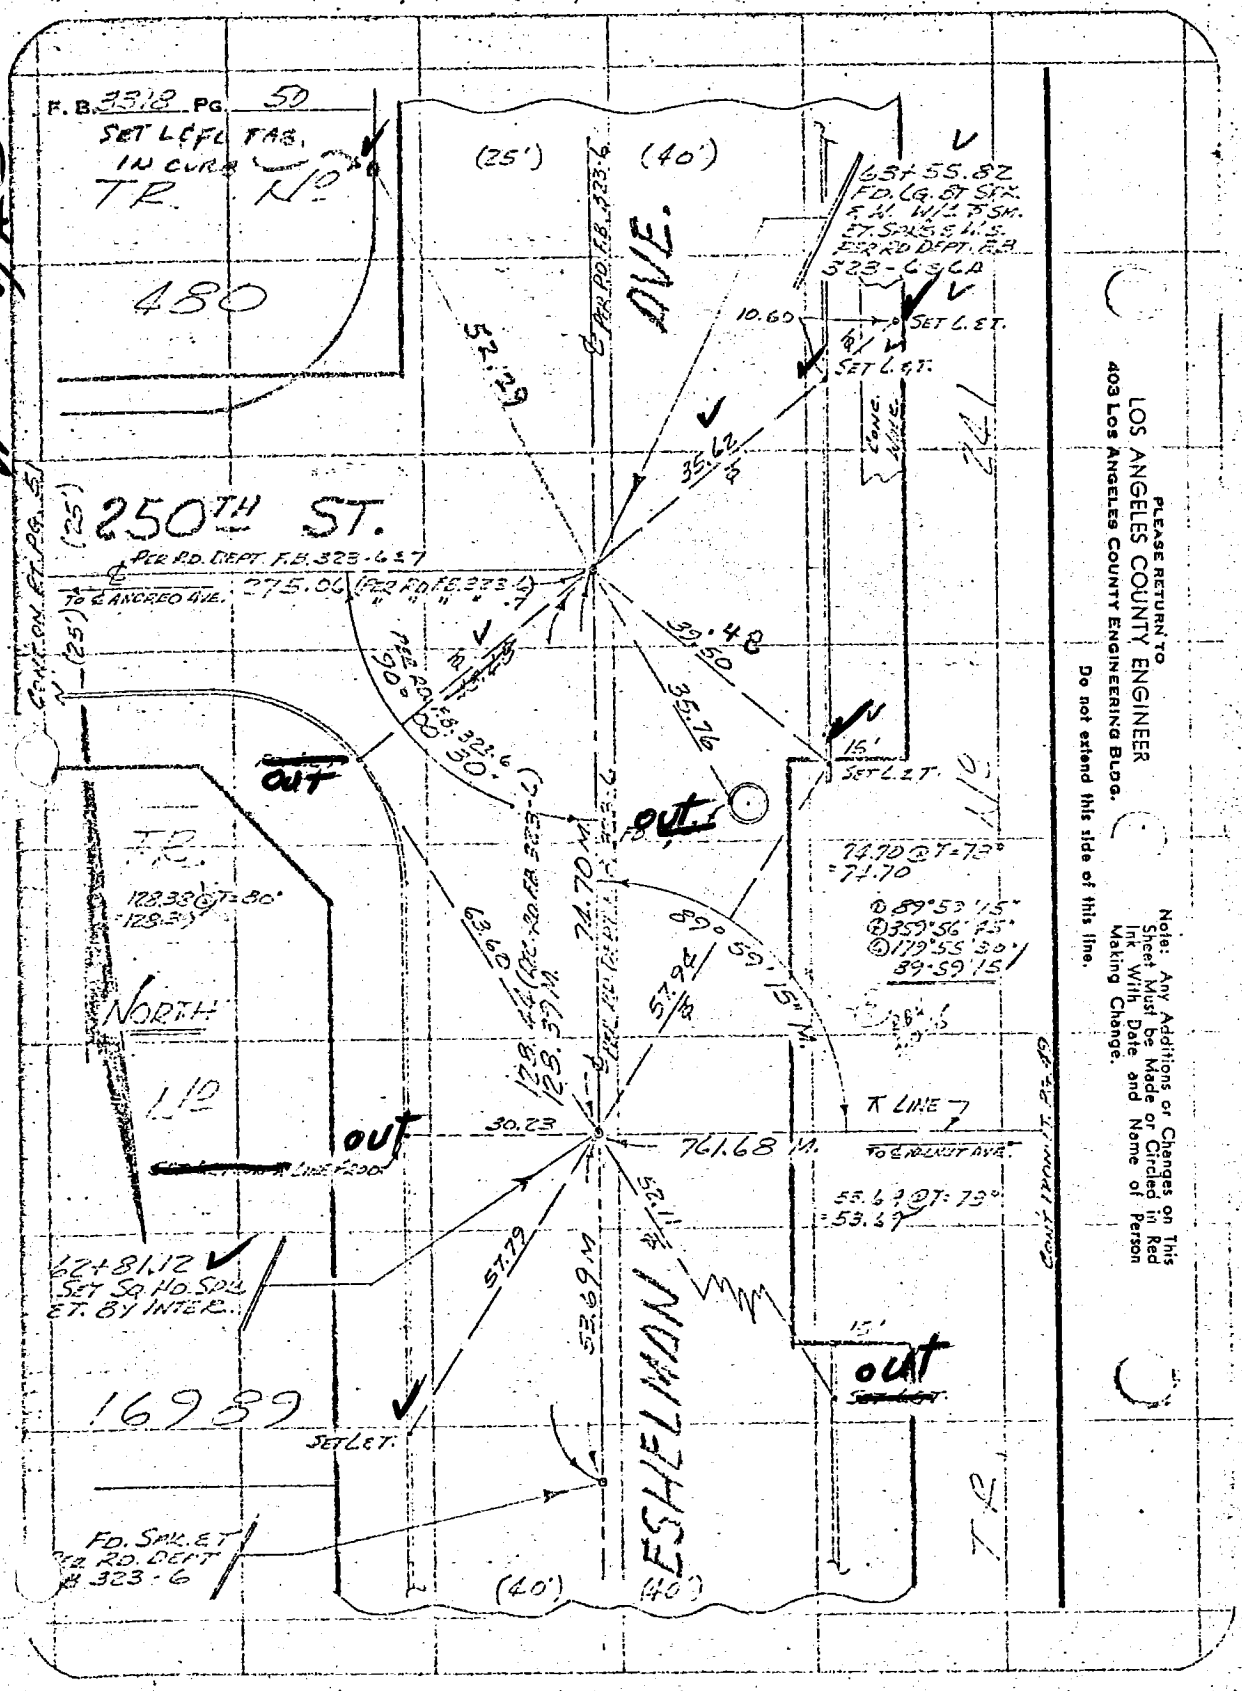


W5 28,43

V=FD IN GOOD CONDT
2-19-70

2-6

Co. Engr. F.B. 3555: 167
FCSD1104 93

WS 284-3

Notes Ck'd by M. ASHLEY
Map No.
Office Work
Checked
Date

Survey of Cond. Tax Sale Prop. Fund
JN 6111.04 Tape 0258 Std 68 °F
Surveyed by R. S. Hasan
Notes E. B. Date
Indexed

F. B. 3313 PG. 51

Note: Any Additions or Changes on this Sheet Must be Made or Circled in Red Ink With Date and Name of Person Making Change.

Do not extend this side of this line.

PLEASE RETURN TO
LOS ANGELES COUNTY ENGINEER
403 Los Angeles County Engineering Bldg.

7 OF 3095 CE/F 310.1-65

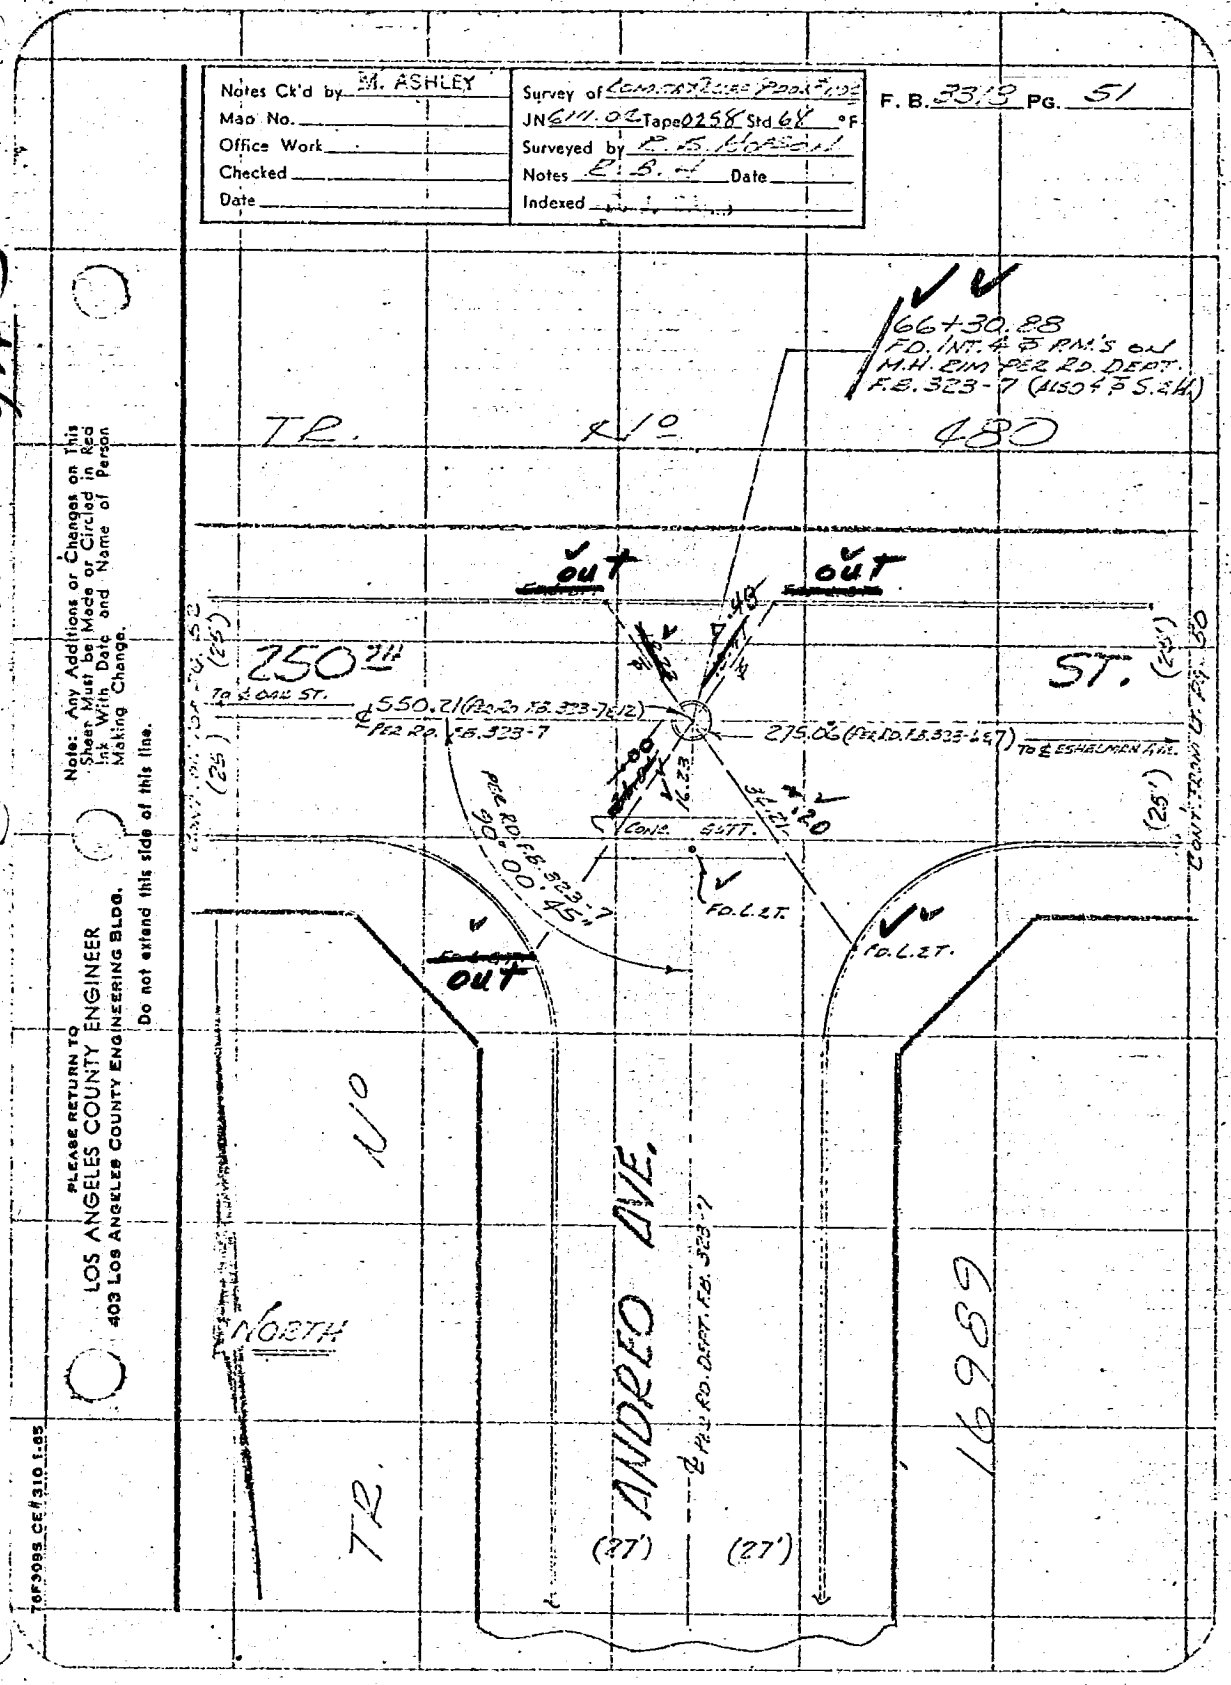
66+30.88
F.D. INT. 4 B.M.'S ON
M.H. RIM PER RD. DEPT.
F.B. 323-7 (ALSO 4 B.S. 2 H)
TR.
480
OUT
OUT
250.24
To ℄ Oak St.
℄ 550.21 (Rad. to R.B. 323-7 & 12)
Per Rd. R.B. 323-7
275.06 (Per Rd. R.B. 323-7 & 7)
To ℄ Eshelman Ave.
ST.
(25')
(25')
(25')

Co. Engr. F.B. 3555: 168
FCSD1104 95

V = FD. IN GOOD CONDT. AFTER CONSTR.
2-19-70
FOR PT'S SET SEE FCSD1104-203

W.S. 28, A 3

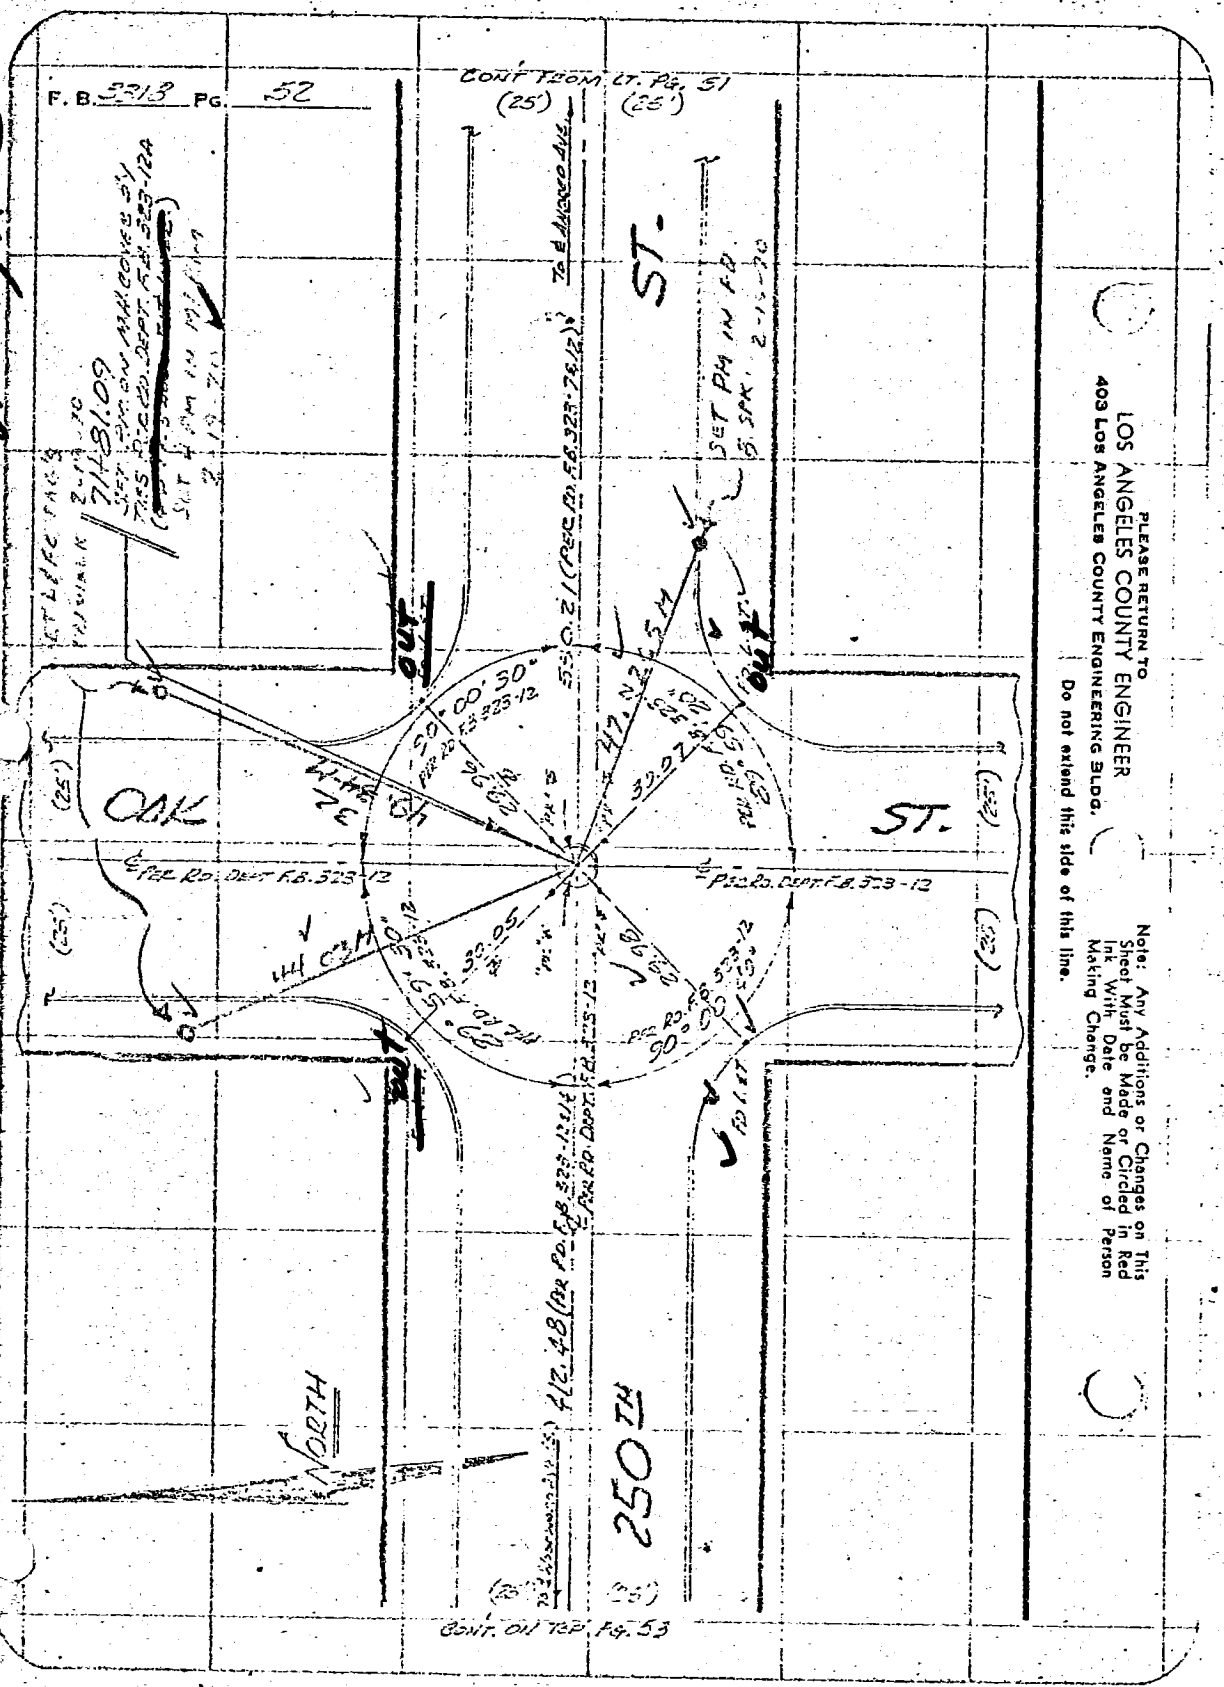


26

Co. Engr. F.B. 3555: 169
FCSD1104 97

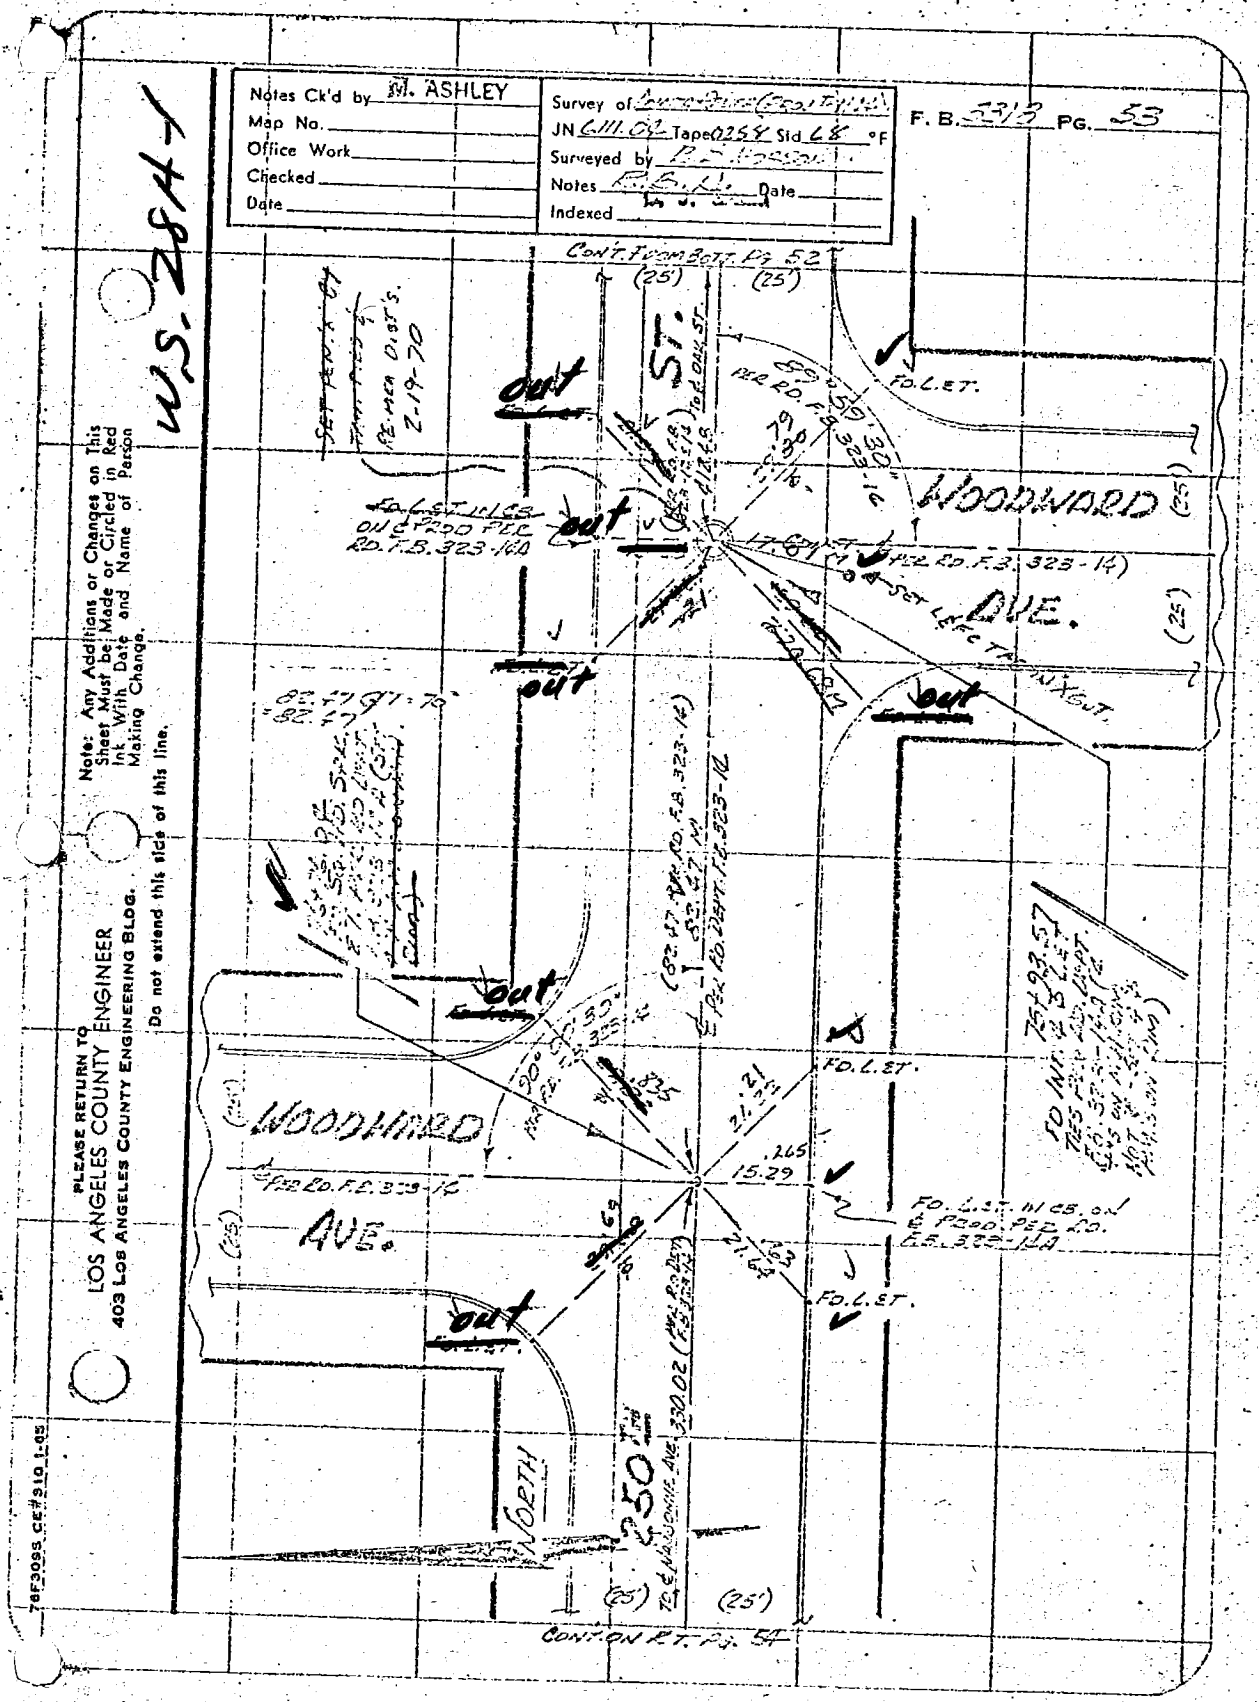


V=FD IN GOOD COND.
2-19-70

V=fd in good cond. after const 4-30-71 BPB

For Pts Set See FCSD 1104-205

Co. Engr. F.B. 3555: 170

FCSD1104 99

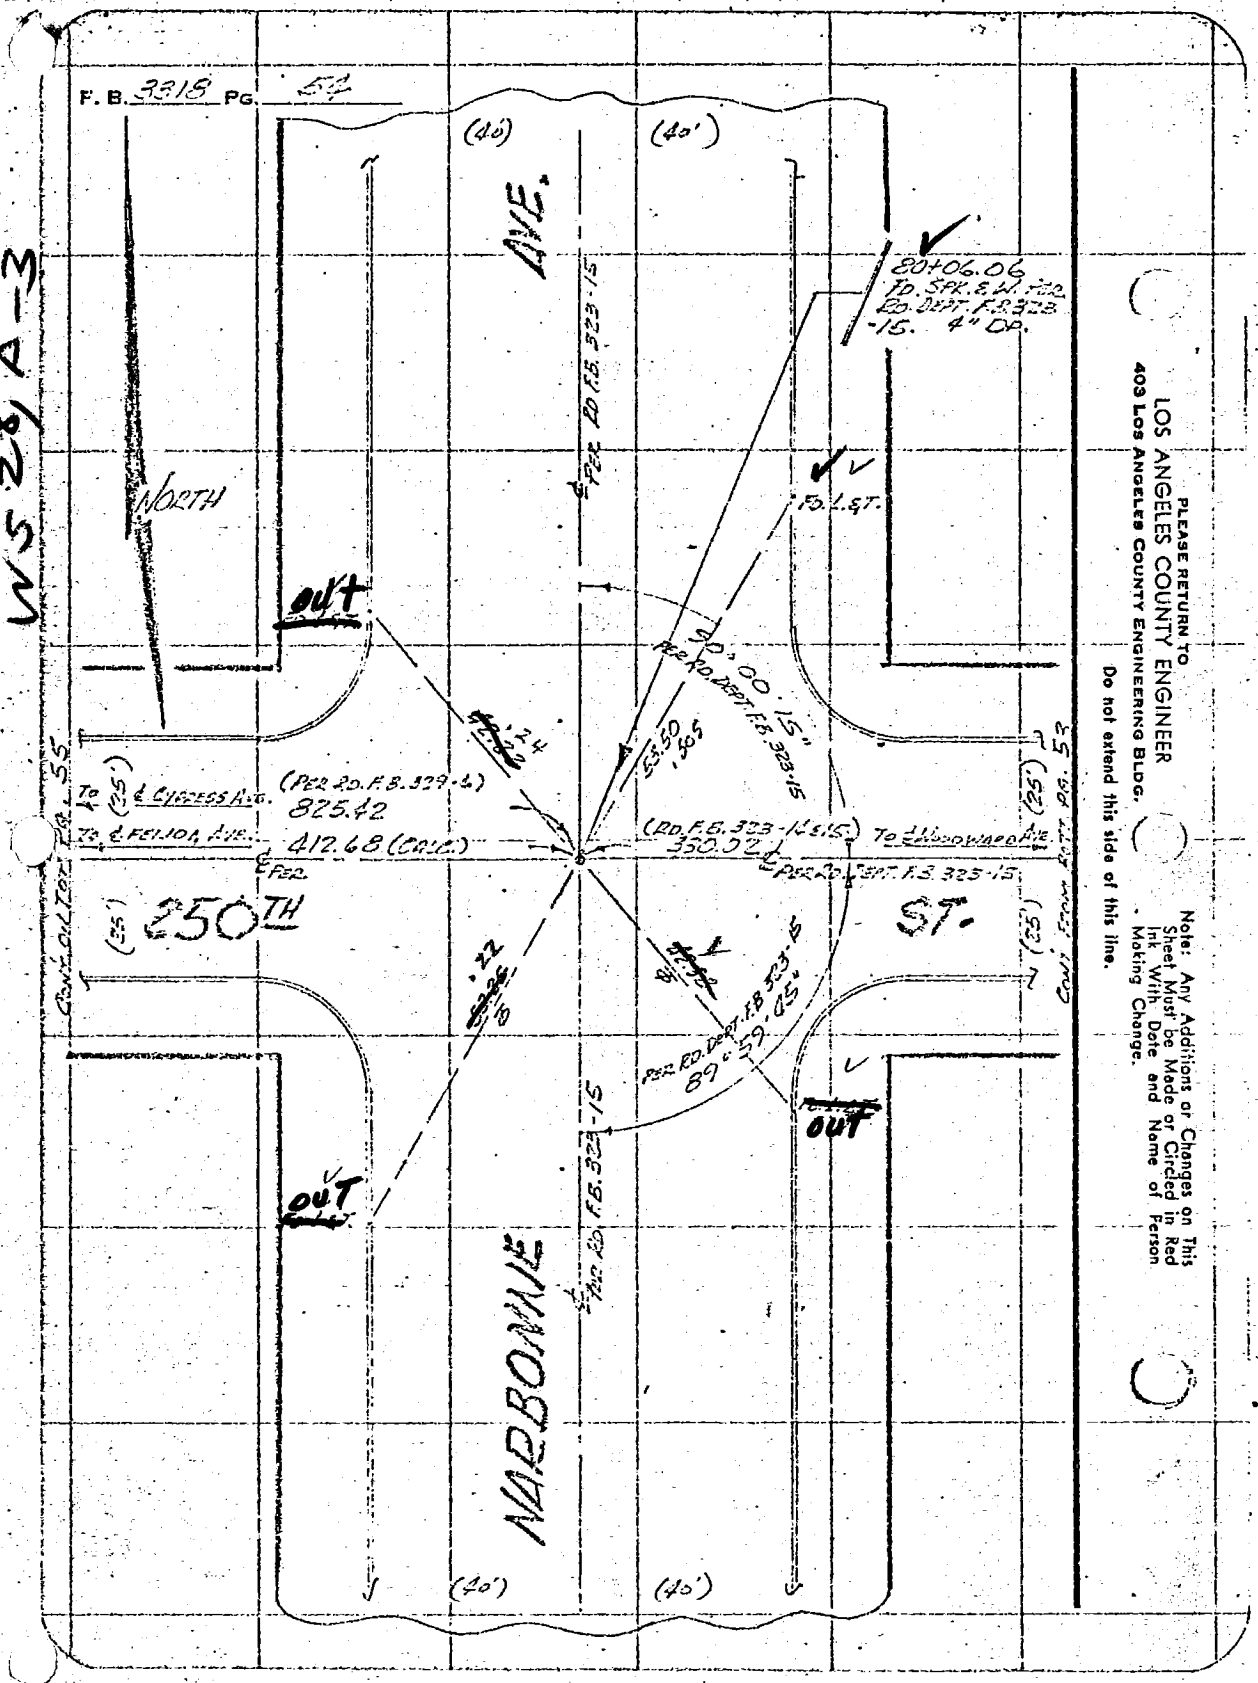


W 5 28 A-3

V = FD. IN GOOD COND'T.
3-19-70

V = Fd in good cond after const 4-14-71 B.F.B.
FOR TIES SET SEE FCSD 1104-207

28

Co. Engr. F.B. 3555: 171
FCSD1104 101

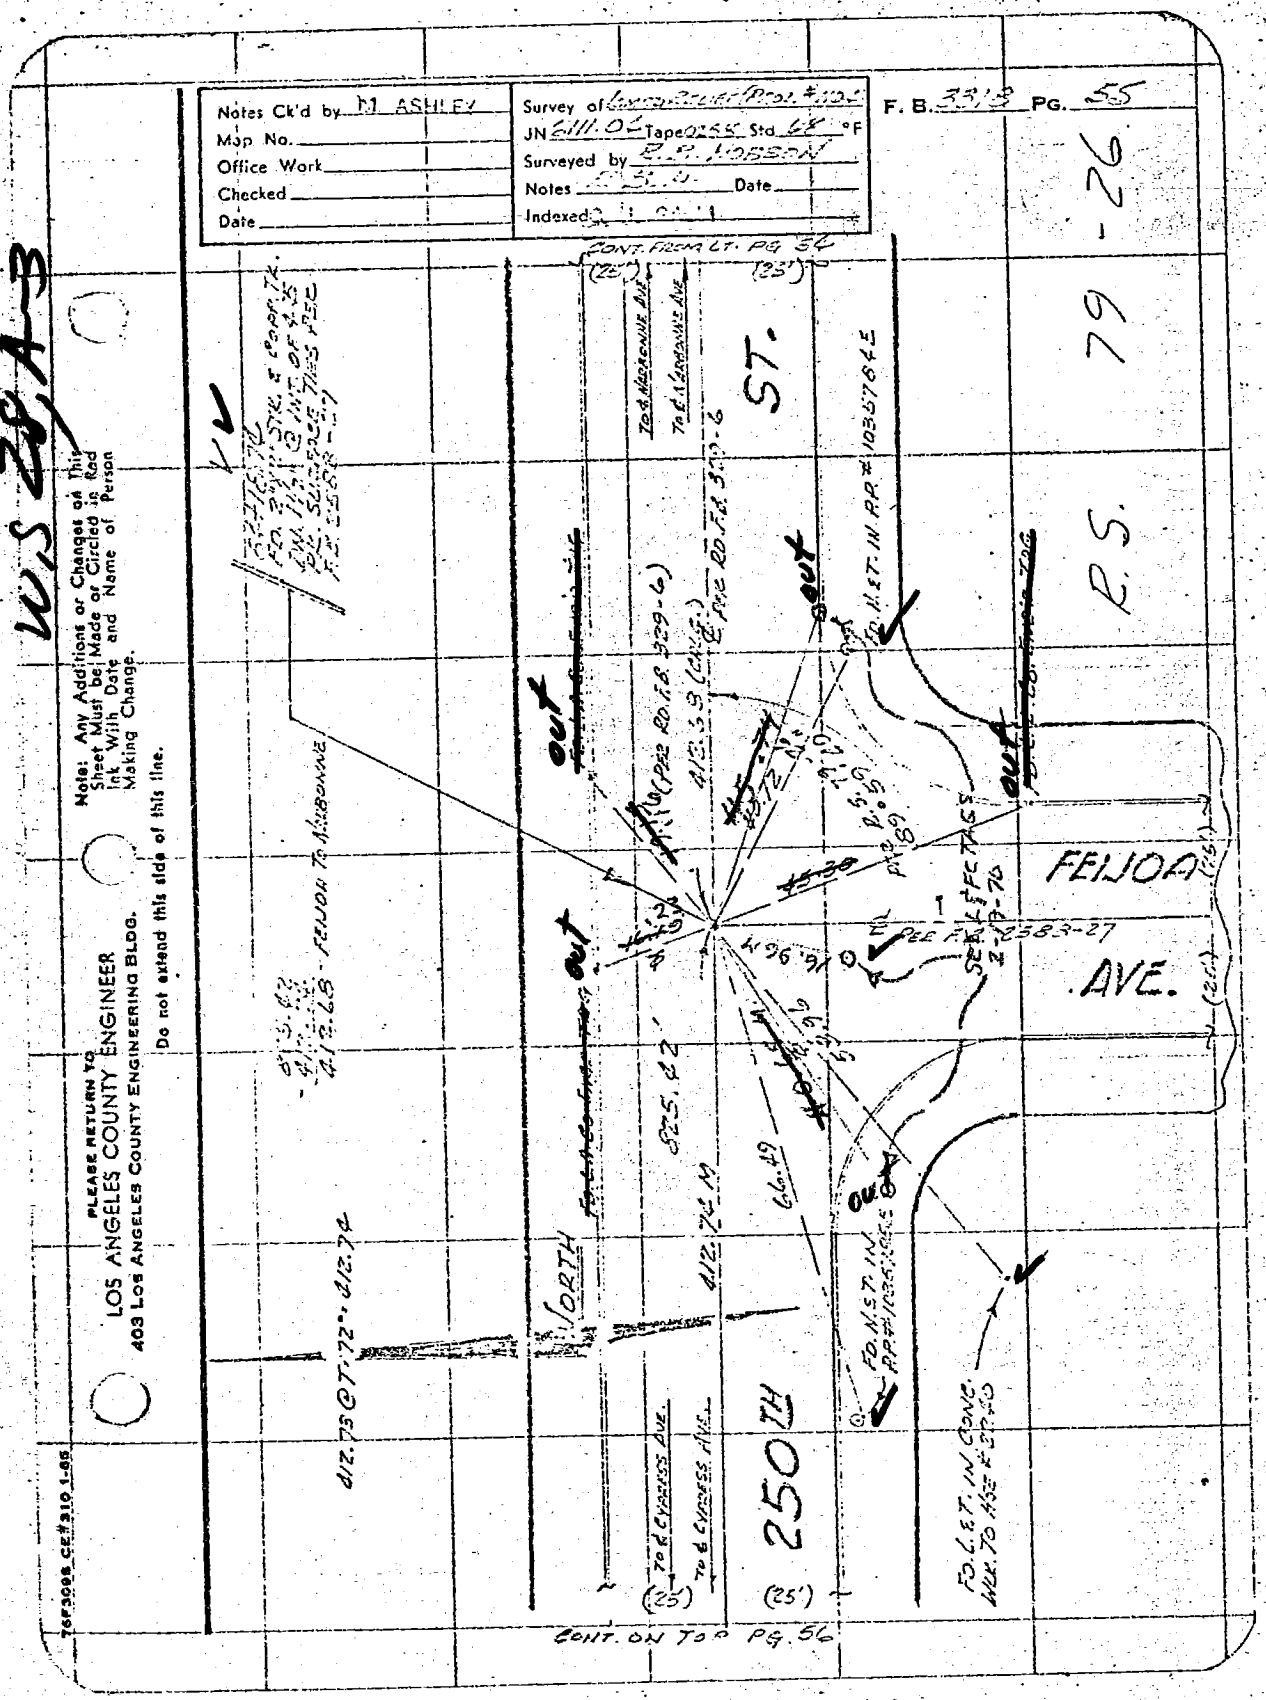


V = FD IN GOOD COND BEFORE CONST.
2-19-70

V = Fd in good cond after const - 4-14-71 BPB.

For Pt's Set See FCSD 1104-209

29

Co. Engr. F.B. 3555: 172
FCSD1104 103

For Pt's Set See FCSD 1104-209

V=Fd in good cond. after const. 4-14-71 B.B.

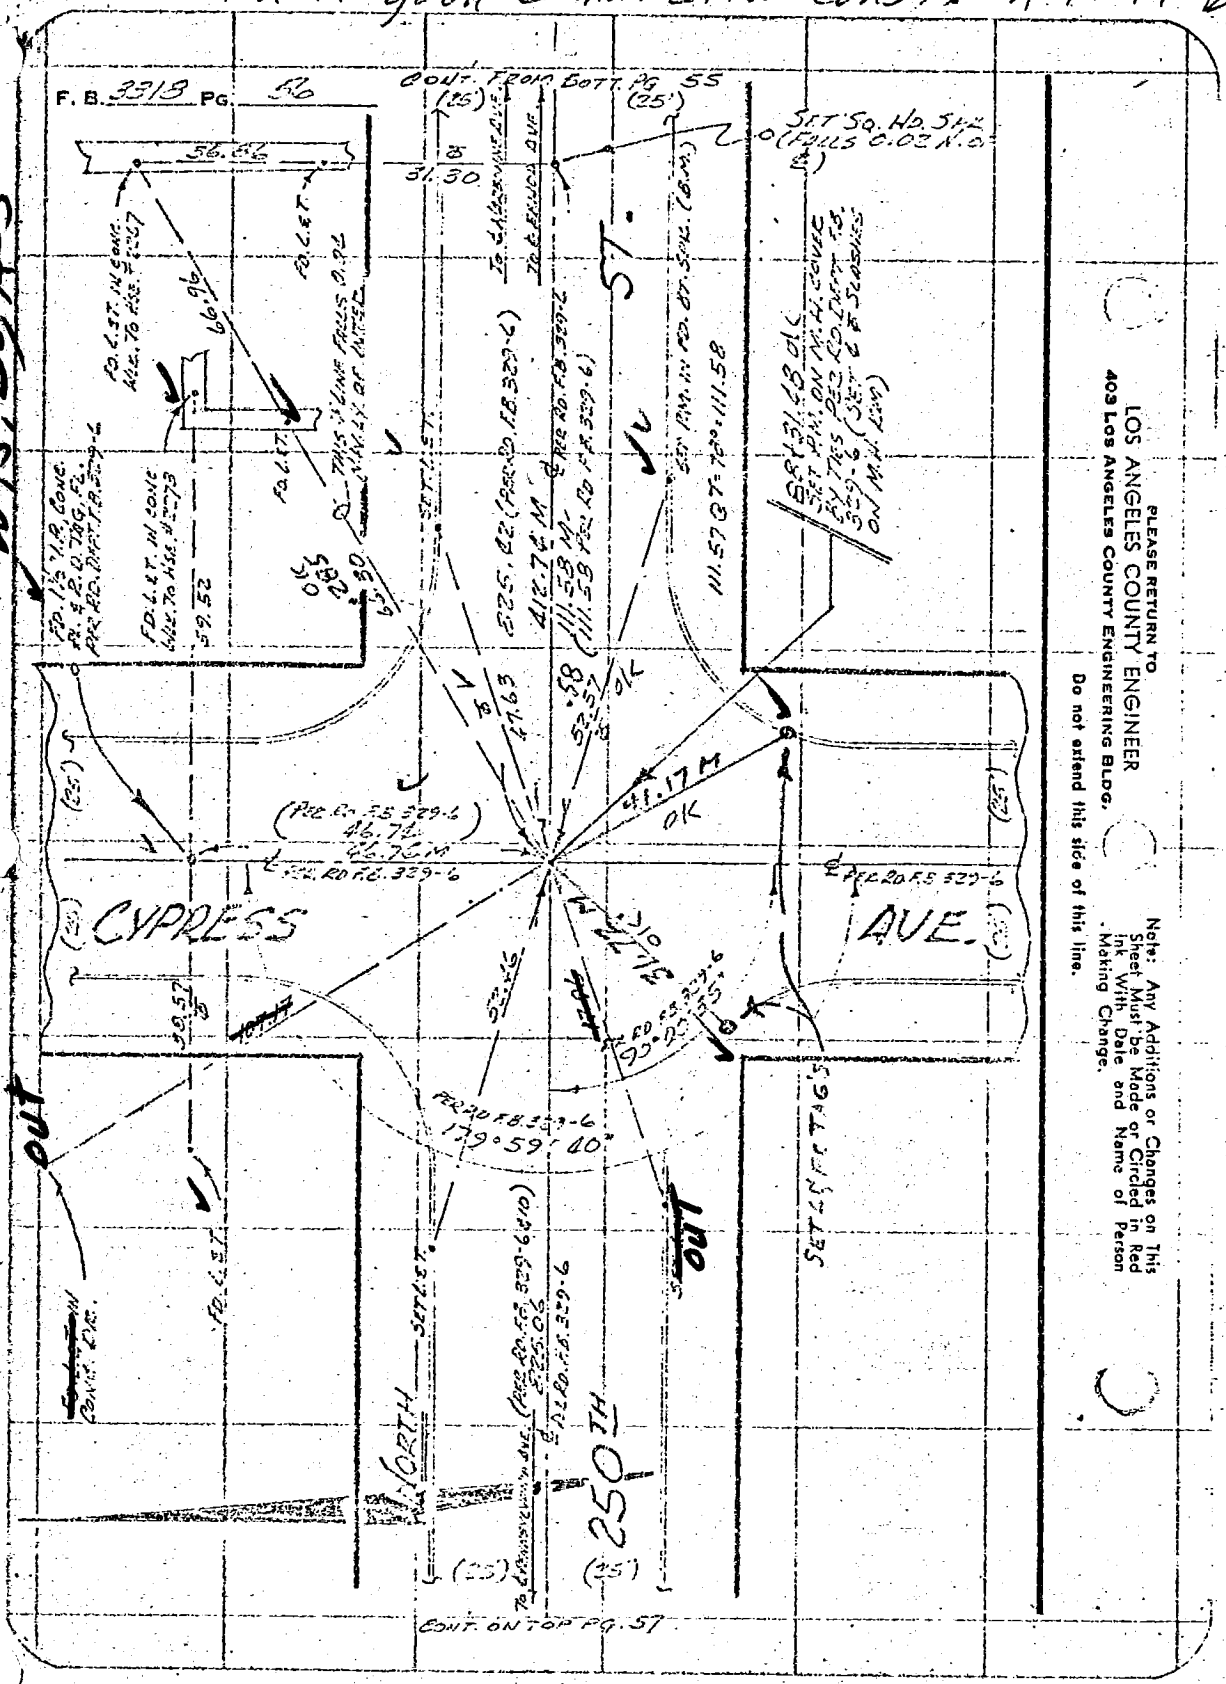


V=FD IN Good cond
7-19-70. BEFORE const.

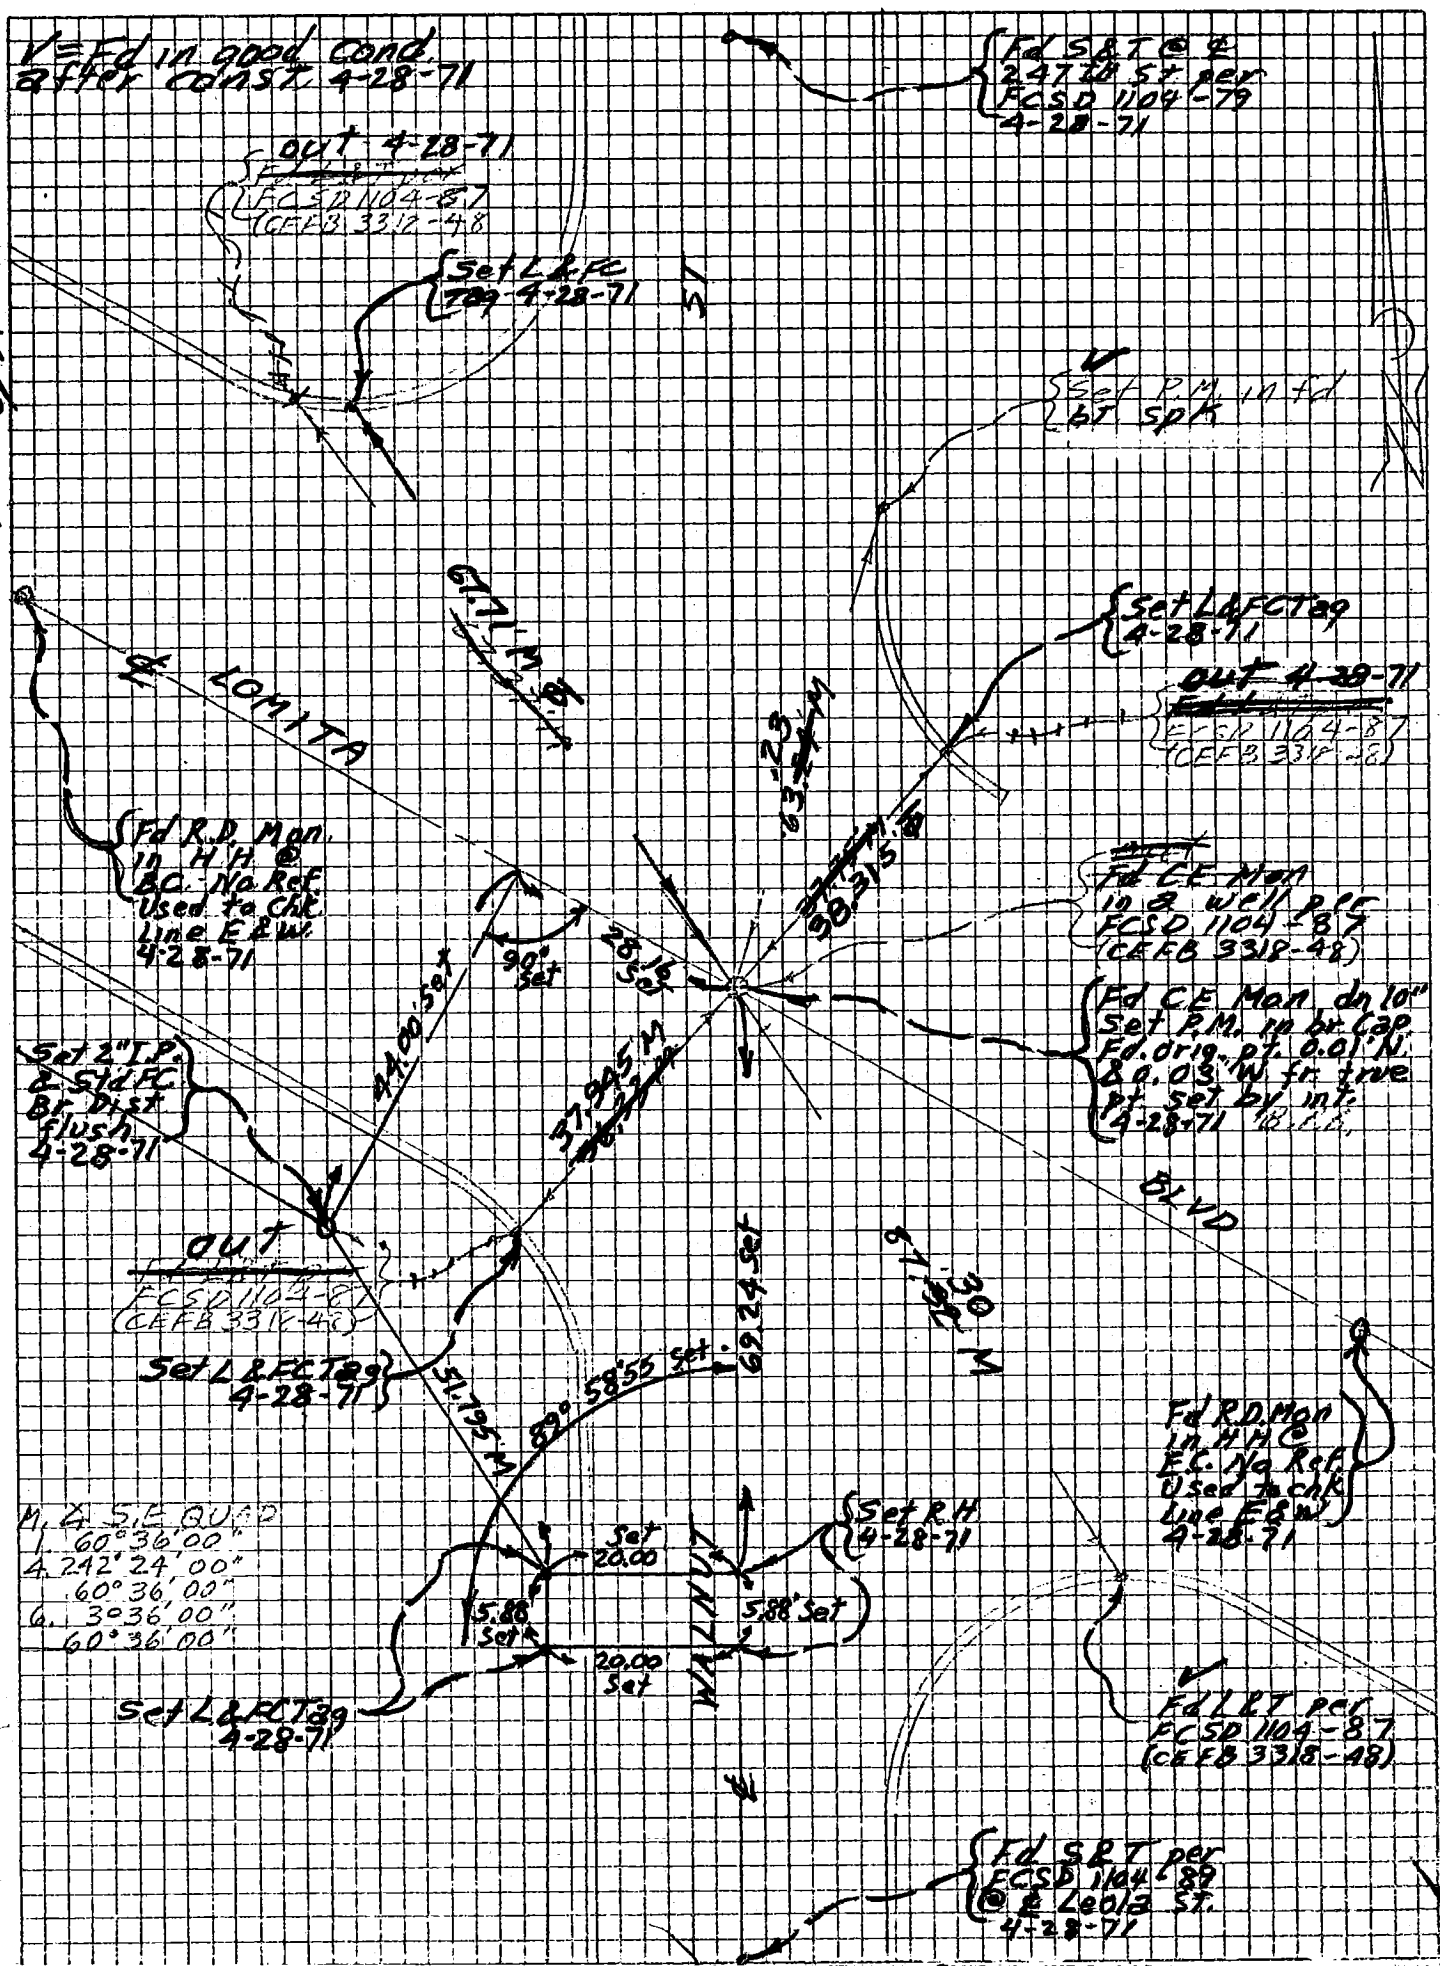
W.S. 28 & 13
V=Fd in good cond. after const. 4-28-71
Fd S&T @ ℄ 24728 St. per FCSD 1104-79 4-28-71
out 4-28-71 FCSD 1104-87 (CEFB 3312-48)
Set L&T FC 789 4-28-71
ST
Set P.M. in Fd Br Spk
Set L&T FC 789 4-28-71
out 4-28-71 FCSD 1104-87 (CEFB 3312-48)
67.71 M
63.23 M
90.31 M
Fd R.D. Mon. in H.H. @ BC. No Ref. Used to chk line E&W 4-28-71
Fd CE Mon in ℄ well pcf FCSD 1104-87 (CEFB 3318-48)
90° Set
28.28 Set
44.00 Set
37.90 M
Fd CE Mon dr 10" Set P.M. in br Cap Fd. Orig. pt. 0.01 N. & 0.03 W fr true pt. set by int. 4-28-71 L.A.
Set 2" I.P. & Std FC Br Dist Flush 4-28-71
out
FCSD 1104-87 (CEFB 3312-48)
Set L&T FC 789 4-28-71
67.71 M
30 M
89° 58'55" Set
69.24 Set
Fd R.D. Mon in H.H. @ E.C. No Ref. Used to chk Line E&W 4-28-71
M, 4, S.E. QUAD
1. 60°36'00"
4. 242°24'00"
60°36'00"
6. 300°36'00"
60°36'00"
Set R.H. 4-28-71
Set 20.00
5.88 Set
5.88 Set
20.00 Set
Set L&T FC 789 4-28-71
Fd L&T pcf FCSD 1104-87 (CEFB 3318-48)
Fd S&T per FCSD 1104-89 @ ℄ Leola St. 4-28-71

W5284-7

K=Fd in good cond after const 4-28-71

OUT Set Ref FCSD 1104-83

Fd Set L&FC Tag

CONC DRIVE

Set S&FC W 4-29-71 B.C.B.

151°49'42" Set 4-30-71 B.C.B.

RESET 4-27-71 Set L&FC Tag OUT

RE-SET L&FC Tag

OUT Set Ref FCSD 1104-83

OUT FCSD 1104-83A

Set L&FC Tag

Set L&FC Tag

OUT FCSD 1101-83A

Set S&FC W 4-29-71 B.C.B.

156°13'47" Set 4-30-71 B.C.B.

CONC DRIVE

RE-SET OUT Set L&FC Tag

Set L&FC Tag

OUT Ref 0.06 S Line

W.S.284-3

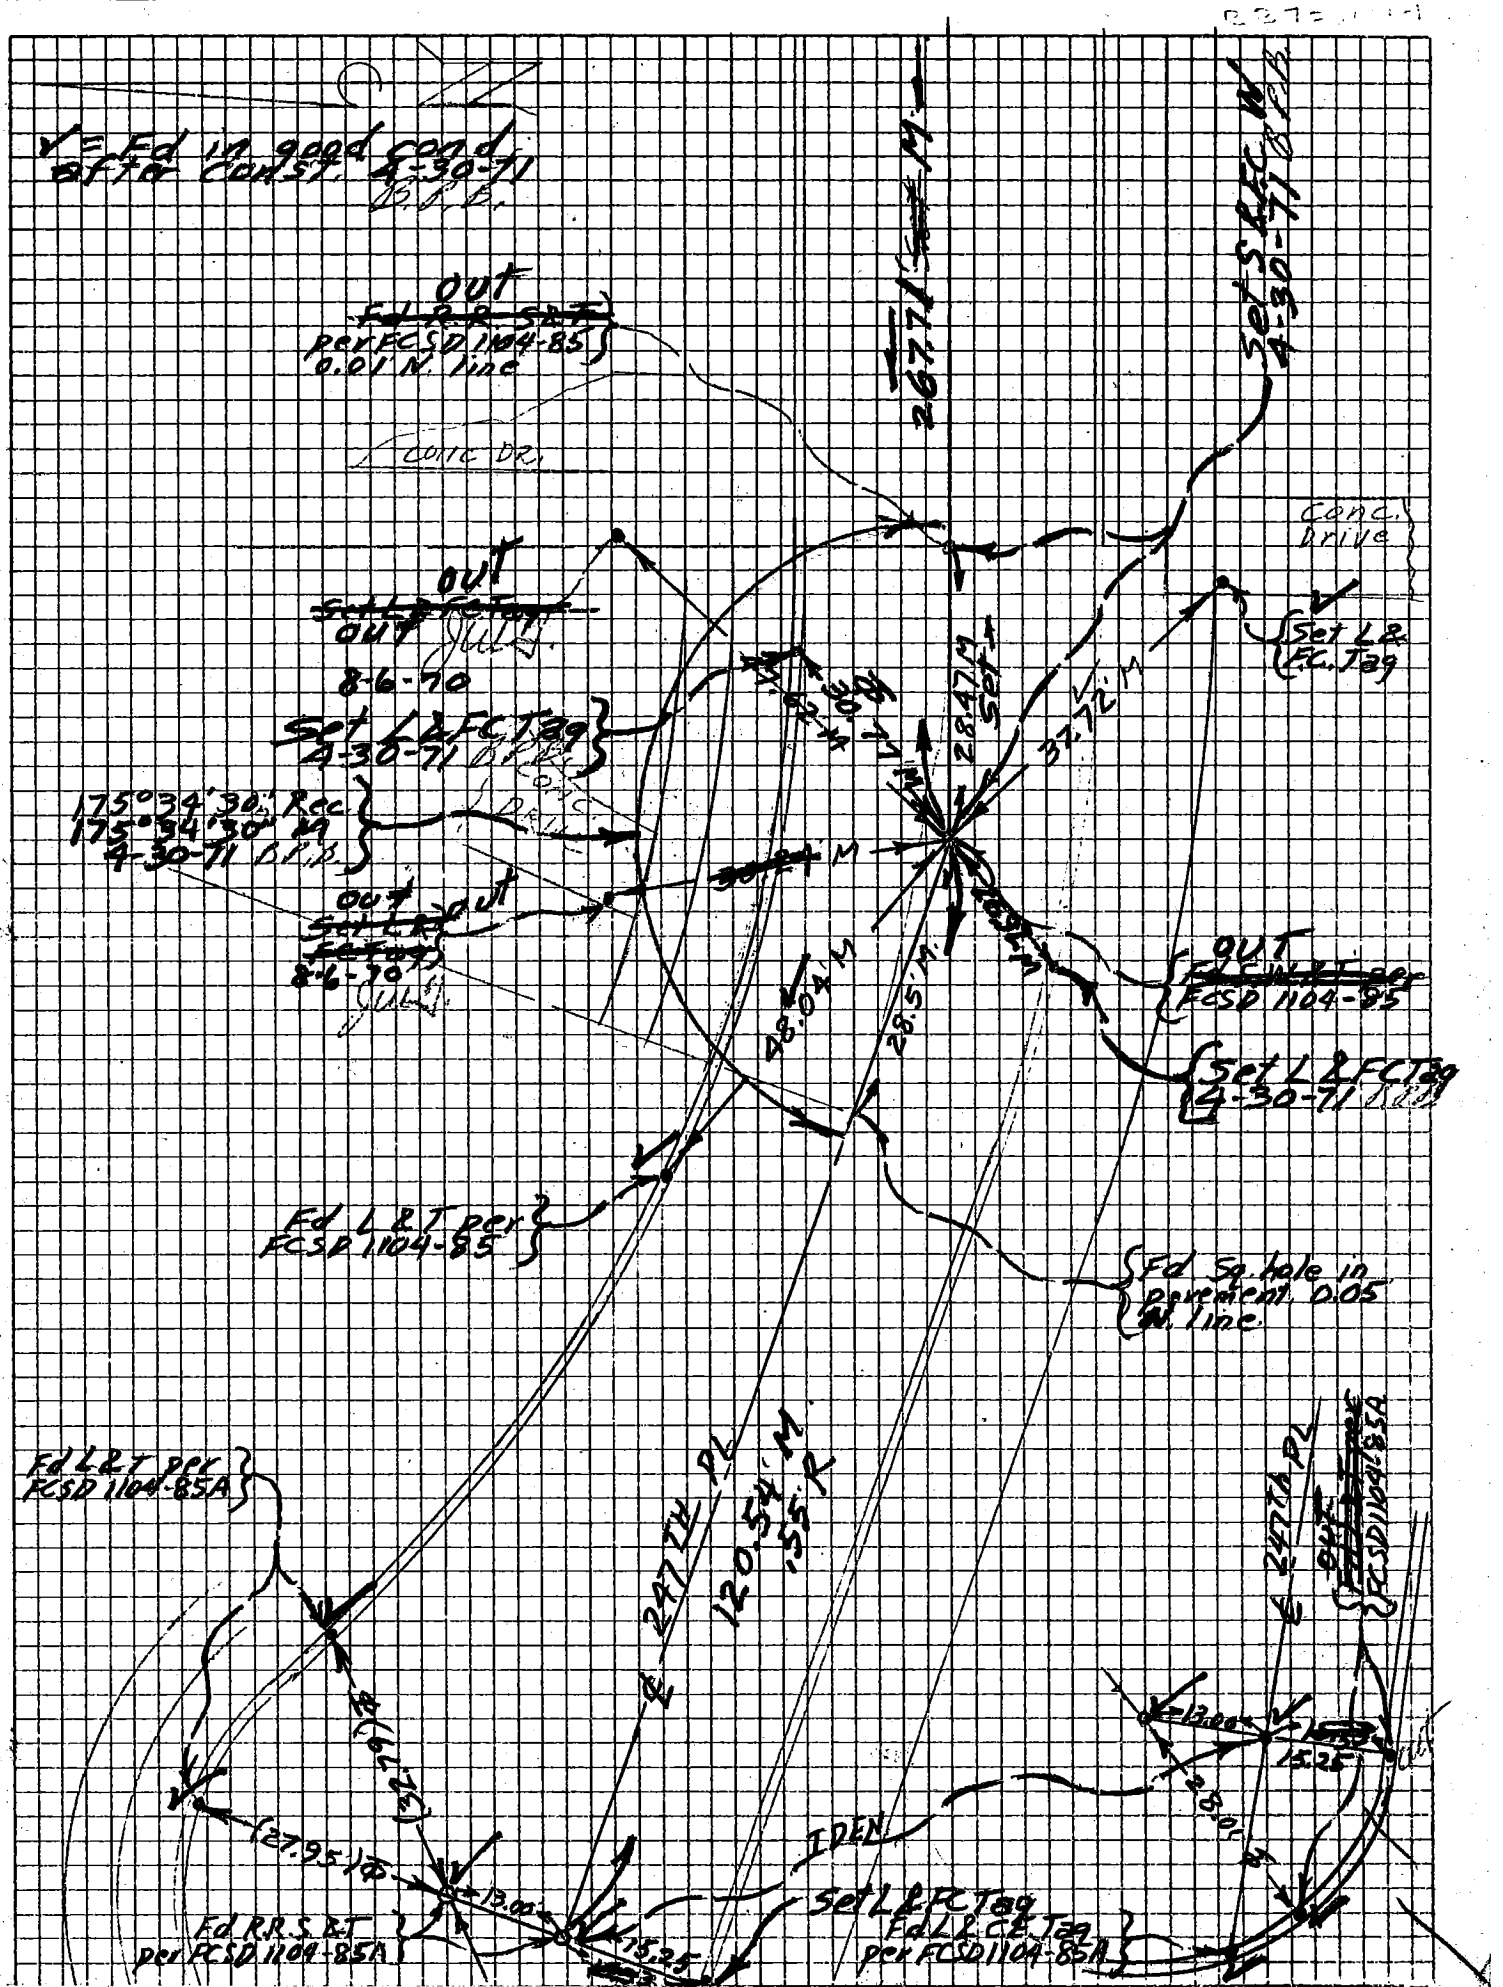
Fd L&T good cond. after Const. 4-30-71 B.F.B.
OUT
per FCSD 1104-85
0.01 N. line
Conc. Dr.
OUT
8-6-70
Set L&FC Tag
4-30-71 B.F.B.
175°34'30" Rec
175°34'30" Cal
4-30-71 B.F.B.
OUT
8-6-70
Set L&FC Tag
4-30-71 B.F.B.
OUT
per FCSD 1104-85
Set L&FC Tag
4-30-71 B.F.B.
Fd L&T per FCSD 1104-85
Fd Sq. hole in pavement 0.05 W. line
Fd L&T per FCSD 1104-85A
Fd R.R.S.&T per FCSD 1104-85A
IDEN
Set L&FC Tag
Fd L&C&T Tag per FCSD 1104-85A
Conc. Drive
Set L&FC Tag
Set L&FC Tag 4-30-71 B.F.B.
OUT per FCSD 1104-85A
120.54' M
15.25
13.00
28.0'
(27.95')

V=Fd in good cond. after Const 4-30-91 B.P.B.

Set pencil 'X' on M.H. Lid by Tom Pim's per FCSD 1104-93

Fd L&T per FCSD 1104-93 out

Set L&FC tag

Set L&FC tag in walk

W.S 29, A-3

53.44 M

Fd L&T per FCSD 1104-93

16.23 M

out

25.20 M

ANDREO AVE

Fd L&T per FCSD 1104-93

33.53 M

out

34.20 M

Set L&FC tag in walk

Fd L&T per FCSD 1104-93

250'± ST.

Set L&FC tag 4-30-91 BPB

Fd L&T per FCSD 1104-91

out

Set L&FC tag 4-30-91 BPB

Set L&FC tag

43.61 M

43.62 M

52.29 M

Fd S.A.W. per FCSD 1104-91

ESHELMAN AVE

39.49 M

11.54 M

10.60 M

Fd L&T per FCSD 1104-91

76S911 Cdb 3-69

PROJECT No. 1104 UNIT 1

SURVEY BY B.P.B. DATE 2-19-70

REVIEWED BY _____ DATE _____

Co. Engr. F.B. 3555:177

INDEX FCSD1104 203

R & R 11

LOS ANGELES COUNTY FLOOD CONTROL DISTRICT

(177)

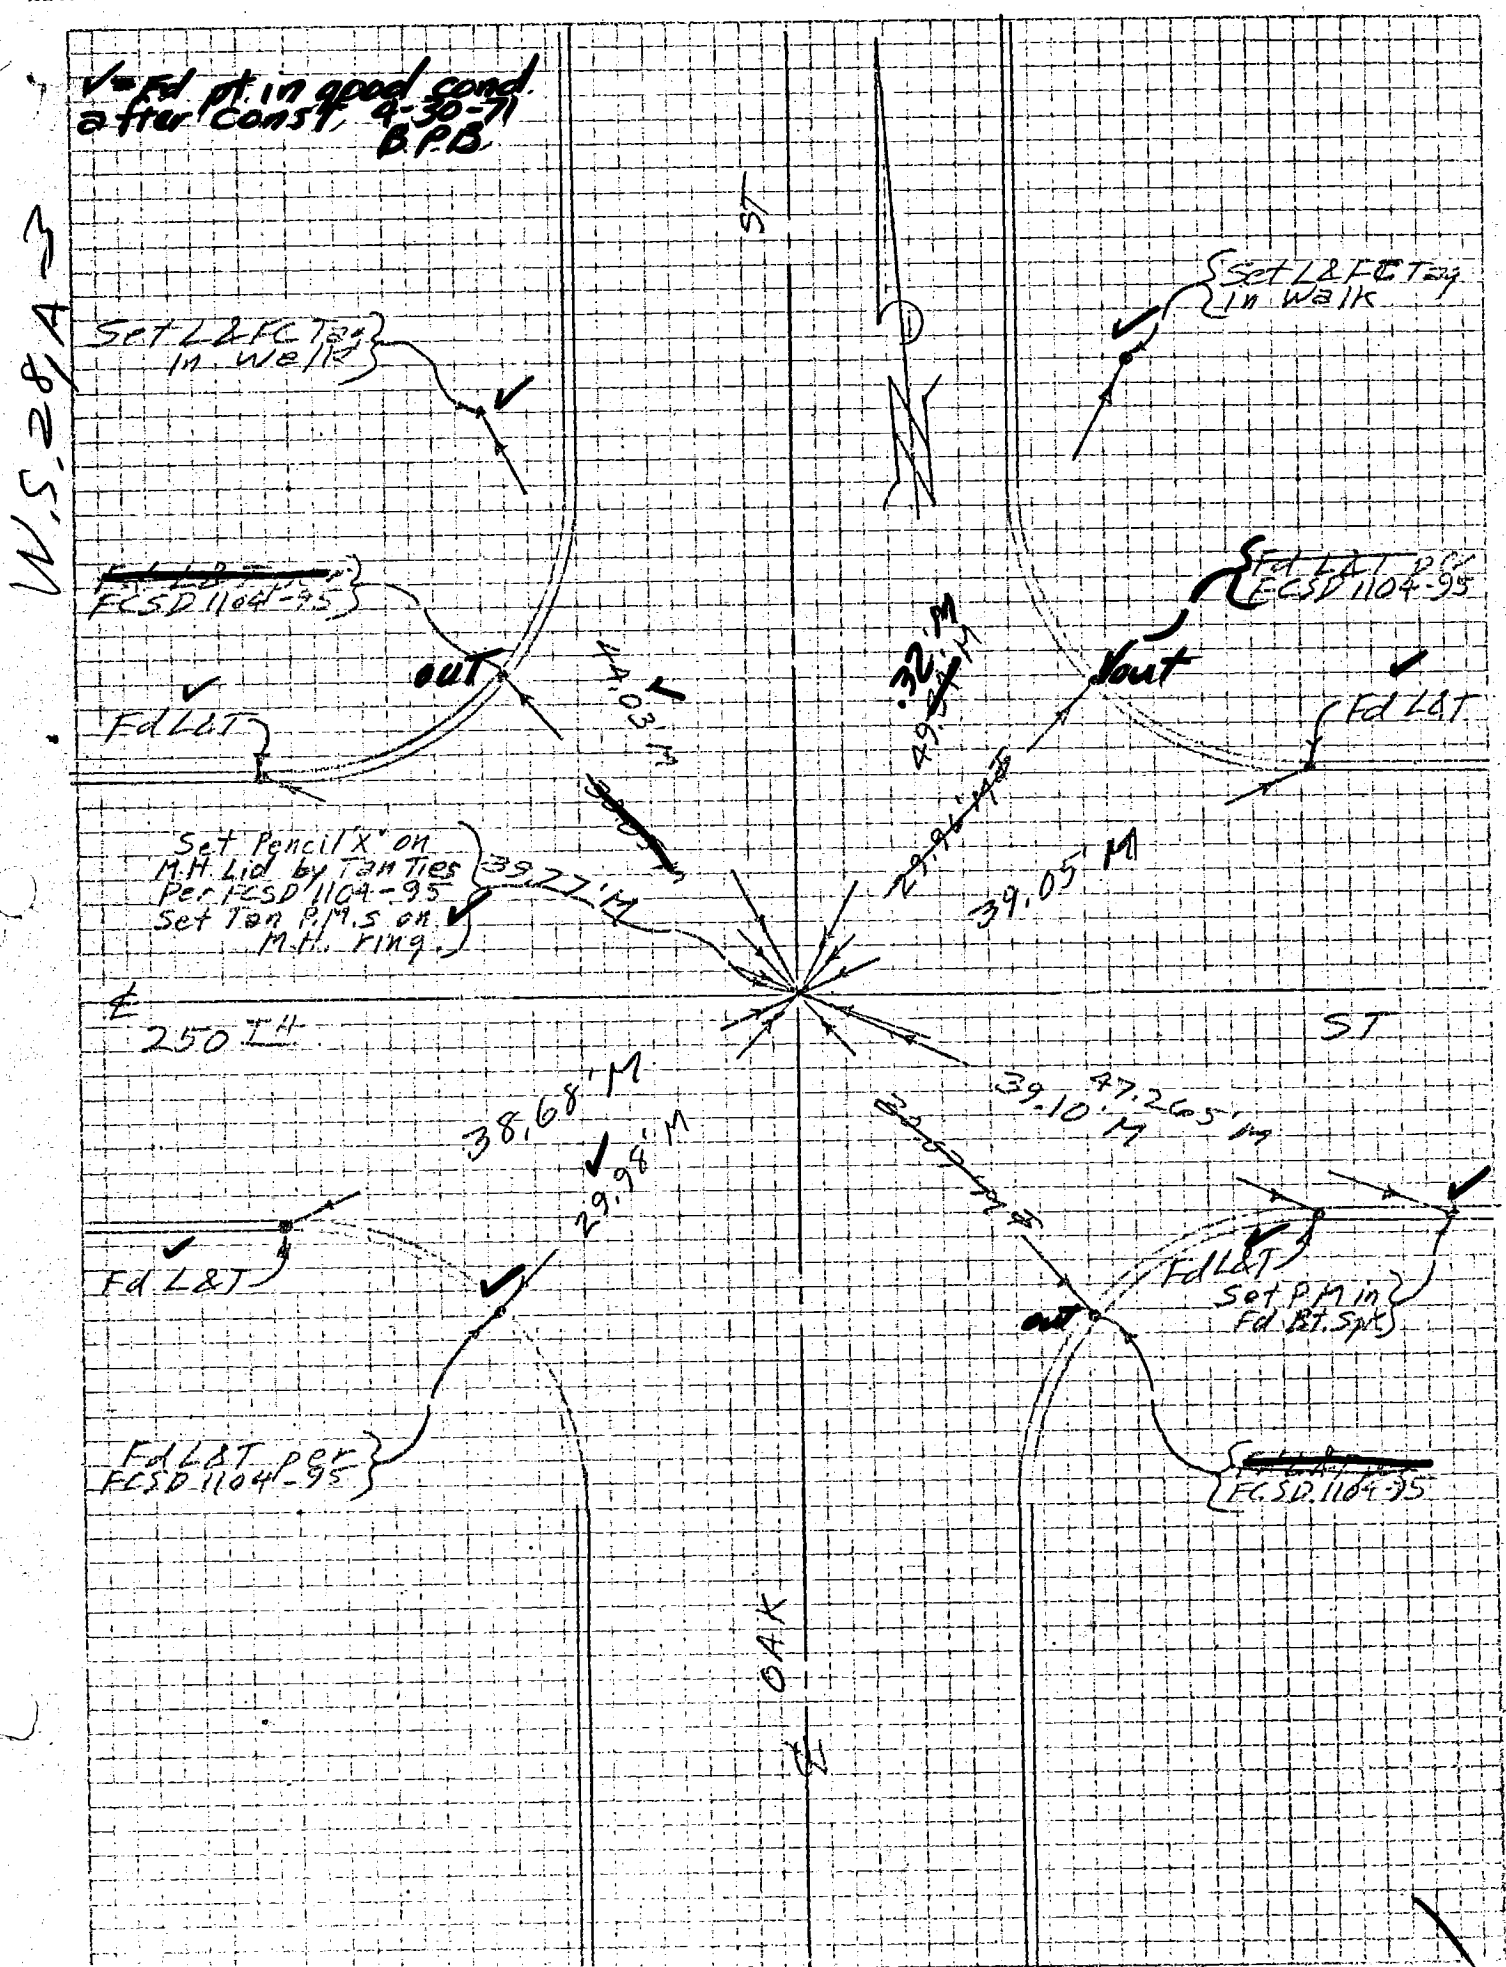

768911-- Cdb 3-69

PROJECT No. 1104 Unit 1

SURVEY BY B.P.B. DATE 4-30-71

REVIEWED BY _____ DATE _____

Co. Engr. F.B. 3555: 178

INDEX FCSD 1104 205

R & R 13

LOS ANGELES COUNTY FLOOD CONTROL DISTRICT

(178)

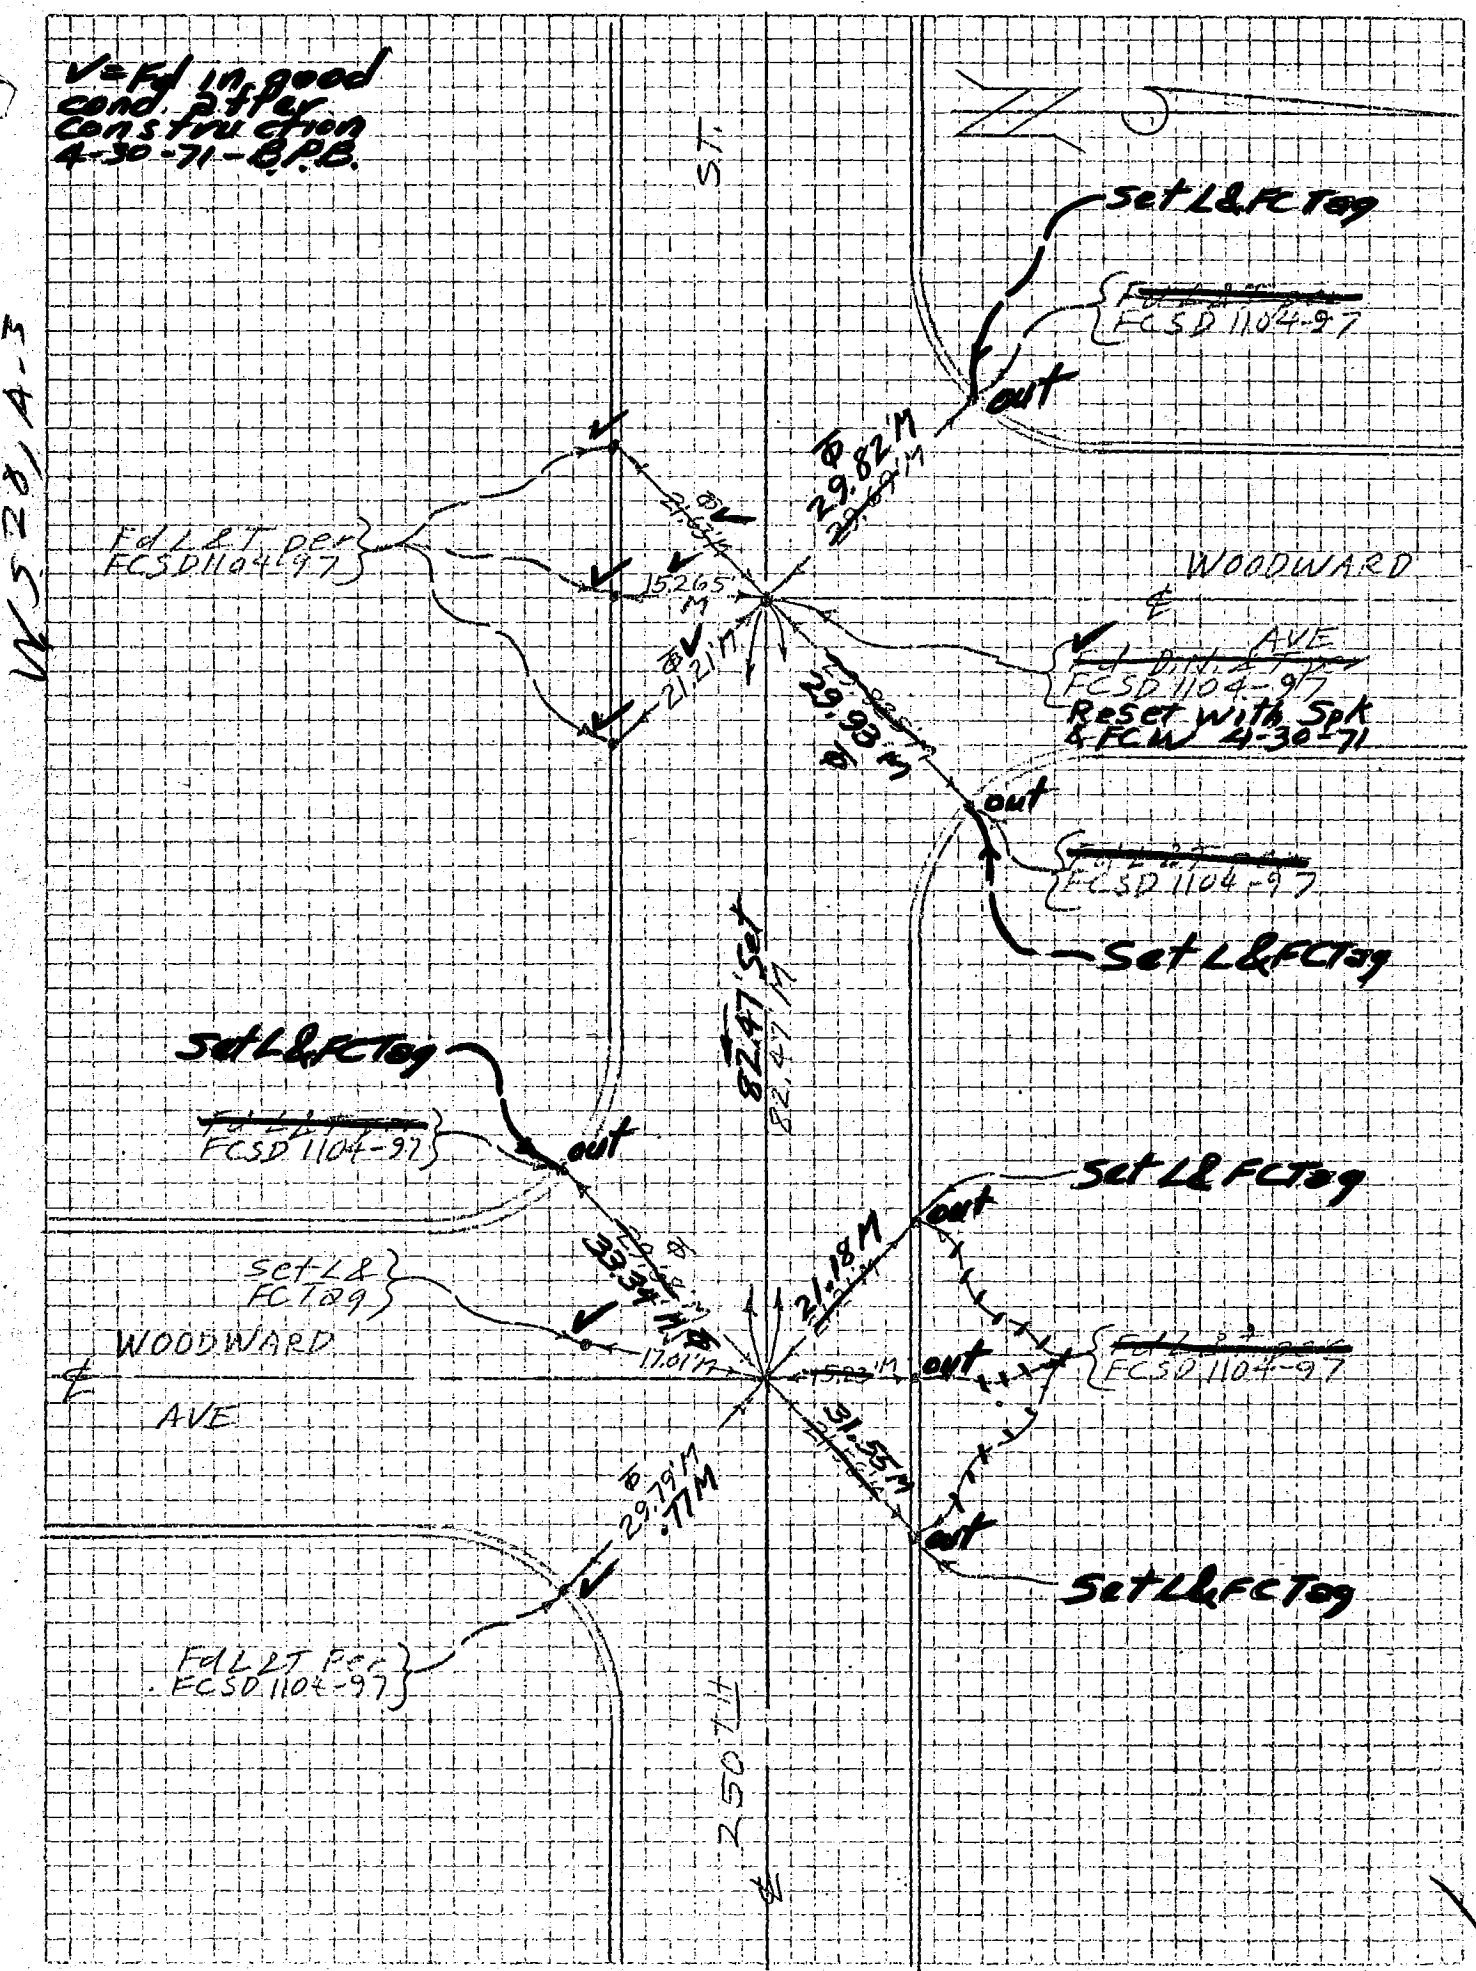

765011– Cdb 3-69

PROJECT No. 1104 Unit 1

SURVEY BY B.F.M. DATE 2-19-70

REVIEWED BY _____ DATE _____

Co. Engr. F.B. 3555, 179

INDEX FCSD1104 207

R&R 15

LOS ANGELES COUNTY FLOOD CONTROL DISTRICT

179

√=Fd in good cond after const. 4-19-71 BPB

Set L&T 4-14-71

~~Fd L&T FCSD 1104-99~~ OUT

Set L&T 4-14-71 OUT

~~Fd L&T FCSD 1104-99~~

S 11° 28' A.M.

5T

53.33 M

37.59 M

NARBONNE

AVE

Fd SA & Pk FCSD 1104-99

53.505 M

36.88 M

~~Fd L&T~~ OUT

~~FCSD 1104-99~~

Set L&T 4-14-71

Fd L&T Pk FCSD 1104-99

ST

7639 M– Cdb 3-69

PROJECT No. 1104 Unit 1

SURVEY BY [illegible] DATE 2-19-70

DRAWN BY [illegible] DATE [illegible]

Co. Engr. F.B. 3555 | 180

INDEX FCSD1104 209

R&R 17
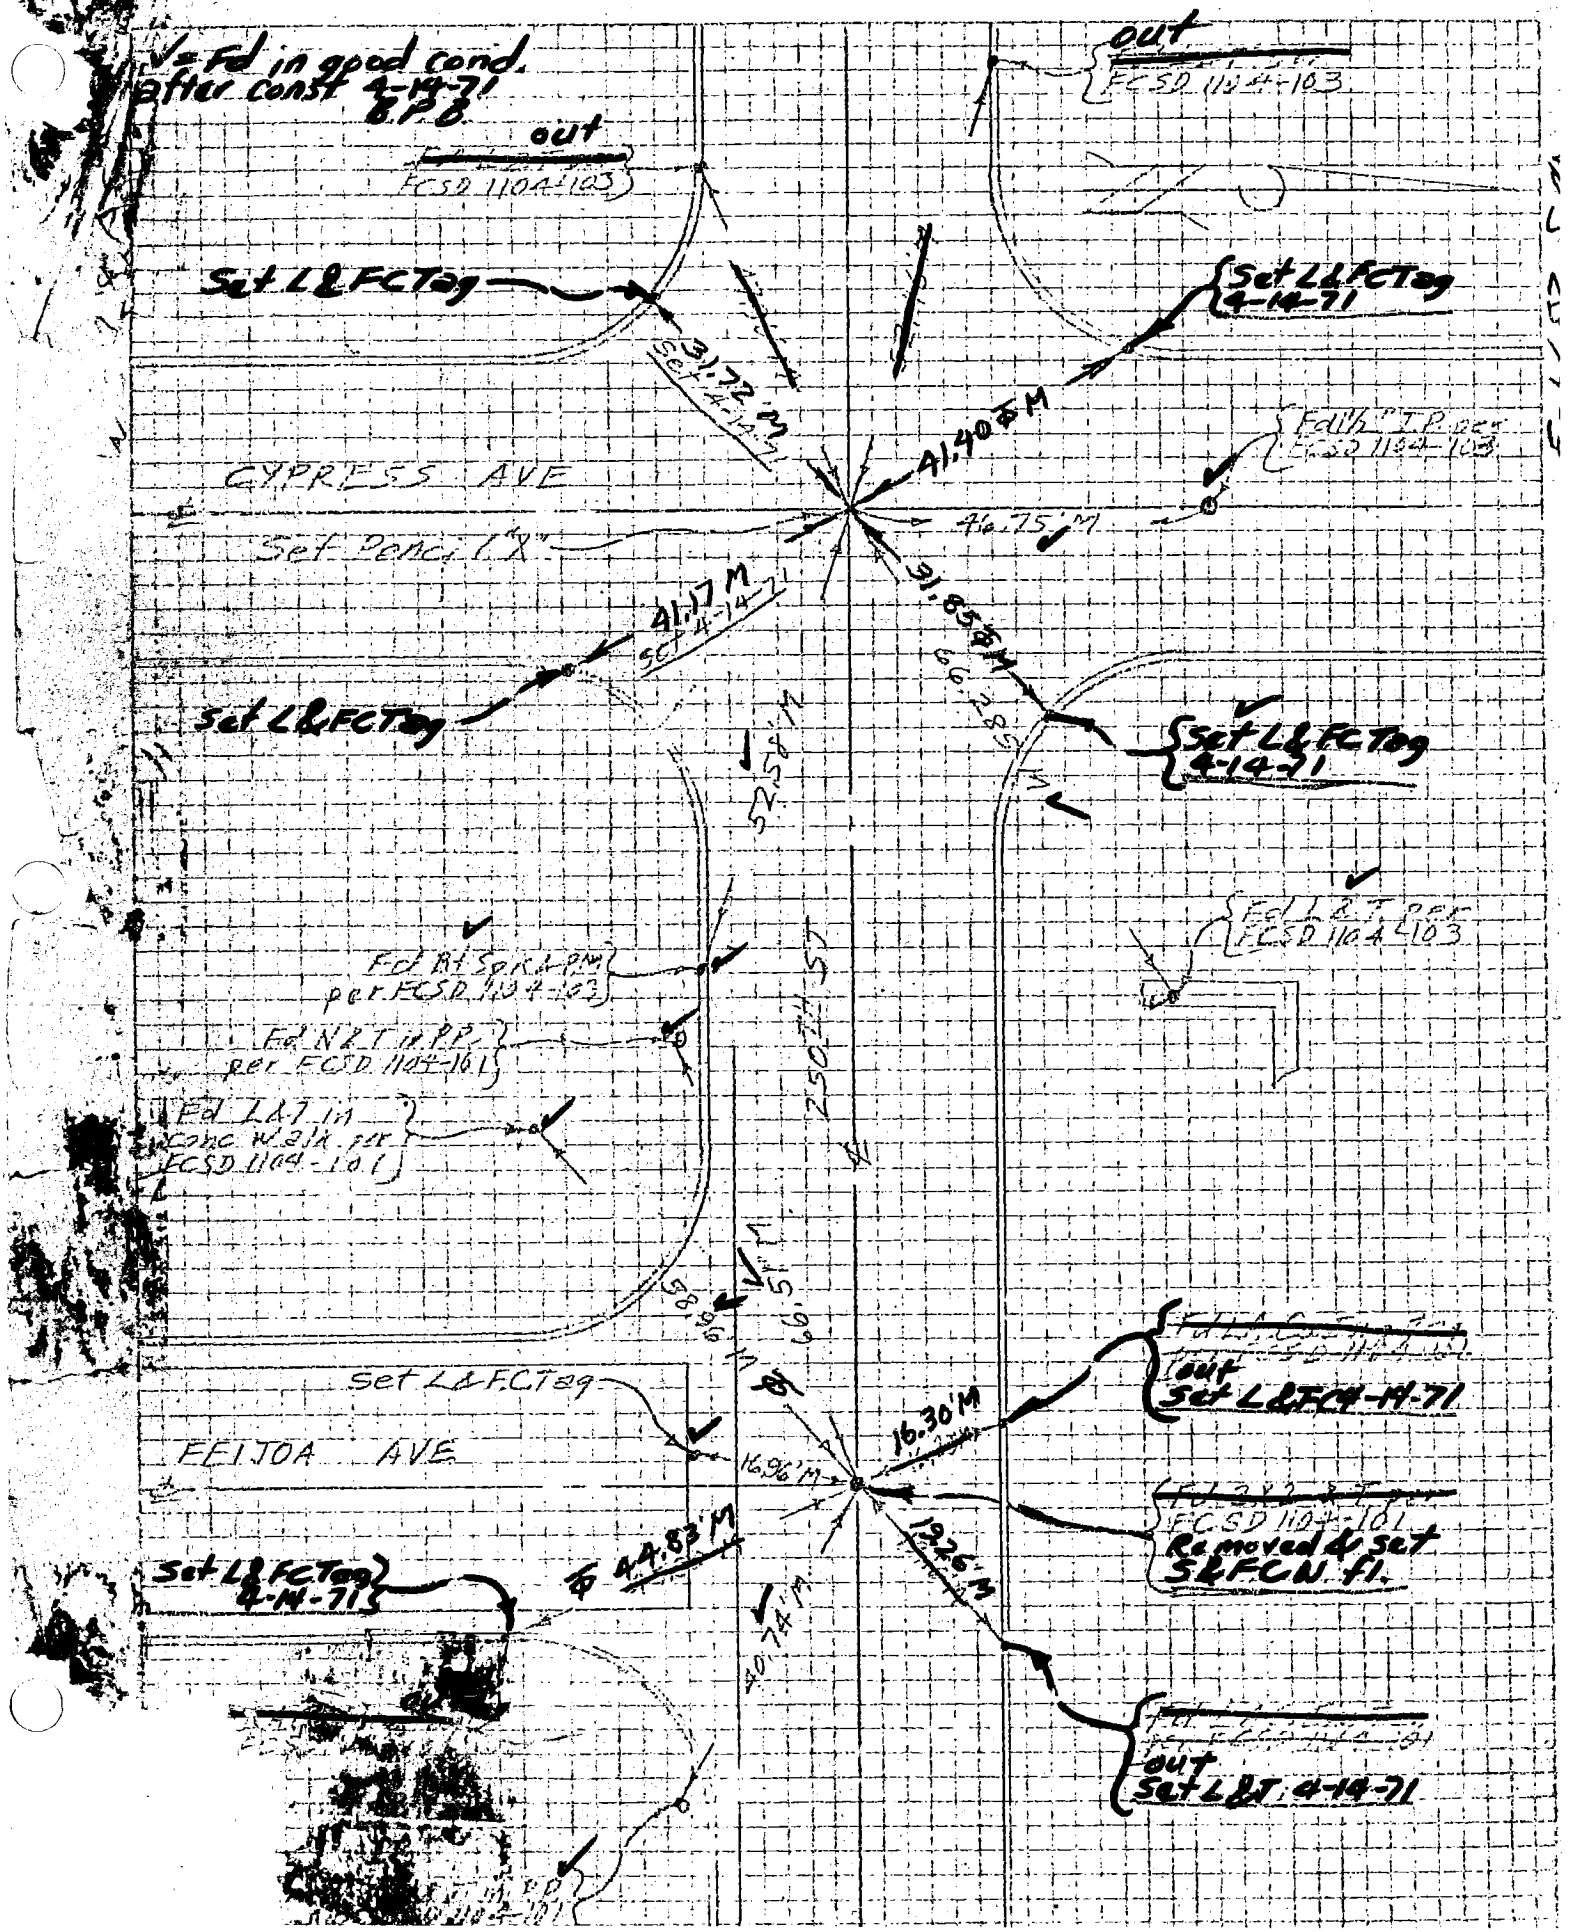
LOS ANGELES COUNTY FLOOD CONTROL DISTRICT