Notes Ck'd by

Map No.

Office Work

d

Survey of

JN Tape Std °F

Surveyed by

Notes Date

Indexed

F.B. PG.

3656

Tr. 32084	1-14	Sikand Eng.
Tr. 33890	15-42	same
Tr. 33889	43-58	same
Tr. 33888	59-85	same
Tr. 41349	86-89	Earl R.Richardson
Tr. 39731	90	James E.Nelson
PM 11247	91	E.L.Pearson & Ass.
PM 10705	92	Harman Rasnow & Ass.
Tr. 40894	93	Boyer Eng. Co.
Tr. 41635	94-95	A.C.Guizado
Tr. 36330	96	Charles J. Beck
PM 13790	97-98	M.W.Finley
PM 13943	99-100	J.M.Negrete & Ass.
Tr. 37579	101-103	W.L.Schulz.
Tr. 42328	104	R.V.Pearsall
Tr. 41331	105-108	Wagner Kerr & Ass.
Tr. 39941	109	Loren Phillips
Tr. 38345	110-112	W.Rose & Ass.
Tr. 32530	113-118	Wesley R.Lind
Tr. 40771	119-122	W.Schulz
PM 14068	123	E.A.Hynes
Tr. 40561	124-125	Crown Eng.
PM 8241	126-130	Classic Eng.
Tr. 32110	131-132	So.Bay Eng.
PM 13477	133	Th. Outland
Tr. 35791	134	J.E.Nelson
Tr. 31224	135-154	Pfeiler & Ass.

b

NOTE: ANY ADDITIONS OR CHANGES ON THIS SHEET MUST BE MADE OR CIRCLED IN RED INK WITH DATE AND NAME OF PERSON MAKING CHANGE

Do not extend note this side of this line

PLEASE RETURN TO
LOS ANGELES COUNTY ENGINEER
403 LOS ANGELES COUNTY ENGINEERING BLDG.

CENTERLINE NOTES
CE 310
76F3095 4/7

CO ENG FB 3656 - 1

SIKAND ENGINEERING ASSOCIATES
15230 Burbank Boulevard
VAN NUYS, CALIFORNIA 91411
Phone (213) 787-8550

F.B. ℄ TIES PG. SHT 1
W.O. TR 32054 1020-115
SURVEY BY POSTON
DATE MARCH 2, 91

249-117, A-1 (21)

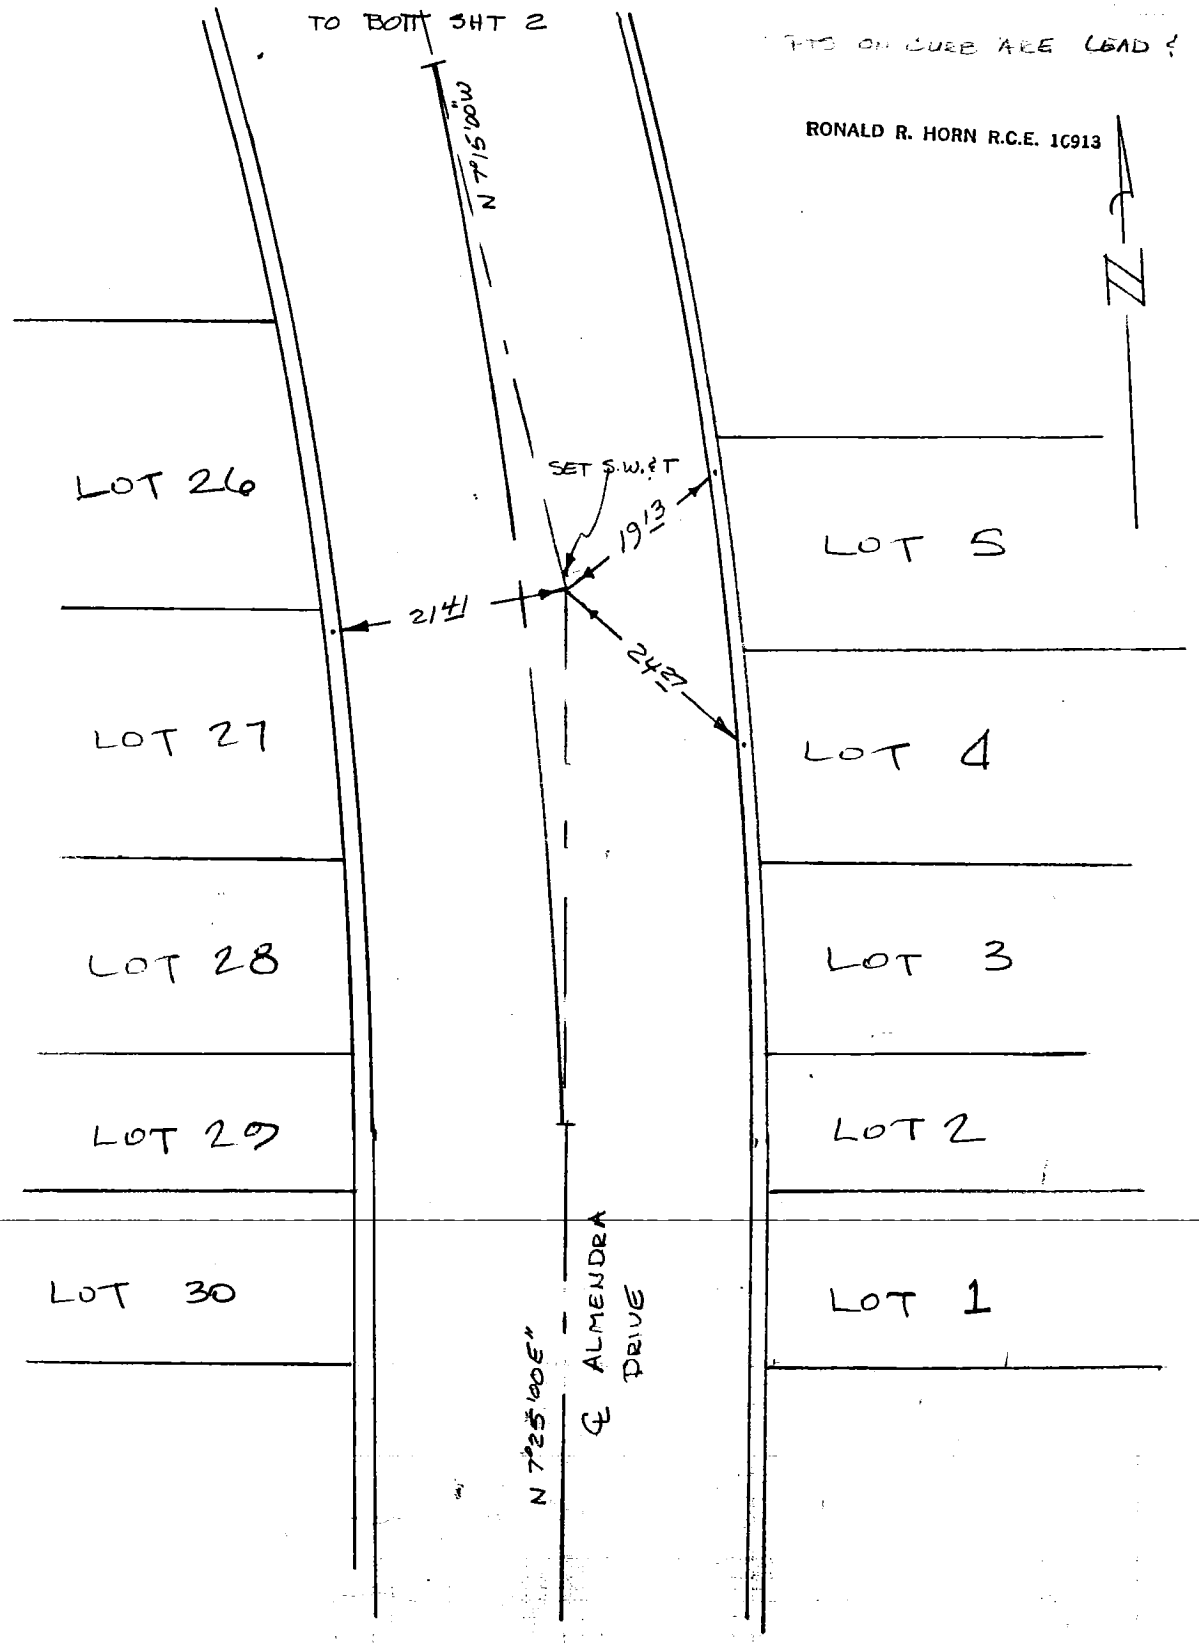

SEE TR 33088

SIKAND ENGINEERING ASSOCIATES
15230 Burbank Boulevard
VAN NUYS, CALIFORNIA 91411
Phone (213) 787-8550

F.B. ℄ TIES PG. SHT 2
W.O. TR 32084 1020-115
SURVEY BY BOSTON
DATE MARCH 2, 81

249-117, A-1 (21)

PTS. IN Cb, ARE LEAD & TAG

TL ? RONALD R. HORN R.C.E. 16913

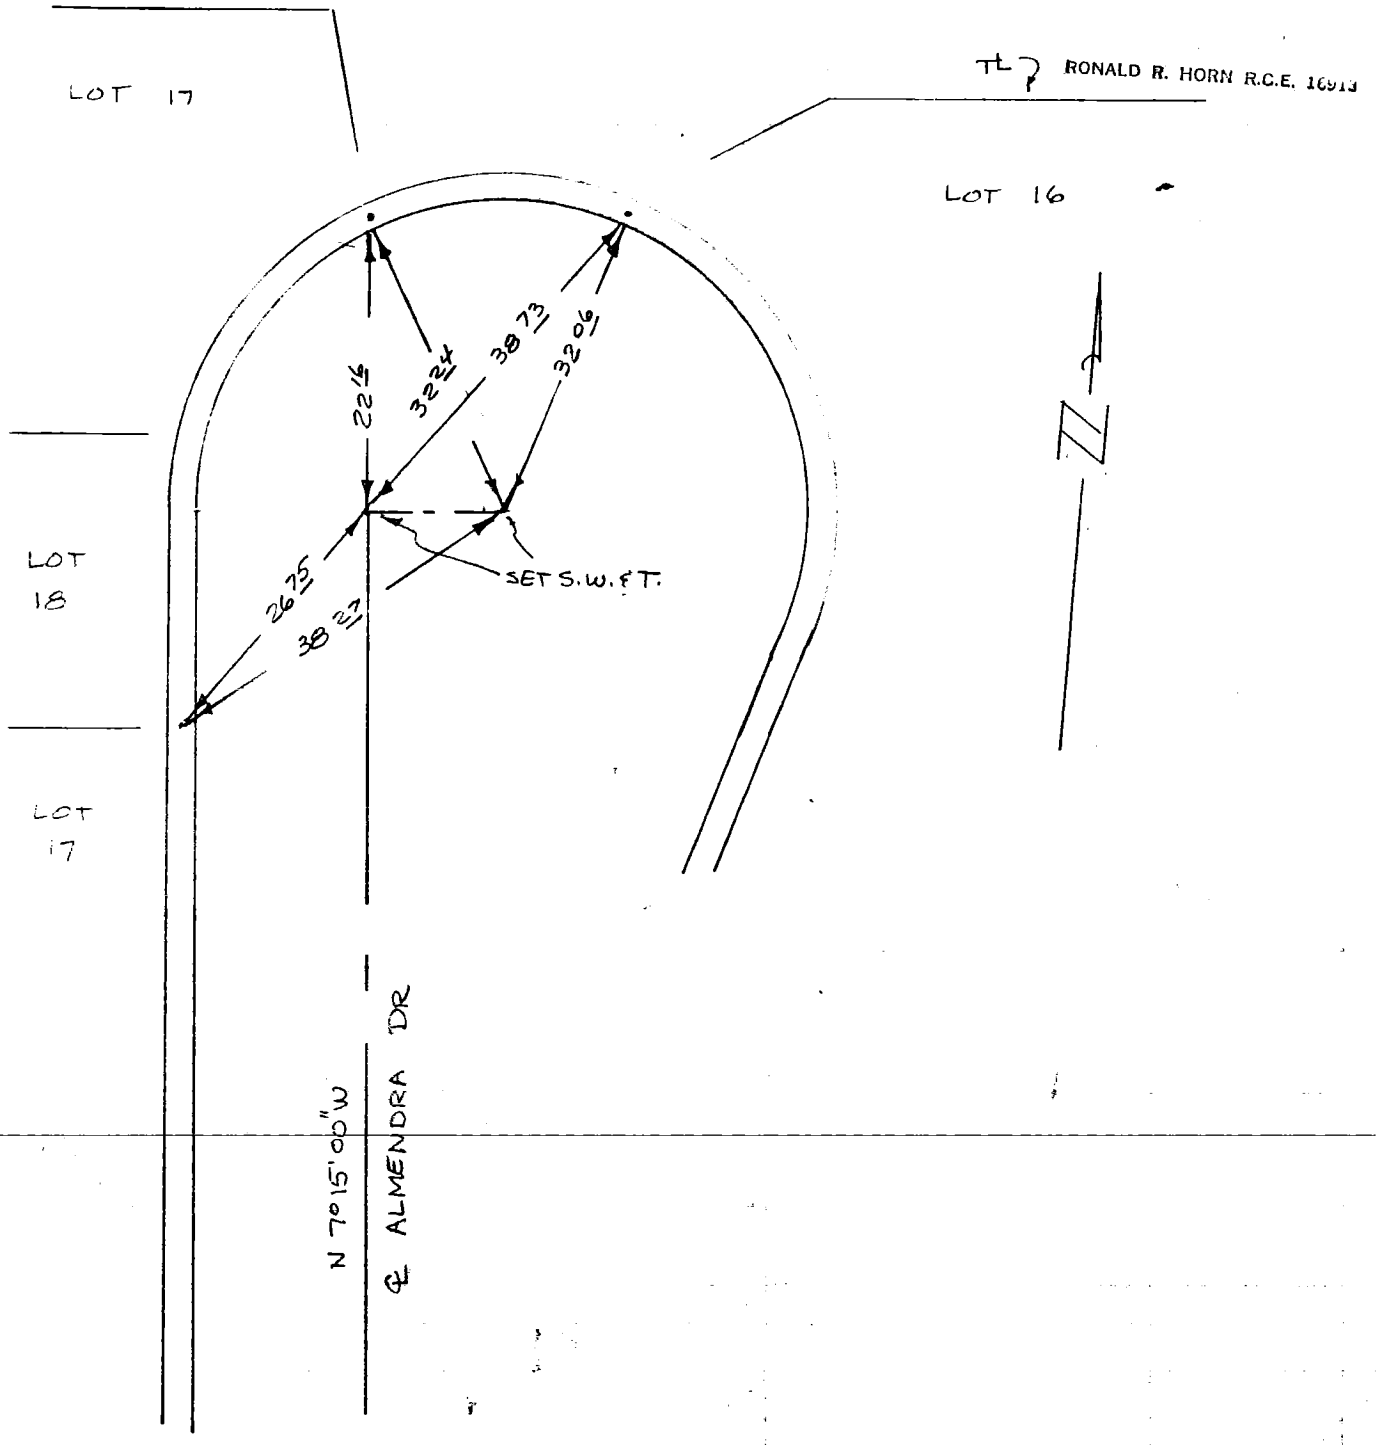

TO TOP SHT 1

CO ENG FB 3656 - 3

SIKAND ENGINEERING ASSOCIATES
15230 Burbank Boulevard
VAN NUYS, CALIFORNIA 91411
Phone (213) 787-8550

F.B. ℄ TIES PG. SHT 3

W.O. TR 32084 1020-115

SURVEY BY BOSTON

DATE MARCH 2, 81

TO BOTT SHT 4

PTS ARE LEAD & TAG IN Cb.

RONALD R. HORN R.C.E. 16913

249-117, A-1 (22)

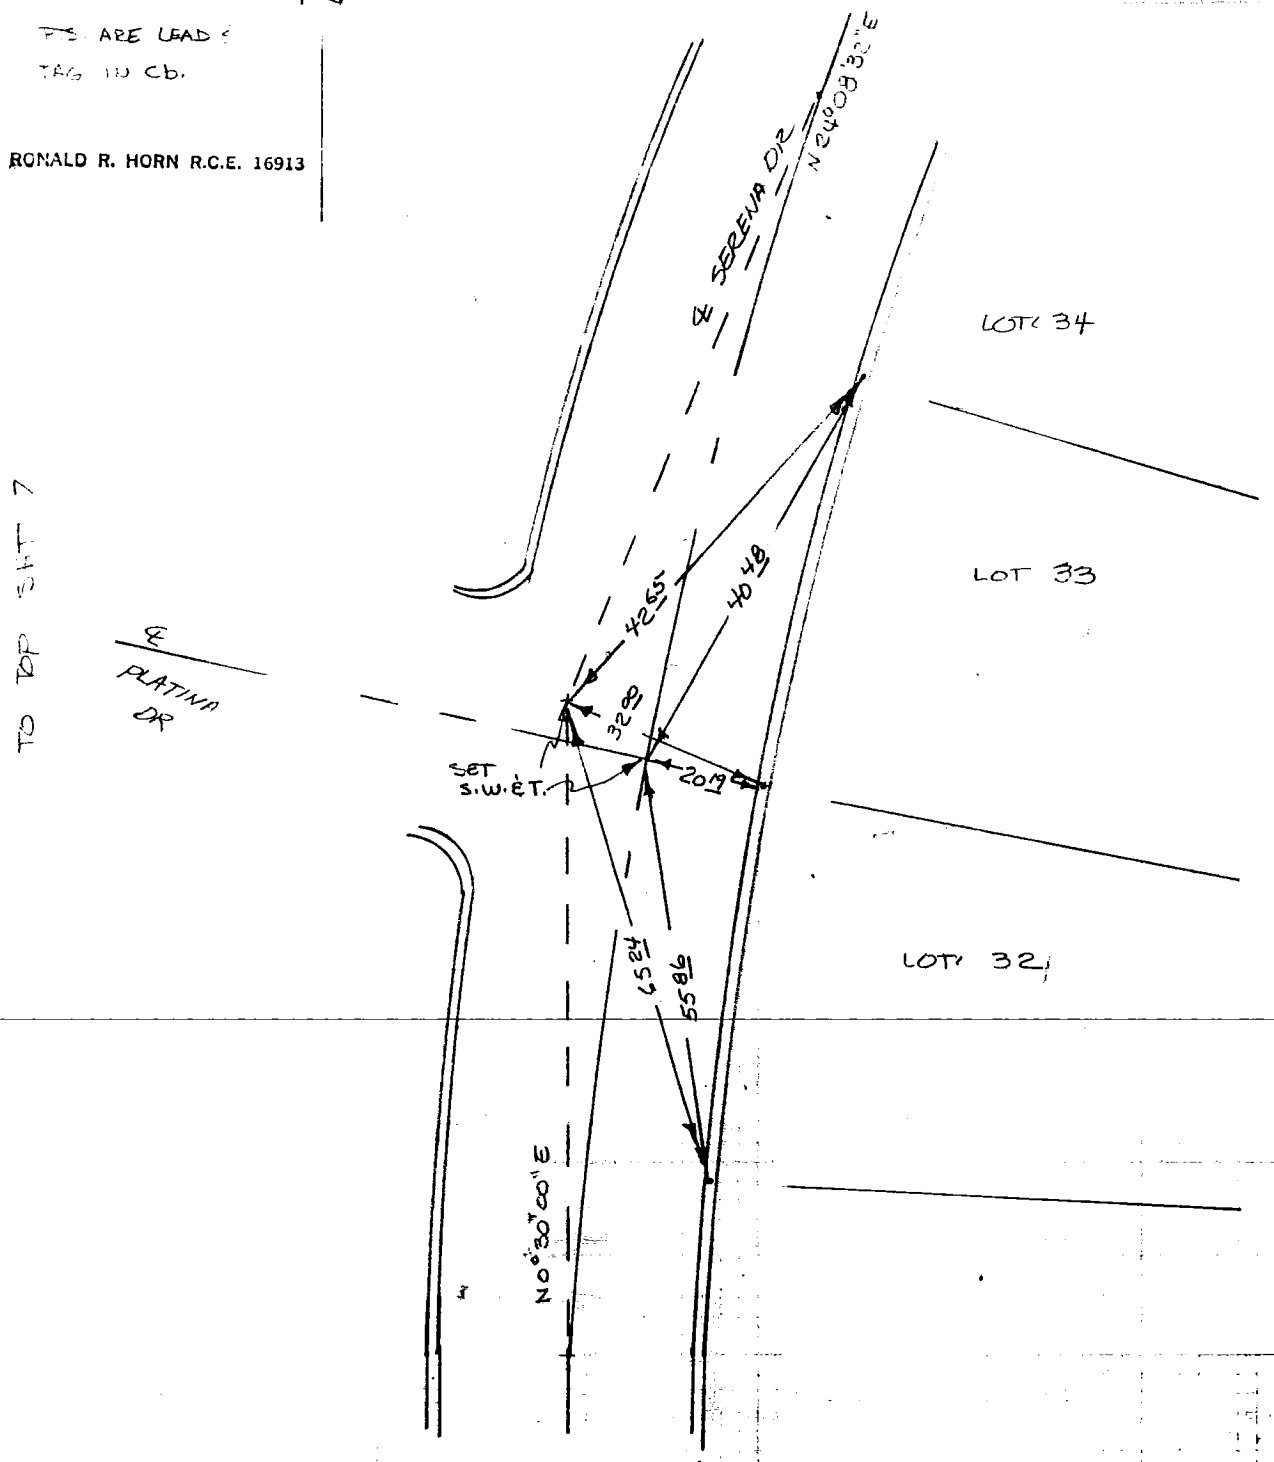

CO ENG FB 3656 - 4

SIKAND ENGINEERING ASSOCIATES
15230 Burbank Boulevard
VAN NUYS, CALIFORNIA 91411
Phone (213) 787-8550

F.B. Ç TIES PG. SHT 4
W.O. TR 32084 1020-115
SURVEY BY BOSTON
DATE MARCH 2, 81

249-117 SA-1 (23)

PTS. ARE L.&T.A.G IN cb.

RONALD R. HORN R.C.E. 16913

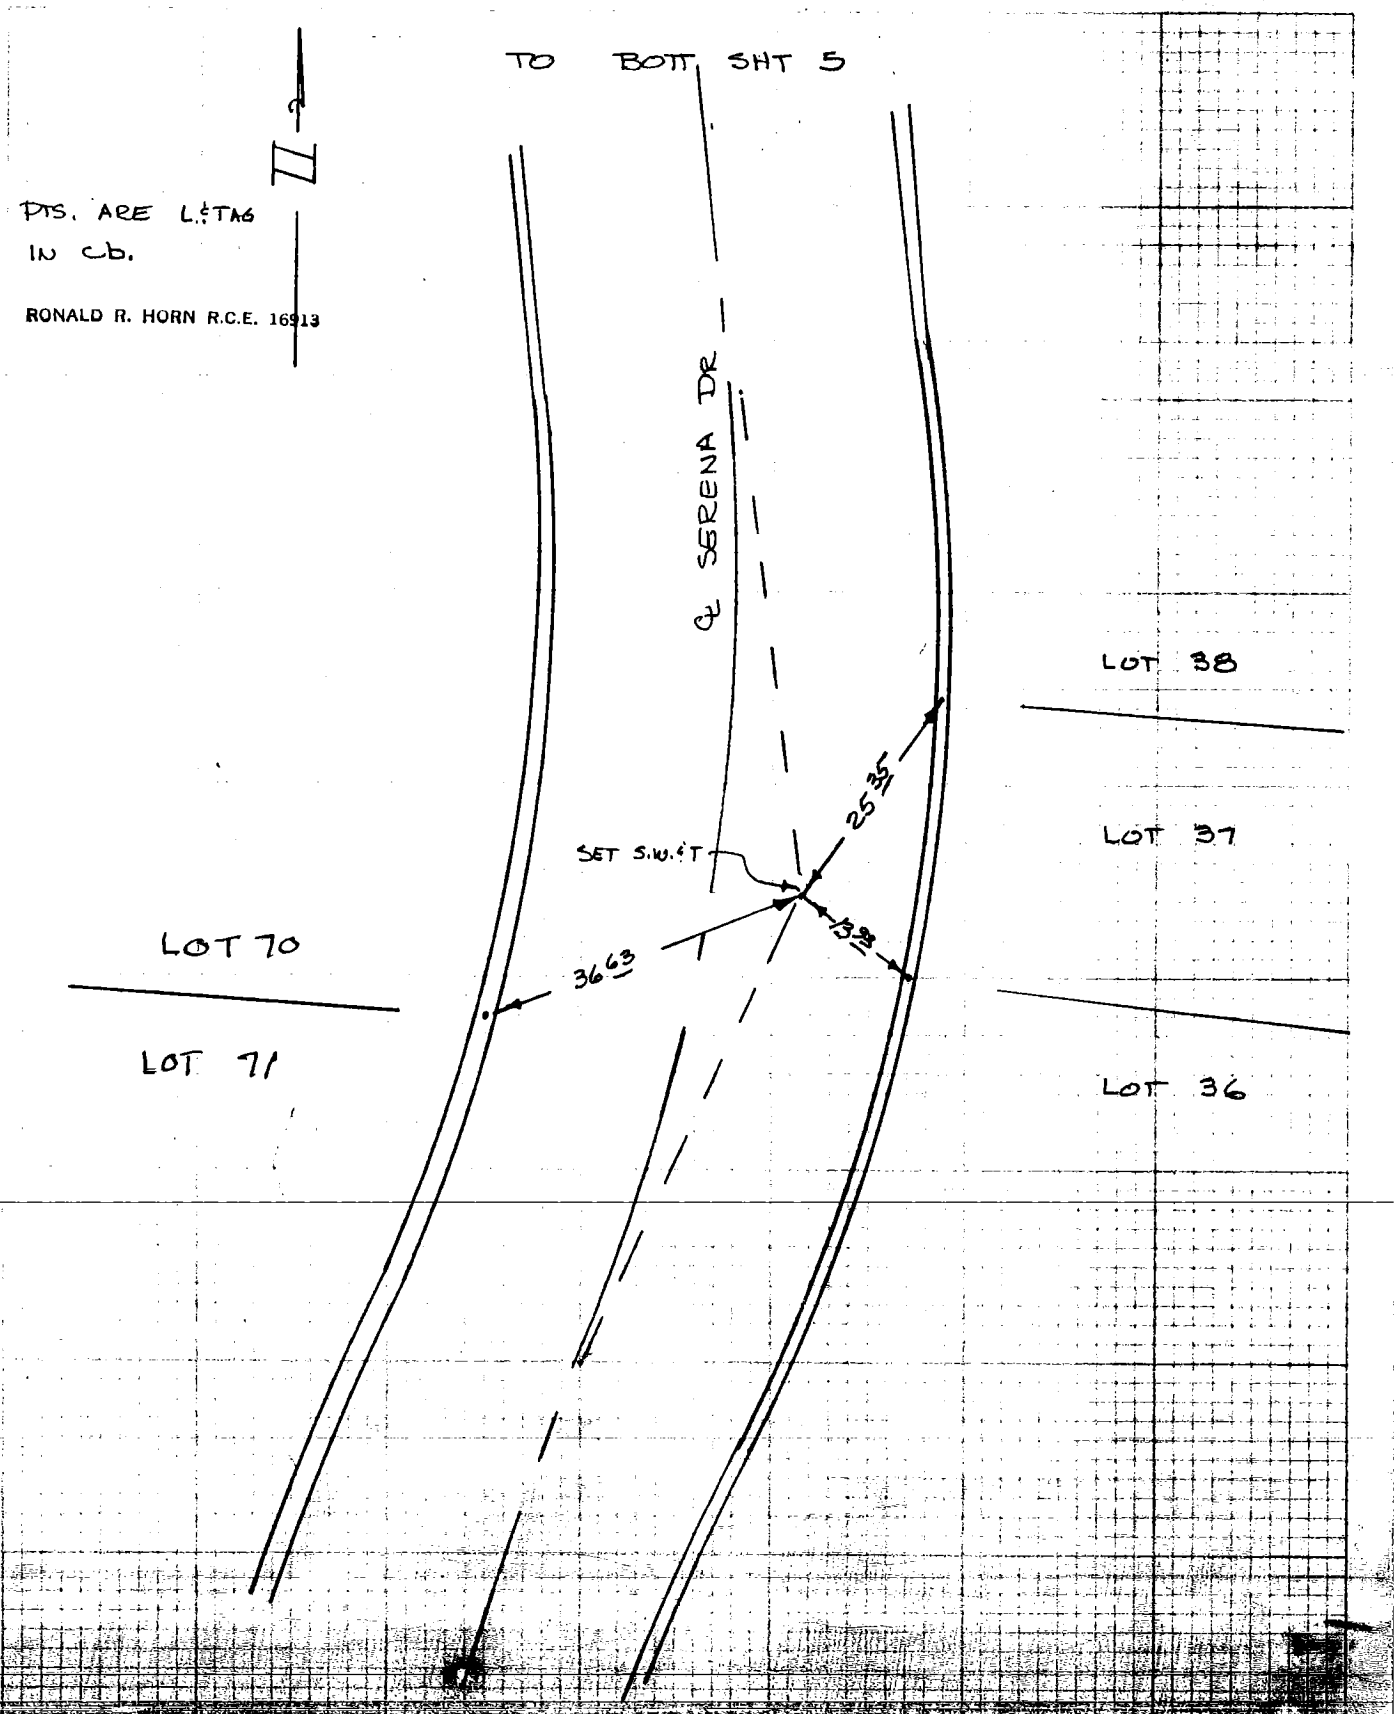

SIKAND ENGINEERING ASSOCIATES
15230 Burbank Boulevard
VAN NUYS, CALIFORNIA 91411
Phone (213) 787-8550

F.B. & TIES PG. SHT 5
W.O. TR 32084 1020-115
SURVEY BY BOSTON
DATE MARCH 2, 91

249-119, A-1 (23)

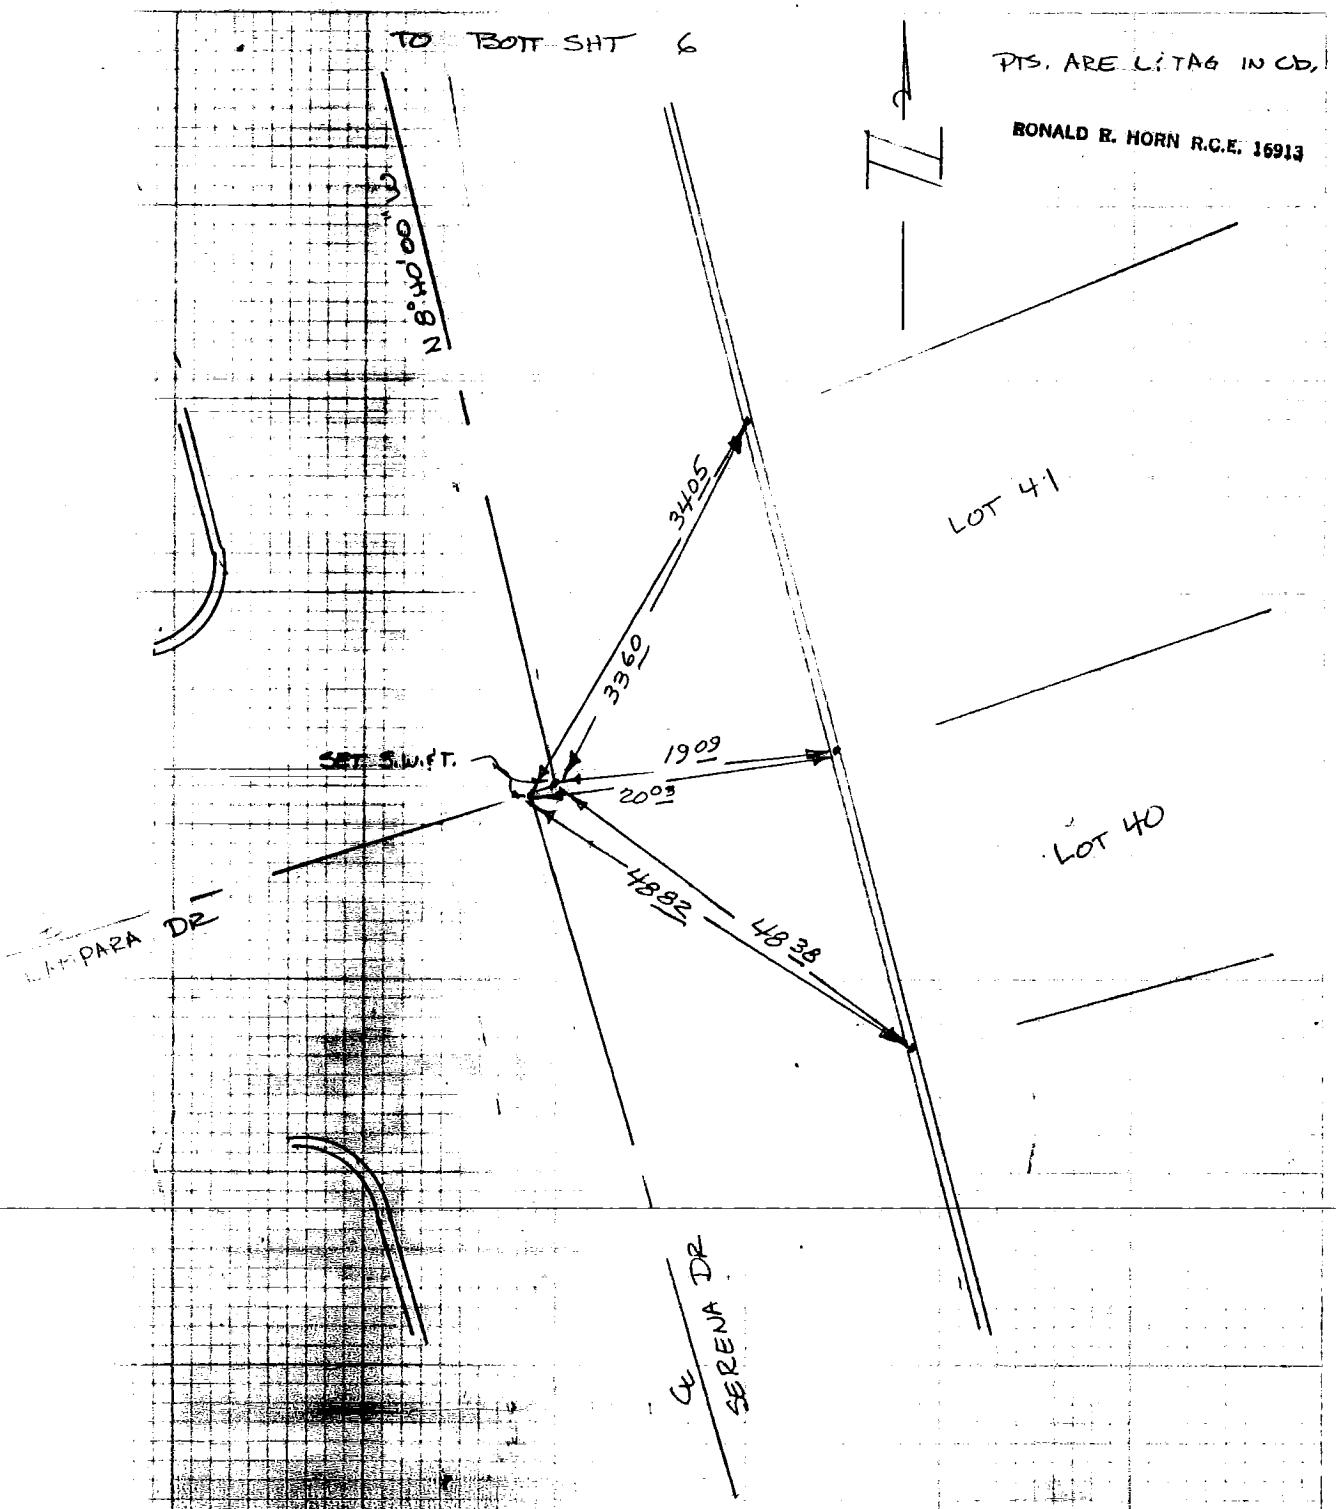

SIKAND ENGINEERING ASSOCIATES
15230 Burbank Boulevard
VAN NUYS, CALIFORNIA 91411
Phone (213) 787-8550

F.B. & TIES PG. SHT 6
W.O. TR 32084 1020-115
SURVEY BY BOSTON
DATE MARCH 2, 81

249-417-1 (23)

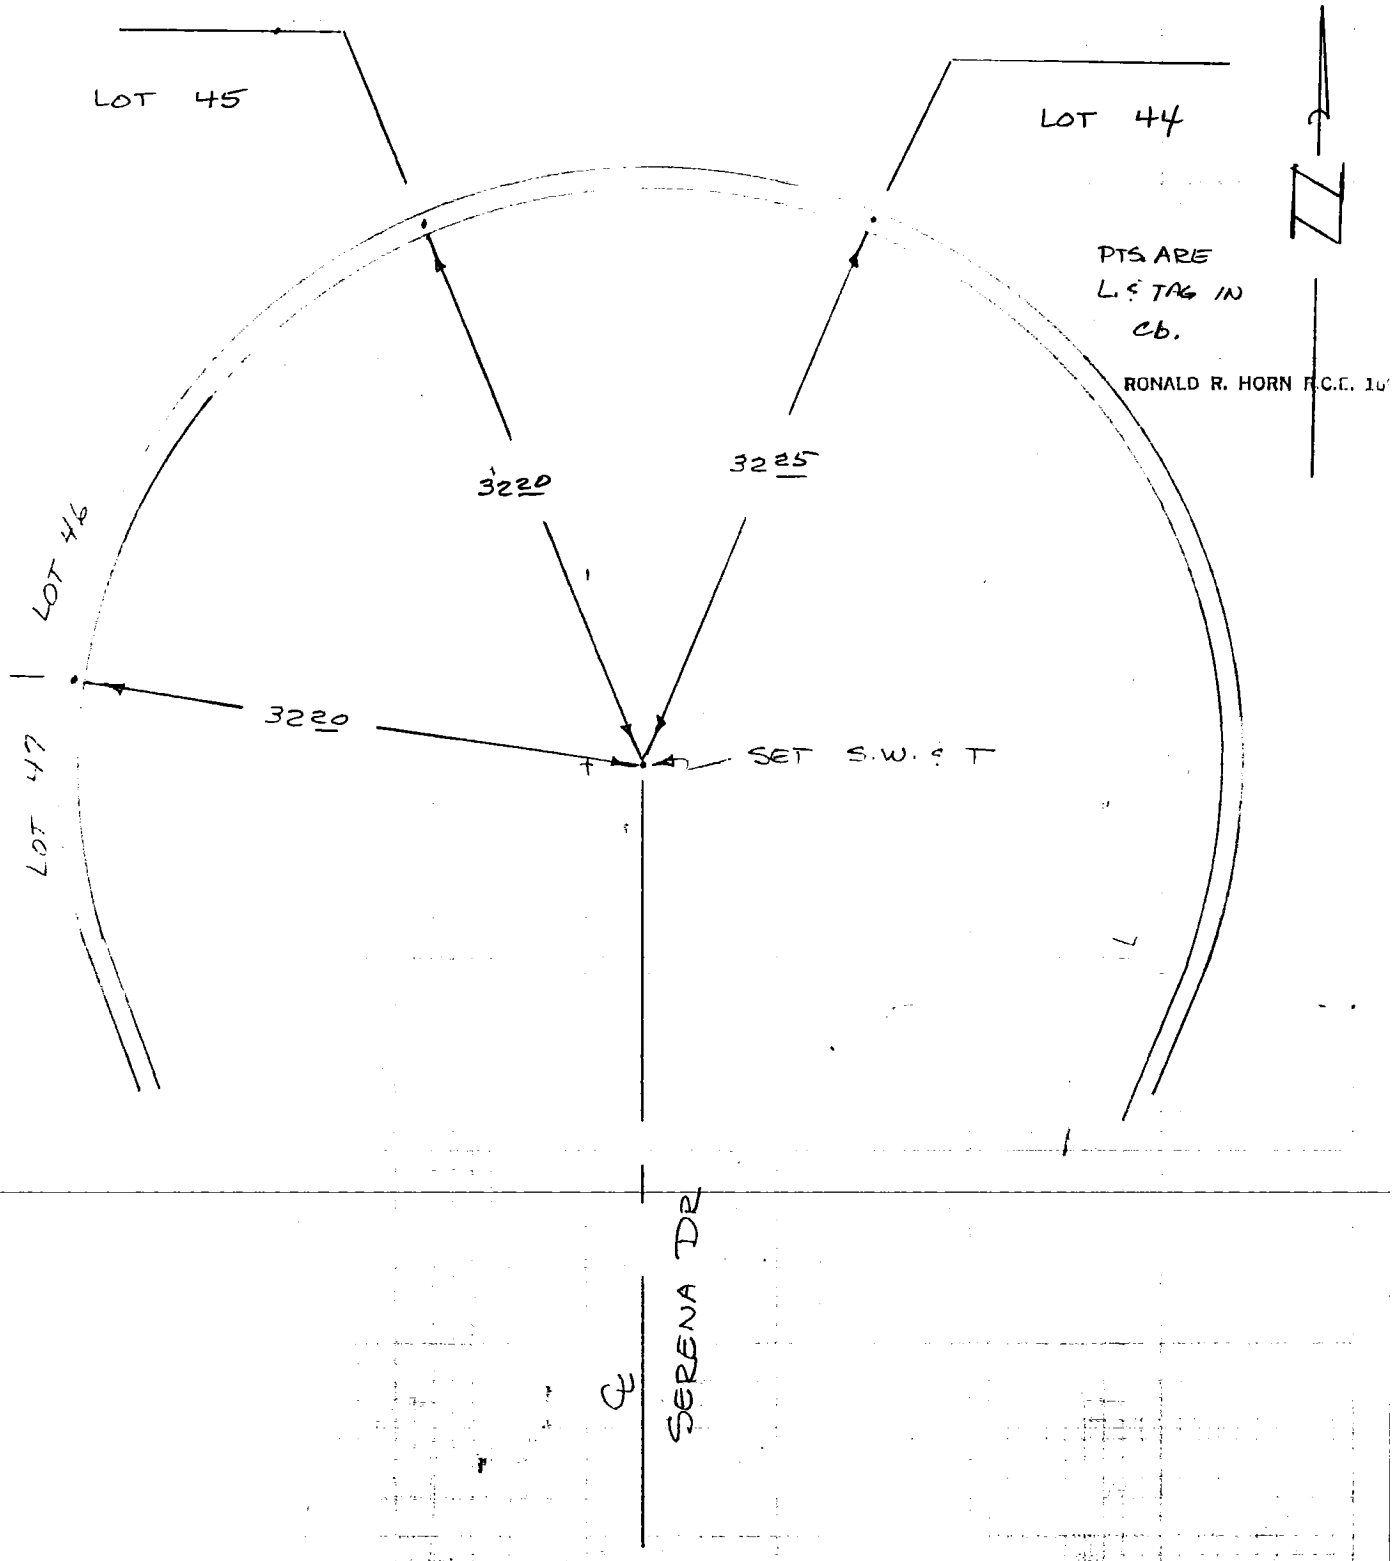

TO TOP SHT 5

CO ENG FB 3656 - 7

SIKAND ENGINEERING ASSOCIATES
15230 Burbank Boulevard
VAN NUYS, CALIFORNIA 91411
Phone (213) 787-8550

F.B. ℄ TIES PG. SHT 7
W.O. TR 32054 1020-115
SURVEY BY BOSTON
DATE MARCH 2 91

TO LT SHT 3

249-17, A-1 (24)

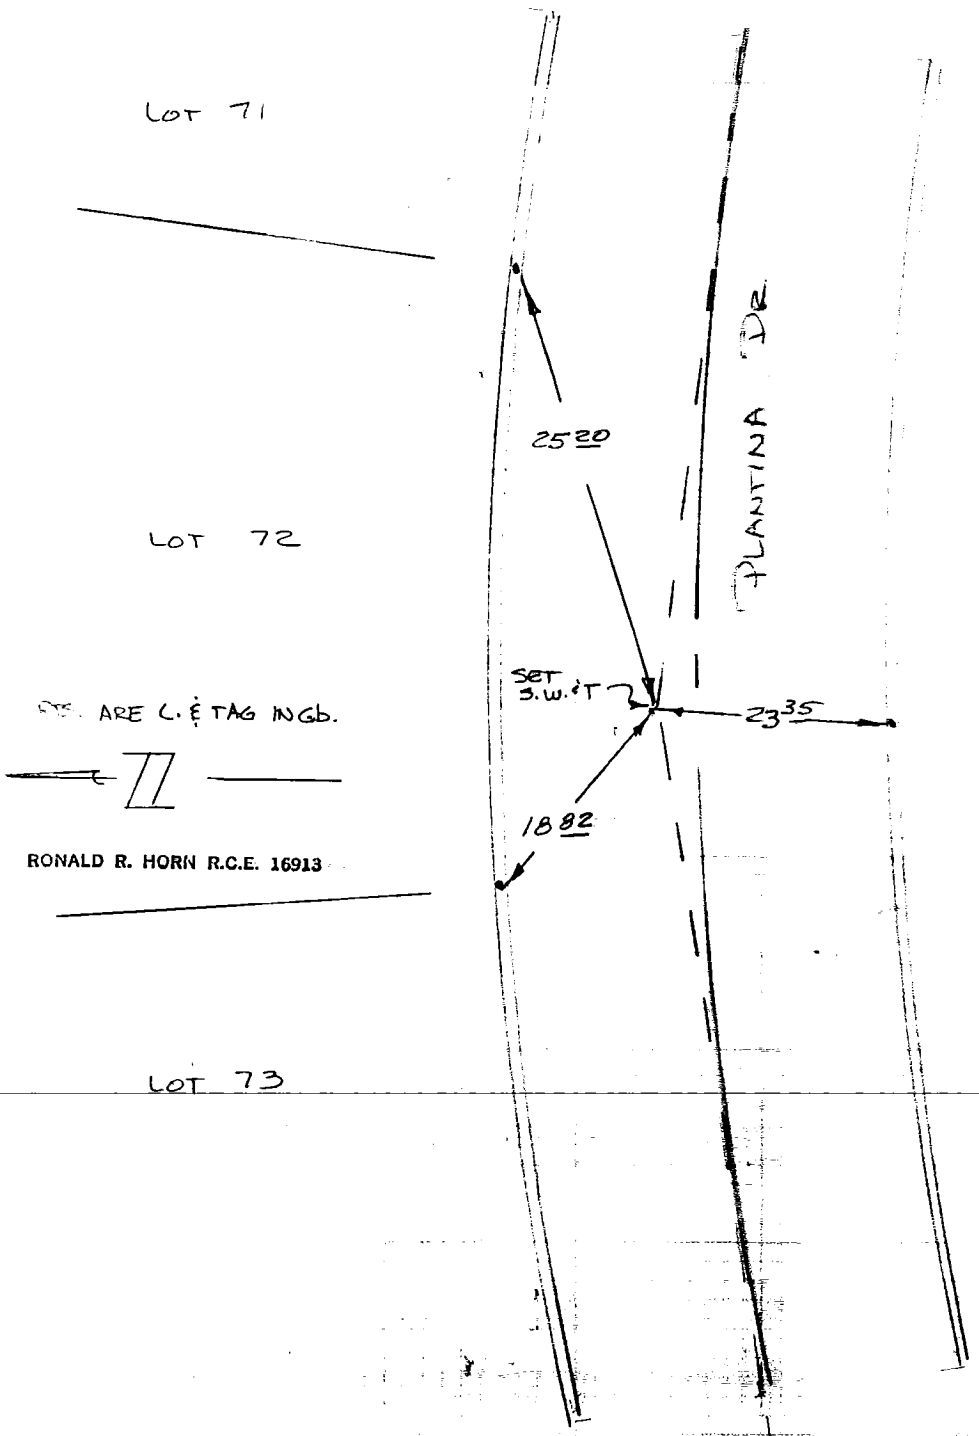

ARE L. & TAG INGb.

RONALD R. HORN R.C.E. 16913

TO TCD SHT 5

SIKAND ENGINEERING ASSOCIATES
15230 Burbank Boulevard
VAN NUYS, CALIFORNIA 91411
Phone (213) 787-8550

F.B. ℄ TIES PG. SHT 8
W.O. TR 32084 WO 1020-115
SURVEY BY BOSTON
DATE MARCH 2, 31

TO BOTT SHT 7

℄ ——

PTS. ARE L! TAG IN CB

RONALD R. HORN R.C.E. 10948

249-117, 4-1 (2)

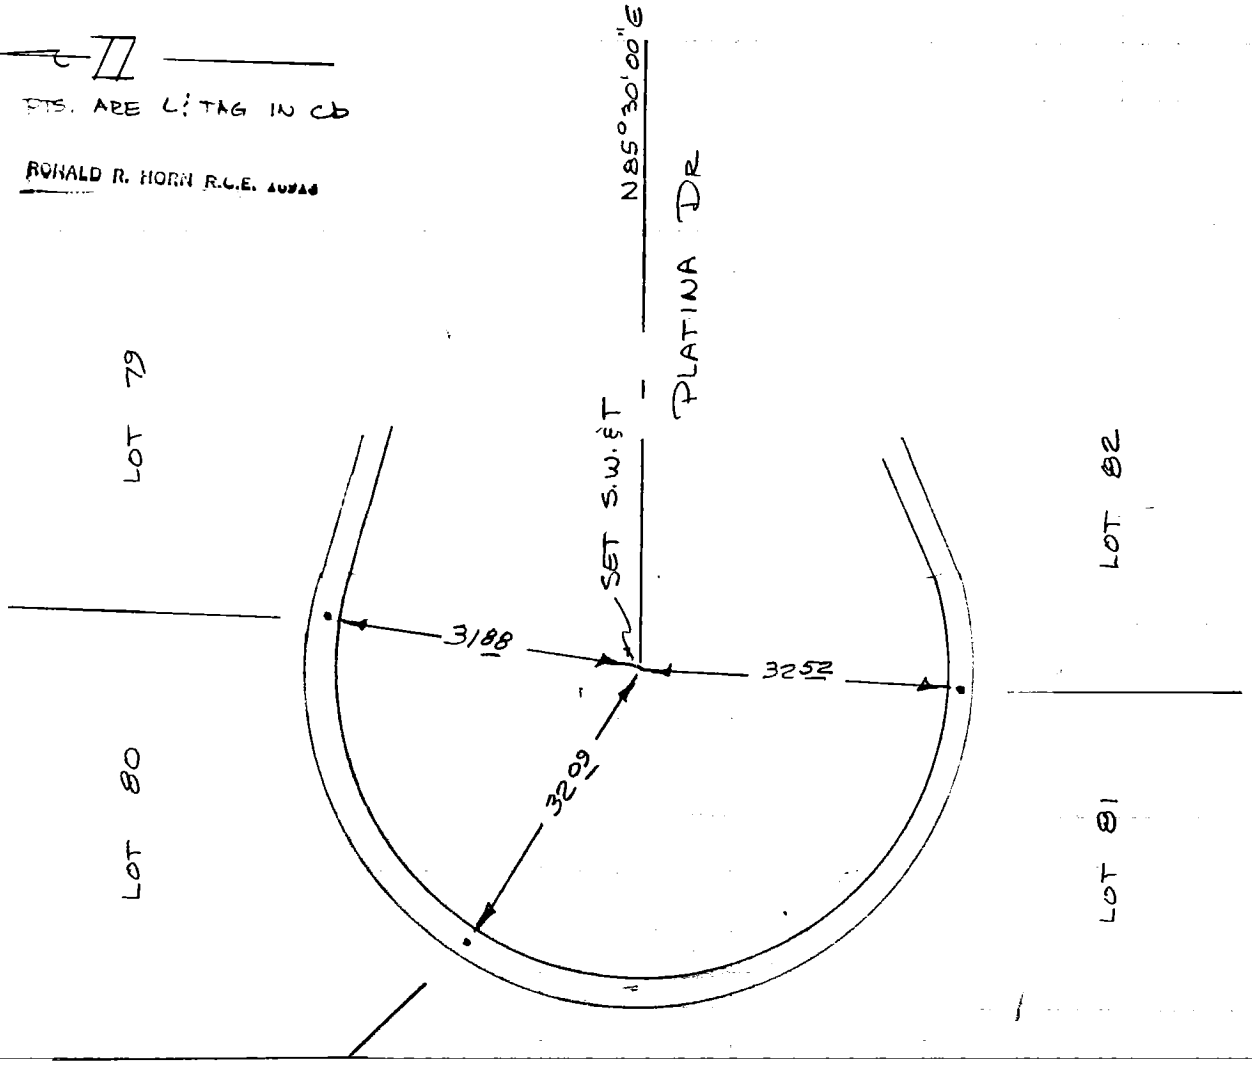

CO ENG FB 3656 -m9

SIKAND ENGINEERING ASSOCIATES
15230 Burbank Boulevard
VAN NUYS, CALIFORNIA 91411
Phone (213) 787-8550

F.B. @ TIES PG. SHT 9
W.O. TR 32084 W1020-11.5
SURVEY BY BOSTON
DATE MARCH 2, 81

TO LT SHT 5

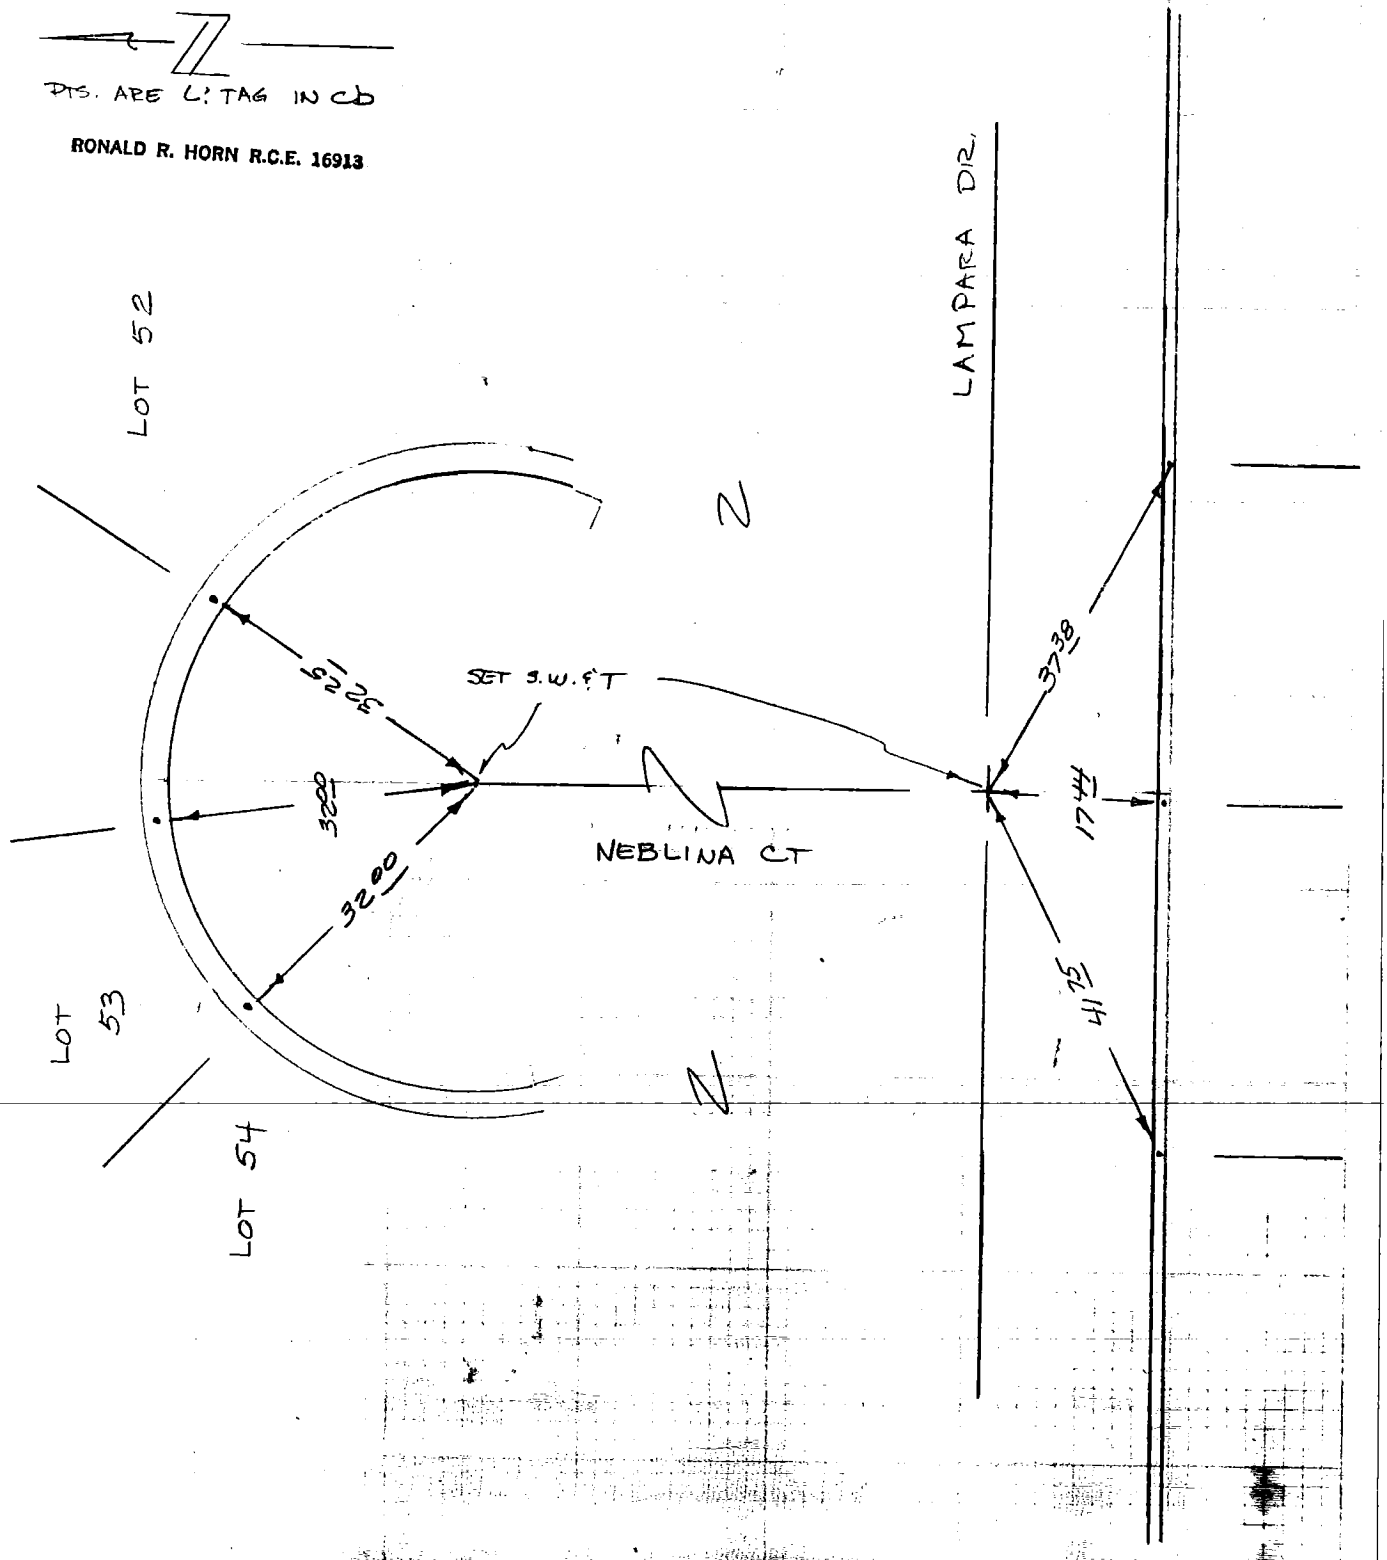

249-117, A-1 (23)

SIKAND ENGINEERING ASSOCIATES
15230 Burbank Boulevard
VAN NUYS, CALIFORNIA 91411
Phone (213) 787-8550

F.B. ℄ TIES PG. SHT 10
W.O. TR 32084 WO 1020-115
SURVEY BY BOSTON
DATE MARCH 2, 81

TO BOTT SHT 9

249-117, M-1 (25)

Z
TIES ARE L. & TAG IN Cb.

RONALD R. HORN R.C.E. 16913

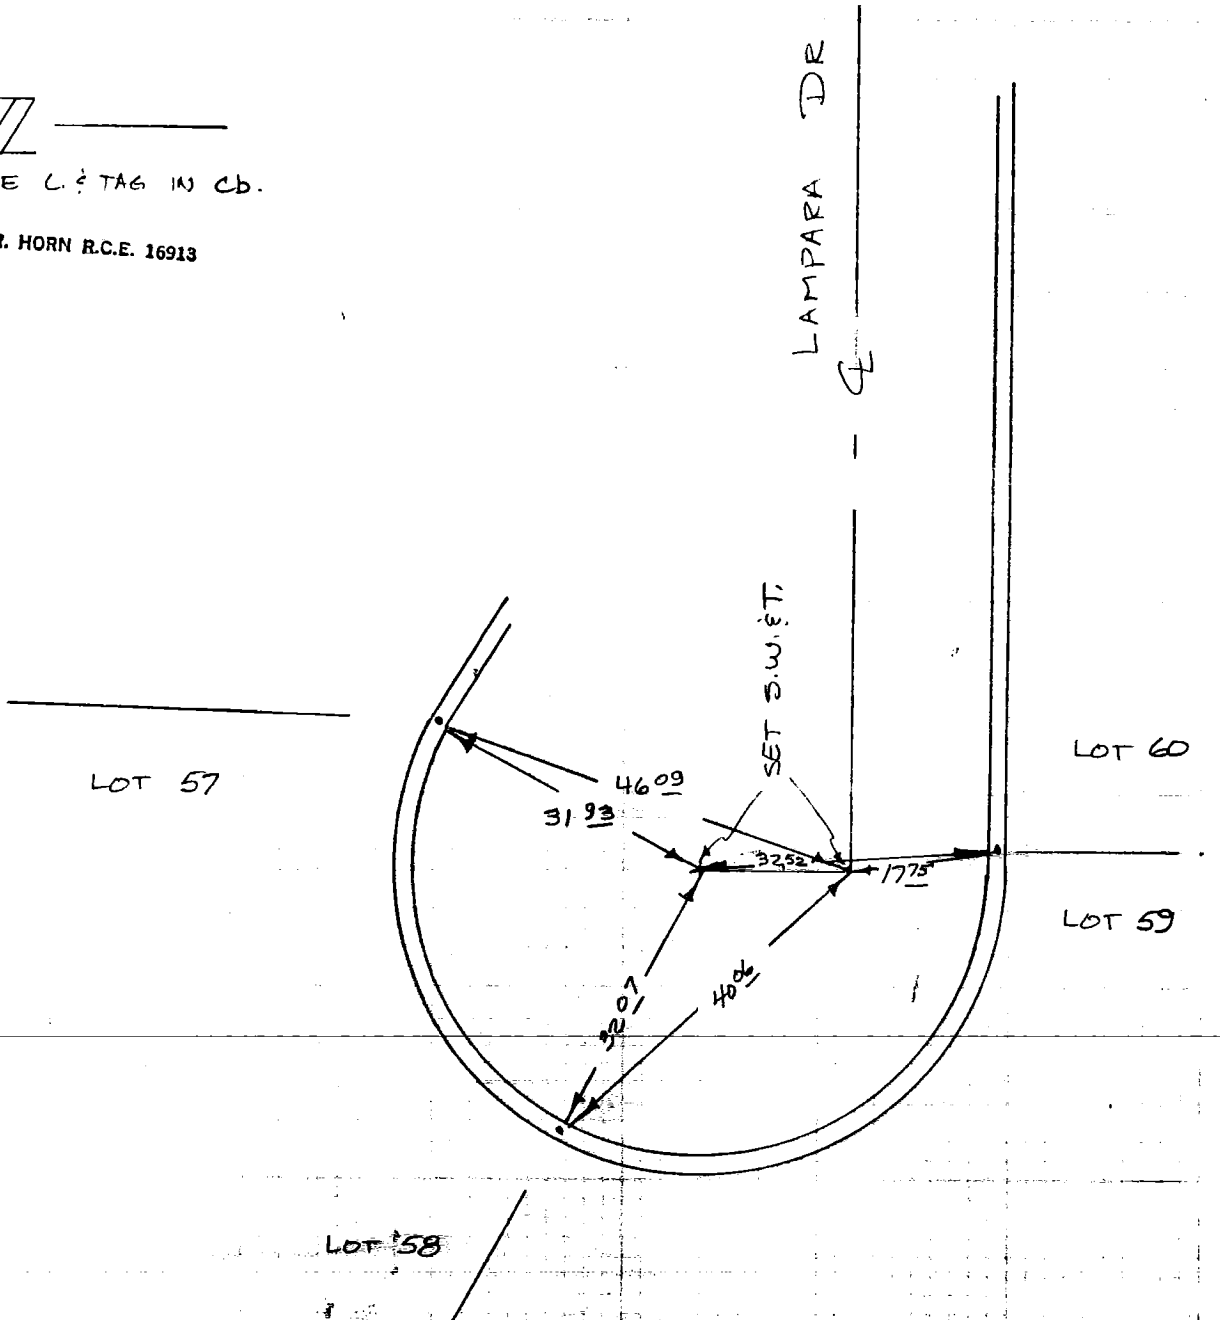

SIKAND ENGINEERING ASSOCIATES
15230 Burbank Boulevard
VAN NUYS, CALIFORNIA 91411
Phone (213) 787-8550

F.B. ℄ TIES PG. 11
W.O. 1020-115 TR 32084
SURVEY BY Boston
DATE Aug 20, 81

℄ TIES

249-HT, A1 (26)

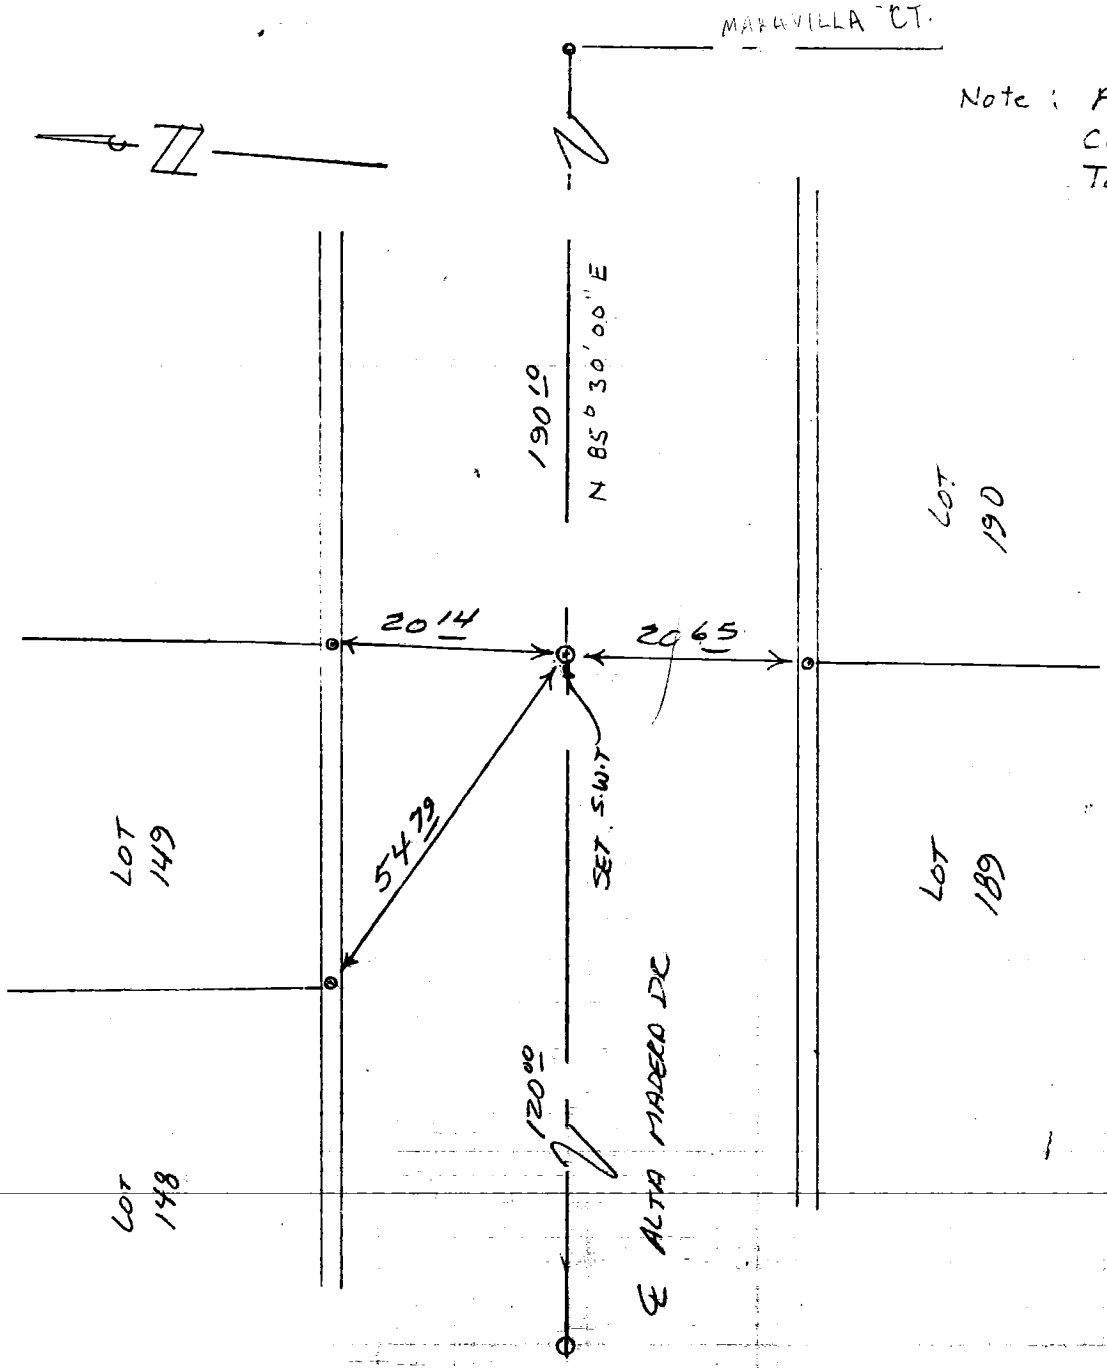

Note: All Pts. on Curb are Tags in Lead
RCE 16913

SIKAND ENGINEERING ASSOCIATES
15230 Burbank Boulevard
VAN NUYS, CALIFORNIA 91411
Phone (213) 787-8550

F.B. 4 TIES PG. 12
W.O. 1020-1.1 TR 32054
SURVEY BY BOSTON
DATE MARCH 2, 1981

249-117, A-1 (27)

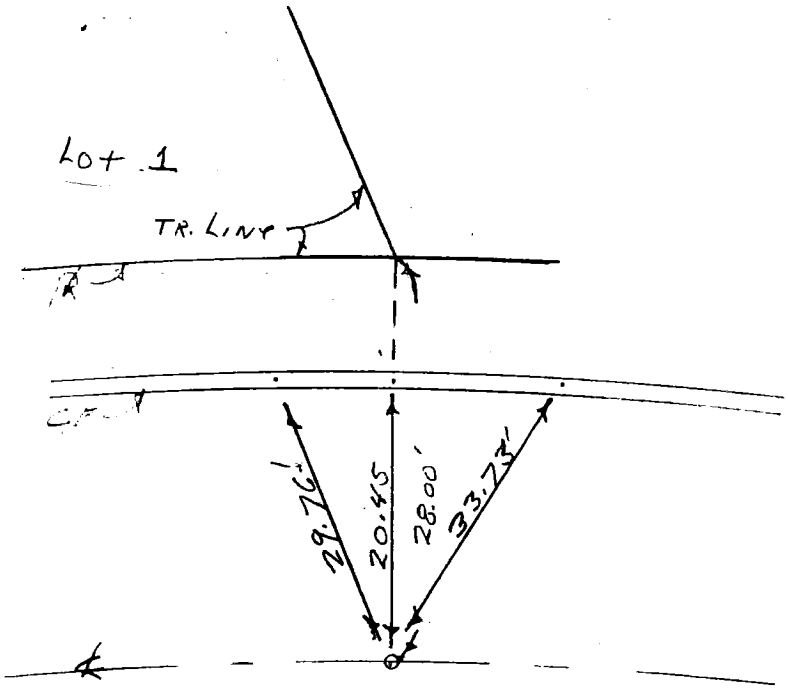

ALTA MADERA DRIVE

CL R

SIKAND ENGINEERING ASSOCIATES
15230 Burbank Boulevard
VAN NUYS, CALIFORNIA 91411
Phone (213) 787-8550

F.B. ℄ TIES PG. 13
W.O. TR. 32084 1020-115
SURVEY BY BOSTON
DATE MARCH 2, 1981

REAR CORNER MONUMENTS

TR. 32084

LOT:	SET:	
1	℄ PROD	RCE 16913
2-29	1" IP	"
30-31	℄ PROD	"
32-47	1" IP	"
48-49	℄ PROD	"
50-55	1" IP	"
56	℄ PROD	"
57-69	1" IP	"
70-71	℄ PROD	"
72-80	1" IP	"
81-90	℄ PROD	"
91	℄ PROD	"

ALL LOTS HAVE L & T, RCE 16913 PRODS IN CURBS ON FRONTS

ANGLE POINTS 1

SIKAND ENGINEERING ASSOCIATES
15230 Burbank Boulevard
VAN NUYS, CALIFORNIA 91411
Phone (213) 787-8550

F.B. & TIES PG. 14
W.O. 1020-1 SA TR. 32034
SURVEY BY BOSTON
DATE MARCH 2, 1991

TRACT LINE MONUMENT CHANGES

SET 2" IP IN LIEU OF L&T IN CONC. WALL FOOTING

ANGLE POINTS LOTS

44
17
16
58
57
53
52
45

NOTE ALL POINTS ARE STAMPED

RONALD R. HORN R.C.E. 16913

CO ENG FB 3656 - 15

SIKAND ENGINEERING ASSOCIATES
15230 Burbank Boulevard
VAN NUYS, CALIFORNIA 91411
Phone (213) 787-8550

JOB TR 33890
SHEET NO. 1 OF 27
CALCULATED BY BOSTON DATE FEB 13, 80
CHECKED BY / DATE
SCALE NONE W.O. 1020-115

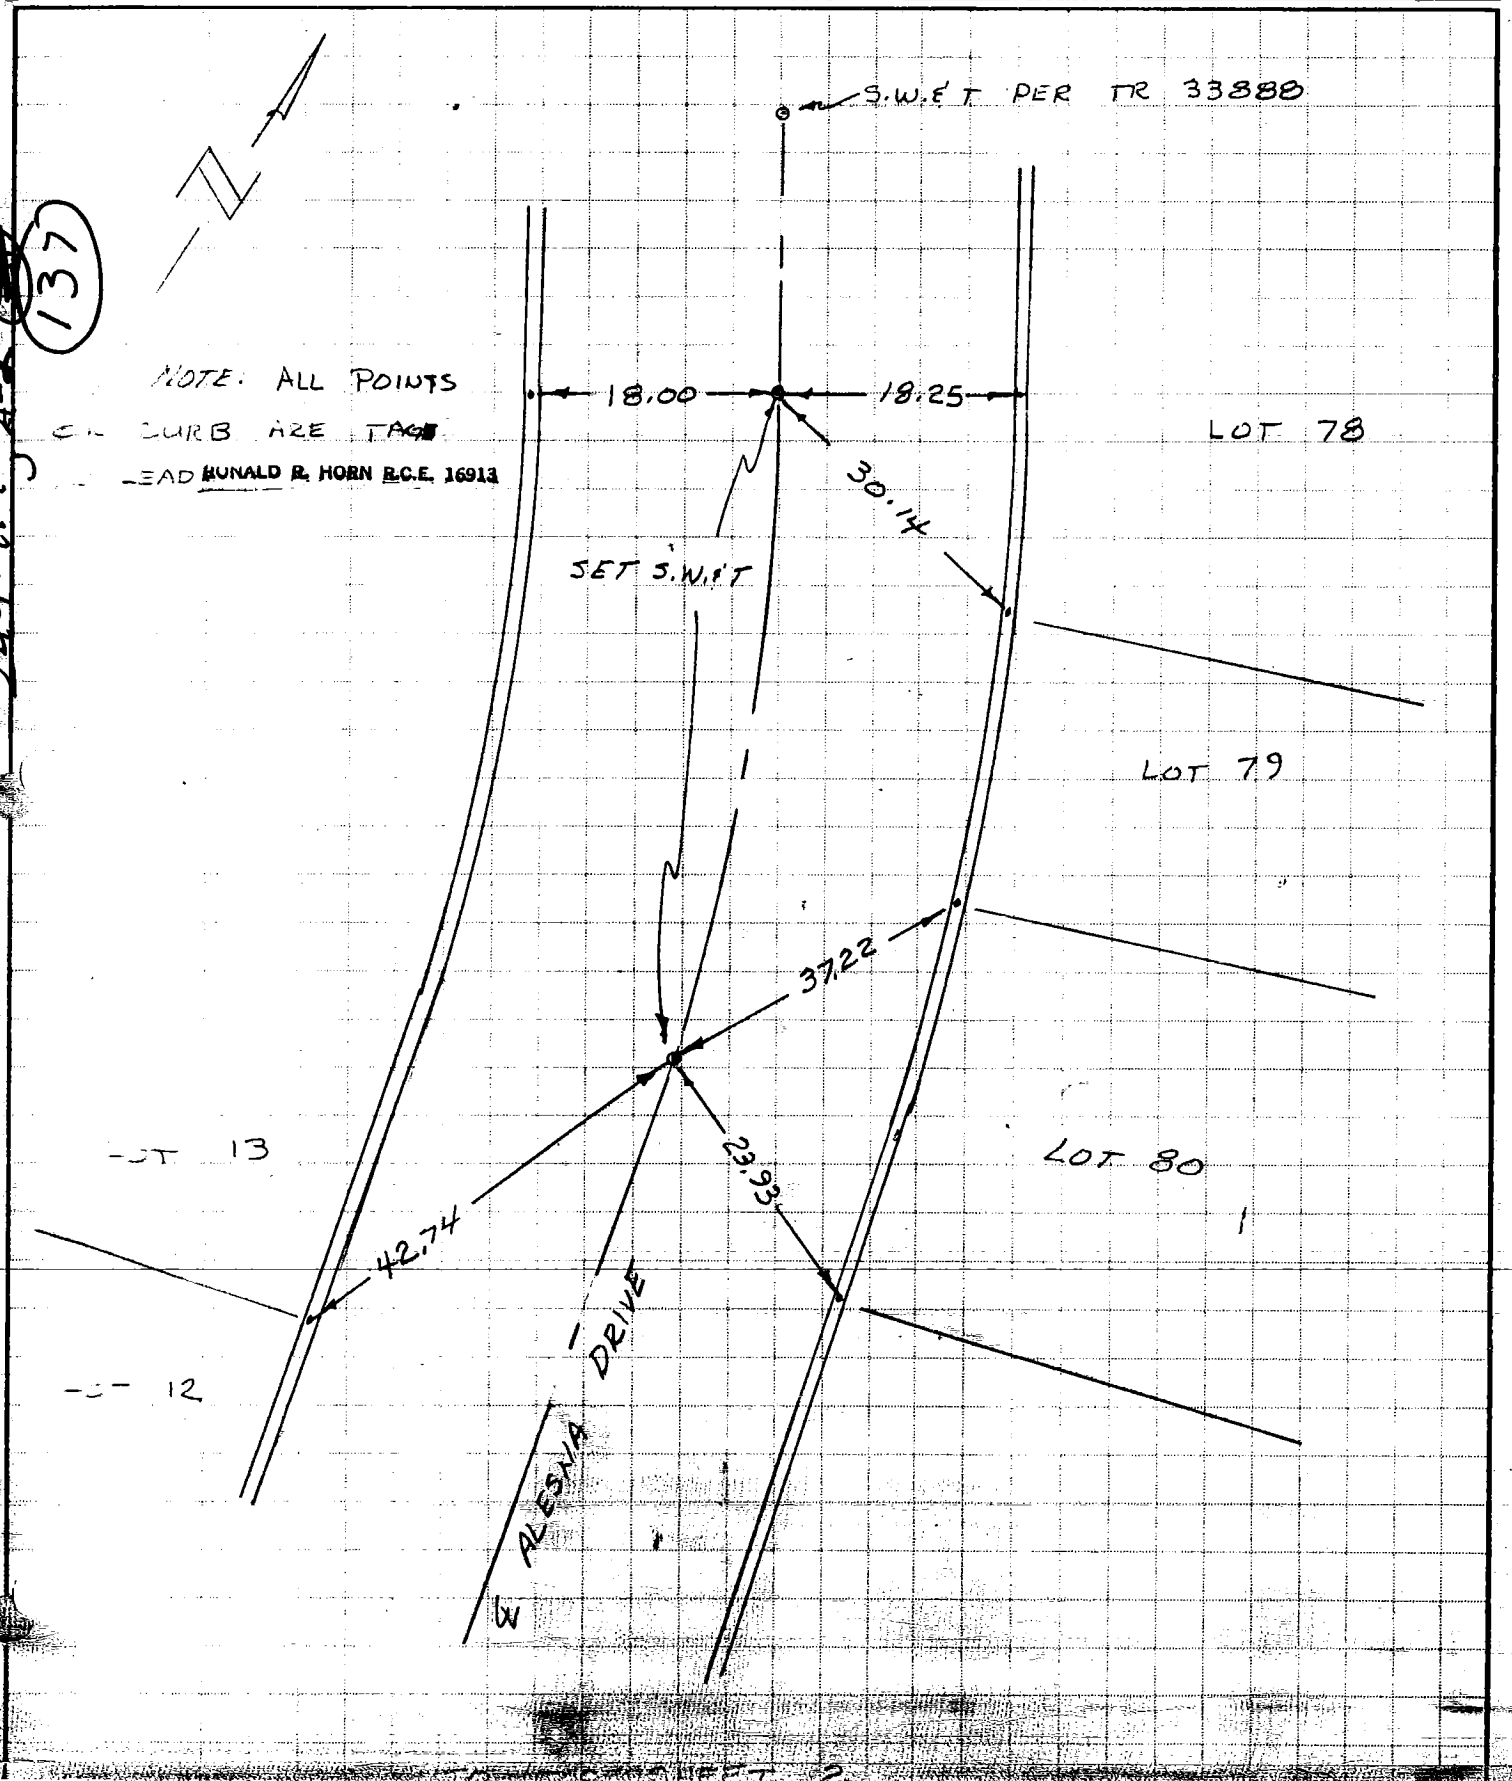

NOTE: ALL POINTS
C.L. CURB AREA TAGGED
LEAD RONALD R. HORN R.C.E. 16913

249-117 A-3 (137)

CO ENG FB 3656 - 16

SIKAND ENGINEERING ASSOCIATES
15230 Burbank Boulevard
VAN NUYS, CALIFORNIA 91411
Phone (213) 787-8550

JOB TR 33890

SHEET NO. 2 OF 27

CALCULATED BY BOSTON DATE FEB 13, 80

CHECKED BY ✓ DATE

SCALE NONE W.O. 1020-115

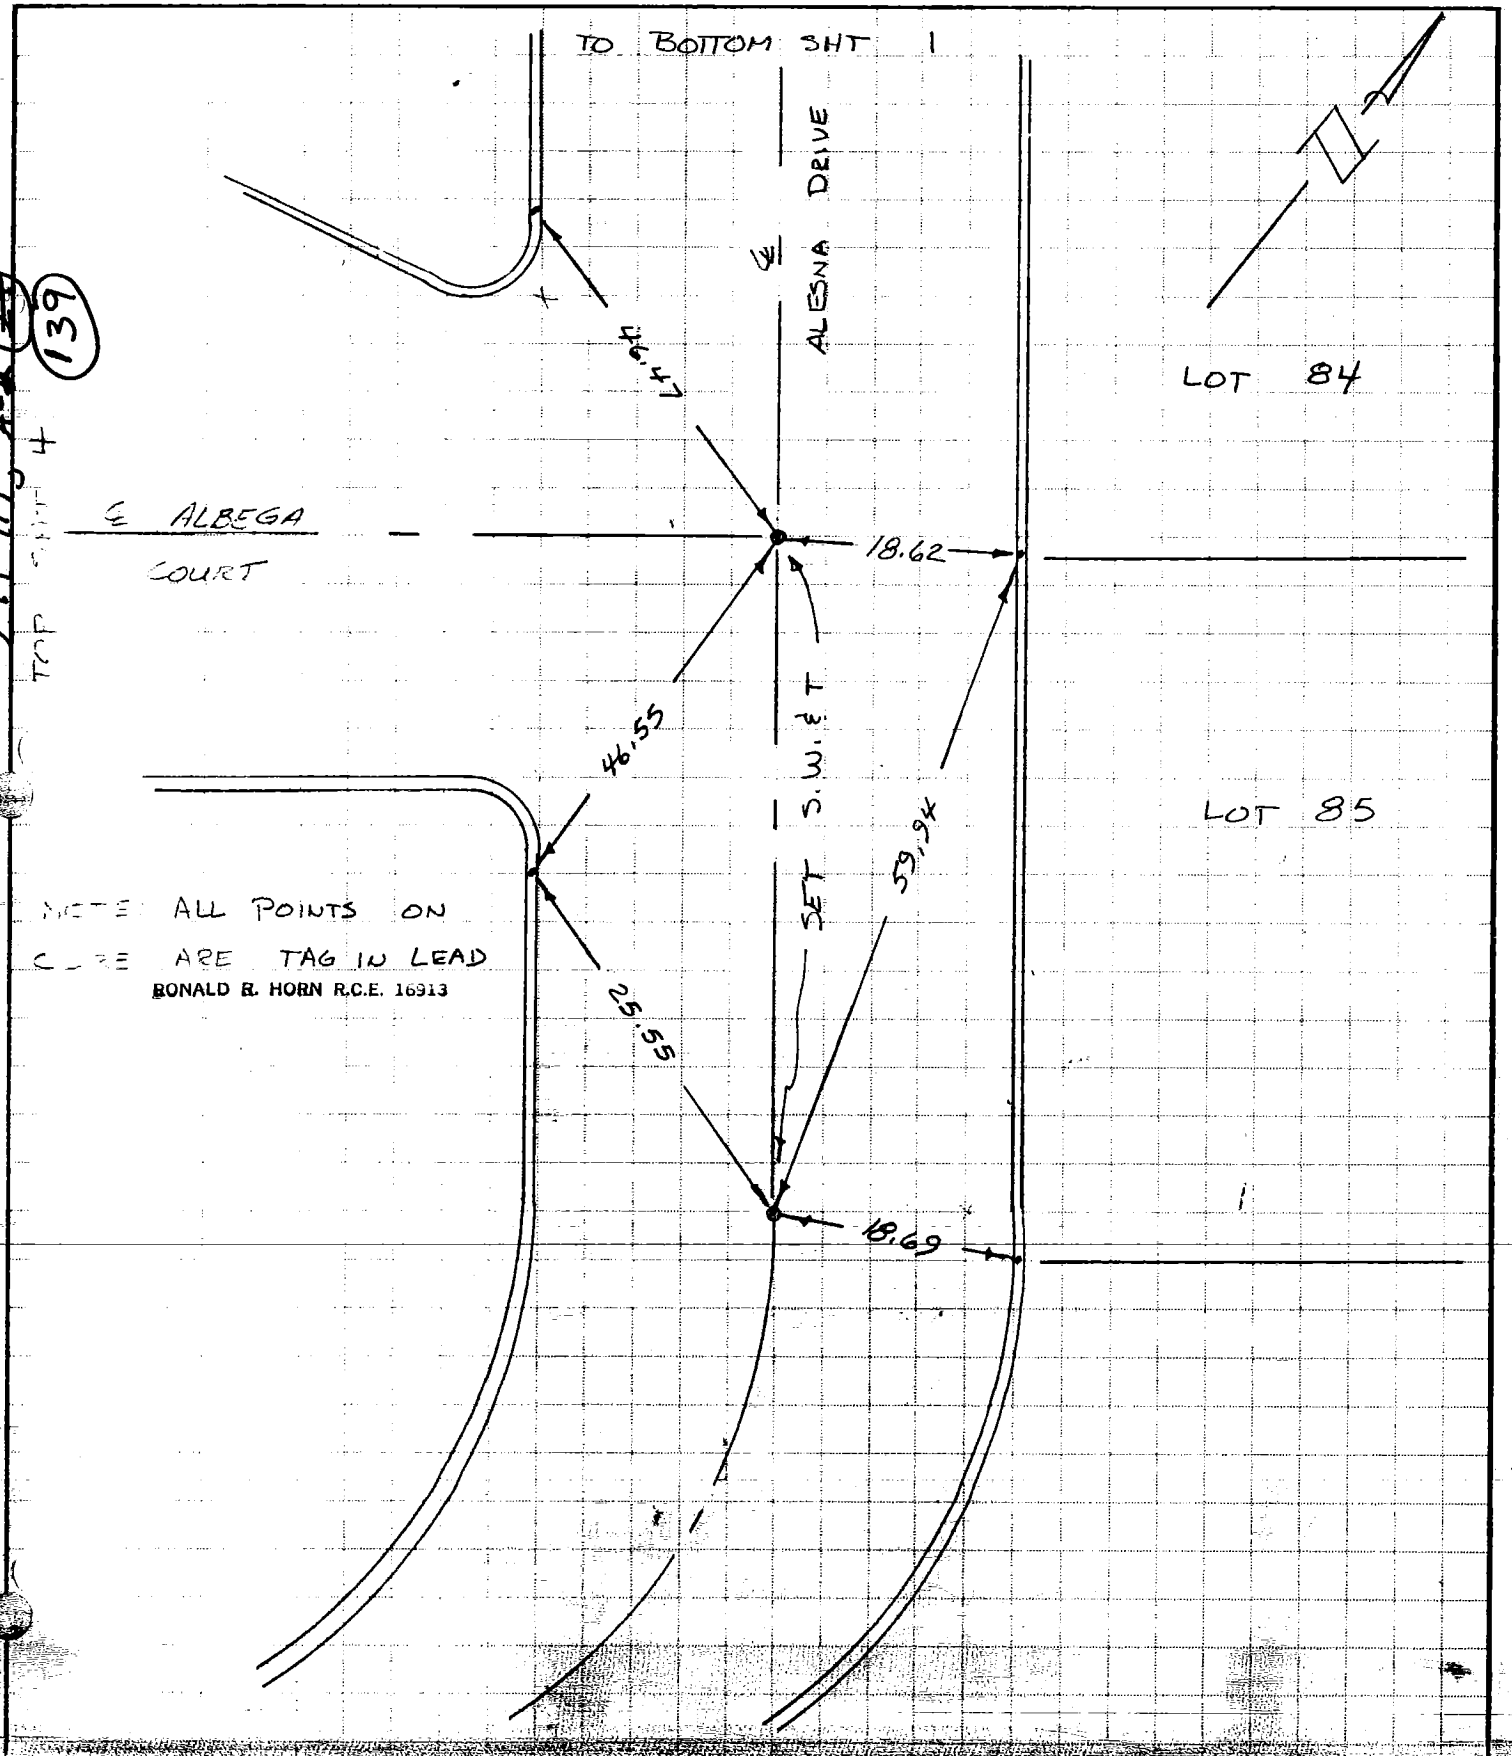

SIKAND ENGINEERING ASSOCIATES
15230 Burbank Boulevard
VAN NUYS, CALIFORNIA 91411
Phone (213) 787-8550

JOB TR 33890
SHEET NO. 3 OF 27
CALCULATED BY BOSTON DATE FEB 13, 80
CHECKED BY ✓ DATE
SCALE NONE W.O. 1020-115

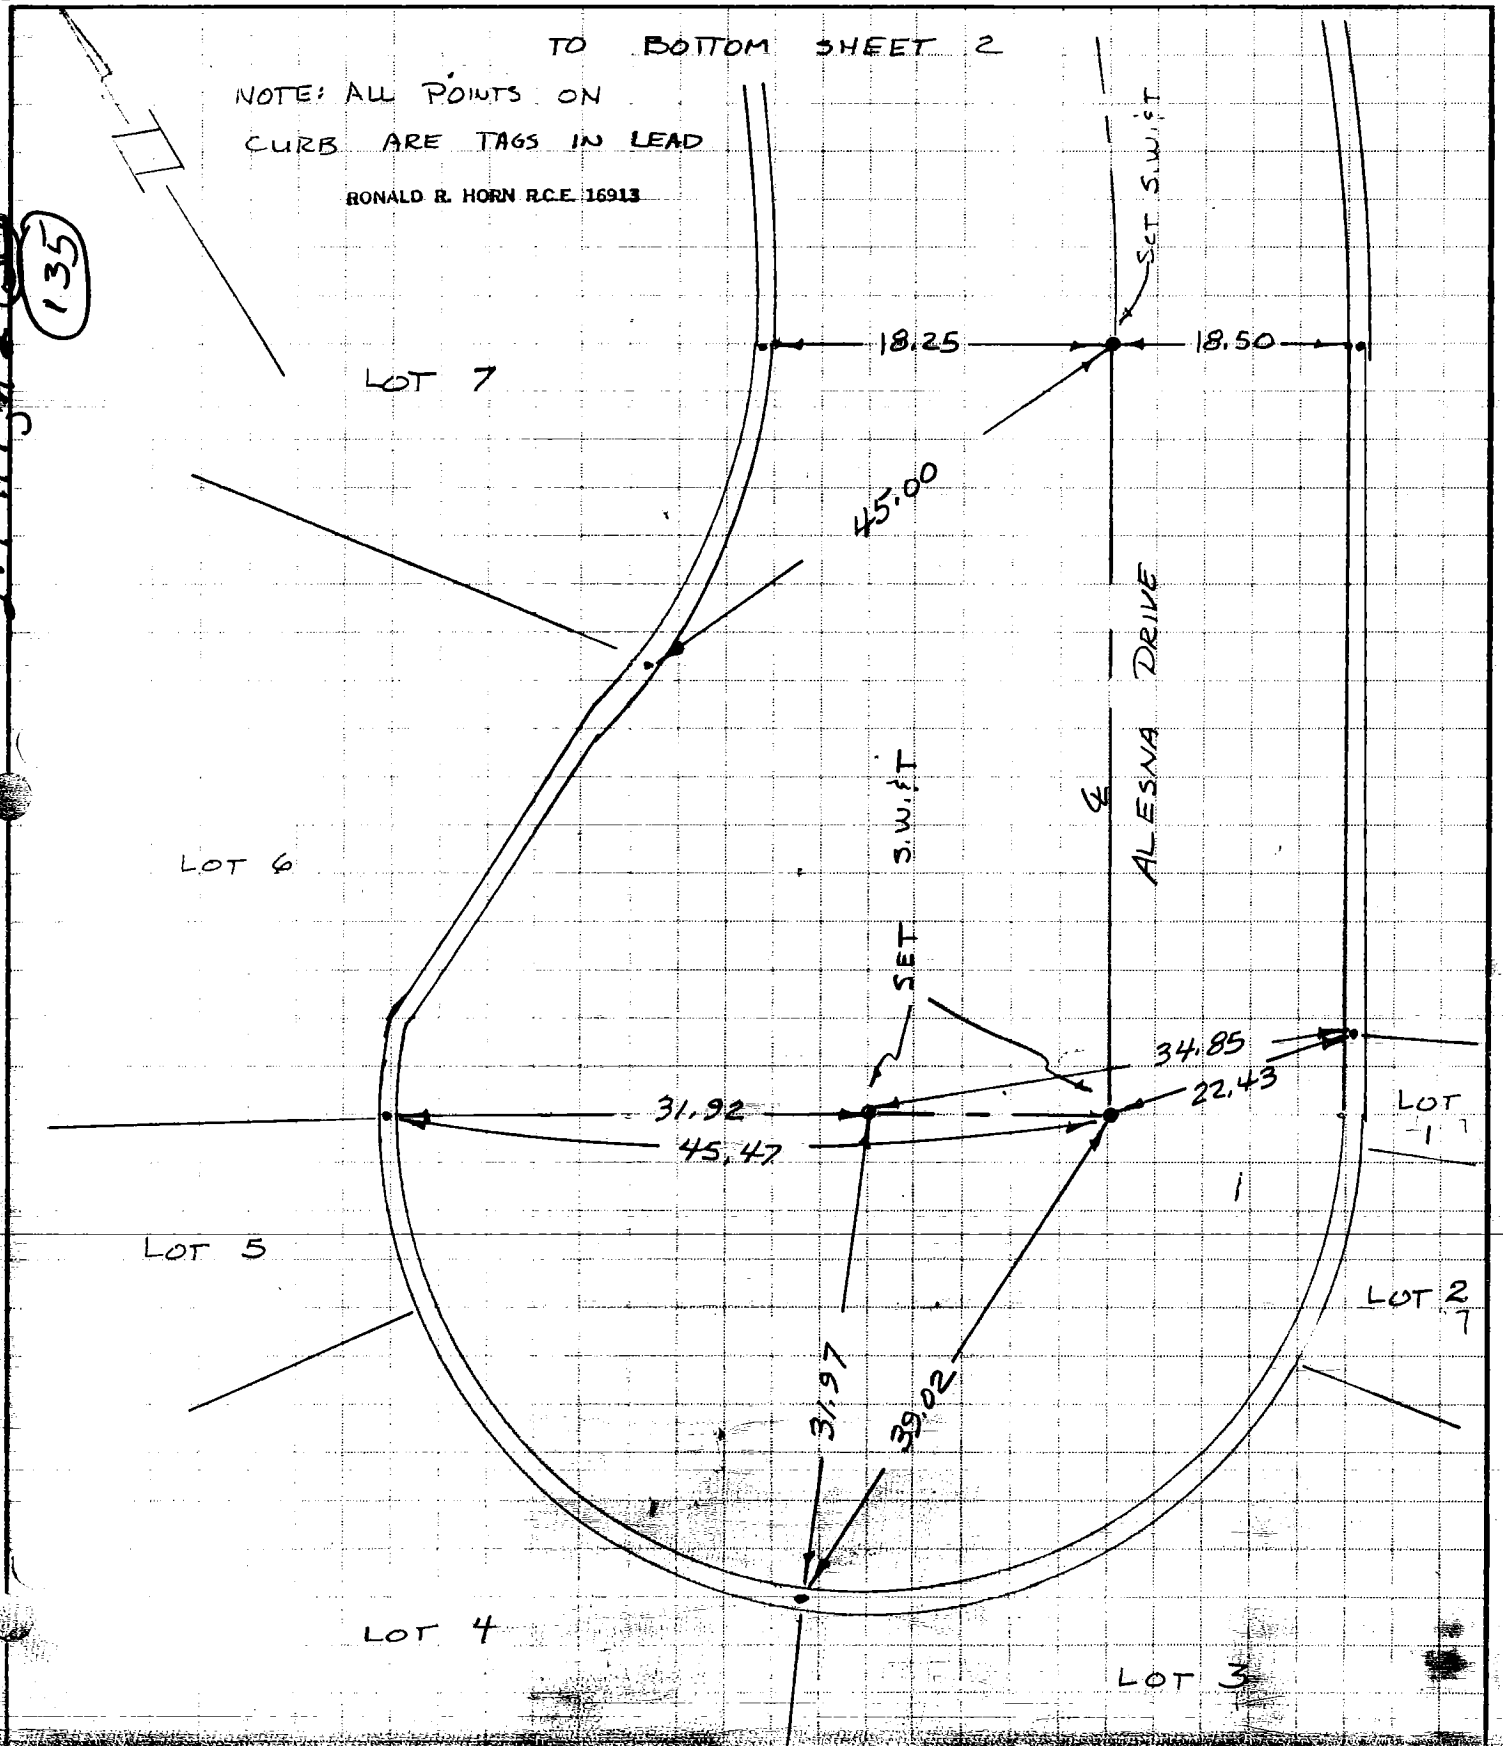

SIKAND ENGINEERING ASSOCIATES
15230 Burbank Boulevard
VAN NUYS, CALIFORNIA 91411
Phone (213) 787-8550

18

JOB TR 33890
SHEET NO. 4 OF 27
CALCULATED BY BOSTON DATE FEB 13, 80
CHECKED BY / DATE
SCALE NONE W.O. 1020-115

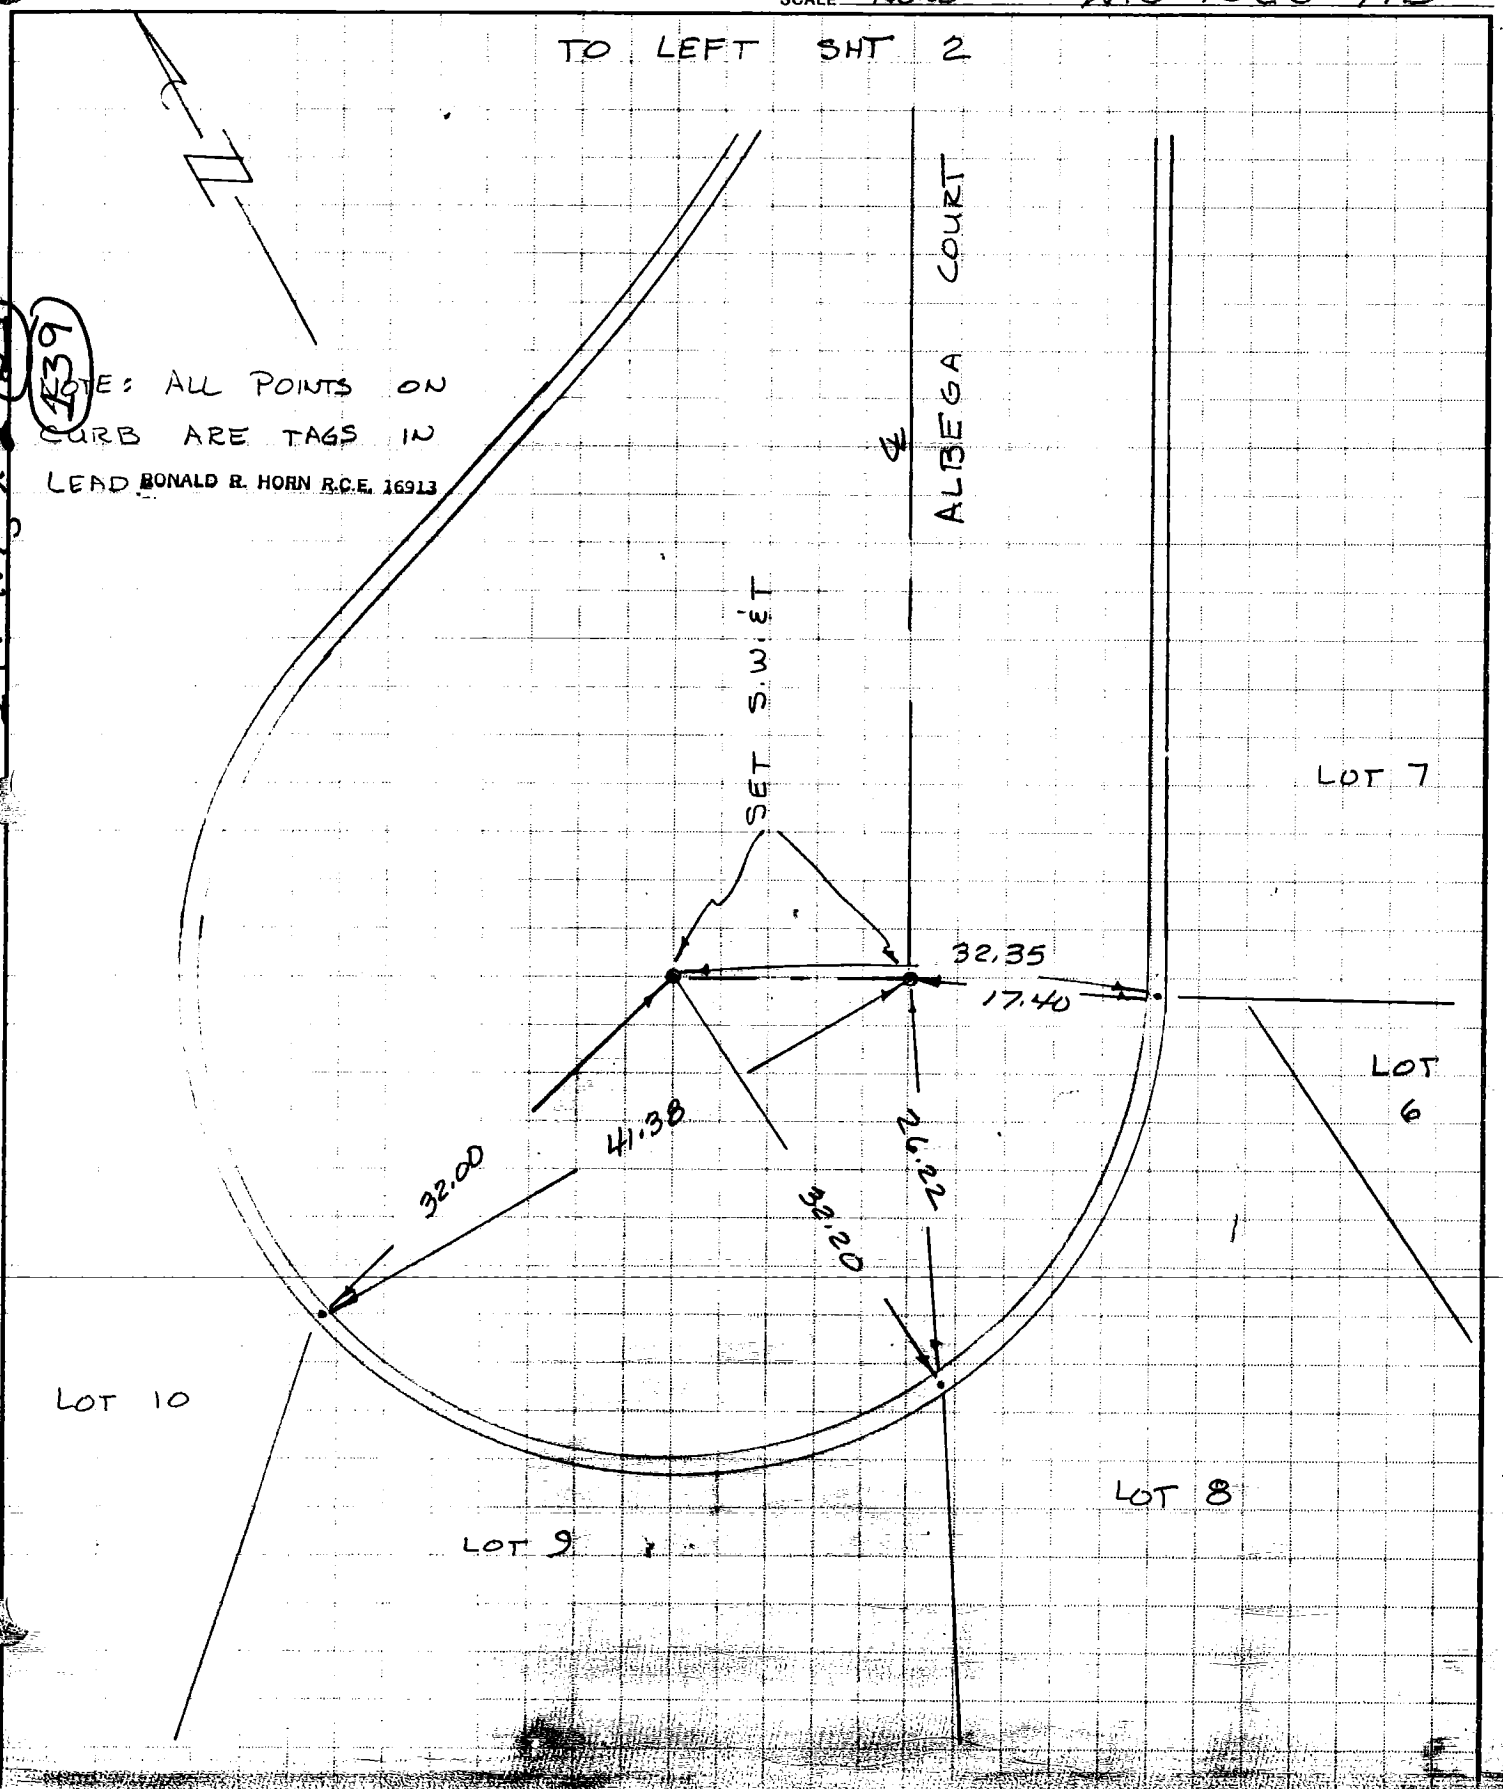

249-117 A-B 439

SIKAND **ENGINEERING ASSOCIATES**
15230 Burbank Boulevard
VAN NUYS, CALIFORNIA 91411
Phone (213) 787-8550

19

JOB TR 33890

SHEET NO. 5 OF 27

CALCULATED BY BOSTON DATE FEB 13, 80

CHECKED BY ✓ DATE

SCALE NONE W.O. 1020-115

249-117, 4-2 (SP 136)

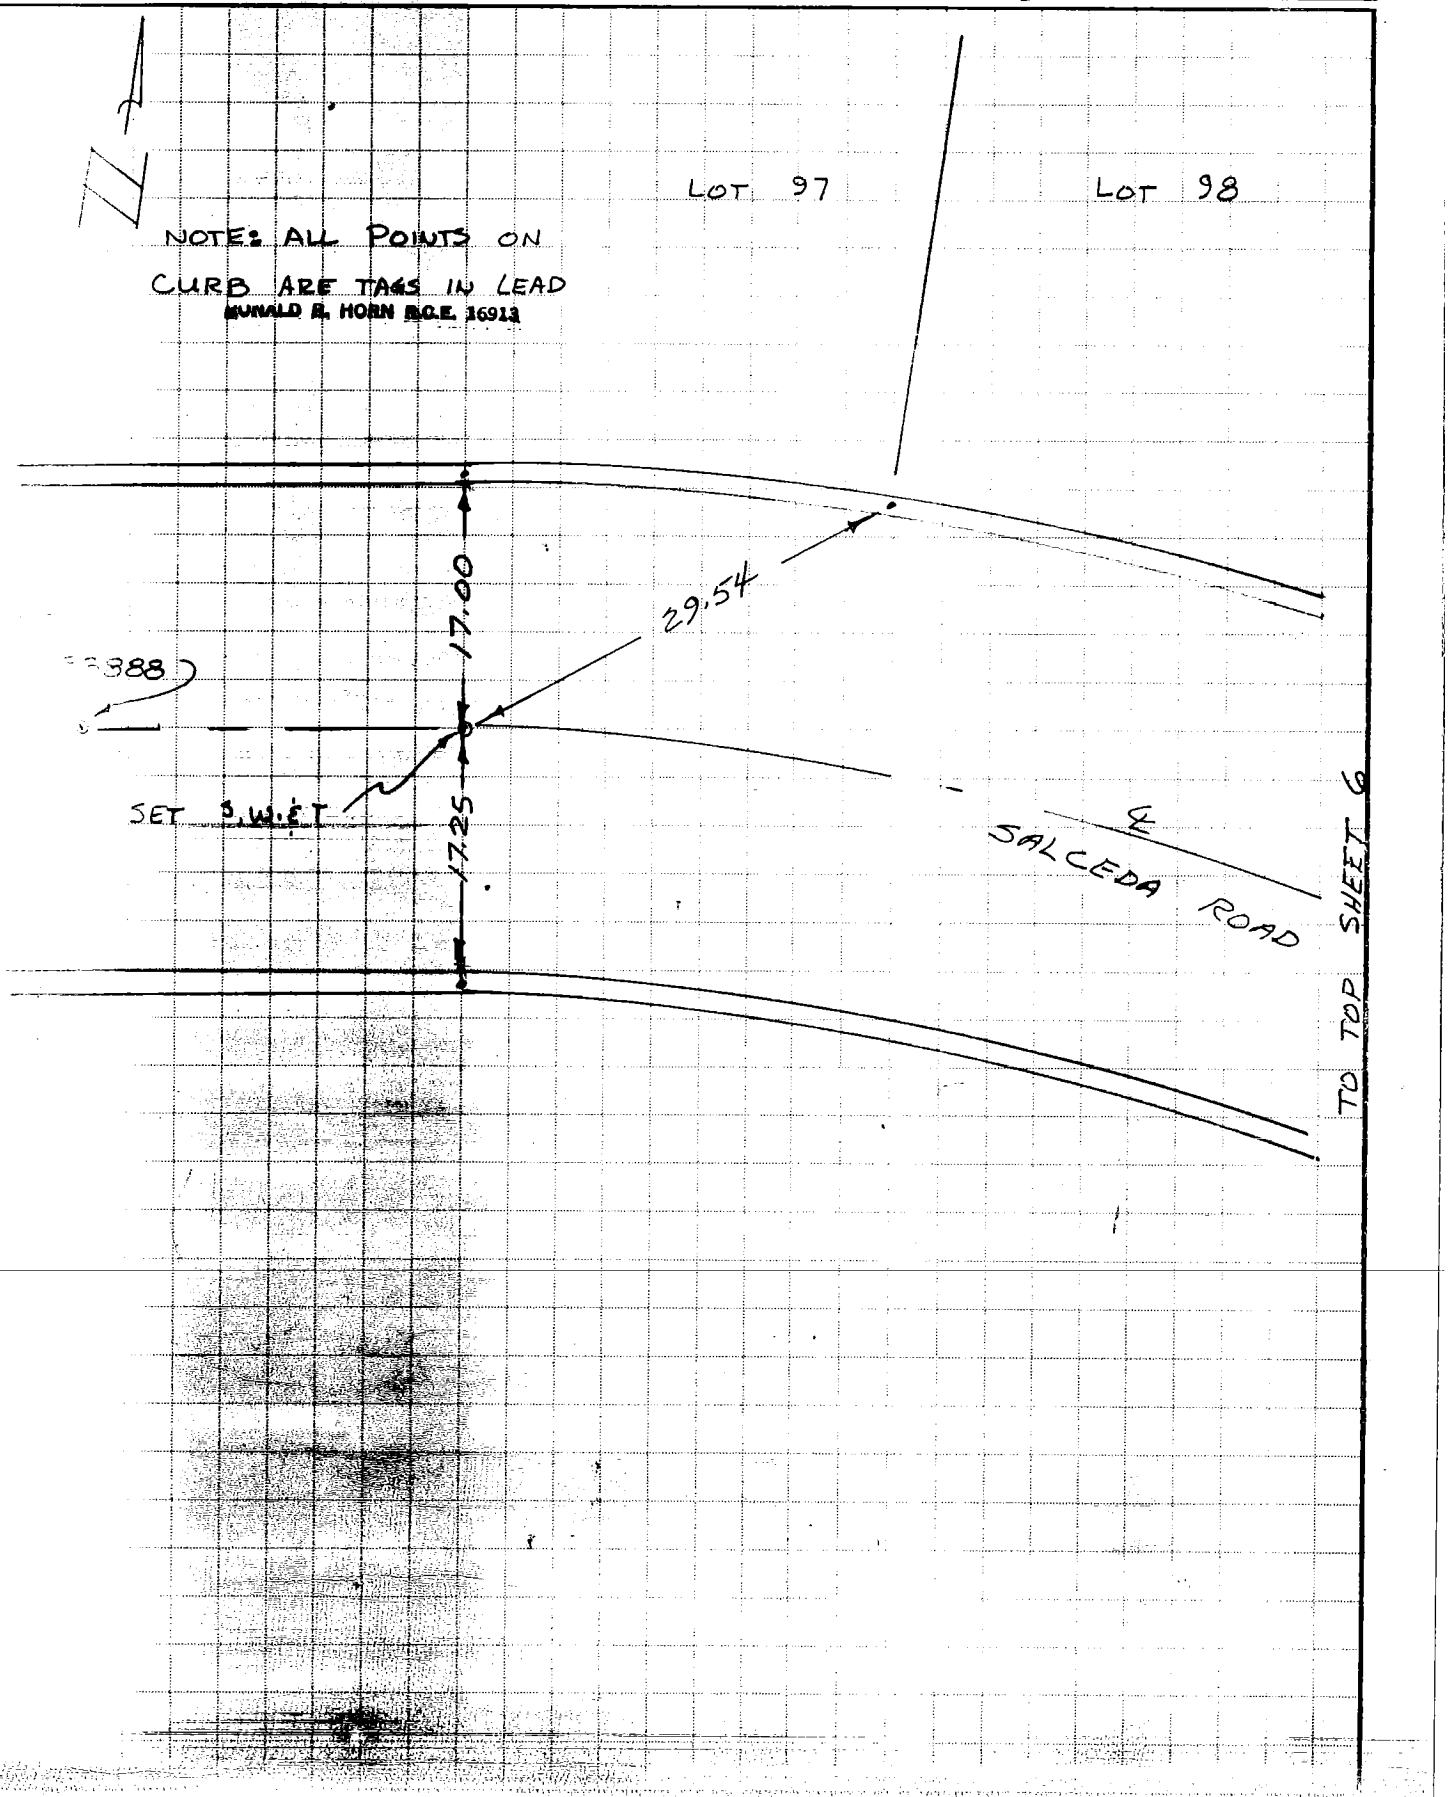

SIKAND ENGINEERING ASSOCIATES
15230 Burbank Boulevard
VAN NUYS, CALIFORNIA 91411
Phone (213) 787-8550

JOB TR 33890
SHEET NO. 6 OF 27
CALCULATED BY BOSTON DATE FEB 13, 80
CHECKED BY — DATE
SCALE NONE W.O. 1020-115

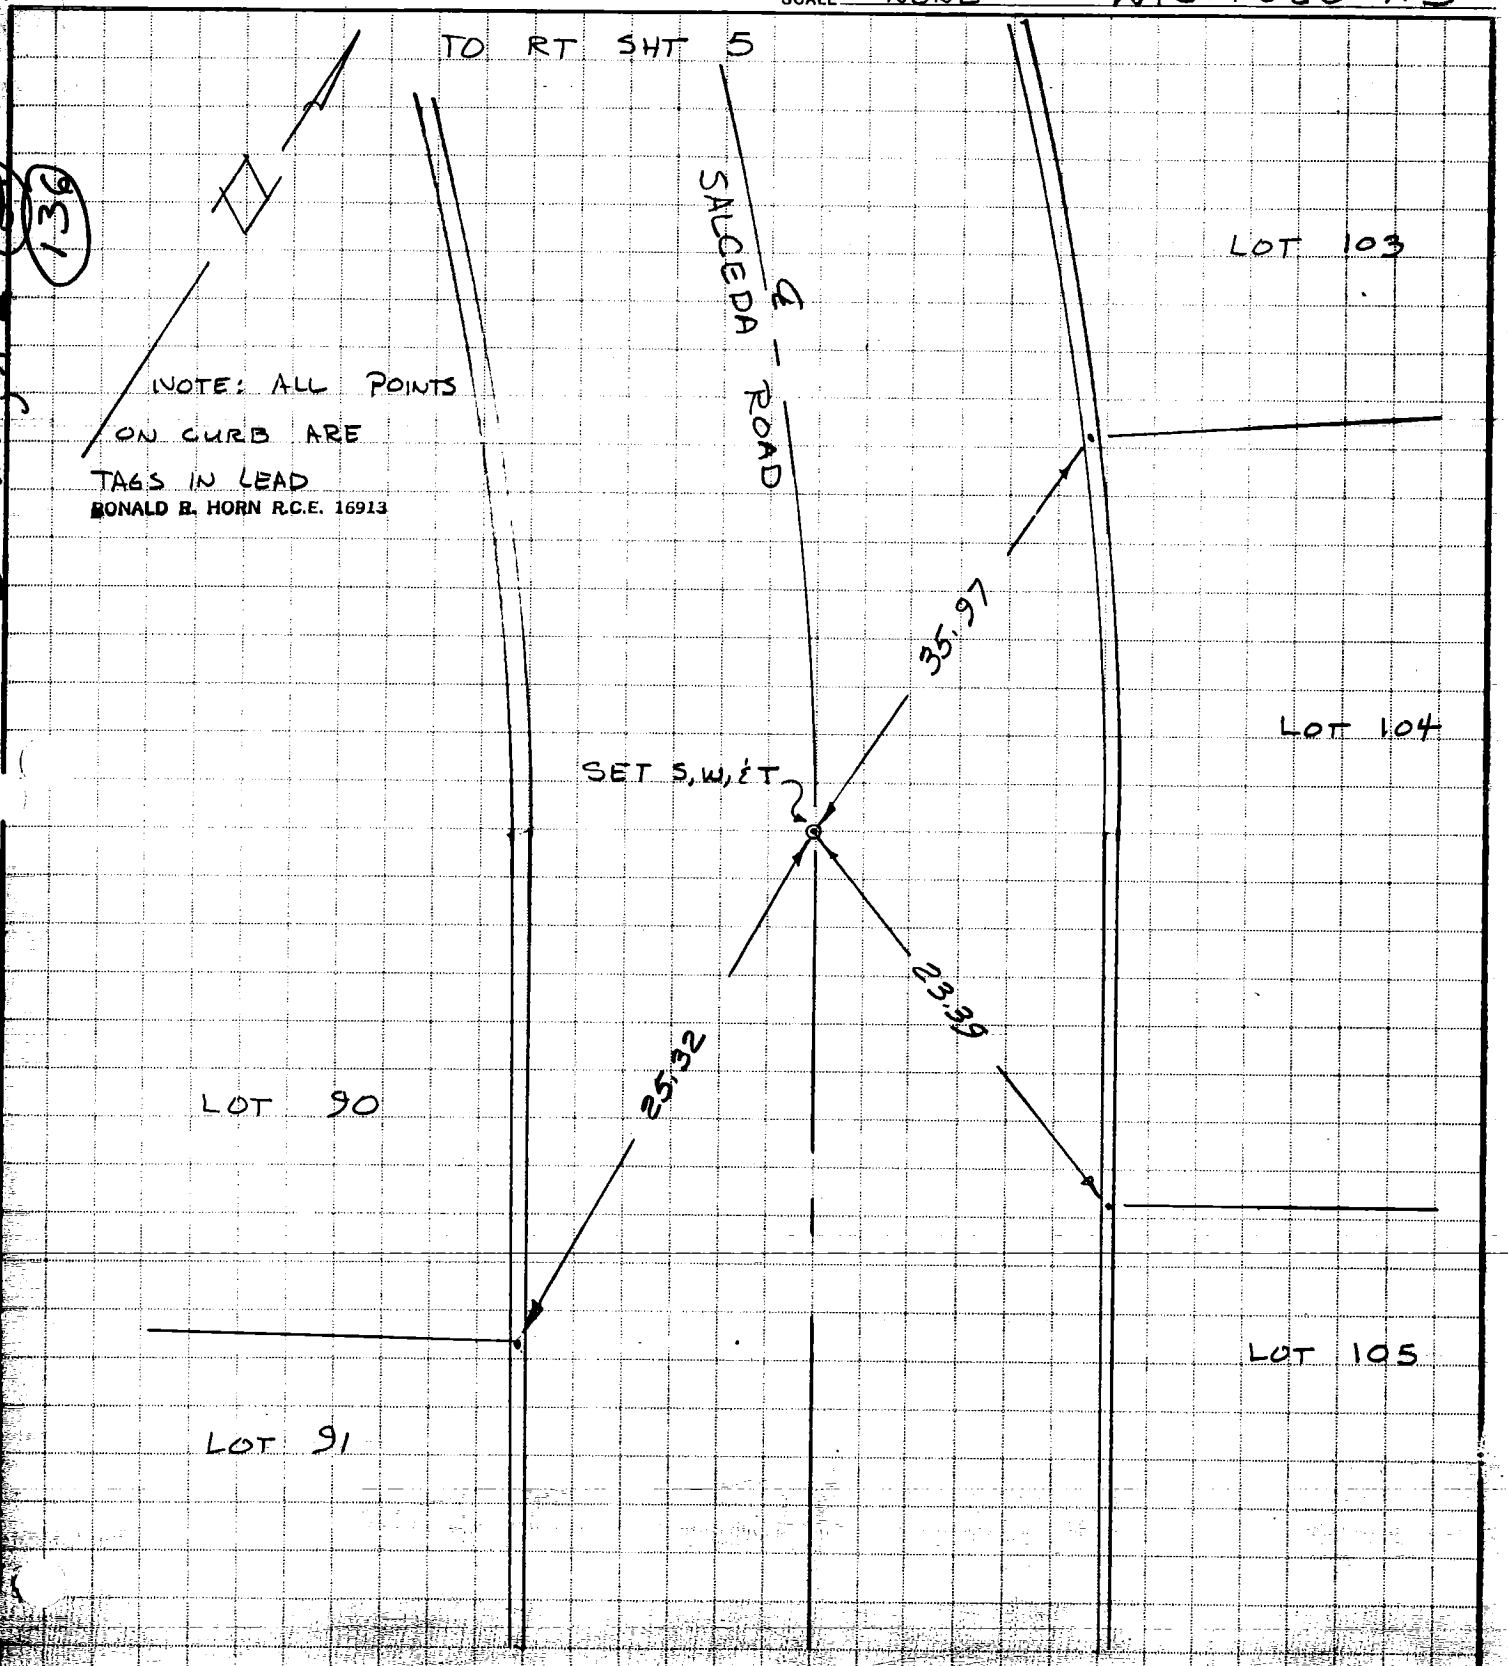

SIKAND ENGINEERING ASSOCIATES
15230 Burbank Boulevard
VAN NUYS, CALIFORNIA 91411
Phone (213) 787-8550

JOB TR 33890
SHEET NO. 7 OF 27
CALCULATED BY BOSTON DATE FEB. 13, 80
CHECKED BY ____ DATE ____
SCALE NONE W.O. 1020-115

TO BOTTOM SHEET 6

NOTE: ALL POINTS ON CURB ARE TAGS IN LEAD

RONALD E. HORN R.C.E. 16913

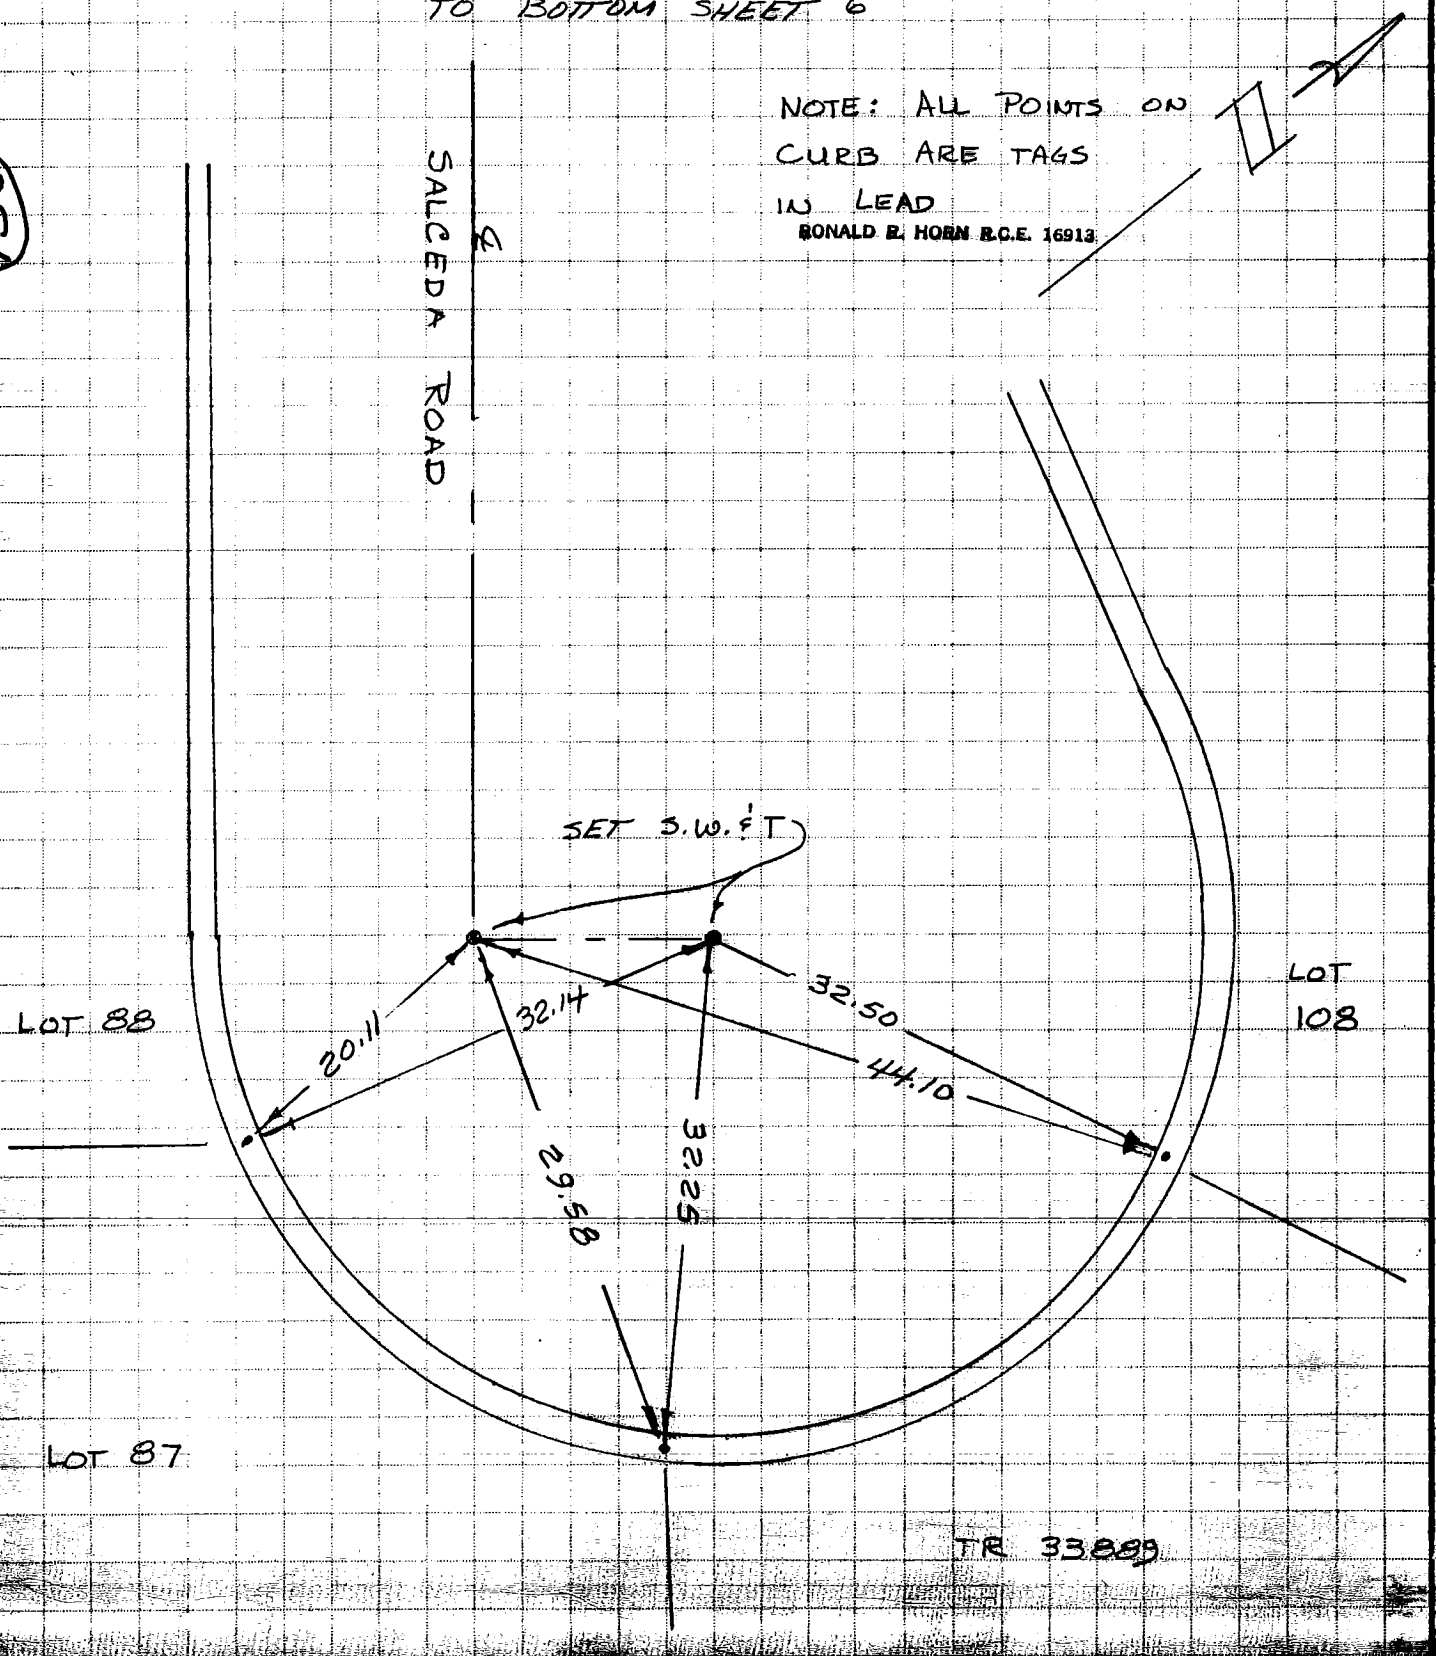

SIKAND ENGINEERING ASSOCIATES
15230 Burbank Boulevard
VAN NUYS, CALIFORNIA 91411
Phone (213) 787-8550

JOB TR 33890
SHEET NO. 8 OF 27
CALCULATED BY BOSTON DATE FEB 13, 80
CHECKED BY — DATE
SCALE NONE W.O. 1020-115

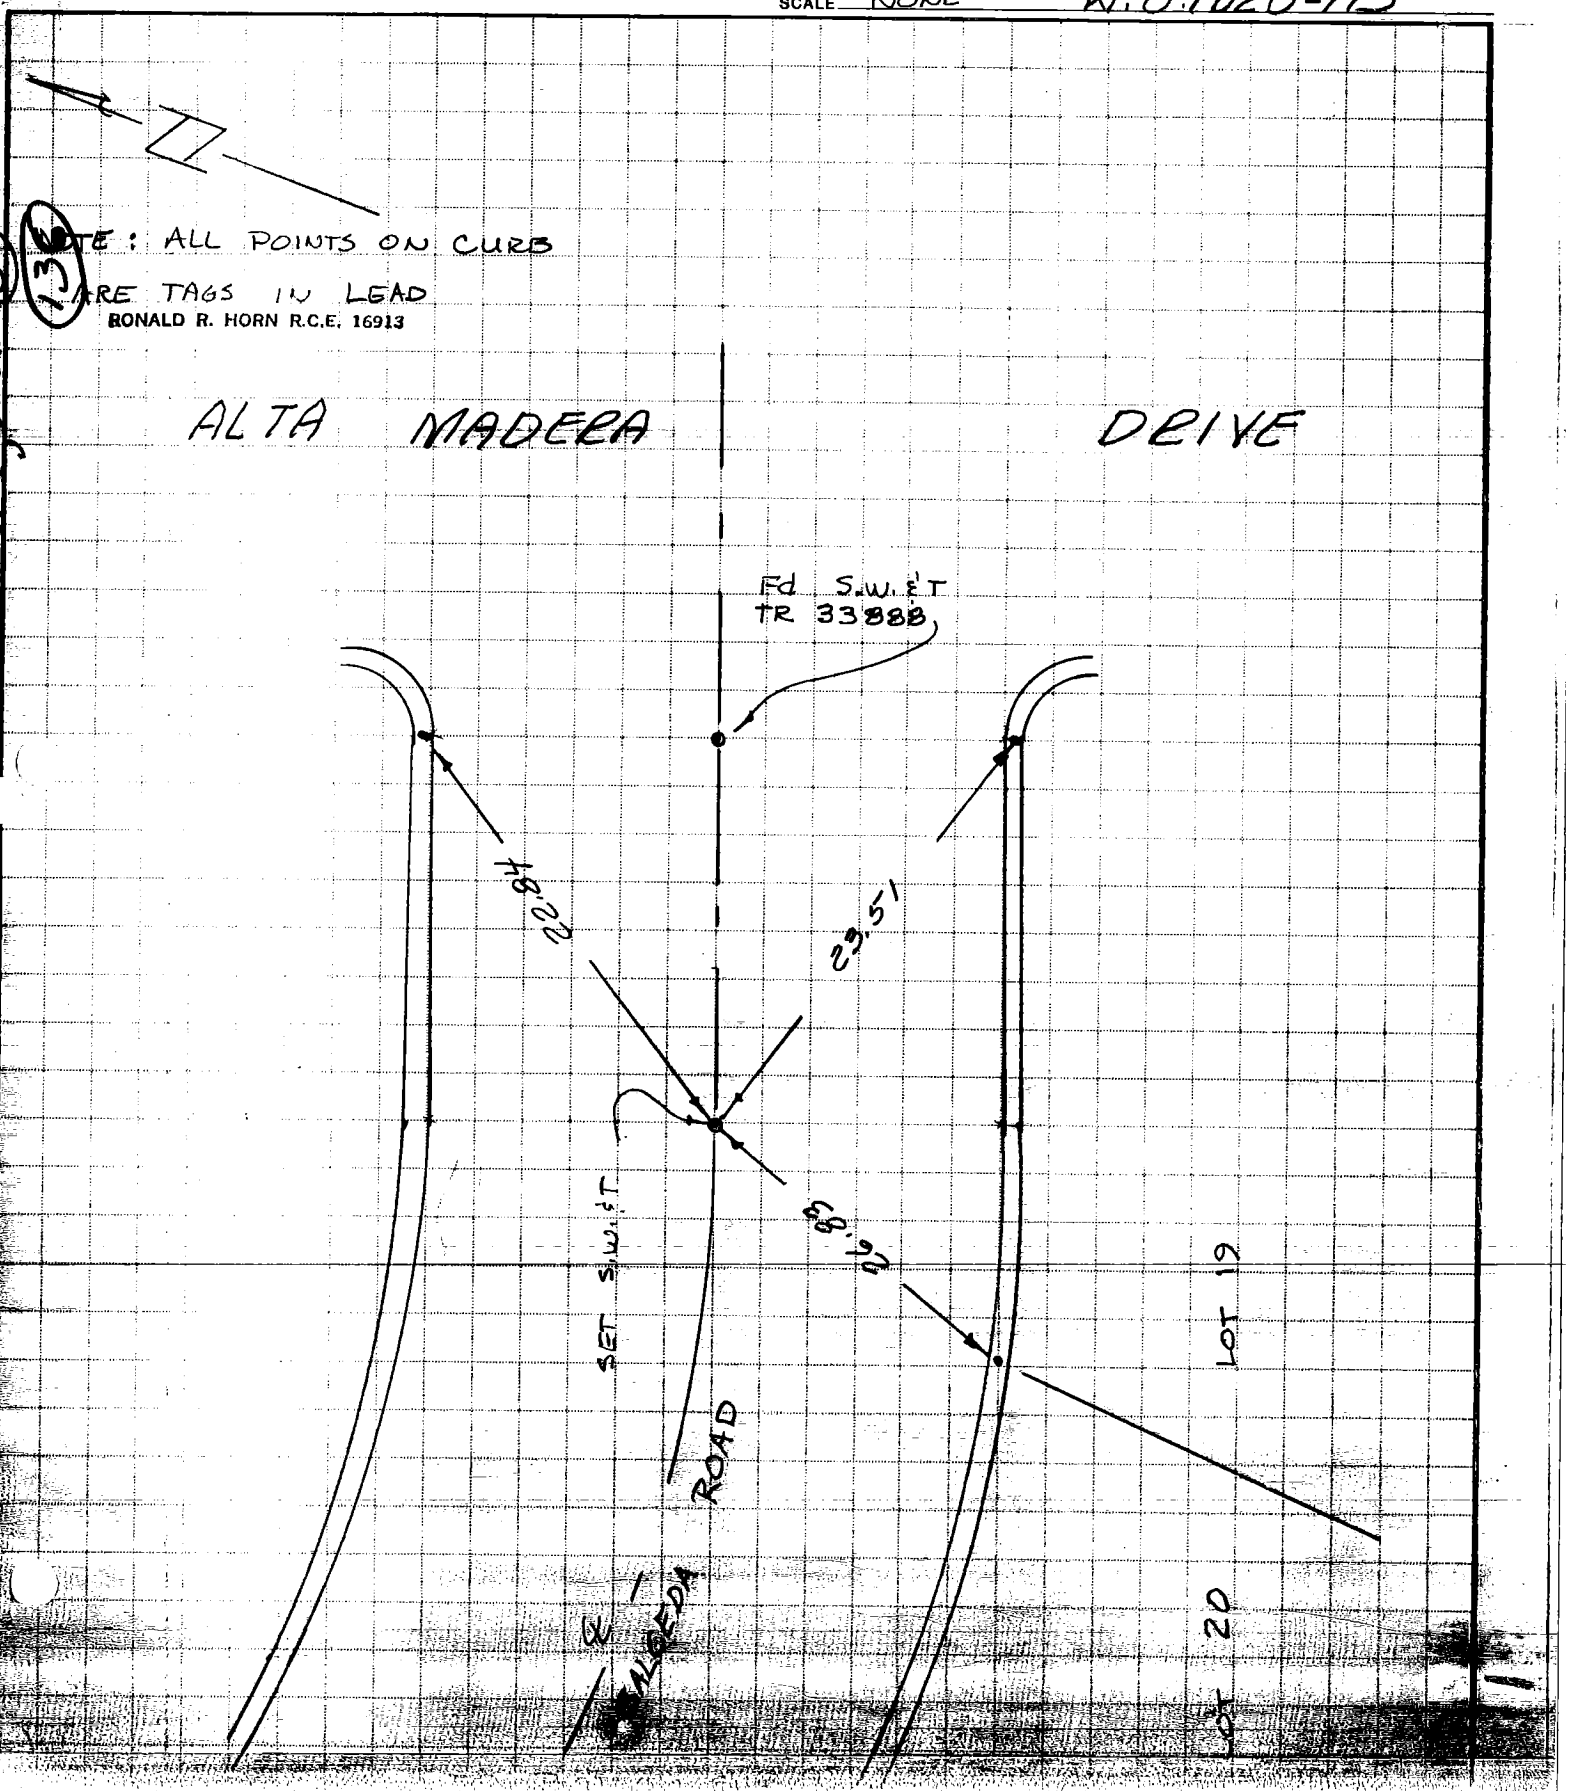

SIKAND ENGINEERING ASSOCIATES
15230 Burbank Boulevard
VAN NUYS, CALIFORNIA 91411
Phone (213) 787-8550

JOB TR 33890
SHEET NO. 9 OF 27
CALCULATED BY BOSTON DATE FEB 13, 80
CHECKED BY _____ DATE _____
SCALE NONE W.O. 1020-115

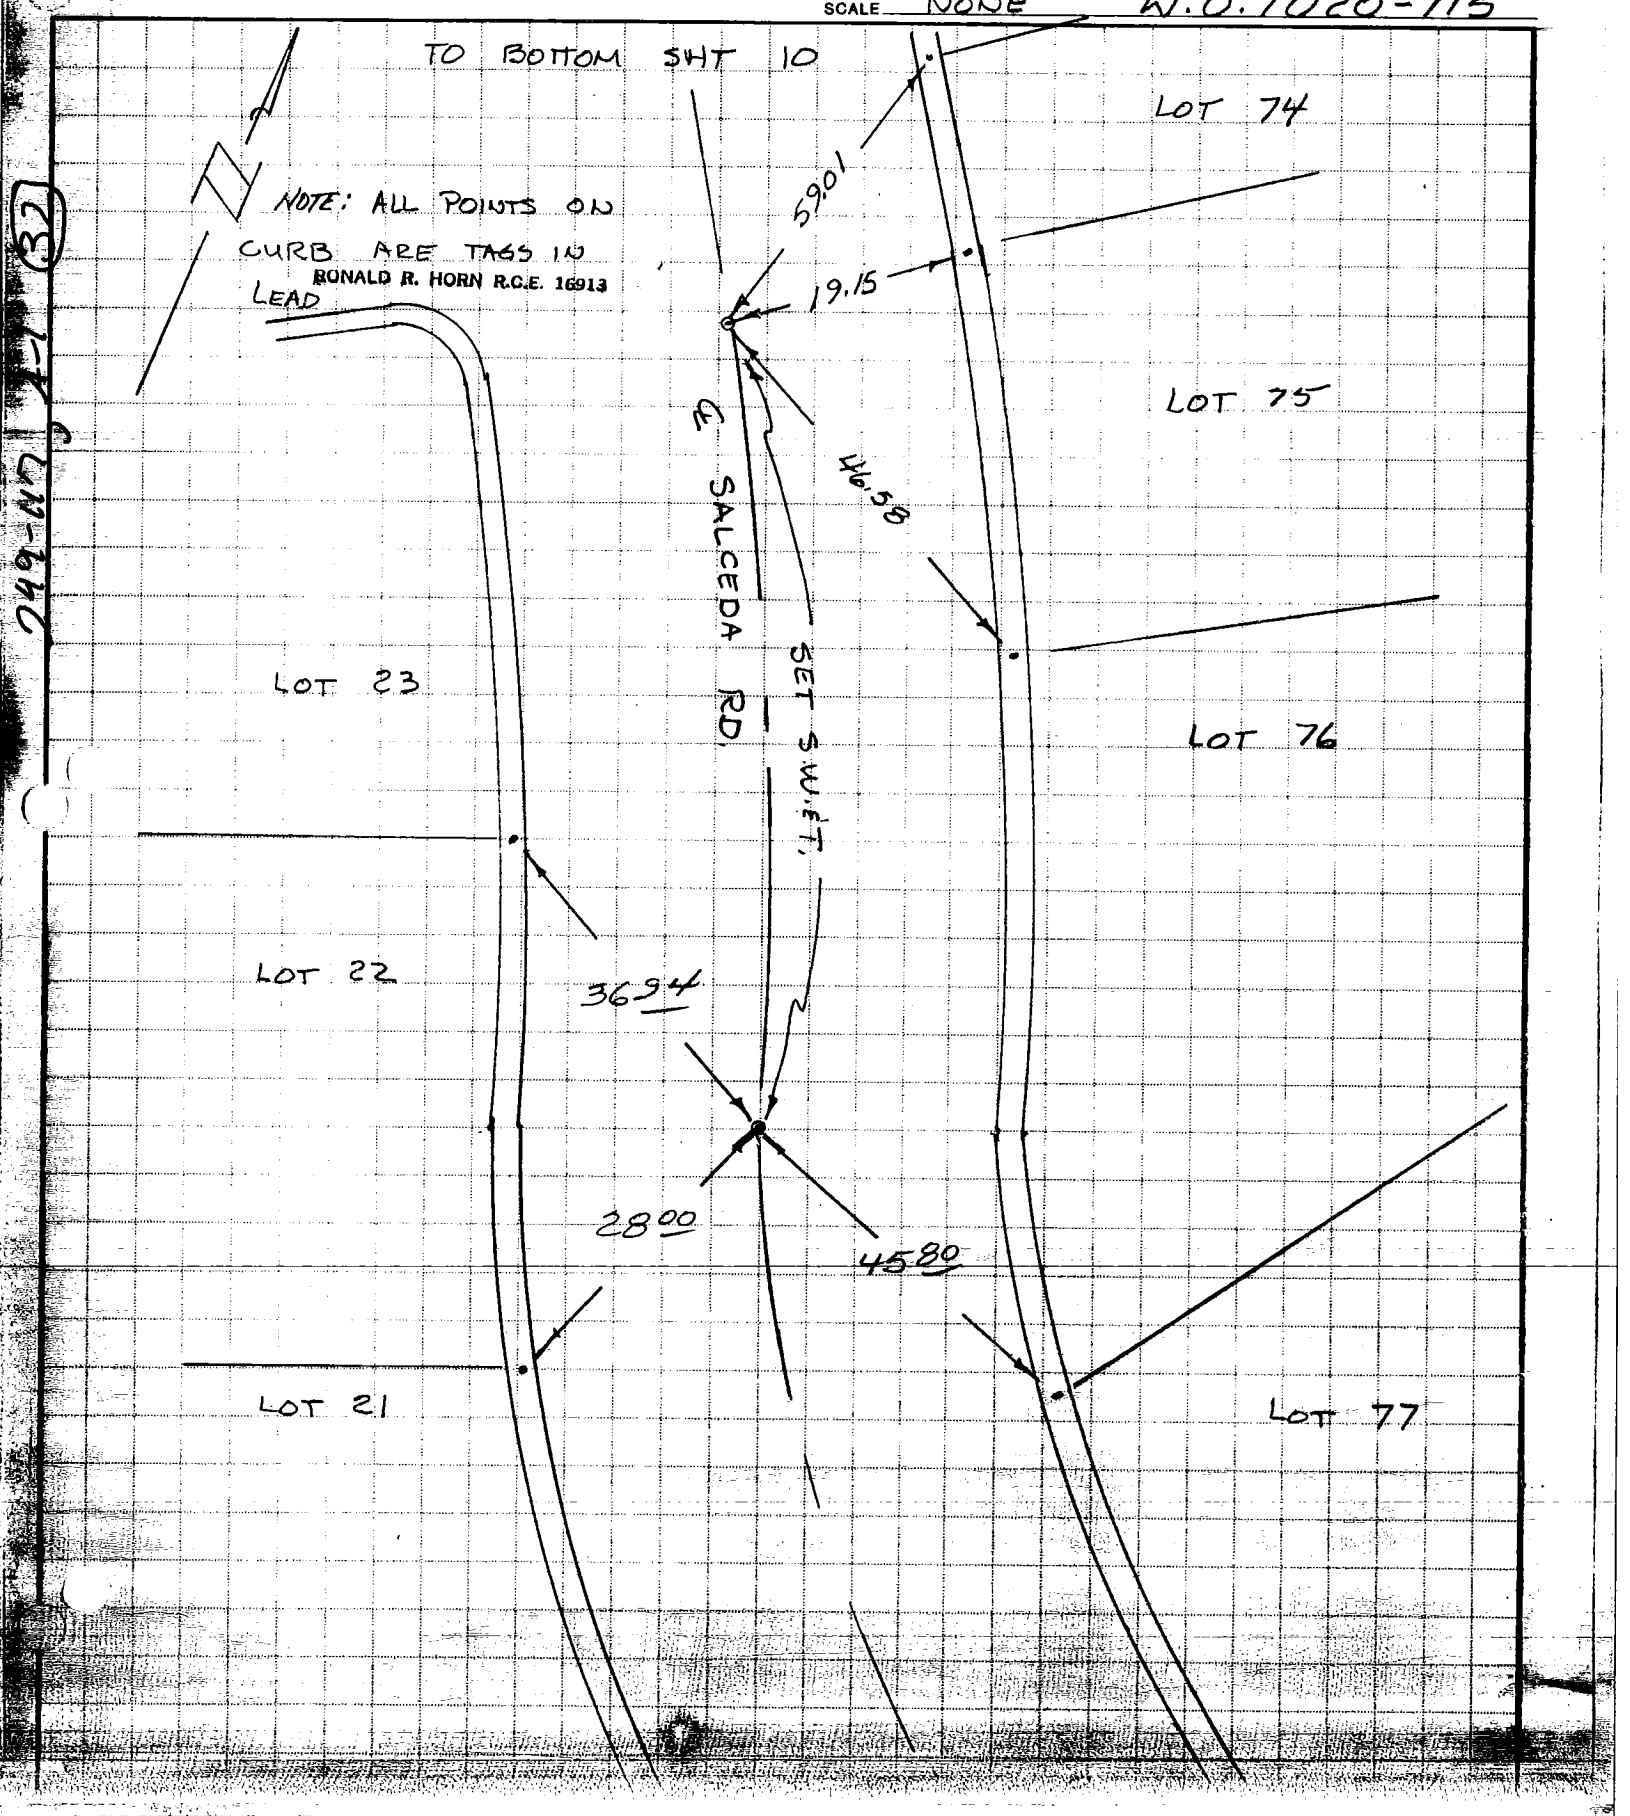

SIKAND ENGINEERING ASSOCIATES
15230 Burbank Boulevard
VAN NUYS, CALIFORNIA 91411
Phone (213) 787-8550

JOB TR 33890
SHEET NO. 10 OF 27
CALCULATED BY BOSTON DATE FEB 13, 80
CHECKED BY DATE
SCALE NONE W.O. 1020-115

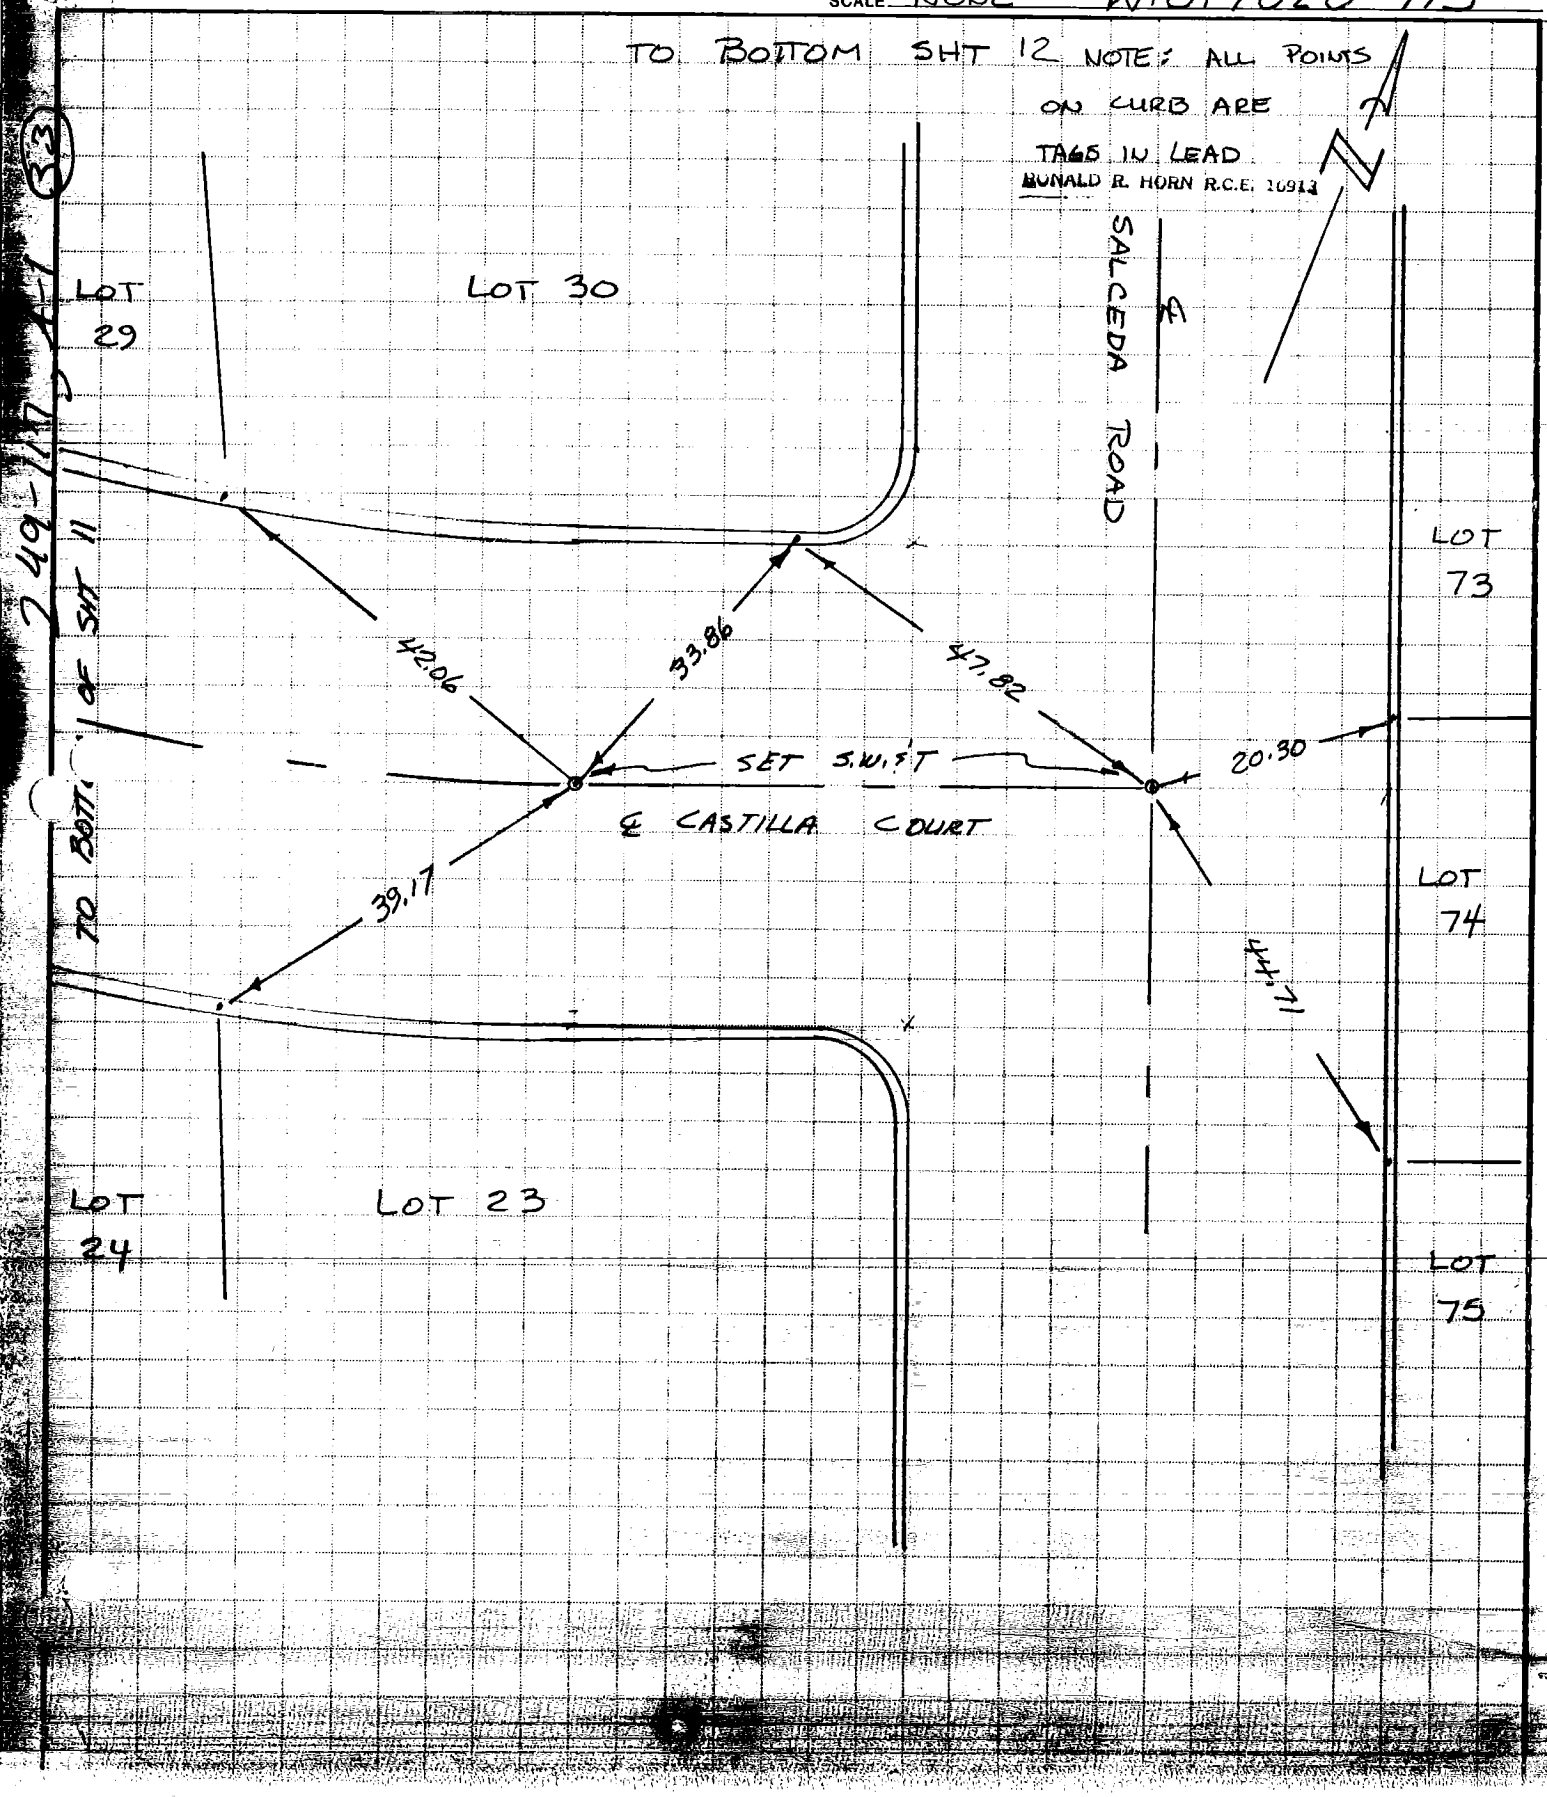

SIKAND ENGINEERING ASSOCIATES
15230 Burbank Boulevard
VAN NUYS, CALIFORNIA 91411
Phone (213) 787-8550

JOB 33890
SHEET NO. 11 OF 27
CALCULATED BY BOSTON DATE FEB 13, 80
CHECKED BY _____ DATE _____
SCALE NONE W.O. 1020-115

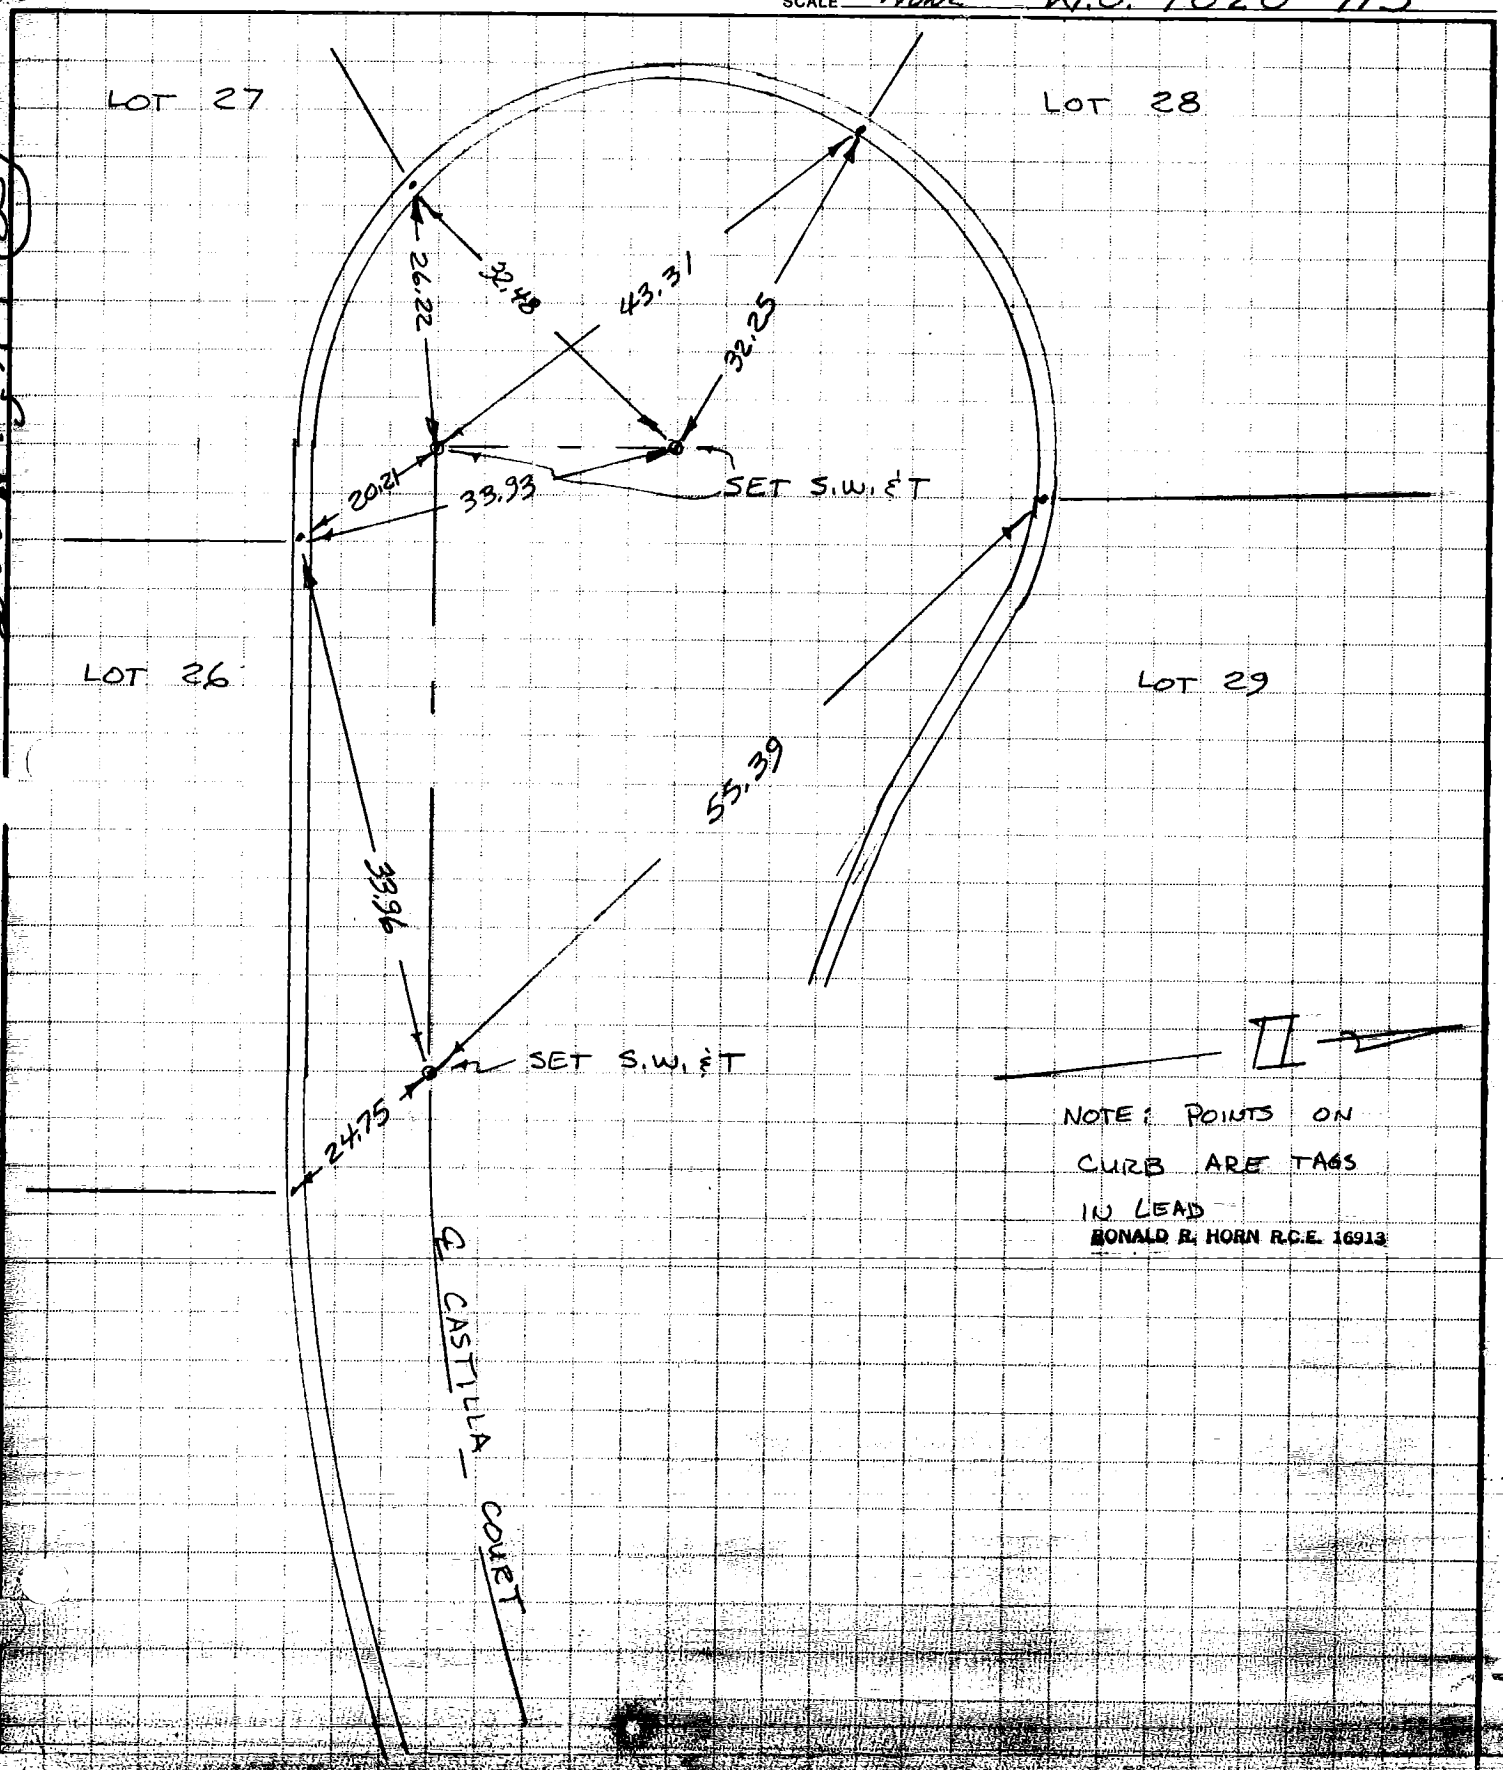

NOTE: POINTS ON CURB ARE TAGS IN LEAD

RONALD R. HORN R.C.E. 16913

CO ENG FB 3656 - 26

SIKAND ENGINEERING ASSOCIATES
15230 Burbank Boulevard
VAN NUYS, CALIFORNIA 91411
Phone (213) 787-8550

JOB TR 33890
SHEET NO. 12 OF 27
CALCULATED BY BOSTON DATE FEB 14, 80
CHECKED BY ____ DATE ____
SCALE NONE W.O. 1020-115

249-117 A-1 (34)

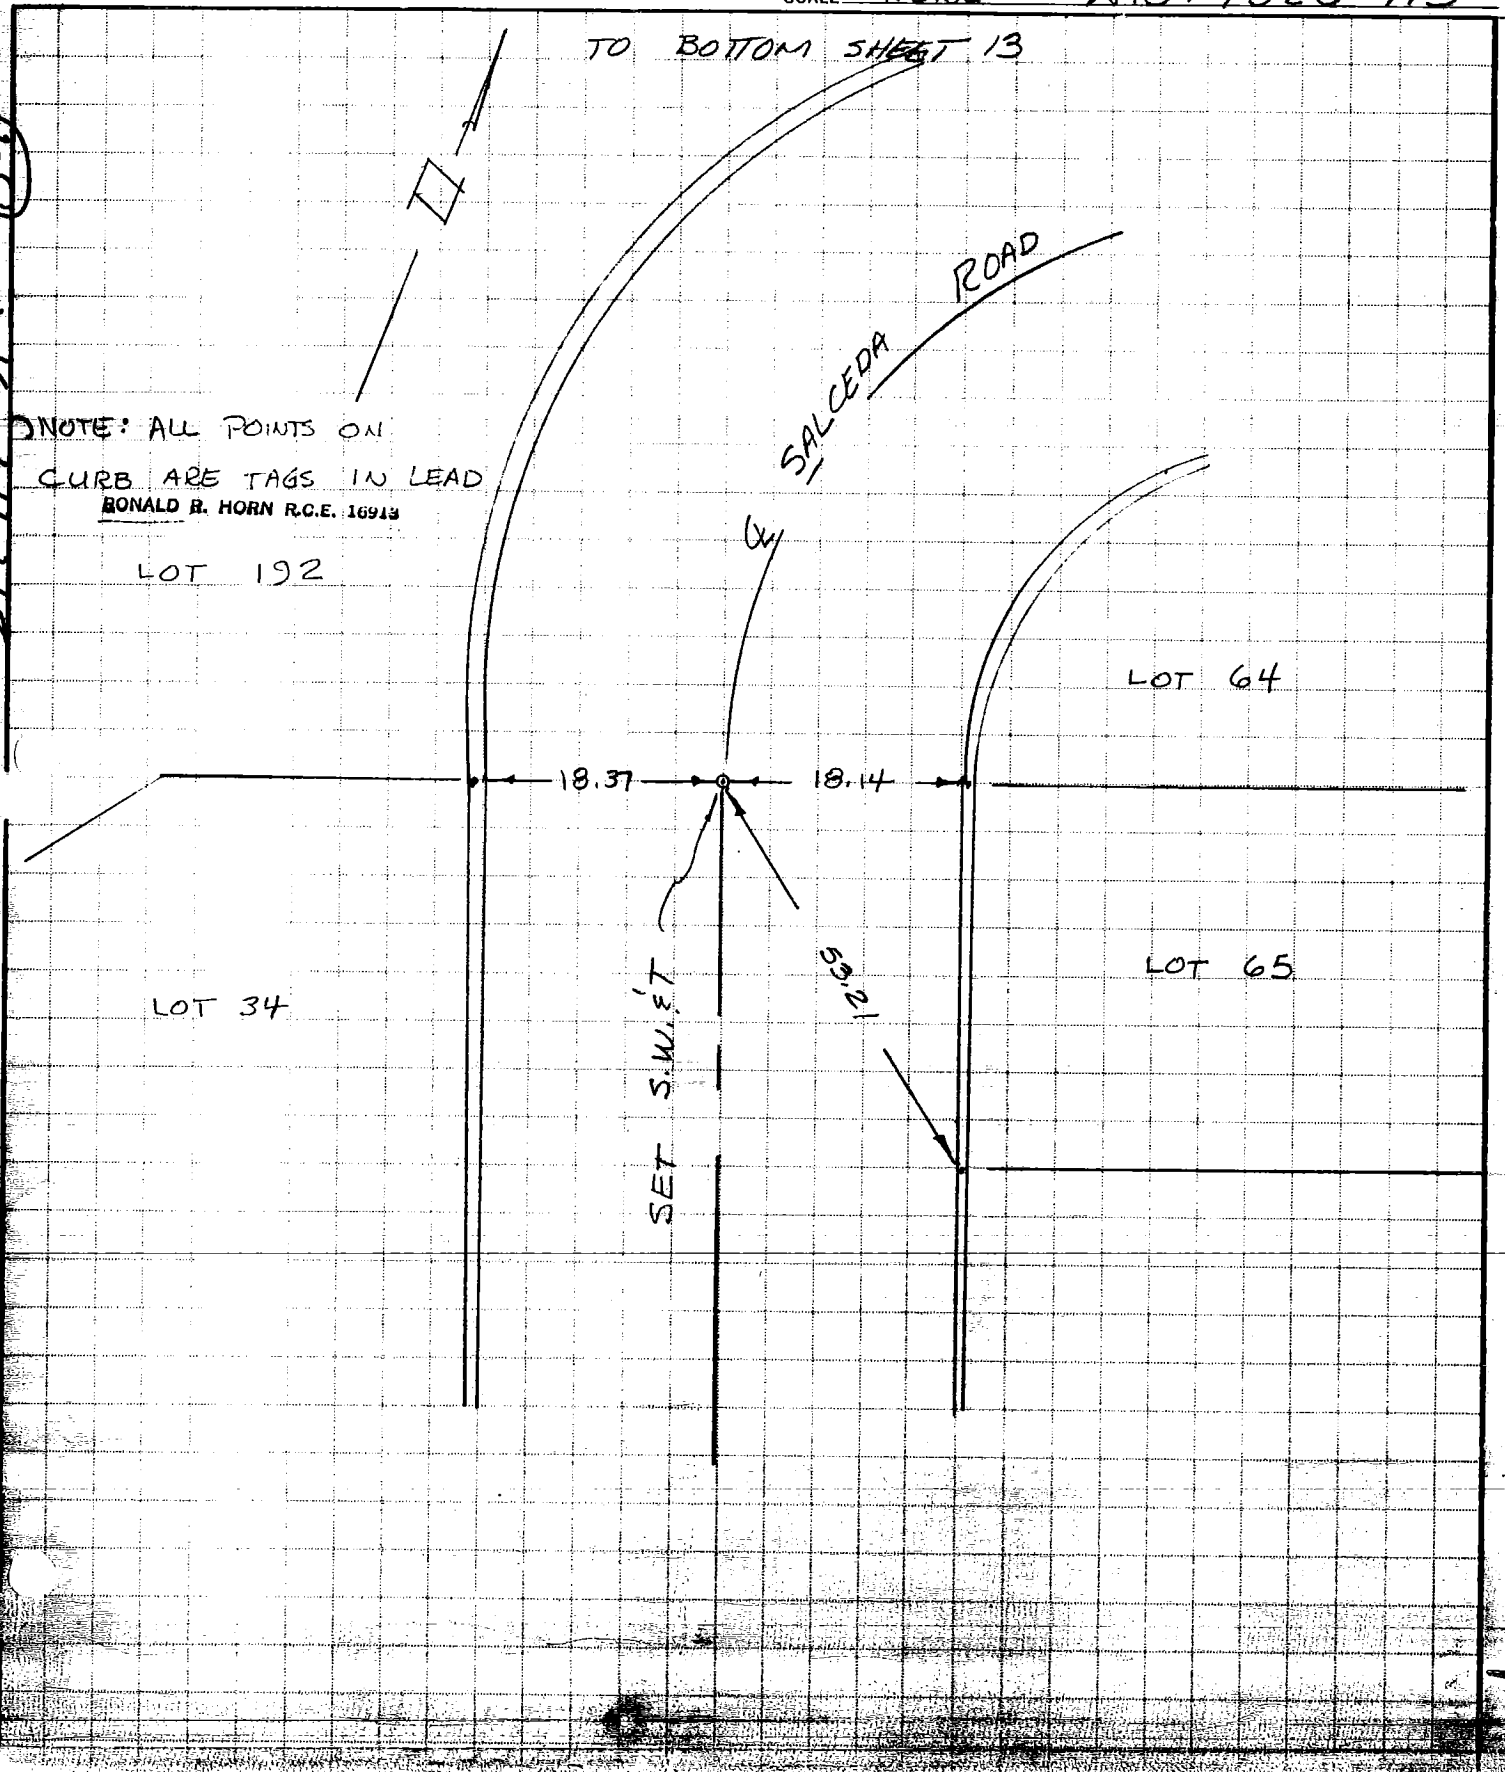

CO ENG FB 3656 - 27

SIKAND ENGINEERING ASSOCIATES
15230 Burbank Boulevard
VAN NUYS, CALIFORNIA 91411
Phone (213) 787-8550

JOB TR 33810
SHEET NO. 13 OF 27
CALCULATED BY BOSTON DATE FEB 14, 80
CHECKED BY ✓ DATE
SCALE NONE W.O. 1020-115

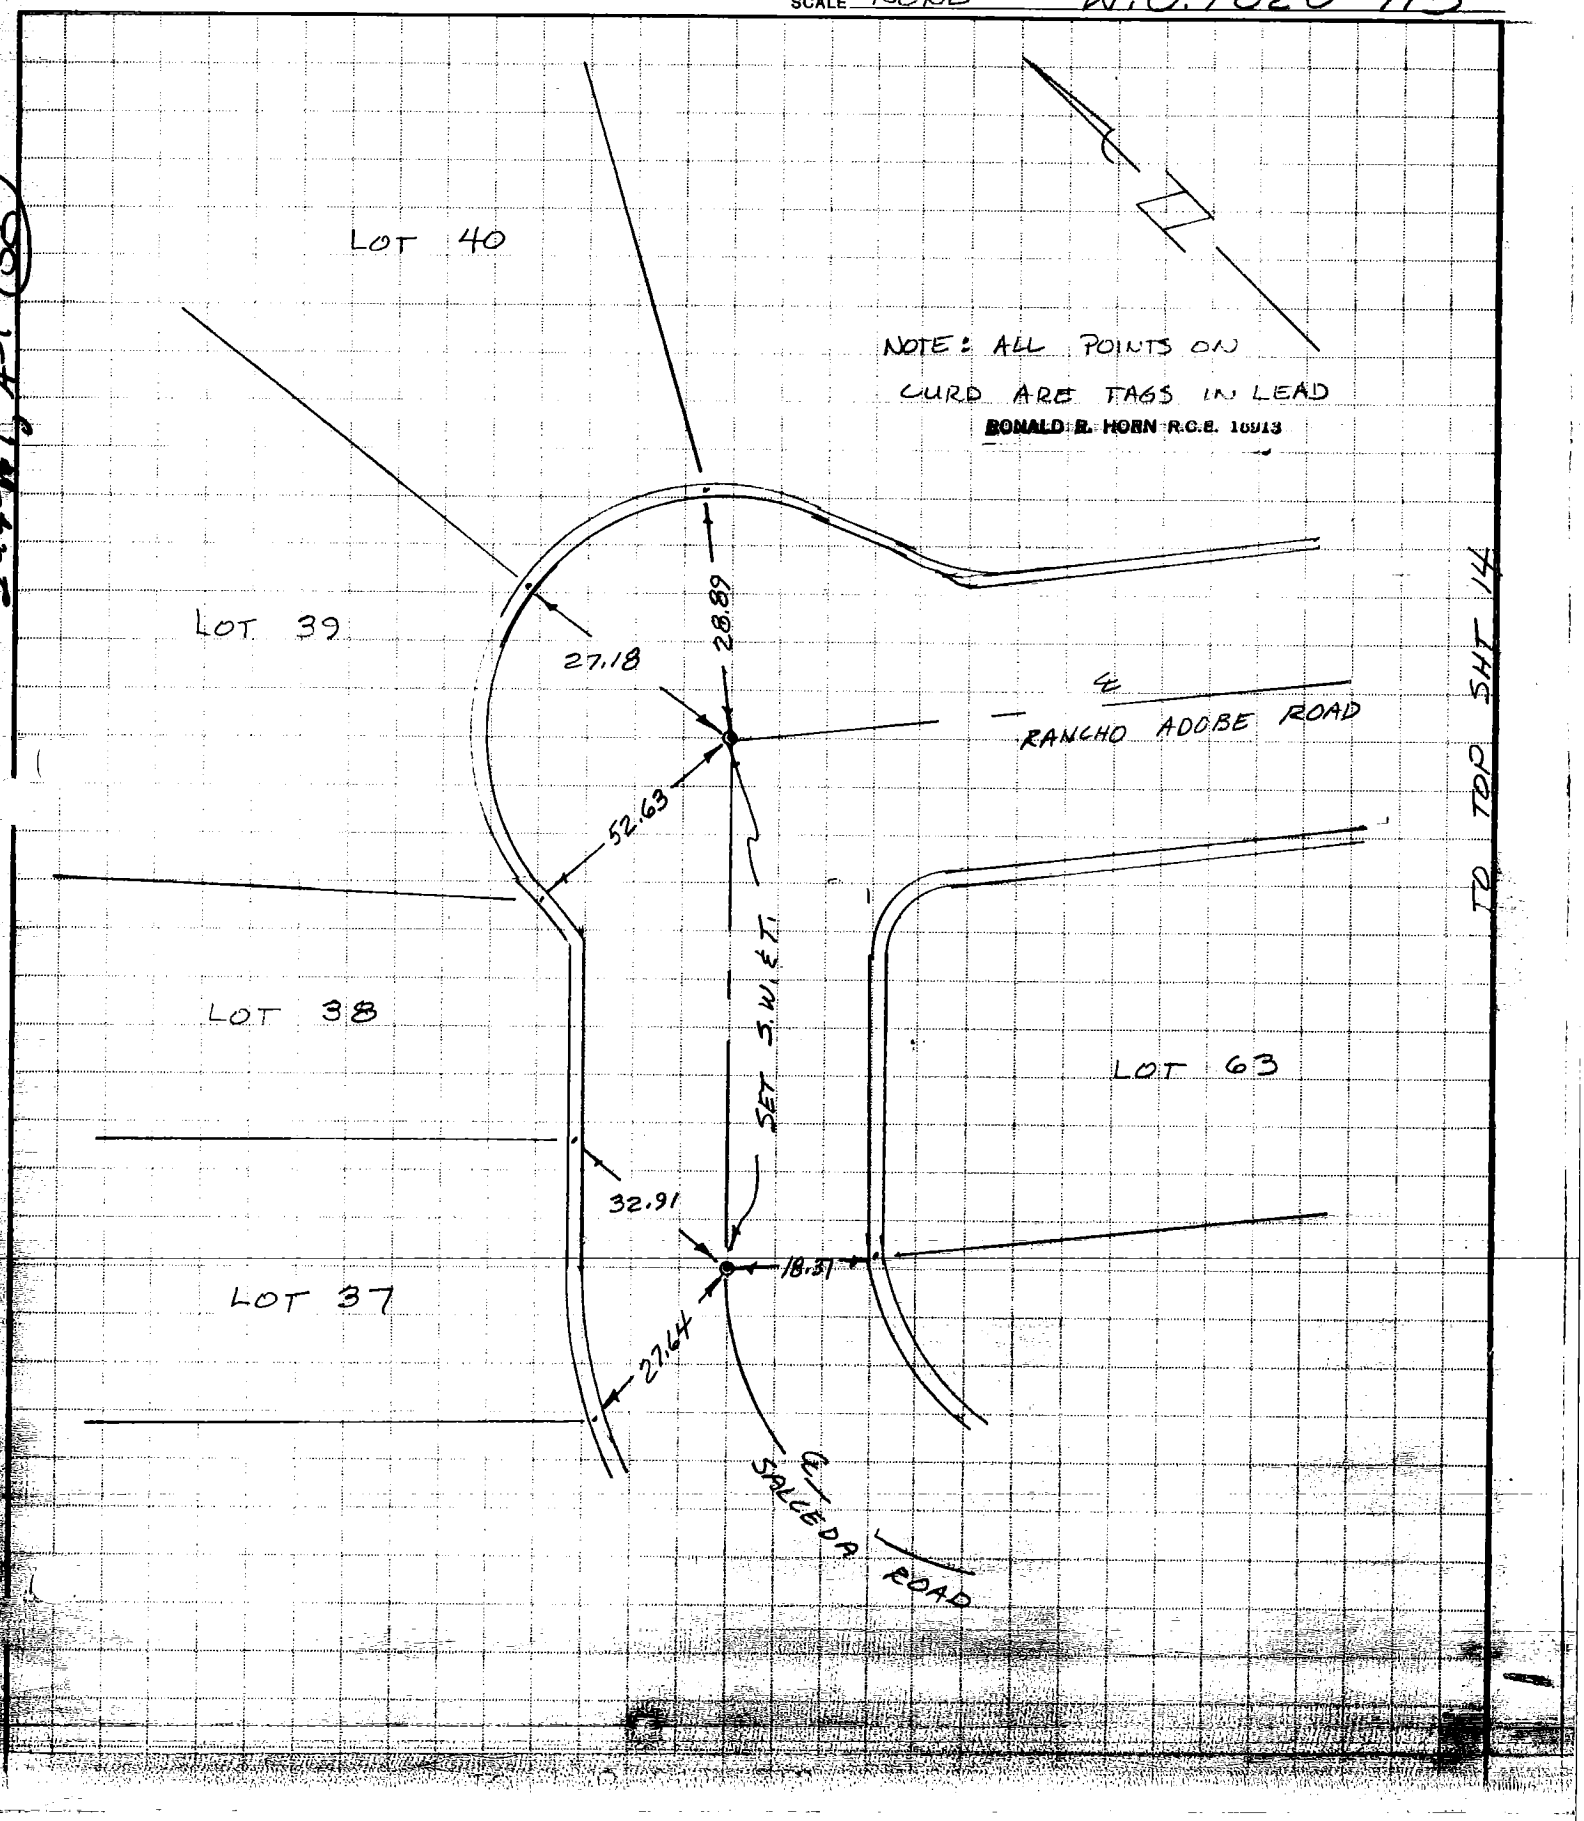

SIKAND ENGINEERING ASSOCIATES
15230 Burbank Boulevard
VAN NUYS, CALIFORNIA 91411
Phone (213) 787-8550

JOB TR 33890
SHEET NO. 14 OF 27
CALCULATED BY BOSTON DATE FEB 14, 80
CHECKED BY DATE
SCALE NONE W.O. 1020-115

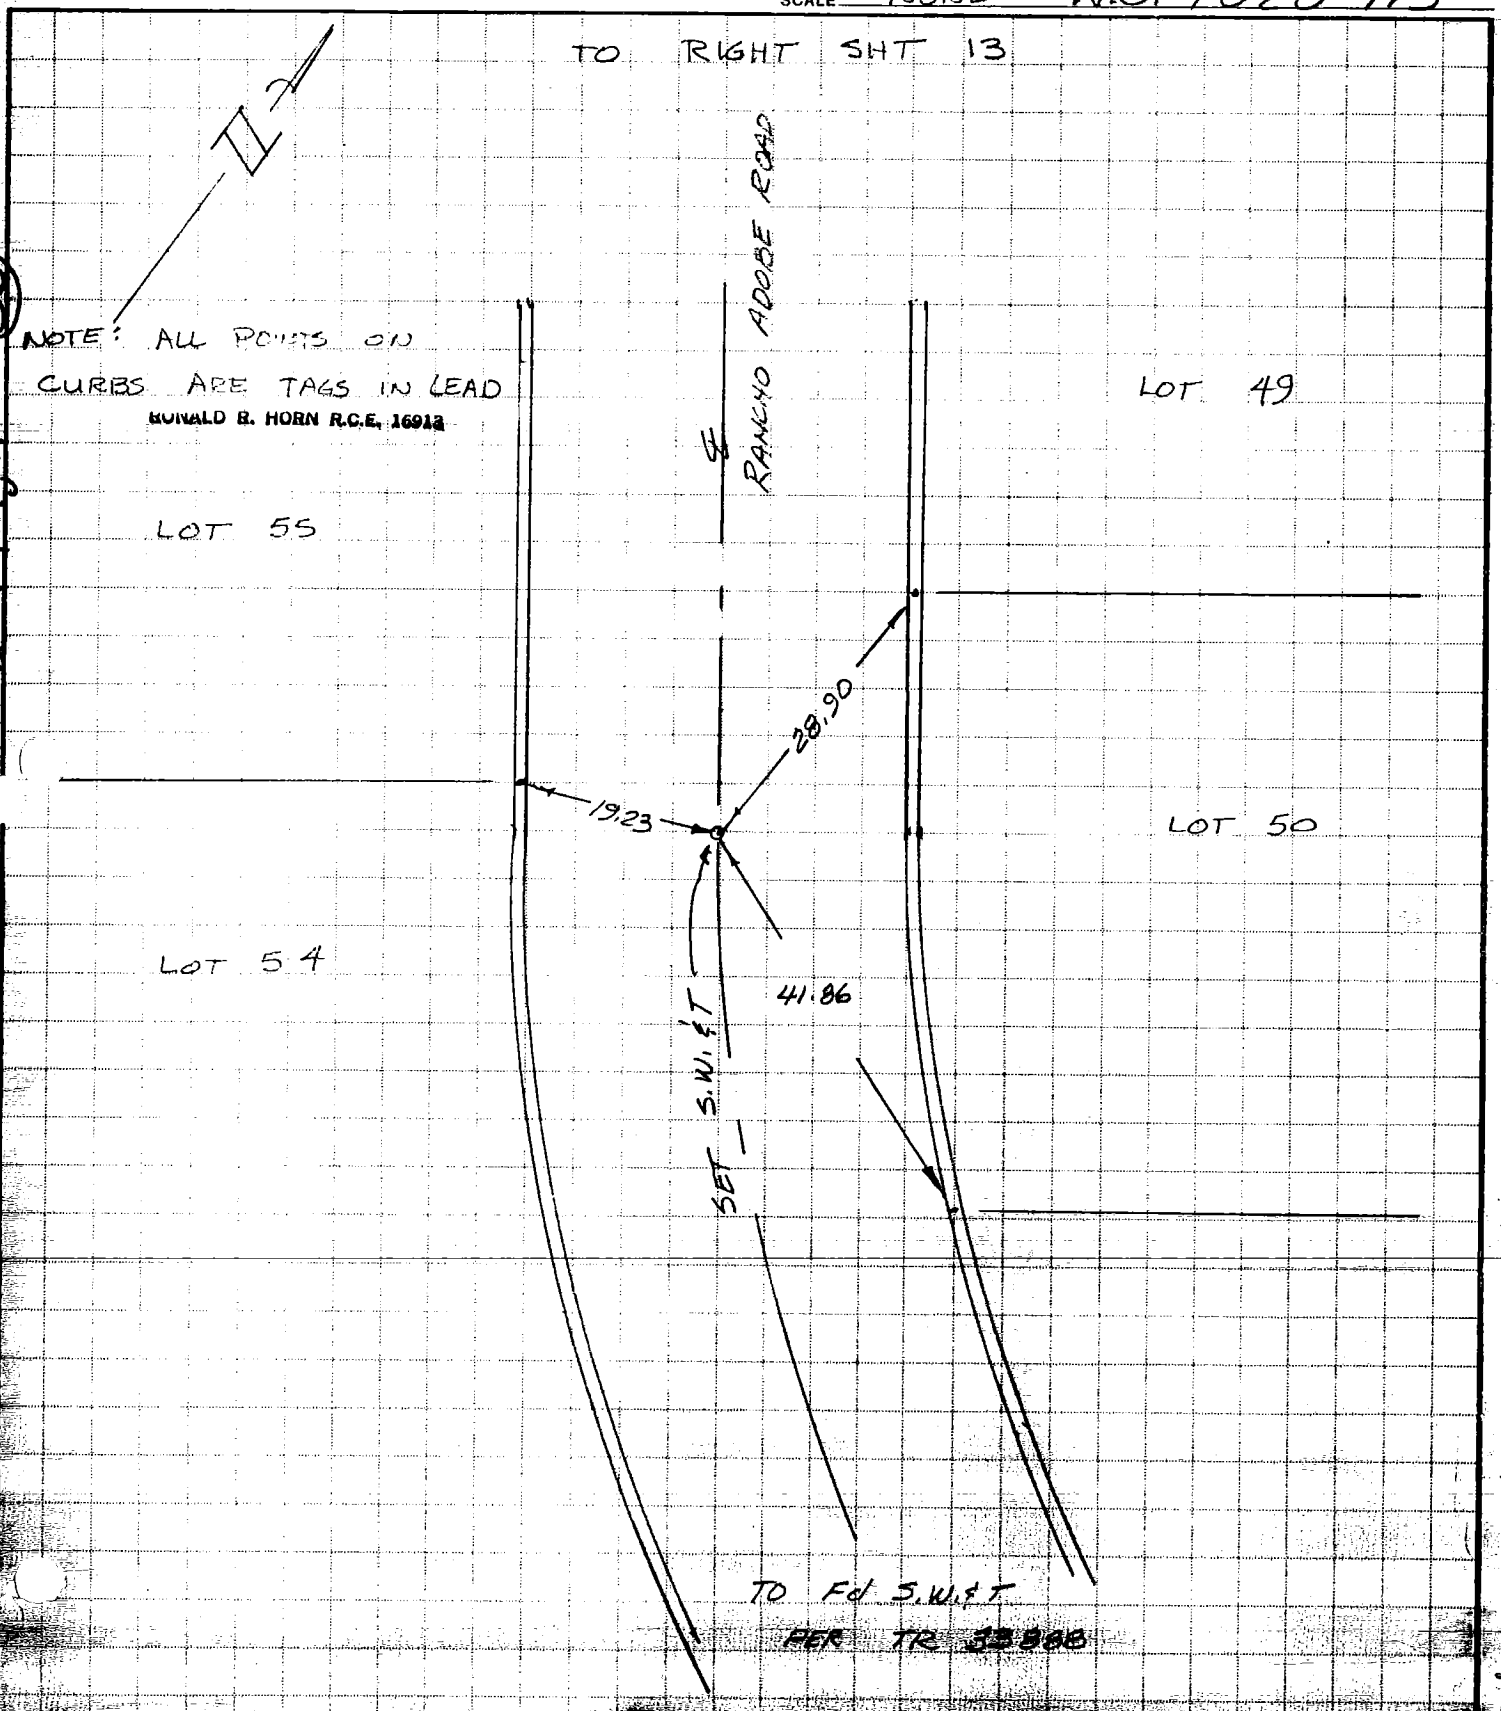

SIKAND ENGINEERING ASSOCIATES
15230 Burbank Boulevard
VAN NUYS, CALIFORNIA 91411
Phone (213) 787-8550

29

JOB TR 33890

SHEET NO. 15 OF 27

CALCULATED BY BOSTON DATE FEB 14, 80

CHECKED BY ~~X~~ DATE

SCALE NONE W.O. 1020-115

249-117-37

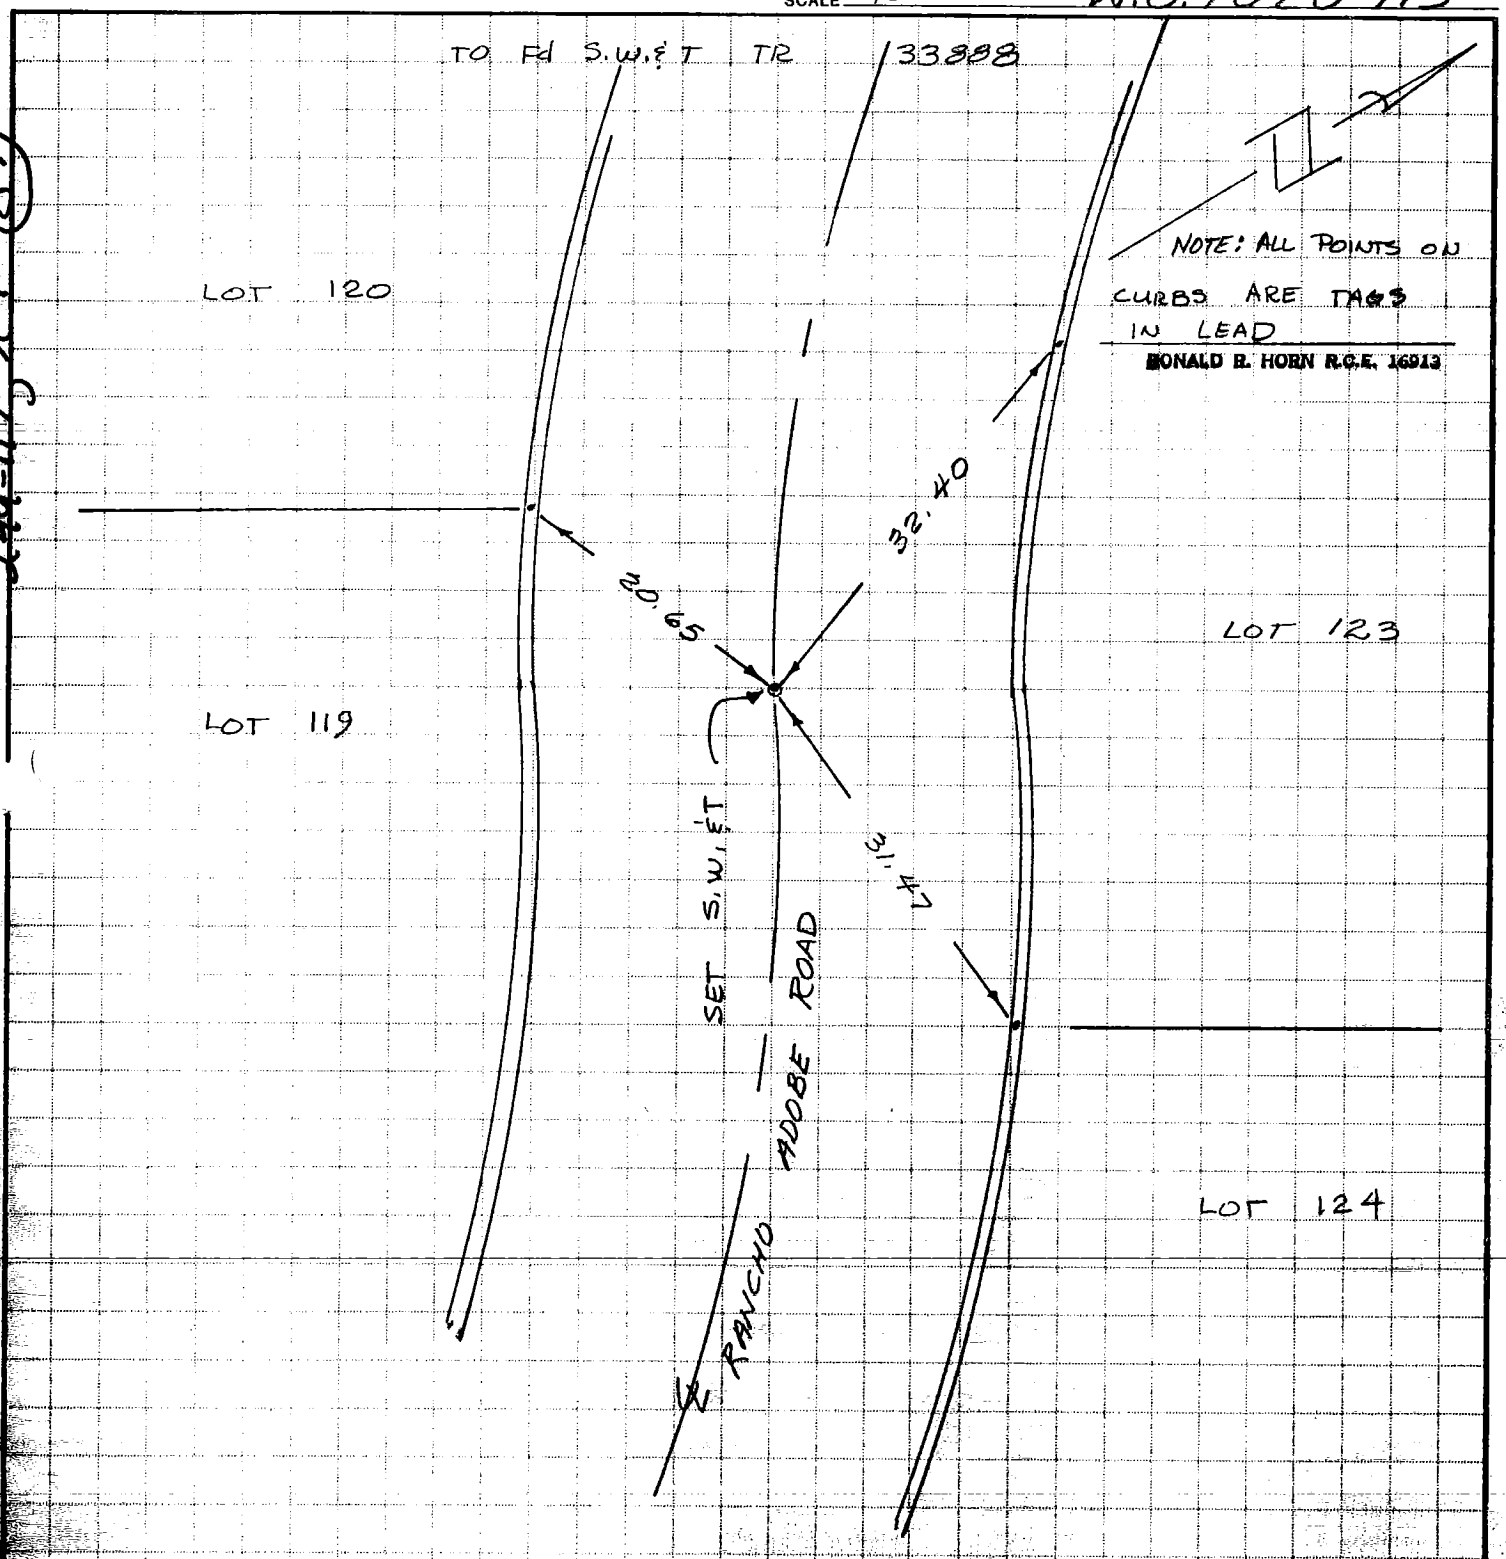

CO ENG FB 3656 - 30

SIKAND ENGINEERING ASSOCIATES
15230 Burbank Boulevard
VAN NUYS, CALIFORNIA 91411
Phone (213) 787-8550

JOB TR 33890
SHEET NO. 16 OF 27
CALCULATED BY BOSTON DATE FEB 14, 80
CHECKED BY ✓ DATE
SCALE NONE W.O. 1020-115

TO BOTTOM SHT 15

LOT 130

LOT 131

LOT 113

NOTE: ALL POINTS ON CURBS ARE TAGS IN LEAD

RONALD R. HORN R.C.E. 16913

55.53

22.34

30.39

SET S, W, & T

℄ RANCHO ADOBE ROAD

249-117, 4-1 (37)

CO ENG FB 3656 - 32

SIKAND ENGINEERING ASSOCIATES
15230 Burbank Boulevard
VAN NUYS, CALIFORNIA 91411
Phone (213) 787-8550

JOB TR 33890
SHEET NO. 17 OF 27
CALCULATED BY BOSTON DATE FEB 14, 80
CHECKED BY / DATE
SCALE NONE W.O. 1020-115

2.49-117, 47

TO BOTTOM SHT 16

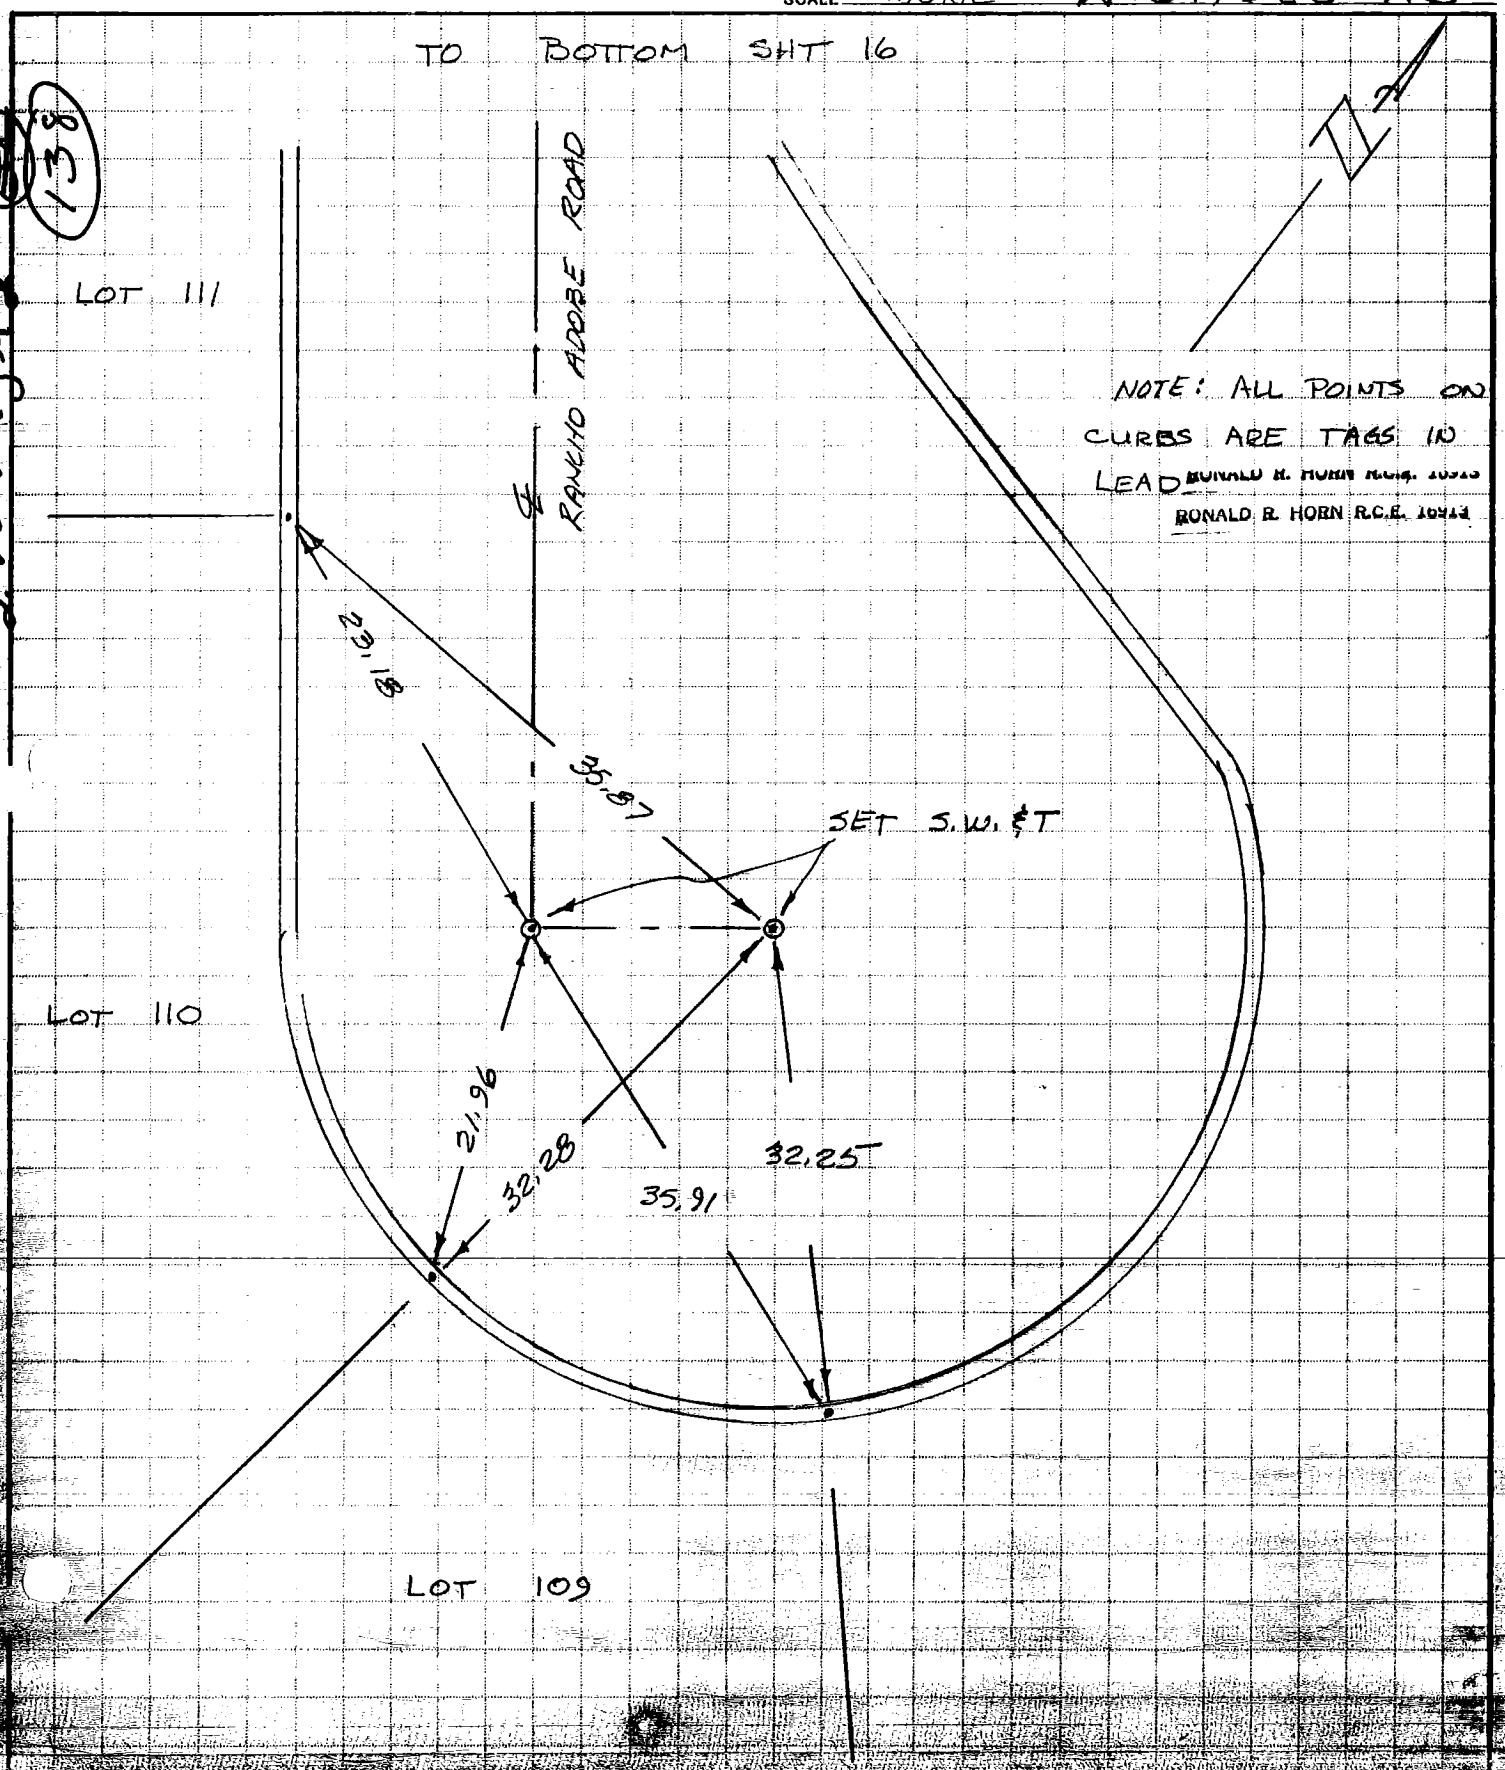

NOTE: ALL POINTS ON CURBS ARE TAGS IN LEAD

RONALD R. HORN R.C.E. 10913

CO ENG FB 3656 - 32

SIKAND ENGINEERING ASSOCIATES
15230 Burbank Boulevard
VAN NUYS, CALIFORNIA 91411
Phone (213) 787-8550

JOB TR 33890
SHEET NO. 18 OF 27
CALCULATED BY BOSTON DATE FEB 14, 80
CHECKED BY ~ DATE
SCALE NONE W.O. 1020-115

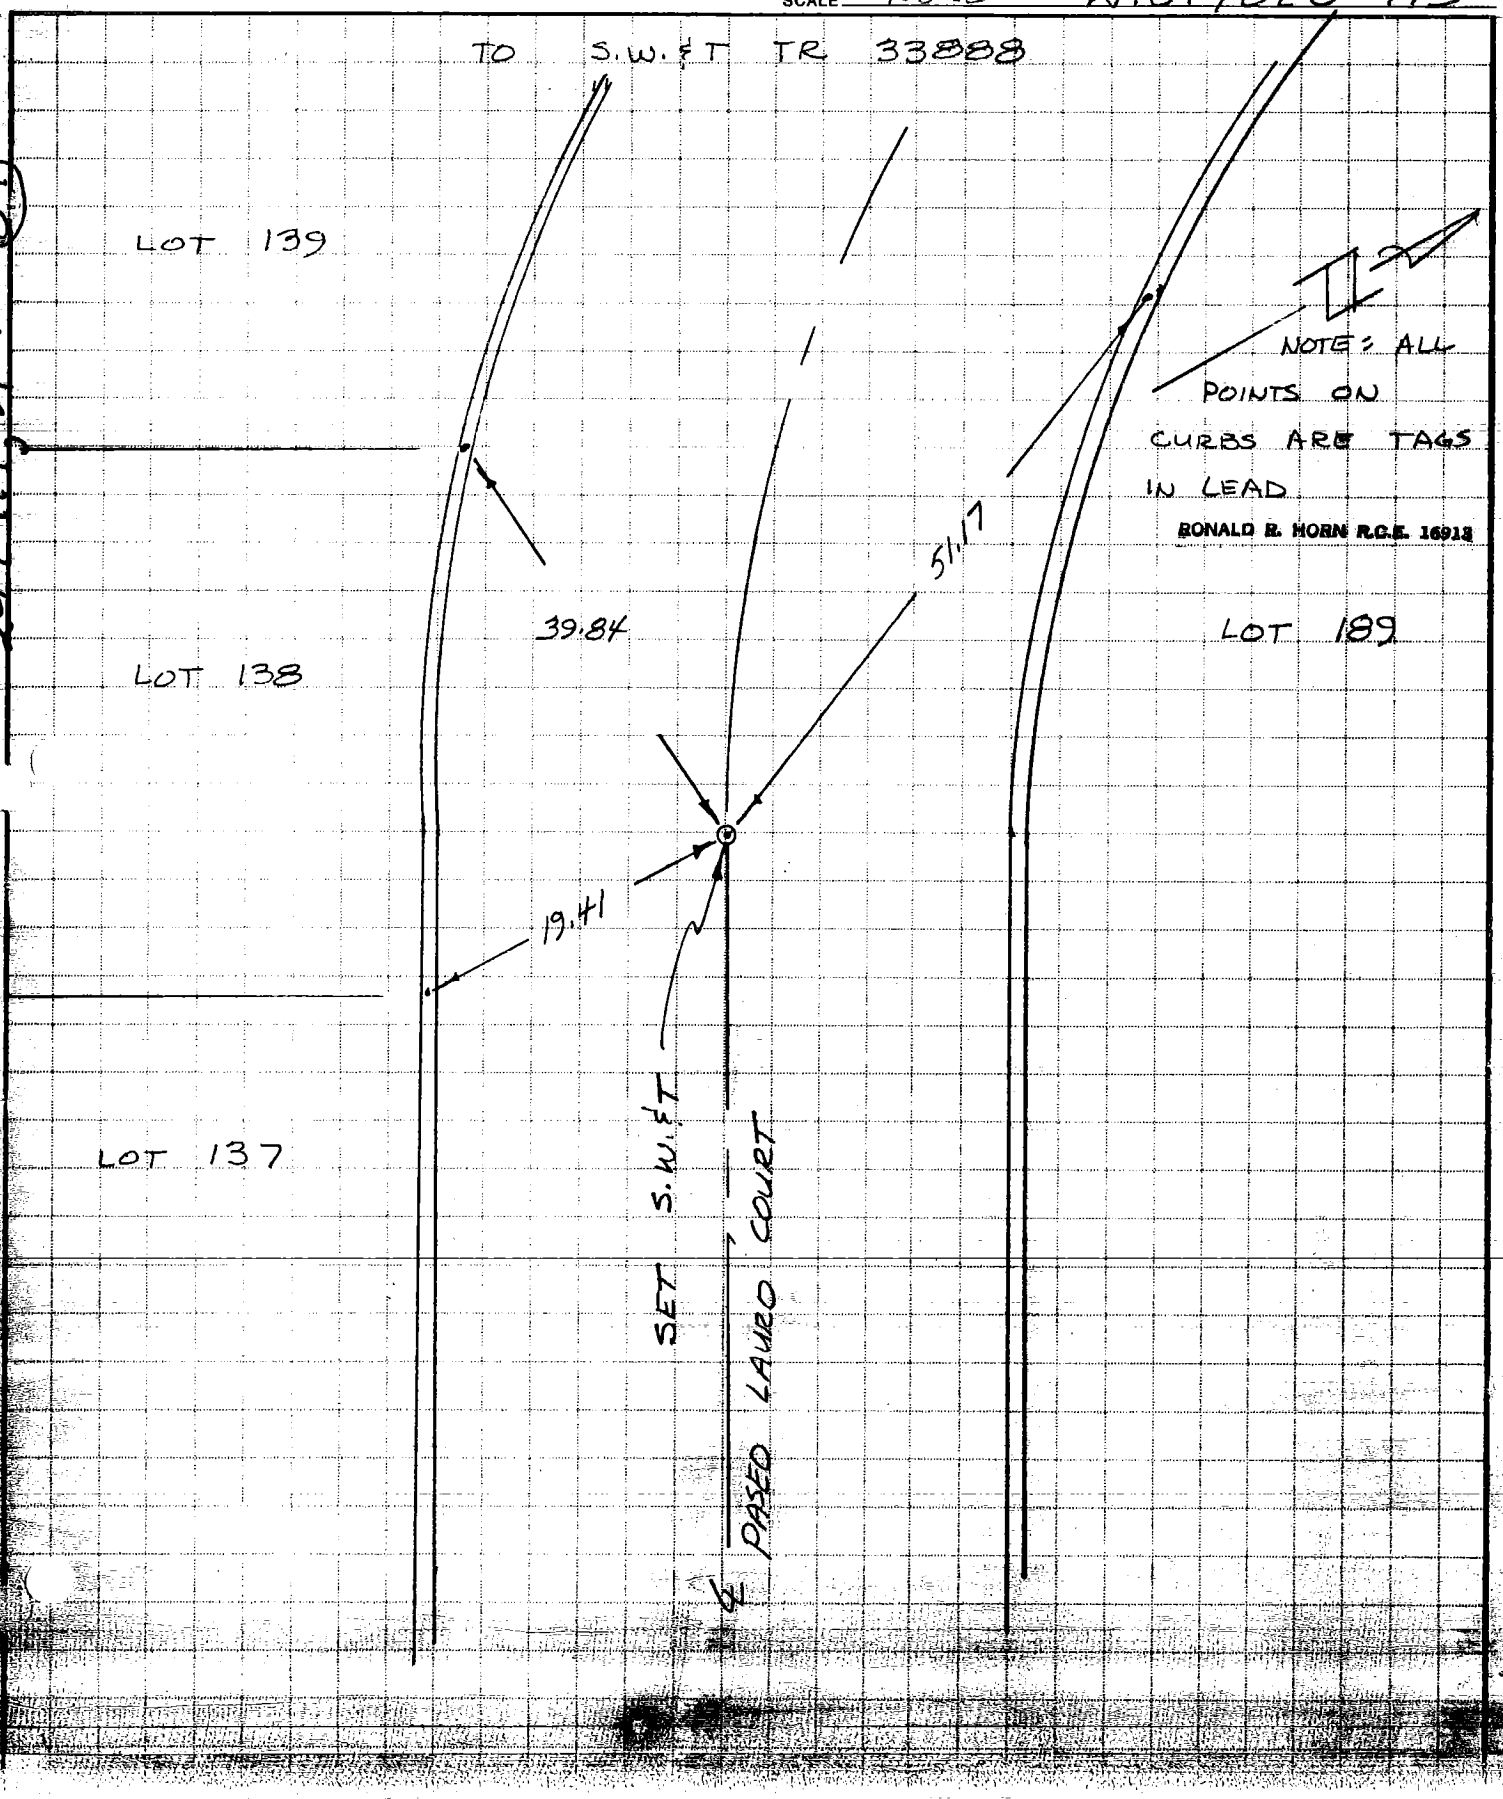

249-11, 4-1 (39)

CO ENG FB 3656 - 33

SIKAND ENGINEERING ASSOCIATES
15230 Burbank Boulevard
VAN NUYS, CALIFORNIA 91411
Phone (213) 787-8550

JOB TR 33890

SHEET NO. 19 OF 27

CALCULATED BY BOSTON DATE FEB 14, 80

CHECKED BY / DATE

SCALE NONE W.O. 1020-115

TO BOTTOM SHT 18

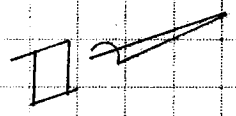

NOTE: ALL POINTS SET ON CURB
ARE TAGS IN LE

RONALD R. HORN R.C.E. 16913

LOT 189

℄ PASEO LAURO COURT

SET S.W.E.T.

46.00

32.00

23.78

32.41

38.64

32.20

LOT 134

LOT 190

LOT 133

2494-17 (39)

CO ENG FB 3656 - 34

SIKAND ENGINEERING ASSOCIATES
15230 Burbank Boulevard
VAN NUYS, CALIFORNIA 91411
Phone (213) 787-8550

F.B. & TIES PG. 20/27
W.O. 1020-115 TR.NO 33890
SURVEY BY BOSTON
DATE FEB 14, 1981

249-W2, A4 (48)

△ = LEAD & TAG IN CURB
RONALD R. HORN R.C.E. 16913

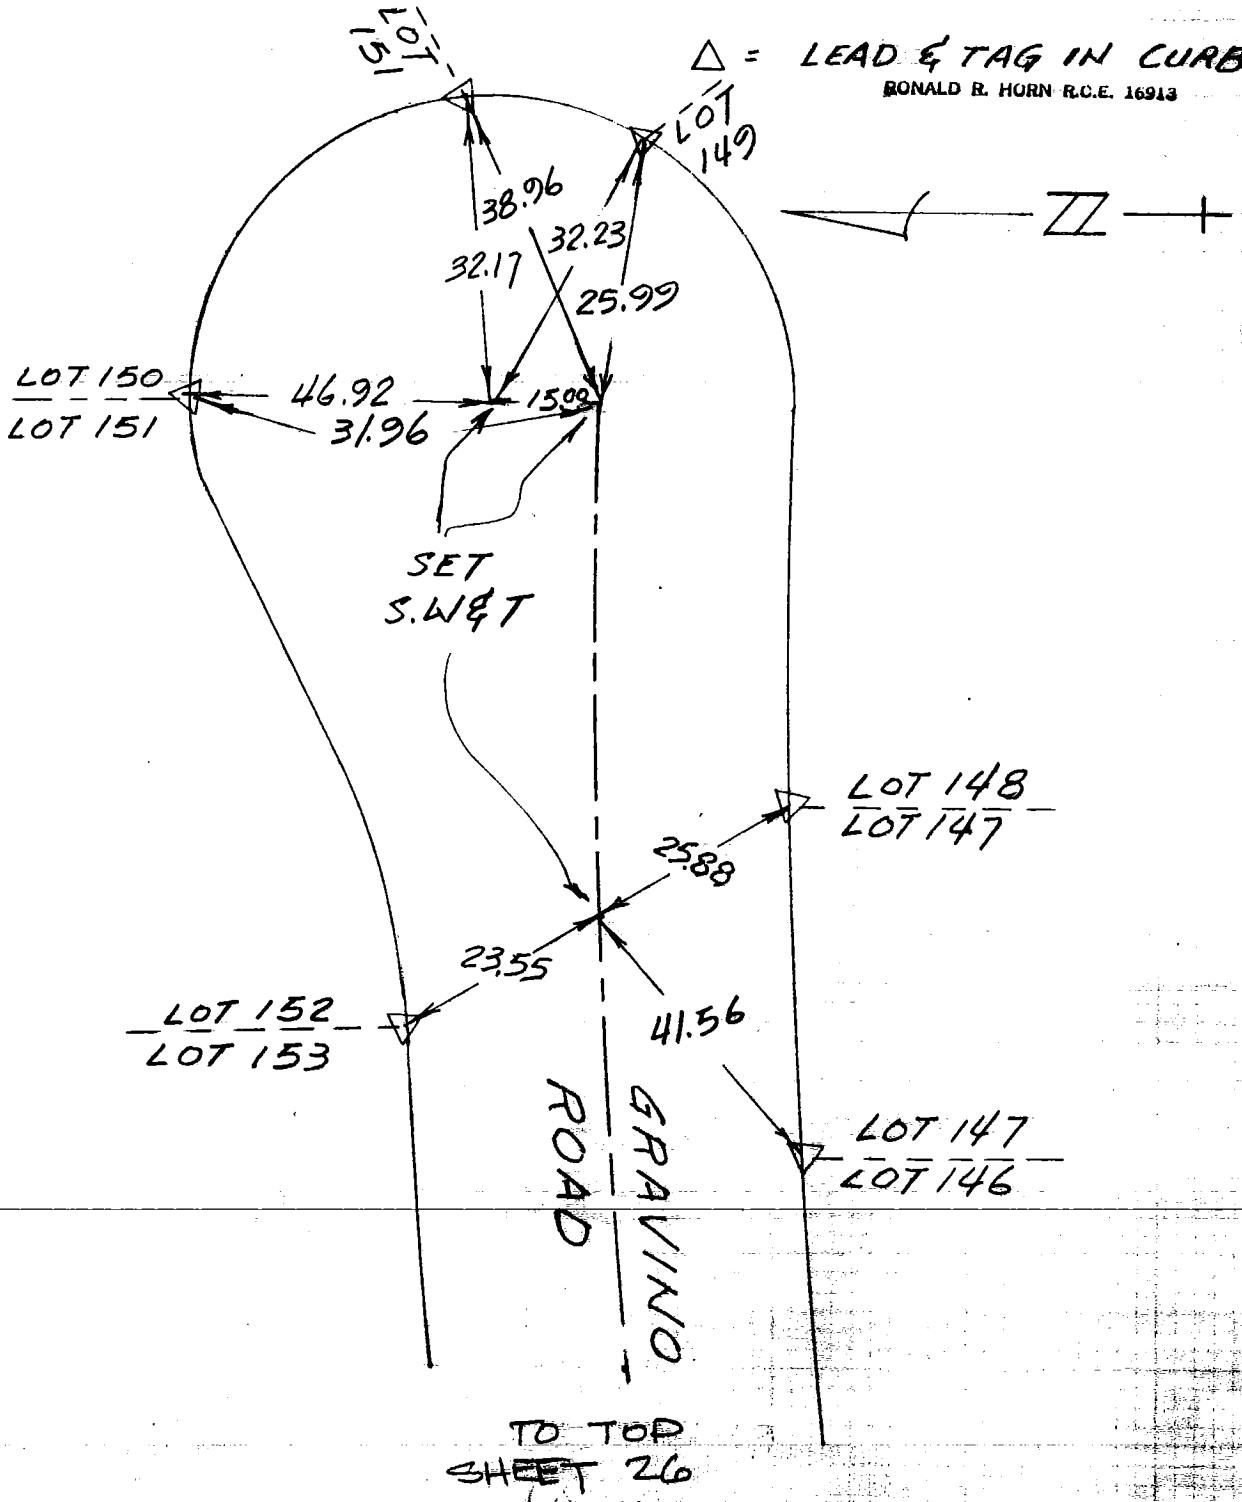

CO ENG FB 3656 - 35

SIKAND ENGINEERING ASSOCIATES
15230 Burbank Boulevard
VAN NUYS, CALIFORNIA 91411
Phone (213) 787-8550

F.B. ℄ TIES PG. 21-27
W.O. 1020-115 TR. Nº 33890
SURVEY BY BOSTON
DATE FEB 14, 1991

Δ = LEAD & TAG IN CURB
RONALD R. HORN R.C.E. 16913

249-117, A-1 (41)

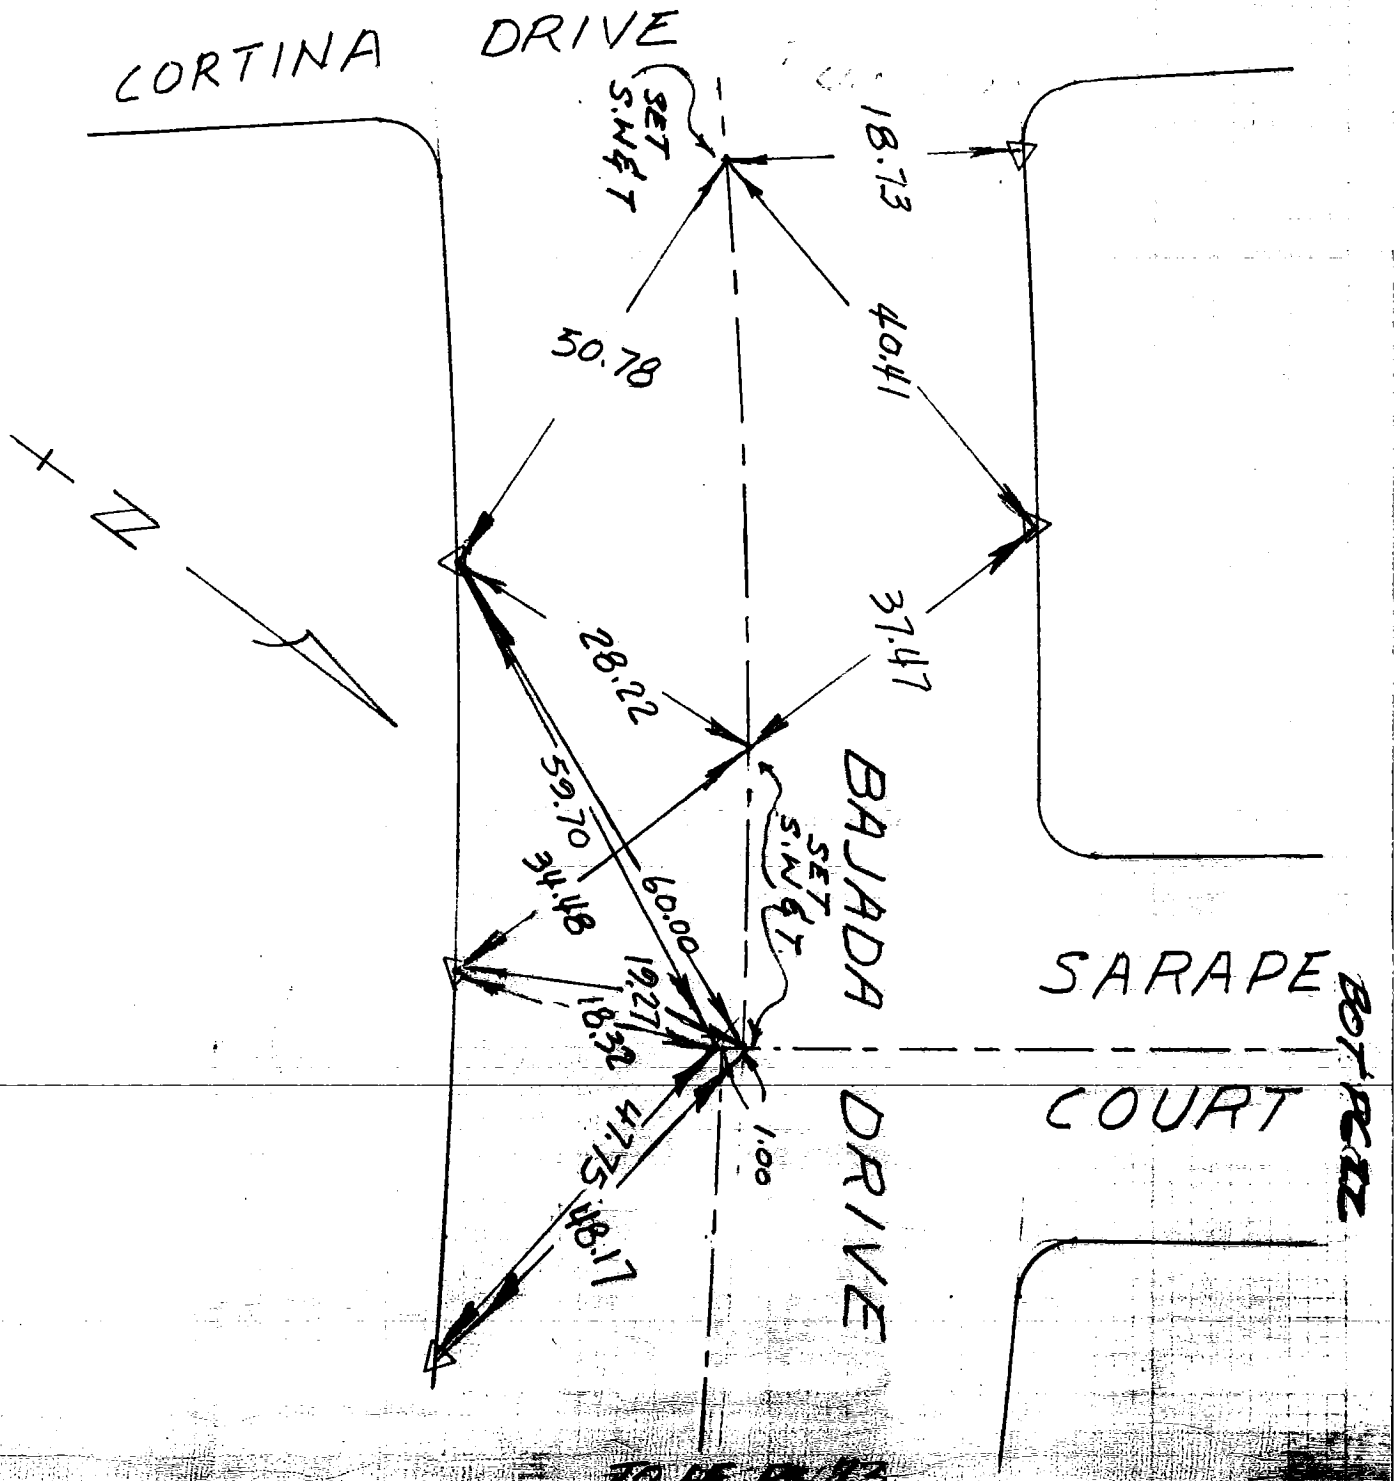

TO DE, PL 23

CO ENG FB 3655 - 36

SIKAND ENGINEERING ASSOCIATES
15230 Burbank Boulevard
VAN NUYS, CALIFORNIA 91411
Phone (213) 787-8550

26

F.B. ℄ TIES PG. 22/27
W.O. 1020-115 TR. № 33890
SURVEY BY BOSTON
DATE FEB 14, 1961

Δ = LEAD & TAG IN CURB
RONALD R. HORN R.C.E. 16913

229-MT, A-1 (M)

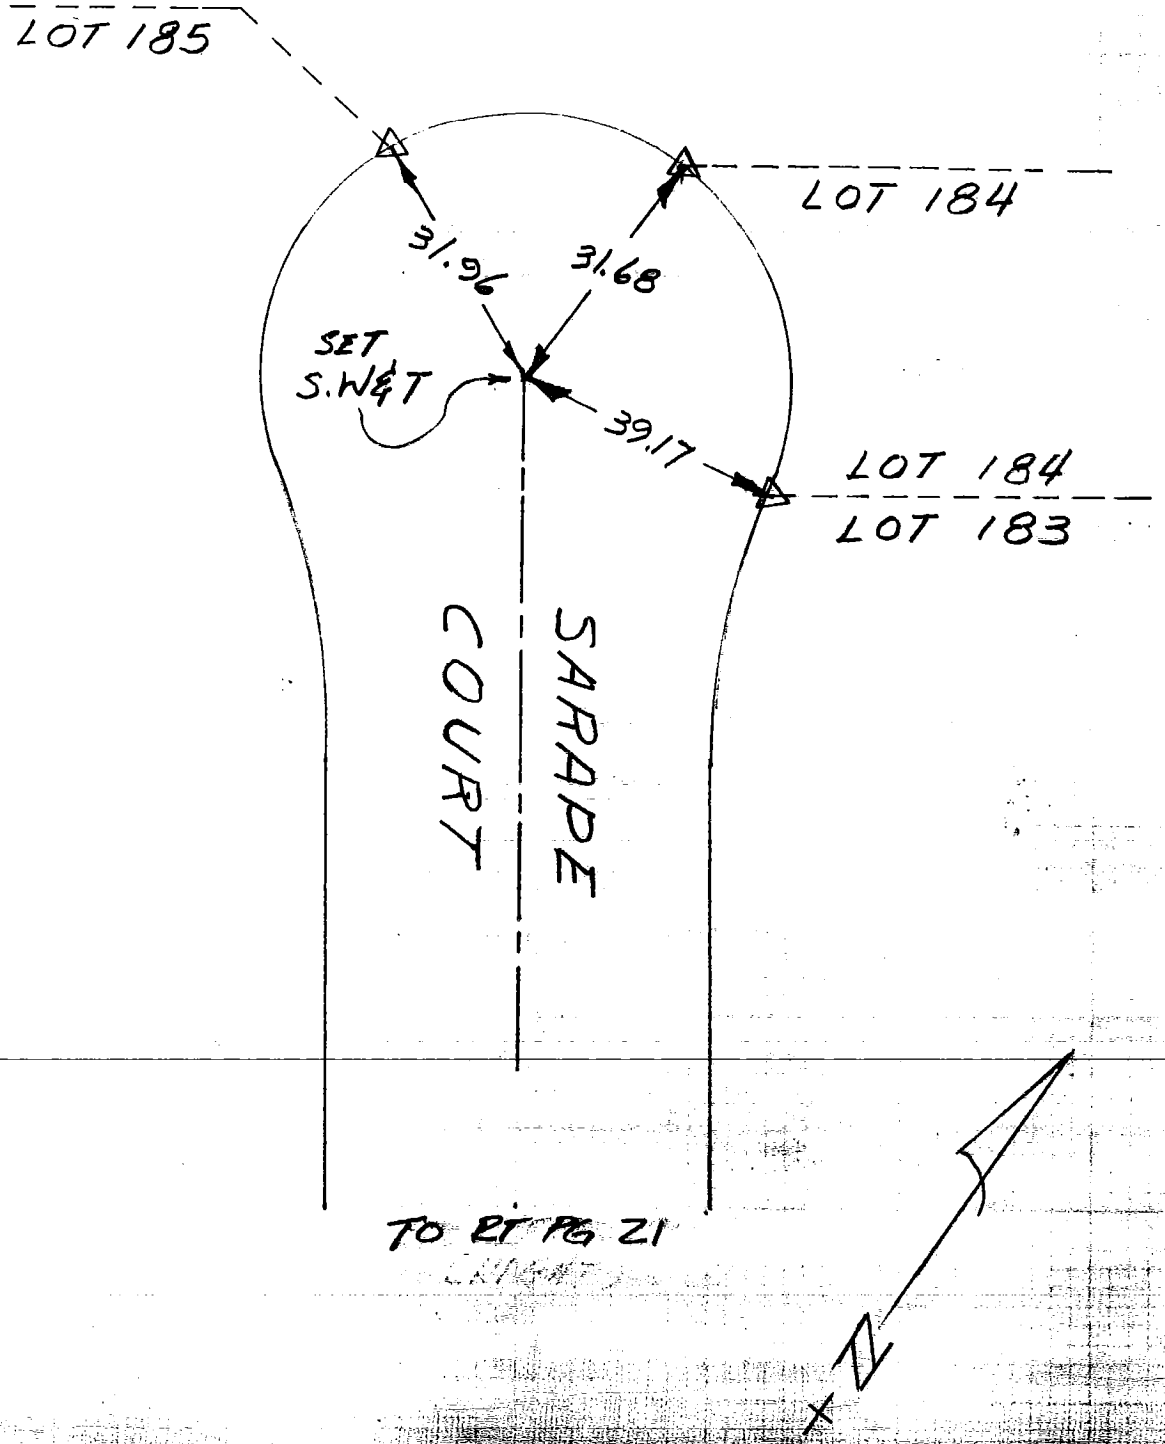

CO ENG FB 3656 - 37

SIKAND ENGINEERING ASSOCIATES
15230 Burbank Boulevard
VAN NUYS, CALIFORNIA 91411
Phone (213) 787-8550

F.B. ℄ TIES PG. 23/27
W.O. 1020-115 TR. №33890
SURVEY BY BOSTON
DATE Feb 14 '85

△ = LEAD & TAG IN CURB
RONALD R. HORN R.C.E. 16913

249-417,4-1 (42)

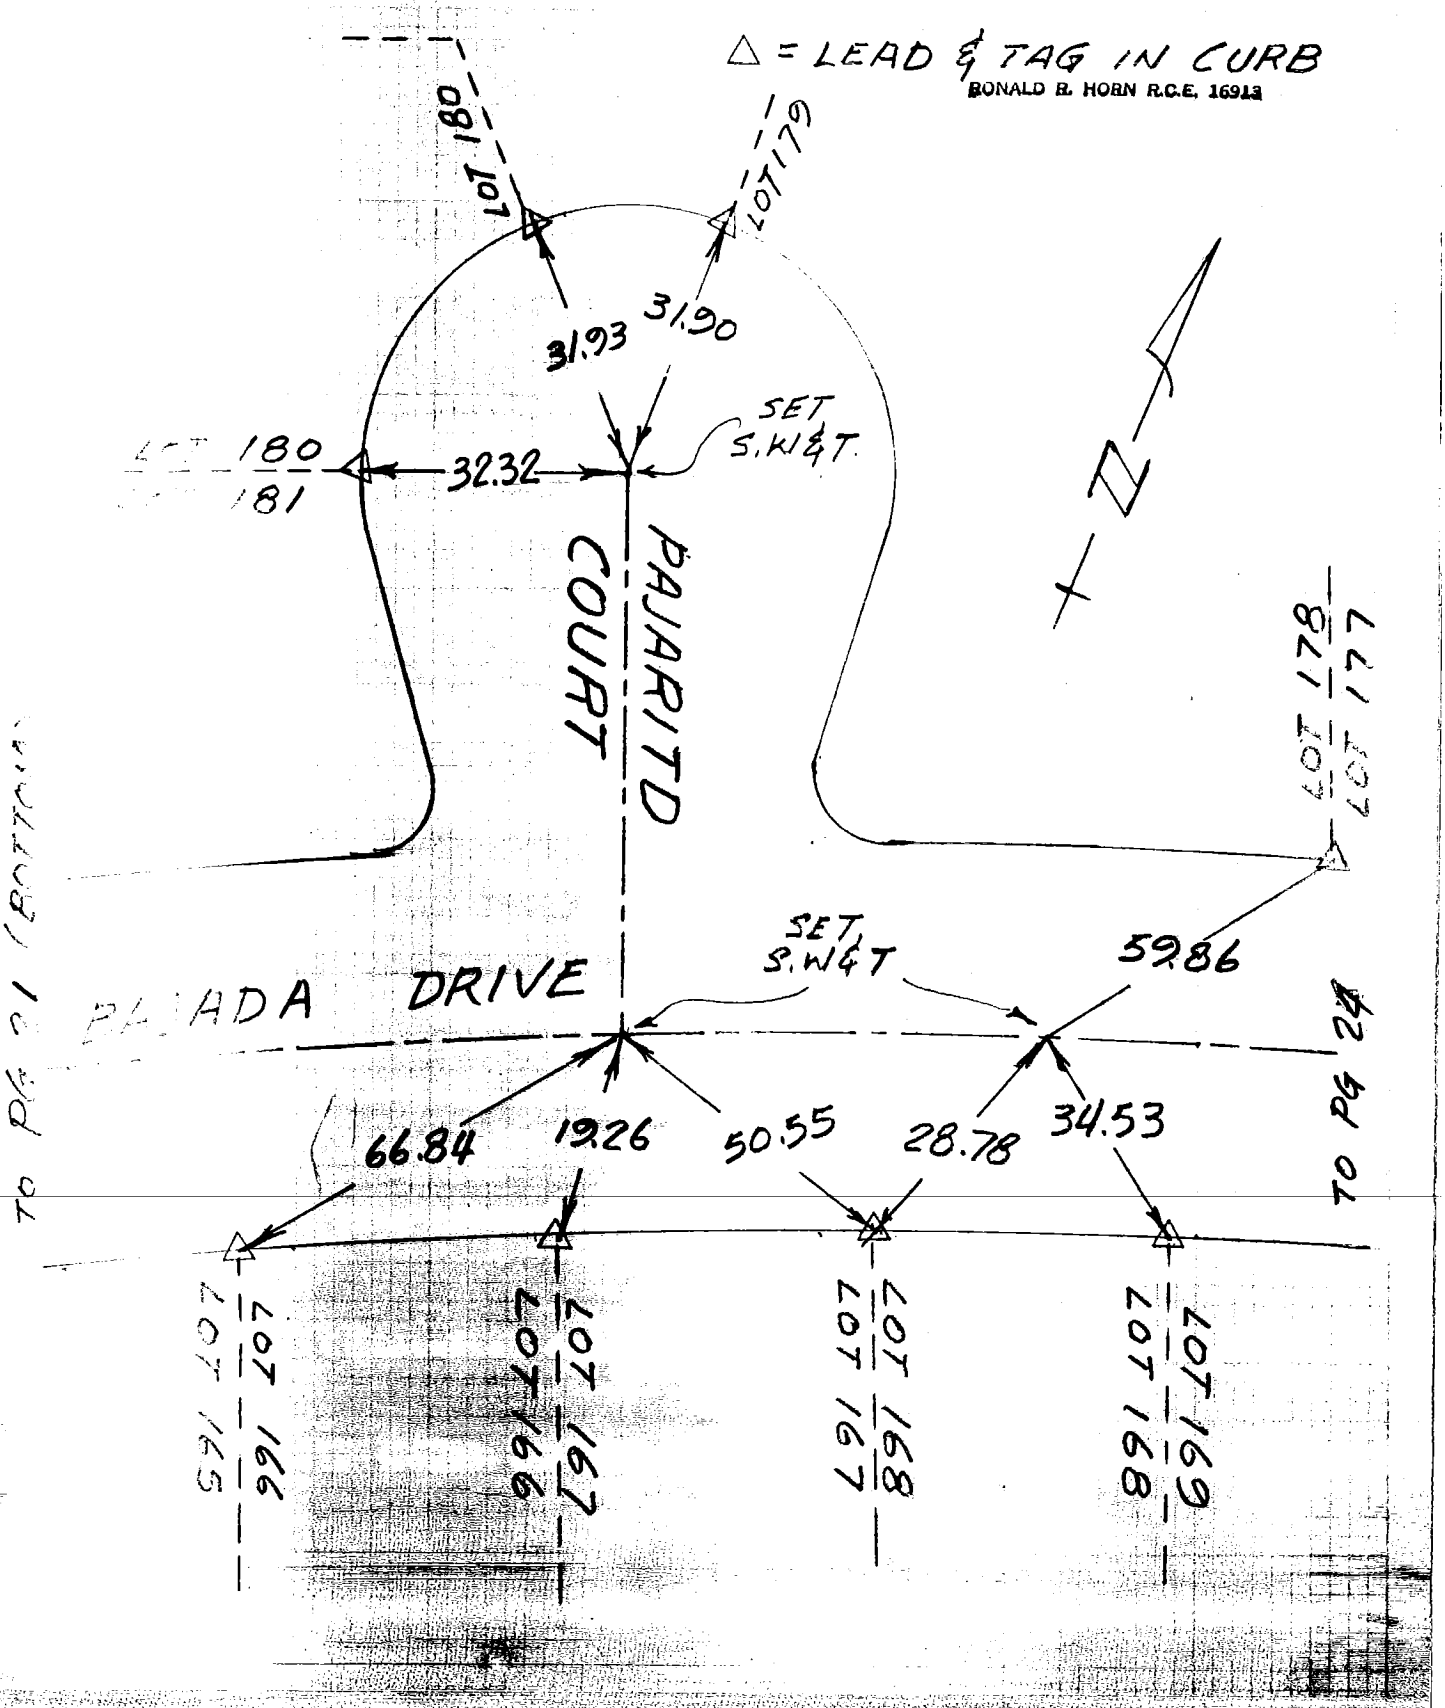

SIKAND ENGINEERING ASSOCIATES
15230 Burbank Boulevard
VAN NUYS, CALIFORNIA 91411
Phone (213) 787-8550

F.B. ℄ TIES PG. 24 / 27
W.O. 1020-115 TR.№ 33890
SURVEY BY BOSTON
DATE Feb 14, 1991

△ = LEAD & TAG IN CURB
RONALD R. HORN R.C.E. 16913

249-117, A-1 (43)

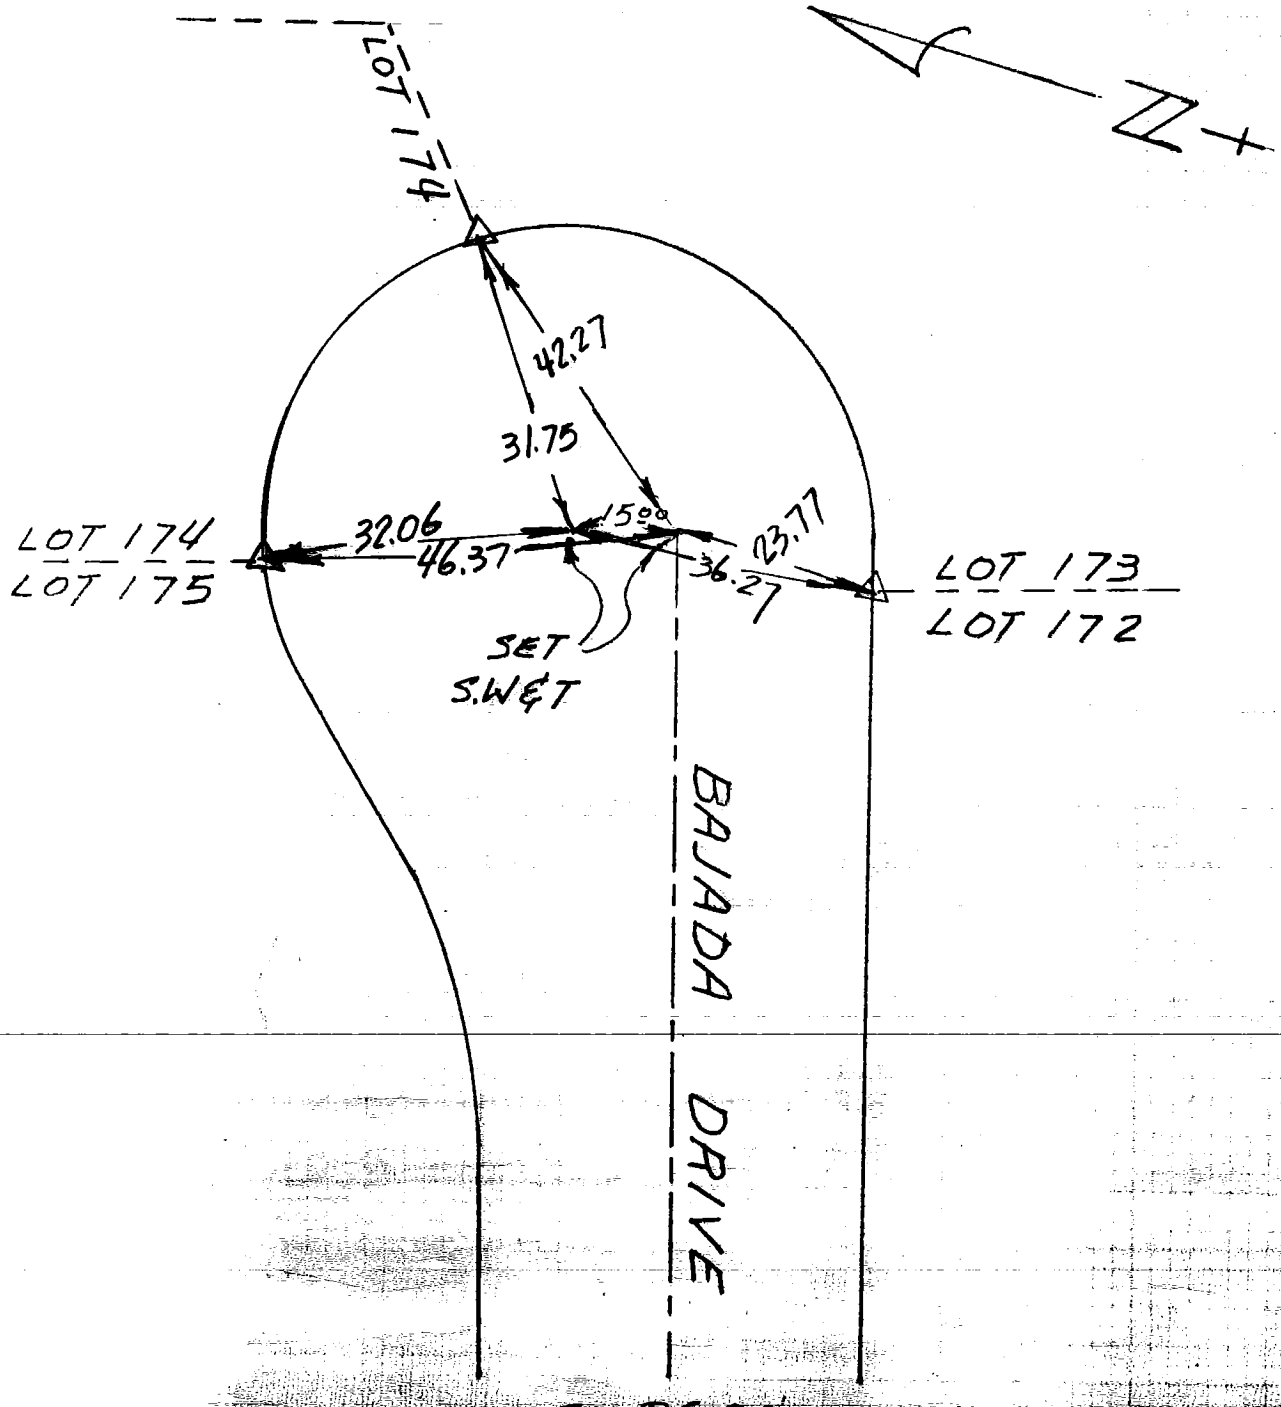

TO PG 28
(RIGHT)

SIKAND ENGINEERING ASSOCIATES
15230 Burbank Boulevard
VAN NUYS, CALIFORNIA 91411
Phone (213) 787-8550

JOB Jo. # 33890
SHEET NO. 25 OF 27
CALCULATED BY WILDMAN DATE FEB. 14, 1980
CHECKED BY DATE
SCALE W.O. 1020-115

REAR CORNER MONUMENTS JO. 33890

LOTS 1-5	SET R PRODS	RCE 16913	
" 6	SET 1" I.P., PLUG	"	
" 7-10	" R PRODS.	"	
" 11-31	" 1" I.P., PLUG	"	
" 32-34	" " " "	"	
" 35-40	" 1" I.P., PLUG	"	
" 41-51	" R PRODS.	"	
" 52-140	" 1" I.P., PLUG	"	
" 141-149	" R PRODS	"	
" 150-173	" 1" I.P., PLUG	"	
" 174-179	" " " "	"	
" 180-184	" " " "	"	
" 185-188	" R PRODS.	"	
& PT LOT 1-2	" 1" I.P., PLUG	"	
" " " 2-3	" " " "	"	
" " " 4-5	" " " "	"	
" " " 8-5	" " " "	"	
" " " 27	" " " "	"	
SW " " " 28	" " " "	"	
" " " 28-32	" " " "	"	
" " " 30-31	" " " "	"	
" " " 34	" " " "	"	
" " " 35	" " " "	"	
" " " 52	" " " "	"	
" " " 78	" " " "	"	
			"

ALL LOTS HAVE L&T, RCE 16913 PRODS IN CURBS ON FRONTS

SIKAND ENGINEERING ASSOCIATES
15230 Burbank Boulevard
VAN NUYS, CALIFORNIA 91411
(213) 787-8550 873-5853

JOB 1020-115 TR 33890 CO ENG FB 3656 - 40

SHEET NO. 26 OF 27

CALCULATED BY _____ DATE _____

CHECKED BY _____ DATE _____

SCALE _____

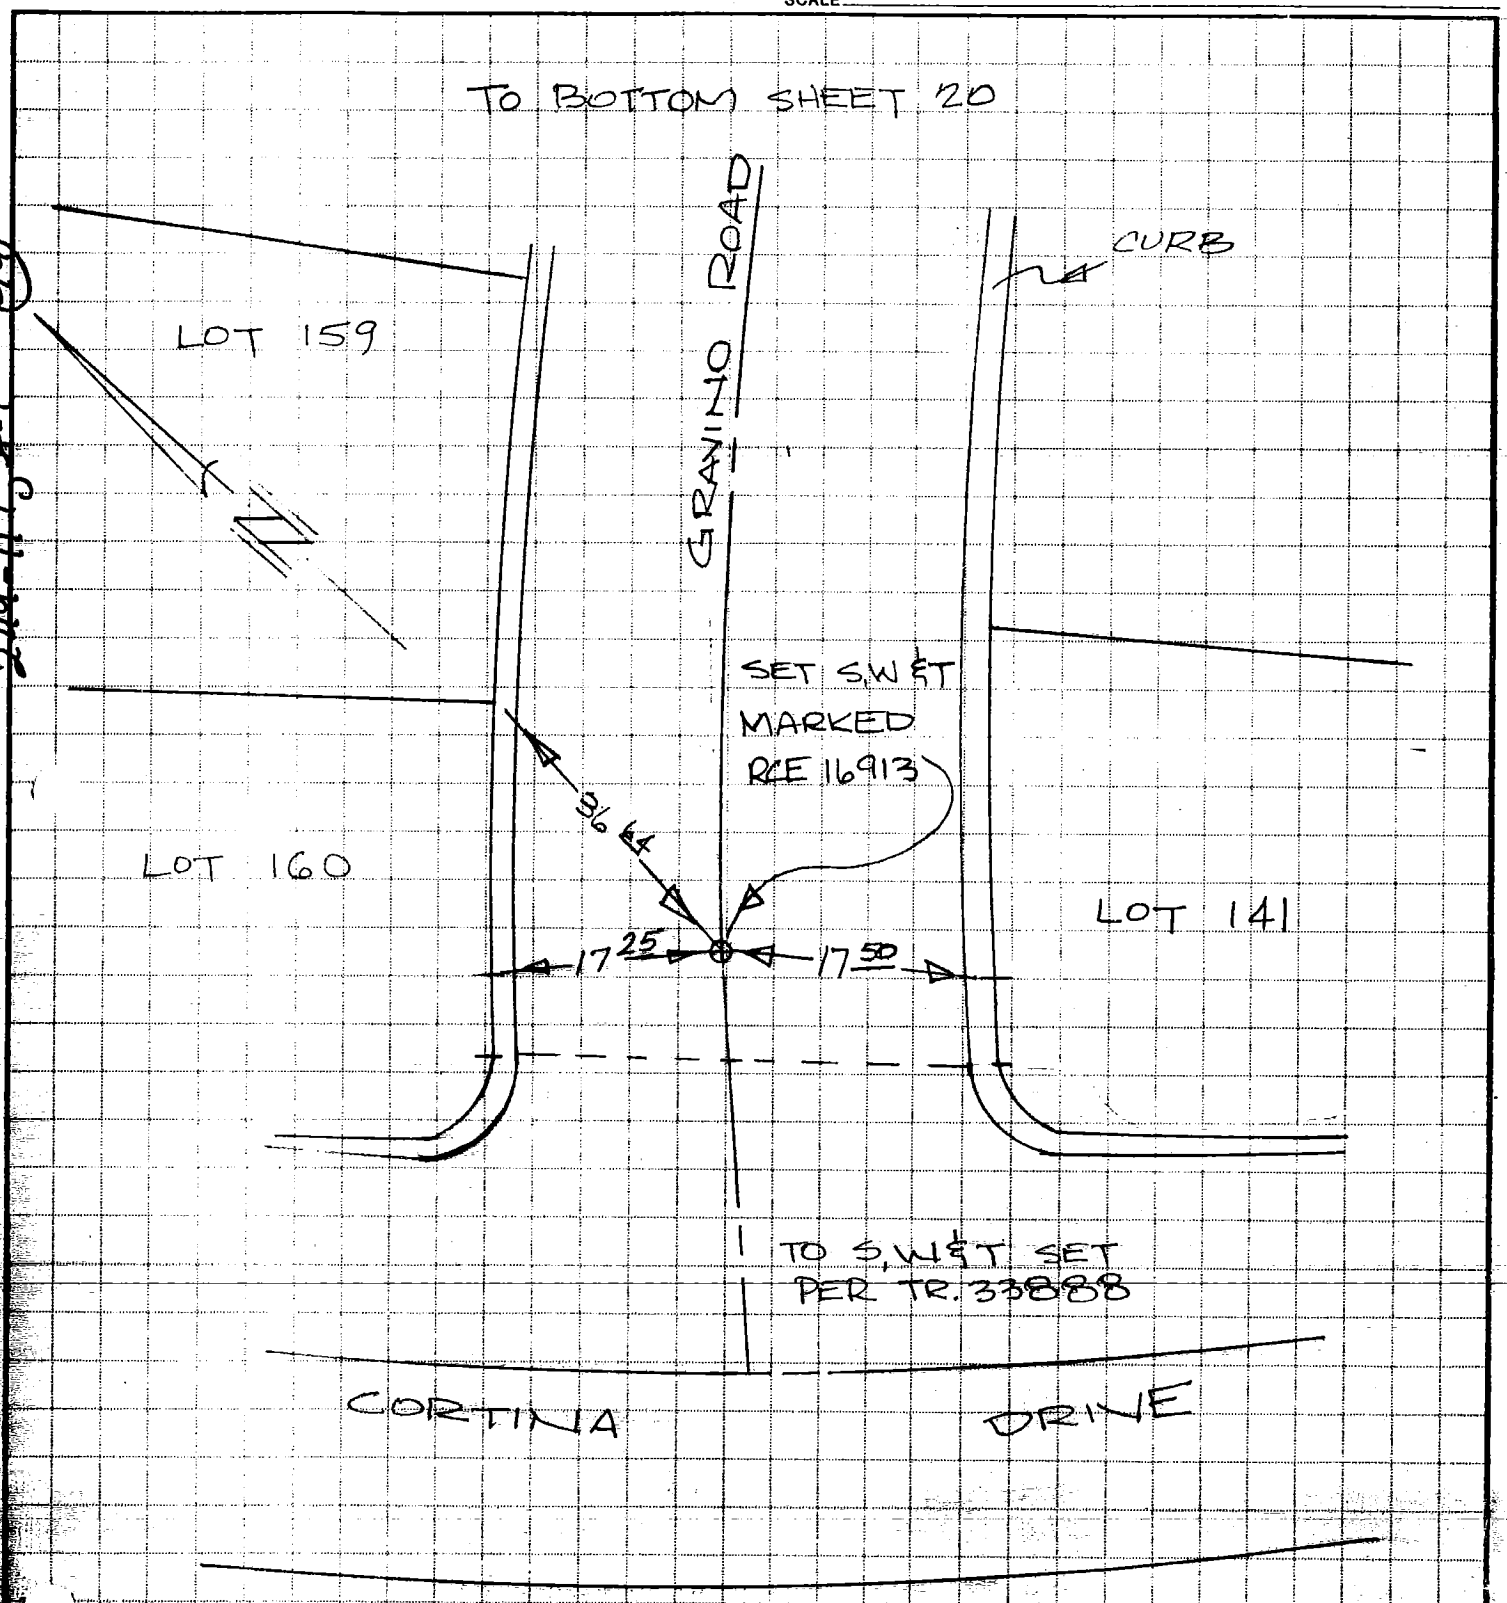

NOTE: ALL POINTS ON CURB ARE TAGGED IN LEAD

RONALD R. HORN R.C.E. 16913

A1

SIKAND ENGINEERING ASSOCIATES
15230 Burbank Boulevard
VAN NUYS, CALIFORNIA 91411
Phone (213) 787-8550

F.B. 1 & TIES PG. 26/27
W.O. TR. 33890 1020-115
SURVEY BY BOSTON
DATE FEB, 13, 1980

REAR CORNER MONUMENTS
TR. 33890

LOT:	SET:	
1-14	℄ PRODS	RCE 16913
15-22	1" IP	"
23	℄ PROD	"
24-29	1" IP	"
30	℄ PROD	"
31-39	1" IP	"
40-52	℄ PROD	"
53-62	1" IP	"
63	℄ PROD	"
64-76	1" IP	"
77-78	℄ PROD.	"
79-95	1" IP	"
96-97	℄ PROD	"
98-120	1" IP	"
121-122	℄ PROD	"
123-139	1" IP	"
140-149	℄ PROD	"
150-159	1" IP	"
160-161	℄ PROD	"
162-177	1" IP	"
178	℄ PROD	"
179-180	1" IP	"
181-182	℄ PROD	"
183-184	1" IP	"
185-192	℄ PROD	"

CO ENG FB 3656 - 42

SIKAND ENGINEERING ASSOCIATES
15230 Burbank Boulevard
VAN NUYS, CALIFORNIA 91411
Phone (213) 787-8550

12

F.B. 4 TIES PG. 27/27
W.O. 1020-115 TR 33890
SURVEY BY BOSTOW
DATE FEB. 14, 1991

TRACT BOUNDARY MONUMENT CHANGES

LOT NO.	SET	IN LIEU OF
X. 40	2" IP	L&T WALL FTS.
X. 185	"	"
X. 184/180	"	"
X. 180	L&T AS TOP WALL	"
X. 179	"	"
X. 179/177	2" IP	"
X. 174	"	"

NOTE ALL POINTS STAMPED

RONALD R. HORN R.C.E. 16913

CO ENG FB 3656 - 43

SIKAND ENGINEERING ASSOCIATES
15230 Burbank Boulevard
VAN NUYS, CALIFORNIA 91411
Phone (213) 787-8550

13

JOB TR. # 33889

SHEET NO. 1 OF 16

CALCULATED BY WILDMAN DATE FEB. 13, 1980

CHECKED BY DATE

SCALE NONE

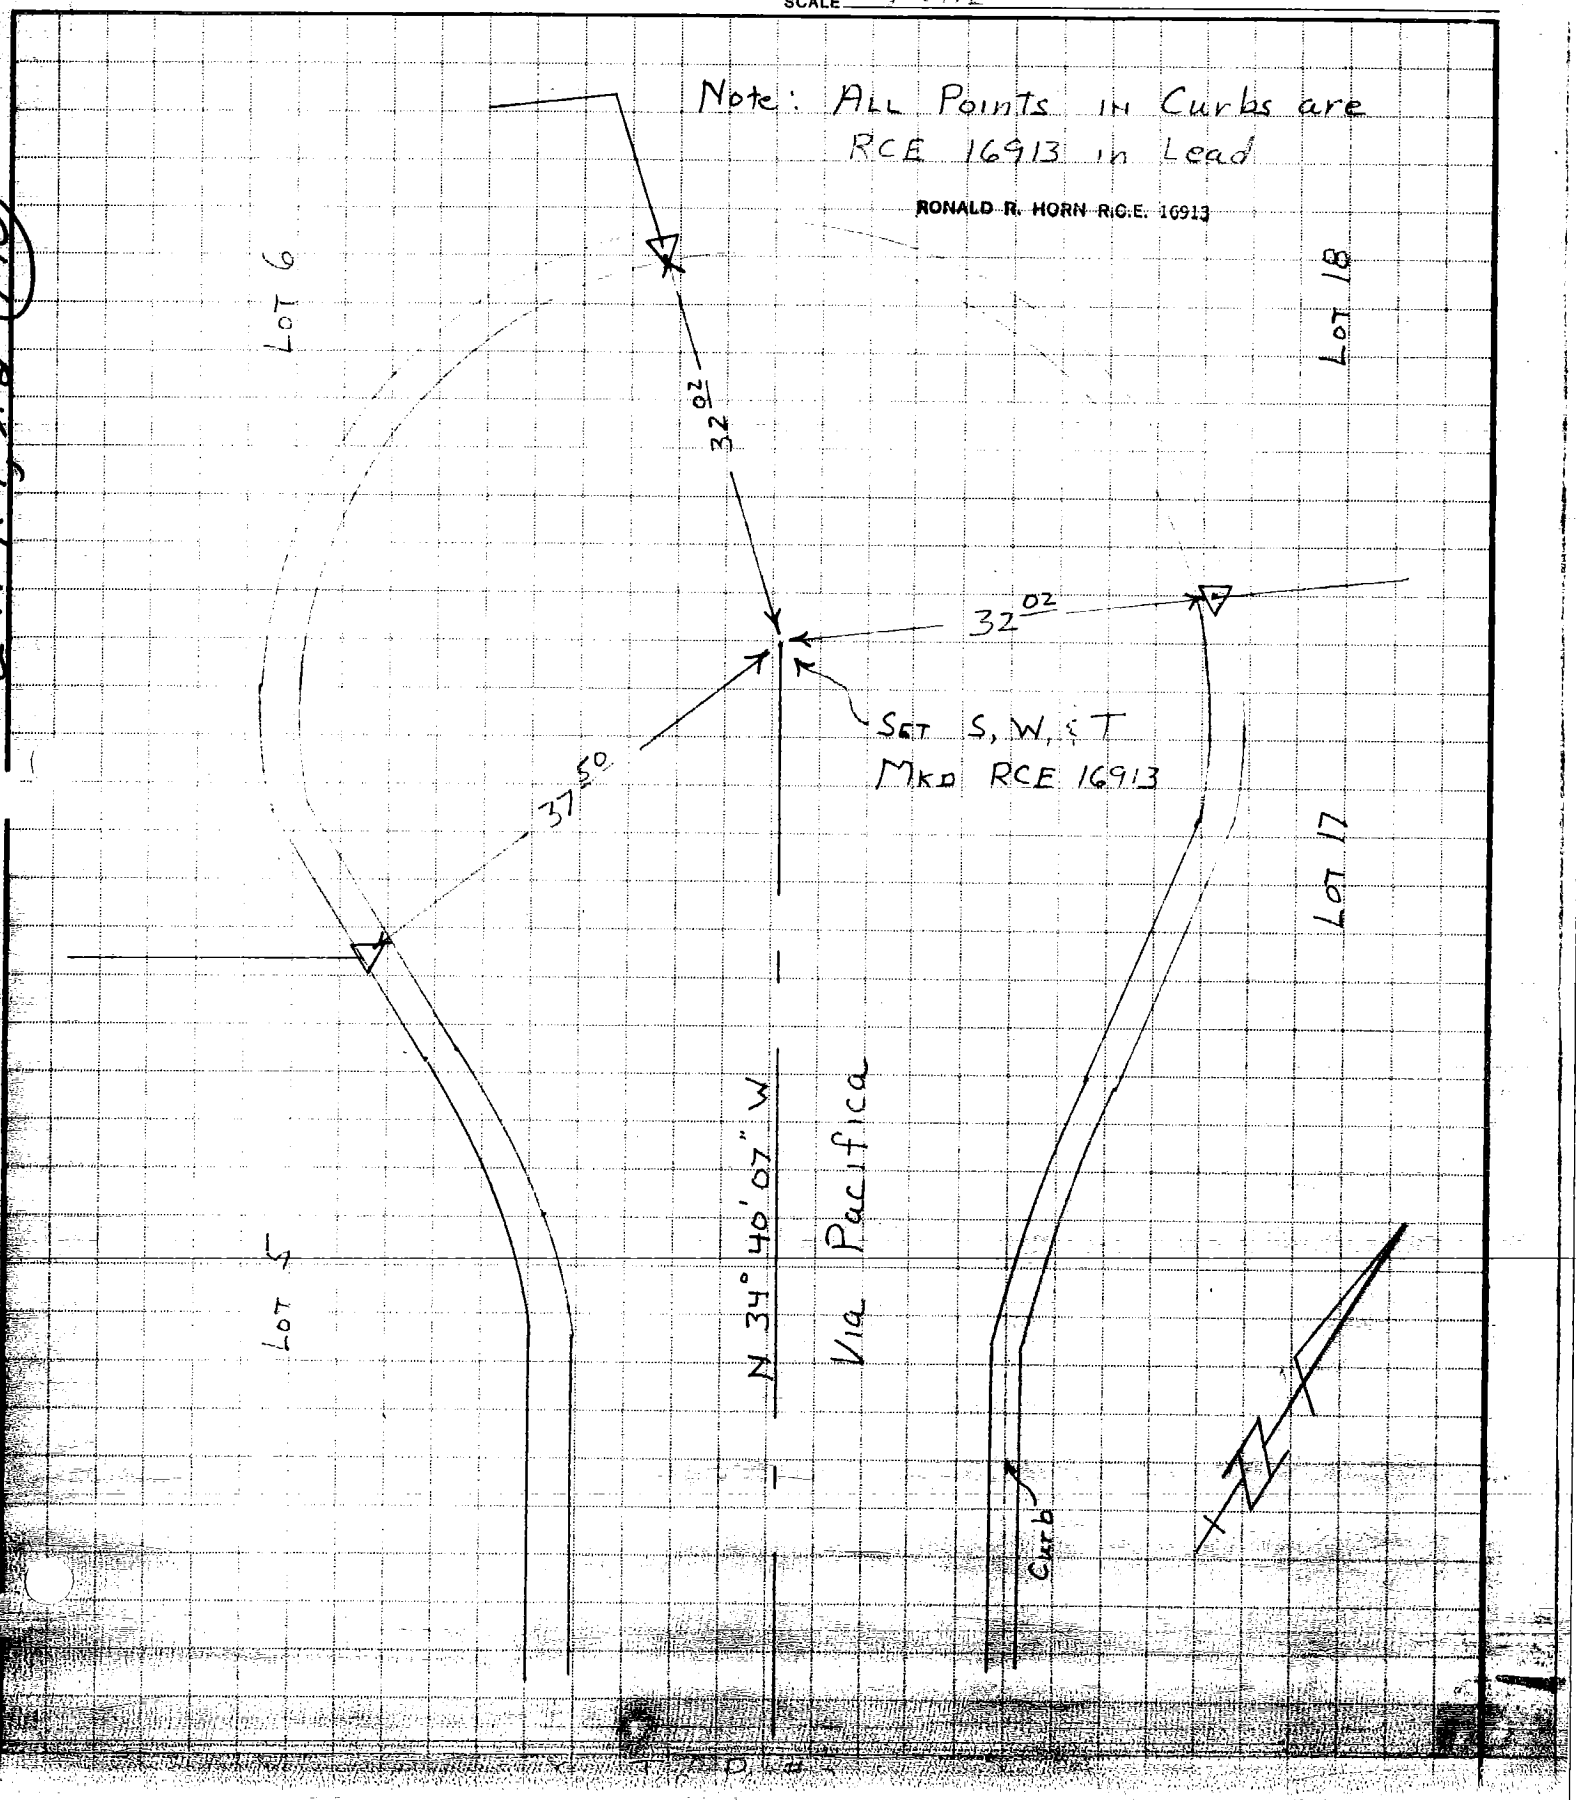

CO ENG FB 3656 - 44

SIKAND ENGINEERING ASSOCIATES
15230 Burbank Boulevard
VAN NUYS, CALIFORNIA 91411
Phone (213) 787-8550

JOB Tr. # 33889

SHEET NO. 2 OF 16

CALCULATED BY WILDMAN DATE FEB 13, 1980

CHECKED BY ✓ DATE

SCALE NONE

See Bottom Pg. 1

Note:
ALL Points in Curbs are RCE 16913 in Lead

RONALD R. HORN RCE 16913

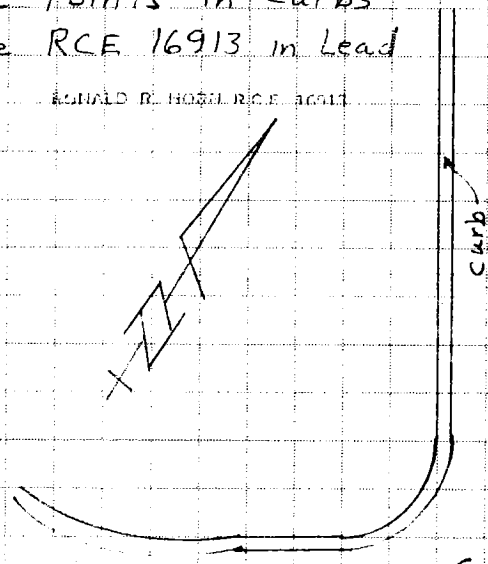

N 34° 40' 07" W

Via Pacifica

Lot 14

Set S, W, & T
Mkd RCE
16913

31.82

N 55° 19' 53" E

Via Calma

Lot 13

48.22

39.47

(1'±)

See Right

Lot 9

Curb

Curb

Lot 12

To Avenida Velarde Tr #2993

CO ENG FB 3656 - 45

SIKAND ENGINEERING ASSOCIATES
15230 Burbank Boulevard
VAN NUYS, CALIFORNIA 91411
Phone (213) 787-8550

JOB T.T. # 33889
SHEET NO. 3 OF 16
CALCULATED BY WILDMAN DATE FEB 13, 1980
CHECKED BY ✓ DATE
SCALE NONE

249-117, A:2 (19)

Note:
All Points in Curbs are RCE 16913 in Lead

RONALD R. HORN R.C.E. 16913

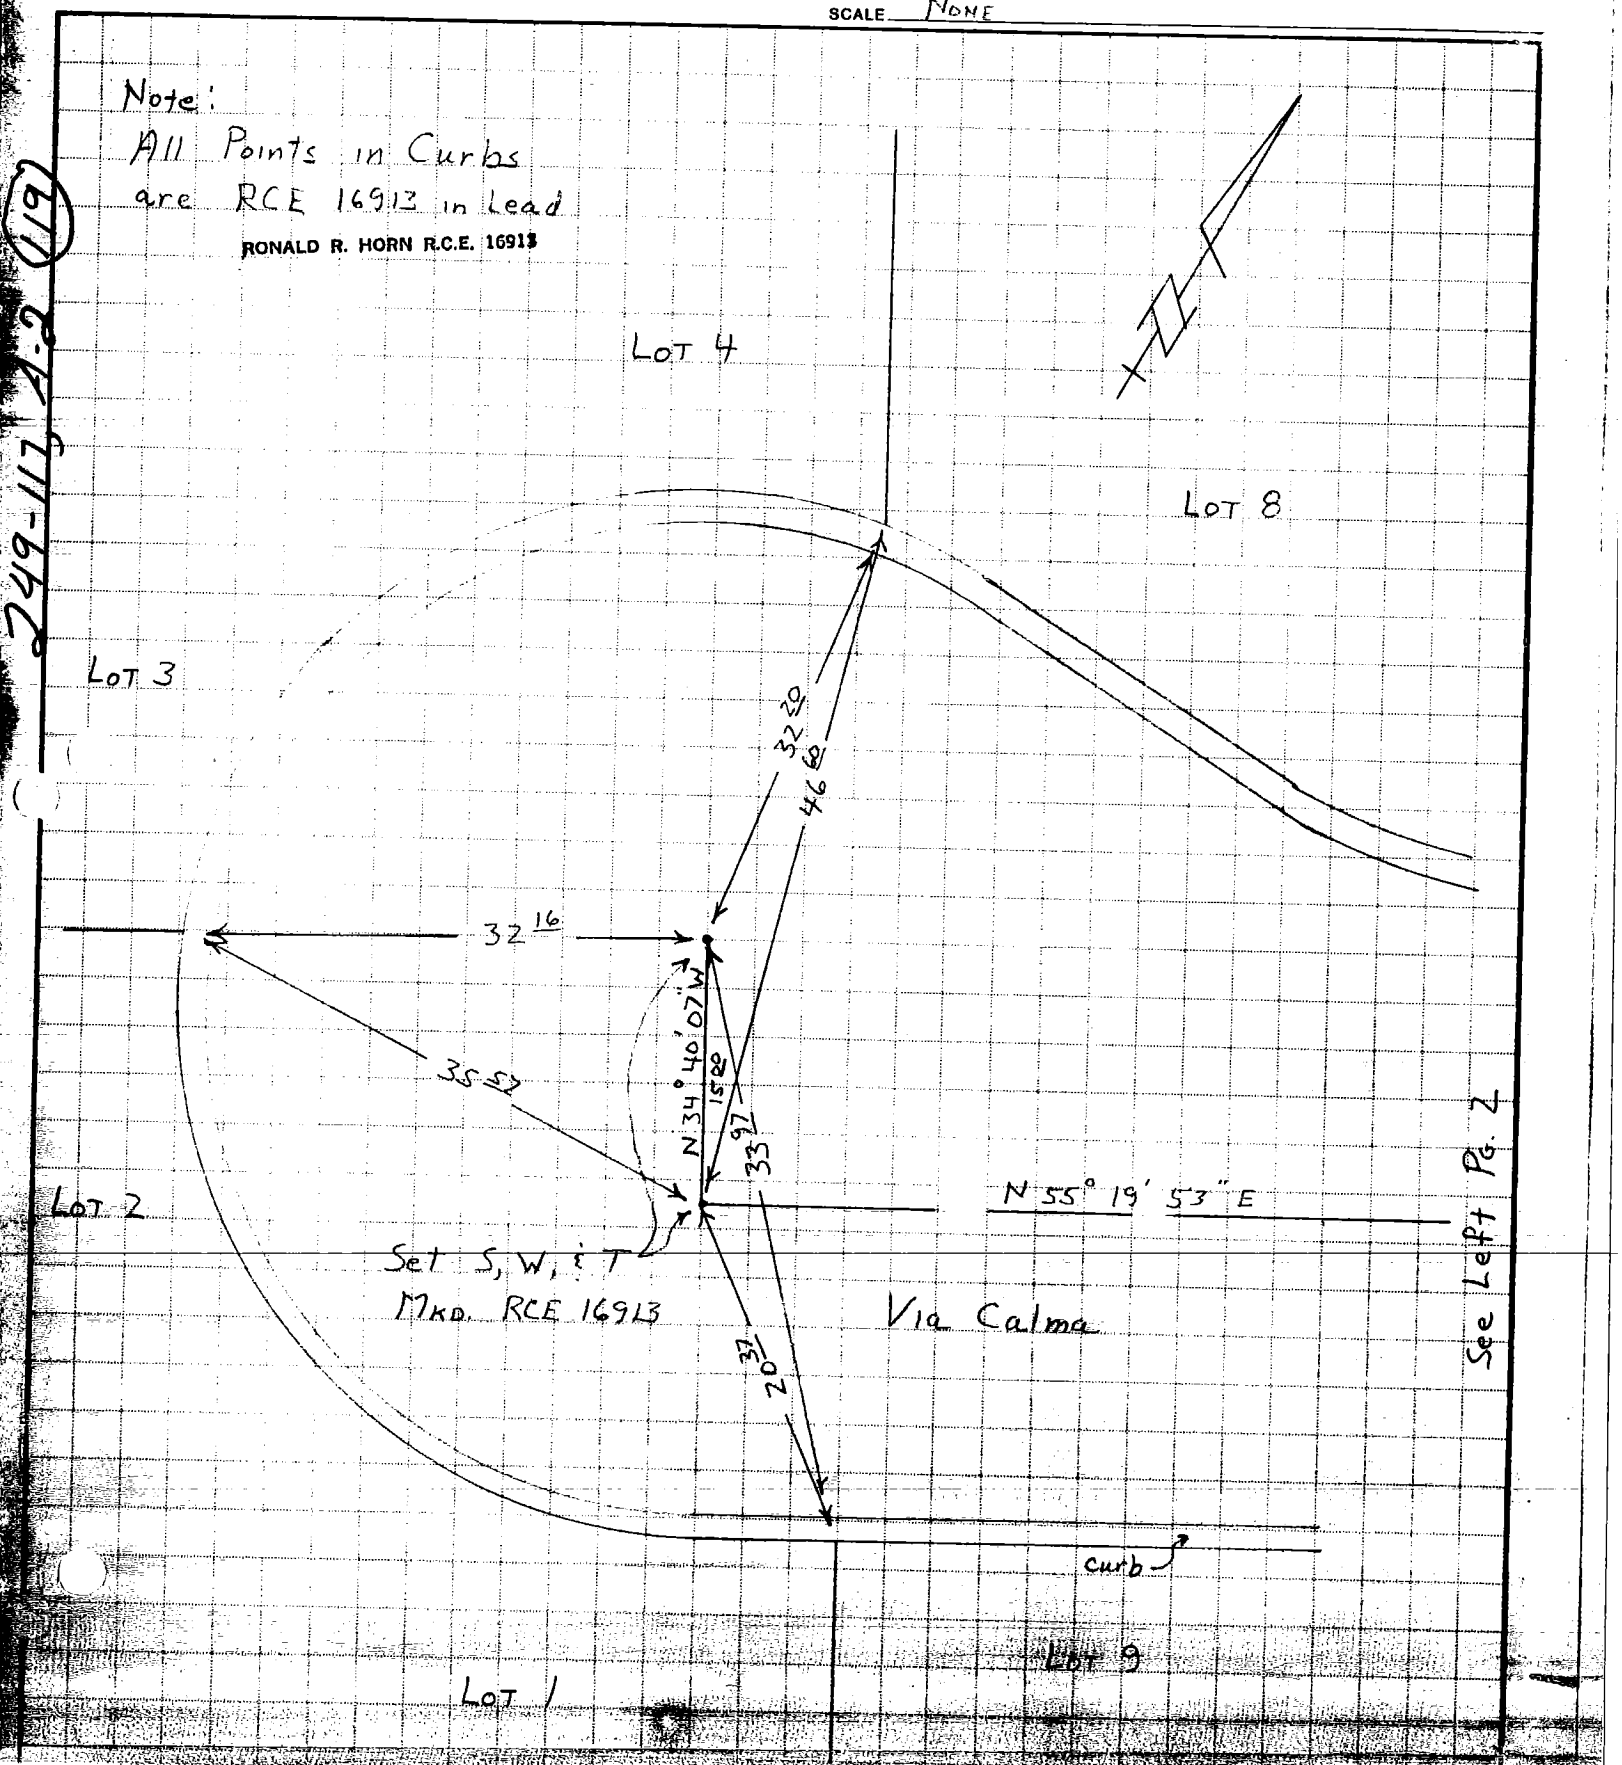

SIKAND ENGINEERING ASSOCIATES
15230 Burbank Boulevard
VAN NUYS, CALIFORNIA 91411
Phone (213) 787-8550

JOB Tr. # 33889
SHEET NO. 4 OF 16
CALCULATED BY WILDMAN DATE FEB. 13, 1980
CHECKED BY ✓ DATE
SCALE NONE

249-117, A-2 (14)

NOTE:
ALL POINTS IN CURB
ARE RCE 16913 in Lead
RONALD R. HORN R.C.E. 16913

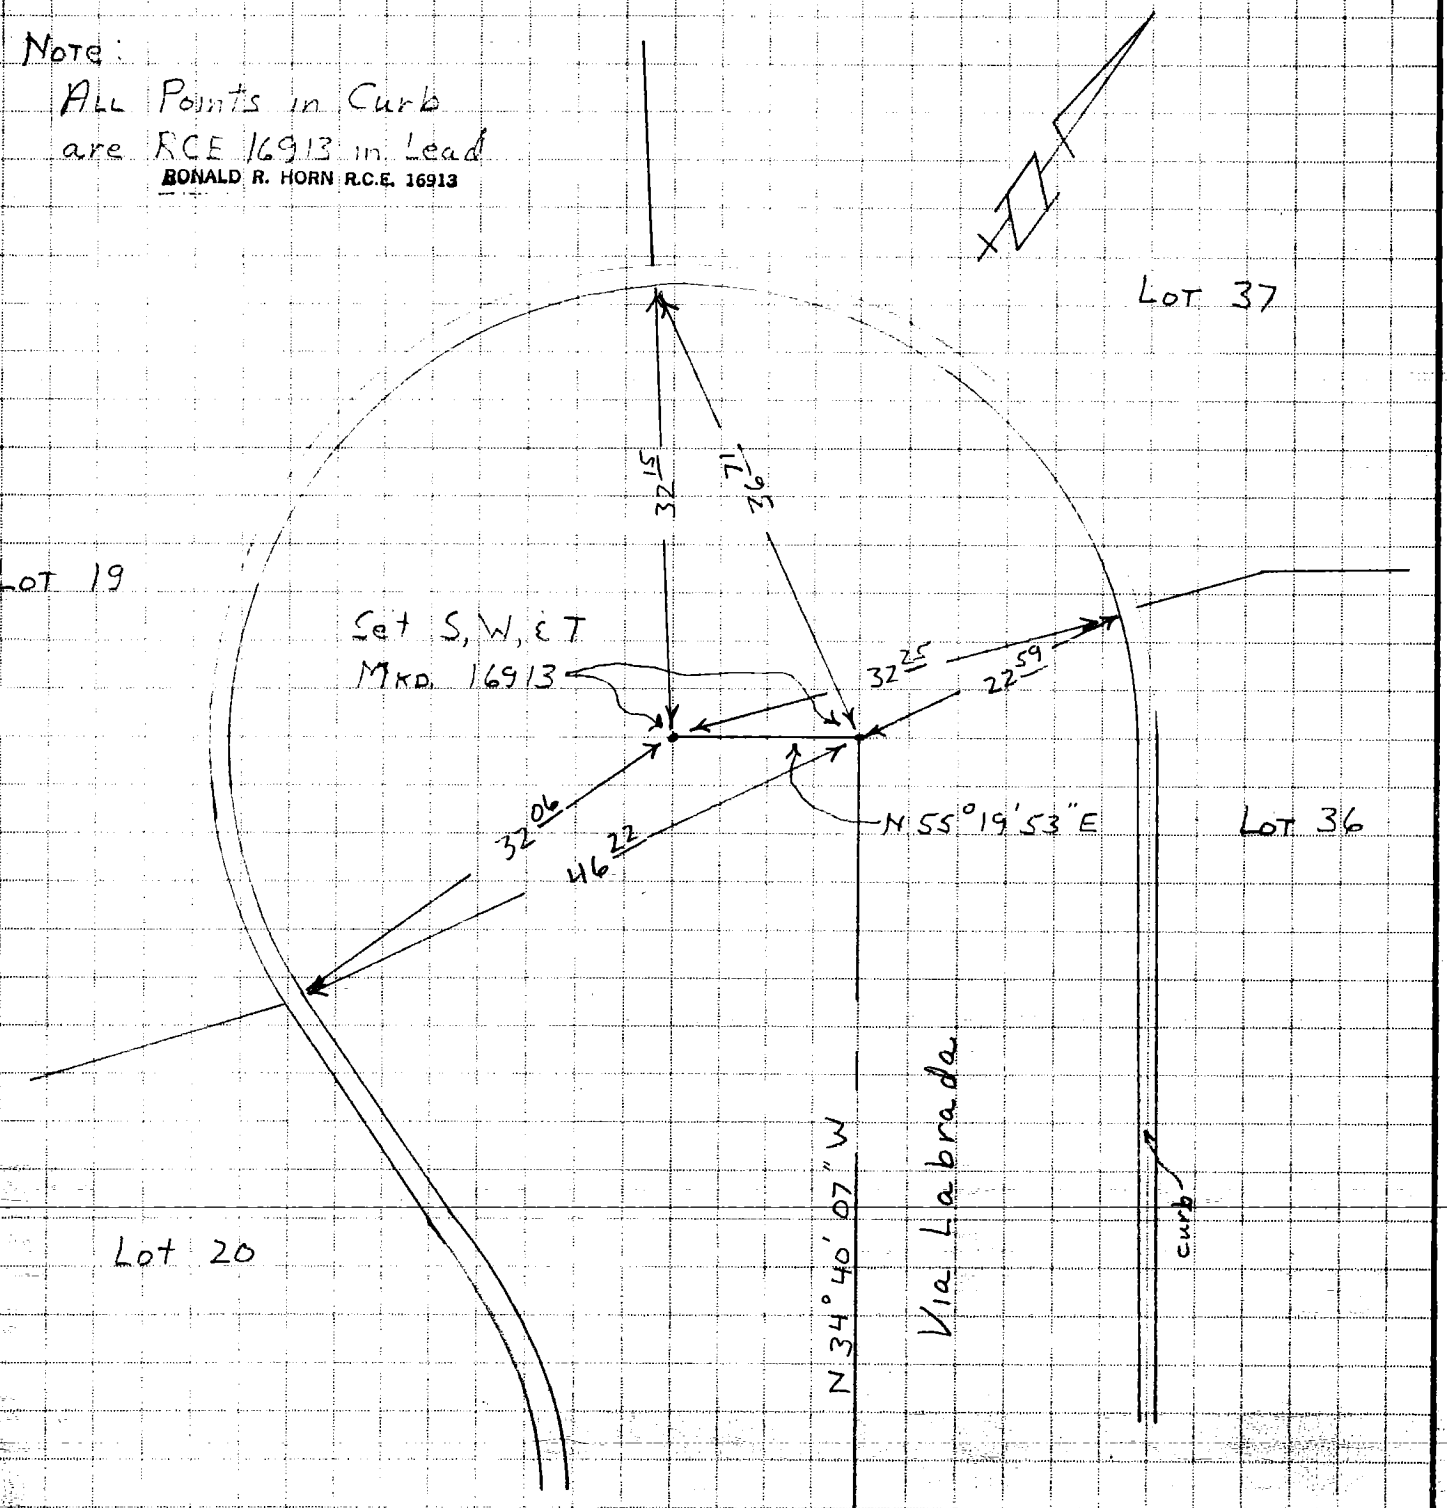

To Avenida Velarte
Tr. # 29903

SIKAND ENGINEERING ASSOCIATES
15230 Burbank Boulevard
VAN NUYS, CALIFORNIA 91411
Phone (213) 787-8550

JOB Tr. # 33889
SHEET NO. 5 OF 16
CALCULATED BY WILDMAN DATE FEB. 13, 1986
CHECKED BY ✓ DATE
SCALE None

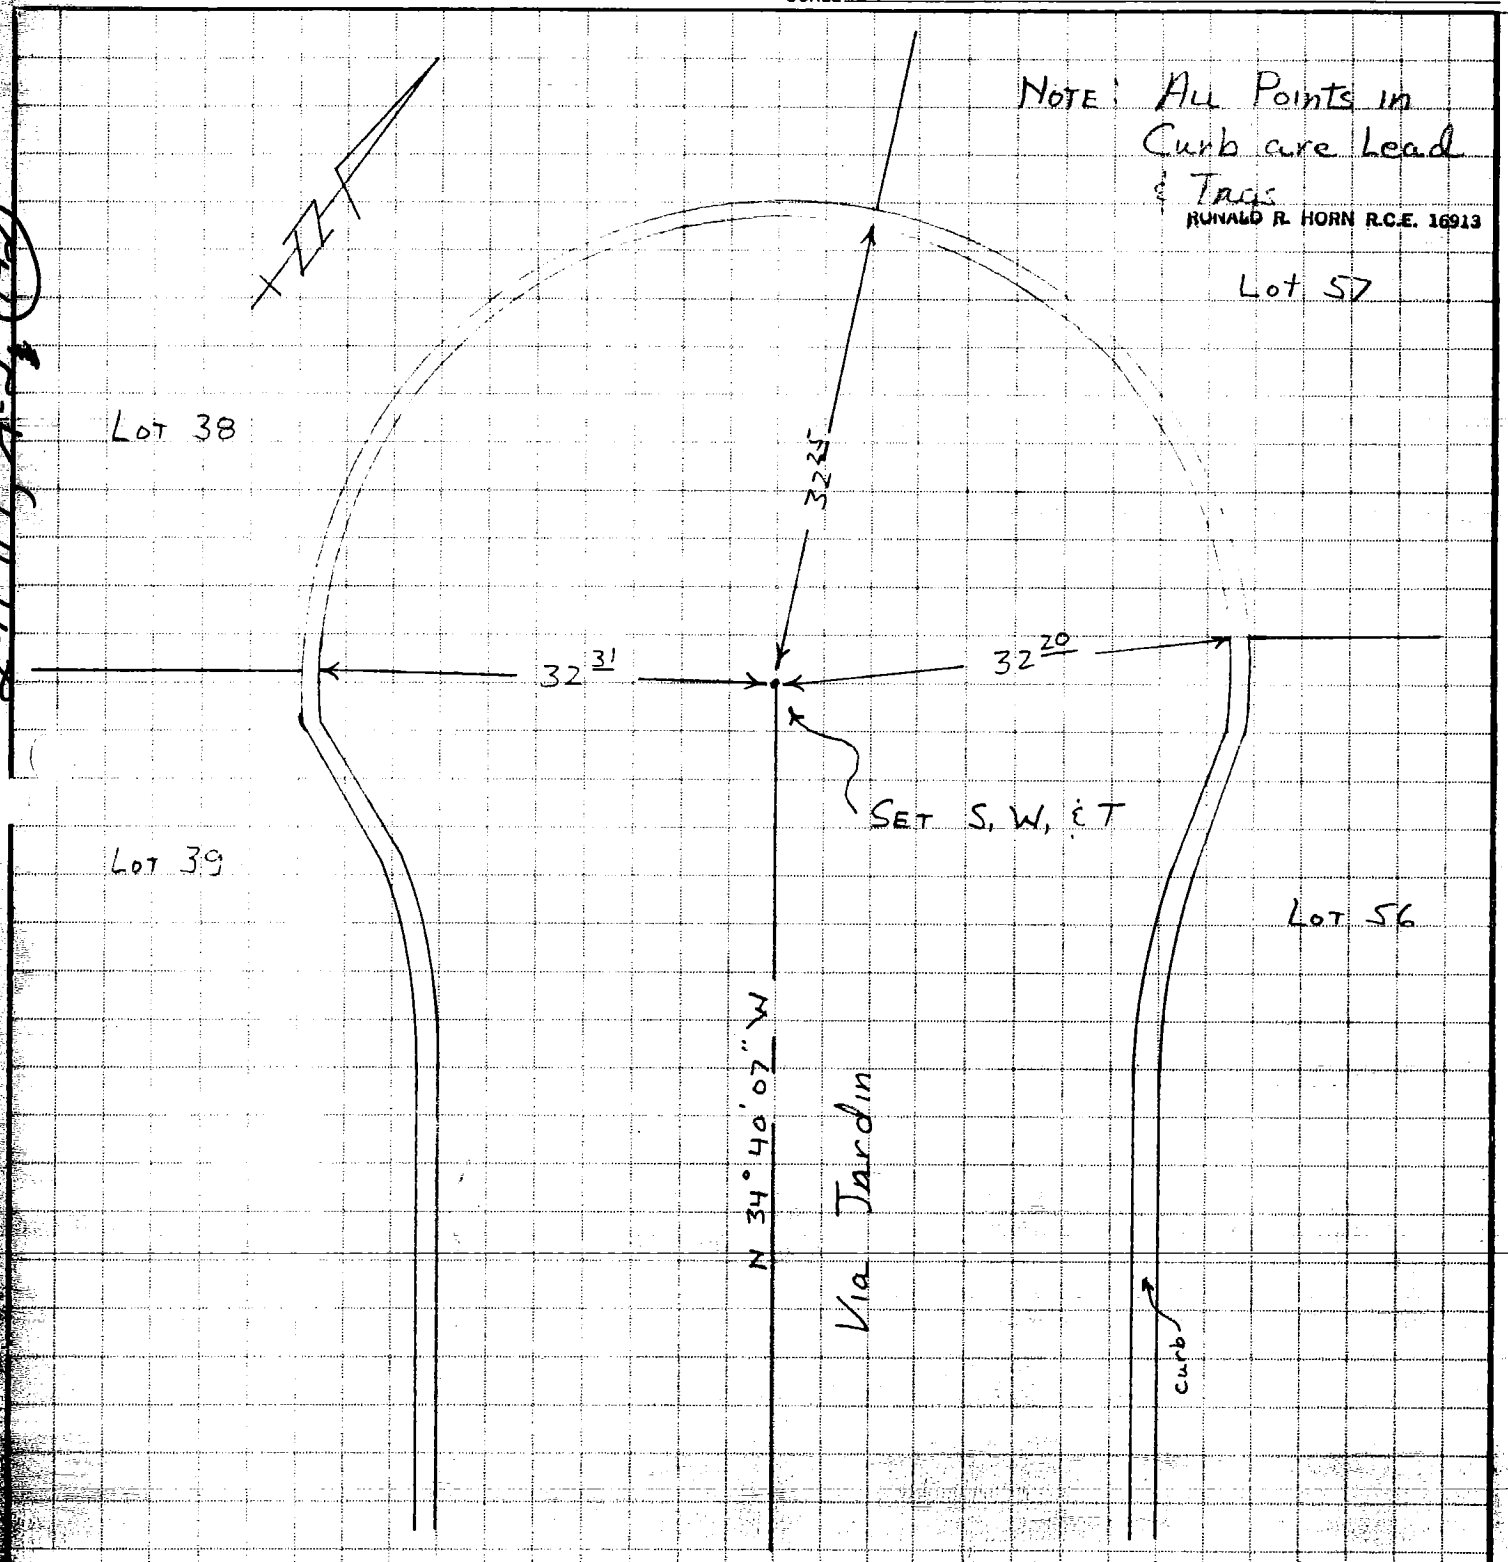

To Avenida Velarte
Tr. # 29903

SIKAND ENGINEERING ASSOCIATES
15230 Burbank Boulevard
VAN NUYS, CALIFORNIA 91411
Phone (213) 787-8550

JOB Tr. # 33889
SHEET NO. 6 OF 16
CALCULATED BY WILDMAN DATE FEB. 13, 1980
CHECKED BY ✓ DATE
SCALE None

249-117, 1-2 (143)

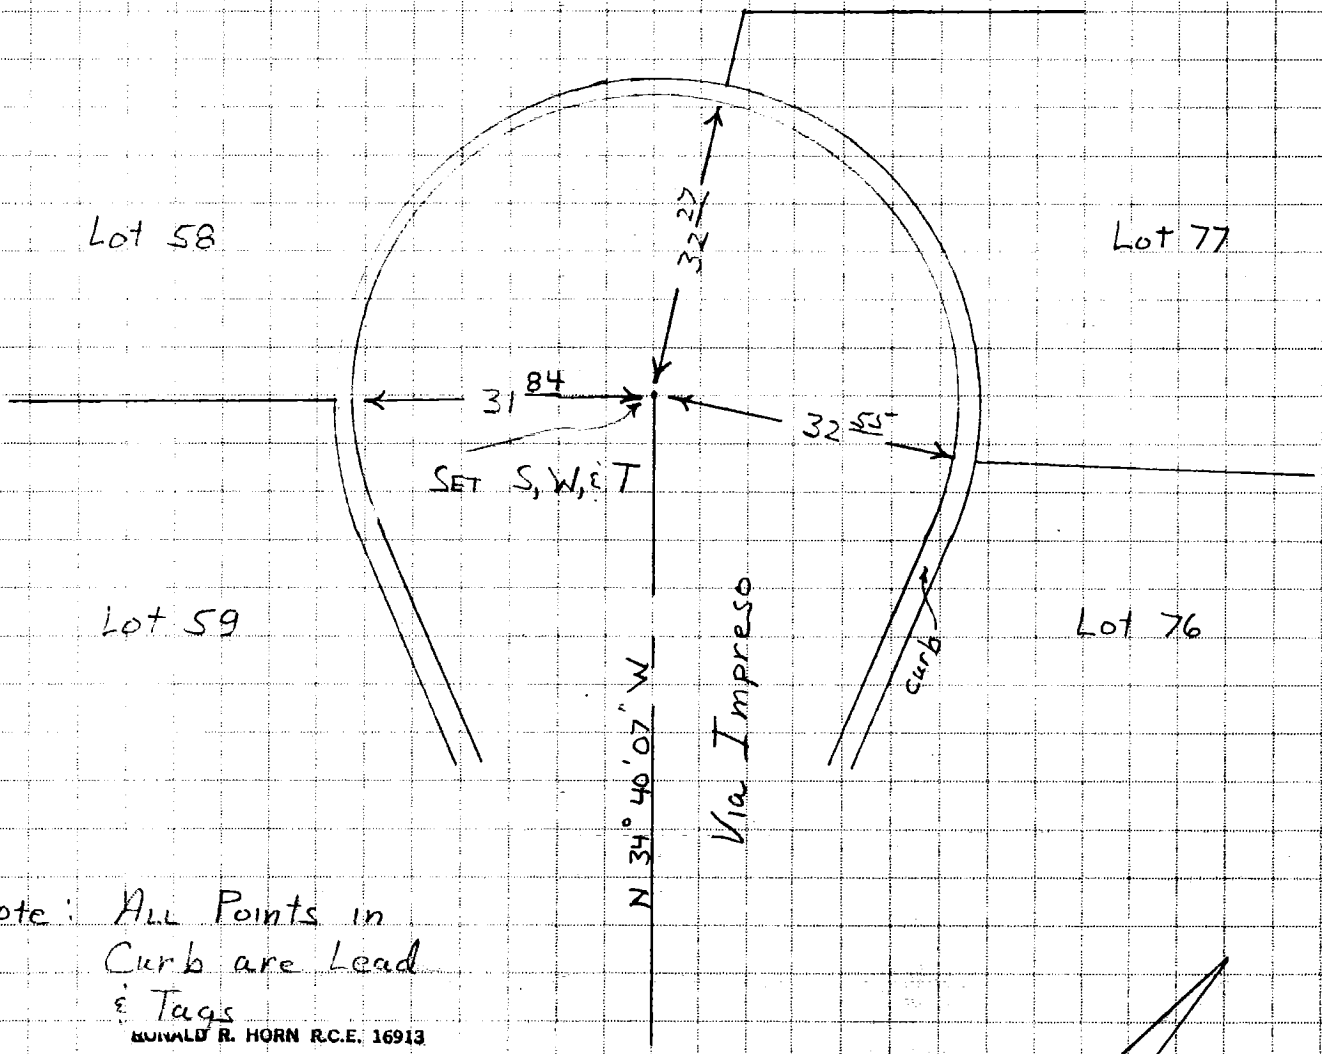

Note: All Points in Curb are Lead & Tags

RONALD R. HORN R.C.E. 16913

To Avenida Velarte
Tr. # 29903

SIKAND ENGINEERING ASSOCIATES
15230 Burbank Boulevard
VAN NUYS, CALIFORNIA 91411
Phone (213) 787-8550

JOB Jr. # 33889
SHEET NO. 7 OF 16
CALCULATED BY WILDMAN DATE FEB. 13, 1980
CHECKED BY ✓ DATE
SCALE None

249-117, A-1 (28)

Note: All Points in Curb are Lead & Tags
RONALD R. HORN R.C.E. 16913

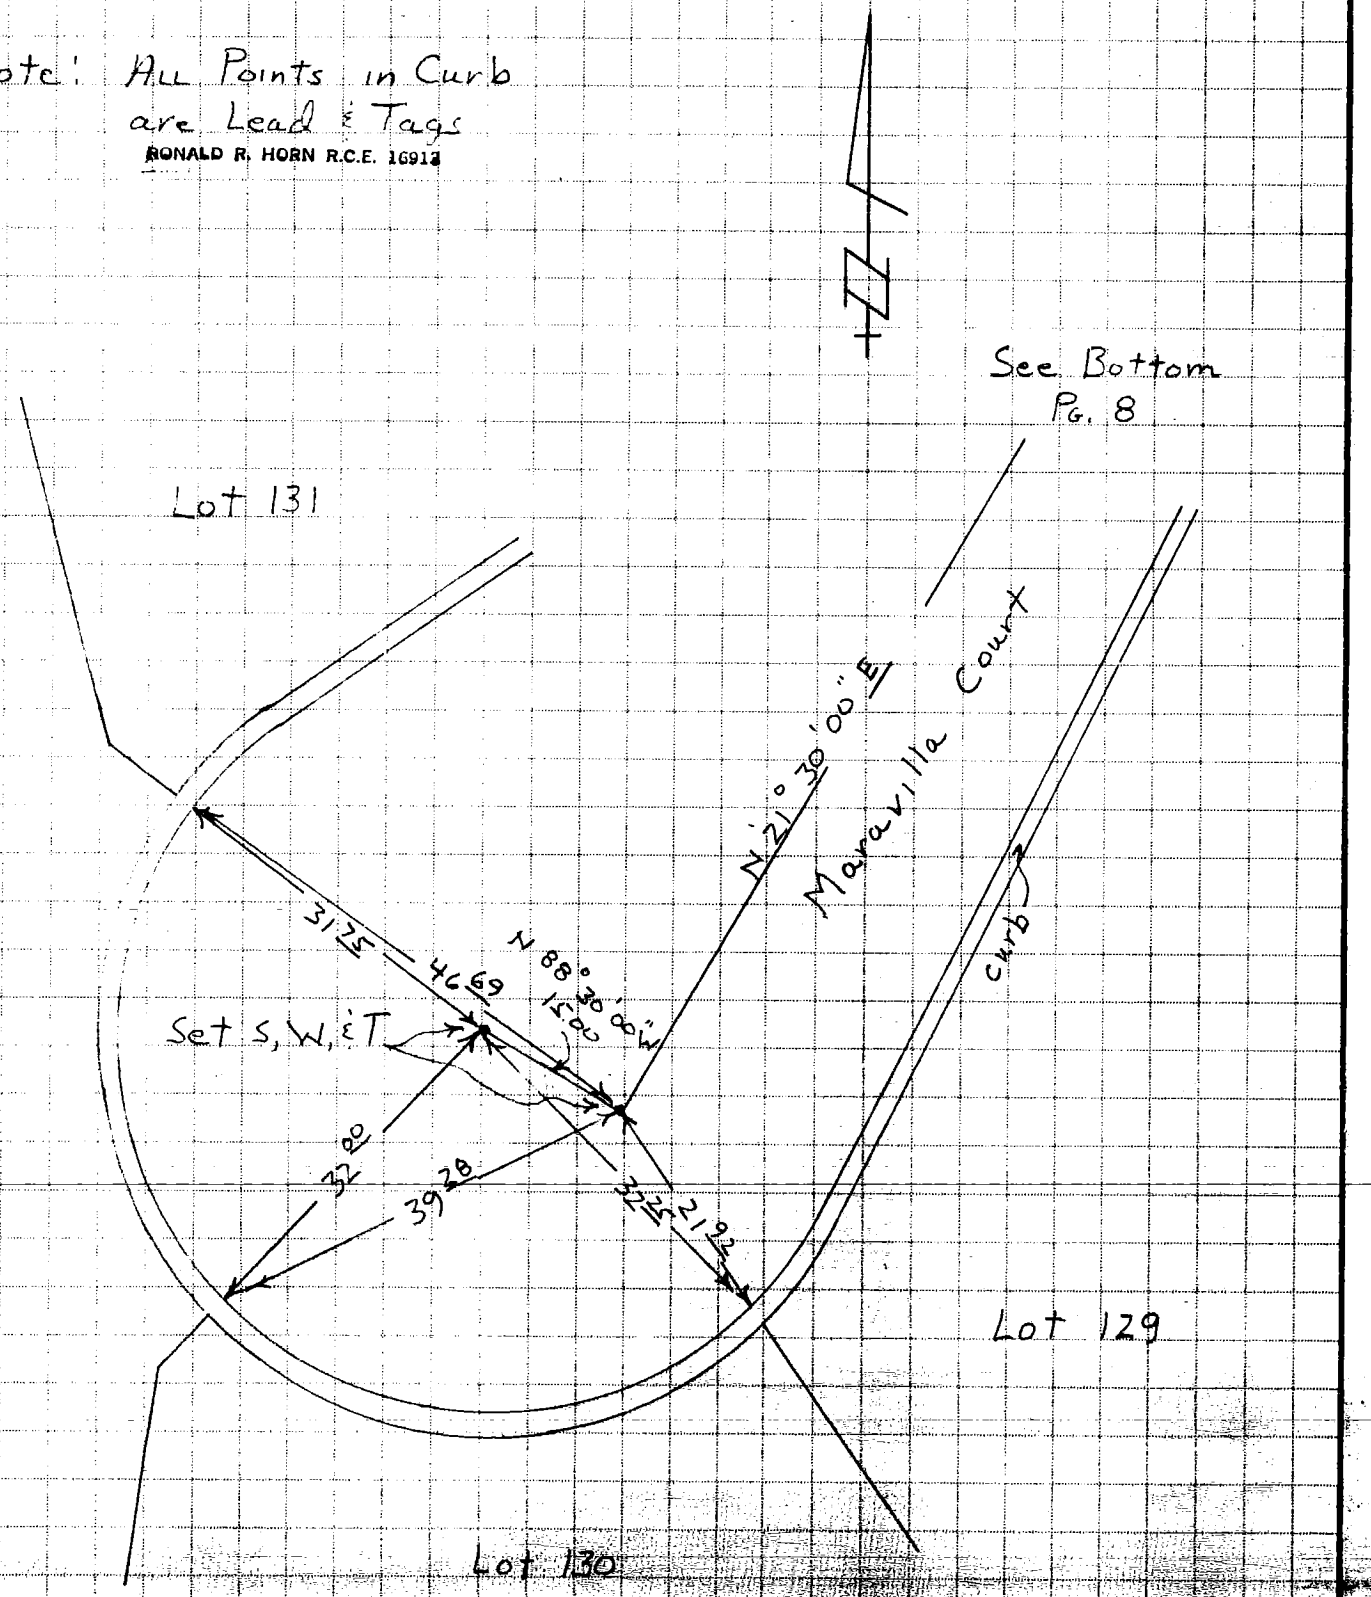

SIKAND ENGINEERING ASSOCIATES
15230 Burbank Boulevard
VAN NUYS, CALIFORNIA 91411
Phone (213) 787-8550

JOB Tr. # 33889
SHEET NO. 8 OF 16
CALCULATED BY WILDMAN DATE FEB. 13, 1980
CHECKED BY — DATE
SCALE None

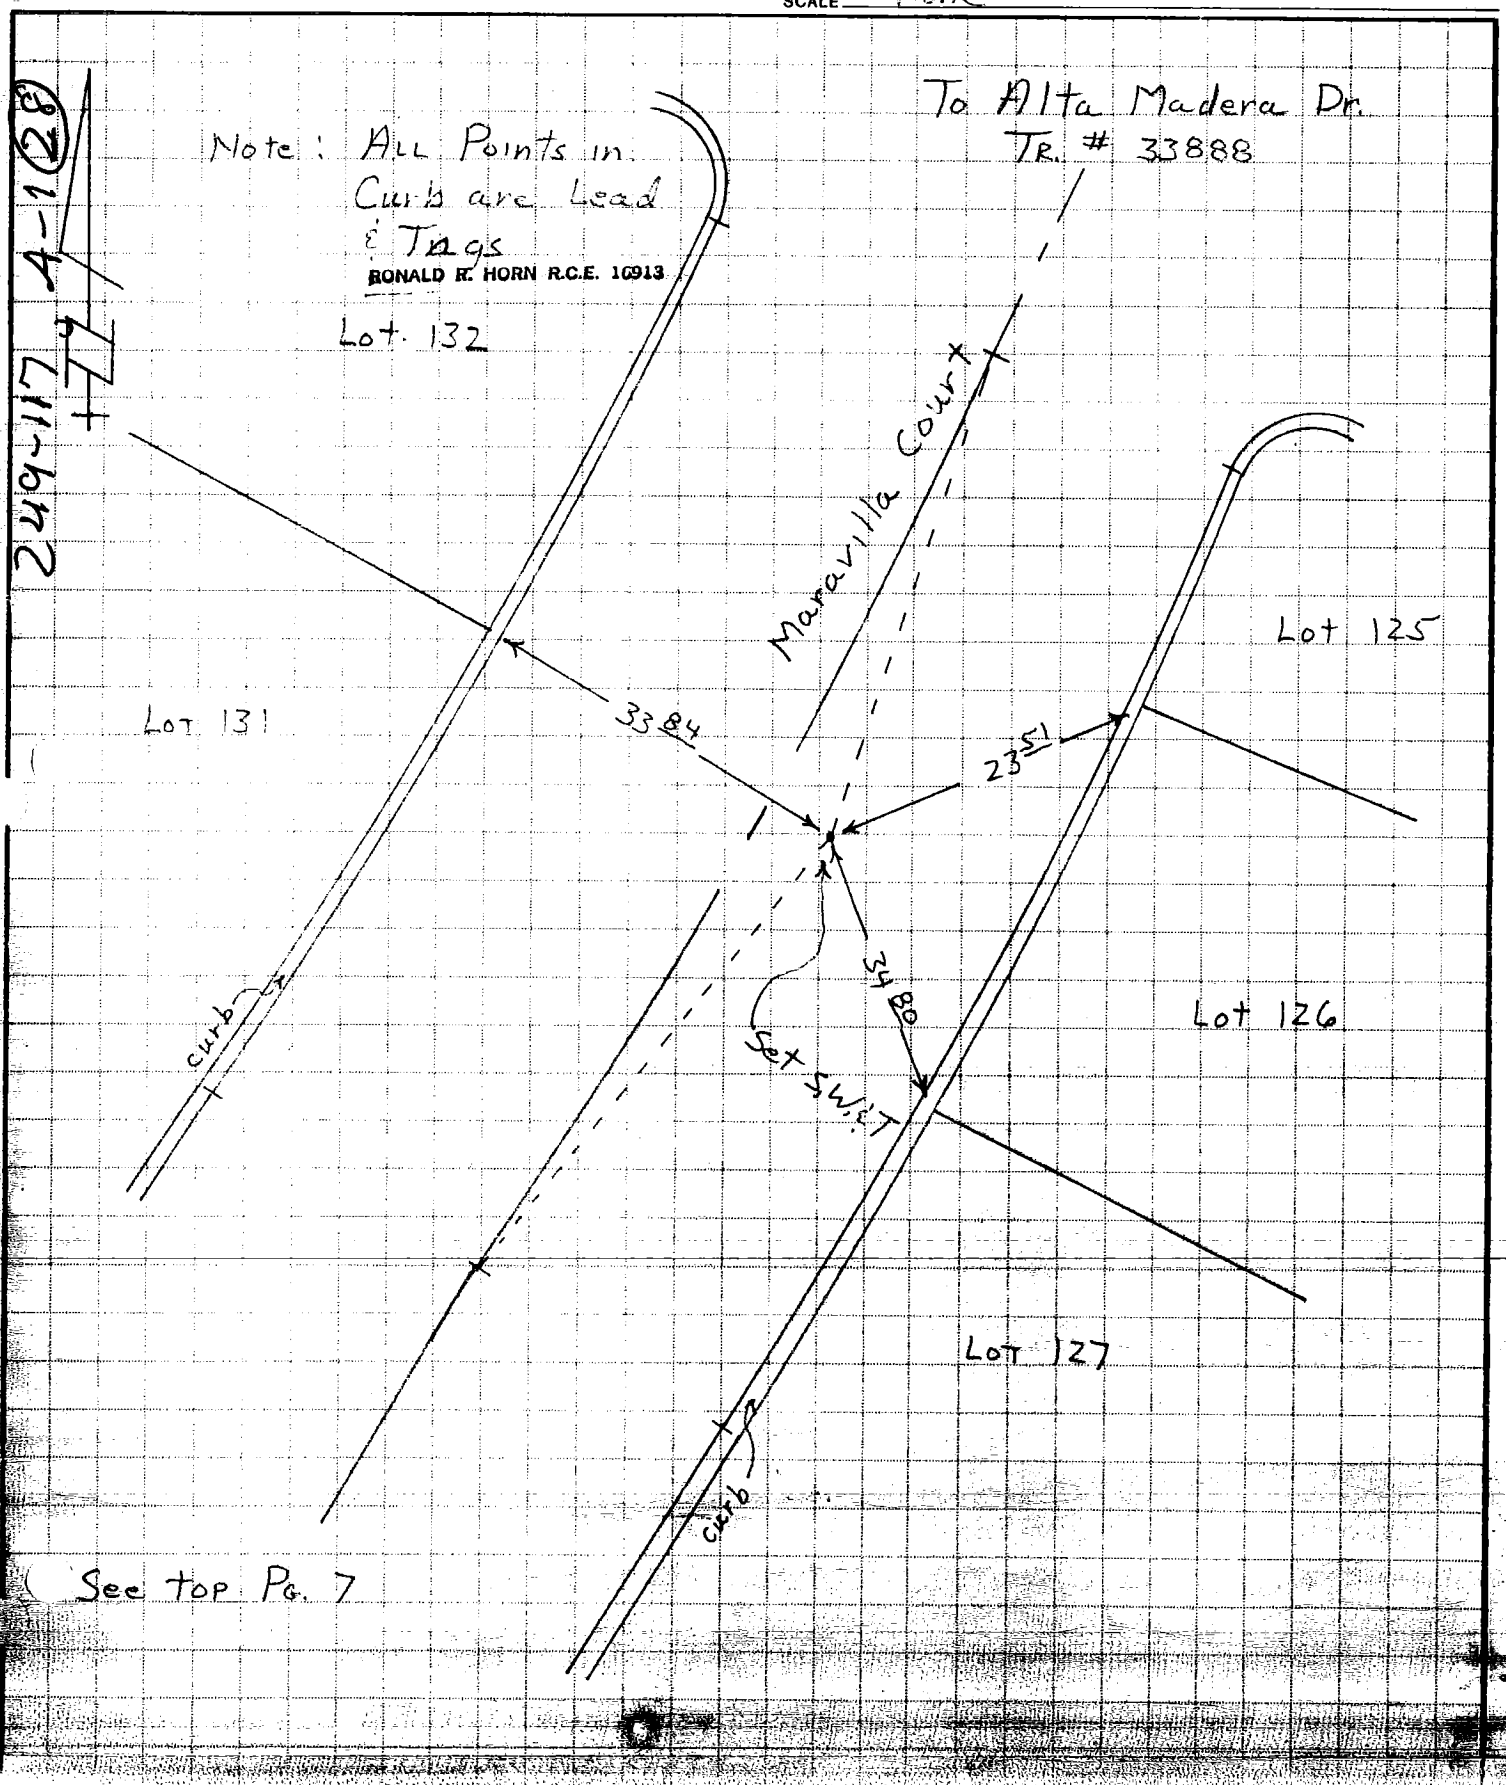

CO ENG FB 3656 - 51

SIKAND ENGINEERING ASSOCIATES
15230 Burbank Boulevard
VAN NUYS, CALIFORNIA 91411
Phone (213) 787-8550

F.B. _____ PG. 9 OF 116
W.O. 1020-115 TR. 33889
SURVEY BY BOSTON
DATE MARCH 20, 1981

249-117, A-1 (29)

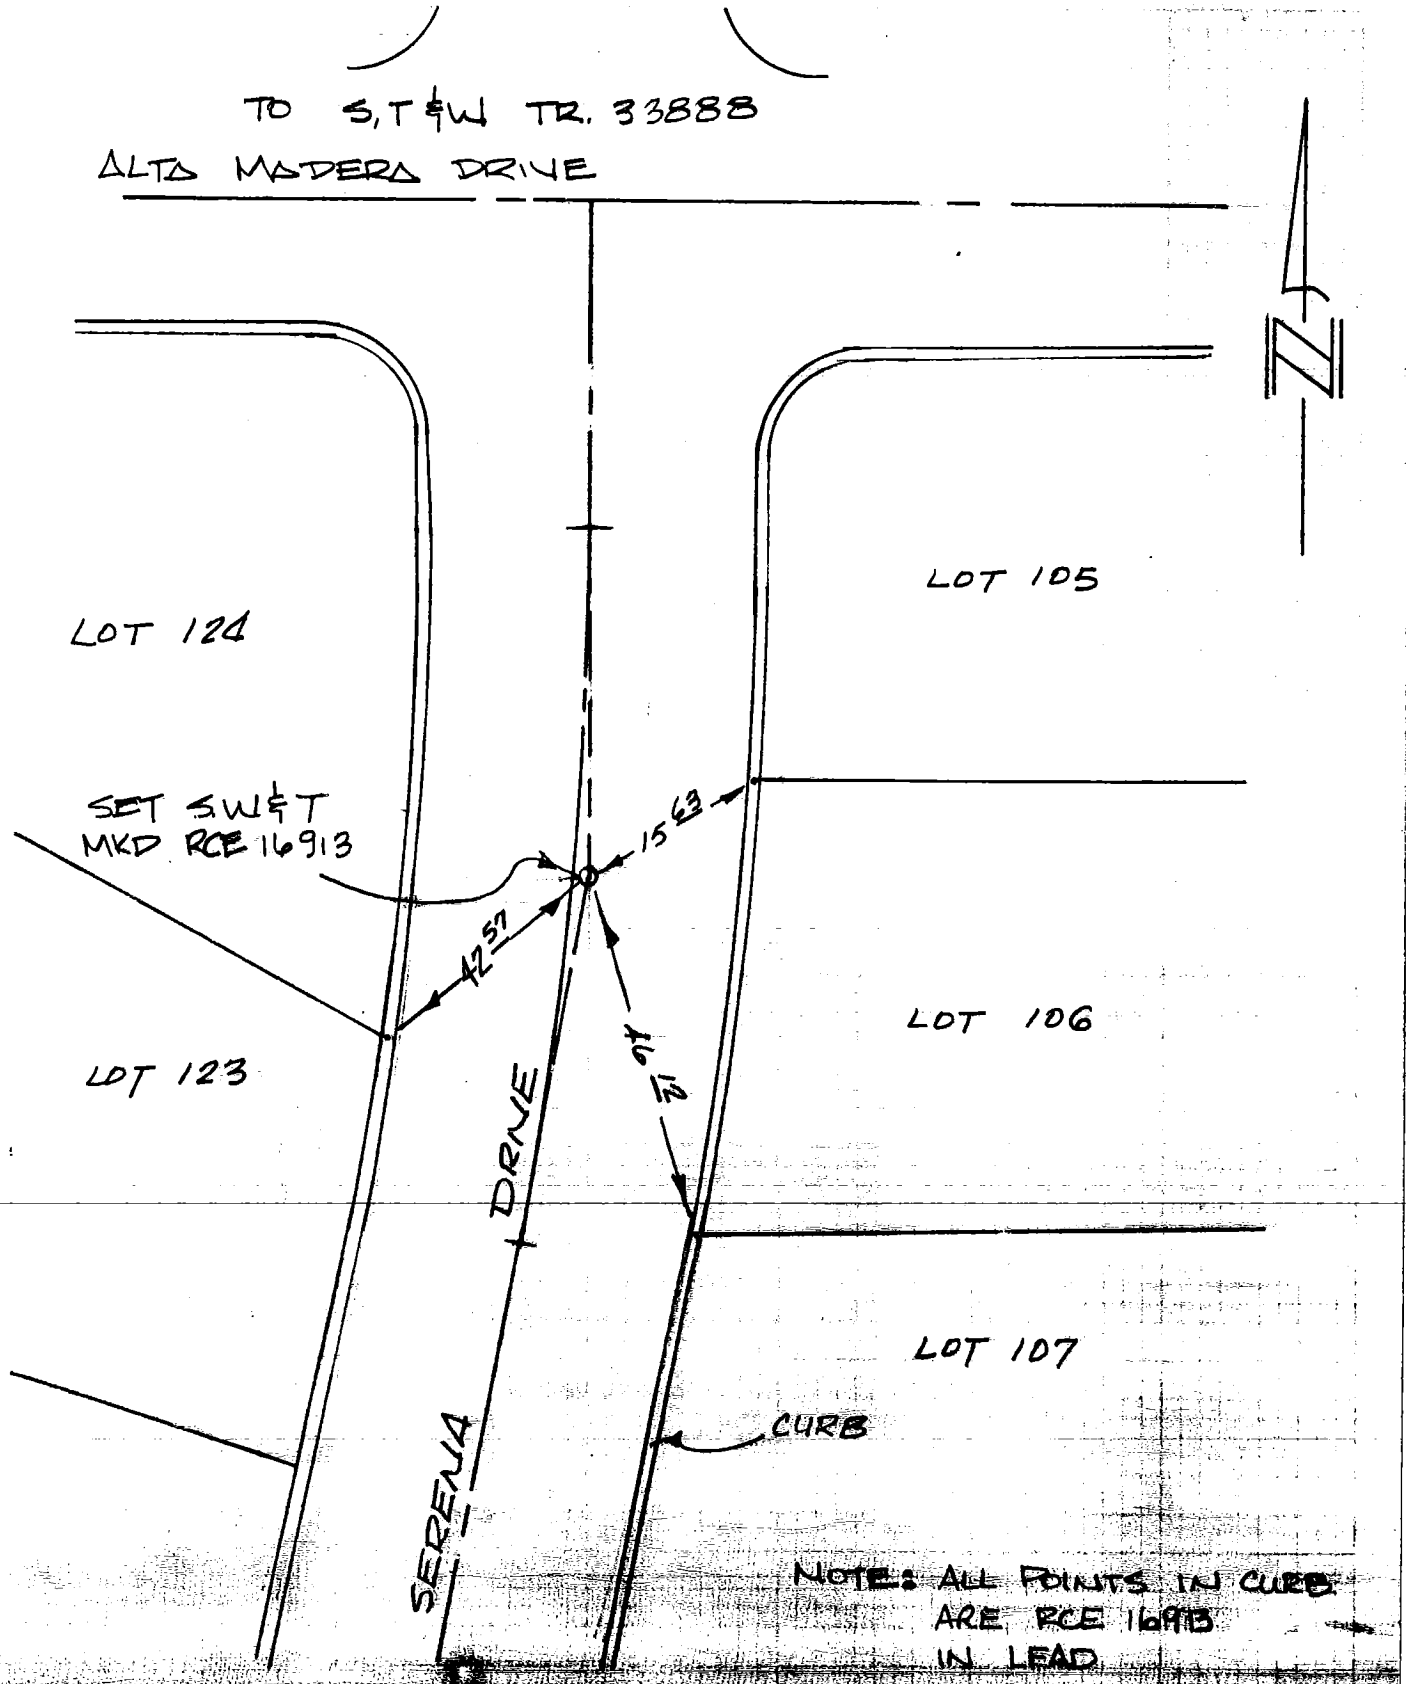

RONALD K. HORN R.C.E. 16913

SIKAND ENGINEERING ASSOCIATES
15230 Burbank Boulevard
VAN NUYS, CALIFORNIA 91411
Phone (213) 787-8550

F.B. _____ PG. 10 OF 16
W.O. 1020-115 TR. 33889
SURVEY BY BOSTON
DATE MARCH 20, 1981

TO BOTTOM PAGE 9

249-117 A1 (30)

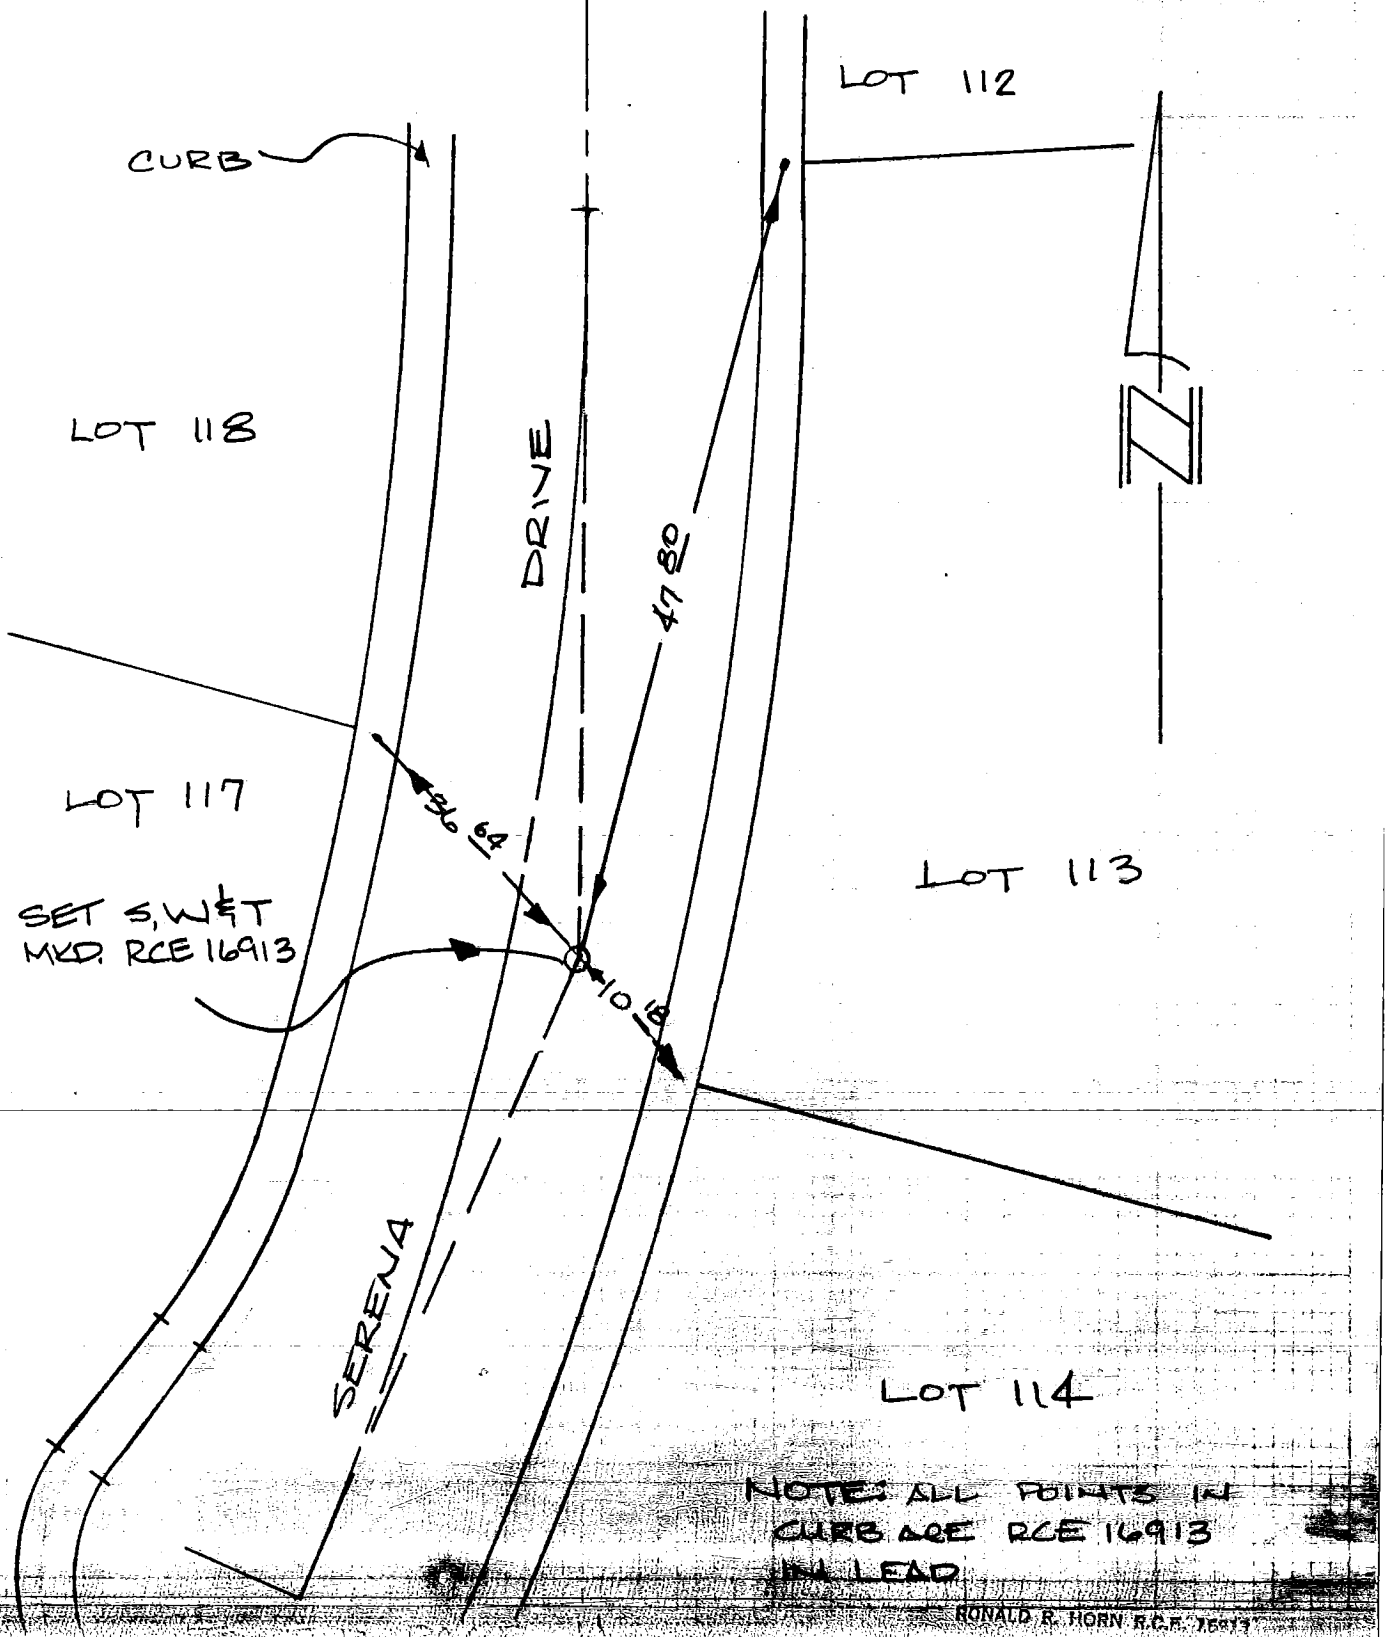

NOTE: ALL POINTS IN CURB ARE RCE 16913 IN LEAD

RONALD R. HORN R.C.E. 16913

SIKAND ENGINEERING ASSOCIATES
15230 Burbank Boulevard
VAN NUYS, CALIFORNIA 91411
Phone (213) 787-8550

F.B. _____ PG. 11 OF 16
W.O. 1020-115 TR 33889
SURVEY BY BOSTON
DATE MARCH 20, 1981

TO BOTTOM PAGE 10

NOTE: ALL POINTS IN CURB ARE RCE16913 IN LEAD

RONALD R. HORN R.C.E. 16913

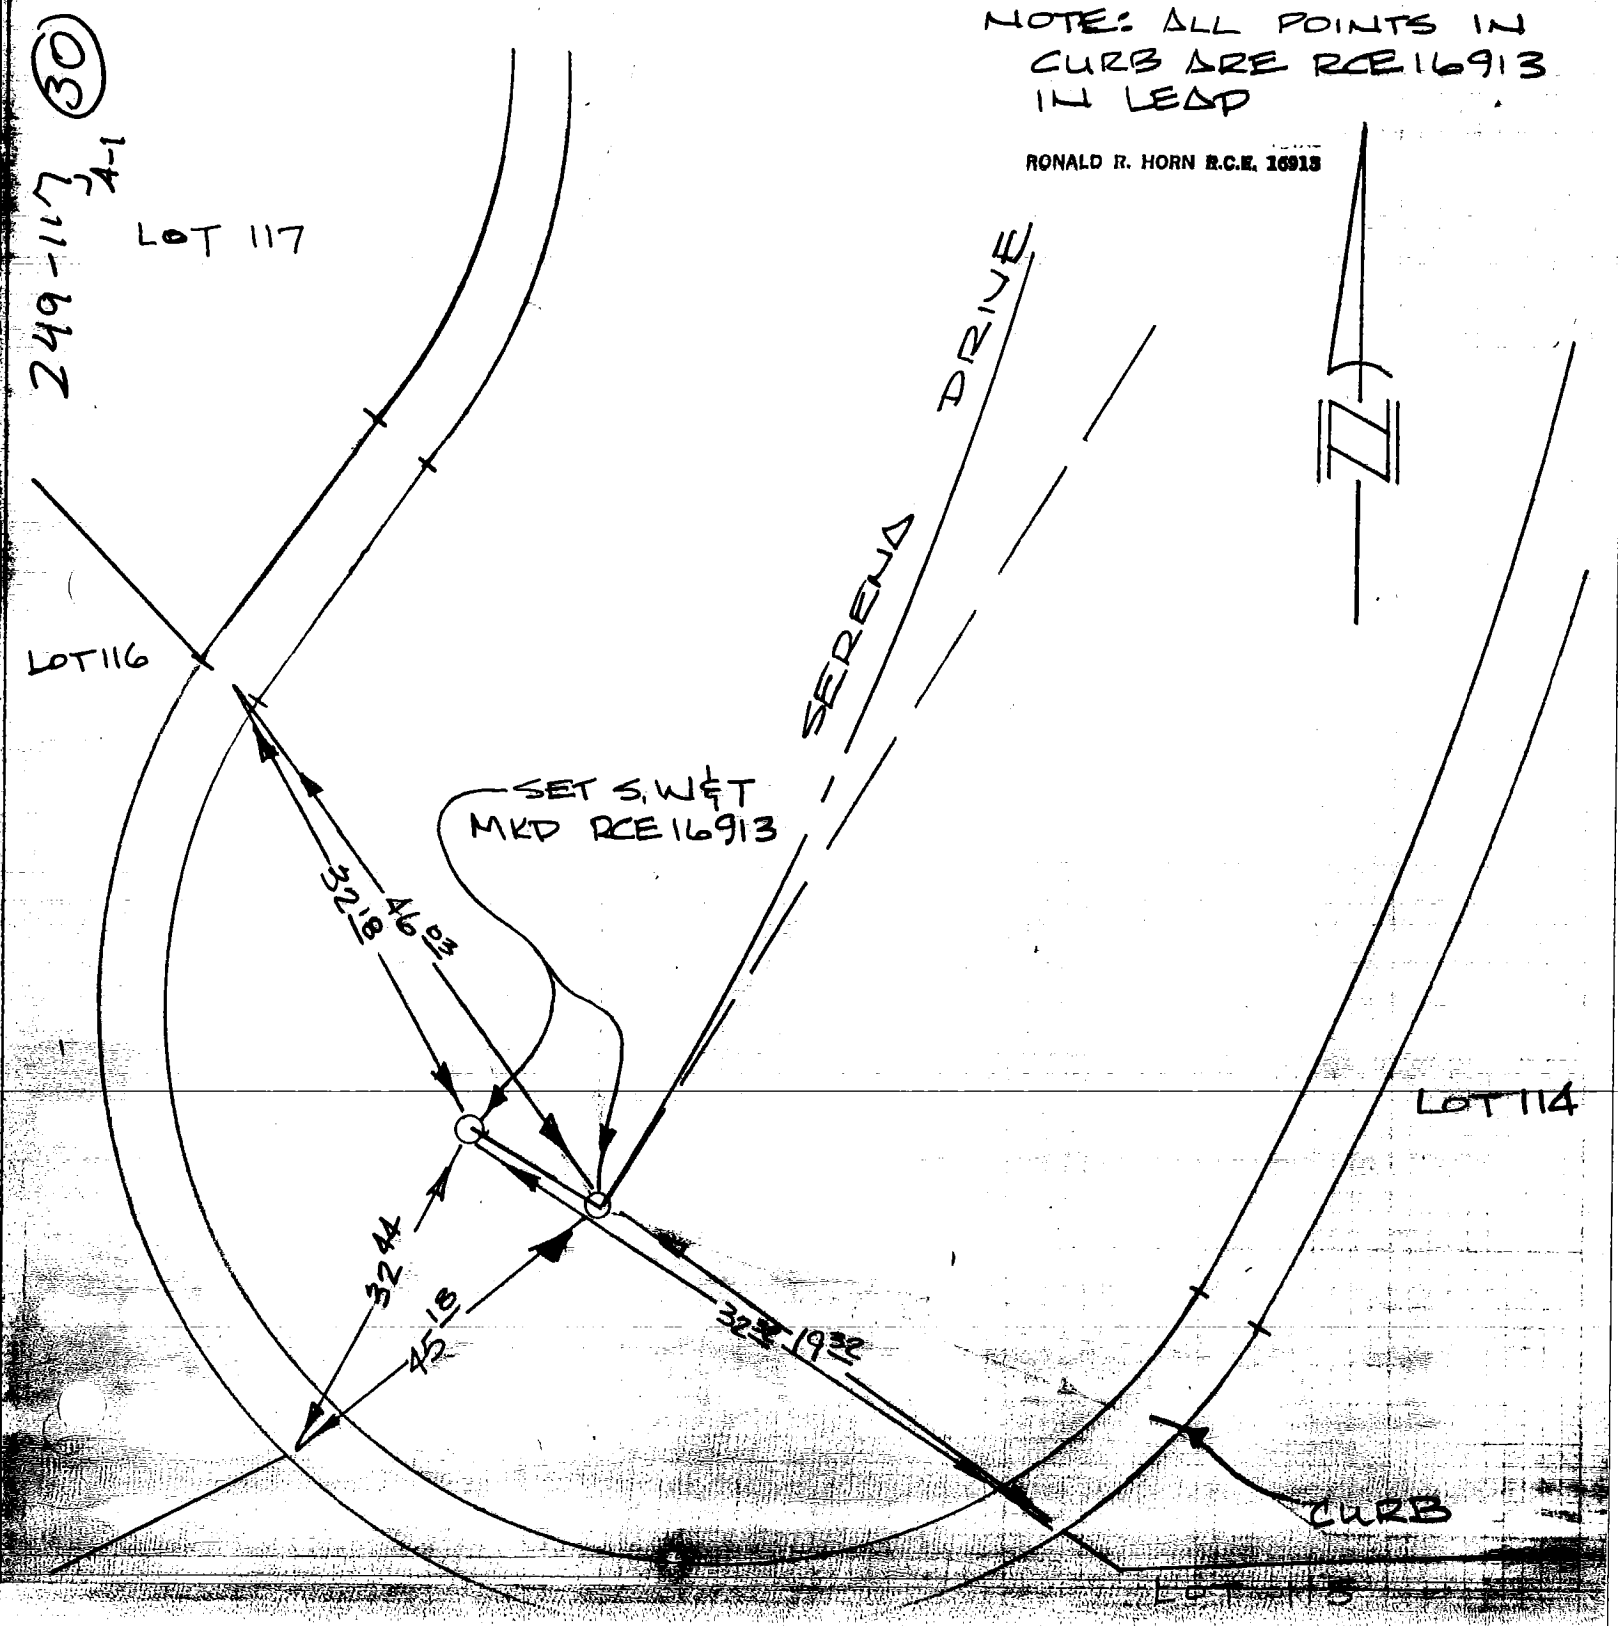

SIKAND ENGINEERING ASSOCIATES
15230 Burbank Boulevard
VAN NUYS, CALIFORNIA 91411
(213) 787-8550 873-5853

JOB 1020-115 CO ENG FB 3656 - 54
TR. 33889
SHEET NO. 12 OF 16
CALCULATED BY _____ DATE _____
CHECKED BY _____ DATE _____
SCALE _____

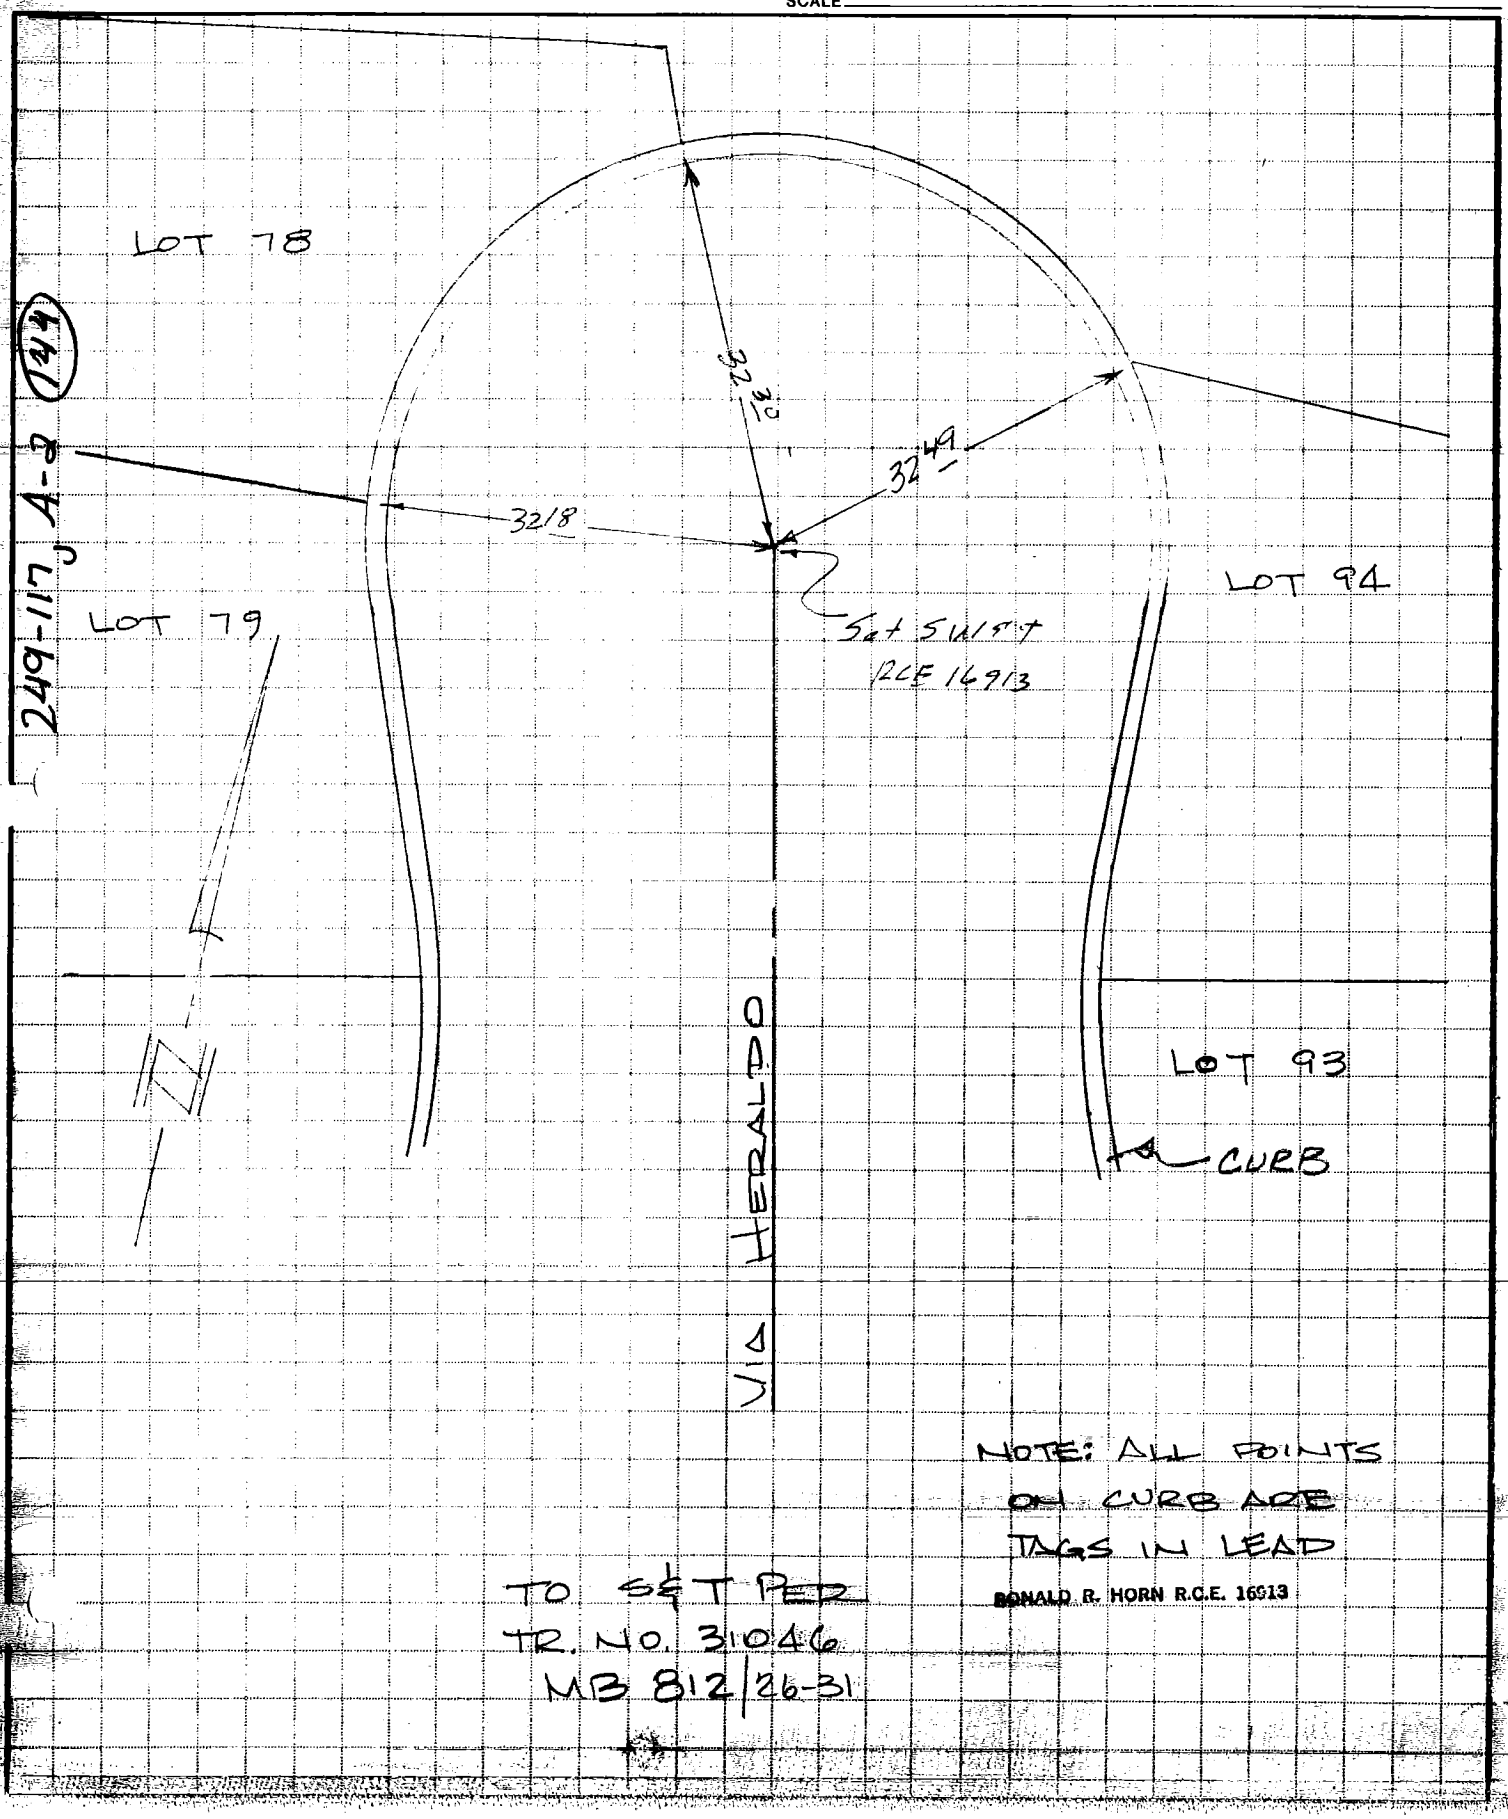

SIKAND ENGINEERING ASSOCIATES
15230 Burbank Boulevard
VAN NUYS, CALIFORNIA 91411
(213) 787-8550 873-5853

JOB 1020-115 CO ENG FB 3656 - 55 TR 33888
SHEET NO. 13 OF 16
CALCULATED BY _____ DATE _____
CHECKED BY _____ DATE _____
SCALE _____

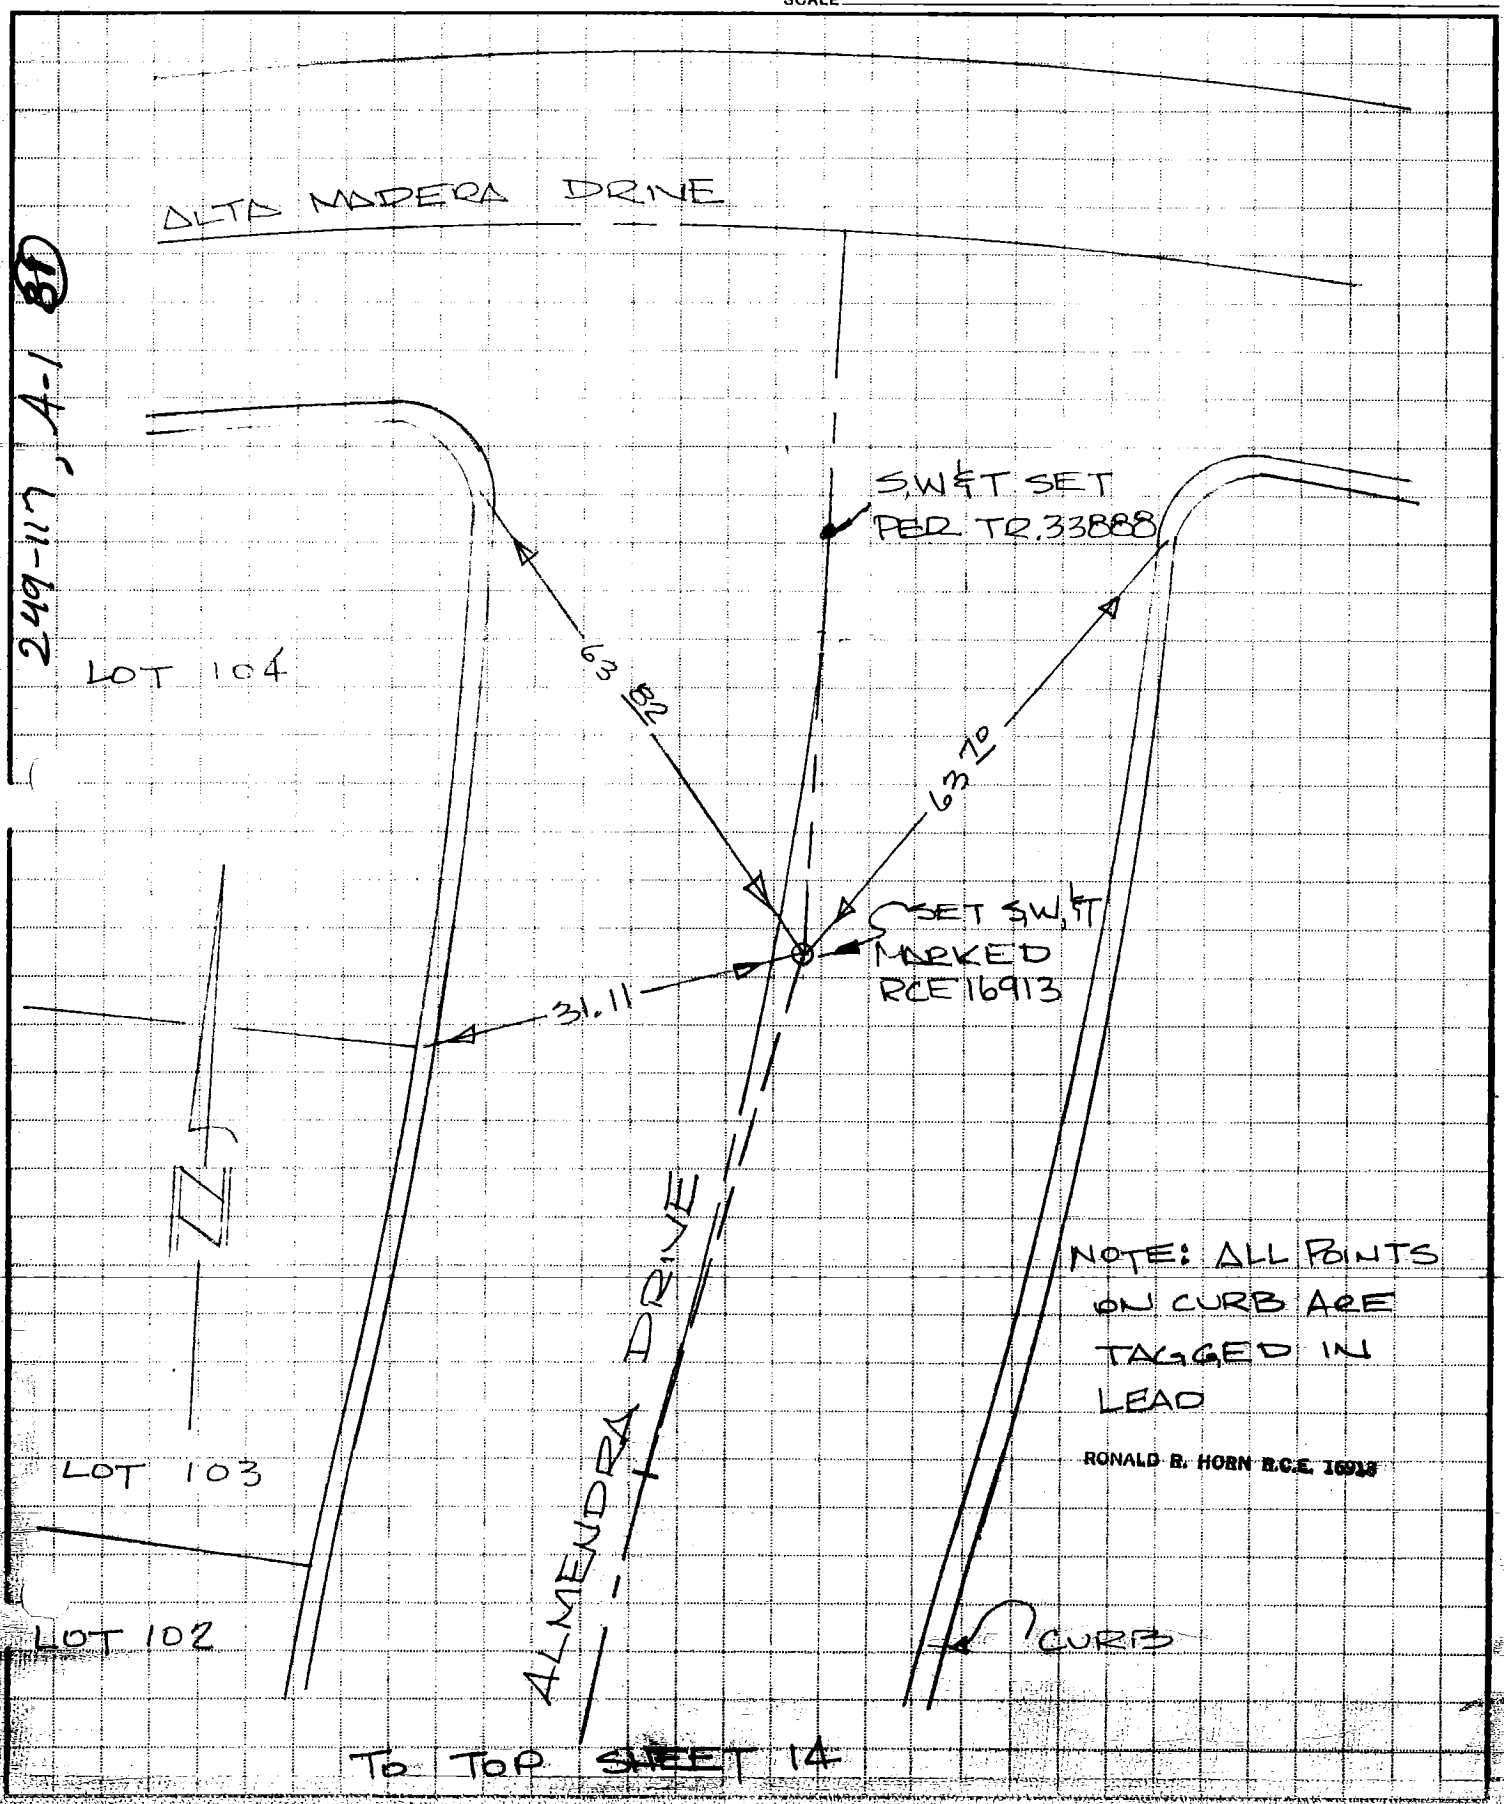

SIKAND ENGINEERING ASSOCIATES
15230 Burbank Boulevard
VAN NUYS, CALIFORNIA 91411
(213) 787-8550 873-5853

CO ENG FB 3656 - 56

JOB 1020-115 TR. 33889

SHEET NO. 14 OF 16

CALCULATED BY _____ DATE _____

CHECKED BY _____ DATE _____

SCALE _____

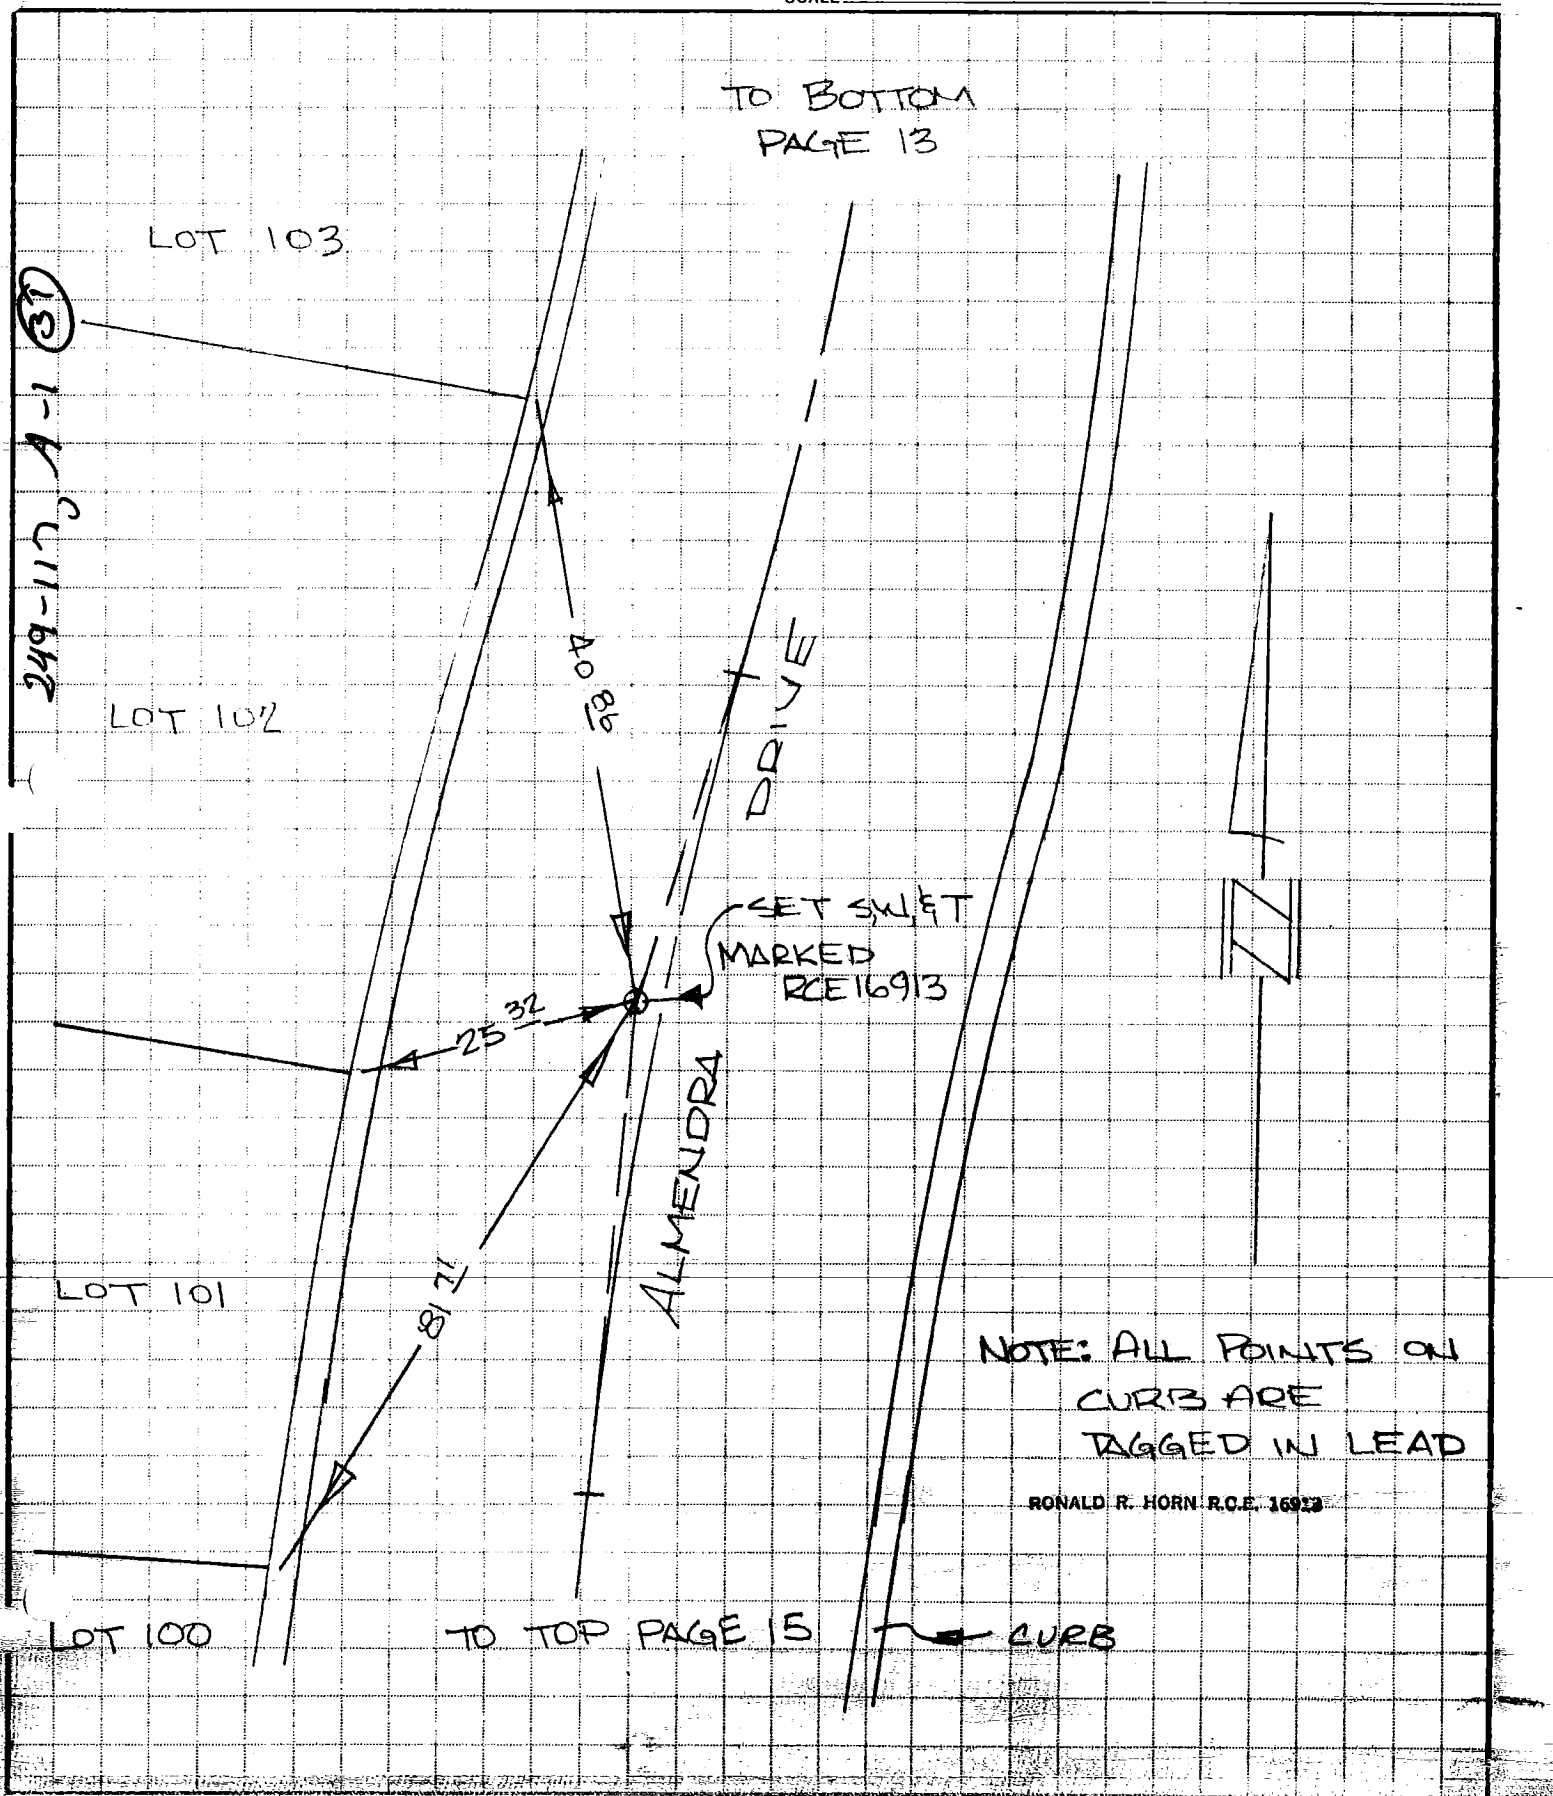

SIKAND ENGINEERING ASSOCIATES
15230 Burbank Boulevard
VAN NUYS, CALIFORNIA 91411
(213) 787-8550 873-5853

CO ENG FB 3656 - 57

JOB 1020-115 TR 33889

SHEET NO. 15 OF 16

CALCULATED BY _____ DATE _____

CHECKED BY _____ DATE _____

SCALE _____

NOTE: ALL POINTS ON CURB ARE TAGGED IN LEAD

TO BOTTOM PAGE 14

RONALD R. HORN R.C.E. 16913

249-17, 4-1 (38)

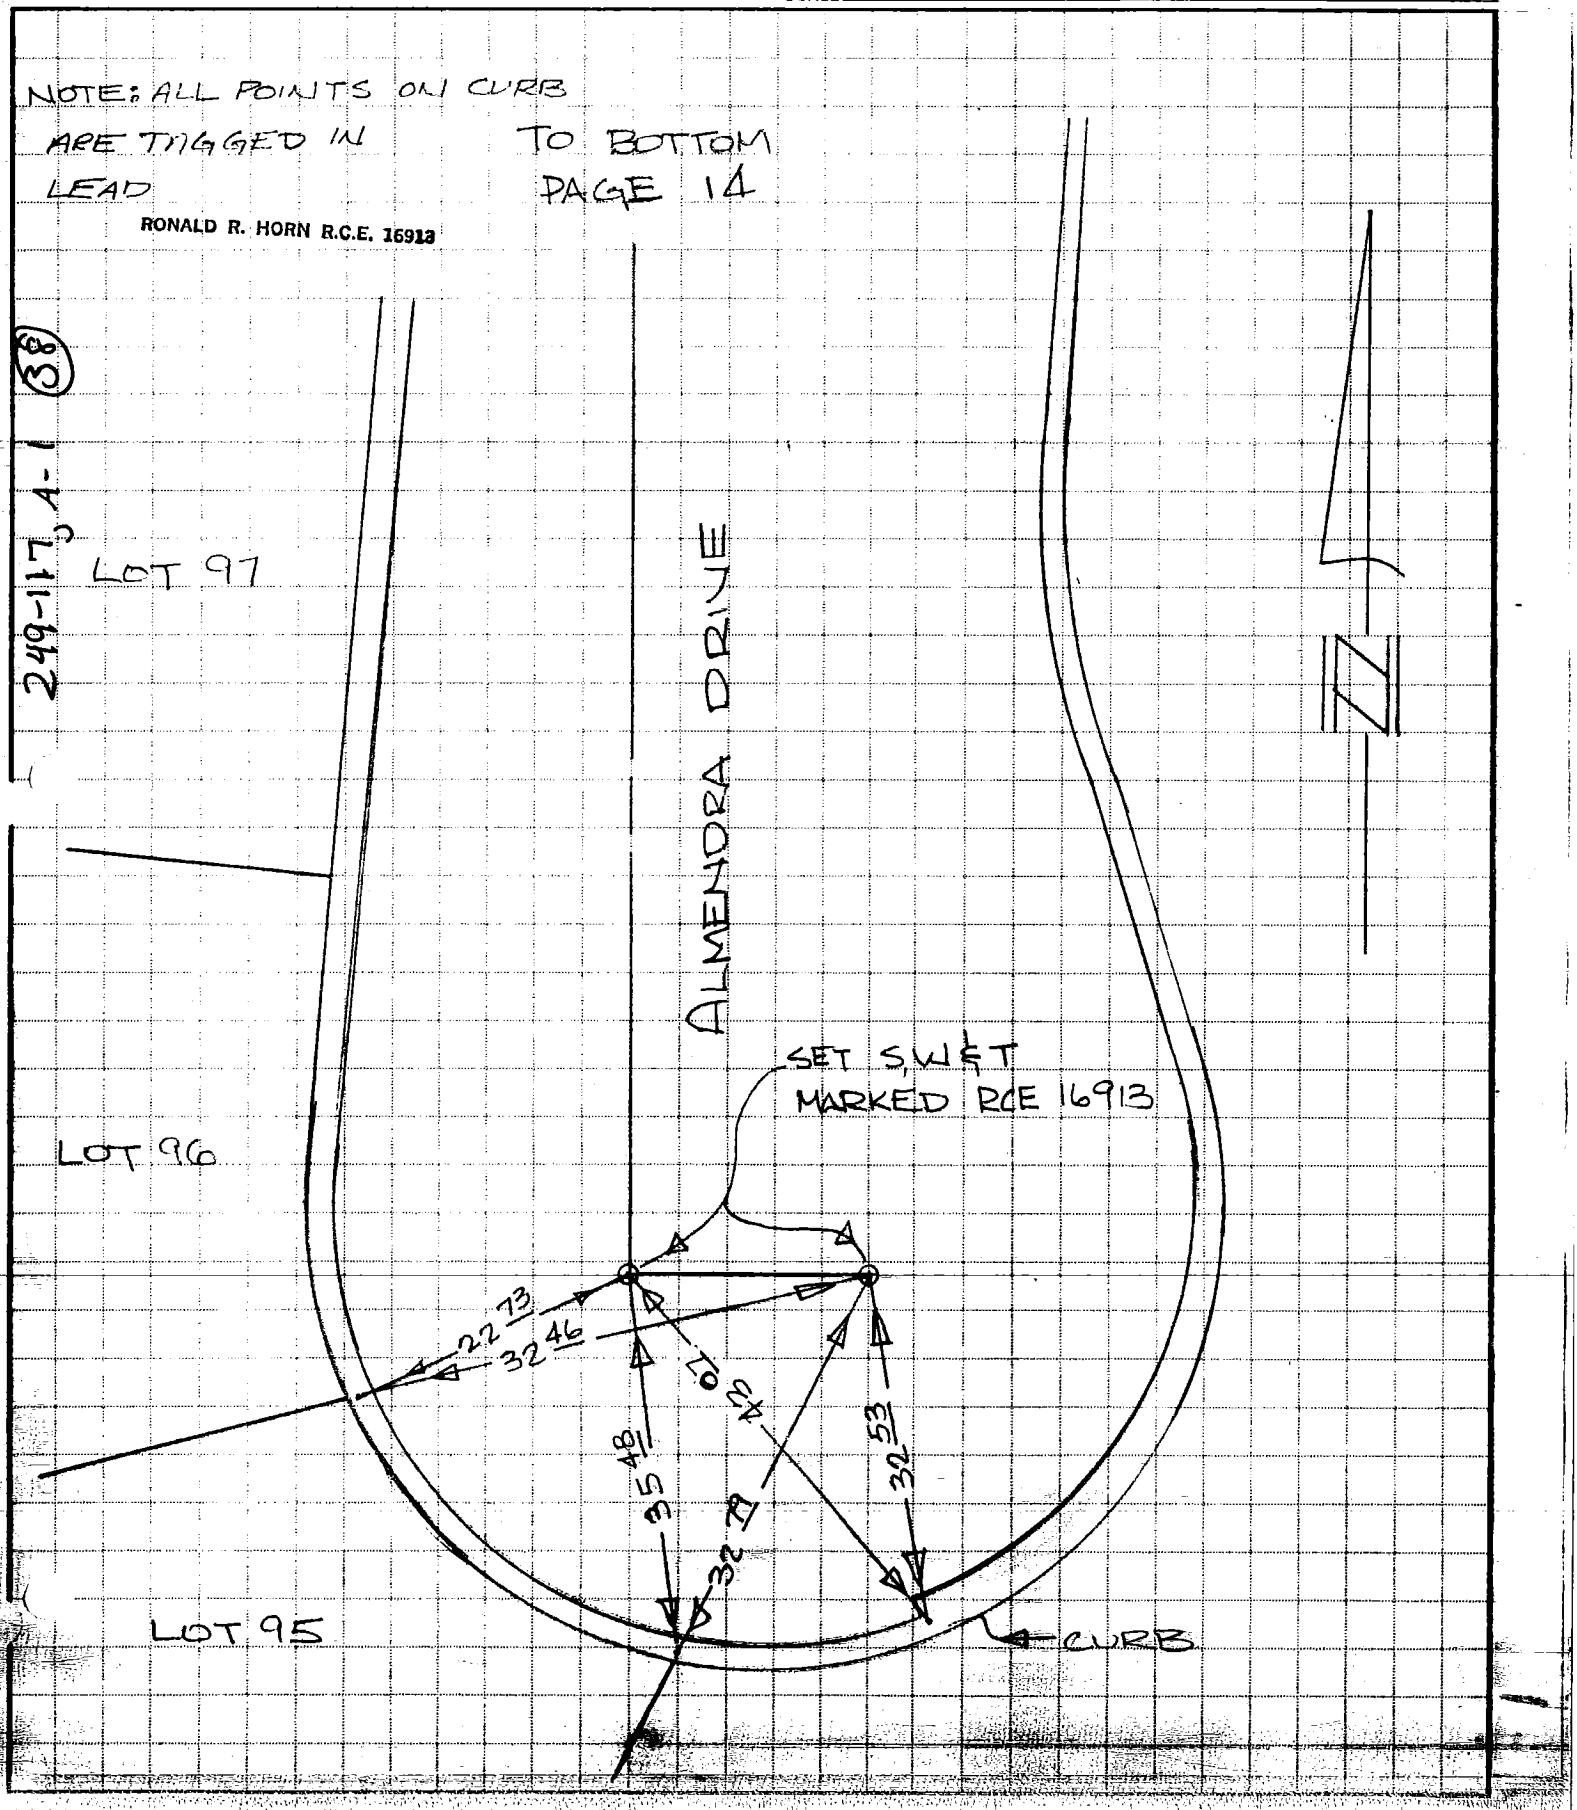

CO ENG FB 3656 - 58

SIKAND ENGINEERING ASSOCIATES
15230 Burbank Boulevard
VAN NUYS, CALIFORNIA 91411
Phone (213) 787-8550

F.B. 1 & TIES PG. 16
W.O. 1020-115 TR. 33889
SURVEY BY BOSTON
DATE FEB. 13, 1980

REAR CORNER MONUMENTS TR. 33889

LOT:	SET:	
1-3	℄ PROD	RCE 16913
4-7	1" IP	"
8-11	℄ PROD	"
12-26	1" IP	"
27-28	℄ PROD	"
29-46	1" IP	"
47-48	℄ PROD	"
49-66	1" IP	"
67-68	℄ PROD	"
69-85	1" IP	"
86-87	℄ PROD	"
88-103	1" IP	"
104-105	℄ PROD	"
106-123	1" IP	"
124-125	℄ PROD	"
126-131	1" IP	"
132-137	℄ PROD	"

ALL LOTS HAVE L&T, RCE 16913, PRODS IN CURB ON FRONTS

59

CO ENG FB 3656 - 59

SIKAND ENGINEERING ASSOCIATES
15230 Burbank Boulevard
VAN NUYS, CALIFORNIA 91411
Phone (213) 787-8550

JOB TR 33888

SHEET NO. 1 OF 27

CALCULATED BY BOSTON DATE FEB 13, 80

CHECKED BY ✓ DATE

SCALE NONE

249-117, A-2 (137)

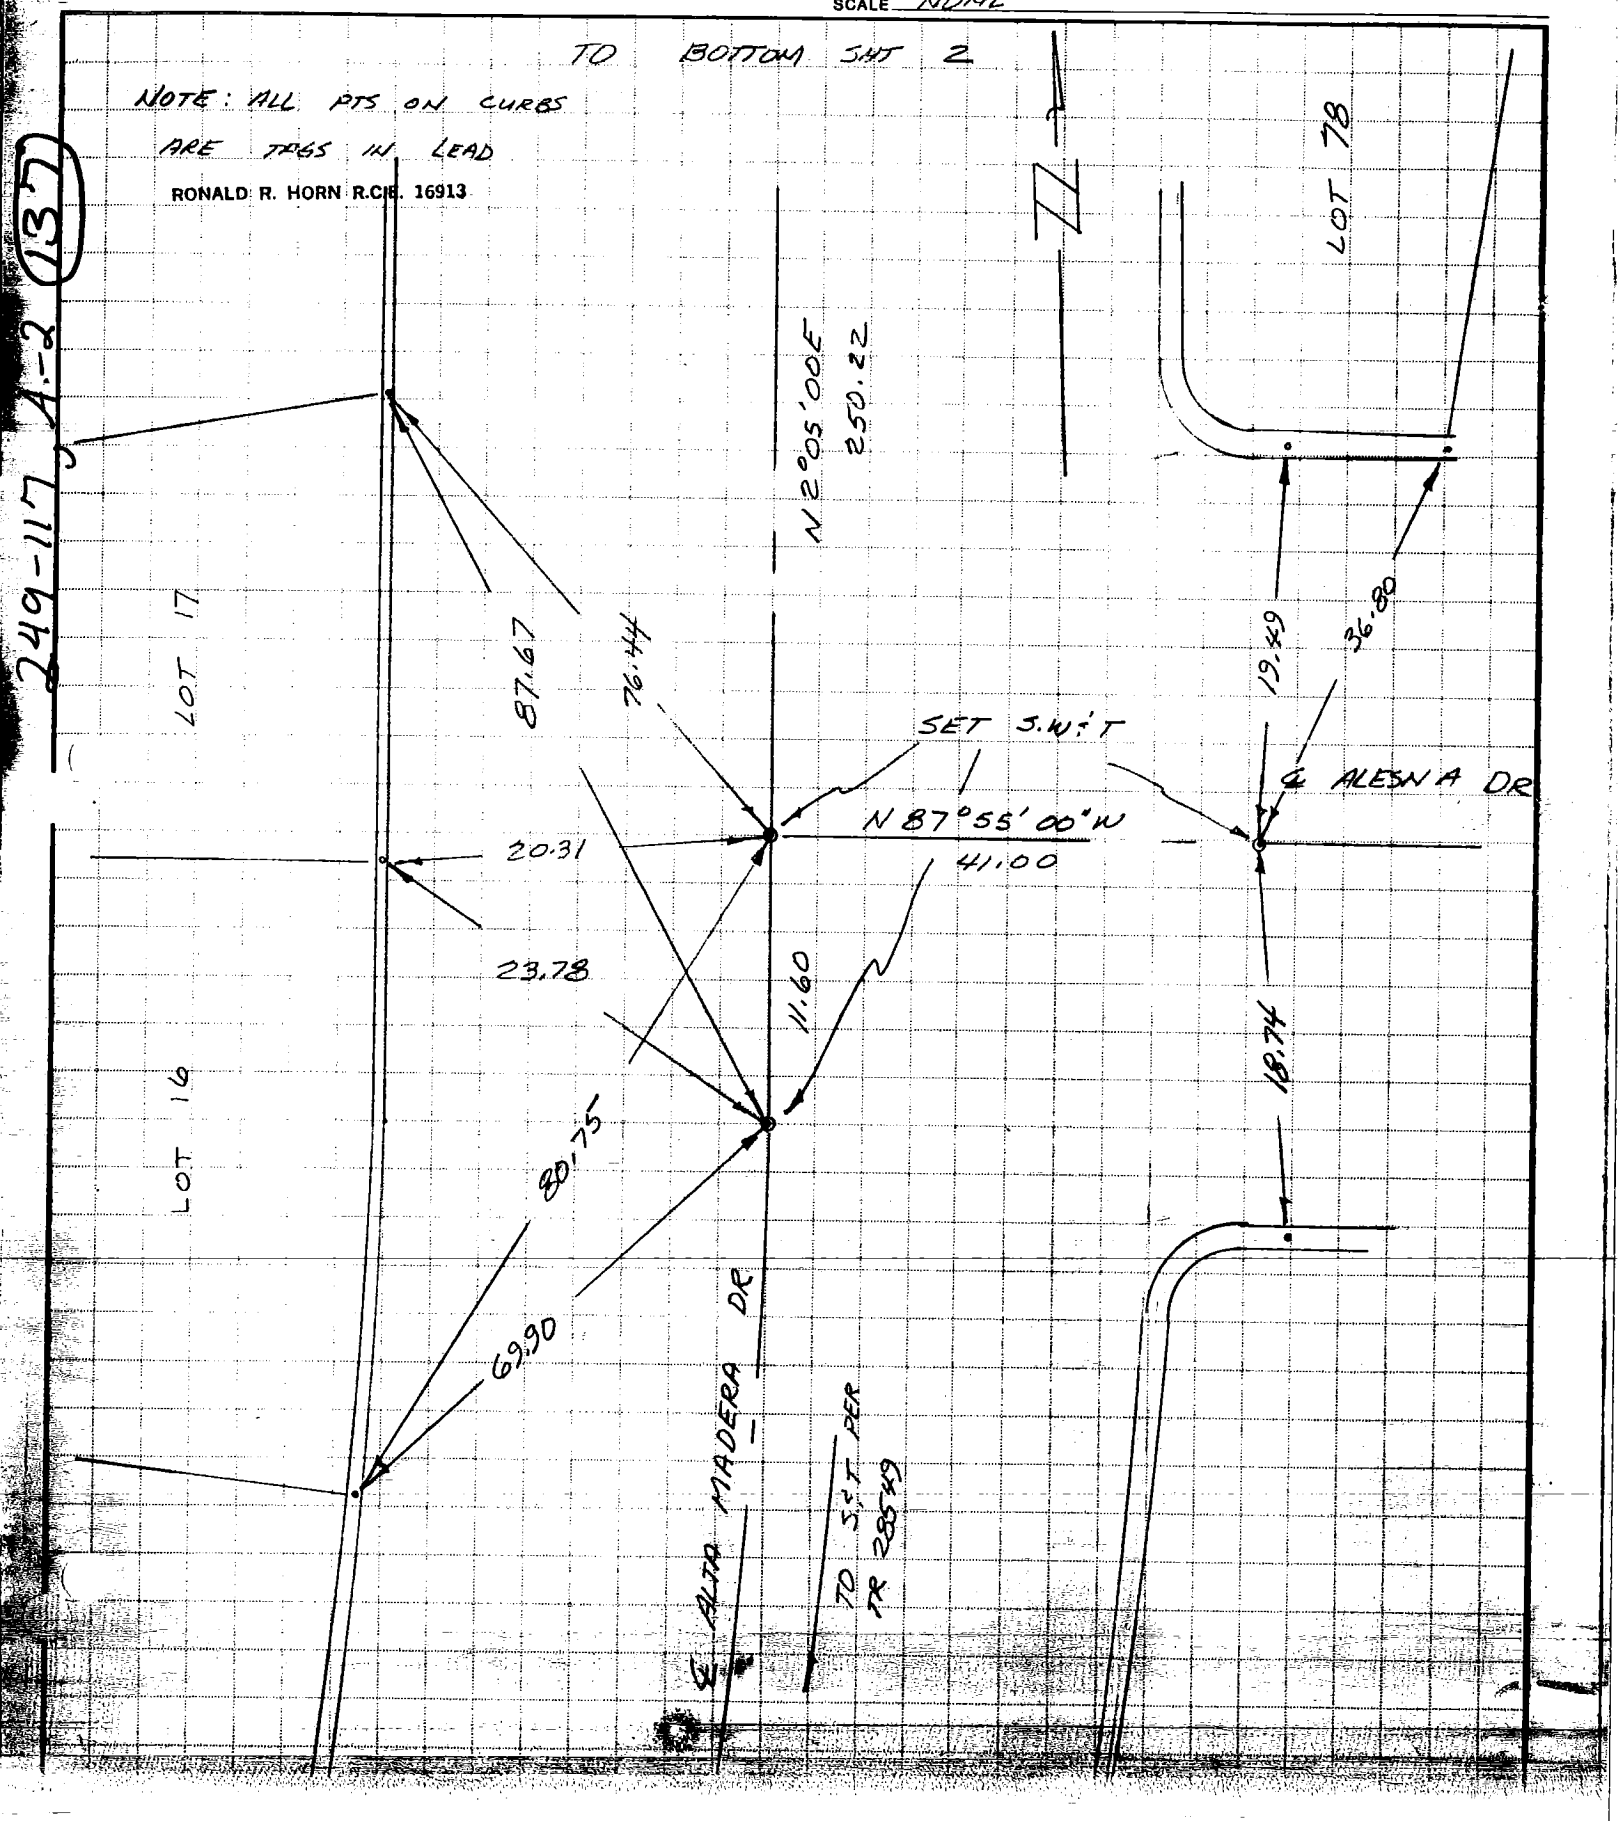

(10)

CO ENG FB 3656 - 60

SIKAND ENGINEERING ASSOCIATES
15230 Burbank Boulevard
VAN NUYS, CALIFORNIA 91411
Phone (213) 787-8550

JOB 33888

SHEET NO. 2 OF 27

CALCULATED BY BOSTON DATE FEB 13, 80

CHECKED BY ~ DATE

SCALE NONE

249-117, A-2 (43)

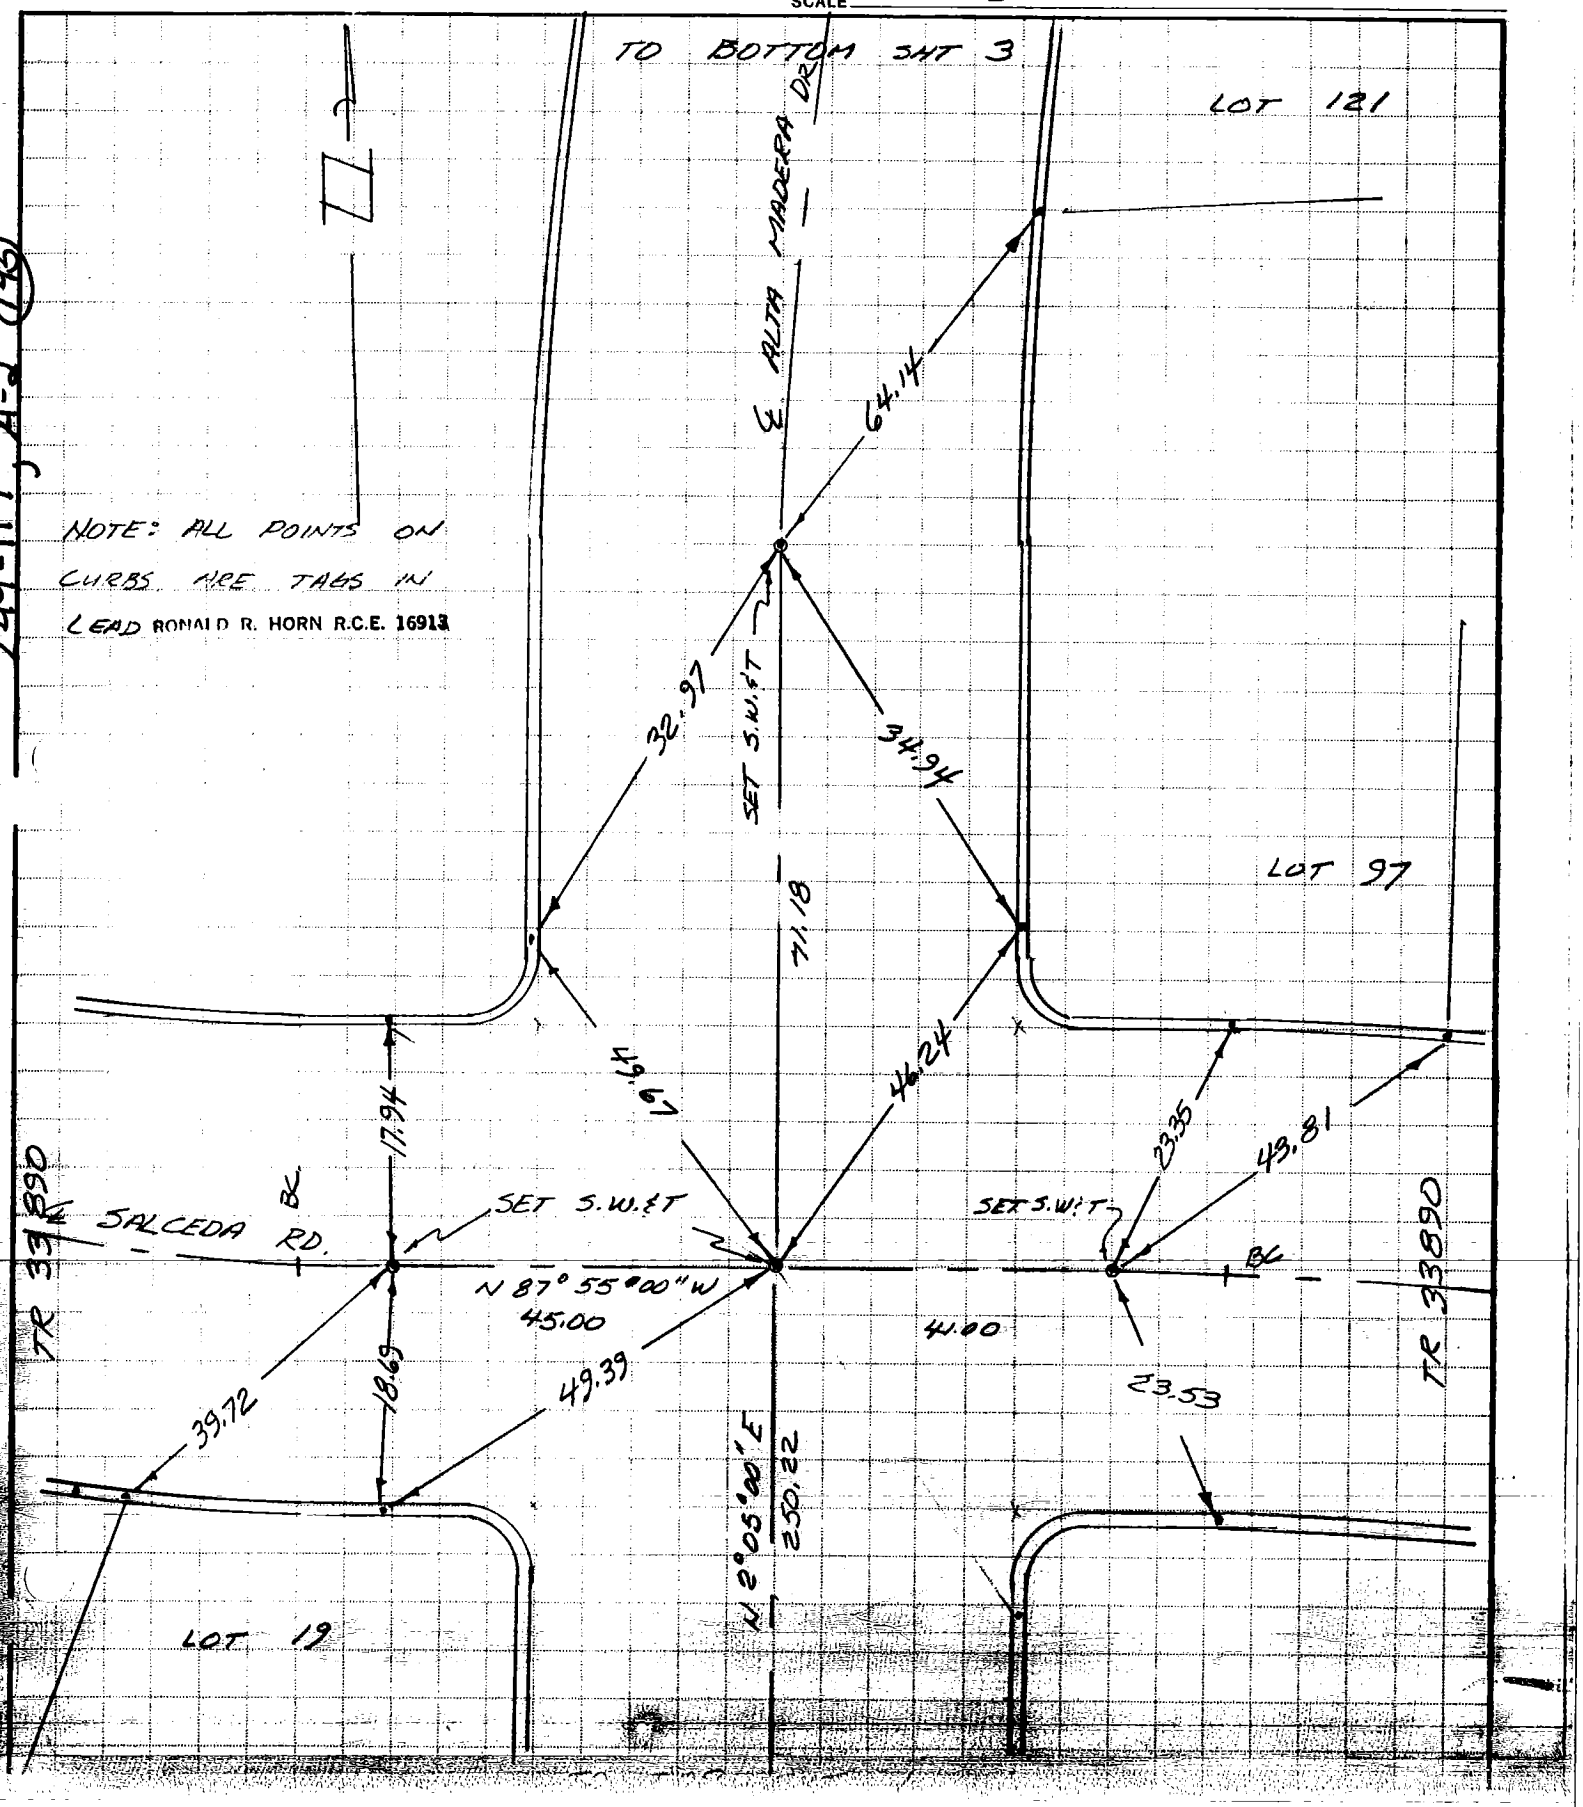

CO ENG FB 3656 - 61

61

SIKAND ENGINEERING ASSOCIATES
15230 Burbank Boulevard
VAN NUYS, CALIFORNIA 91411
Phone (213) 787-8550

JOB TR 33588

SHEET NO. 3 OF 27

CALCULATED BY BOSTON DATE FEB 13, 80

CHECKED BY — DATE

SCALE NONE

TO BOTTOM SHT 4

NOTE: ALL POINTS ON CURB ARE TAGS IN LEAD

RONALD R. HORN R.C.E. 16913

249-117, A-1 (3)

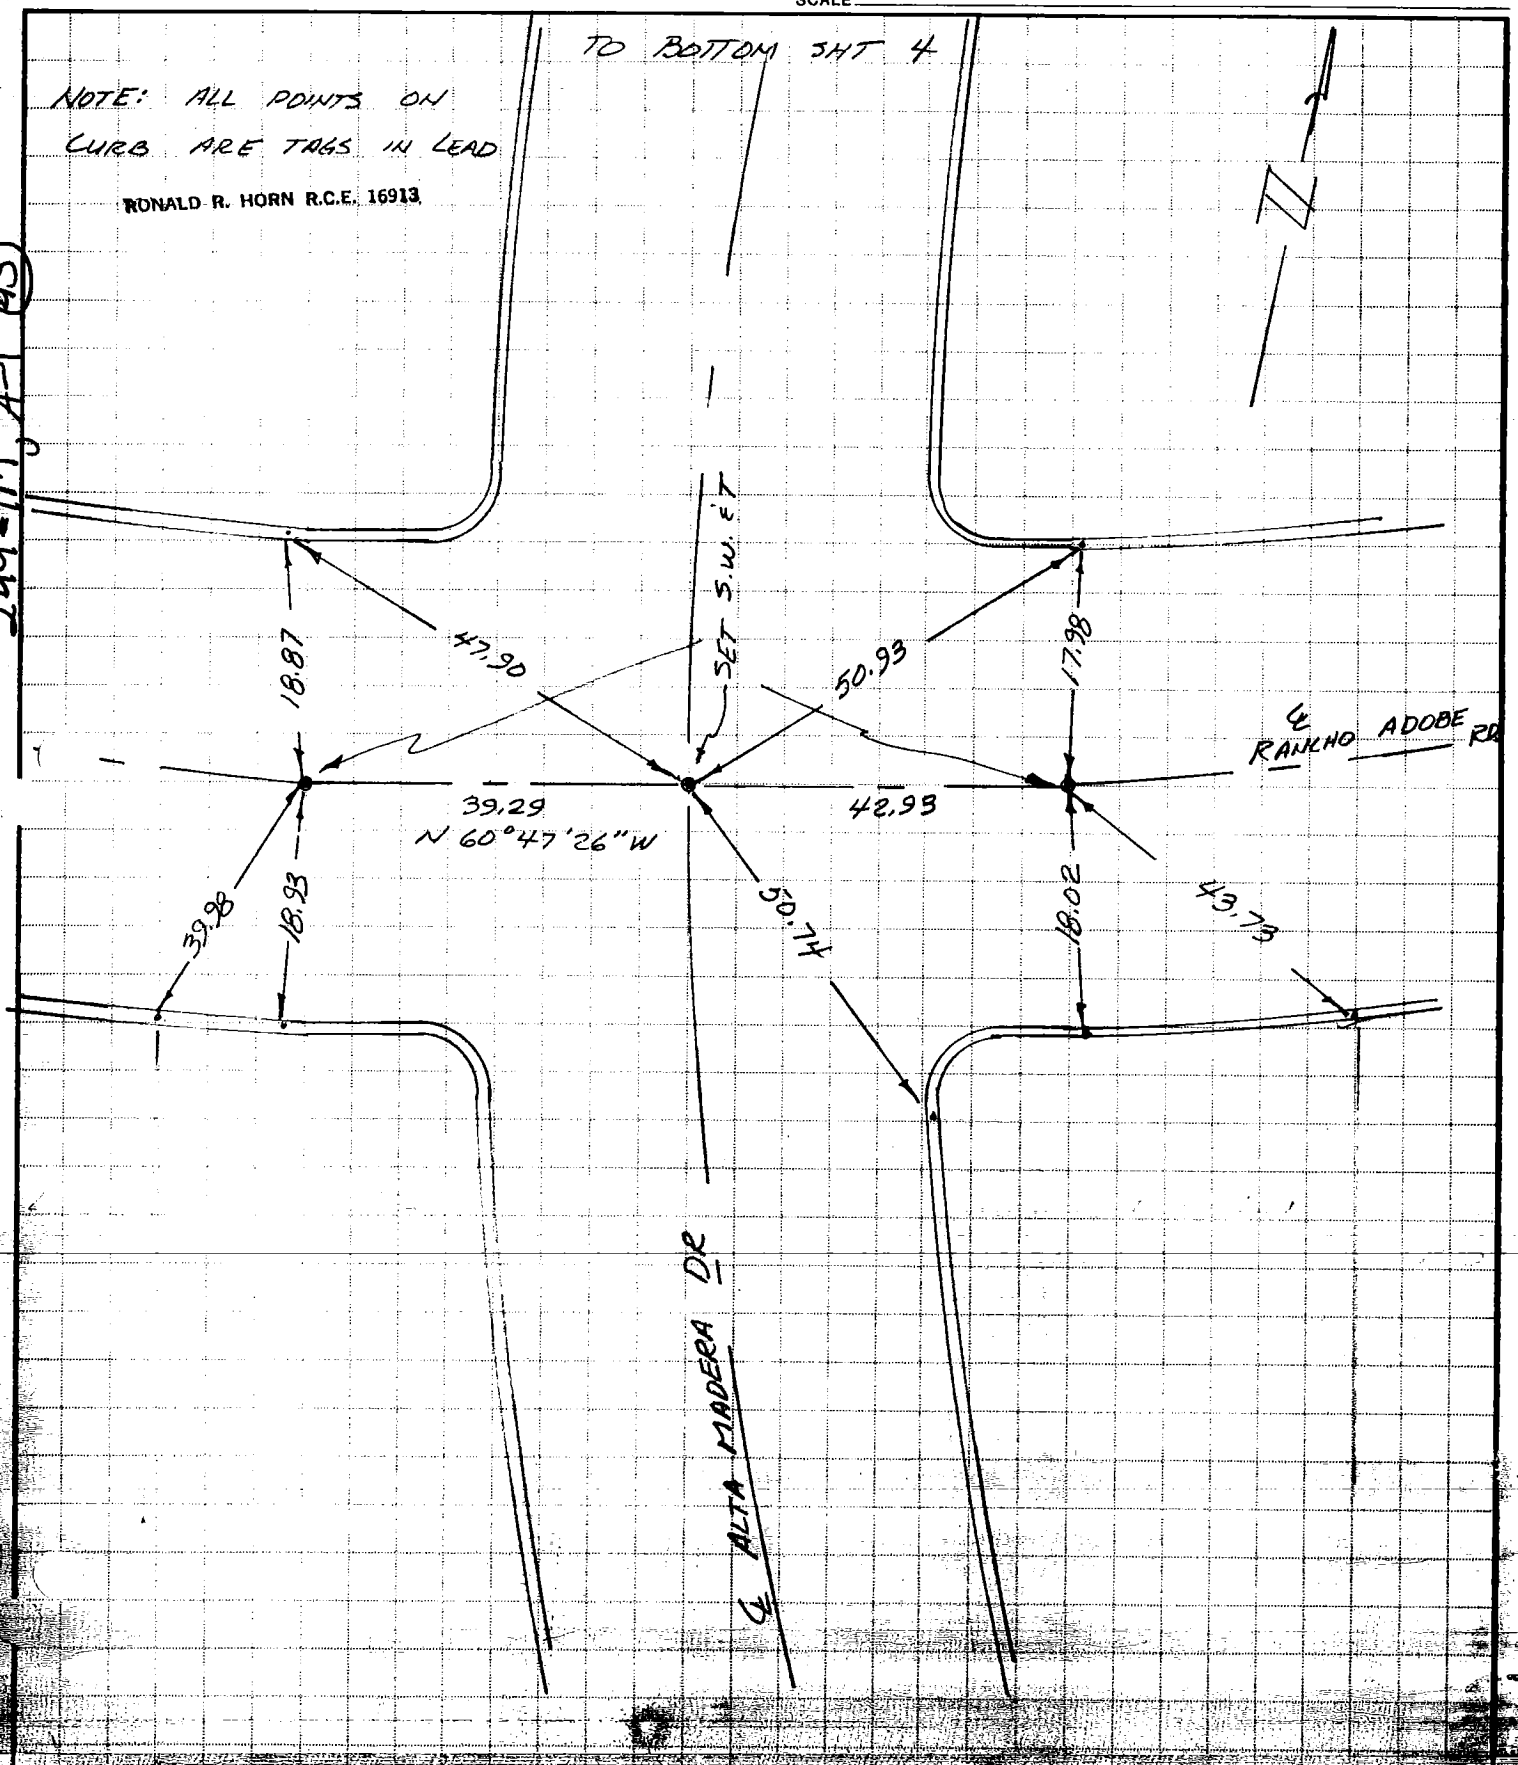

SIKAND ENGINEERING ASSOCIATES
15230 Burbank Boulevard
VAN NUYS, CALIFORNIA 91411
Phone (213) 787-8550

52

CO ENG FB 3656 - 62

JOB TR 33888

SHEET NO. 4 OF 27

CALCULATED BY BOSTON DATE FEB 13, 80

CHECKED BY _____ DATE _____

SCALE NONE

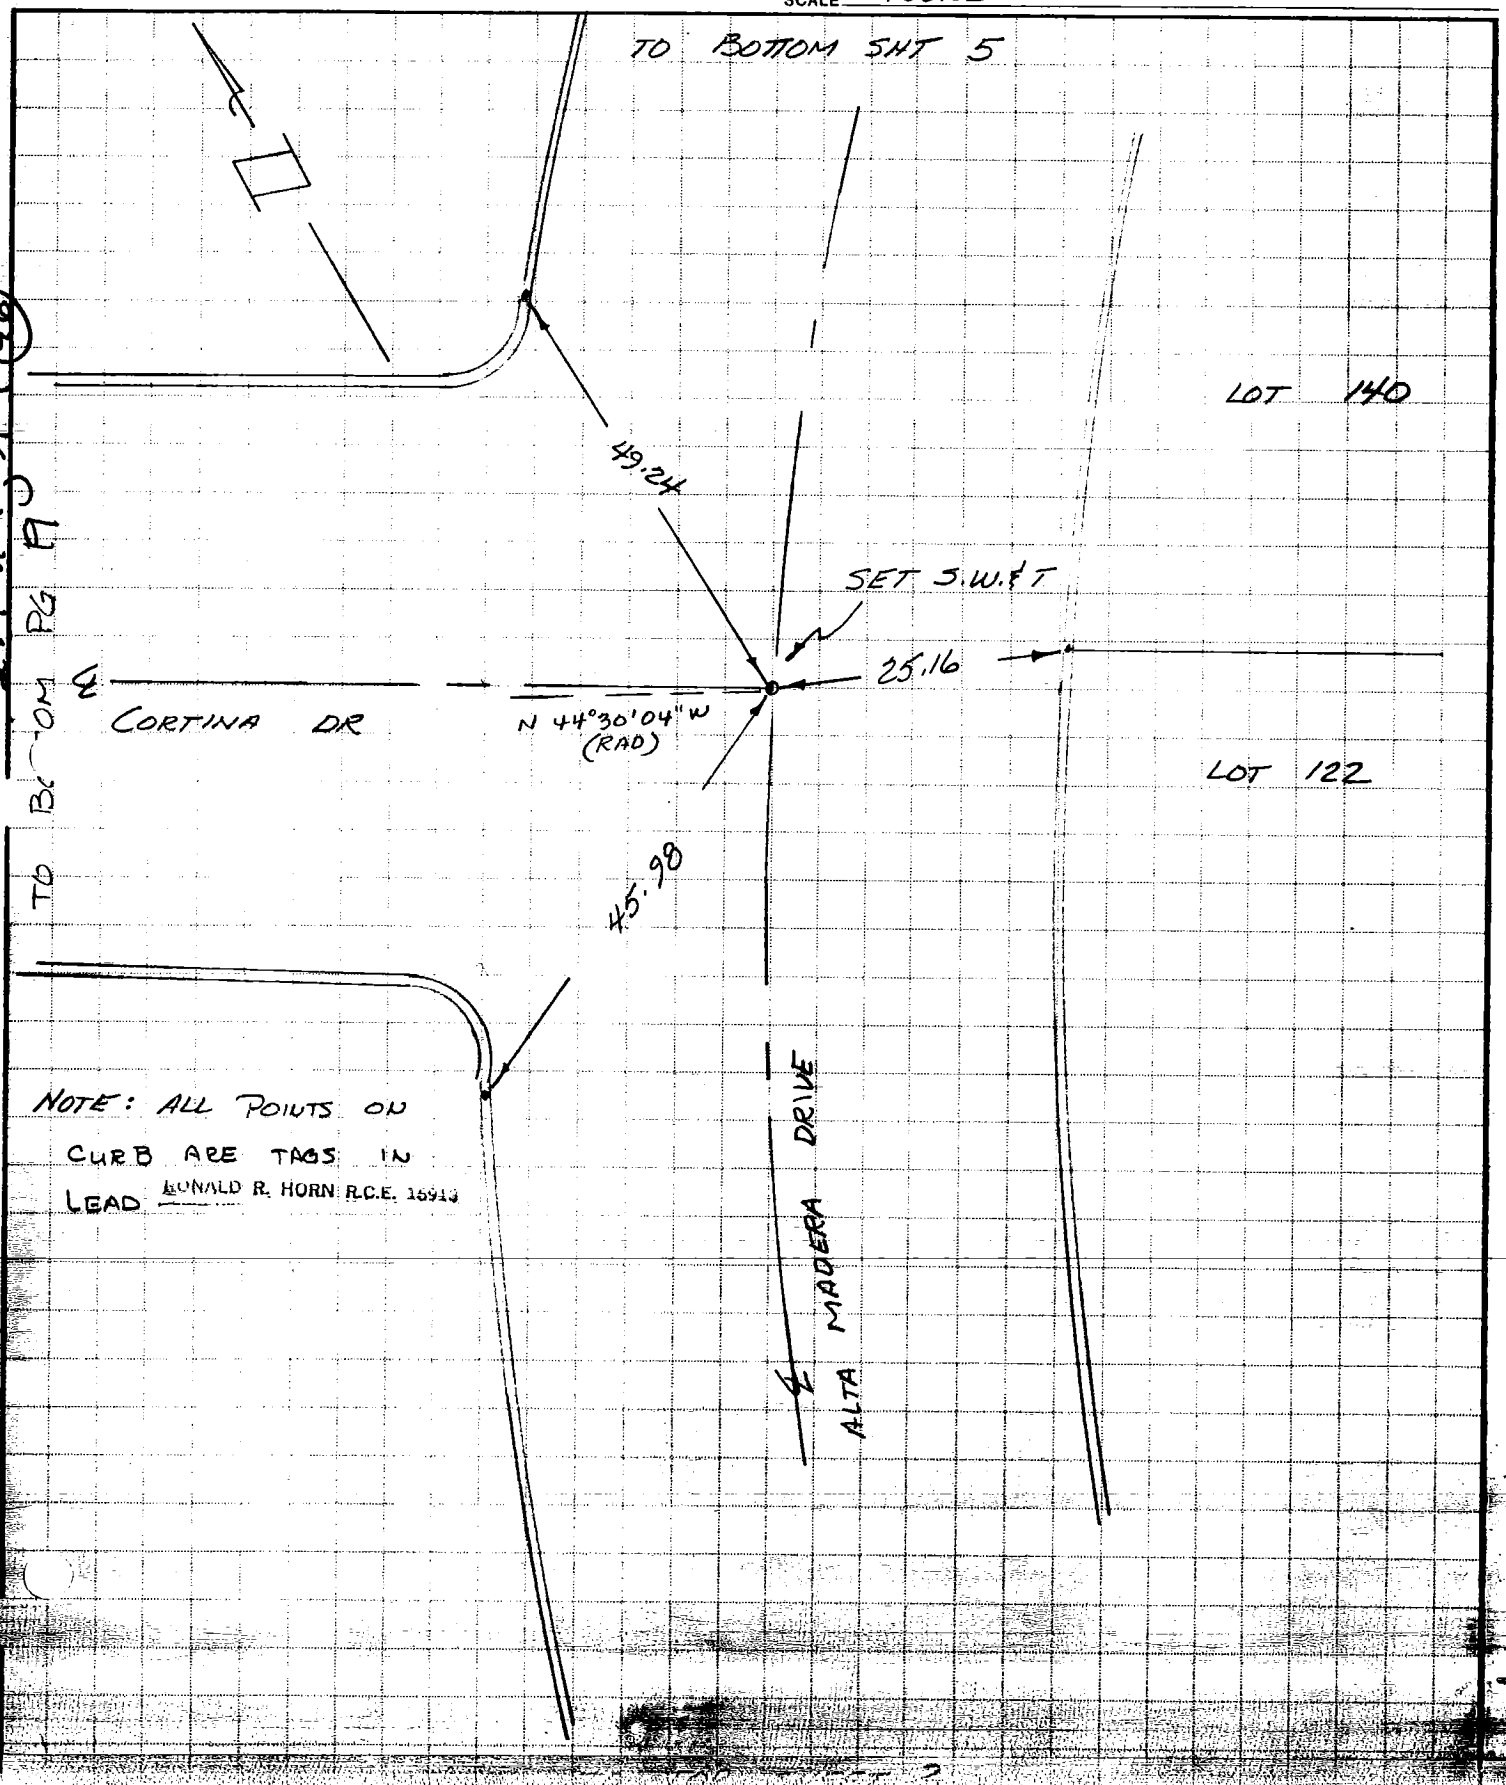

CO ENG FB 3656 - 63

SIKAND ENGINEERING ASSOCIATES
15230 Burbank Boulevard
VAN NUYS, CALIFORNIA 91411
Phone (213) 787-8550

JOB TR 33888

SHEET NO. 5 OF 27

CALCULATED BY BOSTON DATE FEB 13, 80

CHECKED BY ~~/~~ DATE

SCALE NONE

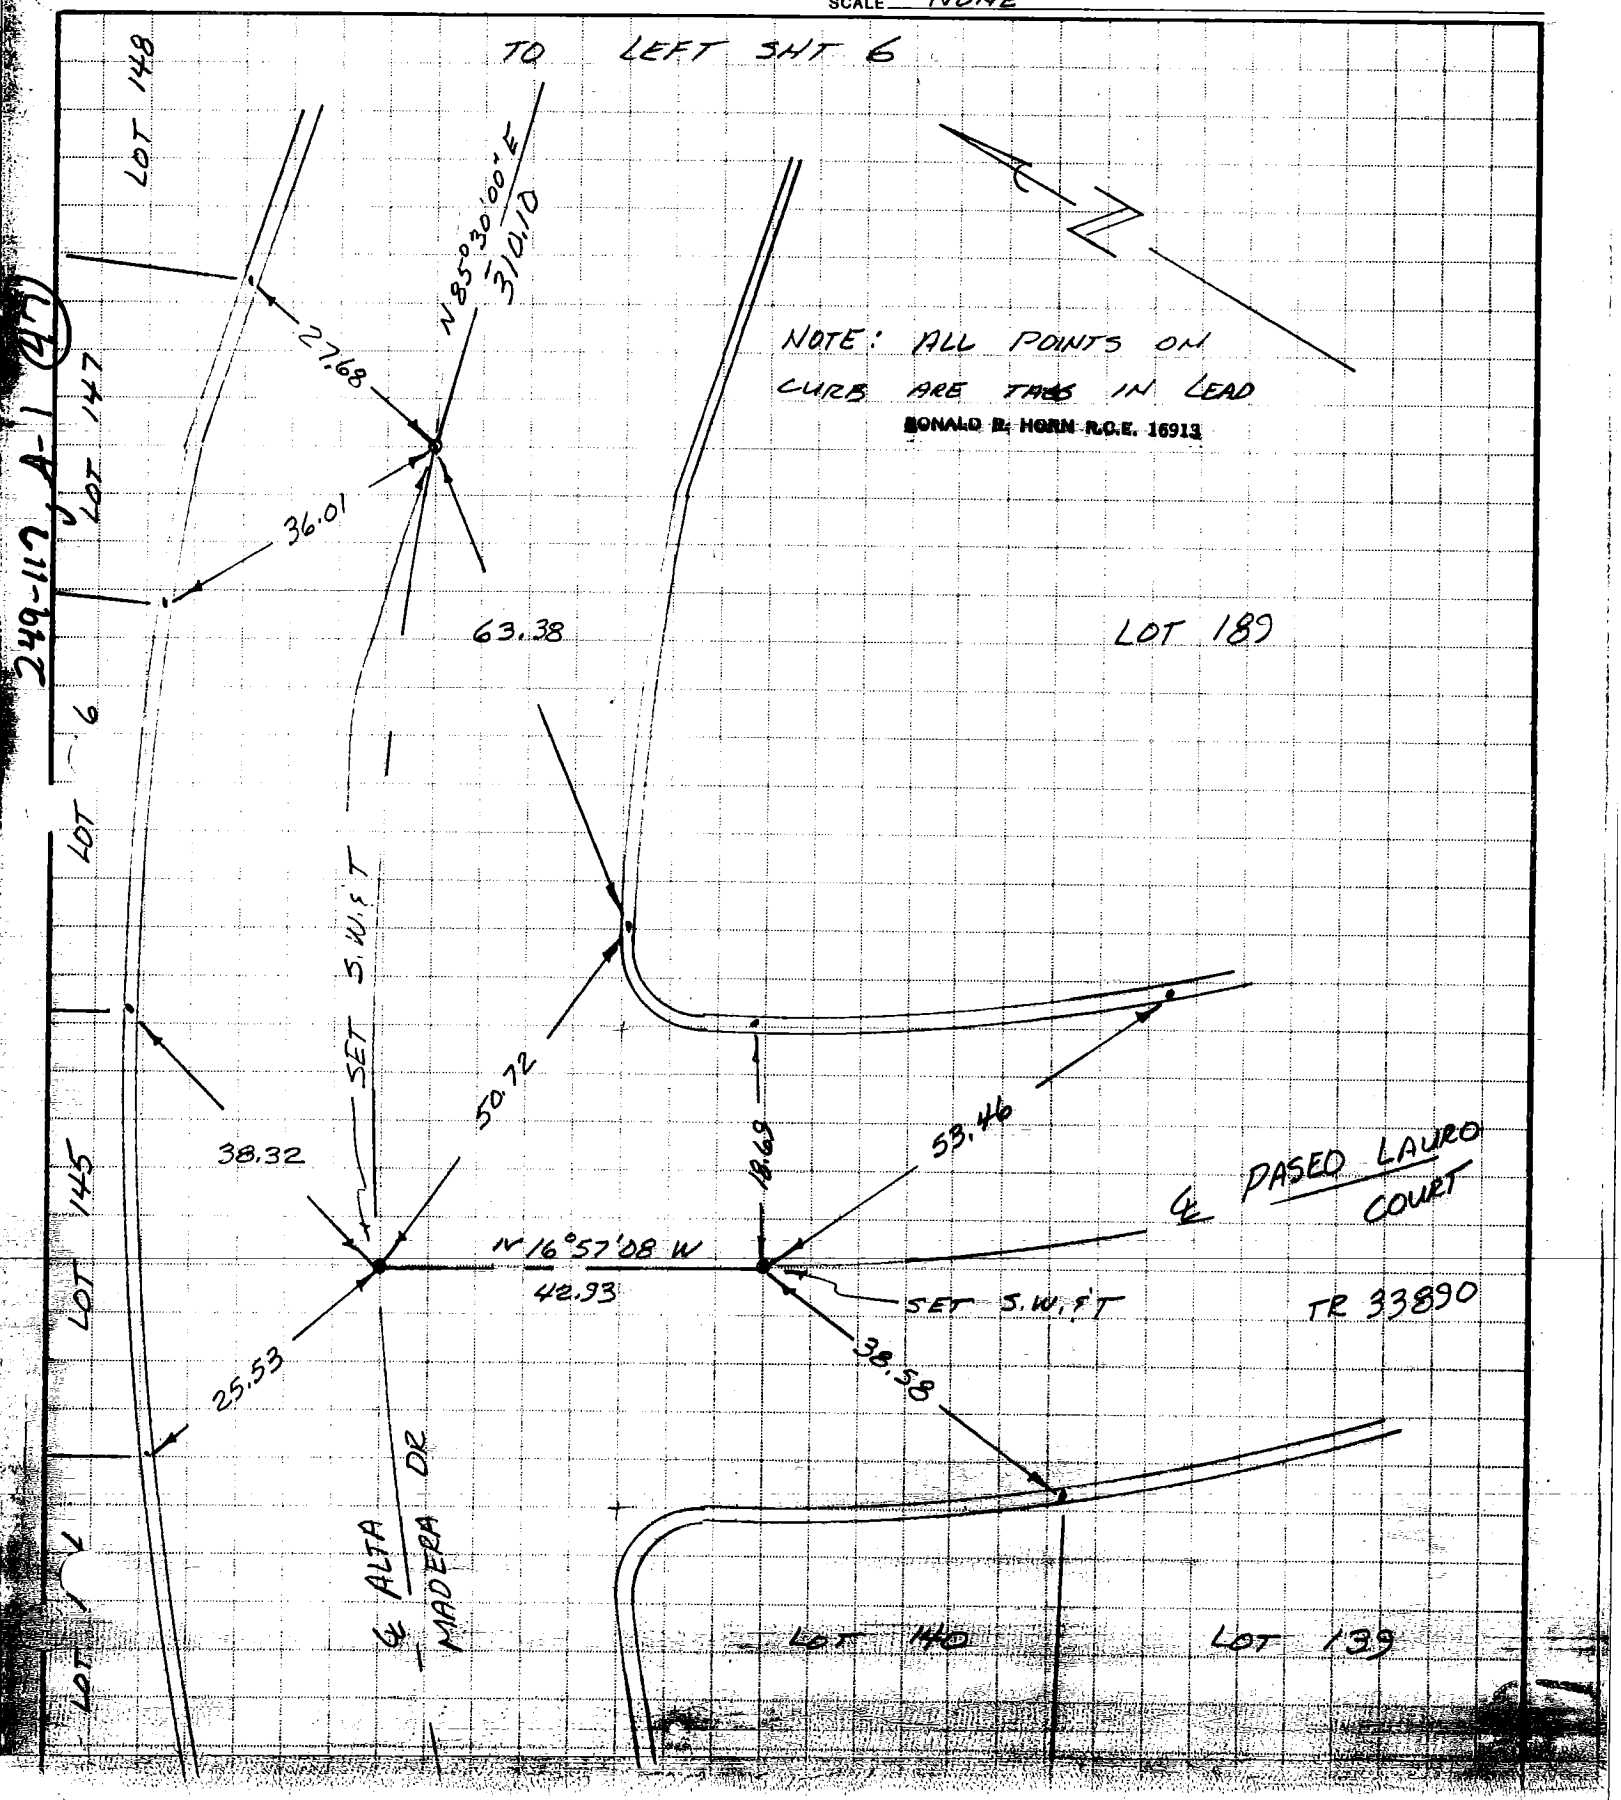

249-112 A-1 (4)

SIKAND ENGINEERING ASSOCIATES
15230 Burbank Boulevard
VAN NUYS, CALIFORNIA 91411
Phone (213) 787-8550

JOB [illegible]

SHEET 6 OF 22

CALCULATED BY WILDMAN DATE FEB. 13, 198[illegible]

CHECKED BY ✓ DATE

SCALE NONE

Note: All Points in Curb are Lead & Tags

RONALD R. HORN R.C.E. 16913

2419-117, A-1 (8)

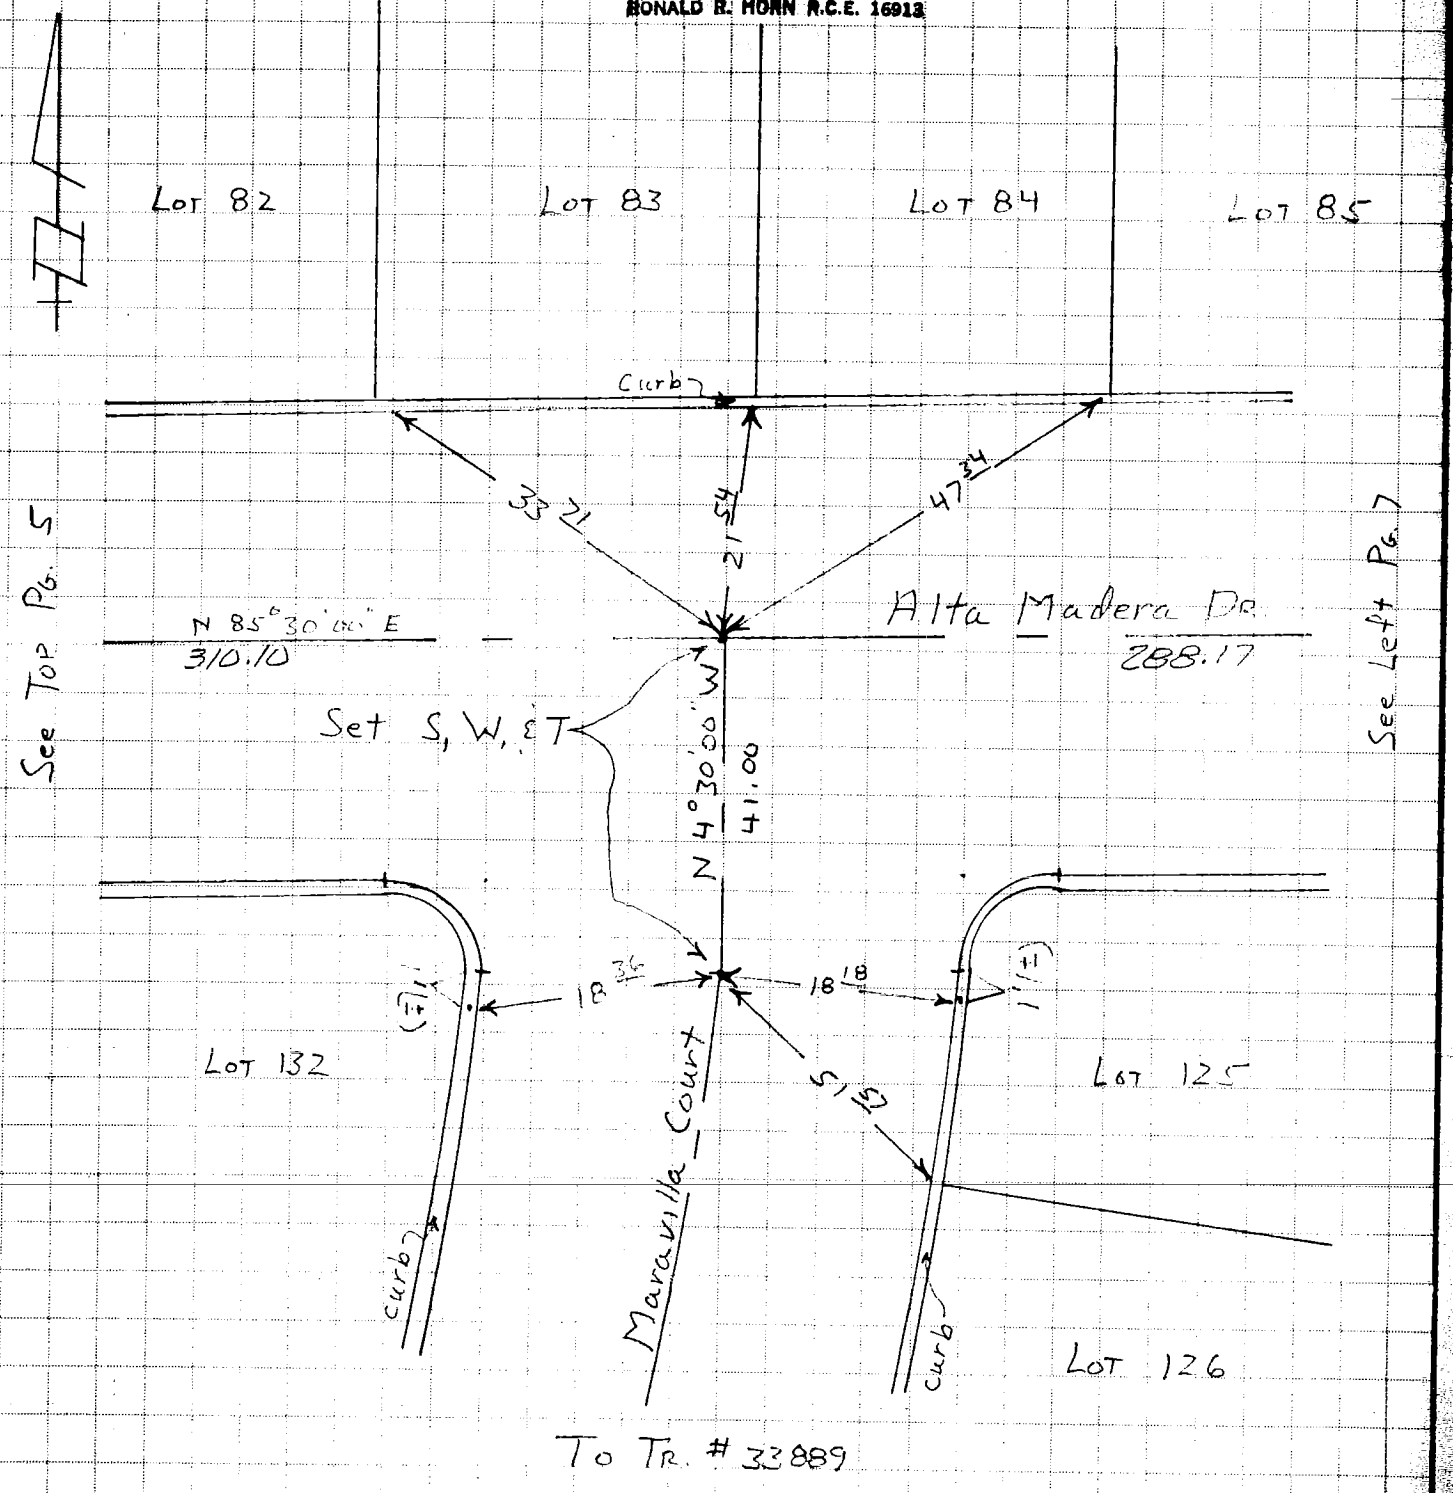

FORM 204 Available from NEBS INC. Townsend, Mass 01470

CO ENG FB 3656 - 65

SIKAND ENGINEERING ASSOCIATES
15230 Burbank Boulevard
VAN NUYS, CALIFORNIA 91411
Phone (213) 787-8550

JOB Tr. # 33888
SHEET NO. 7 OF 27
CALCULATED BY WILDMAN DATE Feb. 13, 1980
CHECKED BY ✓ DATE
SCALE None

249-117 A-1 (48)

Note: All Points on Curb are Lead & Tacks

RONALD R. HORN R.C.E. 16913

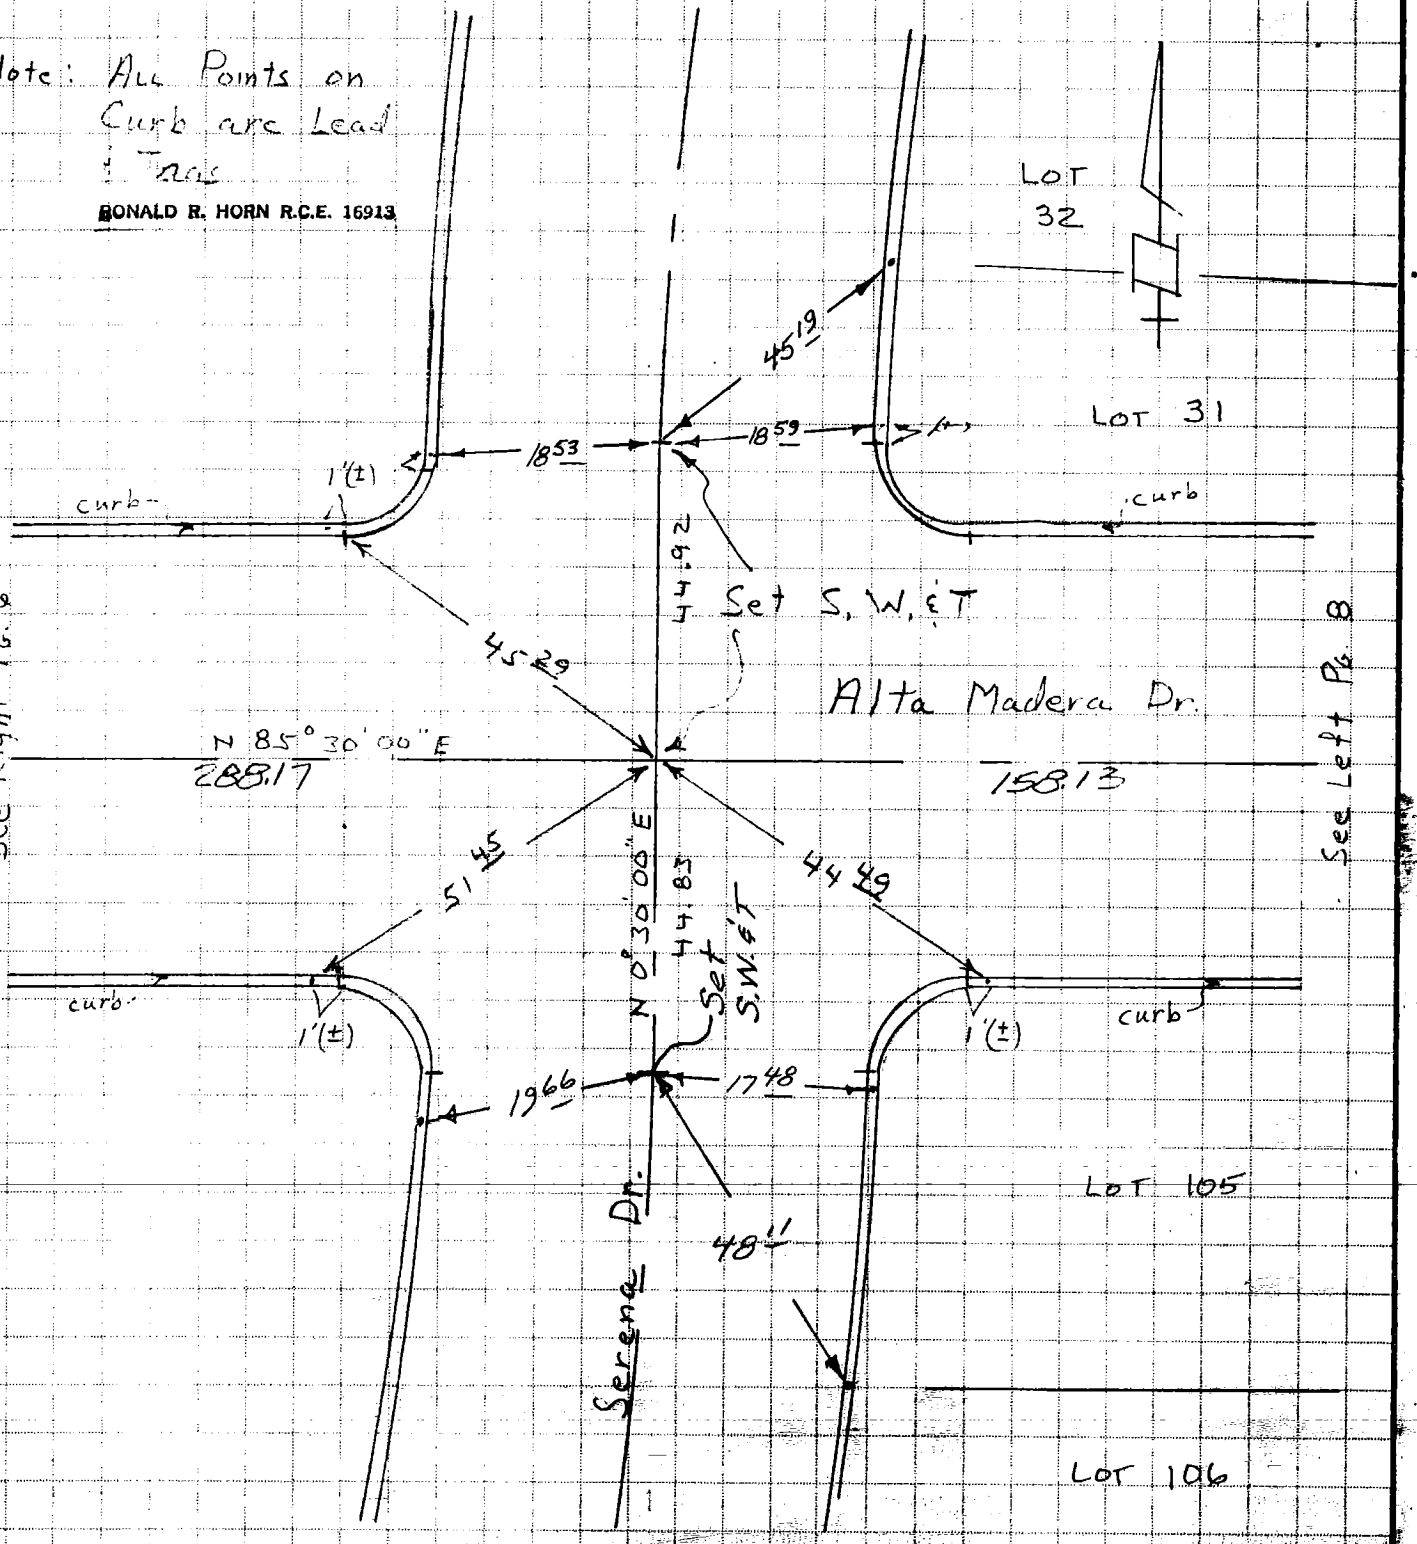

SIKAND ENGINEERING ASSOCIATES
15230 Burbank Boulevard
VAN NUYS, CALIFORNIA 91411
Phone (213) 787-8550

196

CO ENG FB 3656 - 66

JOB Tr # 33888

SHEET NO. 8 OF 27

CALCULATED BY WILDMAN DATE Feb. 13, 1980

CHECKED BY ✓ DATE

SCALE None

249-117-47 (46)

Note: All Points on Curb are Lead & Tags

RONALD R. HORN R.C.E. 16913

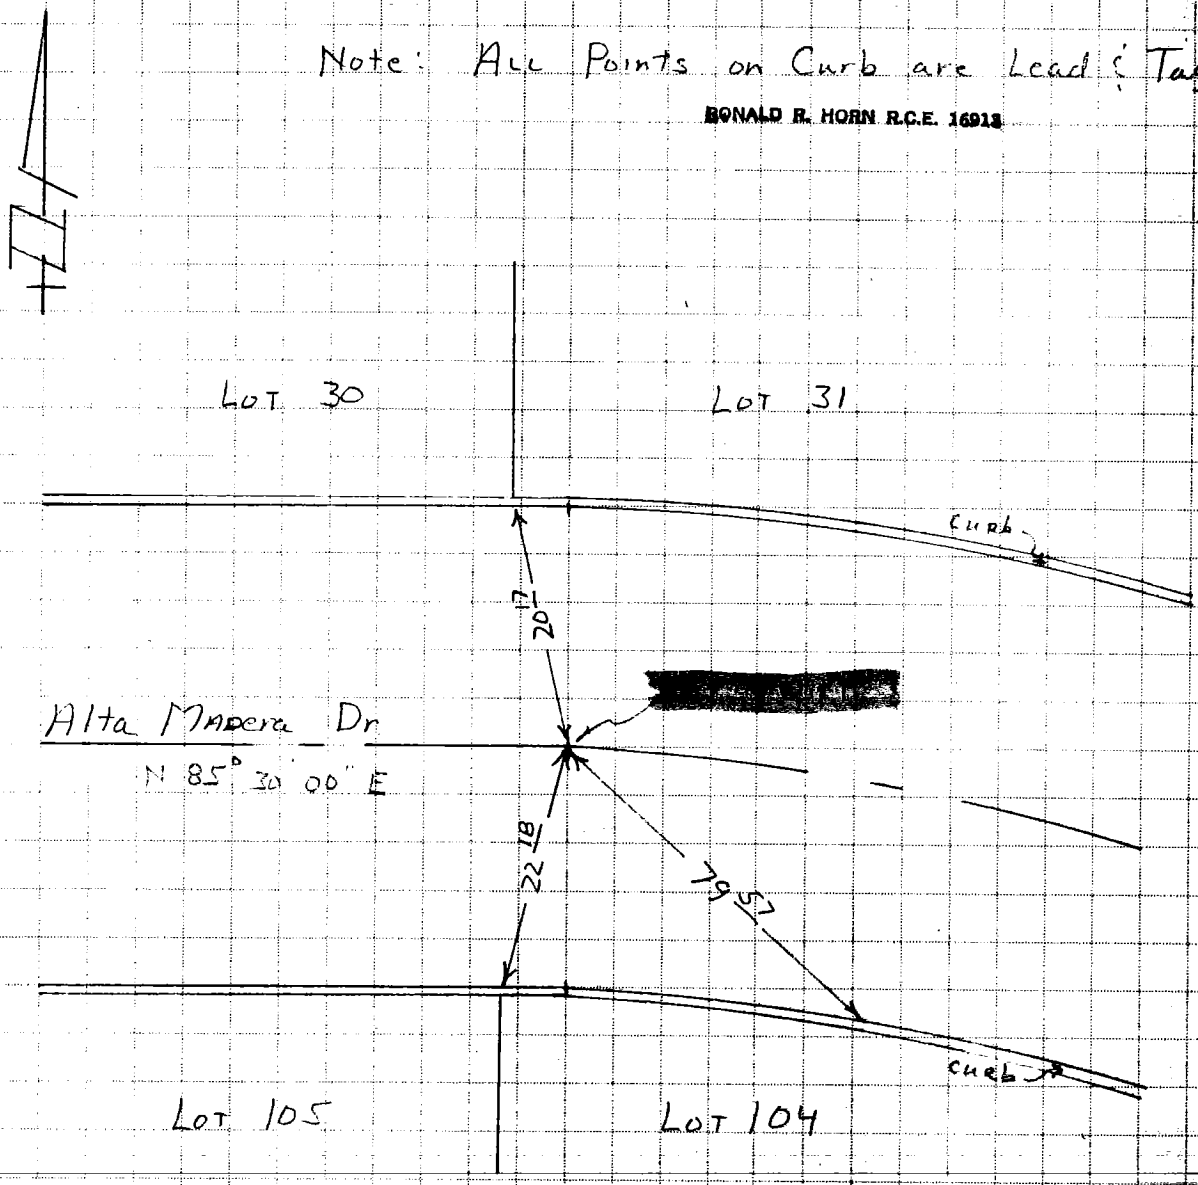

SIKAND ENGINEERING ASSOCIATES
15230 Burbank Boulevard
VAN NUYS, CALIFORNIA 91411
Phone (213) 787-8550

CO ENG FB 3656 - 67

JOB Tr. # 33888

SHEET NO. 9 OF 27

CALCULATED BY WILDMAN DATE FEB. 13, 1980

CHECKED BY ✓ DATE

SCALE NONE

249-117, A-1 (49)

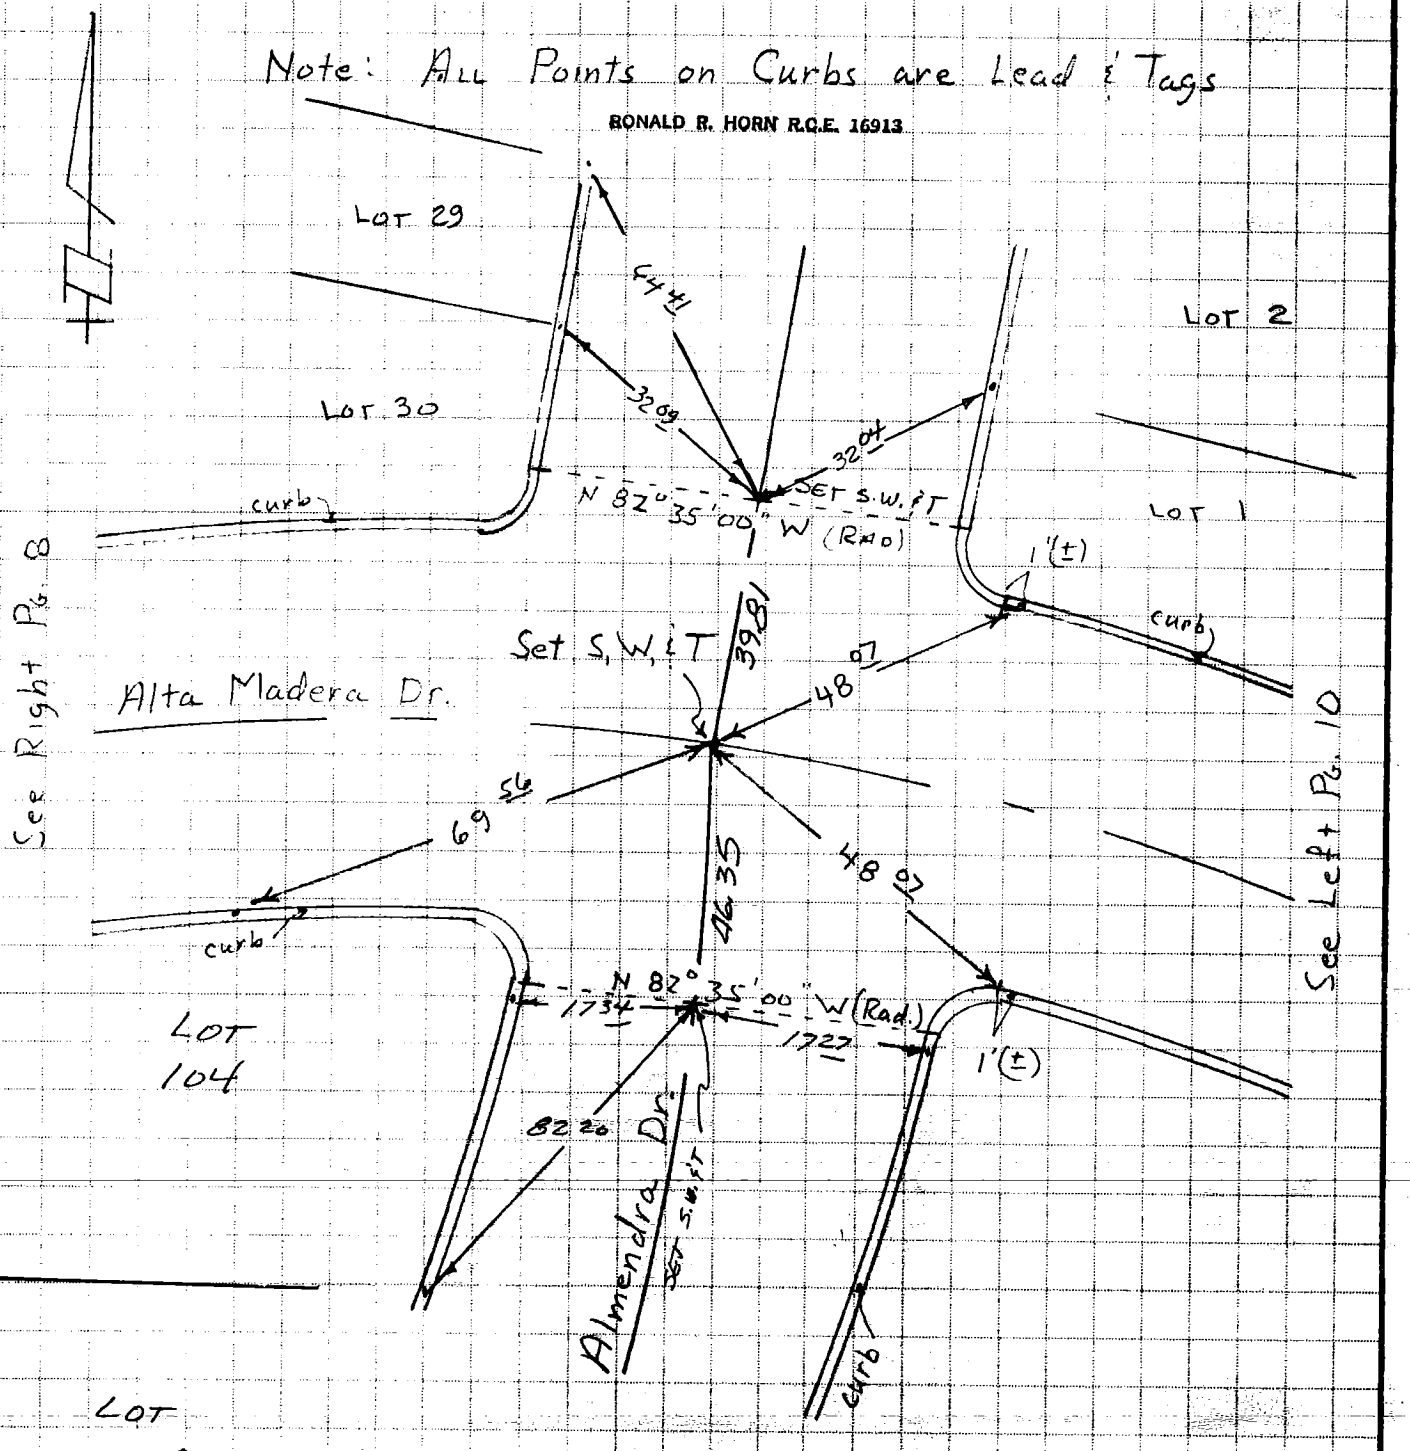

SIKAND ENGINEERING ASSOCIATES
15230 Burbank Boulevard
VAN NUYS, CALIFORNIA 91411
Phone (213) 787-8550

JOB Tr. # 33888
SHEET NO. 10 OF 27
CALCULATED BY WILDMAN DATE FEB. 13, 1980
CHECKED BY ✓ DATE
SCALE NONE

Note: All Points on Curbs are Lead & Tags

RONALD R. HORN R.C.E. 16913

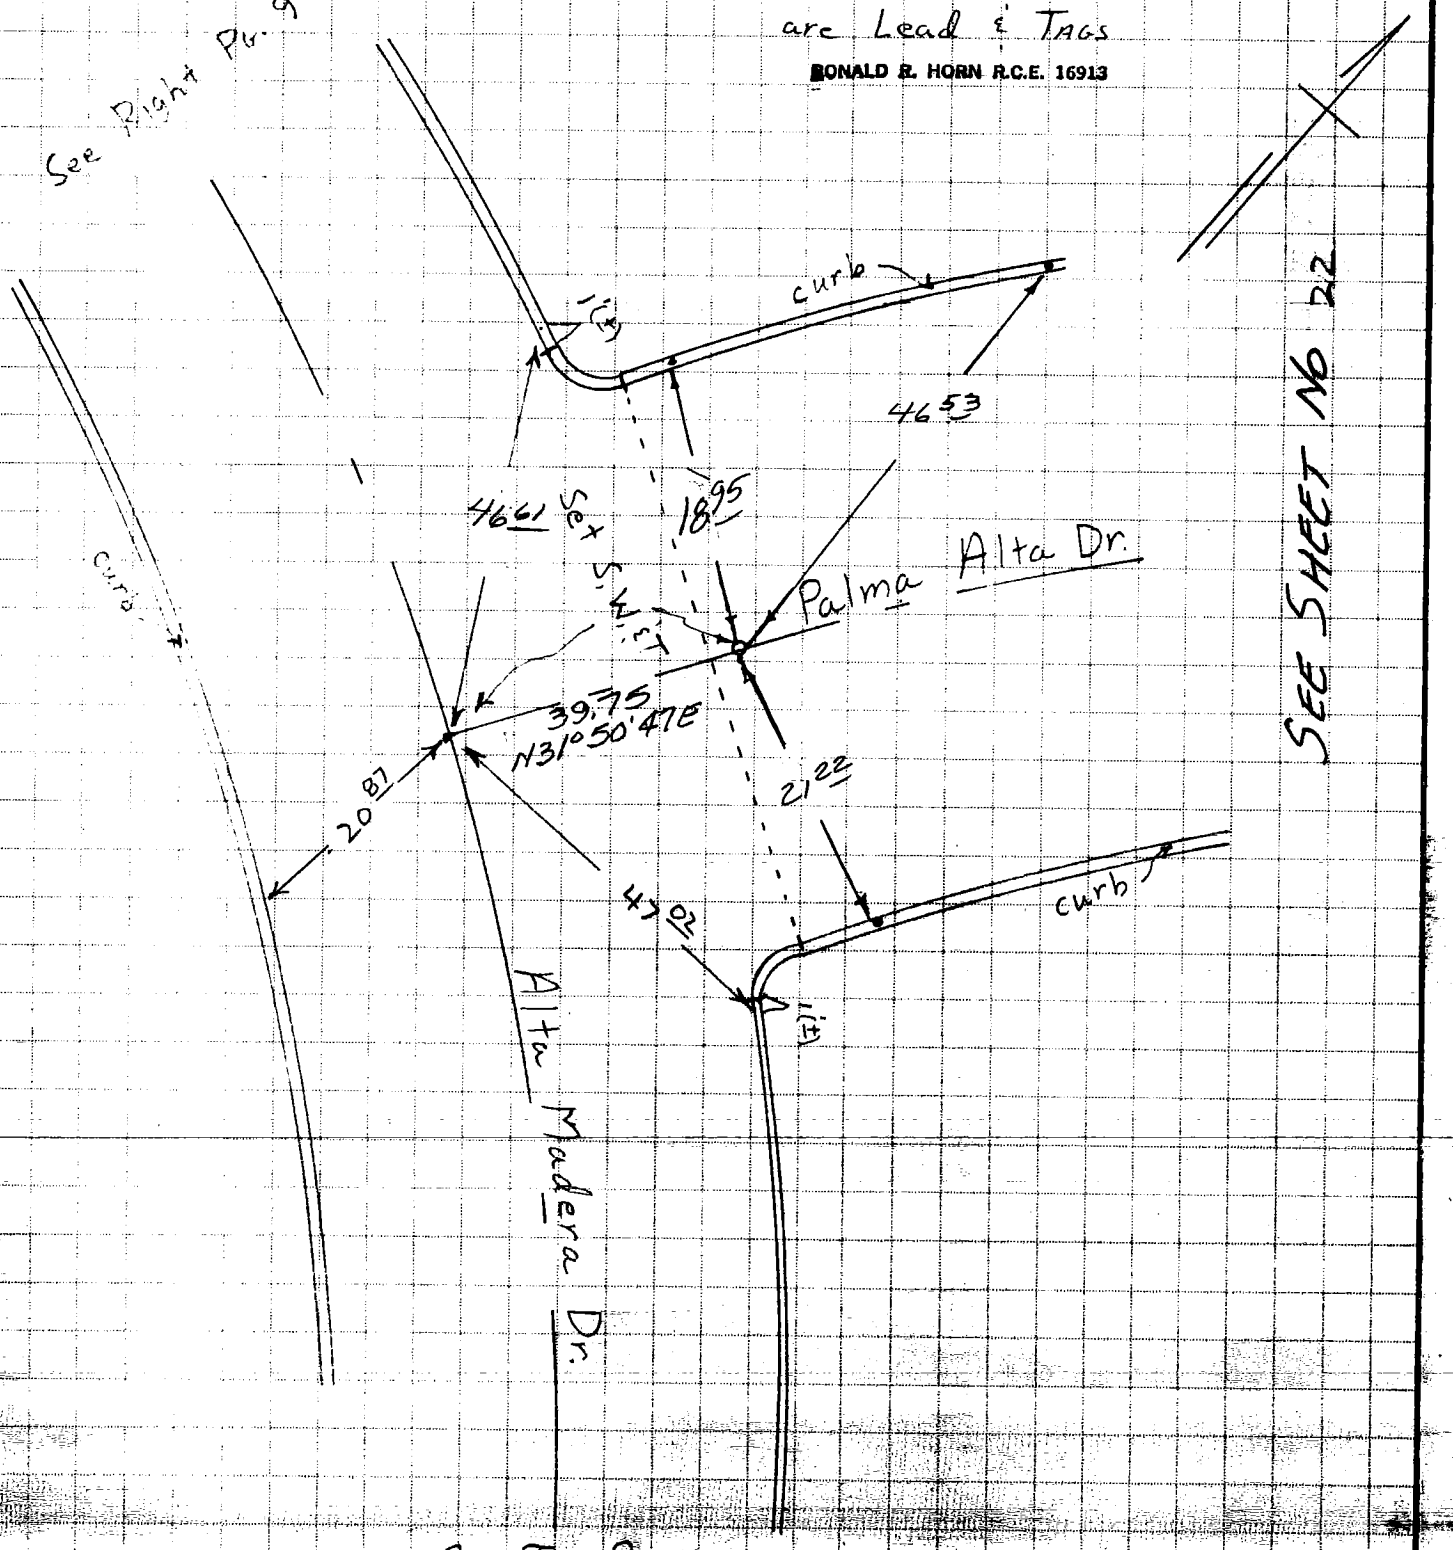

SIKAND ENGINEERING ASSOCIATES
15230 Burbank Boulevard
VAN NUYS, CALIFORNIA 91411
Phone (213) 787-8550

JOB Tr. # 33888
SHEET NO. 11 OF 27
CALCULATED BY WILDMAN DATE FEB 13, 1980
CHECKED BY ' DATE
SCALE NONE

249-117-41 (53)

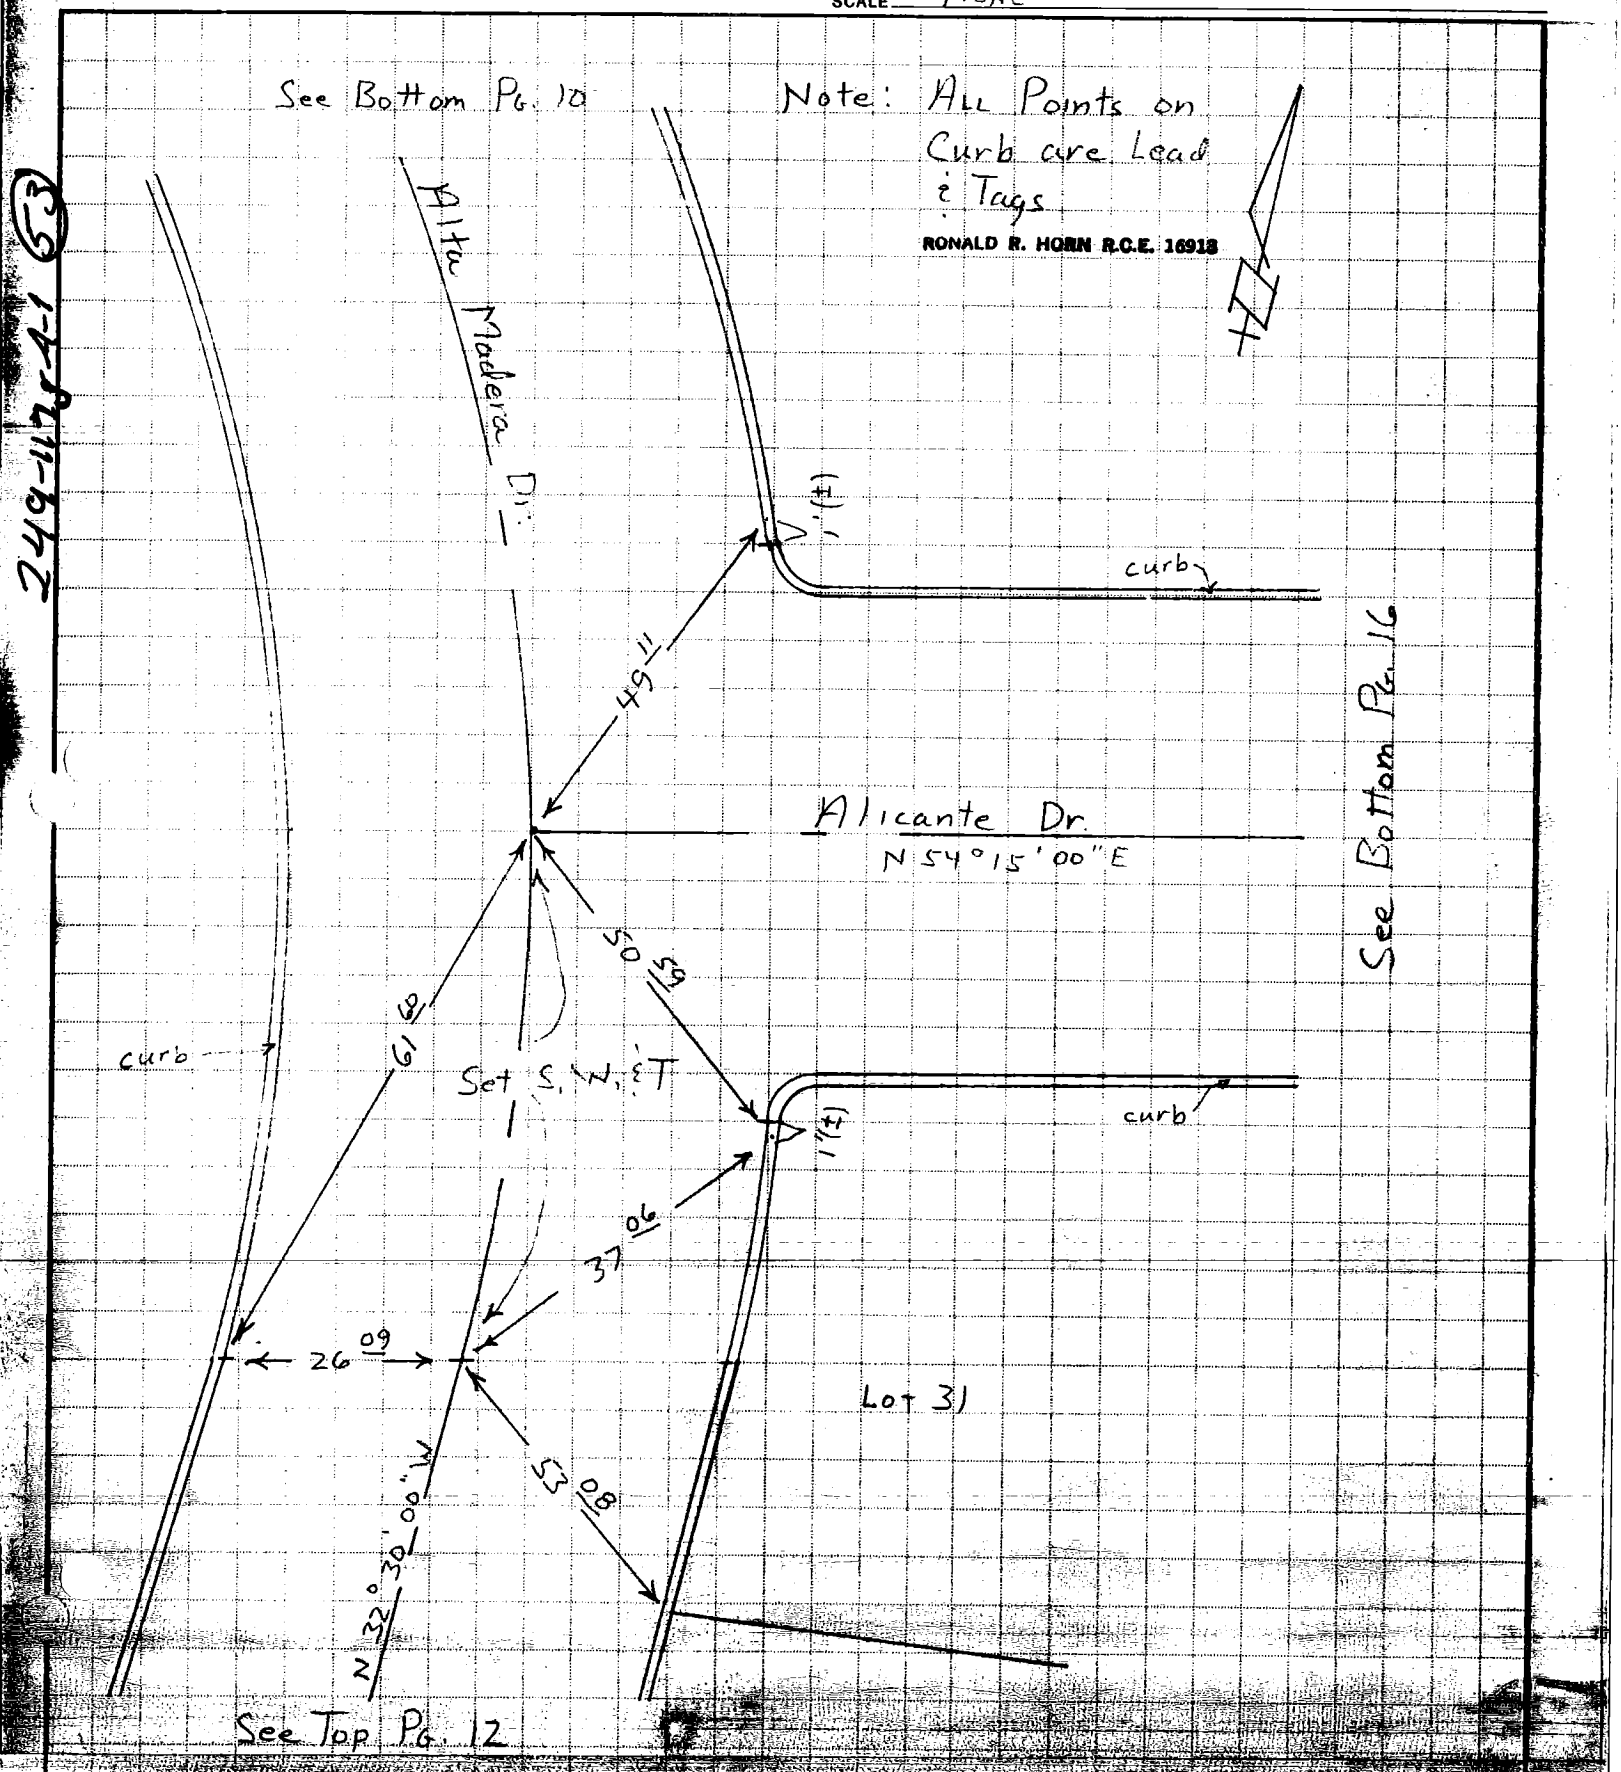

CO ENG FB 3656 - 70

SIKAND ENGINEERING ASSOCIATES
15230 Burbank Boulevard
VAN NUYS, CALIFORNIA 91411
Phone (213) 787-8550

JOB Tr. # 33888
SHEET NO. 12 OF 27
CALCULATED BY WILDMAN DATE FEB. 13, 1980
CHECKED BY ✓ DATE
SCALE None

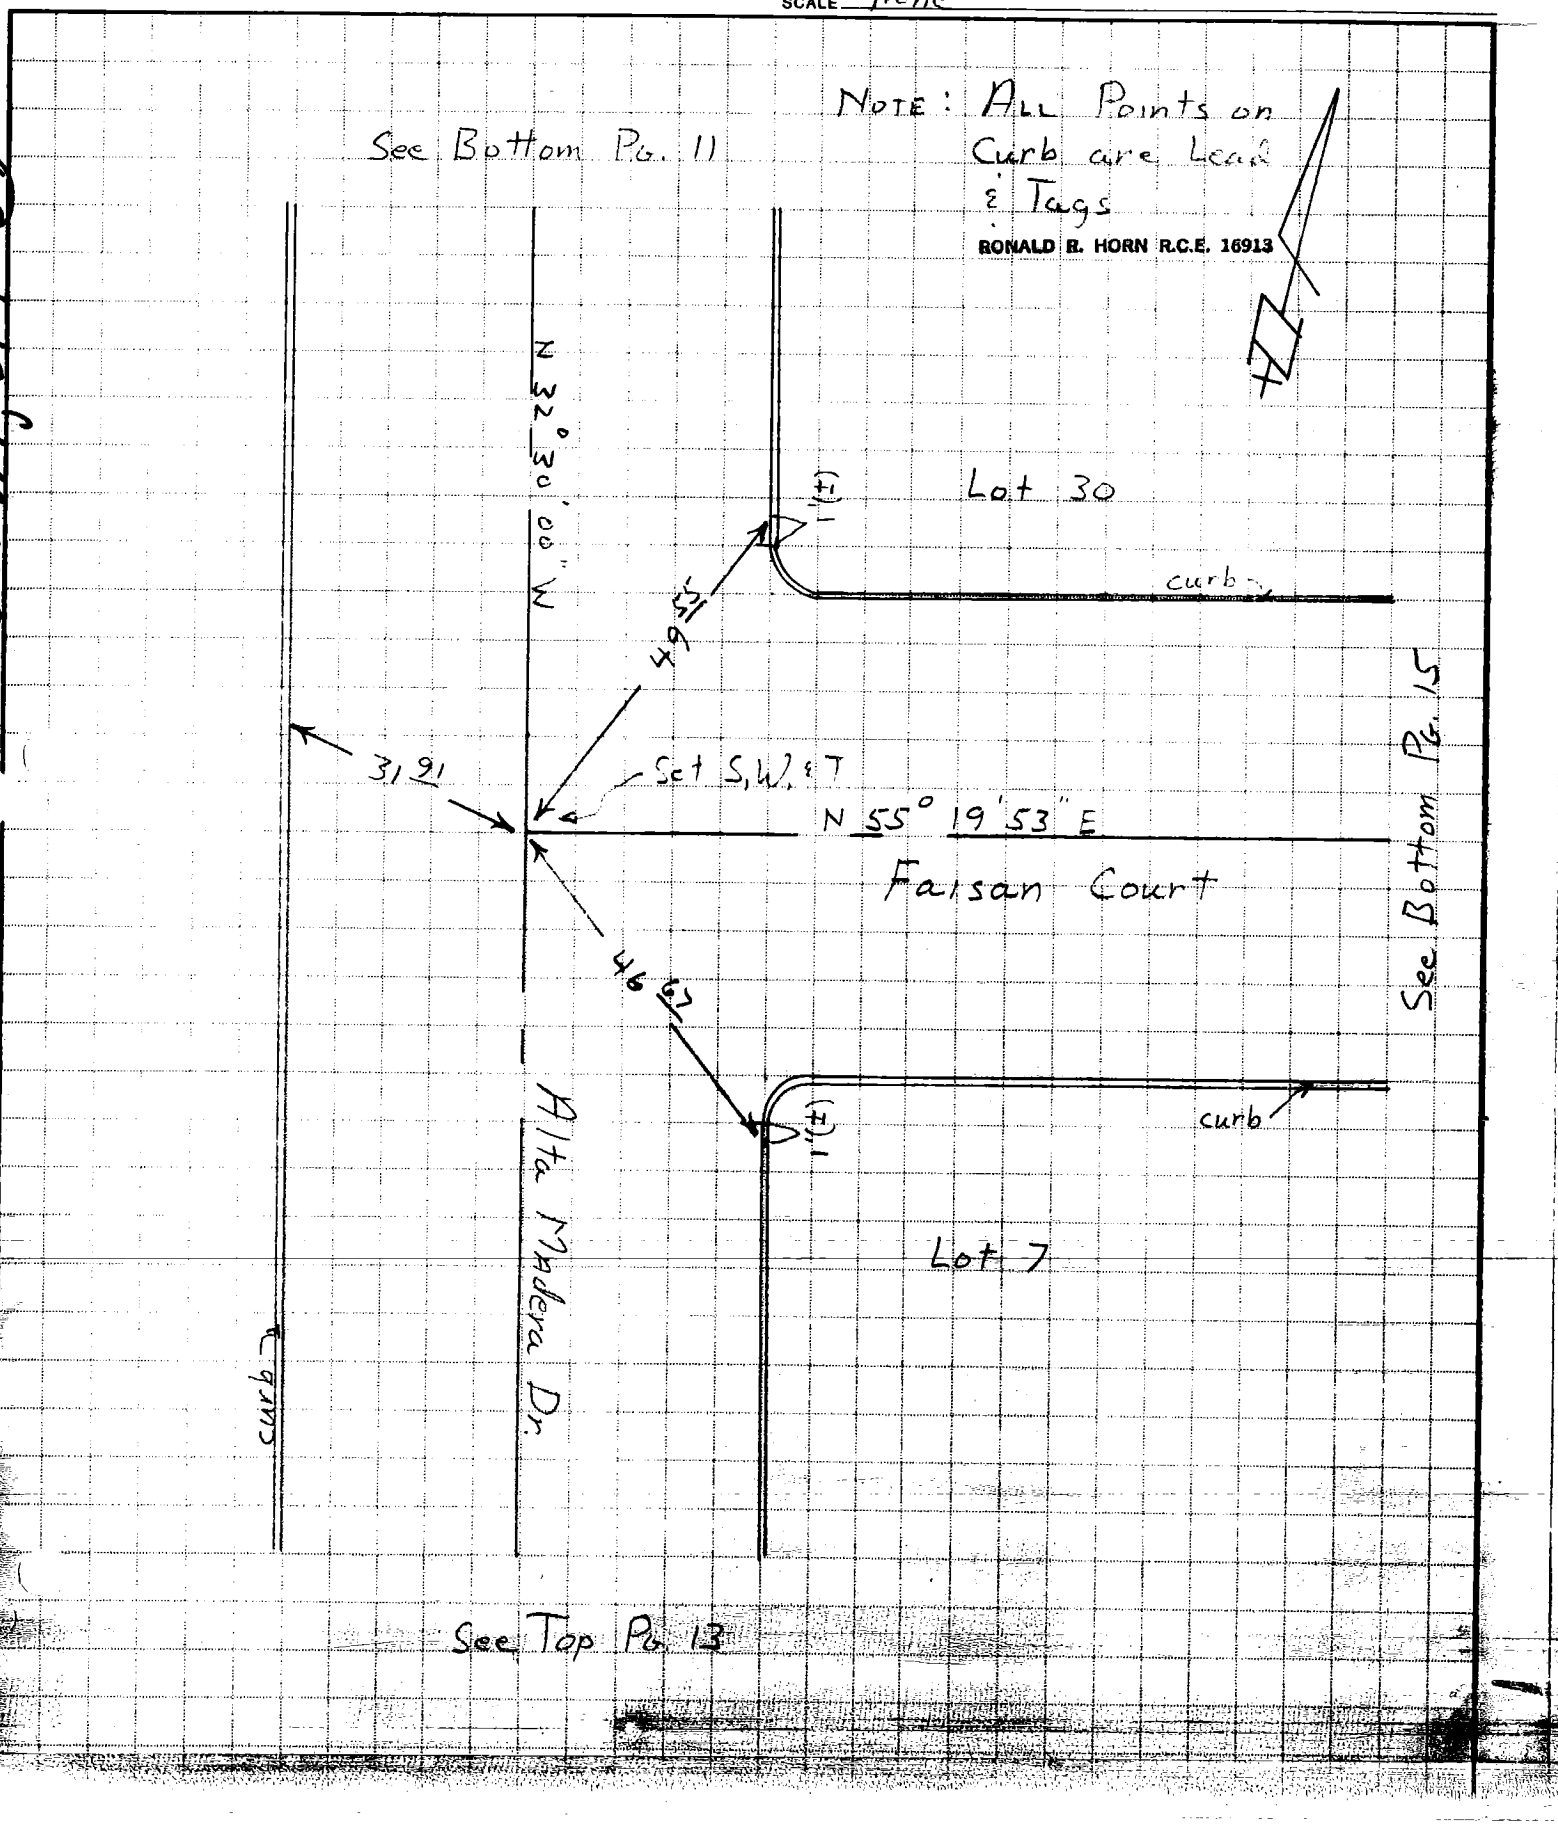

CO ENG FB 3656 - 71

SIKAND ENGINEERING ASSOCIATES
15230 Burbank Boulevard
VAN NUYS, CALIFORNIA 91411
Phone (213) 787-8550

JOB Tr. # 33888

SHEET NO. 13 OF 27

CALCULATED BY WILDMAN DATE FEB. 13, 1980

CHECKED BY ✓ DATE

SCALE None

249-117 A-2 (94)

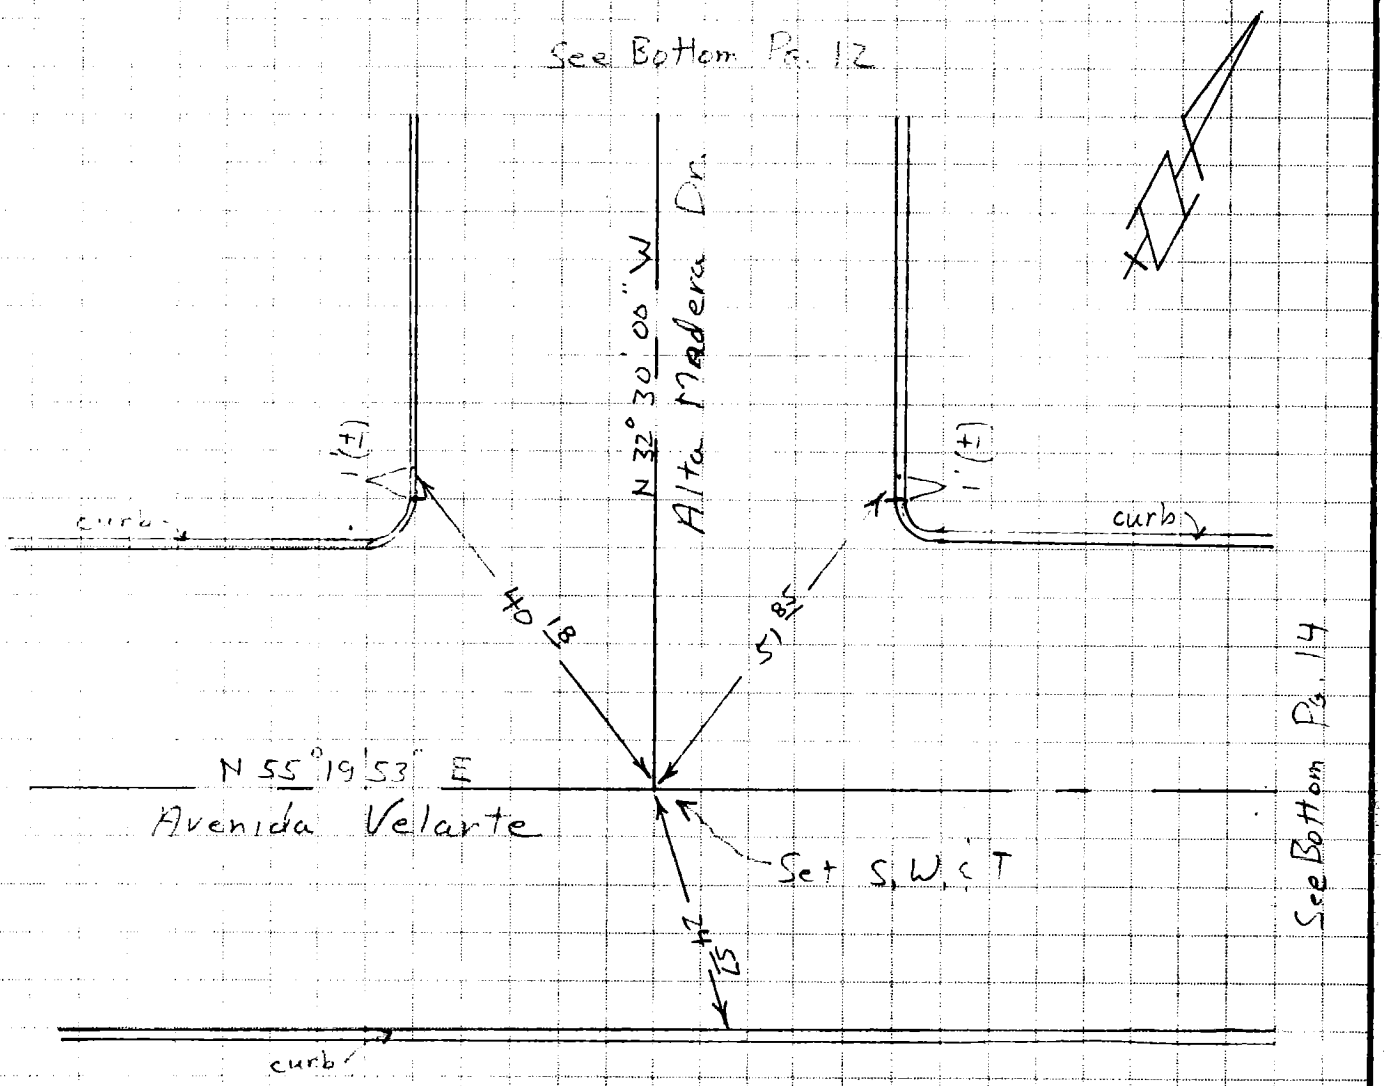

Note: All Points on Curb are Lead & Tags

RONALD R. HORN R.C.E. 16913

CO ENG FB 3656 - 72

SIKAND ENGINEERING ASSOCIATES
15230 Burbank Boulevard
VAN NUYS, CALIFORNIA 91411
Phone (213) 787-8550

JOB Tr. # 33888 72
SHEET NO. 14 OF 27
CALCULATED BY WILDMAN DATE FEB. 13, 1980
CHECKED BY ✓ DATE
SCALE None

249-117 A-1 (55)

Note: All Points on Curb are Lead & Tags

RONALD R. HORN R.C.E. 16913

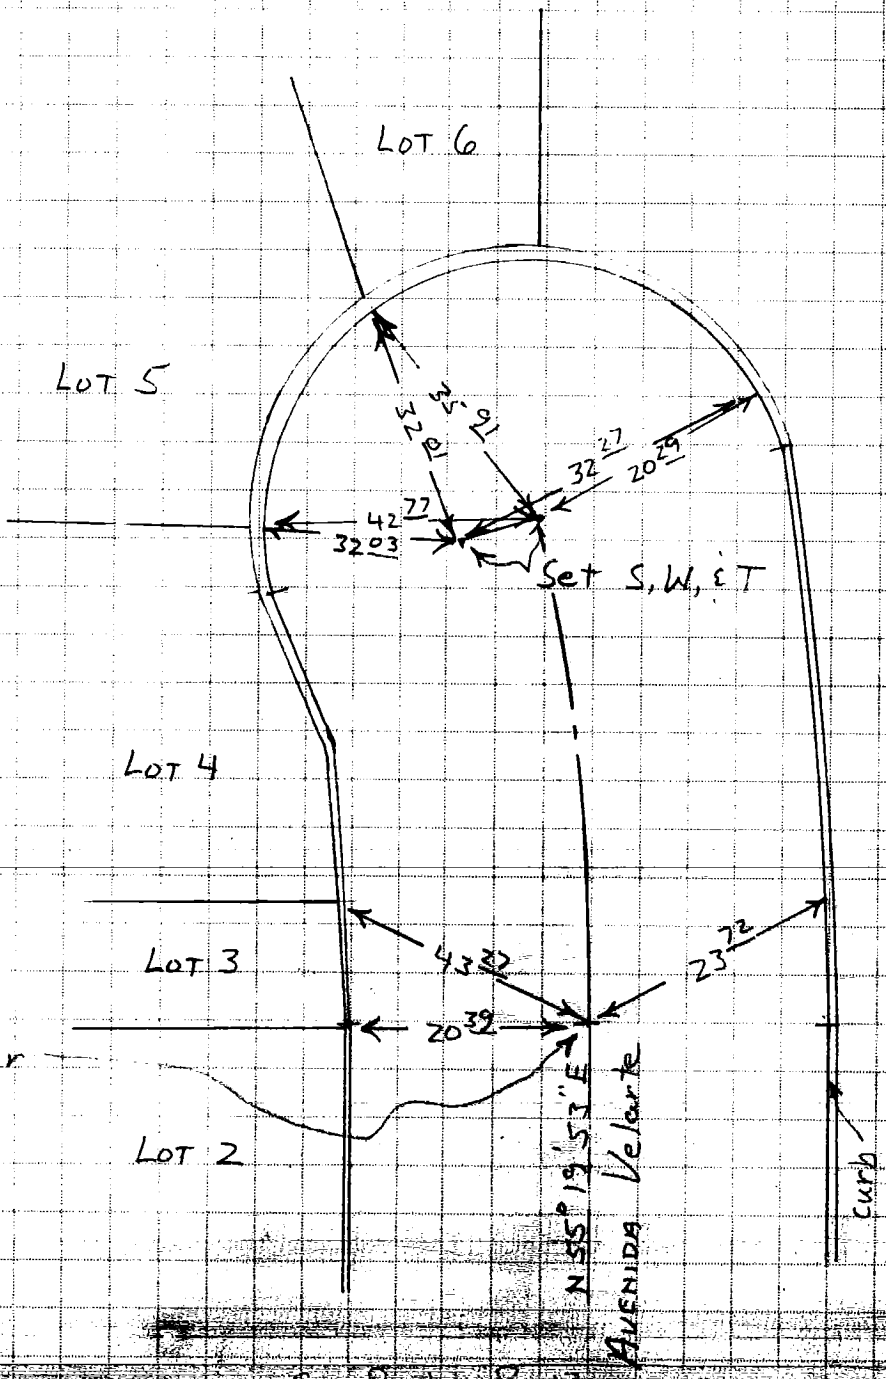

Reset S, W, & T per
Tr. 31046
M.B. 812 / 26-31

CO ENG FB 3656 - 73

SIKAND ENGINEERING ASSOCIATES
15230 Burbank Boulevard
VAN NUYS, CALIFORNIA 91411
Phone (213) 787-8550

17

JOB Tr. 33888
SHEET NO. 15 OF 27
CALCULATED BY WILDMAN DATE FEB. 13, 1986
CHECKED BY ✓ DATE
SCALE None

249-117, A-1 (5)

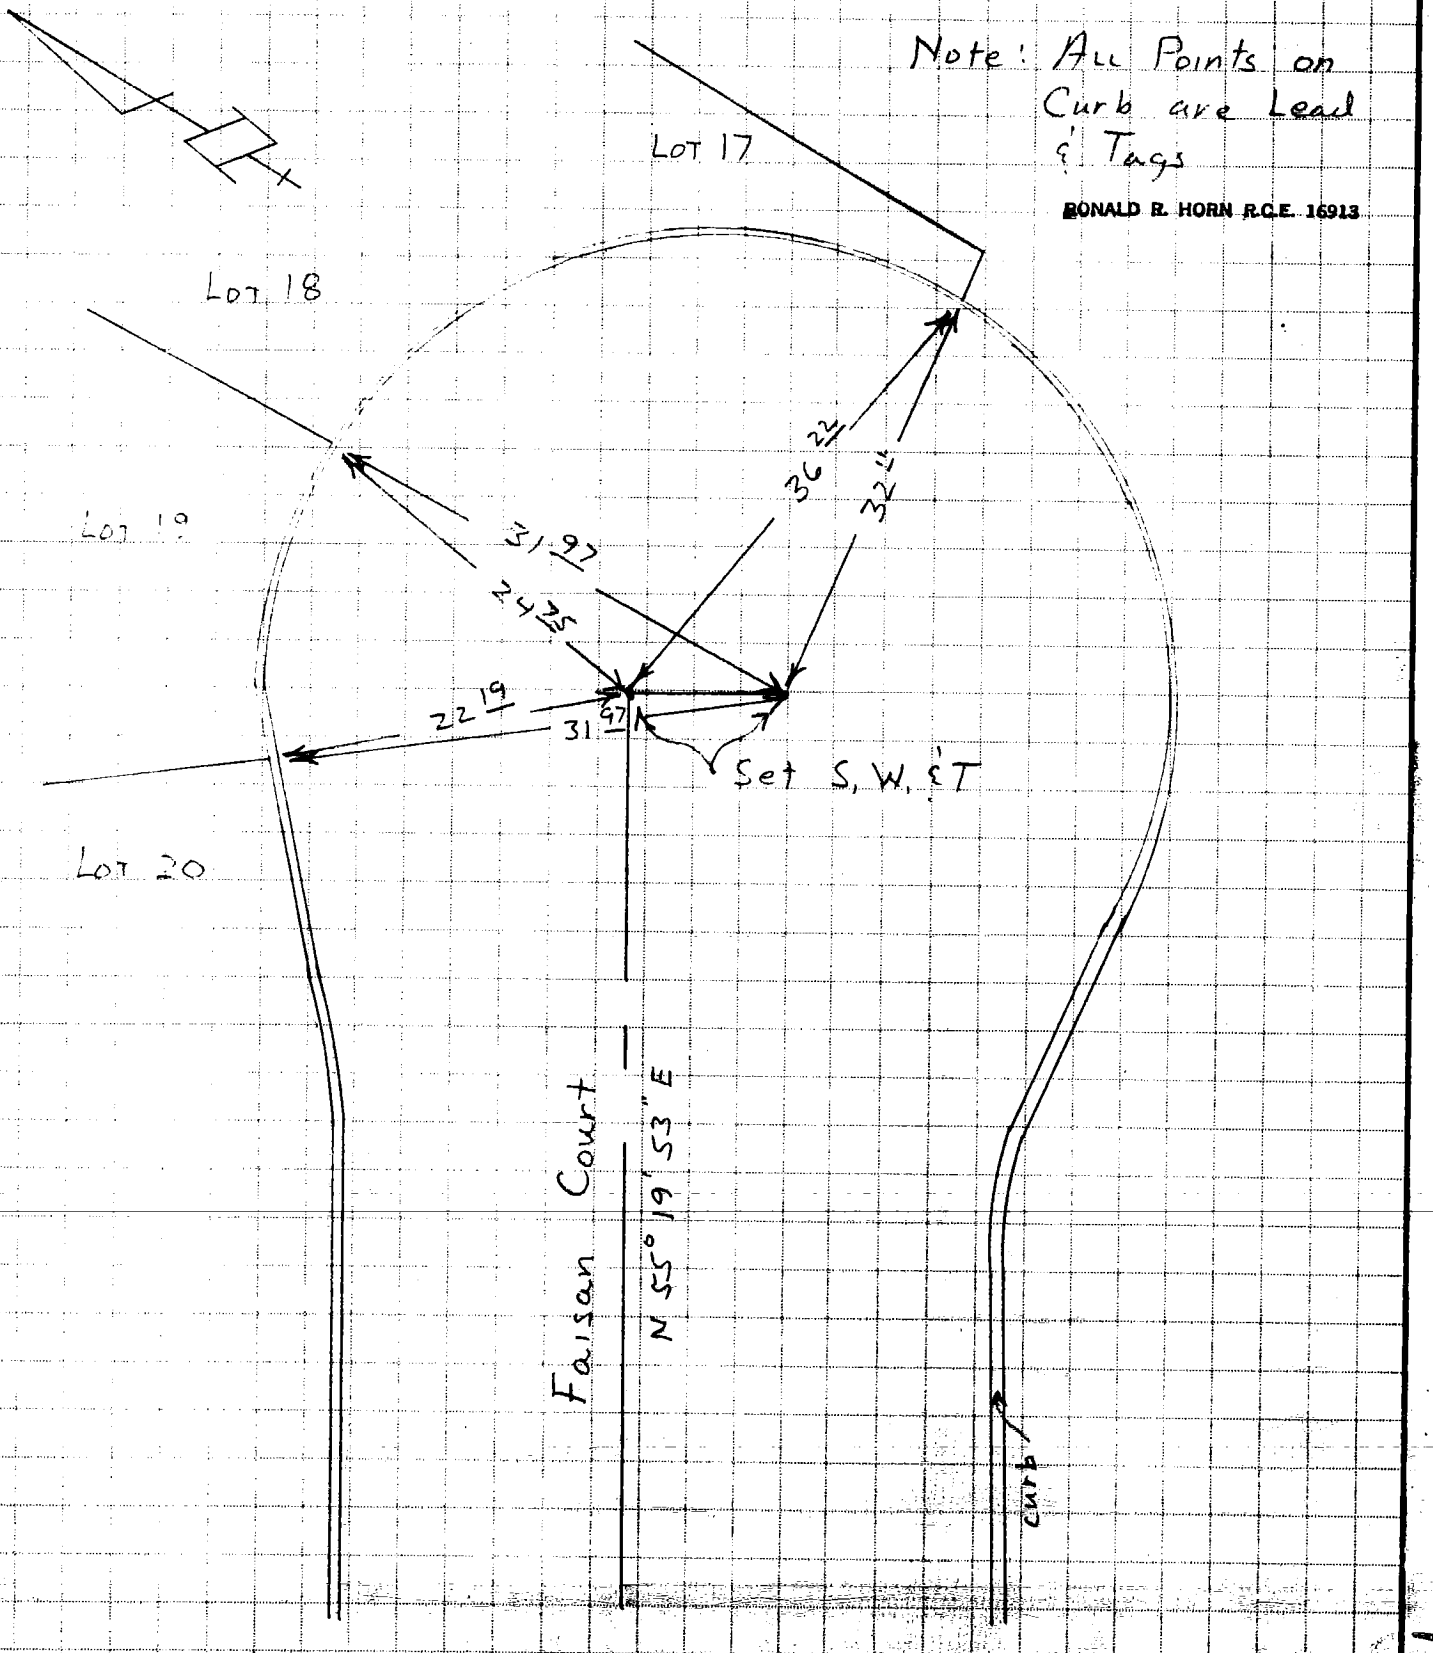

See Right Pg. 12

CO ENG FB 3656 - 74

SIKAND ENGINEERING ASSOCIATES
15230 Burbank Boulevard
VAN NUYS, CALIFORNIA 91411
Phone (213) 787-8550

JOB TE 33888

SHEET NO. 16 OF 27

CALCULATED BY WILDMAN DATE FEB. 13, 1980

CHECKED BY ✓ DATE

SCALE NONE

Note: All Points on Curb are Lead & Tags

RONALD R. HORN R.C.E. 16913

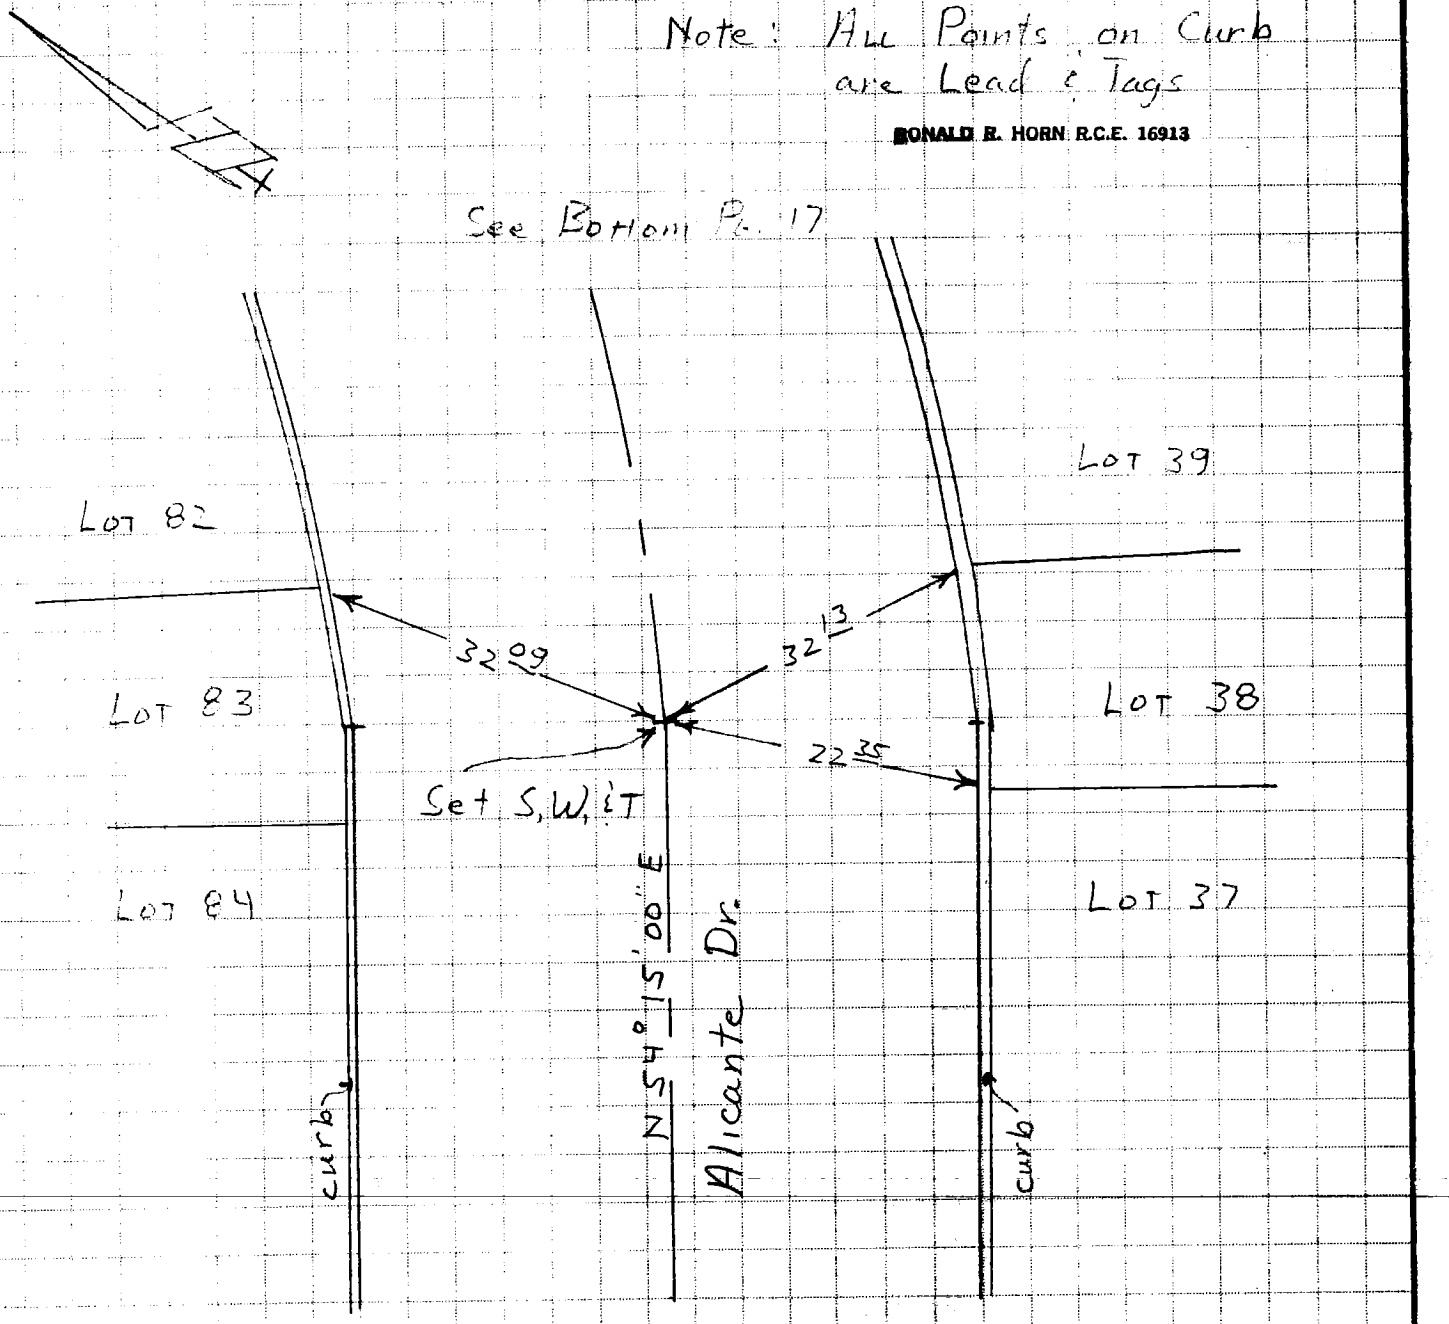

CO ENG FB 3656 - 75

SIKAND ENGINEERING ASSOCIATES
15230 Burbank Boulevard
VAN NUYS, CALIFORNIA 91411
Phone (213) 787-8550

JOB Tr. 33888

SHEET NO. 17 OF 27

CALCULATED BY WILDMAN DATE FEB. 13, 1980

CHECKED BY _____ DATE _____

SCALE None

249-117, A-1 (57)

Note: All Points on Curb are Lead & Tag BONALD B. HORN R.C.E. 16913

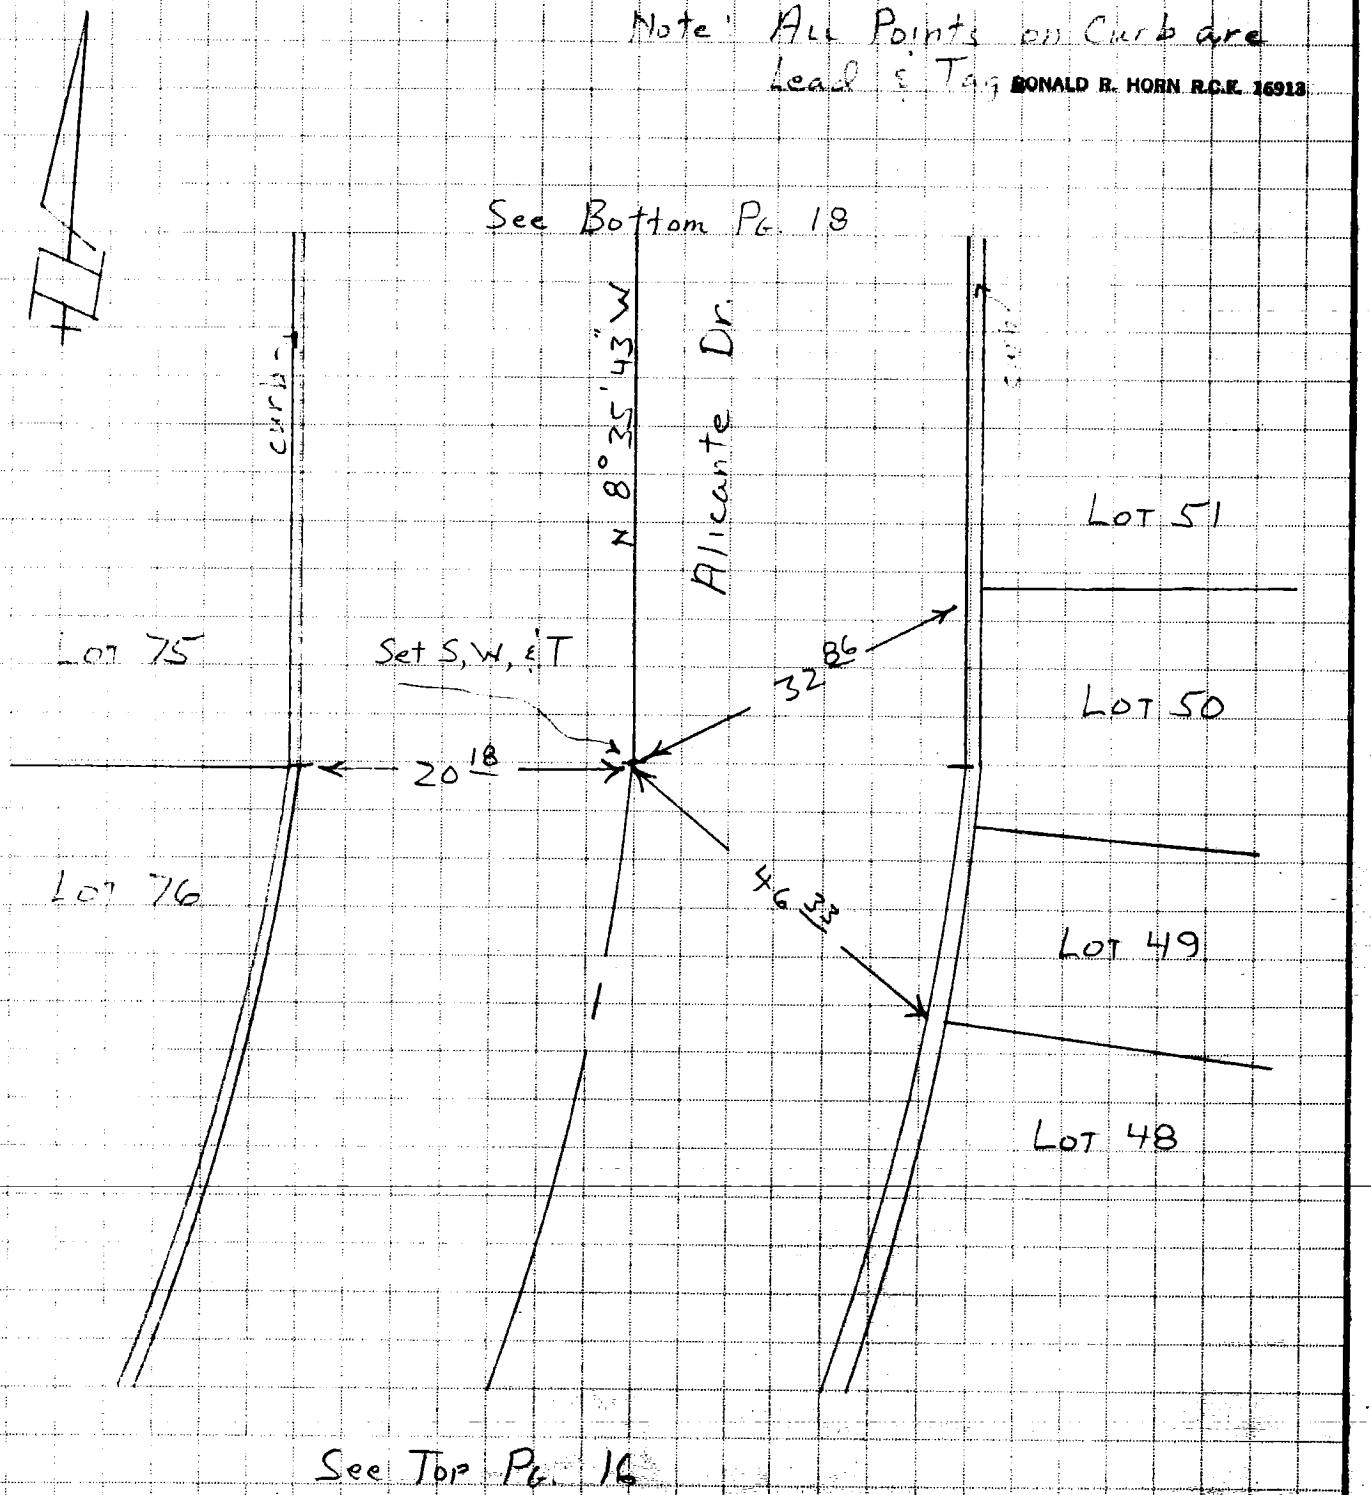

CO ENG FB 3656 - 76

SIKAND ENGINEERING ASSOCIATES
15230 Burbank Boulevard
VAN NUYS, CALIFORNIA 91411
Phone (213) 787-8550

JOB Tr. 33888

SHEET NO. 18 OF 27

CALCULATED BY Wildman DATE Feb. 14, 1980

CHECKED BY ✓ DATE

SCALE None

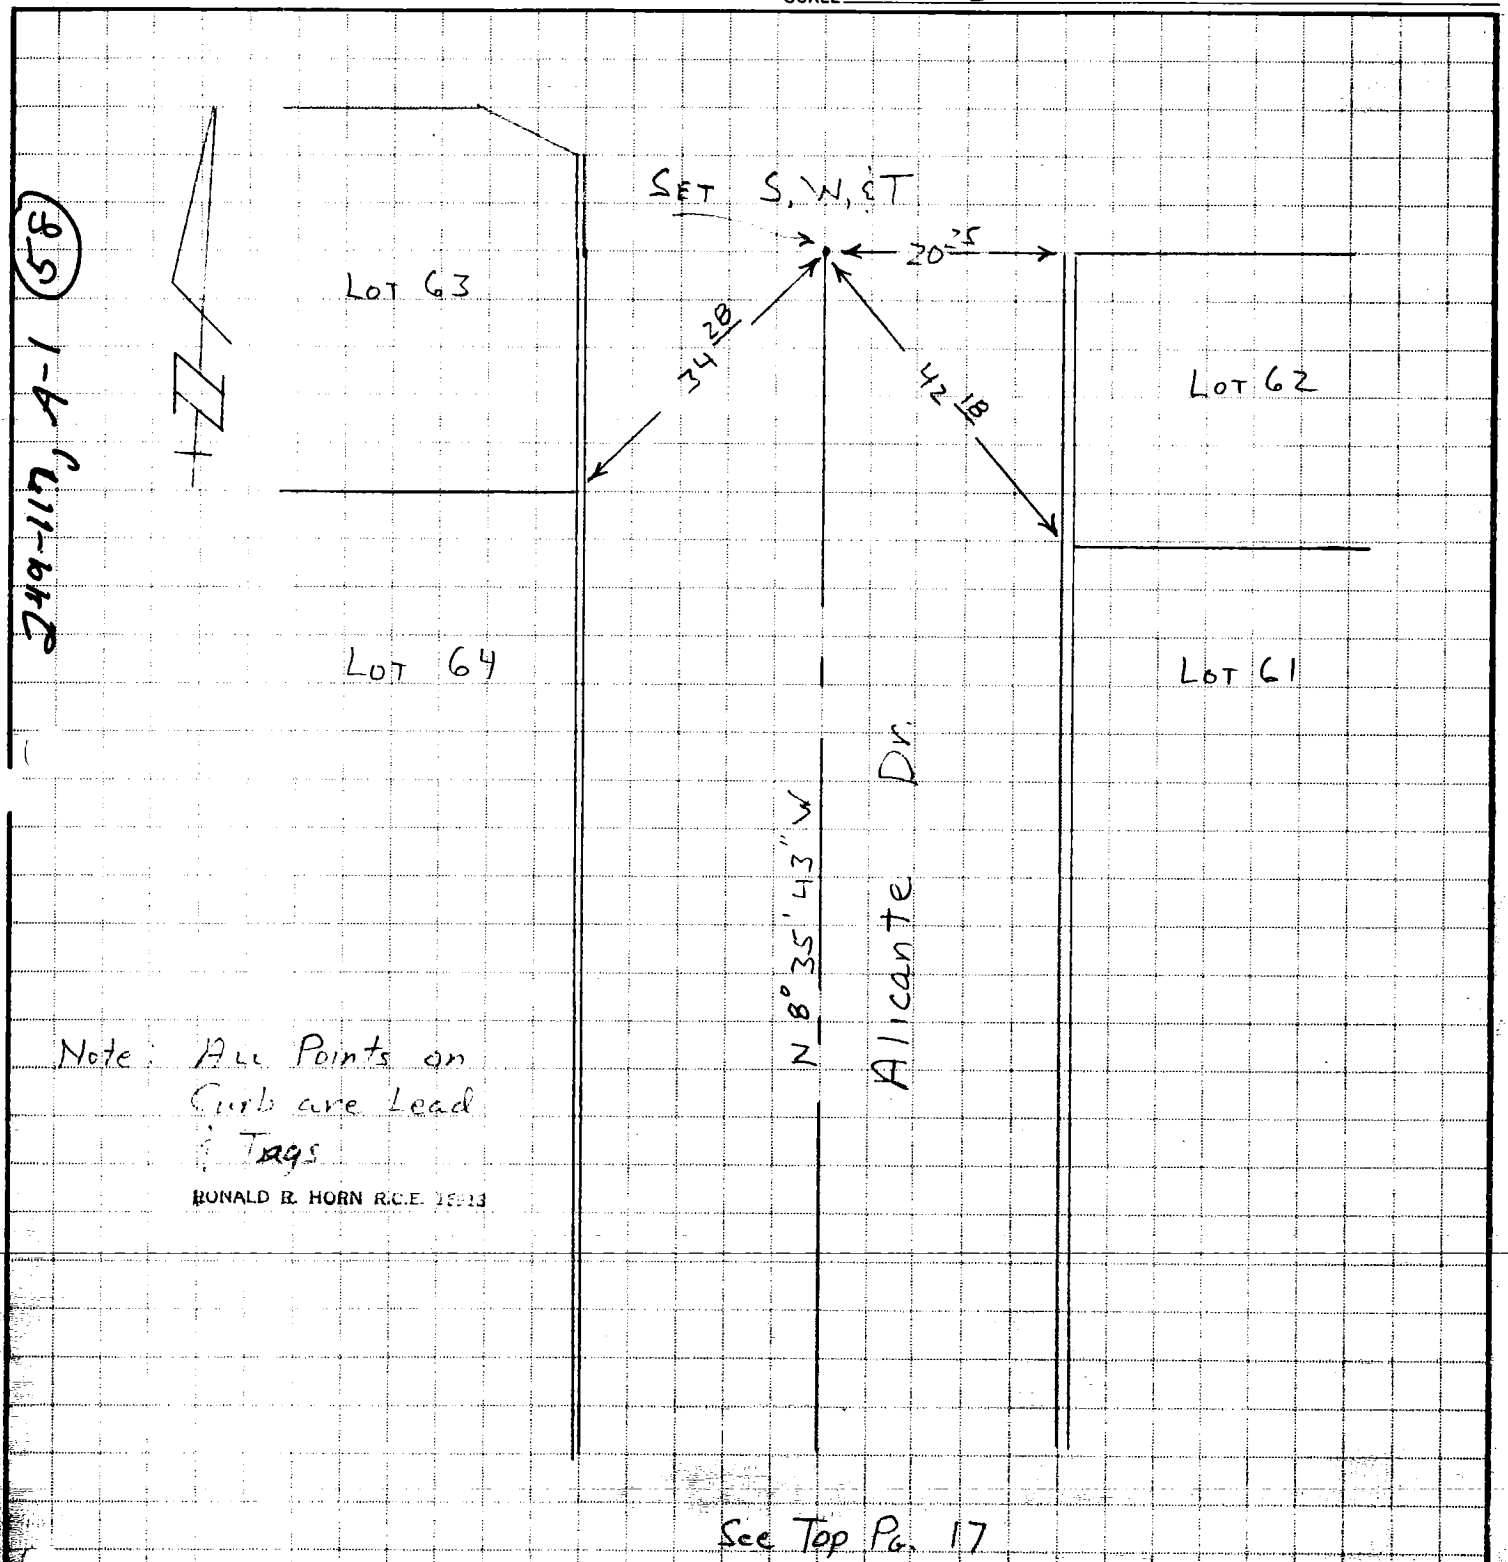

Note: All Points on Curb are Lead & Tags

RONALD R. HORN R.C.E. 15913

See Top Pg. 17

CO ENG FB 3656 - 77

SIKAND ENGINEERING ASSOCIATES
15230 Burbank Boulevard
VAN NUYS, CALIFORNIA 91411
Phone (213) 787-8550

JOB TR 33888
SHEET NO. 9 OF 27
CALCULATED BY BOSTON DATE FEB 14, 80
CHECKED BY _____ DATE _____
SCALE NONE

249-117, 1-1 (44)

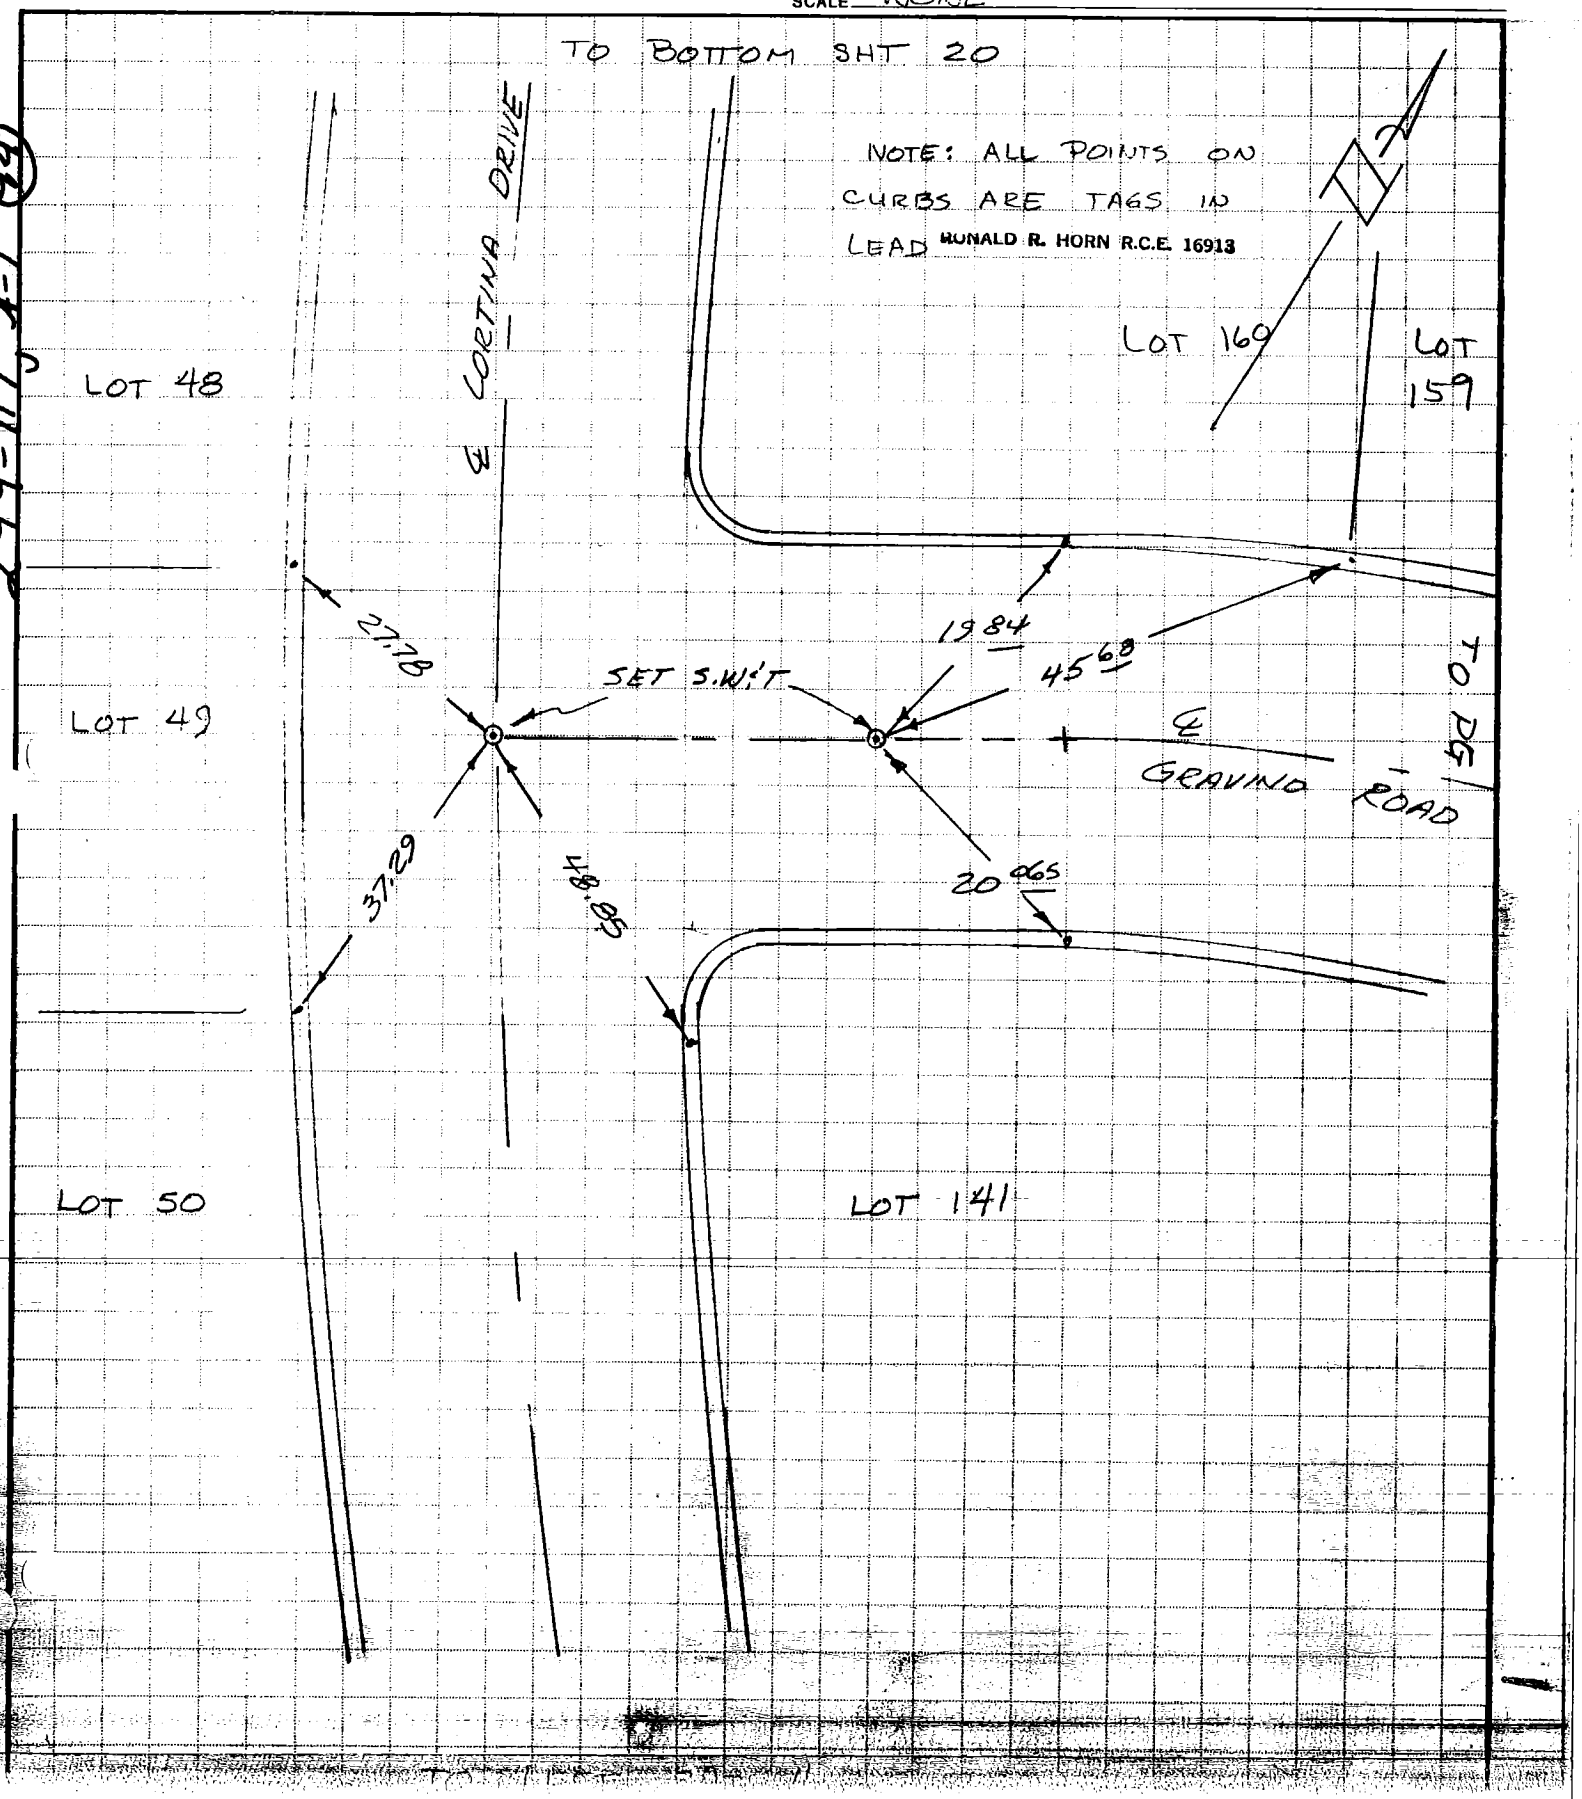

CO ENG FB 3656 - 78

SIKAND ENGINEERING ASSOCIATES
15230 Burbank Boulevard
VAN NUYS, CALIFORNIA 91411
Phone (213) 787-8550

JOB TR 33888

SHEET NO. 20 OF 27

CALCULATED BY BOSTON DATE FEB 14, 80

CHECKED BY _____ DATE _____

SCALE None

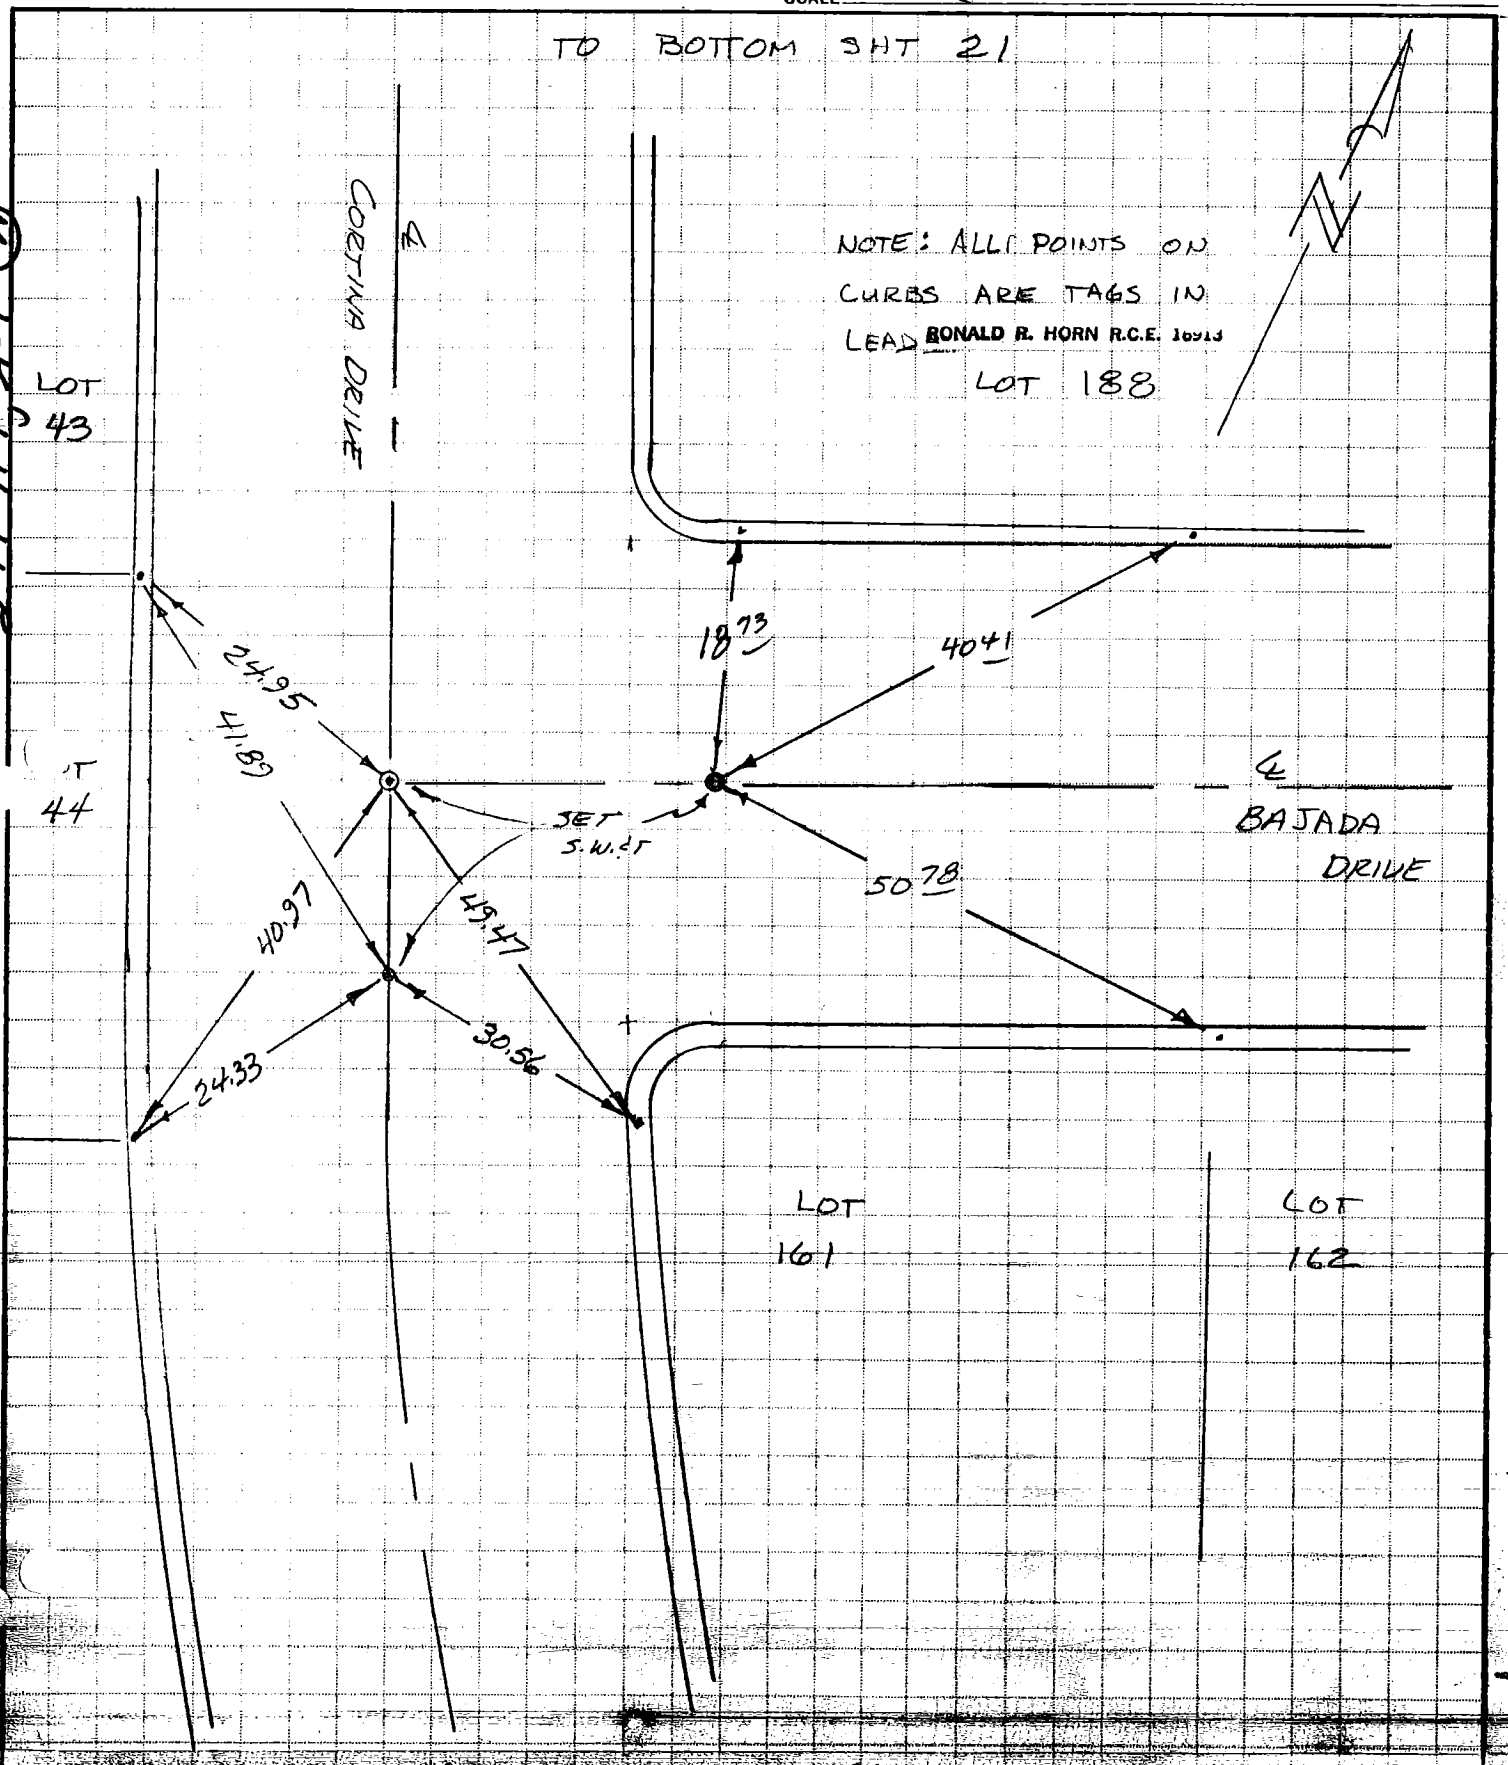

2419-117-42

CO ENG FB 3656 - 79

SIKAND ENGINEERING ASSOCIATES
15230 Burbank Boulevard
VAN NUYS, CALIFORNIA 91411
Phone (213) 787-8550

JOB TR 33888
SHEET NO. 24 OF 27
CALCULATED BY BOSTON DATE FEB 14, 80
CHECKED BY ~ DATE
SCALE NONE

249-117, A-1 (59)

NOTE ALL POINTS ON CURBS ARE TAGS IN LEAD

RONALD R. HORN R.C.E. 16913

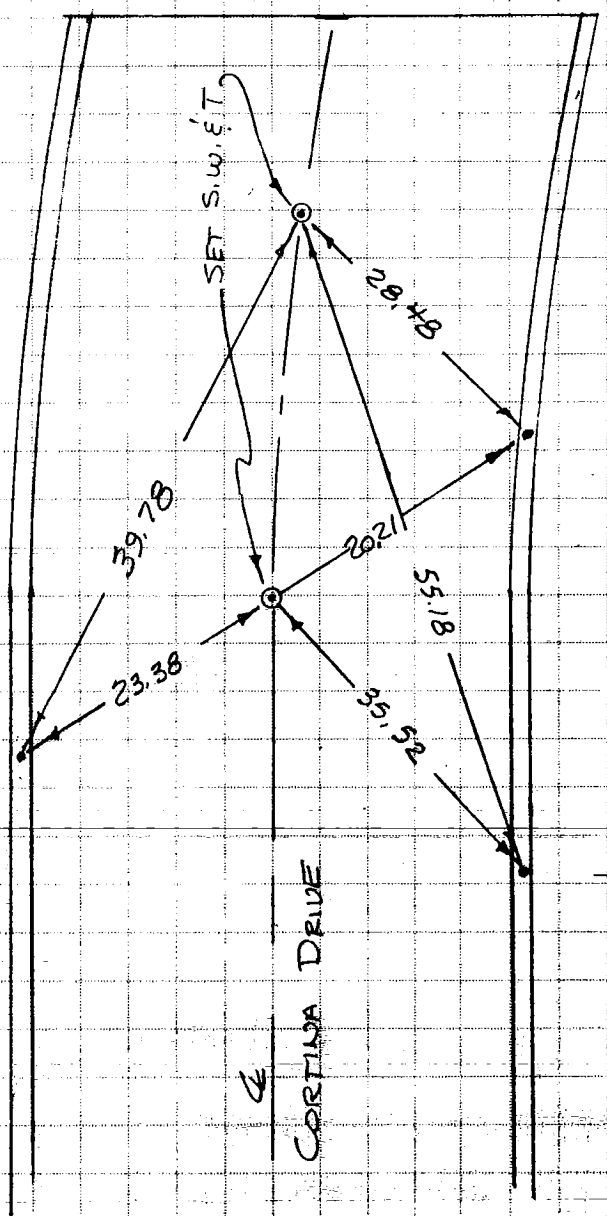

LOT 40

LOT 41

LOT 185

LOT 186

SIKAND ENGINEERING ASSOCIATES
15230 Burbank Boulevard
VAN NUYS, CALIFORNIA 91411
(213) 787-8550 873-5853

JOB TR 33888 CO ENG FB 3656 - 80
SHEET NO. 22 OF 27
CALCULATED BY Wildman DATE Aug. 21, 1981
CHECKED BY DATE
SCALE No Scale

2419-117-4-1 (58)

Note: All Pts. on Curb Tangent to Lead PCE 1621'

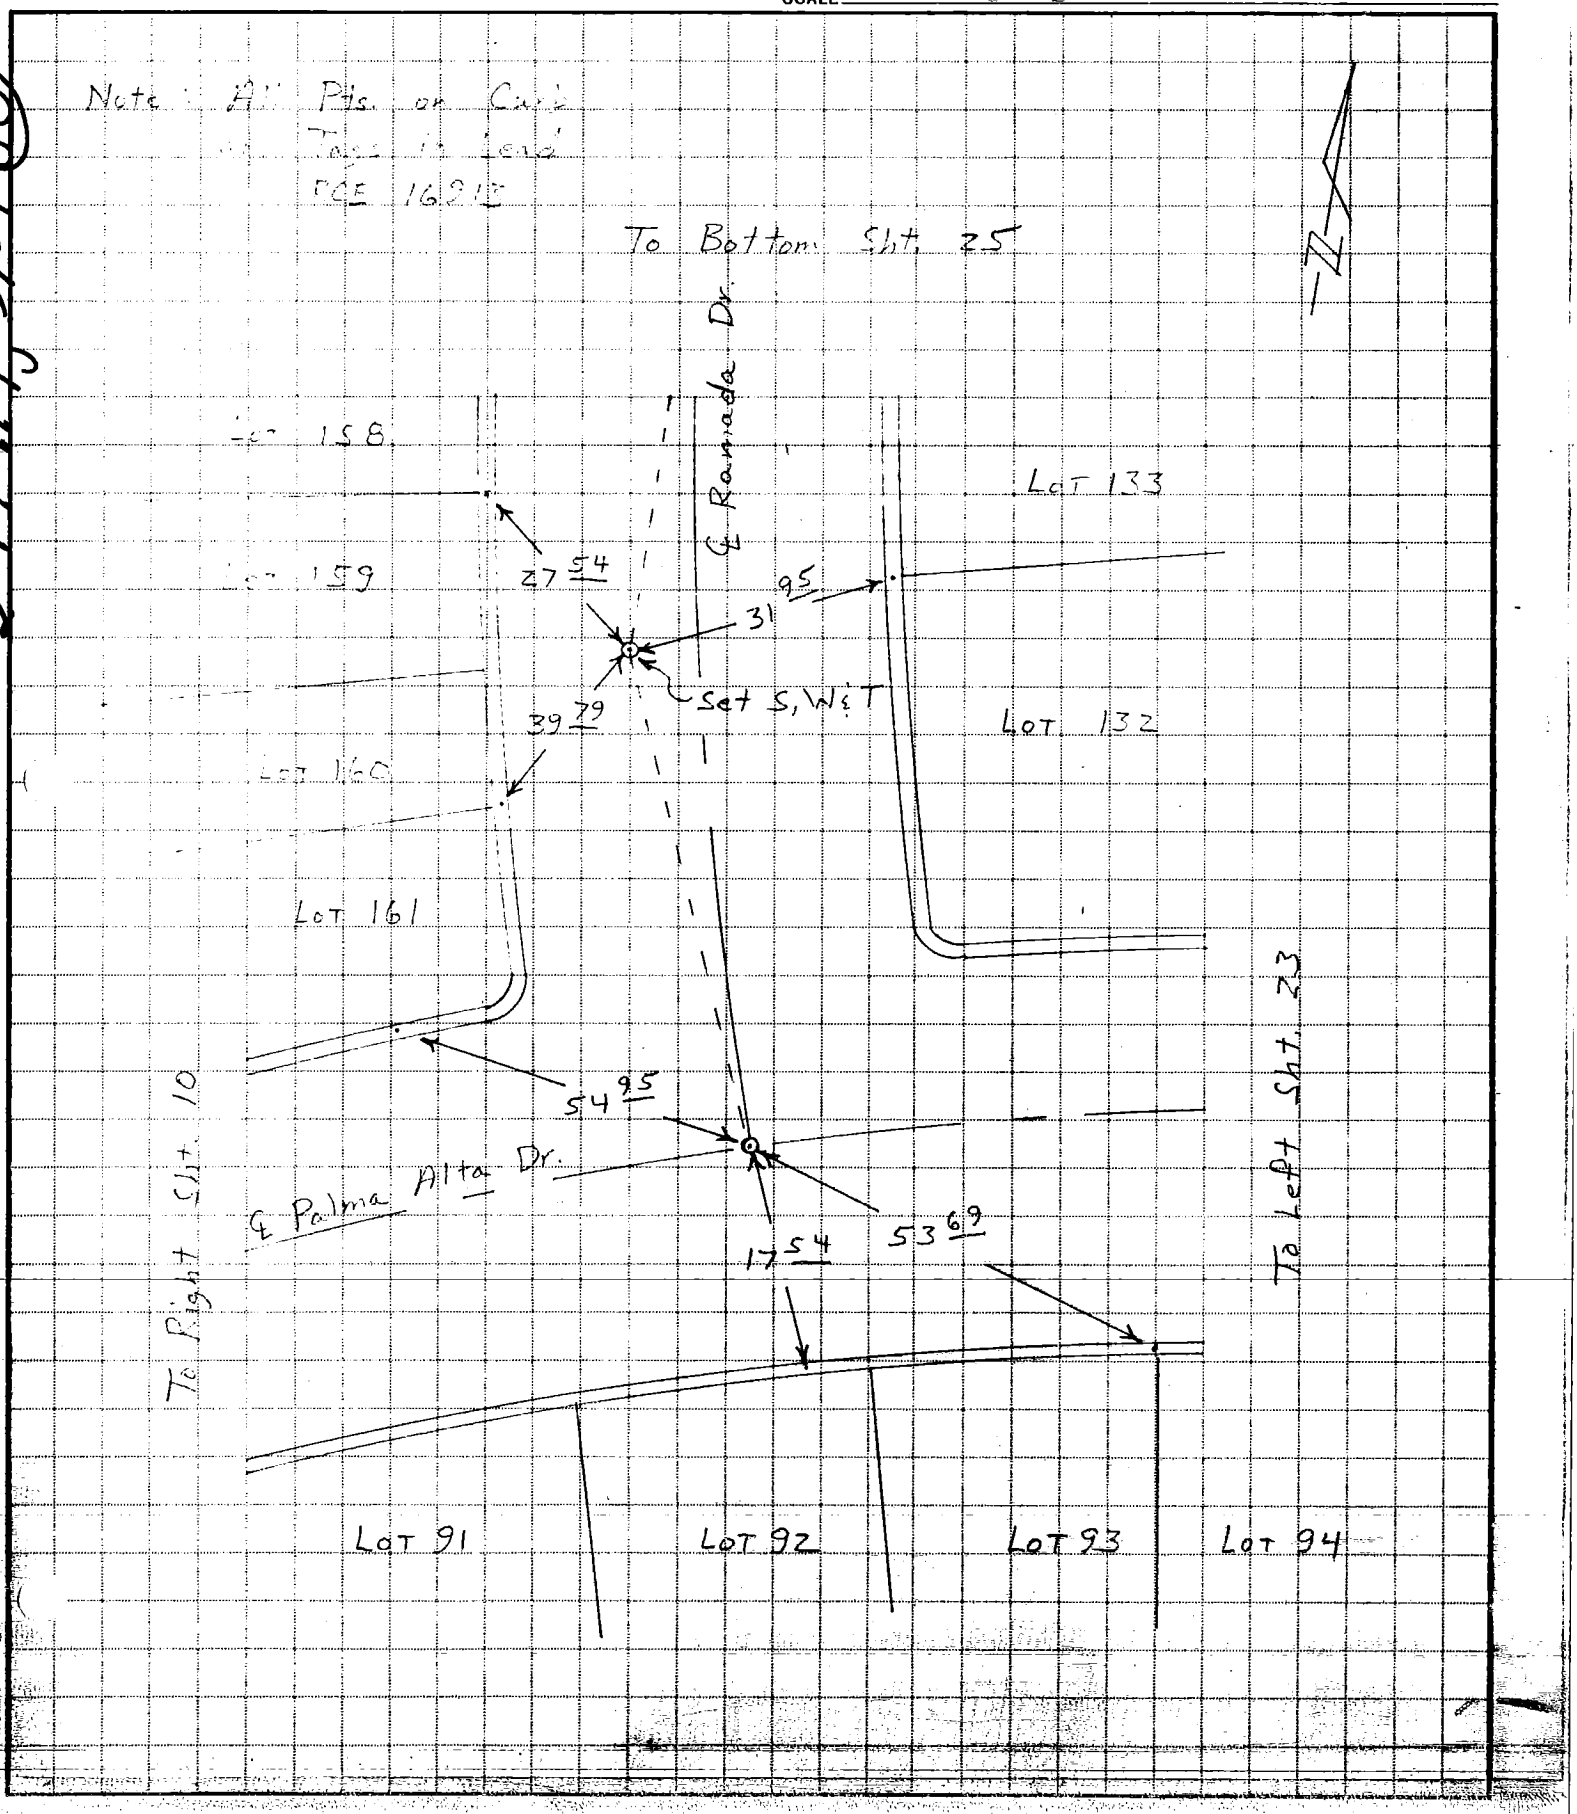

CO ENG FB 3656 - 81

01

SIKAND ENGINEERING ASSOCIATES
15230 Burbank Boulevard
VAN NUYS, CALIFORNIA 91411
Phone (213) 787-8550

F.B. & TIES PG. 23/27
W.O. Tr. 33888
SURVEY BY WILDMAN
DATE AUGUST 21, 1981

249-117, A-1 (80)

Note: All Pts. on Curb are Tags in Lead RCF 16913

To Bottom SHT. 24

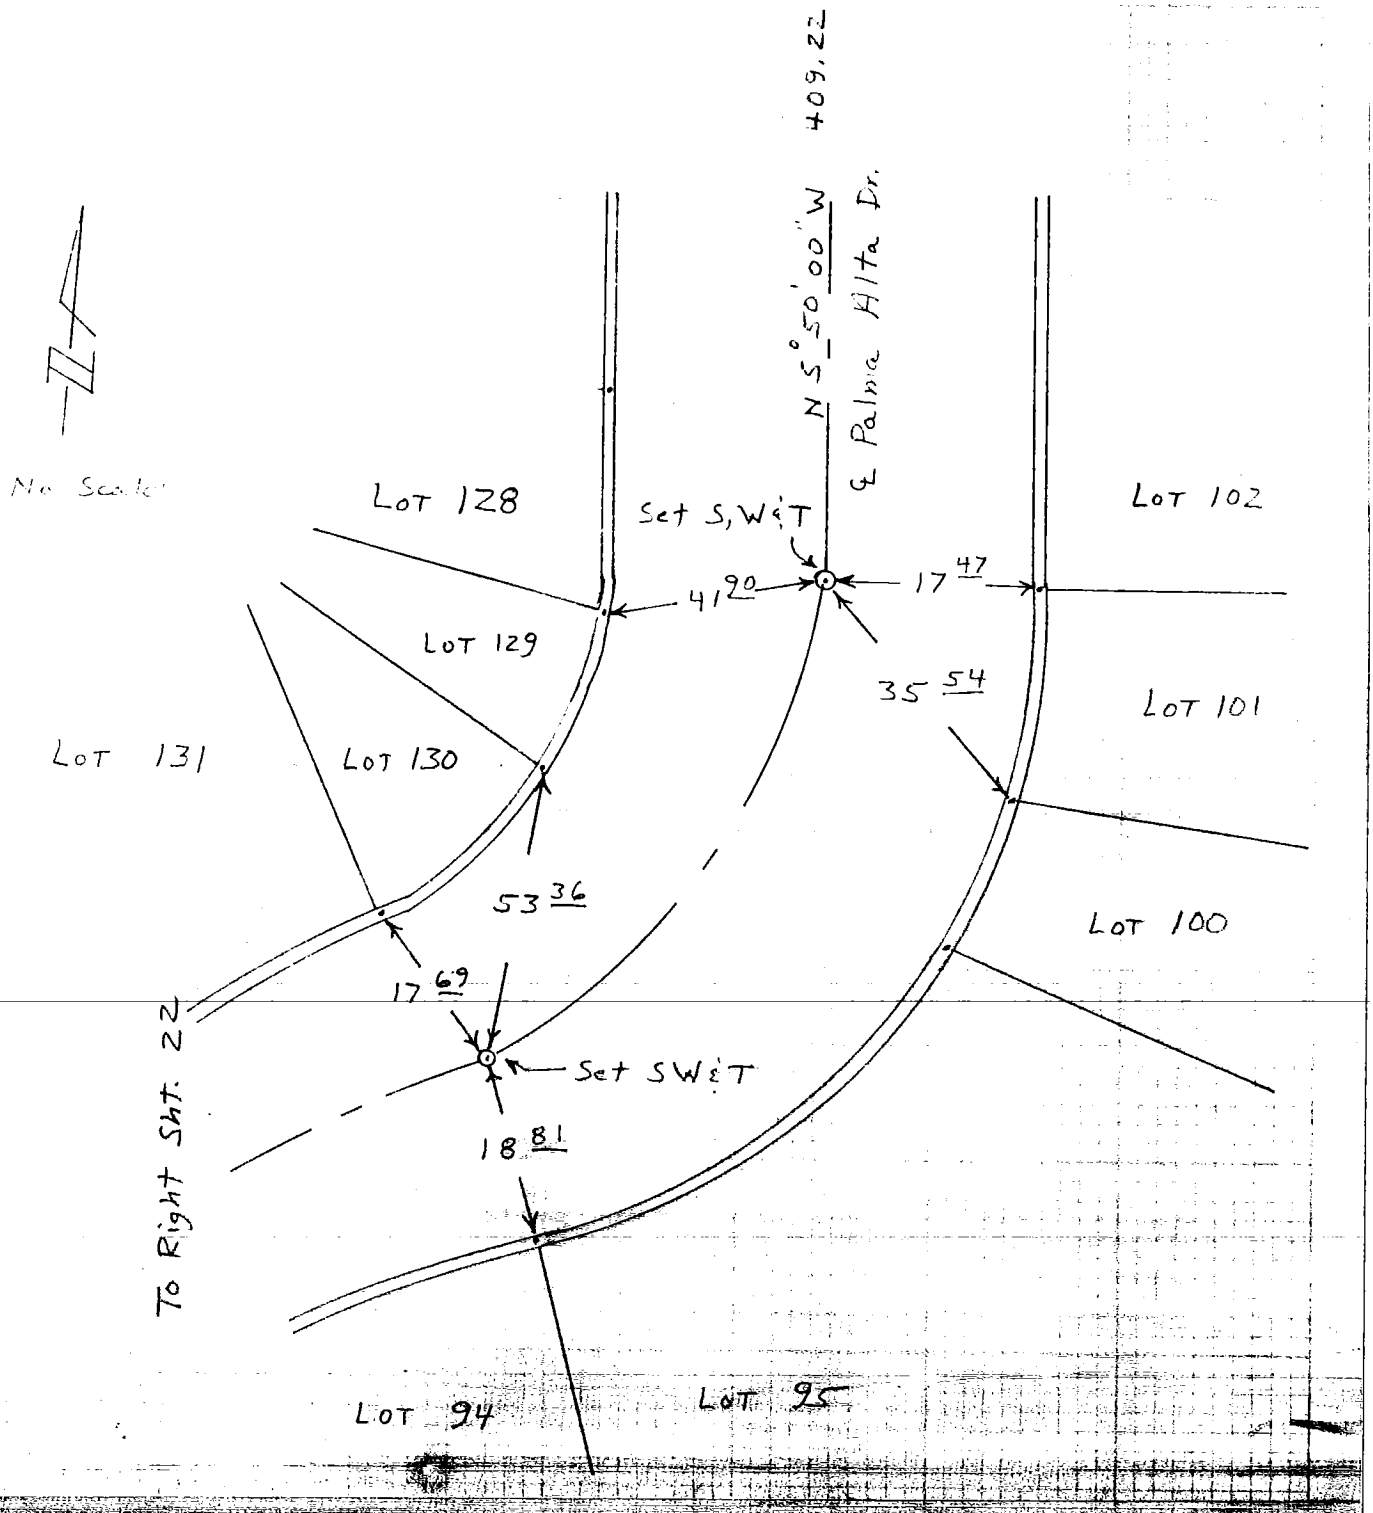

SIKAND ENGINEERING ASSOCIATES
15230 Burbank Boulevard
VAN NUYS, CALIFORNIA 91411
(213) 787-8550 873-5853

JOB Tr. 33888 CO ENG FB 3656 - 82
SHEET NO. 24 OF 27
CALCULATED BY Wildman DATE Aug. 21, 1981
CHECKED BY DATE
SCALE No Scale

2449-17-(1)

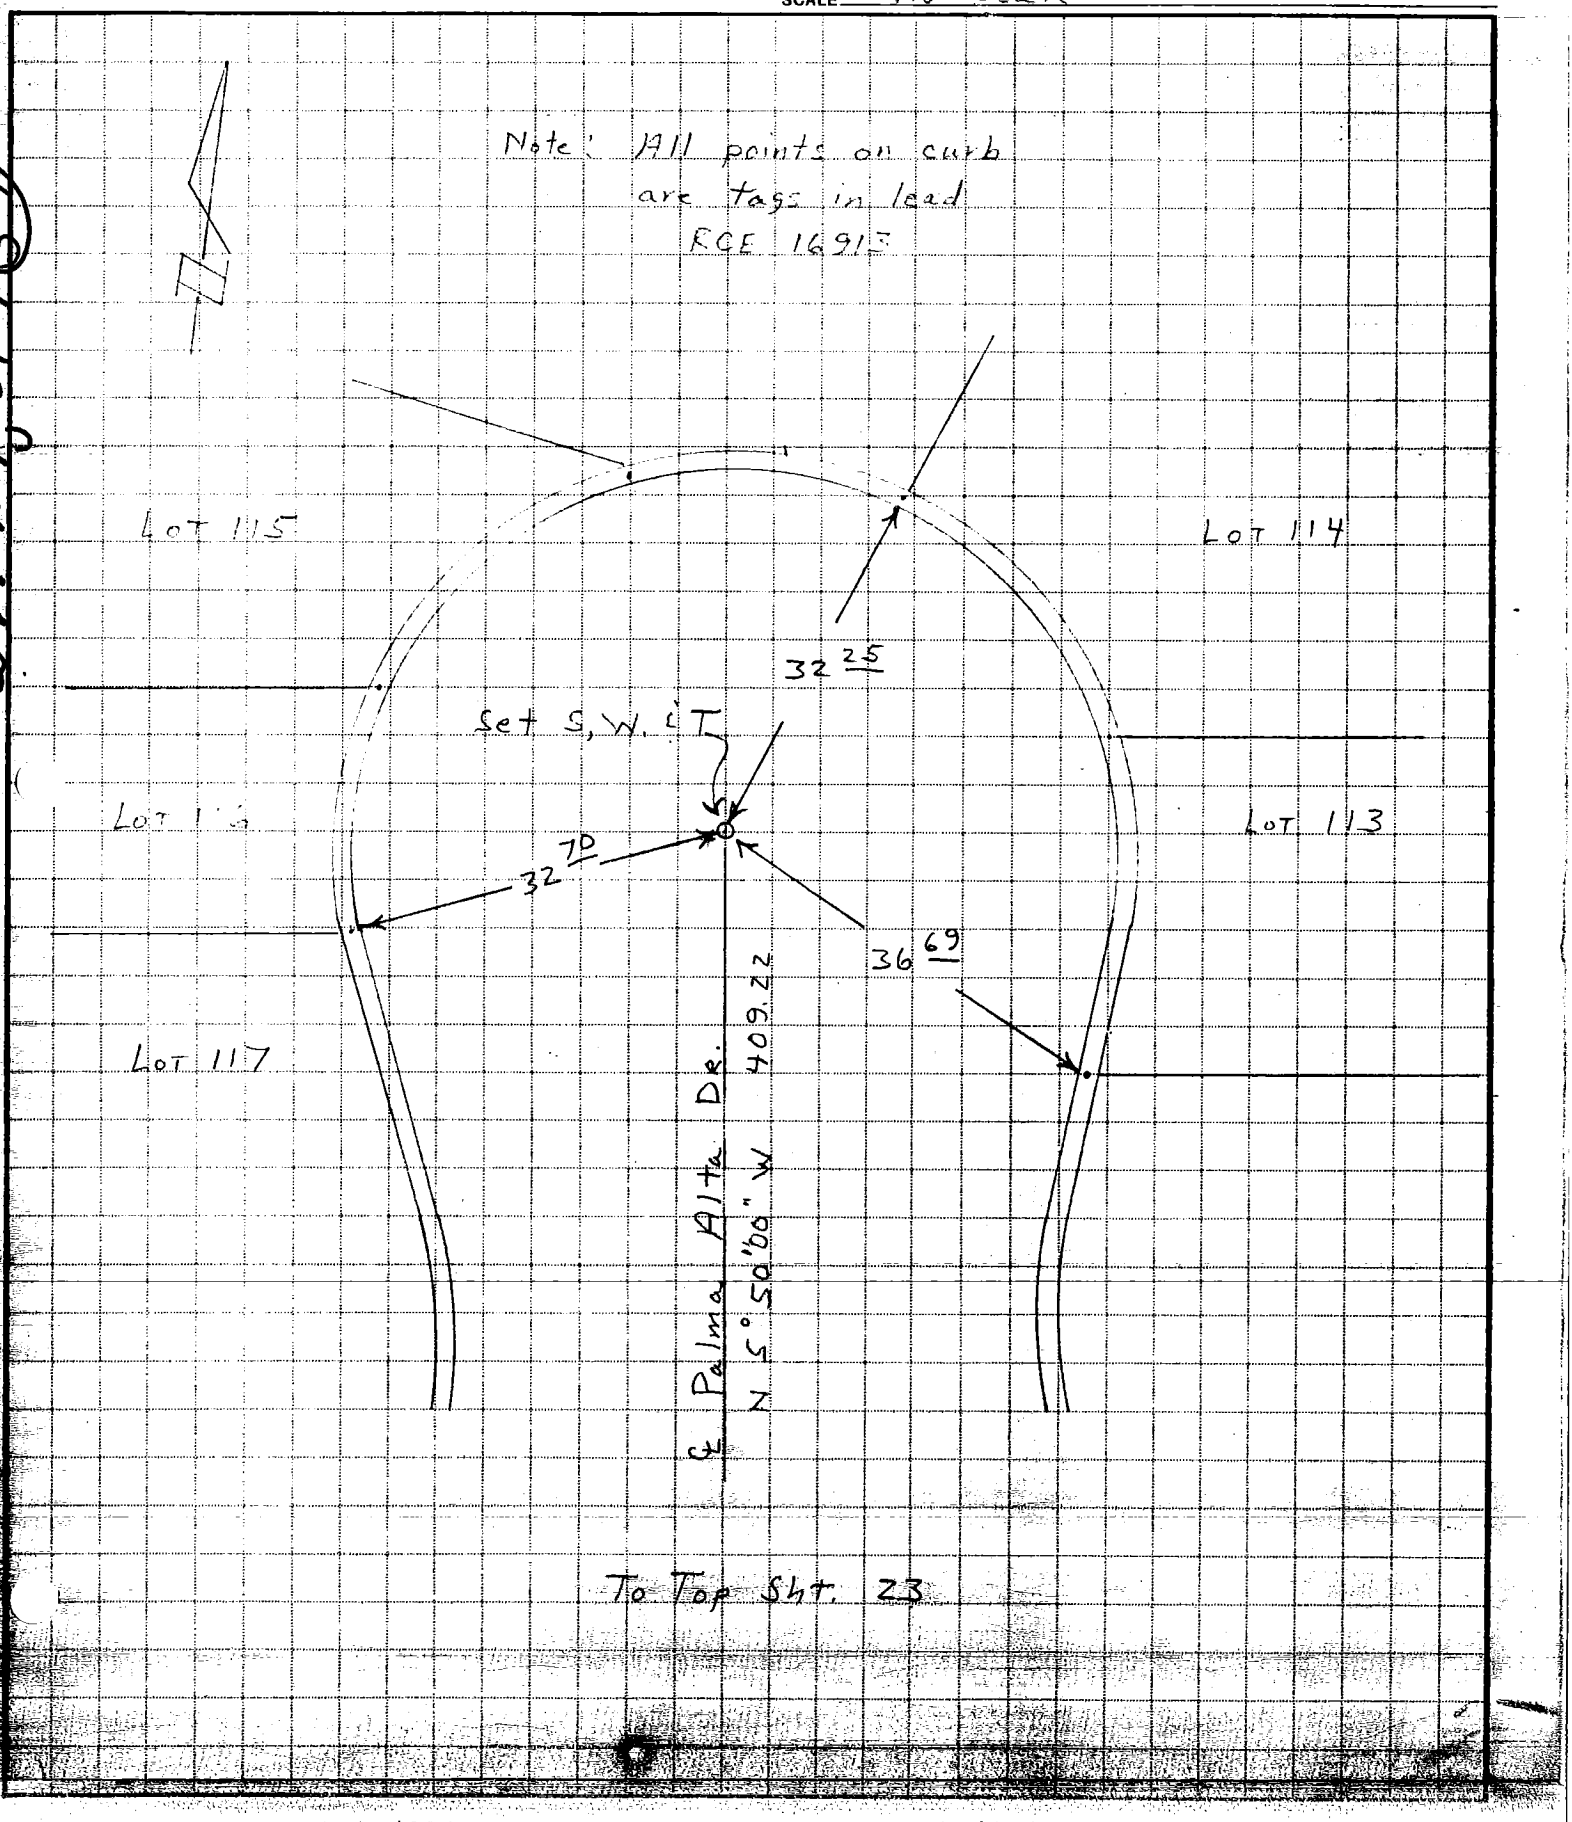

To Top Sht. 23

SIKAND ENGINEERING ASSOCIATES
15230 Burbank Boulevard
VAN NUYS, CALIFORNIA 91411
(213) 787-8550 873-5853

CO ENG FB 3656 - 83

JOB Tr. 33888

SHEET NO. 25 OF 27

CALCULATED BY Wildman DATE Aug. 21, 1981

CHECKED BY DATE

SCALE No Scale

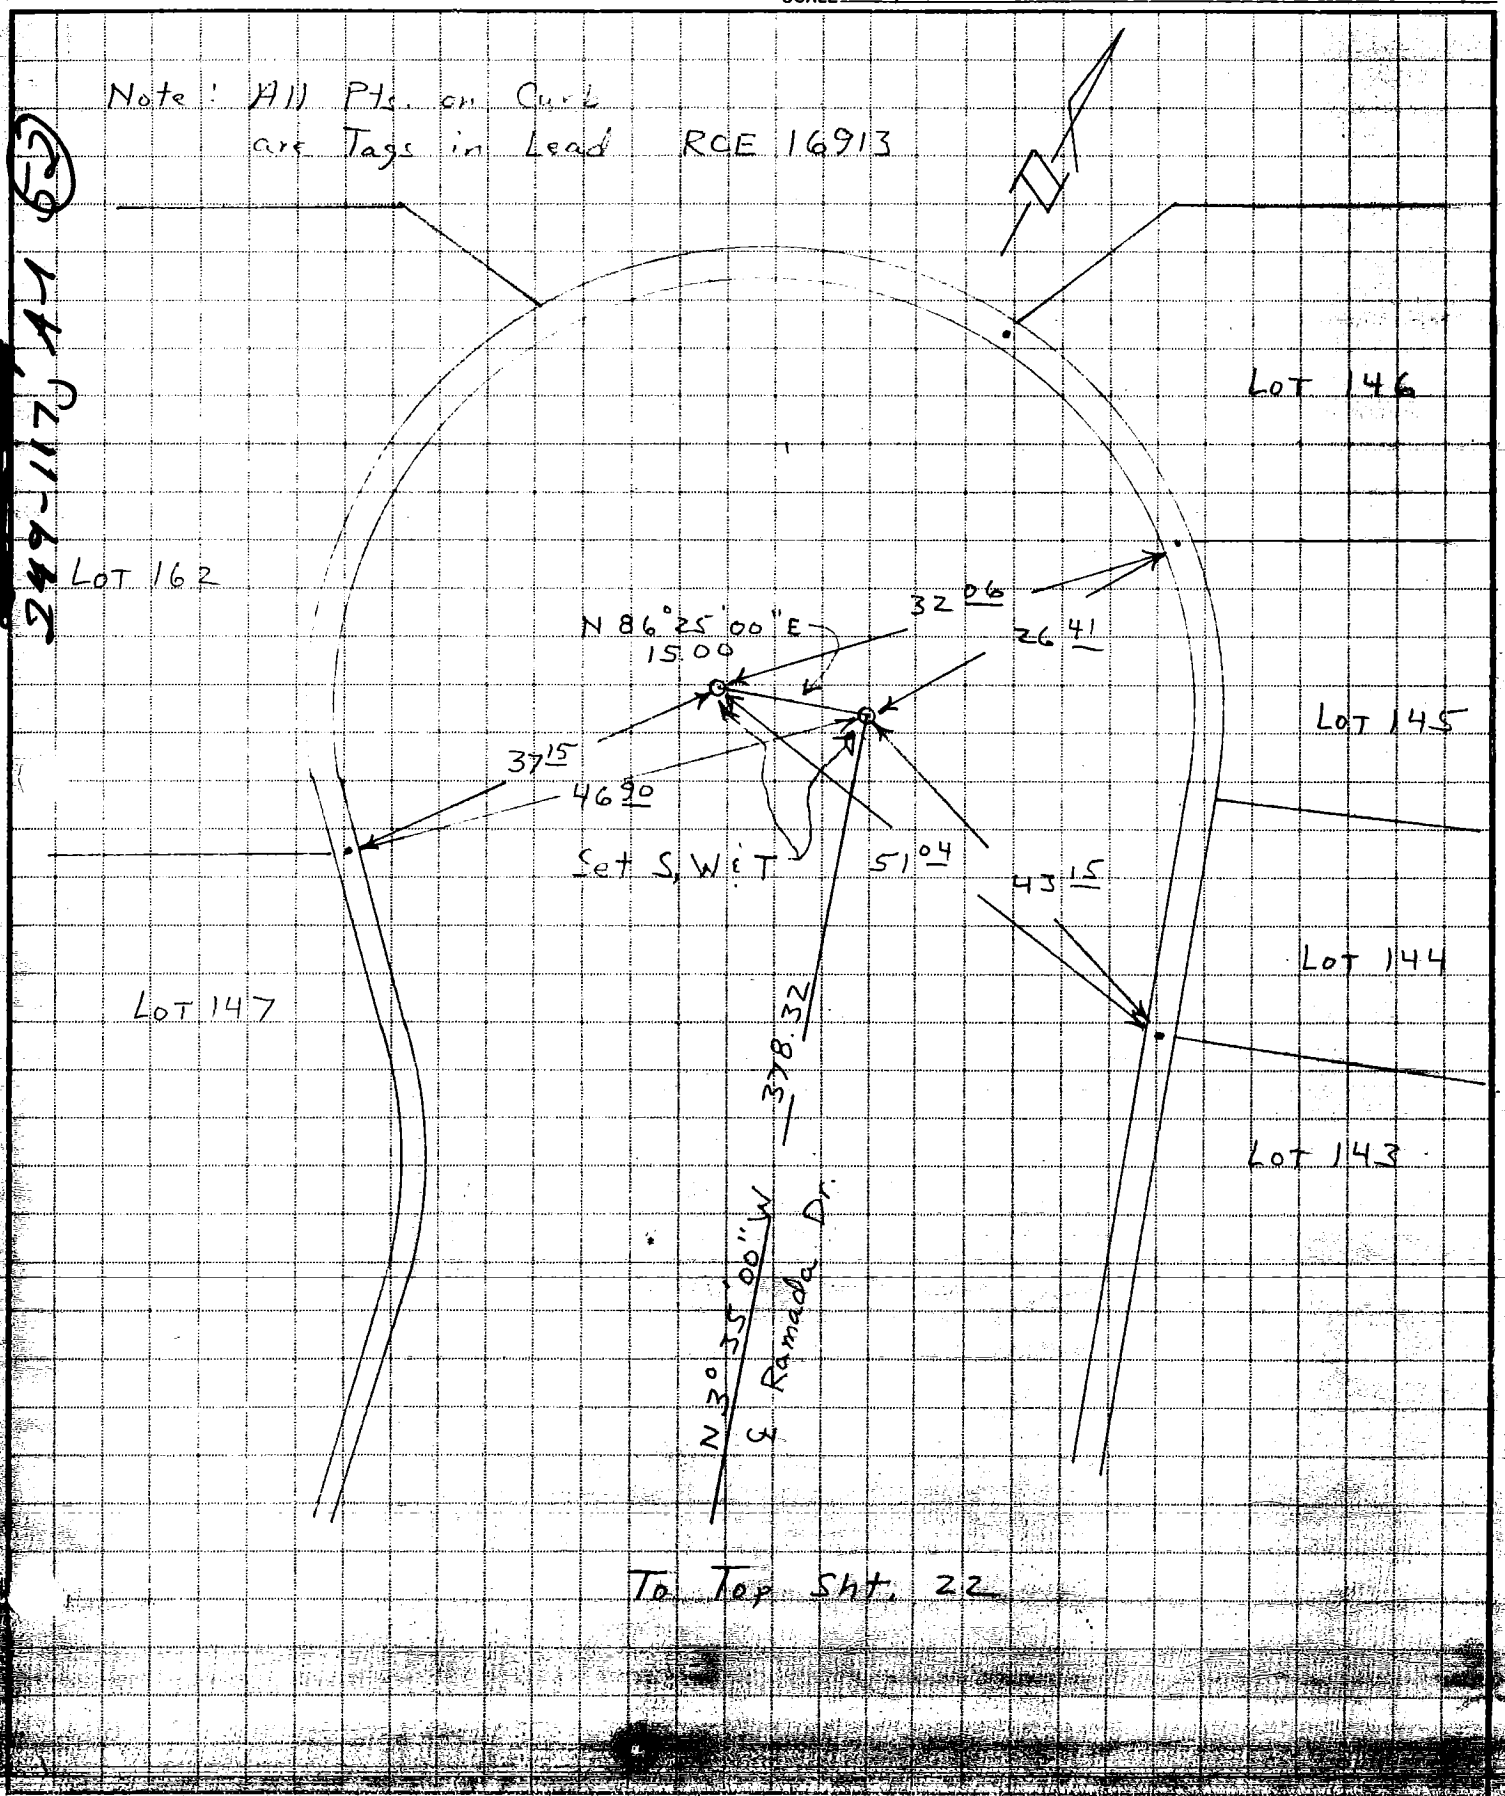

SIKAND ENGINEERING ASSOCIATES
15230 Burbank Boulevard
VAN NUYS, CALIFORNIA 91411
Phone (213) 787-8550

F.B. C TIES PG. 26/27
W.O. 1020-115 TR. 33888
SURVEY BY BOSTON
DATE FEB. 13, 1980

REAR CORNER MONUMENTS TR. 33888

LOT:	SET:	
1	½ PROD	RCE 16913
2-6	1"IP	"
7	½ PROD	"
8-29	1"IP	"
30-31	½ PROD	"
32-89	1"IP	"
90-91	½ PROD	"
92-131	1"IP	"
132	½ PROD	"
133-160	1"IP	"
161	½ PROD	"
162	1"IP	"
163	½ PROD	"

ALL LOTS HAVE L & T, RCE 16913, IN CURBS ON FRONTS

CO ENG FB 3656 - 85

SIKAND ENGINEERING ASSOCIATES
15230 Burbank Boulevard
VAN NUYS, CALIFORNIA 91411
Phone (213) 787-8550

F.B. ℄ TIES PG. 27/27
W.O. 1020-115 TR 33988
SURVEY BY BOSTON
DATE AUGUST 21 1984

TRACT LINE MONUMENT CHANGES

LOT NO.	SET	IN LIEU OF
✗ 14	℄ Tag Top Wall	℄ T WALL PTS.
✗ 63	2" IP	"
✗ 63	"	"
✗ 162	"	"
✗ 162	"	"
✗ 146	℄ Tag Top Wall	"
✗ 115	"	"

NOTE: ALL POINTS ARE STAMPED

RONALD R. HORN R.C.E. 16913

ENG. 3.883B (12/78)
Title & Plat Sheet
50% Rag

86

CO ENG FB 3656 - 86

Surveyed by EARL R. RICHARDSON Date SEPT. 12, 1981 F.B. _____ Pg. _____

Type of Survey SUBDIVISION MONUMENTS Sheet 1 of 4

Distances corrected to 68° ✓ Monuments tagged

L S # 3703 Tract or

~~Parcel Map~~ # 41349

Checked by _____ Date _____ km grid _____ MB _____

NOTE: Additions or changes must be initialed, and dated.

SURVEY OF 97TH STREET WEST
FROM AVENUE F TO AVENUE G

Ground Dist. X Correction Factor. _____ = Grid Distance

Returned to original to
BUREAU OF ENGINEERING
SURVEY DIVISION

ENG. 3.883B (12/78)
Title & Plat Sheet
50% Rag

87

CO ENG FB 3656 - 87

Surveyed by EARL R. RICHARDSON Date SEPT. 12, 1981 F.B. _____ Pg. _____

Type of Survey SUBDIVISION MONUMENTS Sheet 2 of 4

Distances corrected to 68° ✓ Monuments tagged LS # 3703 Tract or ~~RCE~~ # _____ ~~Parcel Map~~ # 41349

Checked by _____ Date _____ km grid _____ MB _____

W.S. 71, A-3 (41)

NOTE: Additions or changes must be initialed, and dated.

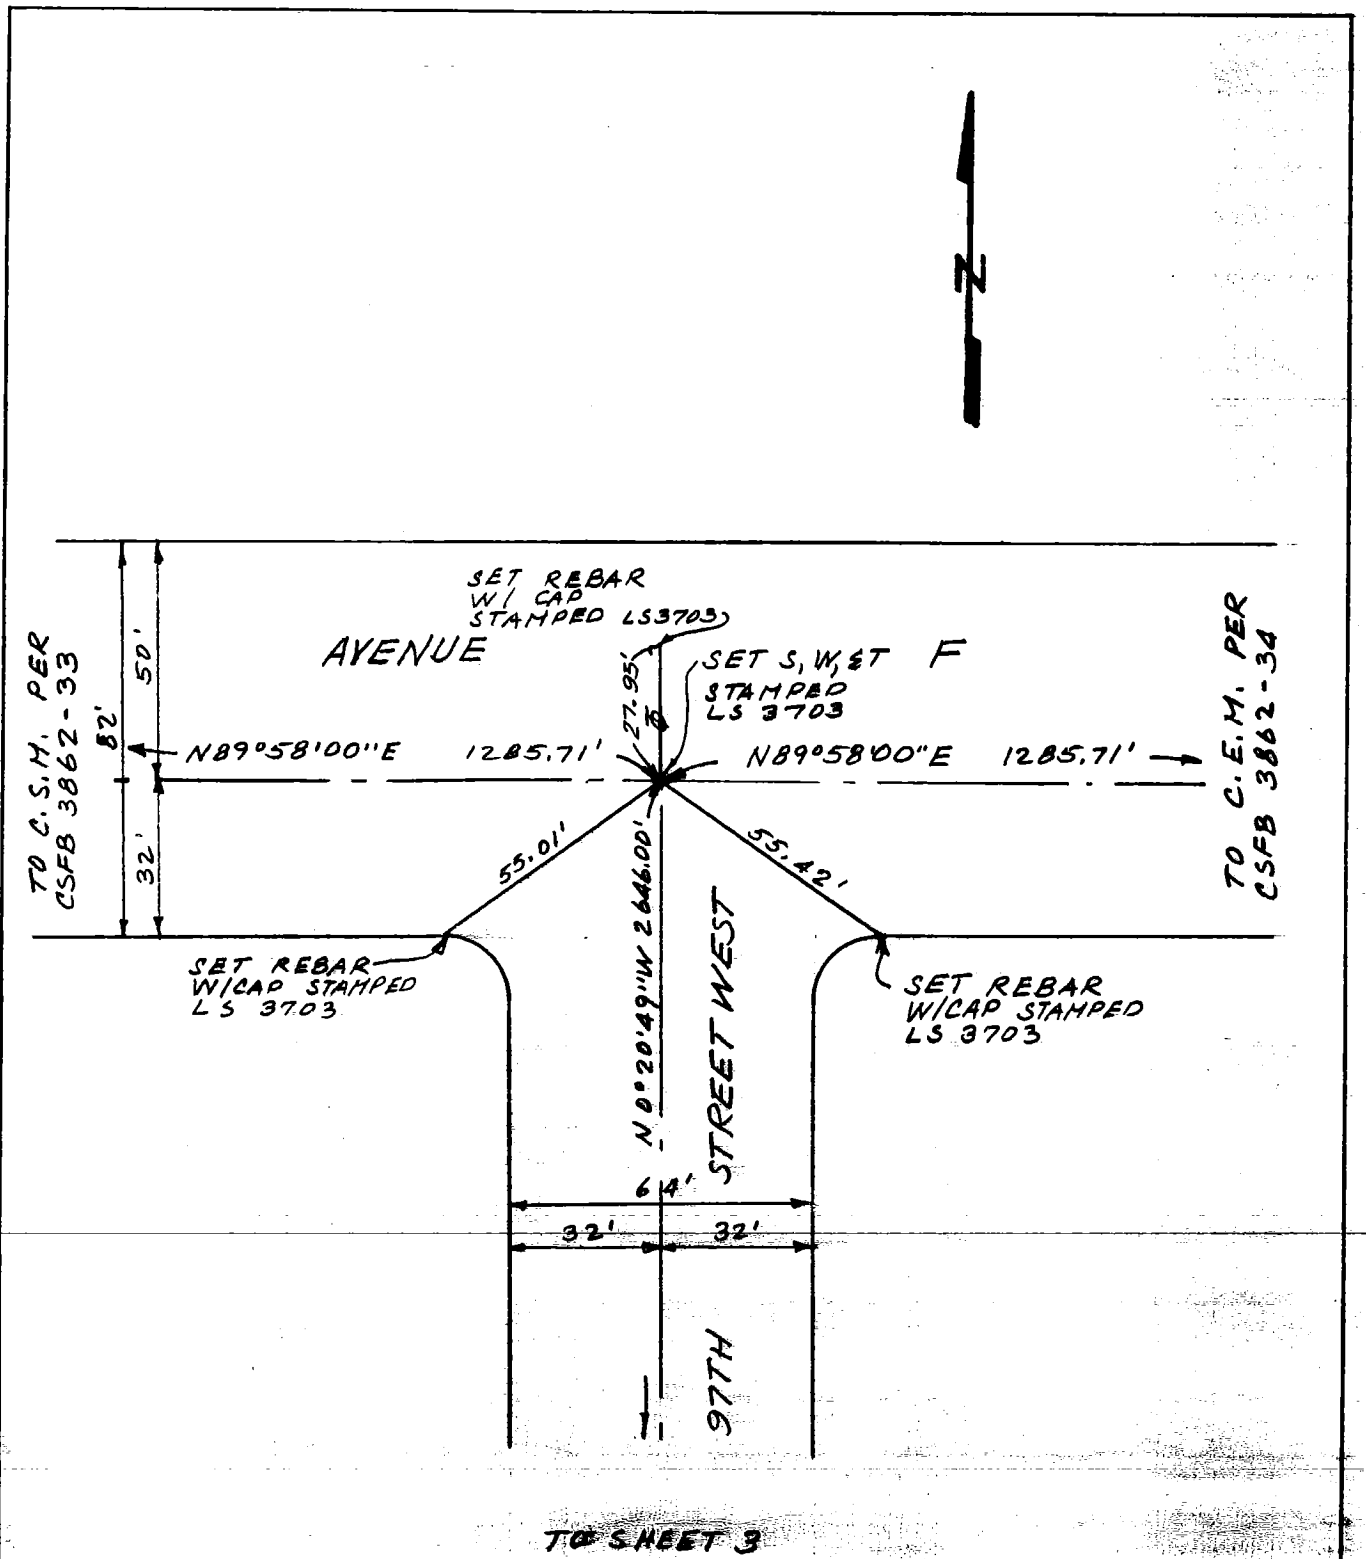

TO SHEET 3

Ground Dist. X Correction Factor: _____ = Grid Distance

ENG. 3.883B (12/78)
Title & Plat Sheet
50% Rag

CO ENG FB 3656 - 88

Surveyed by — EARL R. RICHARDSON — Date SEPT. 12, 1981 F.B. _____ Pg. _____

Type of Survey SUBDIVISION MONUMENTS Sheet 3 of 4

Distances corrected to 68° L — Monuments tagged — LS # 3703 — Tract or ~~Record~~ # _____ ~~Parcel Map~~ # 41349

Checked by _____ Date _____ km grid _____ MB _____

W.S. 71, A-3 (93)

NOTE: Additions or changes must be initialed, and dated.

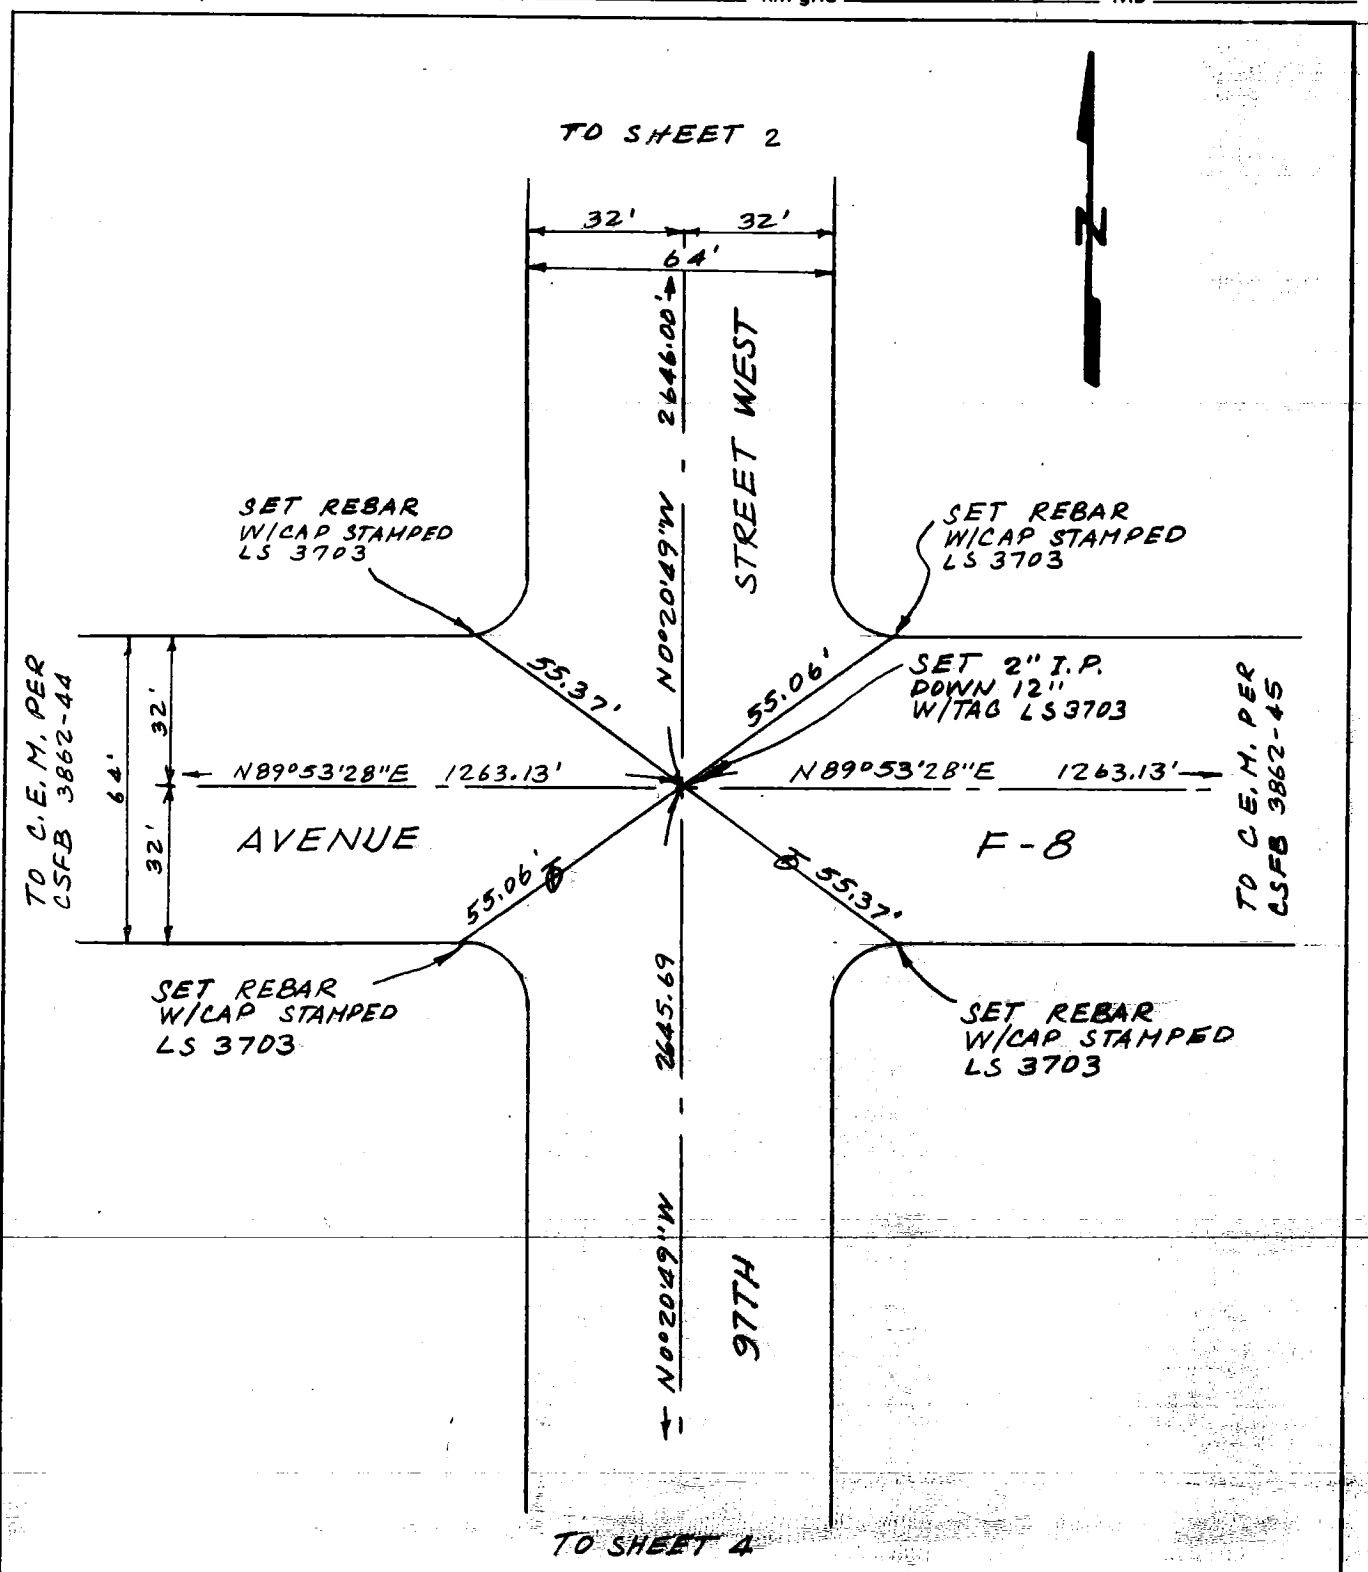

Ground Dist. X Correction Factor: _____ = Grid Distance

ENG. 3.883B (12/78)
Title & Plat Sheet
50% Rag

89

CO ENG FB 3656 - 89

Surveyed by — EARL R. RICHARDSON Date SEPT. 12, 1981 F.B. _____ Pg. _____

Type of Survey SUBDIVISION MONUMENTS Sheet 4 of 4

Distances corrected to 68° L Monuments tagged

LS # 3703 Tract or

~~REC~~ # _____ ~~Parcel Map~~ # 41349

Checked by _____ Date _____ km grid _____ MB _____

W.S. 71, A-3 (43)

NOTE: Additions or changes must be initialed, and dated.

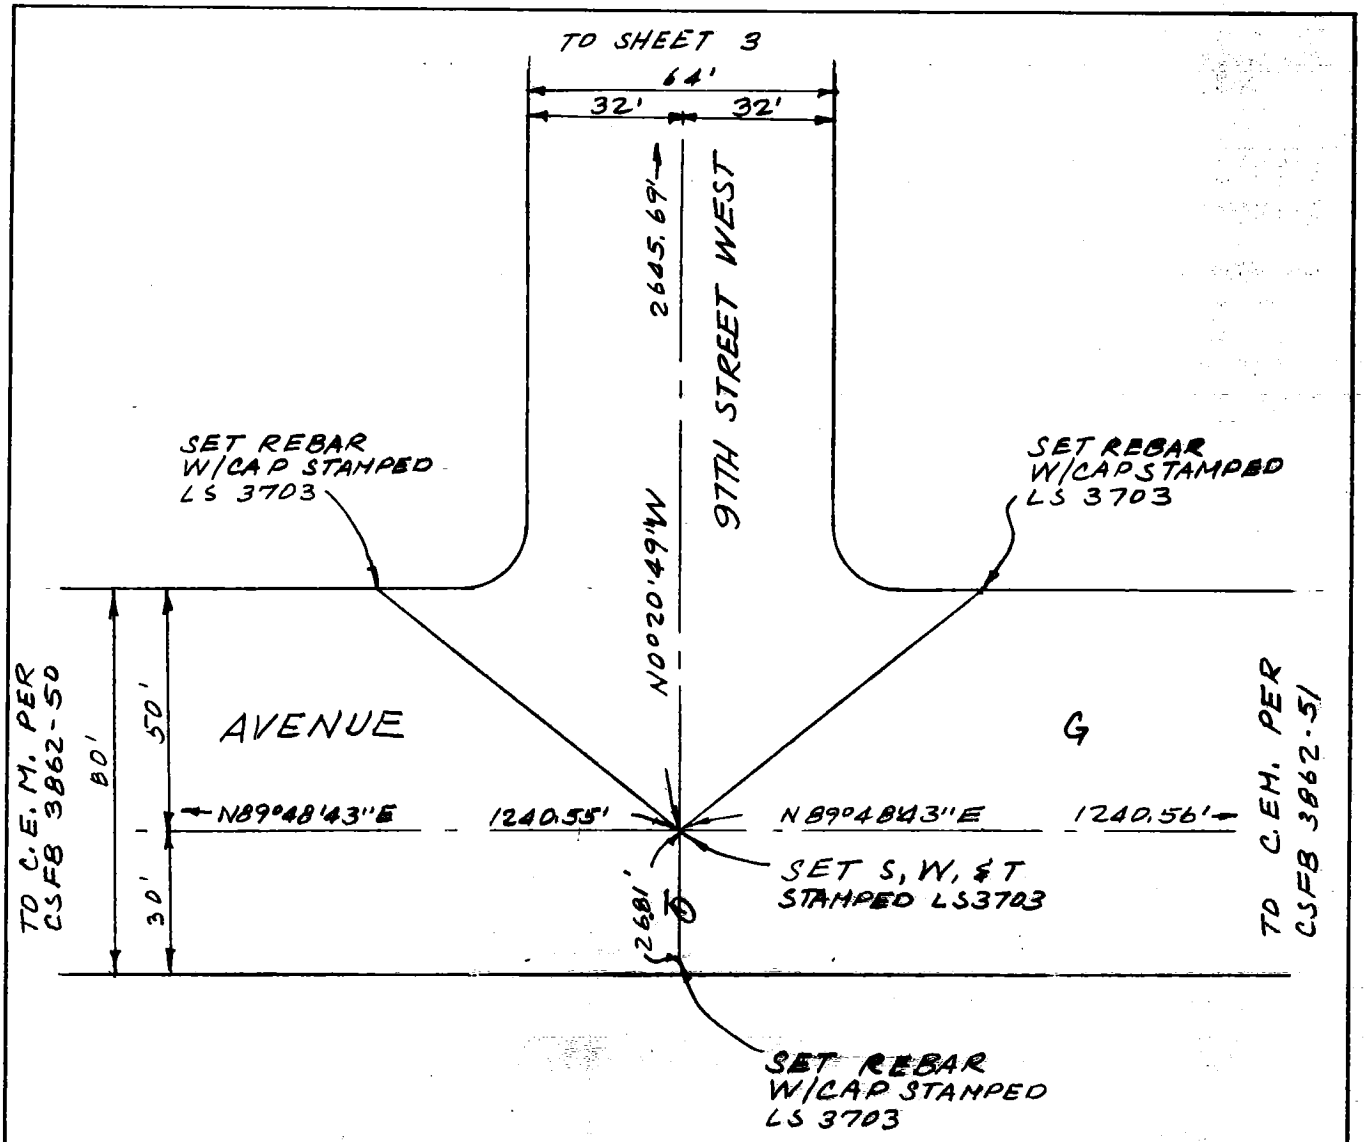

N

Ground Dist. X Correction Factor: _____ = Grid Distance

90

CO ENG FB 3656 - 90

SURVEY OF CENTERLINE TIES F B NO. PAGE

SURVEY BY JAMES E NELSON TRACT NO. 39731
RCE 22405

DATE AUGUST 6 1981

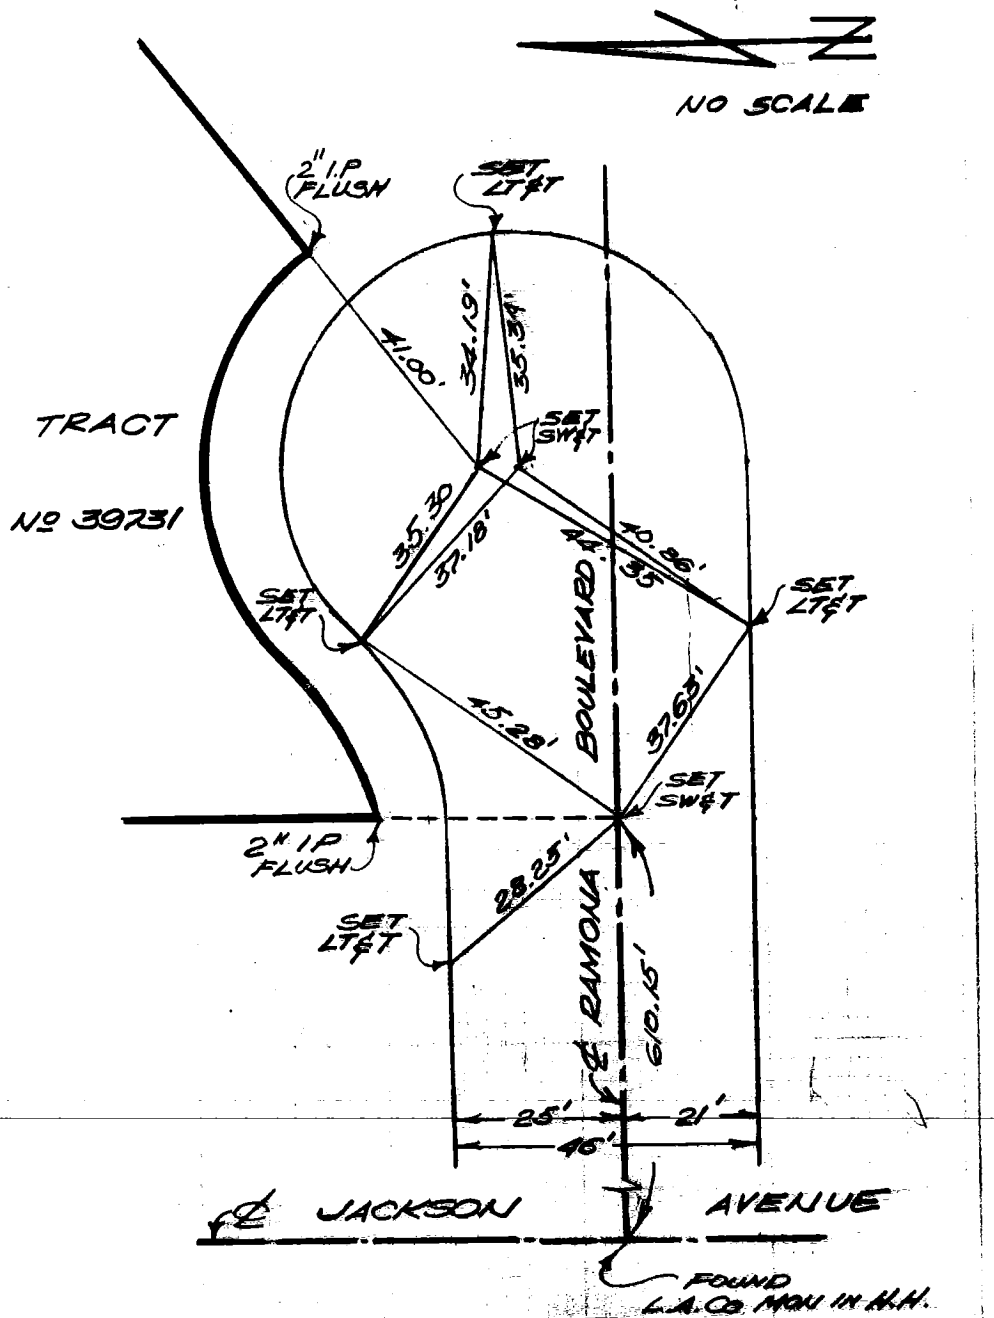

DO NOT EXTEND NOTES THIS SIDE OF LINE

SURVEYORS SERVICE COMPANY · STA MESA · STOCK NO. 411

W.S. 44, B-6 (290)

91

CO ENG FB 3656 - 91

SURVEY OF TIES

F. B. Pg.

SURVEY BY E.L. PEARSON & ASSOCS.

P.M. No. 11247

DATE

249-117, 4-3 (63)

SO. CALIF. BLUE PRINT CO.

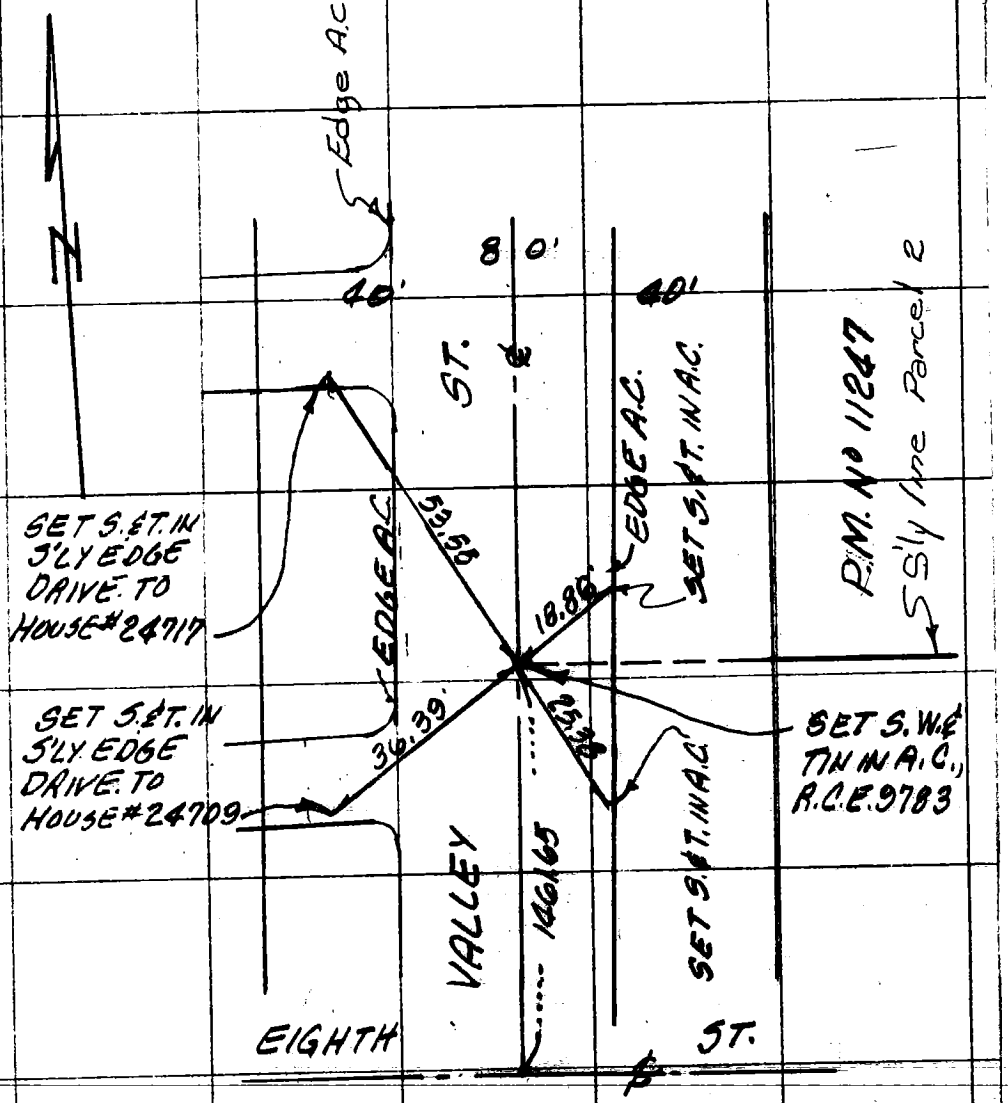

92

CO ENG FB 3656 - 92

SURVEY OF CANWOOD STREET F.M. 1705 INDEX PAGE 1 OF 1

SURVEYED BY Harman Radnow & Assoc. DATE Sept. 8 "1981

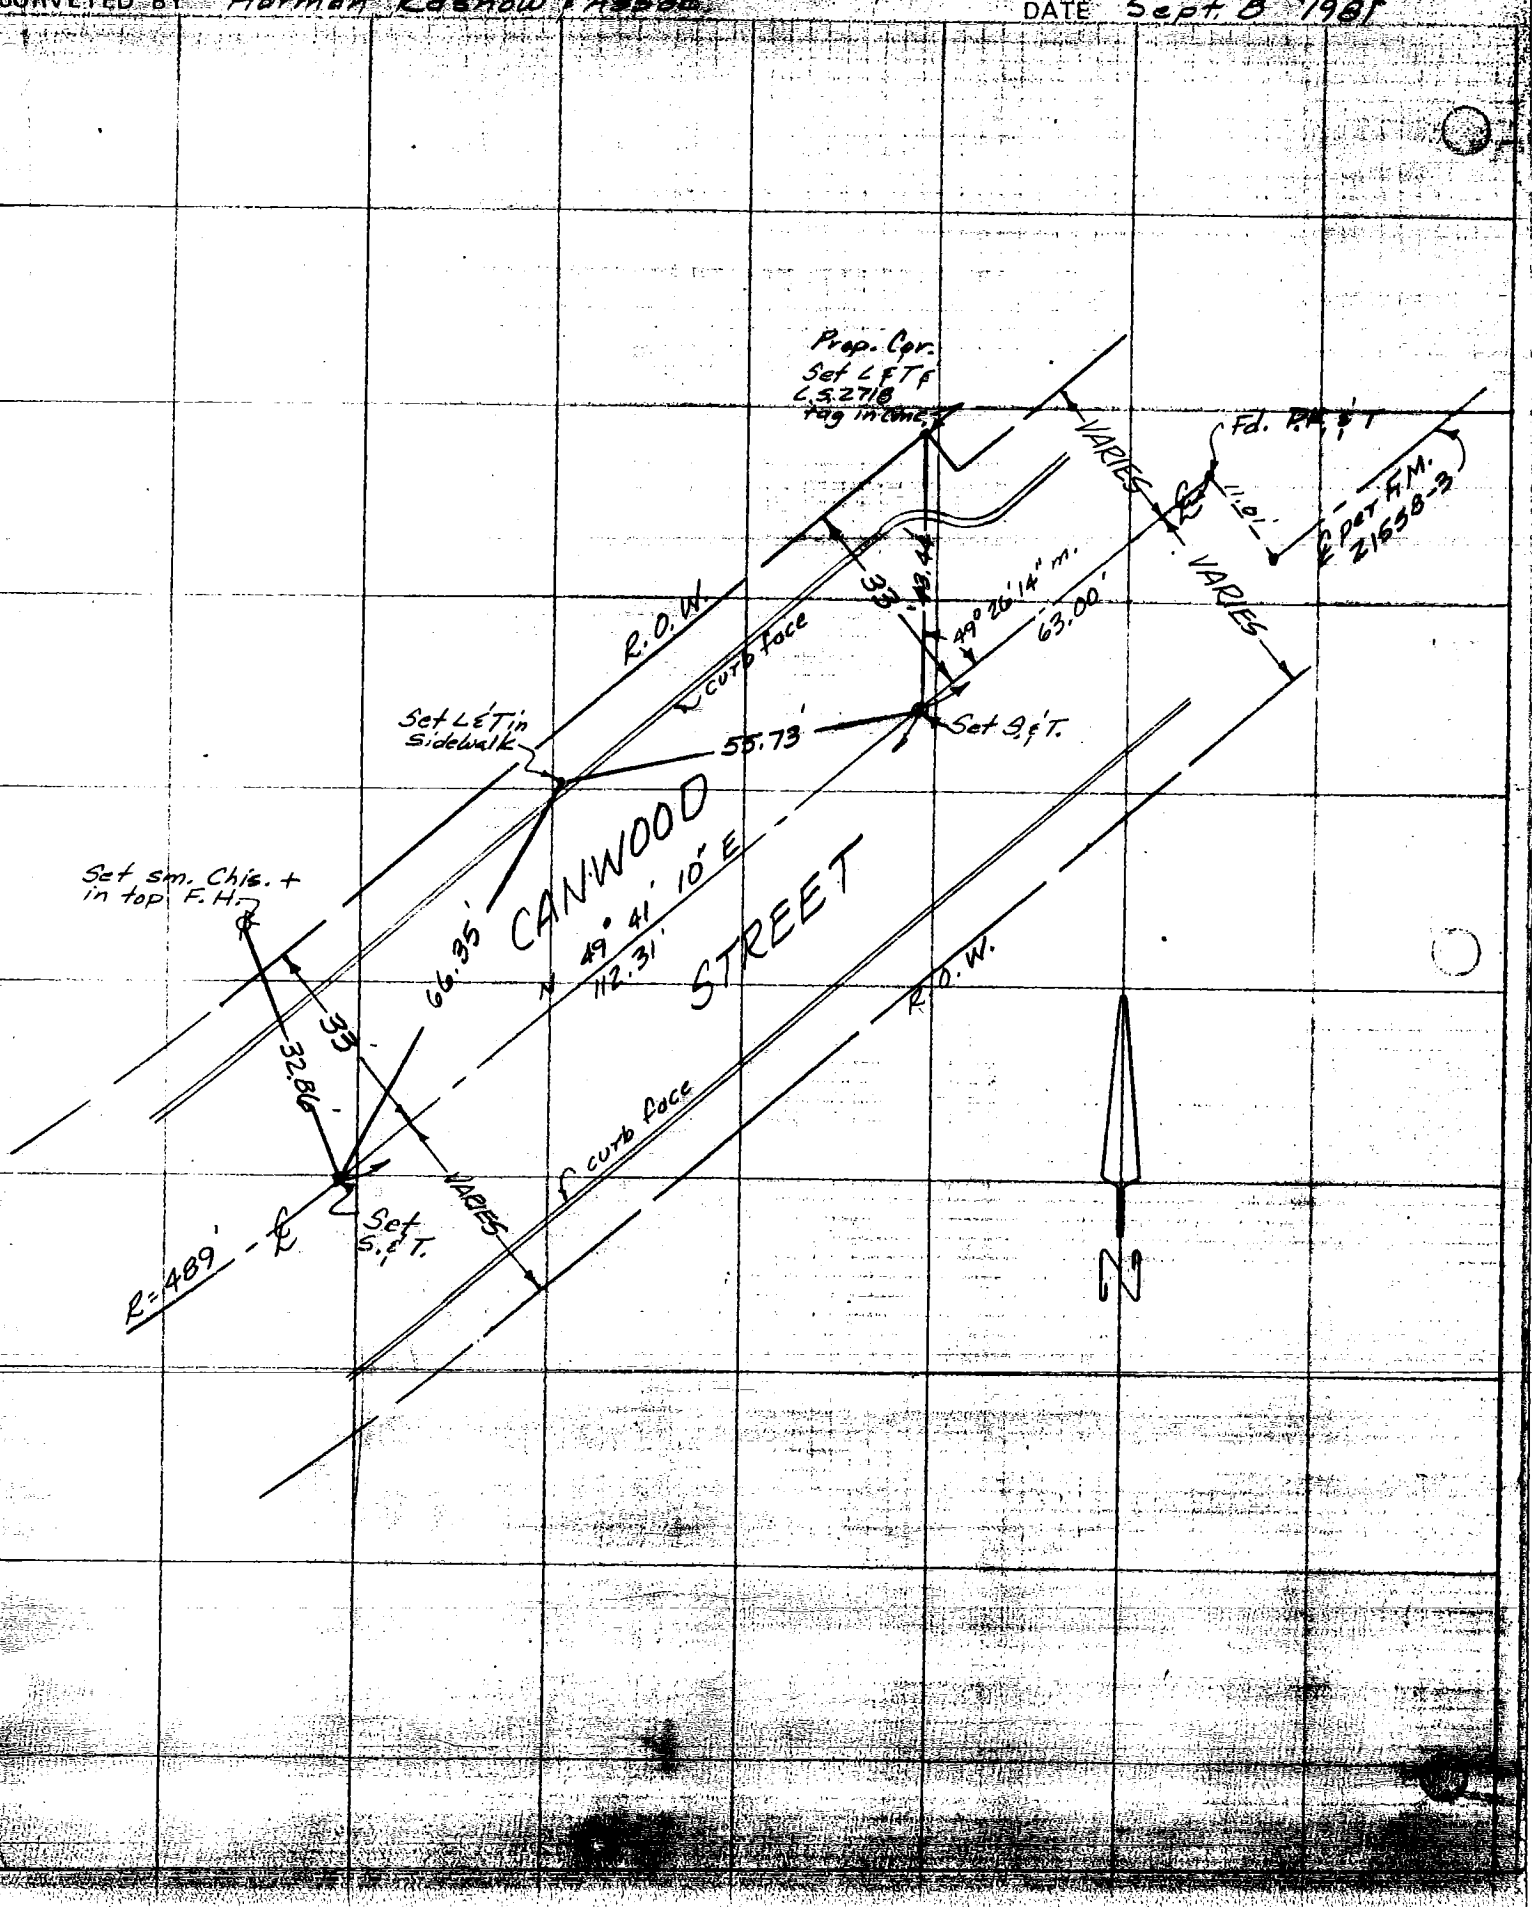

SEEWOO NO. 4004

TRACT NO. 40894

CENTERLINE TIES

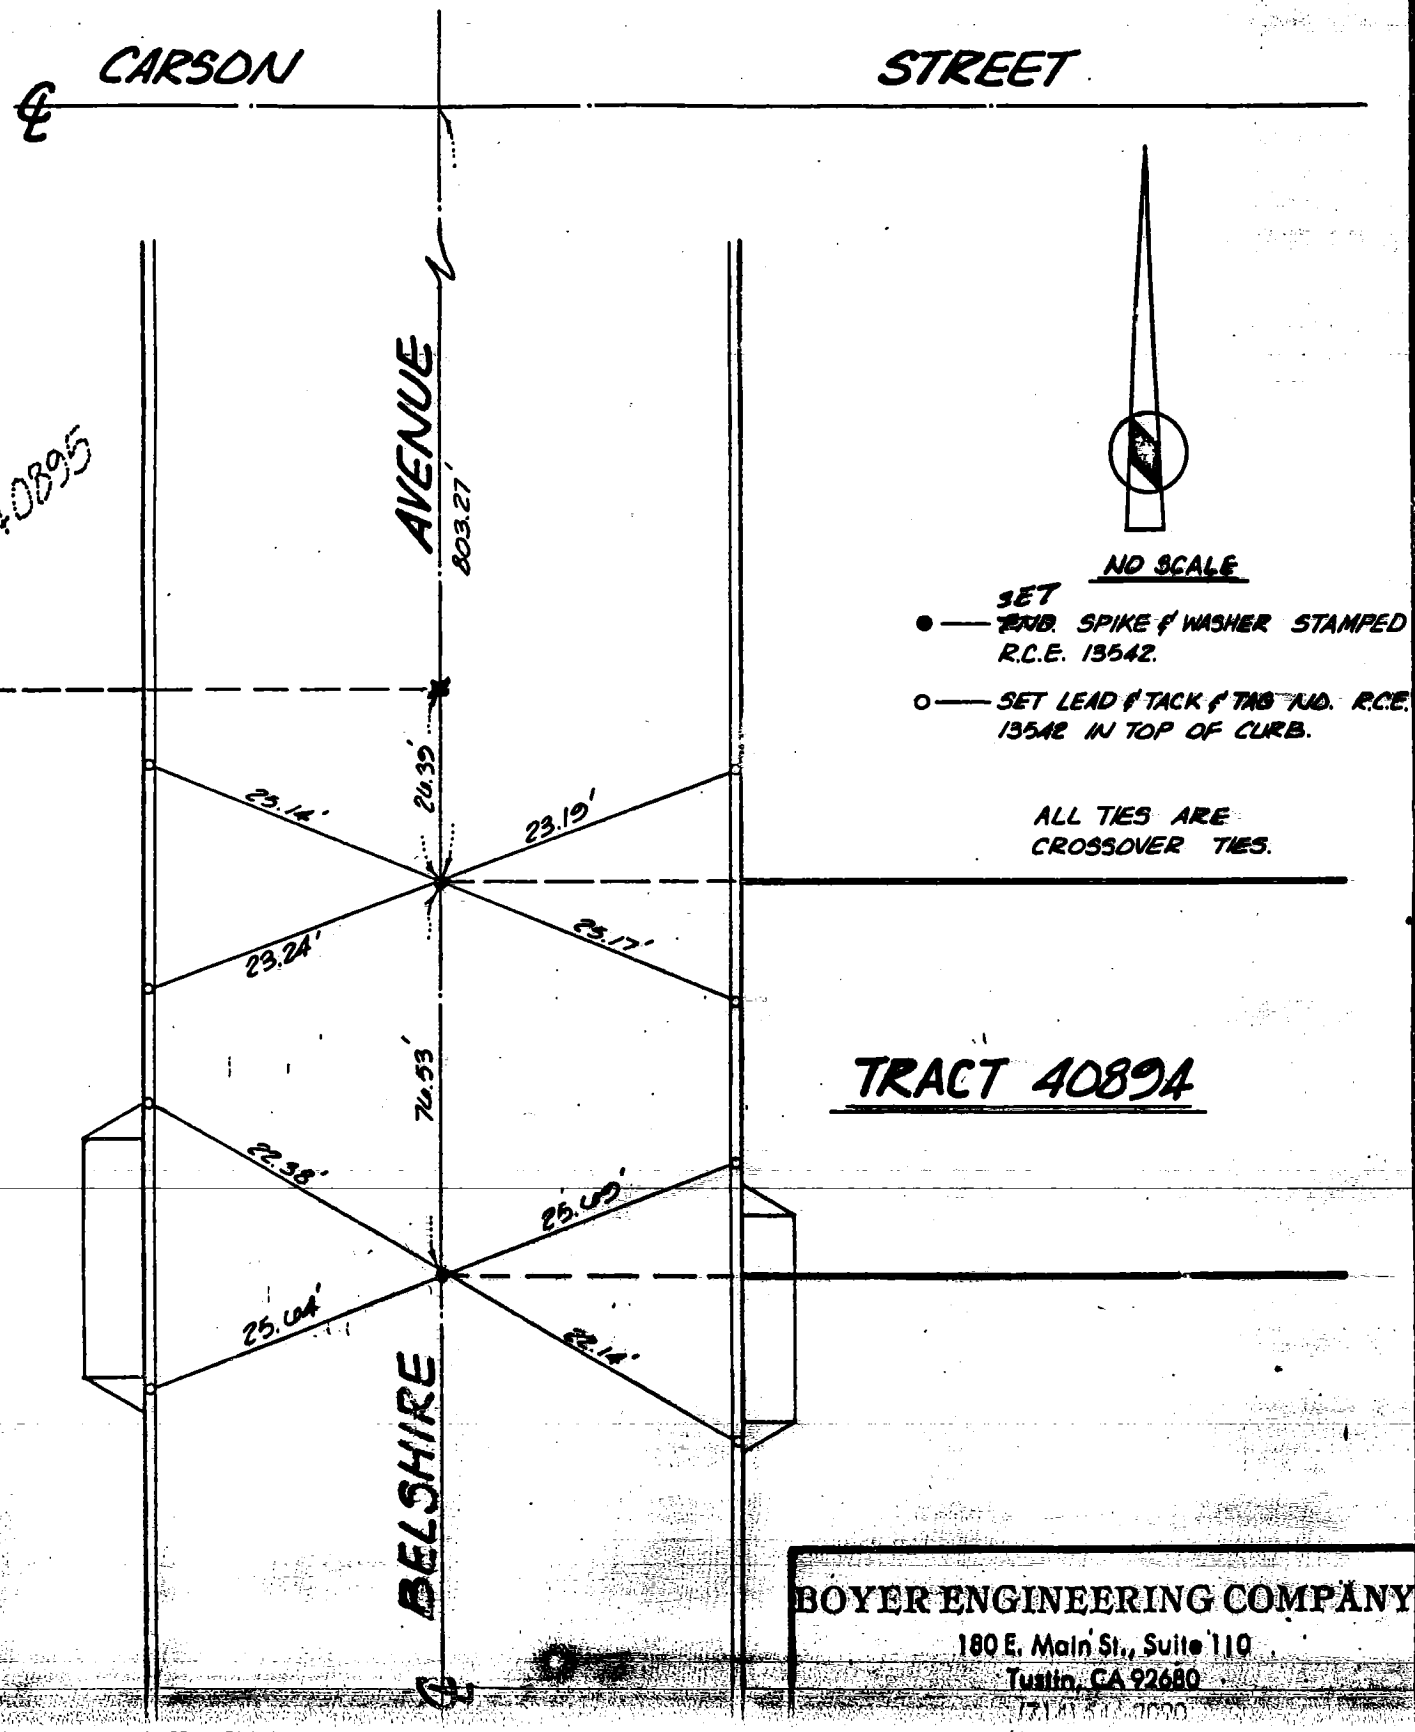

T R W.S. 31, D-2 (188)

TR. 40895

BOYER ENGINEERING COMPANY
180 E. Main St., Suite 110
Tustin, CA 92680

94

CO ENG FB 3656 - 94

Sheet 1 of 2

TRACT Nº 41635
CITY OF LA PUENTE

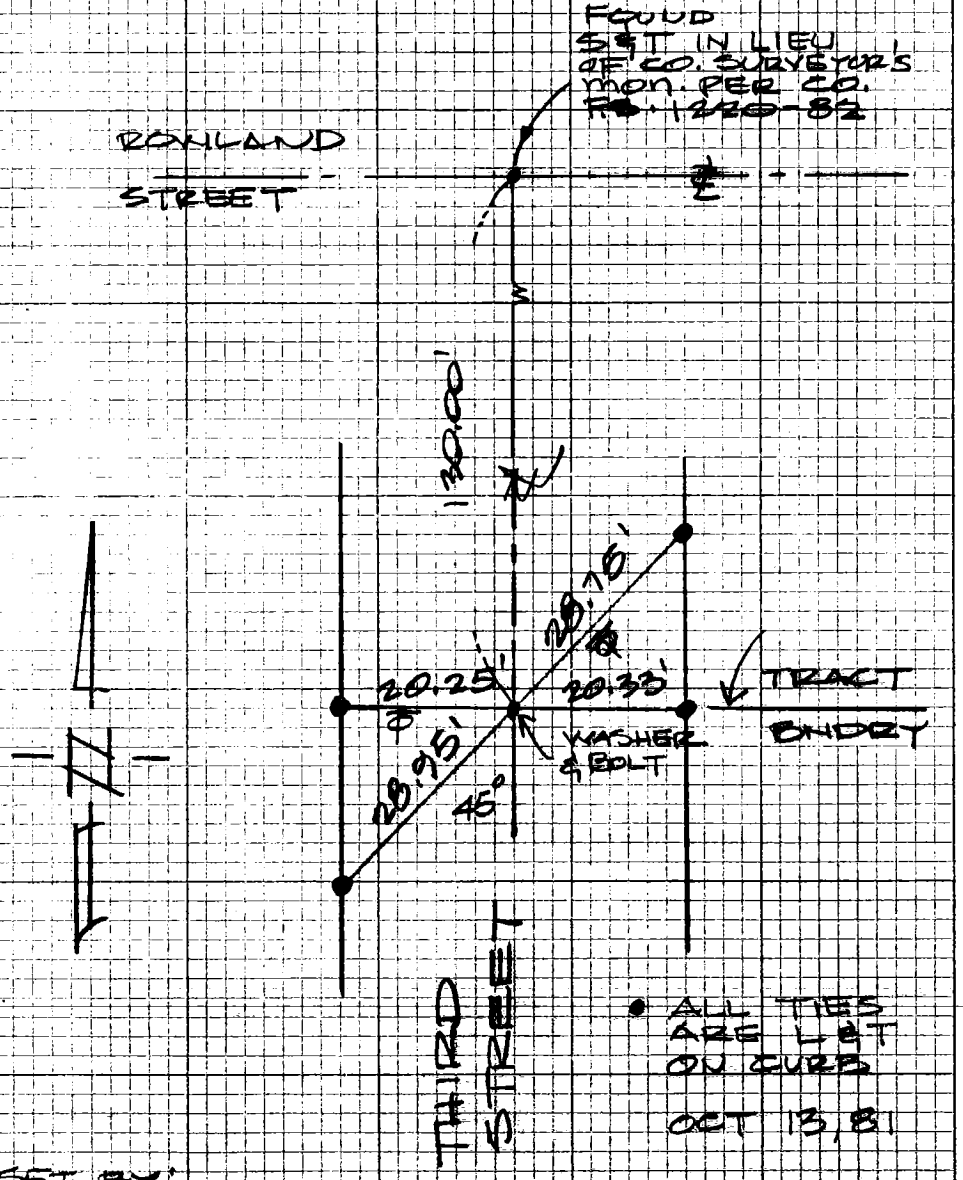

• ALL TIES ARE LEFT ON CURB

OCT 13, 81

SET BY:
A.C. GUZMAN L.S. 3430

Map Bk 27 Pg 44-46

95

CO ENG FB 3656 - 95

Sheet 2 of 2

TRACT NO 41635
CITY OF LA PUENTE

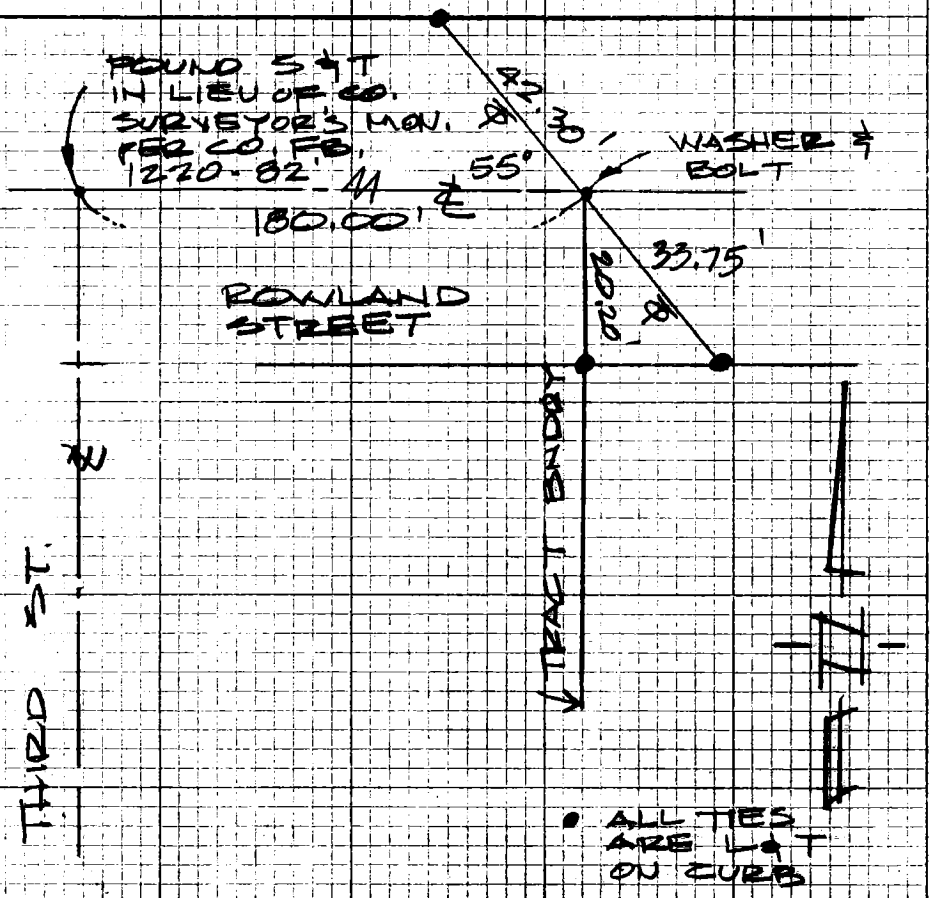

SET BY:
A.C. GUIZADO L.S. 3430

7/26 83

pg 96 missing:

Co Eng FB 3656 - 97

97

W.S. 45, E-3 (7)

SURVEY OF NORUMBEGA AVE. & BRADOAKS F. B. _____ PG. _____

SURVEY BY M. W. FINLEY CO. L.S. 2342 P.M. No. 13790

DATE OCT. 15, 1981

M W Finley
L.S. 2342

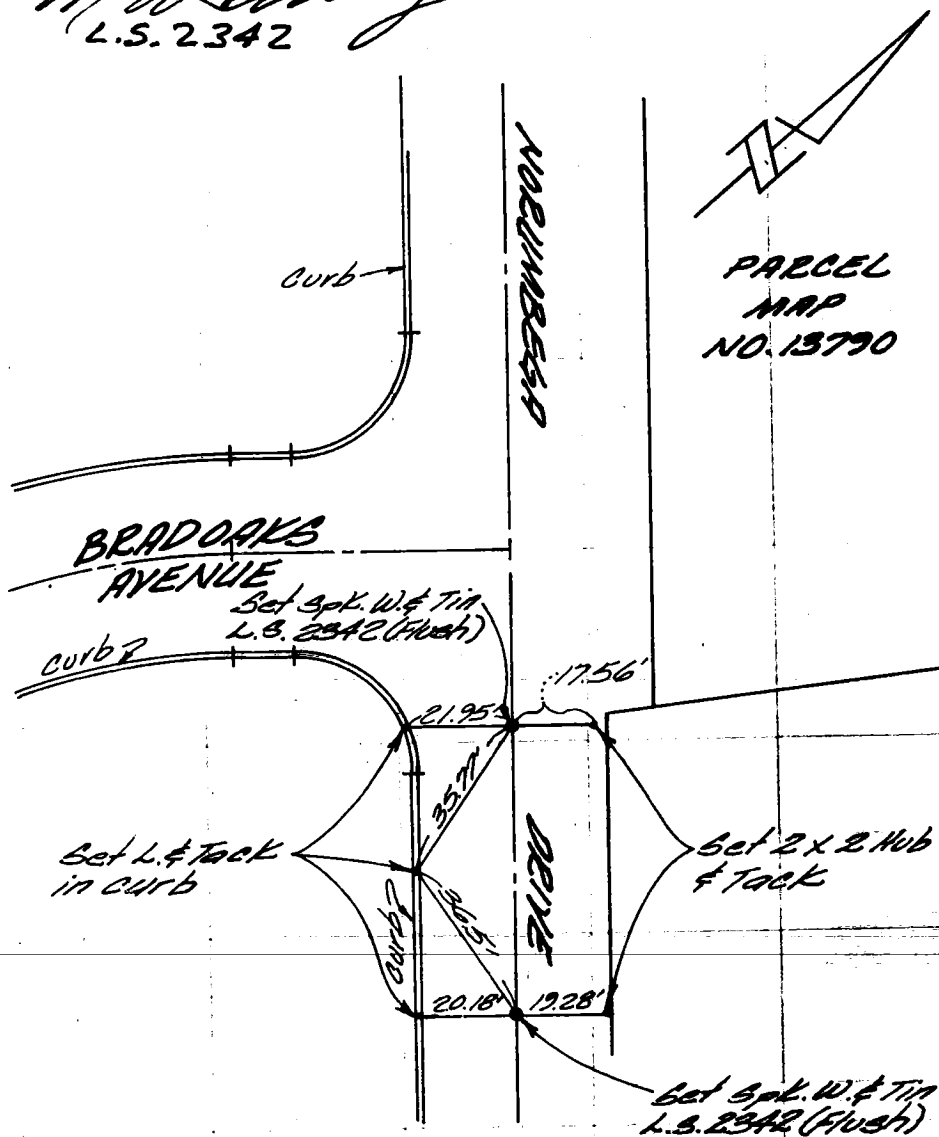

SO. CALIF. BLUE PRINT CO.

98

CO ENG FB 3656 - 98

SURVEY OF NORUMBEGA DRIVE F. B. ____ PG. ____

SURVEY BY M.W. FINLEY CO. P.M. NO. 13790

DATE NOV. 3, 1981

W.S. 45, E. 3 (8)

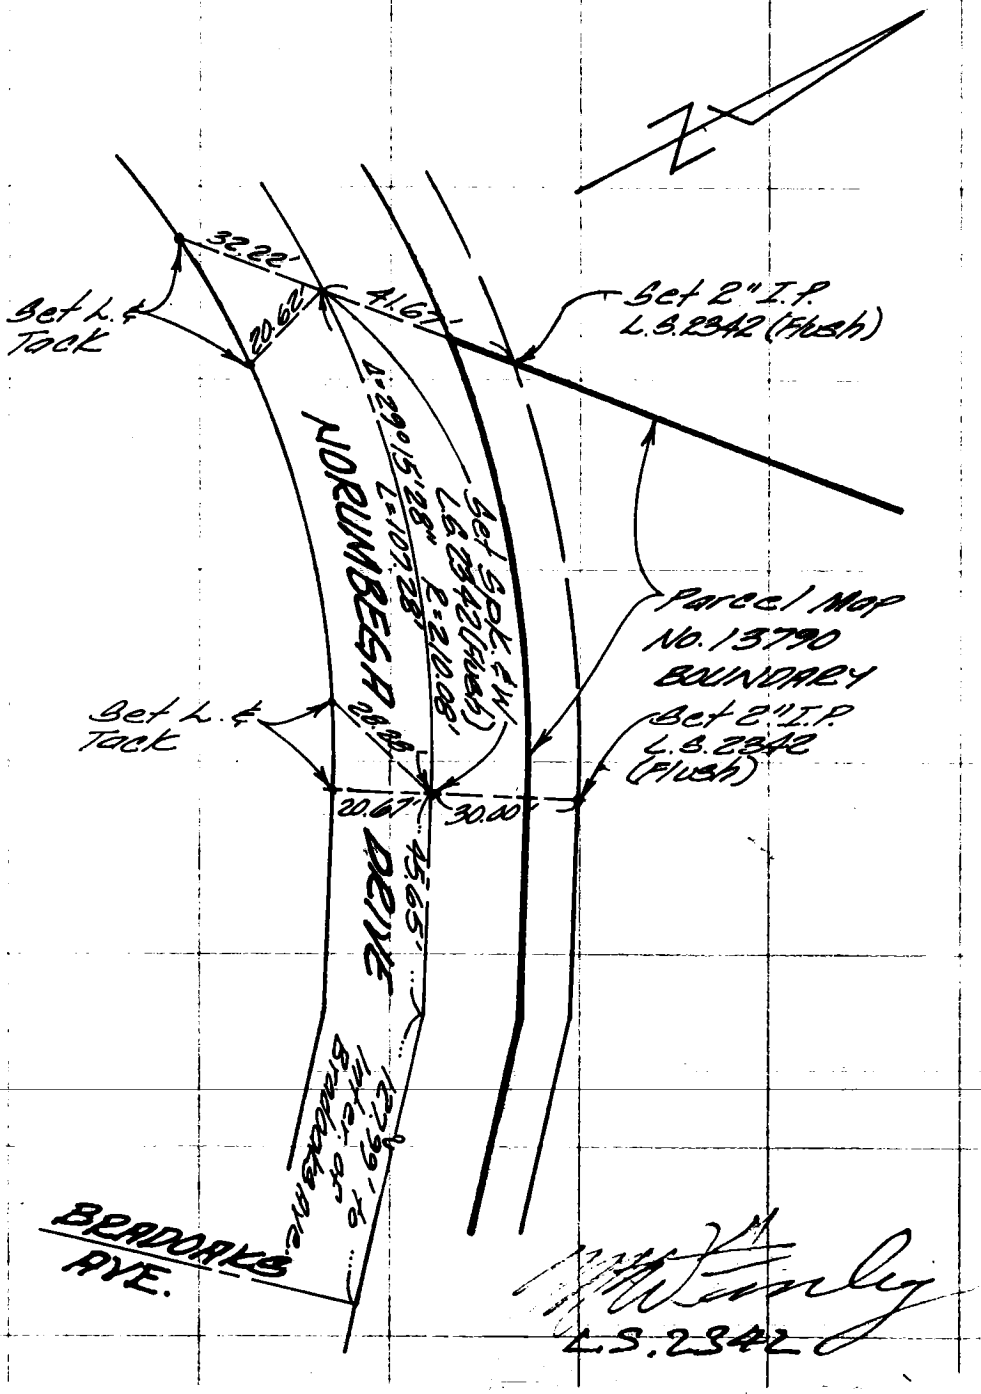

SO. CALIF. BLUE PRINT CO.

99

CO ENG FB 3656 - 99

SURVEY OF PARCEL MAP TIES F B NO ____ PAGE ____

SURVEY BY J.M. NEGRETE & ASSOC. NO PM. 13943

DATE NOV. 1, 1981

W.S. 40, C-2 (33)

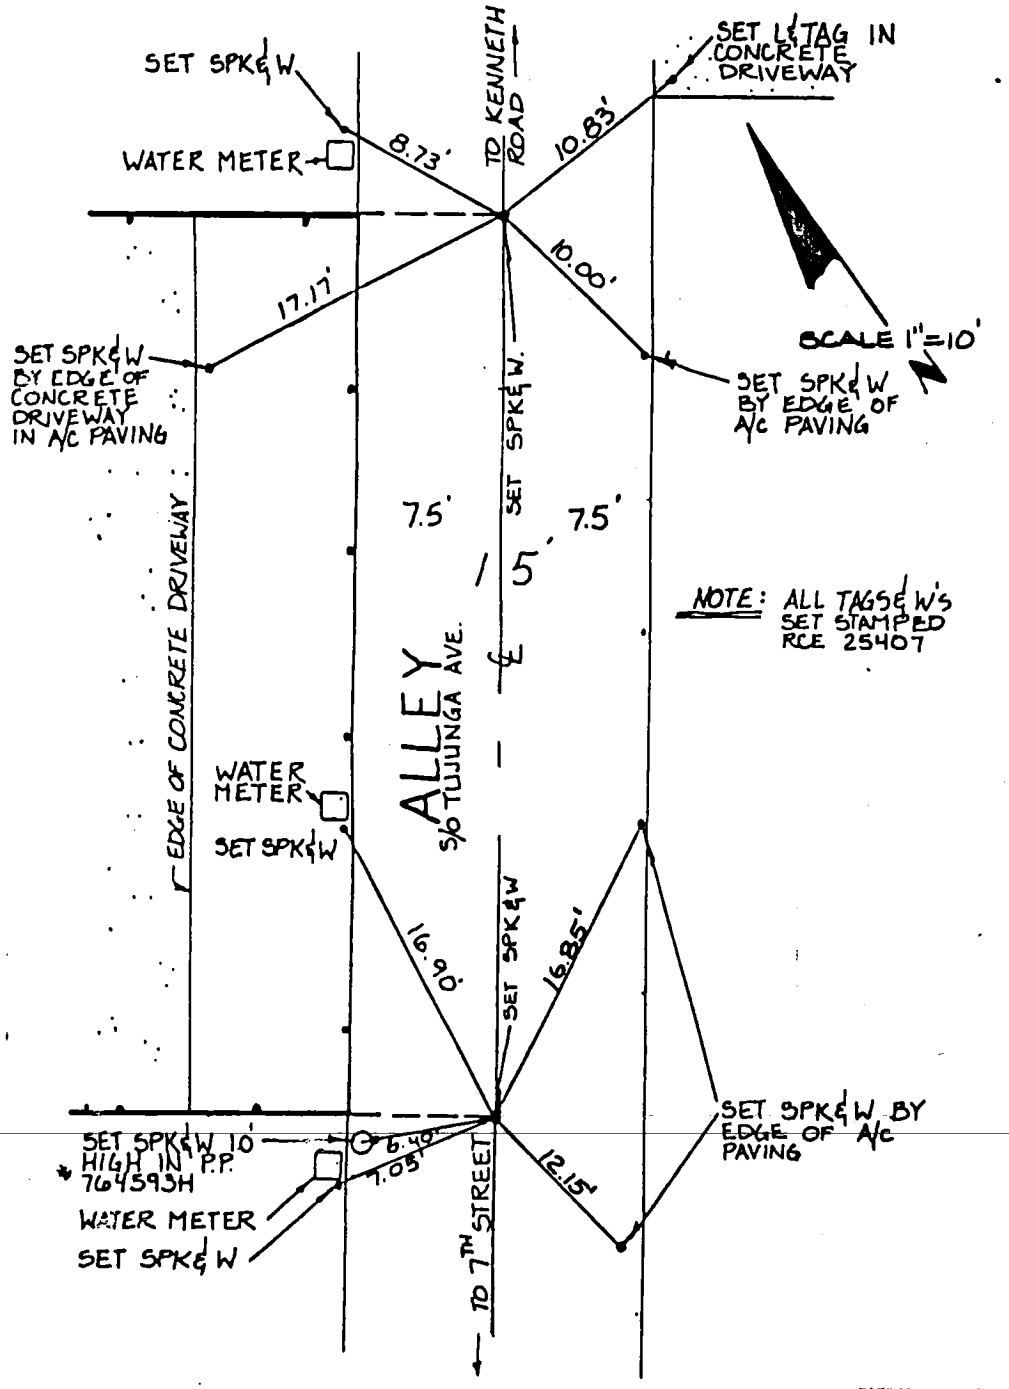

SURVEYORS SERVICE COMPANY, SANTA MESA - STOCK NO 411

DO NOT EXTEND NOTES THIS SIDE OF LINE

SURVEYORS SERVICE COMPANY, SANTA MESA - STOCK NO. 411

SURVEY OF PARCEL MAP TIES F B NO. PAGE
SURVEY BY J.M. NEGRETE & ASSOC. NO PM 13943
DATE NOV. 1, 1981

W.S. 40, C-2 (34)

DO NOT EXTEND NOTES THIS SIDE OF LINE

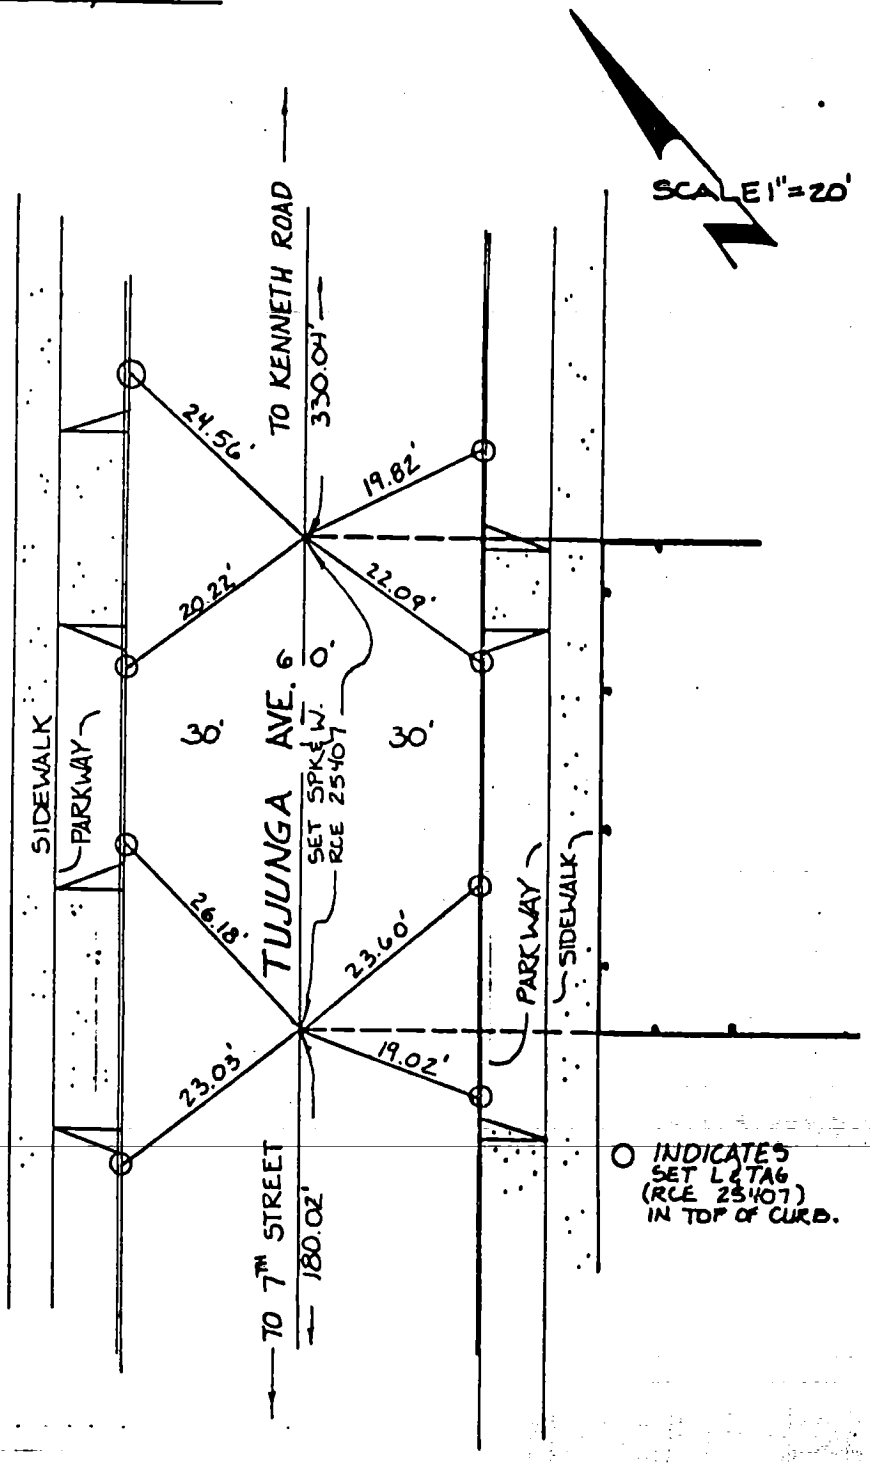

CO ENG FB 3656 - 101

SURVEY OF CENTERLINE TIES F. B. ____ PG. 1 of 3

SURVEY BY William L. Schulz, L.S. 3222 TR. NO. 37579

DATE October 28, 1981

W.S. 44, D-5 (202)

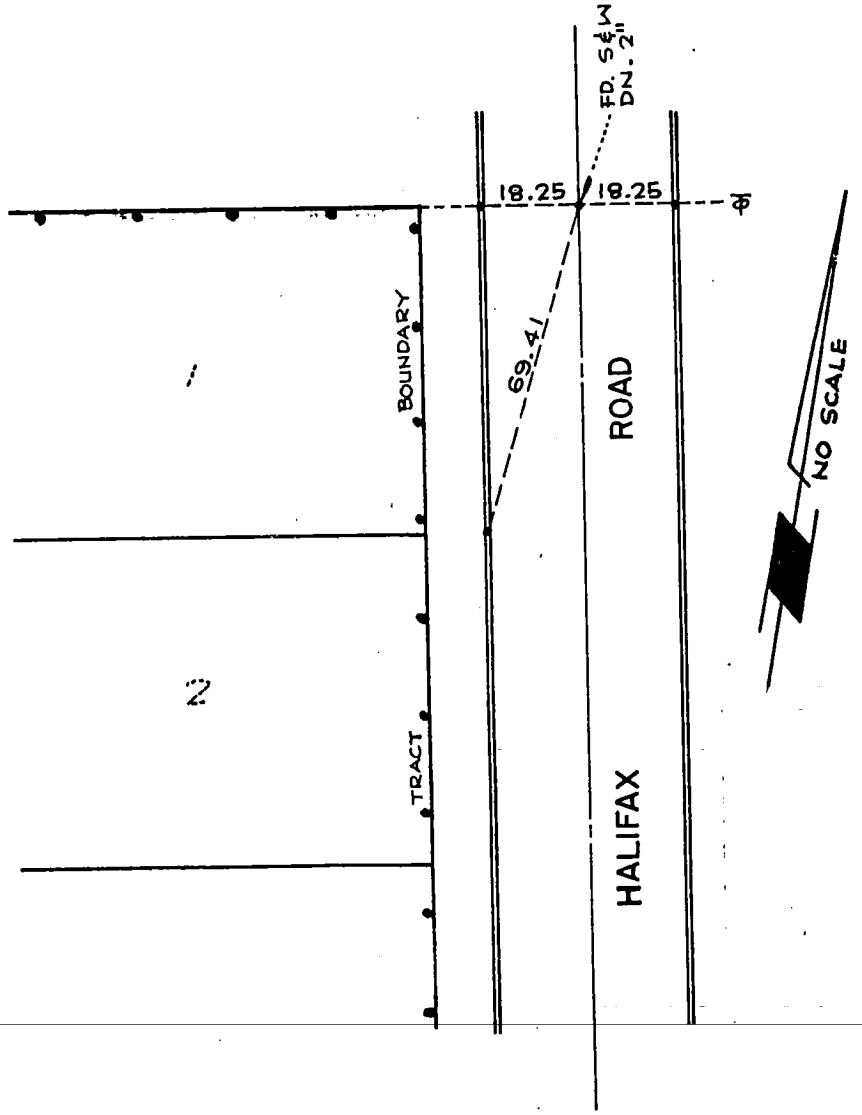

All Ties are to lead & tag. L.S. 3222 in top of curb except as noted.

SO. CALIF. BLUE PRINT CO.

102 CO ENG FB 3656 - 102

SURVEY OF CENTERLINE TIES F. B. ____ PG. 2 of 3

SURVEY BY William L. Schulz, L.S. 3222 TR. No. 37579

DATE October 28, 1981

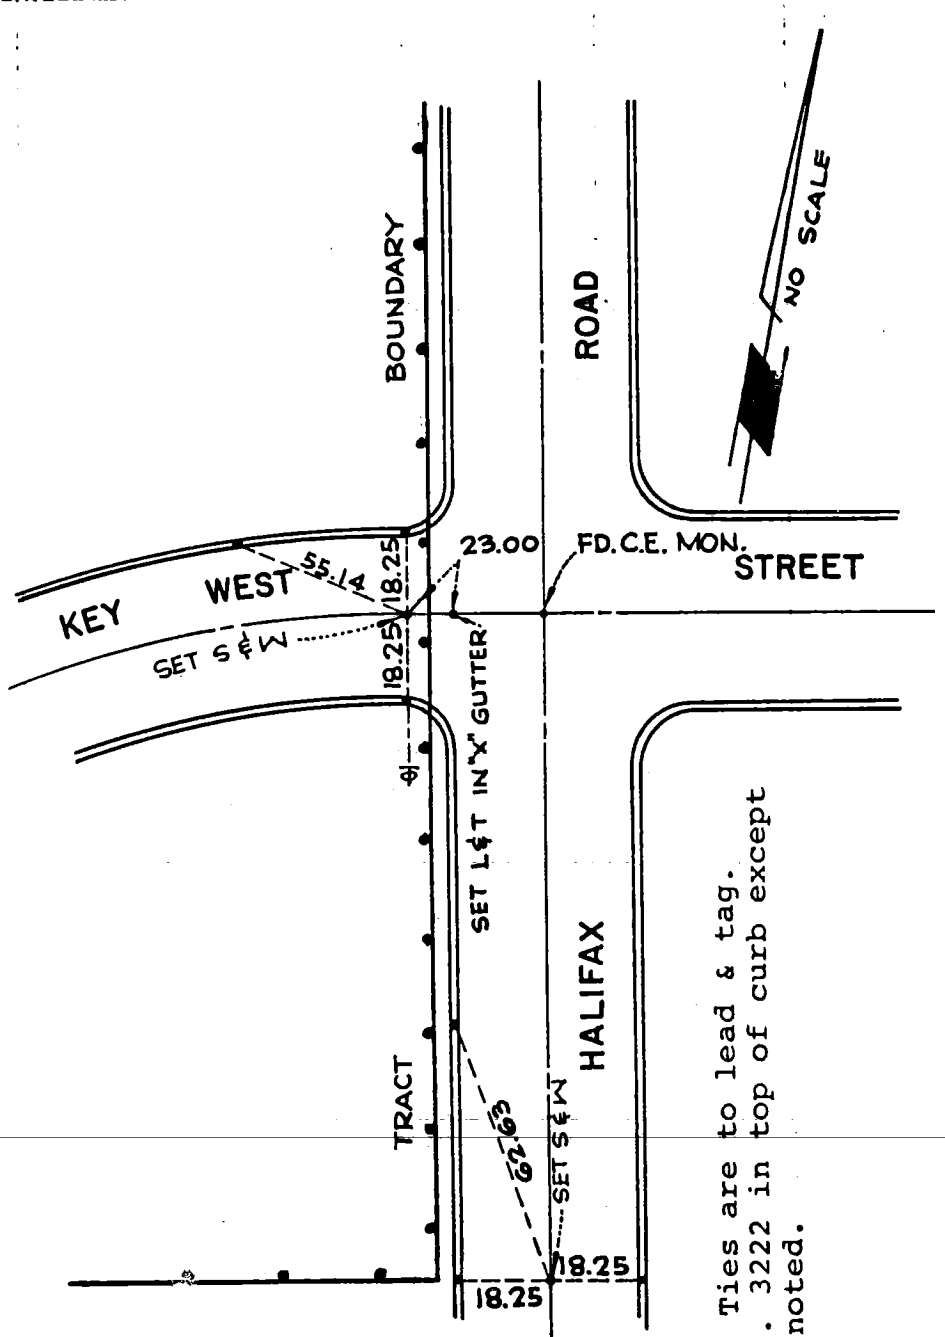

All Ties are to lead & tag.
L.S. 3222 in top of curb except as noted.

W.S. 44

SO. CALIF. BLUE PRINT CO.

103 AO ENG FB 3656 - 103

SURVEY OF CENTERLINE TIES F. B. ____ Pg. 3 of 3

SURVEY BY William L. Schulz, L.S. 3222 TR. No. 37579

DATE October 28, 1981

W.S. 44, D-5 (201)

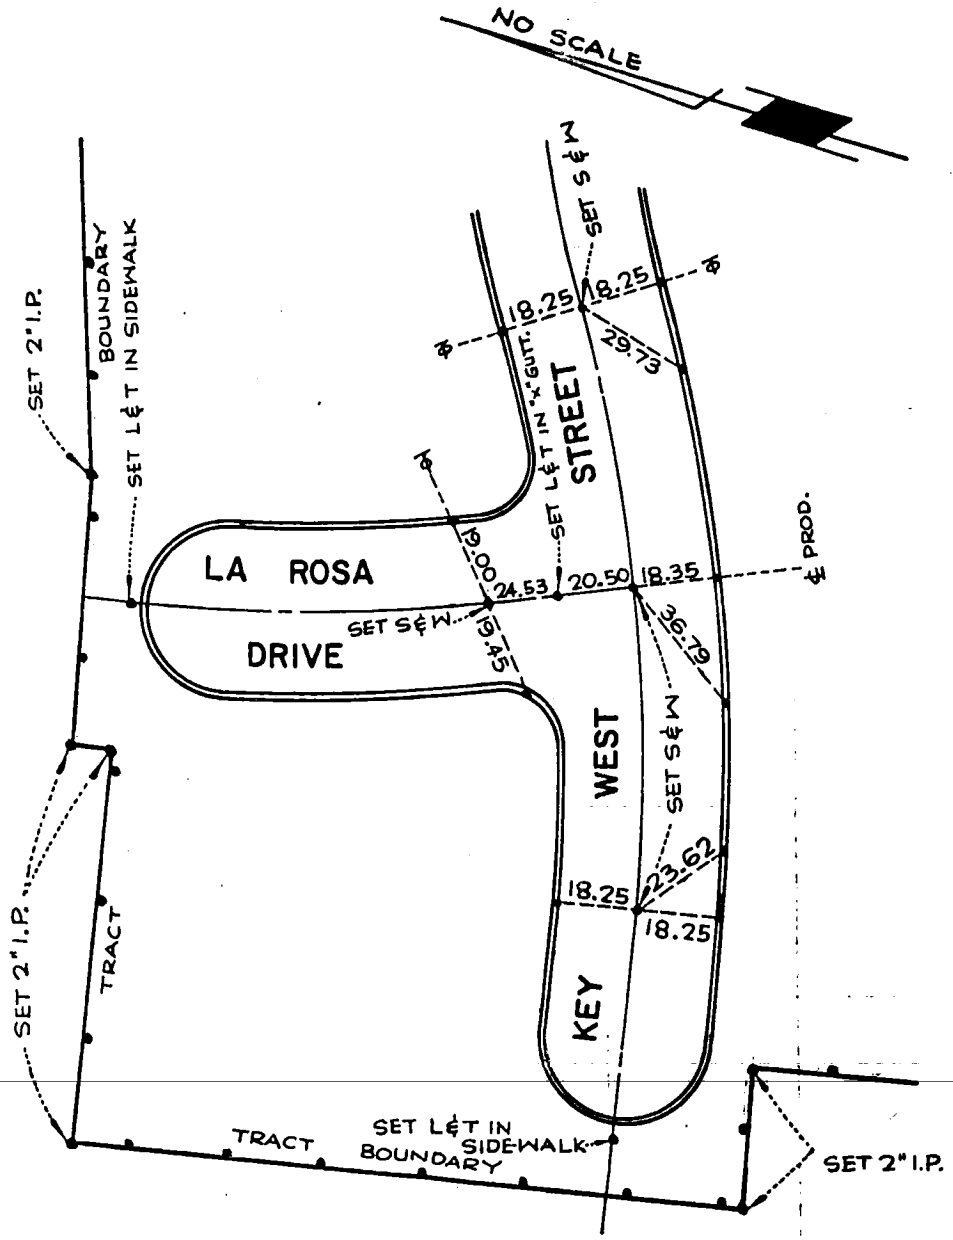

All Ties are to lead & tag. L.S. 3222 in top of curb except as noted.

SO. CALIF. BLUE PRINT CO.

104

CO ENG FB 3656 - 104

SURVEY OF ℄ PALM ST. F B NO. ____ PAGE ____

SURVEY BY R.V. PEARSALL INC. TRACT NO. 42328

DATE 8/10/81

NO SCALE

L.S. 2488

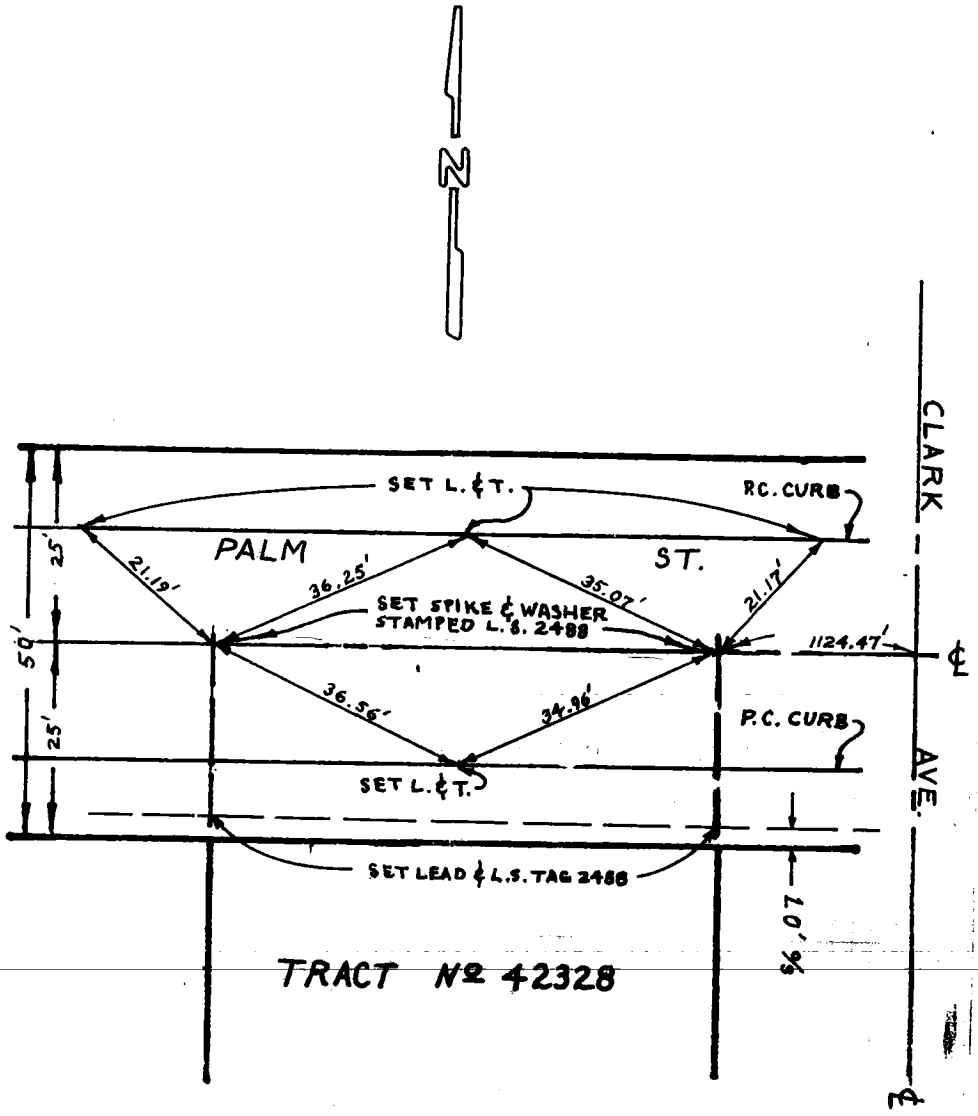

DO NOT EXTEND NOTES THIS SIDE OF LINE

SURVEYORS SERVICE COMPA MESA - STOCK NO. 411

W.S. 33, A-5 (7.1)

105

CO ENG FB 3656 - 105

ENG. 3.883B (12/78)
Title & Plat Sheet
50% Reg

Surveyed by — WAGNER-KERR & ASSOC. Date 10-14-81 F.B. _____ Pg. _____

Type of Survey CENTERLINE TIES Sheet 1 of 4

Distances corrected to 68° _____ Monuments tagged _____ L S # 3164 _____ Tract or ~~R G E #~~ _____ ~~Parcel Map~~ # 41331

Checked by _____ Date _____ km grid _____ MB _____

W8. 40, C-2 (35)

NOTE: Additions or changes must be initialed, and dated.

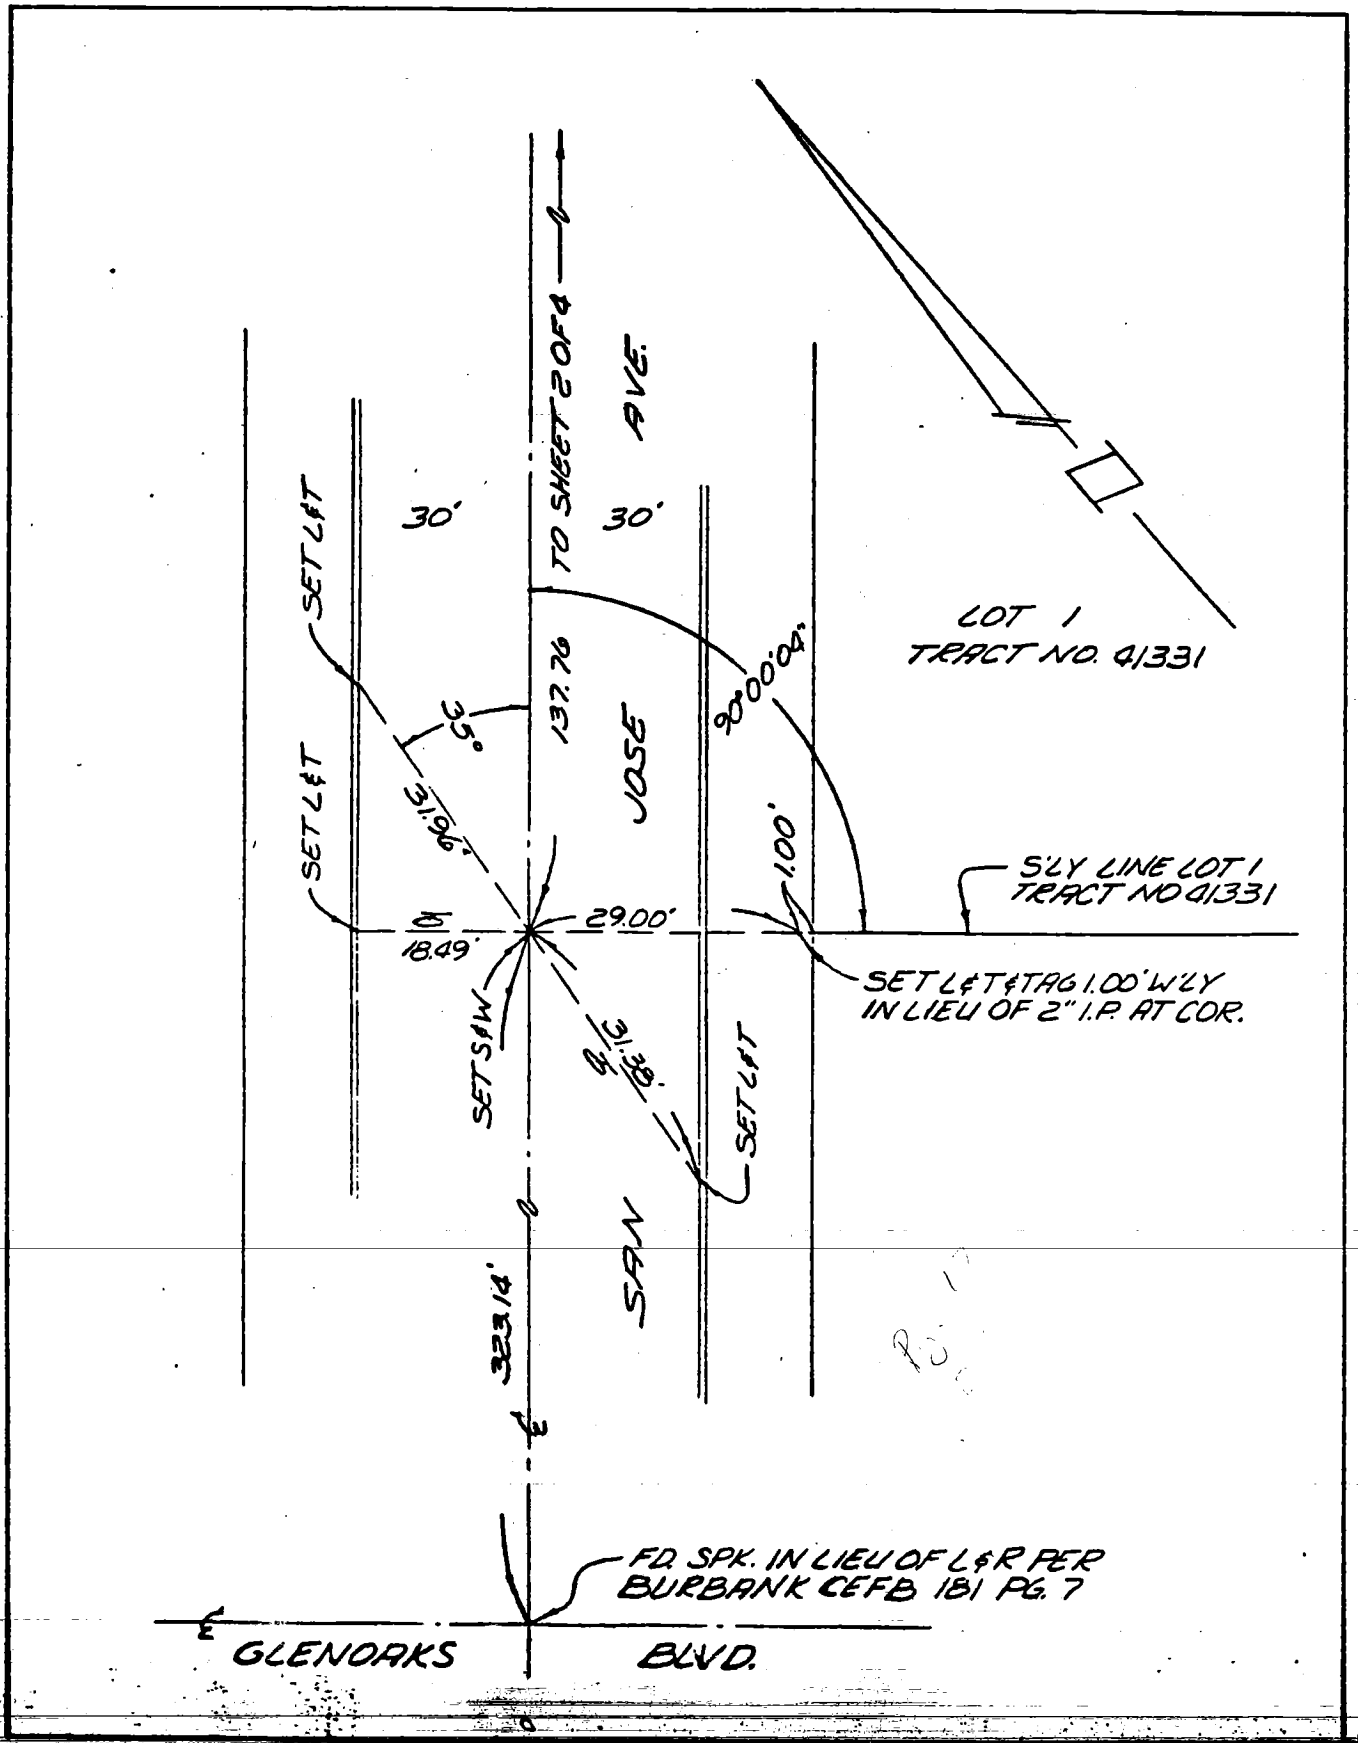

Return original to
BUREAU OF ENGINEERING
SURVEY DIVISION, Rm. 835
200 N. Main St. — Los Angeles 90012

Ground Dist. X Correction Factor: _____ = Grid Distance

12400 + 12401

ENG. 3.883B (12/78)
Title & Plat Sheet
50% Rag

106

CO ENG FB 3656 - 106

Surveyed by — WAGNER-KERR & ASSOC Date 10-19-81 F.B. _____ Pg. _____

Type of Survey CENTERLINE TIES Sheet 2 of 4

Distances corrected to 68° _____ Monuments tagged _____ LS # 3164 Tract or ~~R.G.E.#~~ _____ Parcel Map # 41331

Checked by _____ Date _____ km grid _____ MB _____

W.S. 40, C-2 (33)

NOTE: Additions or changes must be initialed, and dated.

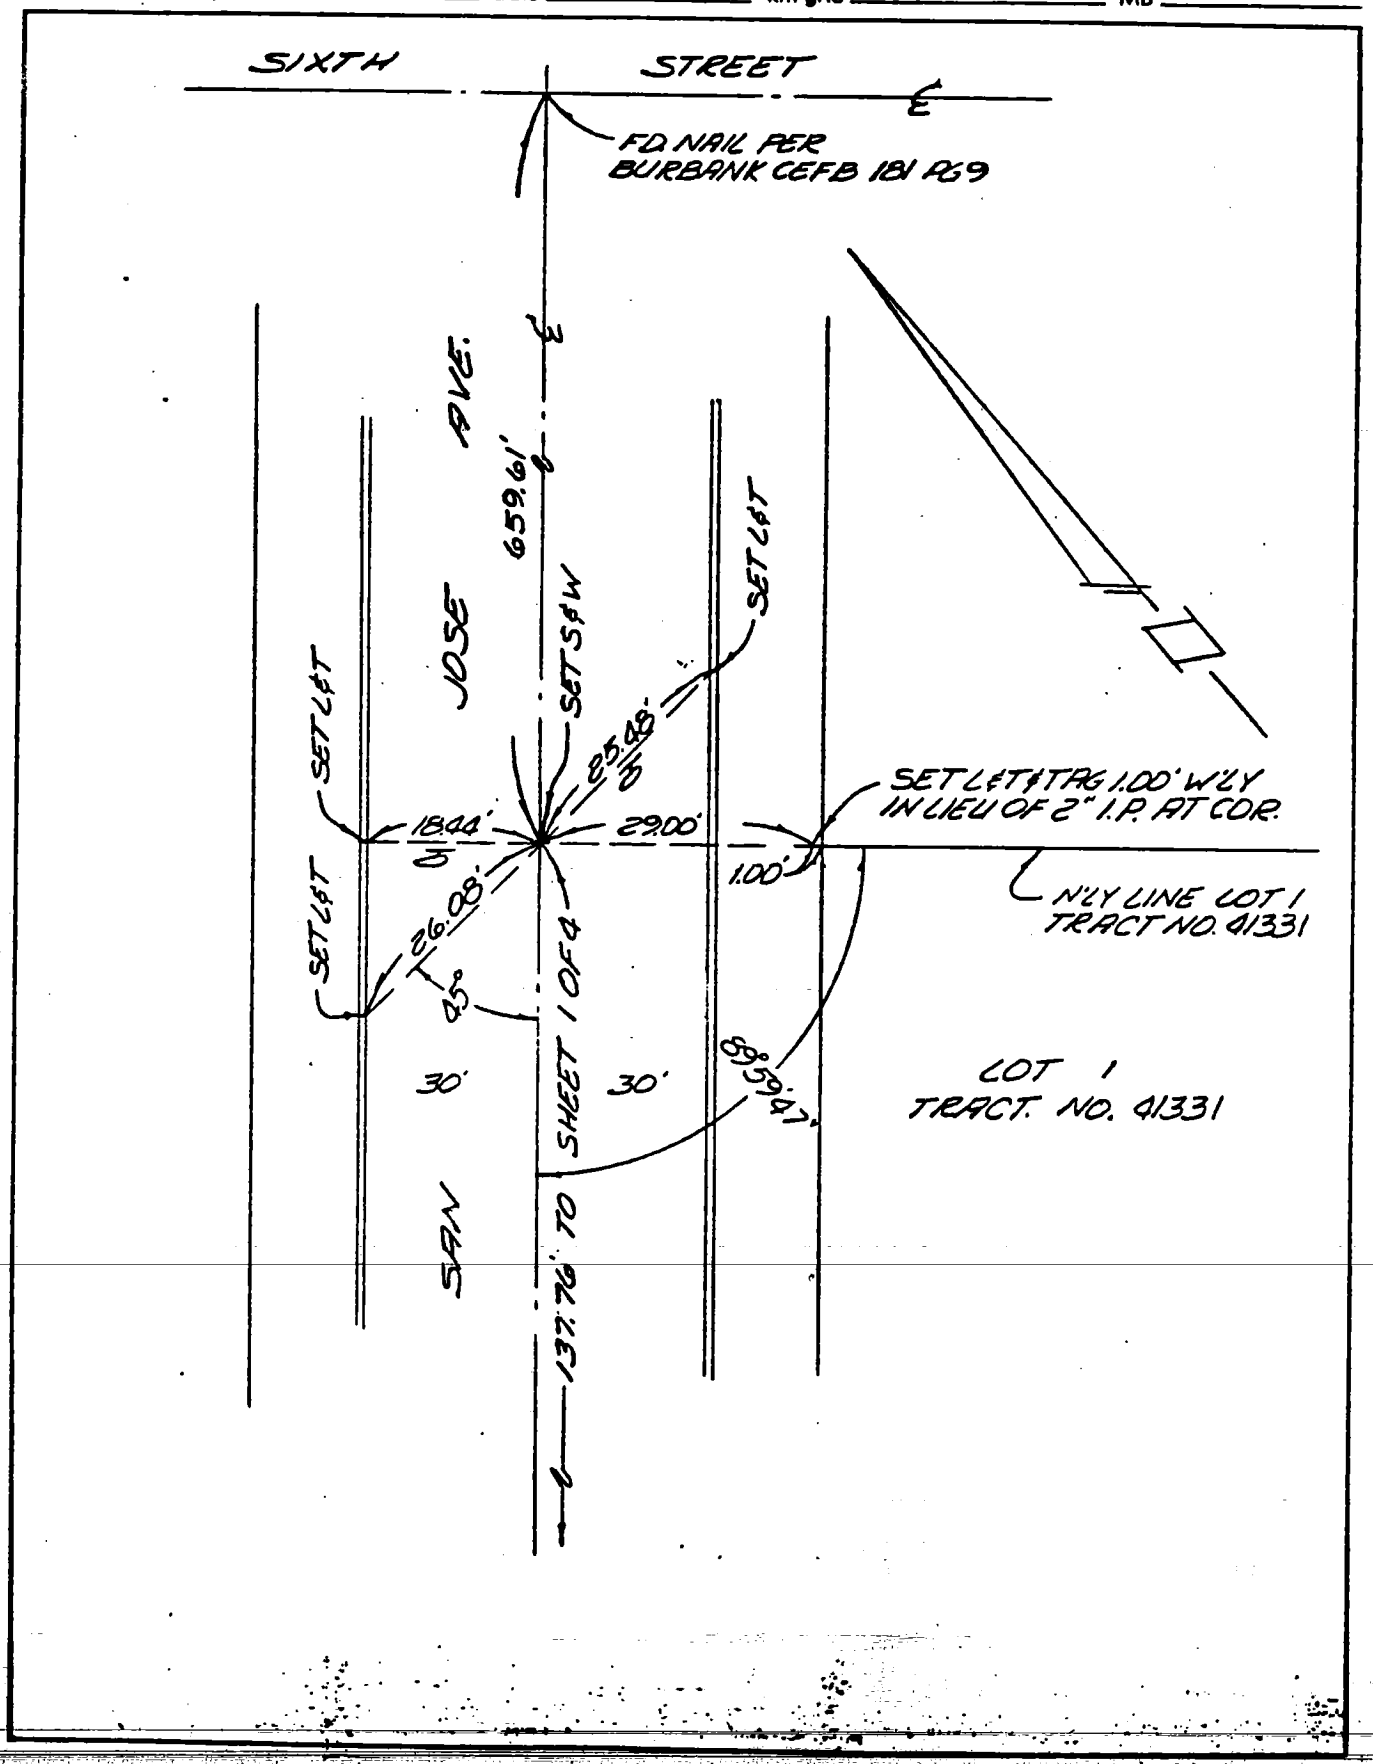

Return original to
BUREAU OF ENGINEERING
SURVEY DIVISION, Rm. 835
200 N. Main St. — Los Angeles 90012

Ground Dist. × Correction Factor: _____ = Grid Distance

ENG. 3.8838 (12/78)
Title & Plat Sheet
50% Reg

107

Surveyed by — WAGNER-KERP & ASSOC Date 10-19-81 F.B. _____ CO ENG FB 3656 - 107 Pg.

Type of Survey CENTERLINE TIES Sheet 3 of 4

Distances corrected to 68° _____ Monuments tagged _____ LS # 3164 Tract or RCE # _____ Parcel Map # 41331

Checked by _____ Date _____ km grid _____ MB _____

W.S. 40 C-2 (36)

NOTE: Additions or changes must be initialed, and dated.

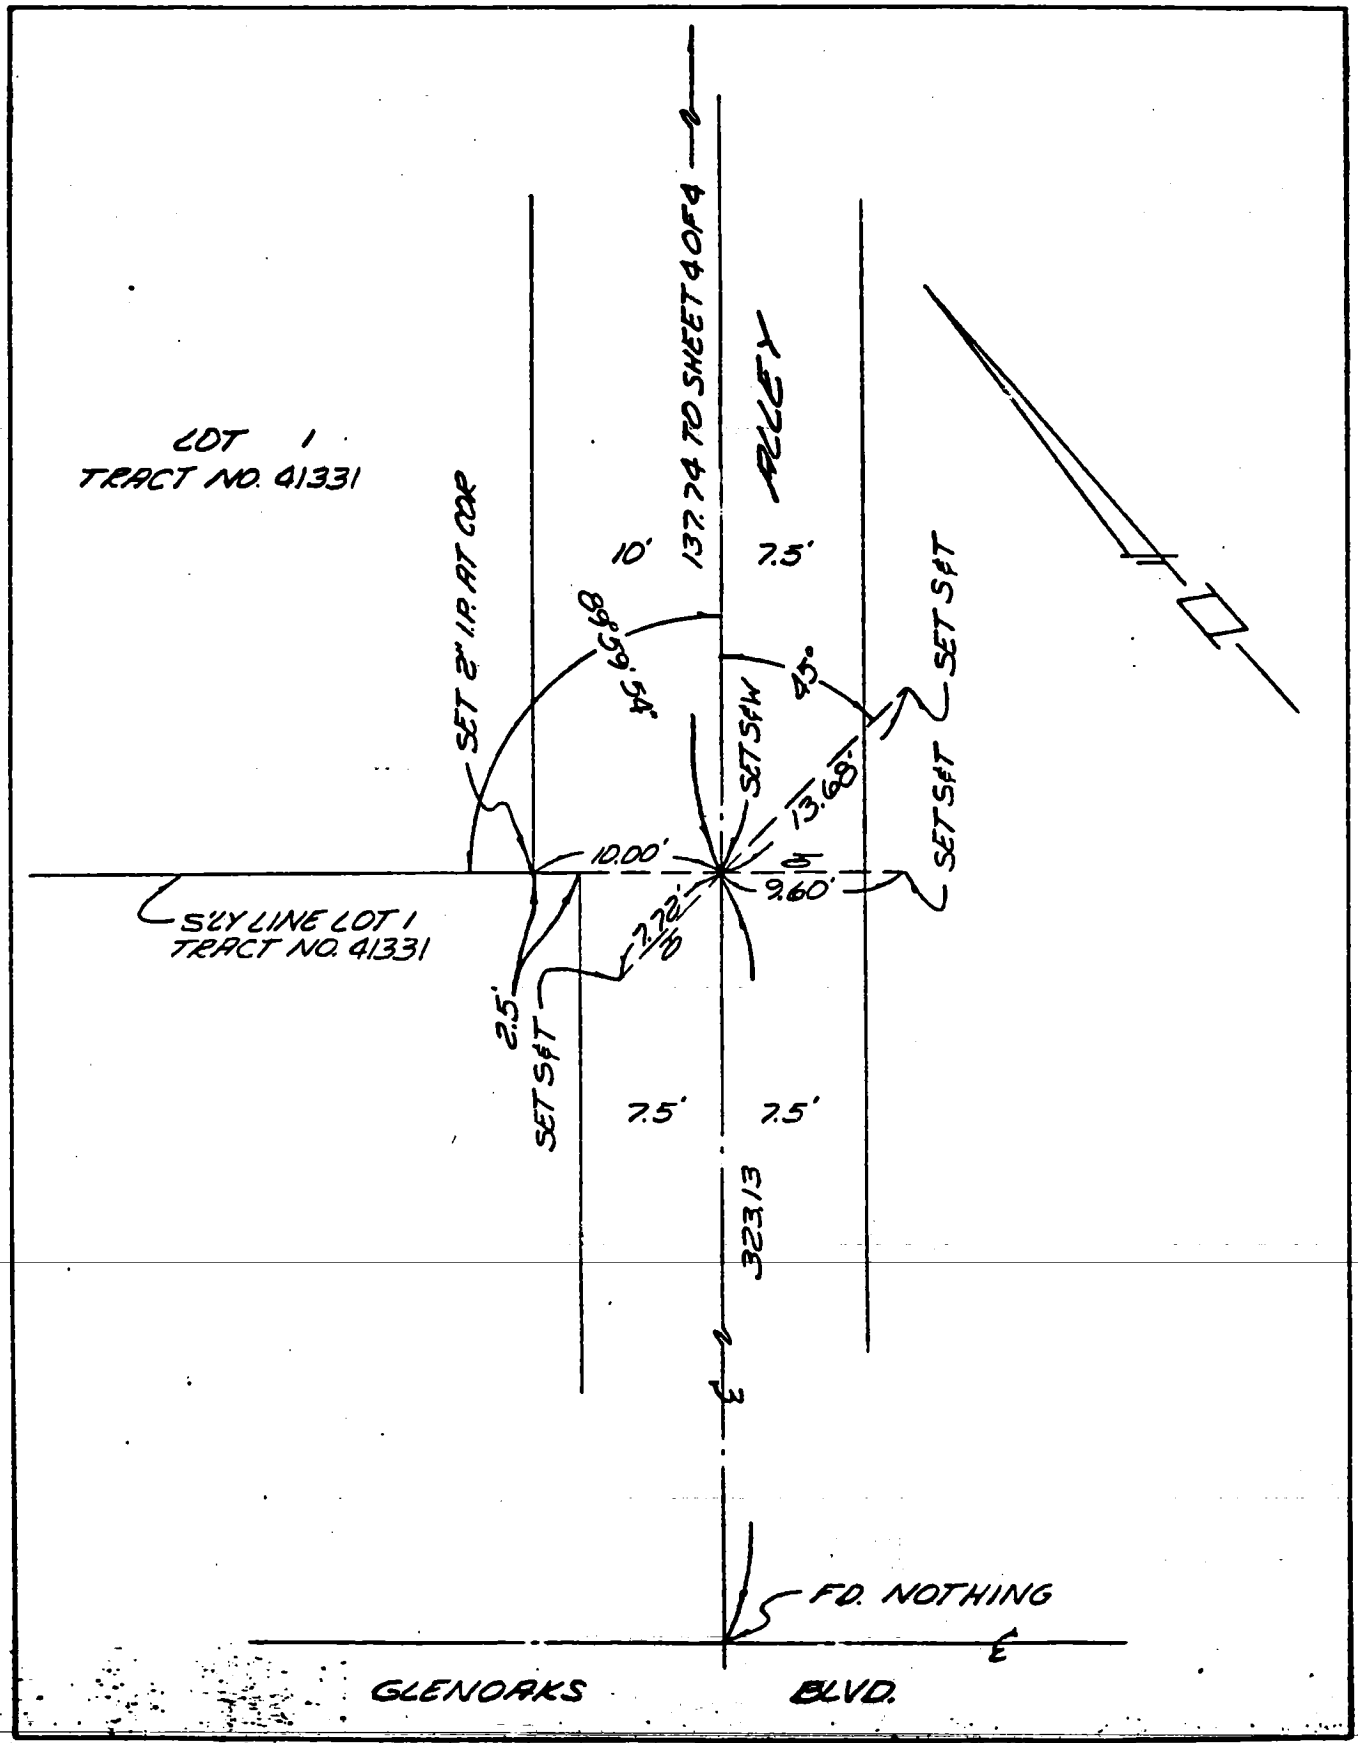

Return original to
BUREAU OF ENGINEERING
SURVEY DIVISION, Rm. 835
200 N. Main St. — Los Angeles 90012

Ground Dist. X Correction Factor: _____ = Grid Distance

Micro-film 5x Mon Index

ENG: 3.8838 (12/78)
Title & Plat Sheet
50% Rag

108

Surveyed by — WAGNER-KERR & ASSOC Date 10-19-81 F.B. _____ Pg. _____

CO ENG FB 3656 - 108

Type of Survey CENTERLINE TIES Sheet 4 of 4

Distances corrected to 68° _____ Monuments tagged _____ LS # 3169 Tract or ~~RCE #~~ _____ Parcel Map # 41331

Checked by _____ Date _____ km grid _____ MB _____

W. St 40, C-2 (36)

NOTE: Additions or changes must be initialed, and dated.

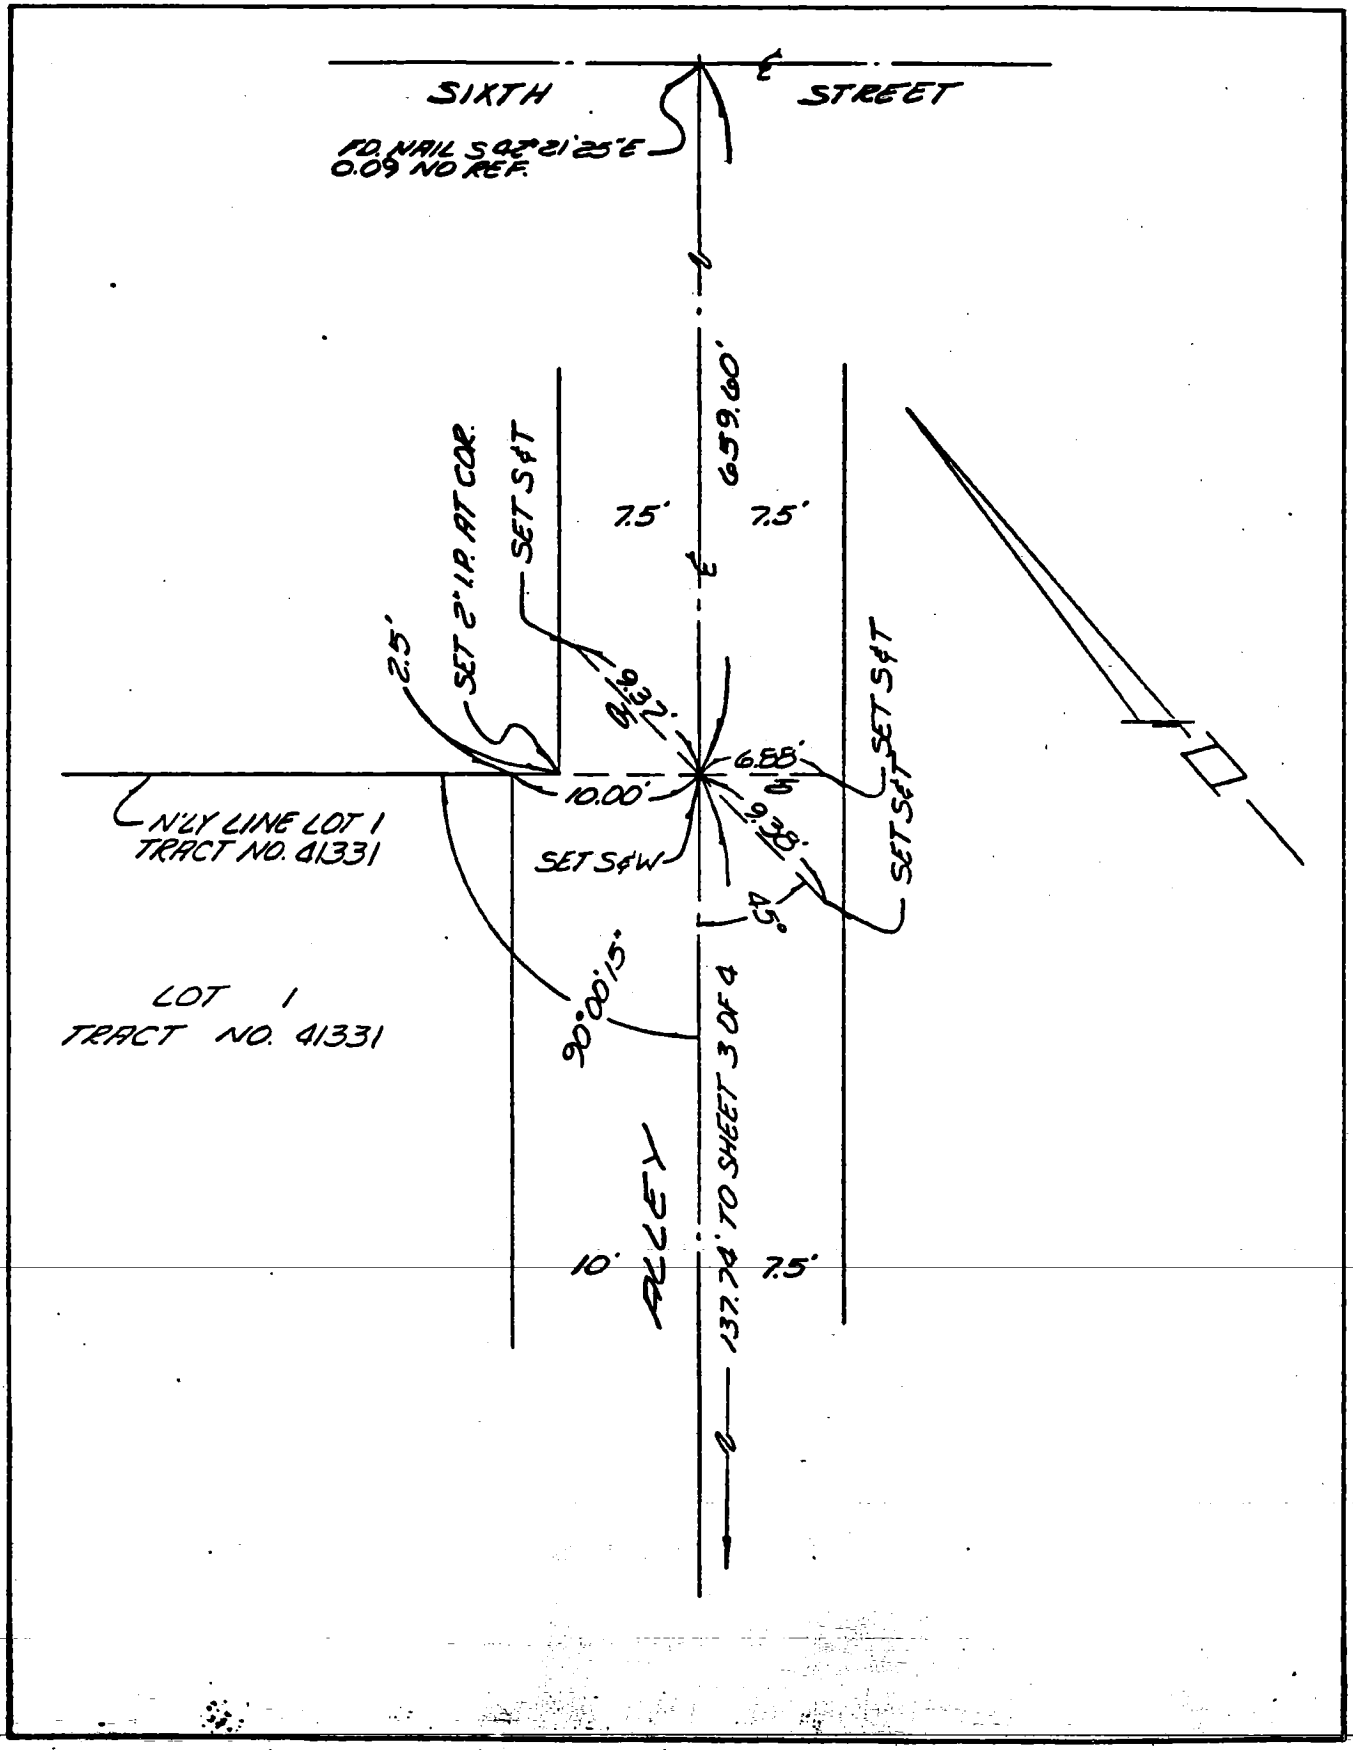

Return original to
BUREAU OF ENGINEERING
SURVEY DIVISION, Rm. 835
200 N. Main St. — Los Angeles 90012

Ground Dist. X Correction Factor: _____ = Grid Distance

Micro-film _____ St Map _____ Index _____

109

CO ENG FB 3656 - 109

SURVEY OF ℄ TIES - SIERRA MADRE BLVD. F. B. ____ PG. ____

SURVEY BY LOREN PHILLIPS & ASSOC. TR. No. 39941

DATE SEPT. 1981

W.S. 44, B-3 (139)

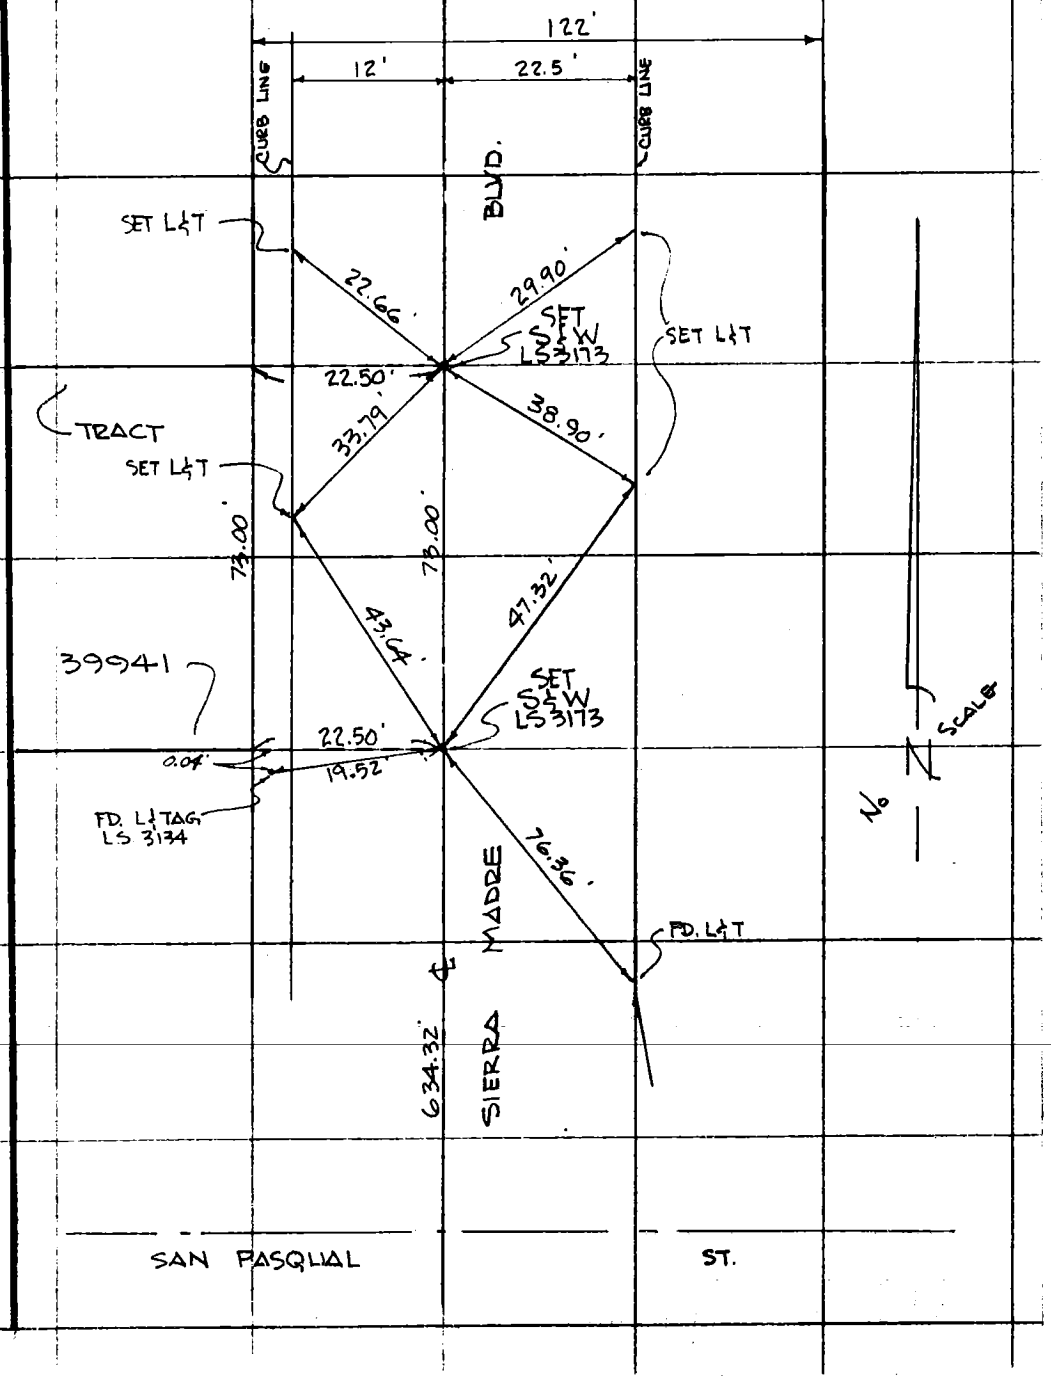

SO. CALIF. BLUE PRINT CO.

CO ENG FB 3656 - 110

Notes Ck'd by	Survey of TRACT NO 38345
Map No.	JN Tape Std °F
Office Work	Surveyed by William Rose & Assoc. Inc.
Checked	Notes 2 Ties Date 9-1-81
Date	Indexed

F.B. PG. 1 OF 3

LEGEND

● - SET SPK. & WASHER STAMPED L.S. 3479

○ - SET SPK & TIN

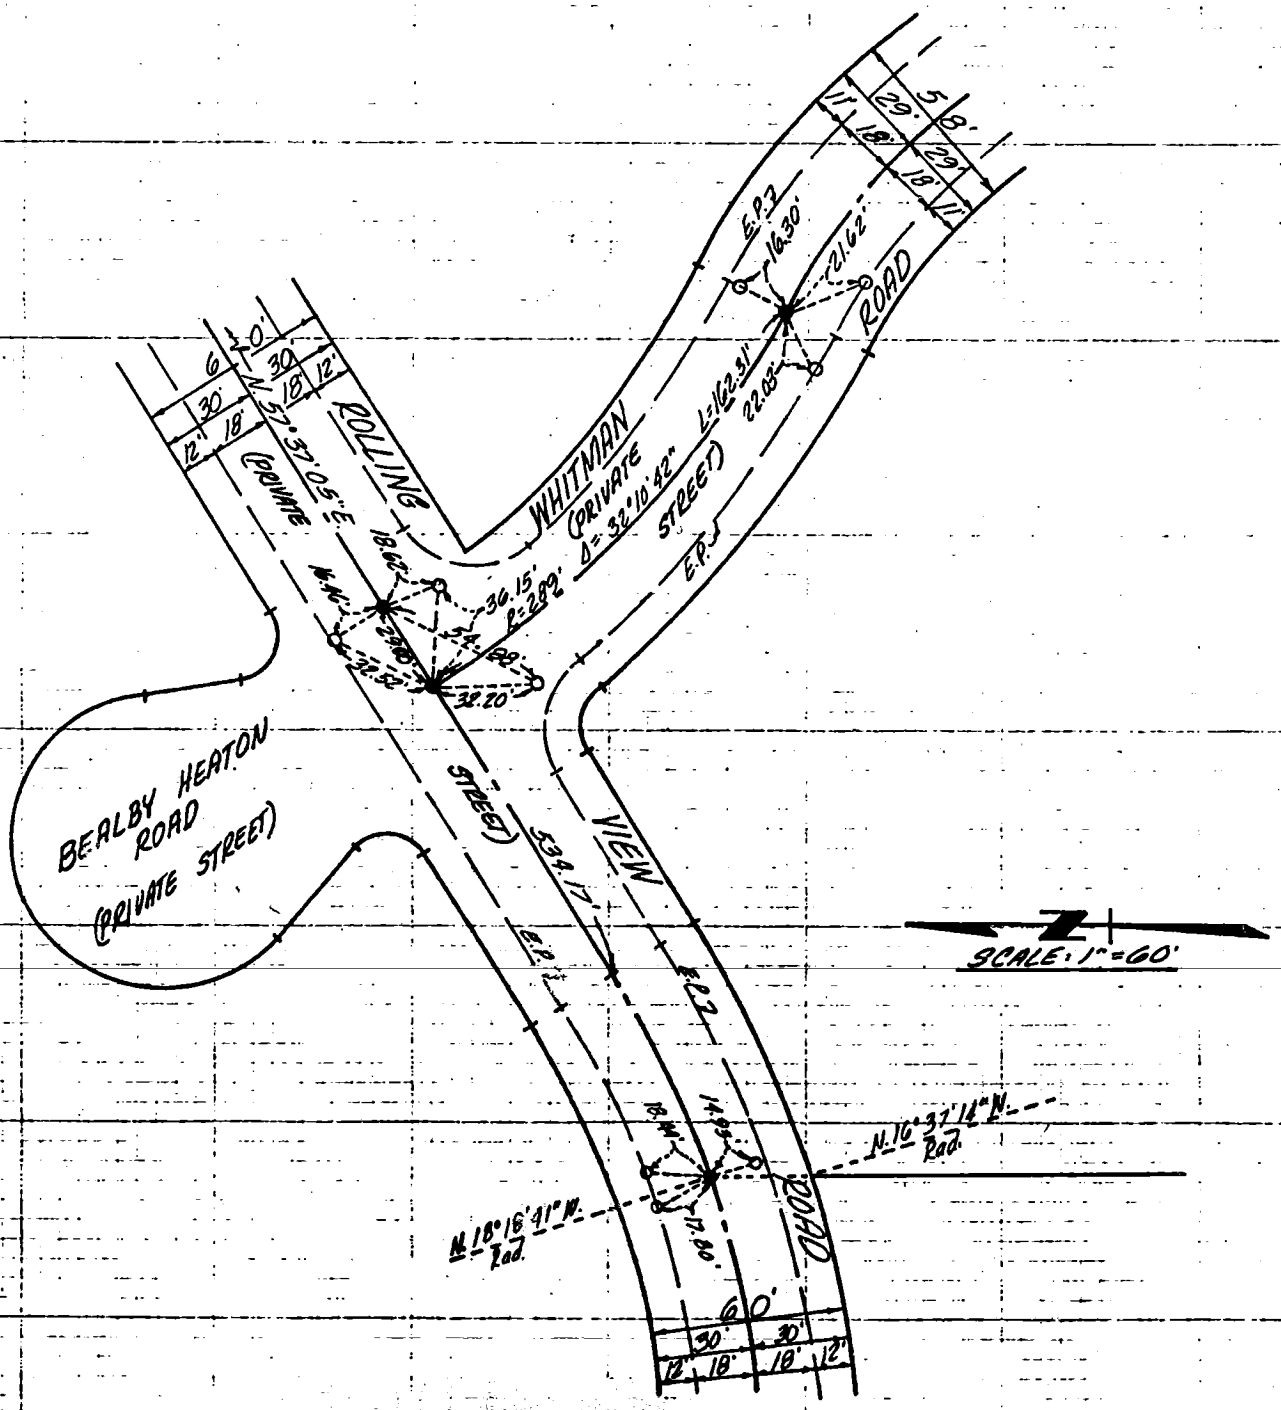

NOTE: ANY CHANGES ON THIS SHEET MUST BE MADE OR CIRCLED IN RED INK WITH DATE AND NAME OF PERSON MAKING CHANGE

Do not extend notes this side of this line

159-077 B-1 (67)

111

NEWLINE NOTES

F 095-473

111

CO ENG FB 3656 - 111

F.B. _____ PG. 20/3

Notes Ck'd by	Survey of TRACT NO. 38345
Map No.	JN _____ Tape _____ Std _____ °F
Office Work	Surveyed by William Rose & Assoc. Inc.
Checked	Notes & Ties Date 9-1-81
Date	Indexed

LEGEND

● - SET SPK. & WASHER STAMPED L.S. 3479

○ - SET SPK. & TIN

SCALE: 1"=60'

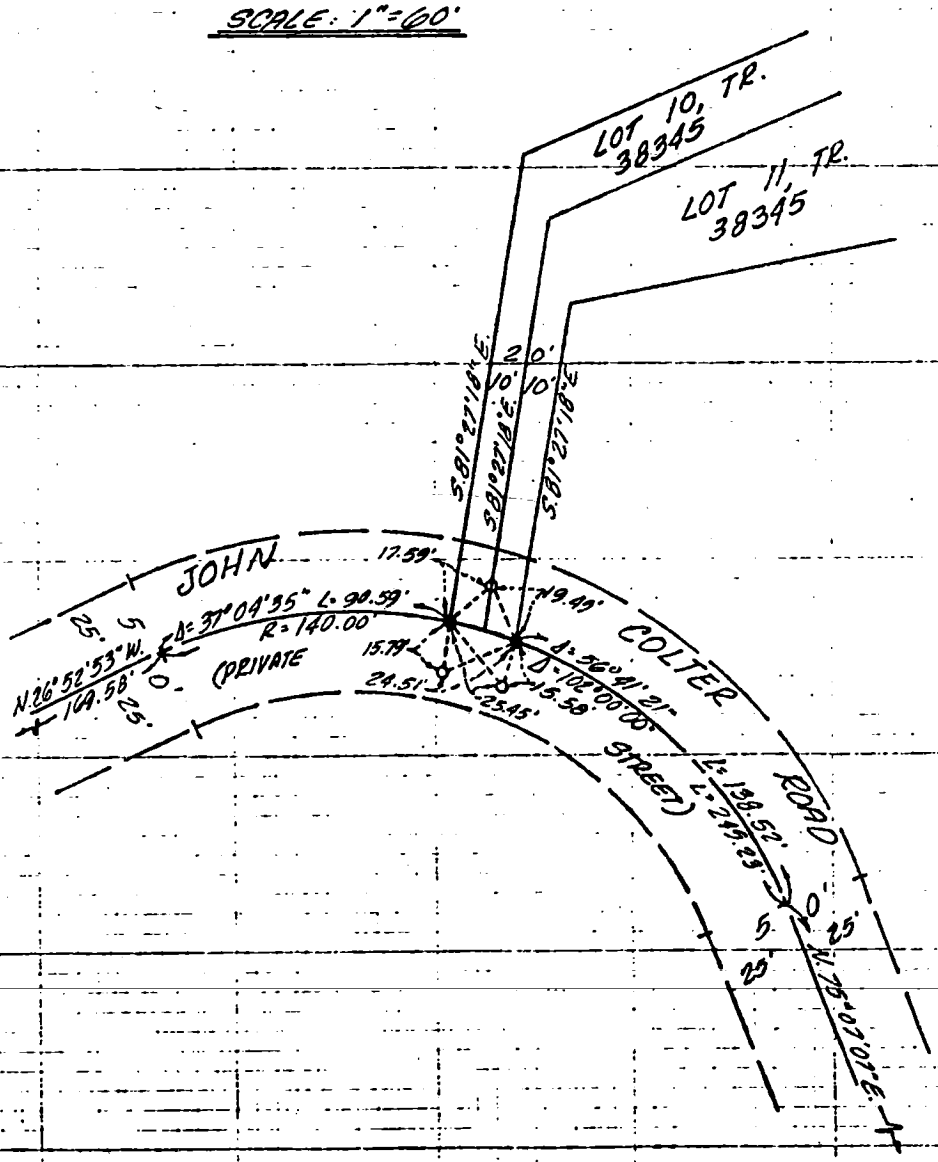

NOTE: ANY ADDITIONS OR CHANGES ON THIS SHEET MUST BE MADE OR CIRCLED IN RED INK WITH DATE AND NAME OF PERSON MAKING CHANGE

Do not extend notes side of this line 159-017, B-1 (19)

111

ENGINEERING NOTES

3 395-473

B. PG.

pg 3 of 3.

112

CO ENG FB 3656 - 112

LEGEND

- ● - SET SPK. & WASHER STAMPED L.S. 3479
- o - SET SPK. & TIN

TR. No 38345

W. Rose & Ass.

9-1-81.

159-07, B-16 (8)

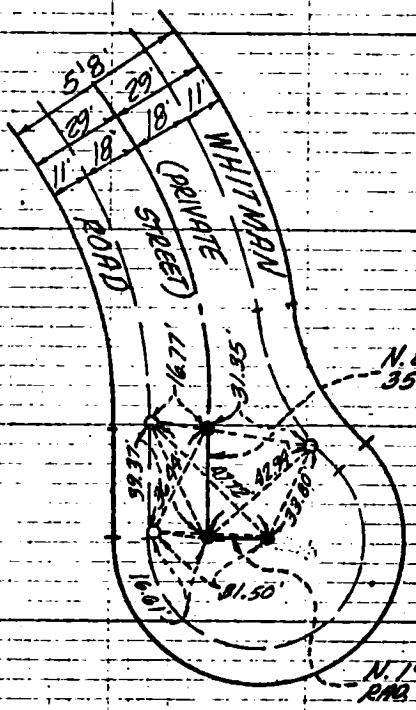

SCALE: 1"=60'

Do not extend notes this side of this line

SURVEY OF Centerline Ties SHT 1 OF 6 SHTS

SURVEY BY Wesley R. Lind R.C.E. 16362

DATE Oct. 20, 1981 TR. No. 32530

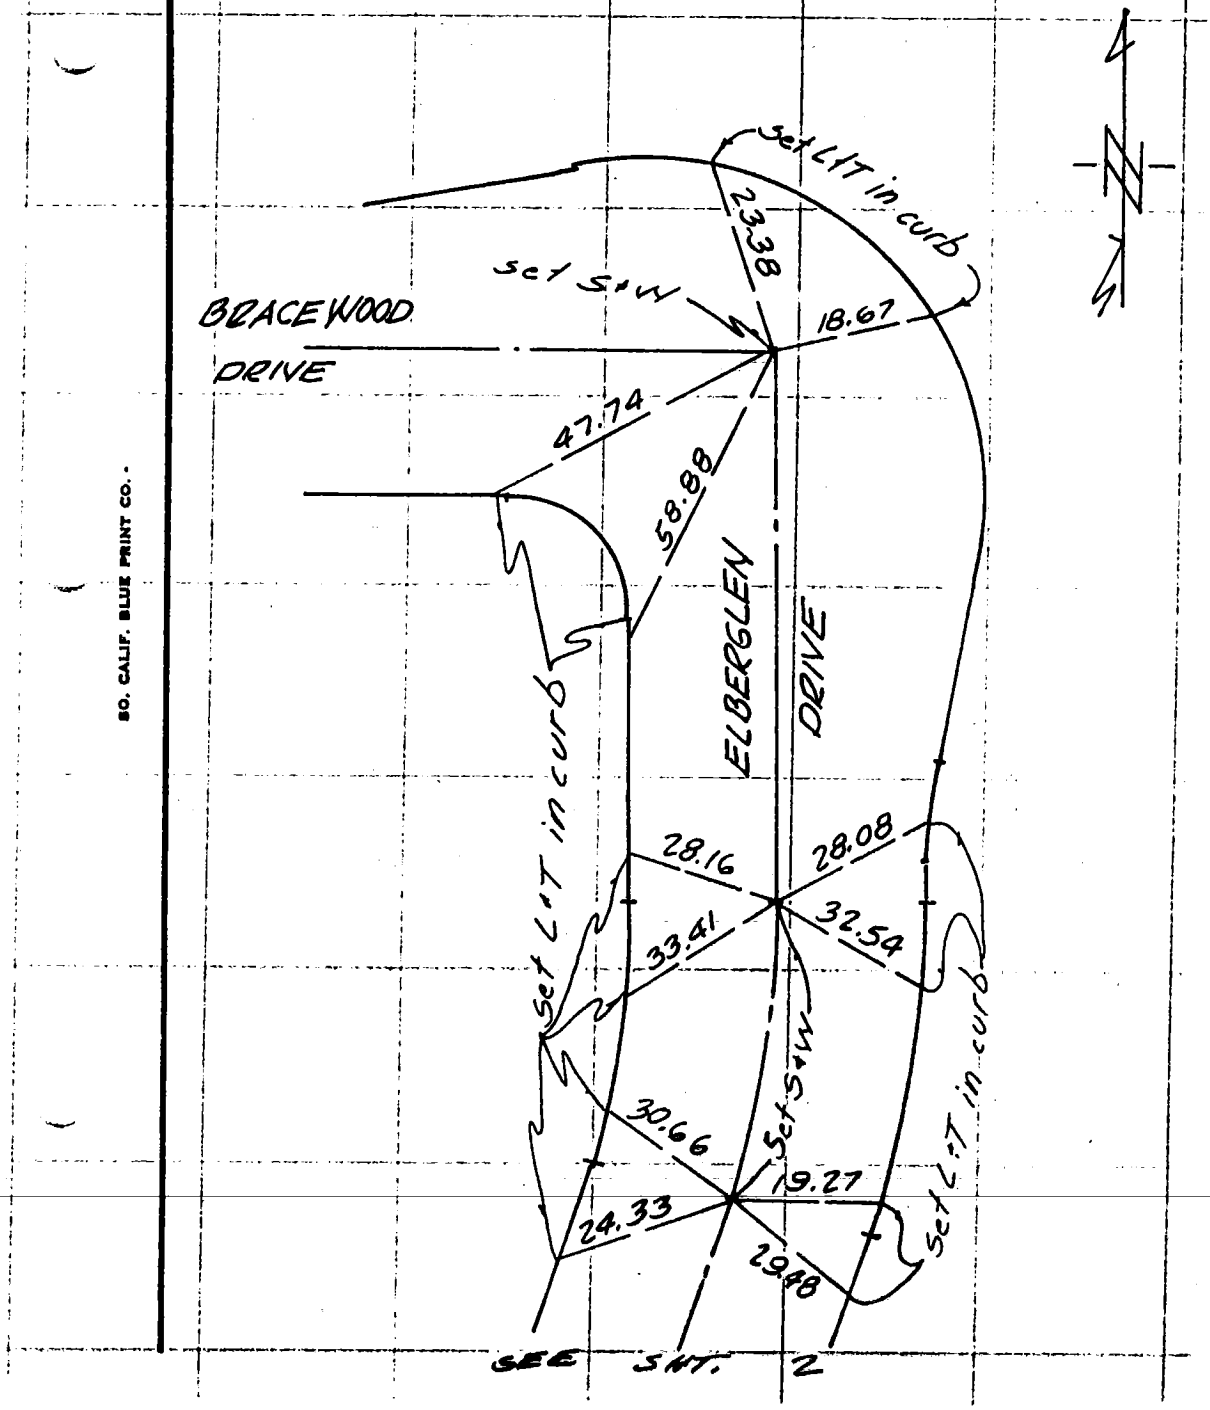

SO. CALIF. BLUE PRINT CO.

099-291, B-2 (51)

SURVEY OF Centerline Ties SHT 2 OF 6 SHTS

SURVEY BY Wesley R. Lind R.C.E. 16362 TR. No. 32530

DATE Oct 20, 1981

099-297, B-2 (51) (52)

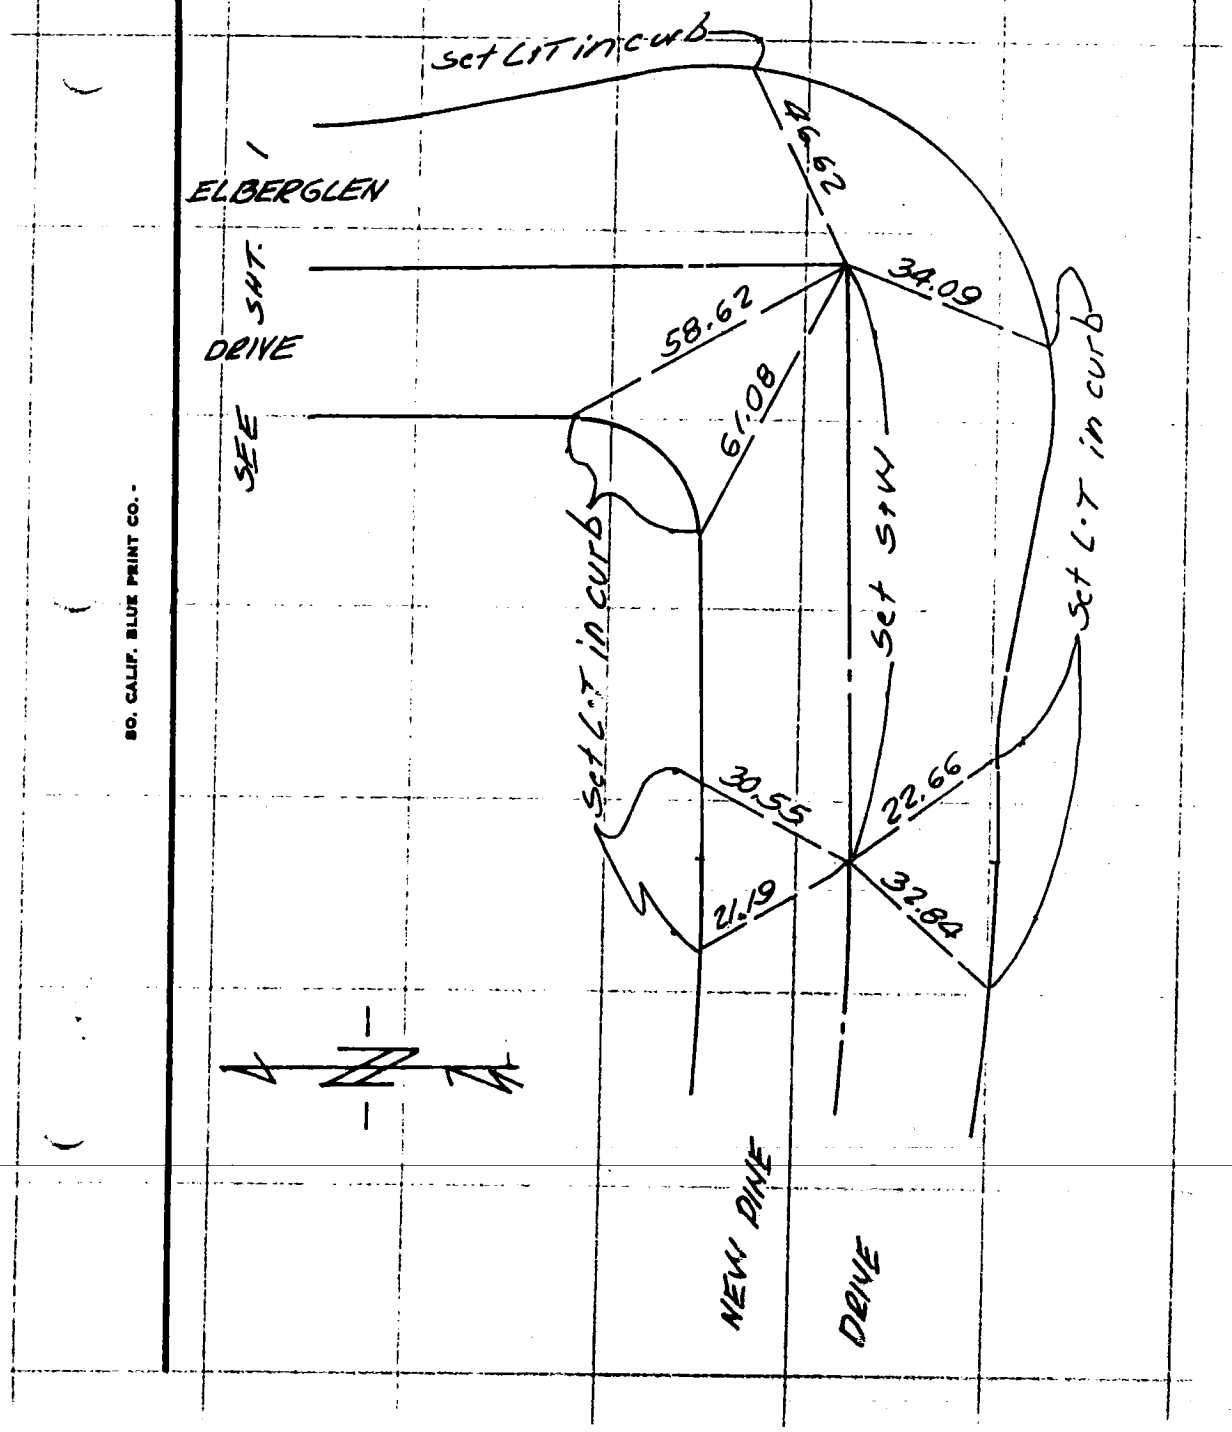

SO. CALIF. BLUE PRINT CO.

115

SHT 3 OF 6 SHTS

SURVEY OF Centerline Ties

SURVEY BY Wesley R. Lind R.C.E. 16362

DATE Oct 20, 1981

TR. No. 32530

SEE SHT 4.

099-297, B-2

SO. CALIF. BLUE PRINT CO.

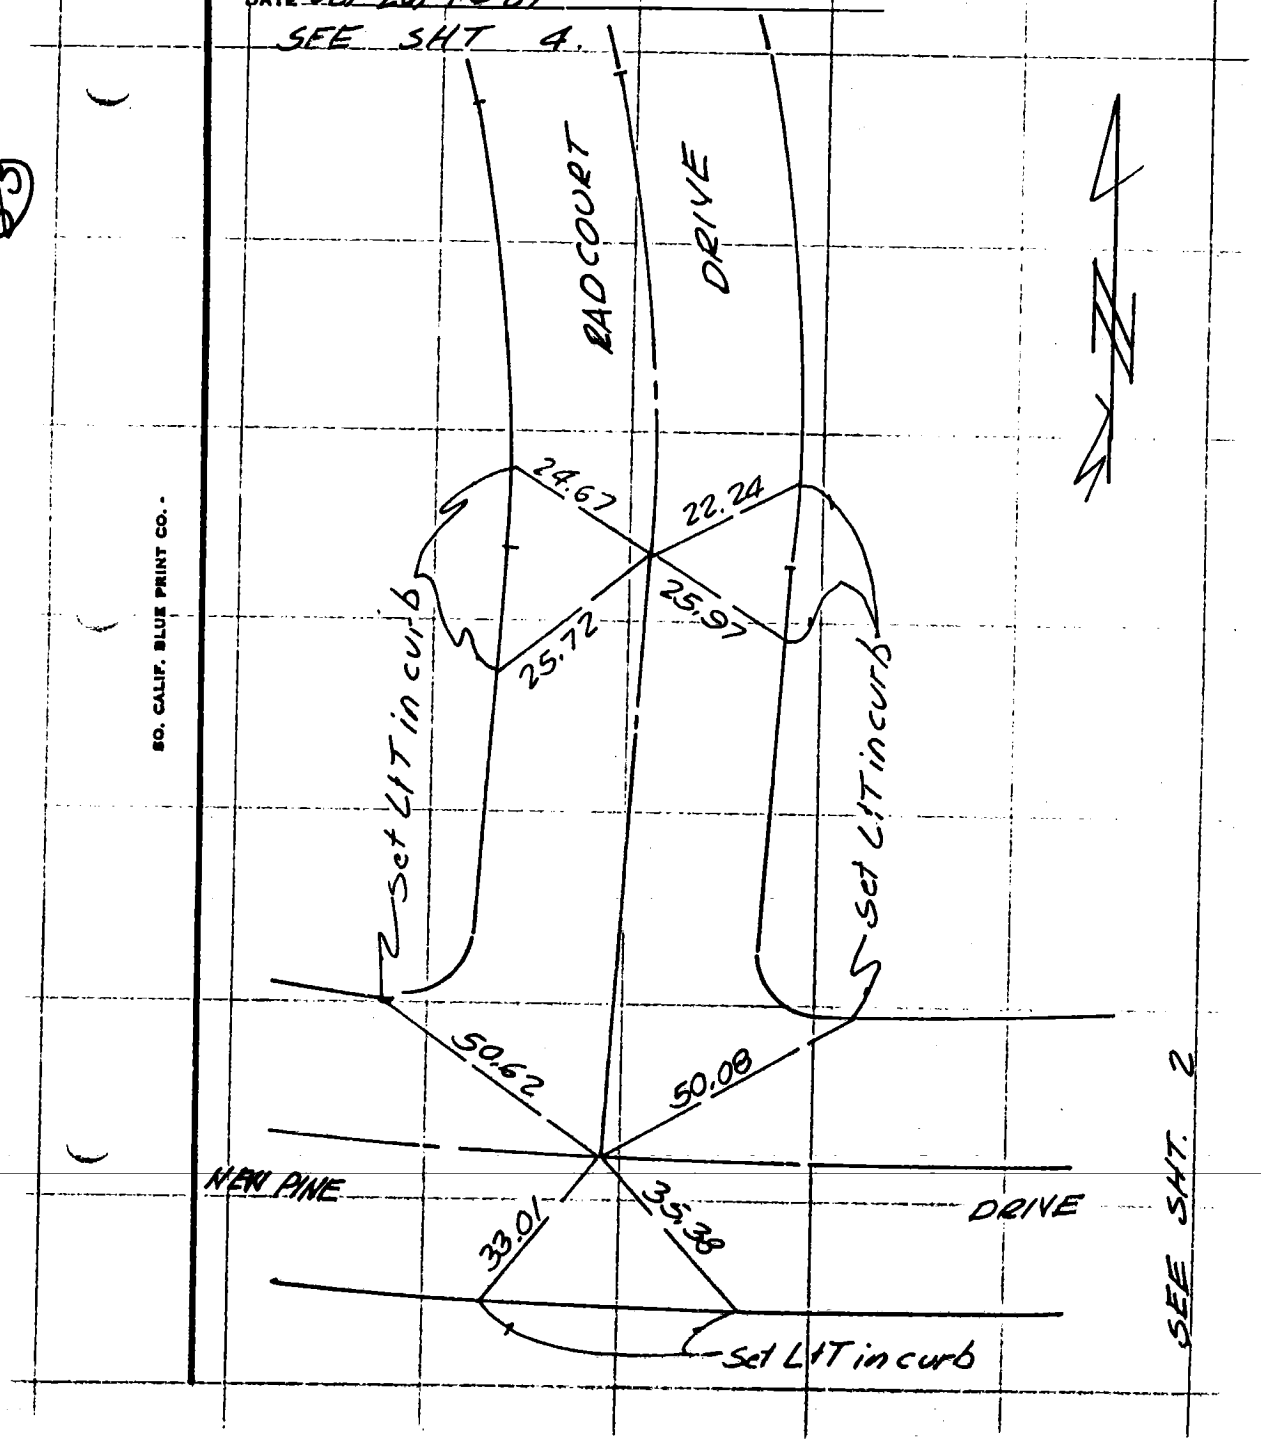

CO ENG FB 3656 - 116

099-297, B-2 (54)

SHT 4 OF 6 SHTS.

SURVEY OF Centerline Ties

SURVEY BY Wesley R. Lind R.C.E. 16362

DATE Oct 20, 1981

TR. No. 32530

SO. CALIF. BLUE PRINT CO.

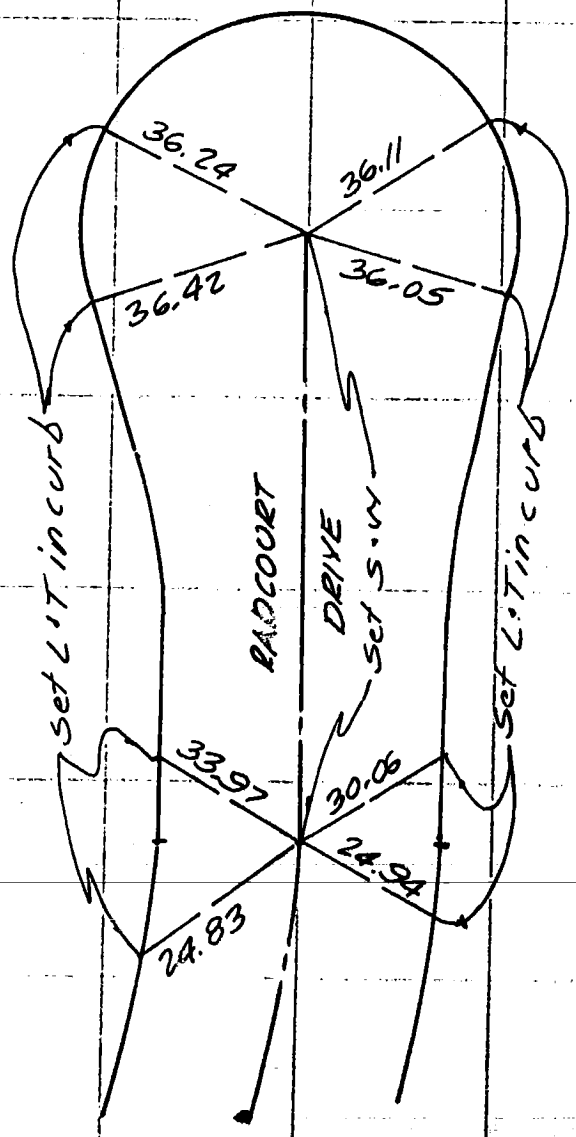

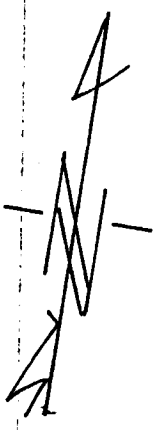

SEE SHT. 3

CO ENG GB 3656 - 117

099-297, B-7 (53)

SURVEY OF Centerline Tics SHT 5 OF 6 SHTS

SURVEY BY Wesley R. Lind R.C.E. 16362

DATE Oct 20, 1981

TR. No. 32530

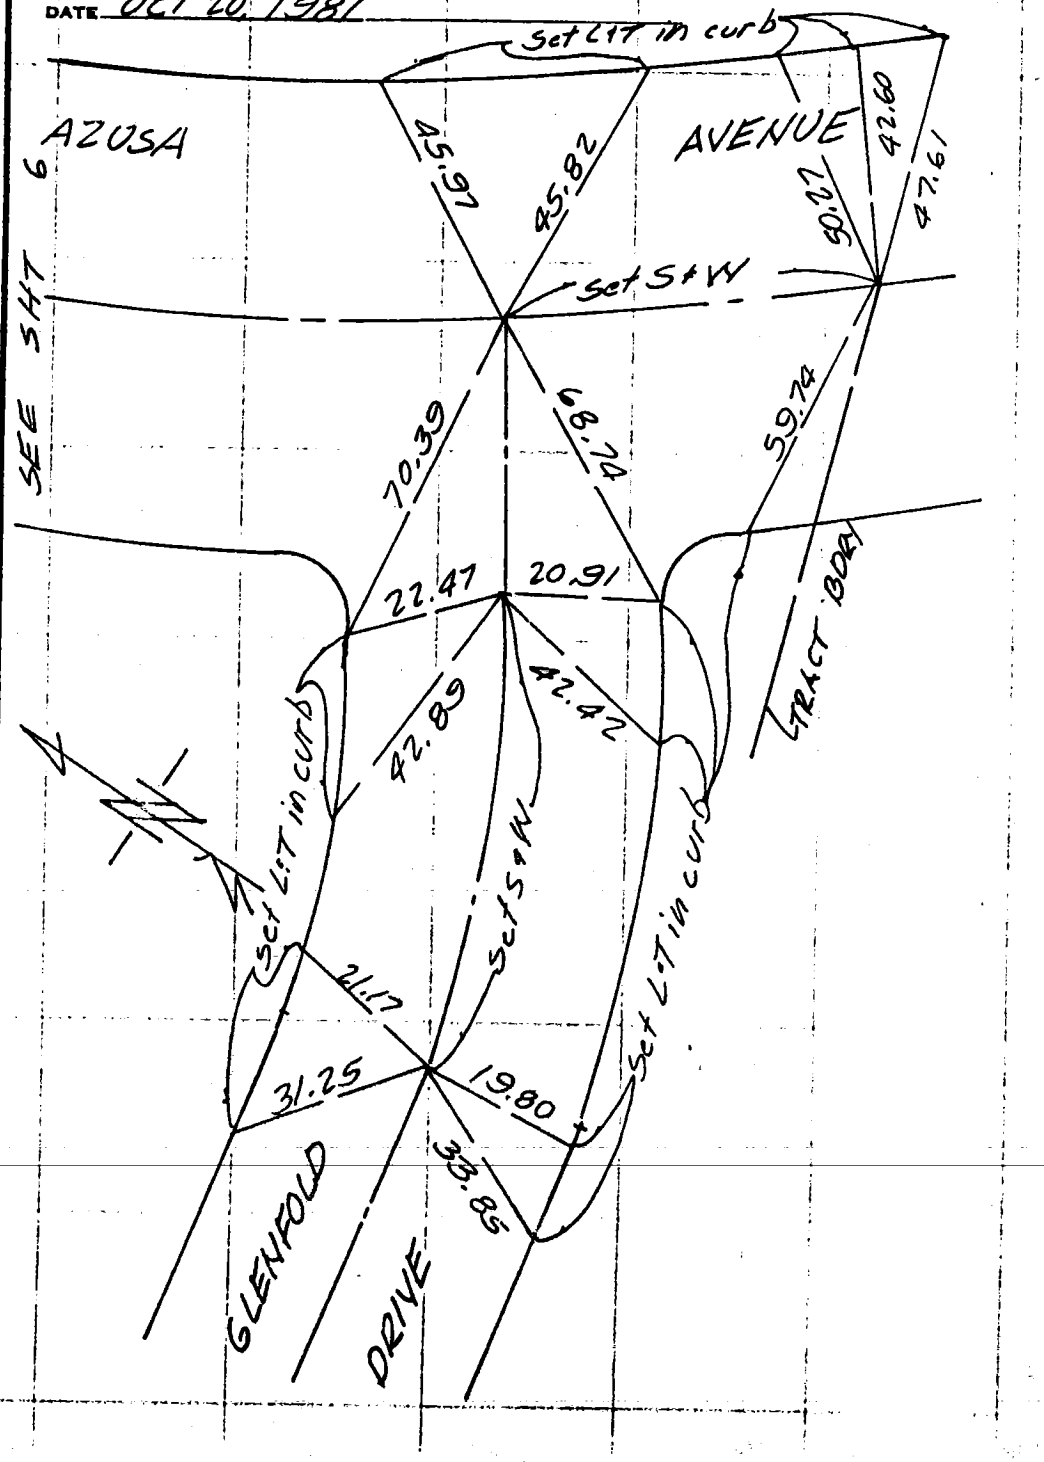

SO. CALIF. BLUE PRINT CO.

SURVEY OF Centerline Ties — SHT. 6 OF 6 SHTS

SURVEY BY Wesley R. Lind R.C.E. 16362 — TR. No. 32530

DATE Oct 20, 1981

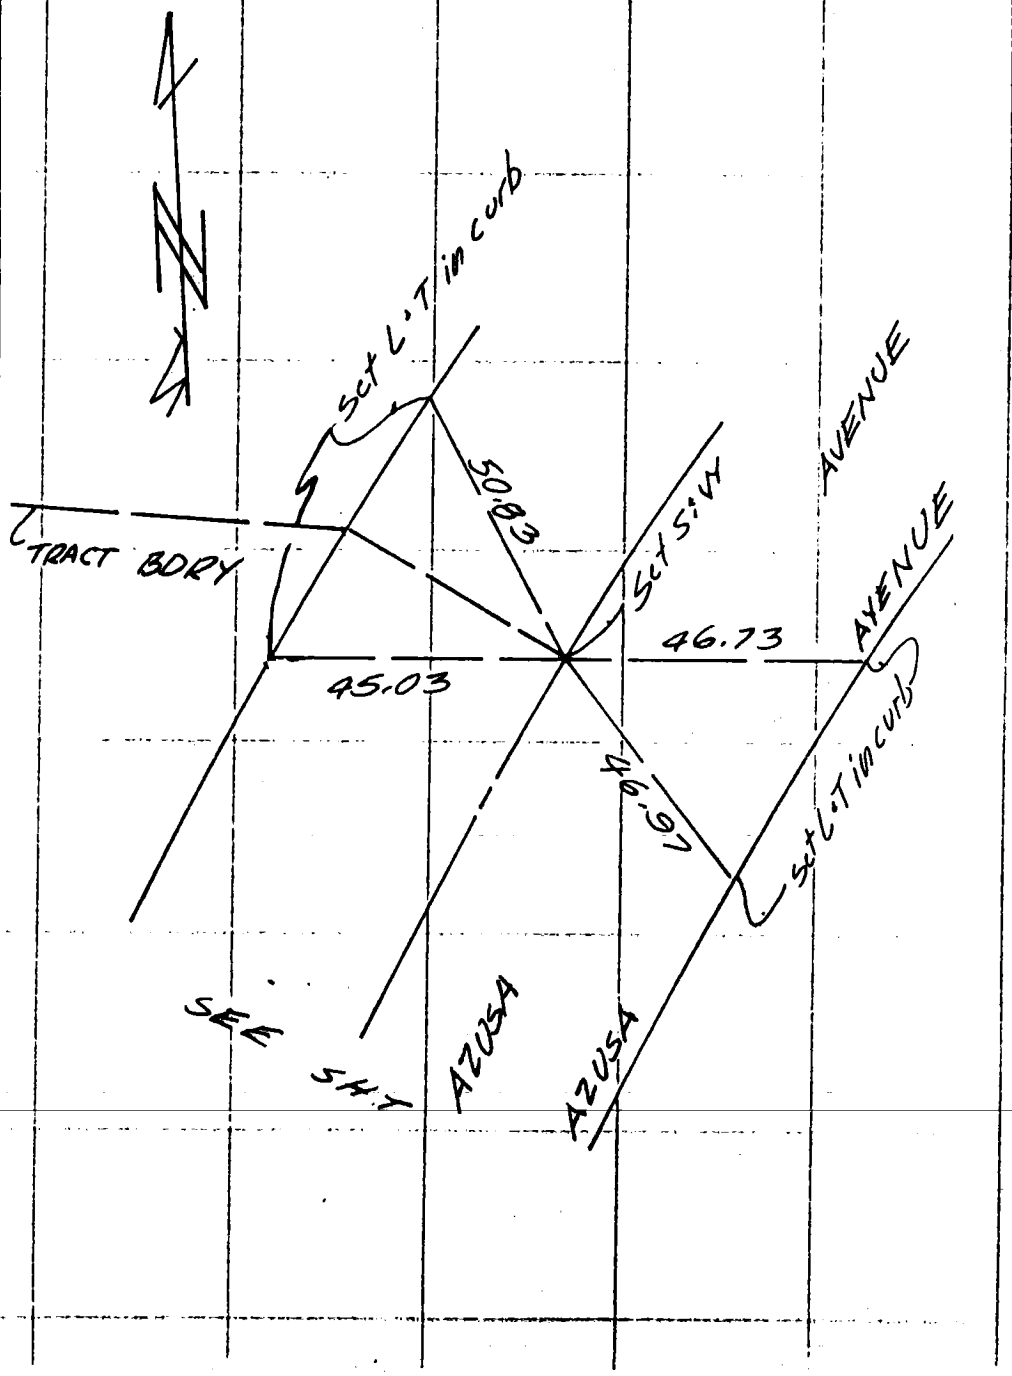

099-297, B-2

SO. CALIF. BLUE PRINT CO.

CO ENG FB 3656 - 119

119

SURVEY OF CENTERLINE TIES F. B. ____ Pg. ____

SURVEY BY WILLIAM L. SCHULZ L.S. 3222 TR. No. 40771

DATE OCTOBER 16, 1981

084-227, B-2 (296)

SO. CALIF. . . PRINT CO.

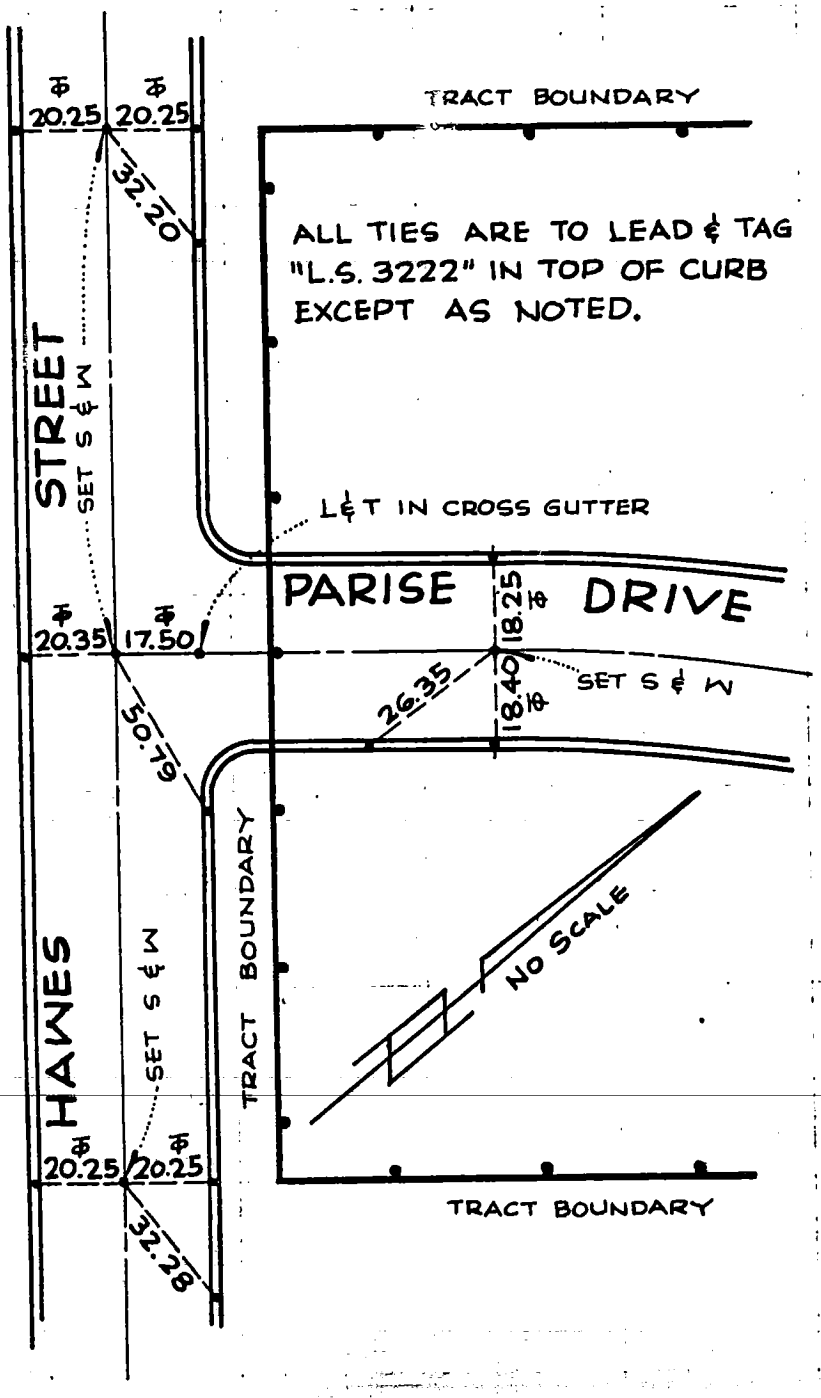

110 CO ENG FB 3656 - 120

SURVEY OF CENTERLINE TIES F. B. ____ PG. ____

SURVEY BY WILLIAM L. SCHULZ L.S.3222 TR. No. 40771

DATE OCTOBER 16, 1981

084-227,8-2

(297)

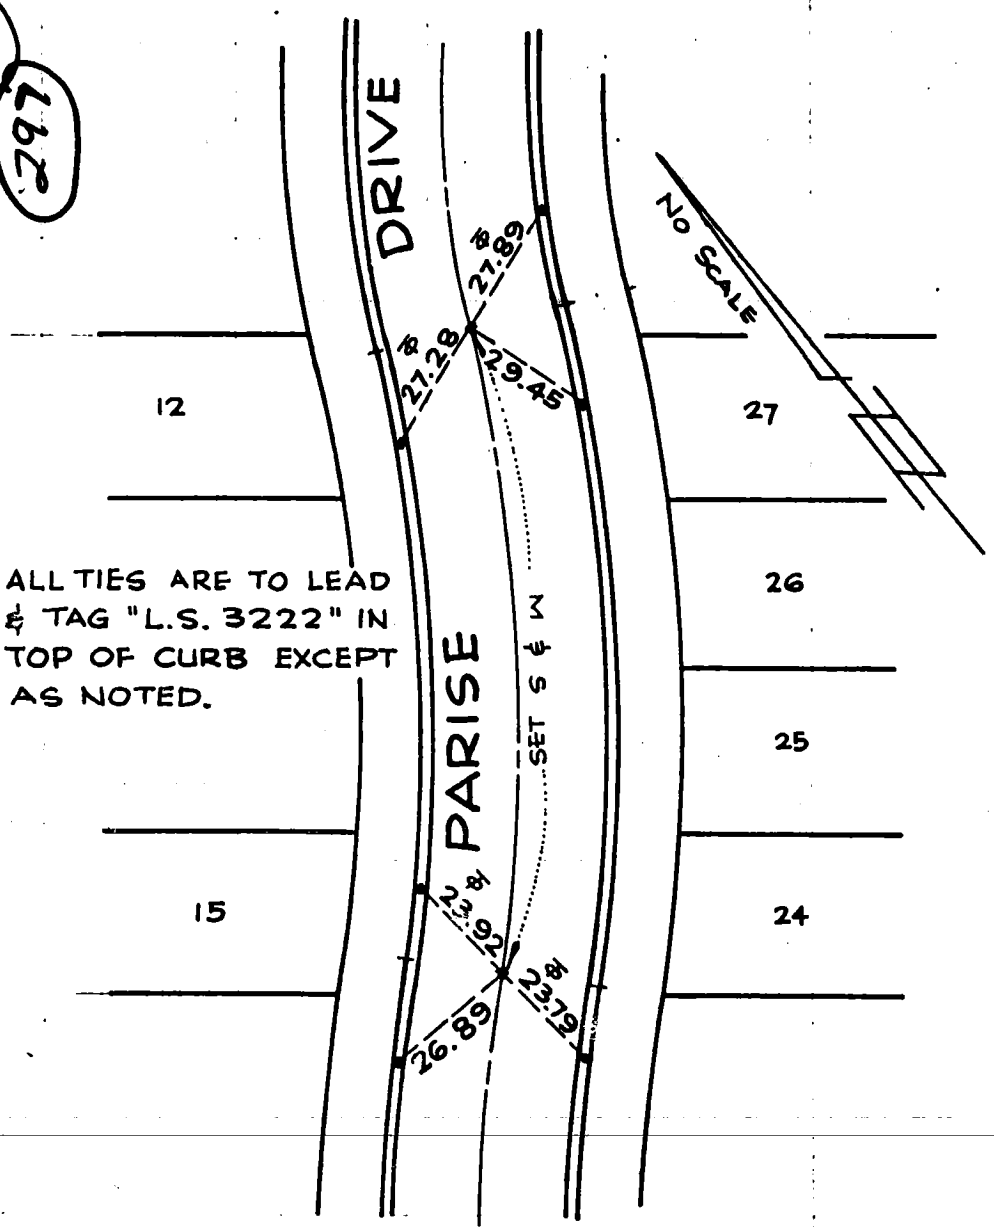

ALL TIES ARE TO LEAD & TAG "L.S. 3222" IN TOP OF CURB EXCEPT AS NOTED.

SO. CALIF. BLUE PRINT CO.

121 CO ENG FB 3656 - 121

SURVEY OF CENTERLINE TIES F. B. ____ PG. ____

SURVEY BY WILLIAM L. SCHULZ L.S. 3222 TR. No. 40771

DATE OCTOBER 16, 1981

084-277, B-2 (254)

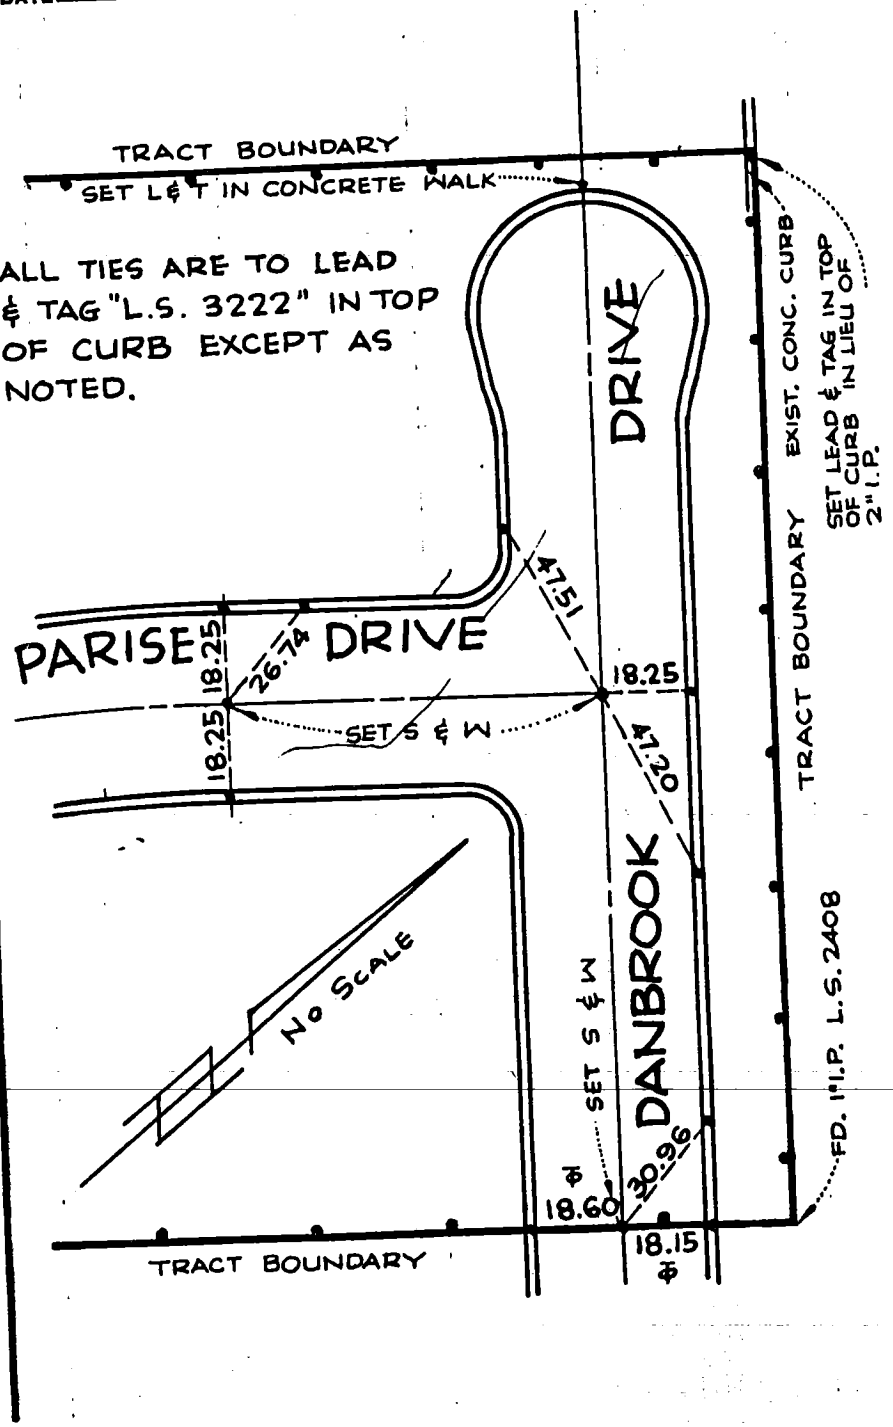

SO. CALIF. BLUE PRINT CO.

122

CO ENG FB 3656 - 122

SURVEY OF CENTERLINE TIES F. B. Pg.

SURVEY BY WILLIAM L. SCHULZ L.S. 3222 TR. No. 40771

DATE OCTOBER 16, 1981

084-277-B2 (29)

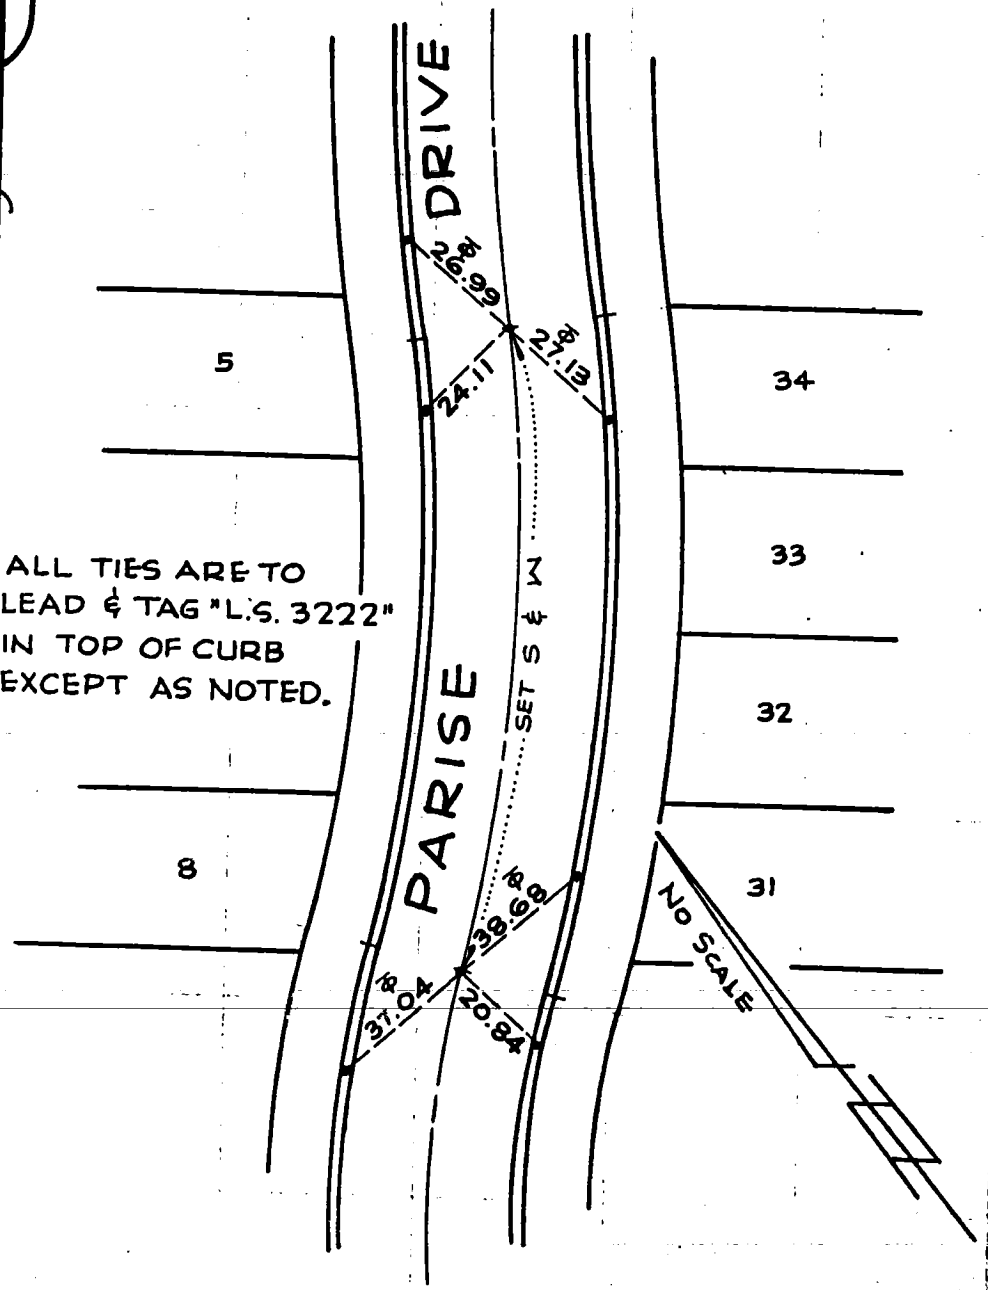

ALL TIES ARE TO LEAD & TAG "L.S. 3222" IN TOP OF CURB EXCEPT AS NOTED.

SO. CALIF. BLUE PRINT CO.

CO ENG FB 3656 - 122

PARCEL MAP NO. 14068 AUG. 2, 1981 PAGE 1 OF 1

SURVEY BY: EDWARD A. HYNES L.S. 3977

114-297, A-1 (233)

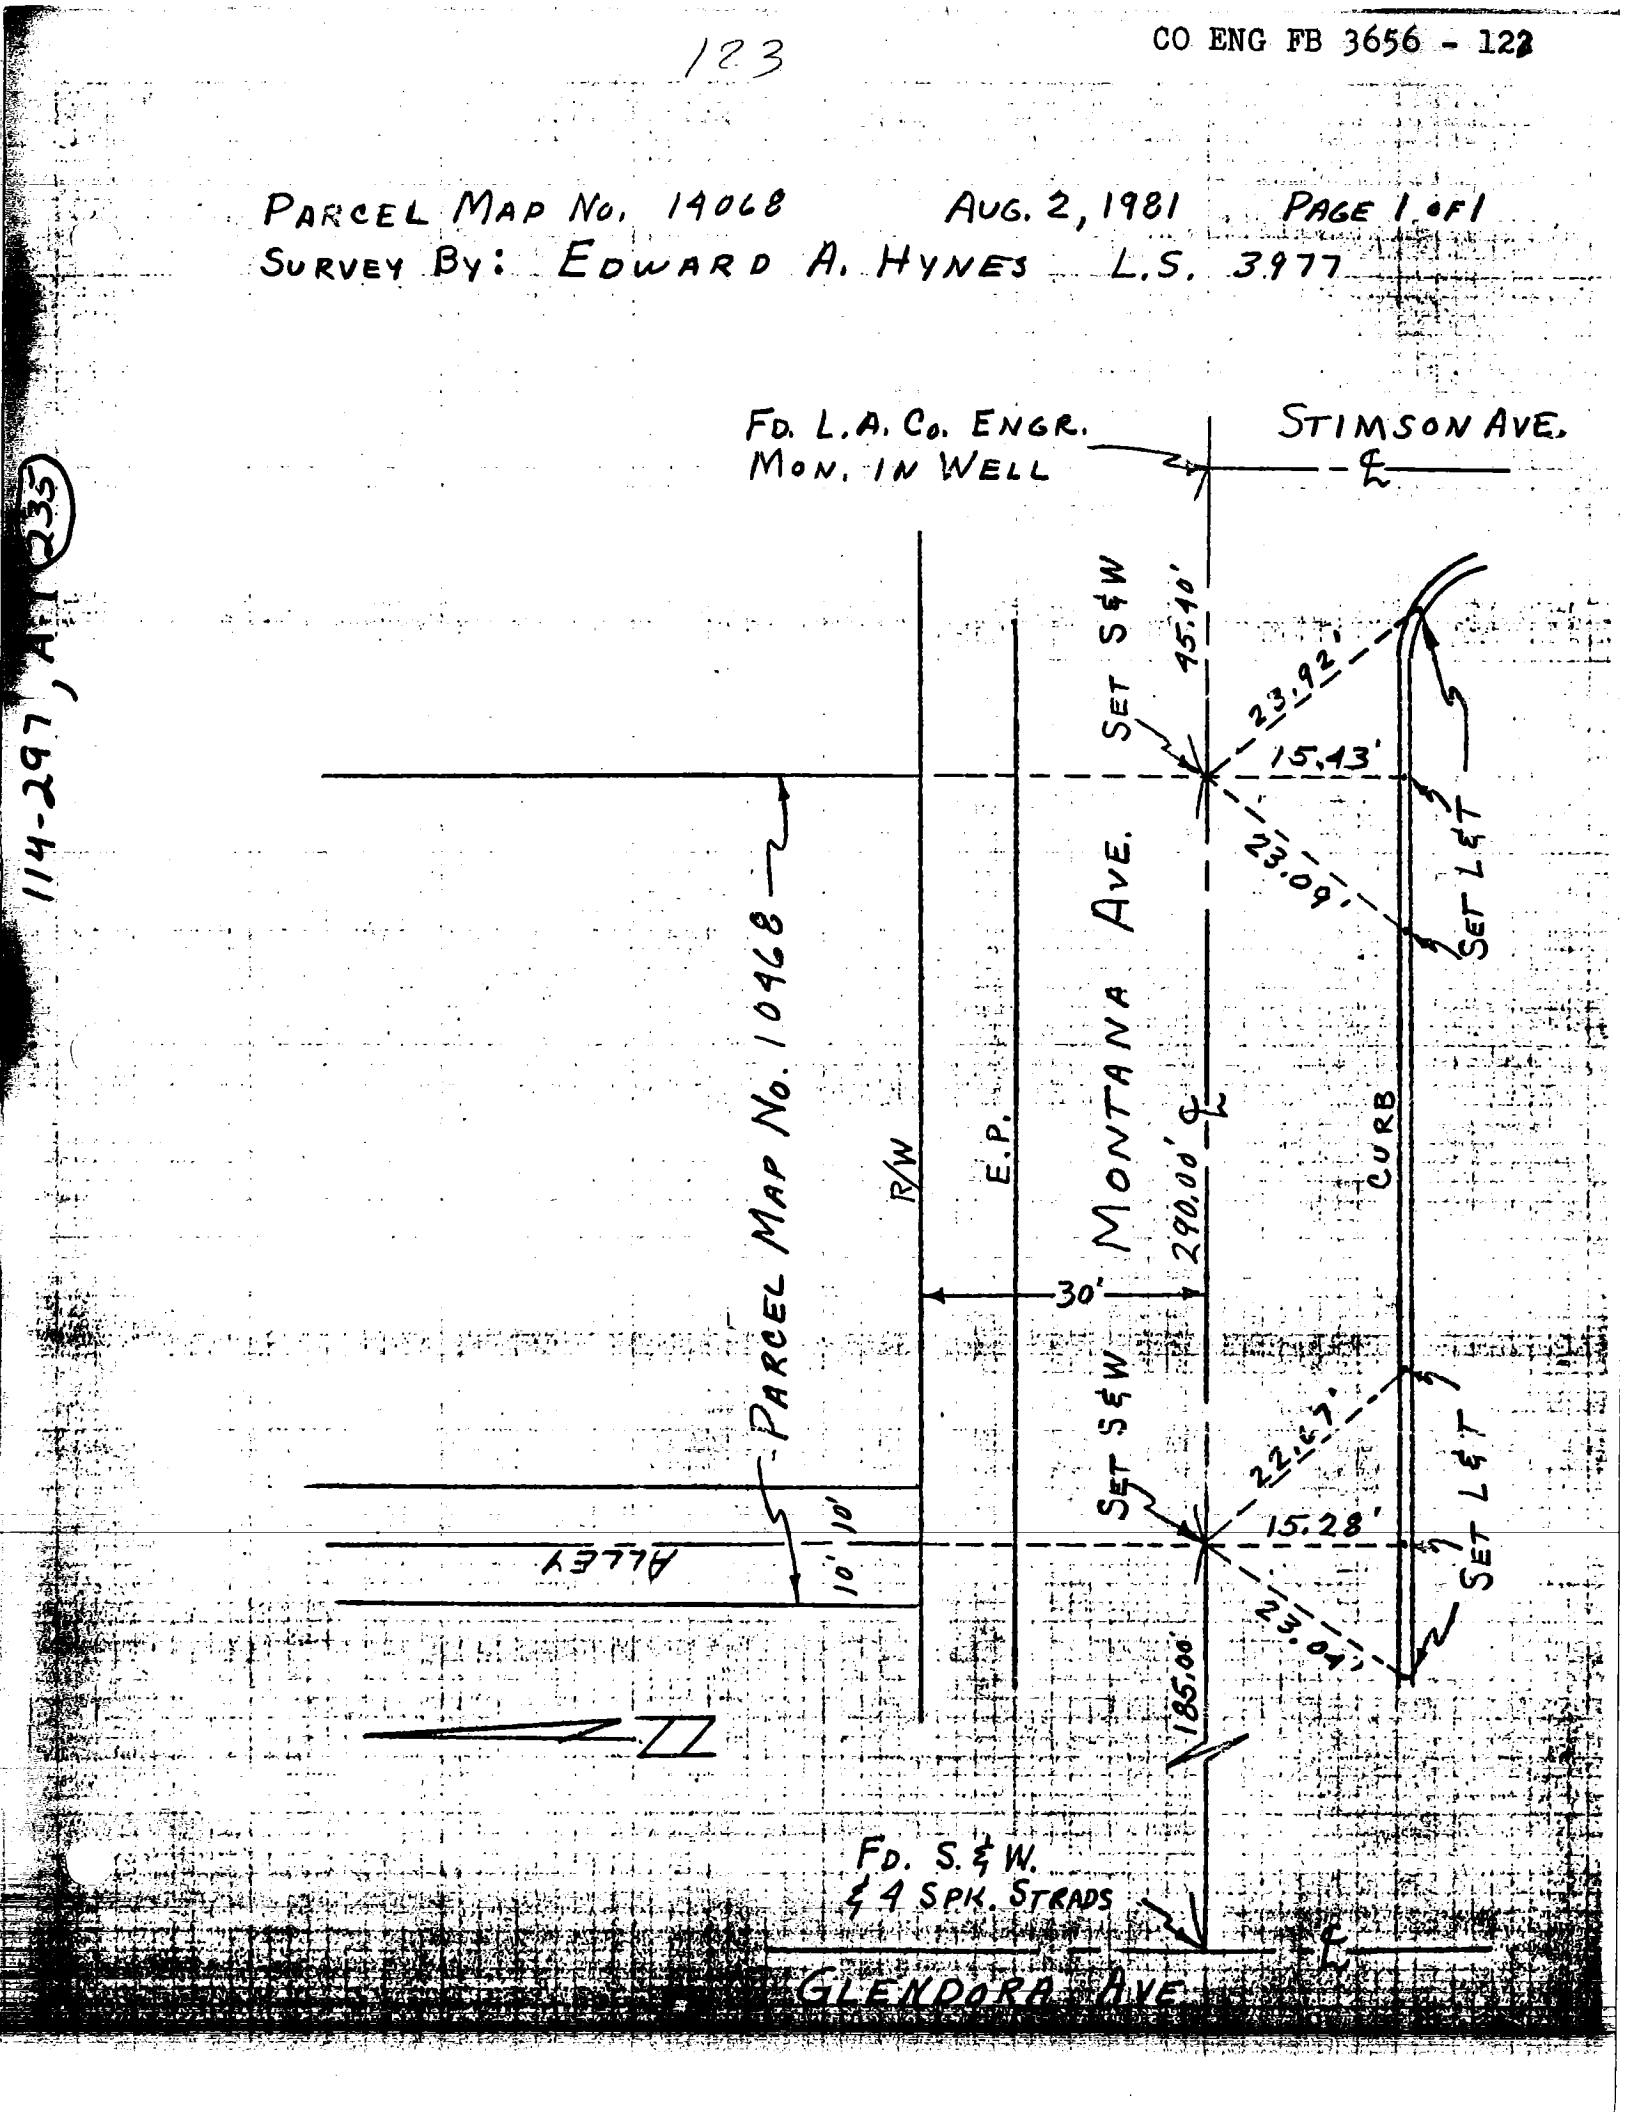

124

CO ENG FB 3656 - 124

SURVEY OF CENTERLINE TIES F B NO. PAGE

SURVEY BY CROWN ENG. & SURV. CORP. TRACT NO. 40561

DATE 10-20-81

MORTON D. SCHWARTZ
R.C.E. 8758

W.S. 22, C-3 (193)

DO NOT EXTEND NOTES THIS SIDE OF LINE

SURVEYORS SERVICE COMPANY - STOCK NO. 411

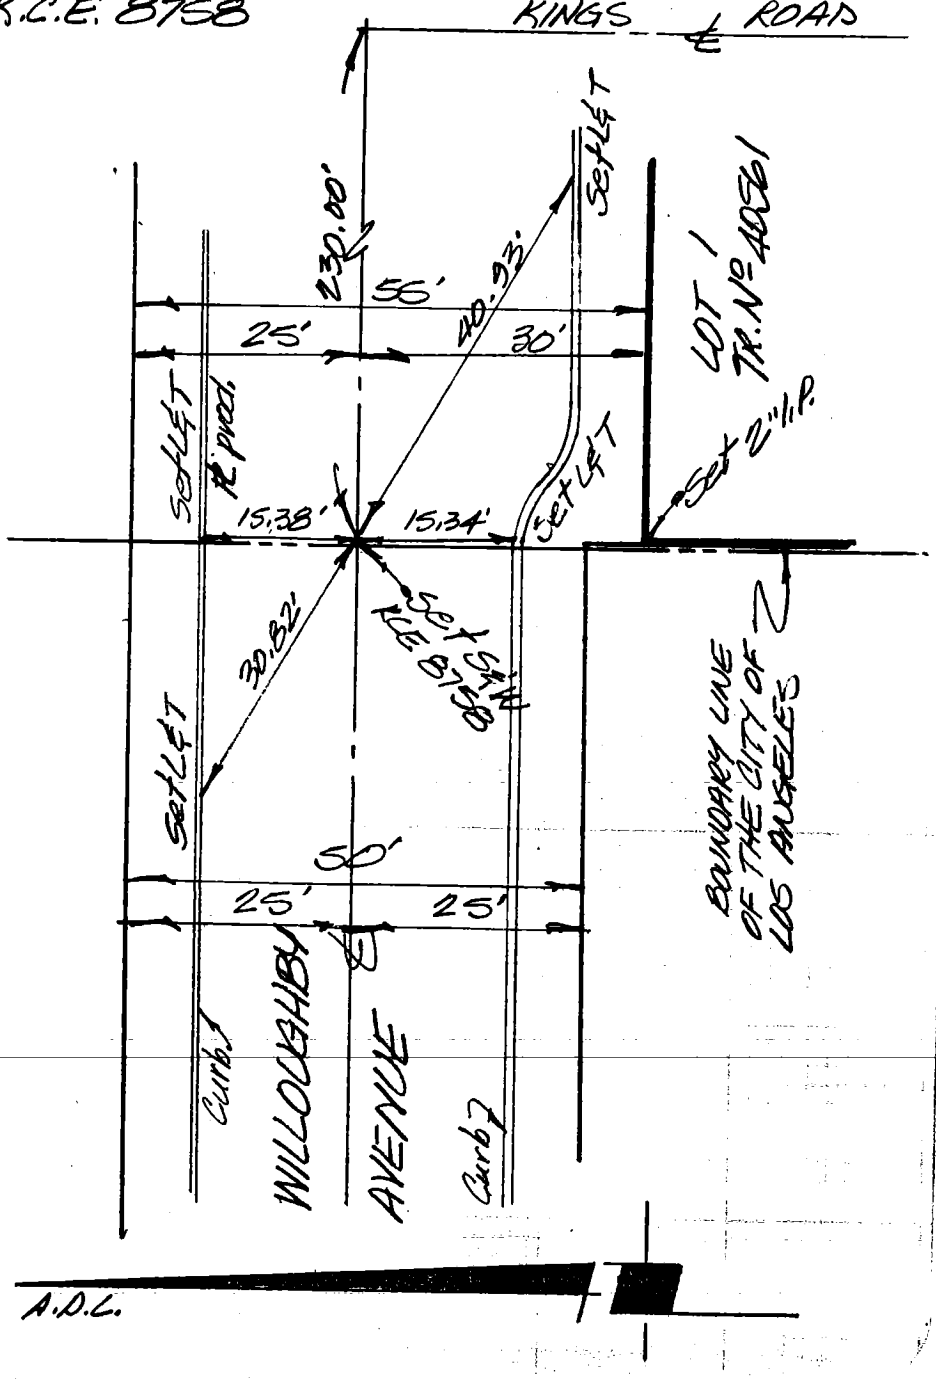

125 CO ENG FB 3656 - 125

SURVEY OF CENTERLINE TIES F B NO. PAGE
SURVEY BY CROWN ENG. & SURV. CORP. TRACT NO. 40561
DATE 10-20-81

MORTON D. SCHWARTZ
R.C.E. 8758

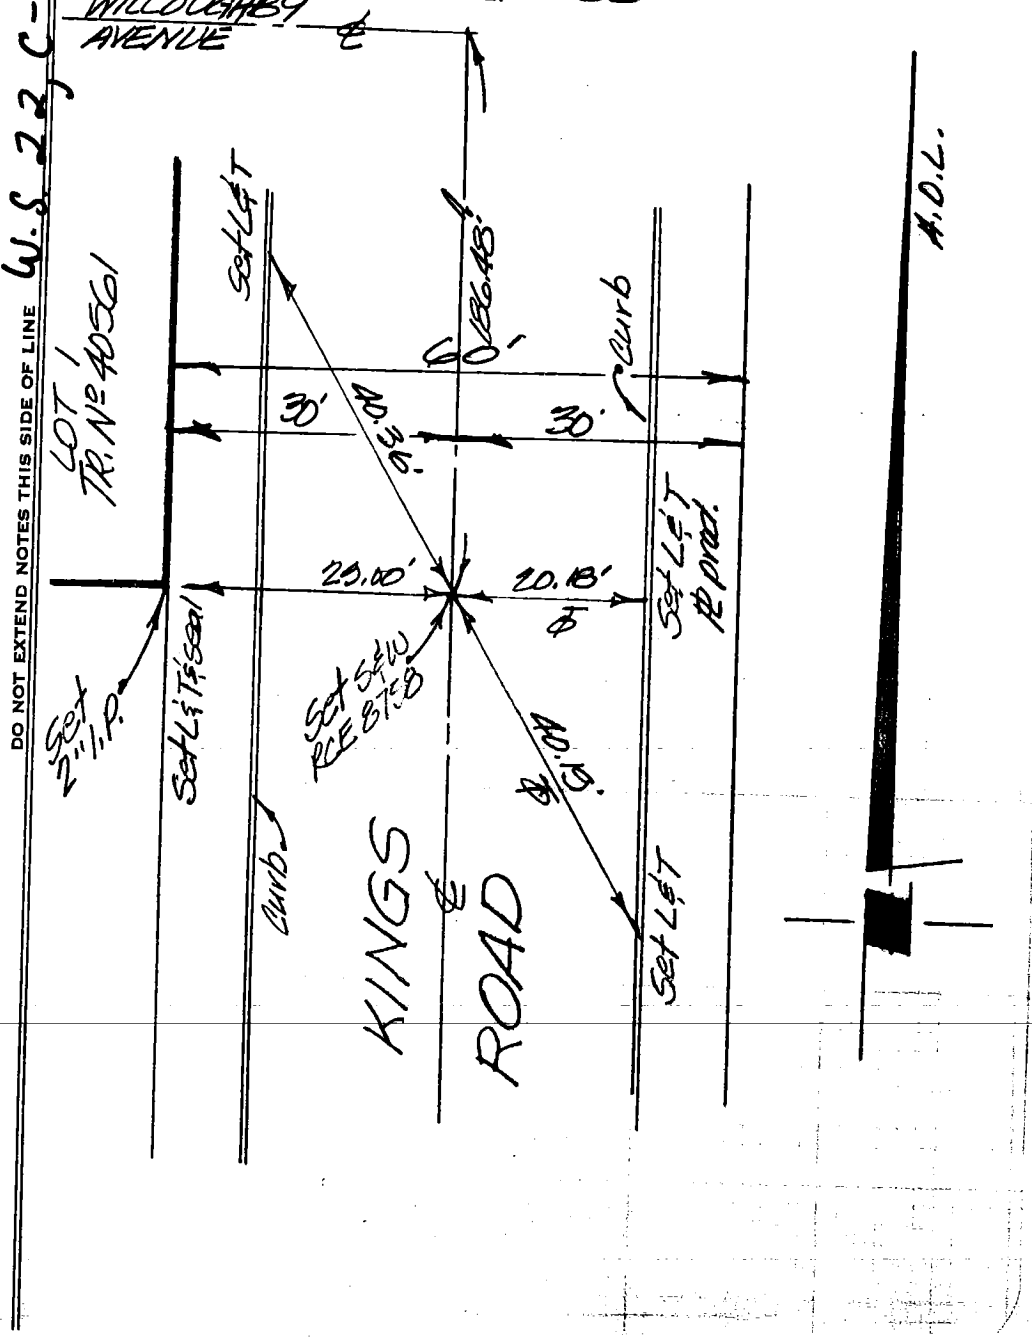

SURVEYORS SERVICE COMP/ STA MESA - STOCK NO. 411

PARCEL MAP 8241

Oct 1, 1981 Page 1 of 5

Survey by: GARY L. KAISER RCE 21938
CLASSIC ENGINEERING

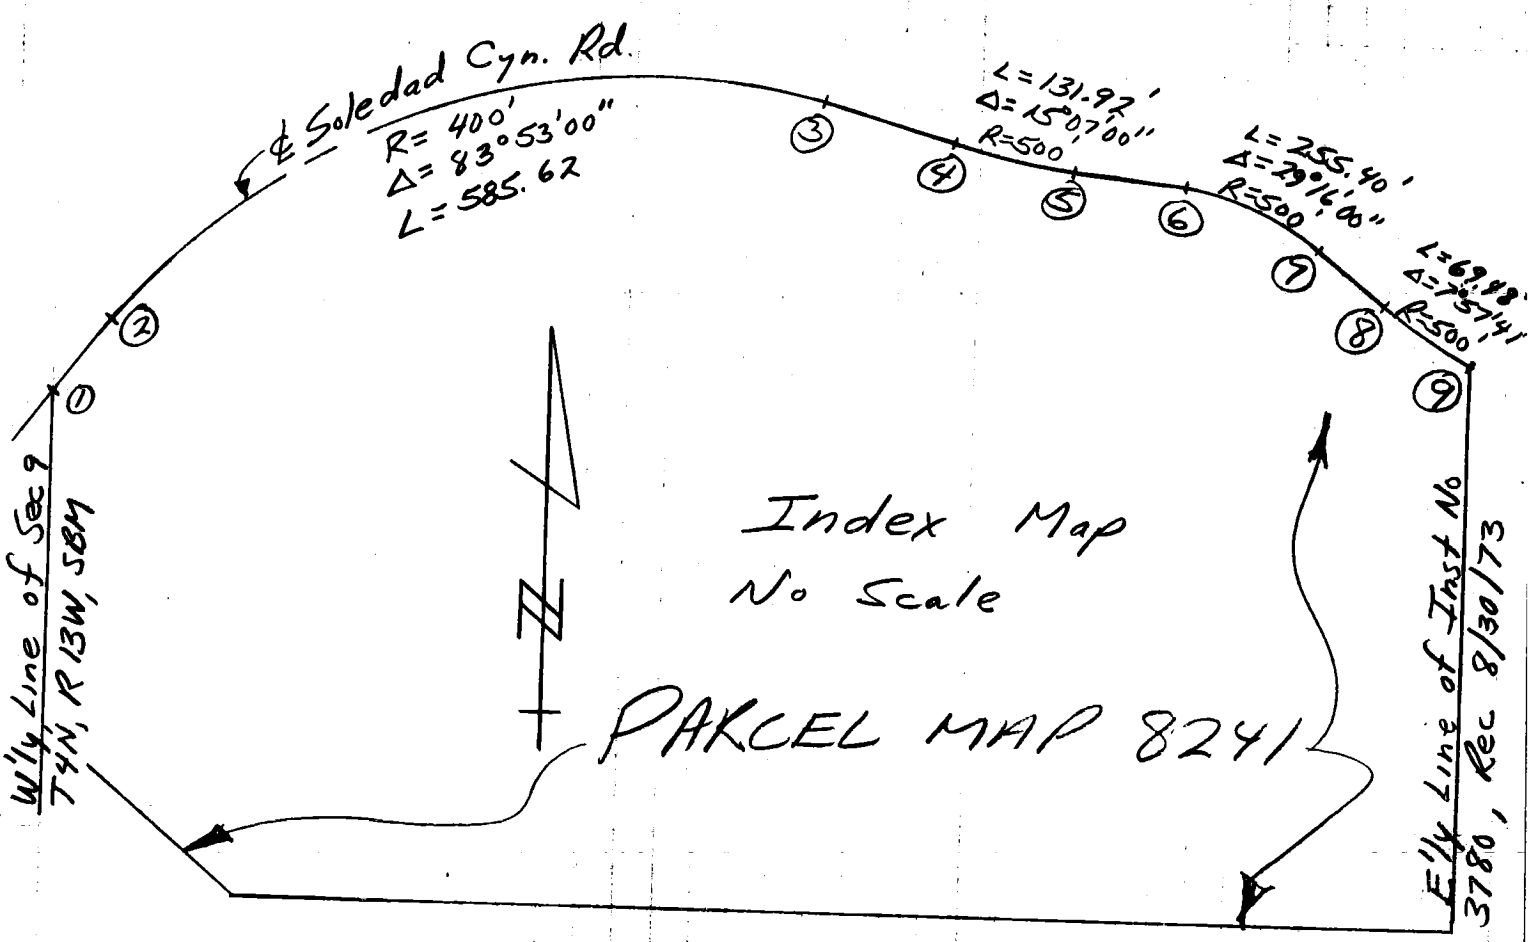

CO ENG FB 3656 - 127

PARCEL MAP 8241 Oct. 1, 1981 Page 2 of 5

Survey By: GARY L. KAISER - RCE 21938
CLASSIC ENGINEERING

W.S. 79, D-1 (12)

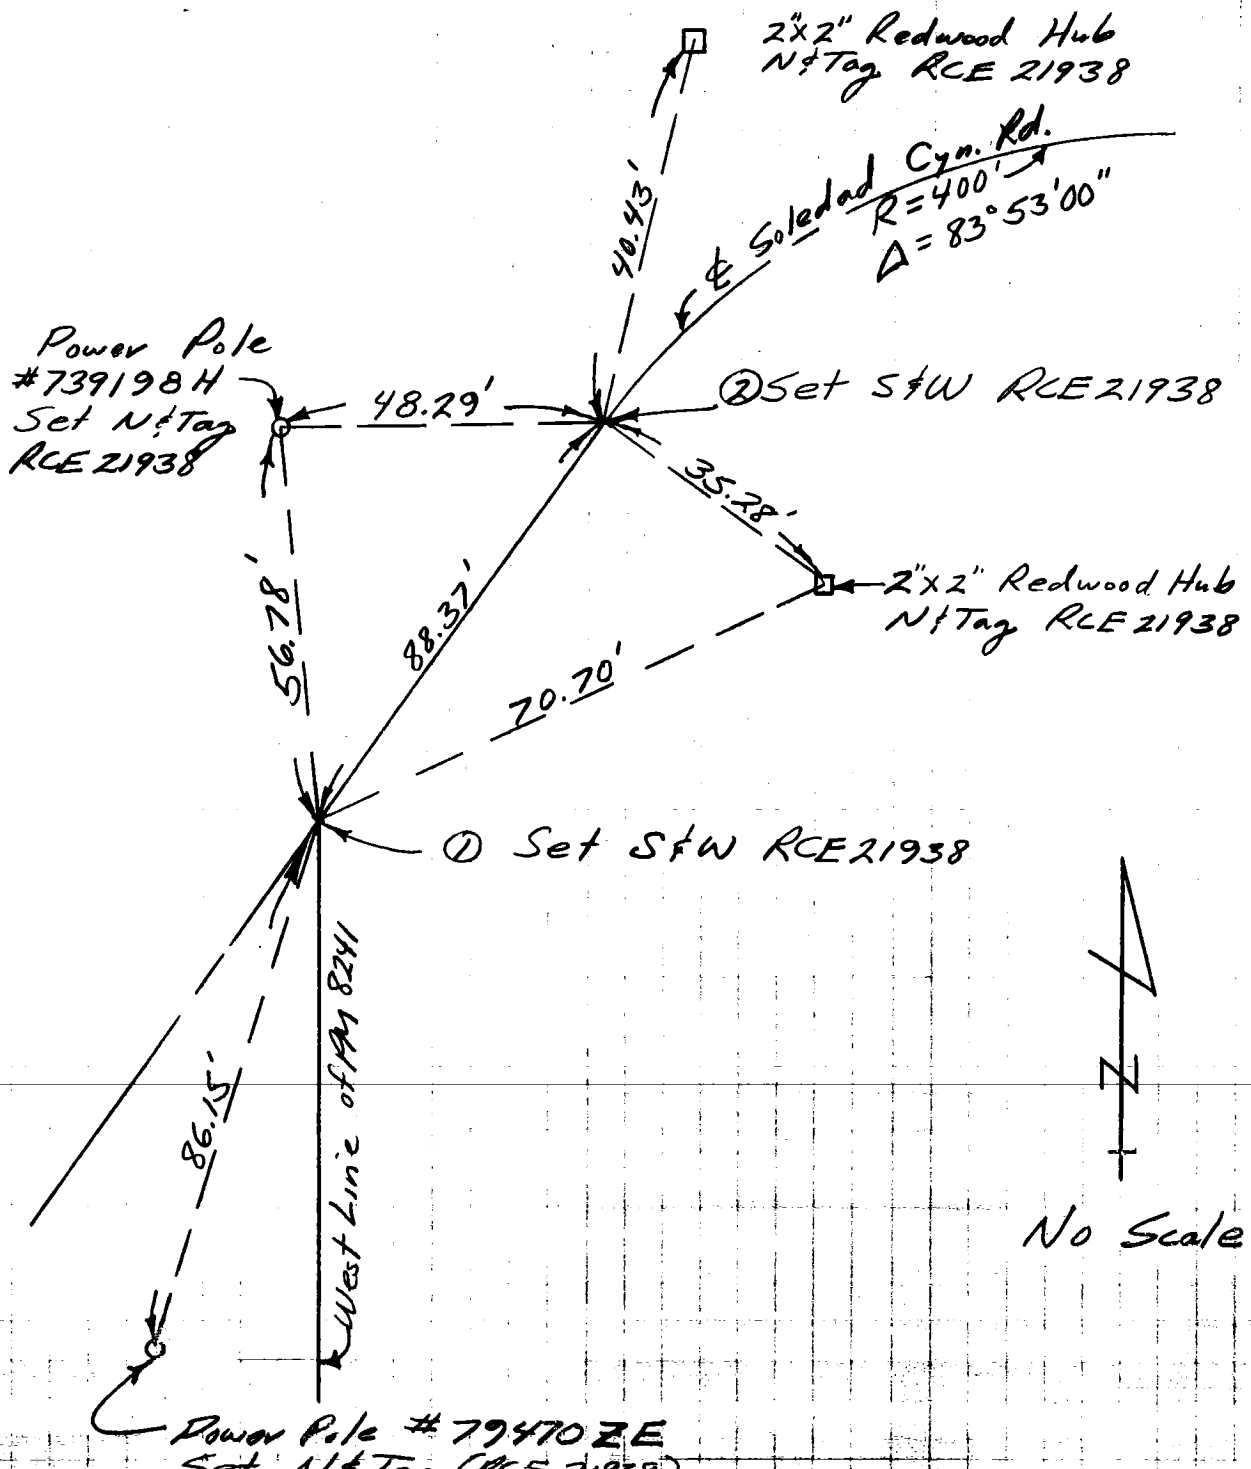

120

PARCEL MAP 8241 Oct 1, 1981 Page 3 of 5

Survey By: GARY L. KAISER - RCE 21938
CLASSIC ENGINEERING

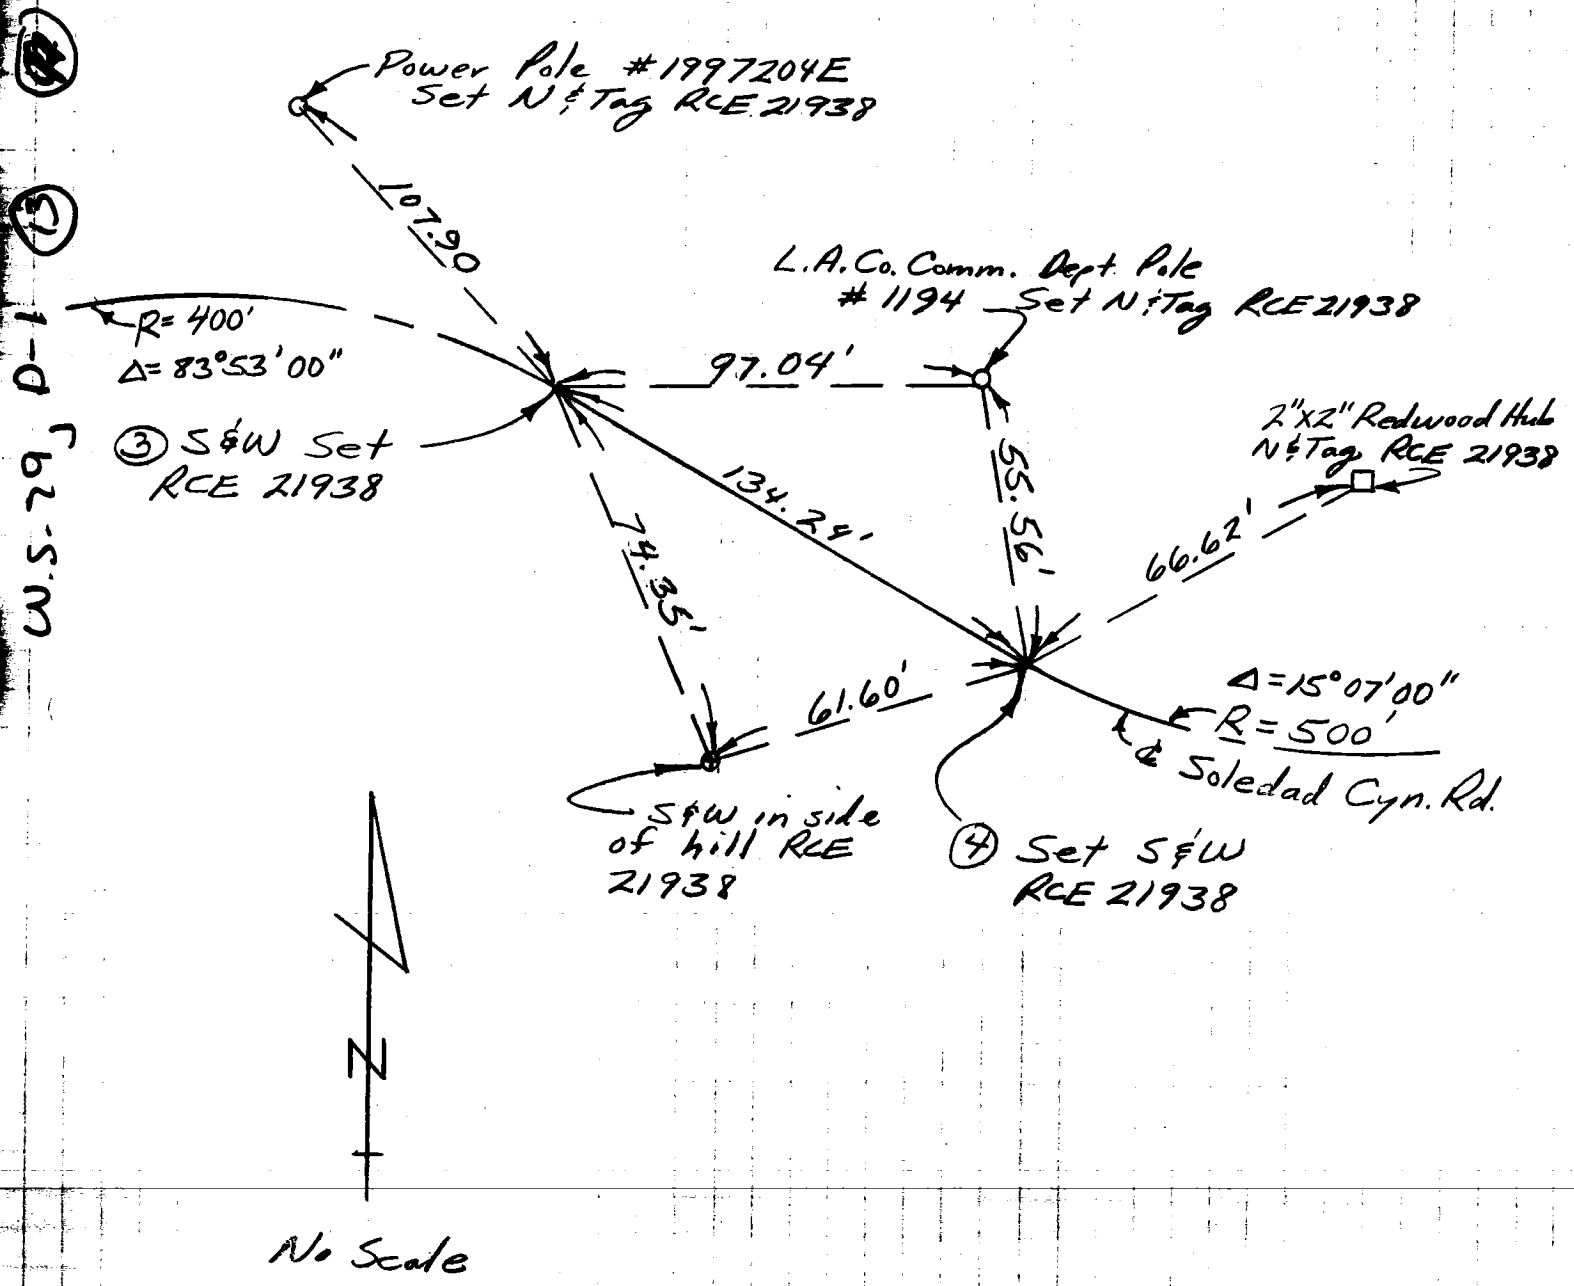

W.S.29 D-1

129

PARCEL MAP 8241 Oct 1, 1981 Page 4 of 5

Survey By: GARY L. KAISER - RCE 21938
CLASSIC ENGINEERING

W.S. 79, D-1

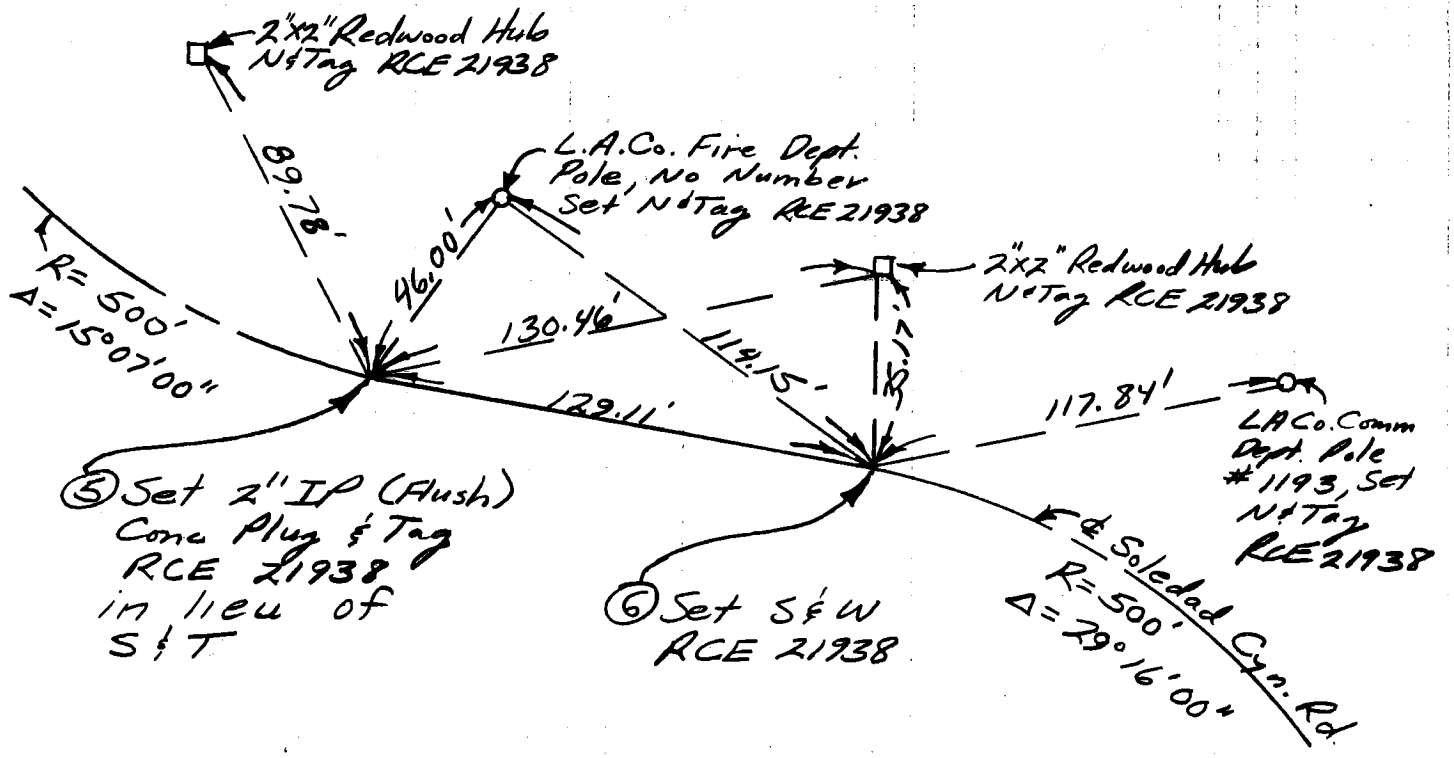

No Scale

130

PARCEL MAP 8241 Oct 1, 1981 Page 5 of 5

Survey By: GARY L. KAISER - RCE 21938
CLASSIC ENGINEERING

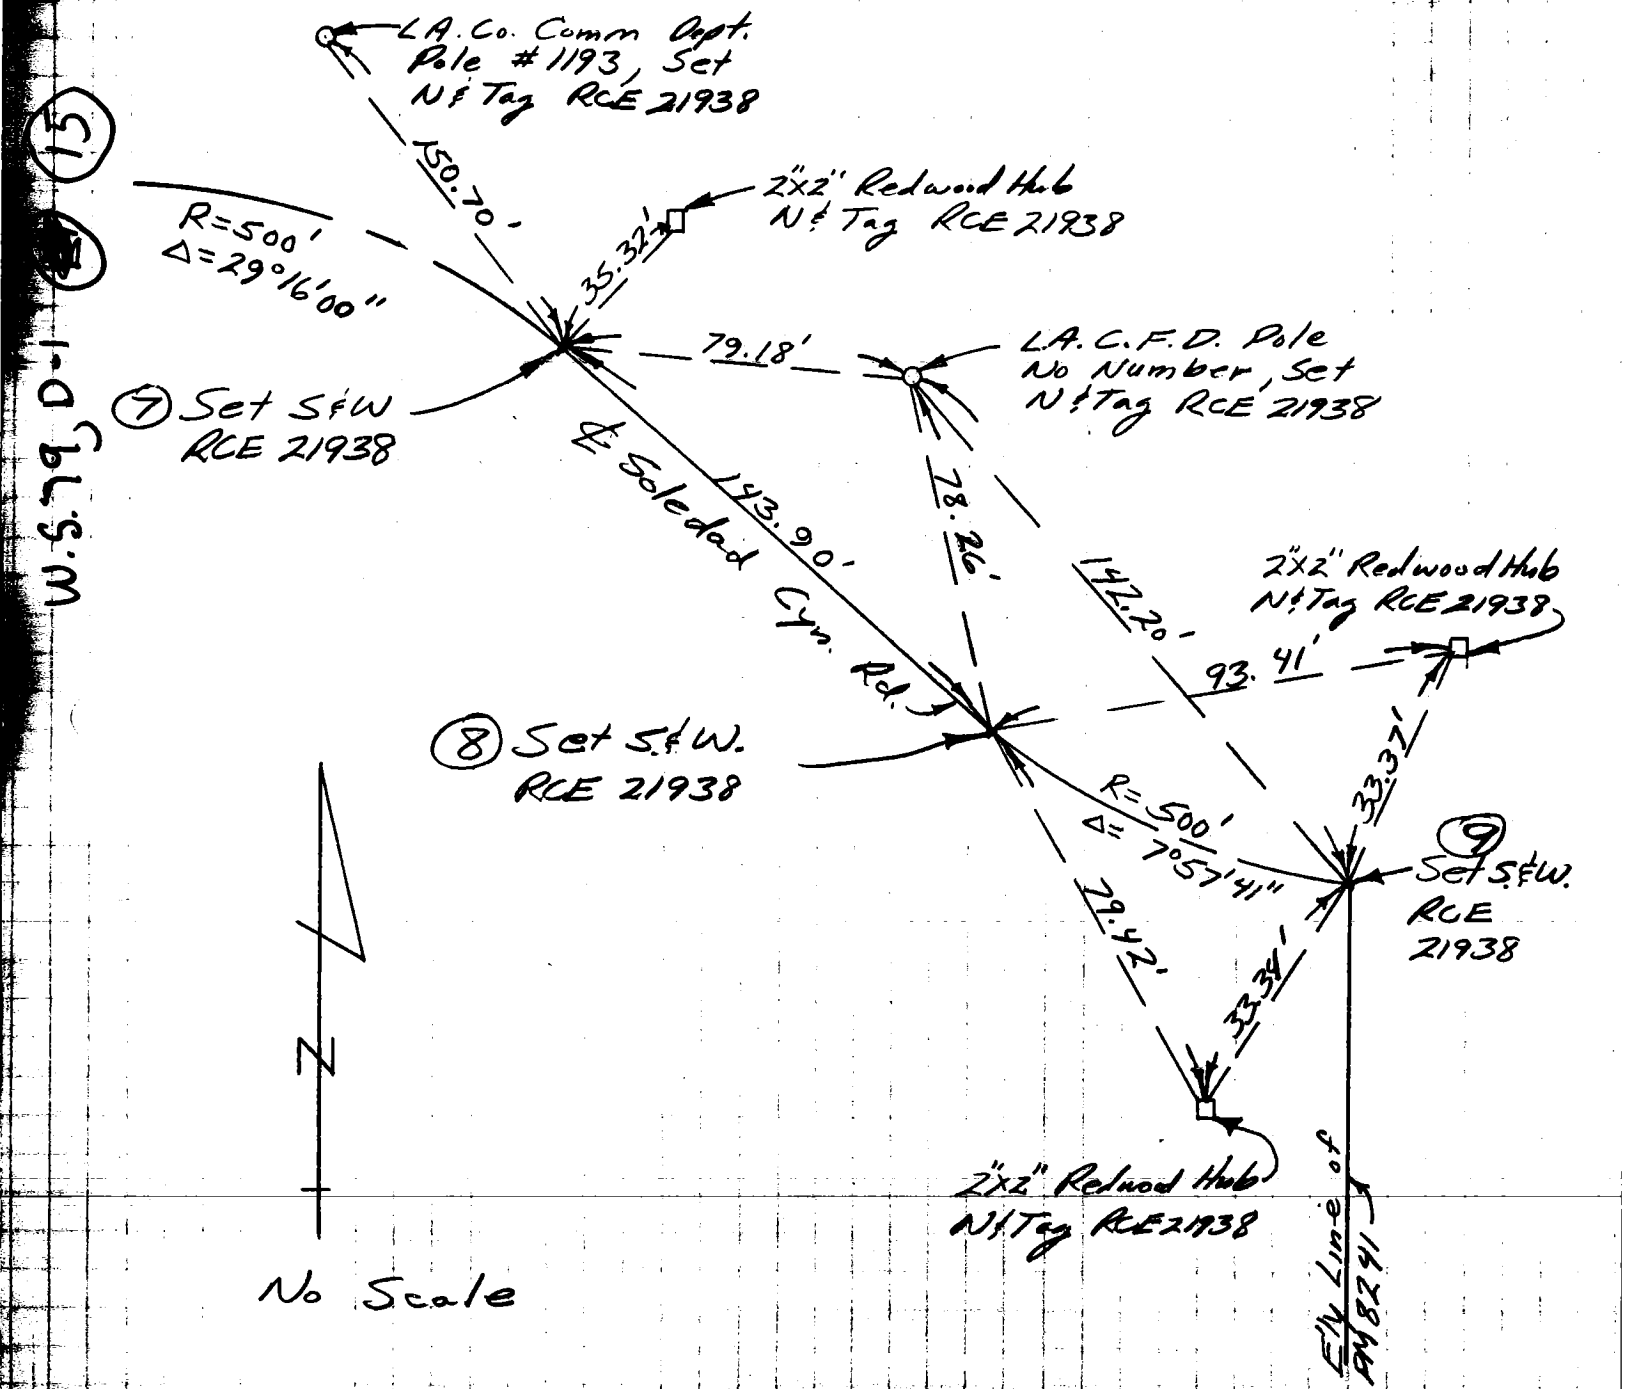

131

CO ENG FB 3656 - 131

SURVEY OF CENTERLINE TIES F B NO. 100-G PAGE 356

SURVEY BY SO. BAY ENGR. CORP TRACT NO. 32110 (RO.EV.)

DATE 10-12-81

ENGINEER: RAYMOND L. QUIGLEY R.C.E. 7191

MARTIN
LISKO
CULLEN

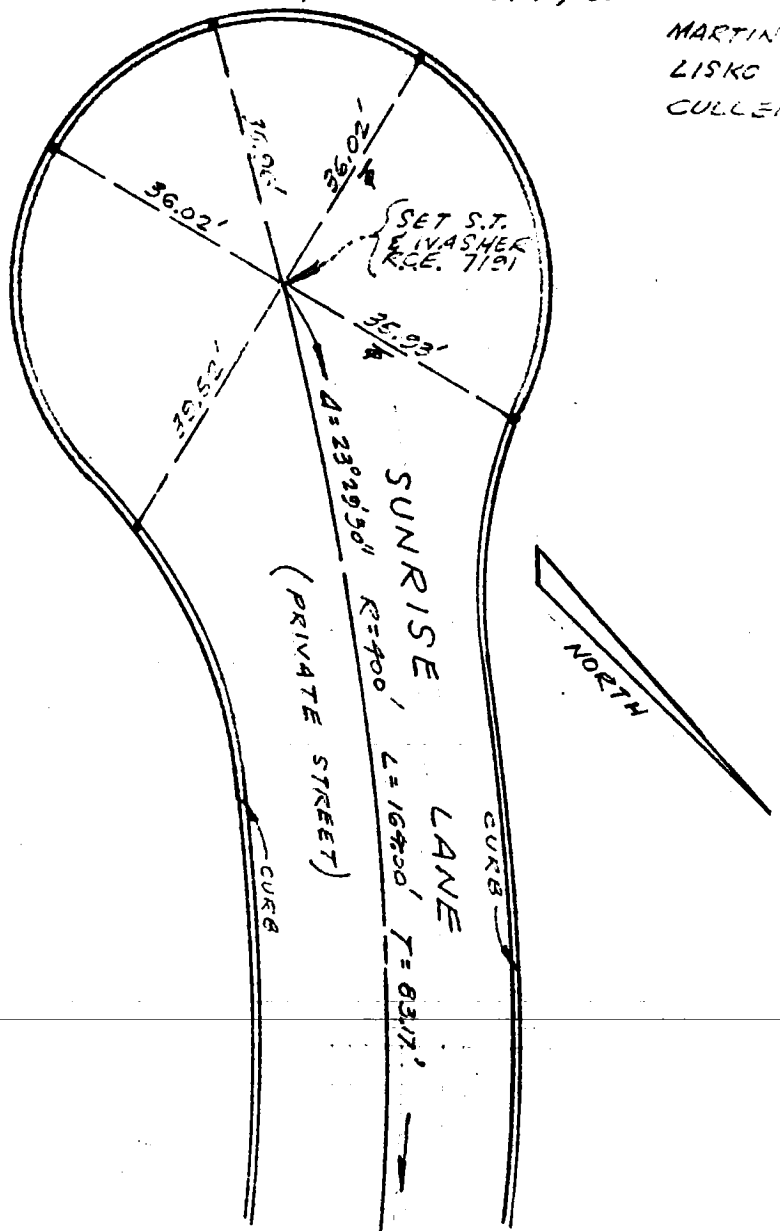

NOTE:
ALL TIES SET .4CE L.T. & TAG IN TOP IN CURB
TAGS STAMPED R.C.E. 7191

DO NOT EXTEND NOTES THIS SIDE OF LINE W.S.27 C-4 (89)

SURVEYORS SERVICE COMPANY, MESA - STOCK NO. 411

SURVEY OF CENTERLINE TIES F B NO 100-C PAGE 137
SURVEY BY SO. BAY ENGR. CORP. TRACT NO. 2216 (COUNTY)
DATE 10-12-81
ENGINEER: RAYMOND L. QUIGLEY RCE 7191

MARTIN
LISKO
CULLEN

SURVEYORS SERVICE COMPANY TUSTIN MESA - STOCK NO. 411
DO NOT EXTEND NOTES THIS SIDE OF LINE

U.S. 27, C-4 (39)

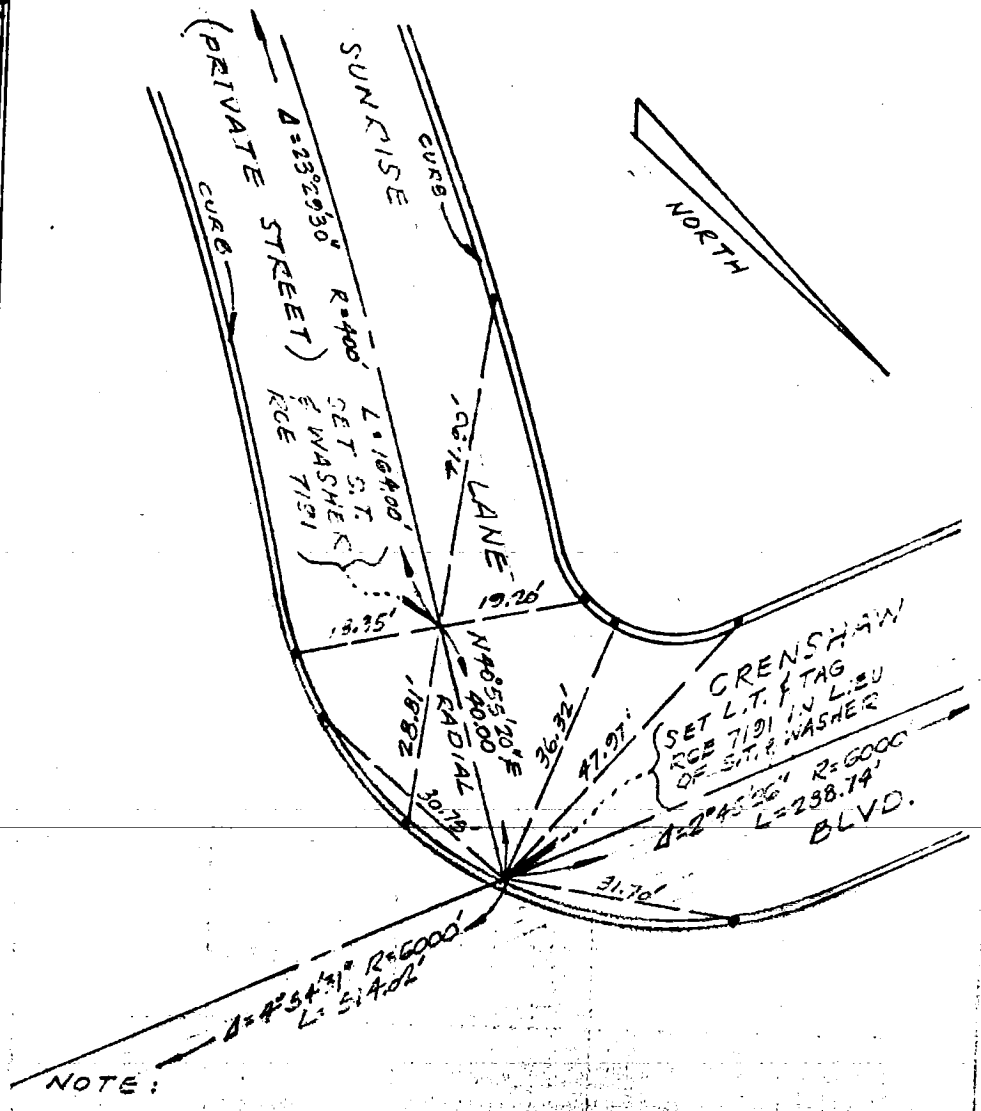

NOTE:
ALL TIES SET ARE L.T. & TAG IN TOP OF CURB
TAGS STAMPED RCE 7191

SURVEY OF ℄ TIES - P.M. NO. 13477 133 INDEX CO WNG FB 3656 - 133
SURVEYED BY Thomas Outland L.S. 3264 DATE 10/17/81 PAGE

U.S. 395, 1-4 (34)

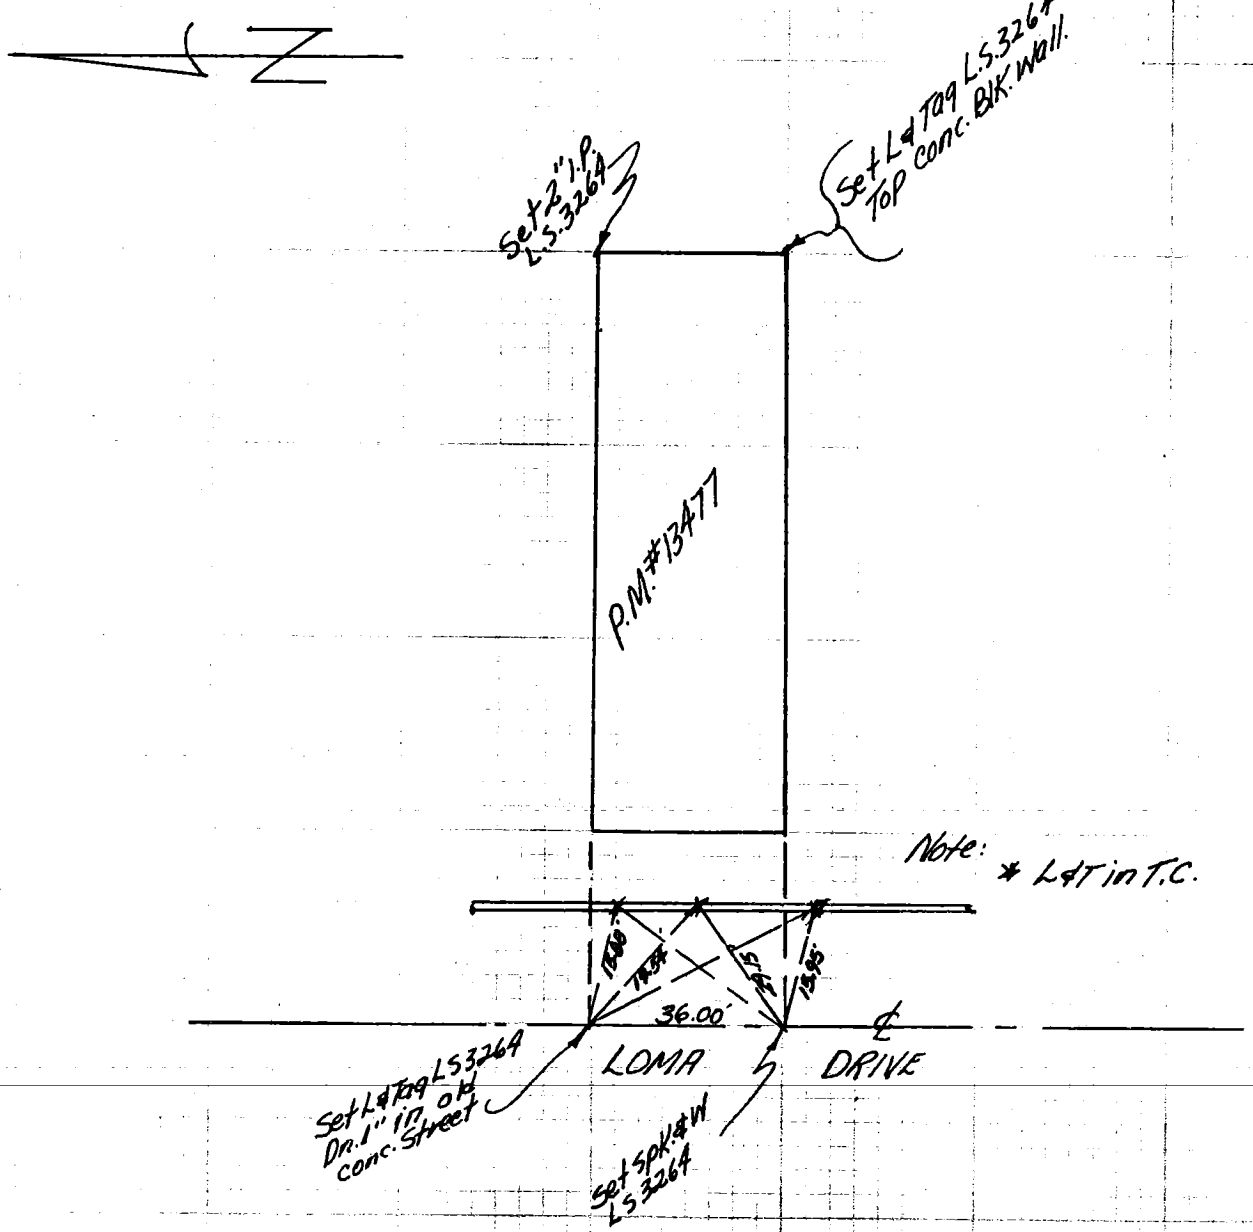

SERVCO NO. 7035

CO ENG FB 3656 - 134

SURVEY OF Centerline Ties Tract 35791 PAGE

SURVEYED B James E. Nelson RCE# 22406 DATE Oct. 16, 1981

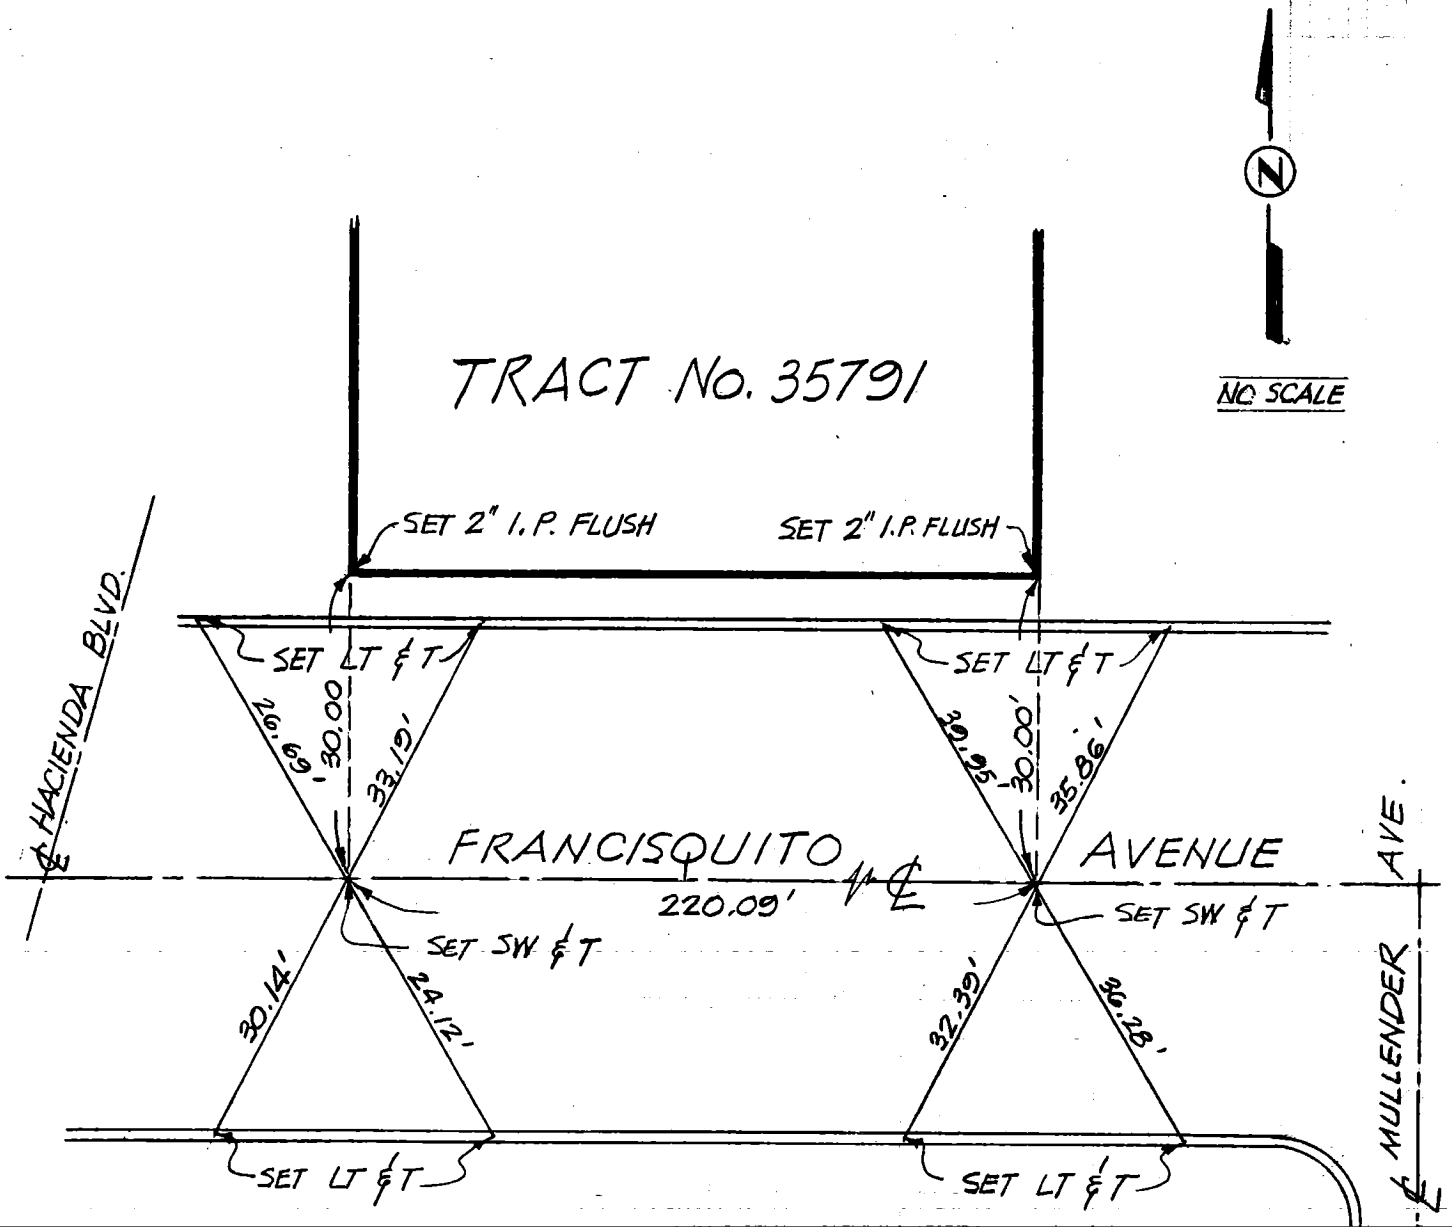

SERVCO NO. 7086

130

CO ENG FB 3656 - 13

135

SURVEY OF CENTERLINE TIES F. B. ____ PG. ____

SURVEY BY PFEILER & ASSOC, FULLERTON, CA. TR. No. 31224

DATE MARCH 25, 1981 Robert Pfeiler R.C.E. 12507

L&T INDICATES LEAD & TACK
S,W&T INDICATES BOAT SPIKE WASHER & TIN

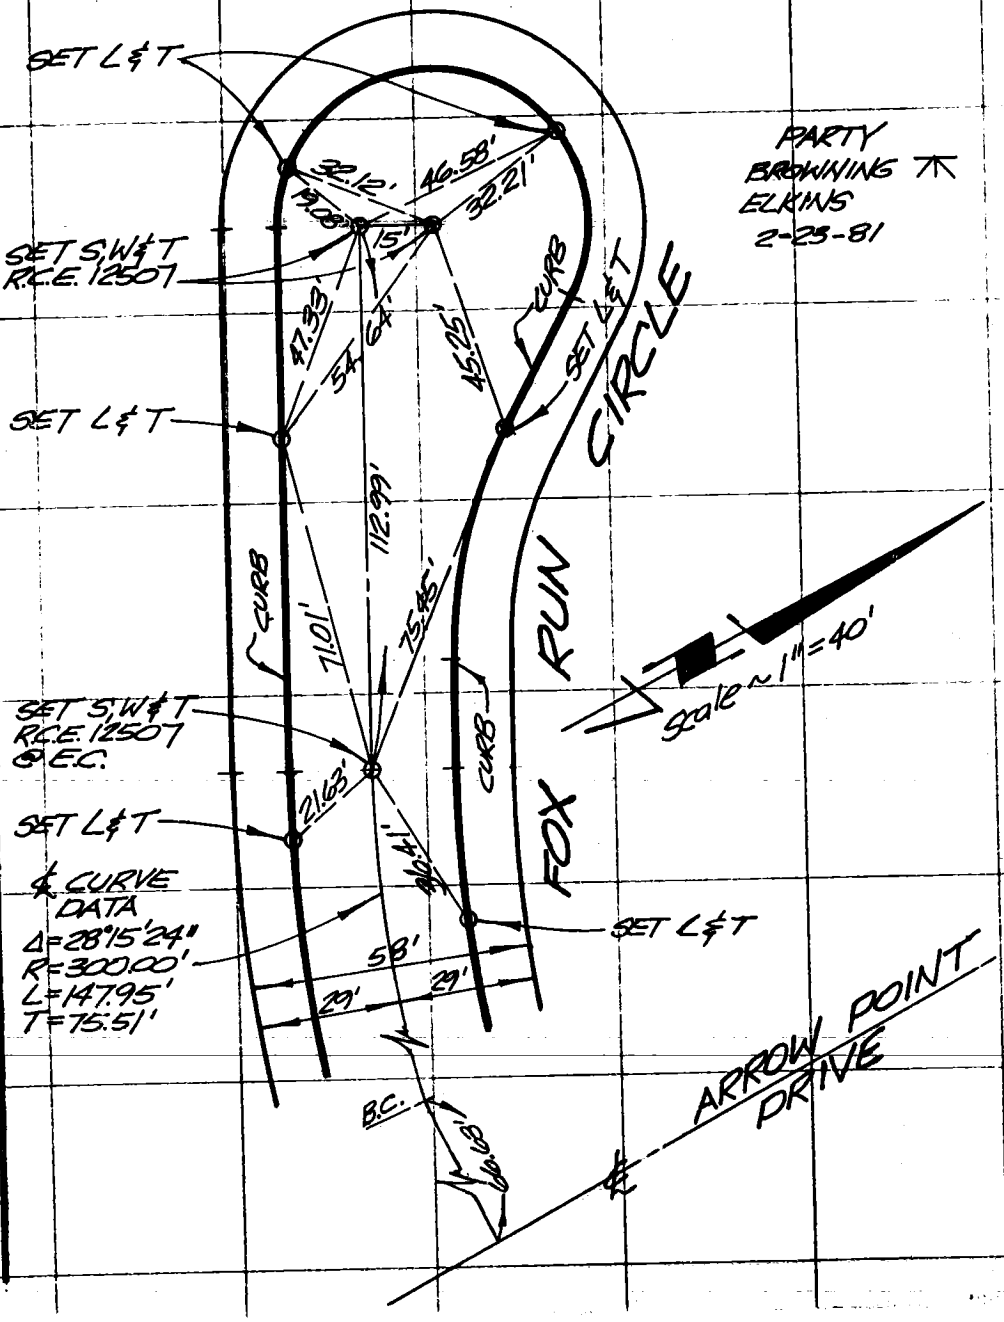

199-097, A-1 (34)

SO. CALIF. BLUE PRINT CO.

12.6 CO ENG FB 3656 - 136

SURVEY OF CENTERLINE TIES F. B. Pg.

SURVEY BY PFEILER & ASSOC, FULLERTON, Ca. TR. No. 31224

DATE MARCH 25, 1981 Robert Pfeiler R.C.E. 12507

279-097, A-1 (33)

SO. CALIF. BLUE PRINT CO.

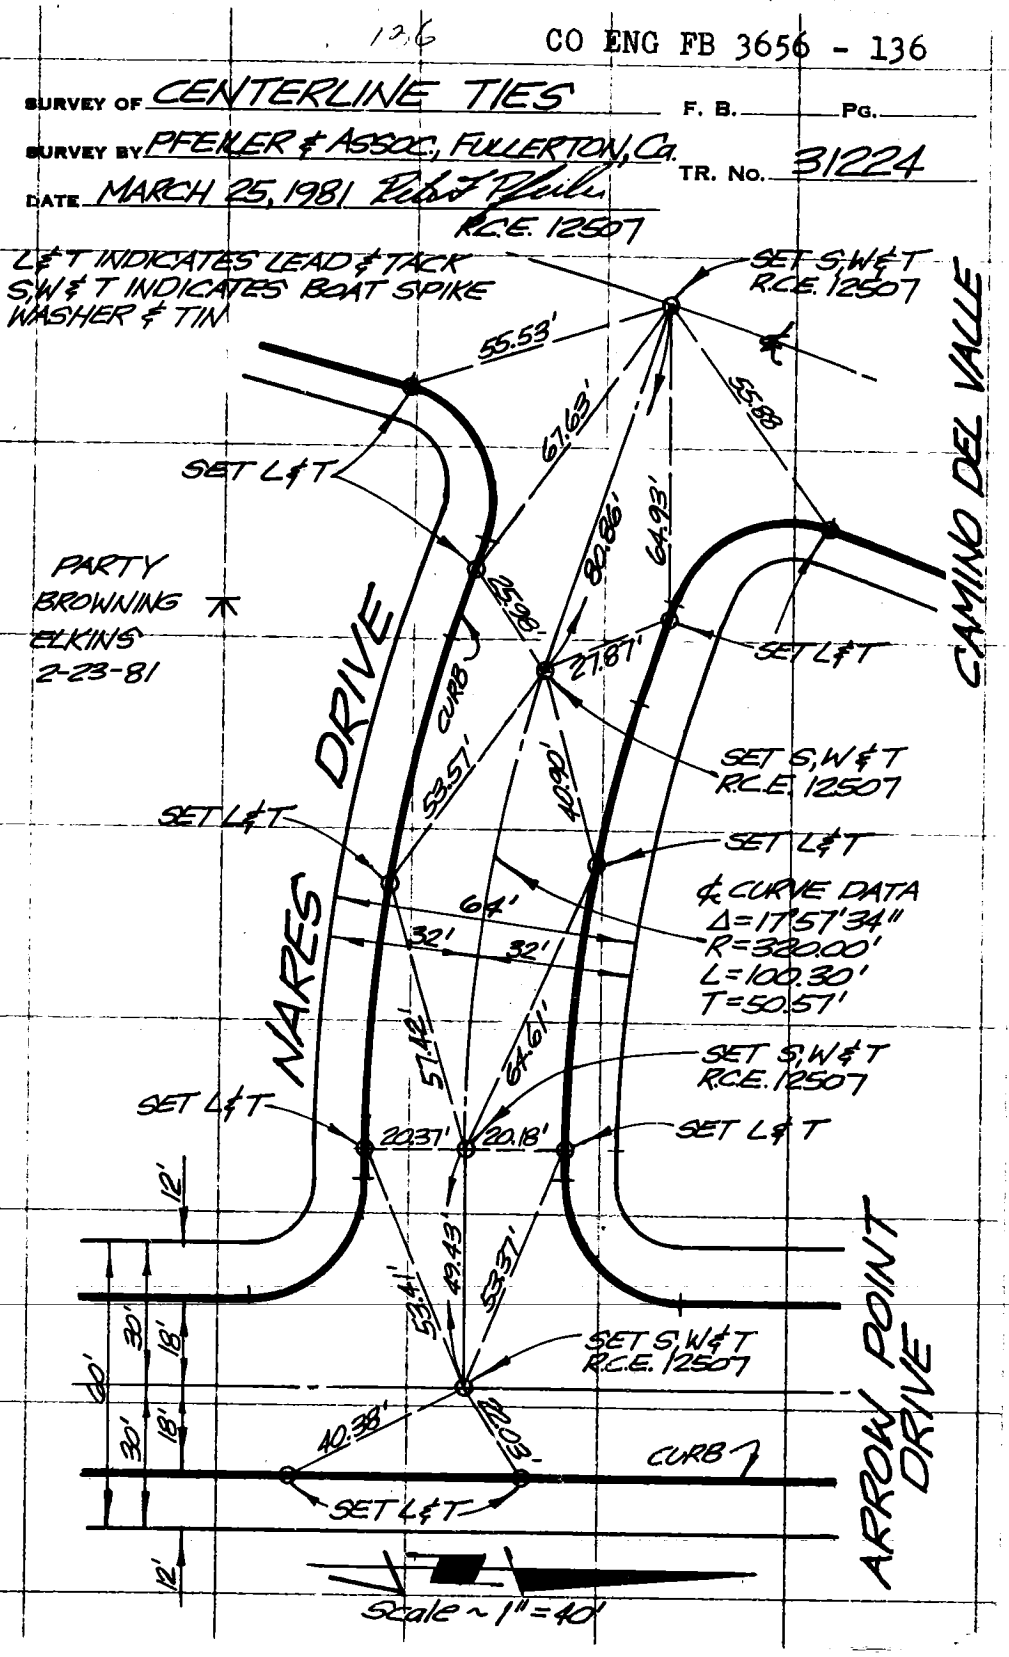

137

CO ENG FB 3656 - 137

SURVEY OF CENTERLINE TIES F. B. ____ Pg. ____

SURVEY BY PFEILER & ASSOC., FULLERTON, Ca. TR. No. 31224

DATE MARCH 25, 1981 Richard F. Pfeiler R.C.E. 12507

279-097, A-1 (36)

SO. CALIF. BLUE PRINT CO. -

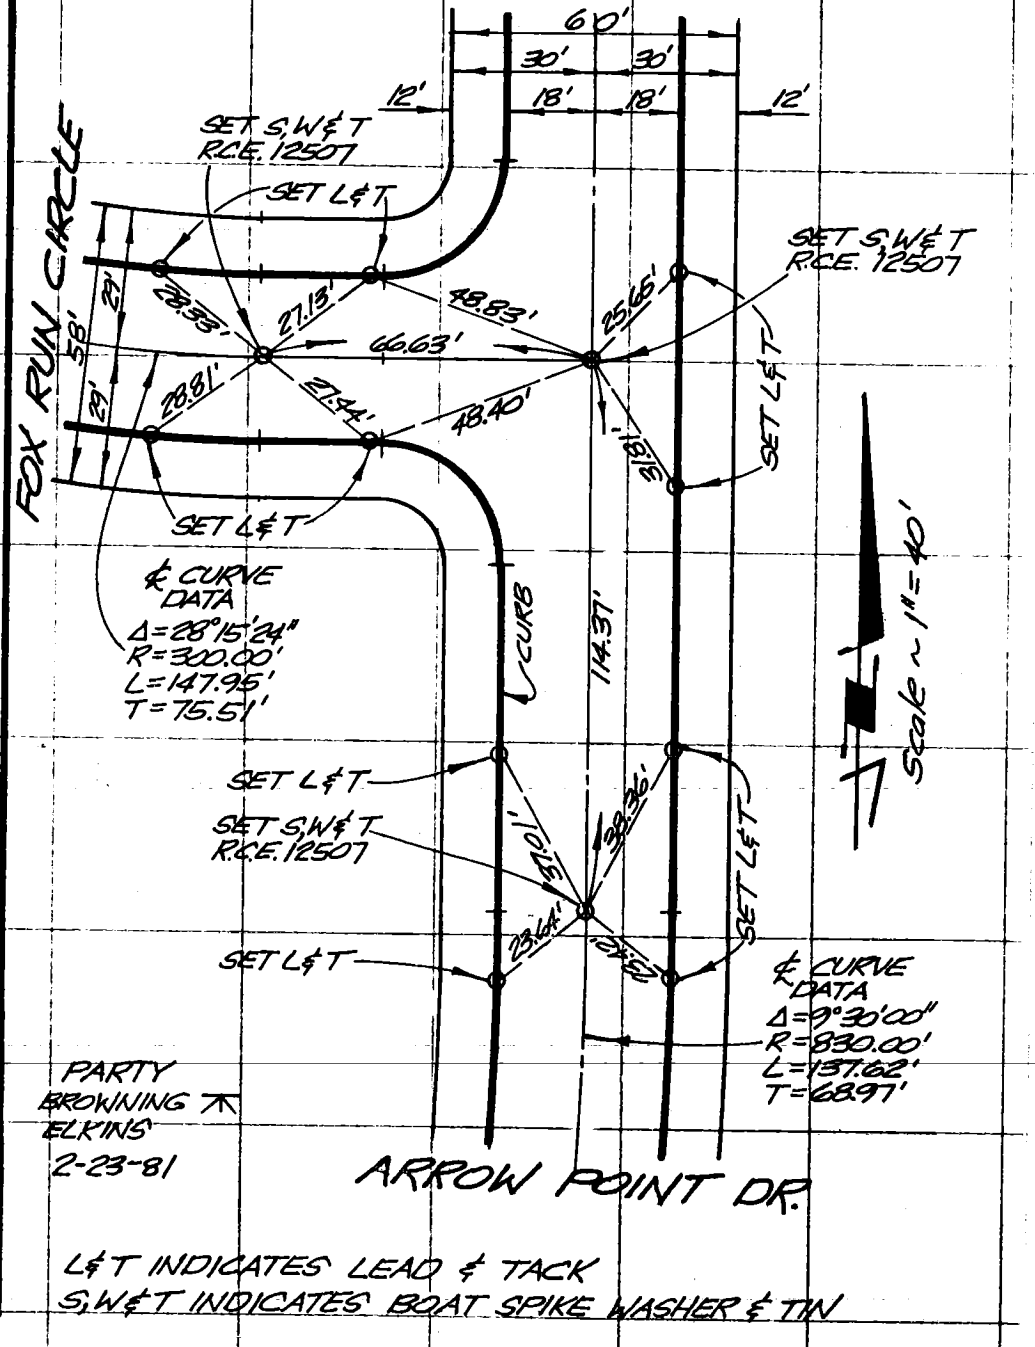

L&T INDICATES LEAD & TACK

S,W&T INDICATES BOAT SPIKE WASHER & TIN

128 CO ENG FB 3656 - 138

SURVEY OF CENTERLINE TIES F. B. ____ Pg. ____

SURVEY BY PFEILER & ASSOC., FULLERTON, Ca. TR. No. 31224

DATE MARCH 25, 1981 Robert T. Pfeiler R.C.E. 12507

L&T INDICATES LEAD & TACK

S,W&T INDICATES BOAT SPIKE WASHER & TIN

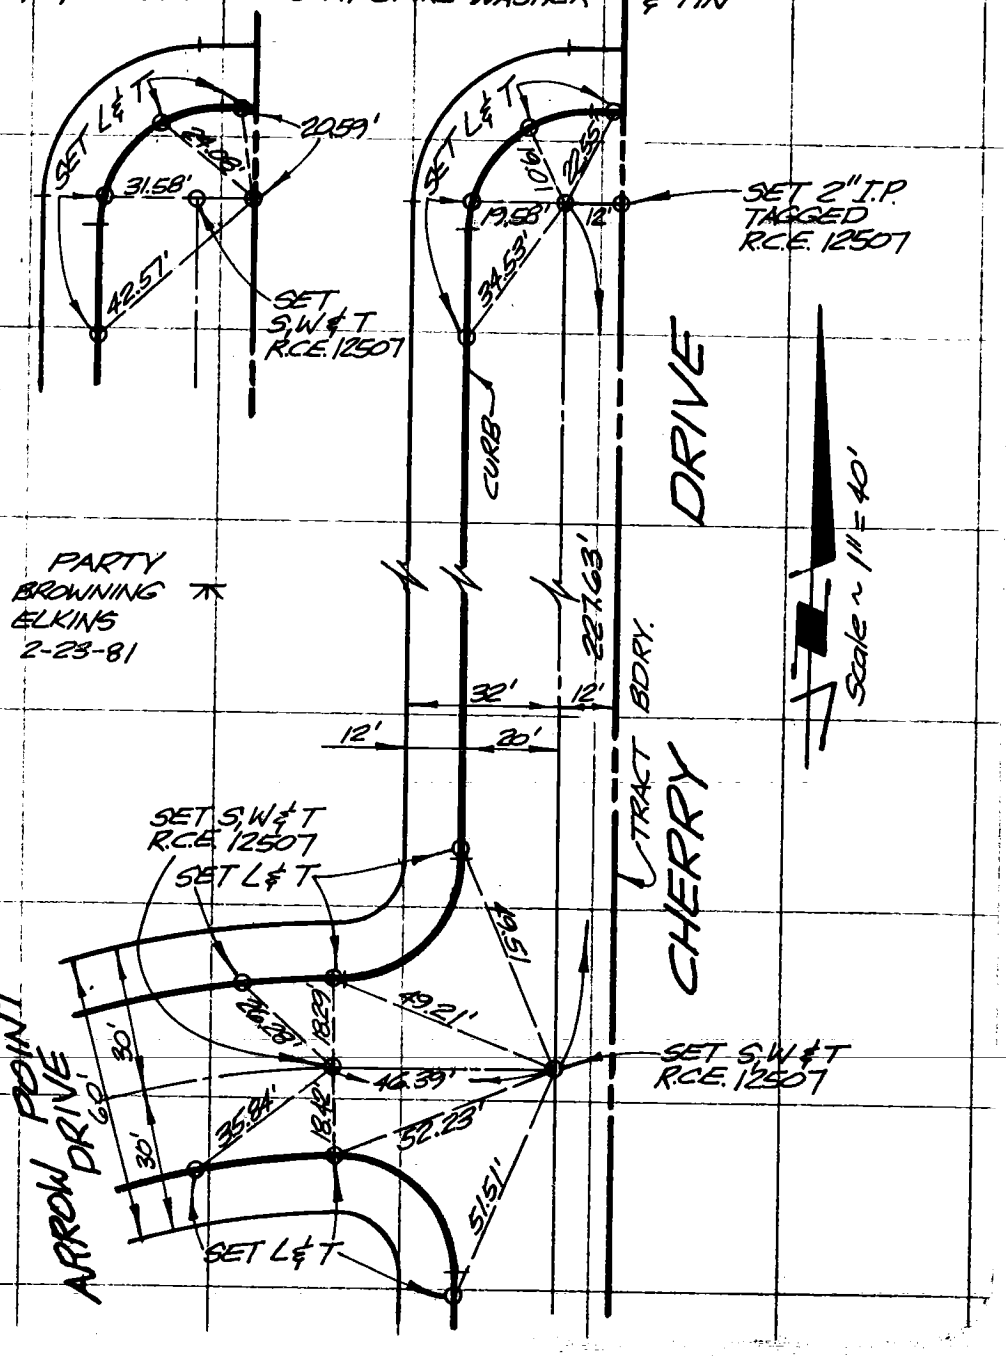

279-09 J 14 (37)

SO. CALIF. BLUE PRINT CO.

CO ENG FB 3656 - 139

SURVEY OF CENTERLINE TIES F. B. Pg.

SURVEY BY PFEILER & ASSOC., FULLERTON, Ca. TR. No. 31224

DATE MARCH 27, 1981 Robert F. Pfeiler R.C.E. 12507

L & T INDICATES LEAD & TACK

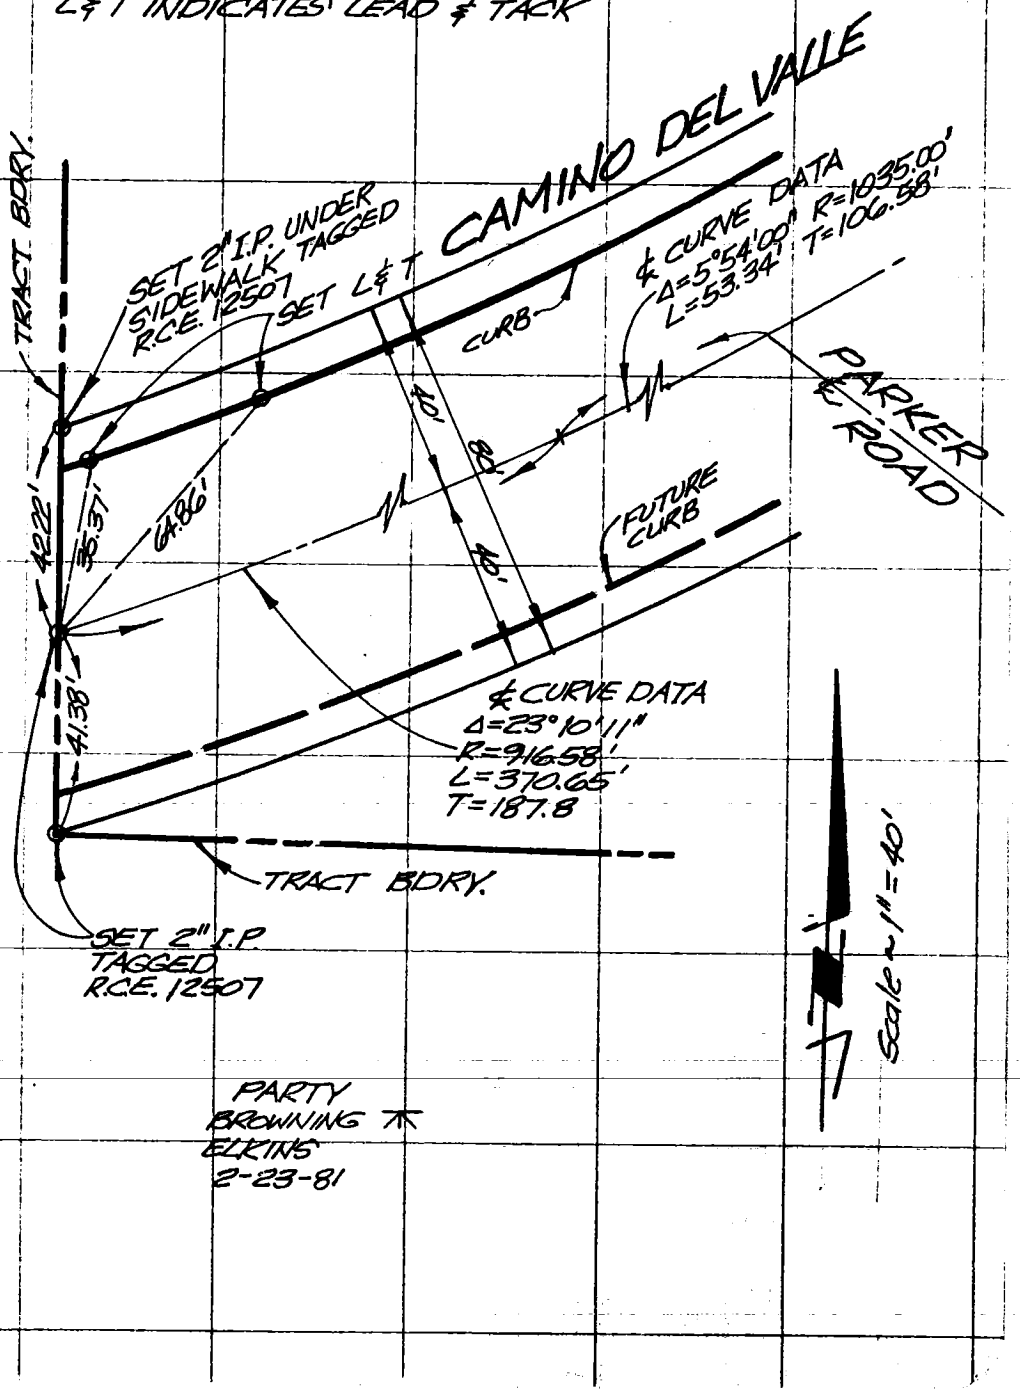

PARTY
BROWNING
ELKINS
2-23-81

279-09 7,4-1 (8)

SO. CALIF. BLUE PRINT CO.

140 CO ENG FB 3656 - 140

SURVEY OF CENTERLINE TIES F. B. Pg.

SURVEY BY PFEILER & ASSOC., FULLERTON, Ca. TR. No. 31224

DATE MARCH 25, 1981 Robert Pfeiler R.C.E. 12507

PARTY
BROWNING
ELKINS
2-23-81

℄ CURVE DATA
Δ=50°40'28"
R=200.00'
L=176.89'
T=94.70'

SET L℄T

SET L℄T

21.02'

24.47'

22.35'

46.00'

28.77'

94.84

29.97'

26.91'

SET S,W℄T R.C.E. 12507

20.11'

SET L℄T

℄ CURVE DATA
Δ=37°30'00"
R=200.00'
L=130.90'
T=67.89'

CURB

60'
30'
30'
12'
18'
18'
12'

ARROW POINT DRIVE

SET L℄T

SET S,W℄T R.C.E. 12507

23.85

23.22'

SET L℄T

22.61'

20.70

SET L℄T

85.61'

℄ NARES DRIVE

Scale 1"=40'

L℄T INDICATES LEAD ℄ TACK
S,W℄T INDICATES BOAT SPIKE WASHER ℄ TIN

279-097 (29)

SO. CALIF. BLUE PRINT CO.

CO ENG FB 3656 - 141

SURVEY OF CENTERLINE TIES F. B. Pg.

SURVEY BY PFEILER & ASSOC., FULLERTON, Ca. TR. No. 31224

DATE MARCH 25, 1981 Robert Pfeiler R.C.E. 12507

L & T INDICATES LEAD & TACK
S, W & T INDICATES BOAT SPIKE WASHER & TIN

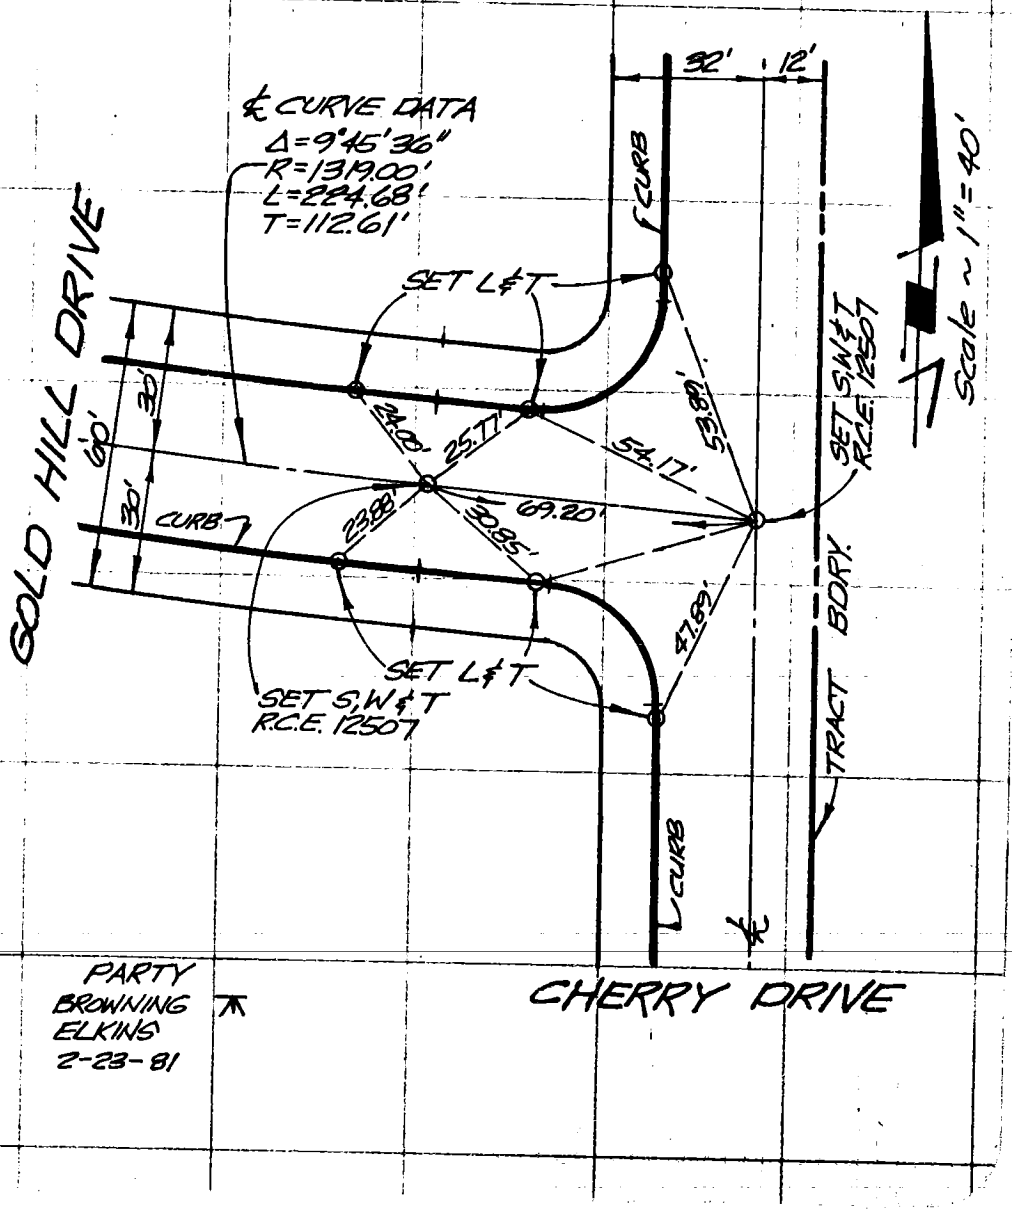

PARTY
BROWNING
ELKINS
2-23-81

274-097, A-1 (41)

SO. CALIF. BLUE PRINT CO.

142 CO ENG FB 3656 - 142

SURVEY OF CENTERLINE TIES F. B. Pg.

SURVEY BY PFEILER & ASSOC., FULLERTON, Ca. TR. No. 31224

DATE MARCH 25, 1981 Robert Pfeiler R.C.E. 12507

L&T INDICATES LEAD & TACK

S,W&T INDICATES BOAT SPIKE WASHER & TIN

PARTY
J. BROWNING
ELKINS
2-13-81

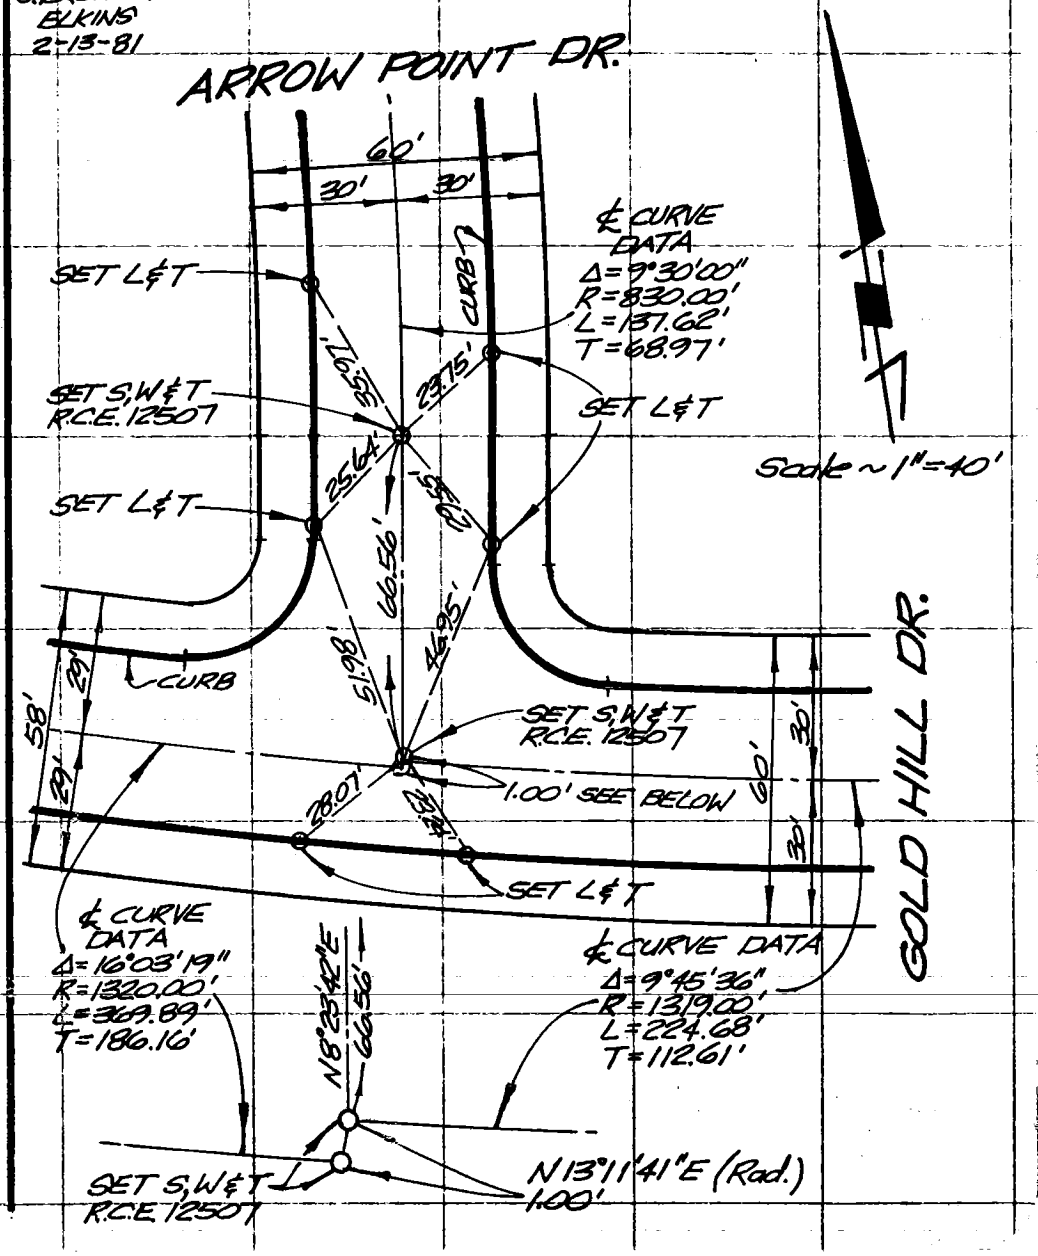

SO. CALIF. BLUE PRINT CO. -

279-043, 1-1

(20)

143 CO ENG FB 3656 - 143

SURVEY OF CENTERLINE TIES F. B. Pg.

SURVEY BY PFEILER & ASSOC, FULLERTON, Ca. TR. No. 31224

DATE MARCH 25, 1981 Robert Pfeiler R.C.E. 12507

L&T INDICATES LEAD & TACK
S,W&T INDICATES BOAT SPIKE WASHER & TIN

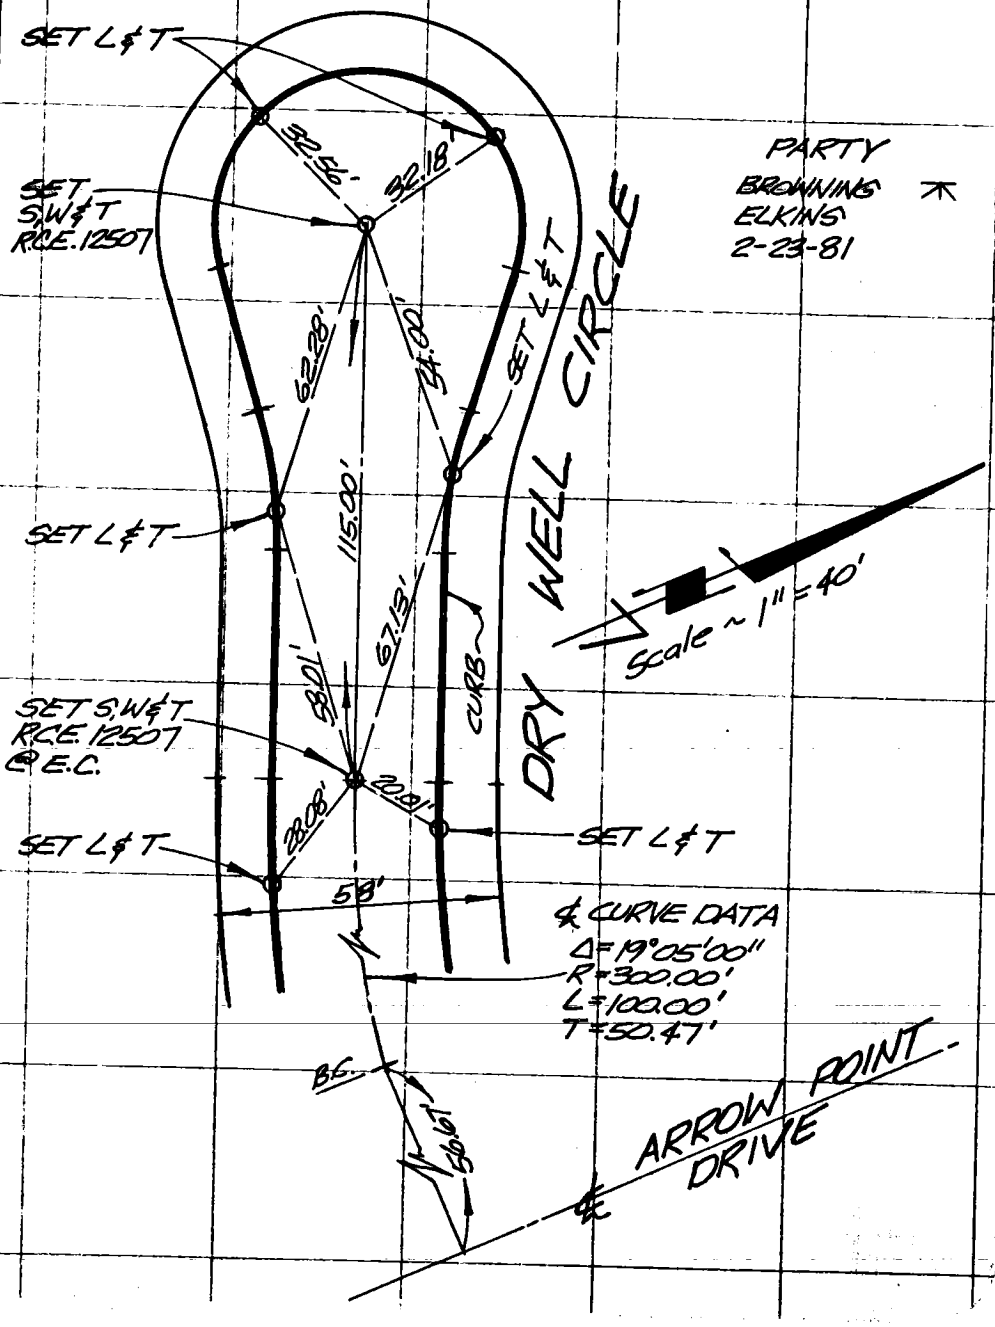

PARTY
BROWNING
ELKINS
2-23-81

Scale ~ 1" = 40'

279-097, 1-1 (12)

SO. CALIF. BLUE PRINT CO.

144 m CO ENG FB 3656 - 144

SURVEY OF CENTERLINE TIES F. B. ____ Pg. ____

SURVEY BY PFEILER & ASSOC., FULLERTON, CA. TR. No. 31224

DATE MARCH 25, 1981 Robert Pfeiler R.C.E. 12507

L & T INDICATES LEAD & TACK

S,W & T INDICATES BOAT SPIKE WASHER & TIN

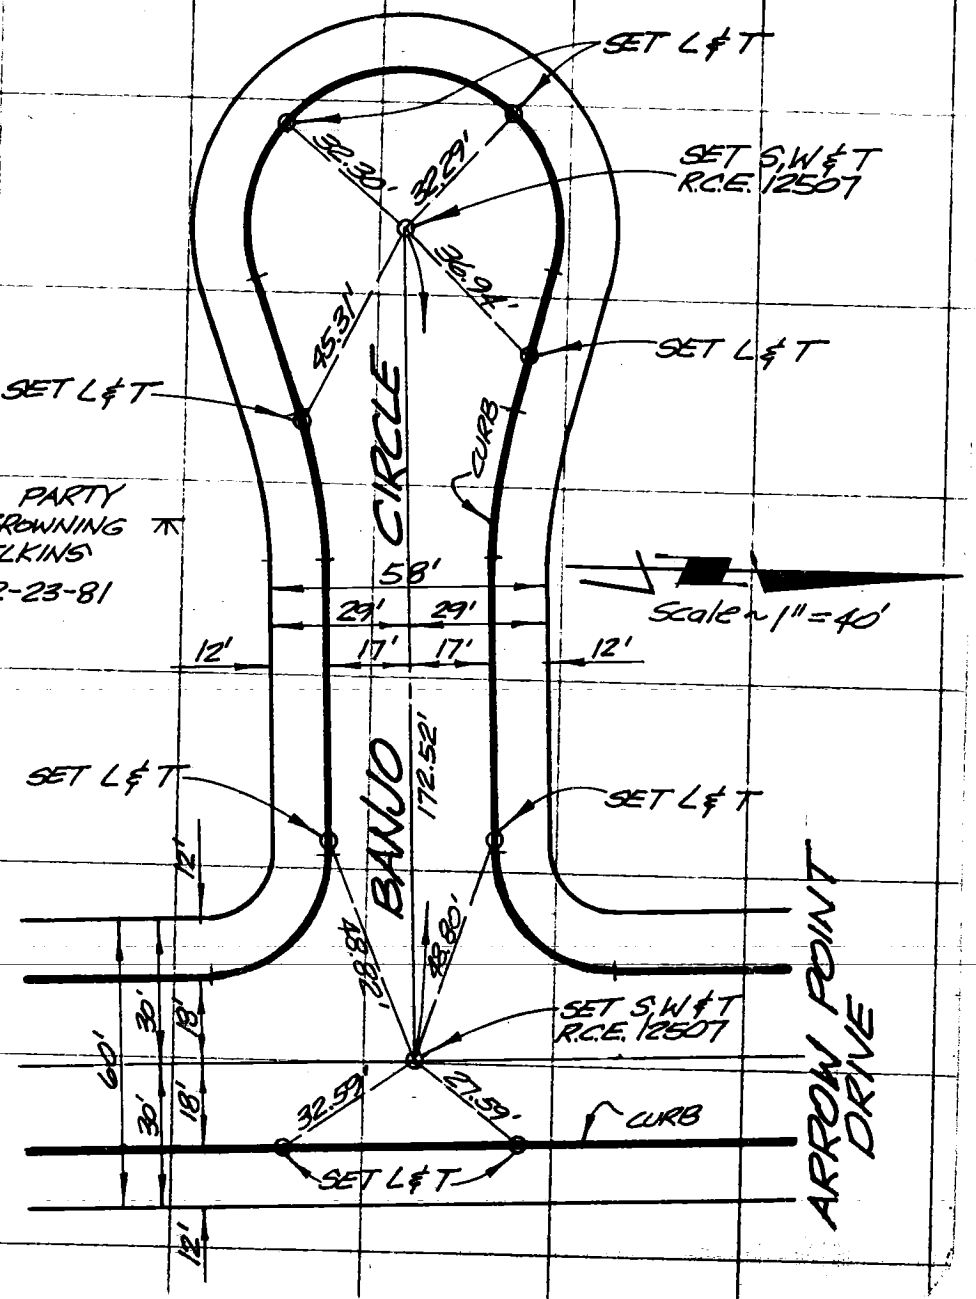

SO. CALIF. BLUE PRINT CO. -

(43) 1-4-79 2,000

105 CO ENG FB 3656 - 145

SURVEY OF CENTERLINE TIES F. B. ____ PG. ____

SURVEY BY PFEILER & ASSOC, FULLERTON, CA. TR. No. 31224

DATE MARCH 25, 1981 Robert F. Pfeiler, R.C.E. 12507

L&T INDICATES LEAD & TACK
S,W&T INDICATES BOAT SPIKE WASHER & TIN

279-097, A-1 (44)

SO. CALIF. BLUE PRINT CO.

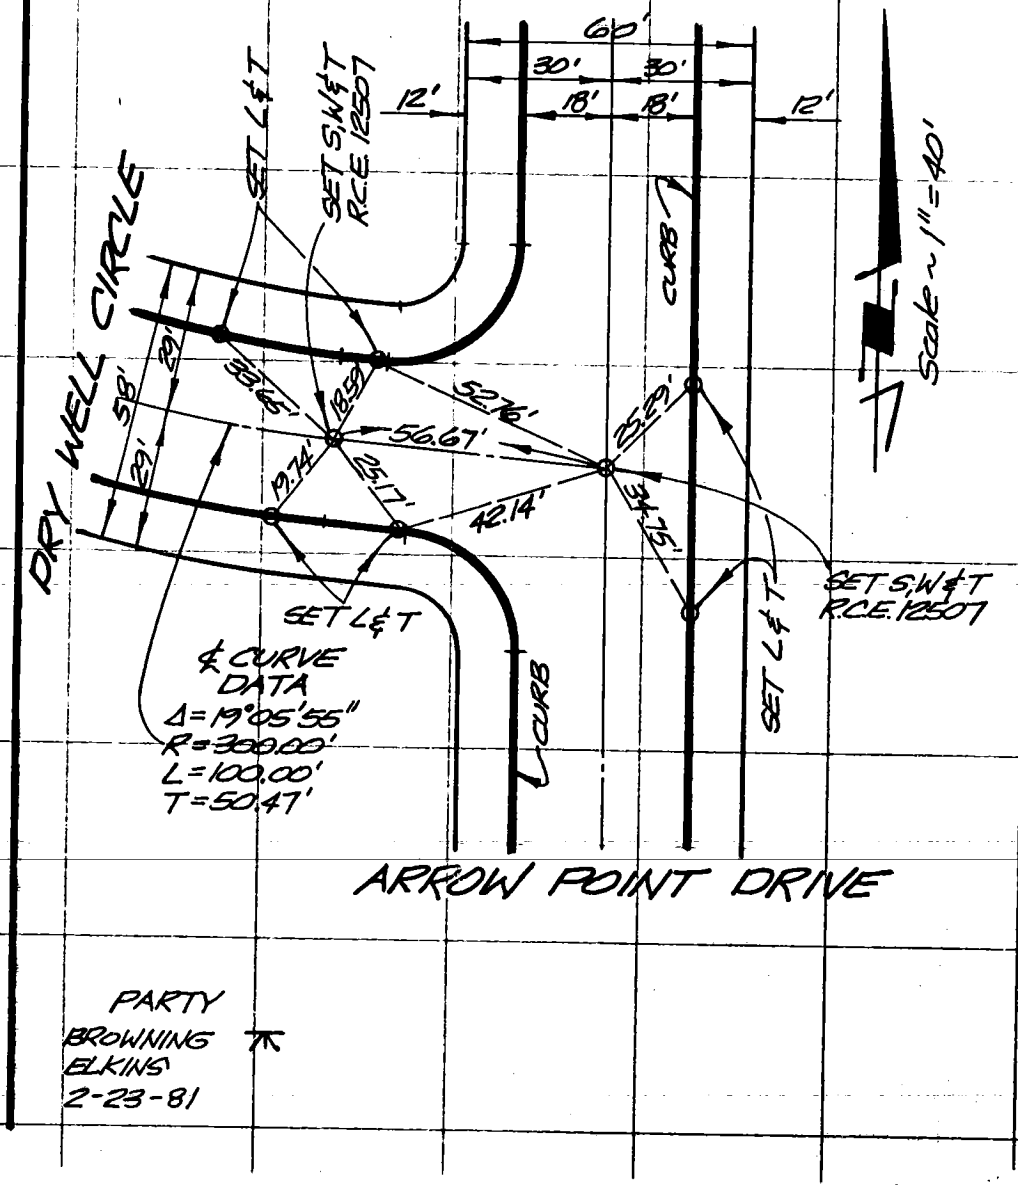

PARTY
BROWNING
ELKINS
2-23-81

SURVEY OF CENTERLINE TIES F. B. PG.

SURVEY BY PFEILER & ASSOC., FULLERTON, CA. TR. No. 31224

DATE MARCH 25, 1981 Robert Pfeiler R.C.E. 12507

L & T INDICATES LEAD & TACK

S,W & T INDICATES BOAT SPIKE WASHER & TIN

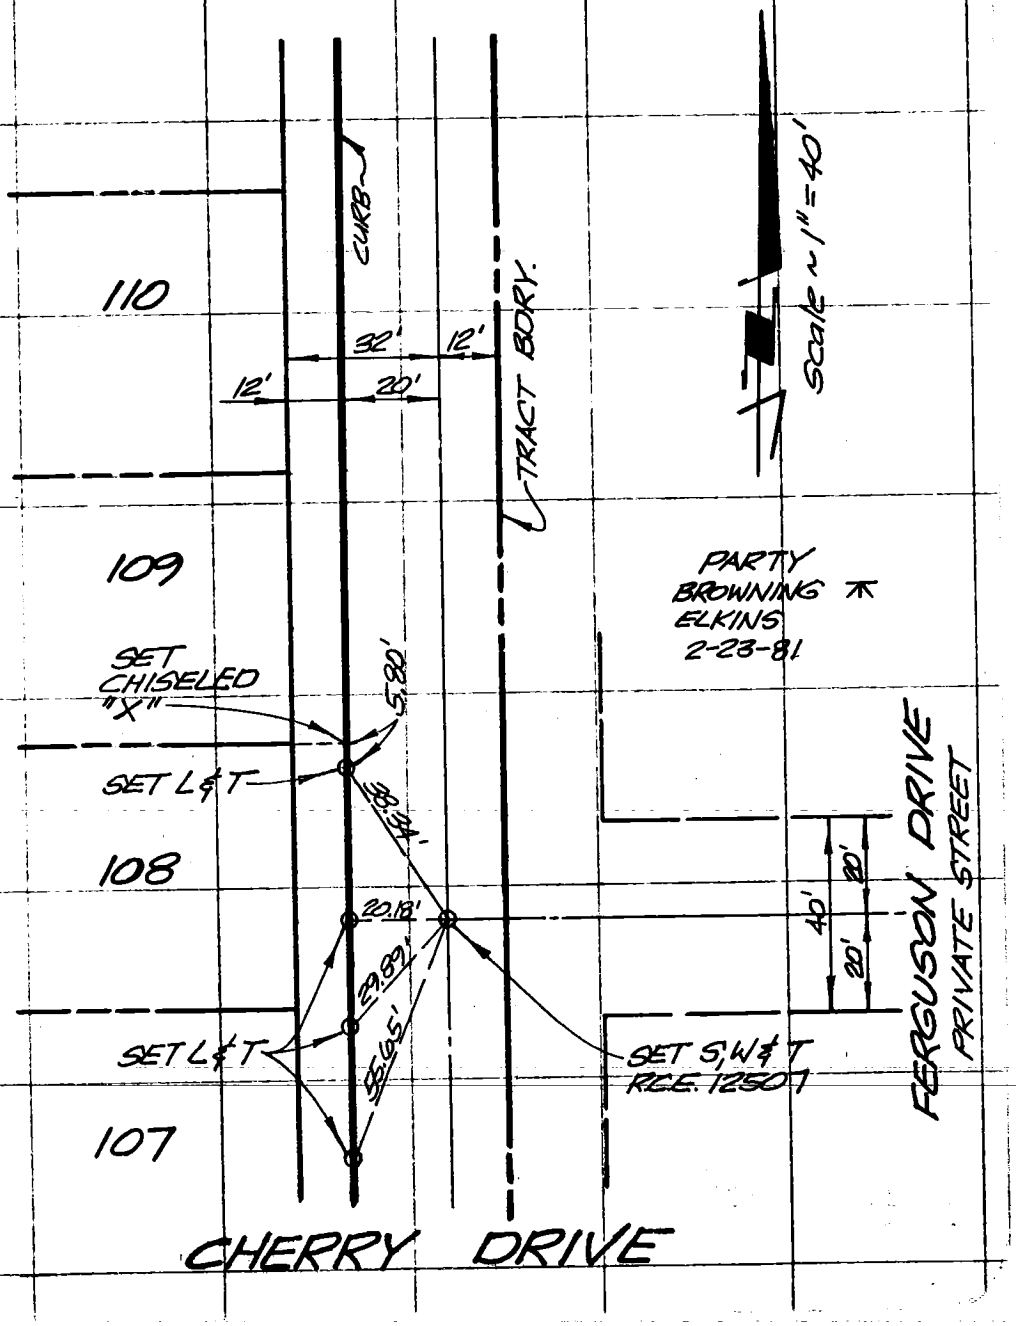

(10)

279-097, A-1

SO. CALIF. BLUE PRINT CO.

147 CO ENG FB 3656 - 147

SURVEY OF CENTERLINE TIES F. B. ____ PG. ____

SURVEY BY PFEILER & ASSOC., FULLERTON, Ca. TR. No. 31224

DATE MARCH 26, 1981 Robert Pfeiler R.C.E. 12507

L & T INDICATES LEAD & TACK

S,W & T INDICATES BOAT SPIKE WASHER & TIN

PARTY
BROWNING
ELKINS
2-28-81

279-09, A-1 (9)

SO. CALIF. BLUE PRINT CO.

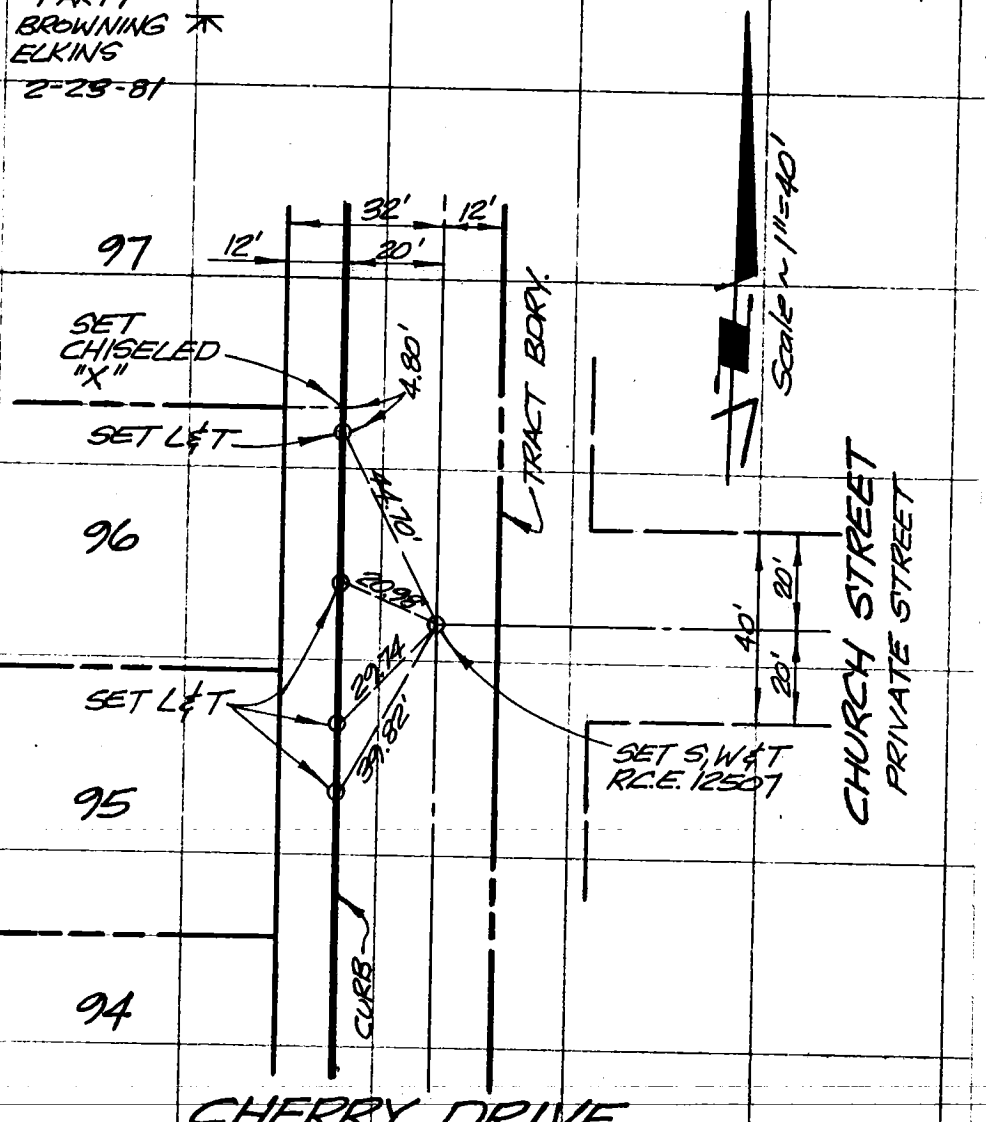

SURVEY OF CENTERLINE TIES F. B. ____ Pg. ____

SURVEY BY PFEILER & ASSOC., FULLERTON, Ca. TR. No. 31224

DATE MARCH 25, 1981 Robert J. Pfeiler R.C.E. 12507

L&T INDICATES LEAD & TACK

S,W & T INDICATES BOAT SPIKE WASHER & TIN

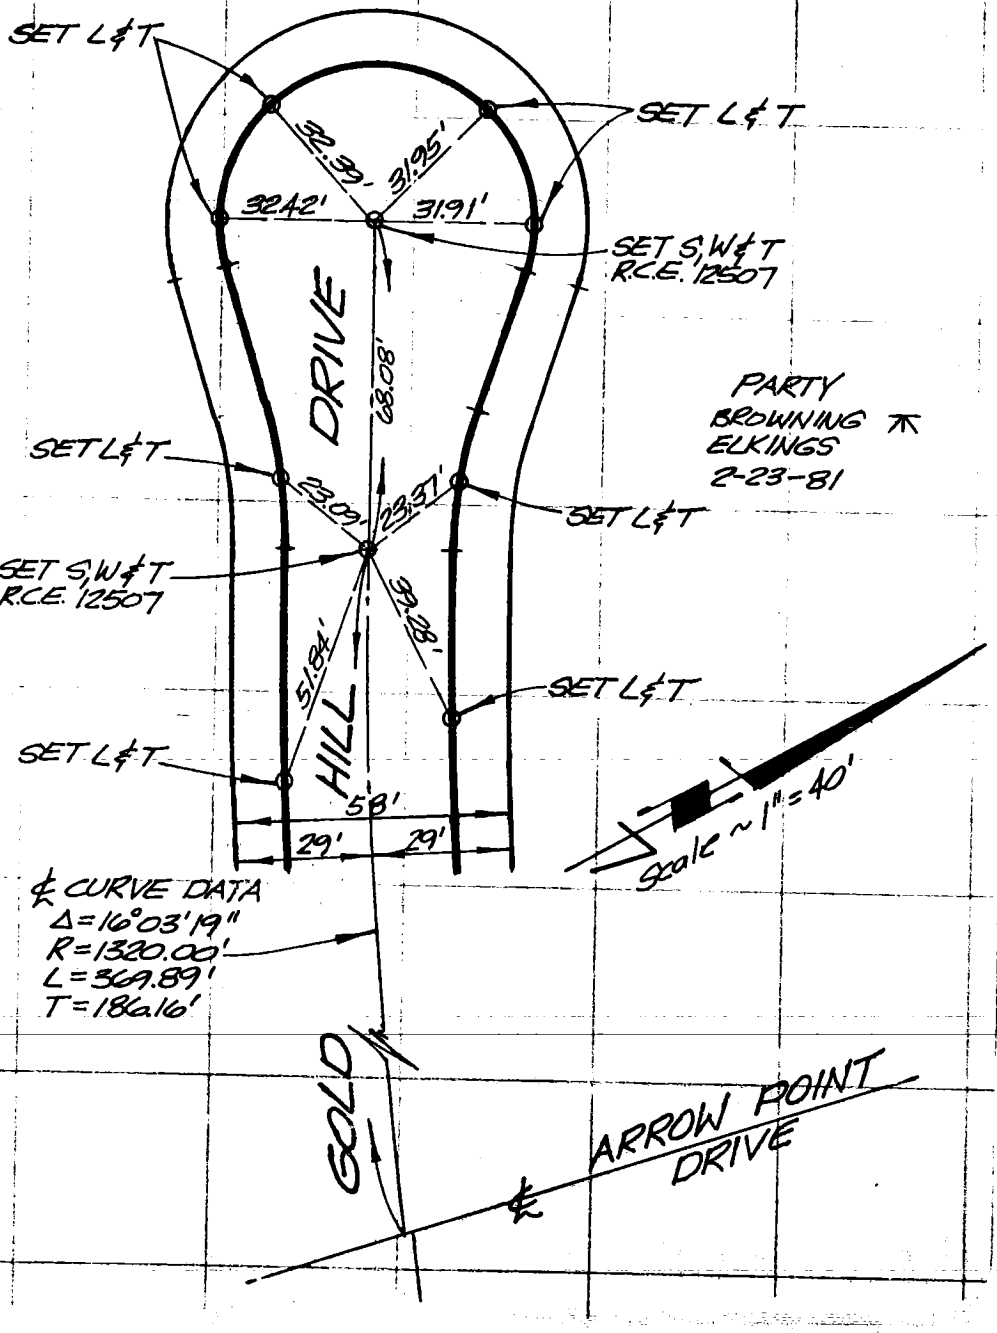

297-097, A-1 (43)

SO. CALIF. BLUE PRINT CO.

SURVEY OF CENTERLINE TIES F. B. ____ PG. ____

SURVEY BY PFEILER & ASSOC., FULLERTON, Ca. TR. No. 31224

DATE MARCH 26, 1981 Robert J. Pfeiler R.C.E. 12507

L&T INDICATES LEAD & TACK
S,W&T INDICATES BOAT SPIKE WASHER & TIN

(14)

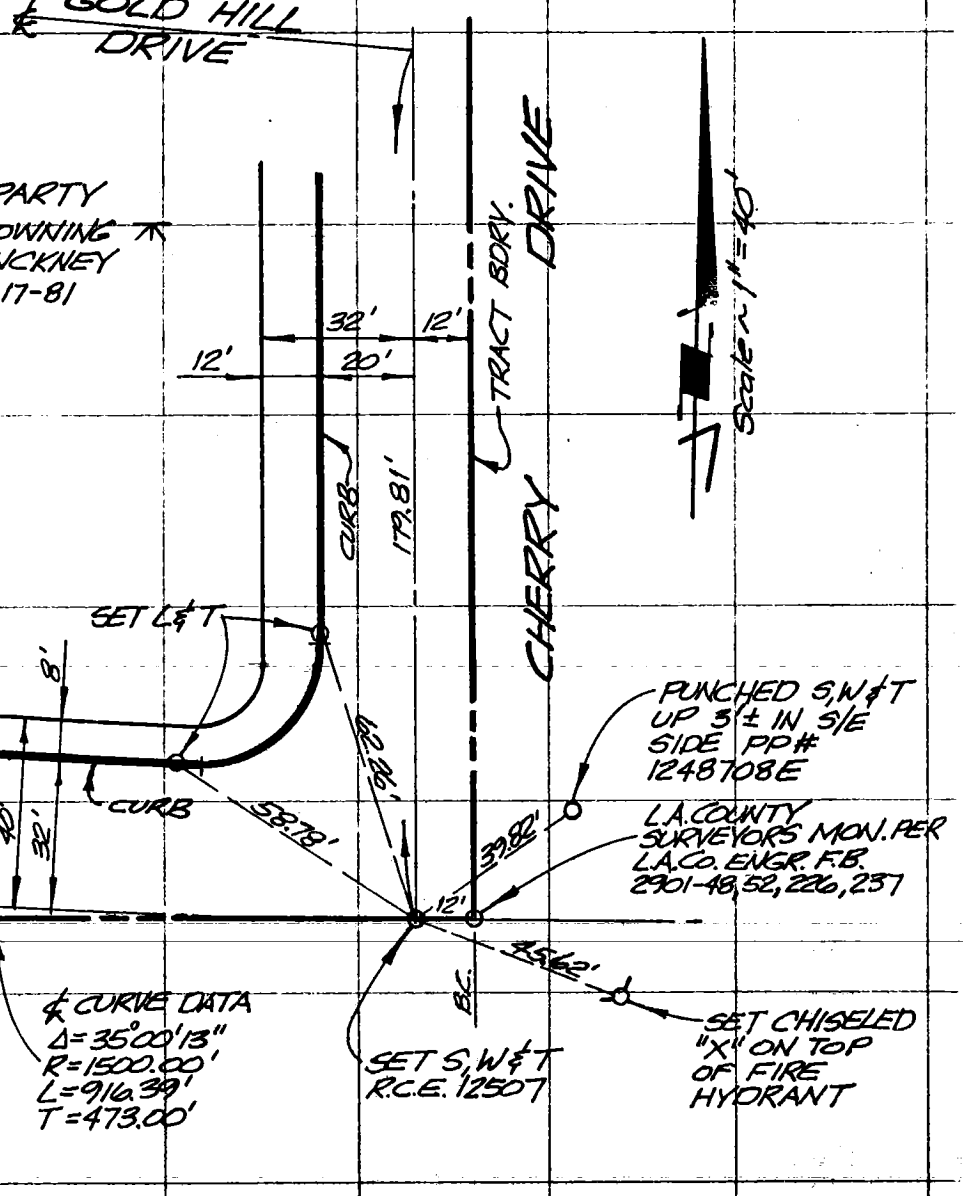

SO. CALIF. BLUE PRINT CO.

279-090, A-1

150 CO ENG FB 3656 - 150

SURVEY OF CENTERLINE TIES F. B. _____ Pg. _____

SURVEY BY PFEILER & ASSOC., FULLERTON, Ca. TR. No. 31224

DATE MARCH 27, 1981 Robert Pfeiler R.C.E. 12507

L&T INDICATES LEAD & TACK

℄ CURVE DATA
Δ=5°54'00"
R=1035.00'
L=53.34'
T=106.58'

℄ CURVE DATA
Δ=29°47'47"
R=1035.00'
L=538.74'
T=275.36'

SET L&T

CAMINO DEL VALLE

8'

CURB

40.50'

32.31'

41.82'

32'

40'

8'

SET 2" I.P. TAGGED R.C.E. 12507

77.42'

73.34'

FUTURE CURB

75.47'

32.39'

SET L&T

CURB

46.24'

SET L&T

℄ CURVE DATA
Δ=35°00'13"
R=1500.00'
L=916.39'
T=473.00'

80'

40'

40'

PARKER ROAD

Scale ~ 1" = 40'

PARTY
BROWNING
ELKINS
2-23-81

279-097, A-1

SO. CALIF. BLUE PRINT CO.

151 CO ENG FB 3656 - 151

SURVEY OF CENTERLINE TIES F. B. ____ PG. ____

SURVEY BY PFEILER & ASSOC., FULLERTON, Ca. TR. No. 31224

DATE JUNE 6, 1981 Robert J Pfeiler R.C.E. 12507

L & T INDICATES LEAD & TACK

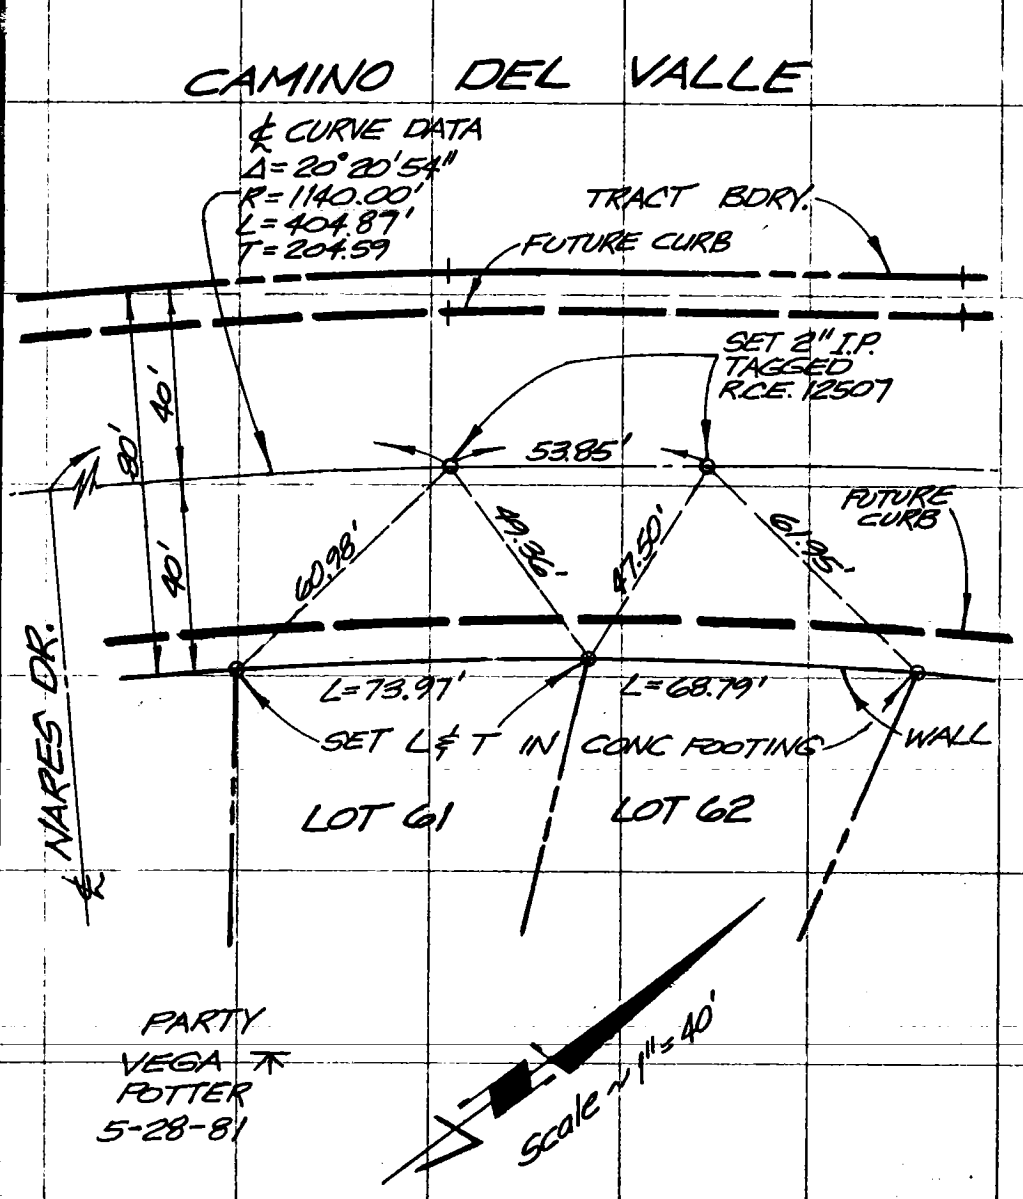

PARTY
VEGA
POTTER
5-28-81

Scale ~ 1" = 40'

279-097, A-1 (47)

SO. CALIF. BLUE PRINT CO.

CO ENG FB 3656 - 152

SURVEY OF CENTERLINE TIES F. B. ____ Pg. ____

SURVEY BY PFEILER & ASSOC., FULLERTON, Co. TR. No. 31224

DATE JUNE 6, 1981 Robert J. Reilly R.C.E. 12507

L & T INDICATES LEAD & TACK

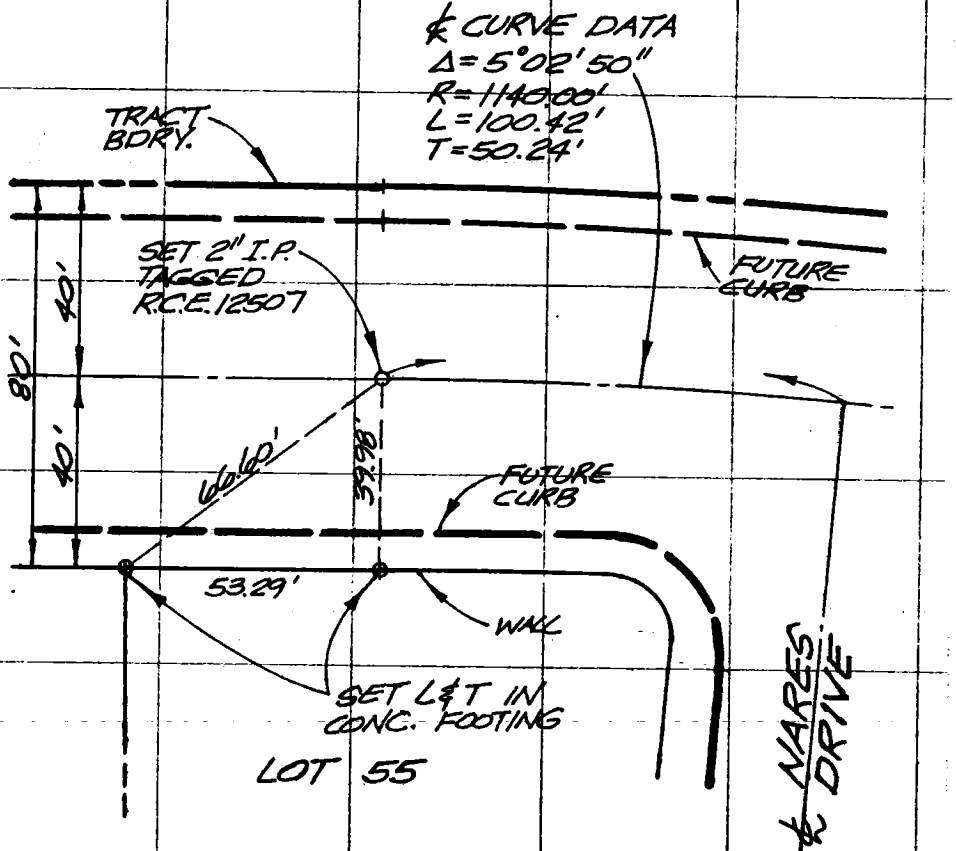

PARTY WALL
VEGA
POTTER
5-28-81

Scale ~ 1" = 40'

279-097, 4-1 (46)

SO. CALIF. BLUE PRINT CO.

157 CO ENG FB 3656 - 153

SURVEY OF CENTERLINE TIES F. B. Pg.

SURVEY BY PFEILER & ASSOC., FULLERTON, Ca. TR. No. 31224

DATE JUNE 6, 1981 Richard Pfeiler R.C.E. 12507

L & T INDICATES LEAD & TACK

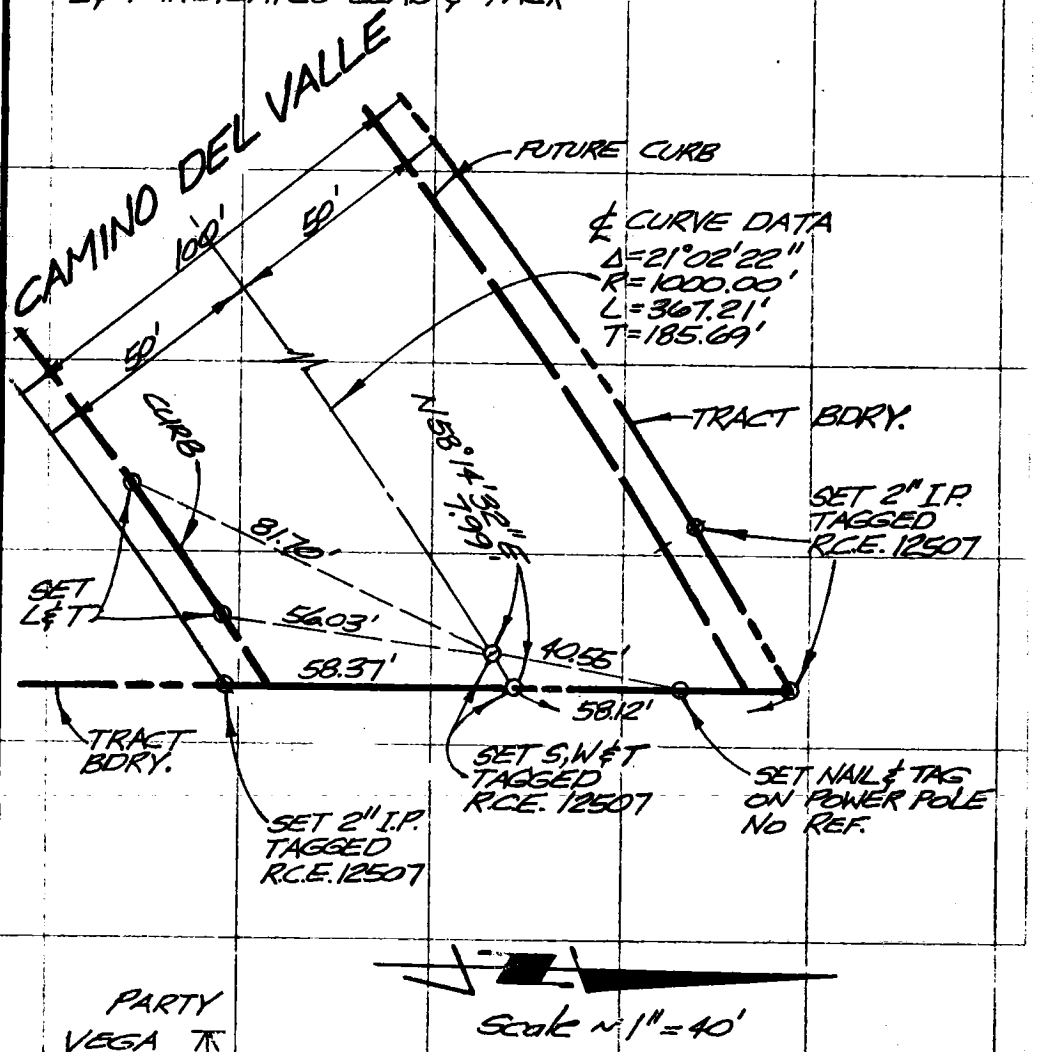

Scale ~ 1" = 40'

PARTY
VEGA
POTTER
5-28-81

64

12-097, 1-1

SO. CALIF. BLUE PRINT CO.

154 CO ENG FB 3656 - 154

SURVEY OF CENTERLINE TIES F. B. ____ Pg. ____

SURVEY BY PFEILER & ASSOC., FULLERTON, Ca. TR. No. 31224

DATE JUNE 6, 1981 Robert Pfeiler R.C.E. 12507

L & T INDICATES LEAD & TACK

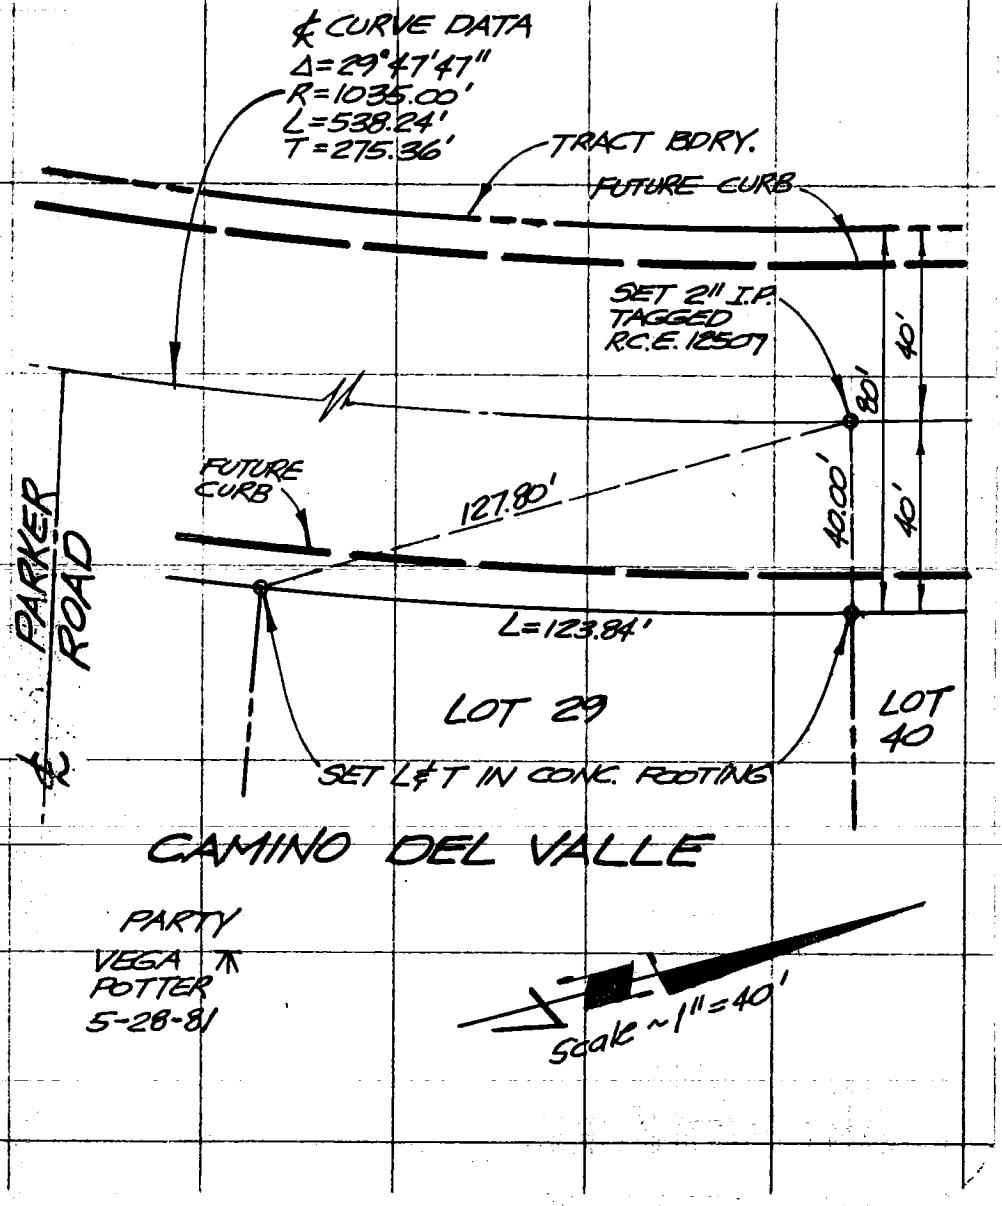

SO. CALIF. BLUE PRINT CO.