Notes Ck'd by		Survey of	F.B. PG.
Map No.		JN Tape Std °F	
Office Work		Surveyed by	
Checked		Notes Date	
Date		Indexed	

3673

1-3	Tr. 32554	Wesley R.Lind
4-7	PM 15104	Engineering Service Corp.
8-14	Tr. 41888	Mc. Cutchan & Barrios Inc.
15-27	Tr. 33406	Advanced Design Associates (see also FB 3668: 69-76)
28-50	Tr. 33405	Advanced Design Ass.
51-55	Flood Control centerline ties in Sun Valley	
56	Tr. 34967	Classic Engineering.
57	PM 15916	Surv's Service Co.
58-59	Road Dept. ties in Soledad Cyn Rd. at Sec's 21,22 T4N-R15W	
60	Tr. 43111	James P. Mc Donough
61-62	Tr. 34843	John B. Abell
63-66	Tr. 33455	Dean Anderson
67-68	Tr. 36823	Don Dresser
69-74	Tr. 33104	Wesley R.Lind
75-83	Tr. 36478	Sloan & Ass.
84-85	Tr. 35278	Warren L.Rakness
86	Tr. 38130	SO. BAY ENG. CORP.
87-91	Tr. 32136	Wesley R.Lind
92-93	Tr. 40896	Salmen & Ass.
94-94A	Tr. 43254	Cantwell & Ass.
95-96	PM 16013	So Bay Eng.
97	Tr. 43119	Loren Phillips & Ass.
98-107	Flood Control Monument replacements.	
108	Tr. 32479	Dalcin Cummins & Ass.
109	Tr. 42778	Speight Engineering Co.
110-111	PM 11448	Wynne Engineering
112-115	Tr. 34360	Pace Engineering Inc.
116	PM 12669	Wynne Eng.
117-122	Flood Control replacement of C.L.mon's Long Beach area.	
123-126	same in Culver City.	
127-134	Flood Ctr. ties: San Pedro St. & 7th St. environment.	
135-139	Tr. 27347	Wesley R. Lind
140-145	Tr. 36724	Sikand Engineering
146-149	Tr. 38836	Sikand Engineering.

Microfilmed July '85

CO ENG FB 3673-1

W.S. 114-317 C-3

SURVEY OF CENTERLINE TIES F. B. Pg.

SURVEY BY WESLEY R. LIND RCE 16362
LIND & HILLERUD, INC. TR. No. 32554

DATE JULY 16, 1981 SHEET 1 OF 3

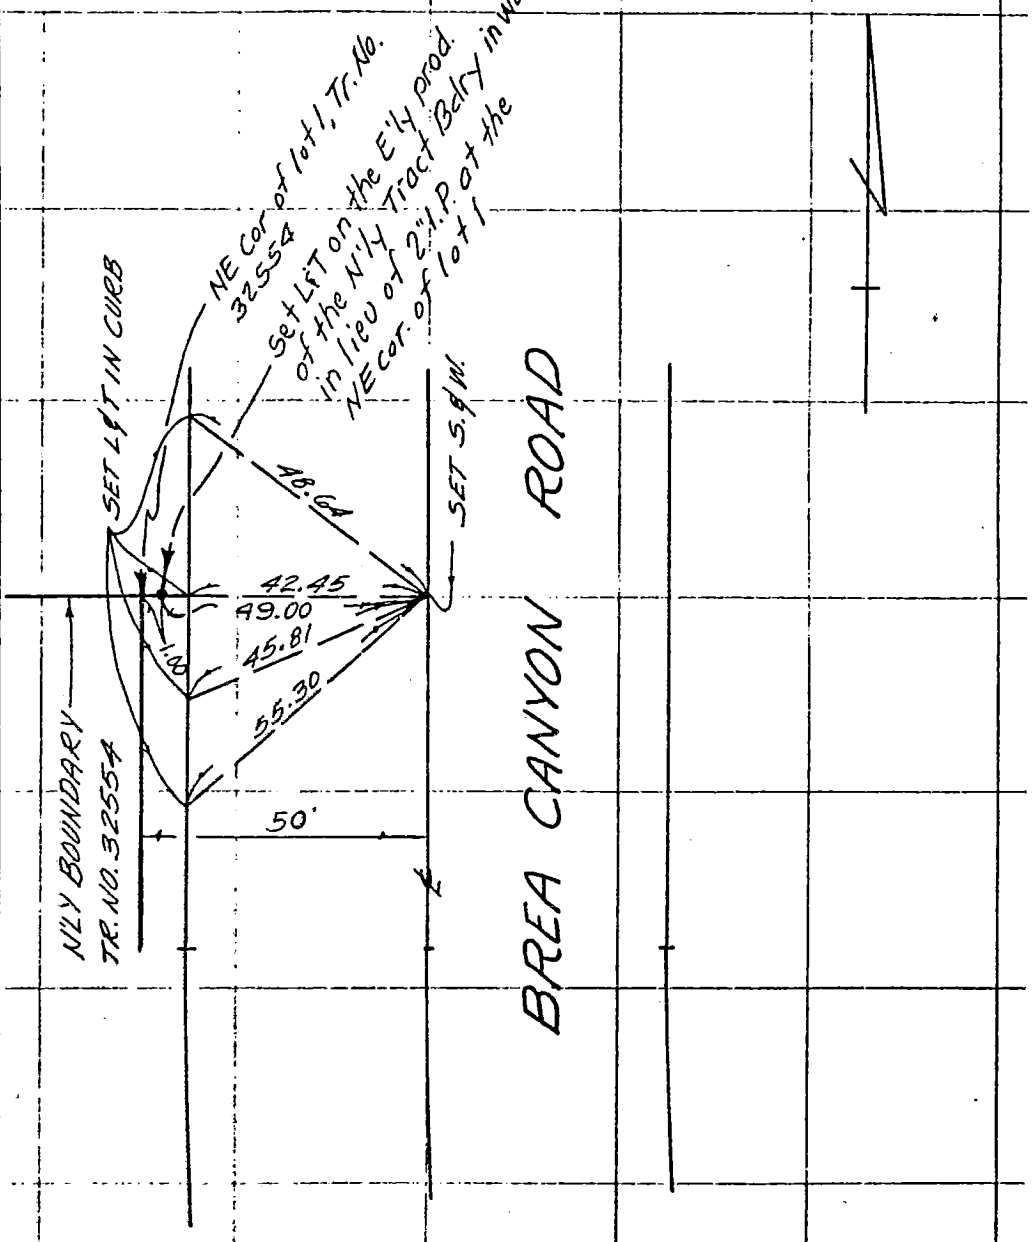

SO. CALIF. BLUE PRINT CO.

W.S. 114-317 C-3

SURVEY OF CENTERLINE TIES F. B. Pg.

SURVEY BY WESLEY R. LIND RCE 16362 LIND & HILLERUD, INC. TR. No. 32554

DATE JULY 16, 1981 SHEET 2 OF 3

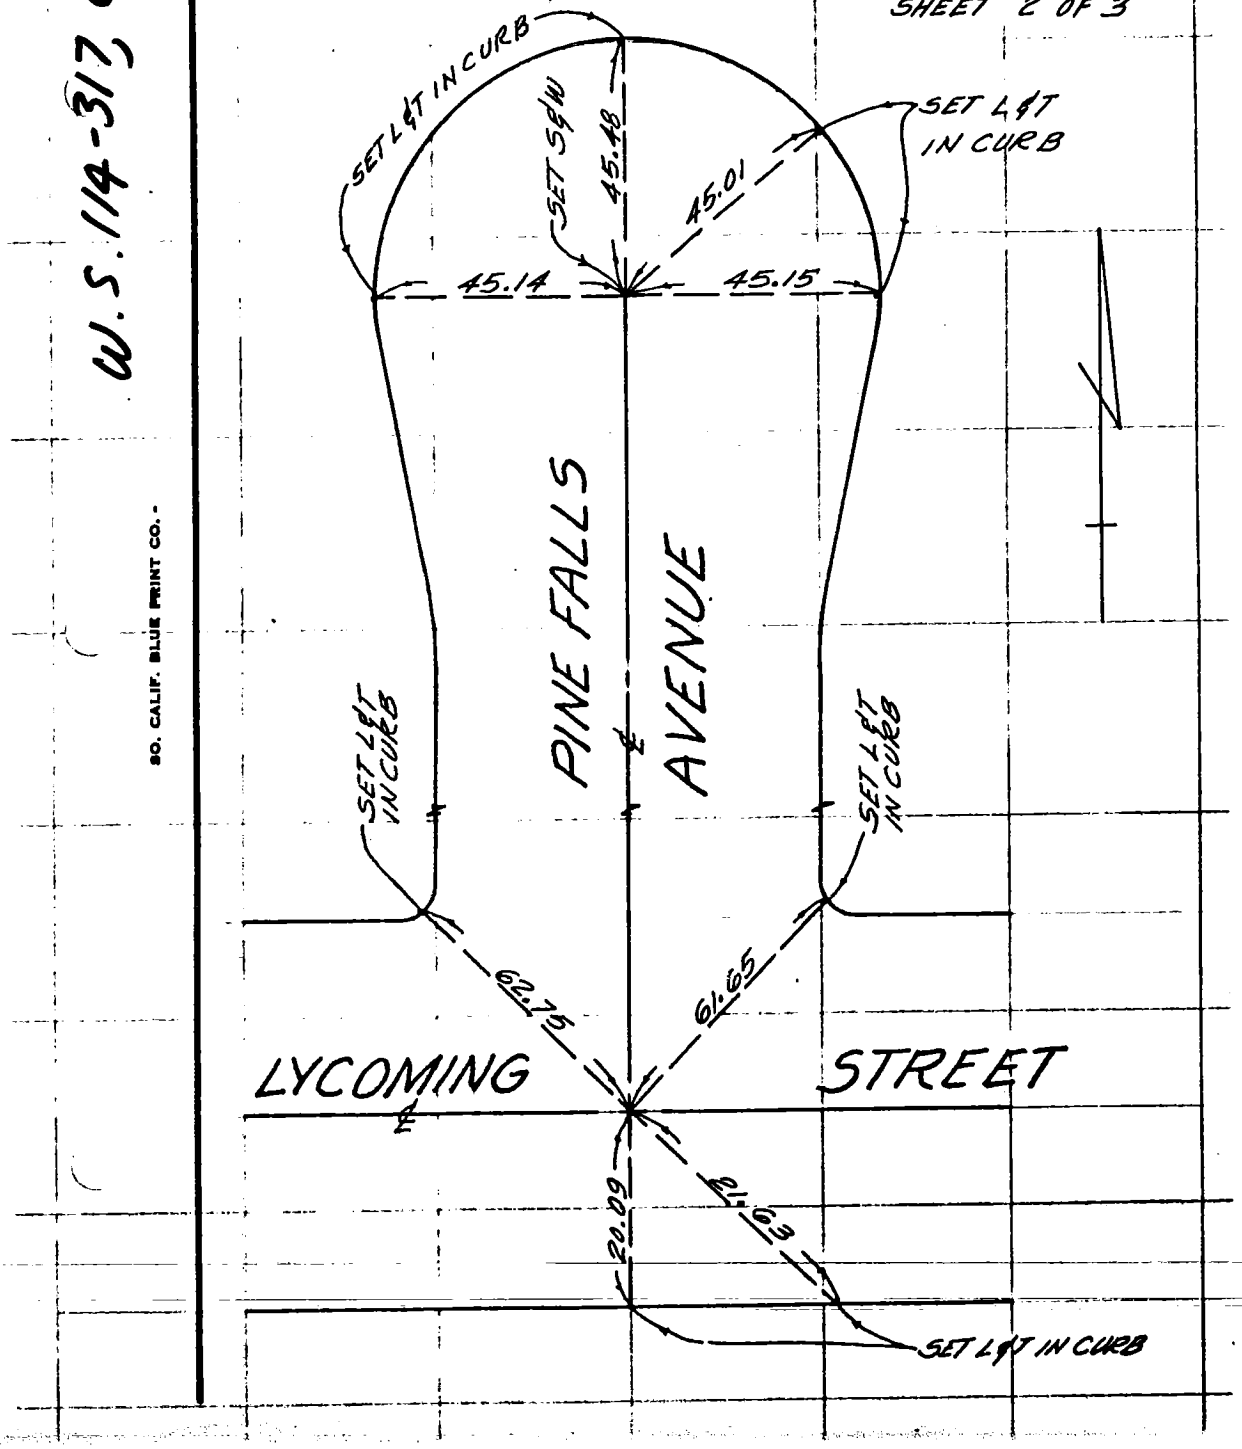

SO. CALIF. BLUE PRINT CO.

CO ENG FB 3673-3

W.S. 114-317, C-3

SURVEY OF CENTERLINE TIES F. B. Pg.

SURVEY BY WESLEY R. LIND RCE 16362
LIND & HILLERUD, INC. TR. No. 32554

DATE JULY 16, 1981 SHEET 3 OF 3

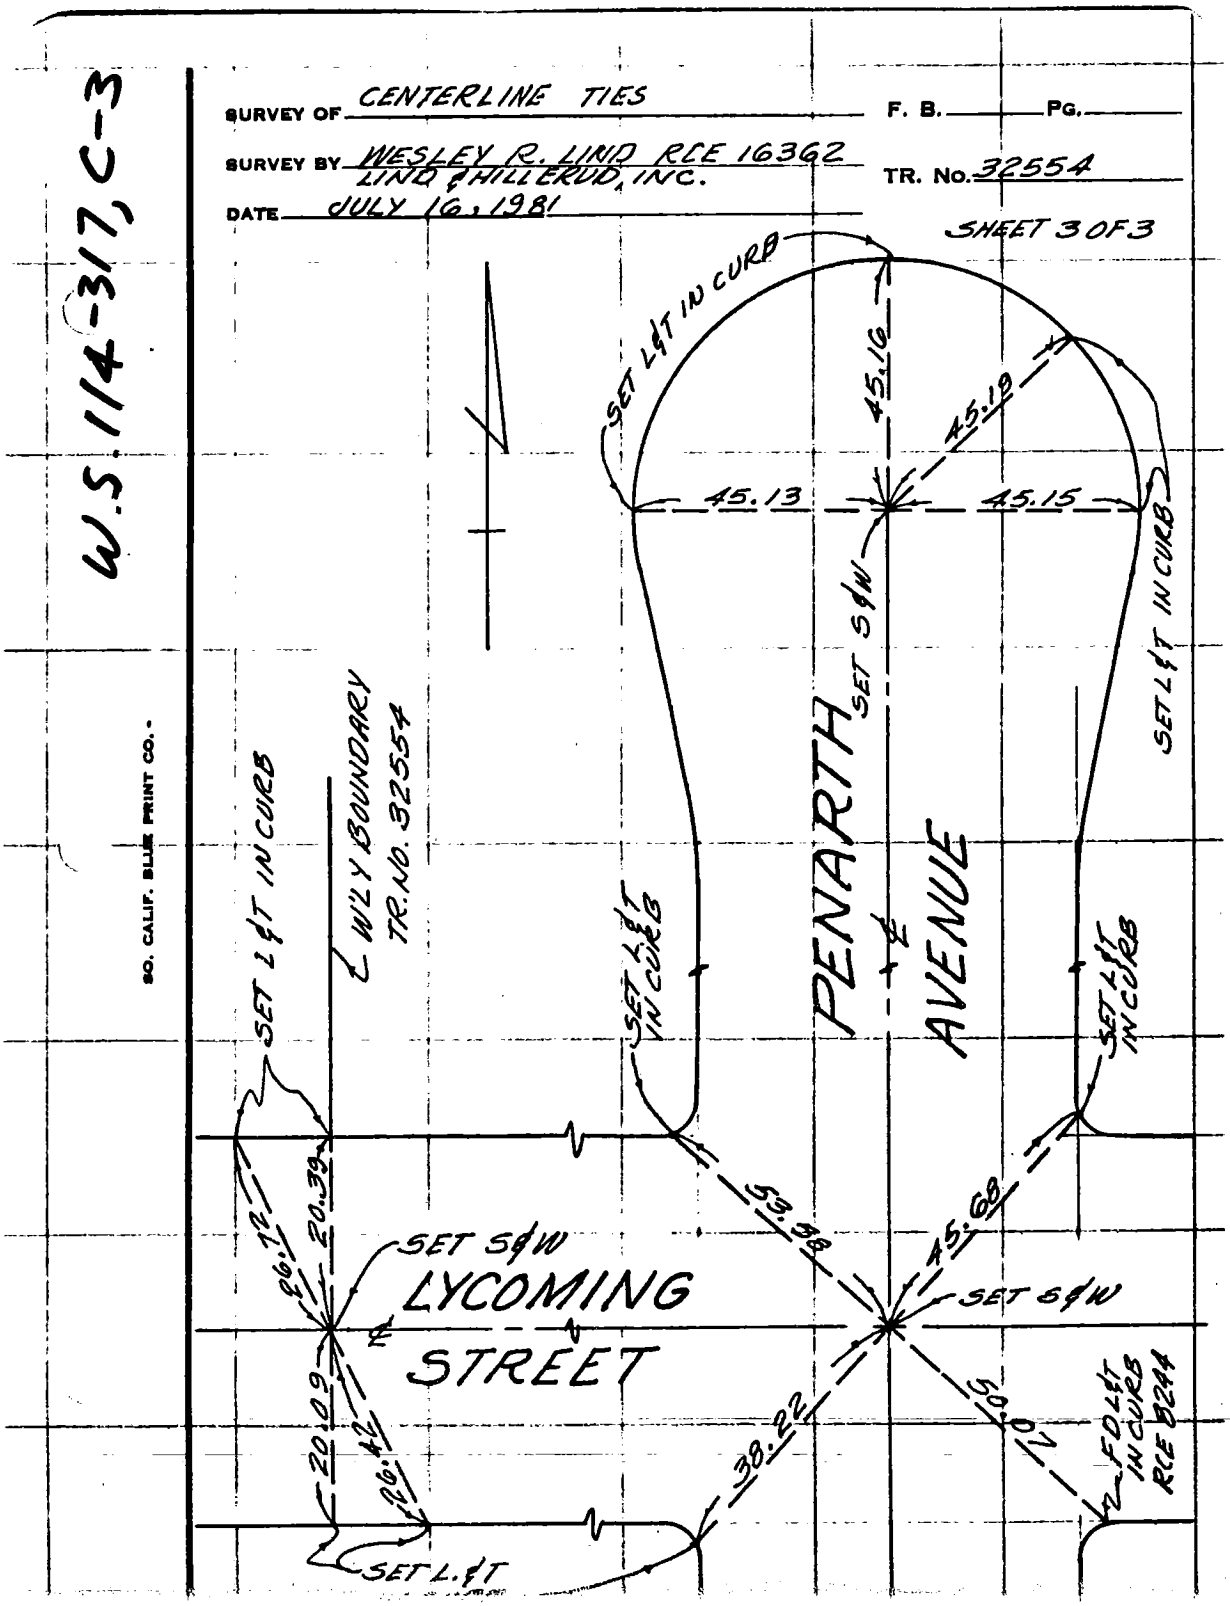

SO. CALIF. BLUE PRINT CO.

W.S. 44-C-3

SURVEYORS SERVICE COMPANY — MESA - STOCK NO. 411

DO NOT EXTEND NOTES THIS SIDE OF LINE

4/ CO ENG FB 3673-4

SURVEY OF DUARTE ROAD F B NO. ____ PAGE 1

SURVEY BY ENGR. SERVICE CORP. F.M. TRACT NO. 15104

DATE 9 JULY 1984

J.K. NEWVILLE
R.C.E. 13095

SEE SHEET 2

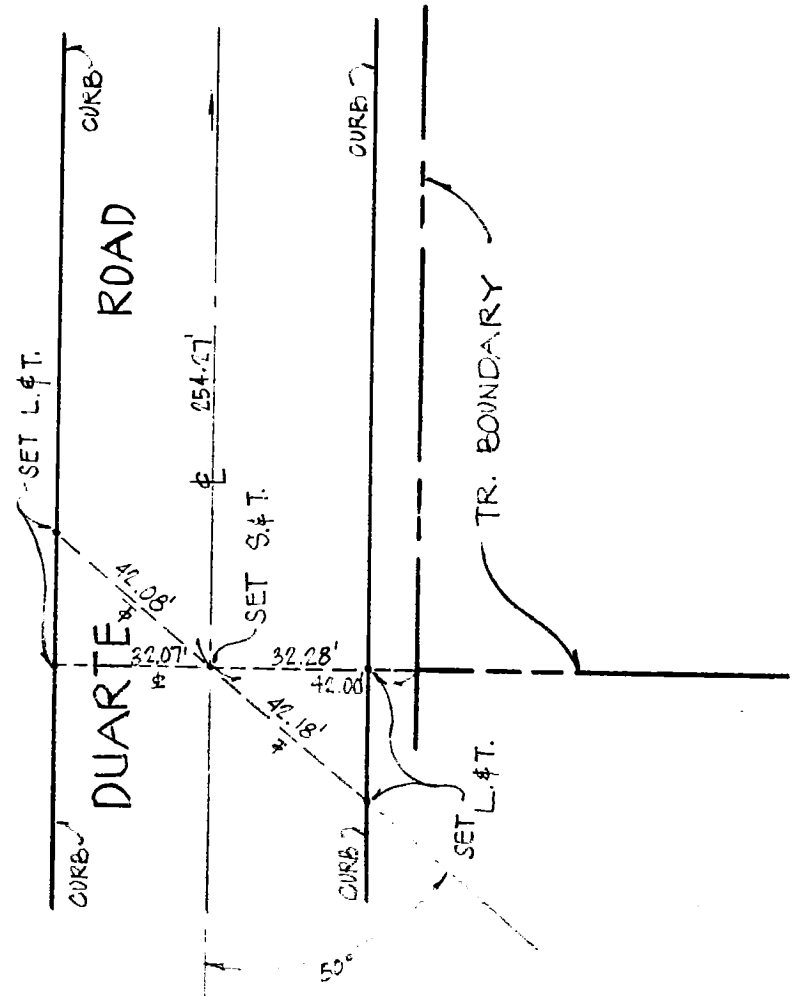

TO P.M's ON MH @
GOLDEN WEST AVE.
PER C.S.F.B. 2245-100

NOTE: ALL SET L.&T's ARE TAGGED R.C.E. 13095

5

CO ENG FB 3673-5

SURVEY OF DUARTE ROAD F B NO. ____ PAGE 2

SURVEY BY ENG'R SERVICE CORP. P.M. TRACT NO. 15104

DATE 9 JULY 1984

J. K. NEWVILLE
R.C.E. 13095

TO P.M's ON MH @
BALDWIN AVE.
PER C.S.F.B. 1492-22

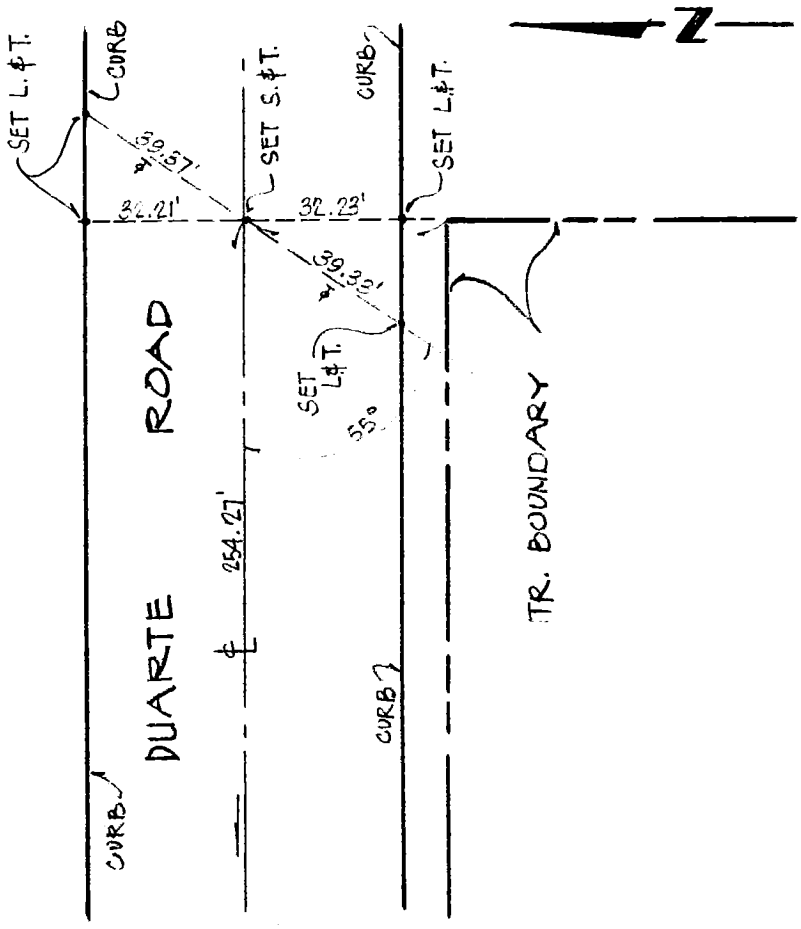

SEE SHEET 1

NOTE: ALL SET L.&T.'s ARE TAGGED R.C.E. 13095

W.S. 44, C-3

SURVEYORS SERVICE COMPANY STA MESA - STOCK NO. 411

DO NOT EXTEND NOTES THIS SIDE OF LINE

W.S. 44, C-3

SURVEYORS SERVICE COMPANY STA MESA - STOCK NO. 411

DO NOT EXTEND NOTES THIS SIDE OF LINE

6

CO ENG FB 3673-6

SURVEY OF NAOMI AVE. F B NO. PAGE 3

SURVEY BY ENGR. SERVICE CORP. P.M. TRACT NO. 15104

DATE 9 JULY 1984

J.K. NEWVILLE
R.C.E. 13095

SEE PAGE 4

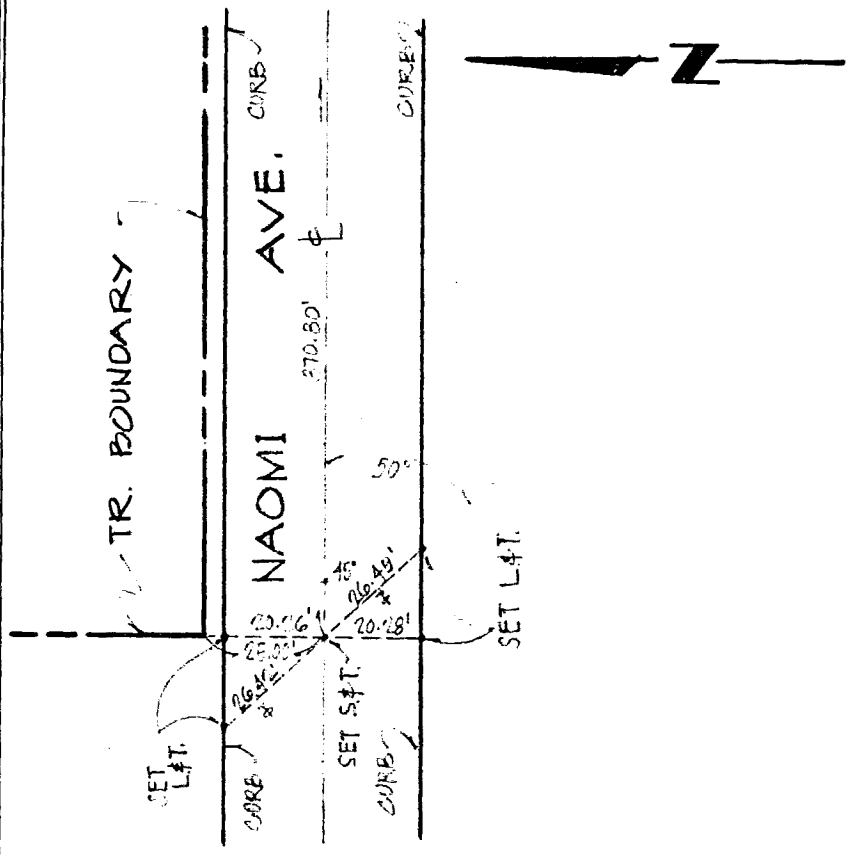

TO SURVEY MON. IN WELL @ GOLDEN WEST AVE.
PER RD. F.B. 1526-1769A

NOTE: ALL SET L&T's. ARE TAGGED R.C.E. 13095.

W.S. 44, D-3

7

CO ENG FB 3673-7

SURVEY OF NAOMI AVE. F B NO. ____ PAGE 4

SURVEY BY ENGR. SERVICE CORP. P.M. ____ TRACT NO. 15104

DATE 9 JULY 1984

J.K. NEWVILLE

R.C.E. 13095

TO SURVEY MON. @
BALDWIN AVE. PER
C.S.F.B. 1492-24

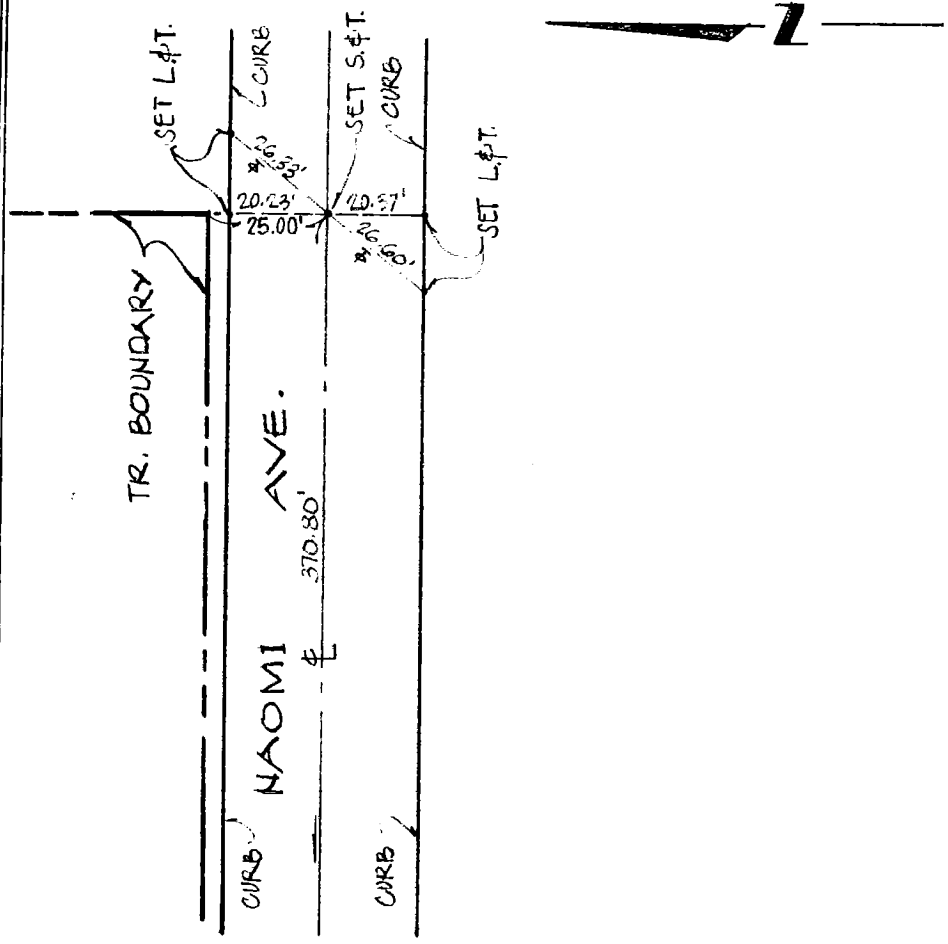

SEE SHEET 3

NOTE: ALL SET L&T's ARE TAGGED R.C.E. 13095.

DO NOT EXTEND NOTES THIS SIDE OF LINE

SURVEYORS SERVICE COMPANY STA MESA - STOCK NO. 411

8

CO ENG FB 3673-8

Notes Ck'd by	Survey of CENTERLINE TIES
~~Map~~ No. 41888	JN ____ Tape ____ Std ____ °F
Office Work	Surveyed by McCUTCHAN & BARRIOS, INC.
Checked	Notes PAUL H. BARRIOS, RCE 15857 Date MAY 29 1984
Date	Indexed

F.B. ____ PG. ____

Tr.

NOTE: ANY ADDITIONS OR CHANGES ON THIS SHEET MUST BE MADE OR CIRCLED IN RED INK WITH DATE AND NAME OF PERSON MAKING CHANGE

Do not extend notes this side of this line

W.S. 33 - A - 4

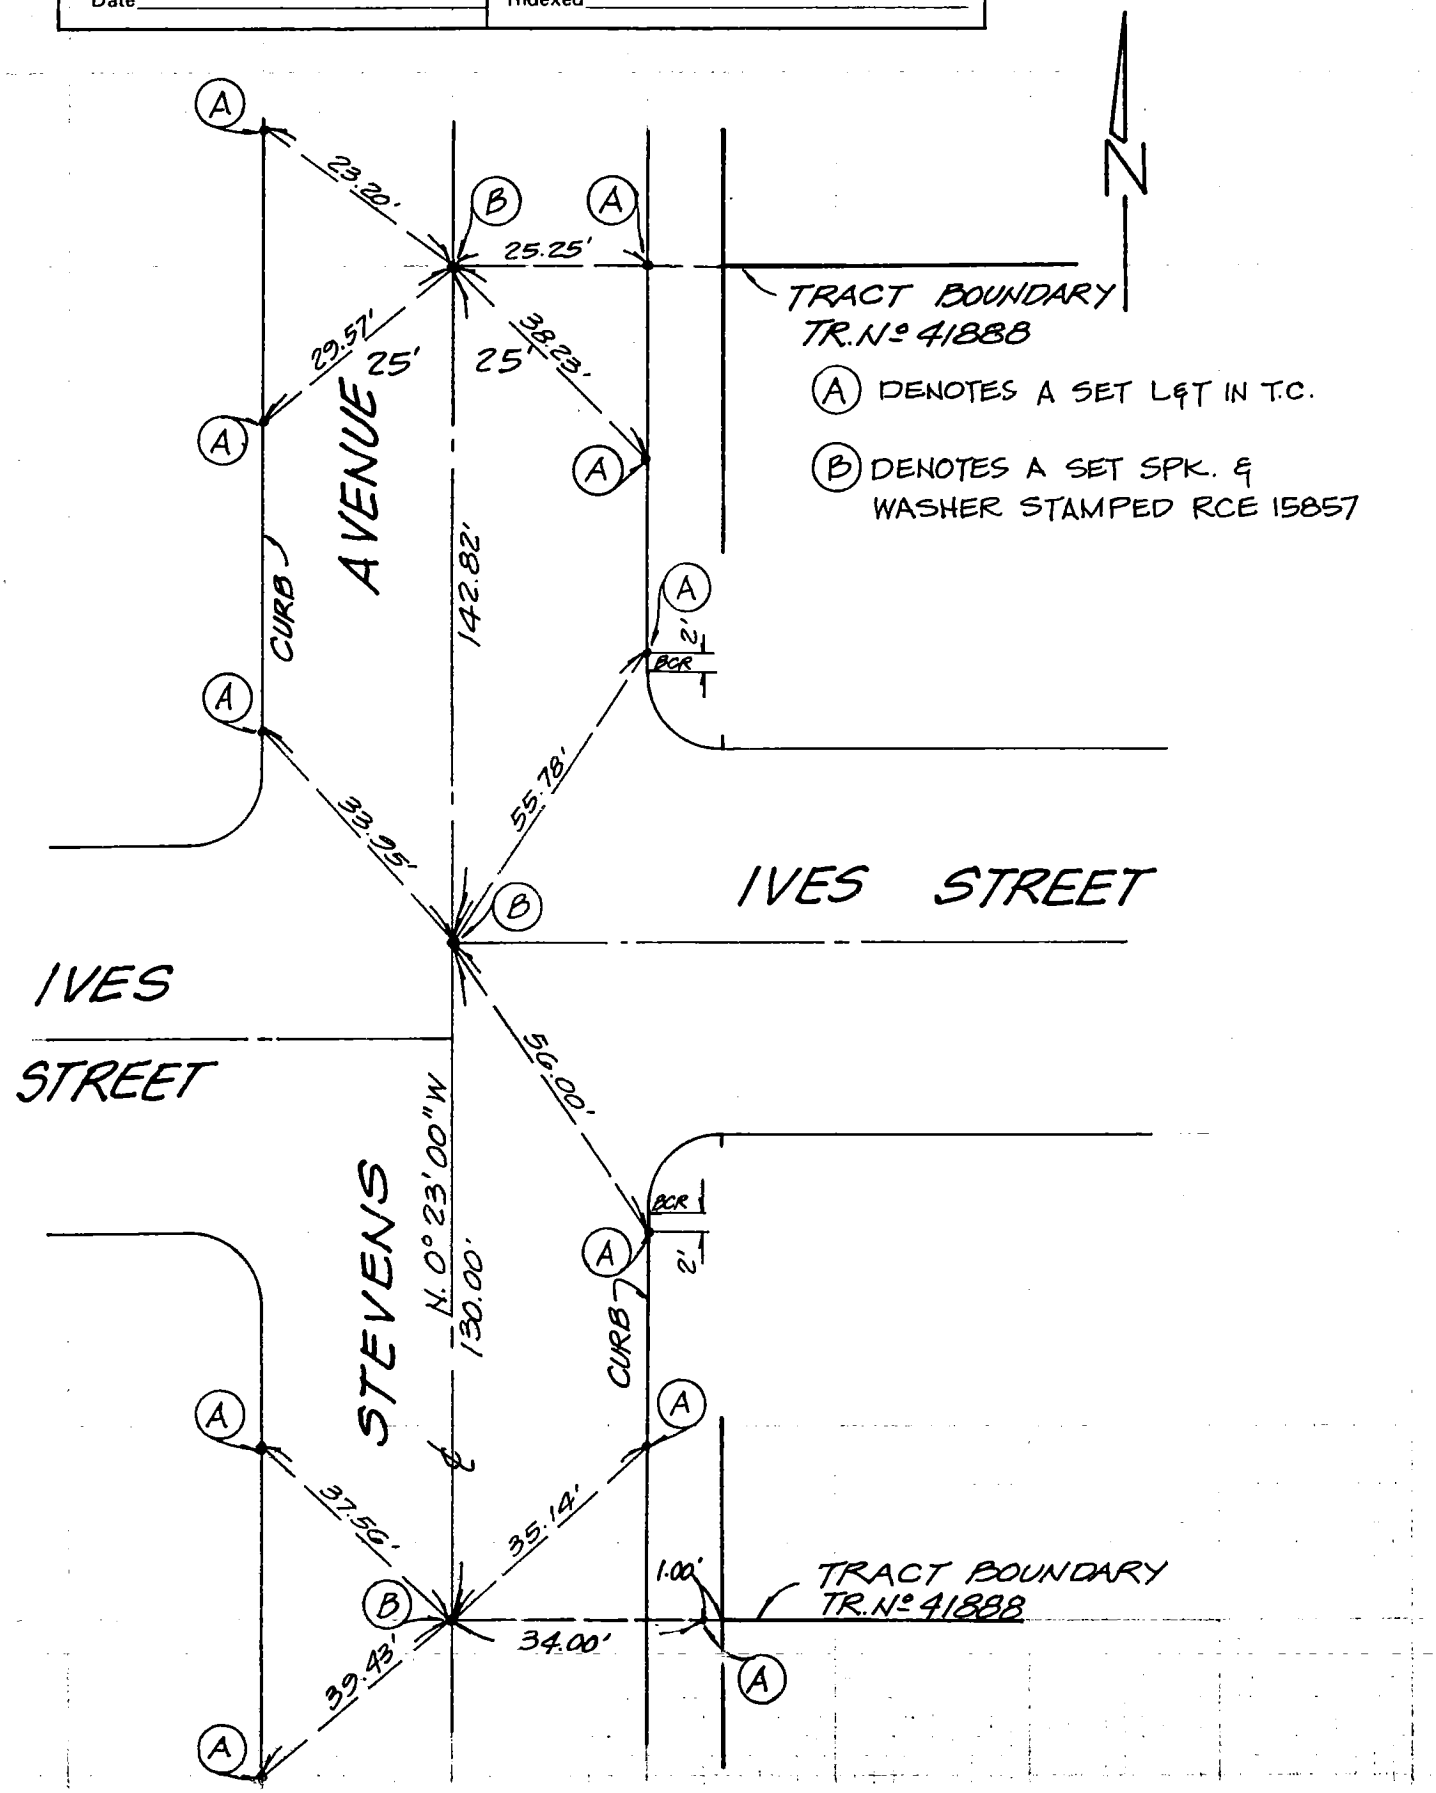

CENTERLINE NOTES
E 310
6F3095-4/73

CO ENG FB 3673-9

Notes Ck'd by	Survey of CENTERLINE TIES
~~Map~~ No. 41888	JN ____ Tape ____ Std ____ °F
Office Work	Surveyed by McCUTCHAN & BARRIOS, INC. PAUL H. BARRIOS RCE 15857
Checked	Notes ____ Date MAY 29 1984
Date	Indexed

F.B. ____ PG. ____

NOTE: ANY ADDITIONS OR CHANGES ON THIS SHEET MUST BE MADE OR CIRCLED IN RED INK WITH DATE AND NAME OF PERSON MAKING CHANGE

Do not extend notes this side of this line

U.S. 33-A-4

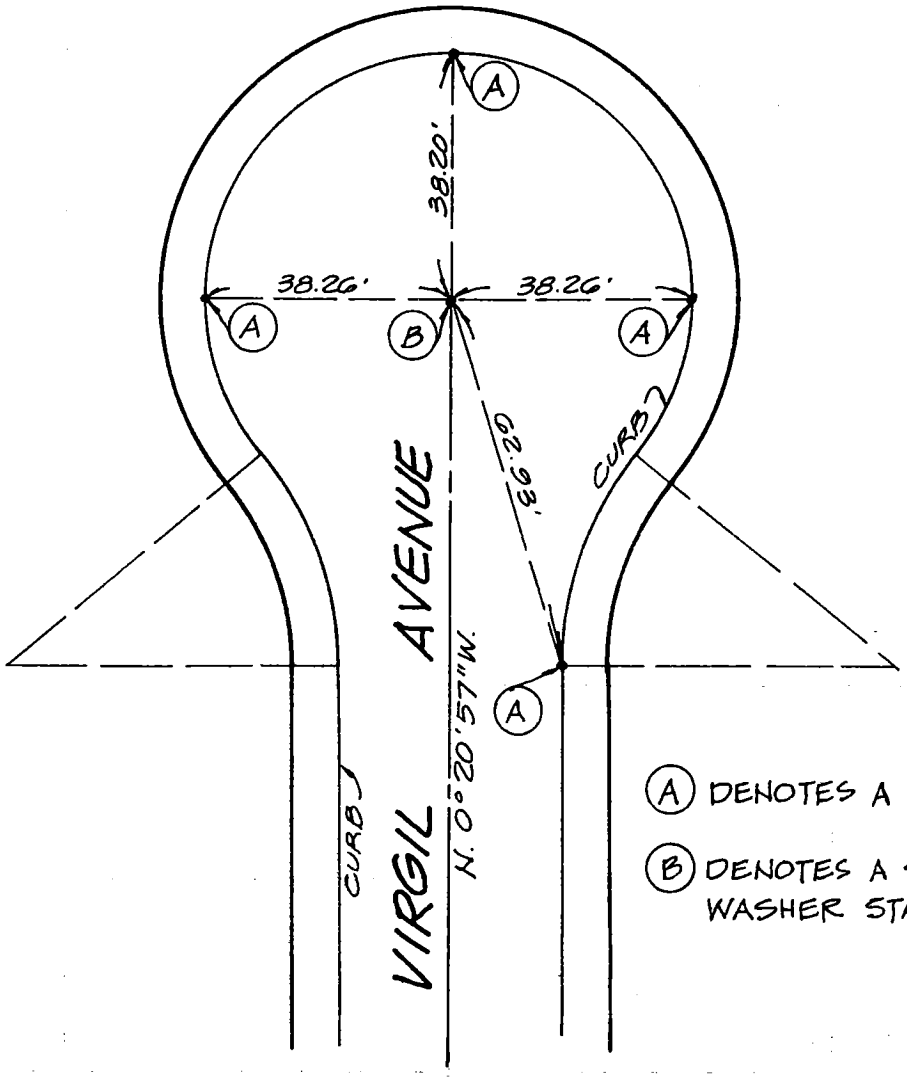

(A) DENOTES A SET L&T IN T.C.

(B) DENOTES A SET SPK. & WASHER STAMPED RCE 15857

CENTERLINE NOTES
E 310
6F3095-4/73

CO ENG FB 3673-10

Notes Ck'd by	Survey of CENTELINE TIES
~~Map~~ No. 41888	JN ____ Tape ____ Std ____ °F
Office Work	Surveyed by McCUTCHAN & BARRIOS, INC.
Checked	Notes PAUL H. BARRIOS RCE 15857 Date MAY 29 1984
Date	Indexed

F.B. ____ PG. ____

Tr.

US 33-4-4

NOTE: ANY ADDITIONS OR CHANGES ON THIS SHEET MUST BE MADE OR CIRCLED IN RED INK WITH DATE AND NAME OF PERSON MAKING CHANGE

Do not extend note this side of this line

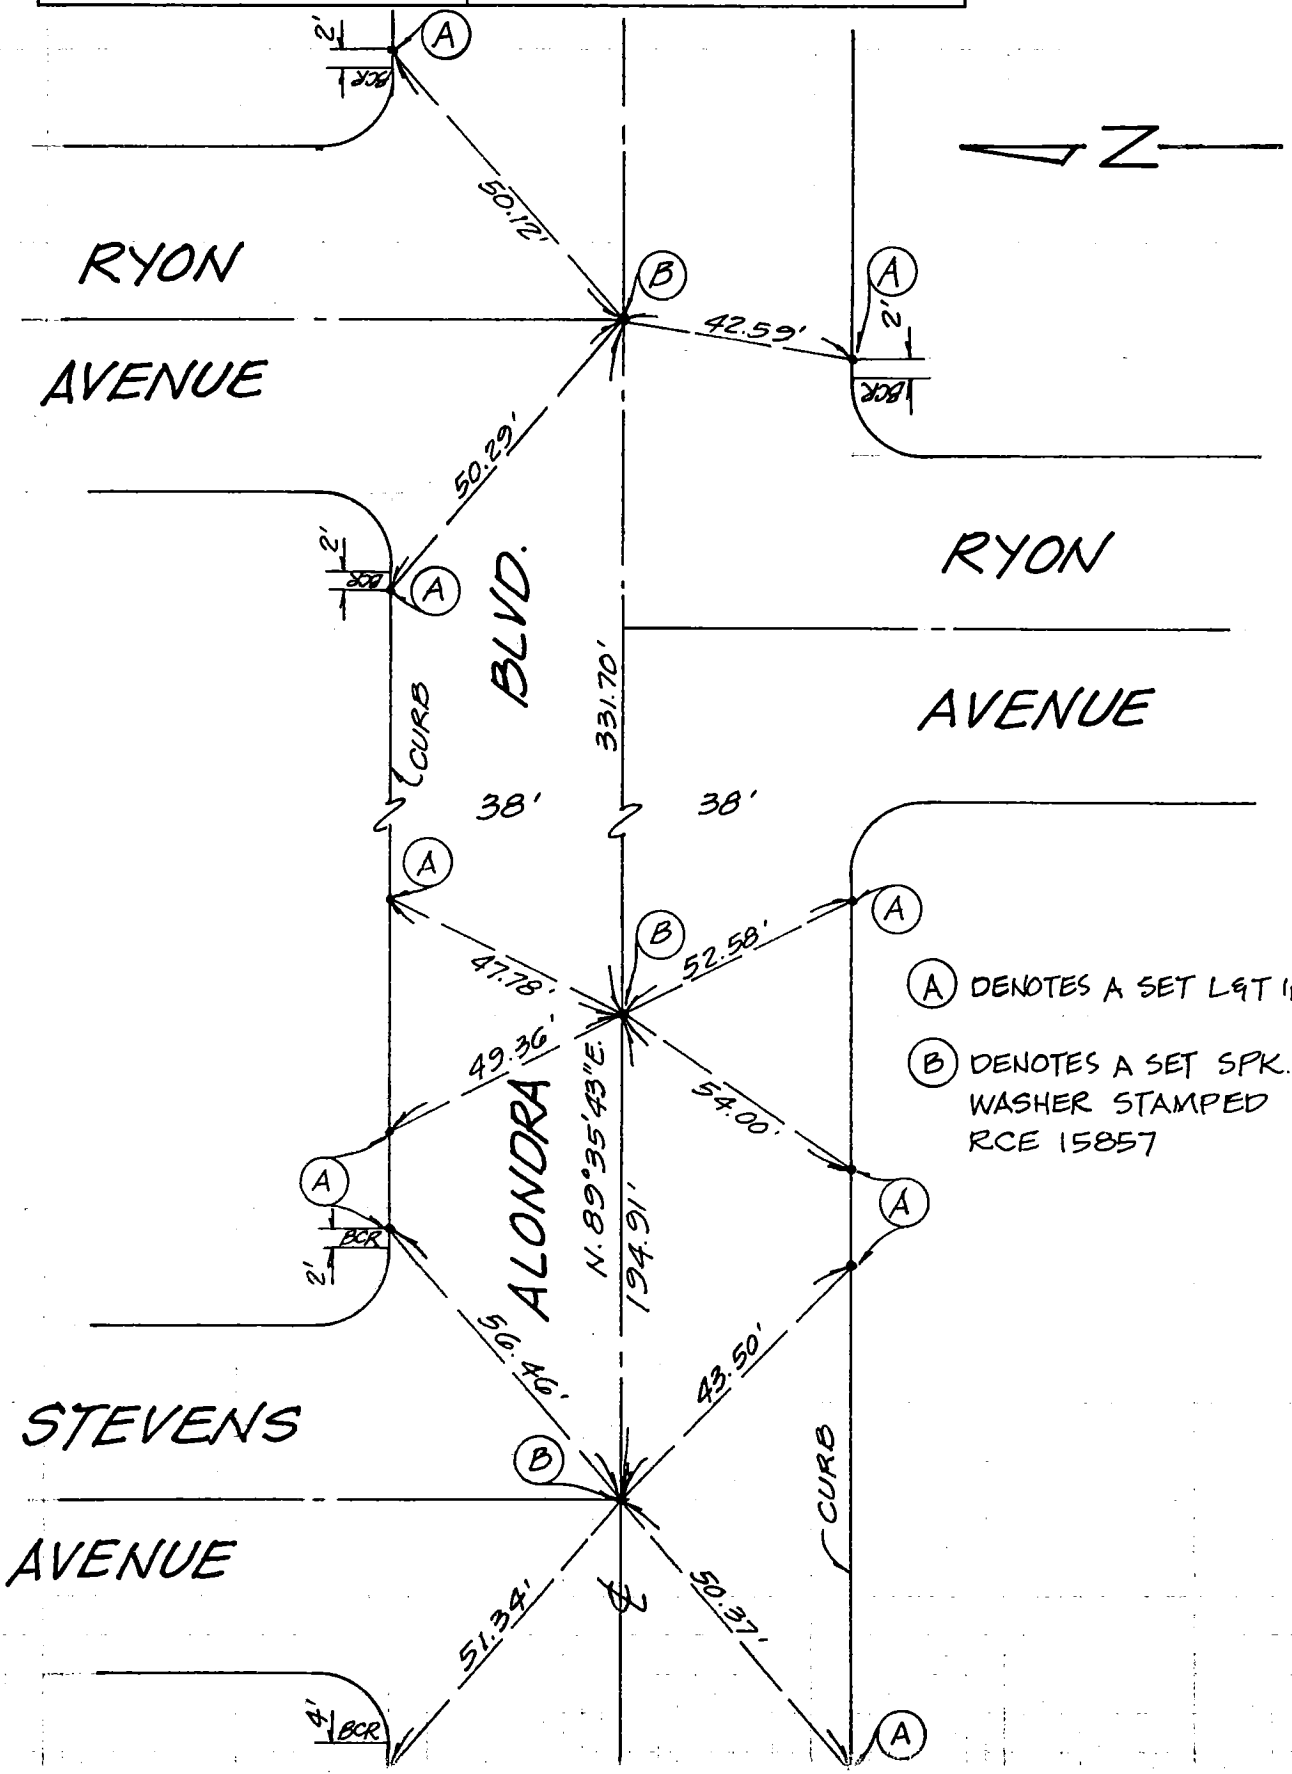

ENTERLINE NOTES
E 310
6F3095-4/73

CO ENG FB 3673-11

Notes Ck'd by	Survey of CENTERLINE TIES
~~Map~~ No. 41888	JN ____ Tape ____ Std ____ °F
Office Work	Surveyed by M S CUTCHAN & BARRIOS, INC.
Checked	Notes PAUL H. BARRIOS RCE 15857 Date MAY 24 1984
Date	Indexed

F.B. ____ PG. ____

T.

W.S. 33-A-4

NOTE: ANY ADDITIONS OR CHANGES ON THIS SHEET MUST BE MADE OR CIRCLED IN RED INK WITH DATE AND NAME OF PERSON MAKING CHANGE

Do not extend notes this side of this line

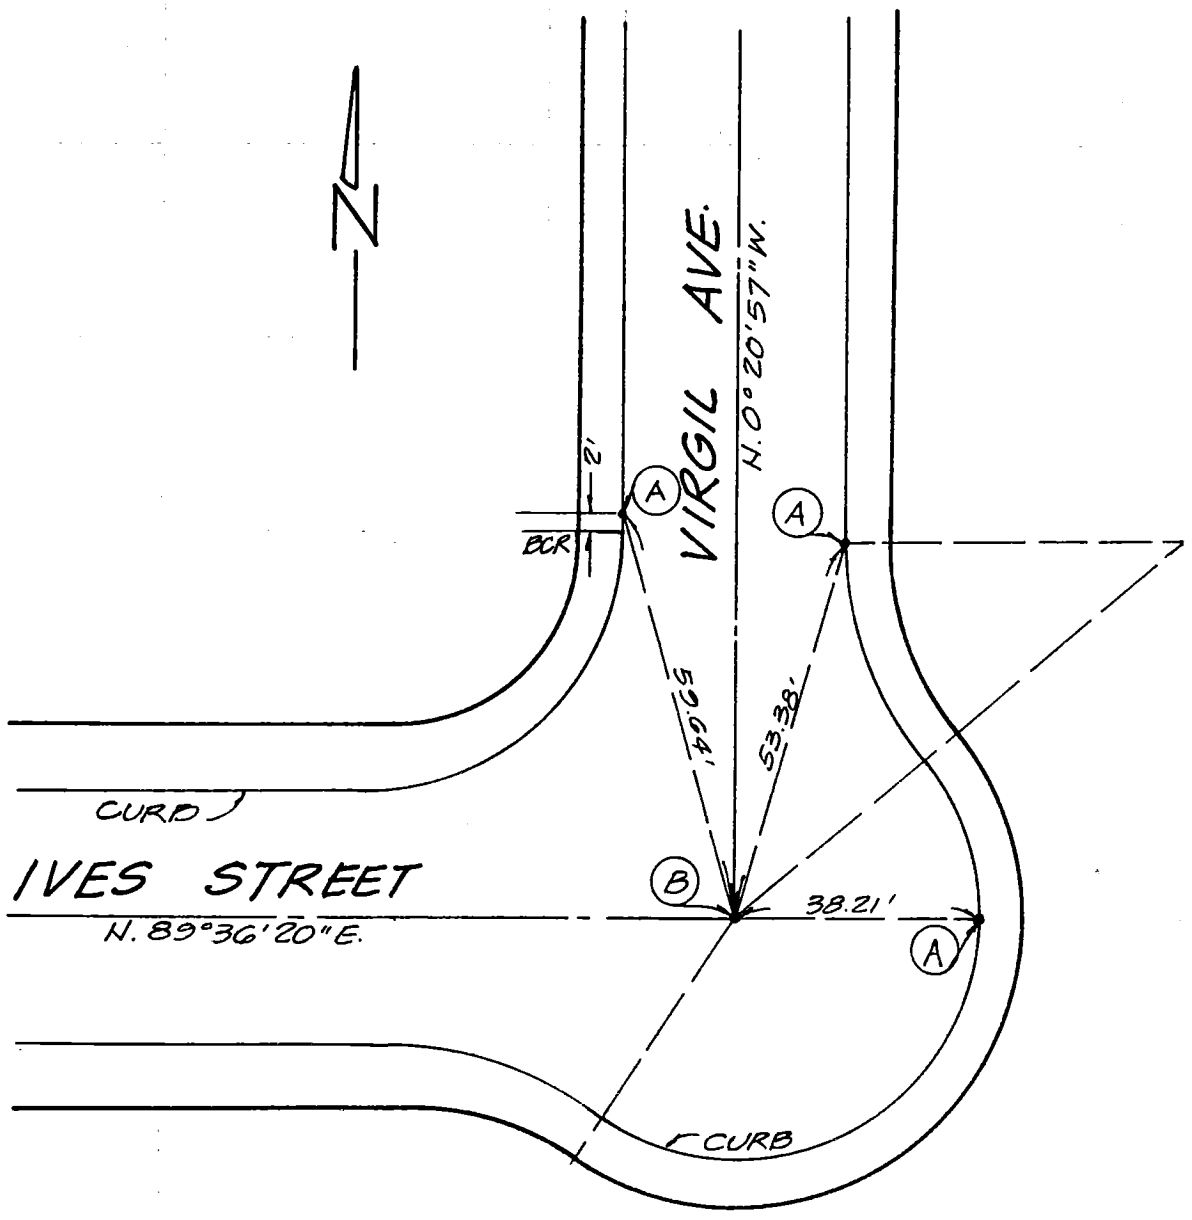

(A) DENOTES A SET L&T IN T.C.

(B) DENOTES A SET SPK. & WASHER STAMPED RCE 15857

CENTERLINE NOTES
E 310
6F3095-4/73

12

CO ENG FB 3673-12

Notes Ck'd by	Survey of CENTERLINE TIES
~~Map~~ No. 41888	JN ____ Tape ____ Std ____ °F
Office Work	Surveyed by MC CUTCHANG BARRIOS, INC PAUL H. BARRIOS RCE 15857
Checked	Notes ____ Date MAY 21 1984
Date	Indexed

F.B. ____ PG. ____

W.S. 33-A-4

NOTE: ANY ADDITIONS OR CHANGES ON THIS SHEET MUST BE MADE OR CIRCLED IN RED INK WITH DATE AND NAME OF PERSON MAKING CHANGE

Do not extend note this side of this line

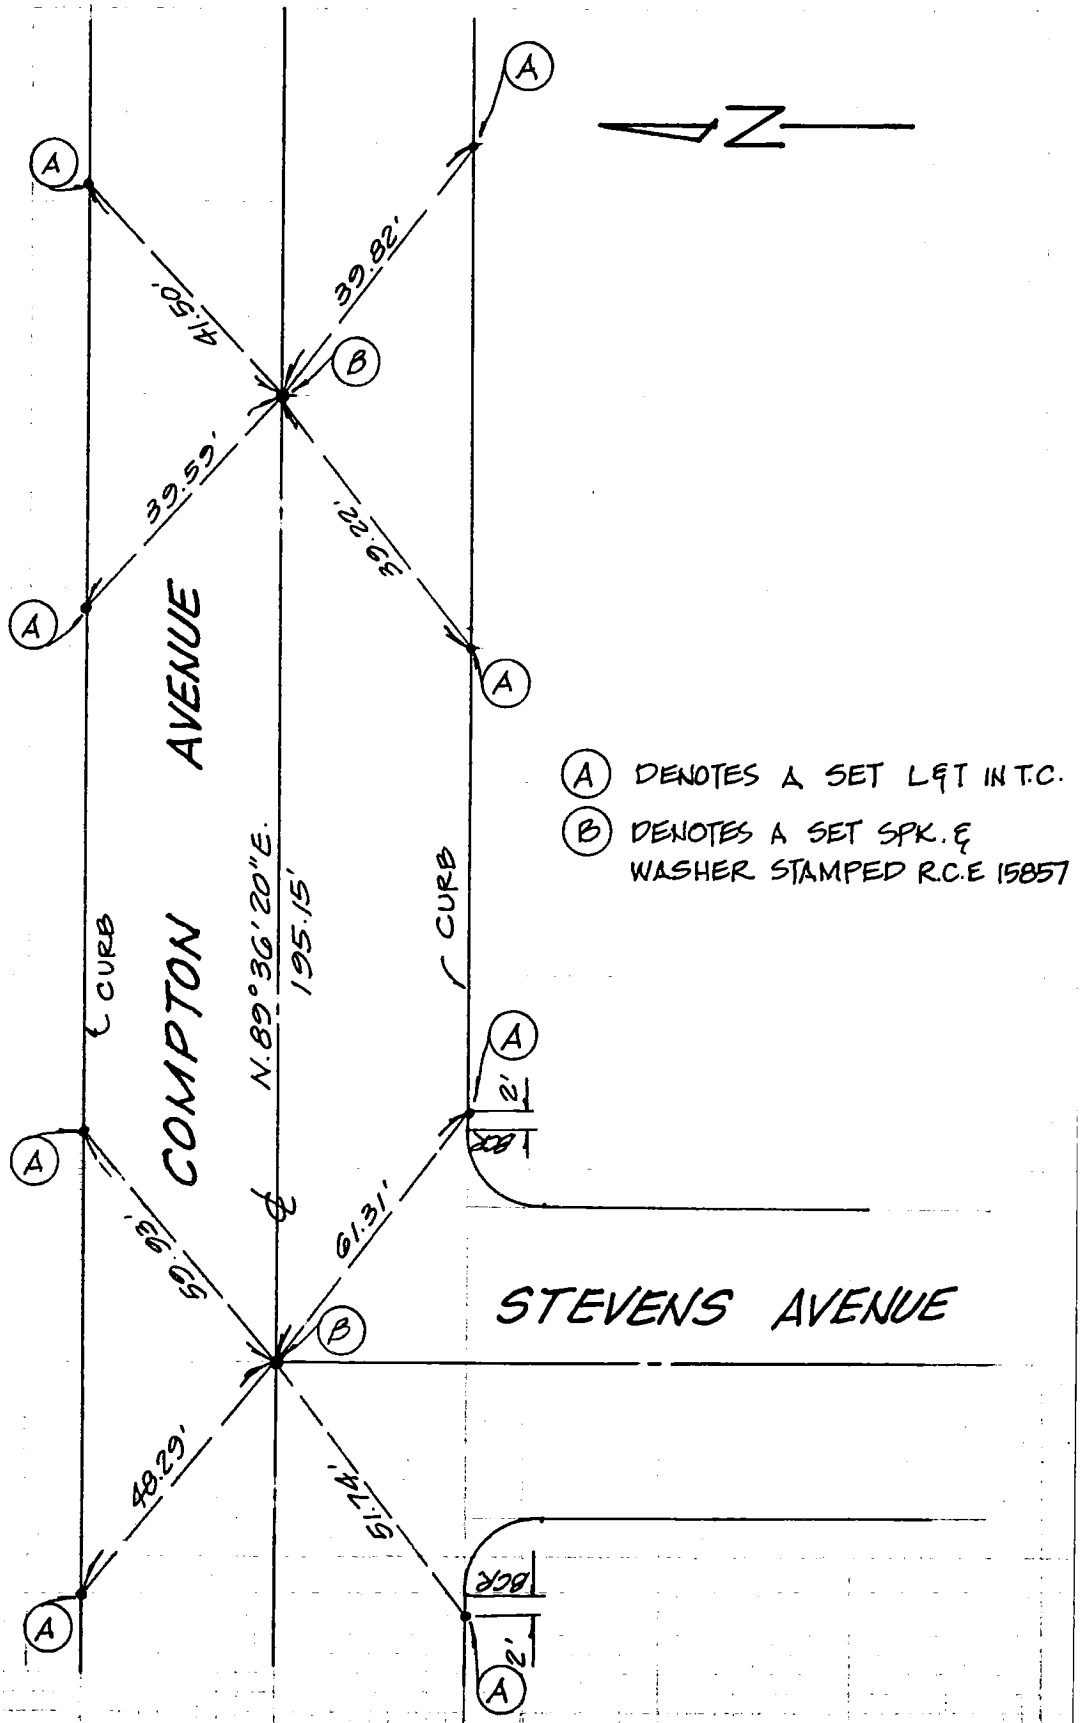

A DENOTES A SET L&T IN T.C.

B DENOTES A SET SPK. & WASHER STAMPED R.C.E 15857

CENTERLINE NOTES
CE 310
6F3095-4/73

Notes Ck'd by	Survey of CENTERLINE TIES
~~Map~~ No. 41888	JN ____ Tape ____ Std ____ °F
Office Work	Surveyed by MCCUTCHANE BARRIOS, INC.
Checked	Notes PAUL H. BARRIOS RCE 15857 Date MAY 22 1984
Date	Indexed

F.B. ____ PG. ____

T.

NOTE: ANY ADDITIONS OR CHANGES ON THIS SHEET MUST BE MADE OR CIRCLED IN RED INK WITH DATE AND NAME OF PERSON MAKING CHANGE

Do not extend note this side of this line W.S. 33-A-4, B-4

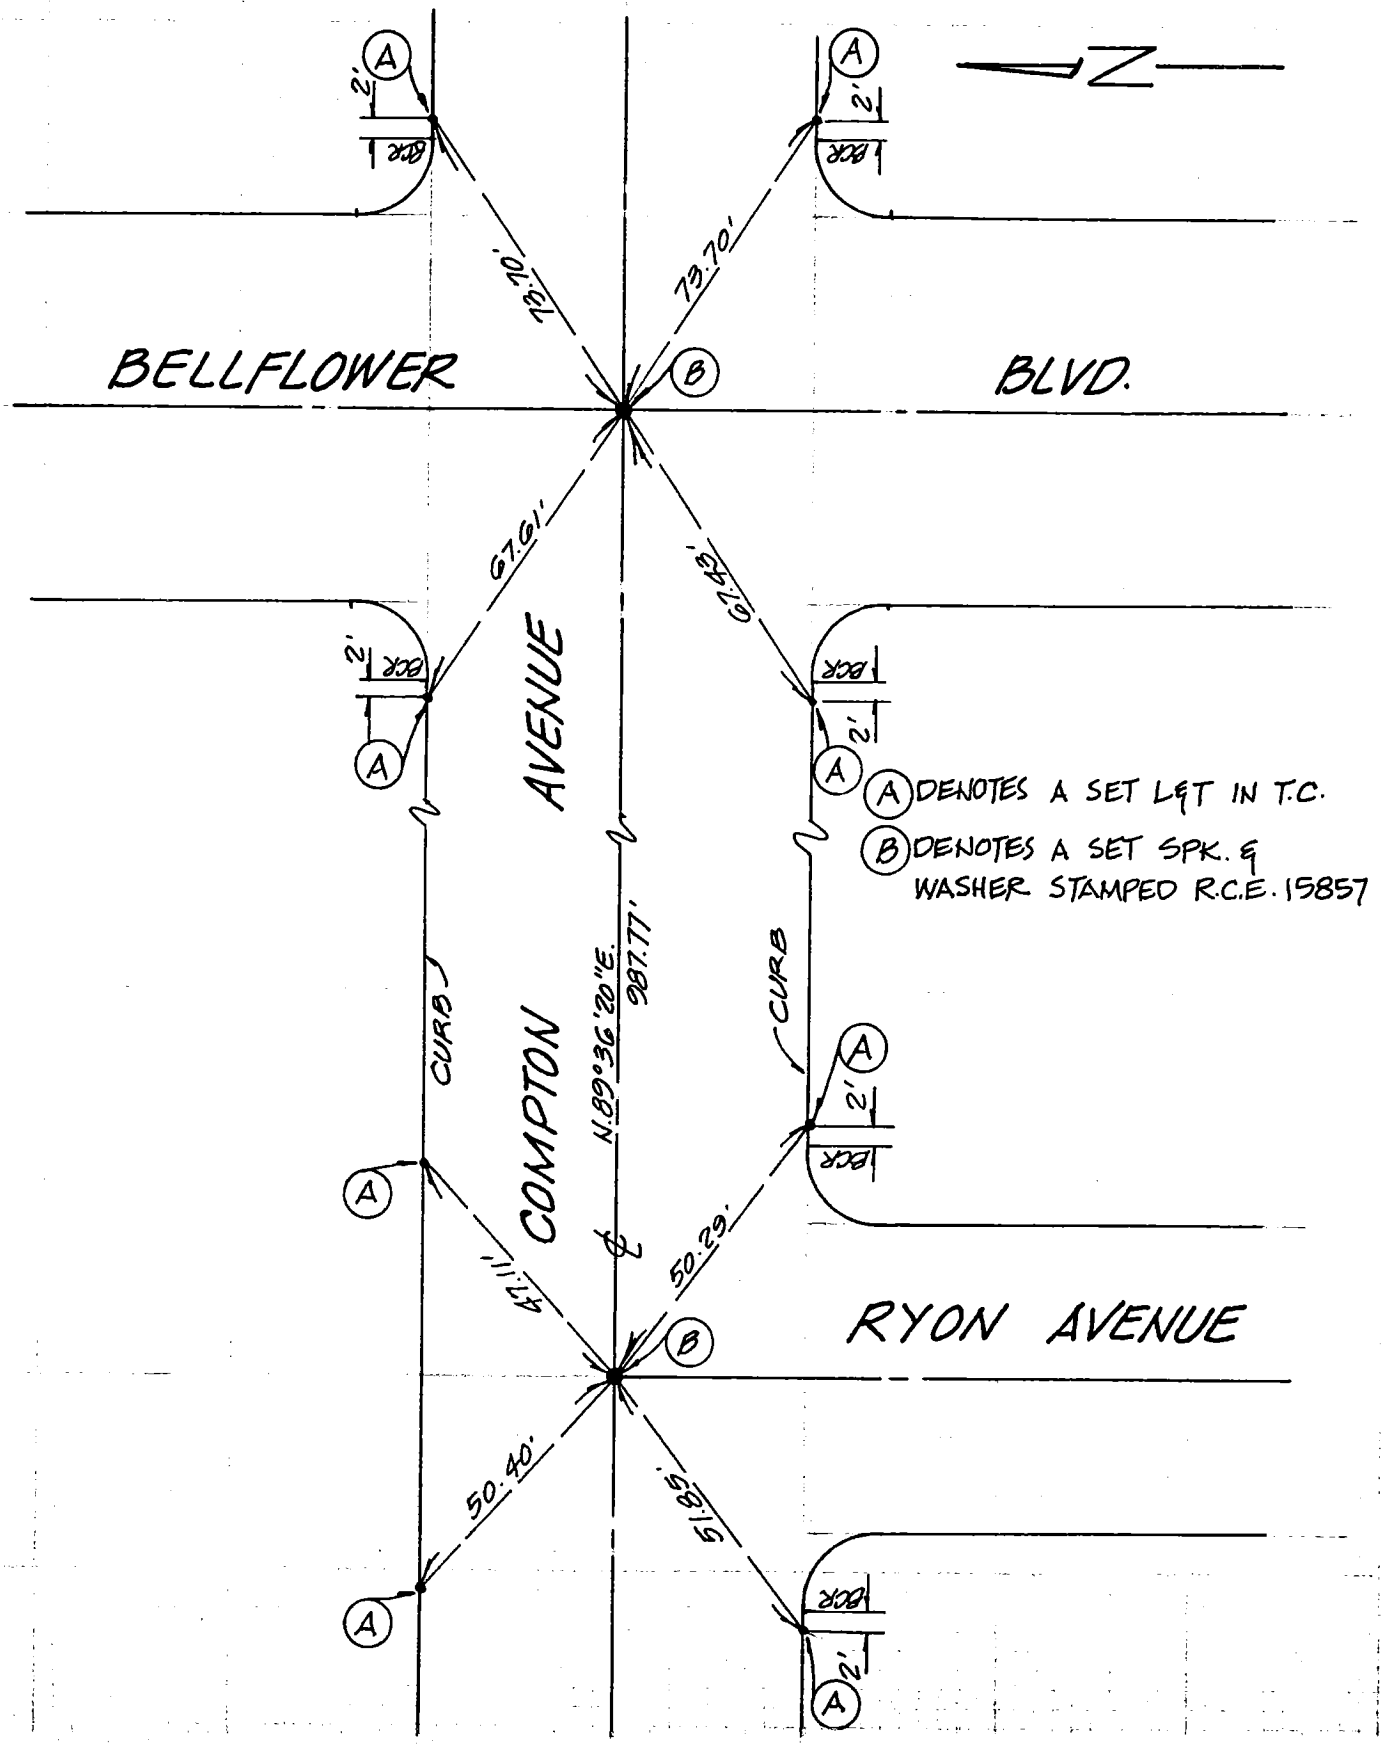

CENTERLINE NOTES
E 310
6F3095-4/73

14

CO ENG FB 3673-14

Notes Ck'd by _____
Map No. 41888
Office Work _____
Checked _____
Date _____

Survey of CENTERLINE TIES
JN _____ Tape _____ Std _____ °F
Surveyed by McCUTCHAN & BARRIOS, INC.
Notes PAUL H. BARRIOS RCE 15857 Date MAY 29 1984
Indexed _____

F.B. _____ PG. _____

Tr.

W.S. 33, 4-4

NOTE: ANY ADDITIONS OR CHANGES ON THIS SHEET MUST BE MADE OR CIRCLED IN RED INK WITH DATE AND NAME OF PERSON MAKING CHANGE

Do not extend note this side of this line

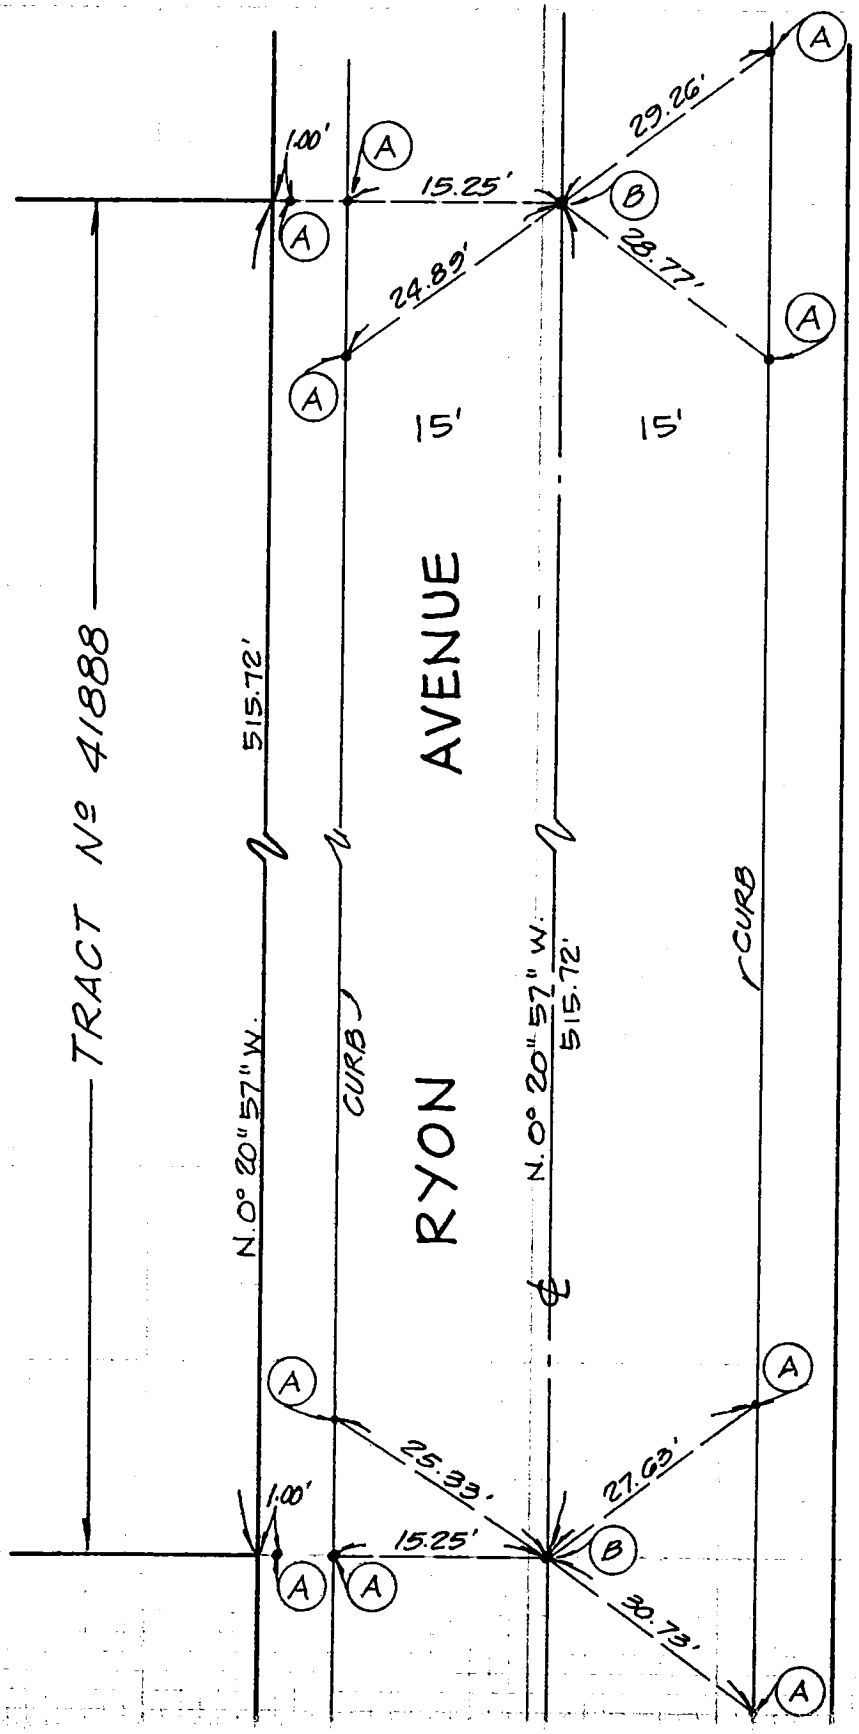

(A) DENOTES A SET L&T IN T.C.

(B) DENOTES A SET SPK. & WASHER STAMPED R.C.E. 15857.

CENTERLINE NOTES
E 310
6F3095-4/73

Notes Ck'd by	Survey of 15	F.B. PG.
Map No.	JN Tape Std °F	CO ENG FB 3673-15
Office Work	Surveyed by	
Checked	Notes Date	
Date	Indexed	

ON THIS SHEET MUST BE MADE OR CIRCLED IN RED INK WITH DATE AND NAME OF PERSON MAKING CHANGE

Do not extend notes this side of this line

159-037, B-1

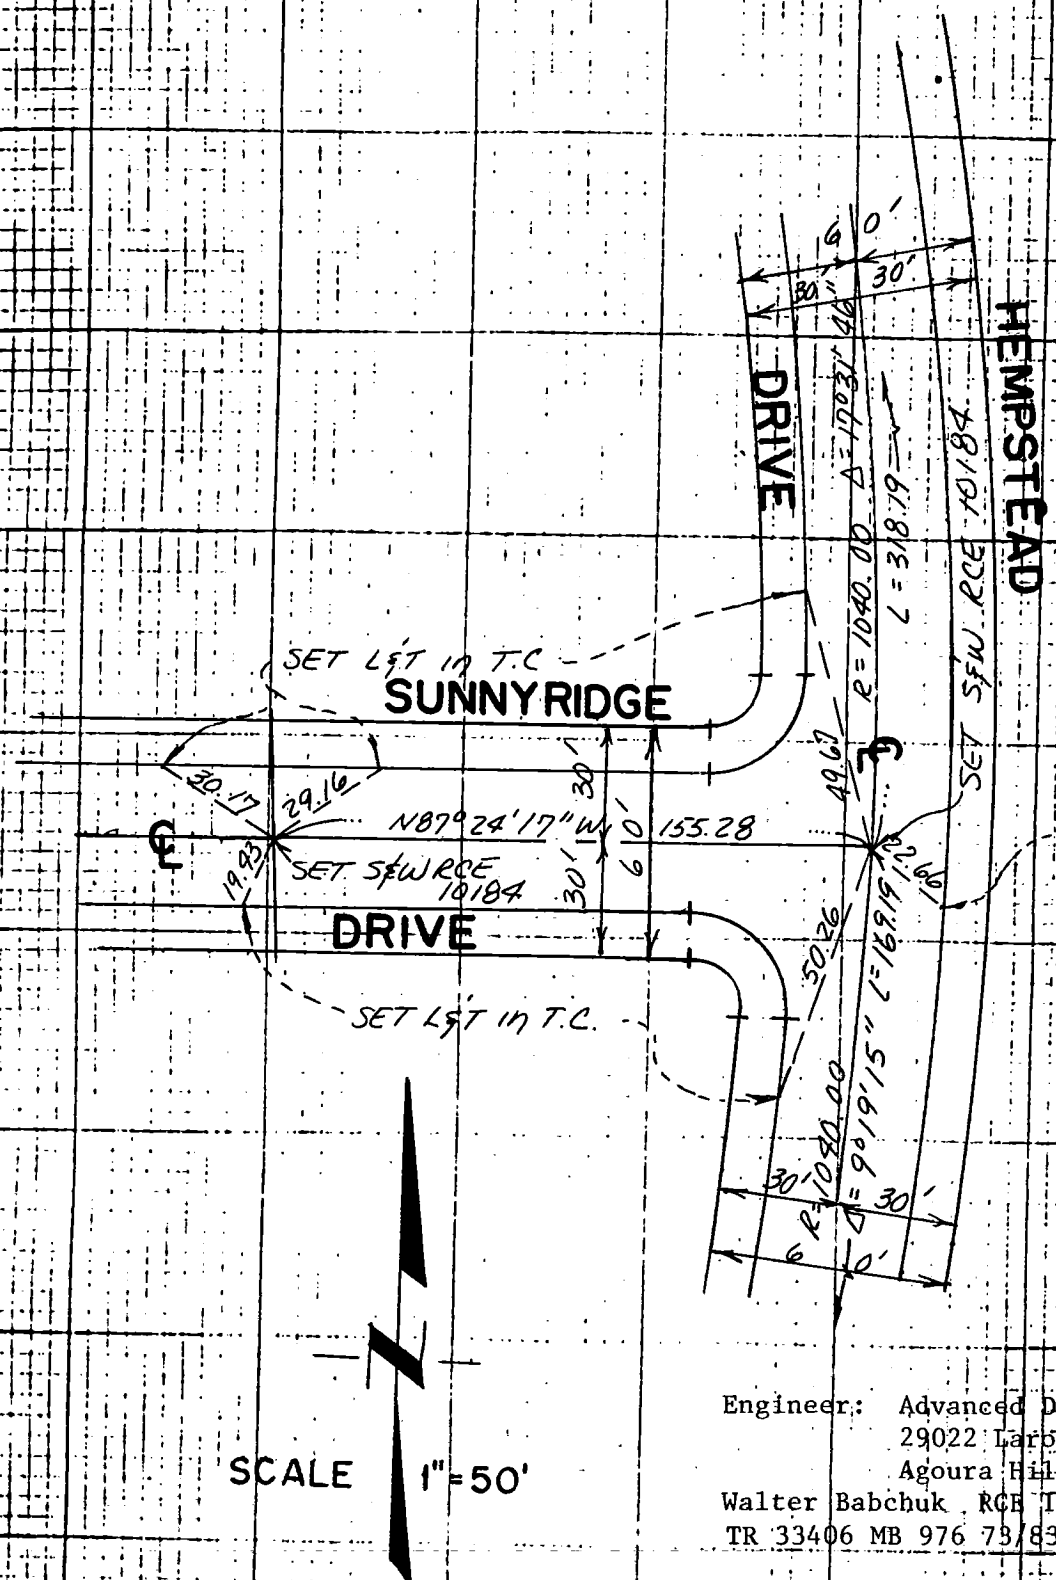

Engineer: Advanced Design Assoc.
29022 Laro Drive
Agoura Hills, CA 91301
Walter Babchuk RCE 10184
TR 33406 MB 976 73/83

Notes Ck'd by _____
Map No. _____
Office Work _____
Checked _____
Date _____

Survey of 16
JN _____ Tape _____ Std _____ °F
Surveyed by _____
Notes _____ Date _____
Indexed _____

F.B. _____ PG. _____

CO ENG FB 3673-16

ON THIS SHEET MUST BE MADE OR CIRCLED IN RED INK WITH DATE AND NAME OF PERSON MAKING CHANGE
Do not extend notes to the side of this line

152-037 B-1

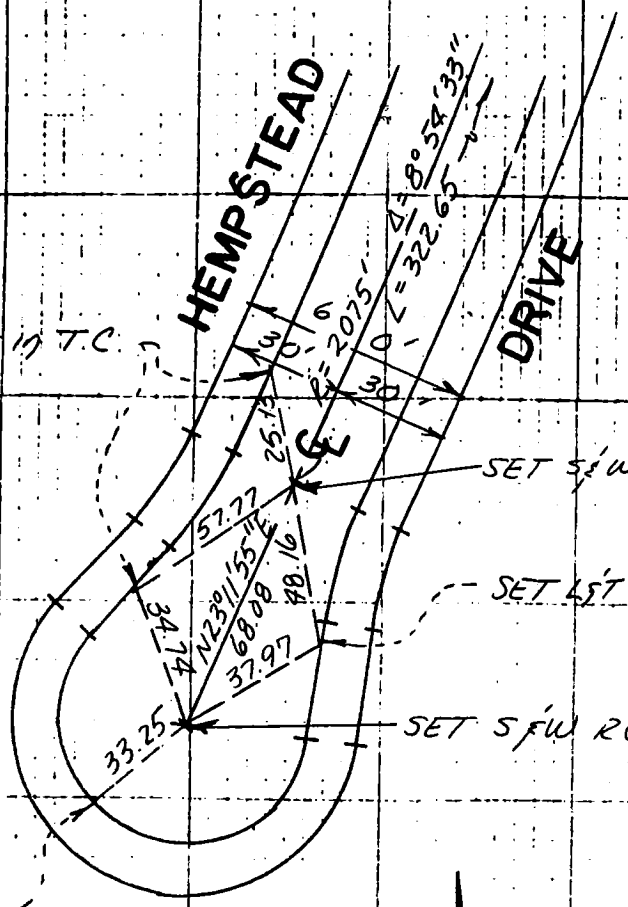

Engineer: Advanced Design Assoc.
29022 Laro Drive
Agoura Hills, CA 91301
Walter BAbchuk RCE 10184
TR 33406 MB 976 73/83

SCALE 1"=50'

3005-4/73

Notes Ck'd by	Survey of 17
Map No.	JN Tape Std °F
Office Work	Surveyed by
Checked	Notes Date
Date	Indexed

F.B. PG.

CO ENG FB 3673-17

ON THIS SHEET MUST BE MADE OR CIRCLED IN RED INK WITH DATE AND NAME OF PERSON MAKING CHANGE

Do not extend notes this side of this line

159-037, B-1

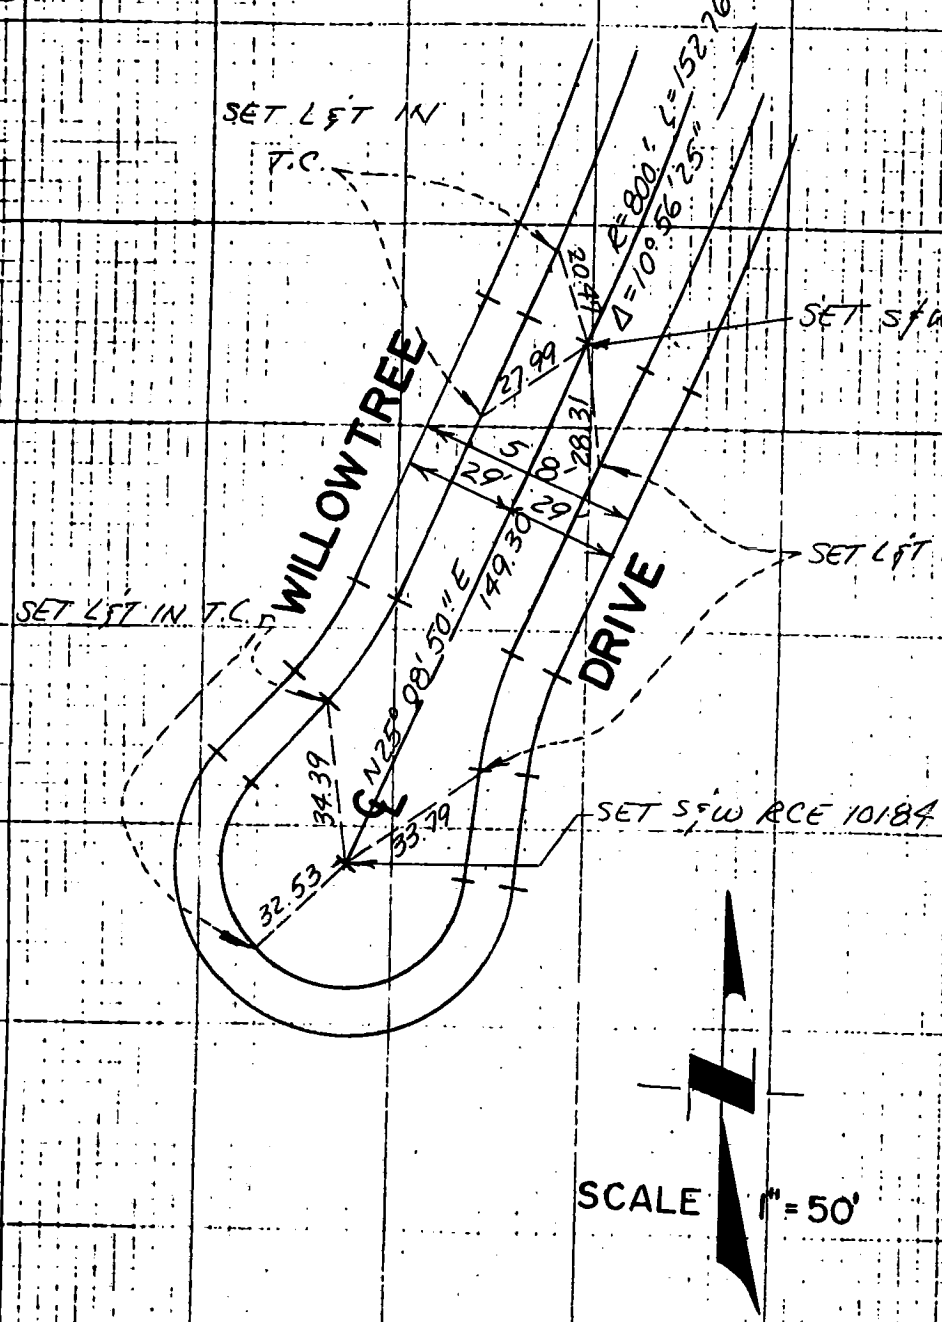

Engineer: Advanced Design Assoc.
29022 Laro Drive
Agoura Hills, CA 91301
Walter Babchuk RCE 10184
TR. 33406 MB 976 PG 73/83

Notes Ck'd by	Survey of 18
Map No.	JN Tape Std °F
Office Work	Surveyed by
Checked	Notes Date
Date	Indexed

F.B. PG.

CO ENG FB 3673-18

ON THIS SHEET MUST BE MADE OR CIRCLED IN RED INK WITH DATE AND NAME OF PERSON MAKING CHANGE

Do not extend notes this side of this line

159-037, C-1

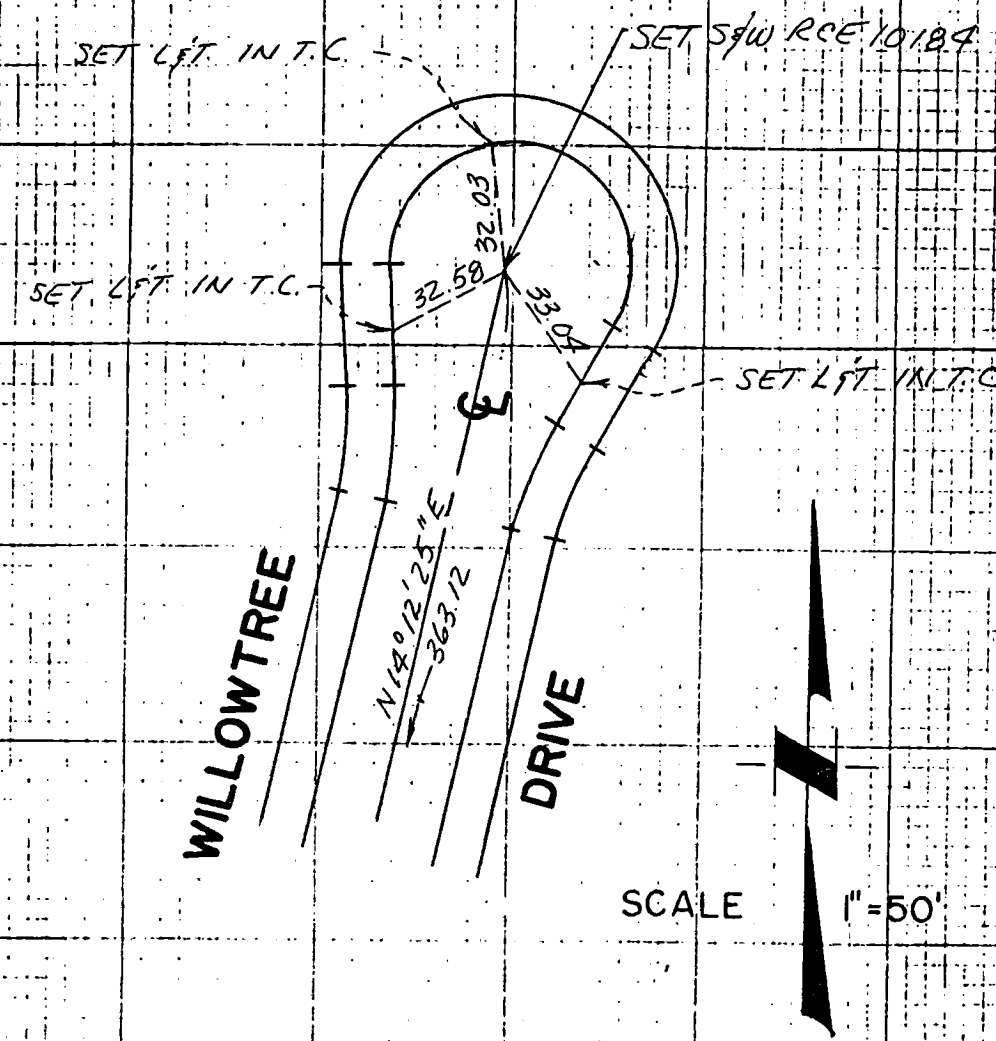

Engineer: Advnaced Design Assoc.
29022 Laro Drive
Agoura Hills, CA 91301
Walter Babchuk RCE 10184
TR 33406 MB 976 73/88

85-4/73

Notes Ck'd by	Survey of 19
Map No.	JN Tape Std °F
Office Work	Surveyed by
Checked	Notes Date
Date	Indexed

F.B. PG.

CO ENG FB 3673-19

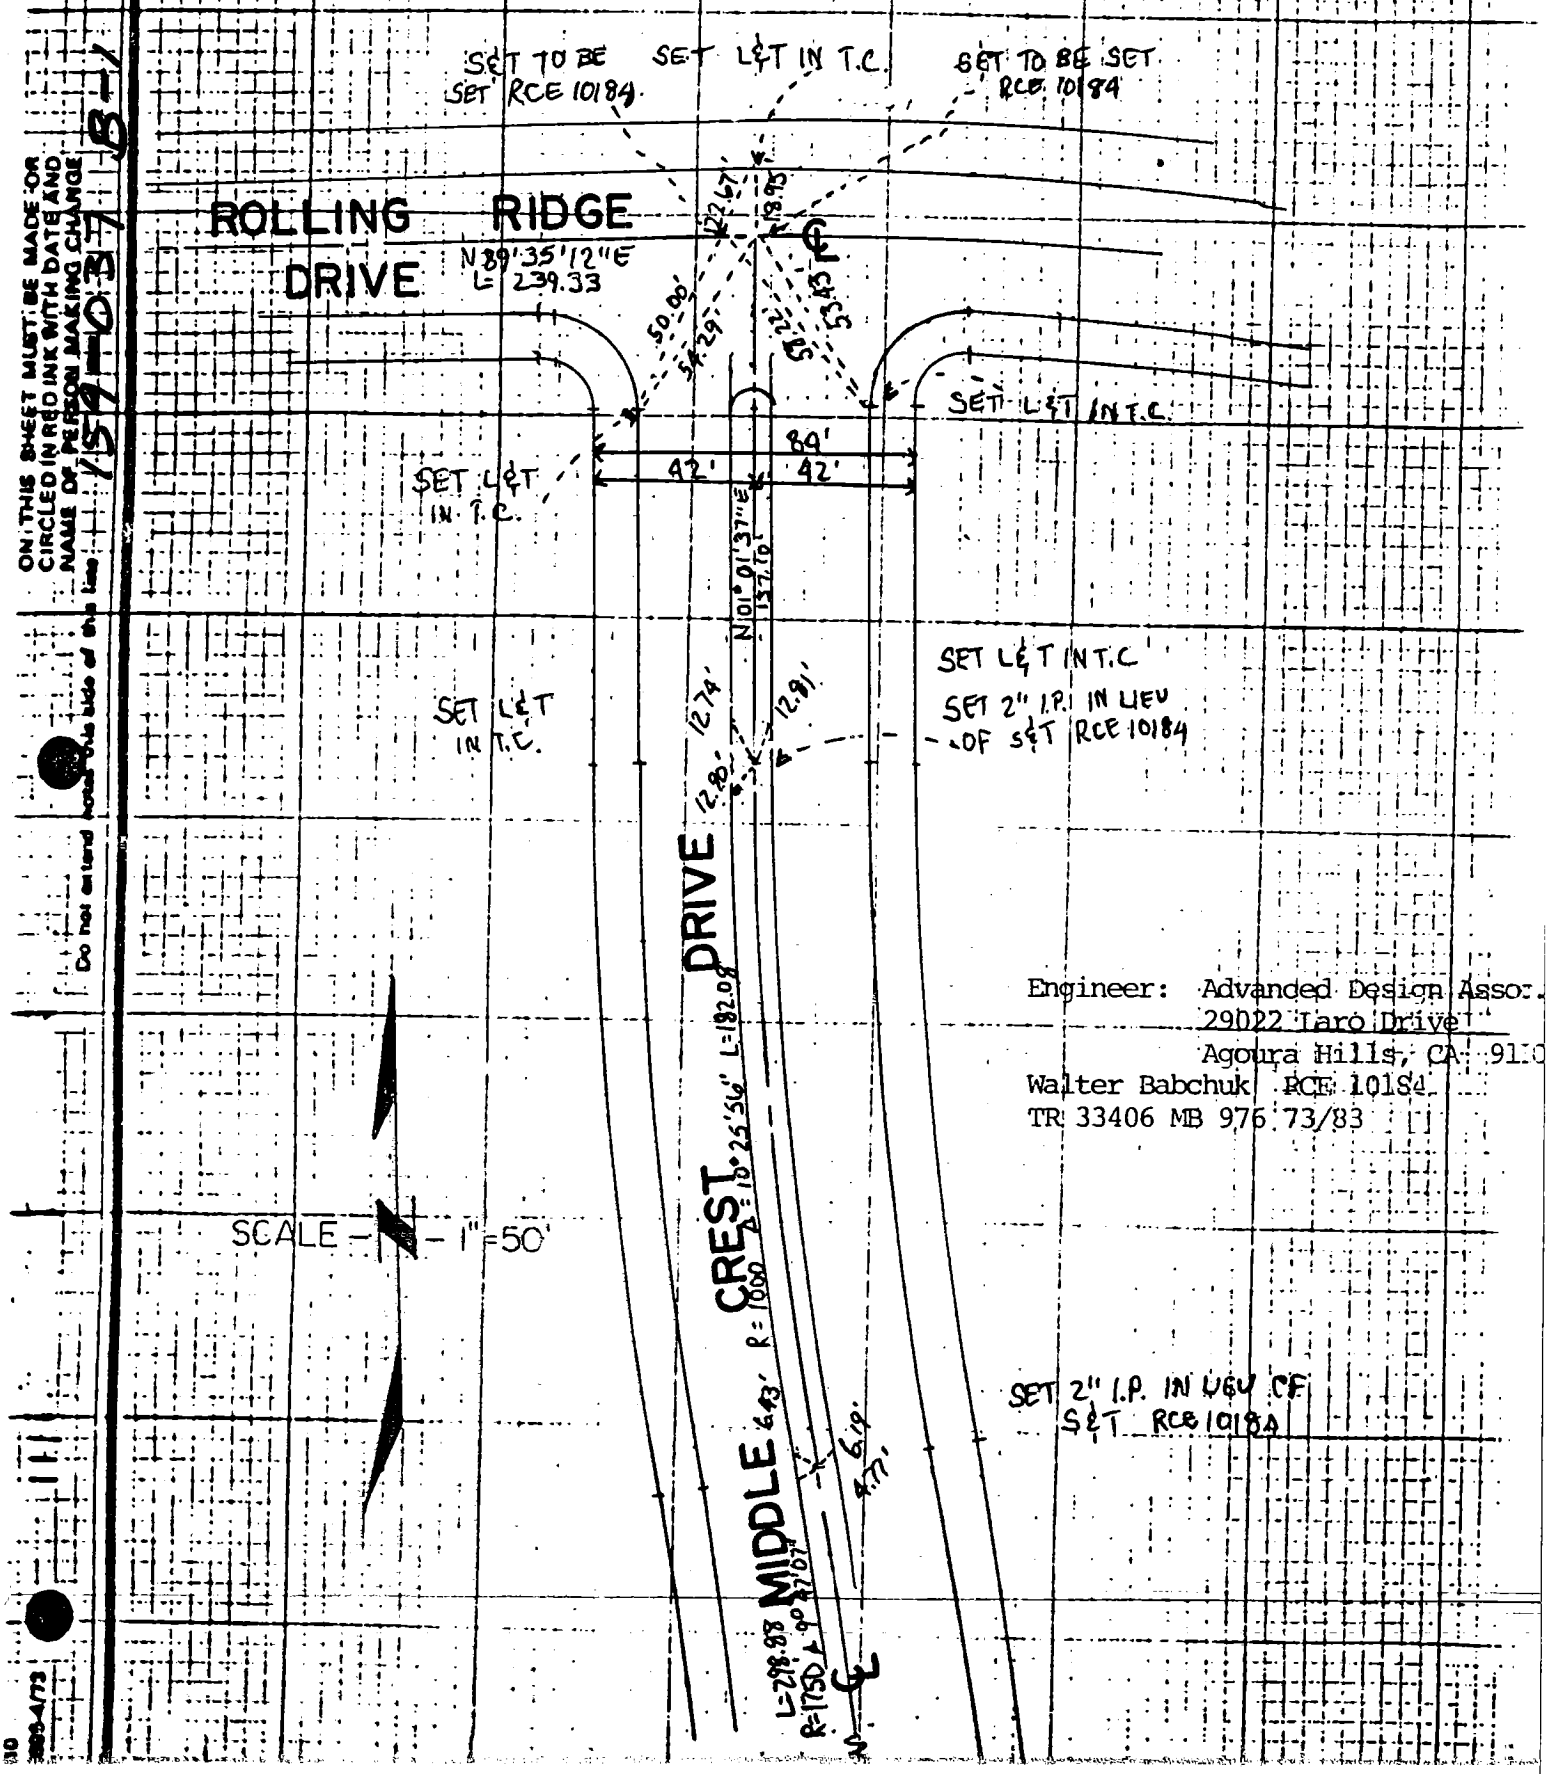

Engineer: Advanced Design Assoc.
29022 Laro Drive
Agoura Hills, CA 91[illegible]
Walter Babchuk RCE 10184
TR 33406 MB 976 73/83

ON THIS SHEET MUST BE MADE OR CIRCLED IN RED INK WITH DATE AND NAME OF PERSON MAKING CHANGE

Do not extend notes this side of this line

159-037 B-1

Notes Ck'd by	Survey of 20
Map No.	JN Tape Std °F
Office Work	Surveyed by
Checked	Notes Date
Date	Indexed

F.B. PG.

CO ENG FB 3673-20

ON THIS SHEET MUST BE MADE OR CIRCLED IN RED INK WITH DATE AND NAME OF PERSON MAKING CHANGE

Do not extend notes this side of this line

159-037, C-1

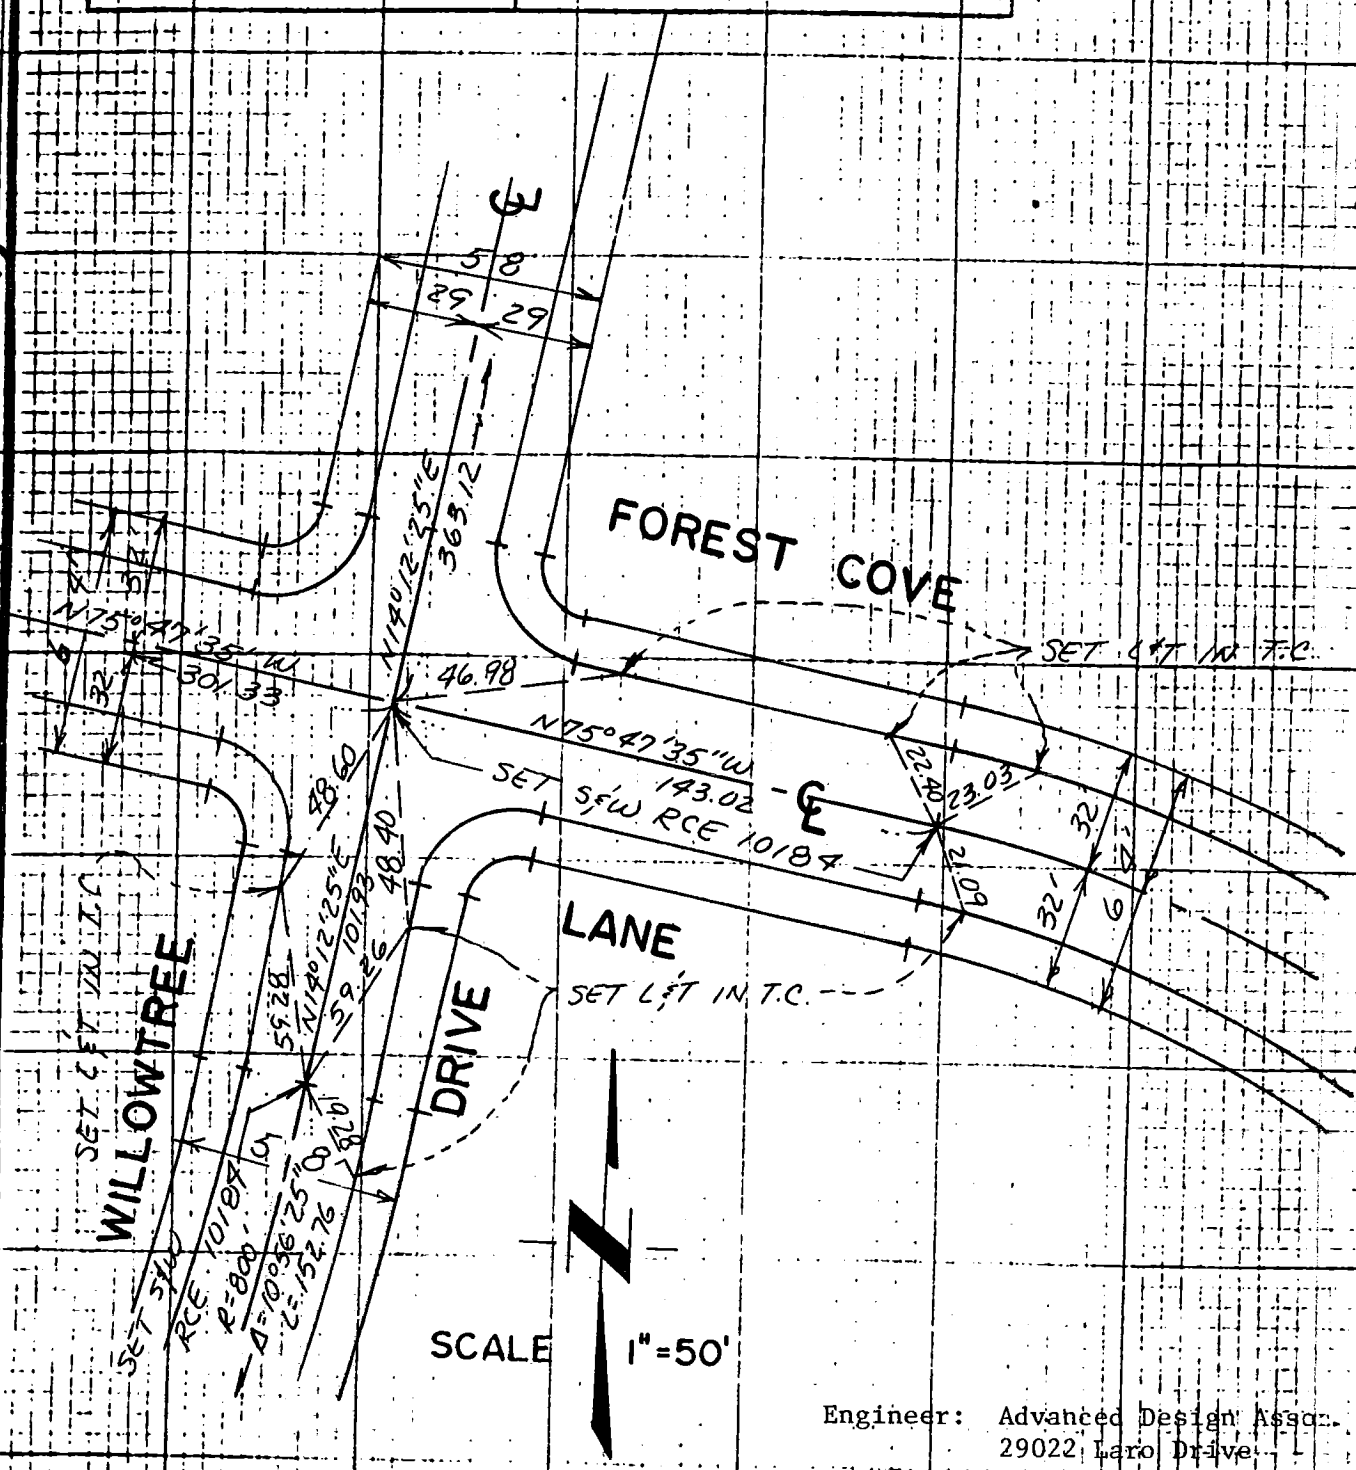

Engineer: Advanced Design Assoc.
29022 Laro Drive
Agoura Hills, CA 91101
Walter Babchuk RCE 10184
TR 33406 MB 976 71/83

3095-4/73

Notes Ck'd by	Survey of 21	F.B. PG.
Map No.	JN Tape Std °F	CO ENG FB 3673-21
Office Work	Surveyed by	
Checked	Notes Date	
Date	Indexed	

ON THIS SHEET MUST BE MADE OR CIRCLED IN RED INK WITH DATE AND NAME OF PERSON MAKING CHANGE

Do not extend notes this side of this line

159-037, 8-1

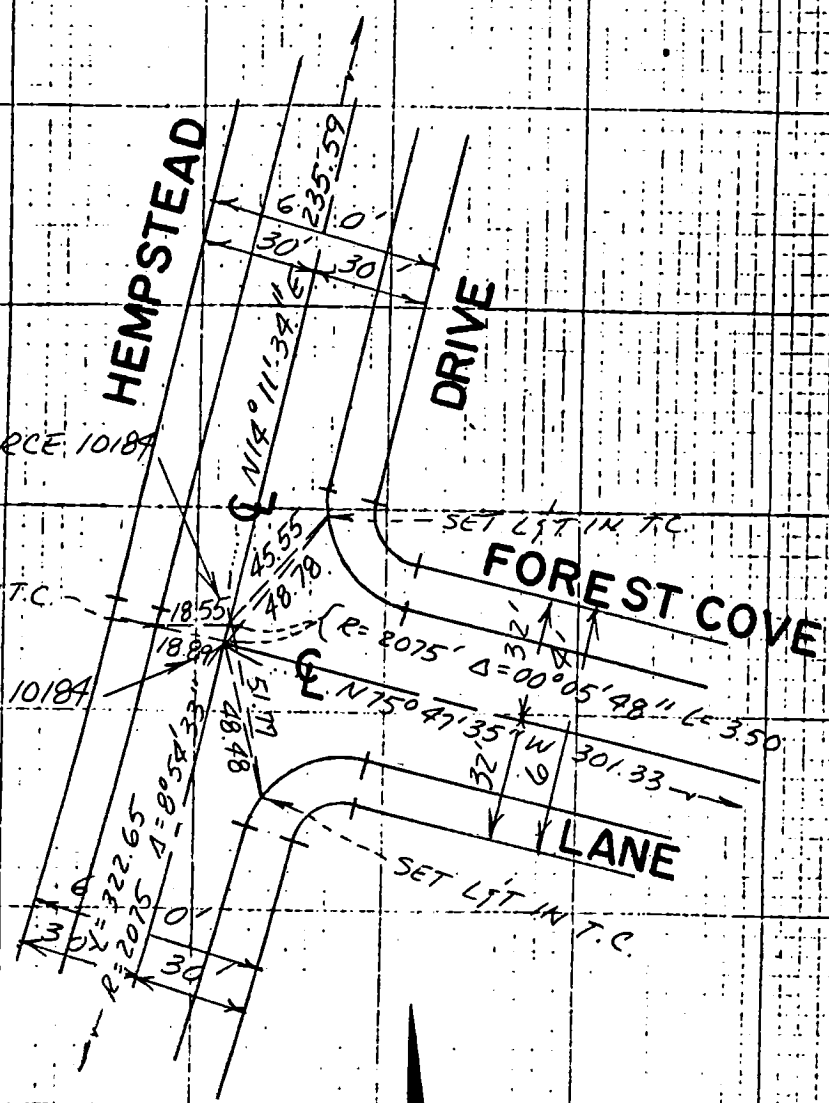

Engineer: Advanced Design Assoc.
29022 Laro Drive
Agoura Hills, CA 91301
Walter Babchuk RCE 10184
TR 33406 MB 976 73/83

SCALE 1"=50'

F310
F3095-4/73

Notes Ck'd by	Survey of 22
Map No.	JN Tape Std °F
Office Work	Surveyed by
Checked	Notes Date
Date	Indexed

F.B. PG.

CO ENG FR 3673-22

ON THIS SHEET MUST BE MADE OR CIRCLED IN RED INK WITH DATE AND NAME OF PERSON MAKING CHANGE

Do not extend notes this side of this line

159-037-C-1

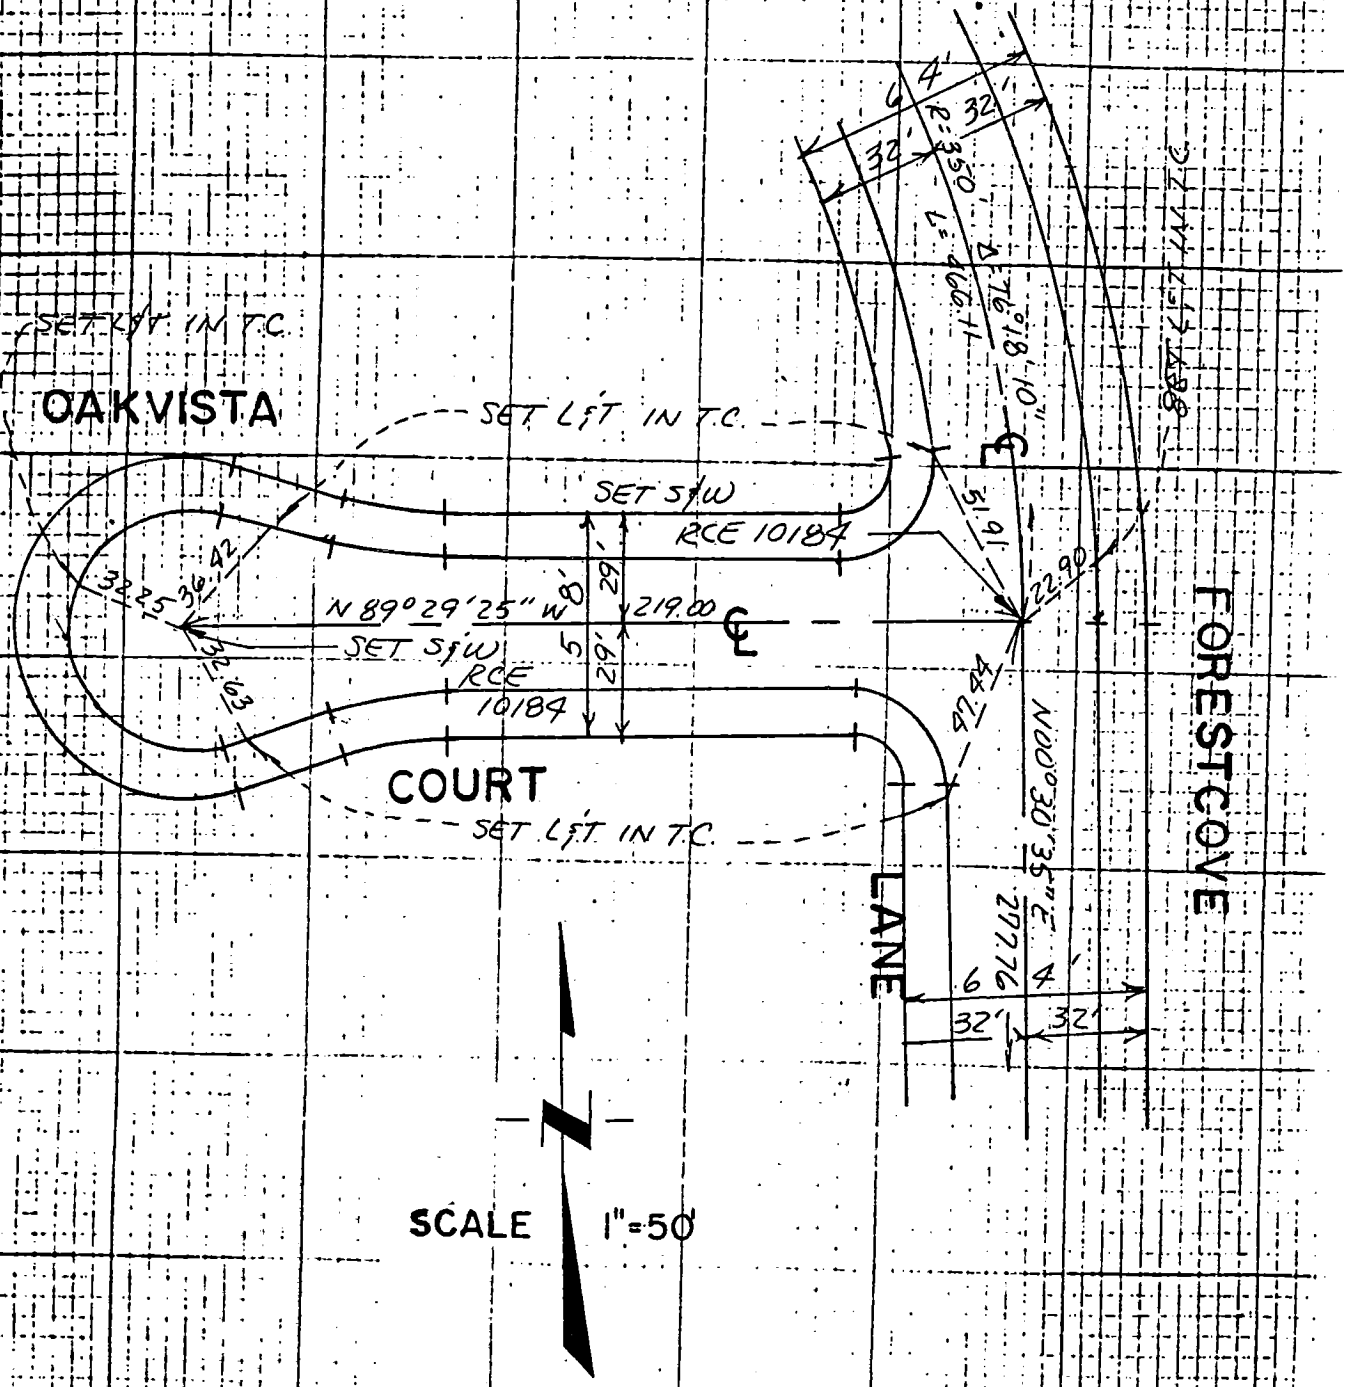

Engineer: Advanced Design Assoc.
29022 Laro Drive
Agoura Hills, CA 91301
Walter Babchuk RCE 10184
TR 33406 MB 976 73/83

Notes Ck'd by		Survey of 23	F.B. PG
Map No		JN Tape Std °F	
Office Work		Surveyed by	
Checked		Notes Date	
Date		Indexed	

CO ENG FB 3673-23

ON THIS SHEET MUST BE MADE OR CIRCLED IN RED INK WITH DATE AND NAME OF PERSON MAKING CHANGE

Do not extend notes to this side of this line

15403 C-1

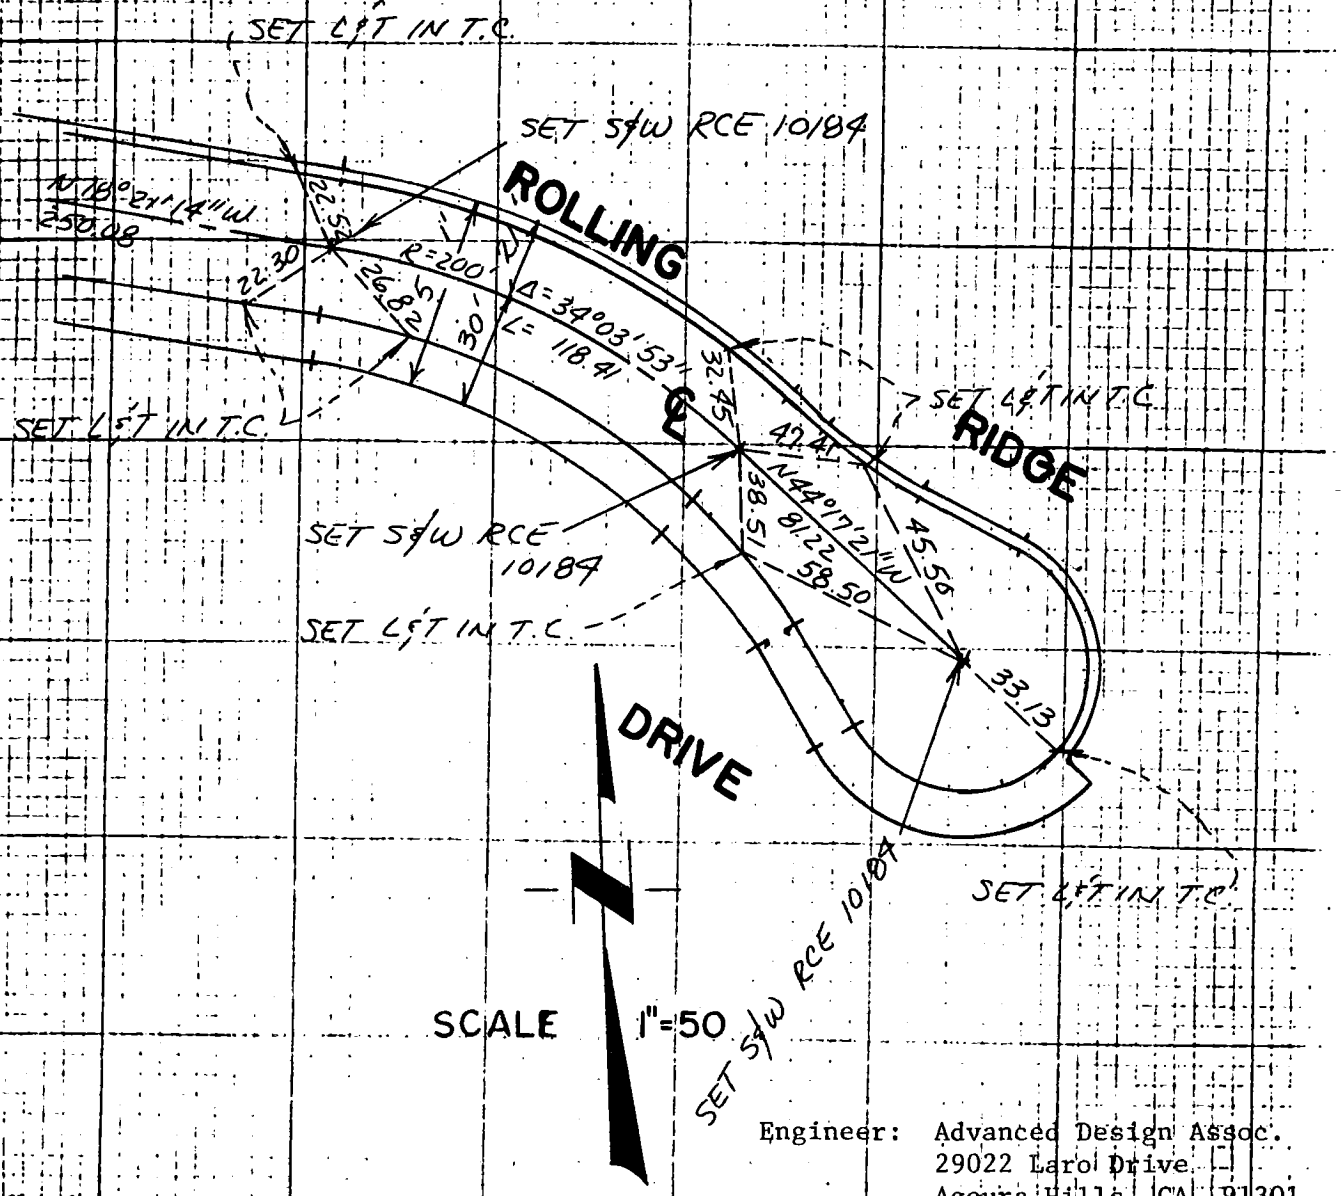

SCALE 1"=50

Engineer: Advanced Design Assoc.
29022 Laro Drive
Agoura Hills, CA 91301
Walter Babchuk RCE 10184
TR 33406 MB 976 73/83

110 2095-473

Notes Ck'd by	Survey of 24
Map No.	JN Tape Std °F
Office Work	Surveyed by
Checked	Notes Date
Date	Indexed

F.B. PG.

CO ENG FB 3673-24

ON THIS SHEET MUST BE MADE OR CIRCLED IN RED INK WITH DATE AND NAME OF PERSON MAKING CHANGE

Do not extend notes this side of this line

159-037, B-1

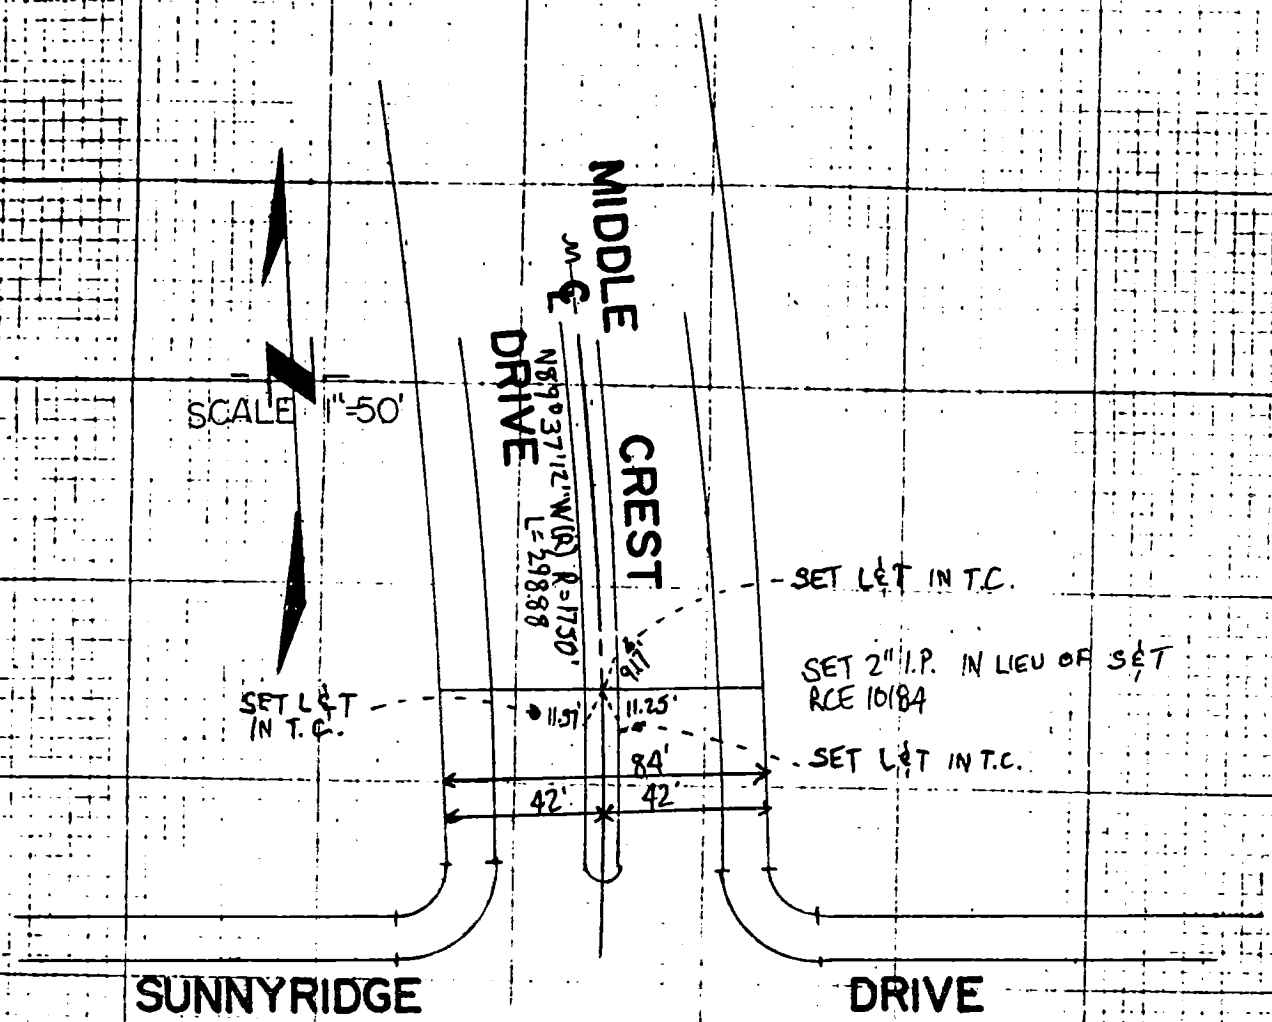

Engineer: Advanced Design Assoc.
29022 Laro Drive
Agoura Hills, CA 91301
Walter Babchuk RCE 10184
TR 33406 MB 976 84/96

Notes Ck'd by	Survey of 9
Map No.	JN Tape Std °F
Office Work	Surveyed by
Checked	Notes Date
Date	Indexed

F.B. PG.

CO Eng fb 3673-25

ON THIS SHEET MUST BE MADE OR CIRCLED IN RED INK WITH DATE AND NAME OF PERSON MAKING CHANGE

Do not extend notes this side of this line

159037 C-1

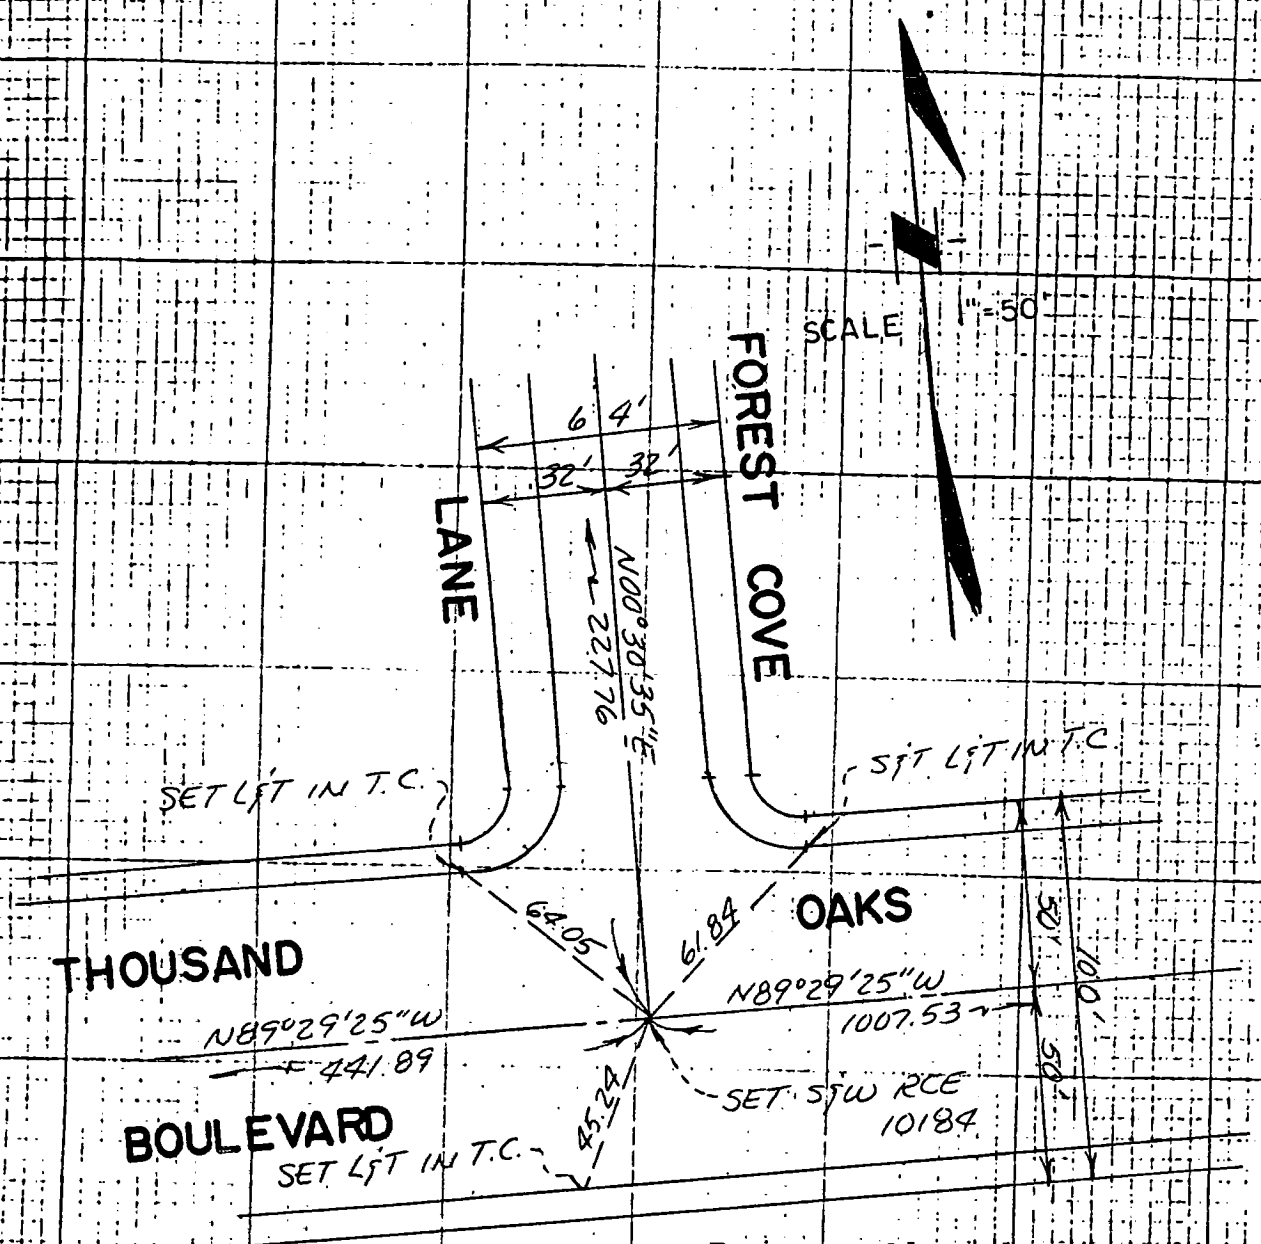

Engineer: Advanced Design Assoc.
29022 Laro Drive
Agoura Hills, CA 91301
Walter Babchuk RCE 10184
TR 33406 MB 976 ~~84/96~~ 73/83

Notes Ck'd by	Survey of 26
Map No.	JN Tape Std °F
Office Work	Surveyed by
Checked	Notes Date
Date	Indexed

F.B. PG.

CO ENG FB 3673-26

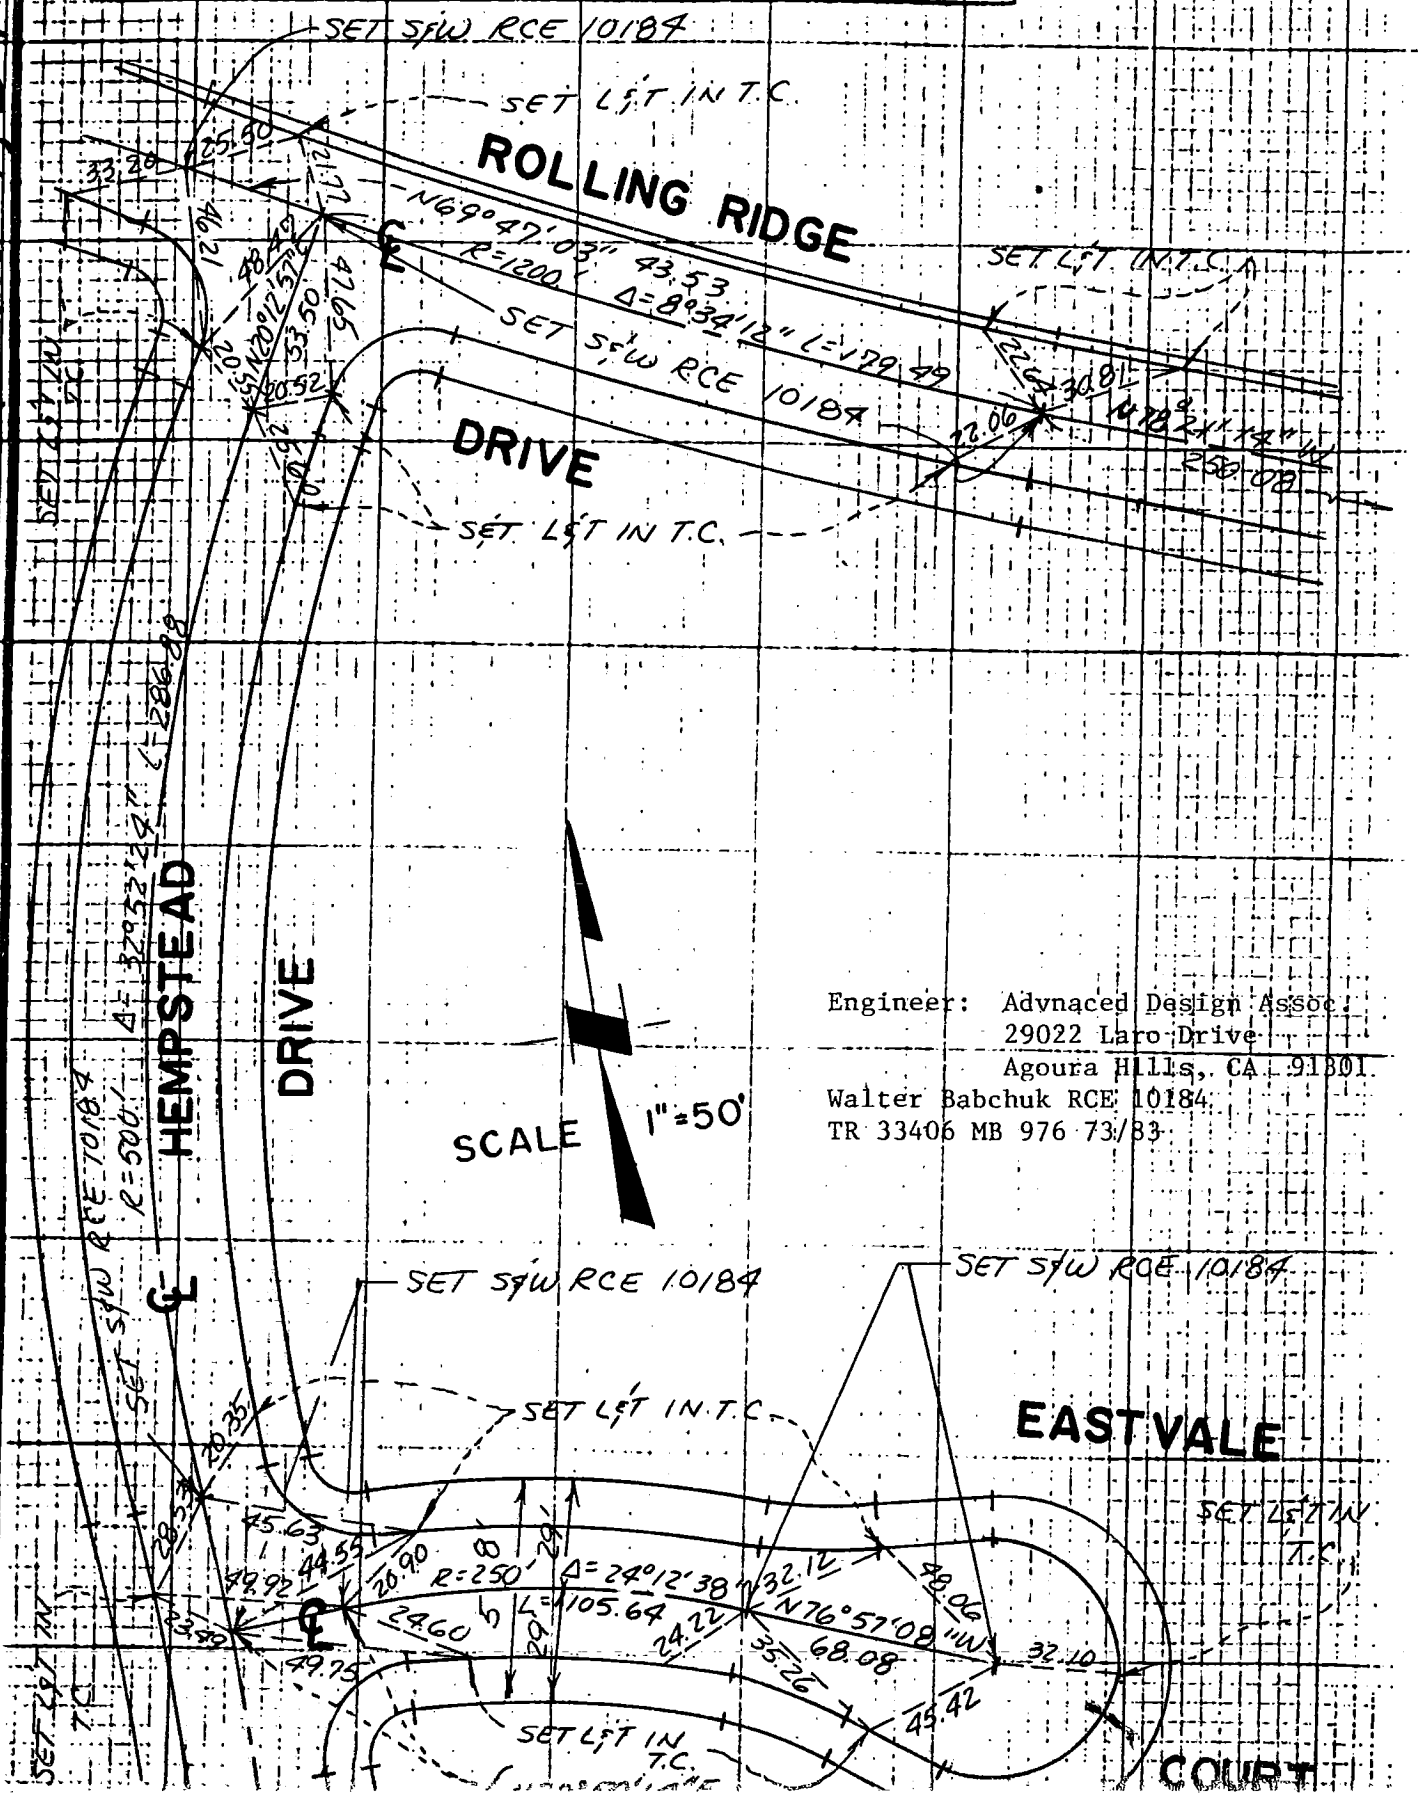

Engineer: Advnaced Design Assoc.
29022 Laro Drive
Agoura Hills, CA 91301
Walter Babchuk RCE 10184
TR 33406 MB 976 73/83

ON THIS SHEET MUST BE MADE OR CIRCLED IN RED INK WITH DATE AND NAME OF PERSON MAKING CHANGE

Do not extend notes this side of this line

159-037, 87

Notes Ck'd by	Survey of 27
Map No.	JN Tape Std °F
Office Work	Surveyed by
Checked	Notes Date
Date	Indexed

F.B. PG.

CO ENG FB 3673-27

Engineer: Advnaced Design Assoc
29022 Laro Drive
Agoura Hills, CA 91301
Walter Babchuk RCE 10184
TR 33406 MB 976 73/83

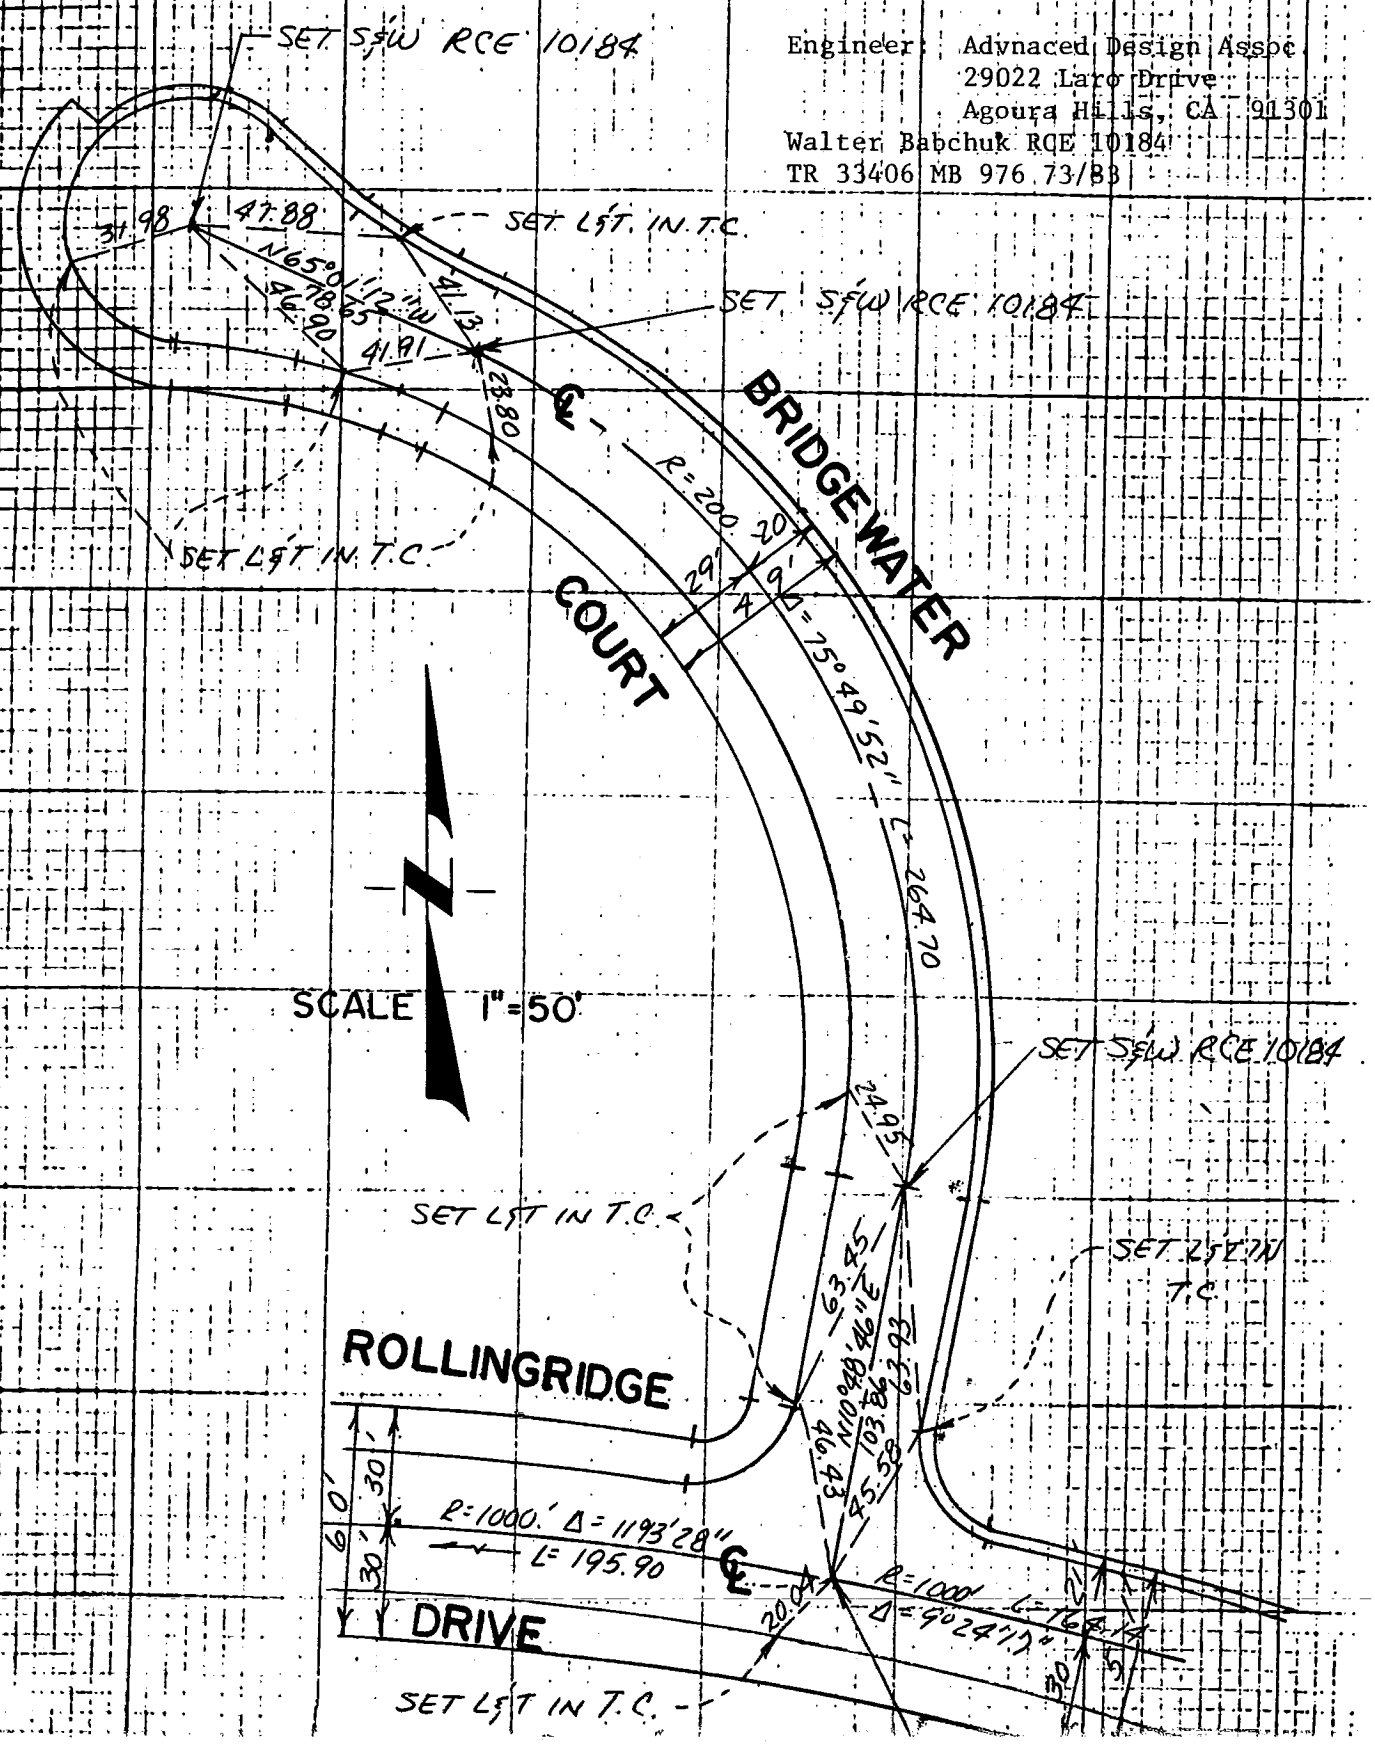

ON THIS SHEET MUST BE MADE OR CIRCLED IN RED INK WITH DATE AND NAME OF PERSON MAKING CHANGE

Do not extend notes this side of this line

159-037, 8-1

110
3695-4/73

Notes Ck'd by	Survey of 28	F.B. PG
Map No.	JN Tape Std °F	CO ENG FB 3673-2
Office Work	Surveyed by	28
Checked	Notes Date	
Date	Indexed	

ON THIS SHEET MUST BE MADE OR CIRCLED IN RED INK WITH DATE AND NAME OF PERSON MAKING CHANGE

Do not extend notes this side of this line

159-037, B-1

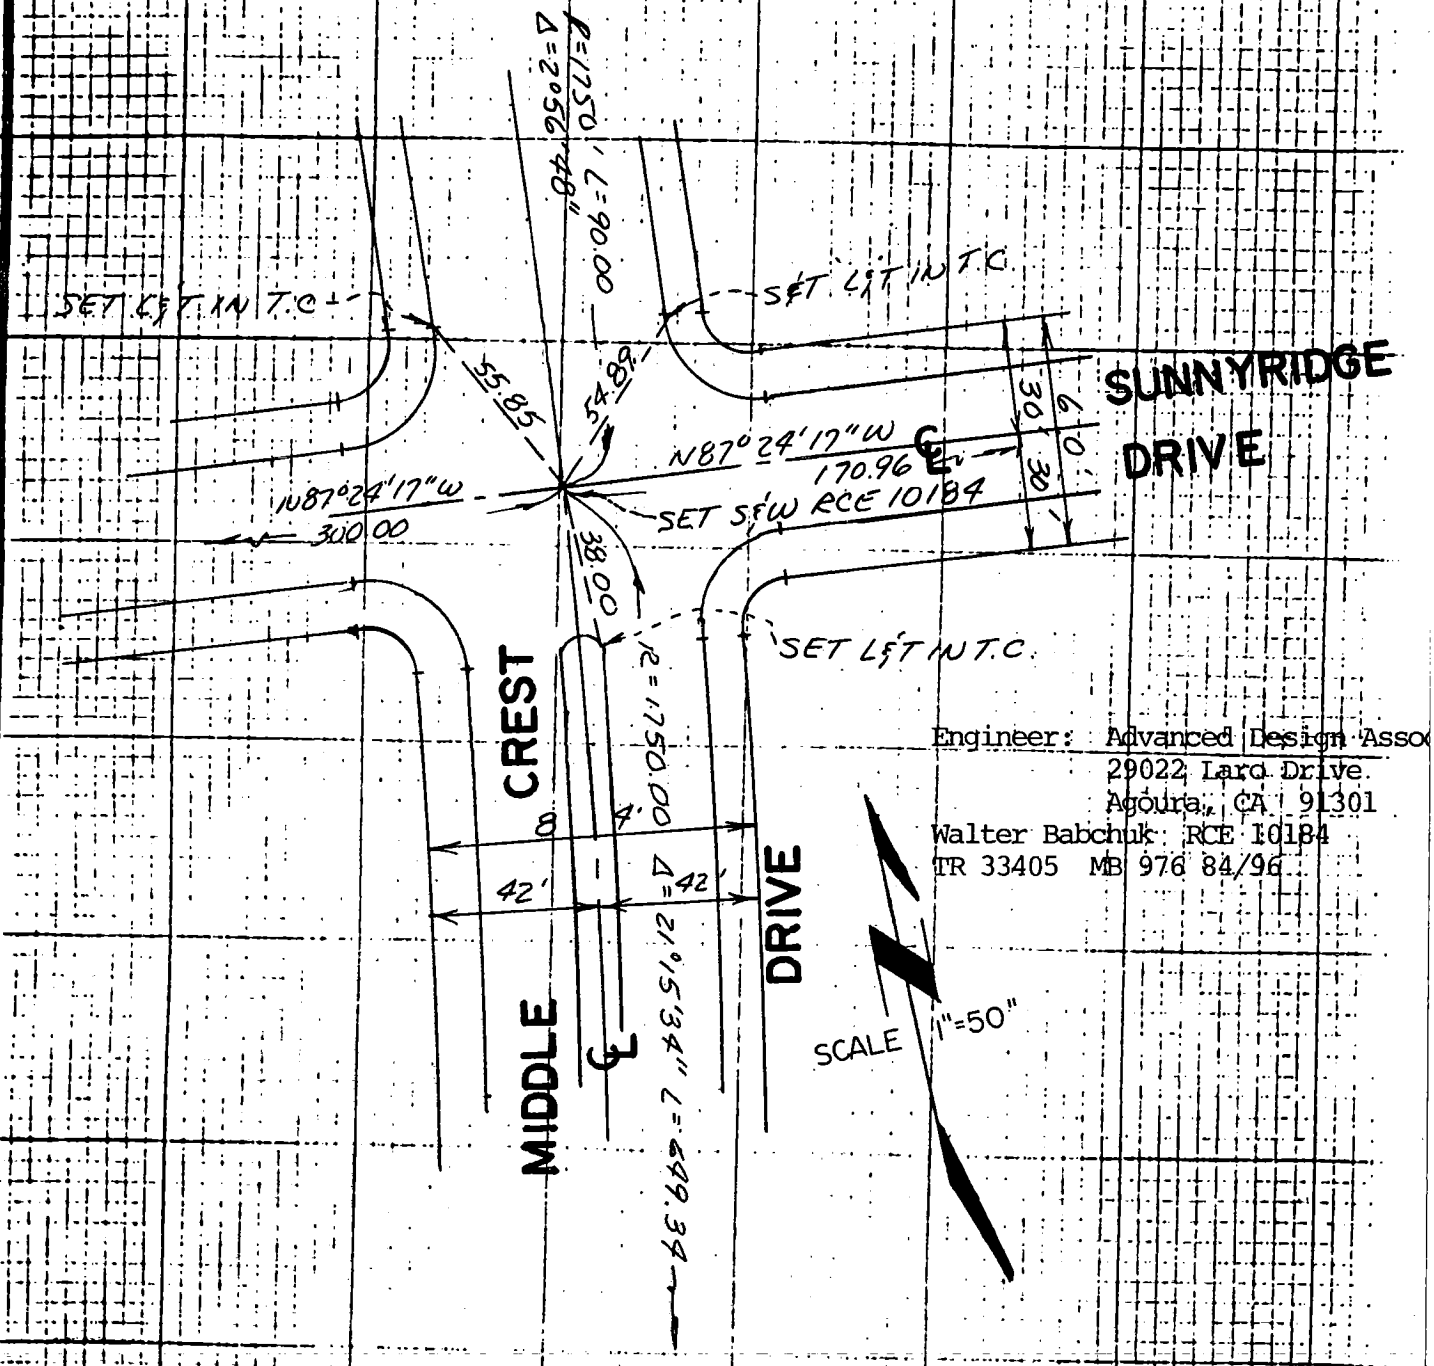

Engineer: Advanced Design Assoc
29022 Laro Drive
Agoura, CA 91301
Walter Babchuk RCE 10184
TR 33405 MB 976 84/96

89

Notes Ck'd by	Survey of
Map No.	JN Tape Std °F
Office Work	Surveyed by
Checked	Notes Date
Date	Indexed

F.B. PG.

CO ENG FB 3673-29

ON THIS SHEET MUST BE MADE OR CIRCLED IN RED INK WITH DATE AND NAME OF PERSON MAKING CHANGE
Do not extend notes this side of this line

159-037 B-1

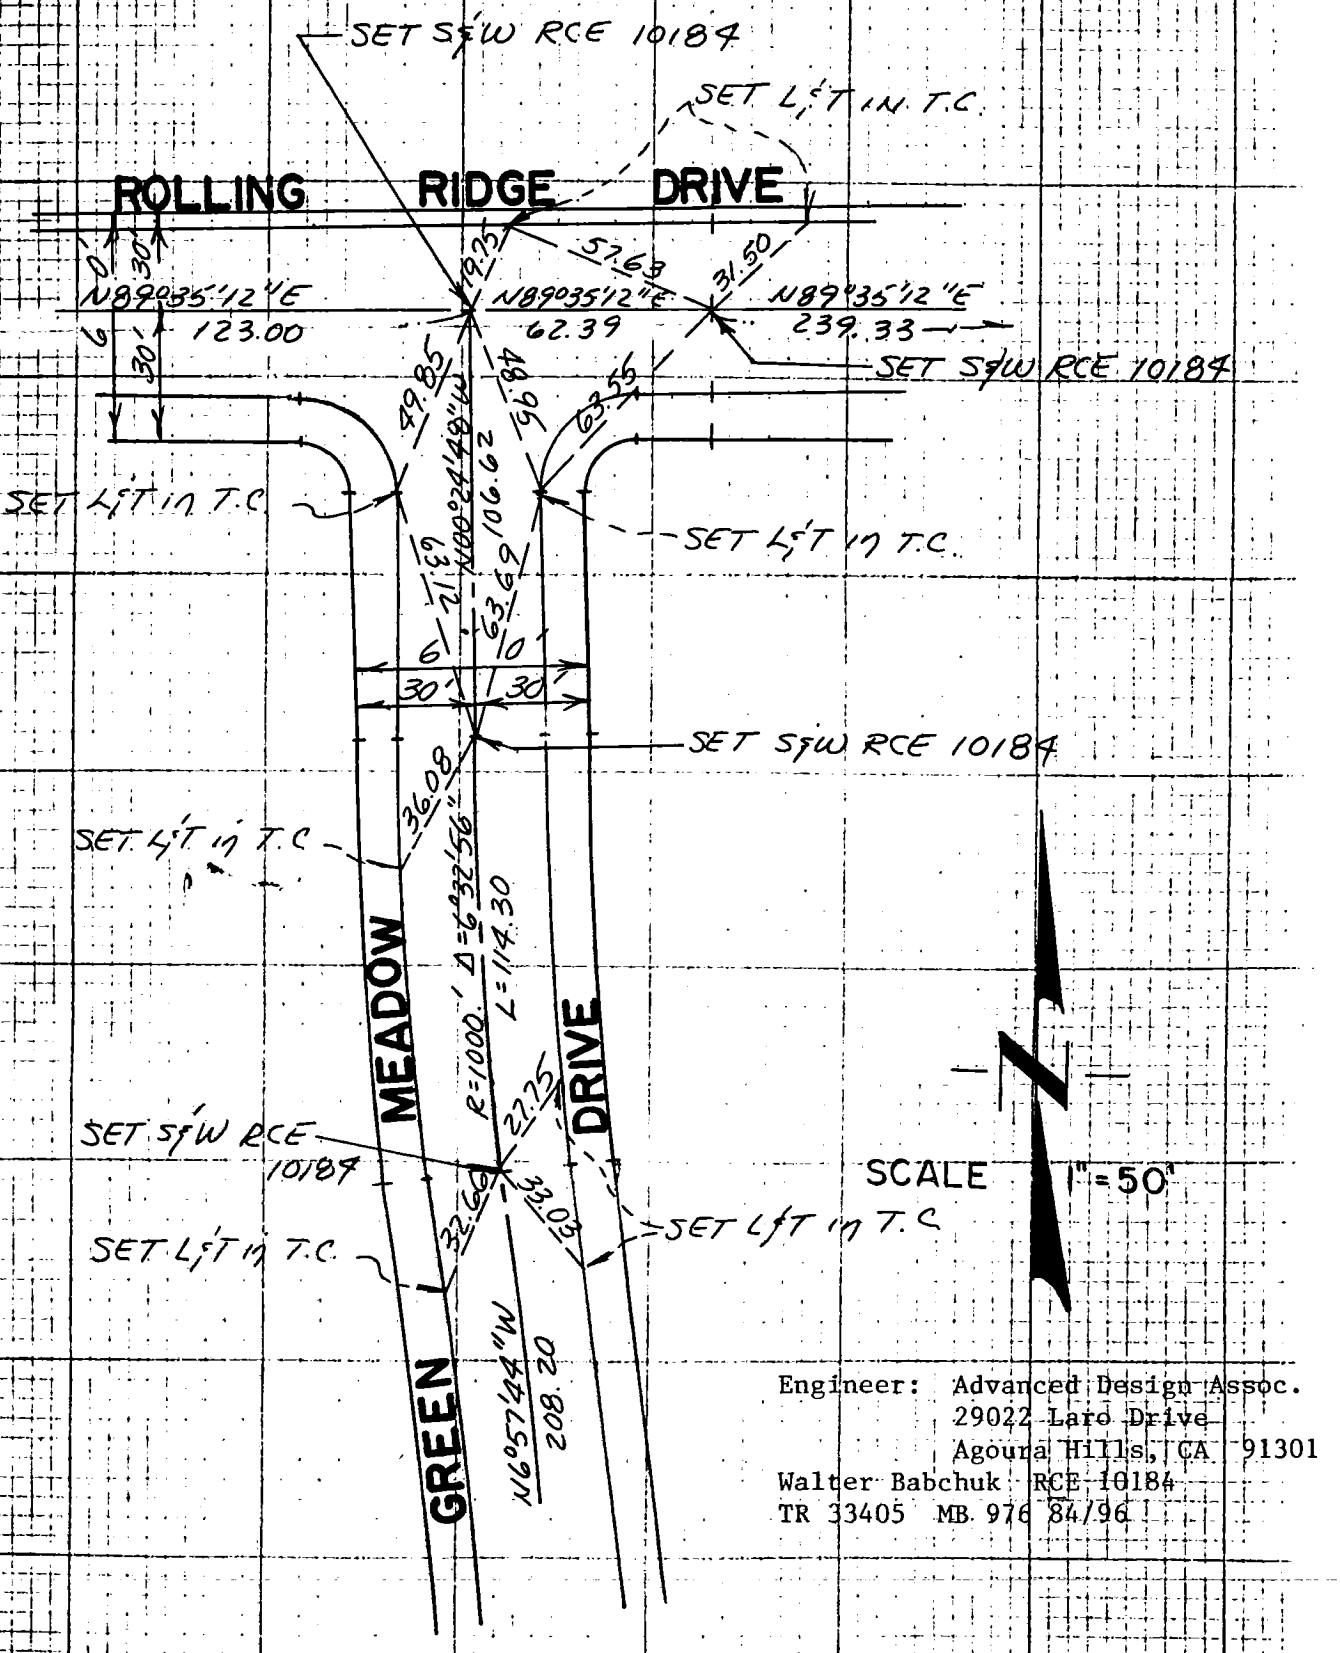

Engineer: Advanced Design Assoc.
29022 Laro Drive
Agoura Hills, CA 91301
Walter Babchuk RCE 10184
TR 33405 MB 976 84/96

310
3095-4/73

30

Notes Ck'd by	Survey of
Map No.	JN Tape Std °F
Office Work	Surveyed by
Checked	Notes Date
Date	Indexed

F.B. PG.

CO ENG FB 3673-30

ON THIS SHEET MUST BE MADE OR CIRCLED IN RED INK WITH DATE AND NAME OF PERSON MAKING CHANGE

Do not extend notes this side of this line

159-037, B-1

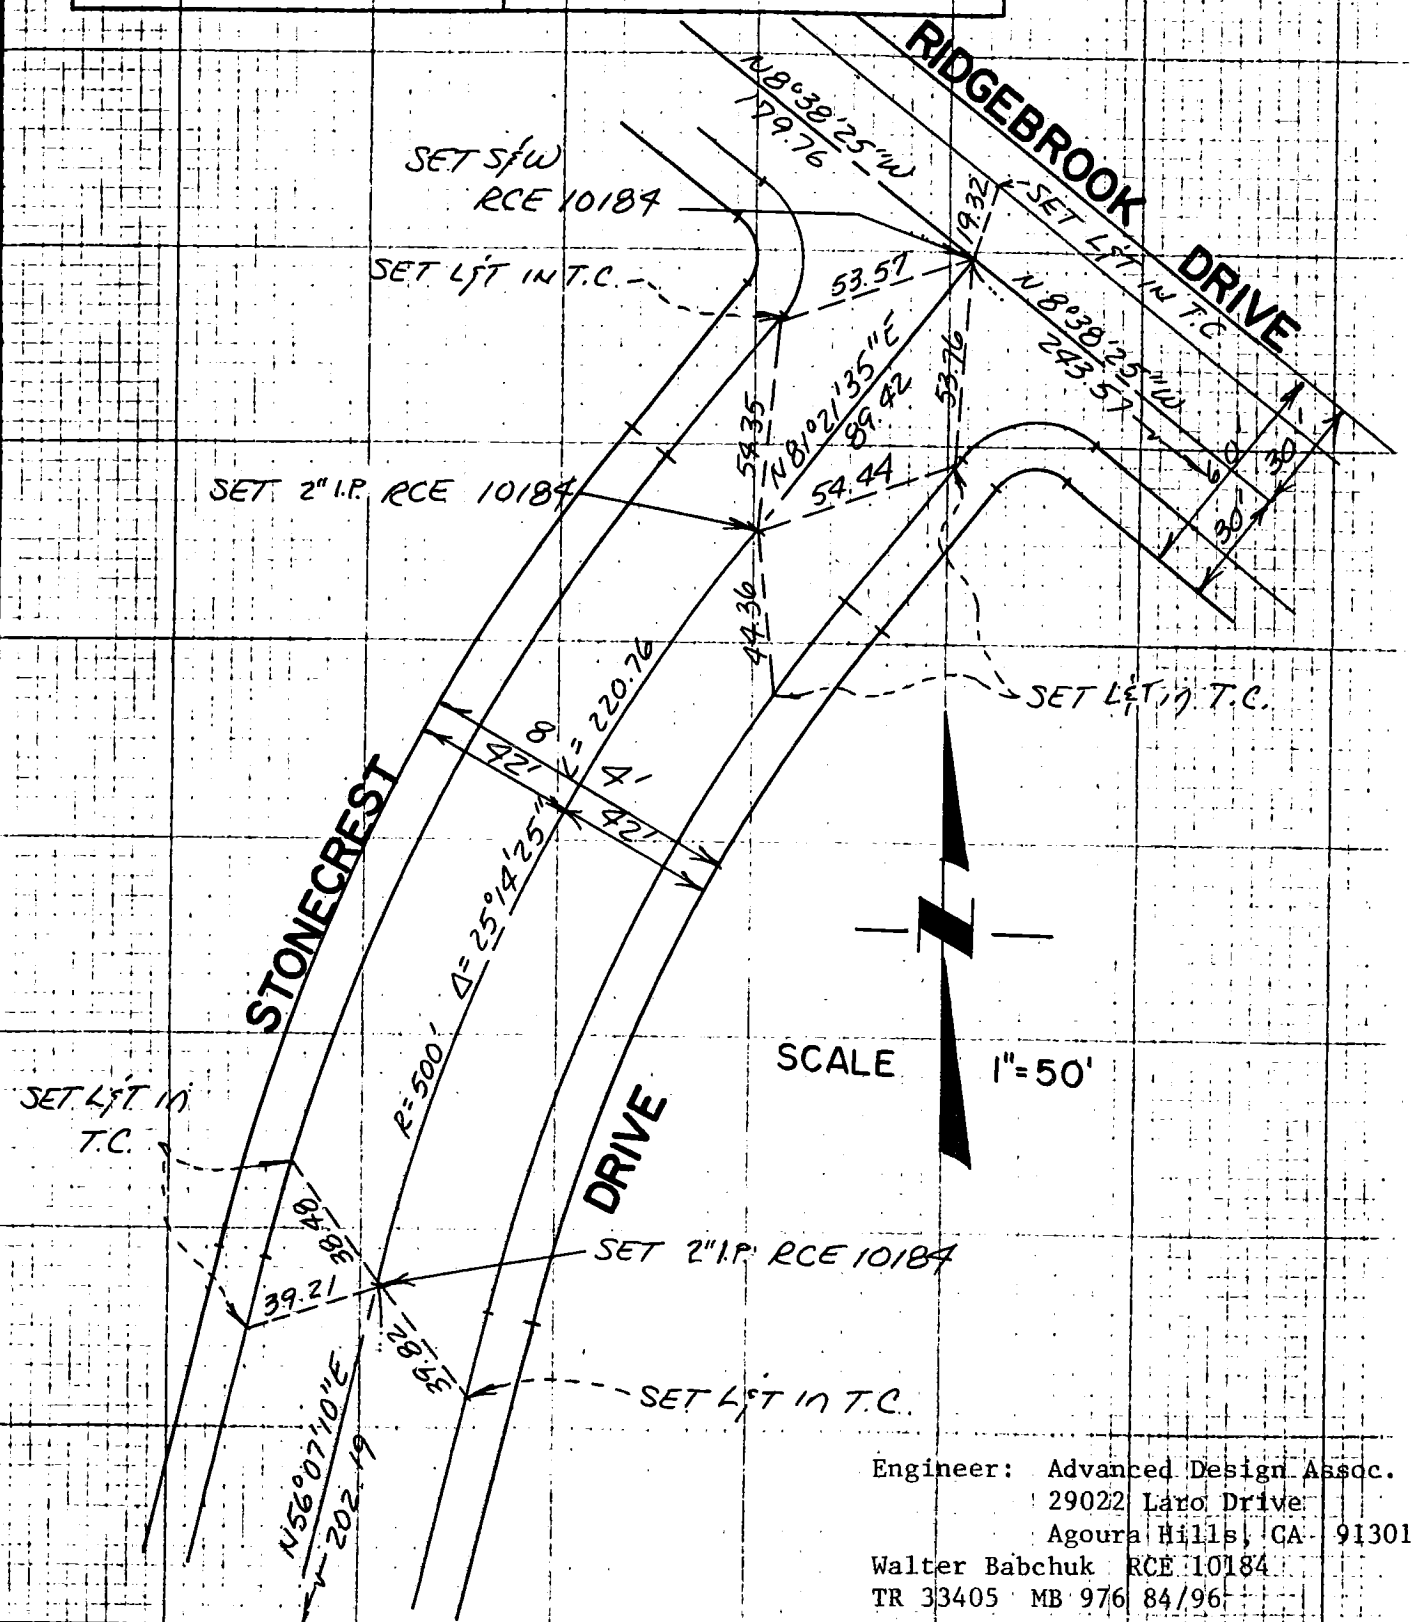

Engineer: Advanced Design Assoc.
29022 Laro Drive
Agoura Hills, CA 91301
Walter Babchuk RCE 10184
TR 33405 MB 976 84/96

310
F3095-4/73

31

Notes Ck'd by	Survey of
Map No.	JN Tape Std °F
Office Work	Surveyed by
Checked	Notes Date
Date	Indexed

F.B. PG.

CO ENG FB 3673-31

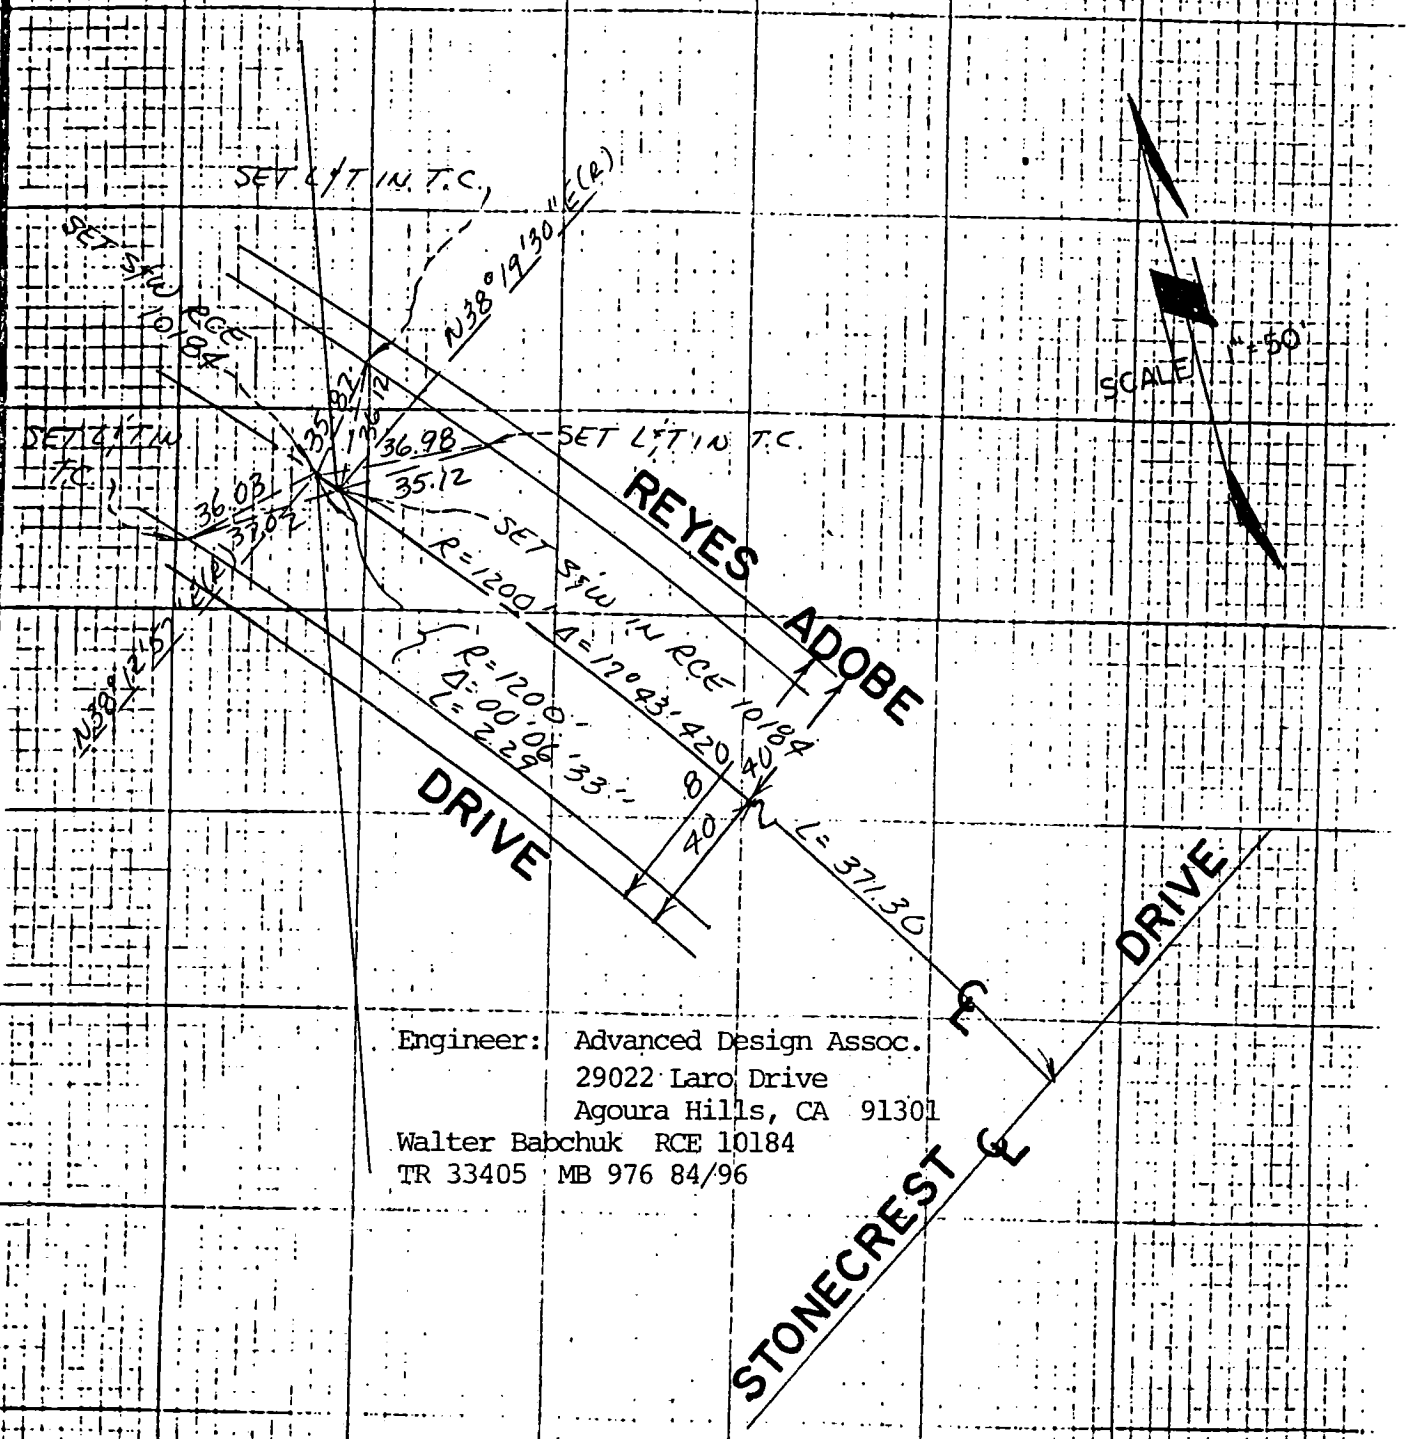

Engineer: Advanced Design Assoc.
29022 Laro Drive
Agoura Hills, CA 91301
Walter Babchuk RCE 10184
TR 33405 MB 976 84/96

ON THIS SHEET MUST BE MADE OR CIRCLED IN RED INK WITH DATE AND NAME OF PERSON MAKING CHANGE

Do not extend notes this side of this line

159-037, B-1

Notes Ck'd by	Survey of 32
Map No.	JN Tape Std °F
Office Work	Surveyed by
Checked	Notes Date
Date	Indexed

F.B. PG.

CO ENG FB 3673-32

ON THIS SHEET MUST BE MADE OR CIRCLED IN RED INK WITH DATE AND NAME OF PERSON MAKING CHANGE

Do not extend notes this side of this line

159-037, B-1

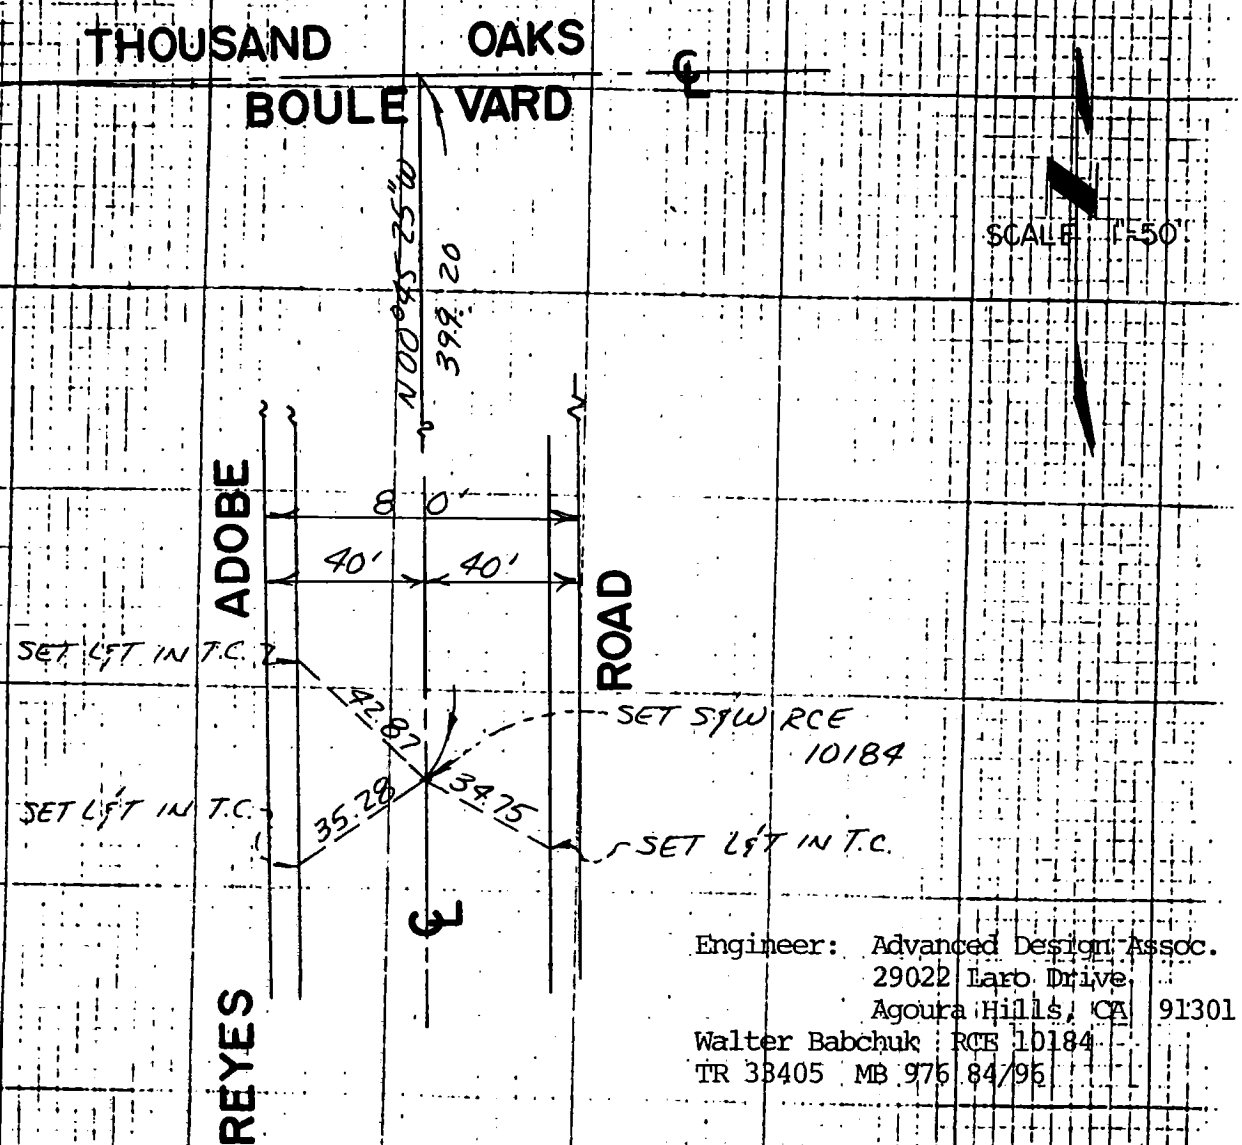

Engineer: Advanced Design Assoc.
29022 Laro Drive
Agoura Hills, CA 91301
Walter Babchuk RCE 10184
TR 33405 MB 976 84/96

3095-4/73

33

Notes Ck'd by	Survey of
Map No.	JN Tape Std °F
Office Work	Surveyed by
Checked	Notes Date
Date	Indexed

F.B. PG.

CO ENG FB 3673-33

Engineer: Advanced Design Assoc.
29022 Laro Drive
Agoura Hills, CA 91301
Walter Babchuk RCE 10184
TR 33405 MB 976 84/96

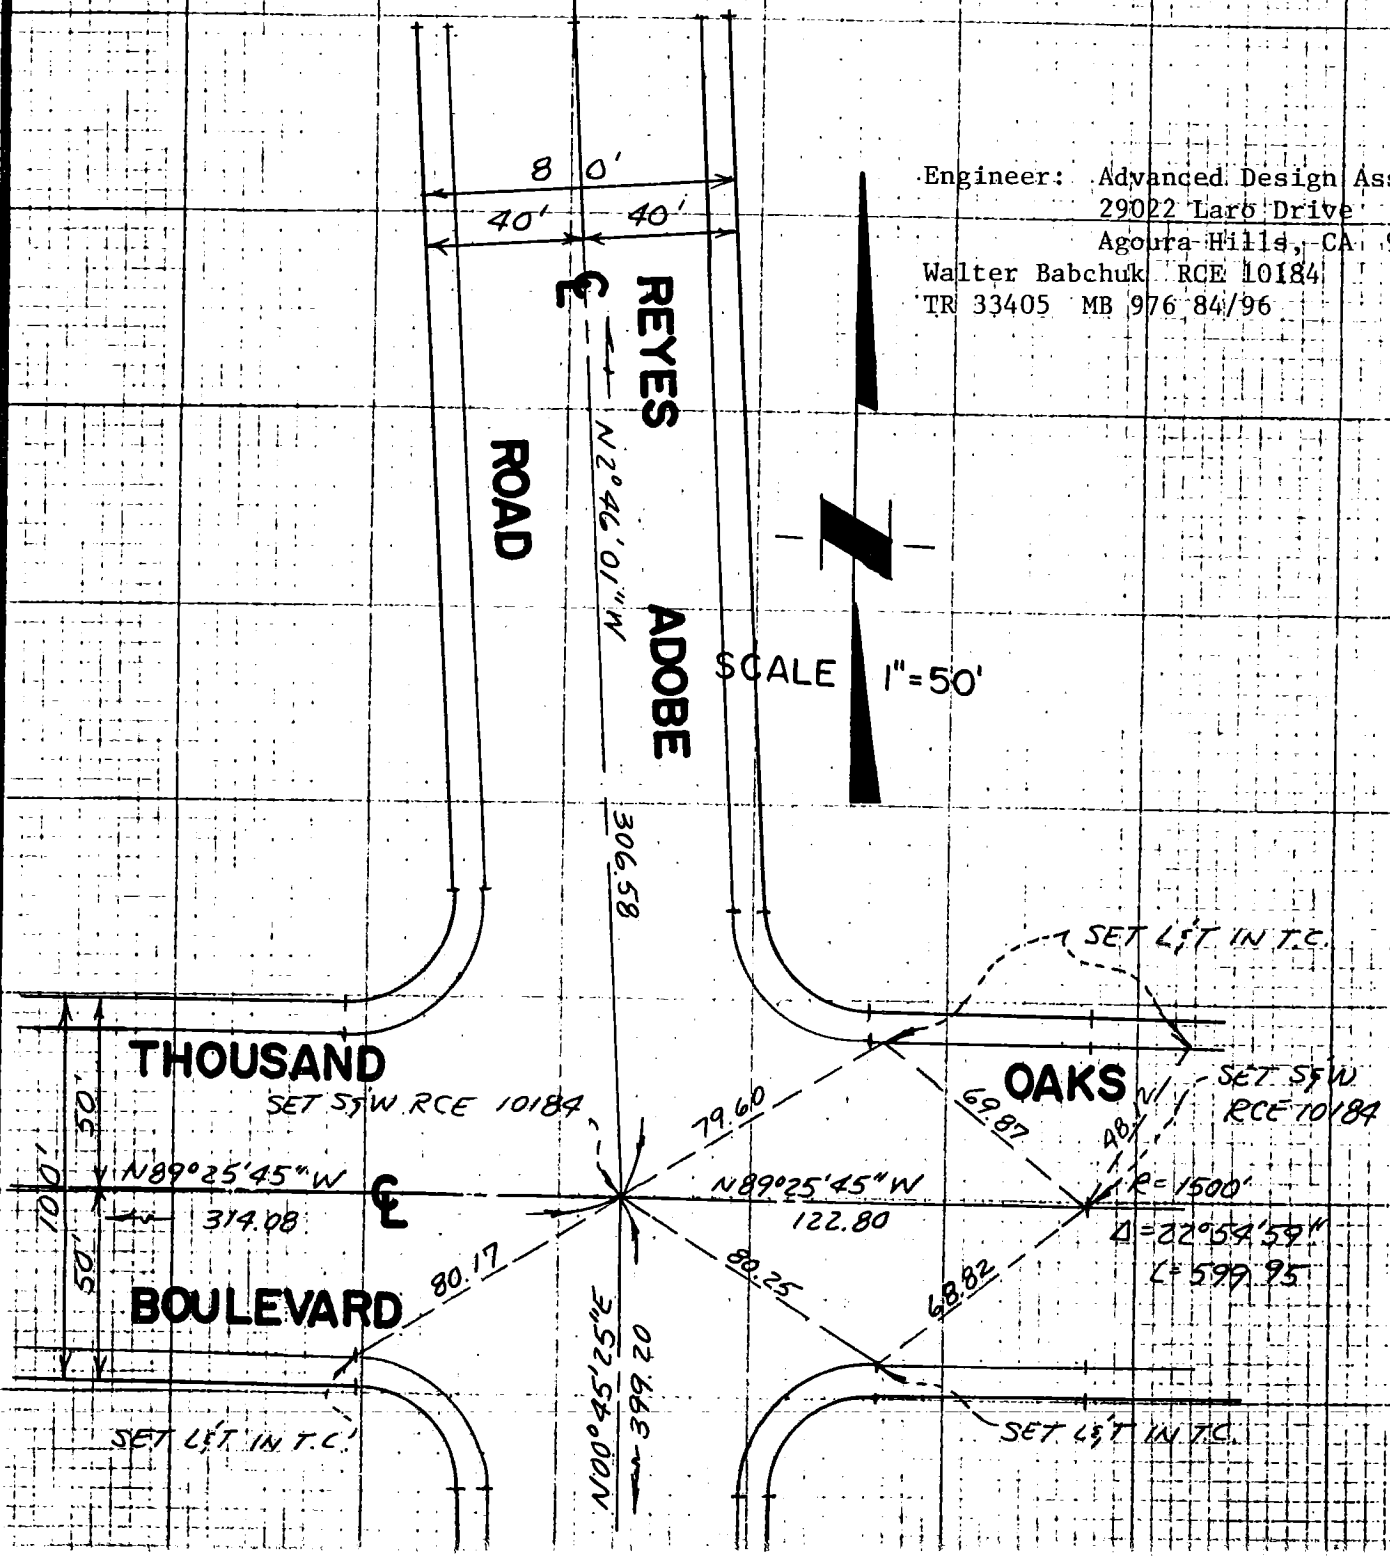

ON THIS SHEET MUST BE MADE OR CIRCLED IN RED INK WITH DATE AND NAME OF PERSON MAKING CHANGE

Do not extend notes this side of this line

159-037, B-1

F3095-4/73

34

Notes Ck'd by	Survey of
Map No.	JN Tape Std °F
Office Work	Surveyed by
Checked	Notes Date
Date	Indexed

F.B. PG.

CO ENG FB 3673-34

NOTE: ANY ADDITIONS OR CHANGES ON THIS SHEET MUST BE MADE OR CIRCLED IN RED INK WITH DATE AND NAME OF PERSON MAKING CHANGE

Do not extend notes this side of this line

159-031, B-1

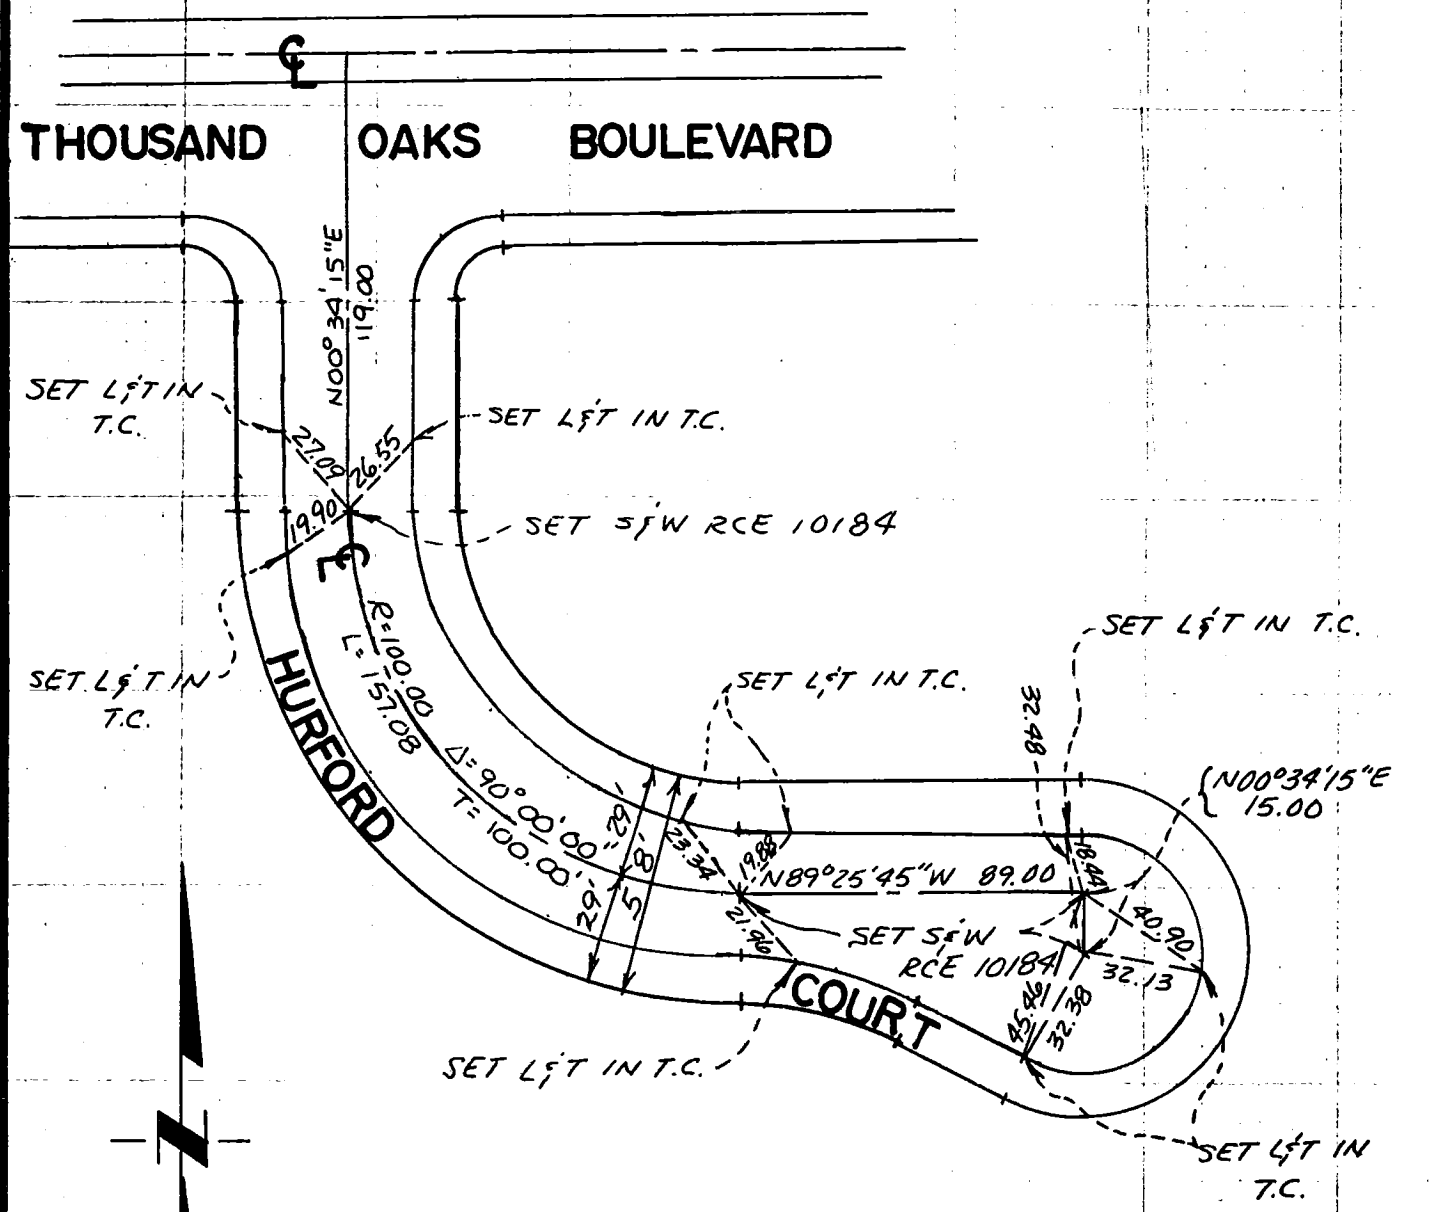

SCALE 1"=50'

Engineer: Advanced Design Assoc.
29022 Laro Drive
Agoura Hills, CA 91301
Walter Babchuk RCE 10184
TR 33405 MB 976 84/96

CENTERLINE NOTES
E 310
F 3095-4/73

35

Notes Ck'd by	Survey of
Map No.	JN Tape Std °F
Office Work	Surveyed by
Checked	Notes Date
Date	Indexed

F.B. PG.

CO ENG FB 3673-35

ON THIS SHEET MUST BE MADE OR CIRCLED IN RED INK WITH DATE AND NAME OF PERSON MAKING CHANGE
Do not extend notes this side of this line

15-1037, B-1

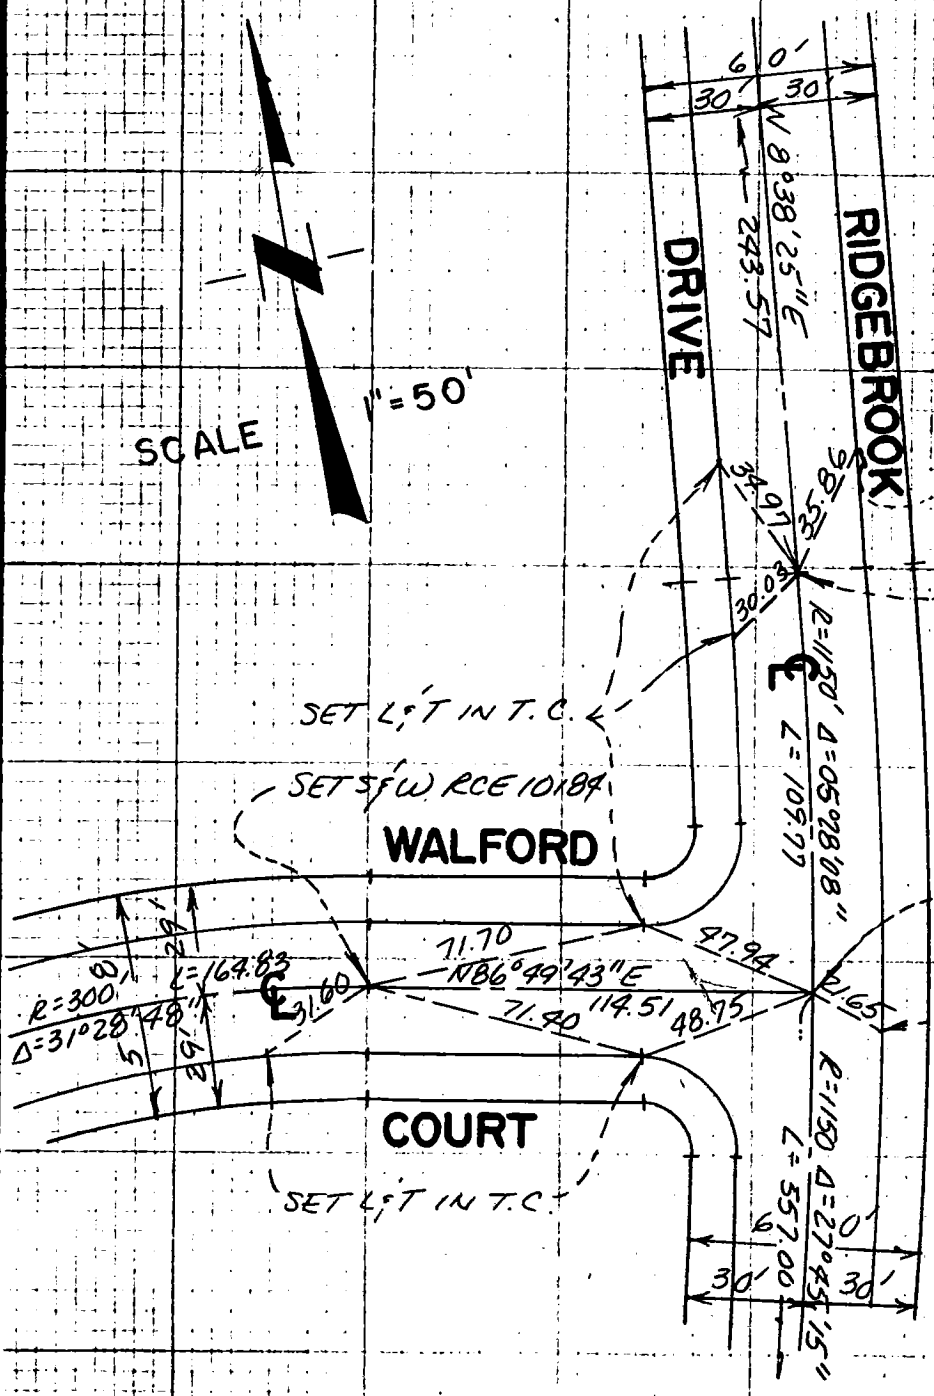

Engineer: Advanced Design Assoc.
29022 Larp Drive
Agoura Hills, CA 91301
Walter Babchuk RCE 10184
TR-33405 MB-976 84/96

310
3095-4/73

36

Notes Ck'd by	Survey of
Map No.	JN Tape Std °F
Office Work	Surveyed by
Checked	Notes Date
Date	Indexed

F.B. PG.

CO ENG FB 3673-36

ON THIS SHEET MUST BE MADE OR CIRCLED IN RED INK WITH DATE AND NAME OF PERSON MAKING CHANGE

Do not extend notes this side of this line

159-037, B-1

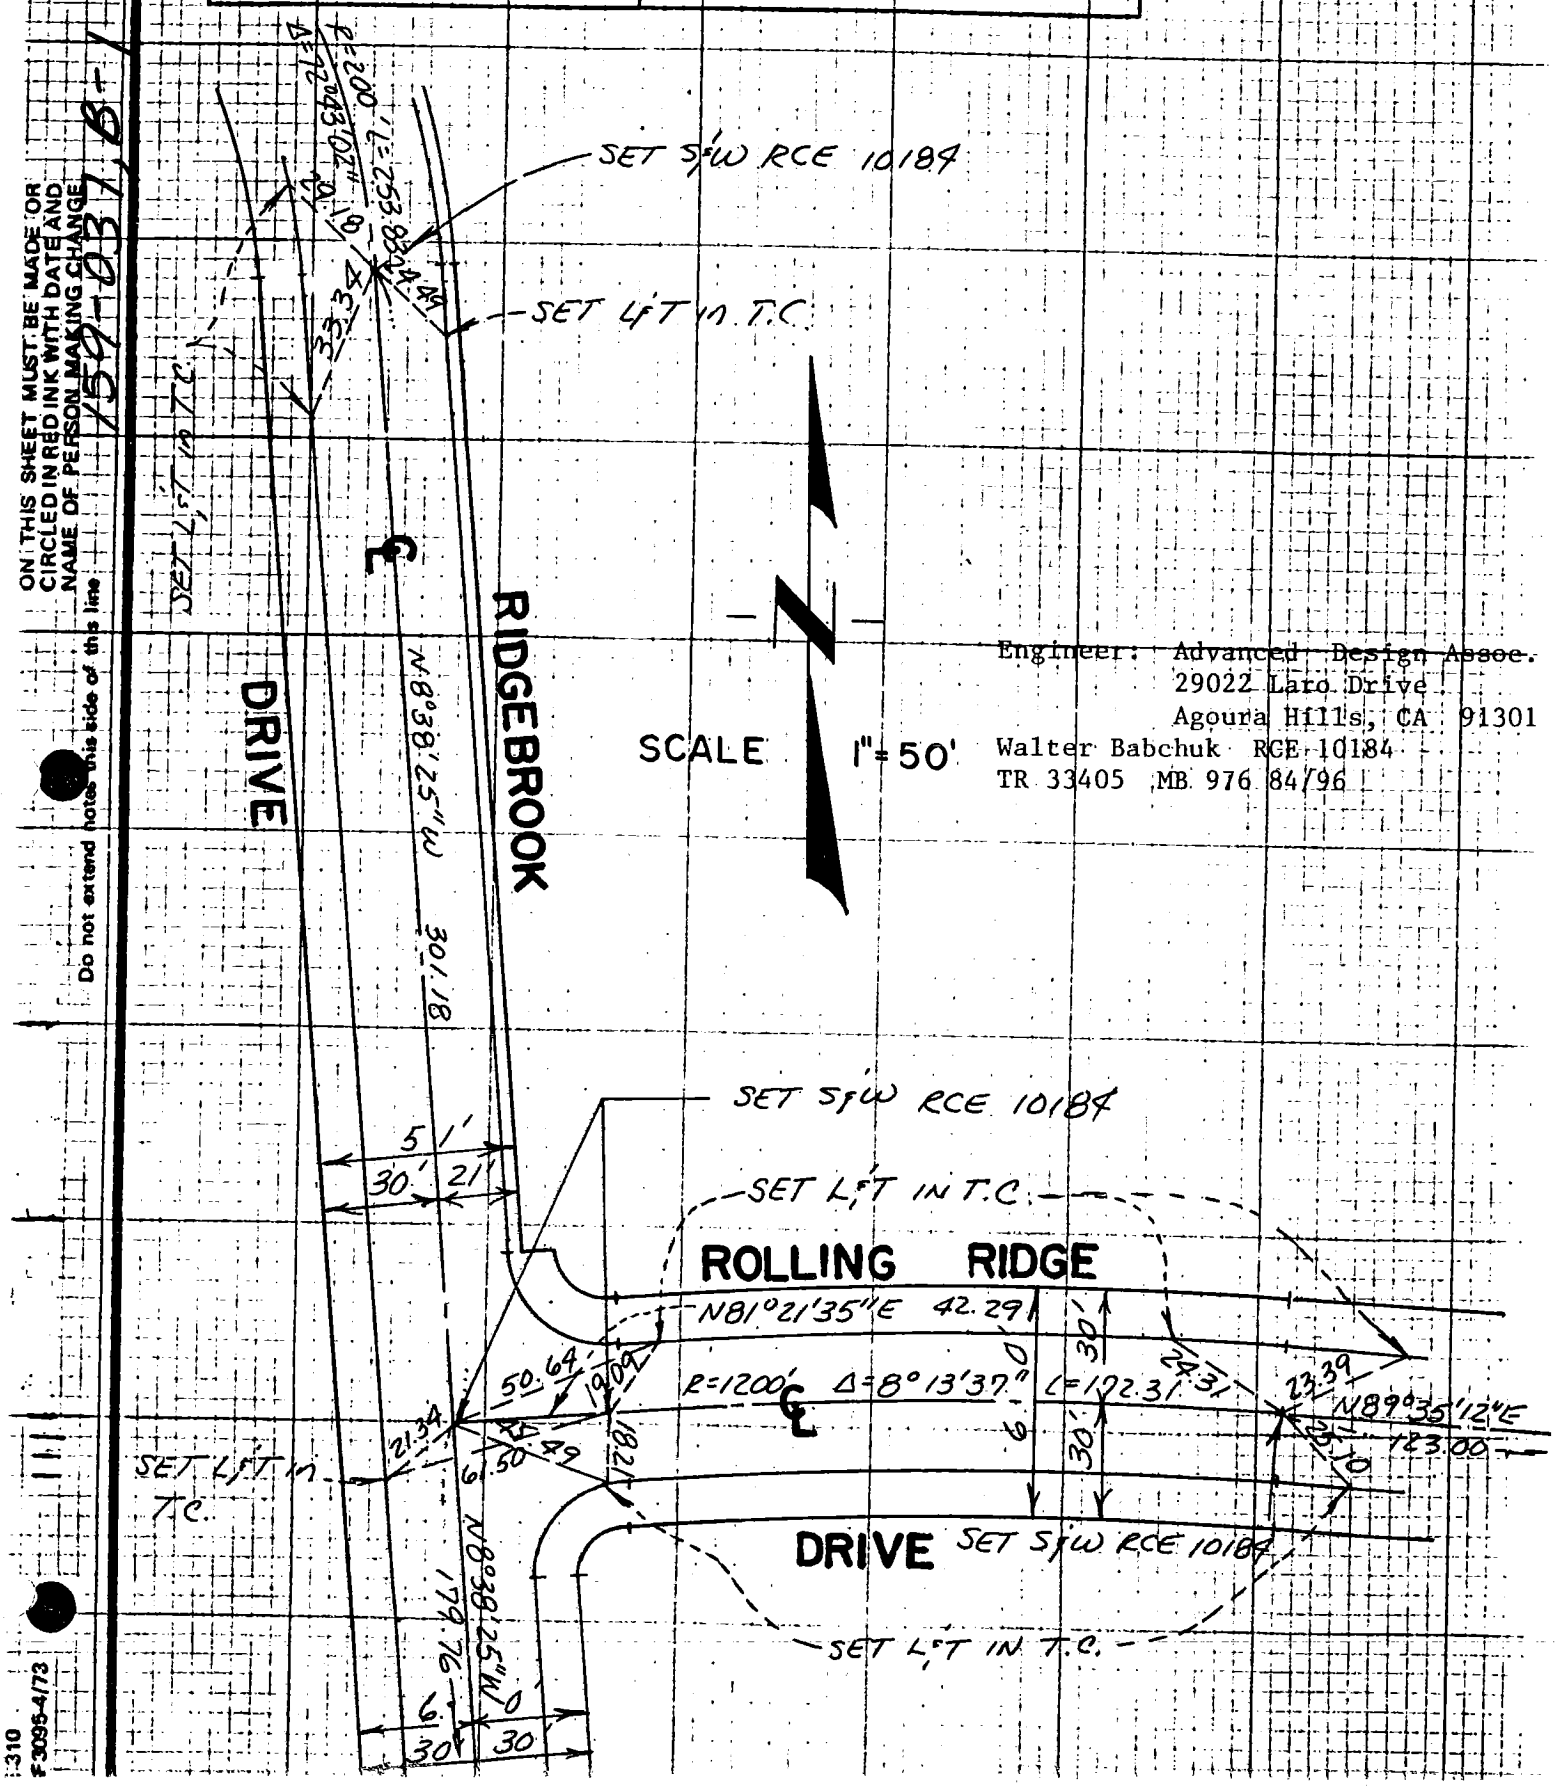

Engineer: Advanced Design Assoc.
29022 Laro Drive
Agoura Hills, CA 91301
Walter Babchuk RCE 10184
TR 33405 MB 976 84/96

310
F3095-4/73

37

Notes Ck'd by	Survey of
Map No.	JN Tape Std °F
Office Work	Surveyed by
Checked	Notes Date
Date	Indexed

F.B. PG.

CO ENG FB 3673-37

NOTE: ANY ADDITIONS OR CHANGES ON THIS SHEET MUST BE MADE OR CIRCLED IN RED INK WITH DATE AND NAME OF PERSON MAKING CHANGE

Do not extend notes this side of this line

139-037, 8-1

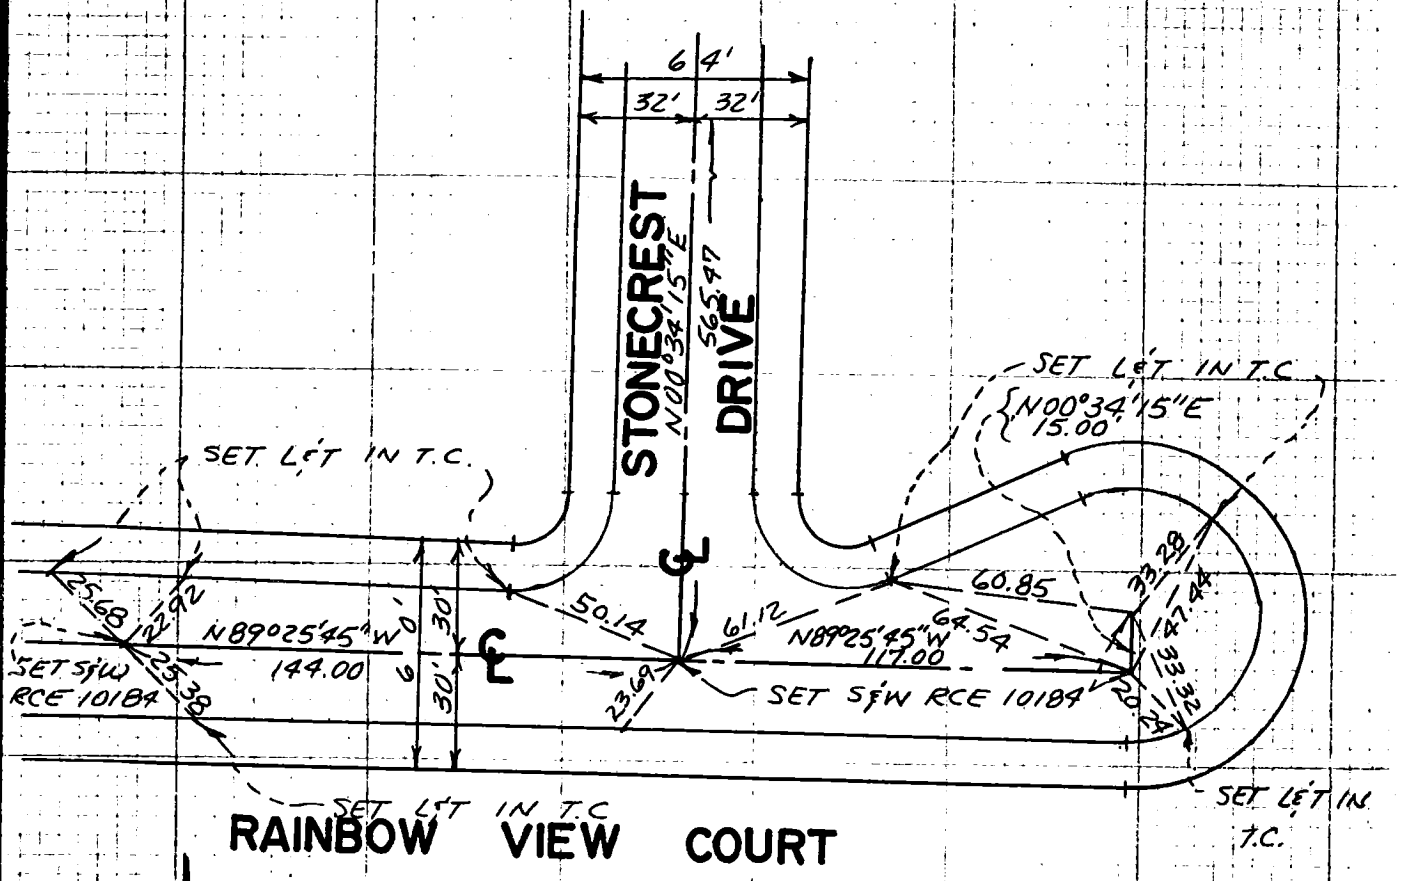

SCALE 1"=50'

Engineer: Advanced Design Assoc.
29022 Laro Drive
Agoura Hills, CA 91301
Walter Babchuk RCE 10184
TR 33405 MB 976 84/96

INTERLINE NOTES
310
#3096-4/73

38

Notes Ck'd by	Survey of
Map No.	JN Tape Std °F
Office Work	Surveyed by
Checked	Notes Date
Date	Indexed

F.B. PG.

CO ENG FB 3673-38

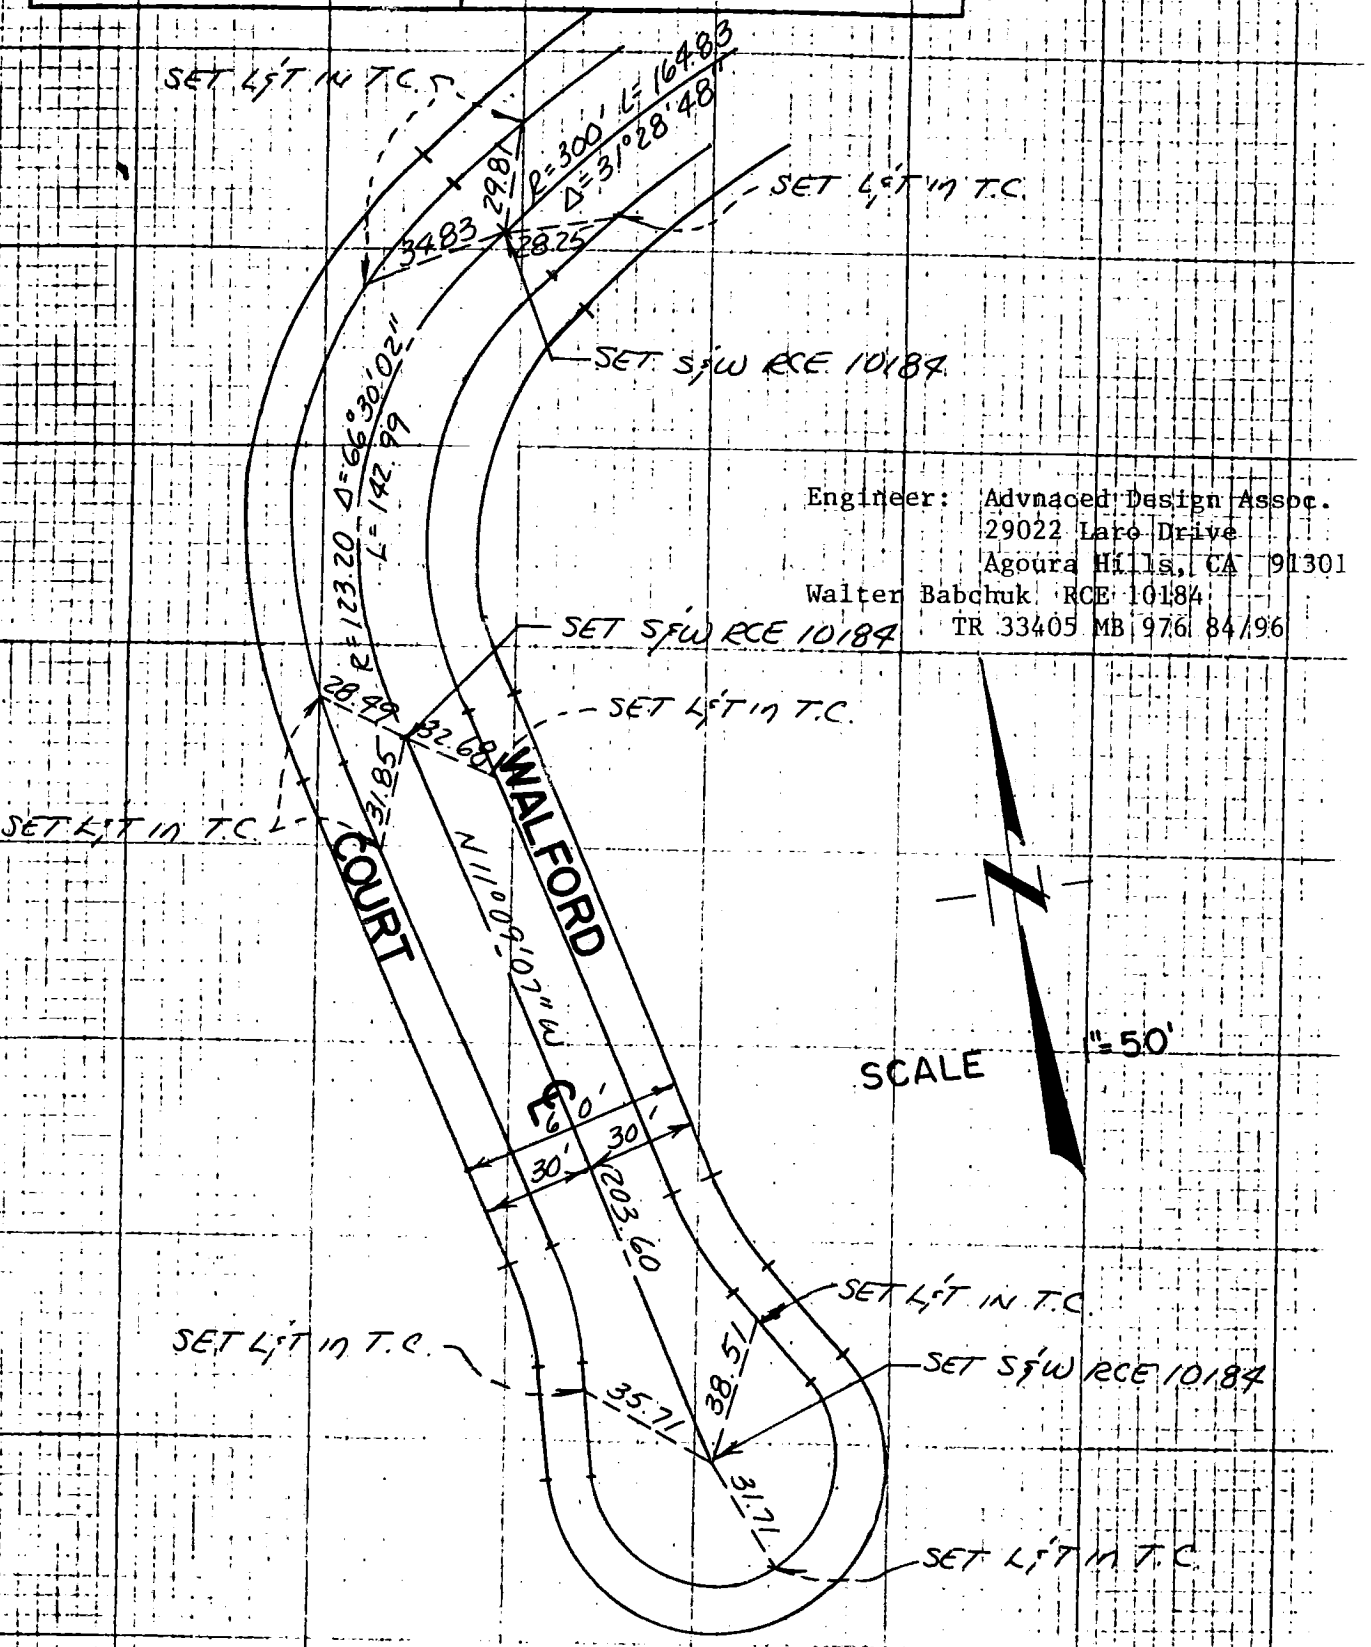

Engineer: Advnaced Design Assoc.
29022 Laro Drive
Agoura Hills, CA 91301
Walter Babchuk RCE 10184
TR 33405 MB 976 84/96

ON THIS SHEET MUST BE MADE OR CIRCLED IN RED INK WITH DATE AND NAME OF PERSON MAKING CHANGE

Do not extend notes this side of this line

159-037, B-1

310
3095-4/73

39

Notes Ck'd by	Survey of
Map No.	JN Tape Std °F
Office Work	Surveyed by
Checked	Notes Date
Date	Indexed

F.B. PG.

CO ENG FB 3673-39

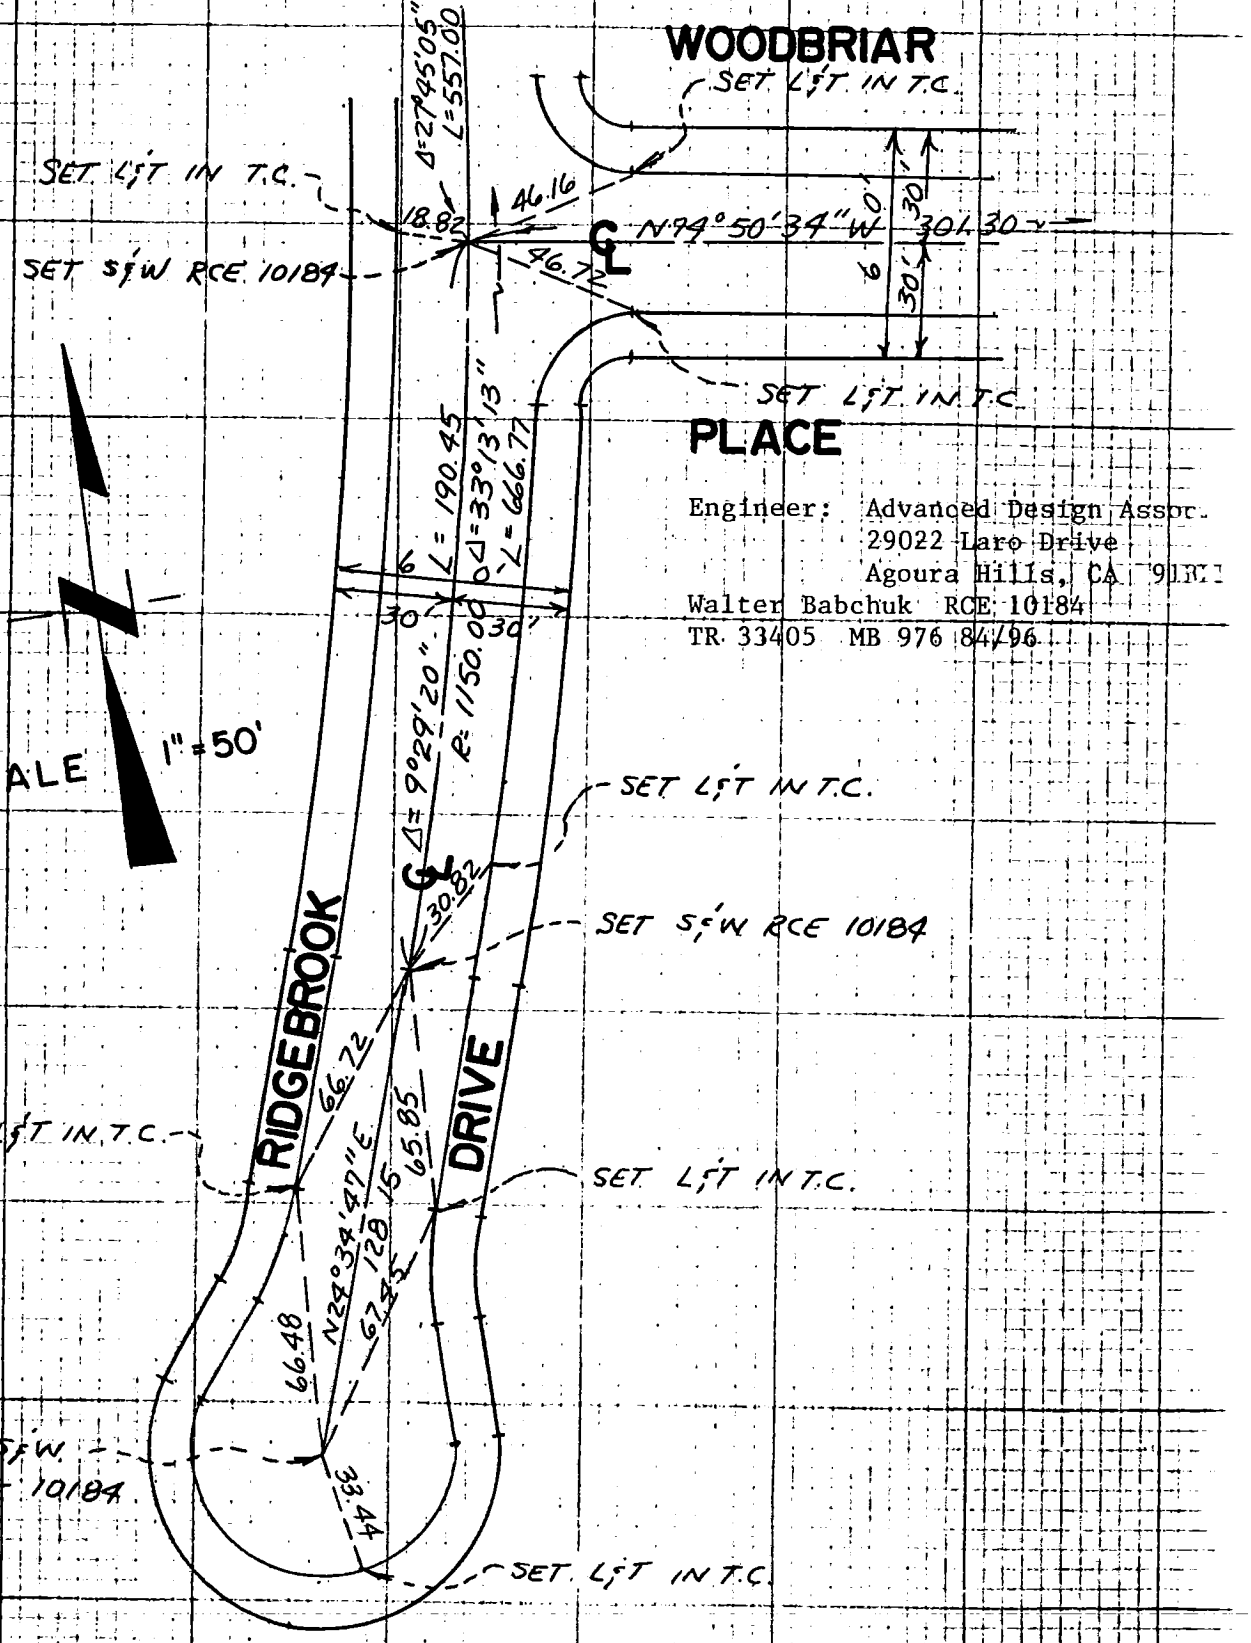

Engineer: Advanced Design Assoc.
29022 Laro Drive
Agoura Hills, CA 91[illegible]
Walter Babchuk RCE 10184
TR 33405 MB 976 84/96

ON THIS SHEET MUST BE MADE OR CIRCLED IN RED INK WITH DATE AND NAME OF PERSON MAKING CHANGE

Do not extend notes this side of this line

159-037, B-1

310 3095-4/73

40

Notes Ck'd by	Survey of
Map No.	JN Tape Std °F
Office Work	Surveyed by
Checked	Notes Date
Date	Indexed

F.B. PG.

CO ENG FB 3673-40

ON THIS SHEET MUST BE MADE OR CIRCLED IN RED INK WITH DATE AND NAME OF PERSON MAKING CHANGE

Do not extend notes this side of this line

15-0377-1

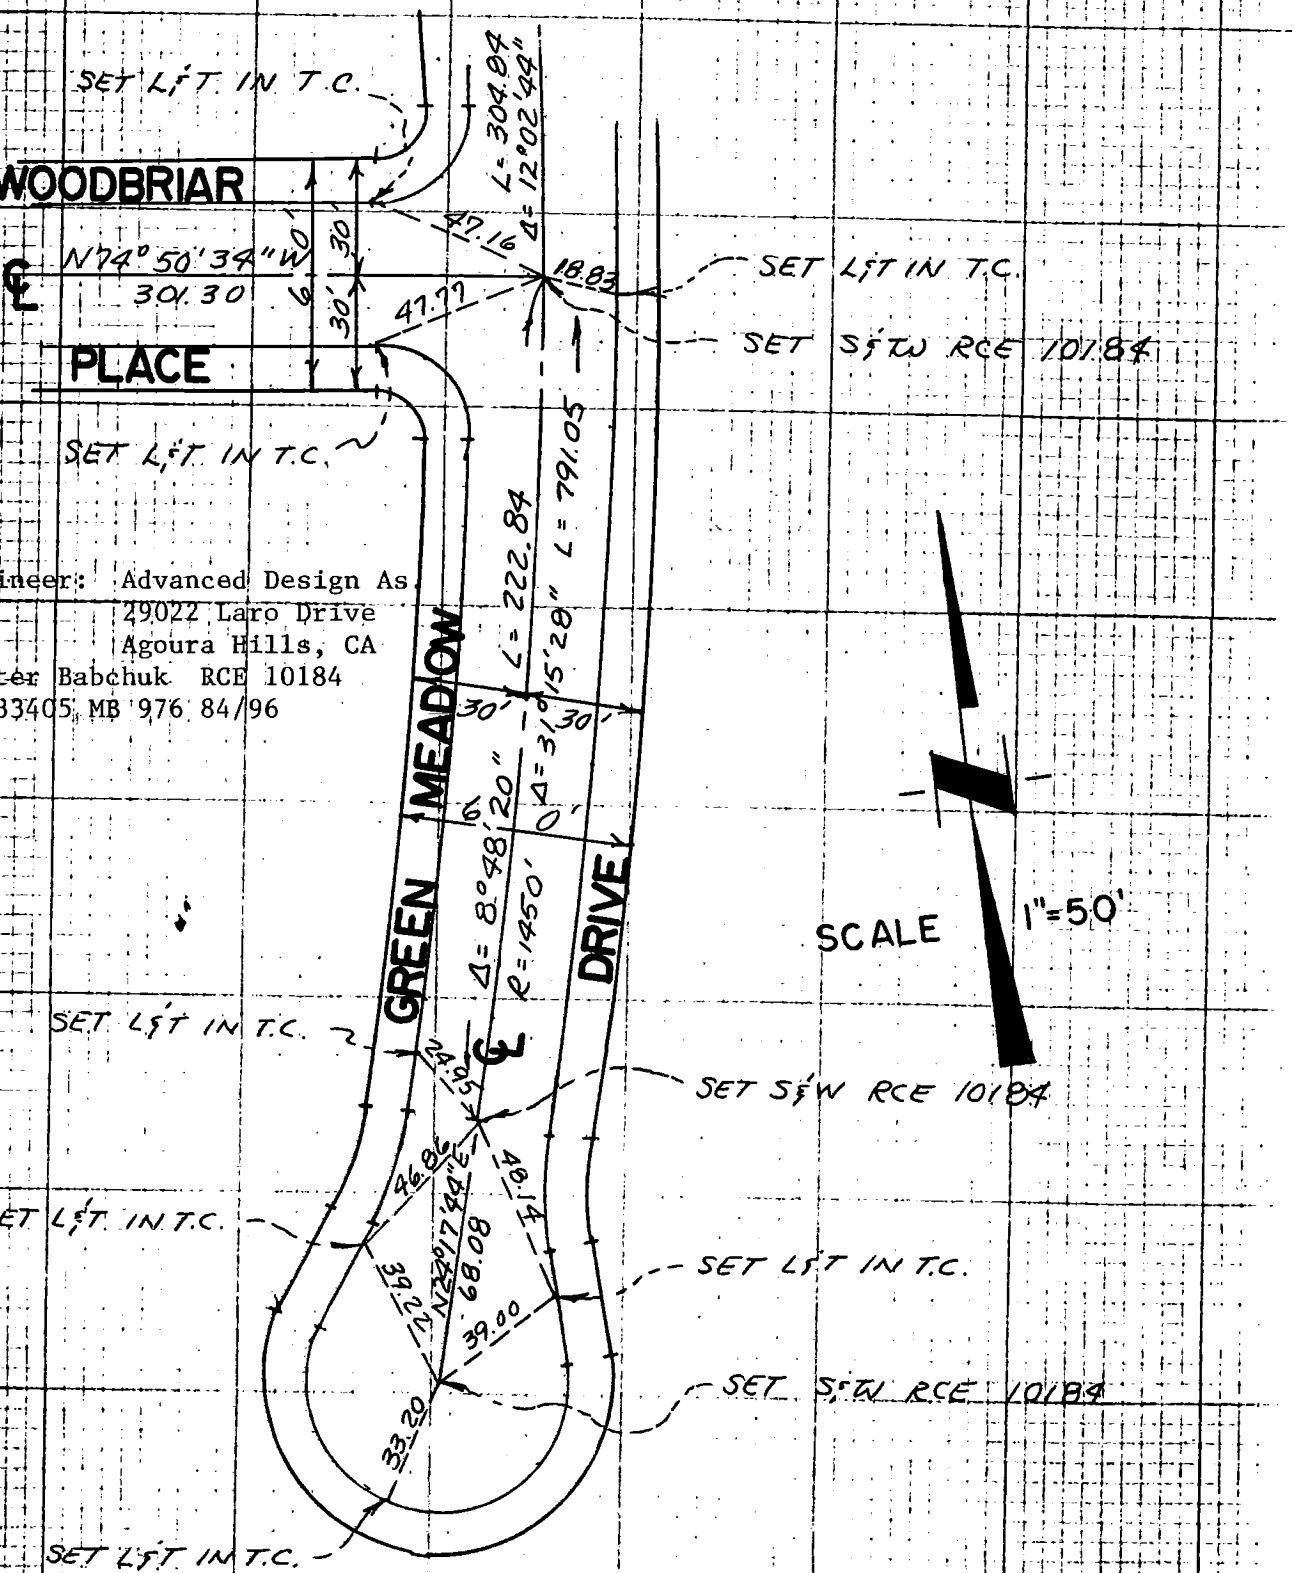

Engineer: Advanced Design As.
29022 Laro Drive
Agoura Hills, CA
Walter Babchuk RCE 10184
TR 33405 MB 976 84/96

SCALE 1"=50'

F3095-4/73

41

Notes Ck'd by	Survey of
Map No.	JN Tape Std °F
Office Work	Surveyed by
Checked	Notes Date
Date	Indexed

F.B. PG.

CO ENG FB 3673-41

ON THIS SHEET MUST BE MADE OR CIRCLED IN RED INK WITH DATE AND NAME OF PERSON MAKING CHANGE.
Do not extend notes this side of this line

154-03 7, 8-1

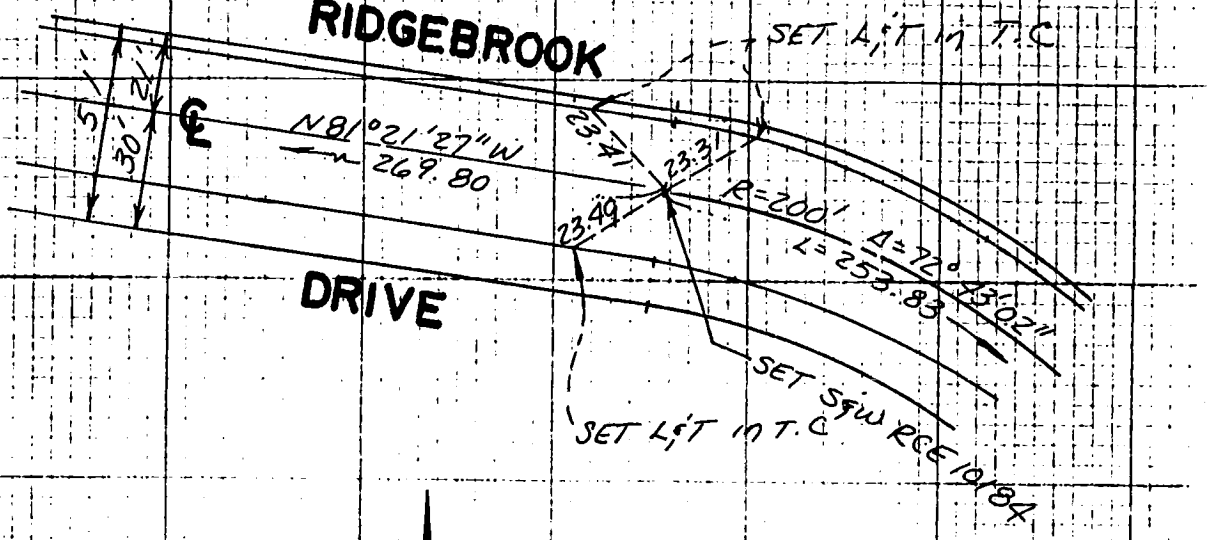

SCALE 1"=50'

Engineer: Advanced Design Assoc.
29022 Laro Drive
Agoura Hills, CA 91301
Walter Babchuk RCE 10184
TR 33405 MB 976 84/96

3095-4/73

42

Notes Ck'd by		Survey of	F.B. PG.
Map No.		JN Tape Std °F	CO ENG FB 3673-42
Office Work		Surveyed by	
Checked		Notes Date	
Date		Indexed	

ON THIS SHEET MUST BE MADE OR CIRCLED IN RED INK WITH DATE AND NAME OF PERSON MAKING CHANGE
Do not extend notes this side of this line
157-03 7, 8-1

BELMONT COURT

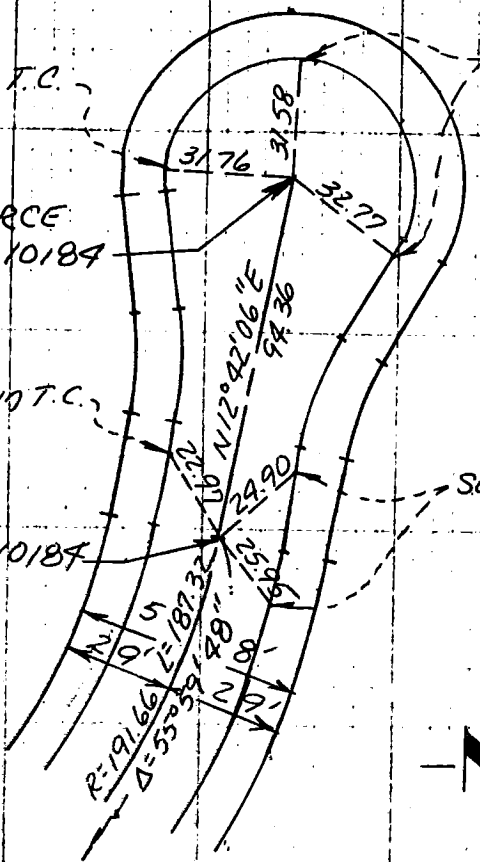

Engineer: Advanced Design Assoc.
29022 Laro Drive
Agoura Hills, CA 91301
Walter Babchuk RCE 10184
TR 33405 MB 976 84/96

SCALE 1"=50'

3095-4/73

43

Notes Ck'd by	Survey of
Map No.	JN Tape Std °F
Office Work	Surveyed by
Checked	Notes Date
Date	Indexed

F.B. PG.

CO ENG FB 3673-43

Engineer: Advanced Design Assoc.
29022 Laro Drive
Agoura Hills, CA 91301
Walter Babchuk RCE 10184
TR 33405 MB 976 84/96

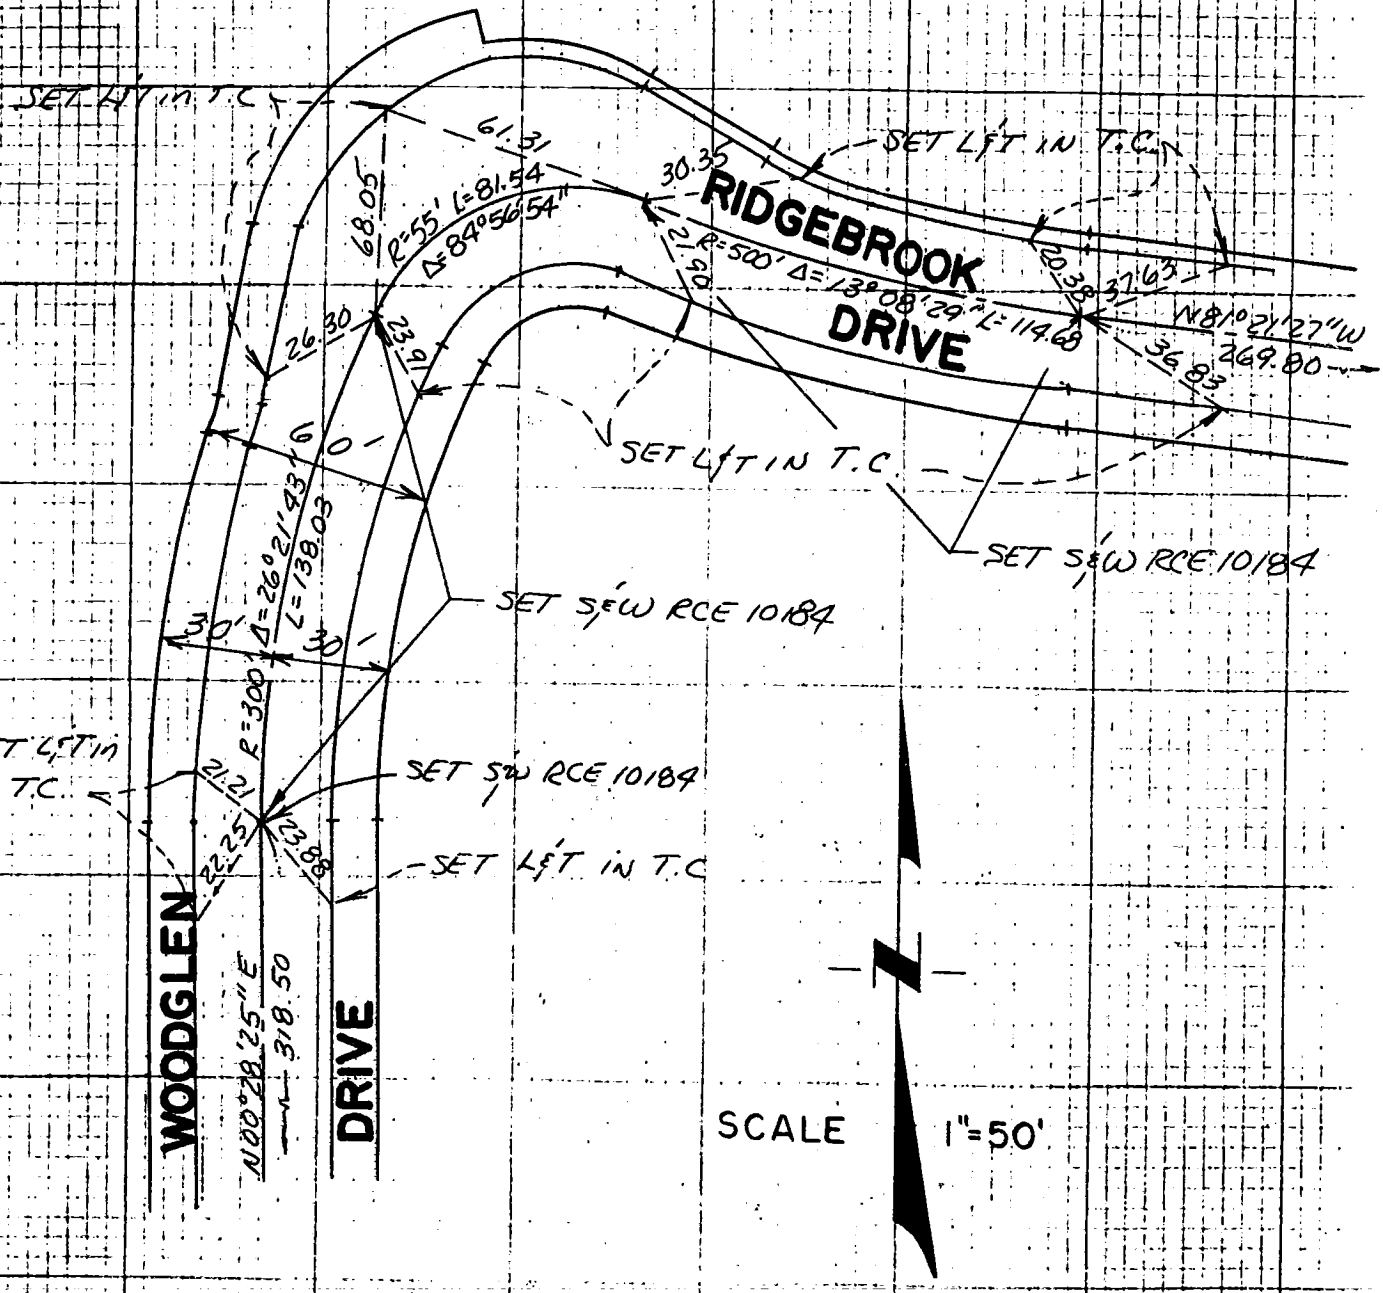

ON THIS SHEET MUST BE MADE OR CIRCLED IN RED INK WITH DATE AND NAME OF PERSON MAKING CHANGE

Do not extend notes this side of this line

159-037, B-1

310 3095-4/73

44

Notes Ck'd by	Survey of
Map No.	JN Tape Std °F
Office Work	Surveyed by
Checked	Notes Date
Date	Indexed

F.B. PG.

CO ENG FB 3673-44

159-037, B-1

ON THIS SHEET MUST BE MADE ON CIRCLED IN RED INK WITH DATE AND NAME OF PERSON MAKING CHANGE

Do not extend notes this side of this line

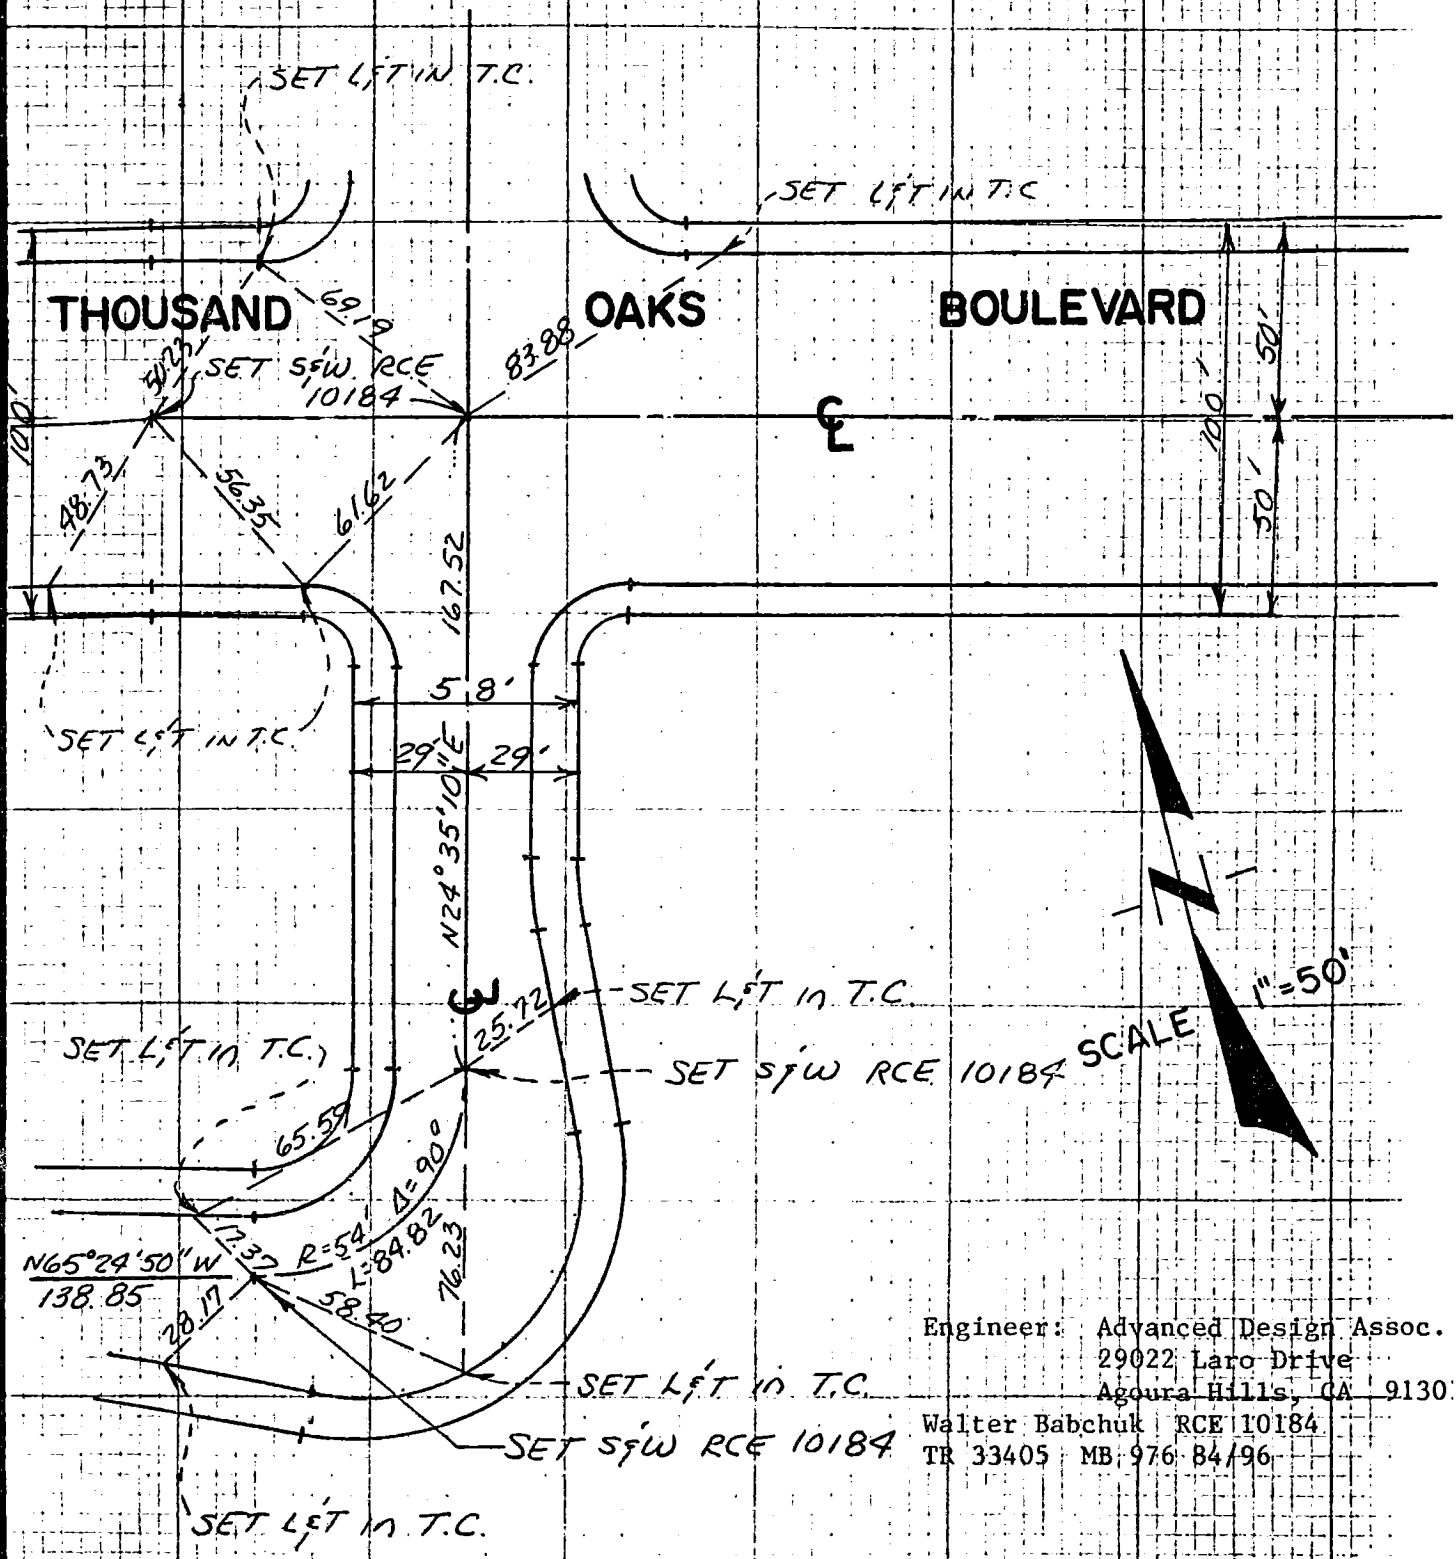

Engineer: Advanced Design Assoc.
29022 Laro Drive
Agoura Hills, CA 9130

Walter Babchuk RCE 10184
TR 33405 MB 976 84/96

E-310
BF3095-4/73

2/5

Notes Ck'd by	Survey of
Map No.	JN Tape Std °F
Office Work	Surveyed by
Checked	Notes Date
Date	Indexed

F.B. PG.

CO ENG FB 3673-45

ON THIS SHEET MUST BE MADE OR CIRCLED IN RED INK WITH DATE AND NAME OF PERSON MAKING CHANGE

Do not extend notes this side of this line

159-037, B-1

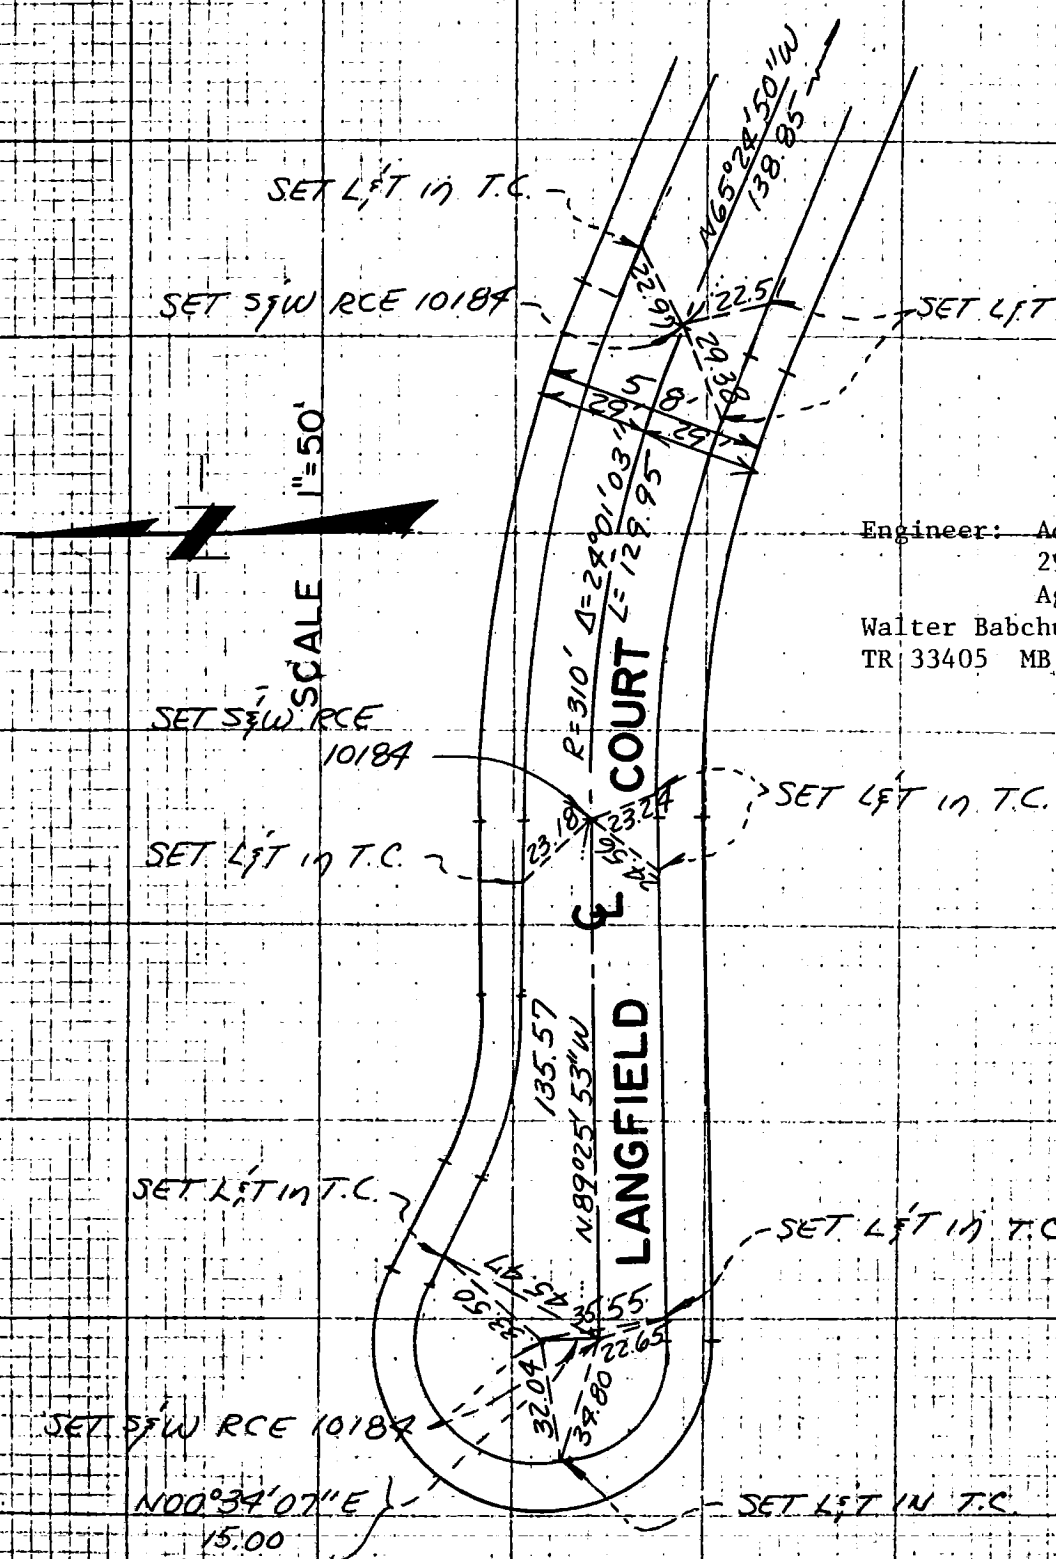

Engineer: Advnaced Design Assoc.
29022 Laro Drive
Agoura Hills, CA 91301
Walter Babchuk RCE 10184
TR 33405 MB 976 84/96

310
F3096-4/73

46

Notes Ck'd by	Survey of
Map No.	JN Tape Std °F
Office Work	Surveyed by
Checked	Notes Date
Date	Indexed

F.B. PG.

CO ENG FB 3673-46

ON THIS SHEET MUST BE MADE OR CIRCLED IN RED INK WITH DATE AND NAME OF PERSON MAKING CHANGE

Do not extend notes this side of this line

159-037, B-1

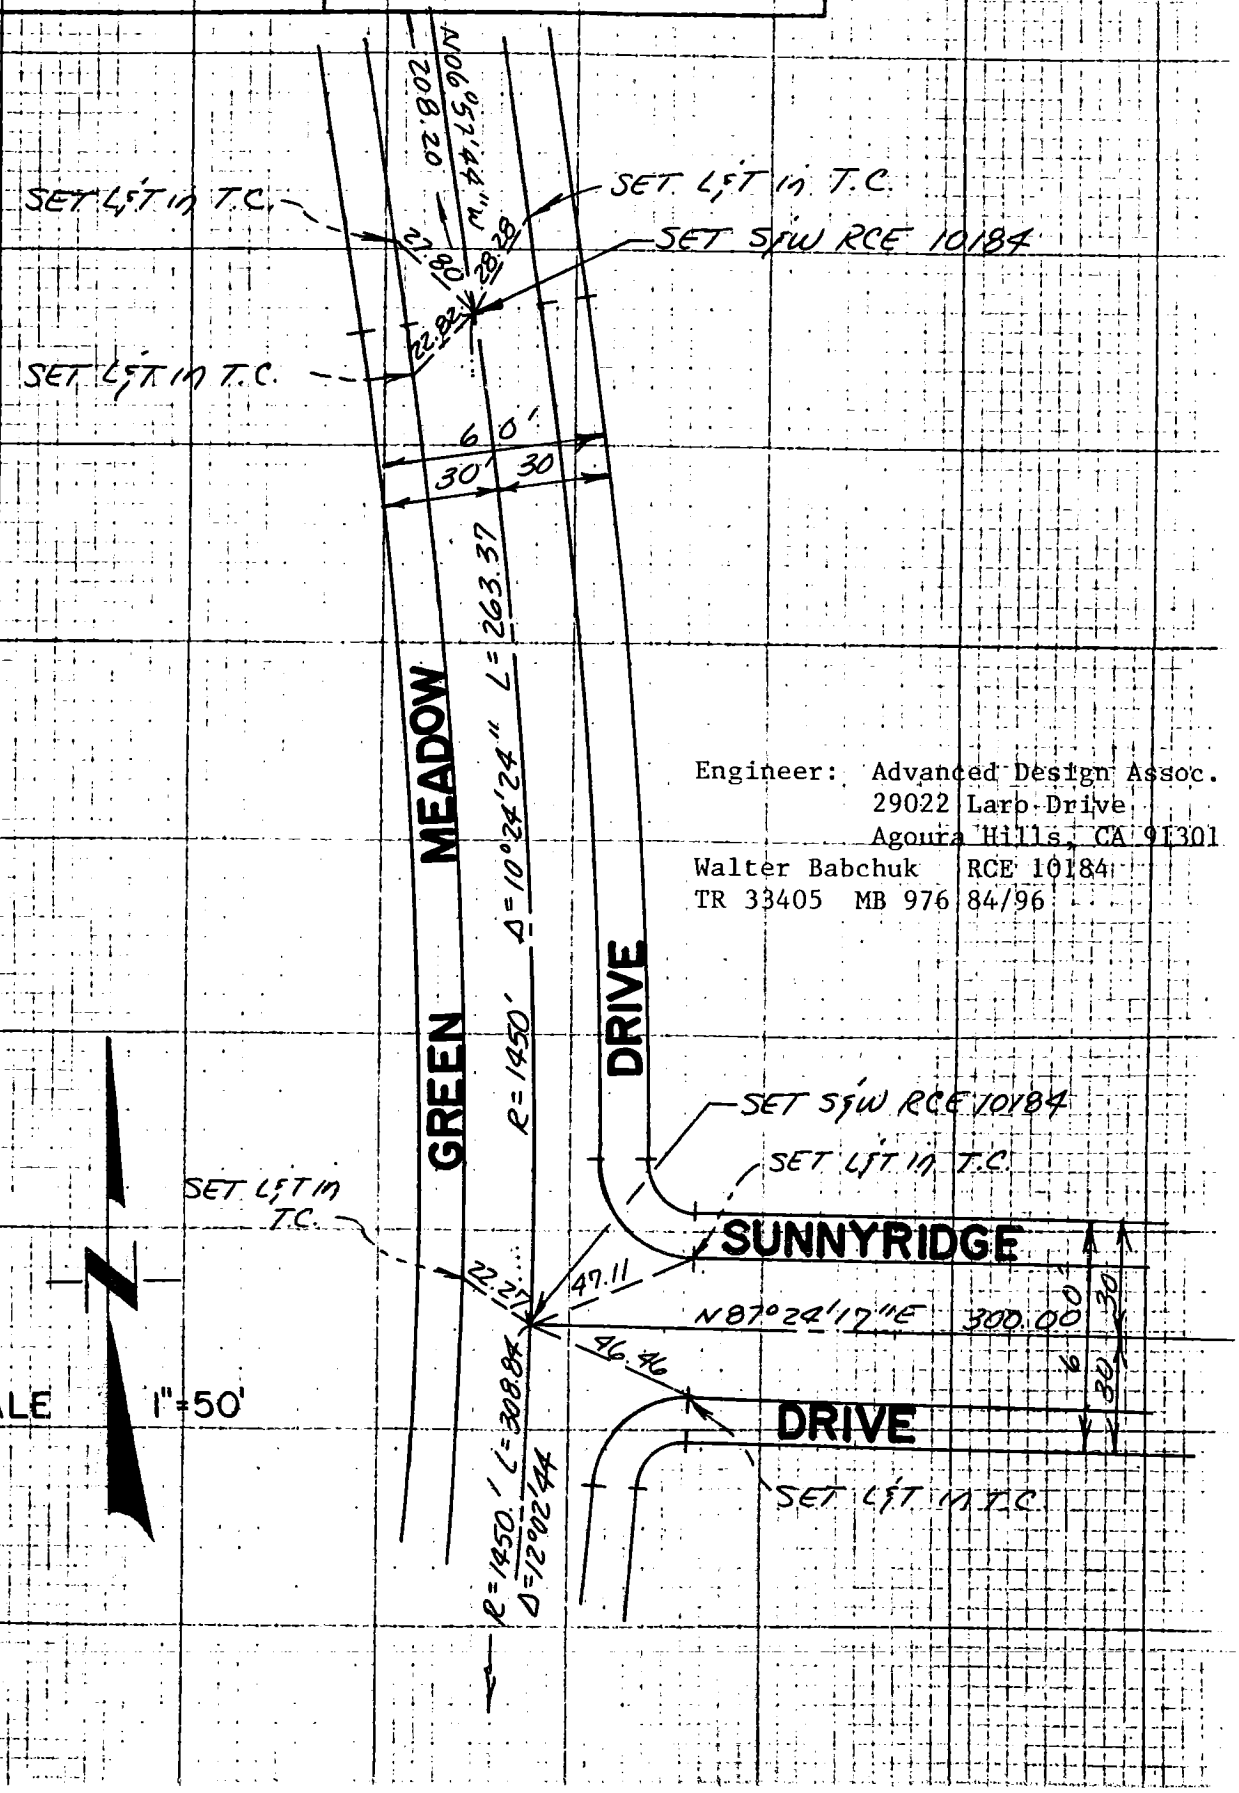

Engineer: Advanced Design Assoc.
29022 Laro Drive
Agoura Hills, CA 91301
Walter Babchuk RCE 10184
TR 33405 MB 976 84/96

E 310
IF 3095-4/73

47

Notes Ck'd by	Survey of
Map No.	JN Tape Std °F
Office Work	Surveyed by
Checked	Notes Date
Date	Indexed

F.B. PG.

CO ENG FB 3673-47

Engineer: Advanced Design Assoc.
29022 Lard Drive
Agoura Hills, CA 91301
Walter Babchuk RCE 10184
TR 33405 MB 976 84/96

ON THIS SHEET MUST BE MADE OR CIRCLED IN RED INK WITH DATE AND NAME OF PERSON MAKING CHANGE
Do not extend notes this side of this line

137-037-01

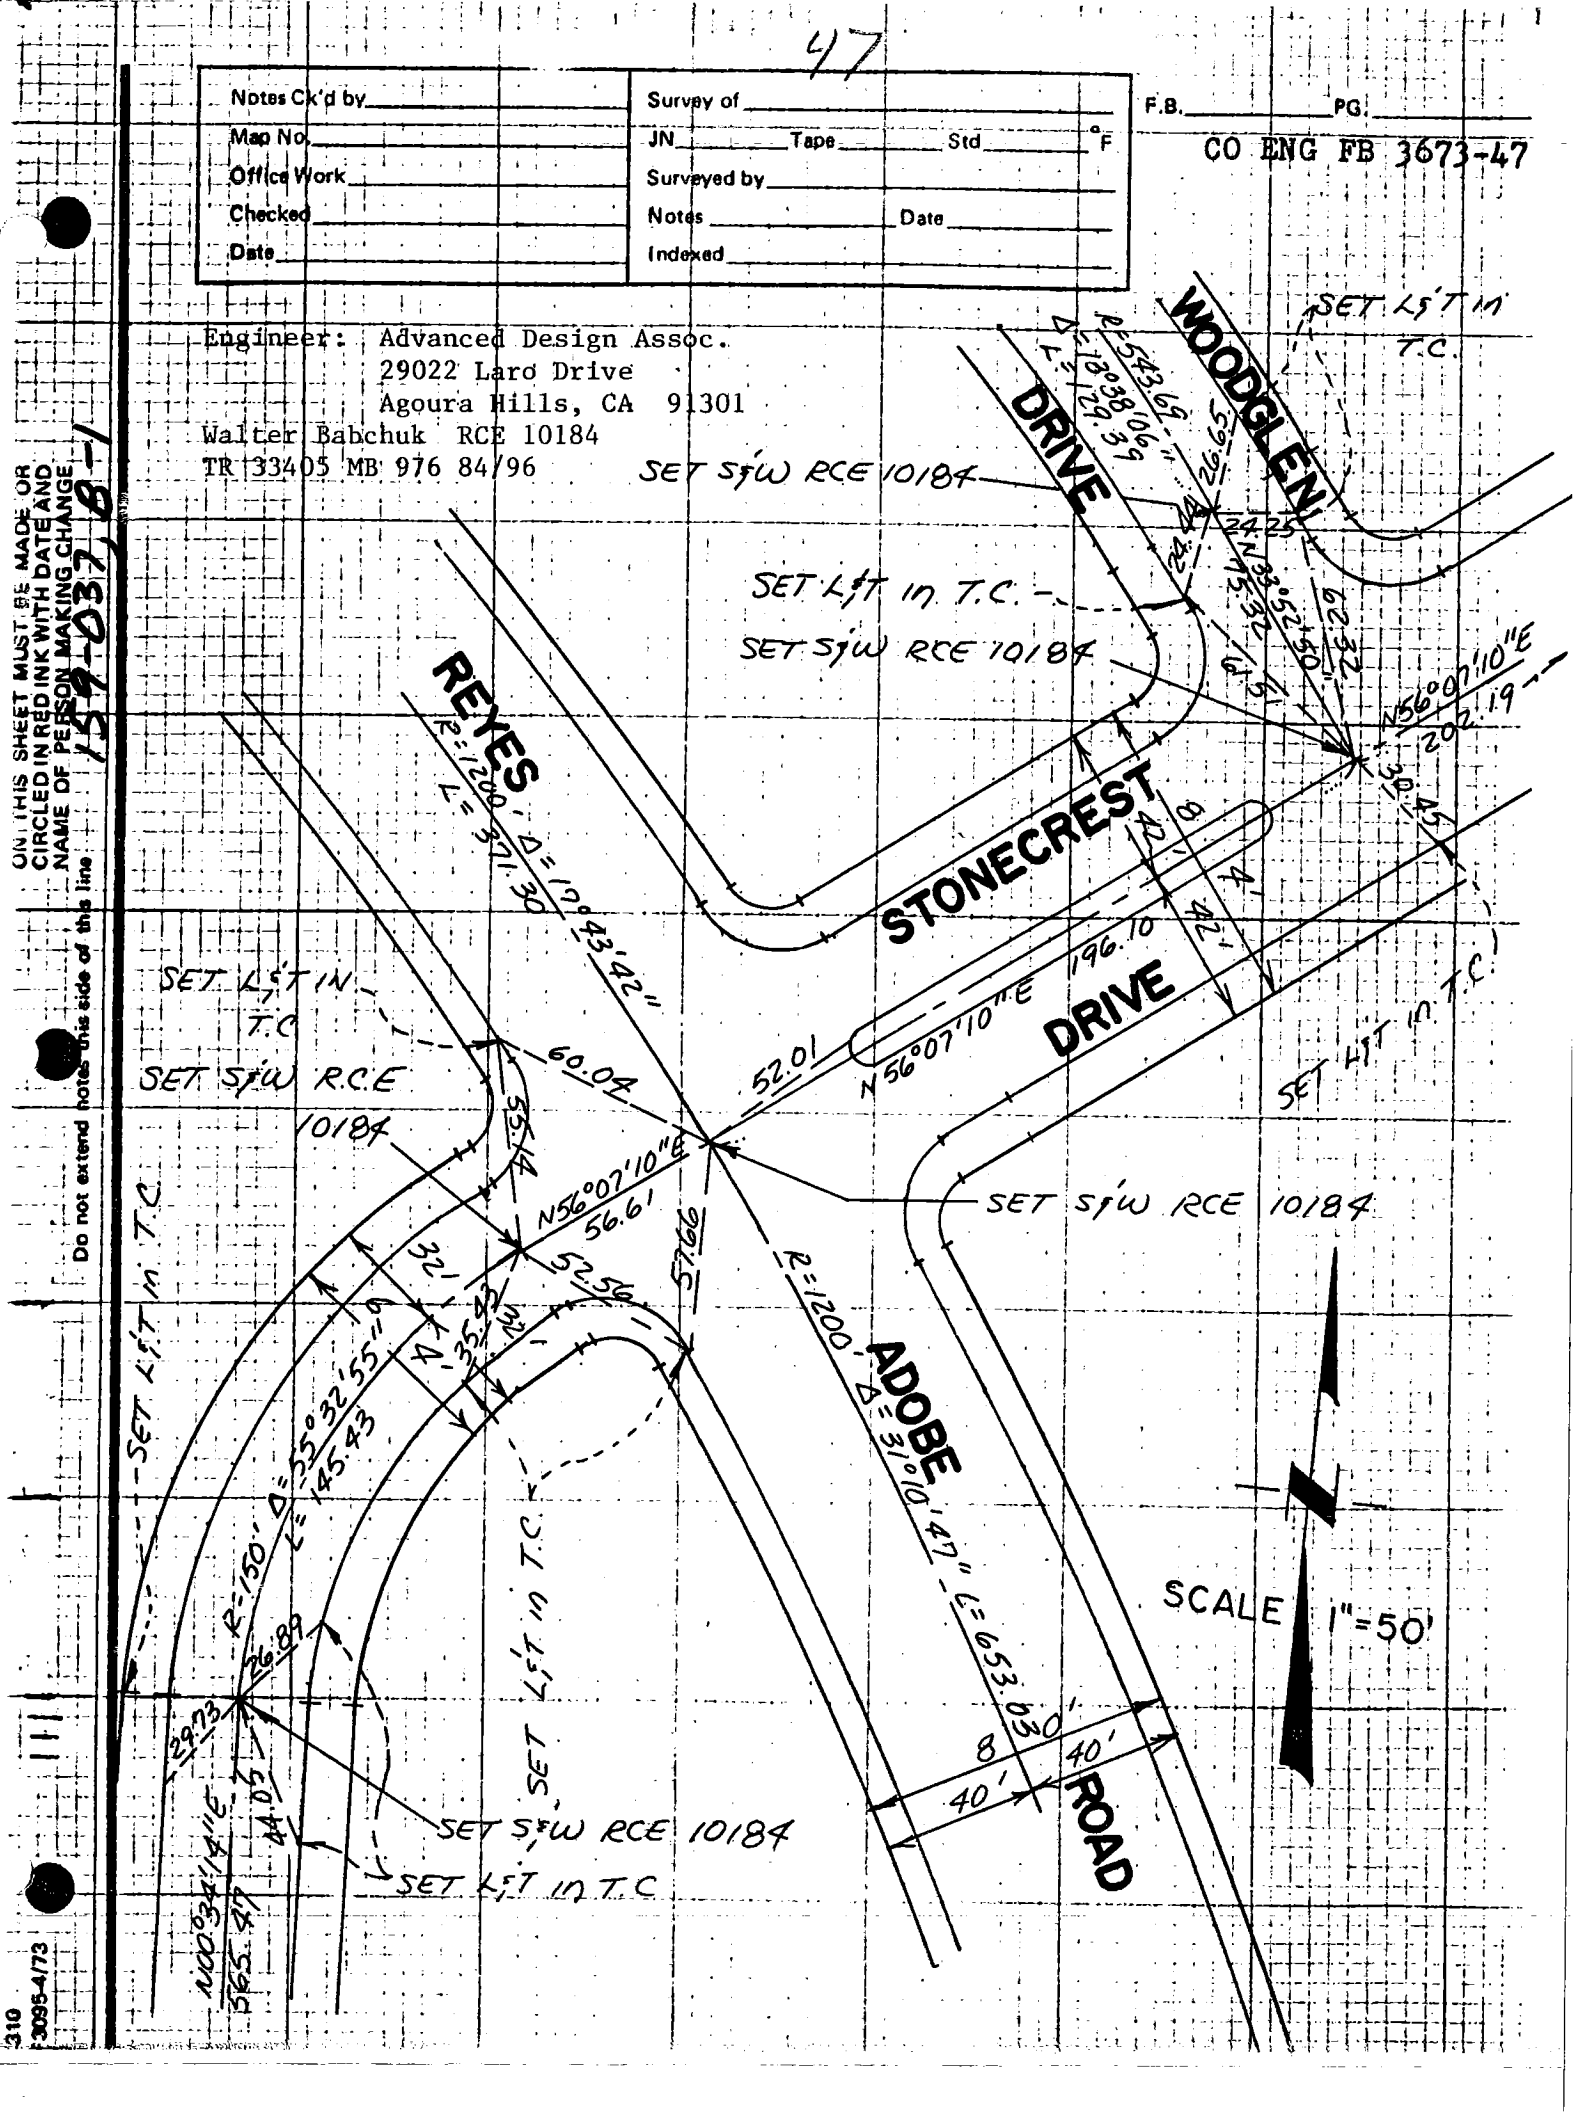

48

Notes Ck'd by	Survey of
Map No.	JN Tape Std °F
Office Work	Surveyed by
Checked	Notes Date
Date	Indexed

F.B. PG.

CO ENG FB 3673-48

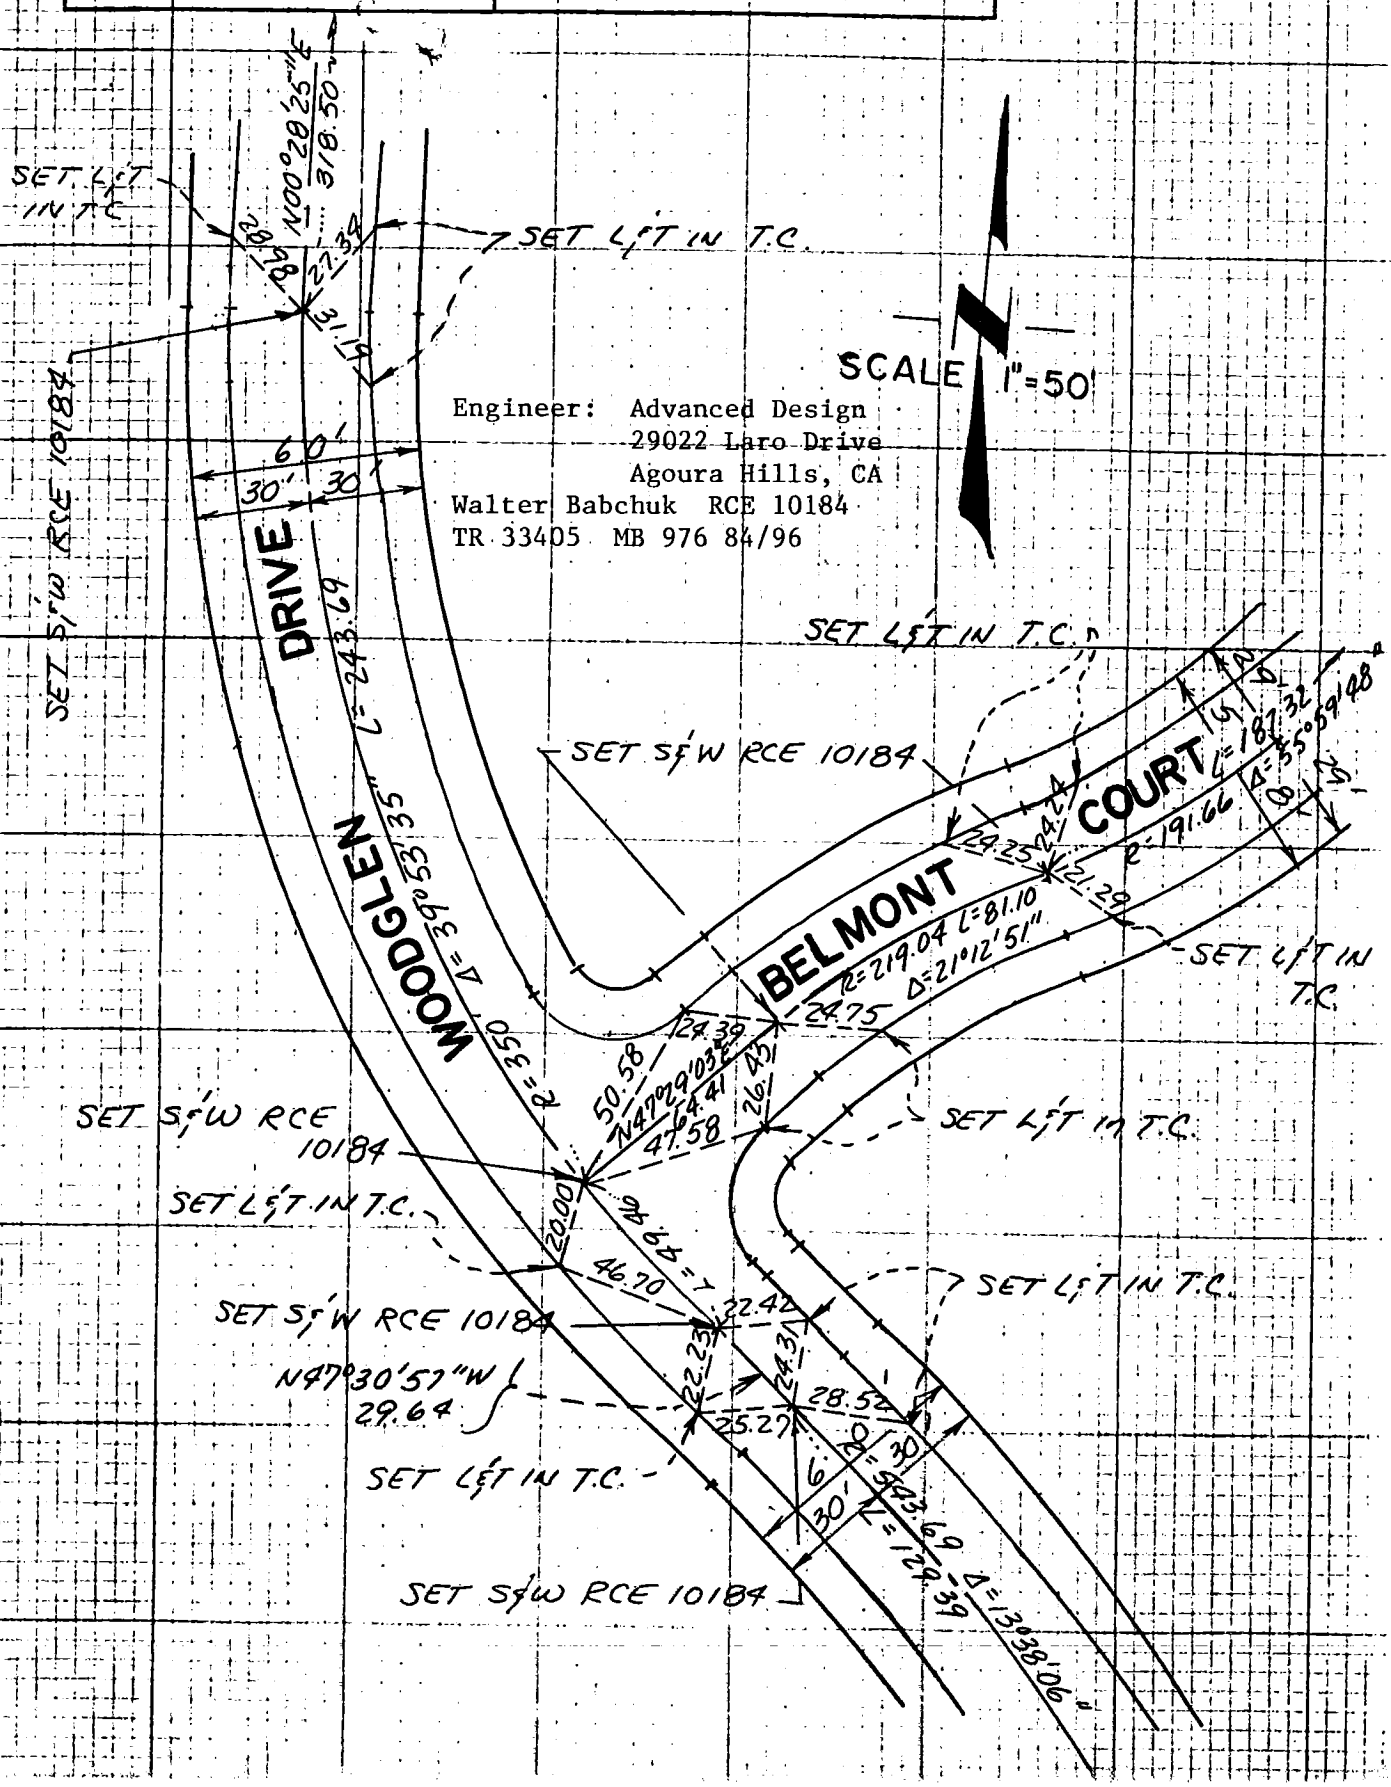

Engineer: Advanced Design
29022 Laro Drive
Agoura Hills, CA
Walter Babchuk RCE 10184
TR 33405 MB 976 84/96

ON THIS SHEET MUST BE MADE OR CIRCLED IN RED INK WITH DATE AND NAME OF PERSON MAKING CHANGE

Do not extend notes this side of this line

159-037, B-1

310 F3095-4/73

Notes Ck'd by	Survey of 49
Map No.	JN Tape Std °F
Office Work	Surveyed by
Checked	Notes Date
Date	Indexed

F.B. PG.

CO ENG FB 3673-49

ON THIS SHEET MUST BE MADE OR CIRCLED IN RED INK WITH DATE AND NAME OF PERSON MAKING CHANGE

Do not extend notes this side of this line

157-037, 8-1

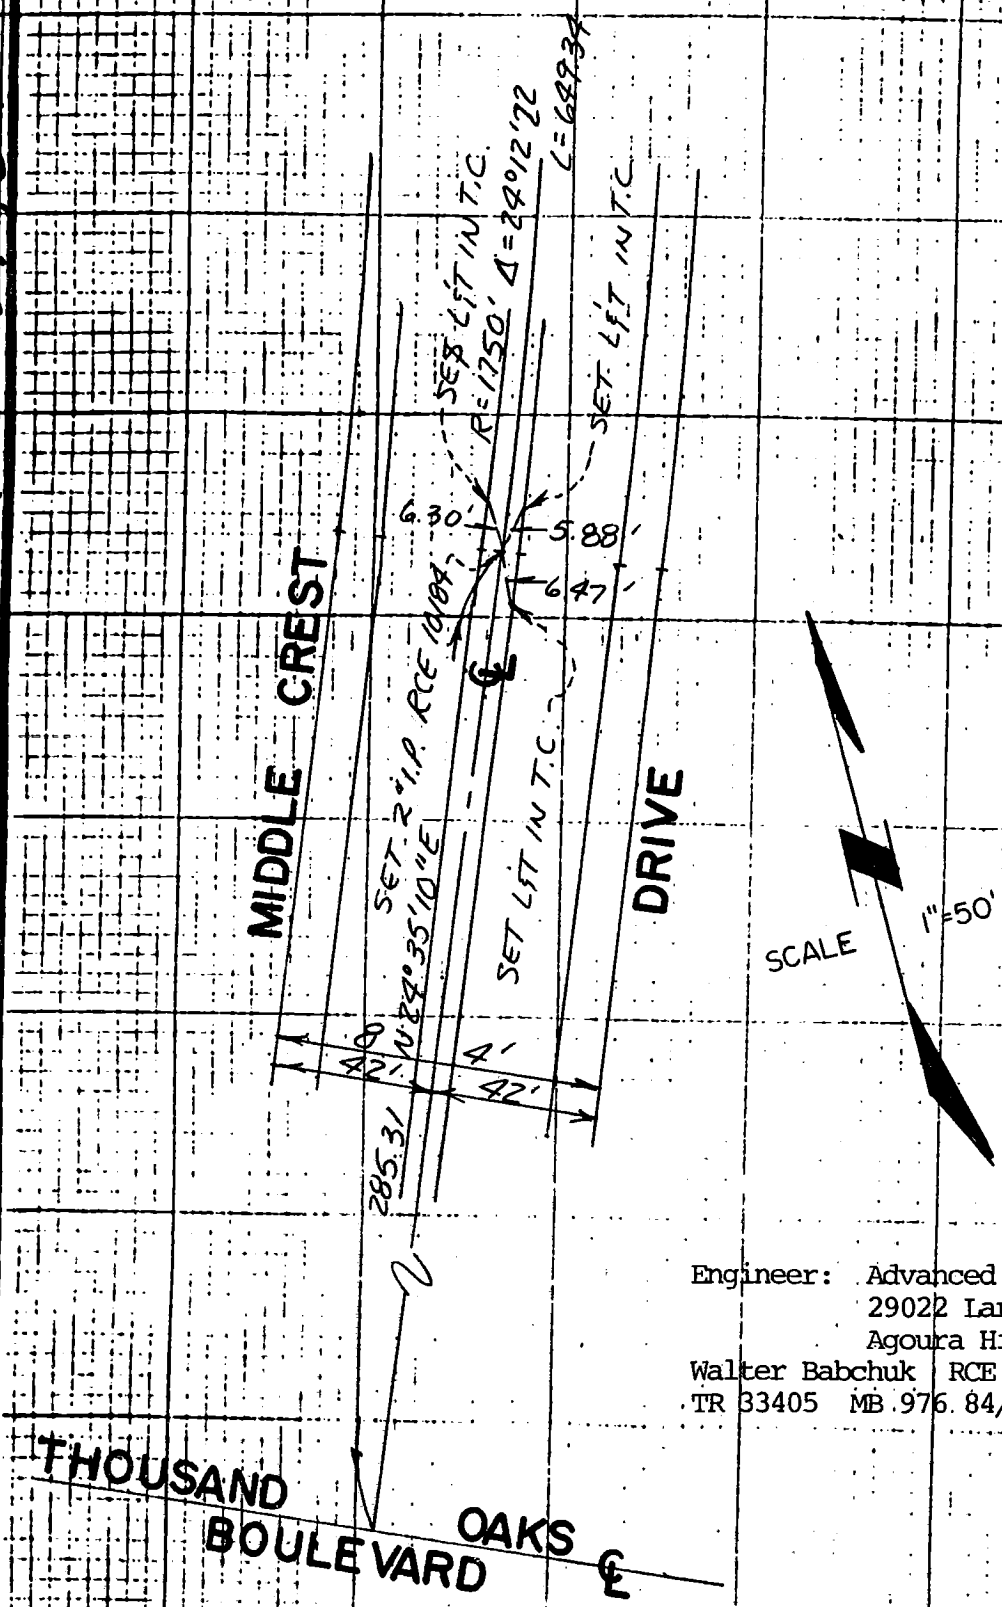

Engineer: Advanced Design Assoc.
29022 Laro Drive
Agoura Hills, CA 91301
Walter Babchuk RCE 10184
TR 33405 MB 976 84/96

3005-4/73

50

Map No. _____
Office Work _____
Checked _____
Date _____

JN _____ Tape _____ Std _____ °F
Surveyed by _____
Notes _____ Date _____
Indexed _____

CO ENG FB 3673-50

ON THIS SHEET MUST BE MADE OR CIRCLED IN RED INK WITH DATE AND NAME OF PERSON MAKING CHANGE

Do not record below this line

SCALE- 1"=40'

43.00' L&T IN T.C.

42.66'

SET L&T IN T.C.

THOUSAND OAKS BOULEVARD

2" I.P. TO BE SET

N89°25'45"W

167.00'

SET 2" I.P. IN LIEU OF L&T PLS 10184

8.57' 9.90'

10.32'

1.75' 1.91'

L&T IN T.C.

SET L&T IN T.C.

6.96'

SET L&T IN T.C.

100'

50'

50'

HURFORD COURT

Engineer: Advanced Design Assoc.
29022 Laro Drive
Agoura Hills, CA 91301

Walter Babchuk RCE 10184
TR 33405 MB 976 84/96

3005-4/73

76S911– PS 12-78

PROJECT ROSCOE DRAIN

SURVEY BY JOSLIN DATE 6-16-82

REVIEWED BY DATE

INDEX FC 3352 83

R7R 3A

LOS ANGELES COUNTY FLOOD CONTROL DISTRICT

CO ENG FB 3673-51

W.S. 53, C-6

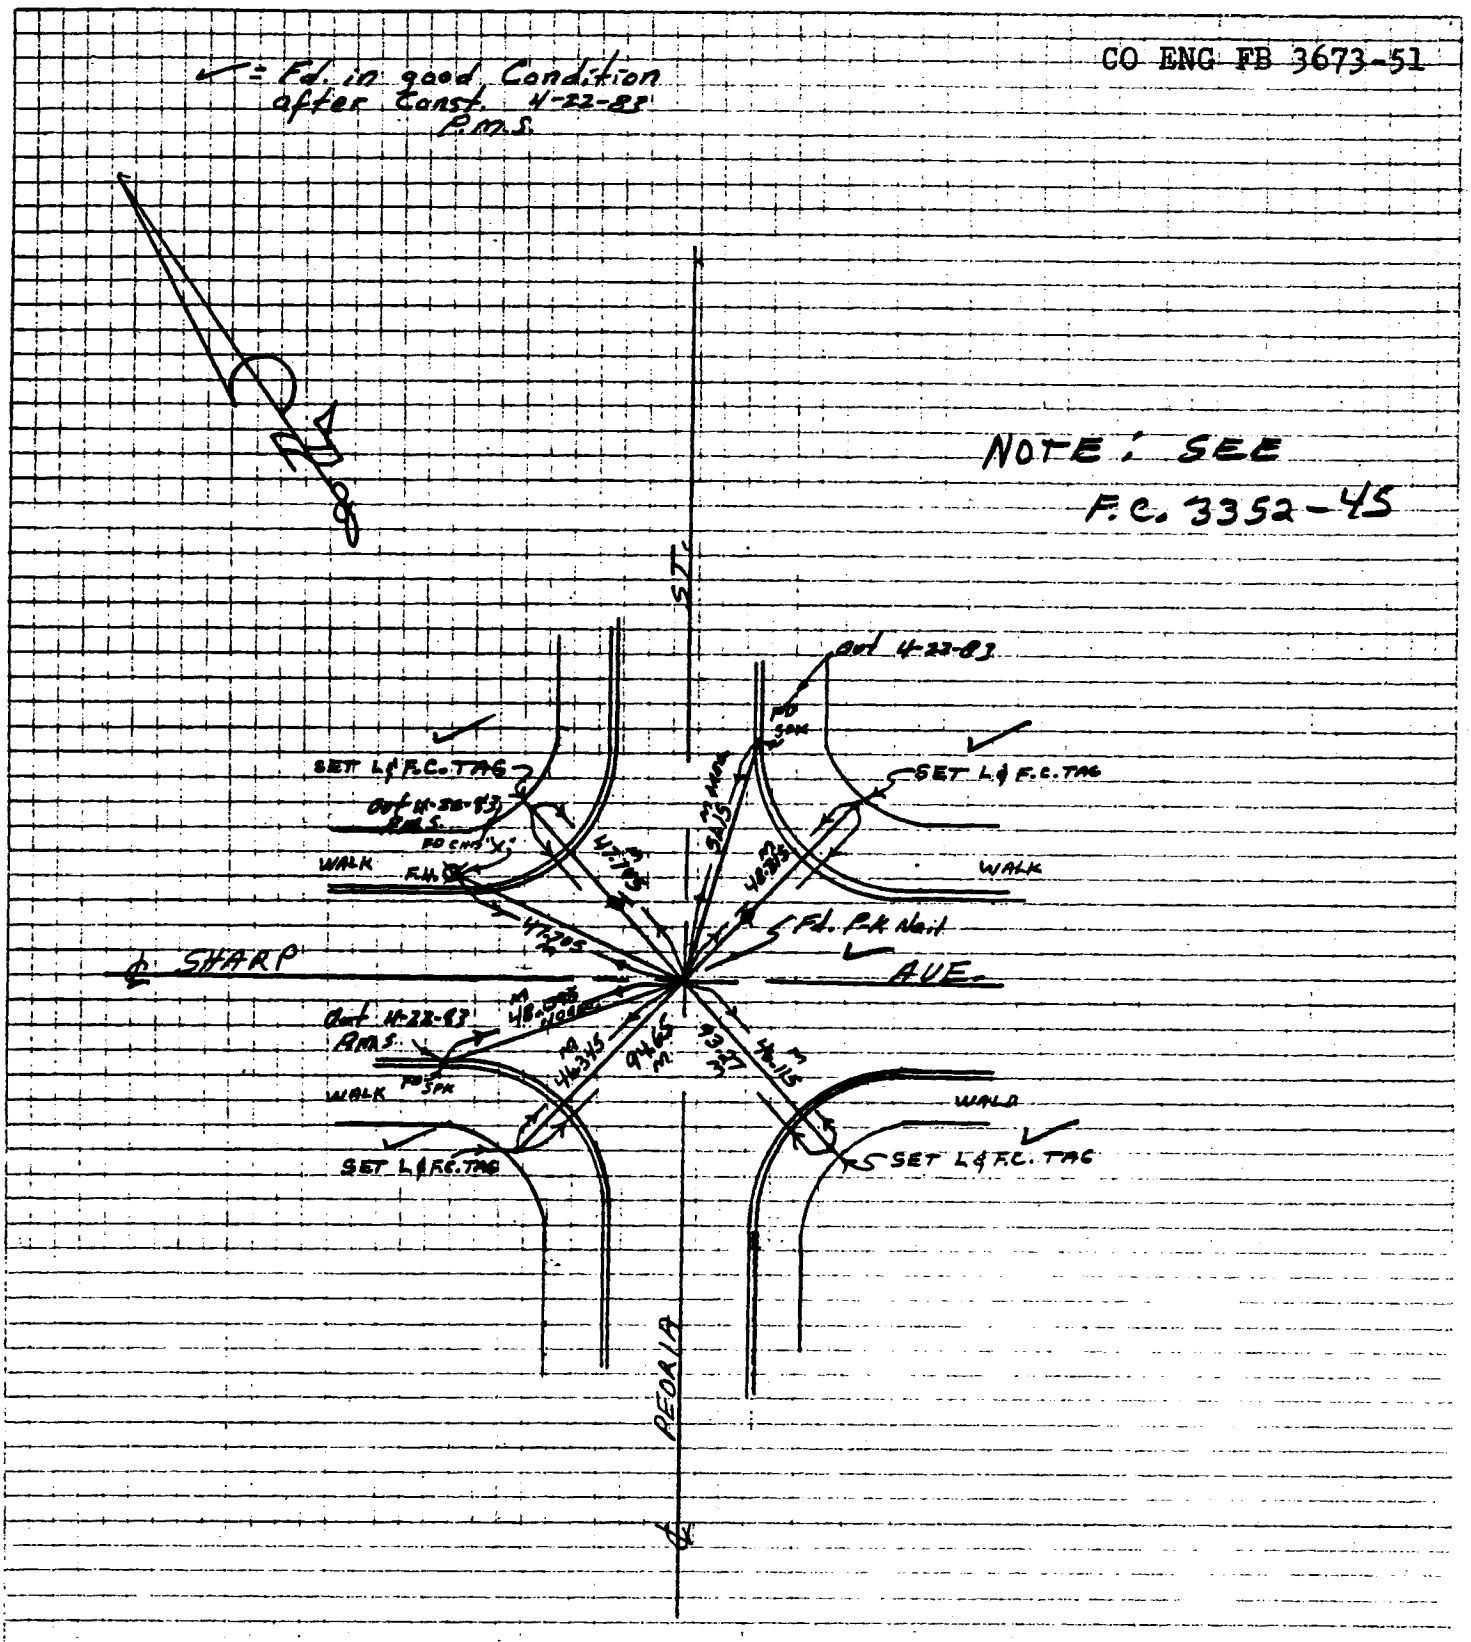

76S911– Cdb 4-75

PROJECT ROSCOE DRAIN

SURVEY BY JOSLIN DATE 6-17-82

REVIEWED BY _____ DATE _____

52

INDEX FC 3352 85

R&R-5A

LOS ANGELES COUNTY FLOOD CONTROL DISTRICT

CO ENG FB 3673-52

W.S. 53, C-6

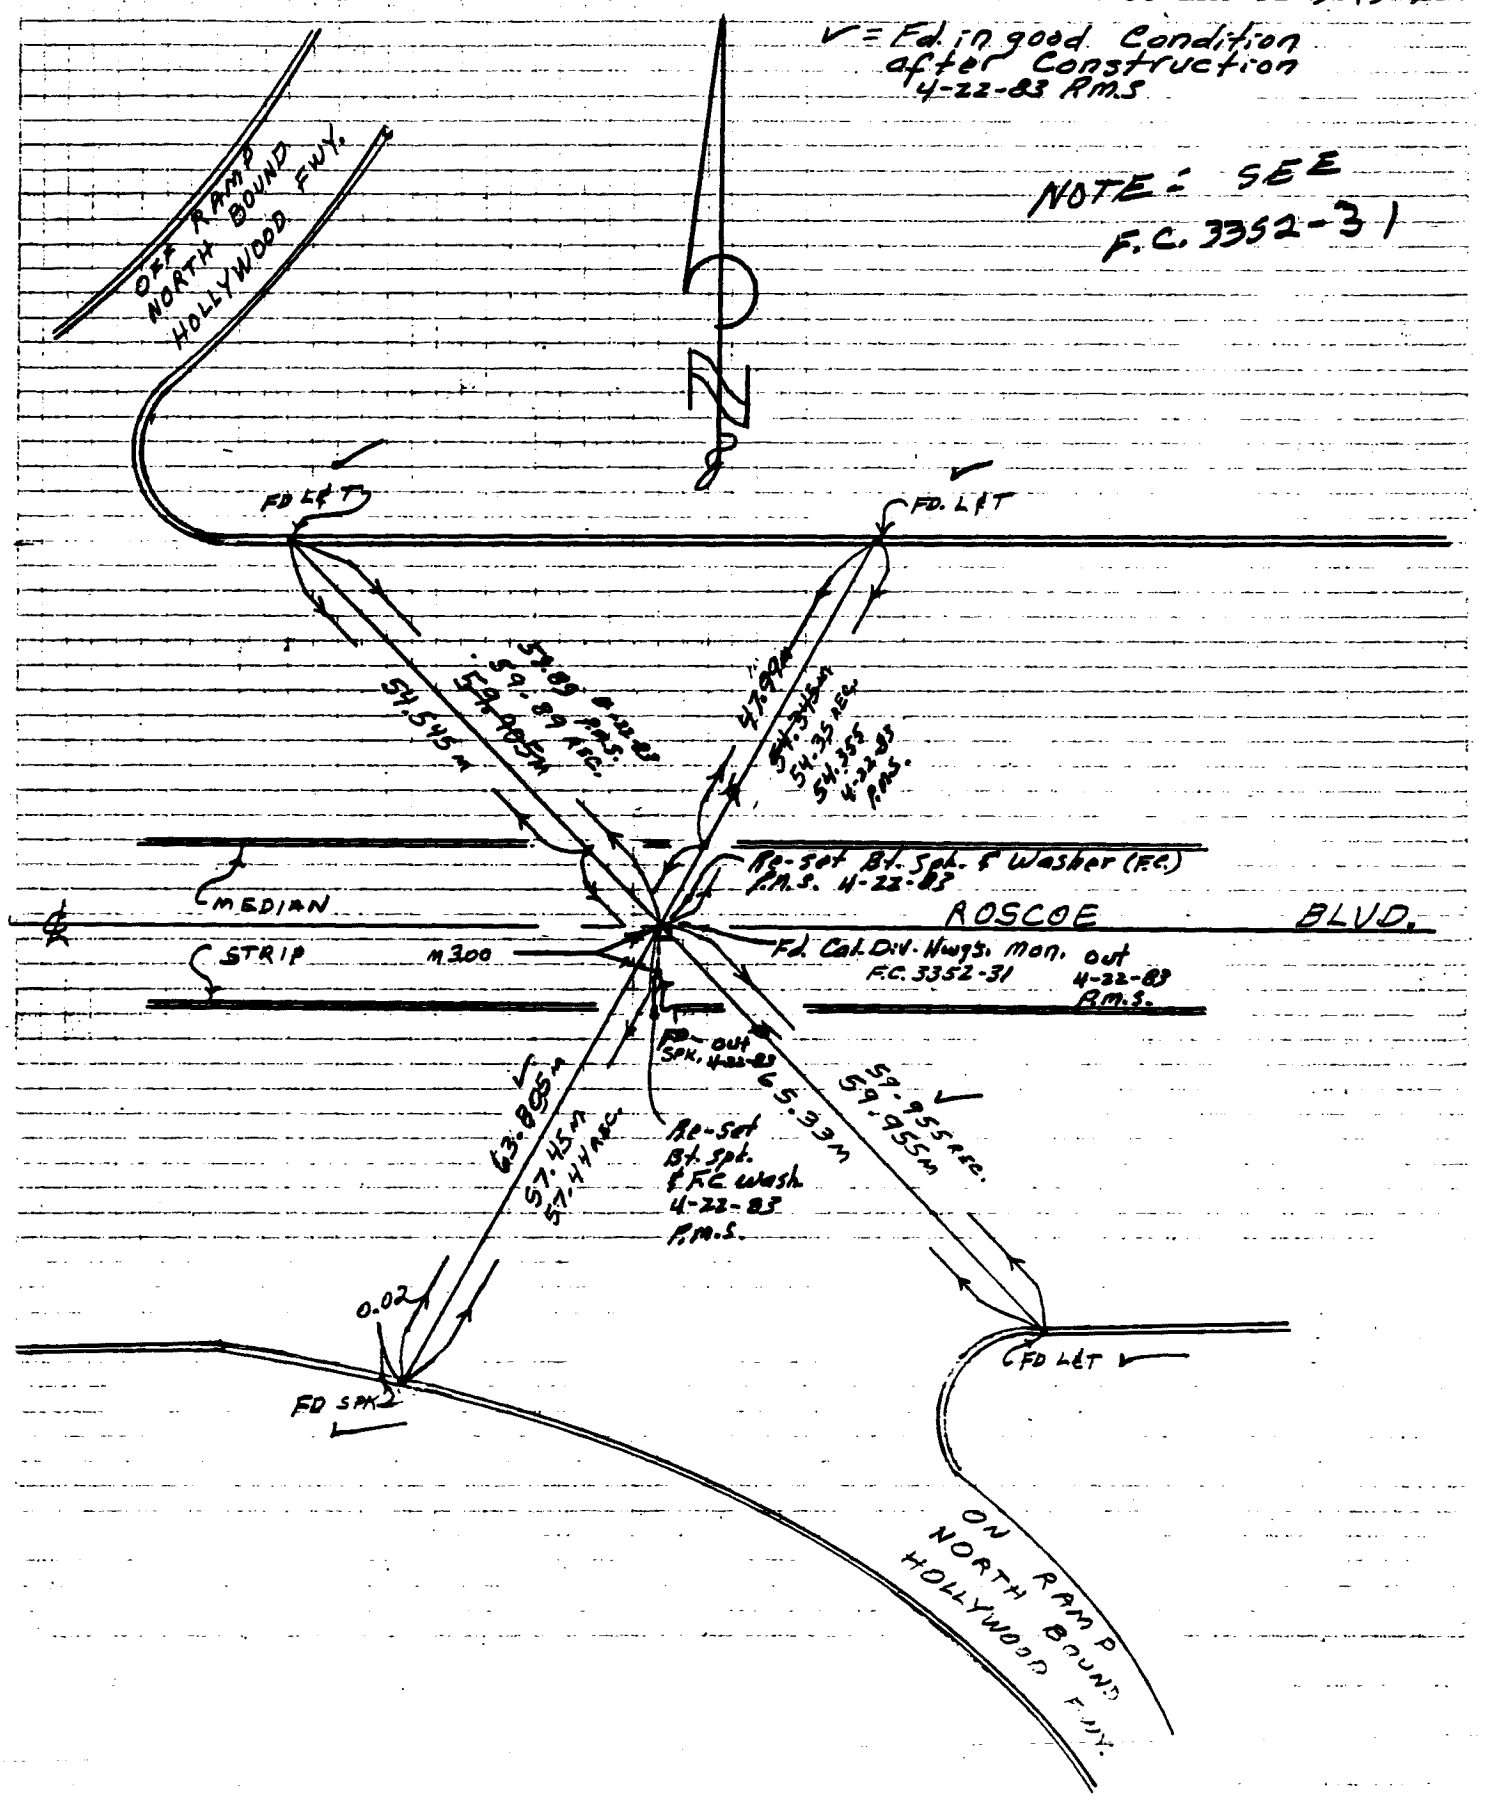

76S911– PS 12-78

PROJECT ROSCOE DRAIN

SURVEY BY JRS DATE 6-17-82

REVIEWED BY _____ DATE _____

INDEX FC 3352 87

R. & R B-3

LOS ANGELES COUNTY FLOOD CONTROL DISTRICT

W.S. 53, C-6

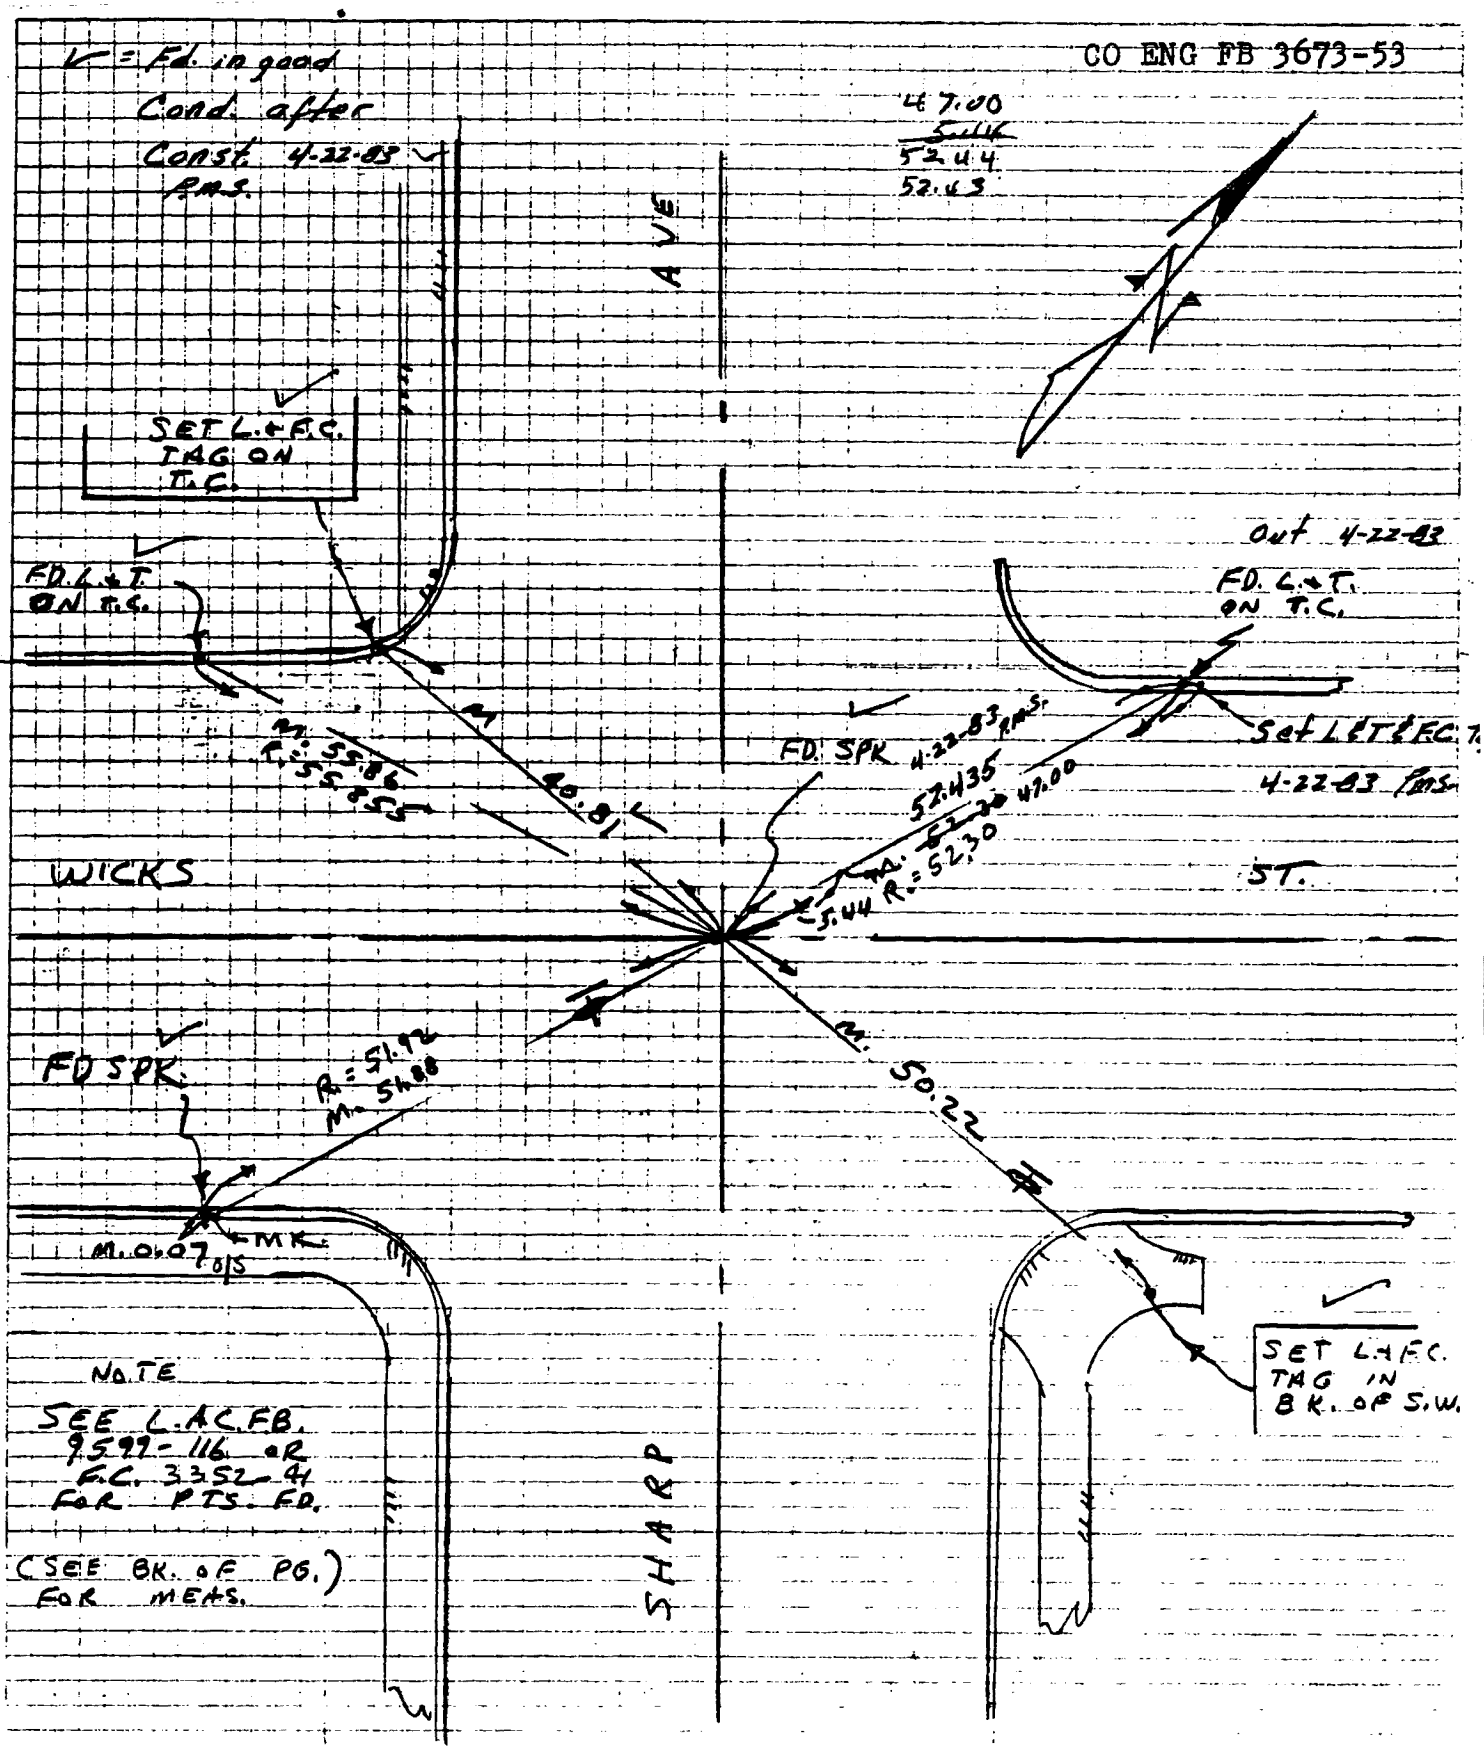

76S911- PS 12-78

PROJECT ROSCOE DRAIN

SURVEY BY JRS DATE 6-17-82

REVIEWED BY _____ DATE _____

54

INDEX FC 3352 89

R+R : B-5

LOS ANGELES COUNTY FLOOD CONTROL DISTRICT

W.S. 53, C-6

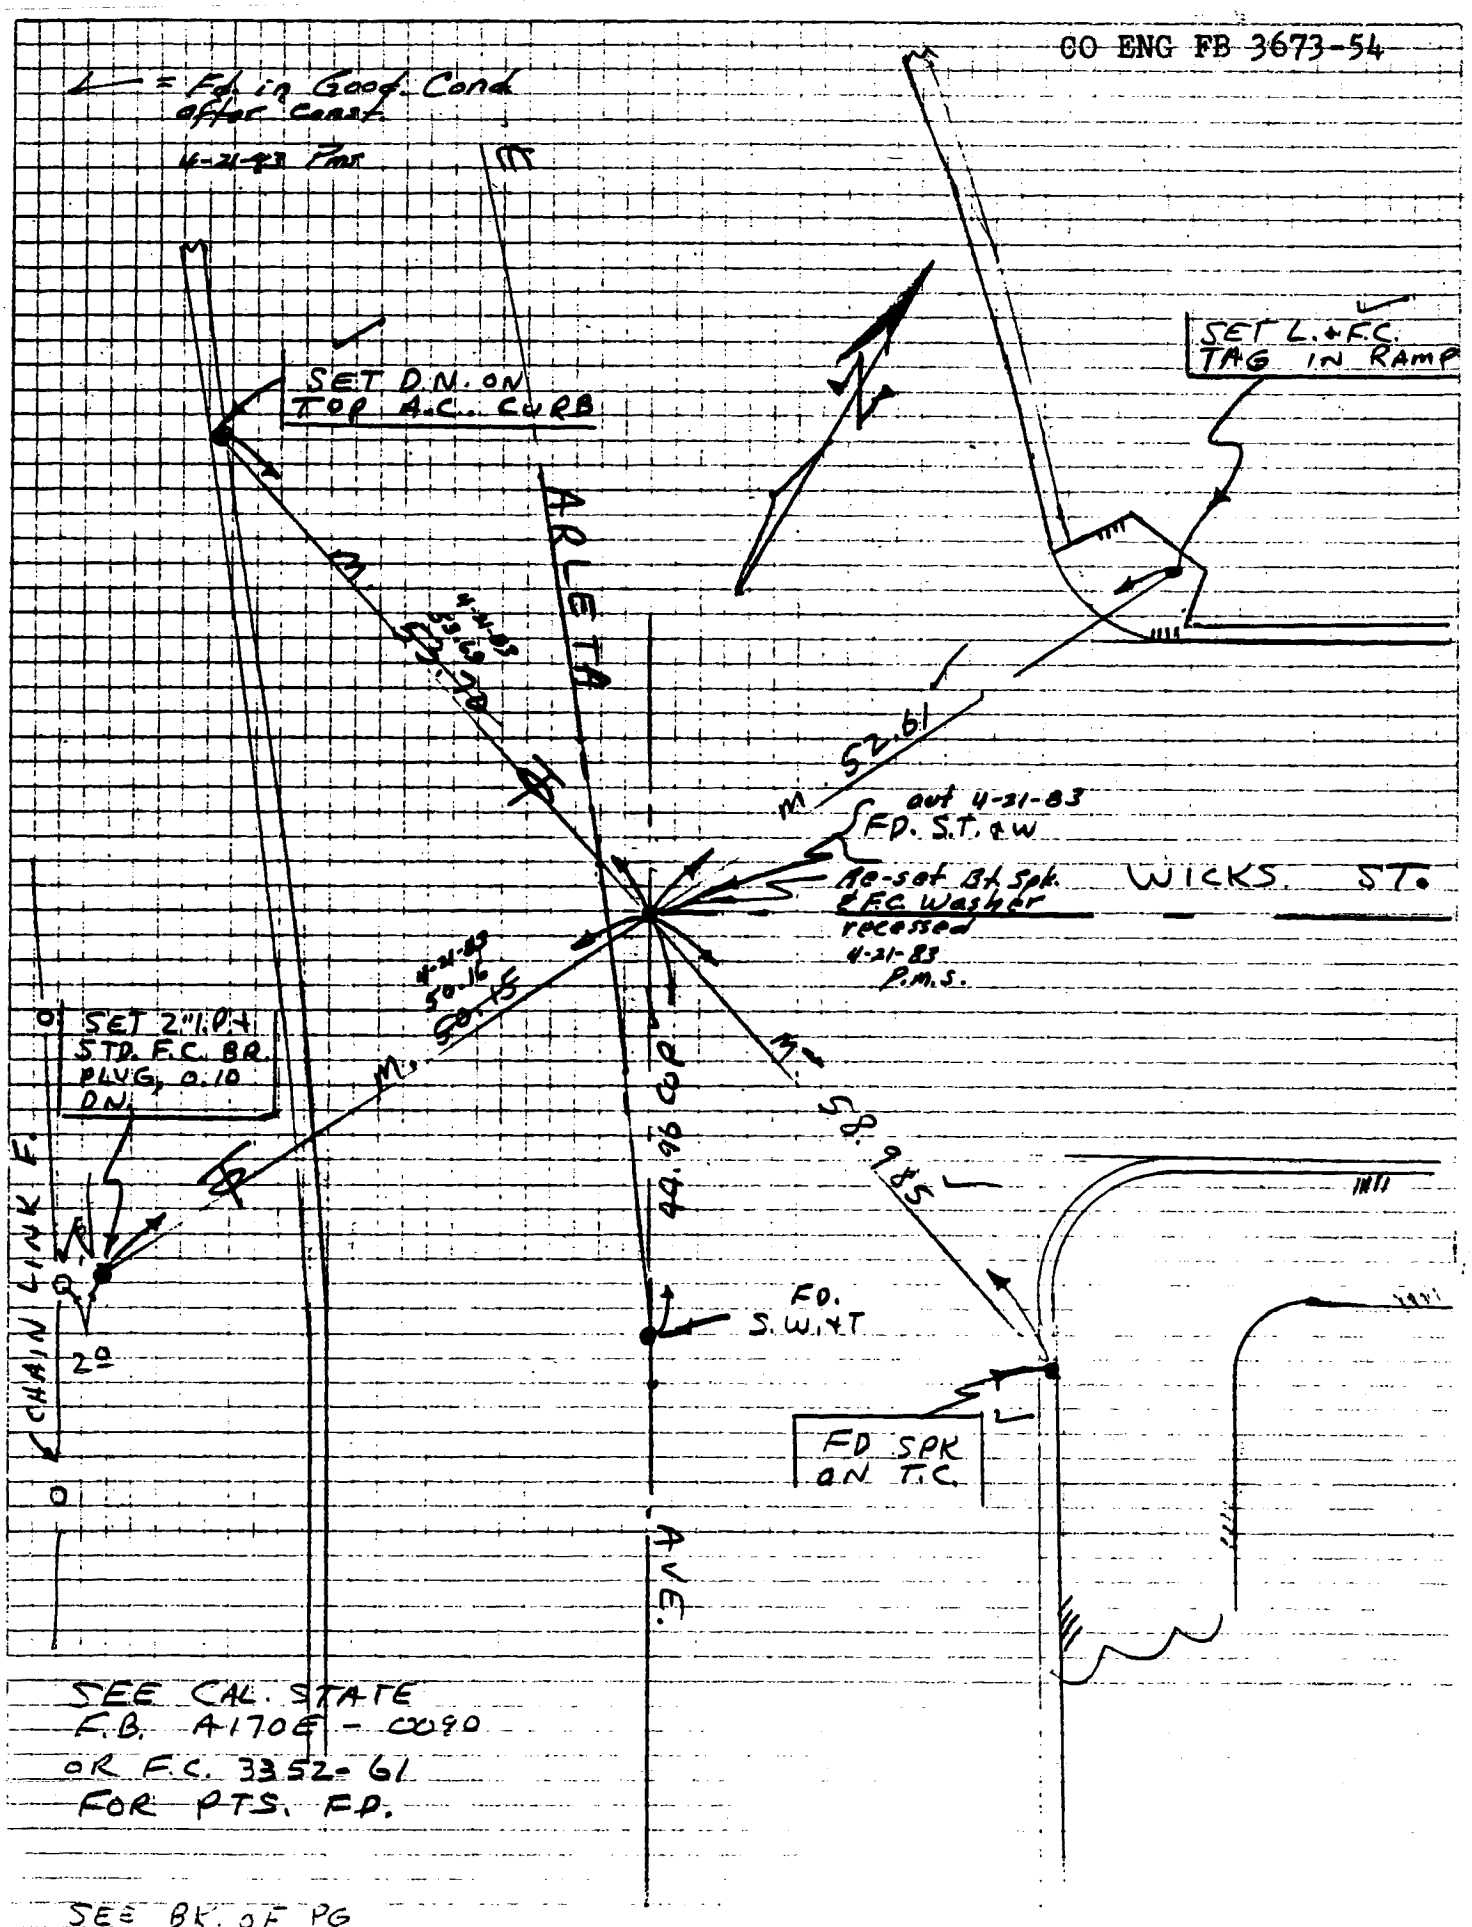

SEE CAL. STATE F.B. A170E - 0080 OR F.C. 3352-61 FOR PTS. FD.

SEE BK. OF PG FOR MEAS.

76S911- PS 12-78

PROJECT ROSCOE DRAIN

SURVEY BY JOSLIN DATE 6-17-82

REVIEWED BY _____ DATE _____

INDEX FC 3352 93

RIR -3C

LOS ANGELES COUNTY FLOOD CONTROL DISTRICT

CO ENG FB 3673-55

W.S. 53, C-6

√ = FD IN GOOD COND.
AFTER CONST.
4-21-83
P.M.S.

Remaining ties
Sufficient for
replacement

NOTE: SEE FC 3352-36

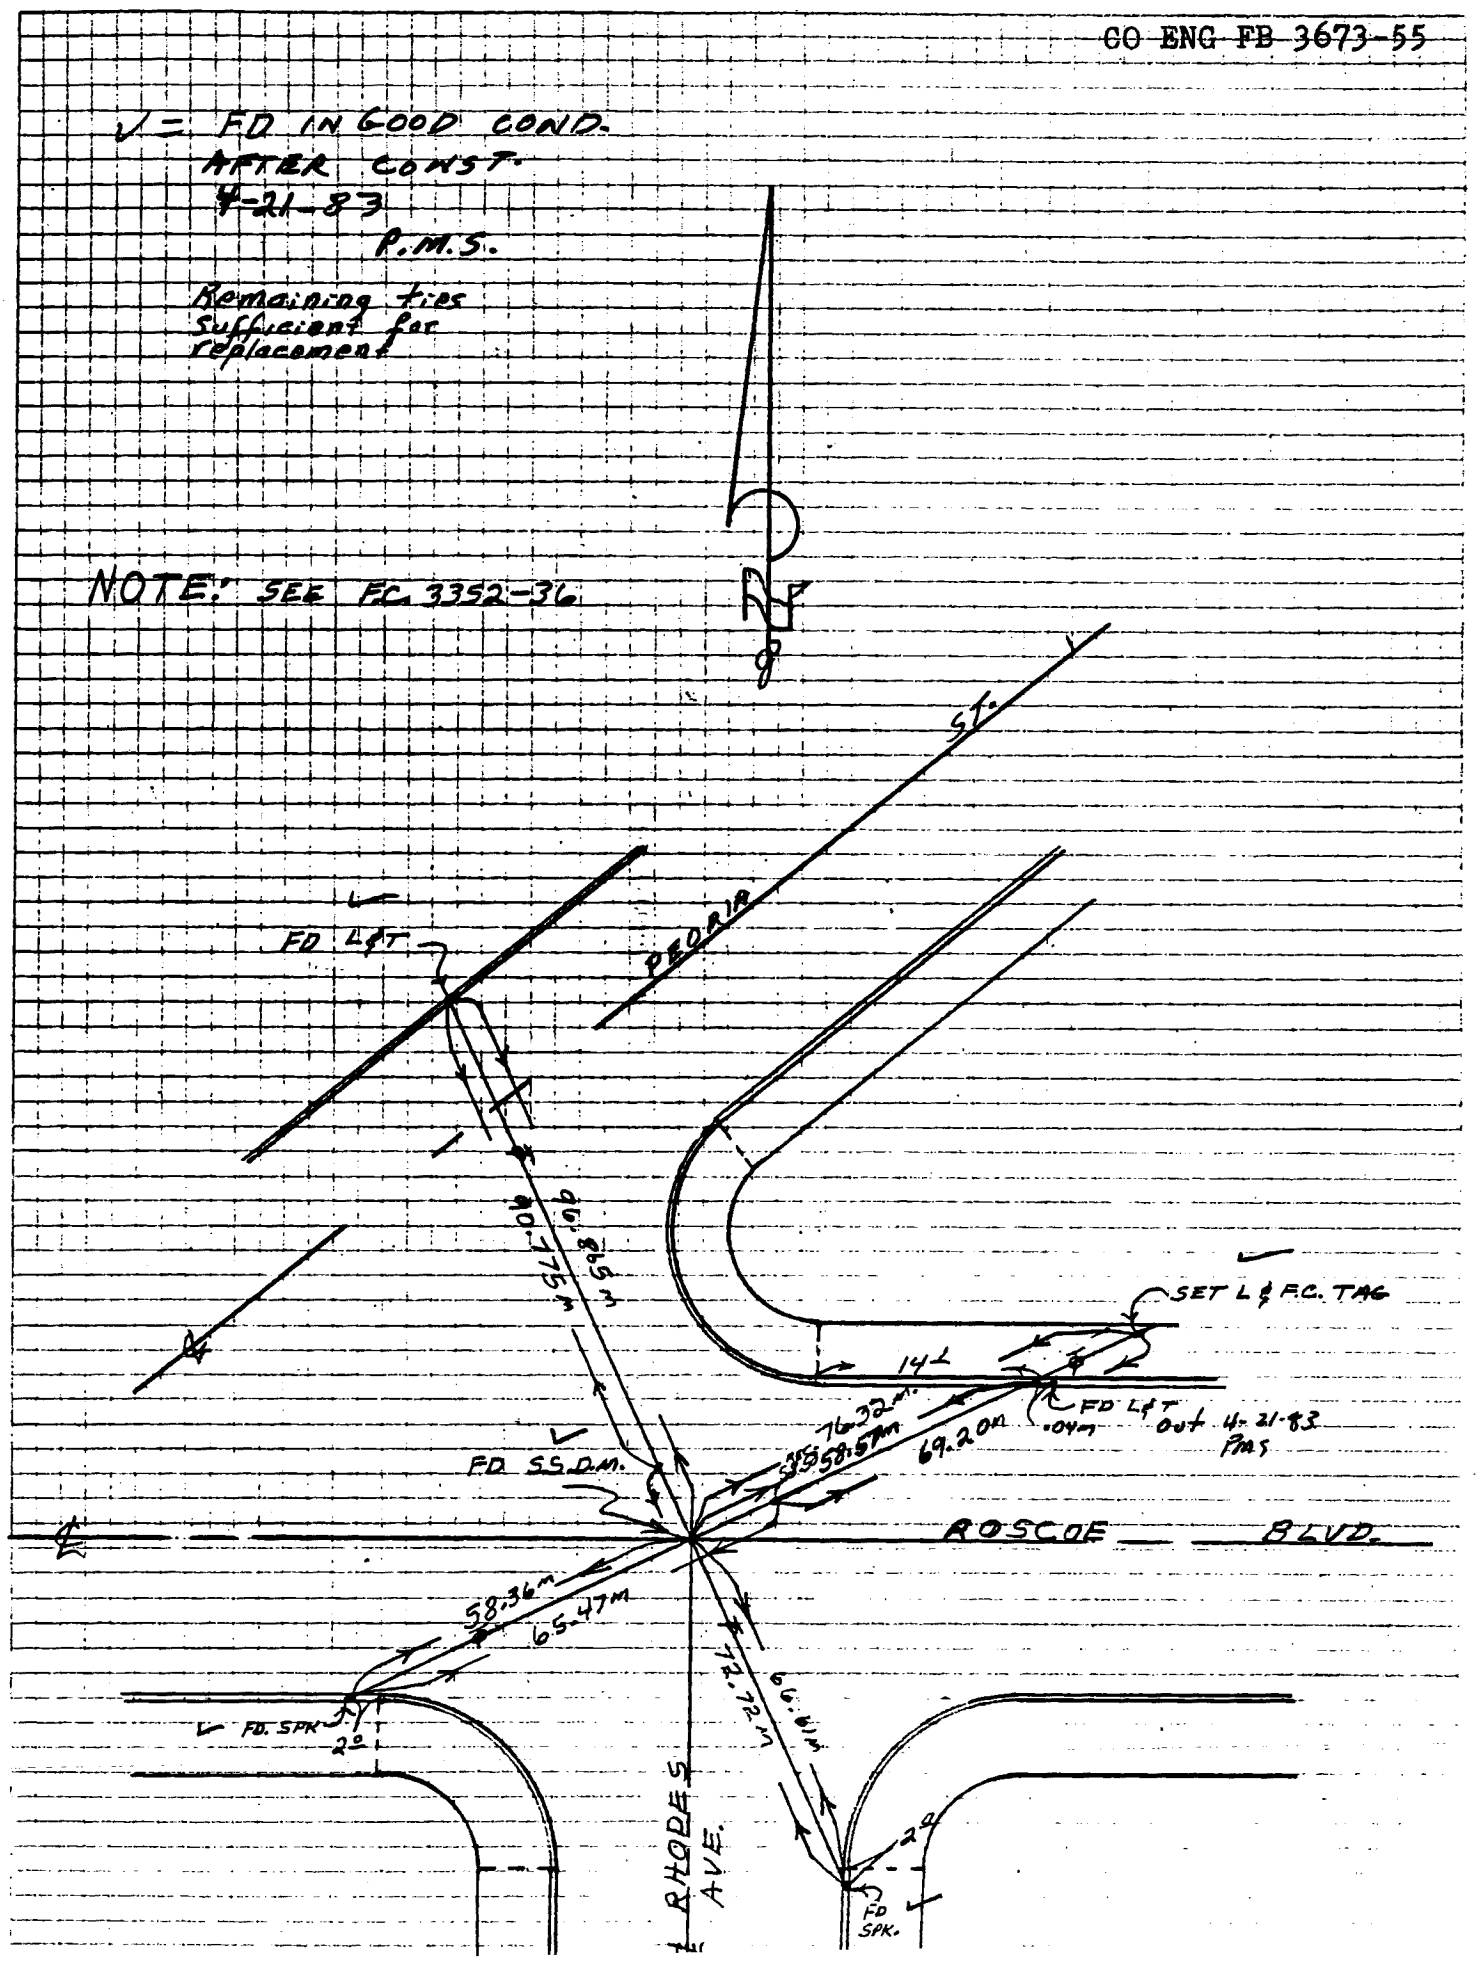

16

TRACT NO 34967 7/16/84 Page 1 of 1

SURVEY BY : CLASSIC ENGINEERING
GARY L. KAISER RCE 21938

W.S. 64, C-5

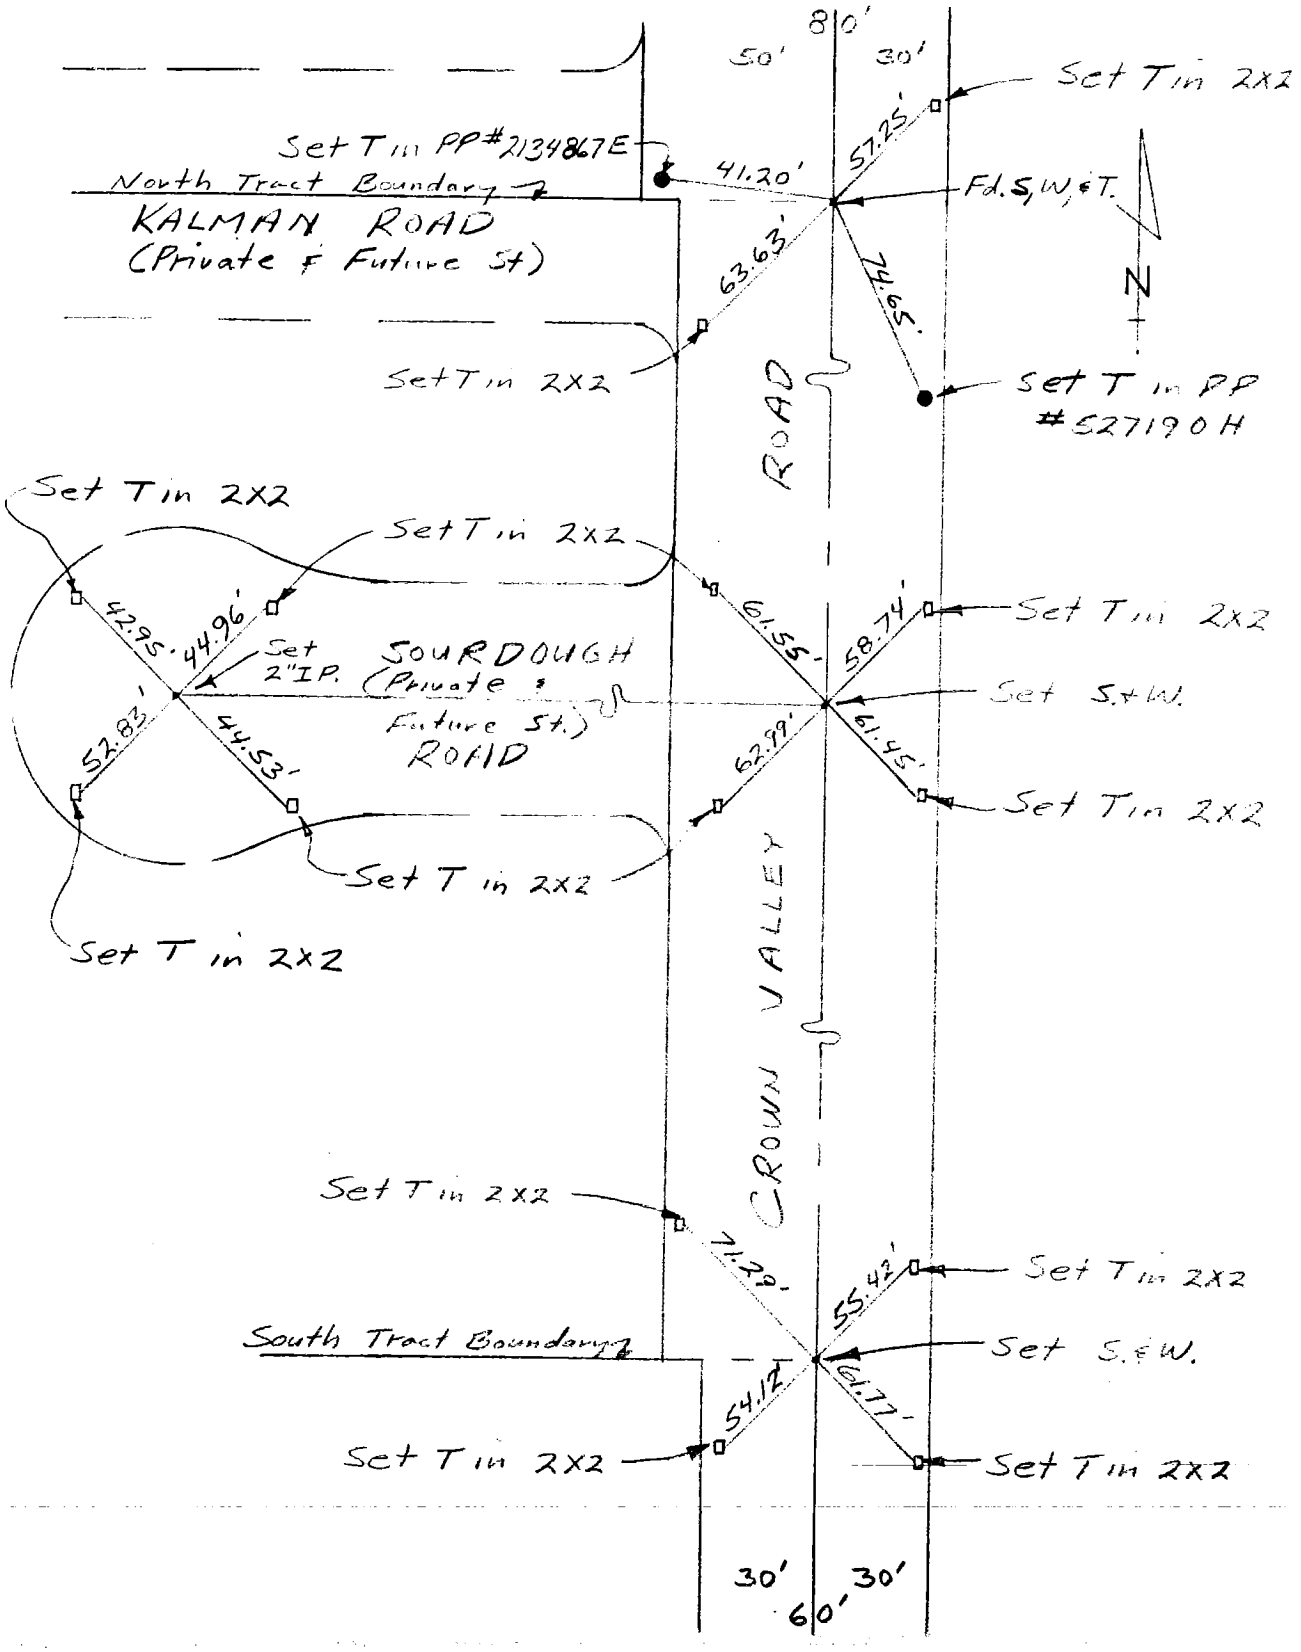

F B NO.________ PAGE________

CO ENG FB 3673-57

DO NOT EXTEND NOTES THIS SIDE OF LINE

SURVEYORS SERVICE COMPANY, COSTA MESA - STOCK NO. 411

SURVEY OF Soledad Cyn. Rd. INDEX RDFB 2615 PAGE 329 D, 330 D

JOB NO. 34367 SURVEY NOTES Const. Ties 2615-329 D

CO ENG FB 3673-58

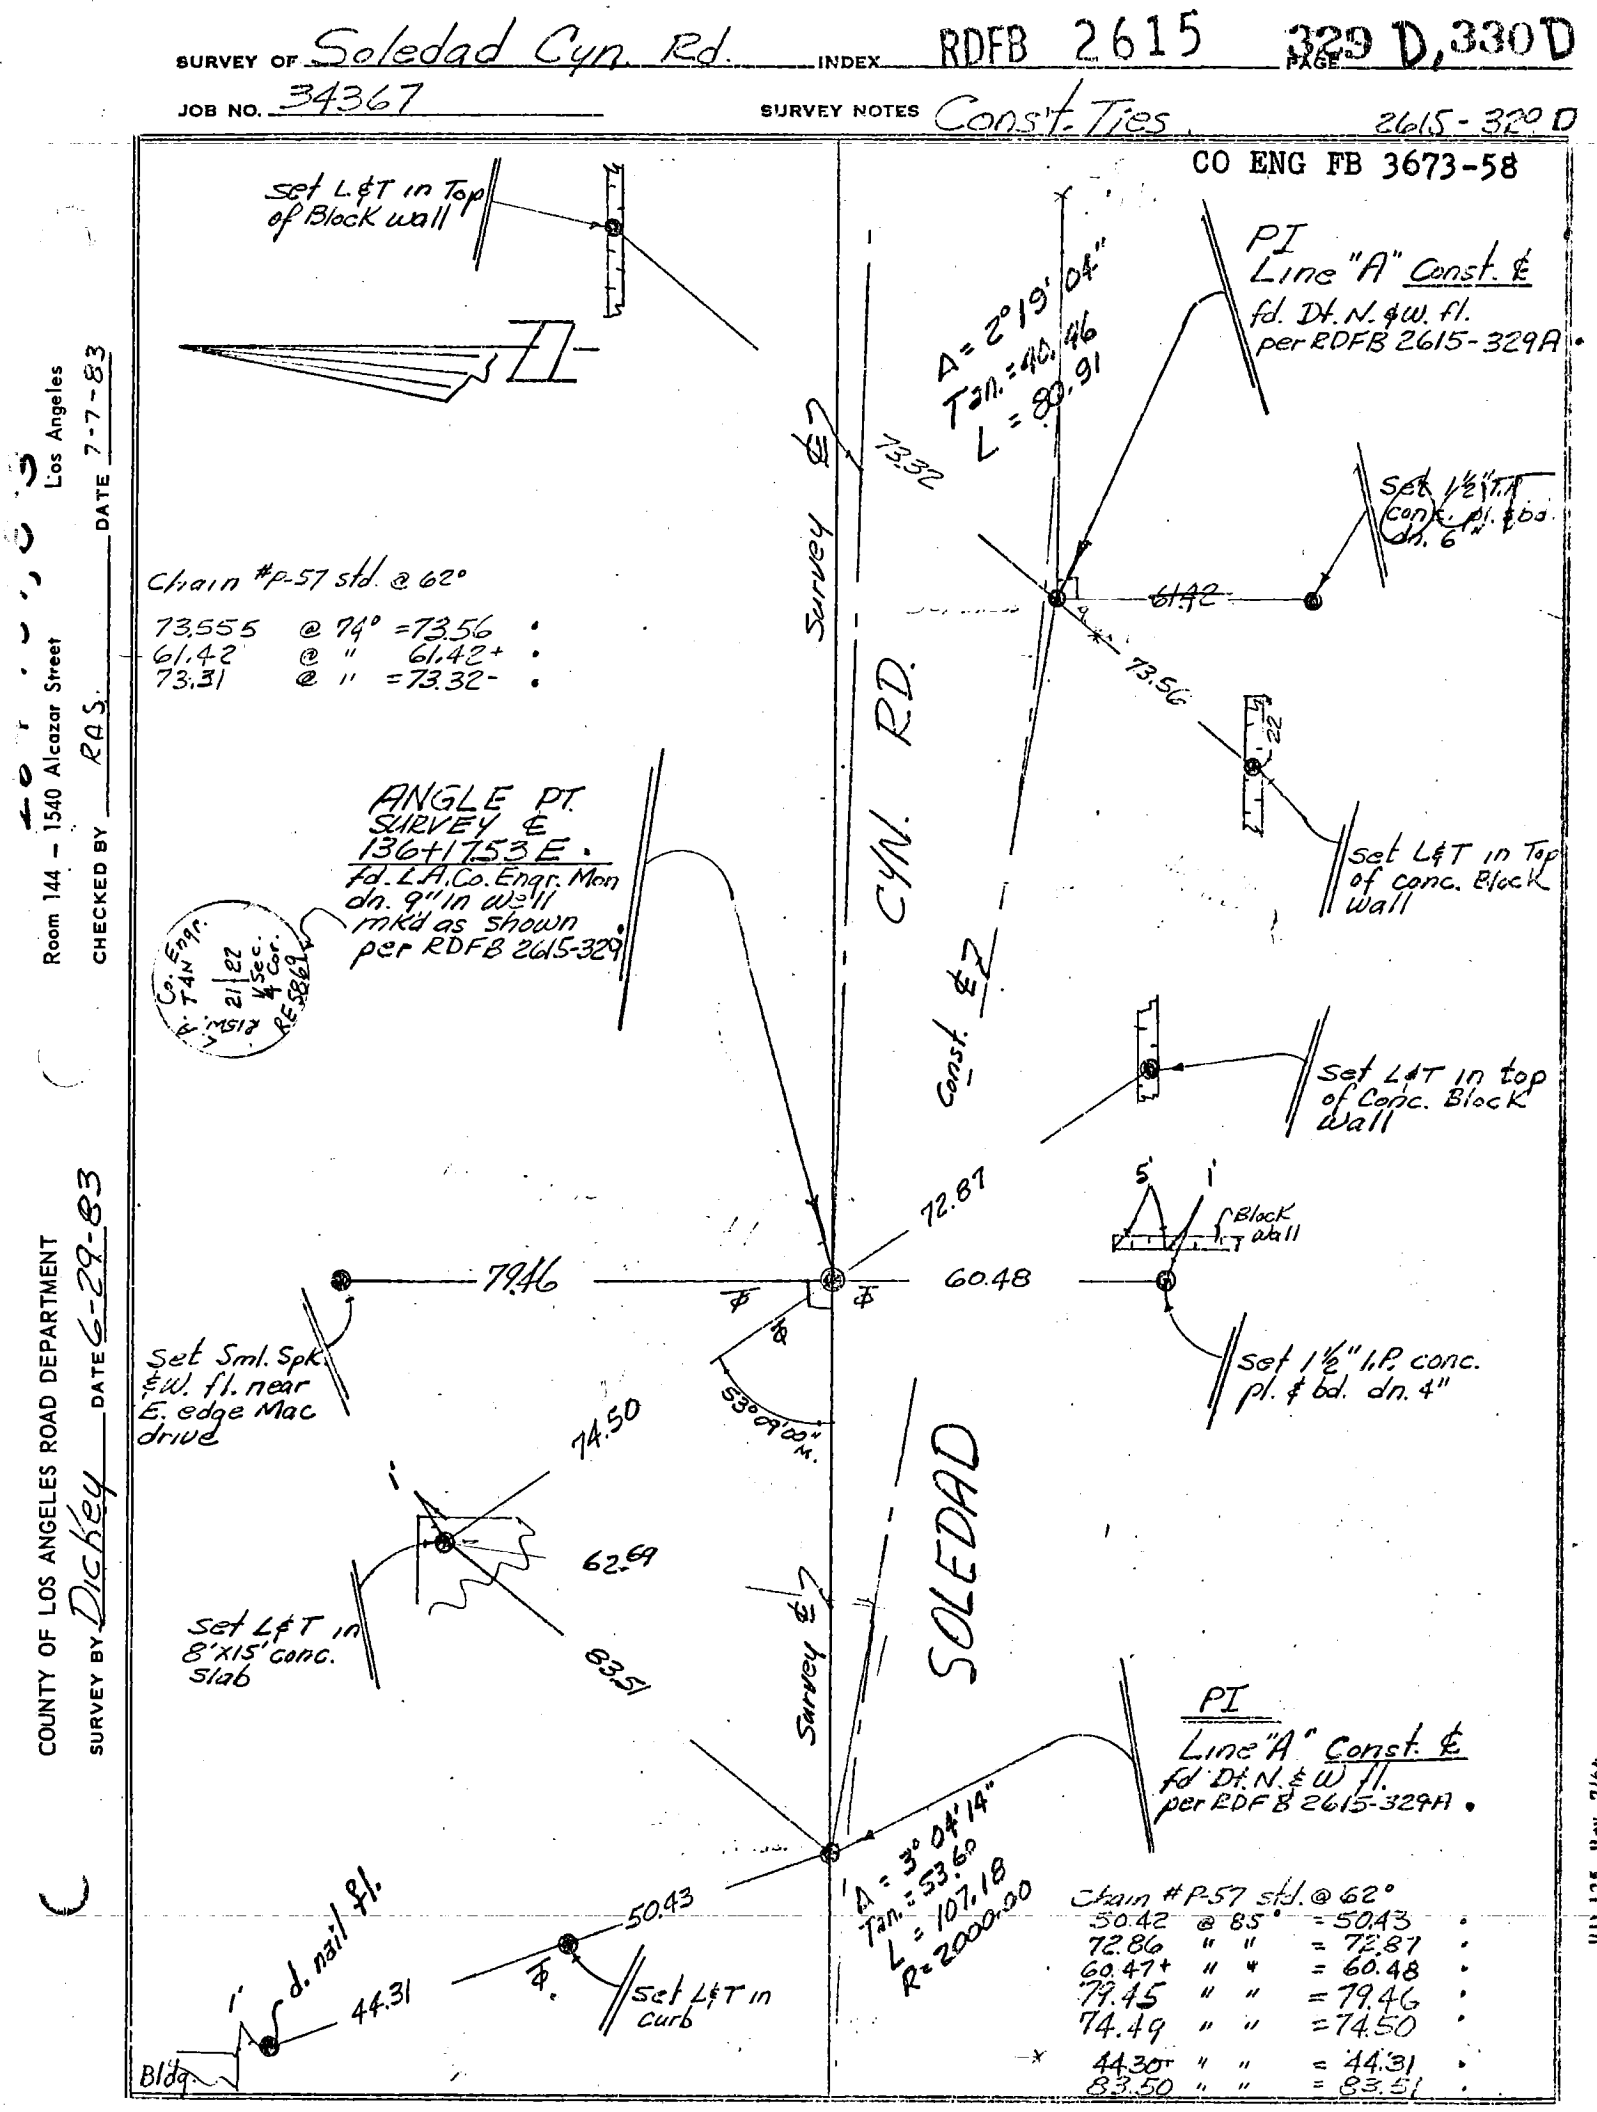

COUNTY OF LOS ANGELES ROAD DEPARTMENT

SURVEY BY Dickey DATE 6-29-83

Room 144 – 1540 Alcazar Street Los Angeles

CHECKED BY RAS. DATE 7-7-83

III 125 Rev 7/66

SURVEY OF Soledad Cñ. Rd. INDEX RDFB 2615 PAGE 329 E, 330 E

JOB NO. 34367 SURVEY NOTES ℄ Re-Ties 2615-329 E

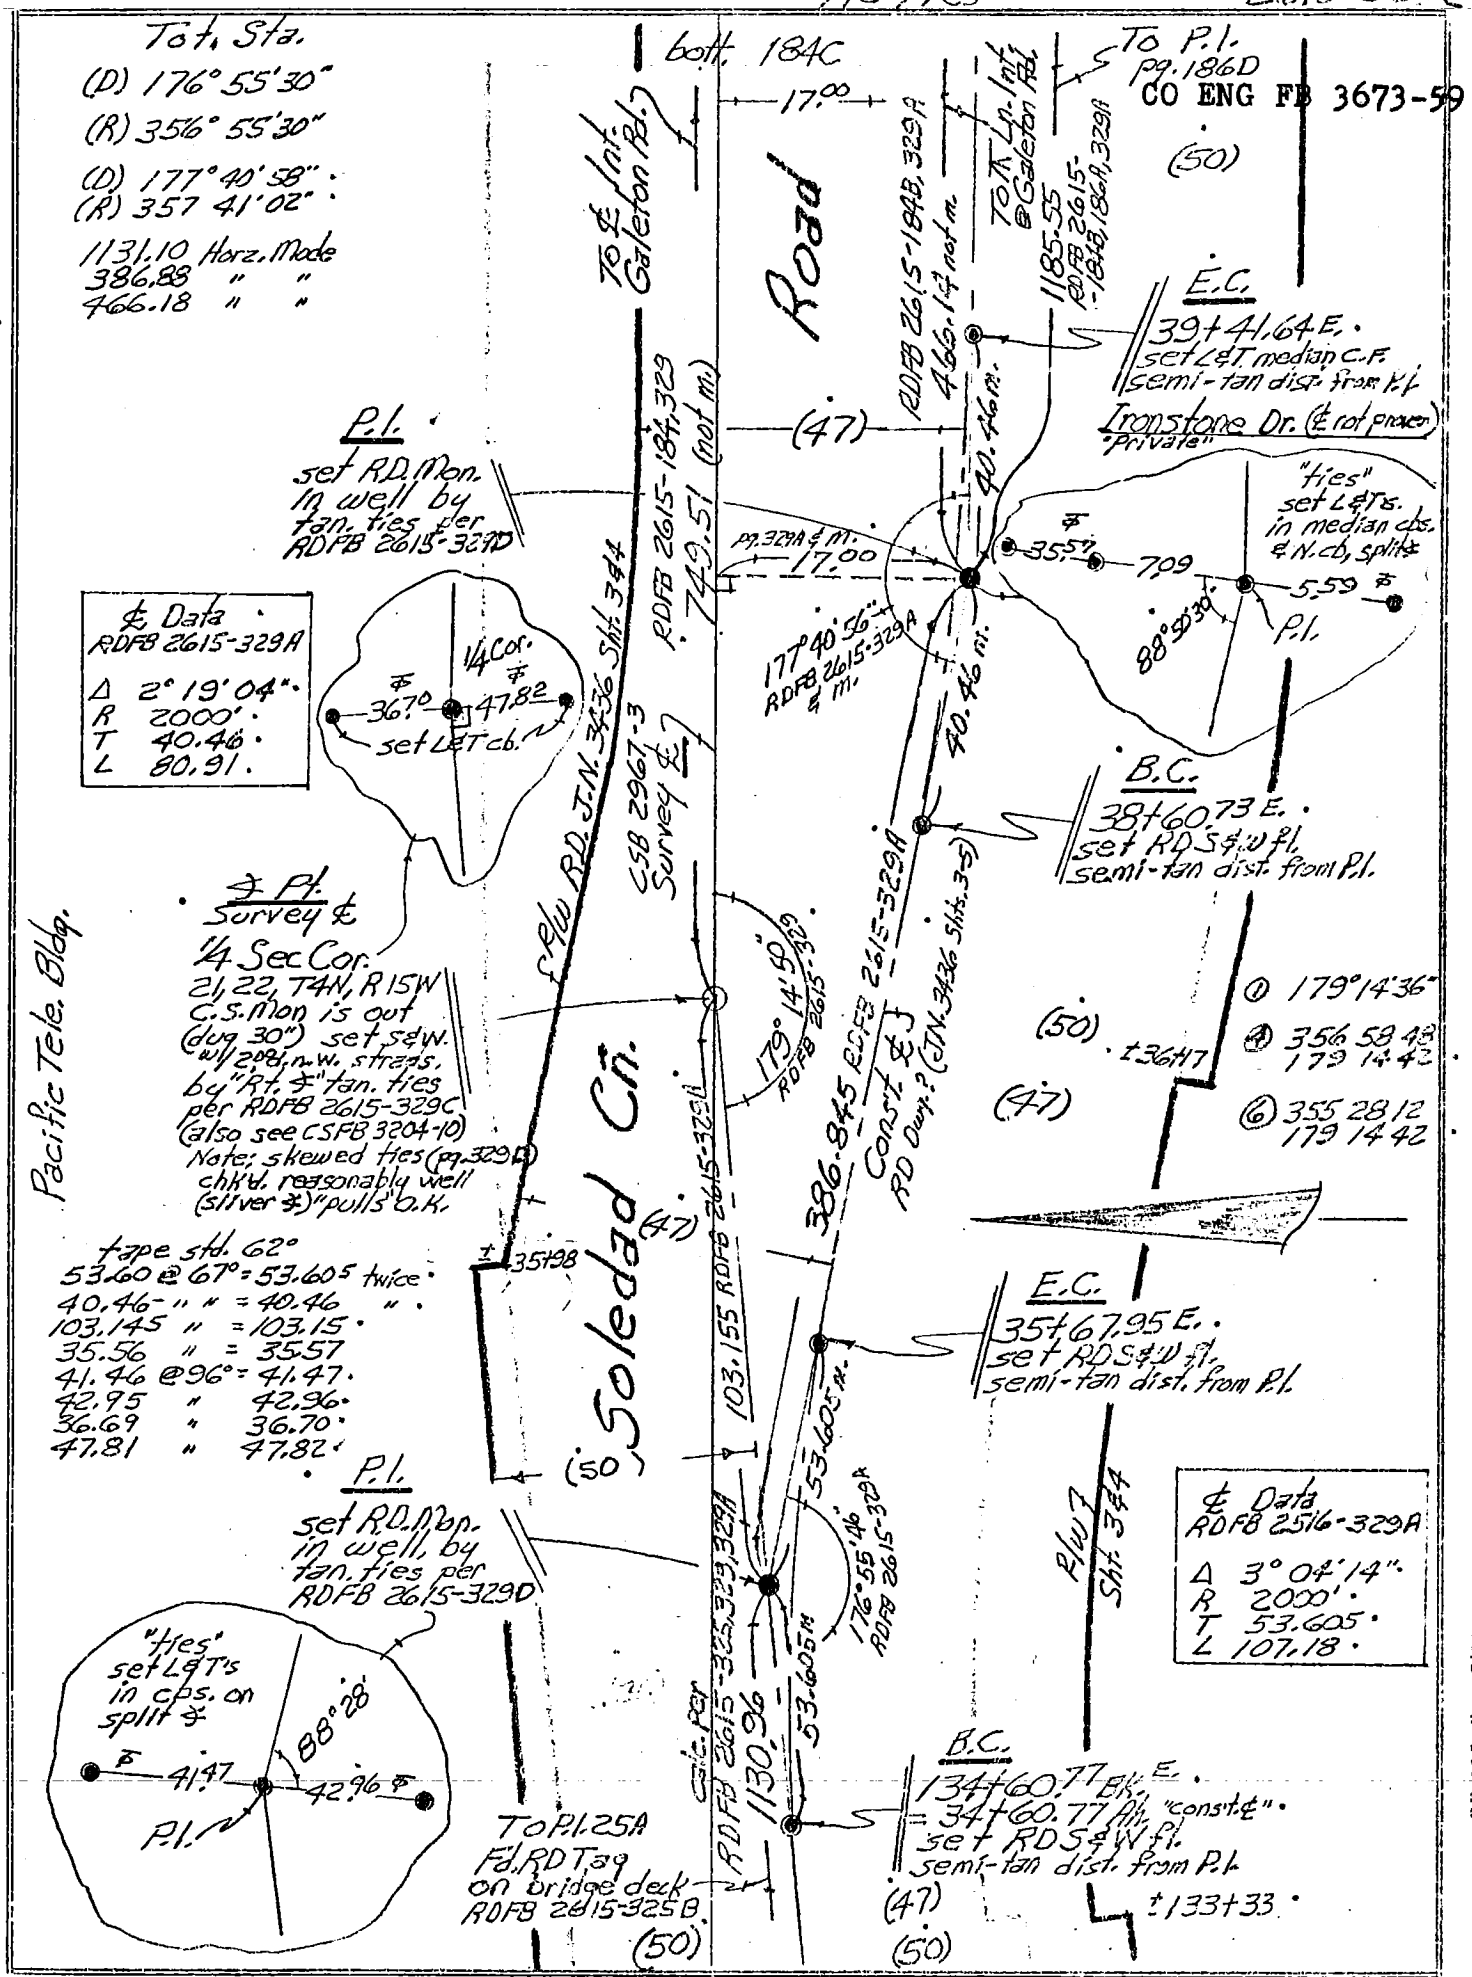

COUNTY OF LOS ANGELES ROAD DEPARTMENT

SURVEY BY RB Smith DATE 6-26-84

Room 144 – 1540 Alcazar Street Los Angeles

CHECKED BY R. Reader DATE 7/30/84

RD 125 Rev. 7/66

CO ENG FB 3673-60

SURVEY OF TRACT NO. 43111 INDEX PAGE

JOB NO. SURVEY NOTES

W.S. 46, A-3

Surveyed By: James P. McDonough RCE 16710 July 28, 1984

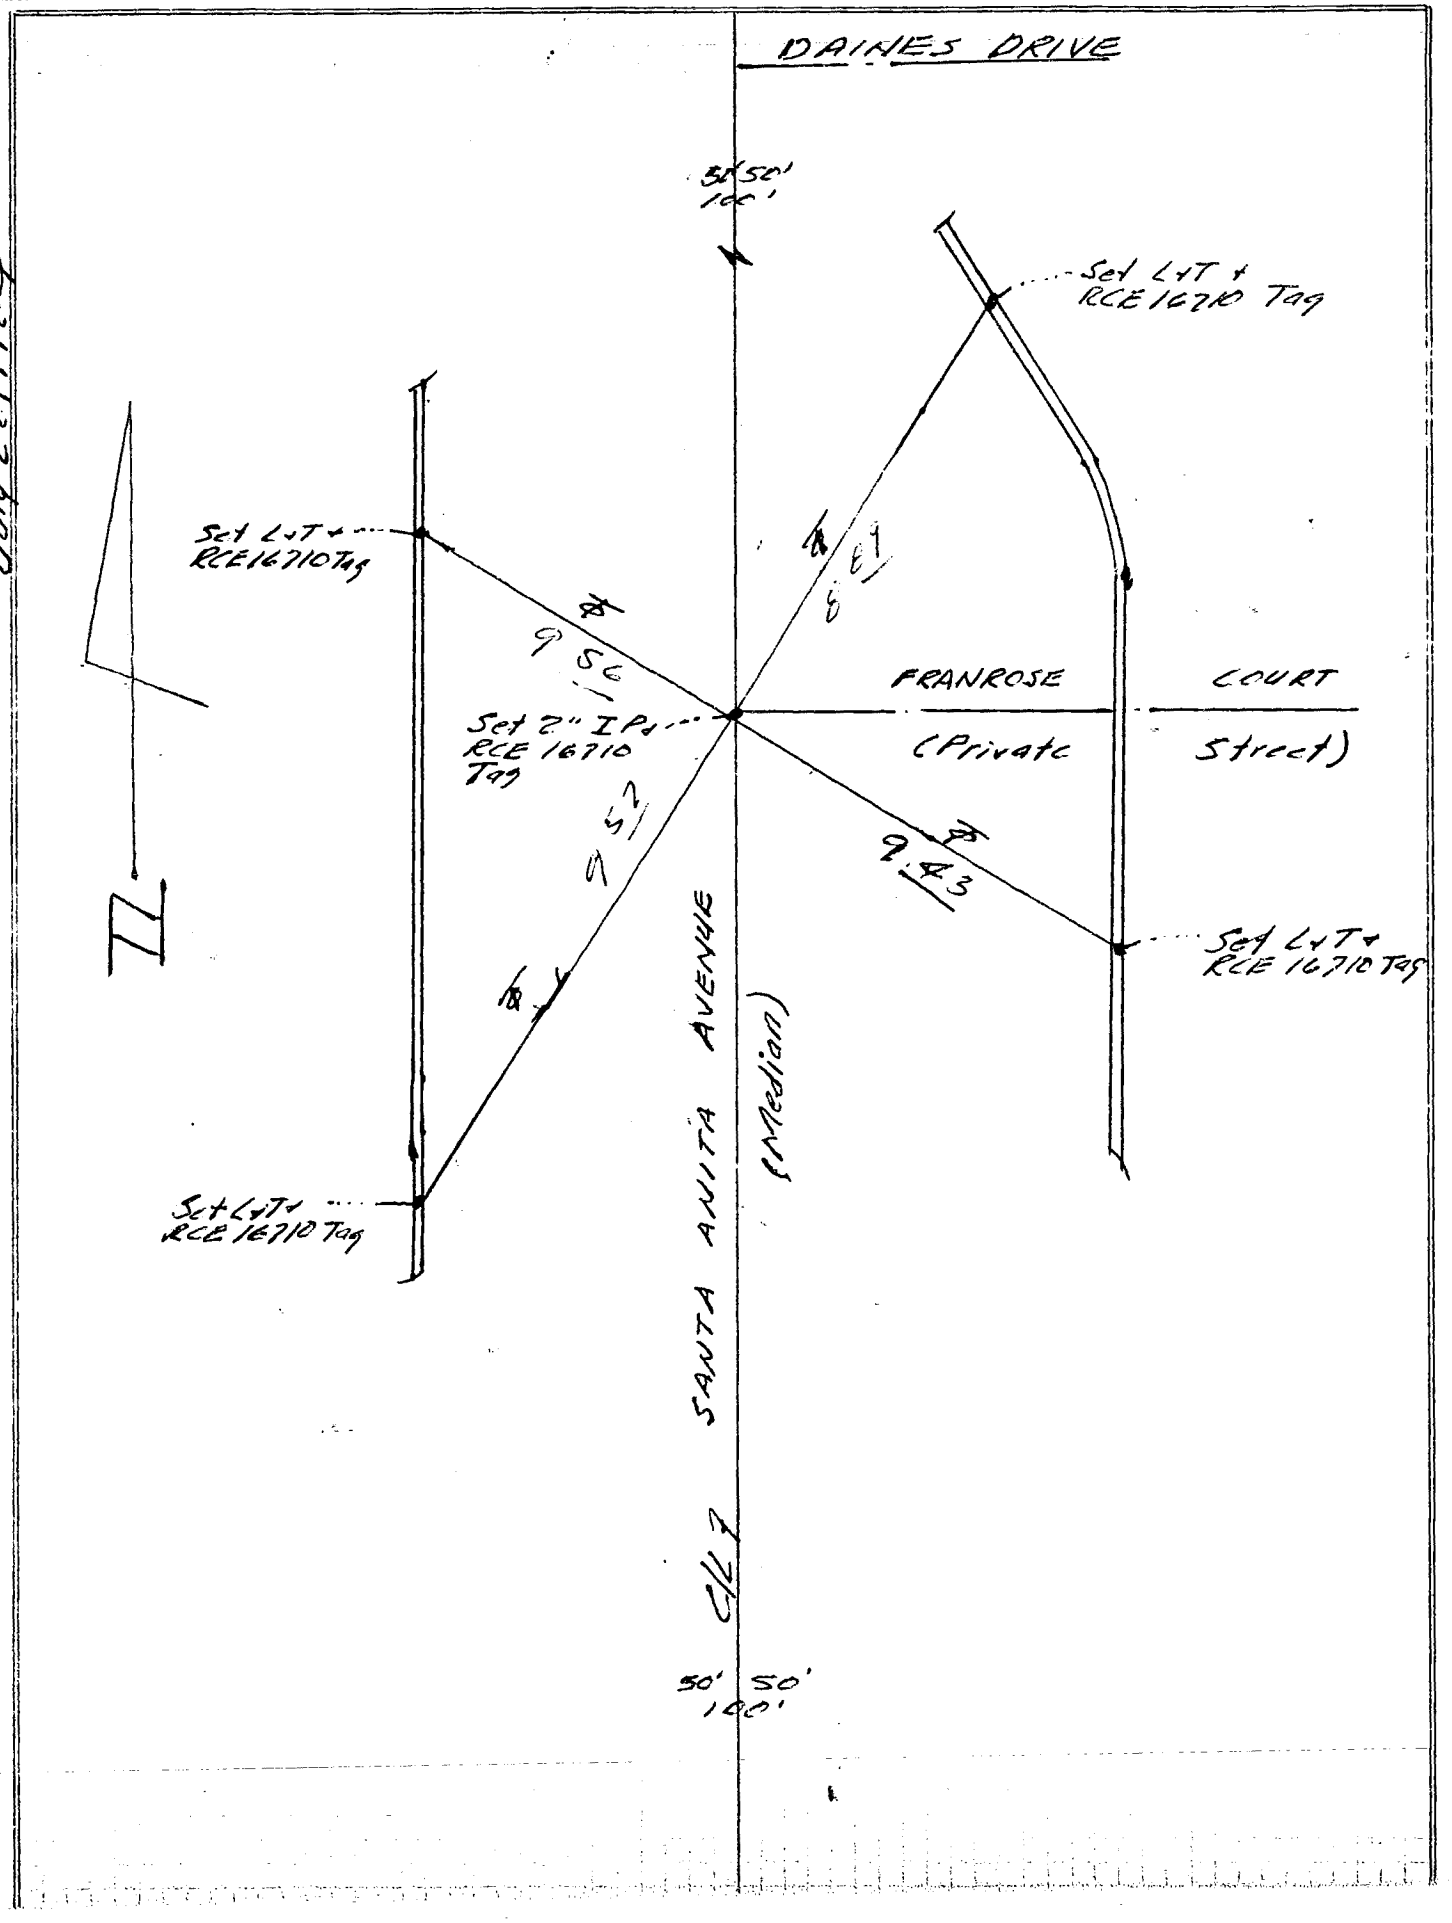

SURVEY BY _____ DATE _____

CHECKED BY _____ DATE _____

DR—141-B—7-62

W.S. 26, D-2

CO RNB FB 3673-61

SURVEY OF ANZAC AVE. F. B. Pg. 1 OF 2

SURVEY BY JOHN B. ABELL RCE 9070 TR. No. 34343

DATE JULY 24, 1994

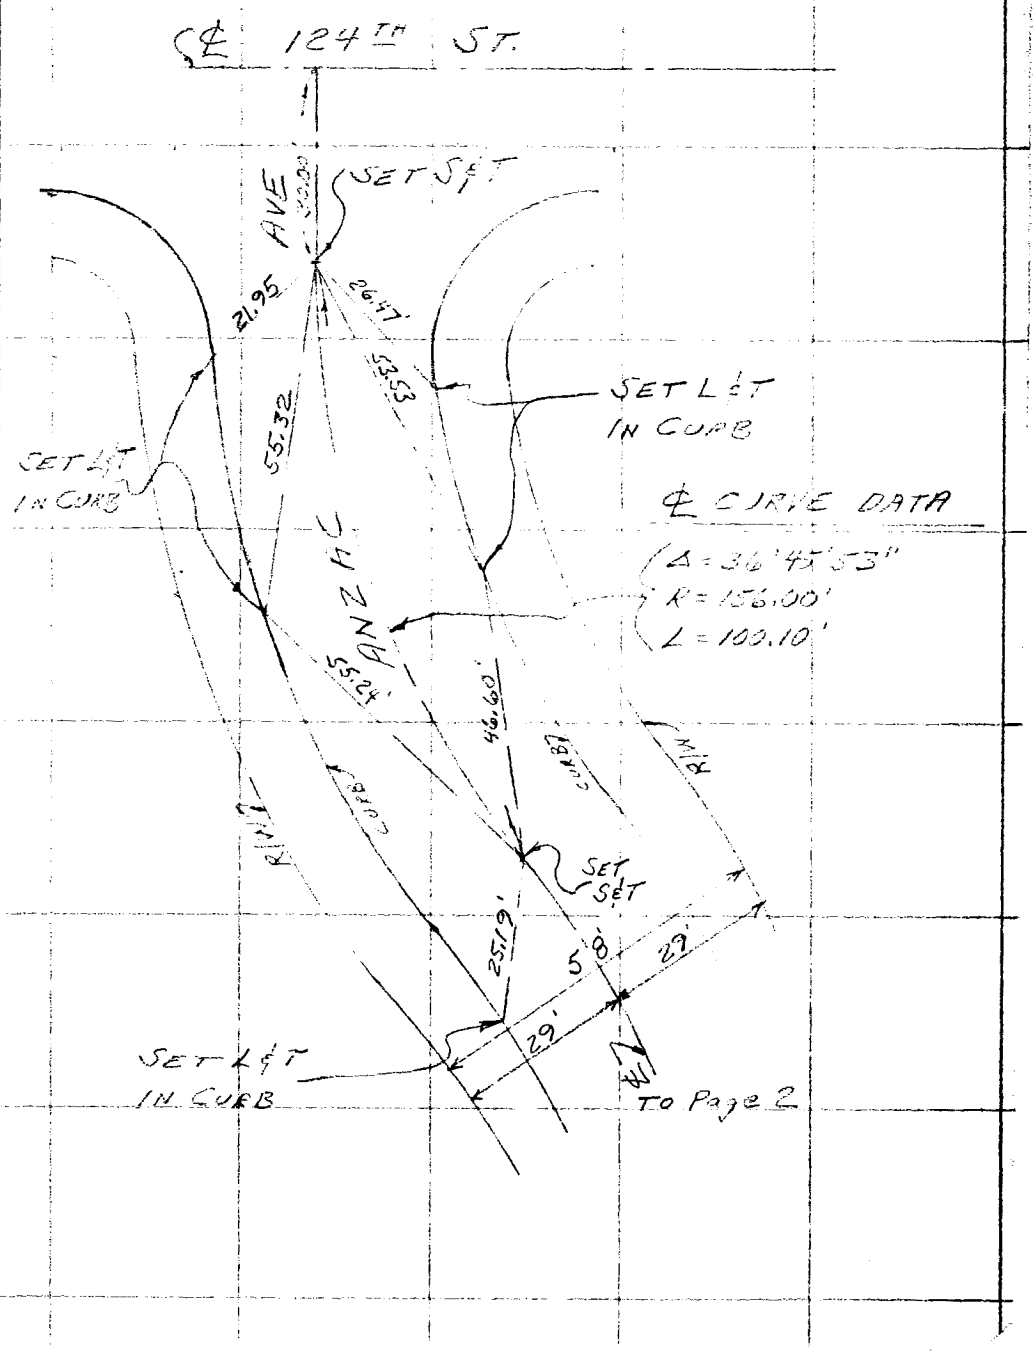

SO. CALIF. BLUE PRINT CO.

W.S. 26, D-2

CO ENG FB 3673-62

SURVEY OF ANZAC AVE. F. B. PG. 20F2

SURVEY BY JOHN B. ABELL RCE9070 TR. No. 34843

DATE JULY 24, 1984

SO. CALIF. BLUE PRINT CO. -

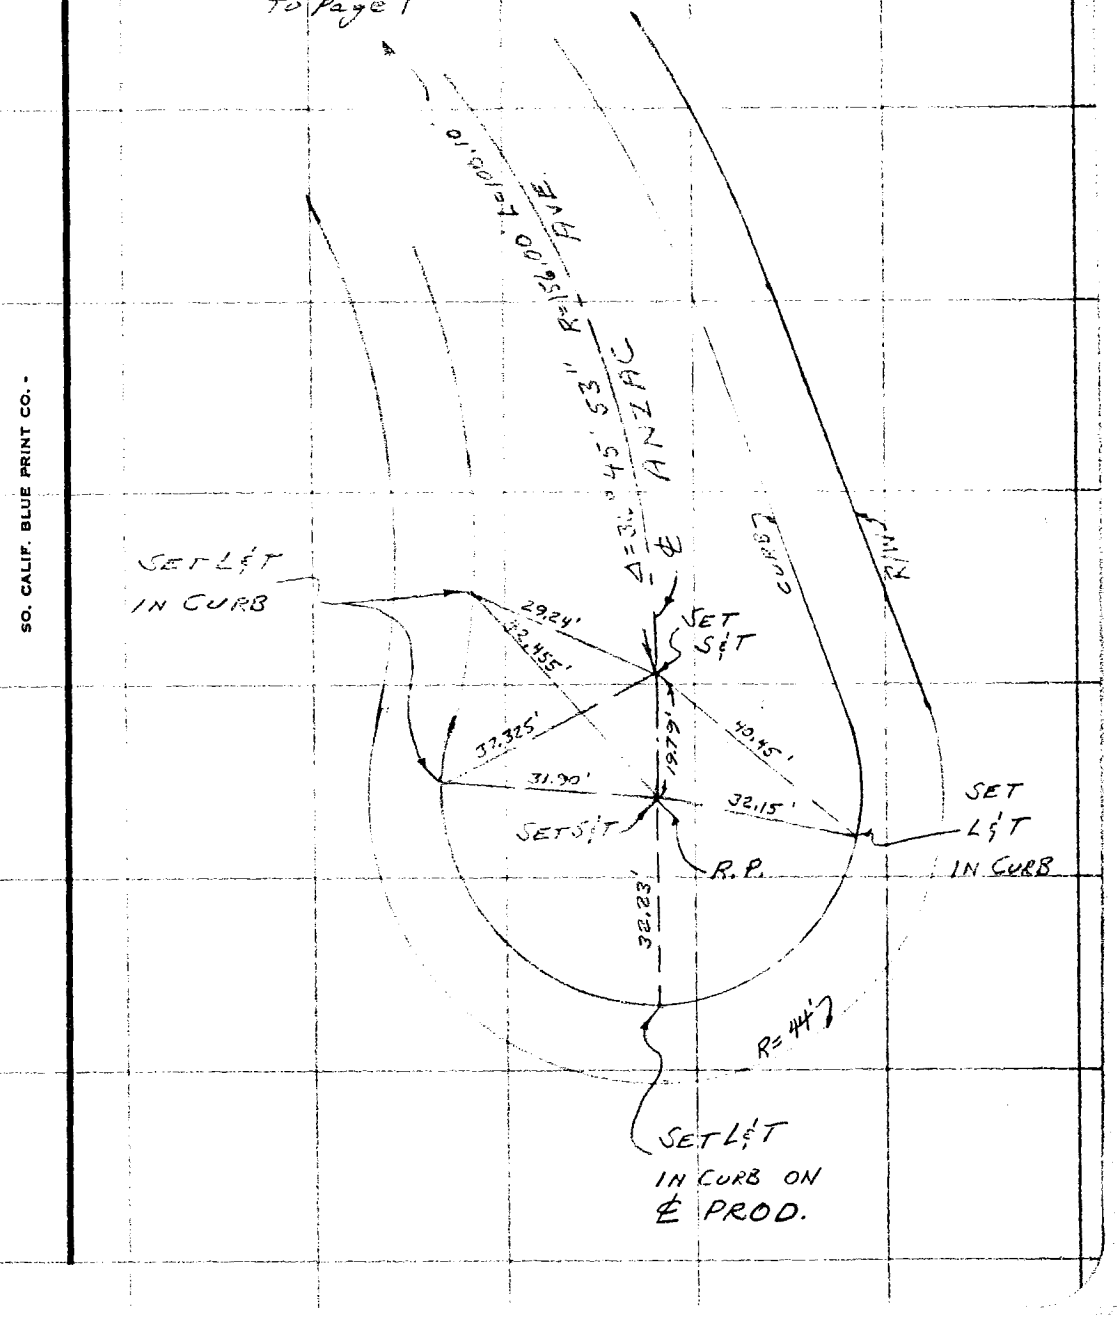

CO ENG FB 3673-63 OK

DEAN ANDERSON
RCE 23718
JULY 1984
TR 33455

144-297C-3

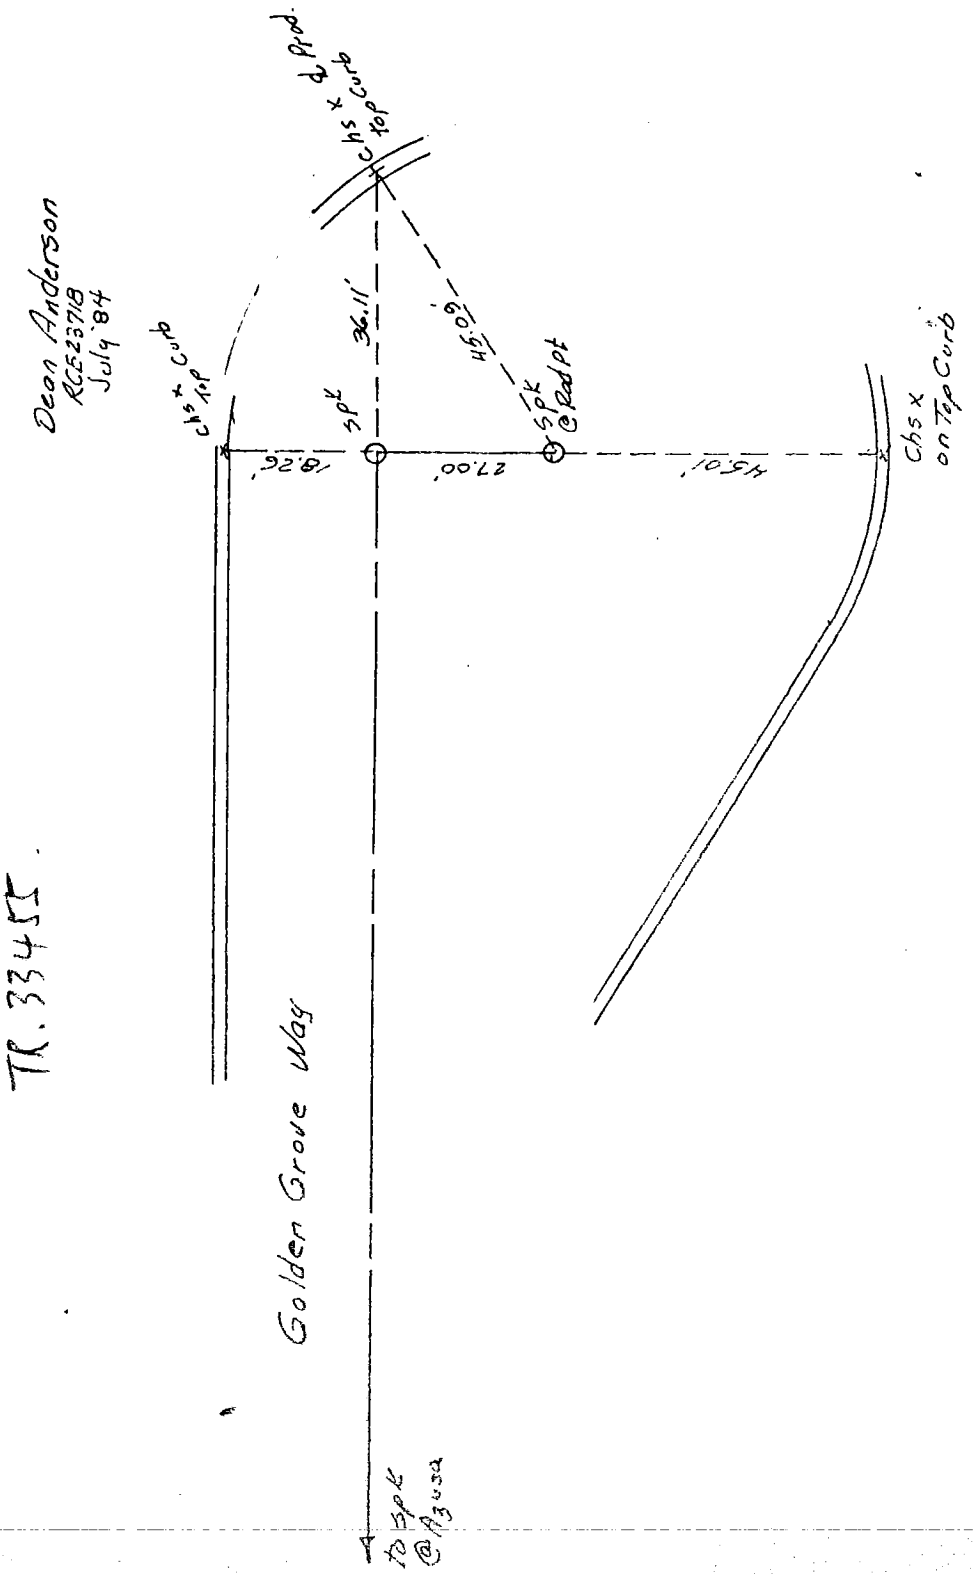

TR. 33455

DEAN ANDERSON
RCE 23718
JULY 1984
TR 33455

CO ENG FB 3673-64

144-297, C-3

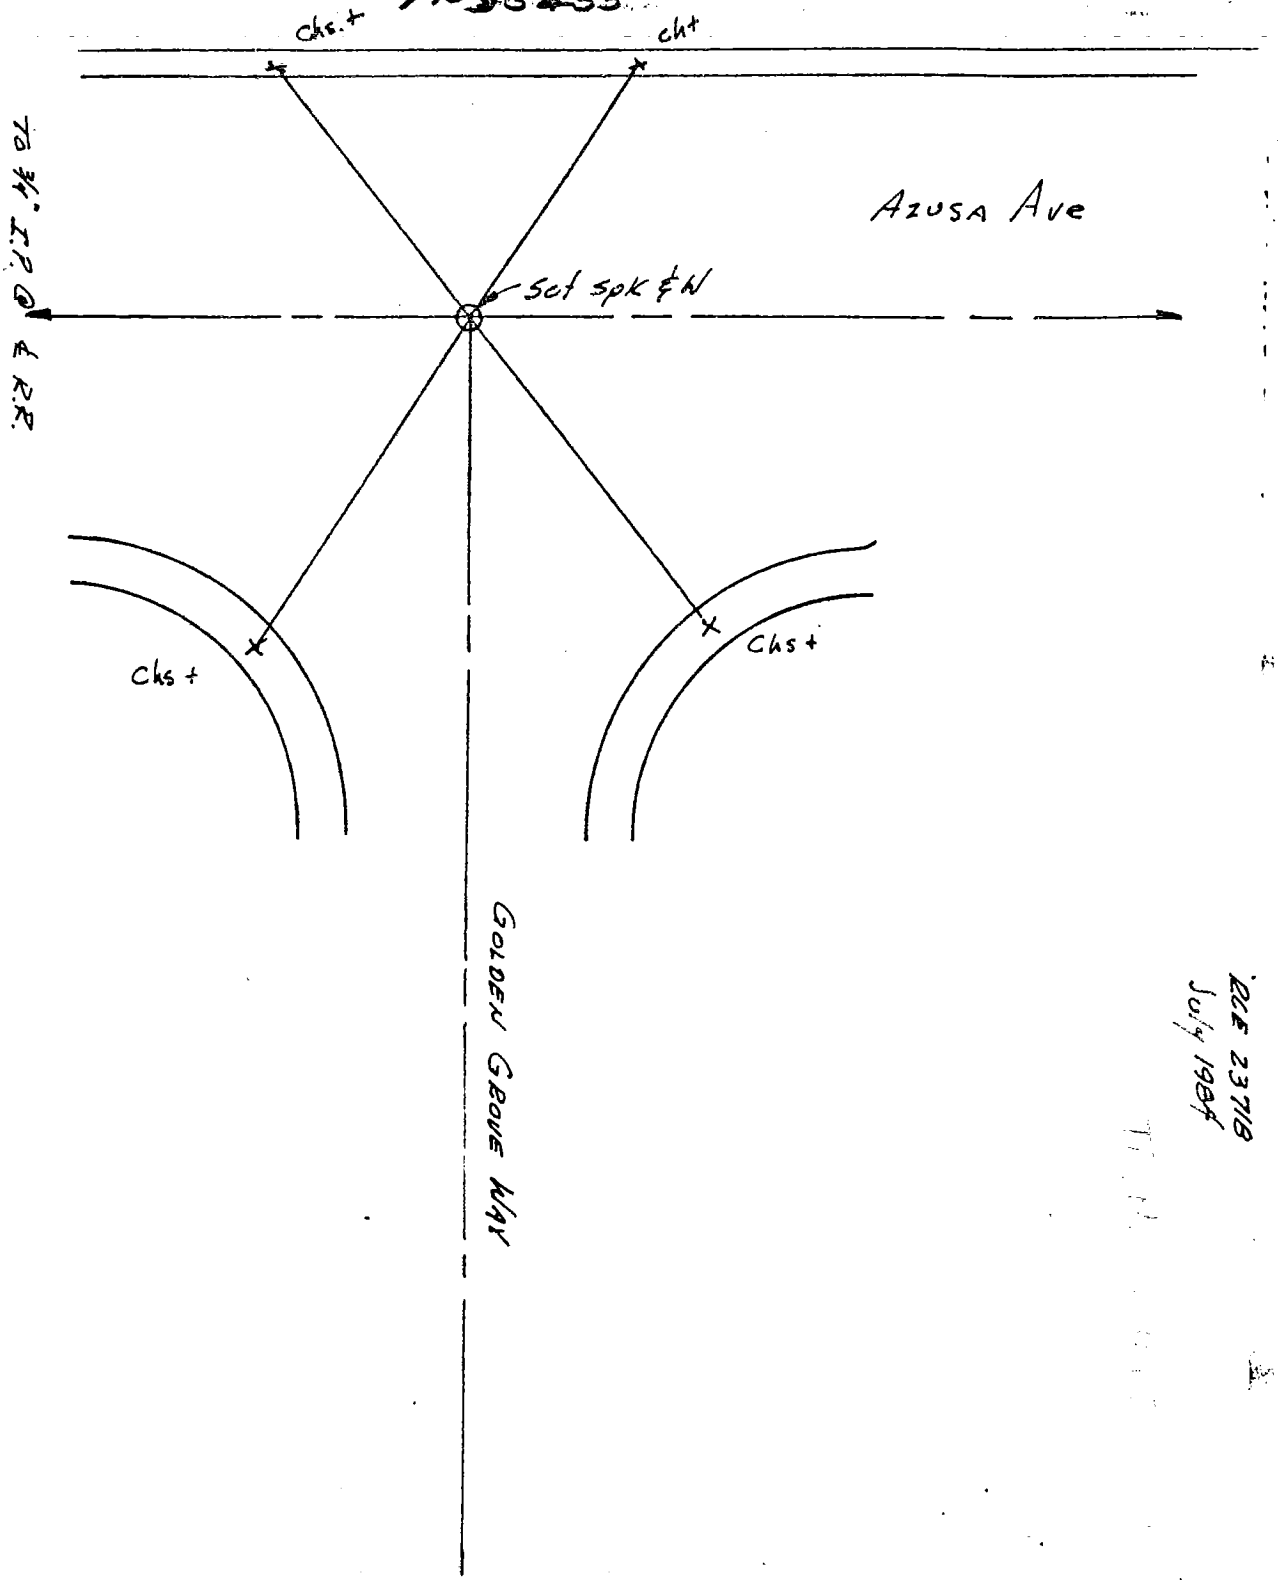

RCE 23718
July 1984

CO ENG FB 3673-65

DEAN ANDERSON
RCE 23718
JULY 1984
TR 33455

144-297 C3

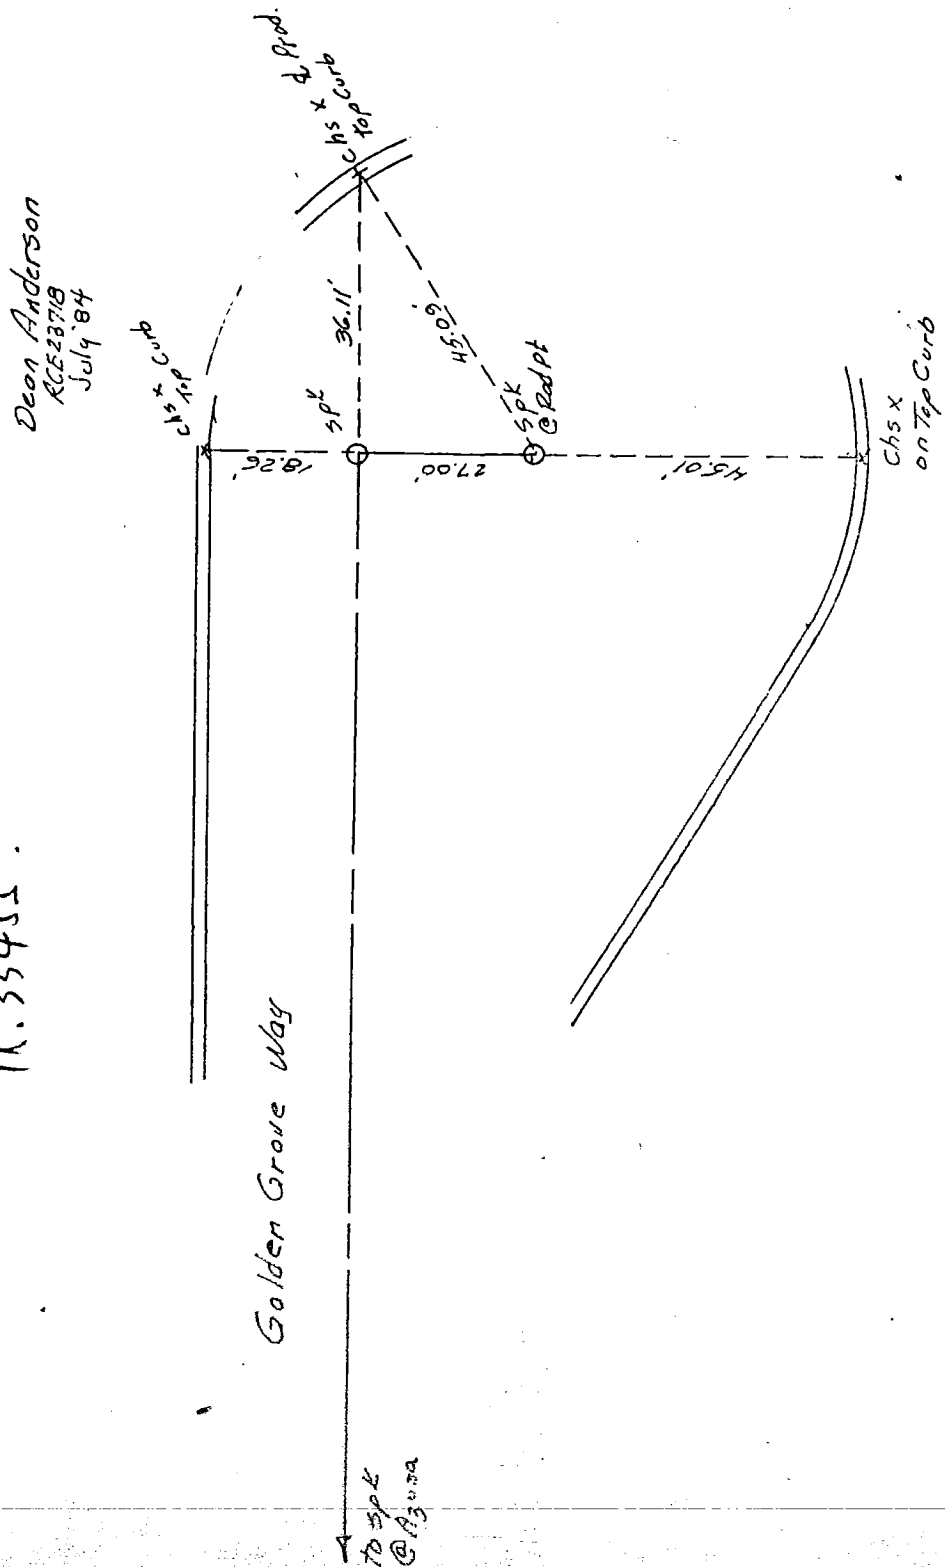

DEAN ANDERSON
RCE 23718
JULY 1984
TR 33455

CO ENG FB 3673-66

144-297, C-3

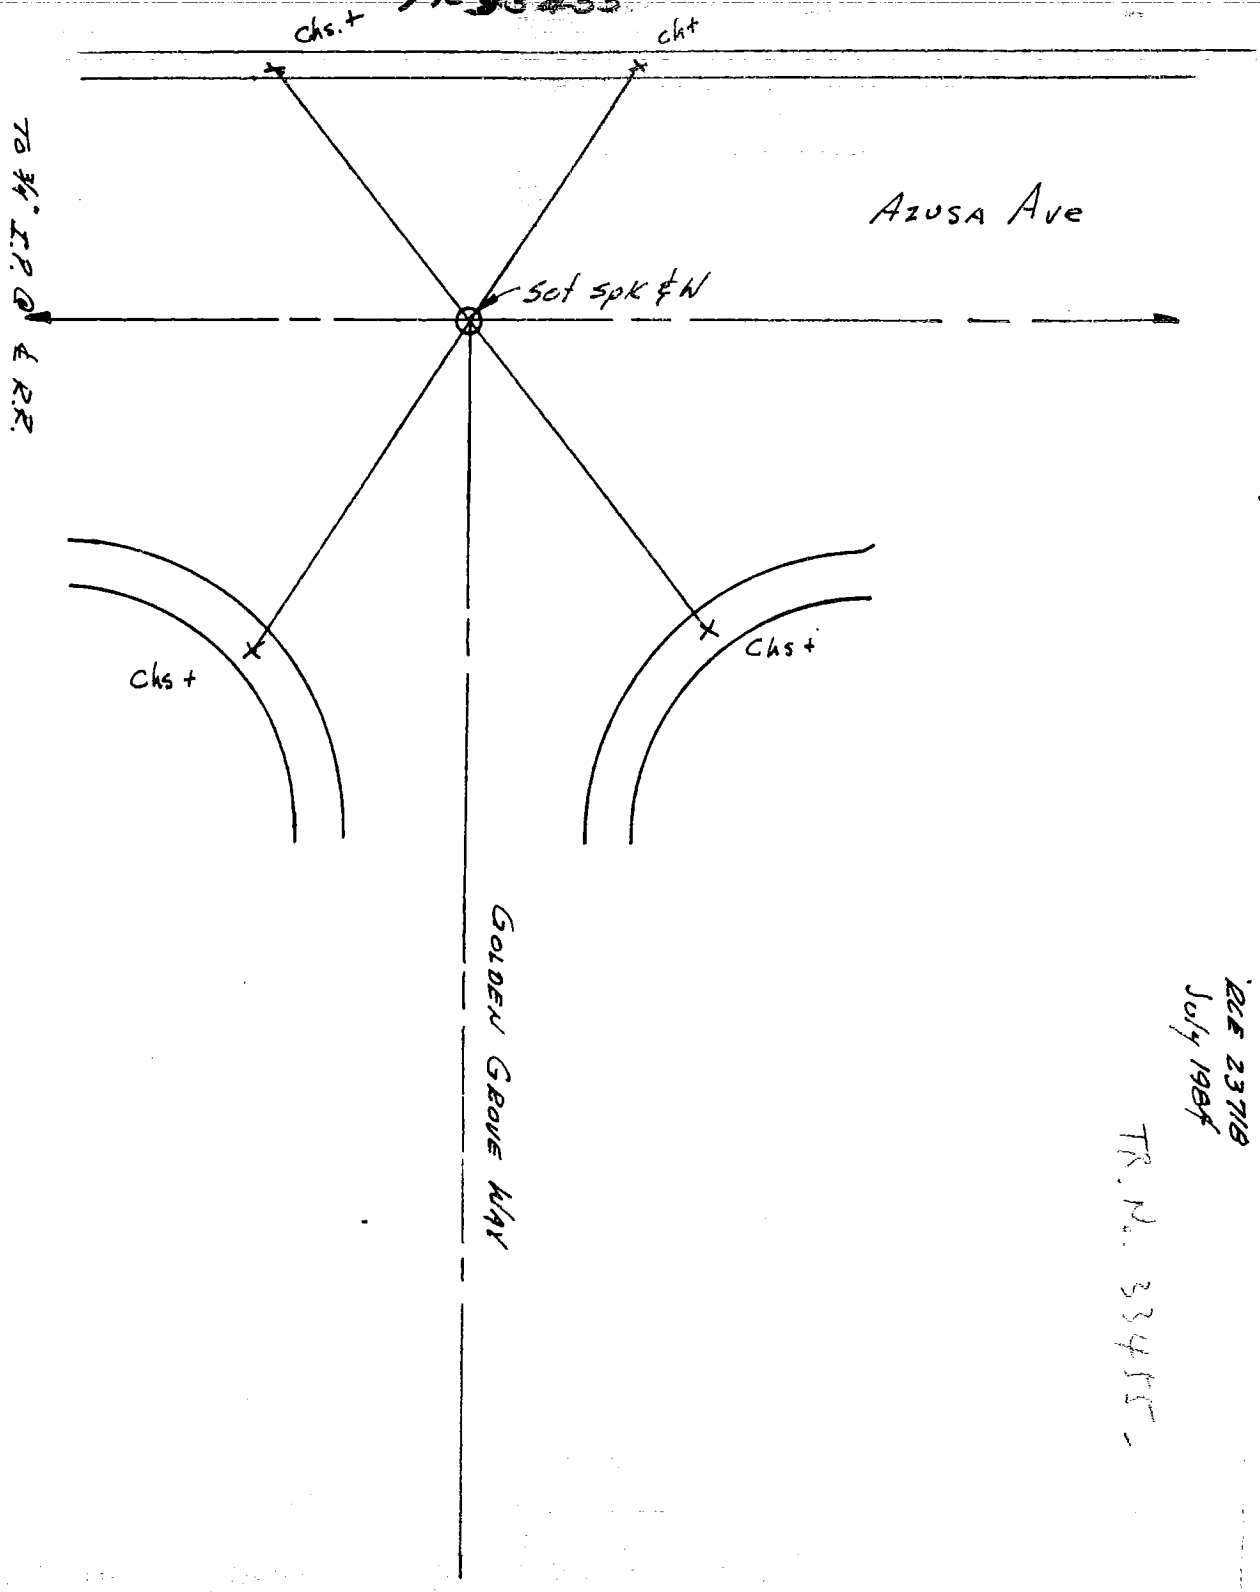

RCE 23718
July 1984
TR. No. 33455

CO ENG FB 3673-67

W.S. 73,8-1

SURVEY OF BOUNDARY TIES F B NO PAGE

SURVEY BY TRACT NO. 36823

DATE

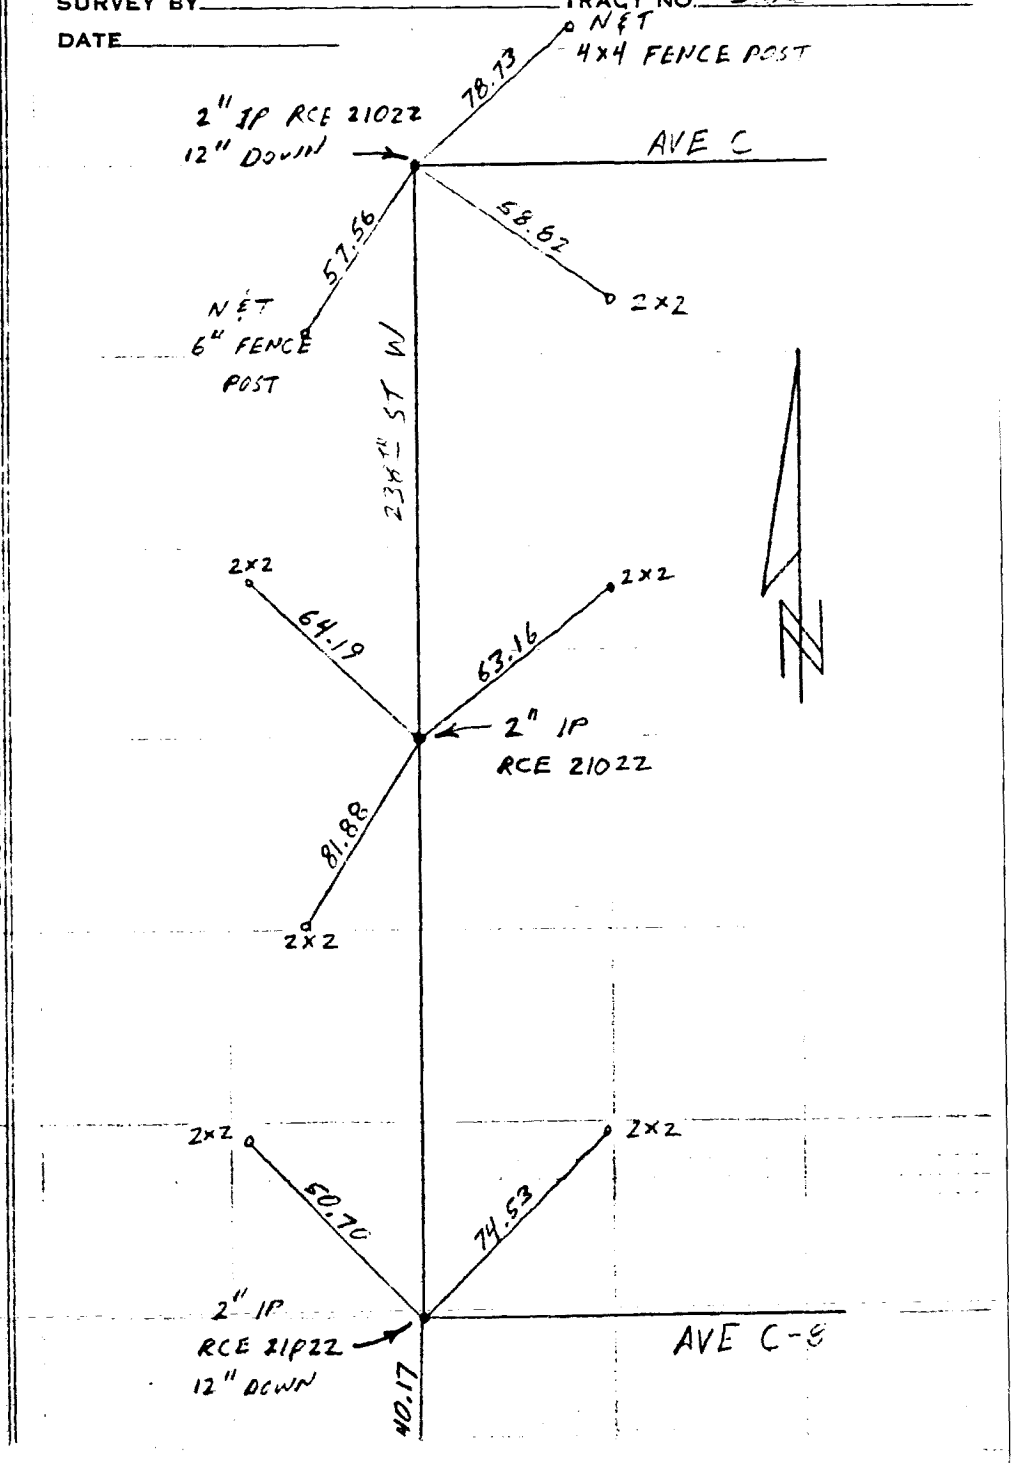

SURVEYORS SERVICE COMPANY — COSTA MESA - STOCK NO. 411

DO NOT EXTEND NOTES THIS SIDE OF LINE

CO ENG FB 3673-68

W.S. 73, C-1

F B NO. ____ PAGE ____

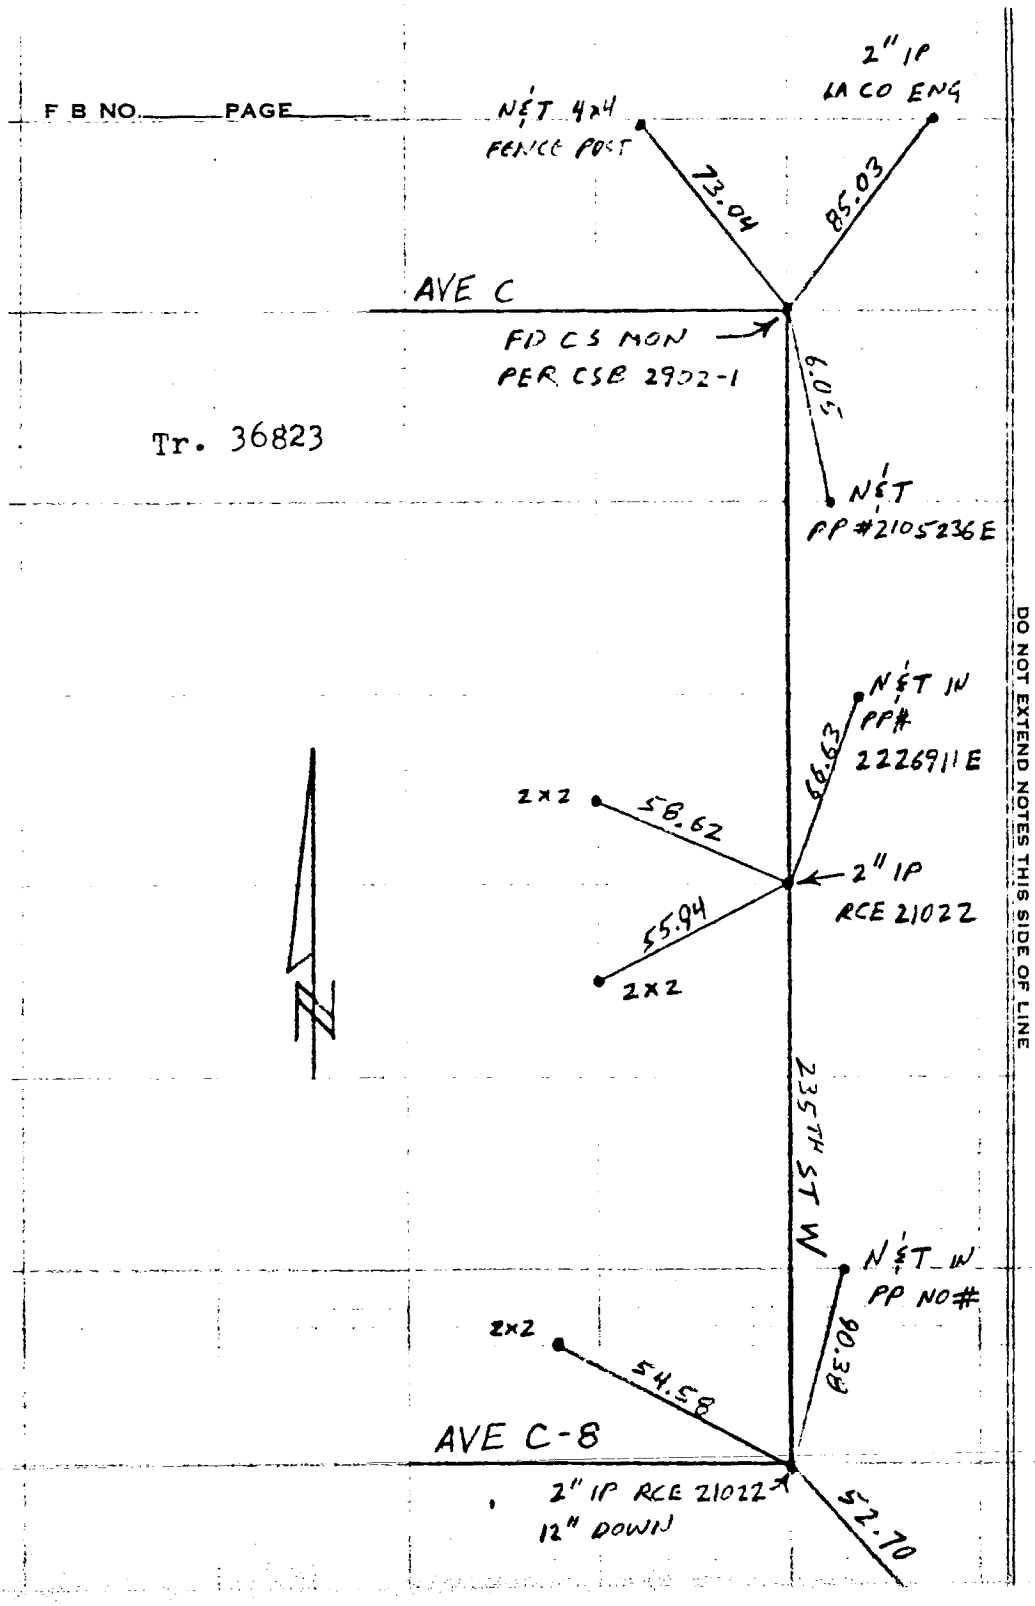

DO NOT EXTEND NOTES THIS SIDE OF LINE

SURVEYORS SERVICE COMPA COSTA MESA - STOCK NO 411

099-317,C-2

CO ENG FB 3673-69
PAGE 1 OF 6

SURVEY OF ℄ TIES

SURVEY BY WESLEY R. LIND R.C.E. 16362

TR. No. 33104

DATE SEPT. 12, 1980

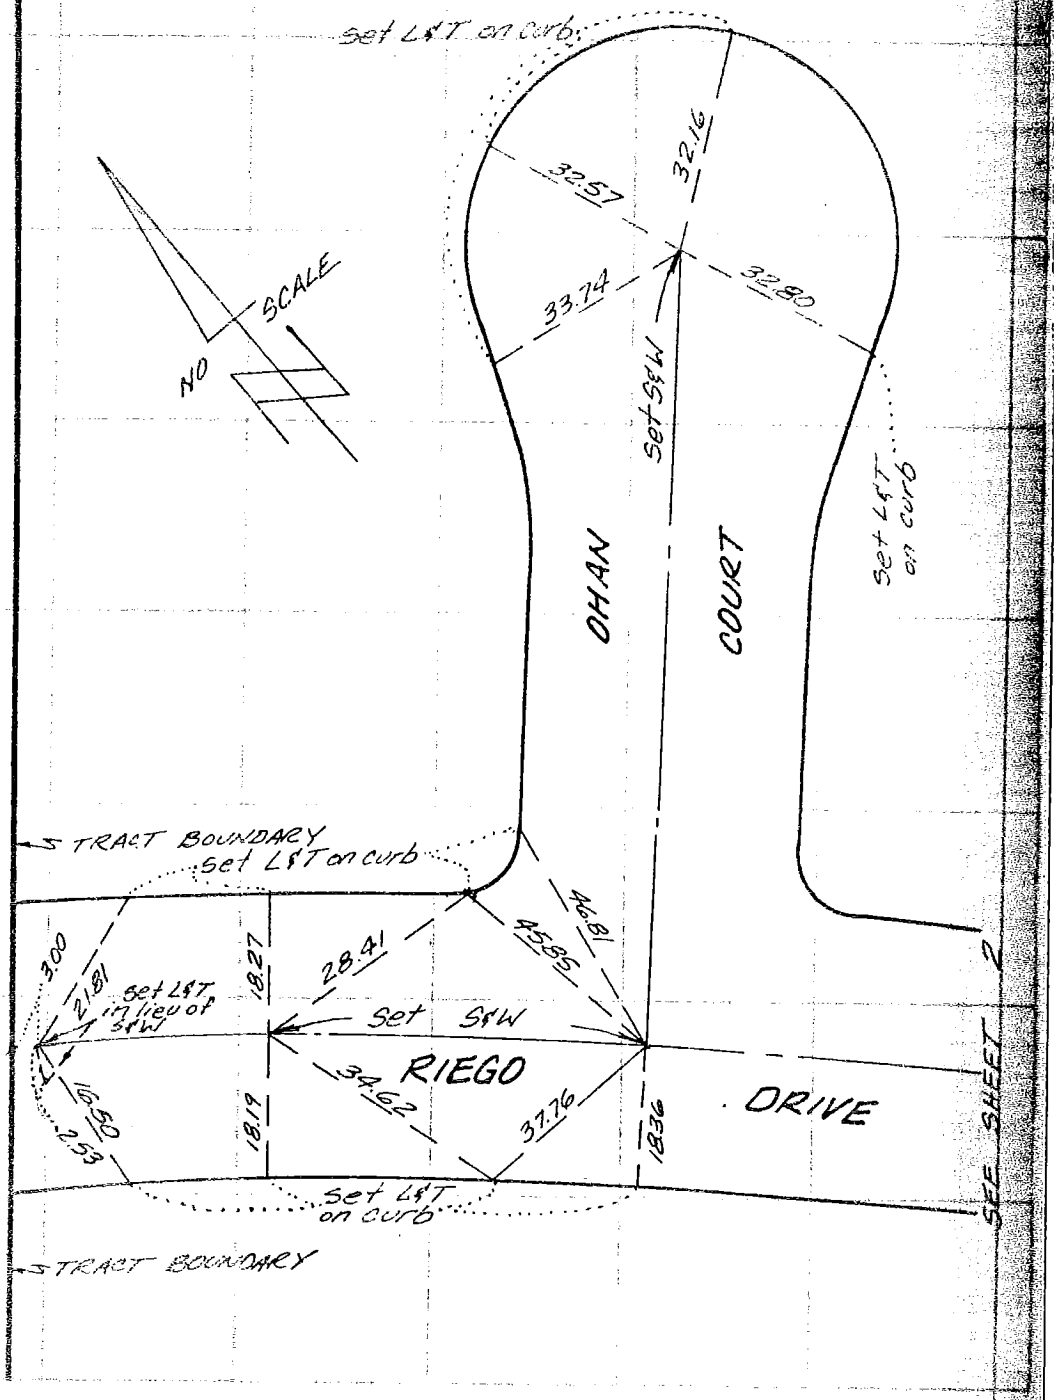

SO. CALIF. BLUE PRINT CO.

099-317 C-2

CO ENG GB 3673-70

PAGE 2 OF 6

SURVEY OF 4 TIES

SURVEY BY WESLEY R. LIND R.C.E. 16362

TR. No. 33104

DATE SEPT. 12, 1980

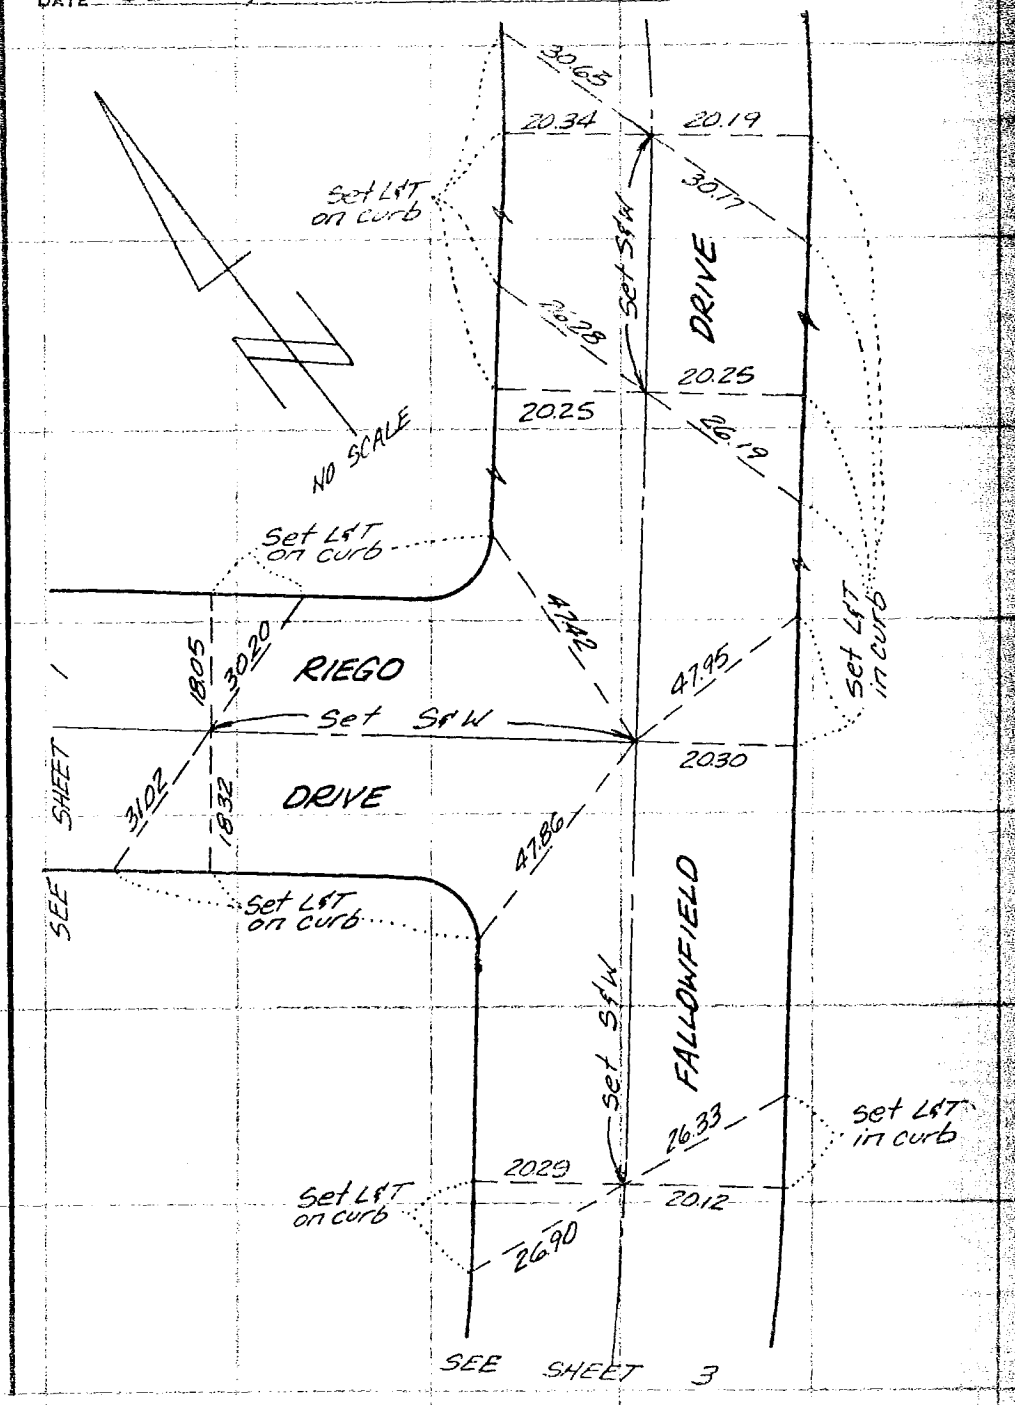

SO. CALIF. BLUE PRINT CO. -

CO ENG FB 3673-71

PAGE 3 OF 6 PGS.

SURVEY OF ℄ TIES

SURVEY BY WESLEY R. LIND R.C.E. 16362

DATE SEPT. 12, 1980

TR. No. 33104

SO. CALIF. BLUE PRINT CO. -

089-317C-2

CO ENG FB 3673-72

PAGE 4 OF 6

SURVEY OF ℄ TIES

SURVEY BY WESLEY R. LIND R.C.E. 16362

DATE SEPT. 12, 1980

TR. No. 33104

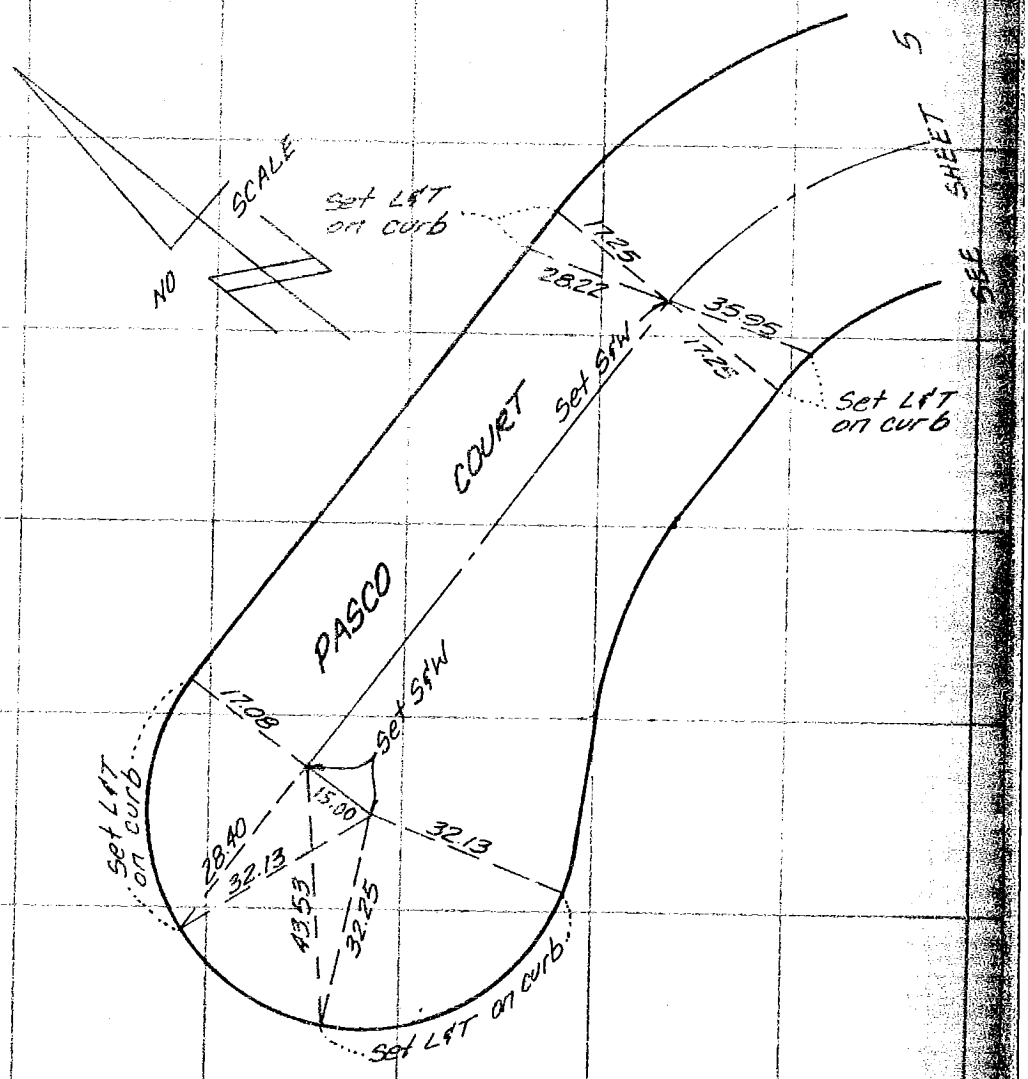

BO. CALIF. BLUE PRINT CO.

09-317 C-2

099-317 C-2

CO ENG FB 3673-73

SURVEY OF ETIES

PAGE 5 OF 6
F. B. Pg.

SURVEY BY WESLEY R. LIND R.C.E. 16362

TR. No. 33104

DATE SEPT. 12, 1980

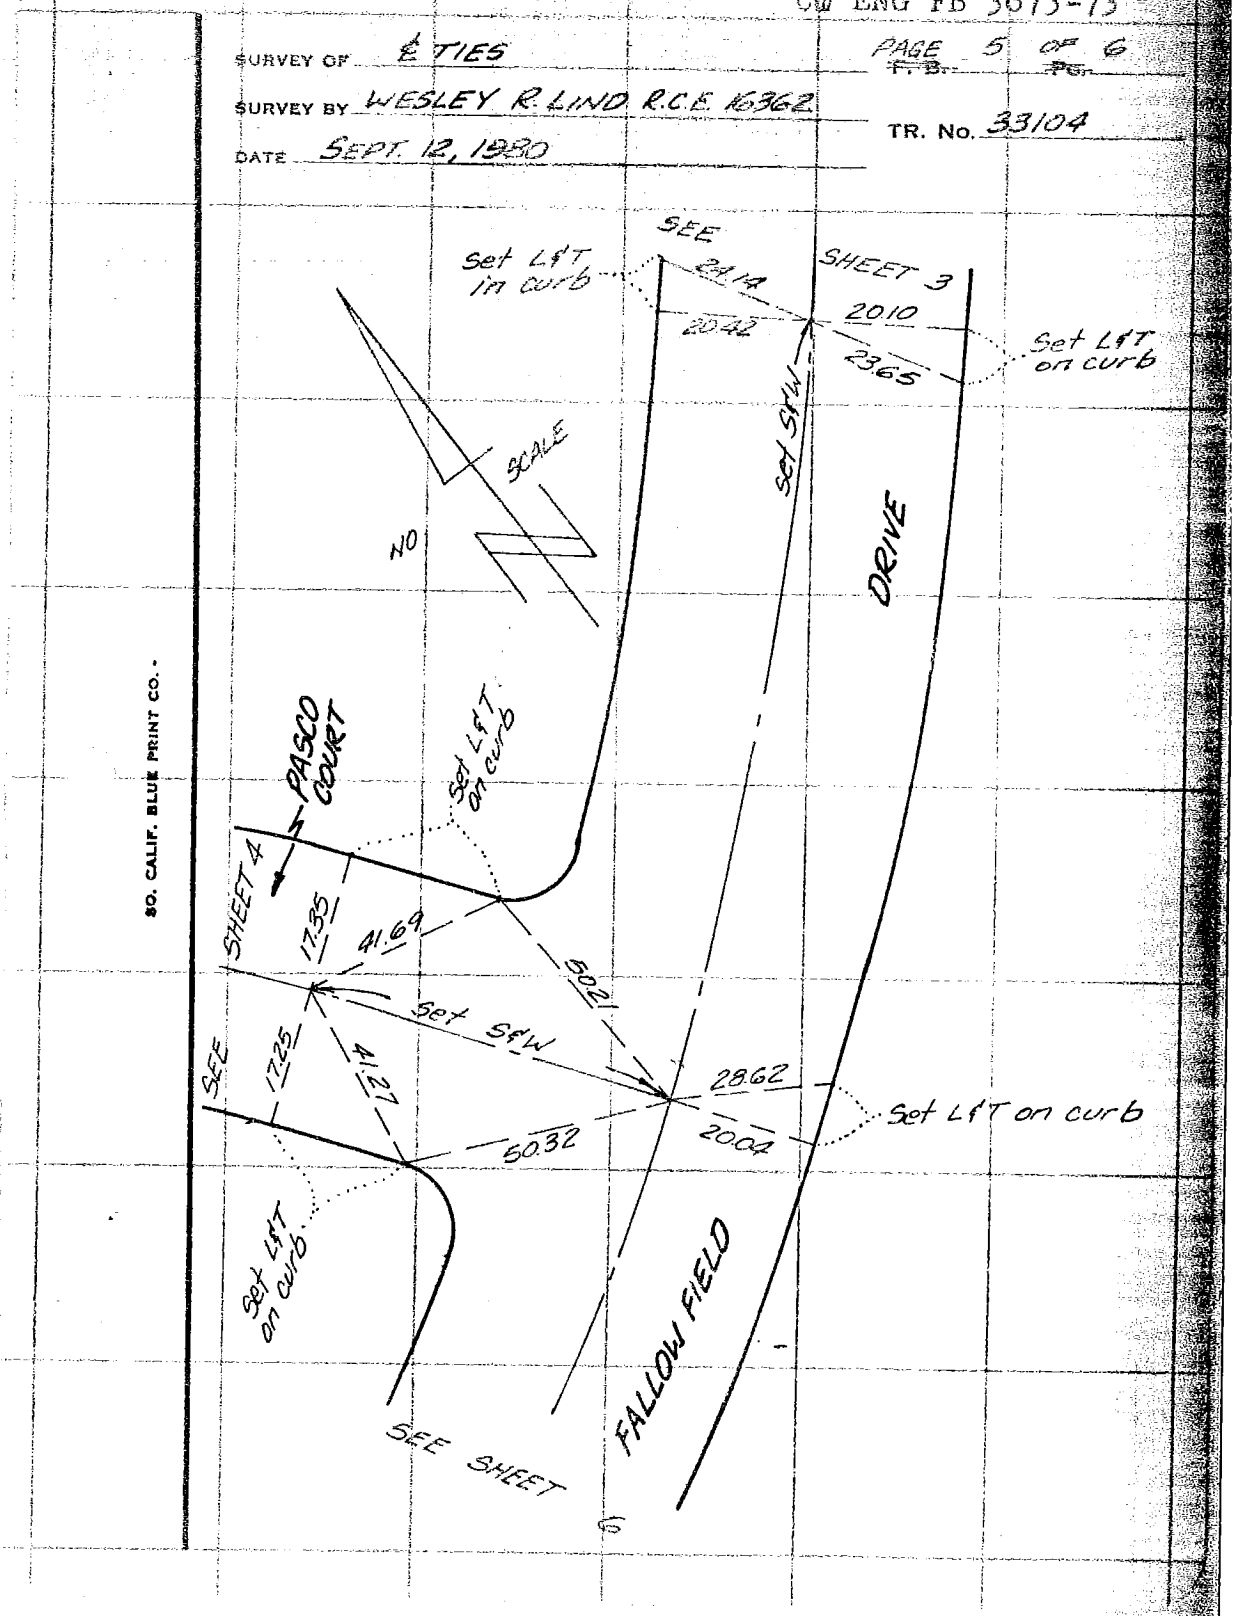

090-317, C-3

CO ENG FB 3673-74

PAGE 6 OF 6

F. B. Pg.

SURVEY OF 4 TIES

SURVEY BY WESLEY R. LIND R.C.E. 16362

DATE SEPT. 12, 1980

TR. No. 33104

SO. CALIF. BLUE PRINT CO.

CO ENG FB 3673-75

TRACT NO. 36478 DATE 7-31-84 PAGE 1 OF 9

SURVEY BY ENGINEER: DENNIS J. SLOAN R.C.E. 29704
COMPANY: D.J. SLOAN & ASSOCIATES, INC.

OK

W.S. 69, A-3

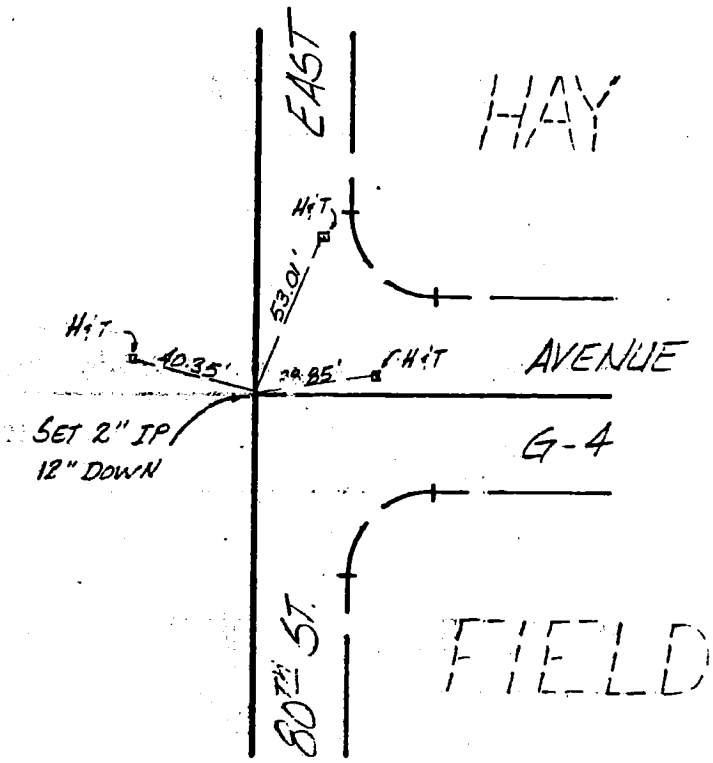

TRACT NO. 36478 DATE 7-31-84 PAG 2 OF 9

SURVEY BY ENGINEER: DENNIS J. SLOAN R.C.E. 29704
COMPANY: D.J. SLOAN & ASSOCIATES, INC.

W.S. 69, A-3

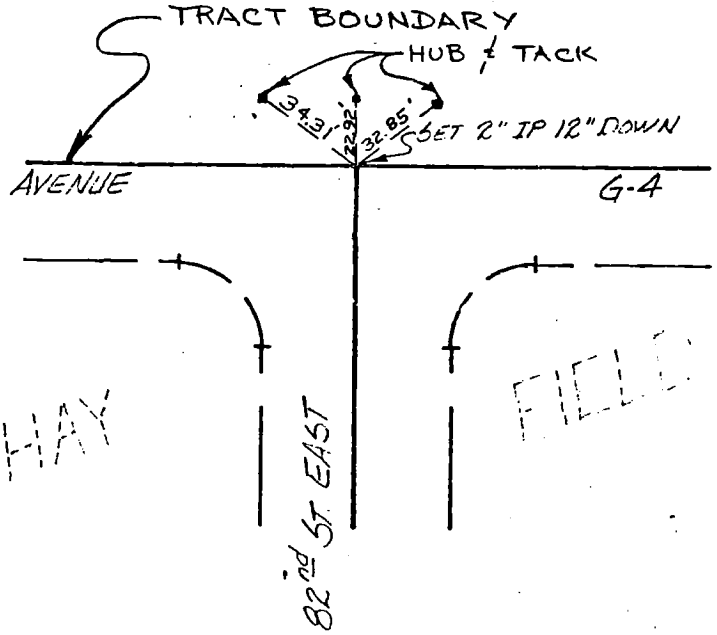

TRACT NO. 3647B DATE 7-31-84 PAGE 3 OF 9

SURVEY BY ENGINEER: DENNIS J. SLOAN R.C.E. 29704
COMPANY: D.J. SLOAN & ASSOCIATES, INC.

W.S.69, A-3

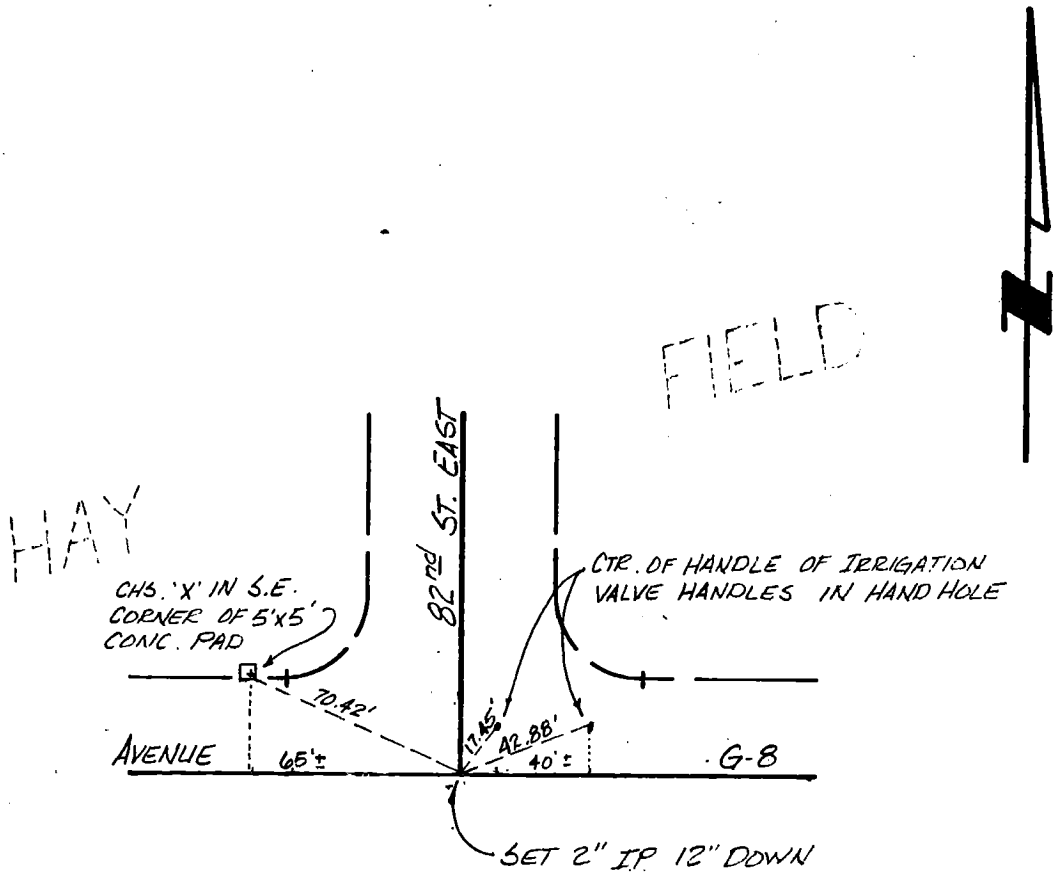

TRACT NO. 36478 DATE 7-31-84 PAGE 1 OF 9

SURVEY BY ENGINEER: DENNIS J. SLOAN R.C.E. 29704
COMPANY: D.J. SLOAN & ASSOCIATES, INC.

W.S. 69A-3

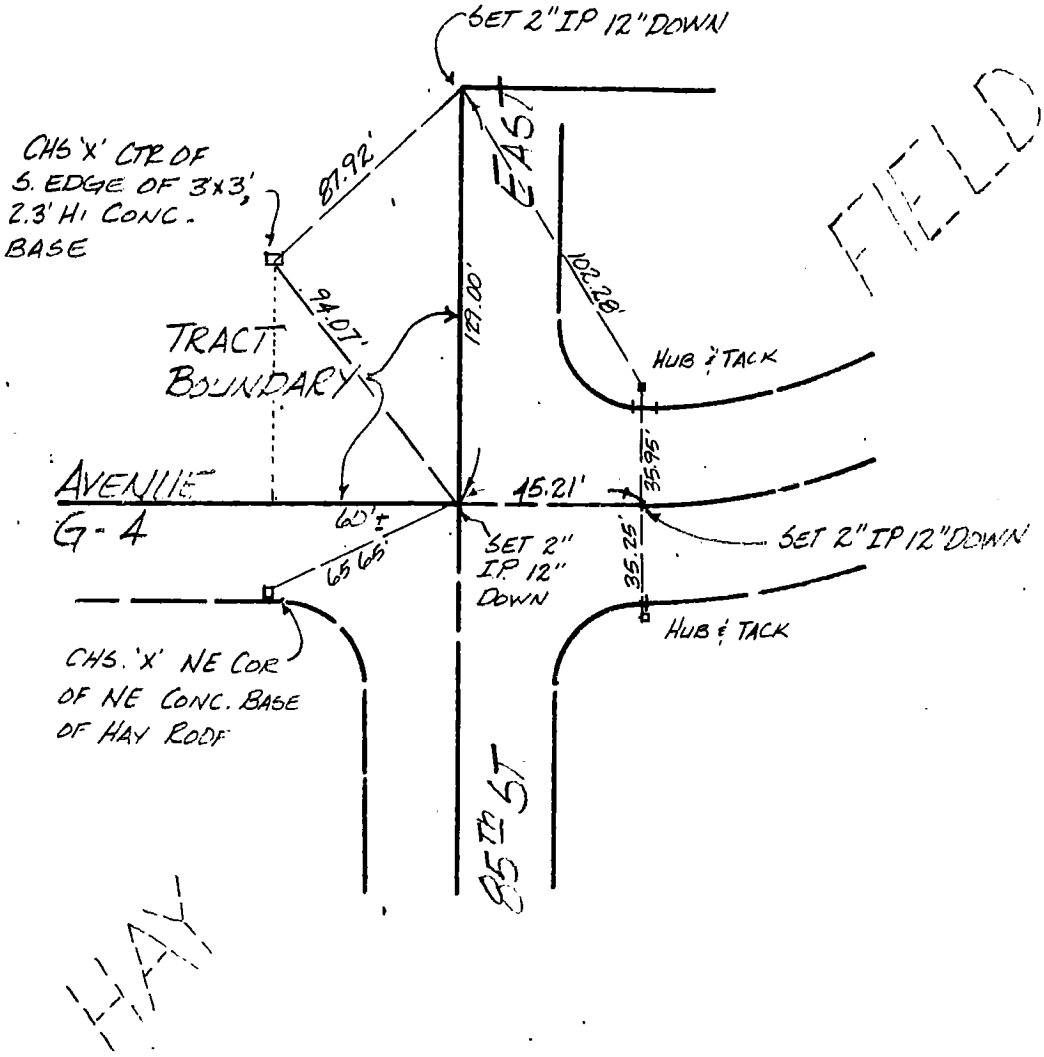

TRACT NO. 36478 DATE 7-31-84 PAGE 5 OF 9

SURVEY BY ENGINEER: DENNIS J. SLOAN R.C.E. 29704
COMPANY: D.J. SLOAN & ASSOCIATES, INC.

W.S. 69, A-3

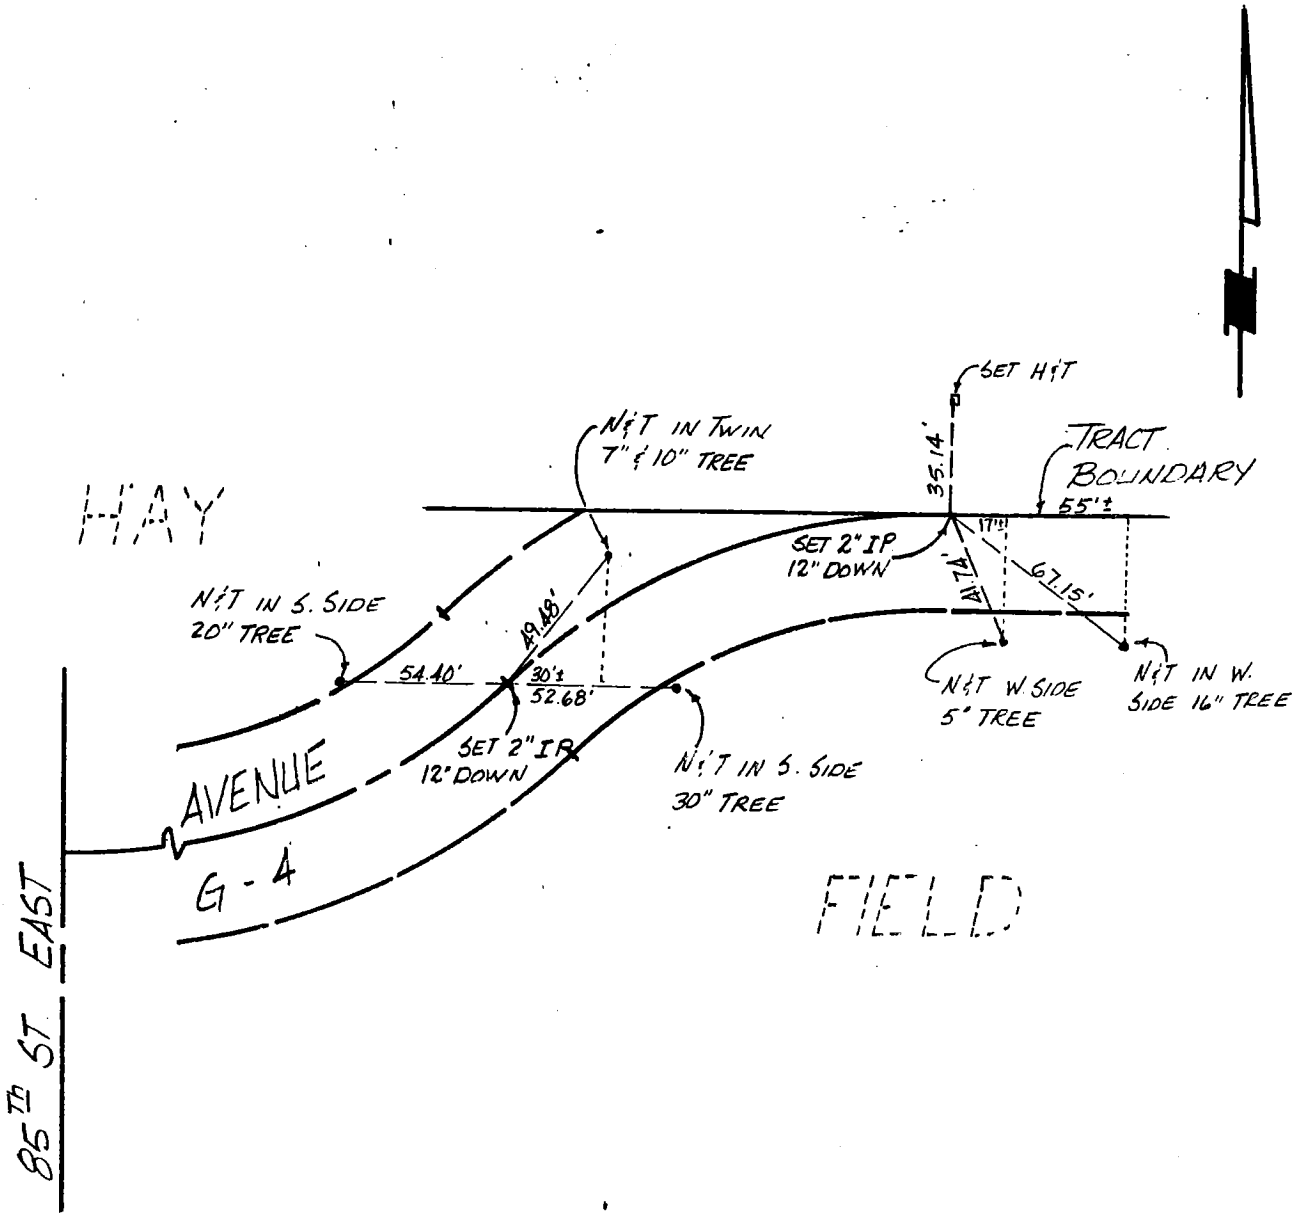

TRACT NO. 36478 DATE 7-31-84 PAGE 6 OF 9

SURVEY BY ENGINEER: DENNIS J. SLOAN R.C.E. 29704
COMPANY: D.J. SLOAN & ASSOCIATES, INC.

W.S. 69, A-3

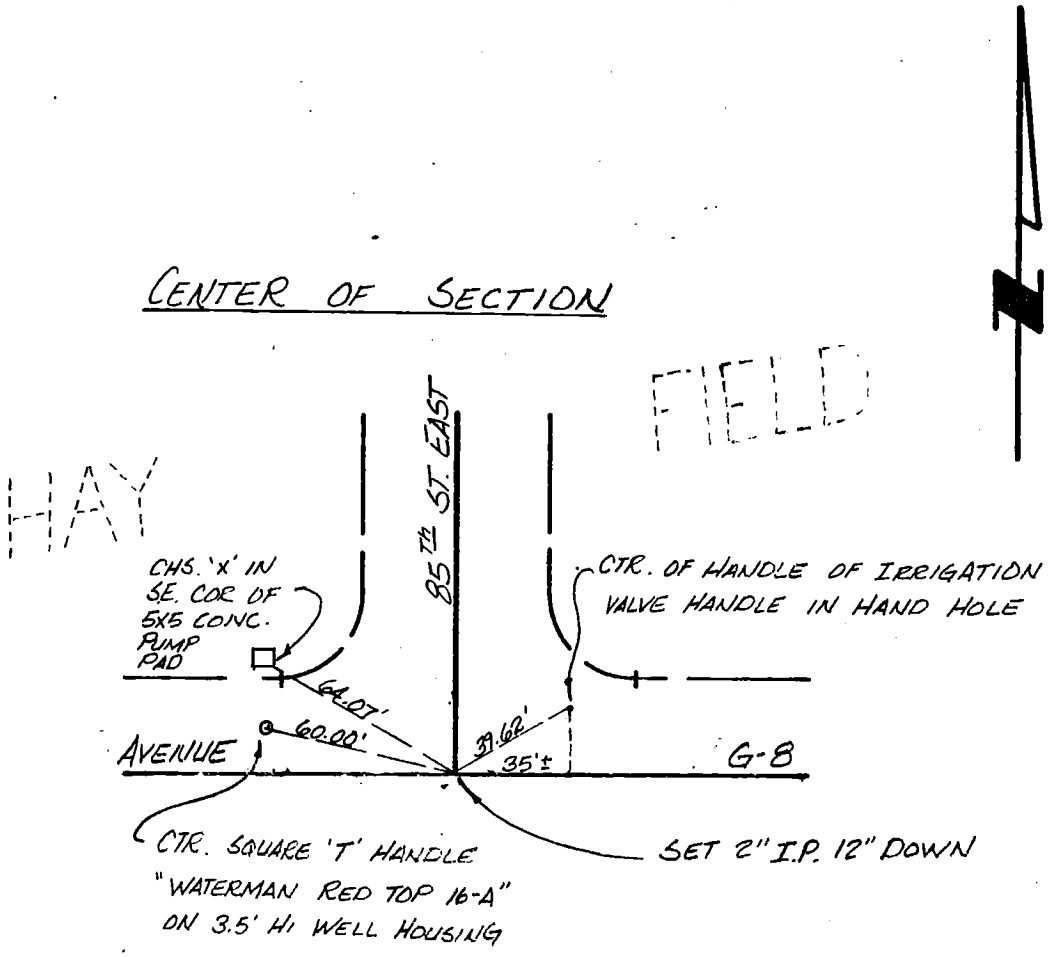

TRACT NO. 36478 DATE 7-31-84 PAGE 7 OF 9

SURVEY BY ENGINEER: DENNIS J. SLOAN R.C.E. 29704

COMPANY: D.J. SLOAN & ASSOCIATES, INC.

W.S. 69A-3

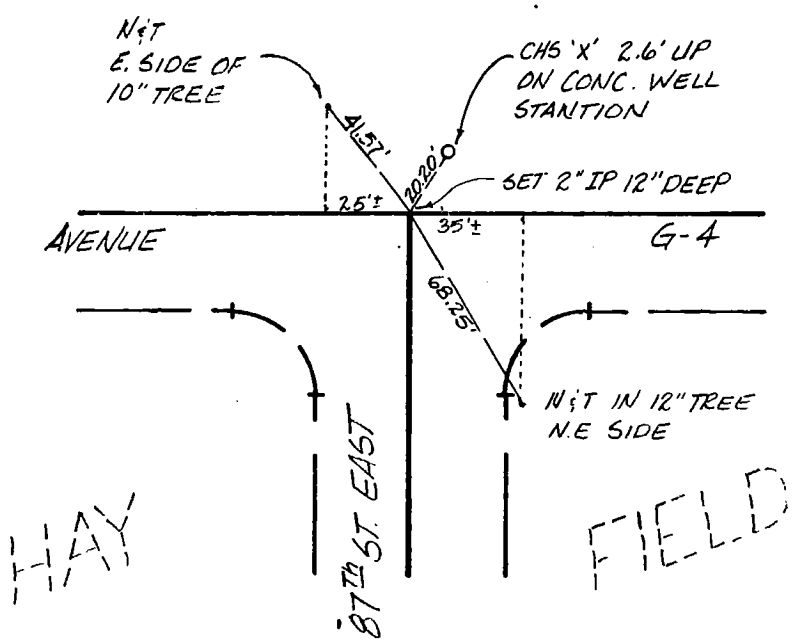

TRACT NO. 36478 DATE 7-31-84 PAGE 8 OF 9

SURVEY BY ENGINEER: DENNIS J. SLOAN R.C.E. 29704
COMPANY: D.J. SLOAN & ASSOCIATES, INC.

W.S. 69, A-3

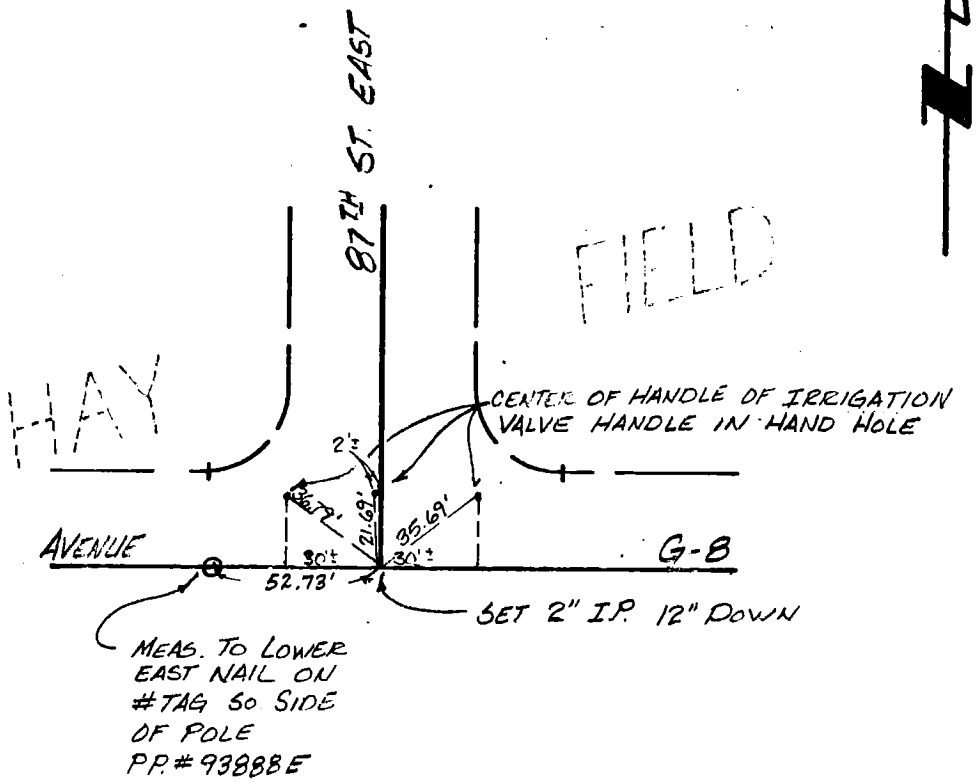

TRACT NO. 36478 DATE 7-31-84 PAGE 9 OF 9

SURVEY BY ENGINEER: DENNIS J. SLOAN R.C.E. 29704
COMPANY: D.J. SLOAN & ASSOCIATES, INC.

W.S. 69A-3

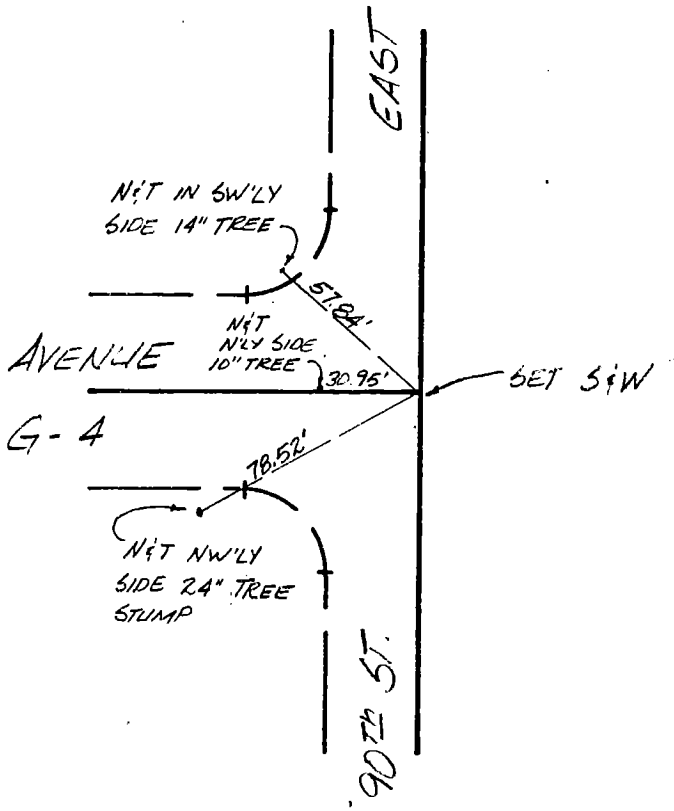

OK

CO ENG FB 3673-84

F. B. _____ PG. _____ SURVEY OF ℄ TIES

TR. No. 35278 SURVEY BY WARREN L. RAKNESS RCE 17746

DATE 8-24-84

W.S. 64 14-5

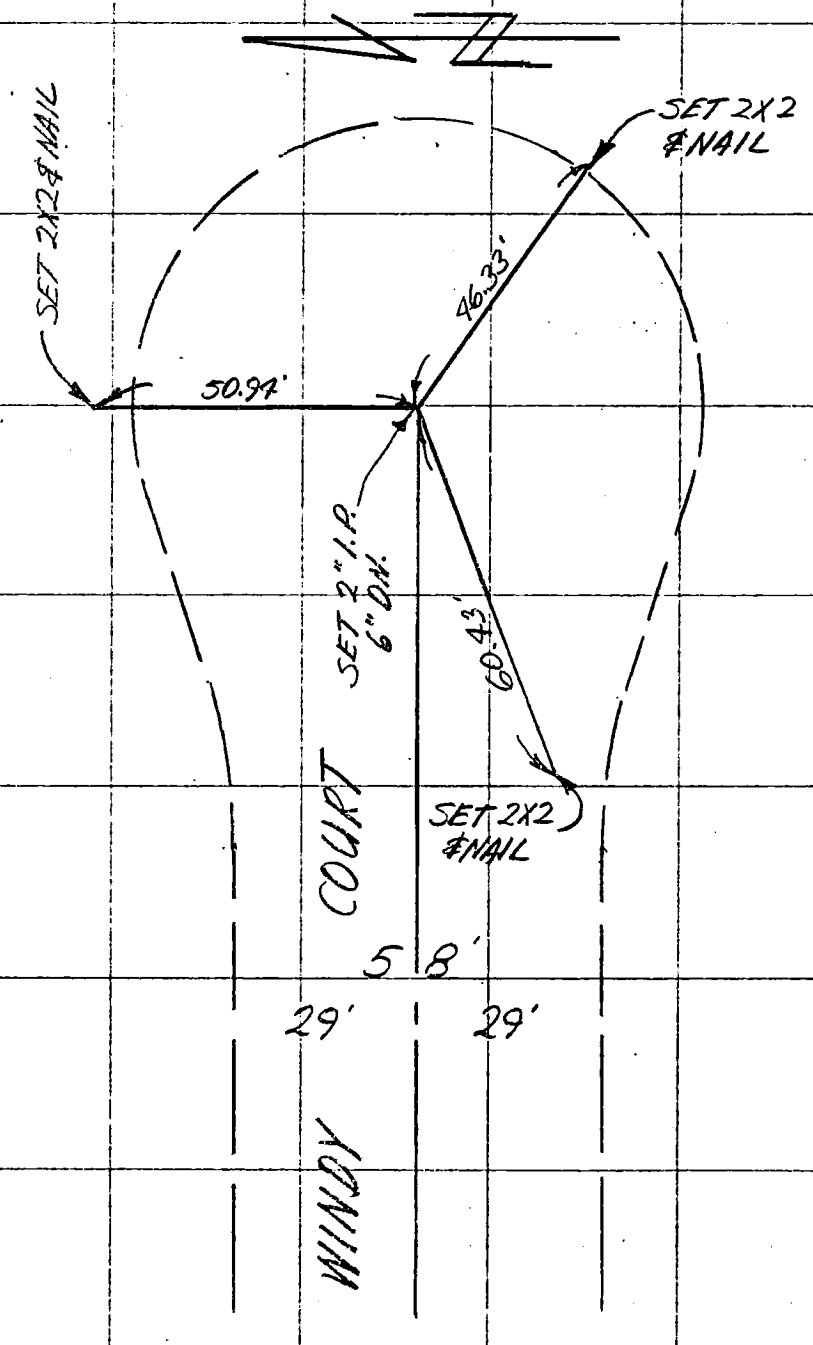

CO ENG FB 3673-85

W.S. 64, 4-5

SURVEY OF ℄ TIES F. B. _____ PG. _____

SURVEY BY: WARREN L. RAKNESS RCE17746 TR. No. 35278

DATE 8-24-84

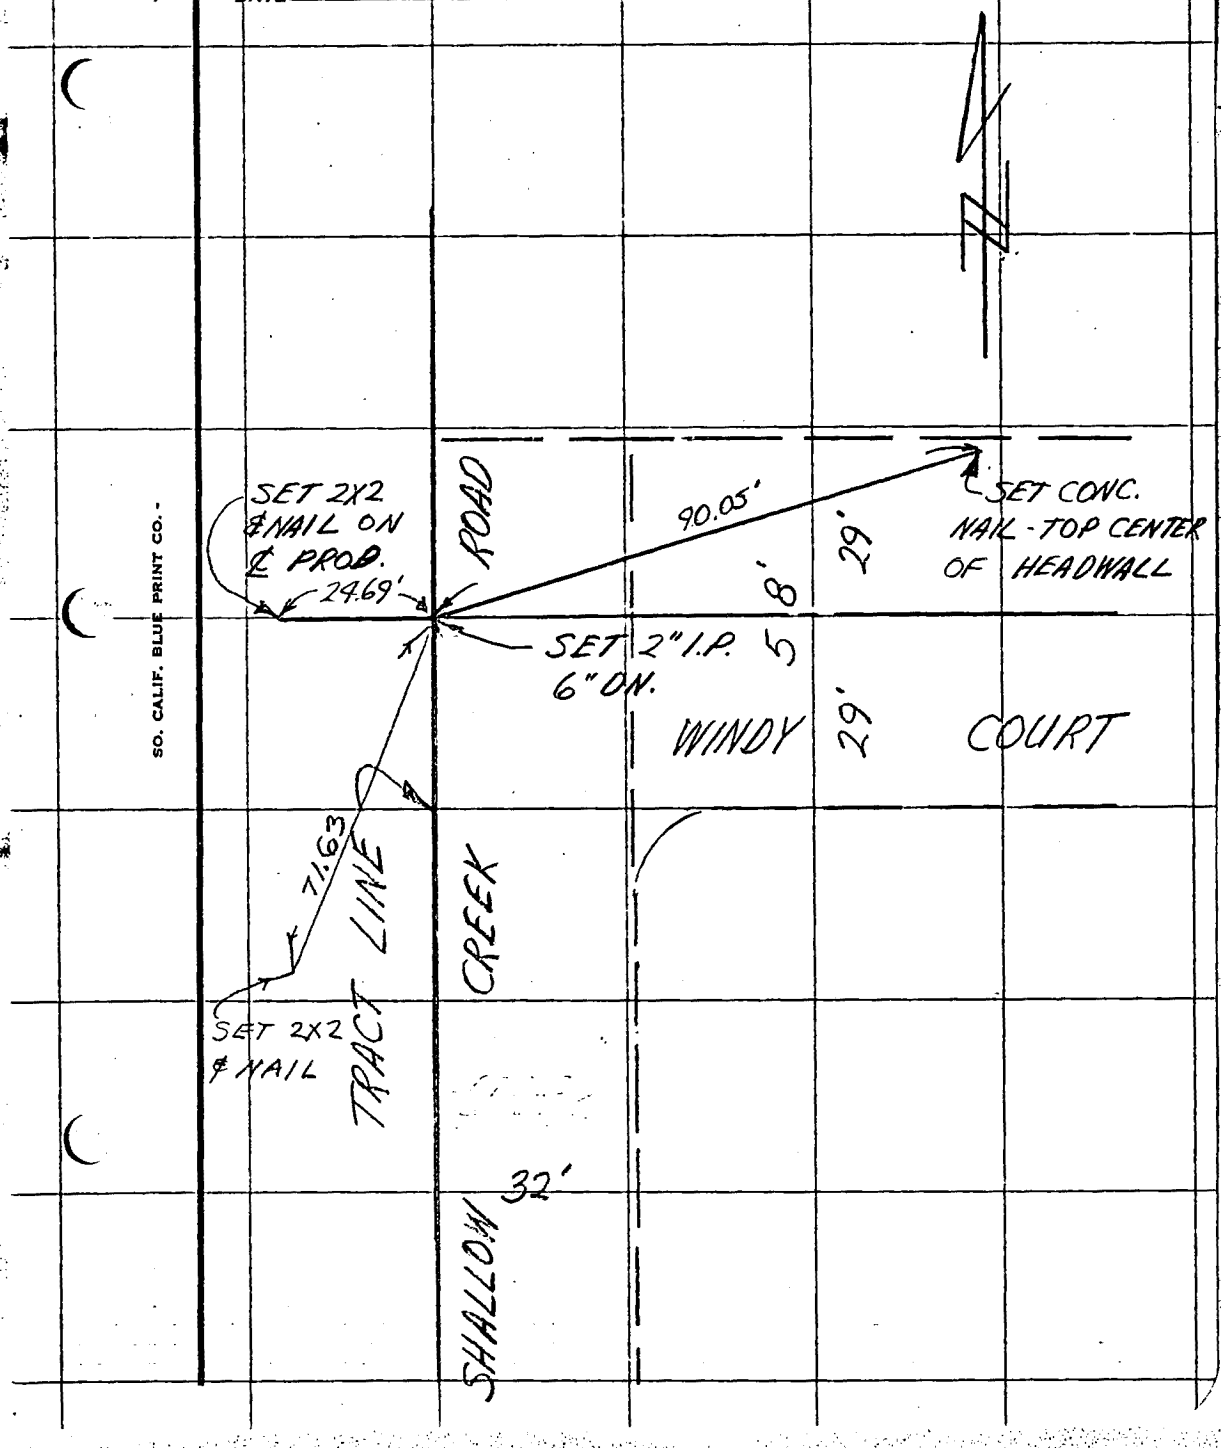

SO. CALIF. BLUE PRINT CO.

CO ENG FB OK 3673-86

SURVEY OF CENTERLINE TIES F B NO 100-G PAGE
SURVEY BY SO. BAY ENGR. CORP TRACT NO 38130 (CARSON)
DATE 8-30-84
ENGINEER: ROSS N. BOLTON RCE 26120

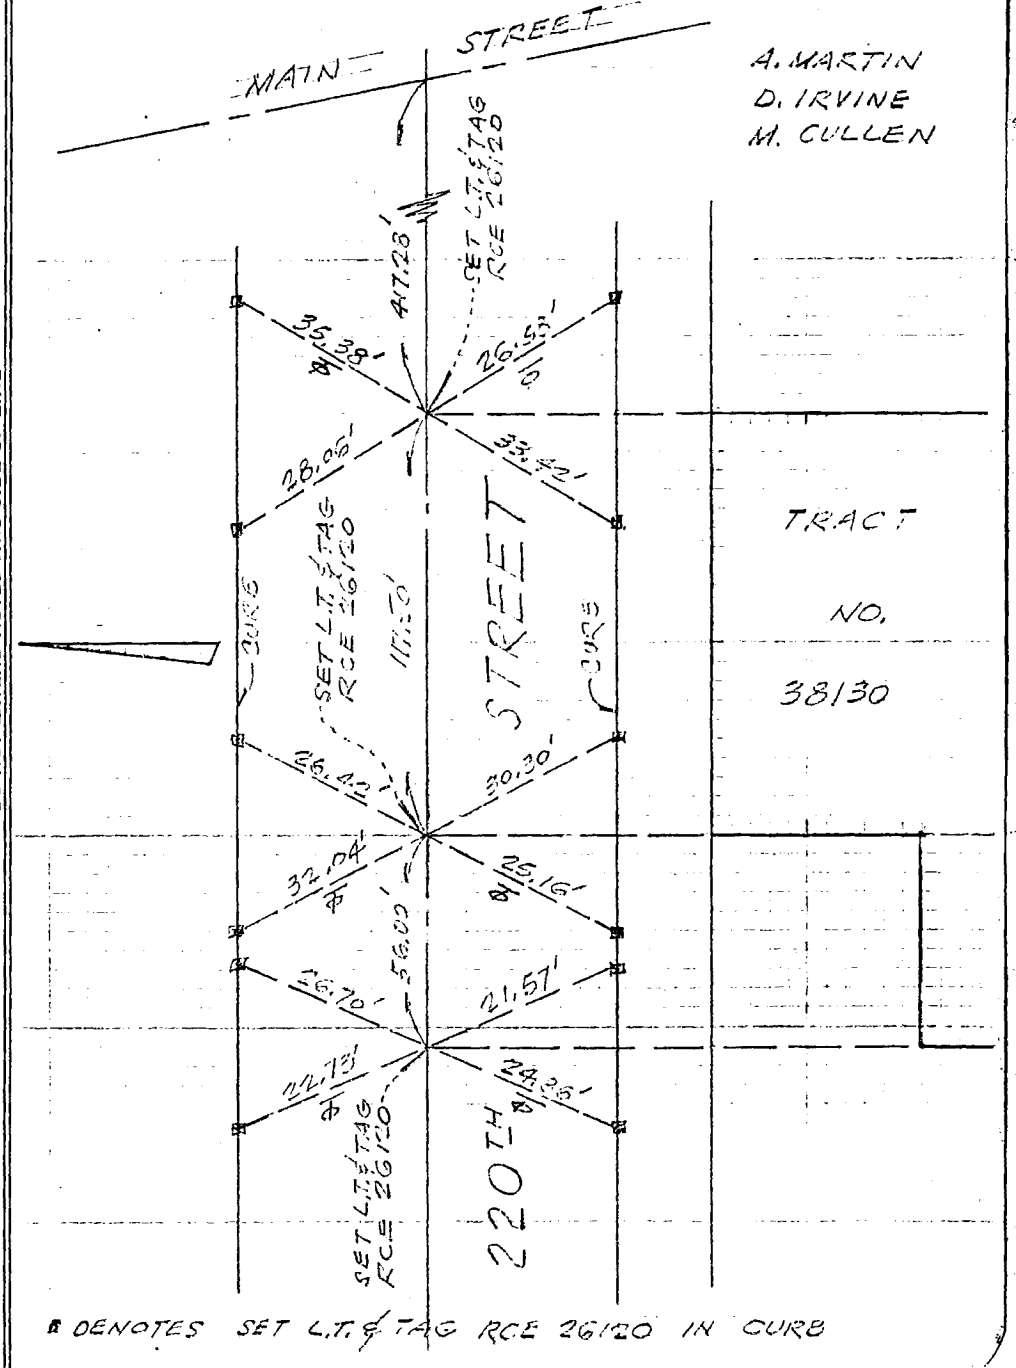

■ DENOTES SET L.T. & TAG RCE 26120 IN CURB

W.S. 28,B-1

SURVEYORS SERVICE COMPANY - COSTA MESA - STOCK NO. 411

DO NOT EXTEND NOTES THIS SIDE OF LINE

OK

CO ENG FB 3673-87

SHT. 1 OF 5 SHTS.

SURVEY OF ℄ TIES

SURVEY BY WESLEY R. LIND R.C.E. 16362 TR. No. 32136

DATE AUGUST 27, 1984

099-297, 82

SO. CALIF. BLUE PRINT CO.

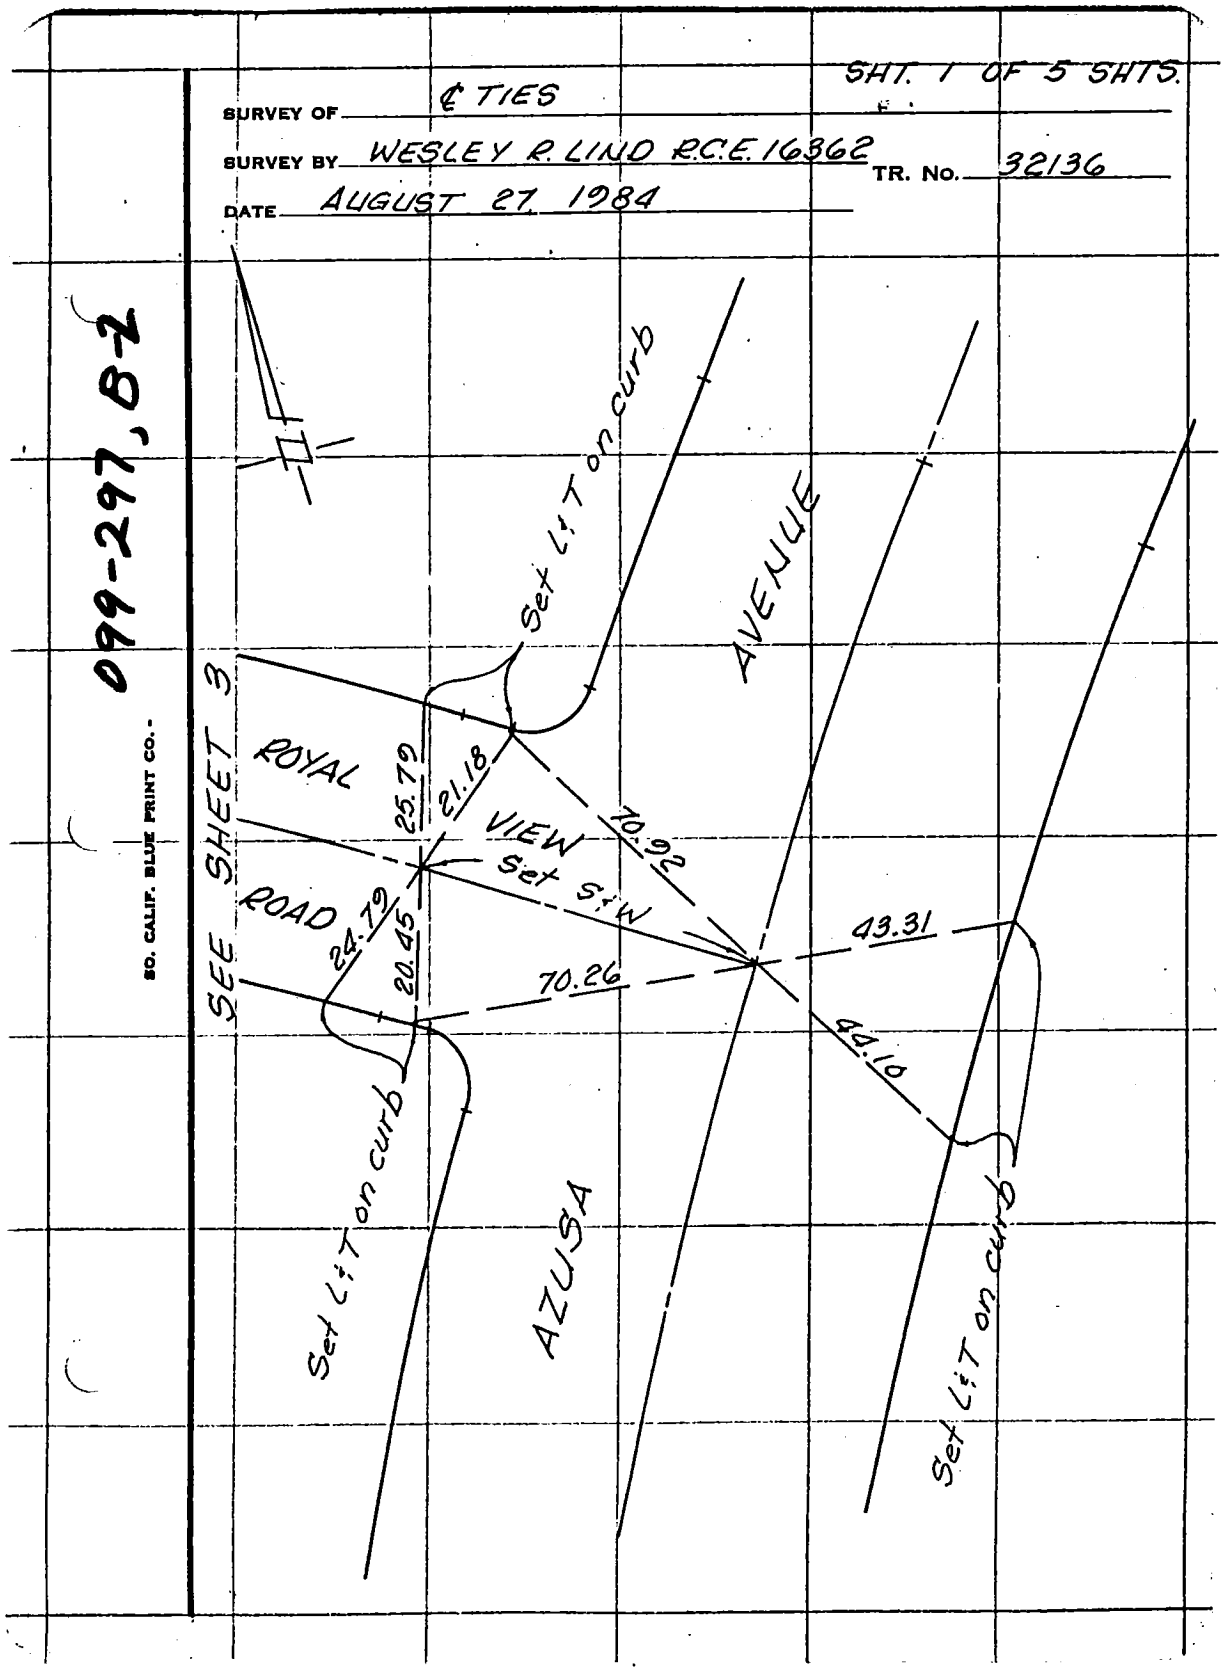

SHT. 2 OF 5 SHTS.

SURVEY OF ℄ TIES

SURVEY BY WESLEY R. LIND R.C.E. 16362 TR. No. 32136

DATE AUGUST 27, 1984

099-297, 8-2

SO. CALIF. BLUE PRINT CO. -

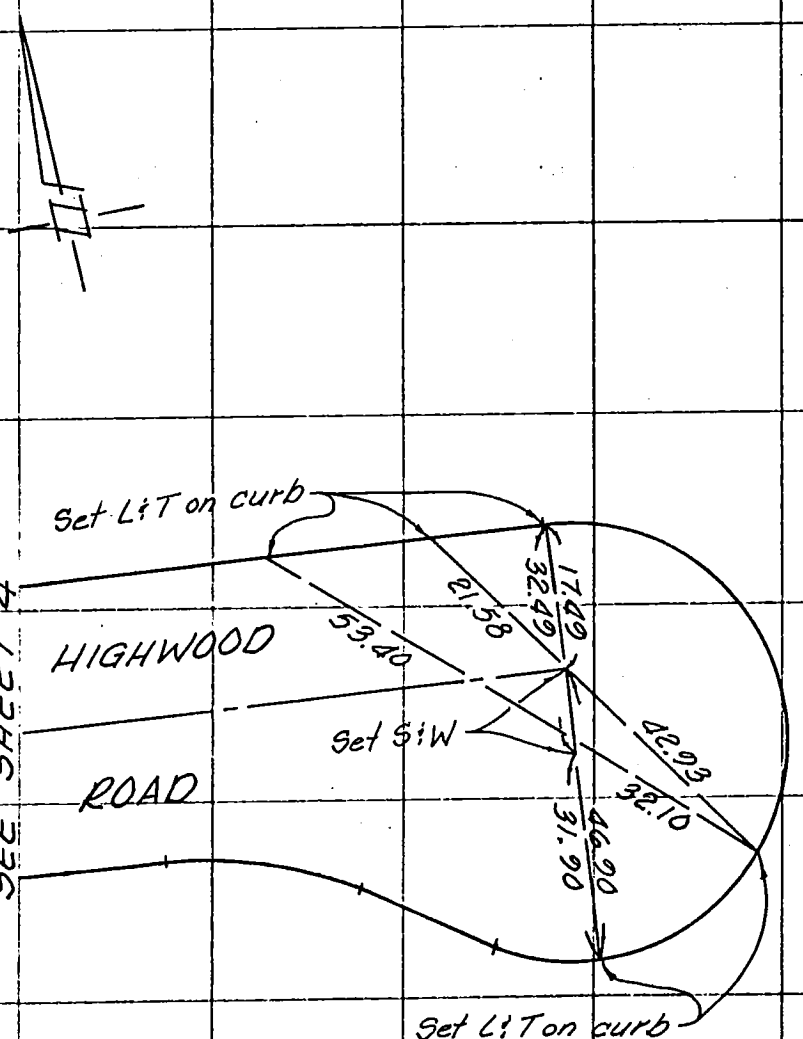

SHT. 3 OF 5 SHTS

SURVEY OF ℄ TIES

SURVEY BY WESLEY R. LIND R.C.E. 16362

TR. No. 32136

DATE AUGUST 27, 1984

069-297, 8-2

SO. CALIF. BLUE PRINT CO.

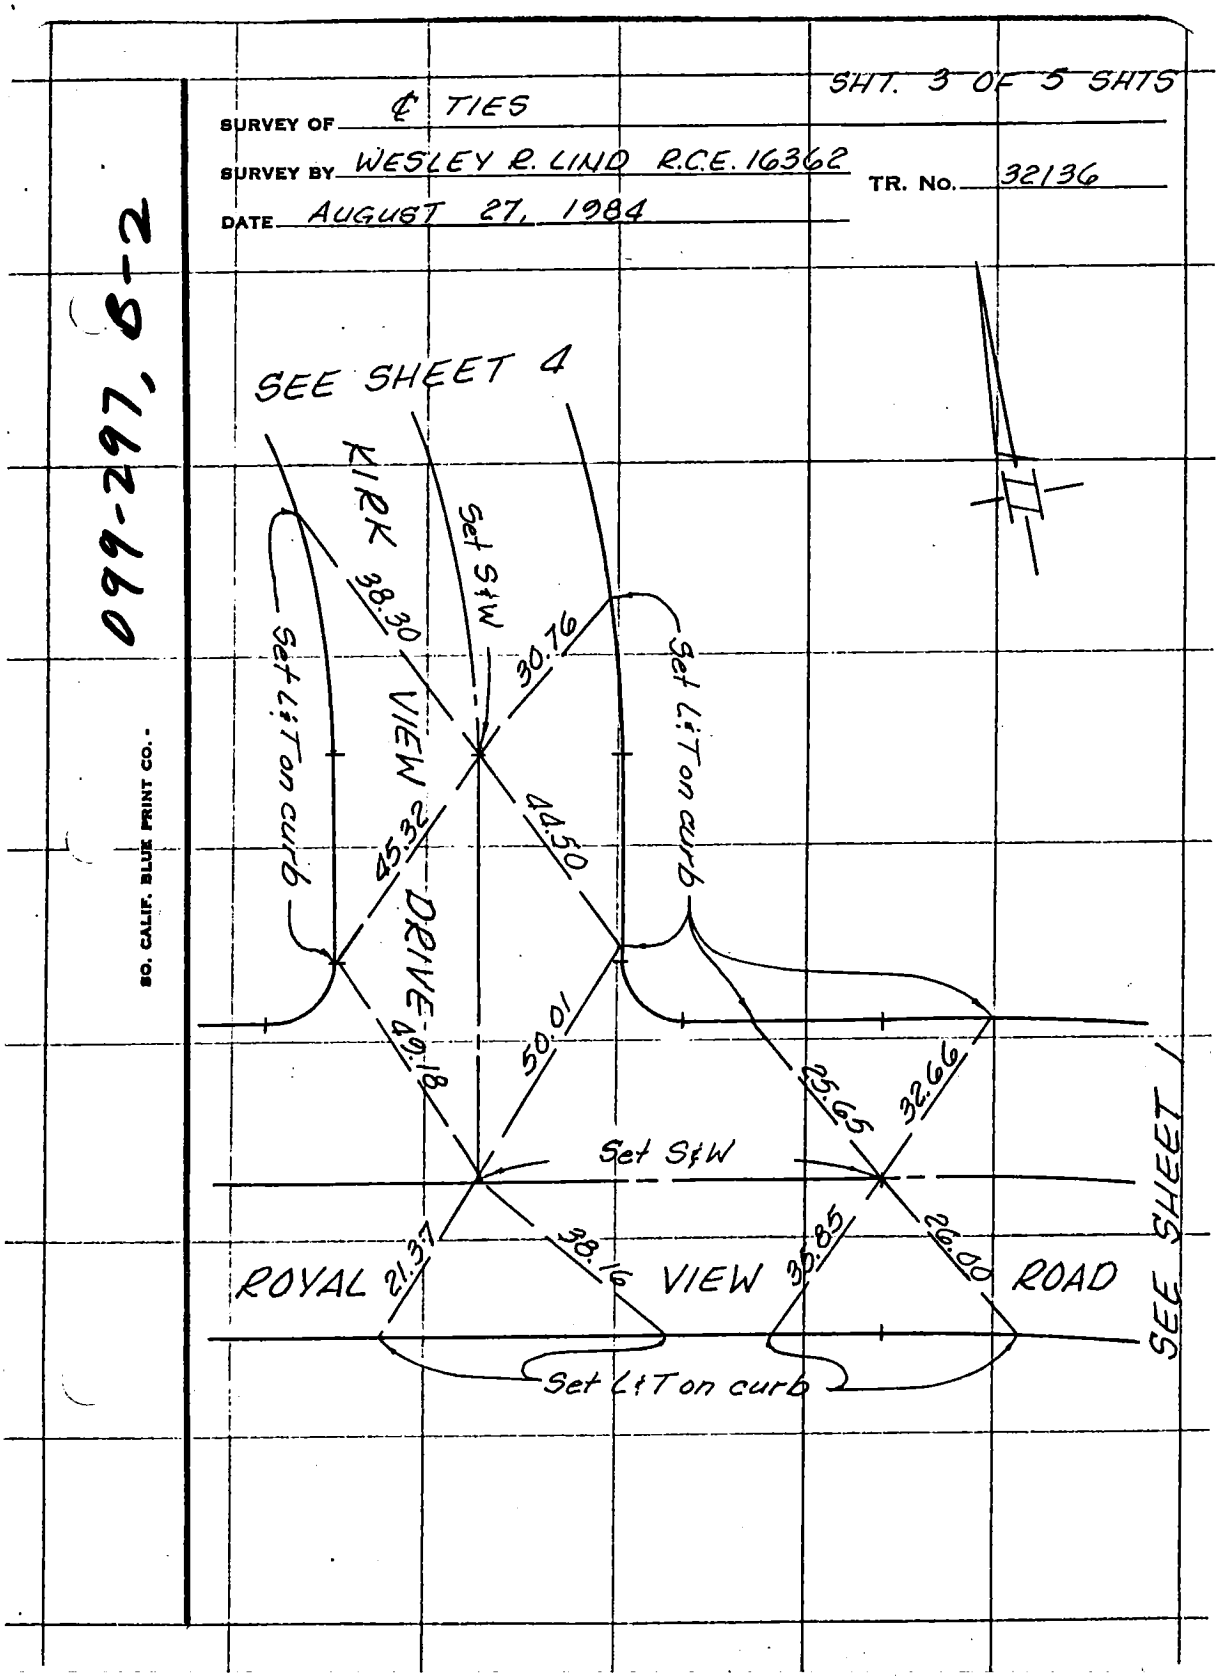

SHT. 4 OF 5 SHTS.

SURVEY OF ℄ TIES

SURVEY BY WESLEY R. LIND R.C.E. 16362 TR. No. 32136

DATE AUGUST 27, 1984

W.S.099-29.7, 8-1

SO. CALIF. BLUE PRINT CO.

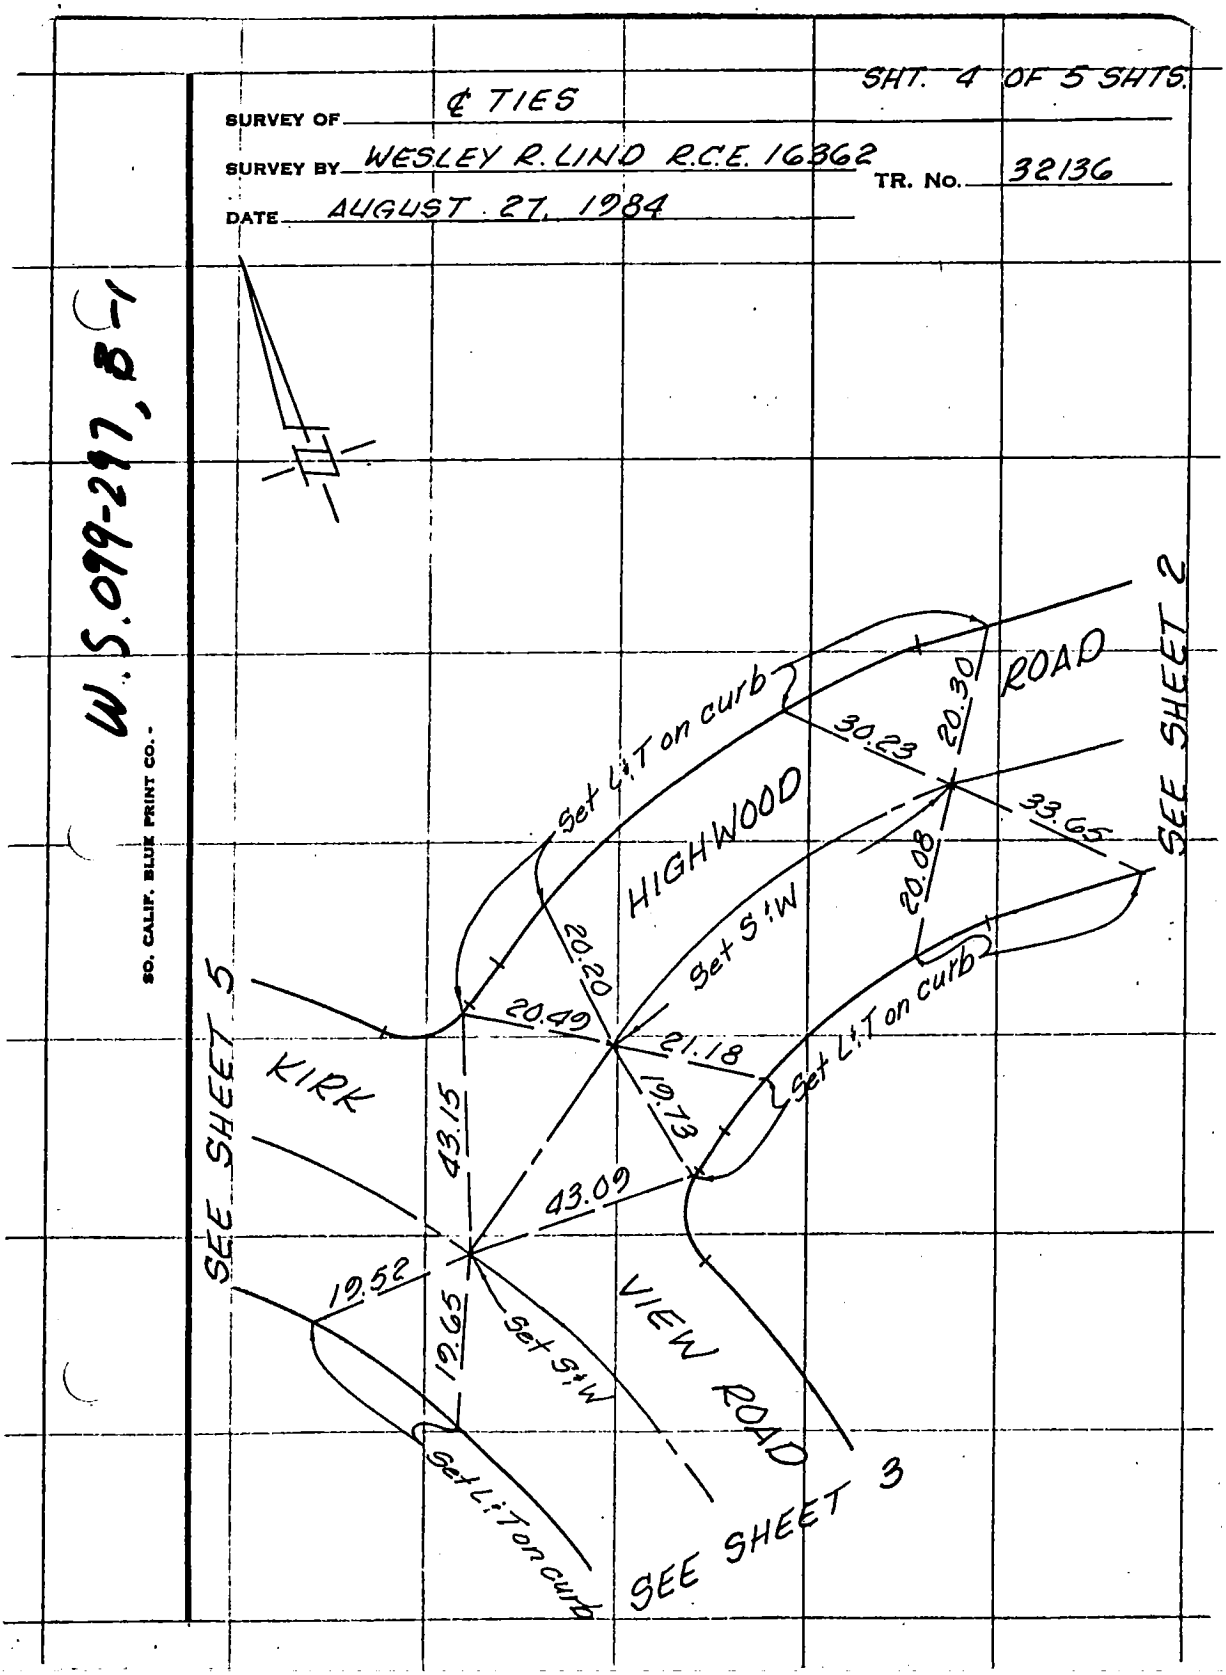

SHT. 5 OF 5 SHTS.

SURVEY OF ℄ TIES

SURVEY BY WESLEY R. LIND R.C.E. 16362 TR. No. 32136

DATE AUGUST 27, 1984

90-297, 8-1

SO. CALIF. BLUE PRINT CO.

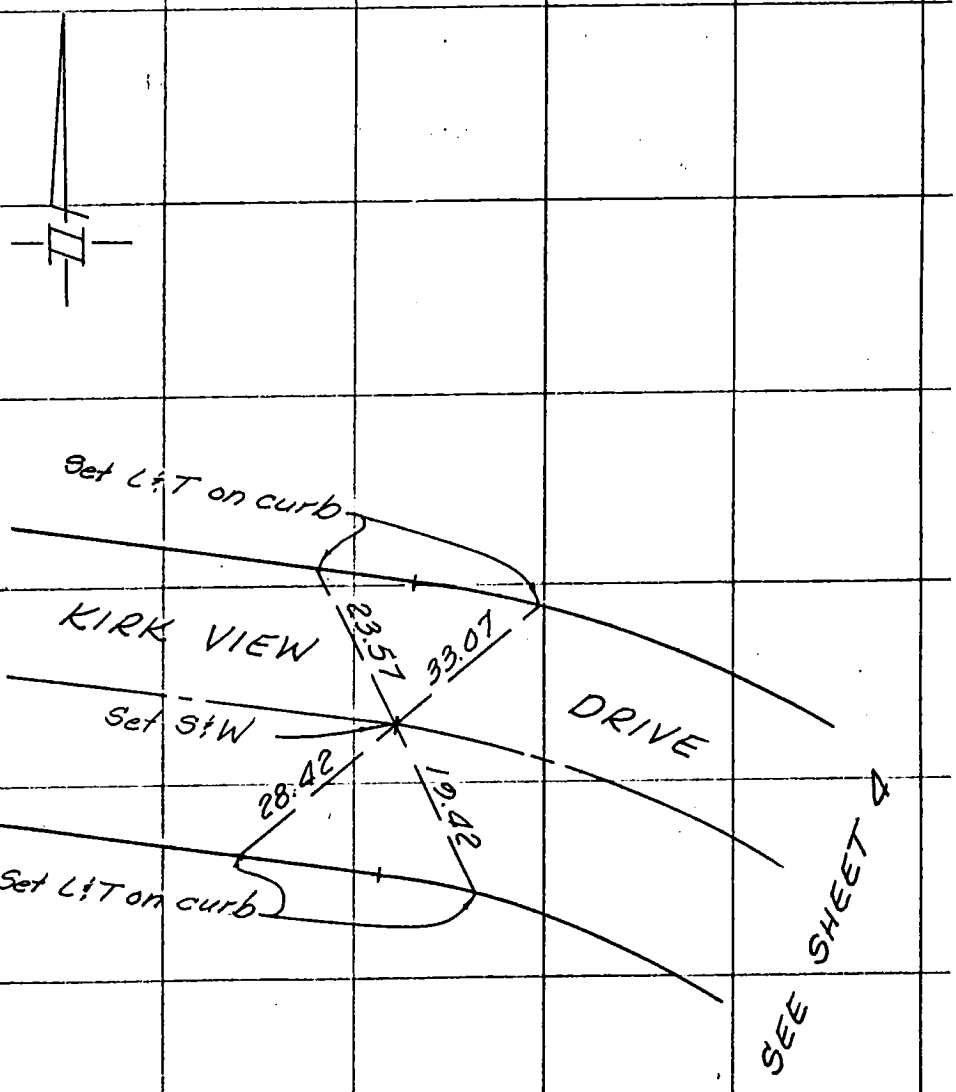

OK

CO ENG FB 3673-92

SURVEY OF CENTERLINE MON. & TIES F B NO 180-1 PAGE 1
SURVEY BY SALMEN + ASSOC. TRACT NO. 40896
DATE 8-6-84

223 RD STREET
264 FEET EAST OF
GRACE AVENUE

F. J. SALMEN SURVEYOR
F. E. SALMEN CHAINMAN

W. S. 28, C1

SURVEYORS SERVICE COMPANY, COSTA MESA - STOCK NO. 411

DO NOT EXTEND NOTES THIS SIDE OF LINE

CO ENG FB 3673-93

SURVEY OF CENTERLINE MON. & TIES F B NO 180-1 PAGE 2

SURVEY BY SALMEN & ASSOC. TRACT NO. 40896

DATE 8-6-84

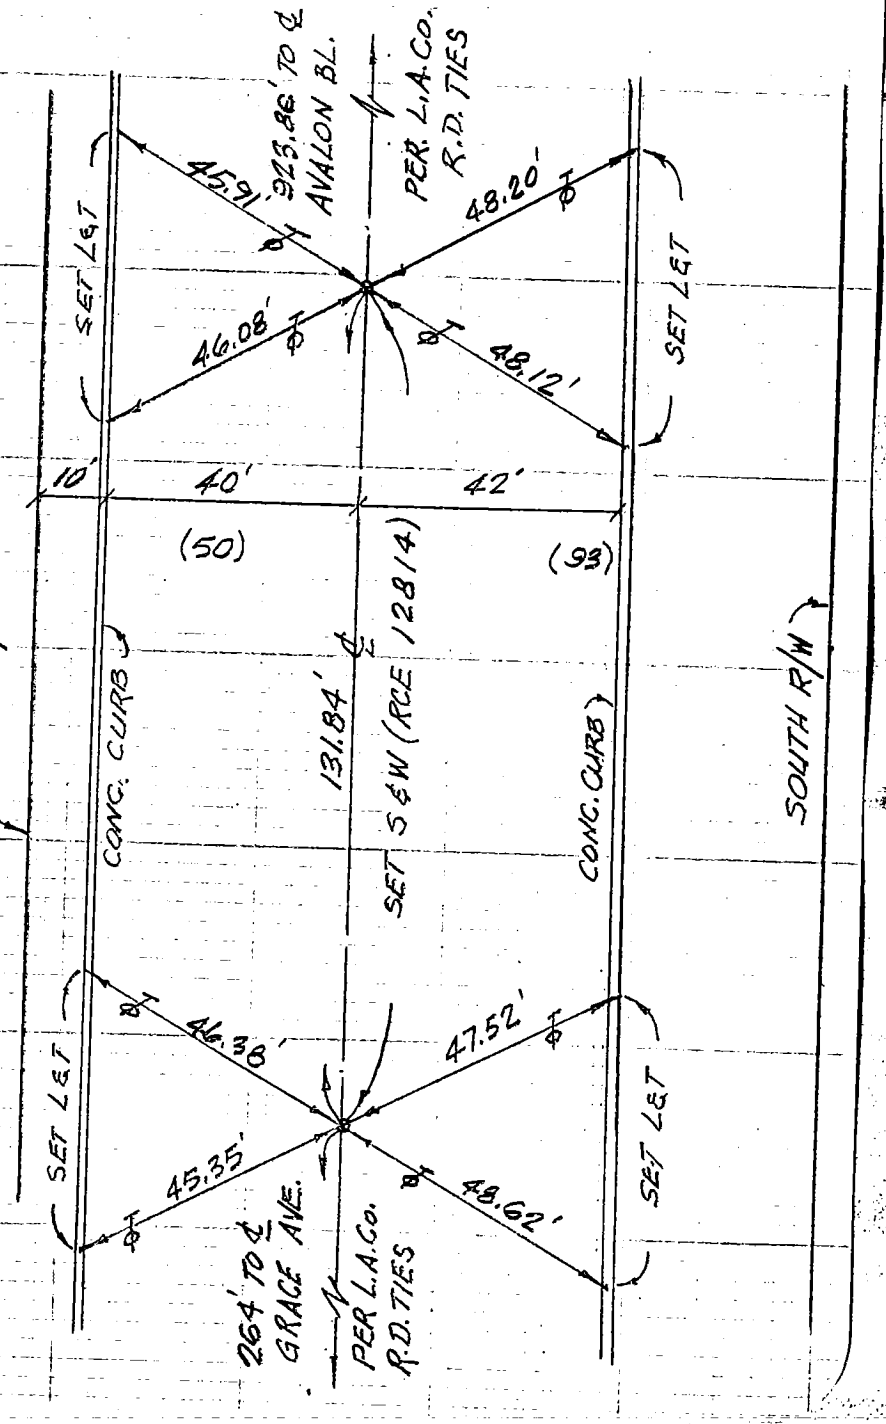

DO NOT EXTEND NOTES THIS SIDE OF LINE

SURVEYORS SERVICE COMPANY, COSTA MESA - STOCK NO. 411

W. S. 28 C-1

SURVEYORS SERVICE COMPANY, STA MESA - STOCK NO. 411

129-317, A-1

DO NOT EXTEND NOTES THIS SIDE OF LINE

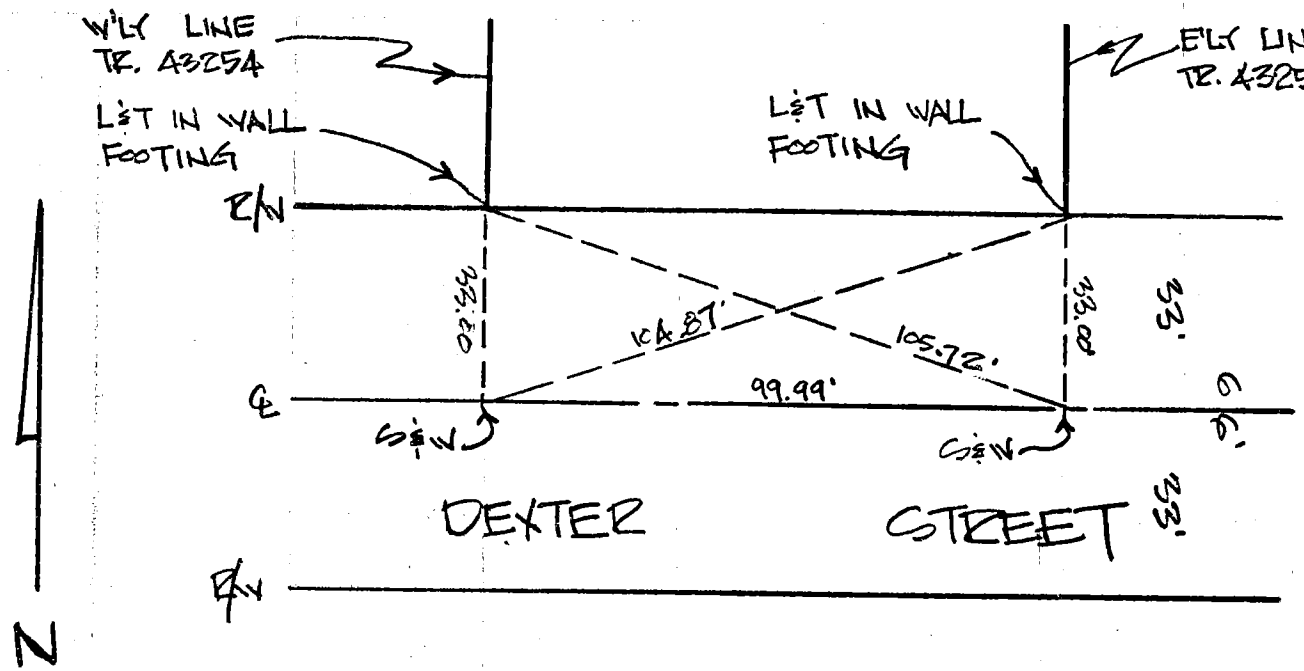

SURVEY OF CENTER LINE TIE F B. NO PAGE

SURVEY BY CANTWELL & ASSOC. TRACT NO 43254

DATE 9-12-64

CO ENG FB 3673-94

CO ENG FB 3673-94A

F.B NO. PAGE

W.S. 129-317, A-1

SURVEYORS SERVICE COMPANY, COSTA MESA - STOCK NO. 411

DO NOT EXTEND NOTES THIS SIDE OF LINE

CO ENG FB 3673-95

SURVEY OF CENTERLINE TIES F B NO 100-C PAGE

SURVEY BY SO. BAY ENGR. CORP. PARCEL MAP NO 16013 (CARSON)

DATE 9-17-84

ENGINEER: ROSS N. BOLTON
RCE 26120

A. MARTIN
D. IRVINE
M. CULLEN

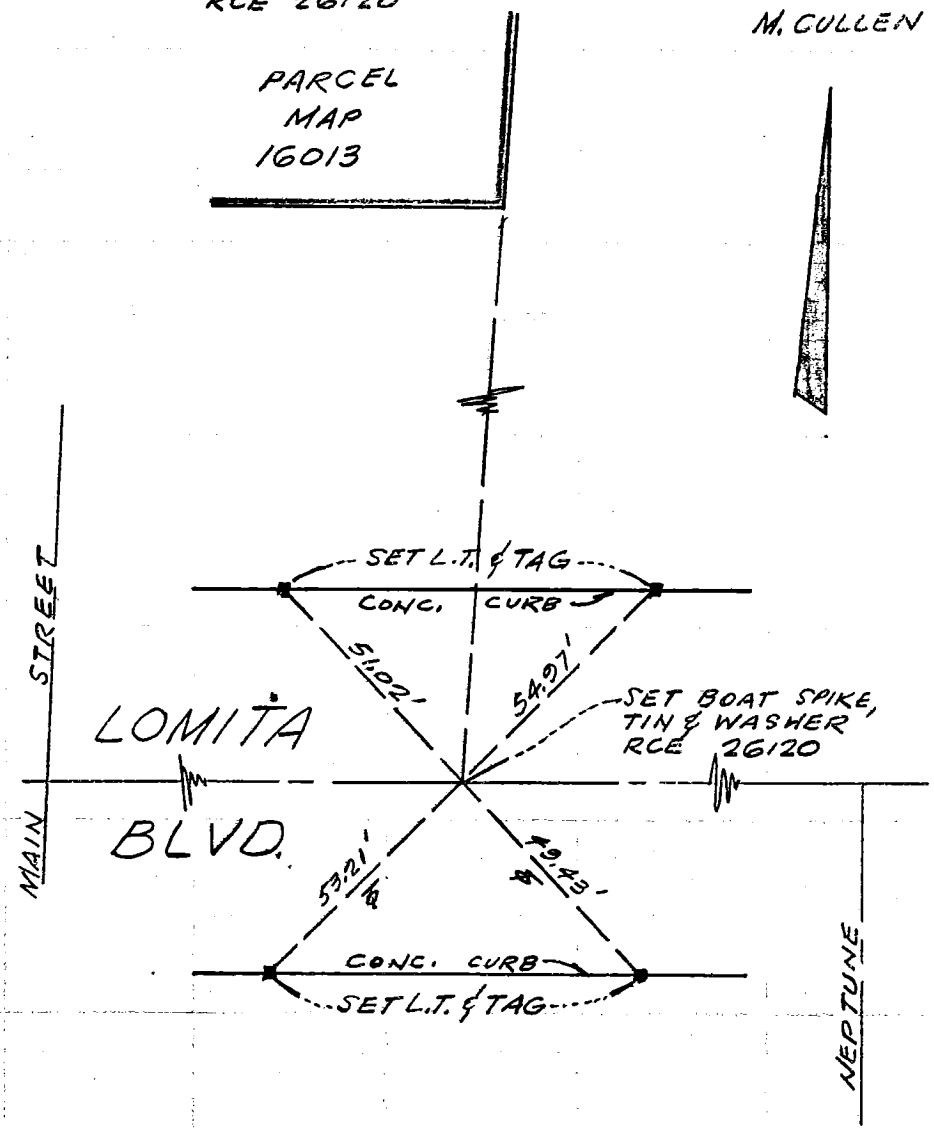

● DENOTES SET L.T. & TAG RCE 26120

W.S. 28, C-3

SURVEYORS SERVICE COMP... TA MESA - STOCK NO. 411

DO NOT EXTEND NOTES THIS SIDE OF LINE

CO ENG FB 3673-96

SURVEY OF CENTERLINE TIES F B NO 100-C PAGE

SURVEY BY SO. BAY ENG. CORP. PARCEL MAP NO. 16013 (CARSON)

DATE 9-17-84

ENGINEER: ROSS N. BOLTON
RCE 26120

A. MARTIN
O. IRVINE
M. CULLEN

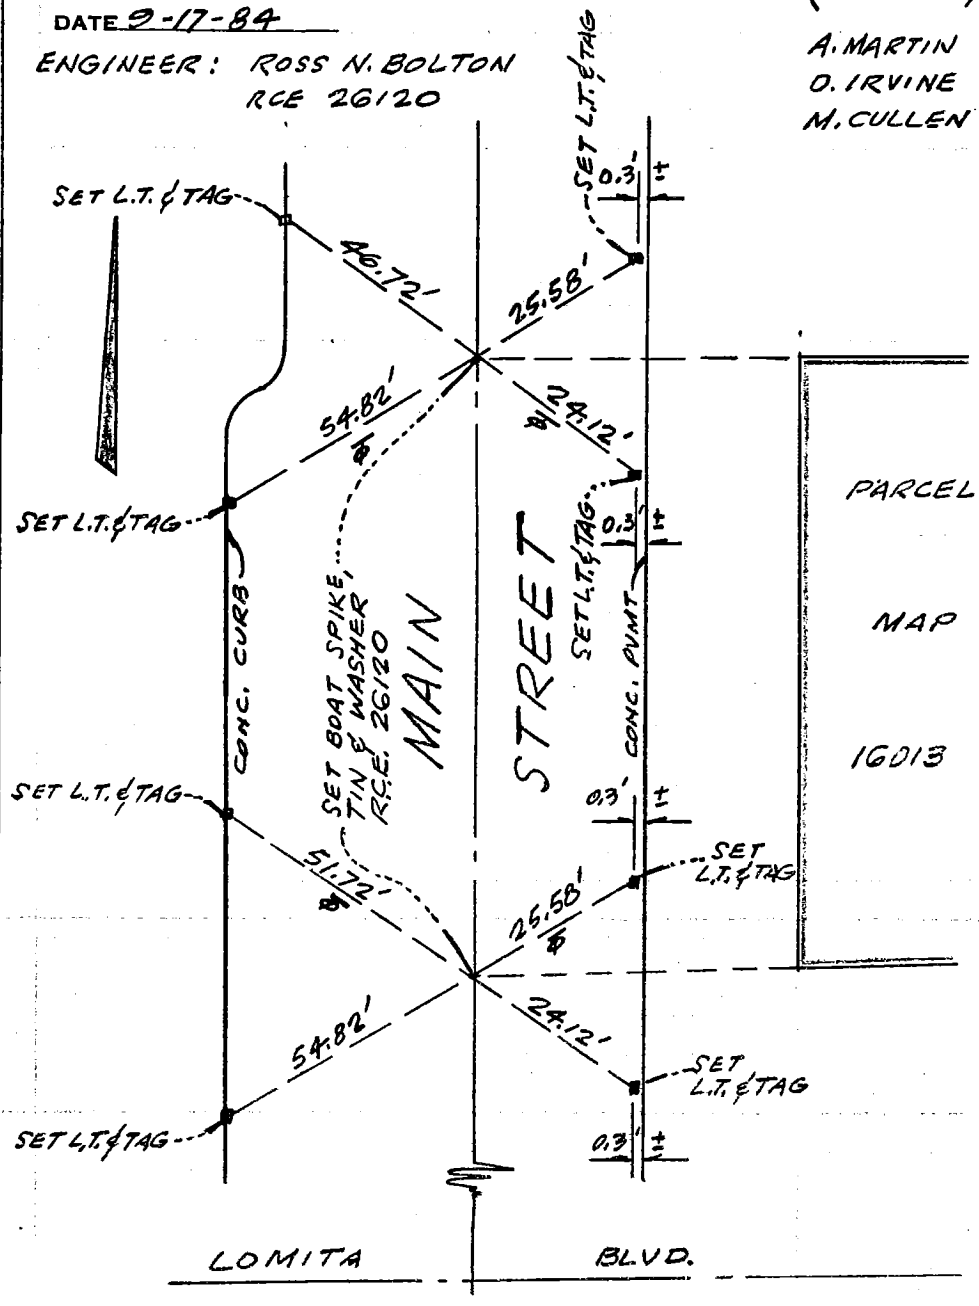

● DENOTES SET L.T. & TAG RCE 26120

W.S. 28, C-3

4ESA - STOCK NO. 411
SURVEYORS SERVICE COMPANY
DO NOT EXTEND NOTES THIS SIDE OF LINE

CO ENG FB 3673-97

SURVEY OF ℄ TIES. BARTLETT AVE. F. B. ____ PG. ____

SURVEY BY LOREN PHILLIPS + ASSOC. INC. TR. No. 43119

DATE SEPT. 1984

W.S.44, C-5

SO. CALIF. BLUE PRINT CO.

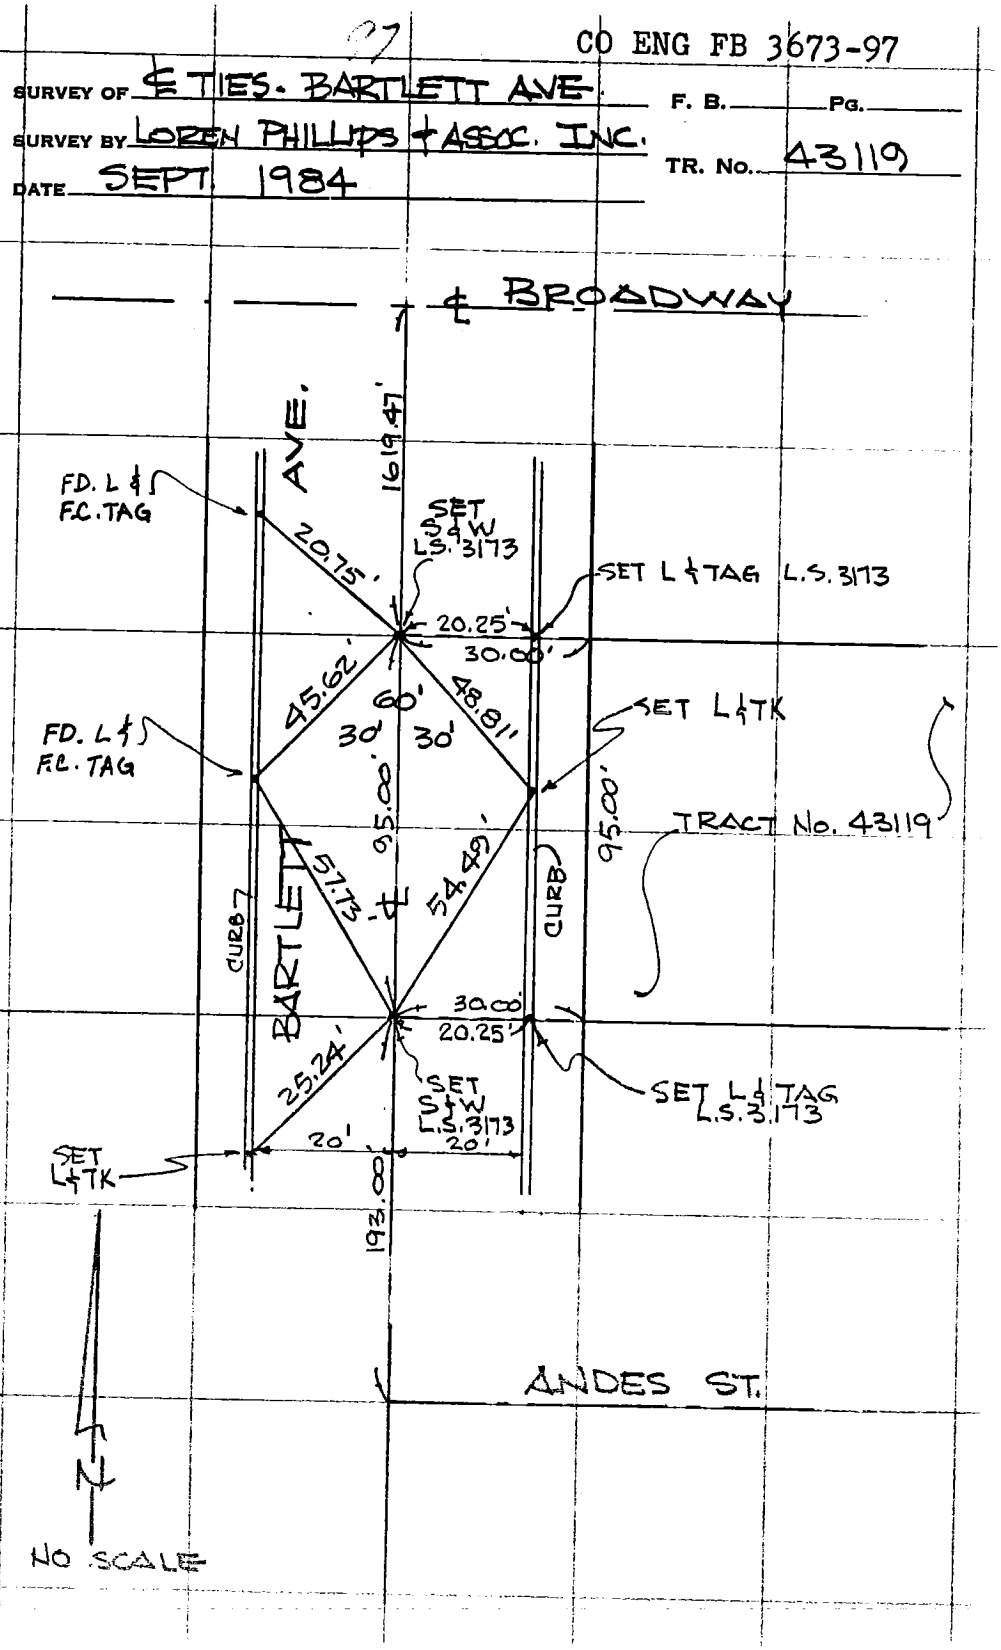

76S911- PS 12-78

PROJECT 21ST STREET DRAIN '98

SURVEY BY SCHONFELDT DATE 6-28-83

REVIEWED BY J.L. DATE 6-27-84 / 8-7-84

CO ENG FB 3673-98

INDEX FC 3438 19

R2R-3

LOS ANGELES COUNTY FLOOD CONTROL DISTRICT

W.S. 25,4-4

1-23-84 T@ 68°

V = FD IN GOOD COND. AFTER CONST. D.W.J.

FOR ORIG TIES SEE F.C. 3438-9

ALL DIST. @ 68°

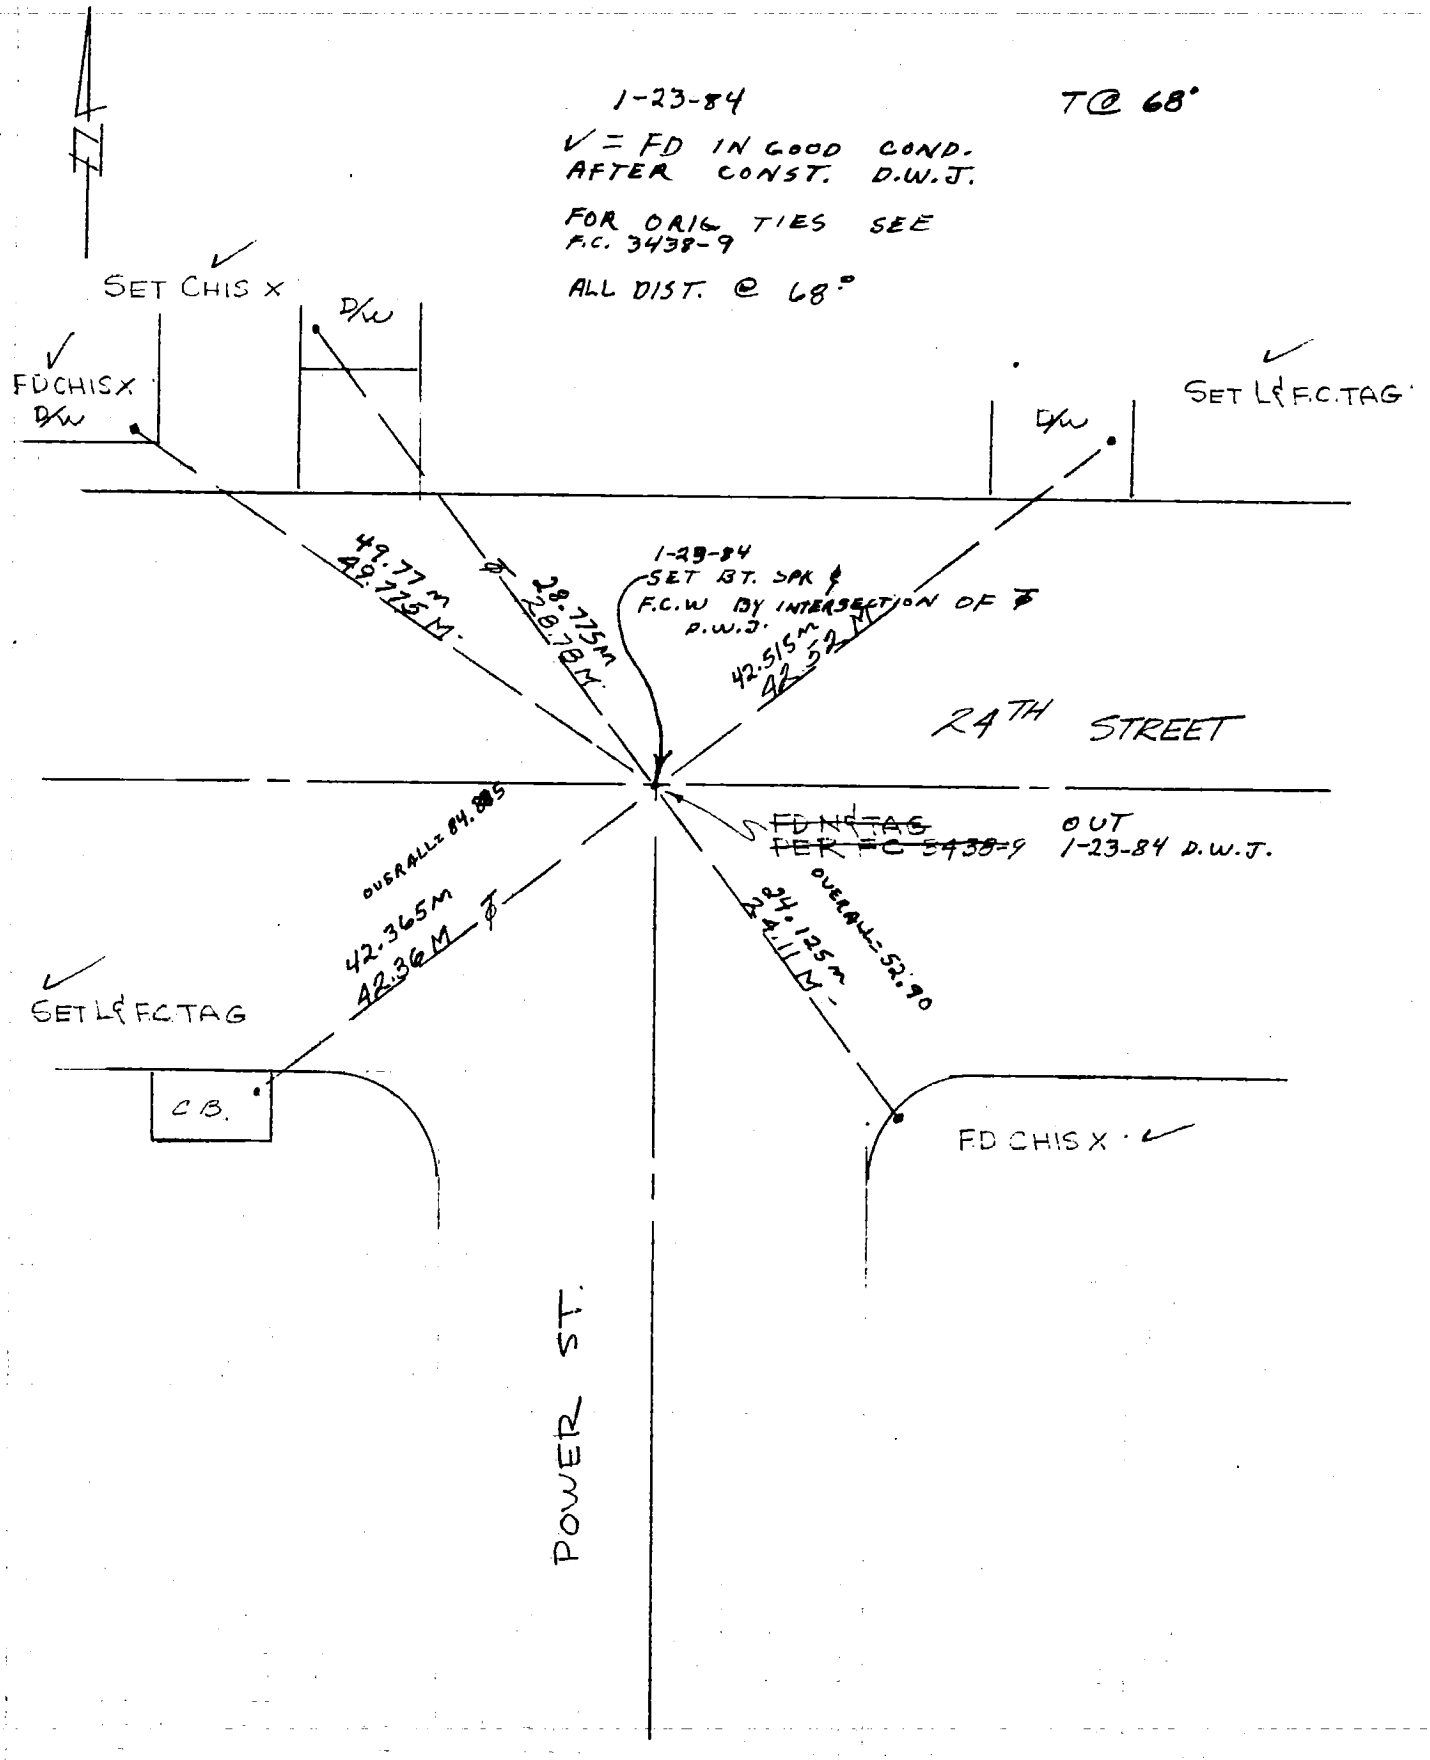

76S911- PS 12-78

99

PROJECT 21ST STREET S.D.

SURVEY BY SCHONFELDT DATE 6-28-83

REVIEWED BY JDE DATE 7-7-83

S.G.B. 8-7-84

CO ENG FB 3673-99

INDEX FC 3438 21

R&R-B-5

LOS ANGELES COUNTY FLOOD CONTROL DISTRICT

W.S. 25, A-4

1-23-84

V = FD. IN GOOD CONDITION AFTER CONSTRUCTION

D. W. J.

FOR ORIG. TIES SEE F.C. 3438-6

T @ 68°

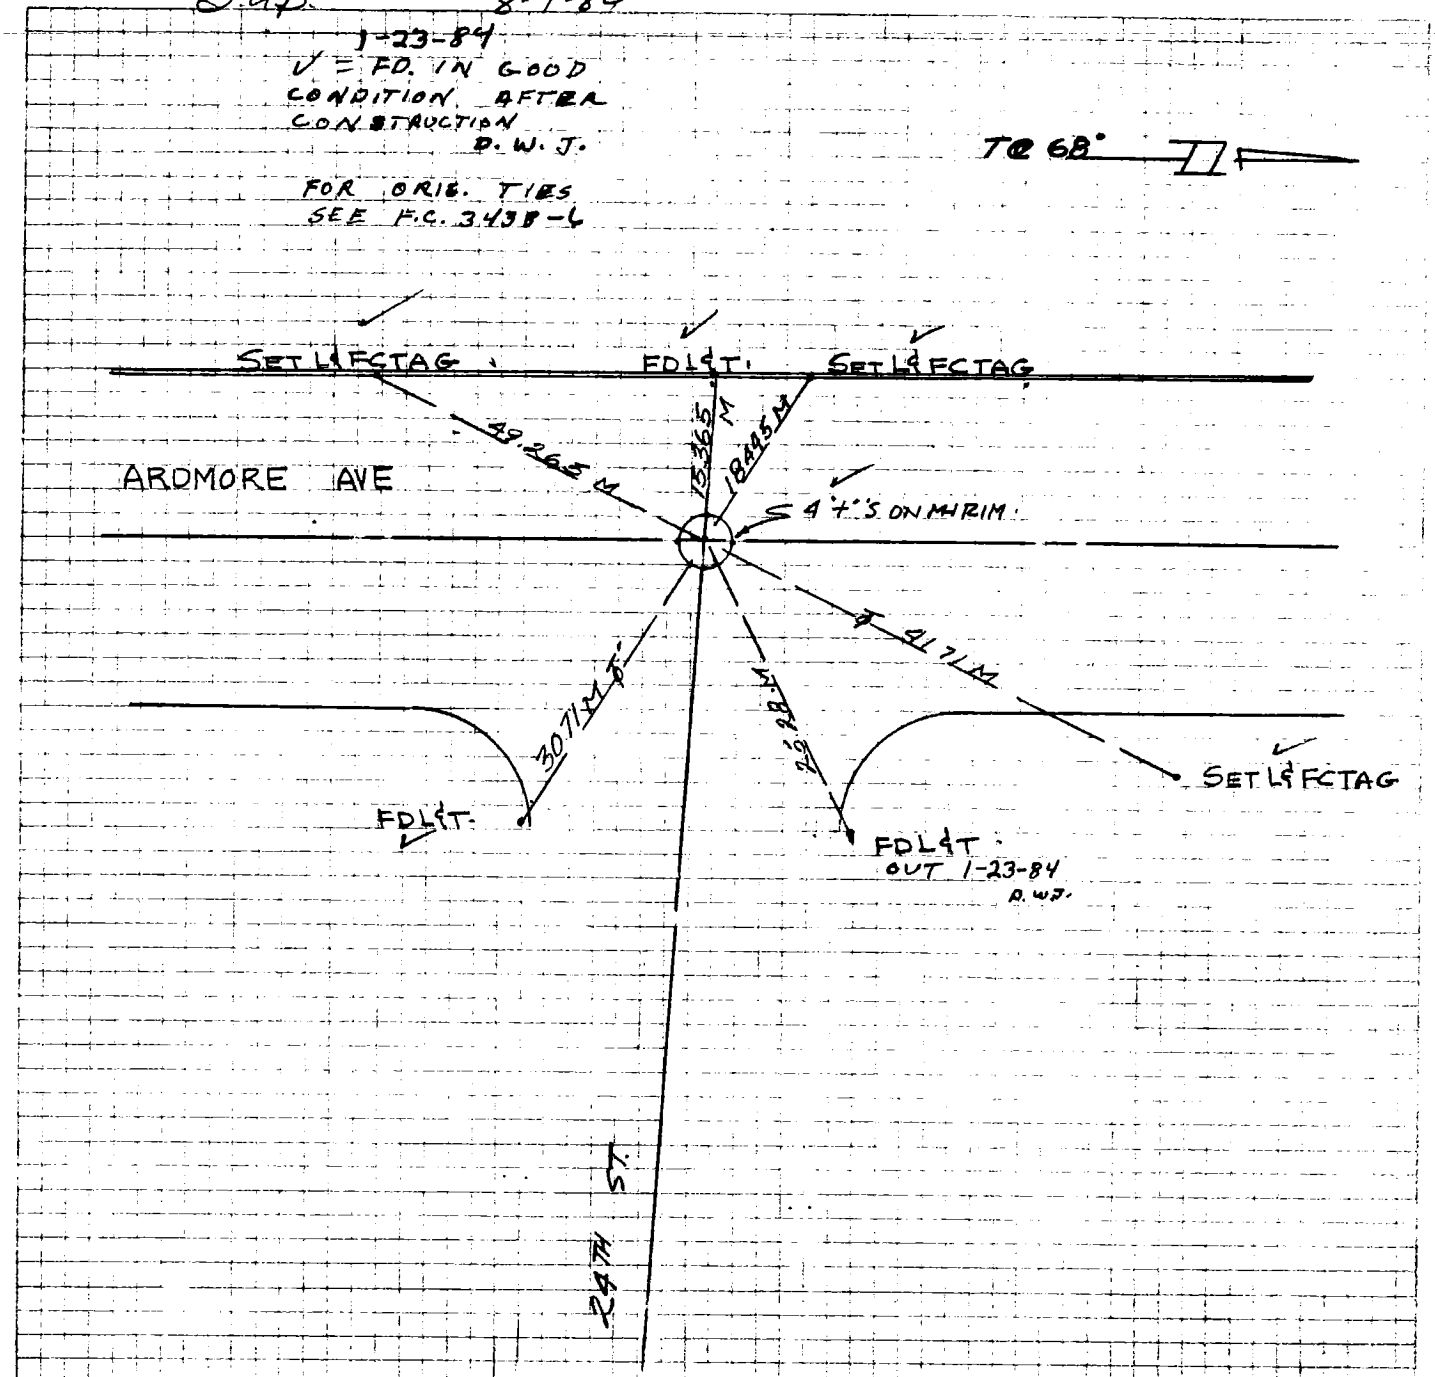

76S911- PS 12-78

100

CO ENG FB 3673-100

PROJECT 21st STREET S.D.

SURVEY BY SCHONFELDT DATE 6-28-83

REVIEWED BY JDE DATE 7-7-83

J.Uf. 8-7-84

INDEX FC 3438 23

R&R B-7

LOS ANGELES COUNTY FLOOD CONTROL DISTRICT

W.S. 25, A-4

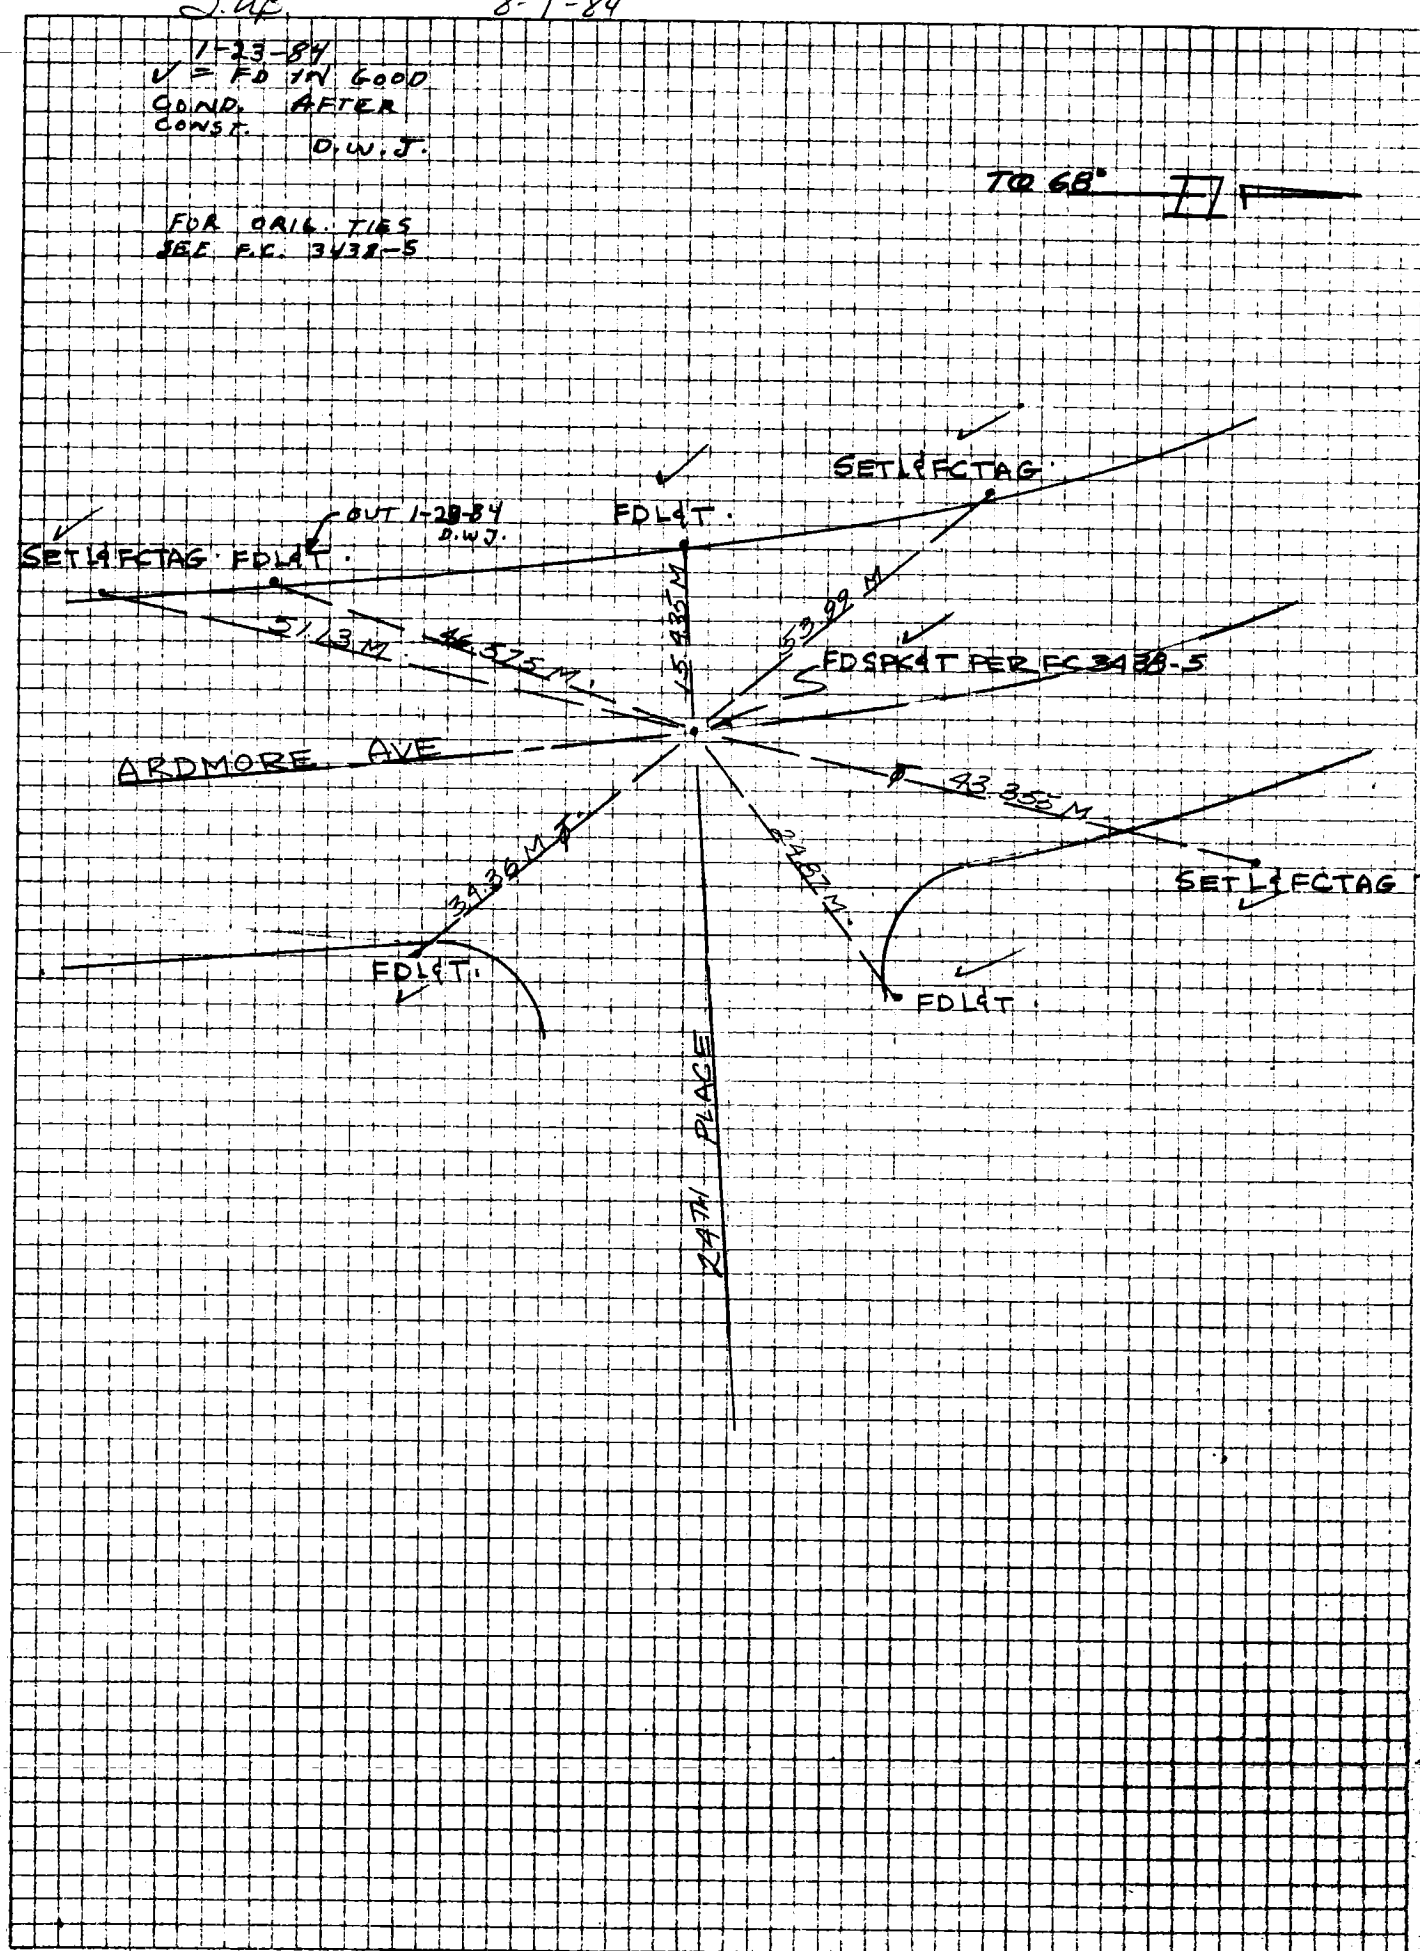

76S911- PS 12-78

PROJECT 21ST STREET DRAIN 101

SURVEY BY JOSLIN DATE 1-24-84

REVIEWED BY J.A.P. DATE 8-7-84

CO ENG FB 3673-101

INDEX FC 3438 25

R&R-3 AFTER CONST.

LOS ANGELES COUNTY FLOOD CONTROL DISTRICT

W 15, 25, A-3

AFTER CONST. SEE F.C. 3438-3 FOR ORIG. TIES

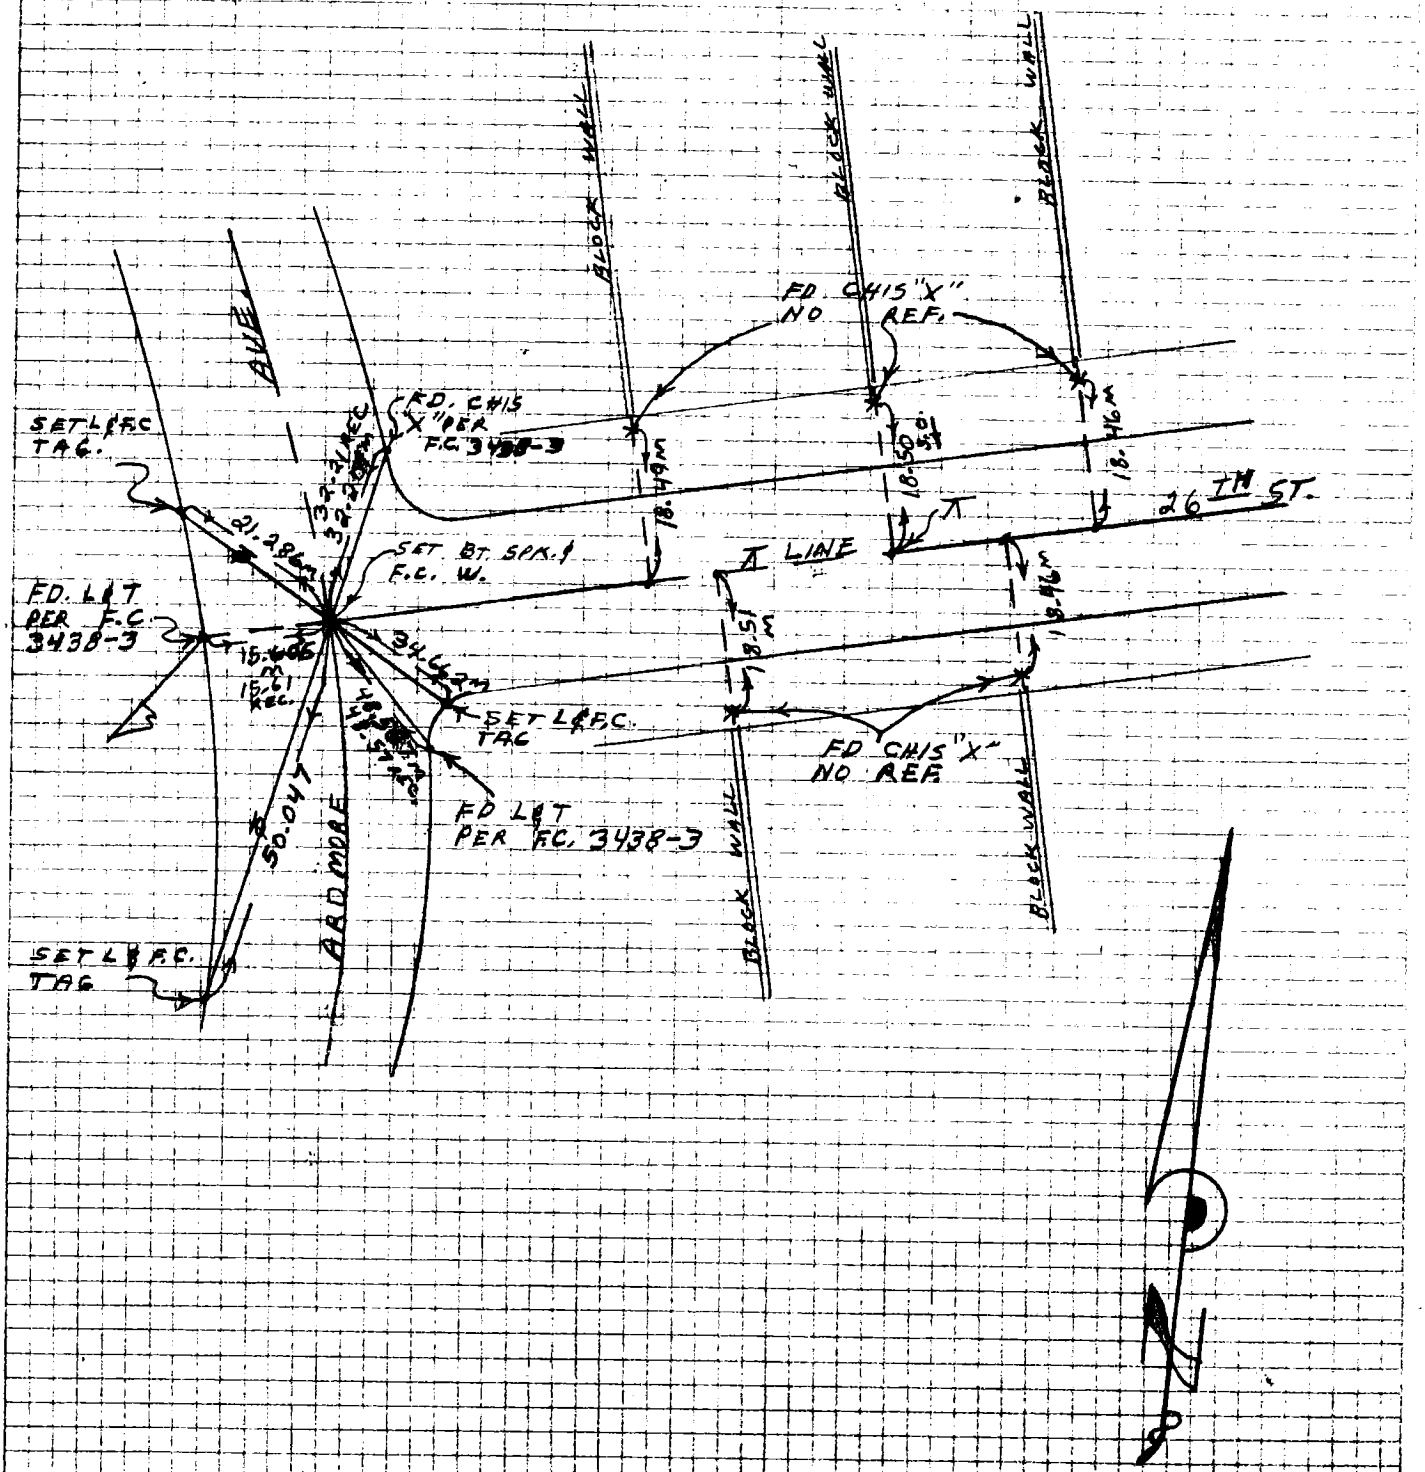

76S911- PS 12-78

102

CO ENG FB 3673-102

PROJECT 111TH PL DRAIN

INDEX FC 3464 03

SURVEY BY G.L. & S.L. DATE 7-22-83

REVIEWED BY J.A.B. DATE 8-6-84

R&R-3

LOS ANGELES COUNTY FLOOD CONTROL DISTRICT

W.S. 26, C-1

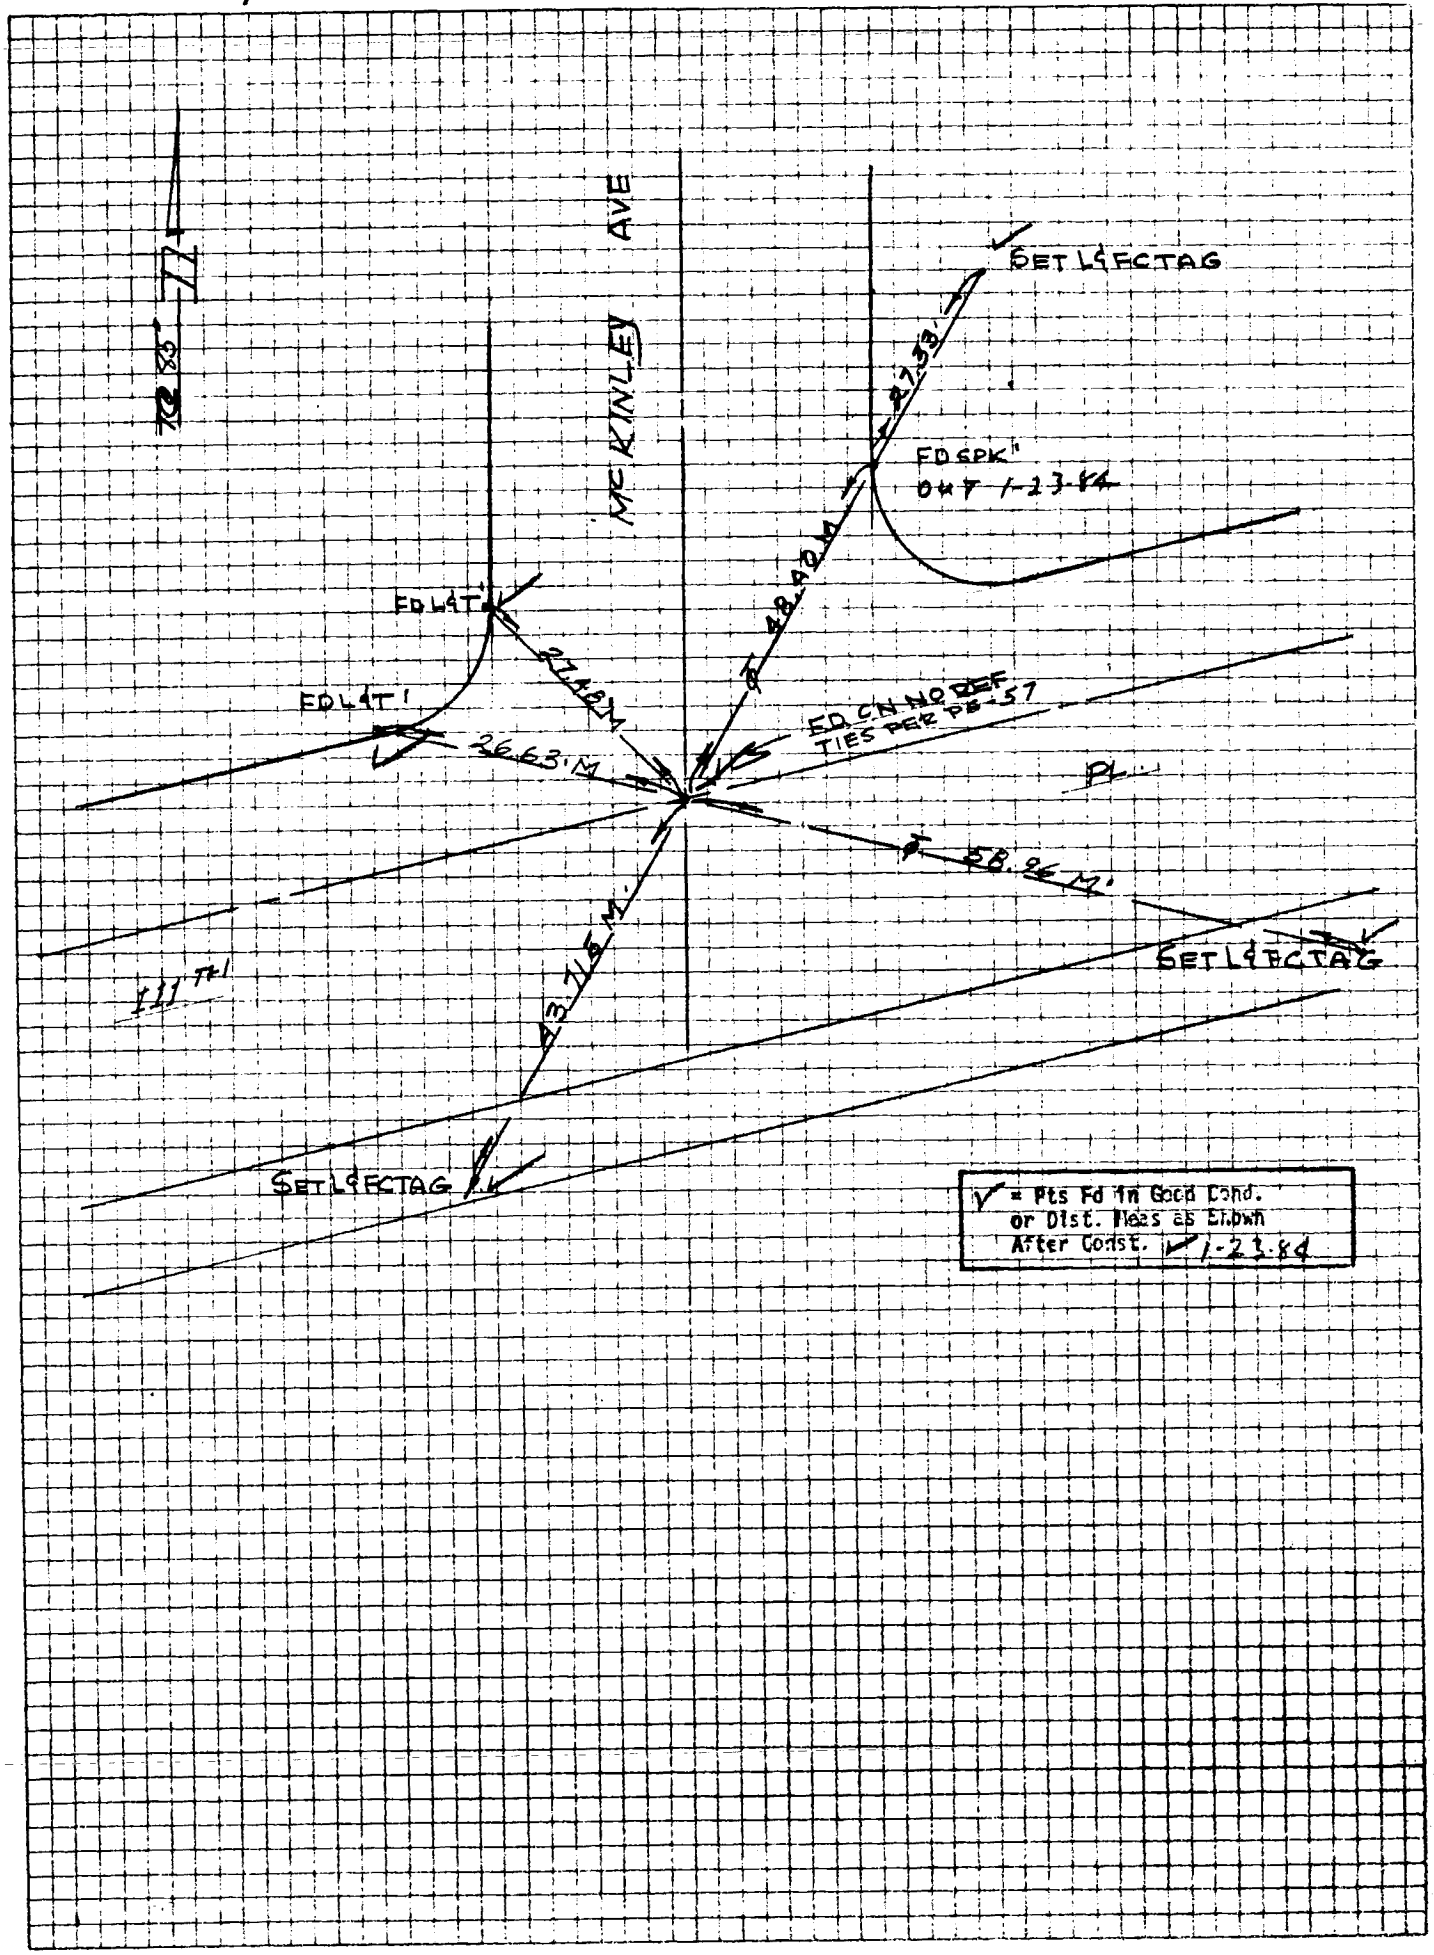

CO ENG FB 3673-103
INDEX FC 3464 05
RSR-S
LOS ANGELES COUNTY FLOOD CONTROL DISTRICT

76S911- PS 12-78

PROJECT 111TH PL DRAIN

SURVEY BY L.W.S DATE 7-22-83

REVIEWED BY J.A.F DATE 8.6.84

W.S.26, C-1

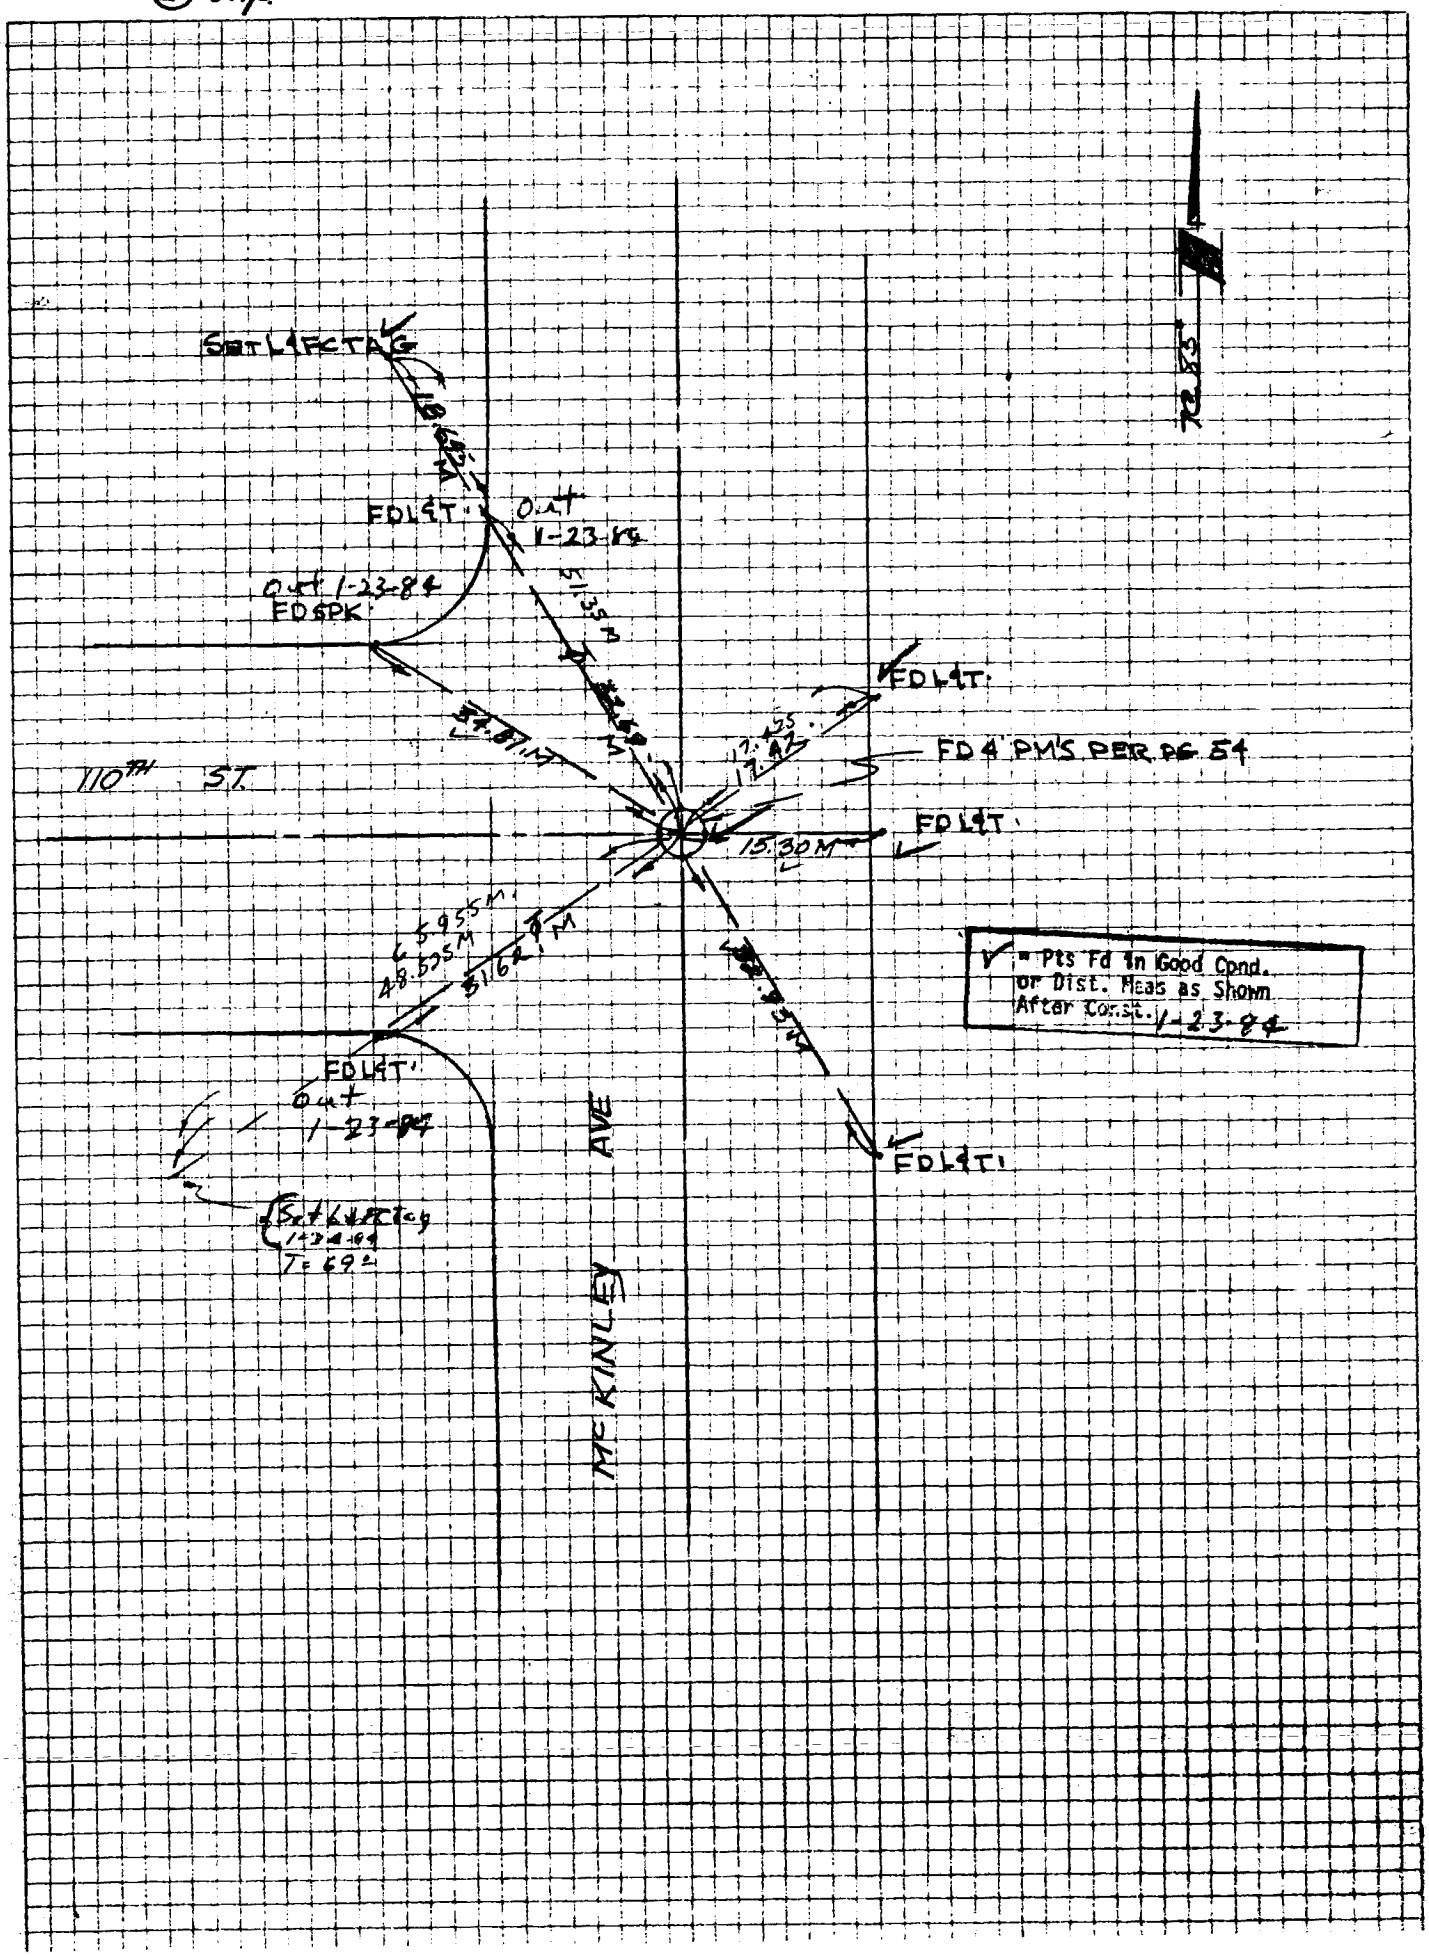

768911- PS 12-78

104

CO ENG FB 3673-104

PROJECT 111TH PL DRAIN

INDEX FC 3464 07

SURVEY BY L.W.S. DATE 7-22-83

REVIEWED BY JAB. DATE 8-6-84

R&R-7

LOS ANGELES COUNTY FLOOD CONTROL DISTRICT

W.S. 26, C-1

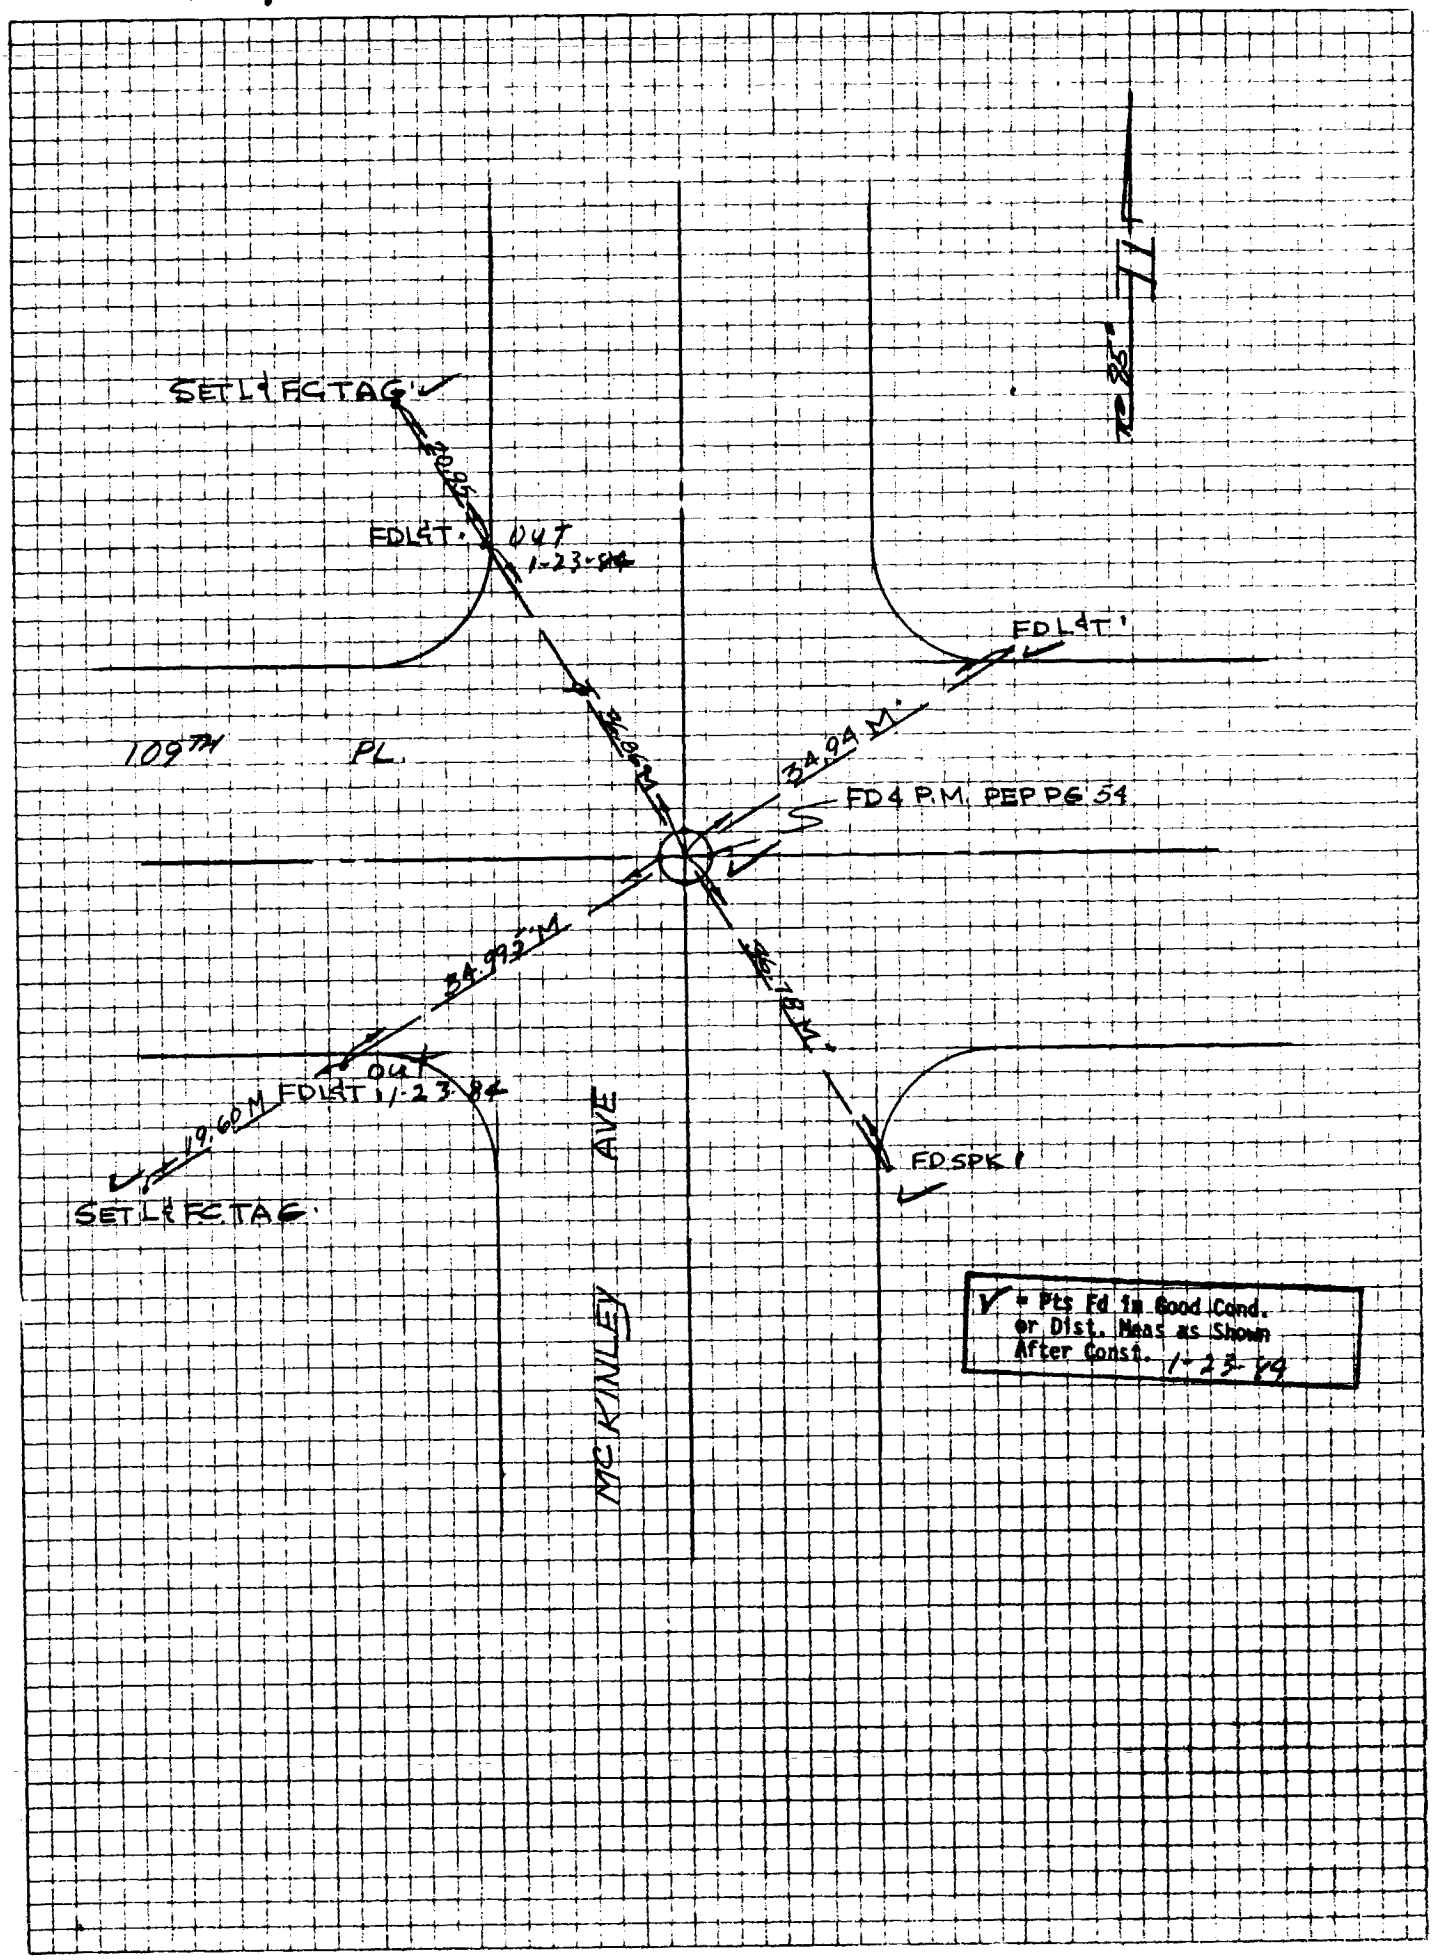

105

CO ENG FB 3673-105

INDEX FC 3464 09

R4R-8

LOS ANGELES COUNTY FLOOD CONTROL DISTRICT

76S911- PS 12-78

PROJECT 111TH PL DRAIN

SURVEY BY G.W.S DATE 7-25-83

REVIEWED BY J.R.P. DATE 8-6-84

W.S. 26, C-1

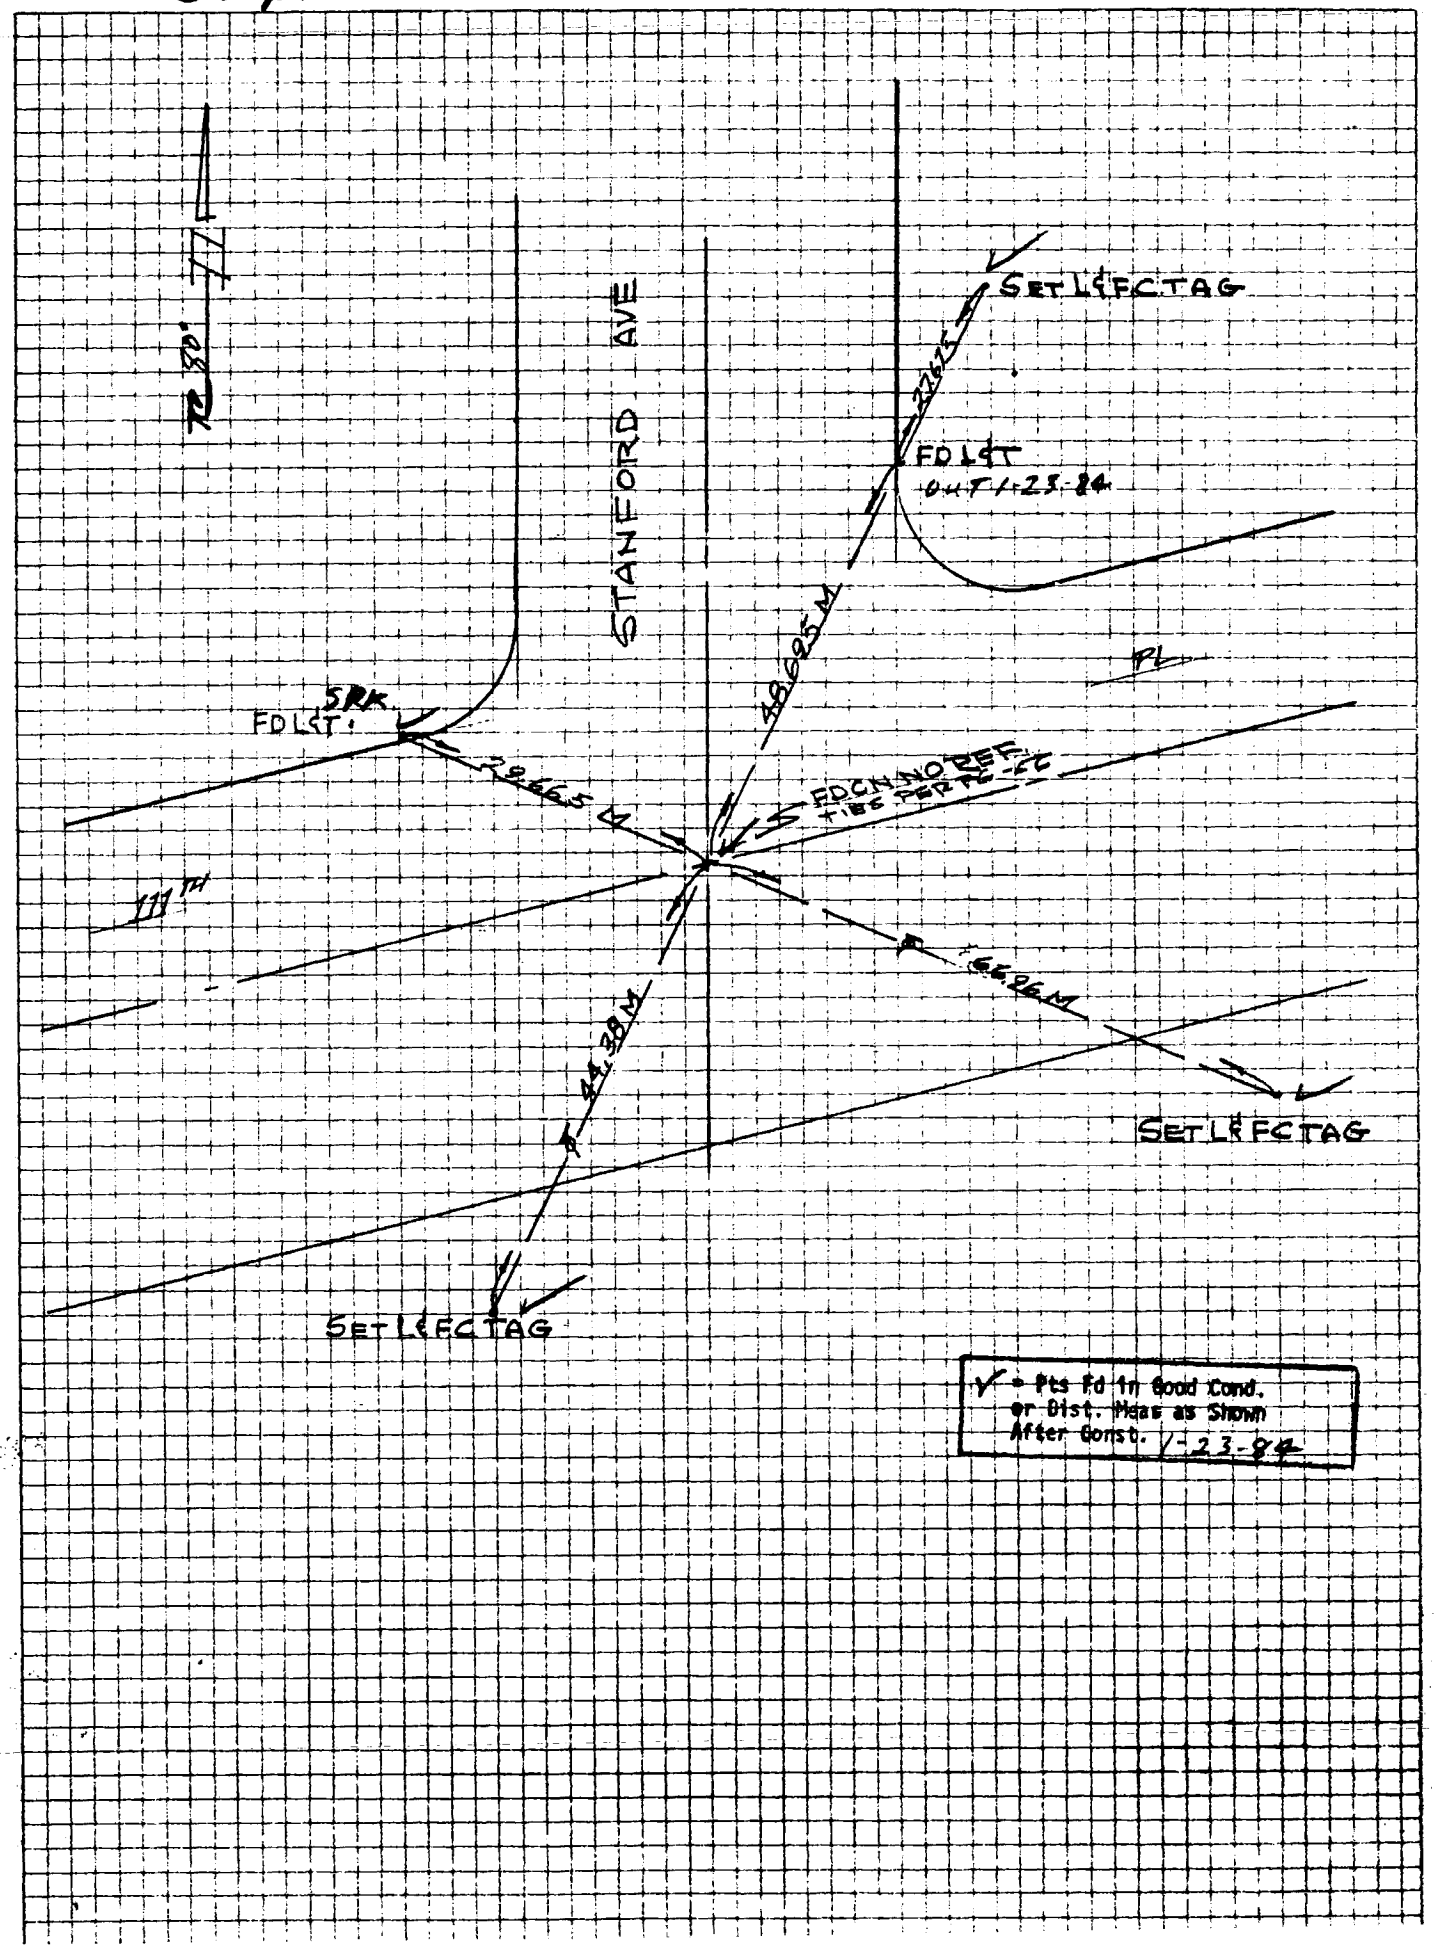

106

CO ENG FB 3673-106

76S911- PS 12-78

PROJECT 111TH PL DRAIN

INDEX FC 3464 11

SURVEY BY G.L.S DATE 7-25-83

REVIEWED BY J.A.P. DATE 8-6-84

RGR-10

LOS ANGELES COUNTY FLOOD CONTROL DISTRICT

W.S. 26, C-1

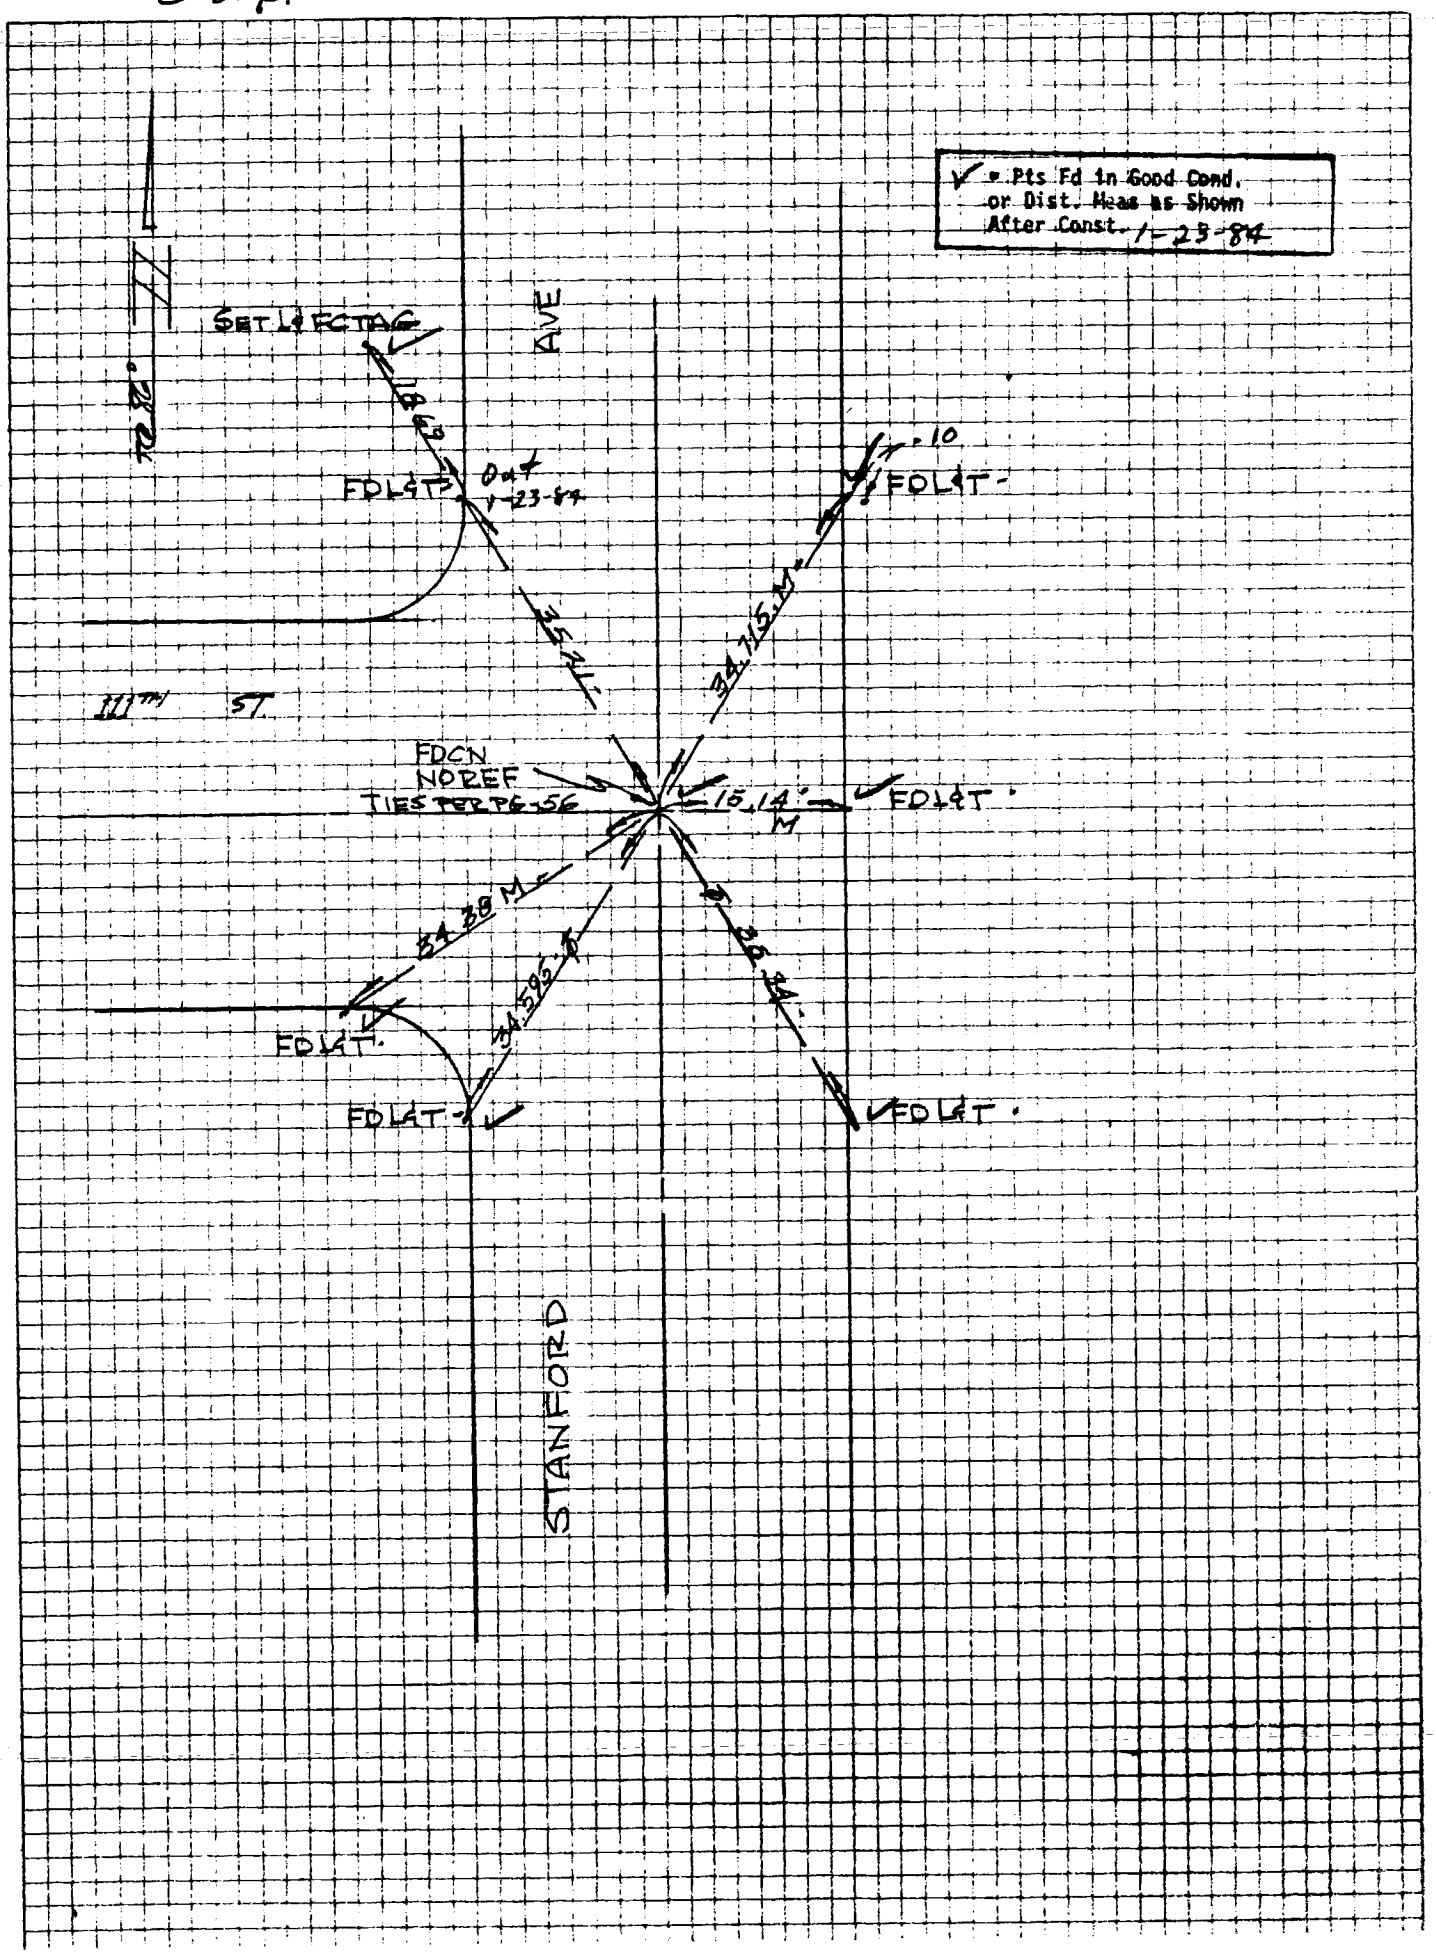

76S911- PS 12-78

107

CO ENG FB 3673-107

PROJECT 177TH PL DRAIN

INDEX FC 3464 13

SURVEY BY E.W.S. DATE 7-25-83

REVIEWED BY J.A.B. DATE 8-6-84

RGR-12

LOS ANGELES COUNTY FLOOD CONTROL DISTRICT

W.S. 26, C-1

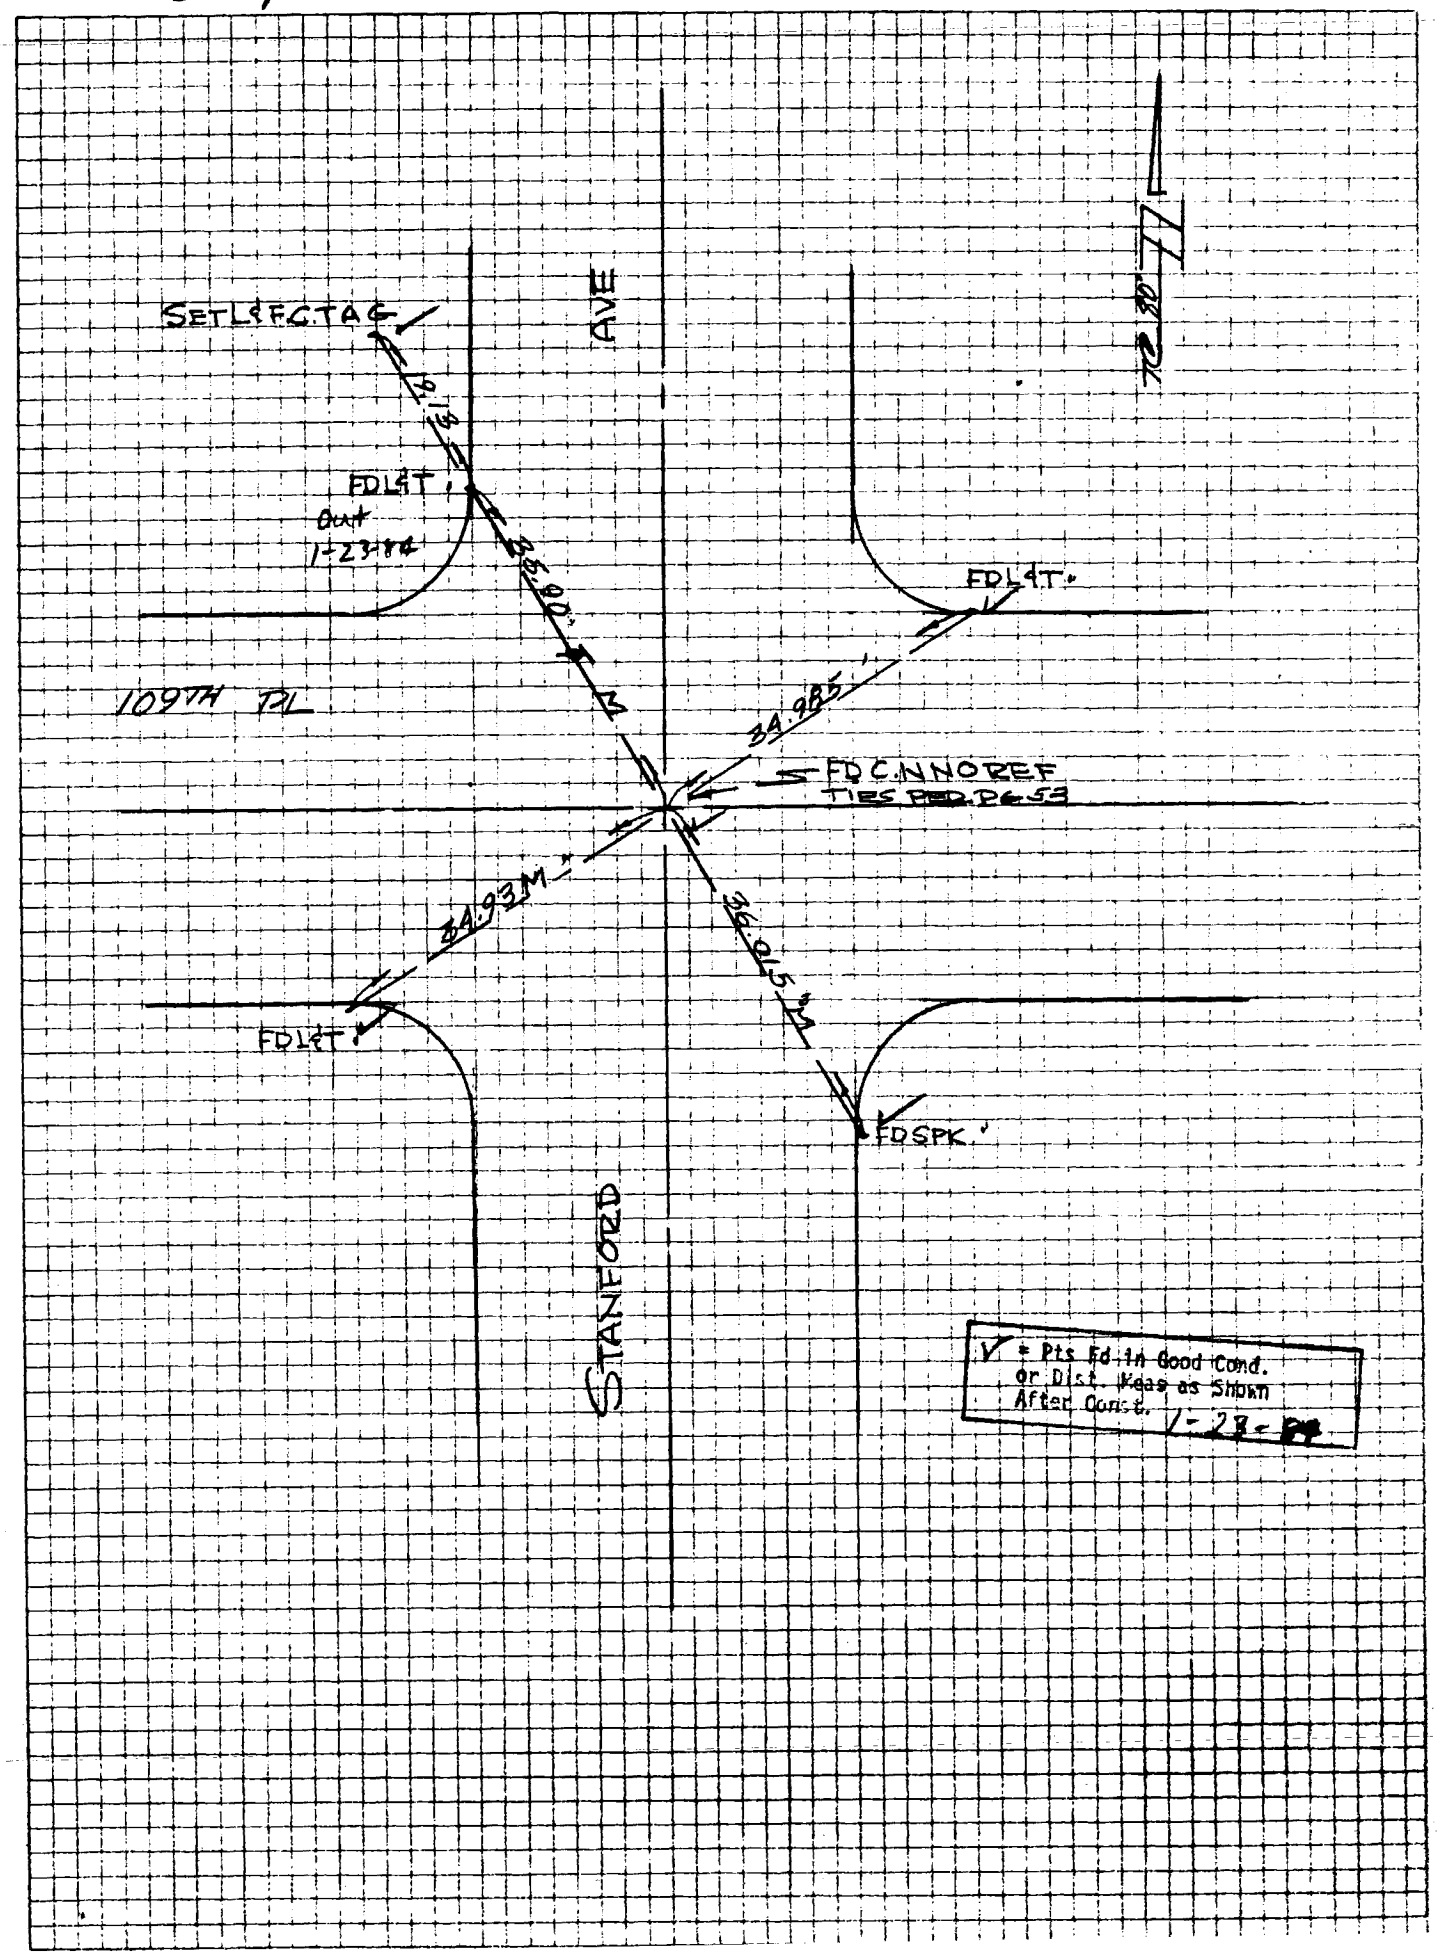

CO ENG FB 3673-108

SURVEY OF FINAL MONUMENTS F B NO. PAGE

SURVEY BY DALCIN CUMMINS & ASSOC. TRACT NO. 32479

DATE 6-5-89 R.C.E. 27797

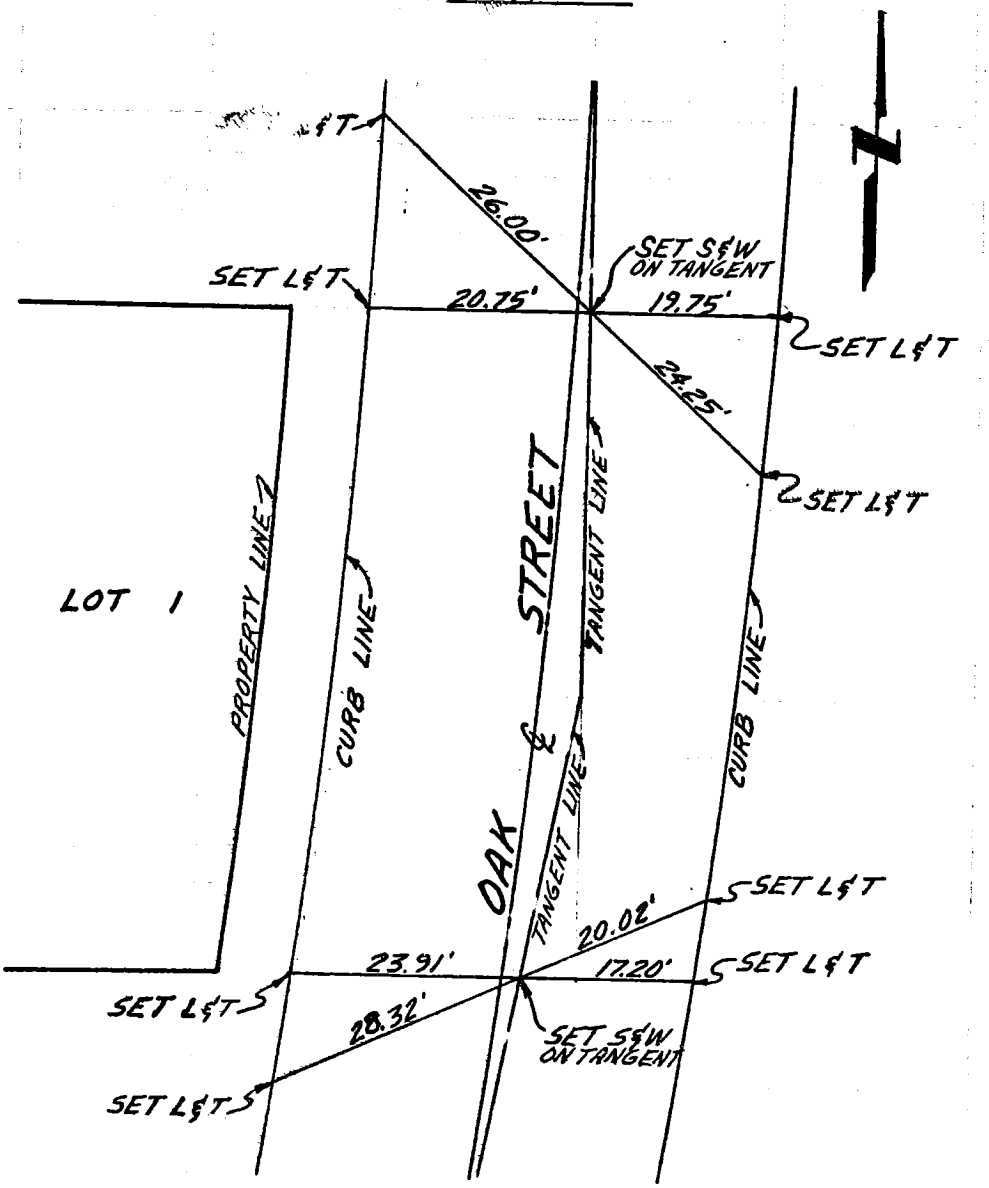

W.S. 28, 4-3

SURVEYORS SERVICE COMPANY STA MESA - STOCK NO. 411

DO NOT EXTEND NOTES THIS SIDE OF LINE

SPEIGHT ENGINEERING COMPANY
P. O. BOX 4644
DOWNEY, CALIFORNIA 90241
(213) 864-3581

JOB NAME & TIES - TR. 42778
JOB NO. 84-182 PAGE 1 OF 1
CALCULATED BY LWS DATE 9/9/84
CHECKED BY DATE
SCALE 1"=20'

CO ENG FB 3673-109

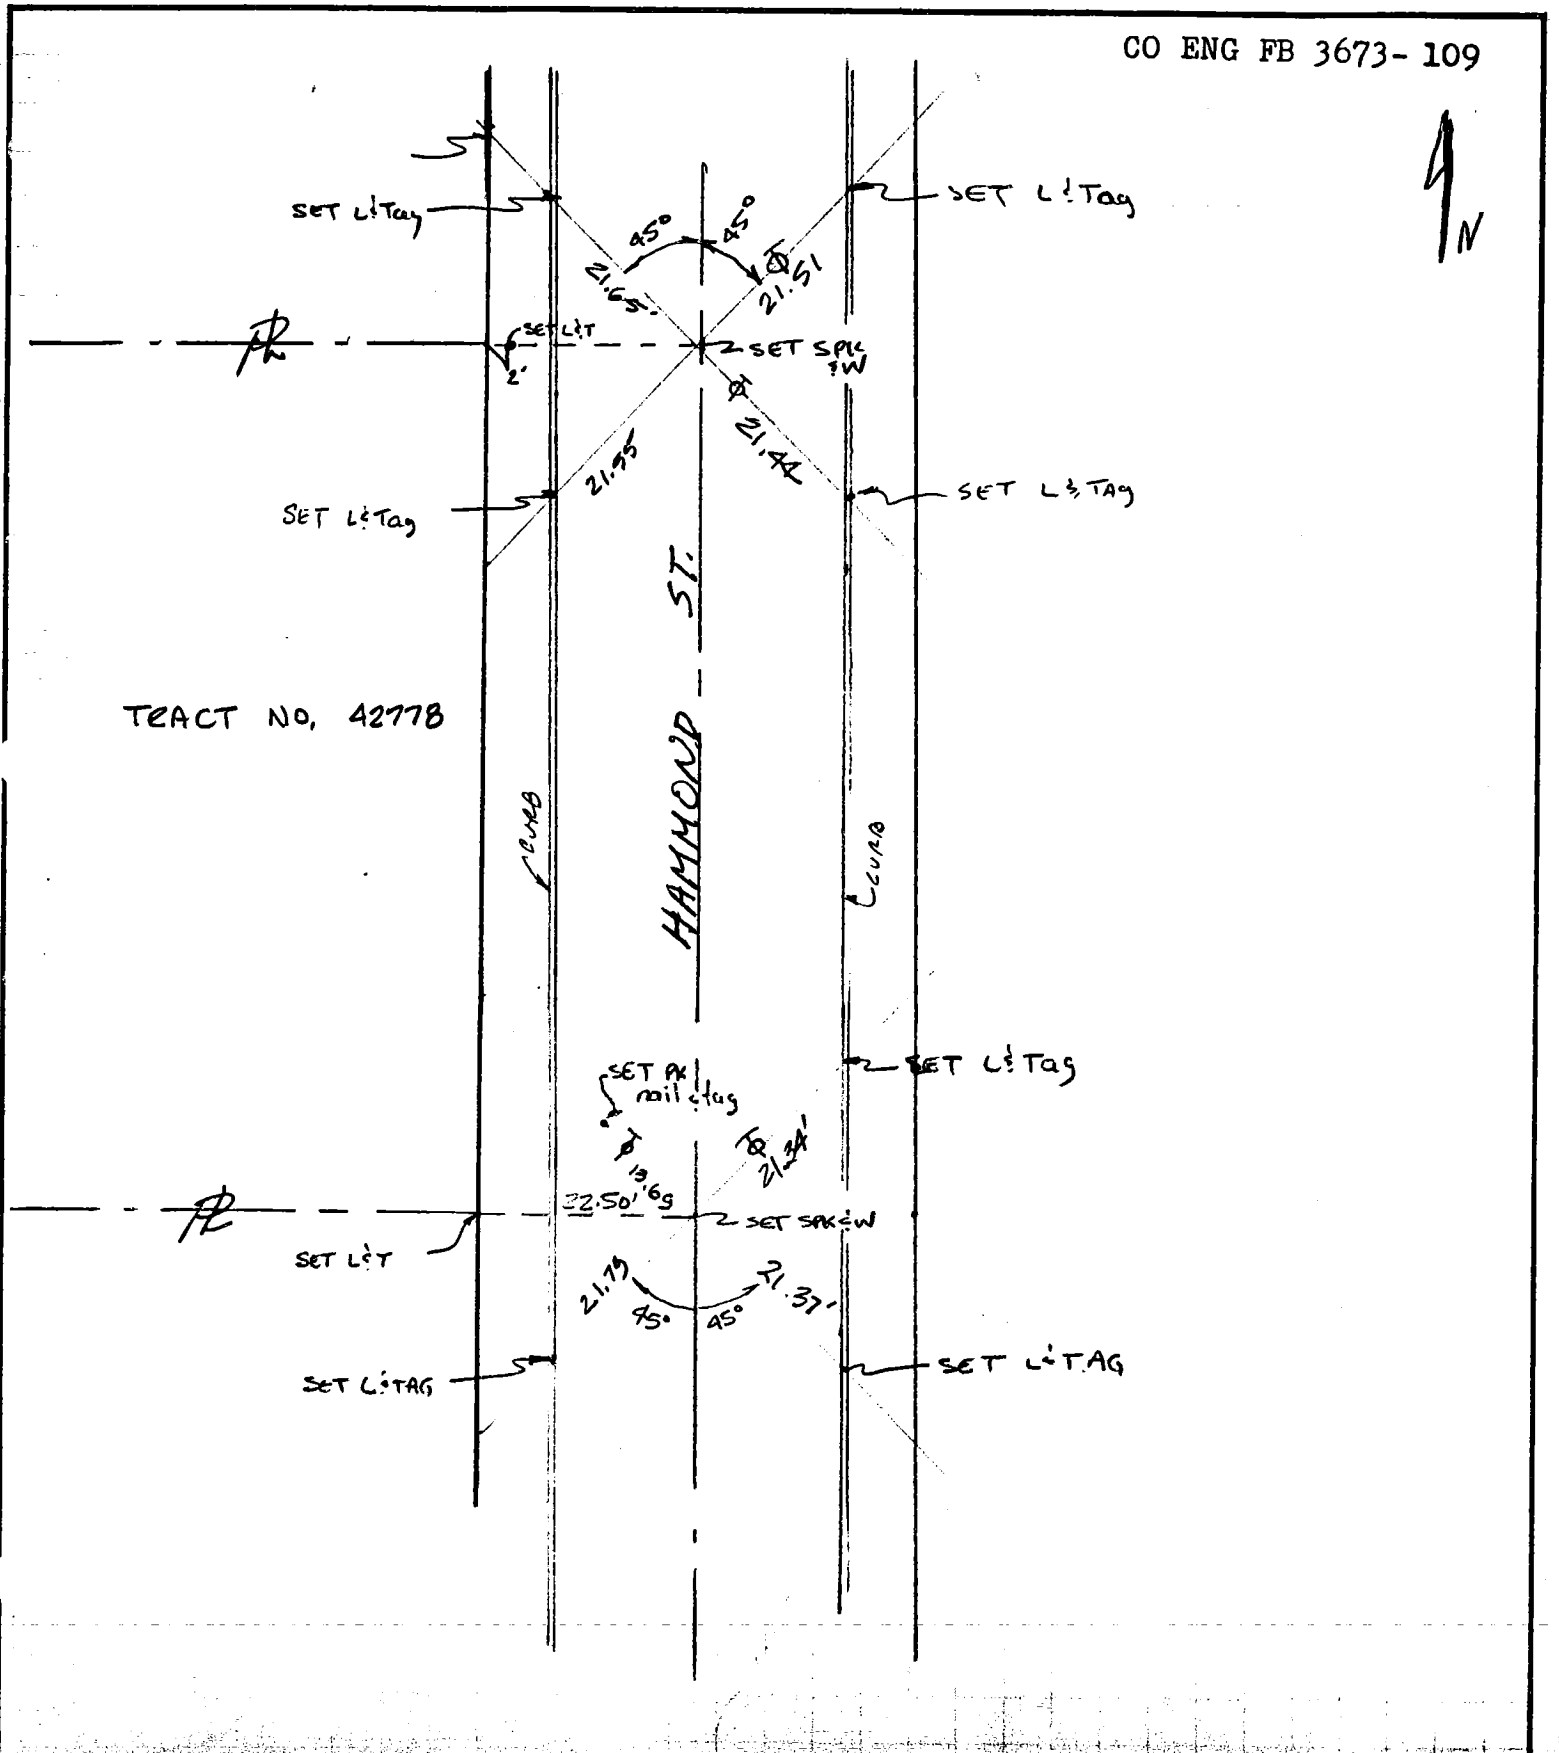

CO ENG FB 3673-110

ENG. 3.883B (12/78)
Title & Plat Sheet
50% Rag

Surveyed by — WYNNE ENG. Date 10/2/84 F.B. _____ Pg. _____

Type of Survey CENTERLINE TIES Sheet 1 of 2

Distances corrected to 68° _____ Monuments tagged

L S # _____ Tract or
R C E # 9438 Parcel Map # P.M. NO. 11448

Checked by _____ Date _____ km grid _____ MB _____

W.S. 099-317, B-1

NOTE: Additions or changes must be initialed, and dated.

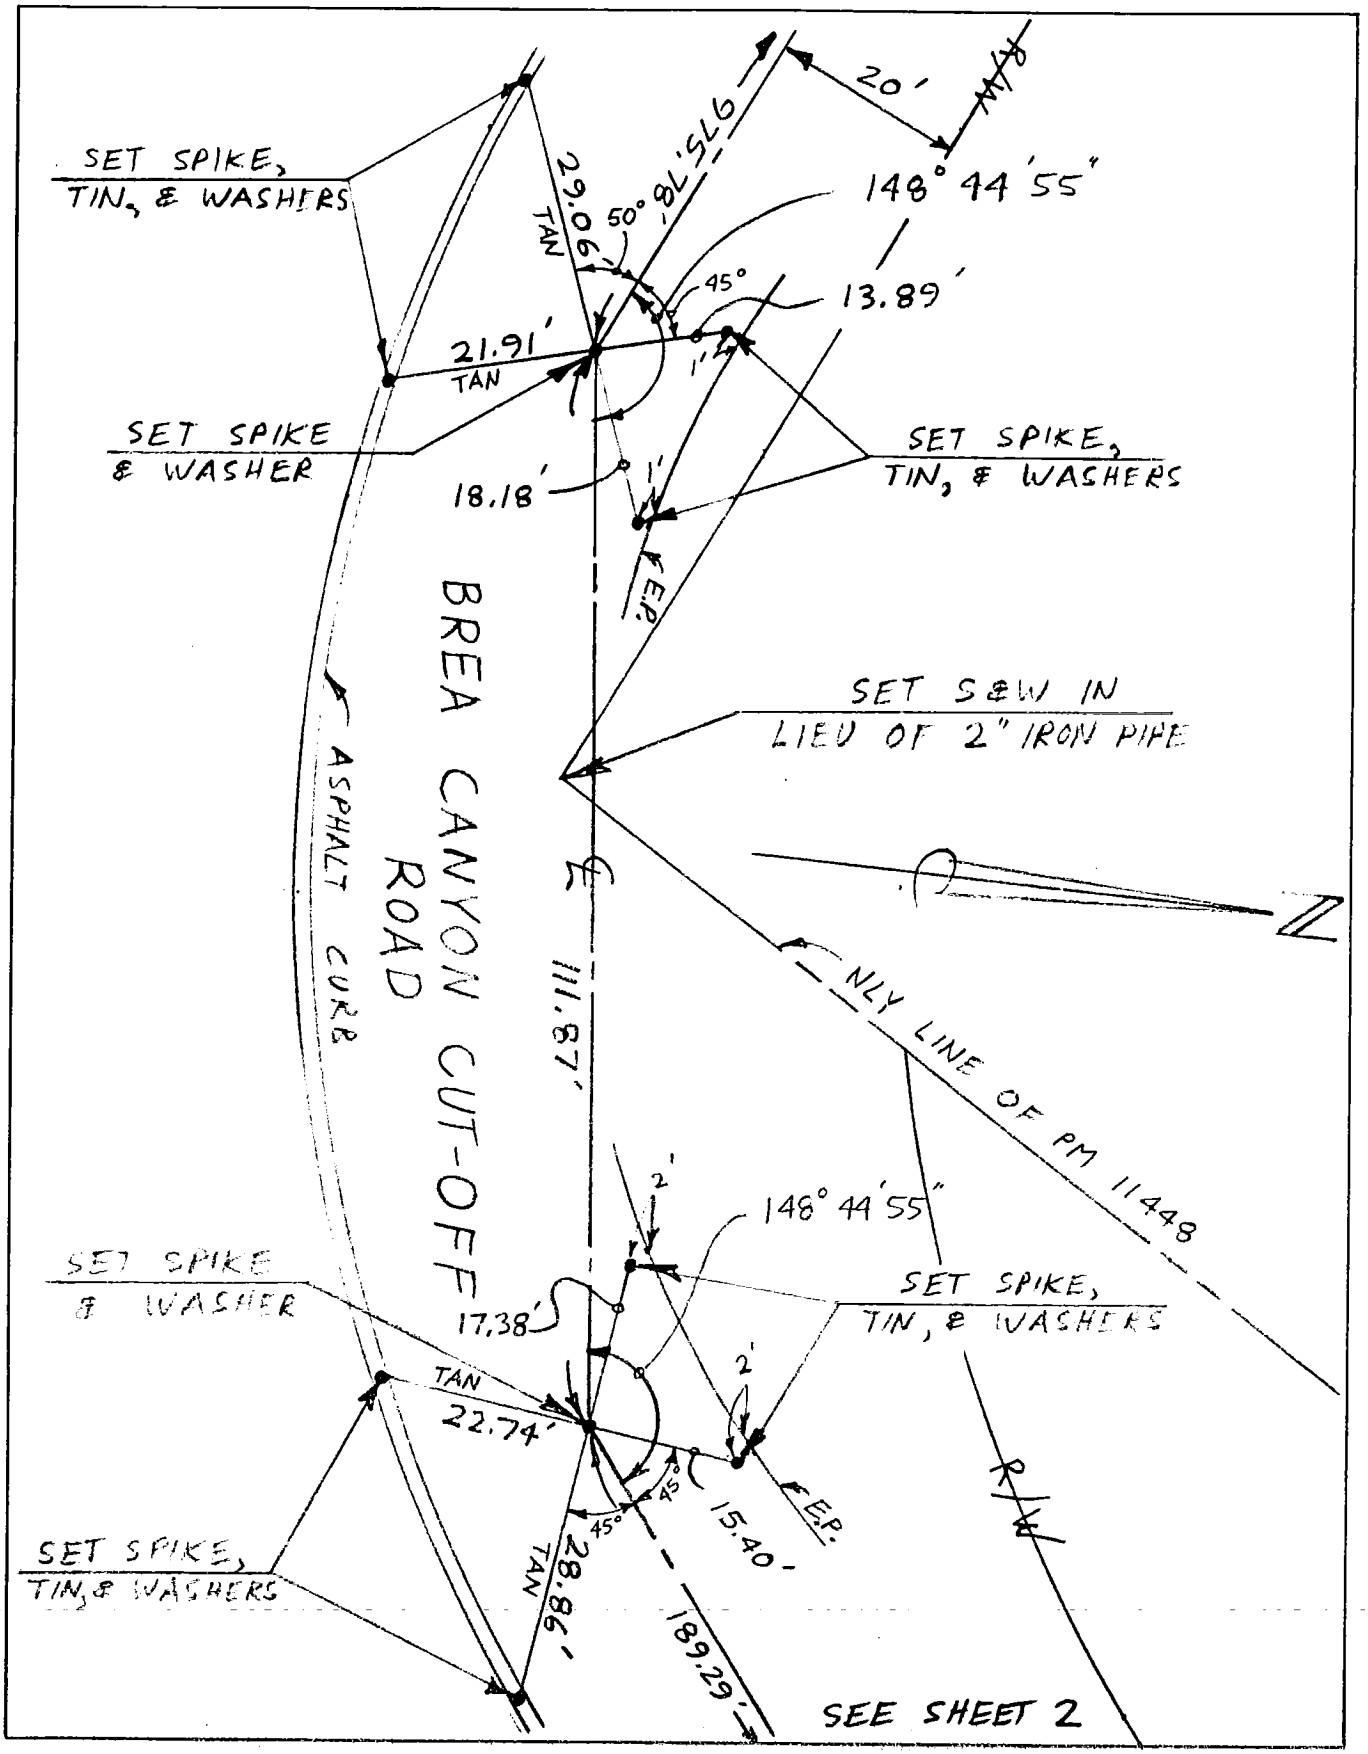

Ground Dist. × Correction Factor: _____ = Grid Distance

ENG. 3.883B (12/78)
Title & Plat Sheet
50% Rag

CO ENG FB 3673-111

Surveyed by — WYNNE ENG. Date 10/2/84 F.B. _____ Pg. _____

Type of Survey CENTERLINE TIES Sheet 2 of 2

Distances corrected to 68° _____ Monuments tagged

L S # _____ Tract or
R C E # 9438 Parcel Map # PM NO. 11448

Checked by _____ Date _____ km grid _____ MB _____

099-317, 8-1

NOTE: Additions or changes must be initialed, and dated.

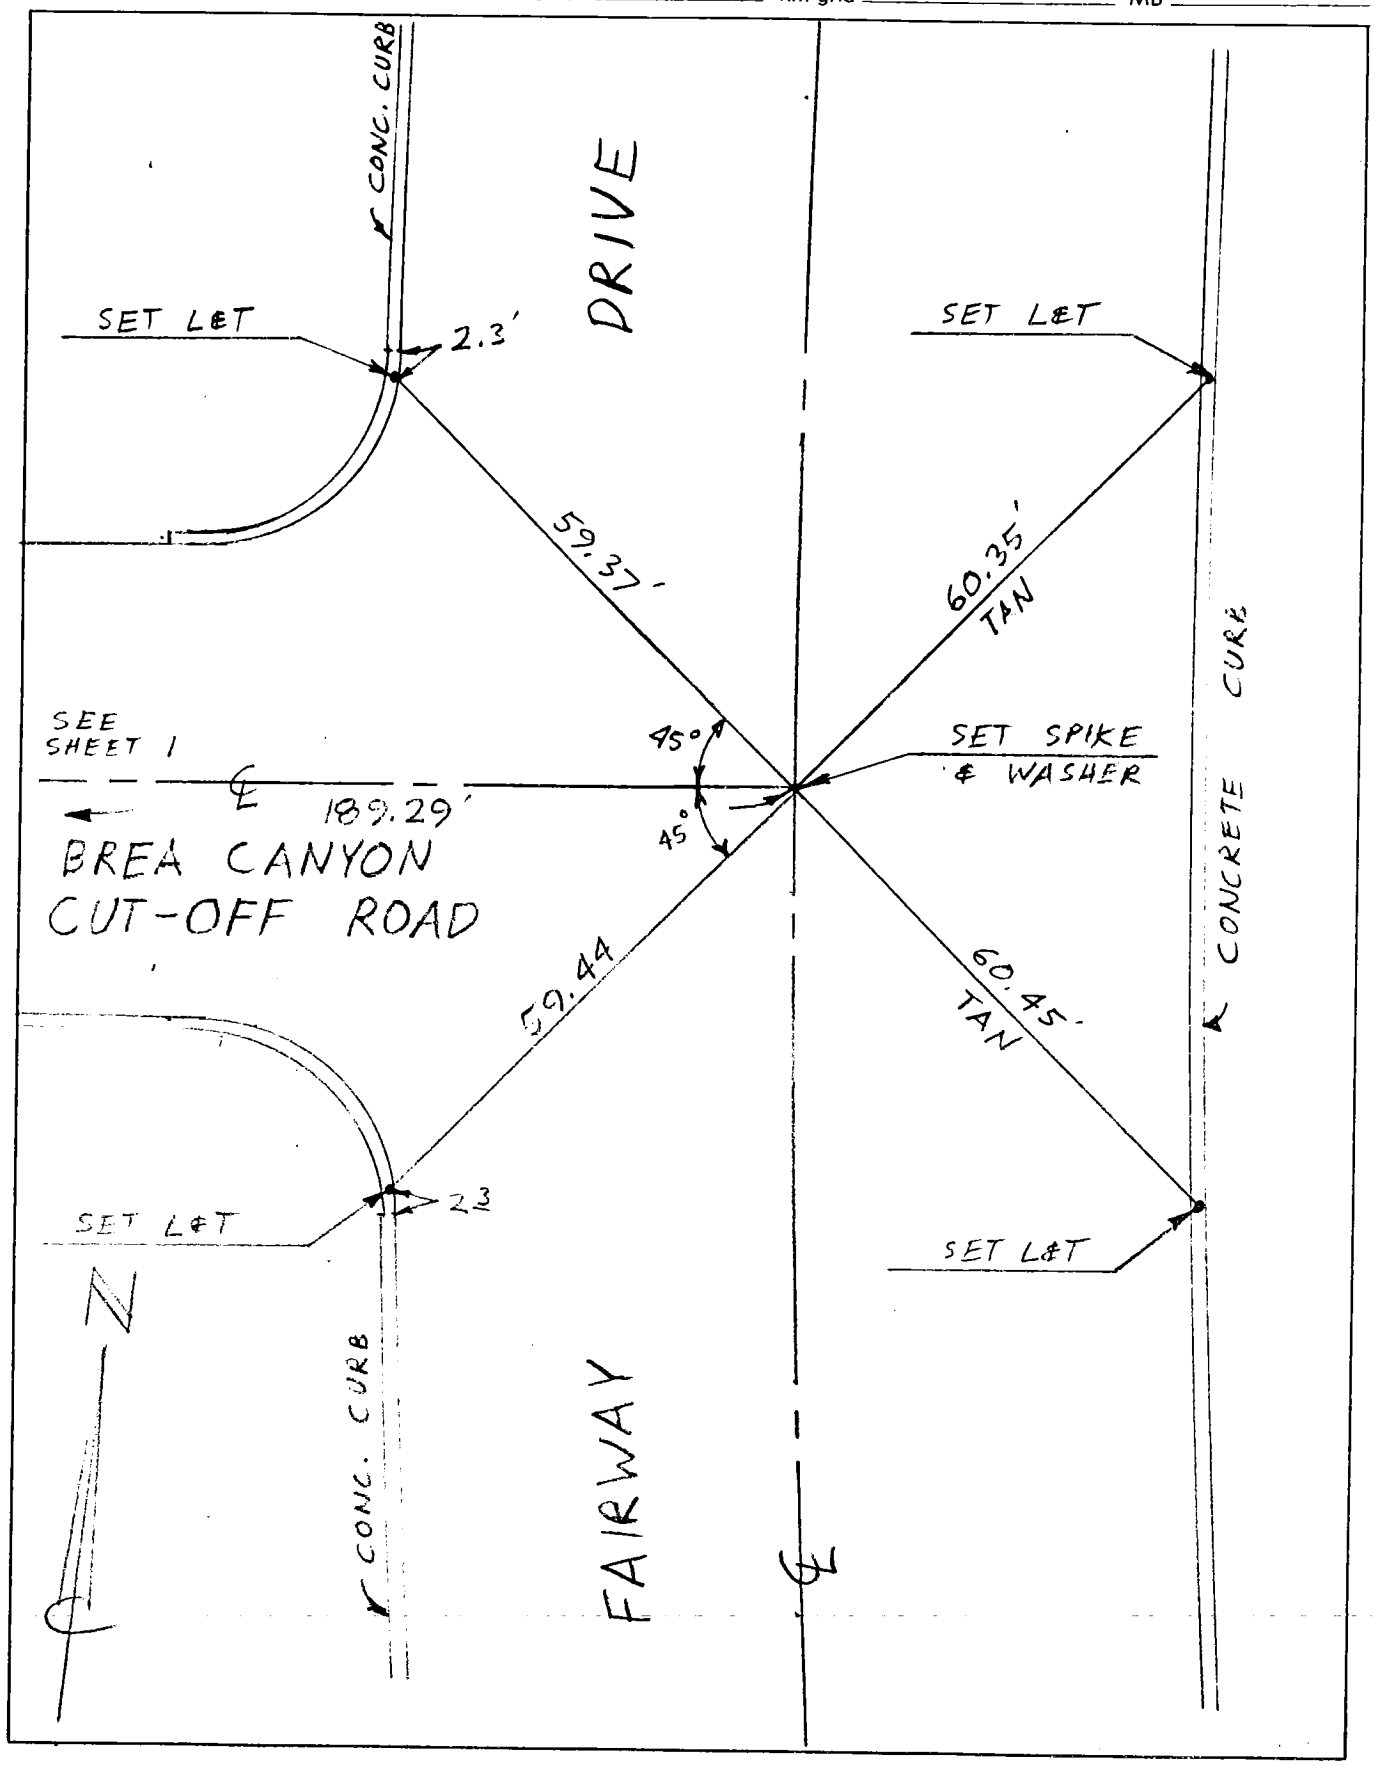

Ground Dist. × Correction Factor: _____ = Grid Distance

CO ENG FB 3673-112

SURVEY OF CENTERLINE TIES F. B. ____ PG. ____

SURVEY BY PACE ENGINEERING INC.

DATE 9/13/84 W.O. 2041 TR. No. 34360

SHT 1 OF 4

114-297, A-2

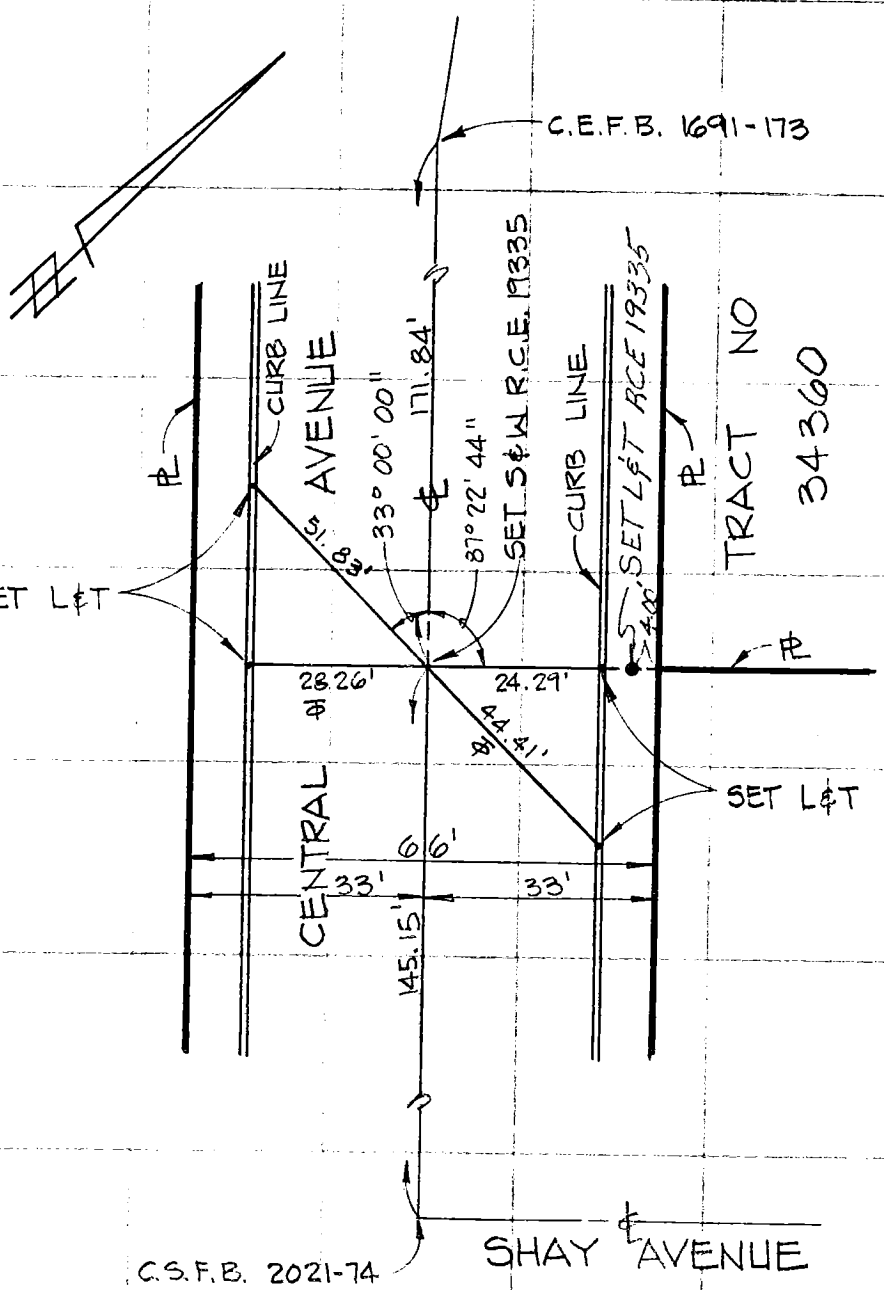

SO. CALIF. BLUE PRINT CO.

CO ENG FB 3673-113

114-297 A-2

SURVEY OF CENTERLINE TIES F. B. ____ PG. ____

SURVEY BY PACE ENGINEERING INC TR. NO. 34360

DATE 9/13/84 W.O. 2041 SHT 2 OF 4

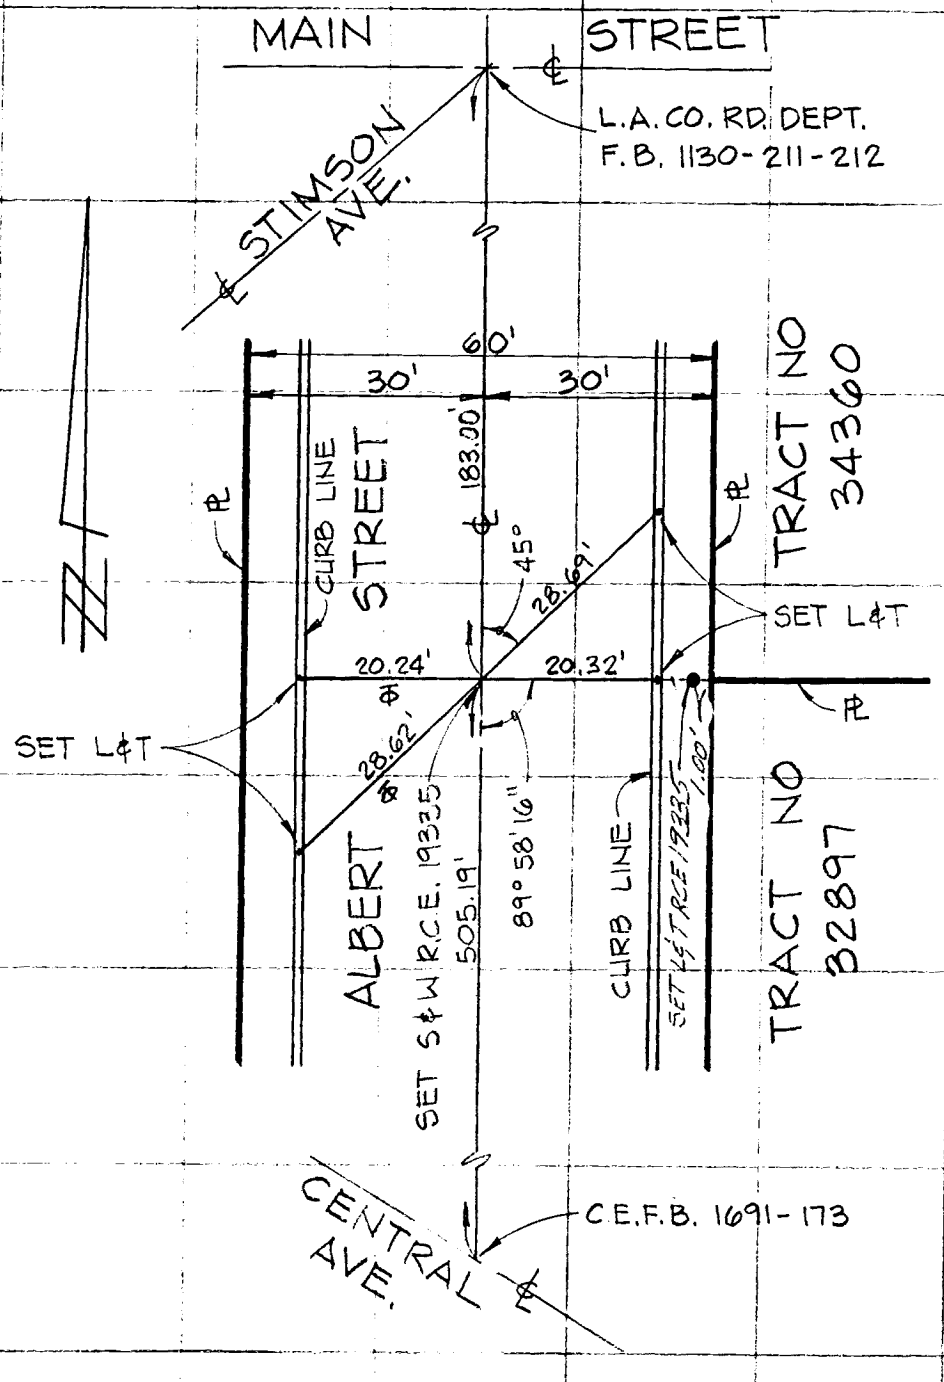

SO. CALIF. BLUE PRINT CO.

CO ENG FB 3673-114

114-297, A-2

SURVEY OF CENTERLINE TIES F. B. Pg.

SURVEY BY PACE ENGINEERING INC. TR. No. 34360

DATE 9/13/84 W.O. 2041 SHT 3 OF 4

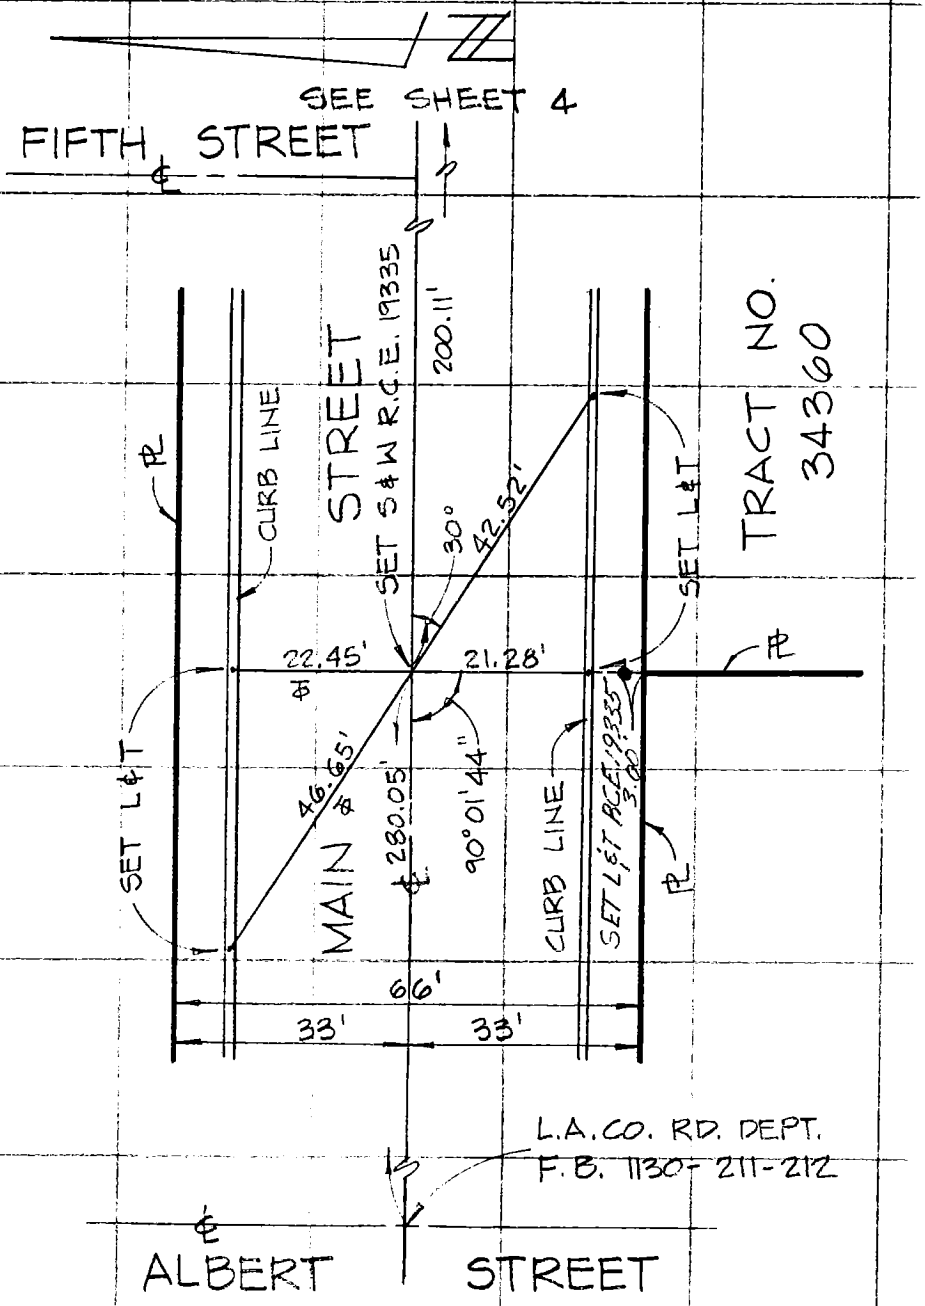

SO. CALIF. BLUE PRINT CO.

114-297, 4-2

CO ENG FB 36730115

SURVEY OF CENTERLINE TIES F. B. ____ PG. ____

SURVEY BY PACE ENGINEERING INC. TR. No. 34360

DATE 9/13/84 W.O. 2041 SHT. 4 OF 4

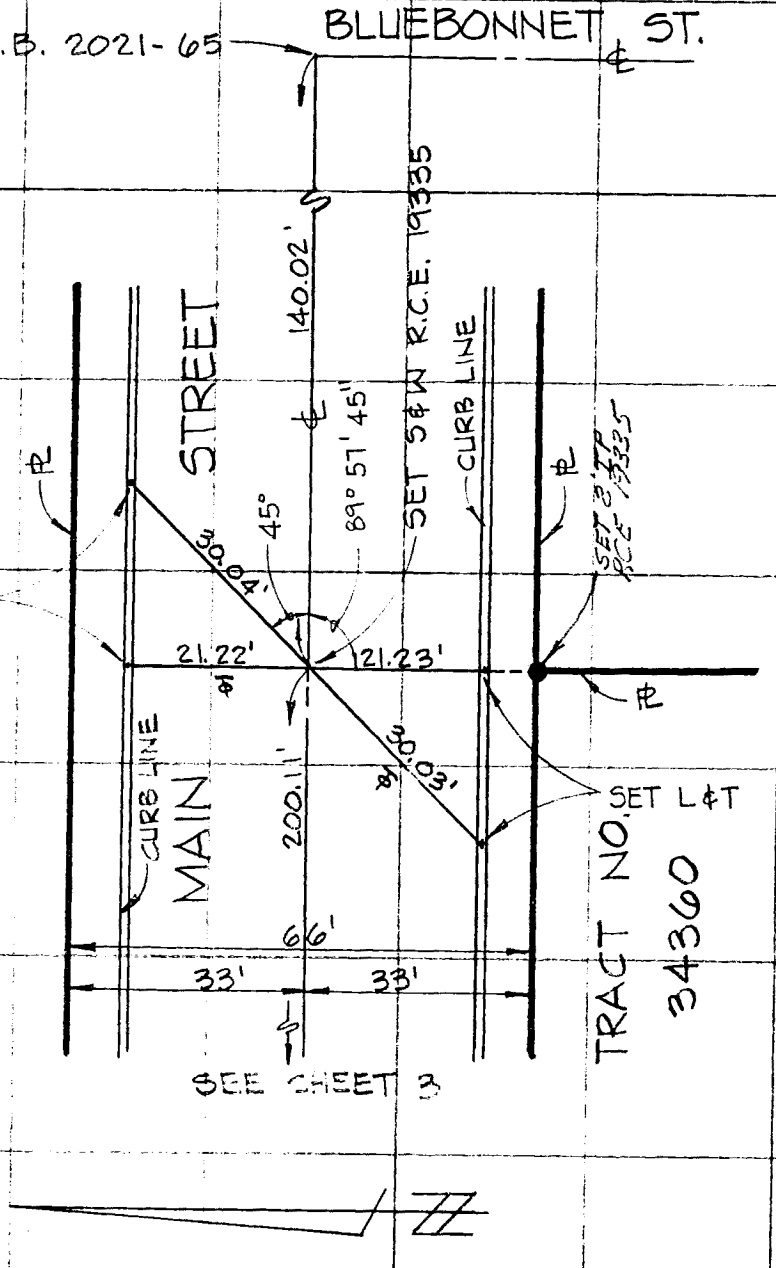

SO. CALIF. BLUE PRINT CO.

CO ENG FB 3673-116

ENG. 3.883B (12/78)
Title & Plat Sheet
50% Rag

Surveyed by — WYNNE ENG. Date 10/2/84 F.B. _____ Pg. _____

Type of Survey SET TRACT MONUMENTS Sheet 1 of 1

Distances corrected to 68° _____ Monuments tagged

L S # _____ Tract or
R C E # 9438 Parcel Map # P.M. NO. 12669

Checked by _____ Date _____ km grid _____ MB _____

W.S. 099-317, B-1, B-2

NOTE: Additions or changes must be initialed, and dated.

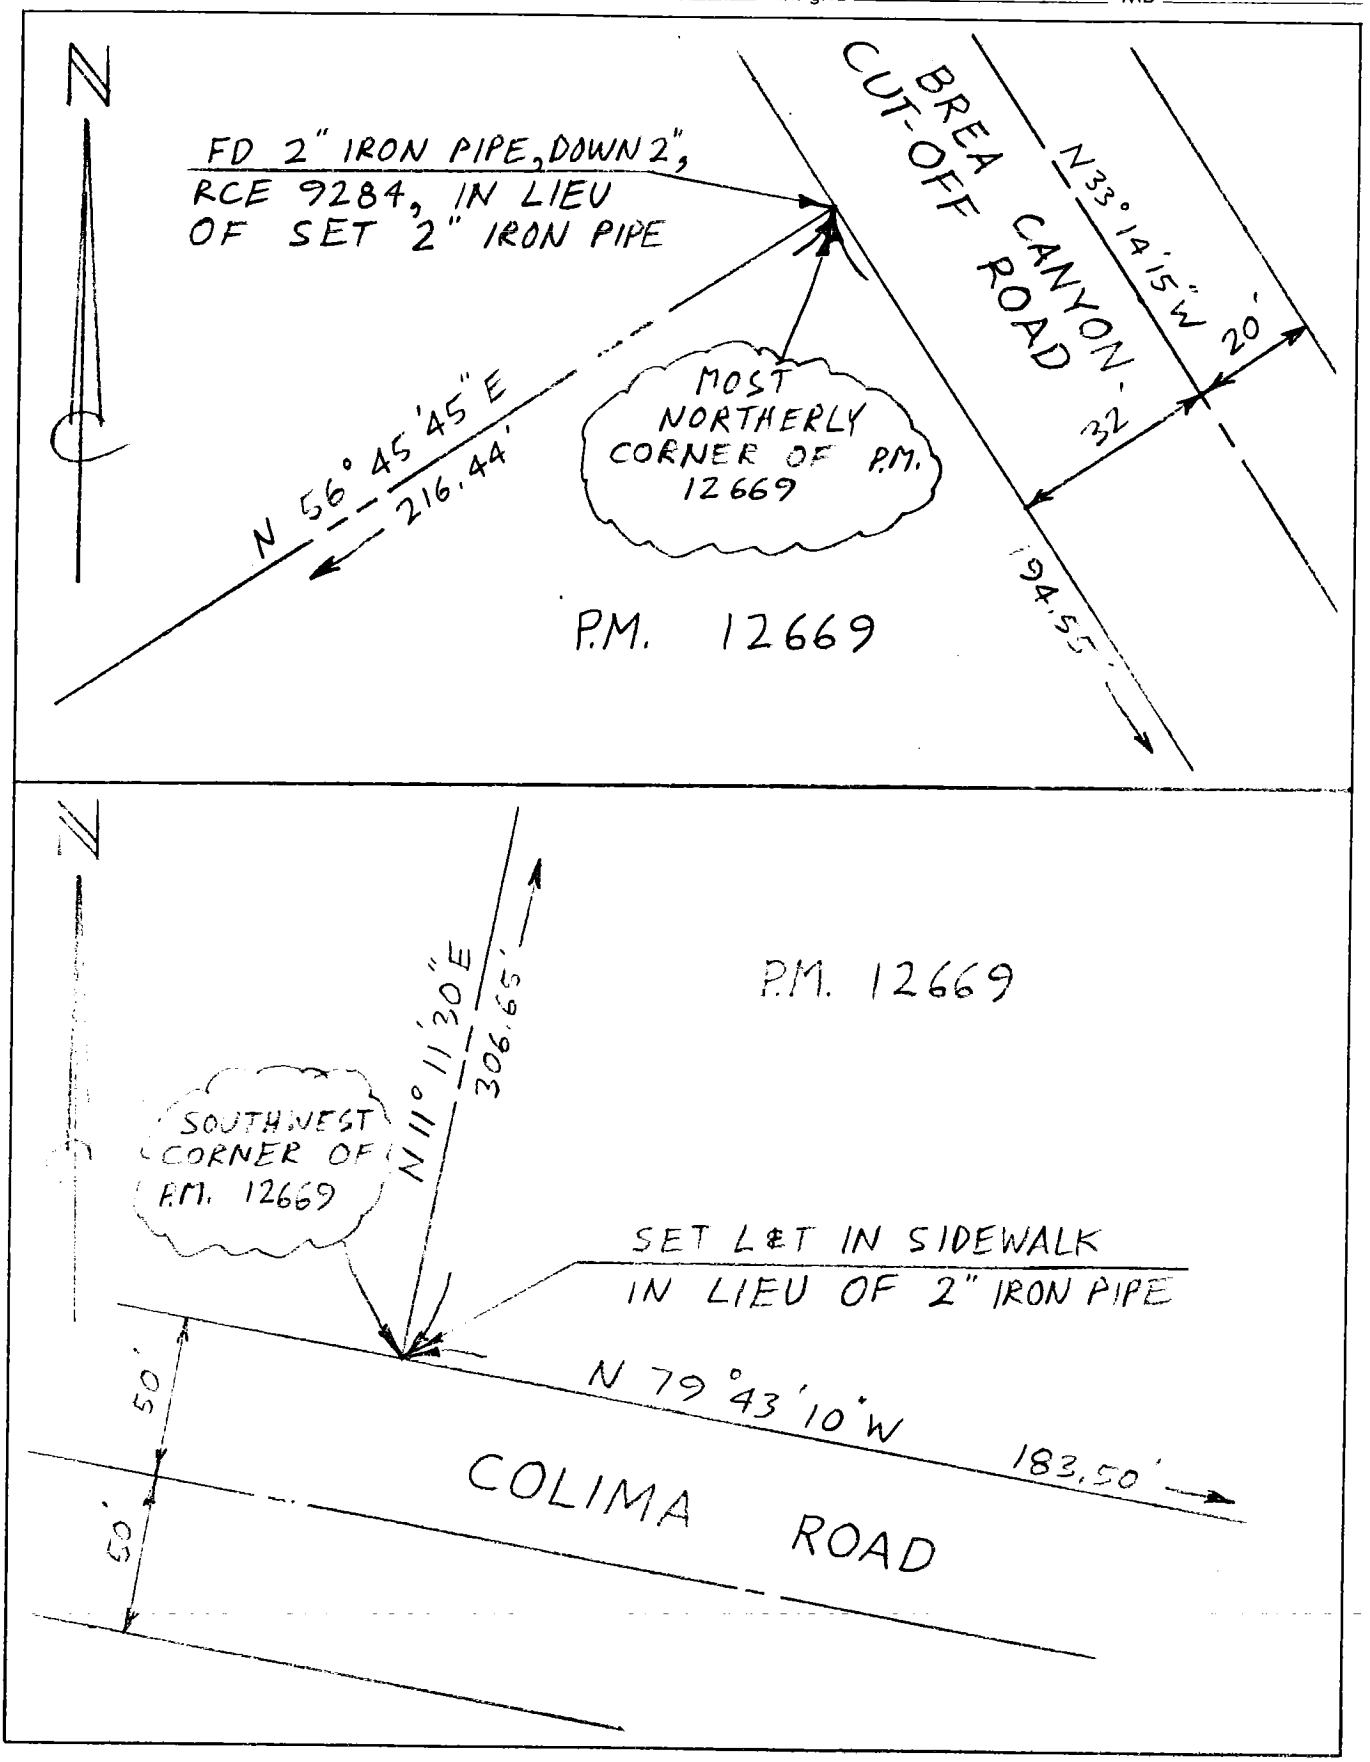

Ground Dist. × Correction Factor: _____ = Grid Distance

76S911- PS 12-78

PROJECT 9036-3 LONG BEACH

SURVEY BY JLH DATE 9-29-84

REVIEWED BY MHH DATE 10.9.84

INDEX CO ENG FB 3673-117

RER-3

LOS ANGELES COUNTY FLOOD CONTROL DISTRICT

FCSD9036 55

W.S. 30, C-4

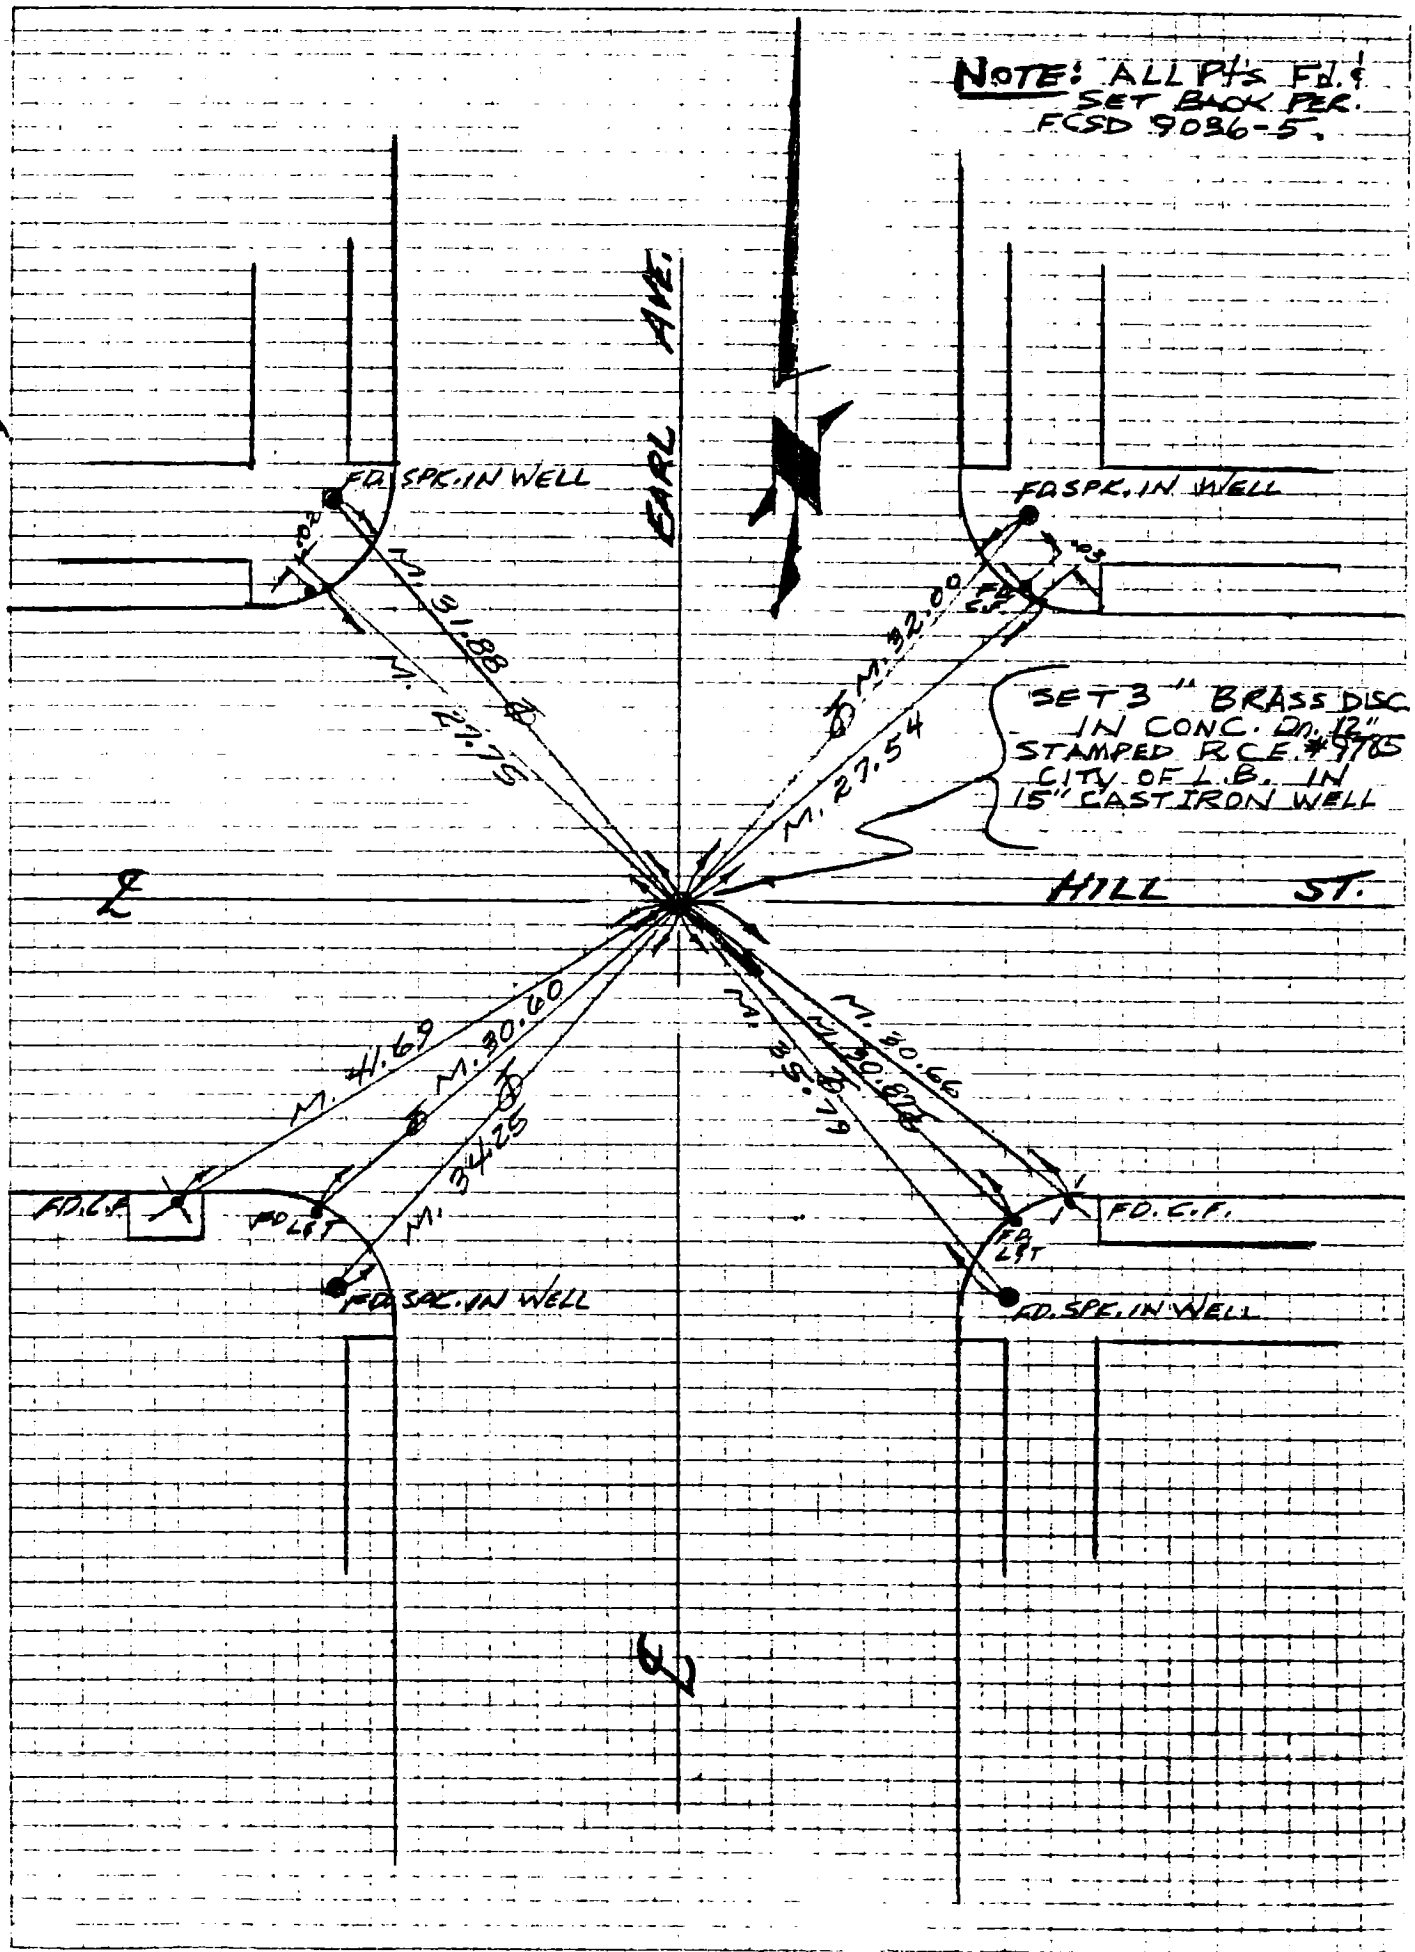

76S911- PS 12-78

PROJECT LONG BEACH 9036.3
SURVEY BY J.L.H. , J.L.C. DATE 9-28-84
REVIEWED BY MHH DATE 10.9.84

INDEX CO ENG FB 3673-118
RGR-5
LOS ANGELES COUNTY FLOOD CONTROL DISTRICT

FCSD9036 57
W.S. 30, C-4

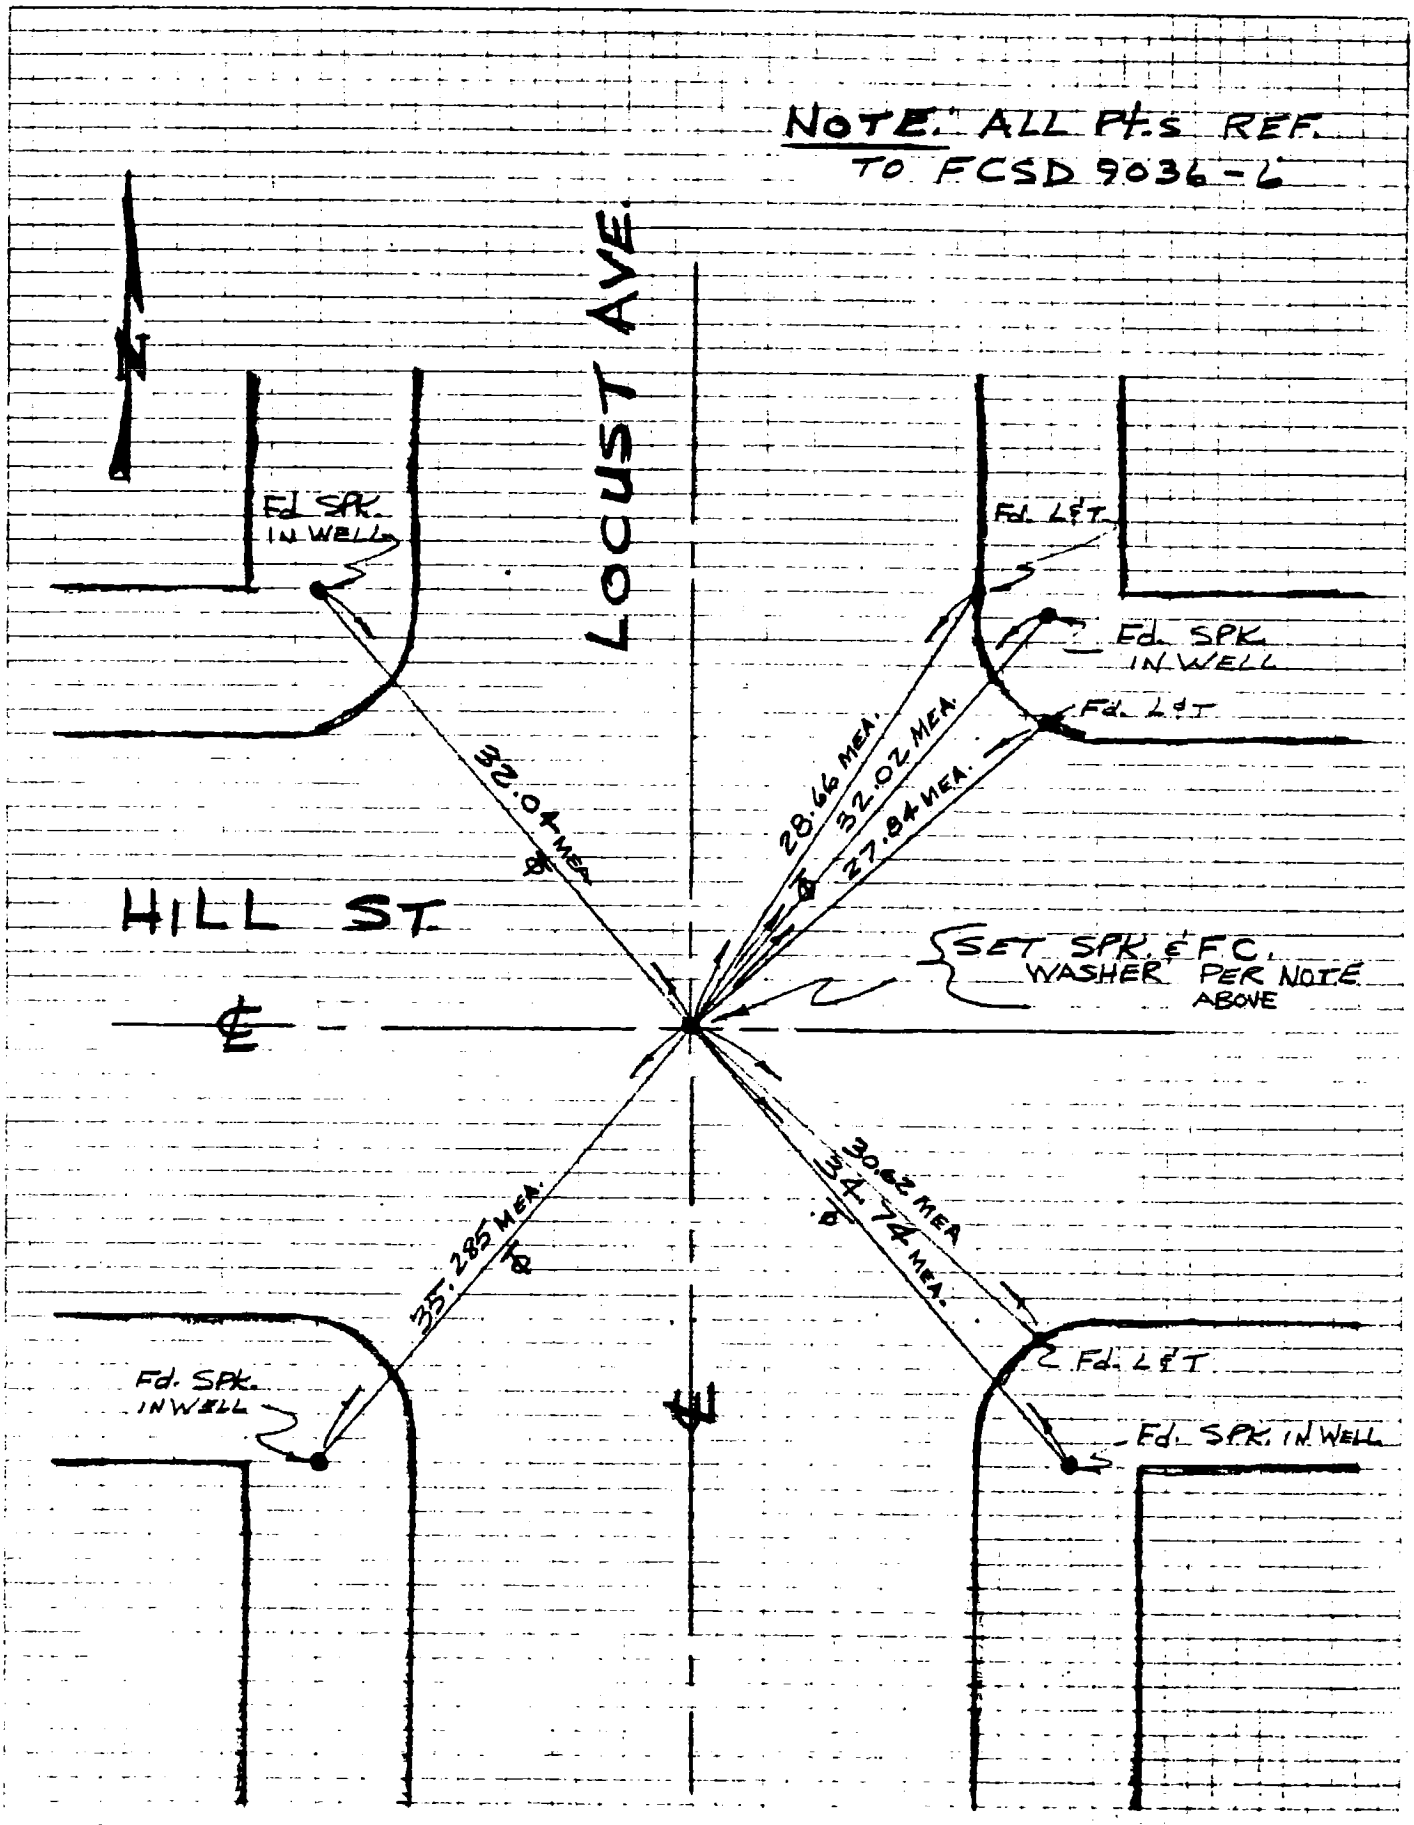

76S911- PS 12-78

PROJECT LONG BEACH 9036-3

SURVEY BY J.L.H. , J.L.C. DATE 9-28-84

REVIEWED BY MHH DATE 10-9-84

CO ENG FB 3673-119

INDEX R&R-7

LOS ANGELES COUNTY FLOOD CONTROL DISTRICT

FCSD9036 59

W.S. 30, C-4

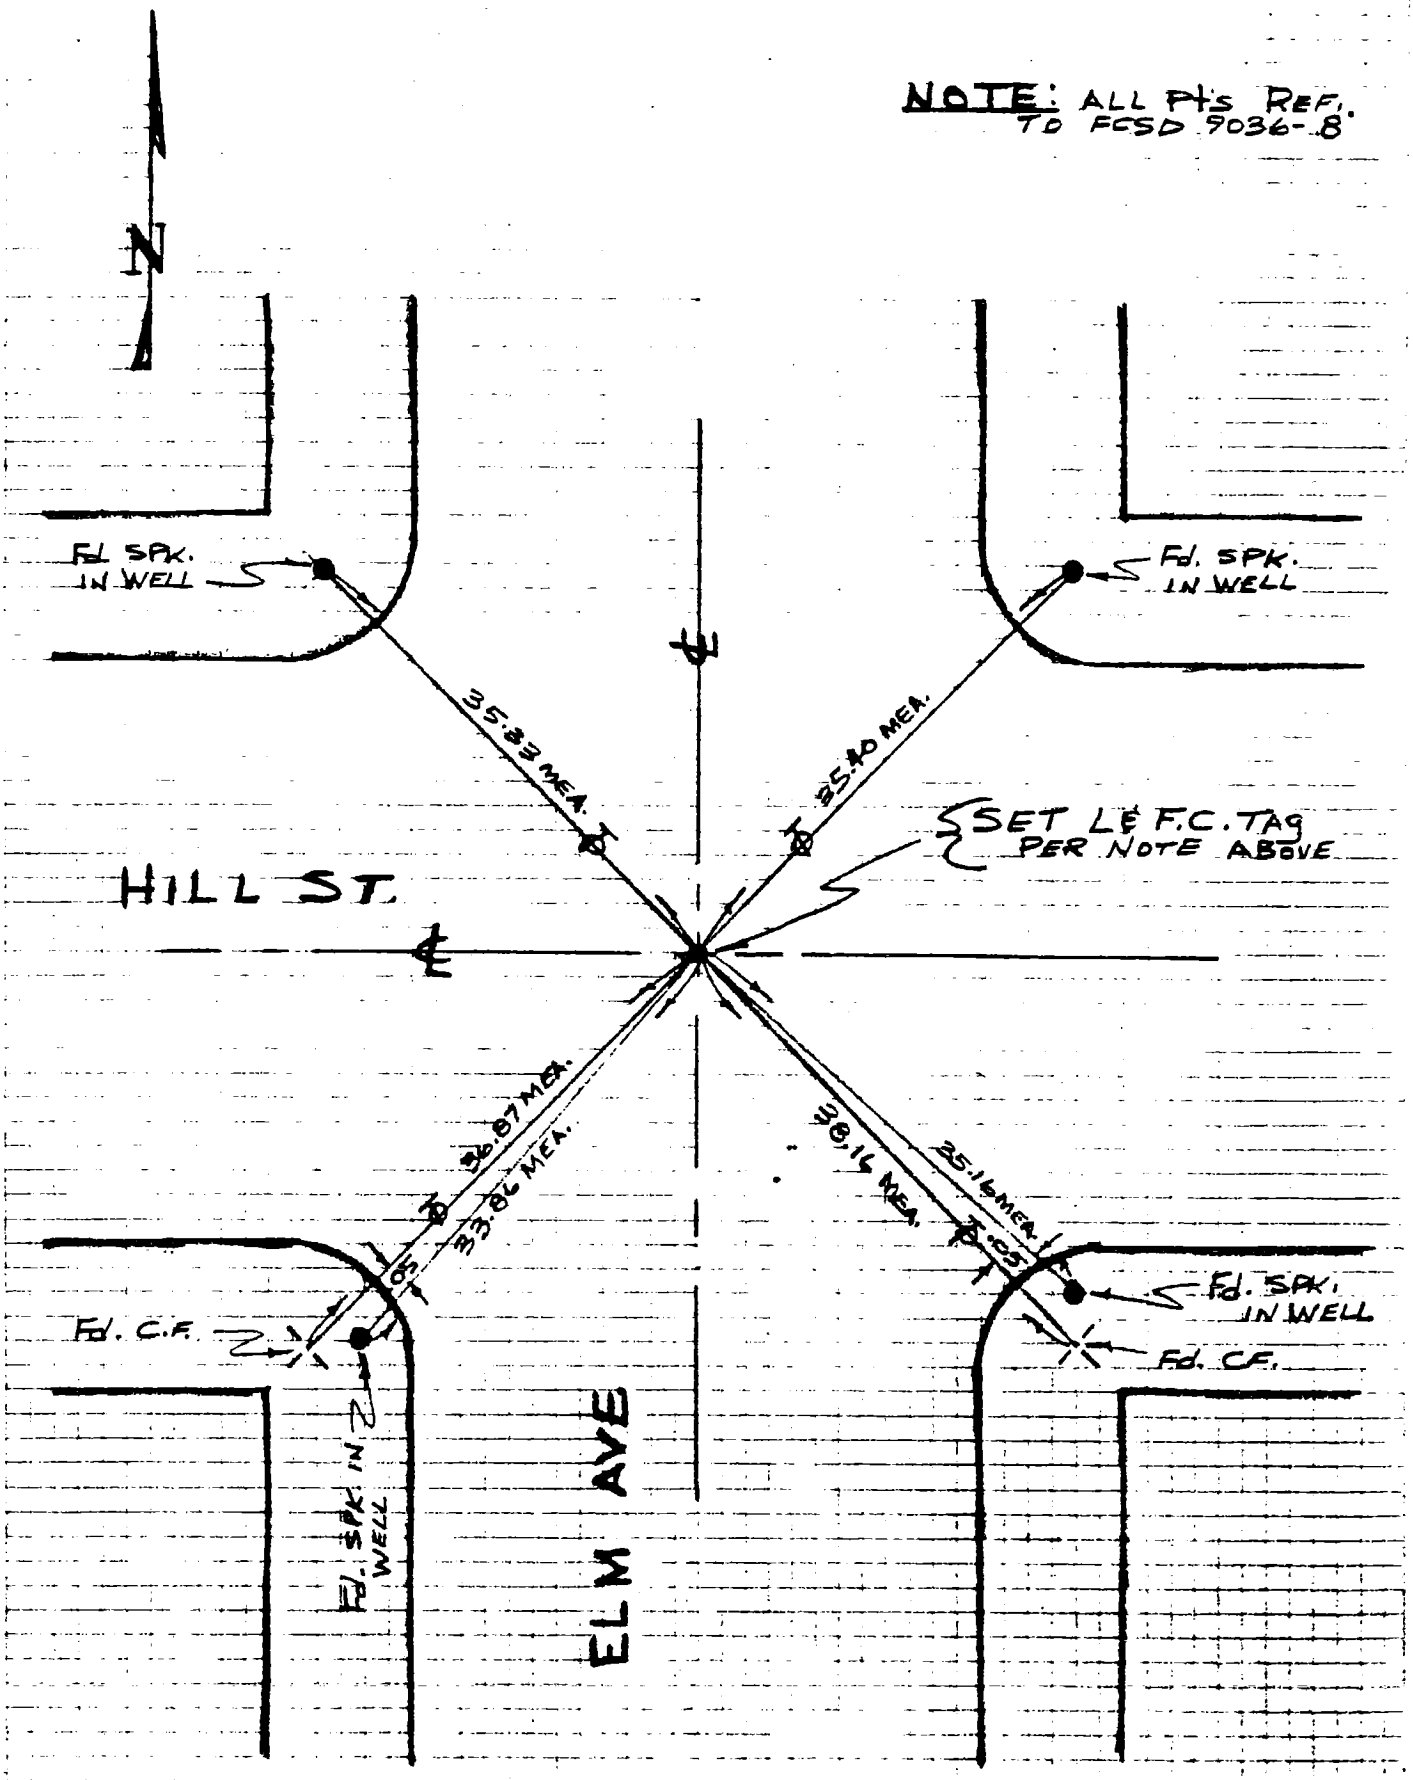

76S911- PS 12-78

PROJECT LONG BEACH 9036-3

SURVEY BY J.L.H., J.L.C. DATE 9-28-84

REVIEWED BY MHH DATE 10-9-84

CO ENG FB 3673-120

INDEX RER-9

LOS ANGELES COUNTY FLOOD CONTROL DISTRICT

FCSD9036 61

W.S. 30, C-4

NOTE: ALL Pt's REF. TO FCSD 9036-9

PASADENA AVE.

HILL ST.

Fd. SPK. IN WELL

Fd. SPK. IN WELL

Fd. SPK. IN WELL

Fd. SPK. IN WELL

35.54 MEA.

35.37 MEA.

34.29 MEA.

34.315 MEA.

SET L & F.C. TAG PER NOTE ABOVE

76S911- PS 12-78

PROJECT LONG BEACH 9036-3

SURVEY BY JLH, JLC DATE 10-1-84

REVIEWED BY MHH DATE 10-9-84

CO ENG FB 3673-121

INDEX R&R-11

LOS ANGELES COUNTY FLOOD CONTROL DISTRICT

FCSD9036 63

W.S. 30, C-4

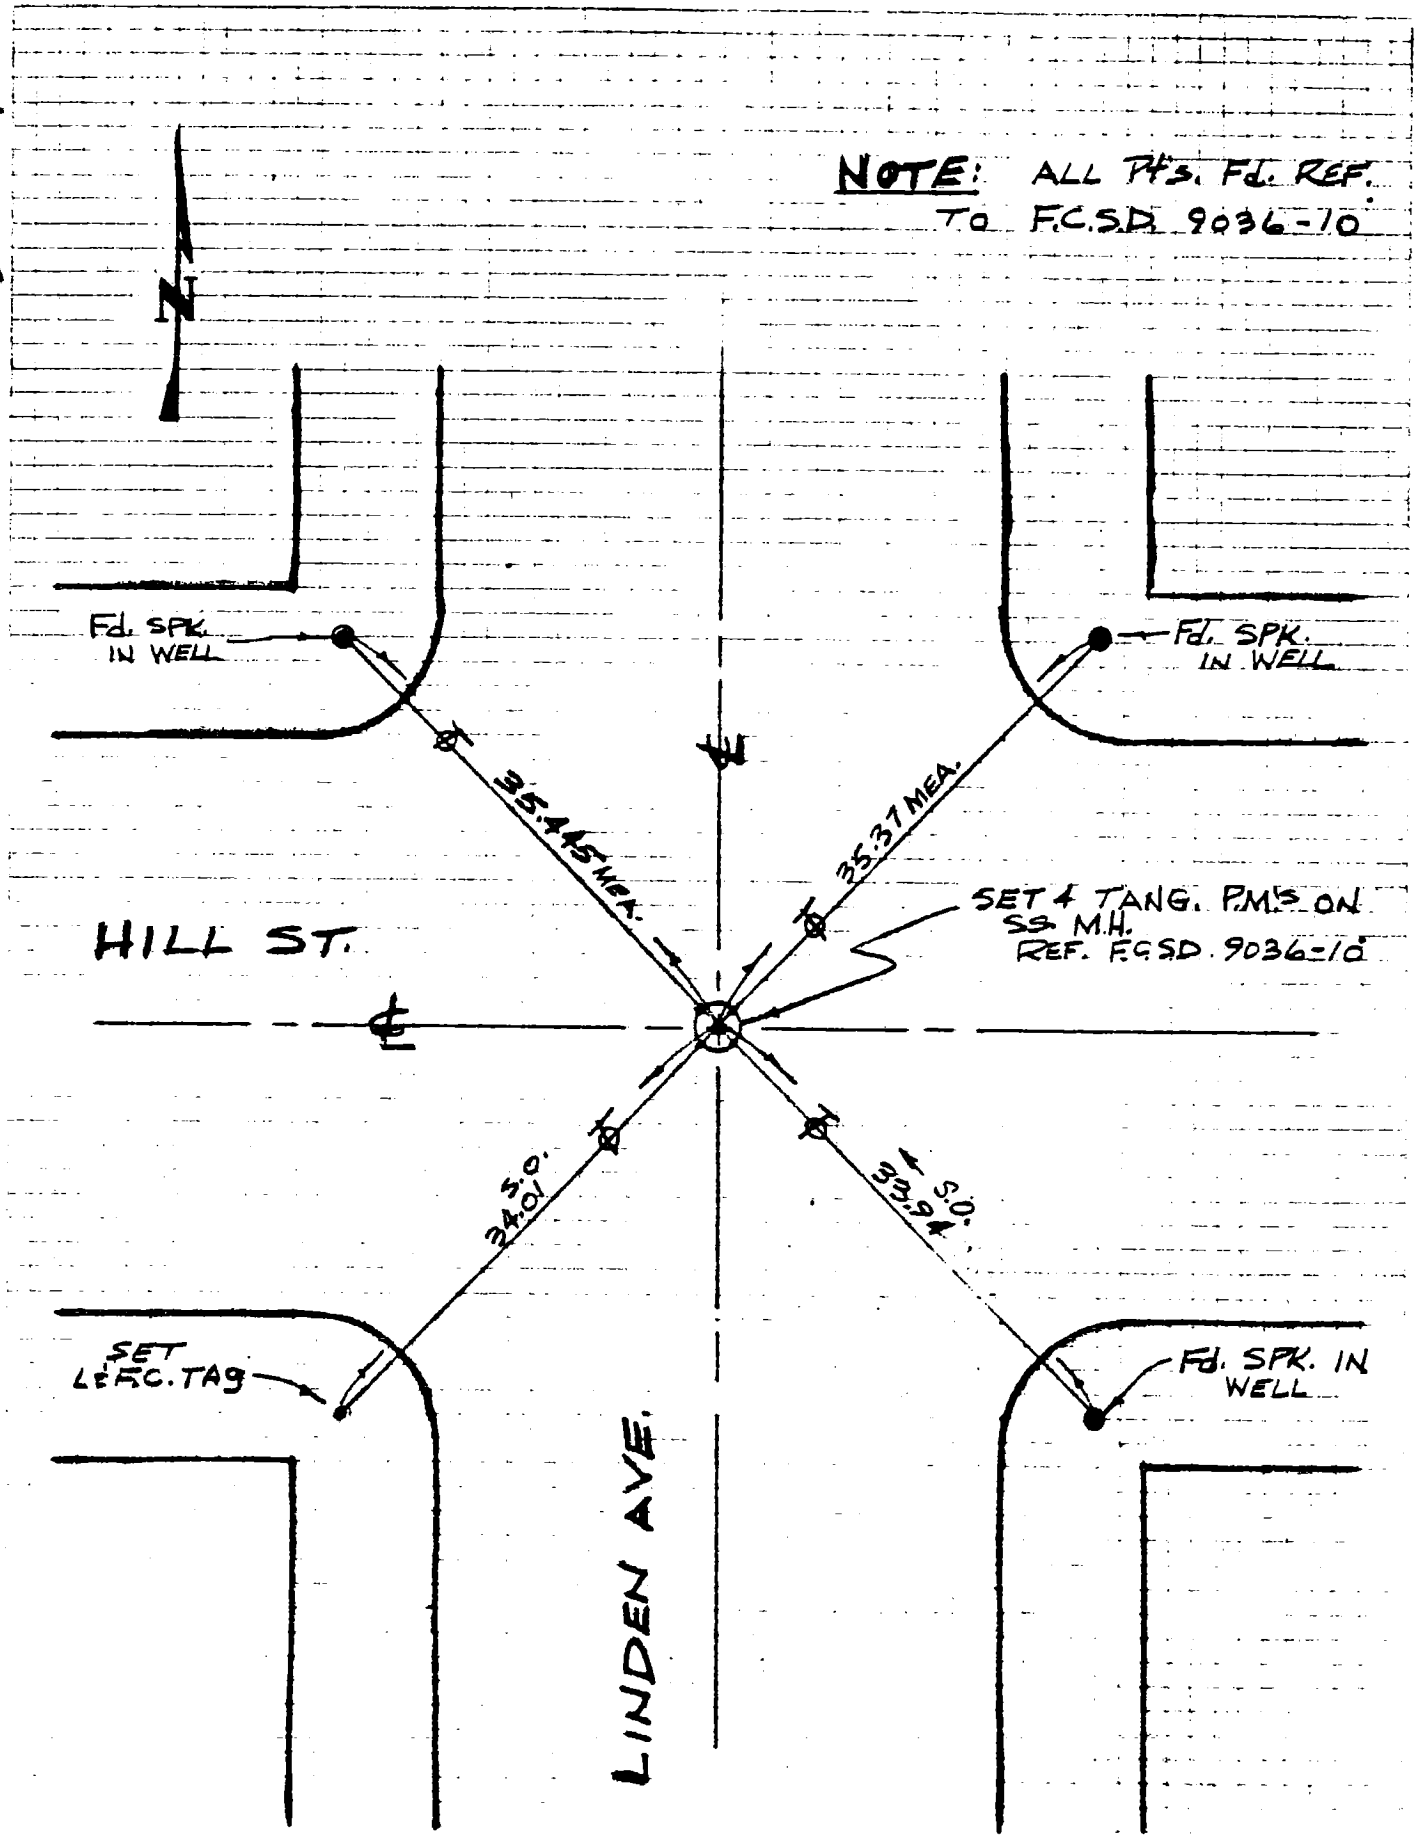

76S911- PS 12-78

PROJECT 9036-3 LONG BEACH

SURVEY BY JLH DATE 9-28-84

REVIEWED BY MHH DATE 10-9-84

CO ENG FB 3673-122

INDEX R&R-13

LOS ANGELES COUNTY FLOOD CONTROL DISTRICT

FCSD9036 65

W.S. 30, C-4

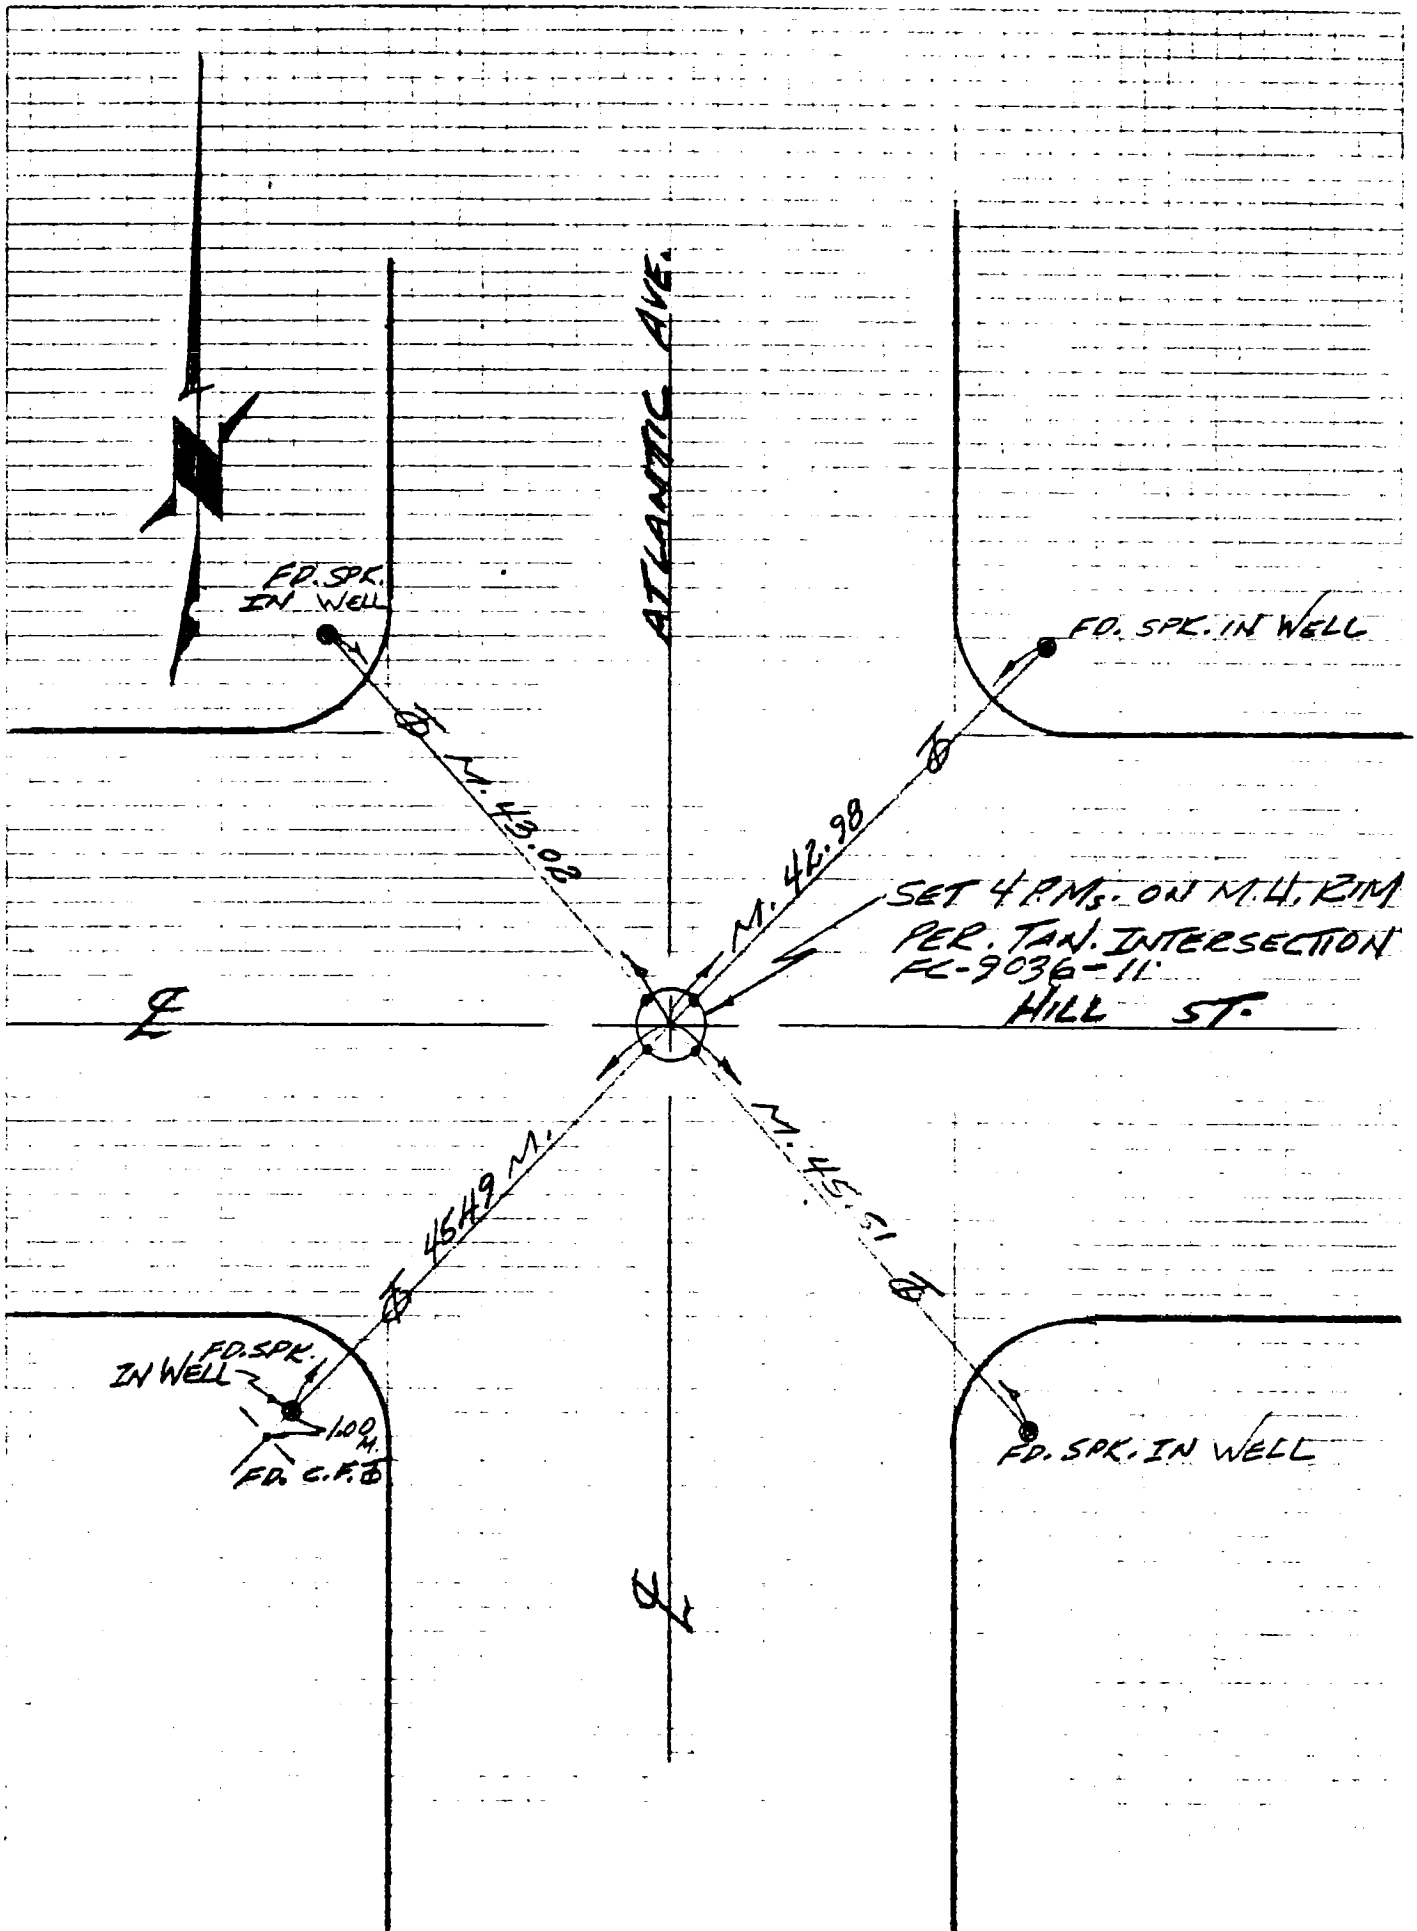

76S911- Cdb 5-71

PROJECT BANKFIELD DRAIN

SURVEY BY HENNON DATE 4-3-84

REVIEWED BY _____ DATE _____

CO ENG FB 3673-123

INDEX FC 3466 15

R&R-05

LOS ANGELES COUNTY FLOOD CONTROL DISTRICT

W.S. 23,D-2

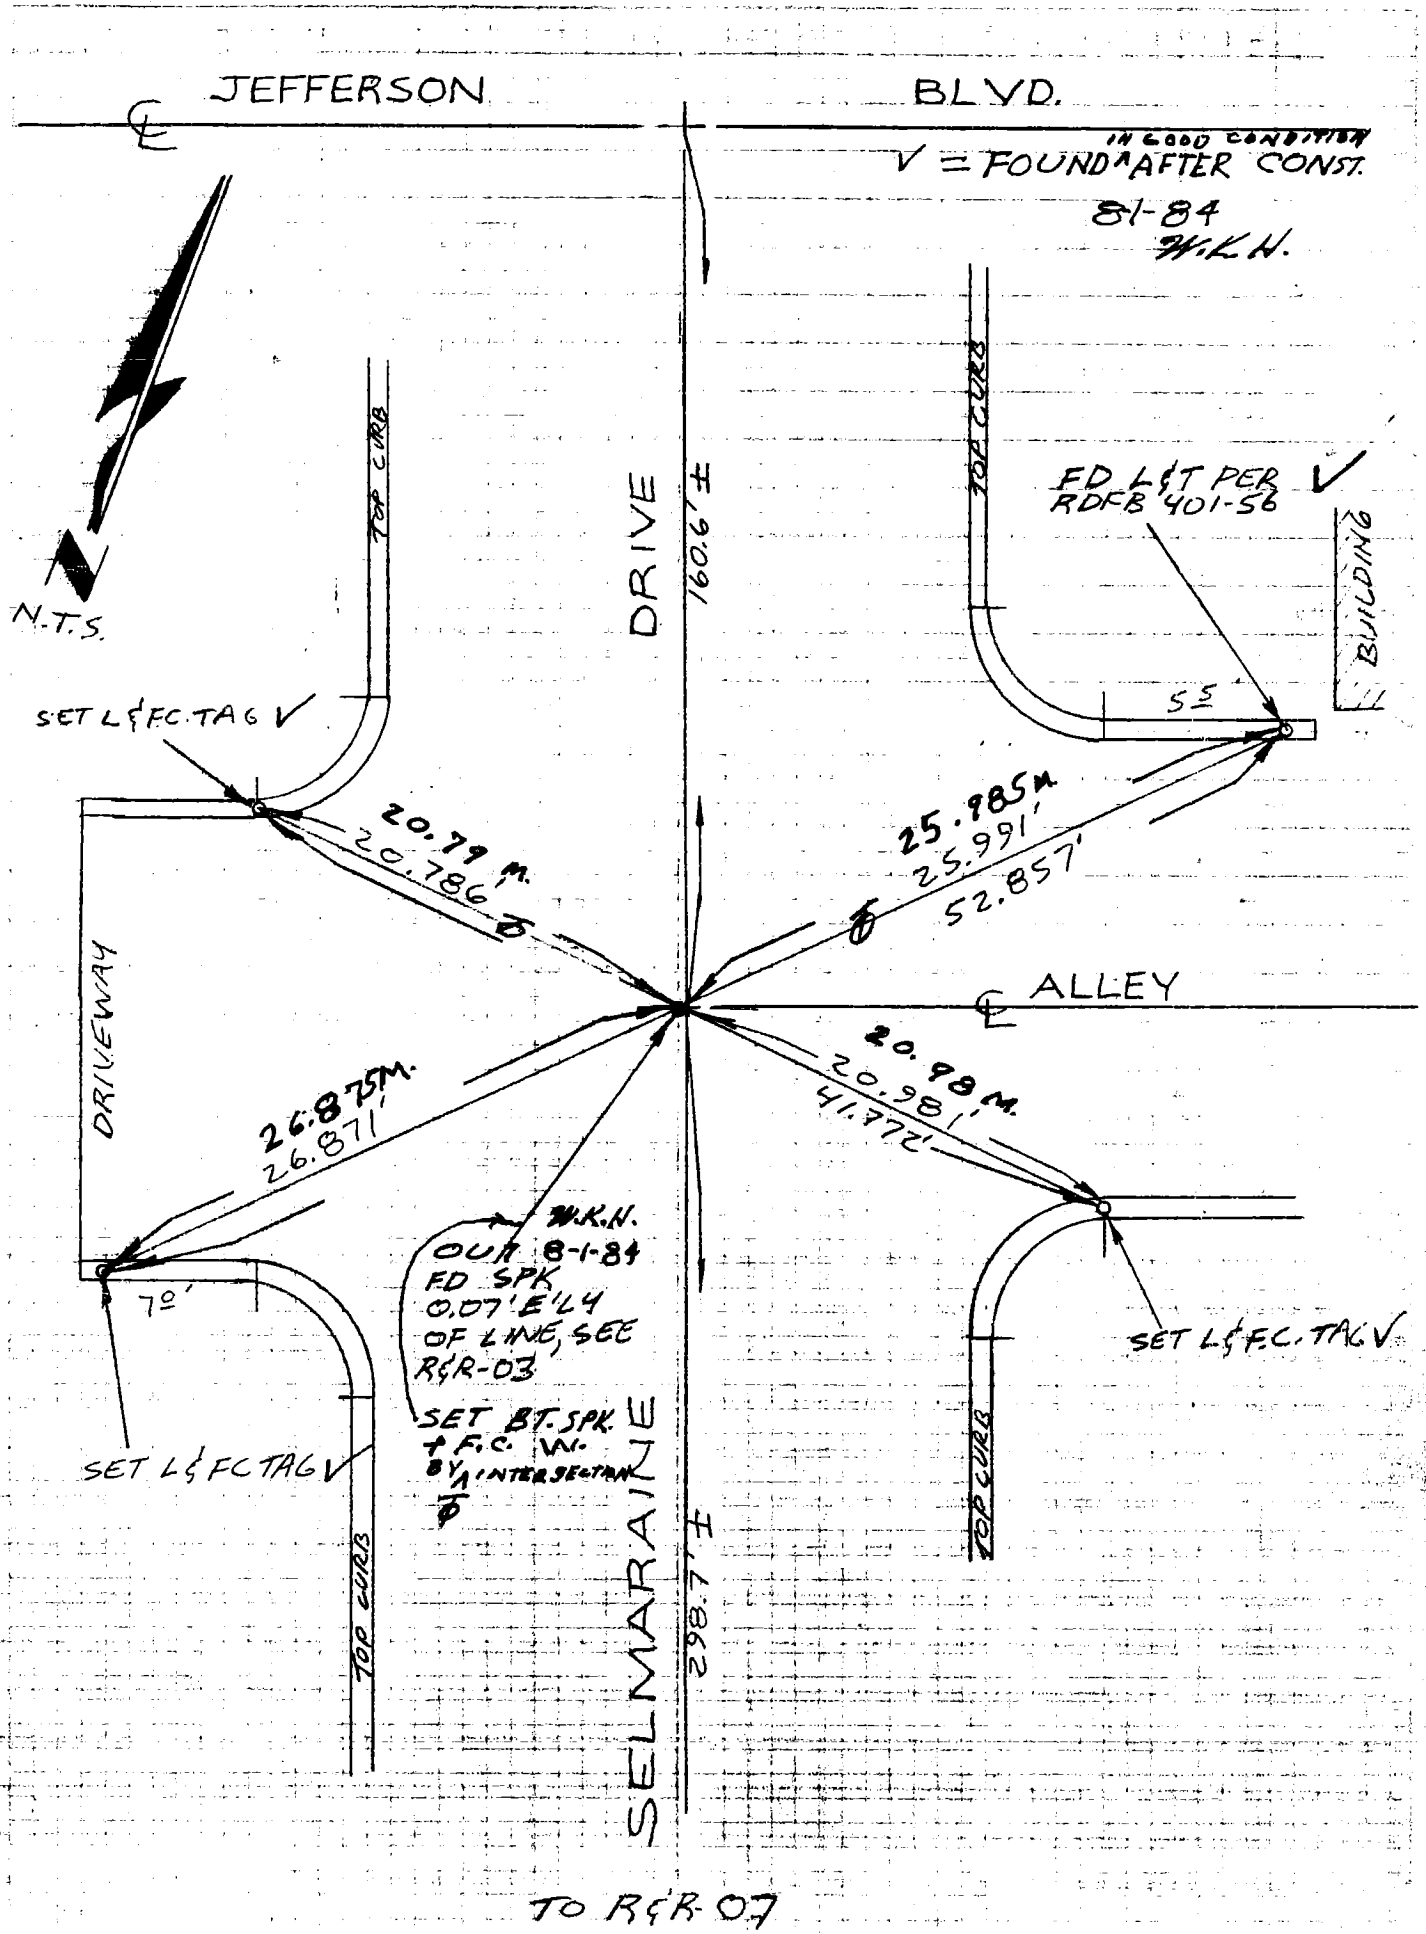

TO R&R-07

76S911- PS 12-78

PROJECT BANKFIELD DRAIN

SURVEY BY HENNON DATE 4-3-84

REVIEWED BY _____ DATE _____

INDEX FC 3466 17

R&R-07

LOS ANGELES COUNTY FLOOD CONTROL DISTRICT

W.S. 2330-2

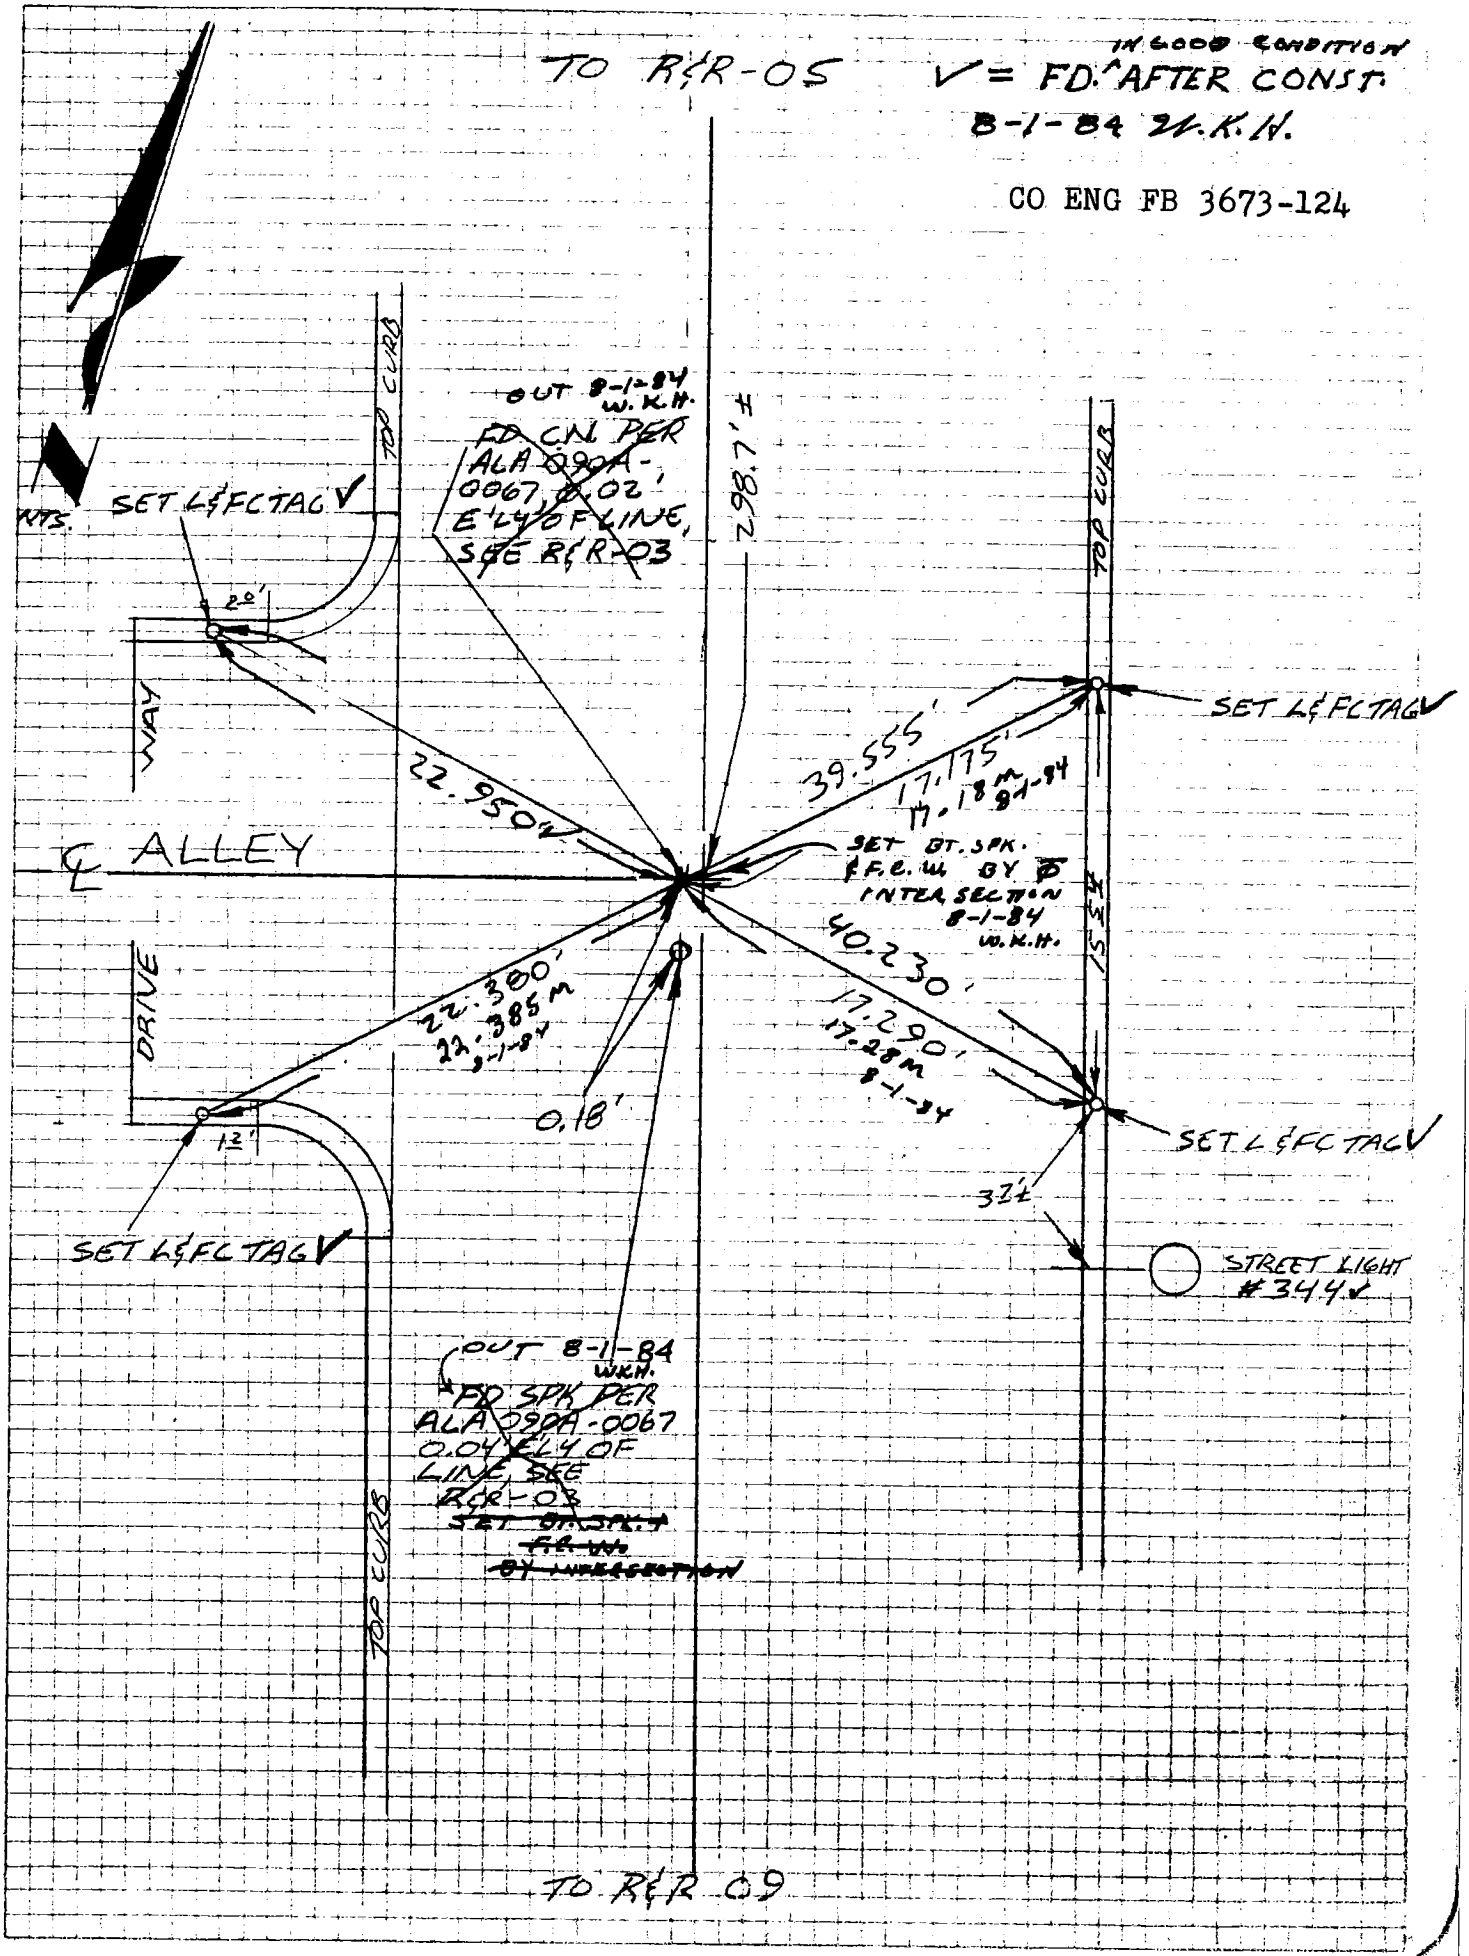

76S911- PS 12-78

PROJECT BANKFIELD DRAIN

SURVEY BY HENNON DATE 4-4-84

REVIEWED BY _____ DATE _____

CO ENG FB 3673-125

INDEX FC 3466 19

RER-09

LOS ANGELES COUNTY FLOOD CONTROL DISTRICT

W.S. 23,0-2

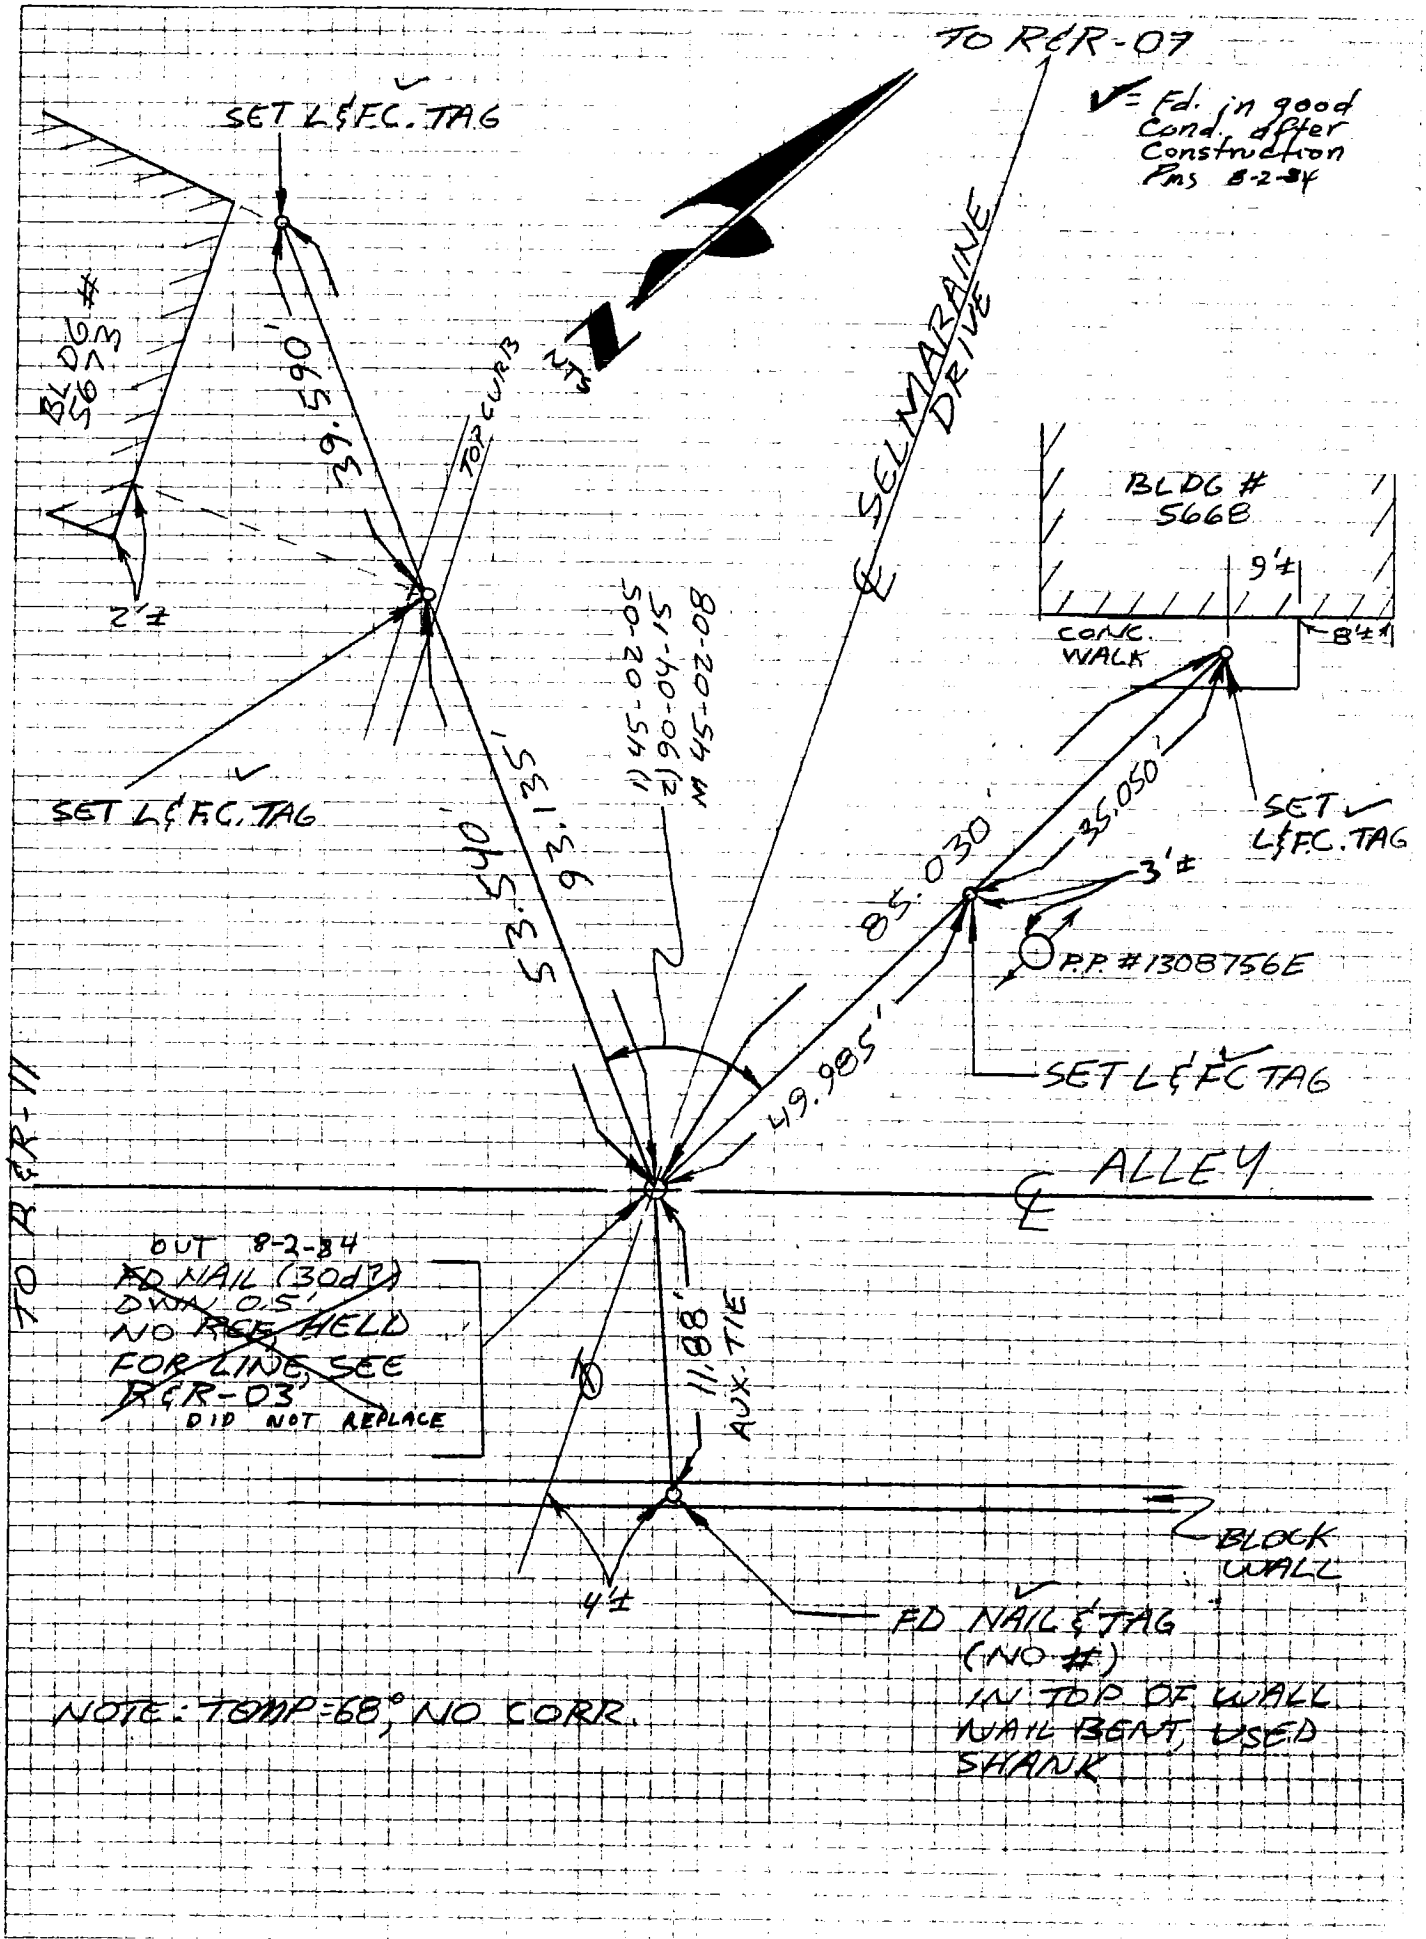

76S911- PS 12-78

PROJECT BANKFIELD DRAIN

SURVEY BY HENNON DATE 4-4-84

REVIEWED BY _____ DATE _____

INDEX FC 3466 21

R&R-11

LOS ANGELES COUNTY FLOOD CONTROL DISTRICT

W.S. 23,0-2

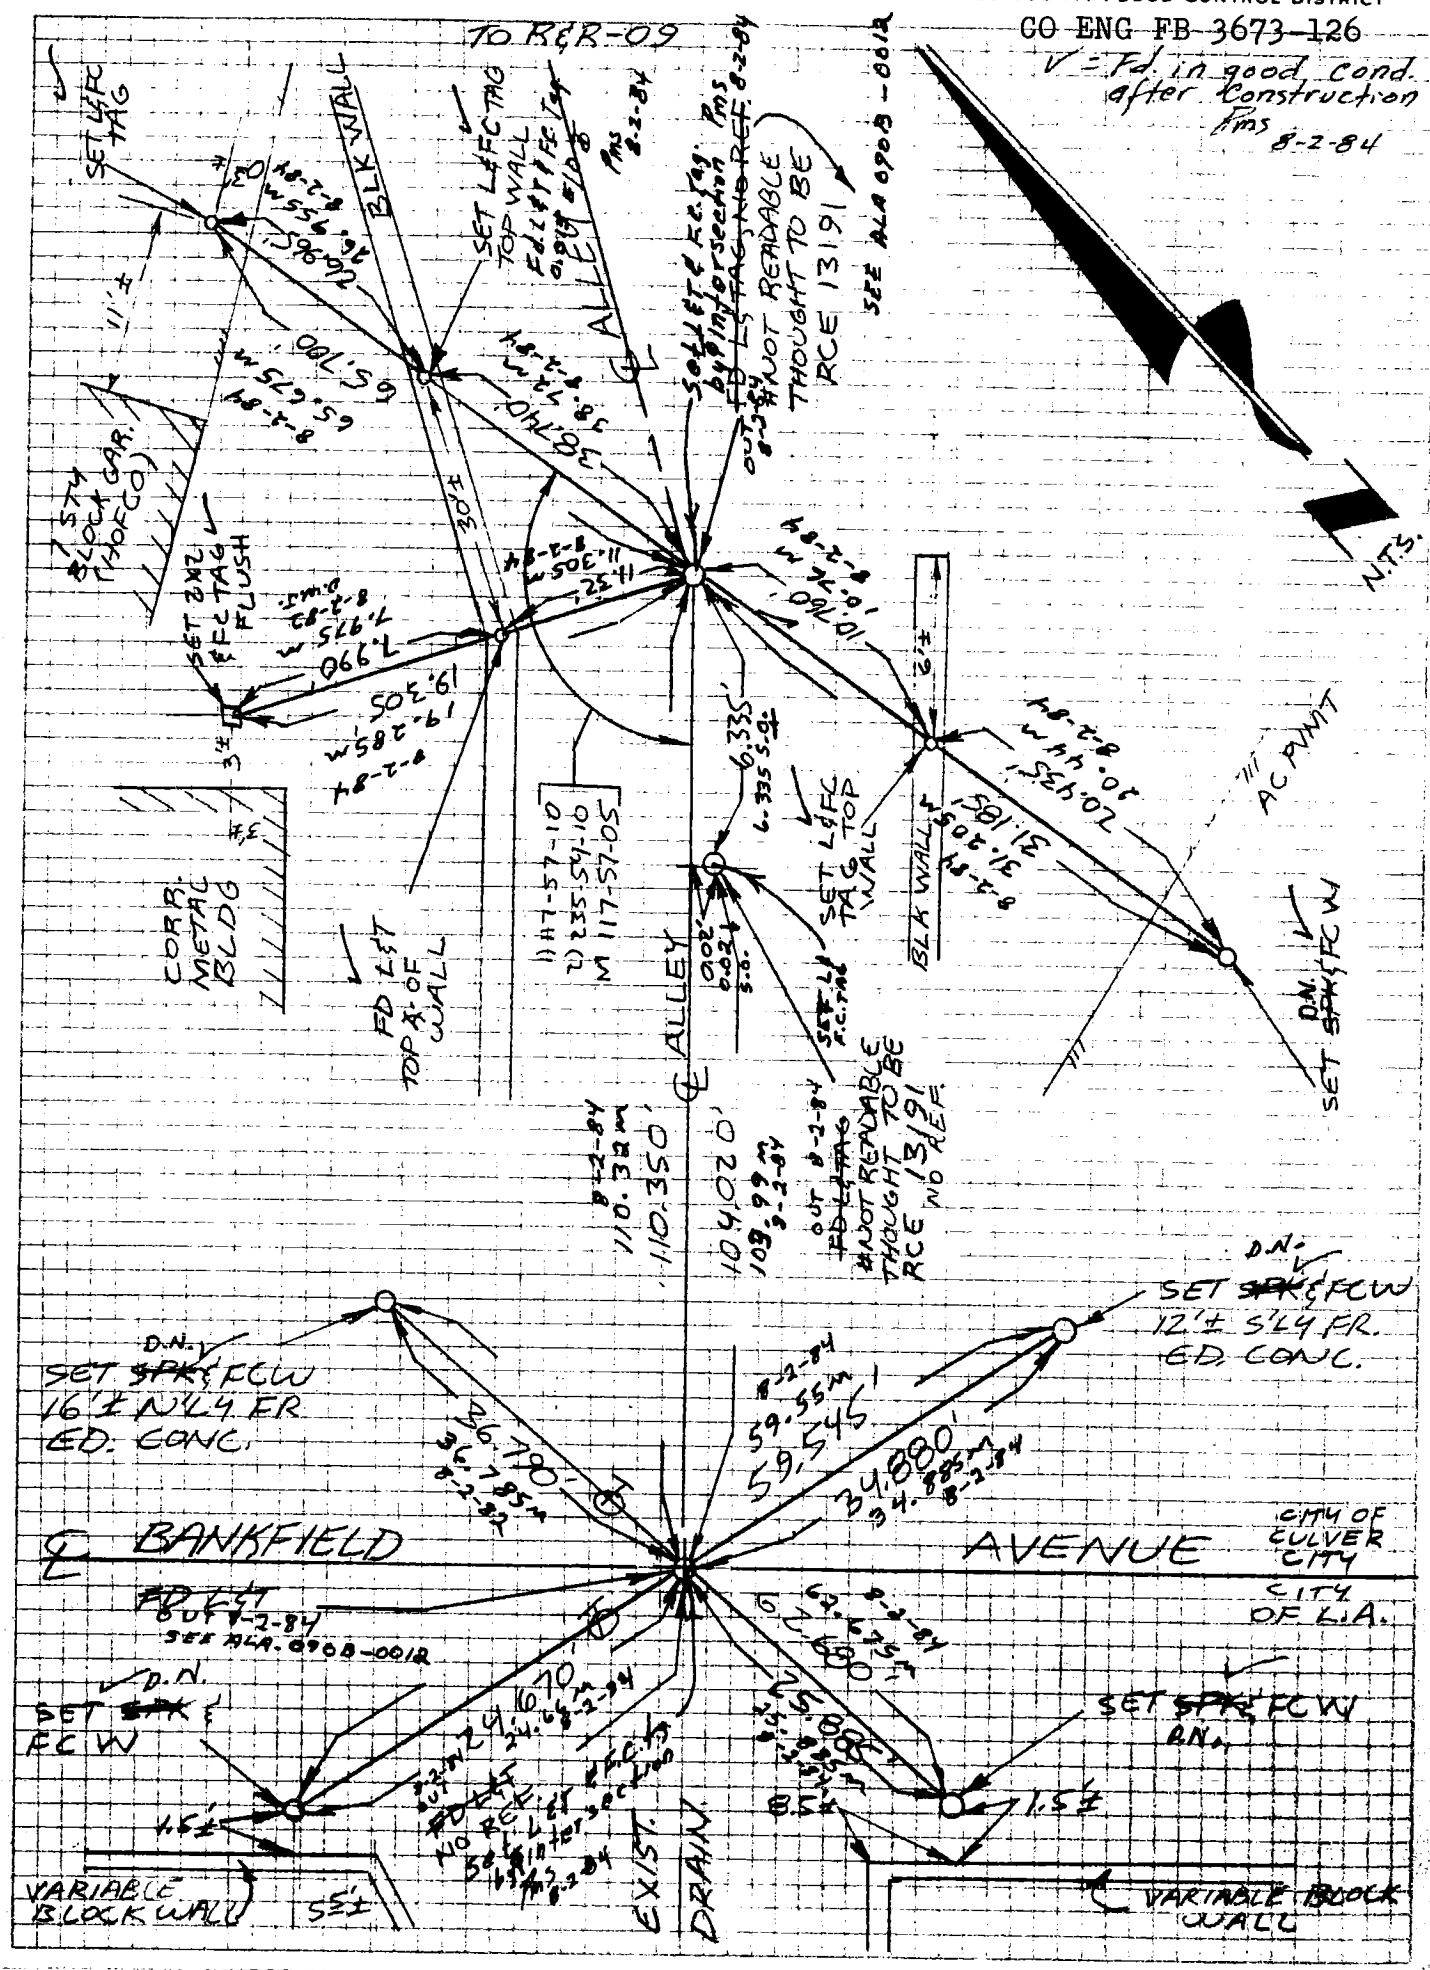

CO ENG FB 3673-126

V = Fd. in good cond. after construction

Fms 8-2-84

76S911- PS 12-78

PROJECT 7TH ST. DRAIN

SURVEY BY VILLAFANA DATE 1-17-84

REVIEWED BY JAB DATE 8-29-84

BH 9-17-84

OK 127

INDEX FC 3449 25

R&R 3

LOS ANGELES COUNTY FLOOD CONTROL DISTRICT

CO ENG FB 3673-127

W.S. 9, E-4

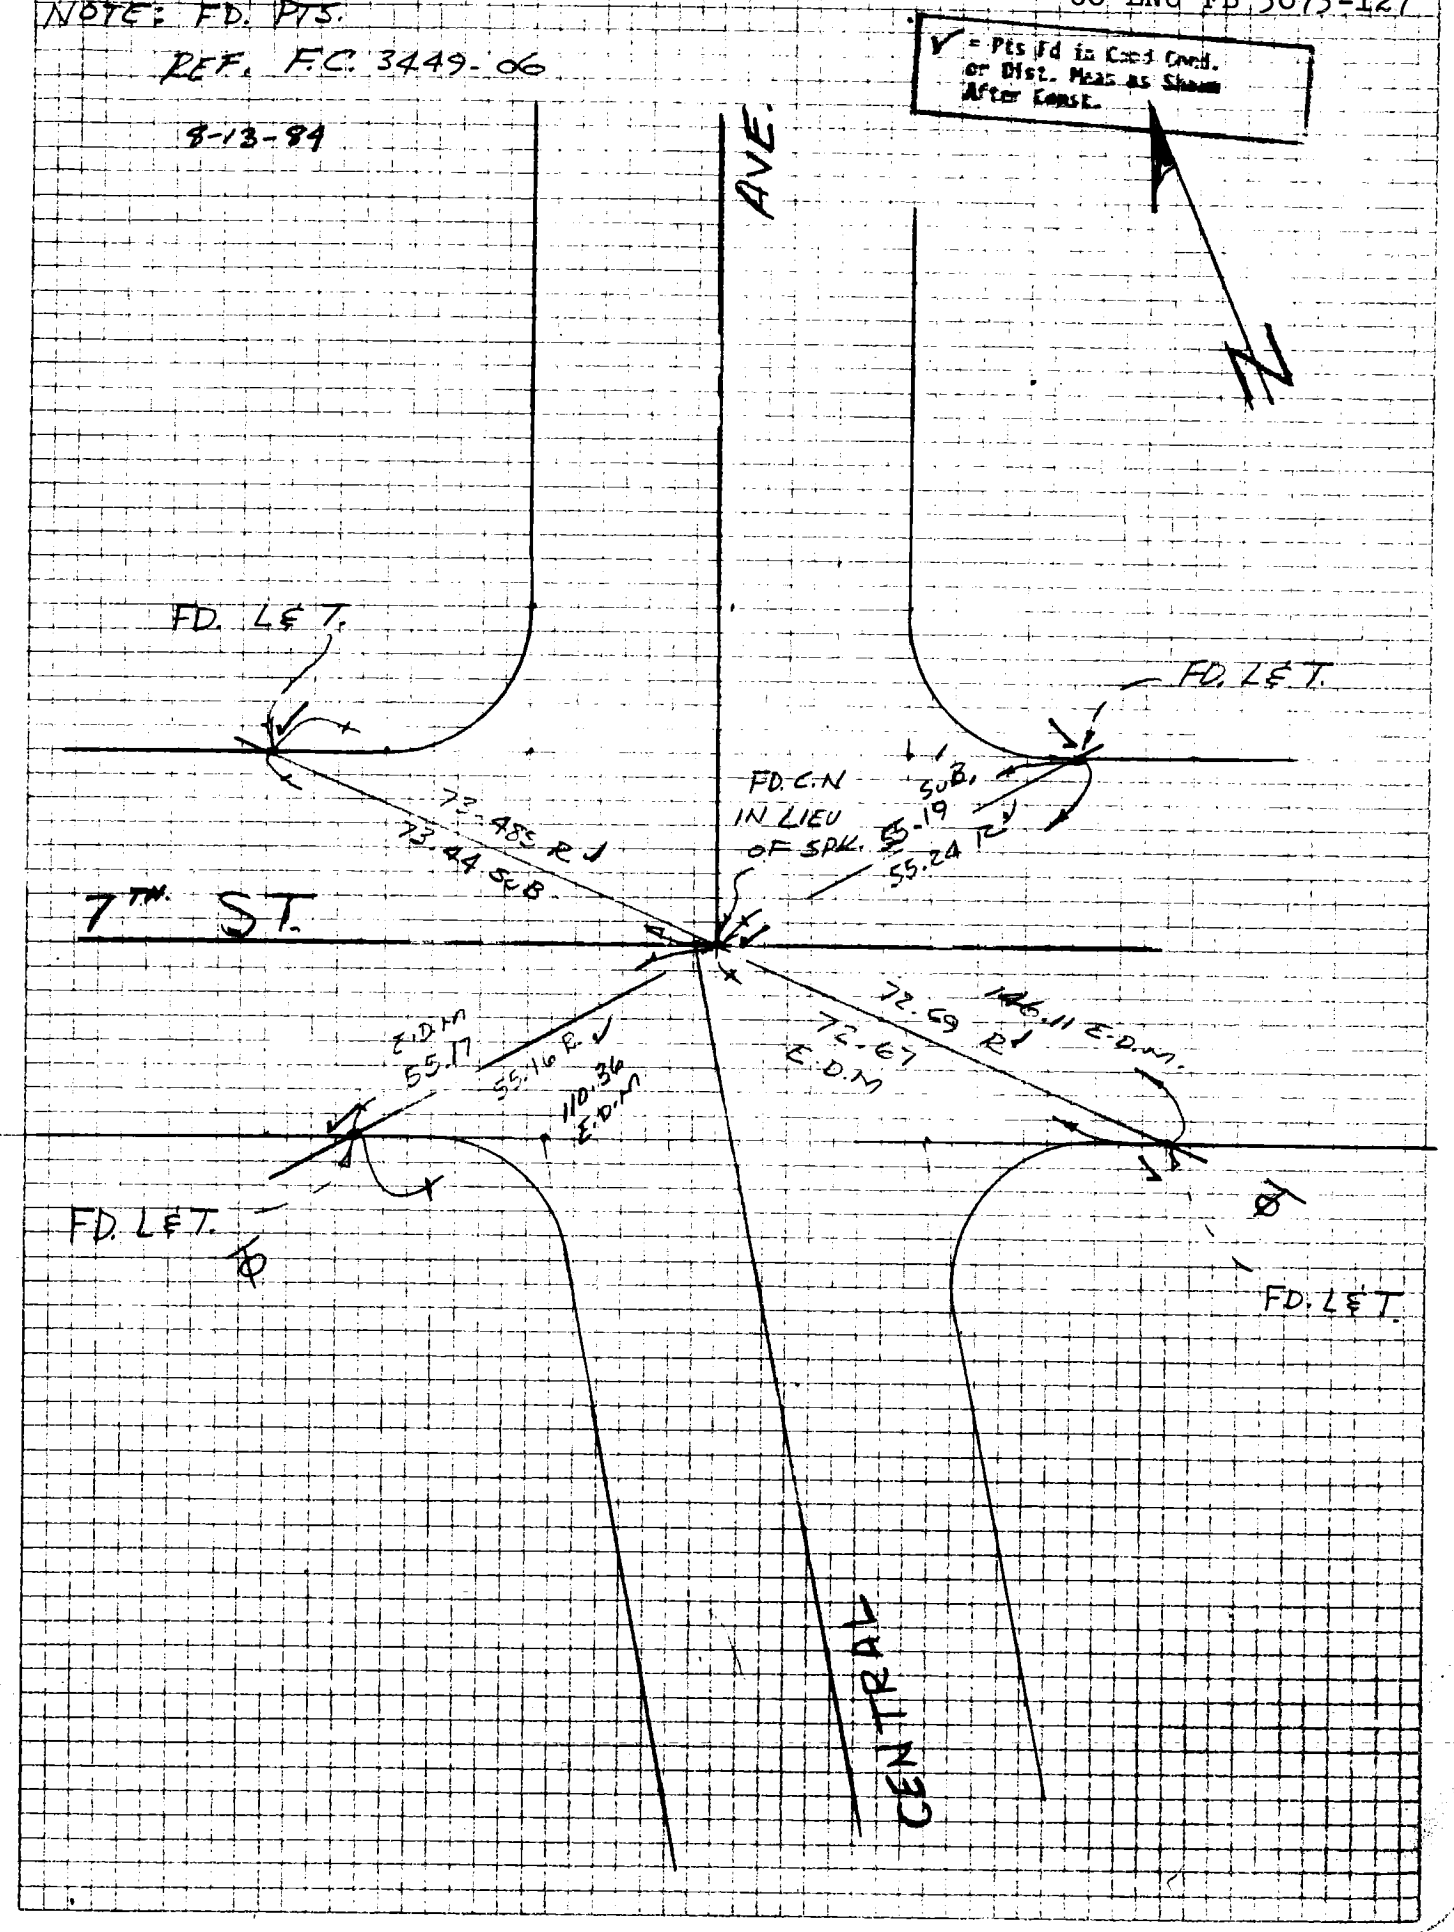

7689.11- PS 12-78

PROJECT 7TH ST. DRAIN

SURVEY BY VILLAFANA DATE 1-27-84

REVIEWED BY JAB DATE 8-29-84

BJH 9-17-84

128

INDEX FC 3449 27

RER 5

LOS ANGELES COUNTY FLOOD CONTROL DISTRICT

CO ENG FB 3673-128

W.S. 9, E-3

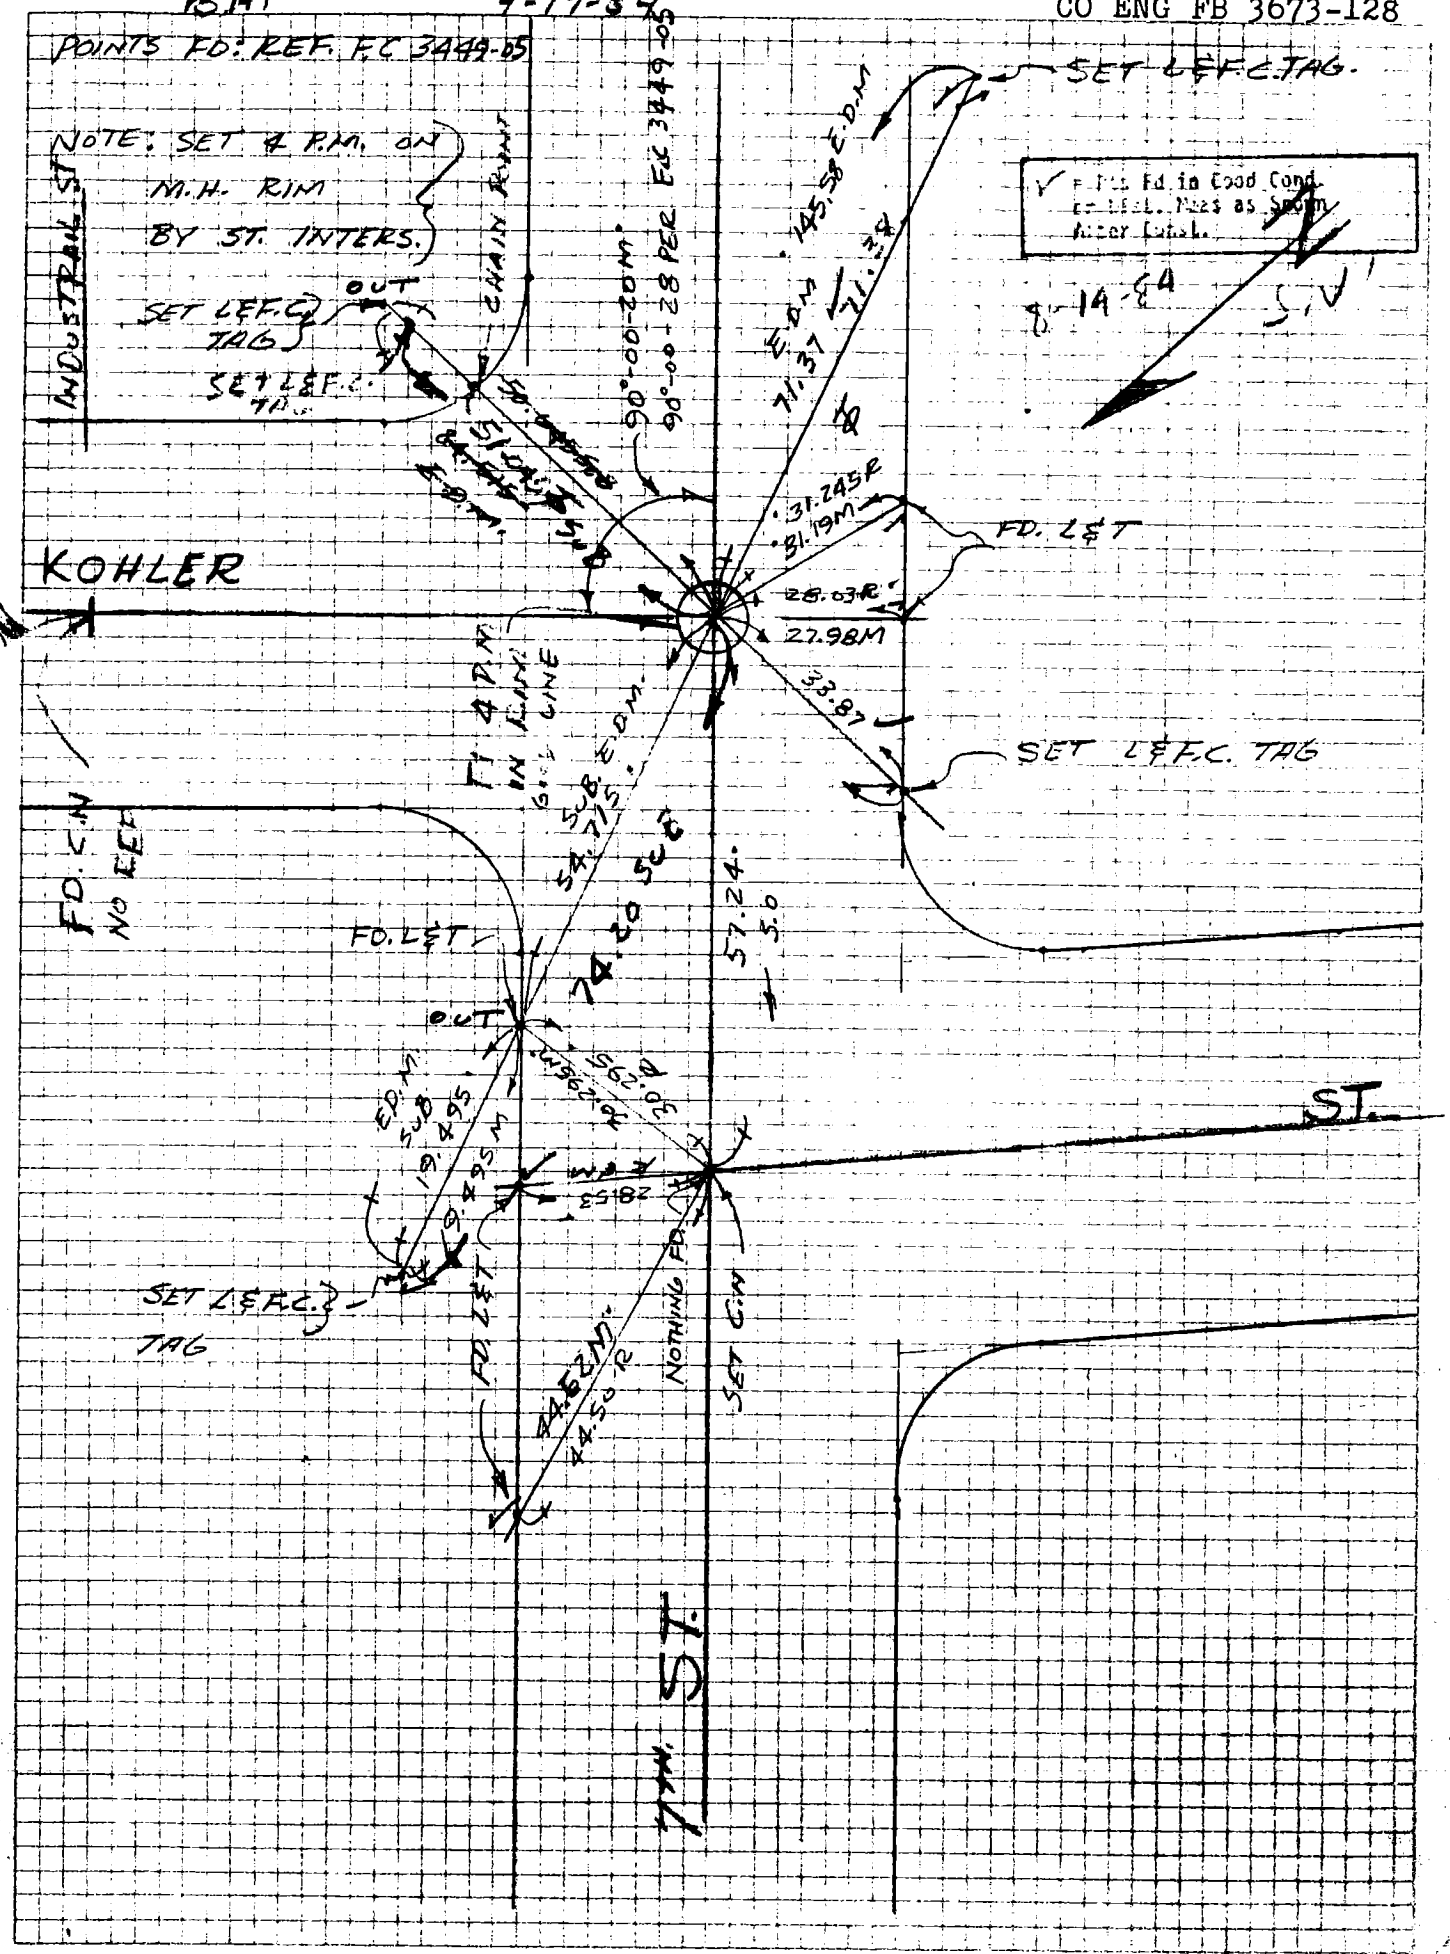

76S911- PS 12-78

PROJECT 7TH. ST. DRAIN

SURVEY BY VILLAFAÑA DATE 1-30-84

REVIEWED BY JAB DATE 8-21-84

BH. 9-17-84

129

INDEX FC 3449 29

R&R 7

LOS ANGELES COUNTY FLOOD CONTROL DISTRICT

CO ENG FB 3673-129

W.S. 9, E-3

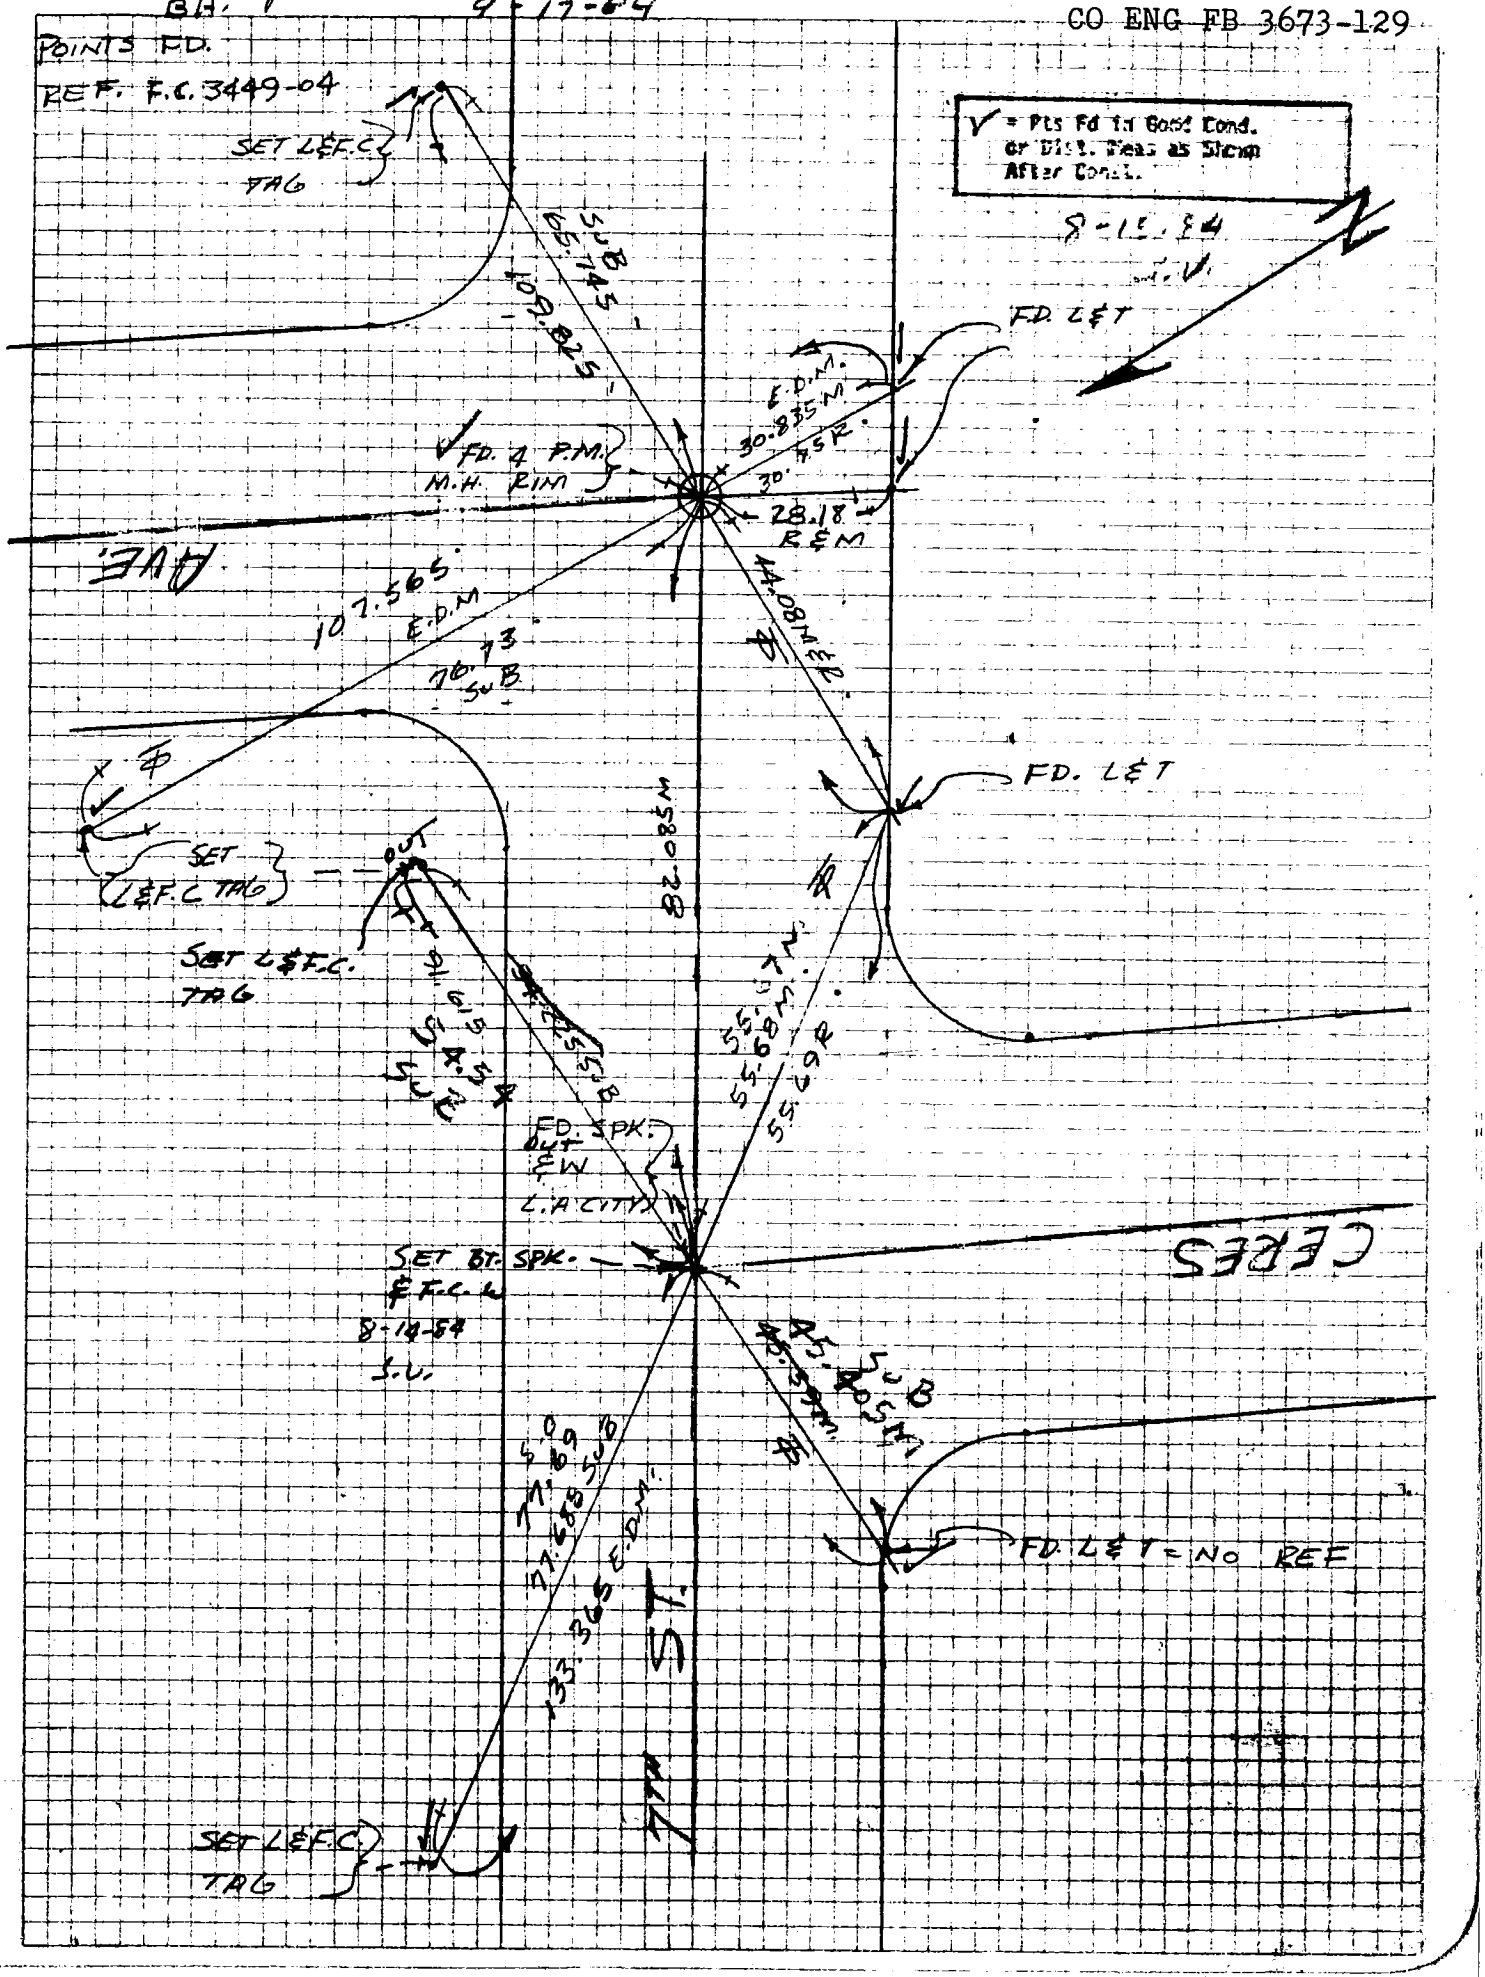

76S911- PS 12-78

PROJECT 7TH. ST. DRAIN

SURVEY BY O VILLARREAL DATE 1-30-84

REVIEWED BY J.A.B. DATE 8-29-84

B.H. 9-17-84

130

INDEX FC 3449 31

R & R 9

LOS ANGELES COUNTY FLOOD CONTROL DISTRICT

CO ENG FB 3673-130

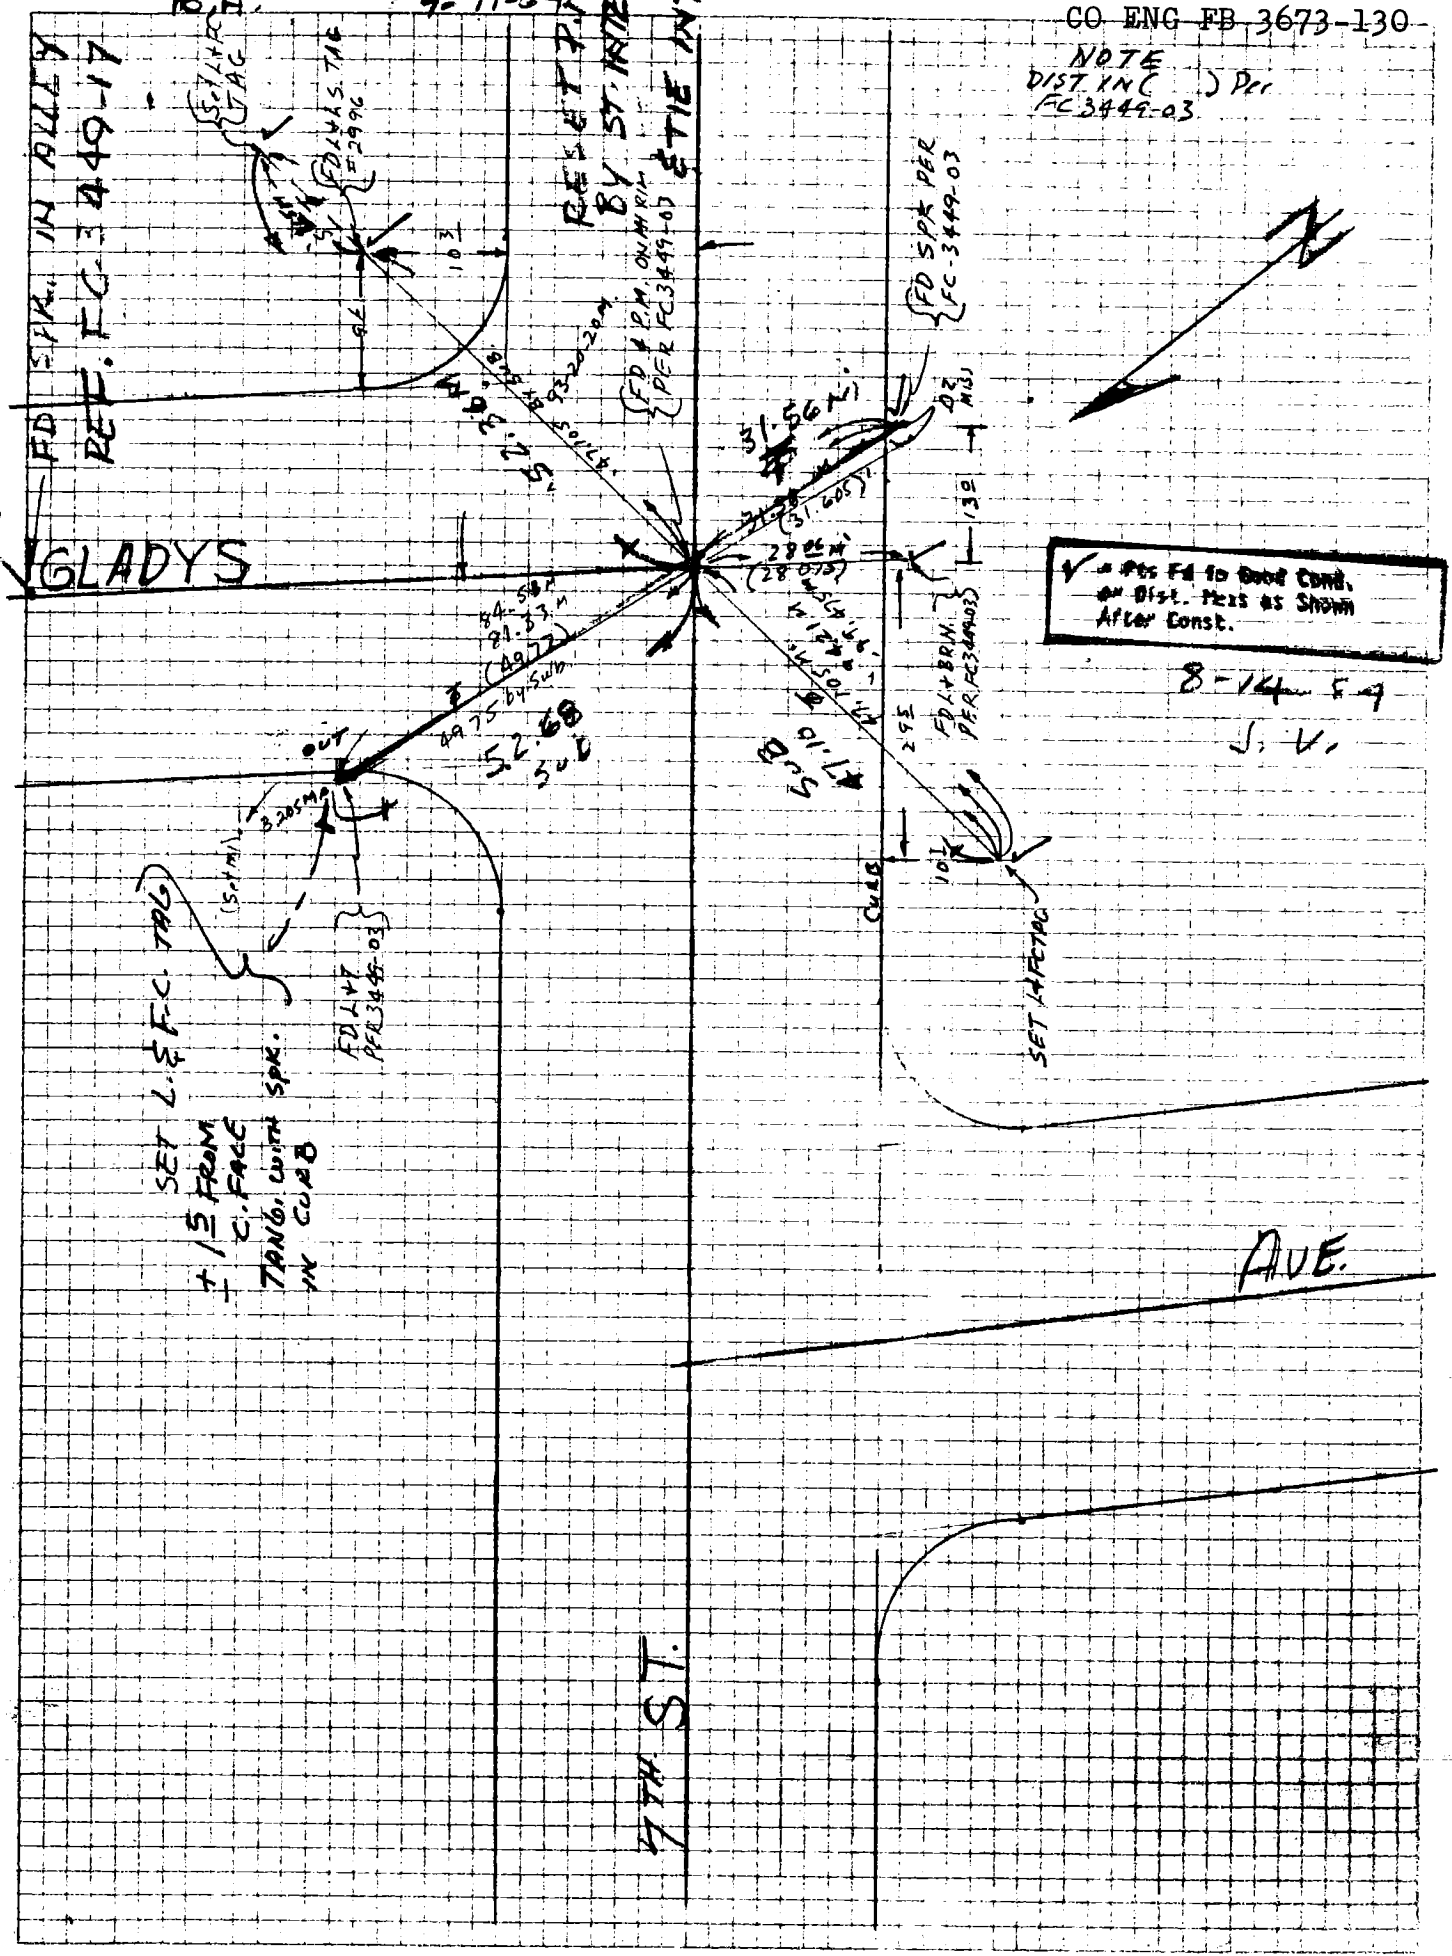

W.S. 9, E-3

76S911- PS 12-78

131

PROJECT 7TH ST. DRAIN

SURVEY BY O VILLARREAL DATE 1-30-84

REVIEWED BY [illegible] DATE 8-29-84

B.H. 9-17-84

INDEX FC 3449 33

R & R 11

LOS ANGELES COUNTY FLOOD CONTROL DISTRICT

CO ENG FB 3673-131

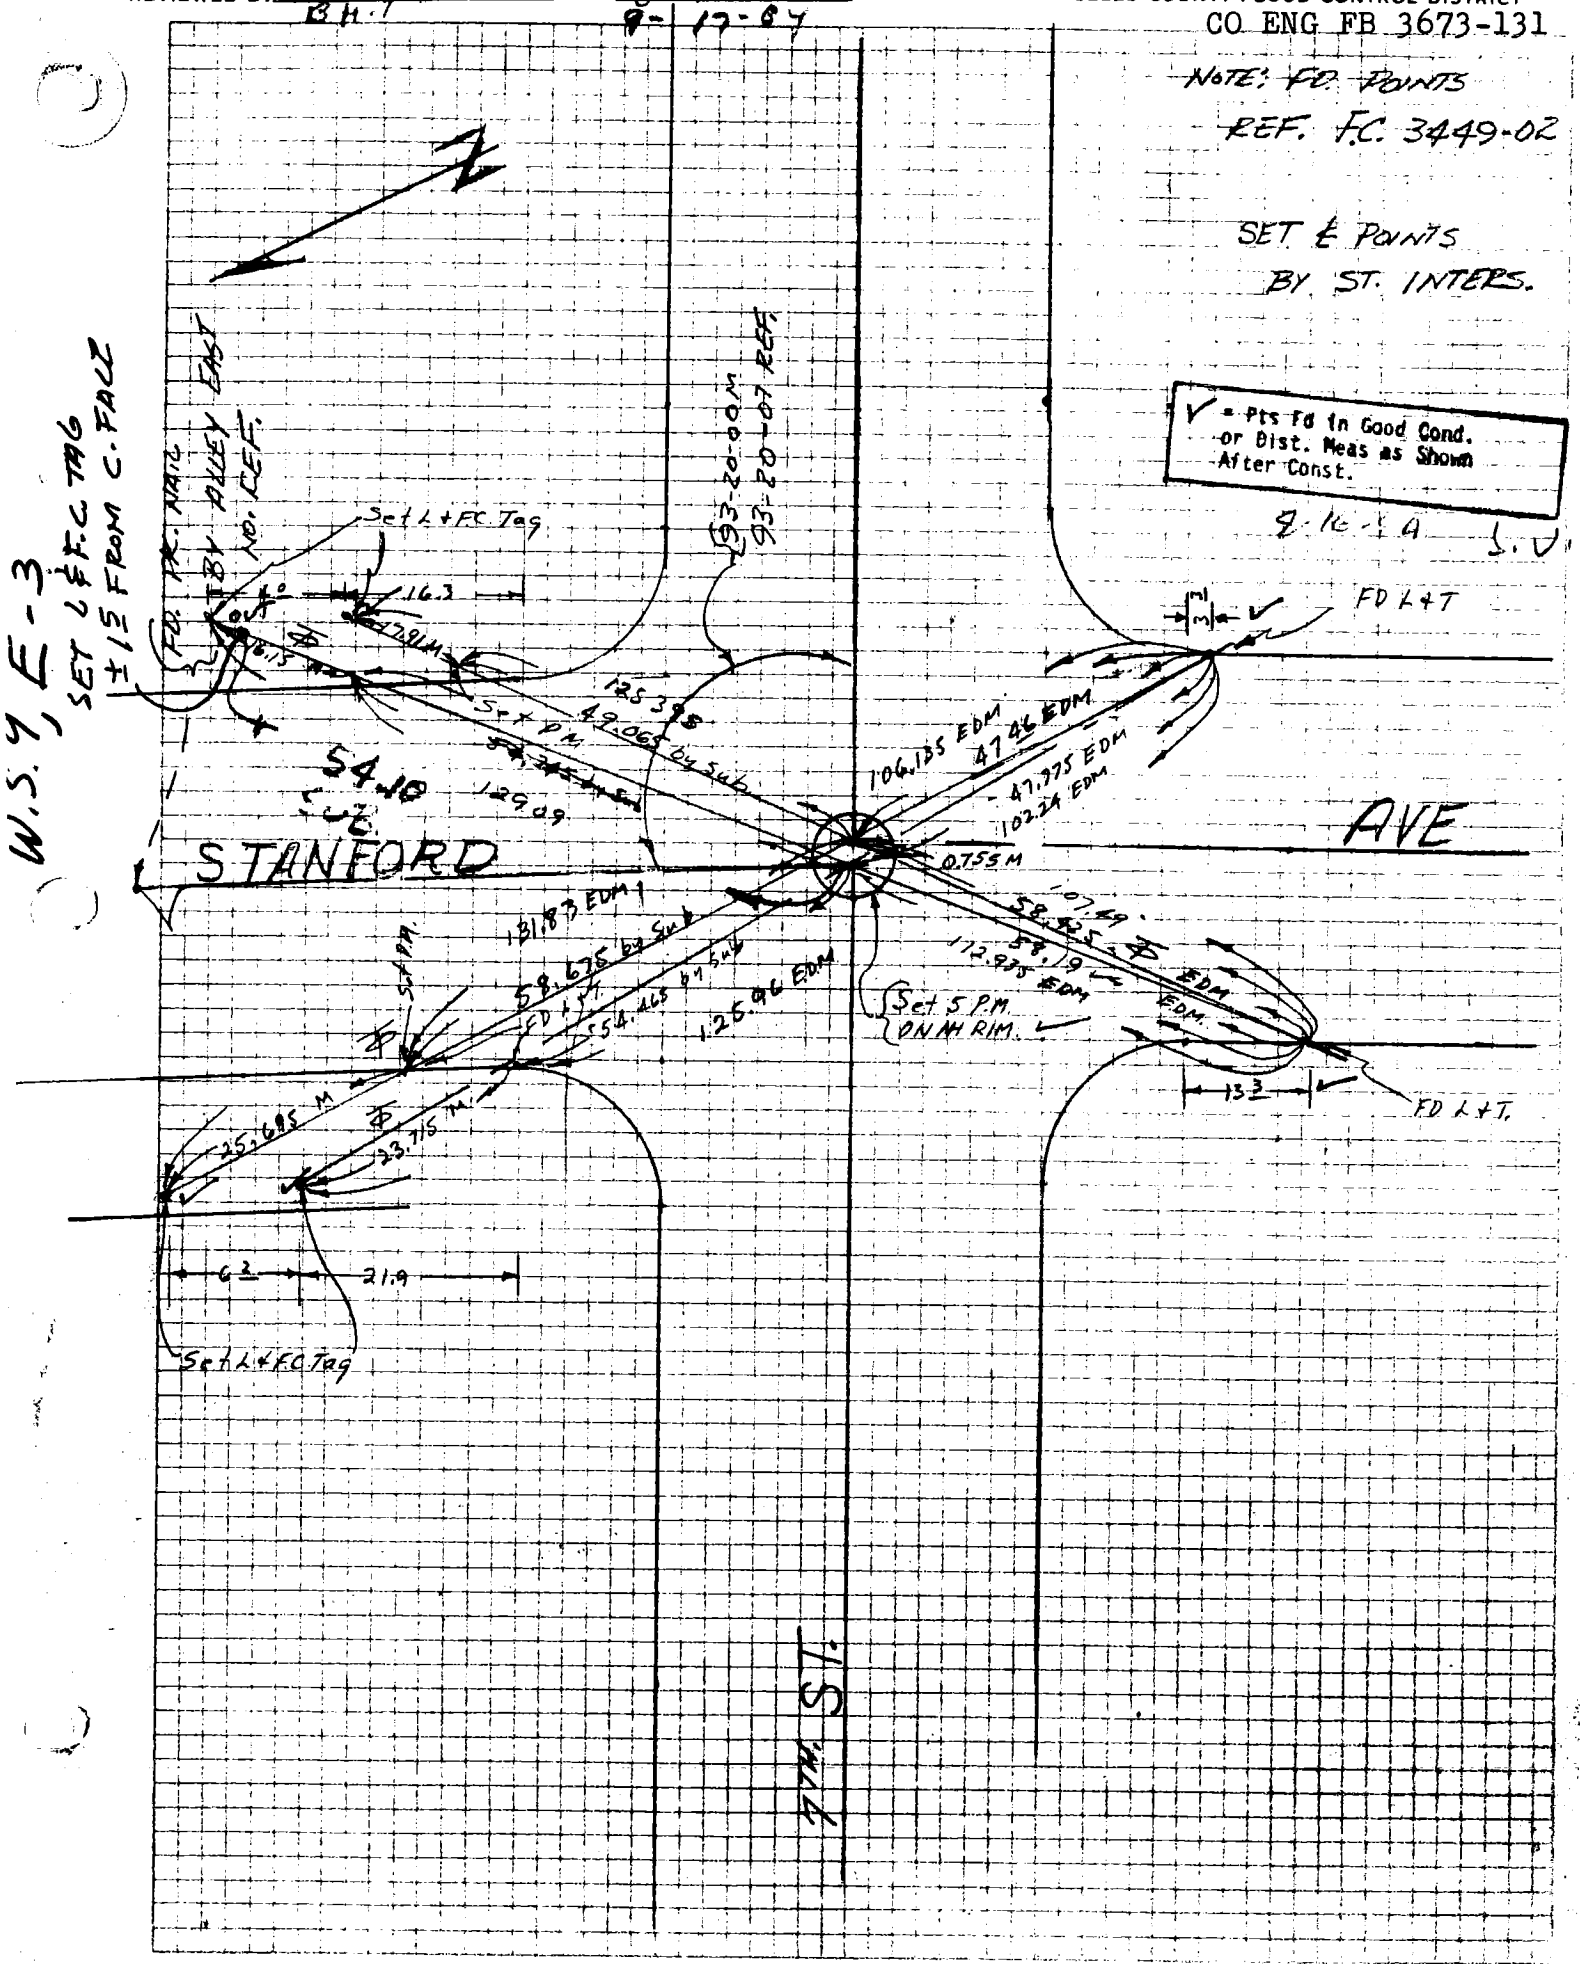

76S911- PS 12-78

PROJECT 7TH. ST. DRAIN

SURVEY BY VILLARREAL DATE 2-3-84

REVIEWED BY [illegible] DATE 8-29-84

B.H.P. 9-17-84

132

INDEX FC 3449 35

R. & R 13

LOS ANGELES COUNTY FLOOD CONTROL DISTRICT

CO ENG FB 3683-132

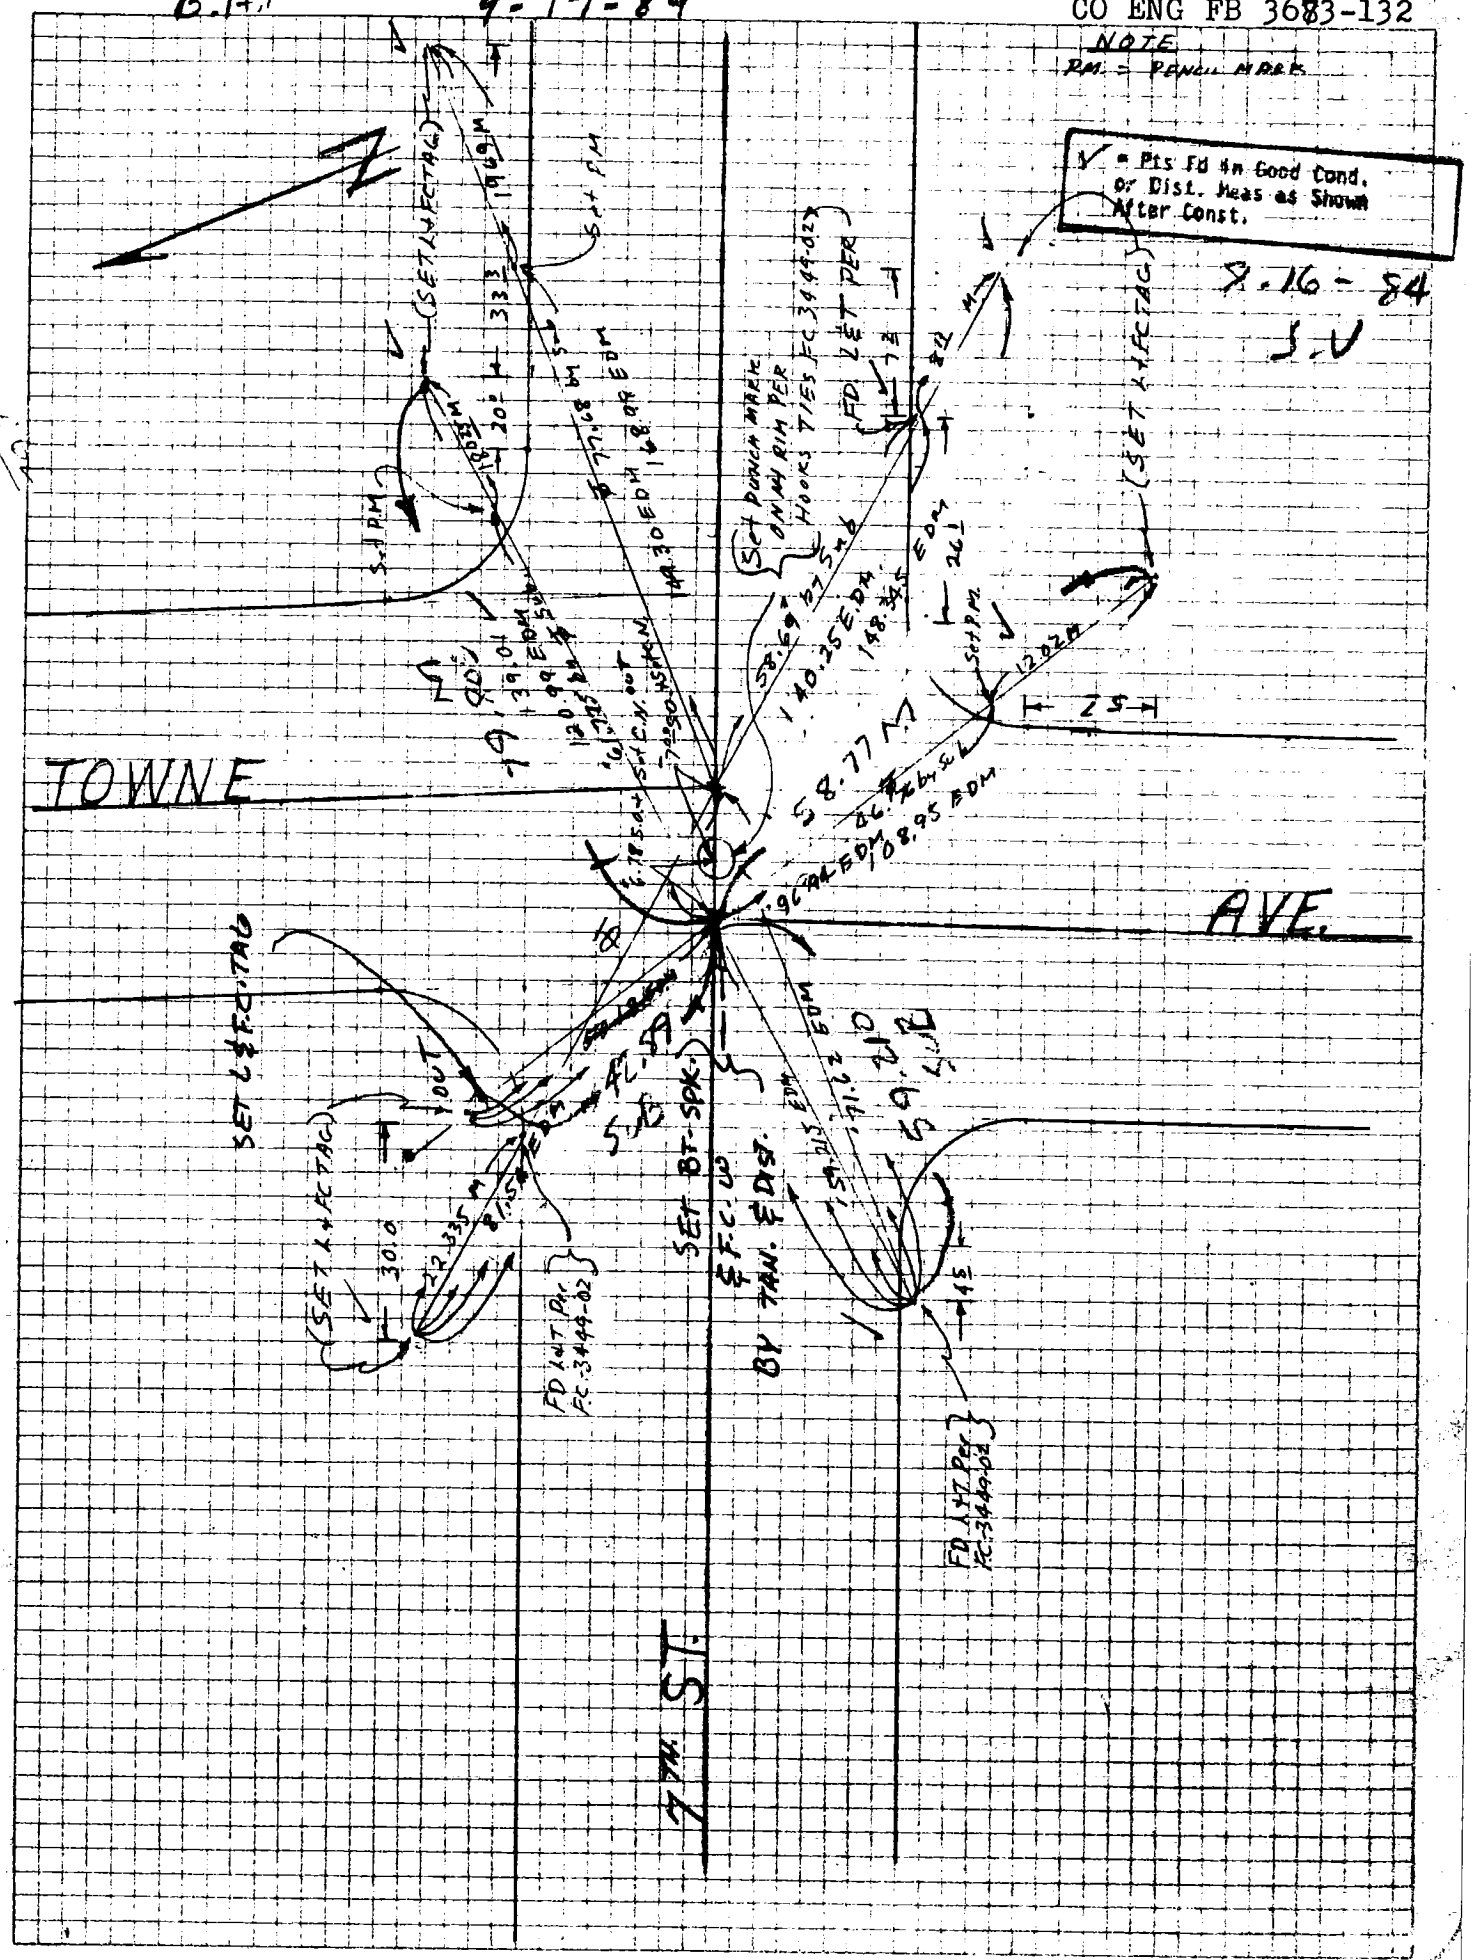

W.S.9, E-3

81.56

768911– PS 12-78

PROJECT 7TH ST. DRAIN — 133 — INDEX FC 3449 37

SURVEY BY HULIN DATE 2-3-84 — R & R 15

REVIEWED BY J.U.B. DATE 8-24-84 — LOS ANGELES COUNTY FLOOD CONTROL DISTRICT

R.H. 9-17-84

~~CO ENG FB 3673-133~~

PTS. FD.

REF. 3449-01

✓ = Pts Fd in Good Cond. or Dist. Meas as Shown After Const.

8-16-84

J.V.

W.S. 9, E-3

76S9?1– PS 12-78

PROJECT 7TH ST. DRAIN

SURVEY BY VILLAFANA DATE 1-17-84

REVIEWED BY J.AB DATE 8-29-84

BH 9-17-84

134

INDEX FC 3449 39

R & R 17

LOS ANGELES COUNTY FLOOD CONTROL DISTRICT

CO ENG FB 3673-134

W.S. 9, E-3

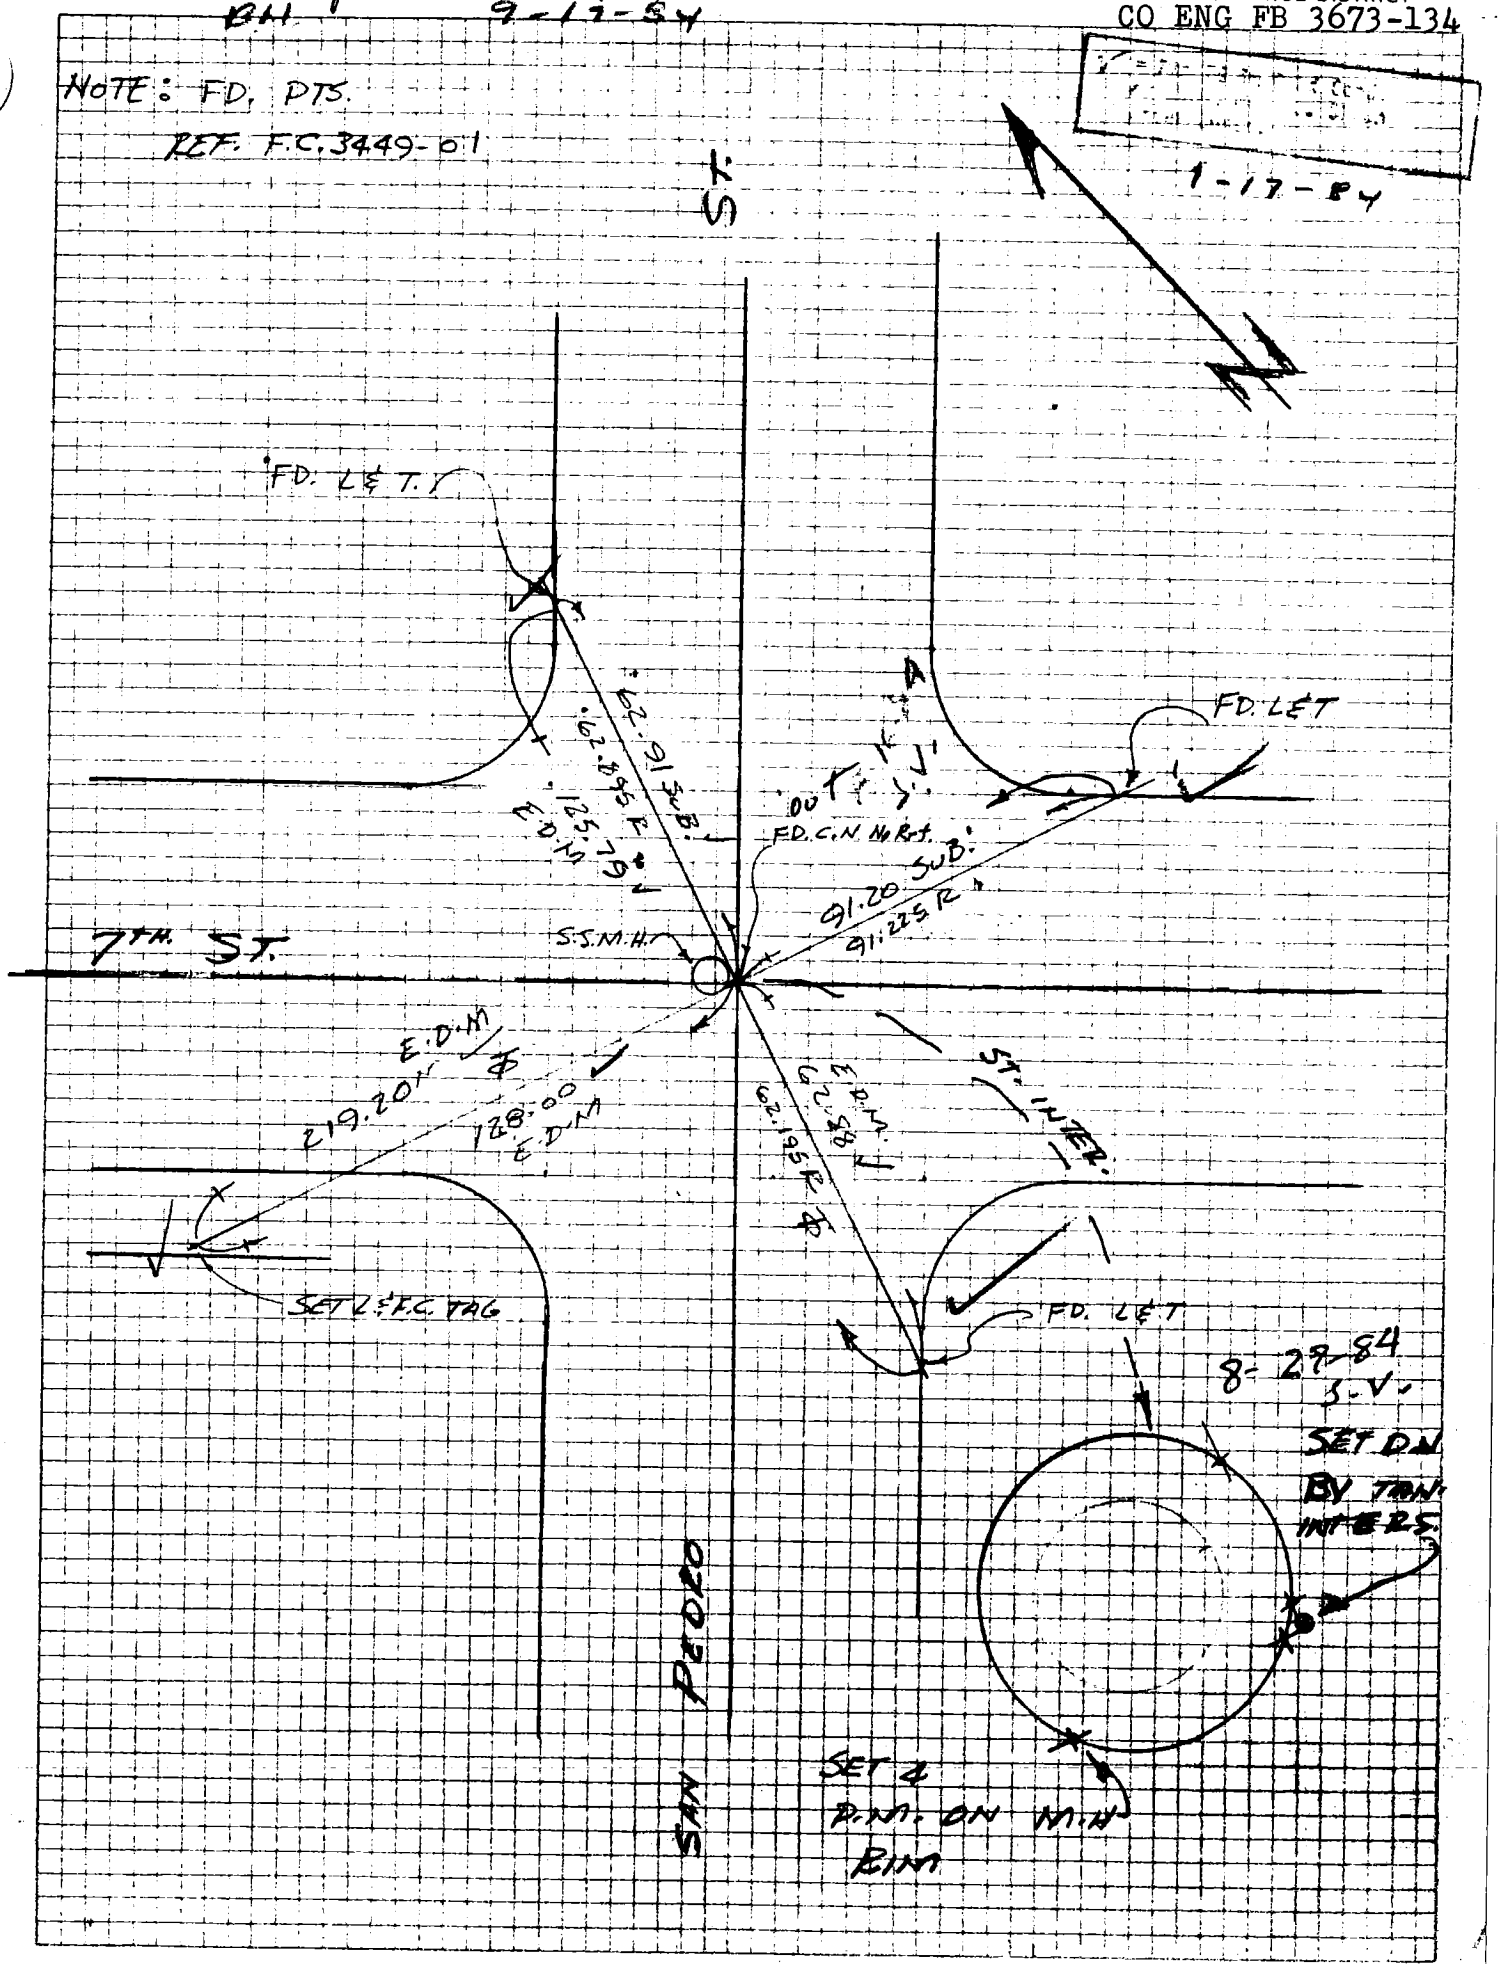

135

SHT. 1 OF 5 SHTS.

SURVEY OF ℄ TIES

SURVEY BY WESLEY R. LIND R.C.E. 16362

TR. No. 27347

DATE SEPT. 24, 1984

099-297, A-2

SO. CALIF. BLUE PRINT CO.

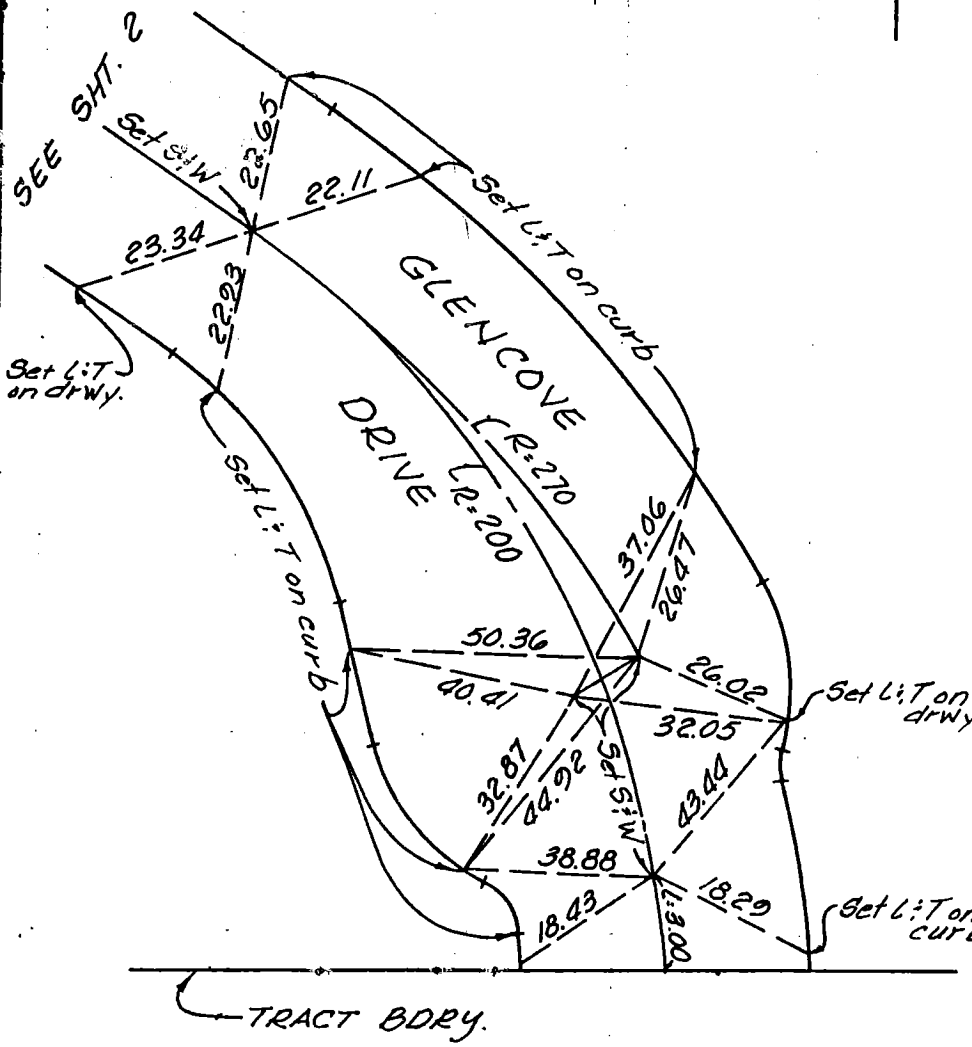

SHT. 2 OF 5 SHTS.

SURVEY OF ℄ TIES

SURVEY BY WESLEY R. LIND R.C.E. 16362 TR. No. 27347

DATE SEPT. 20, 1984

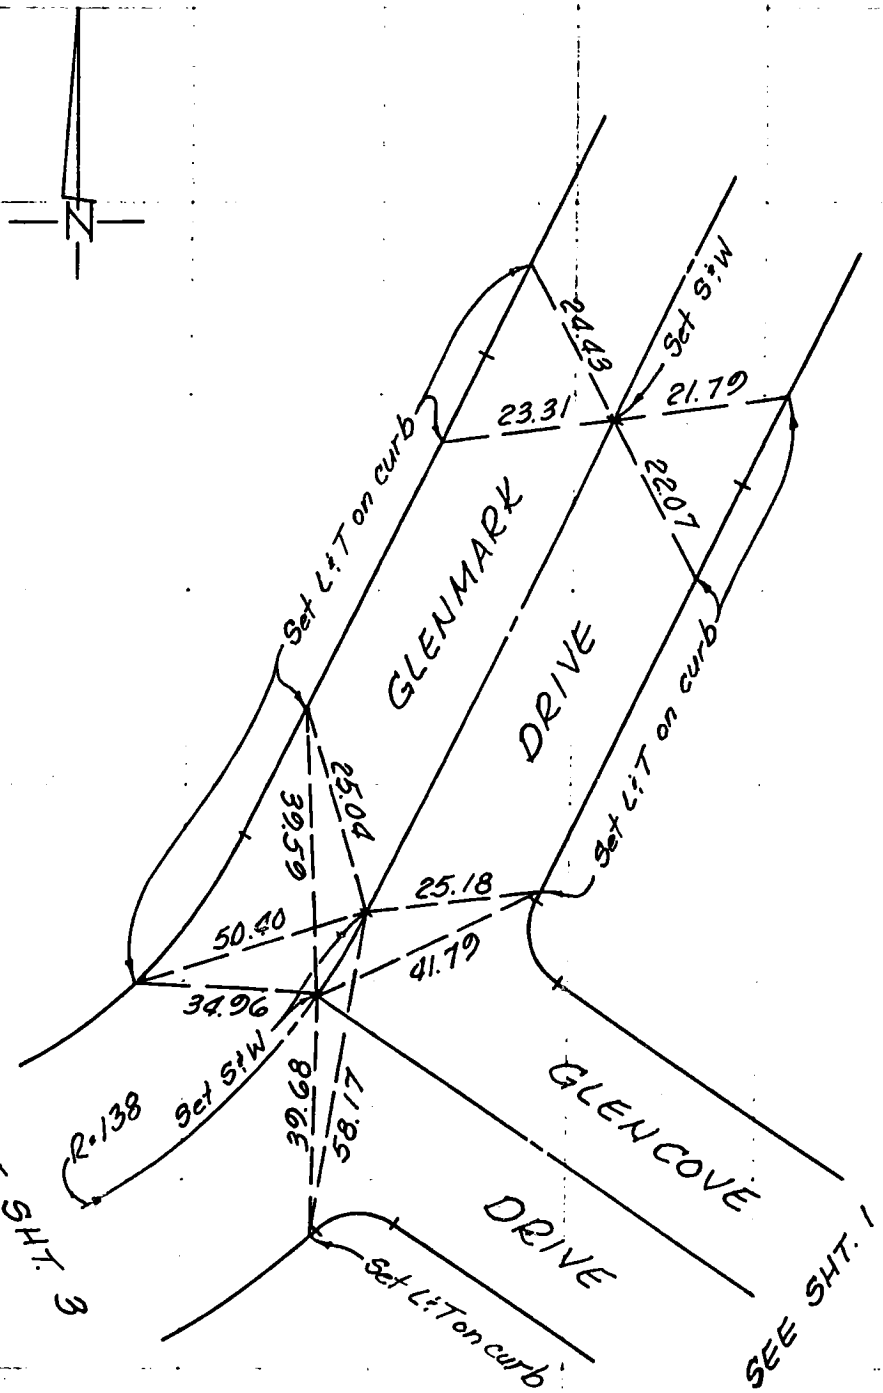

SO. CALIF. BLUE PRINT CO.

099-297-4-2

CO ENG FB 3673-136

CO ENG FB 3673-137

099-297, A-2

SHT. 3 OF 5 SHTS.

SURVEY OF ℄ TIES

SURVEY BY WESLEY R. LIND R.C.E. 16362 TR. No. 27347

DATE SEPT. 24, 1984

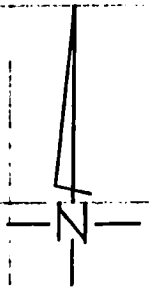

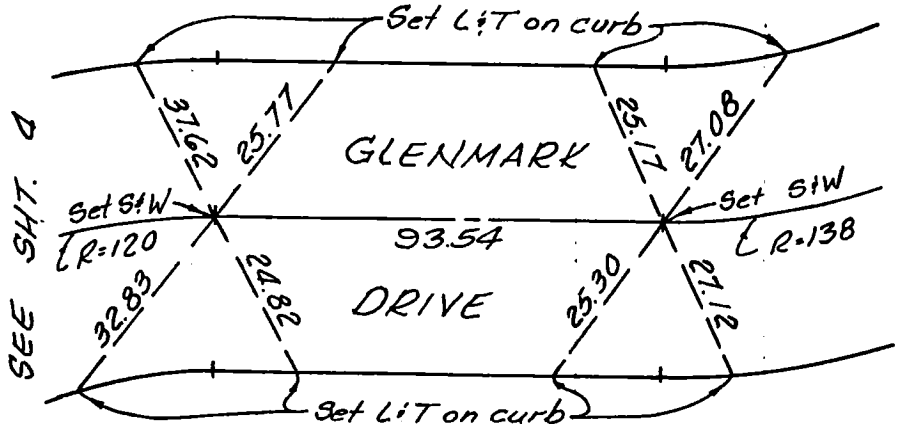

SO. CALIF. BLUE PRINT CO.

CO ENG FB 3673-138

099-297-A-2

SHT. 4 OF 5 SHTS.

SURVEY OF ℄ TIES

SURVEY BY WESLEY R. LIND R.C.E. 16362 TR. No. 27347

DATE SEPT. 24, 1984

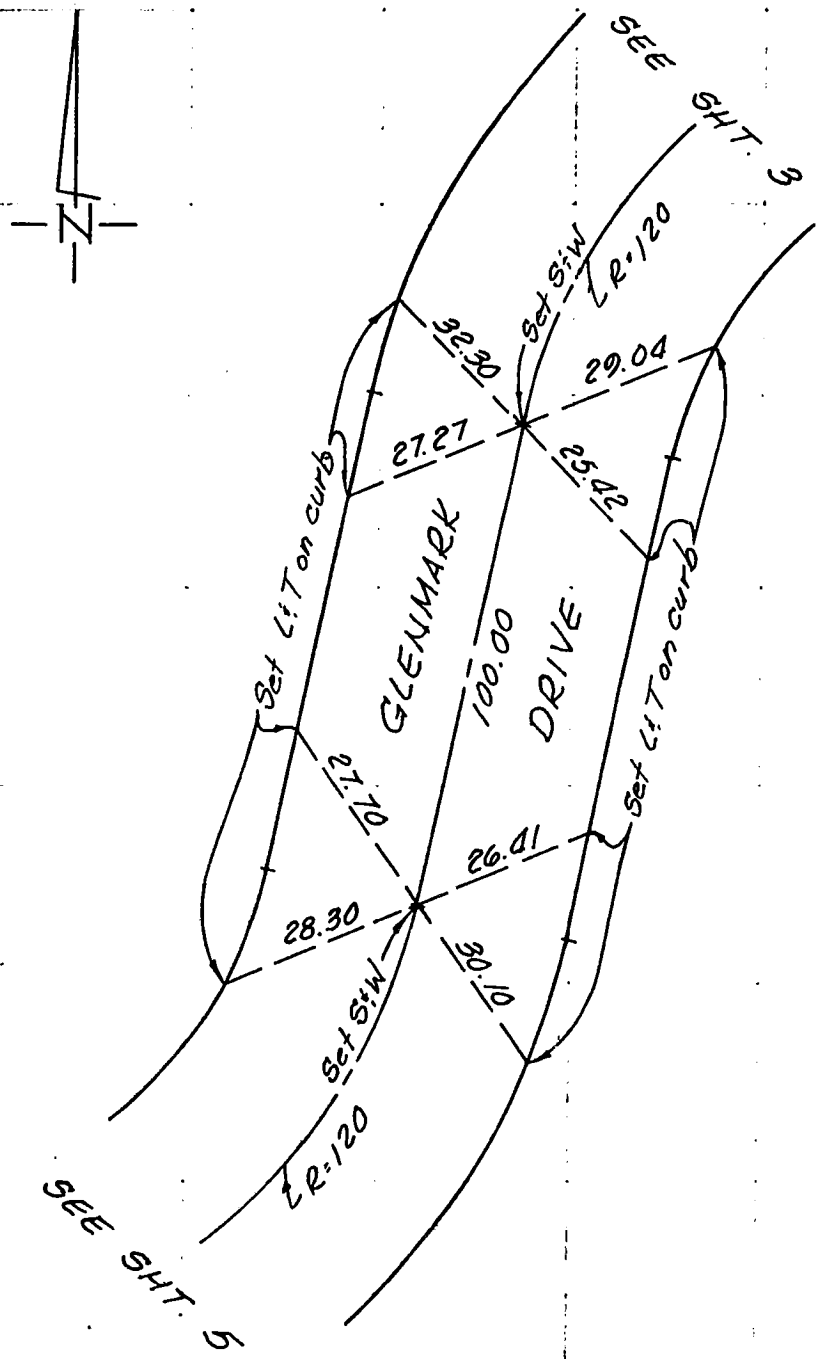

SO. CALIF. BLUE PRINT CO.

CO ENG FB 3673-139

099-297-4-2

SHT. 5 OF 5 SHTS.

SURVEY OF ℄ TIES

SURVEY BY WESLEY R. LIND R.C.E. 16362 TR. No. 27347

DATE SEPT. 24, 1984

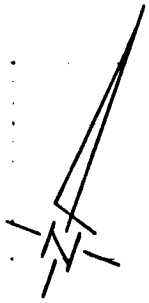

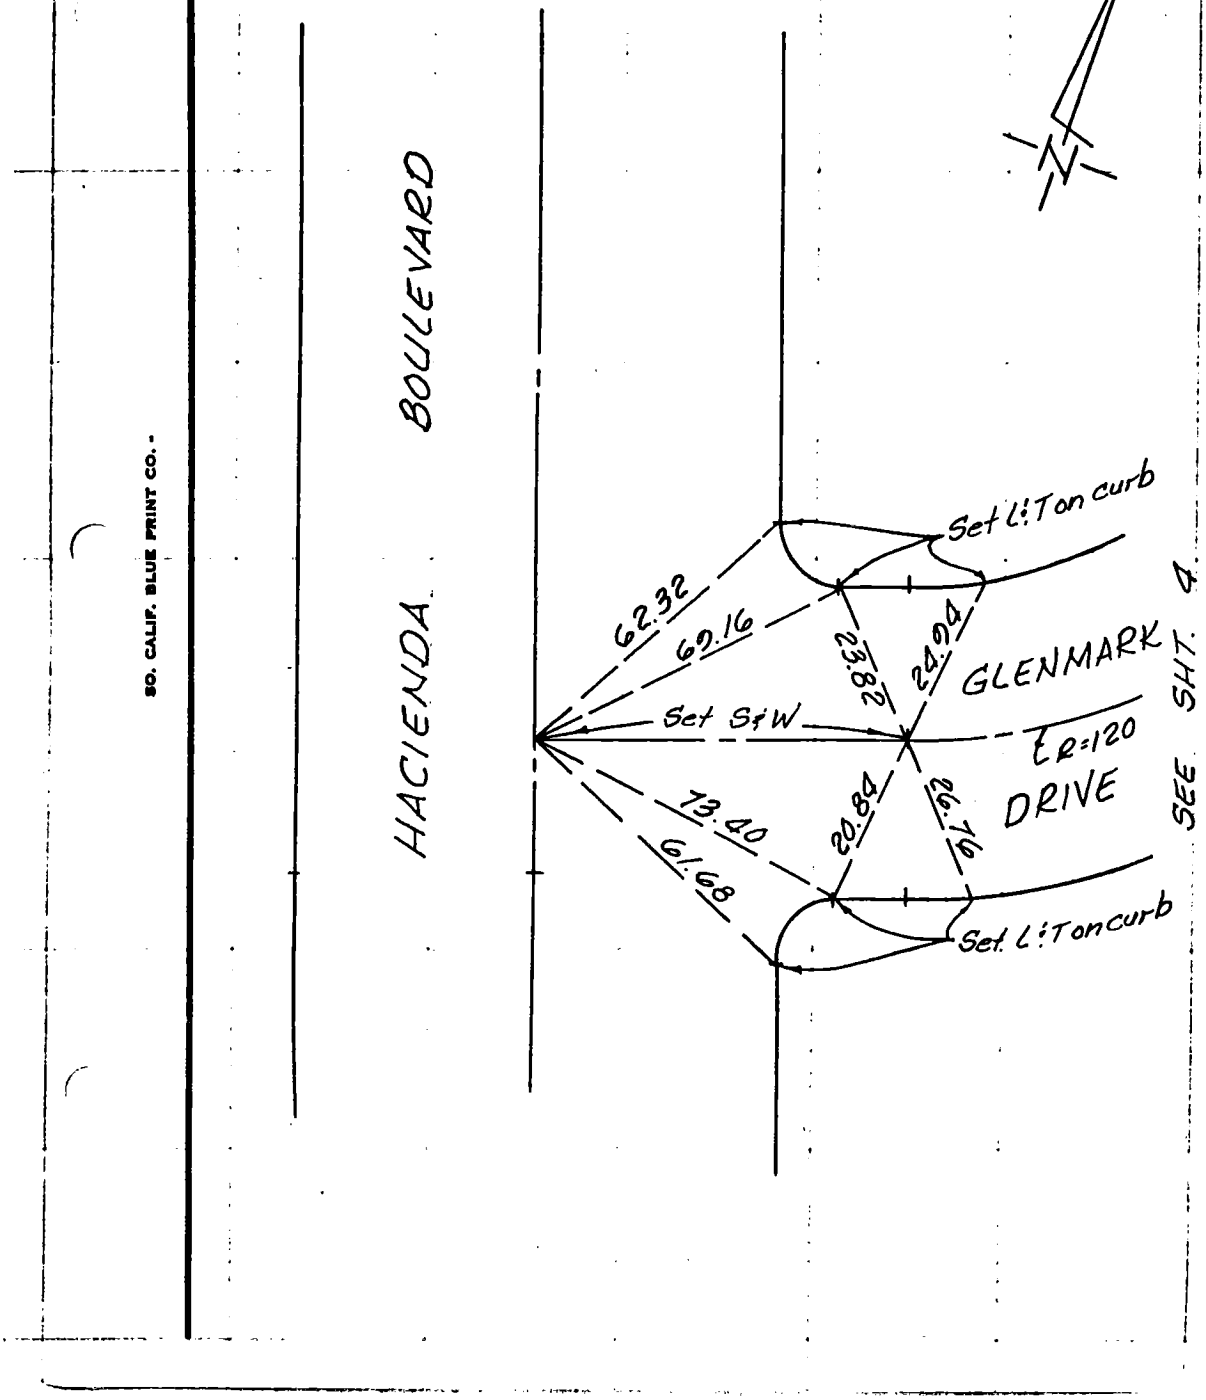

SO. CALIF. BLUE PRINT CO.

1/C

1020-115A

CO ENG FB 3673-140

SIKAND ENGINEERING ASSOCIATES
15230 Burbank Boulevard
VAN NUYS, CALIFORNIA 91411
Phone (213) 787-8550

W.O. 1020-115-01 F.B. 4 TIES PG. 1

SURVEY BY BOSTON

DATE 4-84 TR# 36724 PM#

R.S. P.D. P.C.

OTHER H.C. #

W.S. 249-117-A-1

℄ TIES

LOT 12

LOT 14

LOT 15

CURB FACE

18 72

48 01

27 36

SET S.W. & TN

LOT 11

℄ VIA CANDICE

⊙ = SET L.T. & TAG.
RCE 16913 R. HORN

CURB FACE

SET S.W. & T

LOT 9

41 76

32 13

32 00

22 00

32 30

36 91

LOT 8

CO ENG FB 3673-141

1411

1020-115A

SIKAND ENGINEERING ASSOCIATES
15230 Burbank Boulevard
VAN NUYS, CALIFORNIA 91411
Phone (213) 787-8550

W.O. 1020-115-01 F.B. ℄TIES PG. 2

SURVEY BY BOSTON

DATE 4-84 TR# 36724 PM#

R.S. P.D. P.C.

OTHER H.C. #

249-117-4-1

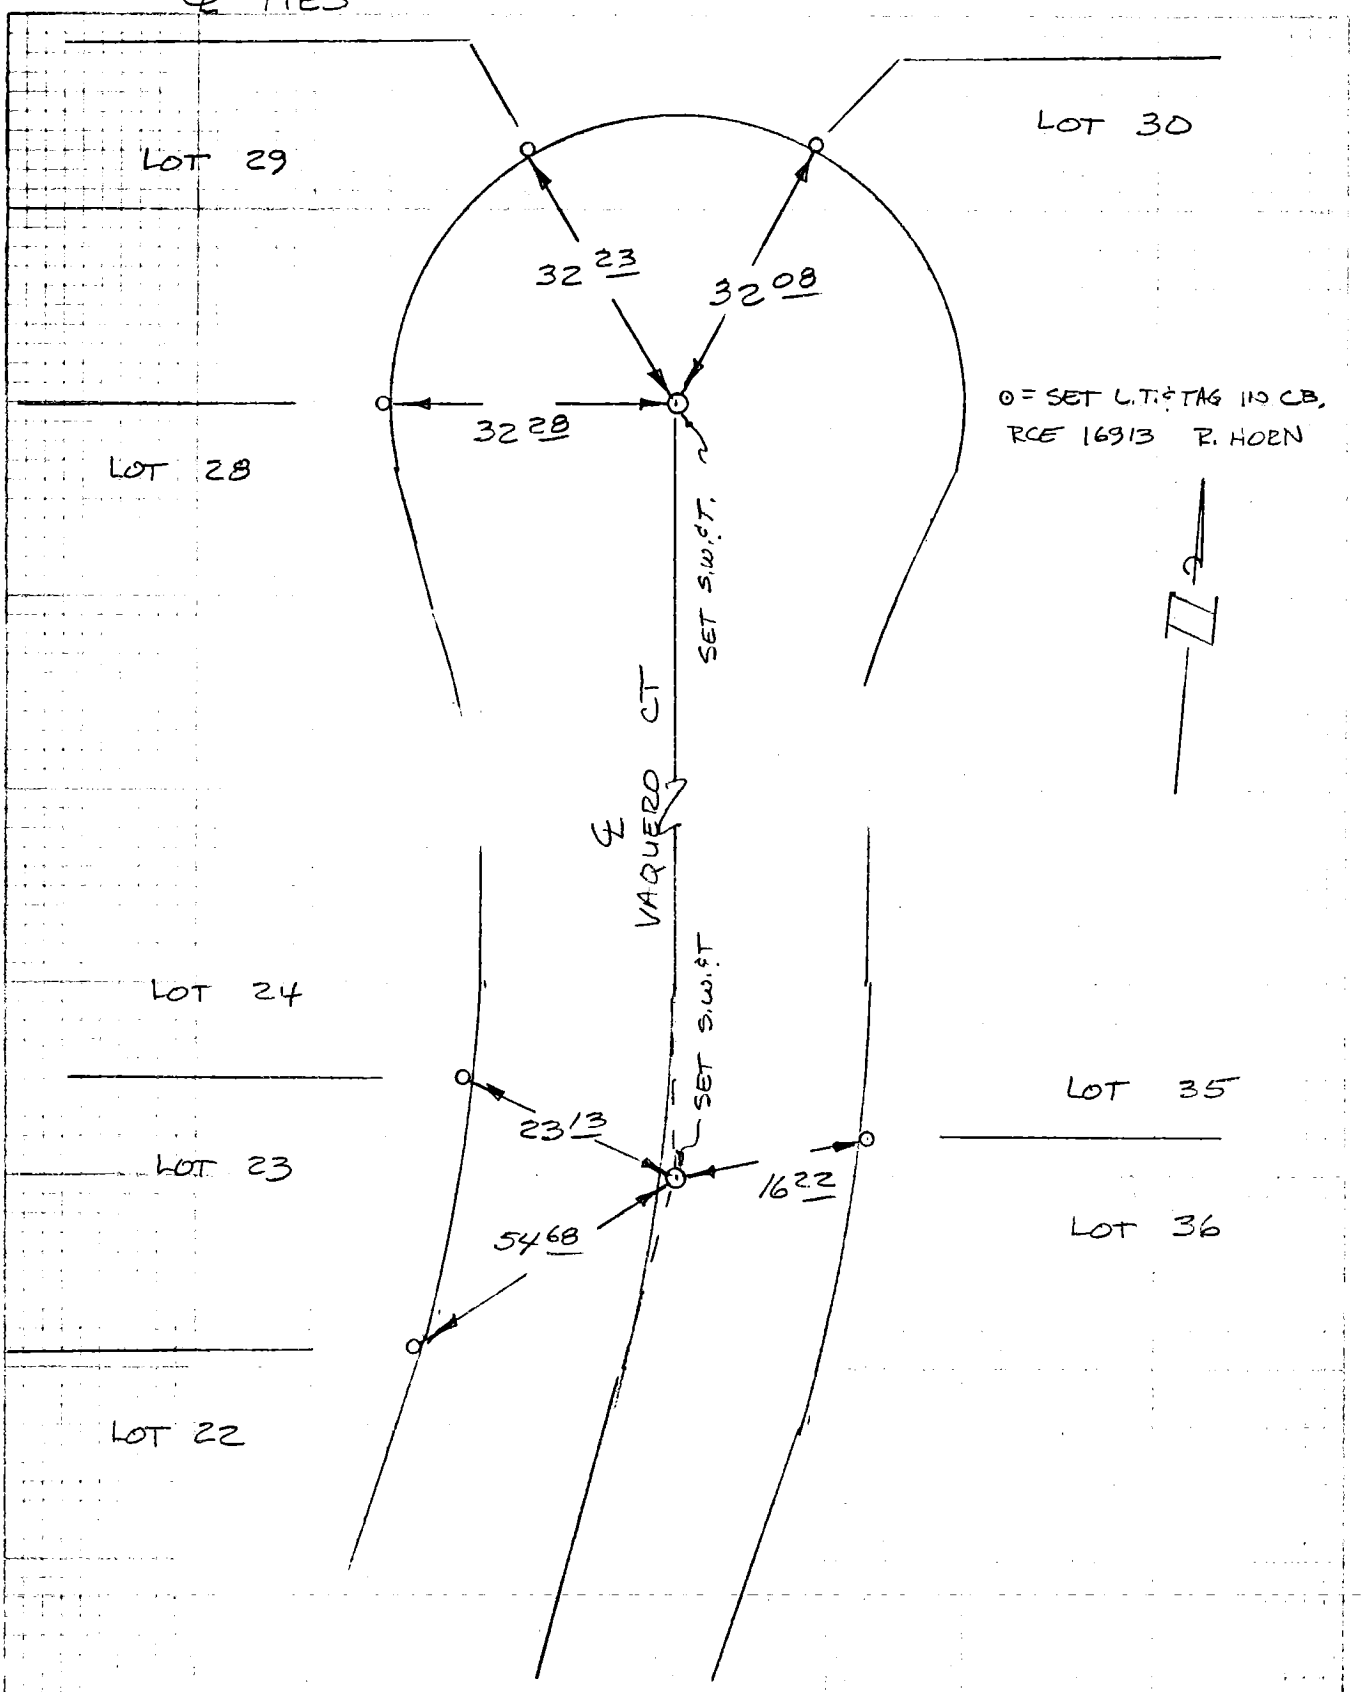

1/2

CO ENG FB 3673-142

(1020-115A)

SIKAND ENGINEERING ASSOCIATES
15230 Burbank Boulevard
VAN NUYS, CALIFORNIA 91411
Phone (213) 787-8550

W.O. 1020-115-01 F.B. ℄ TIES PG. 3

SURVEY BY BOSTON

DATE 4-84 TR# 36724 PM#

R.S. P.D. P.C.

OTHER H.C. #

249-117-A-1

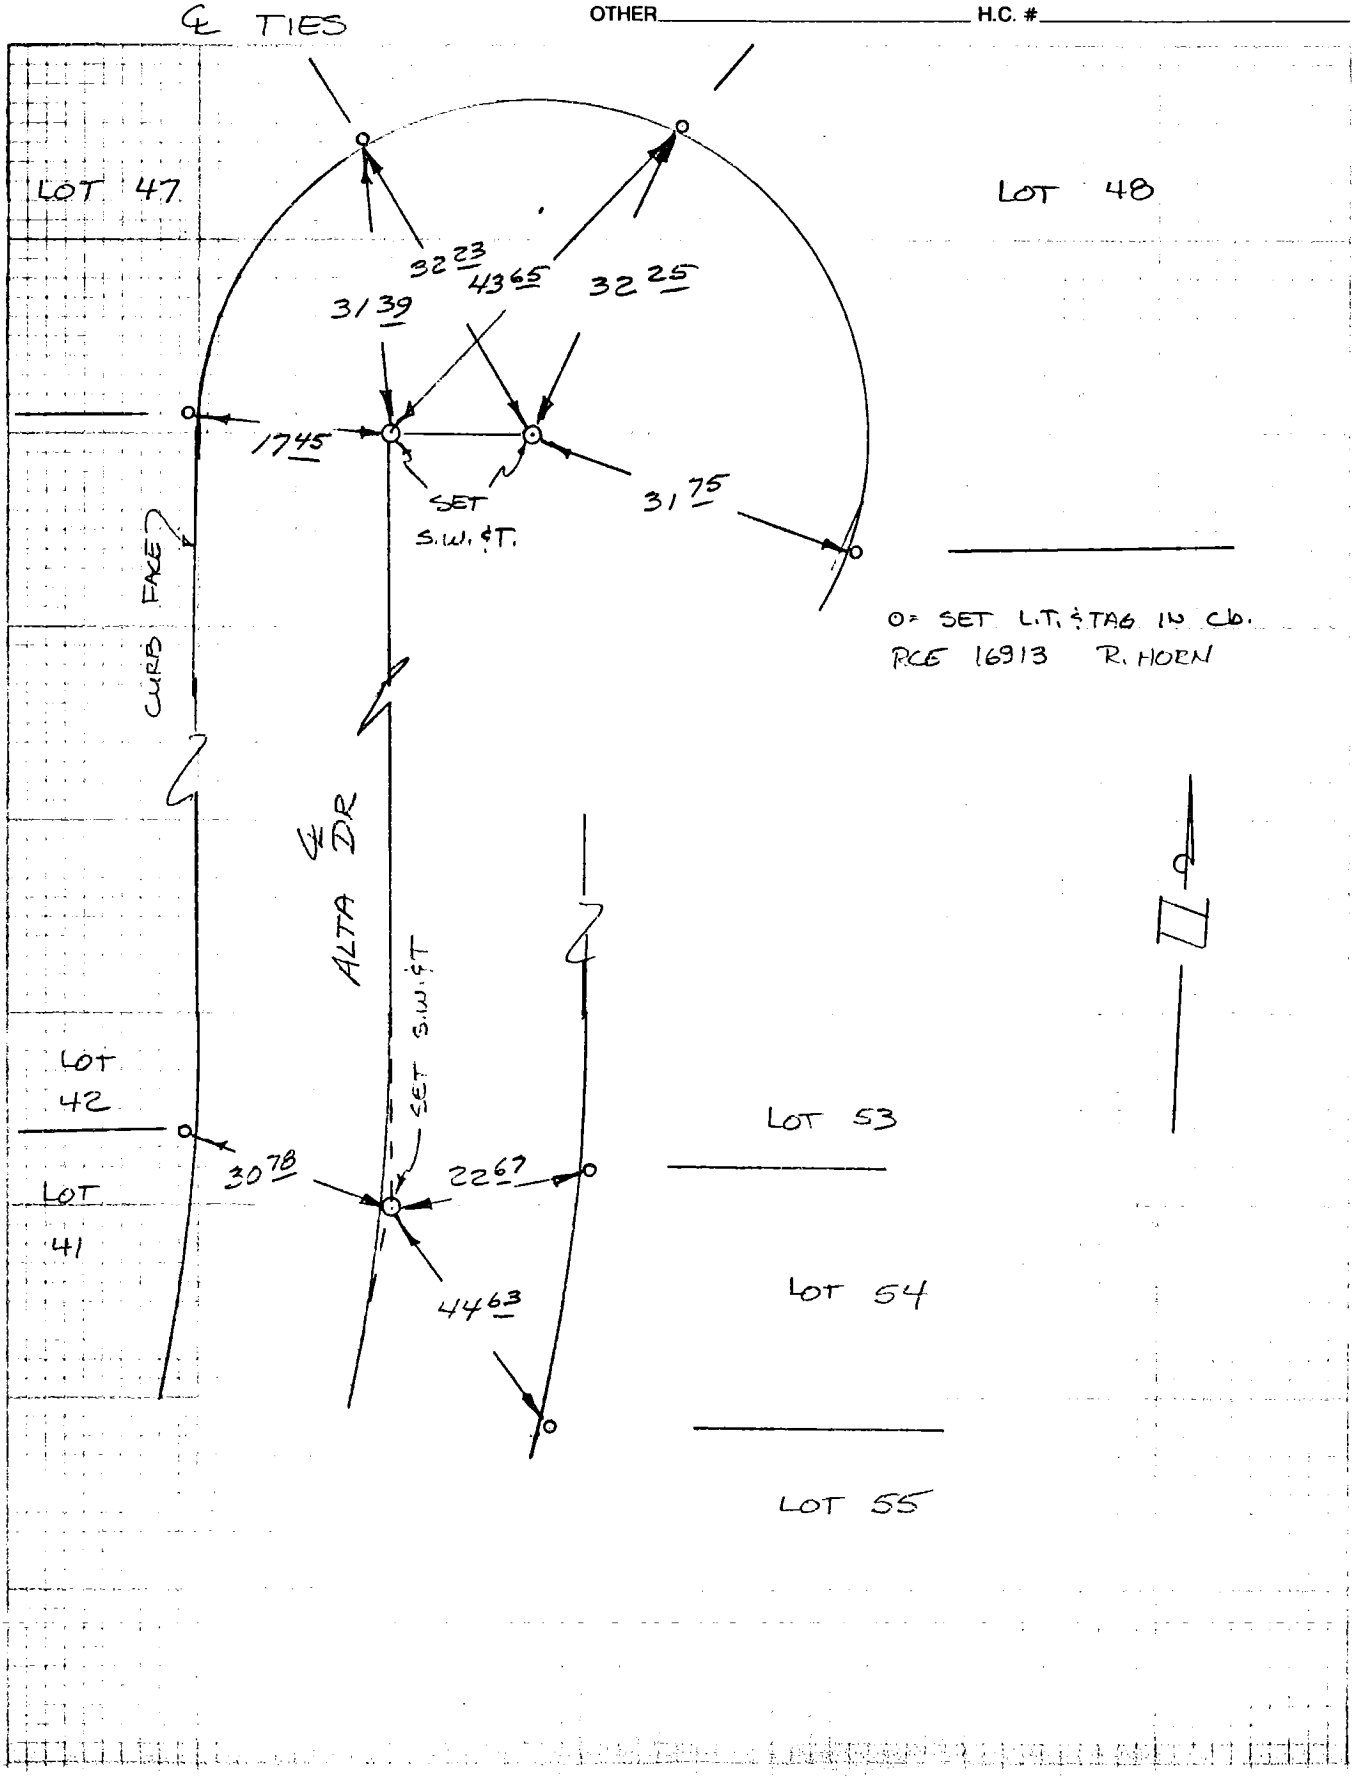

○ = SET L.T. & TAG IN Cb.
RCE 16913 R. HORN

CO ENG FB 3673-143

143

1020-115A

SIKAND ENGINEERING ASSOCIATES
15230 Burbank Boulevard
VAN NUYS, CALIFORNIA 91411
Phone (213) 787-8550

W.O. 1020-115-01 F.B. ℄ TIES PG. 4

SURVEY BY BOSTON

DATE 4-8 TR# 36724 PM#

R.S. P.D. P.C.

OTHER H.C. #

249-117-A-1

℄ TIES

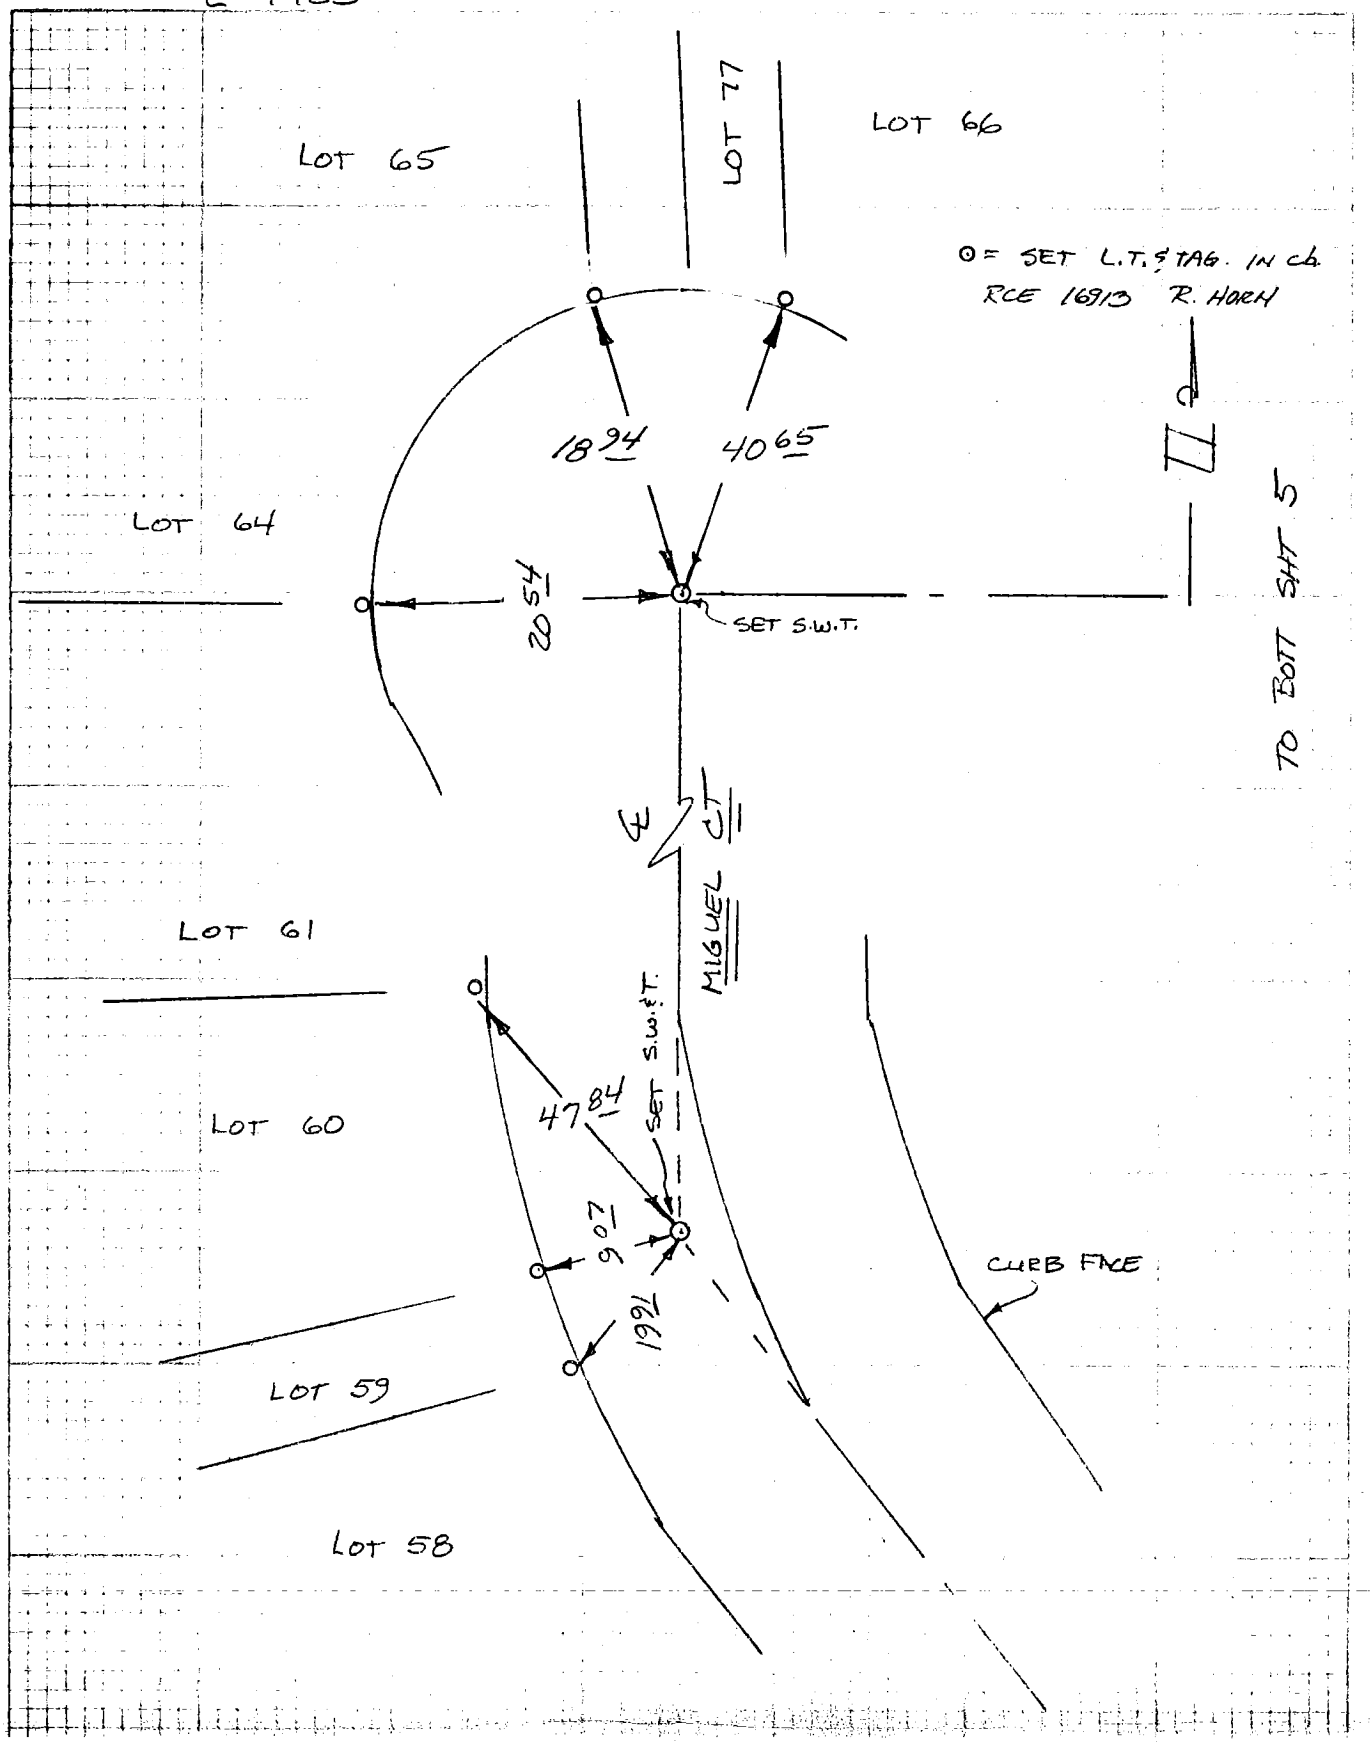

SIKAND ENGINEERING ASSOCIATES
15230 Burbank Boulevard
VAN NUYS, CALIFORNIA 91411
Phone (213) 787-8550

149

1020-115A

CO ENG FB 3673-144

W.O. 1020-115-01 F.B. ℄ TIES PG. 5

SURVEY BY BOSTON

DATE 4-84 TR # 36724 PM #

R.S. P.D. P.C.

OTHER H.C. #

249-117, A-1

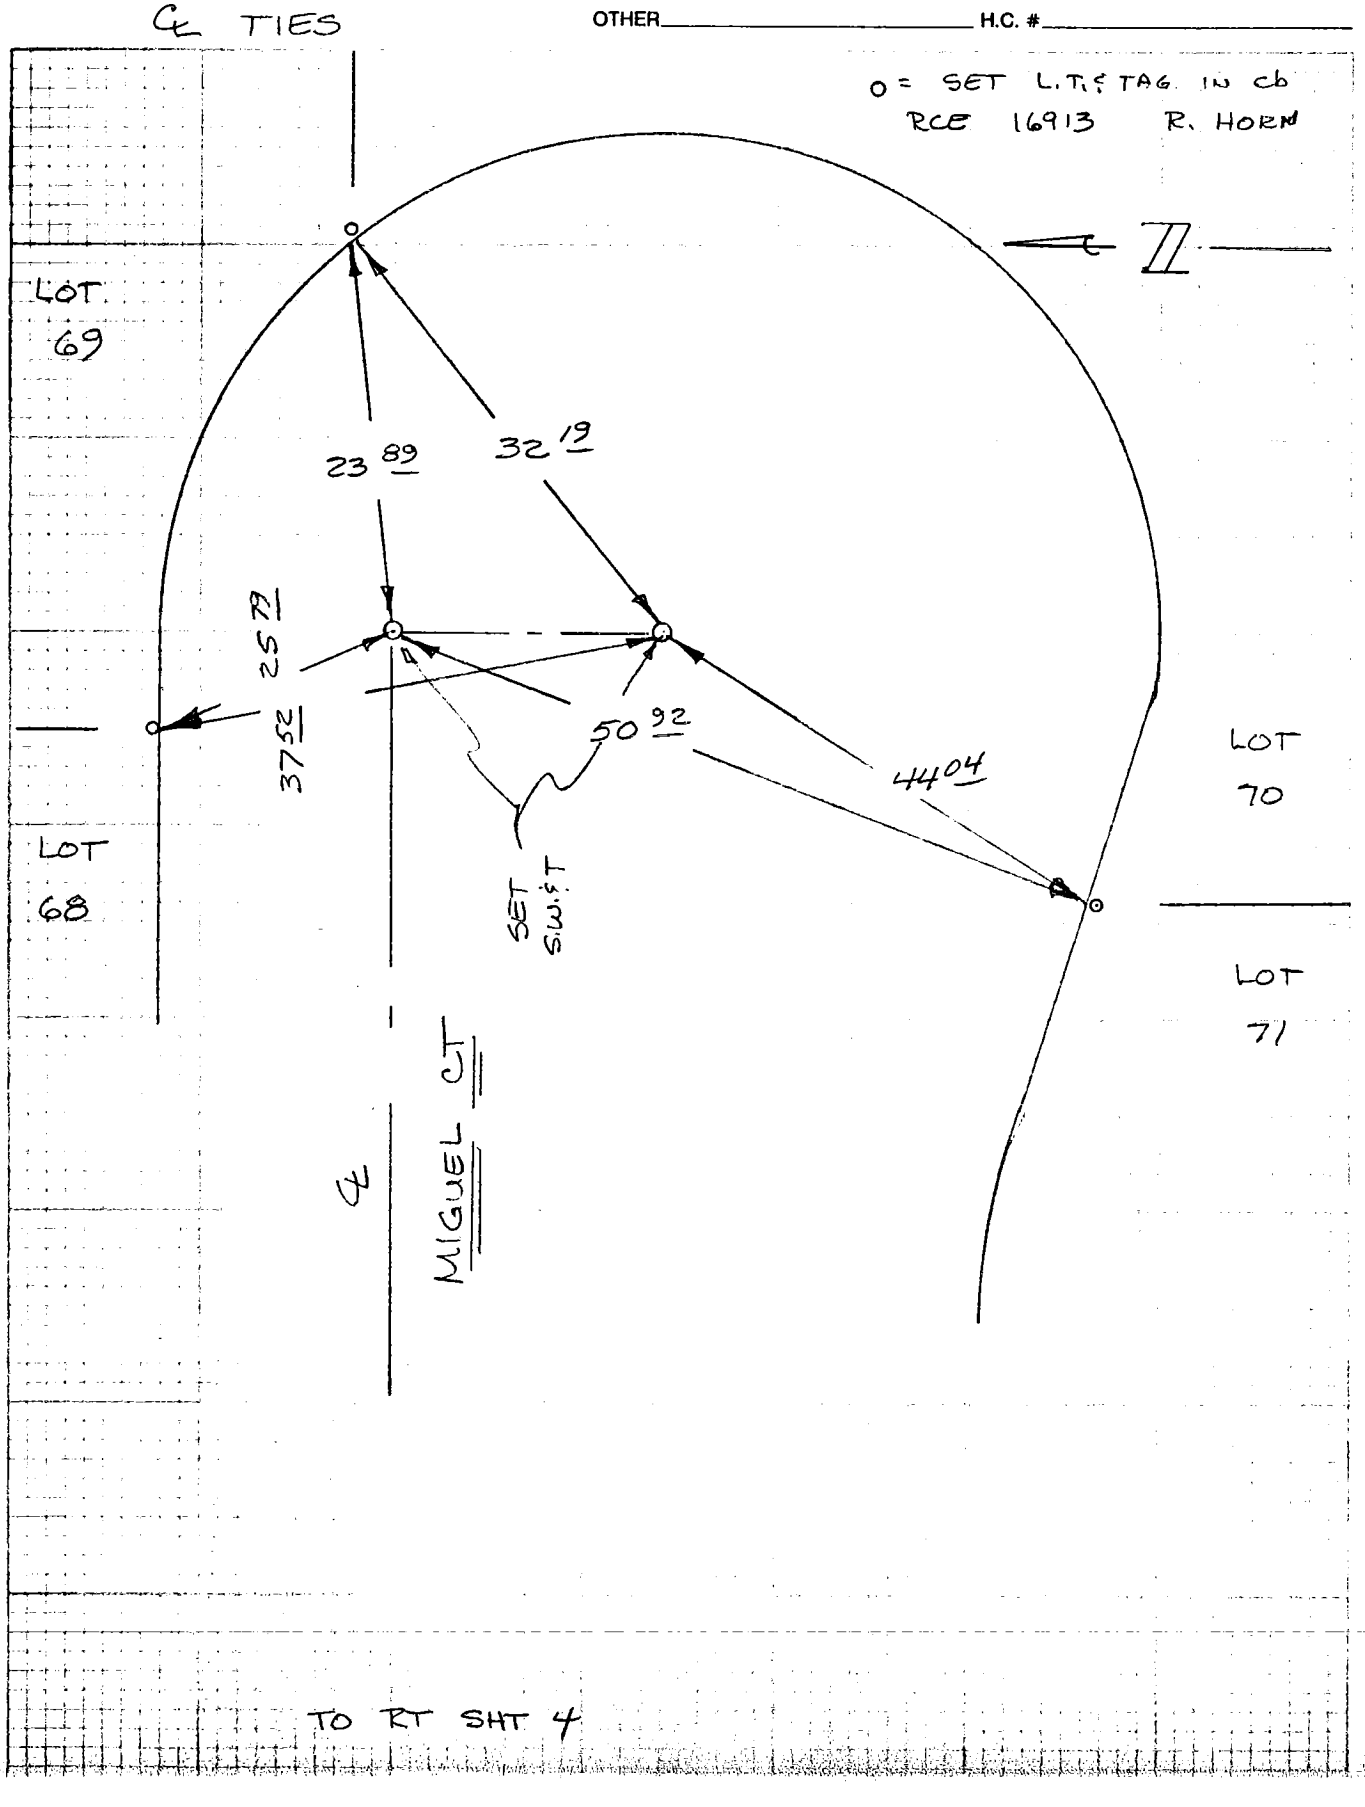

CO ENG FB 3673-145

SIKAND ENGINEERING ASSOCIATES
15230 Burbank Boulevard
VAN NUYS, CALIFORNIA 91411
Phone (213) 787-8550

145

W.O. 1020-115A F.B. 4TIES PG. 6

SURVEY BY BOSTON

DATE APR 84 TR # 36724 PM #

R.S. 4-84 P.D. P.C.

OTHER H.C. #

CORNER RECORD

ALL REAR CORNERS ARE 1" I.P., PLASTIC PLUGS, MARKED RCE 16913 "HORN"

ALL FRONT CORNERS HAVE LEAD AND TAGS MARKED RCE 16913 SET IN CONC. CURBS

SIKAND ENGINEERING ASSOCIATES
15230 Burbank Boulevard
VAN NUYS, CALIFORNIA 91411
Phone (213) 787-8550

116

(120-115C)

CO ENG FB 3673-146

W.O. 1020-115-03 F.B. ℄ TIES PG. 1

SURVEY BY BOSTON

DATE APRIL 11, 84 TR# 38936 PM #

R.S. P.D. P.C.

OTHER H.C. #

℄ TIES

○ = SET L.T.&T. TAG IN Cb.
RCE 16913 R. HORN

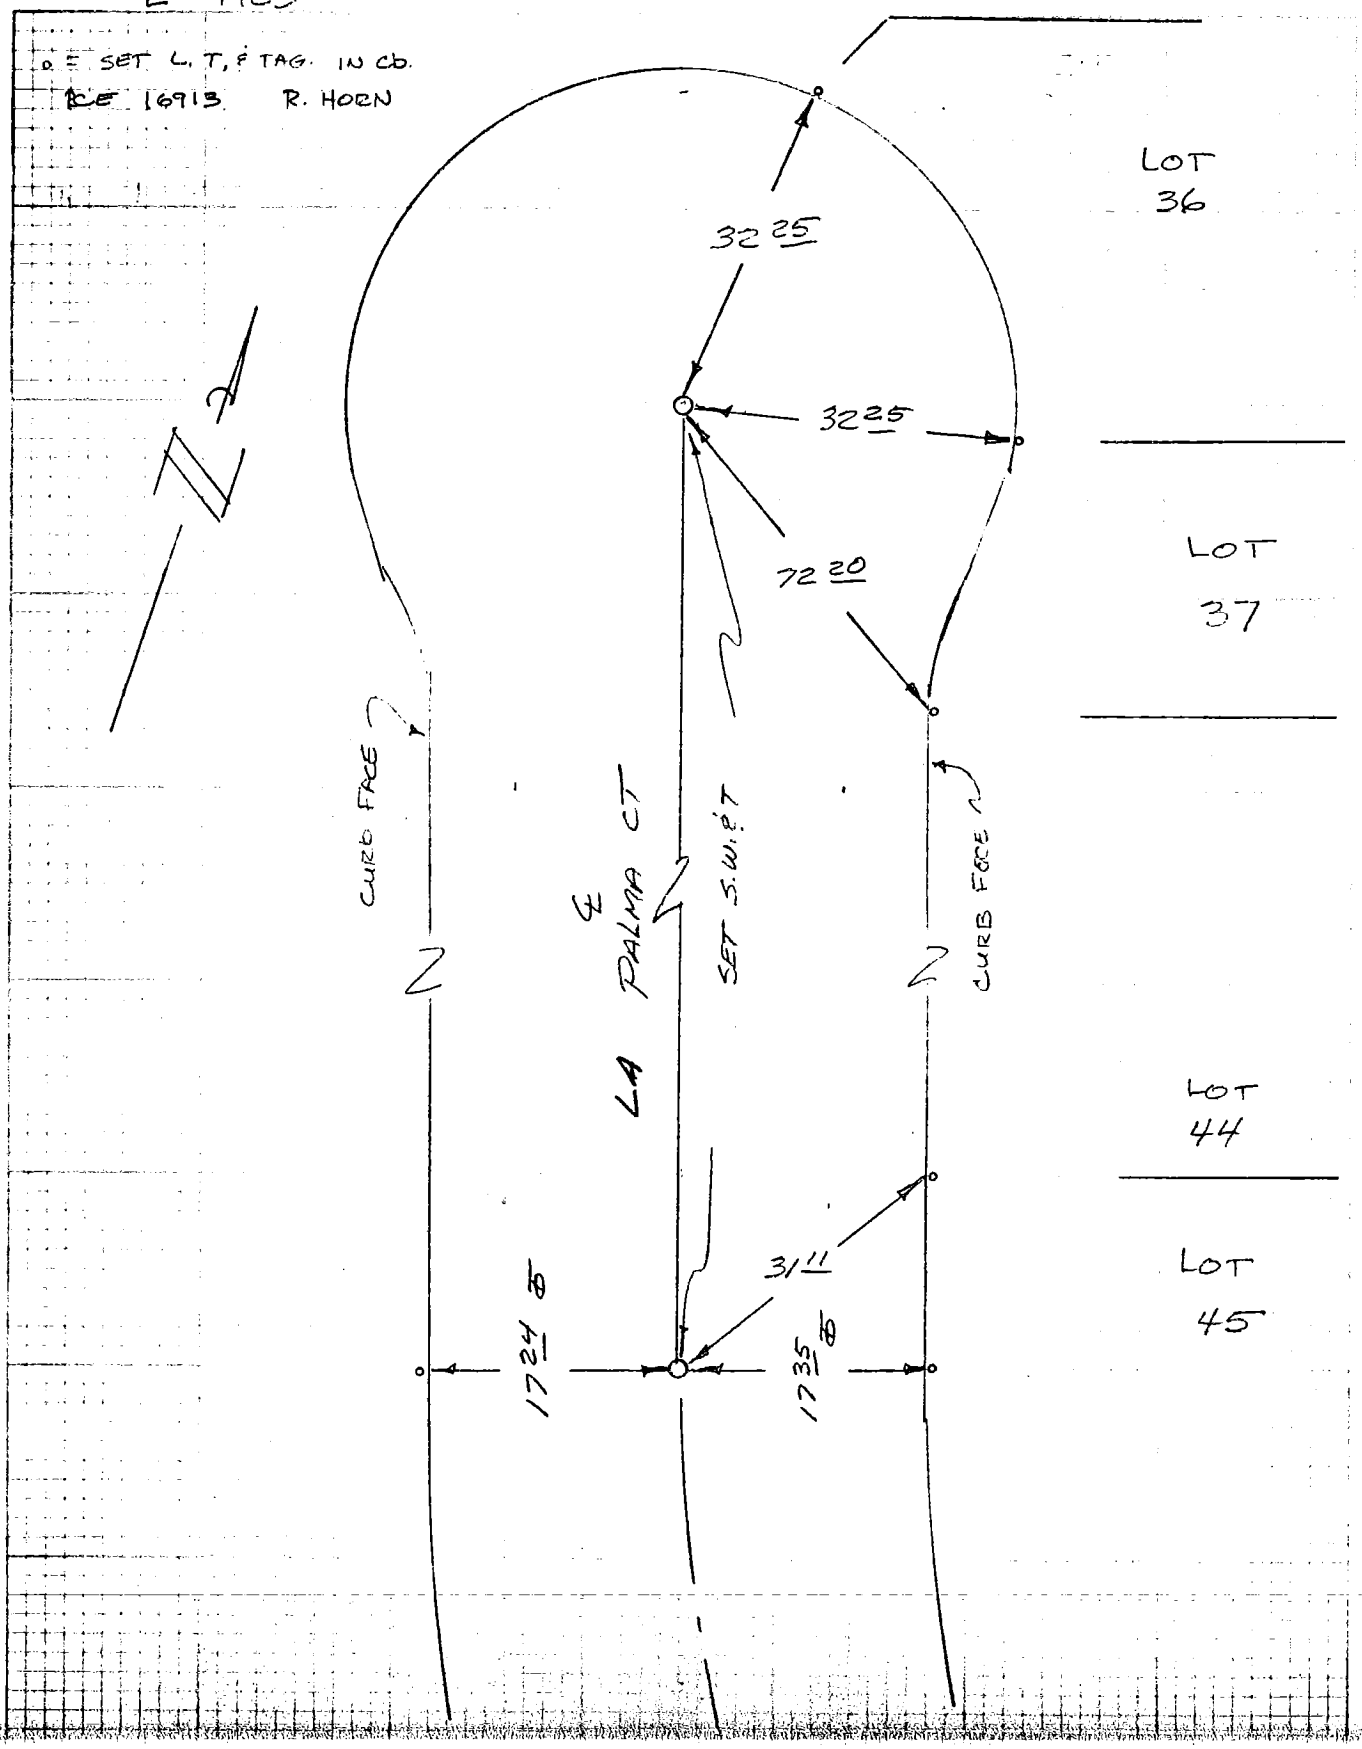

2691-47

CO ENG FB 3673-147

147

(4020-115C)

SIKAND ENGINEERING ASSOCIATES
15230 Burbank Boulevard
VAN NUYS, CALIFORNIA 91411
Phone (213) 787-8550

W.O. 1020-115-03 F.B. & TIES PG. 2

SURVEY BY BOSTON

DATE April 11, 84 TR# 38836 PM #

R.S. P.D. P.C.

OTHER H.C. #

249-117-A-1

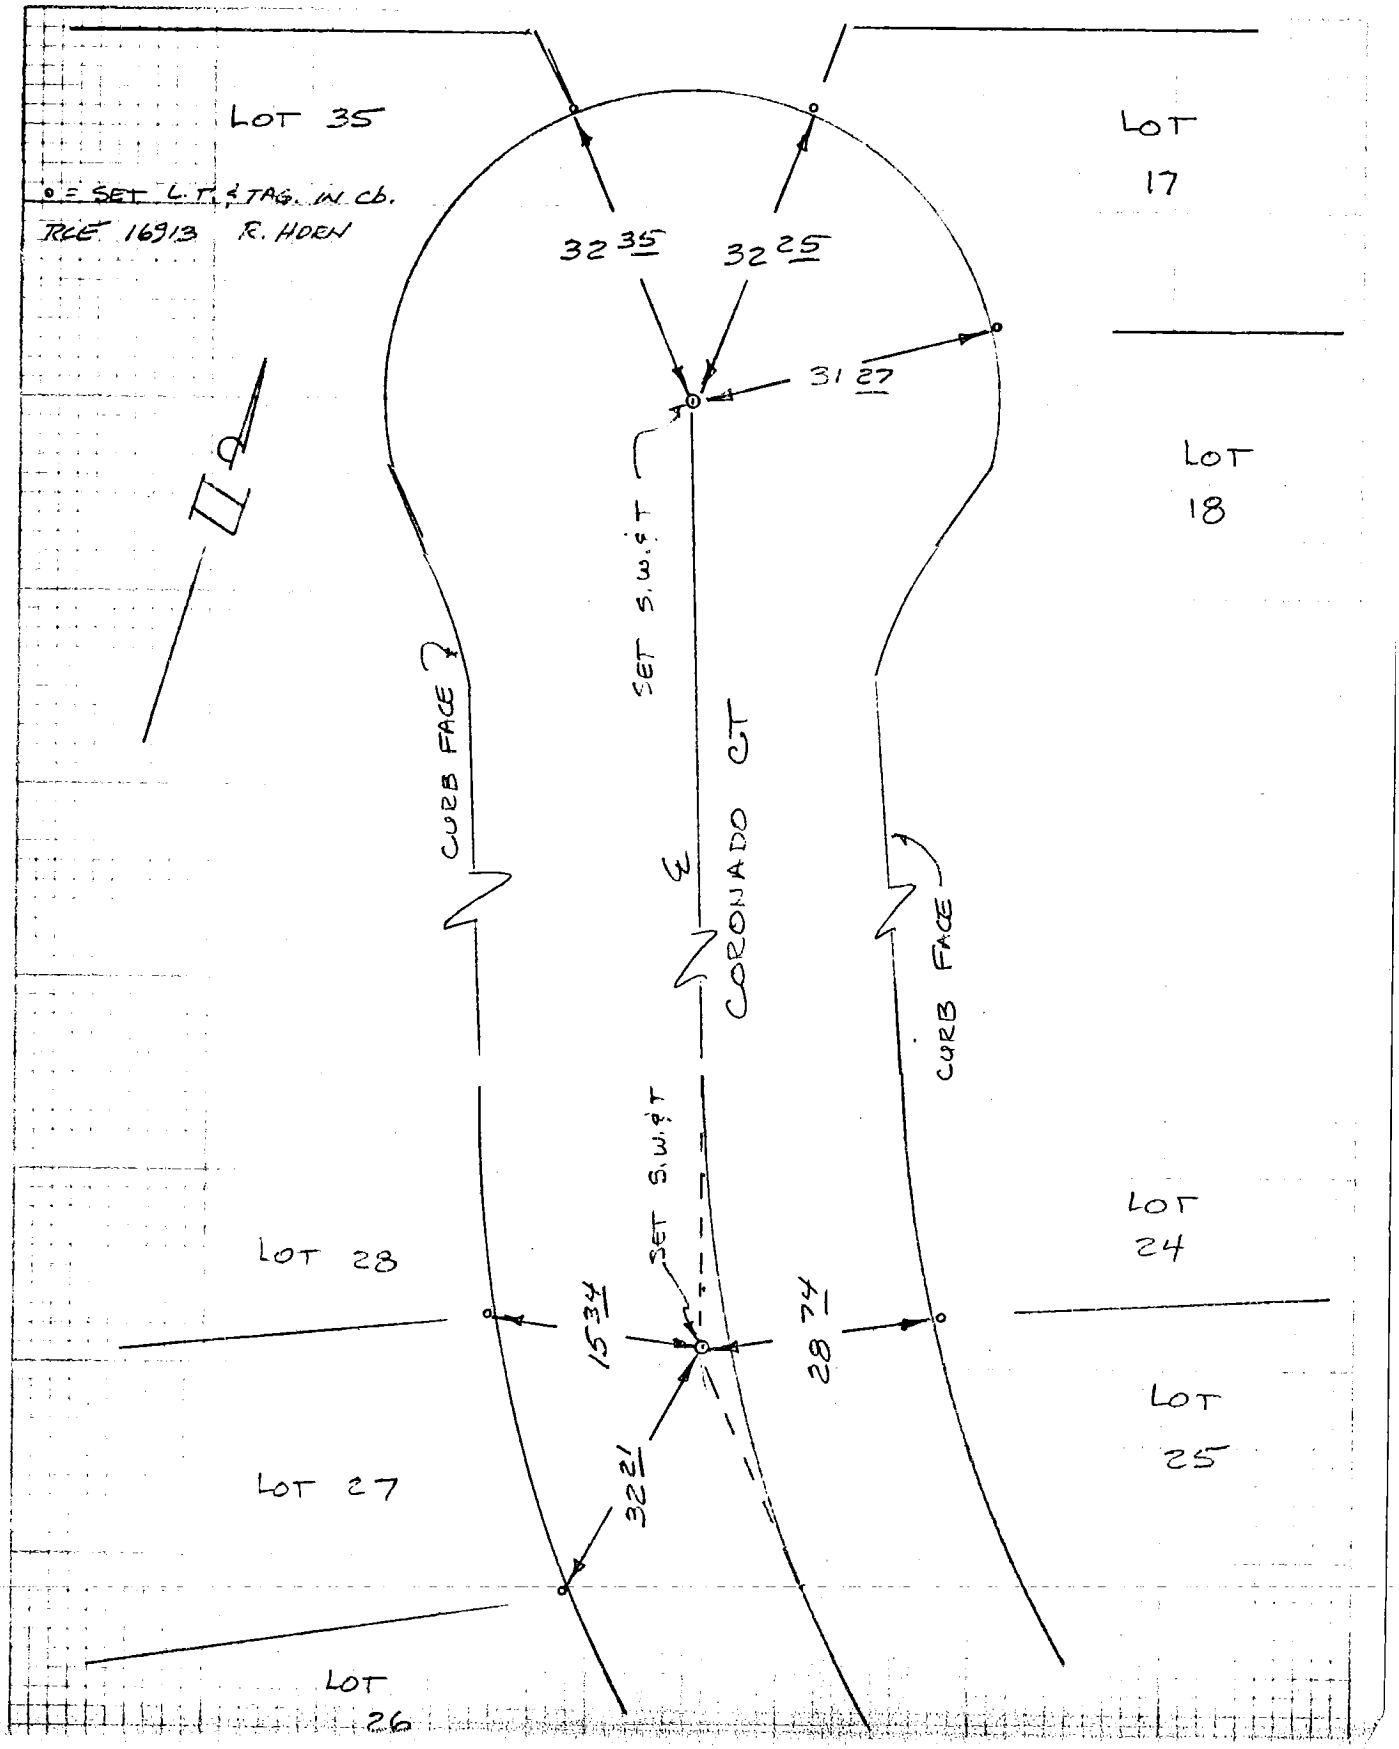

CO ENG FB 3673-148

148

(1020-115C)

SIKAND ENGINEERING ASSOCIATES
15230 Burbank Boulevard
VAN NUYS, CALIFORNIA 91411
Phone (213) 787-8550

W.O. 1020-115-03 F.B. & TIES PG. 3

SURVEY BY BOSTOM

DATE April 11, 84 TR # 35936 PM #

R.S. P.D. P.C.

OTHER H.C. #

249-117-A-1

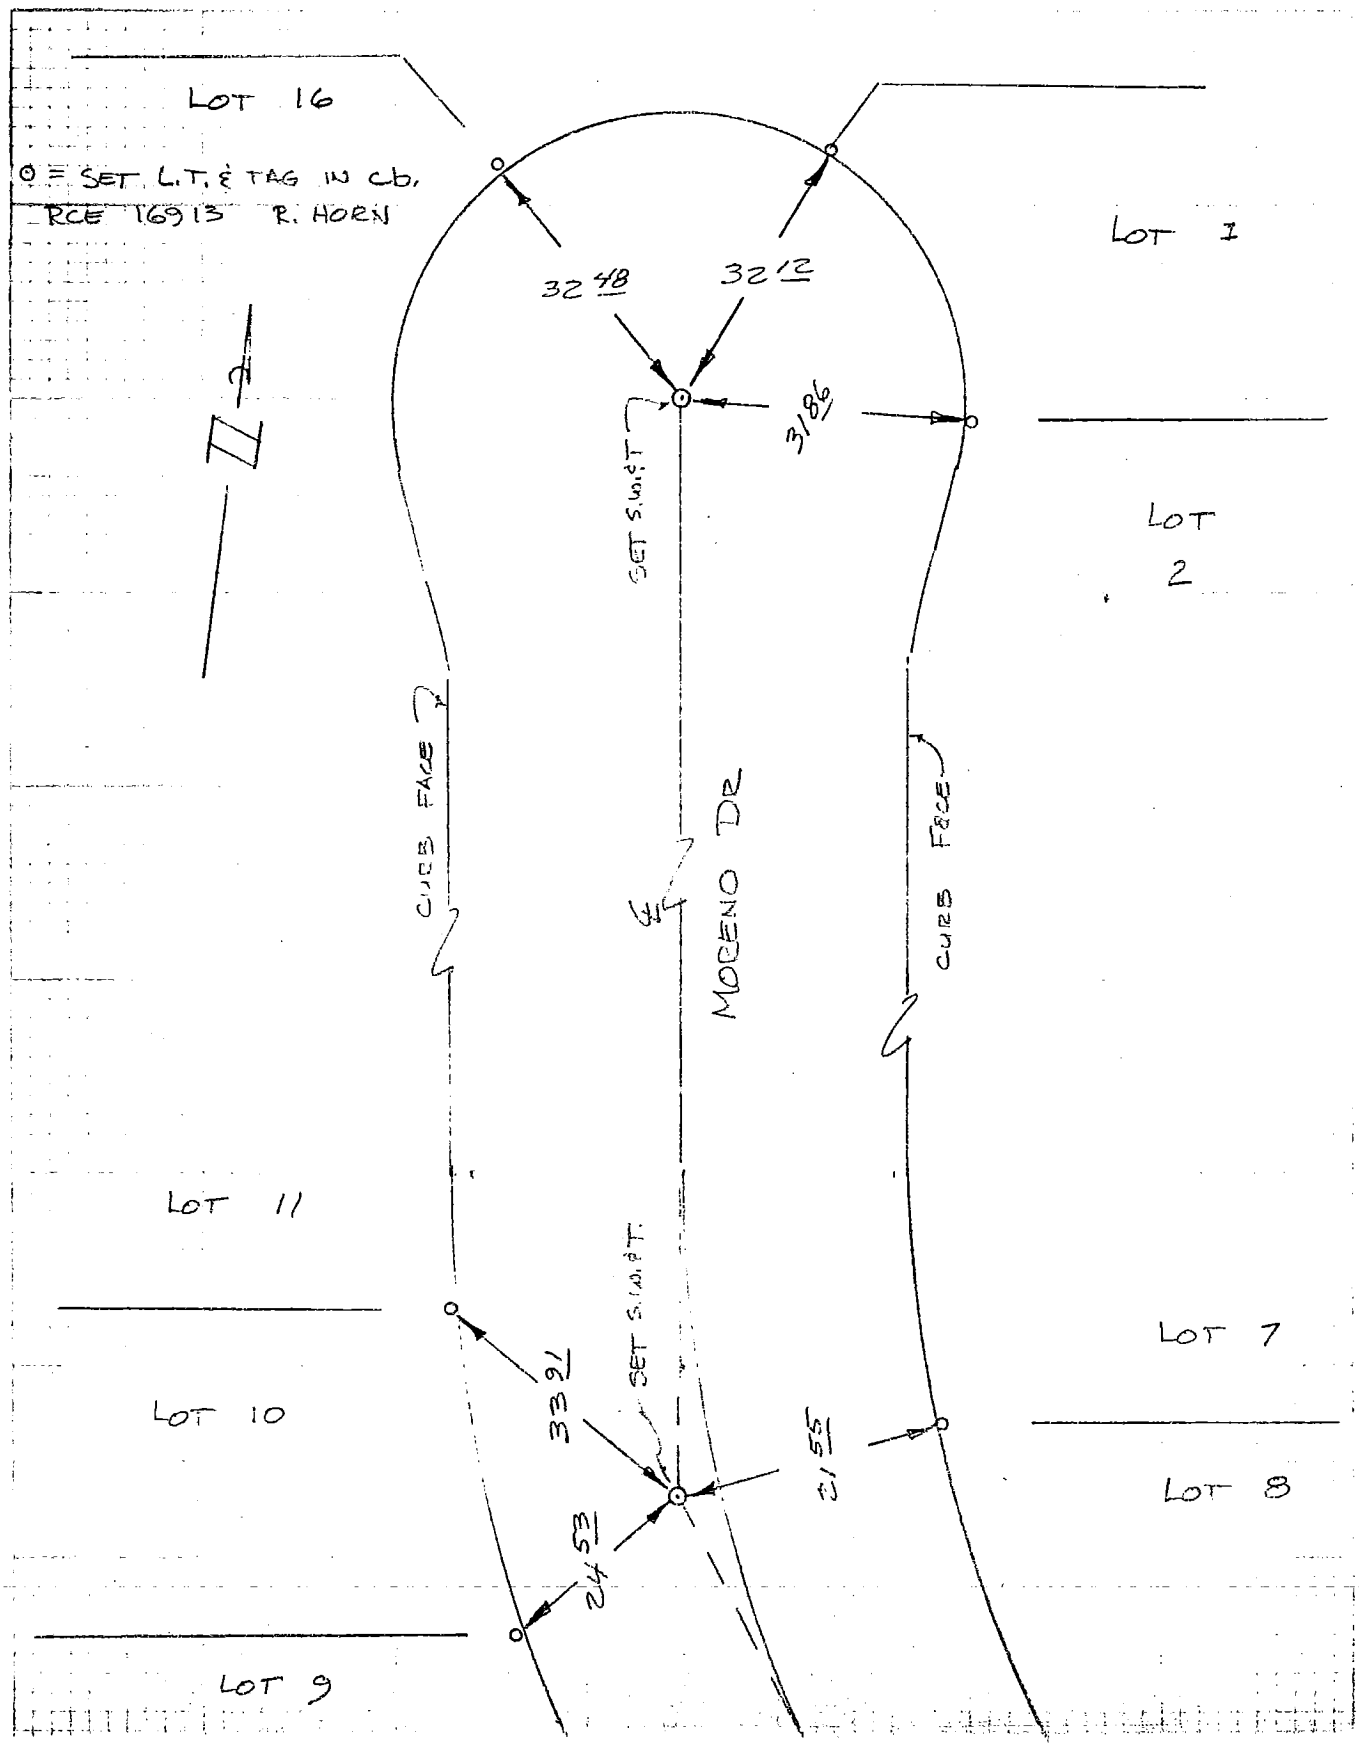

SIKAND ENGINEERING ASSOCIATES
15230 Burbank Boulevard
VAN NUYS, CALIFORNIA 91411
Phone (213) 787-8550

W.O. 1020-115C F.B. 4TIES PG. 149
SURVEY BY BOSTON
DATE APRIL 1, 84 TR # 38836 PM #
R.S. P.D. P.C.
OTHER H.C. #

CORNER RECORD

ALL REAR CORNERS ARE 1" I.P., PLASTIC PLUG, MARKED R.C.E. 16913 "LACEY"

ALL FRONT CORNERS ARE PROP. LINE PRODS, LEAD & TAG'S, MKD R.C.E. 16913 SET IN TOP OF CONC. CURBS.