RDFB 1224 ·1466

Ckd by
Office Work
Checked
Date

DIV. 8
Survey of Belvedere Area
JN 0303.00 Tape 0122 Std 68 °F
Surveyed by K. Kapp
Notes D. Peterson Date 6-73
Indexed T. M. PALMERI FEB 13 1974

F. B. ~~3813~~ PG. 5

BELVEDERE AREA

DIV. 8

J.N. 0303.00

CENTER LINE SURVEY

Party:

H. Spriggs
J. Moody
P. Beasley
J. Wersel

E. Landa
K. Kapp
D. Peterson
J. Goodwin

Rd. Dept. File - July '85
Microfilmed Dec '84

RDFB 1224 1467, 1468, 1469, 1

F. B. ~~3813~~ PG. 6

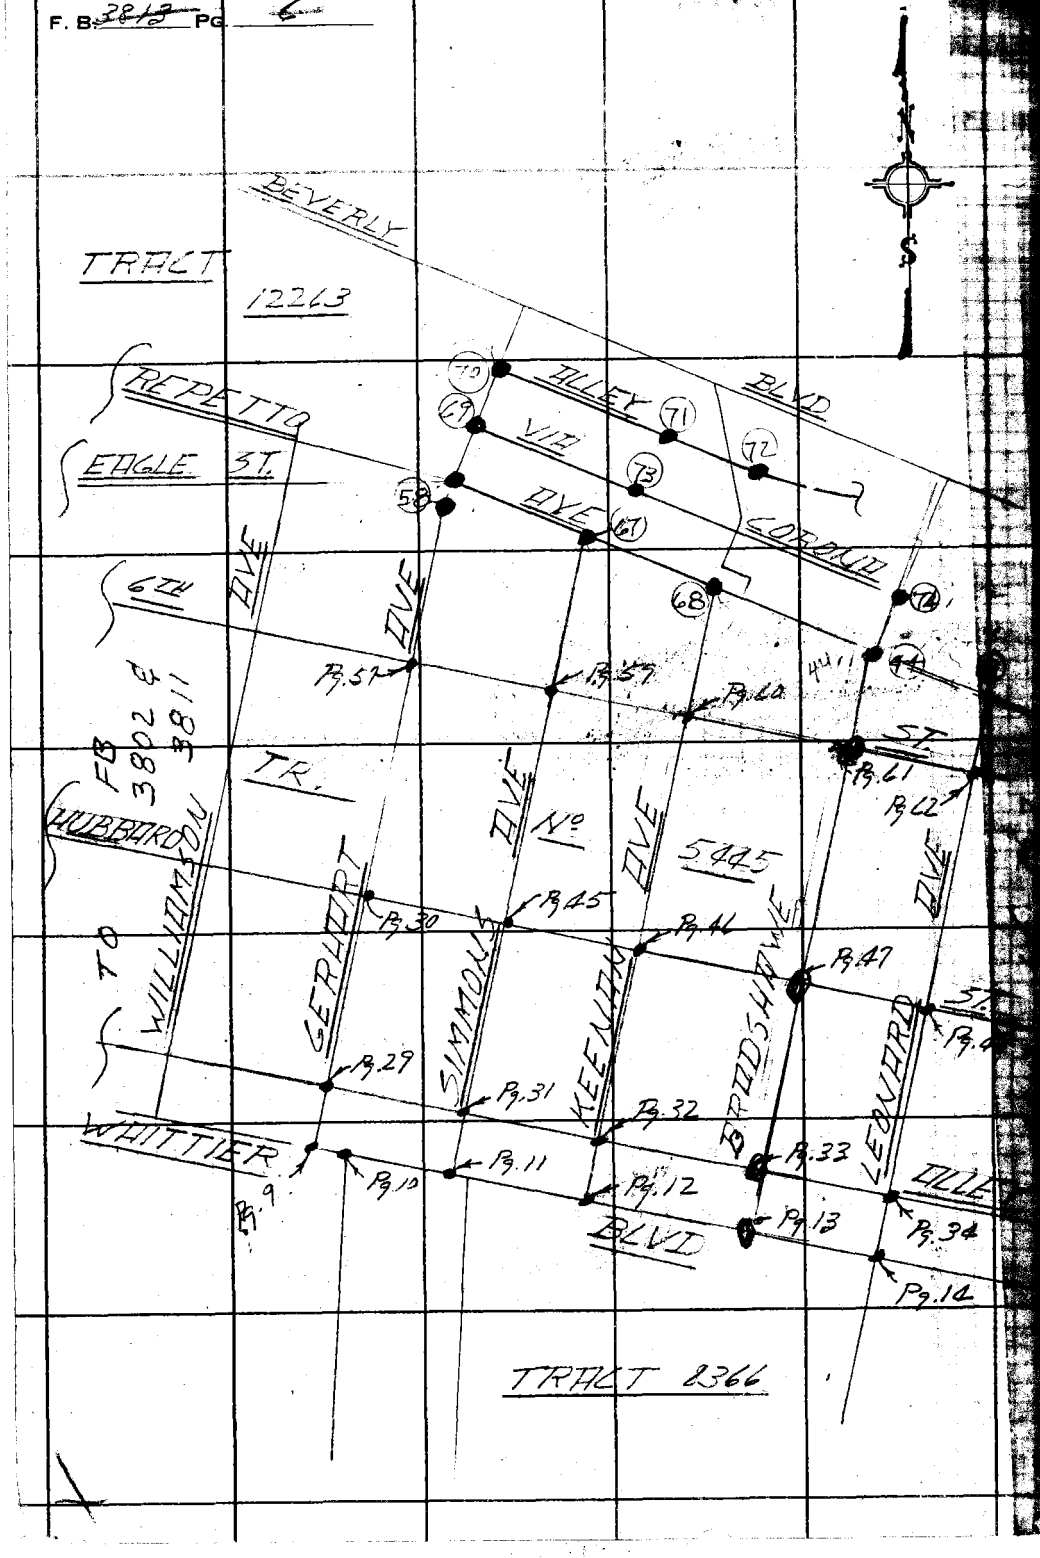

RDFB 1224 1471, 1472

Notes Ck'd by	Survey of Belvedere Area
Map No.	JN 0503.00 Tape 0122 Std 68 °F
Office Work	Surveyed by K. Kapp
Checked	Notes D. Peterson Date 7-73
Date	Index J. M. PALMER FEB 13 1974

F. B. 3818 PG. 7

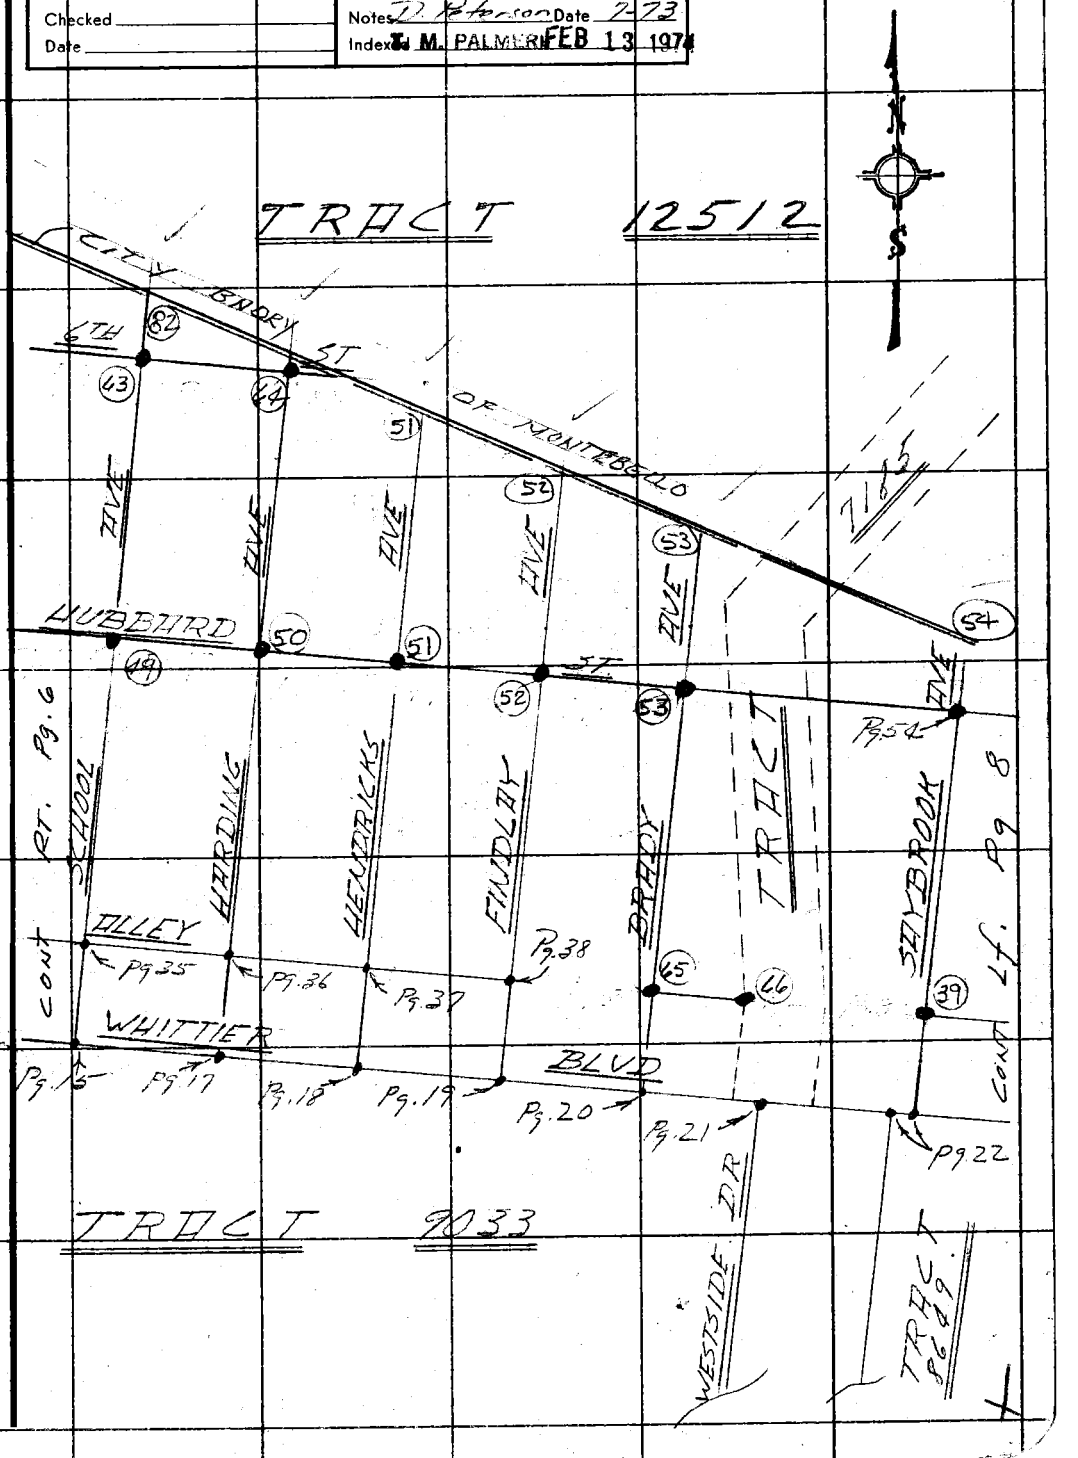

Note: Any Additions or Changes on This Sheet Must be Made or Circled in Red Ink With Date and Name of Person Making Change.

Do not extend this side of this line.

PLEASE RETURN TO
COUNTY OF LOS ANGELES
DEPARTMENT OF COUNTY ENGINEER
403 LOS ANGELES COUNTY ENGINEERING BLDG.

76F309S CE#310 3-68

RDFB 1224

1473

F. B. 38-13 PG. 8

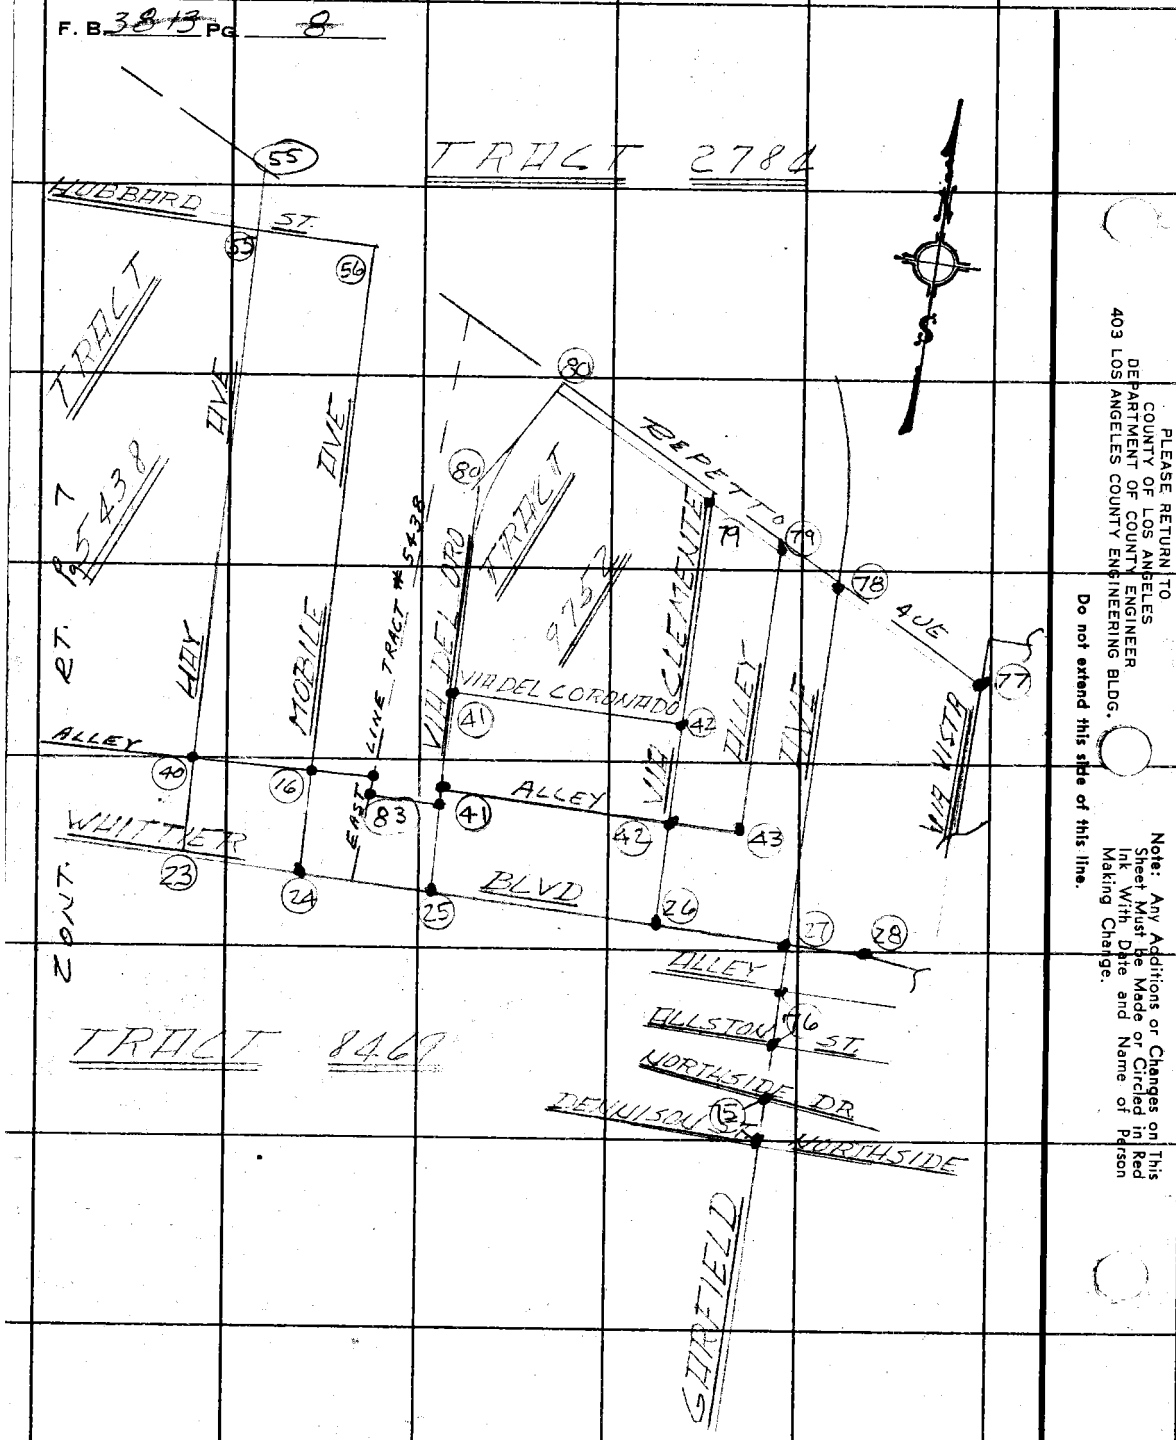

PLEASE RETURN TO
COUNTY OF LOS ANGELES
DEPARTMENT OF COUNTY ENGINEER
403 LOS ANGELES COUNTY ENGINEERING BLDG.

Do not extend this side of this line.

Note: Any Additions or Changes on This Sheet Must be Made or Circled in Red Ink With Date and Name of Person Making Change.

RDFB 1124 1662

Notes Ck'd by	Survey of Belvedere Area ℄
Map No.	JN 0303.00 Tape 024 Std 68 °F
Office Work	Surveyed by HH Spriggs
Checked	Notes HHS Date 5-73
Date	Indexed B. M. PALMER FEB 13 1974

F. B. 3813 PG. 9

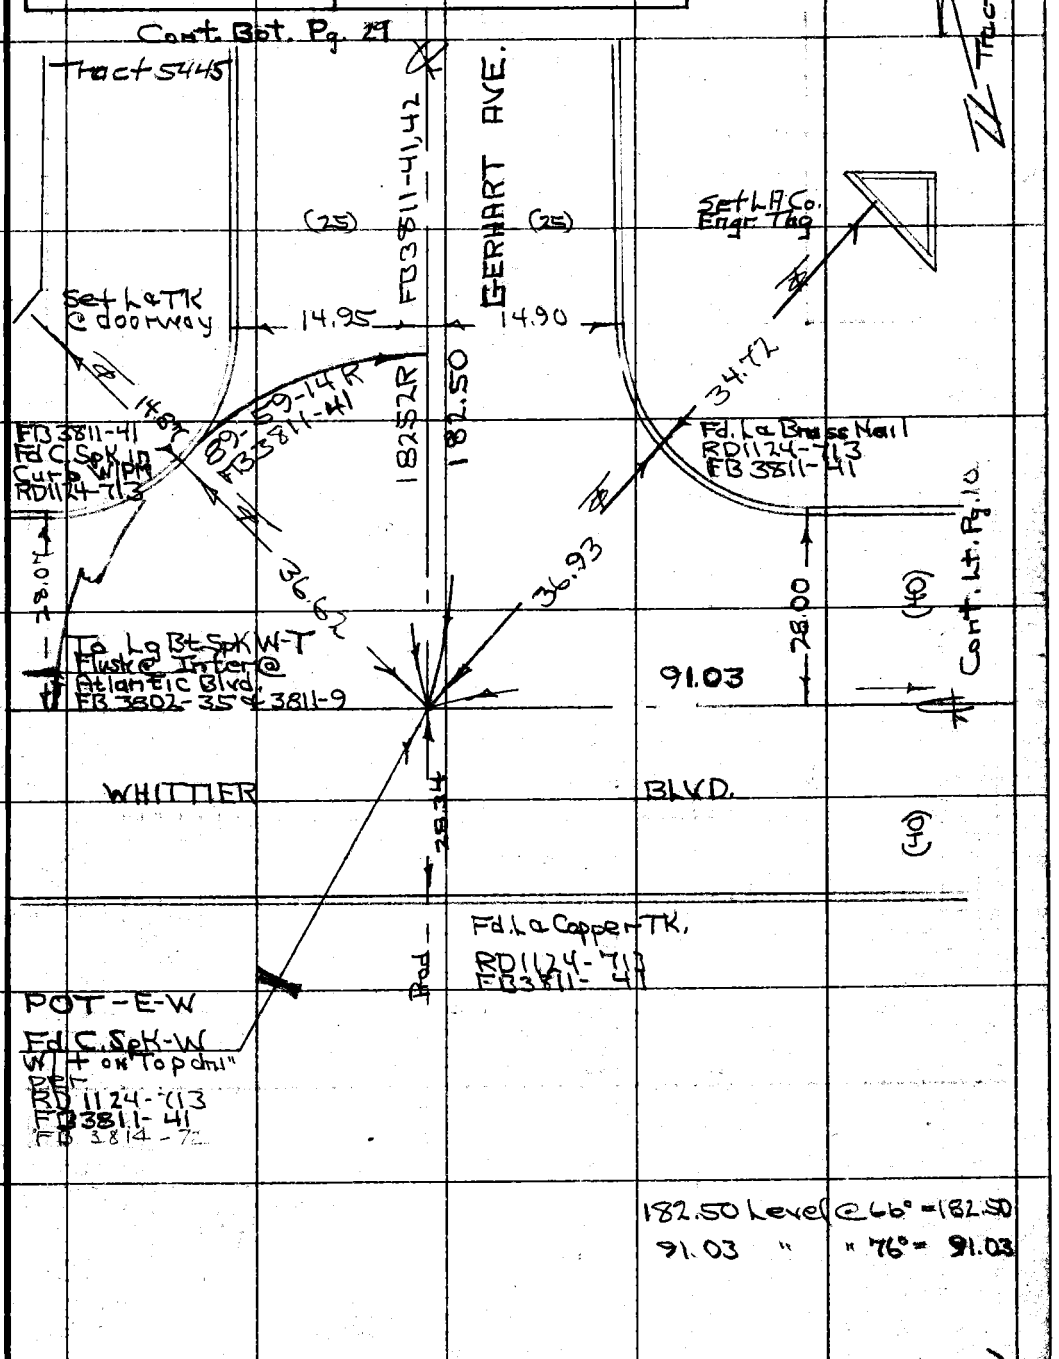

Note: Any Additions or Changes on This Sheet Must be Made or Circled in Red Ink With Date and Name of Person Making Change.

Do not extend this side of this line.

PLEASE RETURN TO
COUNTY OF LOS ANGELES
DEPARTMENT OF COUNTY ENGINEER
403 LOS ANGELES COUNTY ENGINEERING BLDG.

76F309S CE#310 3-68

RDFB 1124 See RD1124-713 1663

F. B. ~~3713~~ PG ~~10~~

Tract 5445

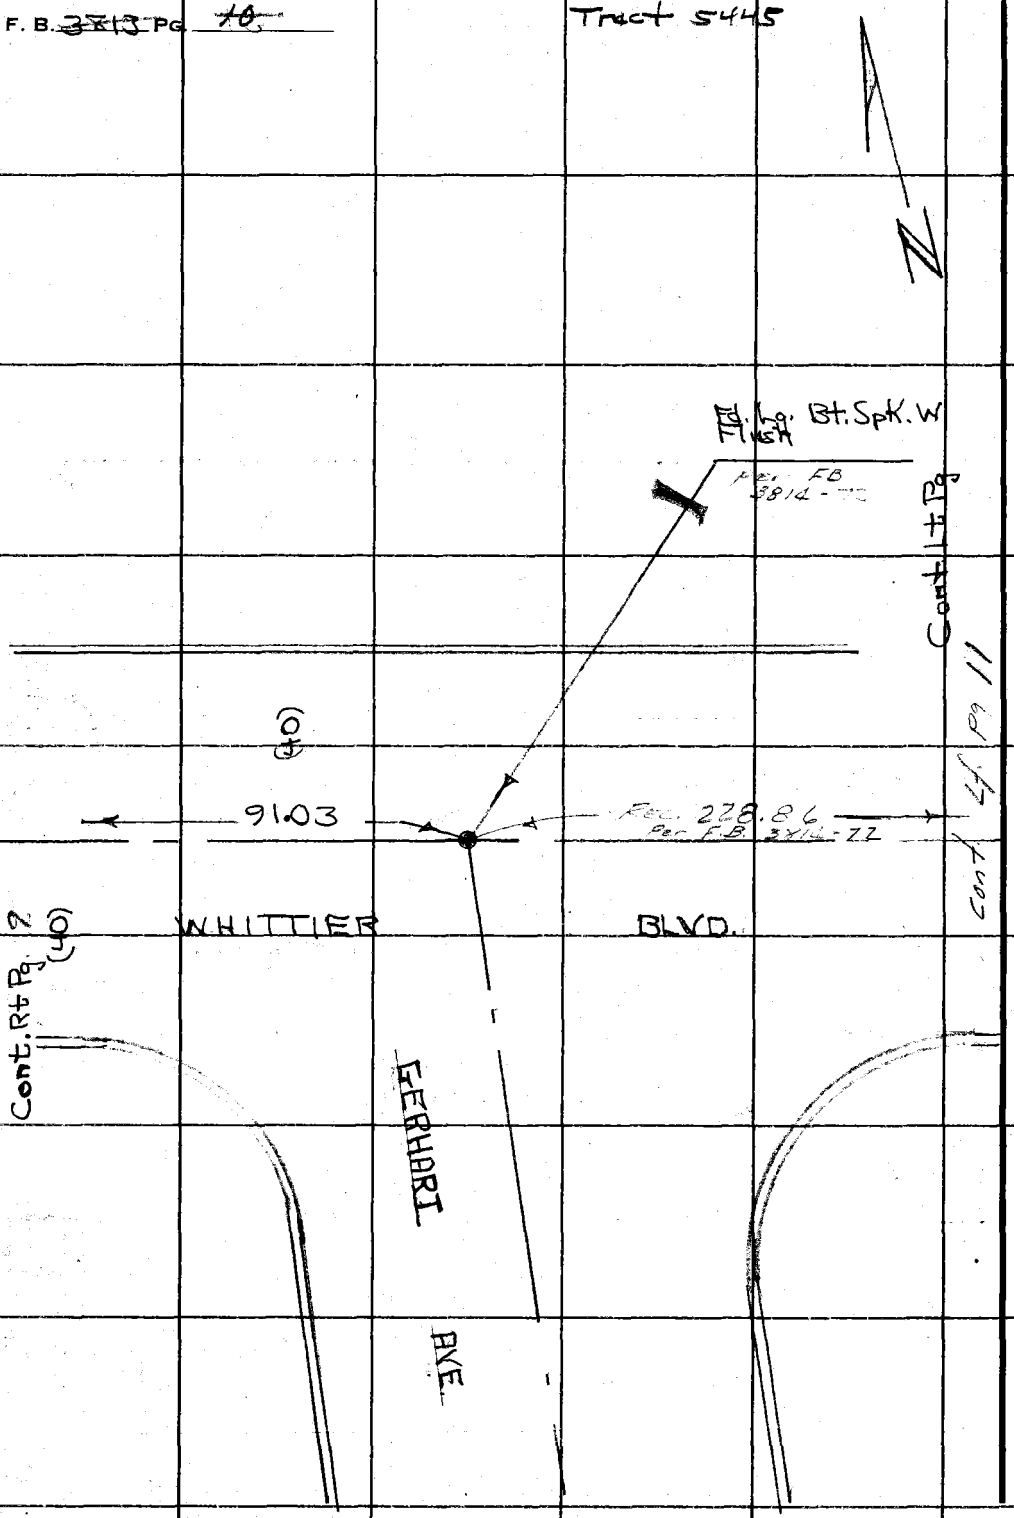

PLEASE RETURN TO
COUNTY OF LOS ANGELES
DEPARTMENT OF COUNTY ENGINEER
403 LOS ANGELES COUNTY ENGINEERING BLDG.

Do not extend this side of this line.

Note: Any Additions or Changes on This Sheet Must be Made or Circled in Red Ink With Date and Name of Person Making Change.

RDFB 1124 1664

Notes Ck'd by	Survey of BELVEDERE DRIVE
Map No.	JN 4803.00 Tape 3122 Std 68 °F
Office Work	Surveyed by E. LANDA
Checked	Notes E. LANDA Date 5-73
Date	Indexed J. M. PALMERI FEB 13 1974


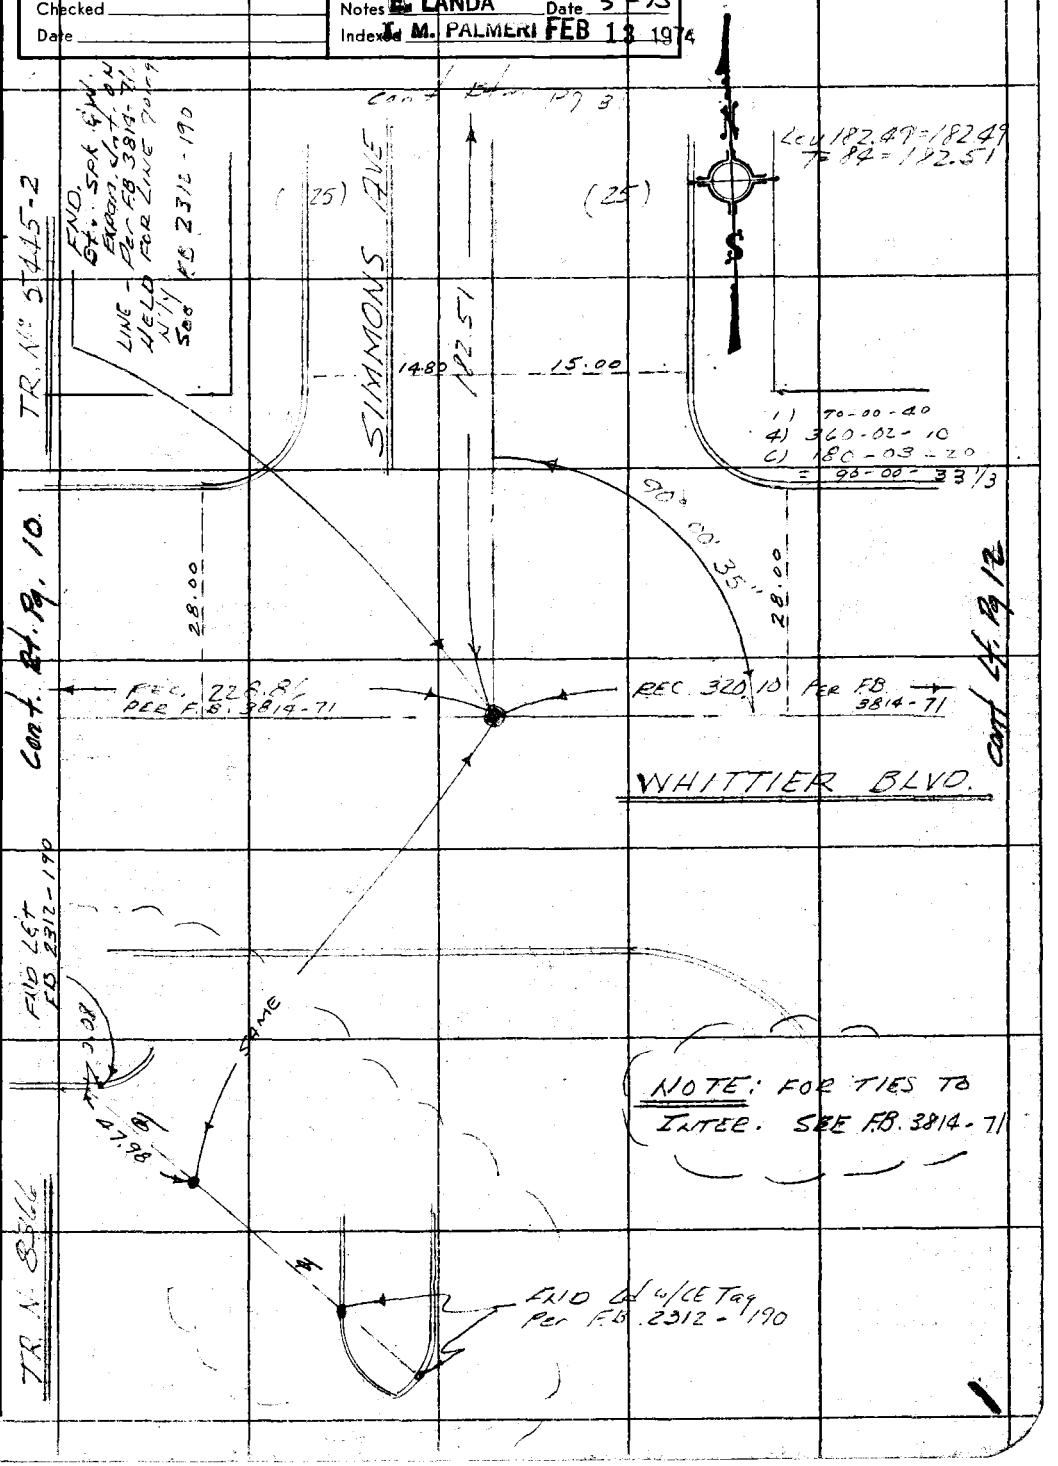

Note: Any Additions or Changes on this Sheet Must be Made or Circled in Red Ink With Date and Name of Person Making Change.

Do not extend this side of this line.

PLEASE RETURN TO
COUNTY OF LOS ANGELES
DEPARTMENT OF COUNTY ENGINEER
403 LOS ANGELES COUNTY ENGINEERING BLDG.

76F309S CE#310 3-68

RDFB 1124 1665, 1666, 1667, 1668

F. B. ~~3813~~ PG. ~~12~~

cont Btm pg 32

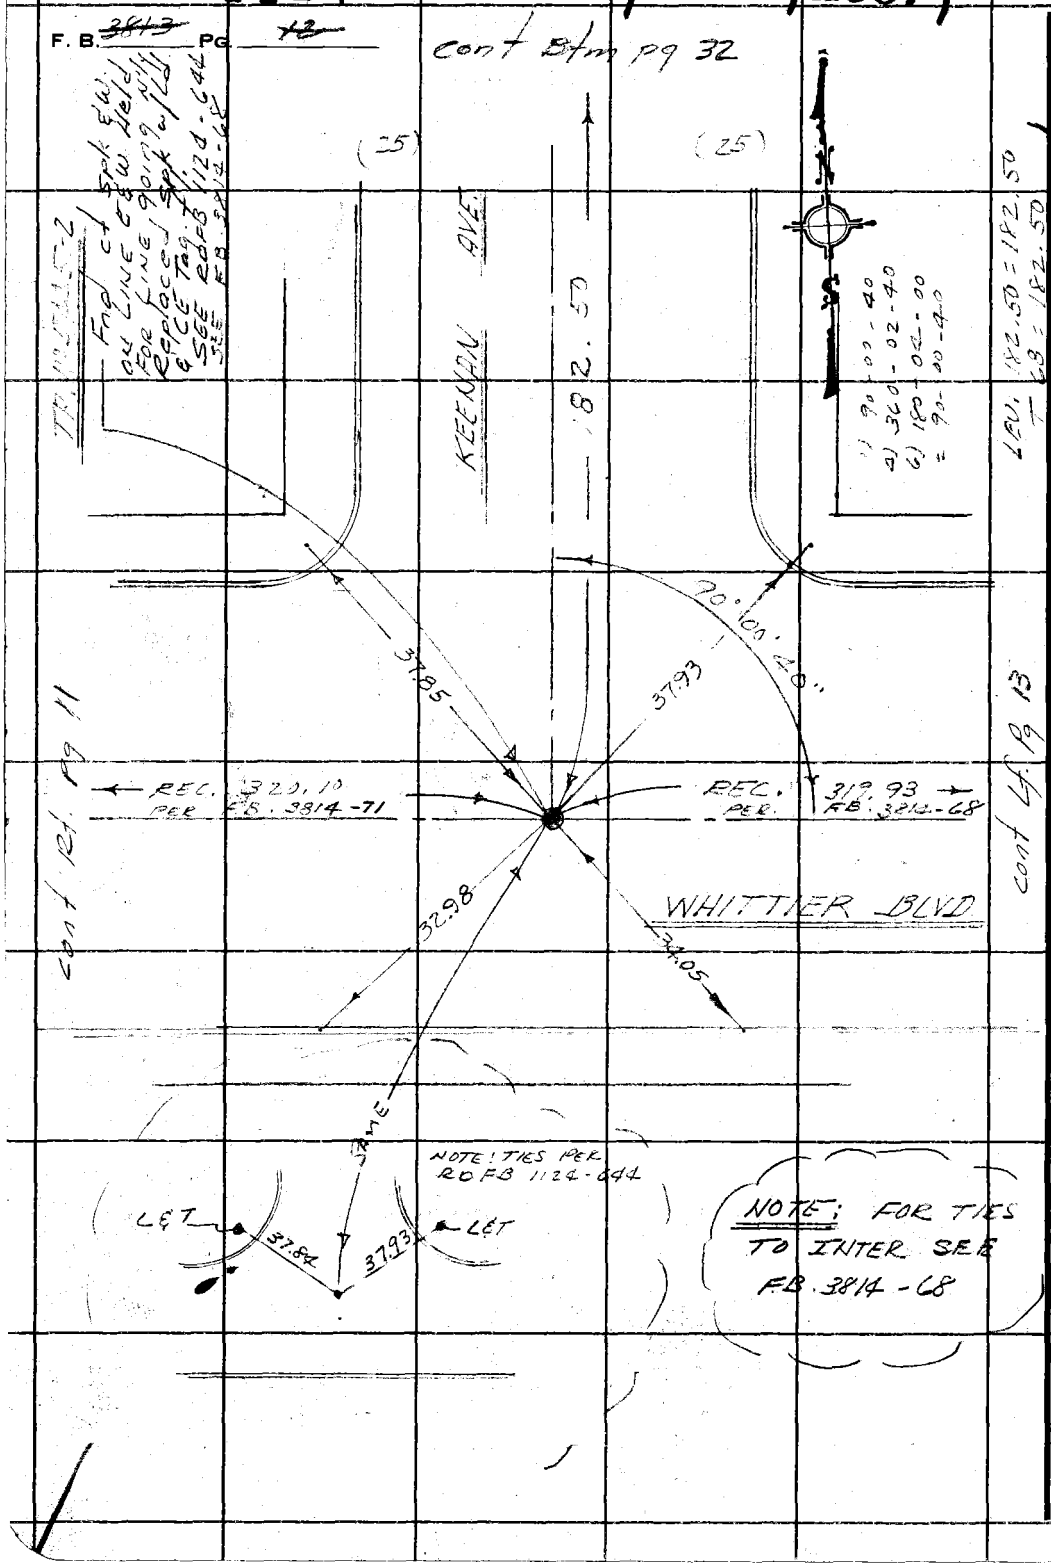

PLEASE RETURN TO
COUNTY OF LOS ANGELES
DEPARTMENT OF COUNTY ENGINEER
403 LOS ANGELES COUNTY ENGINEERING BLDG.

Do not extend this side of this line.

Note: Any Additions or Changes on This Sheet Must be Made or Circled in Red Ink With Date and Name of Person Making Change.

RDFB 1124 1669

Notes Ck'd by	Survey of Belvedere Area ℄
Map No.	JN 0303.00 Tape 0247 Std 68 °F
Office Work	Surveyed by HH Spriggs
Checked	Notes HHS Date 5-73
Date	Indexed T. M. PALMERI FEB 13 1974

F. B. 3813 Pg. 43

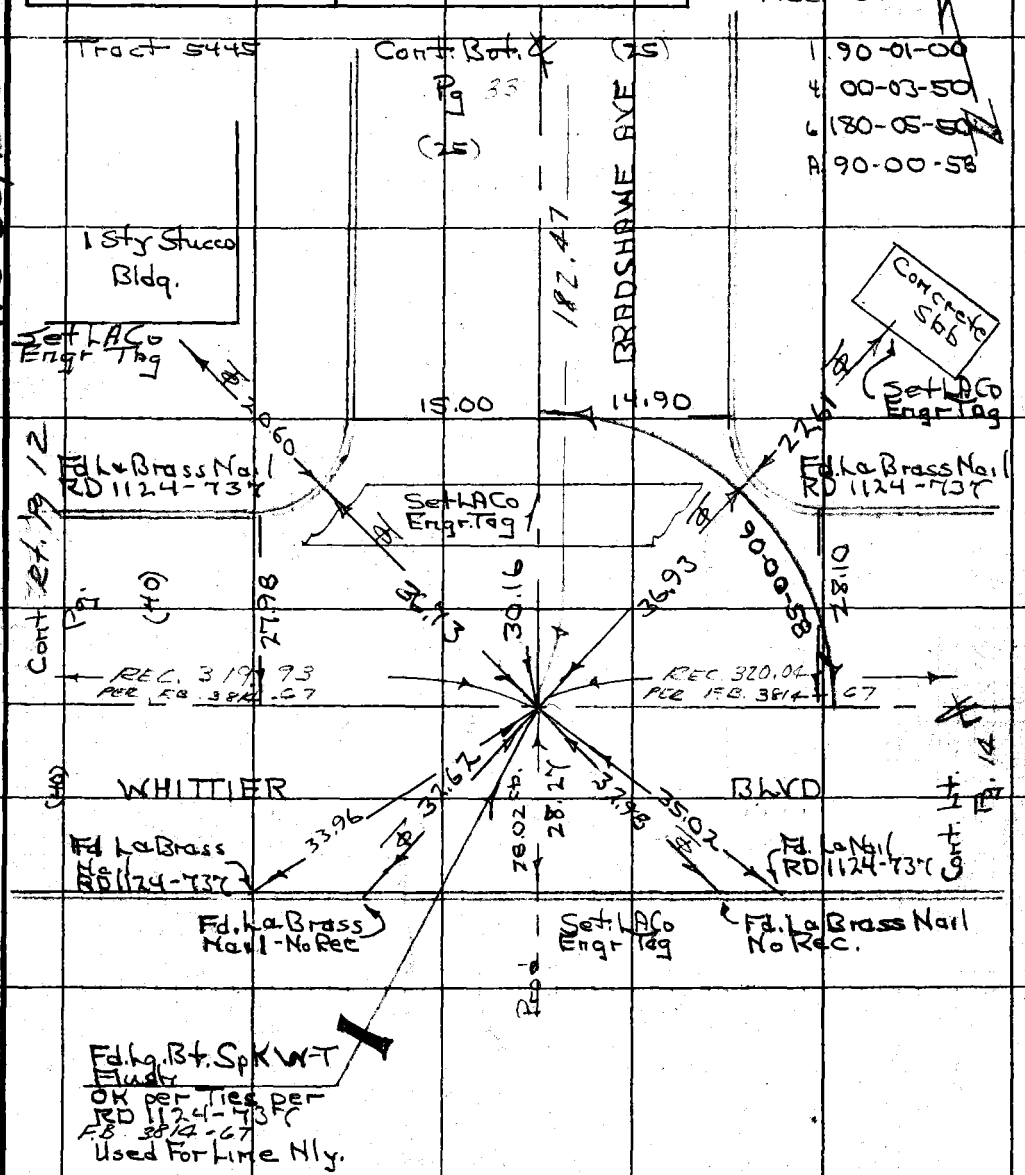

30.16 Level @ 74° = 30.16

LEV. 182.46 = 182.46
T 80 = 182.47

WS.36, B-3

Note: Any Additions or Changes on This Sheet Must be Made or Circled in Red Ink With Date and Name of Person Making Change.

Do not extend this side of this line.

PLEASE RETURN TO
COUNTY OF LOS ANGELES
DEPARTMENT OF COUNTY ENGINEER
403 LOS ANGELES COUNTY ENGINEERING BLDG.

76F309S CE#310 3-68

RDFB 1124

1670

F. B. ~~3813~~ PG. 14

Cont Btm pg 34

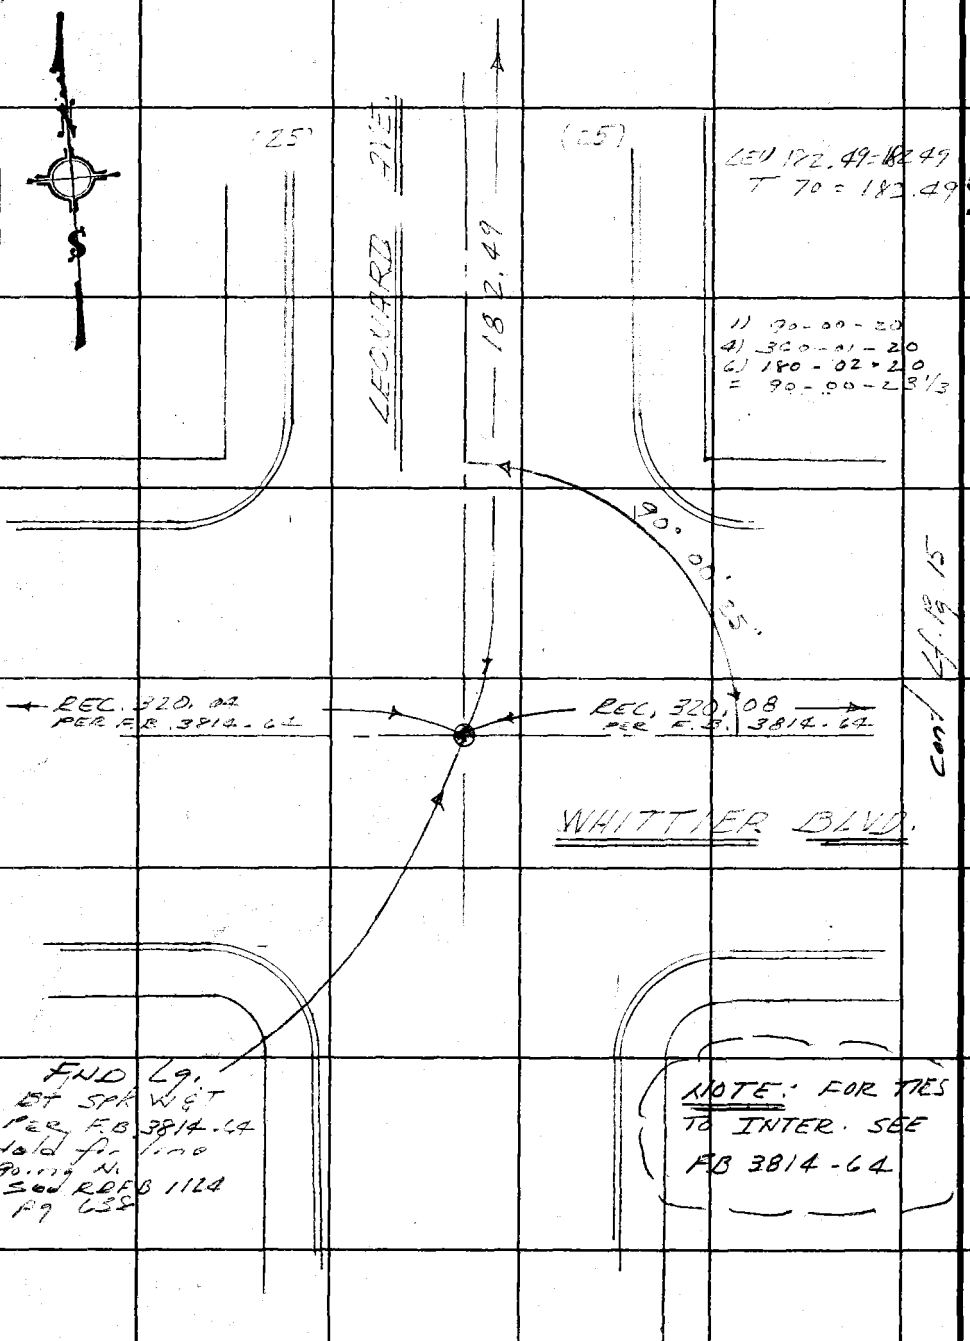

GB-3

PLEASE RETURN TO
COUNTY OF LOS ANGELES
DEPARTMENT OF COUNTY ENGINEER
403 LOS ANGELES COUNTY ENGINEERING BLDG.

Do not extend this side of this line.

Note: Any Additions or Changes on This Sheet Must be Made or Circled in Red Ink With Date and Name of Person Making Change.

RDFB 1124

1671

Notes Ck'd by	Survey of Div 8 BELVEDERE PARK
Map No.	JN 0303.00 Tape 0122 Std 68 °F
Office Work	Surveyed by E. LANDA
Checked	Notes E. LANDA Date 5-73
Date	Indexed I. M. PALMERI FEB 13 1974

F. B. ~~3813~~ PG. ~~15~~

TR. No 5445-2

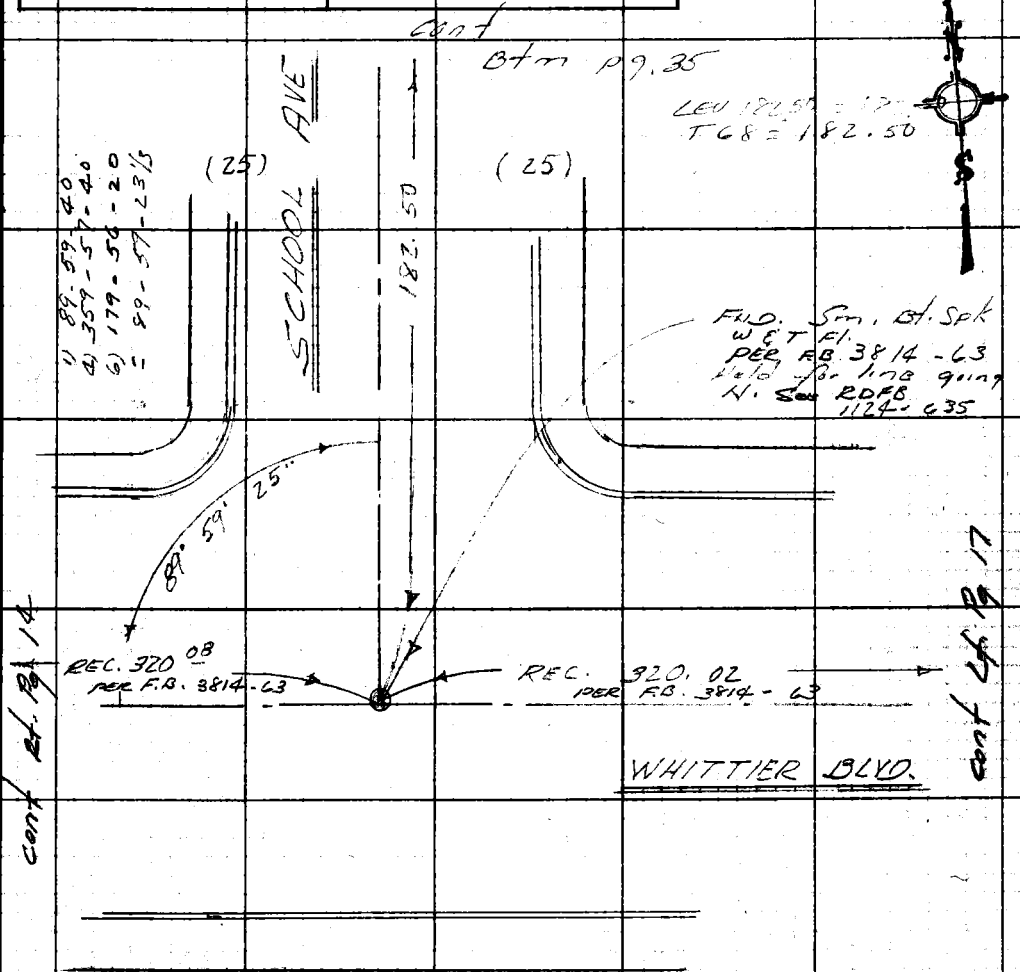

NOTE: FOR TIES TO INTER: SEE FB 3814-63

W.S. 36, B-3

Note: Any Additions or Changes on This Sheet Must be Made or Circled in Red Ink With Date and Name of Person Making Change.

Do not extend this side of this line.

PLEASE RETURN TO
COUNTY OF LOS ANGELES
DEPARTMENT OF COUNTY ENGINEER
403 LOS ANGELES COUNTY ENGINEERING BLDG.

76F309S CE#310 3-69

RDFB 1124 1672

F. B. ~~7018~~ PG. ~~14~~

TRACT No. 5438

1) 90-00-10
4) 360-00-40
6) 180-00-50
= 90-00-08 1/3

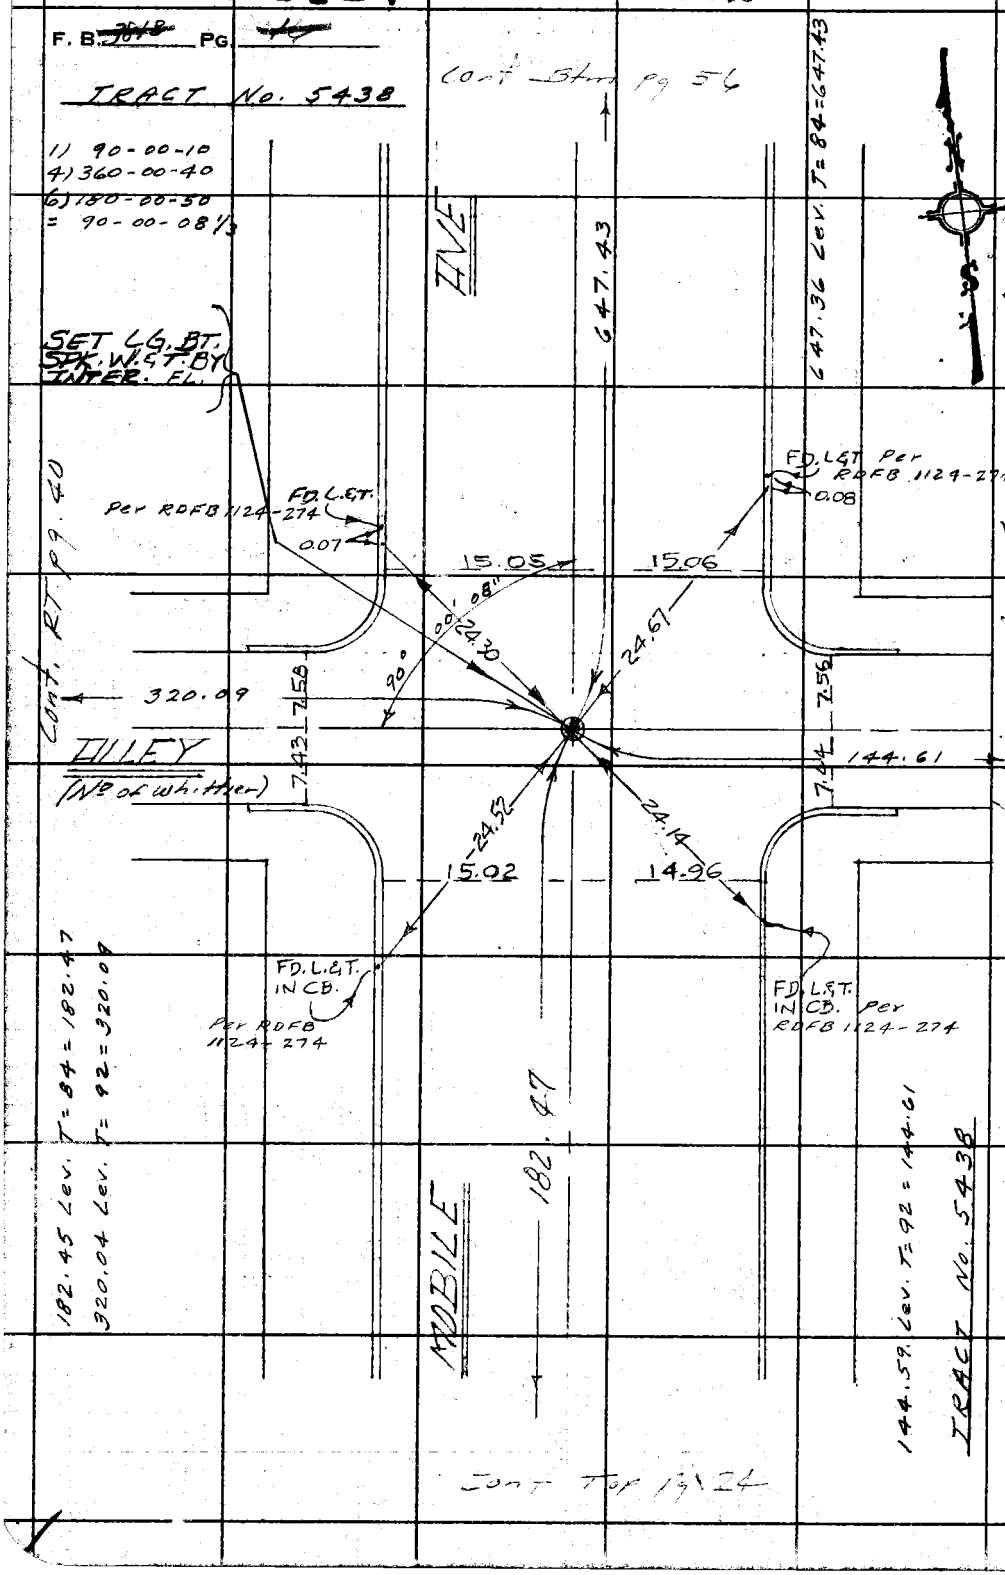

WS 36 B-3

PLEASE RETURN TO
COUNTY OF LOS ANGELES
DEPARTMENT OF COUNTY ENGINEER
403 LOS ANGELES COUNTY ENGINEERING BLDG.

Do not extend this side of this line.

Note: Any Additions or Changes on This Sheet Must Be Made or Circled in Red Ink With Date and Name of Person Making Change.

RDFB 1124 1673

Notes Ck'd by	Survey of Belvedere Area F
Map No.	JN 030300 Tape 0247 Std 68 °F
Office Work	Surveyed by HH Spriggs
Checked	Notes HHS Date 5-73
Date	Indexed J. M. PALMERI FEB 13 1974

F. B. ~~3813~~ Pg. 77

W.S. 36, B-3

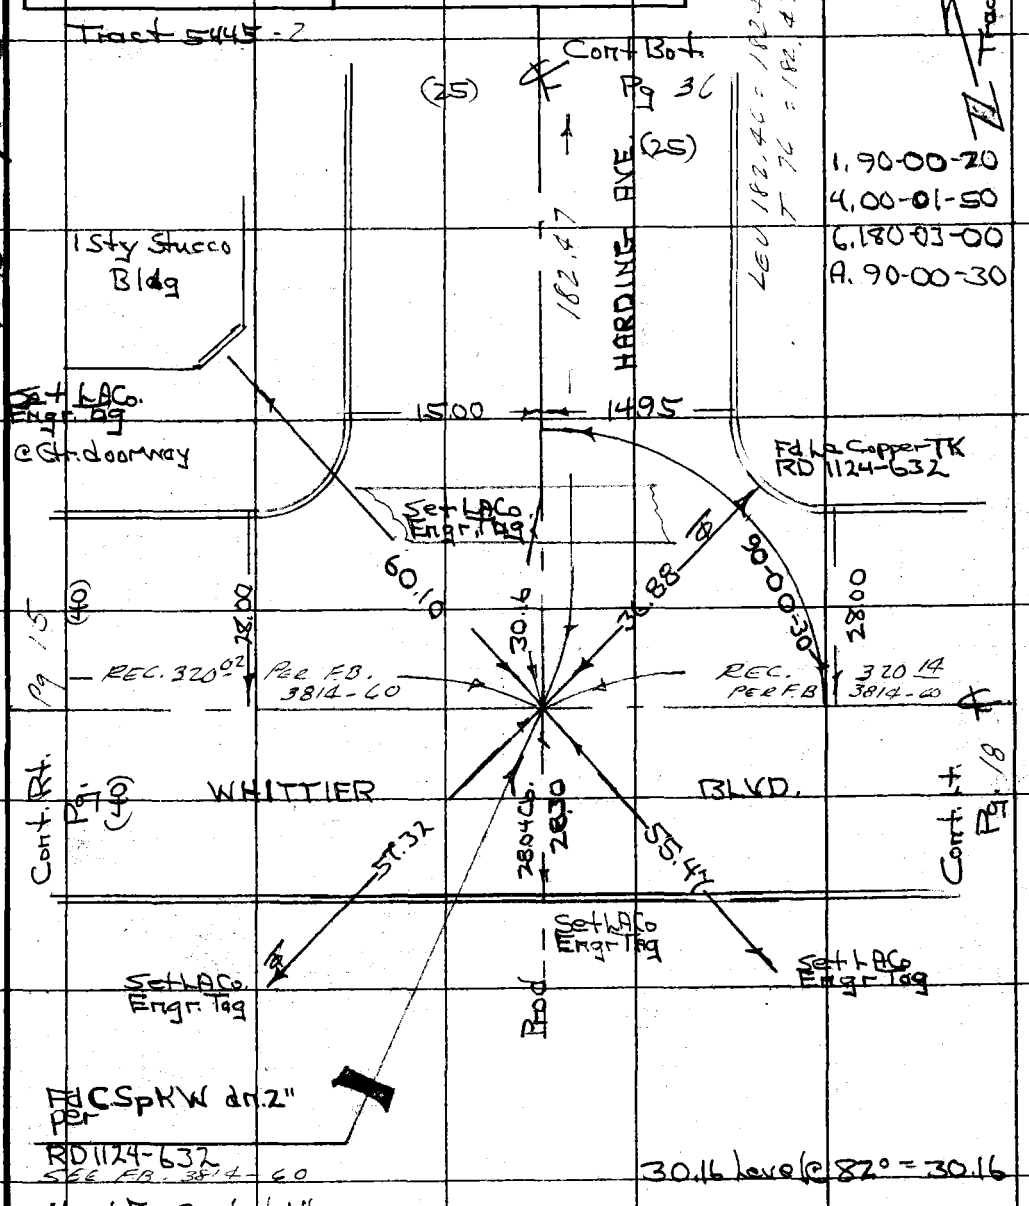

Note: Any Additions or Changes on This Sheet Must be Made or Circled in Red Ink With Date and Name of Person Making Change.

Do not extend this side of this line.

PLEASE RETURN TO
COUNTY OF LOS ANGELES
DEPARTMENT OF COUNTY ENGINEER
403 LOS ANGELES COUNTY ENGINEERING BLDG.

76F309S CE#310 3-68

RDFB 1124

1674

F. B. ~~3813~~ PG. ~~48~~

Cont Btm Pg 37

TR. Nº 5415-2

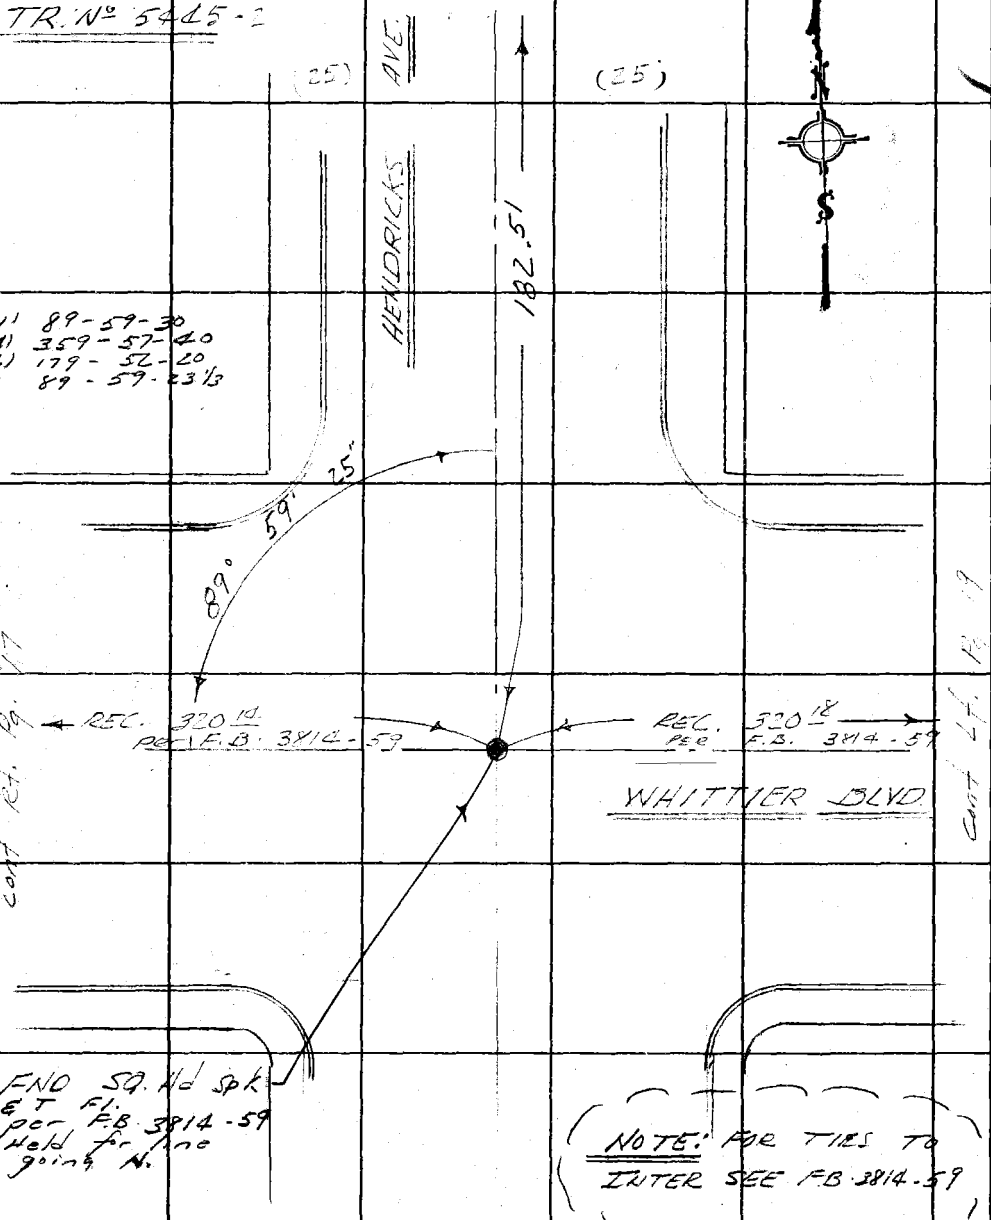

W5368-3

PLEASE RETURN TO
COUNTY OF LOS ANGELES
DEPARTMENT OF COUNTY ENGINEER
403 LOS ANGELES COUNTY ENGINEERING BLDG.

Do not extend this side of this line.

Note: Any Additions or Changes on This Sheet Must be Made or Circled in Red Ink With Date and Name of Person Making Change.

RDFB 1124 1675

Notes Ck'd by	Survey of DIV 8 BELVEDERE AREA
Map No.	JN 0303.00 Tape 0122 Std 68 °F
Office Work	Surveyed by E. LANDA
Checked	Notes E. LANDA Date 5-73
Date	Indexed J. M. PALMERI FEB 13 1974

F. B. ~~3813~~ PG. ~~19~~

TR. 5445-1

cont Btm Pg 38

W.S. 36, B-3

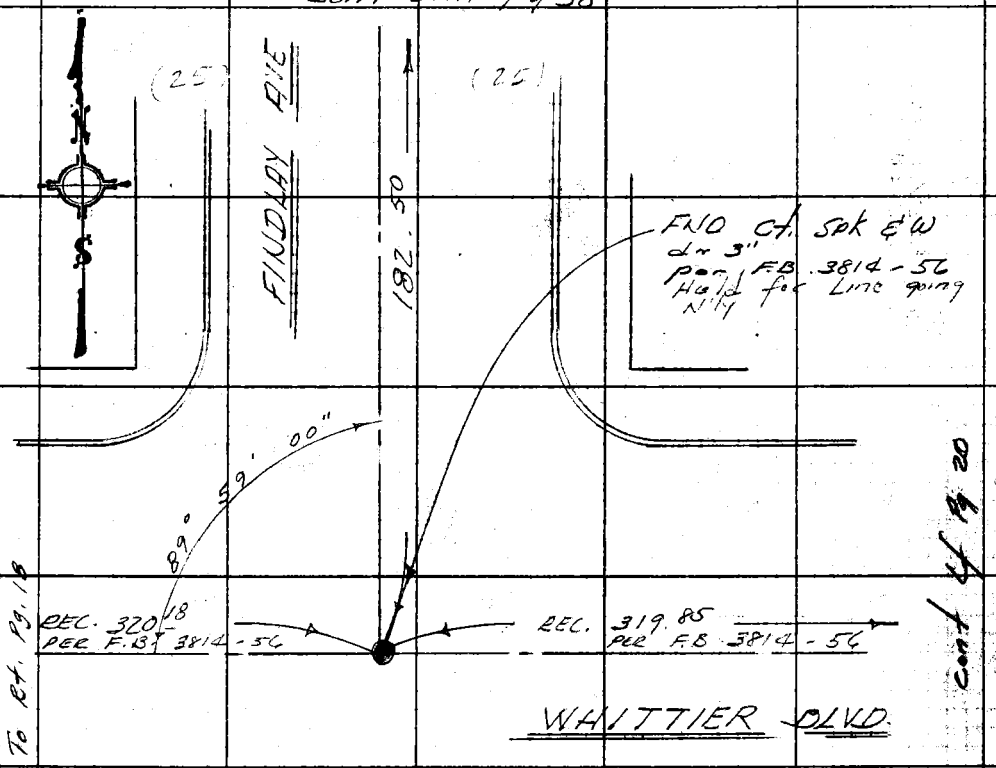

1) 89-59-00
4) 359-56-00
6) 179-54-00
= 89-59-00

NOTE: FOR TIES TO INTER. SEE FB 3814-56

Note: Any Additions or Changes on This Sheet Must be Made or Circled in Red Ink With Date and Name of Person Making Change.

Do not extend this side of this line.

PLEASE RETURN TO
COUNTY OF LOS ANGELES
DEPARTMENT OF COUNTY ENGINEER
403 LOS ANGELES COUNTY ENGINEERING BLDG.

76F3095 CE#310 3-69

RDFB 1124 1676

F. B. ~~3813~~ PG. ~~90~~

Cont Btm Pg 65

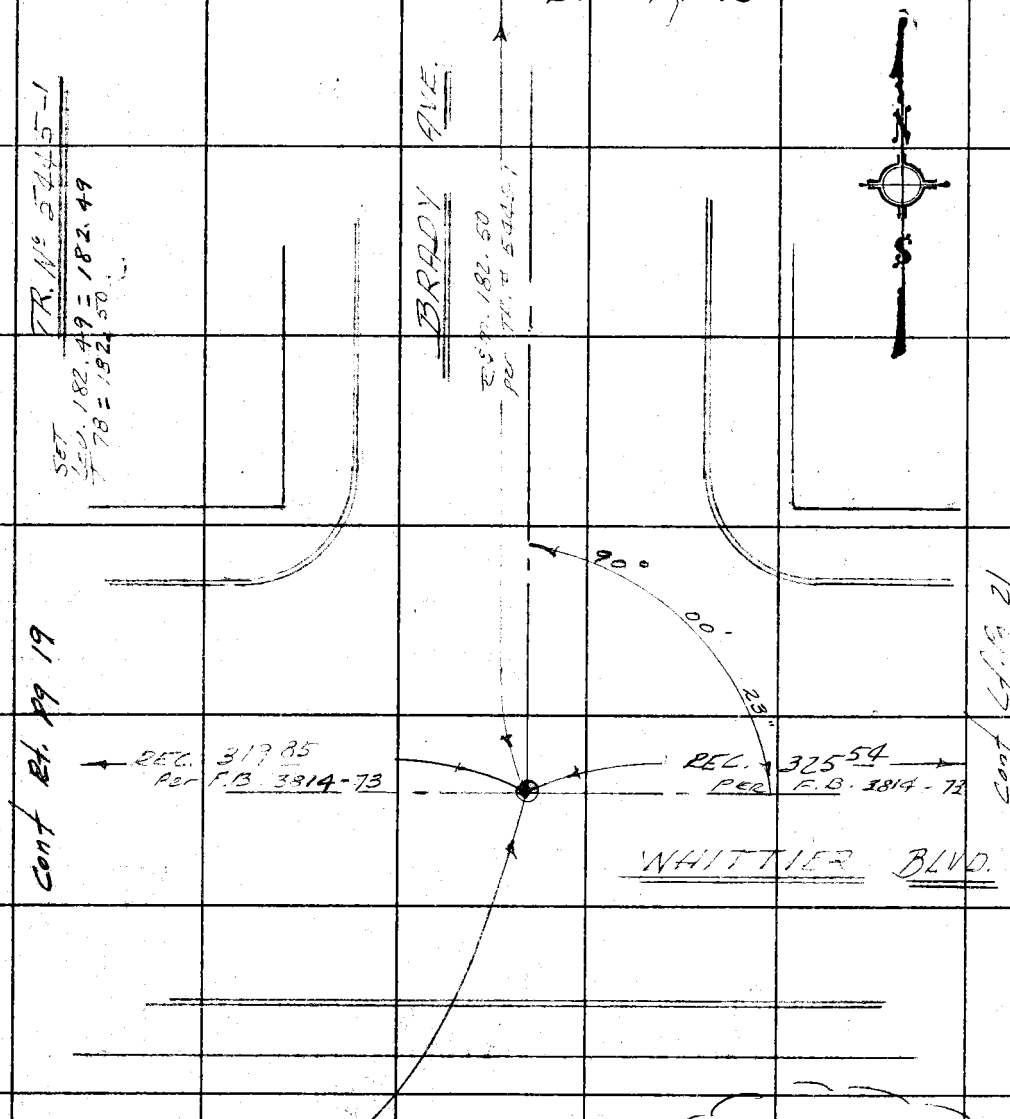

FND Sm. Bt. Spk.
W&T Fl.
Per F.B. 3814-73
HELD FOR LINE going
N'ly

NOTE: FOR TIES
TO INTER. SEE
F.B. 3814-73

1) 90-00-20
4) 360-01-20
6) 180-02-20
= 90-00-23 1/3

WS 36 P-3

PLEASE RETURN TO
COUNTY OF LOS ANGELES
DEPARTMENT OF COUNTY ENGINEER
403 LOS ANGELES COUNTY ENGINEERING BLDG.

Do not extend this side of this line.

Note: Any Additions or Changes on This Sheet Must be Made or Circled in Red Ink With Date and Name of Person Making Change.

RDFB 1124

1677

Notes Ck'd by
Map No.
Office Work
Checked
Date

Div 8
Survey of BELVEDERE AREA
J.N. 9303.00 Tape 0122 Std 68 °F
Surveyed by E. CANDA
Notes E. CANDA Date 5-73
Indexed T. M. PALMERI FEB 13 1974

F. B. ~~3813~~ Pg. ~~21~~

WS 36 B-3

Note: Any Additions or Changes on This Sheet Must be Made or Circled in Red Ink With Date and Name of Person Making Change.

Do not extend this side of this line.

PLEASE RETURN TO
COUNTY OF LOS ANGELES
DEPARTMENT OF COUNTY ENGINEER
403 LOS ANGELES COUNTY ENGINEERING BLDG.

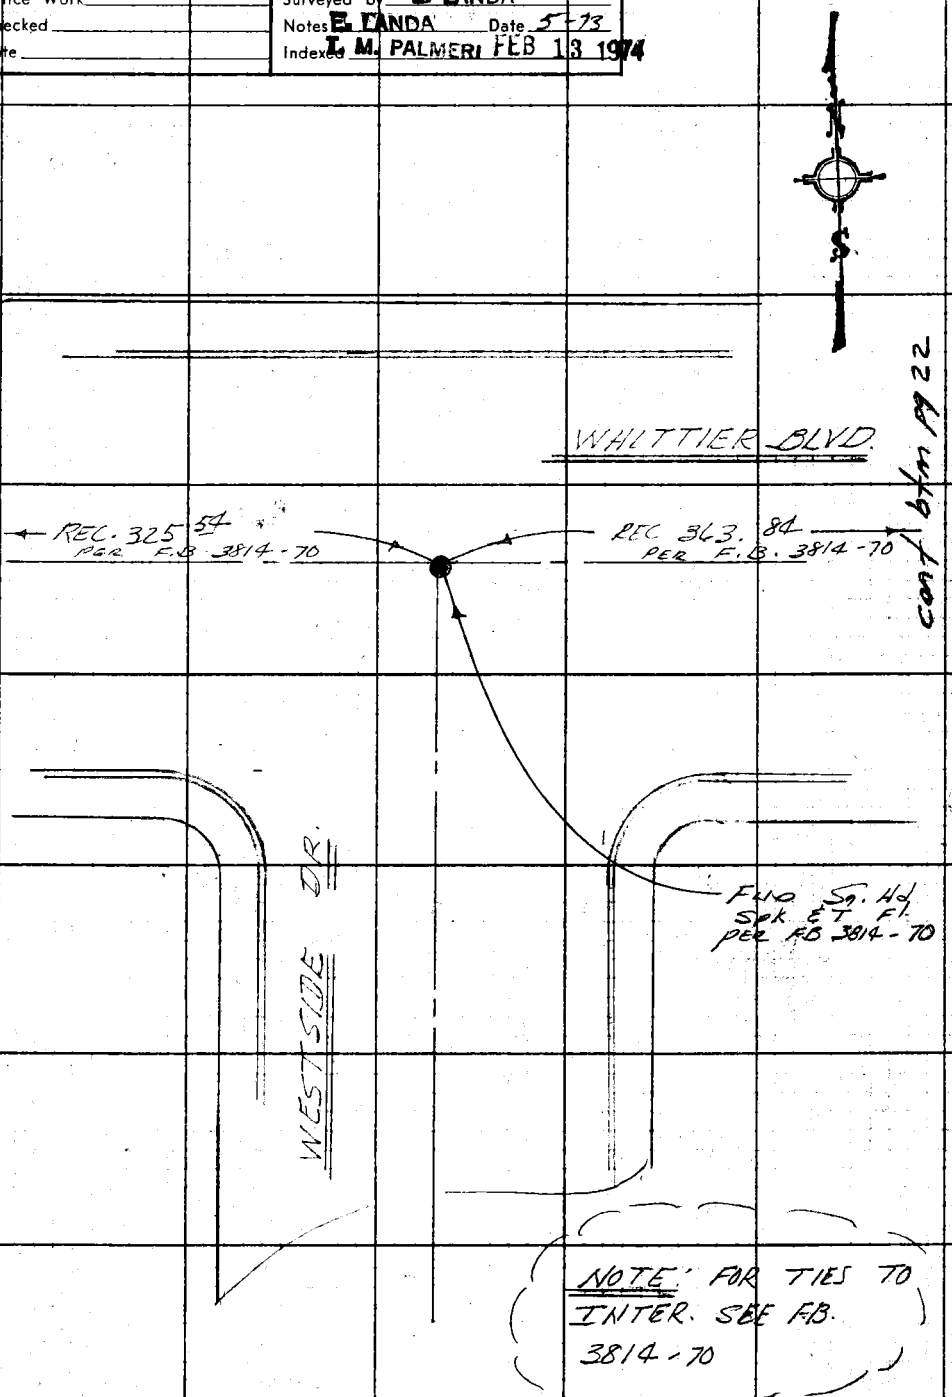

16F309S CE#310 3-69

RDFB 1124 1678

F. B. ~~3813~~ PG. ~~22~~

Cont Lf Pg. 23

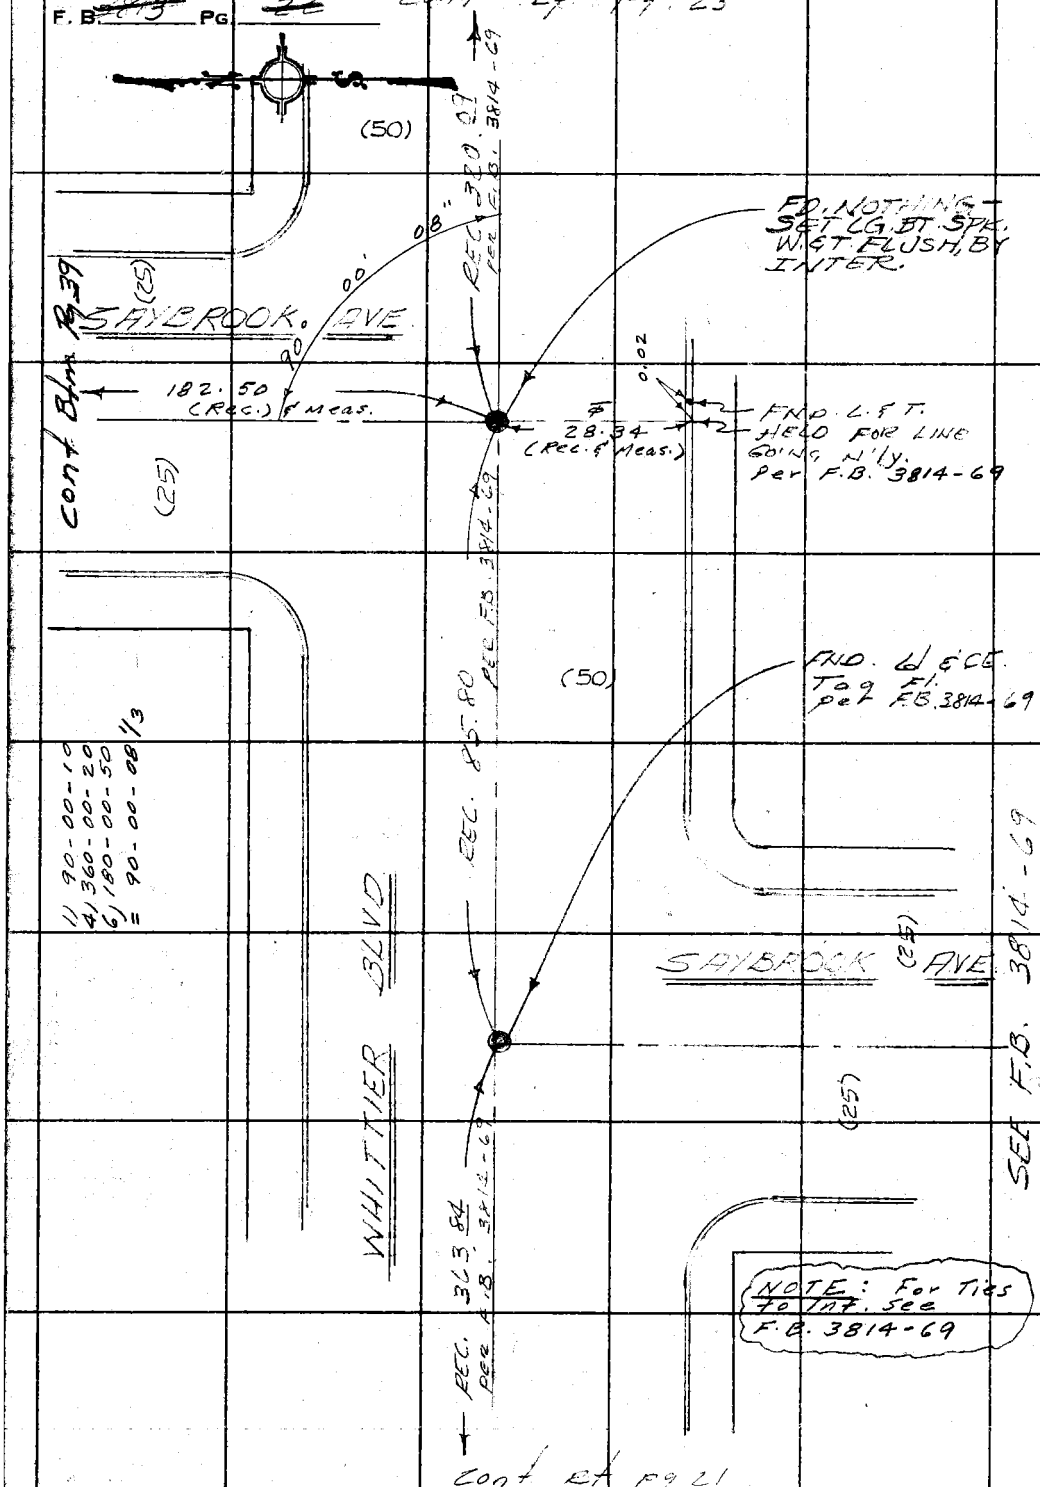

WS 36 B-3

PLEASE RETURN TO
COUNTY OF LOS ANGELES
DEPARTMENT OF COUNTY ENGINEER
403 LOS ANGELES COUNTY ENGINEERING BLDG.

Do not extend this side of this line.

Note: Any Additions or Changes on This Sheet Must Be Made or Circled in Red Ink With Date and Name of Person Making Change.

RDFB 1124 1679

Notes Ck'd by	Survey of DIV 8 BELVEDERE AREA
Map No.	JN 0303.00 Tape 0122 Std 68 °F
Office Work	Surveyed by E. LANDA
Checked	Notes E. LANDA Date 6-73
Date	Indexed T. M. PALMER FEB 13 1974

F. B. ~~3813~~ PG. ~~23~~

W.S. 36 B-3

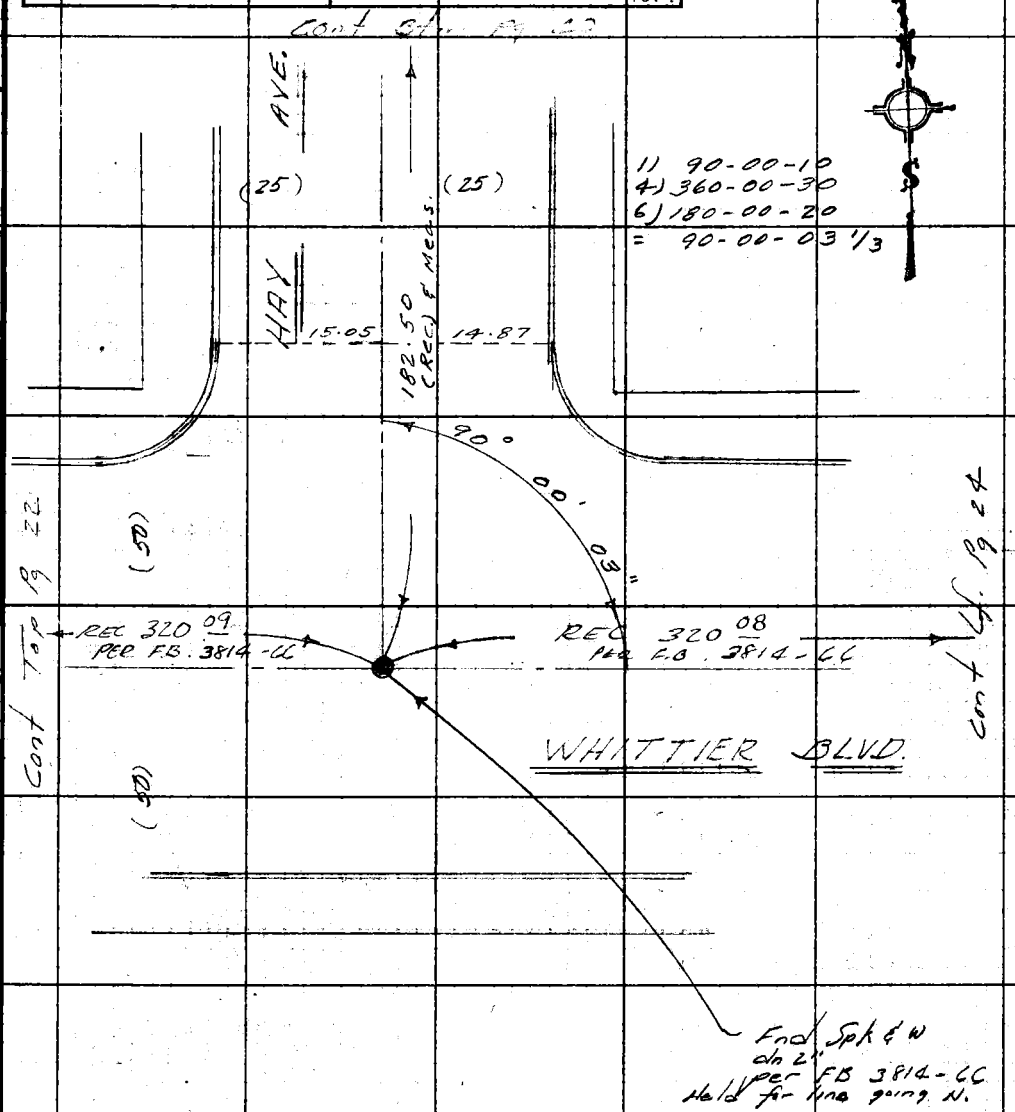

1) 90-00-10
4) 360-00-30
6) 180-00-20
= 90-00-03 1/3

NOTE: FOR TIES TO INTER. SEE FB 3814-66

Note: Any Additions or Changes on This Sheet Must be Made or Circled in Red Ink With Date and Name of Person Making Change.

Do not extend this side of this line.

PLEASE RETURN TO
COUNTY OF LOS ANGELES
DEPARTMENT OF COUNTY ENGINEER
403 LOS ANGELES COUNTY ENGINEERING BLDG.

76F309S CE#310 3-69

RDFB 1124 1680

F. B. ~~3813~~ PG ~~24~~

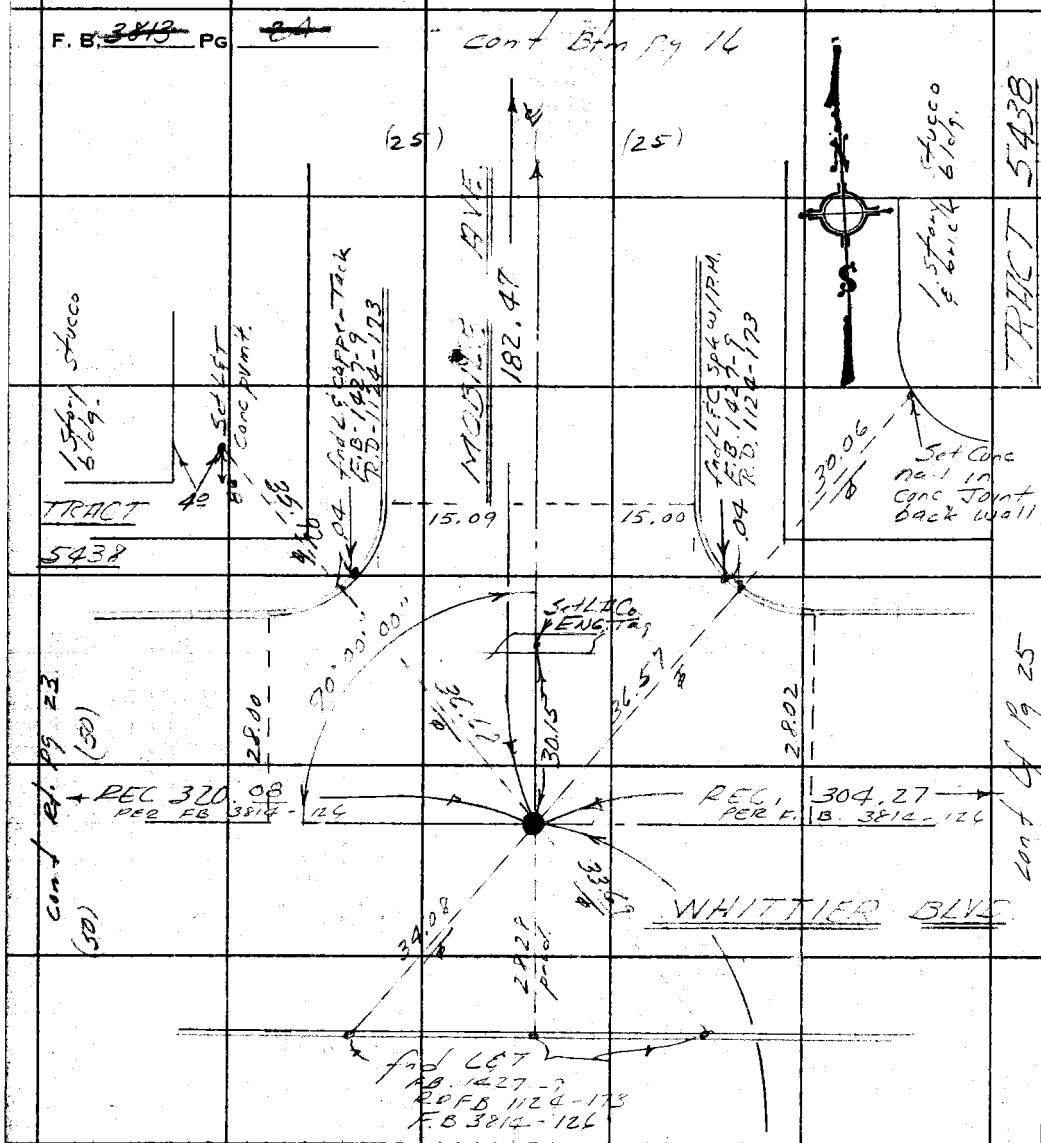

L-30.15=30.15
T=68=30.15

1) 90-00-00
4) 360-00-00
6) 180-00-00
= 90-00-00

INT.
fnd C-spk & W. dn 2"
per F.B. 1427-9
per R.D. 1124-173
Used for control
Northerly

PLEASE RETURN TO
COUNTY OF LOS ANGELES
DEPARTMENT OF COUNTY ENGINEER
403 LOS ANGELES COUNTY ENGINEERING BLDG.

Do not extend this side of this line.

Note: Any Additions or Changes on This Sheet Must be Made or Circled in Red Ink With Date and Name of Person Making Change.

NS 36 B-3

RDFB 1124 1681, 1682

Notes Ck'd by	Survey of BELVEDERE ARRAL
Map No.	JN 030300 Tape 0247 Std 68 °F
Office Work	Surveyed by H.H.SPRIGGS
Checked	Notes HHS Date 4-73
Date	Indexed R. M. PALMER FEB 13 1974

F. B. 3813 PG. 25

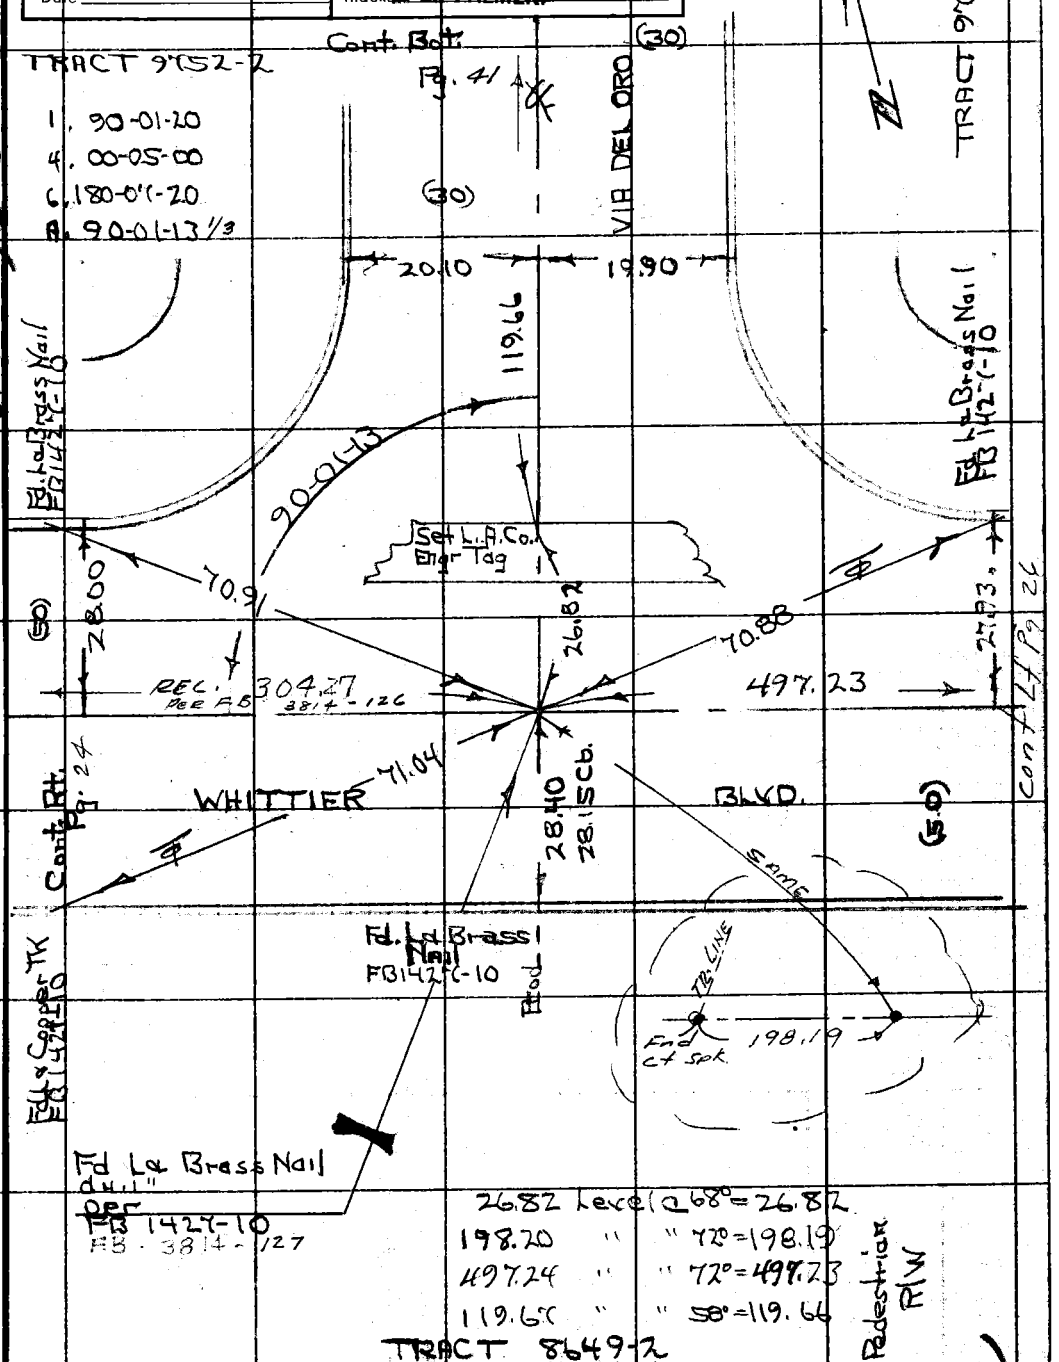

W.S 36, B-3

Note: Any Additions or Changes on This Sheet Must be Made or Circled in Red Ink With Date and Name of Person Making Change.

Do not extend this side of this line.

PLEASE RETURN TO
COUNTY OF LOS ANGELES
DEPARTMENT OF COUNTY ENGINEER
403 LOS ANGELES COUNTY ENGINEERING BLDG.

76F309S CE#310 3-68

RDFB 1124 1683

F. B. ~~3813~~ PG. ~~26~~

Cont. Bot. Pg. 42

TRACT 9752-2

1. 90-00-20
4. 00-00-40
6. 180-01-00
A. 90-00-10

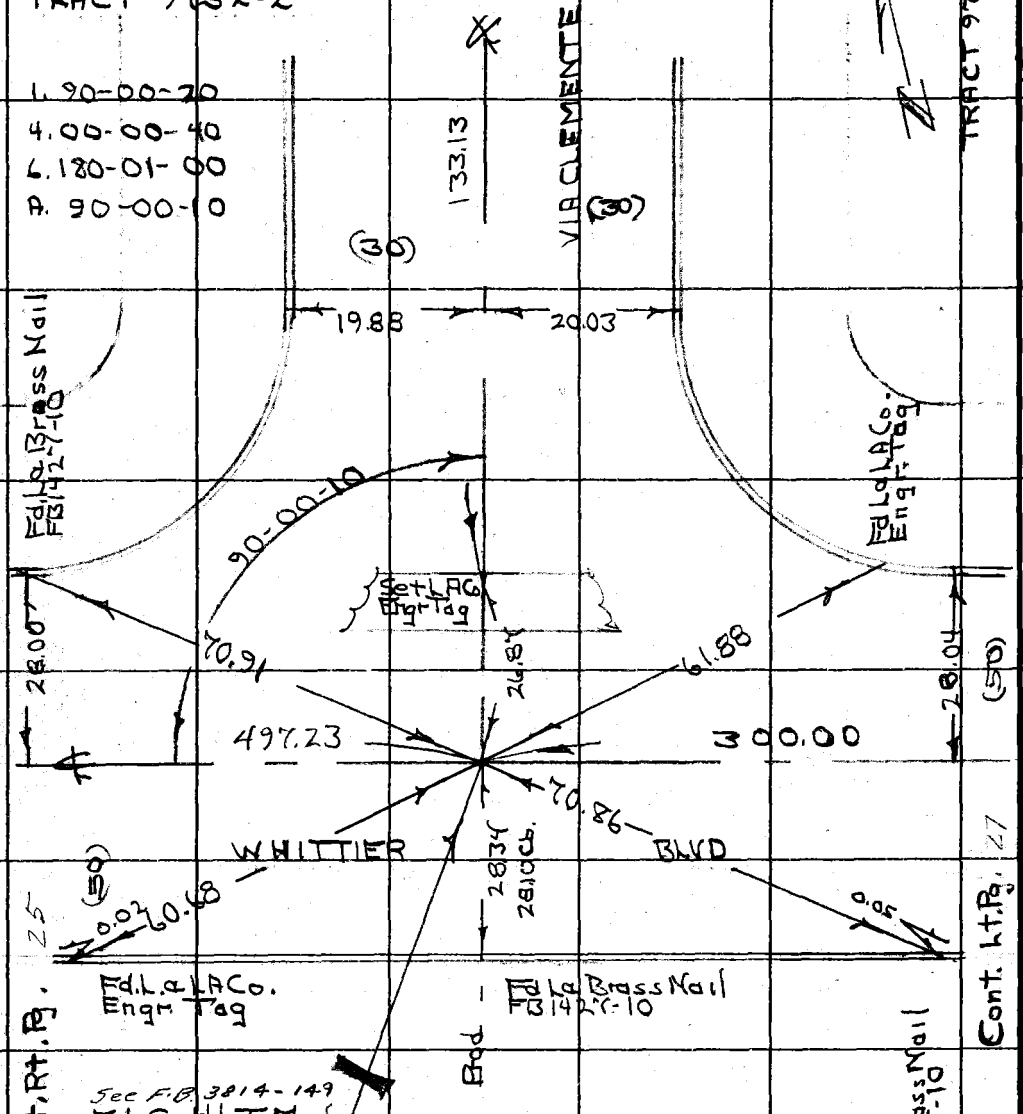

See F.B. 3814-149
Ed. Sq Hd-T-Flush
Removed
Searched to Conc
Pvmt-dn 2" Did
Not Find L & TK per
FB142-7-10
Set Sq Hd Sp K Lg
& Sm W Flush
Mkd. LACo. Engr

26.87 level @ 66° = 26.87
300.01 " " 72° = 300.00
133.14 " " 60° = 133.13

TRACT 8649-2

TRACT 9752-2

E-8 9E5 M

PLEASE RETURN TO
COUNTY OF LOS ANGELES
DEPARTMENT OF COUNTY ENGINEER
403 LOS ANGELES COUNTY ENGINEERING BLDG.

Do not extend this side of this line.

Note: Any Additions or Changes on This Sheet Must be Made or Circled in Red Ink With Date and Name of Person Making Change.

RDFB 1124

1684

Notes Ck'd by	Div 8 Survey of BELVEDERE AREA ℄
Map No.	JN 0303.00 Tape 024' Std 68 °F
Office Work	Surveyed by HHSPRIGGS
Checked	Notes HHS Date 4-73
Date	Indexed T. M. PALMERI FEB 13 1974

F. B. 3813 PG. 27

WS 36, B-3

Note: Any Additions or Changes on This Sheet Must be Made or Circled in Red Ink With Date and Name of Person Making Change.

Do not extend this side of this line.

PLEASE RETURN TO
COUNTY OF LOS ANGELES
DEPARTMENT OF COUNTY ENGINEER
403 LOS ANGELES COUNTY ENGINEERING BLDG.

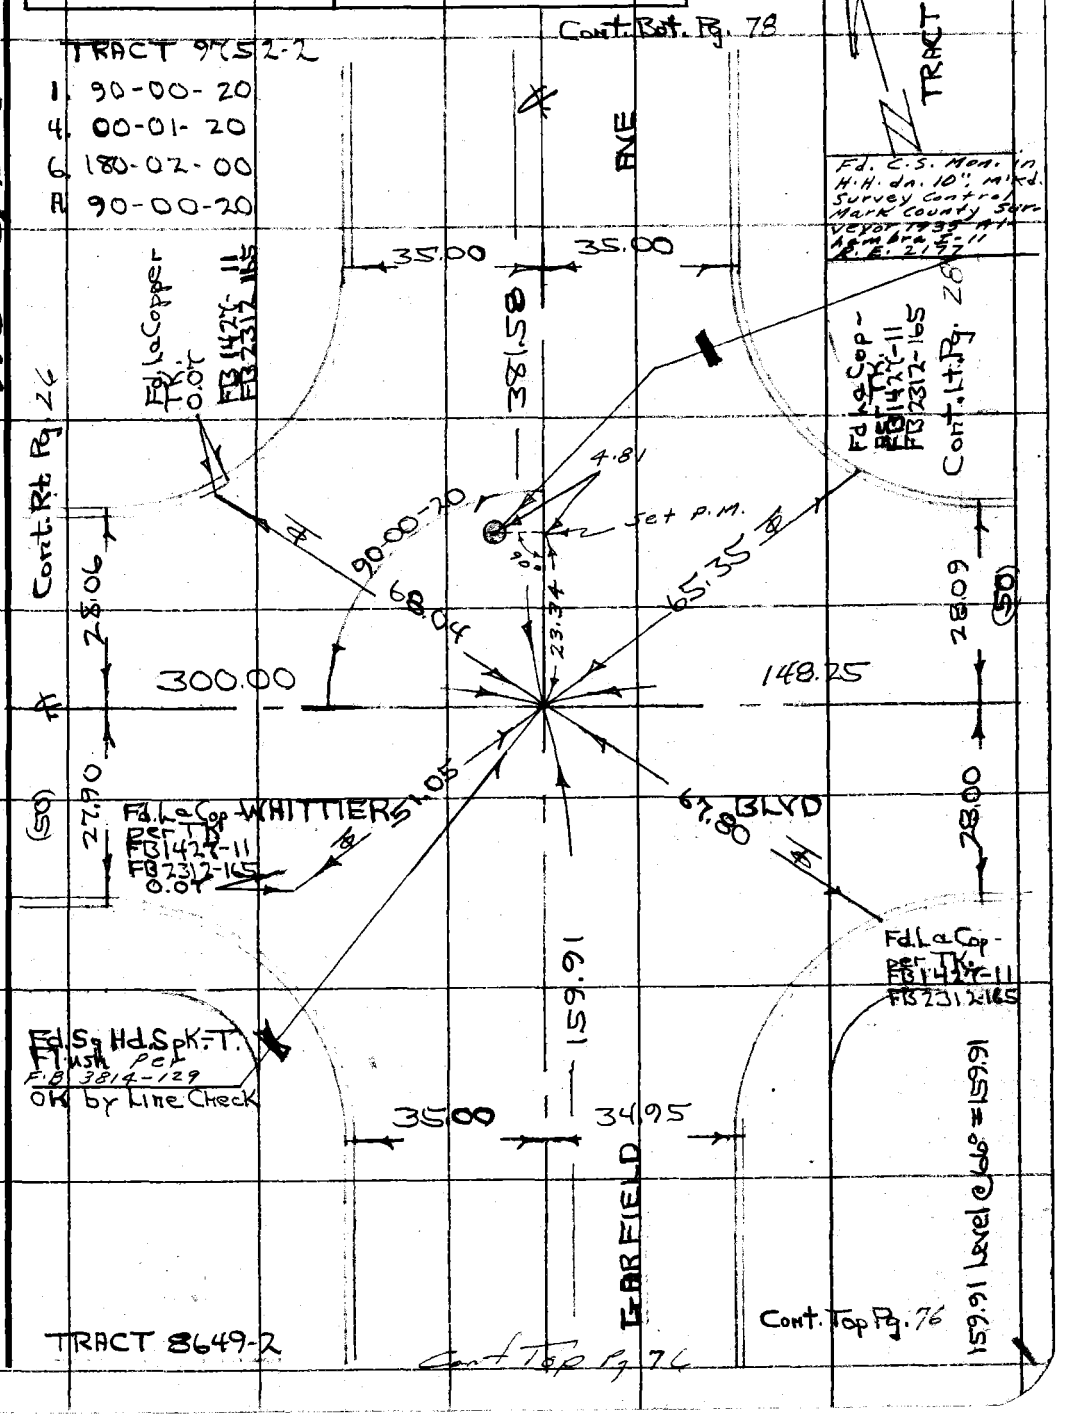

76F309S CE#310 3-68

RDFB 1124

1685

F. B. ~~3813~~ Pg. ~~28~~

TRACT 9752-2

N

℄ Pt. E-W

















TRACT 8649-2

PLEASE RETURN TO
COUNTY OF LOS ANGELES
DEPARTMENT OF COUNTY ENGINEER
403 LOS ANGELES COUNTY ENGINEERING BLDG.

Do not extend this side of this line.

Note: Any Additions or Changes on This Sheet Must be Made or Circled in Red Ink With Date and Name of Person Making Change.

RDFB 1124 1686

Notes Ck'd by	Survey of Belvedere Area ℄
Map No.	JN0303.00 Tape 024' Std 68 °F
Office Work	Surveyed by H H Spriggs
Checked	Notes HHS Date 4-73
Date	Index J. M. PALMER FEB 13 1974

F. B. 3812 PG. 29

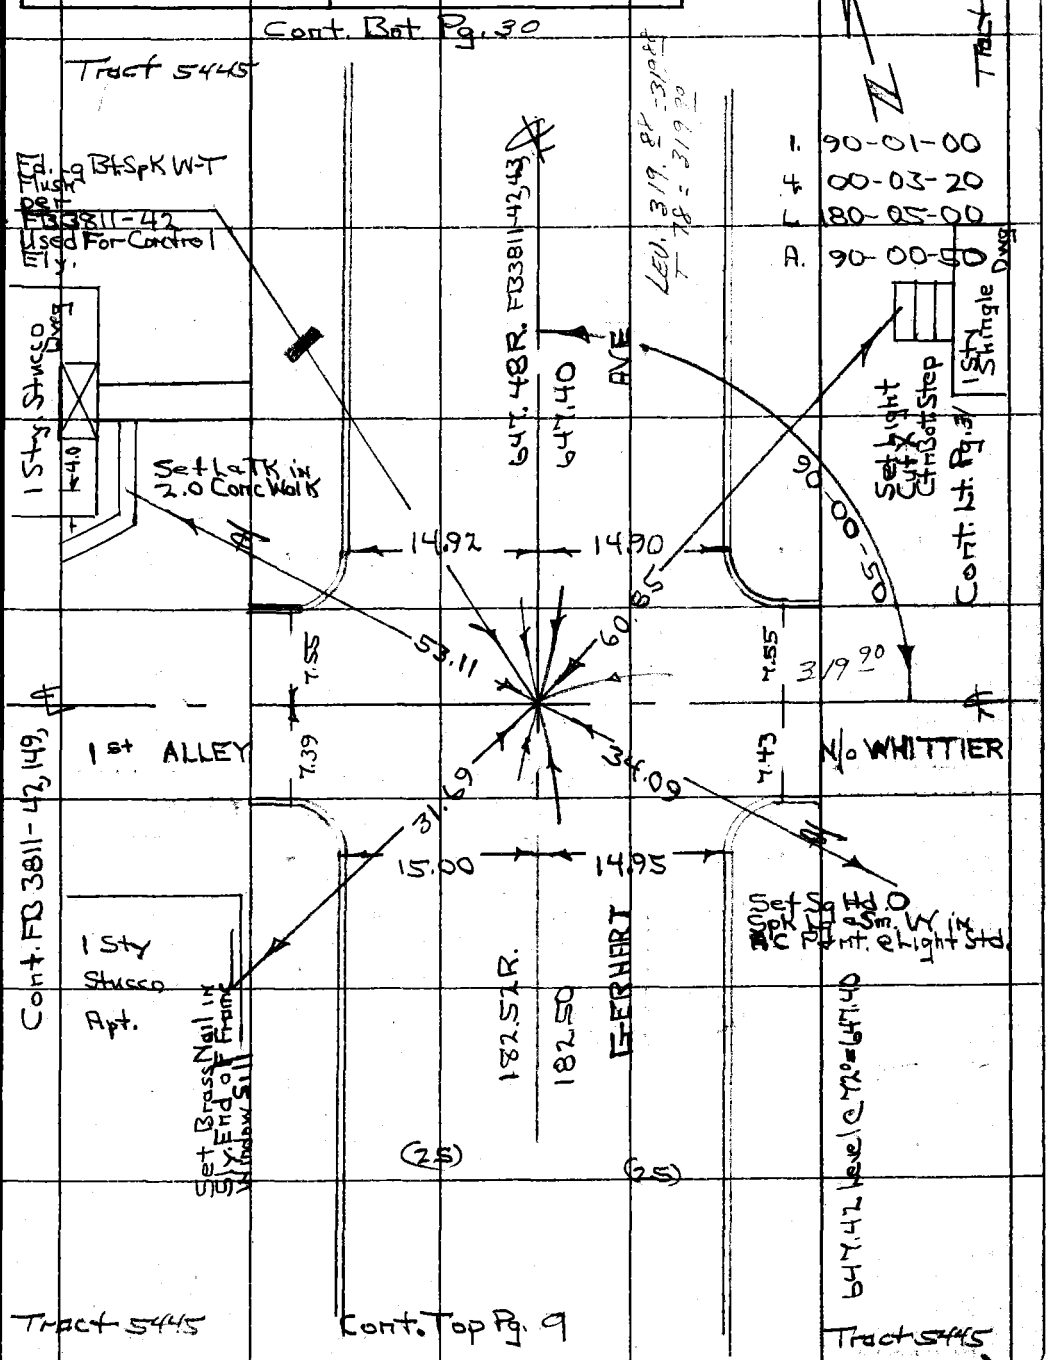

Note: Any Additions or Changes on This Sheet Must be Made or Circled in Red Ink With Date and Name of Person Making Change.

Do not extend this side of this line.

PLEASE RETURN TO
COUNTY OF LOS ANGELES
DEPARTMENT OF COUNTY ENGINEER
403 LOS ANGELES COUNTY ENGINEERING BLDG.

76F309S CE#310 3-68

RDFB 1124 1687

F. B. ~~3813~~ Pg. ~~30~~

Cont. Bot. Pg. 57

Tract 5445

1. 89-59-00
4. 359-56-20
6. 179-54-40
A. 89-59-07

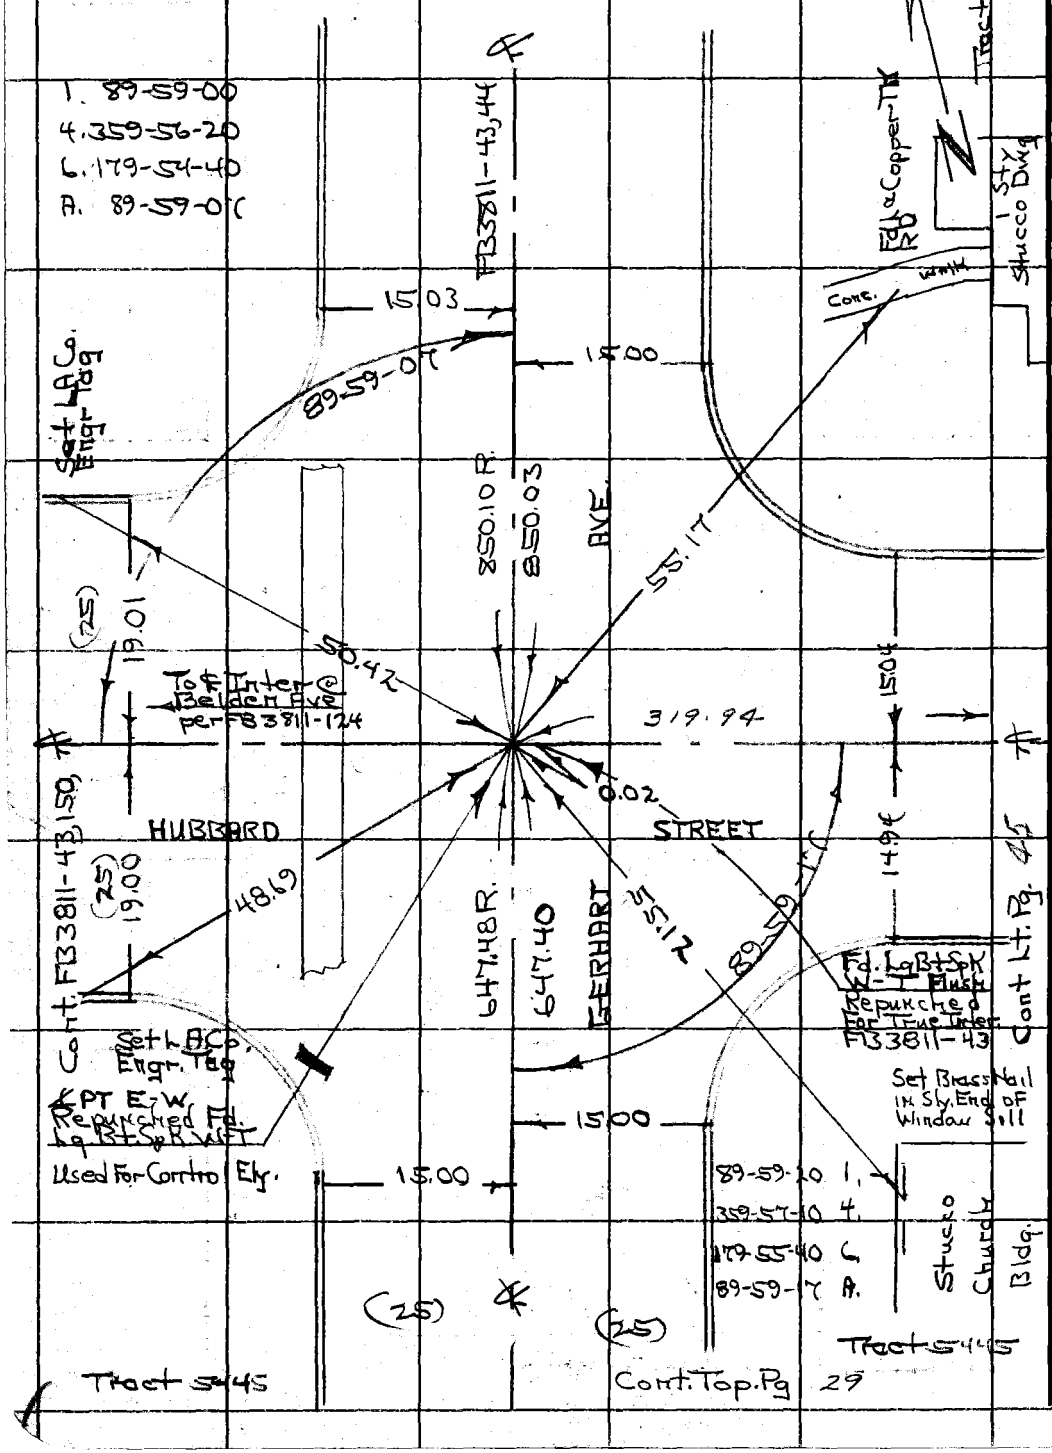

B-3

PLEASE RETURN TO
COUNTY OF LOS ANGELES
DEPARTMENT OF COUNTY ENGINEER
403 LOS ANGELES COUNTY ENGINEERING BLDG.

Do not extend this side of this line.

Note: Any Additions or Changes on This Sheet Must be Made or Circled in Red Ink With Date and Name of Person Making Change.

RDFB 1124 1688

Notes Ck'd by	Survey of Div 8 BELVEDERE Area
Map No.	JN 0303.09 Tape 0122 Std 68 °F
Office Work	Surveyed by [redacted] K. KAPP
Checked	Notes D. Peterson Date 5-72
Date	Indexed T. M. PALMERI FEB 13 1974

F. B. ~~3875~~ PG. ~~31~~

TR. No 5445

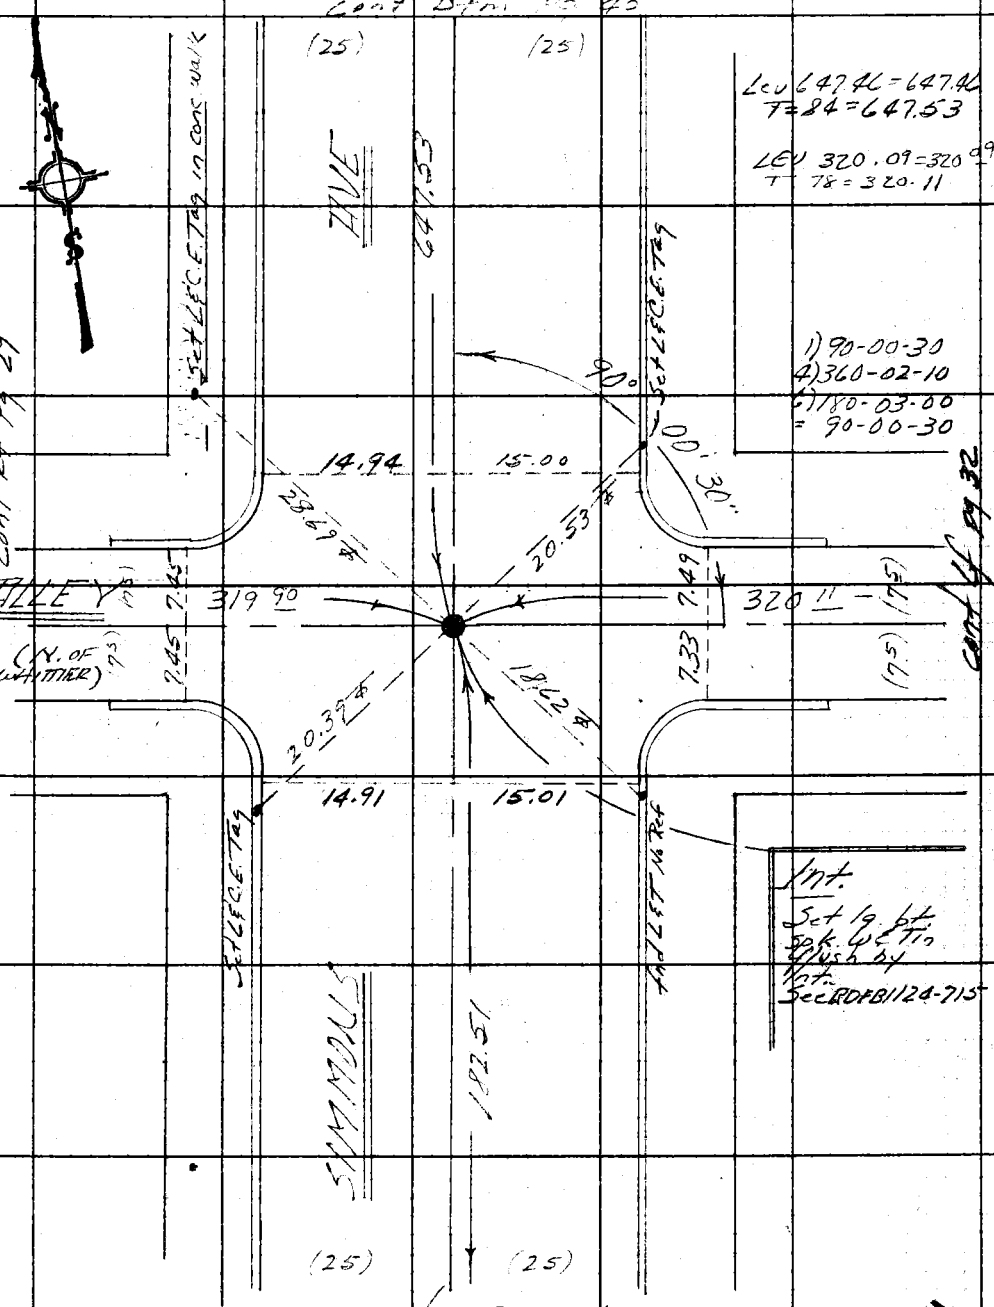

WS36 B-3

Note: Any Additions or Changes on This Sheet Must be Made or Circled in Red Ink With Date and Name of Person Making Change.

Do not extend this side of this line.

PLEASE RETURN TO
COUNTY OF LOS ANGELES
DEPARTMENT OF COUNTY ENGINEER
403 LOS ANGELES COUNTY ENGINEERING BLDG.

76F309S CE#310 3-69

F. B. ~~3813~~ PG. ~~32~~

cont Bfm Pg 44

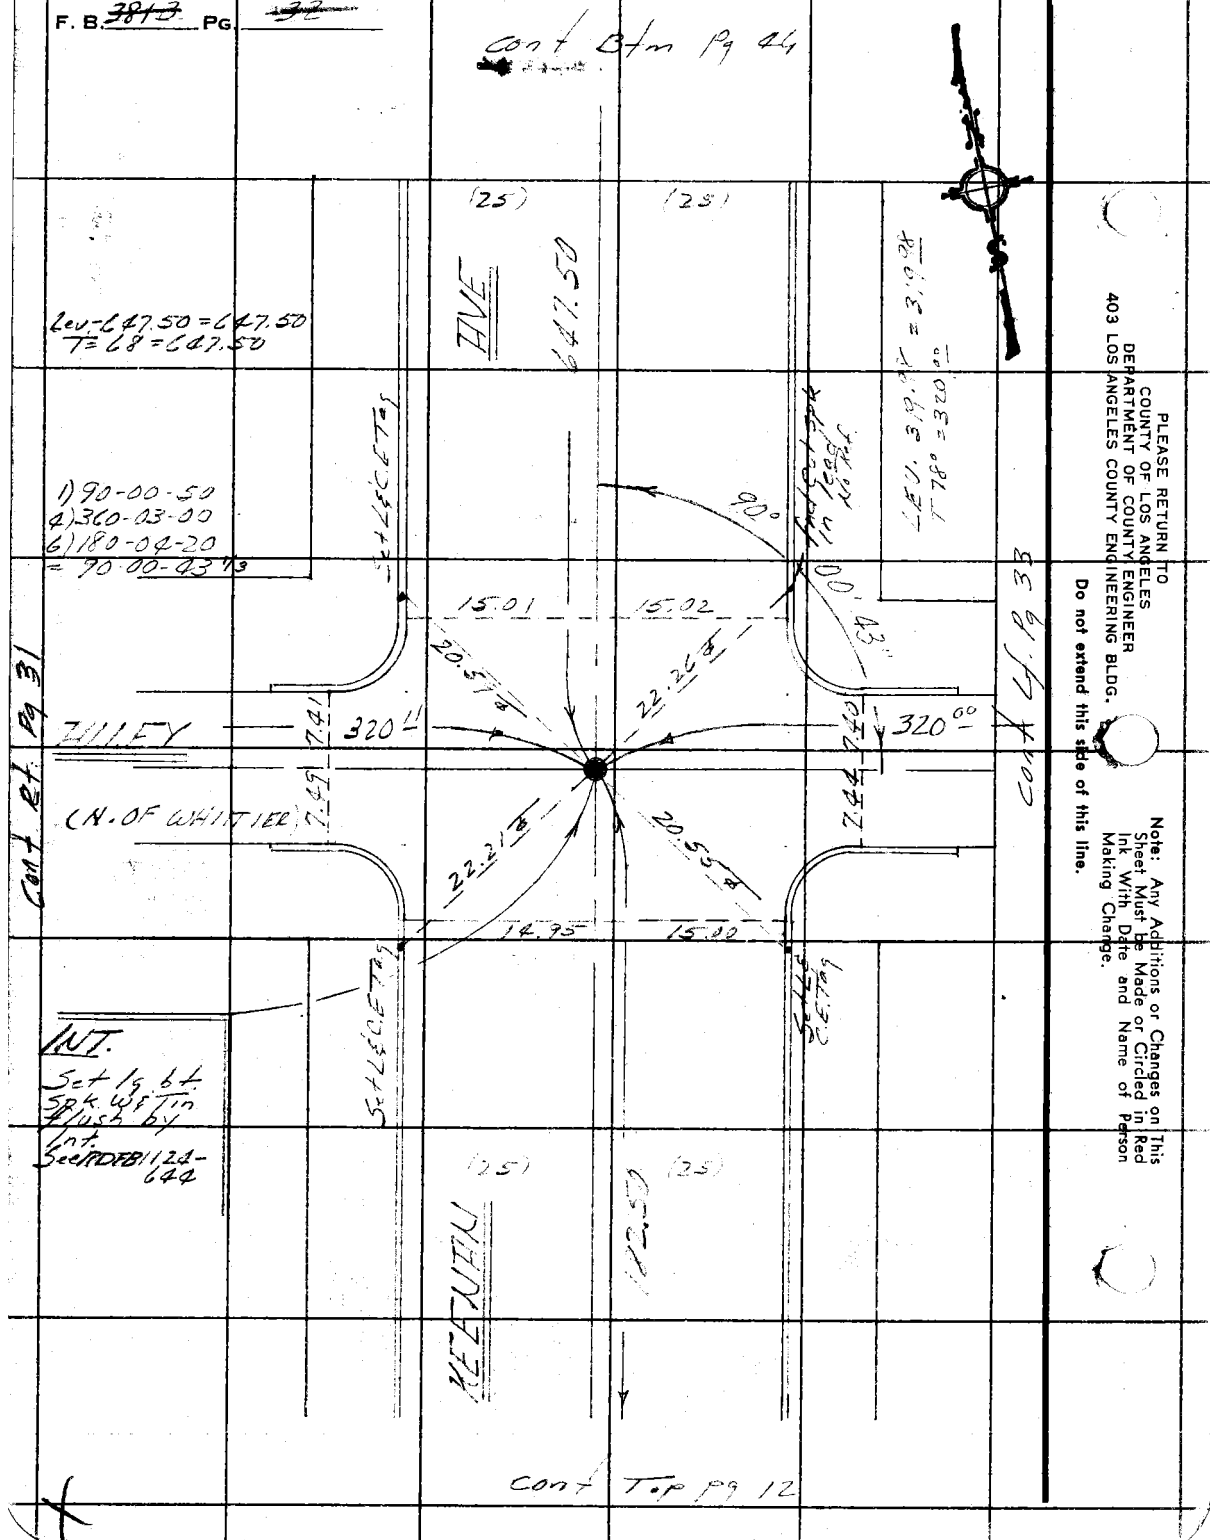

PLEASE RETURN TO
COUNTY OF LOS ANGELES
DEPARTMENT OF COUNTY ENGINEER
403 LOS ANGELES COUNTY ENGINEERING BLDG.

Do not extend this side of this line.

Note: Any Additions or Changes on This Sheet Must be Made or Circled in Red Ink With Date and Name of Person Making Change.

RDFB 1124 1690

Notes Ck'd by	Survey of BELVEDERE AVE
Map No.	JN 0303.00 Tape 0122 Std 68 °F
Office Work	Surveyed by [redacted] K. KAPP
Checked	Notes D. Peterson Date 5-73
Date	Indexed T. M. PALMER FEB 18 1974

F. B. ~~3815~~ Pg. ~~33~~

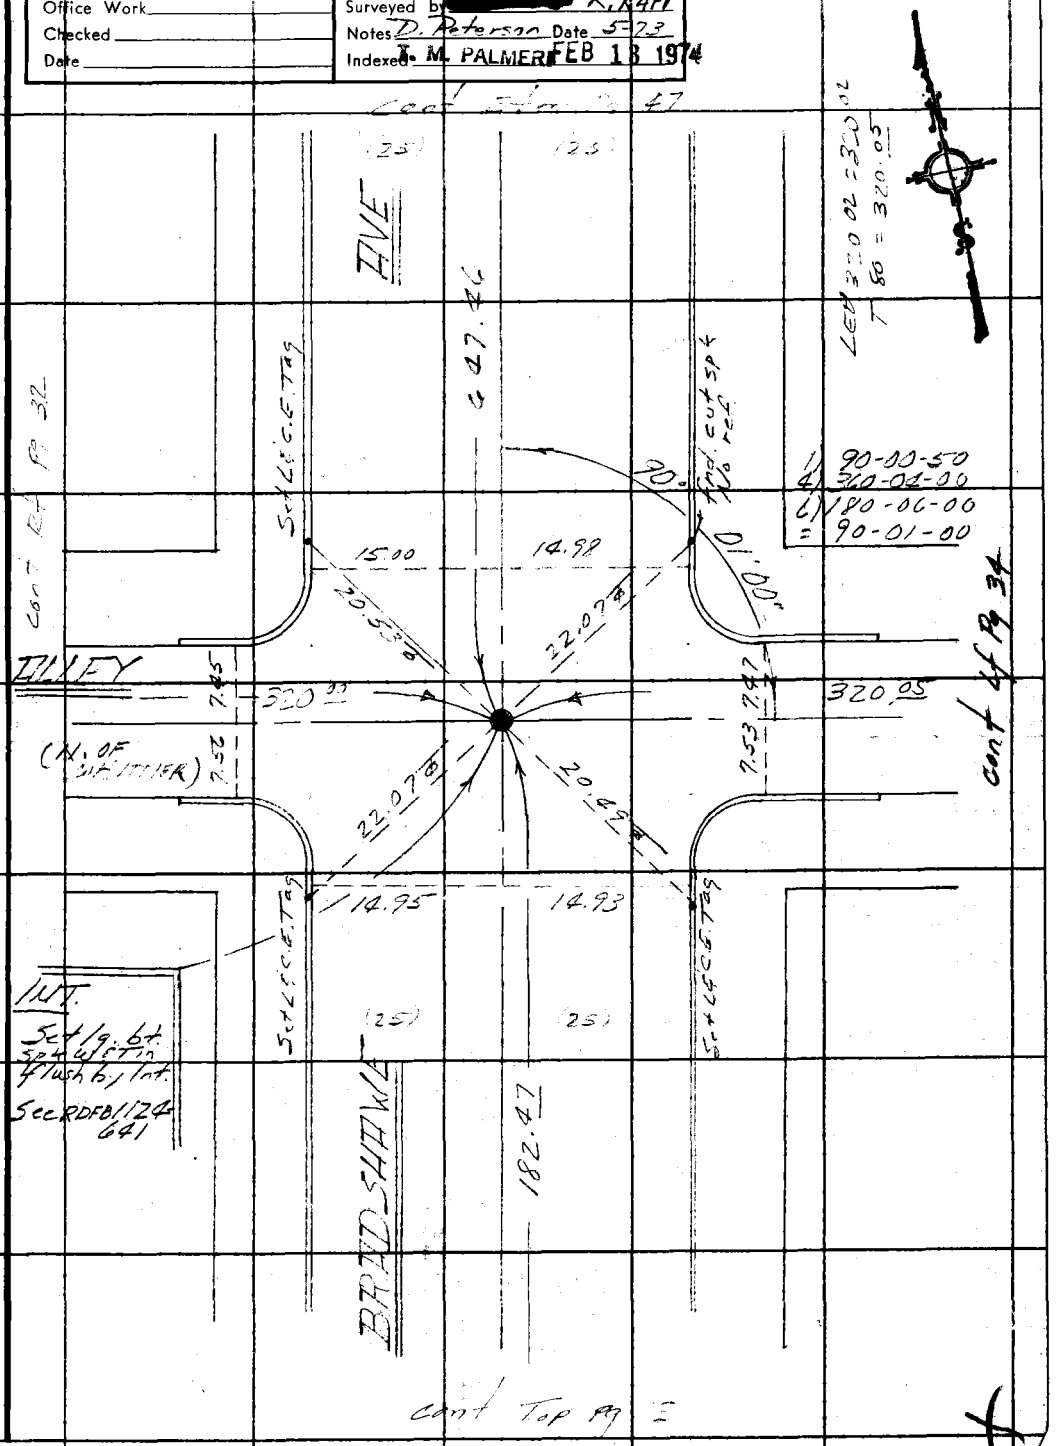

Note: Any Additions or Changes on This Sheet Must be Made or Circled in Red Ink With Date and Name of Person Making Change.

Do not extend this side of this line.

PLEASE RETURN TO
COUNTY OF LOS ANGELES
DEPARTMENT OF COUNTY ENGINEER
403 LOS ANGELES COUNTY ENGINEERING BLDG.

76F309S CE#310 3-69

RDFB 1124 1691 1692

F. B. ~~3813~~ PG ~~34~~

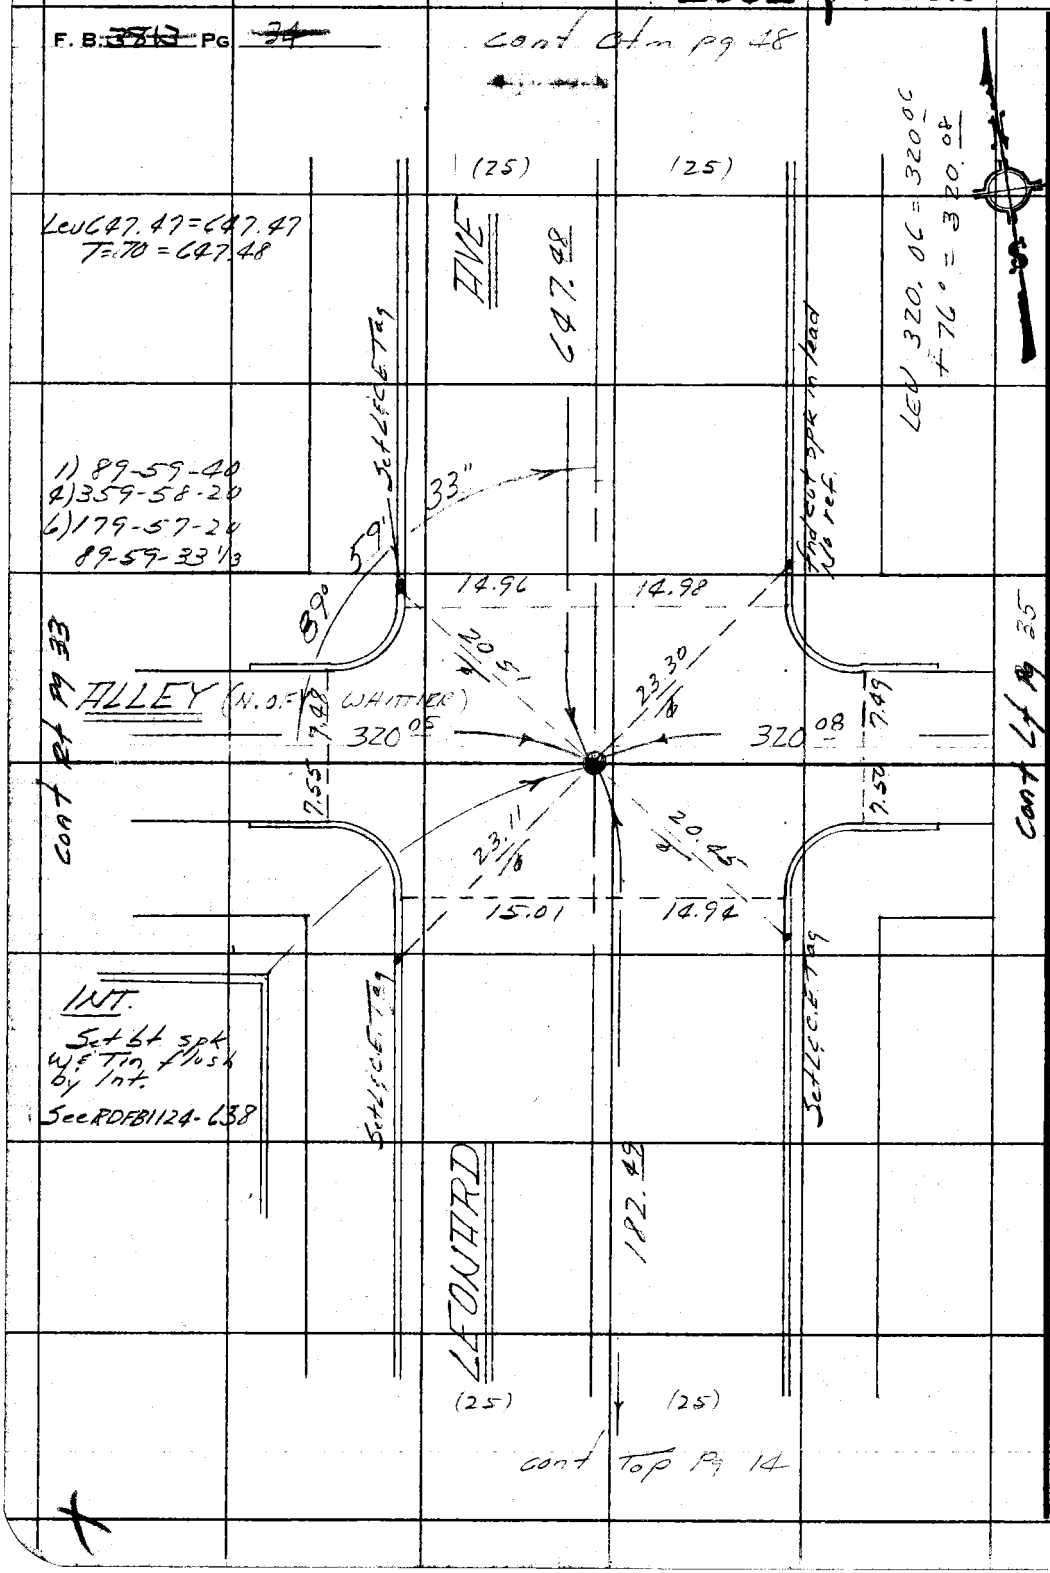

PLEASE RETURN TO
COUNTY OF LOS ANGELES
DEPARTMENT OF COUNTY ENGINEER
403 LOS ANGELES COUNTY ENGINEERING BLDG.

Do not extend this side of this line.

Note: Any Additions or Changes on This Sheet Must be Made or Circled in Red Ink With Date and Name of Person Making Change.

RDFB 1124

1693

Notes Ck'd by	Survey of BELVEDERE AREA
Map No.	JN [illegible] Tape 0122 Std. 68 °F
Office Work	Surveyed [redacted] K. KAPP
Checked	Notes D. Peterson Date 5-73
Date	Indexed T. M. PALMERI FEB 13 1974

F. B. ~~[illegible]~~ PG. ~~35~~

Cont Btm Pg 19

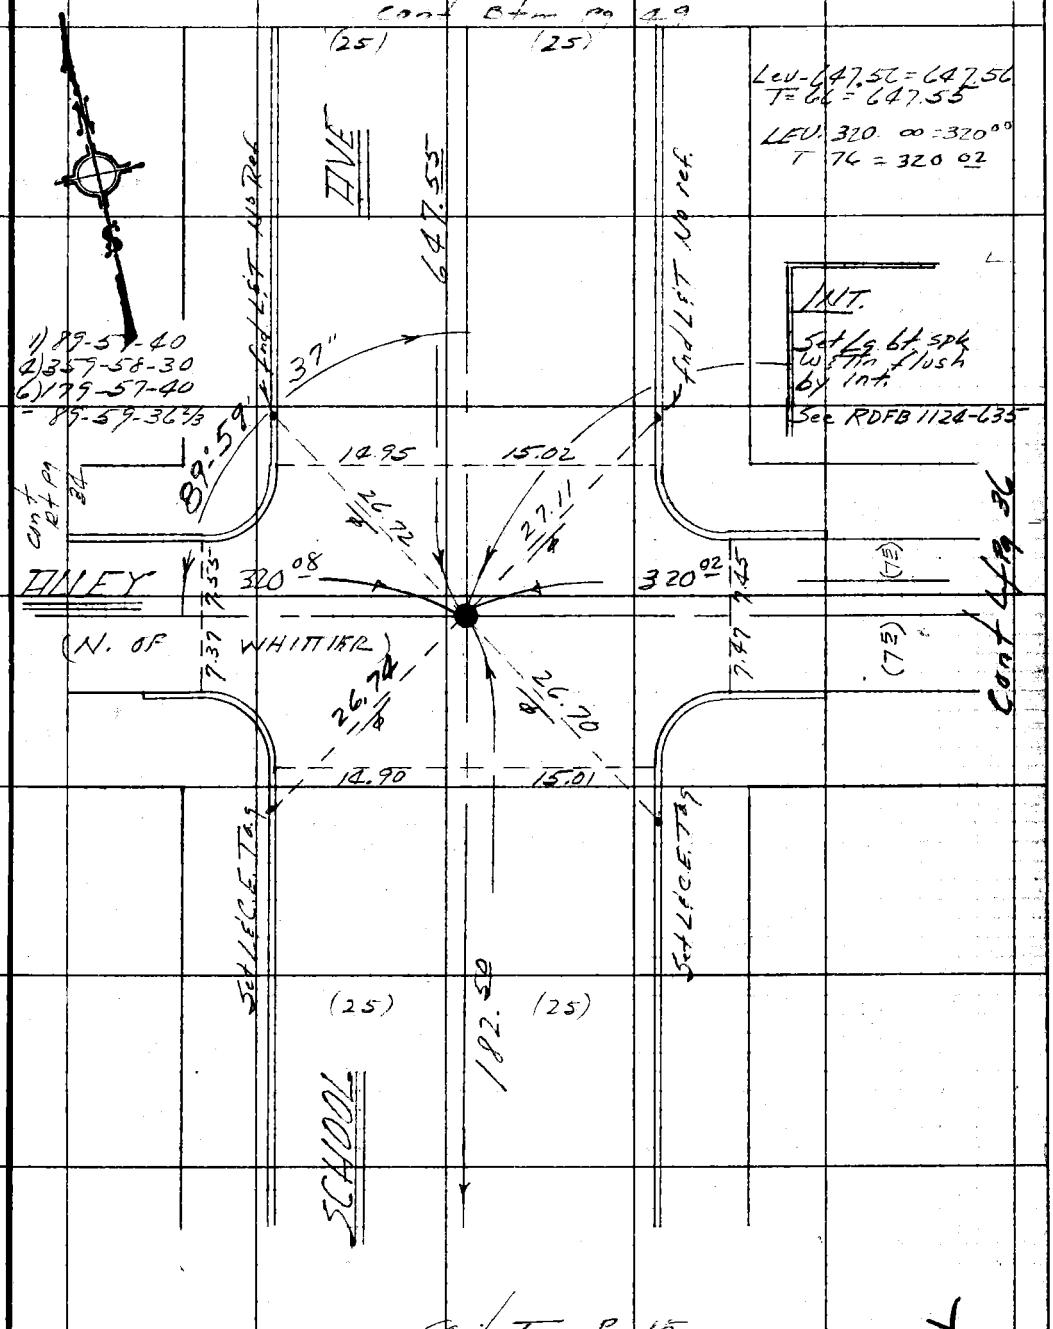

Note: Any Additions or Changes on This Sheet Must be Made or Circled in Red Ink With Date and Name of Person Making Change.

Do not extend this side of this line.

PLEASE RETURN TO
COUNTY OF LOS ANGELES
DEPARTMENT OF COUNTY ENGINEER
403 LOS ANGELES COUNTY ENGINEERING BLDG.

16F309S CE#310 3-69

RDFB 1124 1694

F. B. ~~3813~~ PG. ~~36~~

Cont Btm pg 53

[redacted]

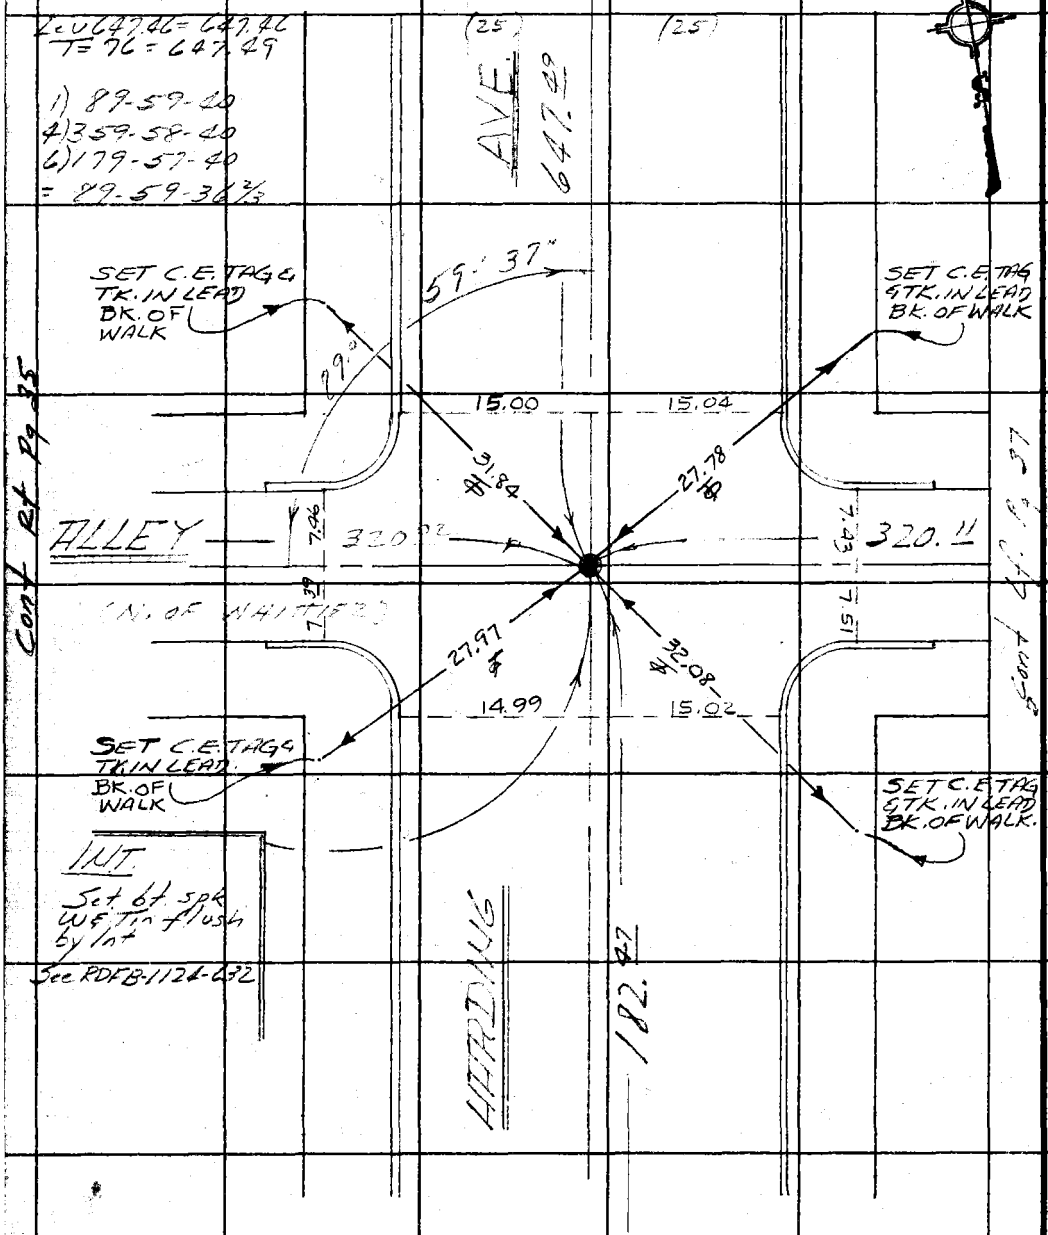

PLEASE RETURN TO
COUNTY OF LOS ANGELES
DEPARTMENT OF COUNTY ENGINEER
403 LOS ANGELES COUNTY ENGINEERING BLDG.

Do not extend this side of this line.

Note: Any Additions or Changes on This Sheet Must be Made or Circled in Red Ink With Date and Name of Person Making Change.

RDFB 1124

1695

Notes Ck'd by	Survey of DIV 8 BELVEDERE [illegible]
Map No.	JN 030300 Tape 0122 Std 68 °F
Office Work	Surveyed by K. Kapp
Checked	Notes D. Peterson Date 6-73
Date	Index T. M. PALMER FEB 13 1974

F. B. ~~3813~~ PG. ~~37~~

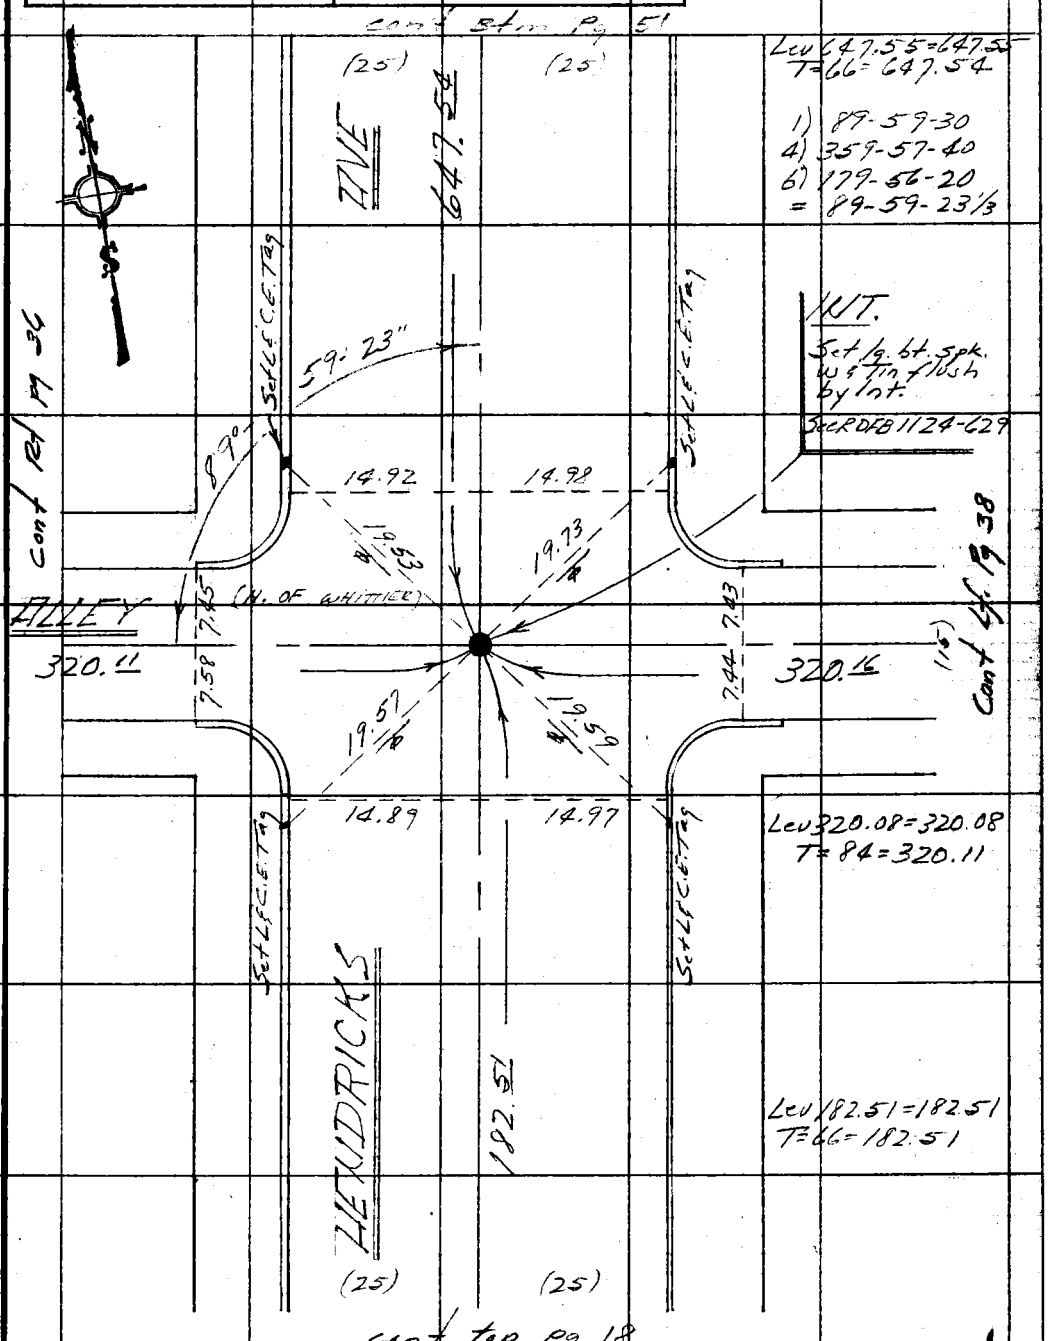

Note: Any Additions or Changes on This Sheet Must be Made or Circled in Red Ink With Date and Name of Person Making Change.

Do not extend this side of this line.

PLEASE RETURN TO
COUNTY OF LOS ANGELES
DEPARTMENT OF COUNTY ENGINEER
403 LOS ANGELES COUNTY ENGINEERING BLDG.

76F309S CE#310 3-69

RDFB 1124 1696

F. B. ~~38~~ 13 Pg. ~~38~~

cont Bfm Pg 53

1) 89-59-20
4) 359-56-40
6) 179-55-20
A - 89-59-13 1/3

INT.
Set Lg. bt spk w/ Tin flush by trk rec. from Whittier Blvd. per TR No 5445-1 See RDFB 1124-626

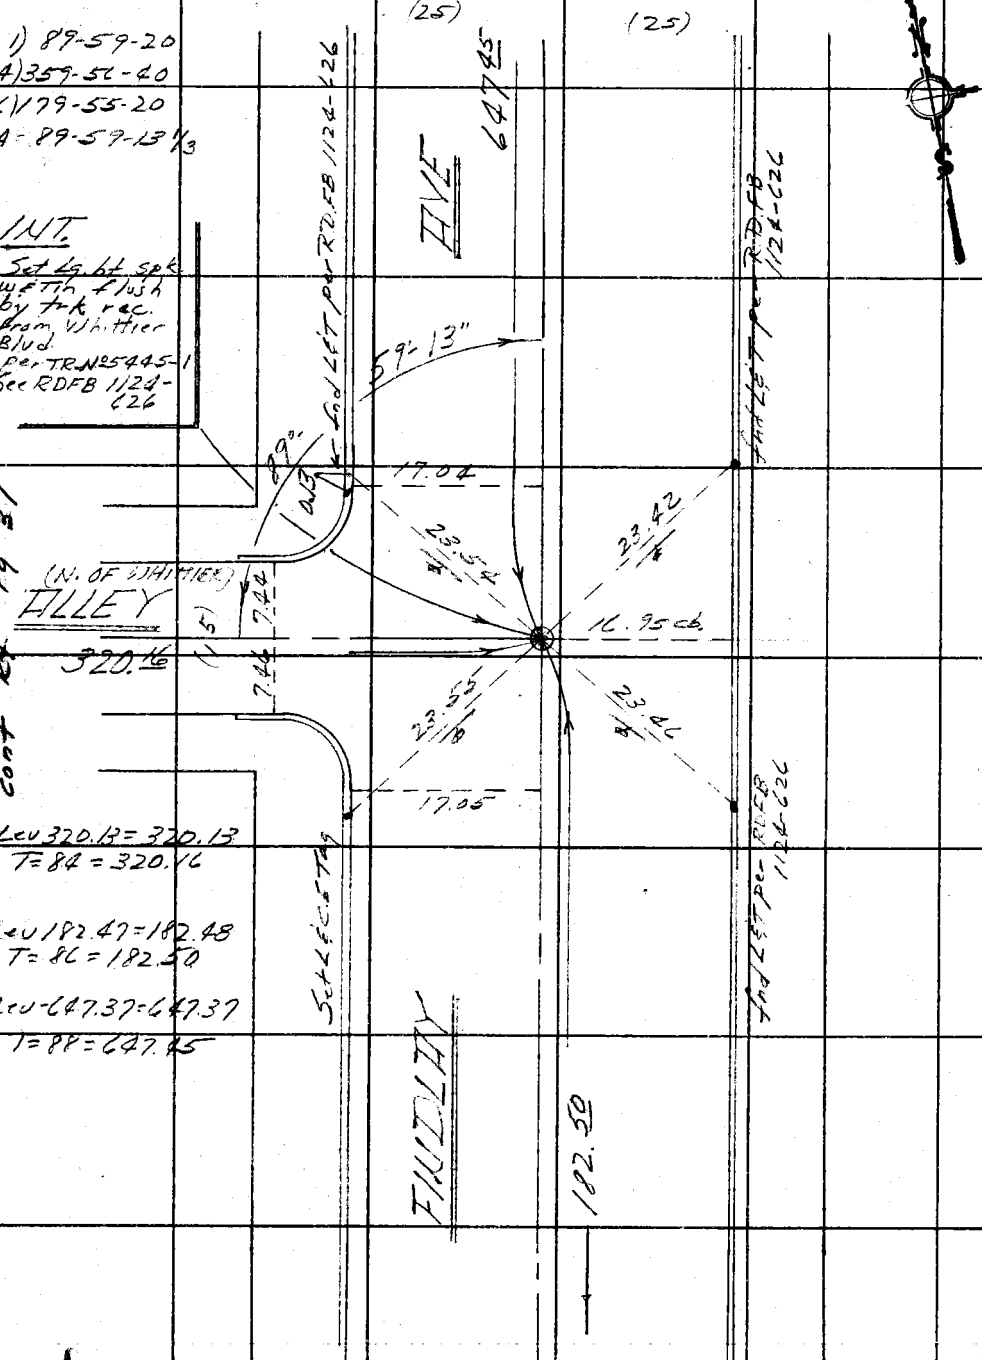

cont Rt Pg 37

Lev 320.13 = 320.13
T = 84 = 320.16

Lev 182.47 = 182.48
T = 86 = 182.50

Lev - 647.37 = 647.37
T = 88 = 647.45

cont Top Pg 19

PLEASE RETURN TO
COUNTY OF LOS ANGELES
DEPARTMENT OF COUNTY ENGINEER
403 LOS ANGELES COUNTY ENGINEERING BLDG.

Do not extend this side of this line.

Note: Any Additions or Changes on This Sheet Must be Made or Circled in Red Ink With Date and Name of Person Making Change.

RDFB 1124

1697

Notes Ck'd by	Survey of BELVEDERE
Map No.	JN 53050 Tape 0122 Std 68 °F
Office Work	Surveyed by K. KAPP
Checked	Notes D. Peterson Date 6-73
Date	Indexed M. PALMERI FEB 13 1974

F. B. ~~3813~~ PG. 39

cont from pg 51

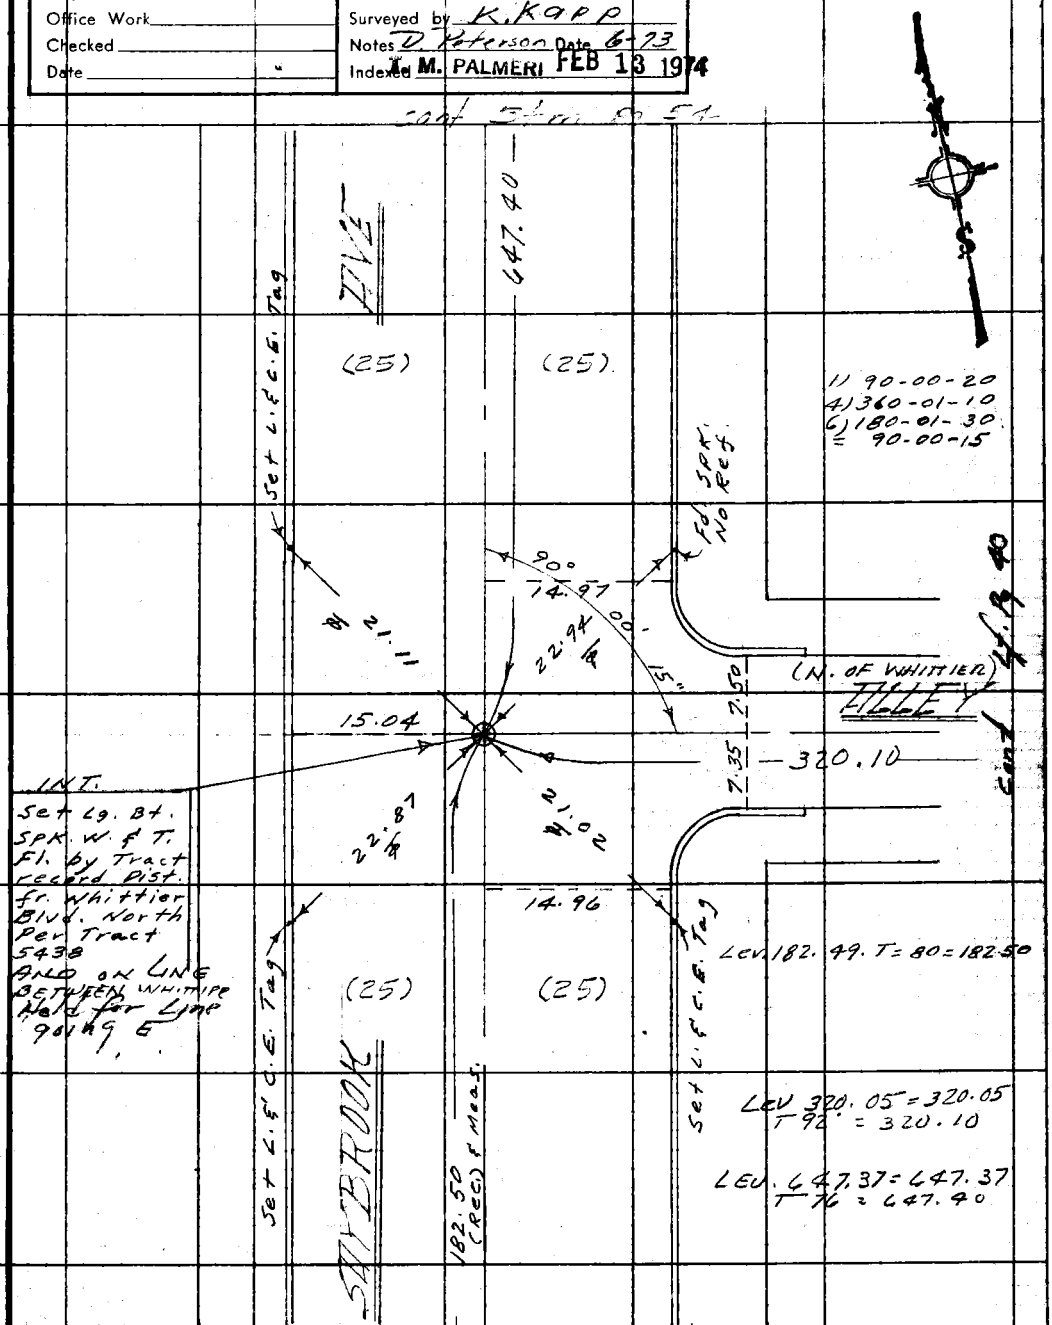

Note: Any Additions or Changes on This Sheet Must be Made or Circled in Red Ink With Date and Name of Person Making Change.

Do not extend this side of this line.

PLEASE RETURN TO
COUNTY OF LOS ANGELES
DEPARTMENT OF COUNTY ENGINEER
403 LOS ANGELES COUNTY ENGINEERING BLDG.

16F309S CE#310 3-69

F. B. ~~3813~~ PG. ~~40~~

Cont Btm Pg 55

TR. No 5438

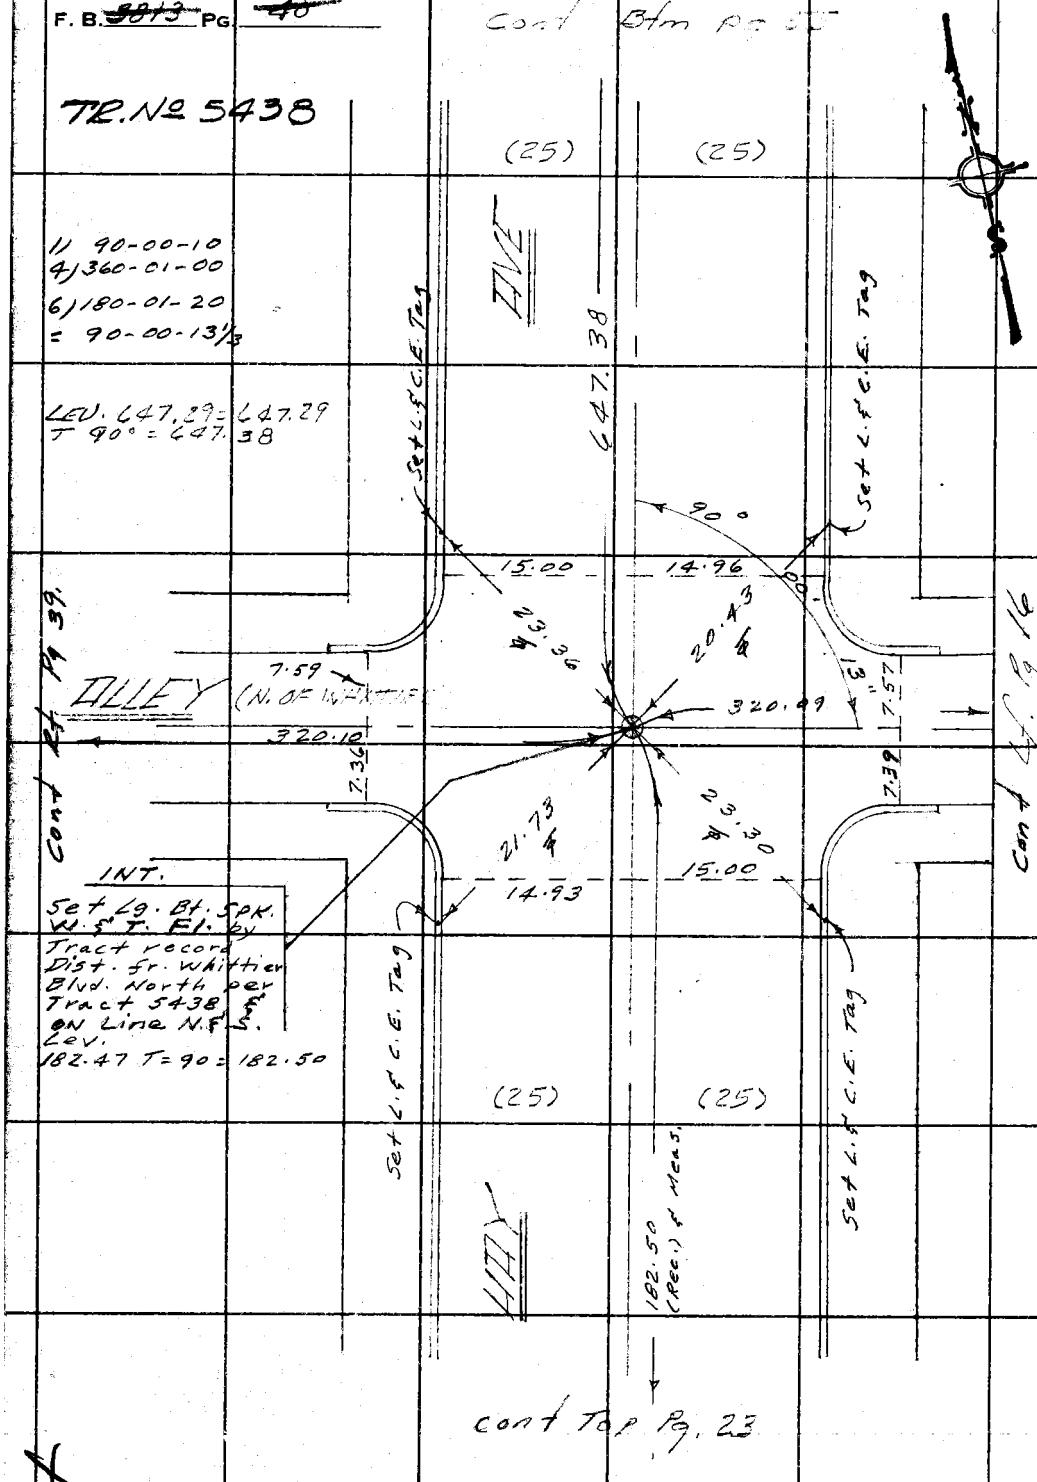

1) 90-00-10
4) 360-01-00
6) 180-01-20
= 90-00-13 1/3

LEV. 647.29 = 647.29
T 90° = 647.38

INT.
Set Lg. Bt. Spk. W. & T. El. by Tract record Dist. fr. Whittier Blvd. North per Tract 5438 & on Line N. & S. Lev.
182.47 T = 90 = 182.50

PLEASE RETURN TO
COUNTY OF LOS ANGELES
DEPARTMENT OF COUNTY ENGINEER
403 LOS ANGELES COUNTY ENGINEERING BLDG.

Do not extend this side of this line.

Note: Any Additions or Changes on This Sheet Must be Made or Circled in Red Ink With Date and Name of Person Making Change.

RDFB 1124 1699, 1700

Notes Ck'd by
Map No.
Office Work
Checked
Date

Div. of Survey of BELVEDERE AREA
JN 0303.04 Tape 0247 Std 68 °F
Surveyed by H.H. SPRIGGS
Notes MOODY Date 4-4-73
Indexed T. M. PALMER FEB 13 1974

F. B. 3015 Pg. 41
TRACT 110 9752

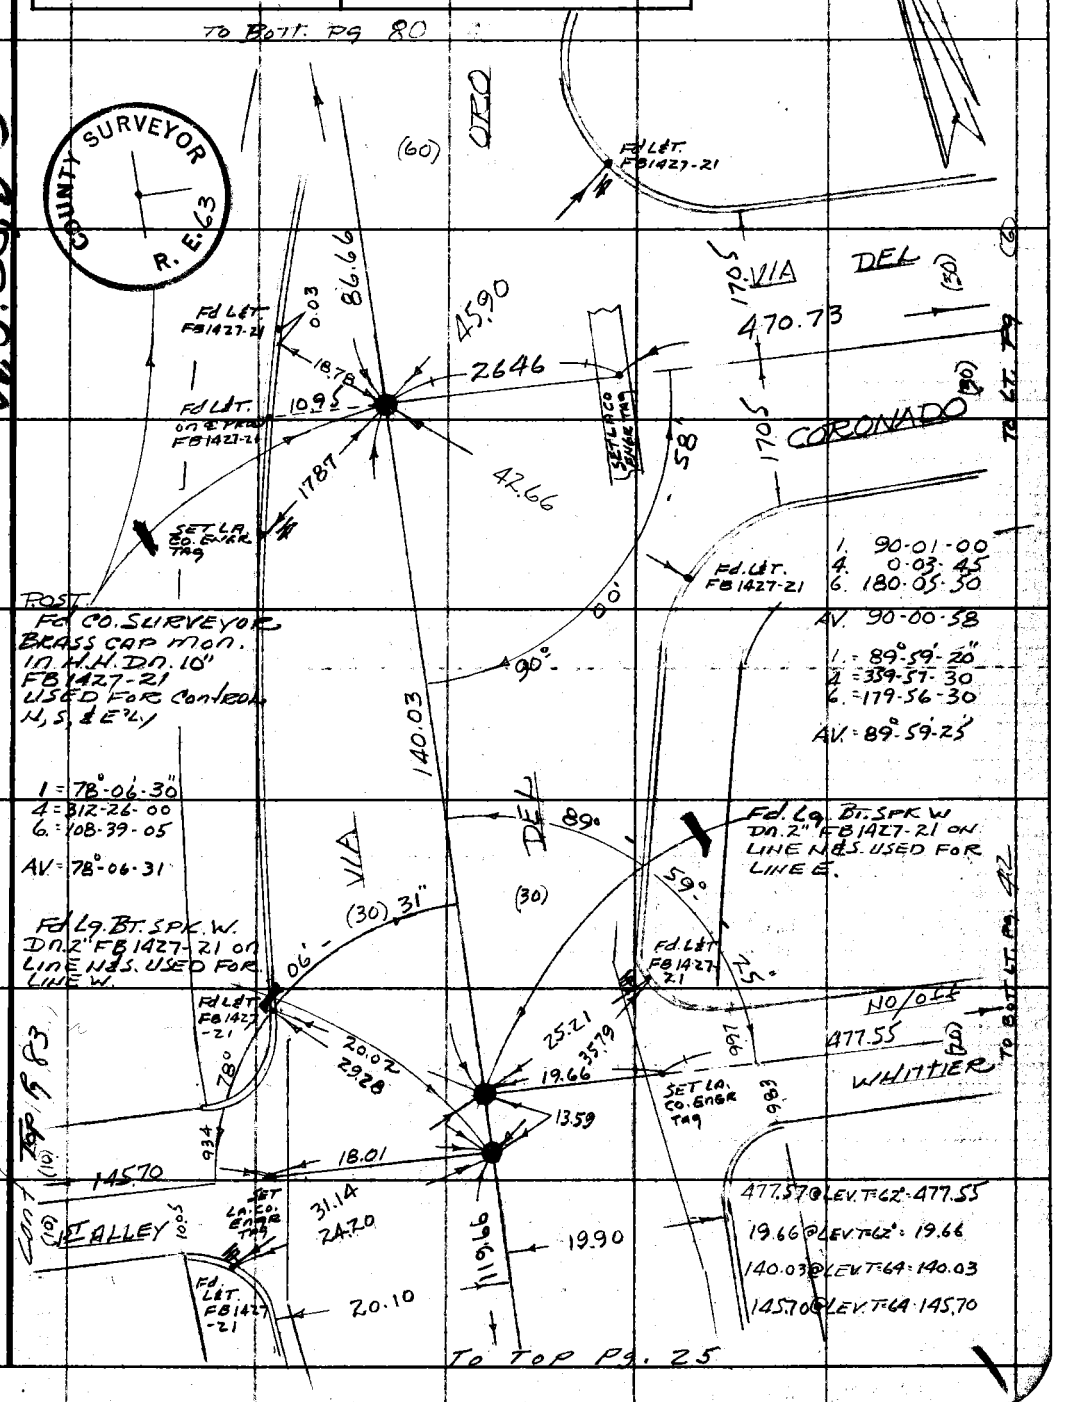

Note: Any Additions or Changes on This Sheet Must be Made or Circled in Red Ink With Date and Name of Person Making Change.

Do not extend this side of this line.

PLEASE RETURN TO
COUNTY OF LOS ANGELES
DEPARTMENT OF COUNTY ENGINEER
403 LOS ANGELES COUNTY ENGINEERING BLDG.

6F309S CE#310 3-69

RDFB 1124 1701, 1702

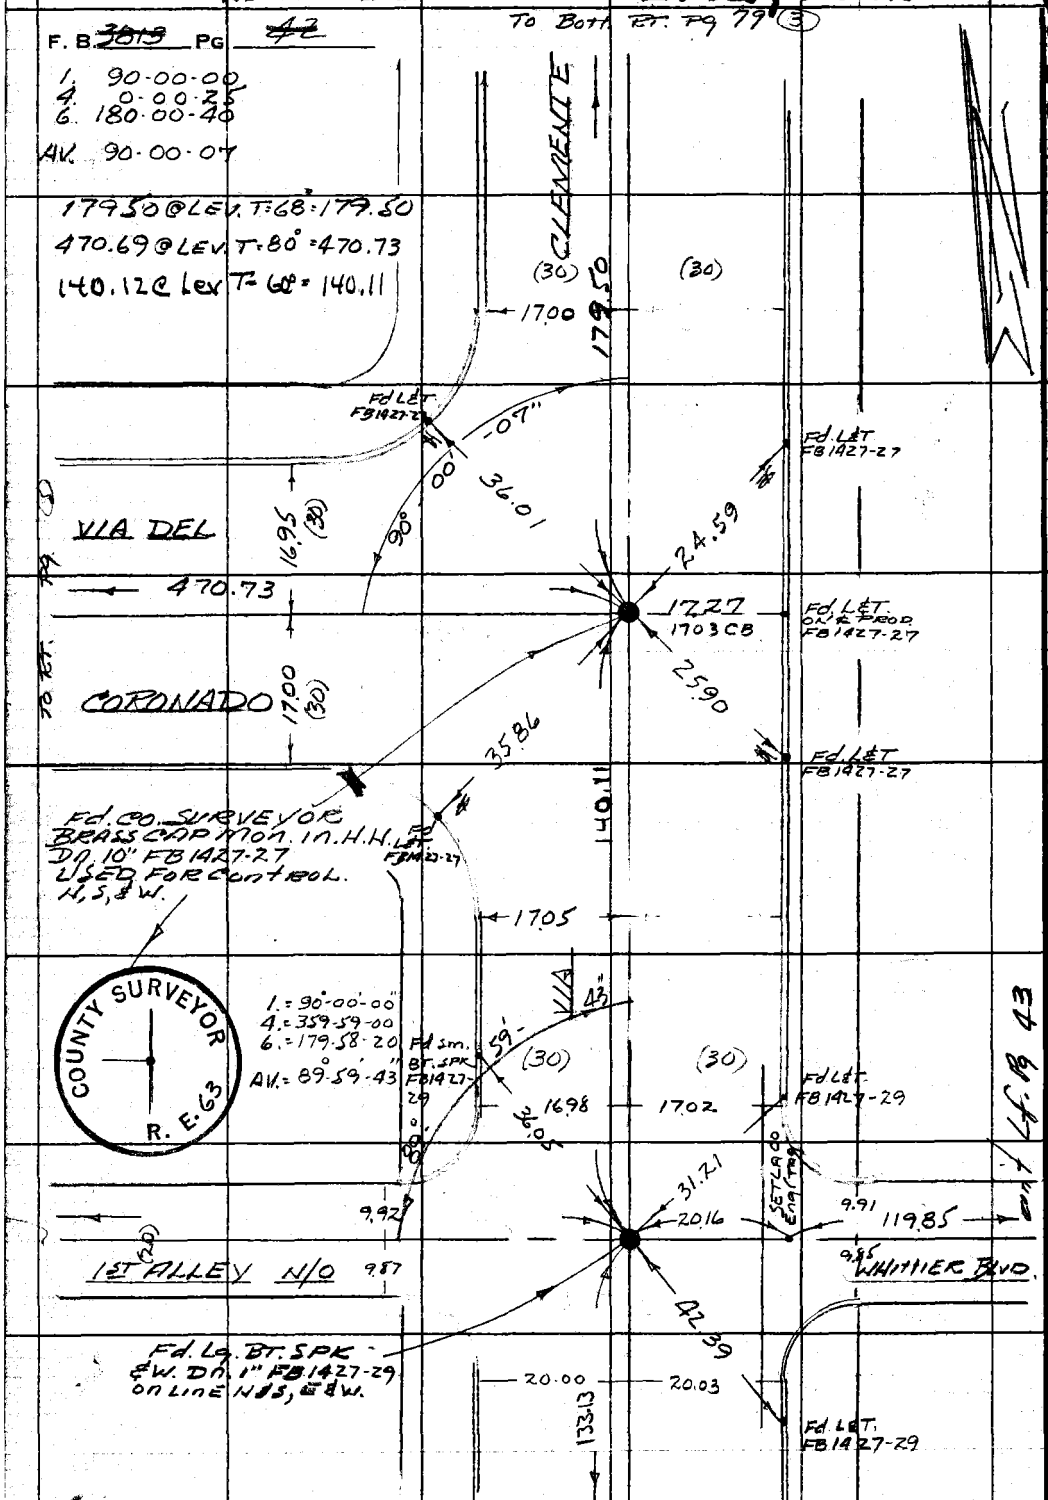

PLEASE RETURN TO
COUNTY OF LOS ANGELES
DEPARTMENT OF COUNTY ENGINEER
403 LOS ANGELES COUNTY ENGINEERING BLDG.

Do not extend this side of this line.

Note: Any Additions or Changes on This Sheet Must Be Made or Circled in Red Ink With Date and Name of Person Making Change.

RDFB 1124 1703

Notes Ck'd by	Survey of BELVEDERE AREA E
Map No.	JN 0303.00 Tape 0247 Std 68 °F
Office Work	Surveyed by H.H. SPRIGGS
Checked	Notes MOODY Date 4-30-73
Date	Indexed T. M. PALMERI FEB 18 1974

F. B 3813 PG.

TO TOP RT. PG. 79 (3)

TRACT #9752

267.57 @ LEV T=62° = 267.56
119.85 @ LEV T=62° = 119.85

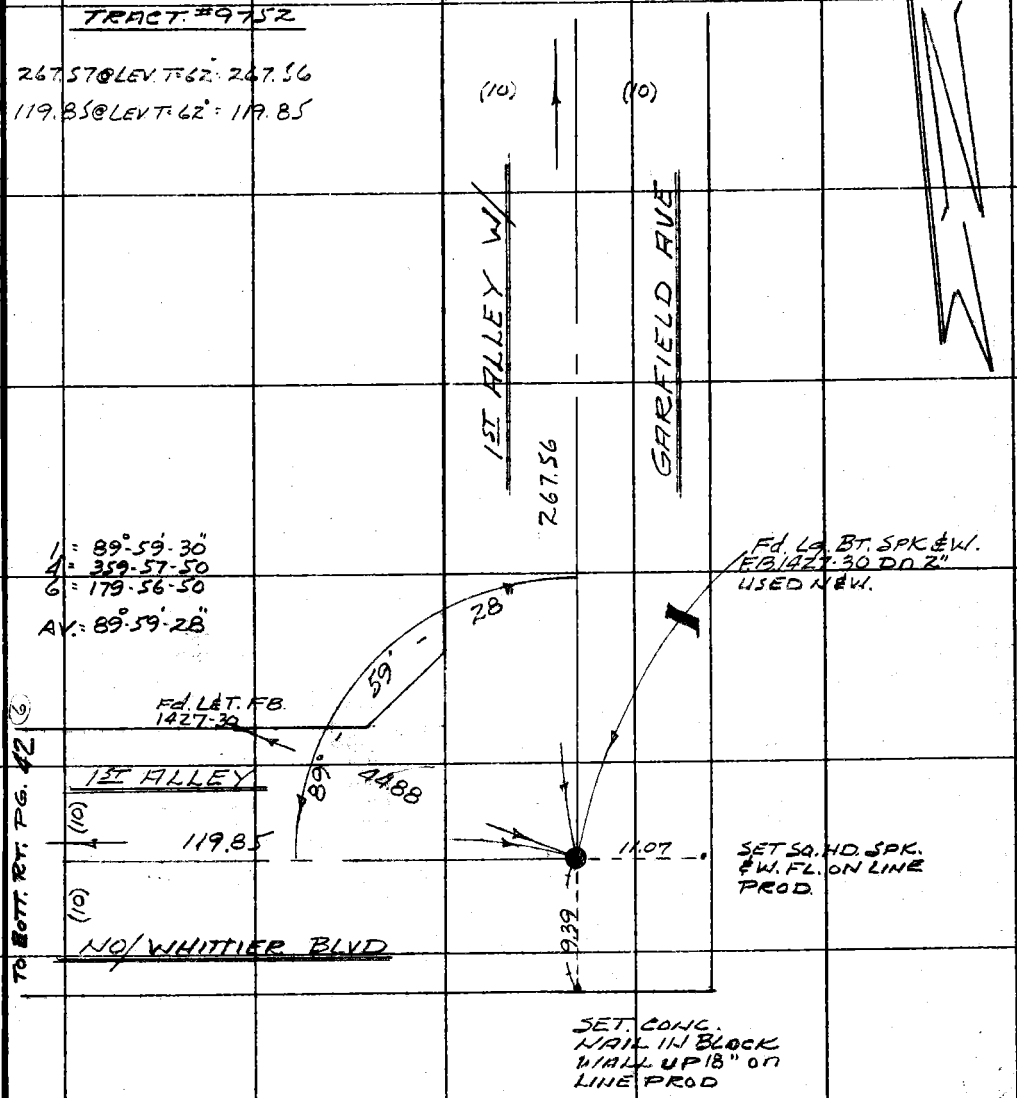

TRACT #9752

Note: Any Additions or Changes on This Sheet Must be Made or Circled in Red Ink With Date and Name of Person Making Change.

Do not extend this side of this line.

PLEASE RETURN TO
COUNTY OF LOS ANGELES
DEPARTMENT OF COUNTY ENGINEER
403 LOS ANGELES COUNTY ENGINEERING BLDG.

76F309S CE#310 3-68

RDFB 1124 1704

F. B. ~~38-13~~ Pg. ~~44~~ cont. Btm. Pg 74

See RDFB1224

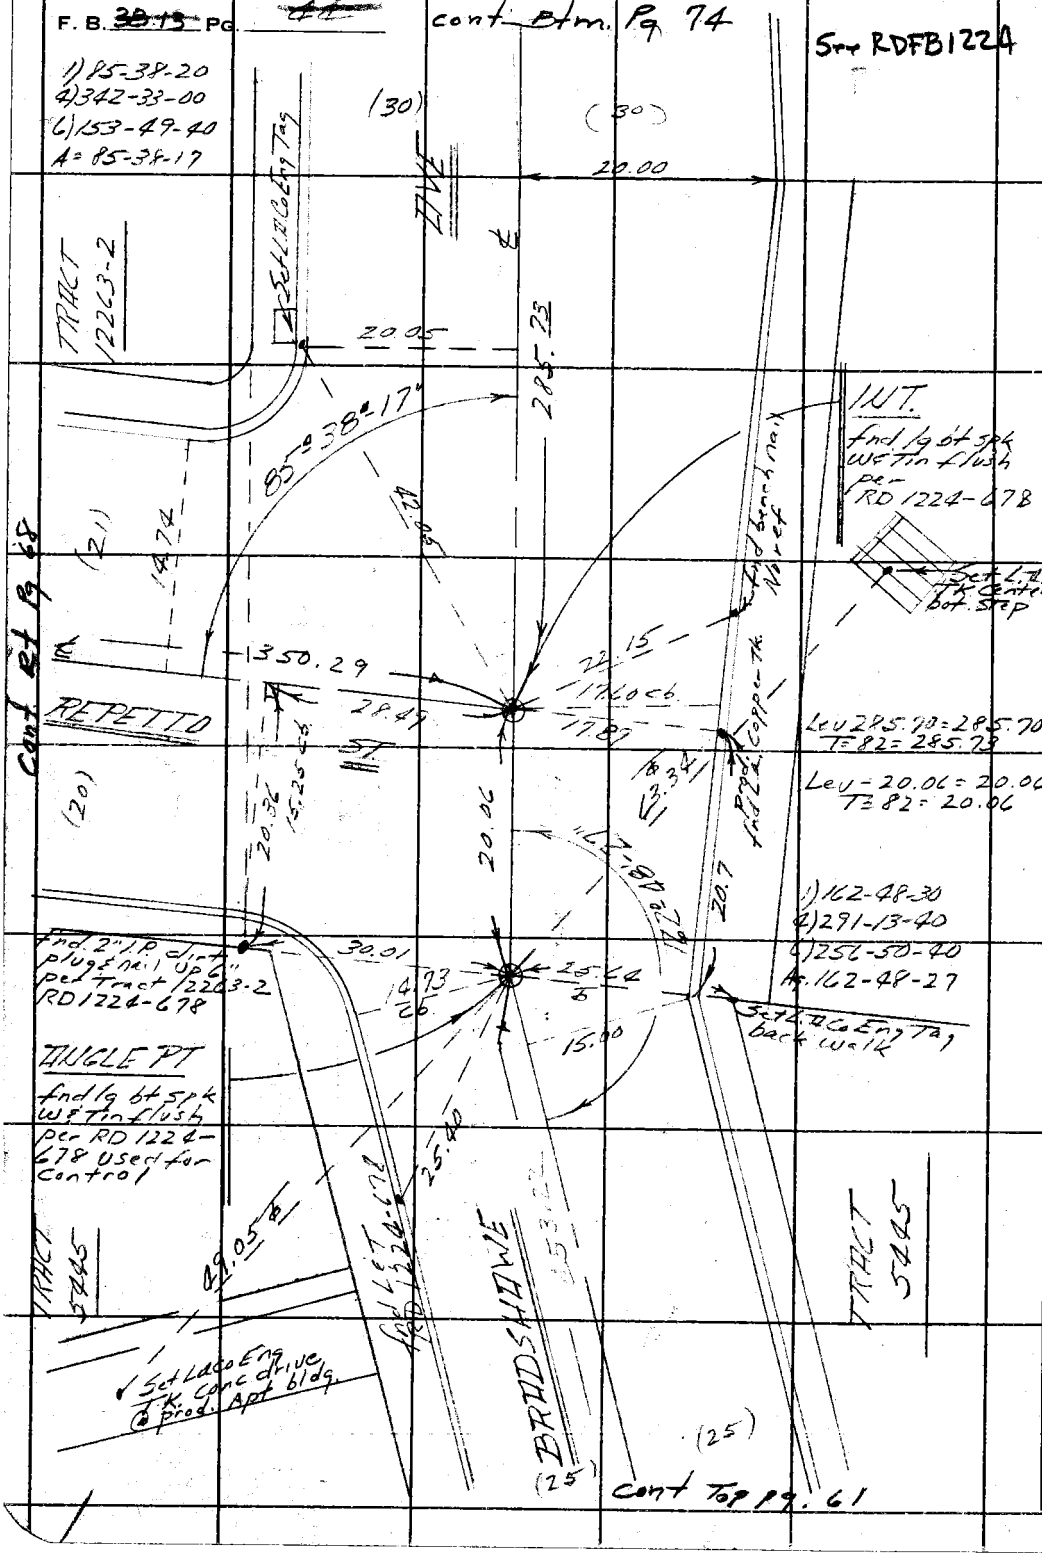

MS 36 B-3

PLEASE RETURN TO
COUNTY OF LOS ANGELES
DEPARTMENT OF COUNTY ENGINEER
403 LOS ANGELES COUNTY ENGINEERING BLDG.

Do not extend this side of this line.

Note: Any Additions or Changes on This Sheet Must be Made or Circled in Red Ink With Date and Name of Person Making Change.

RDFB 1124 1705

Notes Ck'd by	Survey of BELVEDERE AREA
Map No.	JN 0303.00 Tape 0122 Std 68 °F
Office Work	Surveyed by K. Kapp
Checked	Notes D. Peterson Date 6-73
Date	Indexed T. M. PALMER FEB 13 1974

F. B. ~~2012~~ PG. ~~49~~

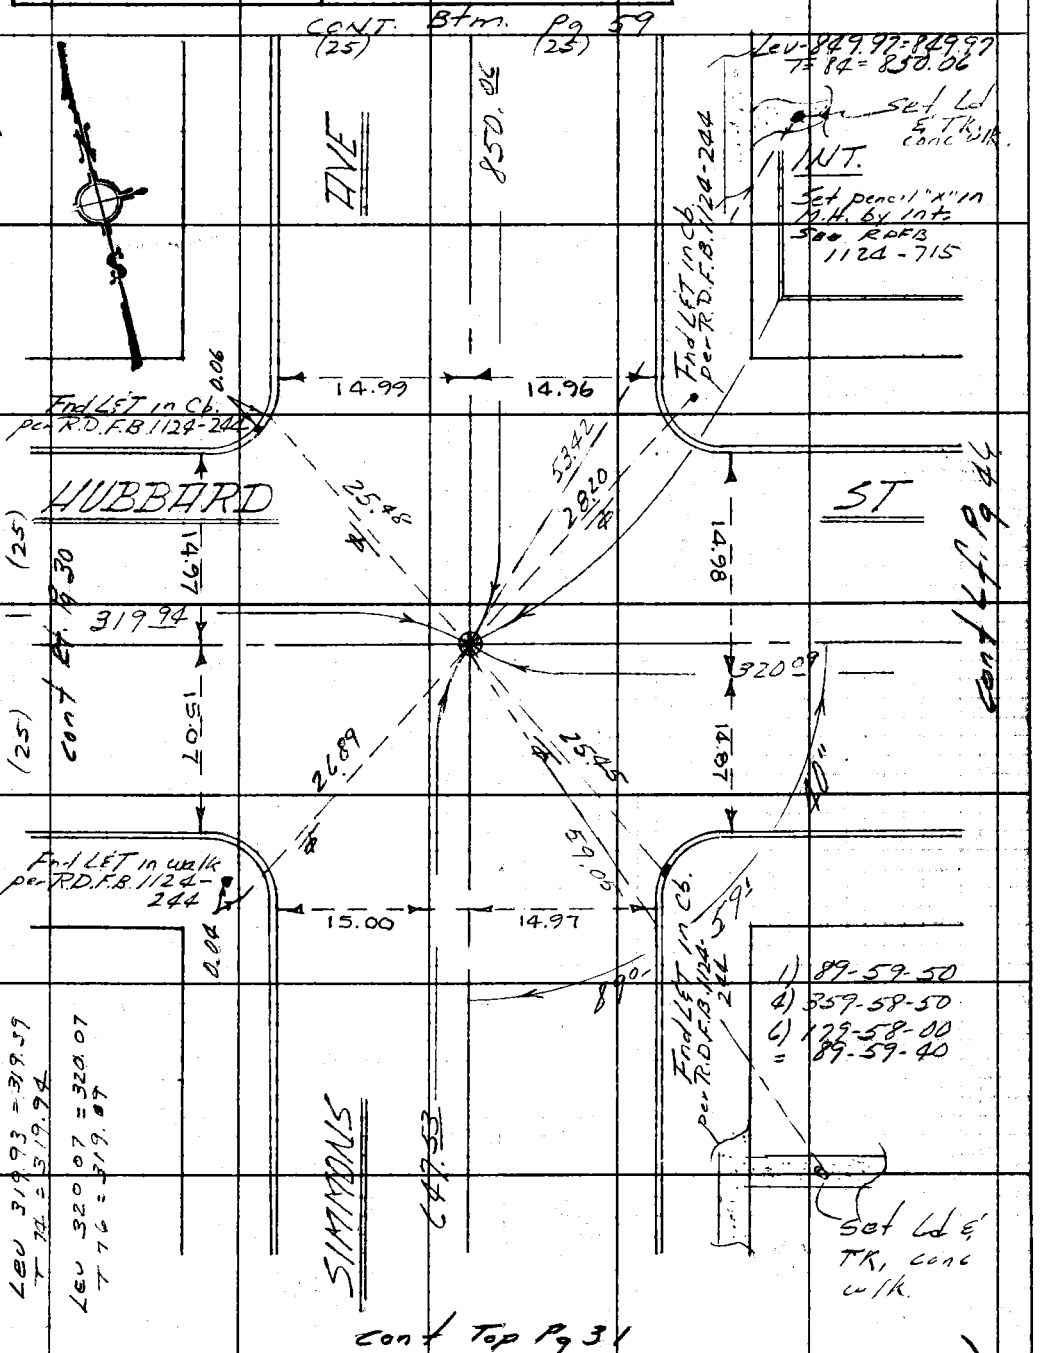

Note: Any Additions or Changes on This Sheet Must be Made or Circled in Red Ink With Date and Name of Person Making Change.

Do not extend this side of this line.

PLEASE RETURN TO
COUNTY OF LOS ANGELES
DEPARTMENT OF COUNTY ENGINEER
403 LOS ANGELES COUNTY ENGINEERING BLDG.

16F309S CE#310 3-69

RDFB 1124 1706

F. B. ~~[illegible]~~ PG. ~~[illegible]~~

Cont Btm Pg 60

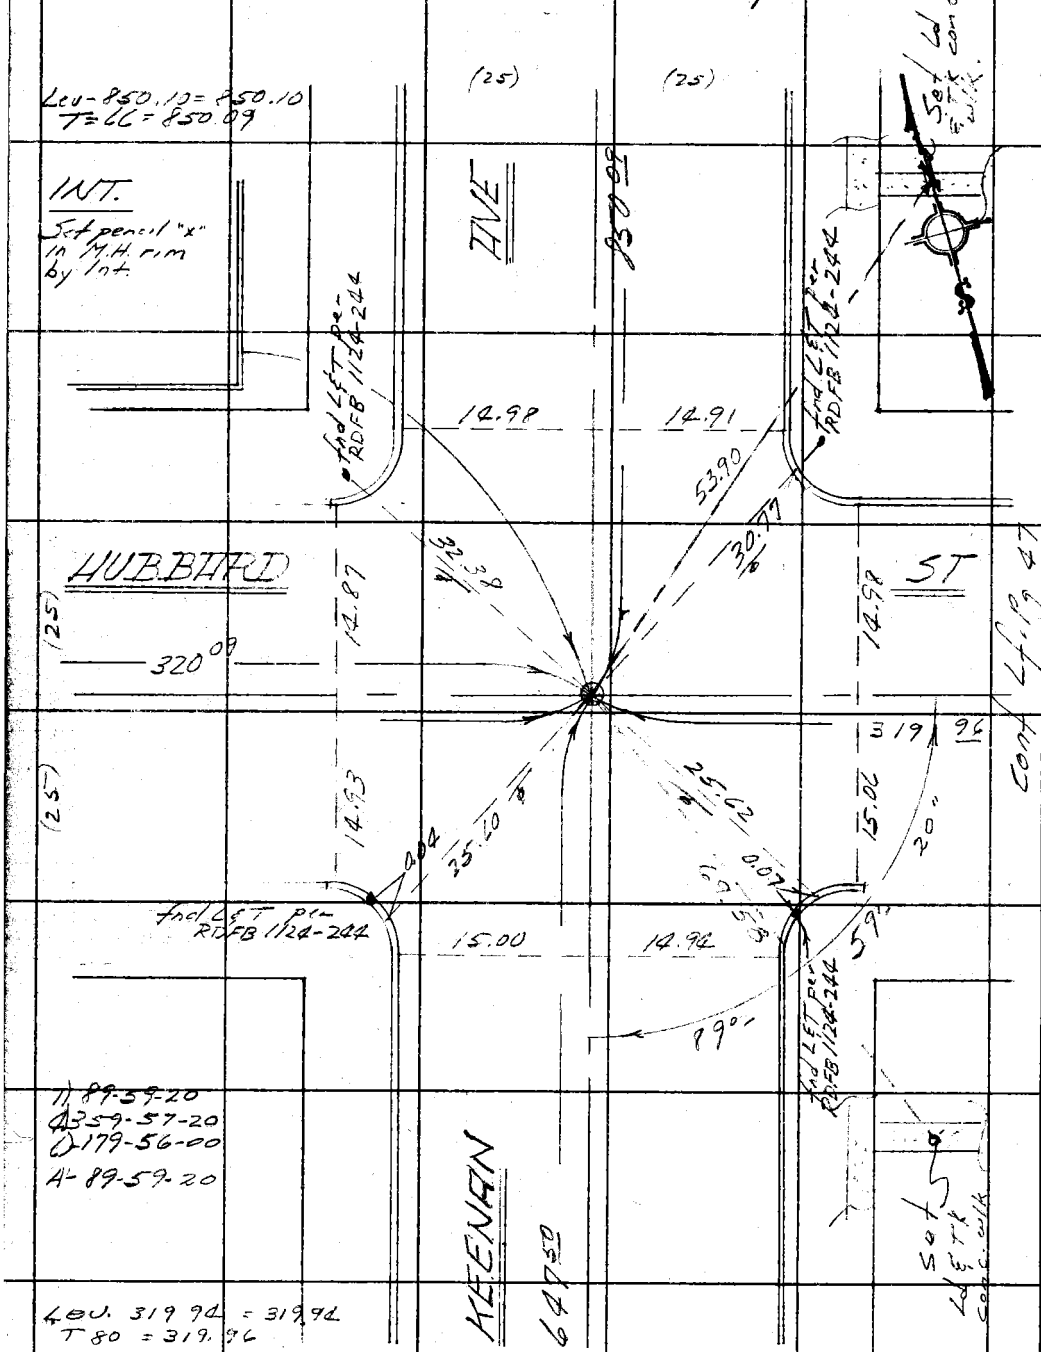

Cont Top Pg 32

PLEASE RETURN TO
COUNTY OF LOS ANGELES
DEPARTMENT OF COUNTY ENGINEER
403 LOS ANGELES COUNTY ENGINEERING BLDG.

Do not extend this side of this line.

Note: Any Additions or Changes on This Sheet Must be Made or Circled in Red Ink With Date and Name of Person Making Change.

MS 36, B-3

RDFB 1124

1707

Notes Ck'd by	Div. #8 Survey of Belvedere Area
Map No.	JN 0303.00 Tape 0247 Std 68 °F
Office Work	Surveyed by K. Kapp
Checked	Notes J. GOODWIN Date 6-73
Date	Indexed T. M. PALMER FEB 13 1974

F. B. 3813 Pg. 77

WS 36 B-3

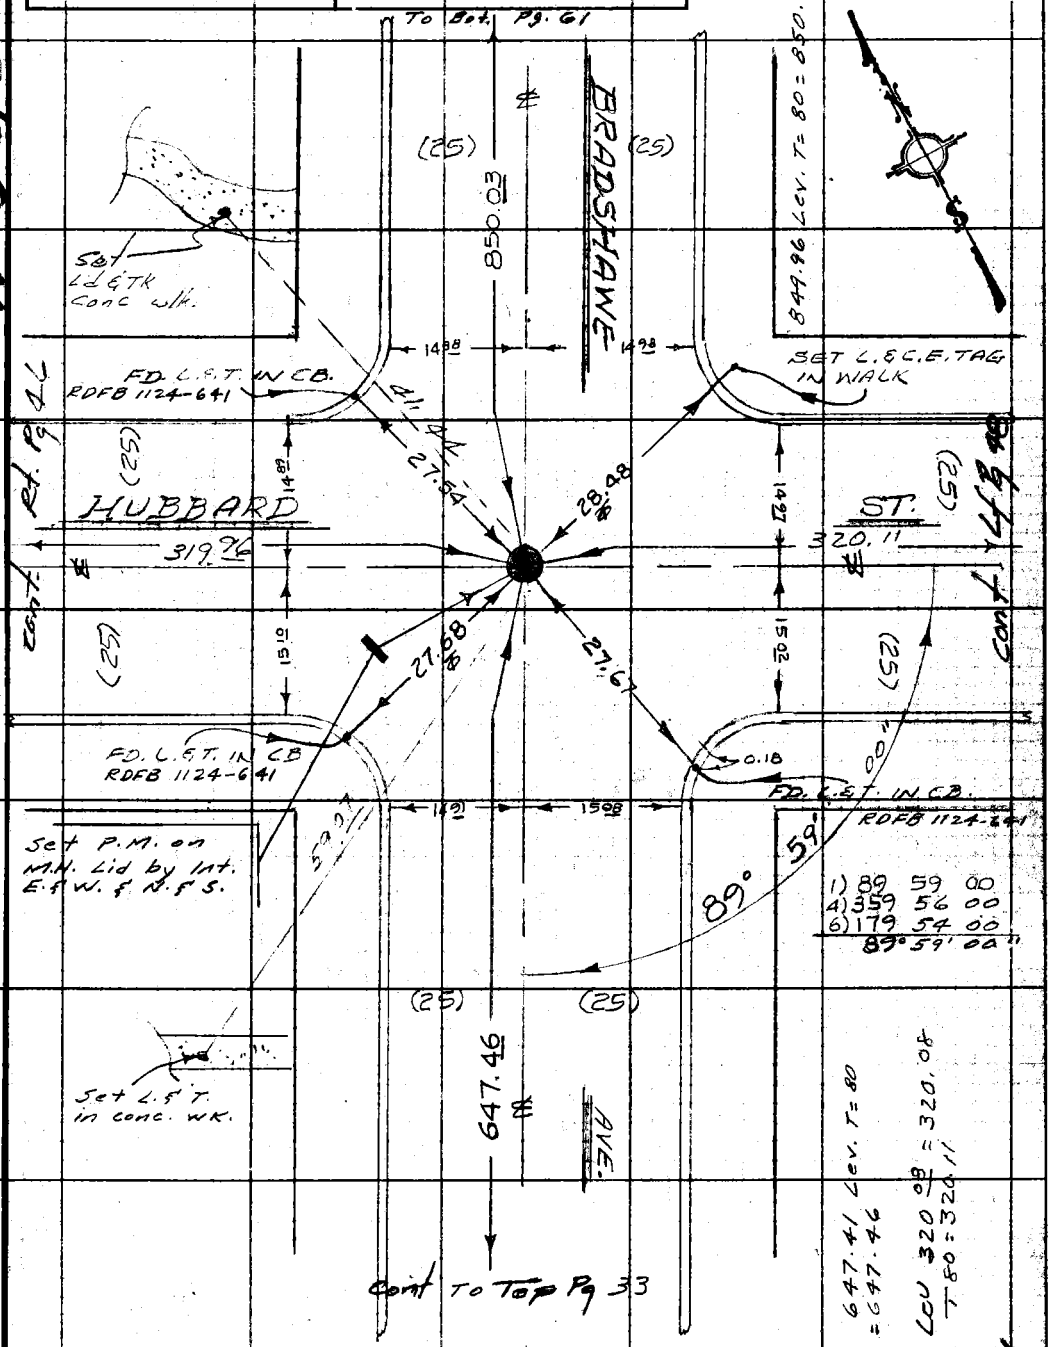

Note: Any Additions or Changes on this Sheet Must be Made or Circled in Red Ink With Date and Name of Person Making Change.

Do not extend this side of this line.

PLEASE RETURN TO
COUNTY OF LOS ANGELES
DEPARTMENT OF COUNTY ENGINEER
403 LOS ANGELES COUNTY ENGINEERING BLDG.

6F309S CE#310 3-69

RDFB 1124 1708

F. B. ~~3013~~ PG ~~48~~

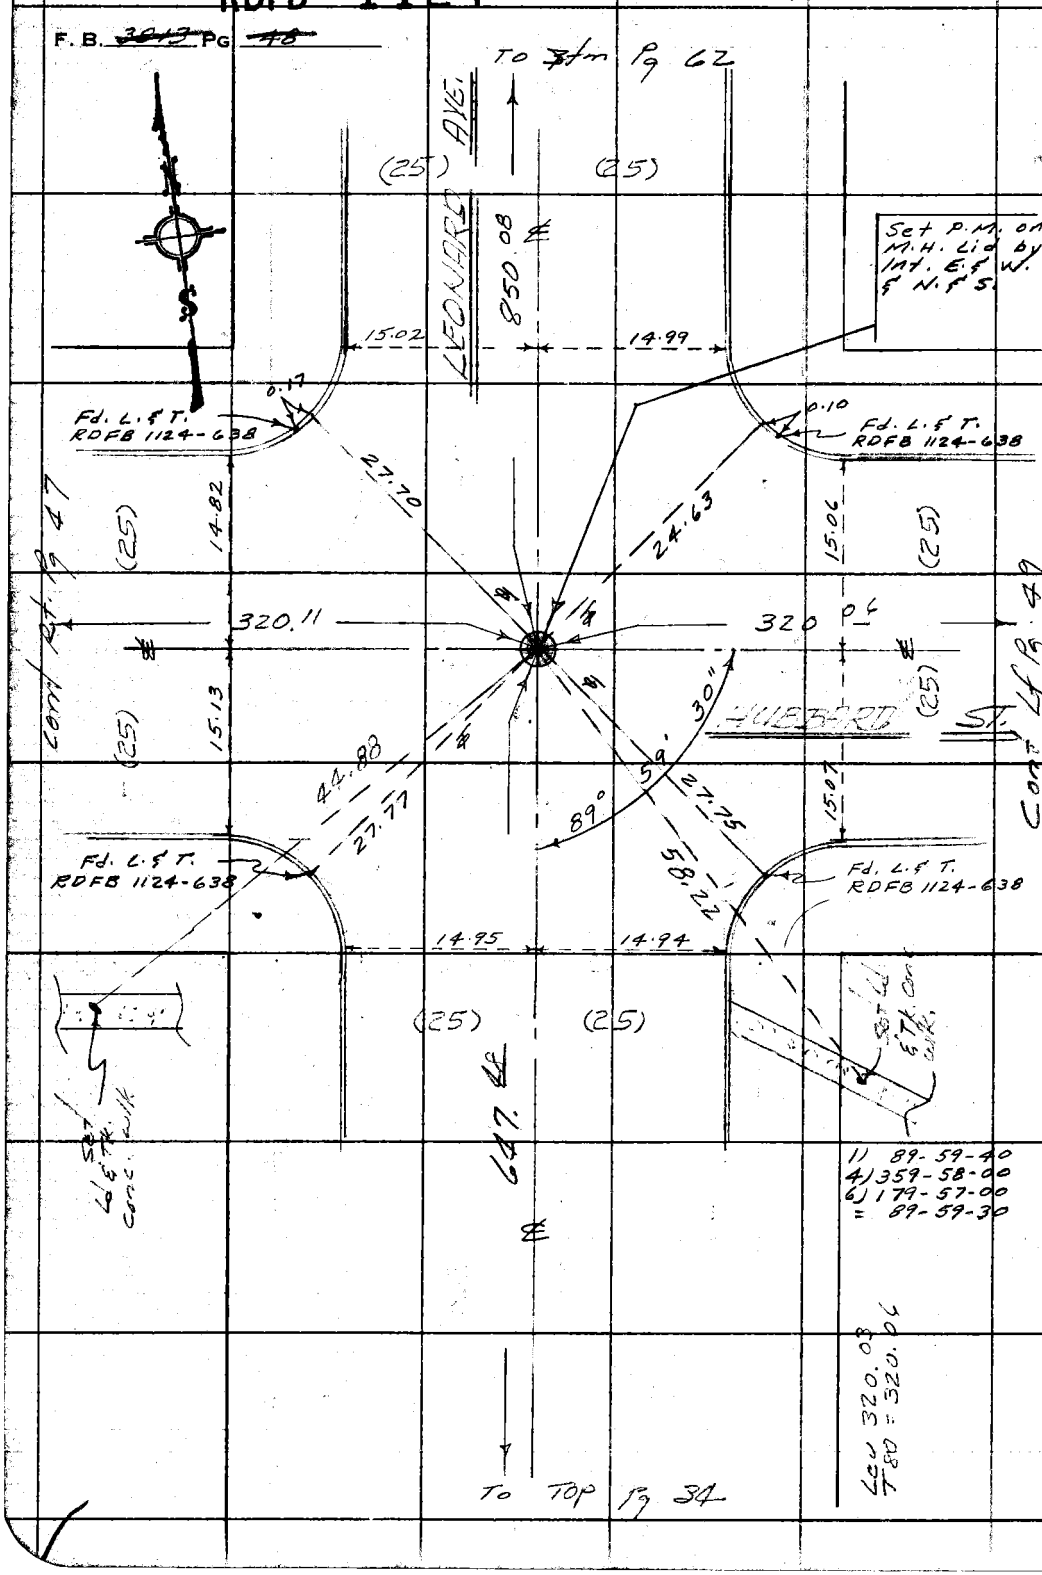

E-8 (6)

PLEASE RETURN TO
COUNTY OF LOS ANGELES
DEPARTMENT OF COUNTY ENGINEER
403 LOS ANGELES COUNTY ENGINEERING BLDG.

Do not extend this side of this line.

Note: Any Additions or Changes on This Sheet Must be Made or Circled in Red Ink With Date and Name of Person Making Change.

RDFB 1124 1709

Notes Ck'd by	Survey of Belvedere Area ℄
Map No.	JN 030300 Tape 0247 Std 68 °F
Office Work	Surveyed by HHSpriggs
Checked	Notes HHS Date 5-73
Date	Indexed T. M. PALMERI FEB 13 1974

F. B. ~~3813~~ PG. ~~44~~

W.S. 36, B-3

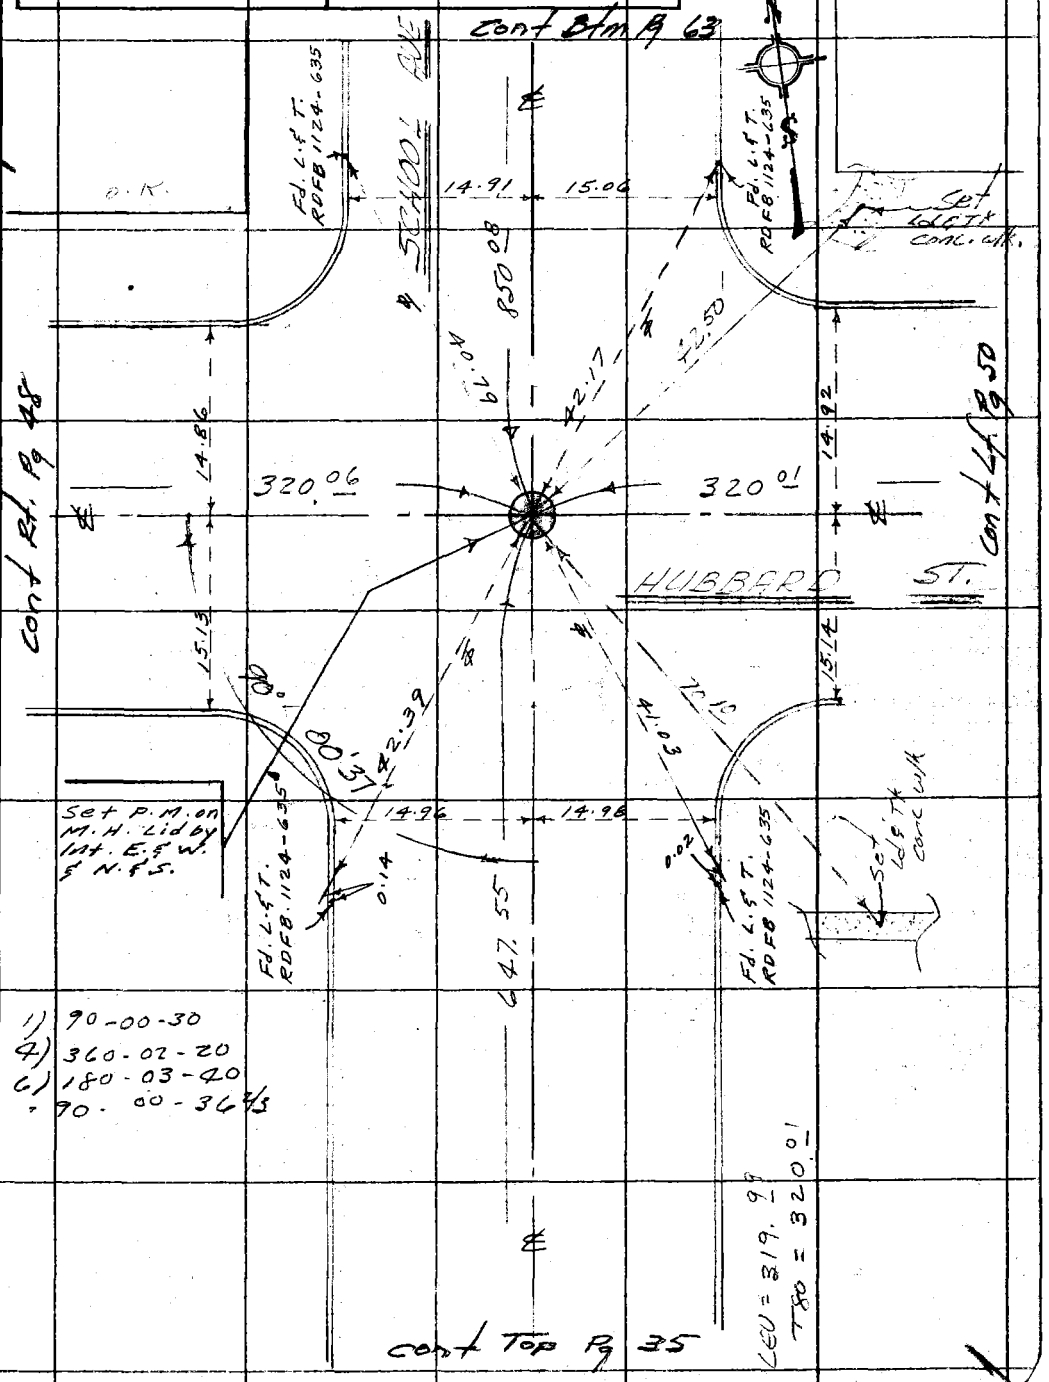

Note: Any Additions or Changes on This Sheet Must be Made or Circled in Red Ink With Date and Name of Person Making Change.

Do not extend this side of this line.

PLEASE RETURN TO
COUNTY OF LOS ANGELES
DEPARTMENT OF COUNTY ENGINEER
403 LOS ANGELES COUNTY ENGINEERING BLDG.

76F309S CE#310 3-68

RDFB 1124 1710

F. B. ~~3813~~ Pg. ~~50~~

1. 89-59-30
4. 359-57-40
6. 179-56-40
A 89-59-26 2/3

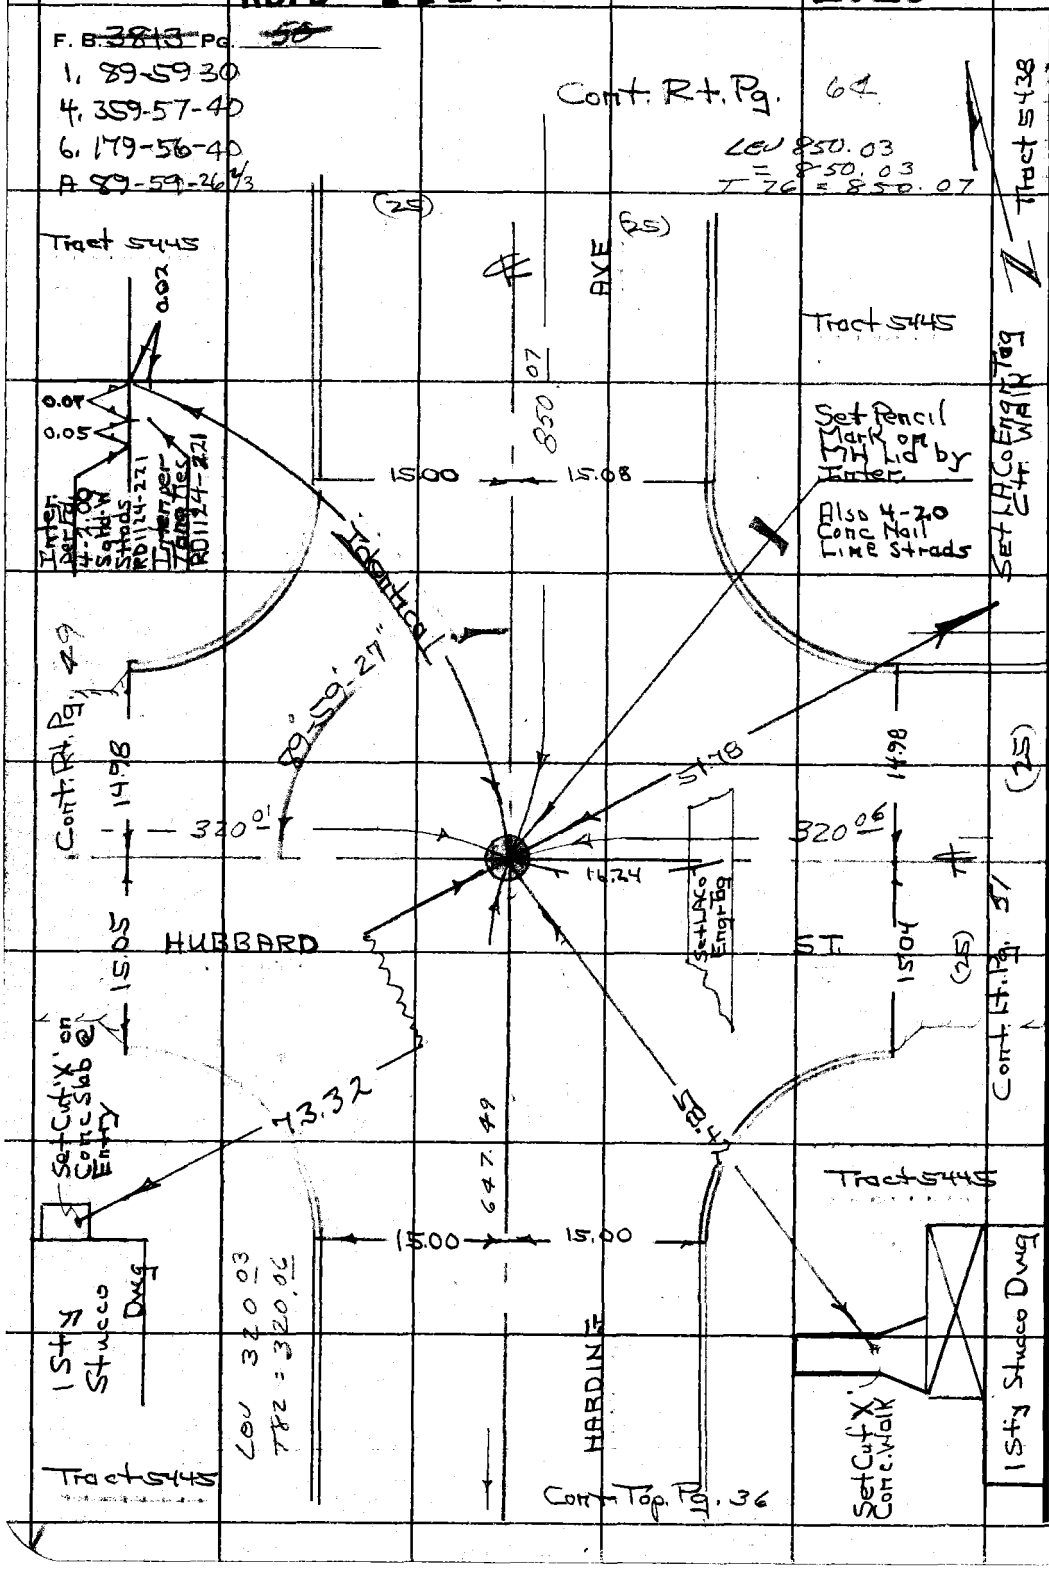

PLEASE RETURN TO
COUNTY OF LOS ANGELES
DEPARTMENT OF COUNTY ENGINEER
403 LOS ANGELES COUNTY ENGINEERING BLDG.

Do not extend this side of this line.

Note: Any Additions or Changes on This Sheet Must be Made or Circled in Red Ink With Date and Name of Person Making Change.

RDFB 1124 1711

Notes Ck'd by	DIV 8 Survey of BELVEDERE AREA 9
Map No.	JN 030300 Tape 0122 Std 68 °F
Office Work	Surveyed by K. KAPP
Checked	Notes J. GOODWIN Date 6-73
Date	Indexed I. M. PALMERI FEB 13 1974

F. B. ~~3813~~ PG. ~~51~~

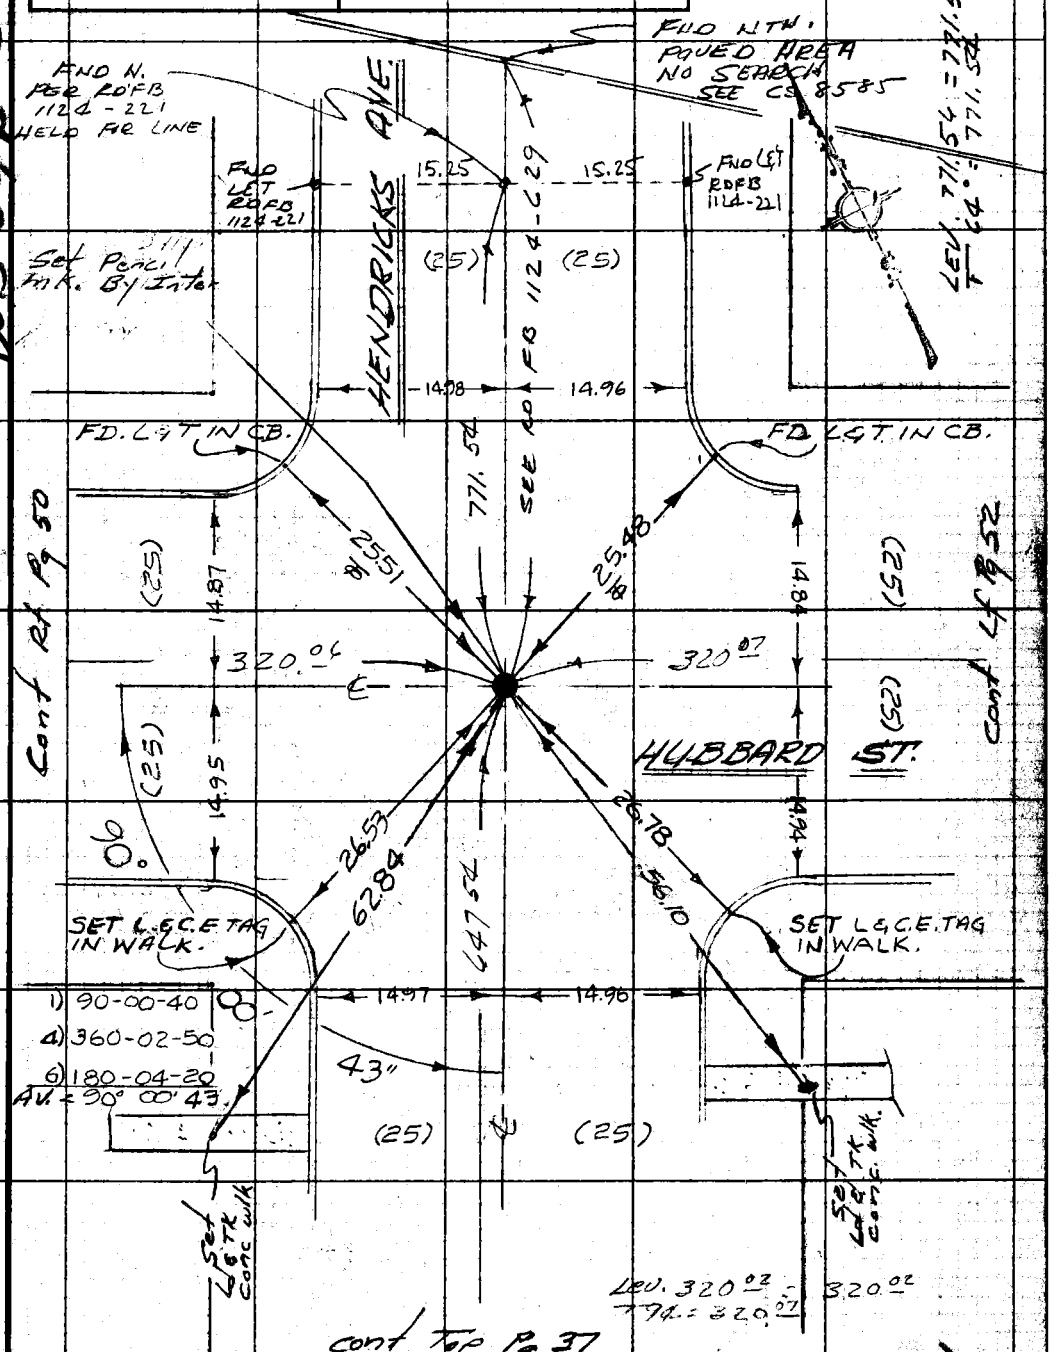

Note: Any Additions or Changes on This Sheet Must be Made or Circled in Red Ink With Date and Name of Person Making Change.

Do not extend this side of this line.

PLEASE RETURN TO
COUNTY OF LOS ANGELES
DEPARTMENT OF COUNTY ENGINEER
403 LOS ANGELES COUNTY ENGINEERING BLDG.

76F309S CE#310 3-69

F. B. ~~3913~~ PG. ~~52~~

PER RDFB F.B. 1124-626, 627

FD. 4 CHIS "X" IN M.H. RIM. NO GOOD. MADE NEW INTER. SET P.M. ON M.H. COVER BY INTER. E.&W., N.&S.

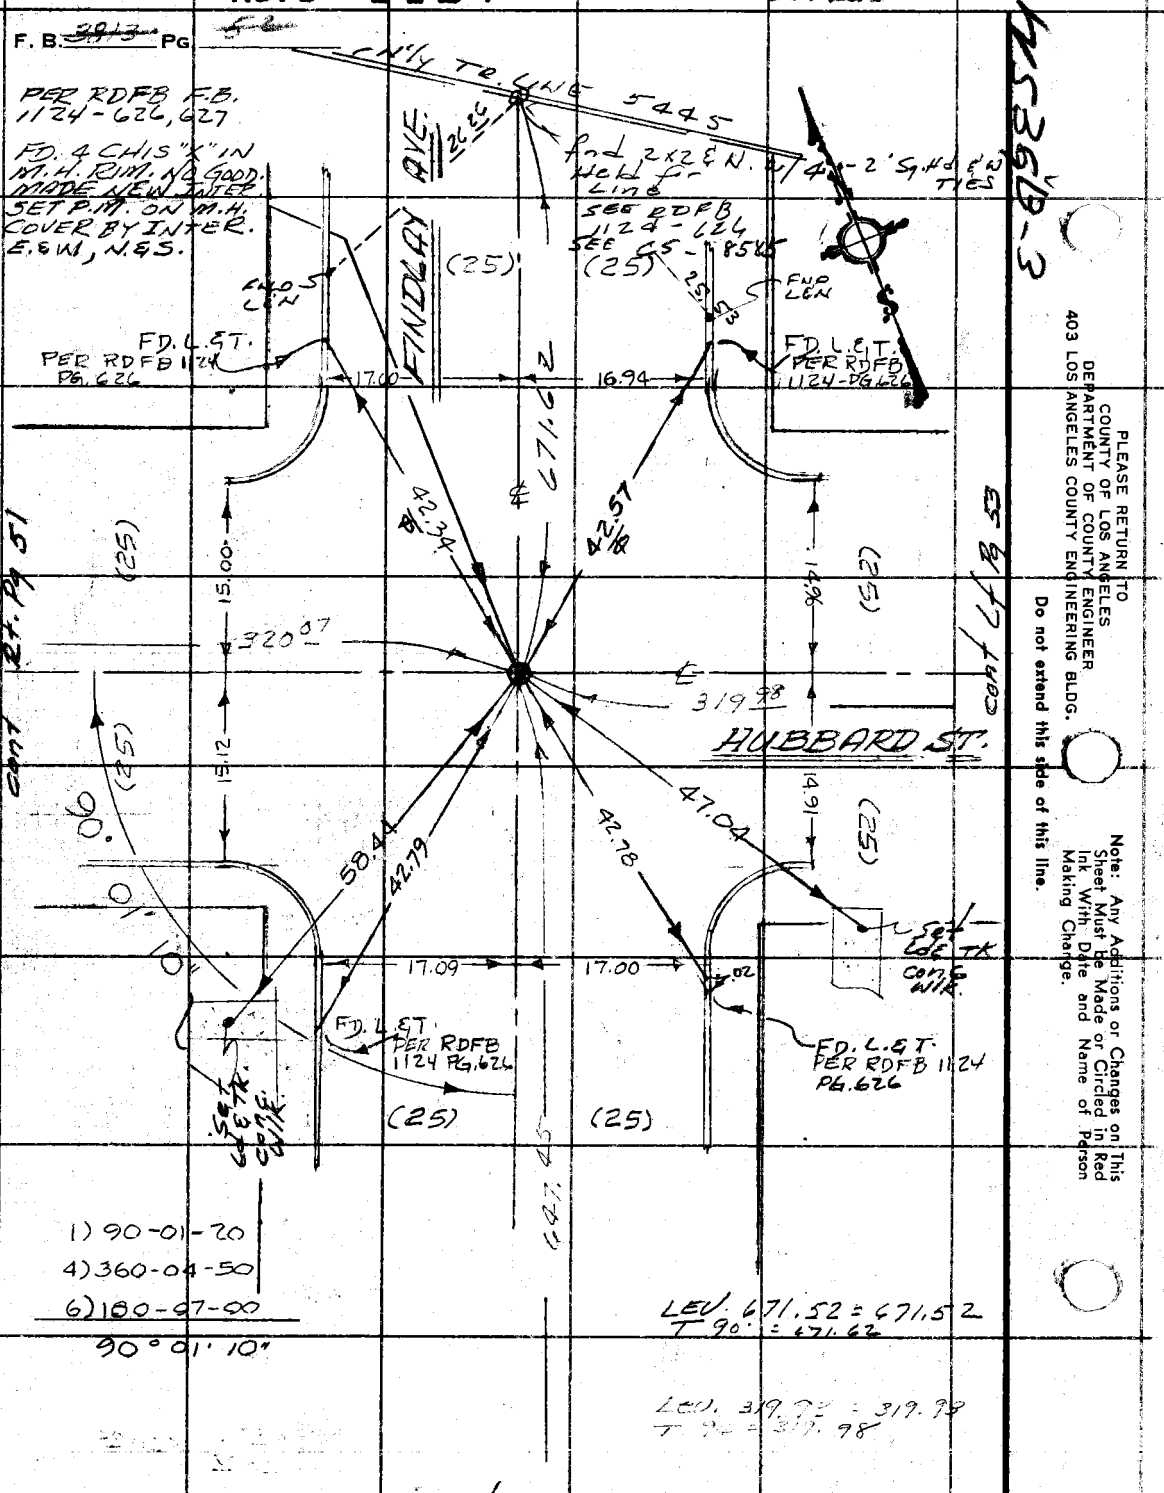

PLEASE RETURN TO
COUNTY OF LOS ANGELES
DEPARTMENT OF COUNTY ENGINEER
403 LOS ANGELES COUNTY ENGINEERING BLDG.

Do not extend this side of this line.

Note: Any Additions or Changes on This Sheet Must be Made or Circled in Red Ink With Date and Name of Person Making Change.

RDFB 1124 1713

Notes Ck'd by	Survey of Belvedere Area
Map No.	JN 0303.00 Tape 0122 Std 68 °F
Office Work	Surveyed by K. KAPP
Checked	Notes D. Peterson Date 6-73
Date	Indexed T. M. PALMERI FEB 13 1974

F. B. ~~3813~~ PG. ~~63~~

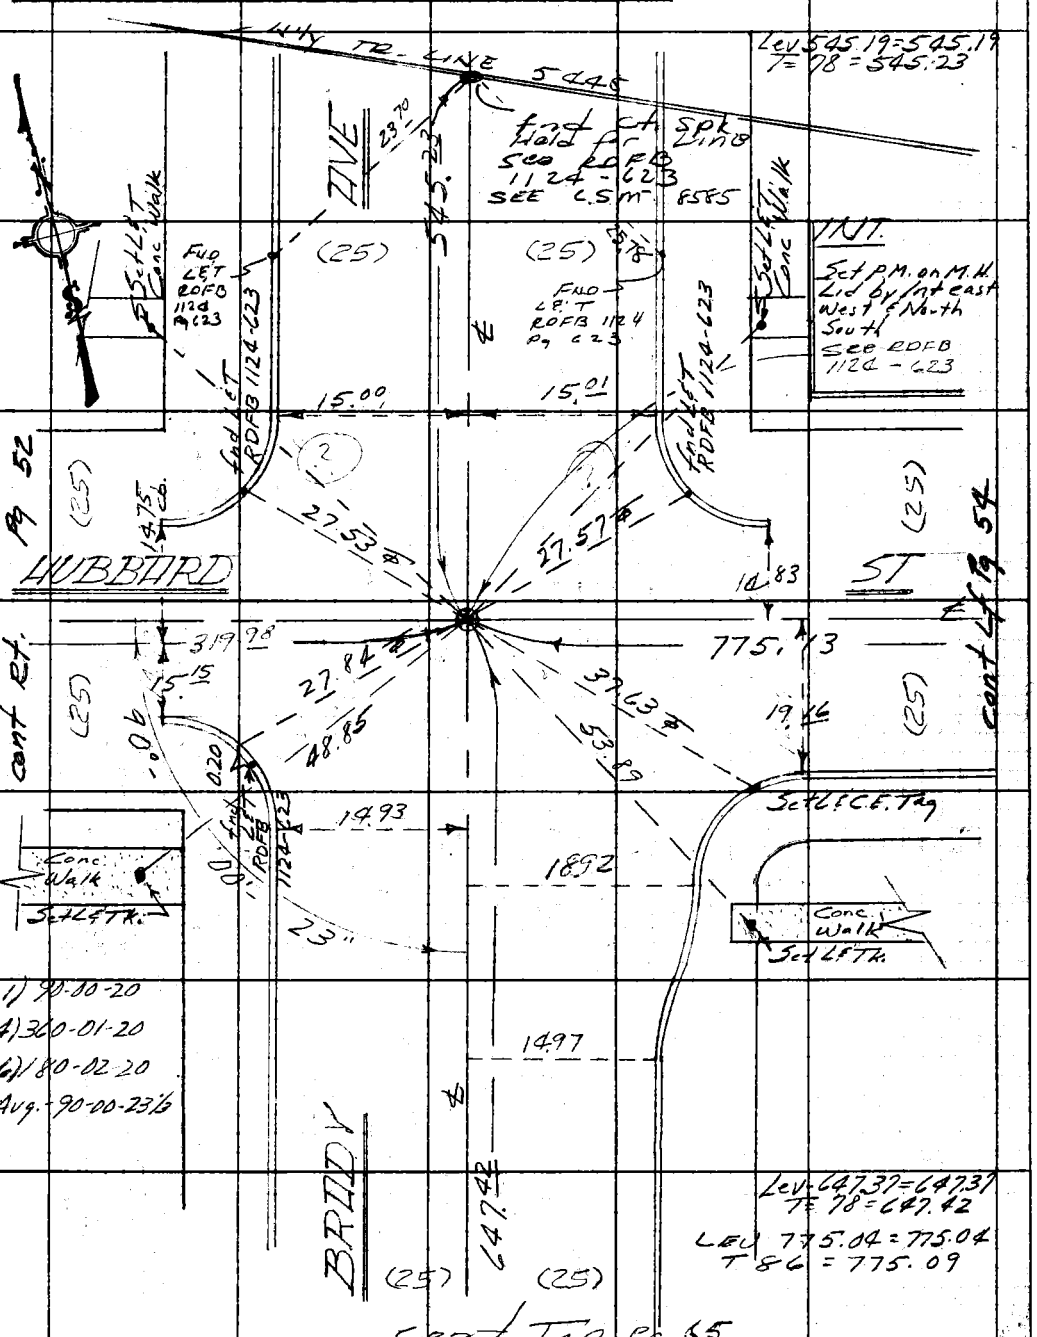

Note: Any Additions or Changes on This Sheet Must be Made or Circled in Red Ink With Date and Name of Person Making Change.

Do not extend this side of this line.

PLEASE RETURN TO
COUNTY OF LOS ANGELES
DEPARTMENT OF COUNTY ENGINEER
403 LOS ANGELES COUNTY ENGINEERING BLDG.

76F309S CE#310 3-69

RDFB 1124 1714, 1715

F. B. ~~3813~~ PG. ~~54~~

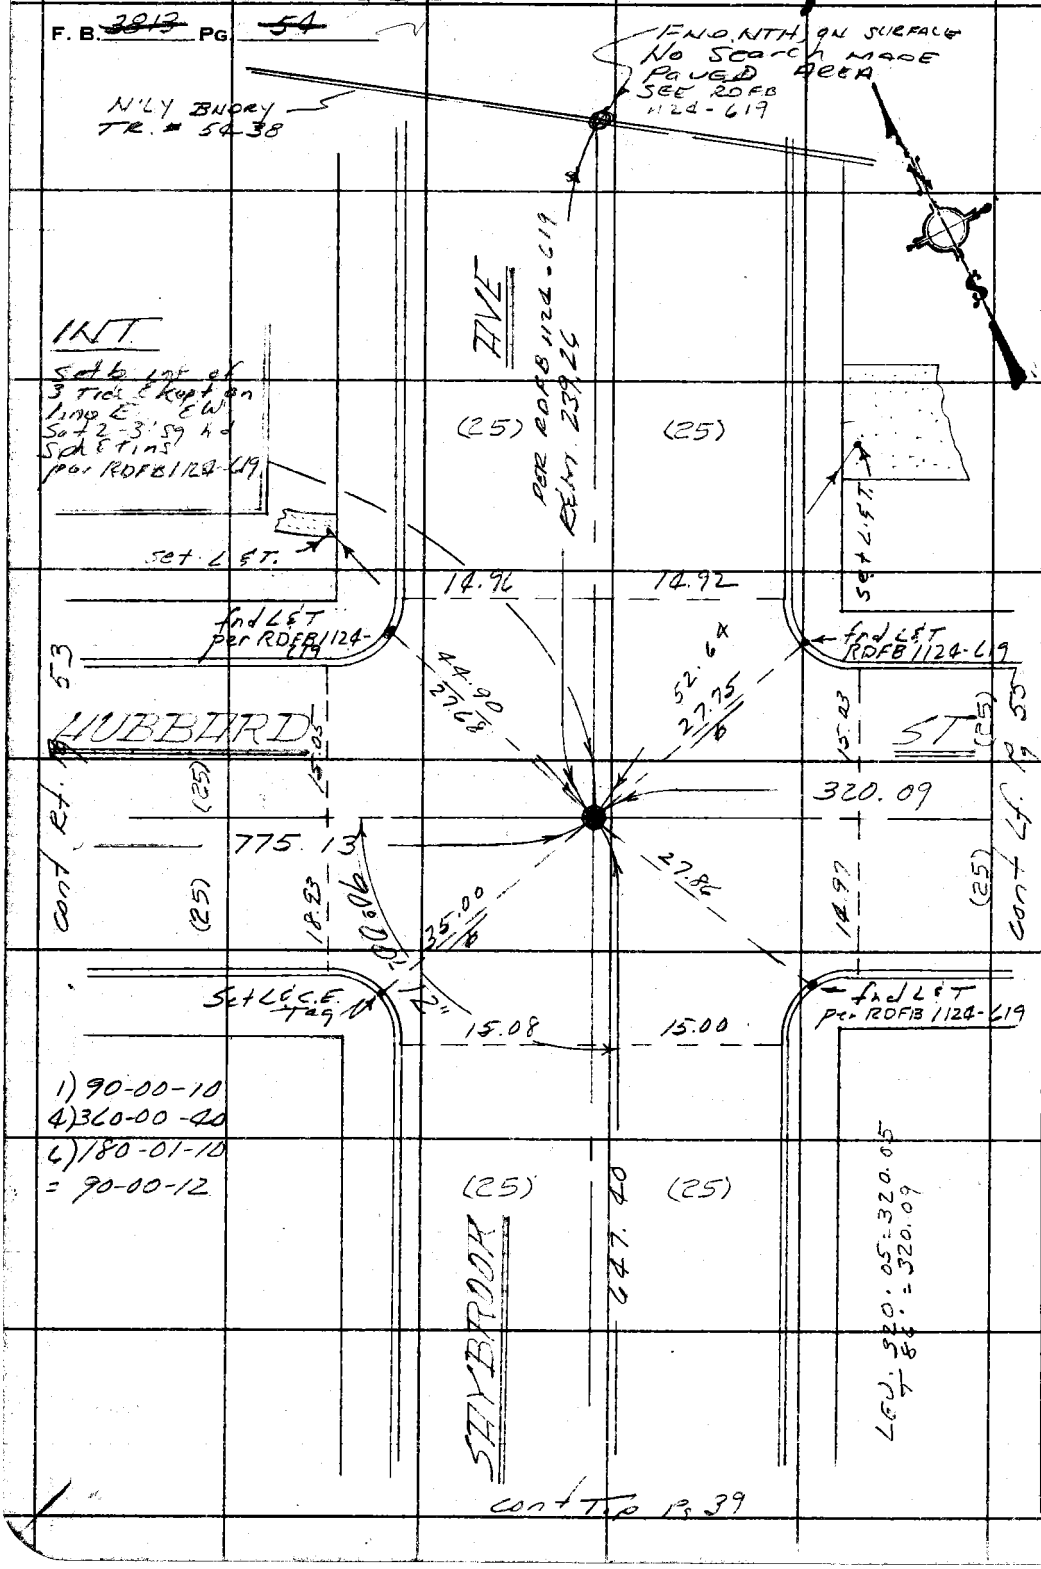

PLEASE RETURN TO
COUNTY OF LOS ANGELES
DEPARTMENT OF COUNTY ENGINEER
403 LOS ANGELES COUNTY ENGINEERING BLDG.

Do not extend this side of this line.

Note: Any Additions or Changes on This Sheet Must be Made or Circled in Red Ink With Date and Name of Person Making Change.

RDFB 1124 1716

Notes Ck'd by	Survey of Belvedere Tract
Map No.	JN 0303.00 Tape 0247 Std. 68 °F
Office Work	Surveyed by HHSpriggs
Checked	Notes HHS Date 5-73
Date	Indexed T. M. PALMER FEB 13 1974

F. B 3813 Pg. 55

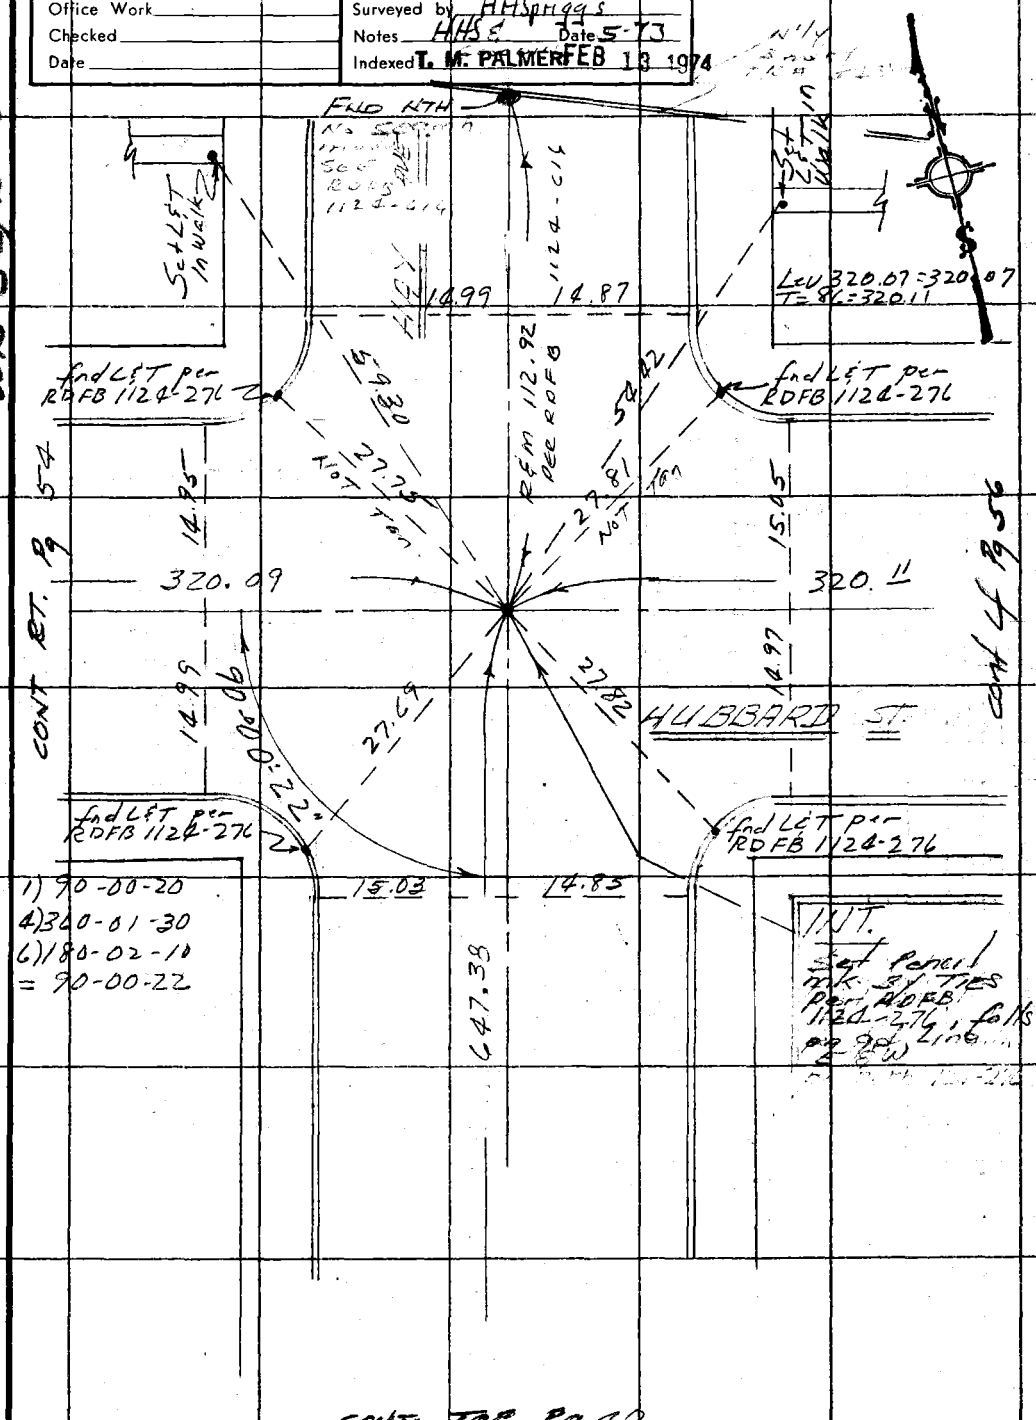

WS 36 B 5

Note: Any Additions or Changes on This Sheet Must be Made or Circled in Red Ink With Date and Name of Person Making Change.

Do not extend this side of this line.

PLEASE RETURN TO
COUNTY OF LOS ANGELES
DEPARTMENT OF COUNTY ENGINEER
403 LOS ANGELES COUNTY ENGINEERING BLDG.

76F309S CE#310 3-68

RDFB 1124 1717

F. B. ~~3513~~ Pg. ~~54~~

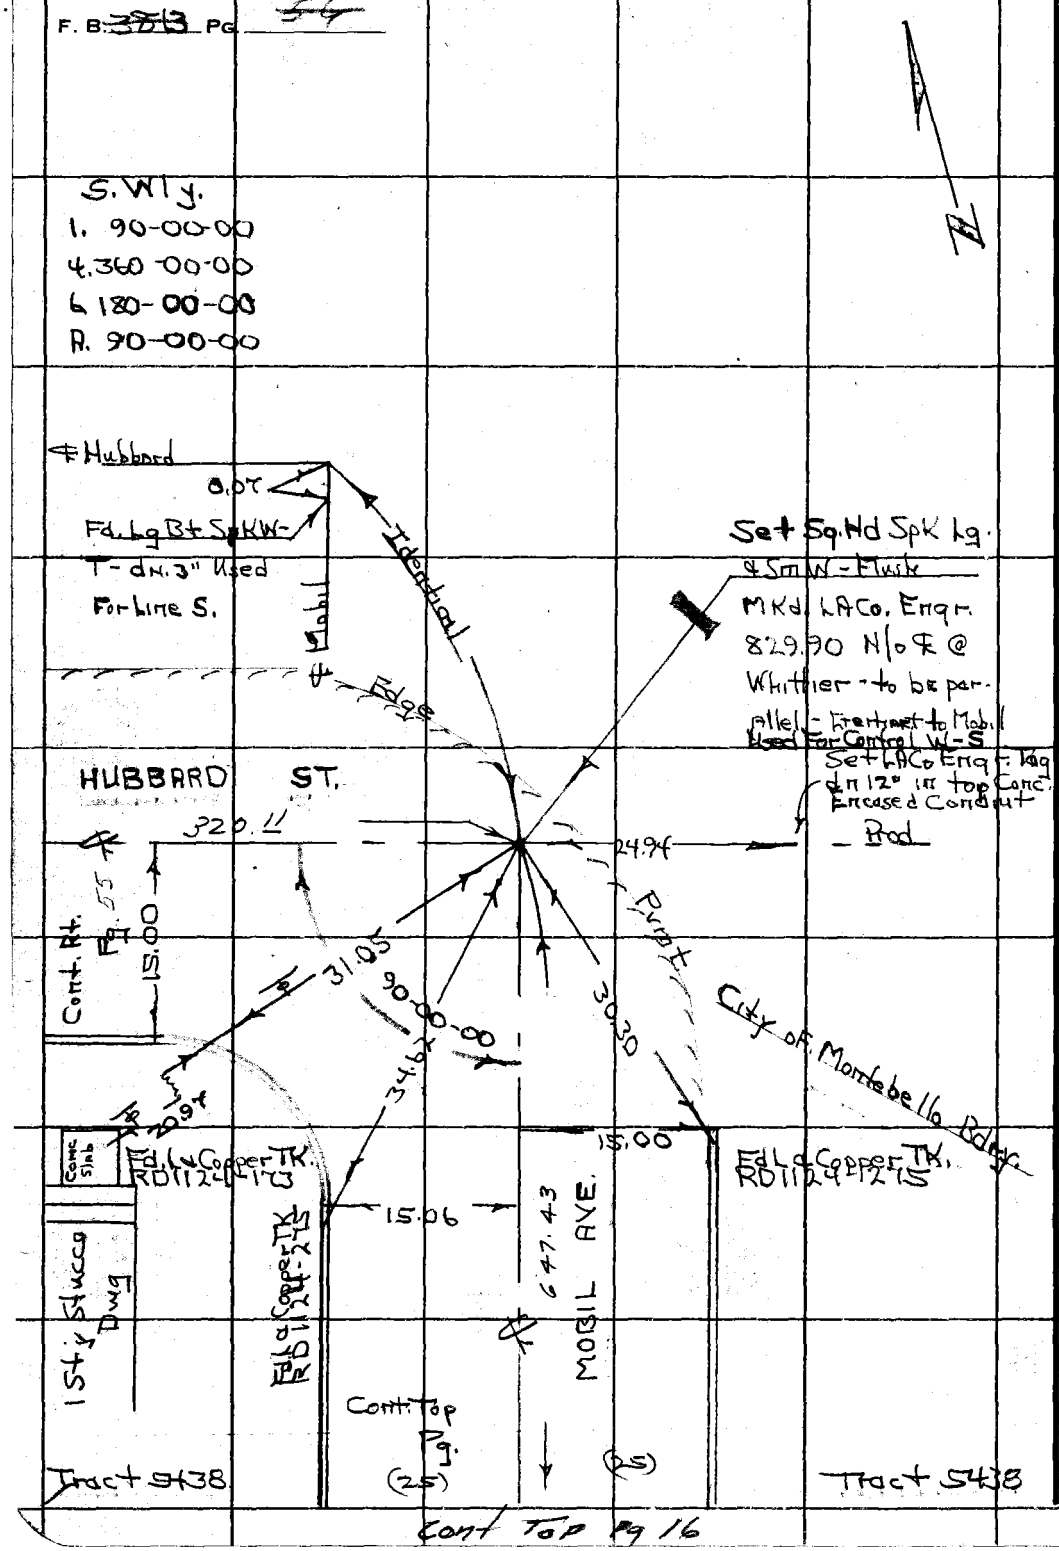

Cont Top Pg 16

PLEASE RETURN TO
COUNTY OF LOS ANGELES
DEPARTMENT OF COUNTY ENGINEER
403 LOS ANGELES COUNTY ENGINEERING BLDG.

Do not extend this side of this line.

Note: Any Additions or Changes on This Sheet Must be Made or Circled in Red Ink With Date and Name of Person Making Change.

WS 36 B-3

RDFB 1224 1476

Notes Ck'd by	Survey of BELVEDERE AREA & F. B. 3813 PG. 57
Map No.	JN 030300 Tape 0247 Std 68 °F
Office Work	Surveyed by HHSpriggs
Checked	Notes HHS Date 5-73
Date	Indexed T. M. PALMERI FEB 13 1974

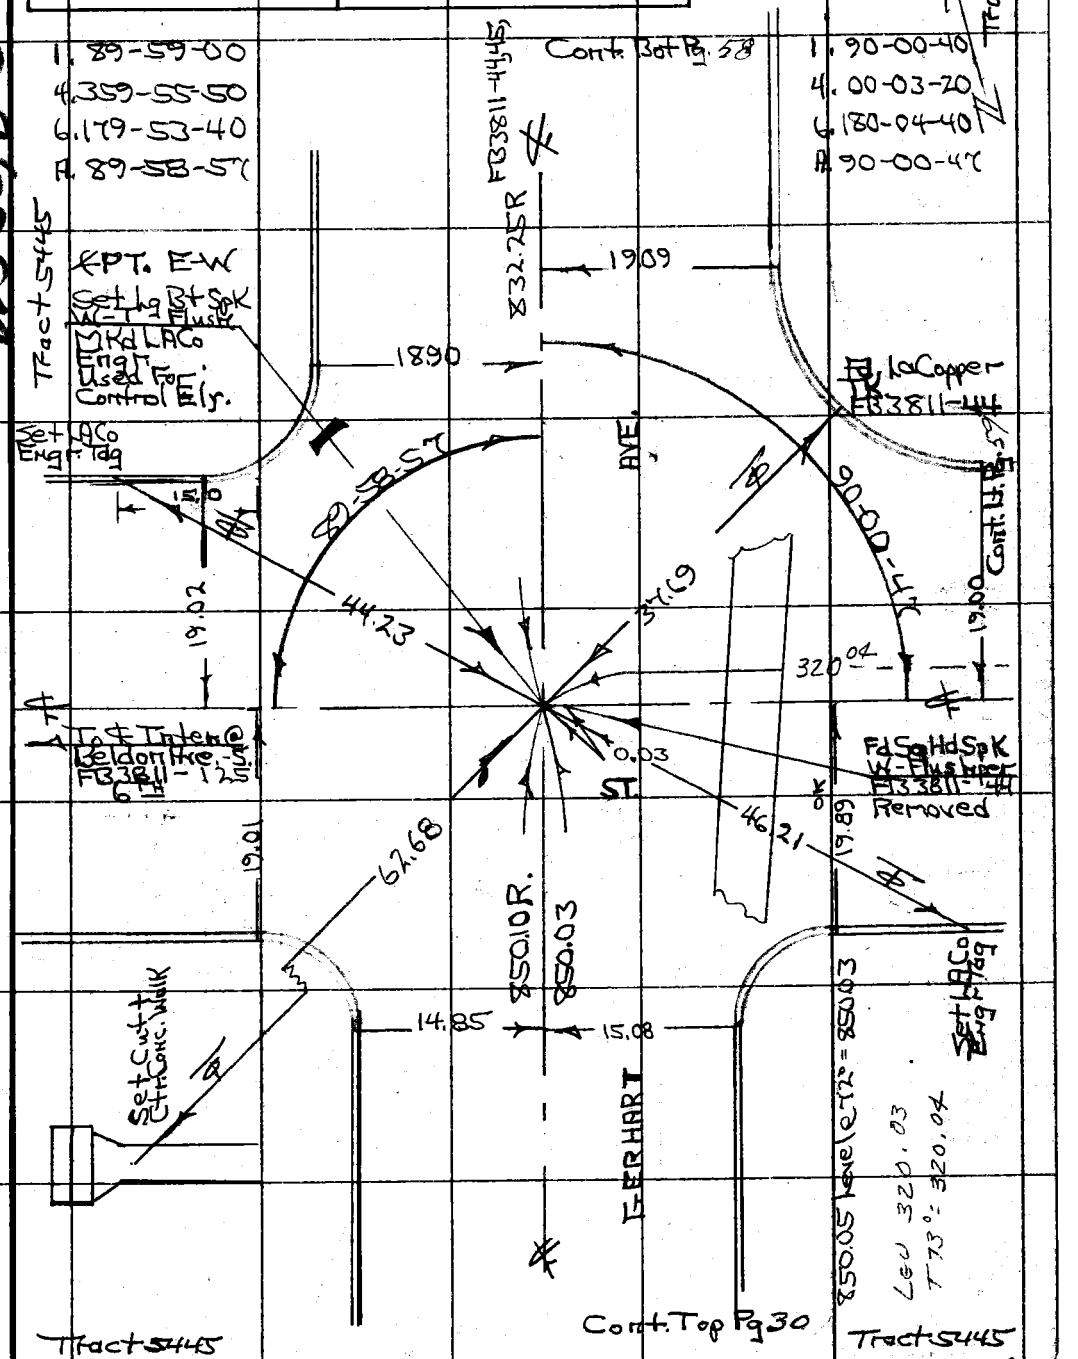

Note: Any Additions or Changes on This Sheet Must be Made or Circled in Red Ink With Date and Name of Person Making Change.

Do not extend this side of this line.

PLEASE RETURN TO
COUNTY OF LOS ANGELES
DEPARTMENT OF COUNTY ENGINEER
403 LOS ANGELES COUNTY ENGINEERING BLDG.

76F309S CE#310 3-68

RDFB 1224 1477, 1478

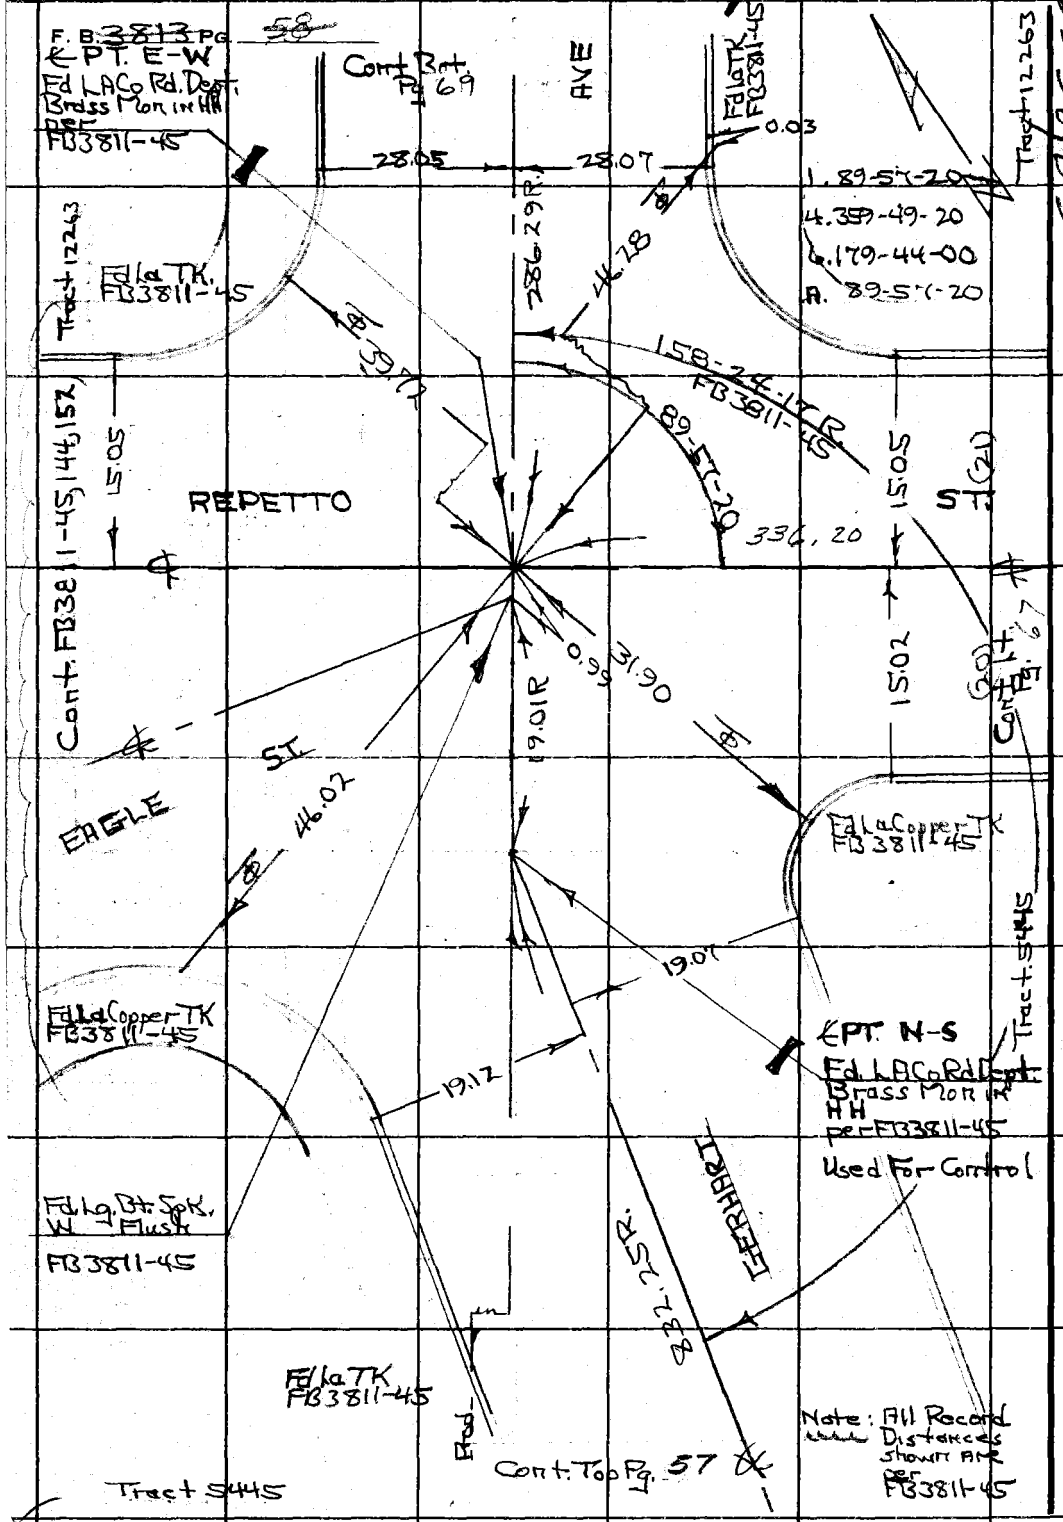

PLEASE RETURN TO
COUNTY OF LOS ANGELES
DEPARTMENT OF COUNTY ENGINEER
403 LOS ANGELES COUNTY ENGINEERING BLDG.

Do not extend this side of this line.

Note: Any Additions or Changes on This Sheet Must be Made or Circled in Red Ink With Date and Name of Person Making Change.

RDFB 1224

1479

Notes Ck'd by	Survey of BELVEDERE AREA
Map No.	JN 0303.00 Tape 0122 Std 68 °F
Office Work	Surveyed by E. LANDA K. KAPP
Checked	Notes D. PETERSON Date 6-73
Date	Indexed T. M. PALMER FEB 13 1974

F. B. ~~3813~~ PG. ~~59~~

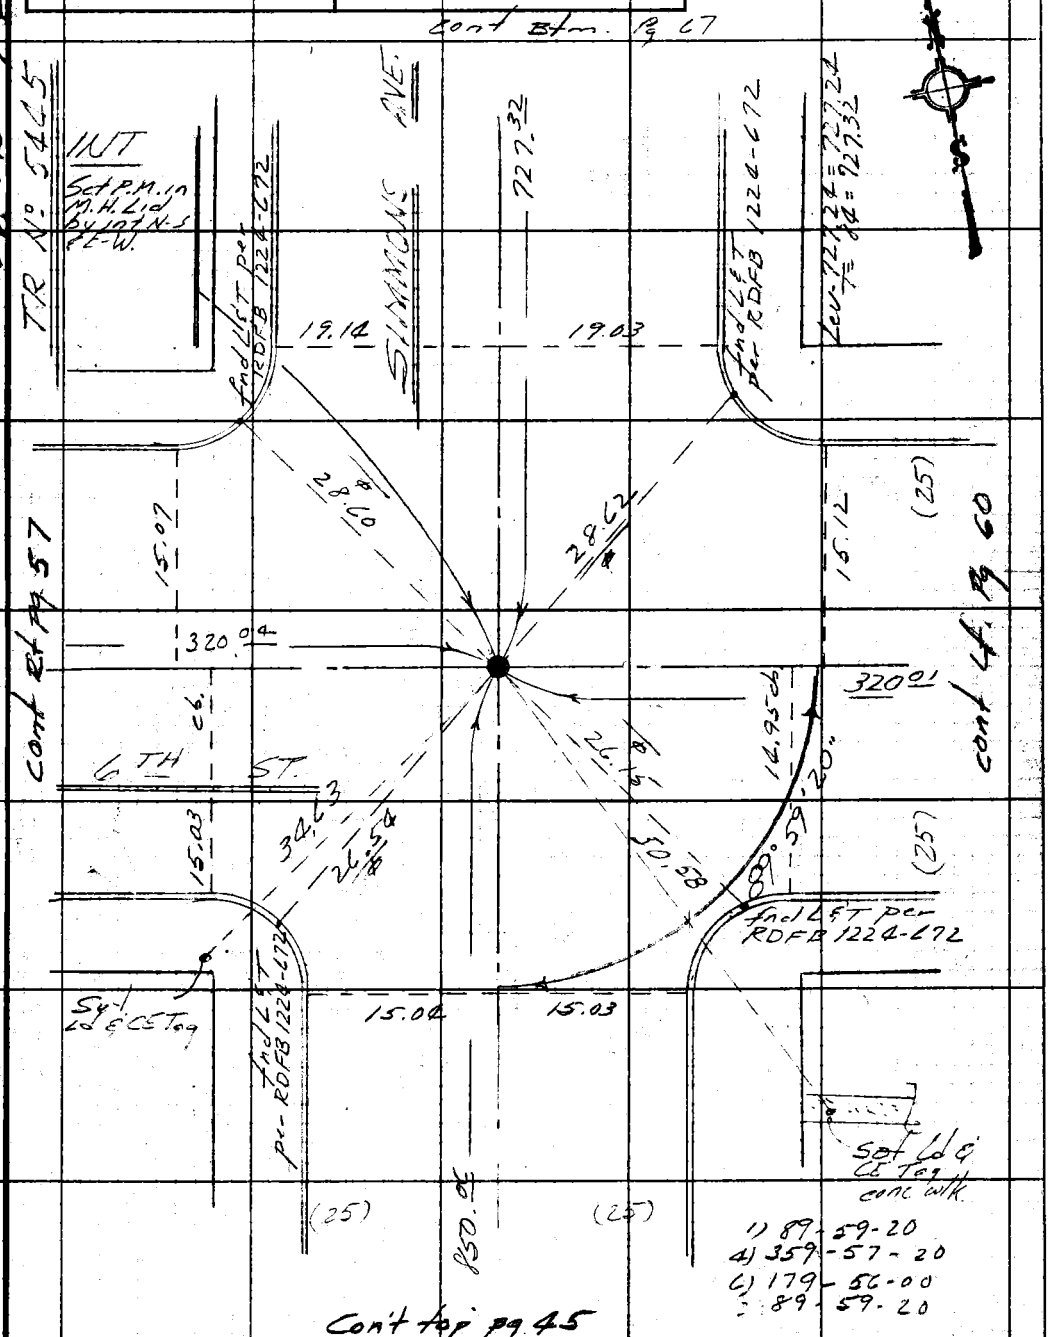

Note: Any Additions or Changes on This Sheet Must be Made or Circled in Red Ink With Date and Name of Person Making Change.

Do not extend this side of this line.

PLEASE RETURN TO
COUNTY OF LOS ANGELES
DEPARTMENT OF COUNTY ENGINEER
403 LOS ANGELES COUNTY ENGINEERING BLDG.

76F309S CE#310 3-69

RDFB 1224 1480

F. B. ~~3817~~ PG. ~~60~~

cont Bk Pg 68

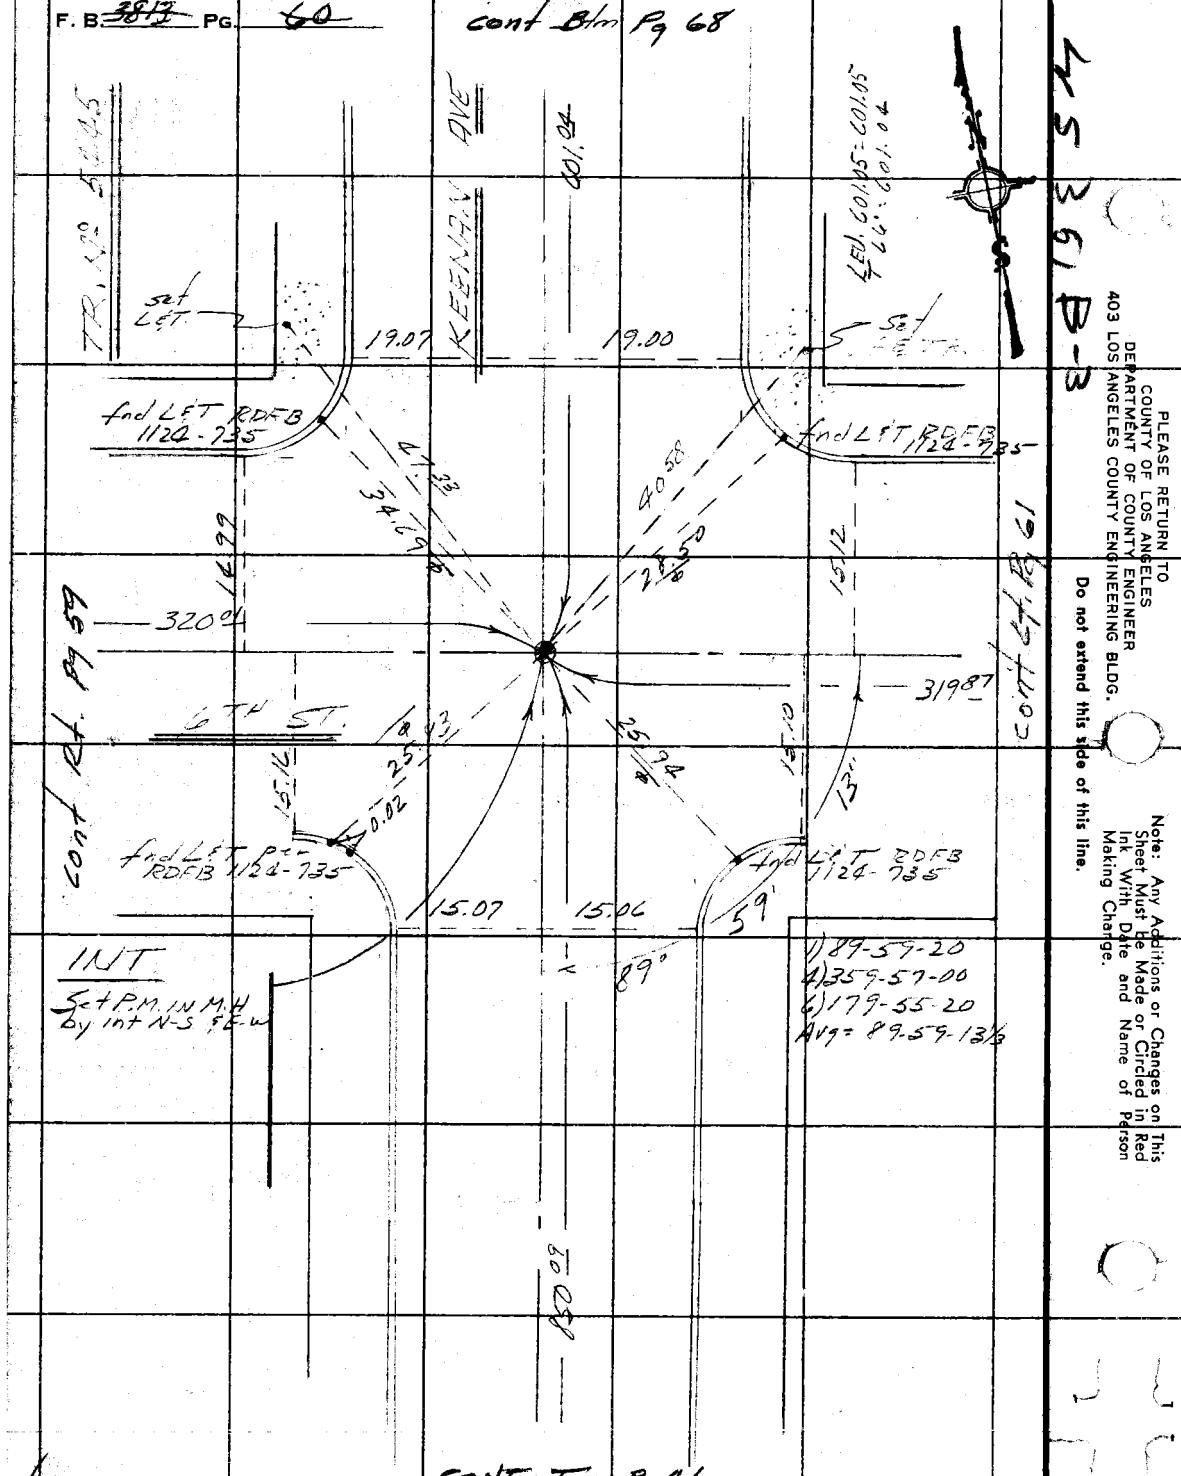

PLEASE RETURN TO
COUNTY OF LOS ANGELES
DEPARTMENT OF COUNTY ENGINEER
403 LOS ANGELES COUNTY ENGINEERING BLDG.

Do not extend this side of this line.

Note: Any Additions or Changes on This Sheet Must Be Made or Circled in Red Ink With Date and Name of Person Making Change.

CONT Top Pg 46

RDFB 1224

1481

Notes Ck'd by	Survey of BELVEDERE AREA
Map No.	JN 0303.00 Tape Std 68 °F
Office Work	Surveyed by K. KAPP
Checked	Notes D. PETERSON Date 6-73
Date	Index E. M. PALMER FEB 18 1974

F. B. ~~1813~~ PG. 61

W.S. 36 B-3

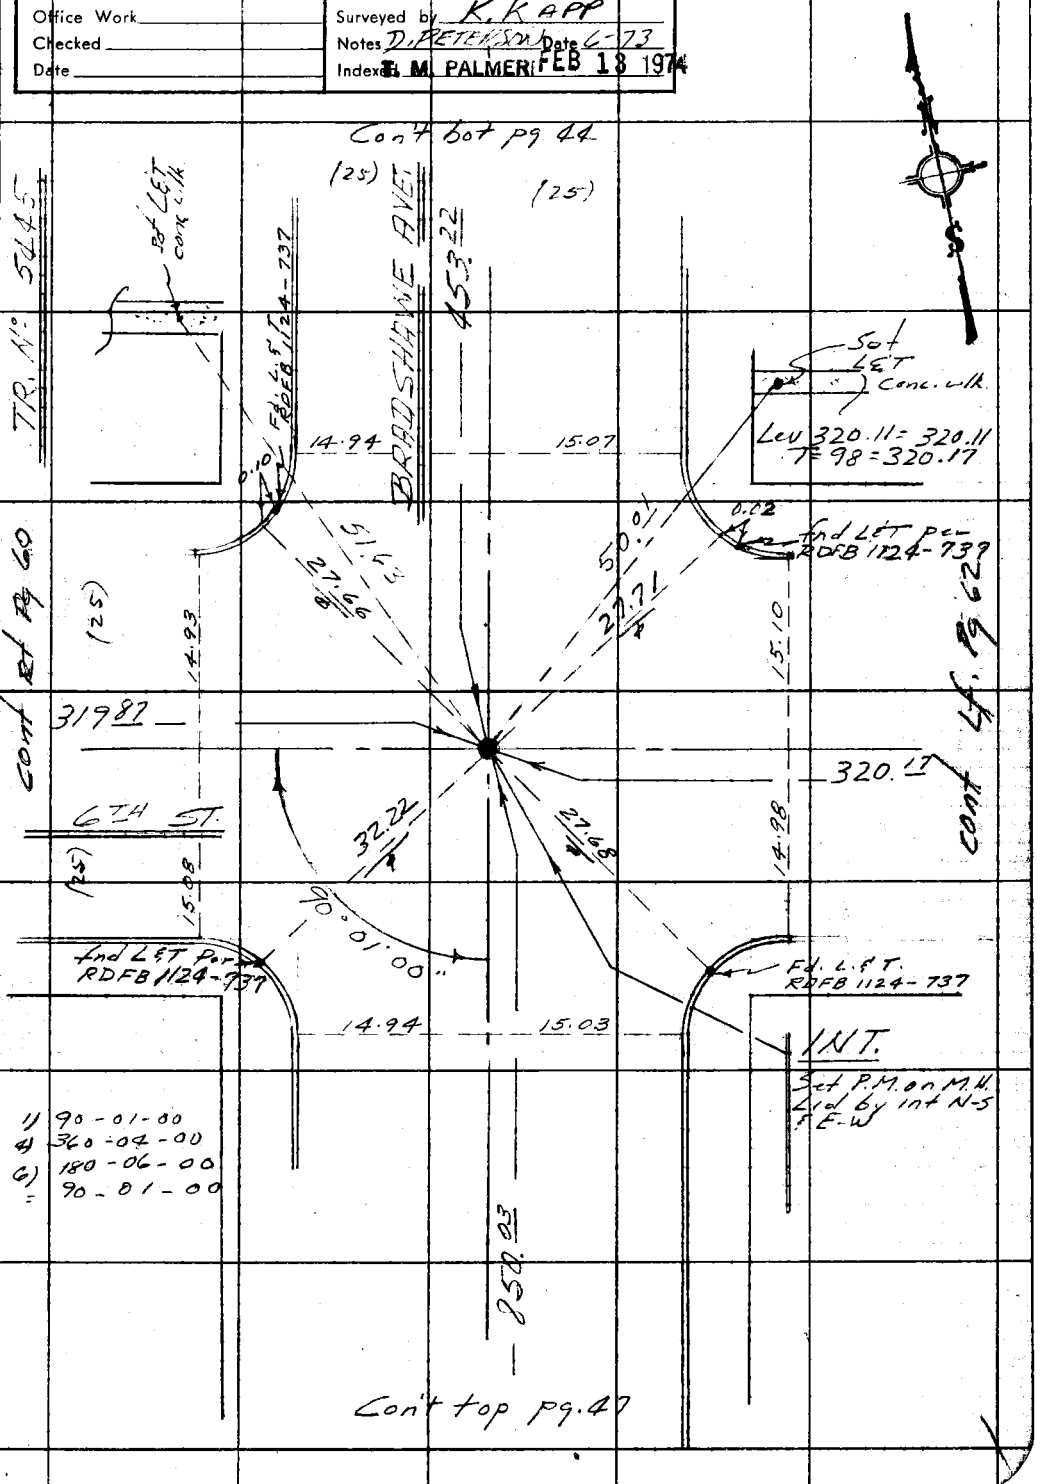

Note: Any Additions or Changes on This Sheet Must be Made or Circled in Red Ink With Date and Name of Person Making Change.

Do not extend this side of this line.

PLEASE RETURN TO
COUNTY OF LOS ANGELES
DEPARTMENT OF COUNTY ENGINEER
403 LOS ANGELES COUNTY ENGINEERING BLDG.

16F309S CE#310 3-69

RDFB 1224 1482

F. B. ~~39~~ Pg. ~~62~~

CONT. BTM. PG. 81

WS 36, B-3

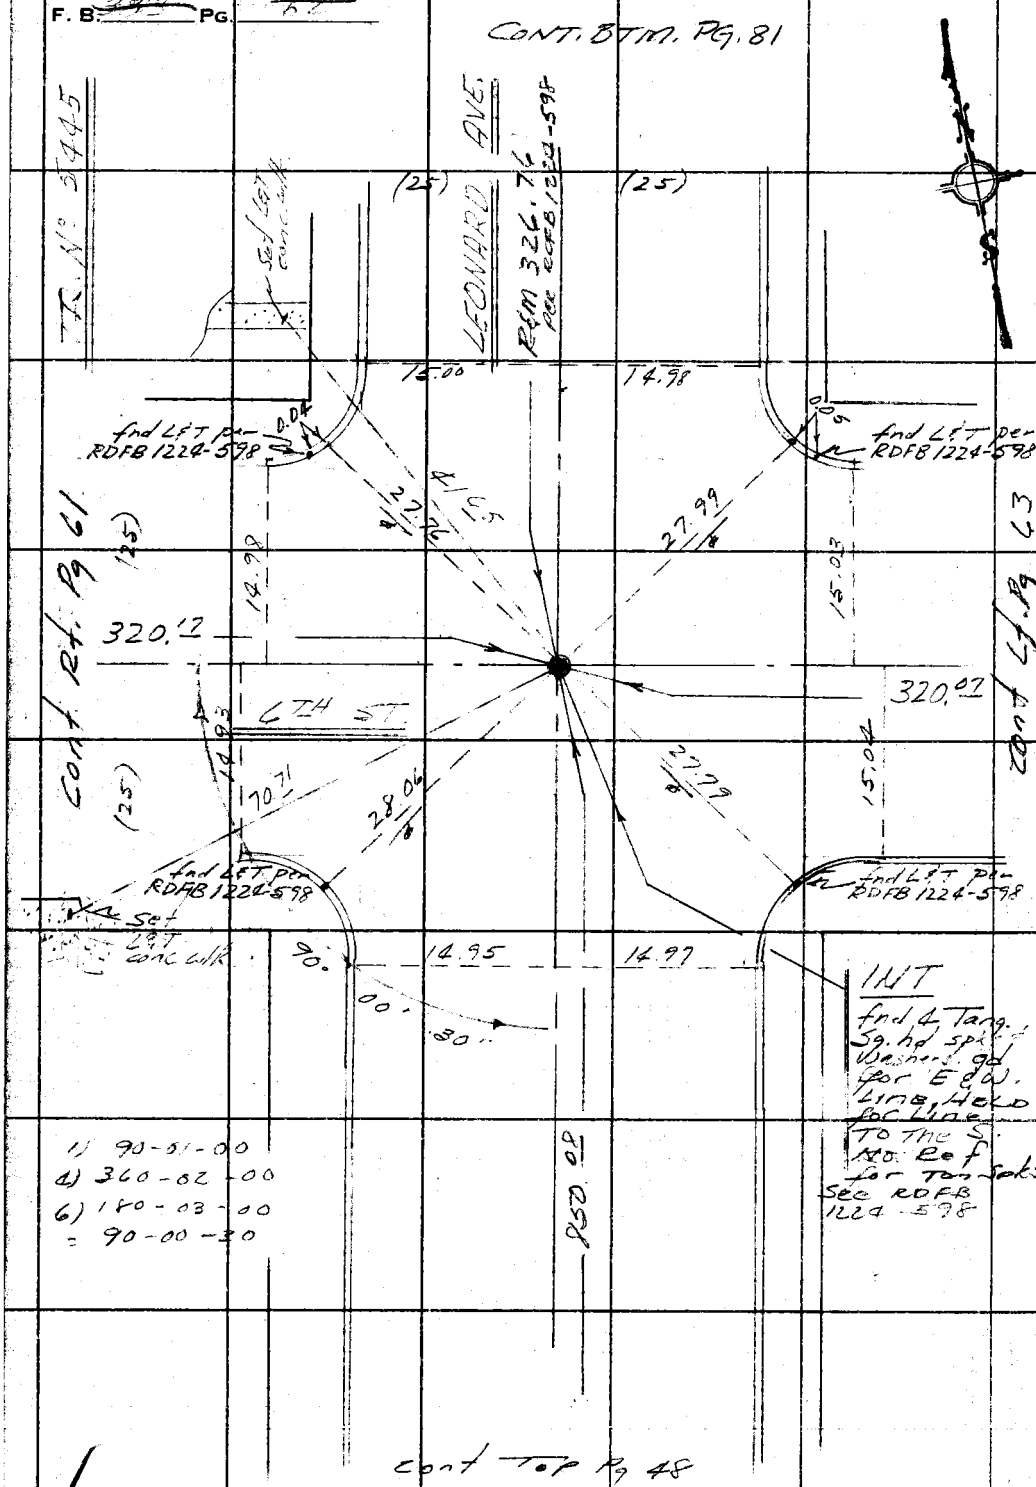

Cont Top Pg 48

PLEASE RETURN TO
COUNTY OF LOS ANGELES
DEPARTMENT OF COUNTY ENGINEER
403 LOS ANGELES COUNTY ENGINEERING BLDG.

Do not extend this side of this line.

Note: Any Additions or Changes on This Sheet Must be Made or Circled in Red Ink With Date and Name of Person Making Change.

RDFB 1224 1483

Notes Ck'd by	Survey of BELVEDERE AREA
Map No.	JN 0303.00 Tape 0122 Std 68 °F
Office Work	Surveyed by K. KAPP
Checked	Notes J. GOODWIN Date 6-73
Date	Indexed I. M. PALMERI FEB 13 1974

F. B. ~~3843~~ PG. ~~63~~

Cont Btm Pg 82

WS36,B-3

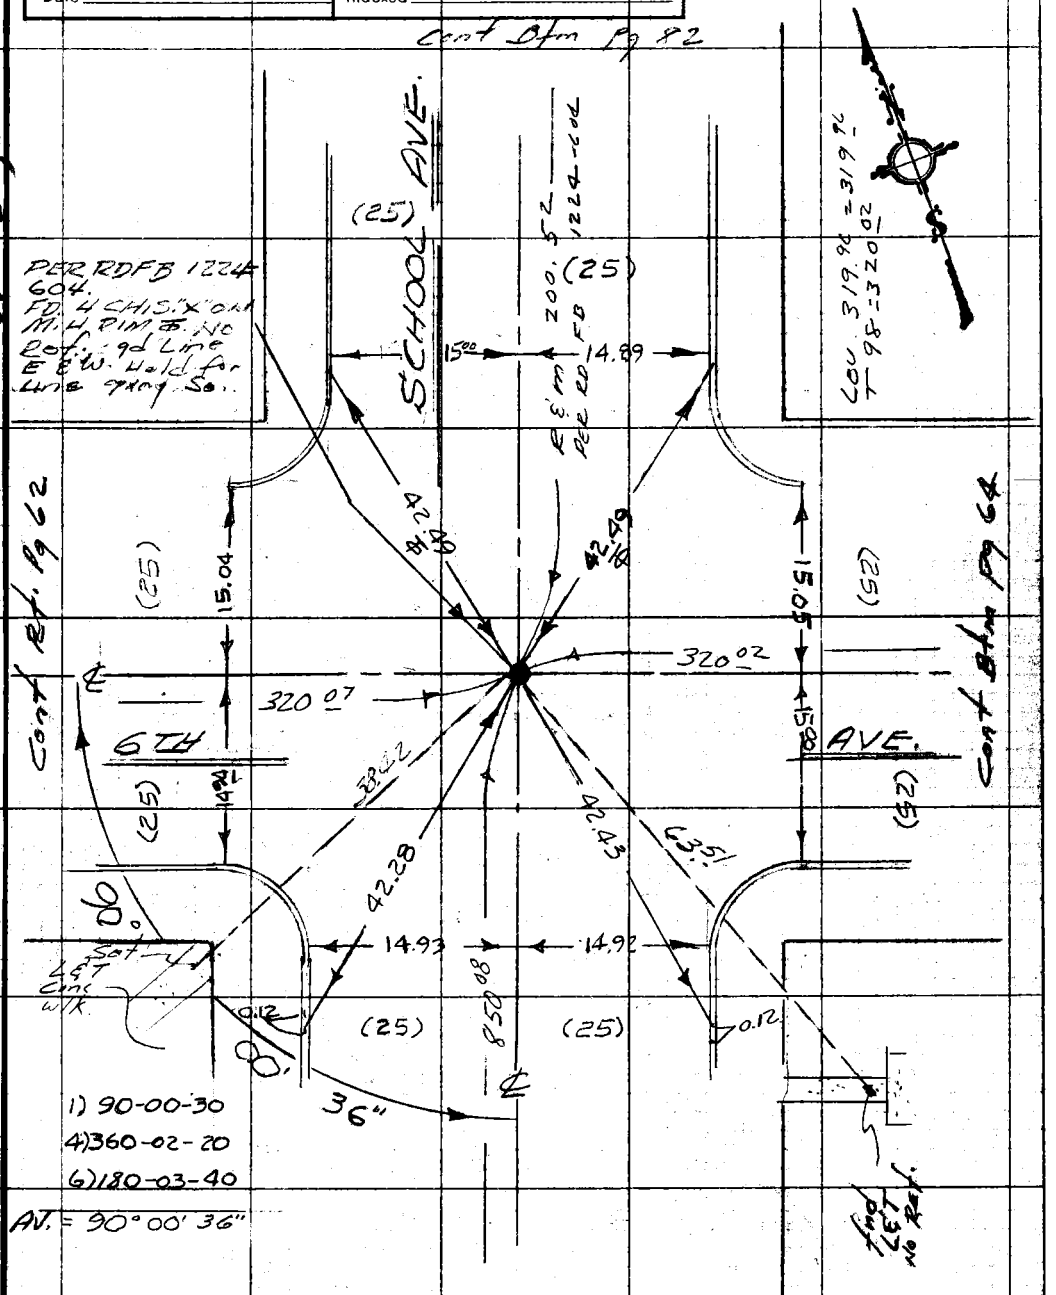

1) 90-00-30
4) 360-02-20
6) 180-03-40

AV. = 90° 00' 36"

Cont Top Pg 49

Note: Any Additions or Changes on This Sheet Must be Made or Circled in Red Ink With Date and Name of Person Making Change.

Do not extend this side of this line.

PLEASE RETURN TO
COUNTY OF LOS ANGELES
DEPARTMENT OF COUNTY ENGINEER
403 LOS ANGELES COUNTY ENGINEERING BLDG.

76F309S CE#310 3-69

RDFB 1224

1484

F. B. 3813 PG. 44

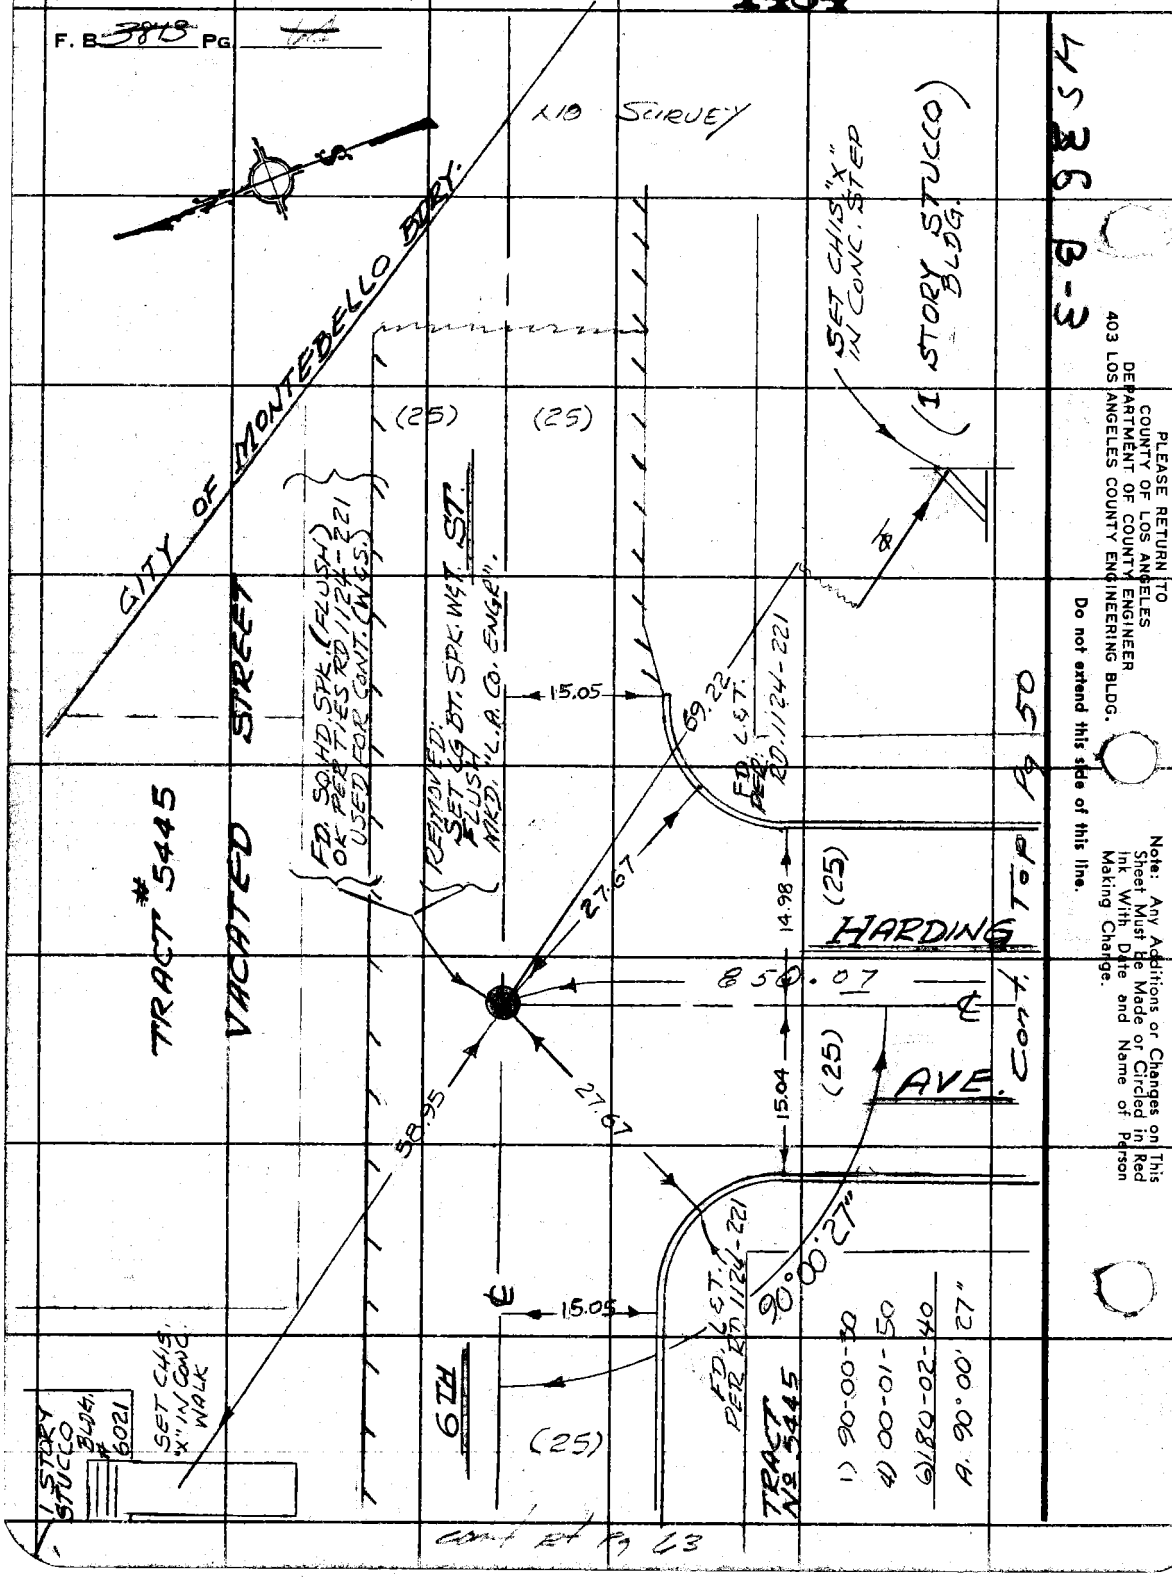

PLEASE RETURN TO
COUNTY OF LOS ANGELES
DEPARTMENT OF COUNTY ENGINEER
403 LOS ANGELES COUNTY ENGINEERING BLDG.

Do not extend this side of this line.

Note: Any Additions or Changes on This Sheet Must be Made or Circled in Red Ink With Date and Name of Person Making Change.

M536 B-3

RDFB 1124

1718

Notes Ck'd by	Survey of Belvedere Area
Map No.	JN 0303.00 Tape 0122 Std 68 °F
Office Work	Surveyed by K. KAPP
Checked	Notes D. Peterson Date 6-73
Date	Indexed J. M. PALMER FEB 13 1974

F. B. ~~2048~~ PG. ~~65~~

Con't bot pg. ~~52~~ 53 CVC

Note: Any Additions or Changes on This Sheet Must be Made or Circled in Red Ink With Date and Name of Person Making Change.

Do not extend this side of this line.

PLEASE RETURN TO
COUNTY OF LOS ANGELES
DEPARTMENT OF COUNTY ENGINEER
403 LOS ANGELES COUNTY ENGINEERING BLDG.

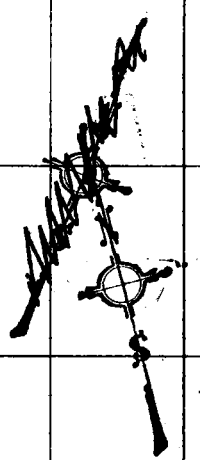

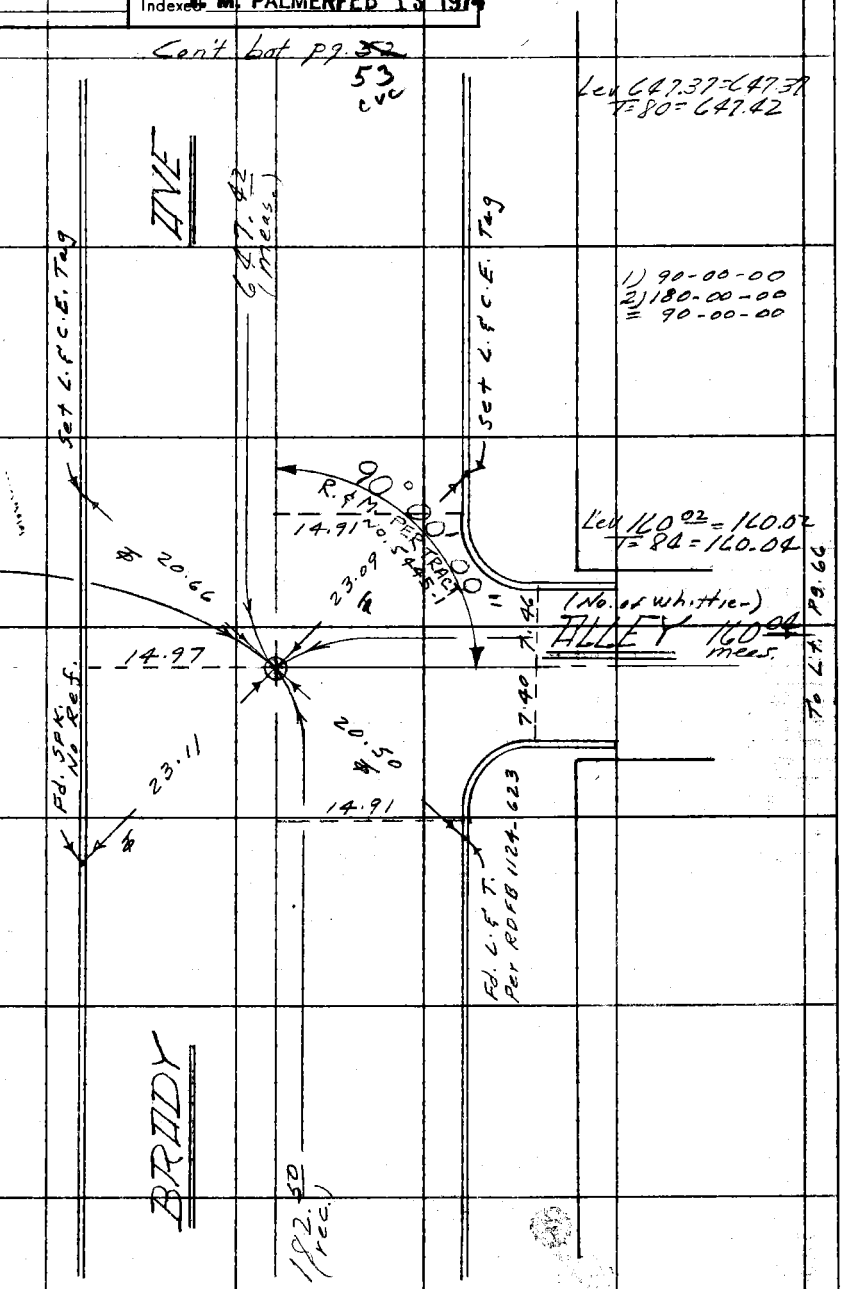

INT.
Set 1/2 bt. spk. within flush by using Tract record from Whittier Blvd North per Tract 5445-1 & on NES line.

Con't top pg. 20

X

16F309S CE#310 3-69

RDFB 1124 1719

F. B. 3813 PG. 66

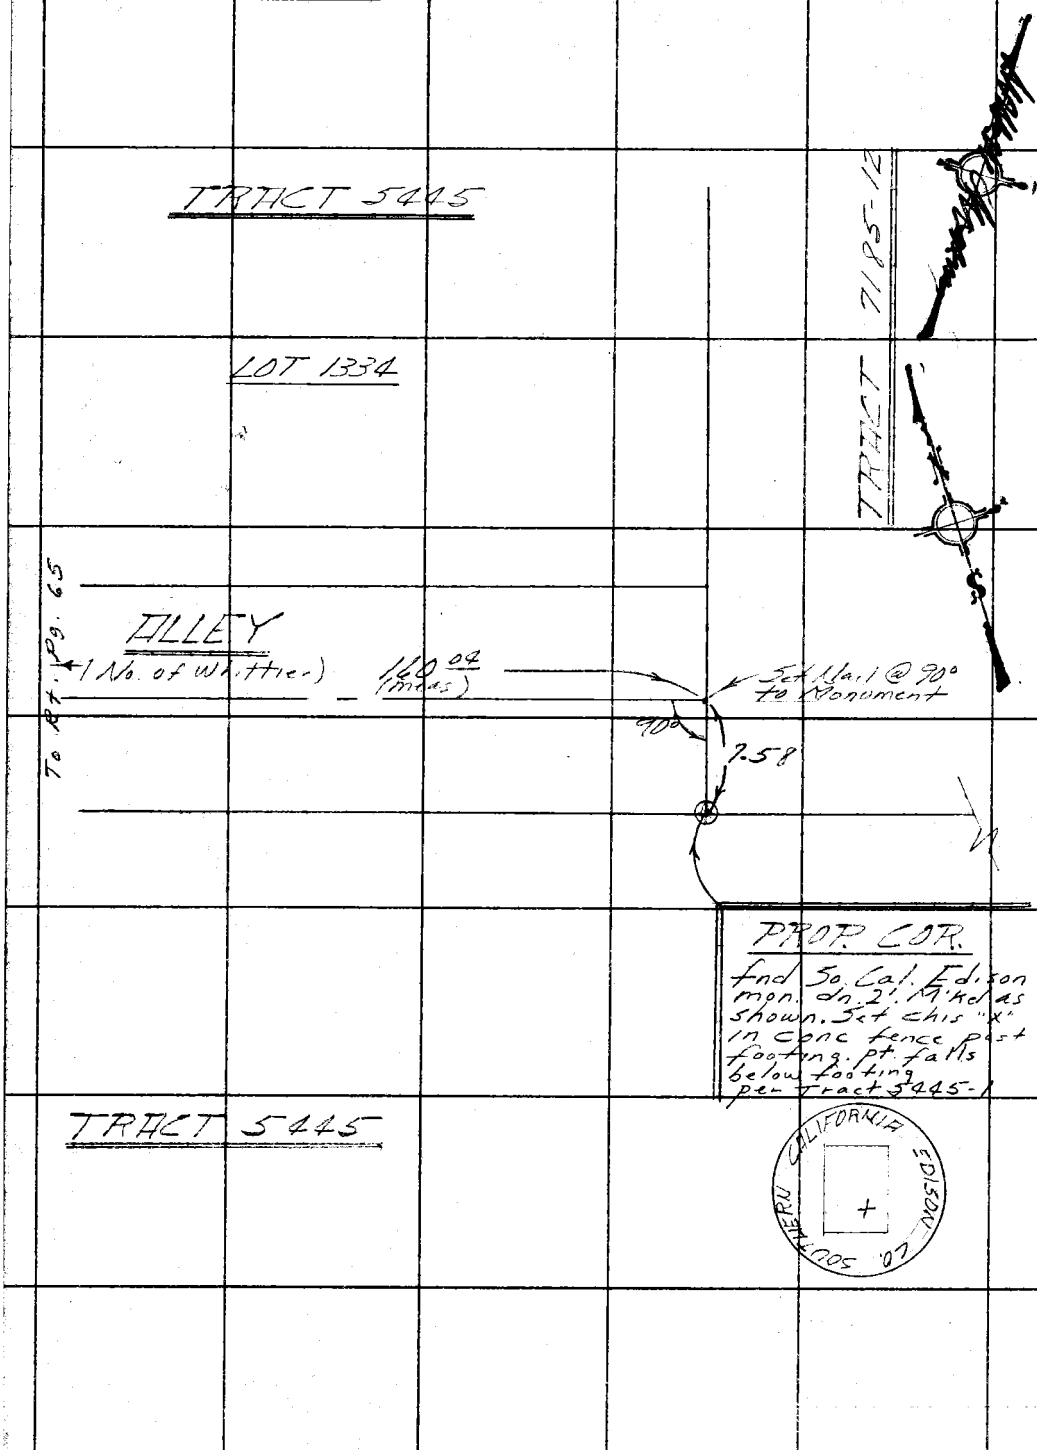

PLEASE RETURN TO
COUNTY OF LOS ANGELES
DEPARTMENT OF COUNTY ENGINEER
403 LOS ANGELES COUNTY ENGINEERING BLDG.

Do not extend this side of this line.

Note: Any Additions or Changes on This Sheet Must be Made or Circled in Red Ink With Date and Name of Person Making Change.

RDFB 1224 1485

Notes Ck'd by	Survey of 8108 ALVEDERE AREA d
Map No.	JN 6303.00 Tape 0122 Std 68 °F
Office Work	Surveyed by K. KAPP
Checked	Notes D. PETERSON Date 7-3-73
Date	Index T. M. PALMERI FEB 13 1974

F. B. ~~3815~~ PG. 67

WS 36 B-3

NOTE: FND LET TIES PER RDFB 1224-672 B

TR Nº 12263

FND. L.A. CO. RD. DEPT MON IN H.H. Held for line going S'ly per RDFB 1224-672B-672

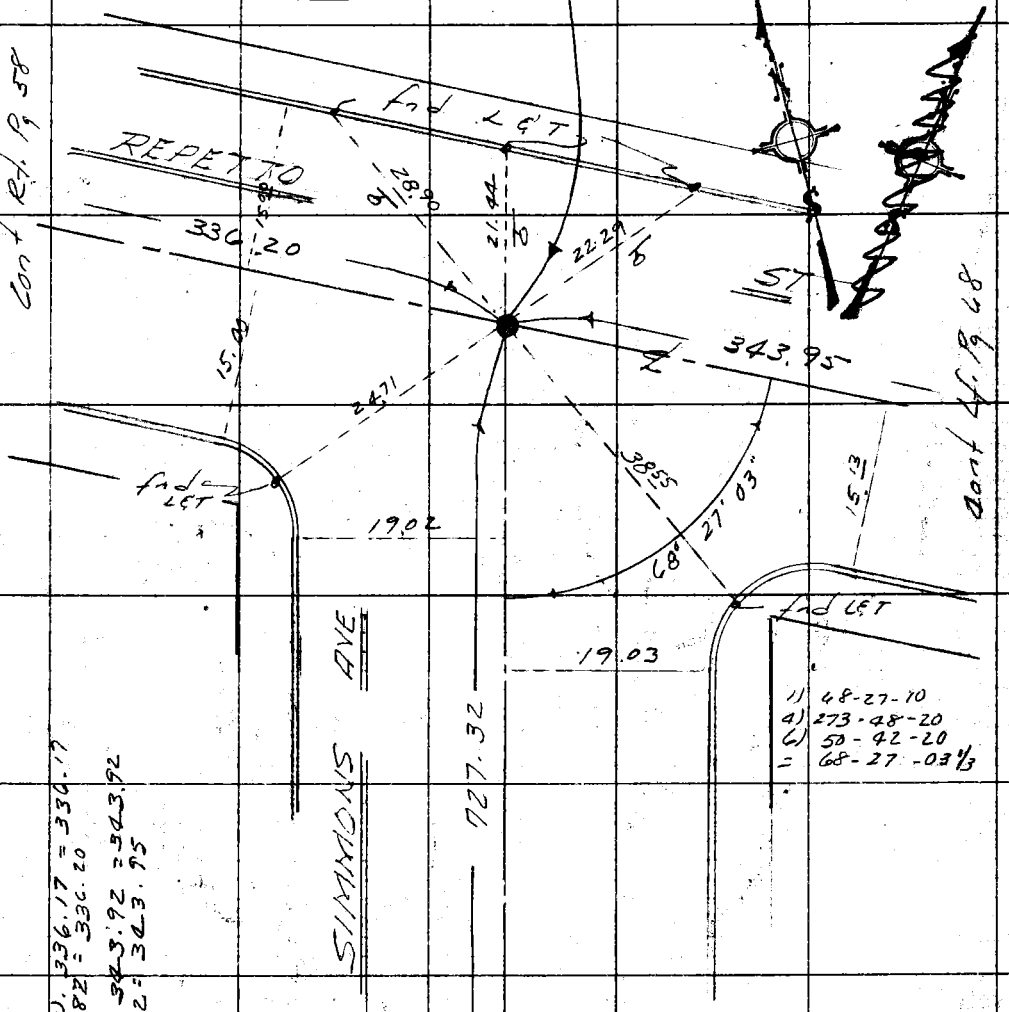

Note: Any Additions or Changes on This Sheet Must be Made or Circled in Red Ink With Date and Name of Person Making Change.

Do not extend this side of this line.

PLEASE RETURN TO
COUNTY OF LOS ANGELES
DEPARTMENT OF COUNTY ENGINEER
403 LOS ANGELES COUNTY ENGINEERING BLDG.

76F309S CE#310 3-69

RDFB 1224

1486

F. B. ~~3813~~ PG. ~~68~~

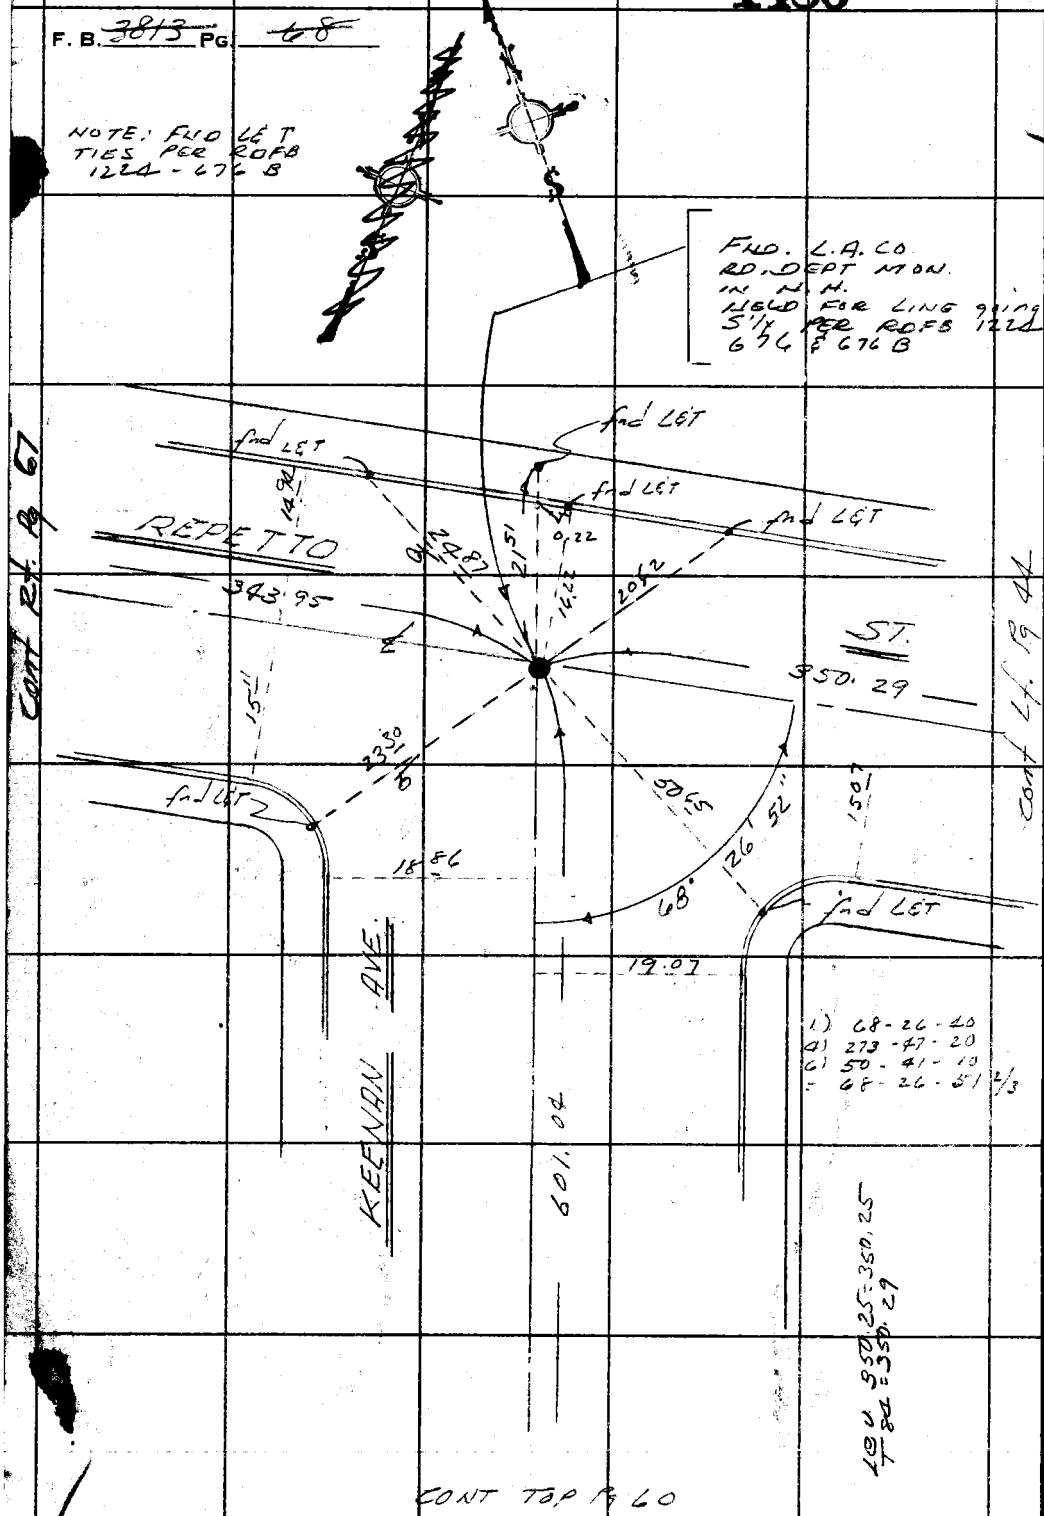

WS 369-3

PLEASE RETURN TO
COUNTY OF LOS ANGELES
DEPARTMENT OF COUNTY ENGINEER
403 LOS ANGELES COUNTY ENGINEERING BLDG.

Do not extend this side of this line.

Note: Any Additions or Changes on This Sheet Must be Made or Circled in Red Ink With Date and Name of Person Making Change.

RDFB 1224 1487

Notes Ck'd by	Survey of Belvedere Area
Map No.	JN 0303.00 Tape 0247 Std 68 °F
Office Work	Surveyed by HHSpriggs
Checked	Notes HHS Date 5-73
Date	Indexed M. PALMERI FEB 13 1974

F. B. ~~3813~~ PG. 69

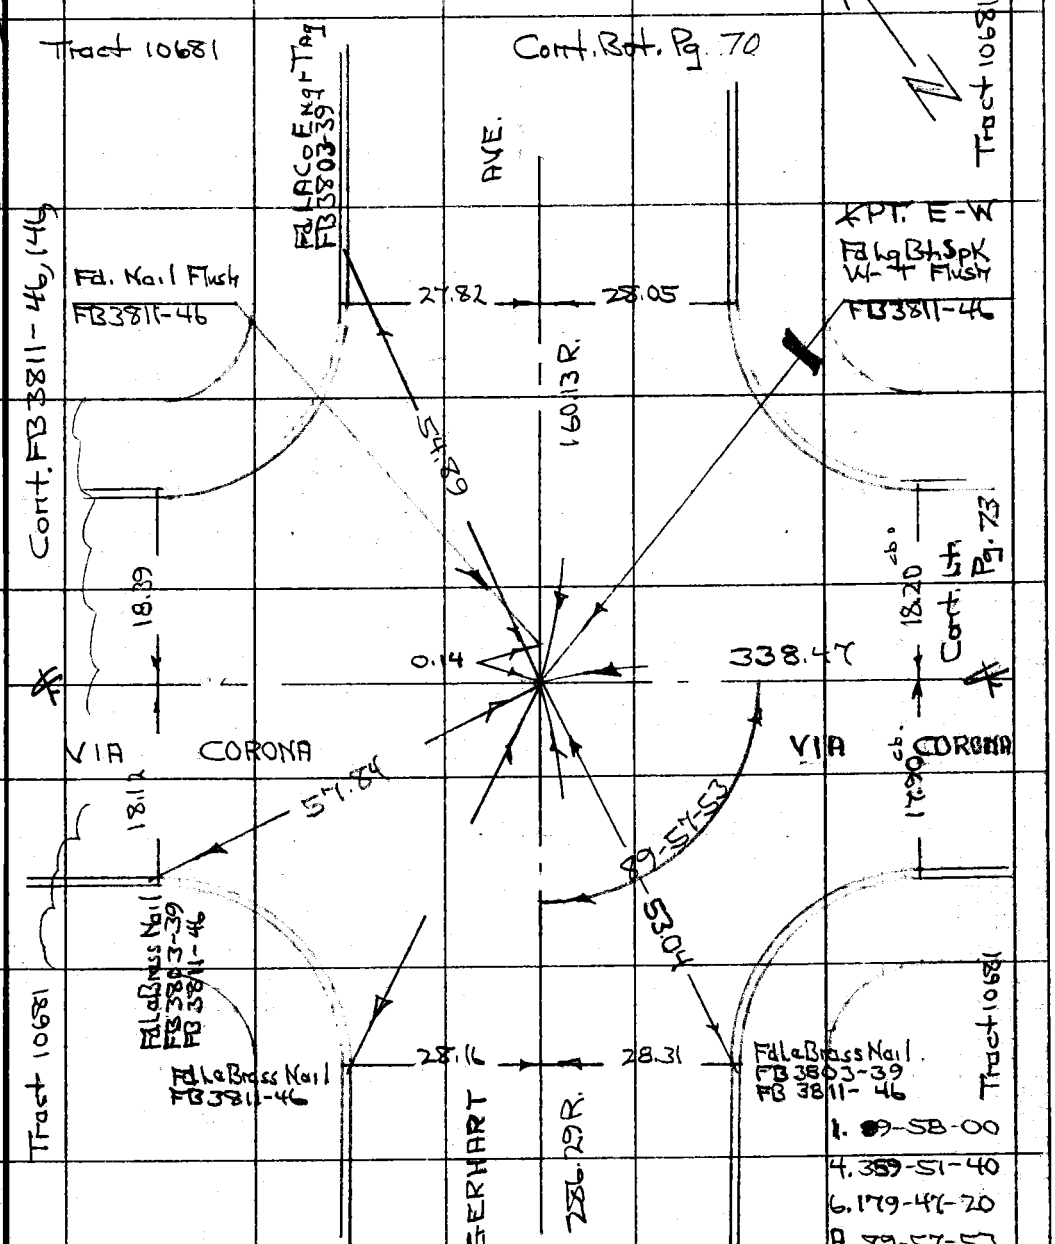

W536 B-3

Note: Any Additions or Changes on This Sheet Must be Made or Circled in Red Ink With Date and Name of Person Making Change.

Do not extend this side of this line.

PLEASE RETURN TO
COUNTY OF LOS ANGELES
DEPARTMENT OF COUNTY ENGINEER
403 LOS ANGELES COUNTY ENGINEERING BLDG.

76F309S CE#310 3-68

RDFB 1224 1488, 1489

F. B. 3813 Pg. 70

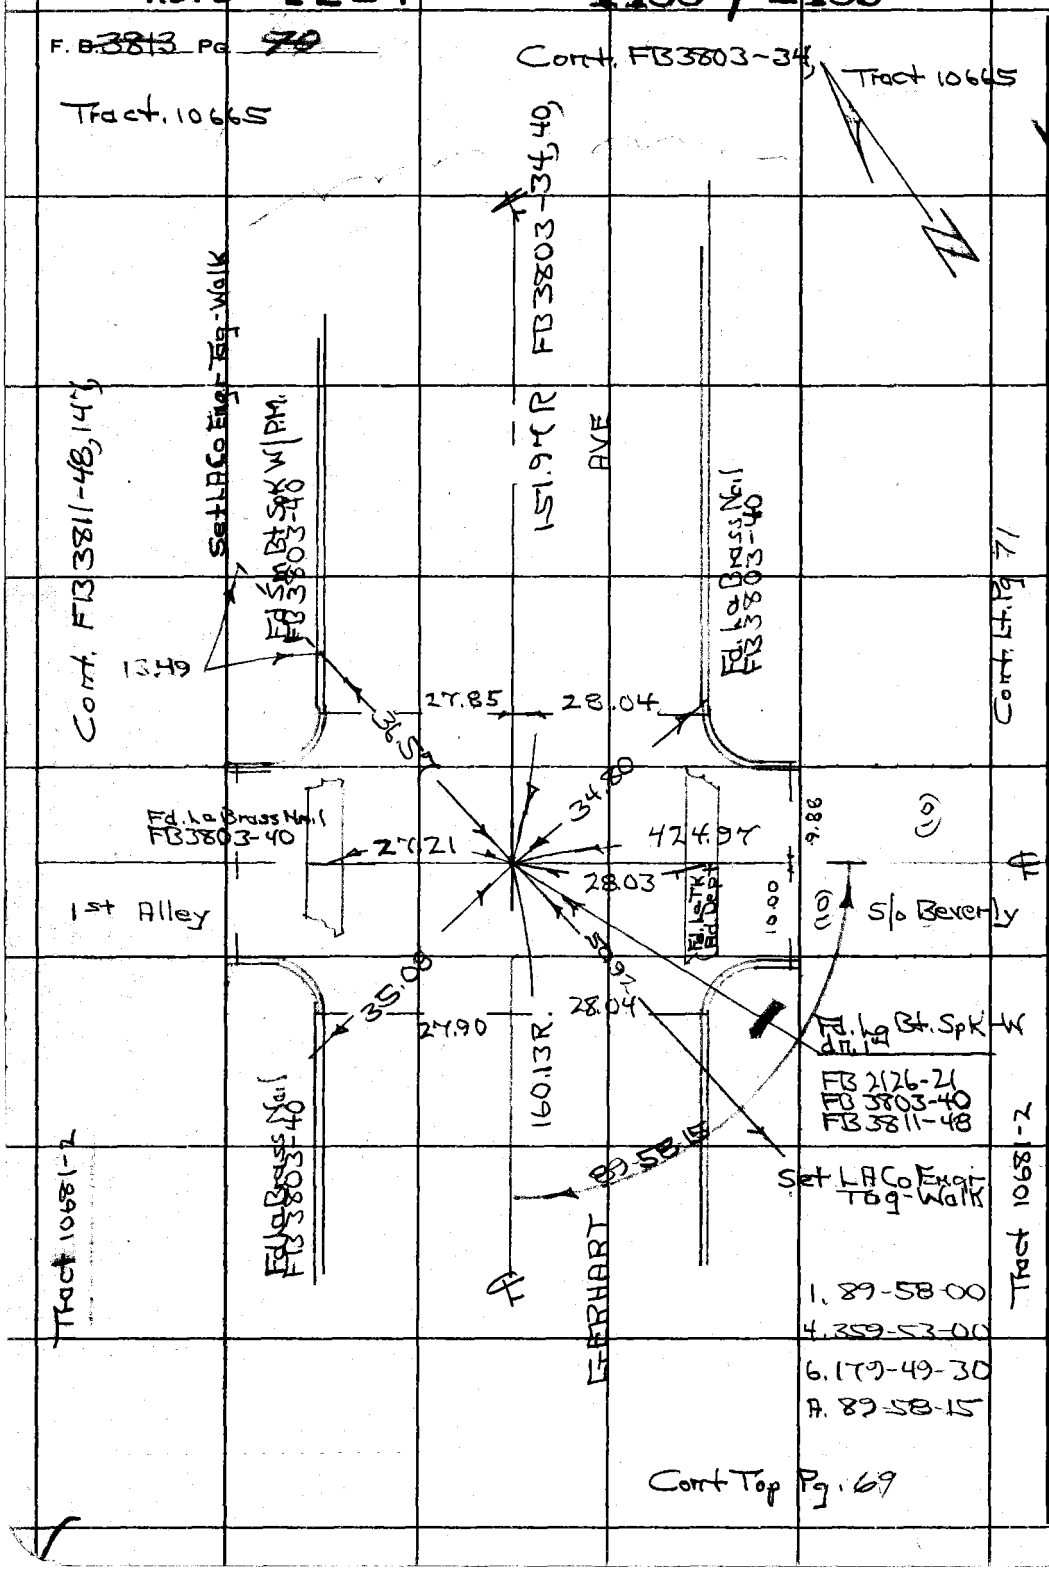

W.S.36, B-3

PLEASE RETURN TO
COUNTY OF LOS ANGELES
DEPARTMENT OF COUNTY ENGINEER
403 LOS ANGELES COUNTY ENGINEERING BLDG.

Do not extend this side of this line.

Note: Any Additions or Changes on This Sheet Must be Made or Circled in Red Ink With Date and Name of Person Making Change.

RDFB 1224 1490

Notes Ck'd by	Survey of BELVEDERE AREA E
Map No.	JN 03B300 Tape 047 Std 65 °F
Office Work	Surveyed by HH SPRINGS
Checked	Notes HHS Date 5-4-73
Date	Indexed T. M. PALMERI FEB 13 1974

F. B. ~~3813~~ Pg. 74

TRACT 10665

N

Cont. Lt. Pg. 70

Cont. Lt. Pg. 72

Fd. ¾" IP Conc Plug & Tag-Flush LS 2427

Fd. ¾" IP Conc. Plug & Tag-Flush LS 2427

(10)

10.01

9.99

424.97

25.00

375.46

(10)

1st Alley

Set Conc. Nail

Set Conc. Nail

S/o Beverly

375.44 Level @ 76° = 376.46

25.00 " " 76° = 25.00

424.95 " " 76° = 424.97

TRACT 10681

Note: Any Additions or Changes on this Sheet Must be Made or Circled in Red Ink With Date and Name of Person Making Change.

Do not extend this side of this line.

PLEASE RETURN TO
COUNTY OF LOS ANGELES
DEPARTMENT OF COUNTY ENGINEER
403 LOS ANGELES COUNTY ENGINEERING BLDG.

76F3005 CE#310 3-68

RDFB 1224 1491

F. B. ~~3813~~ Pg. 72

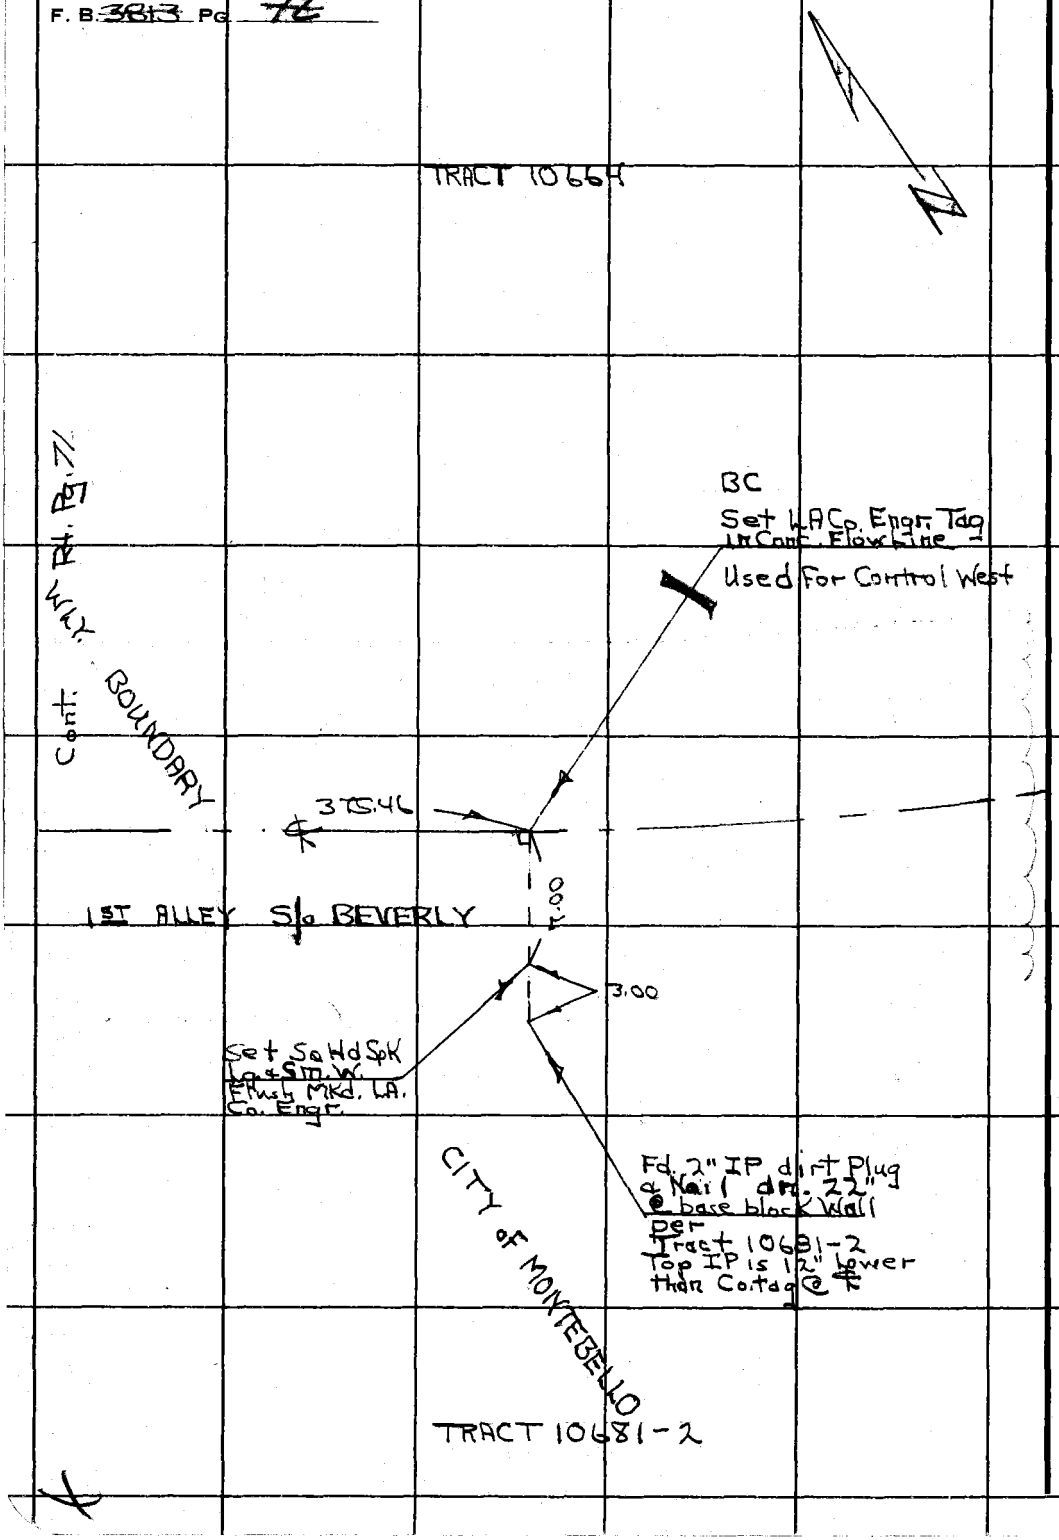

PLEASE RETURN TO
COUNTY OF LOS ANGELES
DEPARTMENT OF COUNTY ENGINEER
403 LOS ANGELES COUNTY ENGINEERING BLDG.

Do not extend this side of this line.

Note: Any Additions or Changes on This Sheet Must be Made or Circled in Red Ink With Date and Name of Person Making Change.

RDFB 1224

1492

Notes Ck'd by	Survey of Belvedere Area &
Map No.	JN0303.00 Tape 0247 Std 68 °F
Office Work	Surveyed by HHSpriggs
Checked	Notes HHS Date 5-73
Date	Indexed T. M. PALMERI FEB 13 1974

F. B. ~~3813~~ PG. ~~73~~

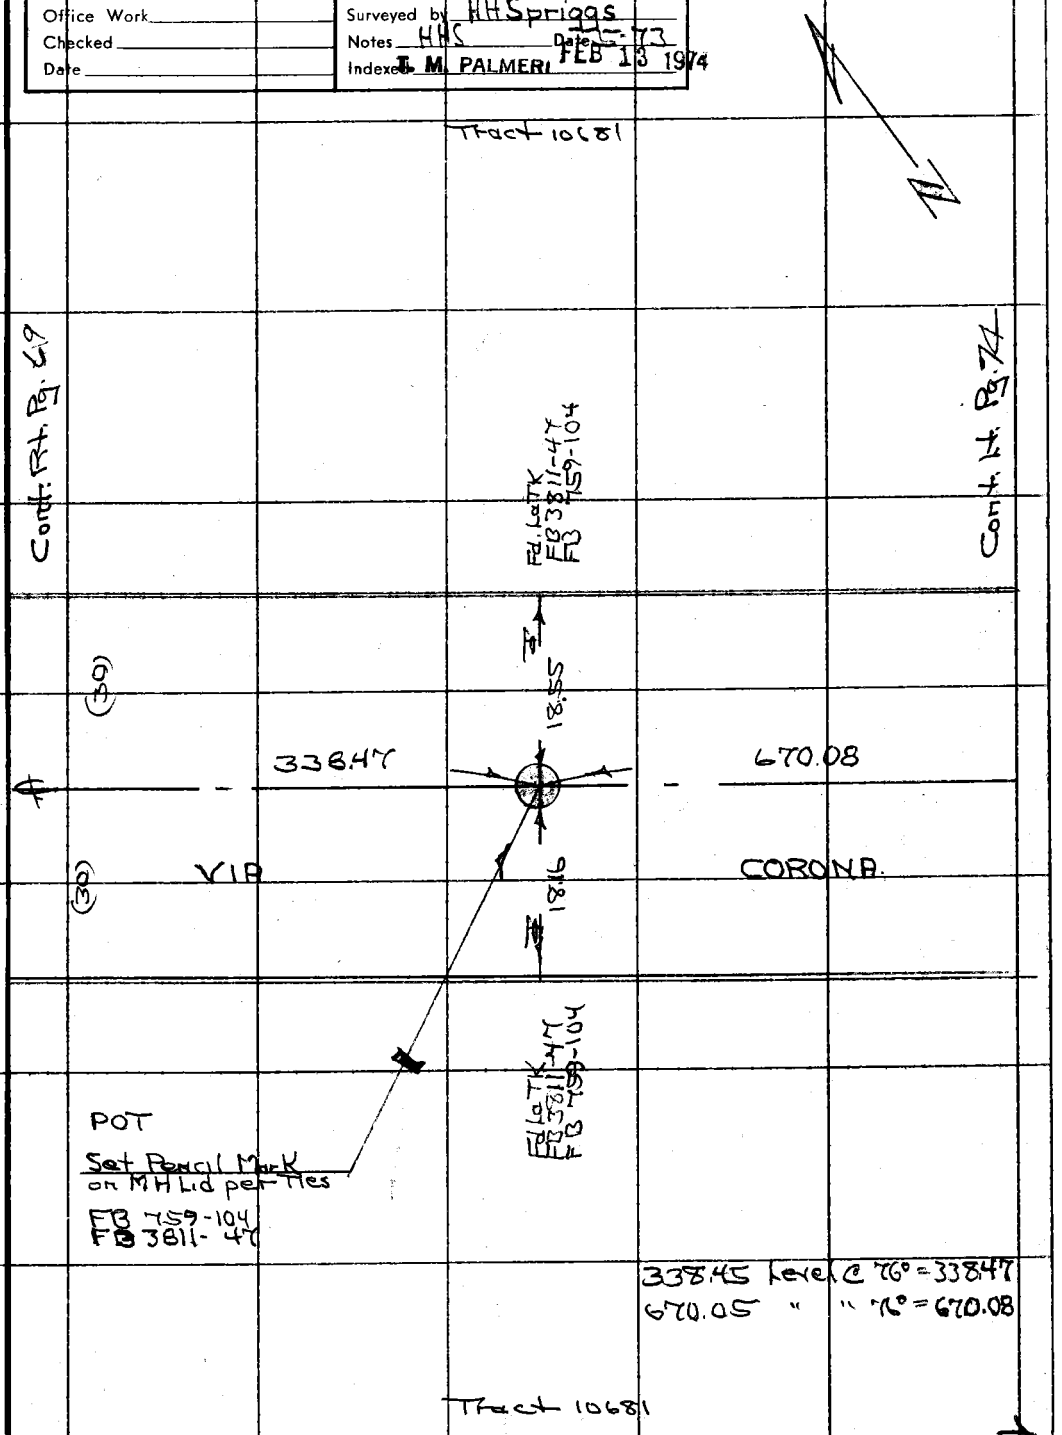

Note: Any Additions or Changes on This Sheet Must be Made or Circled in Red Ink With Date and Name of Person Making Change.

Do not extend this side of this line.

PLEASE RETURN TO
COUNTY OF LOS ANGELES
DEPARTMENT OF COUNTY ENGINEER
403 LOS ANGELES COUNTY ENGINEERING BLDG.

76F309S CE#310 3-68

F. B. ~~3813~~ PG. ~~74~~

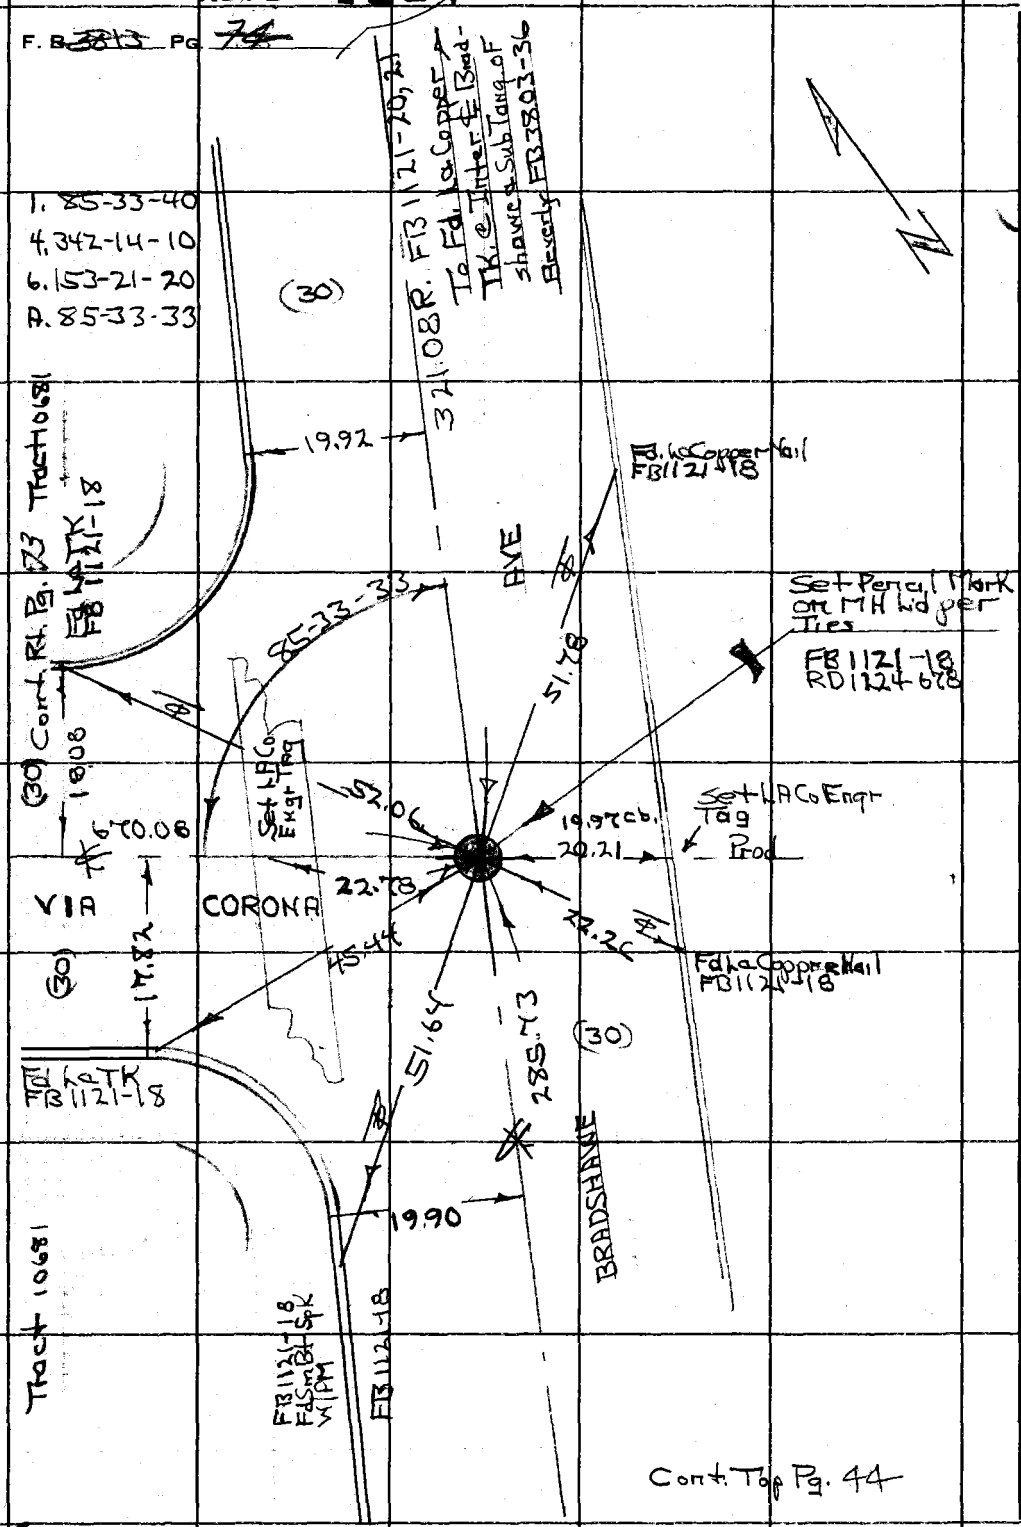

PLEASE RETURN TO
COUNTY OF LOS ANGELES
DEPARTMENT OF COUNTY ENGINEER
403 LOS ANGELES COUNTY ENGINEERING BLDG.

Do not extend this side of this line.

Note: Any Additions or Changes on This Sheet Must be Made or Circled in Red Ink With Date and Name of Person Making Change.

RDFB 1124

1720

Notes Ck'd by	Survey of BELVEDERE AREA ℄
Map No.	JN 0303.00 Tape 0247 Std 68 °F
Office Work	Surveyed by HH SPRIGGS
Checked	Notes HHS Date 4-73
Date	Indexed T. M. PALMERI FEB 18 1974

F. B. 3813 PG. 76

Cont. Bot. Pg 76

W.S 36, B-3

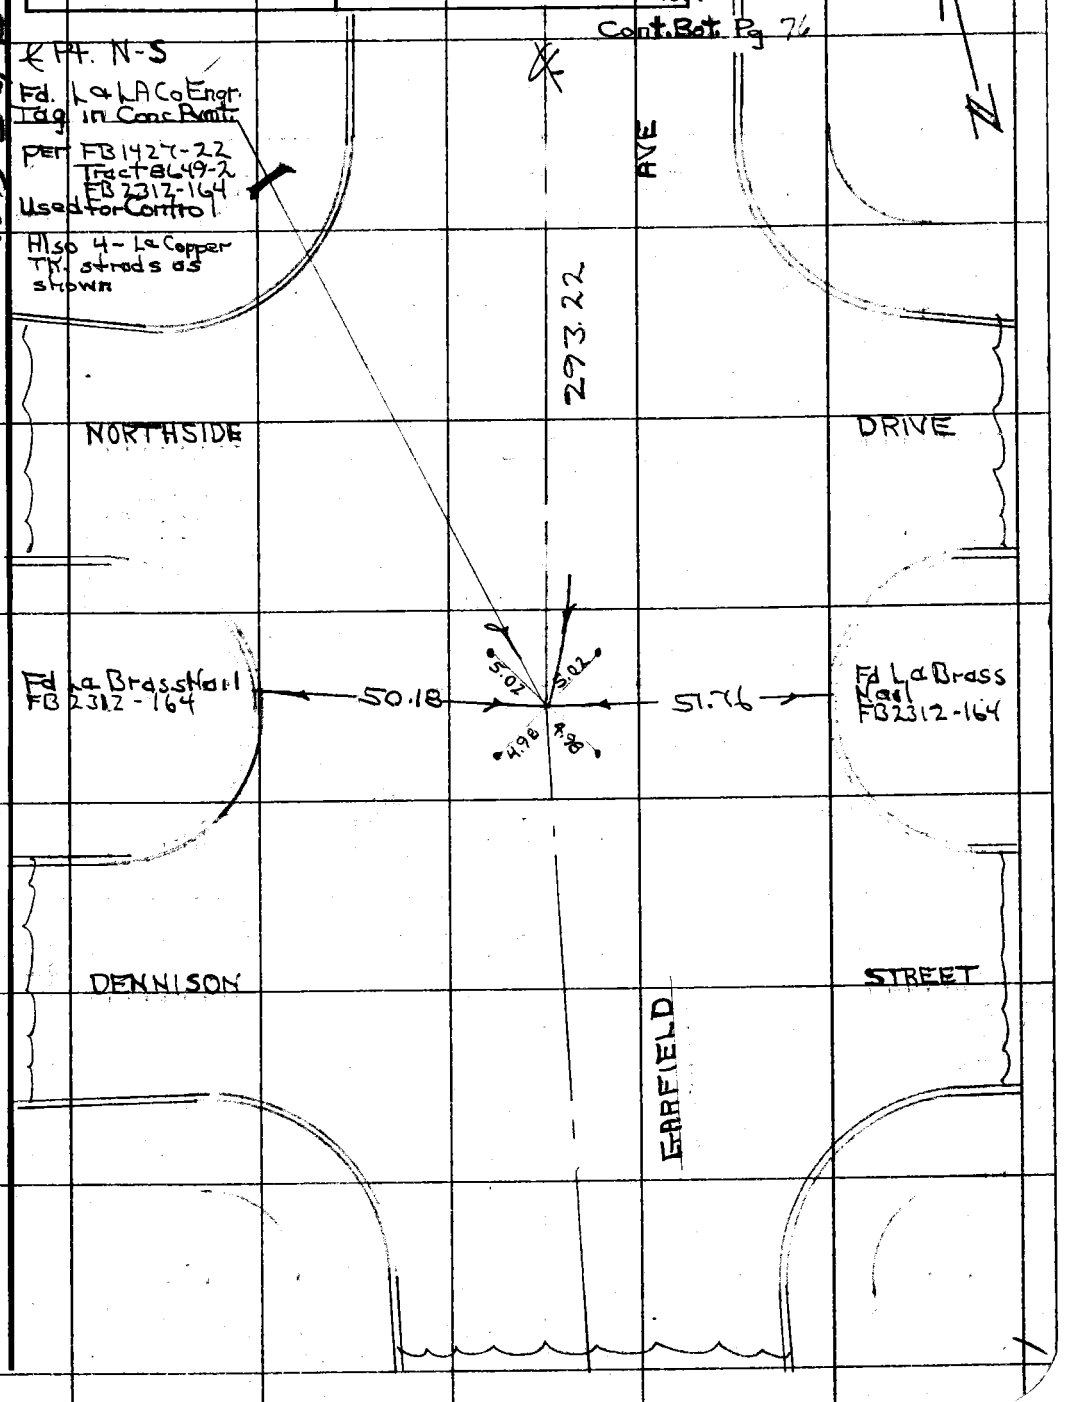

Note: Any Additions or Changes on This Sheet Must be Made or Circled in Red Ink With Date and Name of Person Making Change.

Do not extend this side of this line.

PLEASE RETURN TO
COUNTY OF LOS ANGELES
DEPARTMENT OF COUNTY ENGINEER
403 LOS ANGELES COUNTY ENGINEERING BLDG.

76F309S CE#310 3-68

RDFB 1124 1721

F. B. ~~3813~~ Pg. ~~76~~

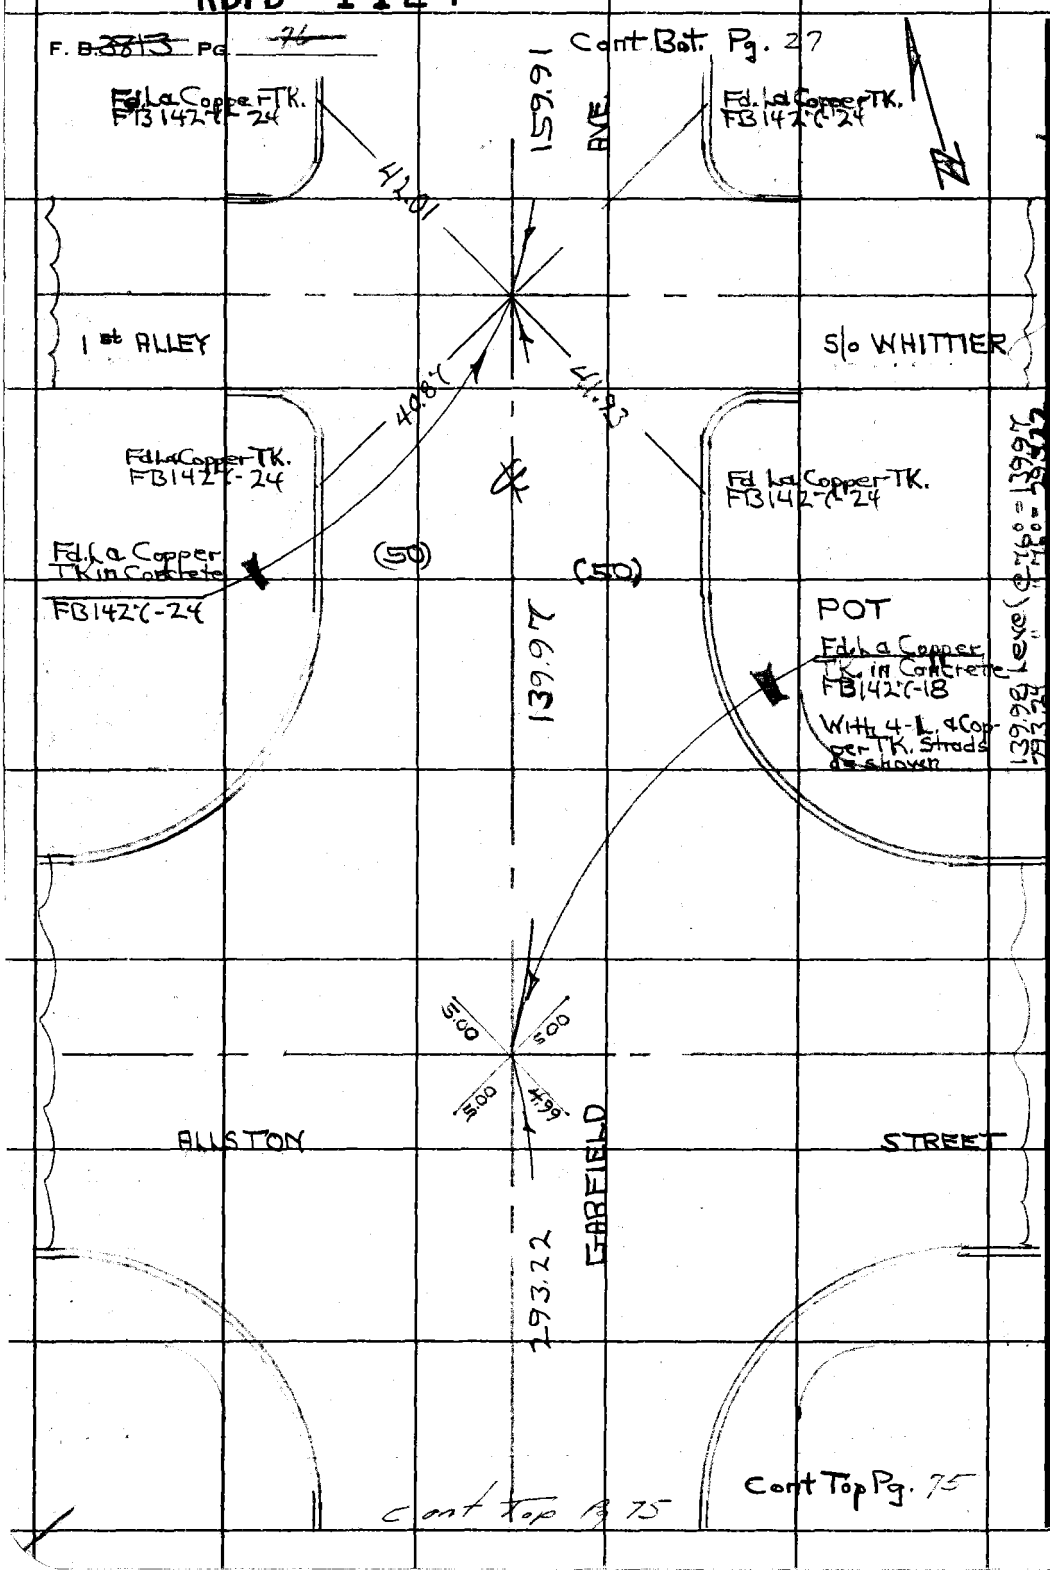

PLEASE RETURN TO
COUNTY OF LOS ANGELES
DEPARTMENT OF COUNTY ENGINEER
403 LOS ANGELES COUNTY ENGINEERING BLDG.

Do not extend this side of this line.

Note: Any Additions or Changes on This Sheet Must be Made or Circled in Red Ink With Date and Name of Person Making Change.

RDFB 1124

1722

Notes Ck'd by	Survey of BELVEDERE AREA R DIV. B
Map No.	JN 0303.00 Tape 0247 Std 68 °F
Office Work	Surveyed by H.H. SPRIGGS
Checked	Notes MOODY Date 4-3-73
Date	Indexed T. M. PALMERI FEB 13 1974

F. B. ~~3813~~ PG. ~~77~~

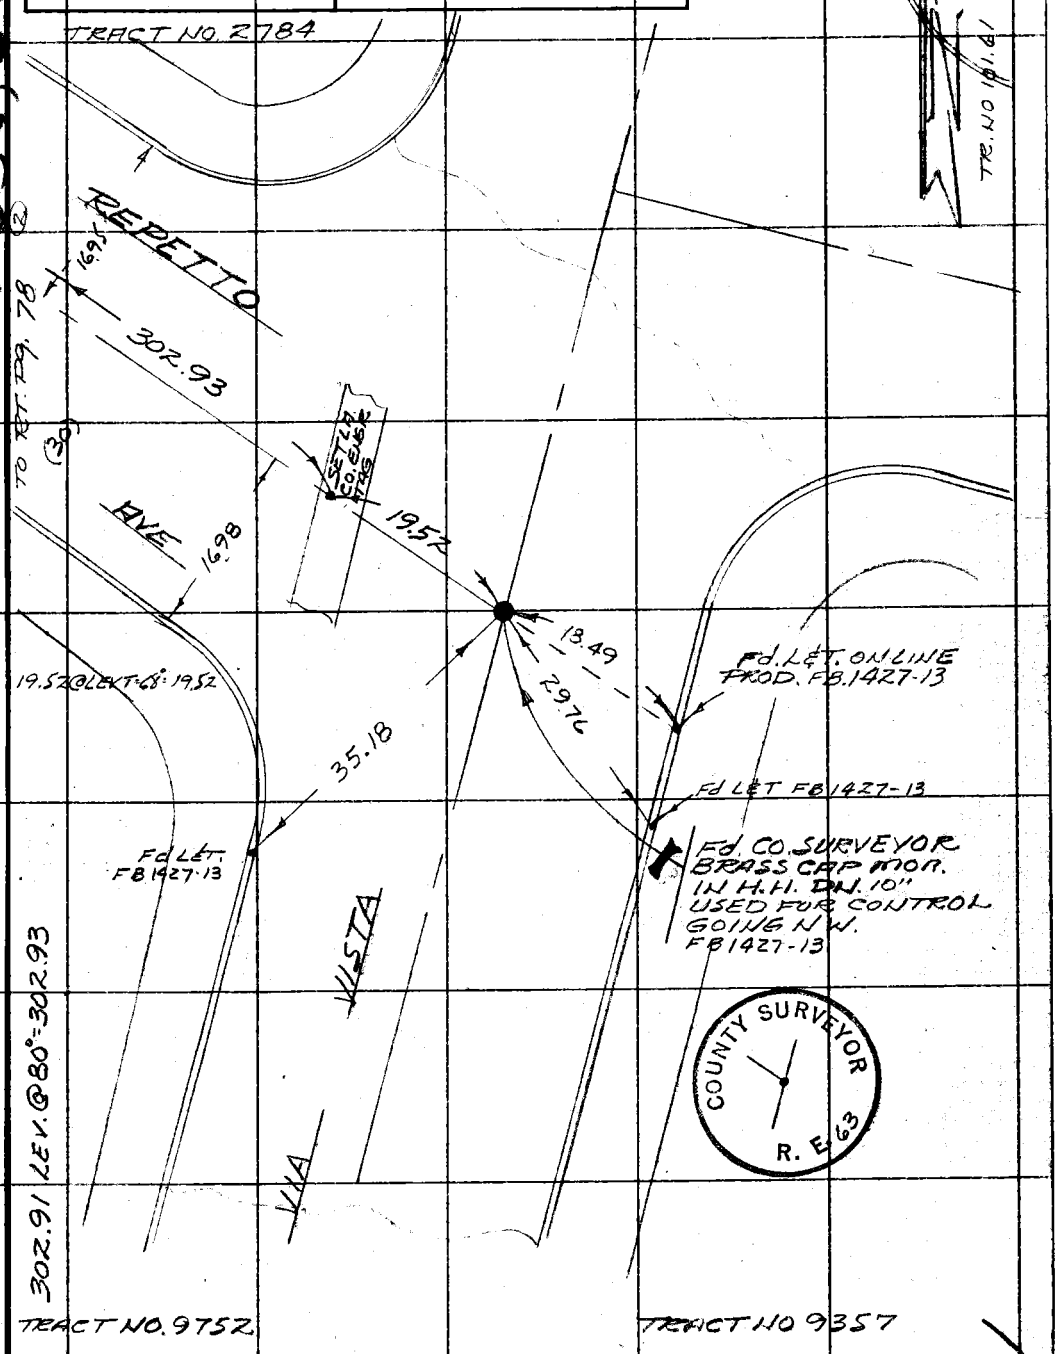

WS 36, C-3

Note: Any Additions or Changes on This Sheet Must be Made or Circled in Red Ink With Date and Name of Person Making Change.

Do not extend this side of this line.

PLEASE RETURN TO
COUNTY OF LOS ANGELES
DEPARTMENT OF COUNTY ENGINEER
403 LOS ANGELES COUNTY ENGINEERING BLDG.

76F309S CE#310 3-68

RDFB 1124 1723

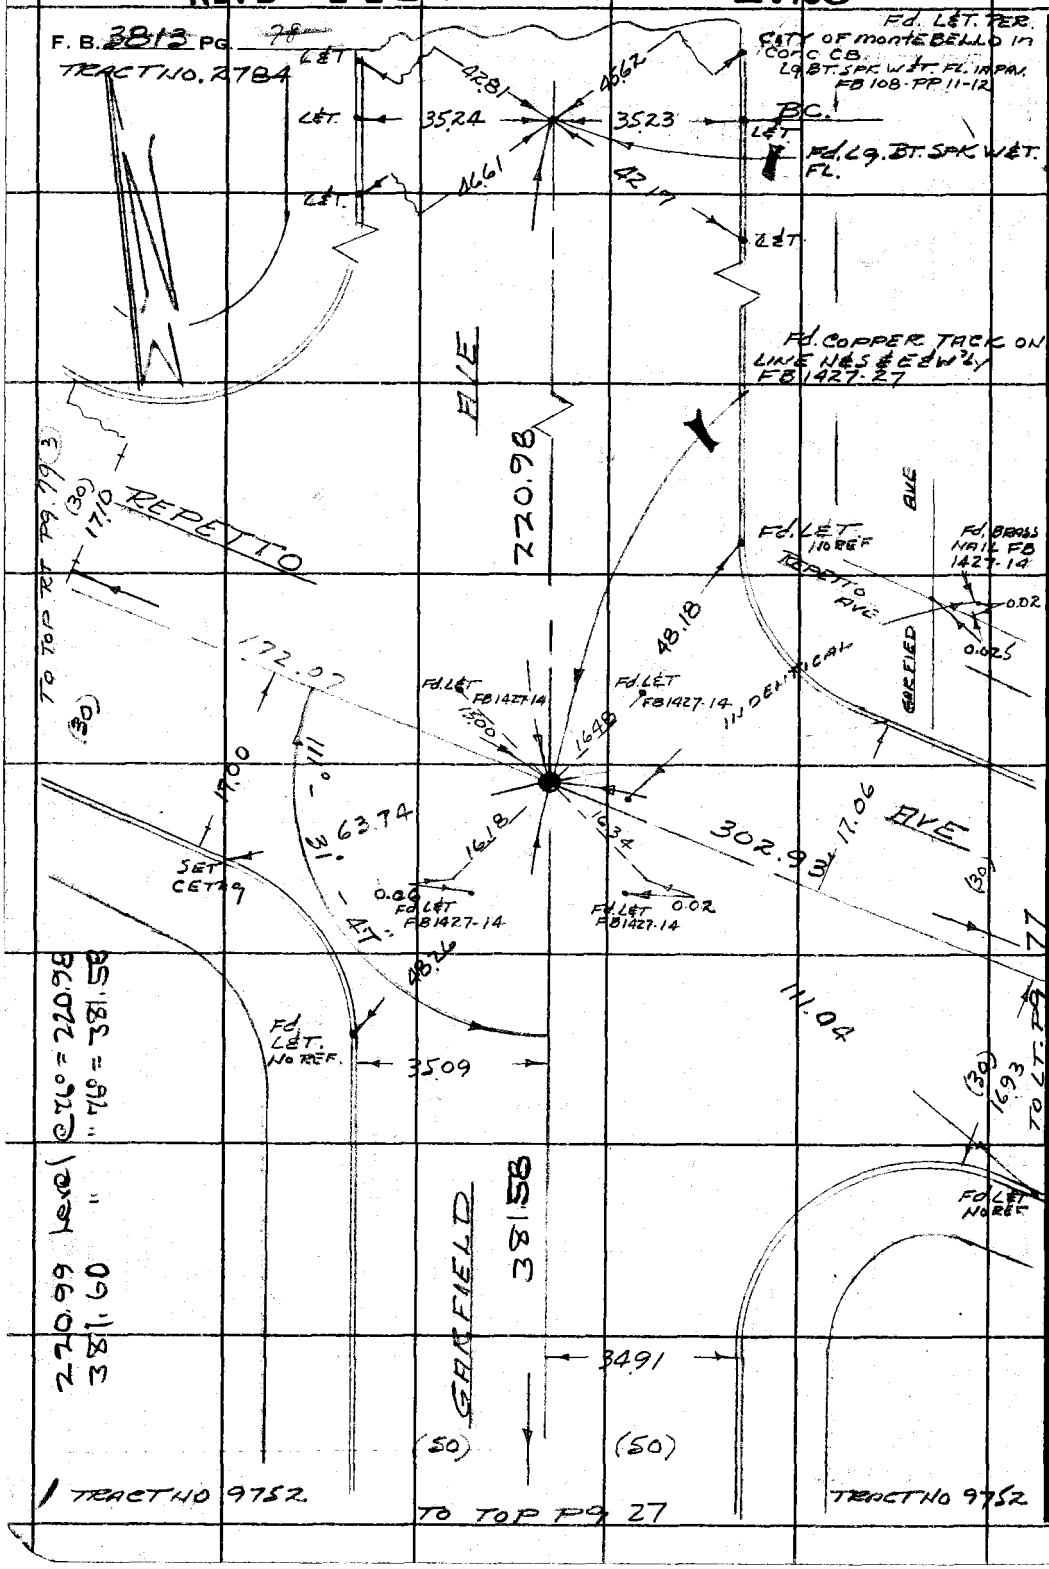

WS.36 C-3

PLEASE RETURN TO
COUNTY OF LOS ANGELES
DEPARTMENT OF COUNTY ENGINEER
403 LOS ANGELES COUNTY ENGINEERING BLDG.

Do not extend this side of this line.

Note: Any Additions or Changes on This Sheet Must be Made or Circled in Red Ink With Date and Name of Person Making Change.

RDFB 1124 1724

Notes Ck'd by	Survey of BELVEDERE AREA 2
Map No.	JN 0303.00 Tape 0247 Std 68 °F
Office Work	Surveyed by H.H SPR 1995
Checked	Notes MOODY Date 9-3-73
Date	Indexed J. M. PALMER FEB 13 1974

F. B. ~~3012~~ PG. ~~79~~

W536, B-3

DID NOT SEARCH FOR 3/4" IP FB 1427-32
SET L9 BT. SPK. W.ET. MK'D LA. CO Engr.
FL. BY REC. DIST BETWEEN CARFIELD
AVE & VIA CLEMENTE

TRACT NO 2784

Fd. CO. SURVEYOR BRASS
CAP mon. PER FB 1427-15
THIS mon WAS SET IN H.H.
& DH 10" 1-5-48, DUE TO
construction THE mon. IS
now DN. 17" & LEANING S.W.
W/ H.H. & COVER gone,
mon Found TO BE ON
LINE N&S. BUT IS 0.04
SO. OF LINE E&W
SET L9 BT. SPK. W.ET. FL
MK'D LA CO Engr. BY
MEER

SET LA. CO. ENGR. TAG ON LINE PROP

SET LA. CO. Engr. Tag

SURVEYOR COUNTY OF LOS ANGELES R. E. 63

150.51 @ LEV. T=68° : 150.51
172.07 @ LEV. T=68° : 172.07
17.23 @ LEV. T=62° : 17.23

AVE

172.07

17.00

17.16

18.63

17.23

26.23

27.33

17.03

111°

32'

17.04

150.51

68.39

TILLEY

9.82

Fd. LET. FB 1427-32

Fd. LET. FB 1427-15

1 = 111°-32'-30"
4 = 86°-09'-25
6 = 309°-14'-20
AV. 111°-32'-23

TRACT NO. 9752

Fd. LET. FB 1427-15

TO TOP PG. 43

TO TOP PG. 42

TO TOP

172.00

VIA

179.50

17.13

(30)

SET LA. CO. ENGR. TAG

17.08

18.58

20.40

0.04

SET LA. CO. ENGR. TAG

40.23

03"

17.00

37.04

32'

CLEMENTE

TERPETTO

434.30

111°

17.04

Fd. LET. FB 1427-15

1 = 111°-32'-00"
4 = 86°-08'-20"
6 = 309°-12'-20"
AV. 111°-32'-03"

TO RT. PG 80

Note: Any Additions or Changes on This Sheet Must be Made or Circled in Red Ink With Date and Name of Person Making Change.

Do not extend this side of this line.

PLEASE RETURN TO
COUNTY OF LOS ANGELES
DEPARTMENT OF COUNTY ENGINEER
403 LOS ANGELES COUNTY ENGINEERING BLDG.

76F309S CE#310 3-68

RDFB 1124 1725

F. B. ~~3813~~ PG. ~~80~~

TRACT NO. 2784

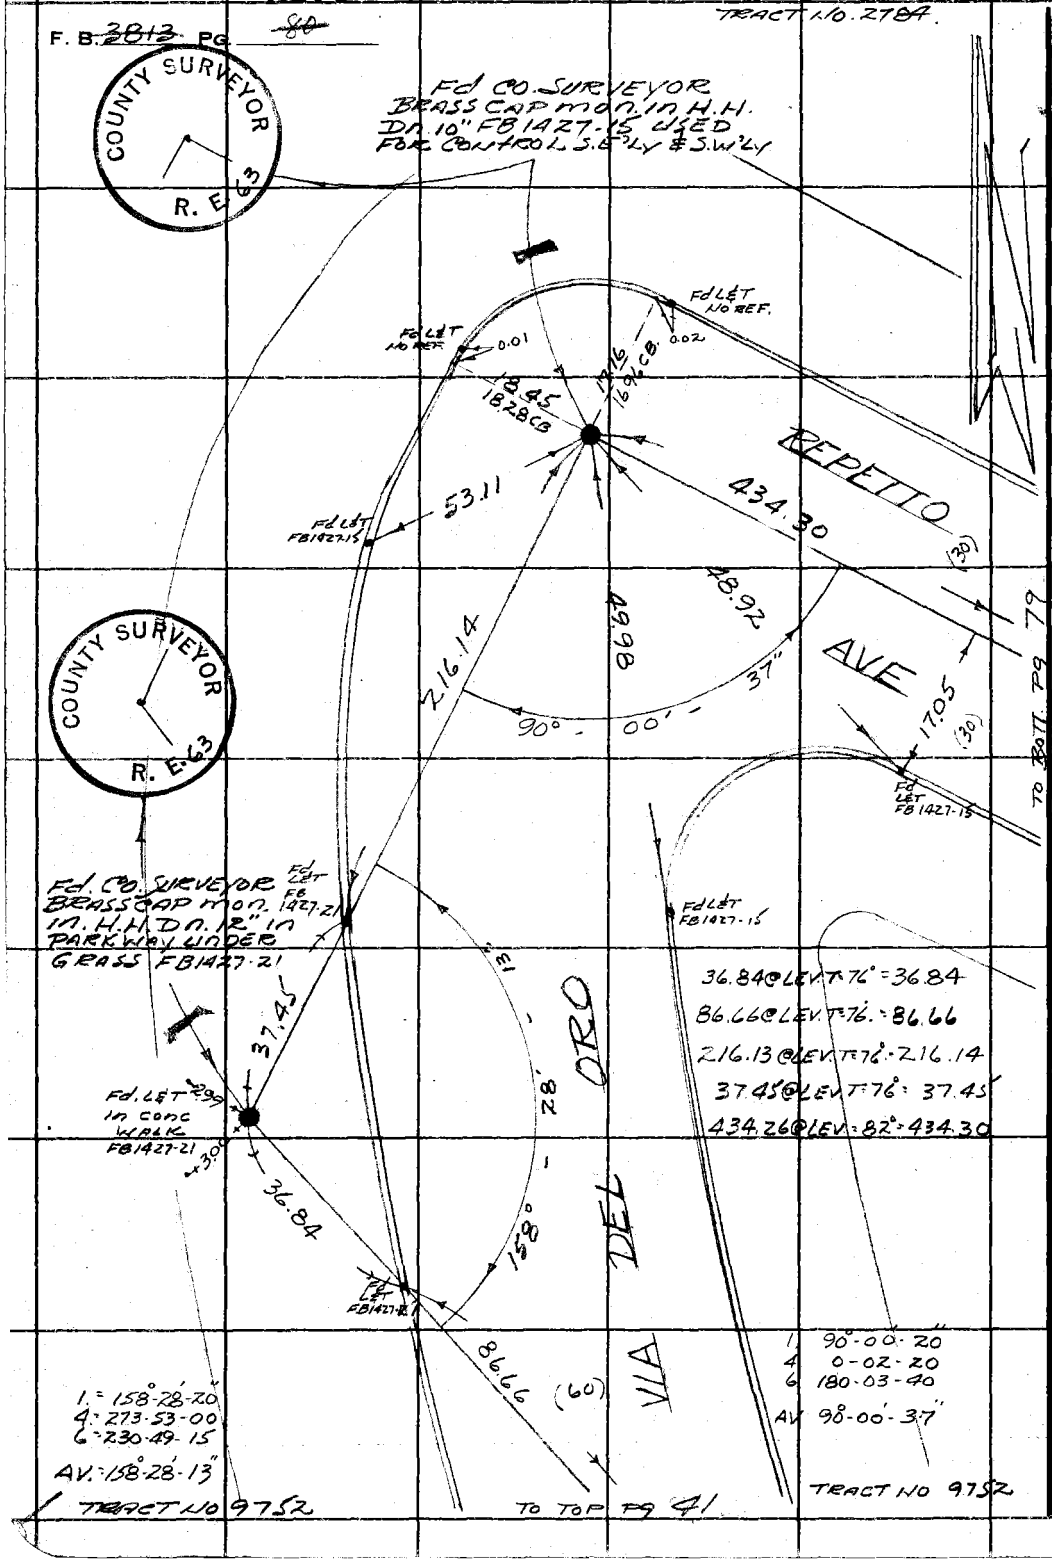

PLEASE RETURN TO
COUNTY OF LOS ANGELES
DEPARTMENT OF COUNTY ENGINEER
403 LOS ANGELES COUNTY ENGINEERING BLDG.

Do not extend this side of this line.

Note: Any Additions or Changes on This Sheet Must be Made or Circled in Red Ink With Date and Name of Person Making Change.

RDFB 1224 1494

Notes Ck'd by	Survey of BELVEDERE AREA ℄
Map No.	JN 0303.00 Tape 0247 Std 68 °F
Office Work	Surveyed by K. KAPP
Checked	Notes J. GOODWIN Date 6-73
Date	Indexed M. PALMER FEB 13 1974

F. B. 3813 PG. 81

WS 36 B-3

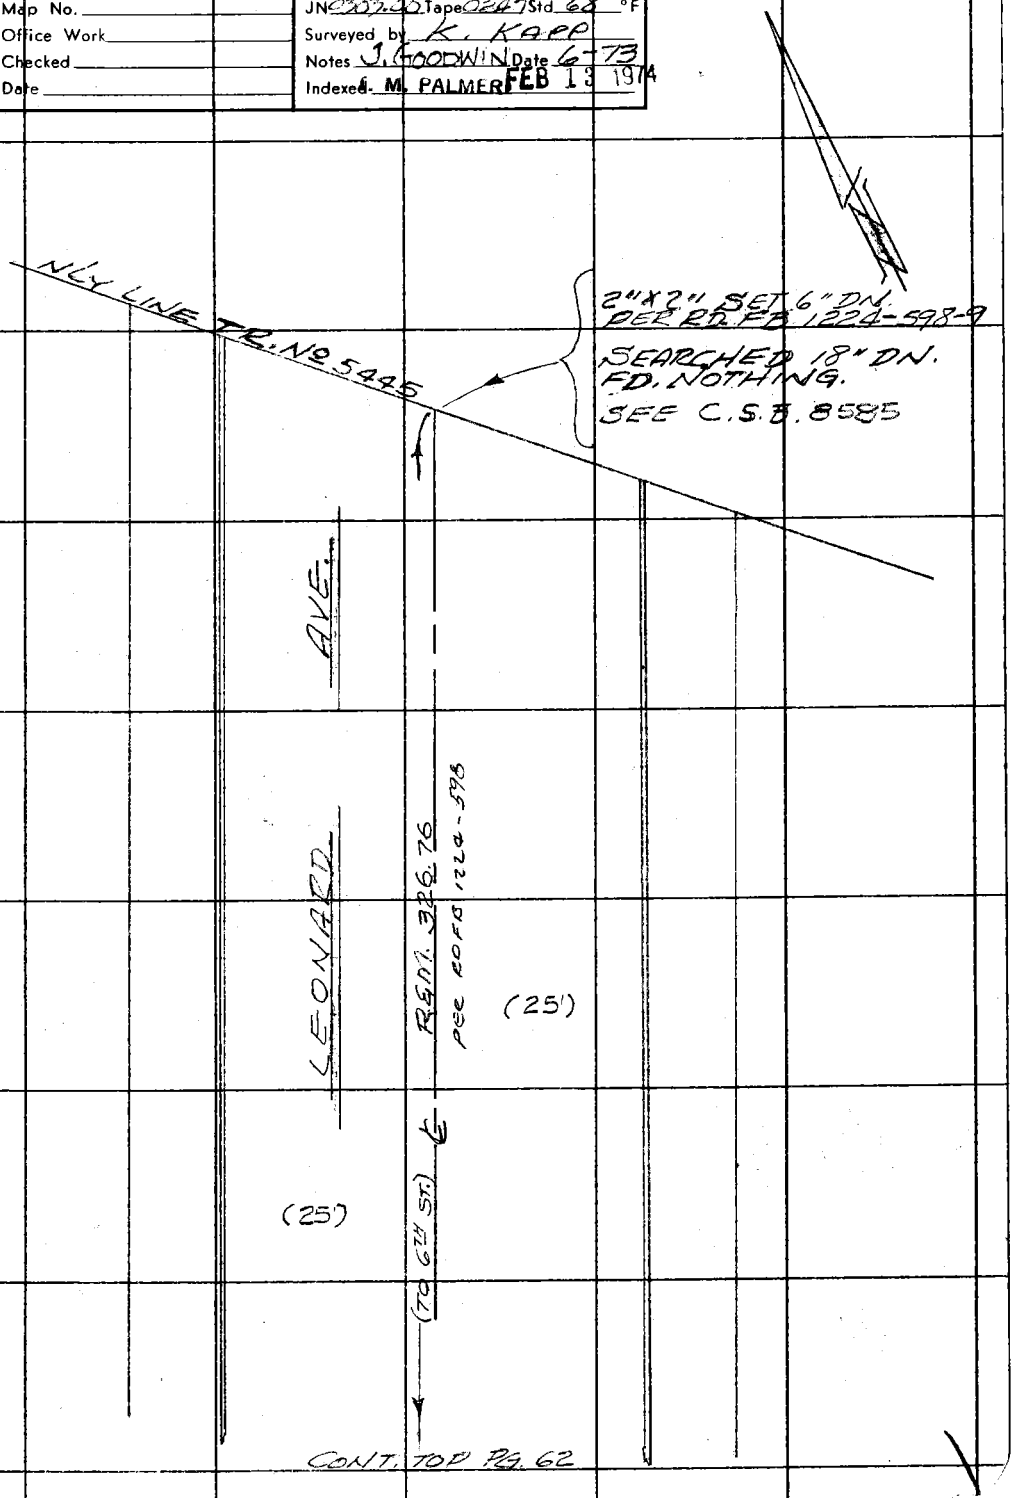

Note: Any Additions or Changes on This Sheet Must be Made or Circled in Red Ink With Date and Name of Person Making Change.

Do not extend this side of this line.

PLEASE RETURN TO
COUNTY OF LOS ANGELES
DEPARTMENT OF COUNTY ENGINEER
403 LOS ANGELES COUNTY ENGINEERING BLDG.

76F309S CE#310 3-68

RDFB 1224

1495

F. B. ~~3813~~ PG. ~~82~~

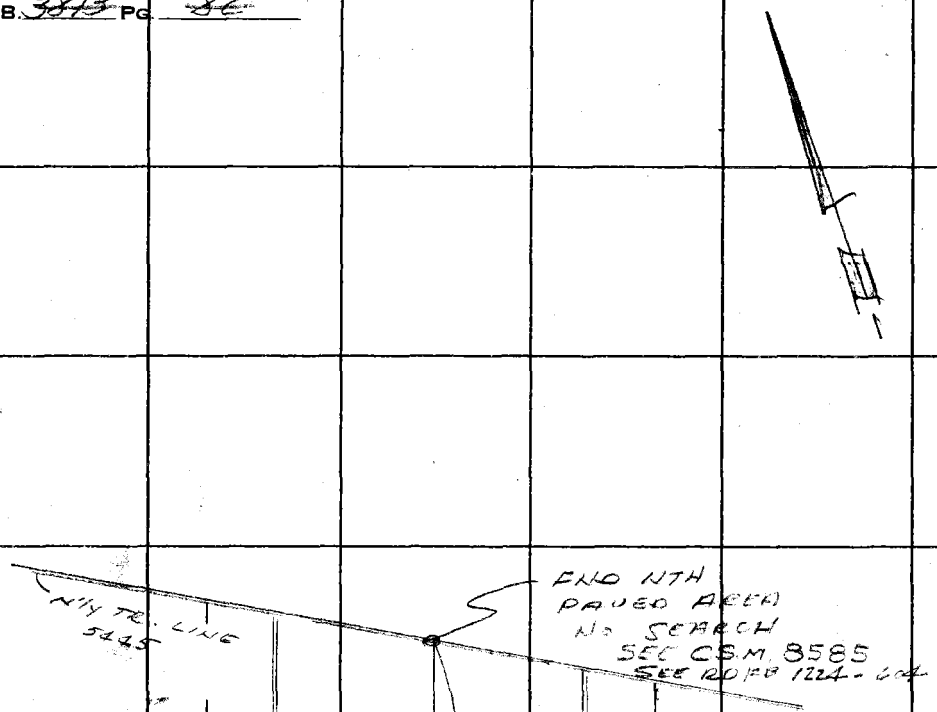

Cont Top Pg 63

PLEASE RETURN TO
COUNTY OF LOS ANGELES
DEPARTMENT OF COUNTY ENGINEER
403 LOS ANGELES COUNTY ENGINEERING BLDG.

Do not extend this side of this line.

Note: Any Additions or Changes on This Sheet Must be Made or Circled in Red Ink With Date and Name of Person Making Change.

RDFB 1124 1726

Drawn by	Survey of DIV. #8 BELVEDERE AREA
Job No.	JN0303.00 Tape 0122 Std 68 °F
Office Work	Surveyed by H. SPRIGGS
Checked	Notes J. GOODWIN Date 8-73
Date	Indexed T. M. PALMER FEB 13 1974
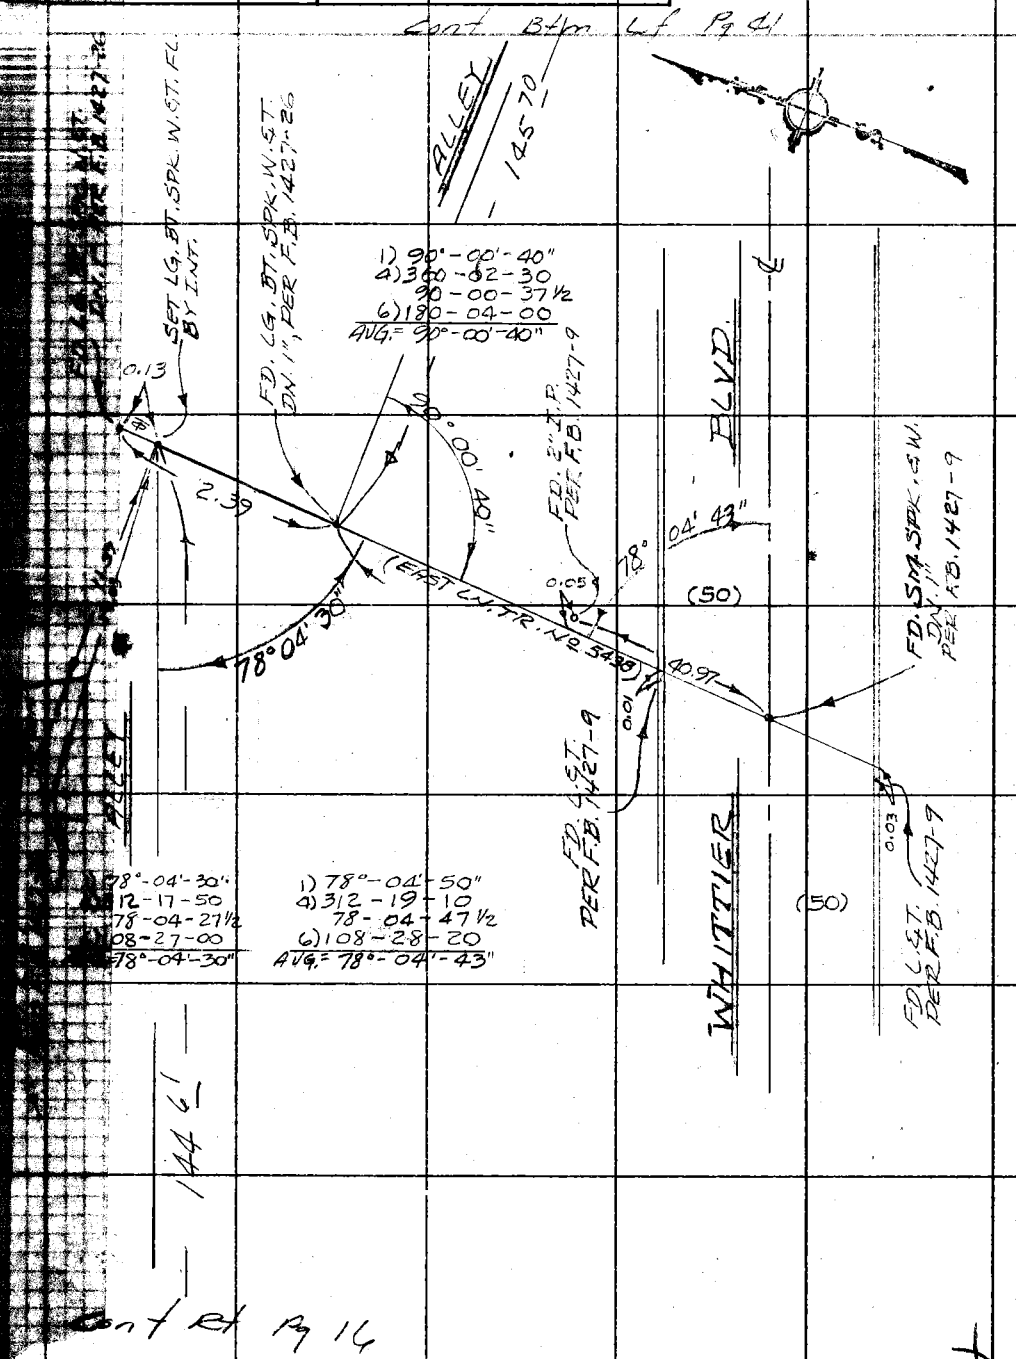
F. B. 3843 PG. 83