Survey of
JN Tape Std. °F
Surveyed by
Notes Date
Indexed

F.B. 3827 Pg.

Job Description

NAME JOB NO.

Index

C.L. Centerline survey between 40th St. East & 77th Street East.

Zone VII ties for above

Rd. Dept. File ; July '85

Microfilmed Jan 86

RDFB 3026

209

F.B. 3827 Pg. 5

Notes Ck'd by W. EDMONDSON	Survey of AVE T-8
Map No. B-5196-1-7	JN 0098.17 Tape 184 Std SEW
Office Work	Surveyed by J.S. COATES
Checked D. F. MUNOZ	Notes J.S.C. Date 7/1/76
Date 3/13/74	Indexed D.L. GARTH OCT 27 '76

J.N. 0098.17

AVE. T-8

CENTER-LINE SURVEY

FROM

40TH ST. E. TO 77TH ST. E.

COATES
VANNESS
ADAMS
BITTEL
CROWE

Note: Any Additions or Changes or Ties Sheet Must be Made or Circled in Red Ink With Date and Name of Person Making Change.

Do not extend this line beyond the end of this line.

PLEASE RETURN TO
LOS ANGELES COUNTY ENGINEER
403 LOS ANGELES COUNTY ENGINEERING BLDG.

765098 CE#310-9-67

RDFB 3026 210, 211

212, 213

FB 3647 Pg 6

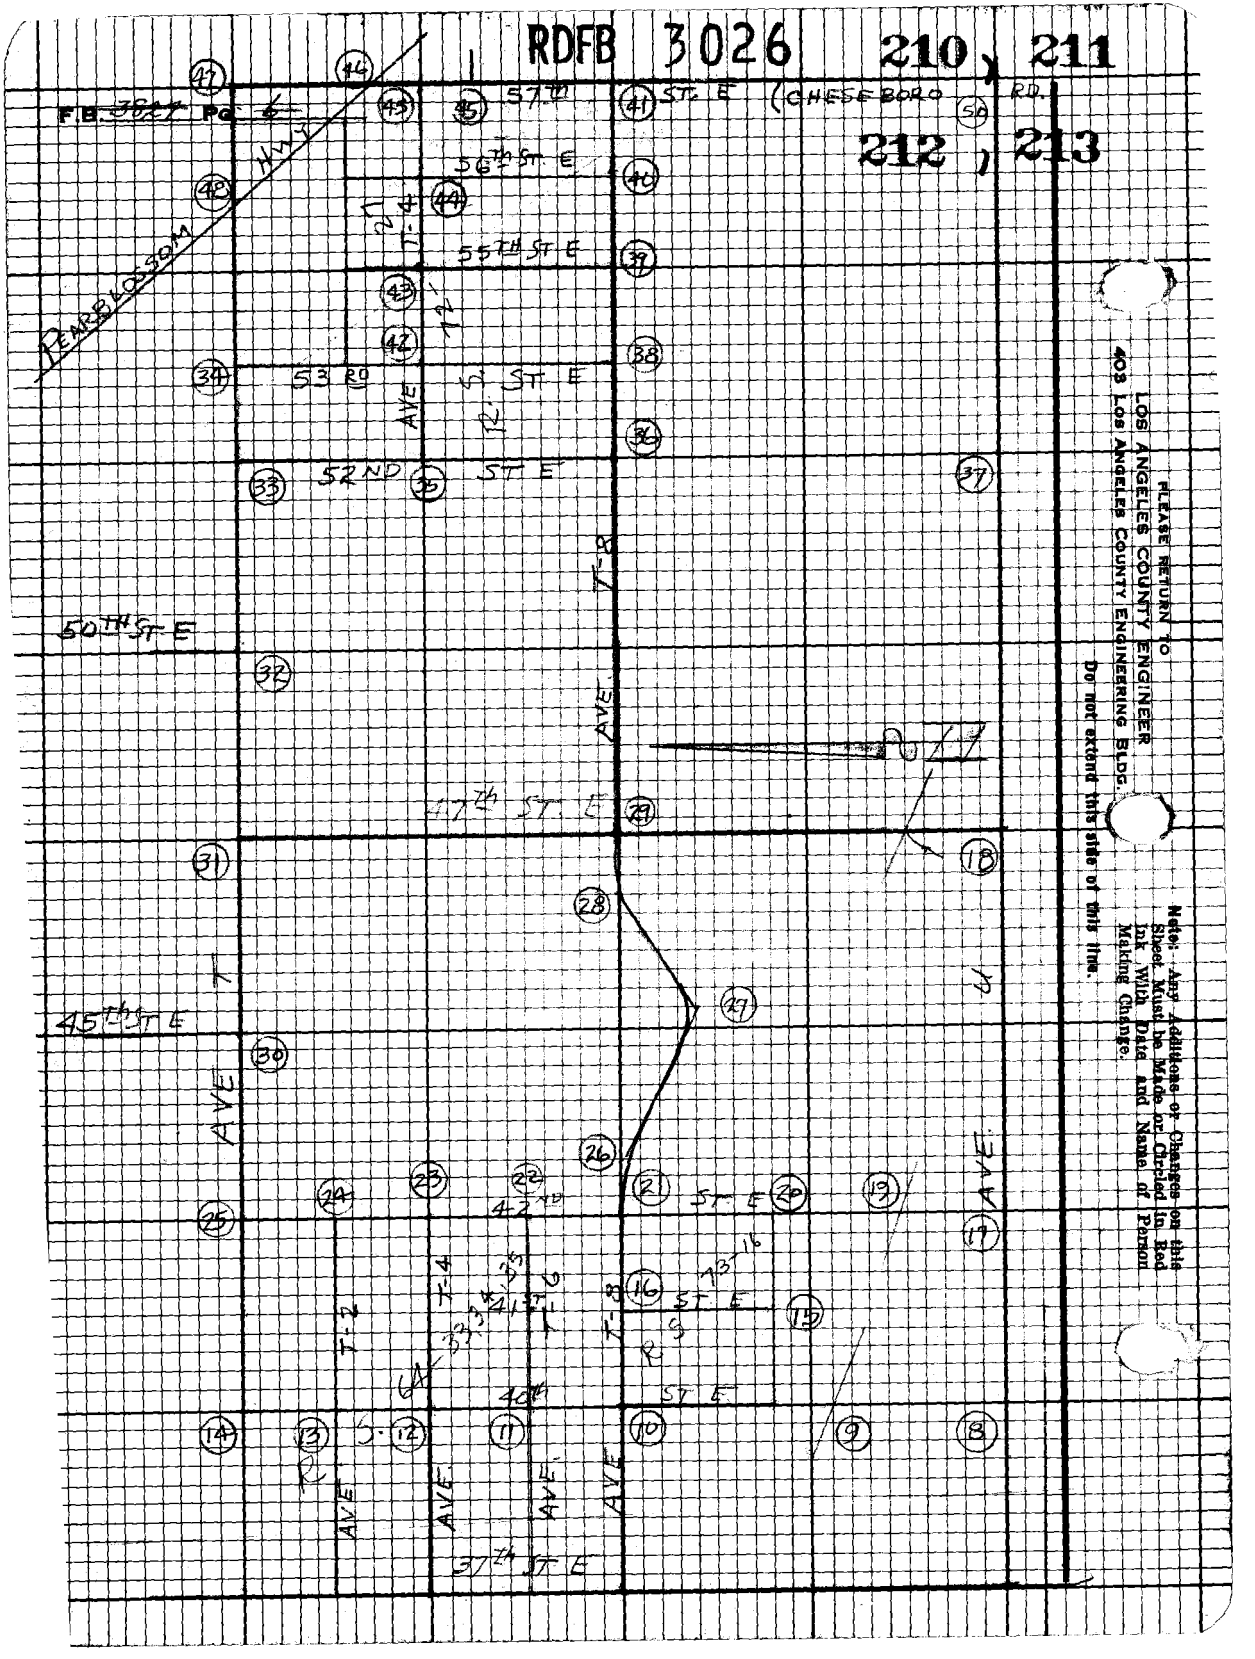

PLEASE RETURN TO
LOS ANGELES COUNTY ENGINEER
403 Los Angeles County Engineering Bldg.

Do not extend this side of this line.

Note: Any Additions or Changes on this Sheet Must be Made or Circled in Red Ink With Date and Name of Person Making Change.

RDFB 3028

49 , 50

51 , 52

Notes Ck'd by
Map No.
Office Work
Checked
Date

Survey of AVE T-8
JN 007812 Tape 18# Sta 0+00
Surveyed by J.S. COATES
Notes J.S. Date 7-1-70
Indexed R.T. GALLI 8/27/70

F.B. 3827 Pg. 7

Note: Any Additions or Changes on this Sheet Must be Made or Circled in Red Ink With Date and Name of Person Making Change.

Do not extend this side of this line.

PLEASE RETURN TO
LOS ANGELES COUNTY ENGINEER
403 LOS ANGELES COUNTY ENGINEERING BLDG.

765098 CE# 310 9-67





















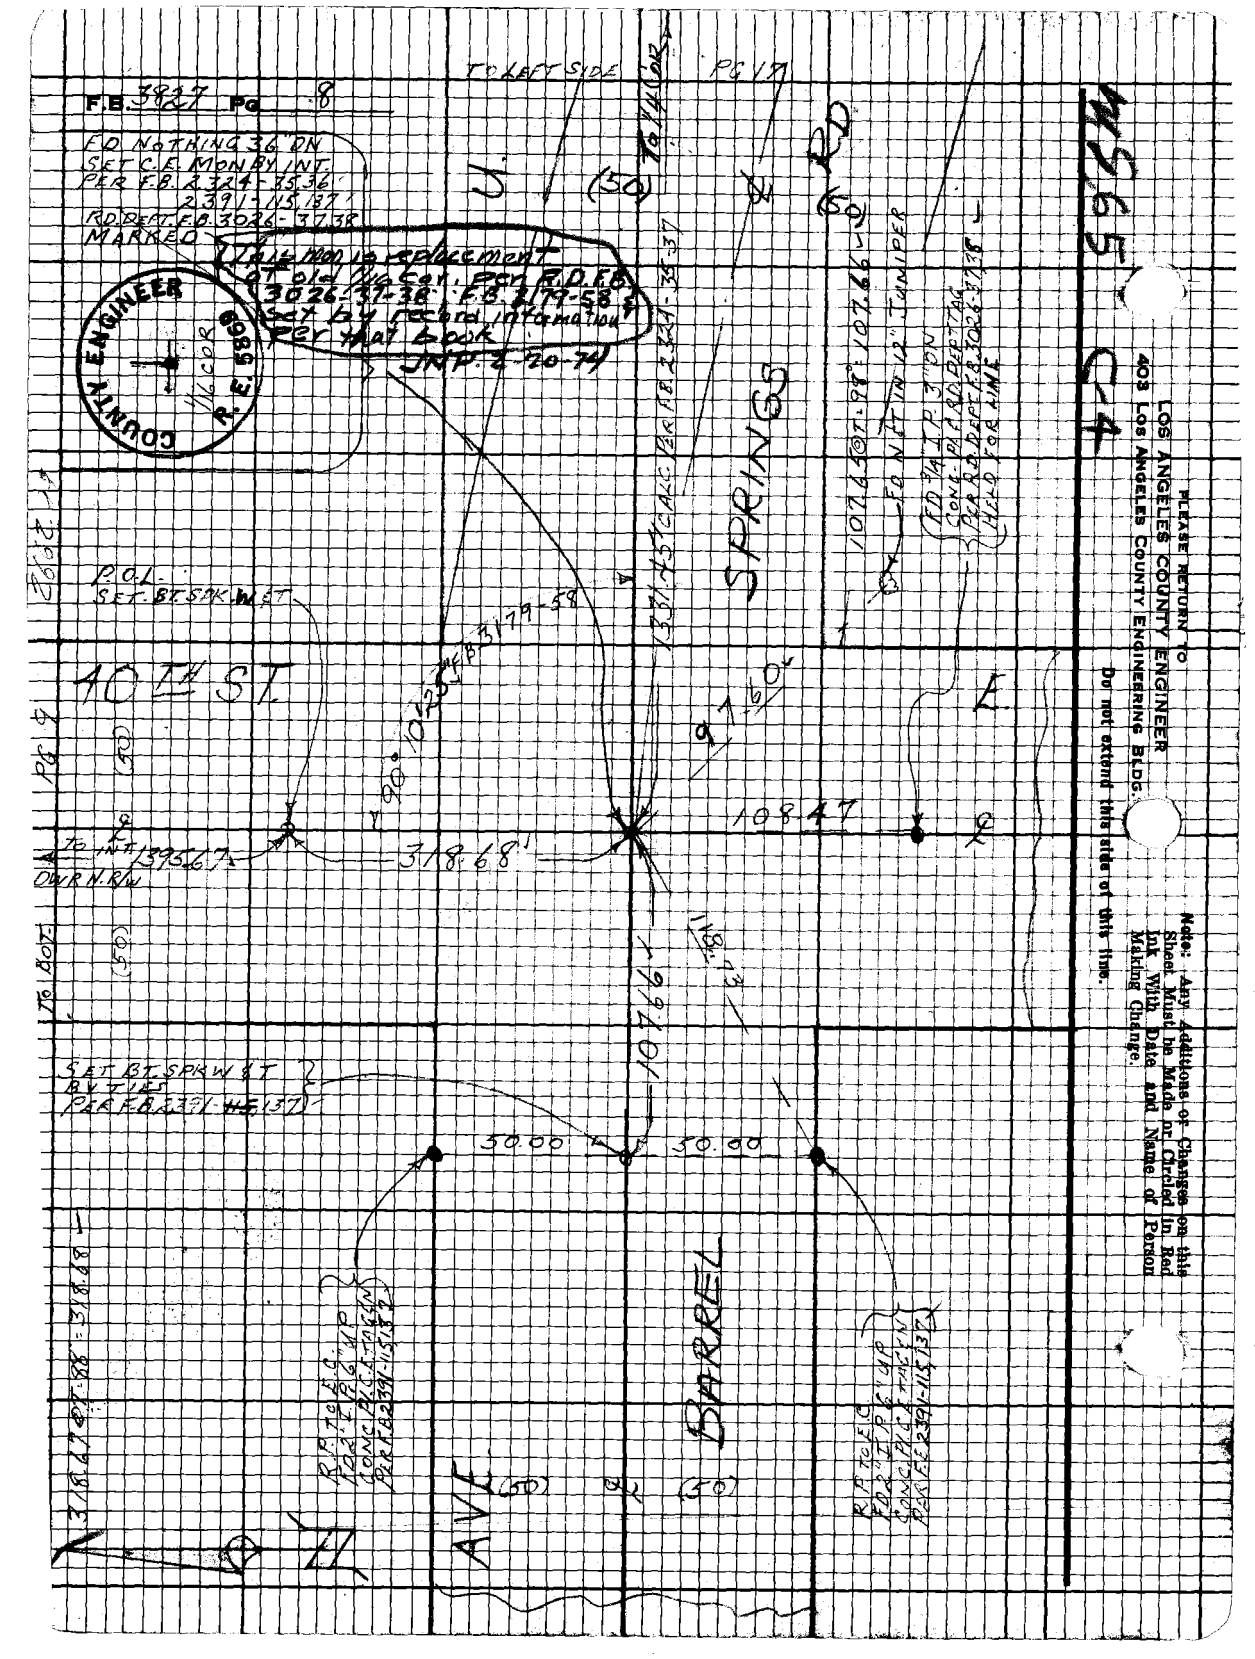
F.B. 3827 Pg 8
FD NOTHING 36' DN
SET C.L. MON BY INT
PER F.B. 2324-35,36
2391-145,187
RD BEAT F.B. 3026-37,38
MARKED
Title Map is replacement
of old Mon. Cor. per R.D. F.B.
3026-37,38 F.B. 2179-58 &
next by record information
per Map Book
JNP 2-20-74
COUNTY ENGINEER
1/4 COR
F.B. 3826
TO LEFT SIDE Pg 17
SPRING ST
(80)
FD NAIL IN 12" JUNIPER
(FD TACK & TAG
CONC. PAVED BEFORE
STAKED 3.18' LEFT
HELD FOR LINE)
107.46 @ N. 88° 10' 46" E.
107.66 - D
P.O.B.
SET BT. SPK W. & T.
40TH ST
(80)
N. 90° 10' 45" W.
3179-58
1387.43 CALC. PER M.B. 2324-35,37
10847
E.
318.68'
To INT 1395.67
A OWR N.R/W
(85)
1176.13'
10766
SET BT. SPK W. & T.
BY TIES
PER F.B. 2391-145,187
3000
3000
AVE
(50)
(50)
R.P. TIED
FD. TACK & TAG
CONC. PAVED
PER F.B. 2391-145,187
R.P. TIED
FD. TACK & TAG
CONC. PAVED
PER F.B. 2391-145,187
3184.88' = 5818
N

PLEASE RETURN TO
LOS ANGELES COUNTY ENGINEER
403 LOS ANGELES COUNTY ENGINEERING BLDG.

Do not extend this side of this line.

Note: Any Additions or Changes on this Sheet Must be Made or Circled in Red Ink With Date and Name of Person Making Change.

RDFB 3026 215

Survey of AVE T-8
JN 2077.7 Page 164 Sta 84+T
Surveyed by J. SCOGGINS
Date 7-21-70
Notes Checked
Indexed

Notes Ckd W. EDMONDSON
Map No. B-3196-1-7
Office Work C.F. MUNOZ
Checked C.R. BRUNES
Date 3/13/74

FD BRASS CAP MON. MARKED

NORTH R/W L.A.D.W.R. AQUADUCT

SET BT. SPK W/ TAG 3Y INT

40TH ST

FROM SHEET 8

TO SHEET 10

AVE T-8

FD BRASS CAP MON. MARKED

300.87	@ 87-01-10	=	300.42
300.87	@ 86-54-10	=	300.45
300.31	@ 99-25-05	=	299.42
300.21	@ 94-14-05	=	299.42
300.16	@ 87-00-45	=	300.15
300.18	@ 86-56-10	=	300.15
300.22	@ 265-57-55	=	299.19
300.19	@ 266-08-35	=	299.51
196.30	@ 87-31-35	=	196.12
196.36	@ 87-18-35	=	196.17
			1395.63
T = 88°			+.04
			1395.67

1395.67

300.40	@ 94-21-40	=	299.51
300.30	@ 91-09-30	=	299.51
300.66	@ 86-53-40	=	300.22
300.73	@ 86-41-30	=	300.23
300.06	@ 265-46-10	=	299.24
300.00	@ 265-51-45	=	299.22
			21.82
			920.78
T = 88°			+.02
			920.80

920.80

171.85	@ 96-13-20	=	170.74
171.67	@ 96-08-50	=	170.73
T = 88°			1.46
			341.93

341.93

FD BRASS CAP MON. MARKED

RDFB 3026

FB 3827 Pg 10

216

PG N

To Bot.

To Int AVE F-6

(50)

(50)

COUNTY SURVEYOR S.MON

T 5 L

R 11 W

SEC 7

SEE 8 4 OF 4

MONUMENT

14 COR. SEC. 7 & 8
T 3 N R 11 W
FD C.S. MON.
FB 3179-40.
MARKED

AVE

SET NAIL & TAG No #

SET NAIL & TAG No #

N 90° E 46.05' CALC. R&A 3179-55

F 8

To Int 4/3 S.E.

SET RED DOT ON MON BY INT.

0.06

0.50

A.P. ERIK'S PIPE ON CONC. PIER

FD 3/4" IP 1.2' DN

FD 3/4" IP 0.4' DN

N 0°47'00" E 1963.96

S 85°20'00" E 1963.96

Pennsylvania

40TH ST.

(50)

(50)

To Int Mary Ellen

From Top

To Int pg 9

PLEASE RETURN TO
LOS ANGELES COUNTY ENGINEER
403 Los Angeles County Engineering Bldg.

Do not extend this side of this line.

Note: Any Additions or Changes on this Sheet Must be Made or Circled in Red Ink With Date and Name of Person Making Change.

RDFB 3026

217

F.B. 3827 Pg. 11

Notes Ckd by W. EDMONDSON
Map No. B-5196-1-7
Office Work L. F. MUNOZ
Checked R. BRONES
Date 3/13/74

Survey of AVE T-8
JN 00 27 12 Tape 184 Sht 84 FT
Surveyed by J. SCOATES
Notes
Date 2-2-70
Indexed G. L. GALLT 00 27

To Bot Pg 12

Point Ave T-8

(50) (50)

FD PIPE 1/2" IP DN CONC. PAVE N.

AVE. (30)

T-6

8.47

1329.50'

(40)

84.91

32' Adj.

89°

FD CHISS "X" IN ST. SIGN POST

0 89-36-30
93.58-25-30
89-36-22½
177.38-20
89-36-23½

40TH ST

FD 1" IP 15" DN CONC. BC & ENCASED IN CONC. FOR P.C. 8.37 179.55 FT. N. & 1.50 FT. W. OF P.C. NAILED IN H.H.

COUNTY ENGINEER R.E. 5869

R.P. 1" IP 12" DN EDGE CONC. PAVE

FD 1" IP 12" DN CONC. PAVE N.

Point Ave T-8

FROM TOP Pg. 10

Note: Any Additions or Changes on this Sheet Must be Made or Circled in Red Ink With Date and Name of Person Making Change.

PLEASE RETURN TO
LOS ANGELES COUNTY ENGINEER
403 LOS ANGELES COUNTY ENGINEERING BLDG.

Do not extend this side of this line.

4455651 C-4

78308B CE#310 9-67

PLEASE RETURN TO
LOS ANGELES COUNTY ENGINEER
403 Los Angeles County Engineering Bldg.

Note: Any Additions or Changes on this Sheet Must be Made or Circled in Red Ink With Date and Name of Person Making Change.

Do not extend this side of this line.

W565, C-4

218

RDFB 3026

F.B. 3027 Pg 12

Pg 13

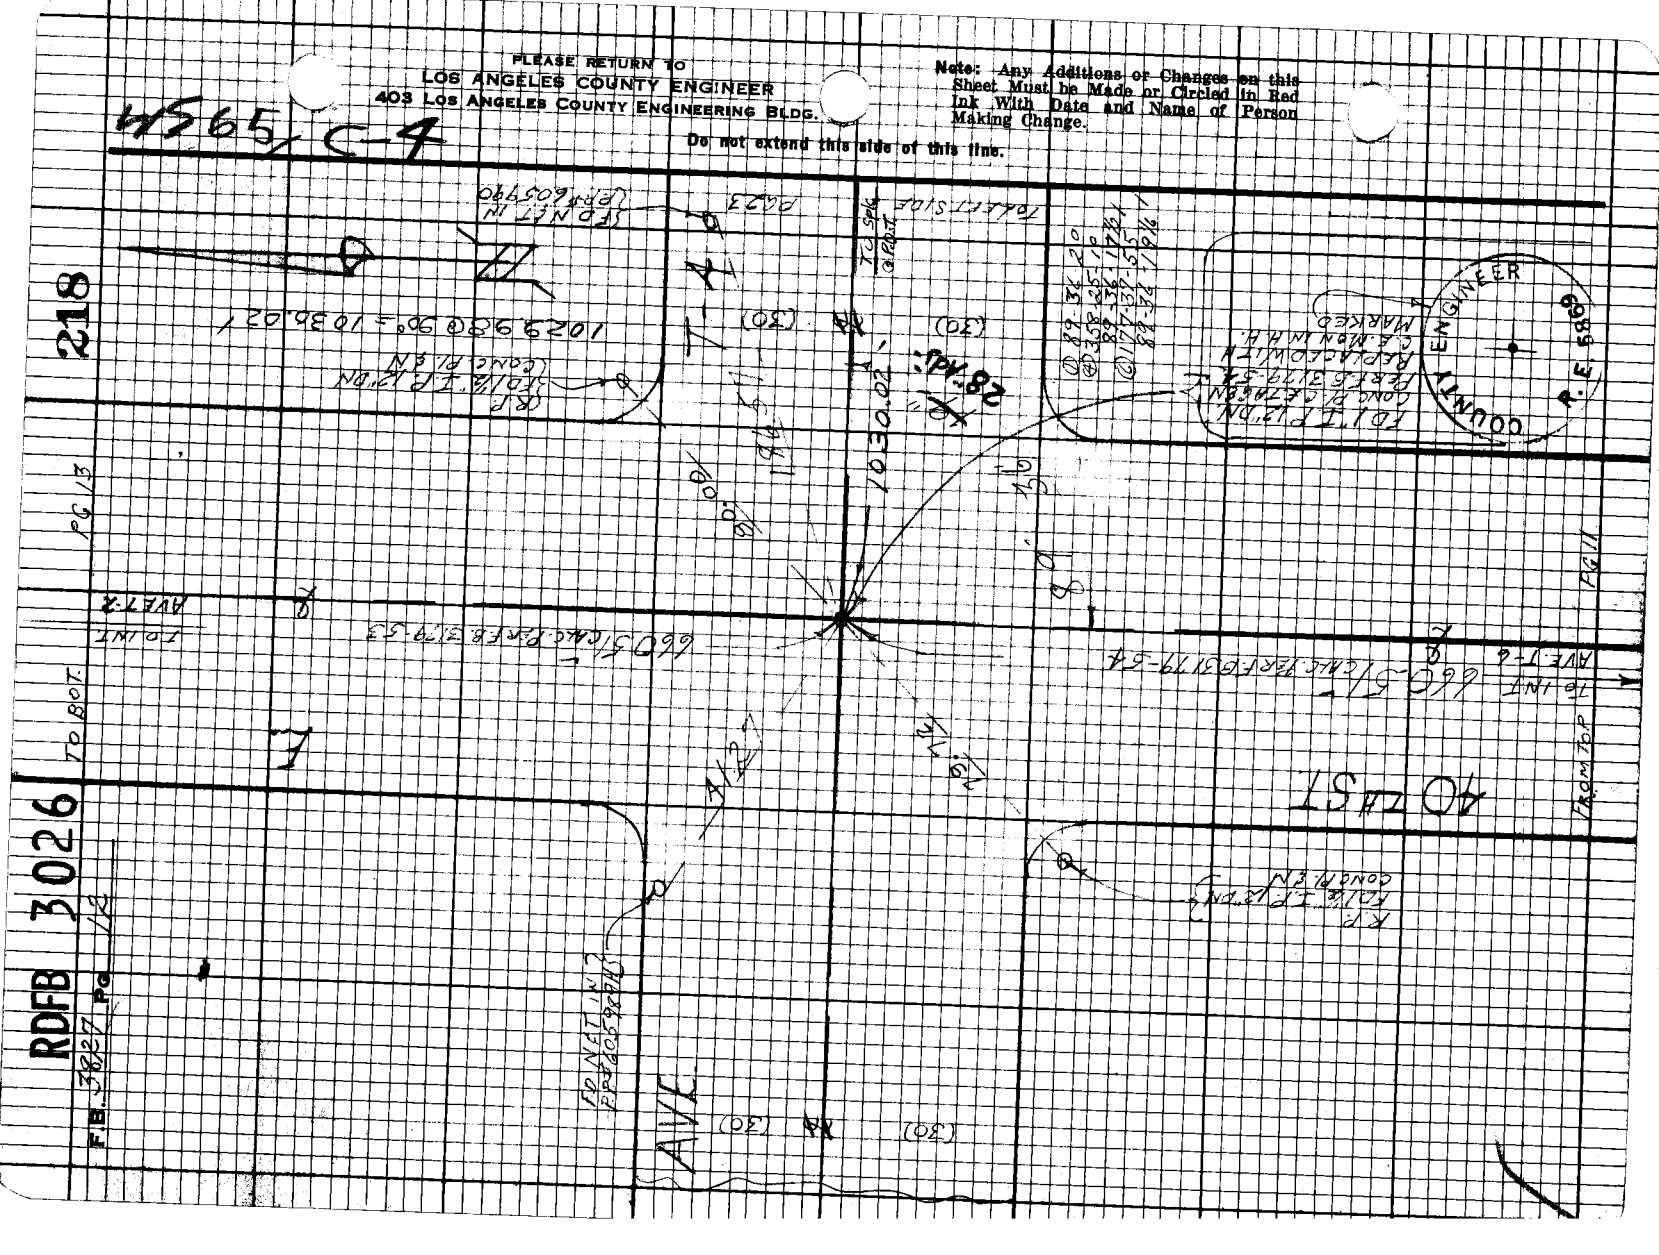

RDFB 3026

219

Notes Ck'd by W. EDMONDSON
Map No. 8-5196-17
Office Work F. MUNOZ
Checked R. BRONES
Date 3/13/14

Survey of AVE T-8
JN 00781 Tape 184 Std B4 "F"
Surveyed by J.S.COATES
Notes J.S.C.
Date 7-2-70
Indexed G.G. GALLI OCT 27 70

F.B. 3827 Pg. 13

Note: Any Additions or Changes on this Sheet Must be Made or Circled in Red Ink With Date and Name of Person Making Change.

PLEASE RETURN TO
LOS ANGELES COUNTY ENGINEER
403 LOS ANGELES COUNTY ENGINEERING BLDG.

Do not extend this side of this line.

RF3098 CE# 310 9.67

W.S.65

To Boat

Point A Pg. 14

Point A Ave T-7

Ave T-7 Pg. 14

Point "A" (Base Line) 124.91' to Ave T-7

160.50' Each Per F.B. 3179-47

624.03' @ 88°-624.05'

T-2

Pg. 24

AVE.

(30)

8' x 99'

624.05'

(30)

To Left Side

85.00'

89°

Ave T-8

Point "A" (Base Line) 124.91' to Ave T-8

Point "A" (Base Line) 124.91' to Ave T-8

160.50' Each Per F.B. 3179-53

(50)

(50)

FD 1" I.P. 28" DN. CONC. P/C.F. TAGEN PER R.B. 3179-53 REPLACED WITH C.E. MON IN H.H. MARKED

COUNTY ENGINEER

R.E. 5869

From Ave T-4 Point — 660.5' Each Per F.B. 3179-47

From Ave T-4 Pg. 13

① 89-35-45
② 338-43-00
89-35-45
③ 177-34-30
89-35-45

PLEASE RETURN TO
LOS ANGELES COUNTY ENGINEER
403 LOS ANGELES COUNTY ENGINEERING BLDG.

Do not extend this side of this line.

Note: Any Additions or Changes on this Sheet Must be Made or Circled in Red Ink With Date and Name of Person Making Change.

RDFB 30026

220

FB 3827 Pg 14

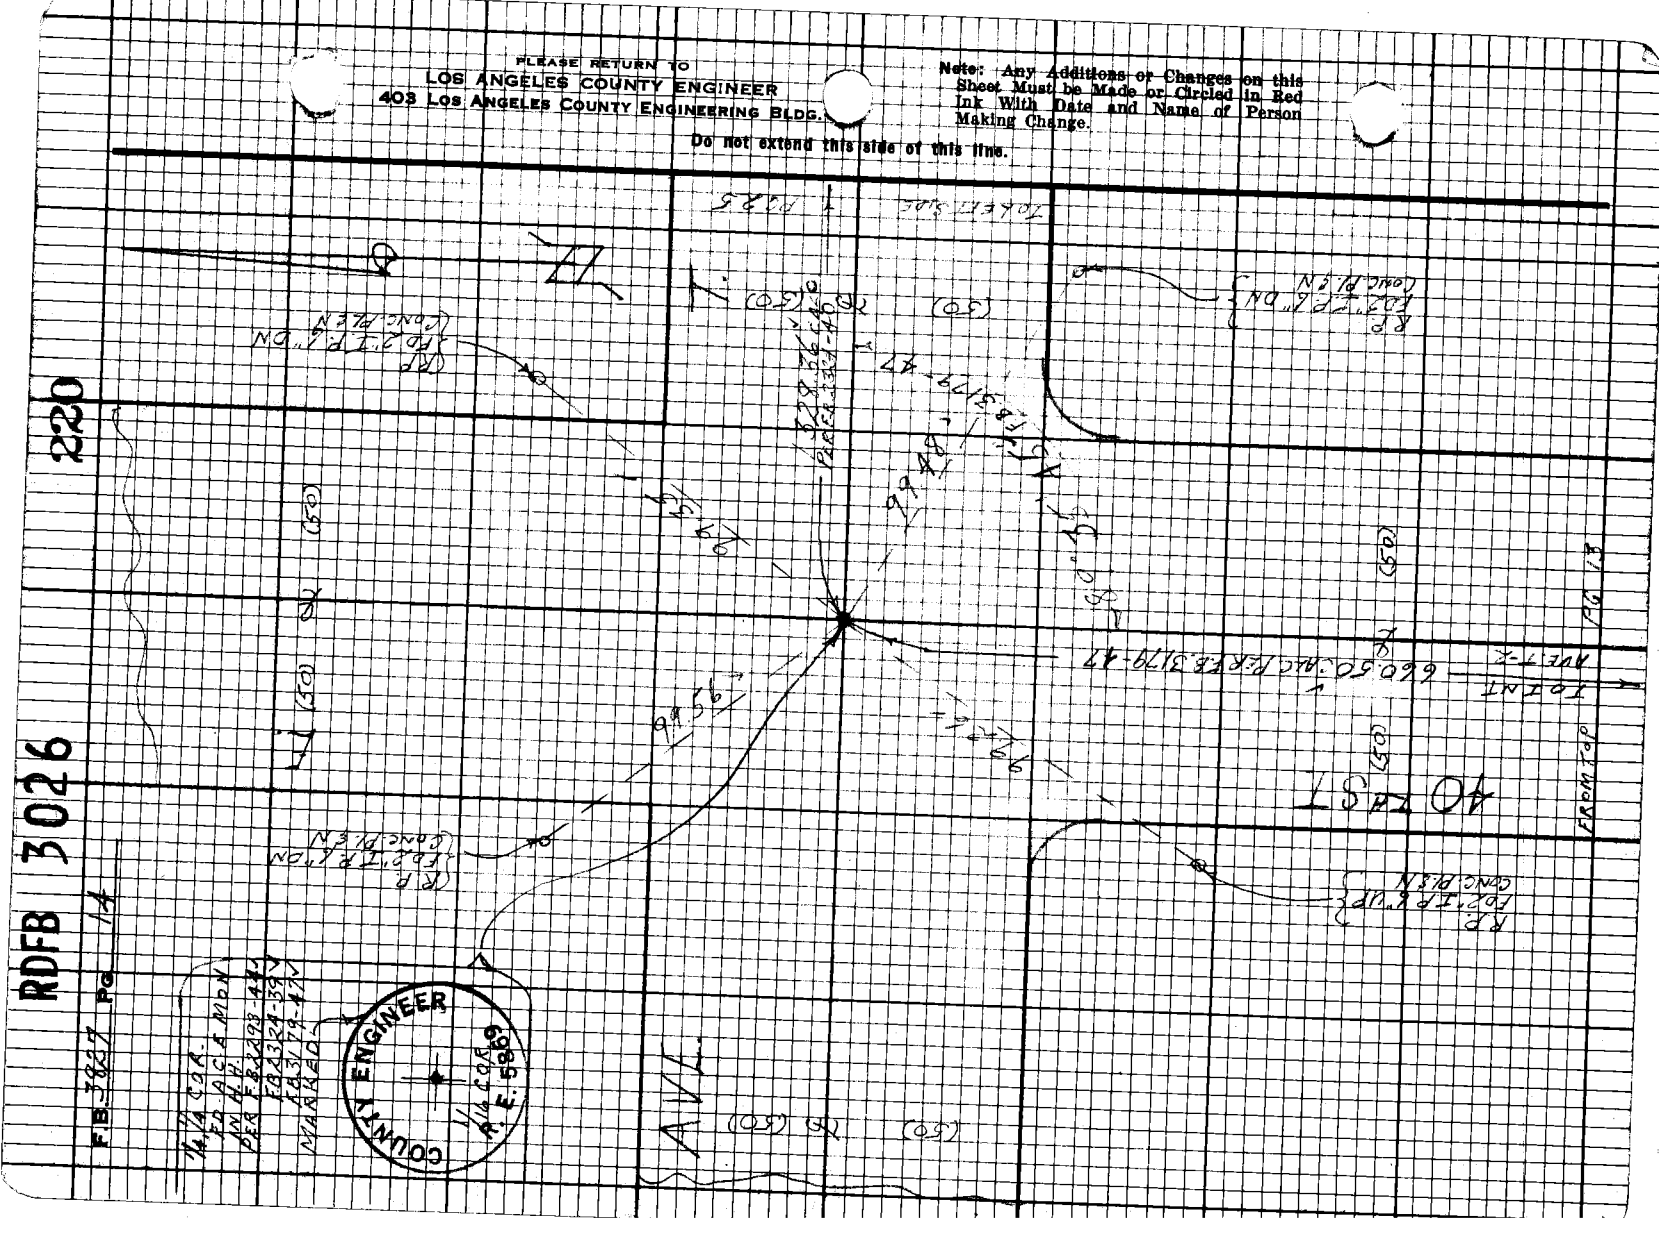

RDFB 3027

277

Notes Ck'd by W. EDMONDSON
Map No. 0-5106-17
Office Work by E. F. MUNOZ
Checked R. BRIONES
Date 3/13/74

Survey of AVE. T-8
JN 0782-11 Tape 184 Std. 84 °F
Surveyed by J. SCOATES
Notes T.S.C. Date 12-70
Indexed GALLI 1977

F.B. 3827 Pg. 15

① 90-17-25
② 361-09-25
③ 90-17-2¼
④ 181-44-26
90-17-23½

Note: Any Additions or Changes on this Sheet Must be Made or Circled in Red Ink With Date and Name of Person Making Change.

Do not extend this side of this line.

PLEASE RETURN TO
LOS ANGELES COUNTY ENGINEER
403 Los Angeles County Engineering Bldg.

75F3038 CE#810 8-67

To Bot Pg 16

To 11+ Ave T

(30) (30)

S 1°22'22" W 2178.98' to 11+

90°

17.

SET NAIL ON LINE

22.

N LINE

66.15'

S 1°22'22" E

To Left

T 11 St

S 88°37'38" W 1176.77'

(ED 2-1-58 "On Prop Line")
(Found Old Tag RS 73-16 "LS")

90.00

SET N & T IN PP 1/2/3/4 E

S TR LINE

90.00

(30) (30)

SET PM IN CHS "X" ON FIRE HYD.

11775 @ T: 1D0" 11767

RDFB 3027

278

F.B. 7827 Pg 16

LOS ANGELES COUNTY ENGINEER
403 Los Angeles County Engineering Bldg.

PLEASE RETURN TO

Do not extend this side of this line.

Note: Any Additions or Changes on this Sheet Must be Made in Red Ink With Date and Name of Person Making Change.

LA 65 C-4

300.51 @ 88-43-30 : 300.44'
300.54 @ 88-47-30 : 300.42'
300.92 @ 94-05-29 : 300.15'
300.86 @ 93-52-29 : 300.17'
300.19 @ 274-12-00 : 298.20'
300.38 @ 274-14-50 : 298.33'

LEVEL

T=100'

AVE

To INT 40TH ST. E.

665.91

SET NAIL & TAG RCE 12/31/10

T 8 S

R 12 W

665.96

To INT 40TH ST. E.

(82)

(82)

SET RSEW 12" JOSHUA

FD 2 I.P. 8" DN CONC PLUG REGO 07 PLS R.S. 73-16 REMOVED

Δ 89-35-30
Δ 358-22-30
89-35-35
Δ 177-38-25
89-35-34

(30)

(30)

From top of hill Pg 15

RDFB 3027

279

FB 3827 Pg. 17

Notes Ck'd by: W. EDMONDSON	Survey of: 4 I T 8
Map No. B-5196-1-7	JN 0078 14 Tape 184 Sta 24 "F"
Office Work: R. BRIONES	Surveyed by: J. SCOTT
Checked: R.E. MUNOZ	Notes: VANNESS Date: 7-2-70
Date: 3/13/74	Indexed: D.D. GALLI 10-27-70

W.S. 65 C-4

Note: Any Additions or Changes on this Sheet Must be Made or Circled in Red Ink With Date and Name of Person Making Change.

Do not extend this side of this line.

LOS ANGELES COUNTY ENGINEER
403 Los Angeles County Engineering Bldg.

PLEASE RETURN TO

7/69 3028 CE# 310 9-67

TO LEFT SIDE PG 16

FD 2" I.P 24" UP CONC. PL. & TAG RE 7217

42ND ST. E

POB FB 2391-112, 114

FD SET FB 2391-112, 114

Ⓐ 90° 46' 35"
Ⓑ 345° 06' 25"
90° 46' 36¼"
Ⓒ 134° 33' 36"
90° 46' 35⅝"

220 48 @ 8° 47 09" 32.115'
260 14 @ 83 38 45" 33.114'

91 37 @ 257 51 20" 87.52'
91 24 @ 258 18 50" 89.51'

162 50 @ 70 46 10" 153.39'
162 31 @ 71 30 20" 159.38'

269 38 @ 271 08 00" 269.32'
269 41 @ 271 14 30" 270.32'
777.35'

I-84

1/4 SECTION 2

777.35'

TO BOT

Ⓓ 89° 47' 15"
Ⓔ 359° 09' 00"
89° 47' 15"
Ⓕ 178° 43' 30"
89° 47' 16⅓"

FD 2" I.P 24" UP CONC. PL. & TAG RE 7217

220 7.49' Calc
FD B.S.W.L.T. FB 2324-23.38

FD B.S.W.L.T. FB 2391-112 FB 2324-138

33.28

33.32

FB 2391-112 115° 44' 30"

FD 2" I.P 24" UP CONC. PL. & TAG RE 7217

1787.71' per FB 2391-112

90°

90°

21.44'

1331.45' per FB 2324-37

FROM TOP PG 8

1/4 COR 8 17
T 5 S R 11 W
FD C.E. MON
per FB 2391-106
FB 2324-37
MARKED

RICHARD E. MUNOZ
No. 6669
REGISTERED ENGINEER
1/4 SEC 8 17
T 5 S R 11 W

RDFB 3027 280

FB 3887 PG 18

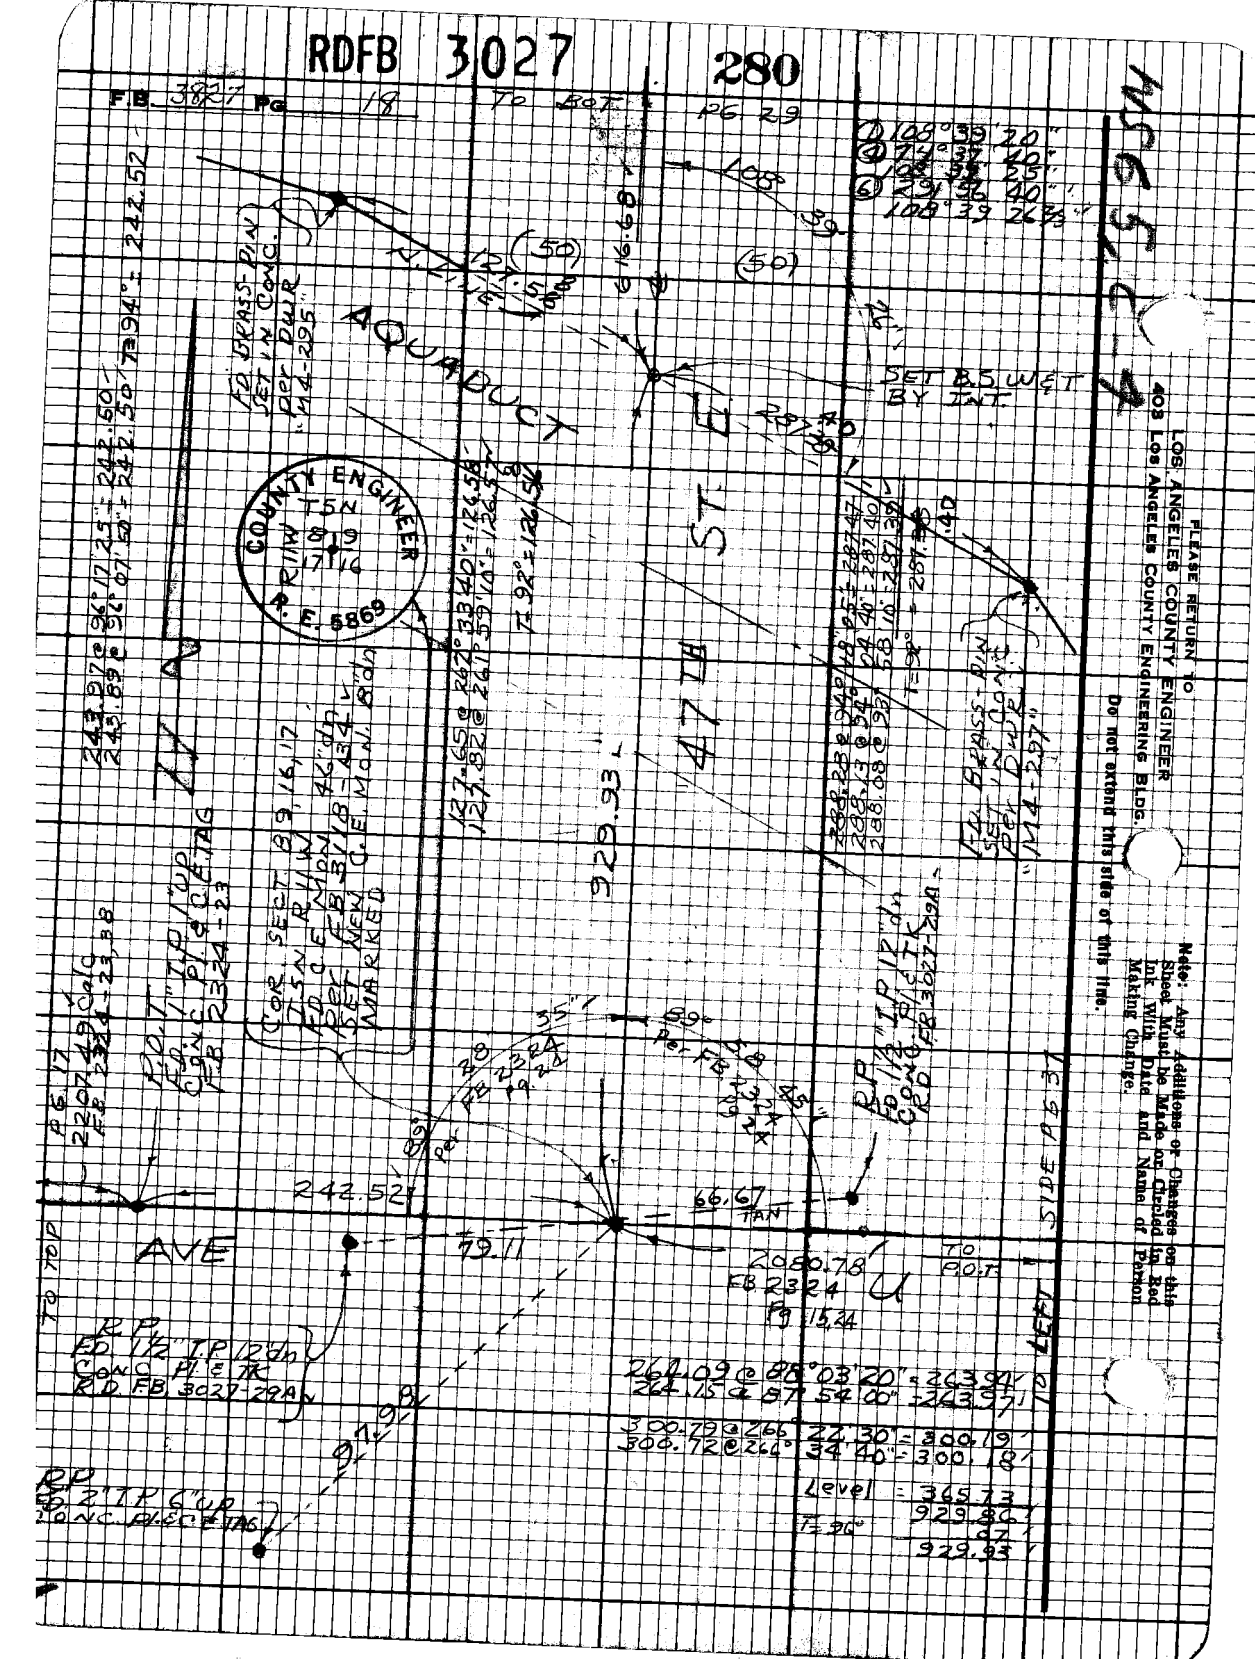
AQUADUCT
47TH ST
AVE
COUNTY ENGINEER
T5N R11W
17 16
L.S. 5869
FD BRASS PIN IN CONC. SET 1/2" IN CONC. PER DWR 44-295
SET B.S. W&T BY I.T.
FD 1/2" I.P. 1/2" DN CONC. PLUG & TAG FB 2324-23
FD 1/2" I.P. 1/2" DN CONC. PLUG & TAG FB 2324-23
SET NAIL & TAG "LS 5869" IN CONC. MONUMENT WELL

RDFB 3027

281

W. EDMONDSON
Notes Ck'd by
Map No. B-5196-1-7
Office Work R. BRIONES
Checked A.F. MUNOZ
Date 3/13/74

Survey of AVE T-8
JN 007817 Tape 184 Std 84 'F'
Surveyed by J.S.C.E.
Notes C.L. Date 7-29-70
Indexed C.L.GALL

F.B. 3827 PG. 19

Note: Any Additions or Changes on this Sheet Must be Made or Circled in Red Ink With Date and Name of Person Making Change.

Do not extend this side of this line.

PLEASE RETURN TO
LOS ANGELES COUNTY ENGINEER
403 Los Angeles County Engineering Bldg.

765-508 CE#810 9-67

TO 80T

0620

(40)

TO S. T.R. LINE

(40)

42ND ST E

340.14'

15"

38

53°

247.48'

TANGENT LINE

247.46 @ 39° = 247.48'

SET 4E.T.&G CONC. APRON

STATE

SET N&T PP# 184.74 15E

33-38

803

FD. 3/4" I.P. 10" DN CONC. PL. & TAG M4-275A PER DWR

STATE AQUADUCT

M4-275 FD. 3/4" I.P. 2" DN CONC. PLUG & TAG PER DWR

SQ. LINE AQUADUCT

1773.22 @ 77-08-45 = 168.89'
123.38 @ 76 55-00 = 168.88'

67.67 @ 82-02-40 = 67.02'
67.81 @ 81-15-10 = 67.02'

LEVEL

T = 86'

290.85
526.75'
+101'
526.76'

FD. BRASS PIN IN CONC. MARKED M4-264A PER DWR

S26.76'

251.18 @ 96 25 20

SET N&T PP# 184.74 16E

90.5

SQ. LINE AQUADUCT

771.35'

TO LEFT SIDE PG. 17

RDFB 3027

282

F.B. 3837 Pg 20

To Bot. Pg 21

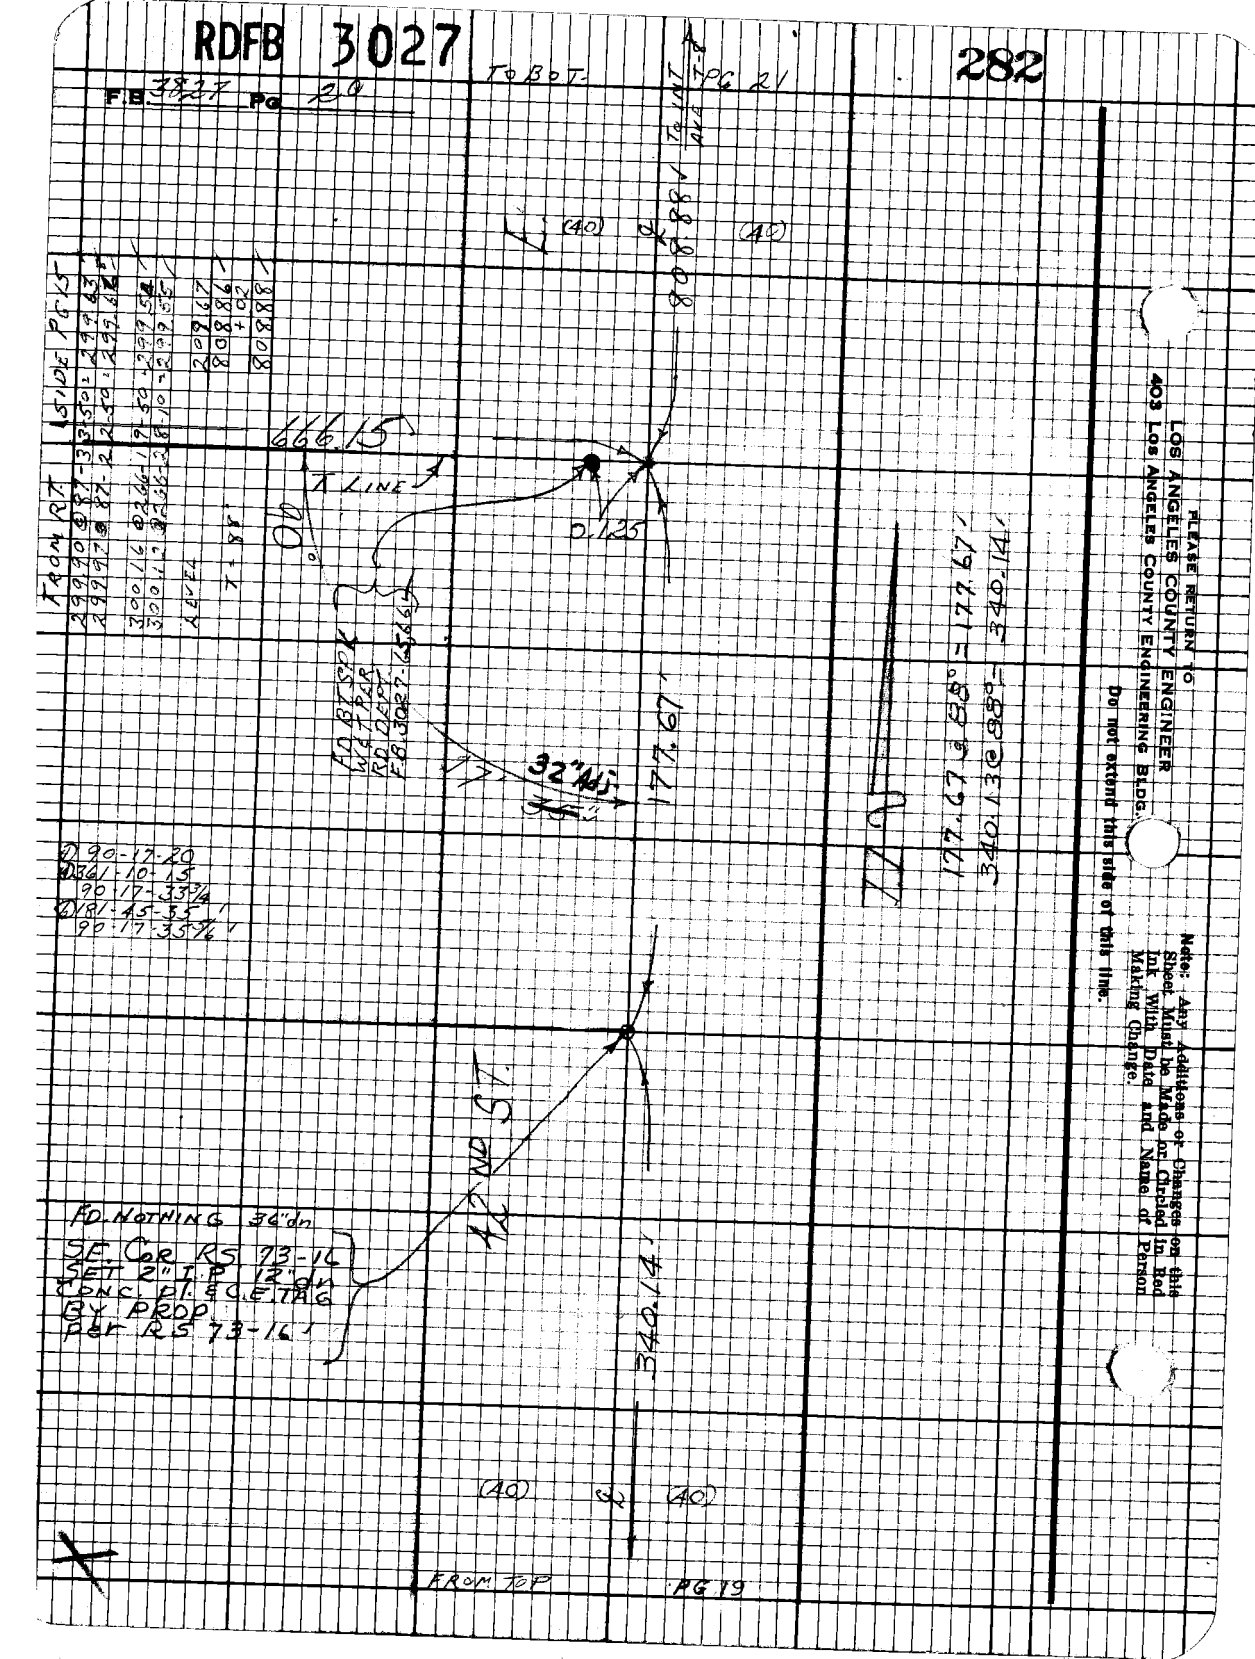

FROM RT


RDFB 3027

283

Notes Ck'd by W. EDMONDSON
Map No. B-5196-1-7
Office Work R. BRIONES
Checked R. F. MUNOZ
Date 3/13/74

Survey of AVE T-8
JN 0098.17 Tape 184 Std 84 "F"
Surveyed by J. S. COATES
Notes J. S. C. Date 7-2-70
Indexed G. J. GALLI

F.B. 3817 Pg. 21

Note: Any Additions or Changes on this Sheet Must be Made or Circled in Red Ink With Date and Name of Person Making Change.

PLEASE RETURN TO
LOS ANGELES COUNTY ENGINEER
403 LOS ANGELES COUNTY ENGINEERING BLDG.
Do not extend this slip or this line.

765098 CE# 310 9-67

AVE T-8

AVE.

FD BRENEMAN SET IN LEAD

FD NAIL IN PP NO 0

FD NAIL & TAG

SET LEAD & TAG ON LINE CONC. CROSS-60 IT

SET LEAD Cross IN Scc.

SET LEAD & TAG BY INT.

FROM RT SIDE

FROM LEFT SIDE

FD NAIL & TAG

FD NAIL & TAG

FD NAIL & TAG

RDFB 3027 TO SCT PG 23 284

FB 3827 Pg 22

65 C 4

PLEASE RETURN TO
LOS ANGELES COUNTY ENGINEER
403 Los Angeles County Engineering Bldg.

Note: Any additions or Changes on this Sheet Must be Made or Circled in Red Ink With Date and Name of Person Making Change.

Do not extend this side of this line.

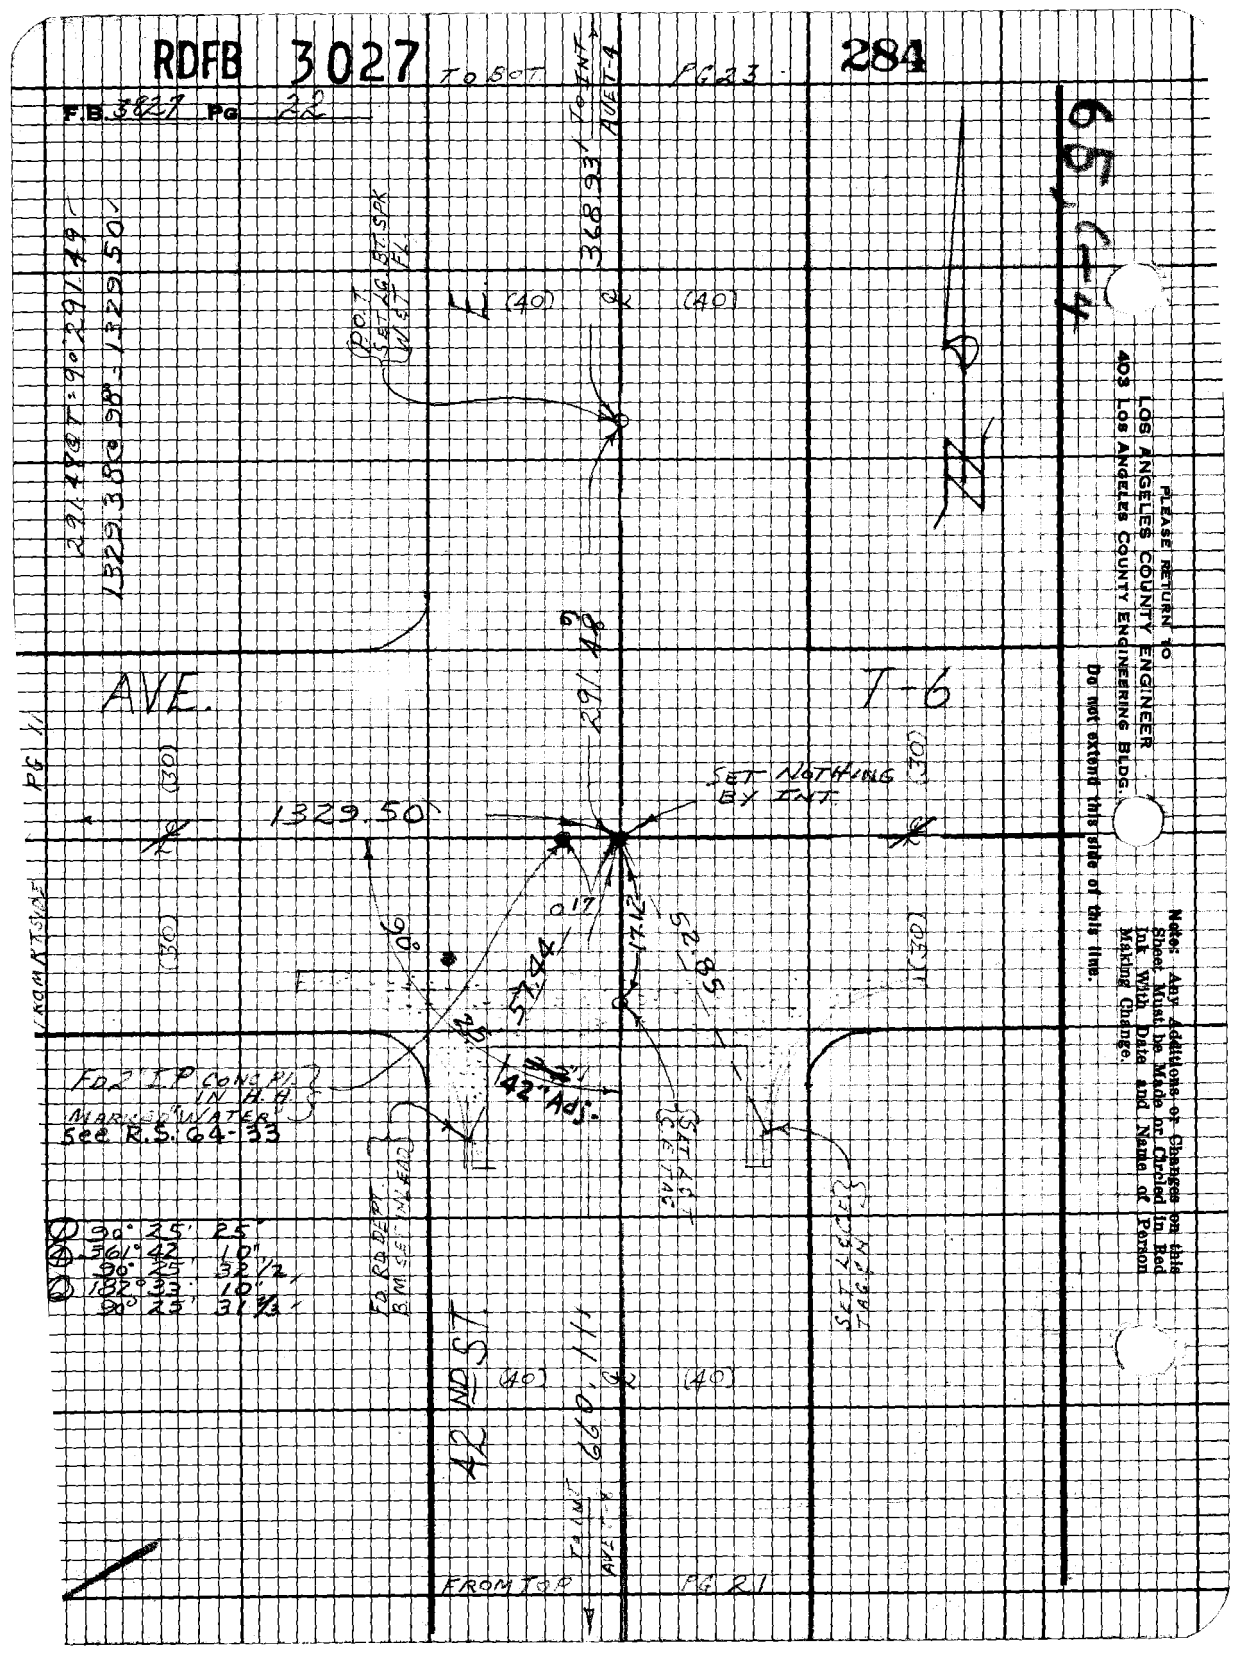

RDFB 3027

285

F.B. 3827 Pg. 23

Notes Ck'd by W. EDMONDSON
Map No. B-5196-17
Office Work R. BRIONES
Checked L.F. MUNOZ
Date 3/13/74

Survey of AVE T-8
JN 0098/7 Tape 184 Stn 84 "F"
Surveyed by J.S. COATES
Notes J.S.C.
Date 7-2-70
Indexed C.J. GAPLI OCT 27

Note: Any Additions or Changes on this Sheet Must be Made or Circled in Red Ink With Date and Name of Person Making Change.

Do not extend this side of this line.

PLEASE RETURN TO
LOS ANGELES COUNTY ENGINEER
LOS ANGELES COUNTY ENGINEERING BLDG.
405 LOS ANGELES

Jacobsen CE#310 9-67

W 5.65 C4

SET ANGLE PT. #6 SET 0.25 FT. IN

SET ANGLE PT. #5 SET 0.25 FT. IN

298.95 S 0°04'04" E = 298.96

AVE T

PG 12

1030.07

(30)

FROM T-8

PUT SET & SWET 1" ALUM

298.96

50.00

T 4

(30)

FD SPK & TACK RD REF

660.43

(40)

SET P.I.P. IN CONC. PAVE AT E.S. 44-33 PER RS

SET P.I.P. IN CONC. PAVE AT E.S. 44-33 PER RS

SET I.P.P. IN CONC. PAVE AT E.S. 44-33 PER RS

SET I.P.P. IN CONC. PAVE AT E.S. 44-33 PER RS

46" ADJ.

SET NAIL & 1" LOCUST

368.93

42ND ST.

(40)

(30)

FROM T-8

TO BTSPK T-8 PG 12

299.45 @ 87°18'00" = 299.45
299.82 @ 87°18'00" = 299.82
Level

92.48
368.52
368.93

T-90°

(1) 90° 25' 30"
(4) 361° 47' 35"
(5) 88° 25' 36 1/4"
(6) 182° 33' 45"
90° 25' 37 1/2"

RDEB 3027

F.B. 7627 Pg 24

To BOT. Pg 25

286

W 65-27

LOS ANGELES COUNTY ENGINEER
403 Los Angeles County Engineering Bldg.

PLEASE RETURN TO

Do not extend this side of this line.

Note: Any additions or Changes on this Sheet Must Be Made in Circled In Red Ink With Date And Name of Person Making Change.

T 2

AVE T

AVE T-4

42ND ST

PUNSTAWAY

660.40 @ 90°- 660.43'

704.43 @ 88°= 704.45'

SET NAIL 4" Locust

SET NAIL 14" Gate post

SET NAIL BP #917 PS&E

SET NAIL 4" Locust

SET NAIL 4" Locust

SET C.E. MON "HH" BY PAINT BETWEEN AVE T & AVE T-4 ON RS 64:33

SET NAIL 4" Locust

SET NAIL 4" Locust

P.O.T. SET B.S. W&T 1" down in dirt

20' Adj.

624.05'

704.45'

660.43'

660.43'

660.43'

660.40'

660.43'

660.43'

660.43

RDFB 3027

287

Notes Ck'd by W. EDMONDSON
Map No. B-5196 1-7
Office Work R. BRIONES
Checked D. F. MUNOZ
Date 3/13/74

Survey of AVE T-8
JNO098 IX Tape 184 Sta 84 +5
Surveyed by J.S.C. COATES
Notes J.S.C. Date 7-2-70
Indexed G.J. GALLI

F.B. 3827 Pg. 25

W 345.54

Note: Any Additions or Changes on this Sheet Must be Made or Circled in Red Ink With Date and Name of Person Making Change.

Do not extend this side of this line.

PLEASE RETURN TO
LOS ANGELES COUNTY ENGINEER
403 LOS ANGELES COUNTY ENGINEERING BLDG.

78P5098 CE#310 9-67

FD 4 COR SEC 5 T 5 S R 11 W FD CE MON IN H.H. PER FB 2324-41 MARKED

COUNTY ENGINEER T 5 S R 11 W 4 COR R.E. 5869

AVE. T-7

(40) (40)

PER FB 2324-41 1328.36 CALC

1328.36 CALC PER FB 2324-40

PER FB 2324-41 1328.74

45° 45° 45°

45.73

SET LEAD & TACK ON LANE

31" Adj.

T. (60) TO E 45TH STE

TO BOT

FD LEAD

① 90-26-20
② 361-45-40
90-26-25
③ 82-38-45
90-26-25
22 1/2

FD LEAD

① 89-38-25
② 358-13-40
89-38-25
③ 177-20-30
89-33-25

1 Adj. 1.62

660.43

89°

12ND ST. (40) (40)

TO AVE T-7

FROM TOP PG 24

PLEASE RETURN TO
LOS ANGELES COUNTY ENGINEER
403 LOS ANGELES COUNTY ENGINEERING BLDG.

Do not extend this side of this time.

Note: Any Additions or Changes on this Sheet Must be Made or Circled in Red Ink With Date and Name of Person Making Change.

RDFB 3027
F.B. 3627 PG 216

288

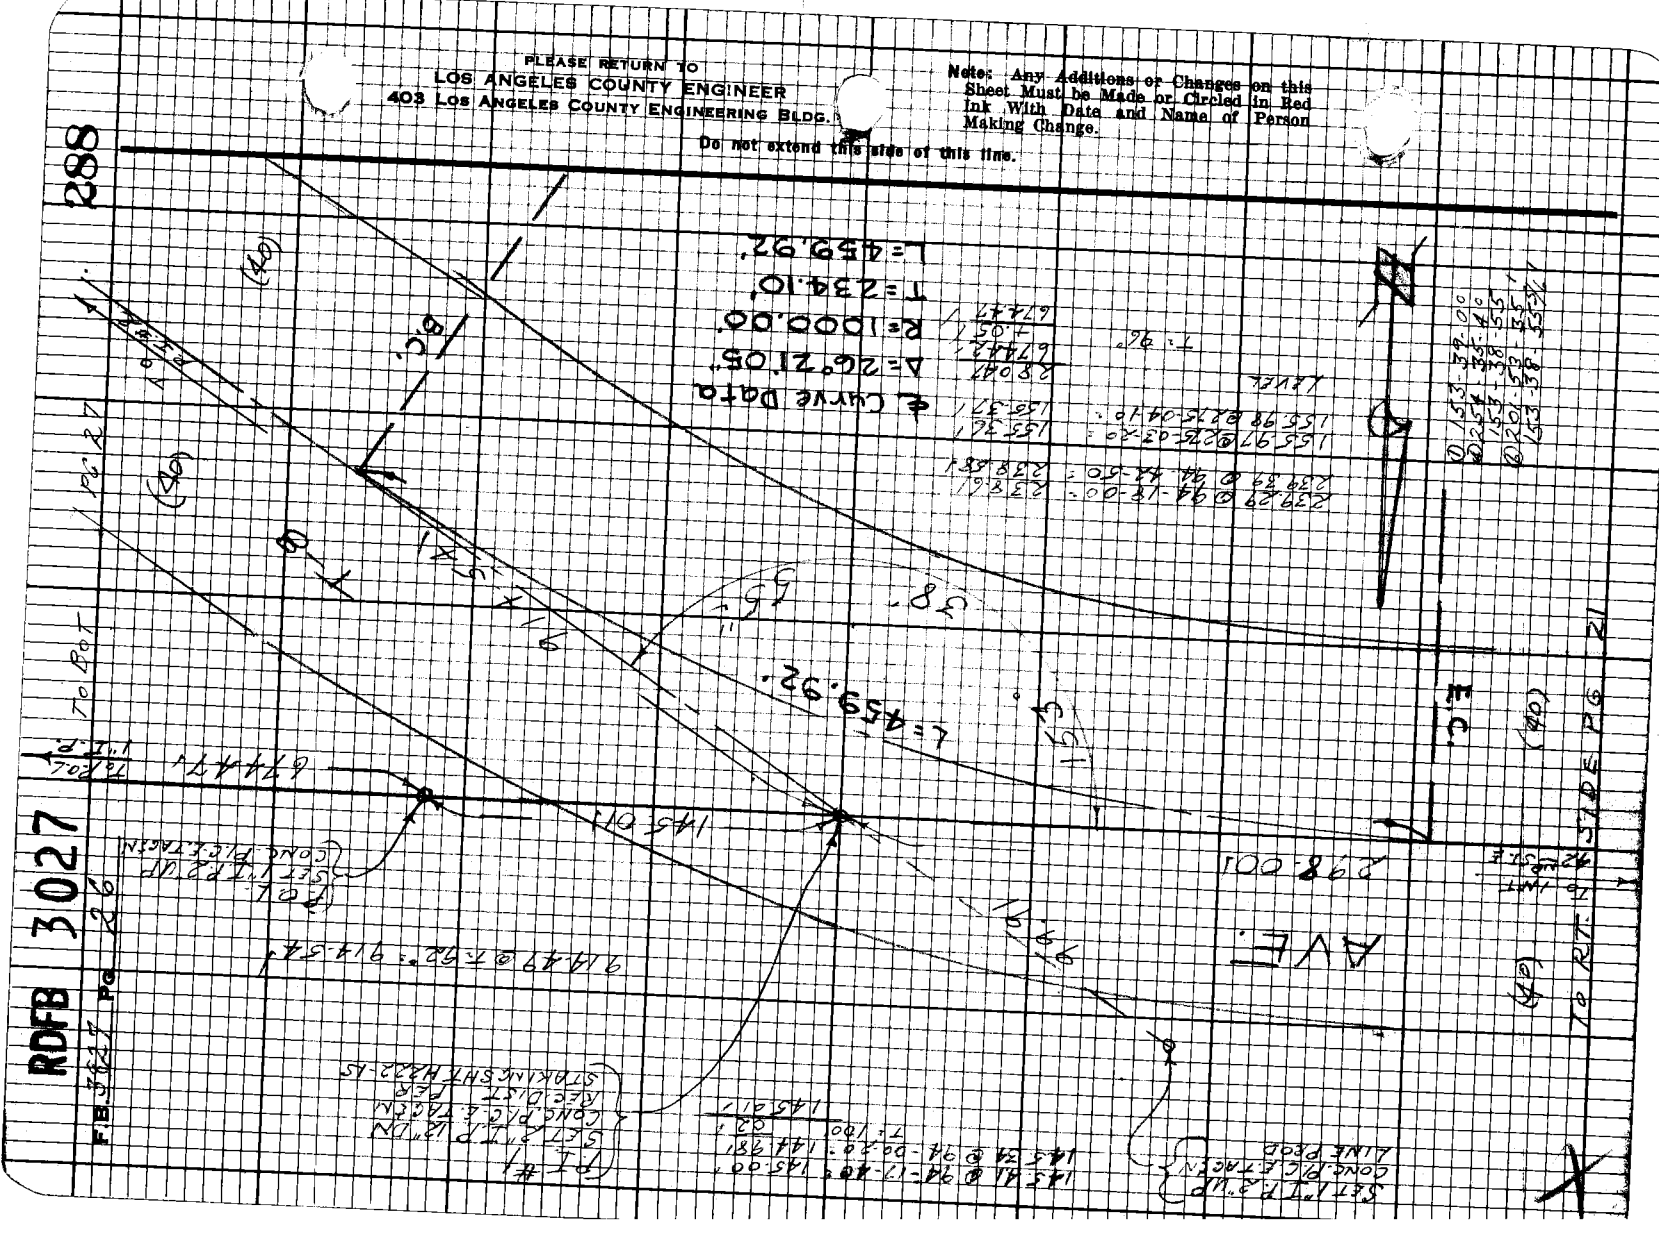
℄ CURVE DATA
Δ=26°21'05"
R=1000.00'
T=234.10'
L=459.92'
℄
AVE.
459.92'
234.10'
298.001
TO RT. SIDE PG 21
TO PGT. 1"=1'
6744.47'
145.01'
℄ C.
(CONC. PLC. TAGEN)
SET 1"I.P. 2.3" UP
CONC. PLC. TAGEN
ALIKE PROP.
SET 3"I.P. 2.3" DN
CONC. PLC. TAGEN
AT CENT. DIST. FROM
STRAIGHT LINE
9.44.29 @ R=52': 917.54'
145.84 @ 94-17-00": 145.00'
145.34 @ 94-00-29": 144.98'
T=100.03'
145.01'
155.37'
155.97 @ 225-02-20": 155.37'
155.98 @ 225-04-10": 155.37'
239.29 @ 94-16-00": 237.61'
239.29 @ 94-44-50": 238.58'
R=1000.00'
T=92.27'
6744.47'
6744.47'
6744.47

RDFB 3027

289

F.B. 382 Pg. 27

Notes Ck'd W. EDMONDSON
Map No. B-5196-1-7
Office Work R. BRIONES
Checked T. F. MUNDT
Date 9/13/74

Survey of AVE. T-8
JN 0098.17 Tape 184 Sta 84+99
Surveyed By J. SCOTT
Notes C.L. Date 8-70
Indexed D. J. GALLI 07 27 70

Note: Any Additions or Changes on this Sheet Must be Made in Red Ink With Date and Name of Person Making Change.

PLEASE RETURN TO
LOS ANGELES COUNTY ENGINEER
403 LOS ANGELES COUNTY ENGINEERING BLDG.

Do not extend this side of this line.

75F3098 CE#310 9-67

To 807

Pg 28

1/4 SEC. LINE

987.73'

403.91' @ T. 100 = 406.00'

℄ Curve Data
Δ = 46° 06' 42"
R = 1000.00'
T = 425.63'
L = 804.80'

SET 1" I.P. 2" UP
CONC. P.C.E. FAGEN
L.S. 3022

SET 1" I.P. 2" UP
CONC. P.C.E. FAGEN
L.S. 3022

SET 1" I.P. 2" UP
CONC. P.C.E. FAGEN
L.S. 3022

SET 1" I.P. 2" UP
CONC. P.C.E. FAGEN
L.S. 3022

SET 1" I.P. 2" UP
CONC. P.C.E. FAGEN
REC. P.S.T. PER
STARING SHT. M2222-LS

1200.49' @ T-32 = 1200.55'

1944.

(A01)

(A0)

L=804.80'

18°46'

406.00'

90°00'00"

90°00'00"

90°00'00"

T-8

AVE

54'

(R0)

(R0)

FROM 700

Pg 26

RDFB 3027

290

F.B. 3827 Pg 28

TO LEFT

TO INT. 44TH ST. S. & EPC 29

(40) (40)

PLEASE RETURN TO
LOS ANGELES COUNTY ENGINEER
403 Los Angeles County Engineering Bldg.

Note: Any Additions or Changes on this Sheet Must be Made or Circled in Red Ink With Date And Name of Person Making Change.

Do not extend this side of this line.

B.C.

T-8

P.O.T. #3
SET 2" I.P. IN
CONC. N.C.E. TAGGED
"LS 4827 DIST. PK
STAKING SHT. 1122-15

R=2000.00'
T=2000.00'
L=4134.98'
Δ=119°45'37"
4 CURVE DATA

E.C.

P.O.T.
SET 1" I.P. 2' UP
CONC. N.C.E. TAGGED

L=413.98'

19°15'37"

T=1000.00'

19-15-35
79-02-30
19-45-37½
118-33-42
19-15-37½

FROM TOP PG 27

RDFB 3027

291

Notes Ck'd by	W. EDMONDSON
Map No.	B-5196-11-7
Office Work	R. BRIONES
Checked	D.F. MUNOZ
Date	3/13/74

Survey of AVE T-8
JN 0078-7 Tape 184 Sta 54 + 5
Surveyed by J. SCOTT
Notes C.V. VANNEST Date 5-14-70
Indexed D.D. GALT 1972 70

F.B. 5827 Pg. 29

(1) 89° 57' 20"
(2) 359° 42' 55"
(3) 89° 57' 28½"
(4) 179° 44' 45"
89° 57' 27½'

TO RT SIDE PG. 31

1/4 COR SEC 8, 9 T5N R11W
FD 3/4" I.P. NO TAG
PER C.S. 8739
FD 2324-27 BTY
MARKED

COUNTY SURVEY T5N R11W SEC 8 9 MONUMENT

Note: Any Additions or Changes on this Sheet Must be Made or Circled in Red Ink With Date and Name of Person Making Change.

Do not extend this data on this line.

PLEASE RETURN TO
LOS ANGELES COUNTY ENGINEER
403 Los Angeles County Engineering Bldg.

FROM TOP

PG 28

AVE T-8

(40)

373.00'

1441.48' To POL

1" I.P.

1100.50'

TO BOT PG 36

T-8

(40)

(RP FD 2" I.P. & TAG
CONC PLUG & TAG
FB 2324-27)

FB 2324-27 2728
2639.76 =

(50)

AVE T

TO

(50)

(50)

89°

89°

89°

RDFB 3027

F.B. 3827 Pg. 30

292

TO BOT. PG. 31

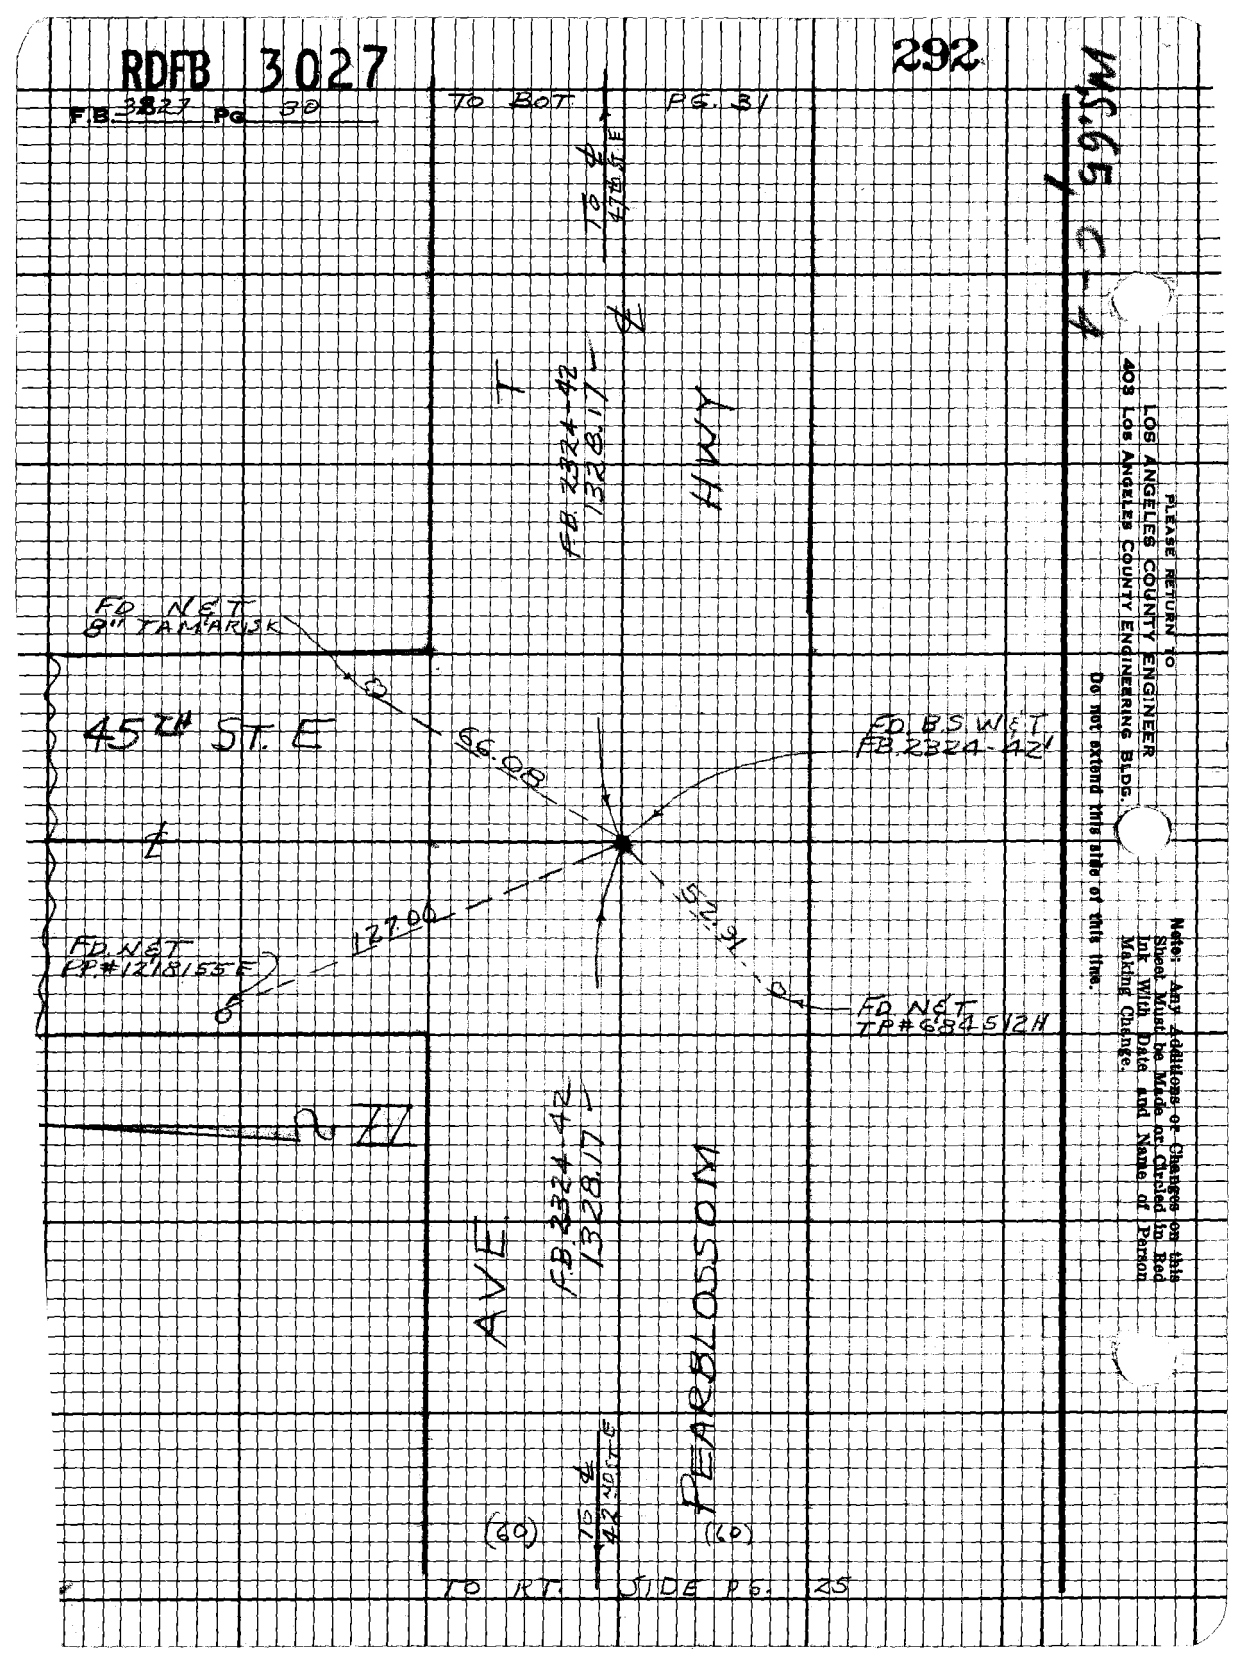

RDFB 3027

293

Notes Ck'd by W. EDMONDSON
Map No. B-5196-1-7
Office Work R. BRIONES
Checked J. F. MUNOZ
Date 3/13/74

Survey of AVE T-8
JN 0098-17 Tape 184 Sta 84-T
Surveyed by J S COATES
Notes JSC Date 8/12/70
Indexed C. J. GALLI 10-27-70

F.B. 3827 Pg. 31

Note: Any Additions or Changes on this Sheet Must be Made or Circled in Red Ink With Date and Name of Person Making Change.

Do not extend this side of this map.

PLEASE RETURN TO
LOS ANGELES COUNTY ENGINEER
403 LOS ANGELES COUNTY ENGINEERING BLDG.

76P5098 EE#310 9-67

W 5 6 5, C-4

TO BOT. PG. 32

HWY

(60)

(60)

RP FD 2" I.P. 6"dn CONC. Pl. & TK

1319.85' TO 45TH ST E

RP FD 2" I.P. 6"dn CONC. Pl. & TK

90° 00'

RP FD 2" I.P. 6"dn CONC. Pl. & TK

47TH

85.10'

84.32'

10.69'

50'

(50)

ST E

PG 29

TO TOP

TO ℄ AVE T-8

2639.76' per FB 2324-28

14.05'

84.86'

FD LEAD & TACK

85.20'

61.21'

50'

(50)

90° per FB

FD LEAD & TACK

RP FD 2" I.P. 6"dn CONC. Pl. & TK

COR. SEC. 4, 5, 8, 9
T 5 S R 11 W
F.D. C. E. N 10W in M.H.
per FB 2324-28

1328.17'

PEARDISSON

RP FD 2" I.P. 6"dn CONC. Pl. & TK

TO ℄ 45TH ST E

(60)

(60)

TO TOP PG. 30

COUNTY ENGINEER
ALLEN E. SMITH
5-14-74
R.E. 5866

RDFB 3027

294

F.B. 3027 Pg. 32 TO RDT PG 33

(60) (60)

HWY

FB 2324-44
1319.85

50TH ST. E

FD. B.S.W. & T
Per FB. 2321-44

50.08

FD N & T
PP# 1195646E

73.11

FD N & T
PP# 4859024H

PEARBLOSSOM

FB 2324-44
1319.85

(60) (40)

TO TOP PG. 31

PLEASE RETURN TO
LOS ANGELES COUNTY ENGINEER
403 Los Angeles County Engineering Bldg.

Do not extend this side of this line.

Note: Any Additions or Changes on this Sheet Must be Made or Circled in Red Ink With Date and Name of Person Making Change.

RDFB 3027

295

Notes Clkd by	W. EDMONDSON	Survey of	AVE T-8
Map No.	B- 5196-1-7	JN 2098 17 Tape 194 Sht 84-T	
Office Work	R. BRIONES	Surveyed by	J.S.C.
Checked	V.F. MUÑOZ	Notes	J.S.C. Date 8/12/70
Date	3/31/74	Indexed	C.J. GALLI OCT 27 '70

F.B. 3827 Pg. 33

Note: Any Additions or Changes on this Sheet Must be Made or Circled in Red Ink With Date and Name of Person Making Change.

Do not extend this side of this time.

PLEASE RETURN TO
LOS ANGELES COUNTY ENGINEER
403 LOS ANGELES COUNTY ENGINEERING BLDG.

76F3098 CE#310 8/67

W.S.S. 4

To BOT. PG. 34

(60)

(82)

HUNT

659.76

RP 2"IP 6"UP Conc. Pile NAIL

RP 2"IP 6"UP Conc. Pile NAIL F.B. 2324-45

RP 2"IP 6"UP Conc. Pile NAIL F.B. 2324-45

89°54'00"
359°26'55"
89°54'13¾"
179°25'15"
89°54'12½"

Sp.

52ND

ST. E

1320.07 To INT AVE T

To TOP

RP 2"I.P. 6"Dn Conc. Pile NAIL F.B. 2324-45

Fd. 1/2" I.P.

90°

FD. 1/2" I.P. CONC. STEP

HOUSE

PEARBLOSSOM

1319.85

F.B. 2324-44

(60)

(60)

1/4 COR. SEC. 4, T 1 S, R 11 W FD. C.E. MON. in H.H. F.B. 2324-45 MARKED

90°05'45"
90°22'45"
90°05'41¼"
180°32'20"
90°05'23½"

COUNTY ENGINEER R.E. 5869

TO TOP PG. (32)

RDFB 3027

296

FB 3027 Pg 34

To BOT

PG. 48

(60)

To

(60)

N65 E74

PLEASE RETURN TO
LOS ANGELES COUNTY ENGINEER
403 Los Angeles County Engineering Bldg.

Do not extend this area of this line.

Note: Any Additions or Changes on this Sheet Must be Made or Circled in Red Ink With Date and Name of Person Making Change.

① 89°52'35"
② 359°30'30"
③ 89°52'37½"
④ 179°15'40"
⑤ 89°52'32½"

HWY

1227.69'

SET N&T
P.P.#1859636E

89°52'

37.11'

SET 18.5 Kief
at Ang. Pt.

53RD ST. E

FD. 2" I.P. 32"dp
Conc. Illegible
REF 6067
Per RS 72-27

30.04

689.74'

TO ANT
MATR. LINE

(30)

SET 4&CE TAG
CONC. Illegible

SET 4&TAG
CONC. Illegible

PEARDISON

AVE

(60)

(82)

To

To TOP

PG. 33

459.73 @ 90° = 459.74'
1227.61 @ 94° = 1227.69'

RDFB 3027

297

Notes Ck'd	W. EDMONDSON	Survey of	Ave T-8
Map No.	B-5196-1-7	JN	78.17 Tape 184 Sta 84+
Office Work	R. BRIONES	Surveyed by	J. SCOATES
Checked	J.F. MUNOZ	Notes	C.J. GALLI Date 2-70
Date	3/13/74	Indexed	C.J. GALLI OCT 27 '70

F.B. 3827 Pg 35

TO RT. SIDE PG 33

TO LT. SIDE PG 36

Note: Any Additions or Changes on this Sheet Must be Made or Circled in Red Ink With Date and Name of Person Making Change.

PLEASE RETURN TO
LOS ANGELES COUNTY ENGINEER
403 LOS ANGELES COUNTY ENGINEERING BLDG.

Do not extend this side of this line.

ASSESSOR SEE # 310 267

US 5-4

AVE T-4

ST

52 ND

(40)

(30)

660.40'

1320.01'

1320.01'

660.40'

45° 16' 15"

89° 54' 00"

359° 35' 45"

89° 53' 36¼"

179° 25' 25"

89° 53' 34½"

RP SET 1" IP 2"OP CONC. PL & C ETAG

RP SET 1" IP 2" OP CONC. PL & C ETAG

FD 2" PIPE & TAG

SET CHISEL X

TO LT

TO RT

SIDE PG 36

SIDEPG 33

TO LEFT

SIDEPG 36

RDFB 3027

298

FB 3827 Pg 36
To Left Side

PG 38

PLEASE RETURN TO
LOS ANGELES COUNTY ENGINEER
403 Los Angeles County Engineering Bldg.

Note: Any additions or Changes on this Sheet Must be Made or Circled in Red Ink With Date and Name of Person Making Change.

Do not extend this side of this line.

N 65° 57' 52" E

2644.37

S 24° 02' 08" E

T-8

TO INT ℄ 1330.07

661.19

R.P. SET 2" I.P. & TAG CONC. PLUG E.IN.

89° 56' 31"

45°

90°

2323.44

ST E

52ND

56° 51' 29"

1320.07

FROM INT ℄ 1330.07

PG 35

CENTER SEC. 9
T.5 N. R.11 W.
FD 2" PIPE 6"dn
PLS 2000
REF. RL 5 72-27 ✓
REPLACED WITH
C.E. MON. 12"dn
BY THAT
MARKED

COUNTY ENGINEER
PLS 6998

89° 53' 30"
359° 36' 24"
89° 39' 05" ✓
179° 24' 55"
89° 54' 05" ✓

AVE

1320.07 TO INT ℄ 52ND ST E

1320.07 TO INT ℄ 1444.18

RP SET 2" I.P. & TAG CONC. PLUG E.IN.

1444.18

TO INT ℄ 52ND ST E

To RT. SIDE PG. 29

RDFB 3027

299

W. EDMONDSON
Notes Ck'd by
Map No. B-5196 I-7
Office Work R. BRIONES
Checked J. F. MUNOZ
Date 3/13/74

Survey of AVE T-8
JN 2218.17 Tape 1/94 Std 84-F
Surveyed by JSC (PATE)
Notes JSC Date 9/3/70
Indexed G.B. GALLI OCT 27 70

F.B. 3827 PG. 37

TO RT. SIDE PG. 36

Note: Any Additions or Changes on this Sheet Must be Made or Circled in Red Ink With Date and Name of Person Making Change.

Do not extend this side of this fms.

PLEASE RETURN TO
LOS ANGELES COUNTY ENGINEER
403 LOS ANGELES COUNTY ENGINEERING BLDG.

78 FSC 88 CE #310 9-67

W.S. 65.14

1189-58-30
1359-53-10
89-58-17½
1179-49-40
89-58-16½

FD. BRASS-PIN SET IN CONC. FL. PER STATE DWR MARKED "M14-300A"

9605 @ 78-22-20 = 94.70'
9617 @ 78-13-00 = 94.41'
LEVEL
T = 84'

226.39
320.79

52ND ST. E

LEVEL

T = 88'

1990-02-30
1340-08-30
90-02-07½
1180-12-40
90-02-06½

300.35 @ 267-14-15 = 300.20'
300.53 @ 267-21-30 = 300.22'

332.38'
332.60'
232.344'
232.344'

300.13'
300.18'
300.40'
300.40'
300.44'
300.48'
300.33'
300.23'
300.18'
300.18'
300.14'
300.10'
300.06'
300.02'

FD. DWR MON. IN CONC. 24" DIA. BRASS-PIN MARKED "M14-300A"

POB = P.O.C. T.1.P. 2" I.P. 6" UP CONC. FILLED PIPE FD. 3324-15

FD. DWR MON. 24" DIA. BRASS-PIN IN CONC. MARKED "M14-300A"

P.O.T. 1.P. 2" UP CONC. FILLED PIPE TAG 2324 FB 23 15

AVE

SIDE PG. 18
N 2080.70 atc
FB 2324 15

367.96'
FB 2324
Pg 15

R00.00'
FB 2324
Pg 15

1/4 COR SEC. 9 T5N R11W
FD. C.S. MON. 18" DIA.
PER C.S. 873 B'
FB 2324-15

COUNTY SURVEYOR'S MONUMENT
T5N
R11W
9
16
1/4 SEC. COR

812.46'

FD. DWR MON. 24" DIA. BRASS-PIN IN CONC. MARKED "M14-300B"

R.P. 2" I.P. 6" UP CONC. FILLED PIPE TAG
P.P. 2324-15

150.00'

TO 80 FT

PT 19

7.04

90°

58°

1225

RDFB 3027

300

W 56TH ST

57TH ST

AVE

To BOT.

PG 42

To INT. 61ST ST W

(30)

(82)

(40)

To INT. 62ND ST W

To INT. 58TH ST W

To INT. 57TH ST W

PG 34

F.B. 3027 Pg. 34

300.51	89° 12' 45"	=	300.37	
300.53	89° 25' 40"	=	300.38	
300.72	267° 27' 45"	=	300.47	
300.67	267° 43' 45"	=	300.43	
300.37	89° 35' 45"	=	300.42	
300.55	90° 28' 45"	=	300.44	
300.29	@ 268° 20' 20"	=	300.15	
300.25	@ 268° 30' 15"	=	300.13	
	Level		1118.34	
	T = 90°		1319.705'	
			1318.75'	

1319.75'

17" Adj.

RP SET 1" I.P. 2" up CONC. PLUG C.E. TAG

T-8

89°

45°

661.19'

661.13'

56° 51' TAN

60.03'

RP SET 1" I.P. 2" up CONC. PLUG C.E. TAG

661.10 @ 104° = 661.19'

SET B.S.W.C.T. @ "JOSHUA"

FD. 2" I.P. 12" dn CONC. PLUG TAG RLS 6061 PER R.S. 72-27

Do not extend this side of this line.

Note: Any Additions or Changes on this Sheet Must be Made on Circled in Red Ink With Date and Name of Person Making Change.

PLEASE RETURN TO
LOS ANGELES COUNTY ENGINEER
403 Los Angeles County Engineering Bldg.

RDFB 3027

301

Notes Ck'd by W. EDMONDSON
Map No. B-5196 1-7
Office Work R. BRIONES
Checked F. MUÑOZ
Date 3/13/74

Survey of AVE. T-8
JNO 72-17 Tape 184 Sta 88 "F"
Surveyed by J. SCOTT
Notes of 2/ 1/ 74 Date 2/ 1/ 70
Indexed G.B. GALLI OCT 27 '70

FB 3821 Pg 39

N 56° E

To Bot Fence

Fence Ave. T-8

(30) (30)

Level 118.89

300.45 @ 268°21'40" = 300.33'
300.46 @ 268 10 00 = 300.31'

300.59 @ 88°44'30" = 300.52'
300.57 @ 88°53'50" = 300.51'

300.13 @ 269°09'40" = 299.98'
300.17 @ 269°51'45" = 299.96'

300.13 @ 88°37'10" = 300.04'
300.09 @ 88°45'00" = 300.02'
1319.72'
T = 92° .07'
1319.79'

196.25 @ 89°26'00" = 196.41 | 0.89.50.45"
196.20 @ 89°45'00" = 196.31 | 0.35.22.15"
263.91 @ 268°47'40" = 263.85' | 0.49.50.33"
263.88 @ 269°00'30" = 263.84' | 0.29.07.10"
Level = 200.27
261.54' | T = 104° = 66113'

SET 2" I.P. 2"up Conc. Pl. & C.E. TAG

55th St.

1312.79'

Note: Any Additions or Changes on this Sheet Must be Made or Circled in Red Ink With Date and Name of Person Making Change.

Do not extend this side of this line.

PLEASE RETURN TO
LOS ANGELES COUNTY ENGINEER
403 LOS ANGELES COUNTY ENGINEERING BLDG.

AVE

38" Adj.

50'

Side Pg 38

(82)

89.

S 89° 51' 45" E

661.12'

T-8

(82)

Side Pg 40

To Int. Ave. T-8 & 55th St. E. 661.13'

(40)

Ave. T-8

To Int. Ave. T-8 & 56th St. E.

To Left

S 56.90' E

S 56° 51' 45" E

SET B.S. & W. 16" JOSHUA

RP SET 2" I.P. 2" up Conc. Pl. & C.E. TAG

FD. 3" I.P. 12" dn Conc. Pl. & TAG Pgh RS 72-27

JEFSCO8 CE#310 9-67

PLEASE RETURN TO
LOS ANGELES COUNTY ENGINEER
403 LOS ANGELES COUNTY ENGINEERING BLDG.

Do not extend this side of this line.

Note: Any Additions or Changes on this Sheet Must be Made or Circled in Red Ink With Date and Name of Person Making Change.

RS 65, D-4

302

RDEB 3027

F.B. 3227 PG 20

1319.87

1319.87

T-8

T-104

AVE

56TH ST E

90°10'

45°

45°

15.57

15.57

66.13

66.12

66.13

66.06 @ 106° = 66.13

360°00'00" 43' 20" 50' 09" 50' 10" 50' 11"

RP SET 2" I.P. 2" UP CONC. PIC ETAG

FD 3/4" I.P. DISTURBED SET LEAD & TACK BY ESE 5/6/98 PER RS 72-171

FD 2" I.P. 2" UP CONC. PIC ETAG

FD 2" I.P. DISTURBED

TO INT

TO BOT

TO INT

TO INT

(28)

(40)

(30)

(30)

(28)

(40)

(28)

(40)

SIDE PC 41

SIDE PG 39

RADIAL RT

RADIAL RT

RADIAL RT

303

RDFB 3027

F.B. 3027 Pg. 41

Notes Ck'd by	W. EDMONDSON	Survey of	AVE. T-8
Map No.	B-5196-17	JN 5098.17	Tape 184 Std 84 'F'
Office Work	R. BRIONES	Surveyed by	J. SCOTT
Checked	L. F. MUNOZ	Notes by	L. VALLES Date 8-29-70
Date	3/12/74	Indexed	G. D. GALLI OCT 27 70

Note: Any Additions or Changes on this Sheet Must be Made or Circled in Red Ink With Date and Name of Person Making Change.

PLEASE RETURN TO
LOS ANGELES COUNTY ENGINEER
403 Los Angeles County Engineering Bldg.

Do not extend this side of this line.

To Bot. Pg 43

COUNTY SURVEYORS T5N R11W 9-10 R.E. 21117 14 COR. MONUMENT

T14 Cor. SEC. 9, 10, T5N R11W, Mon. in H.H. FD. C.S.B. 2-258, PER C.S.B. 2-240, FD. 2" IPP W/ TAG

FD NAIL & TAG

RP SET 2" I.P. 6" UP Conc. P.I. & C.E. TAG

FD 2" I.P. FLK Conc. P.I.

03° Adj. 1/4

90°

AVE T

PITSIDE ROAD (80)

Tgent 661.13'

FROM AVE O

TO LEFT

FD NAIL & TAG

FD NAIL & TAG

FD 1/2 I.P. FLK Conc. P.I. & TIC

RP SET 2 I.P. 6" UP Conc. P.I. & C.E. TAG

TO LEFT

SIDE PG 50

House # 35959

D) 90-16-29
4) 181-05-50
90-16-27½
6) 181-38-35
90-16-25½

1) 89-44-09
2) 358-55-05
89-43-54½
4) 178-23-25
89-43-54½

1) 90-12-15
2) 360-44-10
90-12-17½
6) 181-18-35
90-12-15½

1) 89-47-10
2) 359-09-00
89-47-15
6) 178-43-35
89-47-15½

P) 3° 40' 00"
R) 14° 39' 50"
Δ) 21° 53' 40"
3° 39' 56½"

9372.80
9372.72 @ 07.96
733.21 @ 0.54 = 93803 Kaufman 11/1/70 JSC

851.16

SIDE PG 50

RDFB 3027

304

FB 3827 Pg 42

FROM RT SIDE PG 34

FD 2" I.P. 12" in Conc. Pl. & TAG RE 6067 per RS 72-27

689.74'

(30) (30)

630.22'

689.68' @ 39° 689.74'

630.16' @ 39°

FD 2" I.P. 18" in Conc. Pl. & TAG RE 6067 per RS 72-27

90° 00' 40" 30 45 41 1/3"

1320.07' 1320.07' 1320.07'

1650.09' 1650.09' 1650.09'

RP SET 1" I.P. 2' UP CONC. PL. & C.E. TAG

AVE.

JOINT 58TH ST. E

660.40'

660.42'

SIDE PG 43

TO LEFT

(30)

RP SET 1" I.P. 2' UP CONC. PL. & C.E. TAG

1319.75'

FROM TOP PG 38

PLEASE RETURN TO
LOS ANGELES COUNTY ENGINEER
403 Los Angeles County Engineering Bldg.

Do not extend this side of this line.

Note: Any Additions or Changes on this Sheet Must be Made or Circled in Red Ink With Date and Name of Person Making Change.

RDFB 3027

305

Notes Ck'd by W. EDMONDSON
Map No. B-5196-1-7
Office Work R. BRIONES
Checked T. F. MUNOZ
Date 3/13/74

Survey of AVE T-8
JN 00111 Tape 181 Sta 84 'F
Surveyed by J. SCOTT
Notes C. A. Dull 8-21-70
Indexed R. G. GALLI

F.B. 5[illegible] Pg. 43

Note: Any Additions or Changes on this Sheet Must be Made or Circled in Red Ink With Date and Name of Person Making Change.

Do not extend this side of this line.

PLEASE RETURN TO
LOS ANGELES COUNTY ENGINEER
403 LOS ANGELES COUNTY ENGINEERING BLDG.

75FS098 CE#310 9-67

ED. 8" T.P. 14'dn
CONC. P.I.& TAG
RE 6067
per RS 72-27

.05

ST. A.

(30) (30)

632.88

ED. 8" T.P. 12'dn
CONC. P.I.& TAG
RE 6067
per RS 72-27

660.39 @ 90° = 660.42
660.46 @ 90° = 660.48
632.86 @ 90° = 632.88

RP
SET 1" I.P. 2' UP
CONC. P.I. & C.E. TAG

T-4

AVE.

42.43

660.48

TO INT. 56TH ST. E.

FROM RT. TO INT. 52ND ST. E.

660.42

45°

1313.79

89°

RP
SET 1" I.P. 2" UP
CONC. P.I. & C.E. TAG

55TH

(30) (30)

FROM TOP TO INT. AVE T-8

PG 39

① 99° 50' 40"
② 359° 22' 20"
③ 99° 50' 35"
④ 179° 03' 20"
89° 50' 33 1/3"

RDFB 3027

306

F.B. 5267 Pg. 44

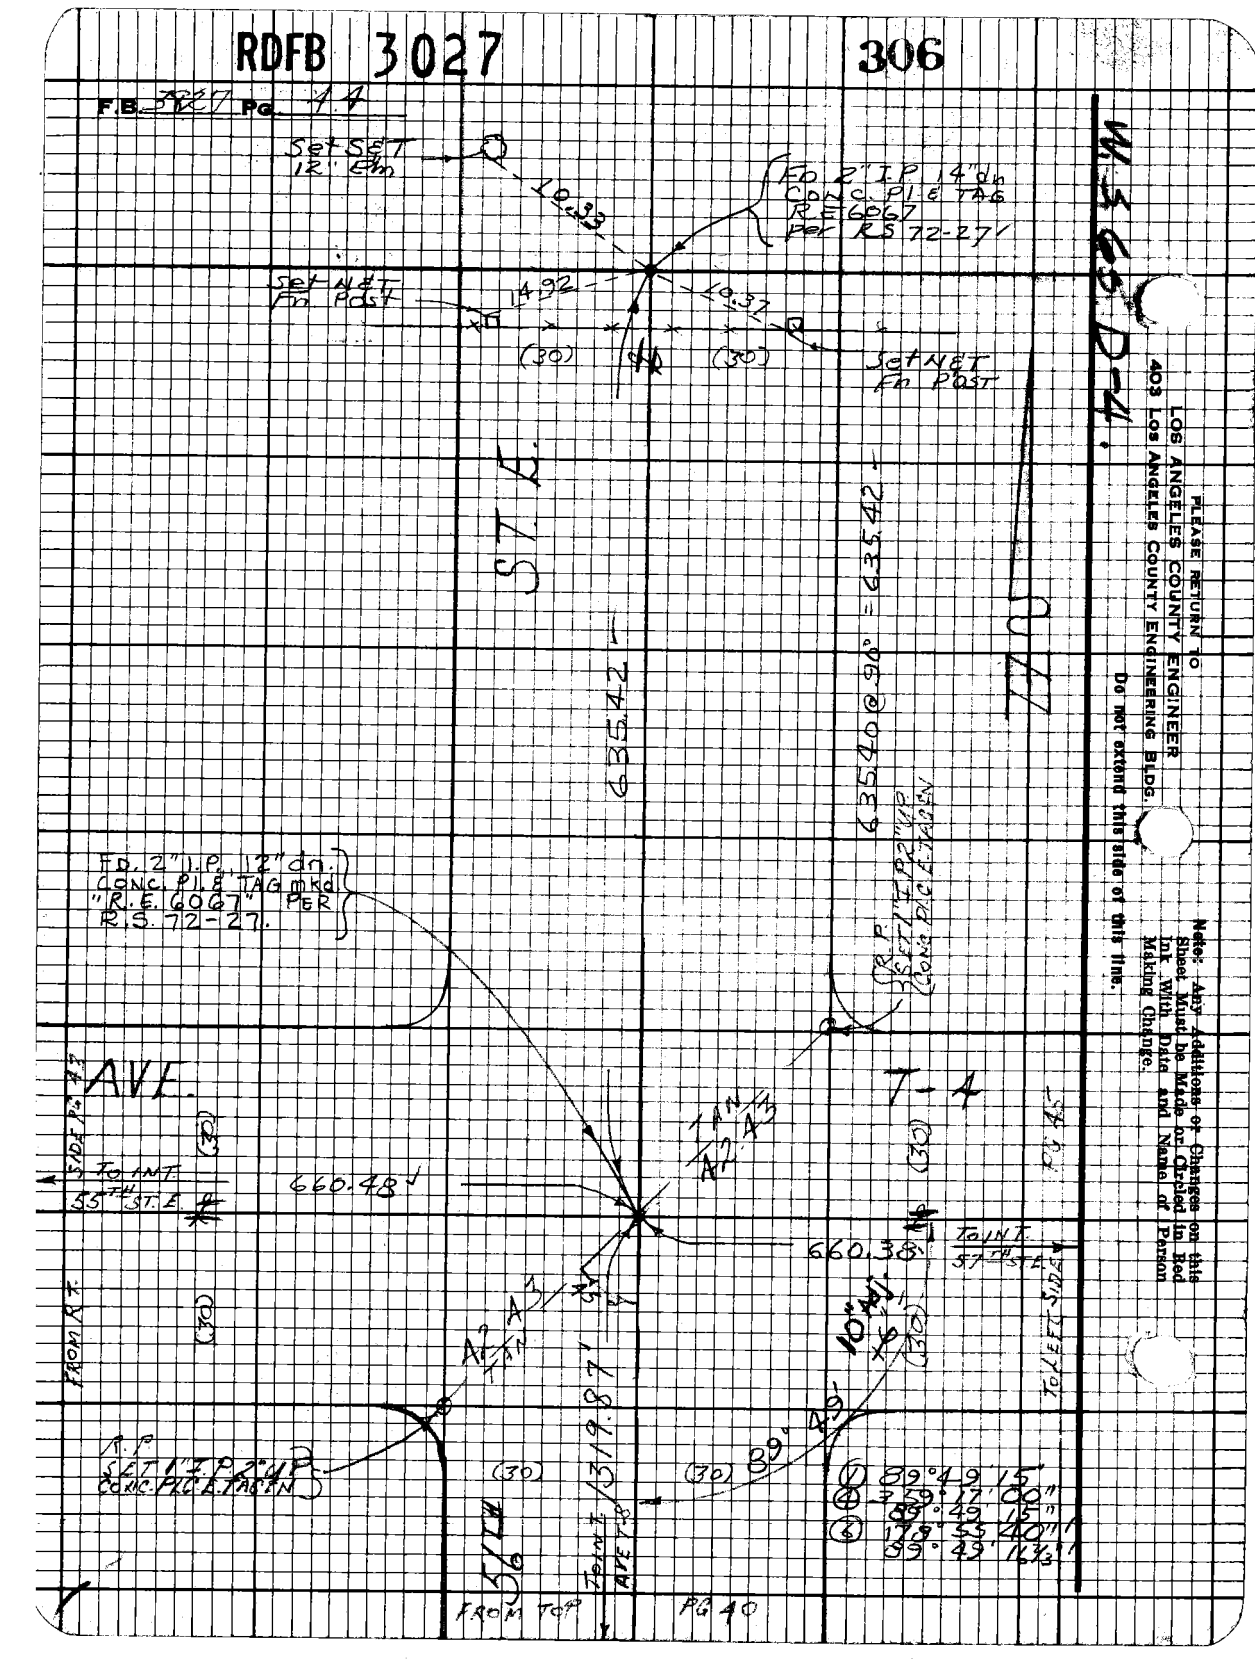

RDFB 3027

307

F.B. 1827 Pg. 45

Notes Ck'd by: W. EDMONDSON
Map No. B-5196-1-7
Office Work: R. BRIONES
Checked: E. MUNOZ
Date: 3/13/74

Survey of: AVE. T-8
JN 009817 Tape 184 Std 84 "F"
Surveyed by: J.S. COATES
Notes by: L. SAUNDERS Date: 8-1-73
Indexed by: G.T. GALLI OCT 27 '73

Note: Any Addition or Changes on this Sheet Must be Made or Circled in Red Ink With Date and Name of Person Making Change.

PLEASE RETURN TO
LOS ANGELES COUNTY ENGINEER
403 LOS ANGELES COUNTY ENGINEERING BLDG.
Do not extend this side of this line.

7875098 CE#310 9-67

W 345.00'

AVE. T-4

SET SPK WET FT. BY INT.

SET NAIL & TAG PER RS 64-39,40

SIDE OF #44

FROM AT

TO INT

(30)

(82)

(40)

660.89'

PEMBROKE

TO INT

TO BOT

PG 16

① 90° 12' 50"
② 269° 47' 10"
③ 90° 12' 53 3/4"
④ 181° 12' 15"
90° 12' 52 1/2"

660.83 @ 98° = 660.89'

FD 2" IP 2A" ON RONC. PI. R.E. TAG 6067 PER RS 72-27

0.1'

103

36

SET CHIS'X' IN CONC. PORCH HOUSE #36126

660.38

36.86'

SET NAIL & TAG

386.38'

FD 2X2 & TAG RE 2000 10 Wh PER RS 64-39,40

SET NAIL & TAG

AVE.

(27)

PG 64

84.72

2700

65.08

90°

190.50'

TO INT

AZ.

T-5

SET PM in CHIS'X' West Gate Post

1090-02-20
360-00-00
90-02-22½
180-00-00
90-02-22½

NORTHING

1904.41' @ N 70° 17' 50" E

386.84 @ 71.71' = 374.38'

660.38' @ S 88° = 660.38'

SET NAIL & TAG PER RS 64-39,40

SET NAIL & TAG PER RS 64-39,40

5,771,100.93

2330.03'

(82)

(40)

90°

TO INT

ANET-E

PG 41

FROM PAR

RDFB 3027

308

F.B. 3827 Pg. 46

659.02 @ 98 = 659.08

TO BOT. PG 47

FD NAIL IN PIPE "TOP" 1.5' H

FD 2" I.P. FL (CONC PIC TACK)

N 65° 10' W

PLEASE RETURN TO LOS ANGELES COUNTY ENGINEER 403 Los Angeles County Engineering Bldg.

Do not extend this title or this line.

Note: Any Additions or Changes on this Sheet Must be Made or Circled in Red Ink With Date and Name of Person Making Change.

PG 48

SIDE

TO APT

FD 2" I.P. FL (STATE F.B. A86-002-36)

FD AT SPK W & T PER STATE F.B. A86-002-36

FD R.R. SPK. PER STATE F.B. A86-002-36

FD 1" I.P. FL CONC PLUG TAG 4-5-2424 NO REF

FD 2" I.P. FL CONC PL TACK

FD 2" I.P. FL CONC PL TACK

FD NAIL & SHINER PER R.S. 33-32

FD 2" I.P. FL CONC PLUG TAG 12-27 NO REF

FD 2" I.P. FL CONC PLUG TAG 12-27 NO REF

FD KET CONCRETE SLAB FOR NAIL

659.08

659.08

100.39

110.00

88.38

90°

87.51

50.56

51.56

0.10

2.35

22.85

0.31

0.22

0.09

0.12

0.10

0.10

0.10

RDFB 3027

309

Notes Ck'd by W. EDMONDSON
Map No. B-5196-1-7
Office Work R. BRIONES
Checked J.F. MUNOZ
Date 3/13/74

Survey of AVE T-8
JN 078.17 Tape 184 Sta 84 "F
Surveyed by T.S. COATES
Notes C.J. VANNESS Date 9/3/70
Indexed G.T. GALLI OCT 27

F.B. 3827 Pg. 47

COUNTY ENGINEER
T5N
R11W
4 3
9 10
R.E. 5869

Cor. Sec. 3, 4, 9 & 10
T5N R11W
Fd. C.E. Mon. in H.H.
per F.B. 2233-47
F.B. 2329-46
F.B. 3216-9
Marked

FD N&T TP #4685294

FD N&T TP #4783811H

FD N&T TP #4778139E

FD N&T TP #4778184E

751.53' @ 94° E 751.60'

751.60'

AVE

(60)

Pg. 48

T

Pg. 49

To Pg. 49

To TOP

To Pg. 47

Per F.B. 3216-9
1332.70'

To ℄ 60' HE

S 32° 53' W 1078.89'

S 32° 53' W 1078.89'

33" Adj.

37" Adj.

2" IP 6" WP
CBNC. PLS
F.B. 2233-97

S 89° 41' 20" E 659.08'

57TH ST E

(50)

(50)

90-12-40
90-50-35
90-12-36½
89-15-45
90-12-37½

89-41-20
89-45-40
89-41-55
178-08-20
89-11-23½

To TOP PG. 46

Note: Any Additions or Changes on this Sheet Must be Made or Circled in Red Ink With Date and Name of Person Making Change.

Do not extend this side of this line.

PLEASE RETURN TO
LOS ANGELES COUNTY ENGINEER
403 LOS ANGELES COUNTY ENGINEERING BLDG.

WS 65 D-4

FB 3827 CE# 310 9-67

RDFB 3027

310

FB. 3827 Pg 48

TO LEFT SIDE PG 47

(60)

(60)

(60)

(60)

TO TOP PG 34

PEARBLOSSOM AVE

FD NAIL & TAG #7025 OH

FD STA STAMPED "LACFCD" PER RD FB 329-784 & RD FB 402-35

FD LEAD & TACK IN WELL

FD CE MON BM 106-13 IN 12"X12" CONC. POST 2" DD

FD LEAD & CONC. SLAB @ GAS PUMP ISLANDS

FD LEAD ON LINE

G.D.B. 8-24-72

751.60'

1001.39'

1227.69'

109.82'














RDFB 3027

311

Notes Ck'd by	W. EDMONDSON	Survey of	AUT. T-8
Map No.	B-5196 1-7	JN	Tape 184 Std 84 °F
Office Work	R. BRIONES	Surveyed by	J.S. COATES
Checked	J.F. MUNOZ	Notes	Date 9-2-70
Date	3/13/74	Indexed	G.J. GALLI 10-27-70

F.B. 3817 Pg. 49

Note: Any Additions or Changes on this Sheet Must be Made or Circled in Red Ink With Date and Name of Person Making Change.

PLEASE RETURN TO LOS ANGELES COUNTY ENGINEER 403 LOS ANGELES COUNTY ENGINEERING BLDG.

Do not extend this side of this line.

785098 CE 310 8-67

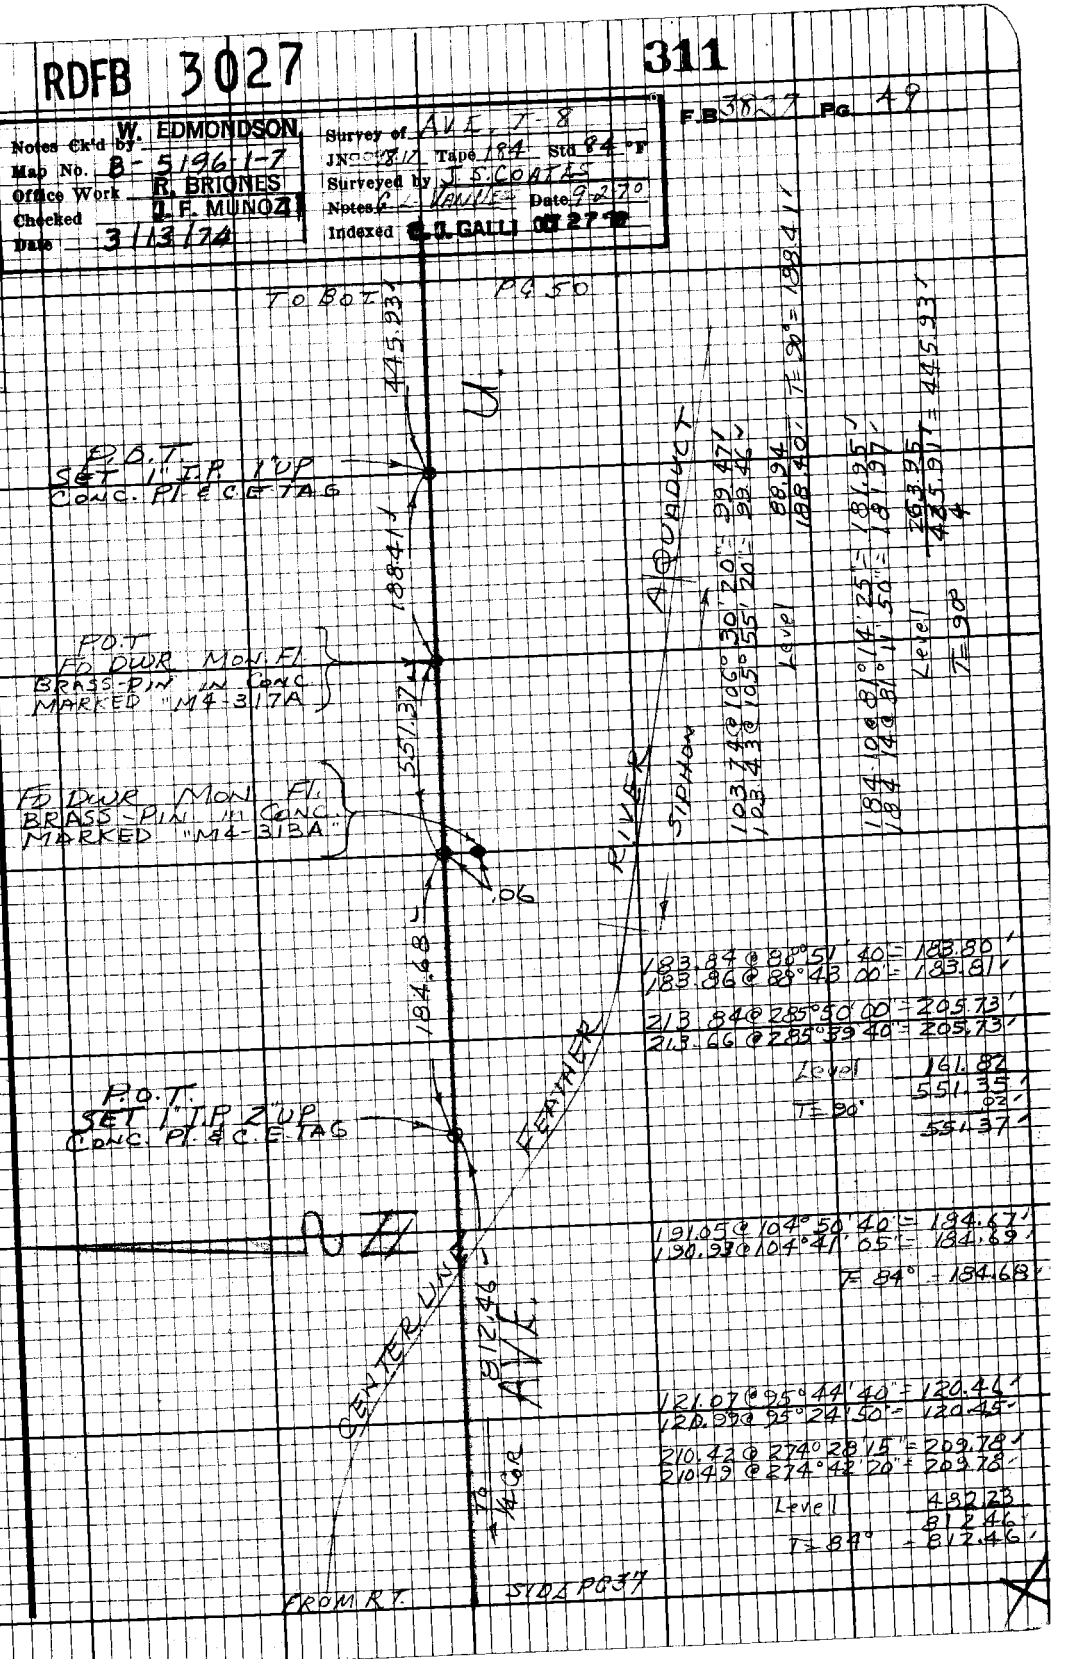

RDFB 3027

312

F.B. 3027 Pg 50

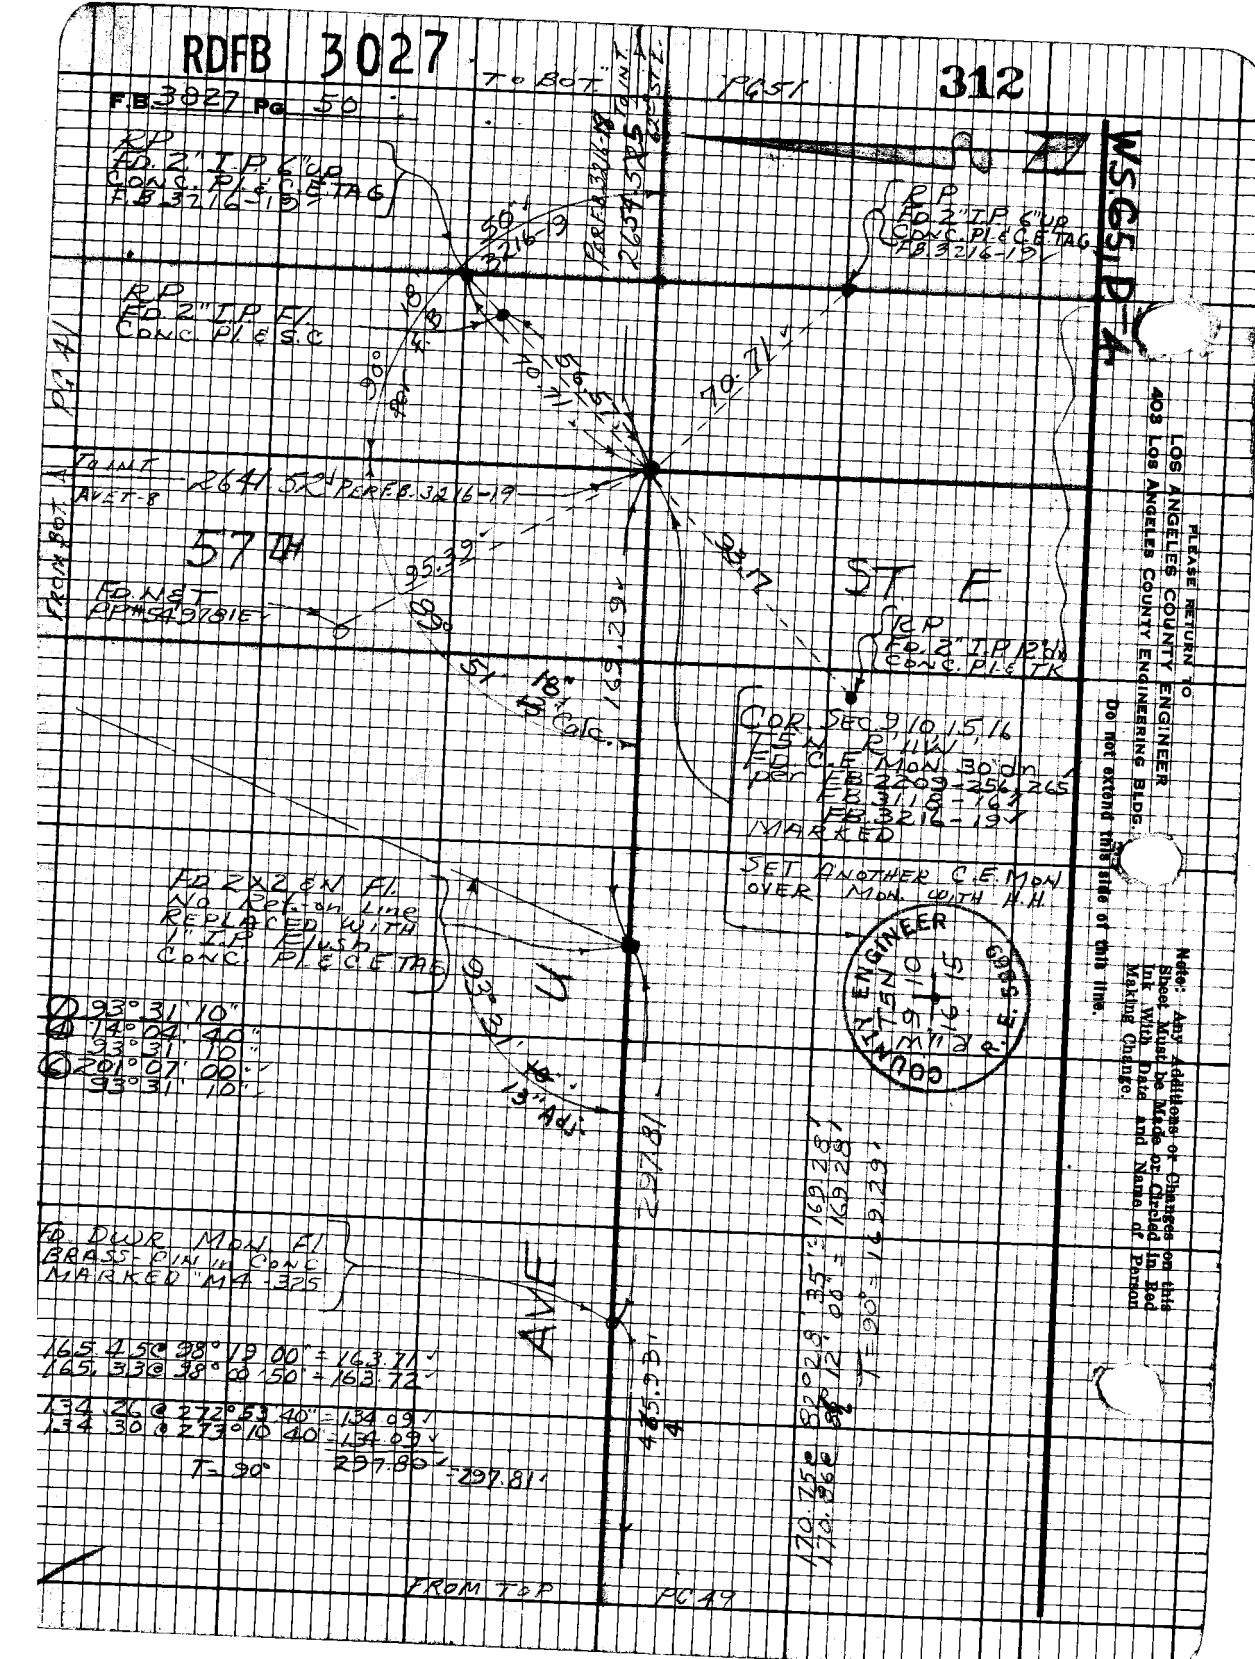

RDFB 3028

53

Notes Ck'd W. EDMONDSON
Map No. B-5196-1-7
Office Work R. BRIONES
Checked E. MUNOZ
Date 3/13/74

Survey of AVE. 7-8
JN 00817 Tape/84 Std 84 'F'
Surveyed by J.S. COATES
Notes by KAMMER Date 9-70
Indexed L. GALLI OCT 27

F.B. 3827 Pg. 51

Note: Any Additions or Changes on this Sheet Must be Made or Circled in Red Ink With Date and Name of Person Making Change.

Do not extend this side of this line.

PLEASE RETURN TO
LOS ANGELES COUNTY ENGINEER
403 LOS ANGELES COUNTY ENGINEERING BLDG.

7ES3088 CE#810 9-67

N 35° 04' W

TO BOT

2296.65 @ 90° = 2296.74

90° 11' 45"
356° 47' 40"
89° 11' 55"
181° 11' 15"
90° 11' 52½"

04" Adj.

2022.09 PR FB 2636-196 TO INT PERPENDICULAR HWY

FOUND 1" I.P. SEE 10/1ST SMR 11W FD C.S. MON 10 ON 12 PR FB 3216-196 FB 3214-18 L.S. 8739 MARKED

COUNTY SURVEY 1" = 100' SEC 15 SEC 10 T 5 S R 14 W FILED MONUMENT

62ND ST. E.

12.56 (40) 90.12± 90.

2296.74

TO BOT (40)

50.04 Adj.

42.56 42.56

FD P.K. NAIL & TAG L.S. 7116 1.8' W

SET B.S.&W. 12" JOSHUA

R.P. SET 1/2" I.P. FD CONC. PK. & TAG L.S. 7116 1.8' W

FD I.P. & TAG L.S. 7116 1.8' W

SET I.P. & CAP CONC. PK. & TAG

89° 48' 15"
359° 12' 30"
89° 48' 07½"
178° 49' 00"
89° 48' 10"

N 35° 04' W 2654.56' PER FB 3216-18

SE'LY LINE

AVE. 7

FROM TOP

PG 50

PLEASE RETURN TO
LOS ANGELES COUNTY ENGINEER
403 LOS ANGELES COUNTY ENGINEERING BLDG.

Note: Any Additions or Changes on this Sheet Must be Made or Circled in Red Ink With Date and Name of Person Making Change.

Do not extend this side of this line.

WS65, D4

54

RDFB 30028
F.B. 38217 Pg 22

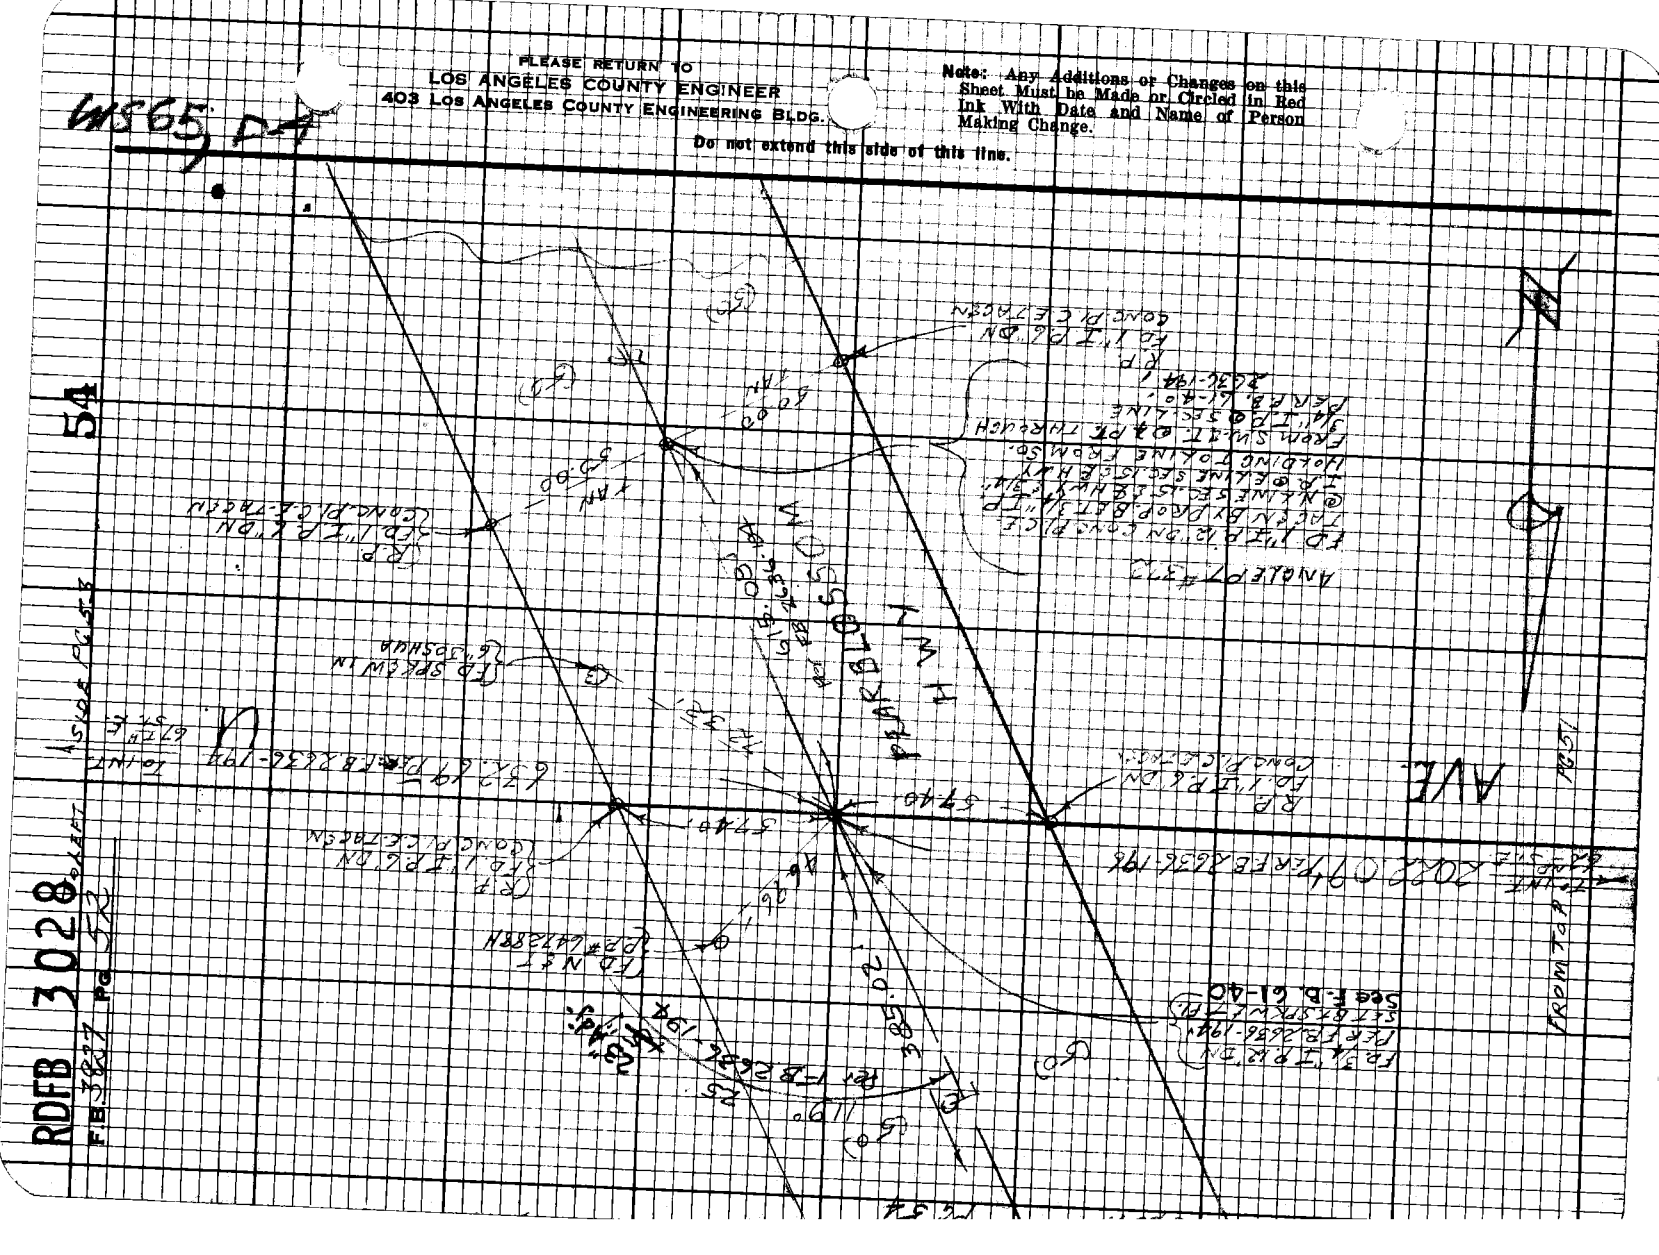

RDFB 3028

55

Notes Ck'd by: W. EDMONDSON
Map No. 8-5196-1-7
Office Work Checked: R. BRIONES
Date: 3/13/74

Survey of: AVE T-8
JN00981 Tape 144 Std 84 °F
Surveyed by: J. SCOALES
Notes: G.L. VANNESS Date: 9-2-70
Indexed: R.T. GALL 11-27-70

F.B. 582 Pg. 53

Note: Any Additions or Changes on this Sheet Must be Made or Circled in Red Ink With Date and Name of Person Making Change.

Do not extend this side of this line.

PLEASE RETURN TO
LOS ANGELES COUNTY ENGINEER
403 LOS ANGELES COUNTY ENGINEERING BLDG.

765098 CE#310 8/67

To 582 PG

73

(50) (50)

AVE T-8

11°45'50" PER F.B.

2645.47' PER F.B. 2436-190

R.P. FD 2" P&6"UP CONC. PK C.E. TAGEN

AVE.

89°

2650.89' PER F.B. 2636-190

70.71'

70.71'

FROM TOP

R.P. FD 2" P&6"UP CONC. PK C.E. TAGEN

SIDE PG. 79

TO LEFT

SEC. COR. SECS 10, 11, 14, 15 T5N R11W FD 6" MON. 12" DN PER C.S. 8319 F.B. 2636-190 MARKED C.E.

COUNTY ENGINEER
T 5 N
R 11 W
10 11
15 14
R.E. 5869

67TH ST

(50) (50)

RDFB 3028

56

F.B. 3827 Pg. 54

T. 80 N.

Pg. 55

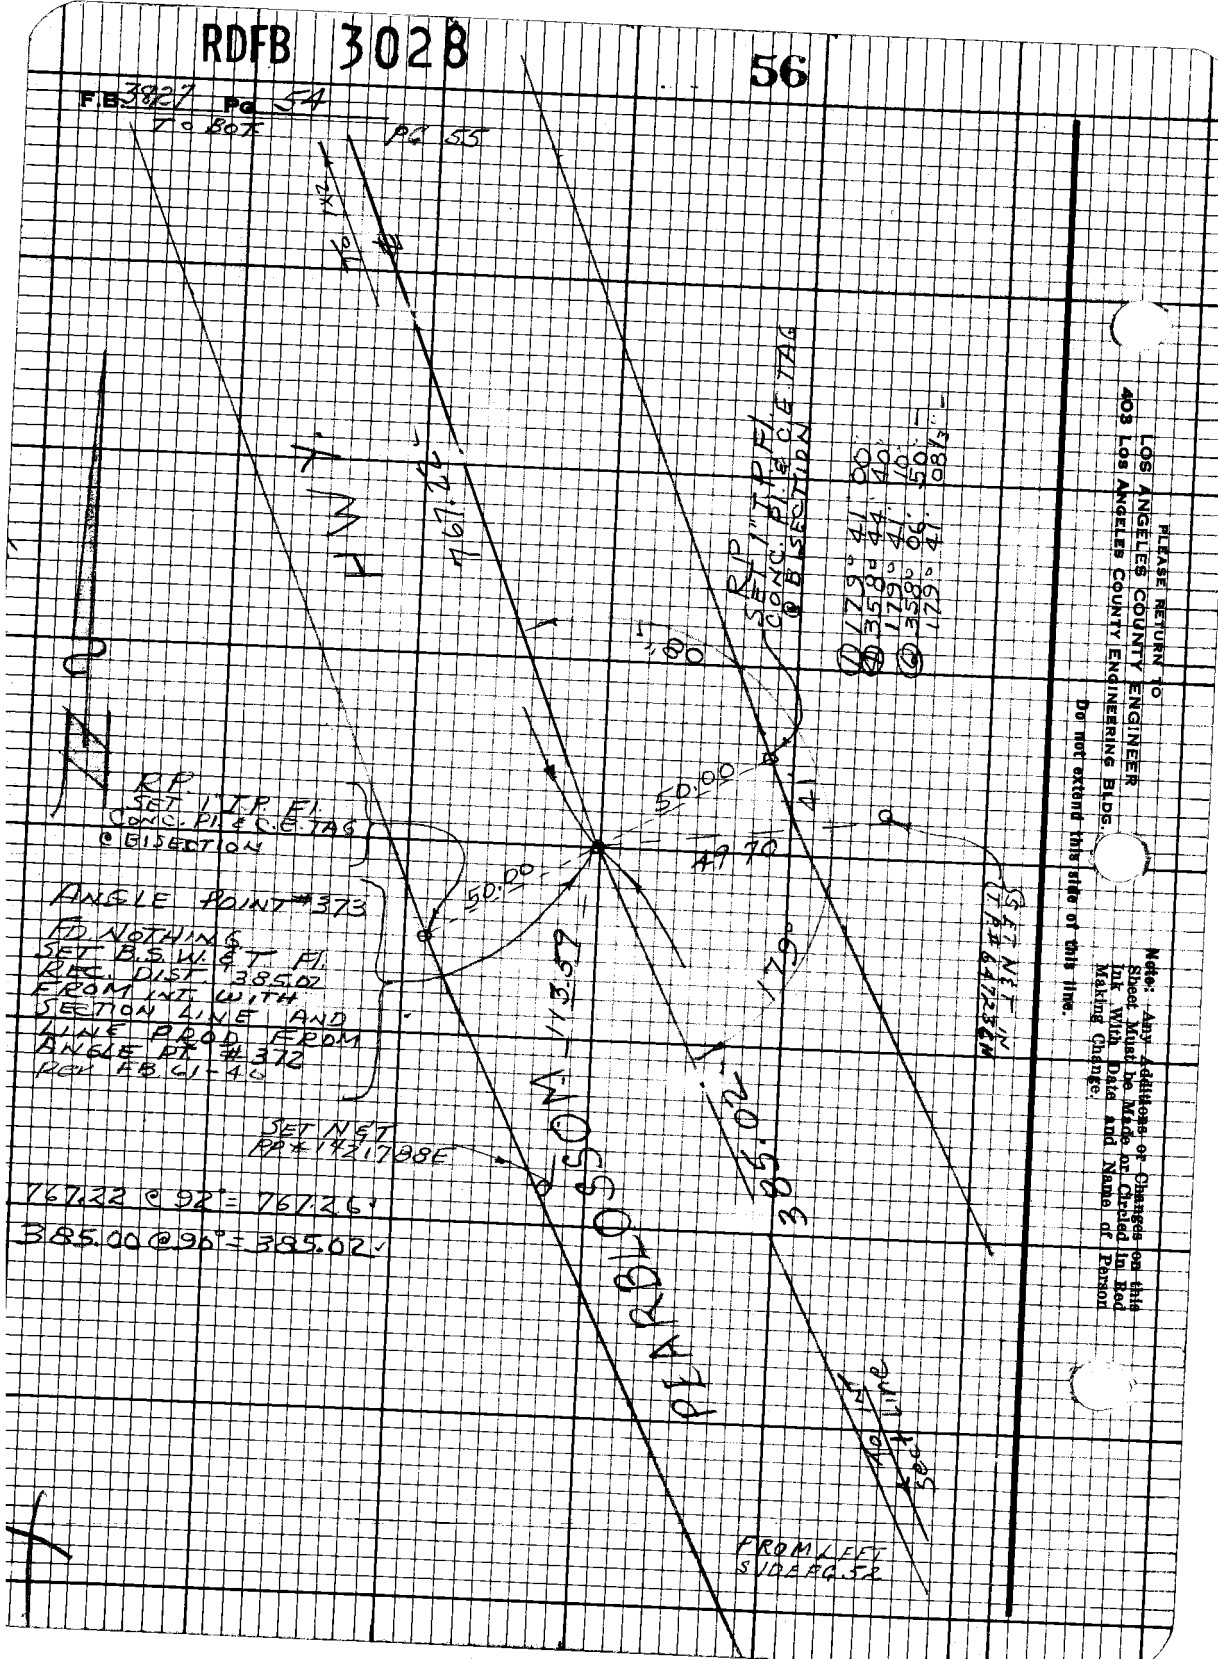

PLEASE RETURN TO
LOS ANGELES COUNTY ENGINEER
403 Los Angeles County Engineering Bldg.

Note: Any Additions or Changes on this Sheet Must be Made or Circled in Red Ink With Date And Name of Person Making Change.

Do not extend this title of this time.

RDFB 3028

57

Notes Ck'd by W. EDMONDSON
Map No. B-5196-1-7
Office Work R. BRIONES
Checked J.F. MUNOZ
Date 3/13/74

Survey of AVE T-8
JN 1098.05 Tape 10 Std 24'T
Surveyed by J.S. COATES
Notes ISC Date DEC 27 '70
Indexed G.L. GALLI

F.B. 3827 Pg. 55

Note: Any Additions or Changes on this Sheet Must be Made or Circled in Red Ink With Date and Name of Person Making Change.

Do not extend this side of this line.

PLEASE RETURN TO
LOS ANGELES COUNTY ENGINEER
403 LOS ANGELES COUNTY ENGINEERING BLDG.

SLIDE PG. 56

(50) 175° 36' 45"
(50) 351° 13' 30"
175° 36' 45"

FD. NGS TA# 447281A

GEODOLIMETER TRAVERSE STATION "DAVE" SET IN CONC. FD. 2" I.P. & DISK IN CONC. PER A 86.001-143 A 86.002-2,

FD 2" I.P. 4"UP Conc. PILE NO. 1

FD 2" I.P. 4"UP Conc. PILE NO. 2

1823.68'

30.77'
5.84'
112.38'
105.15'
103.16'
131.39'
29.69'
29.59'
45°
60°
78°
84°
92°

FD. BRASS CAP BY 2" I.P. 12' down marked "B1" DIVISION OF HIGHWAYS SET IN CONC PER A 86.001-183 A 86.002-2,18'

FD. B.S. W.&T. 2'dn

1994.91'

80'

PEARBLOSSOM HWY

OLD PL.# 375 DID NOT SEARCH FOR 3/4" I.P. in HWY SET B.S.W.&T. BY TIES PER STATE FB A 86.002-21

OLD PL.# 374 SET 1X2 IN REC. & FD DISK FROM PL.# 375 PER FB. 41-40

NEW PL. SET 1" I.P. 12'dn BY JNT CONC. PL. & C.E. TAGS

29.59 @ 60° = 29.58'
29.69 @ 92° = 29.69'
131.39 @ 78° = 131.38'
103.16 @ 84° = 103.16'

(50) 164° 31' 45"
(50) 329° 03' 30"
164° 31' 45"

(50) 160° 08' 55"
(50) 280° 35' 30"
160° 08' 55"

(50)

To Top Pg. 54

FB3028 CE#310 8-67

RDFB 3028

58

F.B. 3627 Pg. 56

To BOT. PG. 65

Sec. 10

T4S R13W

(40) (40)

To LEFT SIDE PG. 59

(50)

SET NAIL & TAG IN CONC. WALL

346.85'

SET NAIL & TAG IN CONC. WALL

SET NAIL & TAG IN CONC. WALL

SET NAIL & TAG IN CONC. WALL

PALATINO

65.14'

92.84'

98.91'

92.33'

1823.66'

48° 45' 50" (40)

SET NAIL IN APPARENT PLUG

1823.66 @ 86° = 1823.68 ✓

346.84 @ 90° = 346.85 ✓

62ND ST

(40) (40)

To LEFT SIDE PG. 51

To BOT. PG. 55

48° 45' 50"

135° 02' 44"

45° 15' 21 1/4"

138° 34' 20"

46° 45' 43 1/3"

PLEASE RETURN TO
LOS ANGELES COUNTY ENGINEER
403 Los Angeles County Engineering Bldg.

Note: Any additions or Changes on this Sheet Must be Made in Circled in Red Ink With Date and Name of Person Making Change.

Do not extend this side of this line.

RDFB 3028

59

Notes Ck'd by	W. EDMONDSON
Map No.	B-5196-1-7
Office Work	R. BRIONES
Checked	J. F. MUNOZ
Date	3/13/74

Survey of AVE T-8 F.B. 3827 Pg. 57
JN 0078.17 Tape 184 Sta 84 "F
Surveyed by J.S. COATES
Notes G.J. VANNES Date 9-27-73
Indexed G.J. GALLI on 27-73

TO LEFT SLOPE PG 58 — TO LEFT SLOPE PG 59

R.P. SET 1" I.P. W/ CONC. P.C.E. TAGGED ON LINE PROD

P.I. #4 SET 3" I.P. W/ 2" BRASS CAP CONC. P.L.S. TAGGED PER MAP #2222-AS

R.P. SET 1" I.P. W/ CONC. P.C.E. TAGGED ON LINE PROD

P.O.T. SET 1X2 SEN W/ LEAD & TACK

Δ = 21°01'02"

(40)

E.C.

FROM 8" SLOPE PG 58

Δ 21°00'00" = 212.00'

283.20 @ 74° = 283.18'

Δ 84°00'00" = 385.00'

Curve Data
Δ = 22°14'54"
R = 1600.00'
T = 314.61'
L = 621.29

(8) 157°45'00"
(9) 22°00'00"
(6) 135°00'00"
226°30'48"
157°45'06"

AVE T-8

R = 1600.00'

T = 314.61'

L = 621.29

(40)

(40)

Note: Any Additions or Changes on this Sheet Must be Made or Circled in Red Ink With Date and Name of Person Making Change.

PLEASE RETURN TO
LOS ANGELES COUNTY ENGINEER
403 Los Angeles County Engineering Bldg.

Do not extend this side of this line.

765098 CE # 310 P.67

RDFB 3028

60

F.B. 3827 Pg 58

FROM TOP PG 66

FROM LEFT SIDE PG 59

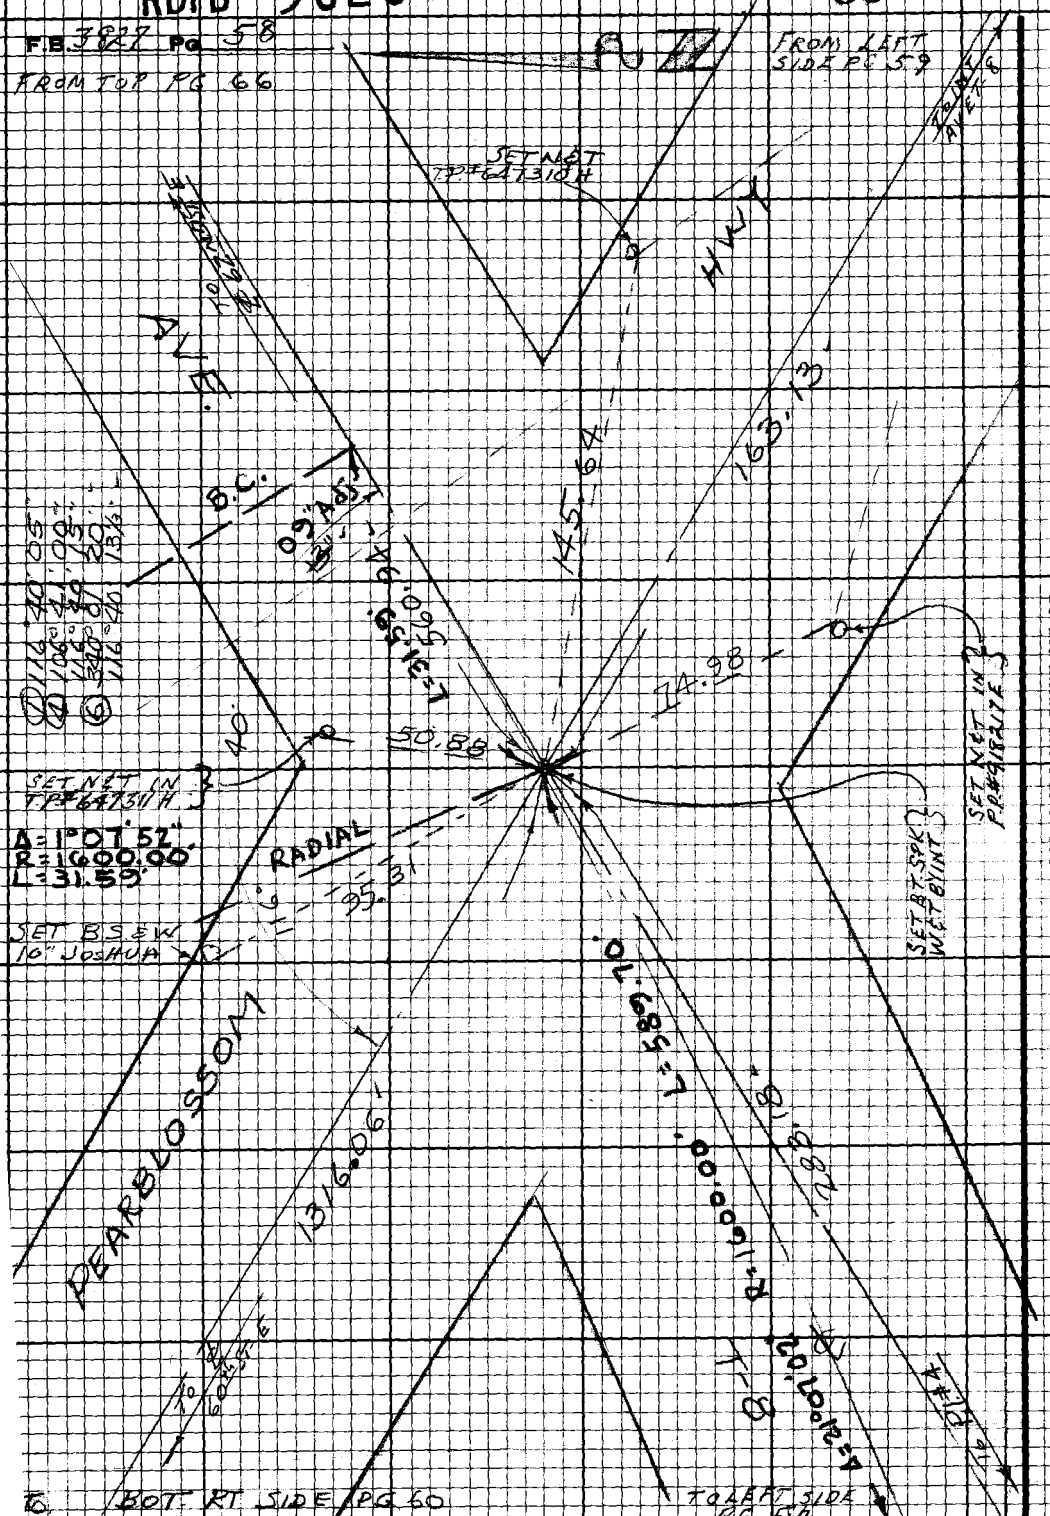

PLEASE RETURN TO
LOS ANGELES COUNTY ENGINEER
403 Los Angeles County Engineering Bldg.

Do not extend this side of this line.

Note: Any Additions or Changes on this Sheet Must be Made in Circled in Red Ink With Date and Name of Person Making Change.

RDFB 3028

61

F.B. 7827 Pg. 59

Notes Ck'd by W. EDMONDSON
Map No. B-5196-1-7
Office Work R. BRIONES
Checked E. MUNOZ
Date 3/13/74

Survey of AVE T-8
JN 0098.17 Tape 184 Std 84 °F
Surveyed by J. SCOATES
Notes G. VANNEST Date 9-3-70
Indexed G. GALLI on 2-7-74

Note: Any Addition or Changes on this Sheet Must be Made or Circled in Red Ink With Date and Name of Person Making Change.

PLEASE RETURN TO
LOS ANGELES COUNTY ENGINEER
403 LOS ANGELES COUNTY ENGINEERING BLDG.

Do not extend this side of this line.

7RF3098 CE#310 8-67

AVE. T-8

SET BT. SPK WITH FL. BY INT.

SET NAIL & TAG WITH FL. BY INT.

SET NAIL & TAG

SET MAG & SHR

SET MAG & SHR

SET NAIL & TAG

SET NAIL & TAG

SET NAIL & TAG

RDFB 3028

62

F.B. 3827 Pg 60

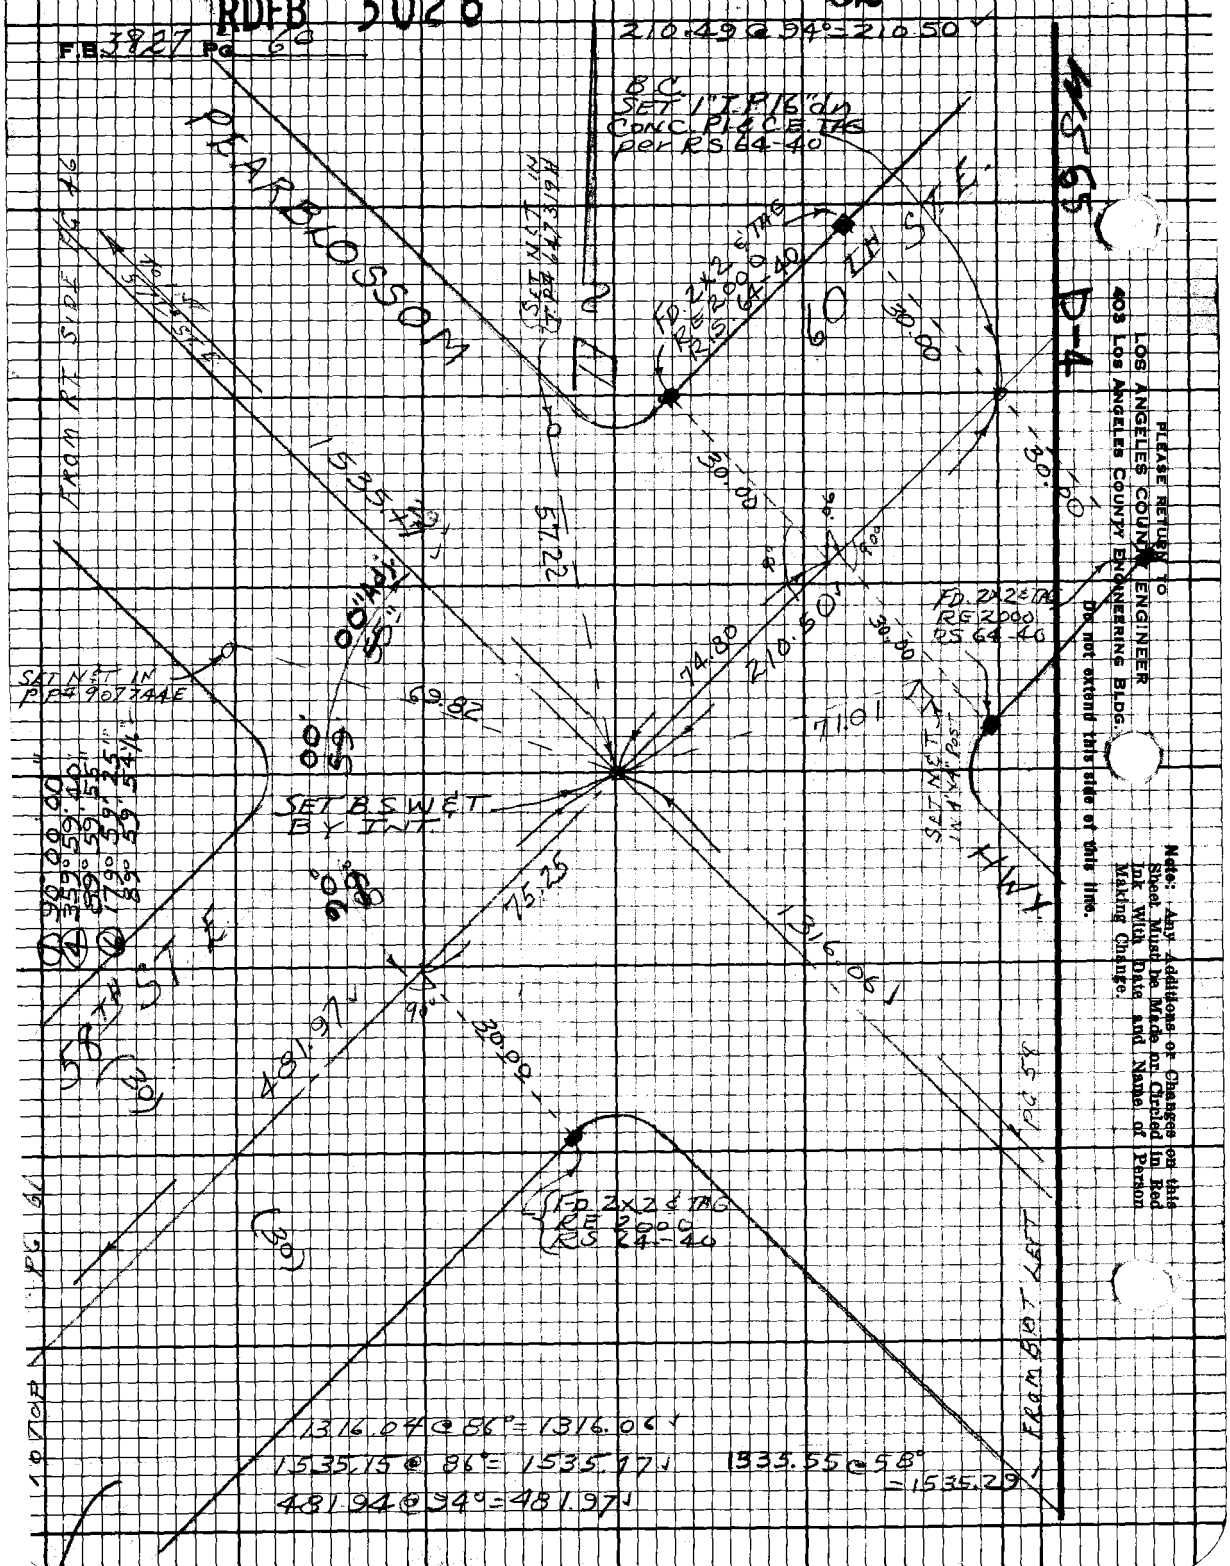

PLEASE RETURN TO
LOS ANGELES COUNTY ENGINEER
403 Los Angeles County Engineering Bldg.

Do not extend this side of this line.

Note: Any additions or Changes on this Sheet Must be Made in Circled in Red Ink With Date And Name of Person Making Change.

RDFB 3028

63

Notes Ck'd by W. EDMONDSON
Map No. B-5196-L-7
Office Work R. BRIONES
Checked A.F. MUNOZ
Date 3/13/74

Survey of AVE T-8
JN Tape 184 Sur 84 F
Surveyed by L.S. & A.
Notes Date: 10-27-70
Indexed B.J. GALE

F.B. 3827 Pg. 61
FROM 44 FT SIDE PG 60

W 56 S 4

Note: Any Additions or Changes on this Sheet Must be Made or Circled in Red Ink With Date and Name of Person Making Change.

RP TO PL
SET 1" I.P. 2" UP
CONC. PL. & C.E. TAG
TAN PROD

PL
SET 1" I.P. 12" DN
CONC. PL. & C.E. TAG
BY INT

RP TO PL
SET 1" I.P. 2" UP
CONC. PL. & C.E. TAG
TAN PROD

FD 1" I.P. 6" DN
No Ref
USED CTR

FD Remains
2x2 6" DN
RS 64-39

GATE

AVE T-8

SET PM
INDUSTRY
GATE ROAD

FD 2x2 & TAG
RE 2000
RS 64-39

FD REMAINS
2x2 6" DN
USED CTR

TO T-7

TO T-8

PL SZ

FD 2x2 & TAG
RE 2000
RS 64-39

(A) 138° 55' 15"
(B) 139° 40' 40"
(C) 138° 55' 10"
(D) 113° 31' 10"
138° 55' 11 3/8"

60.00 @ 94° = 60.00'
101.92 @ 94° = 101.93'

FD 2x2 & TAG
RE 2000
DISTURBED
RS 64-39

SET 1" I.P. 12" DN
CONC. PL. & C.E. TAG
BY INT
PER RS 64-39

RP
SET 1" I.P. 2" UP
CONC. PL. & C.E. TAG
& PROD

(A) 90° 00' 00"
(B) 359° 59' 25"
89° 59' 51 1/4"
(C) 179° 59' 10"
89° 59' 51 1/4"

FD 2x2 & TAG
RE 2000
RS 64-39

PLEASE RETURN TO
LOS ANGELES COUNTY ENGINEER
405 Los Angeles County Engineering Bldg.
Do not extend this side of this time.

75FB98 CE#310 8/67

RDFB 3028

F.B. 3827 Pg. 62

FROM BOT. PG 61

64

WSCS P-4

PLEASE RETURN TO
LOS ANGELES COUNTY ENGINEER
403 Los Angeles County Engineering Bldg.

Do not extend this side of this line.

Note: Any Additions or Changes on this Sheet Must be Made or Circled in Red Ink With Date And Name of Person Making Change.

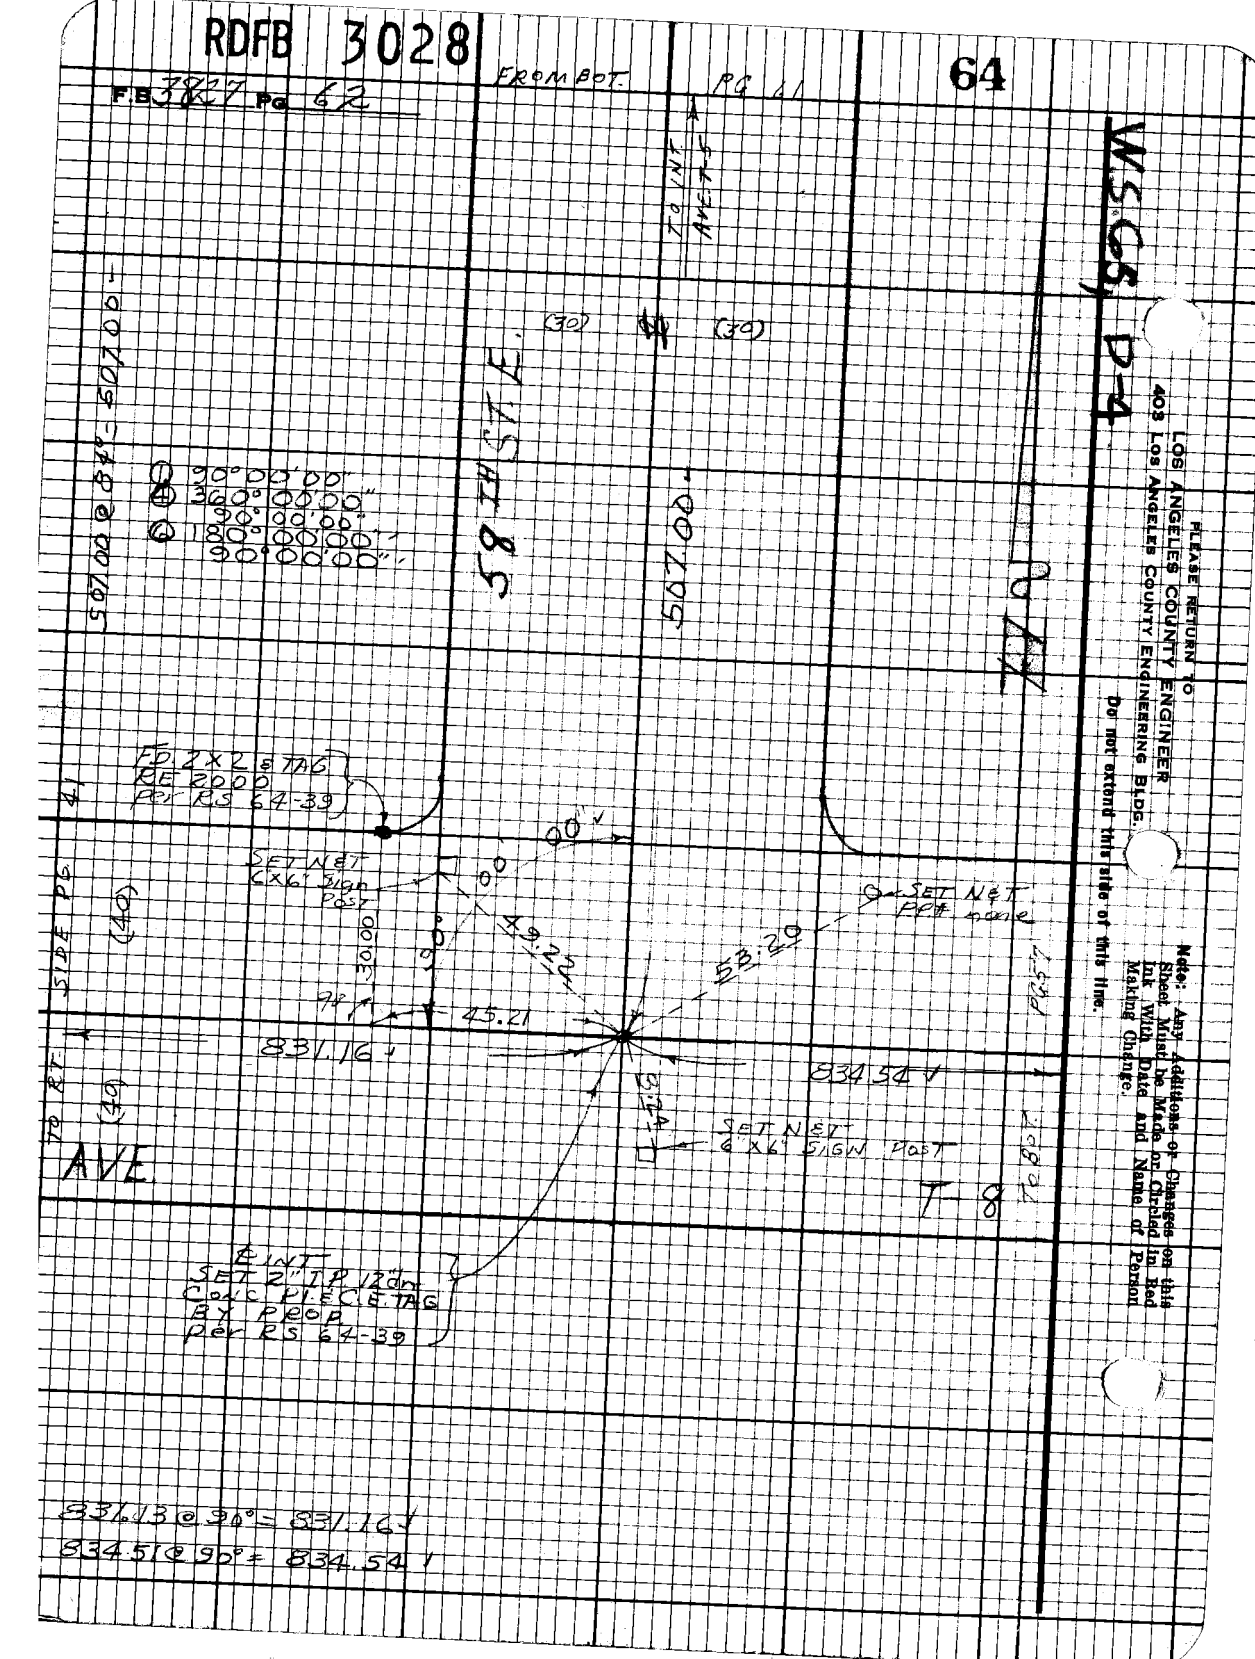

RDFB 3028

65

Notes Ck'd by: W. EDMONDSON
Map No. B-5196-1-7
Office Work: R. BRIONES
Checked: O. F. MUNOZ
Date: 3/13/74

Survey of: ALE T-8
JN 0098.1 Tape 184 Std 84°F
Surveyed by: J.S. COATES 3-1-74
Notes: R. NAVARRO Date: 3-27-74
Indexed: G.L. GALLI

F.B. 3827 Pg. 63

FROM LAFT STOC TO 61

49.88

P/L E.C. REMAINS OF 2X2 FD. REMAINS OF 2X2 USED CAP. PER RS 64-39

P/L E.C. FD. REMAINS OF 2X2 USED CAP. PER RS 64-39

(27) (27)

70°

27.00 27.00

155.09

60.23

Ⓐ 138° 55' 20"
Ⓑ 138° 41' 20"
Ⓒ 138° 55' 20"
Ⓓ 111° 32' 10"
138° 55' 21"

155.09 @ 80° = 155.09

55'

30°

115.30

50.86

P/L SET 1" IP 12" DOWN CONC. PLACE TAG BY INT

P/L B.C. FD 2X2 & TAG RE 2000 per RS 64-39,40

SET M&T AP#955,100E

26.98

80°

26.98

P/L B.C. FD 2X2 & TAG RE 2000 per RS 64-39,40

2.85 Ft Nothing

650' N

(22)

ALE

(22)

10' P.U.E.

TO TOP PG 64

Note: Any Additions or Changes on this Sheet Must be Made or Circled in Red Ink With Date and Name of Person Making Change.

PLEASE RETURN TO
LOS ANGELES COUNTY ENGINEER
403 Los Angeles County Engineering Bldg.

Do not extend this side of this line.

TEPCOR CE-310 8-67

RDFB 3028

66

F.B. 3827 Pg. 64

650.25 @ 94° = 650.29

FROM BOT.

Pg 63

SET N & T PK #9531.27E

PK

SET 1" I.P. IRON & PLASTIC TAG BY ENT

FD NAIL

FD 3/4" I.P. 0.2' DEEP

PK

FD 3/4" I.P. 0.2' DEEP

FD NAIL

SET Chis. X IN 2.5 Steel Gate Post

GATE

FD NAIL

PK

SET TAG 64-3940

FROM RT

(27)

(27)

SIDEWALK

Please Return To
Los Angeles County Engineer
403 Los Angeles County Engineering Bldg.

Do not extend this site of this line.

Note: Any Additions or Changes on this Sheet Must be Made or Circled in Red Ink With Date and Name of Person Making Change.

RDFB 3028

67

Notes Ckd by W. EDMONDSON
Map No. B-5196-1-7
Office Work R. BRIONES
Checked J. E. MUNOZ
Date 3/13/74

Survey of AVE. T-8
JN 0098.11 Tape 184 Std 84-F
Surveyed by J. COATES
Notes C.I. VAN NESS Date 9/6/70
Indexed C.L. GALLI OCT 27 70

F.B. 3827 Pg 65

D 90-09-15
Δ 360-37-00
D 90-09-15
D 180-55-15
D 90-09-14.4

W 5637 D-4

TO BAT PG 66

COUNTY ENGINEER R/W TSI CTR SEC 10 F.E. 5869

CENTER SECT. 10 T5N R11W SET C.E. MON. 12th BY INT. MARKED

R.P. SET 2" I.P. & TAG CONC. F.L.C.E. TAG

319.50'

90°

09'

15"

AVE.

T-8

(40)

397.01'

532.99'

TO 1N 12W

PG 11

FROM RT SIDE

SET BISKEW IN 15" JOSHUA

346.85'

12TH ST.

FROM TOP

PEARBLOSSOM HWY

PG 56

TO BOT

S 37° 99' @ 80° E 37.99'

PLEASE RETURN TO
LOS ANGELES COUNTY ENGINEER
403 LOS ANGELES COUNTY ENGINEERING BLDG.

Note: Any Additions or Changes on this Sheet Must be Made or Circled in Red Ink With Date and Name of Person Making Change.

Do not extend this side of this line.

7RFB308 CE#310 9-67

RDFB 3028

68

F.B. 3287 Pg 66

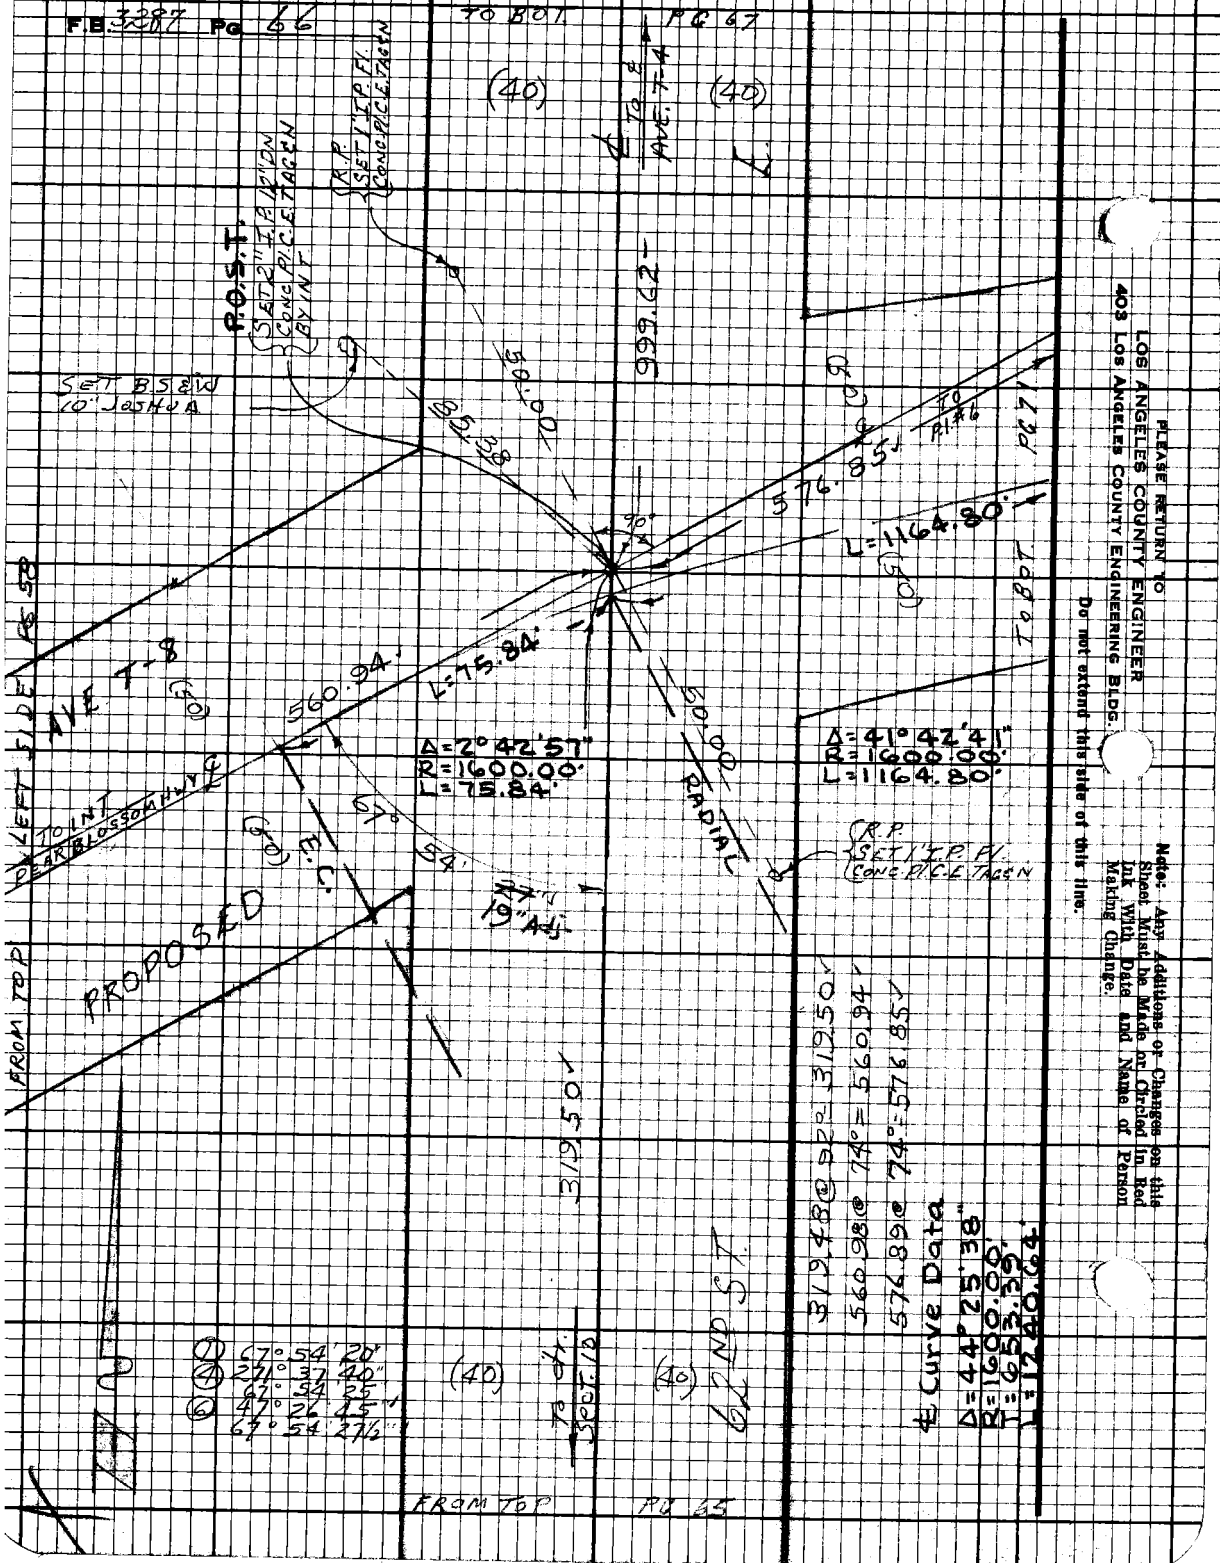

PLEASE RETURN TO
LOS ANGELES COUNTY ENGINEER
403 Los Angeles County Engineering Bldg.

Do not extend this side of this line.

Note: Any Additions or Changes on this Sheet Must be Made on Chrome in Red Ink With Date and Name of Person Making Change.

RDFB 3028

69

Notes Ck'd by	W. EDMONDSON	Survey of	AVE T 8
Map No.	B- 5196-1-7	JN	0098.11 Tape 184 Std 84 °F
Office Work	R. BRIONES	Surveyed by	J.S. COATES
Checked	J.F. MUNOZ	Notes	C.K. VANNOY Date 9-14-70
Date	3/13/74	Indexed	G.B. GALLI 10 27 70

F.B. 3827 Pg 67

Note: Any Additions or Changes on this Sheet Must be Made or Circled in Red Ink With Date and Name of Person Making Change.

Do not extend this dtp of this line.

PLEASE RETURN TO
LOS ANGELES COUNTY ENGINEER
403 Los Angeles County Engineering Bldg.

TO BOT PG 68

AVE T-2

SET B.S&W

SET B.S&W

659.56

SET B.S&W
6" W JOSHUA

AVE

100.42

73.44

SET NT
SET 2" I.P. 12" dp
CONC. PLUG & TAG
BY PROP
PER RS 64-38

T-4

110.13

SET B.S&W
8" JOSHUA

999.62

999.57 @ 92°= 399.62

67 ND

(40)

(40)

TO INT. AVE T-8 PROJECTED

TO TOP

PG 66

187509 CE# 310 9-67

RDFB 3028 To Bot. Pg 70 70

FB 3827 Pg 68

M3.65 D-4

PLEASE RETURN TO
LOS ANGELES COUNTY ENGINEER
403 Los Angeles County Engineering Bldg.

Do not extend this side of this line.

Note: Any Additions or Changes on this Sheet Must be Made in Circled in Red Ink With Date and Name of Person Making Change.

(30) To AVE. T

659.56

E ST

PAVE

SET NAIL
2" I.P. R.M.
CONC. BLOCK TAG
BY PROP
Pax RS 64-38

SET NAIL
4"x4" Fm POST

(60) AVE T-2

(30)

N1.01'

W4.95'

SET B. & TW
12" JOSHUA

SET B. & TW
10" JOSHUA

659.56

659.530 92°=659.54

(30)

17th AVE T-4

FROM TOP

PG 67

RDFB 3028

71

Notes Ck'd By W. EDMONDSON
Map No. B-5196-1-7
Office Work R. BRIONES
Checked J. F. MUNOZ
Date 3/13/74

Survey of AVE T 8
JN 00281 Tape 184 Std 84 °F
Surveyed by J. S. COATES
Notes G. L. KAUNESS Date 9-17-70
Indexed G. L. GALLI OCT 27 '70

F.B. 3827 Pg. 69

Note: Any Additions or Changes on this Sheet Must be Made or Circled in Red Ink With Date and Name of Person Making Change.

Do not extend this side of this line.

PLEASE RETURN TO
LOS ANGELES COUNTY ENGINEER
403 LOS ANGELES COUNTY ENGINEERING BLDG.

TO LEFT SIDEPOST TO

TO SPIKE
FB 3216-12

T.

(50)

FD. 3/4" IRON PIPE
1332 FEET

FD. 2"x2" STK.
R.E. TAG 2000

60TH ST.

(30)

E.

FD. 2"x2" STK.
R.E. TAG 2000

90°

AVE.

(30)

T-2

NOTHING FOUND

1332.10 PLAT BEARING

AVE.

(50)

(50)

FROM R.P. TO INT. 61ST ST. E. & SIDEPOST

JF3008 REV. 8-10 2-67

RDFB 3028

72

F.B. 3827 Pg. 70

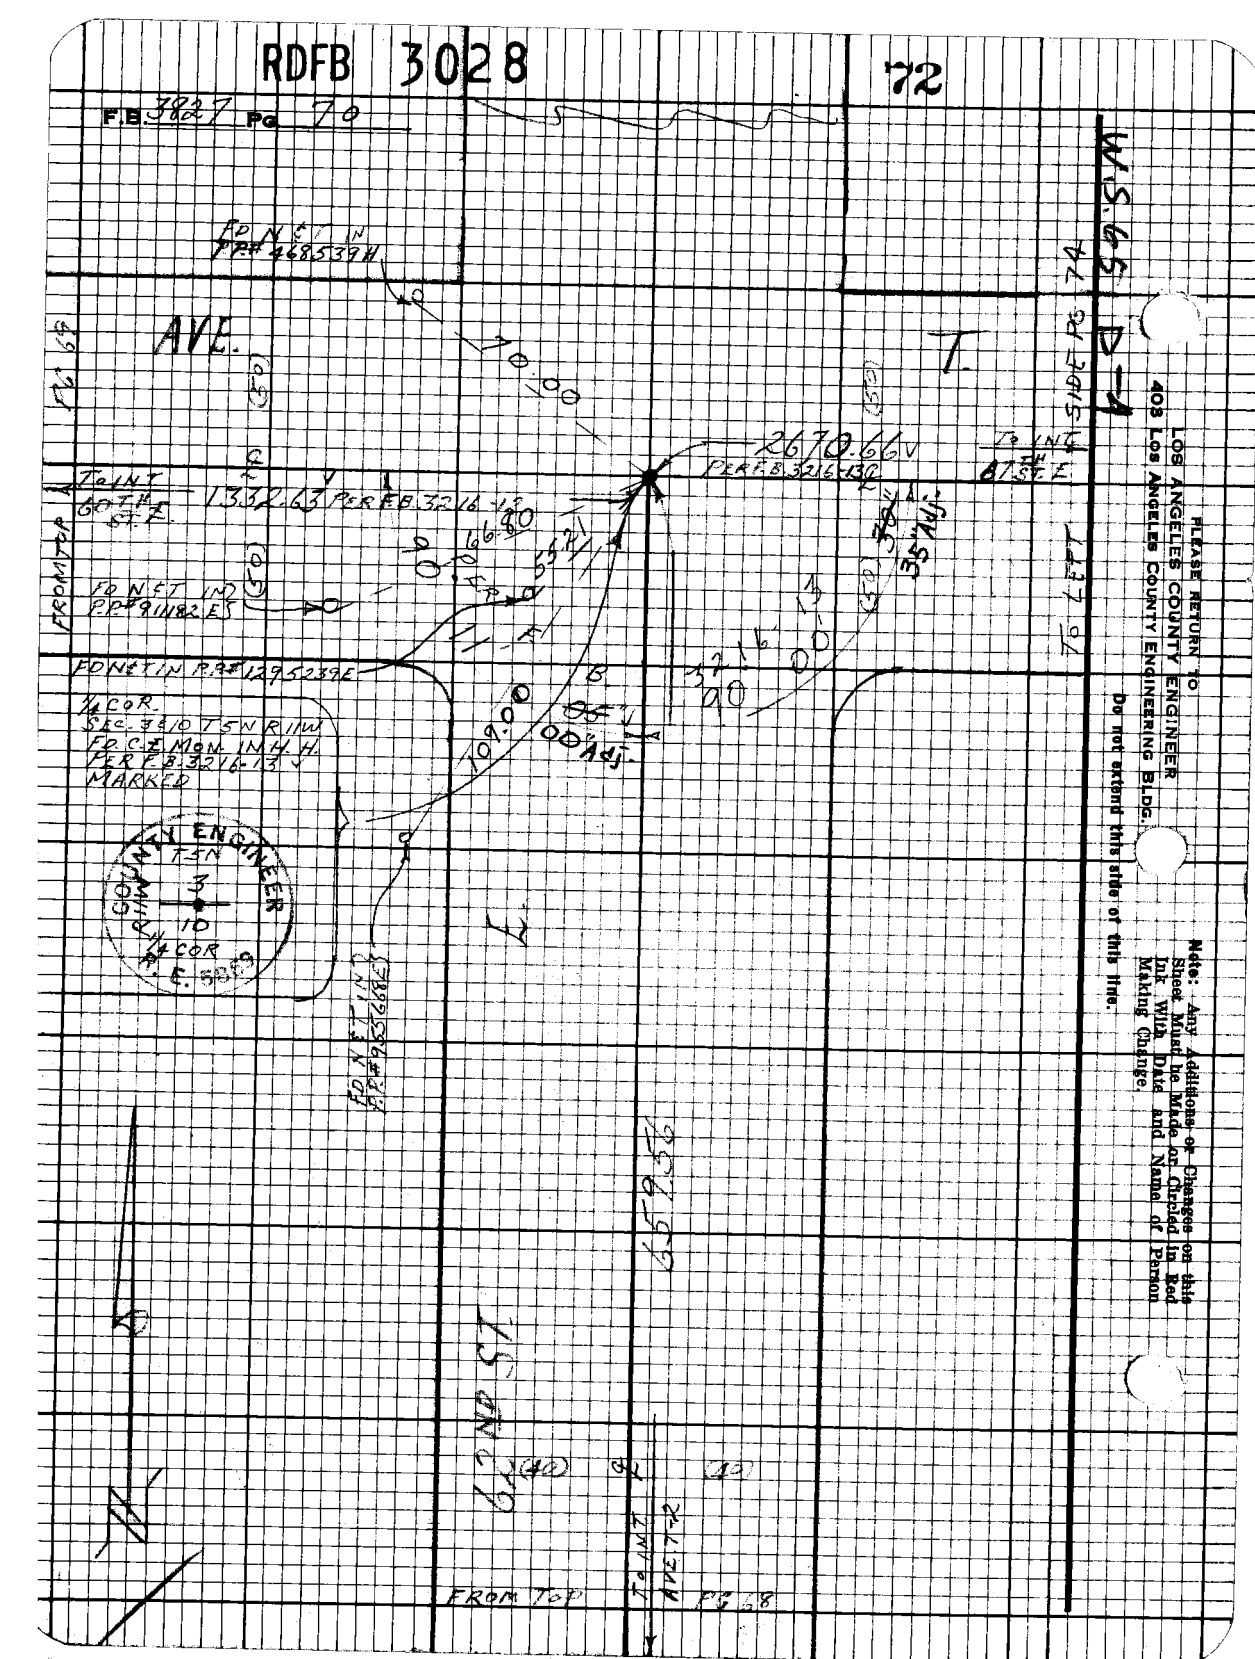

Please Return To
Los Angeles County Engineer
403 Los Angeles County Engineering Bldg.

Do not extend this strip of this line.

Note: Any Additions or Changes on this Sheet Must be Made or Circled in Red Ink With Date and Name of Person Making Change.

RDFB 3028

73

Notes Ck'd by	W. EDMONDSON	Survey of	AVE. T-8
Map No.	B-5196-1-7	JN	07512 Tape 184 Sta 81 "T"
Office Work	R. BRIONES	Surveyed by	J.S. COATES
Checked	J.F. MUNOZ	Notes	C.L./ANNEX Date 9-18-70
Date	3/13/74	Indexed	G.J. GALLI 09 27 70

F.B. 3827 Pg. 71

Note: Any Additions or Changes on this Sheet Must be Made or Circled in Red Ink With Date and Name of Person Making Change.

Do not extend this side of this line.

PLEASE RETURN TO
LOS ANGELES COUNTY ENGINEER
403 Los Angeles County Engineering Bldg.

TO BOT PG 72

P.T. #5
SET 2" I.P.F.I.
CONC. PLUG TAGGED
PAR MAP 8422 L/S

Δ 30°00'00"
Δ 360°00'00"
Δ 30°00'00"
Δ 180°00'00"
Δ 30°00'00"

1425.33'

L=1164.80'

(50)

(50)

℄ Curve Data
Δ=44°25'38"
R=1600.00'
T=653.39'
L=1240.64'

R=1600.00'

T-8

538.00'

90°

90°

SET 1X2 ENA.I

SET 1" I.P.F.I. CONC. PLUG TAG

42.42'

42.42'

42.42'

RDFB 3028

74

F.B. 3827 Pg 72

TO LEFT SIDE 1 PG 73

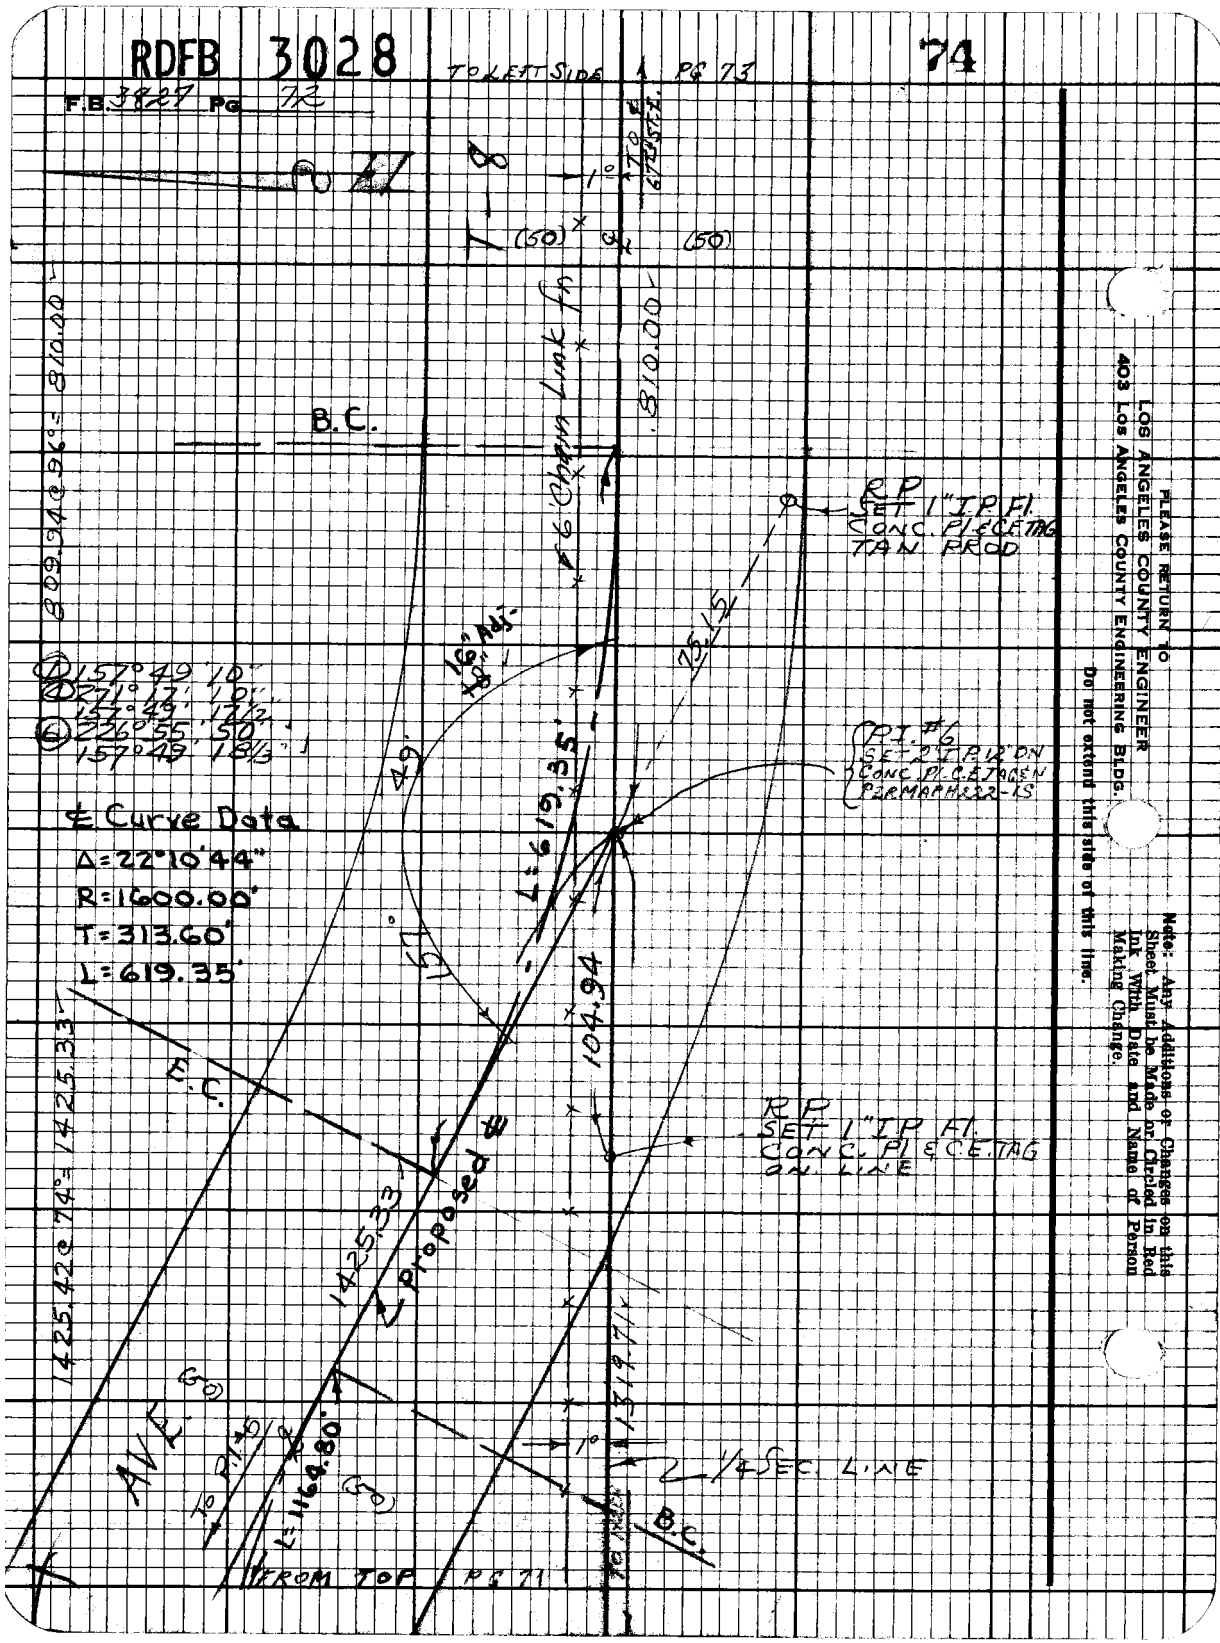

PLEASE RETURN TO
LOS ANGELES COUNTY ENGINEER
403 Los Angeles County Engineering Bldg.

Do not extend this side of this line.

Note: Any Additions or Changes on this Sheet Must be Made or Circled in Red Ink With Date and Name of Person Making Change.

RDFB 3028

75

F.B. 3827 PG 73

Notes Ckd by W. EDMONDSON
Map No. B-5196-1-7
Office Work R. BRIONES
Checked J.F. MUNOZ
Date 3/13/74

Survey of AVE T-8
JN 00981 Tape 184 Sur 84 F
Surveyed by J.S. COATES
Notes G.L. VANNER Date 2-18-70
Indexed C.E. GALLI 03276

TO BOT PG 74

M 5565 D

Note: Any Additions or Changes on this Sheet Must Be Made or Circled in Red Ink With Date and Name of Person Making Change.

Do not extend this side of this time.

PLEASE RETURN TO
LOS ANGELES COUNTY ENGINEER
403 LOS ANGELES COUNTY ENGINEERING BLDG.

TO BOT PG 77

AVE T

(50) ℄ (50)

TO TOP PG 72

AVE.

(50) ℄ (50)

FROM TOP PG 72

℄ 1810.00'

(50) (50)

℄ 1283.32'

TO ℄ 67TH ST

TO ℄ AVE T-8

FROM TOP PG #6

R.P. FD 2" I.P. 10" UP CONC. P.C.E. TAGGED

R.P. FD 2" I.P. 10" UP CONC. P.C.E. TAGGED

2645.71' R. FB 2636-184

2645.47' R. FB 2636-196

T 8 N

R 11 W

T 7 N

R 11 W

70.71' TAN

70.71' TAN

135°

90°

90°

90°

58°42'

13¼ Adj.

FD CUT SPK & TAG IN 10" JOSHUA

1/4 COR SEC 10, 11
T 5 N R 11 W
FD C.S. MON. 18 dn
per FB 1262-204
FB 2636-195
FB 3216-167
MARKED

COUNTY SURVEYOR'S
T 5 N
R 11 W
10 11
1/4 COR
PE 329

67TH ST

(50) ℄ (50)

TO TOP PG 53

AVE U

① 89° 59' 20"
② 359° 56' 50"
89° 59' 12½'
③ 179° 55' 20"
89° 59' 13⅓'

① 90° 21' 05"
② 36° 25' 00"
90° 21' 15"
③ 182° 07' 25"
90° 21' 14⅓'

7RFD098 CE# 810 2167

RDFB 3028

76

F.B. 3027 Pg 74

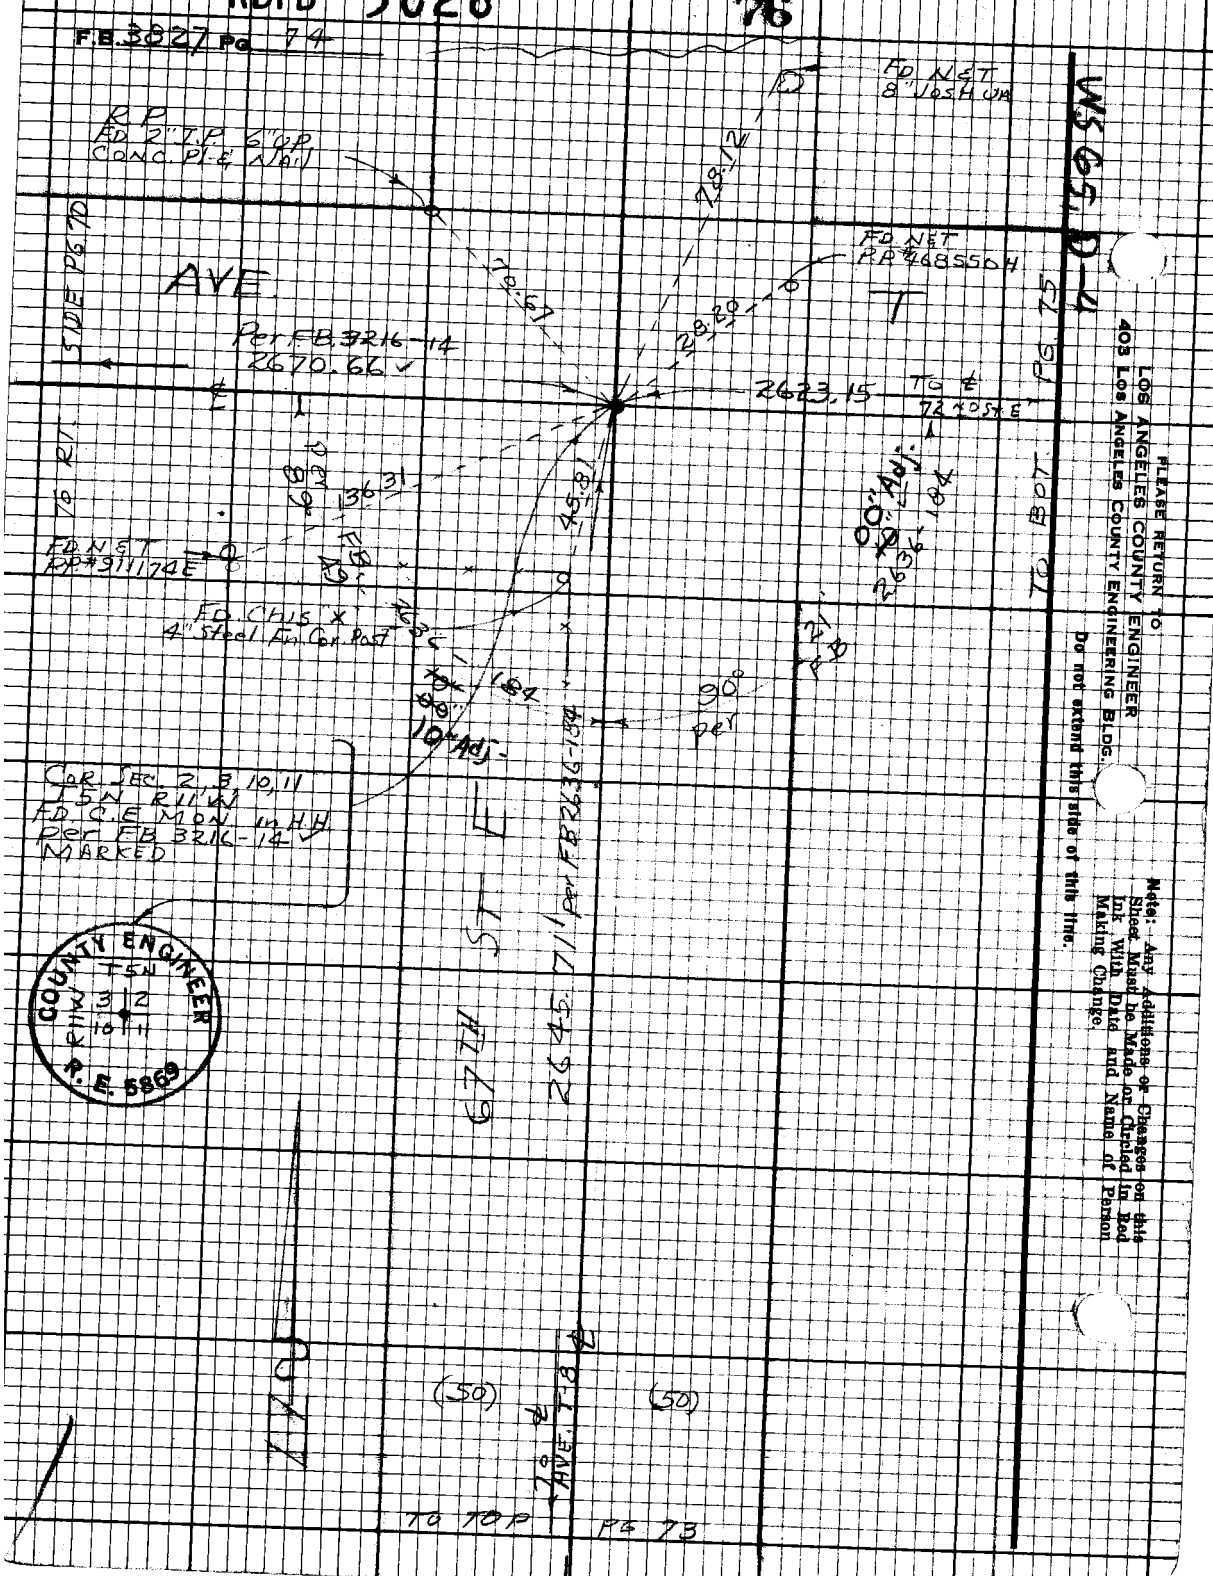

RDFB 3028

77

Notes Ck'd By EDMONDSON
Map No.
Office Work R. BRIONES
Checked E.F. MUNOZ
Date 3/13/74

Survey of AVE T-8
JN 9098.17 Tape 010 Std 84°F
Surveyed by J.S. COATES
Notes JSC Date 10/3/73
Indexed R.L. GALLI

F.B. 3827 Pg. 75

Note: Any Additions or Changes on this Sheet Must be Made or Checked in Red Ink With Date and Name of Person Making Change

Do not extend this side of this line.

PLEASE RETURN TO
LOS ANGELES COUNTY ENGINEER
403 Los Angeles County Engineering Bldg.

7825098 CK #310 5-68

TO LEFT SIDE PG 76

PG 77

(50) (50)

FD NAIL PP#9111658

90°15'00"
361°00'40"
90°15'10"
181°31'00"
90°15'10"

N 65.12 E 2622.60 per EB 2636-183

RP FD 2" IP 6" UP CONC. PLG N

FD NAIL PP#464672H

72 ND

S 70°30' E 1984.42

ST E

PG 78

(49)

(40)

PG 79

RP FD 2" IP 6" UP Con C. PLG W

S 19°30' W 2623.15 per FB 2436-183

AVE.

N 89°50'01" E 44.47' SPK 92

1/4 COR SEC. 2, T 5 N R 11 W FD C.E. MON. IN HH per FB 3216-20 MARKED

COUNTY ENGINEER T 5 N R 11 W 1/4 COR SEC 2 L.A.C.E. 5868

FD NAIL PP#9111662

89°44'20"
358°54'55"
89°44'13 3/4"
178°25'10"
89°44'11 3/4"

(50) (50)

TO RT SIDE PG. 74

RDFB 3028

78

F.B. 3827 Pg. 76

Set PM in Chas "X" End Fd. Post

6' Chain Lk Fn.

FD. N&T P.P.# 6111.85E

AVE

(25)

T & TR N 15° E & 2622.60' Per F.B. 2636-183

50.18

67.59

72.15'

99.0'

(50)

FD. N&T T.P.# 6059.84H

Per

P.O.B.

S 14° 26' E 20.00'

25.93 ± R

42.69'

RP FD. 2" I.P. 6" Up Conc. Pl. E.N.

FD. N&T 6"x8" R.R. TIES

POST

CoR. Sec 1, 2, 11, 12 T5N R11W FD. C.E. Mon in H.H. per F.B. 3216-21

COUNTY ENGINEER T5N R11W 1 2 11 12 R.E. 5869

ST. E.

2644.61' per F.B. 2636-182

(50)

(50)

7th Ave T-3

TO LEAT SIDE P6 81

WS 65, P-4

T

Ave T

LOS ANGELES COUNTY ENGINEER
403 LOS ANGELES COUNTY ENGINEERING BLDG.

PLEASE RETURN TO

Do not extend this side of this line.

Note: Any Additions or Changes on this Sheet Must be Made or Circled in Red Ink With Date and Name of Person Making Change.

RDFB 3028

79

Notes Ck'd W. EDMONDSON
Map No. B-5196-1-1
Office Work R. BRIONES
Checked J.F. MUNOZ
Date 3/13/74

Survey of AVE I-8
JN 0098-17 Tape 010 Std. 84 °F
Surveyed by J.S. COATES
Notes J.S.C. Date 10-15-70
Indexed [illegible]

F.B. 3827 Pg. 77

TO LEFT SIDE PG. 78

1344.22 @ 72° = 1344.12

To be 72 ND St E

1344.12

T-8

P.O.L. SET SET
0.2 W. of E end
paved Drag strip

6' Chain Link Fence

30'

PAVEMENT

45'

DRAG

65'

PAVEMENT

RETURN TAXI

2'

5'

4' Chain Link Fence

1293.41 @ 72° = 1283.32

AVE. I

1283.32

(50)

(50)

To be 67TH St E

TO RT SIDE PG. 73

Note: Any Additions or Changes on this Sheet Must be Made or Circled in Red Ink With Date and Name of Person Making Change

PLEASE RETURN TO
LOS ANGELES COUNTY ENGINEER
403 Los Angeles County Engineering Bldg.

Do not extend this side of this line.

Form CE 310 5-66

RDFB 3028 80

F.B. 3827 Pg. 78

1984.39086'=1984.42'

661.54086'=661.551

To RT. SIDE Pg. 75

WS 65.47'

(40) (40)

1984.42'

72ND ST E

661.55'

FD 2x2 AL RE 6067 No Ref

COUNTY ENGINEER T5N R11W Sec. 11 B.E. 5869

CENTER SEC. 11 T5N R11W SET CE MON. FI. BY TNT. MARKED

PLEASE RETURN TO LOS ANGELES COUNTY ENGINEER 403 Los Angeles County Engineering Bldg.

DO NOT ORDER this strip or this line.

Note: Any Additions or Changes on this Sheet Must be Made in Ink With Date and Name of Person Making Change

S 89° 48' 58" E 5280.00'

FD 2" IP Cons. PLS 6067 Tag

P.O.L. SET 2" IP FI. Conc. PLS 6067 Tag

T-8

(50) AVE.

70 St

1344.12'

58.80'

70.71'

2573.27'

(50)

Pg 77

Pg 77

(50)

70.71'

88.34'

70.71'

To TOP Pg. 78

RP SET 2" IP G'UP CONC. PLS C.E. TAG

P.O.L. SET 1" IP FI. CONC. PLS C.E. TAG

① 89° 43' 15"
② 358° 56' 55"
③ 89° 44' 13¾
④ 178° 25' 20"
⑤ 89° 44' 13¾

(40) (40)

P.O.L. 2409.38'

S 89° 48' 43" E 4437.68'

To TOP Pg. 79

RDFB 3028

81

Notes Ck'd By W. EDMONDSON
Map No. B-5196-1-7
Office Work R. BRIONES
Checked C.F. MUNOZ
Date 3/13/74

Survey of AVE T-8
JN 0098.17 Tape 10 Std 94 °F
Surveyed by JSCOATES
Notes JSC Date 10-15-70
Indexed R.D. GALLI 03 27

F.B. 3827 Pg. 79

To B07 PG. 78

W565

Ⓐ 23°16' 30"
Ⓑ 44°09' 40"
Ⓒ 93°16' 35"
Ⓓ 199°38' 45"
93° 16' 27½"

135.61 S 24° 44' 40" E = 135.15'
135.52 S 39° 14' 20" E = 135.15'
T = 82° = 135.15'

300.29 S 32° 19' 15" E = 300.97'
300.28 S 32° 04' 02" E = 300.08'

Level 2102.34
2409.41
T = 82° 2409.38'

140.00 S 84° E = 100.00'

32nd St.

93°

72ND ST E

(40) (40)

To 11th

24.09 38'

Level 2109.23
2409.44'
2408.17'

Remeasured 2-17-72 JSC
300.49 S 32° 19' 15" E = 300.40'
300.62 S 32° 05' 20" E = 300.42'

T = 54°

Level

P.O.L.
SET 1" I.P.F.F.
Conc. Pl. R.E. TAG

CREEK

No EVIDENCE 2 PIPE
Per F.B. 1262-201
SET 2" I.P. 6" UP
IN ROCK MOUND
Conc. Pl. & C.E. TAG
REC. DIST. 100.00
P.O.D. EAST FROM
W.I.T. COR
Per F.B. 1262-201
F.B. 1673-104

10.00 Calc

135.15'

SIDE PG

(50)

AVE

90°

ROCK

1320.33'

PG. 80

100.00

To ℄ 67th St E

2630.89'
Per F.B. 2636
Pg. 189

(50)

To B07

179.10'

35.1'

26

52'

3276'

LITTLE

COUNTY SURVEY

WITNESS CORNER

W.I.T. Cor. to
¼ Cor. Sec. 11, 14
1S N R 11W
F.D. C.S. MON. FI.
Per F.B. 1262-201
F.B. 1673-104
F.B. 2636-189
F.B. 3276-26
MARKED

Note: Any Additions or Changes on this Sheet Must be Made in Circled Ink With Date and Name of Person Making Change

Do not extend this title.

PLEASE RETURN TO
LOS ANGELES COUNTY ENGINEER
403 Los Angeles County Engineering Bldg.

7695035 CK #310 8-86

RDFB 3028

82, 83

F.B. 3827 Pg. 50

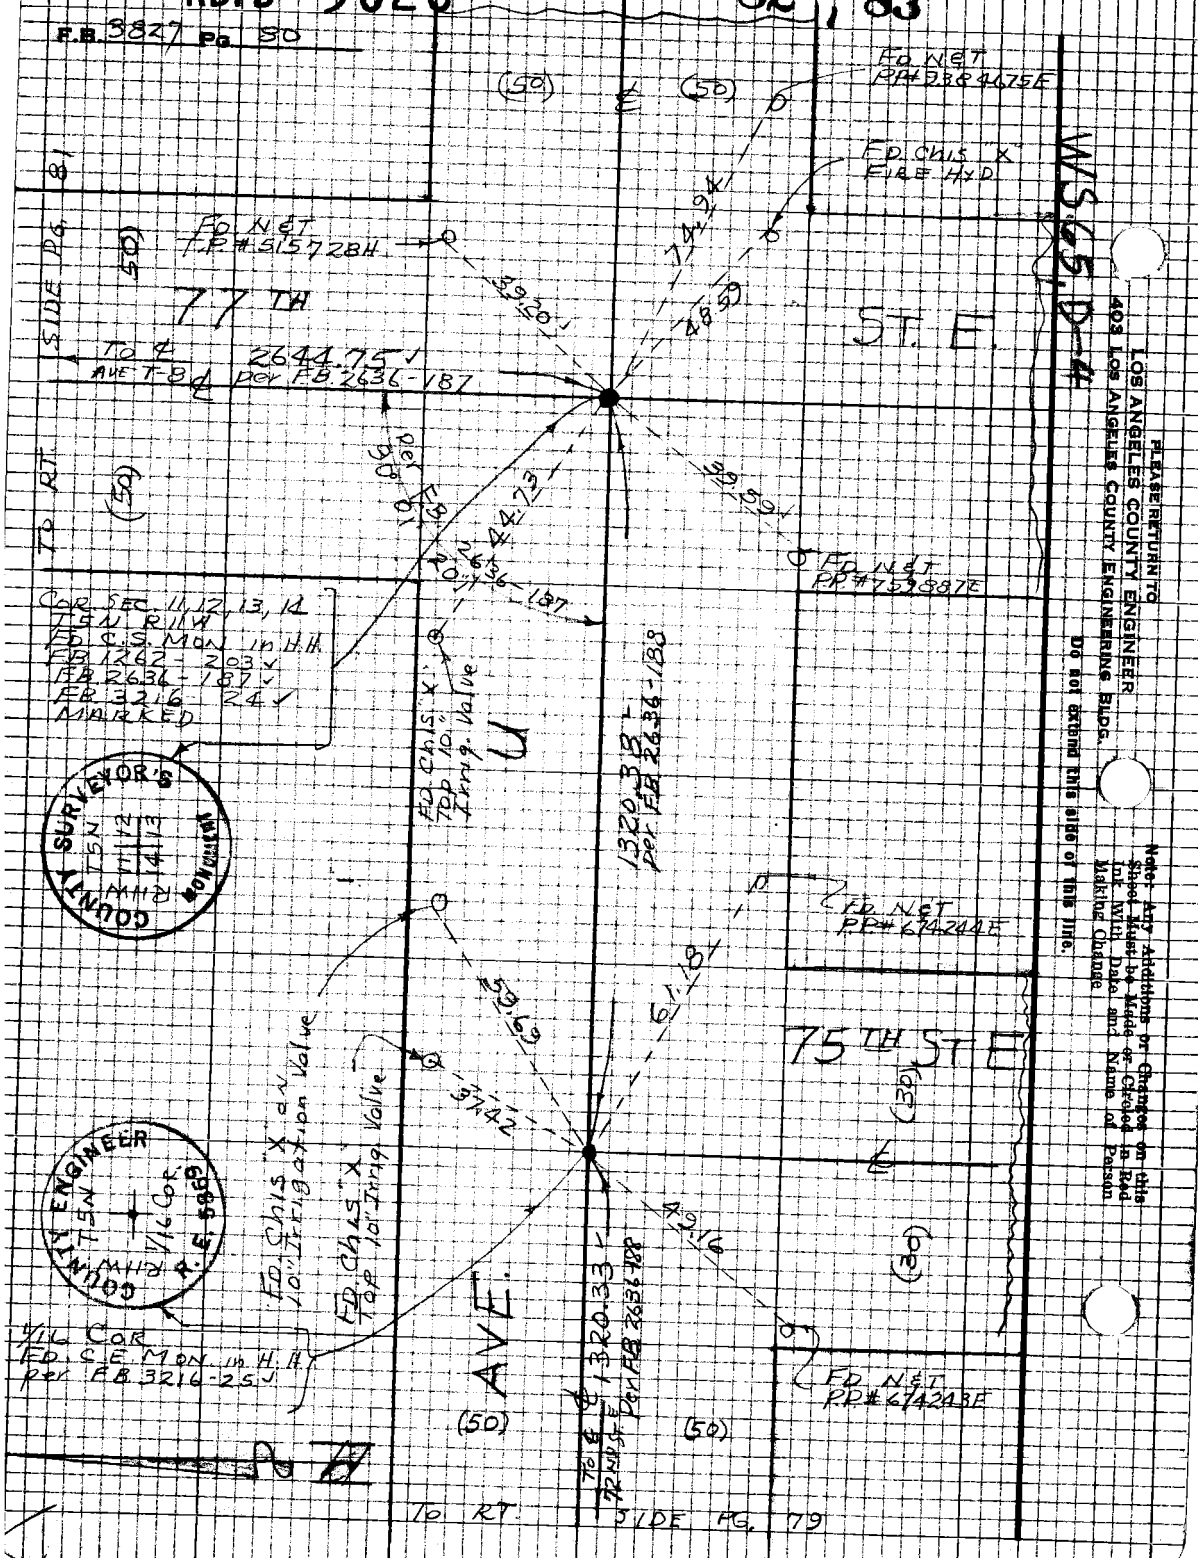

RDFB 3028

84

Notes Ck'd W. EDMONDSON
Map No. B-5196-1-7
Office Work R. BRIONES
Checked L. F. MUNOZ
Date 3/13/74

Survey of AVE T-8
JN 0998.17 Tape 10 Std 84 °F
Surveyed by JSCOATES
Notes JSC Date 12/16/73
Indexed G. J. GALLI

F.B. 3827 Pg. 81

Note: Any Additions or Changes on this Sheet Must be Made or Circled in Red Ink With Date and Name of Person Making Change

Do not extend this side of this file.

PLEASE RETURN TO
LOS ANGELES COUNTY ENGINEER
403 Los Angeles County Engineering Bldg.

7-2503 CK #210 5-66

MW 55 St

(40) (40)

Fd Chis "X" 30" Irrig. STR PIPE

Fd B.S.&T 14" Elm

77 TH

(50)

To ℄ AVE T Per F.B. 2636-182

2641.61'

AG 76

89°

Fd 05" I

Fd 88

Fd 82.10

Fd 80.0 X

Fd 81.8'

S T E

(50)

R644.75 Per F.B. 2636-186

To ℄ AVE U

TO SIDE PG. 80

TO LEFT

(50)

TO EAST

(50)

Fd Chis "X" W. end wall

25" 38" Adj.

55'

89°

Fd N&T pp #4821076

1/4 COR SEC. 11, 12 T5N R11W Fd C.S MON in HH per FB 1858-166 FB 2636-186 FB 3216-234 MARKED

SURVEYOR'S 1/4 SEC. COR. T5N R11W 11 12 COUNTY MONUMENT

AVE T-8

2573.27'

2578.50 @ 270° = 2573.27'

(50) (50)

To 2" Pipe

① 89°55'40"
② 359°41'40"
89°55'25"
③ 179°32'40"
89°55'28"

TO RT SIDE PG. 78

RDFB 3026

221

Notes Ck'd by
Map No.
Office Work
Checked
Date

Survey of AVE T-8
JN 0098.17 Tape 18 Std 84 °F
Surveyed by NEVAREZ
Notes NEVAREZ Date DEC 73
Indexed G. D. BAILEY DEC 17 1973

F. B. 3827 PG. 83

Note: Any Additions or Changes on This Sheet Must be Made or Circled in Red Ink With Date and Name of Person Making Change.

Do not extend this side of this line.

PLEASE RETURN TO
COUNTY OF LOS ANGELES
DEPARTMENT OF COUNTY ENGINEER
403 LOS ANGELES COUNTY ENGINEERING BLDG.

AVE T-8

ZONE VII TIES

JN 0098.17

REF

F.B. 3179
F.B. 3827
F.B. 2824
F.B. 3216

PARTY

NEVAREZ
BITTEL
CROWE
DONLEVY

16F309 CE#310 3-69

RDFB 3026

222

F. B. 3827 Pg. 84

NOT CONT.

W.S. 6 C-4

PLEASE RETURN TO
COUNTY OF LOS ANGELES
DEPARTMENT OF COUNTY ENGINEER
403 LOS ANGELES COUNTY ENGINEERING BLDG.

Note: Any Additions or Changes on This Sheet Must be Made or Circled in Red Ink With Date and Name of Person Making Change.

Do not extend this side of this line.

1) 00-00-30 = 30
180-00-30
90-20-49 = 51 = 21
270-20-53

2) 45-02-32 = 35.5
225-02-39
135-22-56 = 58.5 23.0
315-23-01
90-20-22

T = 60°

@ LEV 88.48 = 88.47
40.00 = 39.99
63.15 = 63.14
80.53 = 80.52
46.70 = 46.69

FD RED DOT . 06 WEST OF PUNCH MARK ON RD DEPT MON. ON 9" IN WELL & COVER PER F.B. 3827-10

DIST MEASURED WITH H.P. #2
1256.72 (CHAIN) @ 89-43-45 = 1256.71
@ LEV = 73.55
1330.26

1330.26

T-8

AVE.

FD 2" I.P. CONC PLUG & NL PER F.B. 3179-60

FD NL & TIN IN P.P. # 1070405 E PER F.B. 3179-60

FD NL & TIN IN P.P. NO NUMBER

22"

20'

80.52

39.99

88.47

90°

88.47

39.99

88.47

1/4 SEC. COR.

FD. L.A. CO. SUR. MON - 2" I.P. & BRASS CAP SET IN CONC - UP 4" PER F.B.S 3179-60 & 3827-10 MON MARKED

COUNTY SURVEYOR (26) MONUMENT
1/4 COR
T 5 N
SEC 8 — SEC 7
R 11 W

2642.93 (PER F.B 3179-49, 59 & 60)

37TH ST. E.

CONT 88

FD NL & TIN IN P.P. NO NUMBER

FD 2" I.P. CONC. PLUG & NL PER F.B. 3179-60

NOT CONT.

RDFB 3026

223

Notes Ck'd by J. F. MUNOZ
Map No. B-5196-1-7
Office Work
Checked J. F. MUNOZ
Date 3/13/74

Survey of AVE T-8
JN0098.17 Tape 18 Std 84 °F
Surveyed by NEVAREZ
Notes B TTEL Date DEC 73
Indexed G. D. BAILEY DEC 19 1973

F. B. 3827 PG. 85

W 5165.54

TRI STAT PALMDALE 0-10 FD. THIS STATION DISTURBED BY A ROAD GRADER

1/4 COR. SEC. 2, 11 ALSO R.M.#2 FOR TRIA. STA. 0-10 FD. C.E. MON. DN. 8" IN H.H. PER FD 3216-20 MARKED

COUNTY ENGINEER T5N R11W 2 11 1/4 COR R.E. 5869

FD. 2" I.P. C/UP CONC. PL. # NAIL

FD. N & T. P.P. # 464672H

AVE. T

TO SEC. COR (F.B. 3827-76)

70.71

30.49

165.58

70.68

165.12

SEE F.B. 3216-20&21 FOR AVE. T BETWEEN 1/4 COR & SEC COR

NOT CONT.

NOT CONT.

FD N & T. PP # 911166E

FD. 2" I.P. 6" UP CONC. PL. # NAIL

FD. N & T. PP # 911165E

Note: Any Additions or Changes on This Sheet Must be Made or Checked in Red Ink With Date and Name of Person Making Change.

PLEASE RETURN TO COUNTY OF LOS ANGELES DEPARTMENT OF COUNTY ENGINEER 403 LOS ANGELES COUNTY ENGINEERING BLDG.

Do not extend this side of this line.

D) 00-00-28 27.5
R) 180-00-27 11.0
D) 44-54-38 38.5
R) 244-54-37

R) 45-02-36 38.0
D) 225-02-40 11.5
R) 109-56-49 49.5
D) 289-56-50

D) 90-05-42 40.0
R) 270-05-38 12.0
D) 154-59-52 52.0
R) 334-59-52

R) 135-07-11 14.0
D) 315-07-17 13.5
R) 200-01-29 27.5
D) 20-01-26

70.71 @ 64° = 70.70
30.49 @ 64° = 30.49
165.60 @ 64° = 165.58
70.68 @ 64° = 70.67
165.14 @ 64° = 165.12

73.46 @ 74° = 73.46
63.50 @ 74° = 63.50

4161.34

R.M.#1 A U.S.#G.S. DISK SET IN TOP OF A 12" CONC. MON. UP 2" MARKED "R.M. NO.1, 1964"

R. M. #2 A U.S. #G.S. DISK SET IN TOP OF A 12" CONC. MON. UP 2" MARKED "R.M. NO.2, 1964"

ANG = 64° 54' 12"

DISTANCE MEASURED WITH H.P. #2

89-21-10
270-38-25
4161.63 @ 89-21-22 = 4161.37

90-39-12
269-21-15
4161.58 @ 90-38-59 = 4161.31

AVG. = 4161.34

73.46

63.50

R4W 5FEB74

A-12 LRK A-12
FD. A U.S.#G.S. DISK SET IN TOP OF A 12" X 12" CONC. MON. UP 3" MARKED AS SHOWN

U.S. COAST AND GEODETIC SURVEY STATION LOGAN 1964

IGF308S CE#310 3-69

RDFB 3026 224
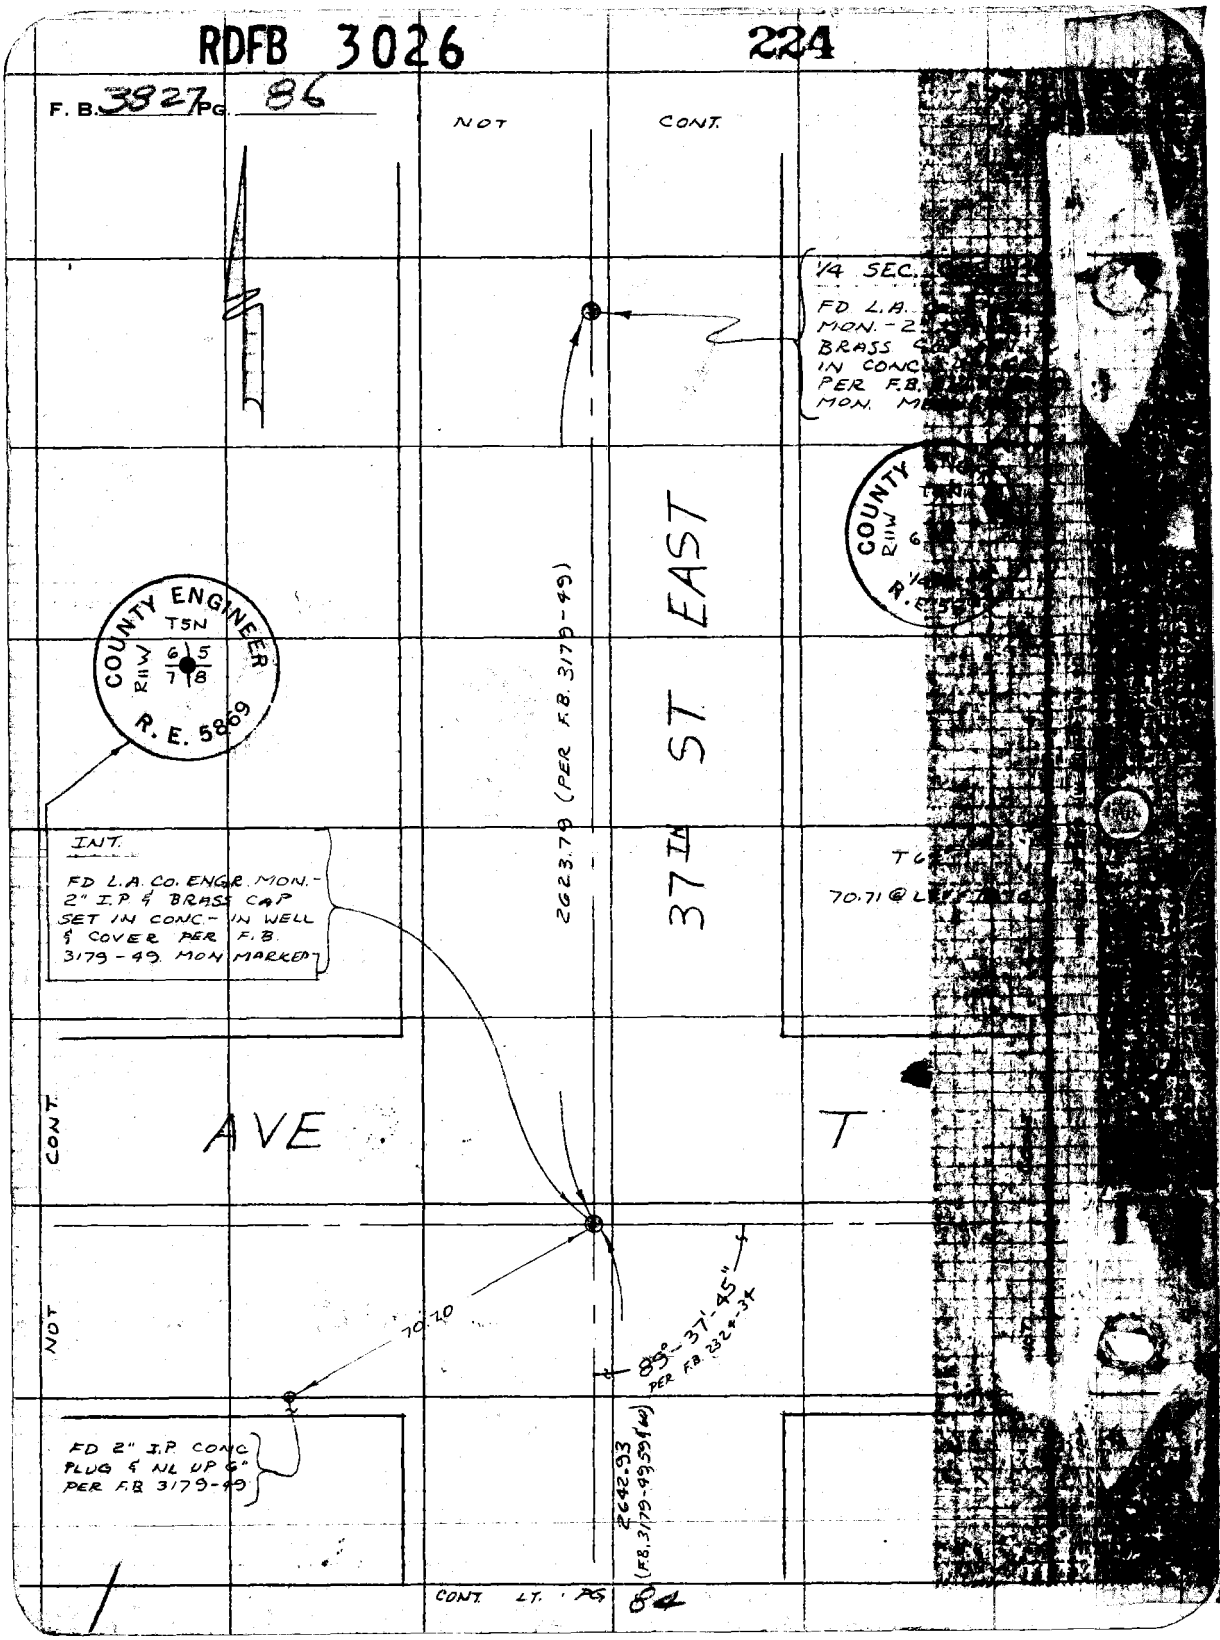
F. B. 3927 PG. 86