PWFB 0817 654

Notes Ck'd by	Survey of LENNOX AREA 1
Map No.	JN 0303.00 Tape 09 Std 68 °F
Office Work	Surveyed by J. BAZEN
Checked	Notes J.B. Date 3-74
Date	Indexed JUN 15 1978

F. B. 3935 Pg. 5

Notes: Any Additions or Changes on This Sheet Must be Made or Circled in Red Ink With Date and Name of Person Making Change.

Do not extend this side of this line.

PLEASE RETURN TO
COUNTY OF LOS ANGELES
DEPARTMENT OF COUNTY ENGINEER
403 LOS ANGELES COUNTY ENGINEERING BLDG.

J.N. 0303.00

LENNOX AREA - DIV. 1

CENTERLINE SURVEY

(FOR CAD. TIES SEE PG. 180)

PARTY
J. BAZEN
E. SHOEMAKER
E. TULLIER
R. CLIFFORD

P.W. file Aug '86

Microfilmed Dec '84.

PWFB 0817

655

F. B. 3935 PG. 6

INDEX (SHEET 1 OF 3)

J.N. 0303.00 - LENNOX AREA - ℄ - DIV. 1.

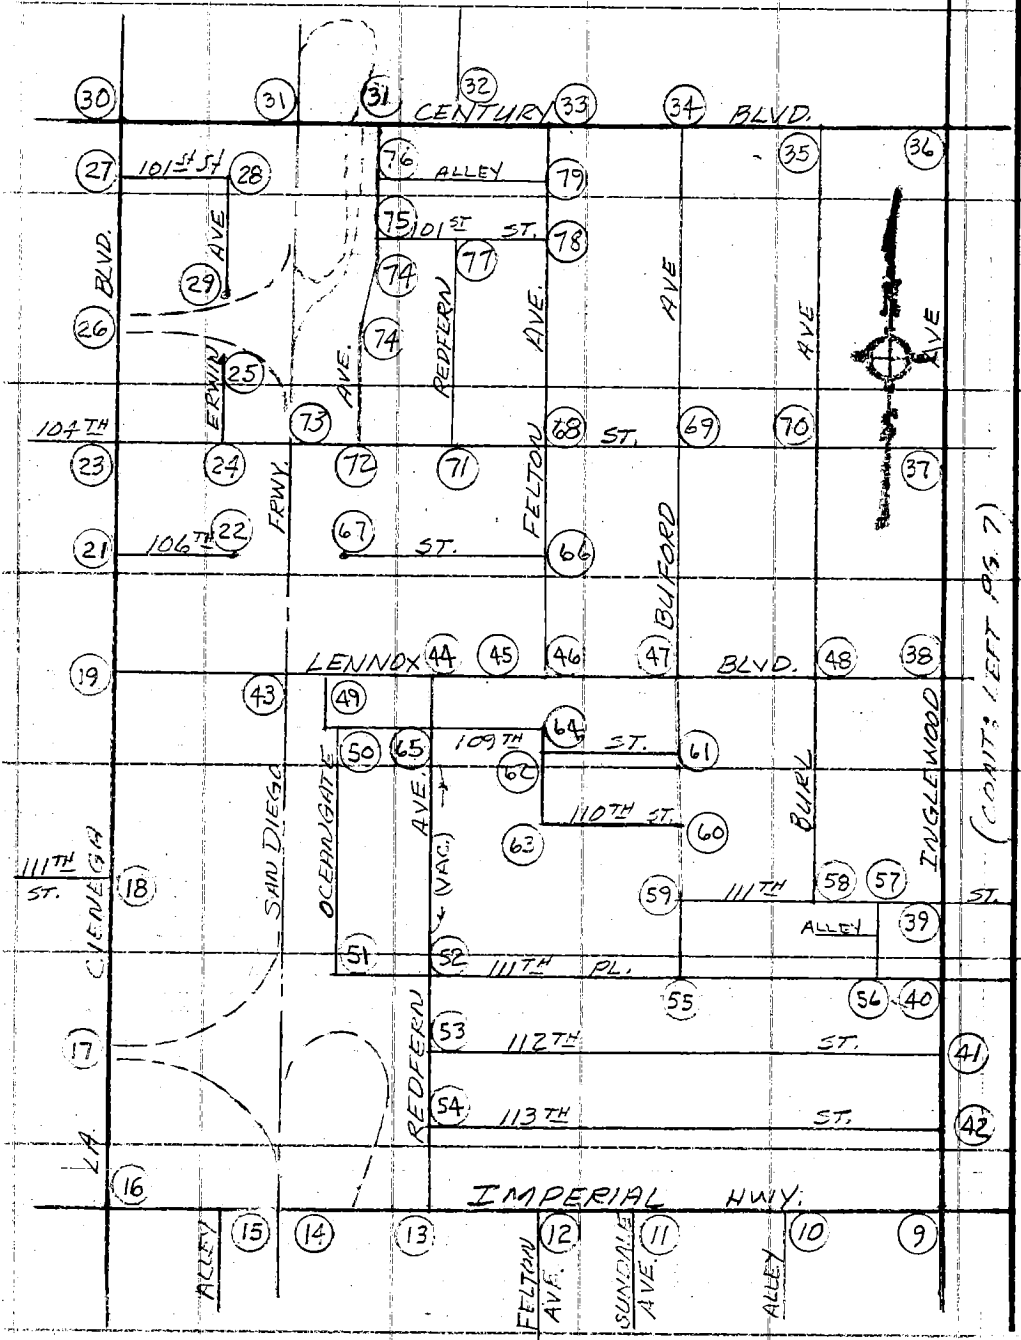

PLEASE RETURN TO
COUNTY OF LOS ANGELES
DEPARTMENT OF COUNTY ENGINEER
403 LOS ANGELES COUNTY ENGINEERING BLDG.

Do not extend this side of this line.

Note: Any Additions or Changes on This Sheet Must be Made or Circled in Red Ink With Date and Name of Person Making Change.

PWFB 0818

678

Notes Ck'd by
Map No.
Office Work
Checked
Date

Survey of LENNOX AREA 2
JN 0303.00 Tape 09 Std 68 °F
Surveyed by J. BAZEN
Notes J.J.B. Date 12-74
Indexed PALMER JUN 15 1976

F.B. 3935 PG. 7

LENNOX AREA 2 - DIV. 1

J.N. 0303.00 - (SHT. 2 OF 3)

INDEX

CENTURY BLVD.

102ND ST.

104TH ST.

111TH ST.

IMPERIAL HWY

LENNOX BLVD.

LENNOX PRK.

ALLEY

DALEROSE AVE.

CONDON AVE.

TRURO AVE.

FIRMONA AVE.

MANSEL AVE.

GREVILLEA AVE.

BURIN AVE.

HAWTHORNE BLVD. (WEST)

SEE PG. 6, FOR CONT.

SEE PG. 8 FOR CONT.

Note: Any Additions or Changes on This Sheet Must be Made or Circled in Red Ink With Date and Name of Person Making Change.

Do not extend this side of this line.

PLEASE RETURN TO
COUNTY OF LOS ANGELES
DEPARTMENT OF COUNTY ENGINEER
403 LOS ANGELES COUNTY ENGINEERING BLDG.

76F309s CE#310 3-69

PWB 0818

679

F. B. 3938 Pg. 8

LENNOX AREA C-DIV. 1

J.N. 0303.00 (SHT. 3 OF 3)

INDEX

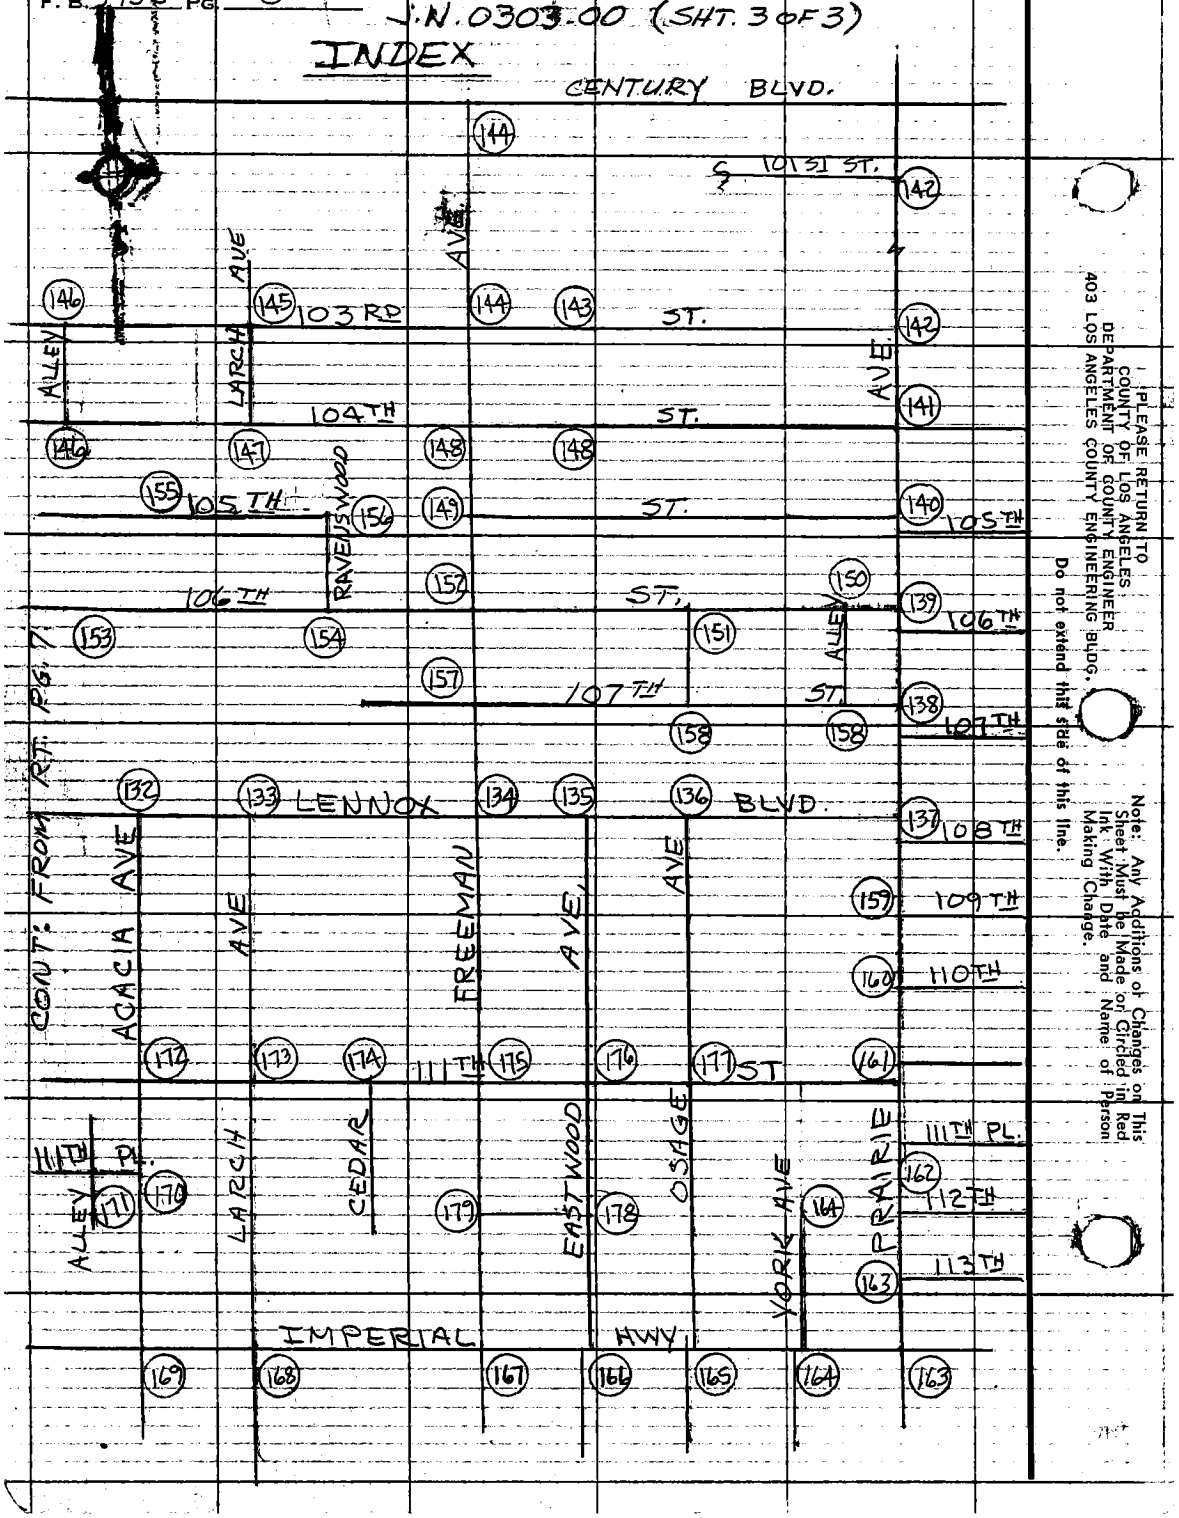

Note: Any Additions or Changes on This Sheet Must be Made or Circled in Red Ink With Date and Name of Person Making Change.

Do not extend this side of this line.

PLEASE RETURN TO
COUNTY OF LOS ANGELES
DEPARTMENT OF COUNTY ENGINEER
403 LOS ANGELES COUNTY ENGINEERING BLDG.

PWFB 0817

657

Notes Ck'd by	Survey of LENNOX AREA ℄
Map No.	JN 0303.00 Tape 09 Std 68 °F
Office Work	Surveyed by J. BAZEN
Checked	Notes J. BAZEN Date 3-74
Date	Indexed R. M. PALMERY JUN 15 1976

F. B. 3935 PG. 9

B5

WS 24

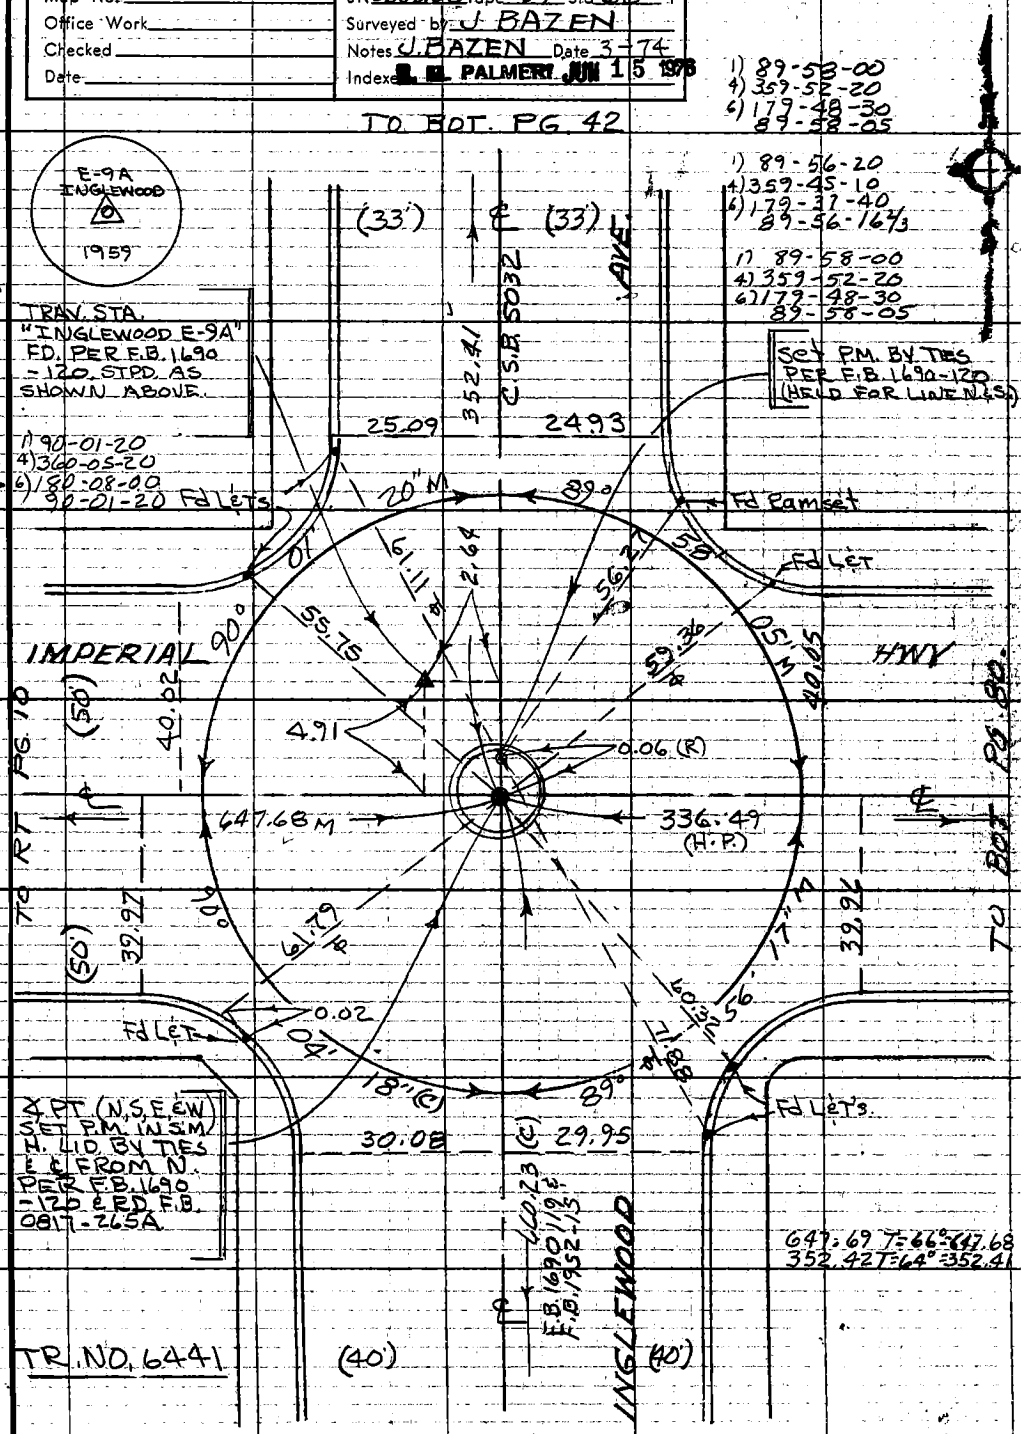

Note: Any Additions or Changes on This Sheet Must be Made or Circled in Red Ink With Date and Name of Person Making Change.

Do not extend this side of this line.

PLEASE RETURN TO
COUNTY OF LOS ANGELES
DEPARTMENT OF COUNTY ENGINEER
403 LOS ANGELES COUNTY ENGINEERING BLDG.

76F309S CE#310 3-69

PWFB - 0817

658

F. B. 3935 PG 10

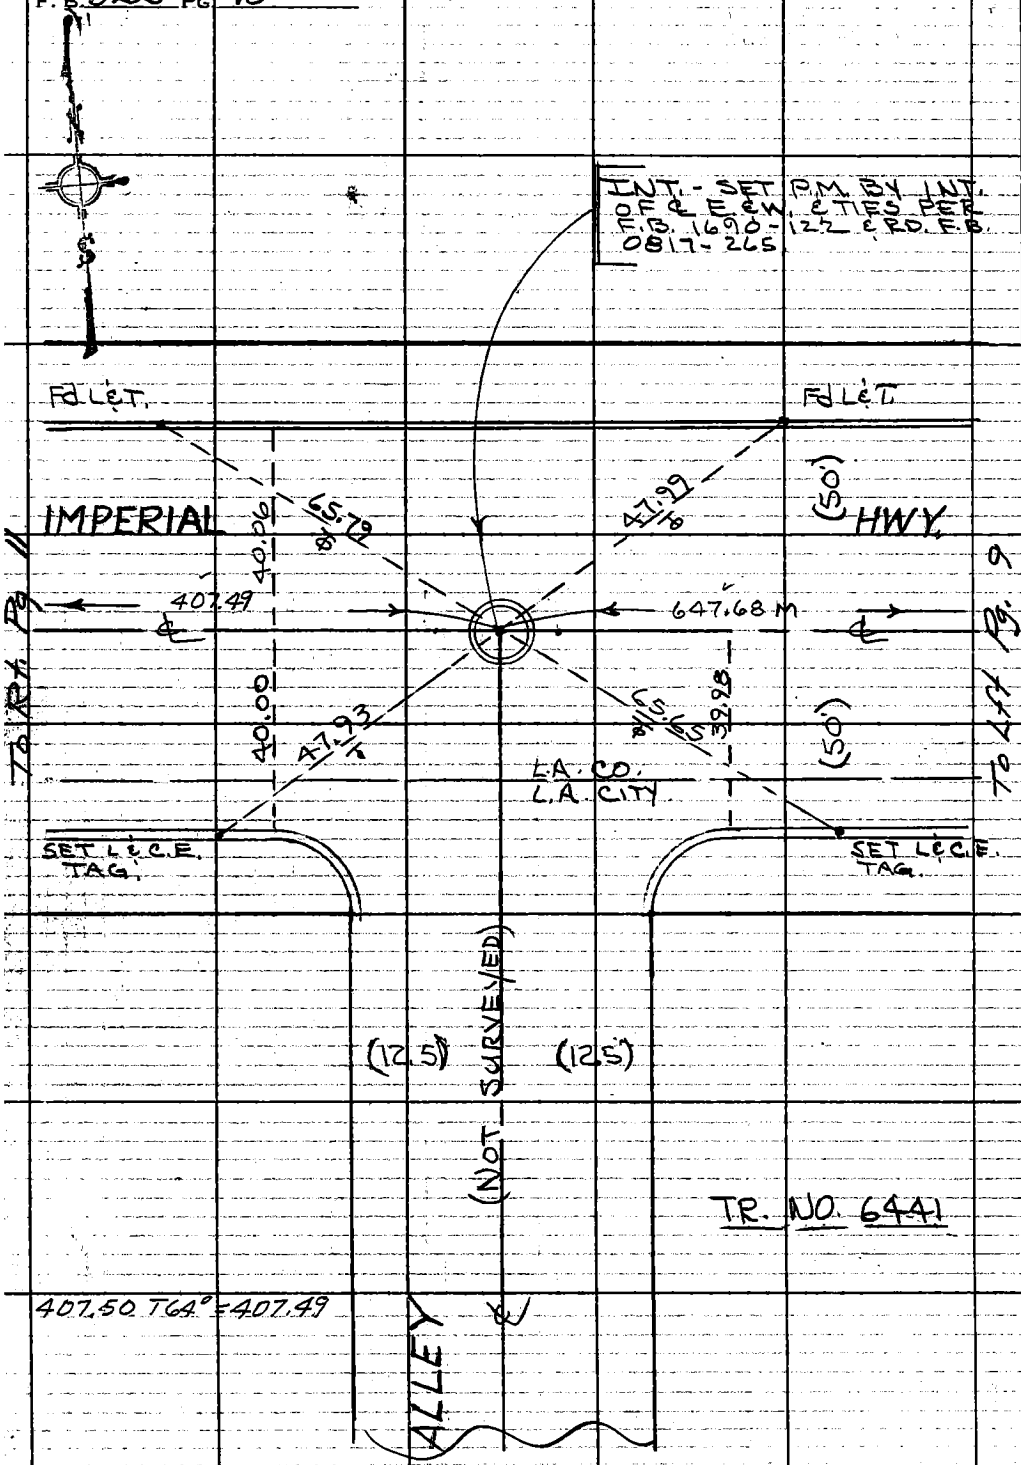

PLEASE RETURN TO
COUNTY OF LOS ANGELES
DEPARTMENT OF COUNTY ENGINEER
403 LOS ANGELES COUNTY ENGINEERING BLDG.

Do not extend this side of this line.

Note: Any Additions or Changes on This Sheet Must Be Made or Circled in Red Ink With Date and Name of Person Making Change.

PWFB 0817 659

Notes Ck'd by	Survey of LENNOX AREA ℄
Map No.	JN 0303.00 Tape 09 Std 68 °F
Office Work	Surveyed by J. BAZEN
Checked	Notes J.J.B. Date 3-74
Date	Indexed T. M. PALMERI JUN 15 1978

F.B. 3935 PG. 11

WS 24 B5

Note: Any Additions or Changes on This Sheet Must be Made or Circled in Red Ink With Date and Name of Person Making Change.

Do not extend this side of this line.

PLEASE RETURN TO
COUNTY OF LOS ANGELES
DEPARTMENT OF COUNTY ENGINEER
403 LOS ANGELES COUNTY ENGINEERING BLDG.

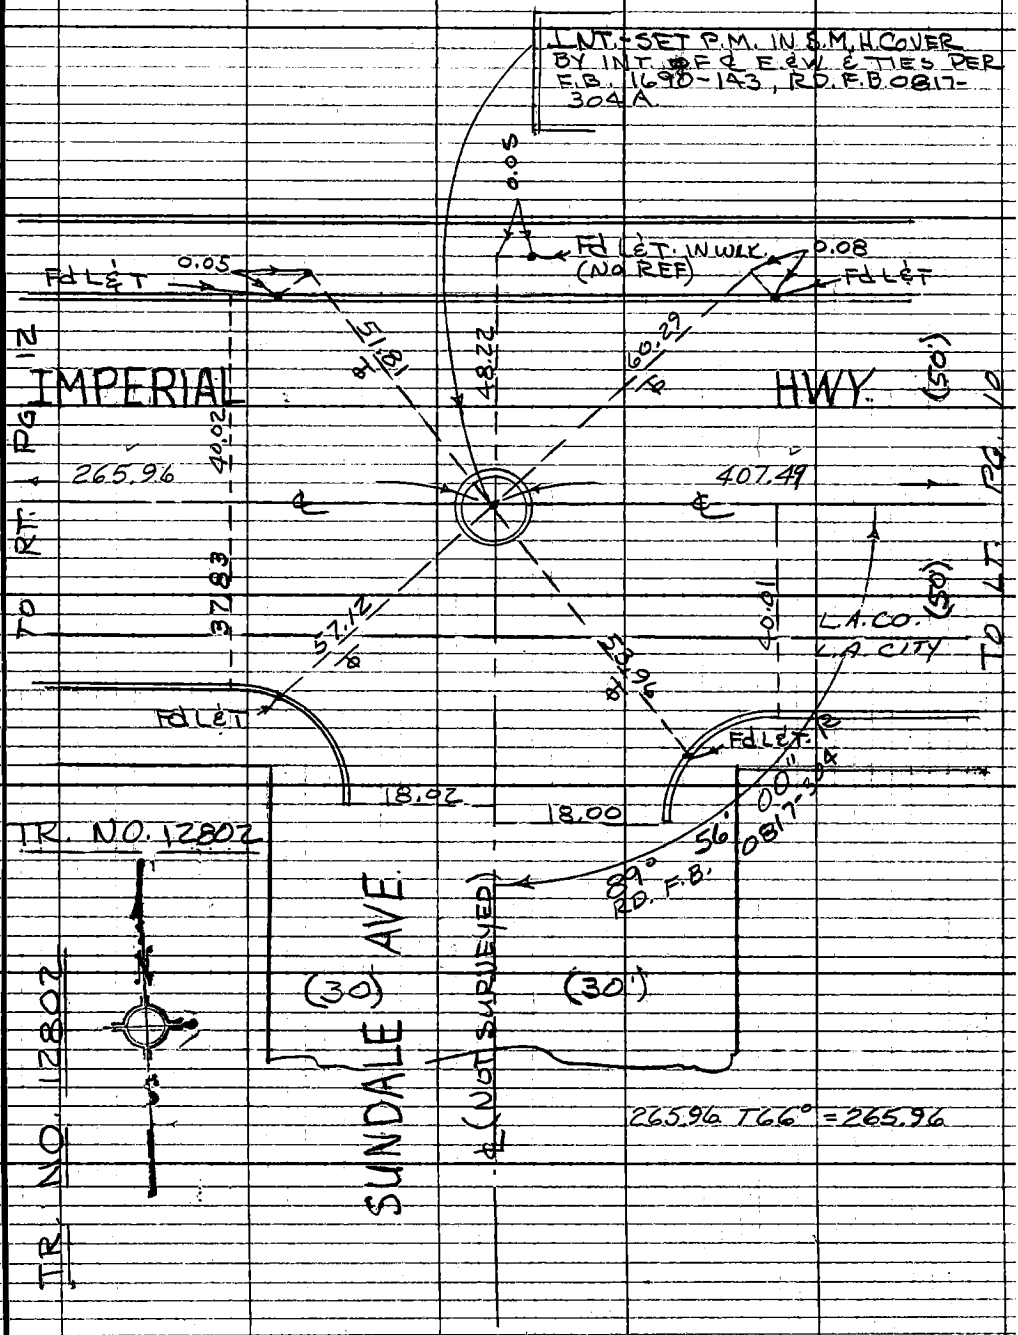

76F309S CE#310 3-69

PWFB 0817 660

F.B. 3935 PG. 12

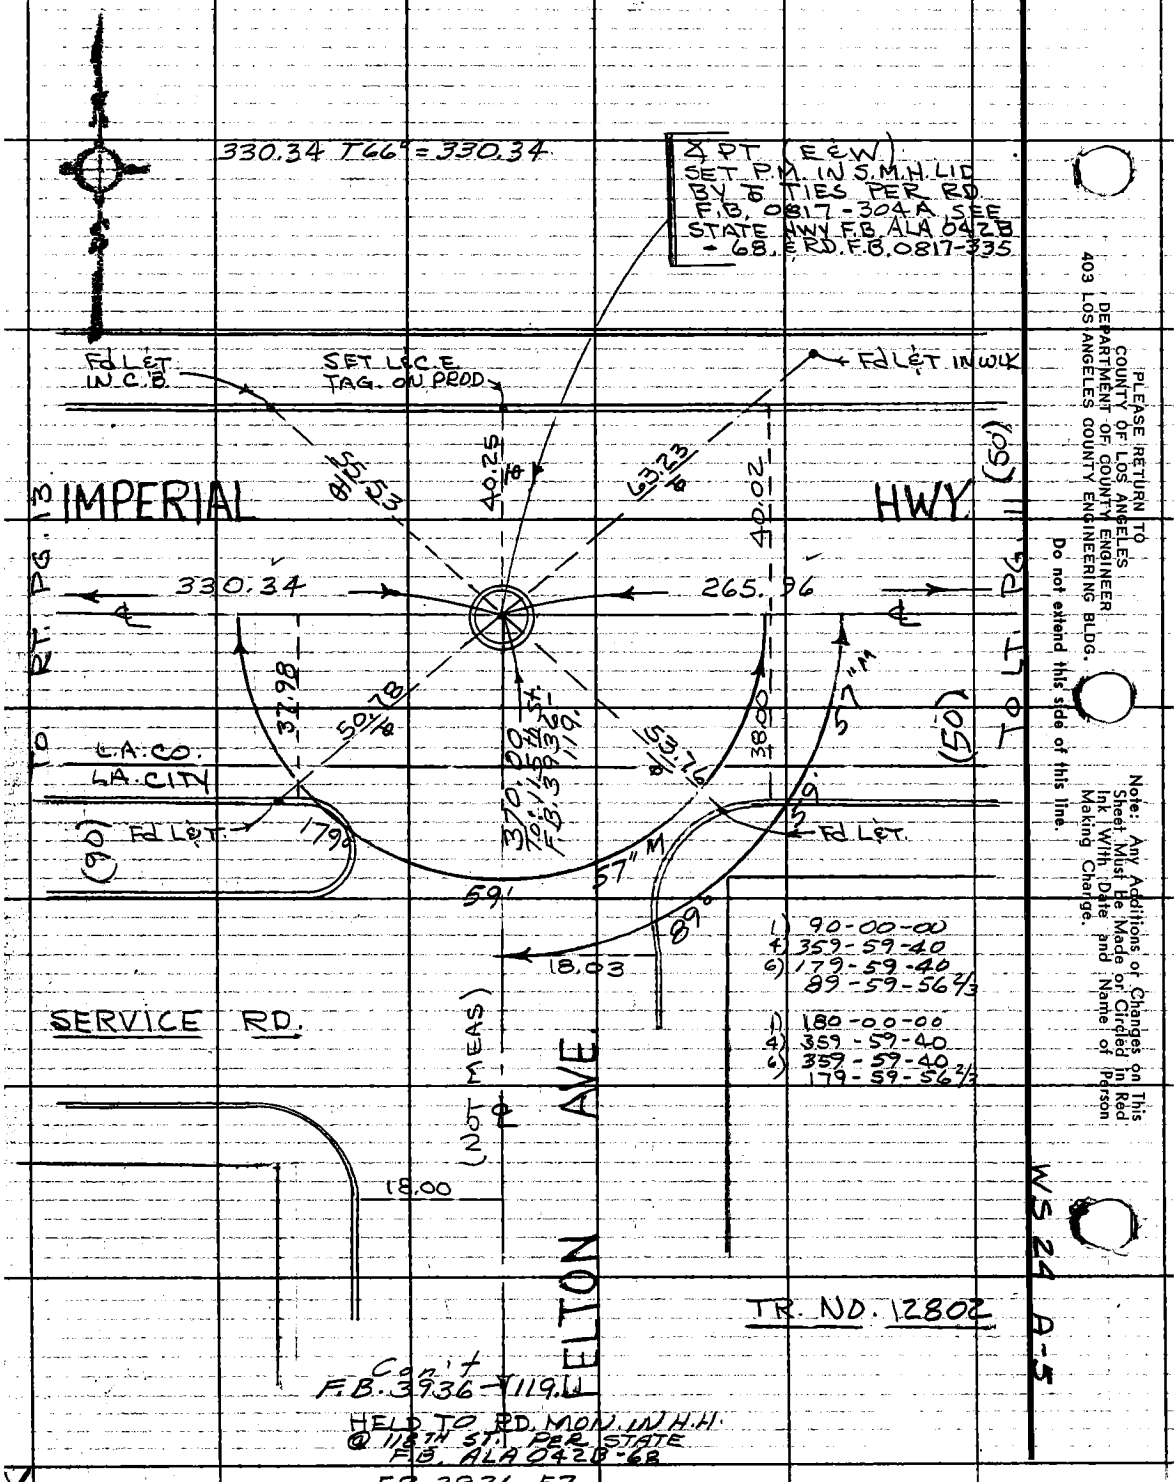

PLEASE RETURN TO
COUNTY OF LOS ANGELES
DEPARTMENT OF COUNTY ENGINEER
403 LOS ANGELES COUNTY ENGINEERING BLDG.

Do not extend this side of this line.

Note: Any Additions or Changes on This Sheet Must Be Made or Circled in Red Ink With Date and Name of Person Making Change.

PWFB 0817 661

Notes Ck'd by	Survey of LENNOX AREA ℄
Map No.	JN 0303.00 Tape 09 Std 68 °F
Office Work	Surveyed by J. BAZEN
Checked	Notes J. J. B. Date 3-74
Date	Index R. M. PALMERI JUN 15 1976

F. B. 3935 PG. 13

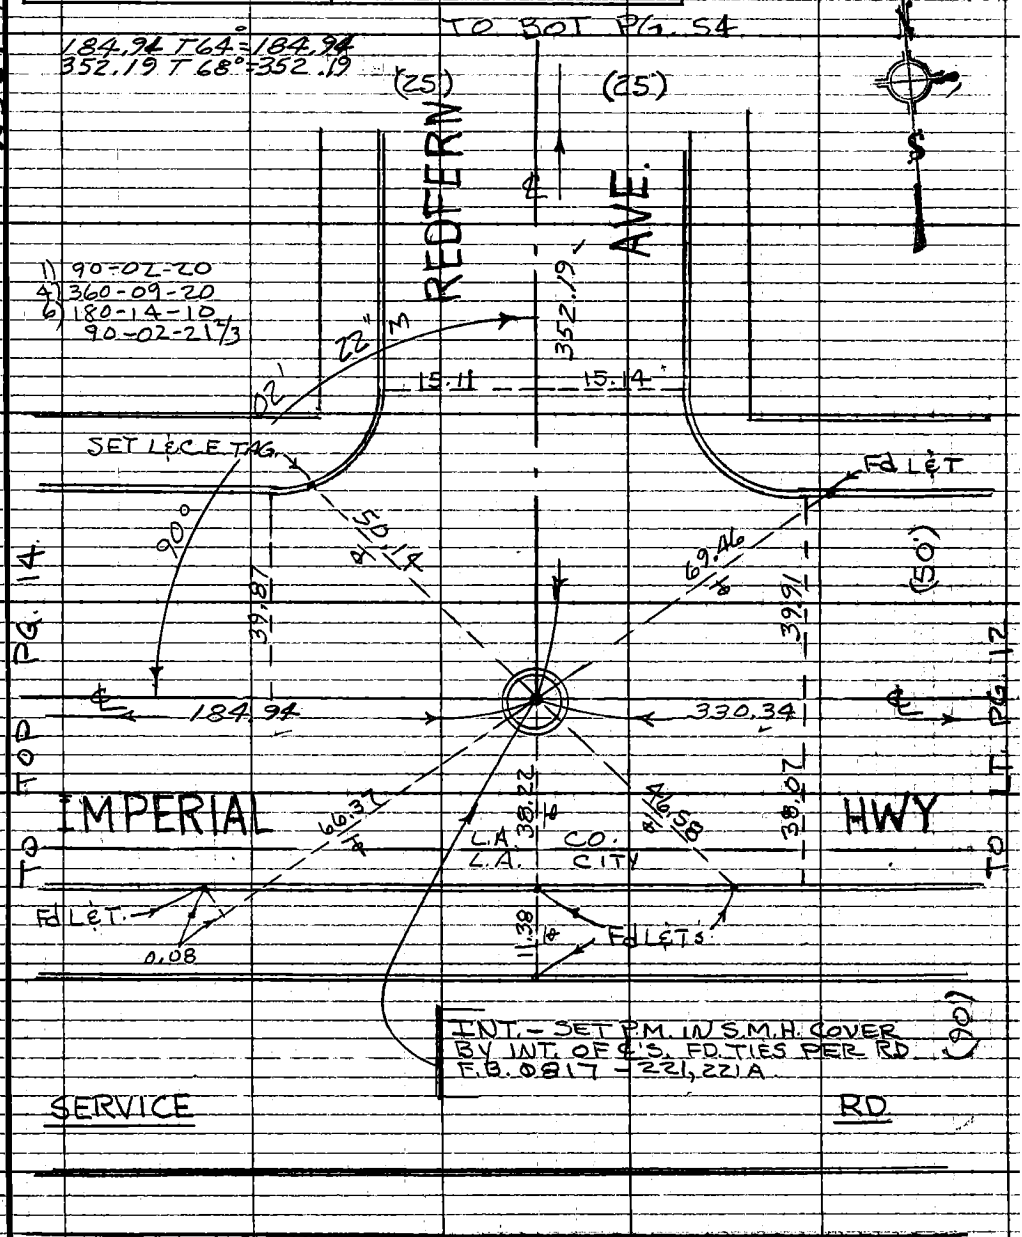

Note: Any Additions or Changes on This Sheet Must be Made or Circled in Red Ink With Date and Name of Person Making Change.

Do not extend this side of this line.

PLEASE RETURN TO
COUNTY OF LOS ANGELES
DEPARTMENT OF COUNTY ENGINEER
403 LOS ANGELES COUNTY ENGINEERING BLDG.

76F309S CE#310 3-69

PWFB 0817

662

F. B. 3935 PG. 14

TO LT. PG. 13.

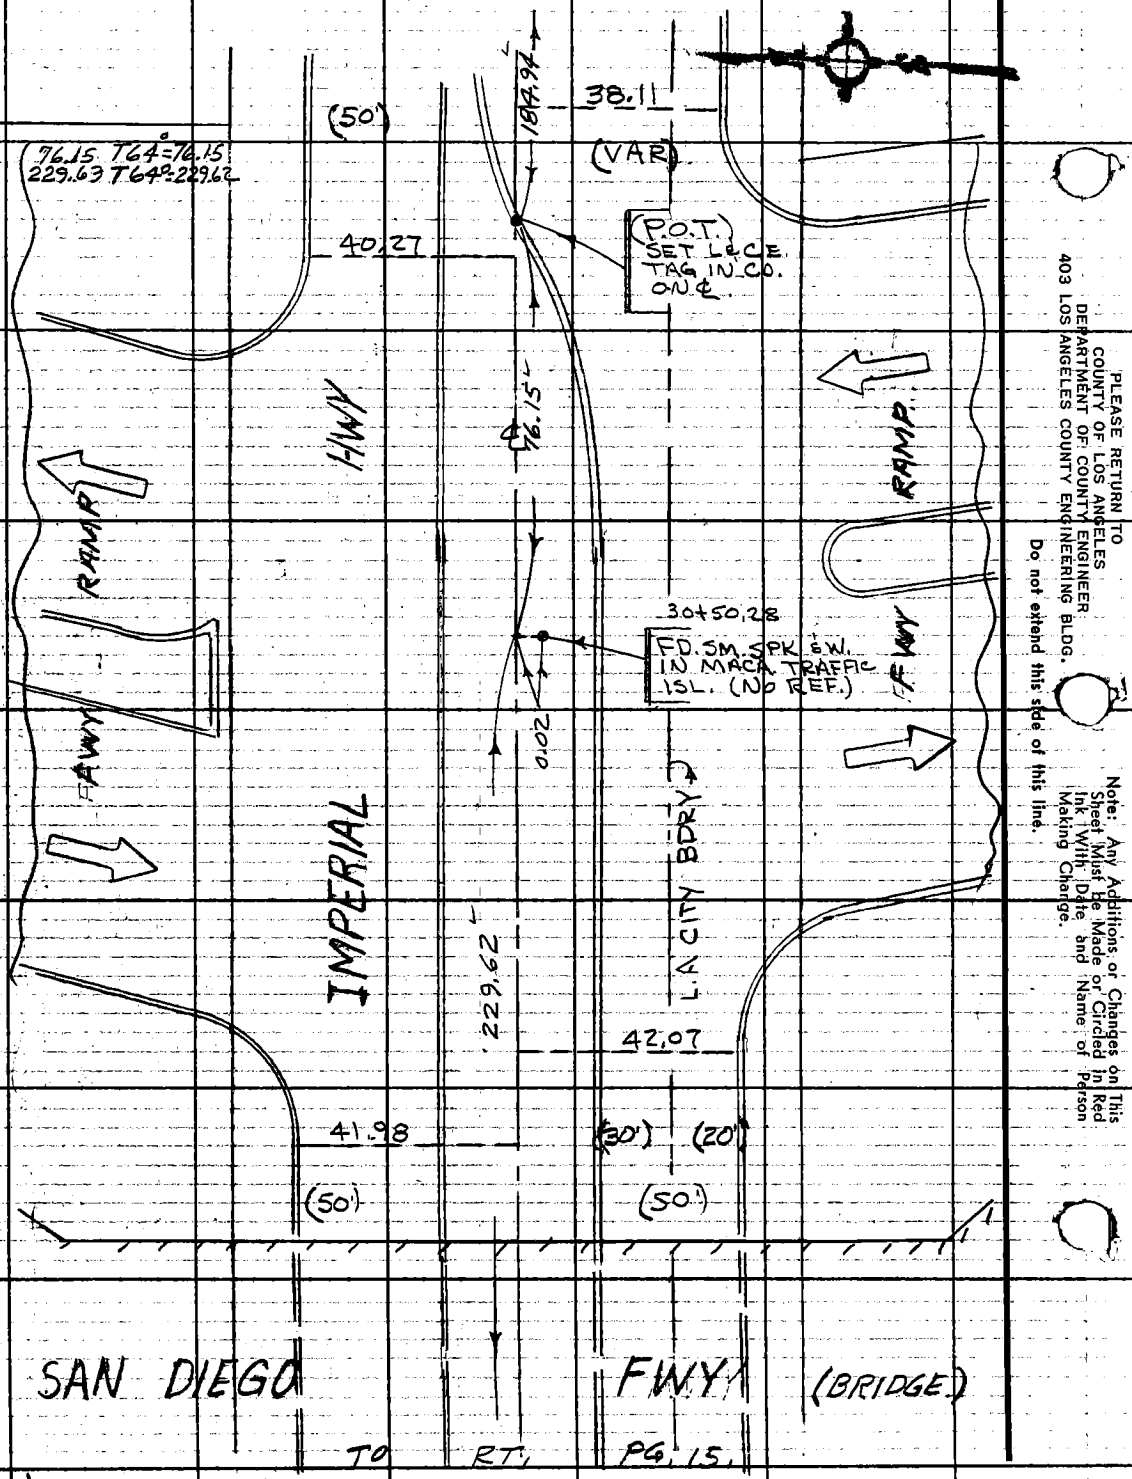

PLEASE RETURN TO
COUNTY OF LOS ANGELES
DEPARTMENT OF COUNTY ENGINEER
403 LOS ANGELES COUNTY ENGINEERING BLDG.

Do not extend this side of this line.

Note: Any Additions or Changes on This Sheet Must Be Made or Circled in Red Ink With Date and Name of Person Making Change.

PWFB 0817 663

Notes Ck'd by	Survey of LENNOX AREA ℄
Map No.	JN 0303.00 Tape 09 Std 68 °F
Office Work	Surveyed by J. J. BAZEN
Checked	Notes J. J. B. Date 3-74
Date	Index [redacted] PALMERI JUN 15 1976

F. B. 3935 PG. 15

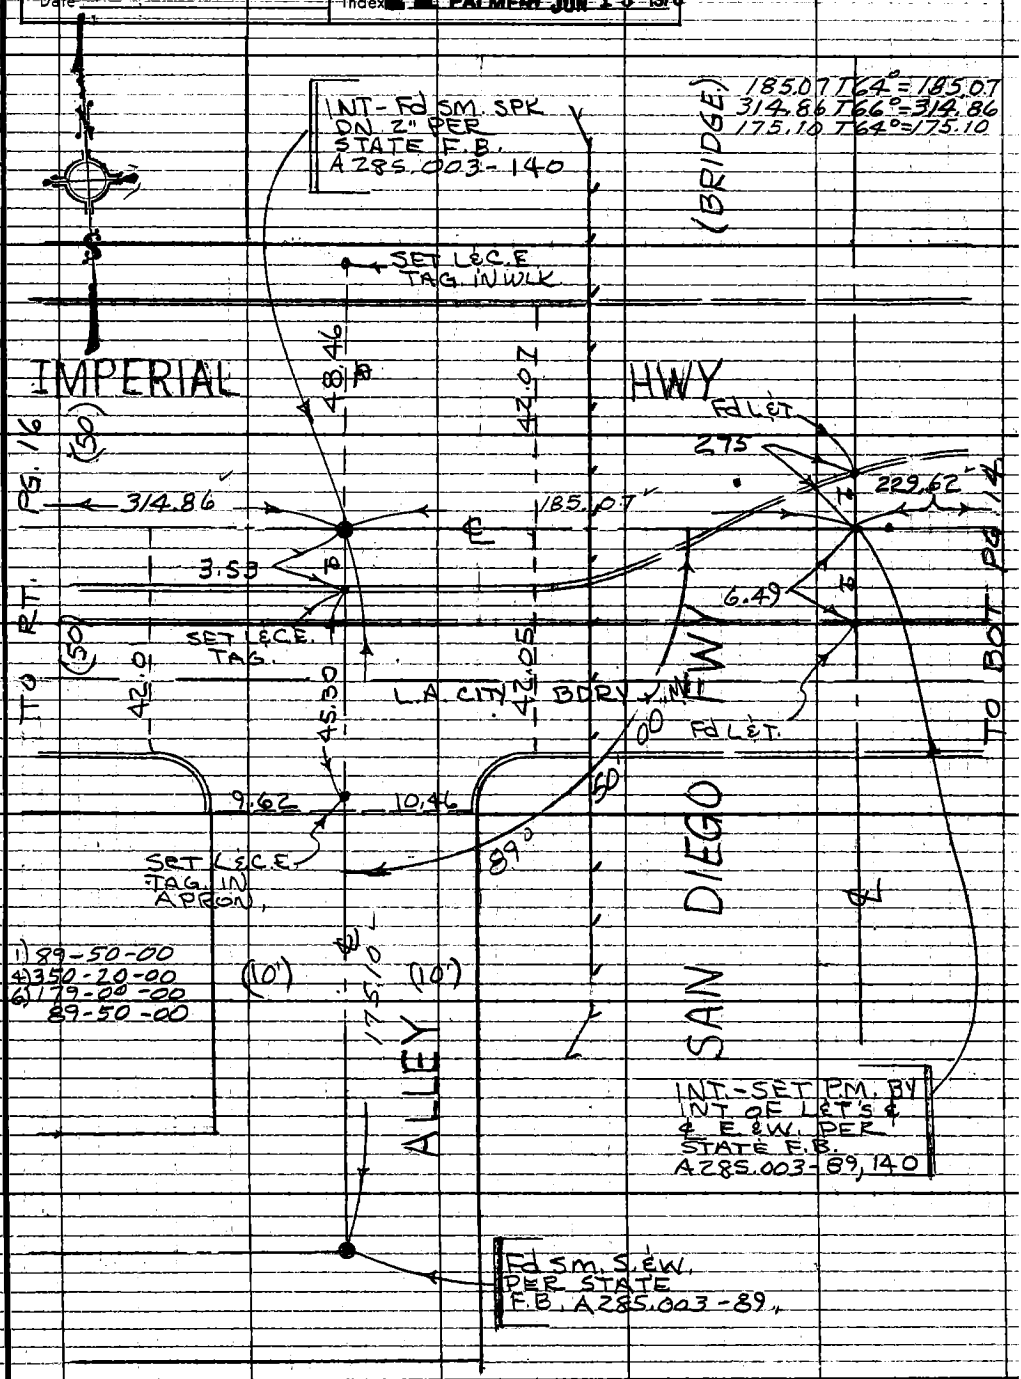

Note: Any Additions or Changes on This Sheet Must be Made or Circled in Red Ink With Date and Name of Person Making Change.

Do not extend this side of this line.

PLEASE RETURN TO
COUNTY OF LOS ANGELES
DEPARTMENT OF COUNTY ENGINEER
403 LOS ANGELES COUNTY ENGINEERING BLDG.

76F309S CE#310 3-69

PWFB 0811

664

F.B. 3935 PG. 16

TO BOT. PG. 17.

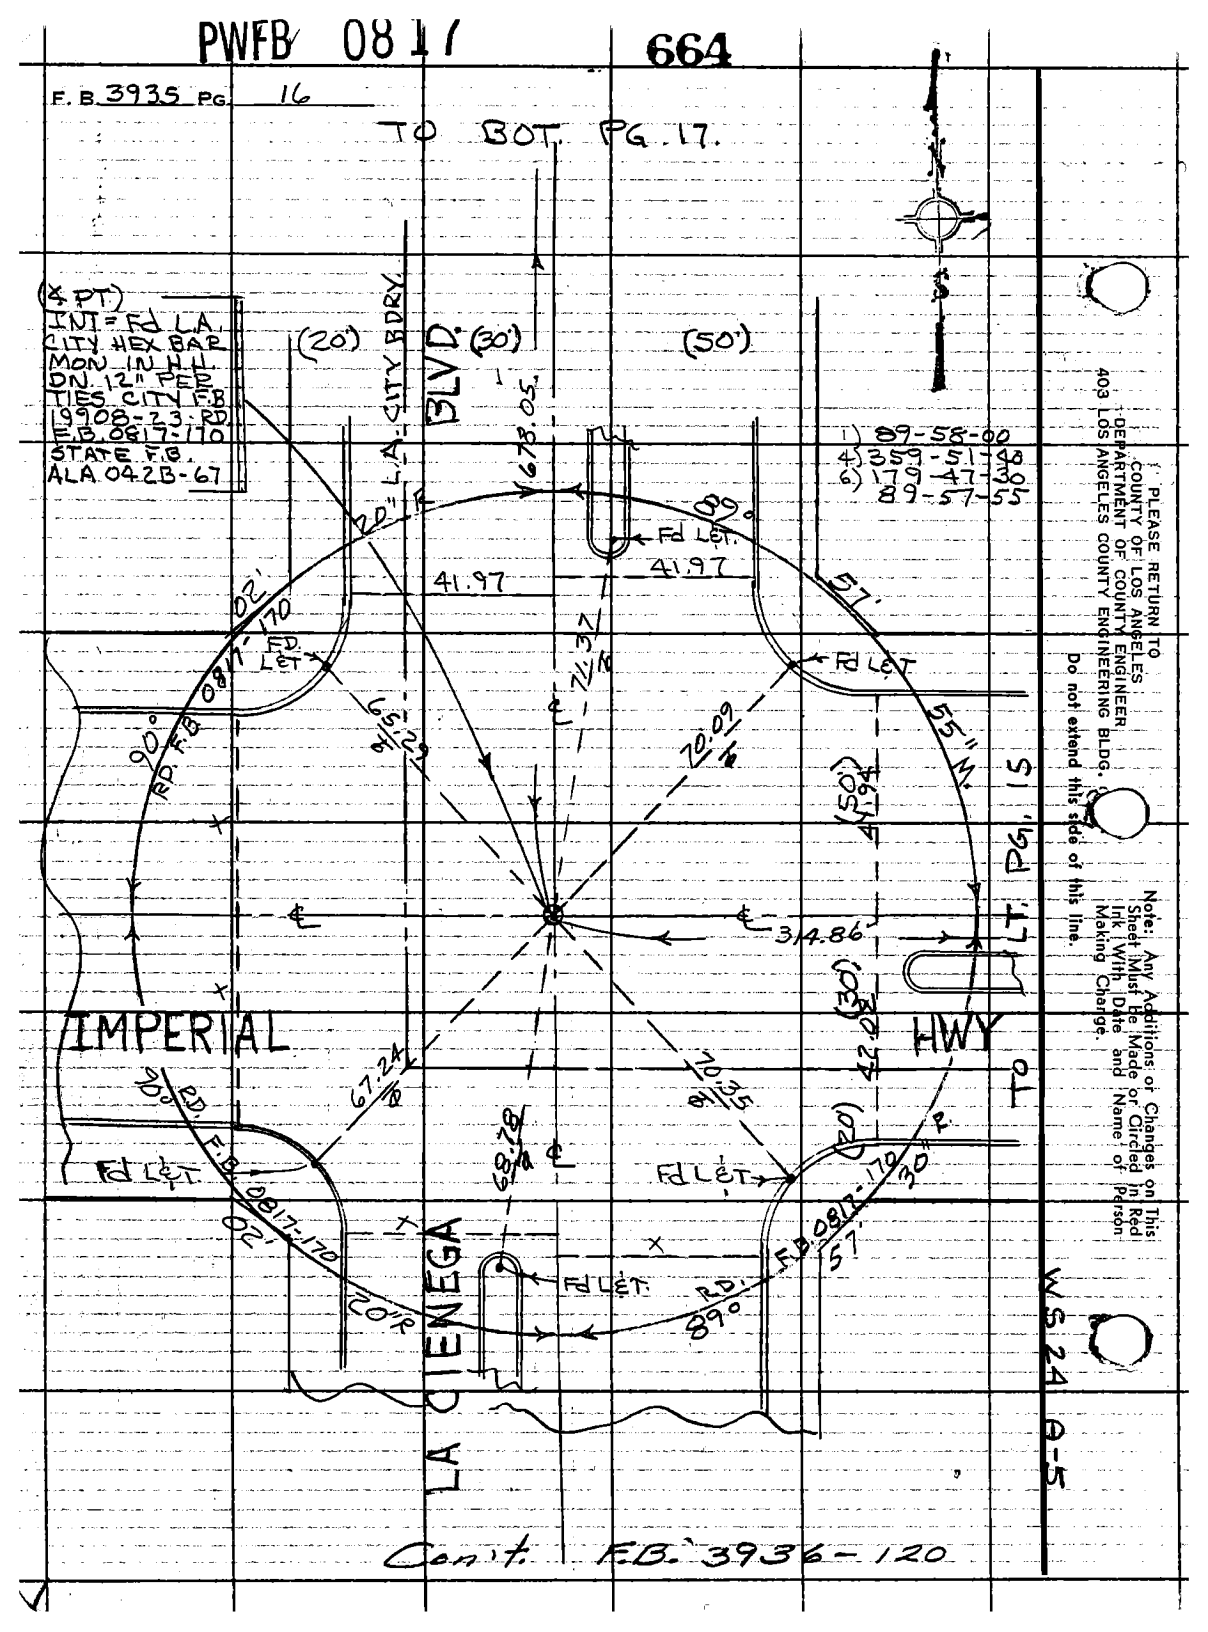

PLEASE RETURN TO
COUNTY OF LOS ANGELES
DEPARTMENT OF COUNTY ENGINEER
403 LOS ANGELES COUNTY ENGINEERING BLDG.
Do not extend this side of this line.

Note: Any Additions or Changes on This Sheet Must Be Made or Circled in Red Ink With Date and Name of Person Making Change.

PWRB 0817

665

Notes Ck'd by	Survey of LENNOX AREA &
Map No.	J.N. 0303.00 Tape 09 Std 68 °F
Office Work	Surveyed by J. BAZEN
Checked	Notes S.J.B. Date 3-74
Date	Index W. M. PALMER JUN 15 1976

F. B. 3935 PG. 17

TO BOT PG. 18

635.92 T=66°=635.91
678.07 T=64°=678.05

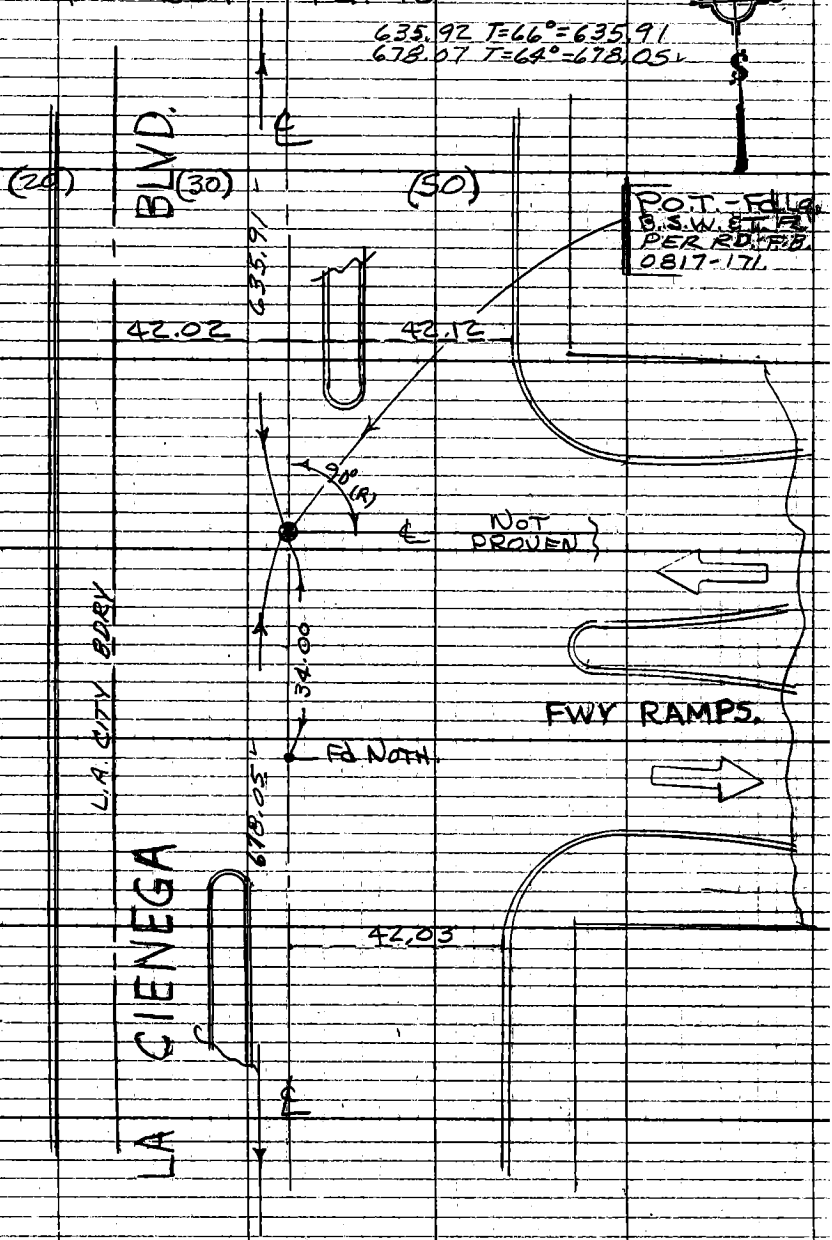

TO TOP PG. 16

Note: Any Additions or Changes on This Sheet Must be Made or Circled in Red Ink With Date and Name of Person Making Change.
Do not extend this side of this line.

PLEASE RETURN TO
COUNTY OF LOS ANGELES
DEPARTMENT OF COUNTY ENGINEER
403 LOS ANGELES COUNTY ENGINEERING BLDG

10F309S CE#3110 3-69

PWHB / 0817

666

F. B. 3935 PG. 18

TO BOT PG. 19.

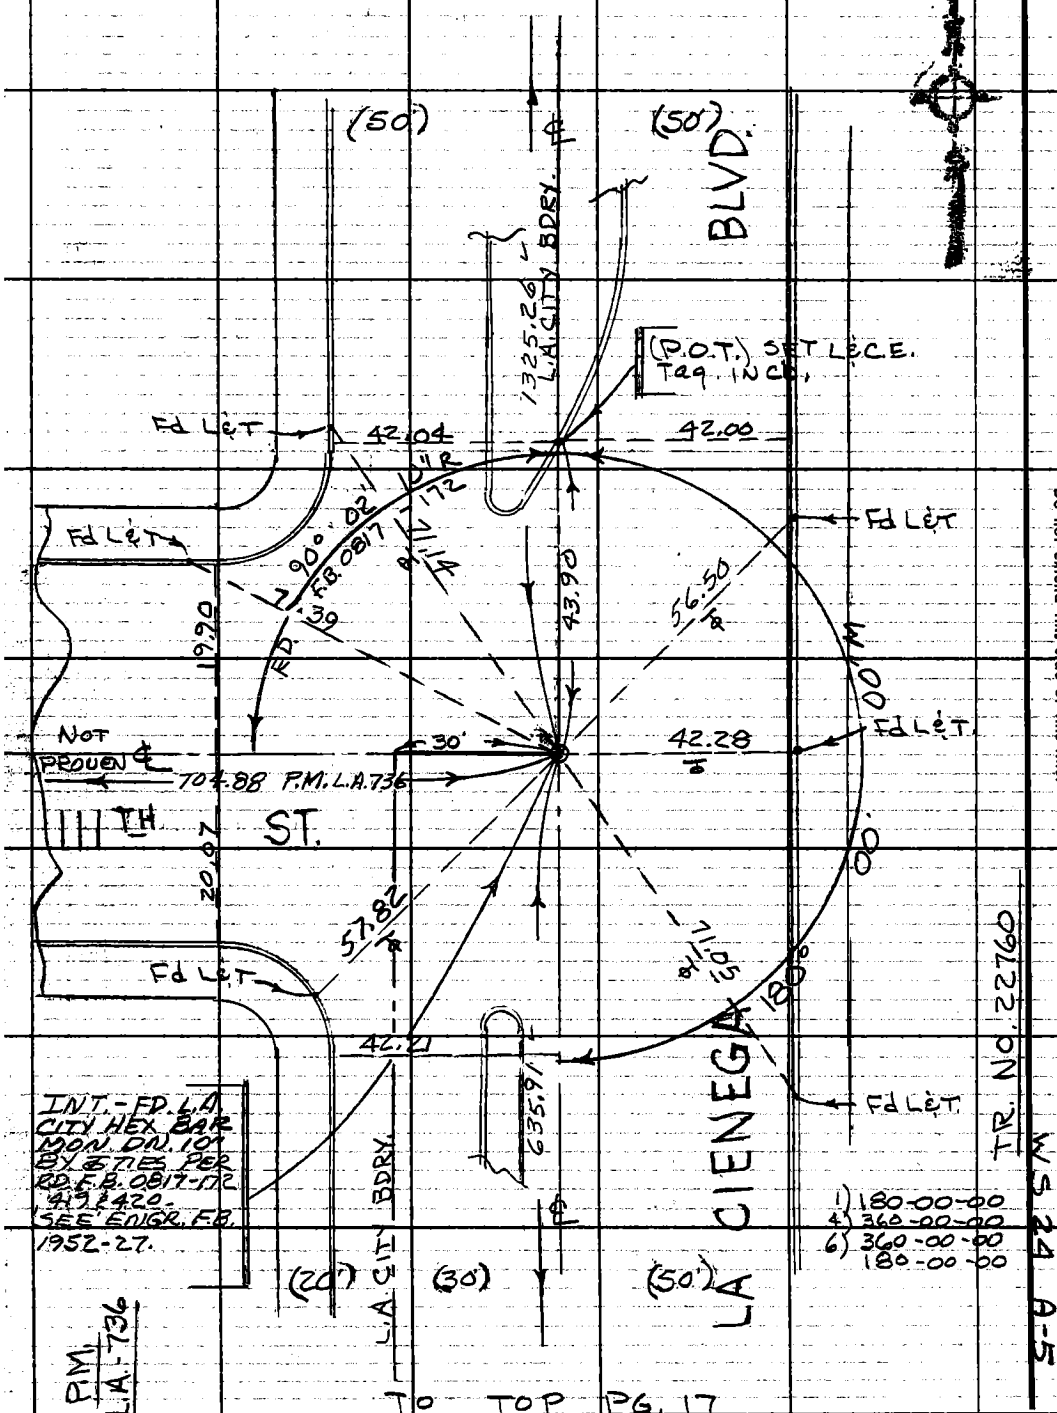

1) 180-00-00
4) 360-00-00
6) 360-00-00
180-00-00

TO TOP PG. 17

PLEASE RETURN TO
COUNTY OF LOS ANGELES
DEPARTMENT OF COUNTY ENGINEER
403 LOS ANGELES COUNTY ENGINEERING BLDG.

Do not extend this side of this line.

Note: Any Additions or Changes on This Sheet Must Be Made or Circled In Red Ink With Date and Name of Person Making Charge.

PWFB 0817 667

Notes Ck'd by	Survey of LENNOX AREA ℄
Map No.	JN 0303.00 Tape 09 Std 68 °F
Office Work	Surveyed by J. BAZEN
Checked	Notes J.J.B. Date 3-74
Date	Index [redacted] PALMER JUN 15 1976

F.B. 3935 PG. 19

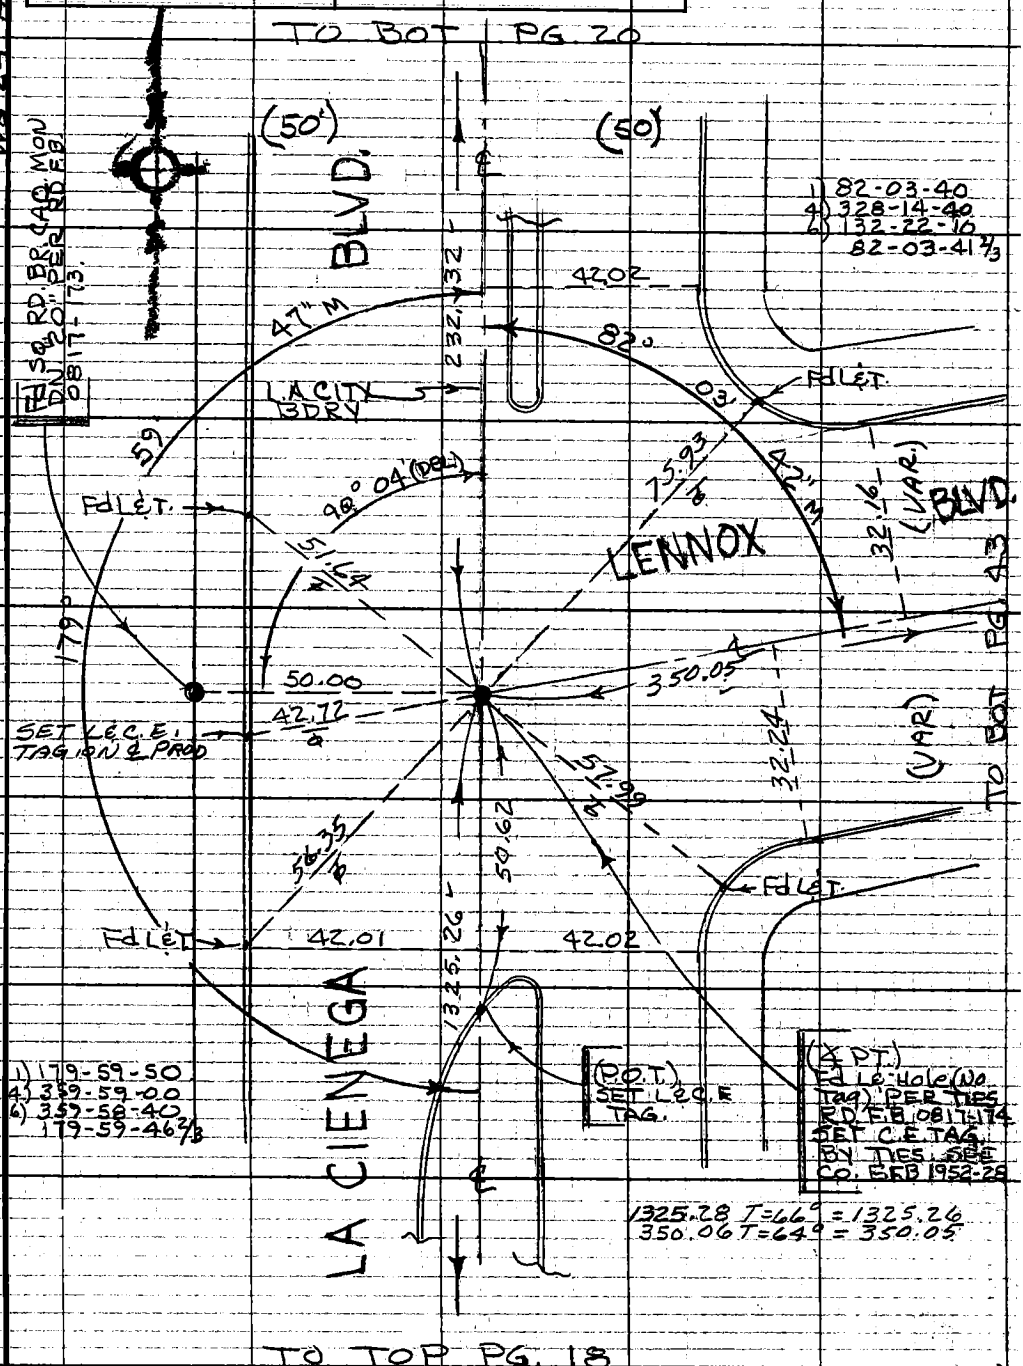

Note: Any Additions or Changes on This Sheet Must be Made or Circled in Red Ink With Date and Name of Person Making Change.

Do not extend this side of this line.

PLEASE RETURN TO
COUNTY OF LOS ANGELES
DEPARTMENT OF COUNTY ENGINEER
403 LOS ANGELES COUNTY ENGINEERING BLDG.

76F309S CE#310 3-69

PWFB 0817 668

F.B. 3935 PG. 20

TO BOT PG. 21

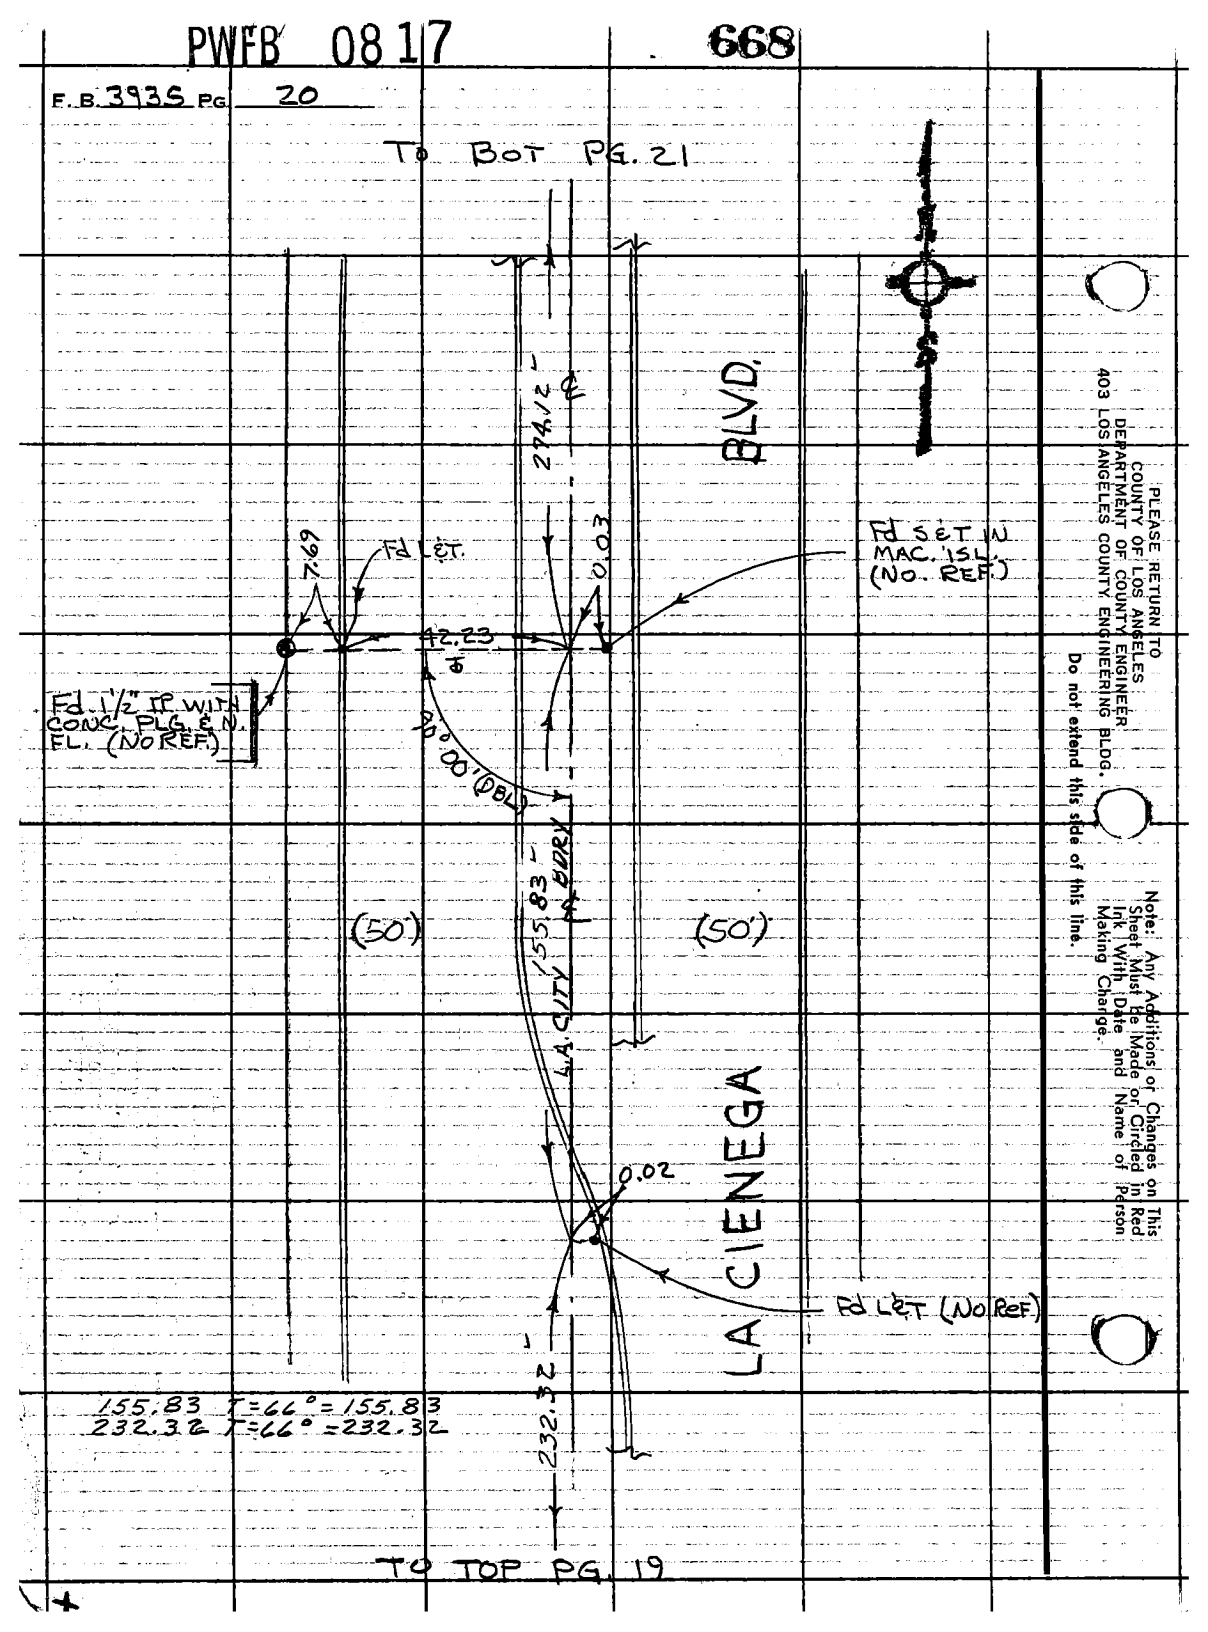

155.83 T=66° = 155.83
232.32 T=66° = 232.32

TO TOP PG. 19

PLEASE RETURN TO
COUNTY OF LOS ANGELES
DEPARTMENT OF COUNTY ENGINEER
403 LOS ANGELES COUNTY ENGINEERING BLDG.

Do not extend this side of this line.

Note: Any Additions or Changes on This Sheet Must Be Made or Circled in Red Ink With Date and Name of Person Making Change.

PWFB 0917

230

Notes Ck'd by	Survey of LENNOX AREA ℄
Map No.	JN 0303.00 Tape 09 Std 68 °F
Office Work	Surveyed by J. BAZEN
Checked	Notes J.J.B. Date 4-74
Date	Indexed [redacted] PALMERI JUN 15 1976

F. B. 3935 PG. 21

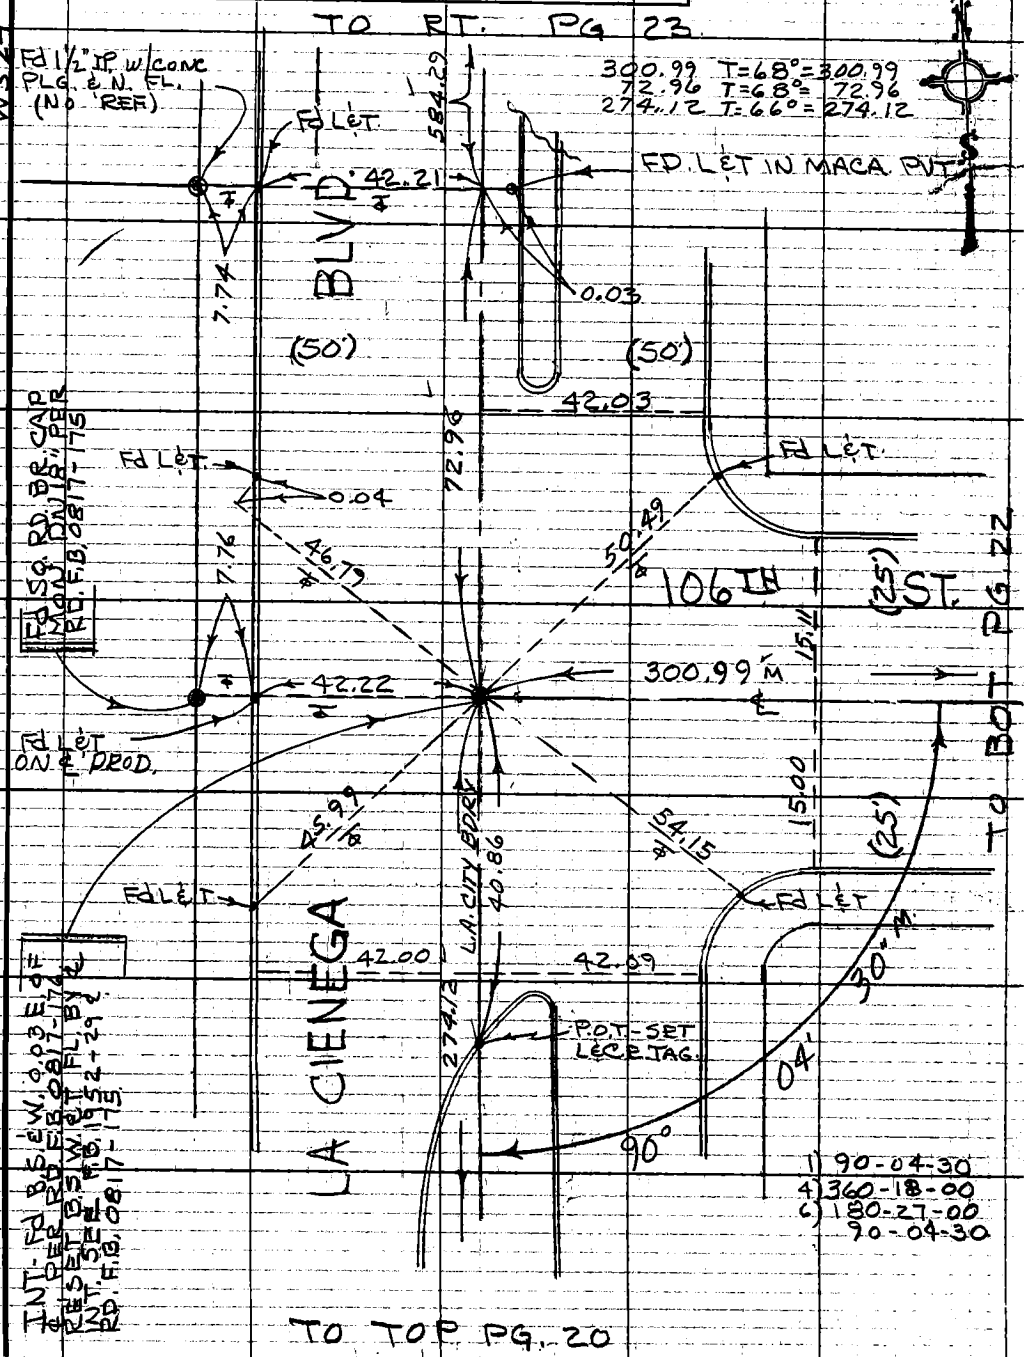

Note: Any Additions or Changes on this Sheet Must be Made or Circled in Red Ink With Date and Name of Person Making Change.

Do not extend this side of this line.

PLEASE RETURN TO
COUNTY OF LOS ANGELES
DEPARTMENT OF COUNTY ENGINEER
403 LOS ANGELES COUNTY ENGINEERING BLDG.

76F309S CE#310 3-69

PWFB 0917

231

F.B. 3935 PG. 22

SAN DIEGO FWY.

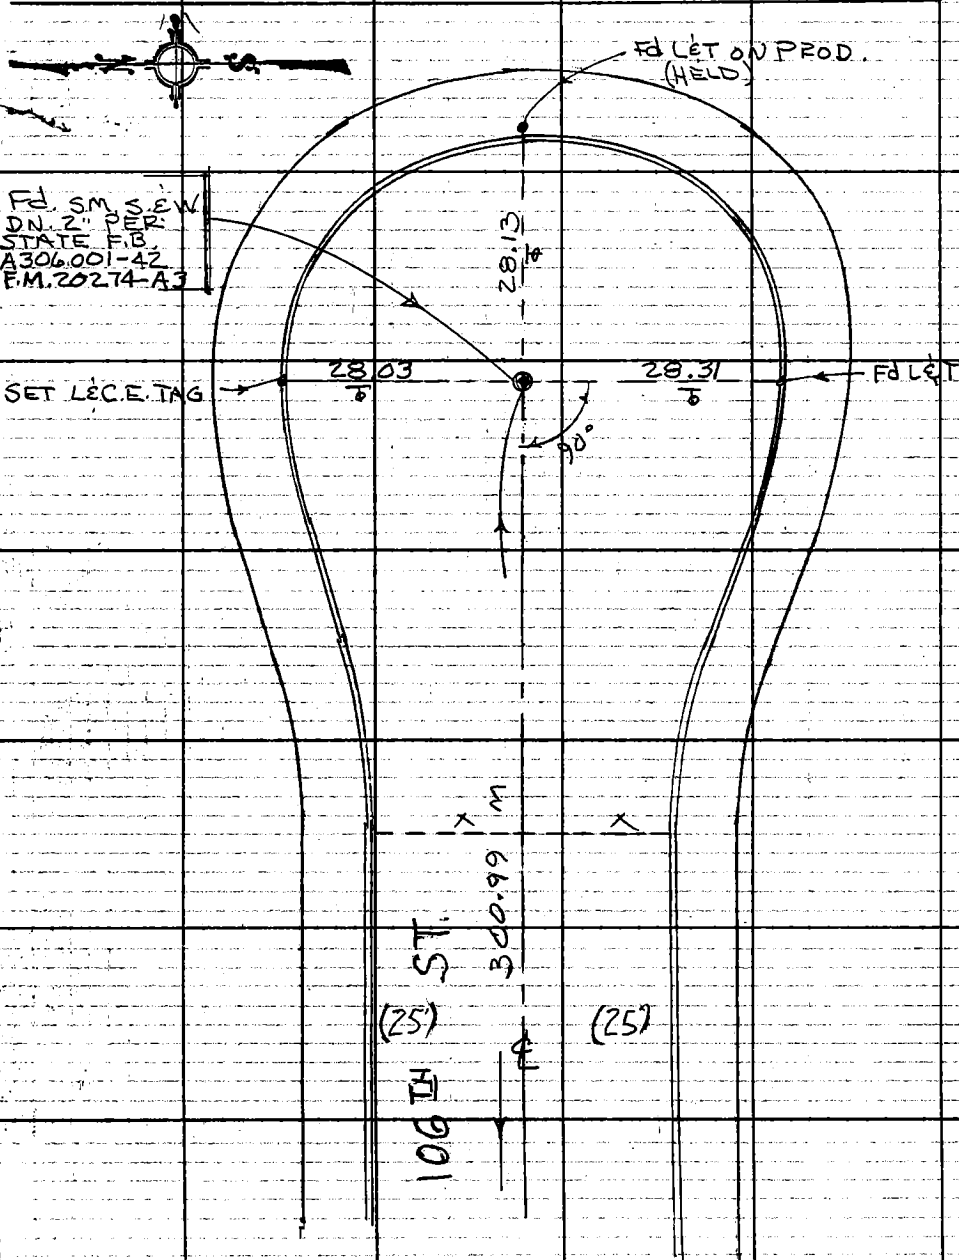

TO RT. PG. 21.

PLEASE RETURN TO
COUNTY OF LOS ANGELES
DEPARTMENT OF COUNTY ENGINEER
403 LOS ANGELES COUNTY ENGINEERING BLDG.

Do not extend this side of this line.

Note: Any Additions or Changes on This Sheet Must Be Made or Circled in Red Ink With Date and Name of Person Making Change.

PWFB 0917 232

Notes Ck'd by	Survey of LENNOX AREA ℄
Map No.	JN 0303.00 Tape 09 Std 68 °F
Office Work	Surveyed by J. BAZEN
Checked	Notes J.J.B. Date 4-74
Date	Indexed L. M. PALMERI JUN 15 1978

F.B. 3935 PG. 23

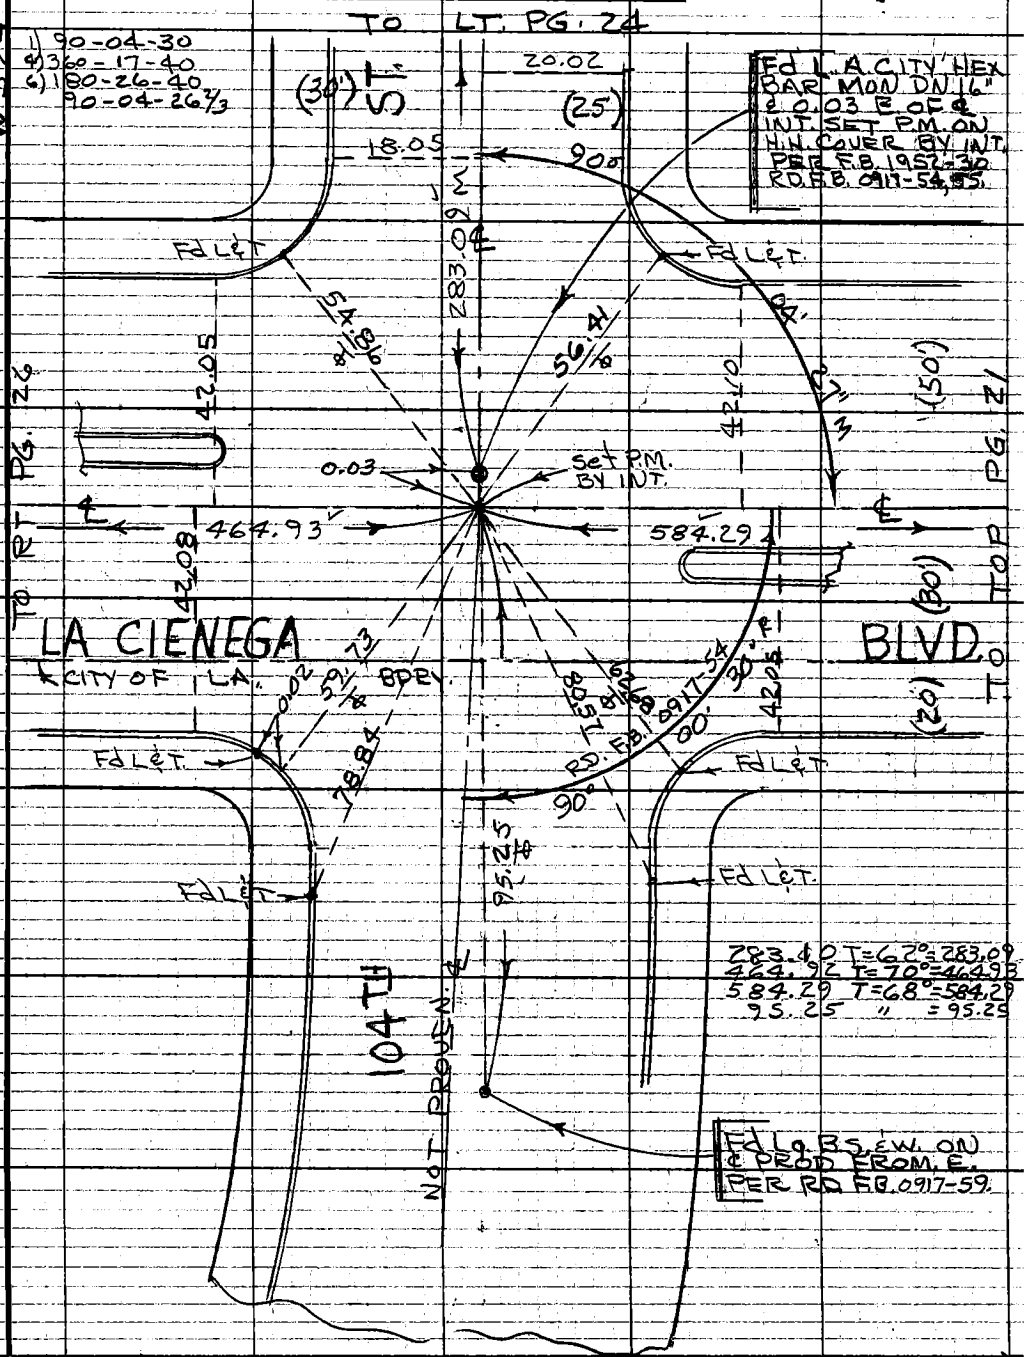

Note: Any Additions or Changes on this Sheet Must be Made or Circled in Red Ink With Date and Name of Person Making Change.

Do not extend this side of this line.

PLEASE RETURN TO
COUNTY OF LOS ANGELES
DEPARTMENT OF COUNTY ENGINEER
403 LOS ANGELES COUNTY ENGINEERING BLDG.

76F309S CE#310 3-69

PWFB 0917 233

F.B. 3935 PG. 24

TO BOT PG. 25

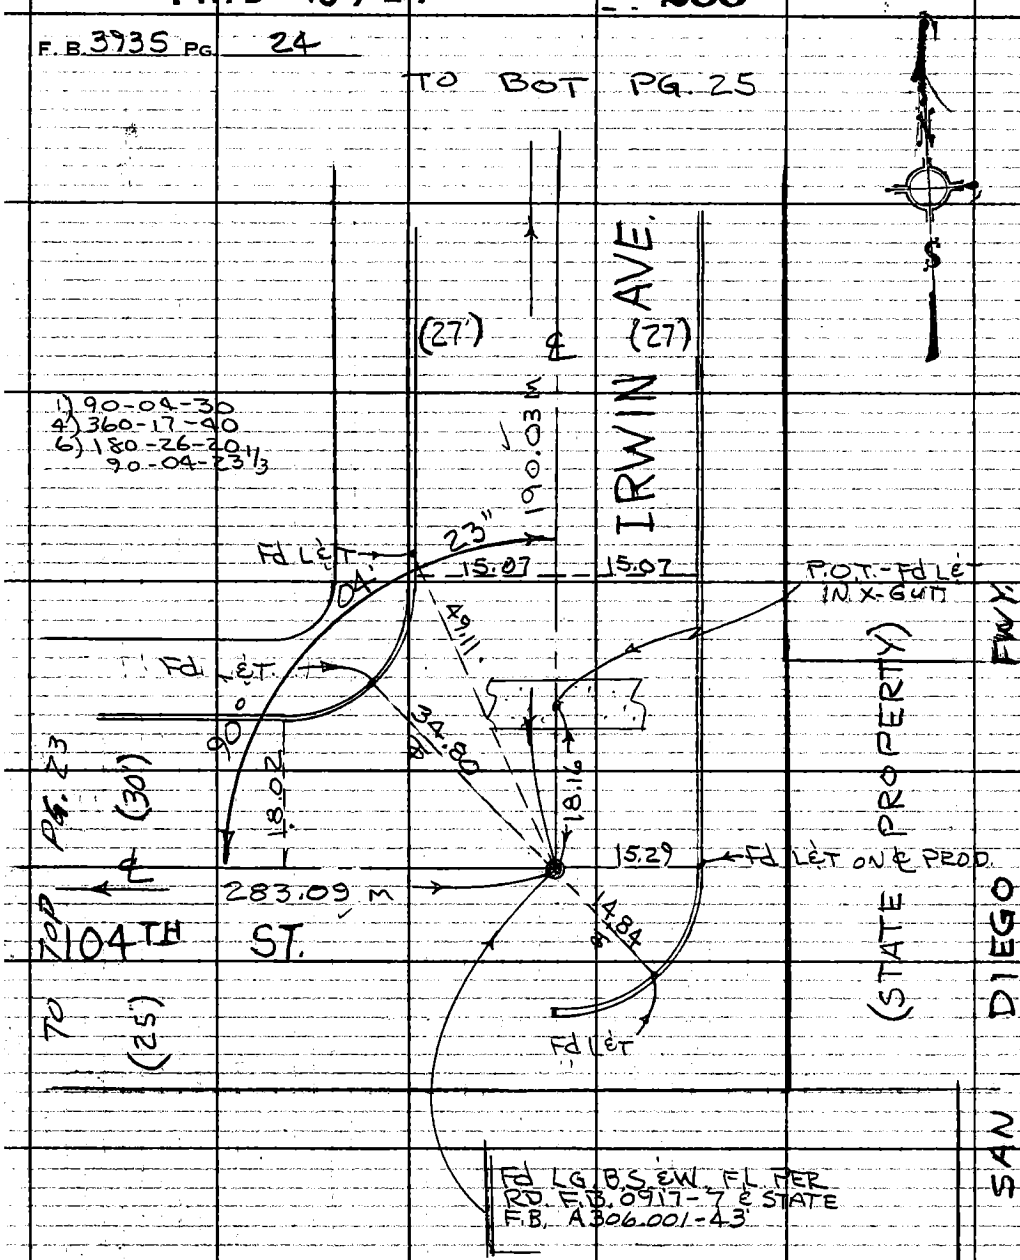

190.04 T=62°=190.03

WS 24 A-5

PLEASE RETURN TO
COUNTY OF LOS ANGELES
DEPARTMENT OF COUNTY ENGINEER
403 LOS ANGELES COUNTY ENGINEERING BLDG.

Do not extend this side of this line.

Note: Any Additions or Changes on This Sheet Must Be Made or Circled in Red Ink With Date and Name of Person Making Change.

PWFB 0917

234

Notes Ck'd by	Survey of LENNOX AREA ℄
Map No.	JN 0303.00 Tape 09 Std 68 °F
Office Work	Surveyed by J. BAZEN
Checked	Notes J.J.B. Date 4-74
Date	Indexed M. PALMERI JUN 15 1976

F.B. 3935 PG. 25

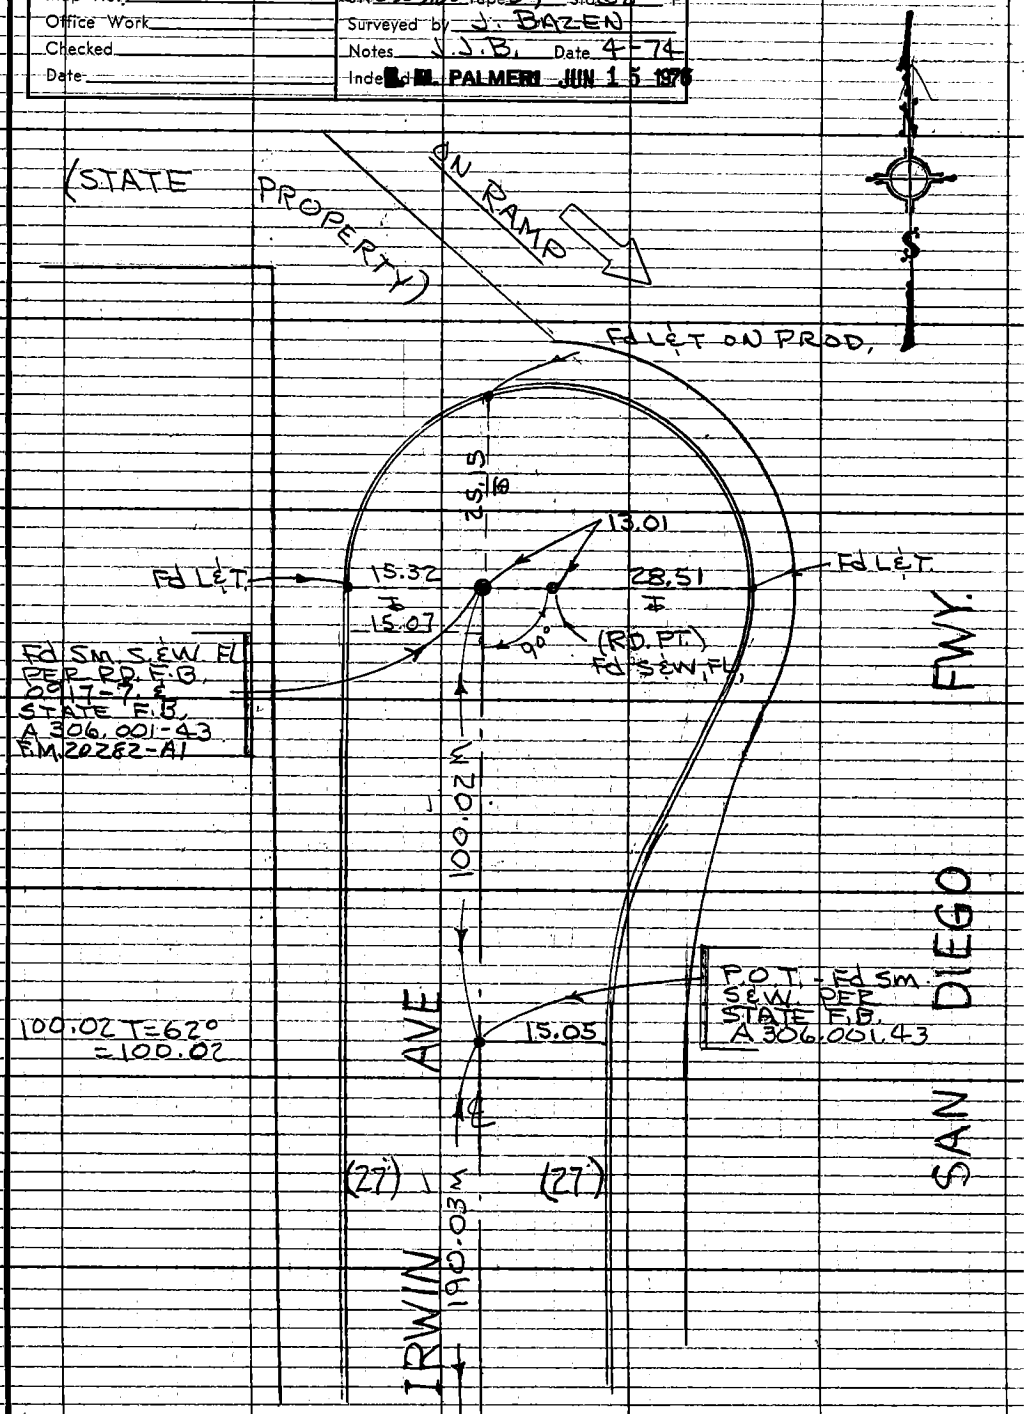

TO TOP PG. 24

Note: Any Additions or Changes on This Sheet Must be Made or Circled in Red Ink With Date and Name of Person Making Change.

Do not extend this side of this line.

PLEASE RETURN TO
COUNTY OF LOS ANGELES
DEPARTMENT OF COUNTY ENGINEER
403 LOS ANGELES COUNTY ENGINEERING BLDG.

76F309S CE#310 3-69

PWB 0917

235

F. B. 3935 PG. 26

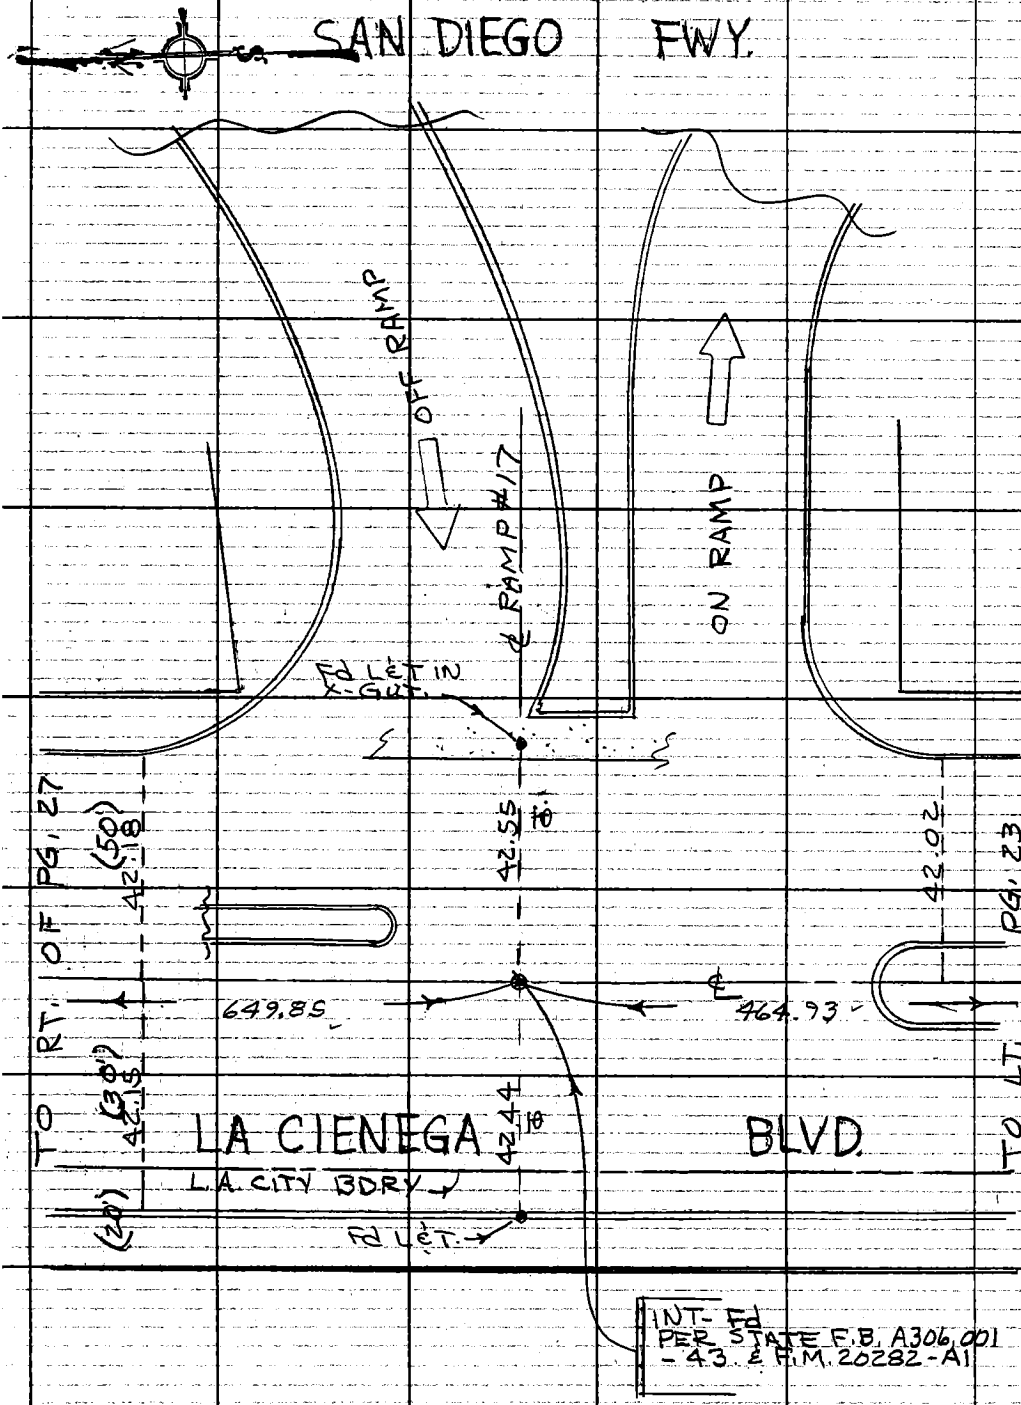

PLEASE RETURN TO
COUNTY OF LOS ANGELES
DEPARTMENT OF COUNTY ENGINEER
403 LOS ANGELES COUNTY ENGINEERING BLDG.

Do not extend this side of this line.

Note: Any Additions or Changes on This Sheet Must Be Made or Circled in Red Ink With Date and Name of Person Making Change.

PWPB 0911

236

Notes Ck'd by	Survey of LENNOX AREA 6
Map No.	JN 0303.00 Tape 09 Std 68 °F
Office Work	Surveyed by J.J. BAZEN
Checked	Notes J.J.B. Date 4-74
Date	Index E. M. PALMERI JUN 15 1976

F. B. 3935 PG. 27

TO BOT PG. 28

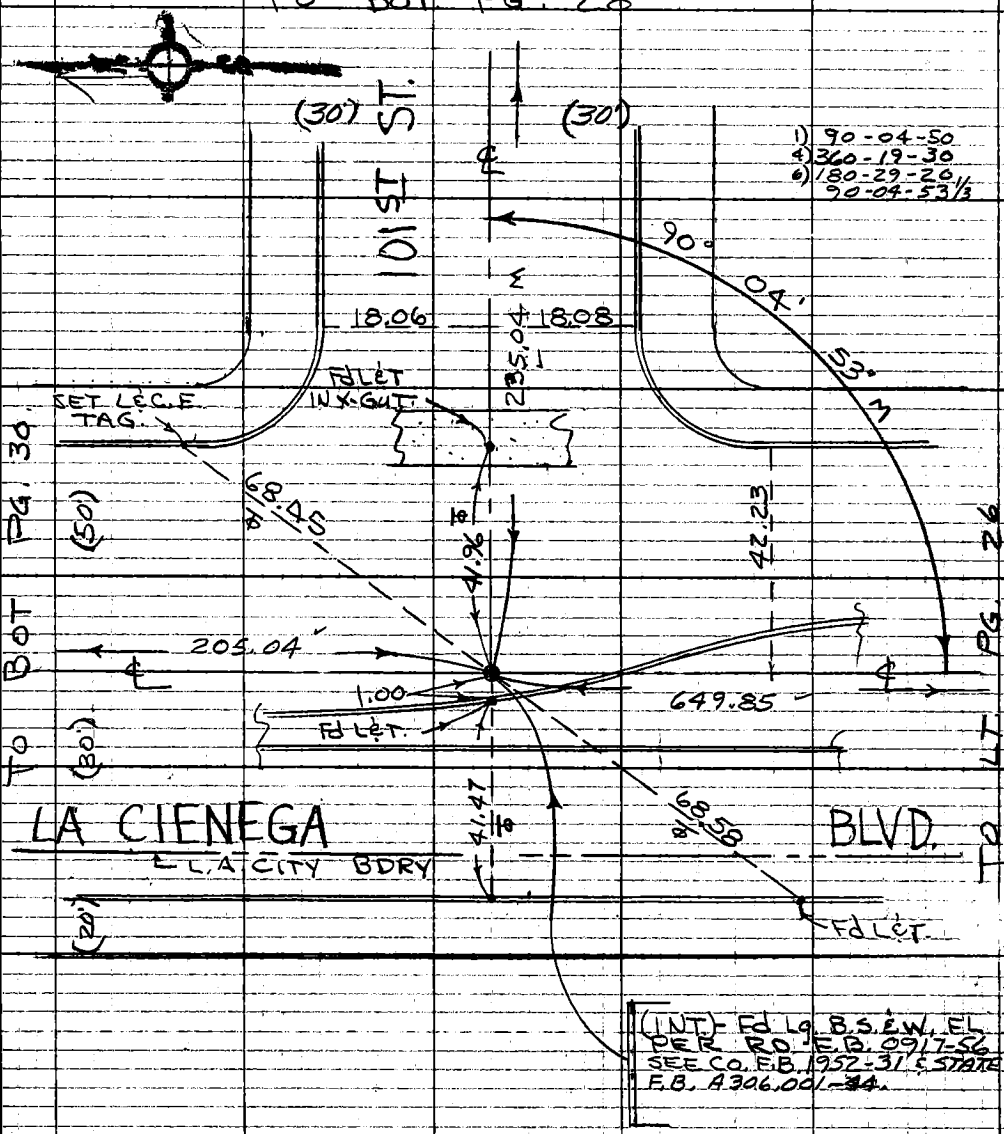

(INT) Fd Lg. B.S. EW. EL PER RO. F.B. 0917-56 SEE CO. F.B. 1952-31 & STATE F.B. A306.001-34.

235.05 T=62°=235.04
205.04 T=68°=205.04
649.85 T=68°=649.85

Note: Any Additions or Changes on this Sheet Must be Made or Circled in Red Ink With Date and Name of Person Making Change.

PLEASE RETURN TO
COUNTY OF LOS ANGELES
DEPARTMENT OF COUNTY ENGINEER
403 LOS ANGELES COUNTY ENGINEERING BLDG.
Do not extend this side of this line.

76F309S CE#310 3-69

PWFB 0917

237

F. B. 3935 PG. 28

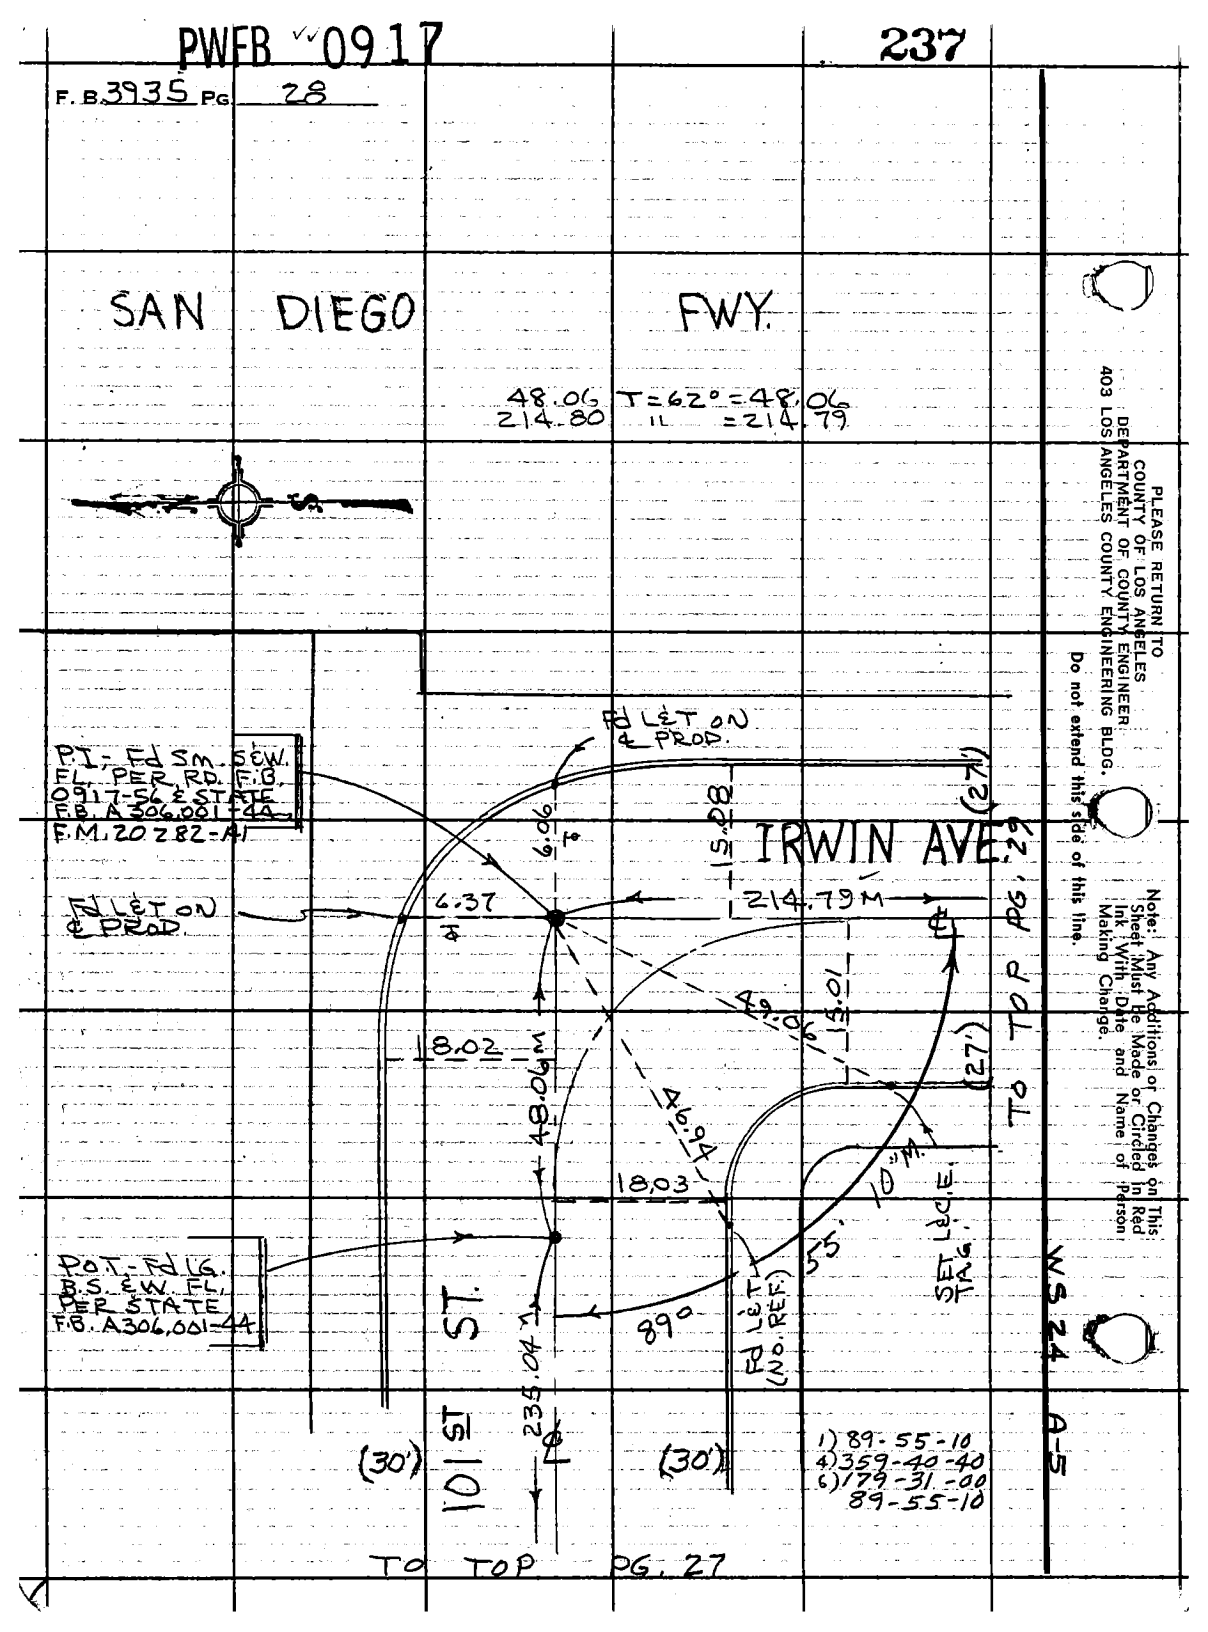

PWFB 0917 238, 239

Notes C'k'd by
Map No.
Office Work
Checked
Date

Survey of LENNOX AREA ℄
JN 0303.00 Tape 09 Std 68 °F.
Surveyed by J. BAZEN
Notes J.J.B. Date 4-74
Index R. PALMER JUN 15 1976

F. B. 3935 Pg. 29

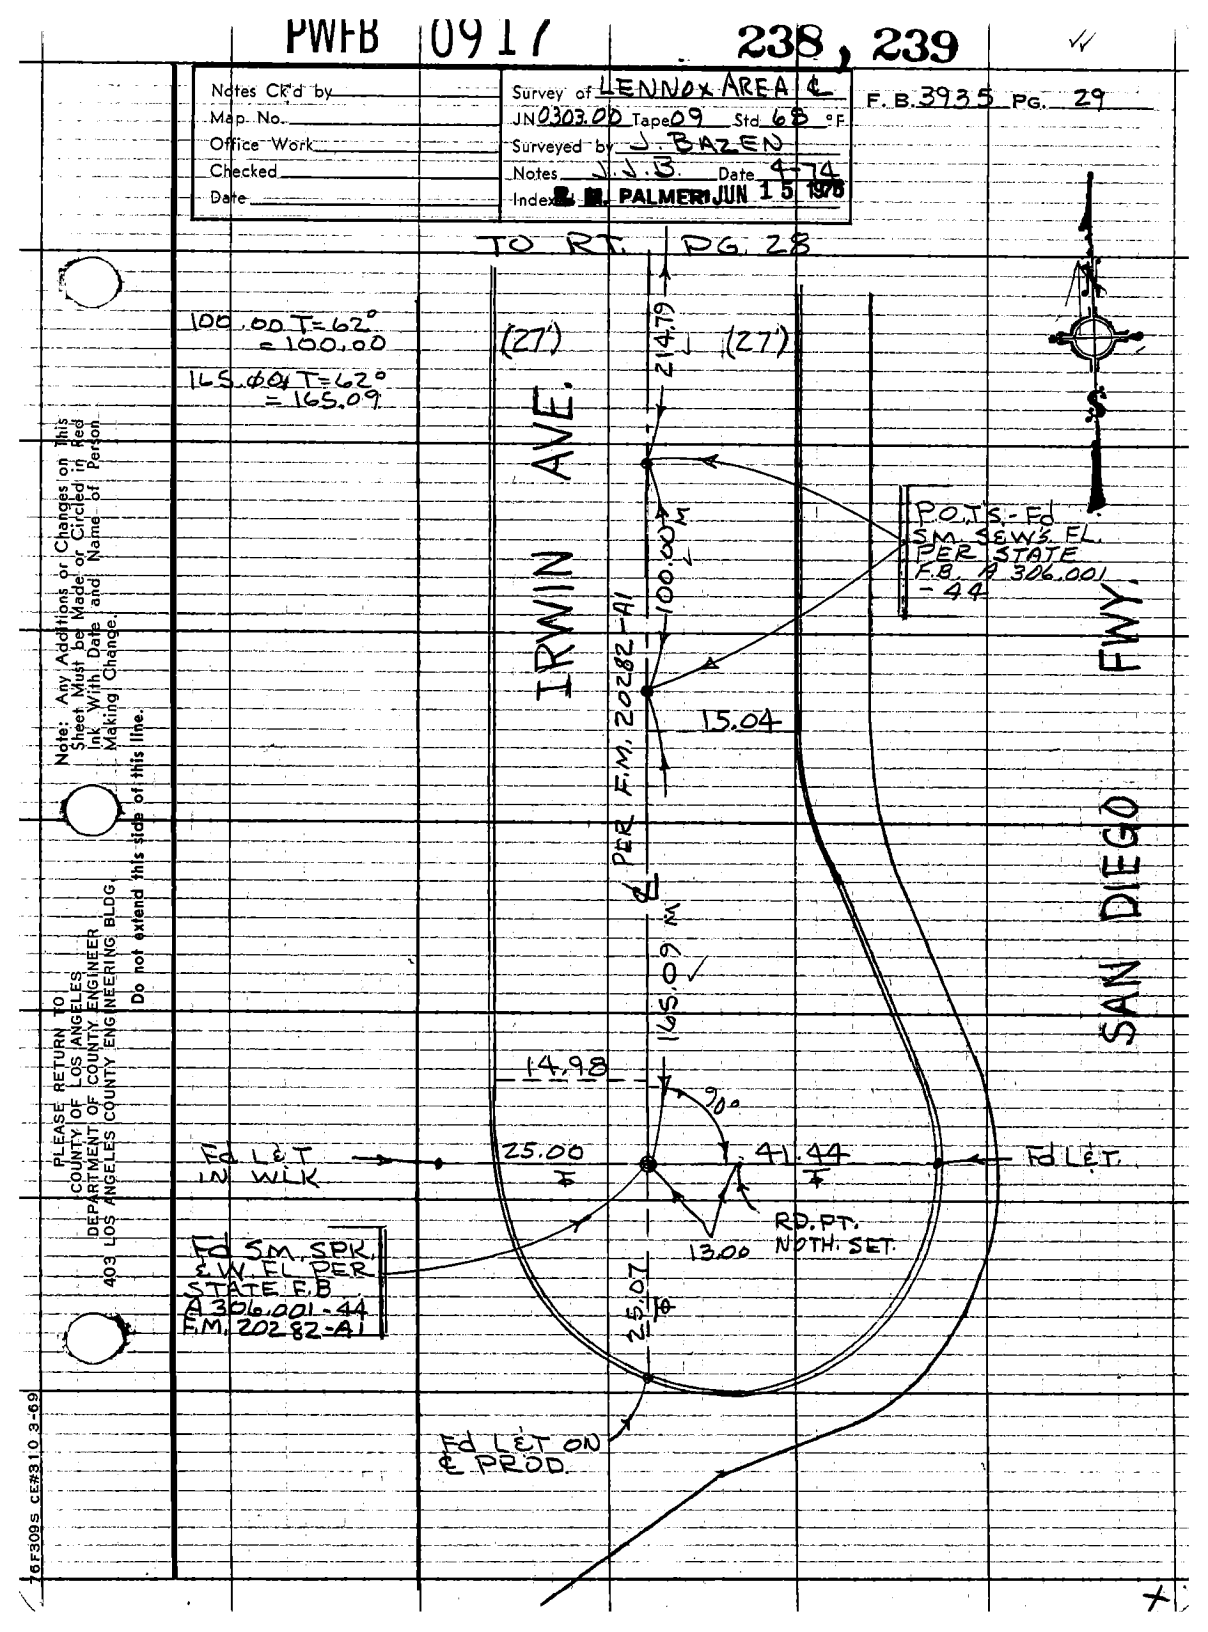

Note: Any Additions or Changes on this Sheet Must be Made or Circled in Red Ink With Date and Name of Person Making Change.
Do not extend this side of this line.

PLEASE RETURN TO
COUNTY OF LOS ANGELES
DEPARTMENT OF COUNTY ENGINEER
403 LOS ANGELES COUNTY ENGINEERING BLDG.

76F309S CE#310 3-69

PWPB 0917 - 240

F. B. 3935 PG. 30

INT = "ING. D-7"
2 PT. - FD HEX-BAR MON IN H.H. DN. 12" PER. RD. F.B. 0917-57 STATE F.B. 090-173-105 FD. 4 & L&T STRADS AS SHOWN - ALSO SEE L.A. CITY F.B. 19908-5 & 10663-184

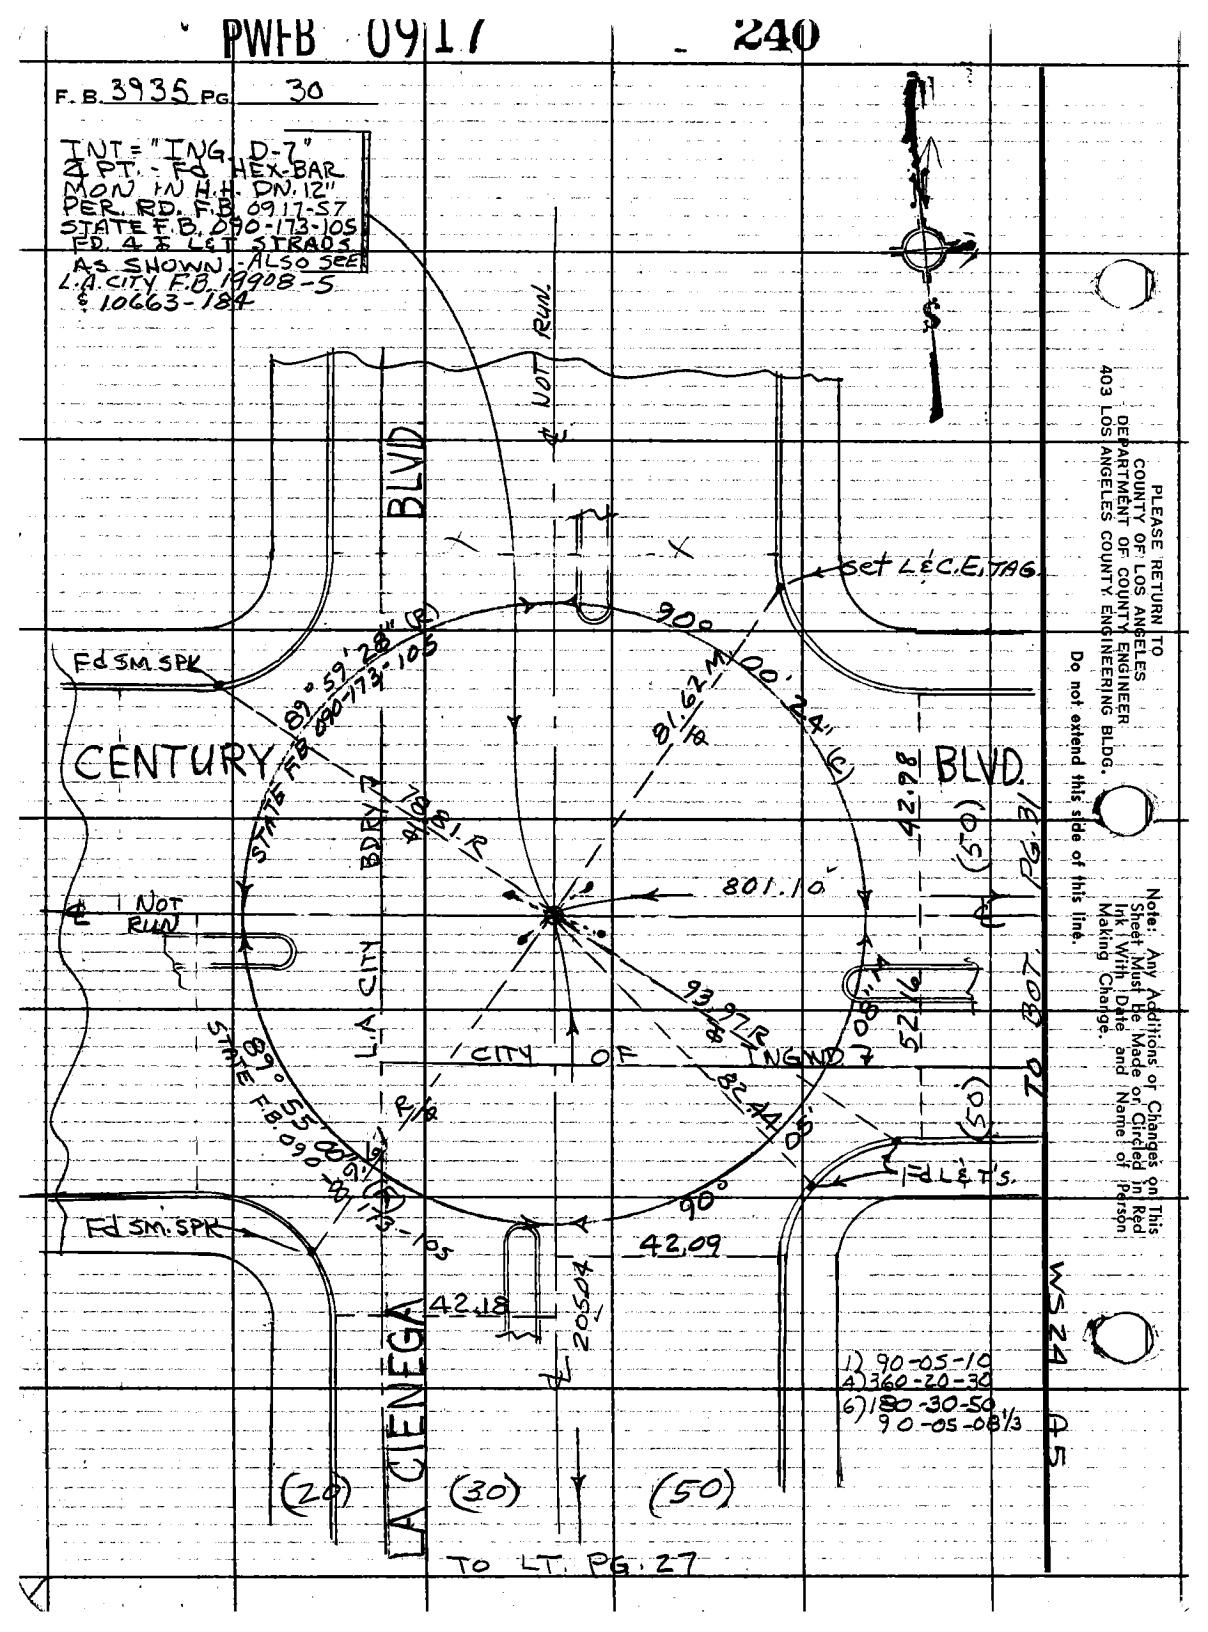

1) 90-05-10
A) 360-20-30
6) 180-30-50
90-05-08 1/3

PLEASE RETURN TO
COUNTY OF LOS ANGELES
DEPARTMENT OF COUNTY ENGINEER
403 LOS ANGELES COUNTY ENGINEERING BLDG.

Do not extend this side of this line.

Note: Any Additions or Changes on This Sheet Must Be Made or Circled in Red Ink With Date and Name of Person Making Change.

PWFB 0917

241

Notes Ck'd by	Survey of LENNOX AREA ℄
Map No.	JN 0303.00 Tape 09 Std 68 °F
Office Work	Surveyed by J. BAZEN
Checked	Notes J.J.B. Date 4-74
Date	Indexed E. M. PALMERI JUN 15 1976

F. B. 3935 PG. 31

1) 90-04-50
4) 360-19-20
6) 180-29-20
90-04-53 1/3

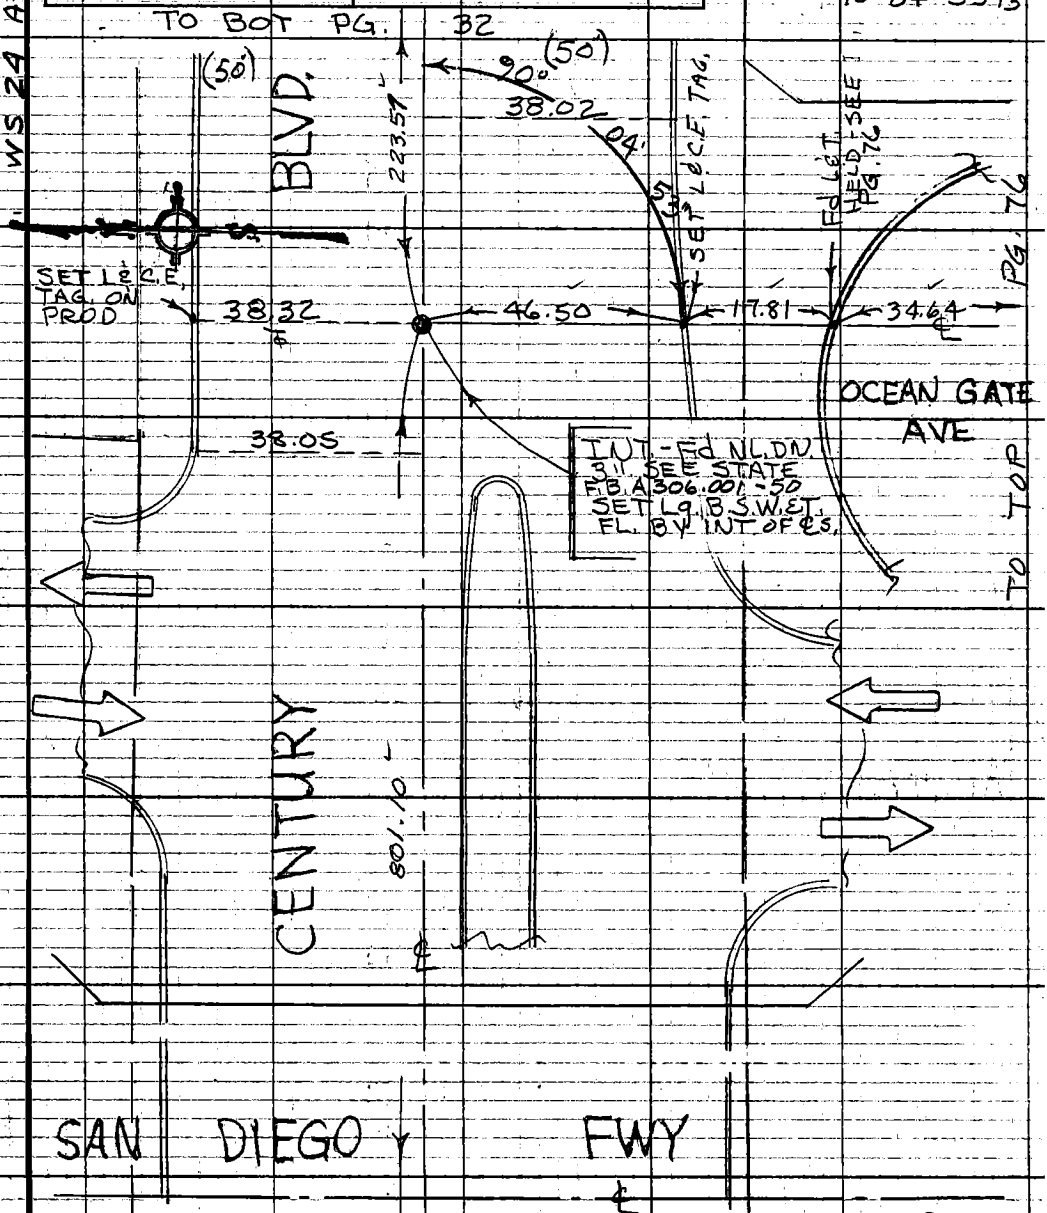

801.10 T68° = 801.10
46.50 T68 = 46.50
17.81 T68 = 17.81
34.64 T68 = 34.64

TO RT. PG. 30.

Note: Any Additions or Changes on This Sheet Must be Made or Circled in Red Ink With Date and Name of Person Making Change.

PLEASE RETURN TO
COUNTY OF LOS ANGELES
DEPARTMENT OF COUNTY ENGINEER
403 LOS ANGELES COUNTY ENGINEERING BLDG.

Do not extend this side of this line.

76F309S CE#310 3-69

PWHB 0911

242

F. B. 3935 PG. 32

TO BOT PG. 33.

223.56 T74°=223.57

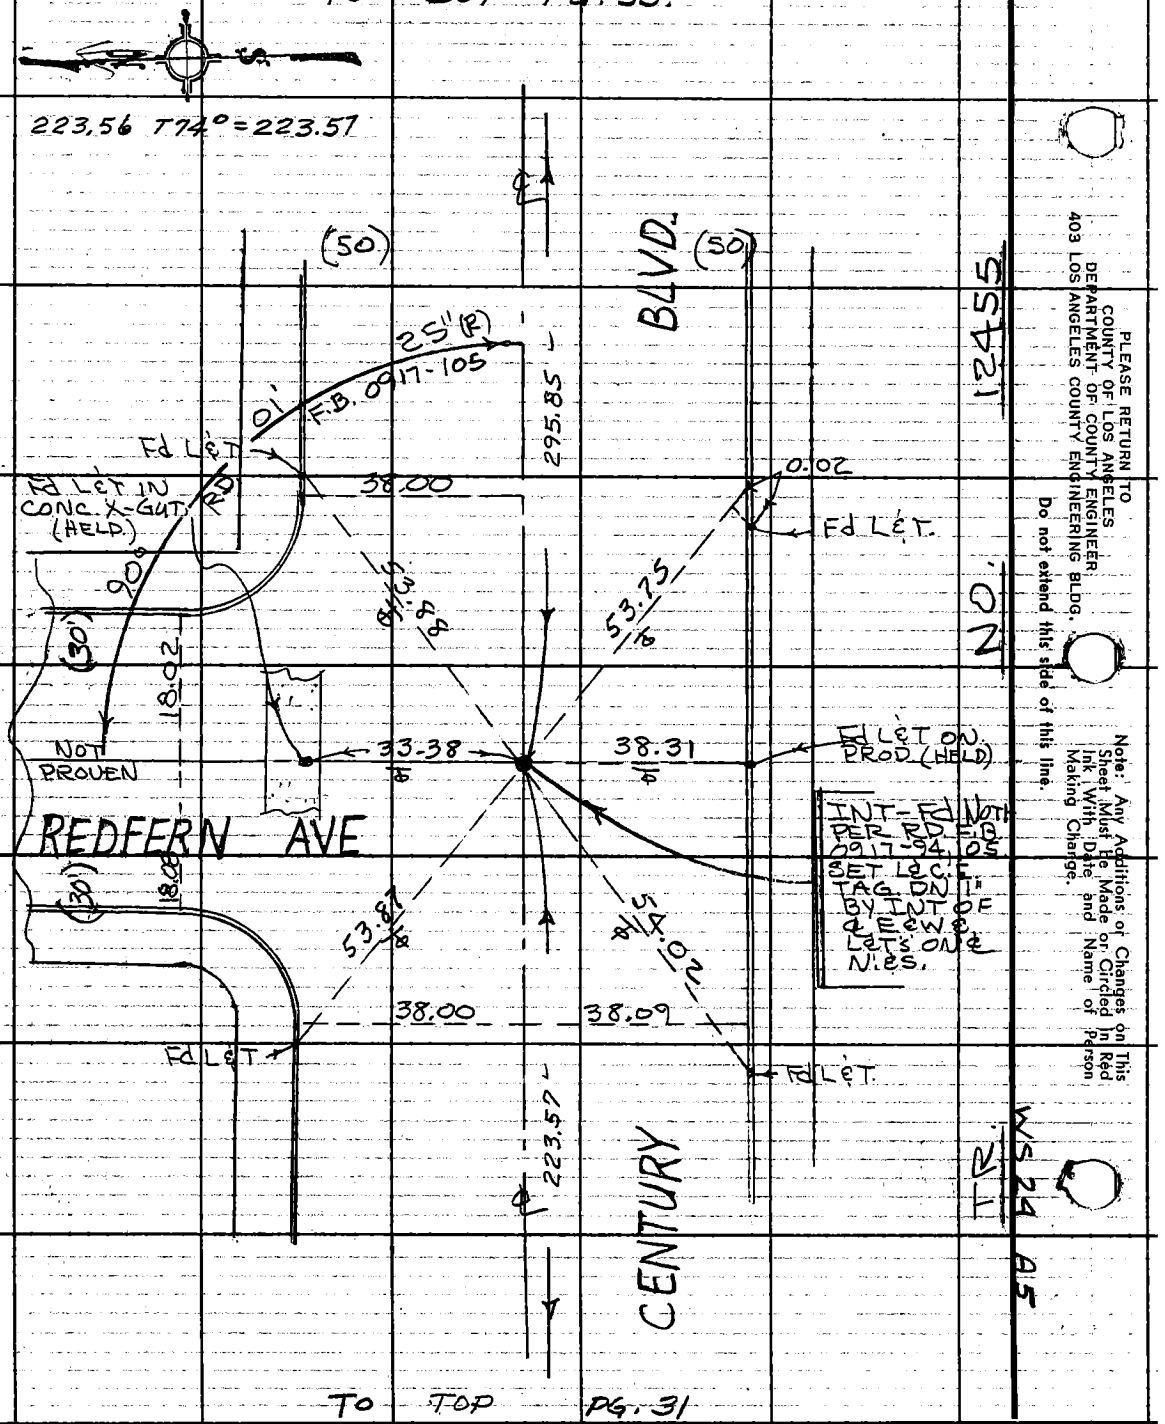

PLEASE RETURN TO
COUNTY OF LOS ANGELES
DEPARTMENT OF COUNTY ENGINEER
403 LOS ANGELES COUNTY ENGINEERING BLDG.

Do not extend this side of this line.

Note: Any Additions or Changes on This Sheet Must Be Made or Circled in Red Ink With Date and Name of Person Making Change.

PWFB 0917

243

Notes Ck'd by	Survey of LENNOX AREA ℄
Map No.	JN 0303.00 Tape 09 Std 68 °F
Office Work	Surveyed by J. BAZEN
Checked	Notes J.J.B. Date 4-74
Date	Indexed M. PALMERI JUN 15 1976

F.B. 3935 PG. 33

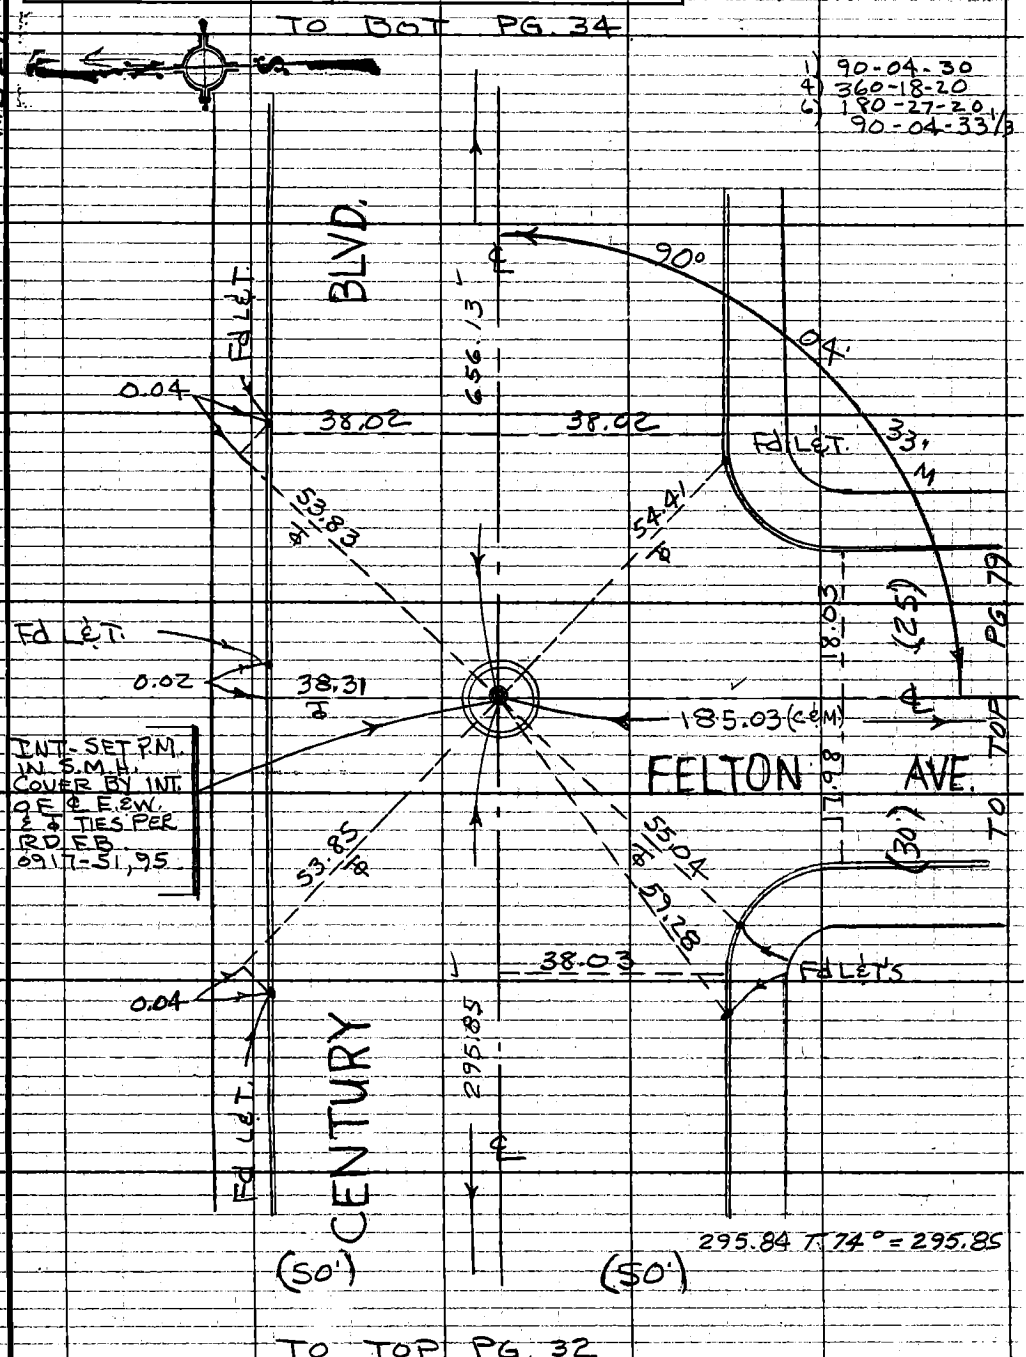

Note: Any Additions or Changes on This Sheet Must be Made or Circled in Red Ink With Date and Name of Person Making Change.

Do not extend this side of this line.

PLEASE RETURN TO
COUNTY OF LOS ANGELES
DEPARTMENT OF COUNTY ENGINEER
403 LOS ANGELES COUNTY ENGINEERING BLDG.

76F309S CE#310 3-69

F. B. 3935 PG 34

TO BOT PG. 35

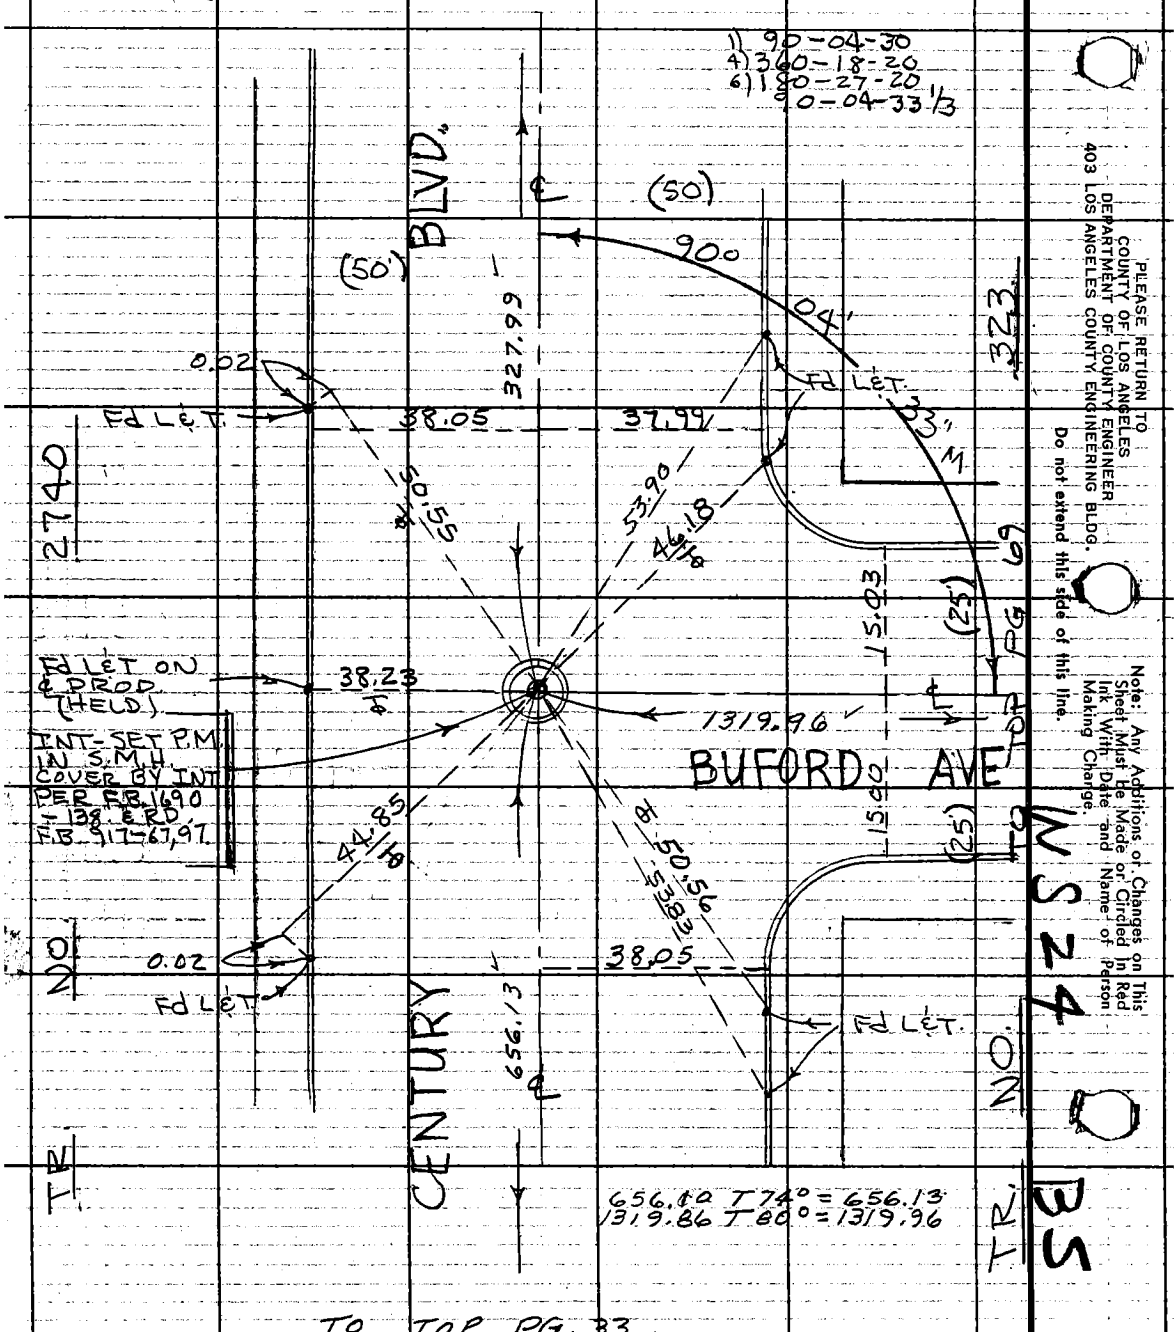

PLEASE RETURN TO
COUNTY OF LOS ANGELES
DEPARTMENT OF COUNTY ENGINEER
403 LOS ANGELES COUNTY ENGINEERING BLDG.
Do not extend this side of this line.

Note: Any Additions or Changes on This Sheet Must be Made or Circled In Red Ink With Date and Name of Person Making Change.

TO TOP PG. 33

PWFB 0917

245

Notes Ck'd by	Survey of LENNOX AREA ℄	F. B. 3935 PG. 35
Map. No.	JN 0303.00 Tape 09 Std 68 °F	
Office Work	Surveyed by J. BAZEN	
Checked	Notes J.J.B. Date 4-74	
Date	Indexed PALMERI JUN 15 1978	

B5

WS 24

TO LT. PG. 36

327.98 T74° = 327.99
1320.01 T74° = 1320.06

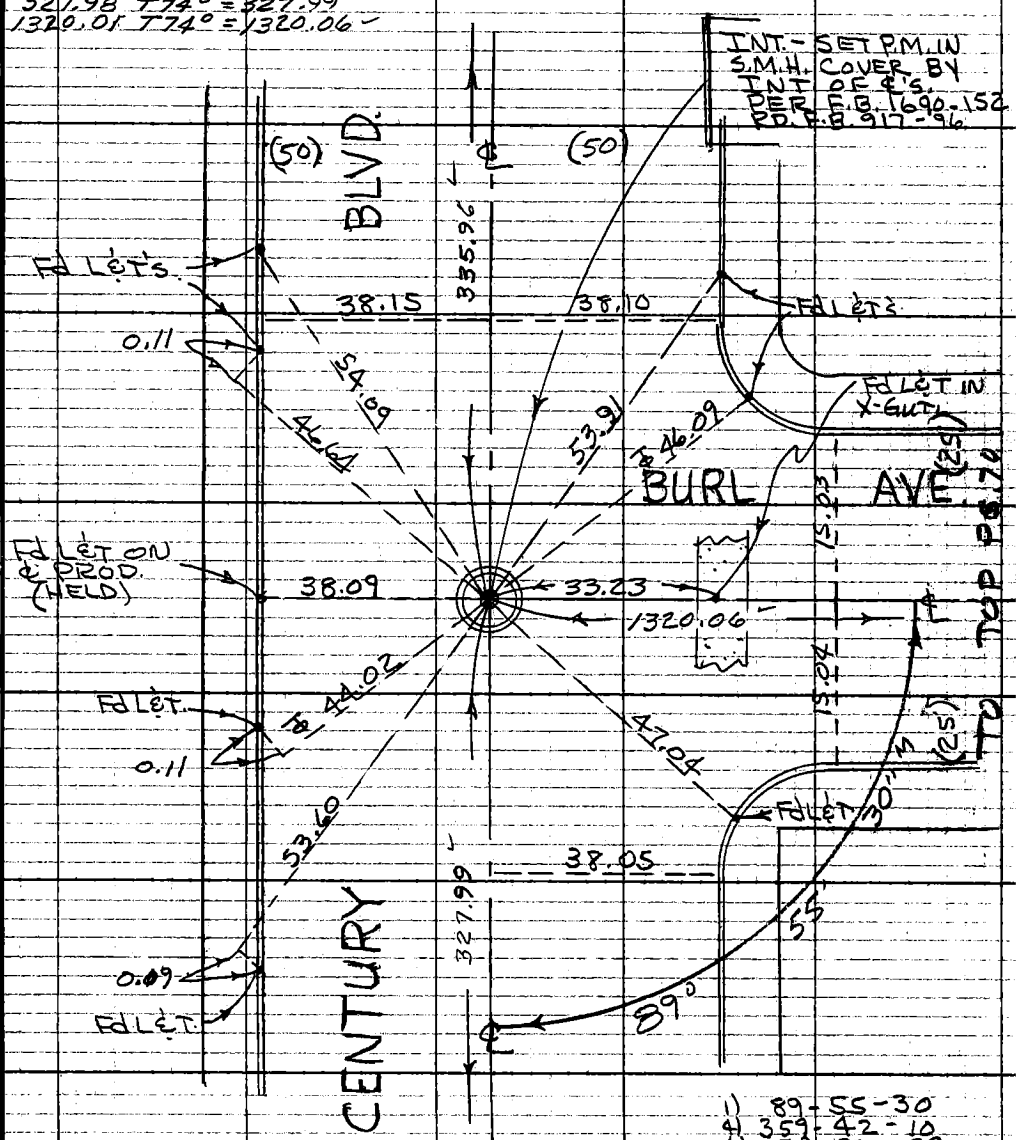

1) 89-55-30
4) 359-42-10
6) 179-33-00
89-55-30

TO TOP PG. 34

Note: Any Additions or Changes on this Sheet Must be Made or Circled in Red Ink With Date and Name of Person Making Change.

Do not extend this side of this line.

PLEASE RETURN TO
COUNTY OF LOS ANGELES
DEPARTMENT OF COUNTY ENGINEER
403 LOS ANGELES COUNTY ENGINEERING BLDG.

76F309S CE#310 3-69

F. B. 3935 PG. 36

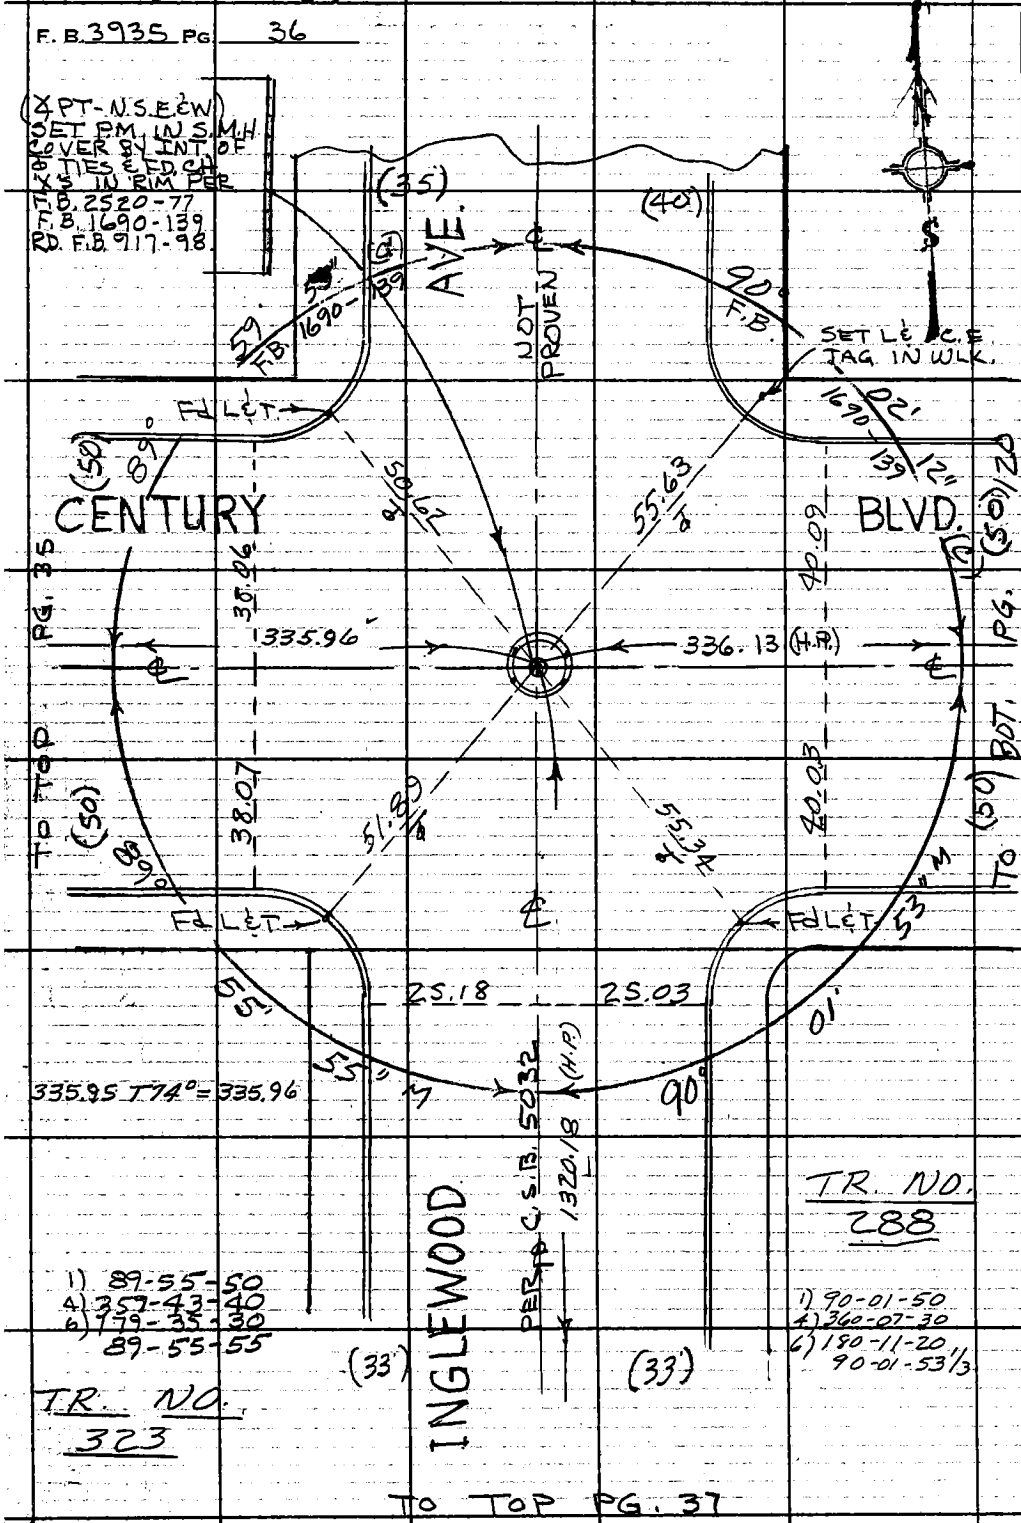

PLEASE RETURN TO
COUNTY OF LOS ANGELES
DEPARTMENT OF COUNTY ENGINEER
403 LOS ANGELES COUNTY ENGINEERING BLDG.

Do not extend this side of this line.

Note: Any Additions or Changes on This Sheet Must Be Made or Circled in Red Ink With Date and Name of Person Making Change.

WS 24

B5

PWFB 0917 247

Notes Ck'd by	Survey of LENNOX AREA ℄
Map No.	JN 0303.00 Tape 09 Std 68 °F
Office Work	Surveyed by J. BAZEN
Checked	Notes J.J.B. Date 4-74
Date	Index L. M. PALMERI JUN 15 1976

F.B. 3935 PG. 37

WS 24 B5

Note: Any Additions or Changes on This Sheet Must be Made or Circled in Red Ink With Date and Name of Person Making Change.

Do not extend this side of this line.

PLEASE RETURN TO
COUNTY OF LOS ANGELES
DEPARTMENT OF COUNTY ENGINEER
403 LOS ANGELES COUNTY ENGINEERING BLDG.

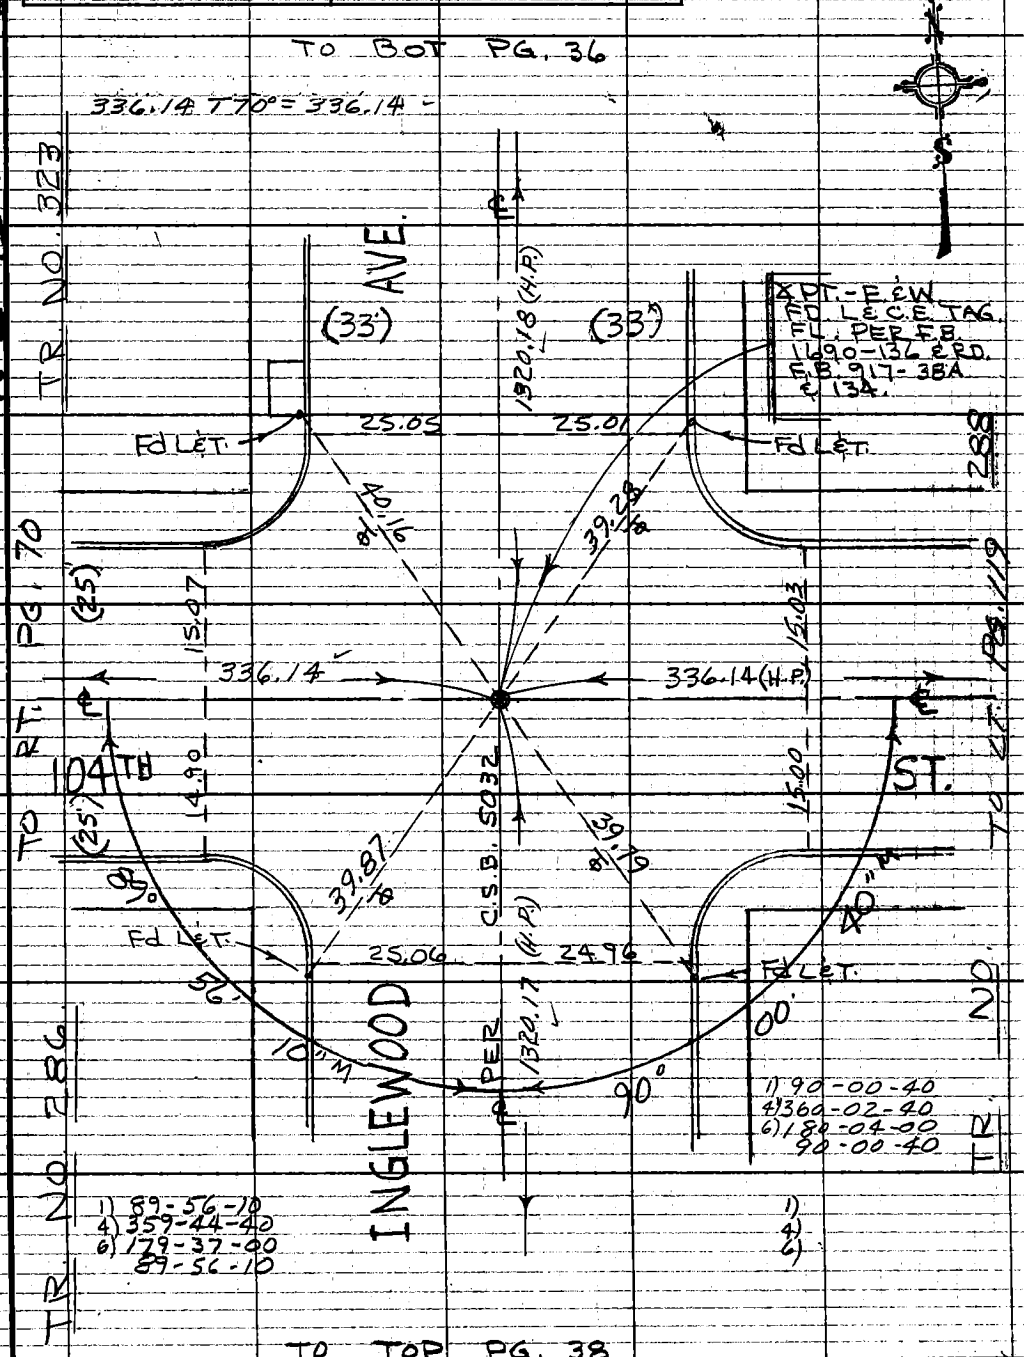

76F309S CE#310 3-69

F.B. 3935 PG. 38

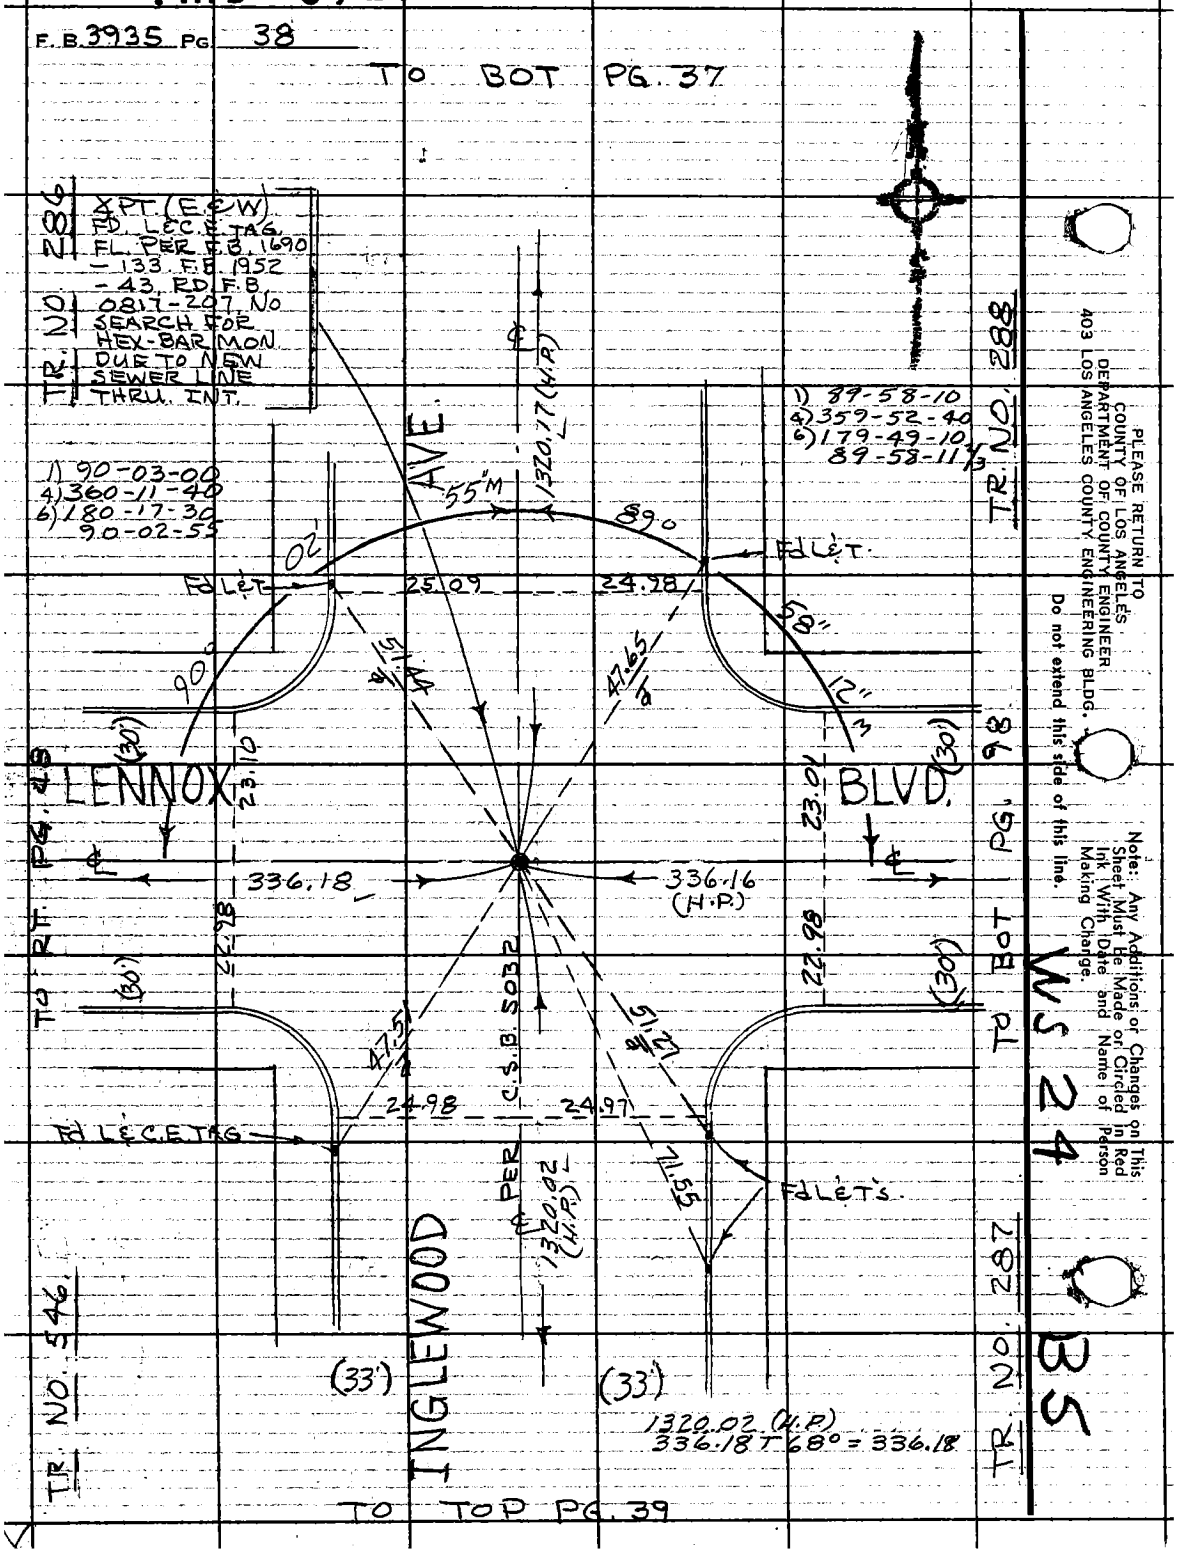
TO BOT PG. 37
TR. NO. 286
∡PT. (E&W)
FD. L&C.E. TAG
FL. PER F.B. 1690
-133. F.B. 1952
-43. RD. F.B.
0817-207. No
SEARCH FOR
HEX-BAR MON.
DUE TO NEW
SEWER LINE
THRU. INT.
1) 90-03-00
4) 360-11-40
6) 180-17-30
90-02-55
1) 89-58-10
4) 359-52-40
6) 179-49-10
89-58-11 1/3
TR. NO. 288
AVE.
1320.17 (H.P.)
55"M
89°
02'
Fd L&T.
25.09
24.98
58"
90°
12"
51.44
47.65
(30')
23.10
23.01
LENNOX
BLVD.
TO RT. PG. 48
TO BOT PG. 98
336.18
336.16 (H.P.)
22.98
22.98
(30')
(30')
47.51
51.27
C.S.B. 5032
24.98
24.97
Fd L&C.E. TAG
71.55
Fd L&T's.
PER
1320.02 (H.P.)
INGLEWOOD
(33')
(33')
TR. NO. 546
TR. NO. 287
1320.02 (H.P.)
336.18 T 68° = 336.18
TO TOP PG. 39
PLEASE RETURN TO
COUNTY OF LOS ANGELES
DEPARTMENT OF COUNTY ENGINEER
403 LOS ANGELES COUNTY ENGINEERING BLDG.
Do not extend this side of this line.
Note: Any Additions or Changes on This Sheet Must Be Made or Circled in Red Ink With Date and Name of Person Making Change.
WS 24
B5

PWFB 0817 670

Notes Ck'd by	Survey of LENNOX AREA ℄
Map No.	JN 0303.00 Tape 09 Std 68 °F
Office Work	Surveyed by J. BAZEN
Checked	Notes J.J.B. Date 4-74
Date	Indexed E. M. PALMER JUN 15 1976

F. B. 3935 PG. 39

B5

WS 24

TO BOT PG. 38

TR. NO. 546

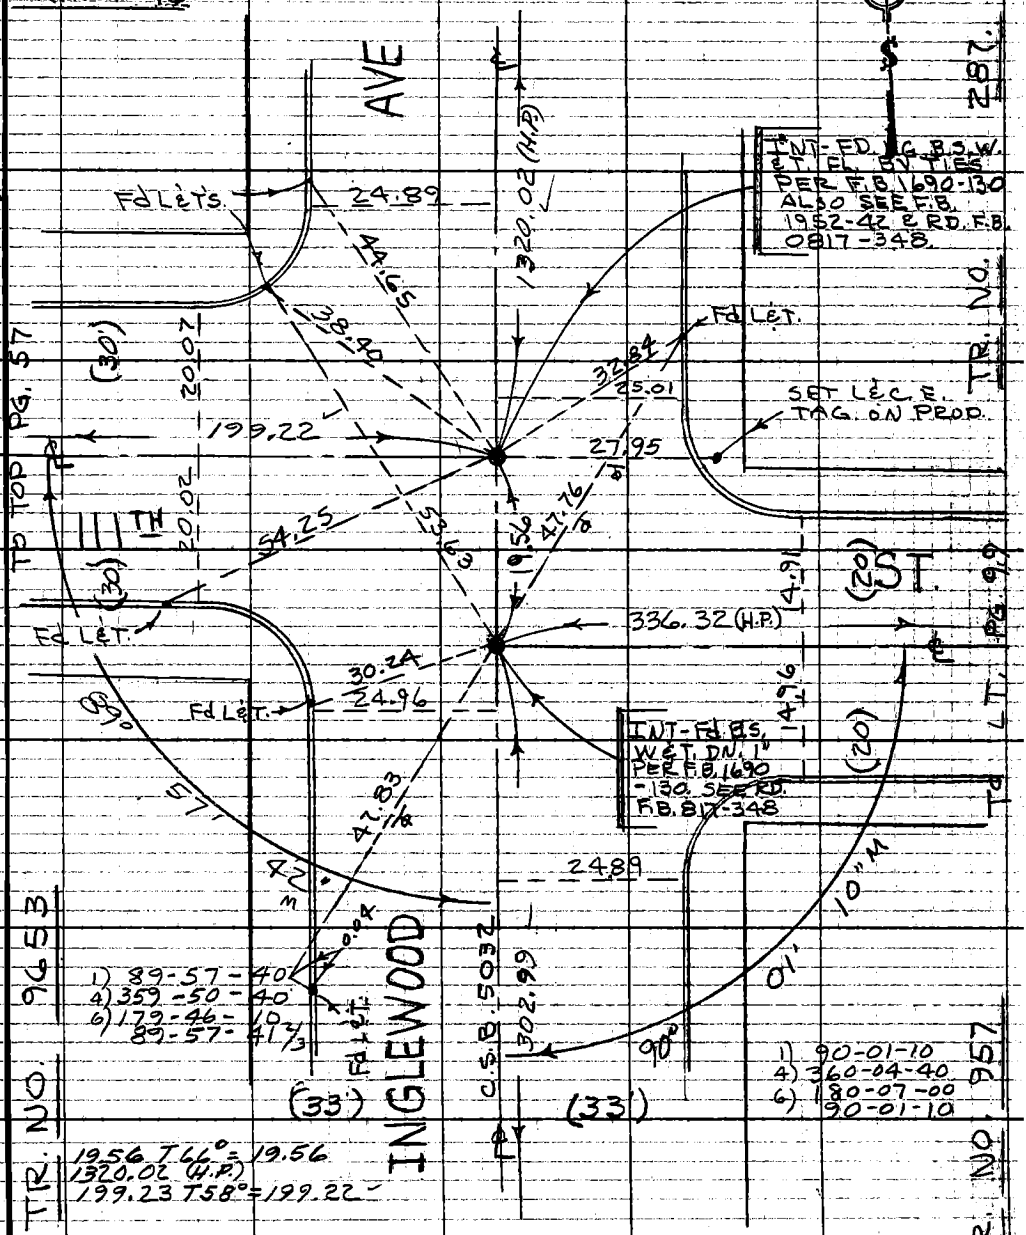

TO TOP PG 40

Note: Any Additions or Changes on This Sheet Must be Made or Circled in Red Ink With Date and Name of Person Making Change.

Do not extend this side of this line.

PLEASE RETURN TO
COUNTY OF LOS ANGELES
DEPARTMENT OF COUNTY ENGINEER
403 LOS ANGELES COUNTY ENGINEERING BLDG.

76F309S CE#310 3-69

F. B. 3935 PG. 40

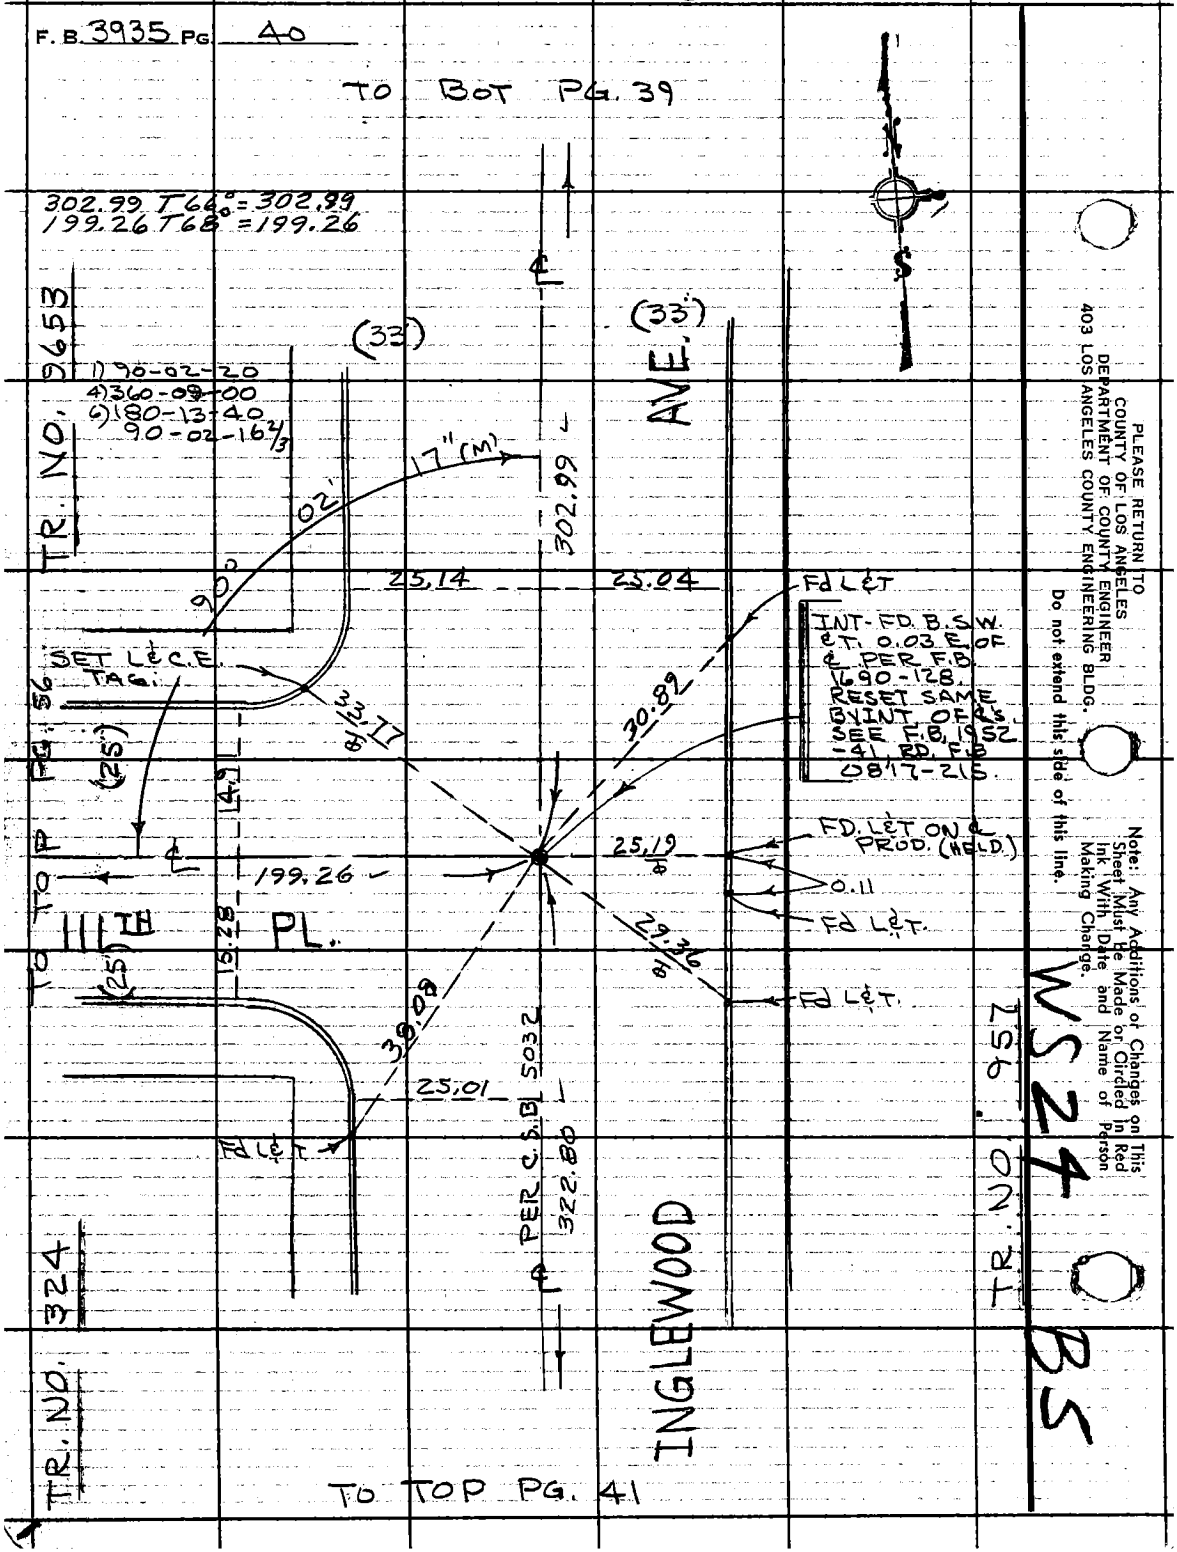

PLEASE RETURN TO
COUNTY OF LOS ANGELES
DEPARTMENT OF COUNTY ENGINEER
403 LOS ANGELES COUNTY ENGINEERING BLDG.

Do not extend this side of this line.

Note: Any Additions or Changes on This Sheet Must Be Made or Circled in Red Ink With Date and Name of Person Making Change.

PWFB 0817 672

Notes Ck'd by	Survey of LENNOX AREA ℄
Map No.	JN 0303.00 Tape 09 Std 68 °F
Office Work	Surveyed by J. BAZEN
Checked	Notes J.J.B. Date 4-74
Date	Indexed I. M. PALMERI JUN 15 1976

F.B. 3935 PG. 41

B5

WS 29

TO BOT PG. 40

322.81 T64° = 322.80
1651.20 T68° = 1651.20

1) 90-01-50
4) 360-07-00
6) 180-10-30
90-01-45

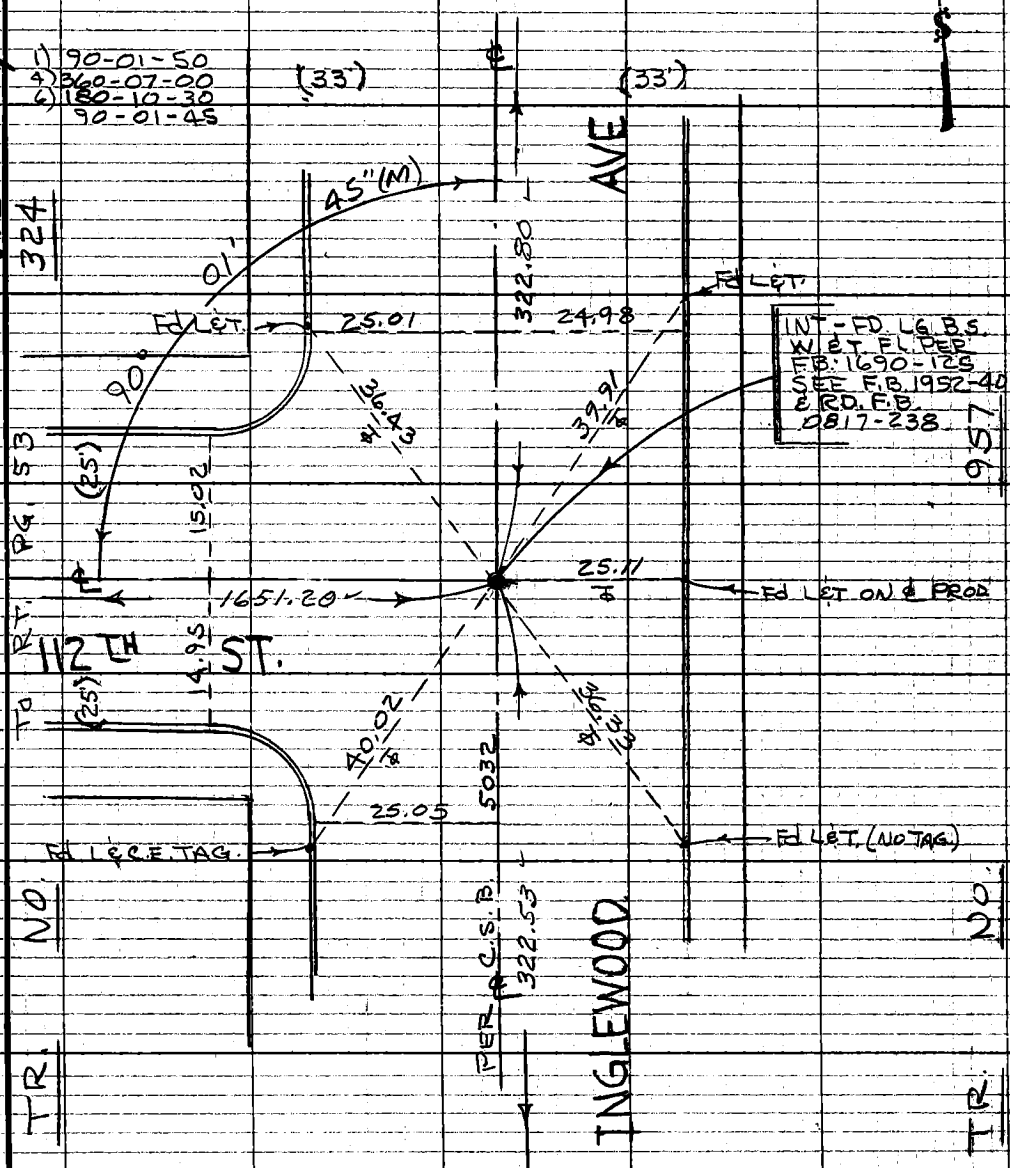

TO TOP PG. 42

Note: Any Additions or Changes on This Sheet Must be Made or Circled in Red Ink With Date and Name of Person Making Change.

Do not extend this side of this line.

PLEASE RETURN TO
COUNTY OF LOS ANGELES
DEPARTMENT OF COUNTY ENGINEER
403 LOS ANGELES COUNTY ENGINEERING BLDG.

76F309S CE#310 3-69

PWFB 0817 673

F.B. 3935 PG. 42

TO BOT PG. 41

322.54 T64° = 322.53
1651.29 T68° = 1651.29

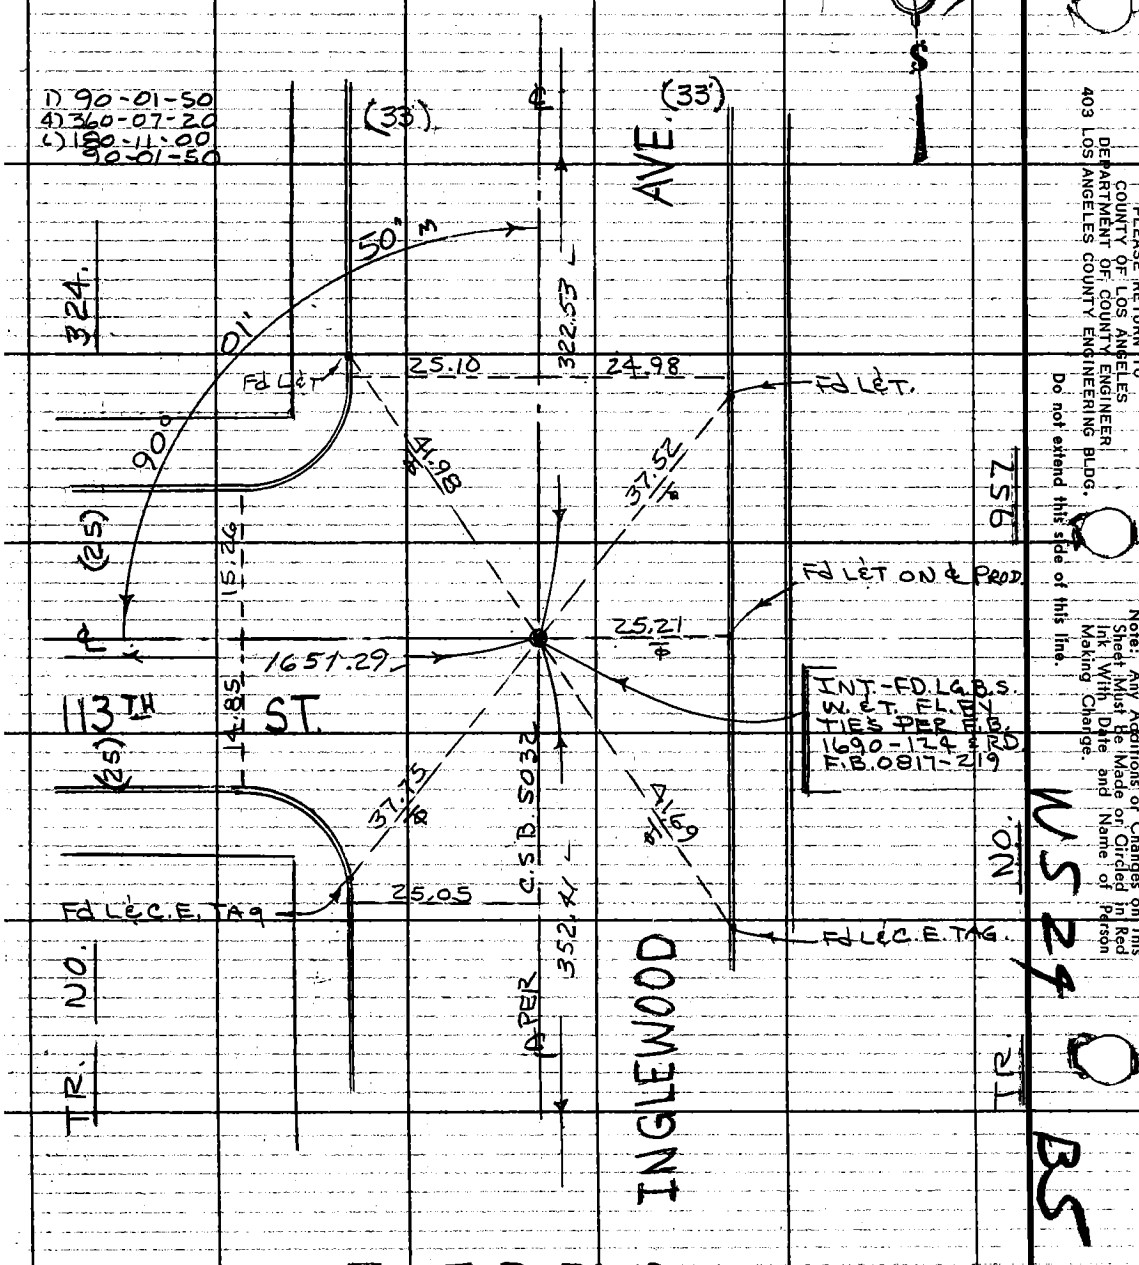

PLEASE RETURN TO
COUNTY OF LOS ANGELES
DEPARTMENT OF COUNTY ENGINEER
403 LOS ANGELES COUNTY ENGINEERING BLDG.

Do not extend this side of this line.

Note: Any Additions or Changes on This Sheet Must Be Made or Circled in Red Ink With Date and Name of Person Making Change.

TO TOP PG. 9.

PWFB 0817

674

Notes Ck'd by	Survey of LENNOX AREA ℄
Map No.	JN0303.00 Tape 09 Std 68 °F
Office Work	Surveyed by J. BAZEN
Checked	Notes Date 5-74
Date	Indexed T. M. PALMERI JUN 15 1976

F. B. 3935, PG. 43

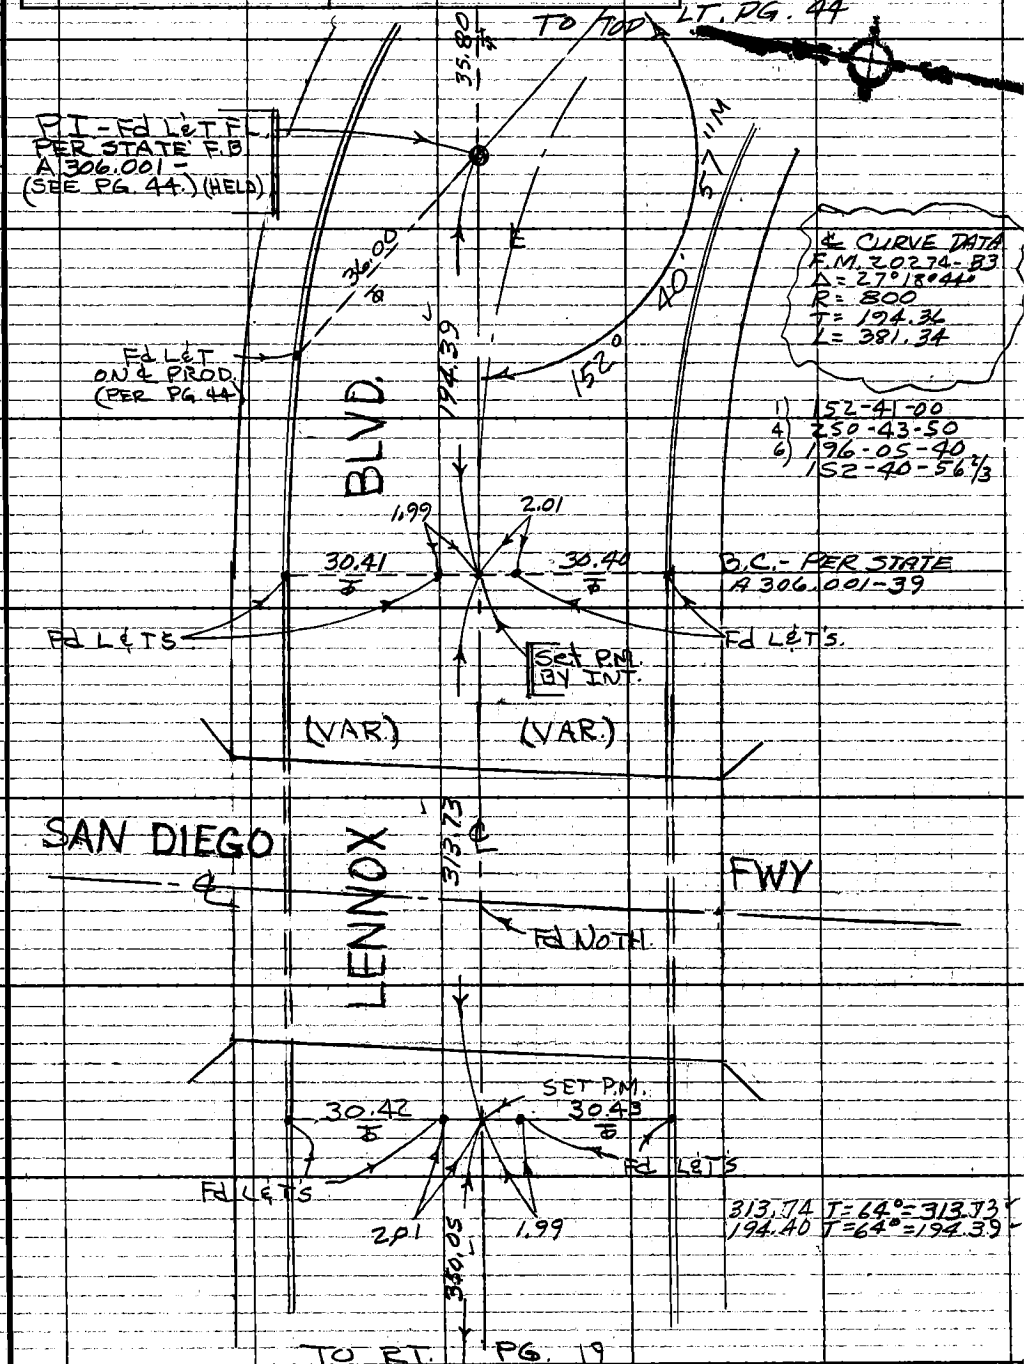

Note: Any Additions or Changes on This Sheet Must be Made or Circled in Red Ink With Date and Name of Person Making Change.

Do not extend this side of this line.

PLEASE RETURN TO
COUNTY OF LOS ANGELES
DEPARTMENT OF COUNTY ENGINEER
403 LOS ANGELES COUNTY ENGINEERING BLDG.

76F309S CE#310 3-69

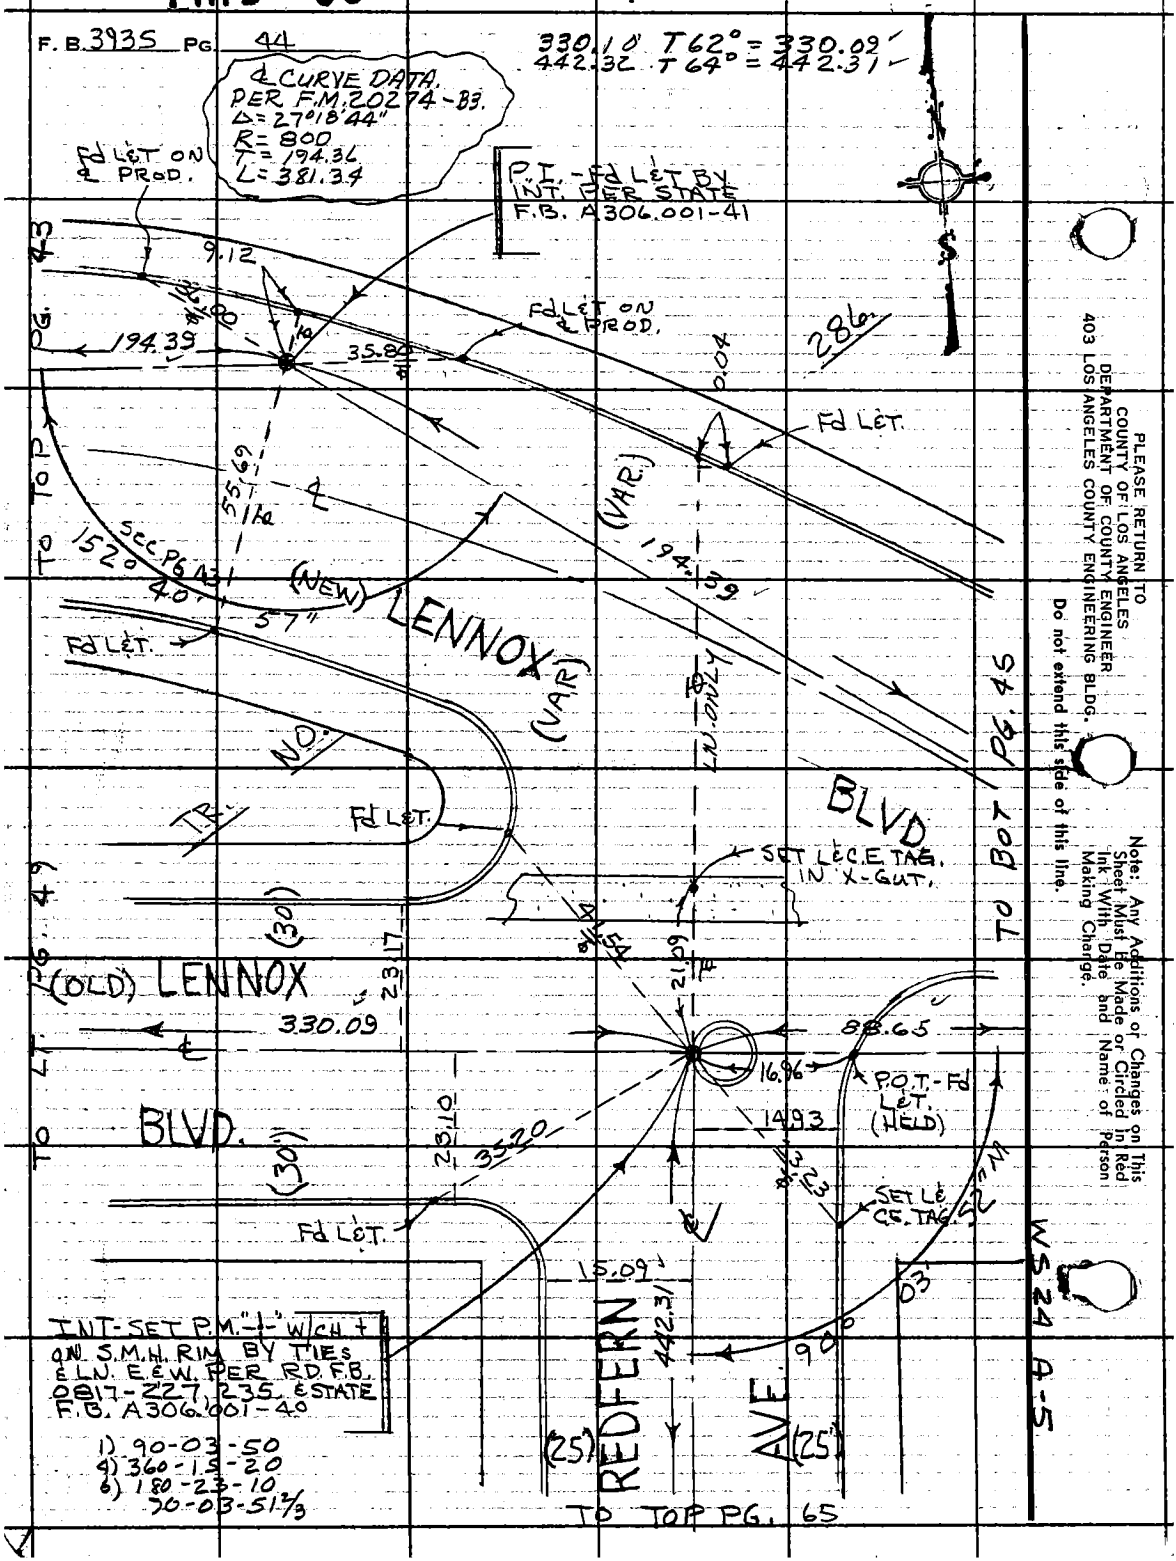
F. B. 3935 PG. 44
330.10 T62° = 330.09
442.32 T64° = 442.31
℄ CURVE DATA.
PER F.M. 20274-B3.
Δ = 27°18'44"
R = 800
T = 194.36
L = 381.34
Fd L&T ON ℄ PROD.
P.I. - Fd L&T BY INT. PER STATE F.B. A306.001-41
9.12
194.39
35.80
Fd L&T ON ℄ PROD.
286
0.04
Fd L&T.
55.69
(VAR.)
194.39
SEC. PG. 43
152°
40'
57"
(NEW)
LENNOX
(VAR)
Fd L&T.
NO.
TR.
Fd L&T.
BLVD
SET L&C.E. TAG. IN X-GUT.
TO BOT PG. 45
(30')
23.17
21.09
(OLD) LENNOX
330.09
88.65
16.96
P.O.T. - Fd L&T. (HELD)
14.93
BLVD.
(30')
23.10
35.20
3.23
SET L&C.E. TAG.
Fd L&T.
15.09
442.31
90°
03'
52" M
REDFERN
AVE
(25')
(25')
TO TOP PG. 65
TO LT. PG. 49
TO TOP PG. 43
INT-SET P.M. "-|-" W/CH + ON S.M.H. RIM BY TIES & LN. E&W. PER RD. F.B. 0817-227, 235, & STATE F.B. A306.001-40
1) 90-03-50
4) 360-15-20
6) 180-23-10
90-03-51 2/3
WS 24 A-5
PLEASE RETURN TO
COUNTY OF LOS ANGELES
DEPARTMENT OF COUNTY ENGINEER
403 LOS ANGELES COUNTY ENGINEERING BLDG.
Do not extend this side of this line.
Note: Any Additions or Changes on This Sheet Must Be Made or Circled in Red Ink With Date and Name of Person Making Change.

PWFB 0817

676

Notes Ck'd by
Map No.
Office Work
Checked
Date

Survey of LENNOX AREA E
J.N. 0303.00 Tape 09 Std. 68 °F
Surveyed by J. BAZEN
Notes J.J.B. Date 5-74
Indexed M. PALMER JUN 15 1976

F.B. 3935 Pg. 45

TO LT. PG. 46

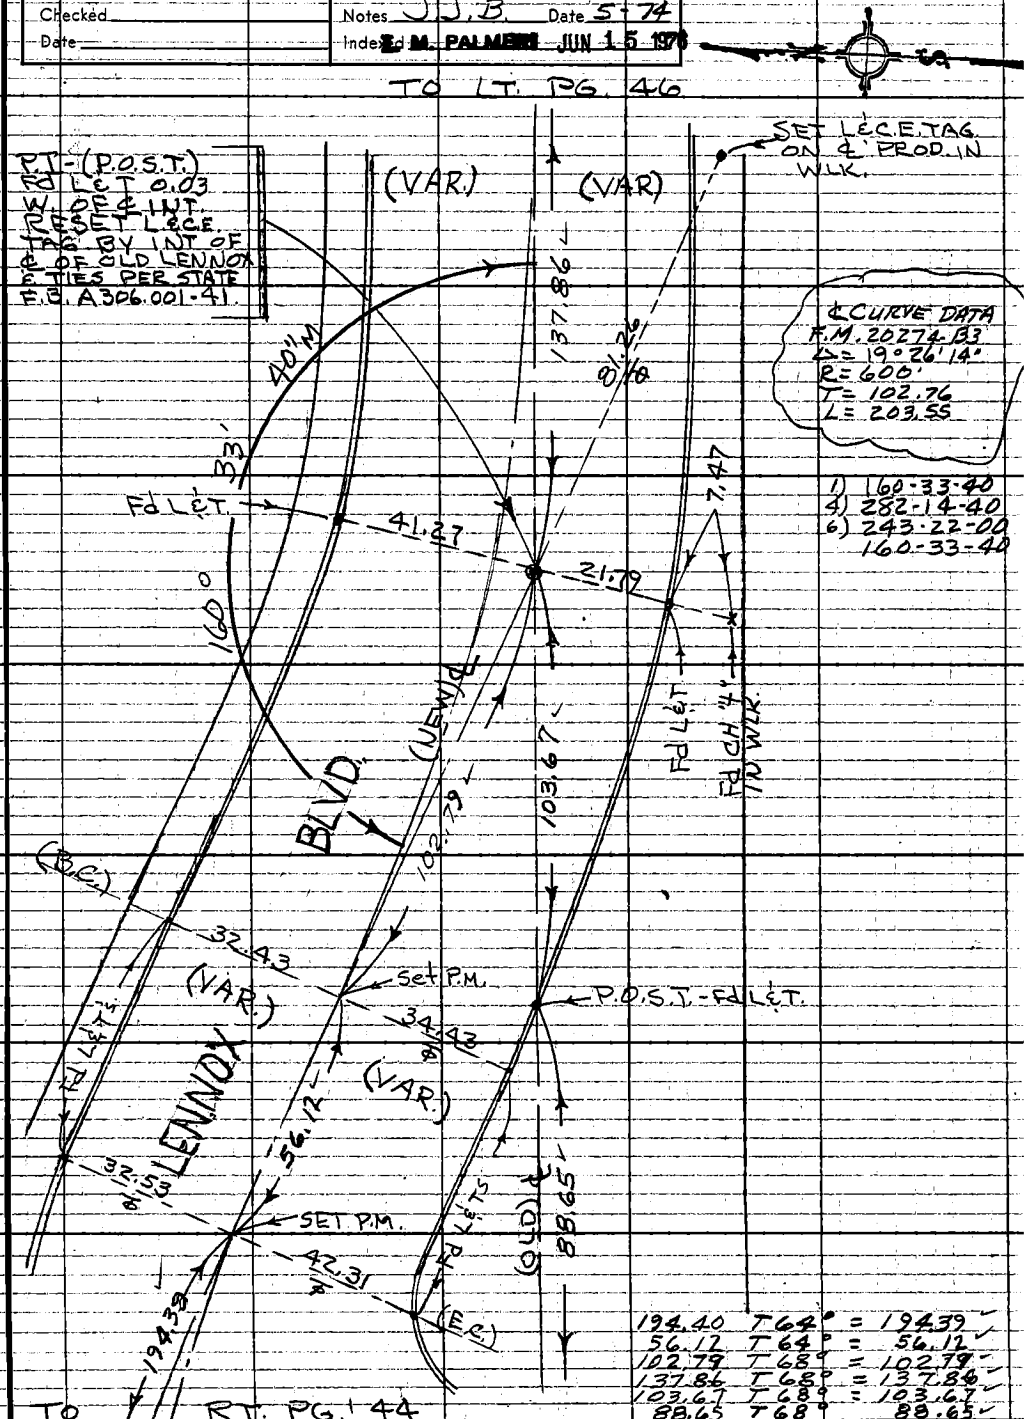

℄ CURVE DATA
F.M. 20274-133
Δ = 19°26'14"
R = 600'
T = 102.76
L = 203.55

1) 160-33-40
4) 282-14-40
6) 243-22-00
160-33-40

194.40	T64°	= 194.39
56.12	T64°	= 56.12
102.79	T68°	= 102.79
137.86	T68°	= 137.86
103.67	T68°	= 103.67
88.65	T68°	88.65

Note: Any Additions or Changes on this Sheet Must be Made or Circled in Red Ink With Date and Name of Person Making Change.

Do not extend this side of this line.

PLEASE RETURN TO
COUNTY OF LOS ANGELES
DEPARTMENT OF COUNTY ENGINEER
403 LOS ANGELES COUNTY ENGINEERING BLDG.

76F309S CE#310 3-69

PWFB-0817 677

F.B. 3935 PG. 46

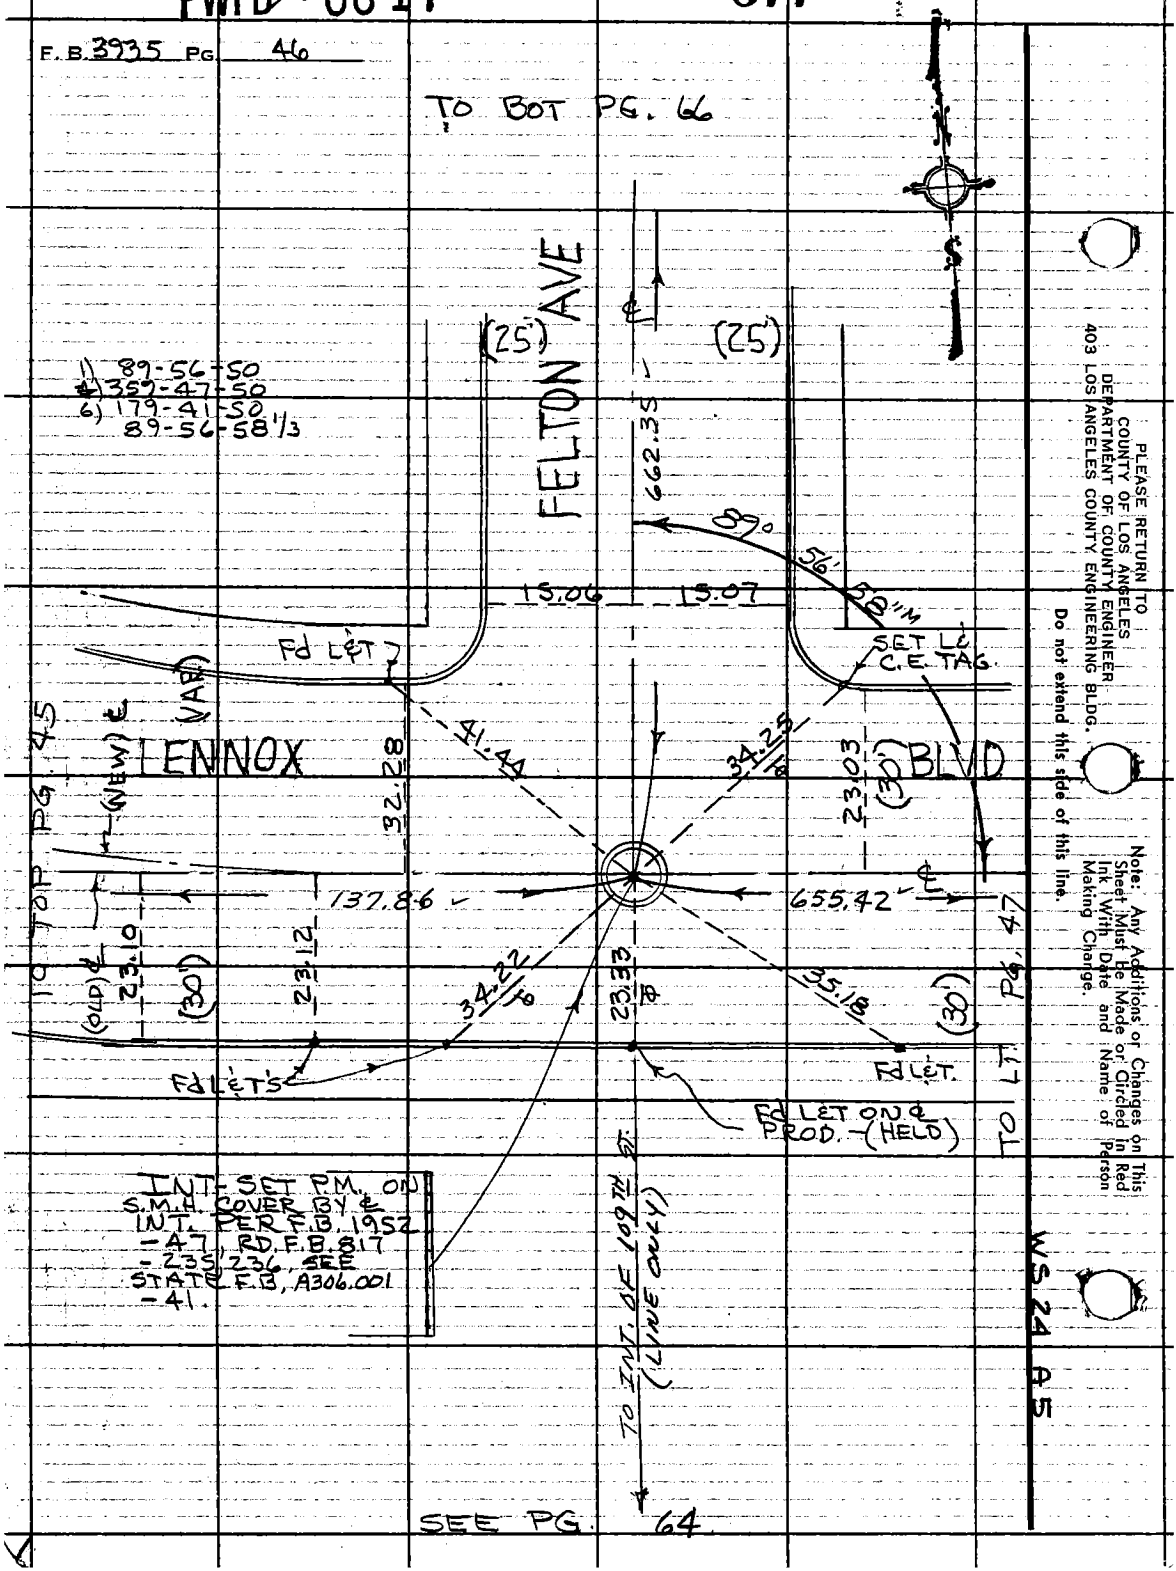

PLEASE RETURN TO
COUNTY OF LOS ANGELES
DEPARTMENT OF COUNTY ENGINEER
403 LOS ANGELES COUNTY ENGINEERING BLDG.

Do not extend this side of this line.

Note: Any Additions or Changes on This Sheet Must Be Made or Circled in Red Ink With Date and Name of Person Making Change.

PWFB 0817 678

Notes Ck'd by	Survey of LENNOX AREA ℄
Map No.	JN 0303.00 Tape 09 Std 68 °F
Office Work	Surveyed by J. BAZEN
Checked	Notes J.J.B Date 5-74
Date	Indexed T. M. PALMERI JUN 15 1976

F.B. 3935 PG. 47

B5

WS 24

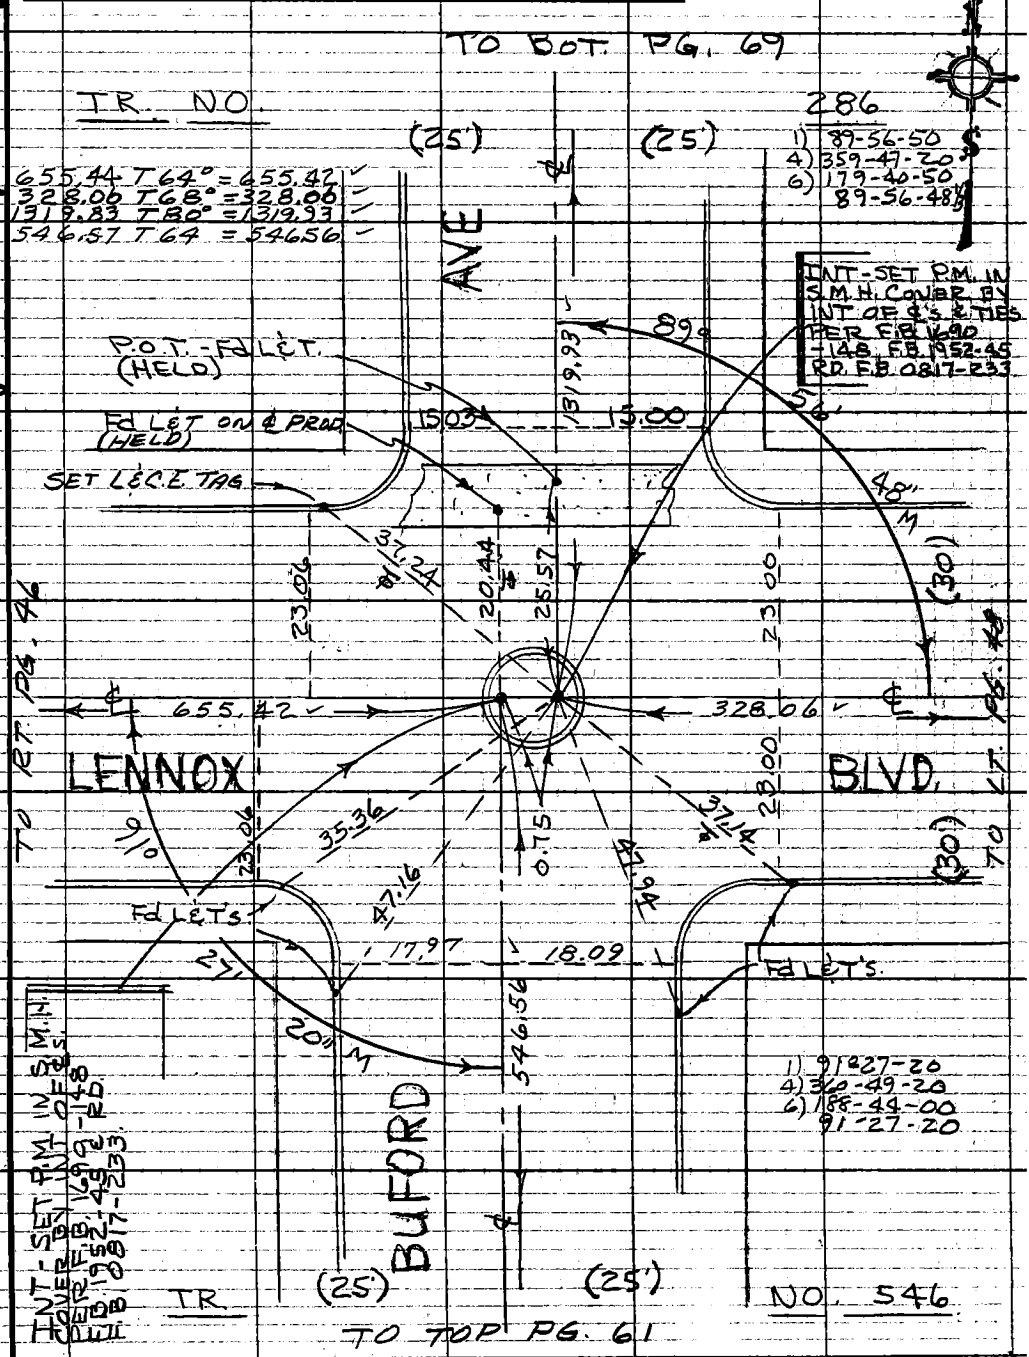

Note: Any Additions or Changes on This Sheet Must be Made or Circled in Red Ink With Date and Name of Person Making Change.

Do not extend this side of this line.

PLEASE RETURN TO
COUNTY OF LOS ANGELES
DEPARTMENT OF COUNTY ENGINEER
403 LOS ANGELES COUNTY ENGINEERING BLDG.

76F309S CE#310 3-69

PWFB 0817 679

F. B. 3935 PG. 48

TO BOT PG. 70

TR. NO. 286

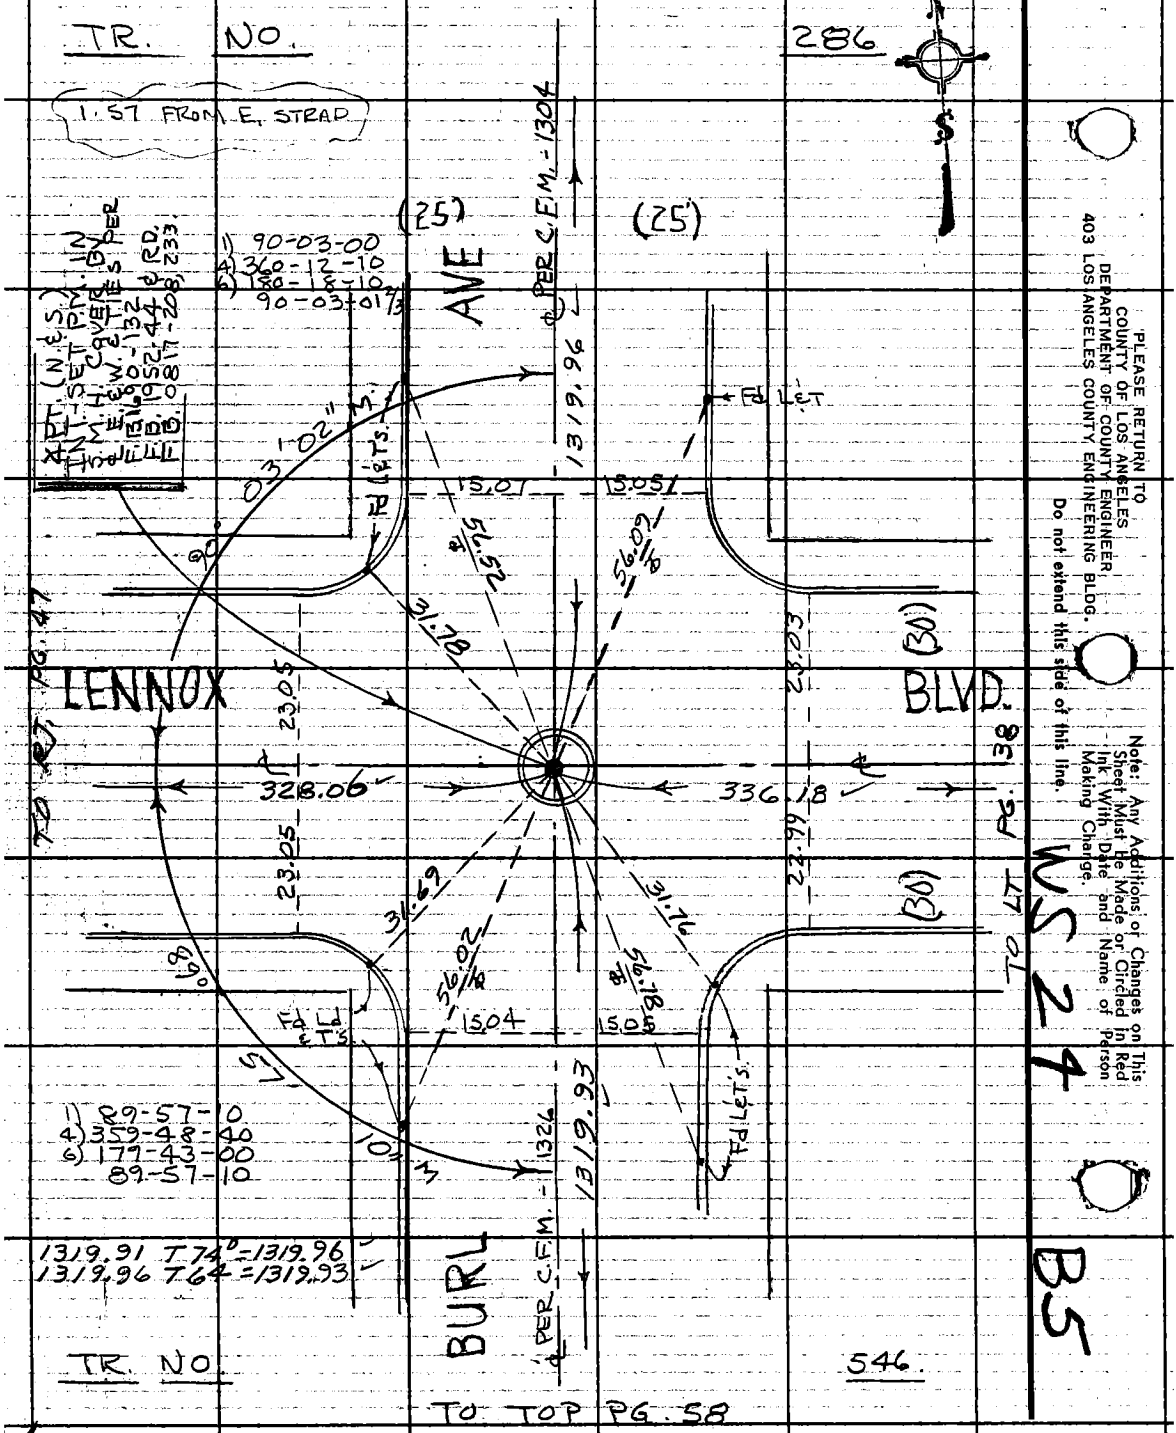

TR. NO. 546.

TO TOP PG. 58

PLEASE RETURN TO
COUNTY OF LOS ANGELES
DEPARTMENT OF COUNTY ENGINEER
403 LOS ANGELES COUNTY ENGINEERING BLDG.

Do not extend this side of this line.

Note: Any Additions or Changes on This Sheet Must Be Made or Circled in Red Ink With Date and Name of Person Making Change.

PWFB 0817 680

Notes Ck'd by	Survey of LENNOX AREA ℄
Map No.	JN 0303.00 Tape 09 Std 68 °F
Office Work	Surveyed by J. BAZEN
Checked	Notes J.D.B. Date 5-74
Date	Indexed J. M. PALMERI JUN 15 1976

F. B. 3935 PG. 49

WS 24 A-5

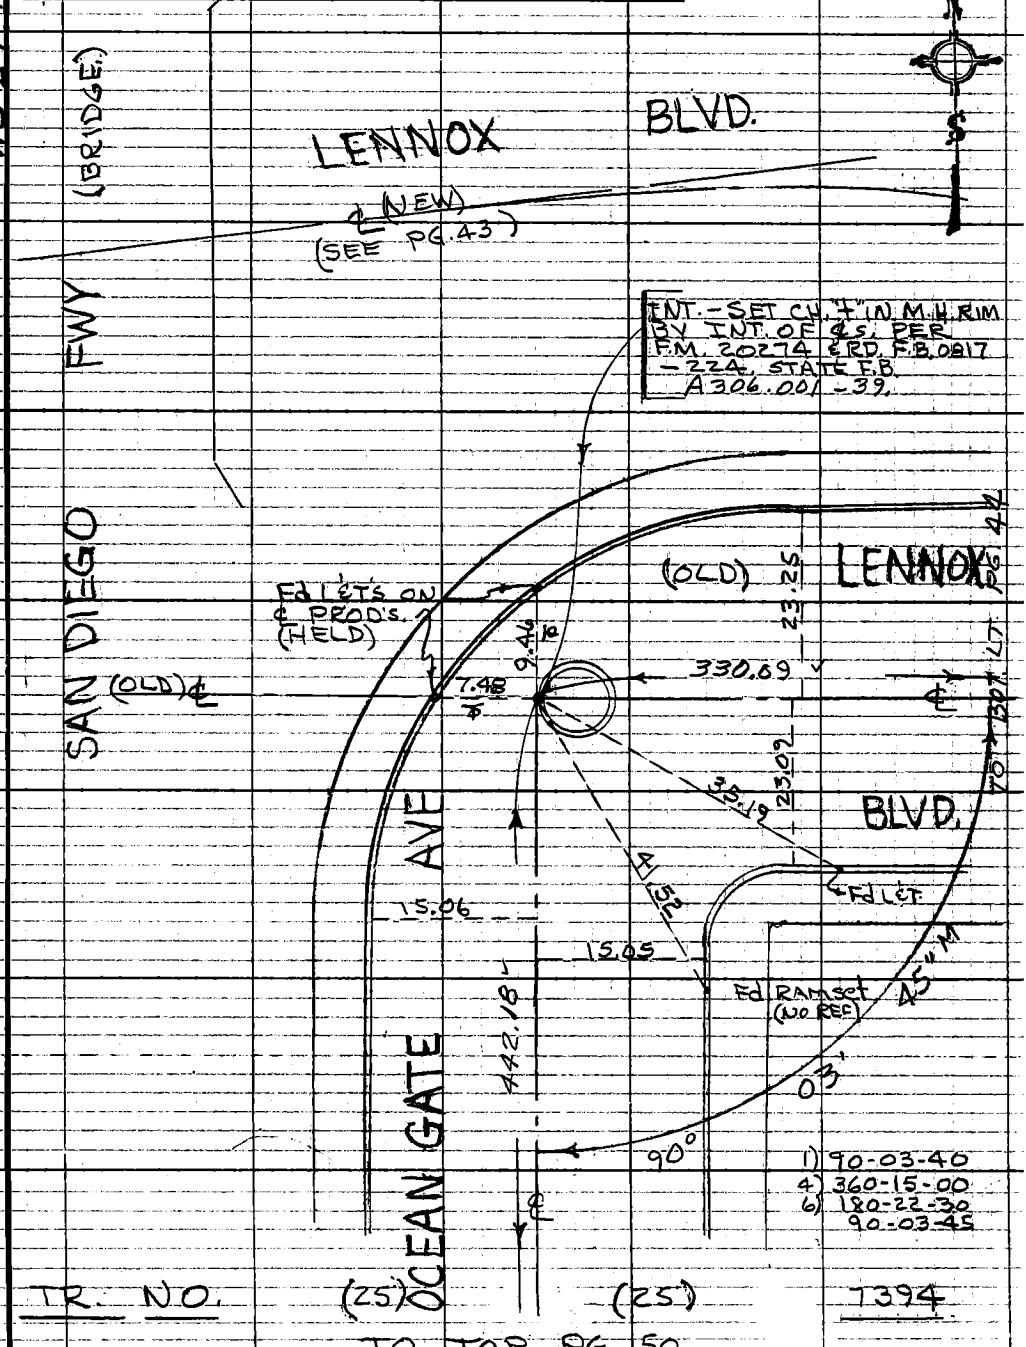

Note: Any Additions or Changes on This Sheet Must be Made or Circled in Red Ink With Date and Name of Person Making Change.

Do not extend this side of this line.

PLEASE RETURN TO
COUNTY OF LOS ANGELES
DEPARTMENT OF COUNTY ENGINEER
403 LOS ANGELES COUNTY ENGINEERING BLDG.

76F309S CE#310 3-69

F.B. 3935 PG. 50

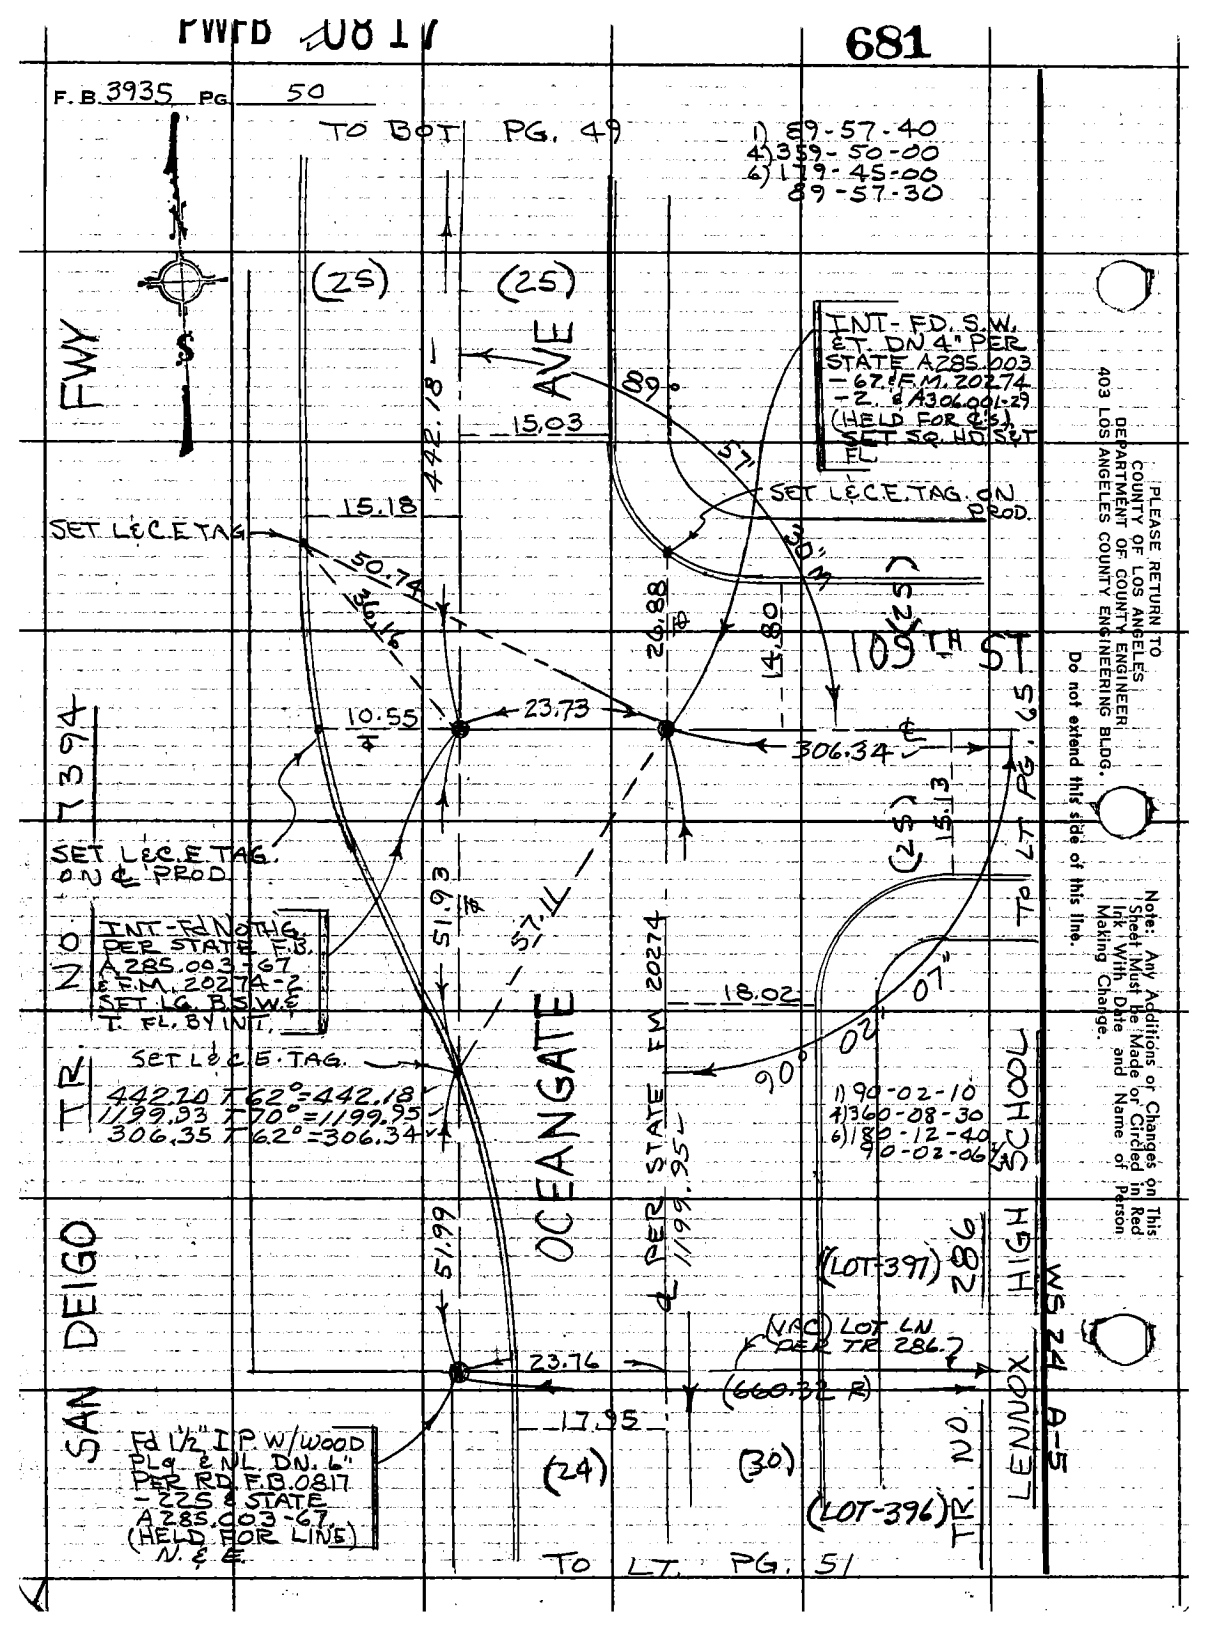

PLEASE RETURN TO
COUNTY OF LOS ANGELES
DEPARTMENT OF COUNTY ENGINEER
403 LOS ANGELES COUNTY ENGINEERING BLDG.
Do not extend this side of this line.

Note: Any Additions or Changes on This Sheet Must Be Made or Circled in Red Ink With Date and Name of Person Making Change.

PWFB 0817

682

Notes Ck'd by	Survey of LENNOX AREA ℄
Map No.	JN 0303.00 Tape 09 Std 68 °F
Office Work	Surveyed by J. BAZEN
Checked	Notes J.J.B. Date 5-74
Date	Index R. M. PALMERI JUN 15 1976

F.B. 3935 PG. 51

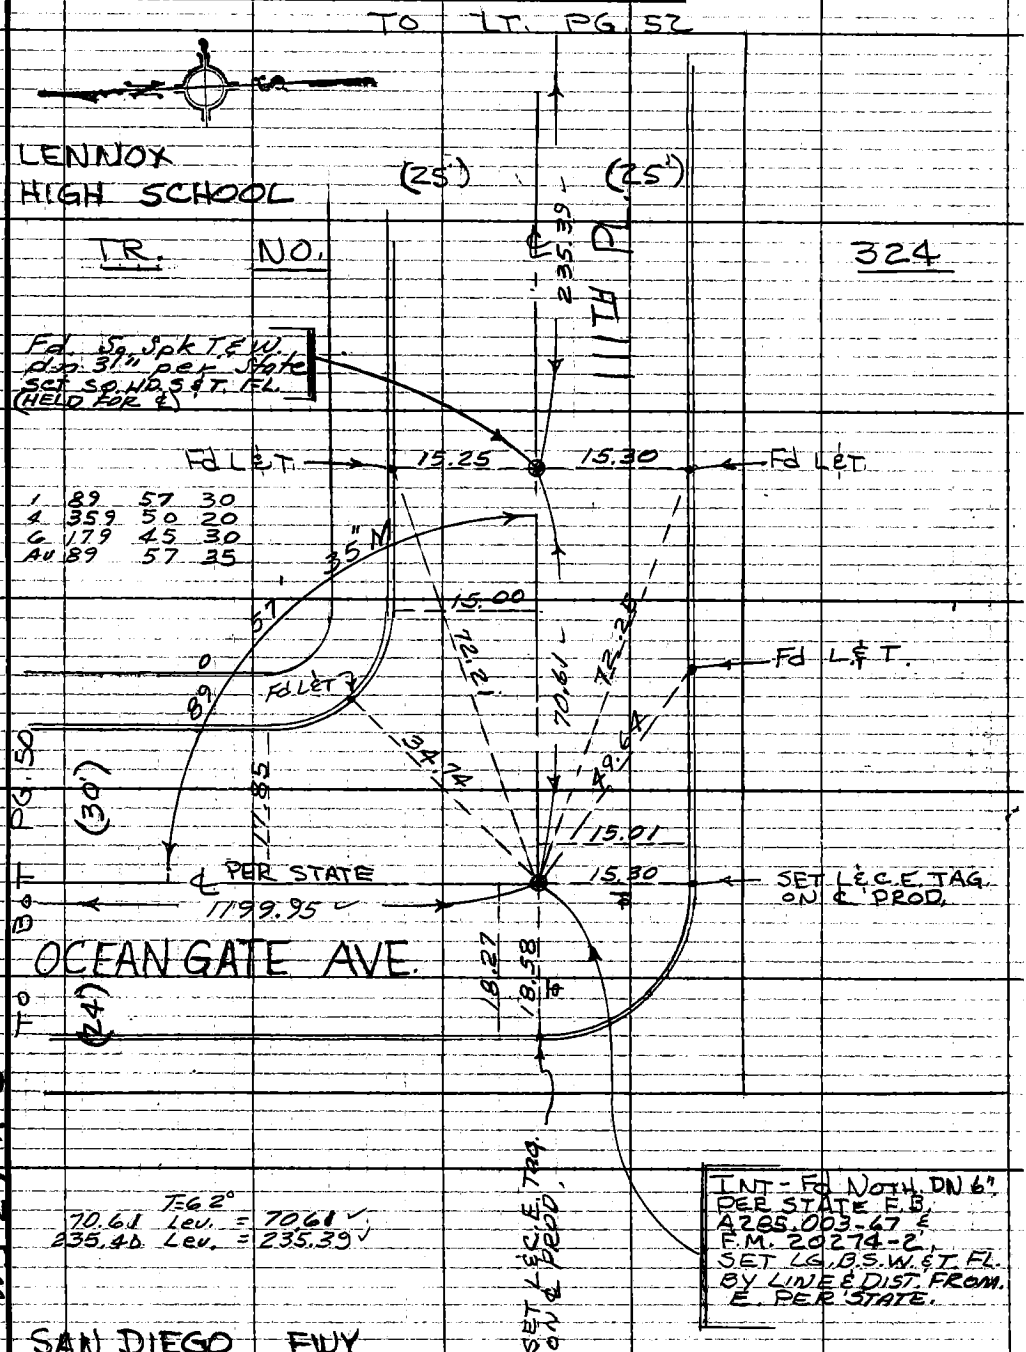

WS 24 4-5

Note: Any Additions or Changes on this Sheet Must be Made or Circled in Red Ink With Date and Name of Person Making Change.

Do not extend this side of this line.

PLEASE RETURN TO
COUNTY OF LOS ANGELES
DEPARTMENT OF COUNTY ENGINEER
403 LOS ANGELES COUNTY ENGINEERING BLDG.

76F309S CE#310 3-69

PWFB 0817

683

F.B. 3935 PG. 52 TO BOT PG. 65

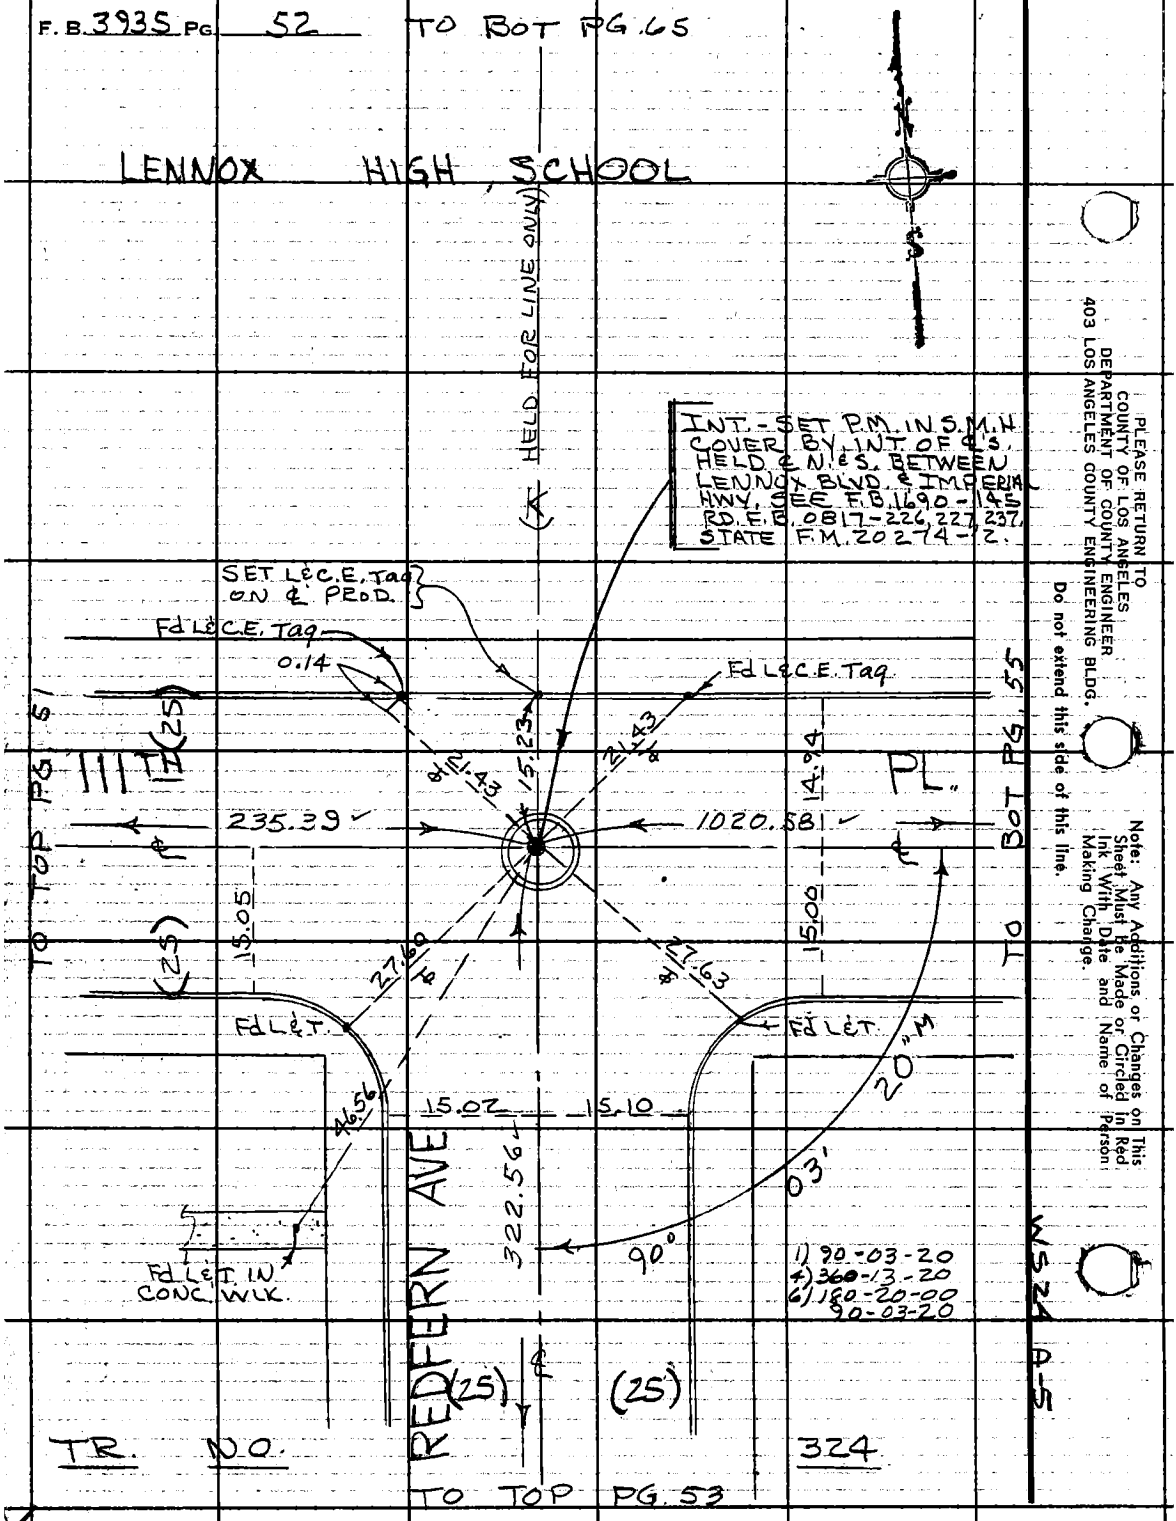

PLEASE RETURN TO
COUNTY OF LOS ANGELES
DEPARTMENT OF COUNTY ENGINEER
403 LOS ANGELES COUNTY ENGINEERING BLDG.

Do not extend this side of this line.

Note: Any Additions or Changes on This Sheet Must Be Made or Circled in Red Ink With Date and Name of Person Making Change.

PWFB 0817 684

Notes Ck'd by	Survey of LENNOX AREA ℄
Map No.	JN 0303.00 Tape 09 Std 68 °F
Office Work	Surveyed by J. BAZEN
Checked	Notes J. J. B. Date 5-74
Date	Indexed M. PALMERI JUN 15 1978

F. B. 3935 PG. 53

WS 24 A-5

TO BOT PG. 5[illegible]

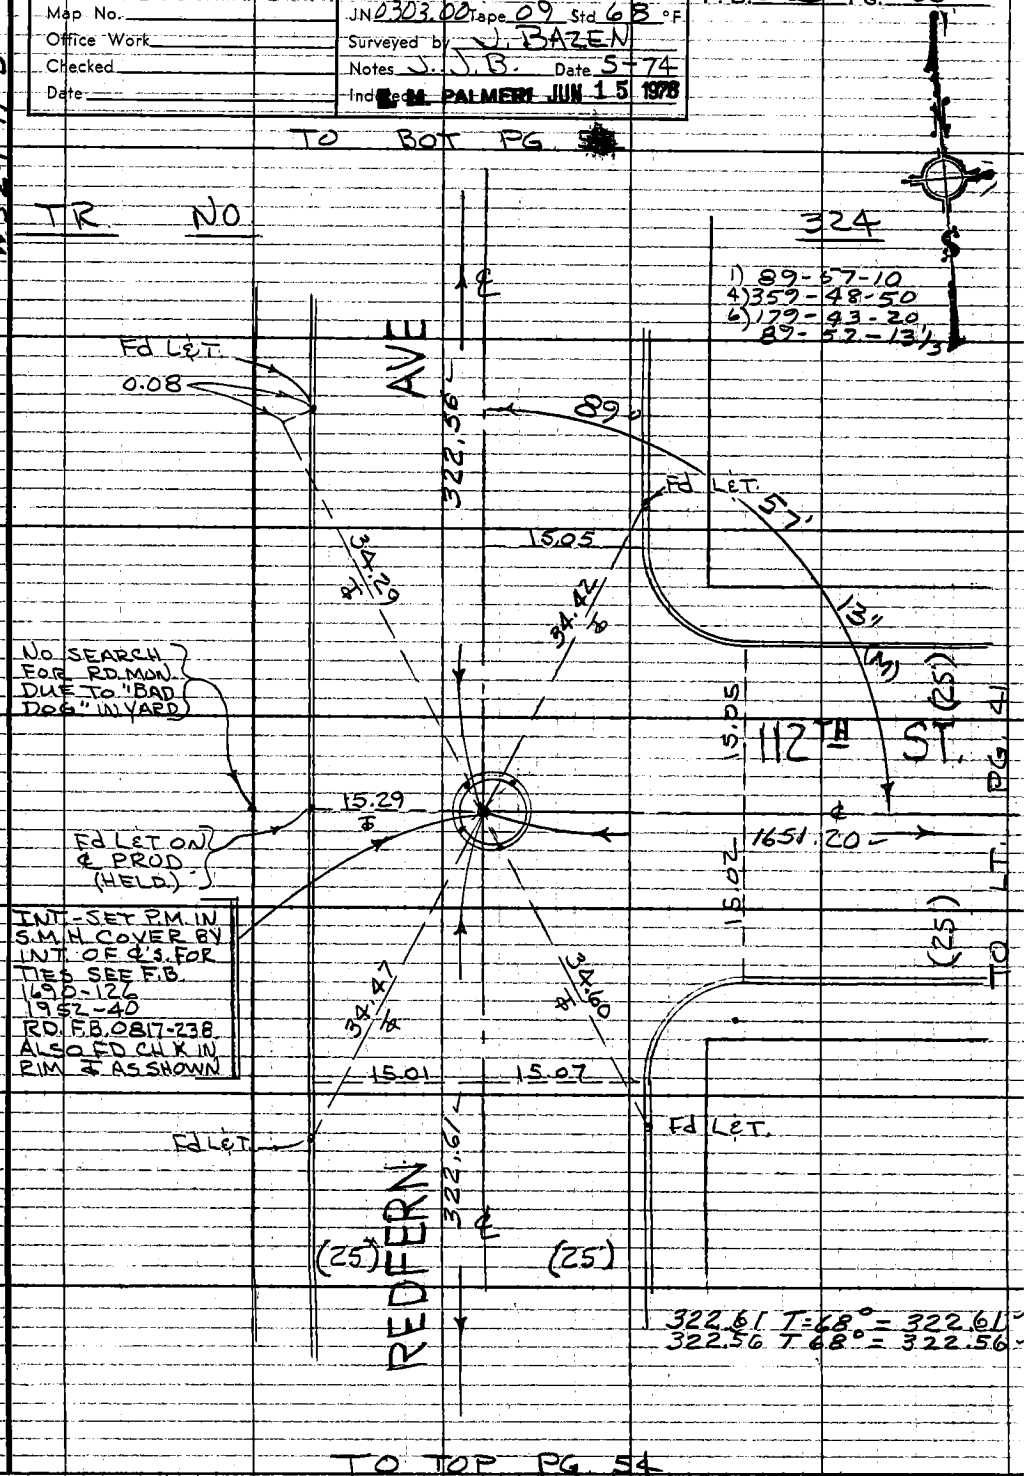

TO TOP PG. 54

Note: Any Additions or Changes on This Sheet Must be Made or Circled in Red Ink With Date and Name of Person Making Change.

Do not extend this side of this line.

PLEASE RETURN TO
COUNTY OF LOS ANGELES
DEPARTMENT OF COUNTY ENGINEER
403 LOS ANGELES COUNTY ENGINEERING BLDG.

76F309S CE#310 3-69

PWFB 0817

685

F. B. 3935 PG. 54

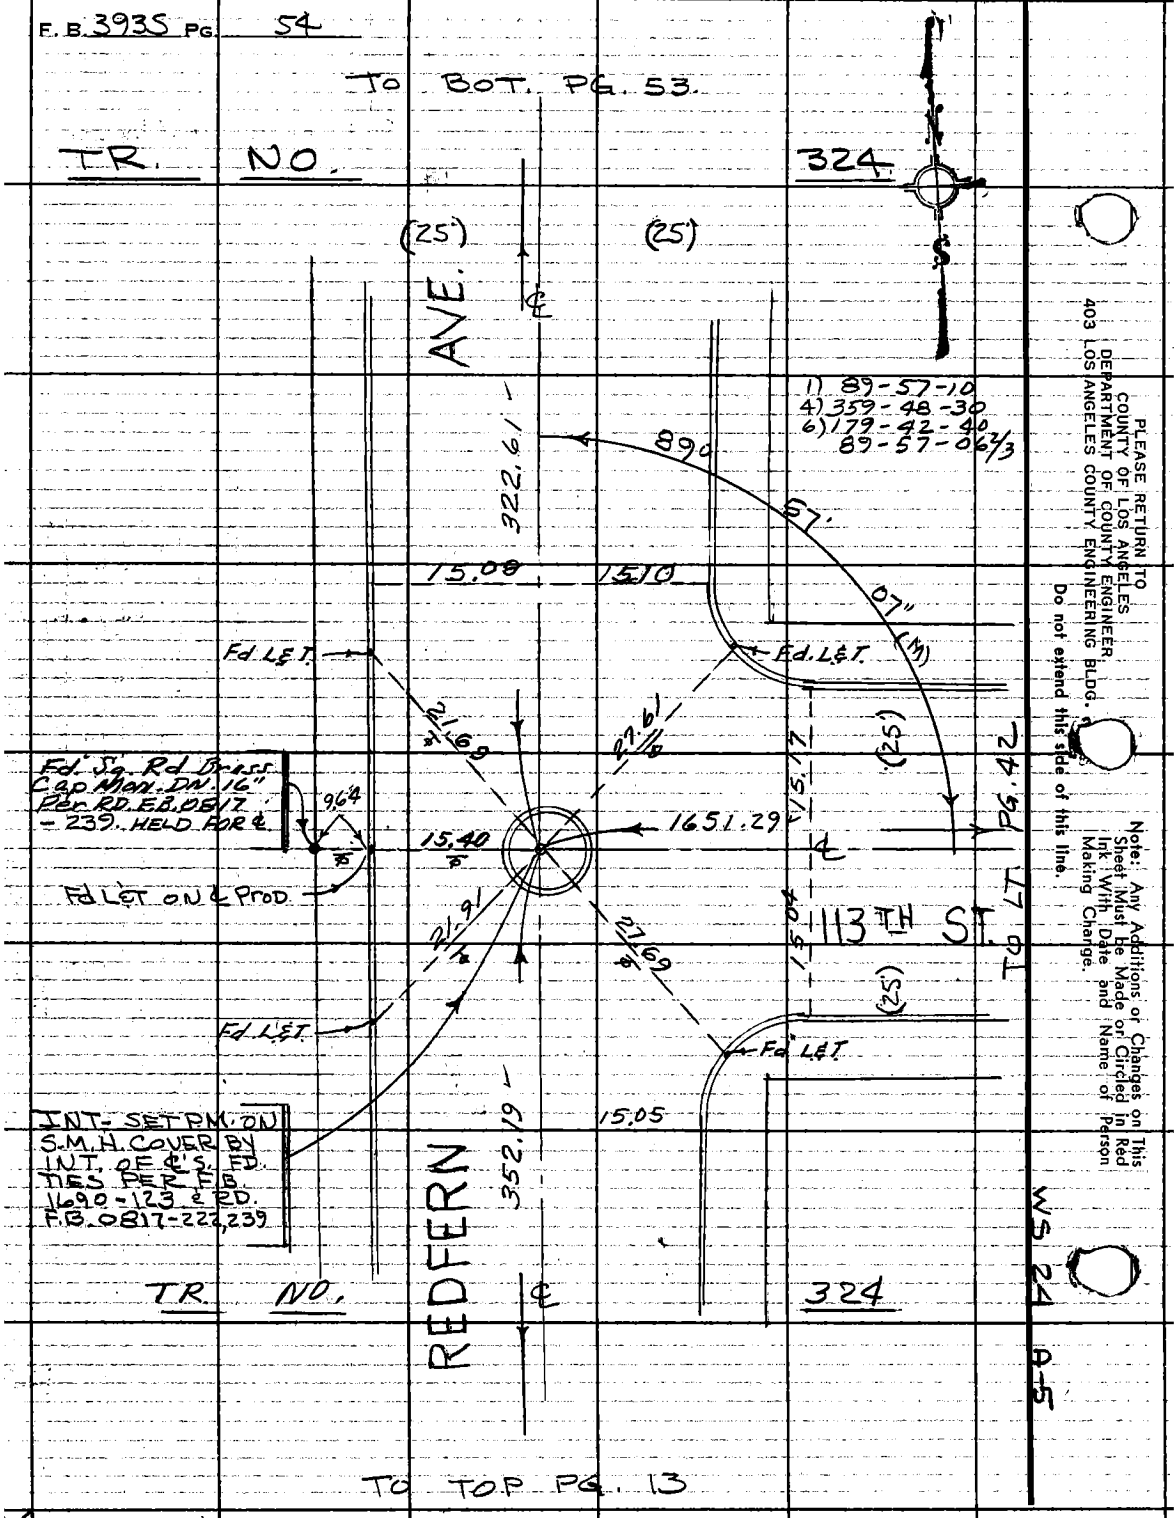

PLEASE RETURN TO
COUNTY OF LOS ANGELES
DEPARTMENT OF COUNTY ENGINEER
403 LOS ANGELES COUNTY ENGINEERING BLDG.

Do not extend this side of this line.

Note: Any Additions or Changes on This Sheet Must be Made or Circled in Red Ink With Date and Name of Person Making Change.

PWFB 0817 686

Notes Ck'd by	Survey of LENNOX AREA ℄
Map. No.	JN 0303.00 Tape 09 Std 68 °F
Office Work	Surveyed by J. BAZEN
Checked	Notes J. J. B. Date 5-74
Date	Indexed T. M. PALMERI JUN 15 1976

F. B. 3935 PG. 55

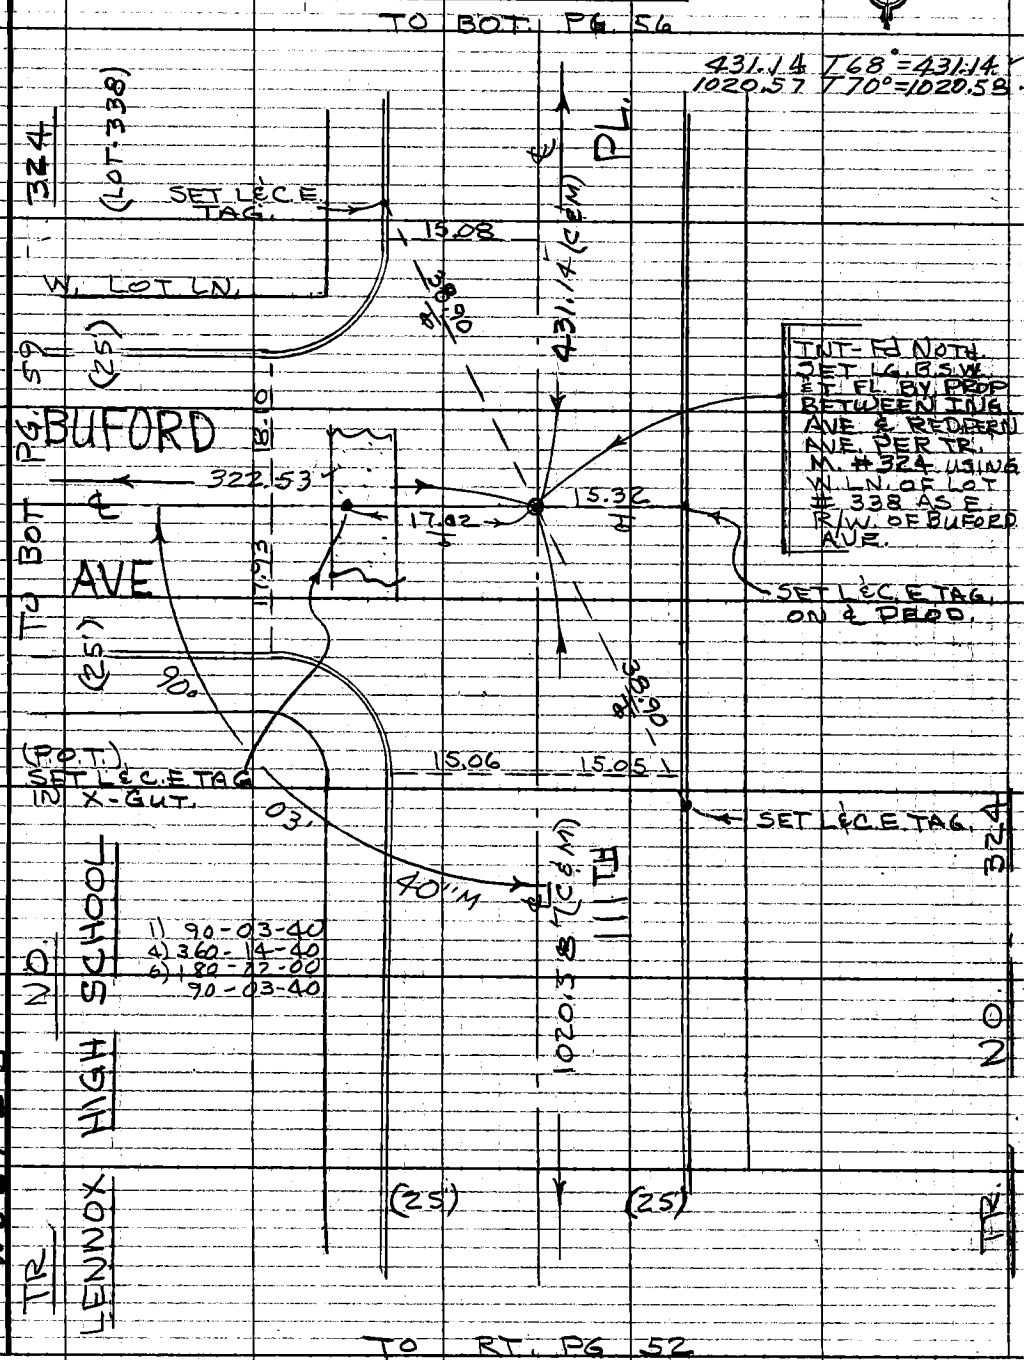

Note: Any Additions or Changes on This Sheet Must be Made or Circled in Red Ink With Date and Name of Person Making Change.

Do not extend this side of this line.

PLEASE RETURN TO
COUNTY OF LOS ANGELES
DEPARTMENT OF COUNTY ENGINEER
403 LOS ANGELES COUNTY ENGINEERING BLDG.

76F309S CE#310 3-69

F.B. 3935 PG. 56

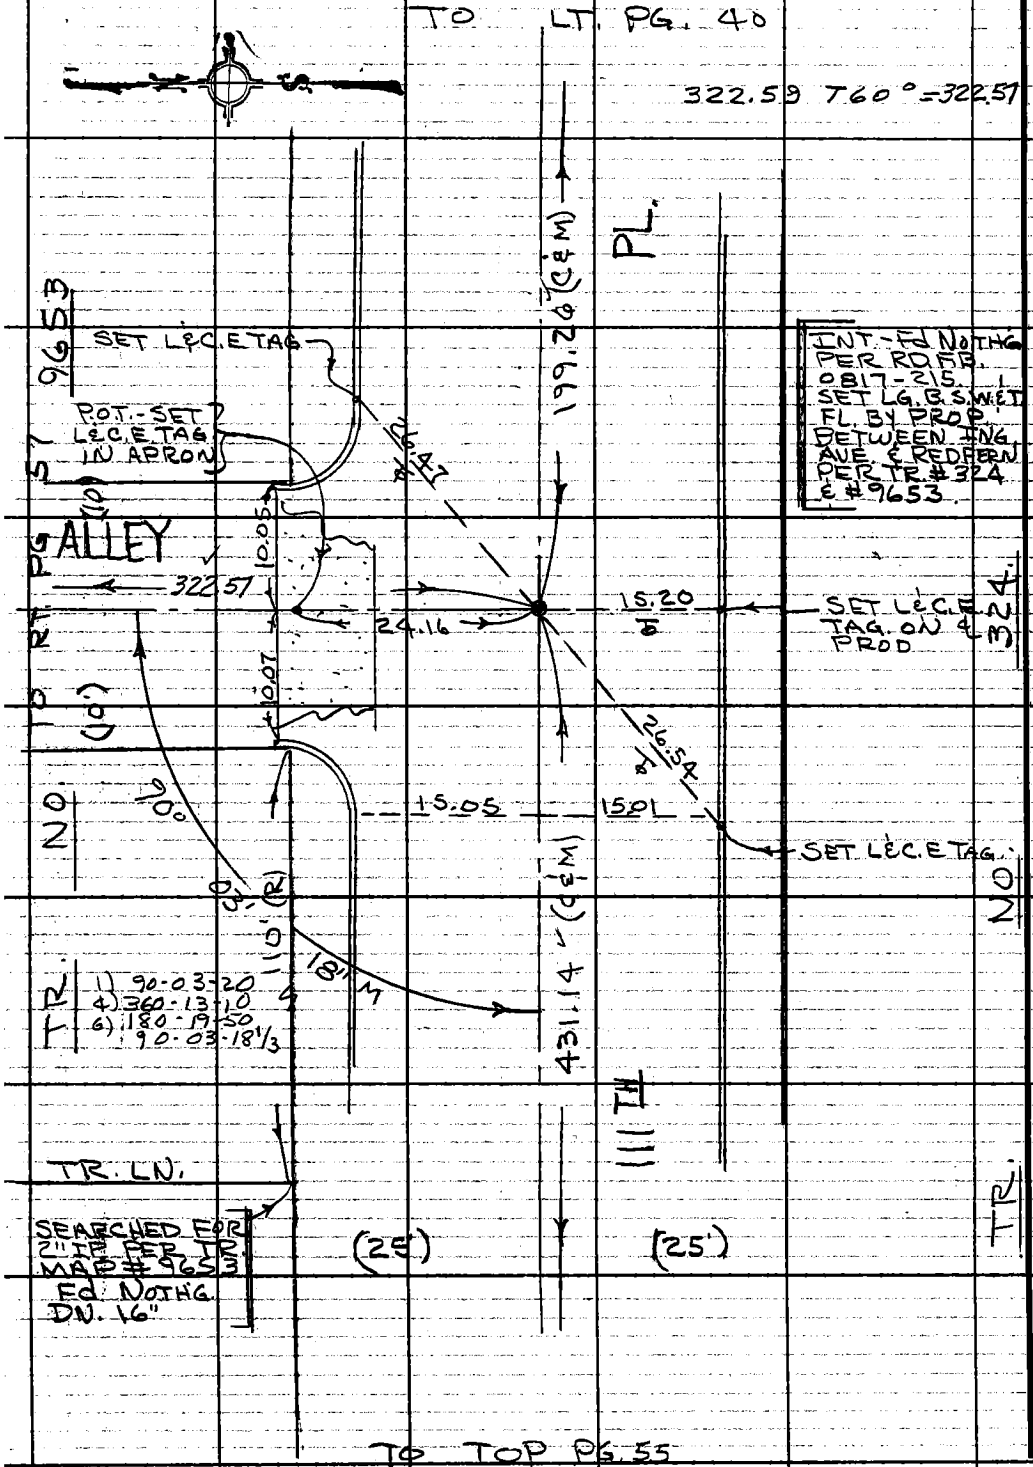

PLEASE RETURN TO
COUNTY OF LOS ANGELES
DEPARTMENT OF COUNTY ENGINEER
403 LOS ANGELES COUNTY ENGINEERING BLDG.

Do not extend this side of this line.

Note: Any Additions or Changes on This Sheet Must Be Made or Circled in Red Ink With Date and Name of Person Making Change.

PWFB 0817

688

Notes Ck'd by	Survey of LENNOX AREA ℄
Map No.	JN 0303.00 Tape 09 Std 68 °F
Office Work	Surveyed by J. BAZEN
Checked	Notes J J.B. Date 5-74
Date	Index [redacted] PALMERI JUN 15 1976

F. B. 3935 PG. 57

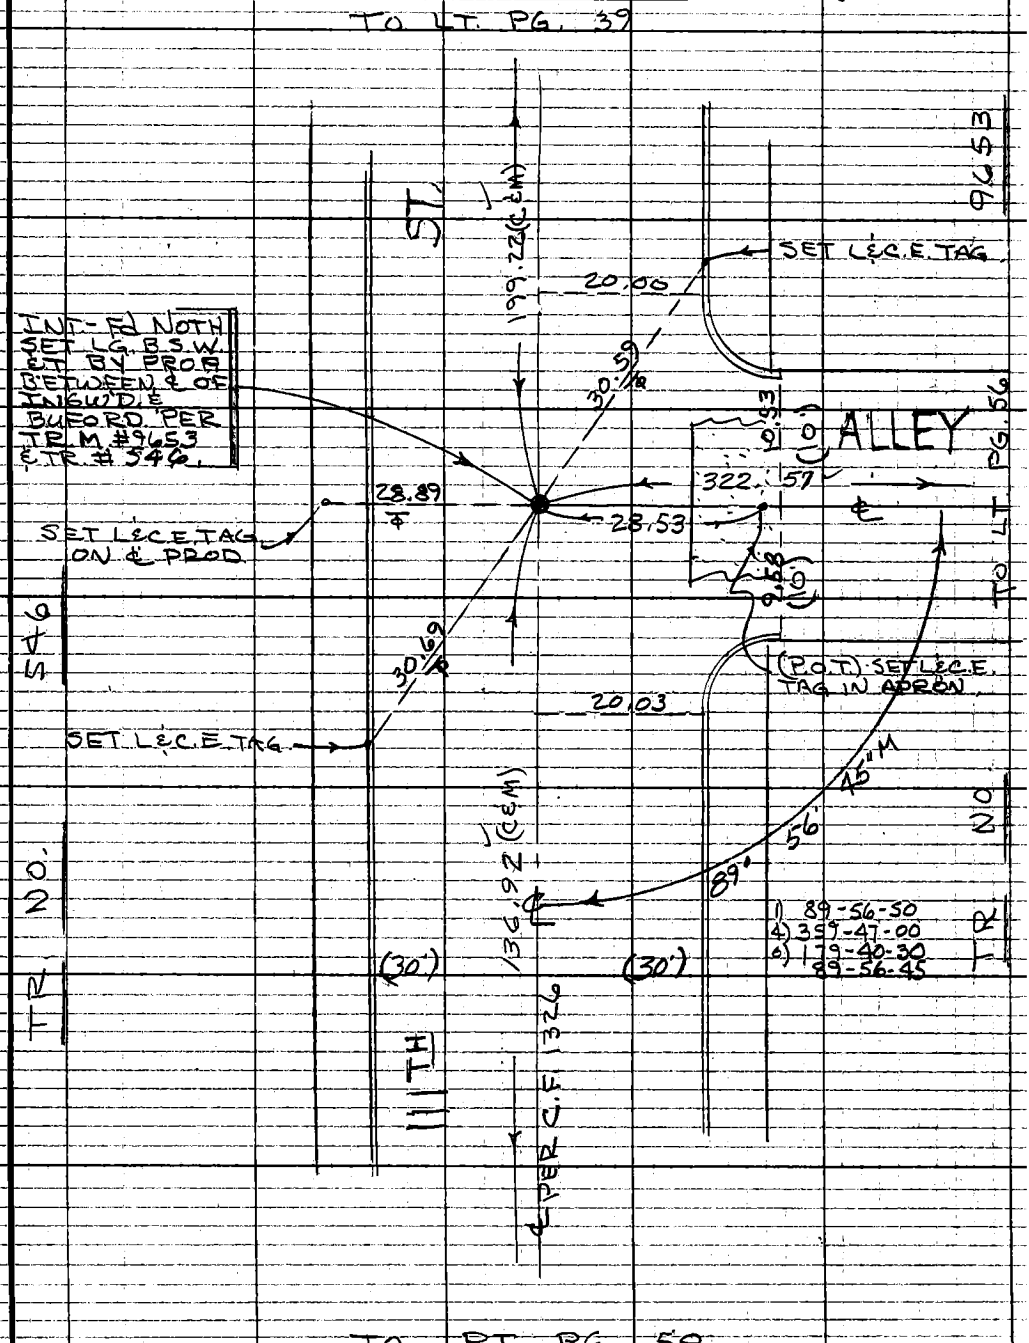

Note: Any Additions or Changes on This Sheet Must be Made or Circled in Red Ink With Date and Name of Person Making Change.

Do not extend this side of this line.

PLEASE RETURN TO
COUNTY OF LOS ANGELES
DEPARTMENT OF COUNTY ENGINEER
403 LOS ANGELES COUNTY ENGINEERING BLDG.

76F309S CE#310 3-69

PWFB 0817 689

F.B. 3935 PG. 58

TO BOT PG. 48

TR. NO.

546

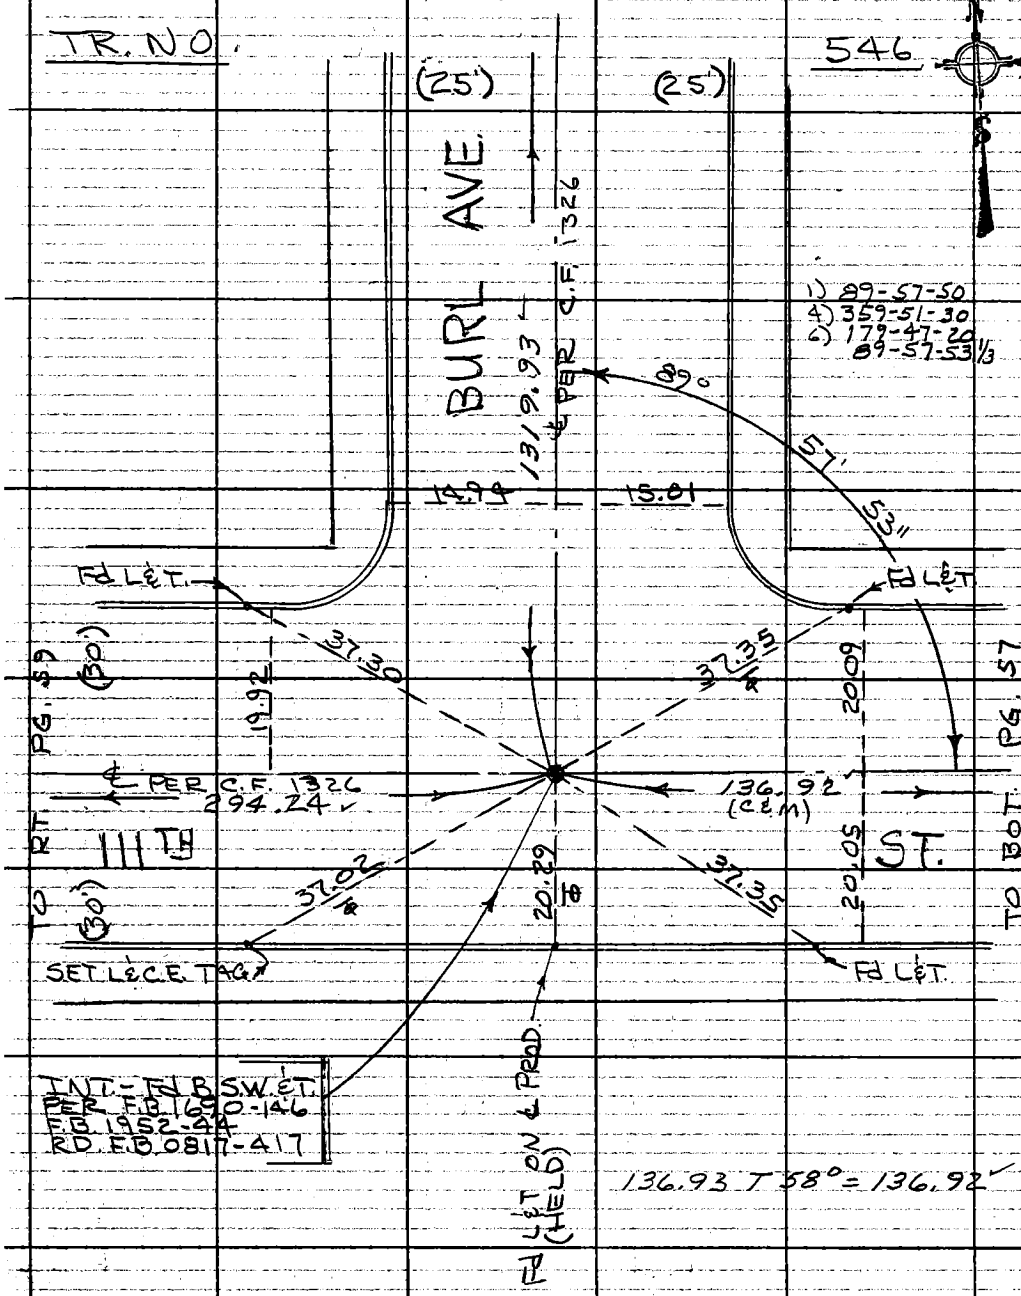

PLEASE RETURN TO
COUNTY OF LOS ANGELES
DEPARTMENT OF COUNTY ENGINEER
403 LOS ANGELES COUNTY ENGINEERING BLDG.

Do not extend this side of this line.

Note: Any Additions or Changes on This Sheet Must Be Made or Circled in Red Ink With Date and Name of Person Making Change.

WS 24

B5

TR. NO. 9653

PWFB 0817 690

Notes Ck'd by
Map No.
Office Work
Checked
Date

Survey of LENNOX AREA ℄
JN 0303.00 Tape 09 Std 68 °F
Surveyed by J. BAZEN
Notes J.J.B. Date 5-74
Indexed T. M. PALMERI JUN 15 1976

F.B. 3935 PG. 59

B5

WS 24

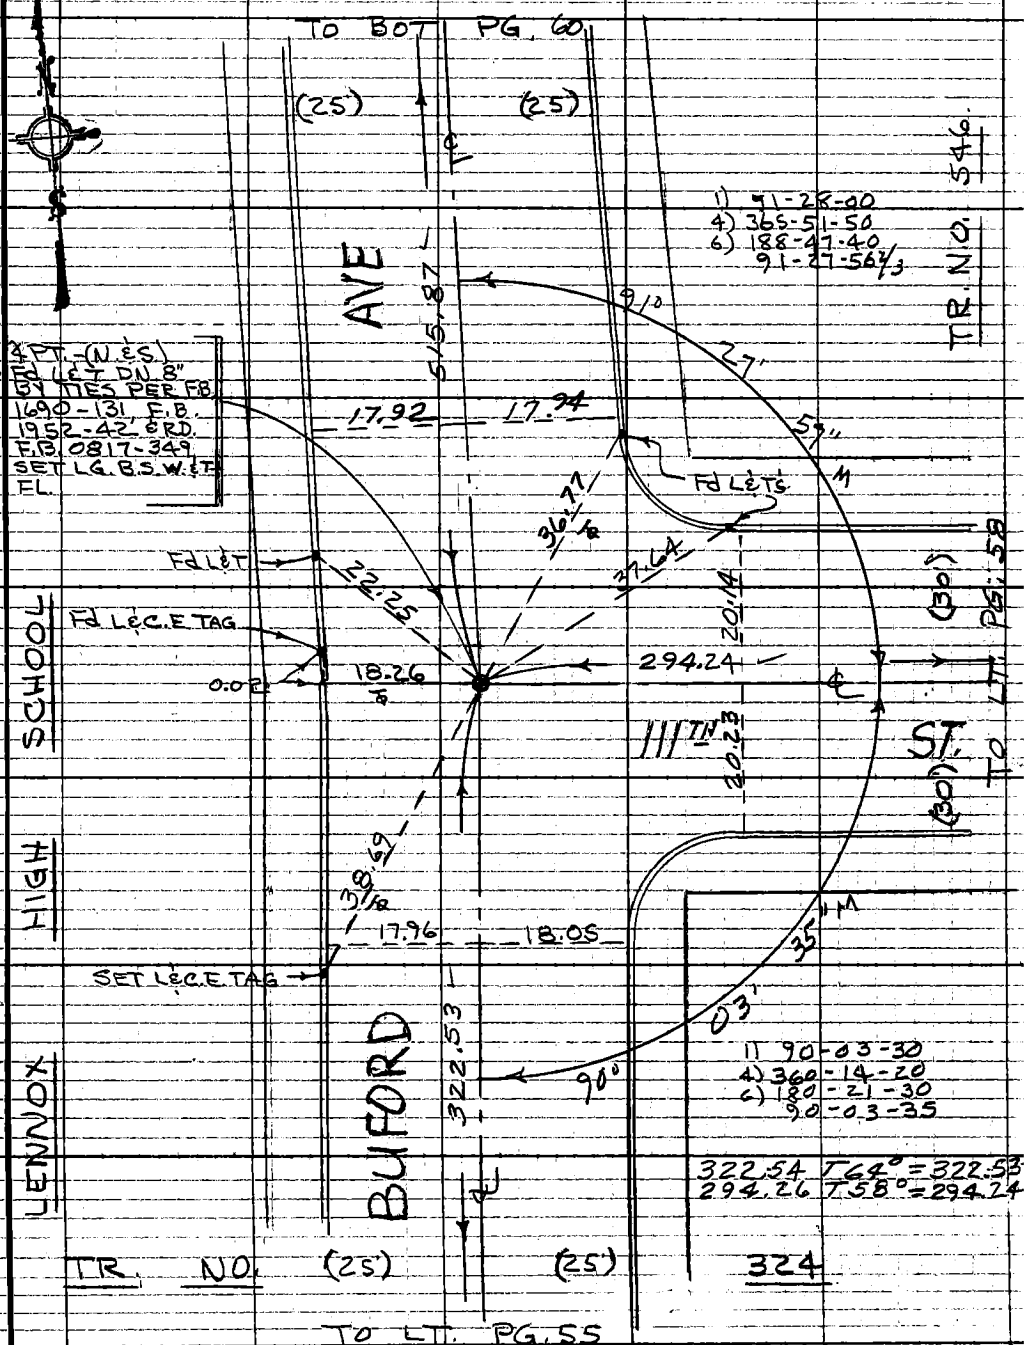

Note: Any Additions or Changes on This Sheet Must be Made or Circled in Red Ink With Date and Name of Person Making Change.

Do not extend this side of this line.

PLEASE RETURN TO
COUNTY OF LOS ANGELES
DEPARTMENT OF COUNTY ENGINEER
403 LOS ANGELES COUNTY ENGINEERING BLDG.

76F309S CE#310 3-69

691

F.B. 3935 PG. 60

TO BOT PG. 61

257.93 TC4°-257.92
515.88 TC4=515.87

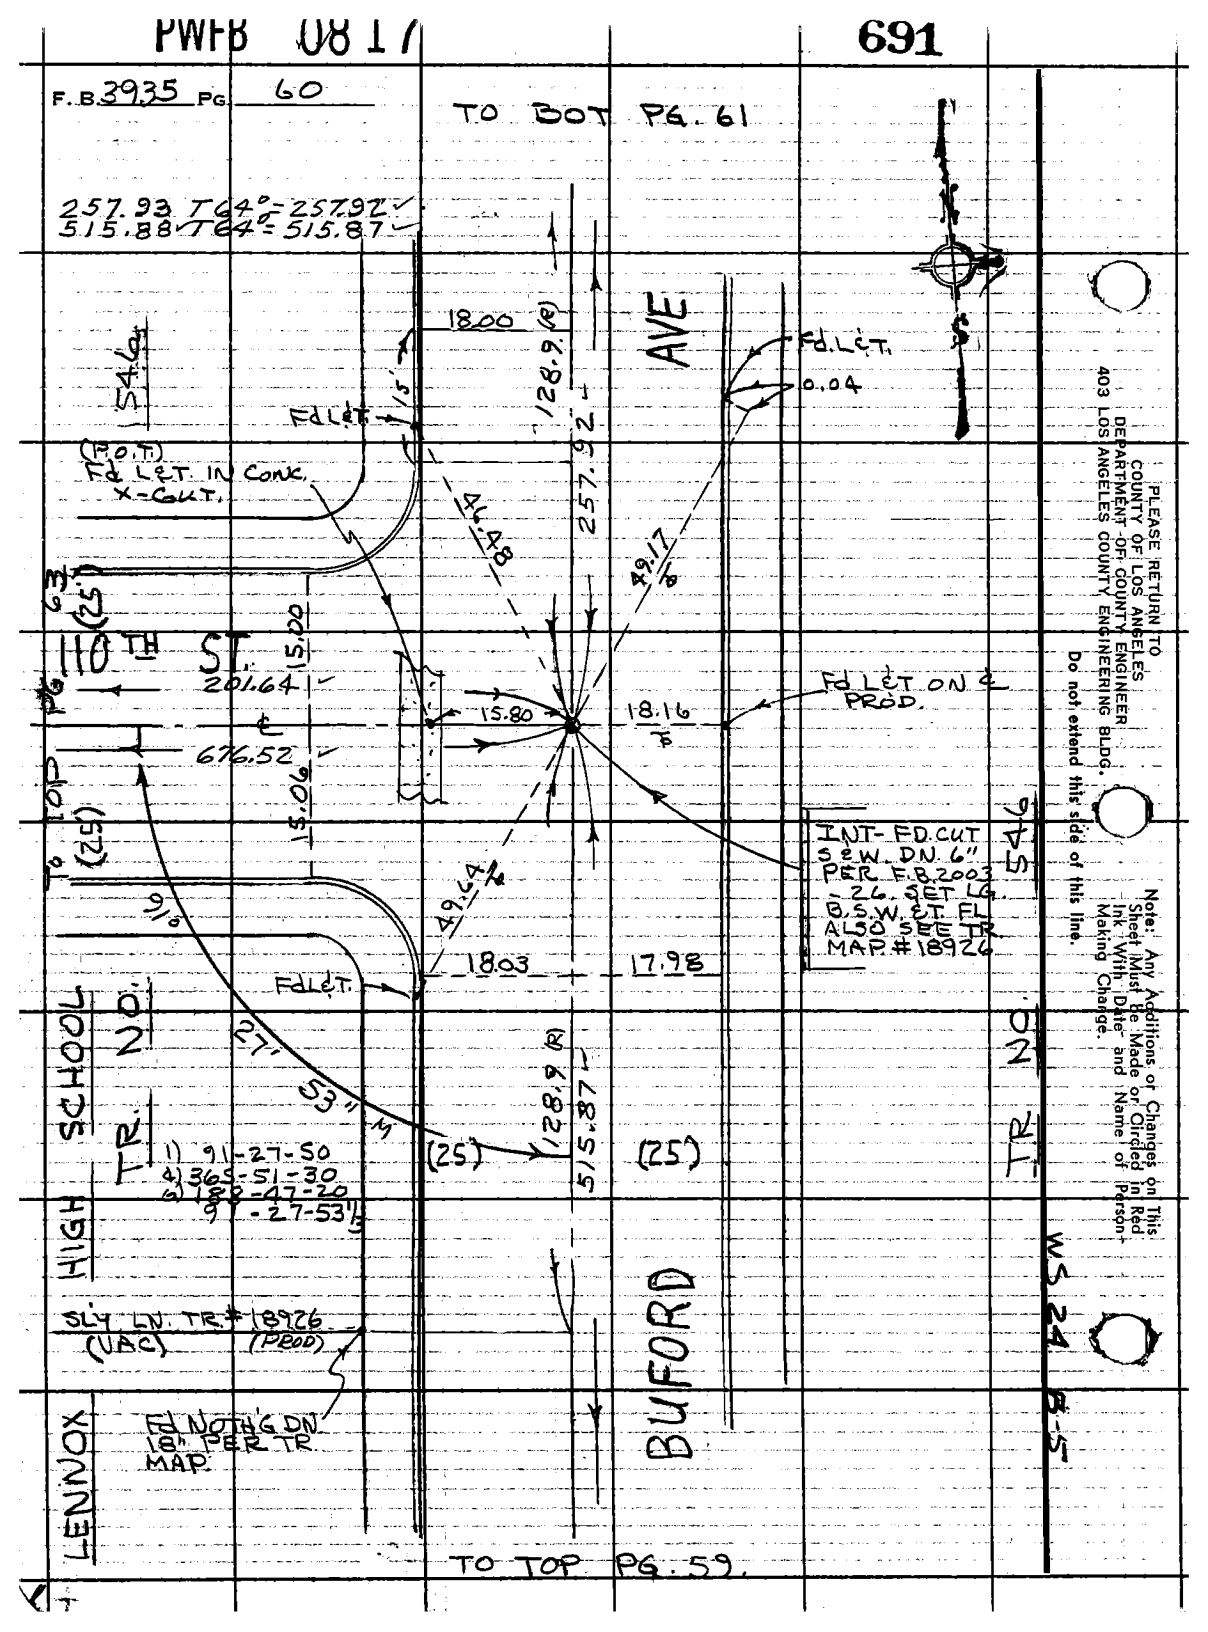

PLEASE RETURN TO
COUNTY OF LOS ANGELES
DEPARTMENT OF COUNTY ENGINEER
403 LOS ANGELES COUNTY ENGINEERING BLDG.
Do not extend this side of this line.

Note: Any Additions or Changes on This Sheet Must Be Made or Circled in Red Ink With Date and Name of Person Making Change.

PWFB 0817 692

Notes Ck'd by	Survey of LENNOX AREA ℄
Map No.	JN 0303.00 Tape 09 Std 68 °F
Office Work	Surveyed by J. BAZEN
Checked	Notes J.J.B. Date 5-74
Date	Indexed PALMER JUN 15 1976

F.B. 3935 PG. 61

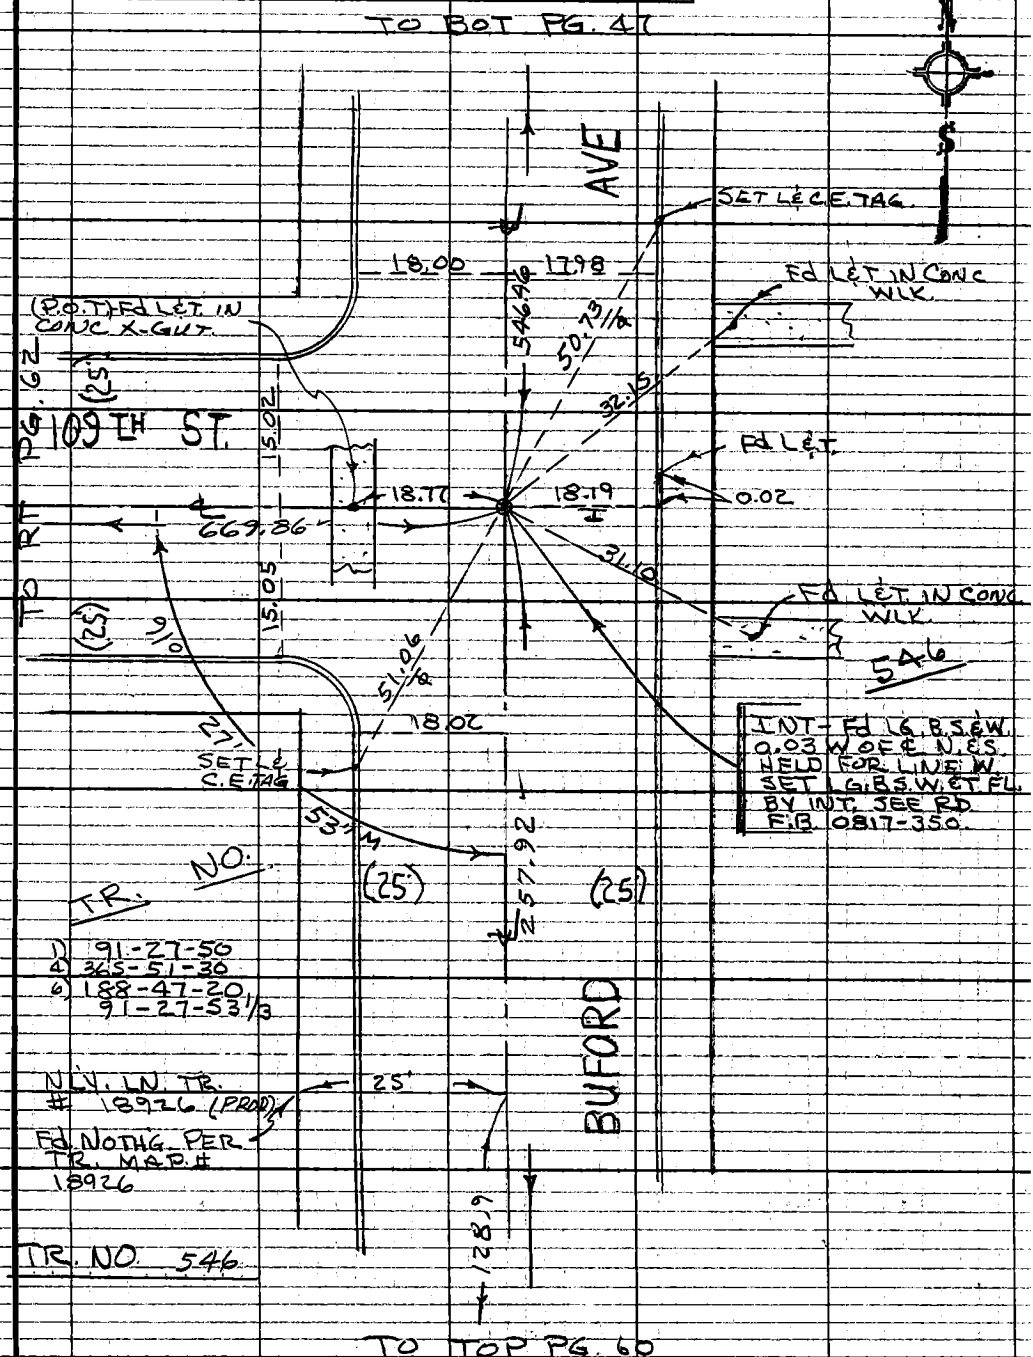

Note: Any Additions or Changes on This Sheet Must be Made or Circled in Red Ink With Date and Name of Person Making Change.

Do not extend this side of this line.

PLEASE RETURN TO
COUNTY OF LOS ANGELES
DEPARTMENT OF COUNTY ENGINEER
403 LOS ANGELES COUNTY ENGINEERING BLDG.

76F309S CE#310 3-69

PWFB 0817 693

F.B. 3935 PG 62

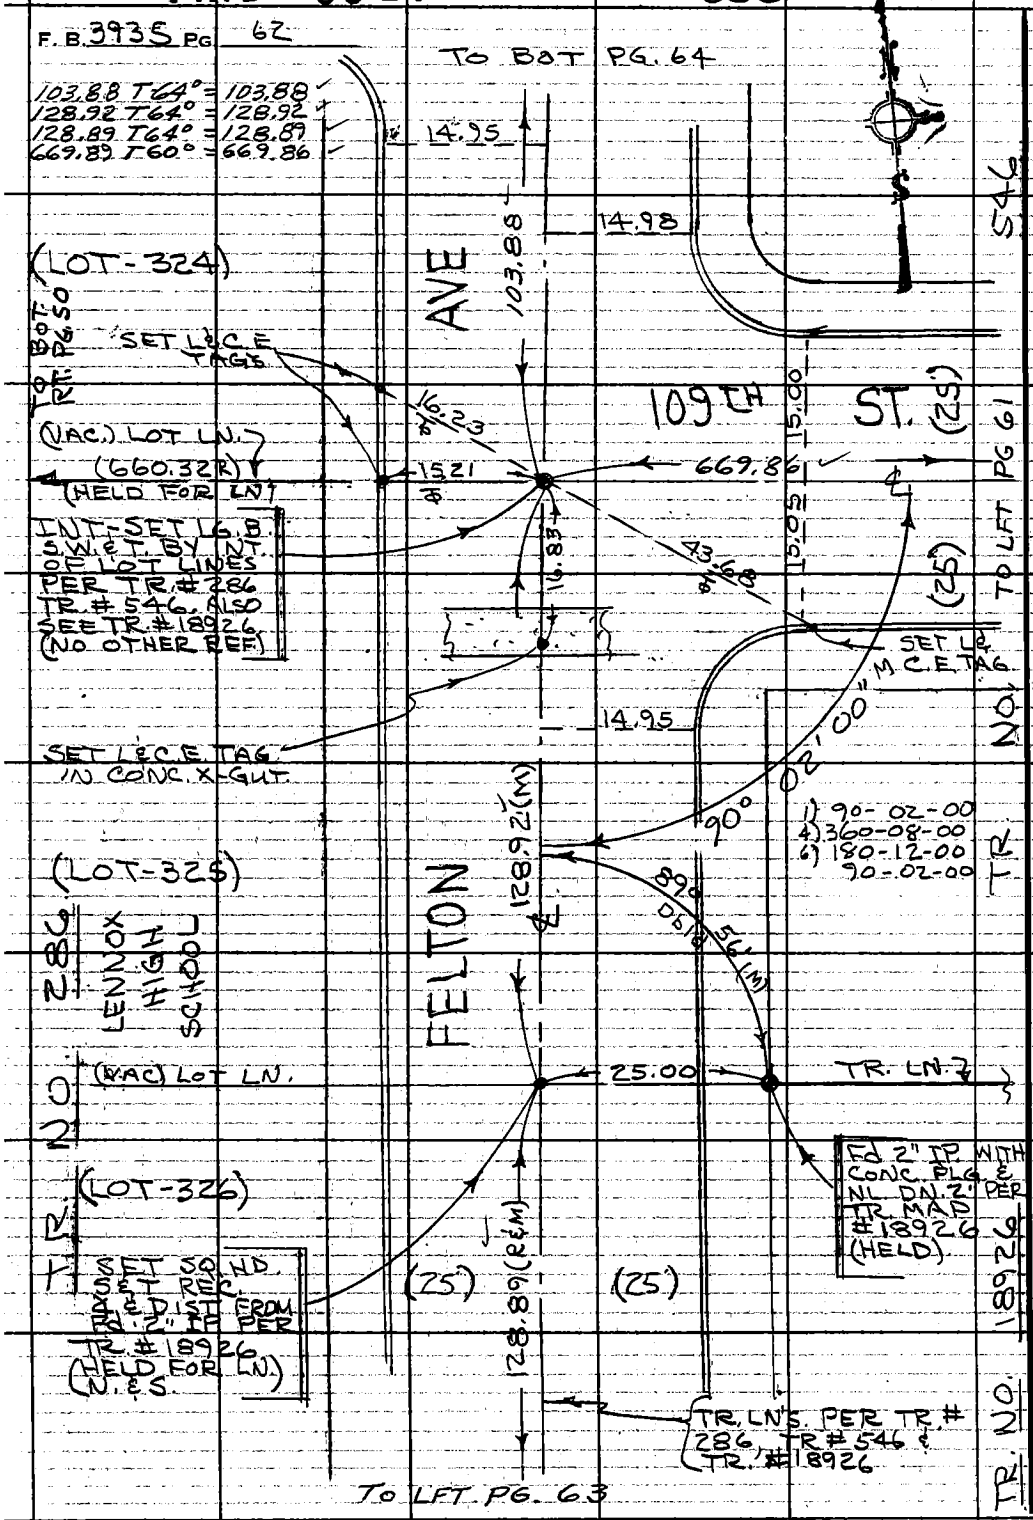

PLEASE RETURN TO
COUNTY OF LOS ANGELES
DEPARTMENT OF COUNTY ENGINEER
403 LOS ANGELES COUNTY ENGINEERING BLDG.

Do not extend this side of this line.

Note: Any Additions or Changes on This Sheet Must be Made or Circled in Red Ink With Date and Name of Person Making Change.

PWFB 0817 694

Notes Ck'd by	Survey of LENNOX AREA C
Map No.	JN 0303.00 Tape 09 Std 68 °F
Office Work	Surveyed by J. BAZEN
Checked	Notes J.B. Date 5-74
Date	Indexed T. M. PALMERI JUN 15 1976

F. B. 3935 PG. 63

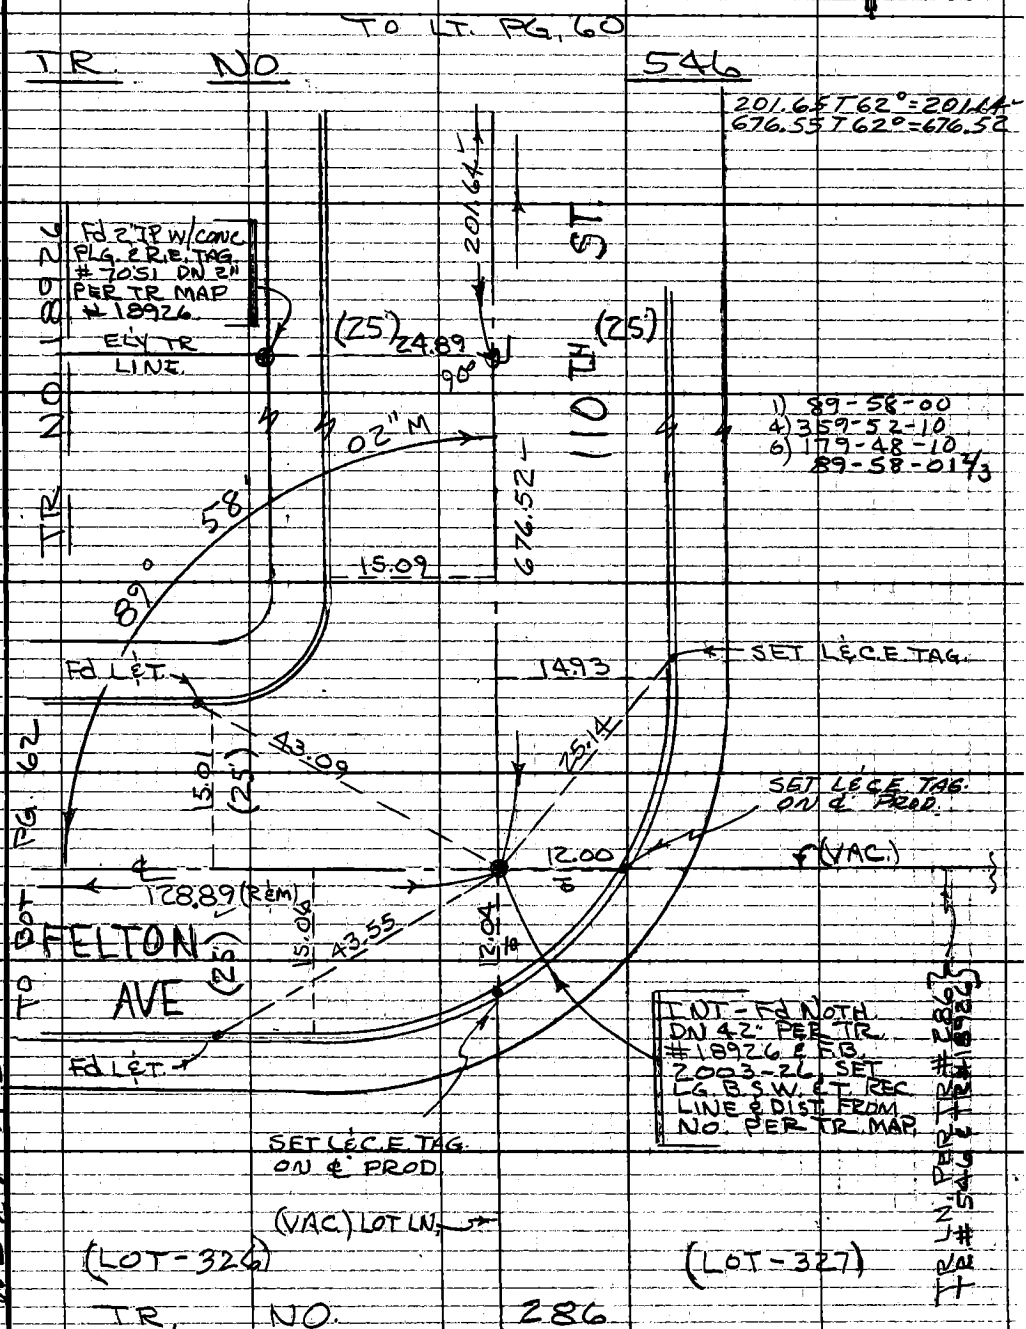

Note: Any Additions or Changes on This Sheet Must be Made or Circled in Red Ink With Date and Name of Person Making Change.

Do not extend this side of this line.

PLEASE RETURN TO COUNTY OF LOS ANGELES DEPARTMENT OF COUNTY ENGINEER 403 LOS ANGELES COUNTY ENGINEERING BLDG.

76F309S CE#310 3-69

PWFB 0817

695

F.B. 3935 PG. 64

SEE PG. 46

330.32 T 62° = 330.35

TO INT. OF FELTON & LENWOOD (LINE ENDS)

BUFORD ELEMENTARY SCHOOL

N

INT. - FD NOTH. (NO REF)
SET LG. B.B.W. & T. FL
BY INT. OF ℄'s

(OLD) TR. LINE BETW.
TR. NO. 286 & TR. 546

286
80
N

NLY LINE LOT-324

NLY LN. LOT-27

FD NOTH

SET L&C.E.
TAG ON PROD.

SET L&E.E. TAG IN WLK

109TH ST.

PG. 65

(25)

330.31

15.09

12.15

16.19

12.10

FD L&T. (NO REF)
(HELD FOR LN.)
(W. FITS TR.
REC. FROM S.
WITHIN 0.04)

S 89° 54' 00" E

RT.

TO

14.92

137.03

SET L&C.E.
TAG IN WLK

15.04

89°

14.95

N 0° 02' 00" E

(LOT-324)

58.

30"

M

103.88 M (R)
(103.90)

(25)

(25)

FELTON AVE.

1) 89-58-30
4) 359-54-00
5) 179-51-00
89-58-30

TO TOP PG. 62

W 5.24 A-5

PLEASE RETURN TO
COUNTY OF LOS ANGELES
DEPARTMENT OF COUNTY ENGINEER
403 LOS ANGELES COUNTY ENGINEERING BLDG.

Do not extend this side of this line.

Note: Any Additions or Changes on This Sheet Must Be Made or Circled in Red Ink With Date and Name of Person Making Change.

PWFB 0817 696

Notes Ck'd by	Survey of LENNOX AREA ℄
Map No.	JN 0303.00 Tape 09 Std 68 °F
Office Work	Surveyed by J. BAZEN
Checked	Notes J.J.B. Date 5-74
Date	Index [illegible] PALMERI JUN 15 [illegible]

F.B. 3935 PG. 65

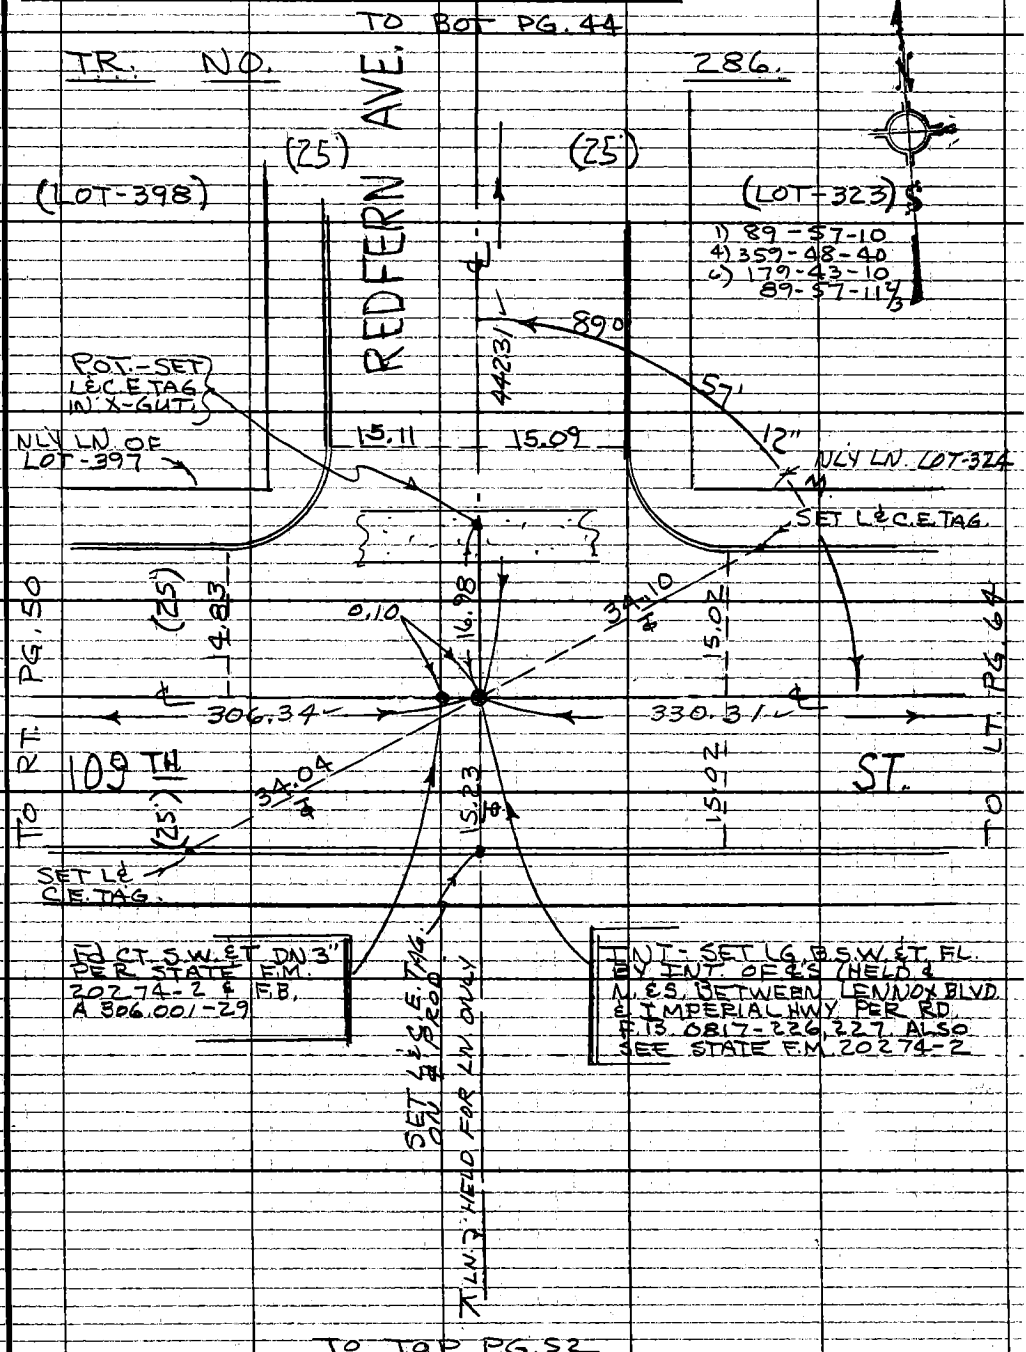

Note: Any Additions or Changes on This Sheet Must be Made or Circled in Red Ink With Date and Name of Person Making Change.

Do not extend this side of this line.

PLEASE RETURN TO
COUNTY OF LOS ANGELES
DEPARTMENT OF COUNTY ENGINEER
403 LOS ANGELES COUNTY ENGINEERING BLDG.

76F309S CE#310 3-69

F.B. 3935 PG. 66

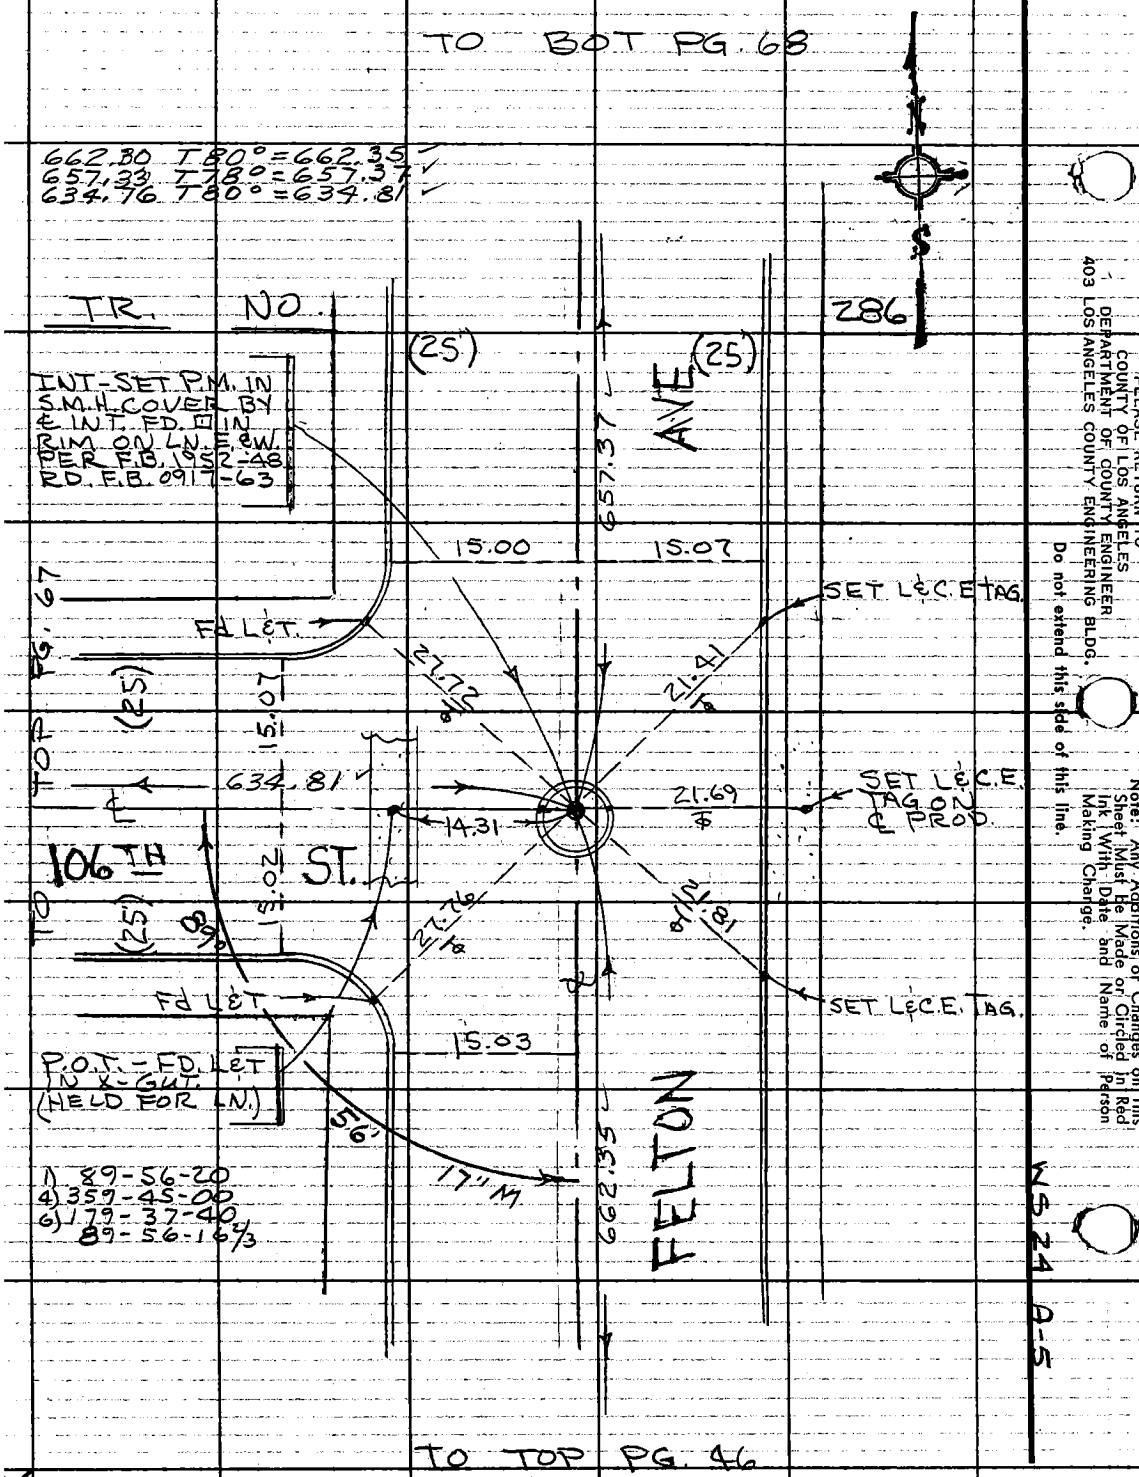

PLEASE RETURN TO
COUNTY OF LOS ANGELES
DEPARTMENT OF COUNTY ENGINEER
403 LOS ANGELES COUNTY ENGINEERING BLDG.

Do not extend this side of this line.

Note: Any Additions or Changes on This Sheet Must be Made or Circled in Red Ink With Date and Name of Person Making Change.

PWFB 0917

250

Notes Ck'd by
Map No.
Office Work
Checked
Date

Survey of LENNOX AREA ℄
J.N. 0303.00 Tape 09 Std. 68 °F.
Surveyed by J. BAZEN
Notes J.d.B. Date 5-74
Index S. M. PALMER JUN 15 1976

F. B. 3935 Pg. 67

TO LT. PG. 66.

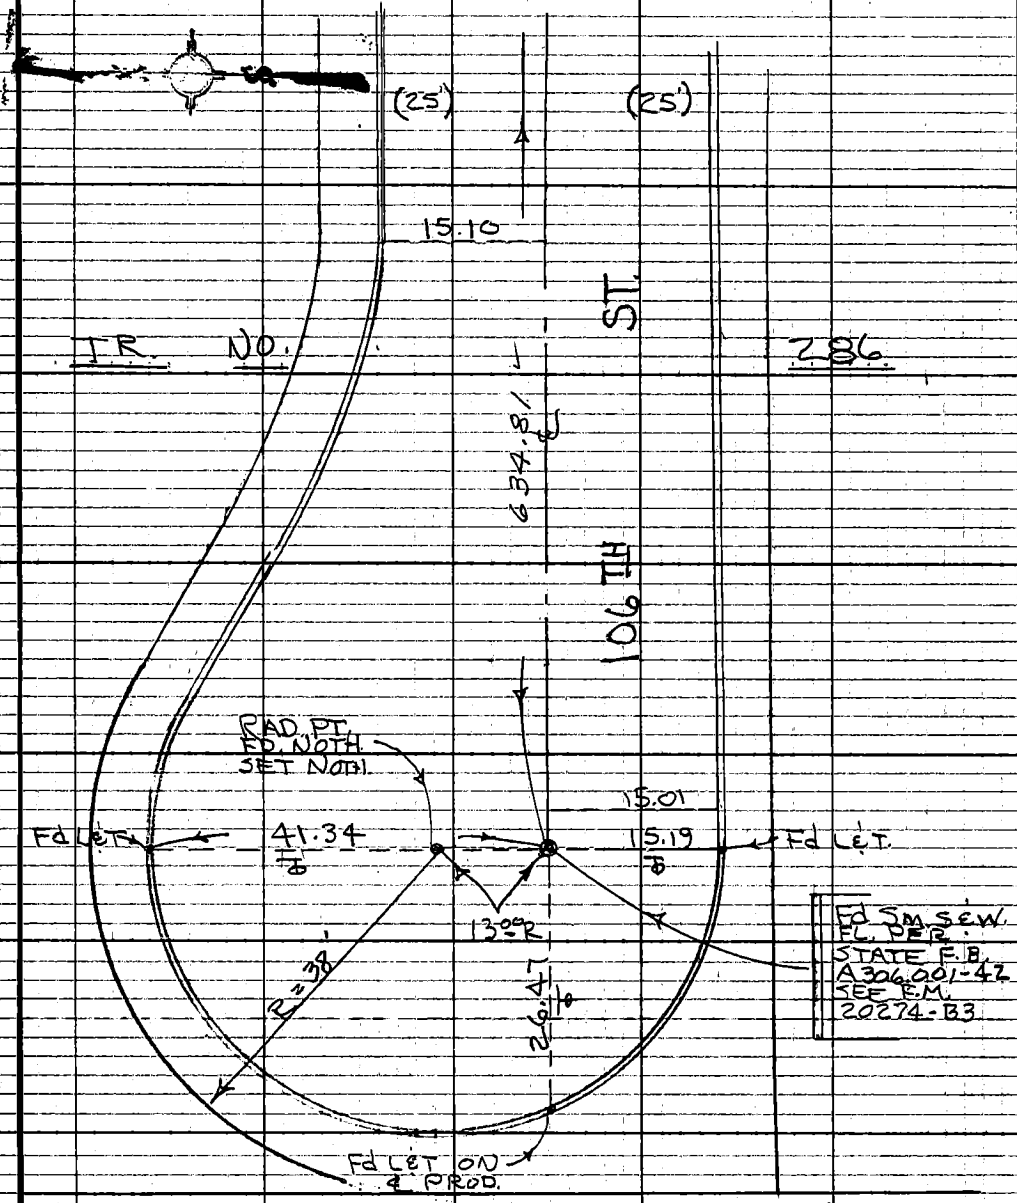

Note: Any Additions or Changes on this Sheet Must be Made or Circled in Red Ink With Date and Name of Person Making Change.

Do not extend this side of this line.

PLEASE RETURN TO
COUNTY OF LOS ANGELES
DEPARTMENT OF COUNTY ENGINEER
403 LOS ANGELES COUNTY ENGINEERING BLDG.

76F309S CE#3 10-3-69

F.B. 3935 PG. 68

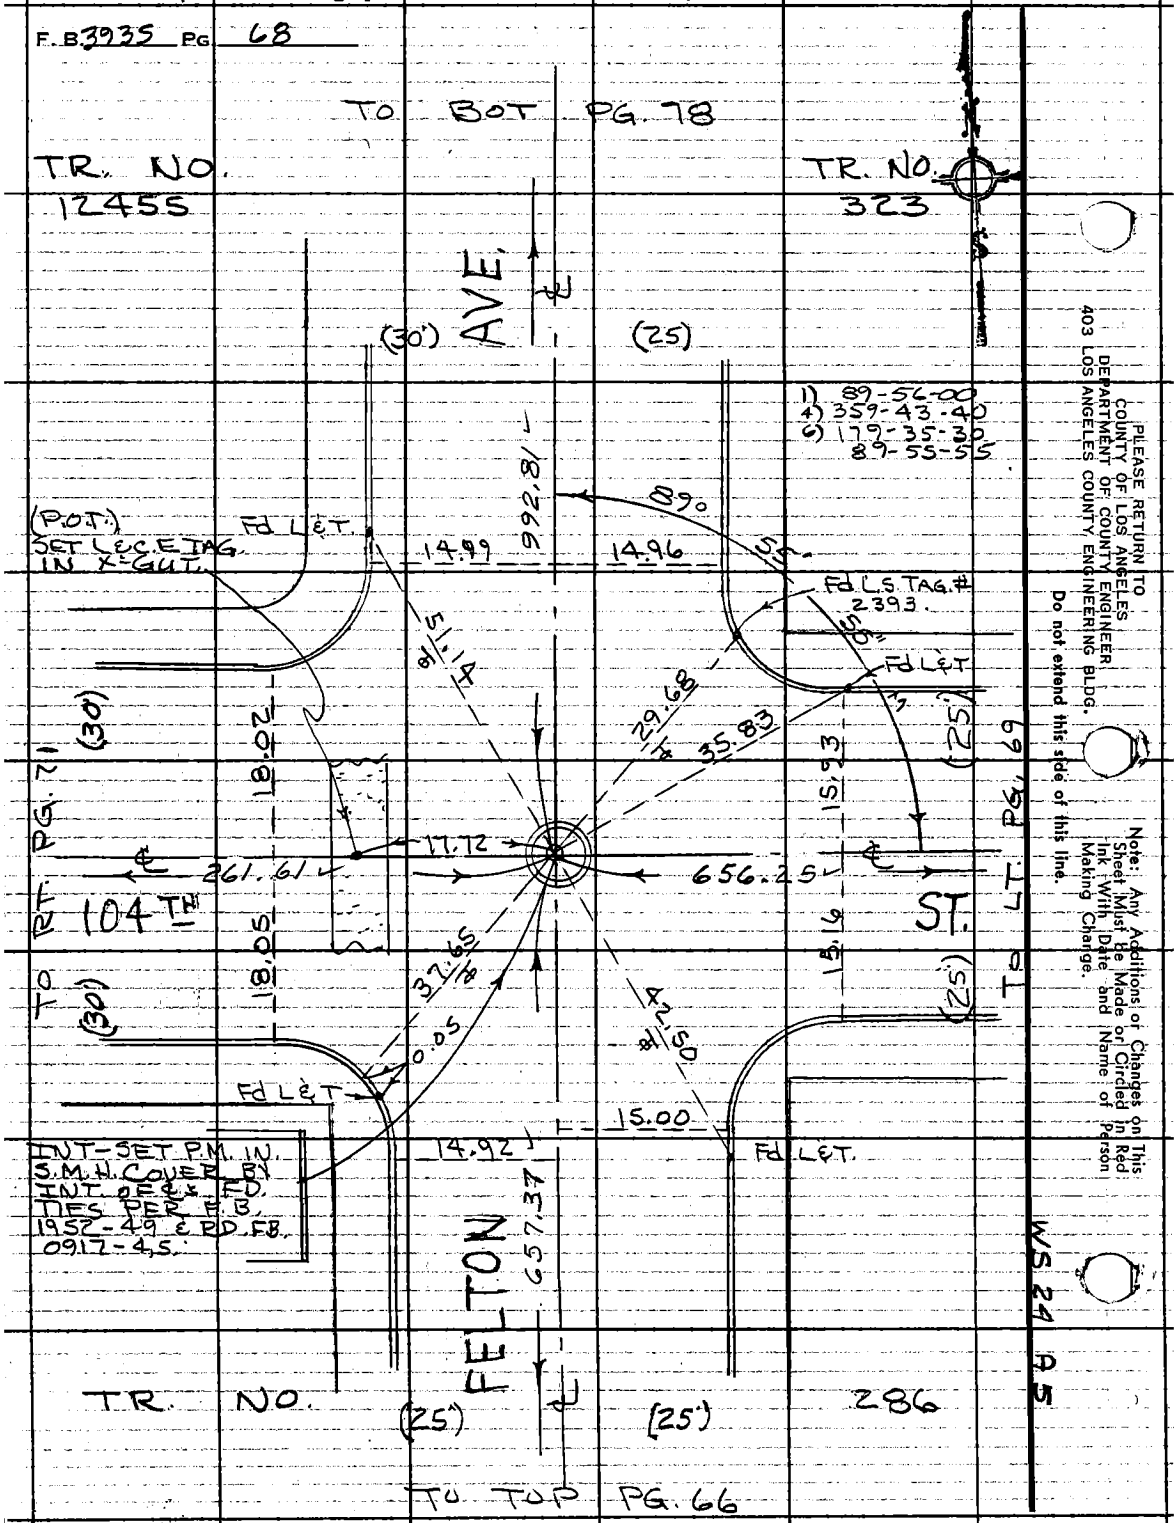

PLEASE RETURN TO
COUNTY OF LOS ANGELES
DEPARTMENT OF COUNTY ENGINEER
403 LOS ANGELES COUNTY ENGINEERING BLDG.
Do not extend this side of this line.

Note: Any Additions or Changes on This Sheet Must be Made or Circled in Red Ink With Date and Name of Person Making Change.

PWFB 0917 252

Notes Ck'd by	Survey of LENNOX AREA ℄
Map No.	JN 0303.00 Tape 09 Std 68 °F
Office Work	Surveyed by J. BAZEN
Checked	Notes J.S.B. Date 5-74
Date	Index R. M. PALMERI JUN 15 1976

F.B. 3935 PG. 69

B5

WS 24

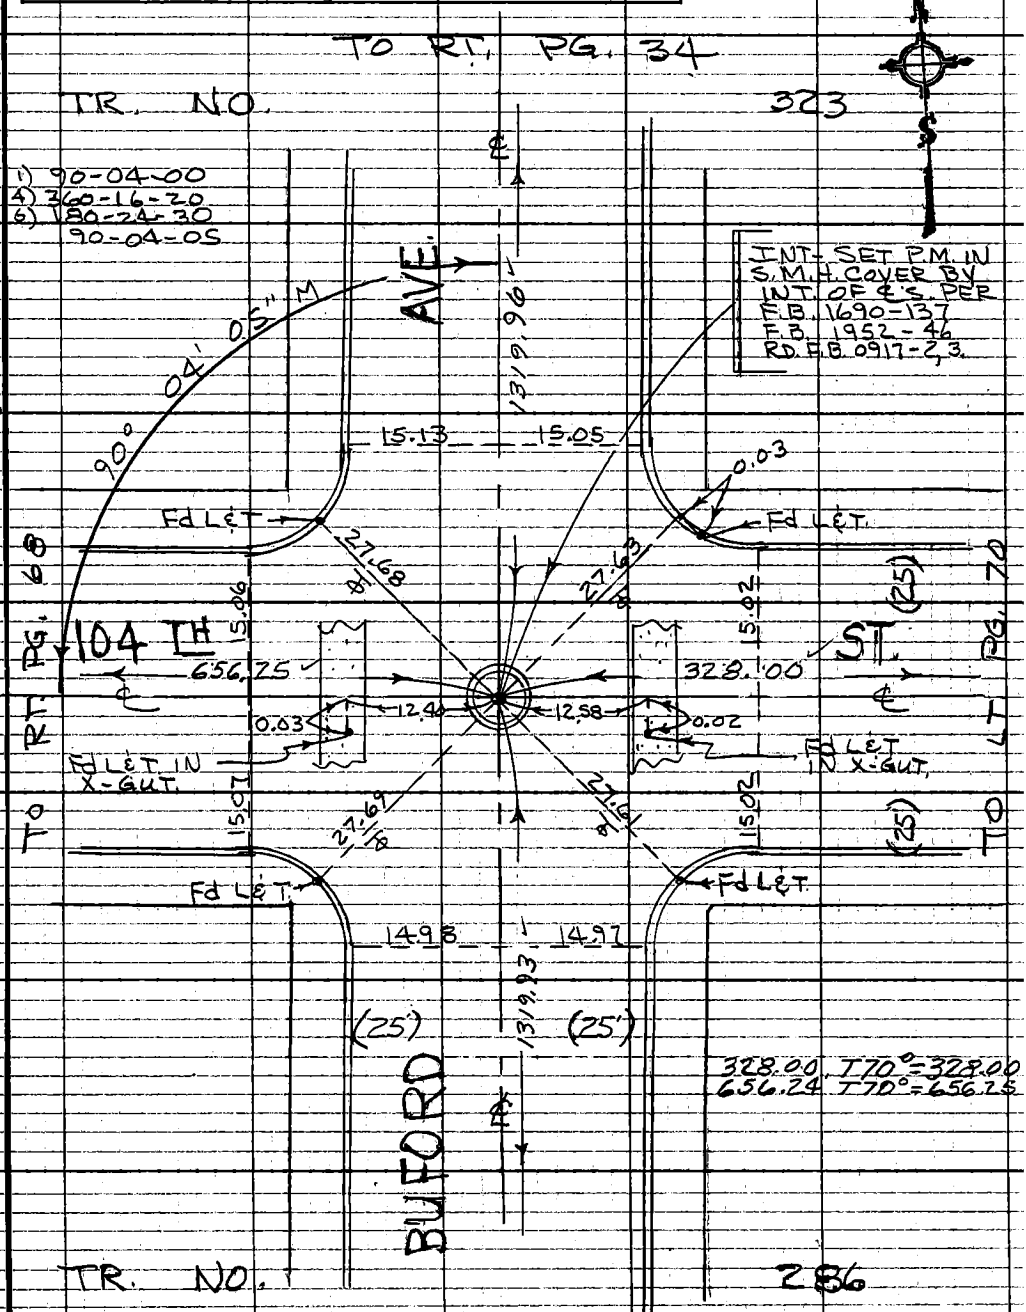

Note: Any Additions or Changes on This Sheet Must be Made or Circled in Red Ink With Date and Name of Person Making Change.

Do not extend this side of this line.

PLEASE RETURN TO
COUNTY OF LOS ANGELES
DEPARTMENT OF COUNTY ENGINEER
403 LOS ANGELES COUNTY ENGINEERING BLDG.

76F309S CE#310 3-69

F.B. 3935 PG. 70

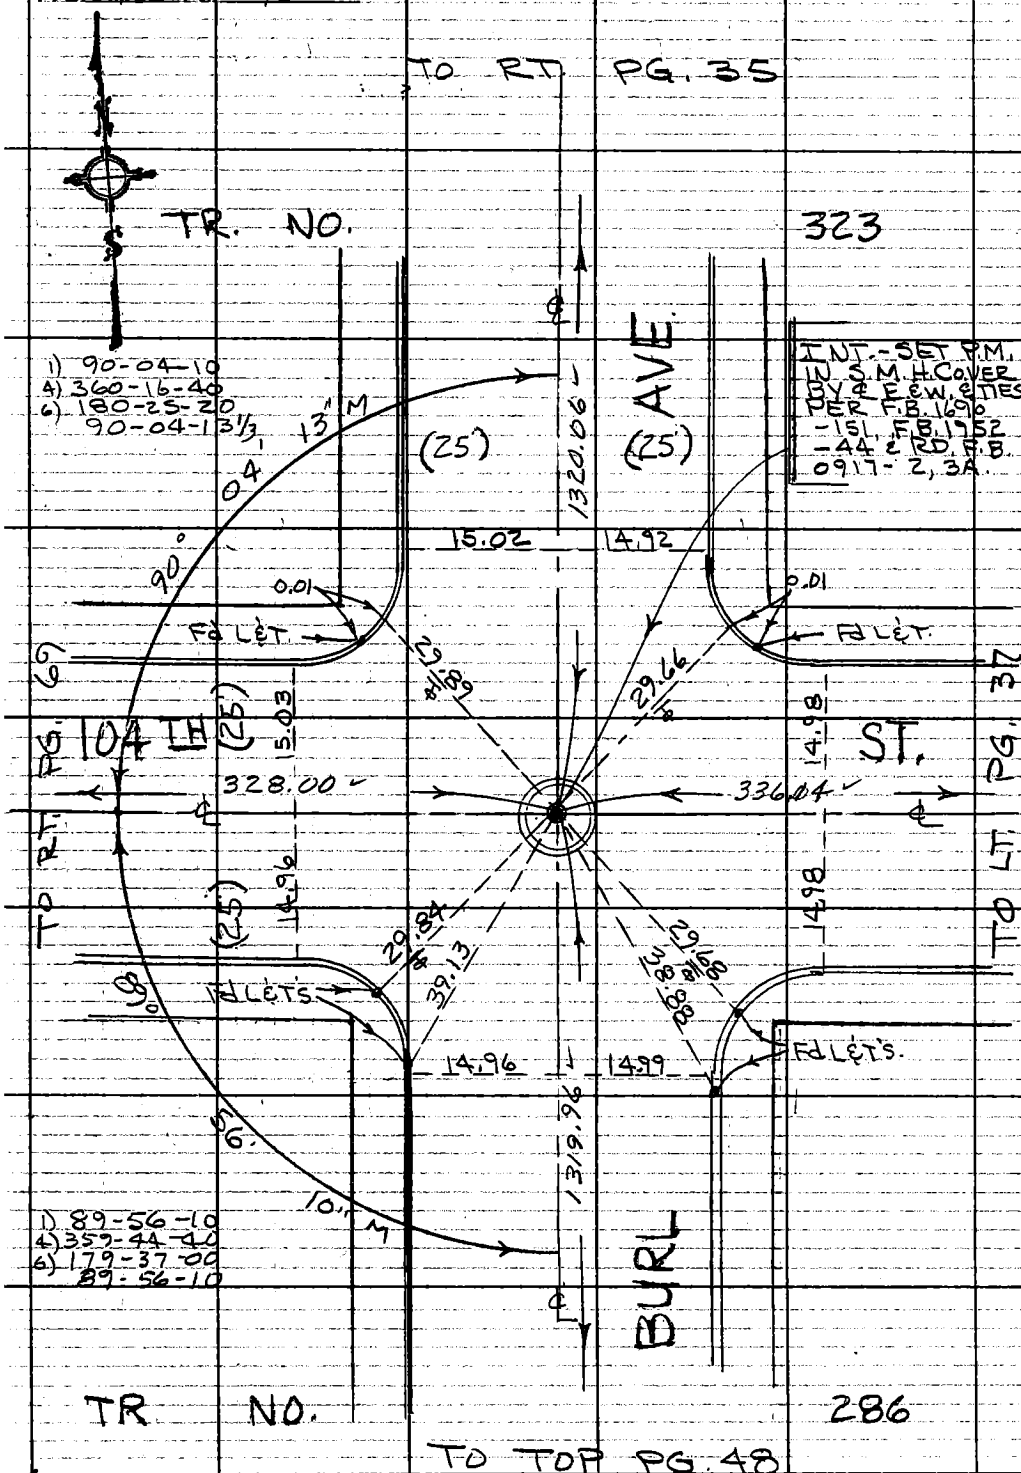

PLEASE RETURN TO
COUNTY OF LOS ANGELES
DEPARTMENT OF COUNTY ENGINEER
403 LOS ANGELES COUNTY ENGINEERING BLDG.

Do not extend this side of this line.

Note: Any Additions or Changes on This Sheet Must Be Made or Circled in Red Ink With Date and Name of Person Making Change.

WS 24 B5

PWFB 0917

254

Notes Ck'd by	Survey of LENNOX AREA ℄
Map No.	JN 0303.00 Tape 09 Std 68 °F
Office Work	Surveyed by J. BAZEN
Checked	Notes J.J.B. Date 5-74
Date	Index [illegible] PALMERI JUN 15 1976

F.B. 3935 PG. 71

WS 24 A-5

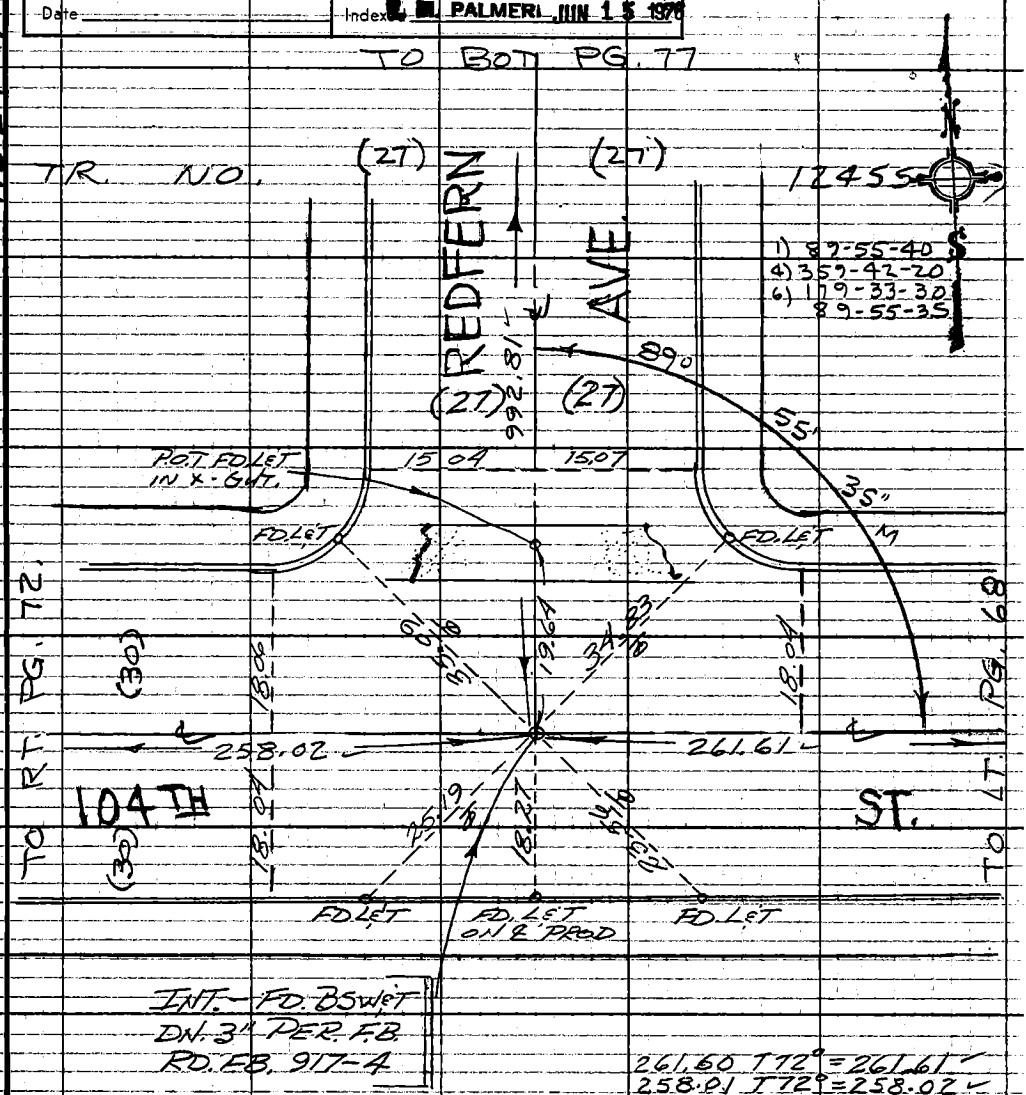

Note: Any Additions or Changes on This Sheet Must be Made or Circled in Red Ink With Date and Name of Person Making Change.

Do not extend this side of this line.

PLEASE RETURN TO
COUNTY OF LOS ANGELES
DEPARTMENT OF COUNTY ENGINEER
403 LOS ANGELES COUNTY ENGINEERING BLDG.

76F309S CE#310 3-69

PWFB 0917

255

F. B. 3935 PG. 72

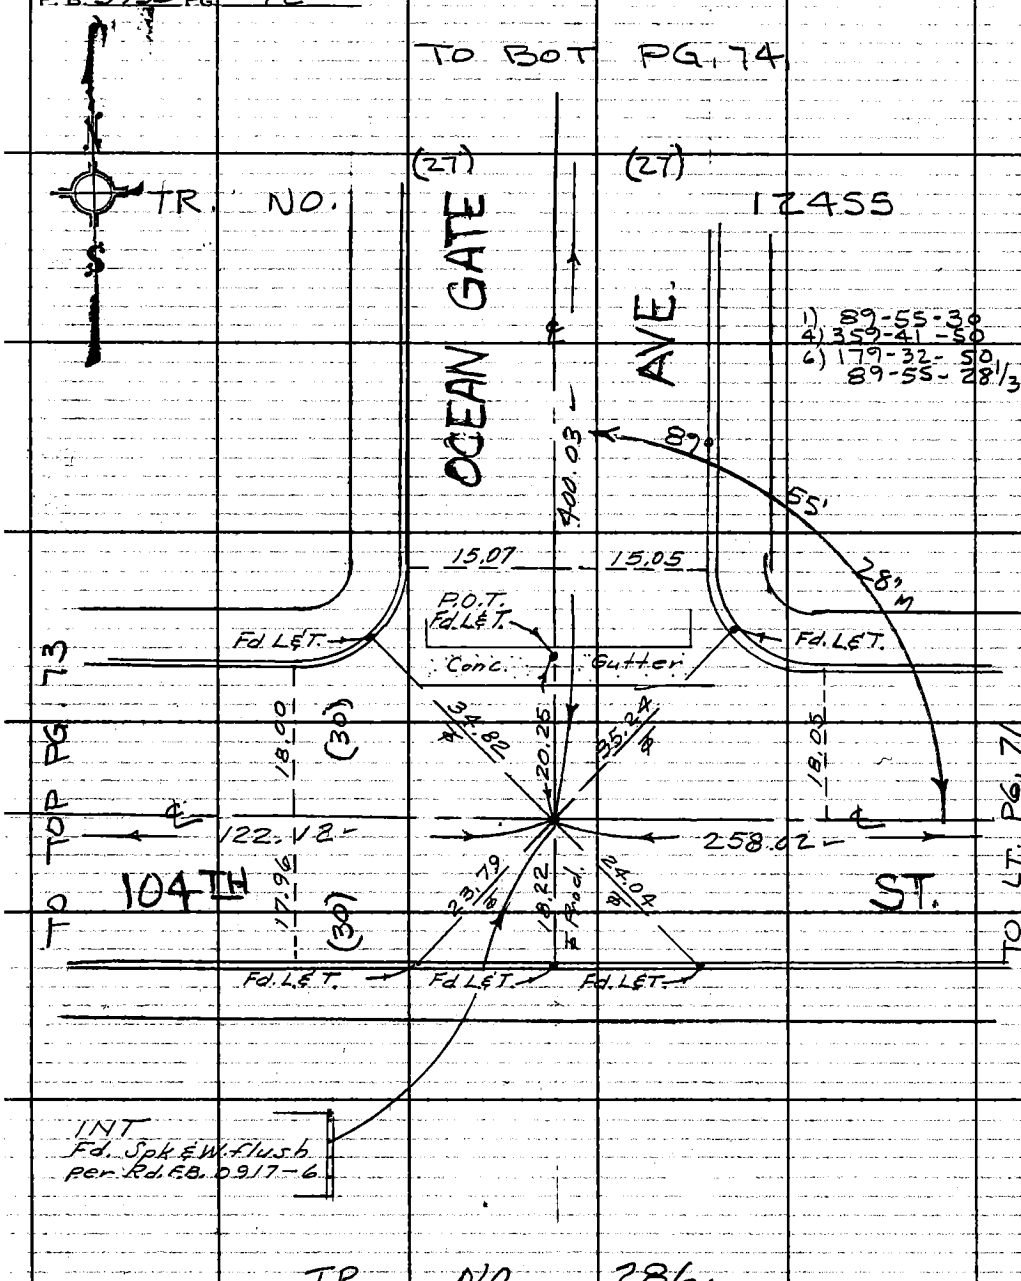

PLEASE RETURN TO
COUNTY OF LOS ANGELES
DEPARTMENT OF COUNTY ENGINEER
403 LOS ANGELES COUNTY ENGINEERING BLDG.

Do not extend this side of this line.

Note: Any Additions or Changes on This Sheet Must Be Made or Circled in Red Ink With Date and Name of Person Making Change.

WS 24 A-5

35.24

PWFB 0917

256

Notes Ck'd by	Survey of LENNOX AREA ℄
Map No.	JN 0303.00 Tape 09 Std 68 °F
Office Work	Surveyed by J. BAZEN
Checked	Notes J. J. B. Date 5-74
Date	Indexed M. PALMERI JUN 15 1976

F. B. 3935 PG. 73

TO LT. PG. 72

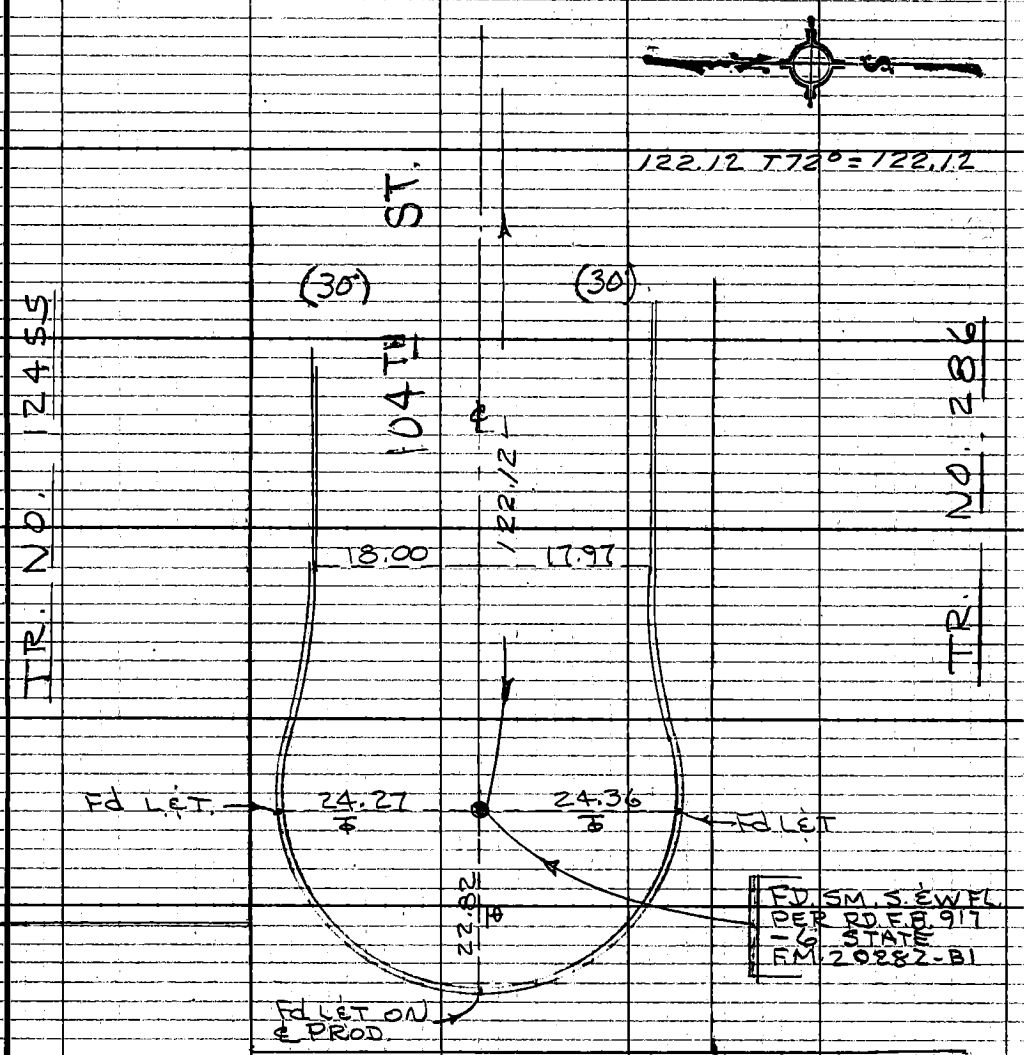

SAN DIEGO FWY

Note: Any Additions or Changes on This Sheet Must be Made or Circled in Red Ink With Date and Name of Person Making Change.

Do not extend this side of this line.

PLEASE RETURN TO
COUNTY OF LOS ANGELES
DEPARTMENT OF COUNTY ENGINEER
403 LOS ANGELES COUNTY ENGINEERING BLDG.

76F309S CE#310 3-69

PWFB 0917

TO BOT. PG. 75

257

F. B. 3935 PG. 74

1) 154-32-40
4) 258-10-20
6) 207-15-30
154-32-35

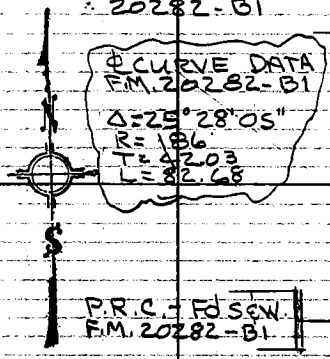

42.02 T 72° = 42.02
42.02 T 72° = 42.02
34.21 T 72° = 34.21
134.79 T 72° = 134.79
100.01 T 72° = 100.01
400.02 T 72° = 400.03

PLEASE RETURN TO
COUNTY OF LOS ANGELES
DEPARTMENT OF COUNTY ENGINEER
403 LOS ANGELES COUNTY ENGINEERING BLDG.
Do not extend this side of this line.

Note: Any Additions or Changes on This Sheet Must Be Made or Circled in Red Ink With Date and Name of Person Making Change.

Notes Ck'd by	Survey of LENNOX AREA ℄
Map No.	JN 0303.00 Tape 09 Std 66 °F
Office Work	Surveyed by J. BAZEN
Checked	Notes J.J.B. Date 5-74
Date	Indexed PALMERI JUN 15 1976

F.B. 3935 PG. 75

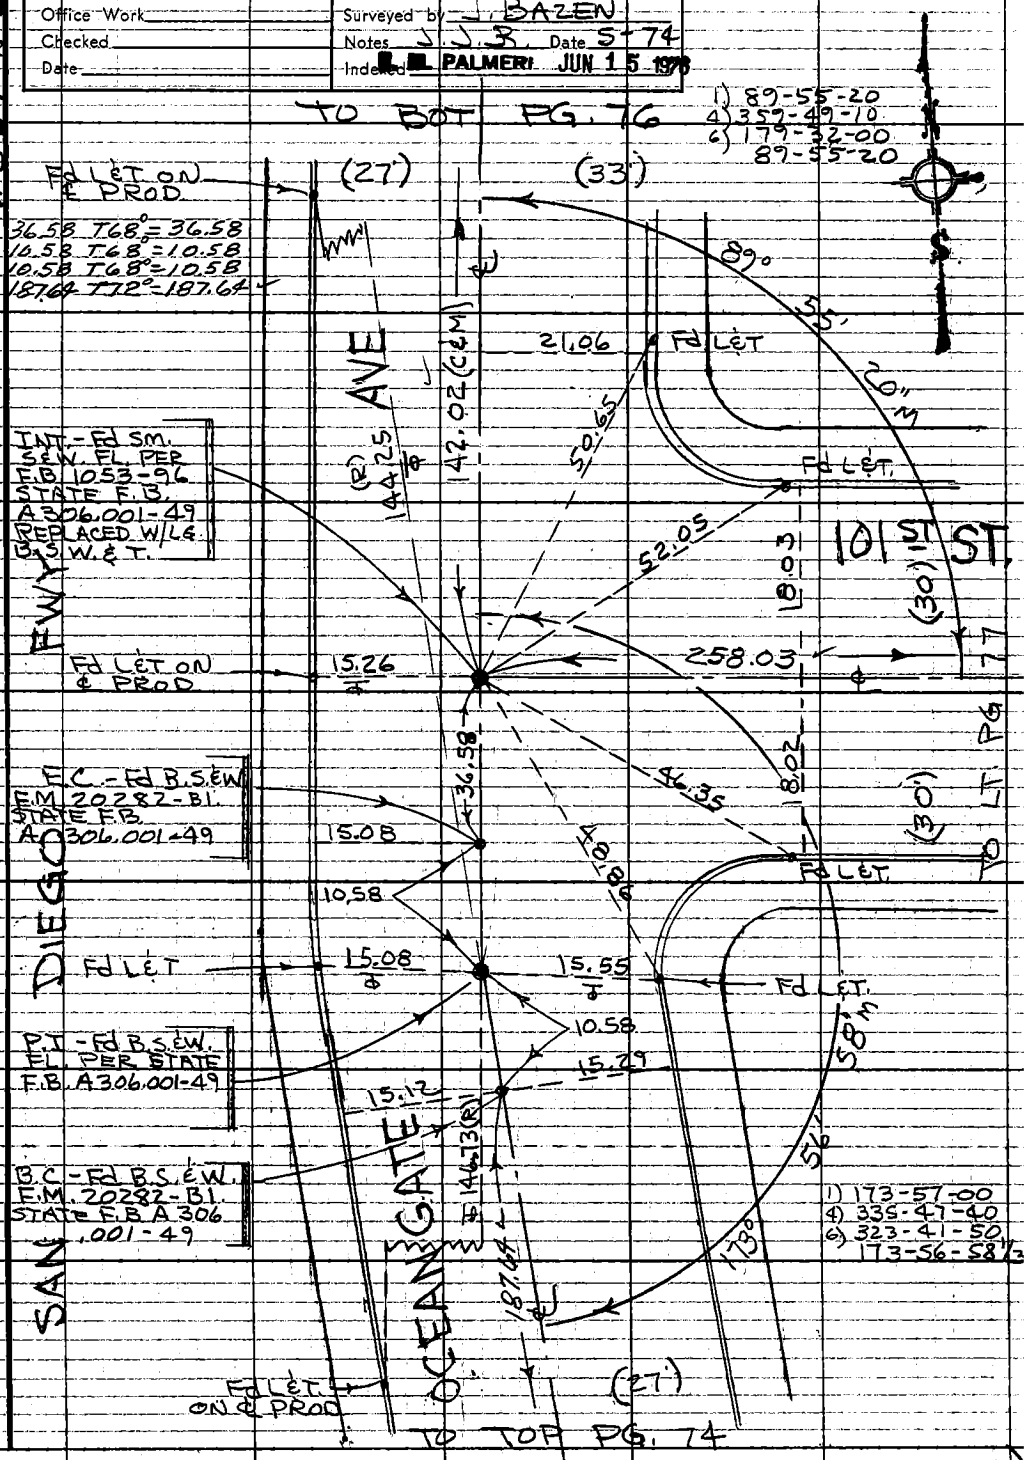

Note: Any Additions or Changes on This Sheet Must be Made or Circled in Red Ink With Date and Name of Person Making Change.

Do not extend this side of this line.

PLEASE RETURN TO
COUNTY OF LOS ANGELES
DEPARTMENT OF COUNTY ENGINEER
403 LOS ANGELES COUNTY ENGINEERING BLDG.

76F309S CE#310 3-69

PWFB 0917 259

F.B. 3935 PG. 76 TO RT. PG. 31

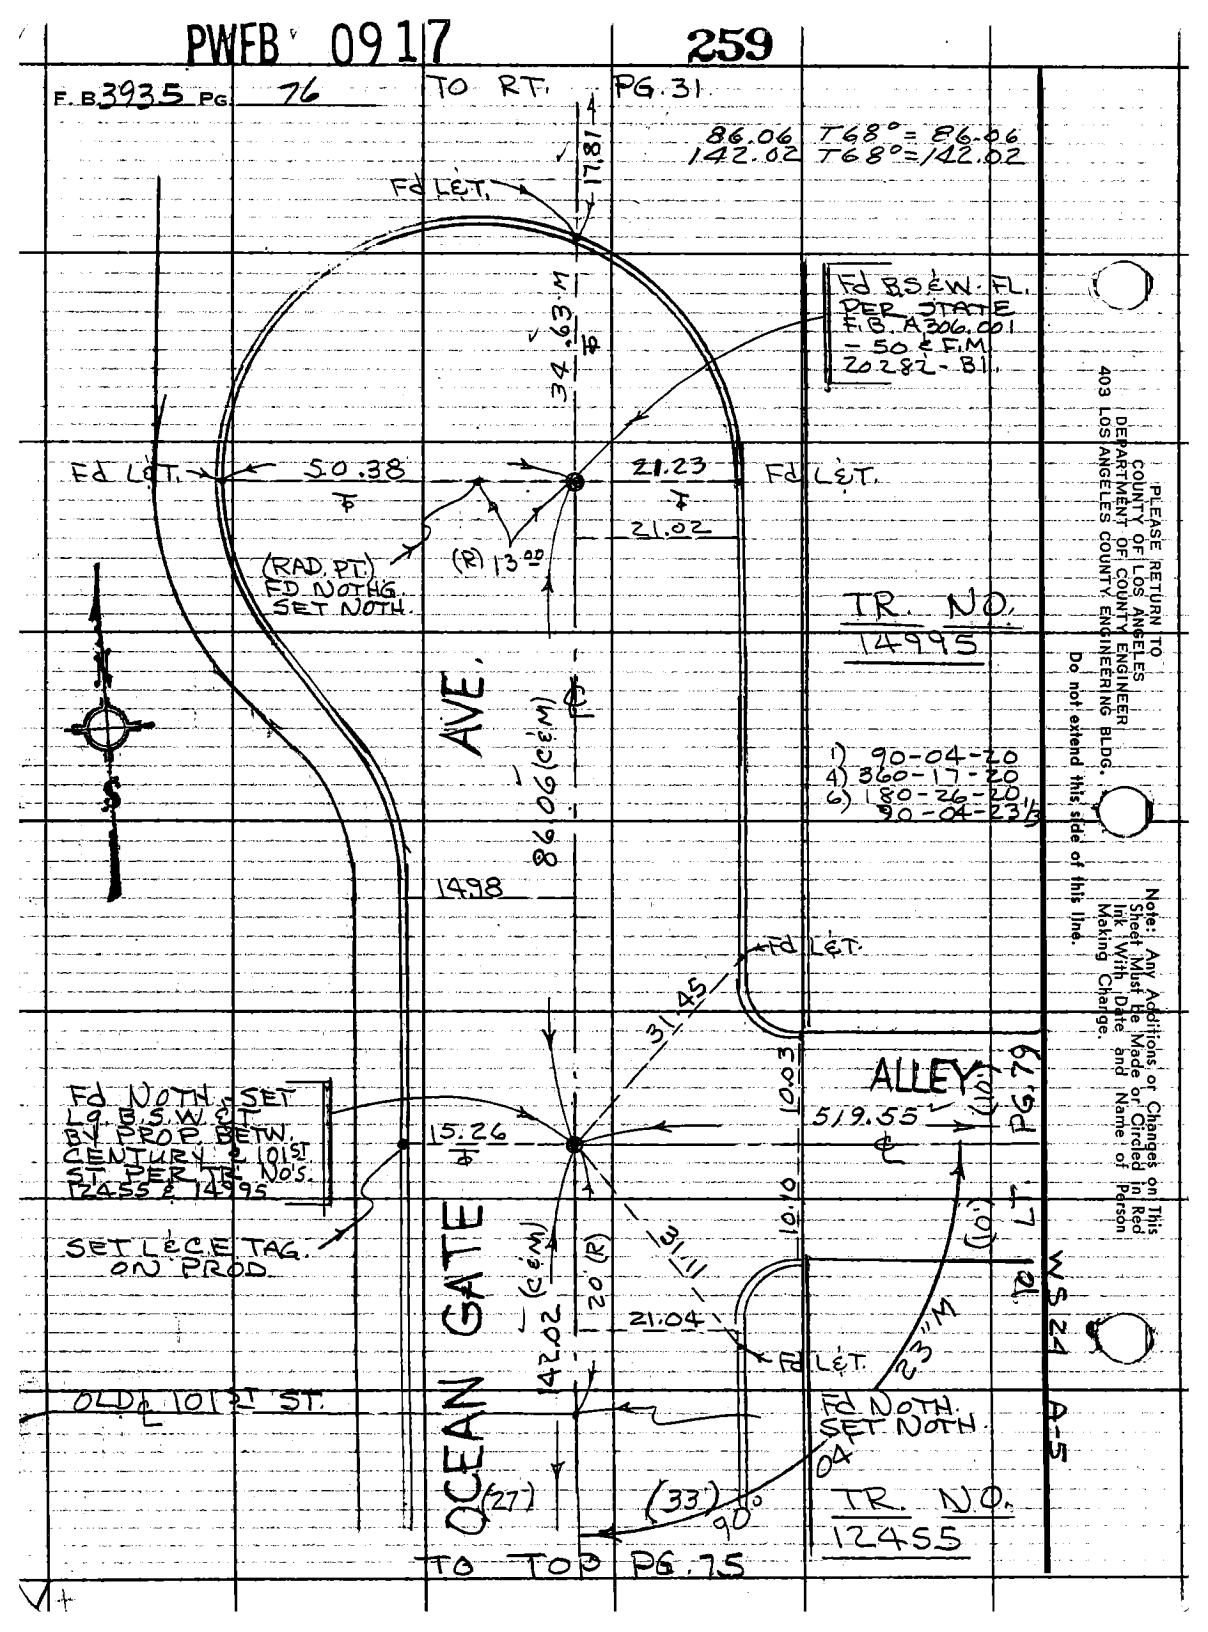

PLEASE RETURN TO
COUNTY OF LOS ANGELES
DEPARTMENT OF COUNTY ENGINEER
403 LOS ANGELES COUNTY ENGINEERING BLDG.
Do not extend this side of this line.

Note: Any Additions or Changes on This Sheet Must Be Made or Circled in Red Ink With Date and Name of Person Making Change.

PWFB 0917

260

Notes Ck'd by	Survey of LENNOX AREA ℄
Map No.	JN 0303.00 Tape 09 Std 68 °F
Office Work	Surveyed by J. BAZEN
Checked	Notes J. J. B. Date 5-74
Date	Indexed E. M. PALMERI JUN 15 1978

F. B. 3935 PG. 77

WS 24 A-5

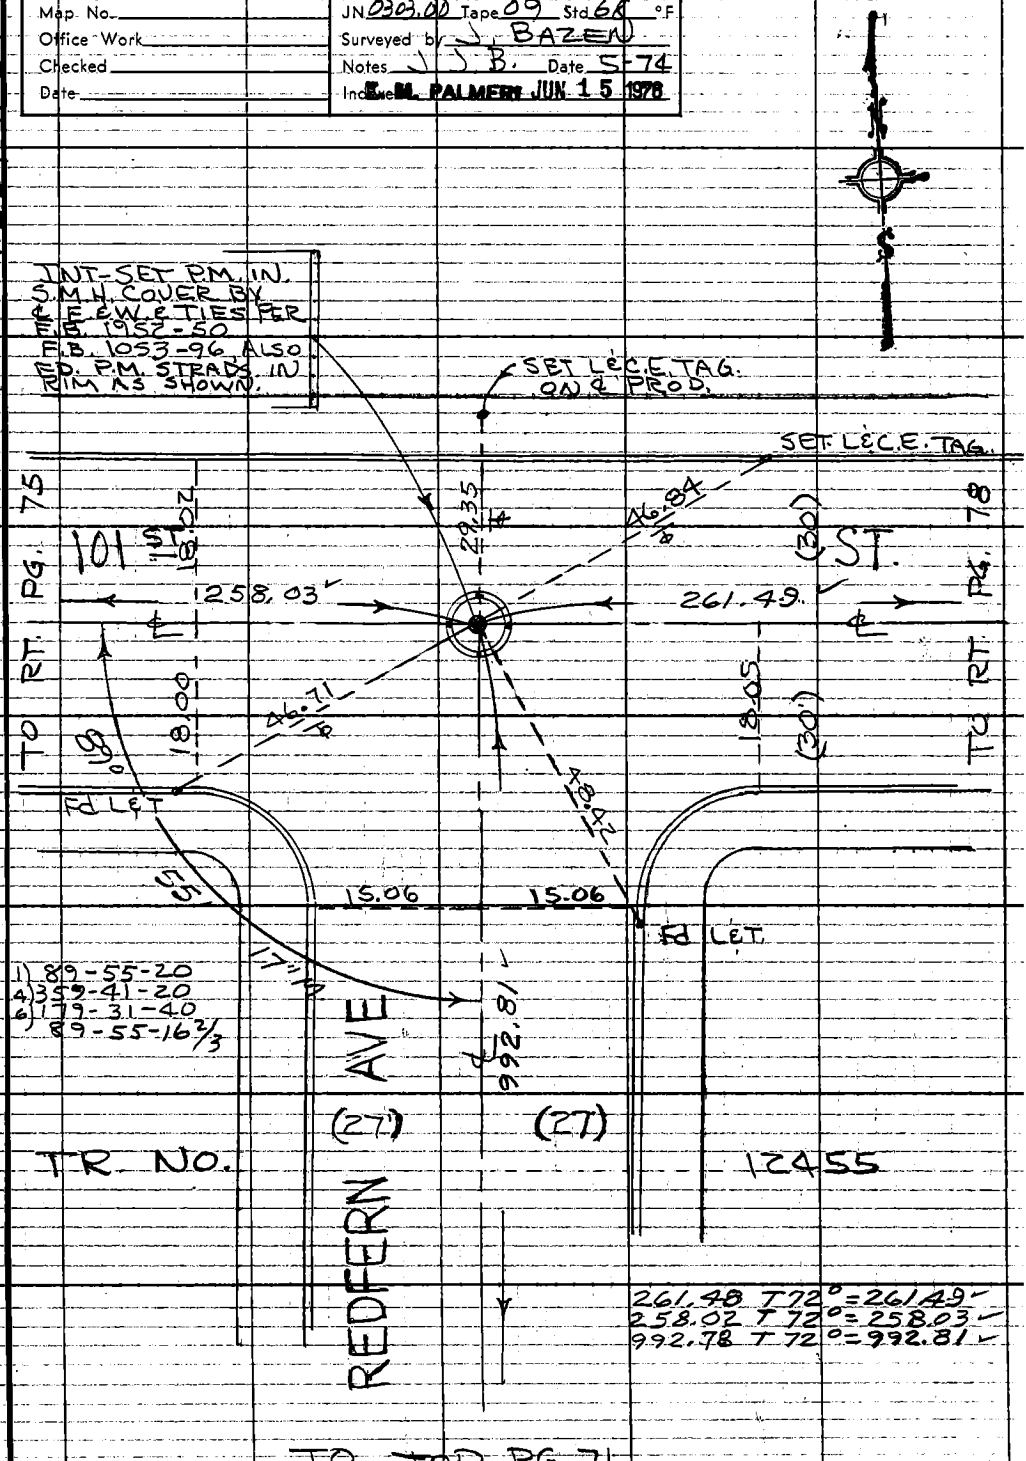

Note: Any Additions or Changes on This Sheet Must be Made or Circled in Red Ink With Date and Name of Person Making Change.

Do not extend this side of this line.

PLEASE RETURN TO COUNTY OF LOS ANGELES DEPARTMENT OF COUNTY ENGINEER 403 LOS ANGELES COUNTY ENGINEERING BLDG.

76F309S CE#310 3-69

PWFB 0917

261

F. B. 3935 PG. 78

TO BOT PG. 79

TR. NO. 12455

992.78 T72 = 992.81

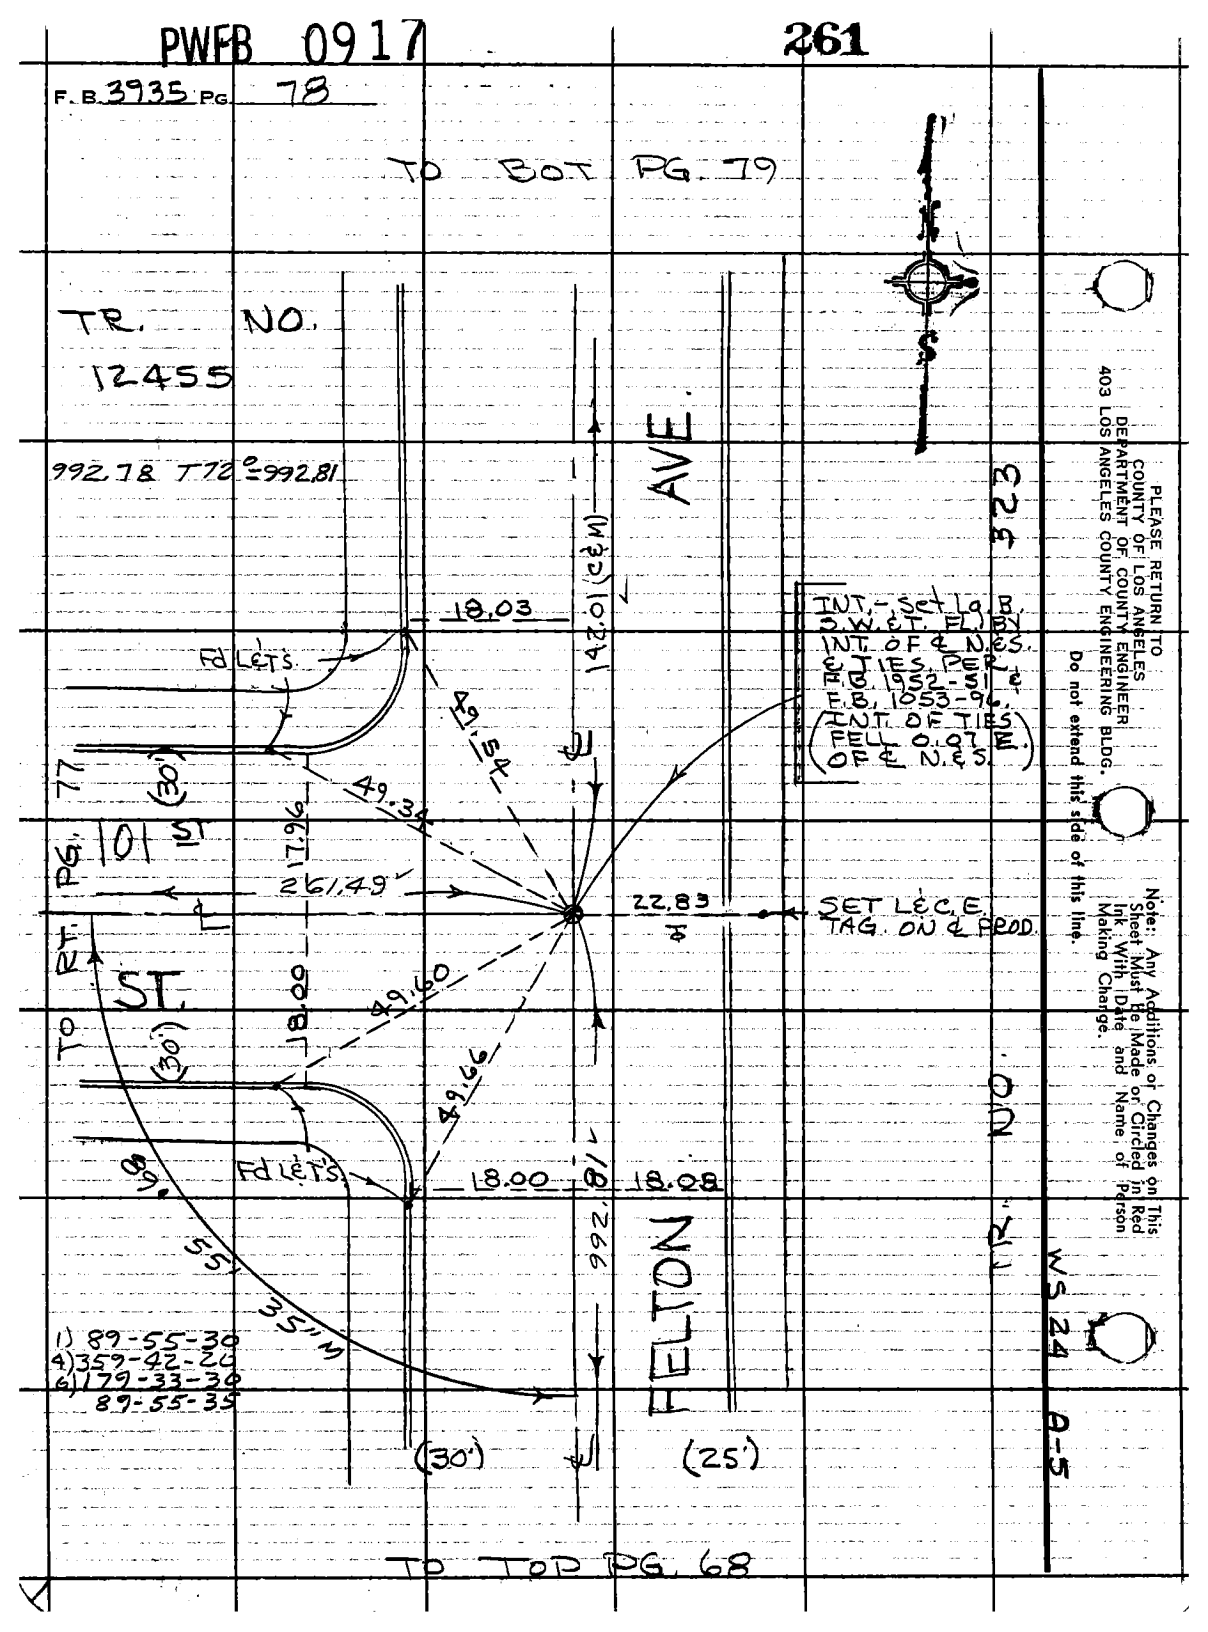

PLEASE RETURN TO
COUNTY OF LOS ANGELES
DEPARTMENT OF COUNTY ENGINEER
403 LOS ANGELES COUNTY ENGINEERING BLDG.

Do not extend this side of this line.

Note: Any Additions or Changes on This Sheet Must Be Made or Circled in Red Ink With Date and Name of Person Making Change.

PWFB 0917

262

Notes Ck'd by	Survey of LENNOX AREA
Map No.	JN 0303.00 Tape 09 Std 68 °F
Office Work	Surveyed by J. BAREN
Checked	Notes J. J. B. Date 5-74
Date	Index M. PALMERI JUN 15 1976

F.B. 3935 PG. 79

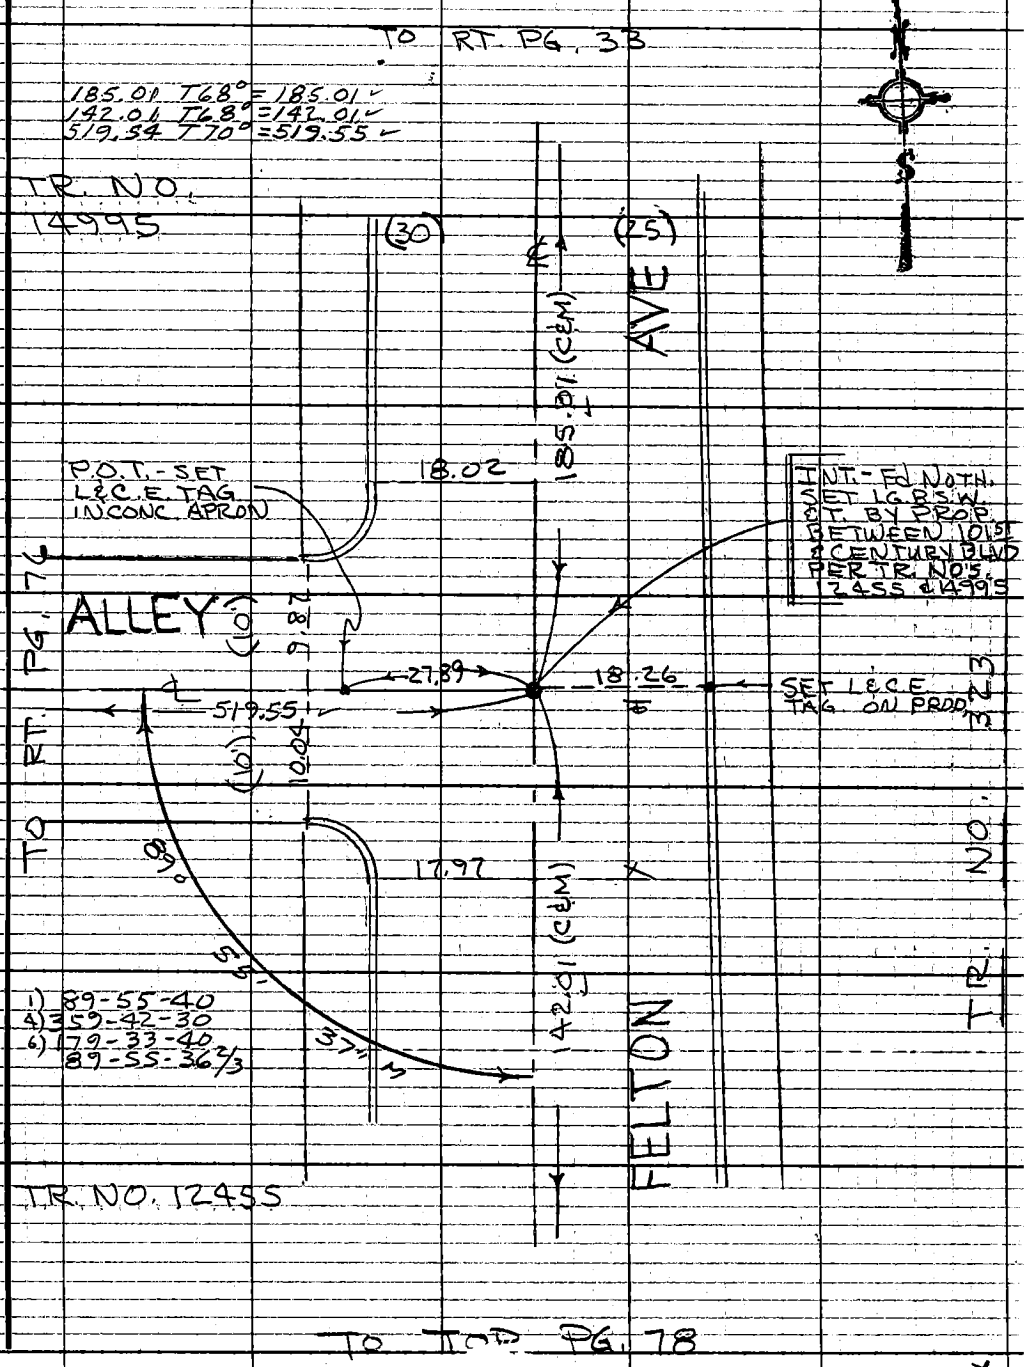

Note: Any Additions or Changes on This Sheet Must be Made or Circled in Red Ink With Date and Name of Person Making Change.

Do not extend this side of this line.

PLEASE RETURN TO
COUNTY OF LOS ANGELES
DEPARTMENT OF COUNTY ENGINEER
403 LOS ANGELES COUNTY ENGINEERING BLDG.

76F309S CE#310 3-69

F.B. 3935 PG. 80

TO BOT PG. 81

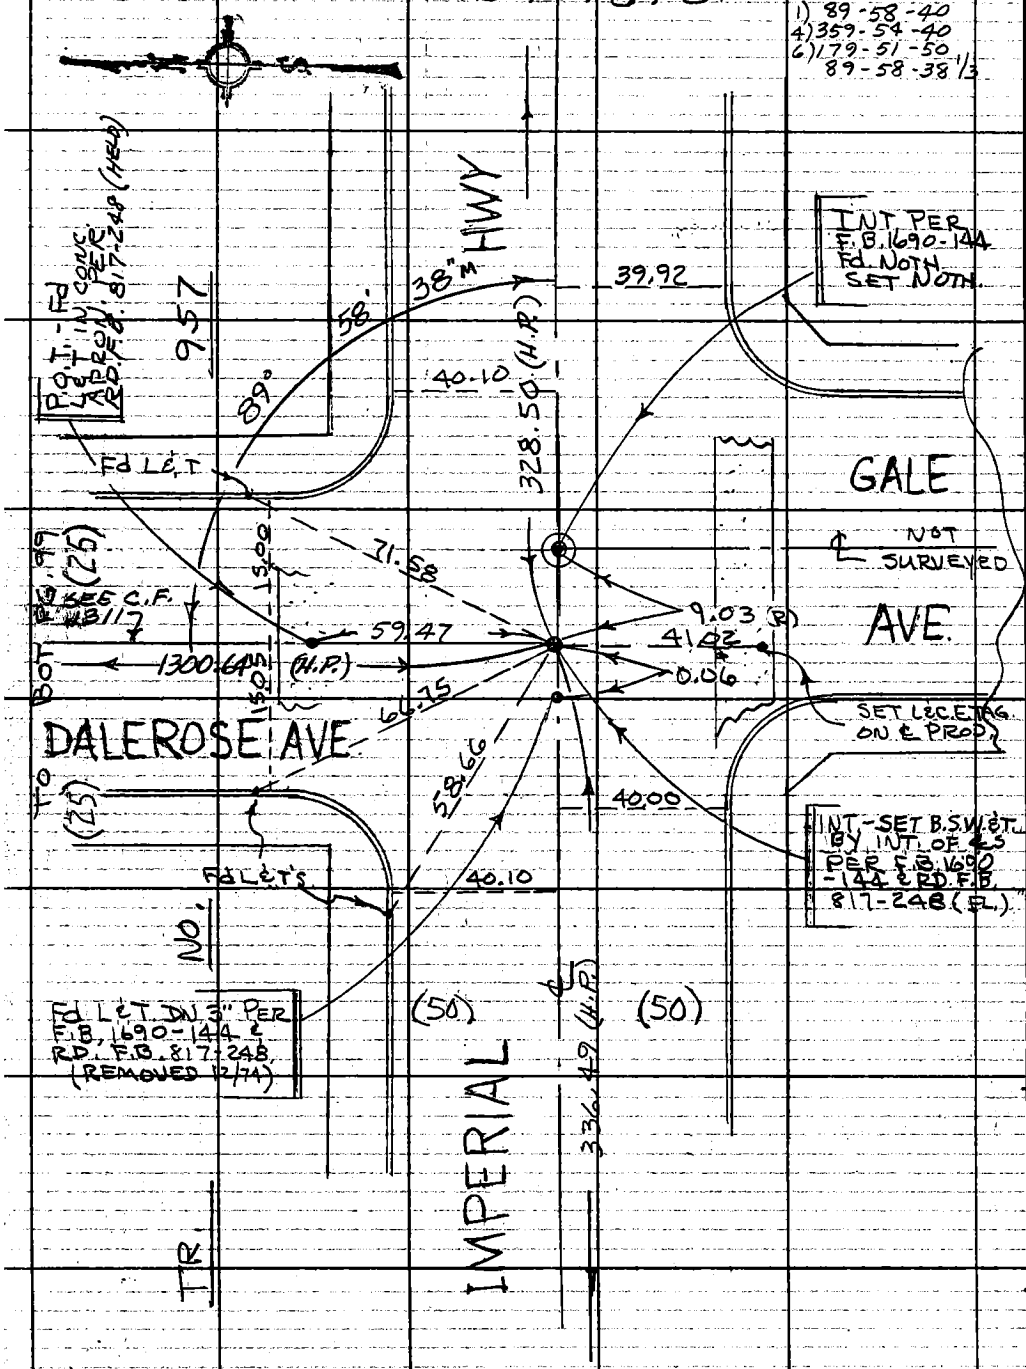

TO RT. PG. 9

PLEASE RETURN TO
COUNTY OF LOS ANGELES
DEPARTMENT OF COUNTY ENGINEER
403 LOS ANGELES COUNTY ENGINEERING BLDG.

Do not extend this side of this line.

Note: Any Additions or Changes on This Sheet Must Be Made or Circled in Red Ink With Date and Name of Person Making Change.

WS 24

B5

PWB 0817

699

Notes Ck'd by	Survey of LENNOX AREA 2
Map No.	JN 030300 Tape 238 Std. 68 °F
Office Work	Surveyed by J. BAZEN
Checked	Notes J.J.B. Date 3-75
Date	Indexed P. PALMER JUN 15 1976

F. B. 3935 PG. 81

B5

WS 24

Note: Any Additions or Changes on This Sheet Must be Made or Circled in Red Ink With Date and Name of Person Making Change.

Do not extend this line. side of

PLEASE RETURN TO COUNTY OF LOS ANGELES DEPARTMENT OF COUNTY ENGINEER 403 LOS ANGELES COUNTY ENGINEERING BLDG.

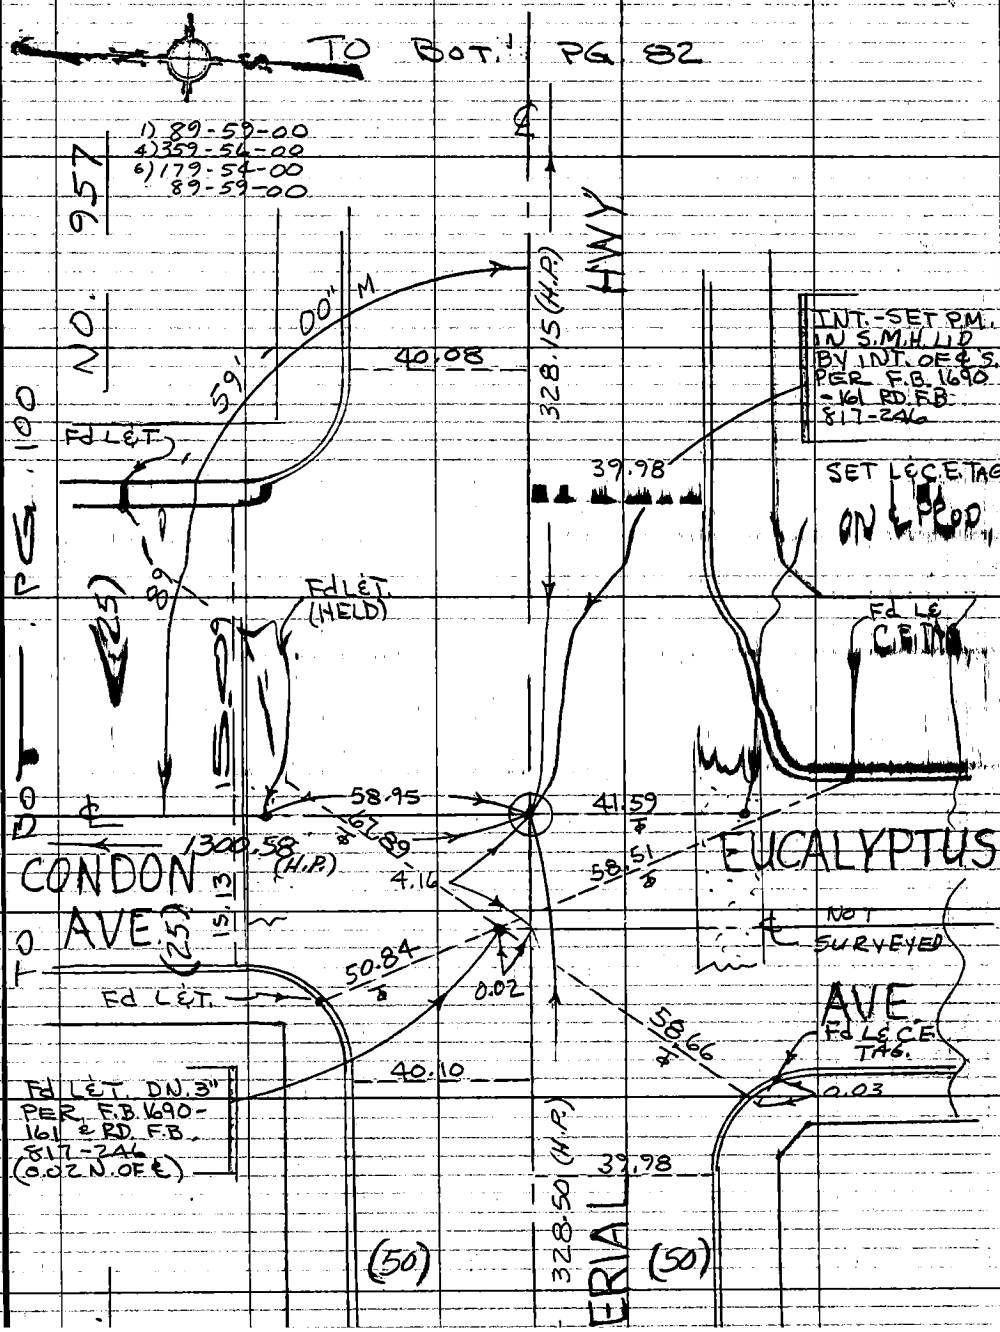

PWFB 0817 700

F.B. 393S PG 82 TO BOT PG. 83

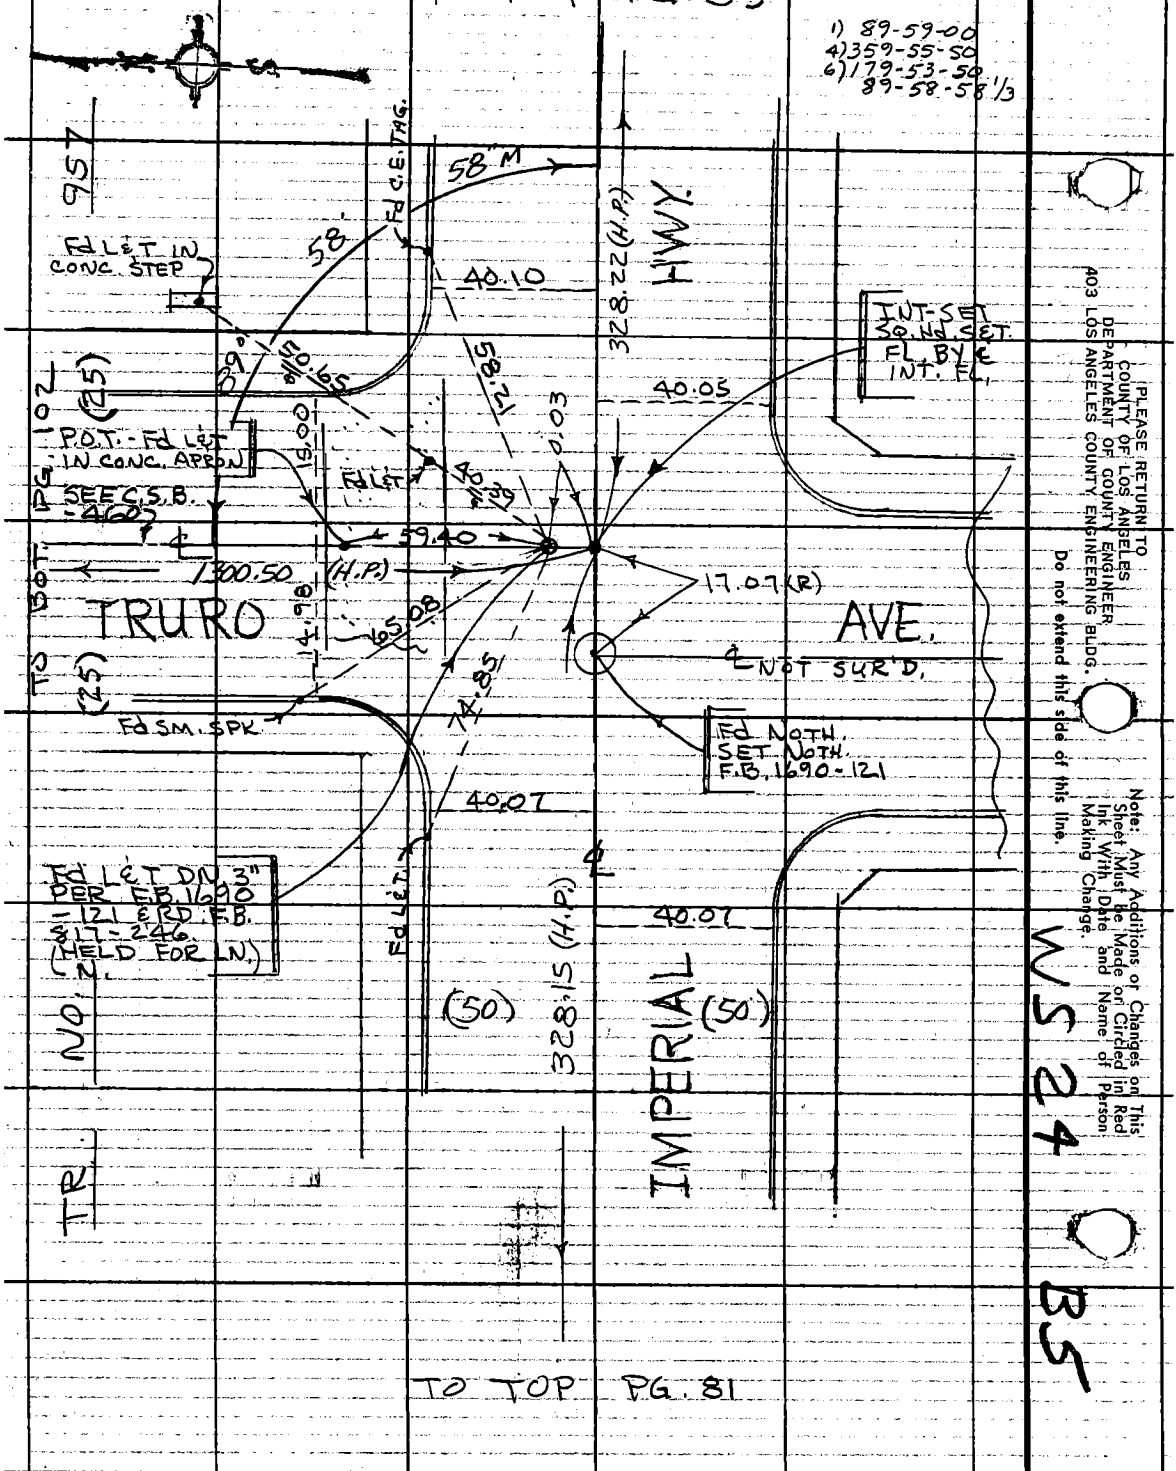

PLEASE RETURN TO
COUNTY OF LOS ANGELES
DEPARTMENT OF COUNTY ENGINEER
403 LOS ANGELES COUNTY ENGINEERING BLDG.

Do not extend this side of this line.

Note: Any Additions or Changes on This Sheet Must be Made or Circled in Red Ink With Date and Name of Person Making Change.

WS 24 B5

PWFB 0817

701

Notes Ck'd by	Survey of LENNOX AREA ℄
Map No.	JN 0303.02 Tape 238 Std 68 °F
Office Work	Surveyed by J. BAZEN
Checked	Notes J J B. Date 3-75
Date	Indexed L. M. PALMER JUN 15 1976

F. B. 3935 PG. 83

B5

WS 24

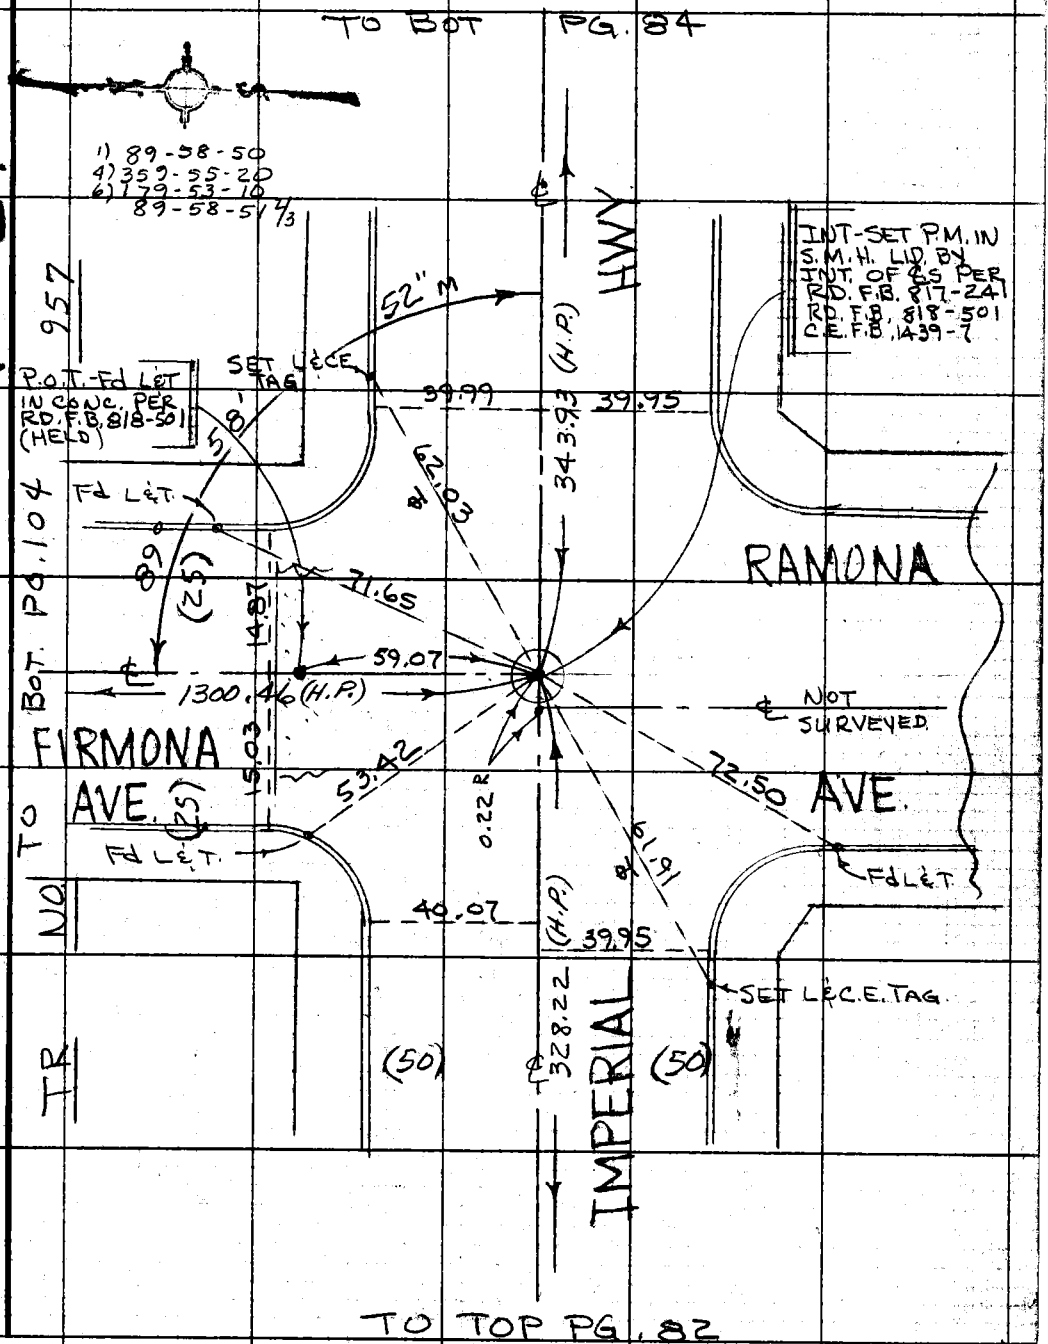

Note: Any Additions or Changes on This Sheet Must be Made or Circled in Red Ink With Date and Name of Person Making Change.

Do not extend this side of this line.

PLEASE RETURN TO
COUNTY OF LOS ANGELES
DEPARTMENT OF COUNTY ENGINEER
403 LOS ANGELES COUNTY ENGINEERING BLDG.

16F309S CE#310 3-69

PWFB 0817

702

F.B. 3935 PG. 84 — TO BOT PG. 85

658.29 T=68°=658.29

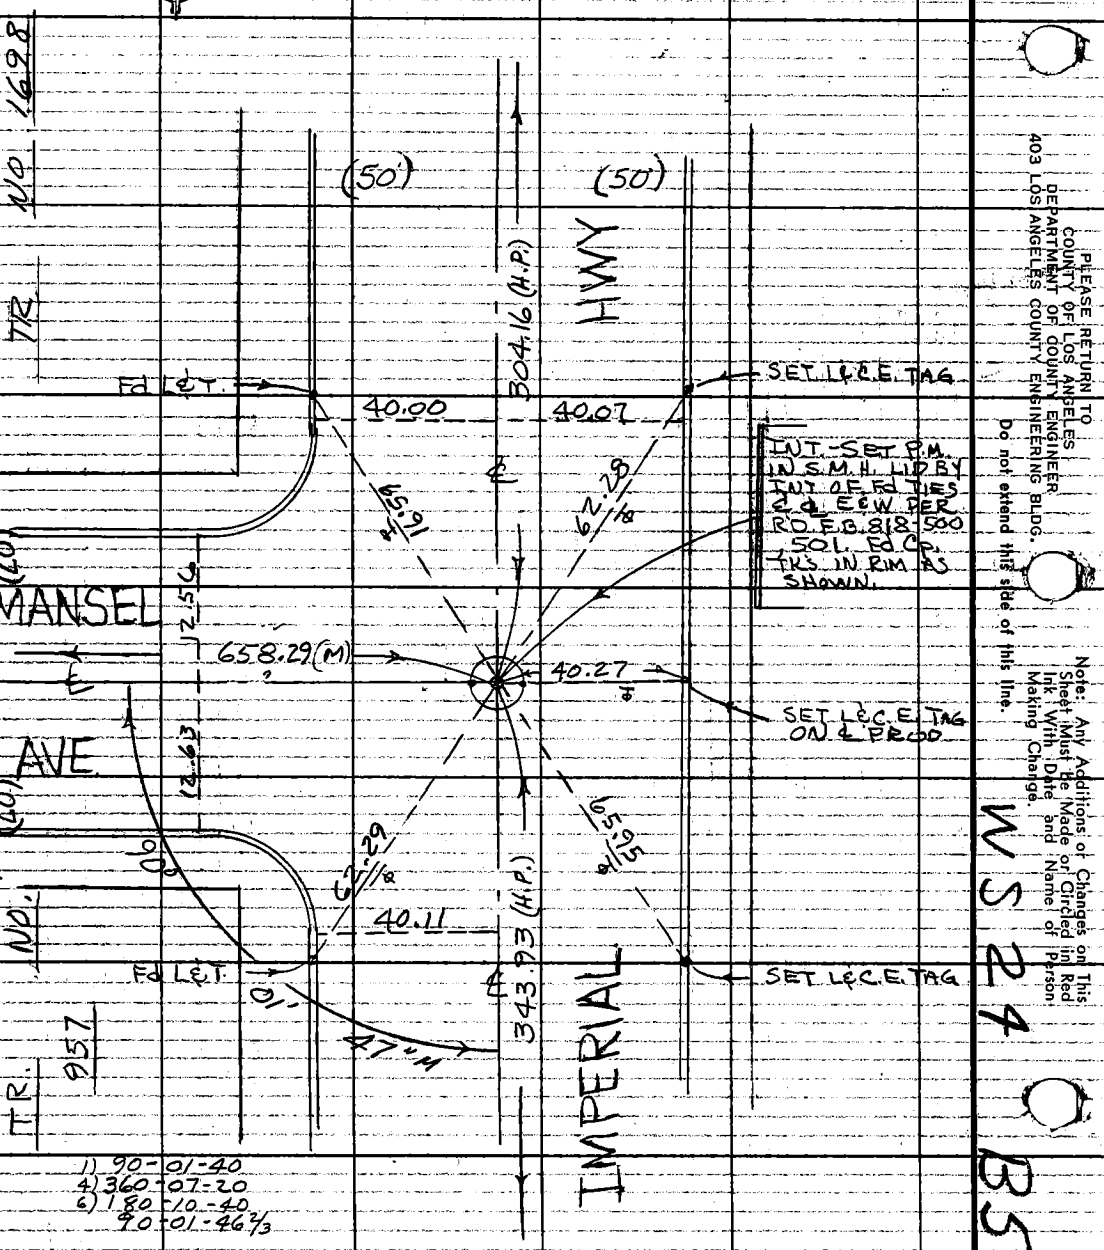

TO TOP PG. 83

PLEASE RETURN TO
COUNTY OF LOS ANGELES
DEPARTMENT OF COUNTY ENGINEER
403 LOS ANGELES COUNTY ENGINEERING BLDG.
Do not extend this side of this line.

Note: Any Additions or Changes on This Sheet Must Be Made or Circled in Red Ink With Date and Name of Person Making Change.

W S 24 185

PWFB 0818 681

Notes Ck'd by	Survey of LENNOX AREA ℄
Map No.	JN 0303.00 Tape 238 Std 68 °F
Office Work	Surveyed by J. BAZEN
Checked	Notes J. J. B. Date 3-75
Date	Indexed PALMERI JUN 15 1976

F. B. 3935 PG. 85

B5

WS 24

TO BOT PG. 86

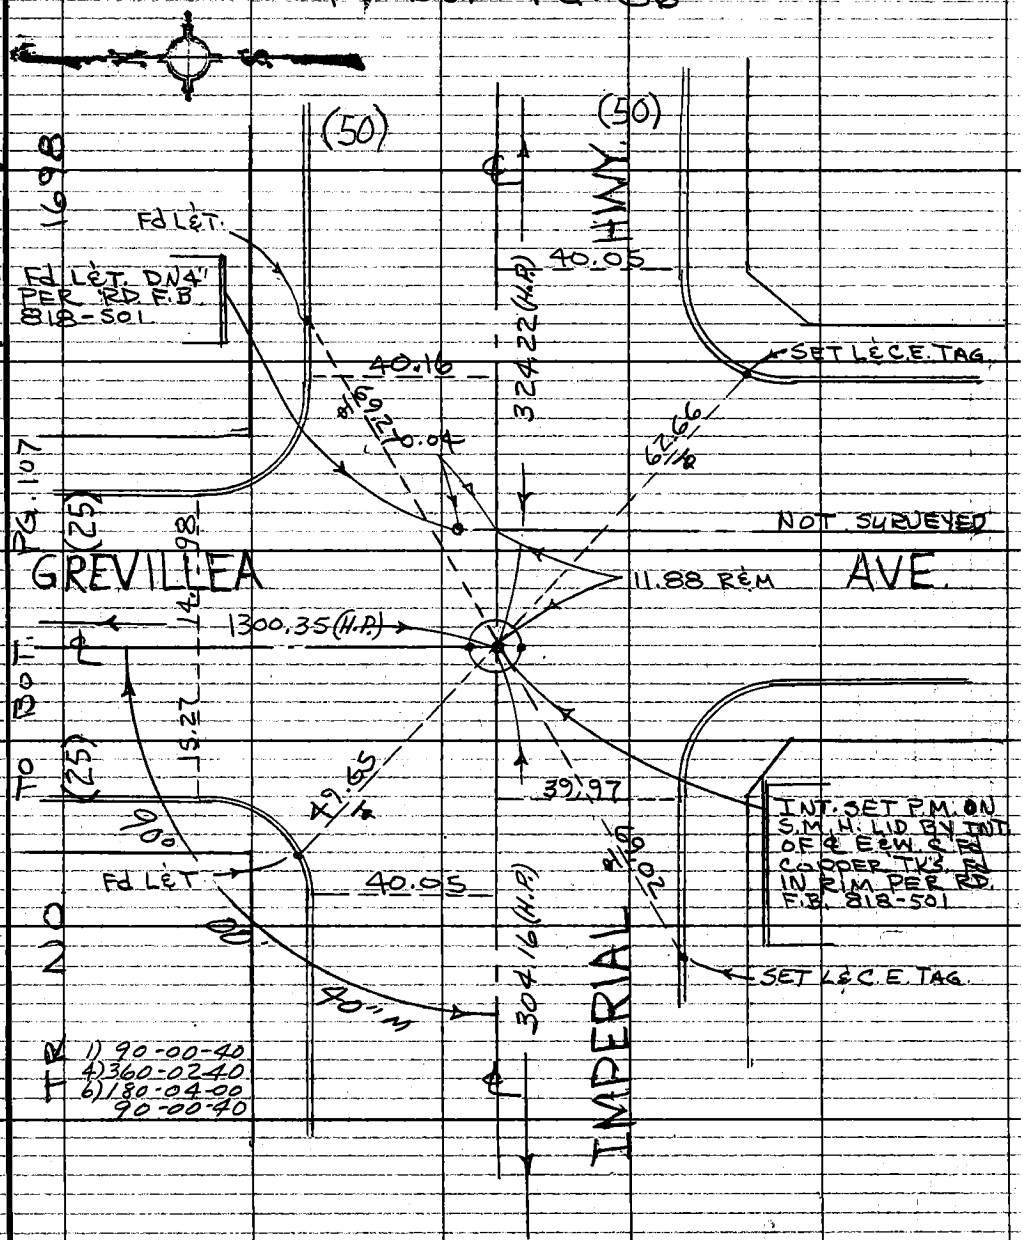

TO TOP PG. 84

Note: Any Additions or Changes on This Sheet Must be Made or Circled in Red Ink With Date and Name of Person Making Change.

Do not extend this side of this line.

PLEASE RETURN TO
COUNTY OF LOS ANGELES
DEPARTMENT OF COUNTY ENGINEER
403 LOS ANGELES COUNTY ENGINEERING BLDG.

76F309S CE#310 3-69

PWFB 0818 682

F.B. 3935 PG 86

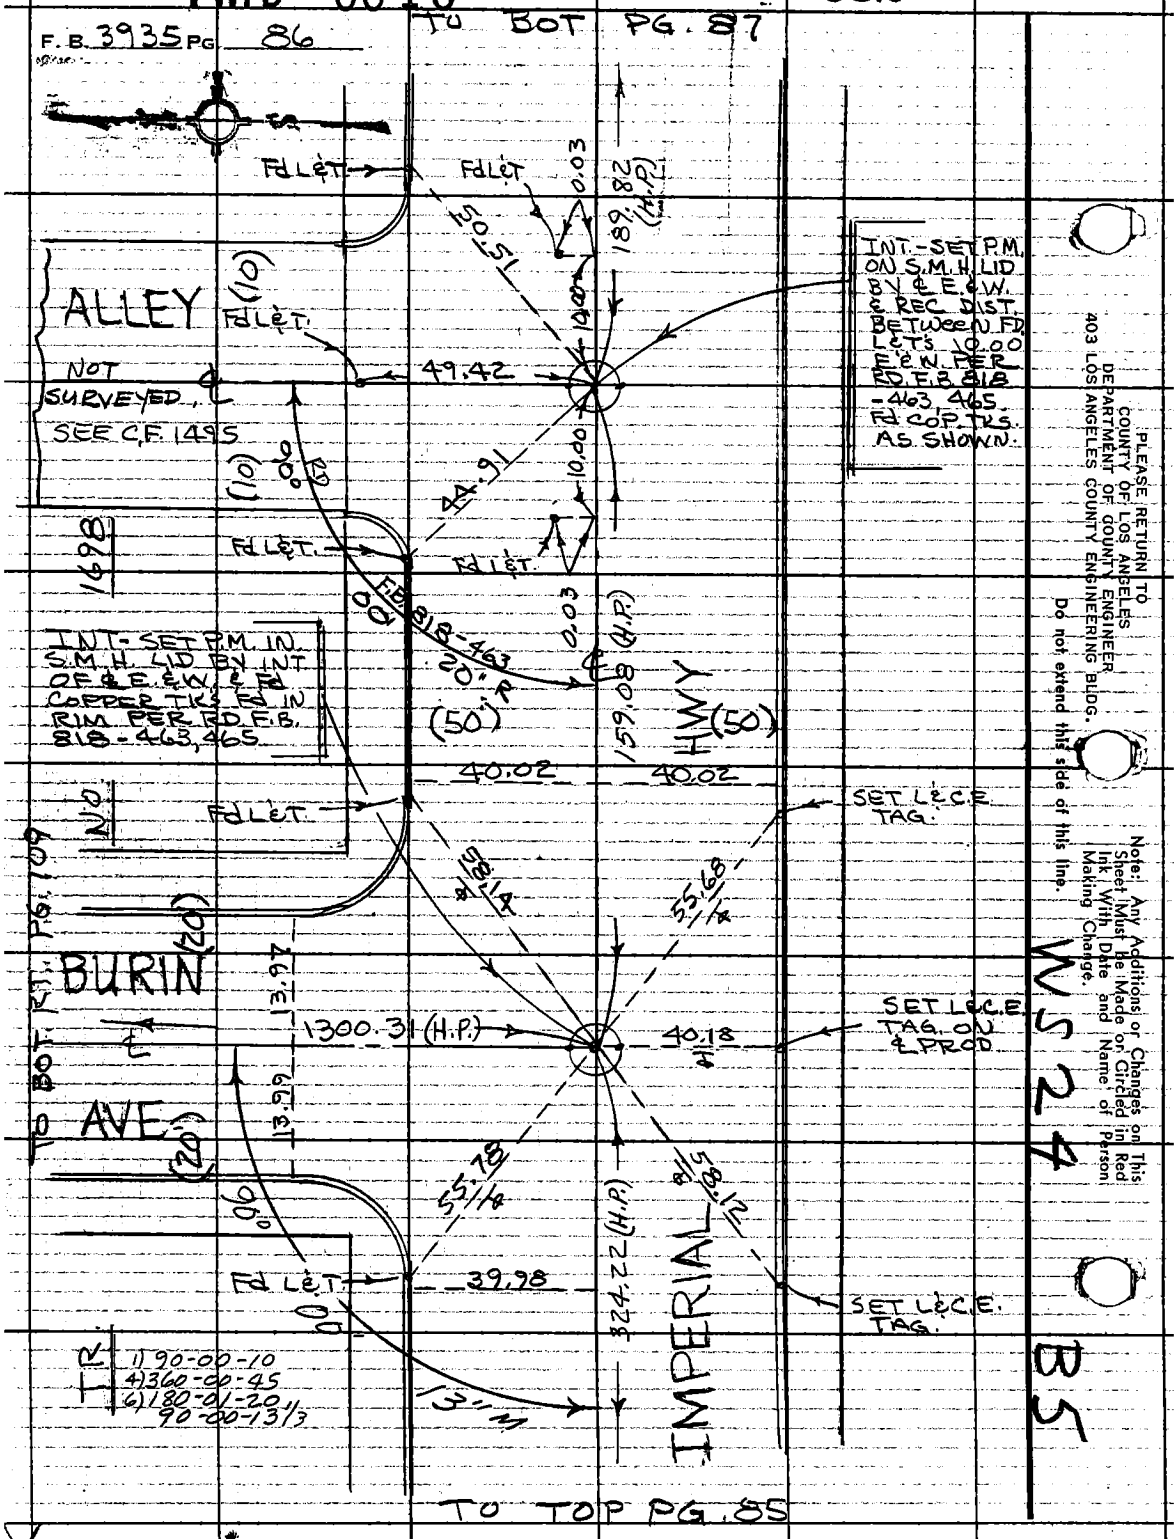

PLEASE RETURN TO
COUNTY OF LOS ANGELES
DEPARTMENT OF COUNTY ENGINEER
403 LOS ANGELES COUNTY ENGINEERING BLDG.

Do not extend this side of this line.

Note: Any Additions or Changes on This Sheet Must Be Made or Circled in Red Ink With Date and Name of Person Making Change.

WS 24 B5

PWFB 0818 683

Notes Ck'd by	Survey of LENNOX AREA ℄
Map No.	JN 0303.00 Tape 238 Std 68 °F
Office Work	Surveyed by J. BAZEN
Checked	Notes J. J. B. Date 3-75
Date	Checked T. M. PALMERI JUN 15 1976

F. B. 3935 PG. 87

WS 24 35

Note: Any Additions or Changes on This Sheet Must be Made or Circled in Red Ink With Date and Name of Person Making Change.

Do not extend this side of this line.

PLEASE RETURN TO
COUNTY OF LOS ANGELES
DEPARTMENT OF COUNTY ENGINEER
403 LOS ANGELES COUNTY ENGINEERING BLDG.

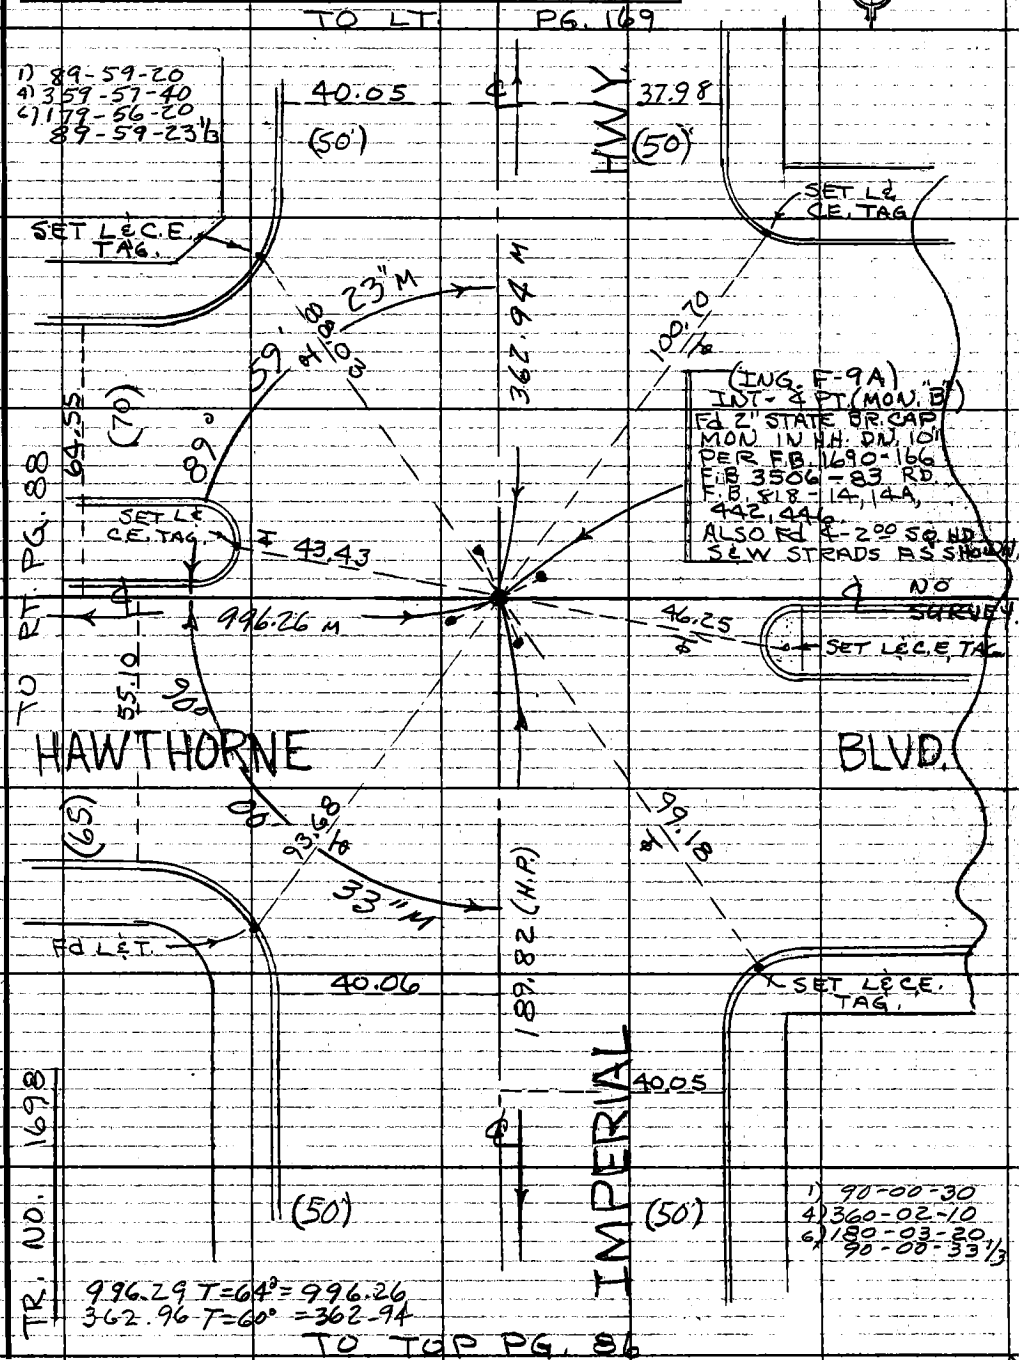

76F309S CE#310 3-69

PWFB 0818 684

F. B. 3935 PG. 88

TO LT. PG. 171

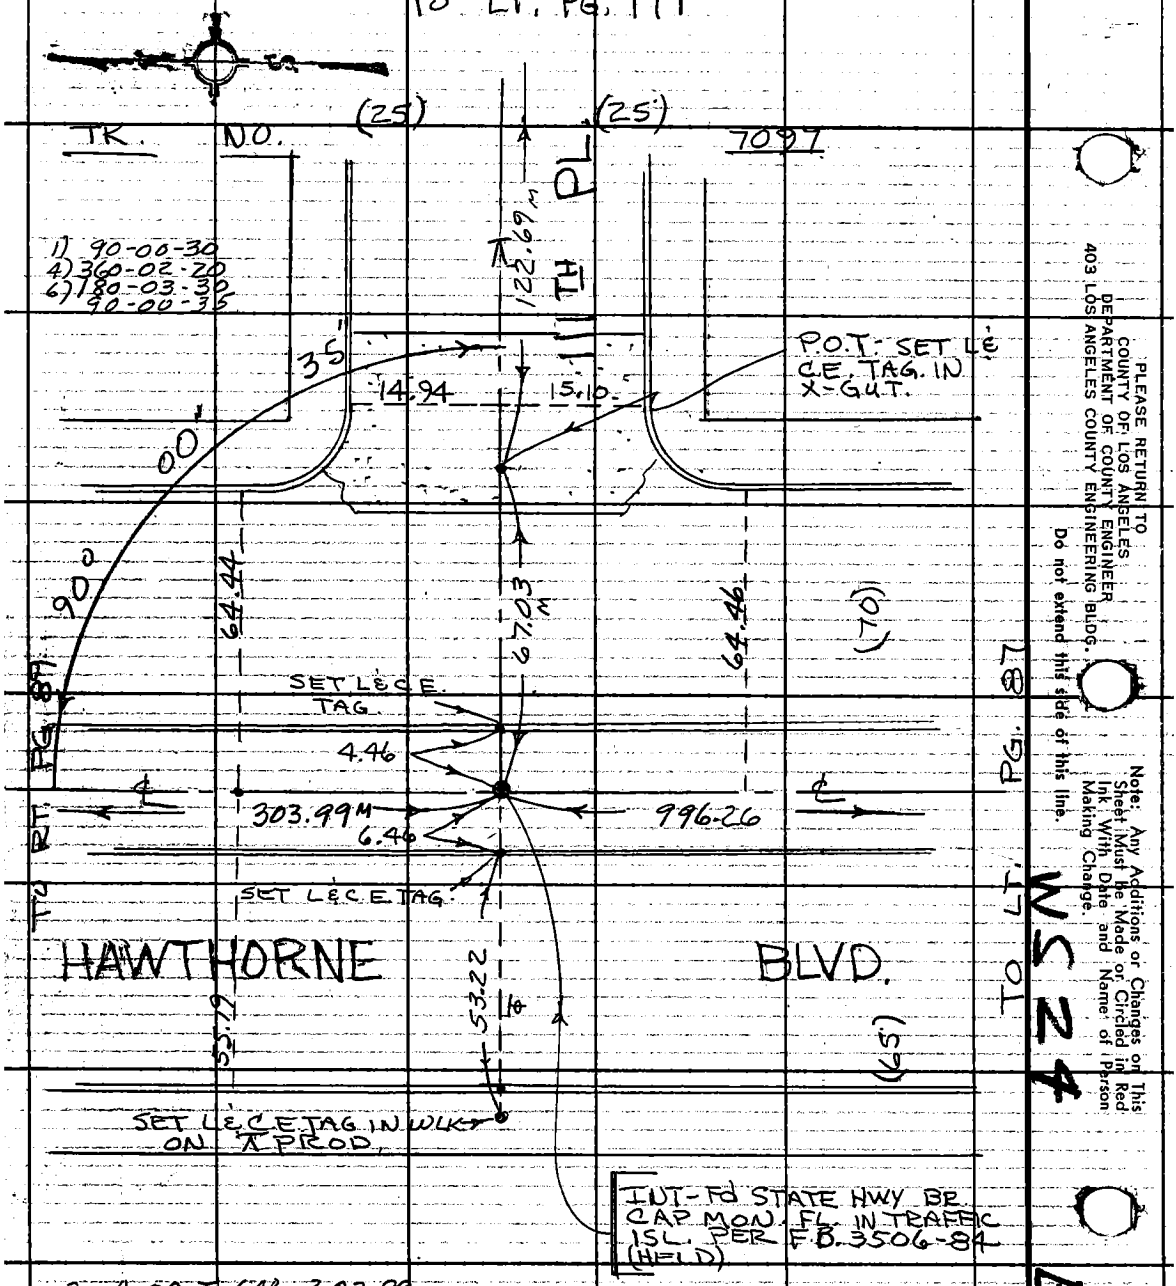

304.00 T=64°=303.99
67.03 T=70°=67.03
122.69 " =122.69

TR NO. 957

PLEASE RETURN TO
COUNTY OF LOS ANGELES
DEPARTMENT OF COUNTY ENGINEER
403 LOS ANGELES COUNTY ENGINEERING BLDG.

Do not extend this side of this line.

Note: Any Additions or Changes on This Sheet Must Be Made or Circled in Red Ink With Date and Name of Person Making Change.

WS 24

B5

PWFB 0818 685

B5

Notes Ck'd by	Survey of LENNOX AREA ℄
Map No.	JN 0303.00 Tape 238 Std 68 °F
Office Work	Surveyed by J. BAZEN
Checked	Notes J. J. B. Date 3-75
Date	Checked E. M. PALMER JUN 15 1976

F. B. 3935 PG. 89

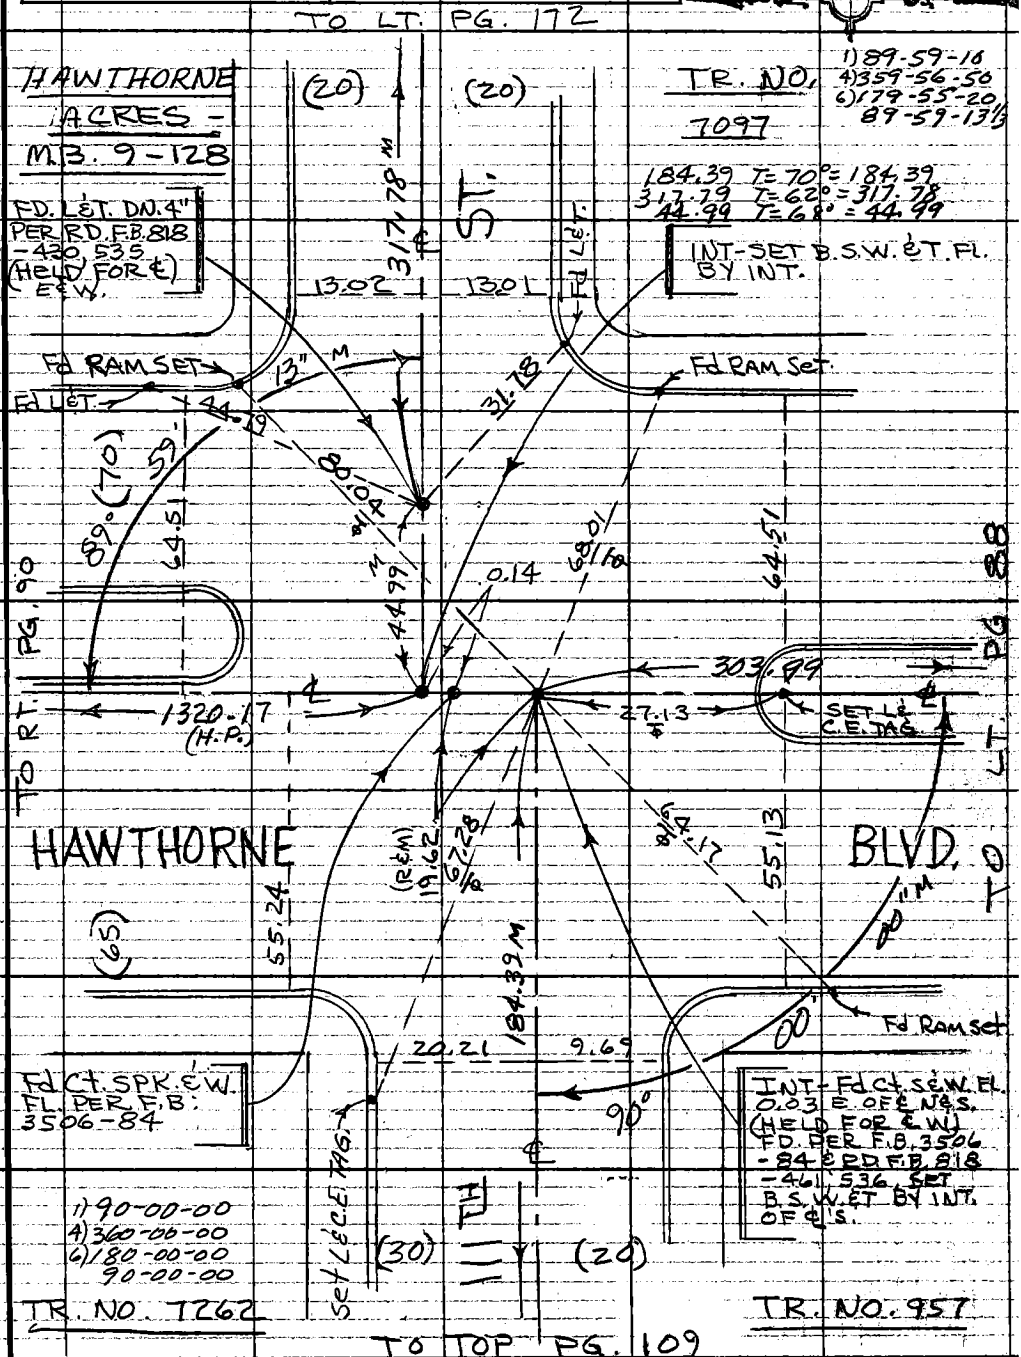

WS24

Note: Any Additions or Changes on This Sheet Must be Made or Circled in Red Ink With Date and Name of Person Making Change.

Do not extend this side of this line.

PLEASE RETURN TO COUNTY OF LOS ANGELES DEPARTMENT OF COUNTY ENGINEER 403 LOS ANGELES COUNTY ENGINEERING BLDG.

76F309S CE#310 3-69

F. B. 3935 PG 90

TO BOT PG 132

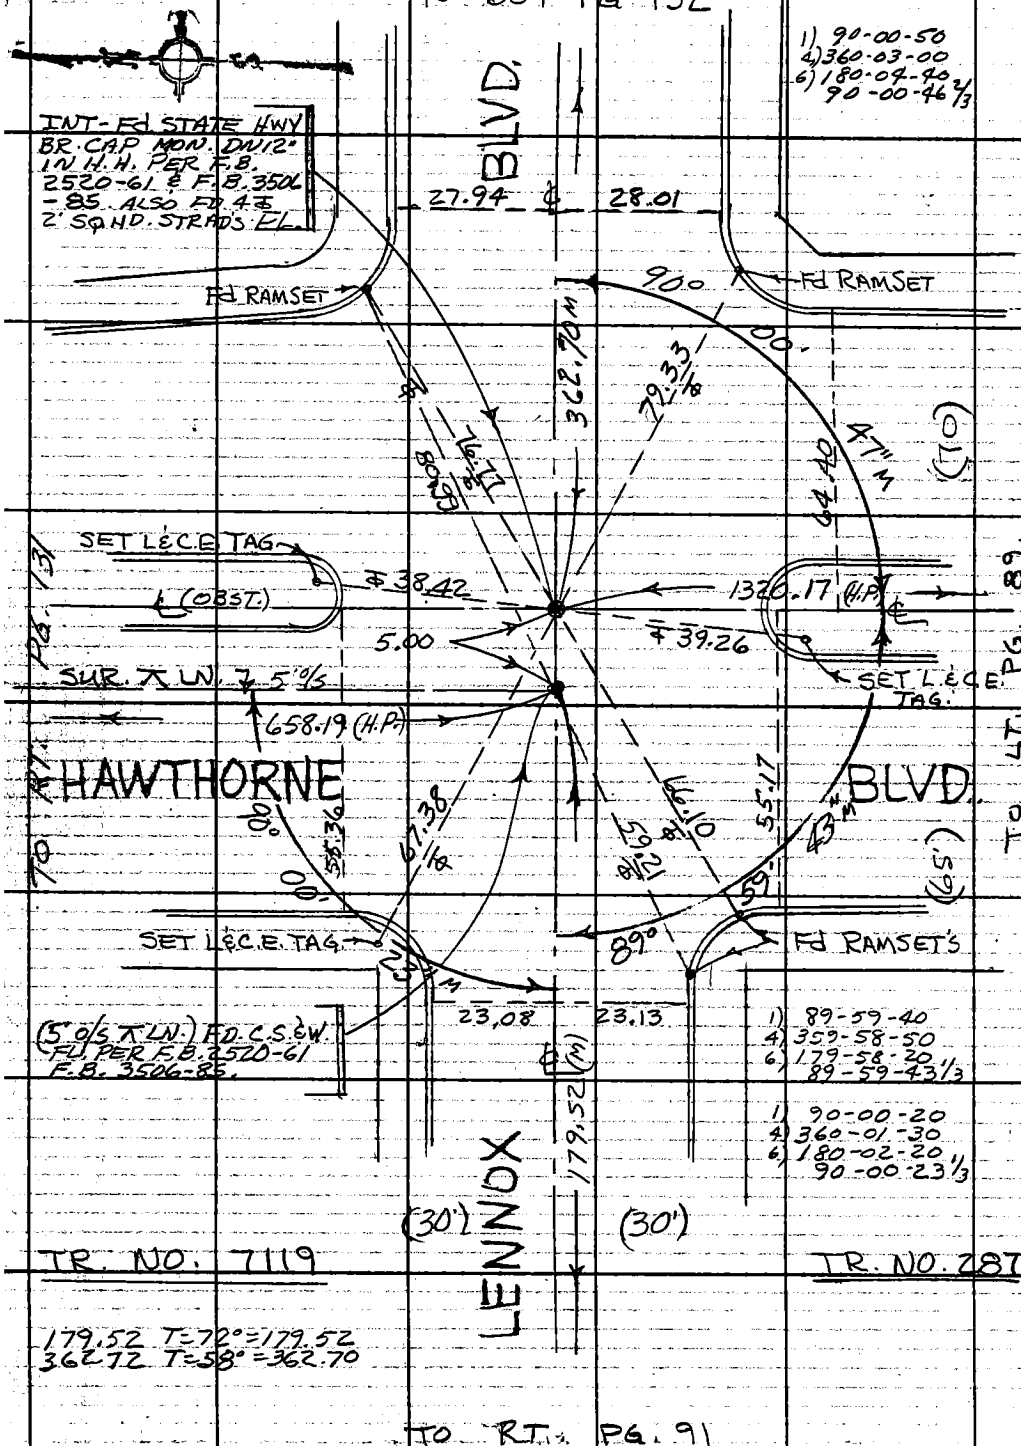

1) 90-00-50
4) 360-03-00
6) 180-04-40
90-00-46 2/3

1) 89-59-40
4) 359-58-50
6) 179-58-20
89-59-43 1/3

1) 90-00-20
4) 360-01-30
6) 180-02-20
90-00-23 1/3

PLEASE RETURN TO
COUNTY OF LOS ANGELES
DEPARTMENT OF COUNTY ENGINEER
403 LOS ANGELES COUNTY ENGINEERING BLDG.
Do not extend this side of this line.

Note: Any Additions or Changes on This Sheet Must Be Made or Circled in Red Ink With Date and Name of Person Making Change.

WS 24

B5

PWFB 0818 687

Notes Ck'd by	Survey of LENNOX AREA ℄
Map No.	JN0303.00 Tape 238 Std 68 °F
Office Work	Surveyed by J. BAZEN
Checked	Notes J.J.B. Date 7-75
Date	Indexed R. M. PALMERI JUN 15 1976

F. B. 3935 PG. 91

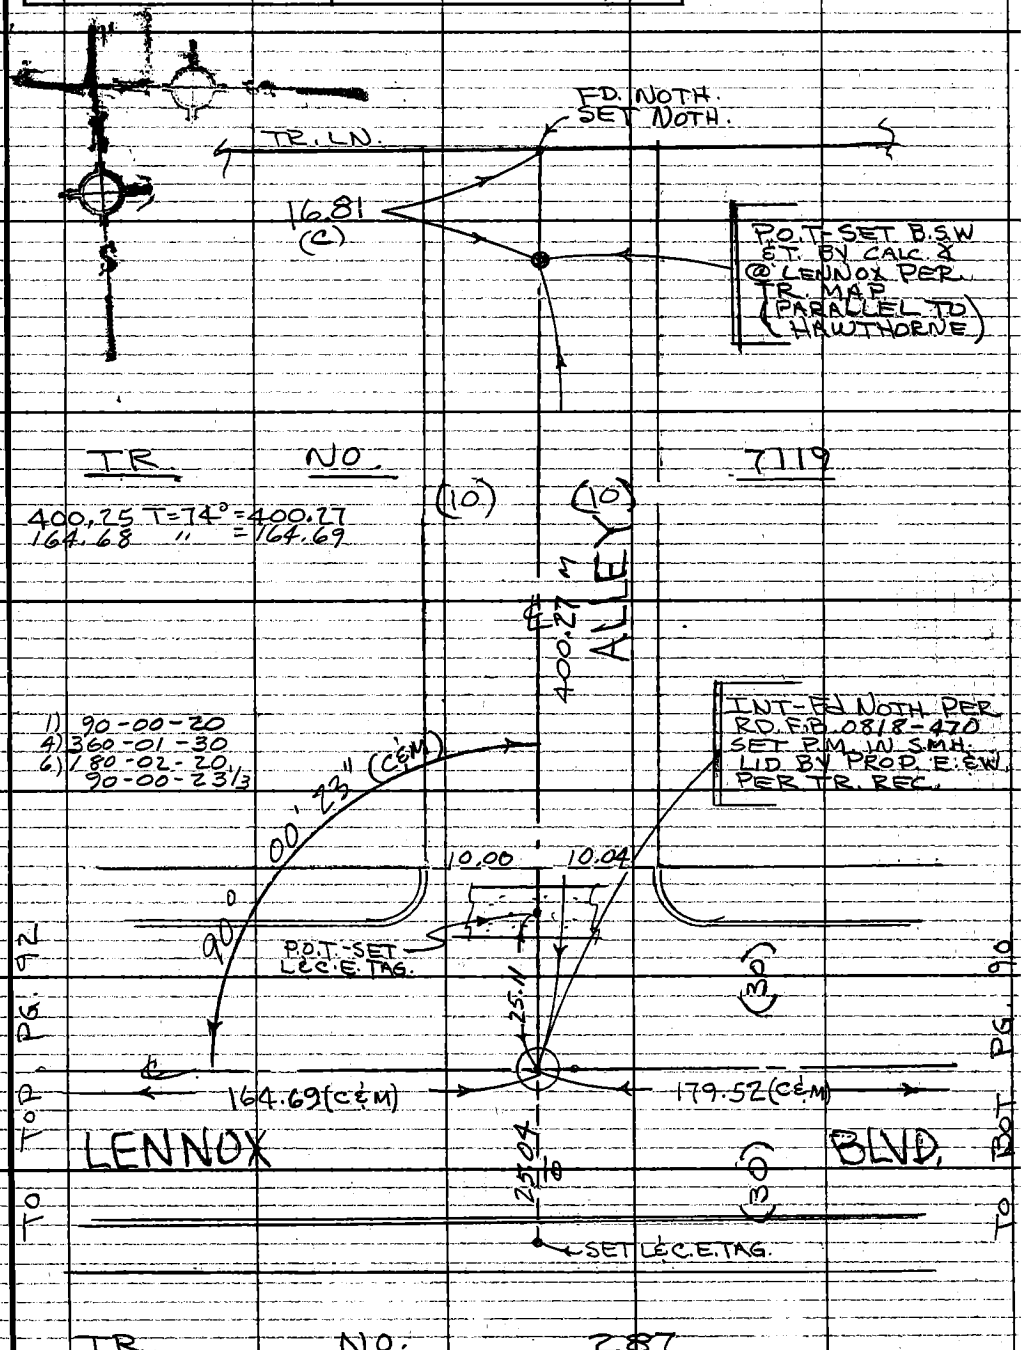

Note: Any Additions or Changes on This Sheet Must be Made or Circled in Red Ink With Date and Name of Person Making Change.

PLEASE RETURN TO
COUNTY OF LOS ANGELES
DEPARTMENT OF COUNTY ENGINEER
403 LOS ANGELES COUNTY ENGINEERING BLDG.

Do not extend this side of this line.

76F309S CE#310 3-69

PWFB 0818 688

F.B. 3935 PG 92

TO LT. PG. 91

TR. NO. 7119

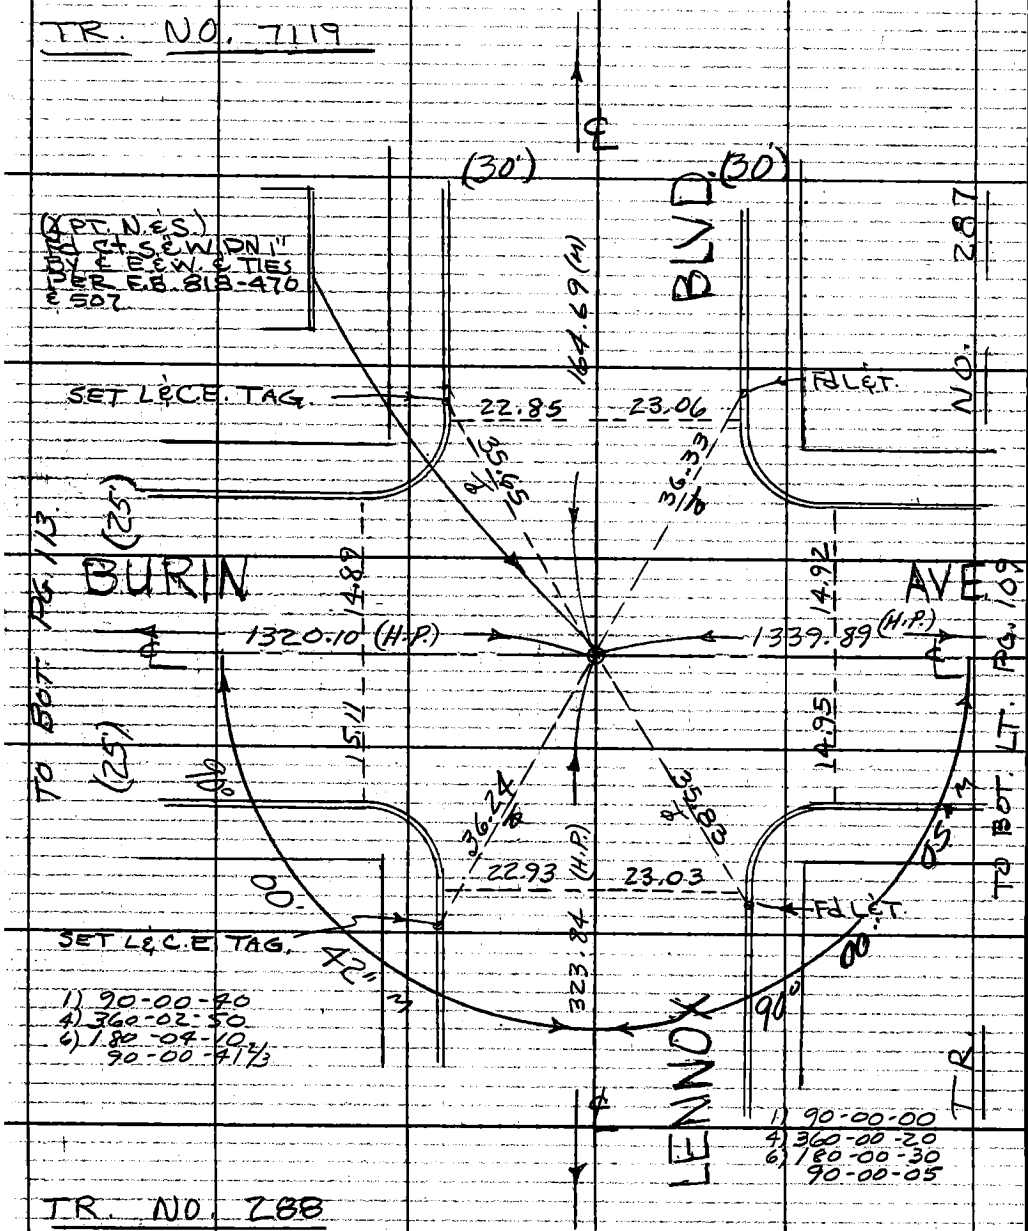

TR. NO. 288

TO TOP PG. 93

PLEASE RETURN TO
COUNTY OF LOS ANGELES
DEPARTMENT OF COUNTY ENGINEER
403 LOS ANGELES COUNTY ENGINEERING BLDG.

Do not extend this side of this line.

Note: Any Additions or Changes on This Sheet Must Be Made or Circled in Red Ink With Date and Name of Person Making Change.

WS 24

B5

PWFB 0818 689

Notes Ck'd by	Survey of LENNOX AREA ℄
Map No.	JN 0303.00 Tape 238 Std 68 °F
Office Work	Surveyed by J. BAZEN
Checked	Notes J.J.B. Date 7-75
Date	Indexed PALMERI JUN 15 1976

F.B. 3935 PG. 93

B5

WS 24

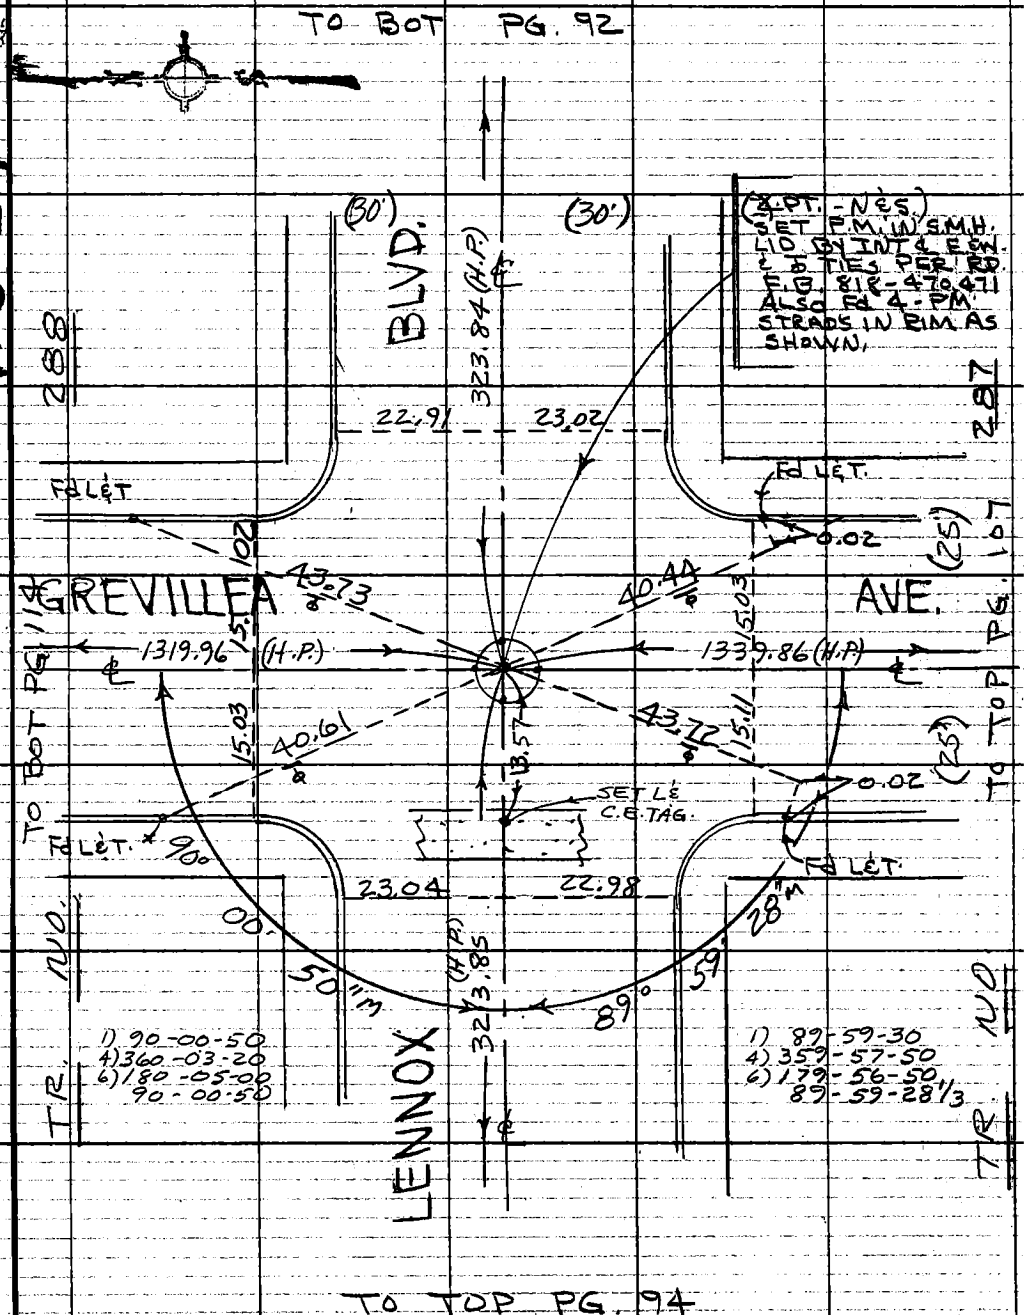

Note: Any Additions or Changes on This Sheet Must be Made or Circled in Red Ink With Date and Name of Person Making Change.

Do not extend this side of this line.

PLEASE RETURN TO
COUNTY OF LOS ANGELES
DEPARTMENT OF COUNTY ENGINEER
403 LOS ANGELES COUNTY ENGINEERING BLDG.

76F309S CE#310 3-69

F. B. 3935 PG. 94

TO BOT PG. 93

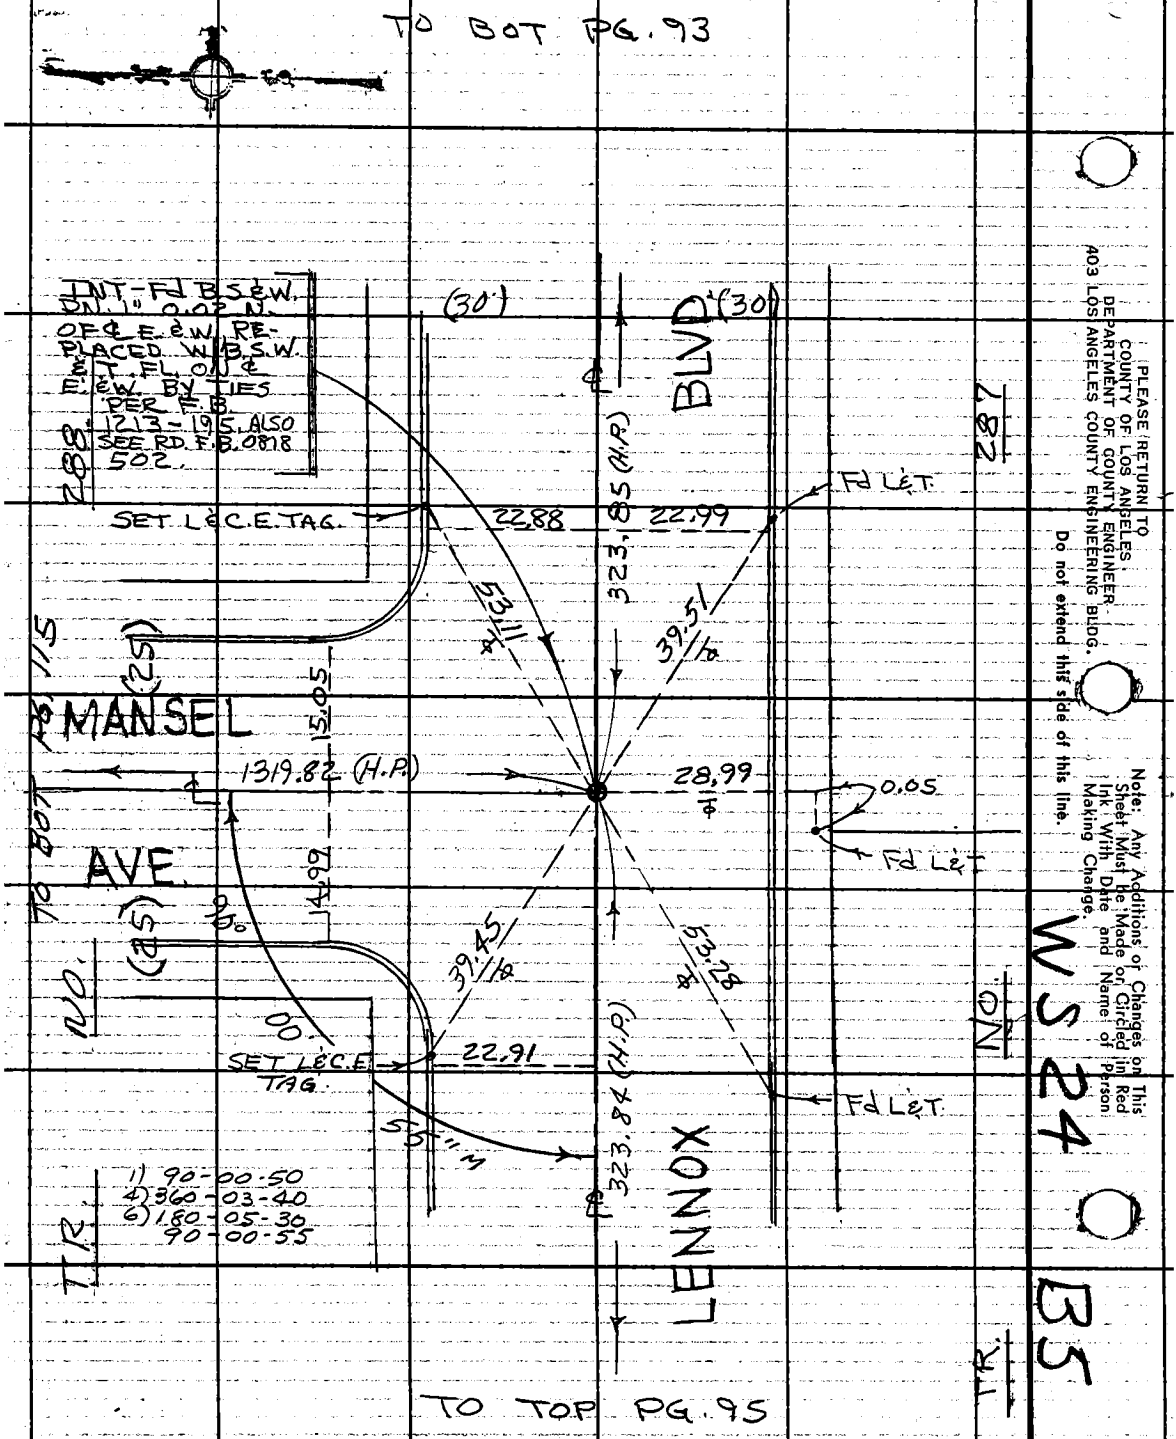

PLEASE RETURN TO
COUNTY OF LOS ANGELES
DEPARTMENT OF COUNTY ENGINEER
403 LOS ANGELES COUNTY ENGINEERING BLDG.
Do not extend this side of this line.
Note: Any Additions or Changes on This Sheet Must Be Made or Circled in Red Ink With Date and Name of Person Making Change.

TO TOP PG. 95

PWFB 0817 703

Notes Ck'd by	Survey of LENNOX AREA ℄
Map No.	JN 0303.00 Tape 238 Std 68 °F
Office Work	Surveyed by J. BAZEN
Checked	Notes J.J.B. Date
Date	Indexed T. M. PALMERI JUN 15 1976

F. B. 3935 PG. 95

WS 24 B 5

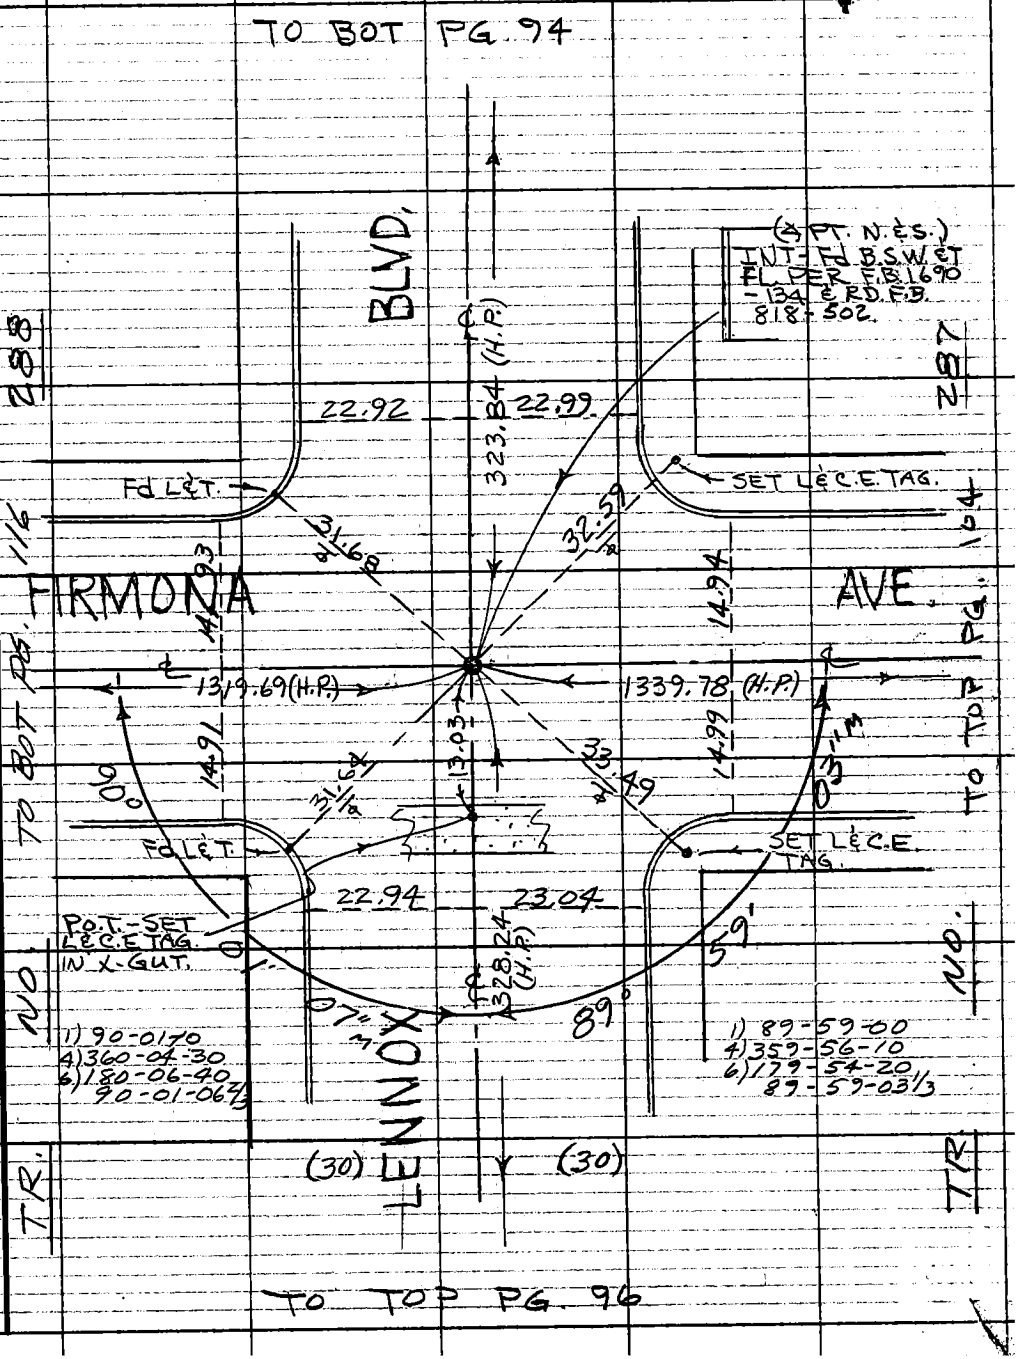

Note: Any Additions or Changes on This Sheet Must be Made or Circled in Red Ink With Date and Name of Person Making Change.

Do not extend this side of this line.

PLEASE RETURN TO
COUNTY OF LOS ANGELES
DEPARTMENT OF COUNTY ENGINEER
403 LOS ANGELES COUNTY ENGINEERING BLDG.

W.S. 24 B-5

76F309S CE#310 3-69

F.B. 3935 PG 96

TO BOT PG. 95.

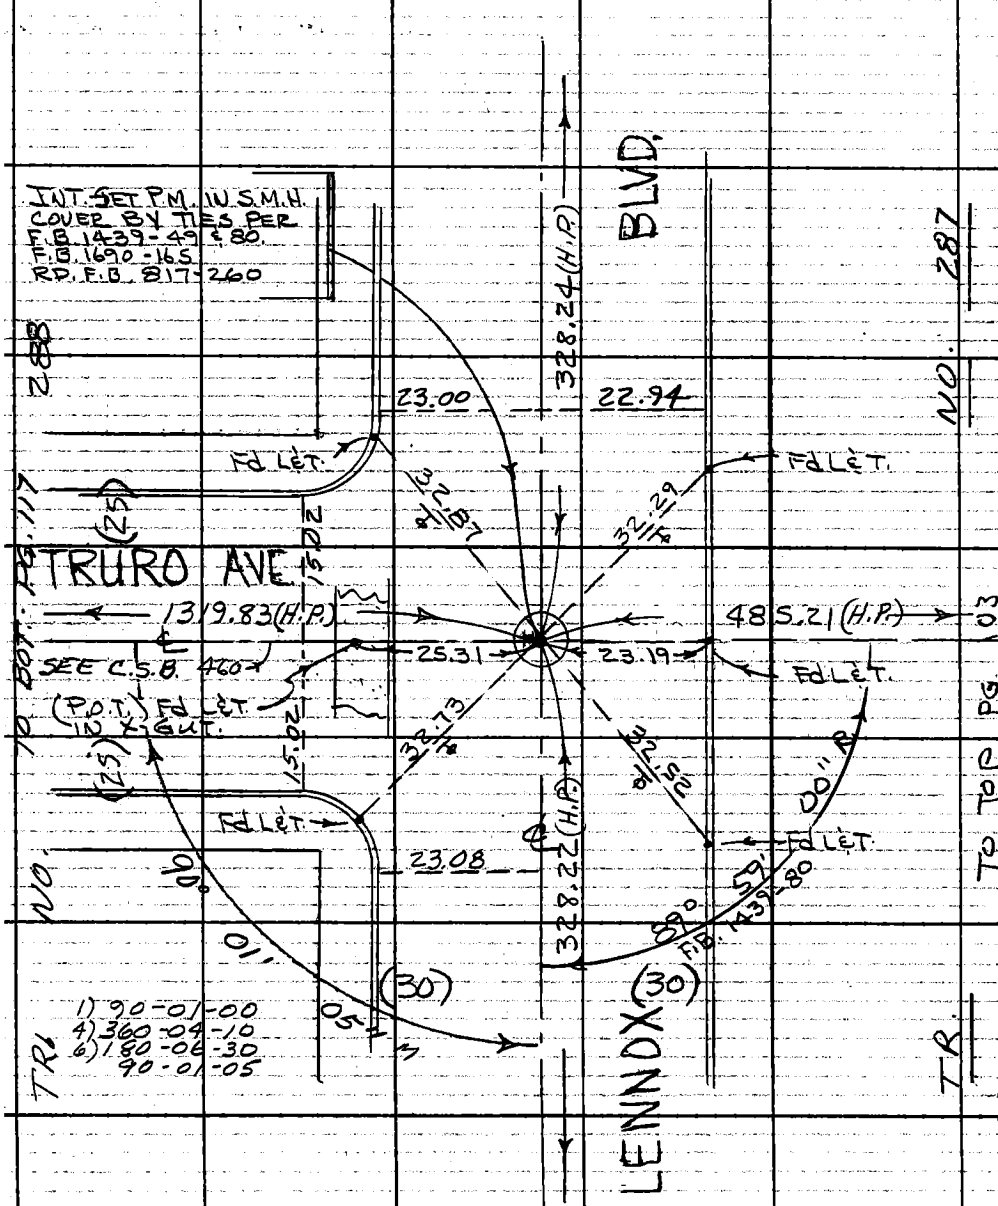

TO TOP PG. 97

PLEASE RETURN TO
COUNTY OF LOS ANGELES
DEPARTMENT OF COUNTY ENGINEER
403 LOS ANGELES COUNTY ENGINEERING BLDG.

Do not extend this side of this line.

Note: Any Additions or Changes on This Sheet Must Be Made or Circled in Red Ink With Date and Name of Person Making Change.

WS 24

B2

PWFB 0817

705

Notes Ck'd by	Survey of LENNOX AREA ℄
Map No.	JN 0303.00 Tape 238 Std 68 °F
Office Work	Surveyed by J. BAZEN
Checked	Notes J.J.B. Date
Date	Indexed PALMERI JUN 15 1978

F.B. 3935 PG. 97

B5

WS 24

Note: Any Additions or Changes on This Sheet Must be Made or Circled in Red Ink With Date and Name of Person Making Change.

Do not extend this side of this line.

PLEASE RETURN TO
COUNTY OF LOS ANGELES
DEPARTMENT OF COUNTY ENGINEER
403 LOS ANGELES COUNTY ENGINEERING BLDG.

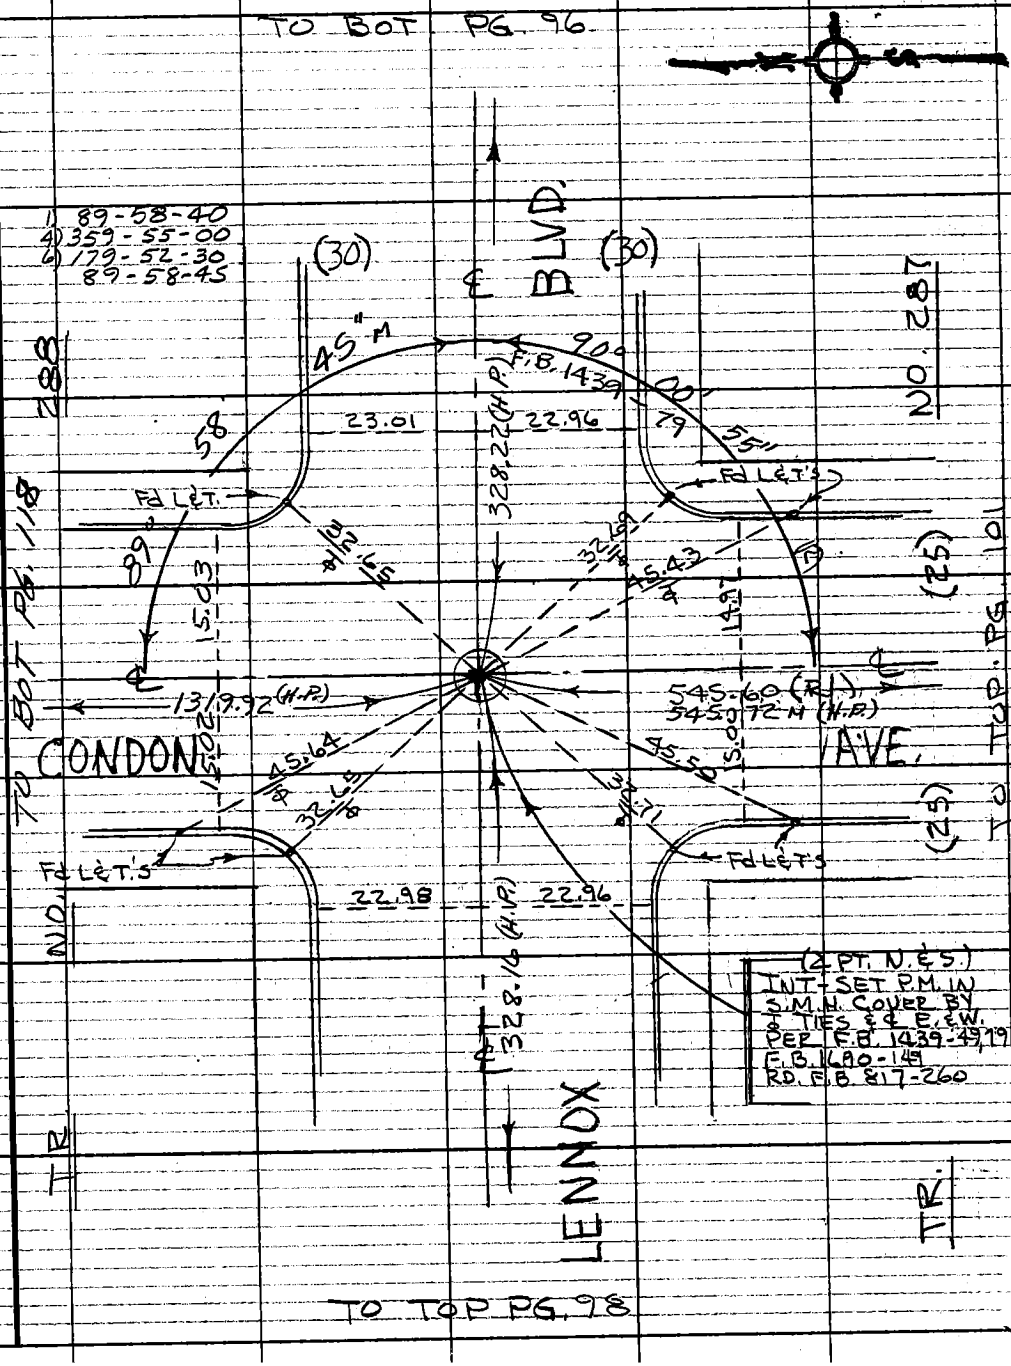

76E309S CE#310 3-69

F.B. 3935 PG. 98

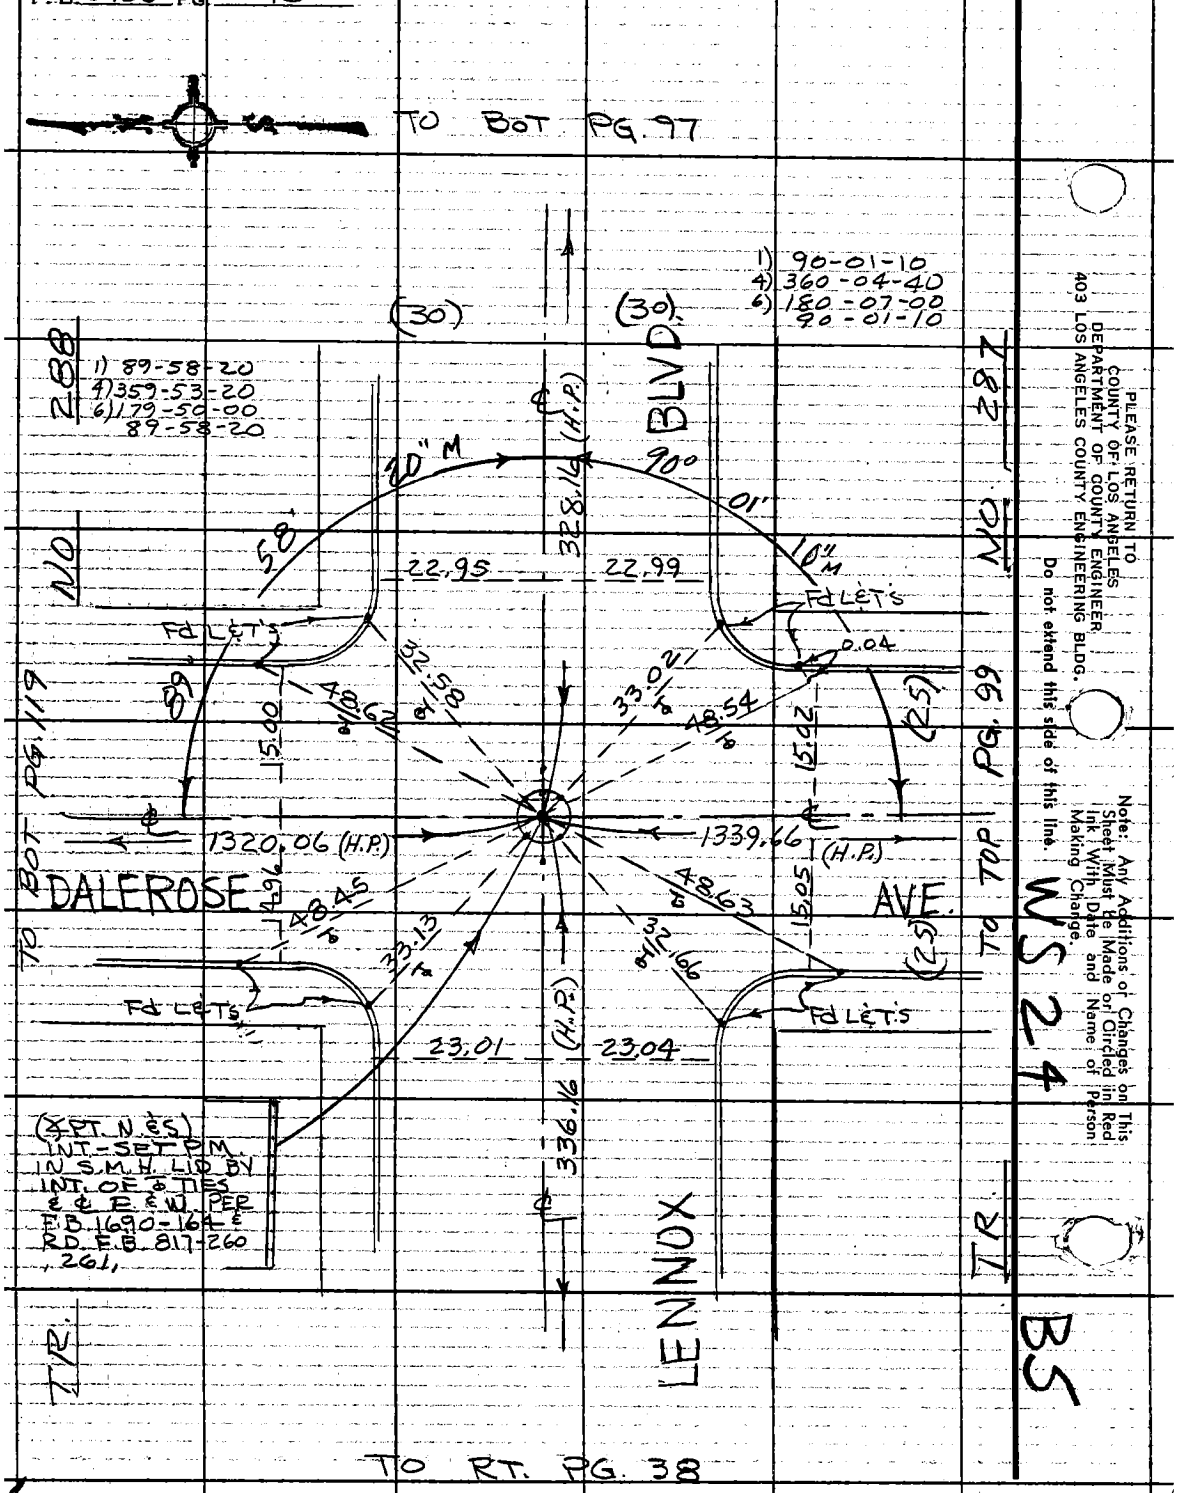

PLEASE RETURN TO
COUNTY OF LOS ANGELES
DEPARTMENT OF COUNTY ENGINEER
403 LOS ANGELES COUNTY ENGINEERING BLDG.

Do not extend this side of this line.

Note: Any Additions or Changes on This Sheet Must be Made or Circled in Red Ink With Date and Name of Person Making Change.

PWFB 0817 707

Notes Ck'd by	Survey of LENNOX AREA ℄
Map No.	JN 0303.00 Tape 238 Std 68 °F
Office Work	Surveyed by J. BAZEN
Checked	Notes J.J.B. Date 3-75
Date	Indexed T. M. PALMERI JUN 15 1976

F. B. 3935 PG. 99

B5

WS 24

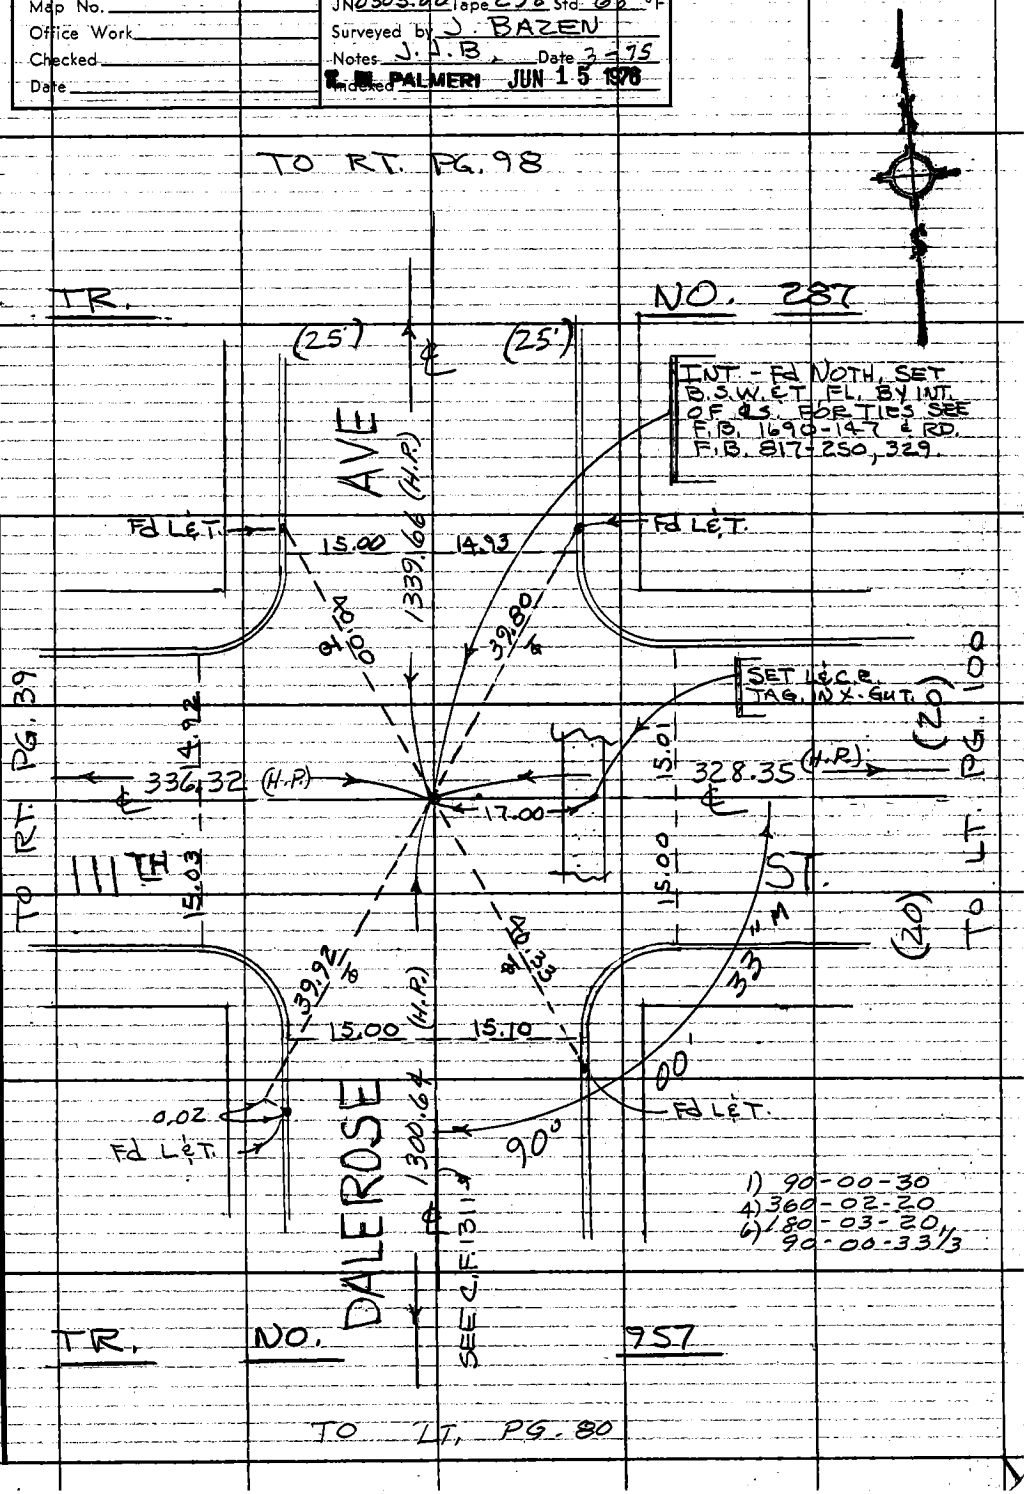

Note: Any Additions or Changes on This Sheet Must be Made or Circled in Red Ink With Date and Name of Person Making Change.

Do not extend this side of this line.

PLEASE RETURN TO
COUNTY OF LOS ANGELES
DEPARTMENT OF COUNTY ENGINEER
403 LOS ANGELES COUNTY ENGINEERING BLDG.

76F309S CE#310 3-69

PWFB 0817 708

F.B. 3935 PG. 100

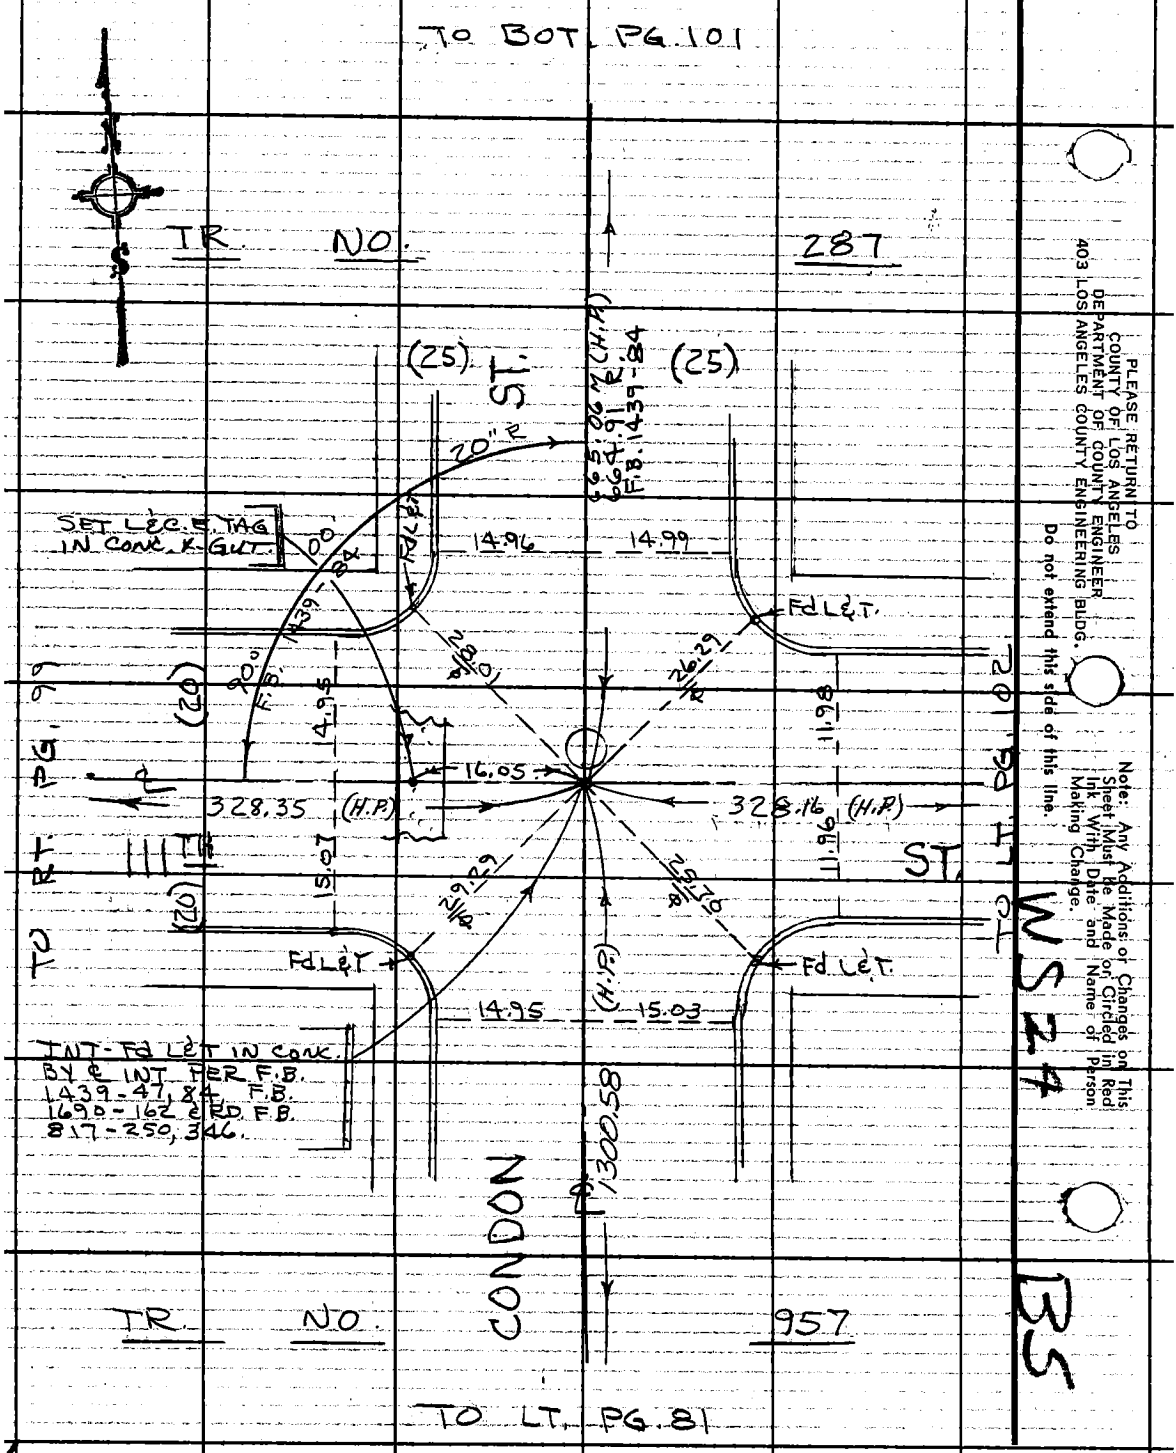

PLEASE RETURN TO
COUNTY OF LOS ANGELES
DEPARTMENT OF COUNTY ENGINEER
403 LOS ANGELES COUNTY ENGINEERING BLDG.

Do not extend this side of this line.

Note: Any Additions or Changes on This Sheet Must Be Made or Circled in Red Ink With Date and Name of Person Making Change.

PWFB 0817 709, 710

Notes Ck'd by	Survey of LENNOX AREA ℄
Map No.	JN 0303.00 Tape 238 Std 68 °F
Office Work	Surveyed by J. BAZEN
Checked	Notes J.D.B. Date 3-75
Date	Indexed T. M. PALMERI JUN 15 1976

F. B. 393S PG. 101

B-5

WS 24

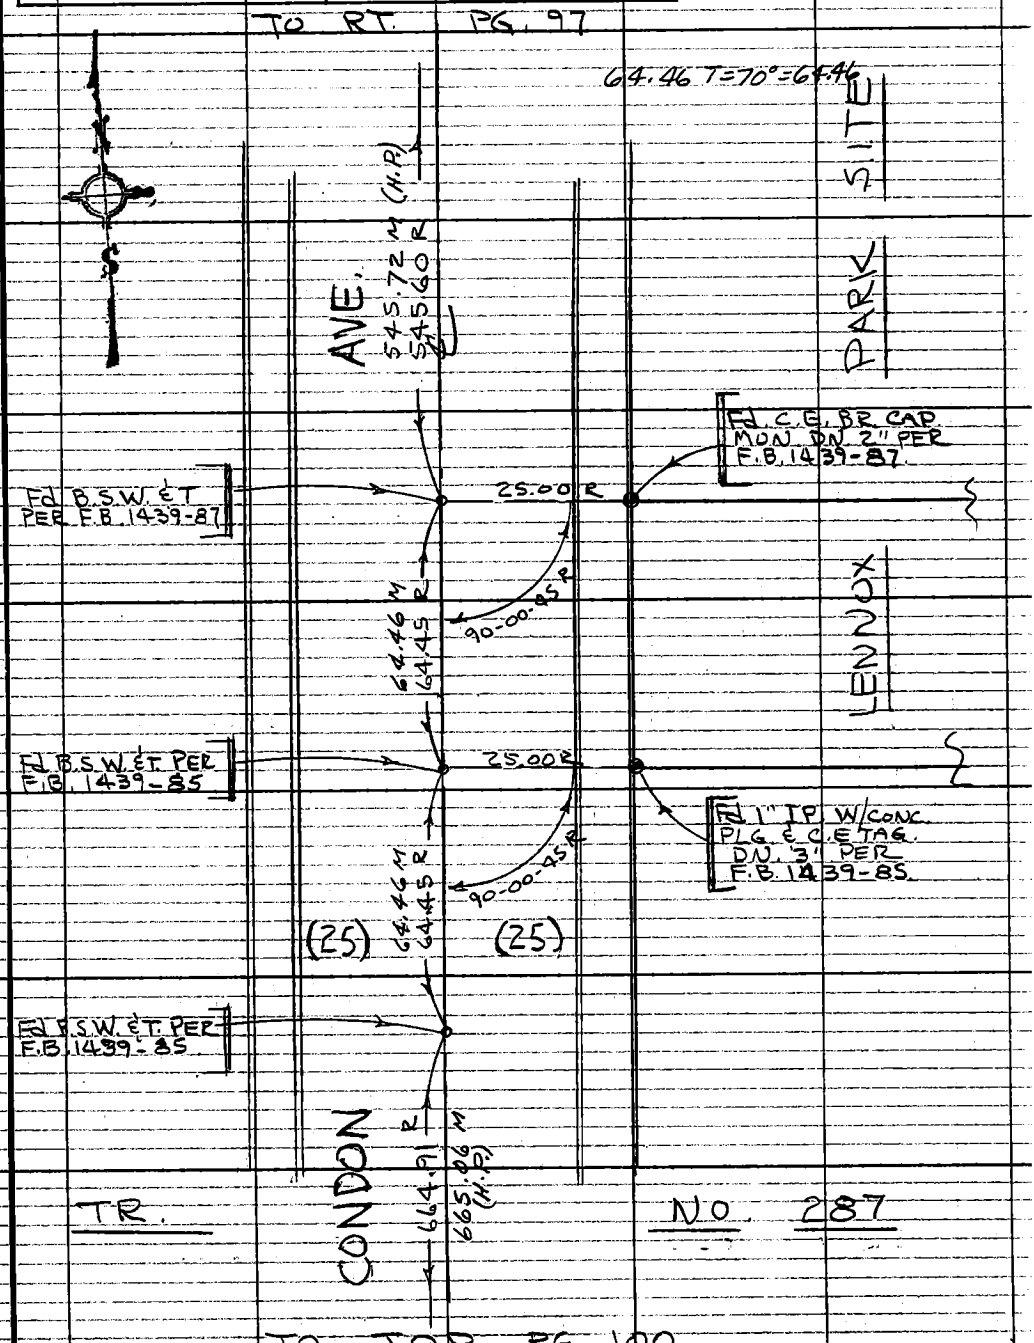

Note: Any Additions or Changes on This Sheet Must be Made or Circled in Red Ink With Date and Name of Person Making Change.

Do not extend this side of this line.

PLEASE RETURN TO
COUNTY OF LOS ANGELES
DEPARTMENT OF COUNTY ENGINEER
403 LOS ANGELES COUNTY ENGINEERING BLDG.

6F309S CE#310 3-69

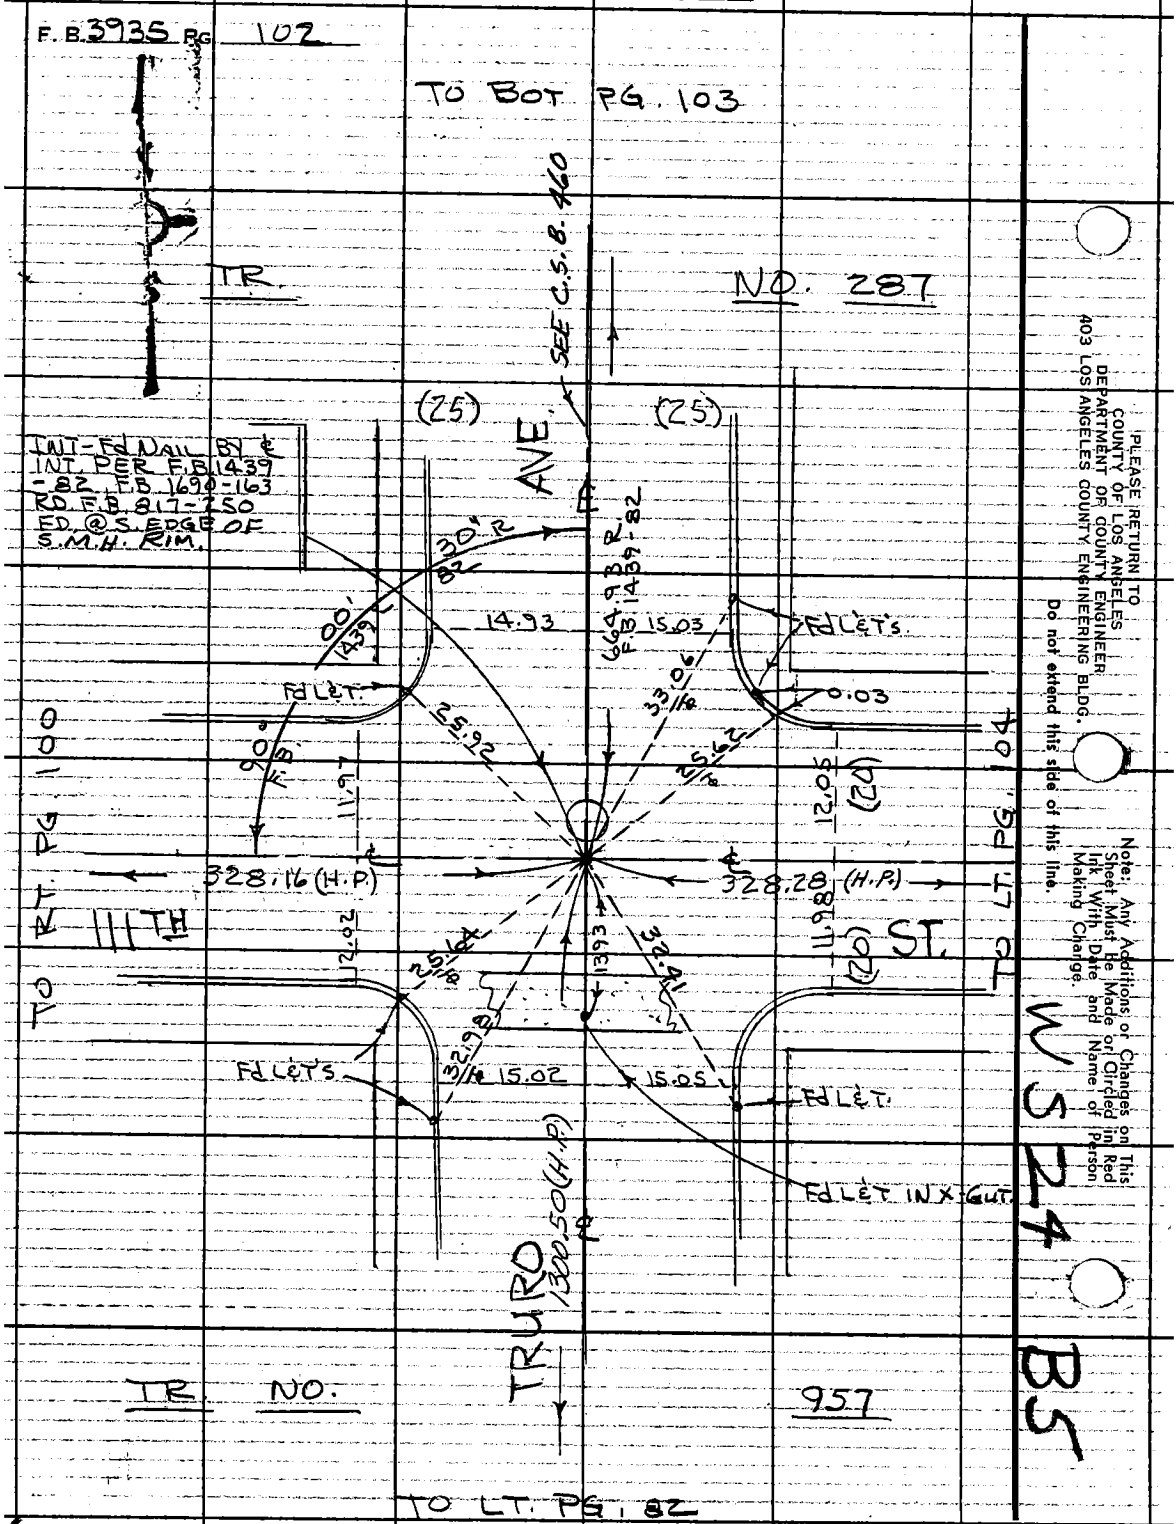

PLEASE RETURN TO
COUNTY OF LOS ANGELES
DEPARTMENT OF COUNTY ENGINEER
403 LOS ANGELES COUNTY ENGINEERING BLDG.

Do not extend this side of this line.

Note: Any Additions or Changes on This Sheet Must Be Made or Circled in Red Ink With Date and Name of Person Making Change.

PWFB 0817 712

Notes Ck'd by	Survey of LENNOX AREA ℄
Map No.	JN 0303.00 Tape 238 Std 68 °F
Office Work	Surveyed by J. BAZEN
Checked	Notes J.J.B. Date 4-75
Date	Indexed E. M. PALMERI JUN 15 1976

F. B. 3935 PG. 103

WS 24 B-5

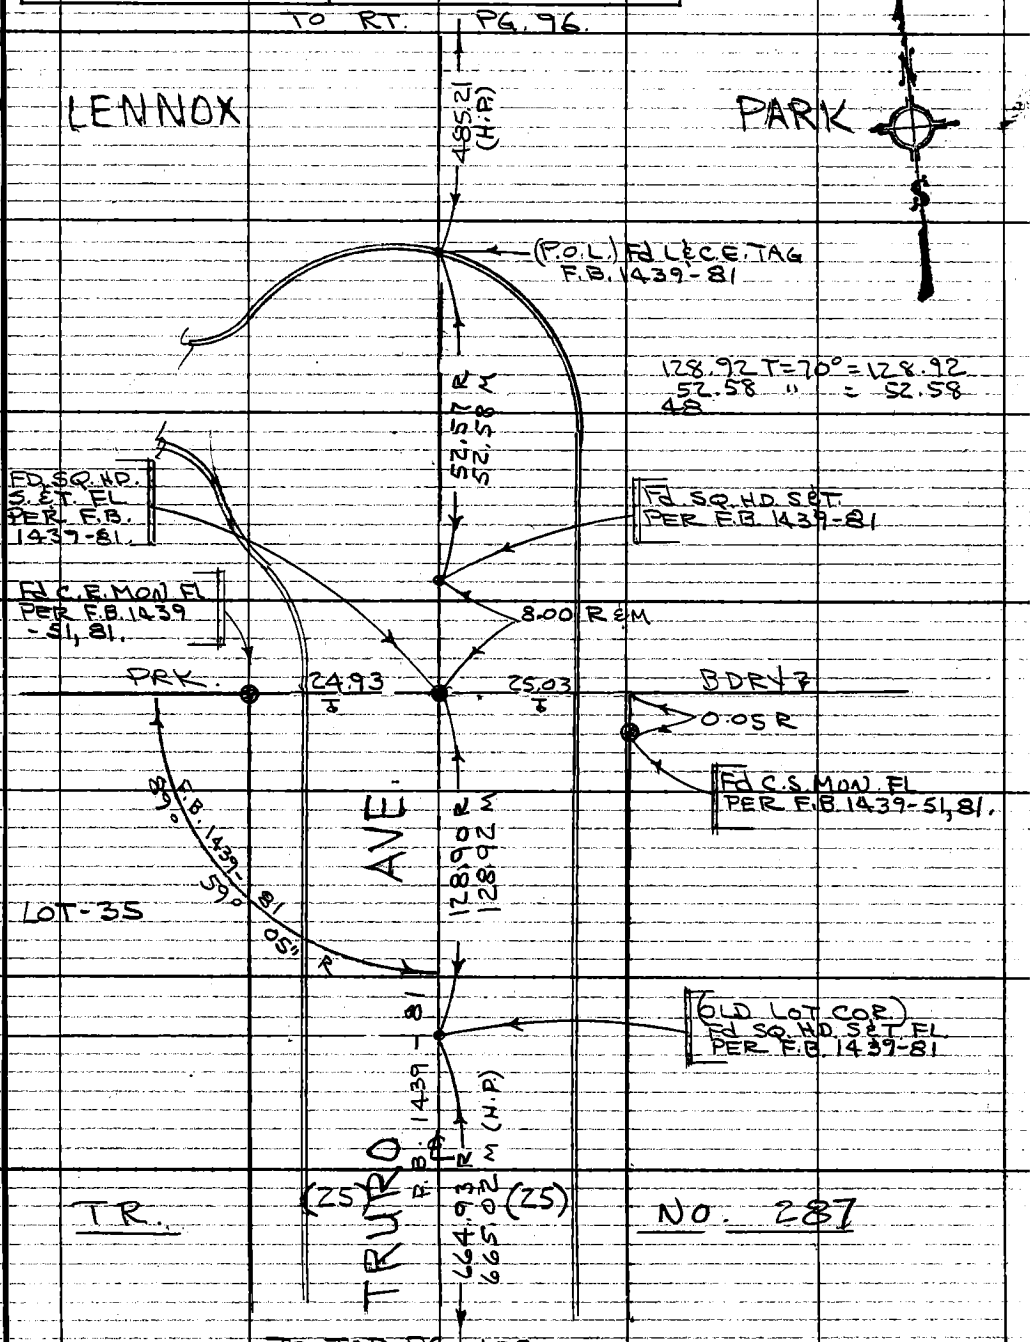

Note: Any Additions or Changes on This Sheet Must be Made or Circled in Red Ink With Date and Name of Person Making Change.

Do not extend this side of this line.

PLEASE RETURN TO
COUNTY OF LOS ANGELES
DEPARTMENT OF COUNTY ENGINEER
403 LOS ANGELES COUNTY ENGINEERING BLDG.

76F309S CE#310 3-69

PWFB 0817

713

F. B. 3935 PG 104

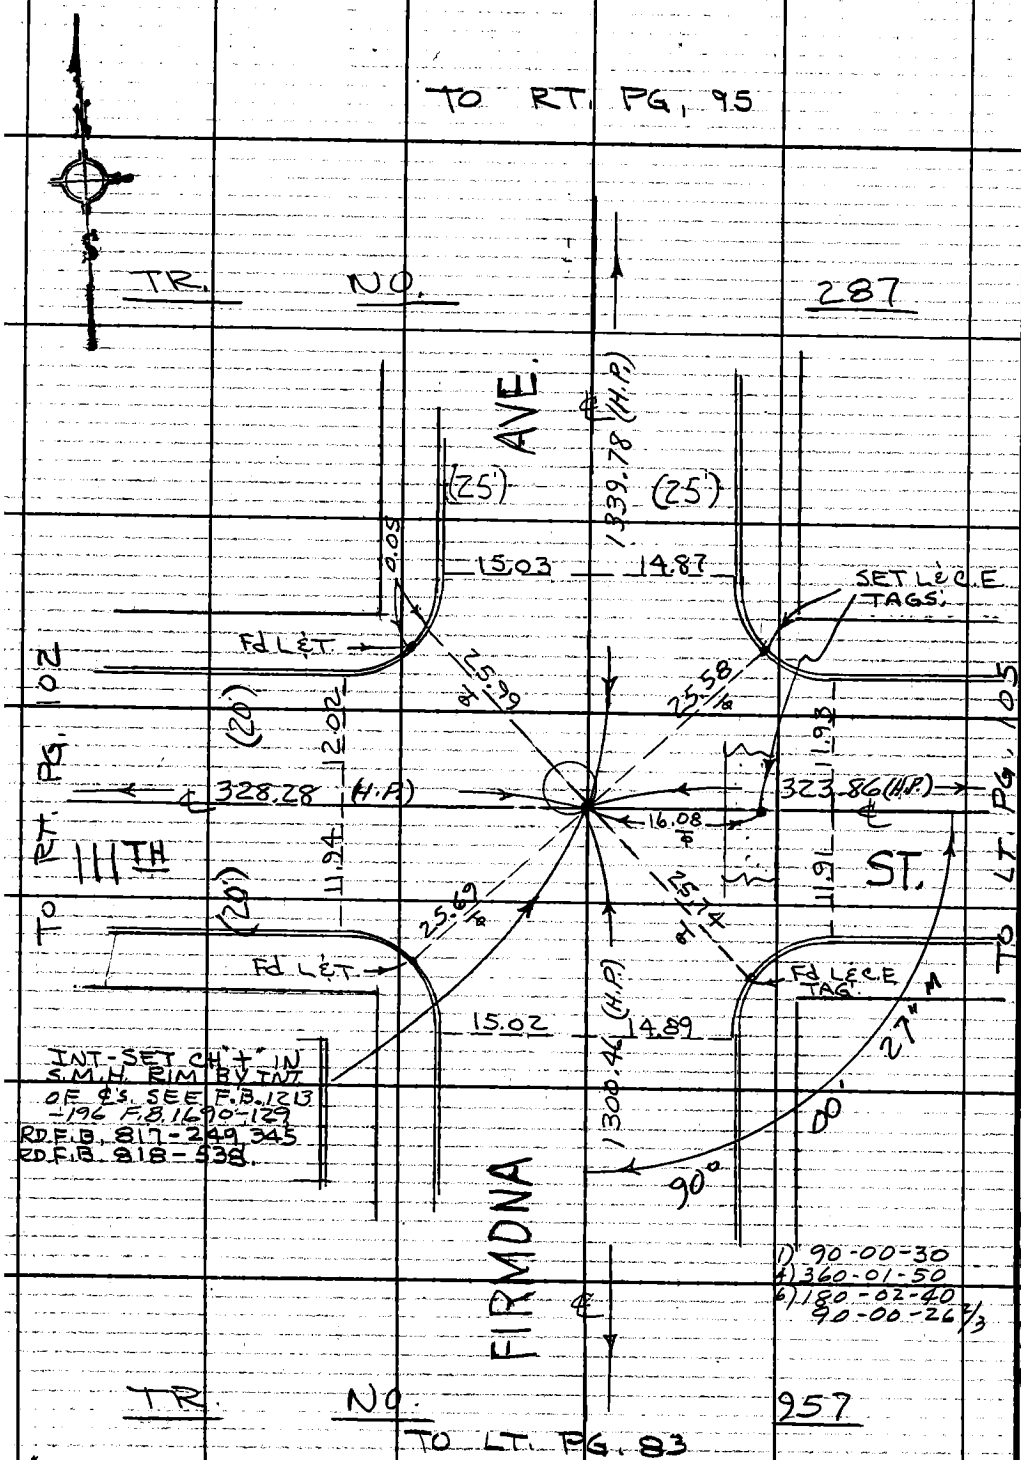

PLEASE RETURN TO
COUNTY OF LOS ANGELES
DEPARTMENT OF COUNTY ENGINEER
403 LOS ANGELES COUNTY ENGINEERING BLDG.

Do not extend this side of this line.

Note: Any Additions or Changes on This Sheet Must be Made or Circled in Red Ink With Date and Name of Person Making Change.

PWFB 0818 691

Notes Ck'd by	Survey of LENNOX AREA ℄
Map No.	JN 03.03.00 Tape 238 Std 68 °F
Office Work	Surveyed by J. BAZEN
Checked	Notes J.J.B. Date 3-75
Date	Indexed L. M. PALMERI JUN 15 1976

F. B. 3935 PG. 105

WS 24 B5

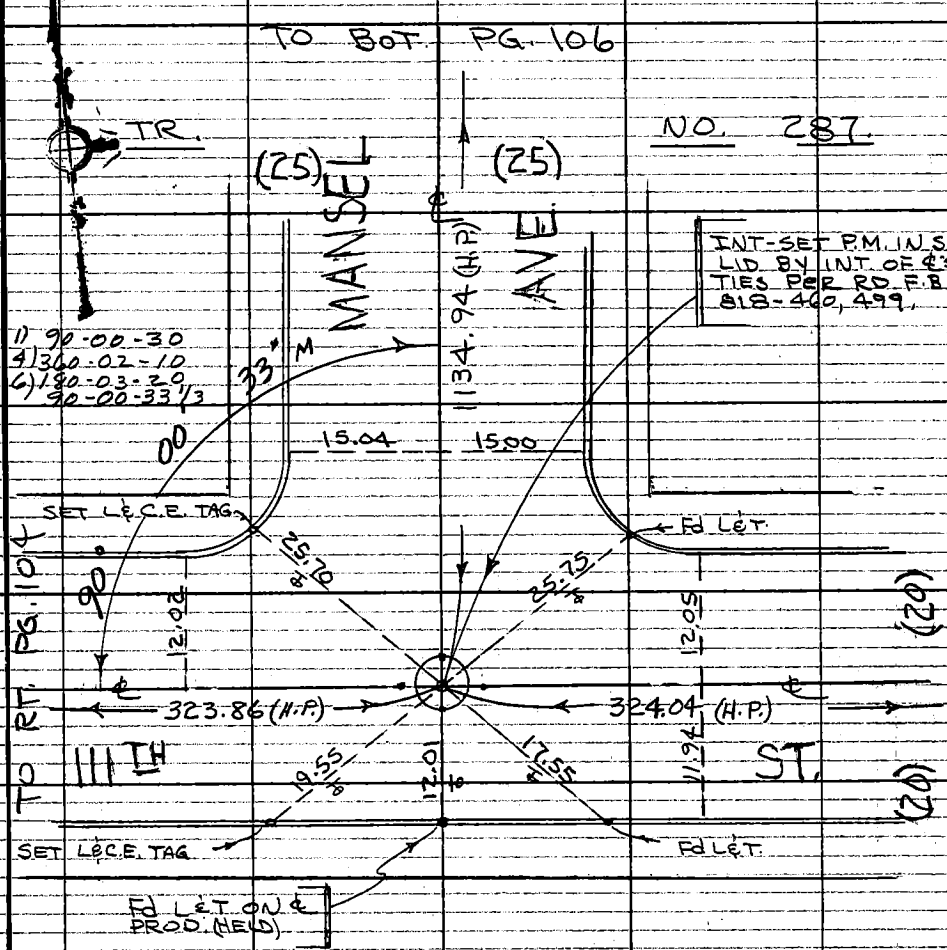

TR. NO. 957

Note: Any Additions or Changes on This Sheet Must be Made or Circled in Red Ink With Date and Name of Person Making Change.

Do not extend this side of this line.

PLEASE RETURN TO
COUNTY OF LOS ANGELES
DEPARTMENT OF COUNTY ENGINEER
403 LOS ANGELES COUNTY ENGINEERING BLDG.

16F309S CE#310 3-69

692

F.B. 3935 PG. 106

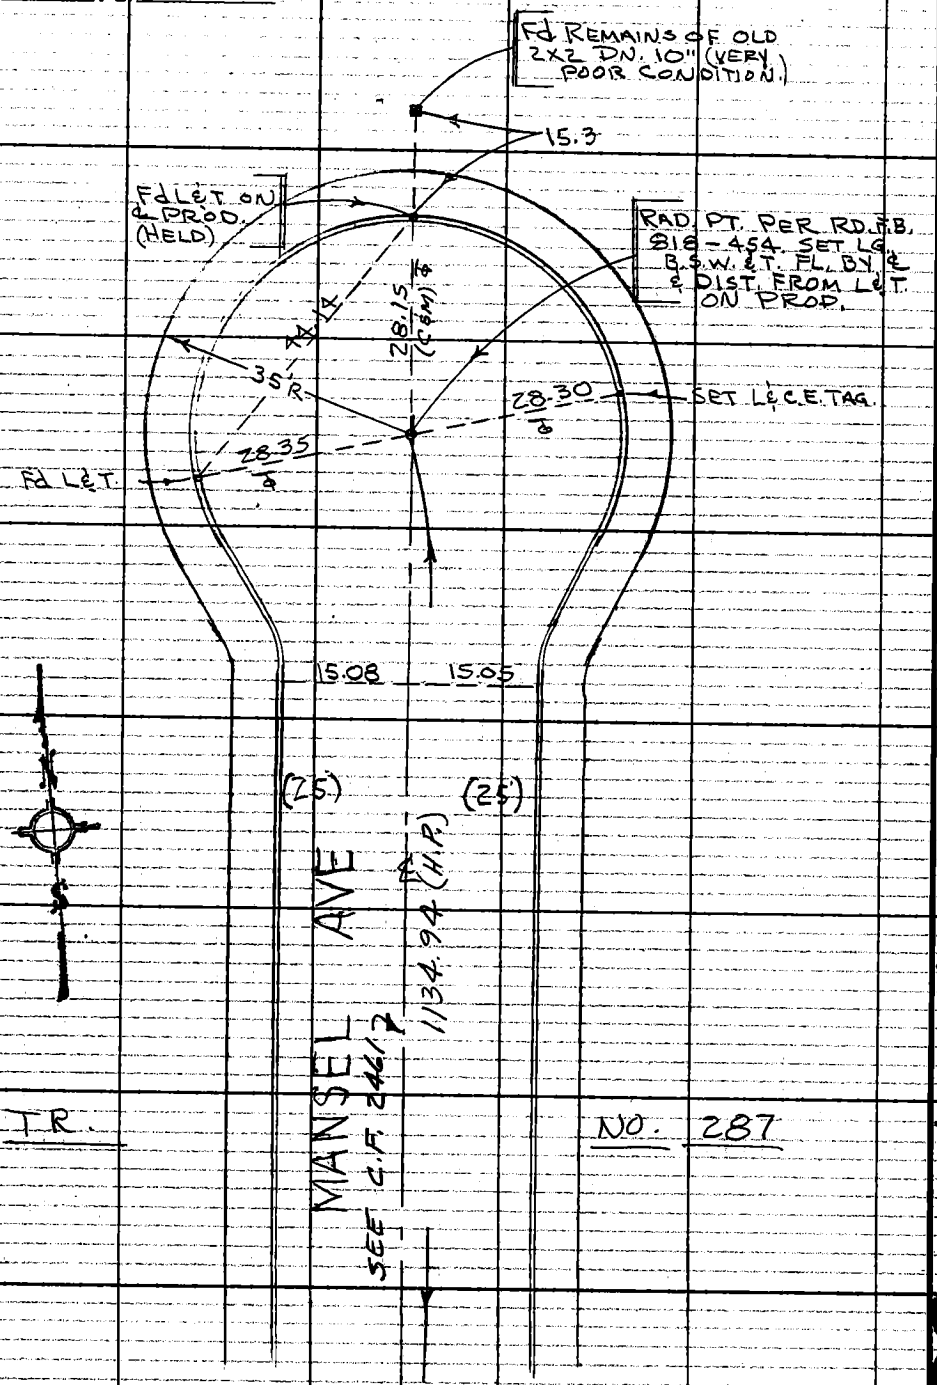

T.R.

NO. 287

TO TOP PG. 105

PLEASE RETURN TO
COUNTY OF LOS ANGELES
DEPARTMENT OF COUNTY ENGINEER
403 LOS ANGELES COUNTY ENGINEERING BLDG.
Do not extend this side of this line.

Note: Any Additions or Changes on This Sheet Must be Made or Circled in Red Ink With Date and Name of Person Making Change.

WS 24 B5

PWFB 0818 693

Notes Ck'd by	Survey of LENNOX AREA ℄
Map No.	JN 0303.00 Tape 238 Std 68 °F
Office Work	Surveyed by J. BAZEN
Checked	Notes J.J.B. Date 3-75
Date	Checked E. M. PALMERI JUN 15 1976

F. B. 3935 PG. 107

B5

WS24

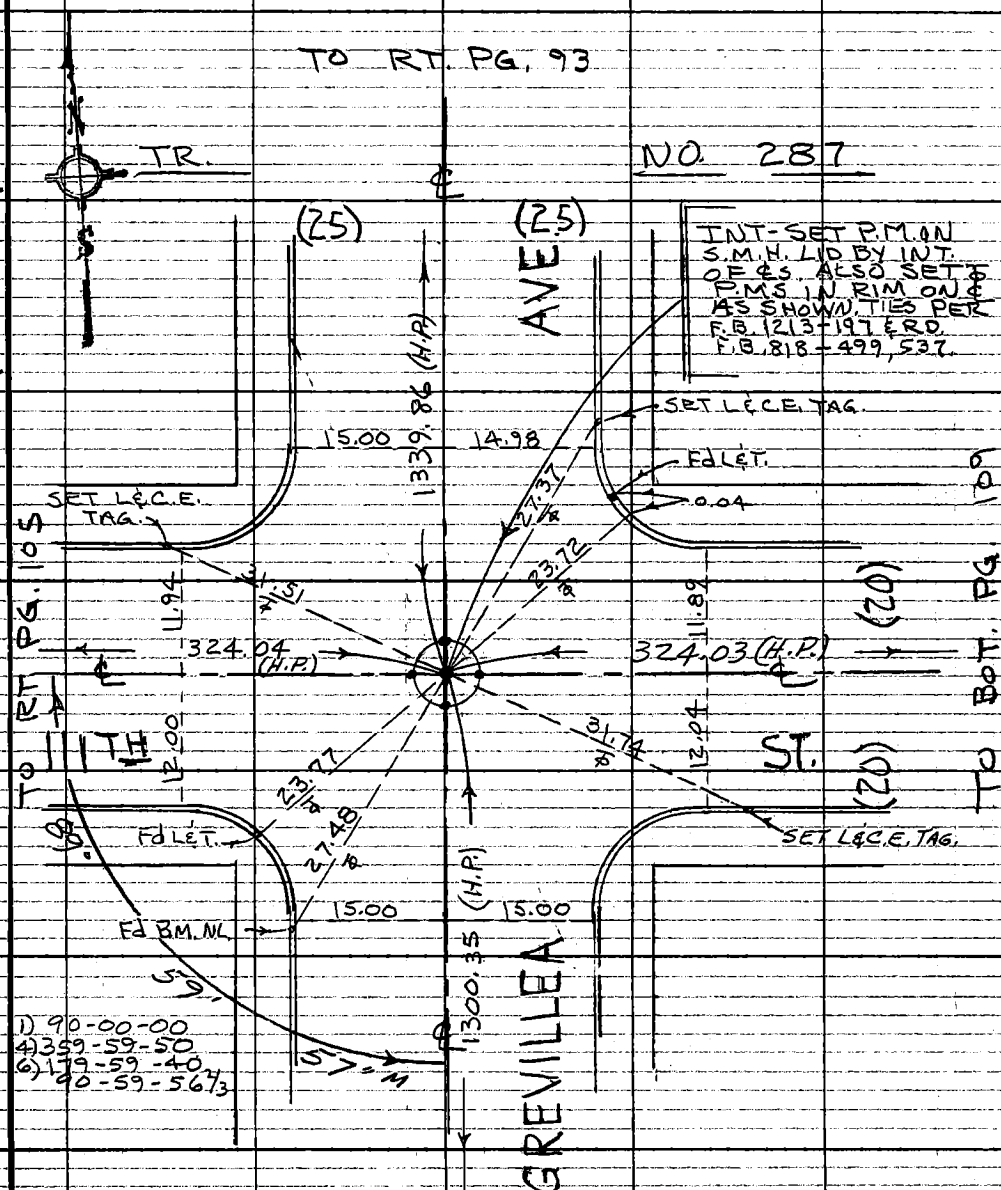

TR. NO. 957 TO LT. PG. 85

TR NO. 6553

Note: Any Additions or Changes on This Sheet Must be Made or Circled in Red Ink With Date and Name of Person Making Change.

Do not extend this side of this line.

PLEASE RETURN TO COUNTY OF LOS ANGELES DEPARTMENT OF COUNTY ENGINEER 403 LOS ANGELES COUNTY ENGINEERING BLDG.

76F309S CE#310 3-69

F.B. 3935 PG 108

229.52 T=68° = 229.52

TR NO. 957

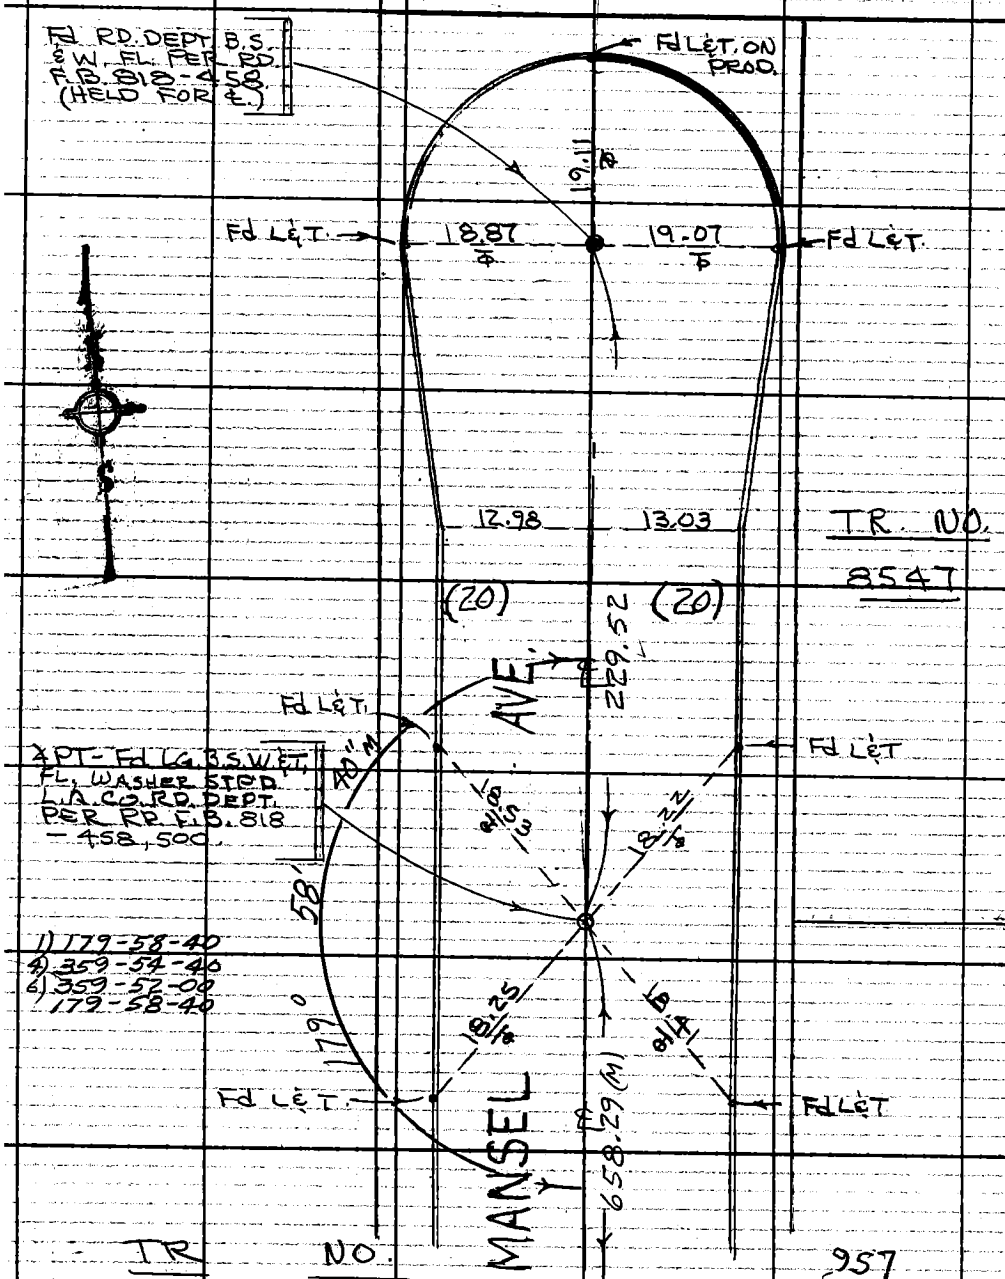

1) 179-58-40
4) 359-54-40
6) 359-52-00
179-58-40

TO LT. PG. 84

PLEASE RETURN TO
COUNTY OF LOS ANGELES
DEPARTMENT OF COUNTY ENGINEER
403 LOS ANGELES COUNTY ENGINEERING BLDG.

Do not extend this side of this line.

Note: Any Additions or Changes on This Sheet Must Be Made or Circled in Red Ink With Date and Name of Person Making Change.

PWFB 0818 695

Notes Ck'd by	Survey of LENNOX AREA ¢
Map No.	JN 0303.00 Tape 238 Std 68 °F
Office Work	Surveyed by J. BAZEN
Checked	Notes J.B. Date 3-75
Date	Reviewed PALMERI JUN 15 1976

F.B. 3935 PG. 109

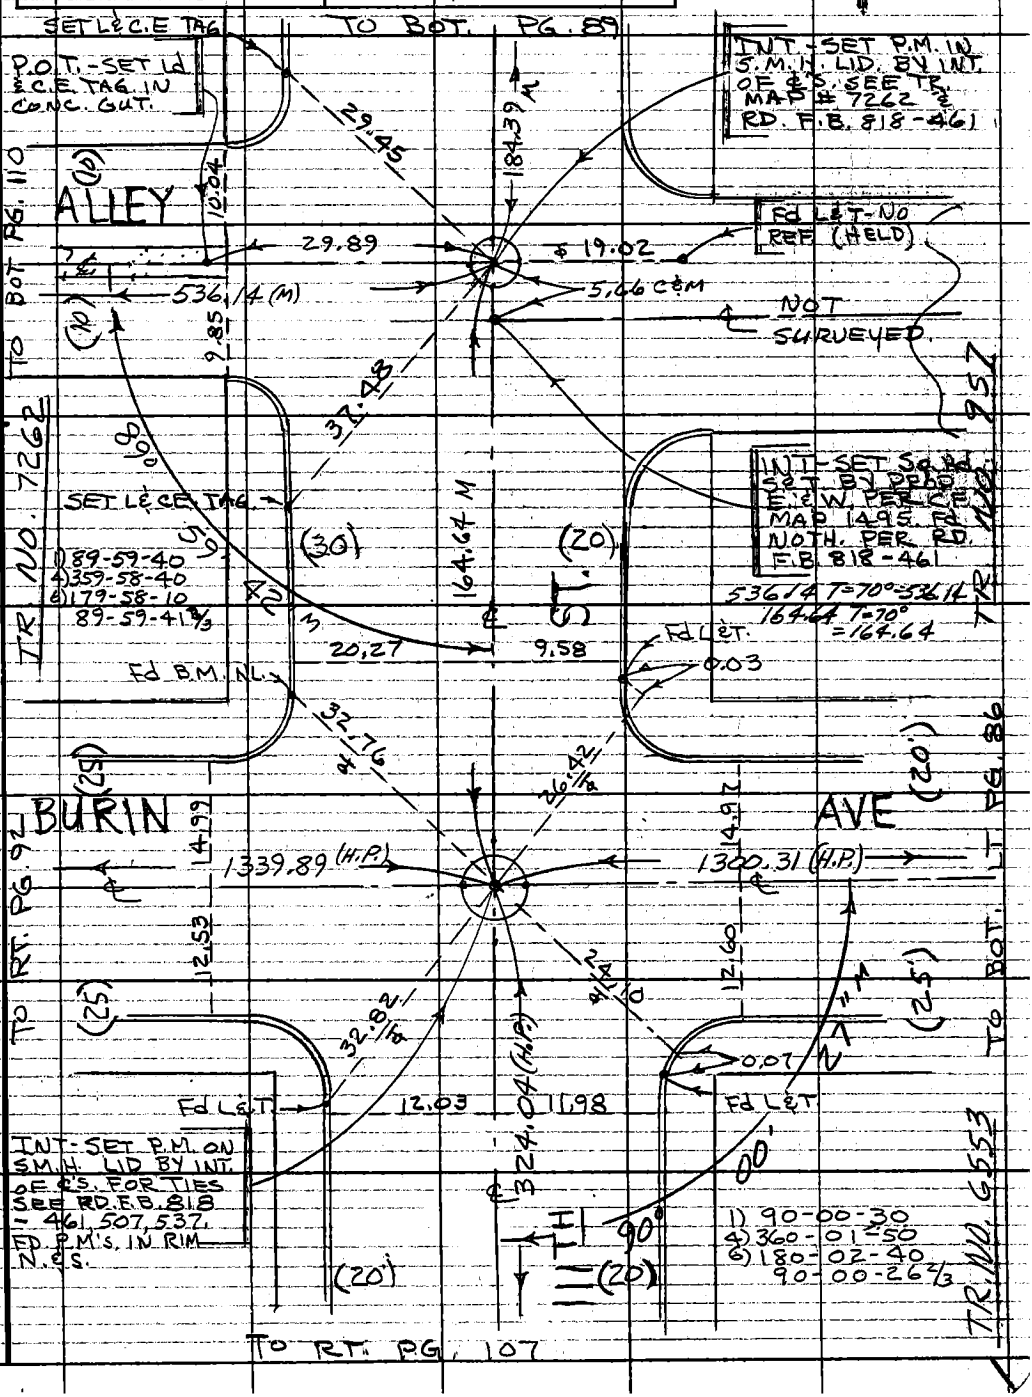

WS 24 B5

Note: Any Additions or Changes on This Sheet Must be Made or Circled in Red Ink With Date and Name of Person Making Change.

Do not extend this side of this line.

PLEASE RETURN TO COUNTY OF LOS ANGELES DEPARTMENT OF COUNTY ENGINEER 403 LOS ANGELES COUNTY ENGINEERING BLDG.

16F309S CE#310 3-69

F. B. 3935 PG 110

TR. NO. 287

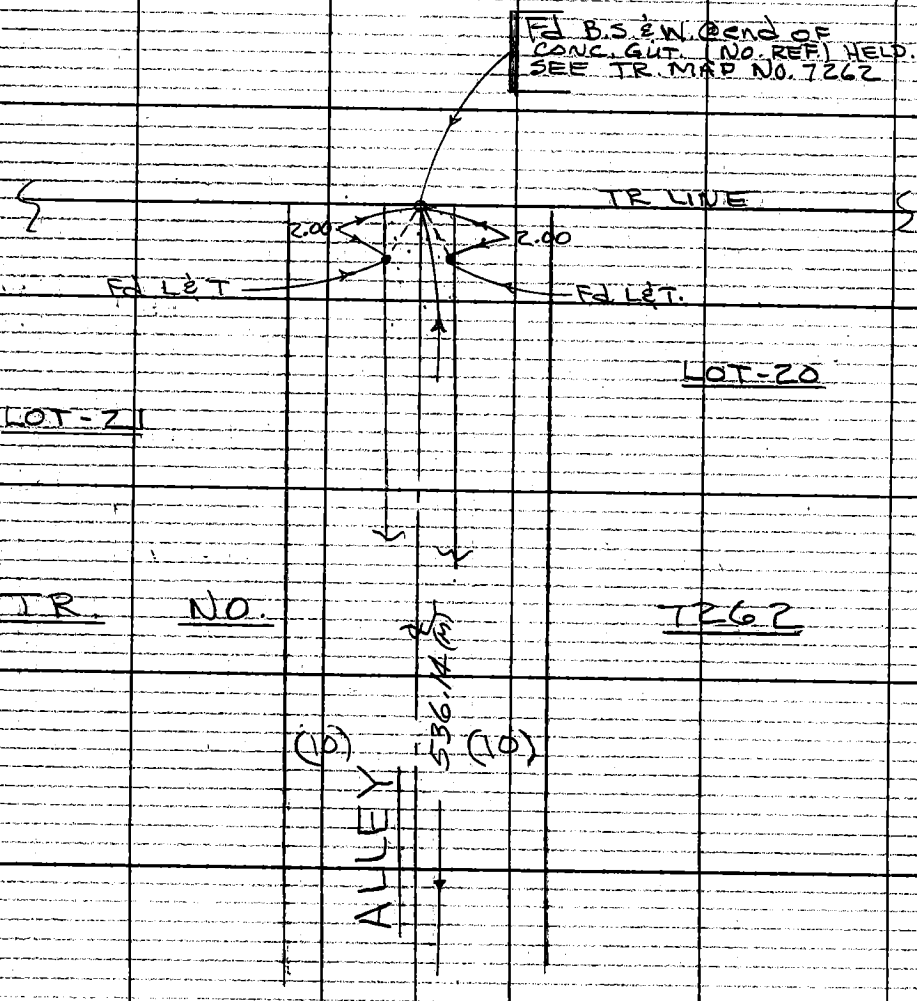

TO TOP LT. PG 109

PLEASE RETURN TO
COUNTY OF LOS ANGELES
DEPARTMENT OF COUNTY ENGINEER
403 LOS ANGELES COUNTY ENGINEERING BLDG.
Do not extend this side of this line.
Note: Any Additions or Changes on This Sheet Must Be Made or Circled in Red Ink With Date and Name of Person Making Change.

PWFB 0918 244

Notes Ck'd by	Survey of LENNOX AREA ℄
Map No.	JN 0303.00 Tape 0238 Std 68 °F
Office Work	Surveyed by J.J. BAZEN
Checked	Notes J.J.B. Date 7-75
Date	Indexed T. M. PALMERI JUN 15 1976

F.B. 3935 PG. 111

WS 24 B5

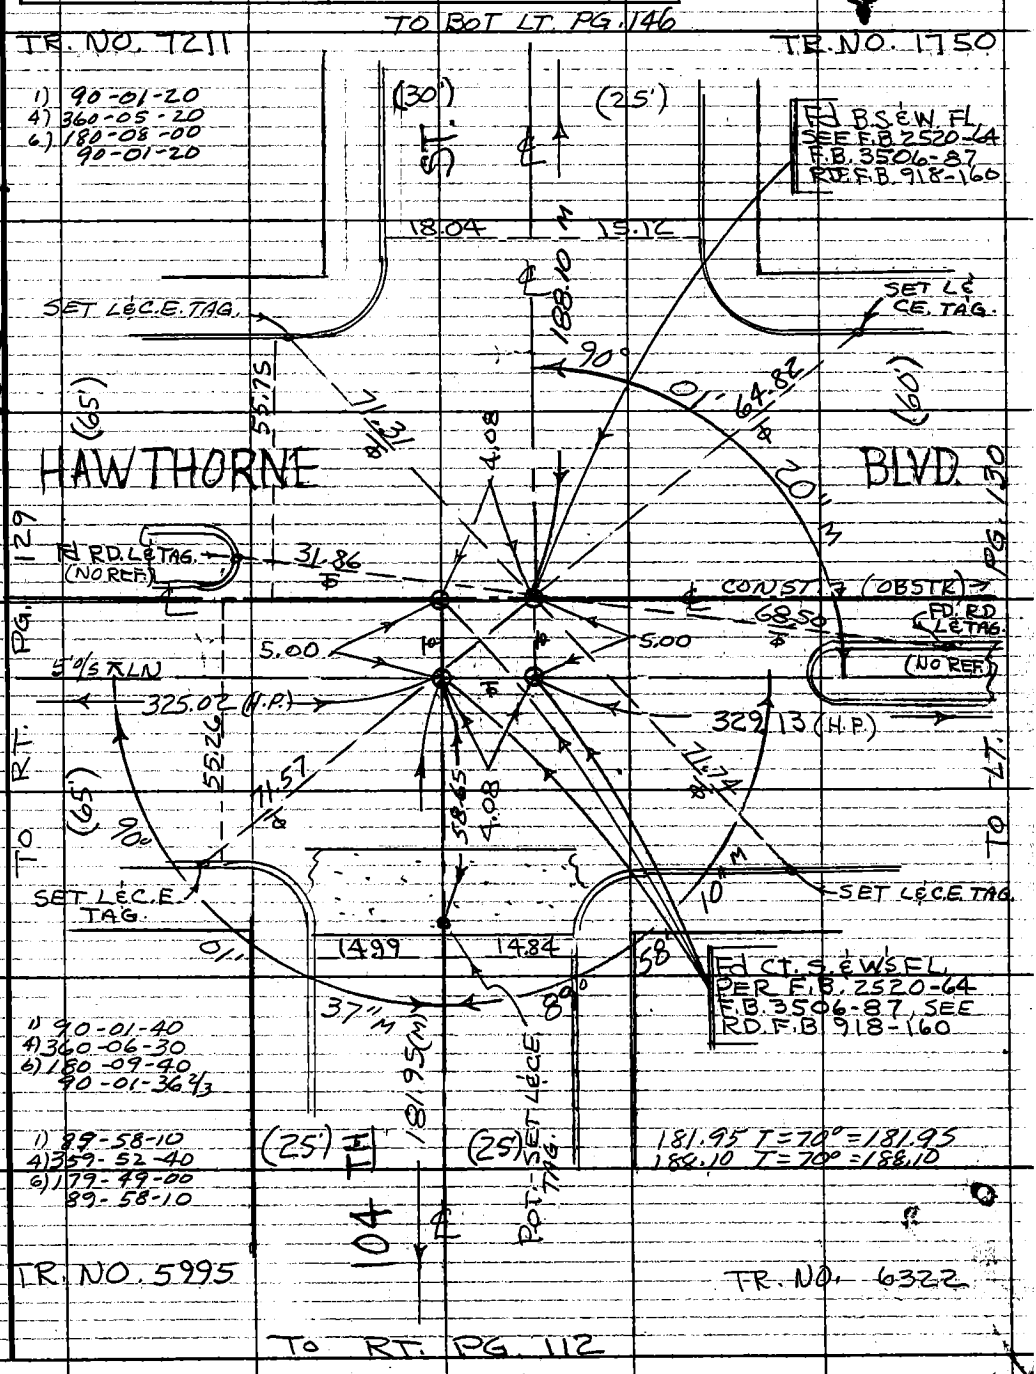

Note: Any Additions or Changes on This Sheet Must be Made or Circled in Red Ink With Date and Name of Person Making Change.

Do not extend this side of this line.

PLEASE RETURN TO
COUNTY OF LOS ANGELES
DEPARTMENT OF COUNTY ENGINEER
403 LOS ANGELES COUNTY ENGINEERING BLDG.

76F309S CE#310 3-69

RWRD 0918 245

F. B. 3935 PG 112

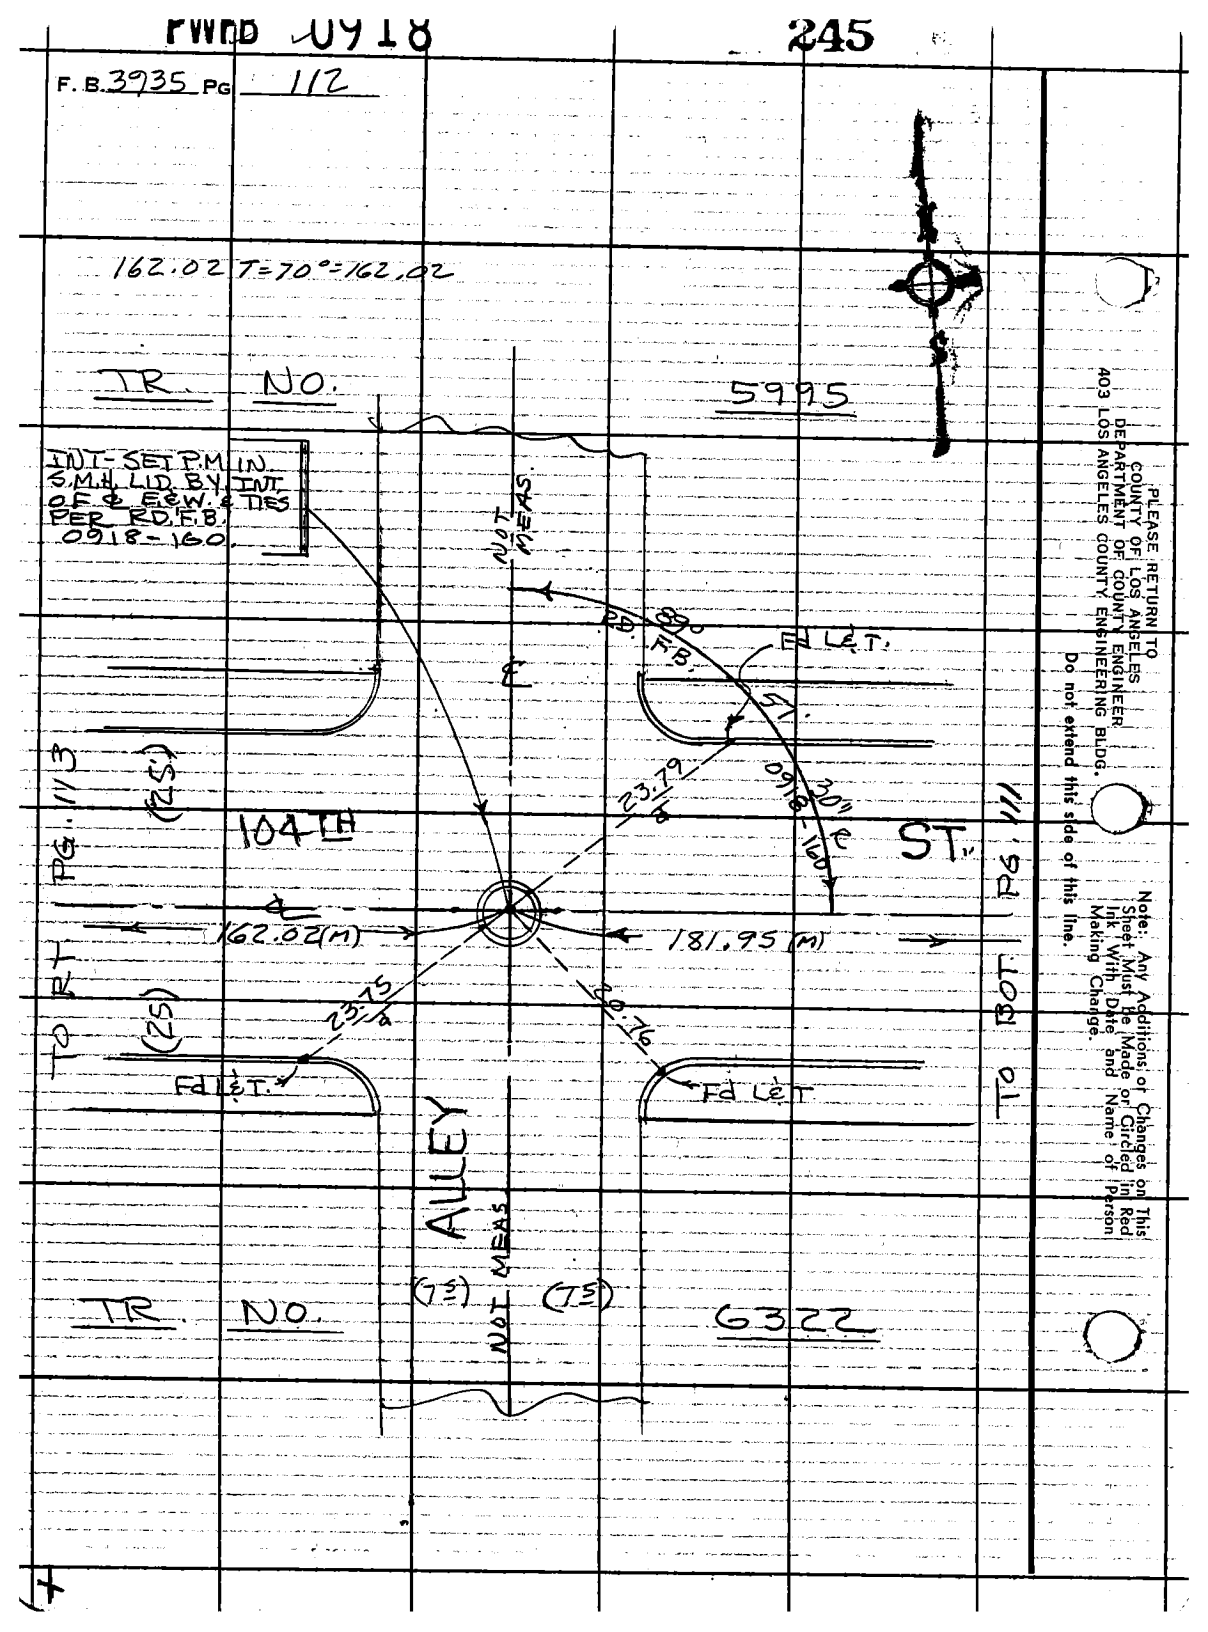

PLEASE RETURN TO
COUNTY OF LOS ANGELES
DEPARTMENT OF COUNTY ENGINEER
403 LOS ANGELES COUNTY ENGINEERING BLDG.
Do not extend this side of this line.

Note: Any Additions or Changes on This Sheet Must Be Made or Circled in Red Ink With Date and Name of Person Making Change.

PWFB 0918 246

Notes Ck'd by	Survey of LENNOX AREA ℄
Map No.	JN 0303.00 Tape 238 Std 68 °F
Office Work	Surveyed by J. BAZEN
Checked	Notes J.J.B. Date 7-75
Date	Indexed E. M. PALMERI JUN 15 1978

F.B. 3935 PG. 113

WS 24 B5

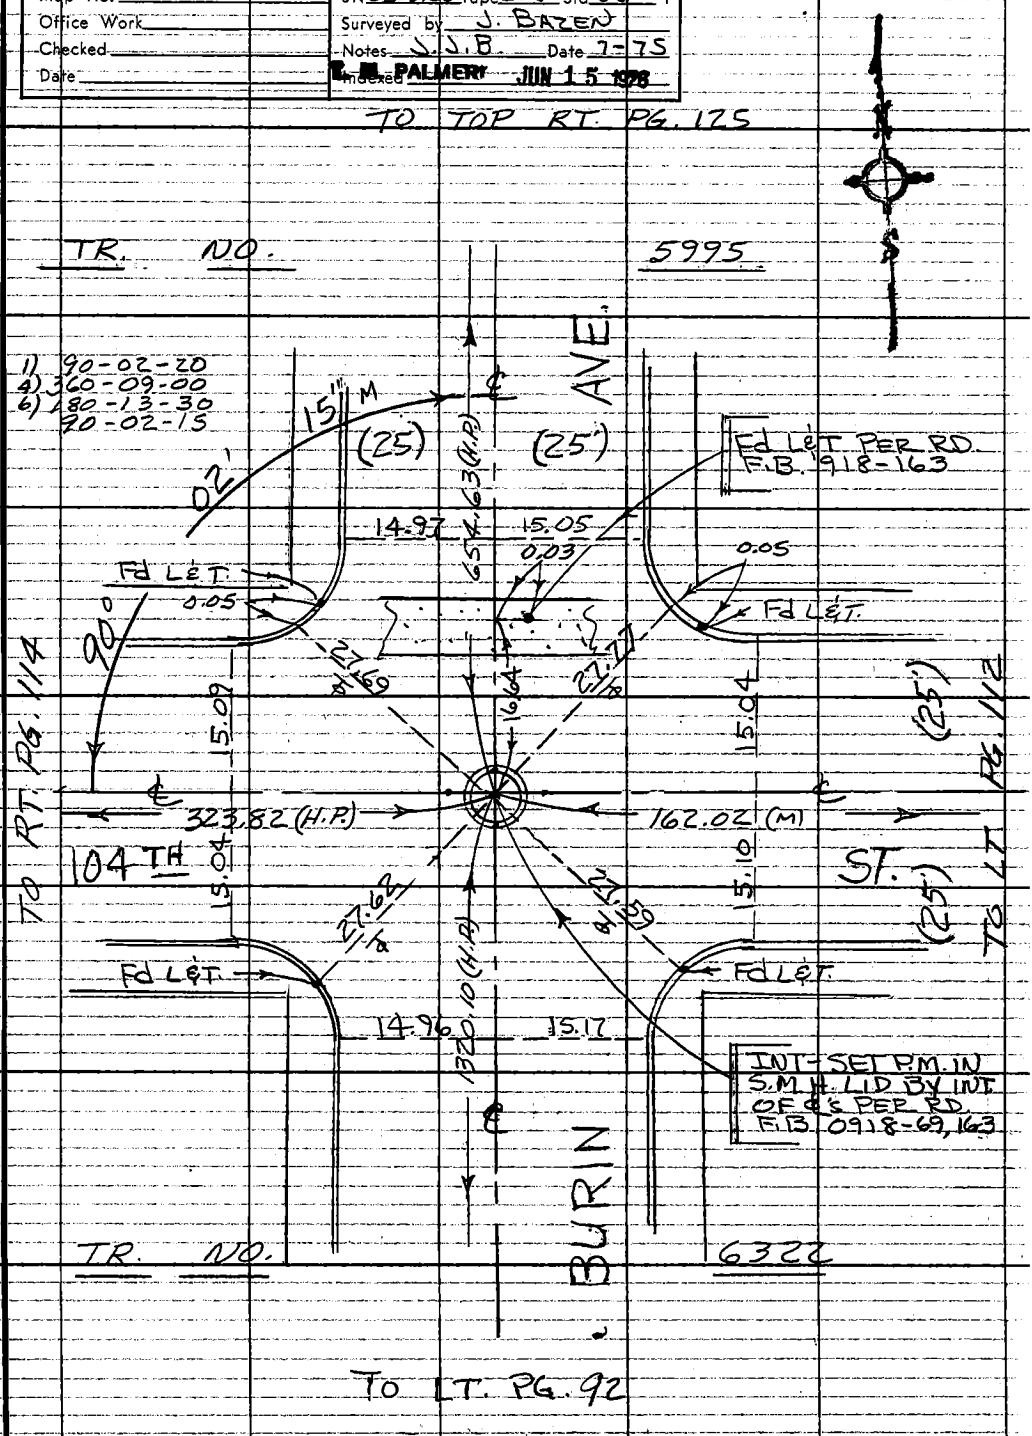

Note: Any Additions or Changes on This Sheet Must be Made or Circled in Red Ink With Date and Name of Person Making Change.

Do not extend this side of this line.

PLEASE RETURN TO COUNTY OF LOS ANGELES DEPARTMENT OF COUNTY ENGINEER 403 LOS ANGELES COUNTY ENGINEERING BLDG.

76F309S CE#310 3-69

F. B. 3935 PG 114

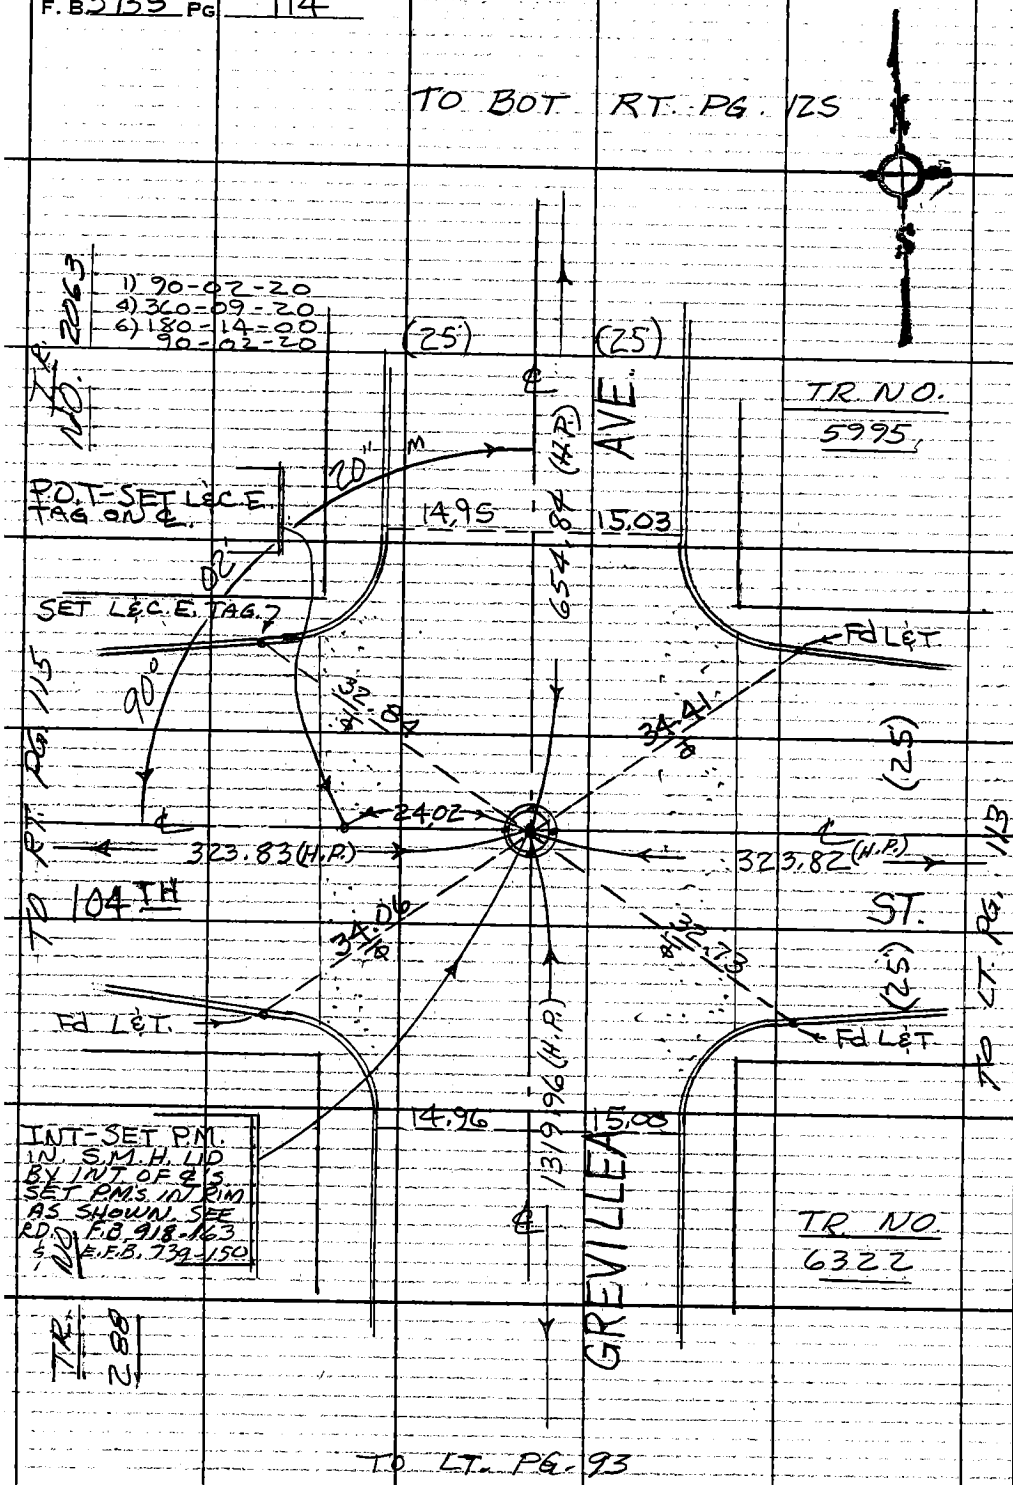

PLEASE RETURN TO
COUNTY OF LOS ANGELES
DEPARTMENT OF COUNTY ENGINEER
403 LOS ANGELES COUNTY ENGINEERING BLDG.

Do not extend this side of this line.

Note: Any Additions or Changes on This Sheet Must be Made or Circled in Red Ink With Date and Name of Person Making Change.

WS 24 B5

PWFB 0918 248

Notes Ck'd by	Survey of LENNOX AREA ℄
Map No.	JN 0303.00 Tape 238 Std 68 °F
Office Work	Surveyed by J. BAZEN
Checked	Notes J.J.B. Date 7-75
Date	Indexed PALMERT JUN 15 1976

F.B. 3935 PG. 115

WS 24 B5

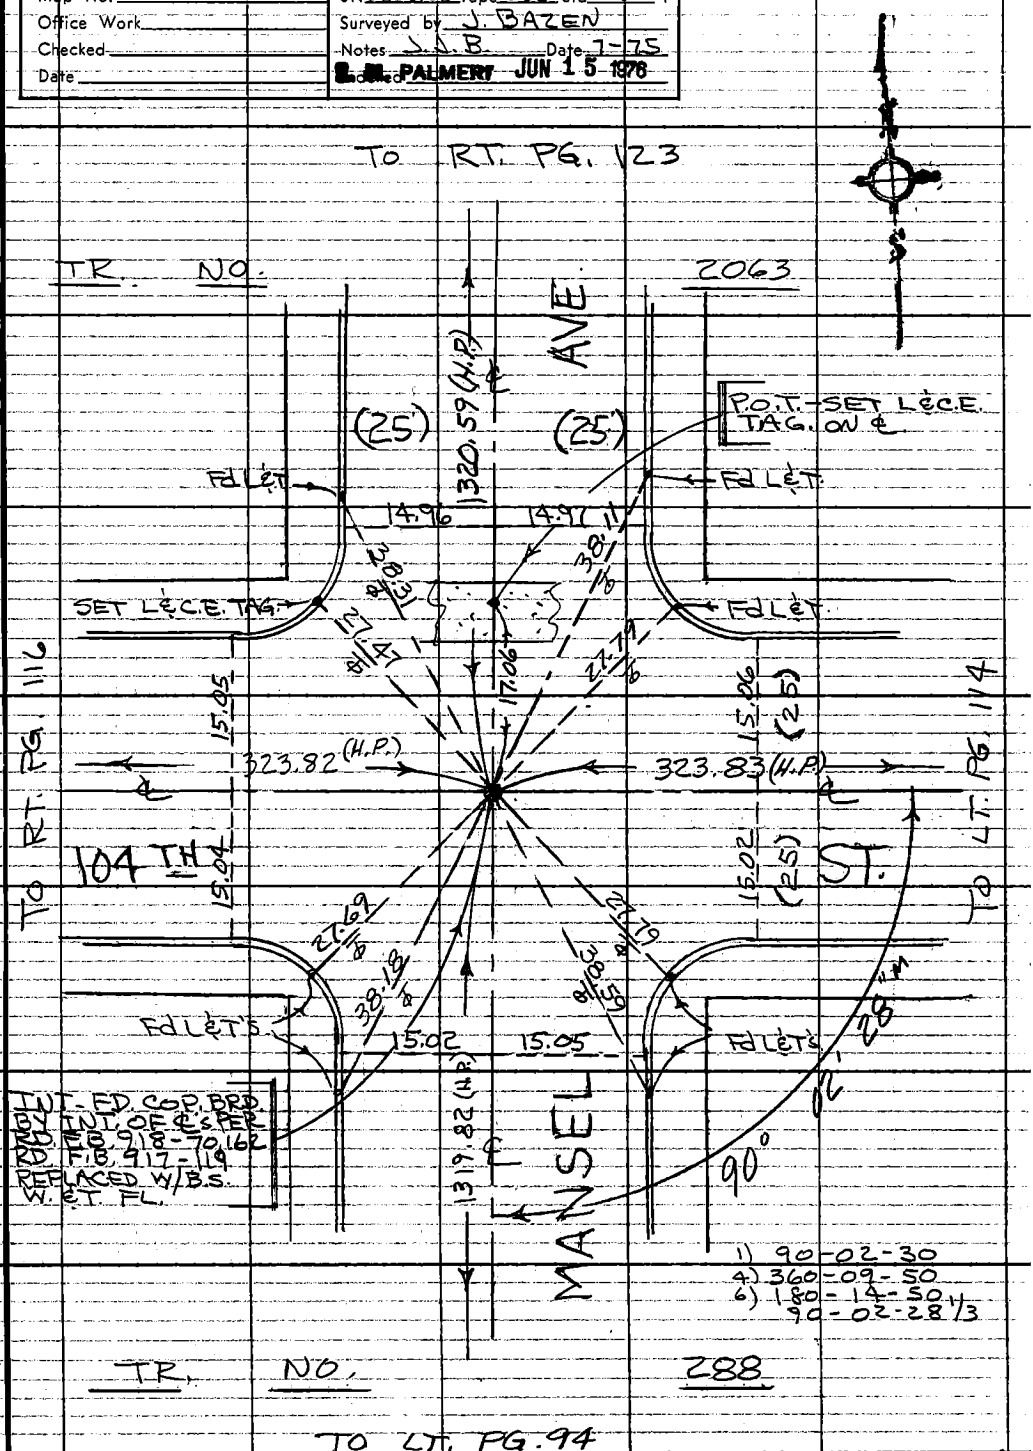

Note: Any Additions or Changes on This Sheet Must be Made or Circled in Red Ink With Date and Name of Person Making Change.

Do not extend this side of this line.

PLEASE RETURN TO
COUNTY OF LOS ANGELES
DEPARTMENT OF COUNTY ENGINEER
403 LOS ANGELES COUNTY ENGINEERING BLDG.

76F309S CE#310 3-69

F.B. 3935 PG. 116

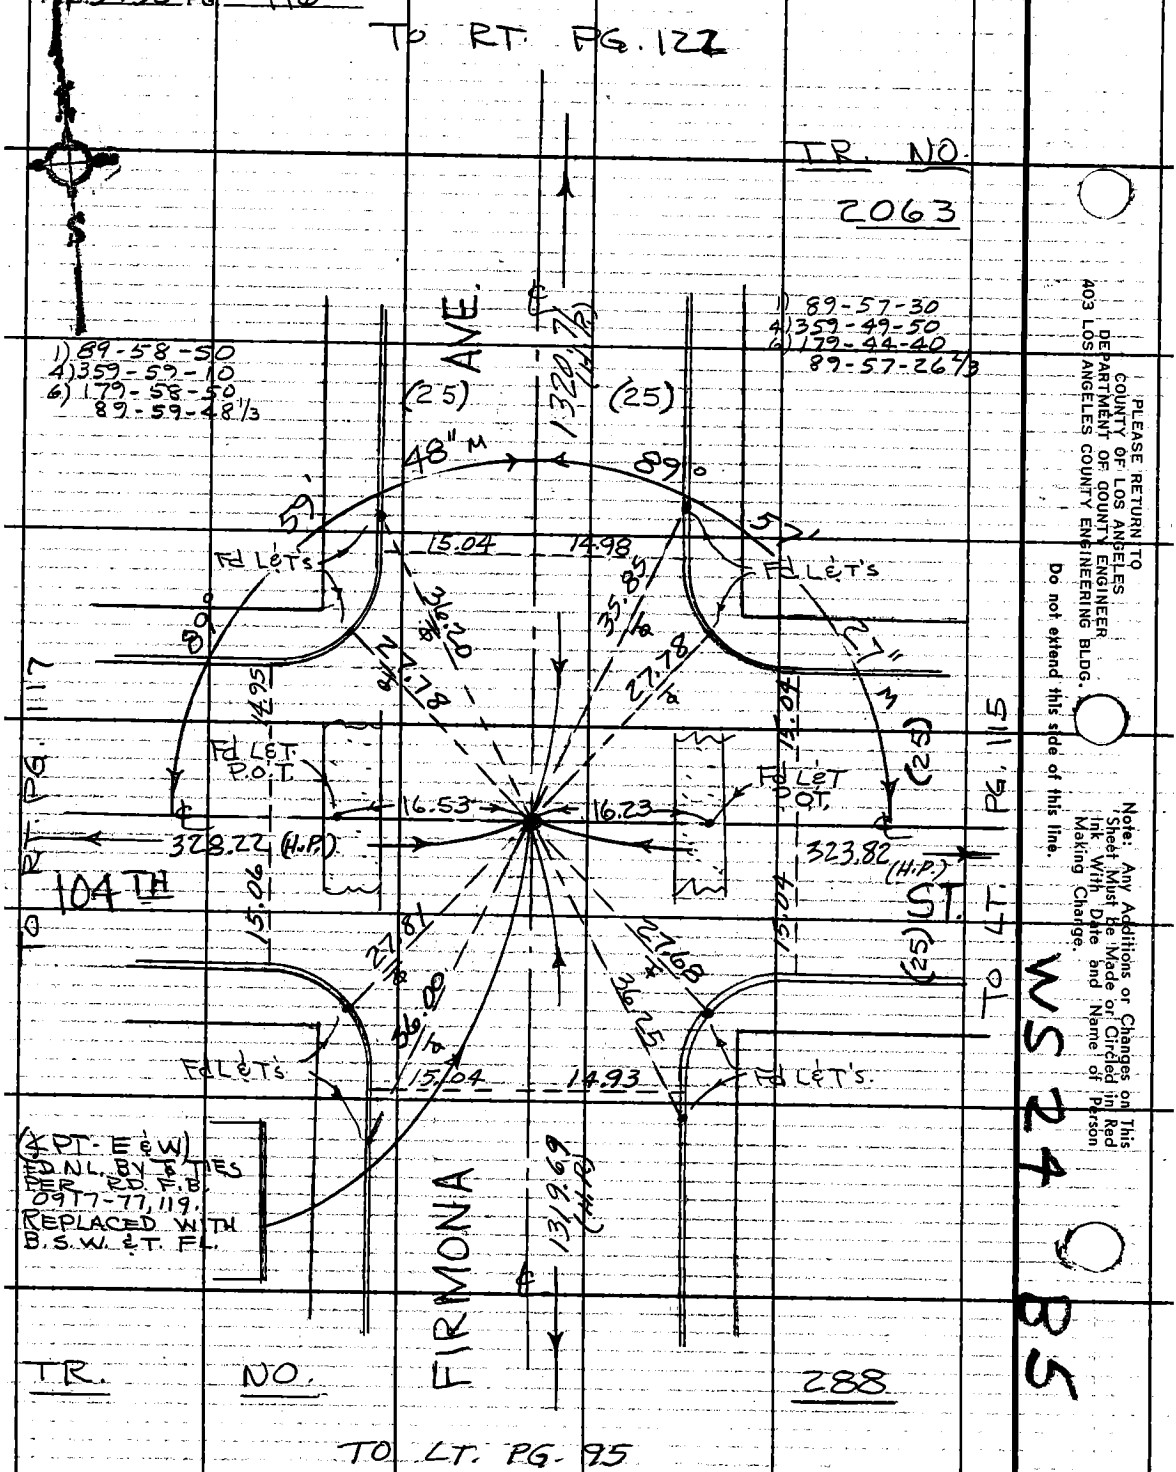

PLEASE RETURN TO
COUNTY OF LOS ANGELES
DEPARTMENT OF COUNTY ENGINEER
403 LOS ANGELES COUNTY ENGINEERING BLDG.

Do not extend this side of this line.

Note: Any Additions or Changes on This Sheet Must Be Made or Circled in Red Ink With Date and Name of Person Making Change.

PWFB 0917

264

Notes Ck'd by	Survey of LENNOX AREA ℄
Map No.	JN0303.00 Tape 238 Std 68 °F
Office Work	Surveyed by J. BAZEN
Checked	Notes J.J.B Date 7-75
Date	Indexed T. M. PALMERI JUN 15 1976

F. B. 3935 PG. 117

WS 24 B5

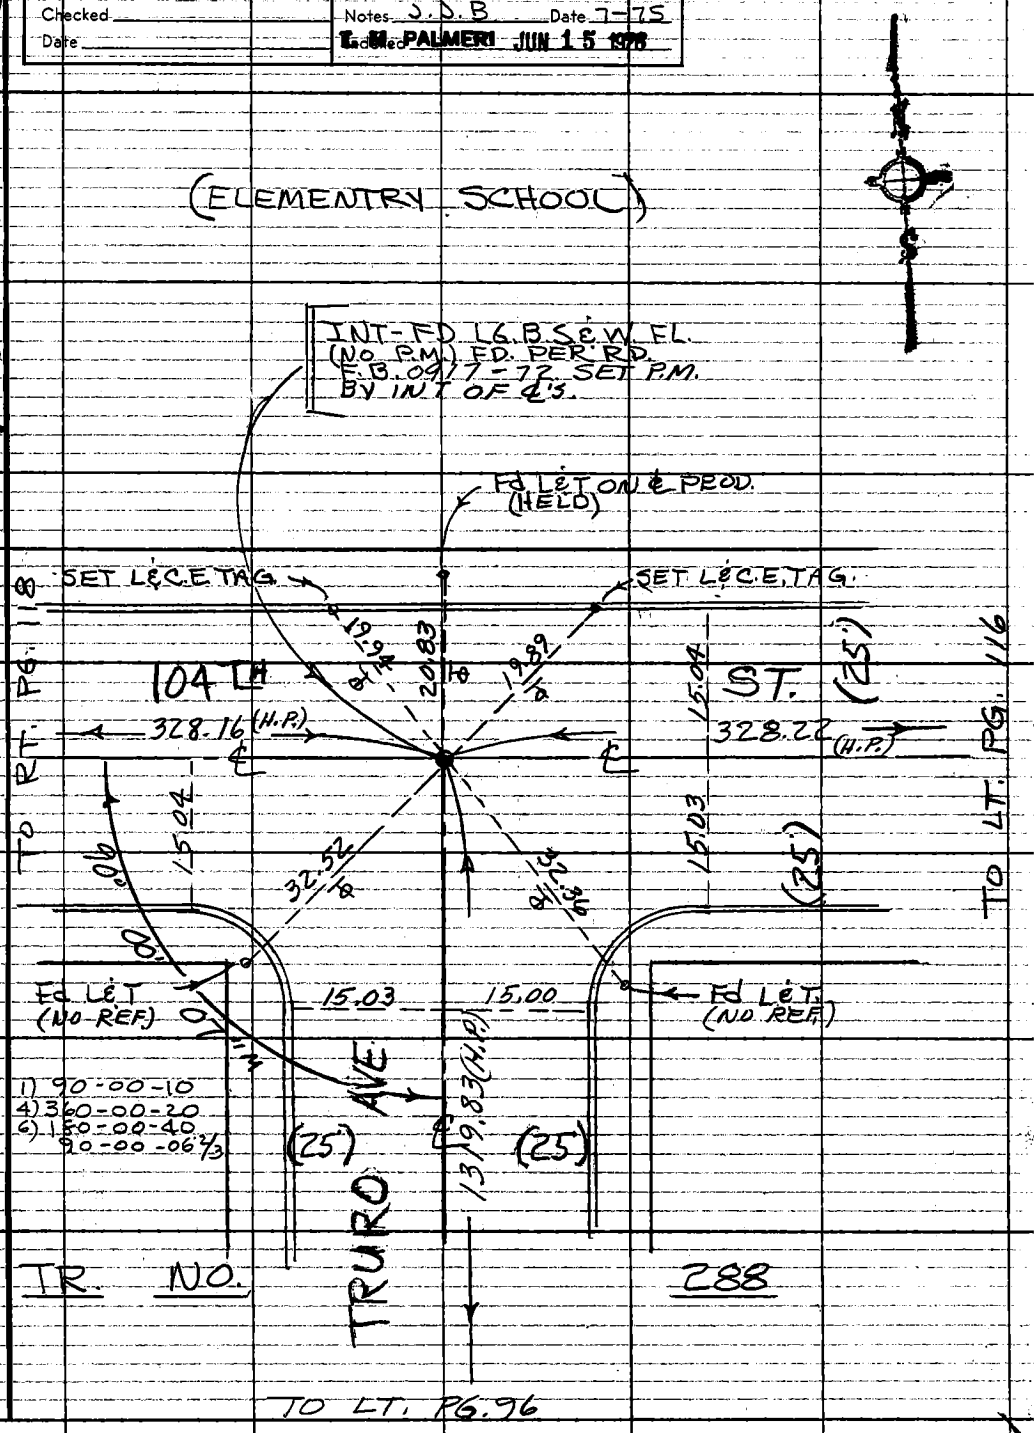

Note: Any Additions or Changes on This Sheet Must be Made or Circled in Red Ink With Date and Name of Person Making Change.

Do not extend this side of this line.

PLEASE RETURN TO
COUNTY OF LOS ANGELES
DEPARTMENT OF COUNTY ENGINEER
403 LOS ANGELES COUNTY ENGINEERING BLDG.

76F309S CE#310 3-69

PWPB 0917

265

F. B. 3935 PG 118

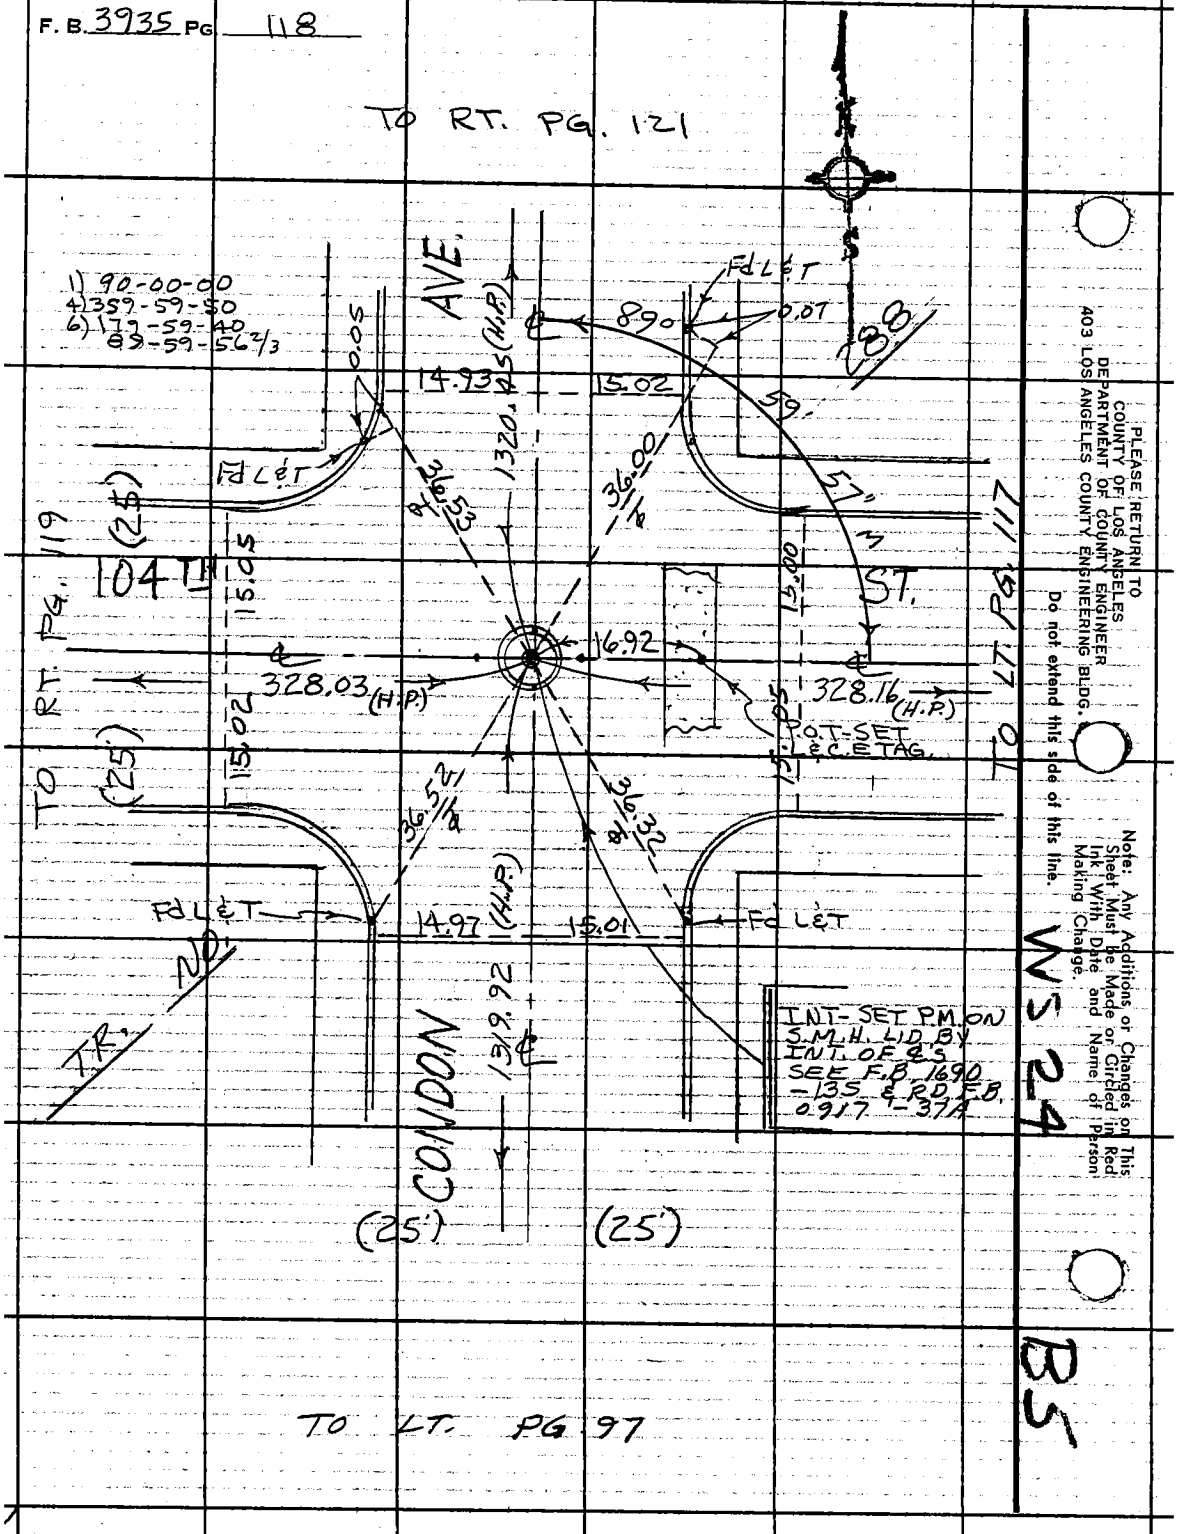

PLEASE RETURN TO
COUNTY OF LOS ANGELES
DEPARTMENT OF COUNTY ENGINEER
403 LOS ANGELES COUNTY ENGINEERING BLDG.

Do not extend this side of this line.

Note: Any Additions or Changes on This Sheet Must be Made or Circled in Red Ink With Date and Name of Person Making Change.

PWFB 0917

266

Notes Ck'd by	Survey of LENNOX AREA ℄
Map. No.	JN 0303.00 Tape 238 Std 68 °F
Office Work	Surveyed by J. BAZEN
Checked	Notes J.J.B. Date 7-75
Date	Checked M. M. PALMER JUN 15 1976

F. B. 3935 PG. 119

WS 24 B5

TO RT. PG. 120

I.R. NO. 288

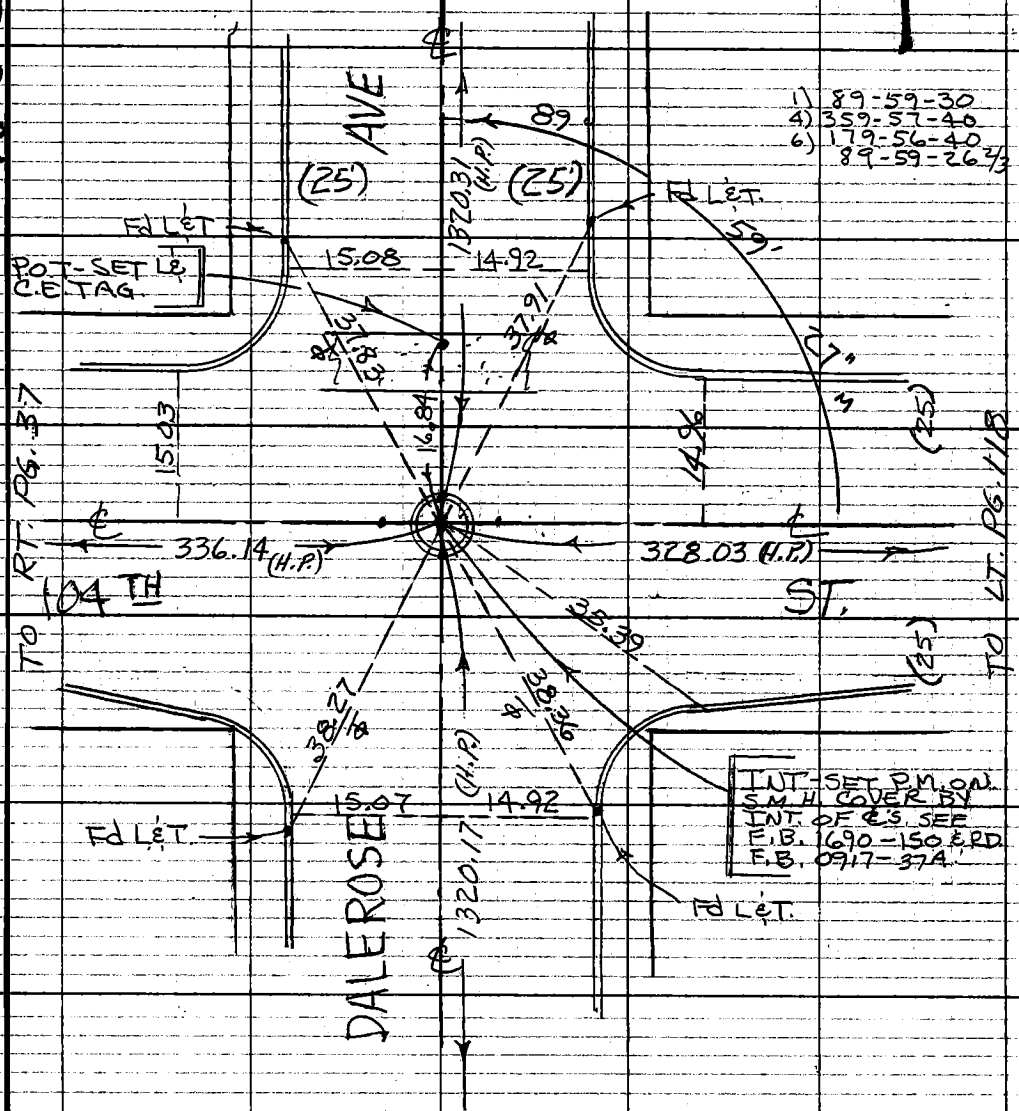

1) 89-59-30
4) 359-57-40
6) 179-56-40
89-59-26 2/3

TO LT. PG. 98

Note: Any Additions or Changes on This Sheet Must be Made or Circled in Red Ink With Date and Name of Person Making Change.

Do not extend this side of this line.

PLEASE RETURN TO
COUNTY OF LOS ANGELES
DEPARTMENT OF COUNTY ENGINEER
403 LOS ANGELES COUNTY ENGINEERING BLDG.

76F309S CE#310 3-69

F. B. 3935 PG. 120

TO BOT. PG. 121

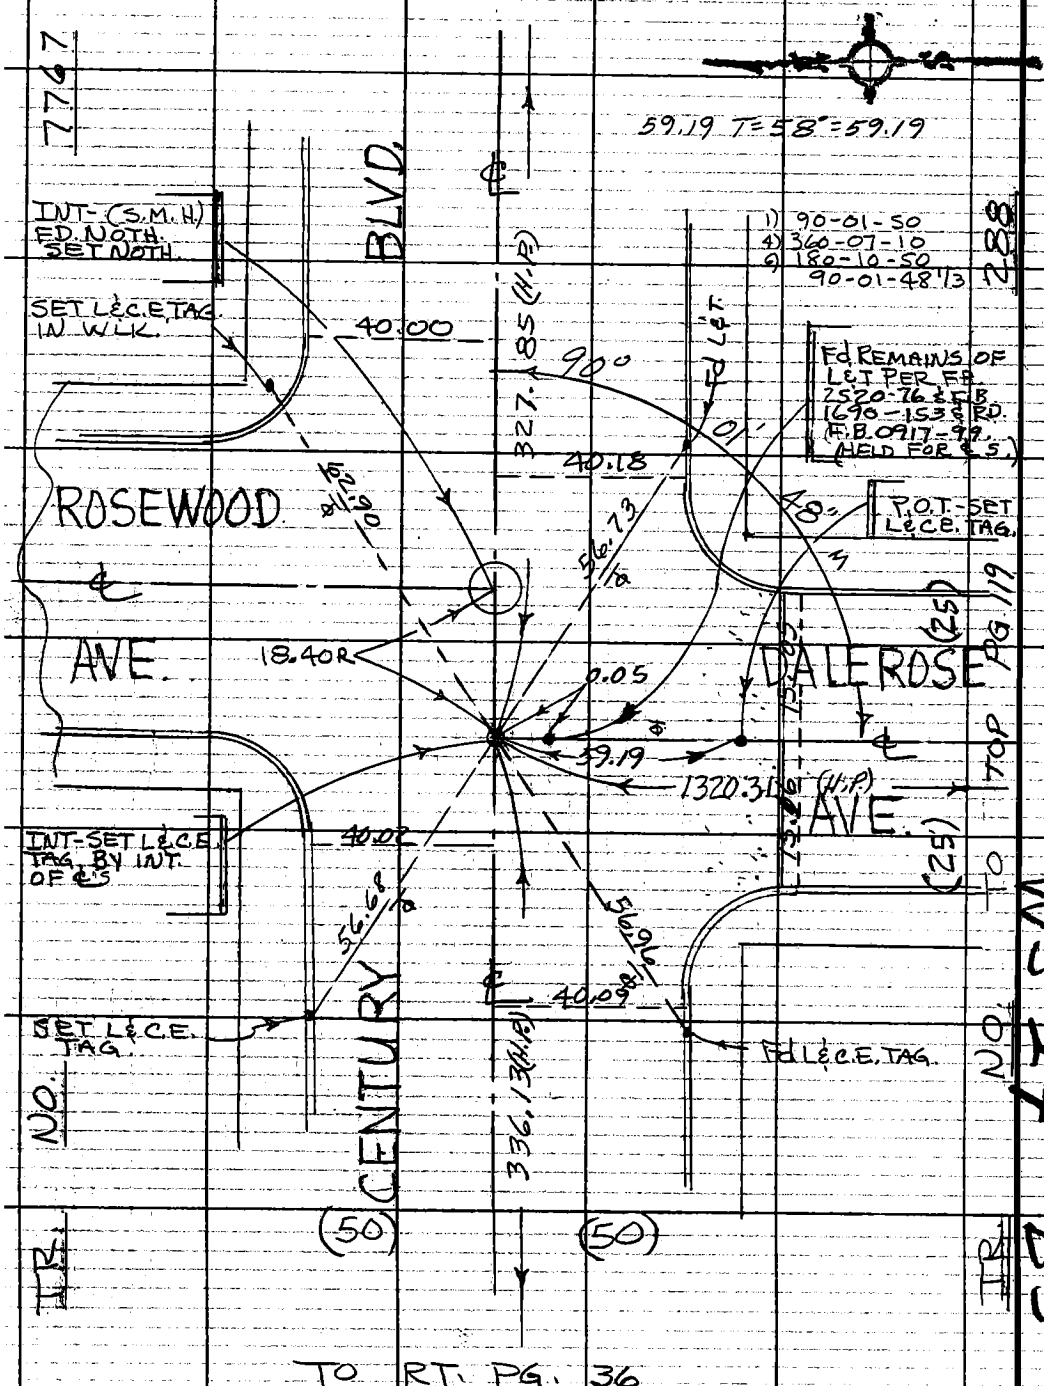

TO RT. PG. 36

PLEASE RETURN TO
COUNTY OF LOS ANGELES
DEPARTMENT OF COUNTY ENGINEER
403 LOS ANGELES COUNTY ENGINEERING BLDG.

Do not extend this side of this line.

Note: Any Additions or Changes on This Sheet Must Be Made or Circled in Red Ink With Date and Name of Person Making Change.

PWFB 0917

268

Notes Ck'd by	Survey of LENNOX AREA ℄	F. B. 3935 Pg. 121
Map No.	JN 0303.00 Tape 238 Std 68 °F	
Office Work	Surveyed by J. BAZEN	
Checked	Notes J.J.B. Date 4-75	
Date	Indexed R. M. PALMER JUN 15 1976	

B5

WS 24

TO BOT PG. 122

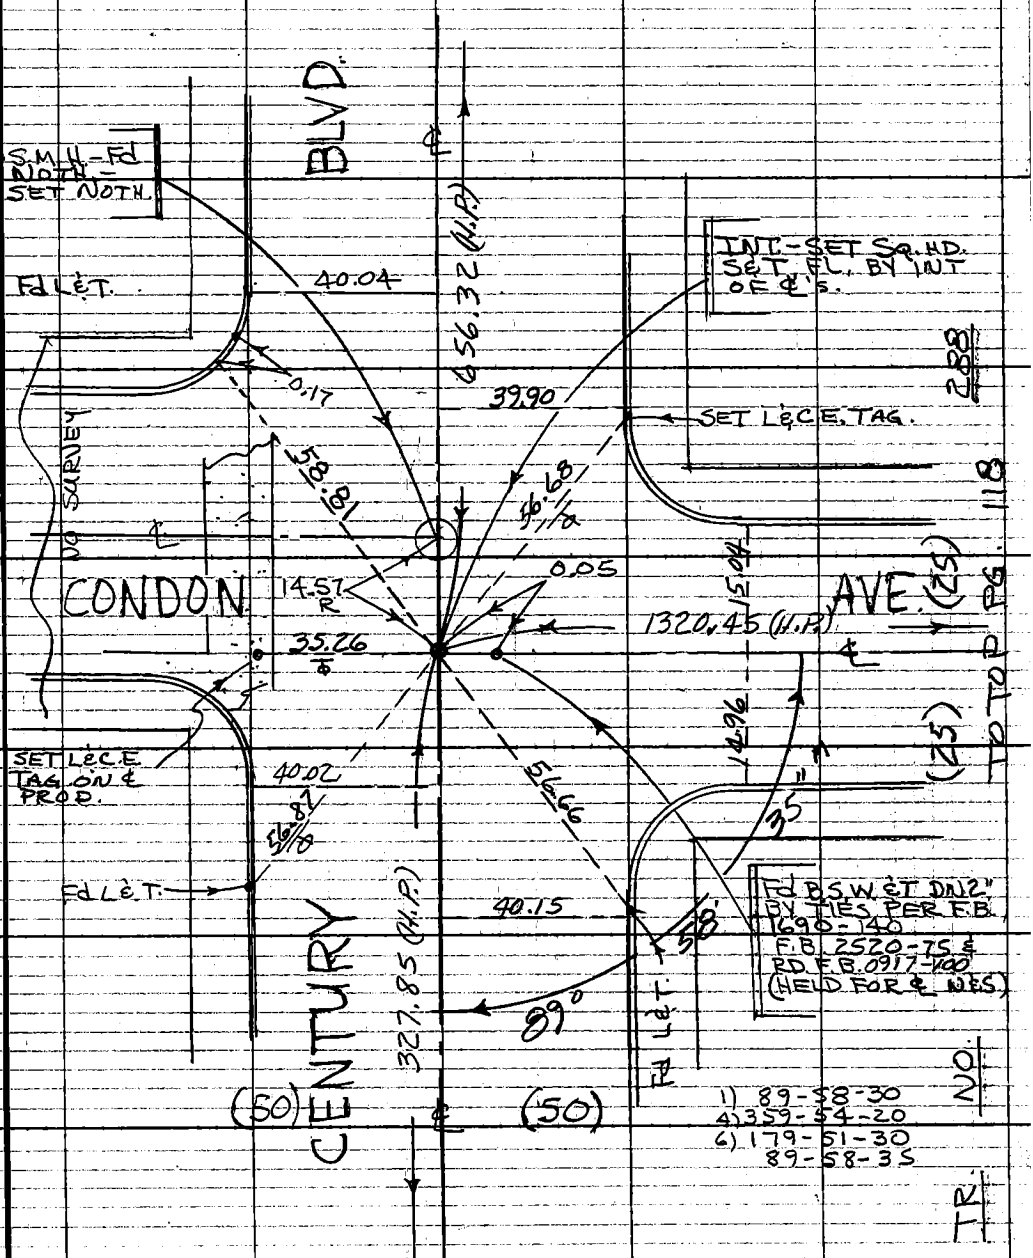

TO TOP PG. 120

Note: Any Additions or Changes on this Sheet Must be Made or Circled in Red Ink With Date and Name of Person Making Change.

Do not extend this side of this line.

PLEASE RETURN TO COUNTY OF LOS ANGELES DEPARTMENT OF COUNTY ENGINEER 403 LOS ANGELES COUNTY ENGINEERING BLDG.

76F309S CE#310 3-69

F. B. 3935 PG. 122

TO BOT. PG. 123

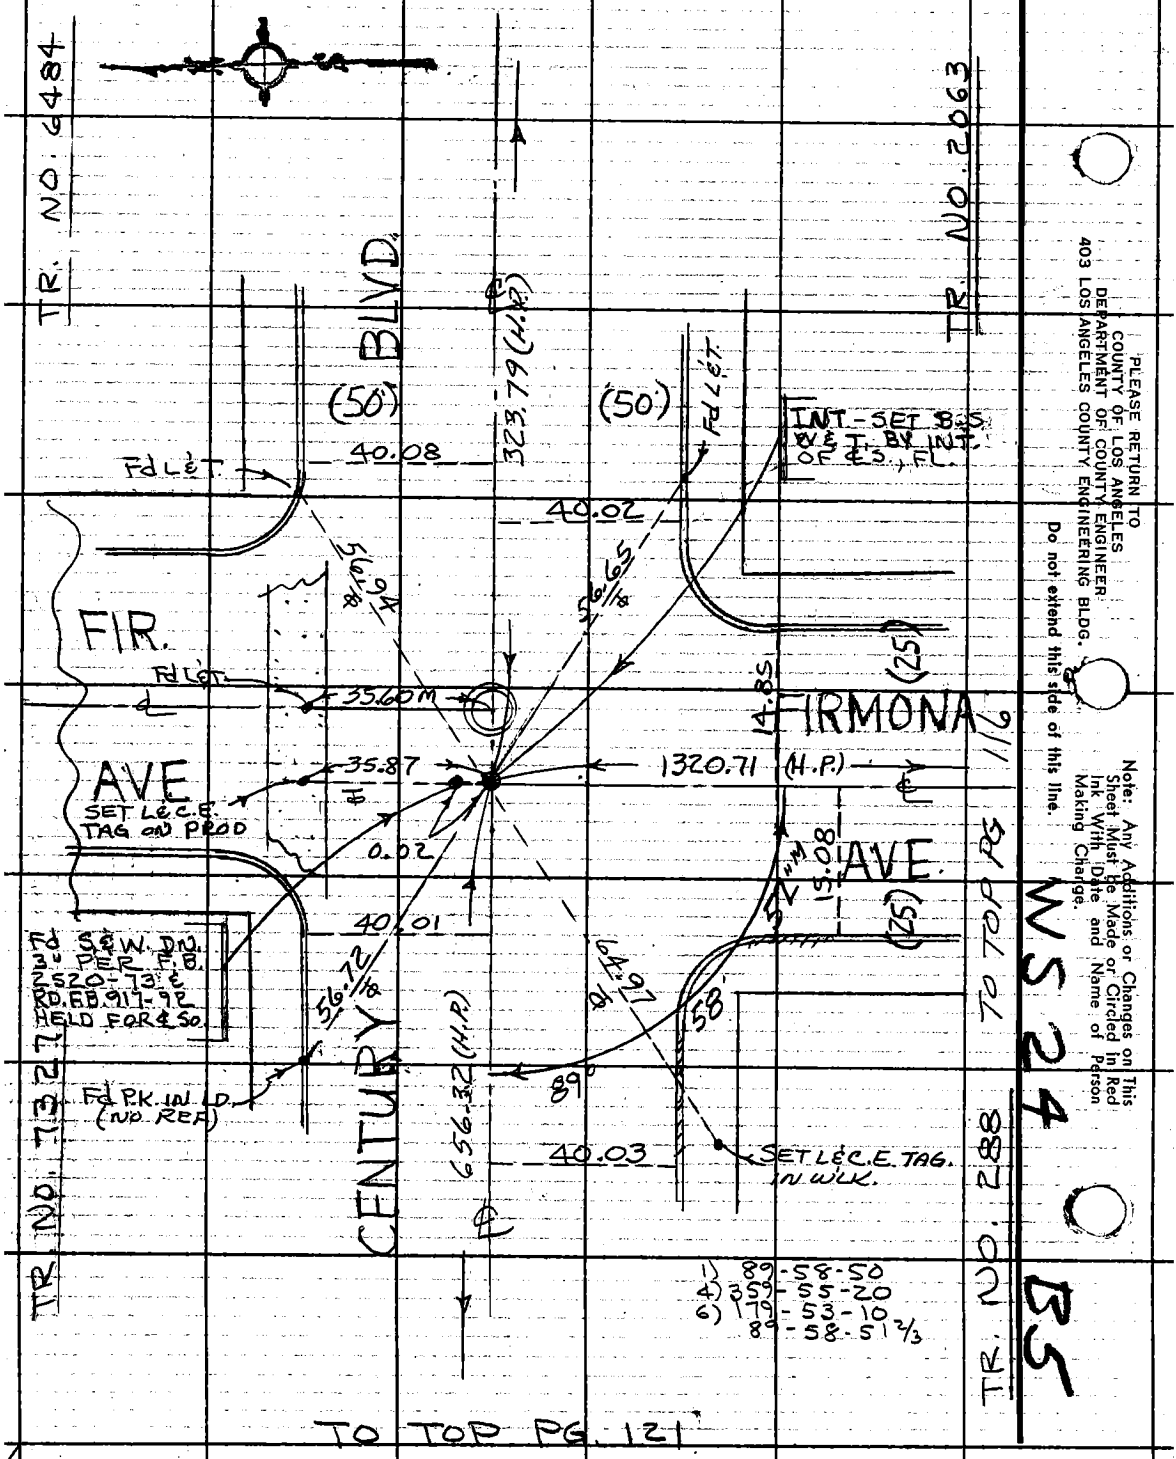

TO TOP PG. 121

PLEASE RETURN TO
COUNTY OF LOS ANGELES
DEPARTMENT OF COUNTY ENGINEER
403 LOS ANGELES COUNTY ENGINEERING BLDG.

Do not extend this side of this line.

Note: Any Additions or Changes on This Sheet Must be Made or Circled in Red Ink With Date and Name of Person Making Change.

PWFB 0918 250

Notes Ck'd by	Survey of LENNOX AREA ℄
Map No.	JN 0303.00 Tape 238 Std 68 °F
Office Work	Surveyed by J. BAZEN
Checked	Notes J.J.B. Date 4-75
Date	Indexed PALMERI JUN 15 1976

F. B. 3935 PG. 123

WS 24 B5

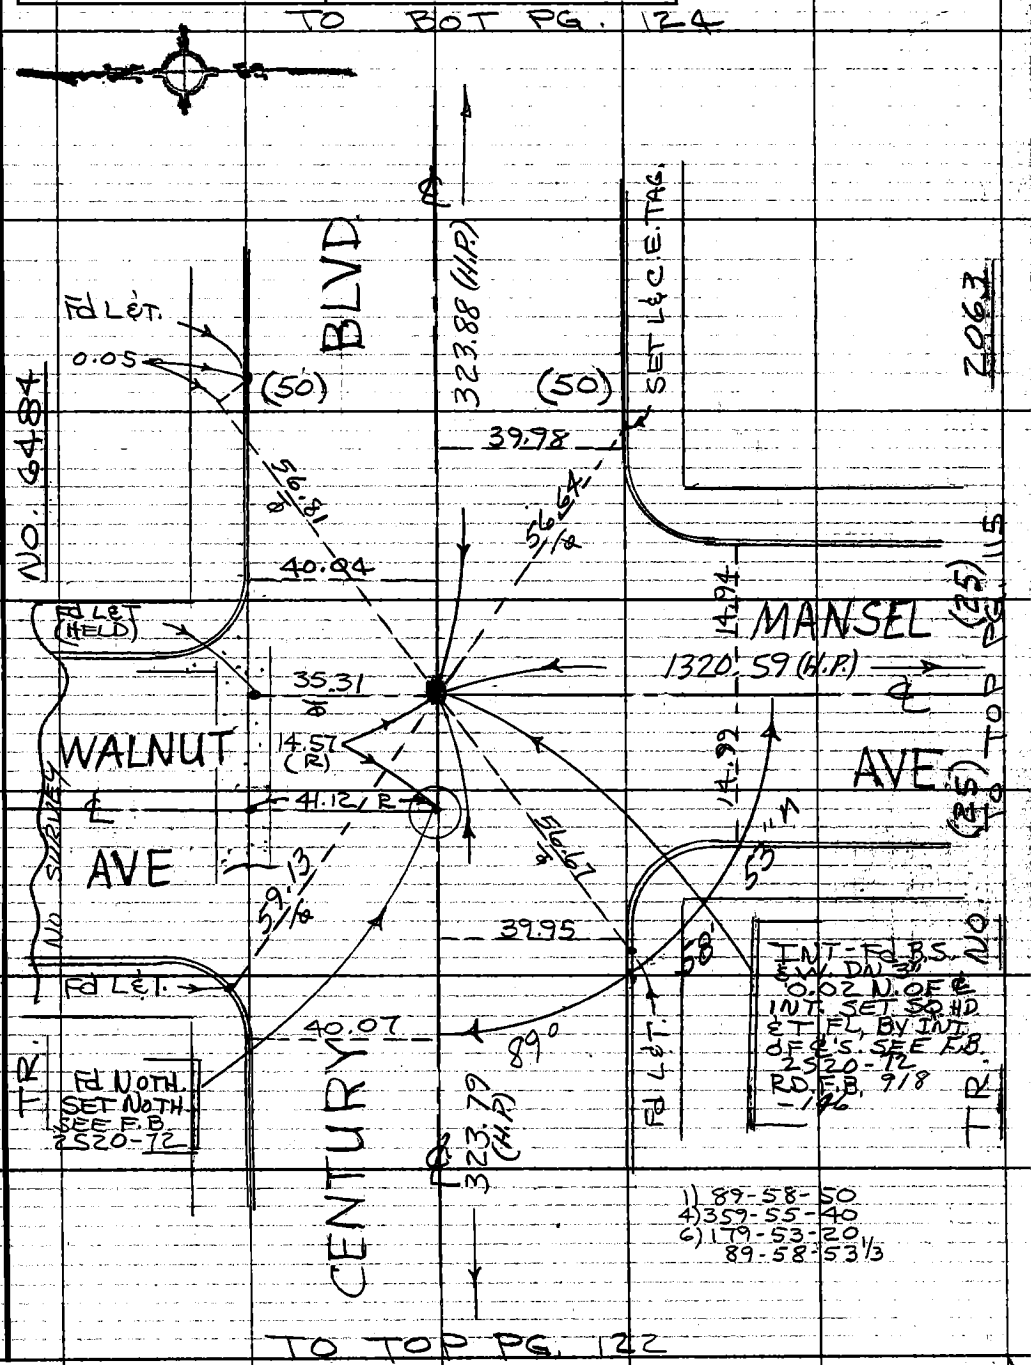

Note: Any Additions or Changes on This Sheet Must be Made or Circled in Red Ink With Date and Name of Person Making Change.

Do not extend this side of this line.

PLEASE RETURN TO COUNTY OF LOS ANGELES DEPARTMENT OF COUNTY ENGINEER 403 LOS ANGELES COUNTY ENGINEERING BLDG.

16F309S CE#310 3-69

PWTB - 04 18 251

F. B. 3935 PG. 124

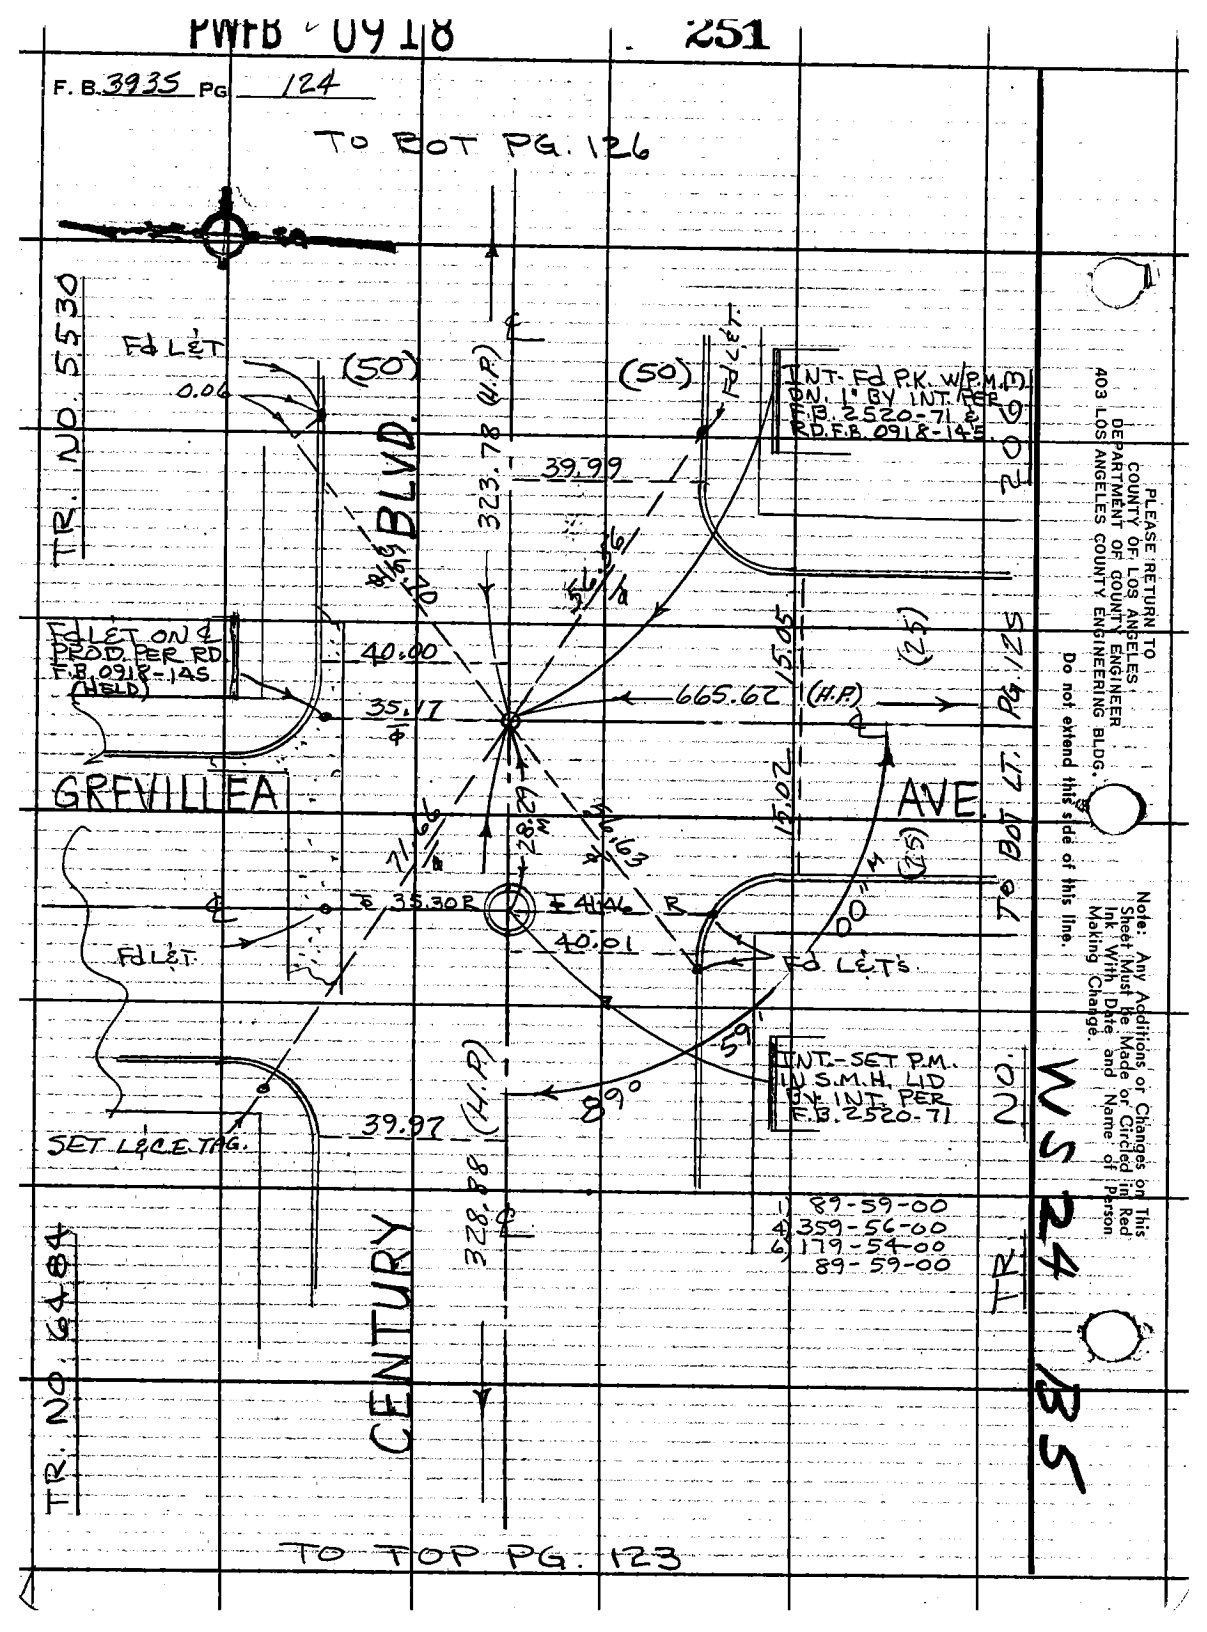

PLEASE RETURN TO
COUNTY OF LOS ANGELES
DEPARTMENT OF COUNTY ENGINEER
403 LOS ANGELES COUNTY ENGINEERING BLDG.

Do not extend this side of this line.

Note: Any Additions or Changes on This Sheet Must be Made or Circled in Red Ink With Date and Name of Person Making Change.

PWFB 0918 252

Notes Ck'd by	Survey of LENNOX AREA ℄
Map No.	JN 0303.00 Tape 238 Std 68 °F
Office Work	Surveyed by J. BAZEN
Checked	Notes J.J.B. Date 4-75
Date	Indexed PALMER JUN 15 1976

F. B. 3935 PG. 125

W524 B5

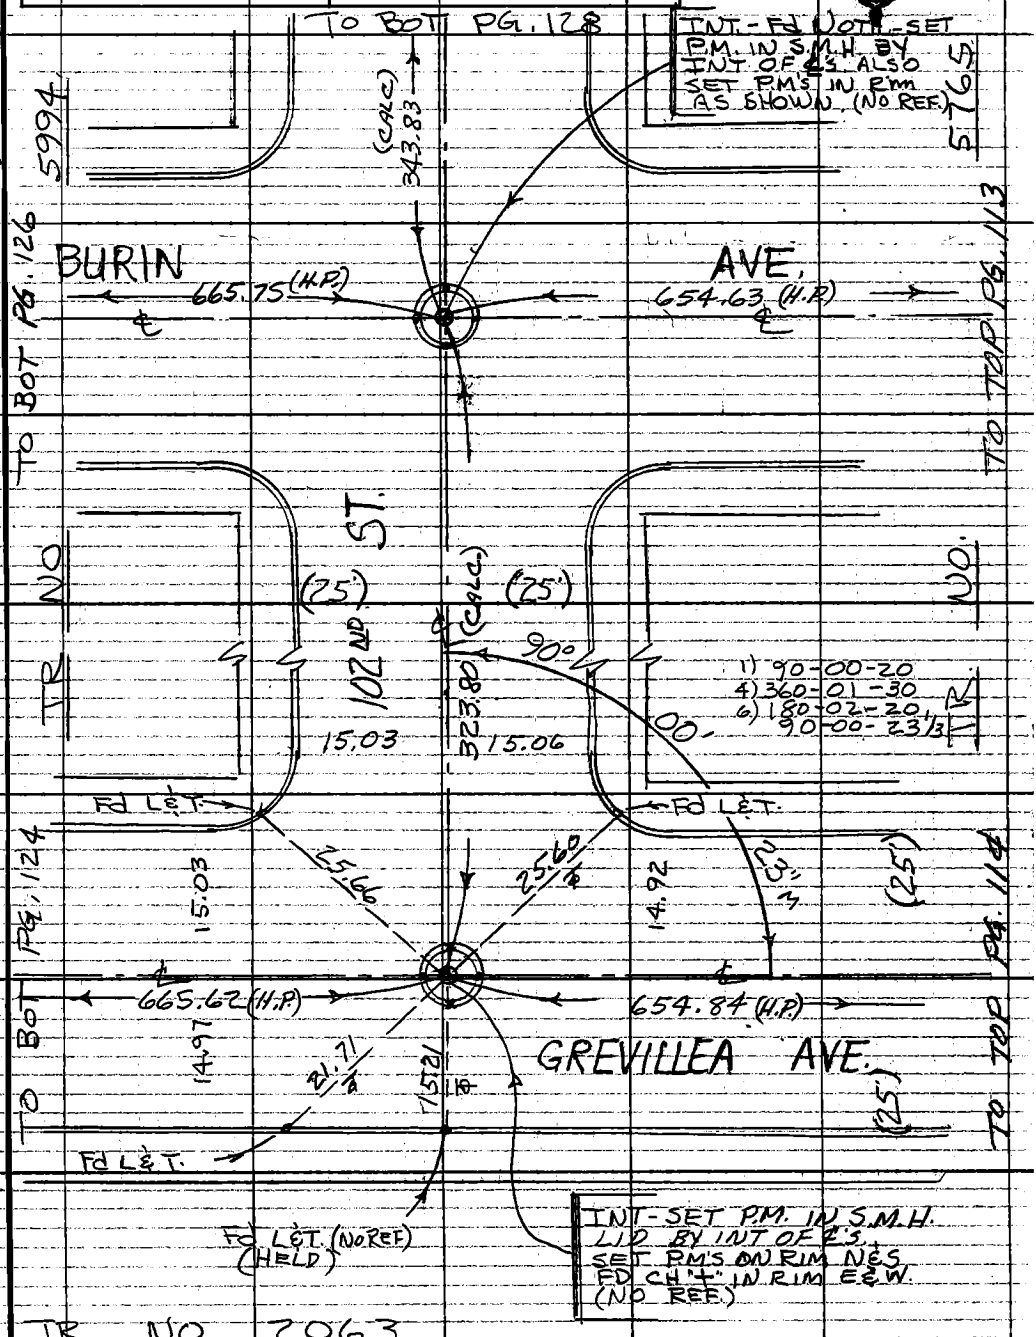

Note: Any Additions or Changes on This Sheet Must be Made or Circled in Red Ink With Date and Name of Person Making Change.

Do not extend this side of this line.

PLEASE RETURN TO COUNTY OF LOS ANGELES DEPARTMENT OF COUNTY ENGINEER 403 LOS ANGELES COUNTY ENGINEERING BLDG.

16F309S CE#310 3-69

F. B. 3935 PG. 126

TO BOT. PG. 127

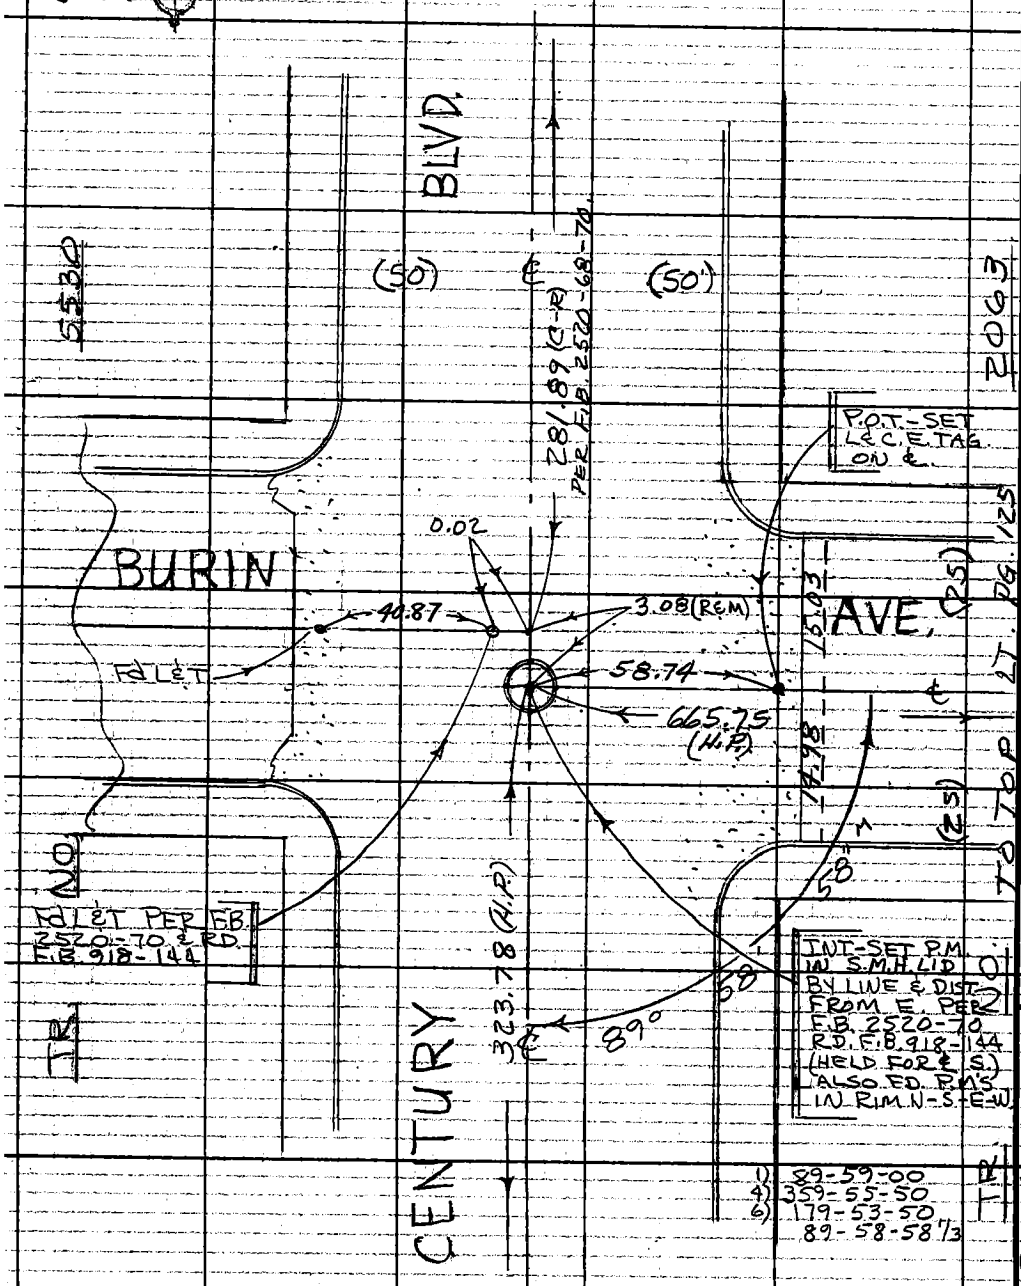

TO TOP PG. 124

PLEASE RETURN TO
COUNTY OF LOS ANGELES
DEPARTMENT OF COUNTY ENGINEER
403 LOS ANGELES COUNTY ENGINEERING BLDG.

Do not extend this side of this line.

Note: Any Additions or Changes on This Sheet Must Be Made or Circled in Red Ink With Date and Name of Person Making Change.

WS 24 B5

PWFB 0918

254

Notes Ck'd by	Survey of LENNOX AREA 2
Map No.	J.N. 2303.00 Tape 238 Std. 68 °F
Office Work	Surveyed by J. DAZEN
Checked	Notes J.N.B. Date 4-75
Date	Indexed E. M. PALMER JUN 15 1976

F. B. 3935 PG. 127

B5

WS 24

Note: Any Additions or Changes on This Sheet Must be Made or Circled in Red Ink With Date and Name of Person Making Change.

Do not extend this side of this line.

PLEASE RETURN TO COUNTY OF LOS ANGELES DEPARTMENT OF COUNTY ENGINEER 403, LOS ANGELES COUNTY ENGINEERING BLDG.

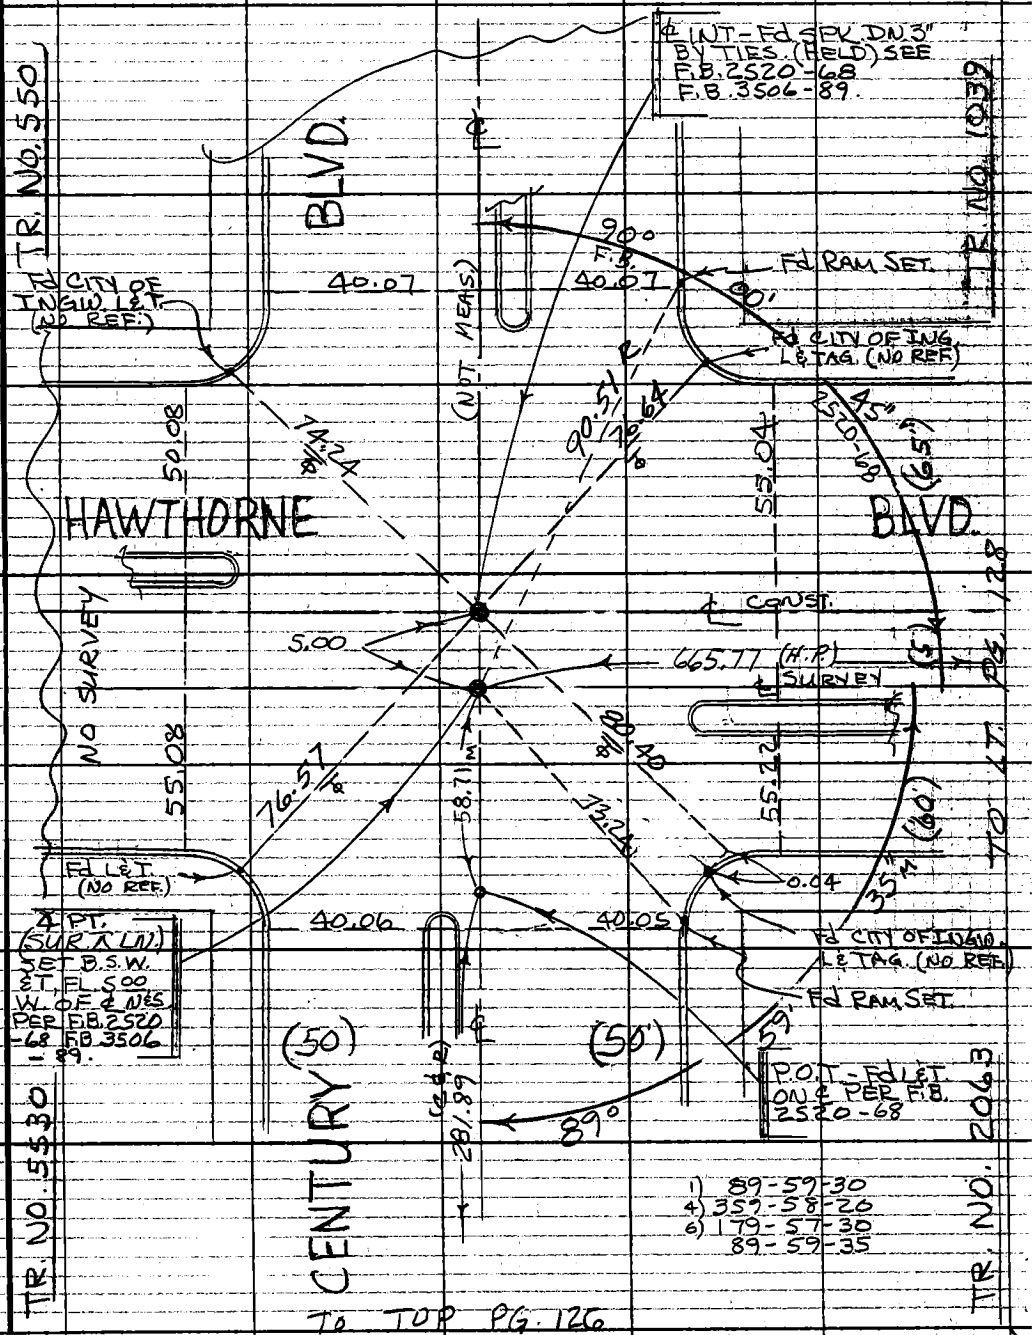

PWTB 0918

255

F.B. 3935 Pg. 128

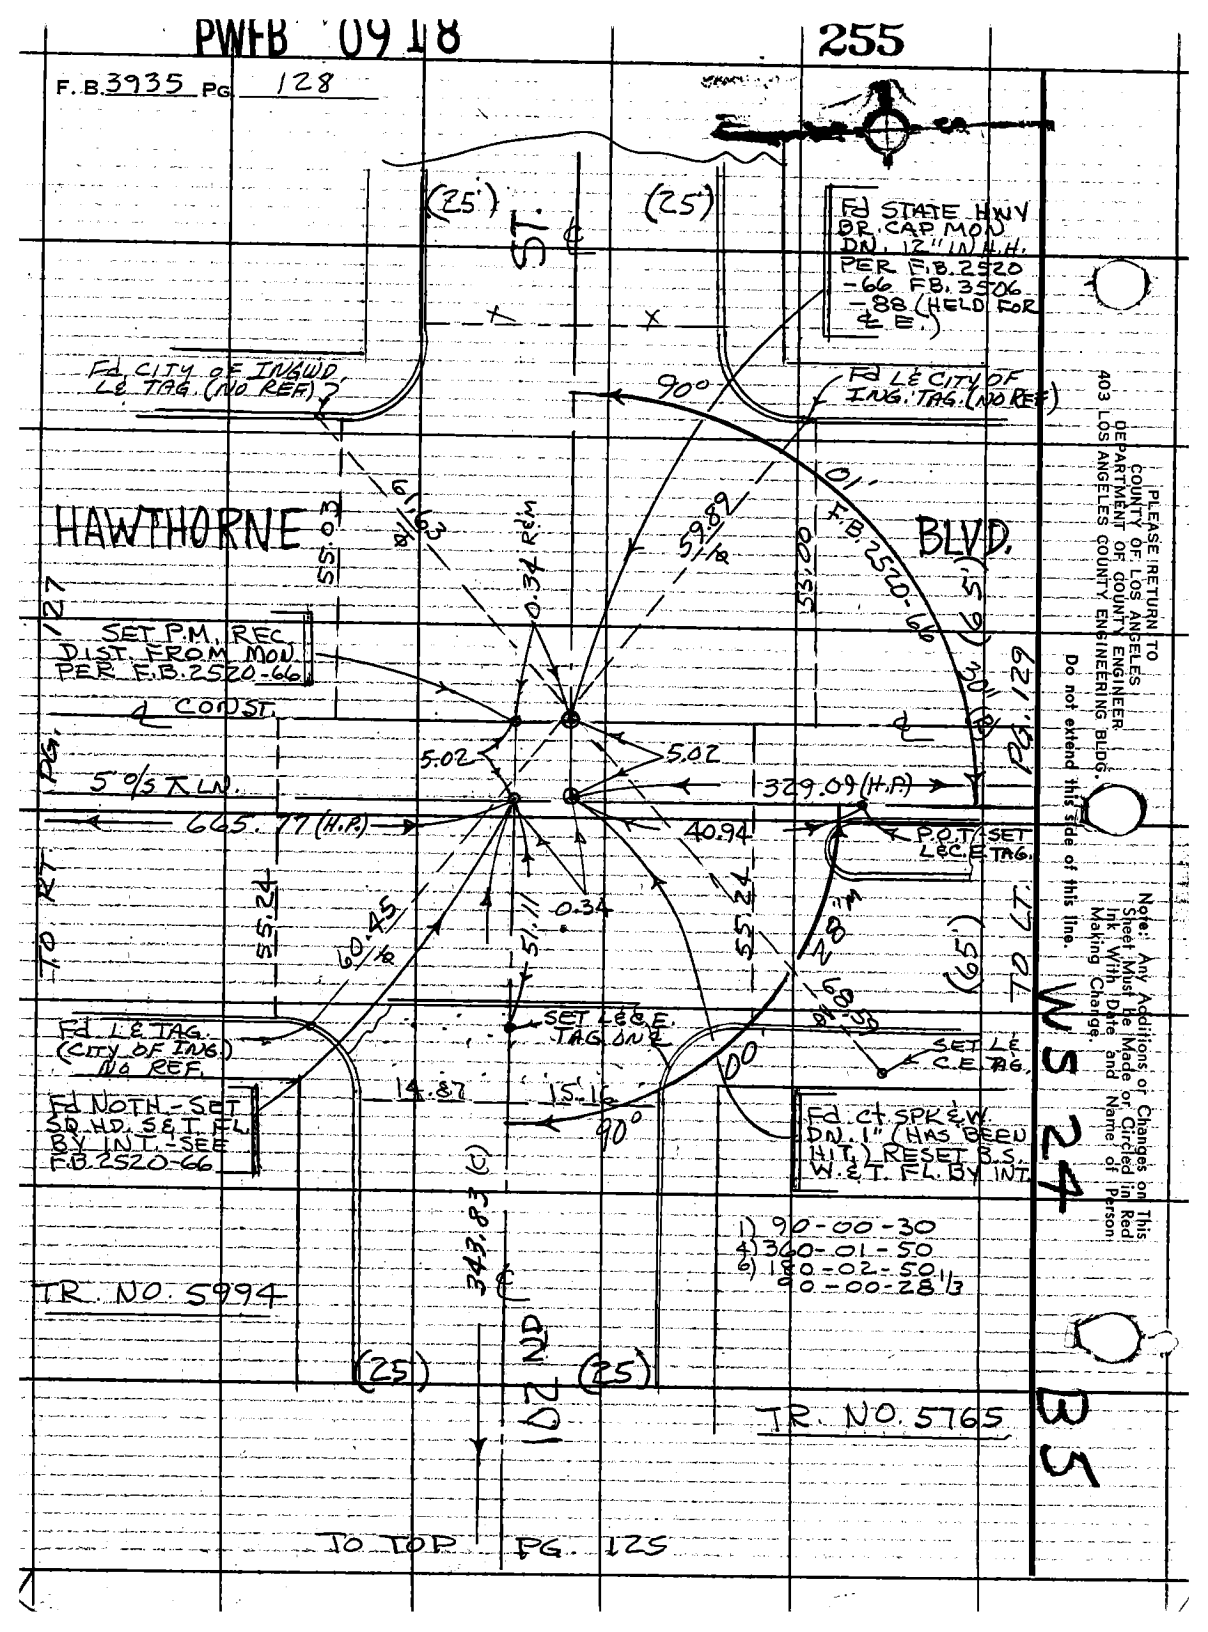

PLEASE RETURN TO
COUNTY OF LOS ANGELES
DEPARTMENT OF COUNTY ENGINEER
403 LOS ANGELES COUNTY ENGINEERING BLDG.

Do not extend this side of this line.

Note: Any Additions or Changes on This Sheet Must be Made or Circled in Red Ink With Date and Name of Person Making Change.

WS 24 W5

PWFB 0918

256

Notes Ck'd by	Survey of LENNOX AREA ℄
Map No.	JN 0303.00 Tape 238 Std. 68 °F
Office Work	Surveyed by J. BAZEN
Checked	Notes J.J.B. Date 8-75
Date	Indexed T. M. PALMERI JUN 15 1976

F. B. 3935 PG. 129

B5

WS24

Note: Any Additions or Changes on This Sheet Must be Made or Circled in Red Ink With Date and Name of Person Making Change.

Do not extend this side of this line.

PLEASE RETURN TO
COUNTY OF LOS ANGELES
DEPARTMENT OF COUNTY ENGINEER
403 LOS ANGELES COUNTY ENGINEERING BLDG.

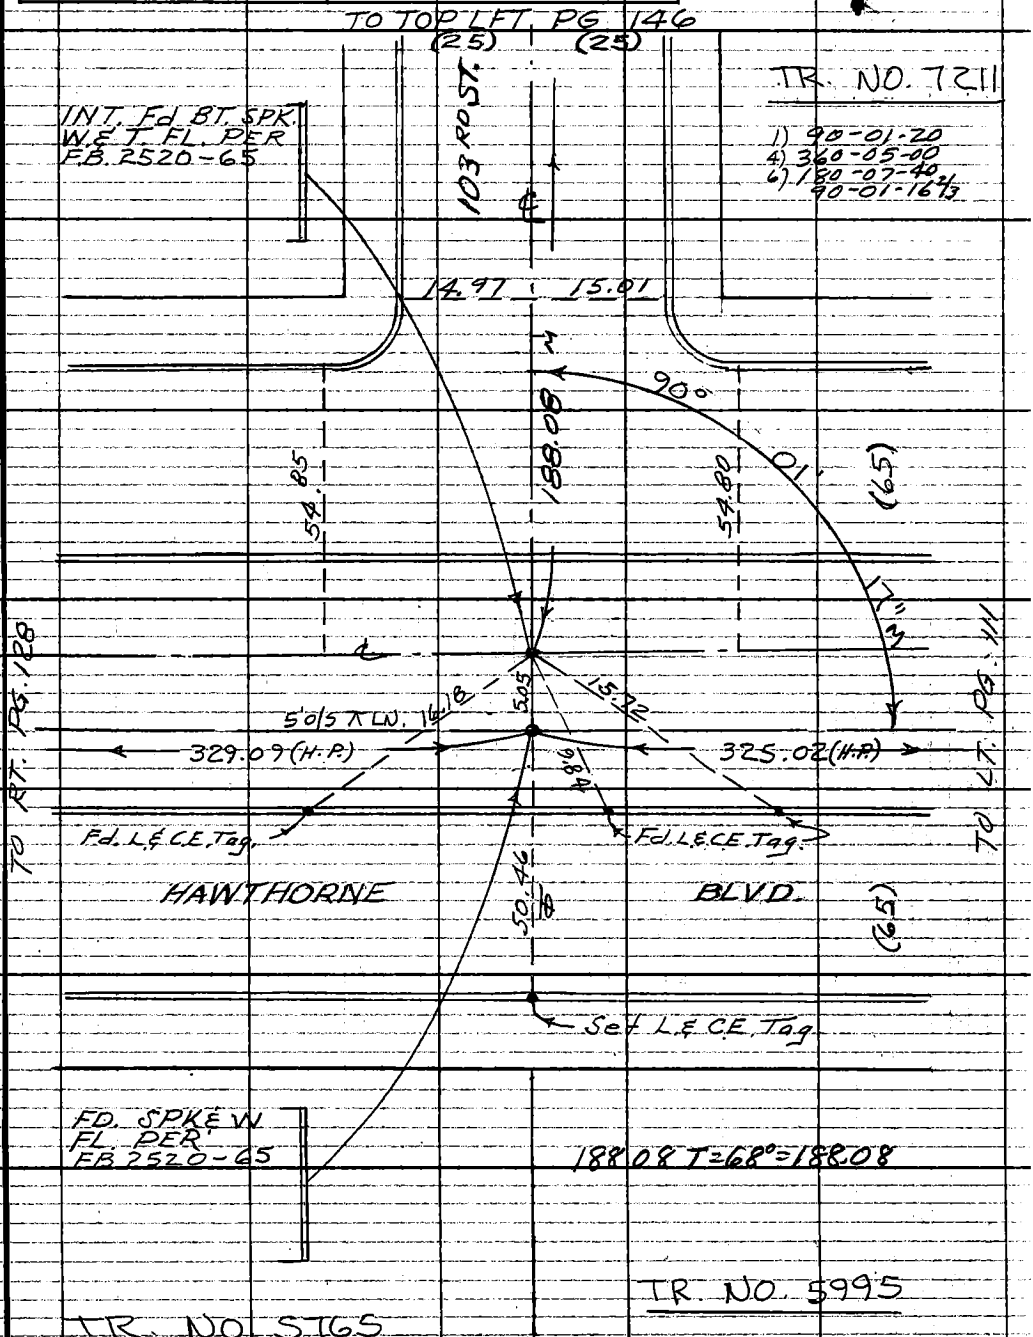

76F309S CE#310 3-69

F. B. 3935 PG 130

TO BOT PG 155

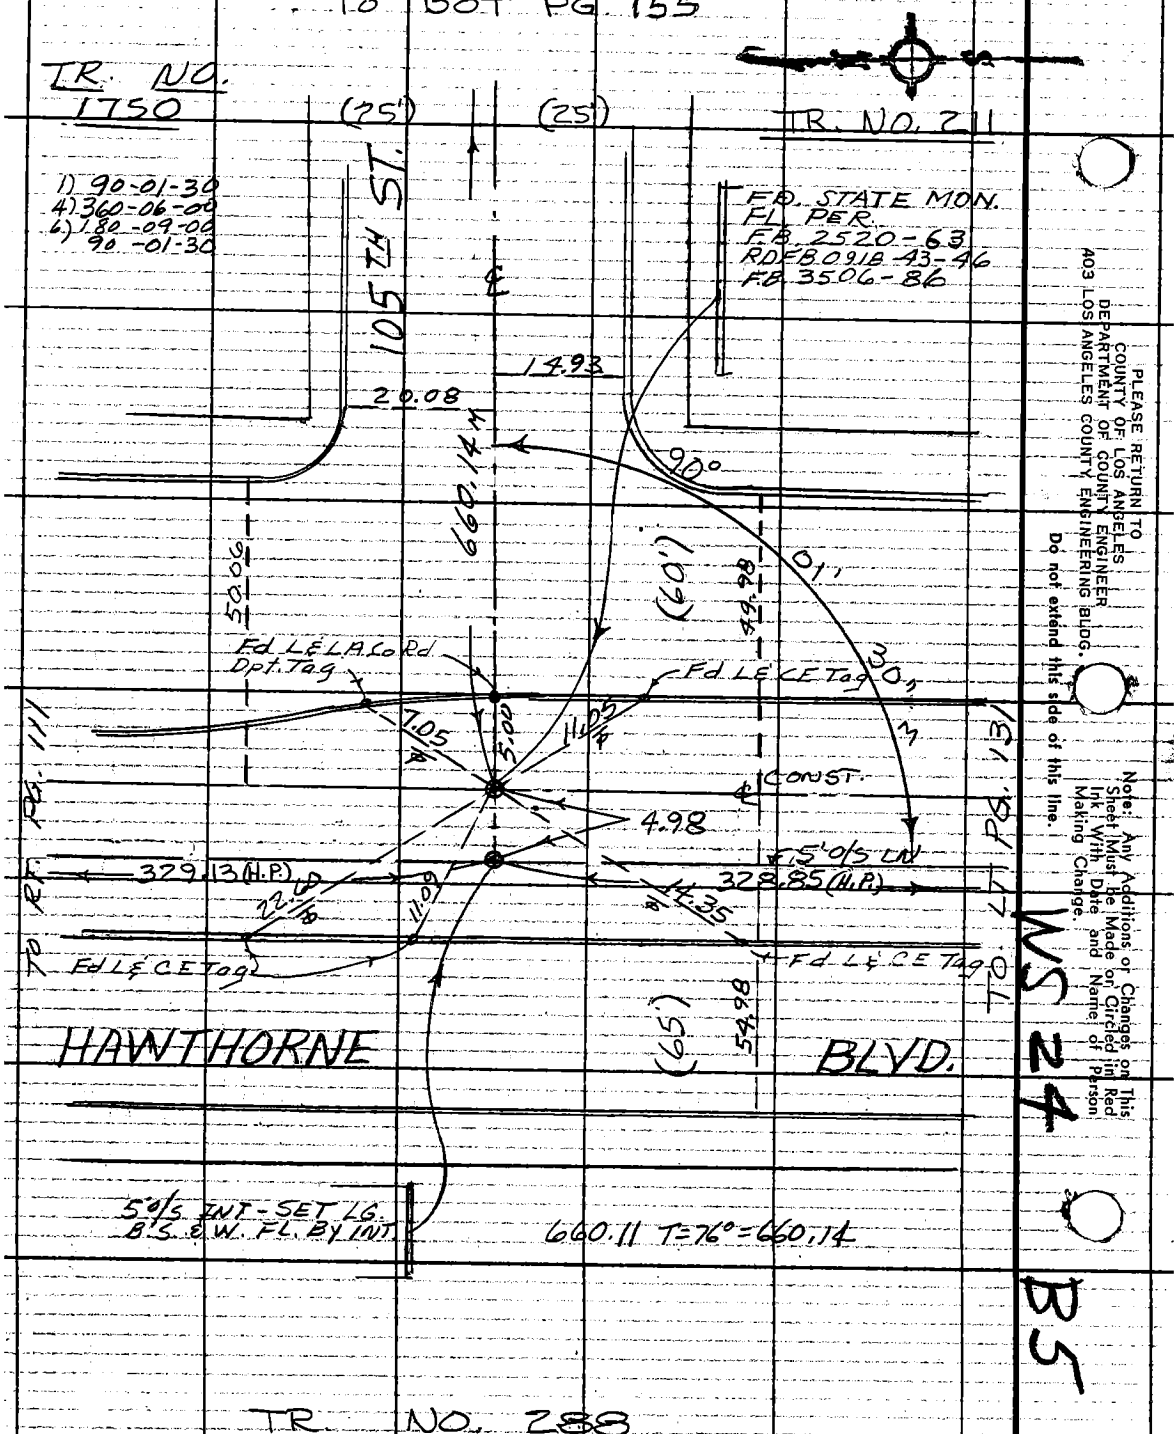

PLEASE RETURN TO
COUNTY OF LOS ANGELES
DEPARTMENT OF COUNTY ENGINEER
403 LOS ANGELES COUNTY ENGINEERING BLDG.

Do not extend this side of this line.

Note: Any Additions or Changes on This Sheet Must be Made or Circled in Red Ink With Date and Name of Person Making Change.

PWFB 0918

258

Notes Ck'd by	Survey of LENNOX AREA ℄
Map No.	JN 0303.00 Tape 238 Std 68 °F
Office Work	Surveyed by J. BAZEN
Checked	Notes J. J. B. Date 8-75
Date	Indexed T. M. PALMER JUN 15 1976

F. B. 3935 PG. 131

B5

WS 24

1) 90-00-50
4) 360-03-20
6) 180-05-00
90-00-50

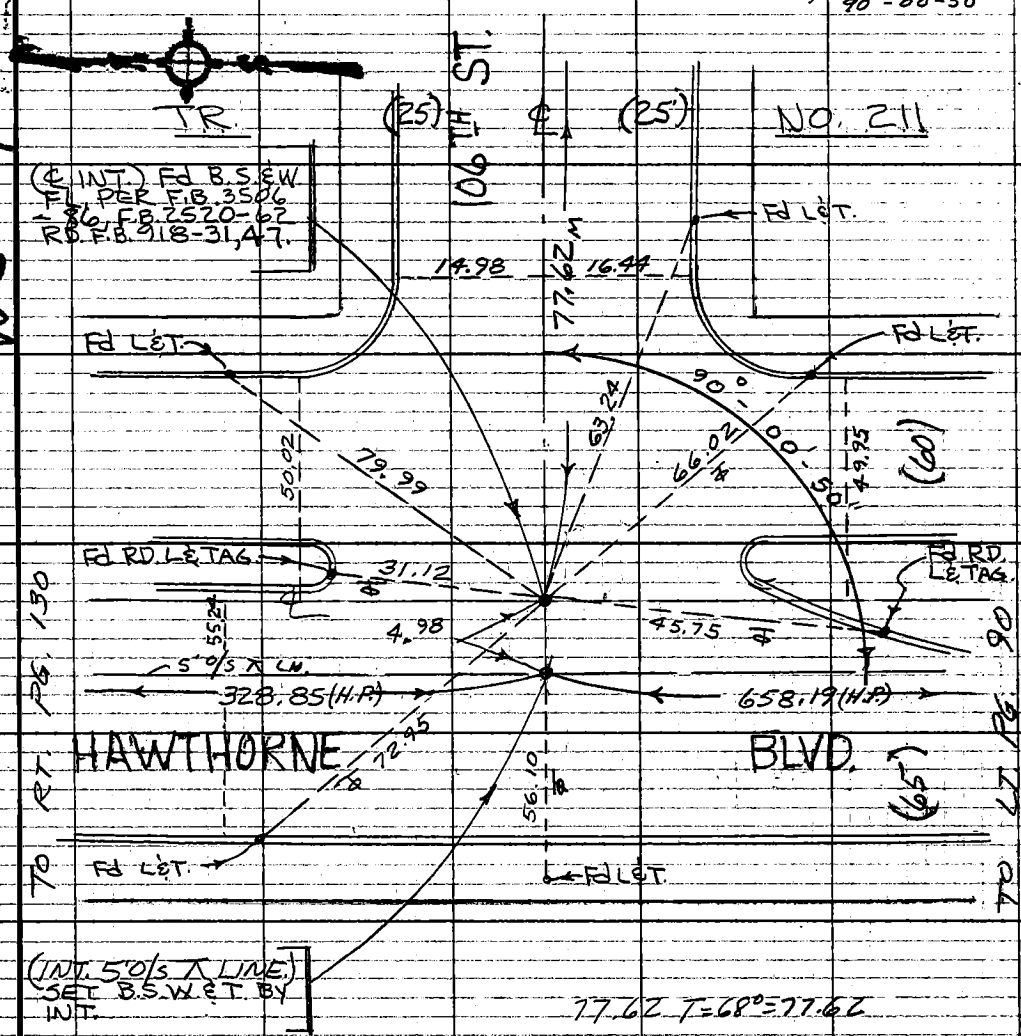

TR. NO. 288

Note: Any Additions or Changes on this Sheet Must be Made or Circled in Red Ink With Date and Name of Person Making Change.

Do not extend this side of this line.

PLEASE RETURN TO
COUNTY OF LOS ANGELES
DEPARTMENT OF COUNTY ENGINEER
403 LOS ANGELES COUNTY ENGINEERING BLDG.

76F309S CE#310 3-69

F.B. 3935 PG. 132 TO BOT PG. 133

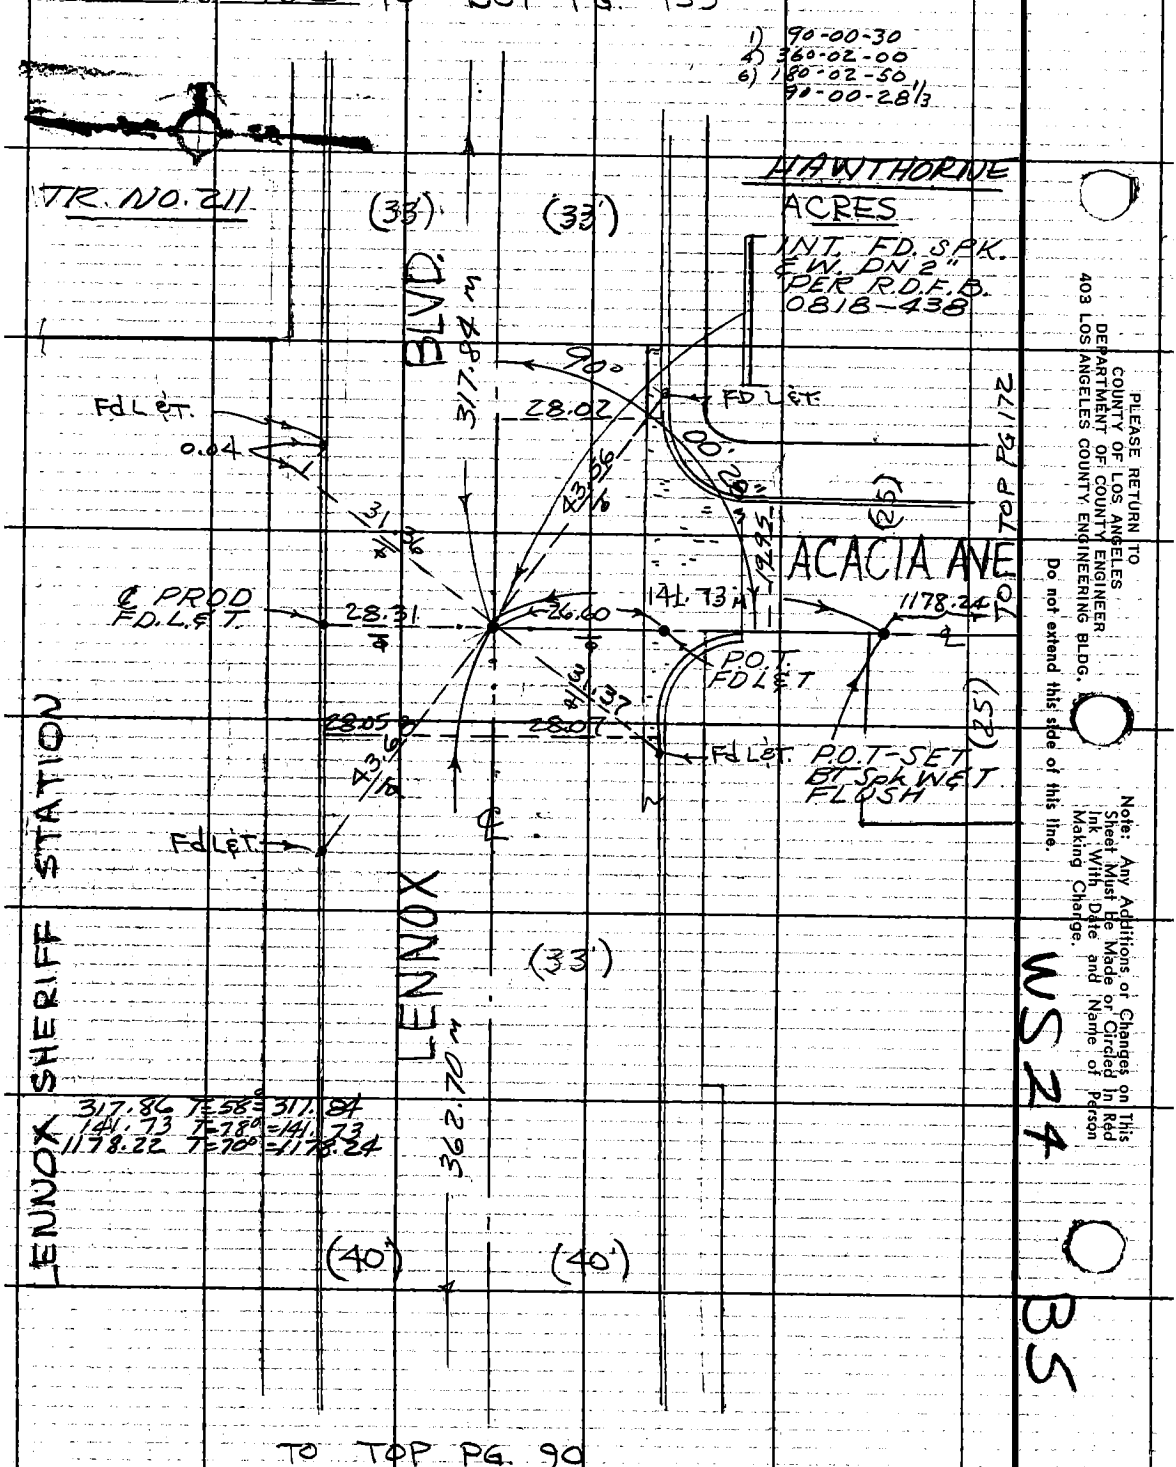

PLEASE RETURN TO
COUNTY OF LOS ANGELES
DEPARTMENT OF COUNTY ENGINEER
403 LOS ANGELES COUNTY ENGINEERING BLDG.

Do not extend this side of this line.

Note: Any Additions or Changes on This Sheet Must Be Made or Circled In Red Ink With Date and Name of Person Making Change.

WS 24 B5

PWFB 0818 698

Notes Ck'd by	Survey of LENNOX AREA ℄
Map No.	JN 0303.00 Tape 238 Std 68 °F
Office Work	Surveyed by J. BAZEN
Checked	Notes J.J.B. Date 8-75
Date	Indexed T. M. PALMERI JUN 15 1976

F.B. 3935 PG. 133

B5

WS24

TO BOT PG. 134

1) 90-00-20
4) 360-01-20
6) 180-02-00
90-00-20

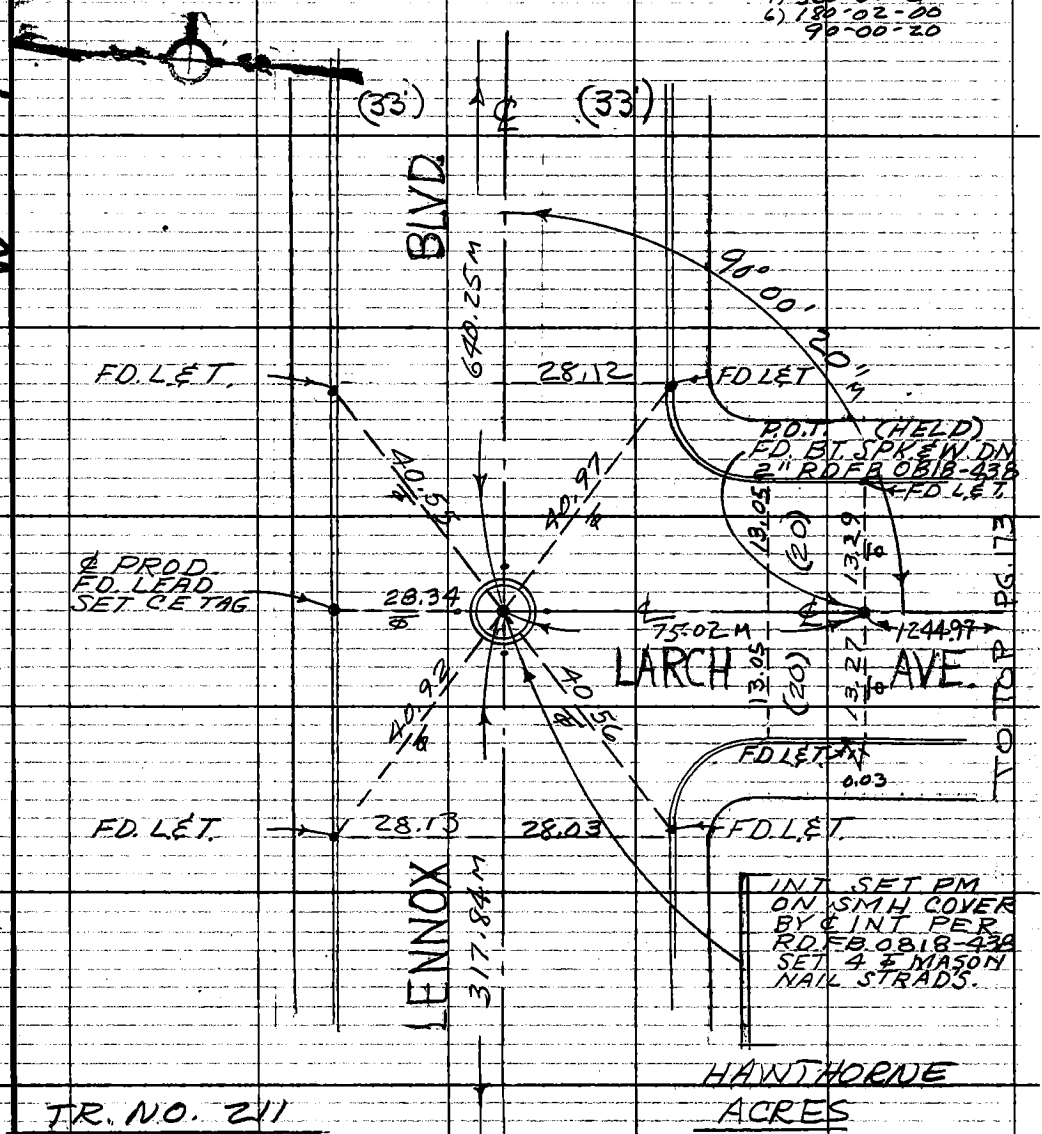

TR. NO. 211

640.29 T=58°=640.25
75.02 T=66°=75.02
1244.94 T=72°=1244.97

TO TOP PG. 132

Note: Any Additions or Changes on This Sheet Must be Made or Circled in Red Ink With Date and Name of Person Making Change.

Do not extend this side of this line.

PLEASE RETURN TO
COUNTY OF LOS ANGELES
DEPARTMENT OF COUNTY ENGINEER
403 LOS ANGELES COUNTY ENGINEERING BLDG.

76F309S CE#310 3-69

699

F. B. 3935 PG 134

TO BOT PG. 135

329.06 T=74°=329.07
330.72 T=60°=330.70
1319.94 T=60°=1319.89

1) 90-00-20
4) 360-01-40
6) 180-02-20
90-00-23 1/3

1) 90-00-00
4) 360-00-10
6) 180-00-20
90-00-03 1/3

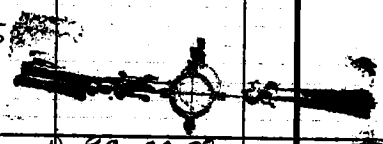

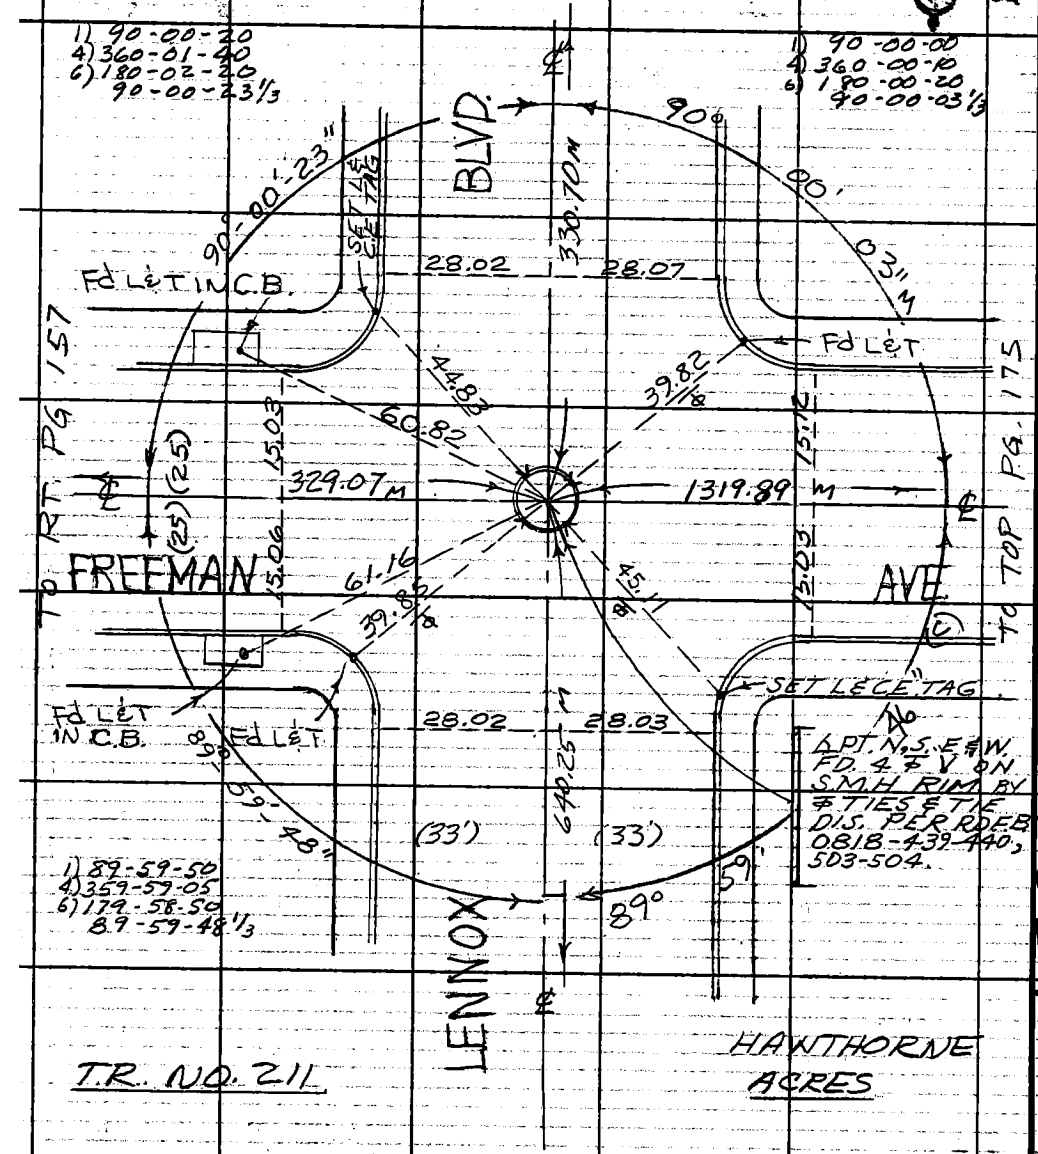

1) 89-59-50
4) 359-59-05
6) 179-58-50
89-59-48 1/3

TO TOP PG. 133

PLEASE RETURN TO
COUNTY OF LOS ANGELES
DEPARTMENT OF COUNTY ENGINEER
403 LOS ANGELES COUNTY ENGINEERING BLDG.

Do not extend this side of this line.

Note: Any Additions or Changes on This Sheet Must be Made or Circled in Red Ink With Date and Name of Person Making Change.

WS 24 B5

PWFB 0818

700

Notes Ck'd by	Survey of LENNOX AREA ℄
Map No.	JN0303.00 Tape 238 Std 68 °F
Office Work	Surveyed by J. BAZEN
Checked	Notes J.J.B. Date 8-75
Date	Indexed T. M. PALMERI JUN 15 1976

F. B. 3935 PG. 135

B5

WS 24

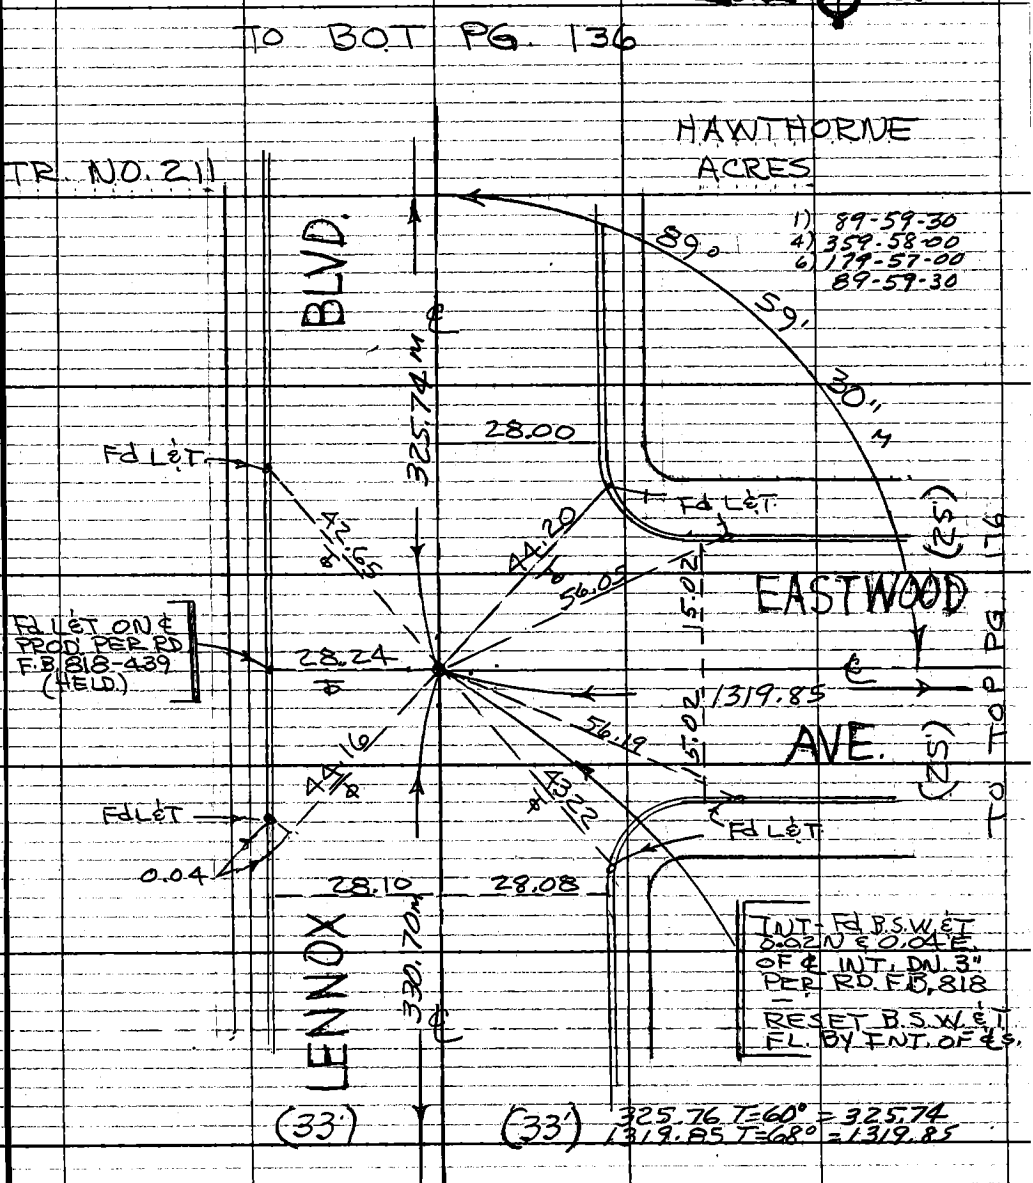

Note: Any Additions or Changes on This Sheet Must be Made or Circled in Red Ink With Date and Name of Person Making Change.

Do not extend this side of this line.

PLEASE RETURN TO COUNTY OF LOS ANGELES DEPARTMENT OF COUNTY ENGINEER 403 LOS ANGELES COUNTY ENGINEERING BLDG.

76F309S CE#310 3-69

F. B. 3935 PG. 136

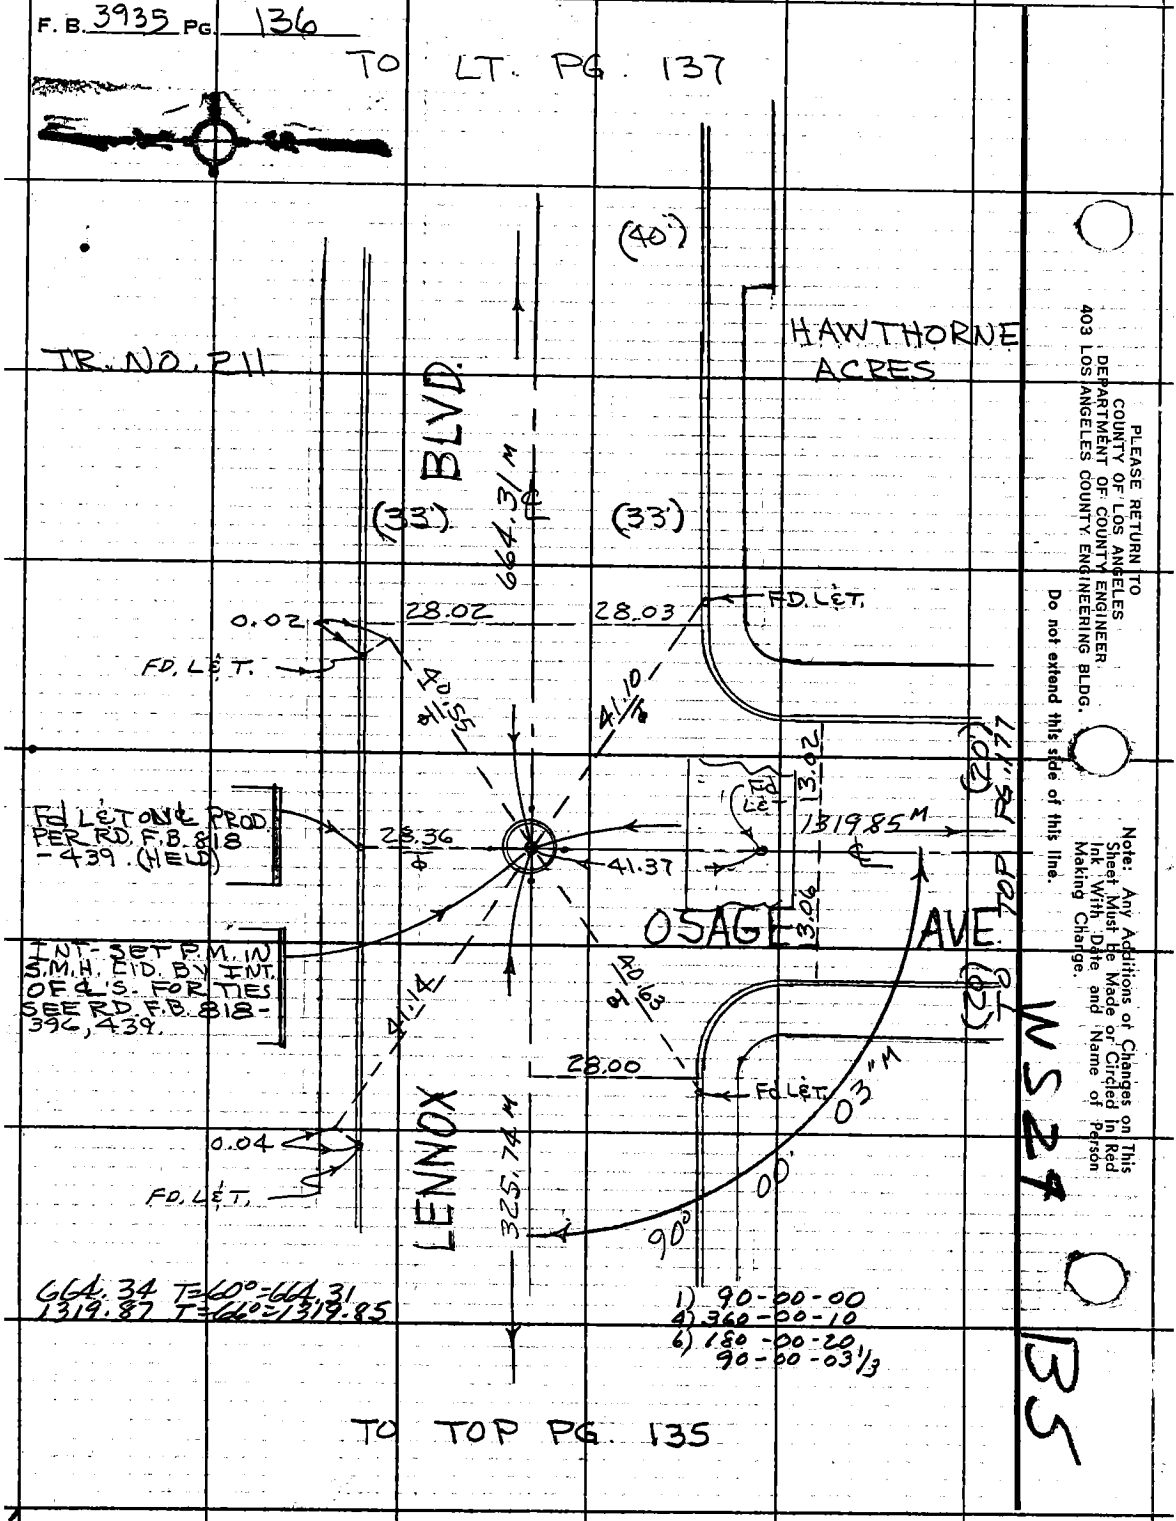

PLEASE RETURN TO
COUNTY OF LOS ANGELES
DEPARTMENT OF COUNTY ENGINEER
403 LOS ANGELES COUNTY ENGINEERING BLDG.

Do not extend this side of this line.

Note: Any Additions or Changes on This Sheet Must Be Made or Circled in Red Ink With Date and Name of Person Making Change.

PWFB 0818 702

Notes Ck'd by	Survey of LENNOX AREA ℄
Map No.	JN 0303.00 Tape 238 Std 68 °F
Office Work	Surveyed by J. BAZEN
Checked	Notes J. J. B. Date 8-75
Date	Indexed PALMER JUN 15 1976

F. B. 3935 PG. 137

206.31 T=76°=206.32
175.45 T=56°=175.44
351.11 T=56°=351.08

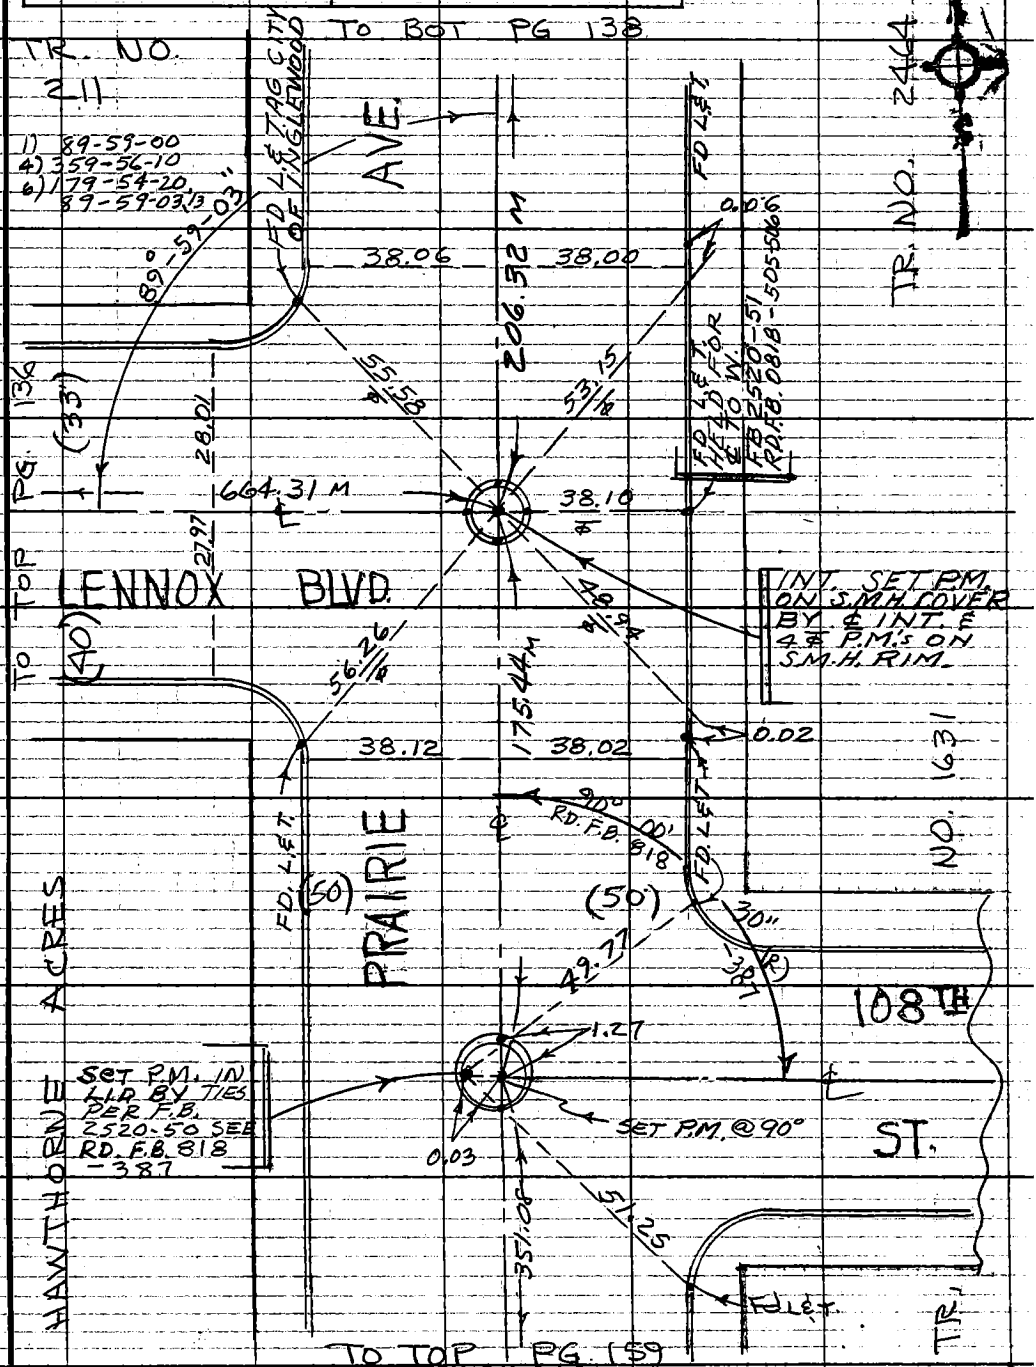

Note: Any Additions or Changes on This Sheet Must be Made or Circled in Red Ink With Date and Name of Person Making Change.

Do not extend this side of this line.

PLEASE RETURN TO
COUNTY OF LOS ANGELES
DEPARTMENT OF COUNTY ENGINEER
403 LOS ANGELES COUNTY ENGINEERING BLDG.

76F309S CE#310 3-69

PWFB 0818

703

F. B. 3935 PG. 138 TO BOT PG. 139

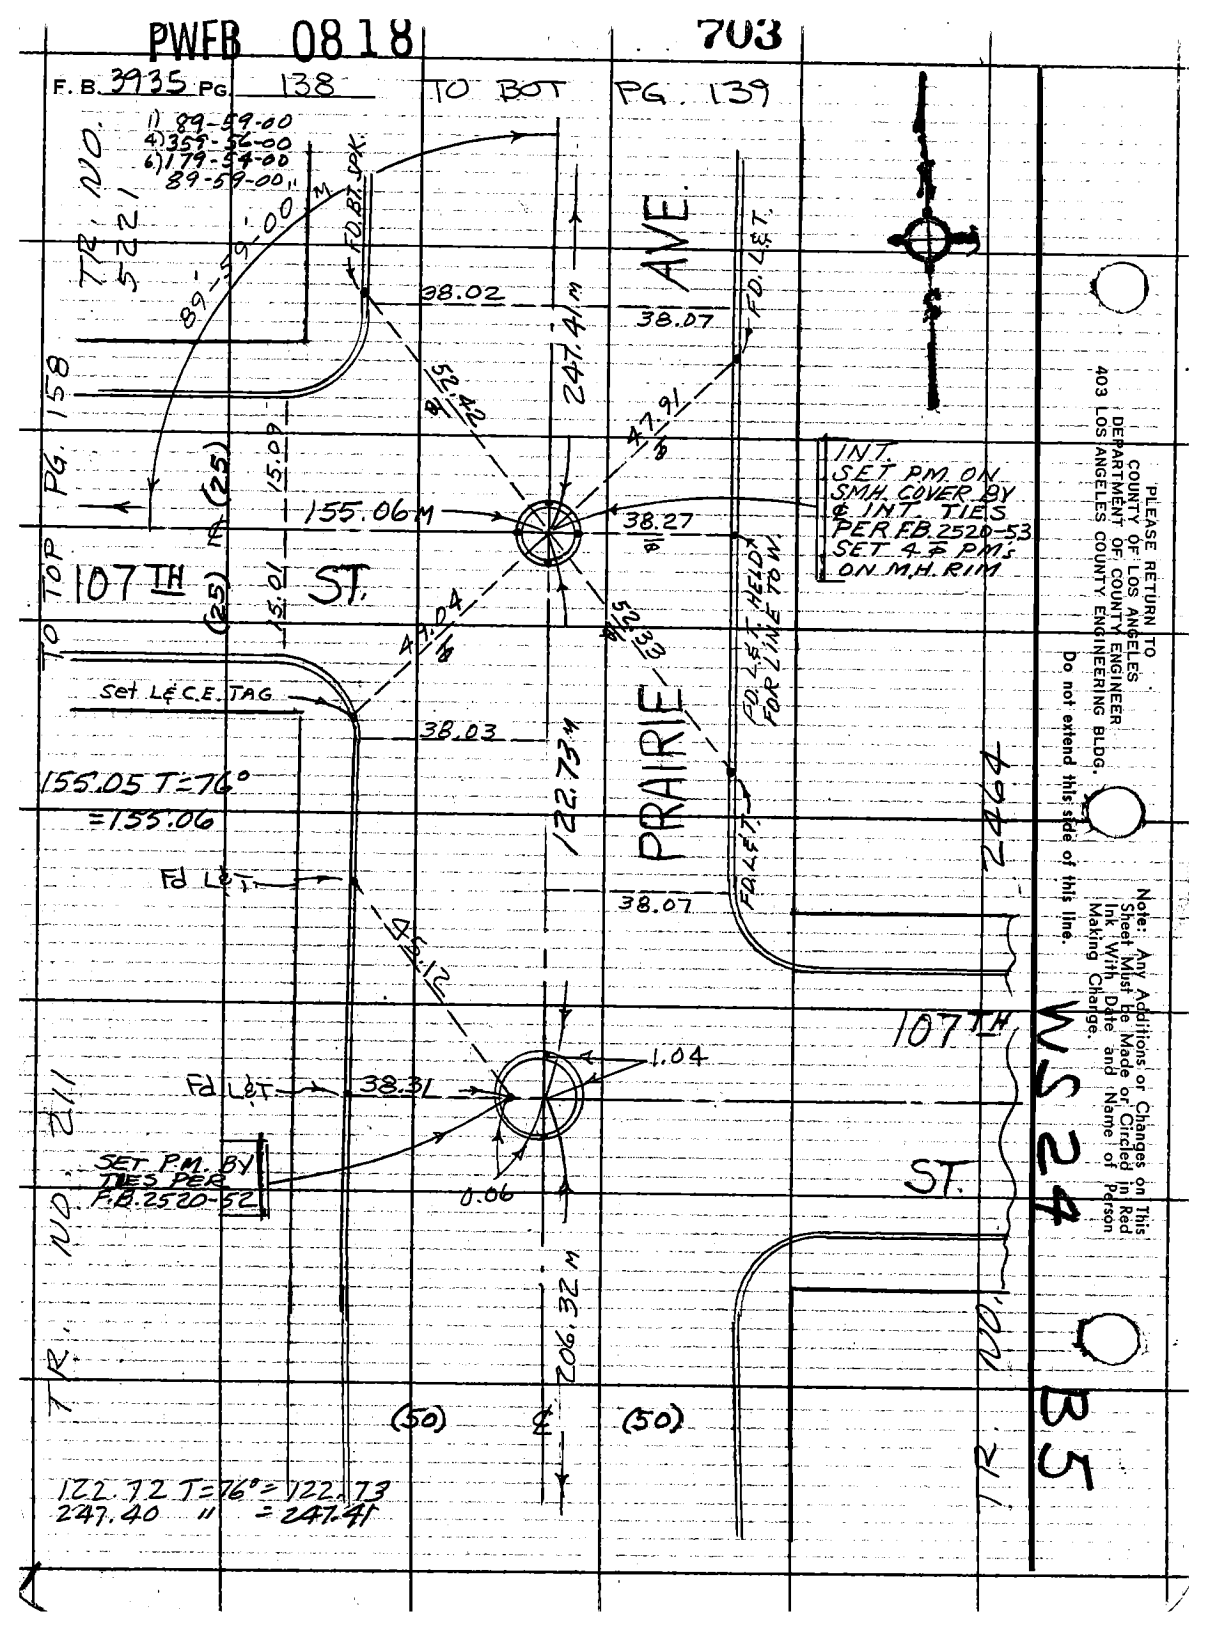

PLEASE RETURN TO
COUNTY OF LOS ANGELES
DEPARTMENT OF COUNTY ENGINEER
403 LOS ANGELES COUNTY ENGINEERING BLDG.

Do not extend this side of this line.

Note: Any Additions or Changes on This Sheet Must Be Made or Circled in Red Ink With Date and Name of Person Making Change.

PWFB 0918

260

Notes Ck'd by	Survey of LENNOX AREA ℄
Map No.	JN 0303.00 Tape 238 Std 68 °F
Office Work	Surveyed by J. BAZEN
Checked	Notes J.J.B. Date 8-75
Date	Ad Md PALMER JUN 15 1978

F. B. 3935 PG. 139

WS 24 B5

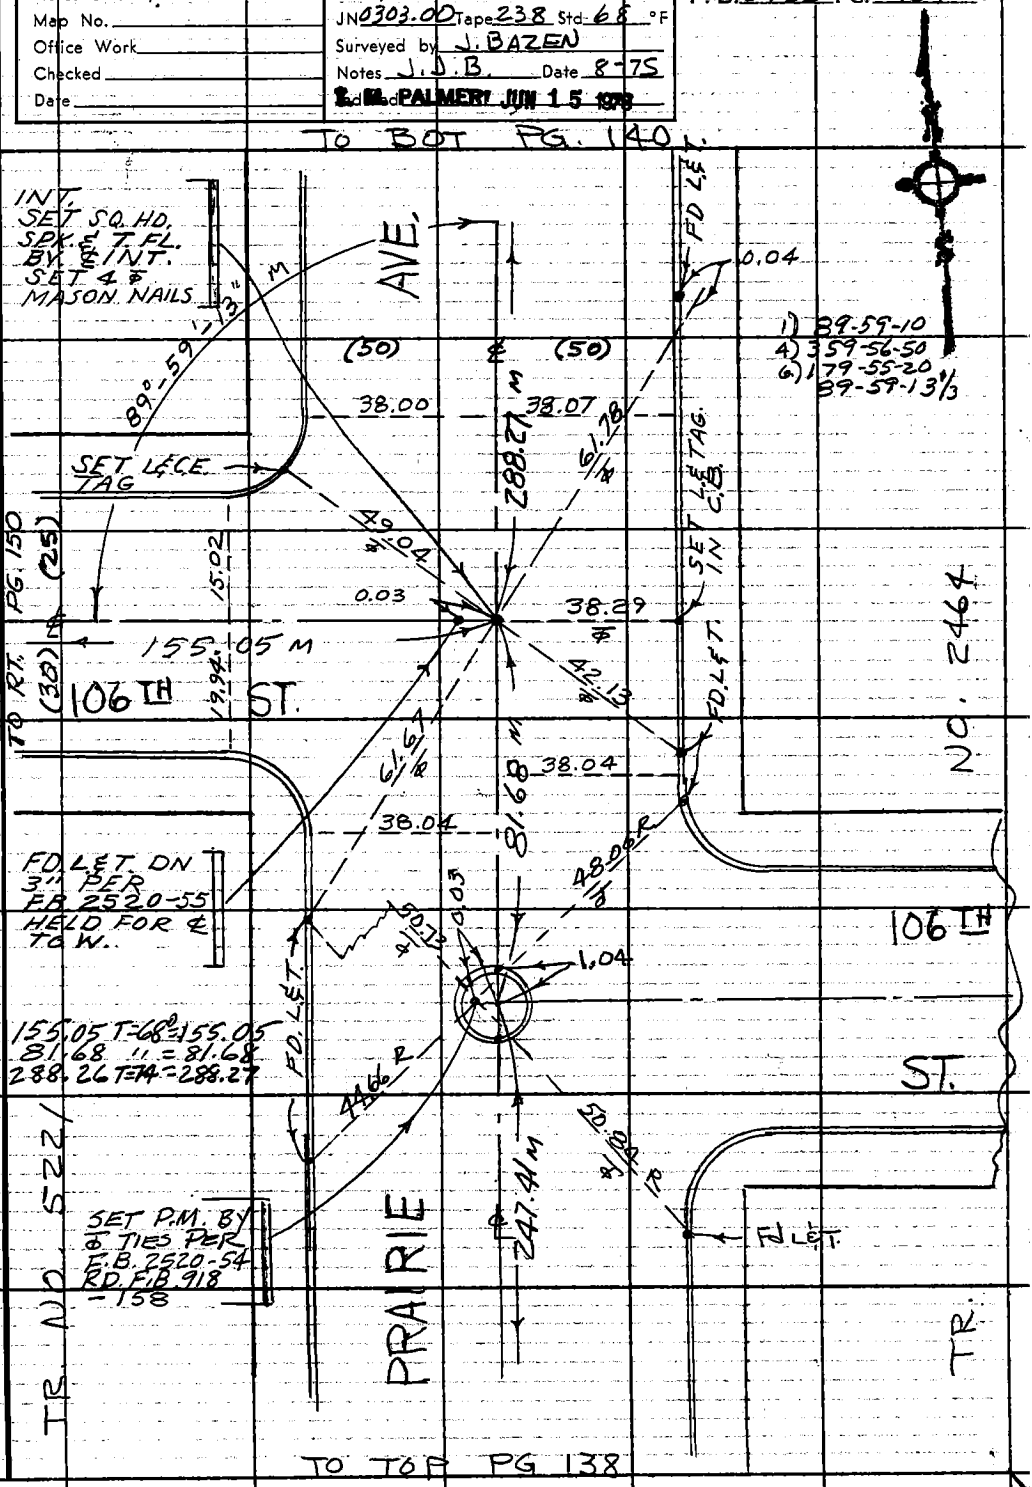

Note: Any Additions or Changes on This Sheet Must be Made or Circled in Red Ink With Date and Name of Person Making Change.

Do not extend this side of this line.

PLEASE RETURN TO COUNTY OF LOS ANGELES DEPARTMENT OF COUNTY ENGINEER 403 LOS ANGELES COUNTY ENGINEERING BLDG.

76F309S CE#310 3-69

F.B. 3935 PG. 140

TO BOT PG. 141

329.11 T=74°=329.12

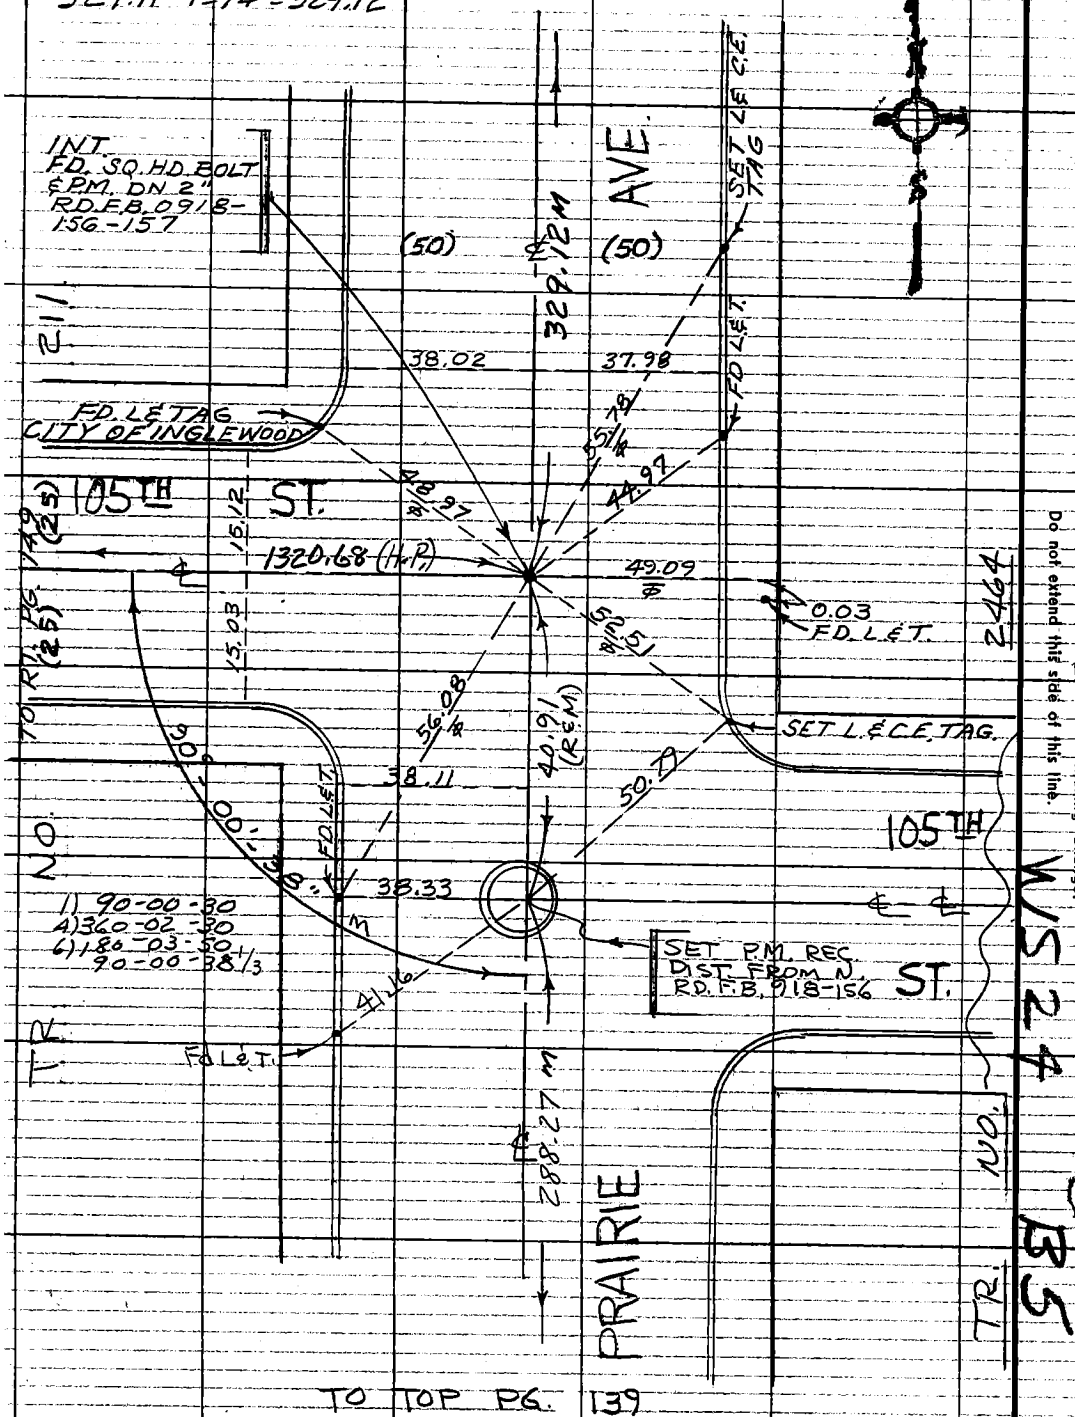

TO TOP PG. 139

PLEASE RETURN TO
COUNTY OF LOS ANGELES
DEPARTMENT OF COUNTY ENGINEER
403 LOS ANGELES COUNTY ENGINEERING BLDG.

Do not extend this side of this line.

Note: Any Additions or Changes on This Sheet Must be Made or Circled in Red Ink With Date and Name of Person Making Change.

PWFB 0918 262

Notes Ck'd by	Survey of LENNOX AREA ℄
Map No.	JN 0303.00 Tape 238 Std 68 °F
Office Work	Surveyed by J. BAZEN
Checked	Notes J.J.B. Date 8-75
Date	[illegible] PALMER JUN 15 1976

F. B. 3935 PG. 141

B5

WS24

TO BOT PG. 142

1) 89-59-20
4) 359-57-20
6) 179-56-10
89-59-21 2/3

1) 90-00-20
4) 360-01-20
6) 180-02-00
90-00-20

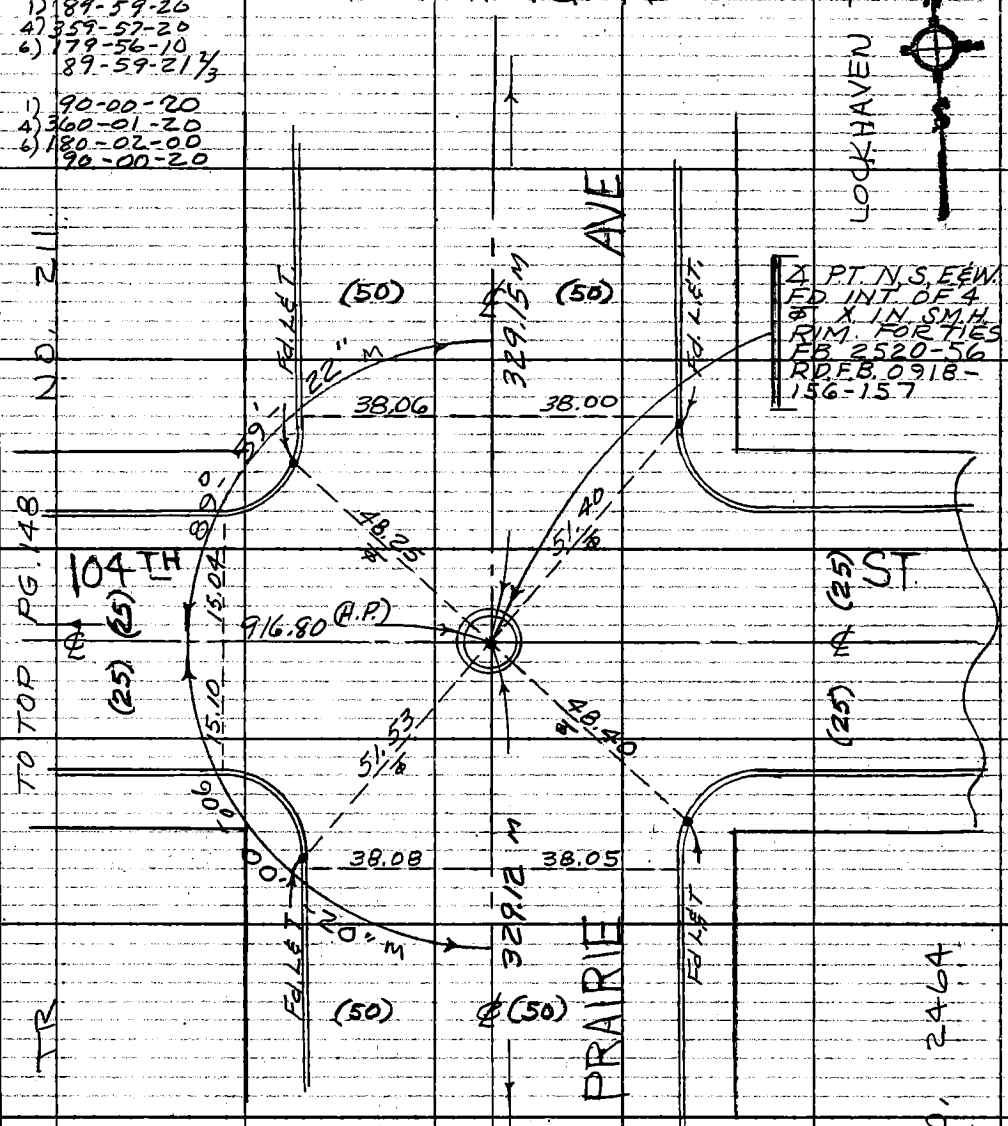

329.14 T=74°=329.15

TO TOP PG. 140

Note: Any Additions or Changes on This Sheet Must be Made or Circled in Red Ink With Date and Name of Person Making Change.

Do not extend this side of this line.

PLEASE RETURN TO
COUNTY OF LOS ANGELES
DEPARTMENT OF COUNTY ENGINEER
403 LOS ANGELES COUNTY ENGINEERING BLDG.

76F309S CE#310 3-69

PWFB 0918

263

F.B. 3935 Pg. 142

Fd City of Inglewood L.S. Tag

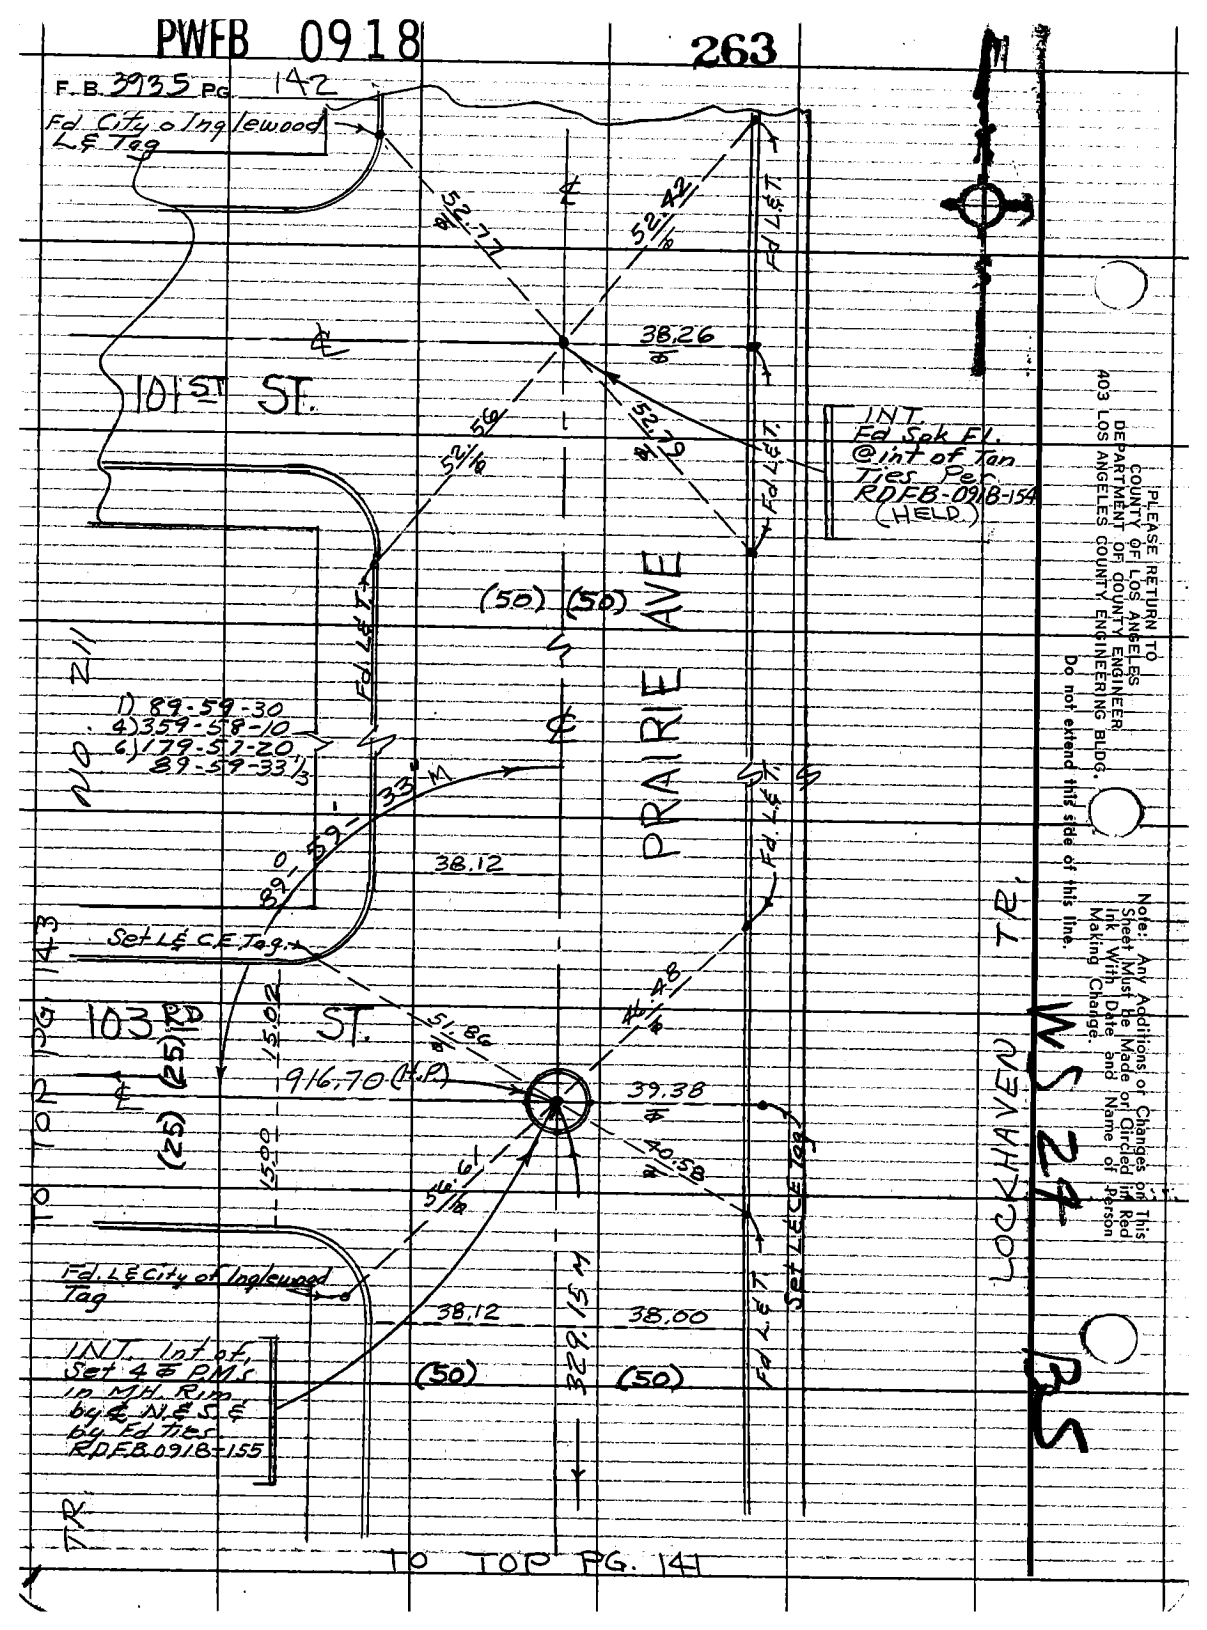

PLEASE RETURN TO
COUNTY OF LOS ANGELES
DEPARTMENT OF COUNTY ENGINEER
403 LOS ANGELES COUNTY ENGINEERING BLDG.
Do not extend this side of this line.

Note: Any Additions or Changes on This Sheet Must be Made or Circled in Red Ink With Date and Name of Person Making Change.

PWFB 0918 264, 265

Notes Ck'd by	Survey of LENNOX AREA ℄
Map No.	JN 0303.00 Tape 238 Std 68 °F
Office Work	Surveyed by J. BAZEN
Checked	Notes J.J.B. Date 8-75
Date	Index PALMERI JUN 15 1978

F.B. 3935 PG. 143

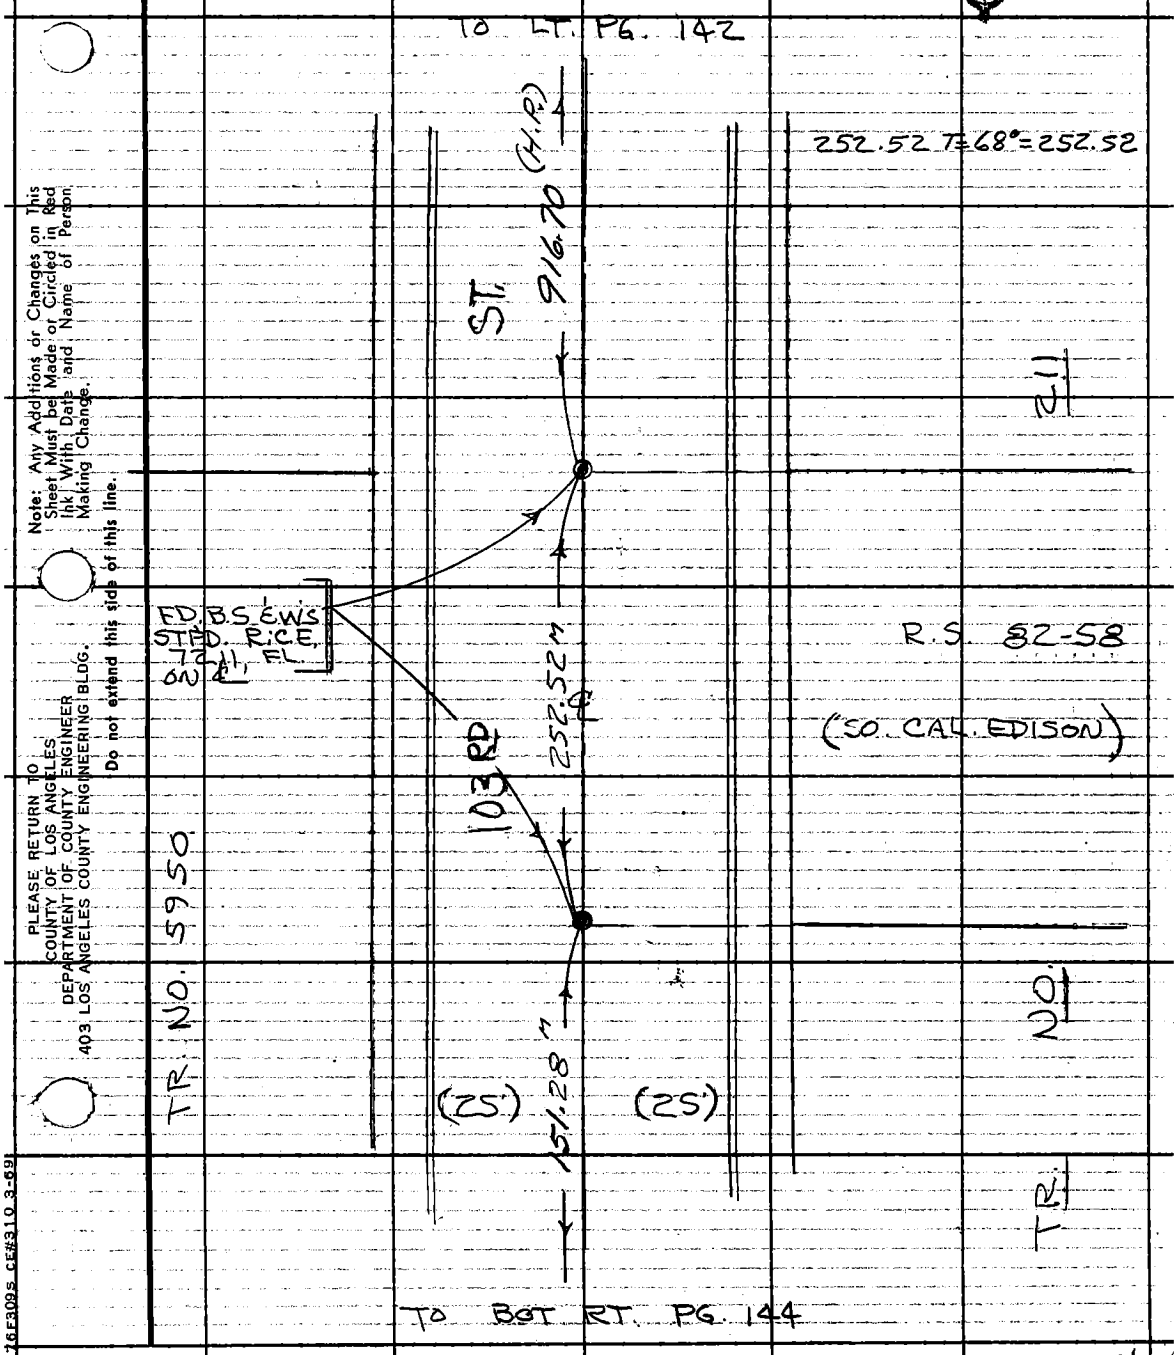

Note: Any Additions or Changes on This Sheet Must be Made or Circled in Red Ink With Date and Name of Person Making Change.

Do not extend this side of this line.

PLEASE RETURN TO
COUNTY OF LOS ANGELES
DEPARTMENT OF COUNTY ENGINEER
403 LOS ANGELES COUNTY ENGINEERING BLDG.

76F309S CE#310 3-69

F.B. 3935 PG. 144

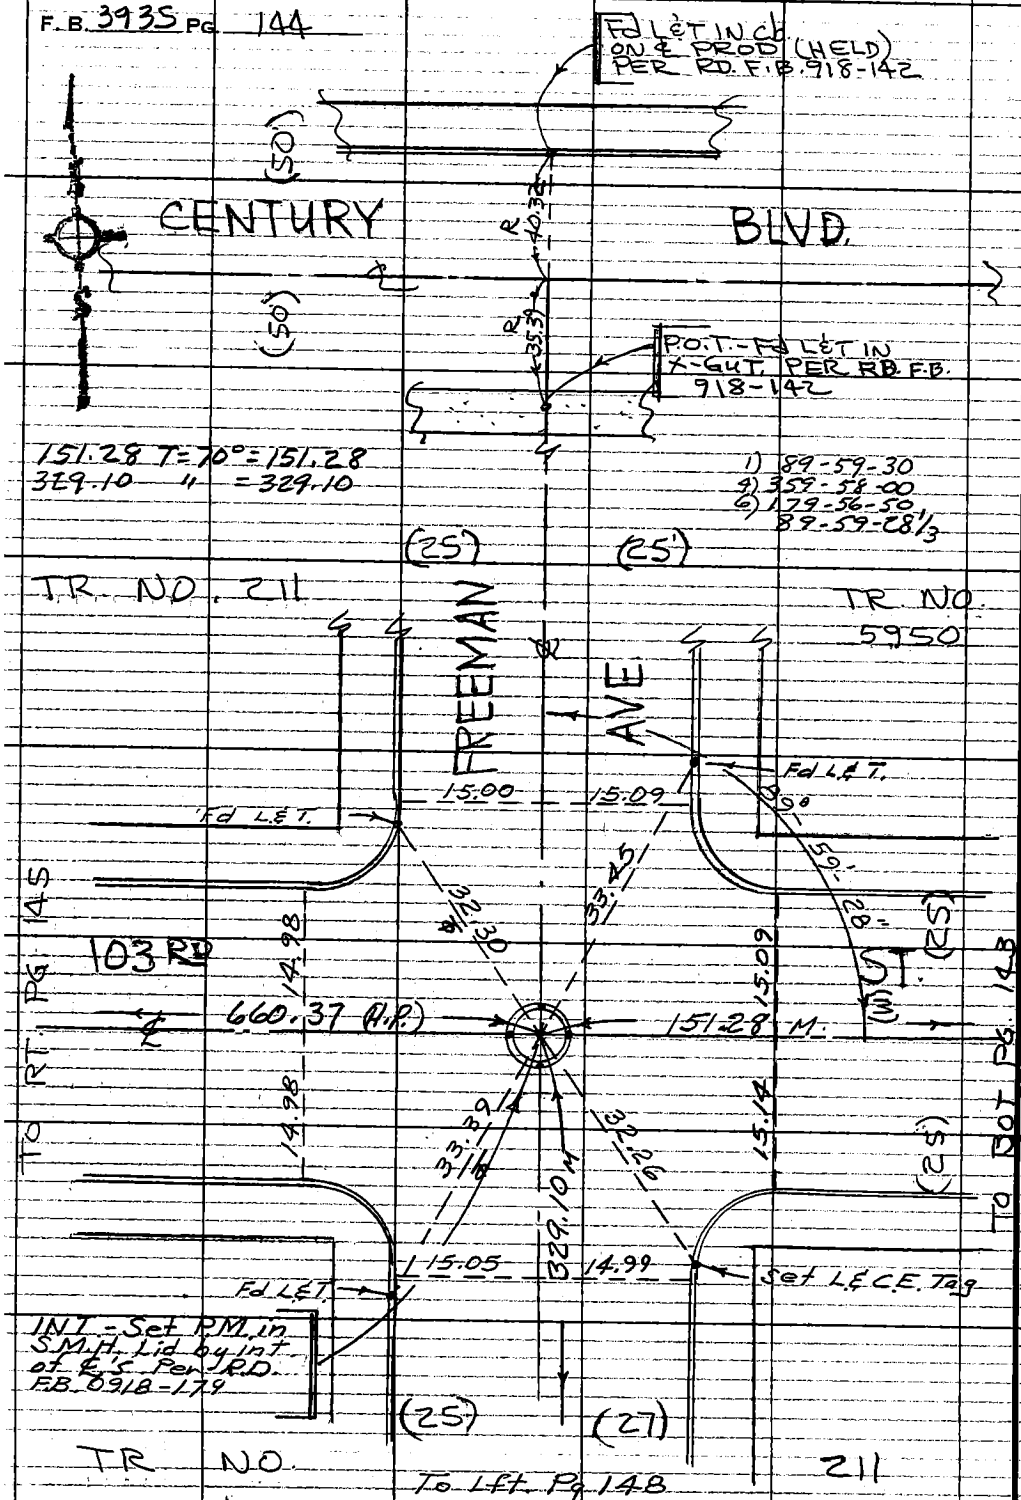

WS 24

B5

PLEASE RETURN TO
COUNTY OF LOS ANGELES
DEPARTMENT OF COUNTY ENGINEER
403 LOS ANGELES COUNTY ENGINEERING BLDG.

Do not extend this side of this line.

Note: Any Additions or Changes on This Sheet Must be Made or Circled in Red Ink With Date and Name of Person Making Change.

PWFB 0918

267

Notes Ck'd by	Survey of LENNOX AREA 4
Map No.	JN 0303.00 Tape 238 Std. 68 °F
Office Work	Surveyed by J. BAZEN
Checked	Notes J. J. B. Date 8-75
Date	Indexed T. M. PALMERI JUN 15 1976

F. B. 3935 PG. 145

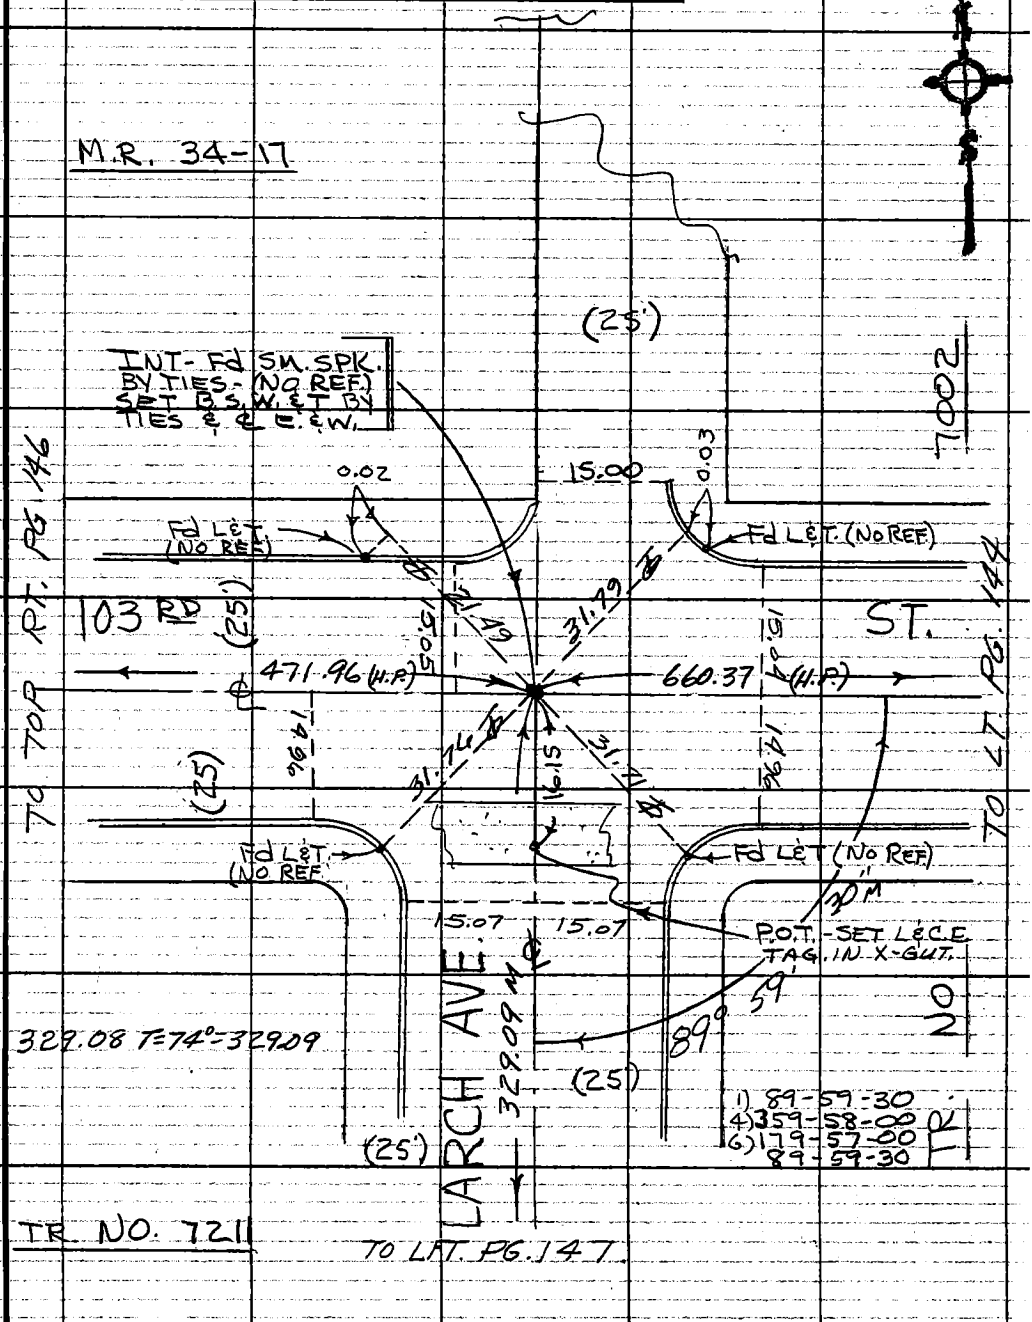

Note: Any Additions or Changes on This Sheet Must be Made or Circled in Red Ink With Date and Name of Person Making Change.

Do not extend this side of this line.

PLEASE RETURN TO COUNTY OF LOS ANGELES DEPARTMENT OF COUNTY ENGINEER 403 LOS ANGELES COUNTY ENGINEERING BLDG.

76F309S CE#310 3-69

PWB 0918

268

F.B. 3935 PG. 146

M.R. 34-17

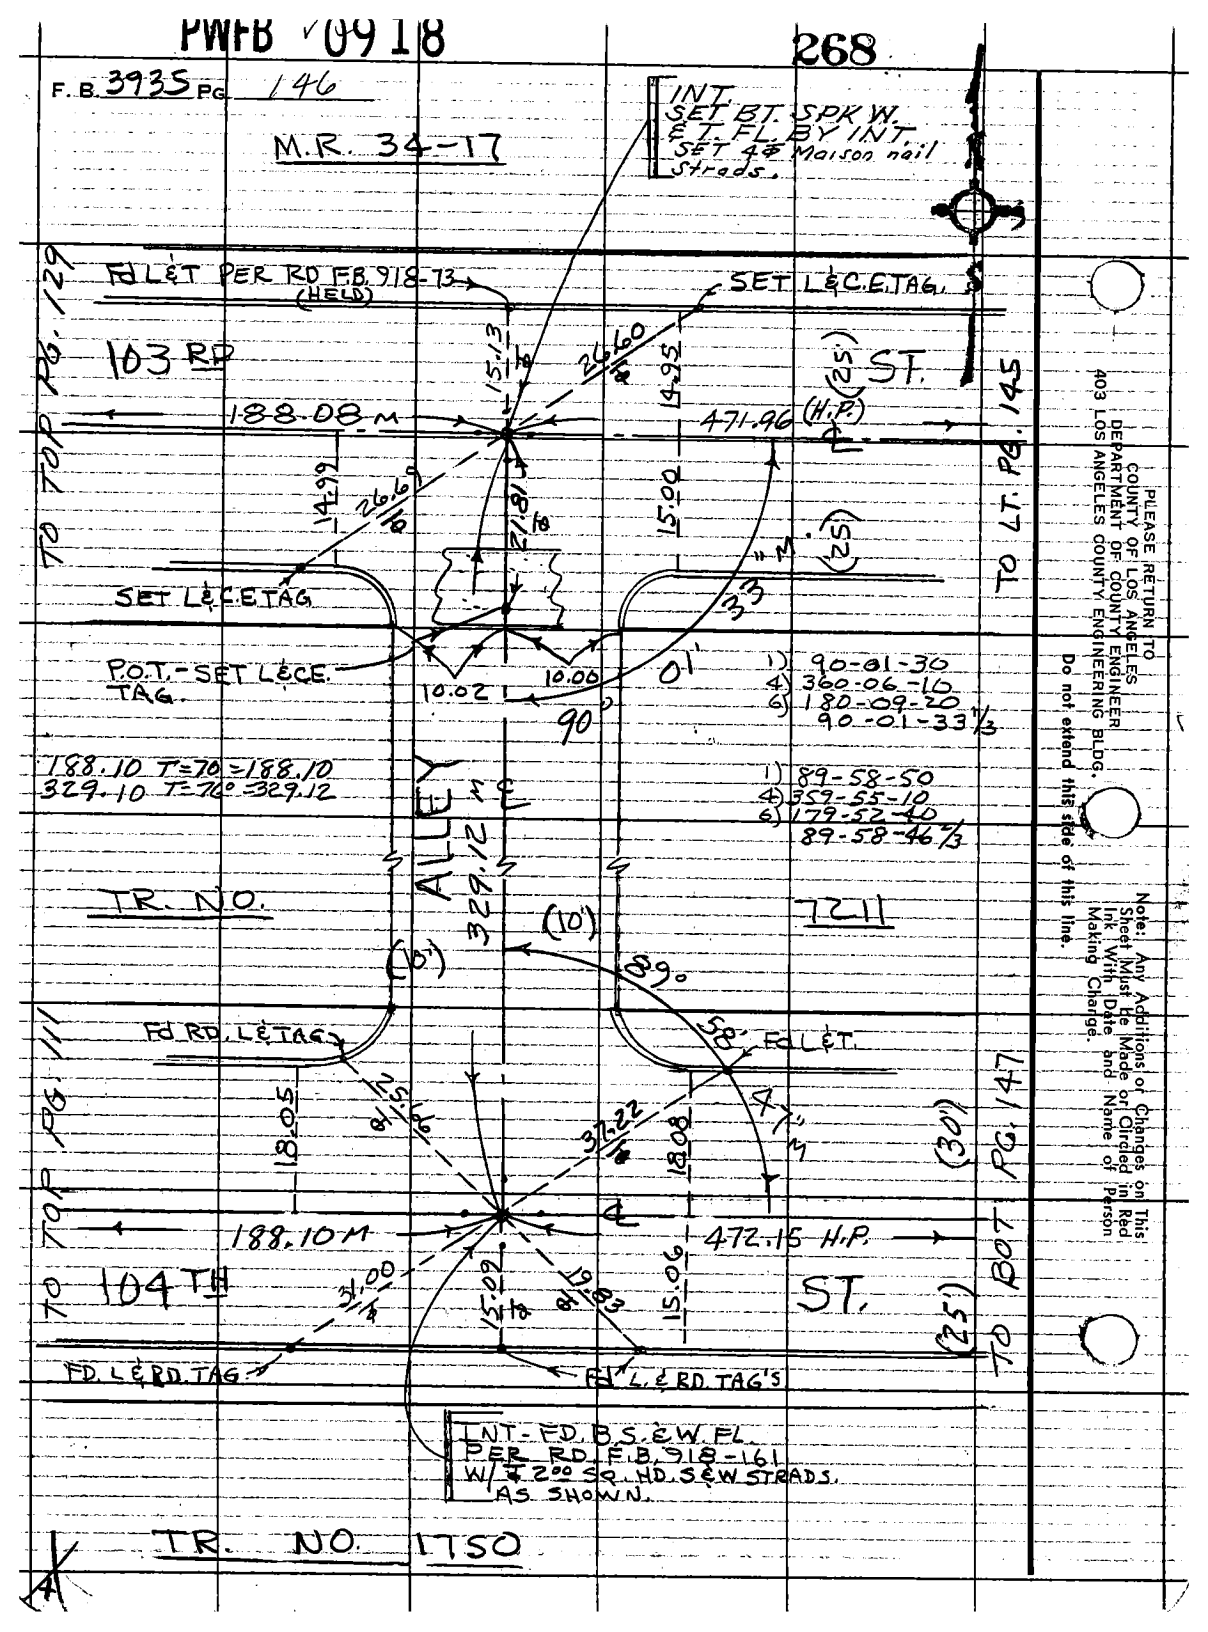

PLEASE RETURN TO
COUNTY OF LOS ANGELES
DEPARTMENT OF COUNTY ENGINEER
403 LOS ANGELES COUNTY ENGINEERING BLDG.

Do not extend this side of this line.

Note: Any Additions or Changes on This Sheet Must be Made or Circled in Red Ink With Date and Name of Person Making Change.

PWFB 0918 269

Notes Ck'd by	Survey of LENNOX AREA ℄
Map No.	JN 0303.00 Tape 238 Std 68 °F
Office Work	Surveyed by J. J. BAZEN
Checked	Notes J. J. B. Date 8-75
Date	In Pixe PALMER JUN 15 1976

F. B. 3935 PG. 147

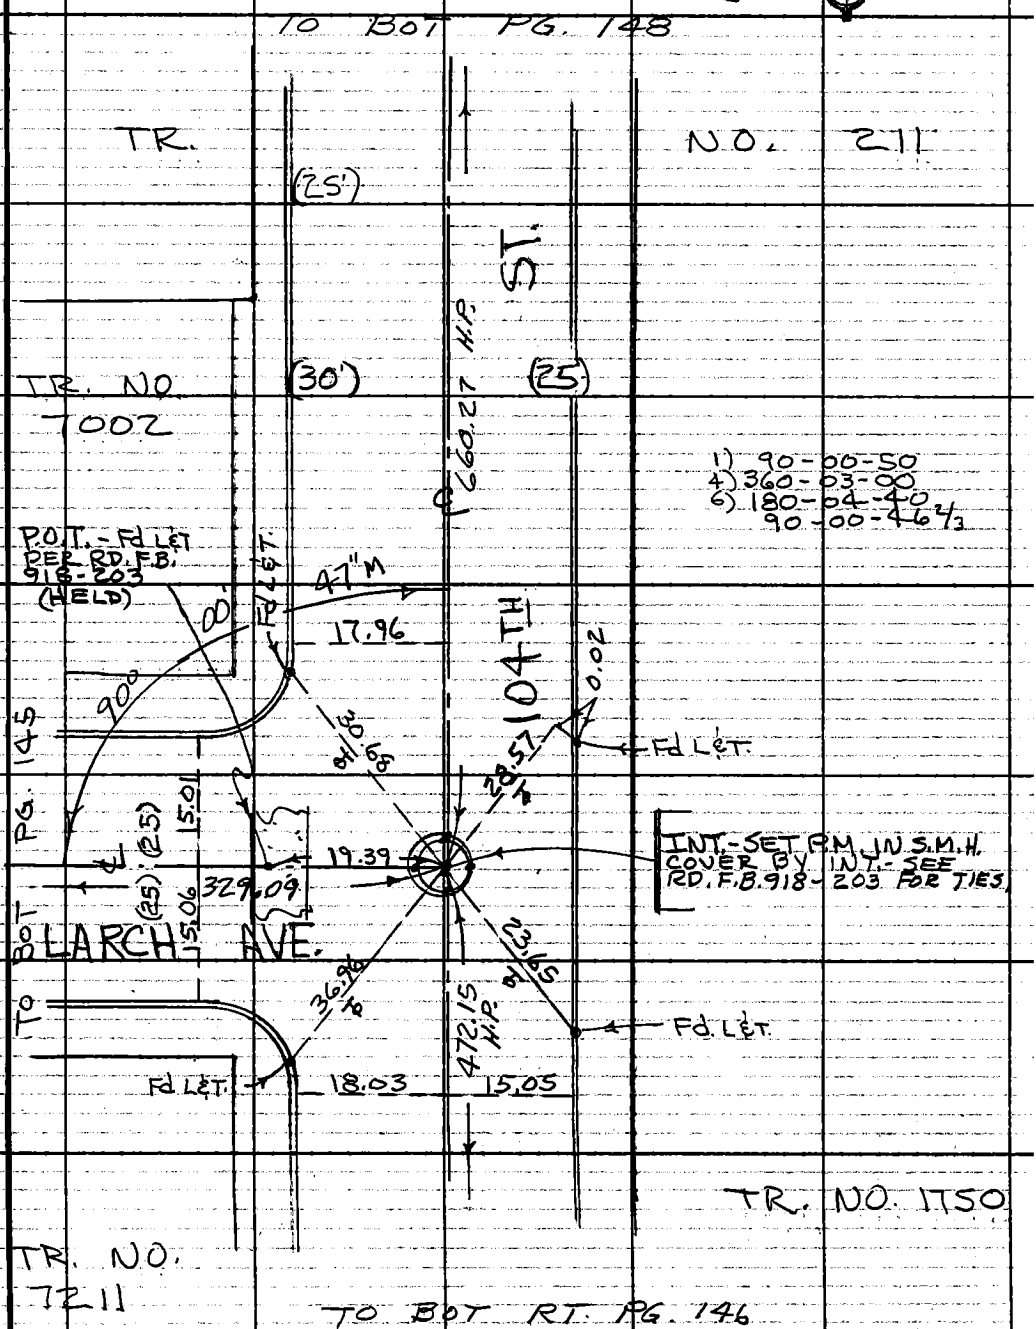

Note: Any Additions or Changes on This Sheet Must be Made or Circled in Red Ink With Date and Name of Person Making Change.

Do not extend this side of this line.

PLEASE RETURN TO COUNTY OF LOS ANGELES DEPARTMENT OF COUNTY ENGINEER 403 LOS ANGELES COUNTY ENGINEERING BLDG.

76F309S CE#310 3-69

PWFB 0418 270

F.B. 3935 PG. 148 TO LT PG. 141

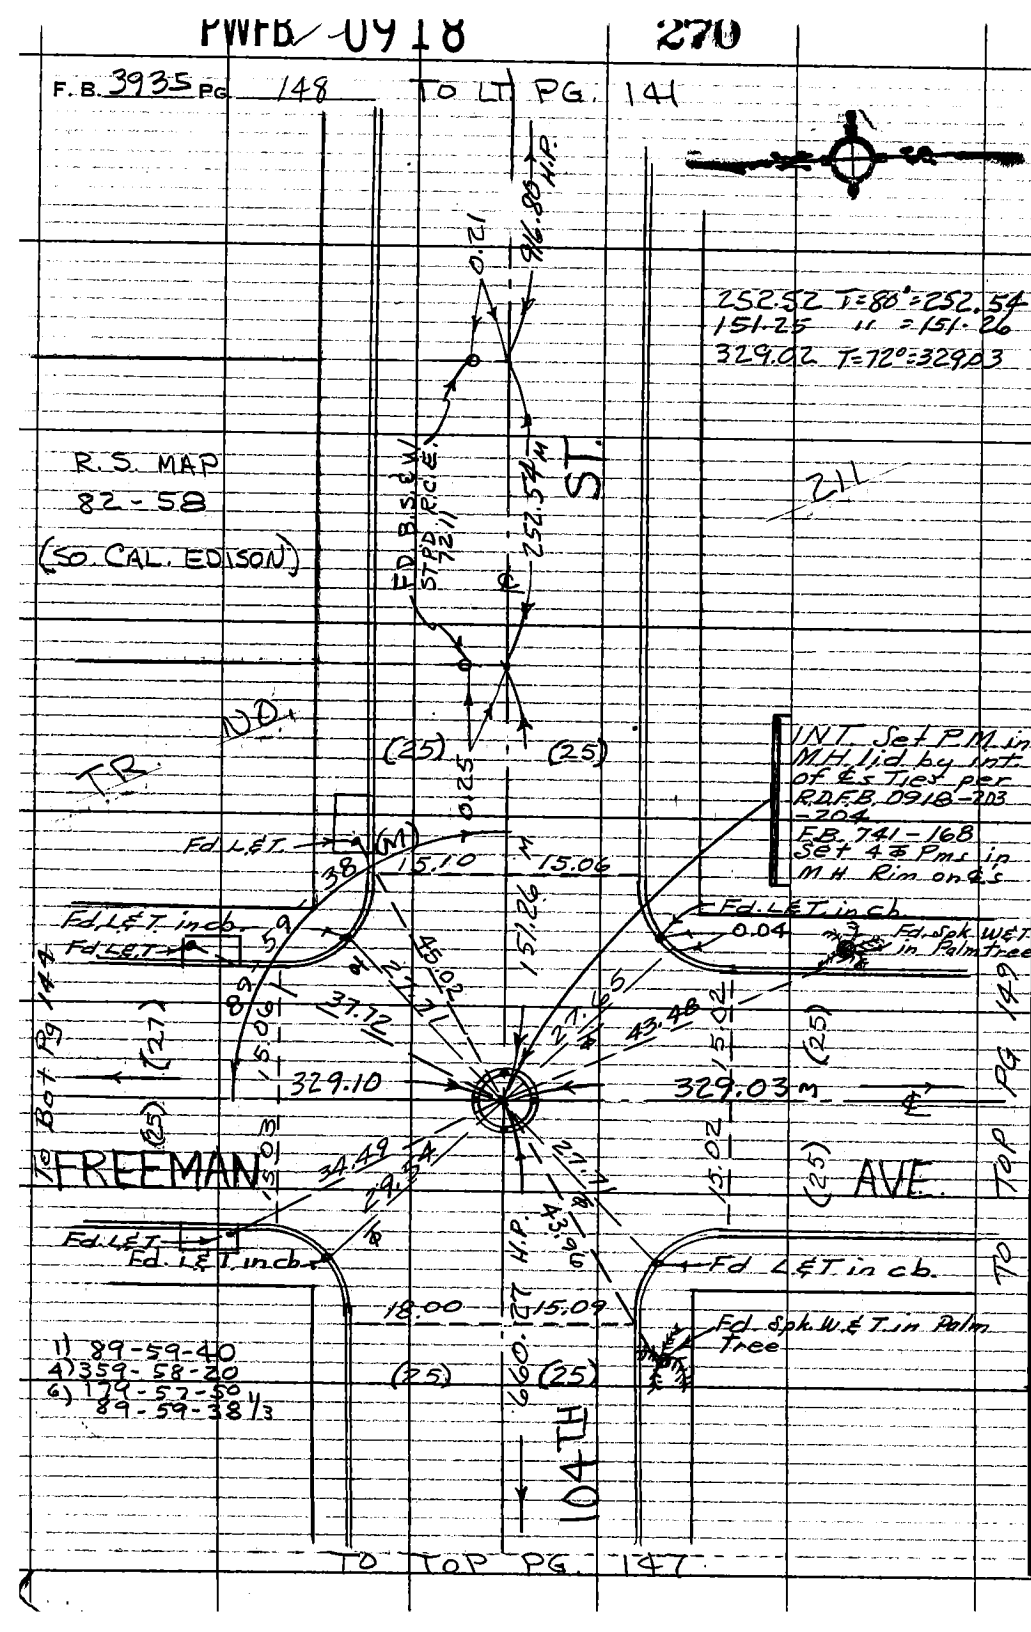

PLEASE RETURN TO
COUNTY OF LOS ANGELES
DEPARTMENT OF COUNTY ENGINEER
403 LOS ANGELES COUNTY ENGINEERING BLDG.
Do not extend this side of this line.

Note: Any Additions or Changes on This Sheet Must be Made or Circled in Red Ink With Date and Name of Person Making Change.

PWFB 0918 271

Notes Ck'd by	Survey of LENNOX AREA ℄
Map No.	JN 030300 Tape 238 Std 68 °F
Office Work	Surveyed by J. BAZEN
Checked	Notes J. J. B. Date 8-75
Date	Indexed T. M. PALMERI JUN 15 1978

F. B. PG. 149

WS 24 B5

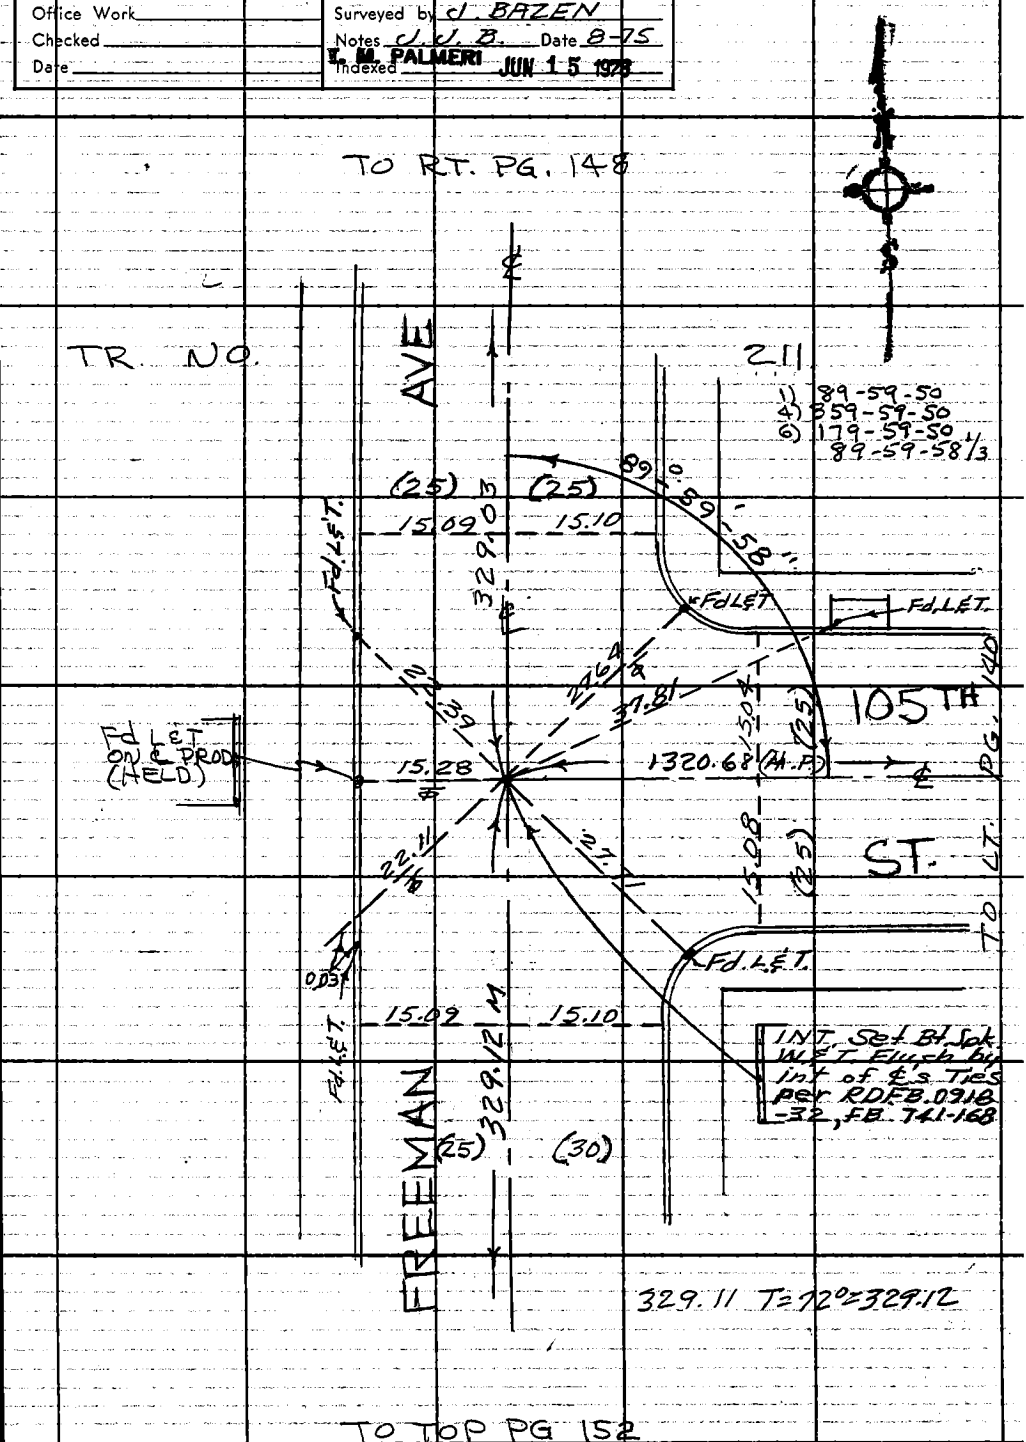

Note: Any Additions or Changes on This Sheet Must be Made or Circled in Red Ink With Date and Name of Person Making Change.

Do not extend this side of this line.

PLEASE RETURN TO
COUNTY OF LOS ANGELES
DEPARTMENT OF COUNTY ENGINEER
403 LOS ANGELES COUNTY ENGINEERING BLDG.

76F309S CE#310 3-69

PWFB 0418 272

F. B. 3935 PG. 150

IR NO. 211.

505.32 T=70°=505.33
329.09 T=68°=329.09

INT.-Fd B.S.&W.
EL. BY INT. OF C's
PER F.B. 2520-57
& R.O. F.B. 918-2

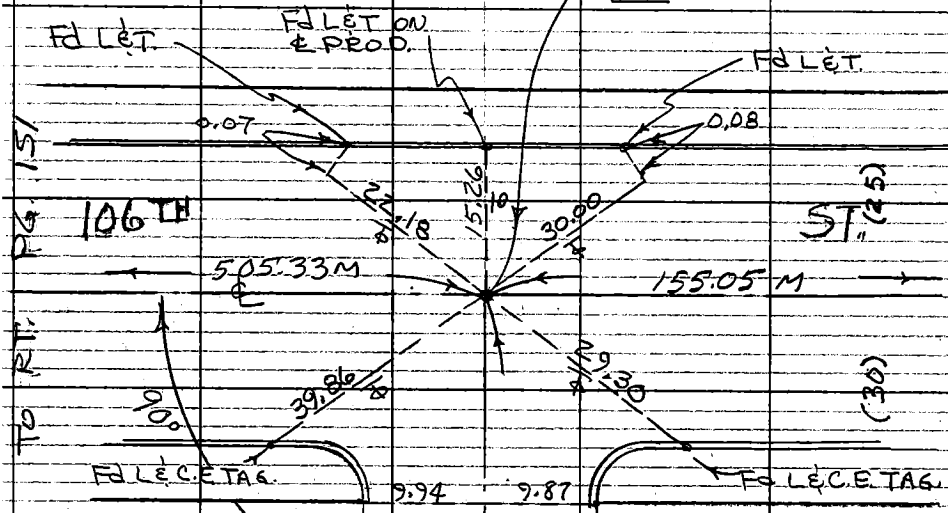

TO TOP LT. PG. 158

TO LT. PG. 159

IR NO. 5221

WS 24 R-5

PLEASE RETURN TO
COUNTY OF LOS ANGELES
DEPARTMENT OF COUNTY ENGINEER
403 LOS ANGELES COUNTY ENGINEERING BLDG.

Do not extend this side of this line.

Note: Any Additions or Changes on This Sheet Must be Made or Circled in Red Ink With Date and Name of Person Making Change.

PWFB 0918

273

Notes Ck'd by	Survey of LENNOX AREA ℄.
Map No.	JN 0303.00 Tape 238 Std 68 °F
Office Work	Surveyed by J. BATEN
Checked	Notes J.J.B. Date 8-75
Date	Edited PALMER JUN 15 1976

F. B. 3935 PG. 151

WS 24 B-5

TR. NO 211

660.20 T=78°=660.24

329.02 " =329.04

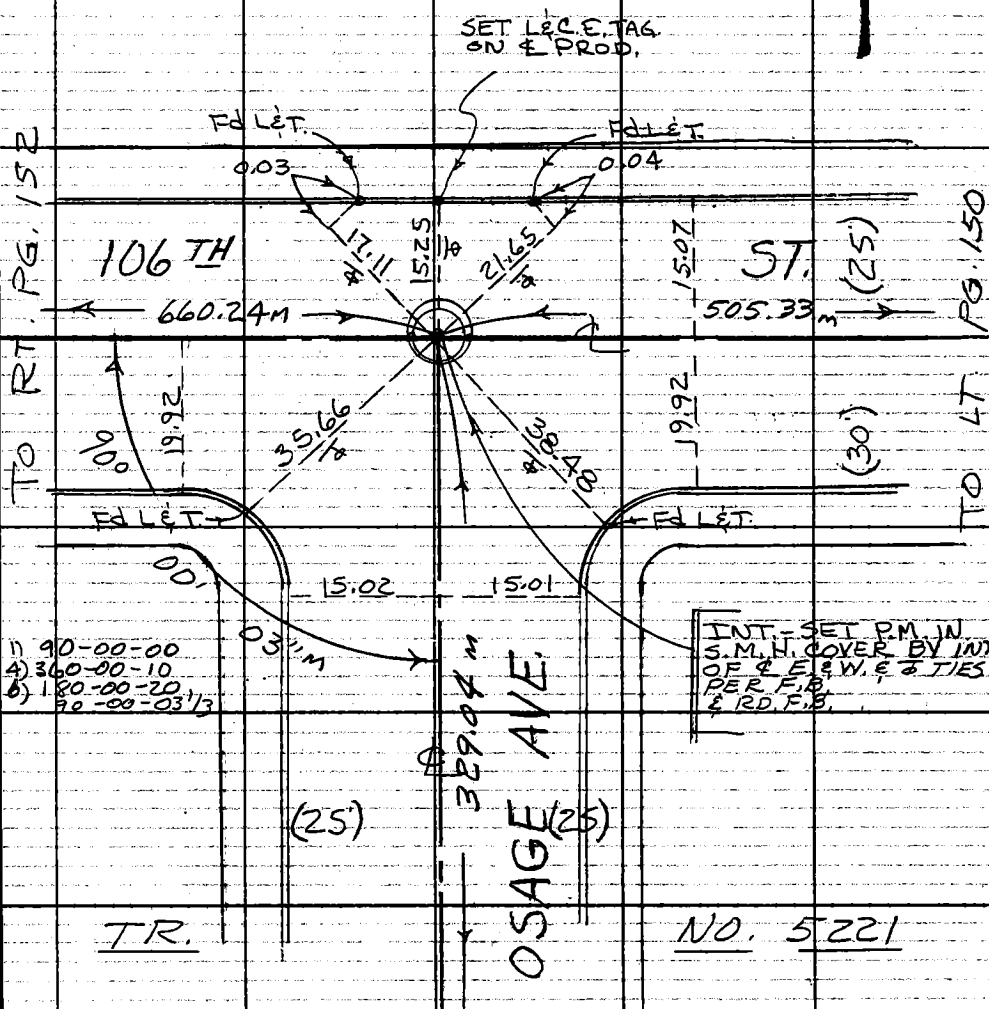

Note: Any Additions or Changes on This Sheet Must be Made or Circled in Red Ink With Date and Name of Person Making Change.

Do not extend this side of this line.

PLEASE RETURN TO COUNTY OF LOS ANGELES DEPARTMENT OF COUNTY ENGINEER 403 LOS ANGELES COUNTY ENGINEERING BLDG.

76F309S CE#310 3-69

F.B. 3935 PG. 152

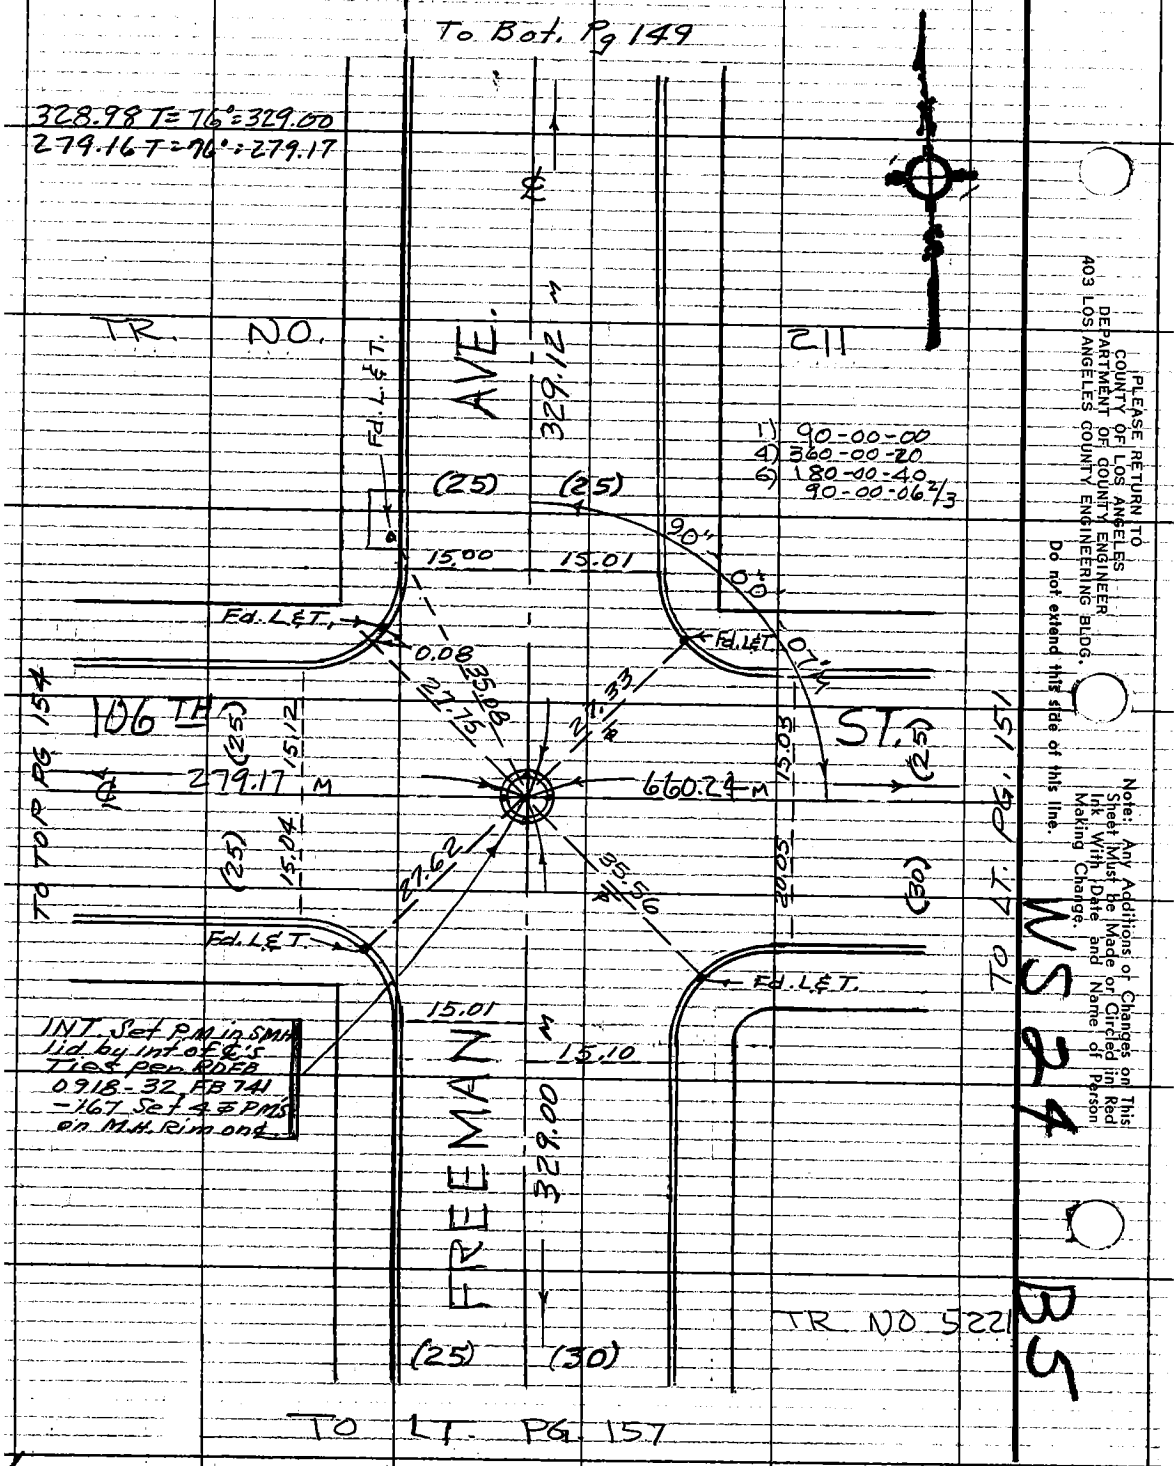

PLEASE RETURN TO
COUNTY OF LOS ANGELES
DEPARTMENT OF COUNTY ENGINEER
403 LOS ANGELES COUNTY ENGINEERING BLDG.

Do not extend this side of this line.

Note: Any Additions or Changes on This Sheet Must be Made or Circled in Red Ink With Date and Name of Person Making Change.

PWFB 0918

275

Notes Ck'd by
Map No.
Office Work
Checked
Date

Survey of LENNOX AREA 2
JN 0303.00 Tape 238 Std 68 °F
Surveyed by J. BAZEN
Notes J.J.B. Date 8-75
Indexed PALMER JUN 15 1976

F. B. 3935 Pg. 153

TO BOT PG. 154

963.69 T=76 = 963.73

Note: Any Additions or Changes on This Sheet Must be Made or Circled in Red Ink With Date and Name of Person Making Change.

Do not extend this side of this line.

PLEASE RETURN TO
COUNTY OF LOS ANGELES
DEPARTMENT OF COUNTY ENGINEER
403 LOS ANGELES COUNTY ENGINEERING BLDG.

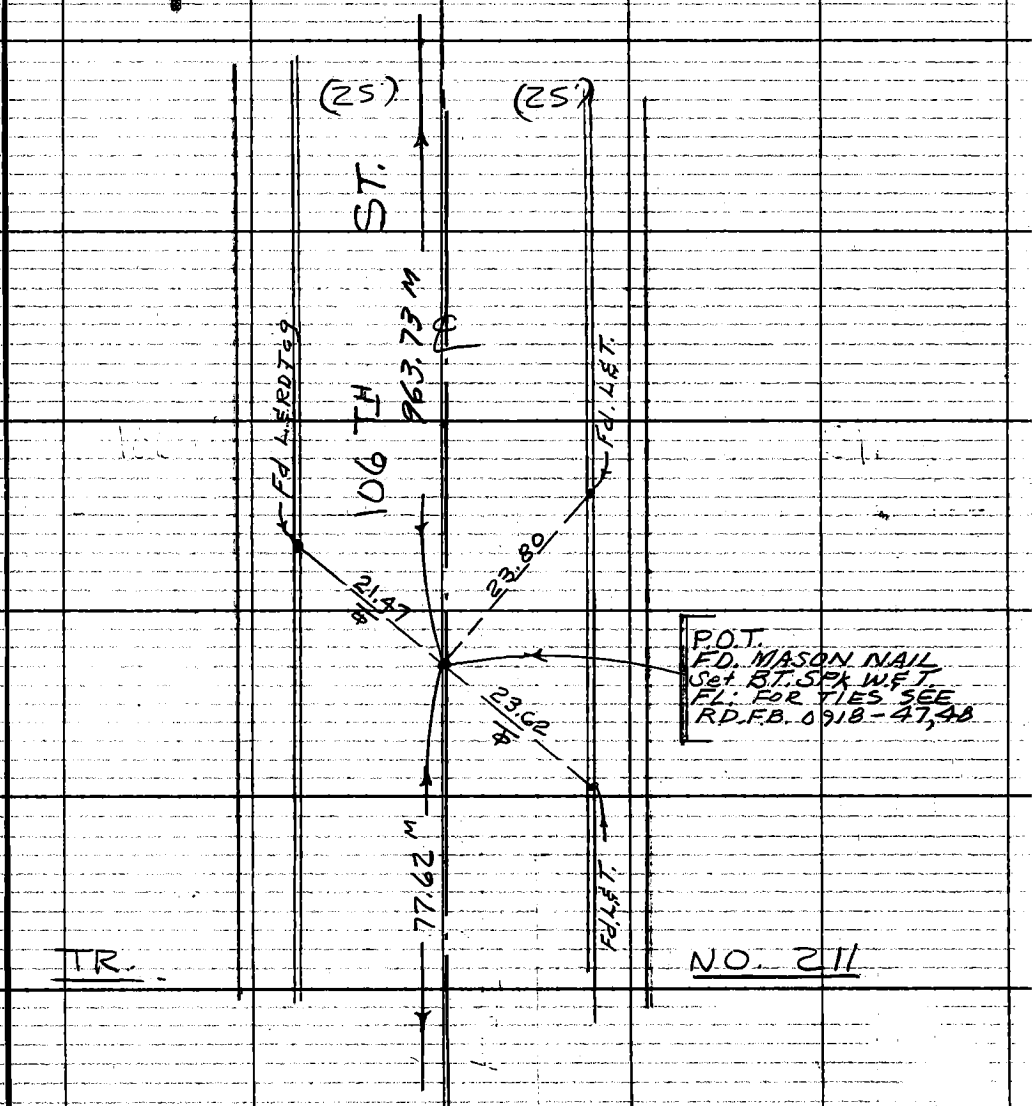

TO TOP PG. 131

16F309S CE#310 3-69

F.B. 3935 PG. 154 TO LT. PG. 152

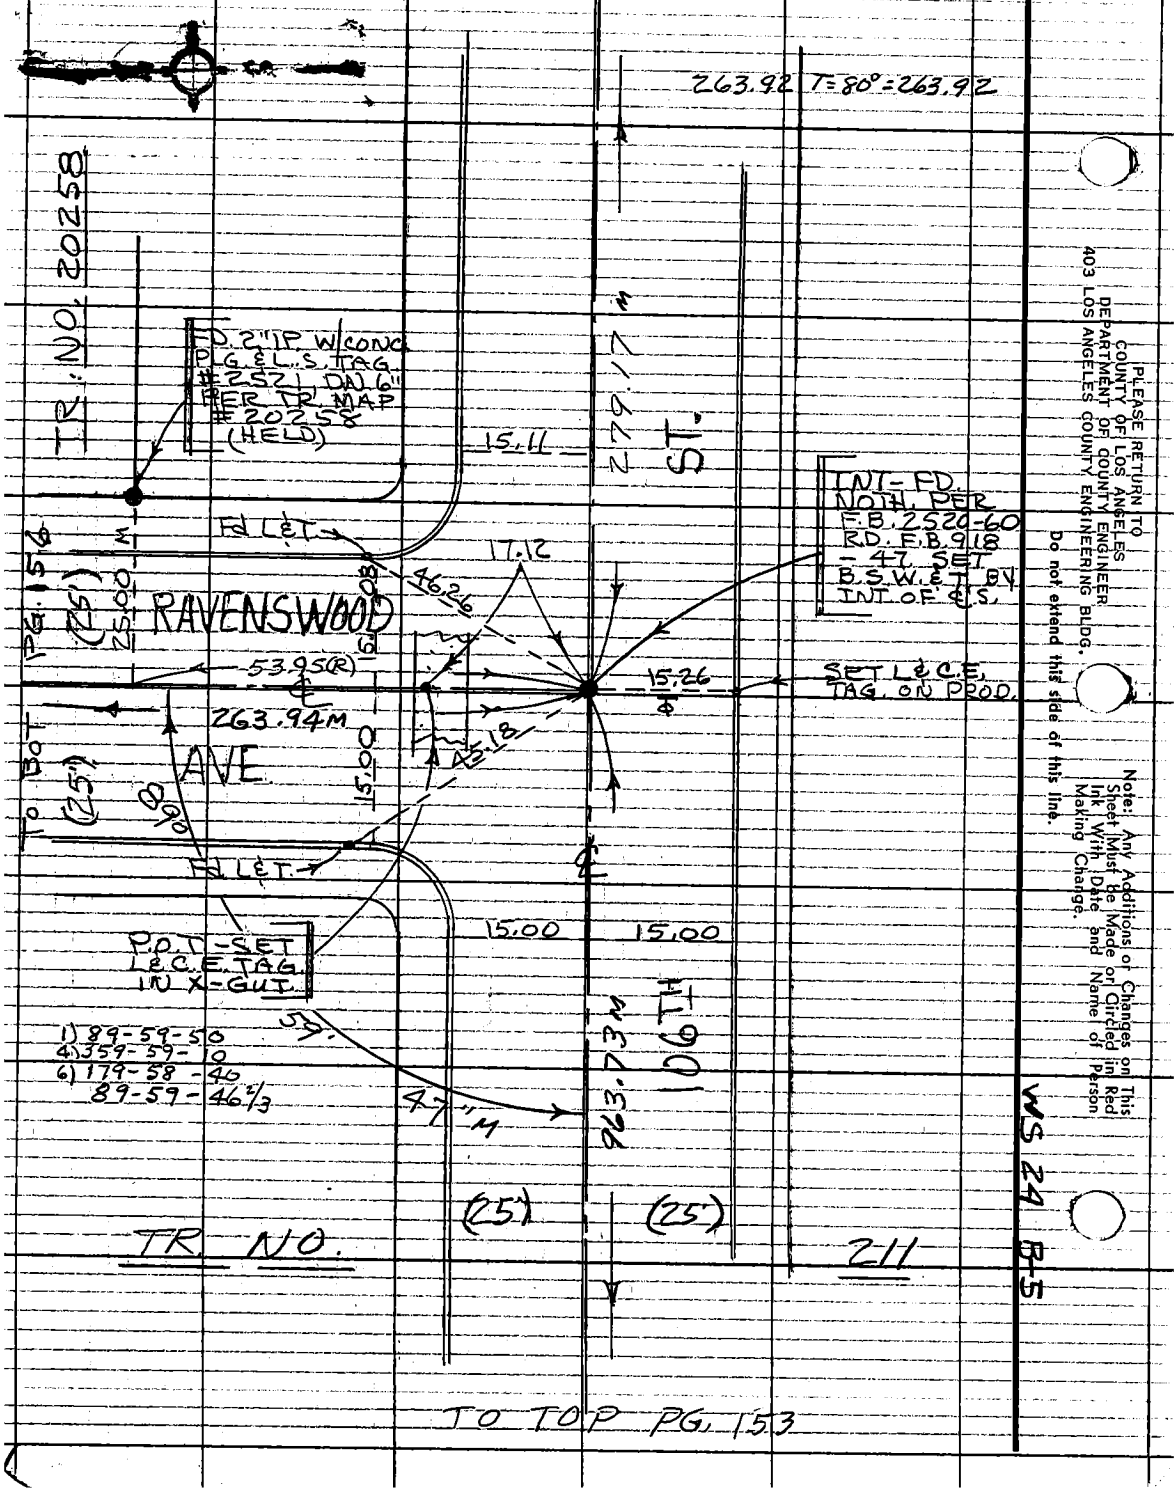

PLEASE RETURN TO
COUNTY OF LOS ANGELES
DEPARTMENT OF COUNTY ENGINEER
403 LOS ANGELES COUNTY ENGINEERING BLDG.

Do not extend this side of this line.

Note: Any Additions or Changes on This Sheet Must be Made or Circled in Red Ink With Date and Name of Person Making Change.

PWFB 0918 277

Notes Ck'd by	Survey of LENNOX AREA ℄
Map No.	JN 0303.00 Tape 238 Std 68 °F
Office Work	Surveyed by J. BAZEN
Checked	Notes J.J.B. Date 8-75
Date	Indexed L. M. PALMERI JUN 15 1976

F. B. 3935 PG. 155

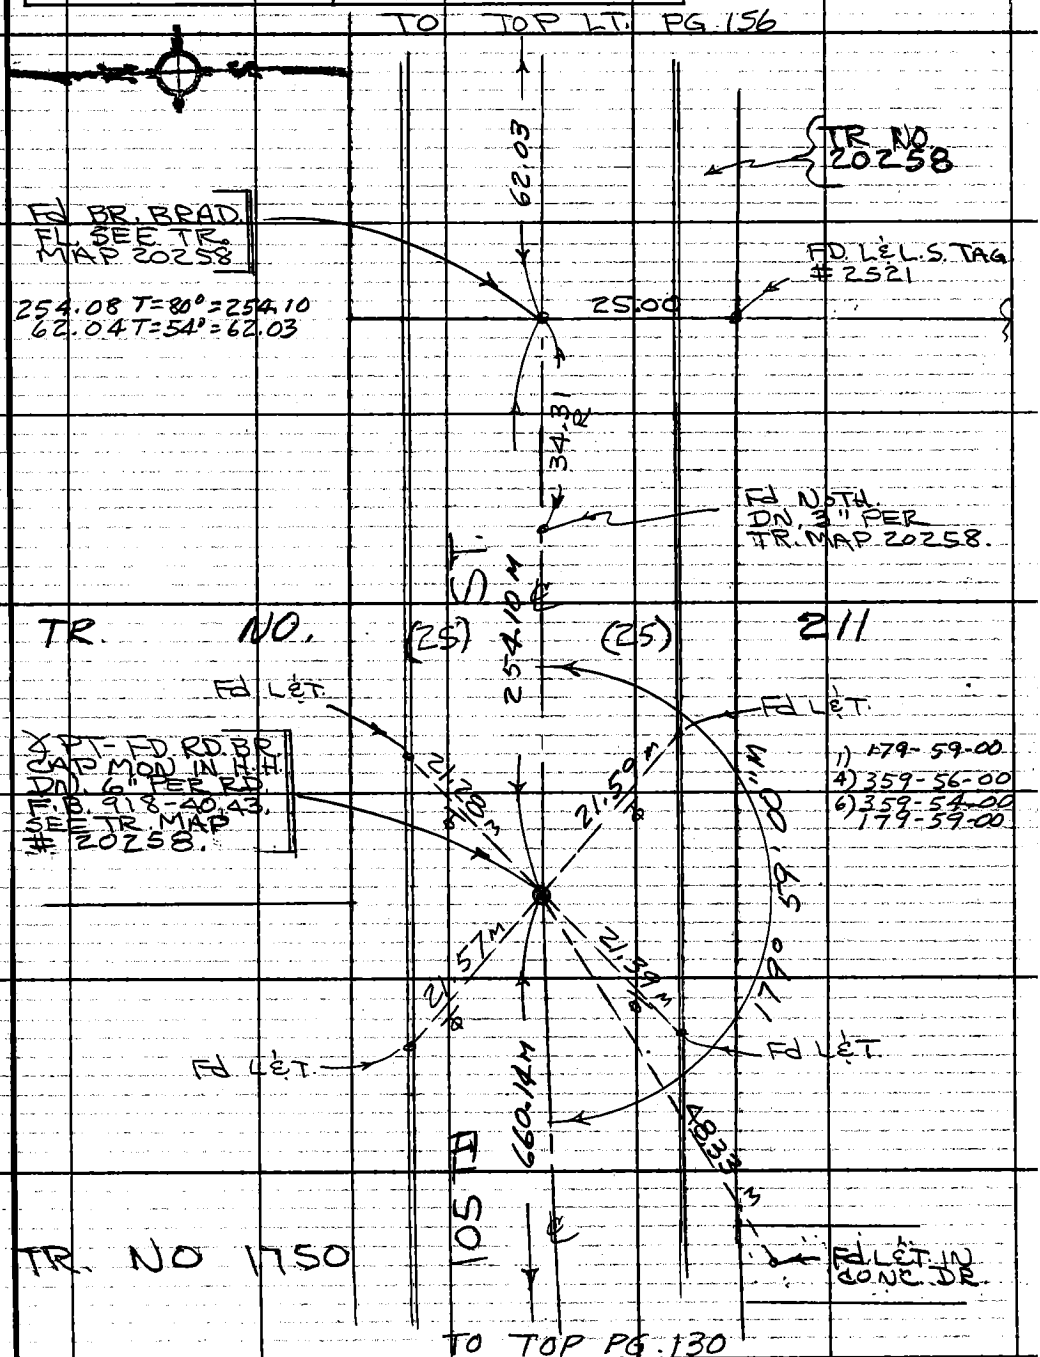

Note: Any Additions or Changes on This Sheet Must be Made or Circled in Red Ink With Date and Name of Person Making Change.

Do not extend this side of this line.

PLEASE RETURN TO COUNTY OF LOS ANGELES DEPARTMENT OF COUNTY ENGINEER 403 LOS ANGELES COUNTY ENGINEERING BLDG.

76F309S CE#310 3-69

PWB ✓ 0918

278

F.B. 3935 PG. 156

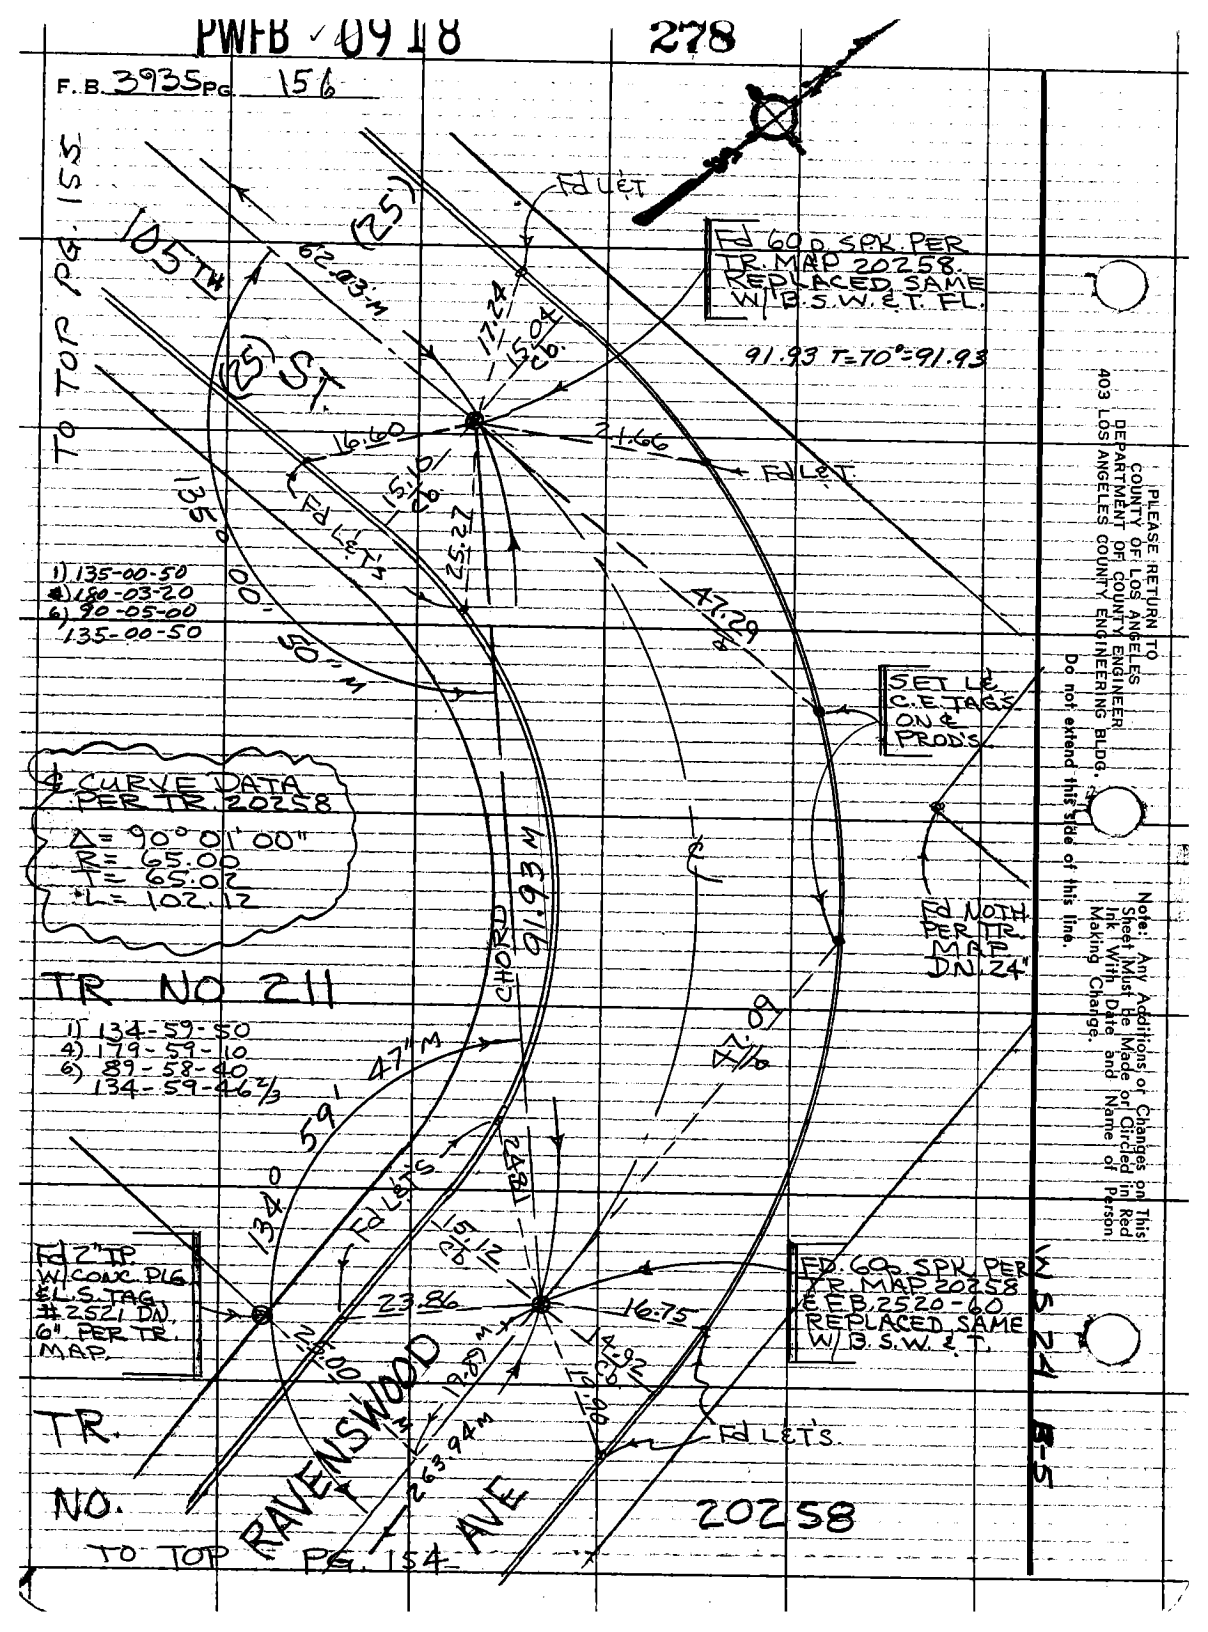

PWFB 0918 279

Notes Ck'd by	Survey of LENNOX AREA ℄
Map No.	JN 0303.00 Tape 238 Std. 68 °F
Office Work	Surveyed by J. BAZEN
Checked	Notes J.J.B. Date 8-75
Date	Indexed T. M. PALMERI JUN 15 1978

F. B. 3935 PG. 157

B5

W S 24

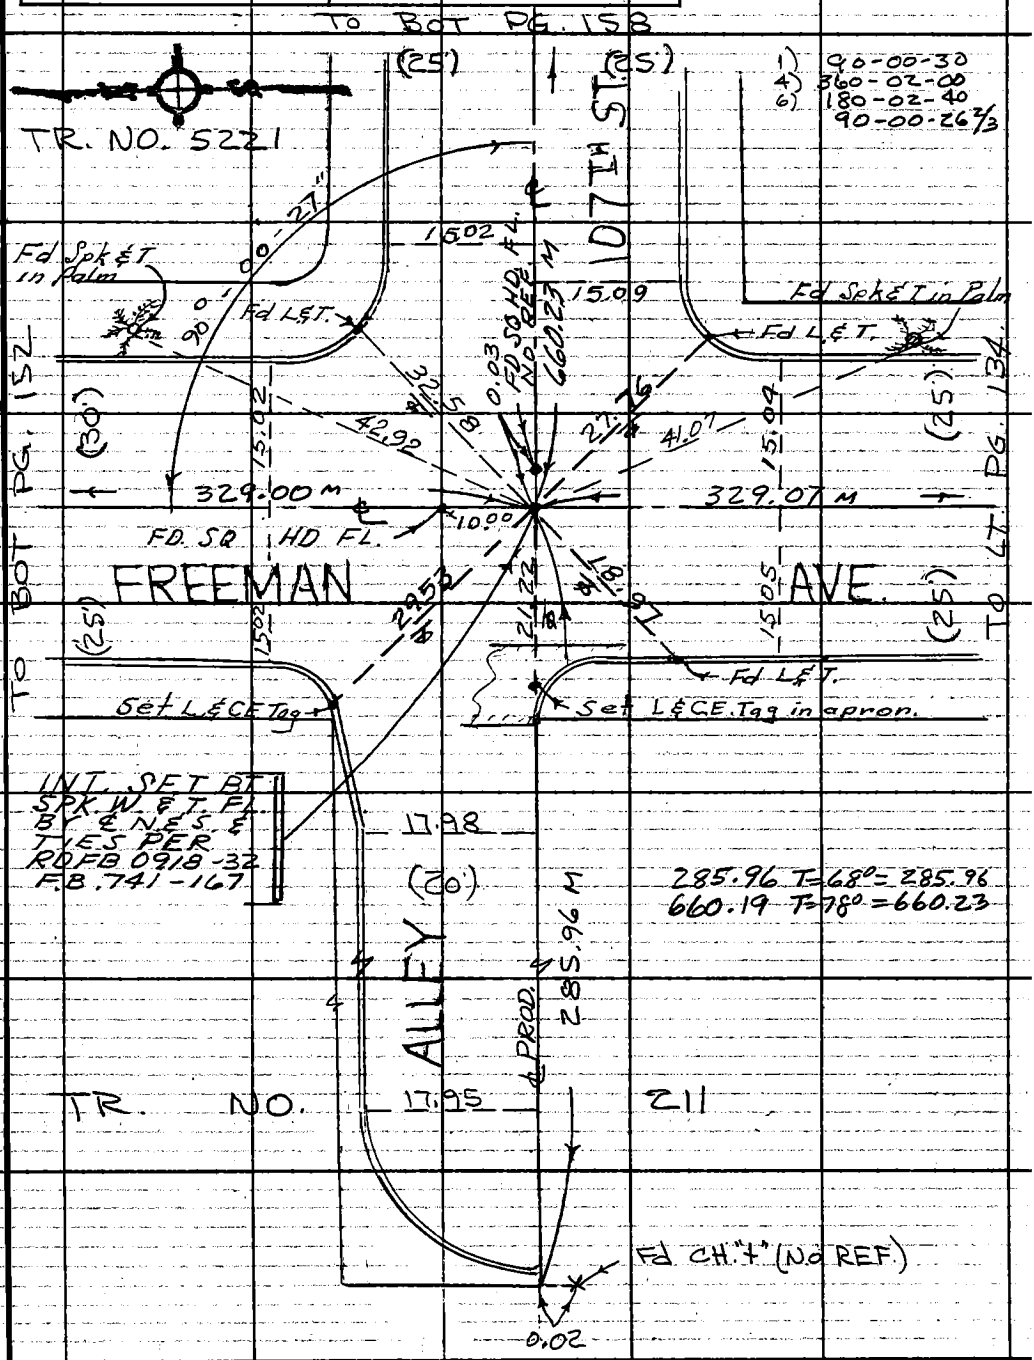

Note: Any Additions or Changes on This Sheet Must be Made or Circled in Red Ink With Date and Name of Person Making Change.

Do not extend this side of this line.

PLEASE RETURN TO COUNTY OF LOS ANGELES DEPARTMENT OF COUNTY ENGINEER 403 LOS ANGELES COUNTY ENGINEERING BLDG.

16F309S CE#310 3-69

PWFB 0918

TO LT. PG. 138

280

F. B. 3935 PG. 158

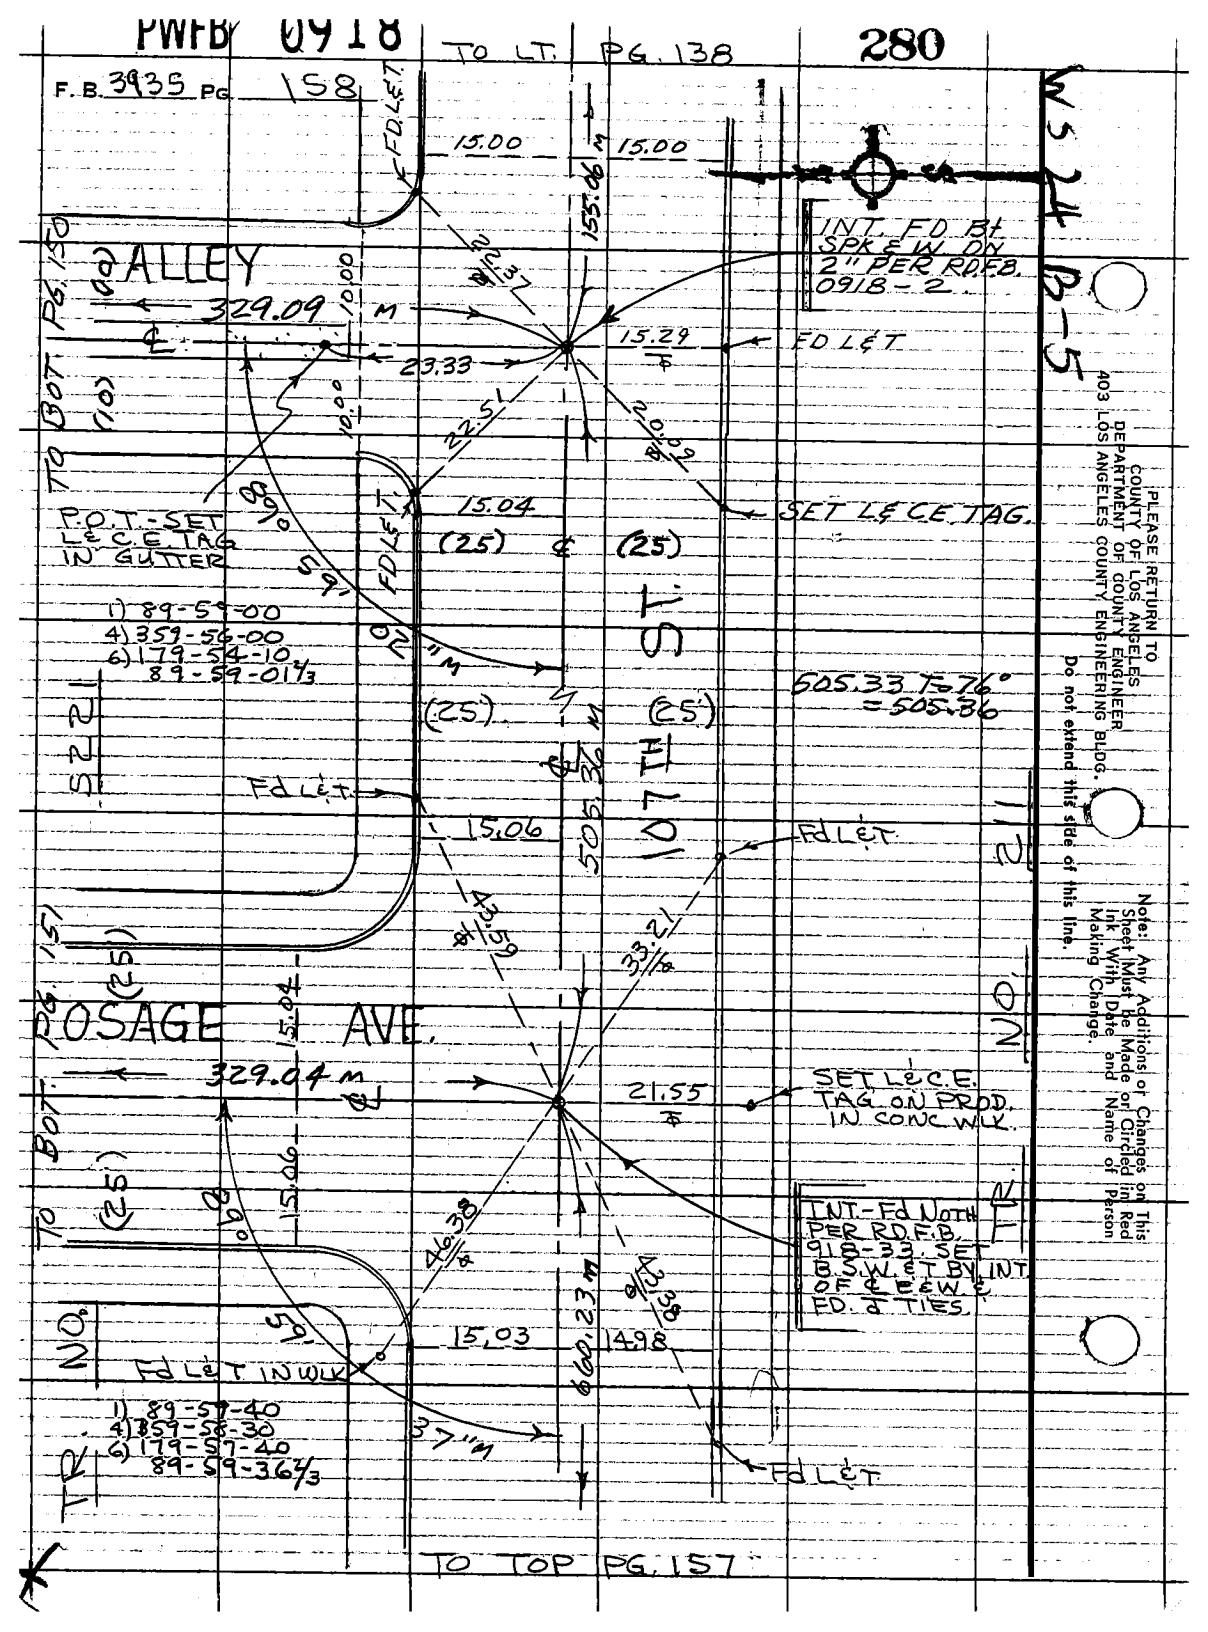

PWFB 0818 704

Notes Ck'd by	Survey of LENNOX AREA ℄
Map No.	JN 0303.00 Tape 02 Std 68 °F
Office Work	Surveyed by J. J. BAZEN
Checked	Notes J. J. B. Date 10-75
Date	Indexed PALMER JUN 15 1978

F. B. 3935 PG. 159

B5

WS 24

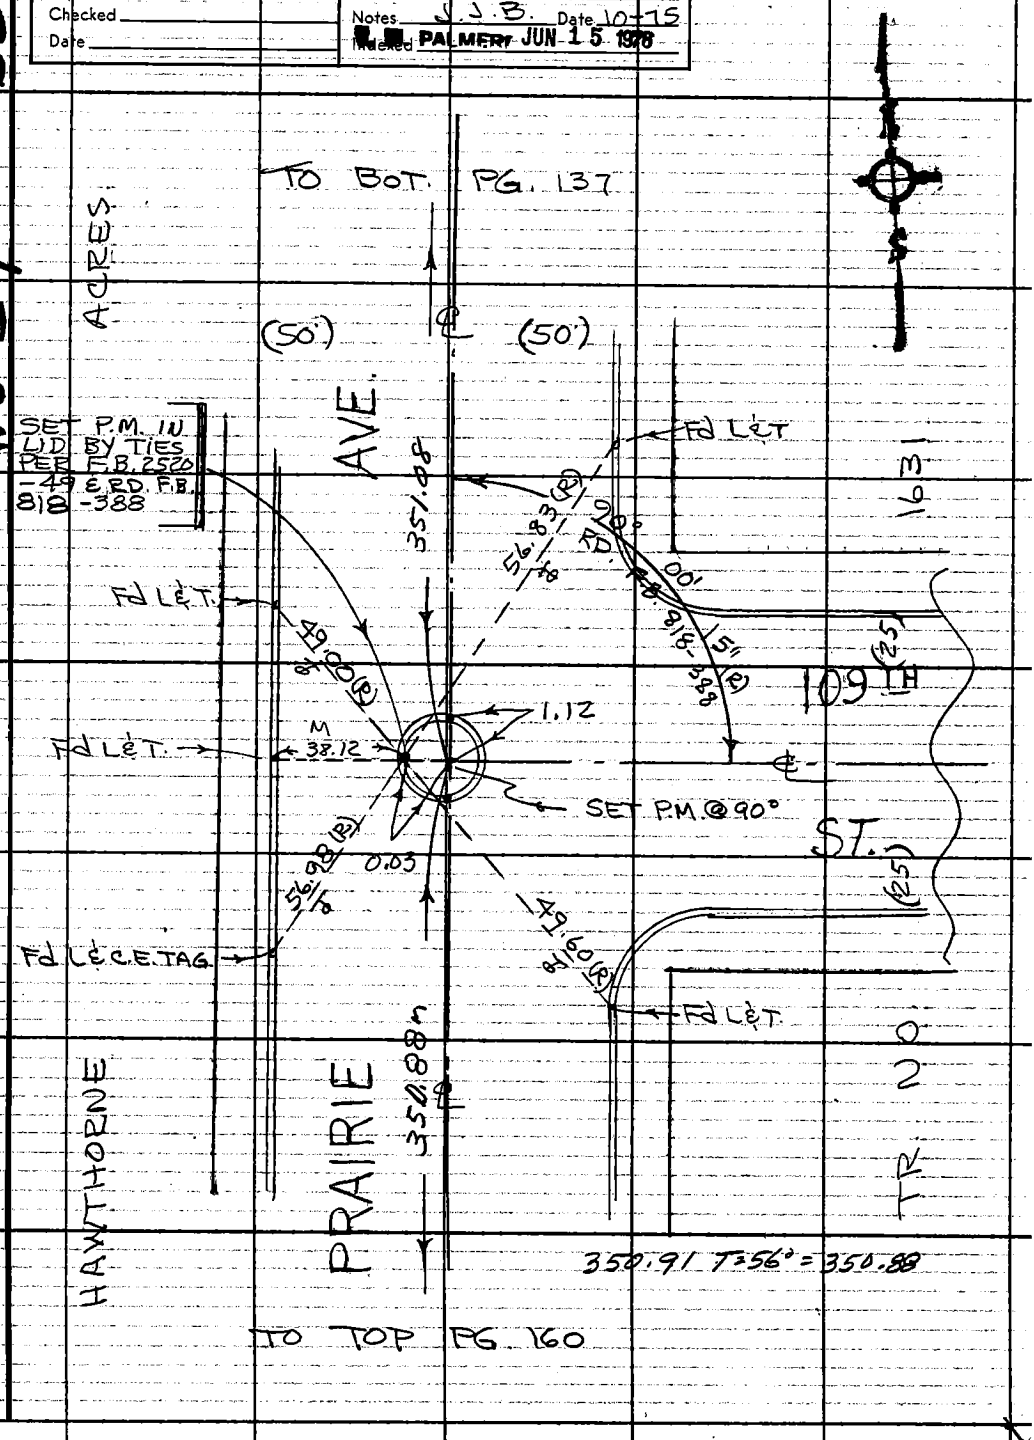

Note: Any Additions or Changes on This Sheet Must be Made or Circled in Red Ink With Date and Name of Person Making Change.

Do not extend this side of this line.

PLEASE RETURN TO
COUNTY OF LOS ANGELES
DEPARTMENT OF COUNTY ENGINEER
403 LOS ANGELES COUNTY ENGINEERING BLDG.

76F309S CE#310 3-69

F.B. 3935 PG. 166

TO 301 - PG. 159

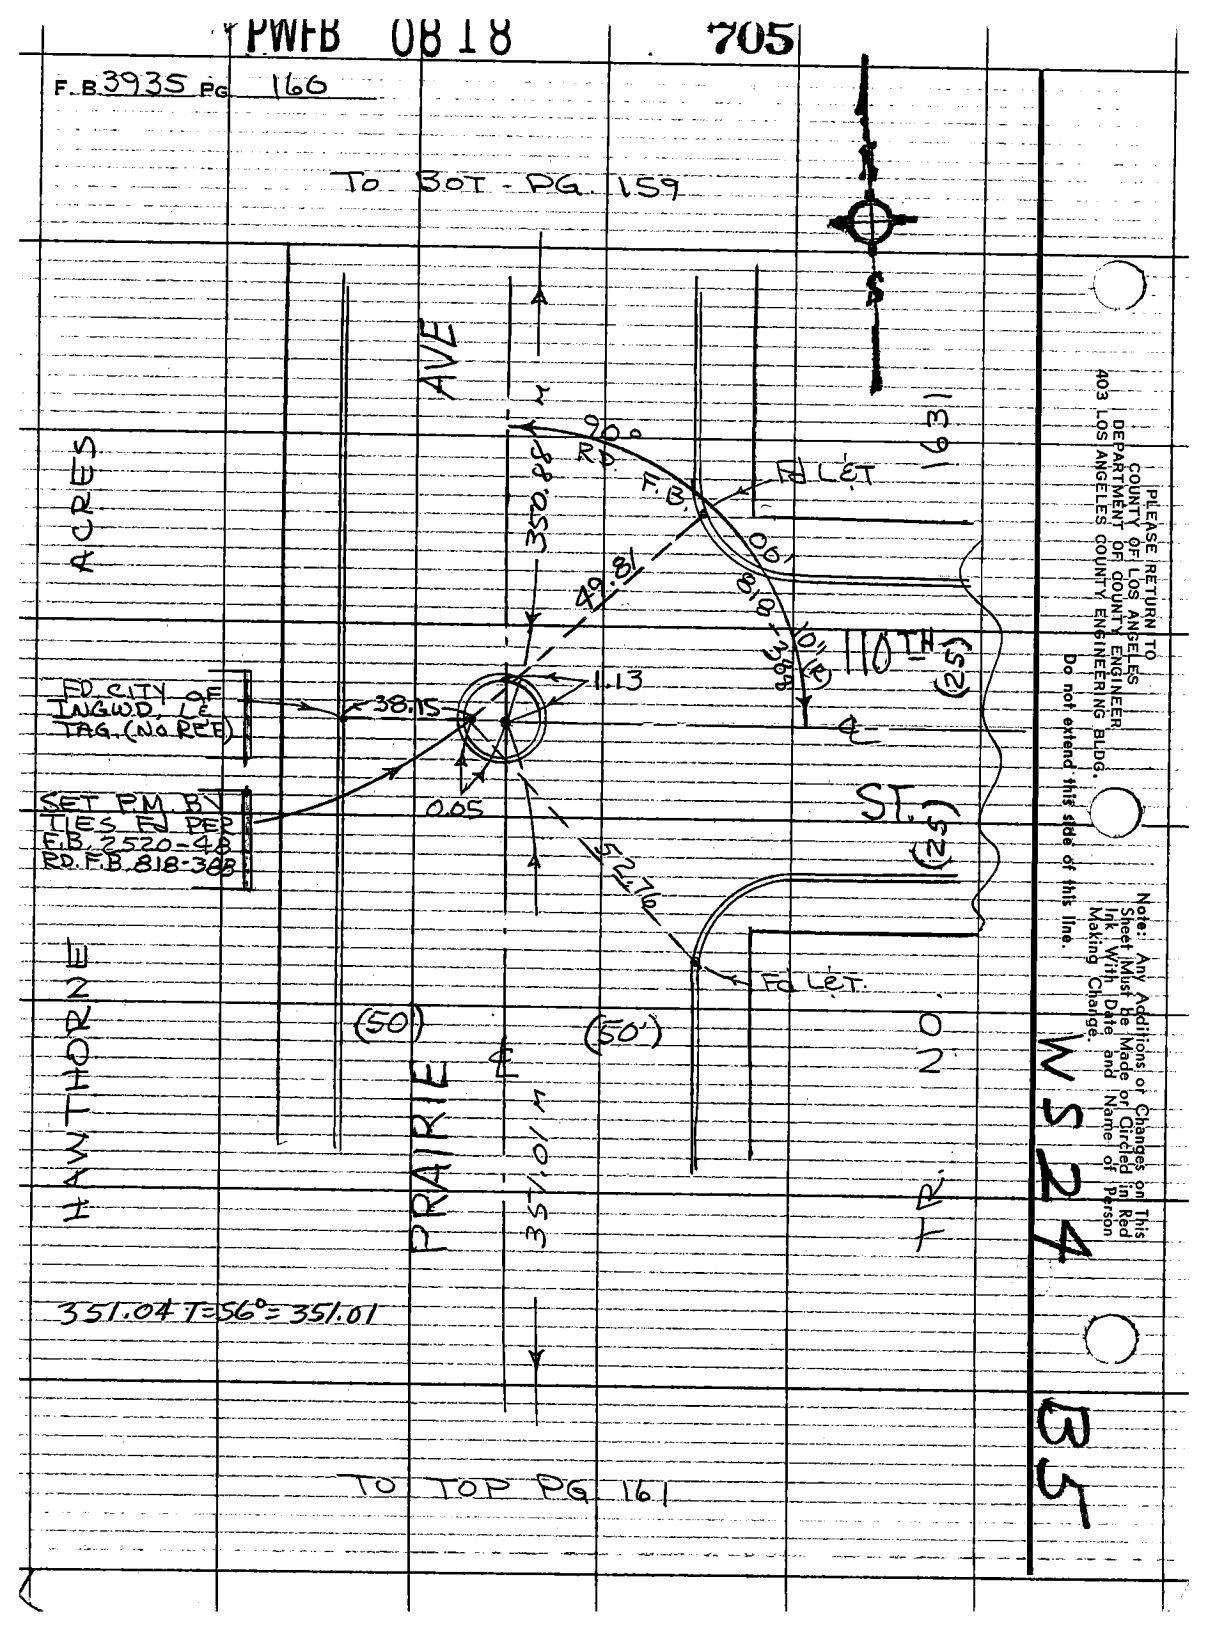

PLEASE RETURN TO
COUNTY OF LOS ANGELES
DEPARTMENT OF COUNTY ENGINEER
403 LOS ANGELES COUNTY ENGINEERING BLDG.

Do not extend this side of this line.

Note: Any Additions or Changes on This Sheet Must be Made or Circled in Red Ink With Date and Name of Person Making Change.

TO TOP PG. 161

PWFB 0818 706

Notes Ck'd by	Survey of LENNOX AREA ℄
Map No.	JN 0303.00 Tape 02 Std 68 °F
Office Work	Surveyed by J. BAZEN
Checked	Notes J.J.B. Date 10-75
Date	Indexed L. M. PALMER JUN 15 1976

F.B. 3935 PG. 161

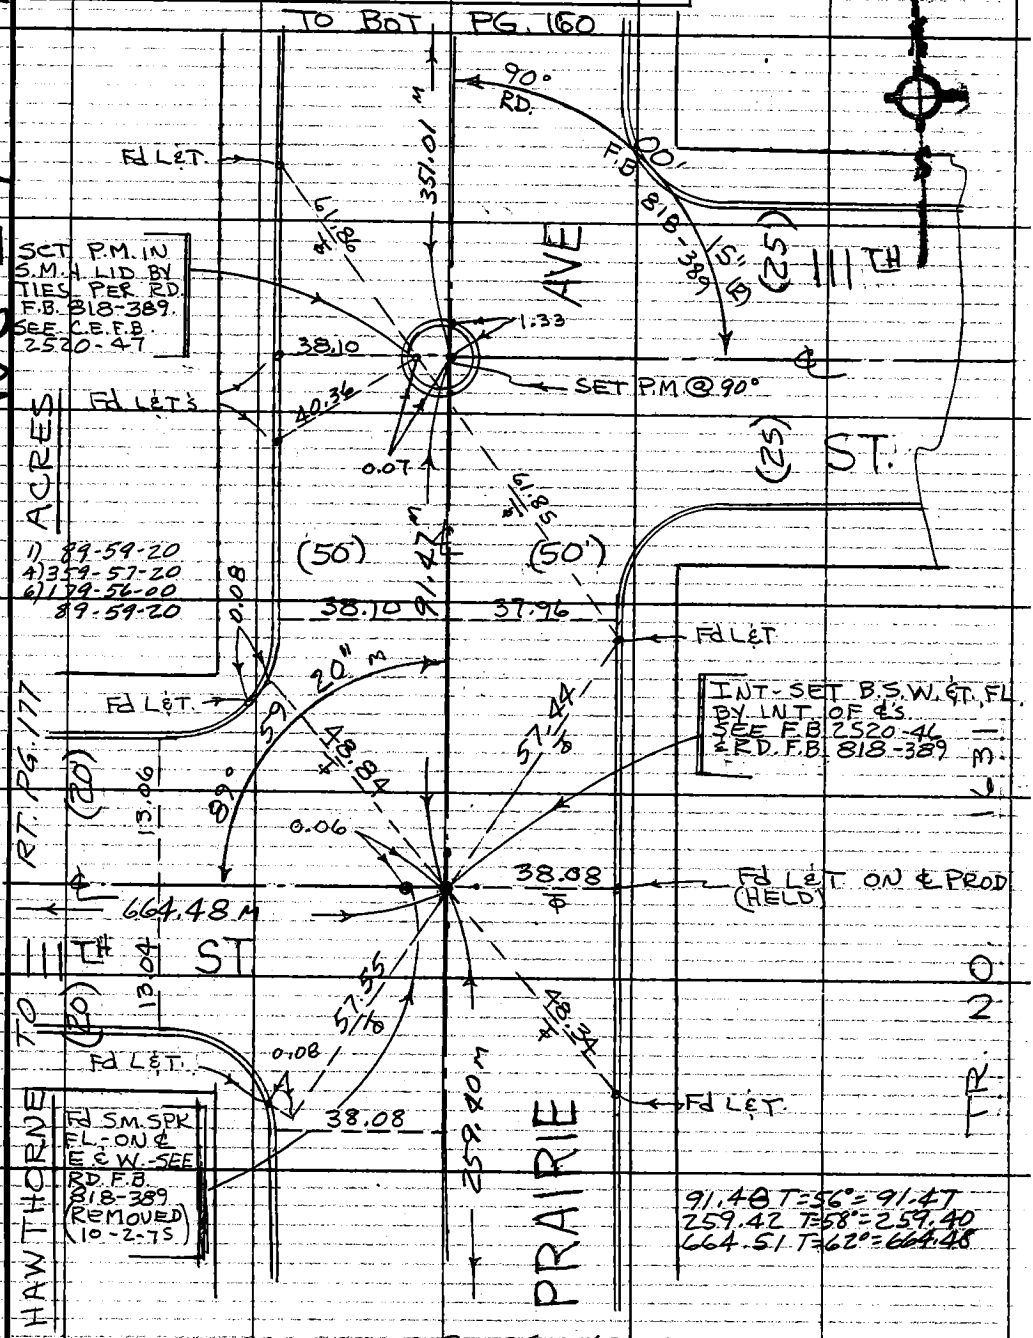

WS 24 B5

Note: Any Additions or Changes on This Sheet Must be Made or Circled in Red Ink With Date and Name of Person Making Change.

PLEASE RETURN TO COUNTY OF LOS ANGELES DEPARTMENT OF COUNTY ENGINEER 403 LOS ANGELES COUNTY ENGINEERING BLDG.

Do not extend this side of this line.

76F309S CE#310 3-69

PWFB 0818 707 708

F.B. 3935 PG. 162 TO BOT. PG. 161

351.07 T = 58° = 351.05
350.58 " = 350.56

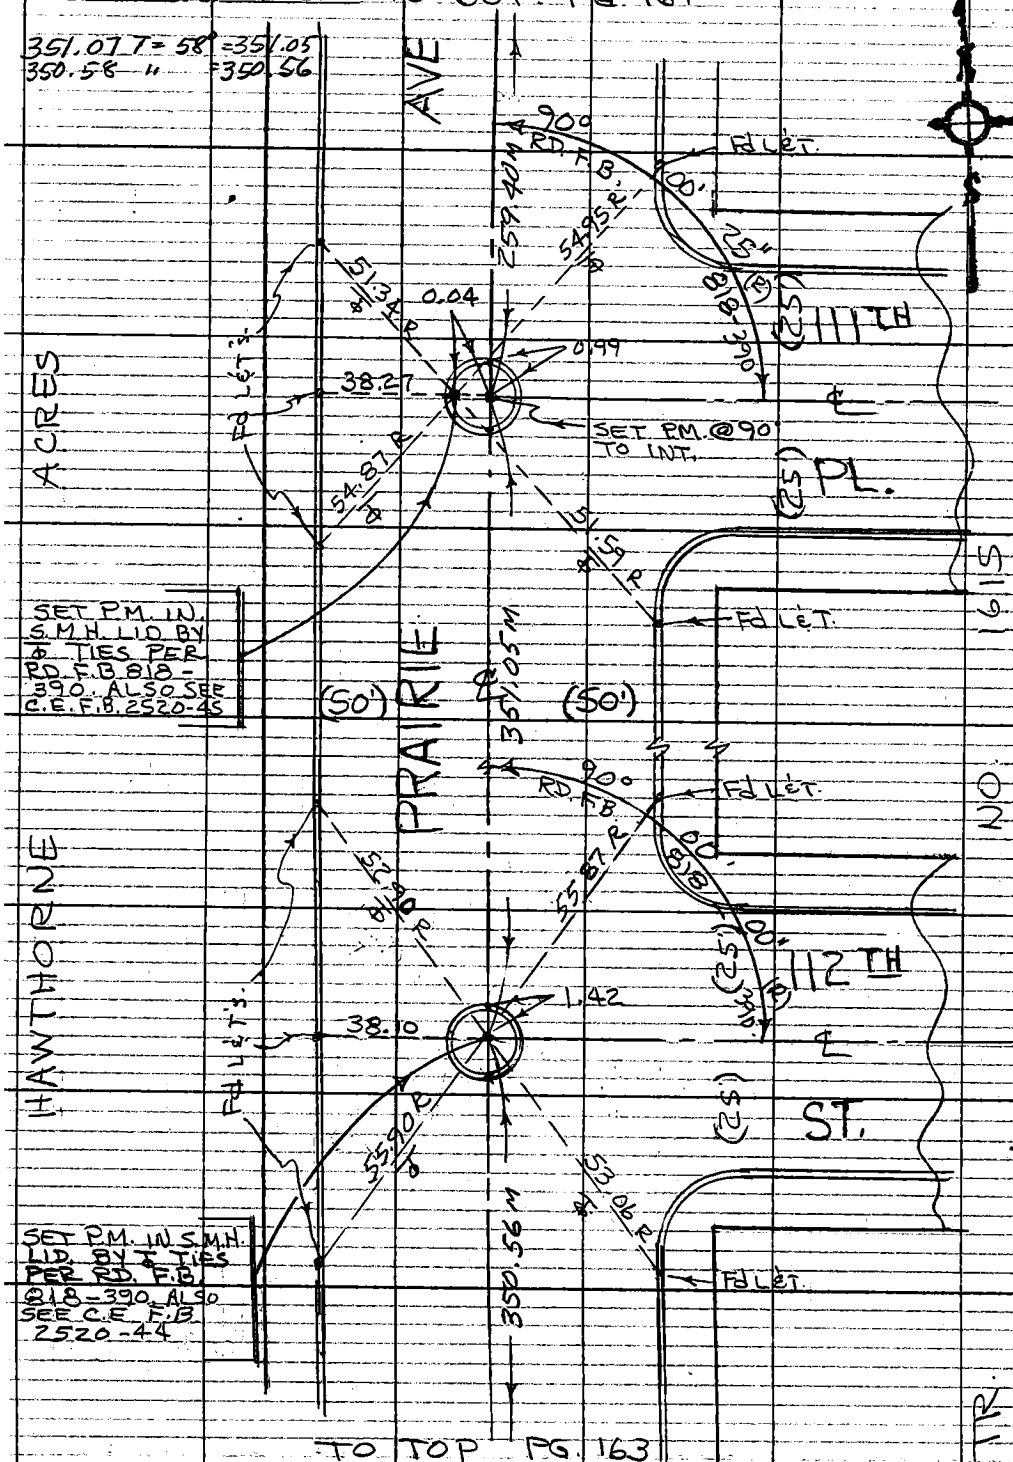

TO TOP PG. 163

PLEASE RETURN TO
COUNTY OF LOS ANGELES
DEPARTMENT OF COUNTY ENGINEER
403 LOS ANGELES COUNTY ENGINEERING BLDG.

Do not extend this side of this line.

Note: Any Additions or Changes on This Sheet Must be Made or Circled in Red Ink With Date and Name of Person Making Change.

WS24 B5

PWFB 0818

709

Notes Ck'd by	Survey of LENNOX AREA ℄
Map No.	JN 0303.00 Tape 62 Std 68 °F
Office Work	Surveyed by J. BAZEN
Checked	Notes J. J. B. Date 10-75
Date	Checked PALMERI JUN 15 1976

F. B. 3935 PG. 163

WS 24 B5

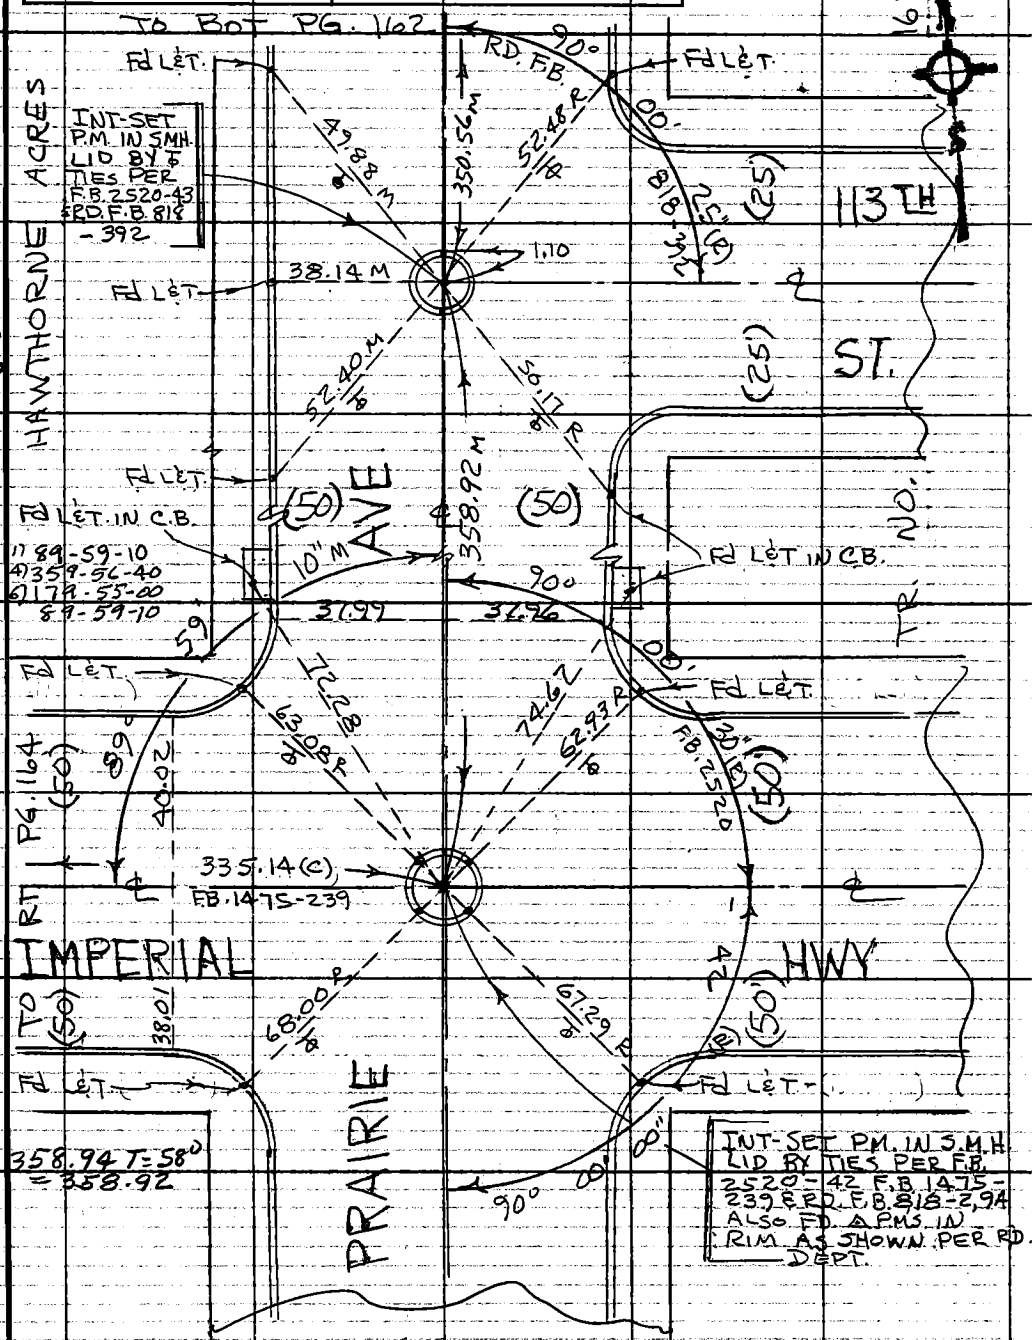

Note: Any Additions or Changes on This Sheet Must be Made or Circled in Red Ink, With Date and Name of Person Making Change.

Do not extend this side of this line.

PLEASE RETURN TO
COUNTY OF LOS ANGELES,
DEPARTMENT OF COUNTY ENGINEER
403 LOS ANGELES COUNTY ENGINEERING BLDG.

76F309S CE#310 3-69

PWFB 0818 710

F.B. 3935 PG. 164

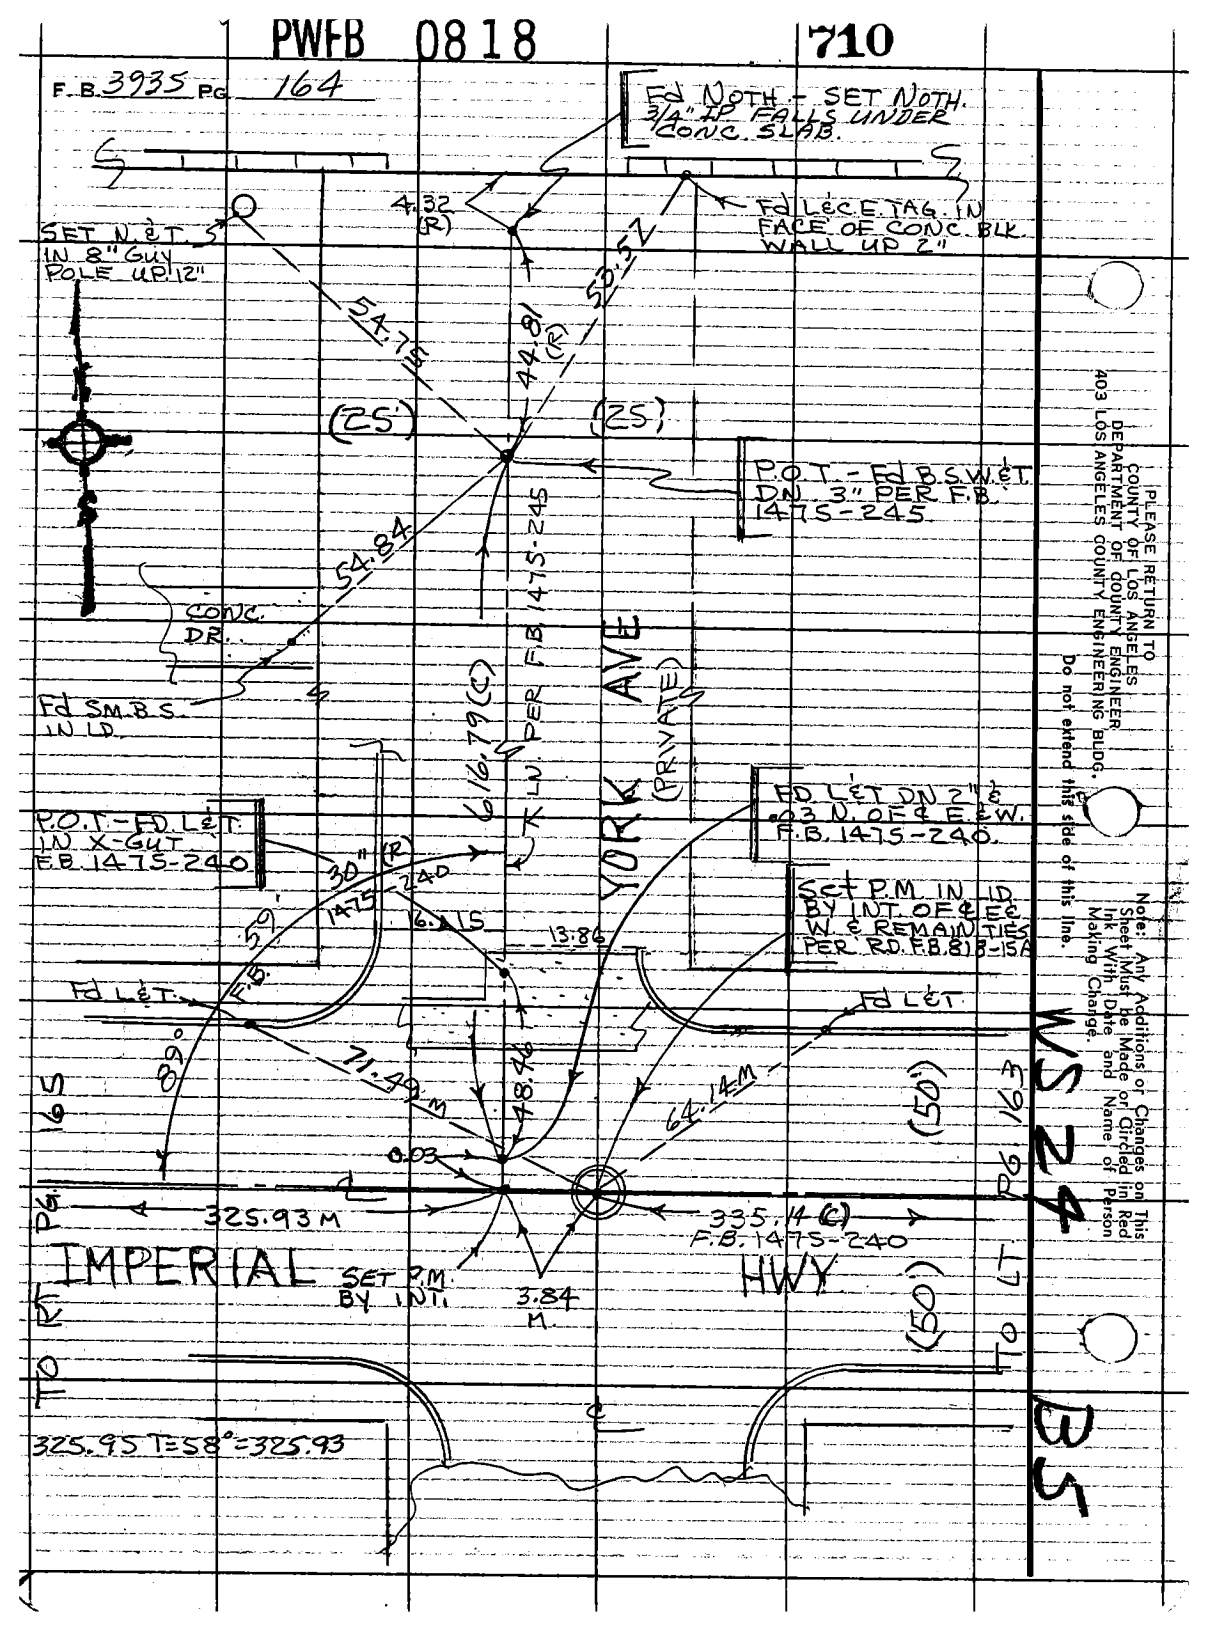

PLEASE RETURN TO
COUNTY OF LOS ANGELES
DEPARTMENT OF COUNTY ENGINEER
403 LOS ANGELES COUNTY ENGINEERING BLDG.
Do not extend this side of this line.

Note: Any Additions or Changes on This Sheet Must be Made or Circled in Red Ink With Date and Name of Person Making Change.

PWFB 0818 711

Notes Ck'd by	Survey of LENNOX AREA ℄
Map No.	JN 0303.00 Tape 02 Std 68 °F
Office Work	Surveyed by J. BAZEN
Checked	Notes J.J.B. Date 10-1-75
Date	Indexed PALMER JUN 15 1976

F. B. 3935 PG. 165

B5

WS 24

TO BOT PG. 177

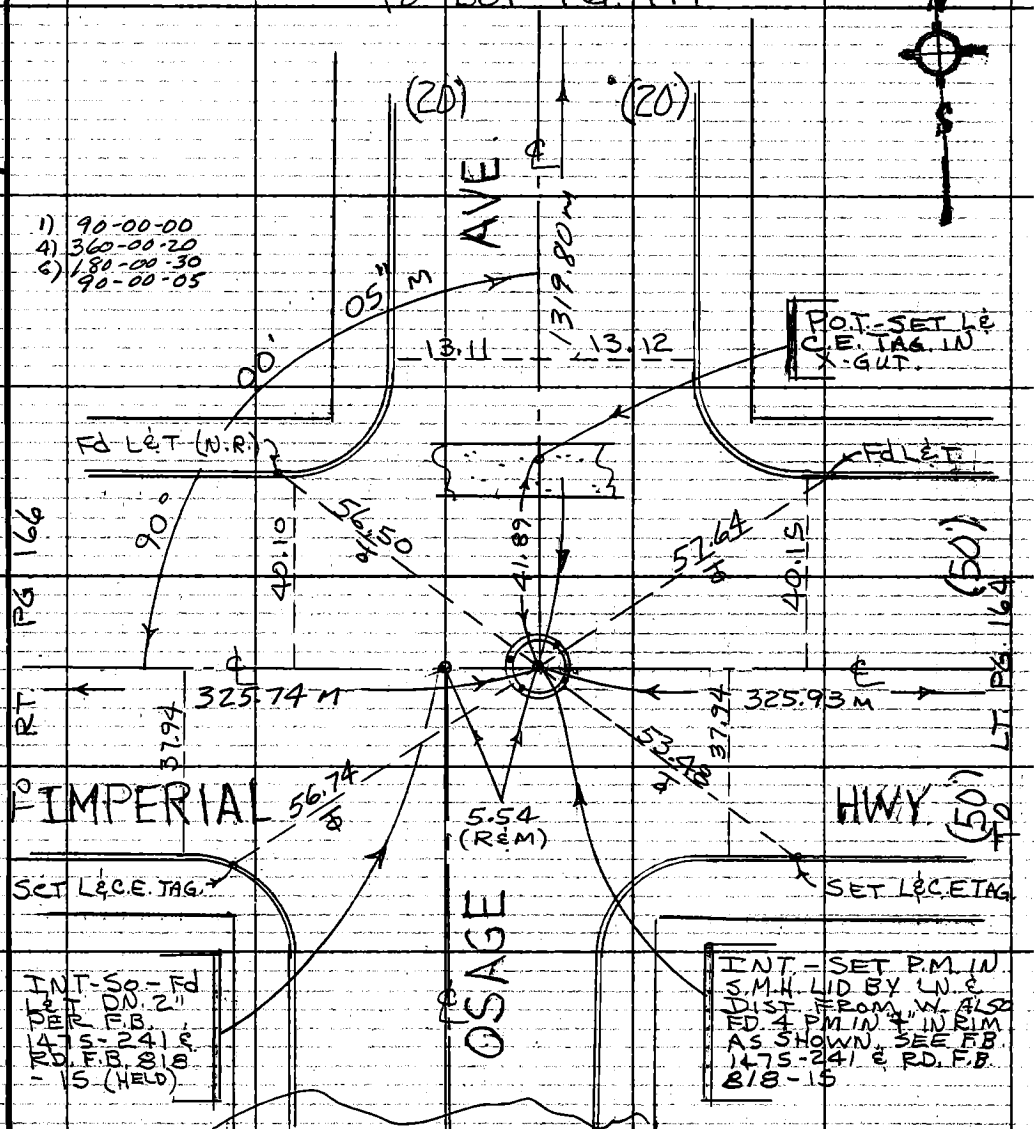

1) 90-00-00
4) 360-00-20
6) 180-00-30
90-00-05

325.76 T=58°=325.74
1319.82 T=66°=1319.80

Note: Any Additions or Changes on This Sheet Must be Made or Circled in Red Ink With Date and Name of Person Making Change.

Do not extend this side of this line.

PLEASE RETURN TO COUNTY OF LOS ANGELES DEPARTMENT OF COUNTY ENGINEER 403 LOS ANGELES COUNTY ENGINEERING BLDG.

76F309S CE#310 3-69

F.B. 3935 PG. 166

TO BOT. PG. 178

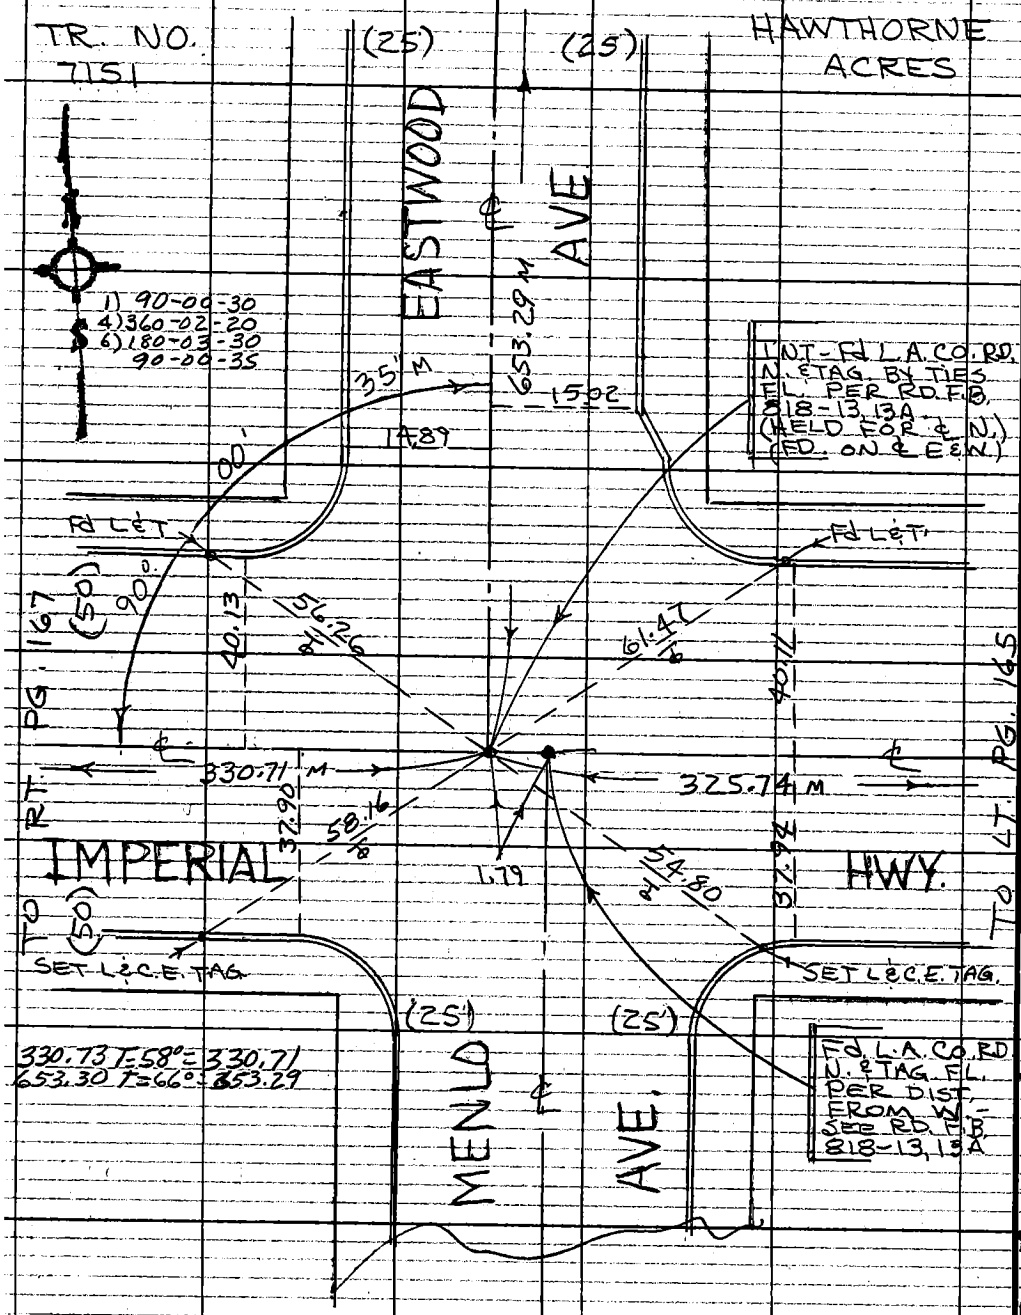

PLEASE RETURN TO
COUNTY OF LOS ANGELES
DEPARTMENT OF COUNTY ENGINEER
403 LOS ANGELES COUNTY ENGINEERING BLDG.

Do not extend this side of this line.

Note: Any Additions or Changes on This Sheet Must be Made or Circled in Red Ink With Date and Name of Person Making Change.

WS 24 B5

PWFB 0818

713

Notes Ck'd by	Survey of LENNOX AREA ℄
Map No.	JN 0303.00 Tape 02 Std 68 °F
Office Work	Surveyed by J. BAZEN
Checked	Notes J.J.B. Date 10-75
Date	Ed PALMER JUN 15 1978

F.B. 3935 PG. 167

B5

WS 24

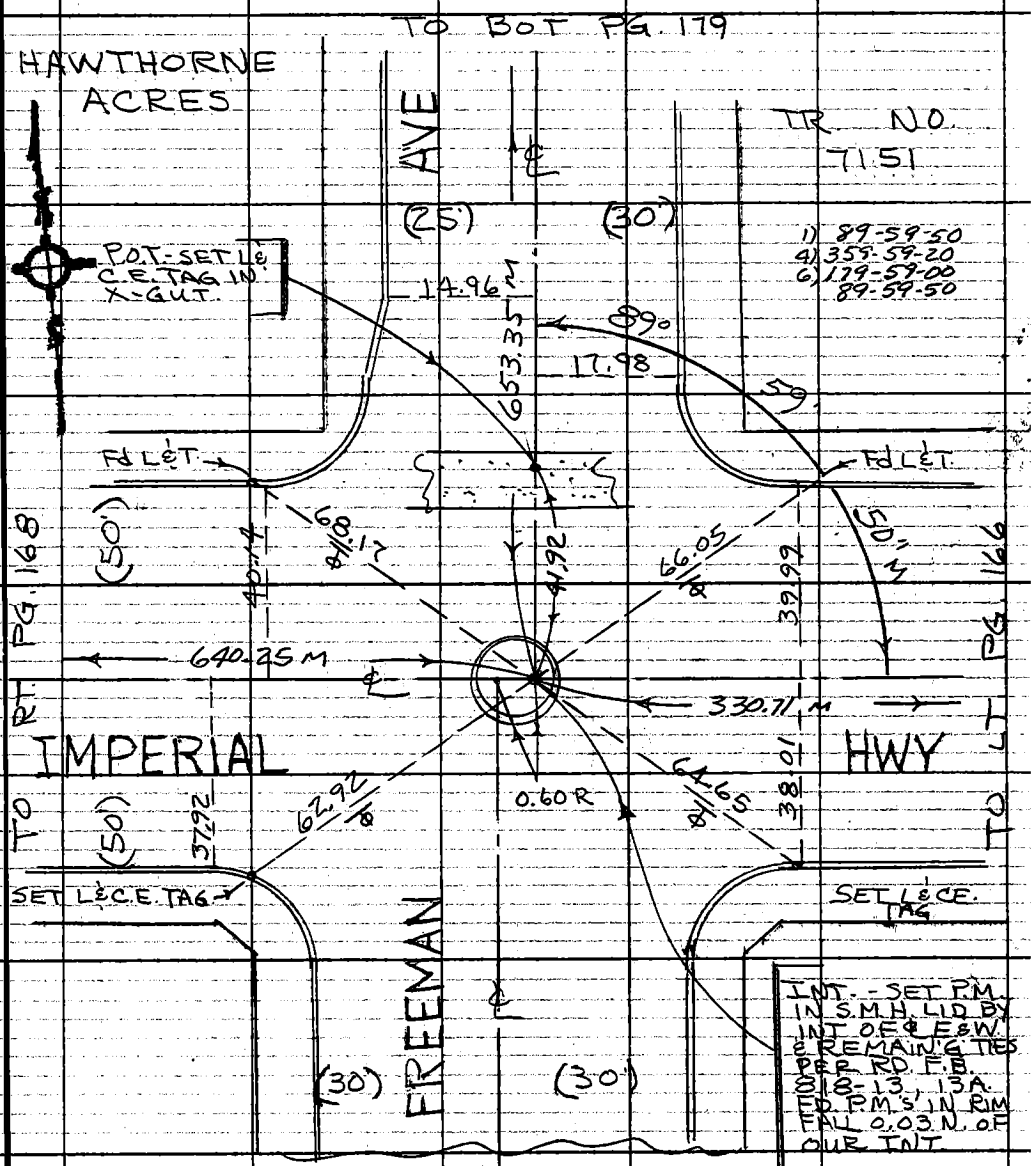

640.29 T=58° = 640.25
653.36 T=64° = 653.35

Note: Any Additions or Changes on This Sheet Must be Made or Circled in Red Ink With Date and Name of Person Making Change.

Do not extend this side of this line.

PLEASE RETURN TO COUNTY OF LOS ANGELES DEPARTMENT OF COUNTY ENGINEER 403 LOS ANGELES COUNTY ENGINEERING BLDG.

16F309S CE#310 3-69

F.B. 3935 PG. 168

TO BOT PG. 173

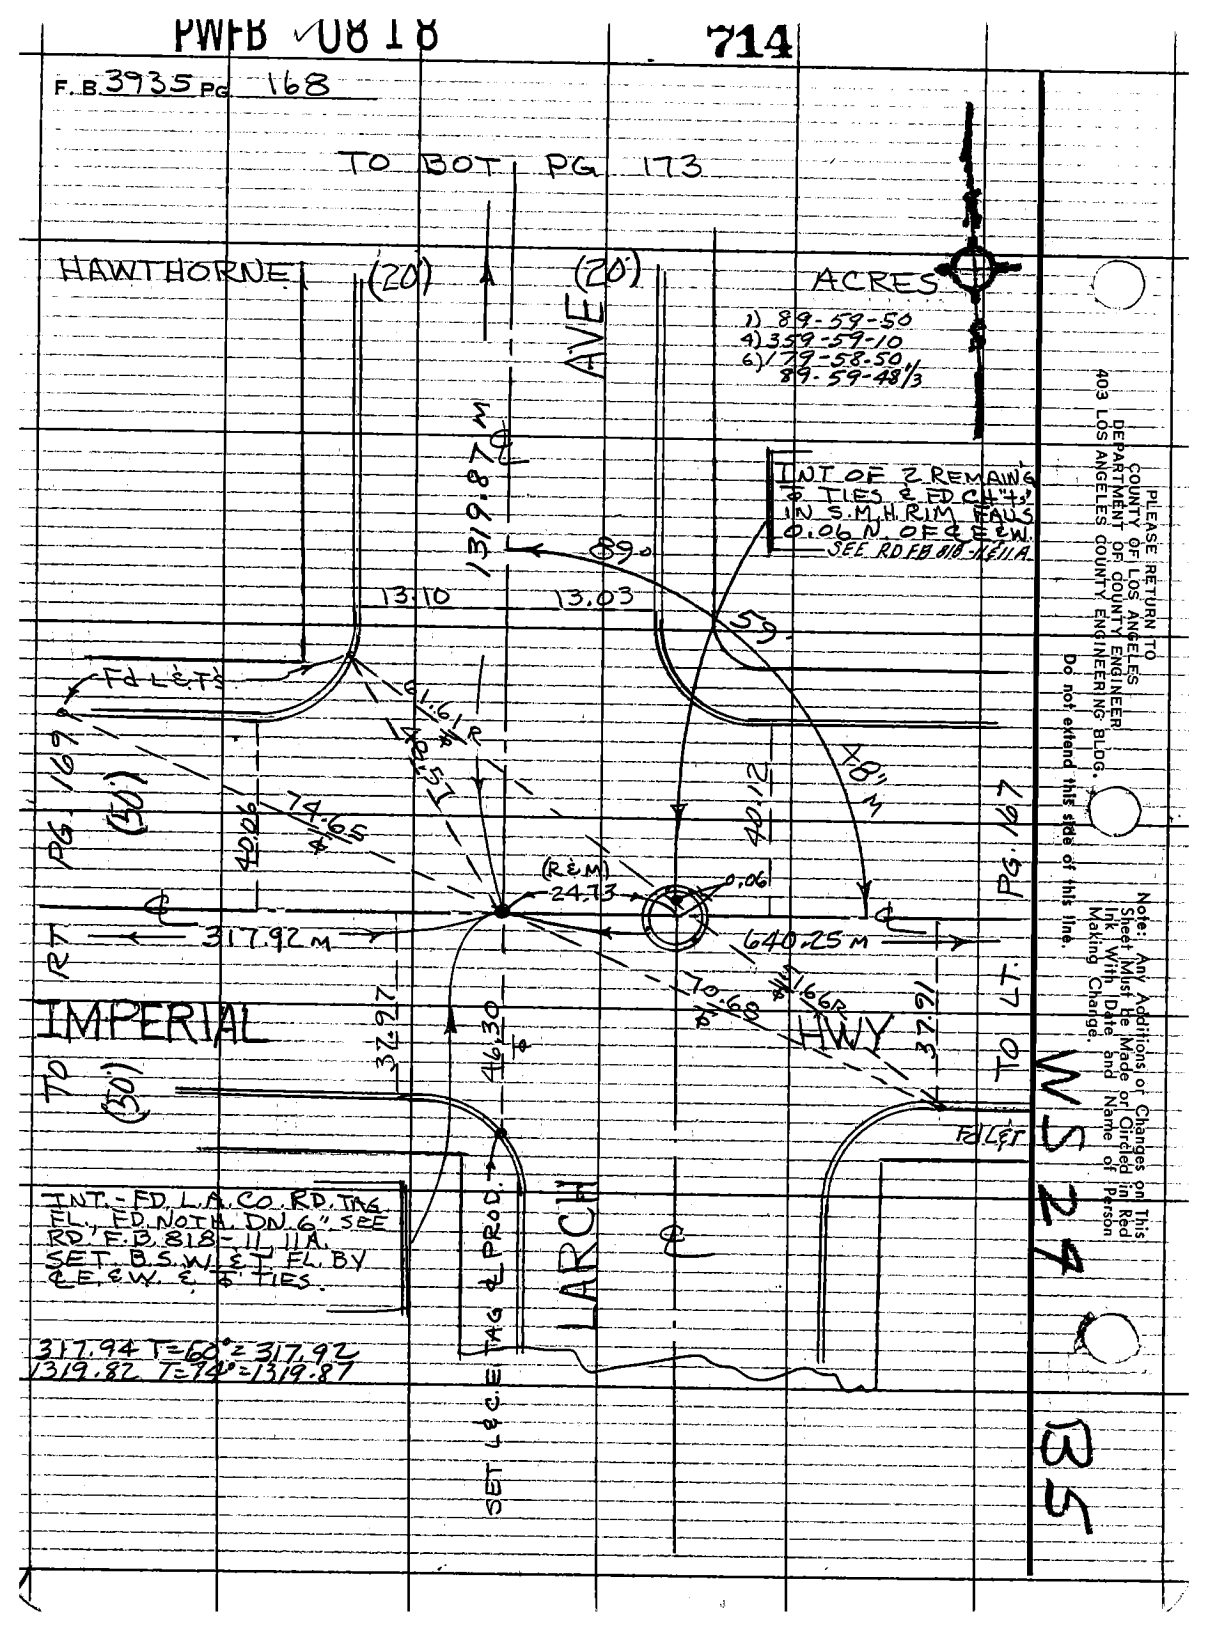

PLEASE RETURN TO
COUNTY OF LOS ANGELES
DEPARTMENT OF COUNTY ENGINEER
403 LOS ANGELES COUNTY ENGINEERING BLDG.

Do not extend this side of this line.

Note: Any Additions or Changes on This Sheet Must be Made or Circled in Red Ink With Date and Name of Person Making Change.

W.S. 24

35

PWFB 0818 715

Notes Ck'd by	Survey of LENNOX AREA ℄
Map No.	JN 0303.00 Tape 02 Std 68 °F
Office Work	Surveyed by J. BAZEN
Checked	Notes J.J.B. Date 10-75
Date	Indexed PALMERI JUN 15 1976

F. B. 3935 PG. 169

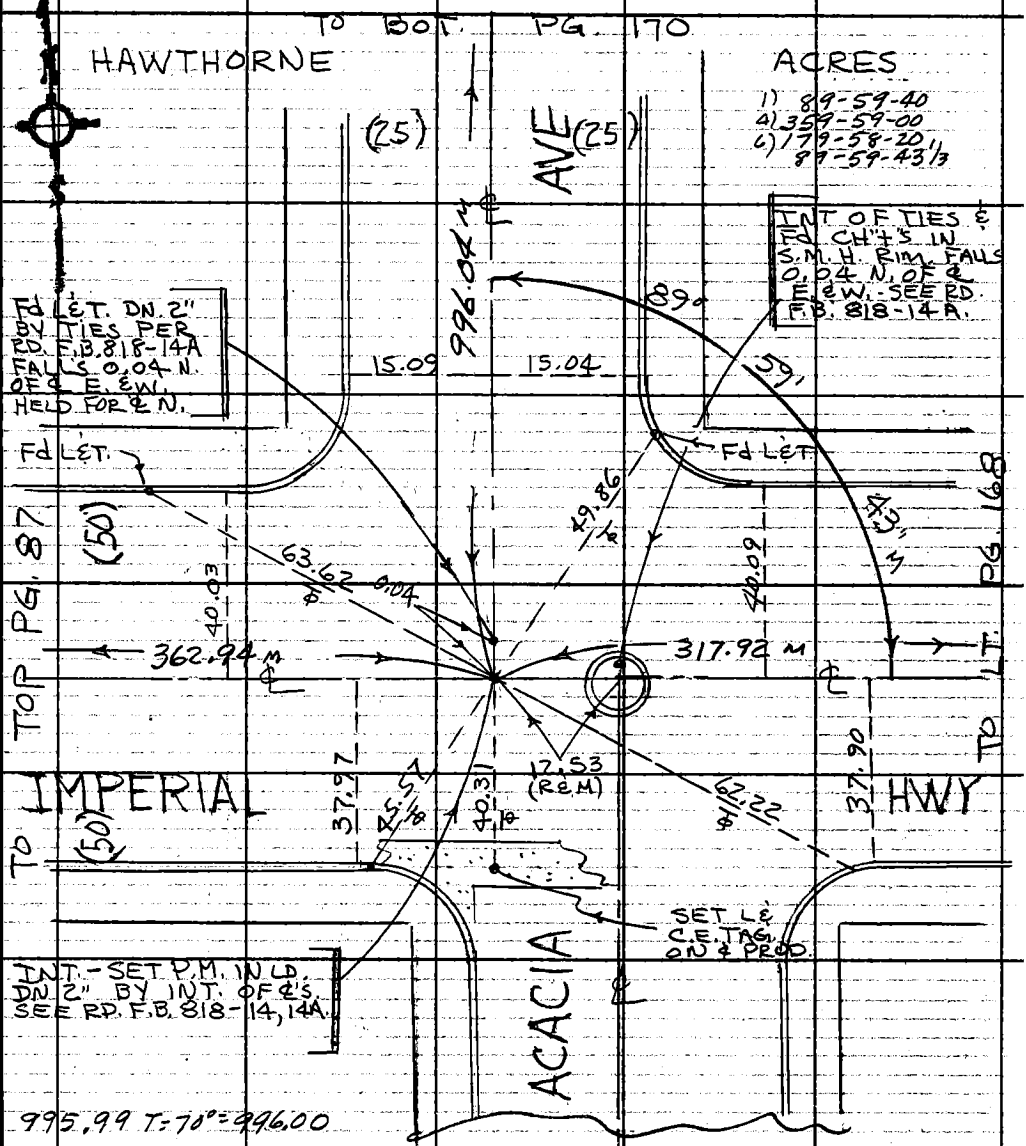

Note: Any Additions or Changes on This Sheet Must be Made or Circled in Red Ink With Date and Name of Person Making Change.

Do not extend this side of this line.

PLEASE RETURN TO
COUNTY OF LOS ANGELES
DEPARTMENT OF COUNTY ENGINEER
403 LOS ANGELES COUNTY ENGINEERING BLDG.

76F309S CE#310 3-69

F. B. 3935 PG. 170

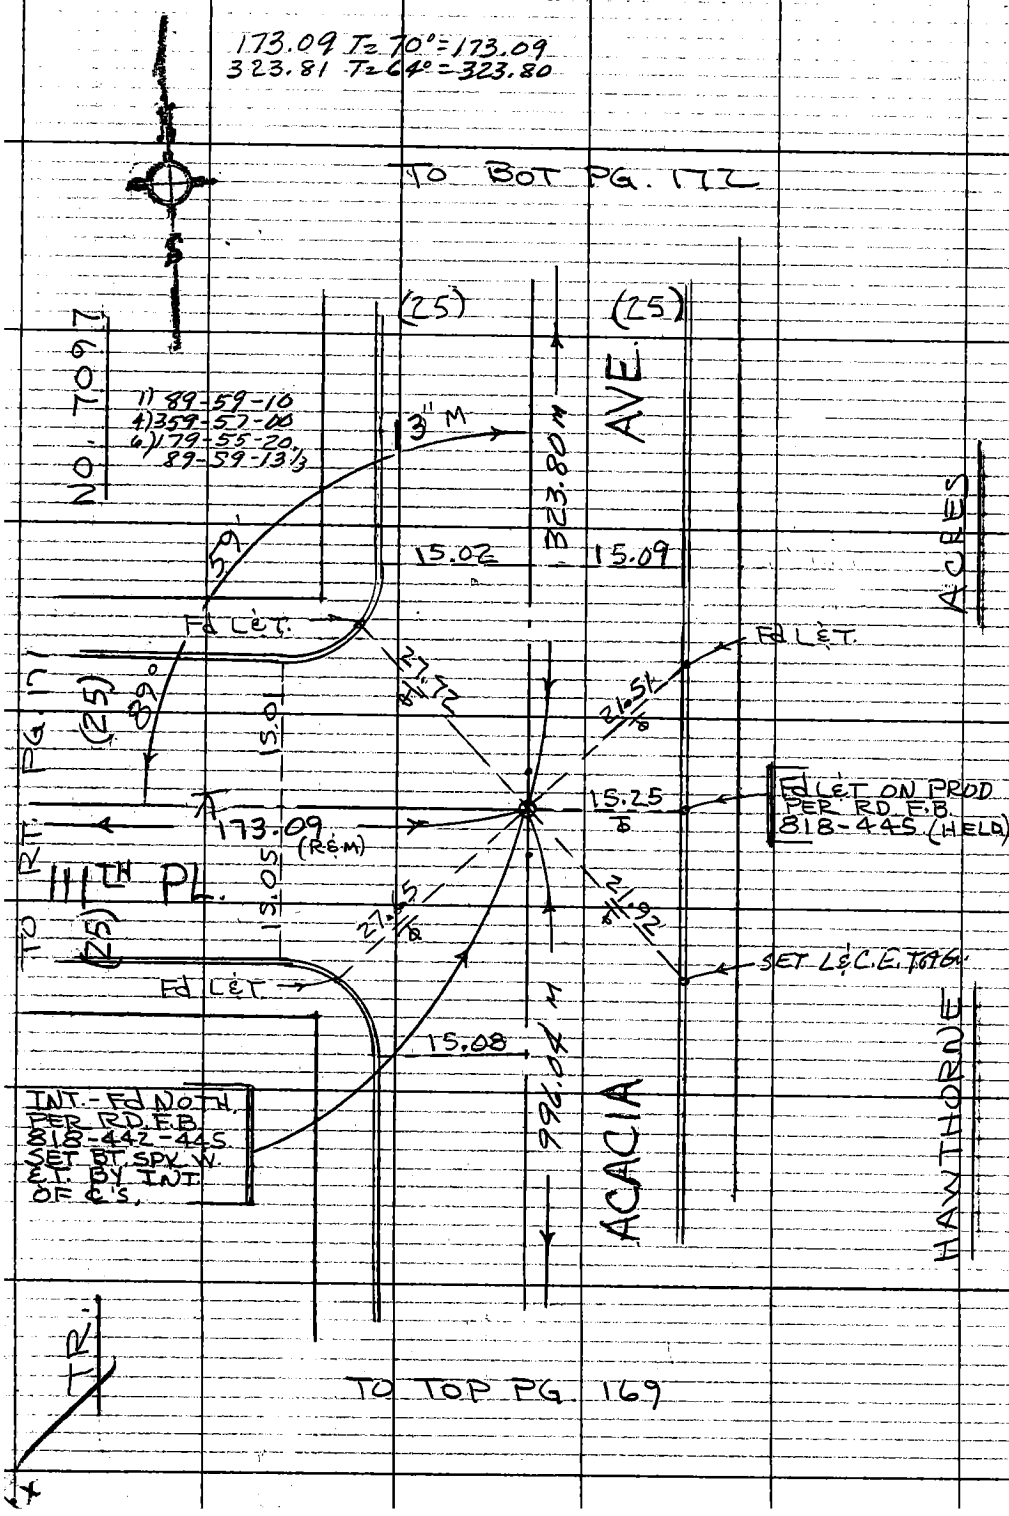

W.S. 24 B-5

PLEASE RETURN TO
COUNTY OF LOS ANGELES
DEPARTMENT OF COUNTY ENGINEER
403 LOS ANGELES COUNTY ENGINEERING BLDG.

Do not extend this side of this line.

Note: Any Additions or Changes on This Sheet Must be Made or Circled in Red Ink With Date and Name of Person Making Change.

PWFB 0818

717

Notes Ck'd by	Survey of LENNOX AREA ℄
Map No.	JN 0303.00 Tape 02 Std 68 °F
Office Work	Surveyed by J. BAZEN
Checked	Notes J.J.B. Date 10-75
Date	Indexed PALMERI JUN 15 1976

F. B. 3935 PG. 171

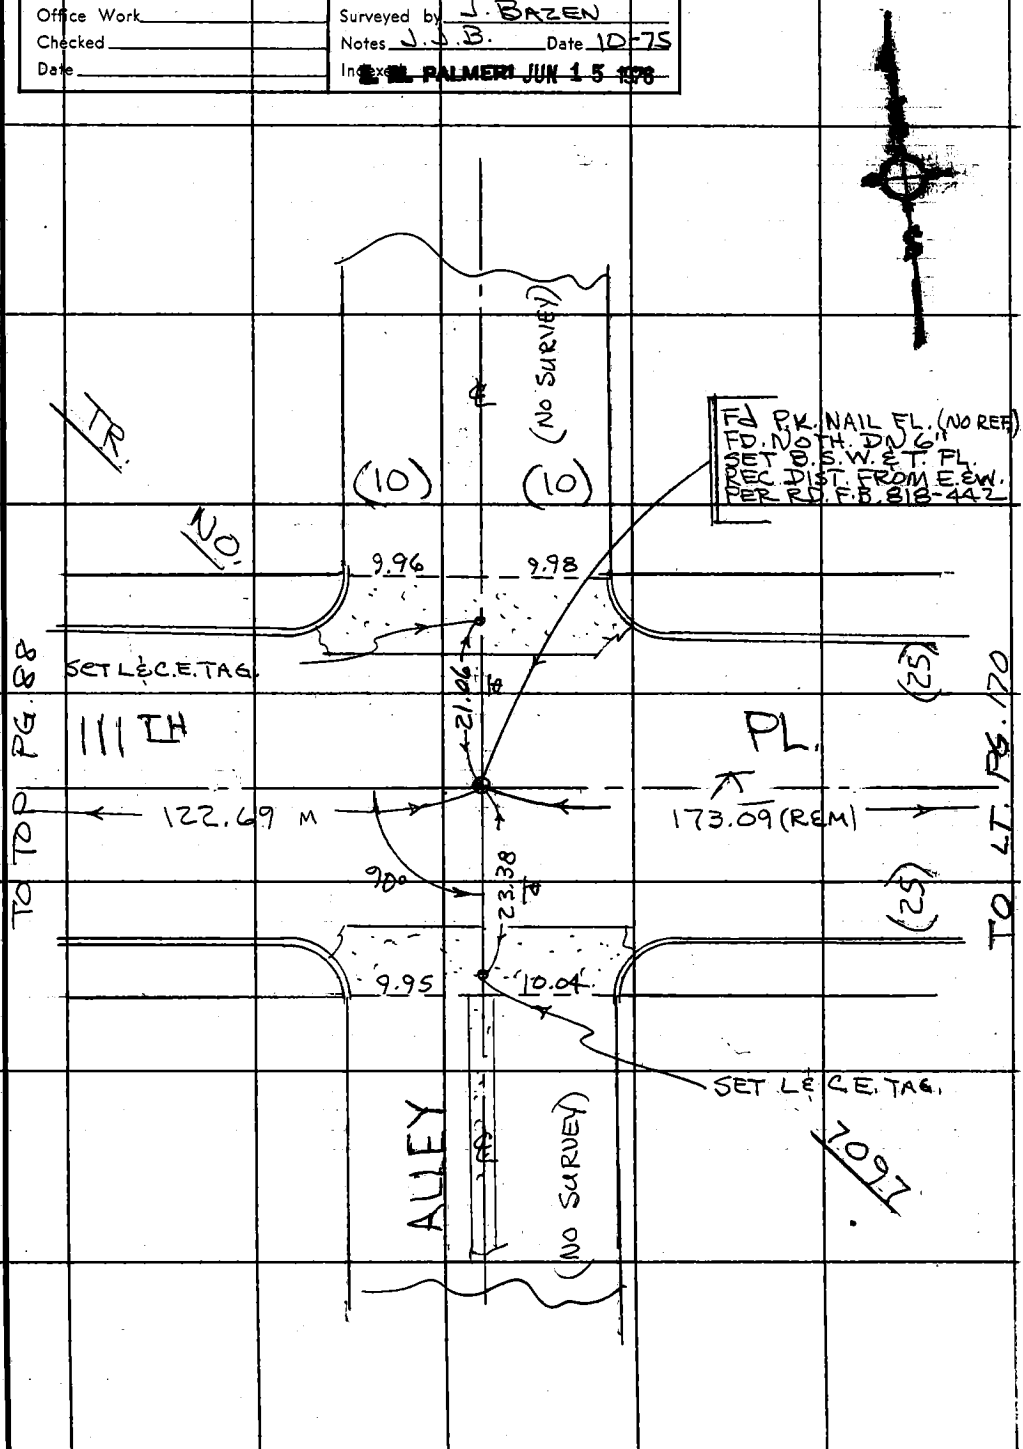

Note: Any Additions or Changes on This Sheet Must be Made or Circled in Red Ink With Date and Name of Person Making Change.

Do not extend this side of this line.

PLEASE RETURN TO
LOS ANGELES COUNTY ENGINEER
700 LOS ANGELES COUNTY ENGINEERING BLDG.

76F309S S&E #247 1-56

F. B. 3935 PG. 172

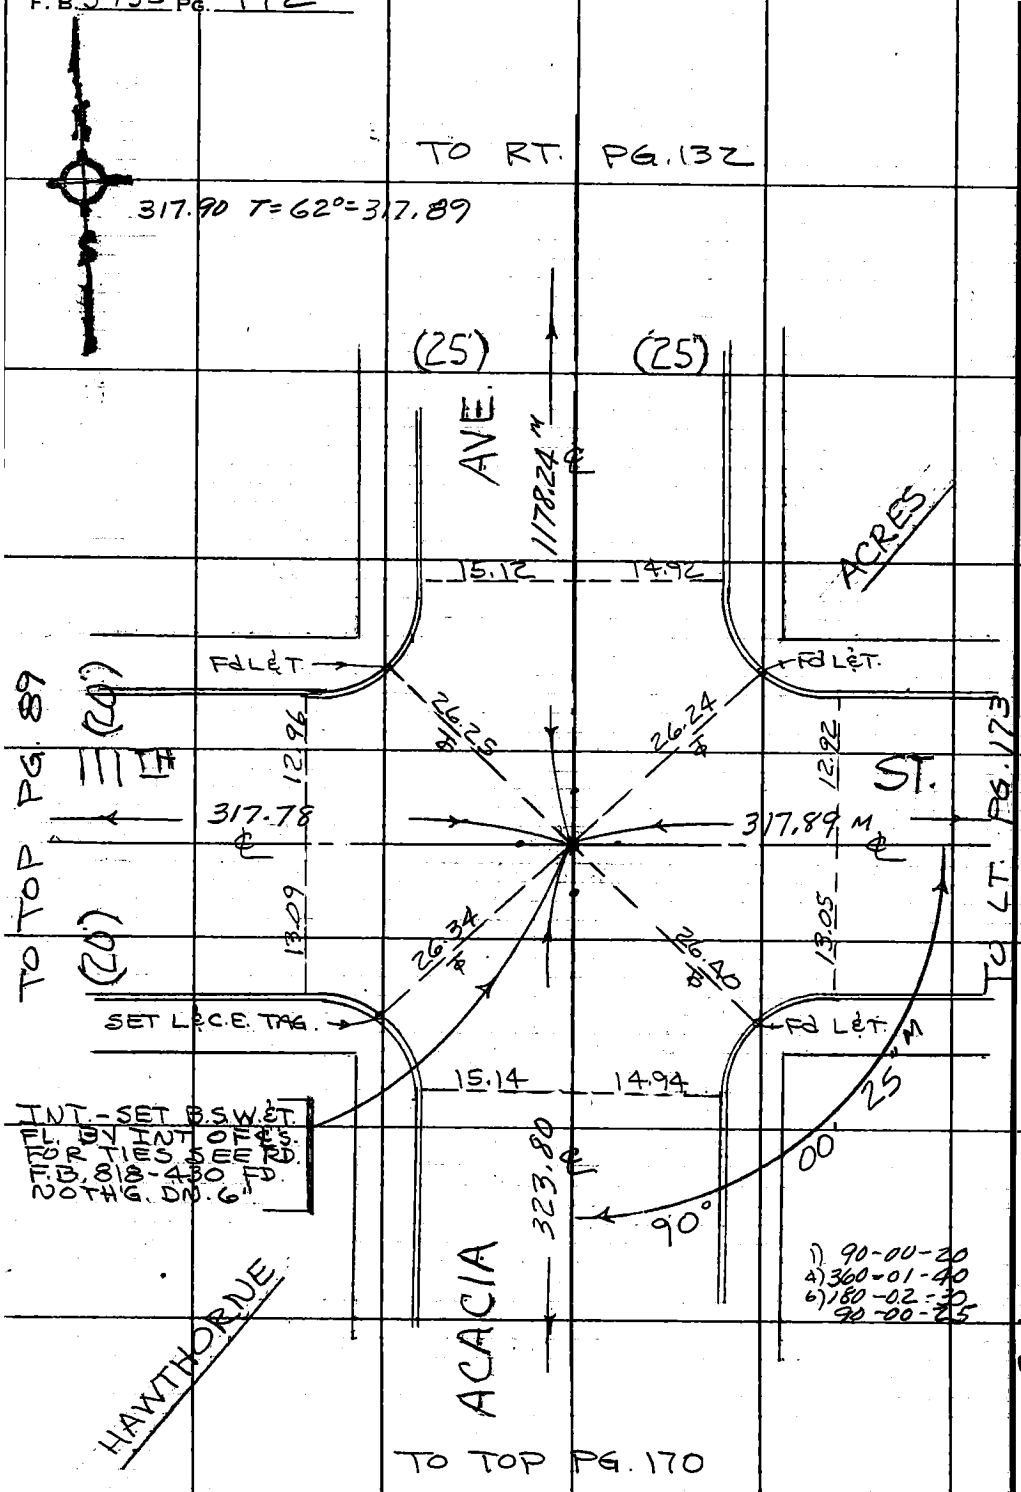

PLEASE RETURN TO
LOS ANGELES COUNTY ENGINEER
700 LOS ANGELES COUNTY ENGINEERING BLDG.

Do not extend this side of this line.

Note: Any Additions or Changes on This Sheet Must be Made or Circled in Red Ink With Date and Name of Person Making Change.

WS 24 B-5

PWFB 0818

719

Notes Ck'd by	Survey of LENNOX AREA ℄
Map No.	JN 0303.00 Tape 02 Std 68 °F
Office Work	Surveyed by J. BAZEN
Checked	Notes J.J.B. Date 10-75
Date	Indexed PALMERI JUN 15 1976

F. B. 393S PG. 173

B5

WS 24

317.50 T=62°=317.49

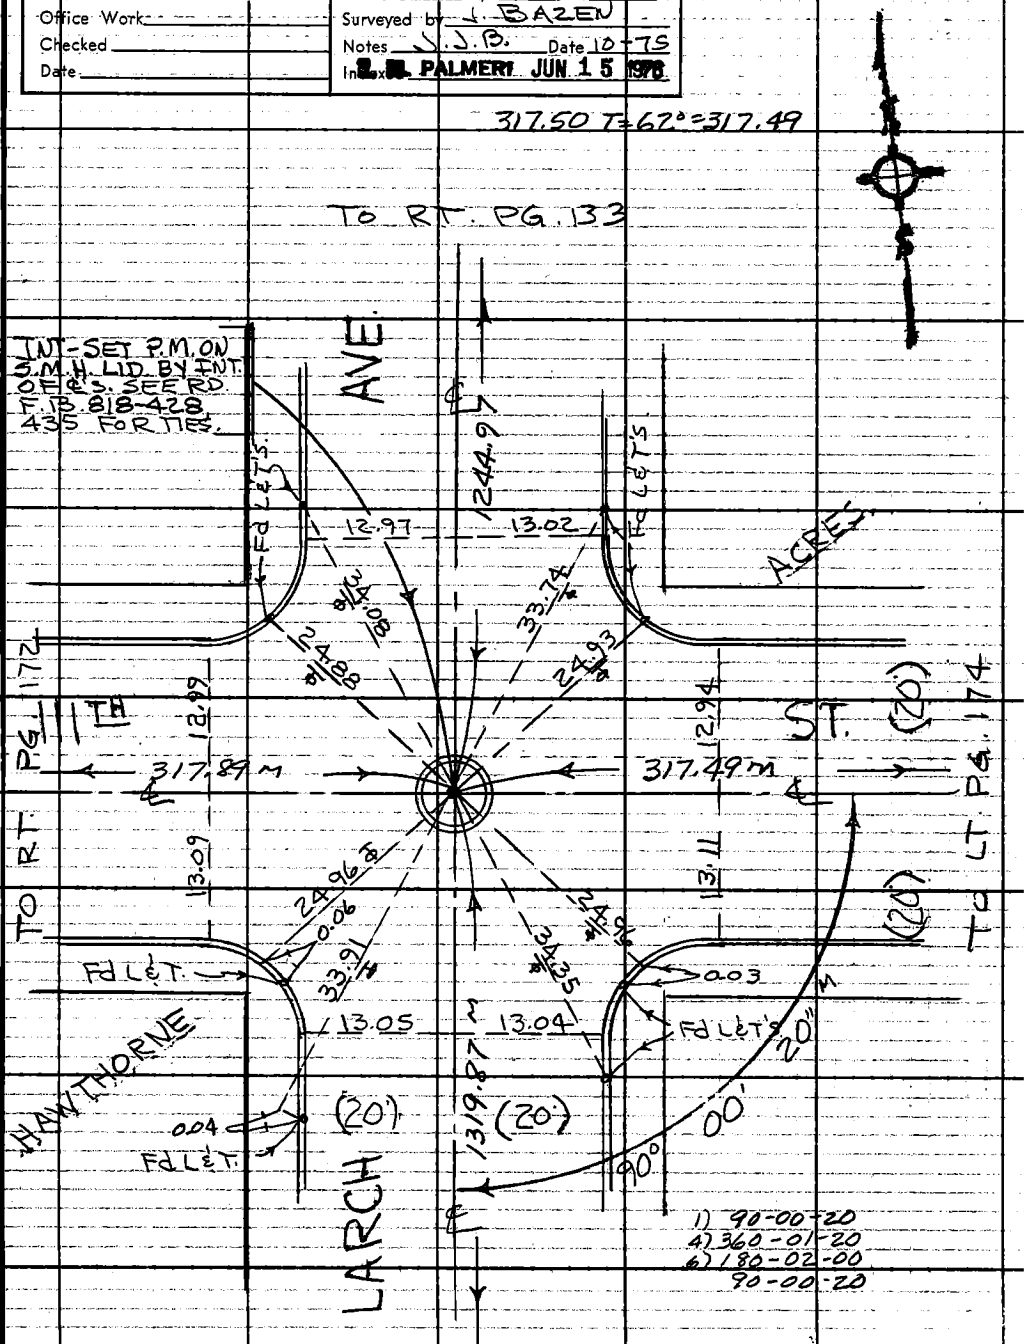

Note: Any Additions or Changes on This Sheet Must be Made or Circled in Red Ink With Date and Name of Person Making Change.

Do not extend this side of this line.

PLEASE RETURN TO
COUNTY OF LOS ANGELES
DEPARTMENT OF COUNTY ENGINEER
403 LOS ANGELES COUNTY ENGINEERING BLDG.

76F309S CE#310 3-69

PWFB 0818 720

F. B. 3935 PG. 174

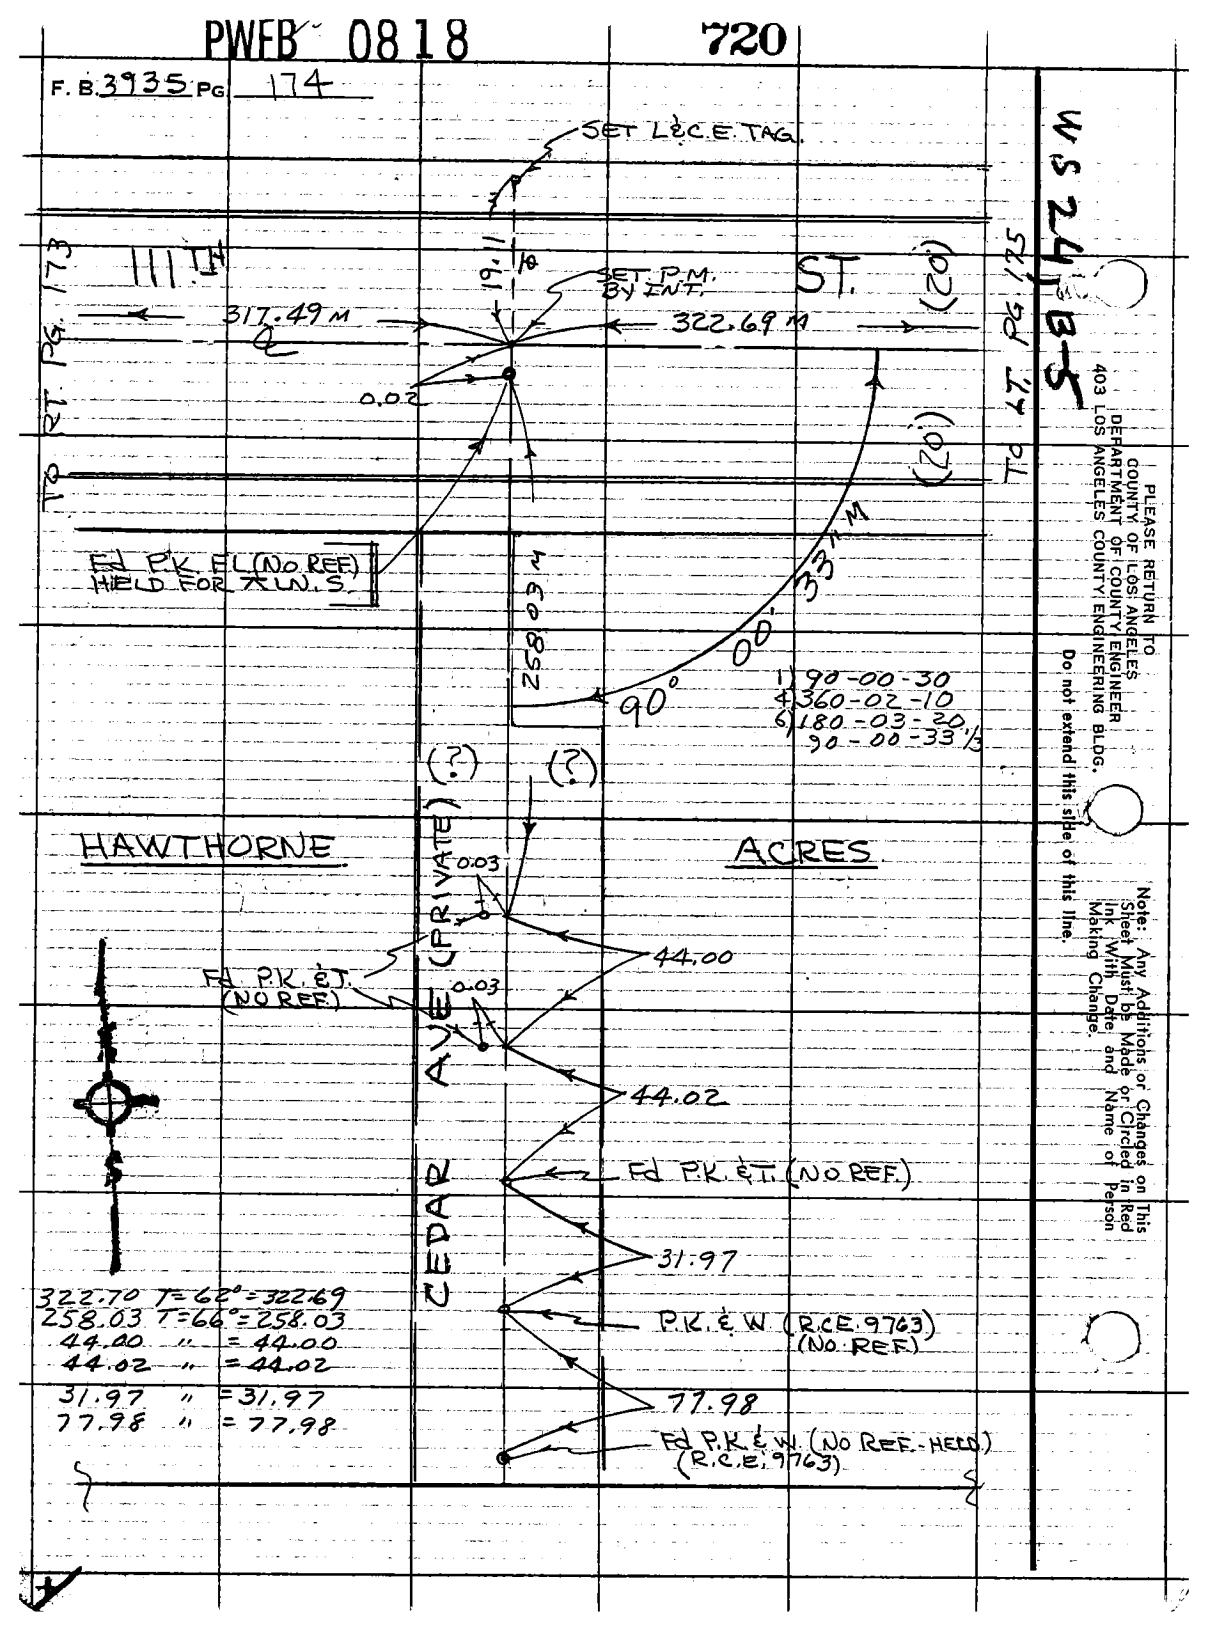

PLEASE RETURN TO
COUNTY OF LOS ANGELES
DEPARTMENT OF COUNTY ENGINEER
403 LOS ANGELES COUNTY ENGINEERING BLDG.

Do not extend this side of this line.

Note: Any Additions or Changes on This Sheet Must be Made or Circled in Red Ink With Date and Name of Person Making Change.

PWFB 0818 721

Notes Ck'd by	Survey of LENNOX AREA ℄
Map No.	JN 0303.00 Tape 02 Std 68 °F
Office Work	Surveyed by J. BAZEN
Checked	Notes J.J.B. Date 10-75
Date	Indexed F. M. PALMERI JUN 15 1978

F. B. 3935 PG. 175

B5

WS24

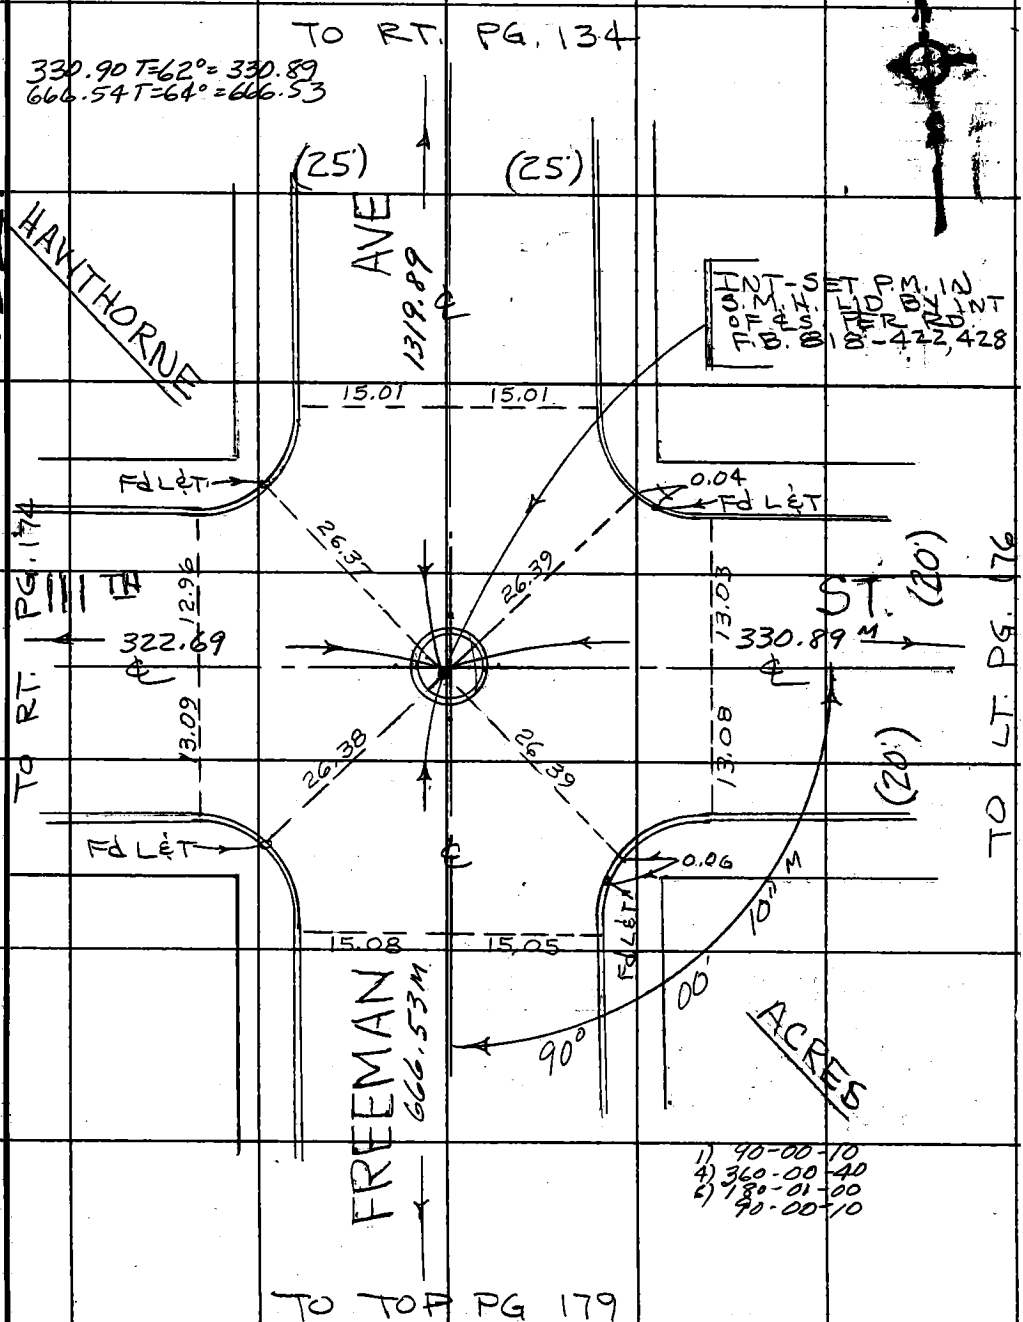

Note: Any Additions or Changes on this Sheet Must be Made or Circled in Red Ink With Date and Name of Person Making Change.

Do not extend this side of this line.

PLEASE RETURN TO
LOS ANGELES COUNTY ENGINEER
700 LOS ANGELES COUNTY ENGINEERING BLDG.

76F309S S&E #247 1-56

F. B. 3935 PG. 176

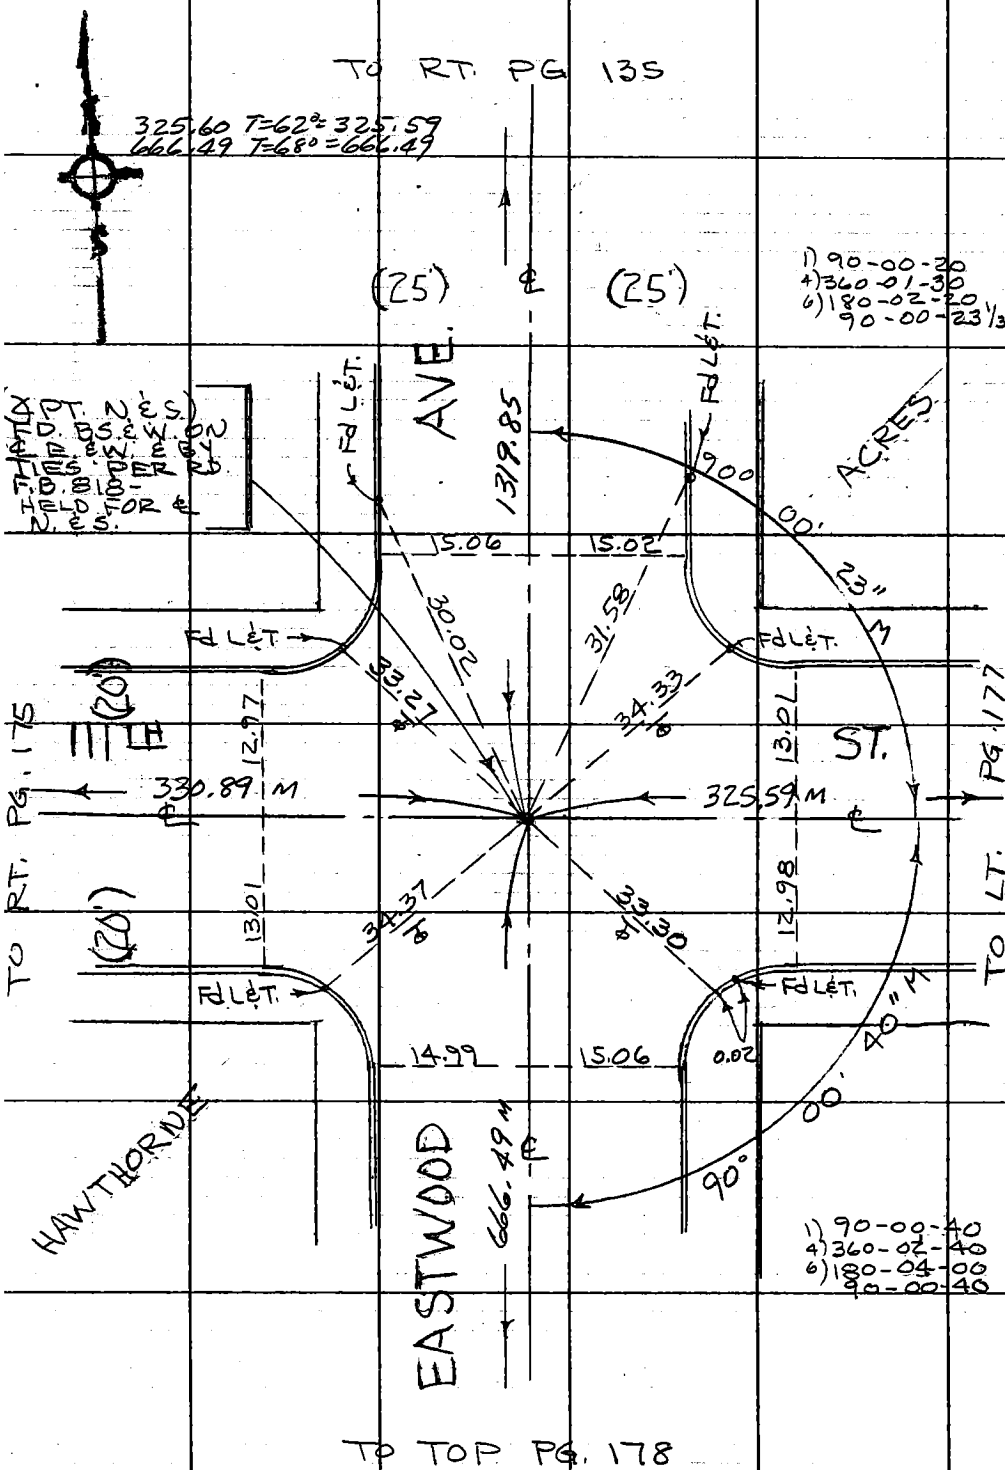

PLEASE RETURN TO
LOS ANGELES COUNTY ENGINEER
700 LOS ANGELES COUNTY ENGINEERING BLDG.

Do not extend this side of this line.

Note: Any Additions or Changes on This Sheet Must be Made or Circled in Red Ink With Date and Name of Person Making Change.

WS 24 BS

PWFB 0818

723

Notes Ck'd by	Survey of LENNOX AREA ℄
Map No.	JN 0303.00 Tape 02 Std 68 °F
Office Work	Surveyed by J. BAZEN
Checked	Notes J.J.B. Date 10-75
Date	Indexed T. M. PALMER JUN 15 1976

F. B. 3935 PG. 177

B5

WS 24

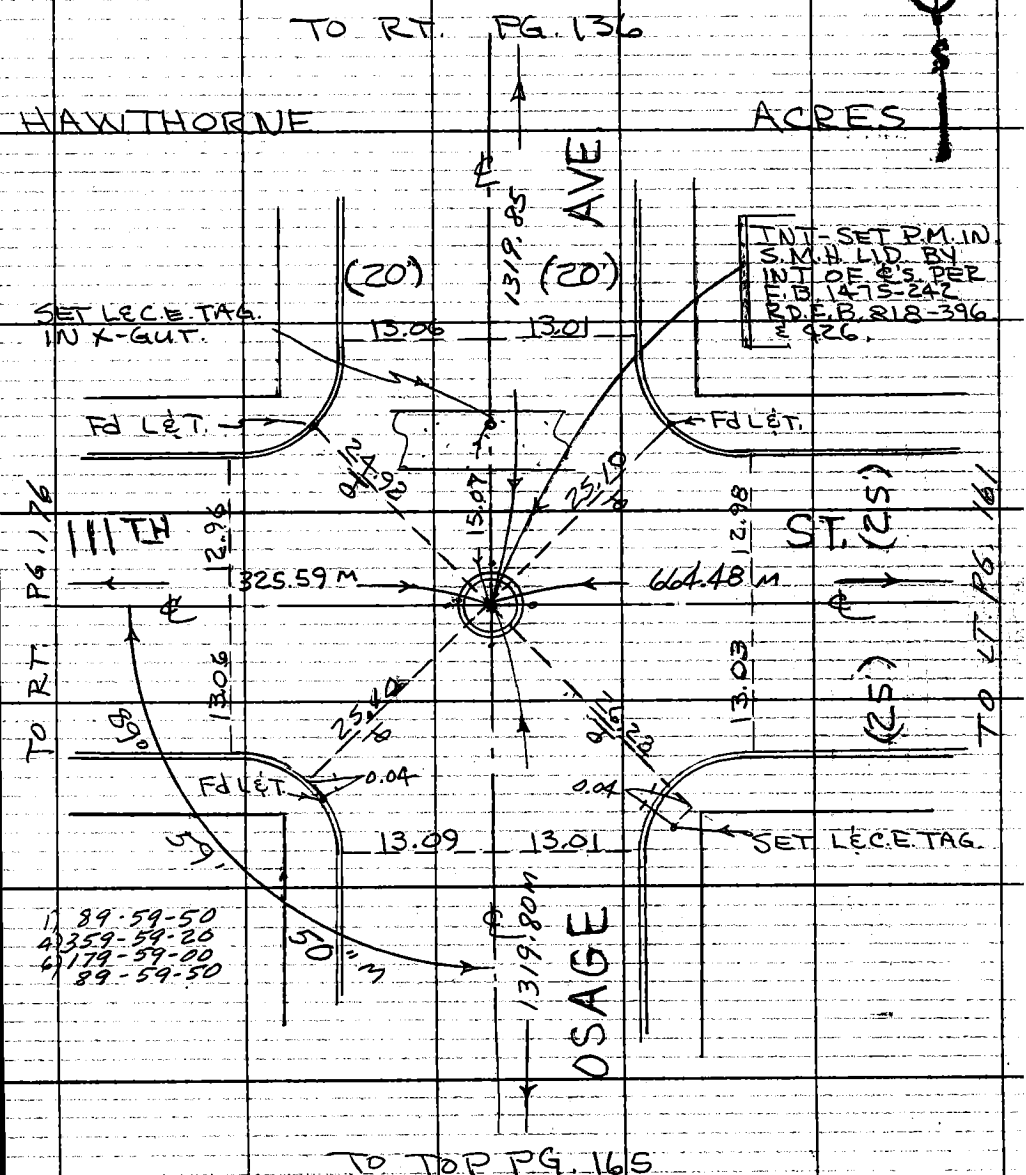

Note: Any Additions or Changes on This Sheet Must be Made or Circled in Red Ink With Date and Name of Person Making Change.

Do not extend this side of this line.

PLEASE RETURN TO
COUNTY OF LOS ANGELES
DEPARTMENT OF COUNTY ENGINEER
403 LOS ANGELES COUNTY ENGINEERING BLDG.

16F309S CE#310 3-69

F.B. 3935 PG. 178

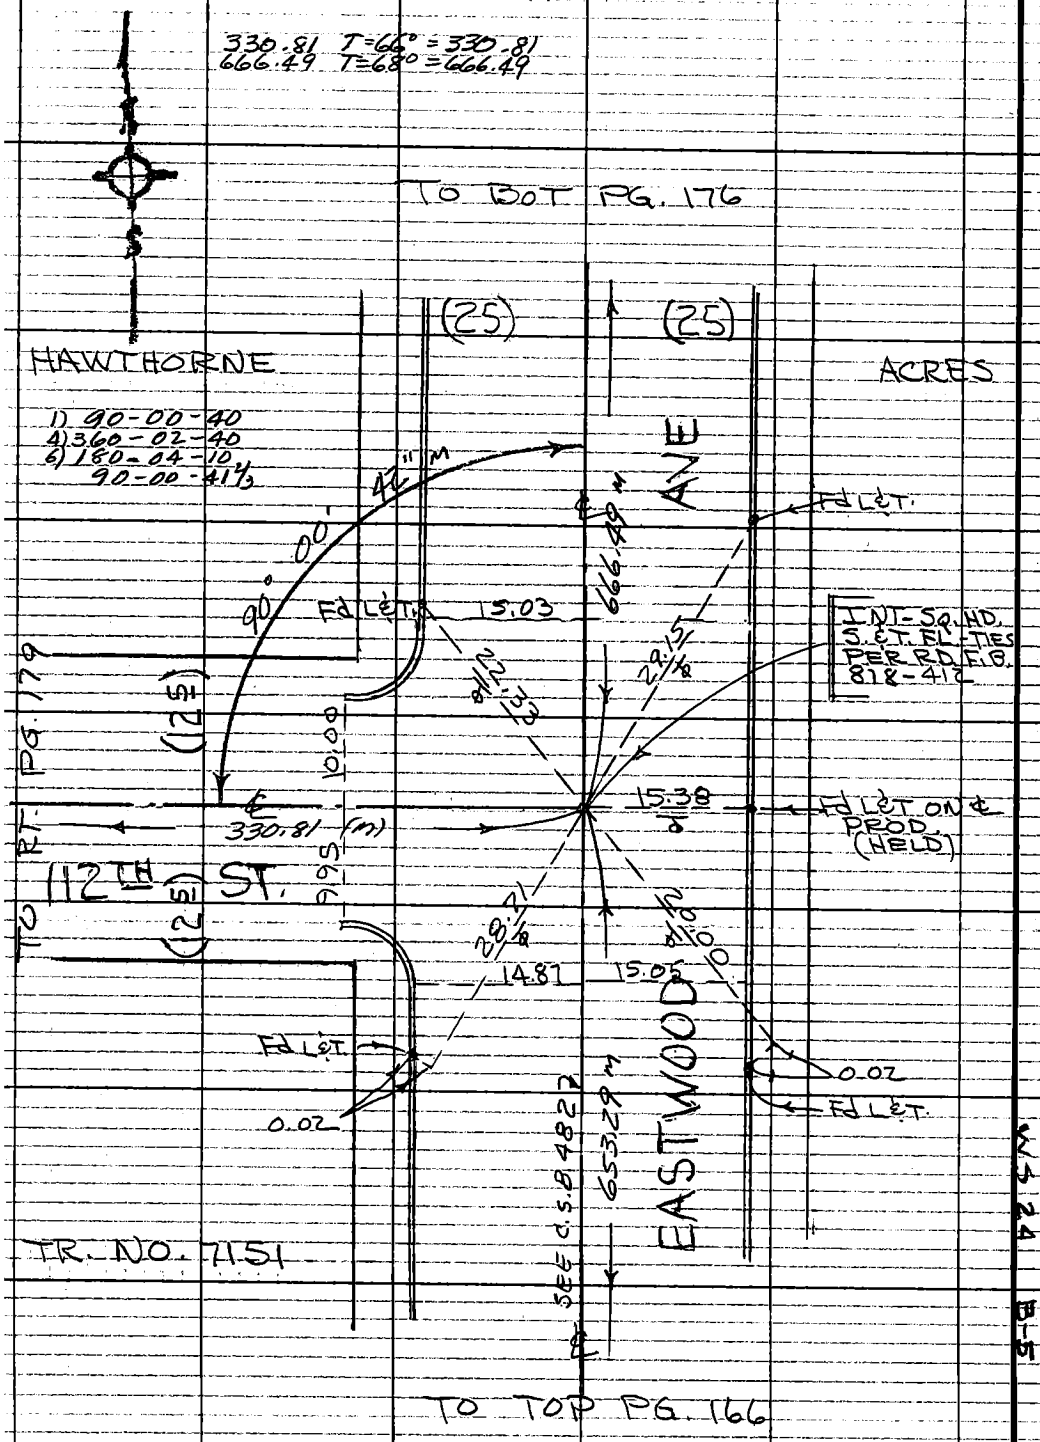

PLEASE RETURN TO
COUNTY OF LOS ANGELES
DEPARTMENT OF COUNTY ENGINEER
403 LOS ANGELES COUNTY ENGINEERING BLDG.

Do not extend this side of this line.

Note: Any Additions or Changes on This Sheet Must be Made or Circled in Red Ink With Date and Name of Person Making Change.

PWFB 0818

725

Notes Ck'd by	Survey of LENNOX AREA ℄
Map No.	JN 0303.00 Tape 02 Std 68 °F
Office Work	Surveyed by J. BAZEN
Checked	Notes J.J.B. Date 10-75
Date	Indexed T. M. PALMER JUN 15 1976

F. B 3935 PG. 179

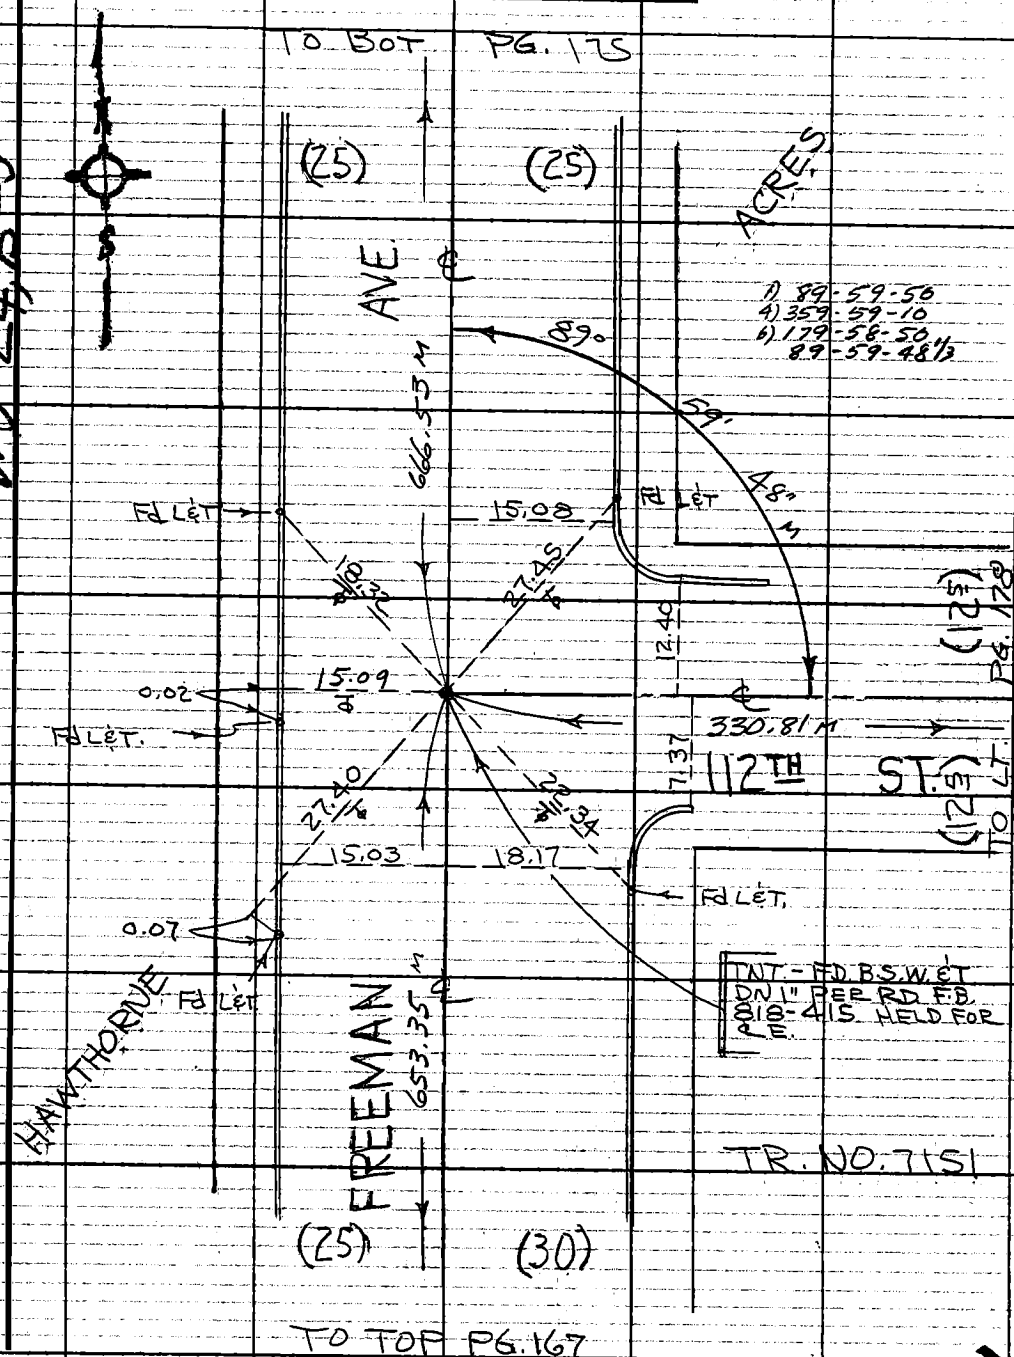

Note: Any Additions or Changes on this Sheet Must be Made or Circled in Red Ink With Date and Name of Person Making Change.

Do not extend this side of this line.

PLEASE RETURN TO
COUNTY OF LOS ANGELES
DEPARTMENT OF COUNTY ENGINEER
403 LOS ANGELES COUNTY ENGINEERING BLDG.

76F309S CE#310 3-69

Notes Ck'd by	Survey of LENNOX AREA ℄	F. B. 3935 PG. 181
Map No.	JN 0303-00 Tape 02 Std 68 °F	
Office Work	Surveyed by J. BAZEN	
Checked	Notes J. J. B. Date 10-75	
Date	Indexed T. M. PALMERI JUN 15 1976	

CADASTRAL TIES TO
J.N. 0303.00
LENNOX AREA ℄ DIV. #1.

W.S. 24, B-5

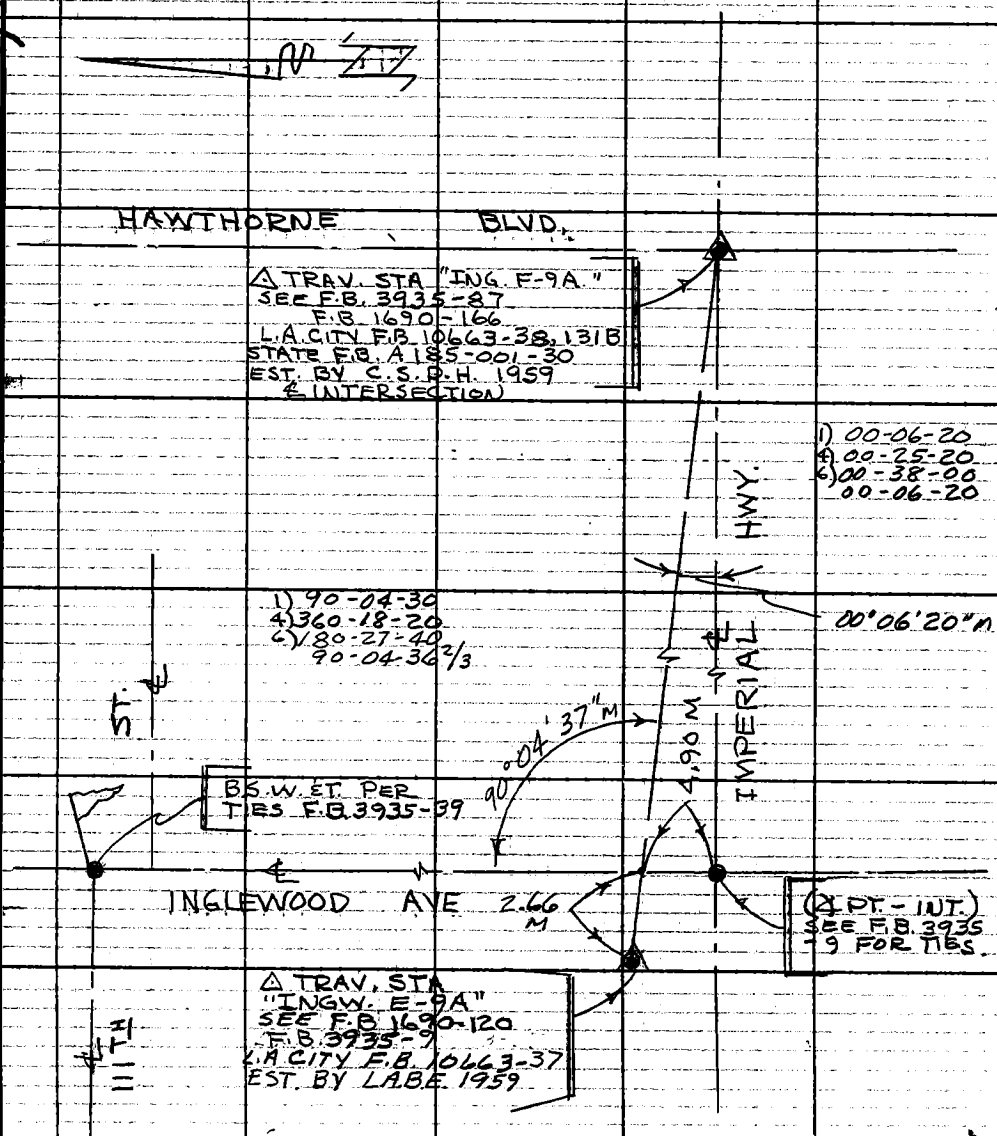

Note: Any Additions or Changes on this Sheet Must be Made or Circled in Red Ink With Date and Name of Person Making Change.

Do not extend this side of this line.

PLEASE RETURN TO
COUNTY OF LOS ANGELES
DEPARTMENT OF COUNTY ENGINEER
403 LOS ANGELES COUNTY ENGINEERING BLDG.

76F309S CE#310 3-69

PWD 0017

714

Notes Ck'd by
Map No.
Office Work
Checked
Date

Survey of HOUSEING DEVELOPMENT
JN 150434 Tape 09 Std 94 °F
Surveyed by M. I. W
Notes A. L. G Date 6-13-80
Indexed H. HOLMAN JUN 1 1980

F. B. 3935 Pg. 183

HOUSEING DEVELOPMENT

J.N. 150434

TRACT 288 LOT 151

MB 14-162/163

To:

REF.

FB 3935

TR 288

WACKER

GOBLE

PYLE

FALSEY

Note: Any Additions of Changes on This Sheet Must be Made or Circled in Red Ink With Date and Name of Person Making Change.

Do not extend this side of this line.

PLEASE RETURN TO
LOS ANGELES COUNTY ENGINEER
403 Los Angeles County Engineering Bldg.

75F309S CE #310 6-63

PWTD 0041

715

F.B. 3935 Pg. 184

INDEX

PLEASE RETURN TO
LOS ANGELES COUNTY ENGINEER
403 Los Angeles County Engineering Bldg.

Do not extend this side of this Map.

Note: Any Additions or Changes on This Sheet Must be Made or Circled in Red Ink With Date and Name of Person Making Change.

PWFB 0817

716

Notes Ck'd by	Survey of HOUSEING DEVELOPMENT
Map No.	JN 1504.37 Tape 09 Std 80 °F
Office Work	Surveyed by M.E.W
Checked	Notes A.L.G. Date 6-13-80
Date	Indexed H HOLMAN JUN 19 1980

F.B. 3935 PG. 185

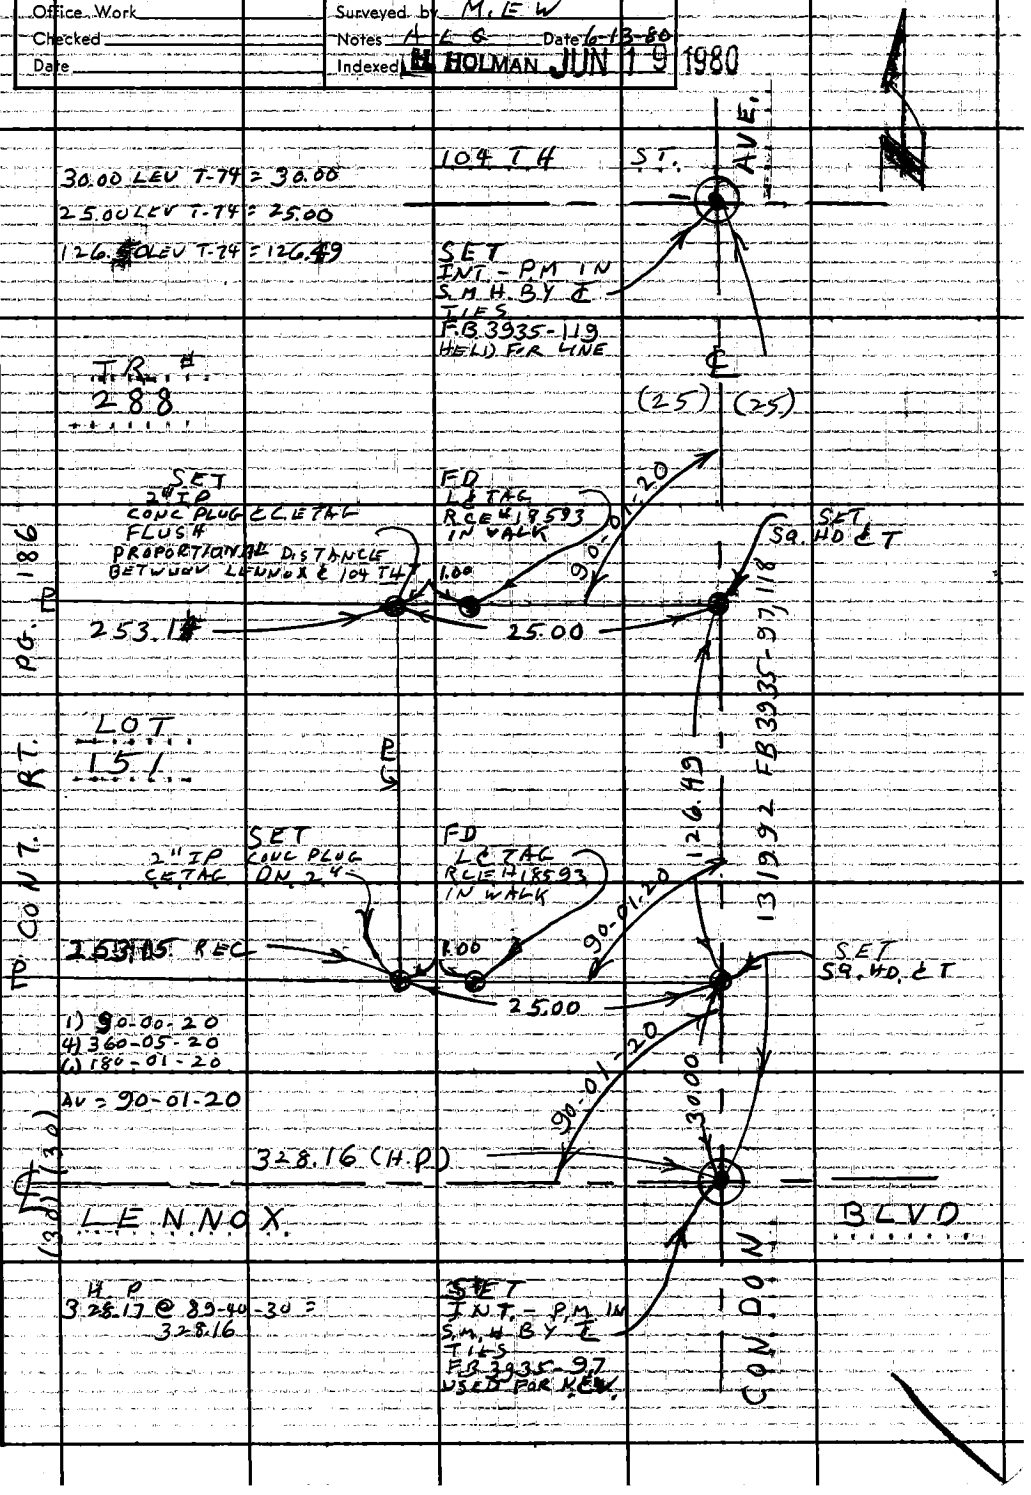

Note: Any Additions or Changes on This Sheet Must be Made or Circled in Red Ink With Date and Name of Person Making Change.

Do not extend this side of this line.

PLEASE RETURN TO LOS ANGELES COUNTY ENGINEER 403 LOS ANGELES COUNTY ENGINEERING BLDG.

76F309S CE #310 6-83

PWFB 0817 717

F.B. 3935 PG. 186

126.43 LEV T-74 = 126.42
253.16 LEV T-74 = 253.14
50.00 LEV T-74 = 50.00
30.00 LEV T-74 = 30.00

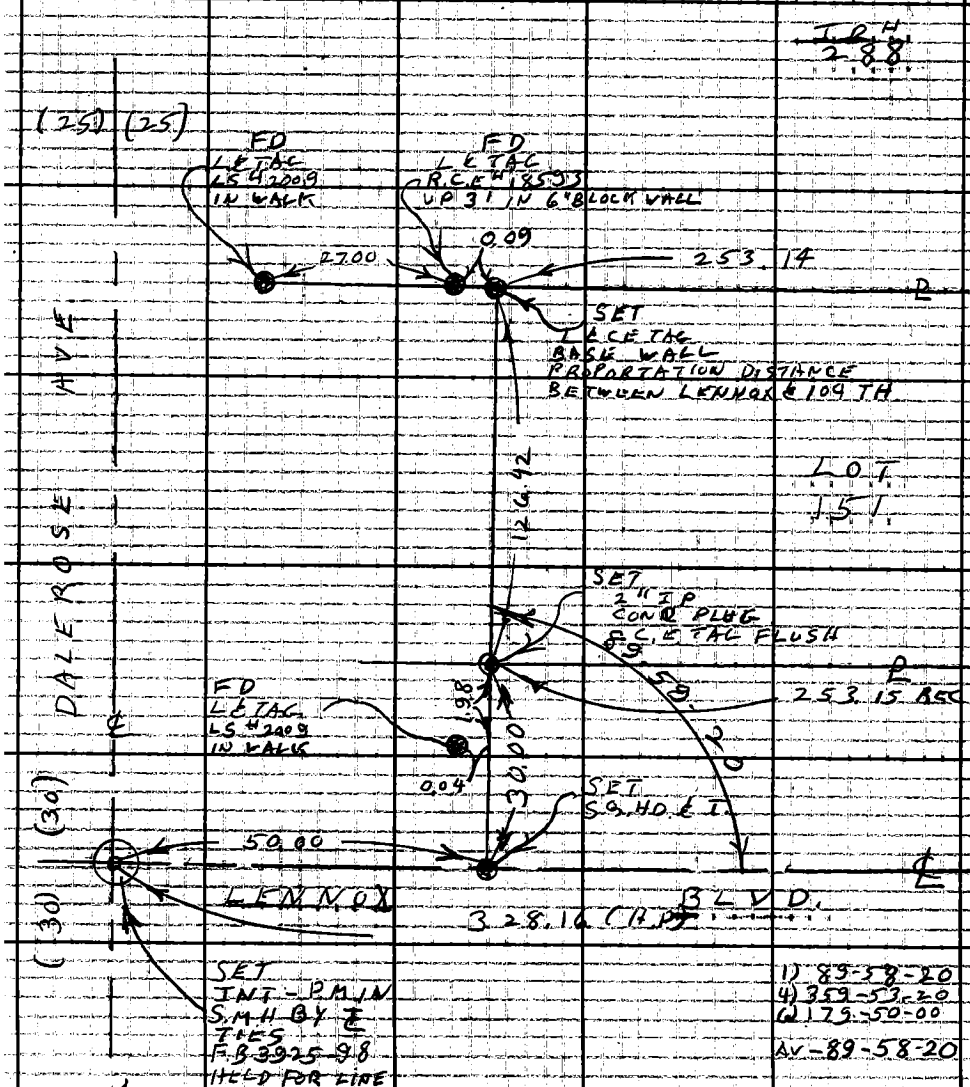

1) 89-58-20
4) 359-53-20
6) 179-50-00
AV - 89-58-20

CONT LT PG. 185

RELEASE RETURN TO
LOS ANGELES COUNTY ENGINEER
403 LOS ANGELES COUNTY ENGINEERING BLDG.
Do not extend this side of this line.
Note: Any Additions or Changes on This Sheet Must be Made or Circled in Red Ink With Date and Name of Person Making Change.

Notes Ck'd by J.F.	Survey of LENNOX SHERIFF STA.
Map No.	J.N. 1509.59 Tape 0255 Std. GB °F
Office Work	Surveyed by M.E. WACKER
Checked	Notes M.E.W. Date 3-5-81
Date	Indexed H. HOLMAN MAR 24 1981

F. B. 3935 Pg. 187

J.N. 1509.59

LENNOX SHERIFF STA.

HORIZONTAL CONTROL

FOR TOPOG.

REF:
F.B. 3935

PARTY
WACKER
PYLE
FALSEY

3-5-81

Note: Any Additions or Changes on this Sheet Must be Made or Circled in Red Ink With Date and Name of Person Making Change.

Please Return To
County of Los Angeles
Dept. of County Engineer-Facilities
550 So. Vermont Ave., Los Angeles #610
Do not extend this side of this line.

76F-309S-CE #310-12/79

Please Return To
County of Los Angeles
Dept. of County Engineer-Facilities
550 So. Vermont Ave. Los Angeles #610

Lys 24 B 5

Do not extend this side of this line.

Note: Any Additions or Changes on This Sheet Must be Made or Circled in Red Ink With Date and Name of Person Making Change.

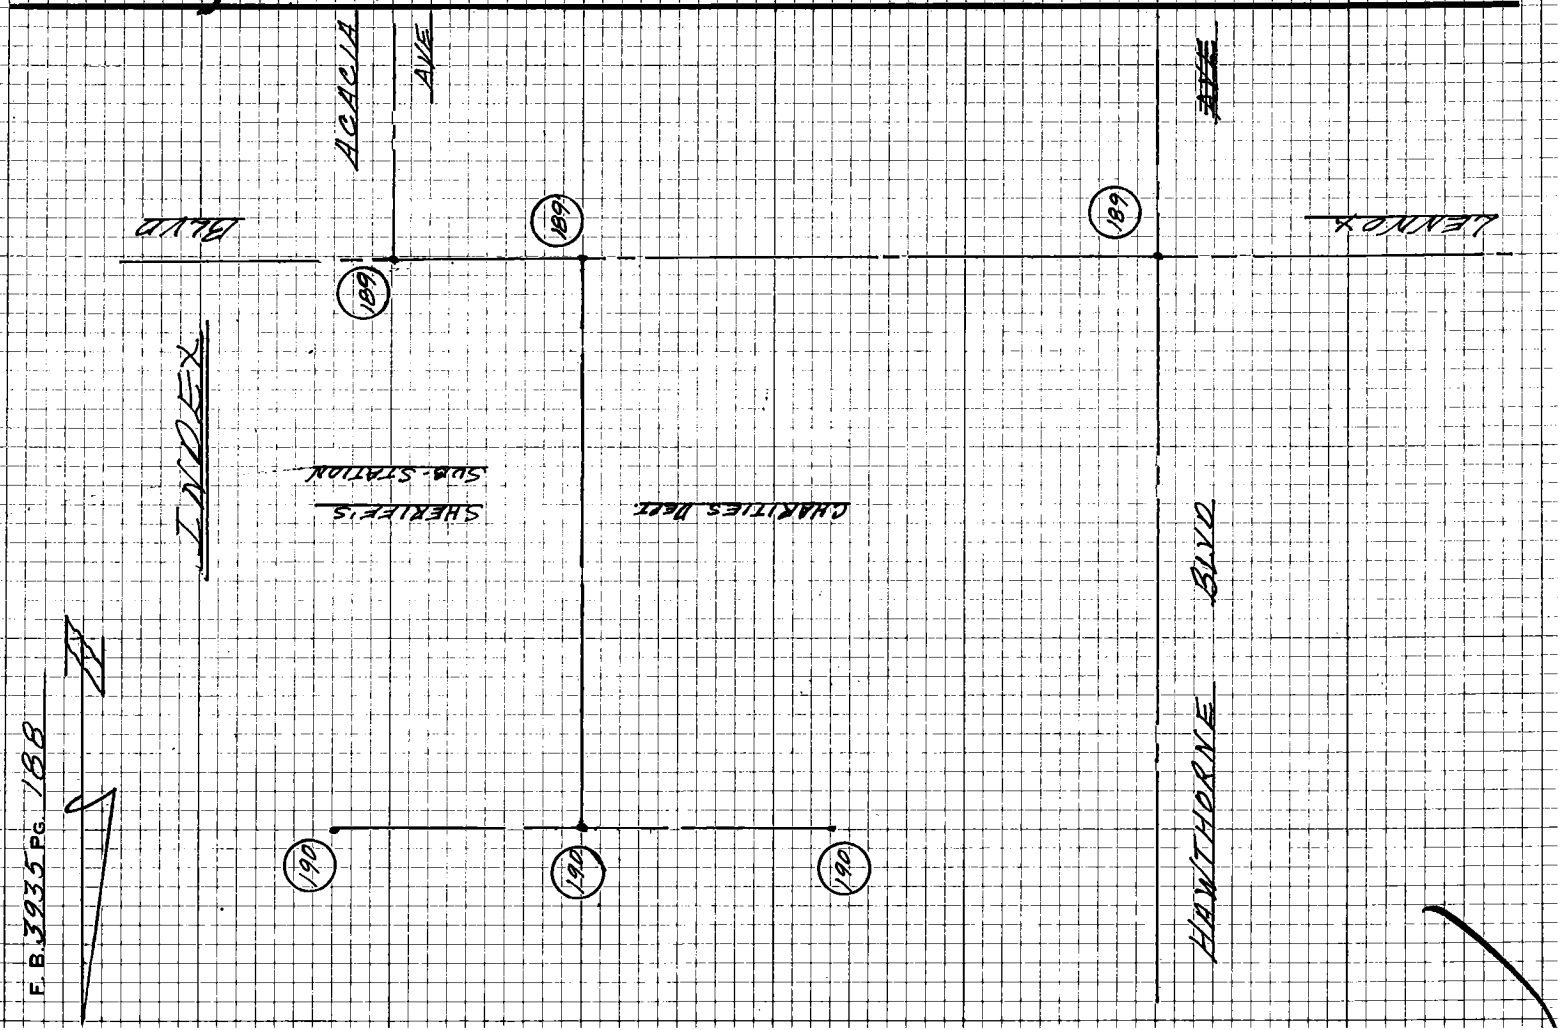

Notes Ck'd by J.F.	Survey of LENNOX SHERIFF STA.
Map No.	JN 1509.59 Tape 0255 Std 68 °F
Office Work	Surveyed by M.E. WACKER
Checked	Notes M.E.W. Date 3-81
Date	Indexed H. HOLMAN MAR 24 1981

F. B. 3935 PG. 189

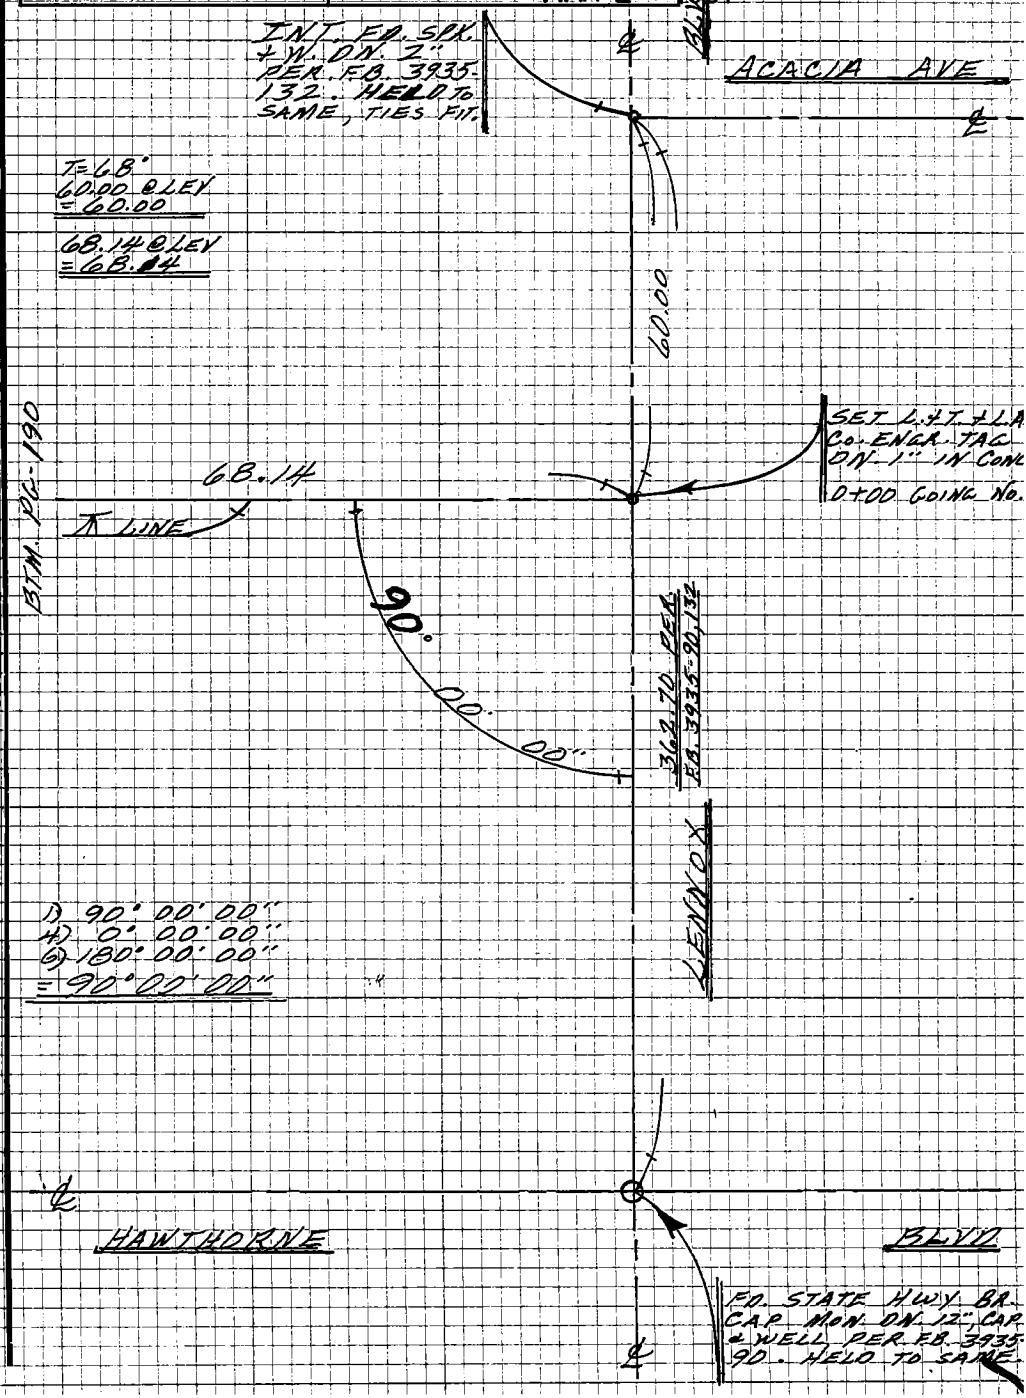

Note: Any Additions or Changes on This Sheet Must be Made or Circled in Red Ink With Date and Name of Person Making Change.

Please Return To
County of Los Angeles
Dept. of County Engineer-Facilities
550 So. Vermont Ave. - Los Angeles #610
Do not extend this side of this line.

N524B.5

76F309S CE #310 12/79

F. B. 3935 PG. 190

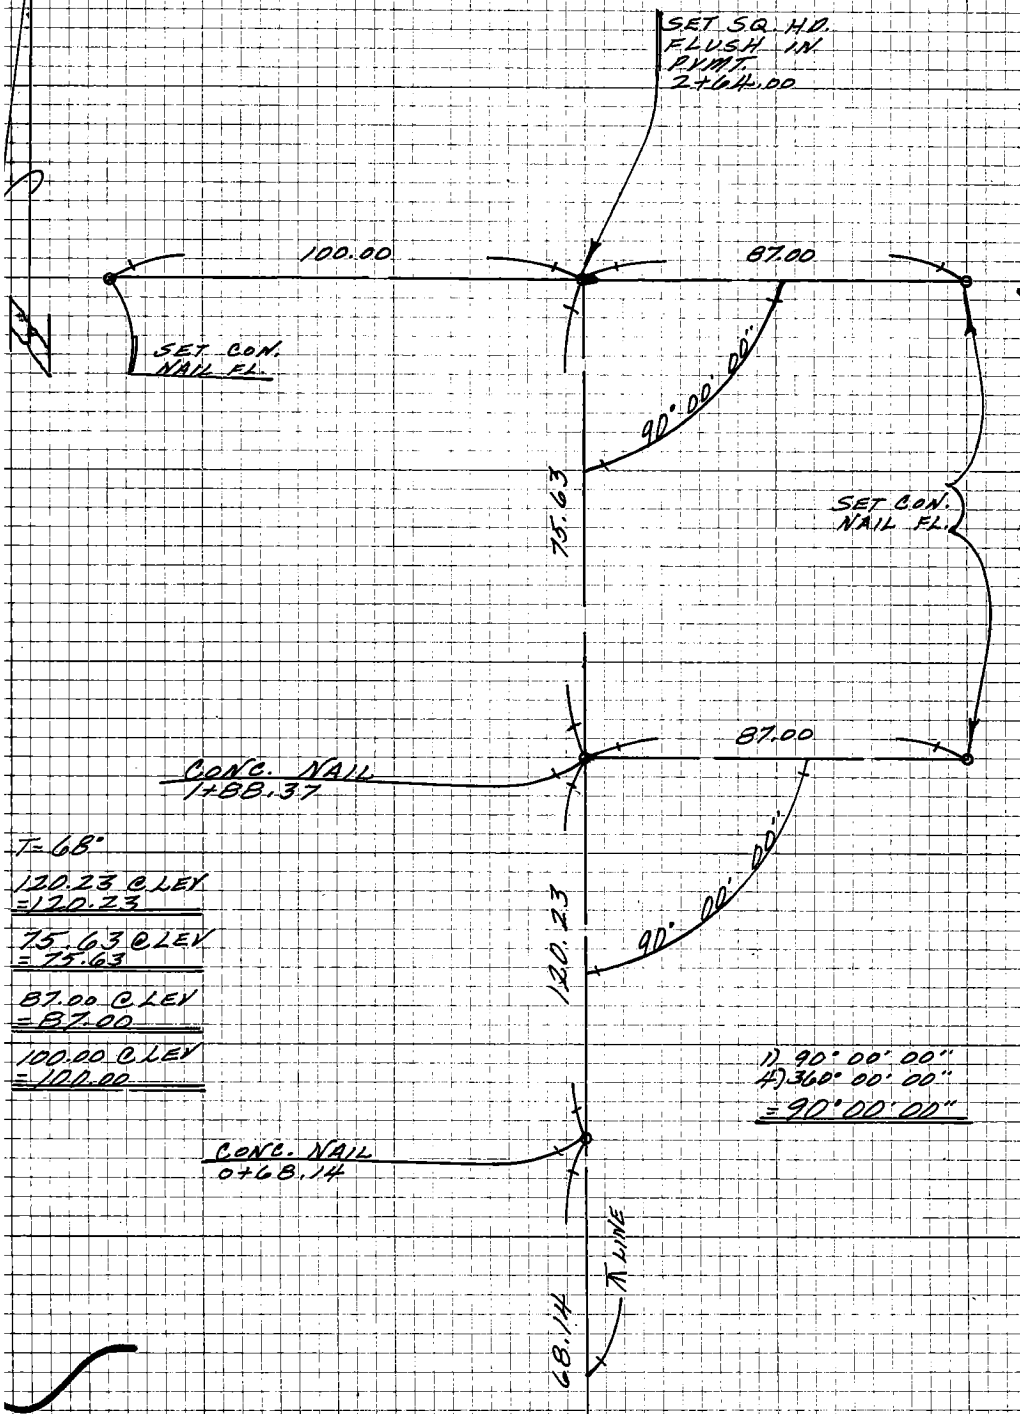

Δ = 68°

120.23 @ LEV
= 120.23

75.63 @ LEV
= 75.63

87.00 @ LEV
= 87.00

100.00 @ LEV
= 100.00

1) 90° 00' 00"
4) 360° 00' 00"
= 90° 00' 00"

W.S. 248-5

Please Return To
County of Los Angeles
Dept. of County Engineer-Facilities
5500 Fremont Ave., Los Angeles #610

Do not extend this side of this line.

Note: Any Additions or Changes on This Sheet Must be Made or Circled in Red Ink With Date and Name of Person Making Change.

IT PG. 189

F. B. 3935 PG. 191

Profile No. | Notes Red | Plotted | Job No. 1509.59 Division No.
Date 3\6\81 | Date | Survey of
X-Sec. No. | Notes Chk'd. J.F. | Checked | Survey by M. E. W. Notes C.A.PYLE Date 3\6\81
Date | Date | Map No. | Indexed H. HOLMAN Date MAR 24 1981

NOTE: ANY ADDITIONS OR CHANGES ON THIS SHEET MUST BE MADE OR CIRCLED IN RED INK, WITH DATE AND NAME OF PERSON MAKING CHANGE.

Do not extend notes this side of this line.

PLEASE RETURN TO
LOS ANGELES COUNTY ENGINEER
403 Los Angeles County Engineering Bldg.

LENNOX SHERIFF STA.

DRAINAGE MODIFICATION

VERTICAL CONTROL

FOR TOPOG.

STATION	B. S.	H. I.	F. S.	ELEV.
	REF. FB741-129 FB1198-314			

PARTY
M.E. WACKER
C.A. PYLE
J.R. FALSEY

76-L-298 CE 307 8-70

76-L-298 CE 307 8-70

PLEASE RETURN TO
LOS ANGELES COUNTY ENGINEER
403 LOS ANGELES COUNTY ENGINEERING BLDG.

NOTE: ANY ADDITIONS OR CHANGES ON THIS SHEET MUST BE MADE OR CIRCLED IN RED INK, WITH DATE AND NAME OF PERSON MAKING CHANGE.

Do not extend notes this side of this line.

STATION	B. S.	H. I.	F. S.	ELEV.	
BM PH-4				75 87	B.M. PH-4 FREEMAN AVE & 107TH ST., N.W. COR L&T IN WALK OF HOUSE #10625 F.B. 741-129 & FB 1198-314
	5 17	81 04			
P			5 925	75 115	
	5 115	80 23			
P			5 37	74 86	
	4 71	79 57			
P			5 44	74 13	
	4 89	79 02			
P			5 99	73 03	
	4 71	77 74			
P			5 61	72 13	
	4 77	76 90			
T.B.M. 1			4 68	72 22	T.B.M 1 - CH "+" IN TOP OF REBAR IN CONC. FT NO ADJ. TO S.W. COR. OF PLANTER BOX \ BARRIER IN FRONT OF SHERIFF'S STA. @ 4331 LENNOX BLVD.
	5 02	77 24			
T.B.M. 2			2 36	74 88	T.B.M 2 - TOP OF 4"x4" AIRON CORNER PROTECTOR ON S.E. COR. OF N. ELY PORTION OF JUVENILE & DETECTIVE BLDG.
	3 18	78 06			
T.B.M. 3			4 54	73 52	TBM 3 - CH "+" IN TOP OF S.W. ANCHOR BOLT OF WLY. SUPPORT STANCHION FOR GAS ISLAND ROOF
	4 47	77 99			
P			3 06	74 93	
	2 18	77 11			
B.M.			6 03	71 08	N.E. COR. BM FB 1198-314 & FB 1439-30 LENNOX BLVD. & HAWTHORNE AVE. BT SPK. IN CB. 15' ± E. OF E. END OF C.R.

F.B. 3935 PG. 192

Job No. 1509.59 Division No. ____ Notes Red ____ Plotted ____ Profile ____

Survey of LENNOX SHERIFF STATION Date 3/5/81 Date ____ No. ____

Survey by J.F. Notes J.F. Notes Chk'd. ____ Checked ____ X-Sec. ____

Indexed ____ Date ____ Date ____ Date ____ No. ____

Notes Ck'd by	Survey of LENNOX SHER. STA
Map No.	JN 0208.11 Tape Std °F
Office Work	Surveyed by G GUIZADO
Checked	Notes G.O.G. Date 7-30-81
Date	Indexed H. HOLMAN AUG 6 1981

F. B. 3935 Pg. 193

LENNOX SHERIFF STATION
DRAINAGE MODIFICATIONS

STAKING OF CATCH BASINS AND DRAIN LINES

PER

SPEC. Nº 4167

REFER:
F.B. 3935
SPEC. Nº 4167

GUIZADO
GOBLE
McCOY

Please Return To
County of Los Angeles
Dept. of County Engineer-Facilities
550 So. Vermont Ave., Los Angeles #610
Do not extend this side of this line.

Note: Any Additions or Changes on This Sheet Must be Made or Circled in Red Ink With Date and Name of Person Making Change.

76F309S-GE #310 12/79

F. B. 3935 PG. 194

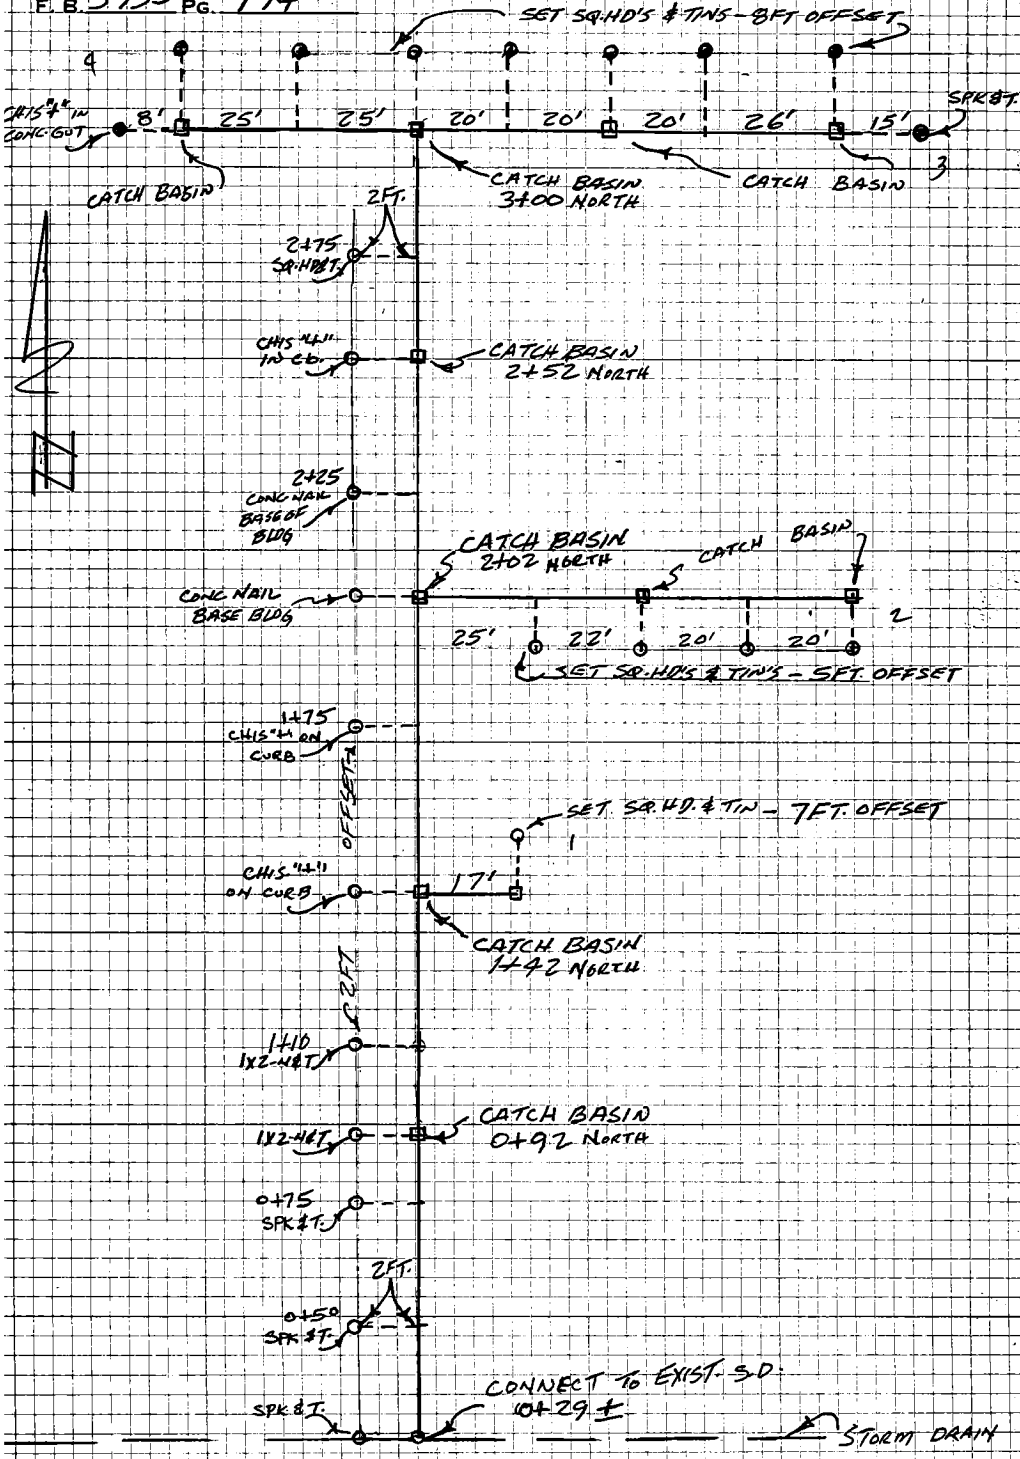

Please Return To
County of Los Angeles
Dept. of County Engineer-Facilities
550 So. Vermont Ave. - Los Angeles #610

Note: Any Additions or Changes on This Sheet Must be Made or Circled in Red Ink With Date and Name of Person Making Change.

Do not extend this side of this line.

F. B. 3935 PG. 195

Profile No. | Notes Red | Plotted | Job No. | Division No.
Date | Date | Survey of LENNOX SHERIFF STATION
X-Sec. No. | Notes Chk'd. | Checked | Survey by G.GUIZADO Notes G-09 Date 7-30-81
Date | Date | Map No. | Indexed H. HOLMAN Date AUG 6 1981

LENNOX SHERIFF STATION

DRAINAGE MODIFICATIONS

GRADES FOR DRAIN
AND CATCH BASIN

PER SPEC. No. 4167

JN 0208.11

STATION	B.S.	H.I.	F.S.	ELEV.

GUIZADO
GOBLE
McCOY

NOTE: ANY ADDITIONS OR CHANGES ON THIS SHEET MUST BE MADE OR CIRCLED IN RED INK, WITH DATE AND NAME OF PERSON MAKING CHANGE.

Do not extend notes this side of this line.

PLEASE RETURN TO
LOS ANGELES COUNTY ENGINEER
403 Los Angeles County Engineering Bldg.

76-L-298 CE 307 5-66

2+52 72.57

PLEASE RETURN TO
LOS ANGELES COUNTY ENGINEER
403 LOS ANGELES COUNTY ENGINEERING BLDG.

NOTE: ANY ADDITIONS OR CHANGES ON THIS SHEET MUST BE MADE OR CIRCLED IN RED INK, WITH DATE AND NAME OF PERSON MAKING CHANGE.

Do not extend notes this side of this line.

F. B. 3935 PG. 196 | Job No. 0208.4 Division No. Notes Red Plotted Profile
Survey of LENNOX SHERIFF STATION Date 7-30-81 Date No. X-Sec.
Survey by G.016 Notes G. GUZADO Notes Chk'd. Checked
Indexed Date Date No.

STATION	B. S.	H. I.	F. S.	ELEV.				
T.B.M. 1				72	22	T.B.M.1 EL.: 72.22 FB 3955-192		
						GRADE	CUT/FILL	
0+29 (SPK&T)				71	42	67.57	C-3.85	CONNECTION @ DRAIN
0+50 "				70	86	67.87	C-2.99	
0+75 "				71	72	68.23	C-3.49	
0+92 (1X2-NAT)				71	82	71.62	C-0.20	FINISH GRADE @ GRATE
0+92 (1X2 DET)				71	82	68.48	C-3.34	INVERT.
1+10 (1X2-NAT)				71	86	68.58	C-3.28	
1+42 (CHIS"4"CB)				72	48	71.89	C-0.59	FINISH GRADE @ GRATE
" "				72	48	68.61	C-3.87	INVERT.
1+75 (CHIS"4"CB)				72	47	68.72	C-3.75	
2+02 (CONC. NAIL-BLDG)				72	38	71.90	C-0.48	FINISH GRADE @ GRATE
" "				72	38	68.76	C-3.63	INVERT
2+25 (CONC. NAIL BLDG)				72	68	69.02	C-3.66	
2+52 (CHIS"4"CB)				72	94	69.05	C-3.89	INVERT.
" "				72	94	72.57	C-0.37	FINISH GRADE @ GRATE
2+75 (SPK&TIN)				72	68	69.08	C-3.60	
3+08 (SPK&TIN)				72	66	69.10	C-3.56	INVERT.
3+08 (SPK&TIN)				72	66	72.15	C-0.51	FINISH GRADE @ GRATE

76-L-298 CE 307 5-66

PLEASE RETURN TO
LOS ANGELES COUNTY ENGINEER
403 LOS ANGELES COUNTY ENGINEERING BLDG.

NOTE: ANY ADDITIONS OR CHANGES ON THIS SHEET MUST BE MADE OR CIRCLED IN RED INK, WITH DATE AND NAME OF PERSON MAKING CHANGE.

Do not extend notes this side of this line.

STATION	B. S.	H. I.	F. S.	ELEV.	GRADE	CUT/FILL	
1+42 LATERAL				72 03	68.93	C-3.10	17 FT RIGHT (EAST) INVERT
" "				72 03	71.63	C-0.40	" " " " FINISH @ GRATE
2+02 LATERAL				72 18	68.86	C-3.32	25 FT. RT (EAST)
" "				72 25	68.88	C-3.37	47 FT. RT (EAST) INVERT
" "				72 25	71.75	C-0.50	47 FT RT (EAST) FINISH GR. @ GRATE
" "				72 34	68.98	C-3.36	67 FT. RT. (EAST)
2+02 LATERAL				72 42	69.00	C-3.42	87 FT. RT (EAST) INVERT
" "				72 42	71.75	C-0.67	87 FT. RT. (EAST) FINISH GR. @ GRATE
3+00 LATERAL				72 66	69.18	C-3.48	CATCH BASIN INVERT (EAST)
" "				72 68	69.20	C-3.48	20 FT. RT (EAST)
" "				72 72	72.14	C-0.58	40 FT. RT (EAST) FINISH @ GRATE
" "				72 72	69.22	C-3.50	40 FT. RT (EAST) INVERT
3+00 LATERAL				72 72	69.32	C-3.40	60 FT. RT. (EAST)
"				72 71	69.35	C-3.36	86 FT. RT. (EAST) INVERT.
"				72 71	72.10	C-0.61	86 FT. RT. (EAST) FINISH GR. @ GRATE
"				72 75	—	—	101 FT RT (EAST) ℄
"				72 66	69.26	C-3.40	INVERT @ CATCH BASIN (WEST)
"				72 64	69.28	C-3.36	25 FT. LT. (WEST)
"				72 61	69.31	C-3.30	50 FT. LT. (WEST) INVERT
"				72 61	72.06	C-0.55	50 FT. LT. (WEST) FIN. GR @ GRATE

Profile Notes Red ____ Plotted ____ Job No. 0208.11 Division No. ____ F.B. 3935 PG. 197
No. ____ Date ____ Date ____ Survey of LENNOX SHERIFF STATION
X-Sec. Notes Chk'd. ____ Checked ____ Survey by G.O.G. Notes G. GUZMAN Date 7-30-81
No. ____ Date ____ Date ____ Map No. ____ Indexed H. HOLMAN Date AUG 6 1981

76-L-298 CE 307 5-66

PLEASE RETURN TO
LOS ANGELES COUNTY ENGINEER
403 Los Angeles County Engineering Bldg.

NOTE: ANY ADDITIONS OR CHANGES ON THIS SHEET MUST BE MADE OR CIRCLED IN RED INK, WITH DATE AND NAME OF PERSON MAKING CHANGE.

Do not extend notes this side of this line.

F. B. 3935 Pg. 198 | Job No. 0208.11 | Division No. | Notes Red | Plotted | Profile
Survey of LENNOX SHERIFF STATION | Date 7-30-81 | Date | No.
Survey by G.C.G. | Notes G. GUIZADO | Notes Chk'd. | Checked | X-Sec.
Indexed | Date | Date | Date | No.

STATION	B. S.	H. I.	F. S.	ELEV.	GRADE	CUT / FILL	
3400 LATERAL				72 34	—	—	58 FT. LT. (WEST)
TBM-3				73 52	T.B.M.-3 EL. 73.52 FB 3955-192		