| Notes Ck'd by | Survey of | F.B. 4005 Pg. |
|---|---|---|
| Map No. | JN Tape Std °F | |
| Office Work | Surveyed by | |
| Checked | Notes Date | |
| Date | Indexed | |

| TRACT | PAGE | FIRM |
|---|---|---|
| 28481 | 1-27 | E.L. Pearson & Assoc. |
| P.M. 1107 | 28-30 | Jennings-Halderman-Hood |
| 27577 | 31-39 | Lanco Eng. Co. |
| 29296 | 40 | William L. Schulz |
| 27979 | 41-63 | Jennings-Halderman-Hood |
| 28367 | | ng. Co. |
| 28173 | | " " |
| 28431 | | & Quiros |
| P.M. 1465 | | lake & Wynne |
| 26894 | | on |
| 28212 | | Welsh |
| 27821 | | man |
| 29072 | | ice Corp. |
| 28297 | | Eng's. |
| 29739 | [illegible] | Verpet Eng. |
| 28489 | 113-125 | E.L. Pearson & Assoc. |
| 28482 | 126-149 | " " " " |
| 28949 | 150-164 | Ervin Engineering |
| 30985 | 165-171 | Verpet Eng. Co. |

4005

Scan pages 74-81 for Santa Clarita LIW

Co. Eng. F.B. 4005: 1

SURVEY OF _____ F. B. _____ Pg. _____

SURVEY BY E. L. Pearson & Assoc. RE 9783 TR. No. 28481

DATE 1-12-70

# Centerline Ties Tr. No. 28481

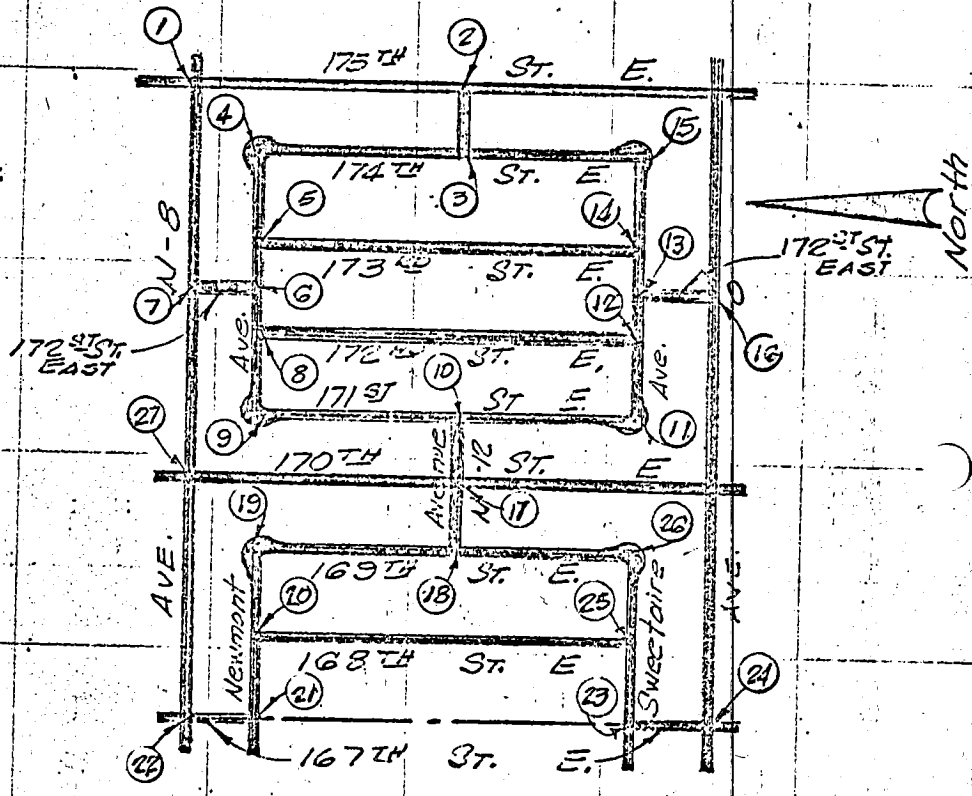


Note: All Centerline Mon Are Spike & Tin & Tag Unless Noted

All Ties Are 2x2's Buried 6" Deep Unless Noted

X

SO. CALIF. BLUE PRINT CO.

Co. Eng. F.B. 4005:2

F. B. _____ PG. _____ SURVEY OF _____

TR. No. 28481 SURVEY BY E.L. Pearson & Assoc. R.E.9783

DATE 1-12-70

Sheet 1

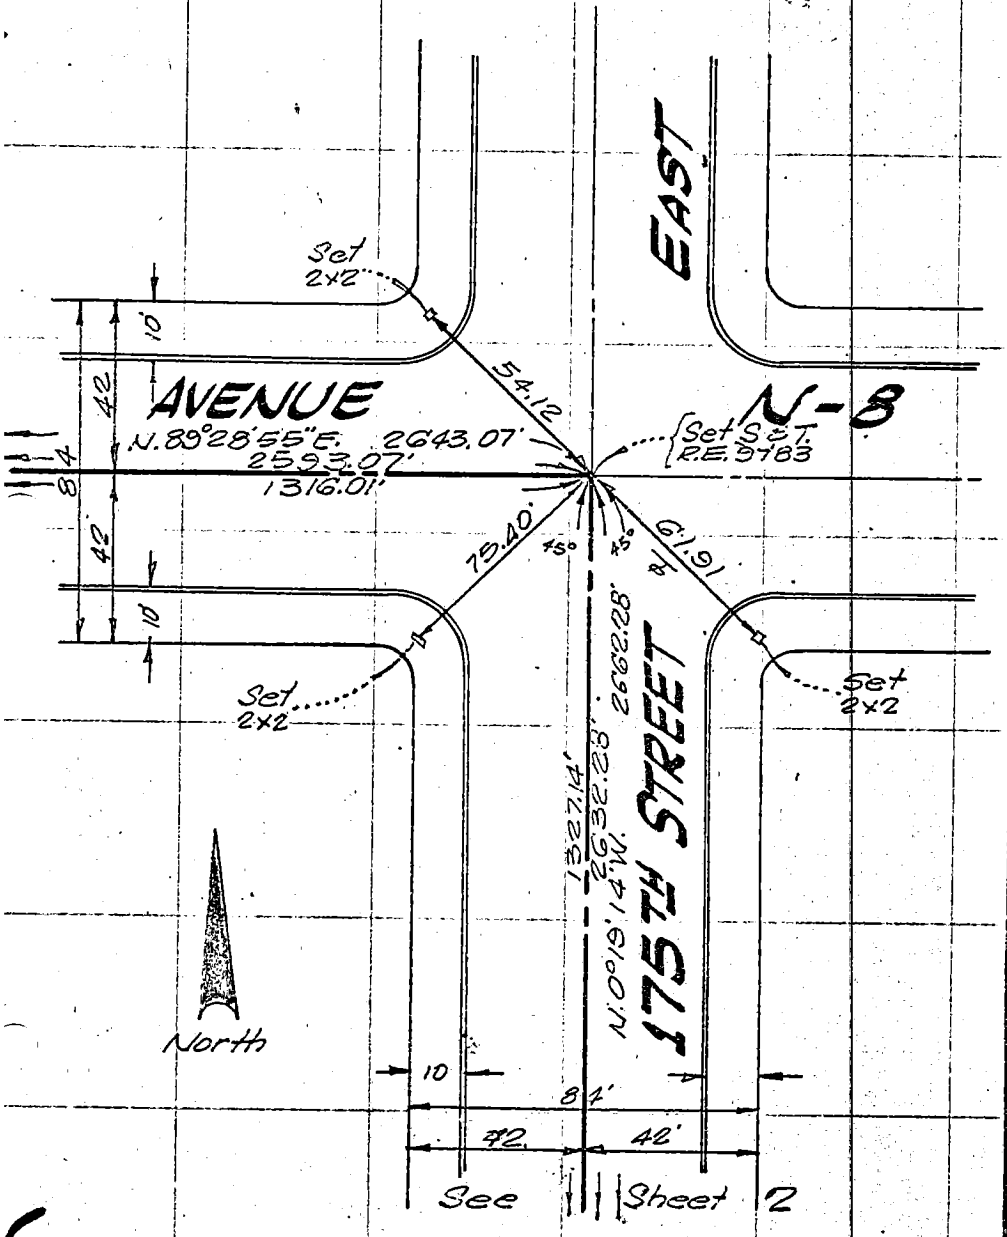

Co. Eng. F.B. 4005: 3

SURVEY OF _____ F. B. _____ PG. _____

SURVEY BY E.L. Pearson & Assoc. R.E. 9783 TR. No. 28481

DATE 1-12-70

Sheet 2

W.S. 67N-1

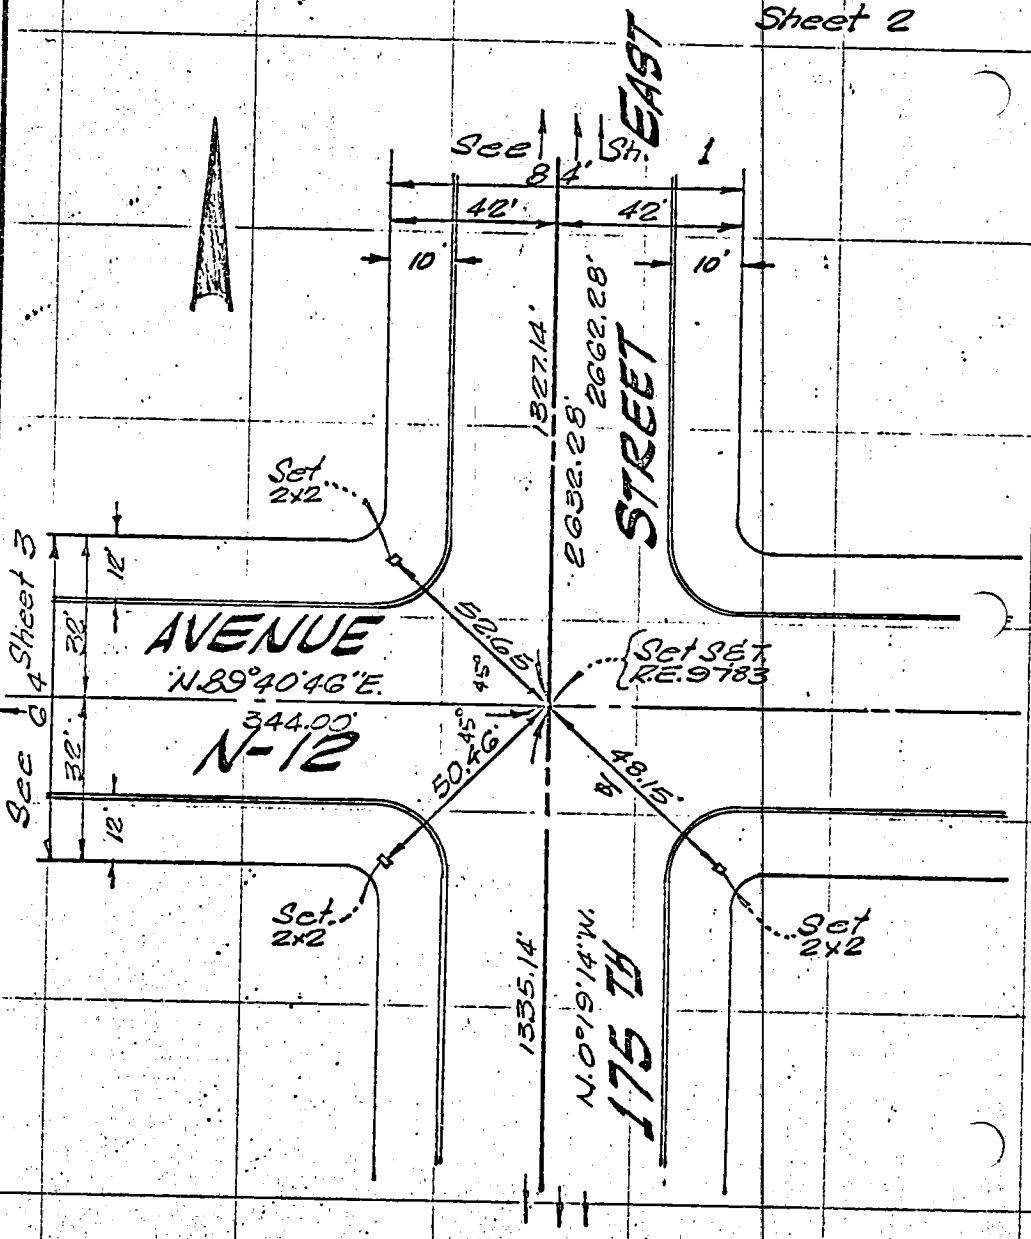


SO. CALIF. BL... PRINT CO.

Co. Eng. F.B. 4005: 4.

F. B. _____ PG. _____ SURVEY OF _____

R. No. 28481 SURVEY BY E.L. Pearson & Assoc. R.E. 9783

DATE 1-12-70

Sheet 3

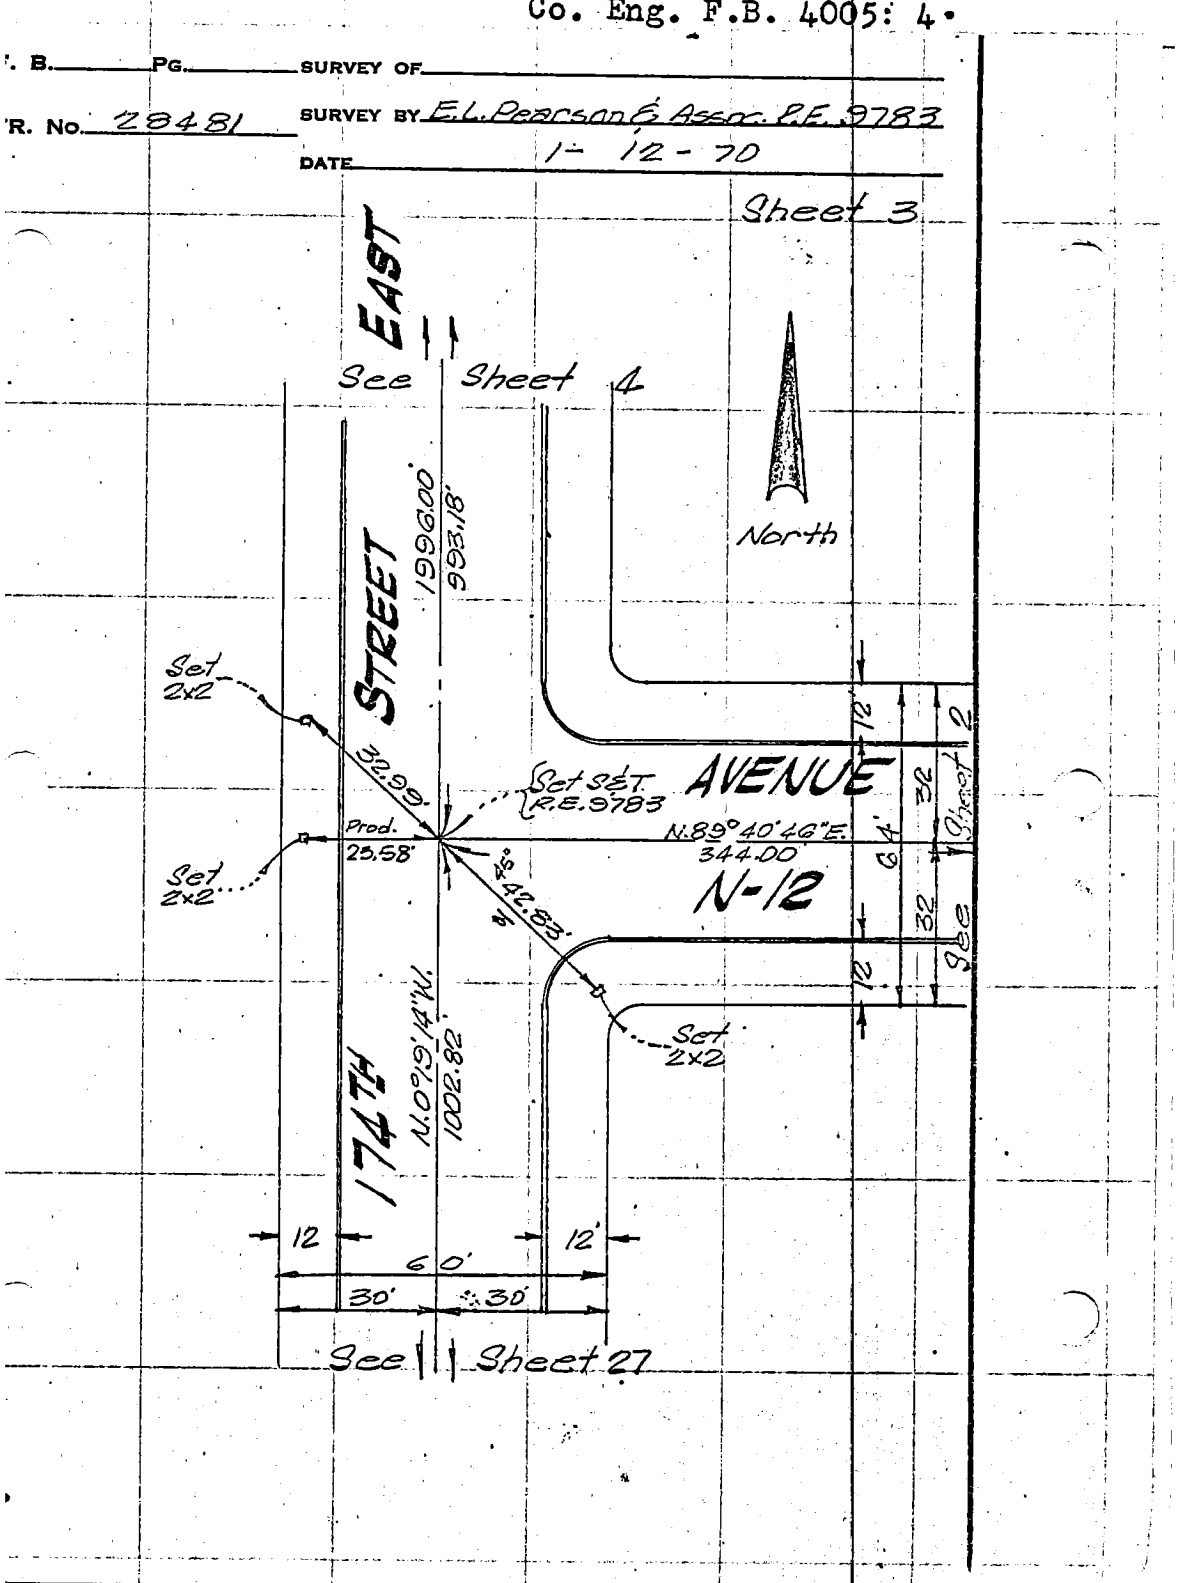

Co. Eng. F.B. 4005: 5

SURVEY OF _____ F. B. _____ PG. _____

SURVEY BY E.L. Pearson & Assoc. R.E. 9783 TR. No. 28481

DATE 1-12-70

Sheet 4

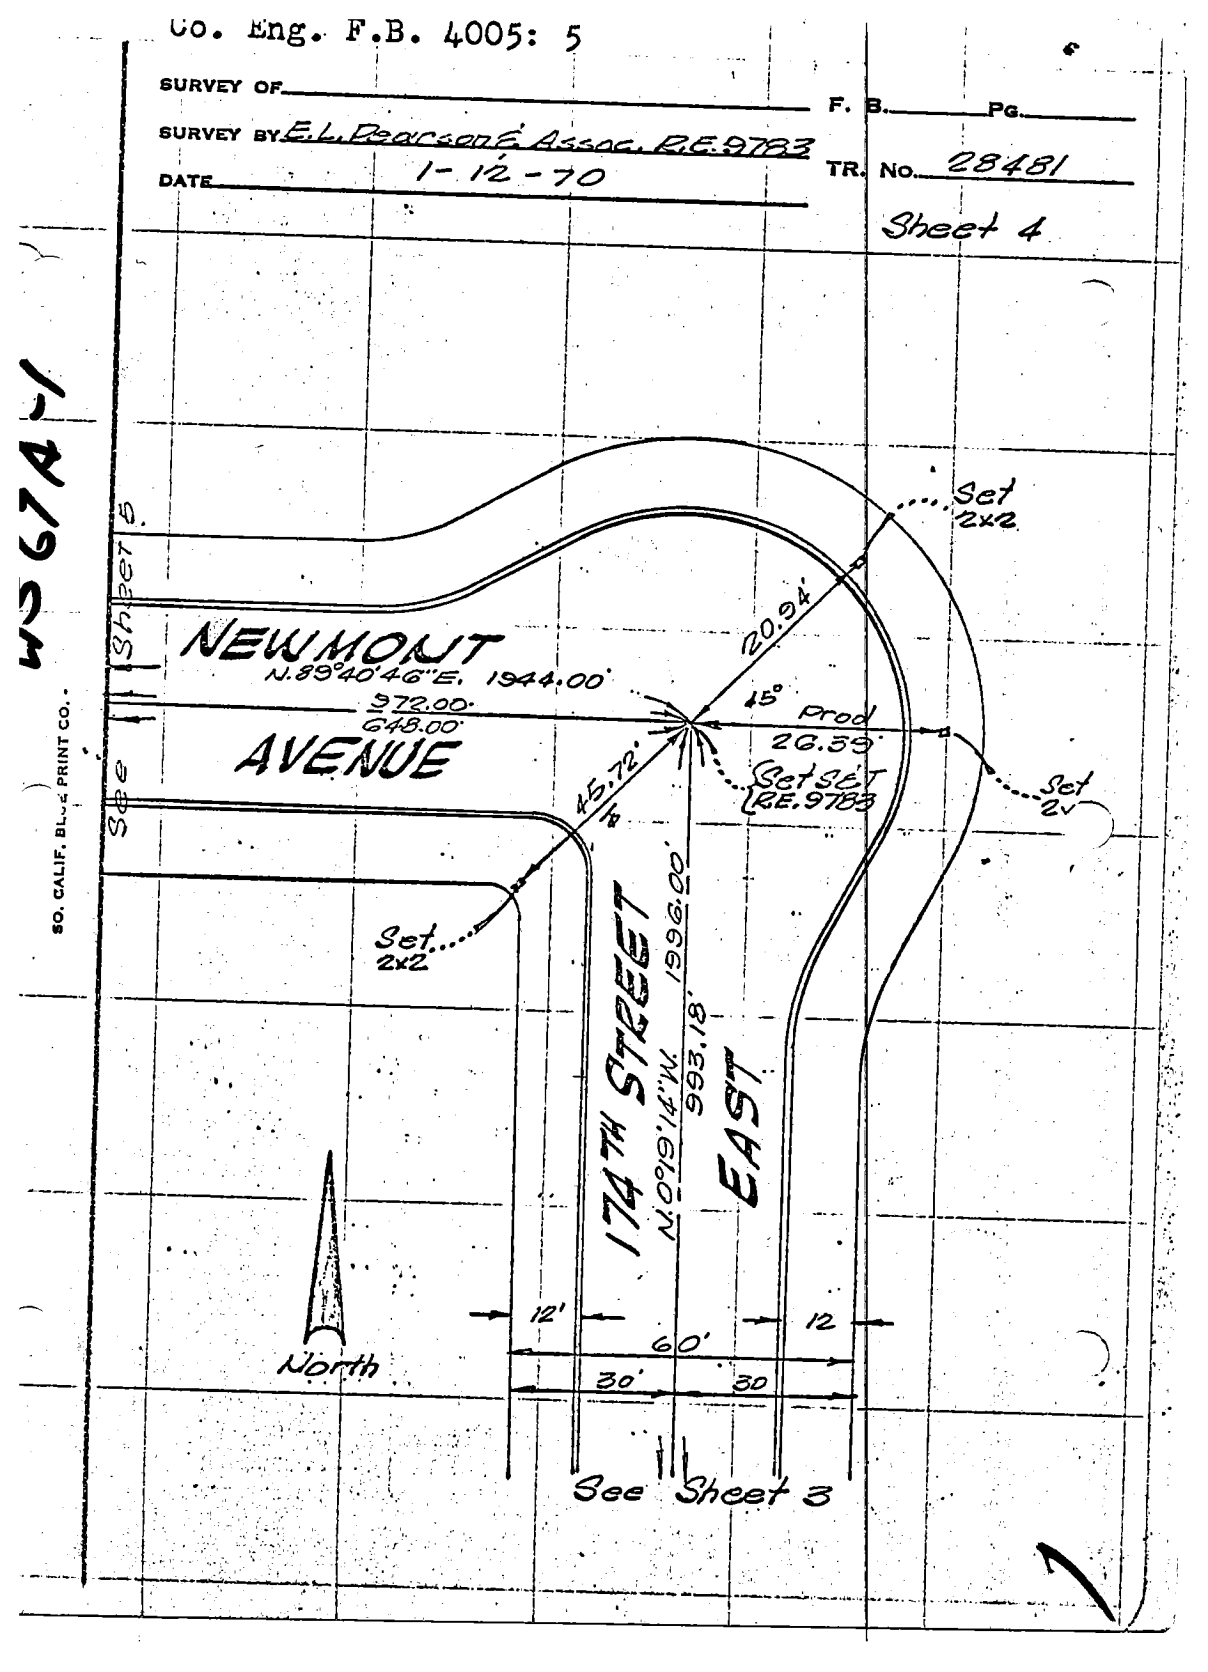


SO. CALIF. BLUE PRINT CO.

1

Co. Eng. F.B. 4005: 6

F. B. _____ Pg. _____ SURVEY OF _____

TR. No. 28481 SURVEY BY E. L. Pearson & Assoc. R.E. 9783

DATE 1 - 12 - 70

Sheet 5

North

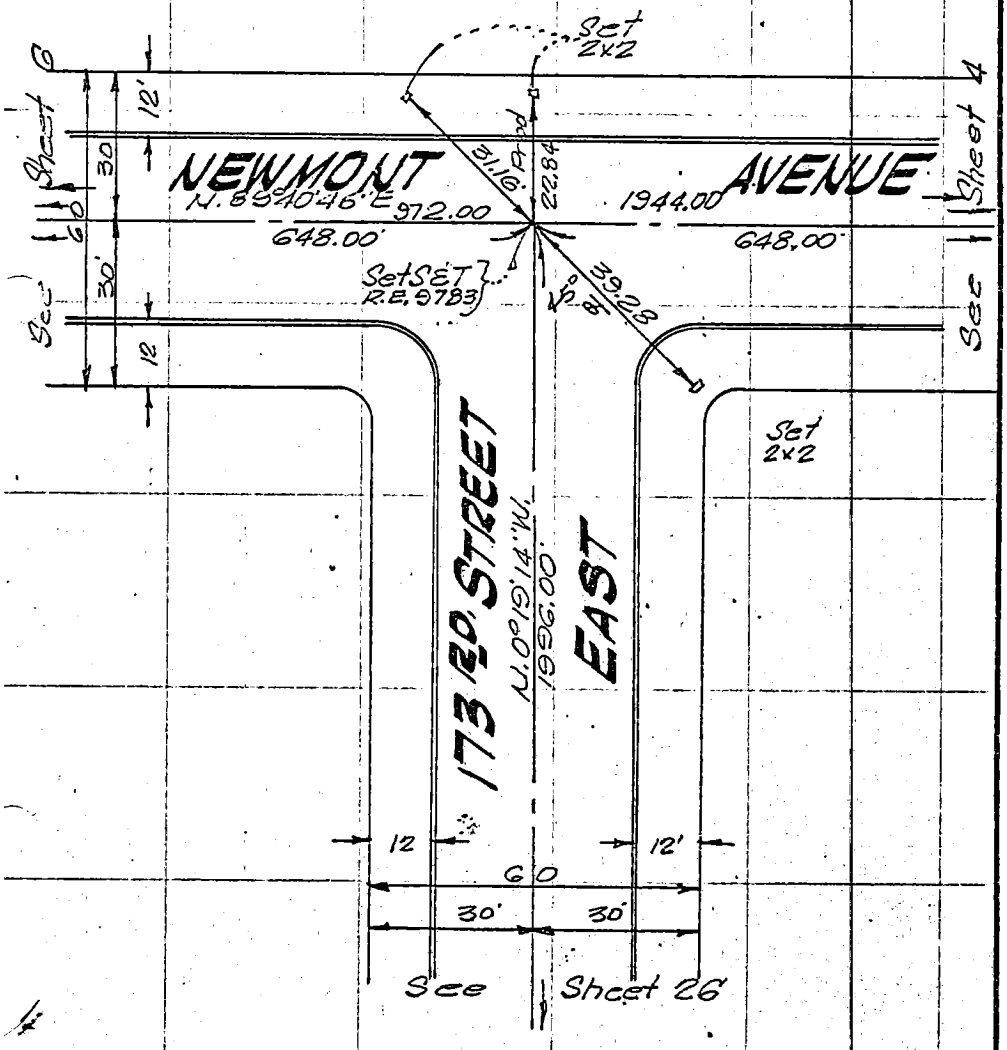

Co. Eng. F.B. 4005: 7

SURVEY OF _____ F. B. _____ Pg. _____

SURVEY BY E.L. Pearson & Assoc. R.E. 9783 TR. No. 28481

DATE 1 - 12 - 70

Sheet 6

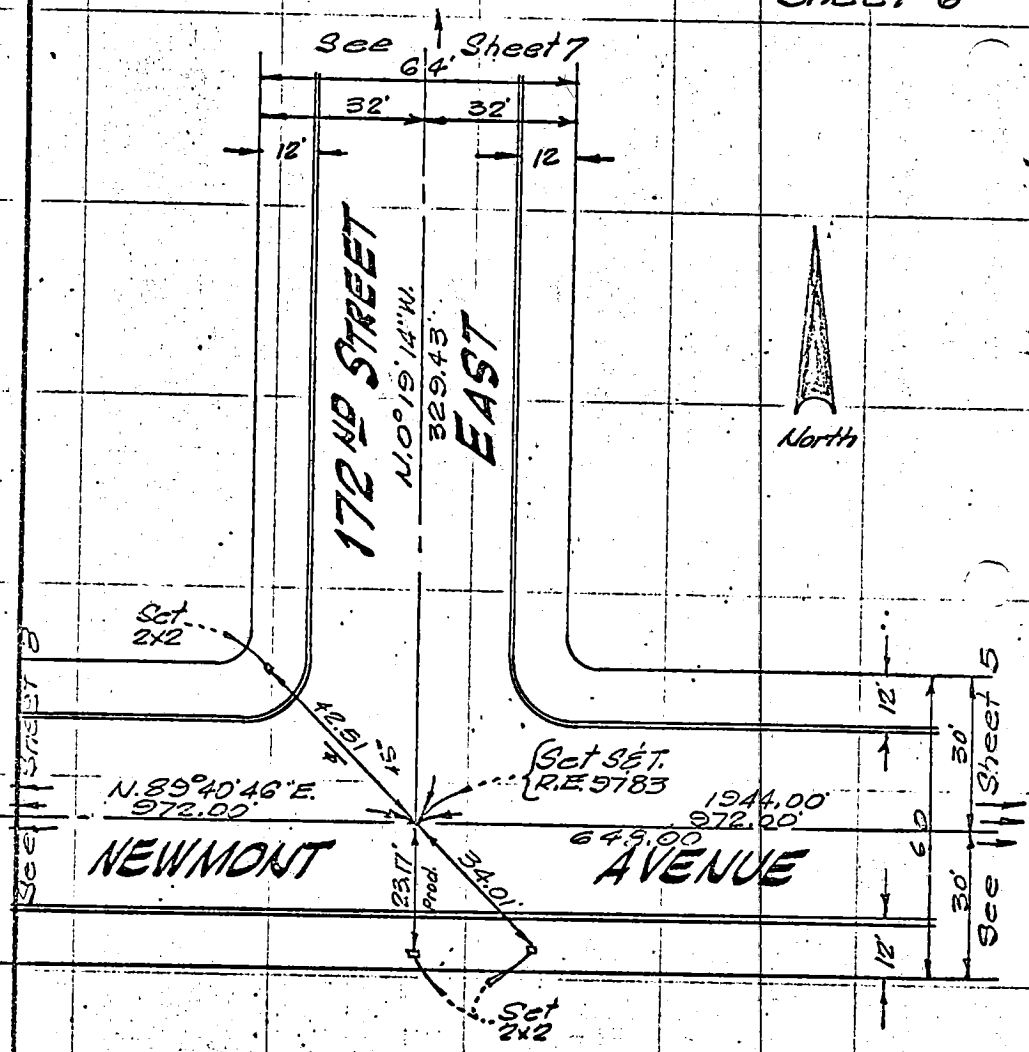


SO. CALIF. BLUE PRINT CO.

Co. Eng. F.B. 4005:8

F. B. _____ Pg. _____ SURVEY OF _____

TR. No. 28481 SURVEY BY E.L. Pearson & Assoc. RE.9783

DATE 1 - 12 - 70

Sheet 7

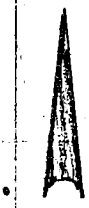

North

Set 2x2

Set 2x2

43.48

46.78

AVENUE

N.89°28'55"E.

1327.06'

45°

45°

2593.07

1316.01'

N - 8

2643.07

12

42

84

42

12

See Sheet 1

43.86

Set SET. R.E. 9783

Set 2x2

172 ND. ST.

N0°15'14"W.

329.43'

EAST

12'

64'

12'

32'

32'

See Sheet 6

Co. Bldg. P.B. 4005: 9

SURVEY OF _____ F. B. _____ PG. _____

SURVEY BY E.L. Pearson & Assoc. R.E. 9783 TR. No. 28481

DATE 1-12-70

Sheet 8

LMS 674.1

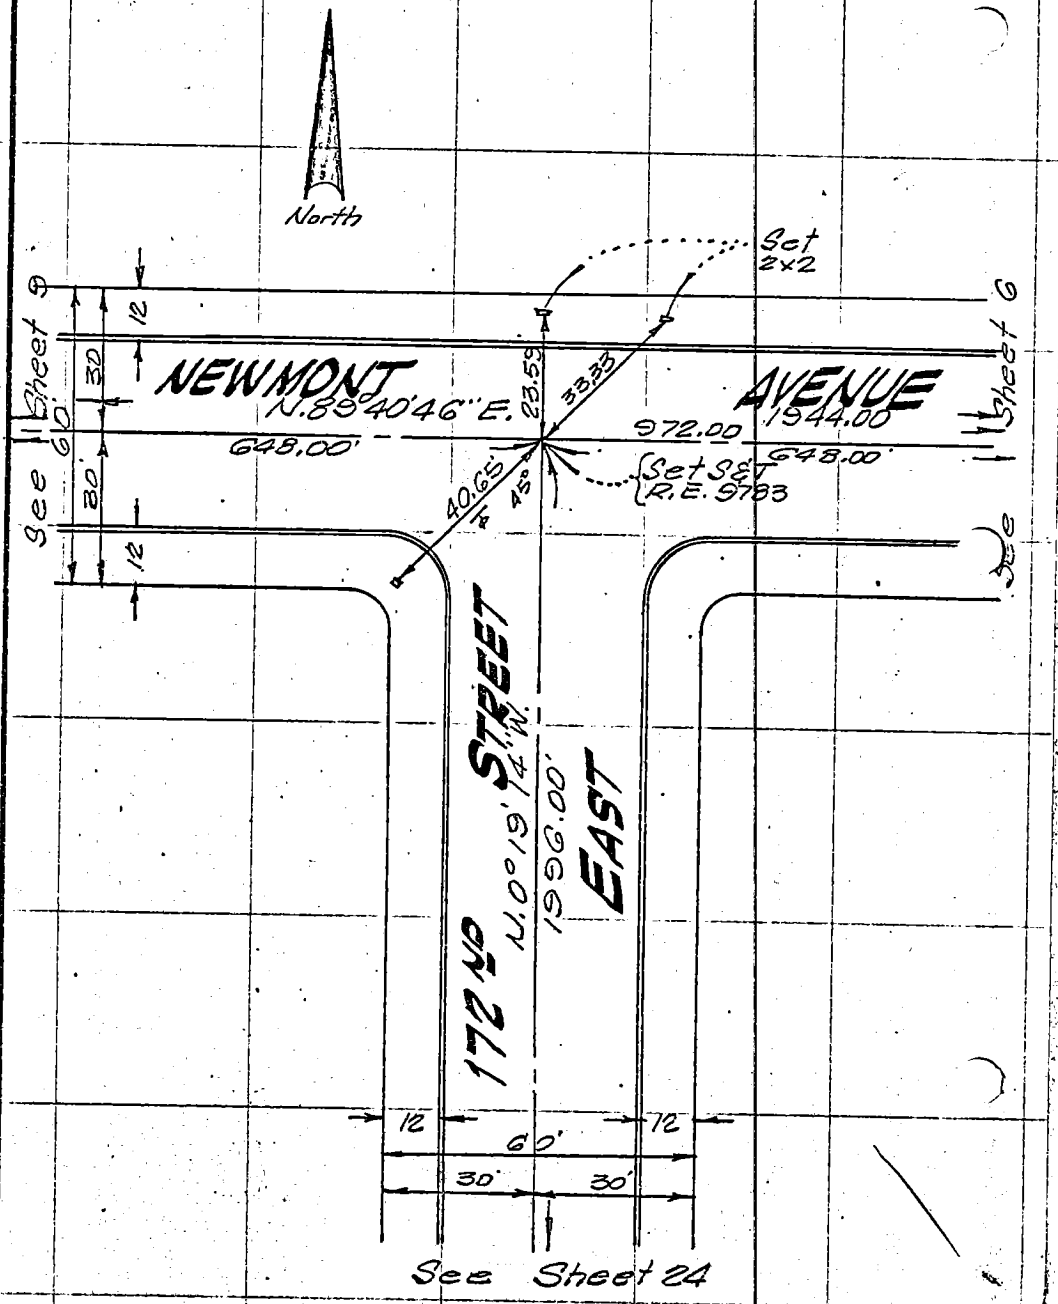


SO. CALIF. BLUE PRINT CO.

F. B. _____ PG. _____ SURVEY OF _____

TR. No. 28481 SURVEY BY E. L. Pearson & Assoc. R.E. 9783

DATE 1 - 12 - 70

Sheet 9

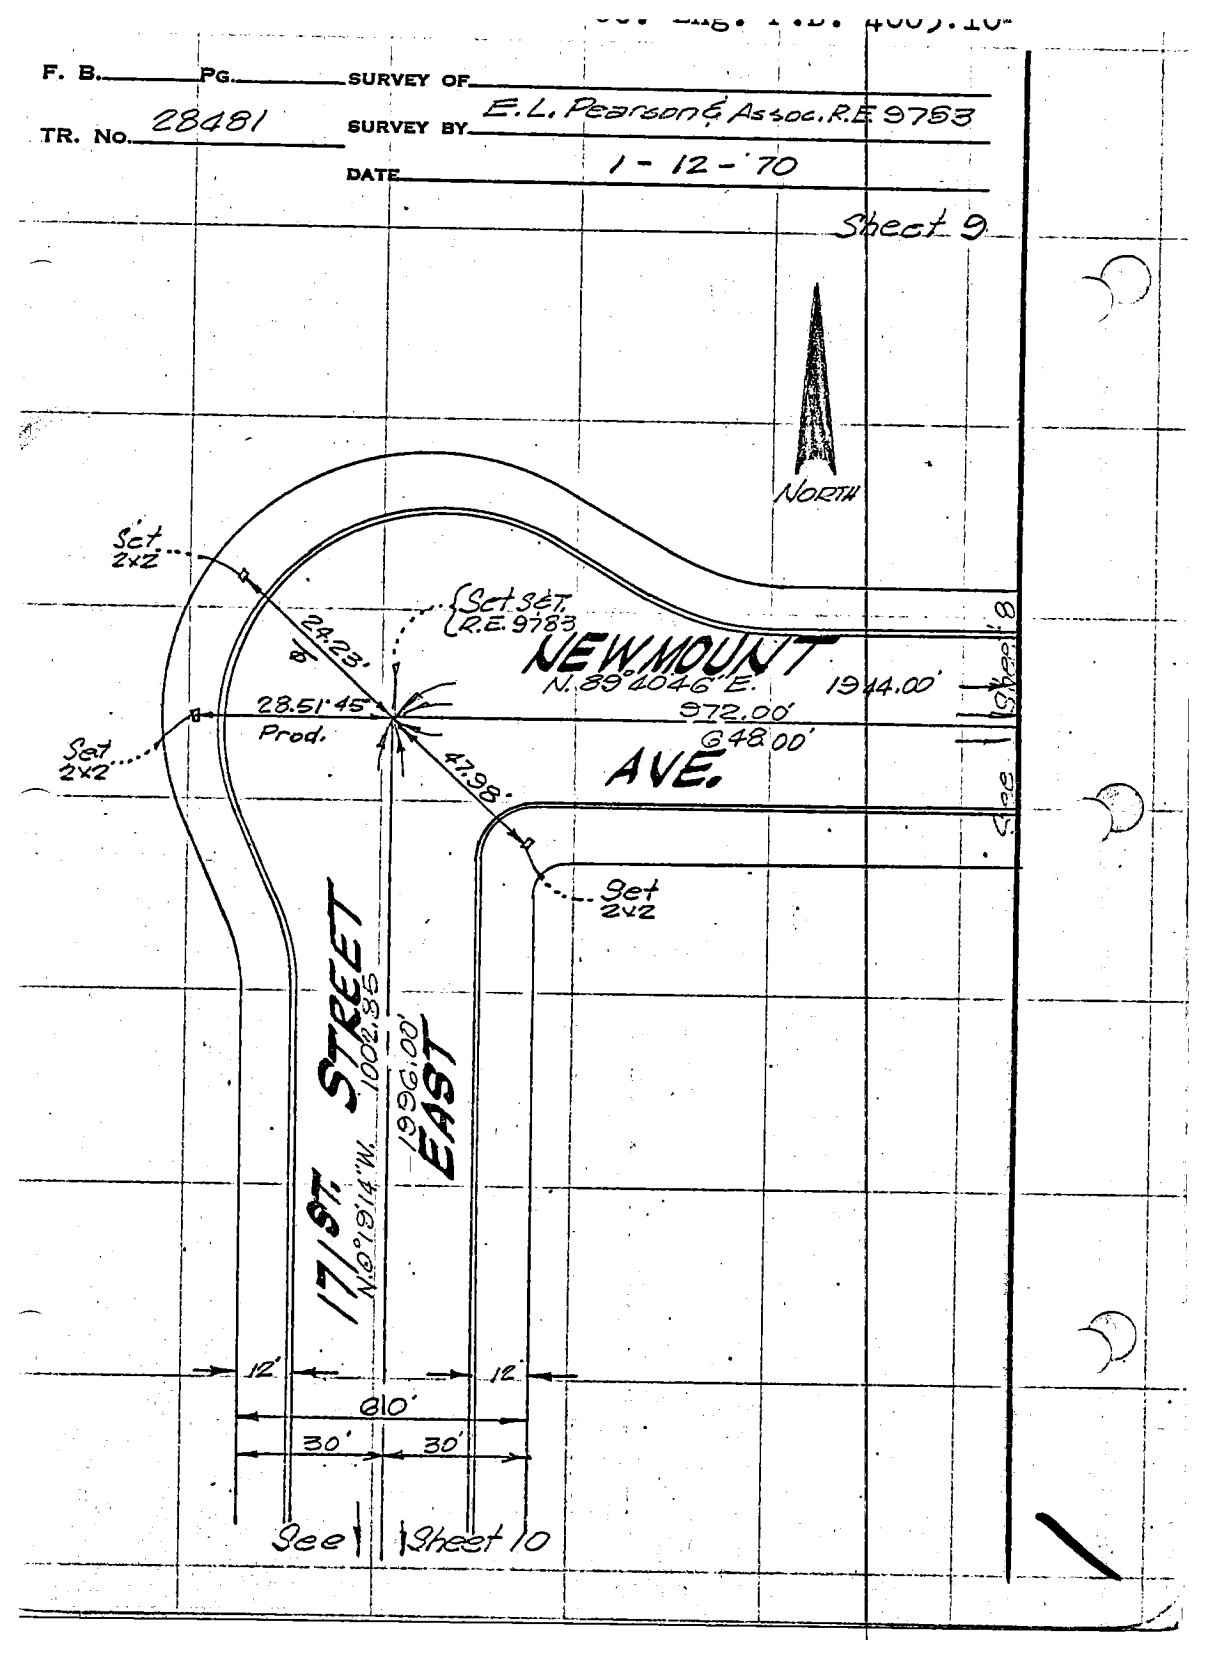

Co. Eng. F.B. 4005: 11

SURVEY OF _____ F. B. _____ PG. _____

SURVEY BY E.L. Pearson & Assoc. R.E. 9783 TR. No. 28431

DATE 1-12-70

Sheet 10

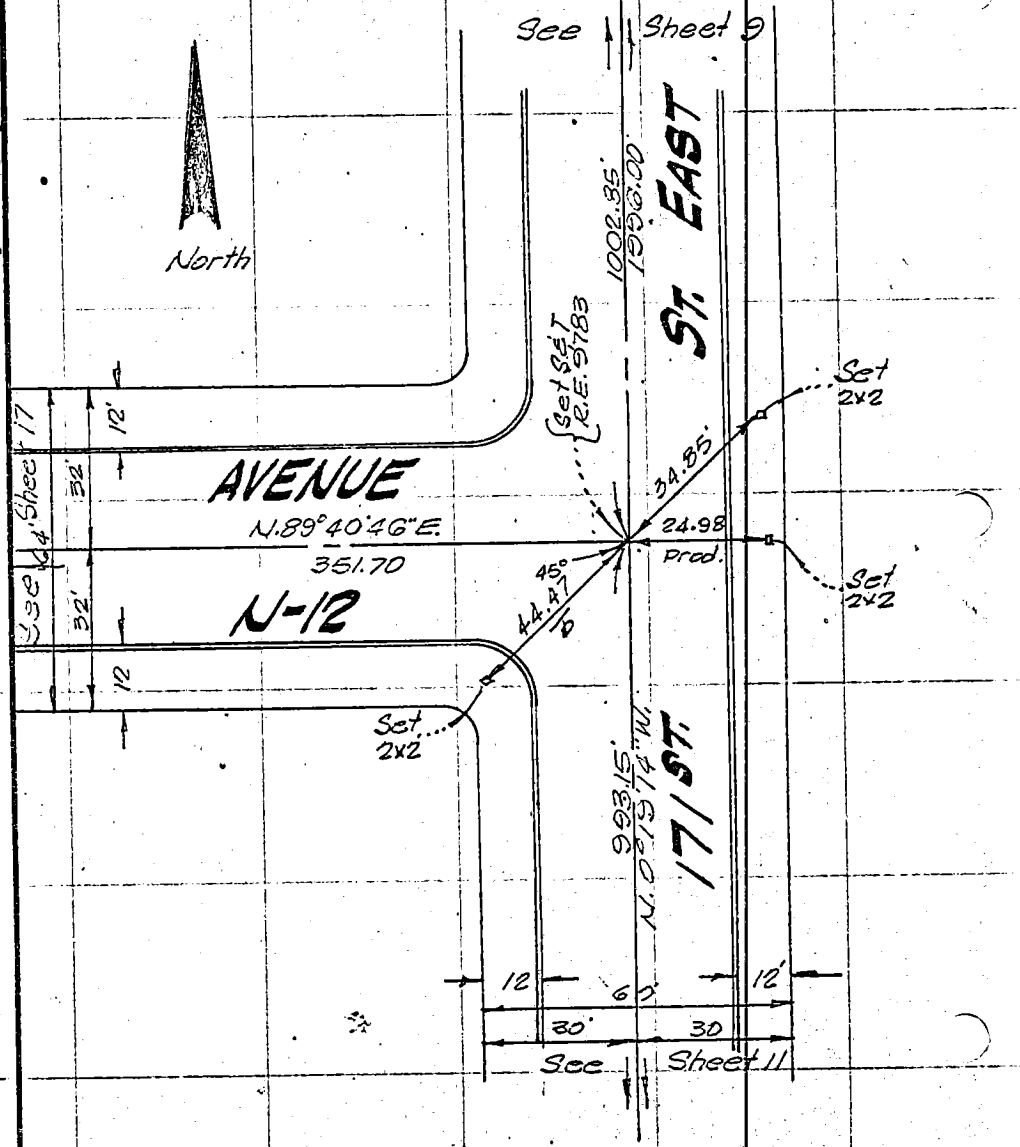


SO. CALIF. BLUE PRINT CO.

B. PG. SURVEY OF

R. No. 28481 SURVEY BY E.L. Pearson & Assoc. RE 9783

DATE 1-12-70

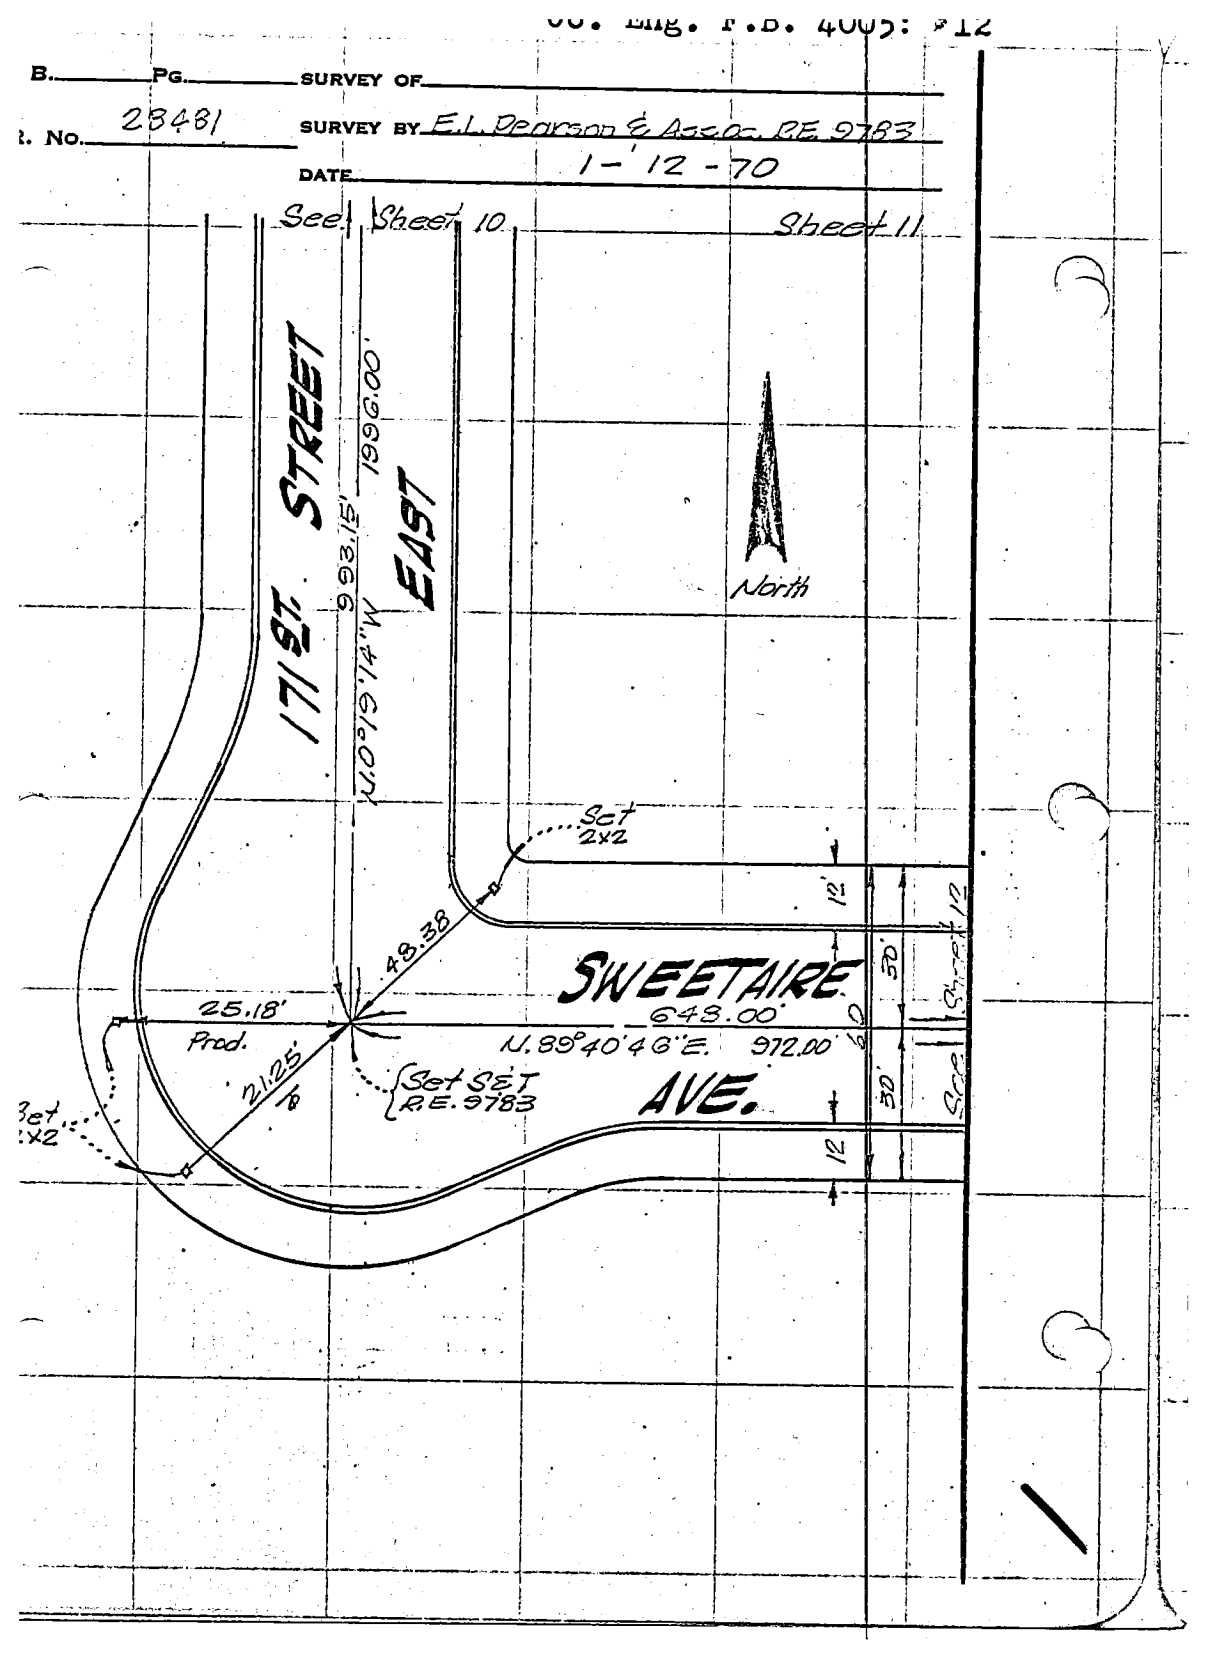

Co. Eng. F.B. 4005: 13

SURVEY OF _____ F. B. _____ Pg. _____

SURVEY BY E.L. Pearson & Assoc. R.E. 9783 TR. No. 28451

DATE 1 - 12 - 70

Sheet 12

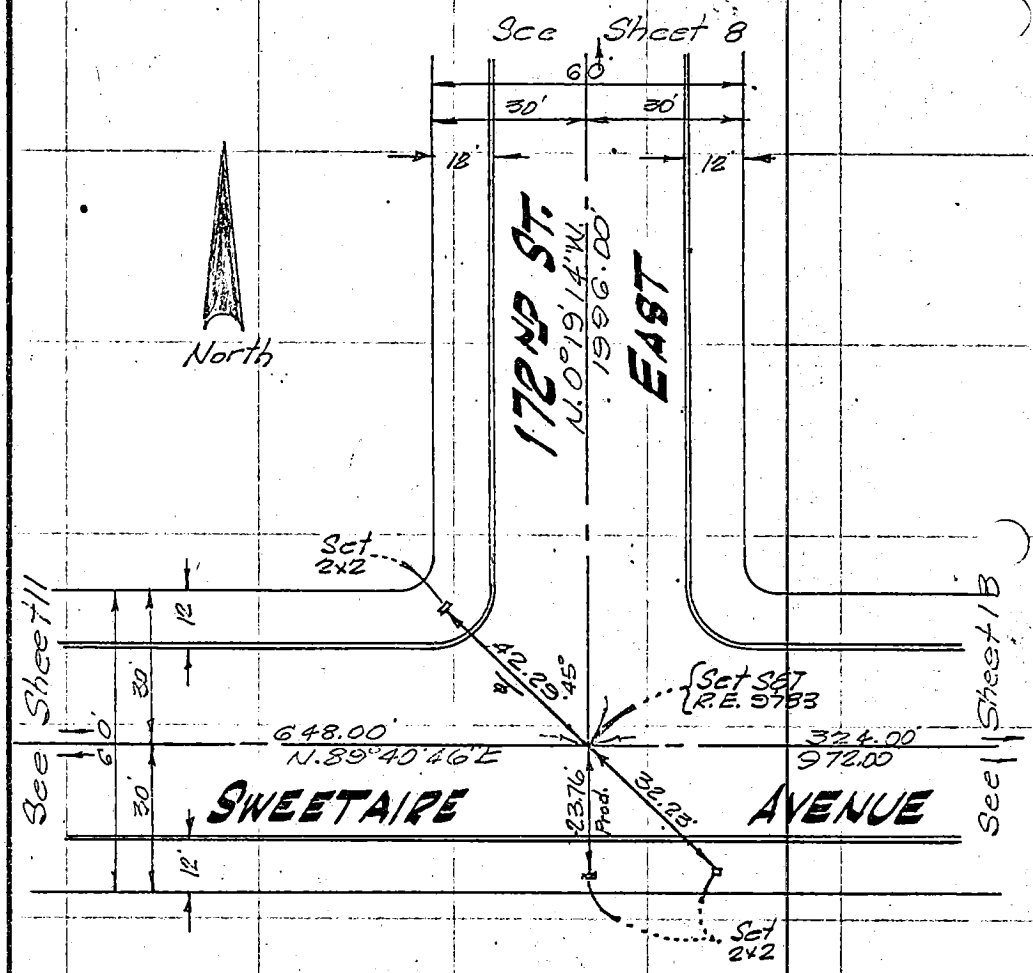


SO. CALIF. BL. PRINT CO.

Co. Eng. F.B. 4005:14

F. B. _____ PG. _____ SURVEY OF _____

R. No. 28481 SURVEY BY E.L. Pearson & Assoc. R.E. 9783

DATE 1 - 12 - 70

Sheet 13

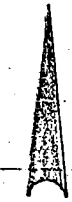


Set 2x2

See Sheet 12

N.89°48'46"E. 324.00 972.00

Prod.

33.73

N.89°48'46"E. 324.00 972.00

12'

30'

60'

30'

12'

See Sheet 14

SWEETAIRE

43.78'

46°

Set

SET R.E. 9783

AVENUE

Set 2x2

172 nd. ST.

N 0° 19' 14" W.

337.43'

EAST

12'

12'

64'

32'

32'

See Sheet 16

Co. Eng. F.B. 4005: 17

SURVEY OF _____ F. B. _____ PG. _____

SURVEY BY E. L. Pearson & Assoc. R.E. 9783 TR. No. 28481

DATE 1-12-70

Sheet 14

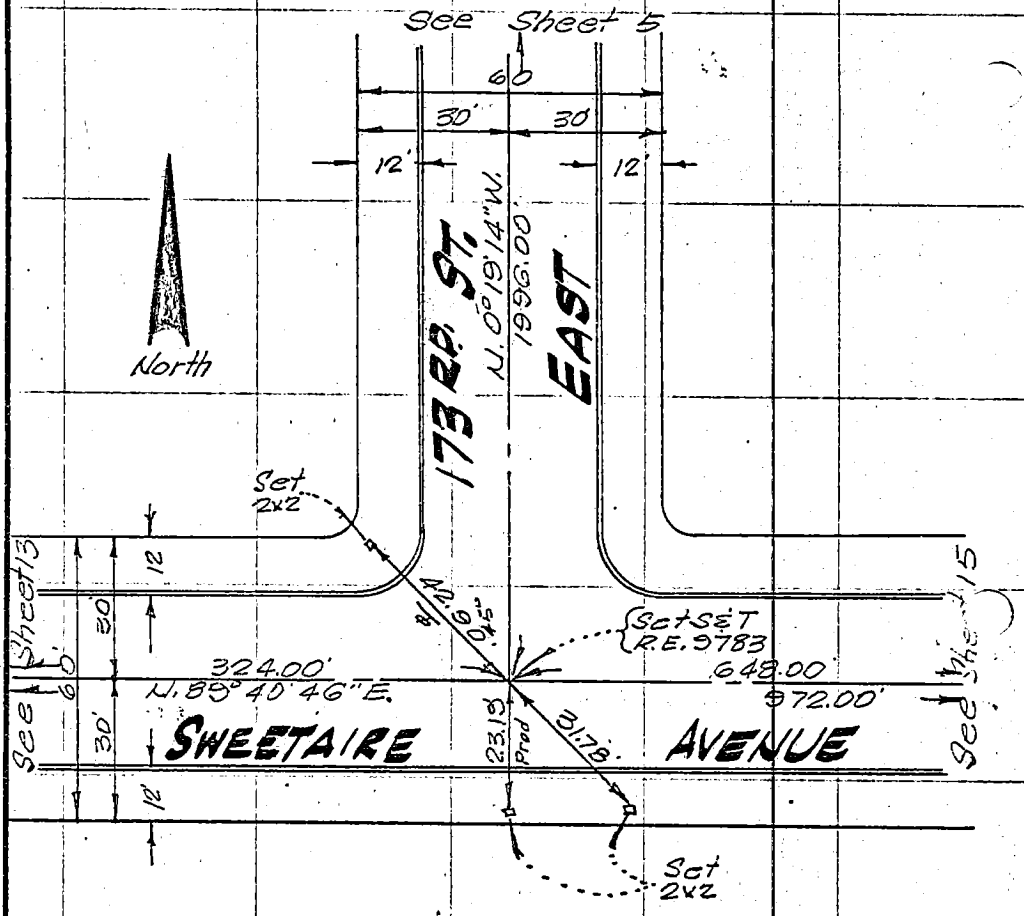


SO. CALIF. BLUE PRINT CO. — F-1638

Co. Eng. F.B. 4005:16,

F. B.____ Pg.____ SURVEY OF____

TR. No. 28481 SURVEY BY E. L. Pearson & Assoc. R.E. 9783

DATE 1 - 12 - 70

See Sheet 3 Sheet 15

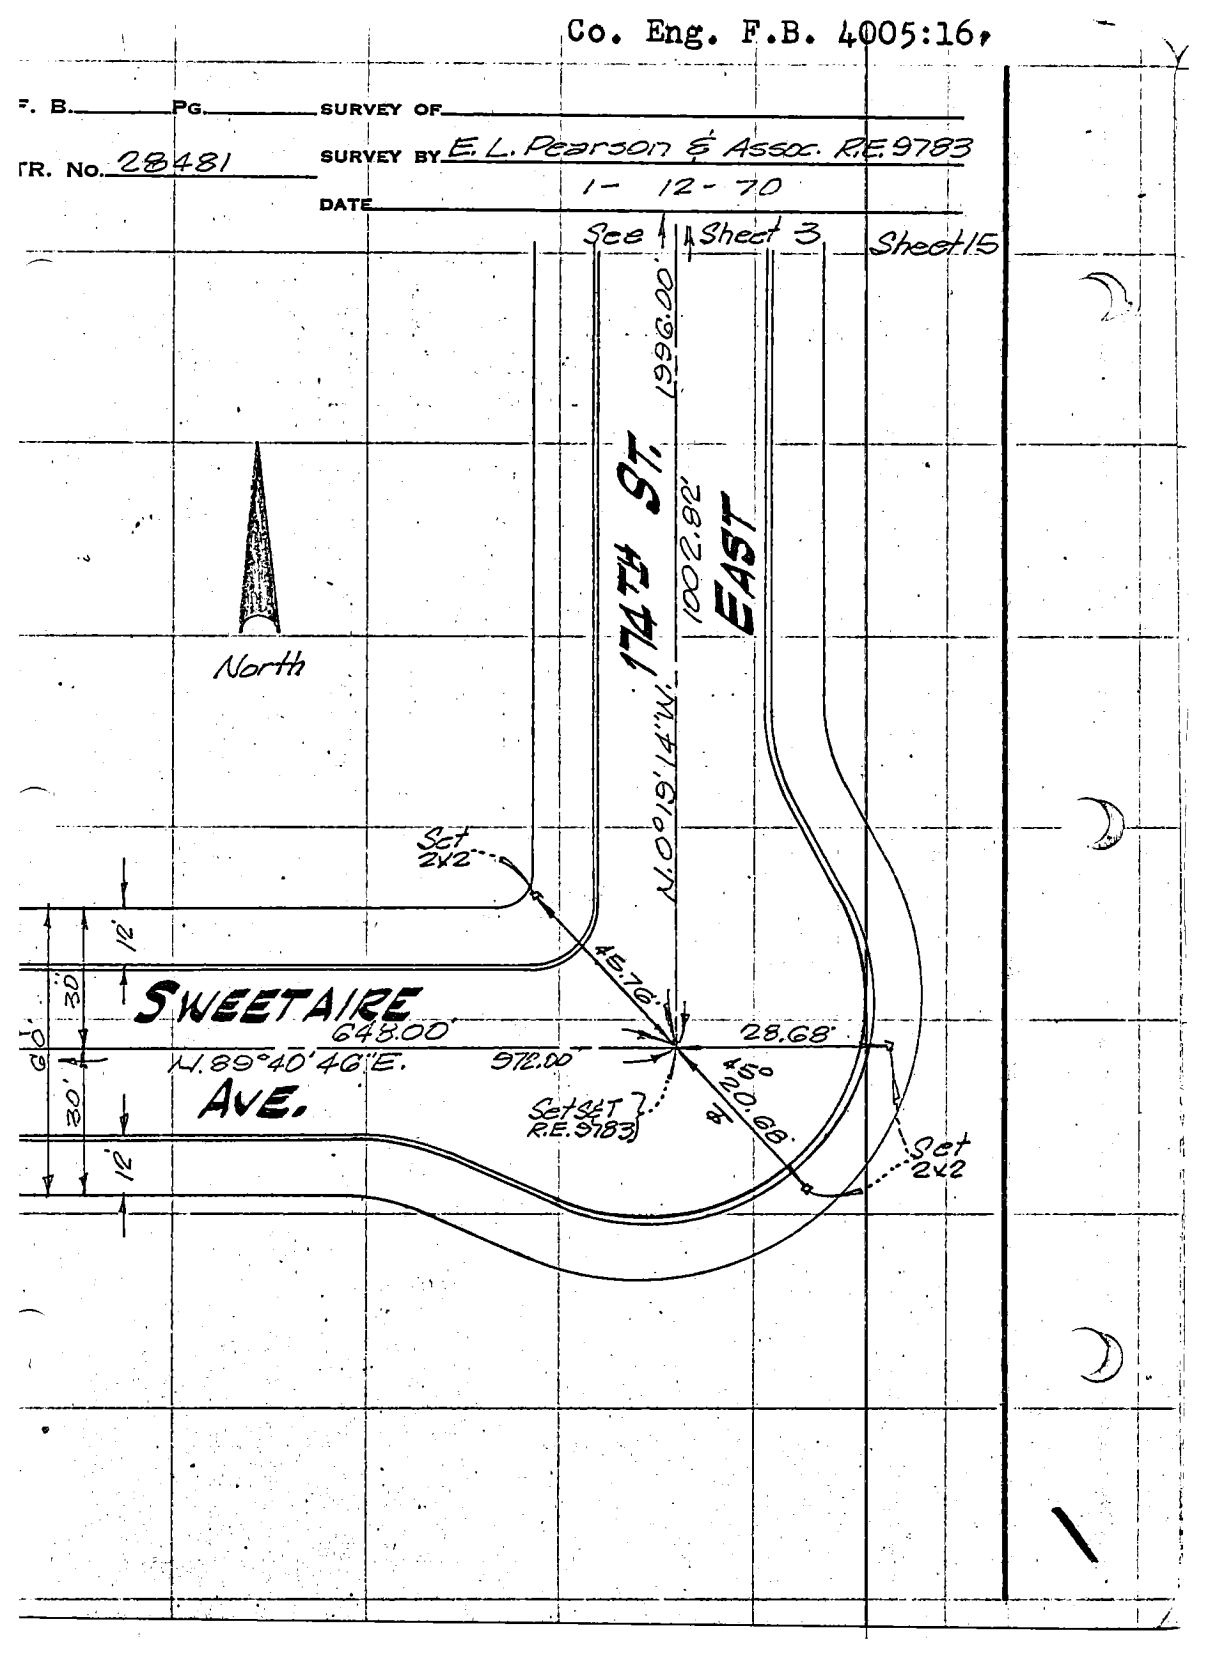

Co. Eng. F.B. 4005: 17

SURVEY OF _____ F. B. _____ Pg. _____

SURVEY BY E.L. Pearson & Assoc. R.E. 9783 TR. No. 28481

DATE 1-12-70

Sheet 16

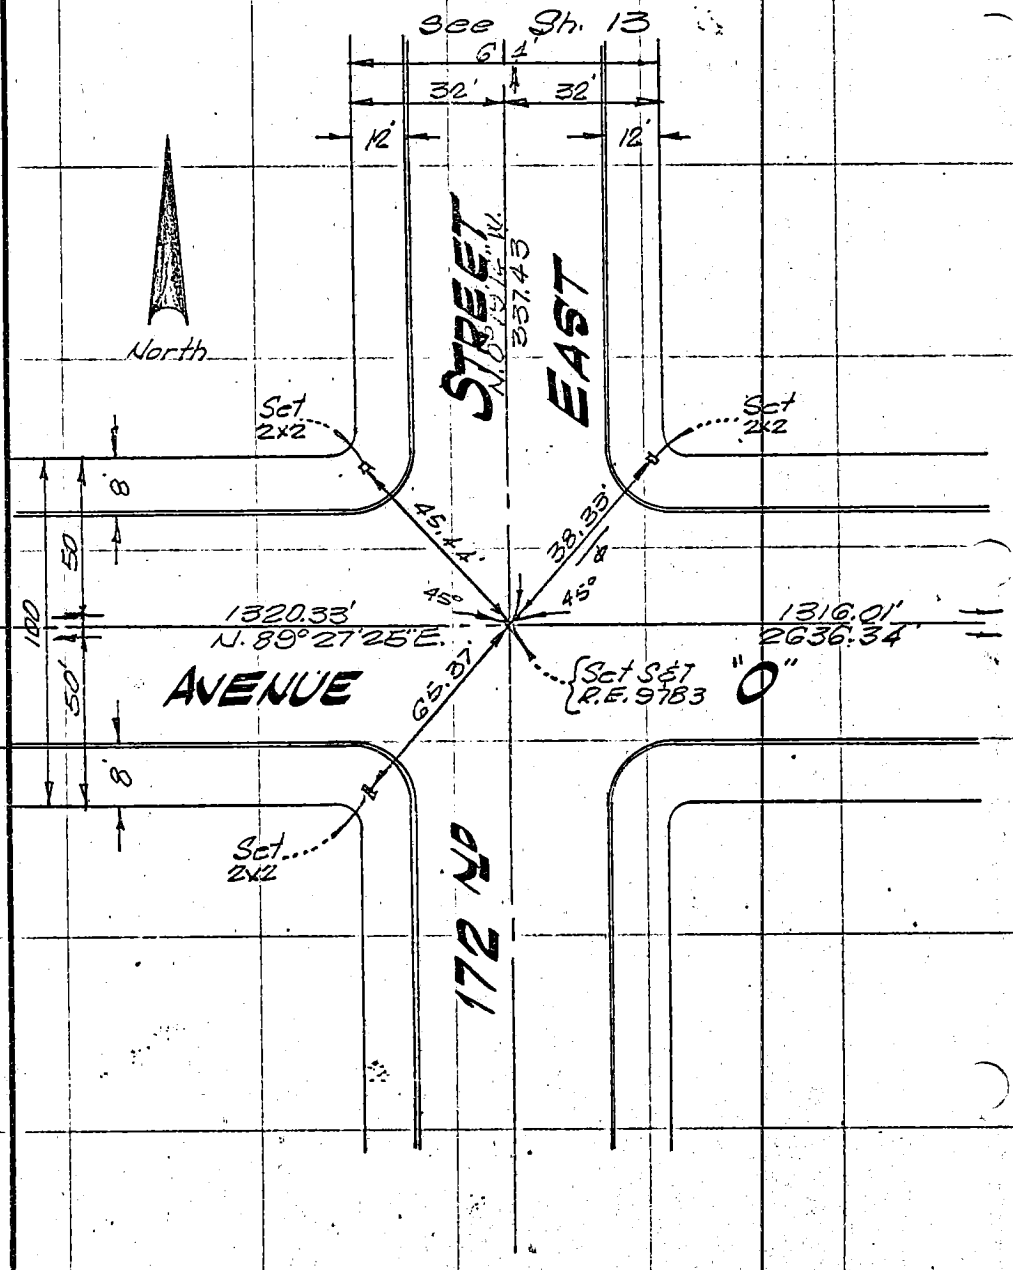


SO. CALIF. BLUE PRINT CO. — F-1638

Co. Eng. F.B. 4005: 18

F. B. _____ PG. _____ SURVEY OF _____

TR. No. 28481 SURVEY BY E. L. Pearson & Assoc. R.E. 9783

DATE 1-12-70

Sheet 17

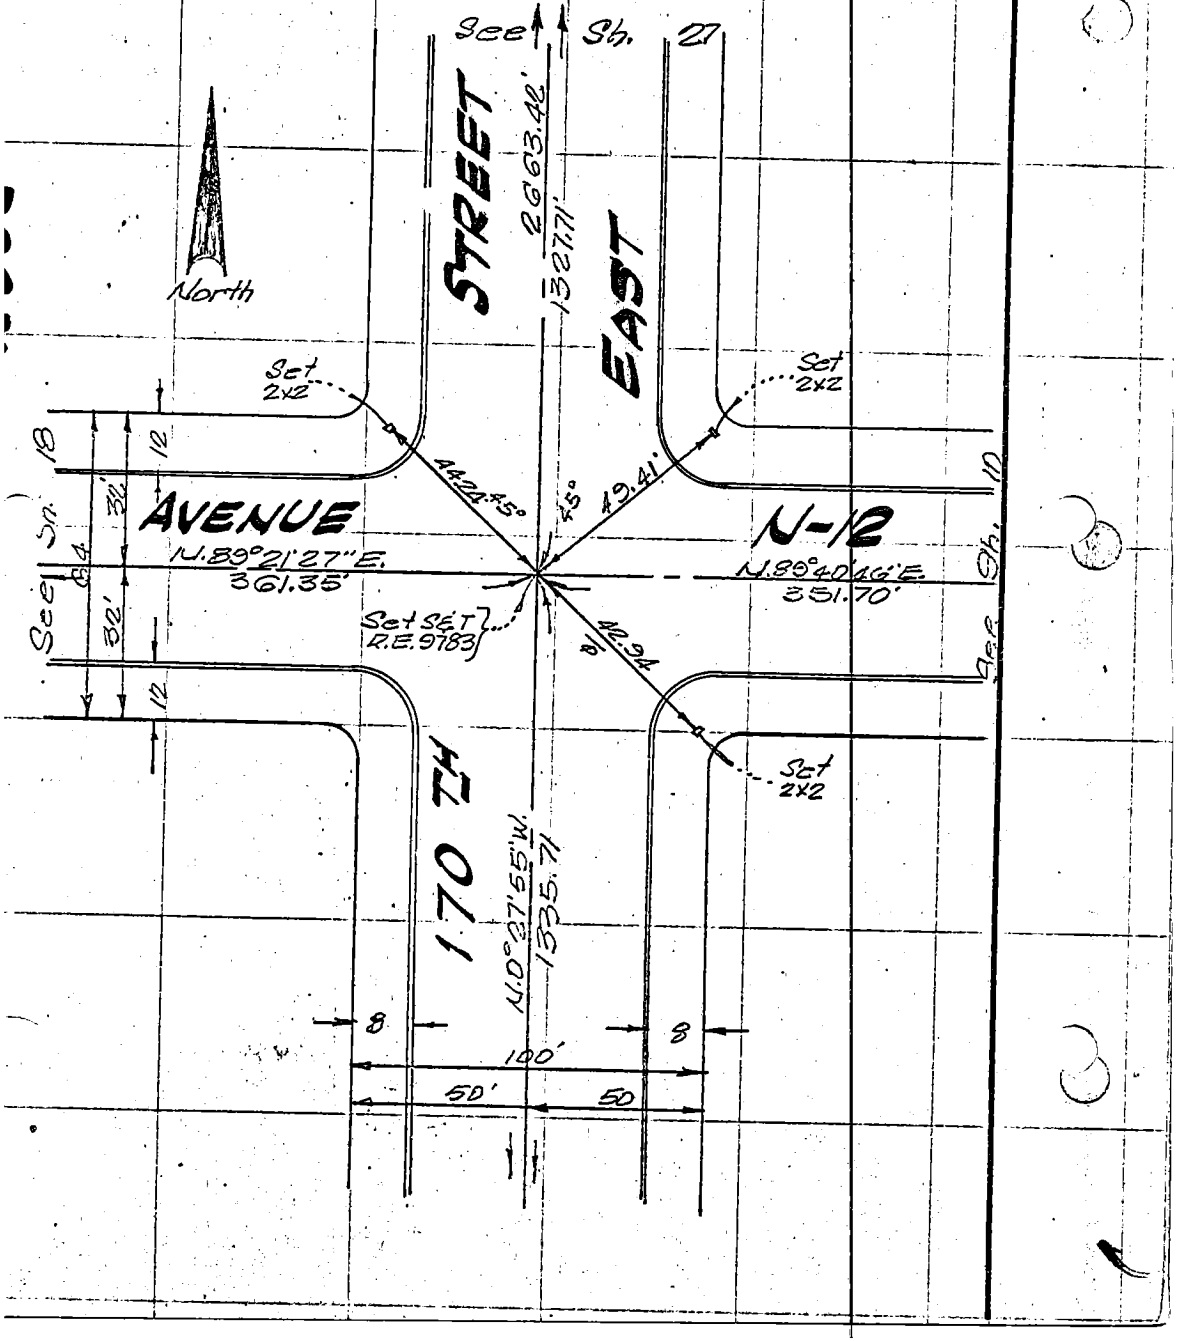

Co. Eng. F.B. 4005: 19

SURVEY OF _____ F. B. _____ PG. _____

SURVEY BY E.L. Pearson & Assoc. R.E. 9783 TR. No. 28481

DATE 1 - 12 - 70

Sheet 18

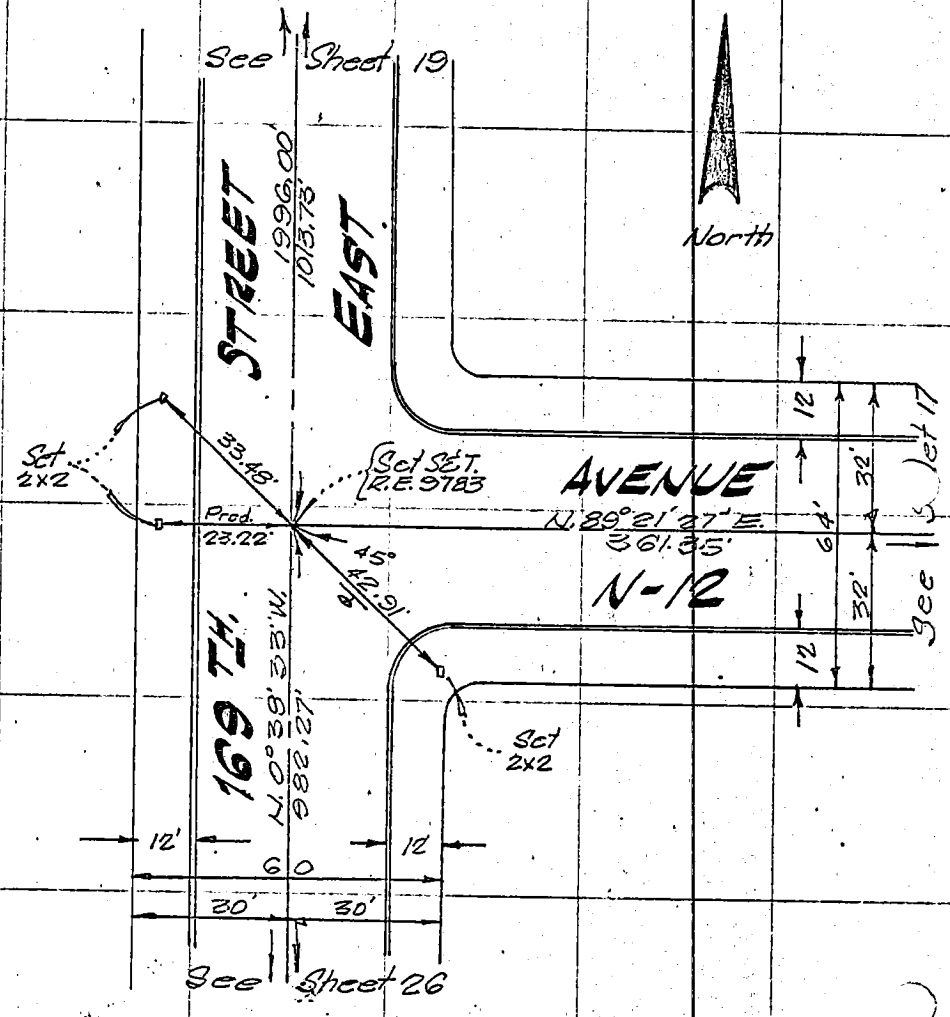


SO. CALIF. BLUE PRINT CO. — F-1638

Co. Eng. F.B. 4005:20

B. ____ Pg. ____ SURVEY OF ____

No. 28481 SURVEY BY E.L. Pearson & Assoc. R.E. 9783

DATE ____

Sheet 19

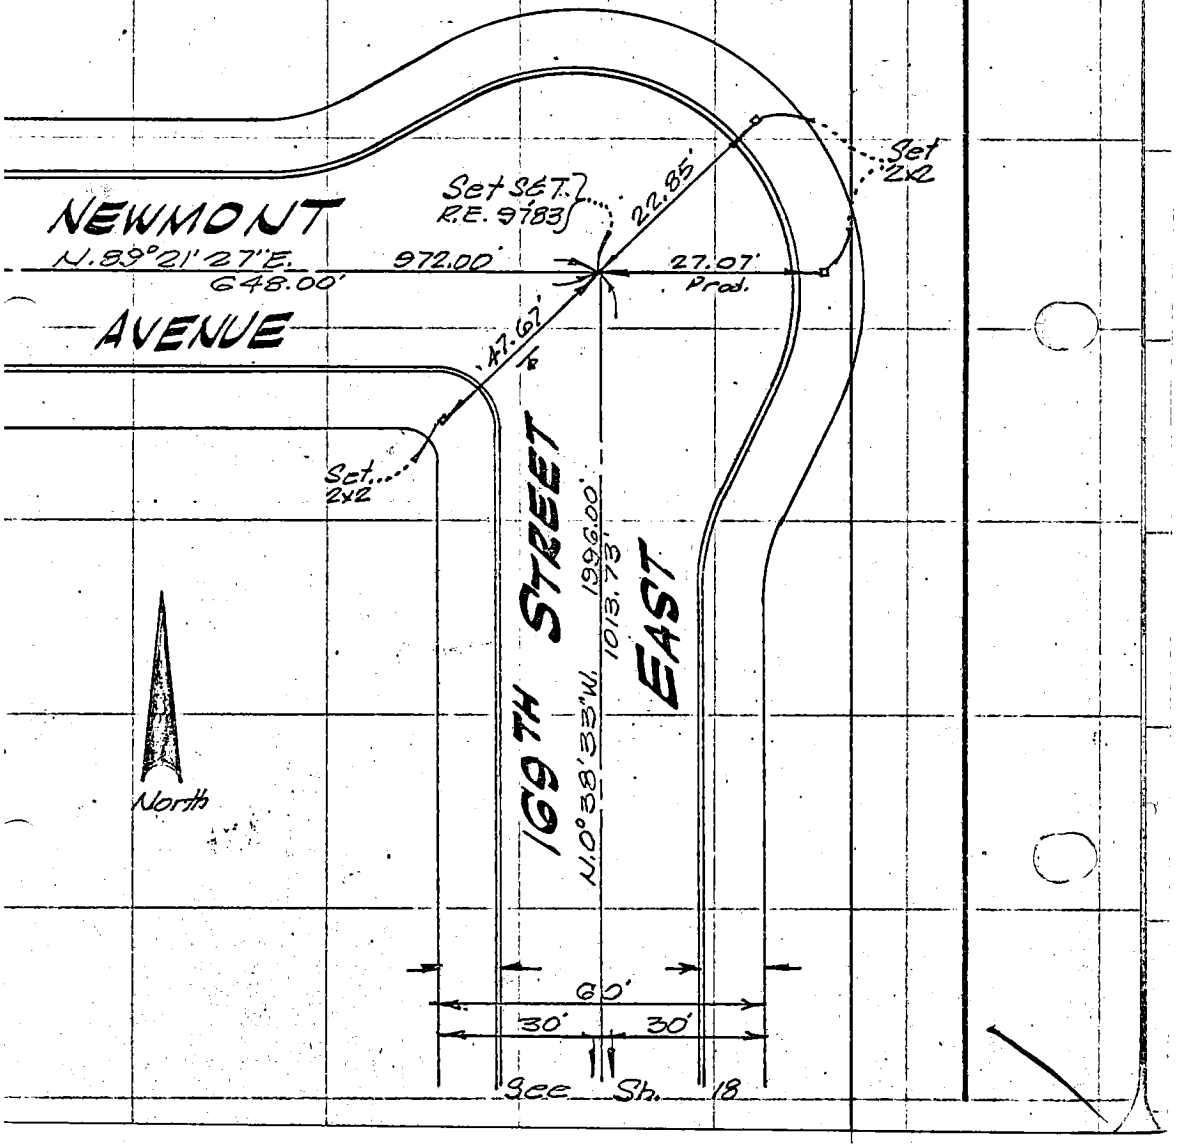

Co. Eng. F.B. 4005: 21

SURVEY OF _____ F. B. _____ Pg. _____

SURVEY BY E.L. Pearson & Assoc. R.E. 9783 TR. No. 28481

DATE 1 - 12 - 70

Sheet 20

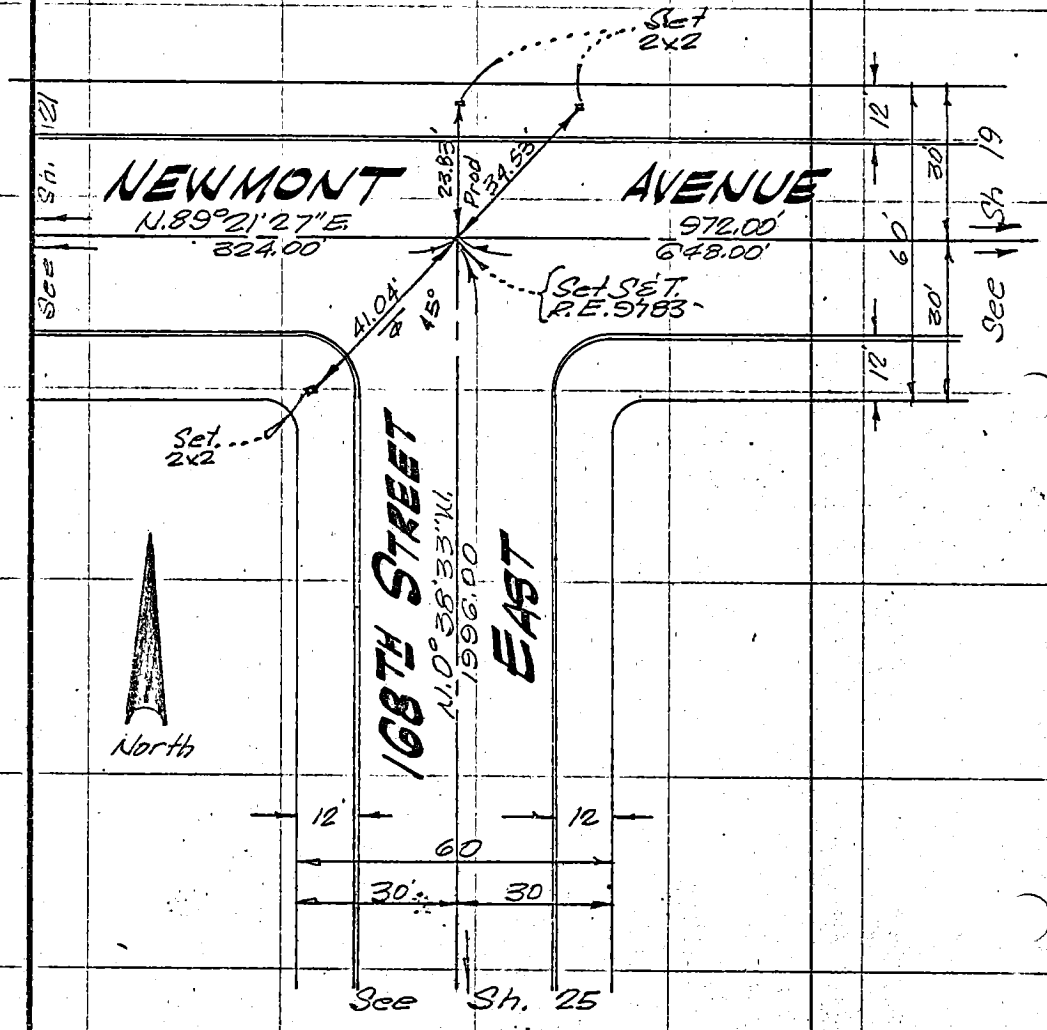


SO. CALIF. BLUE PT CO. — F-1638

Co. Eng. F.B. 4005:22

F. B. _____ PG. _____ SURVEY OF _____

R. No. 28481 SURVEY BY E. L. Pearson & Assoc. RE 9783

DATE 1 - 12 - 70

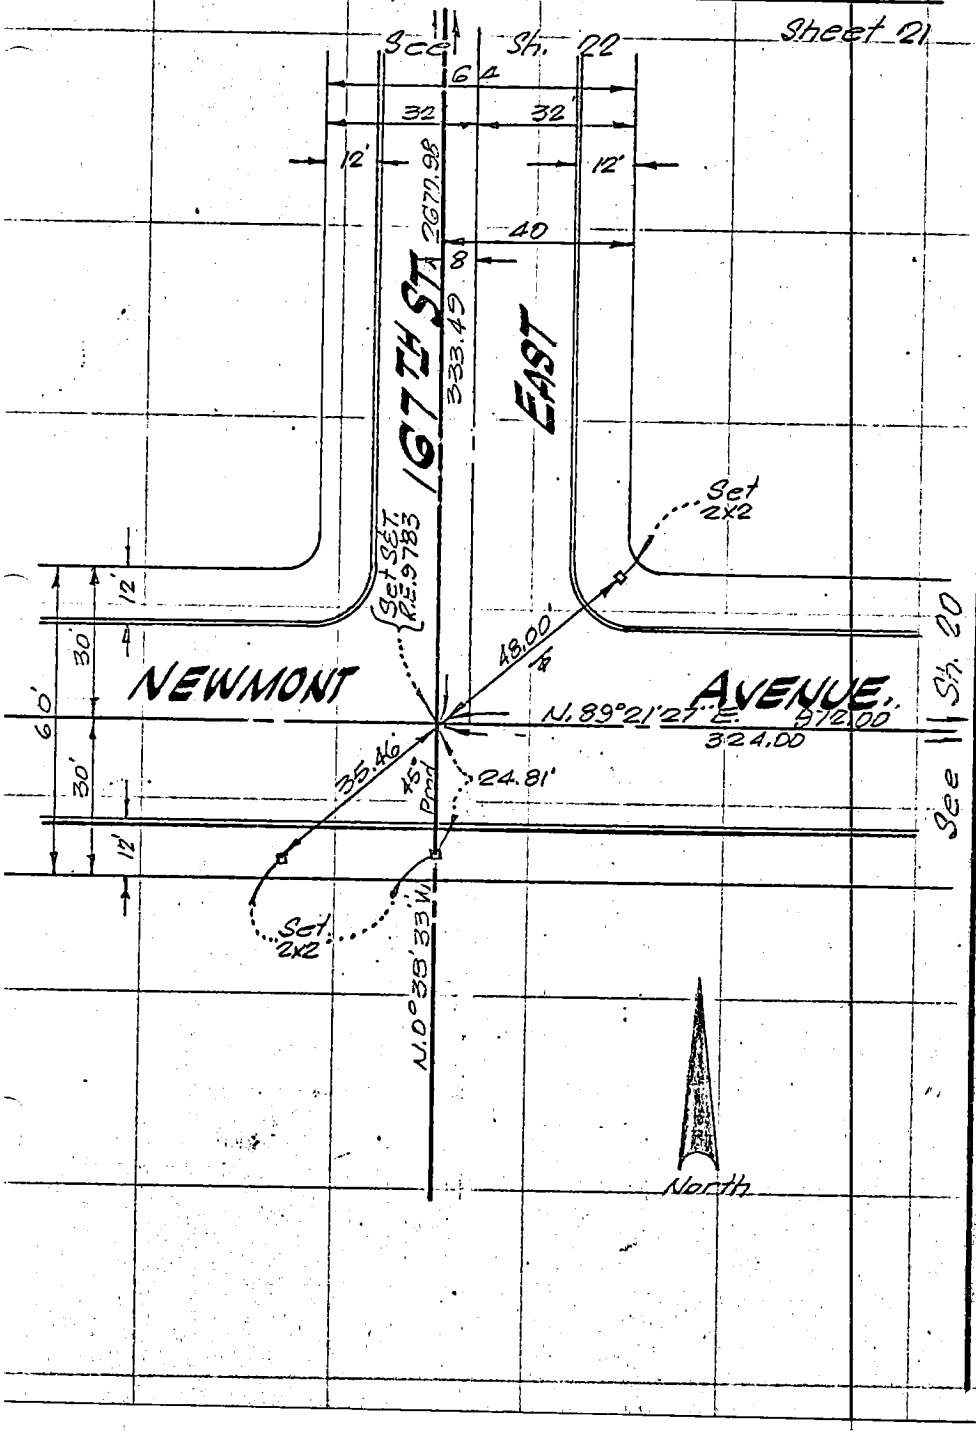

Co. Eng. F.B. 4005: 23

SURVEY OF _____ F. B. _____ PG. _____

SURVEY BY E.L. Pearson & Assoc. RE9783 TR. No. 28481

DATE 1 - 12 - 70

Sheet 22

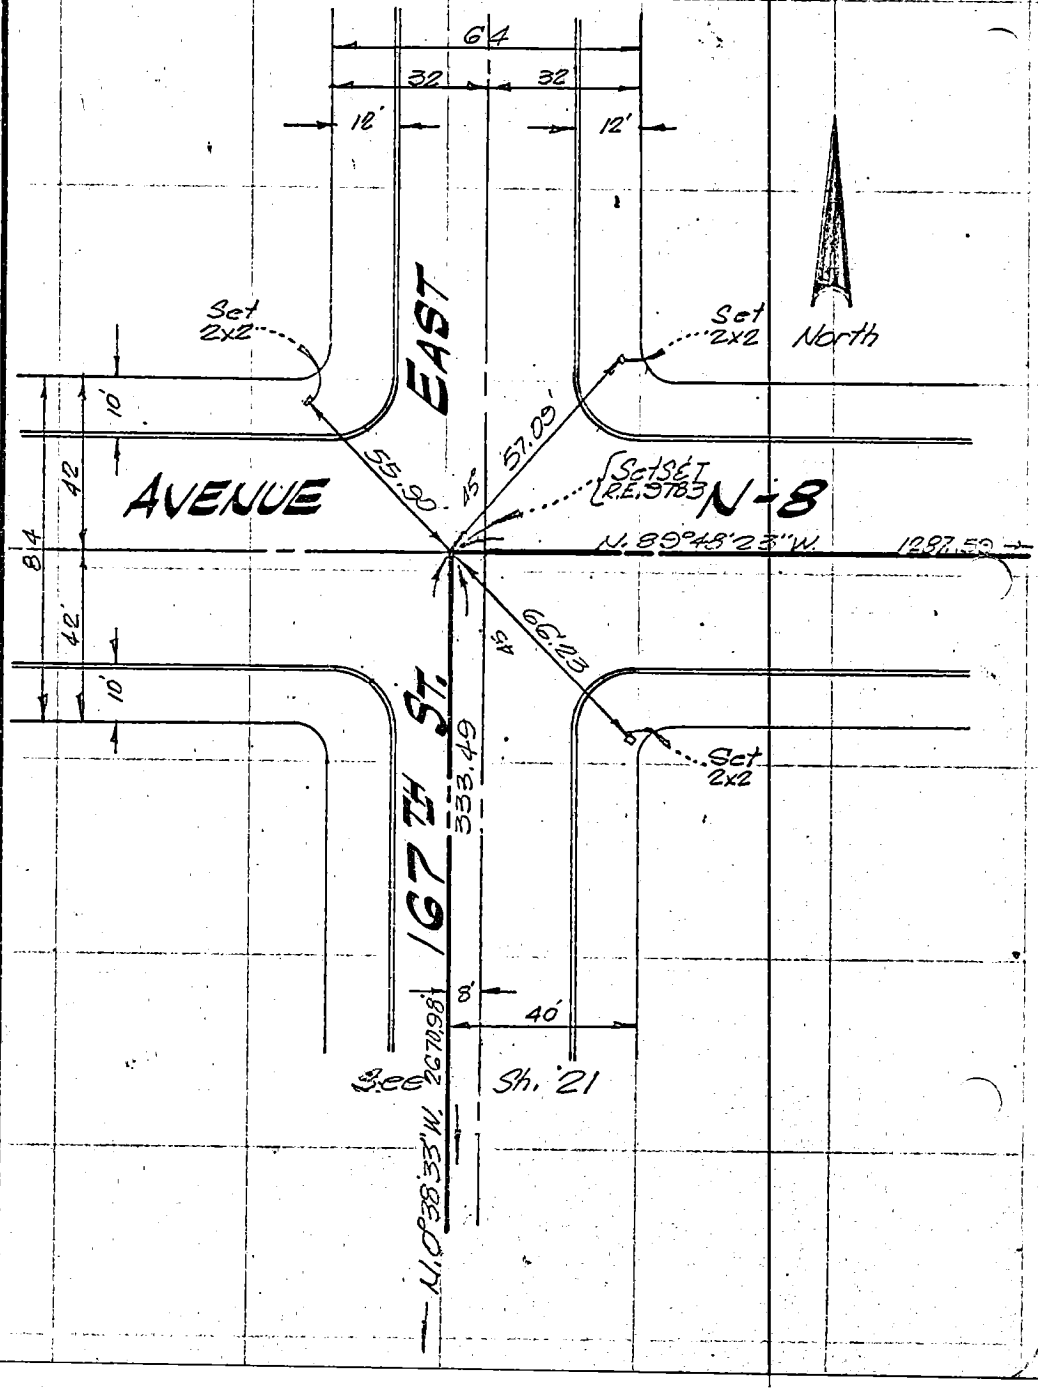


SO. CALIF. BLUE PRINT CO. V3726/

Co. Eng: F.B. 4005: 24

F. B. _____ PG. _____ SURVEY OF _____


DATE 1 - 12 - 70

Sheet 23

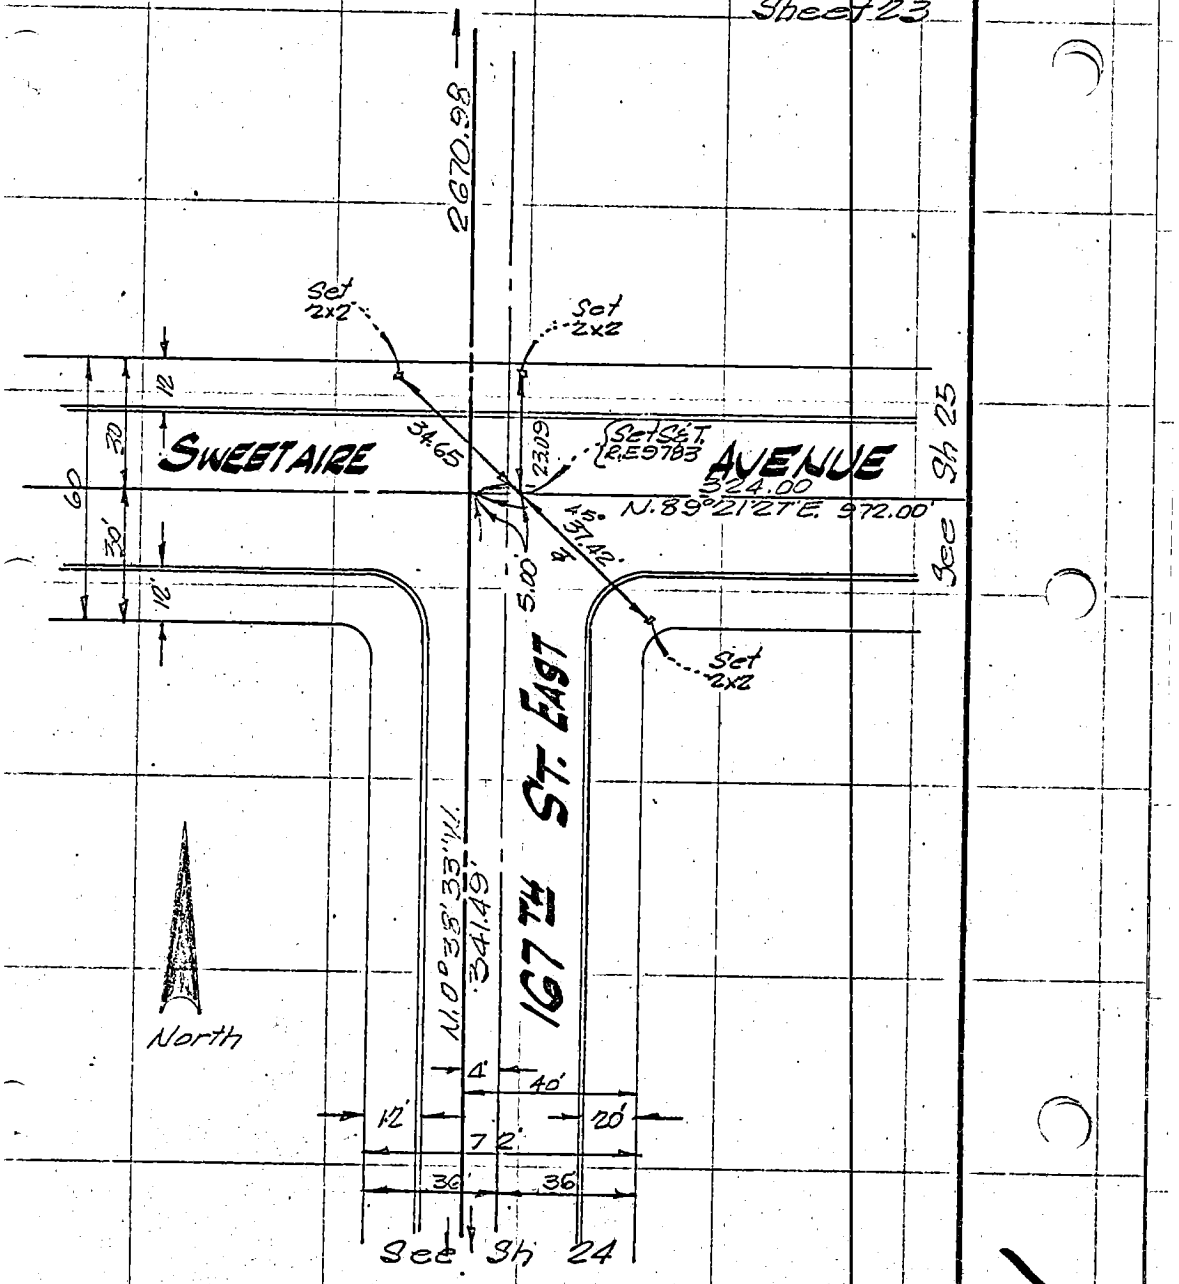

Co. Eng. F.B. 4005: 25

SURVEY OF _____ F. B. _____ PG. _____

SURVEY BY E.L. Pearson & Assoc. R.E. 9783 TR. NO. 28481

DATE 1-12-70

Sheet 24

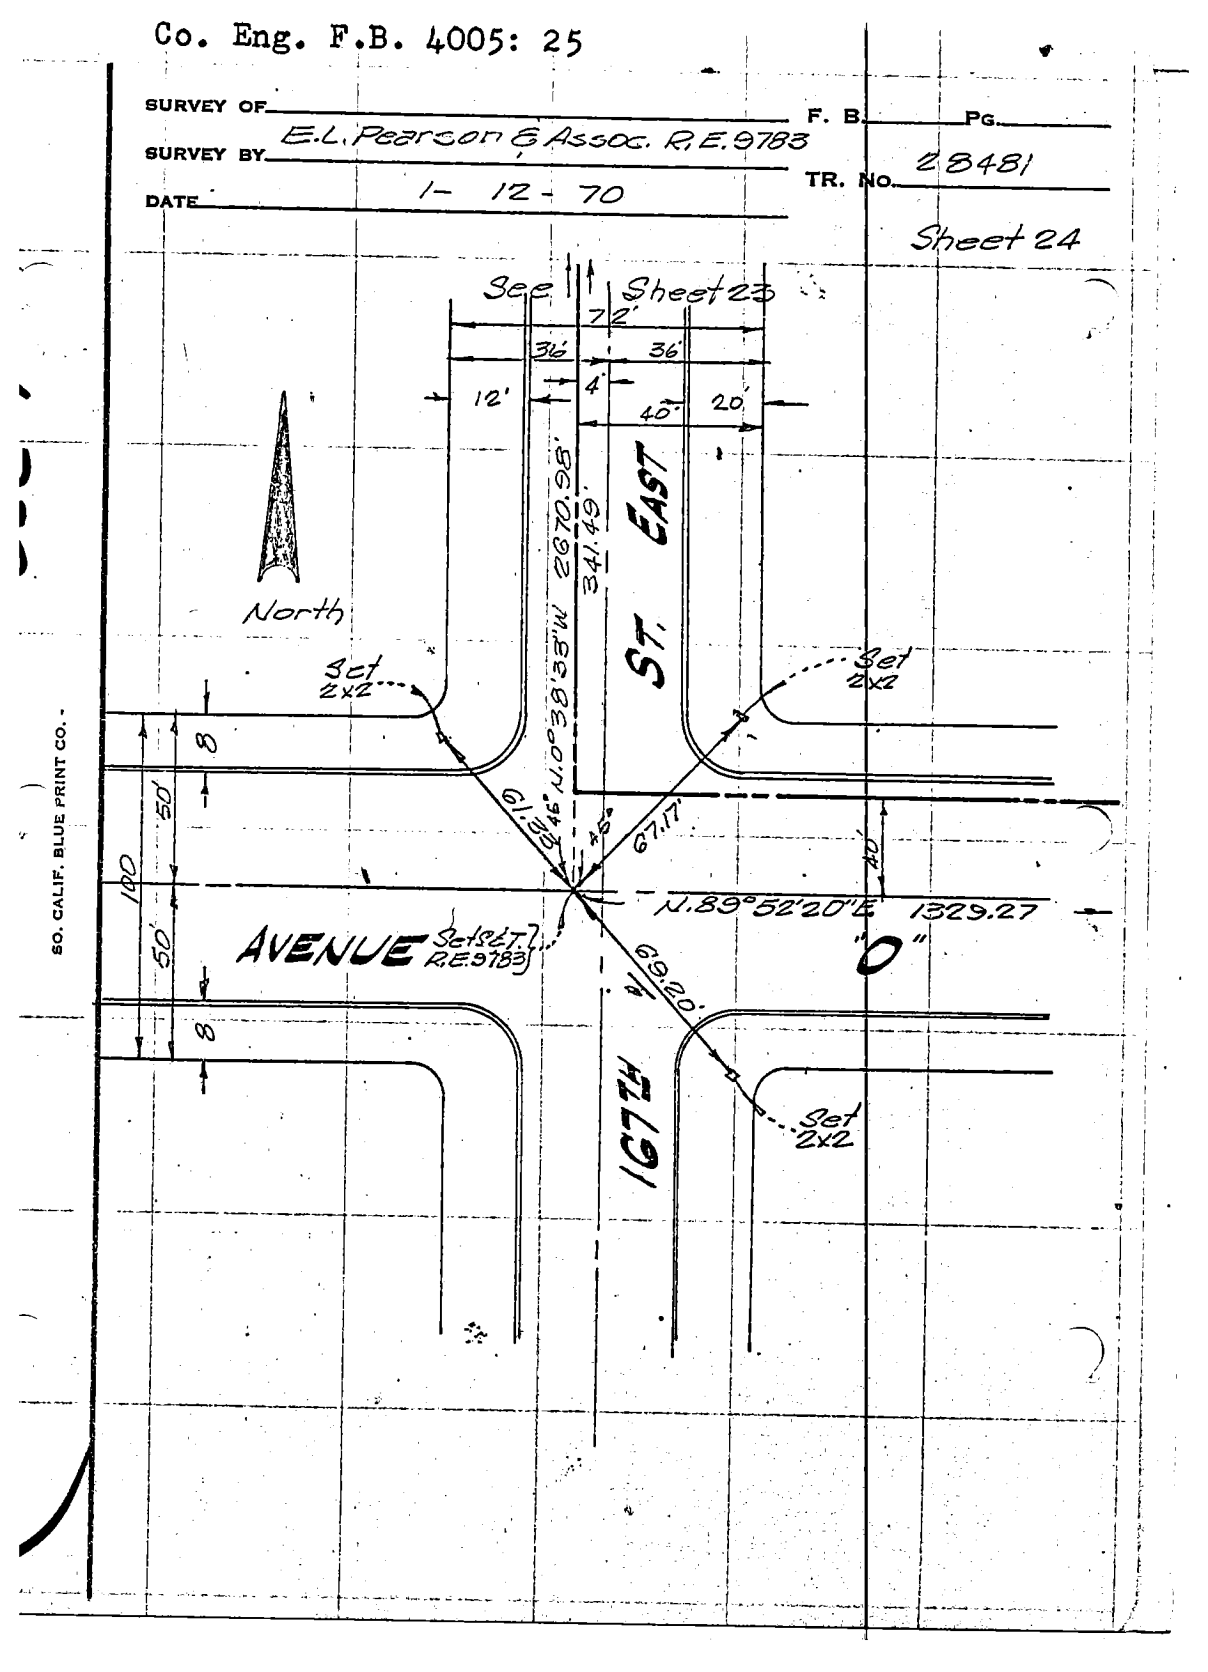


SO. CALIF. BLUE PRINT CO.

Co. Eng. F.B. 4005:26 •

F. B. _____ PG. _____ SURVEY OF _____

TR. No. 28481 SURVEY BY E. L. Pearson & Assoc. R.E. 9783

DATE 1 - 12 - 70

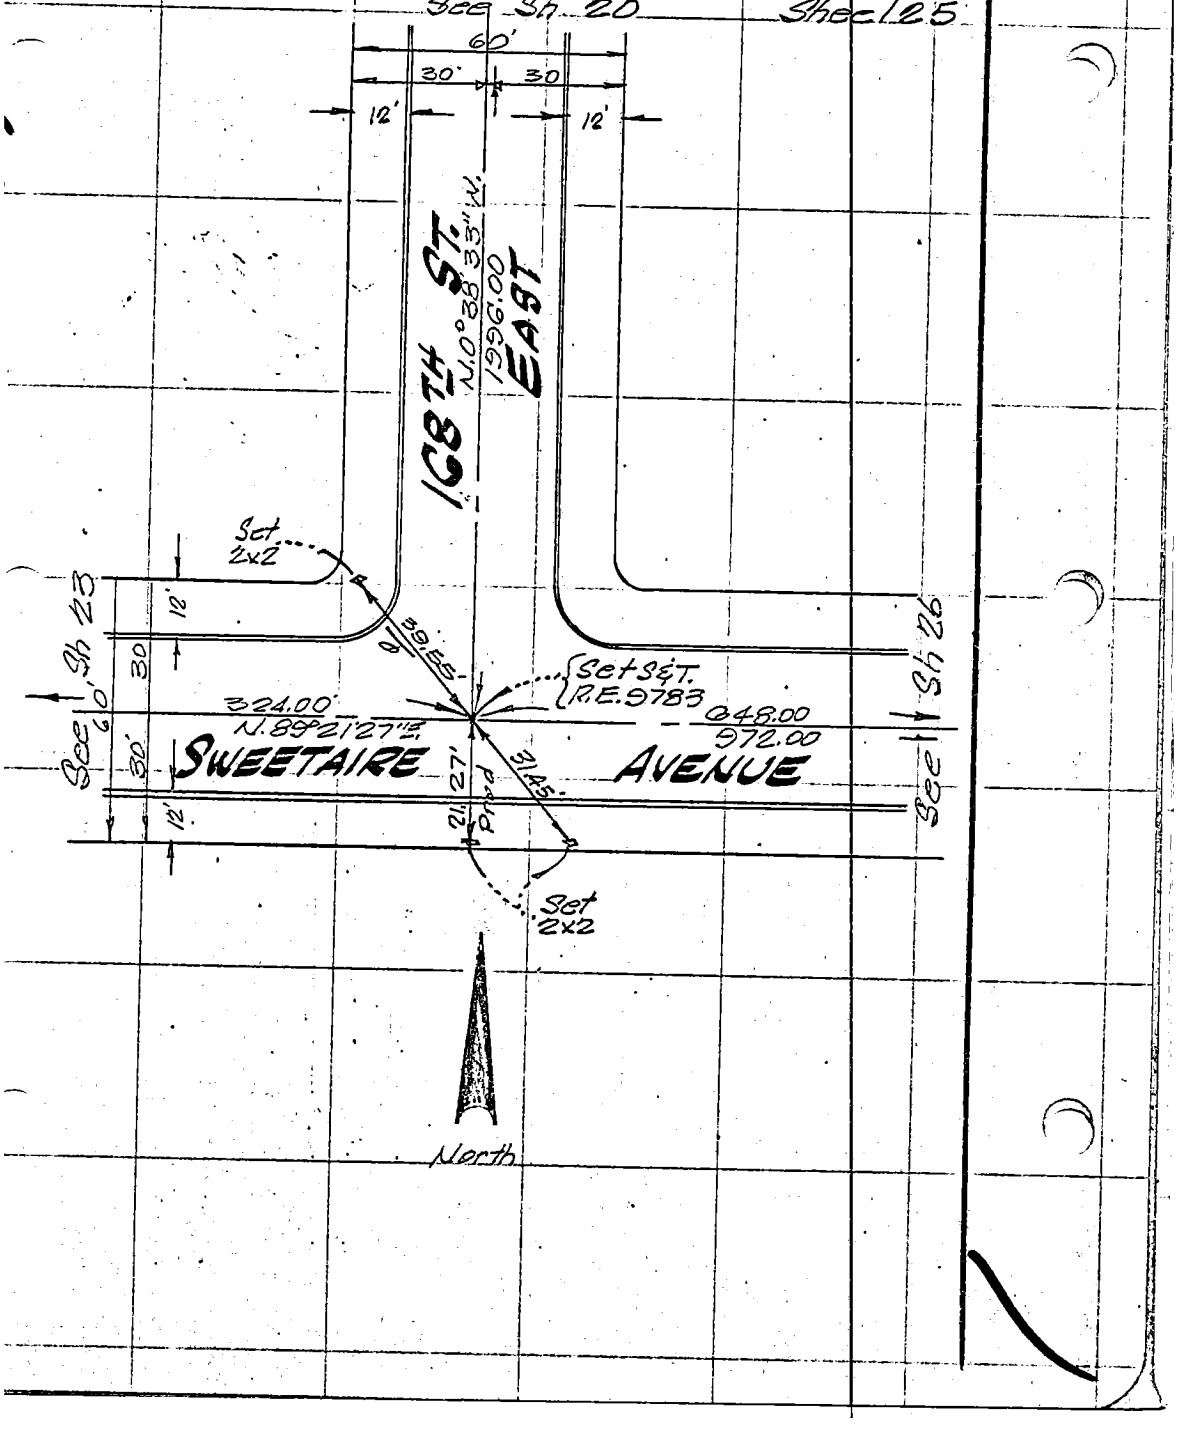

Co. Eng. F.B. 4005: 27

SURVEY OF _____ F. B. _____ PG. _____

SURVEY BY E.L. Pearsons & Assoc. R.E. 5783 TR. No. 28481

DATE 1-12-70

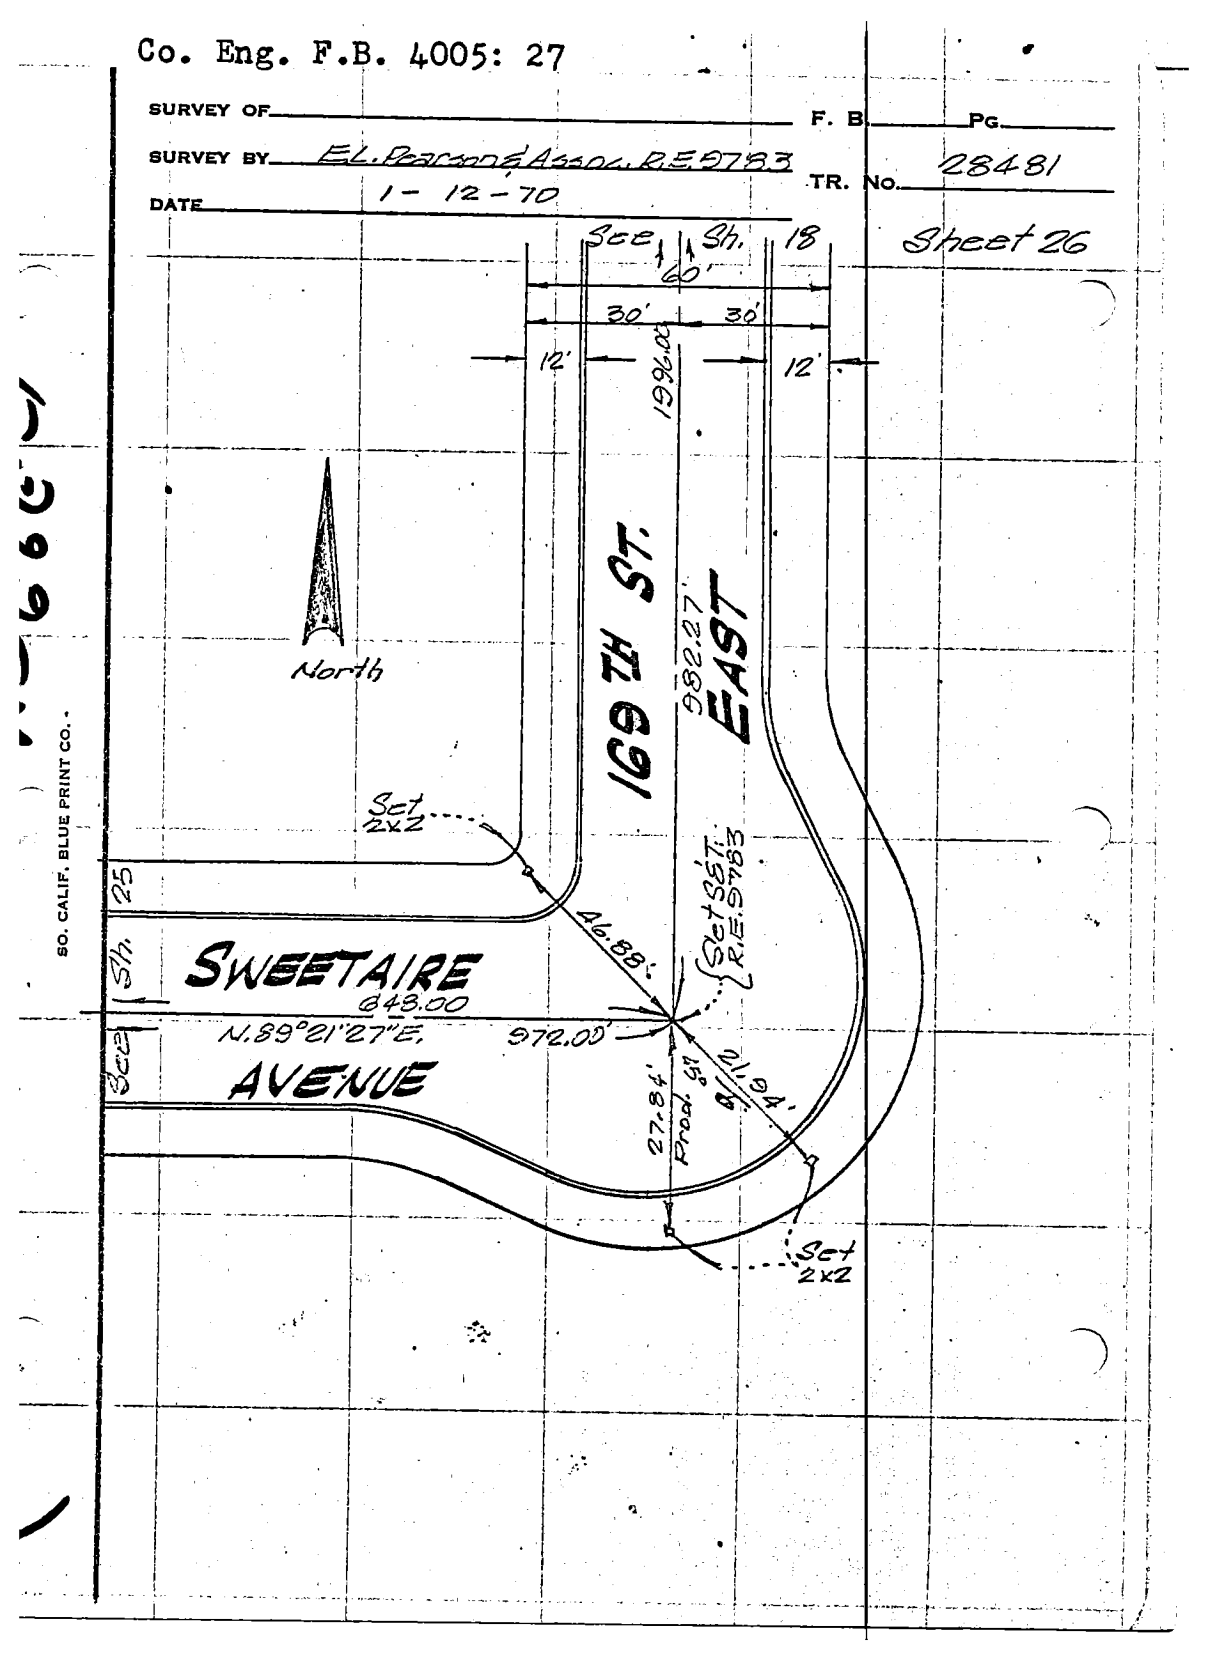


SO. CALIF. BLUE PRINT CO.

SURVEY OF _____ F B NO. _____ PAGE 1

SURVEY BY JENNINGS-HALDERMAN-HOOD ~~TRACT NO.~~ PARCEL MAP

DATE FEB. 1970 BOOK 20 PAGE 91

ARB # 1107

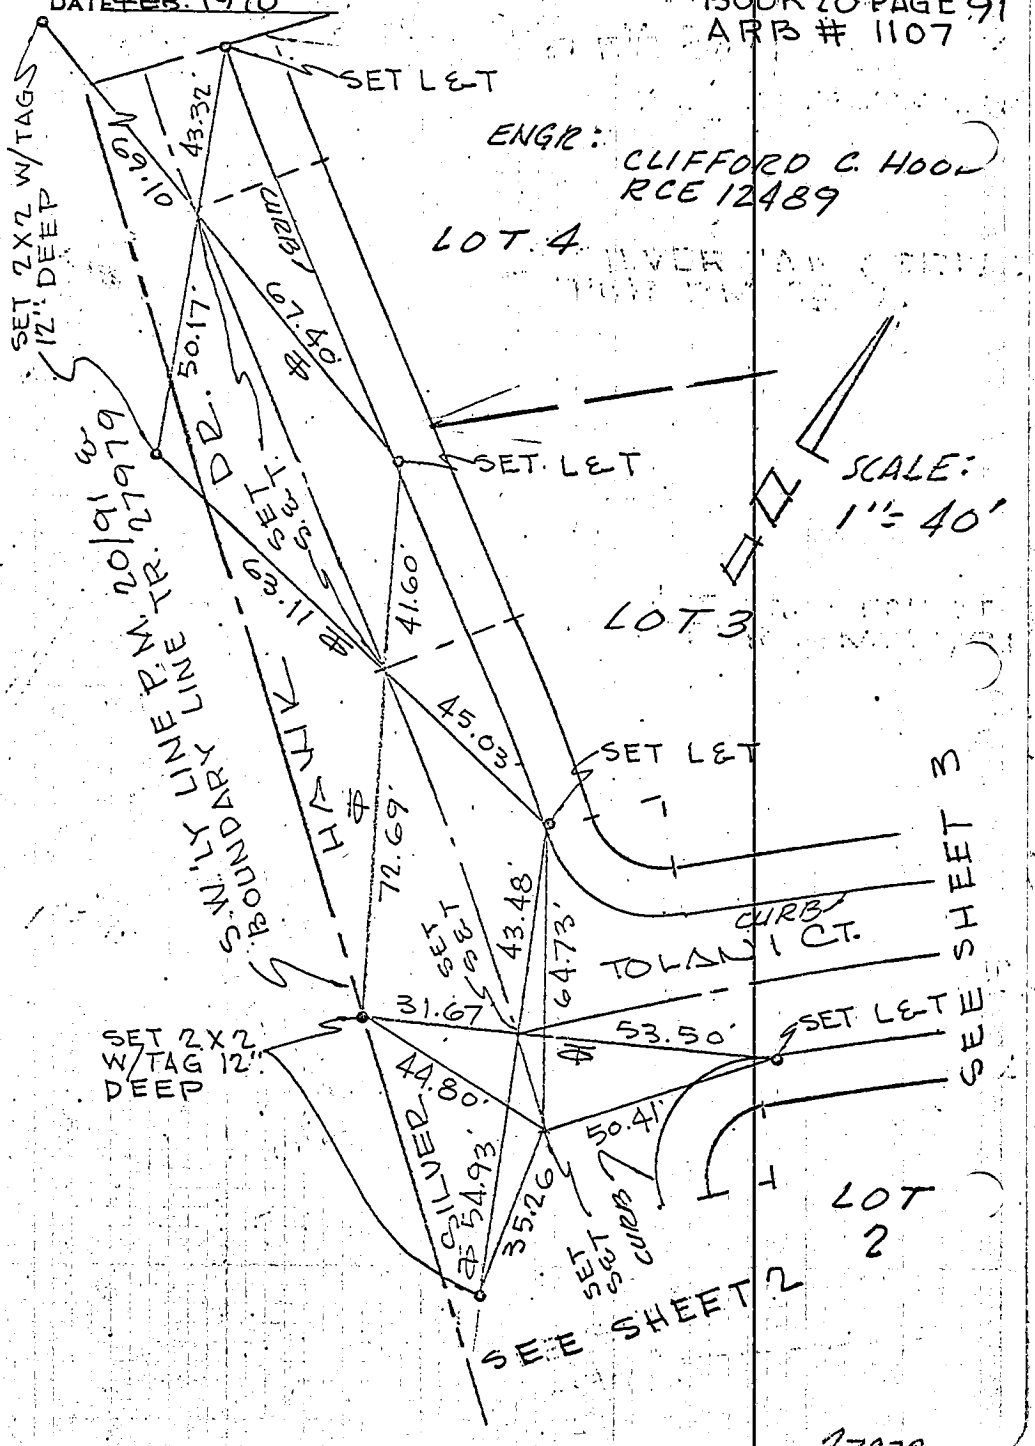


27922

W.S. 099-3: 7, A-1

W.S. 39 B-4

DO NOT EXTEND NOTES THIS SIDE OF LINE

Co. Eng. F.B.4005: 29

SURVEY OF _____ F B NO. _____ PAGE 2

SURVEY BY JENNINGS-HALDERMAN-HOOD ~~TRACT NO~~ PARCEL MAP

DATE ~~FEB~~. 1970 BOOK 20 PAGE 91

ARB # 1107

ENGR: CLIFFORD C. HOOD-RCE 12421

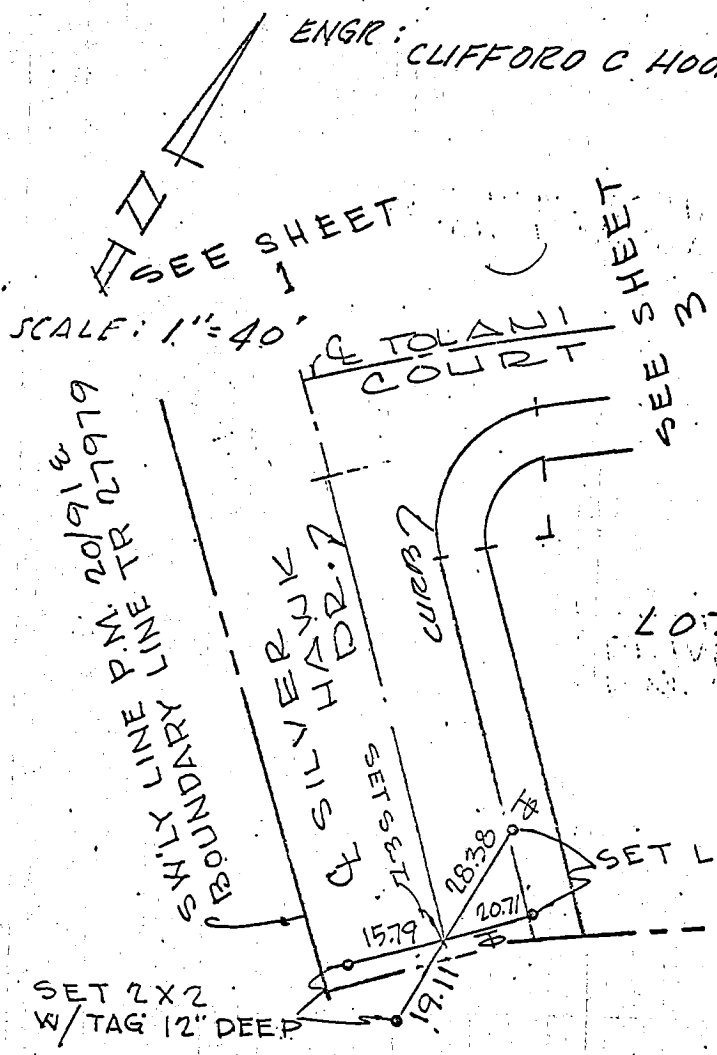


DO NOT EXTEND NOTES THIS SIDE OF LINE

Co. Eng. F.B. 4005: 30

SURVEY OF _____ F B NO. _____ PAGE 3

SURVEY BY JENNINGS-HALDERMAN-HOOD ~~TRACT NO.~~ PARCEL MAP

DATE FEB. 1970

BOOK 20 PAGE 91
ARB # 1107

ENGR: CLIFFORD C. HOOD-R.C.E. 12489

DO NOT EXTEND NOTES THIS SIDE OF LINE

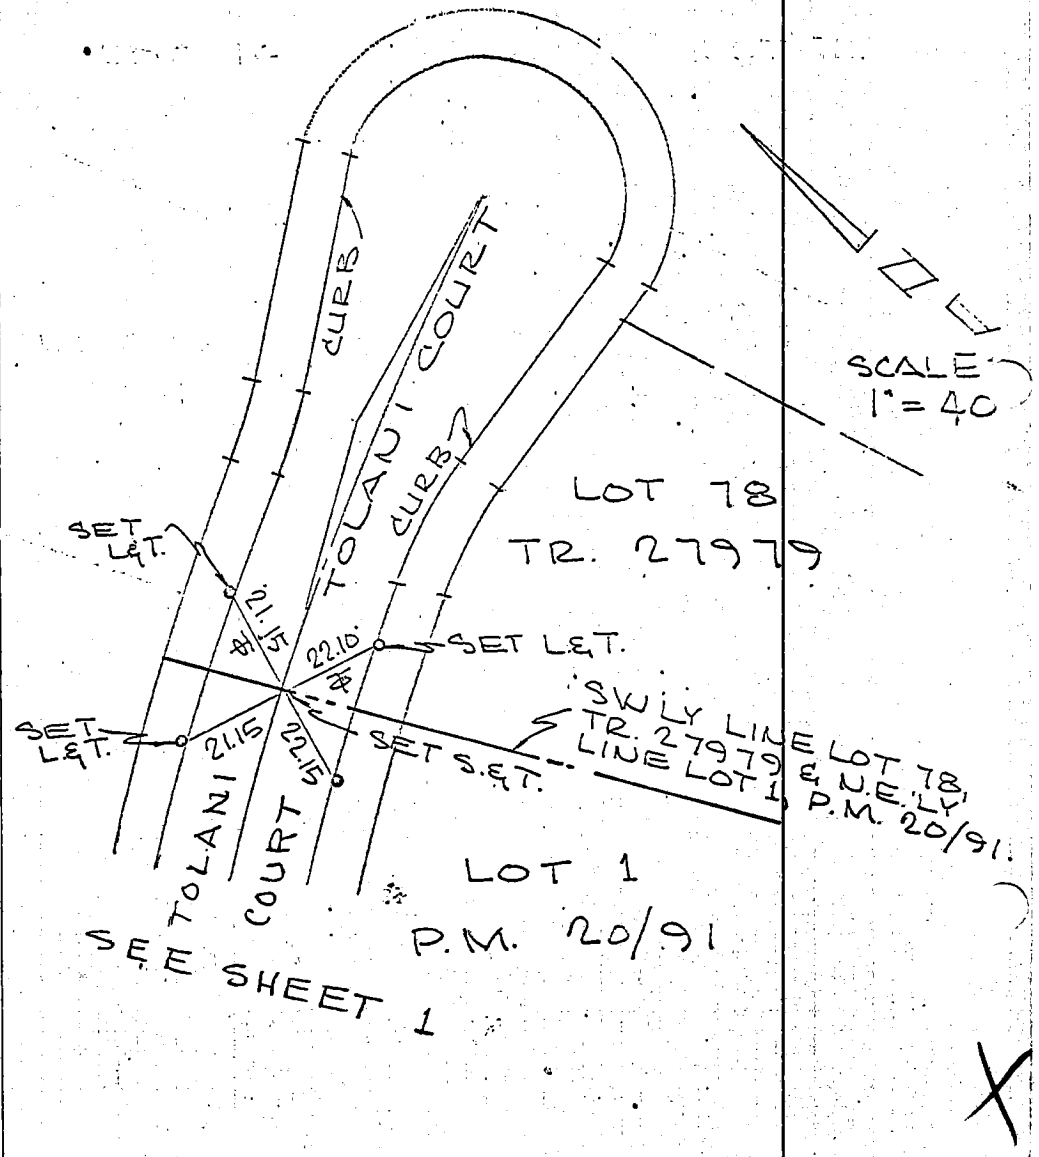

SURVEY OF CENTER-LINE TIES F. B. PG. 1

SURVEY BY LANCO ENGINEERING CO. TR. No. 27577

DATE FEB., 1970

ENGINEER: SURVEY BY RCE 13167 UNDER DIRECTION OF E.C. FOERSTEL, R.C.E. 9183

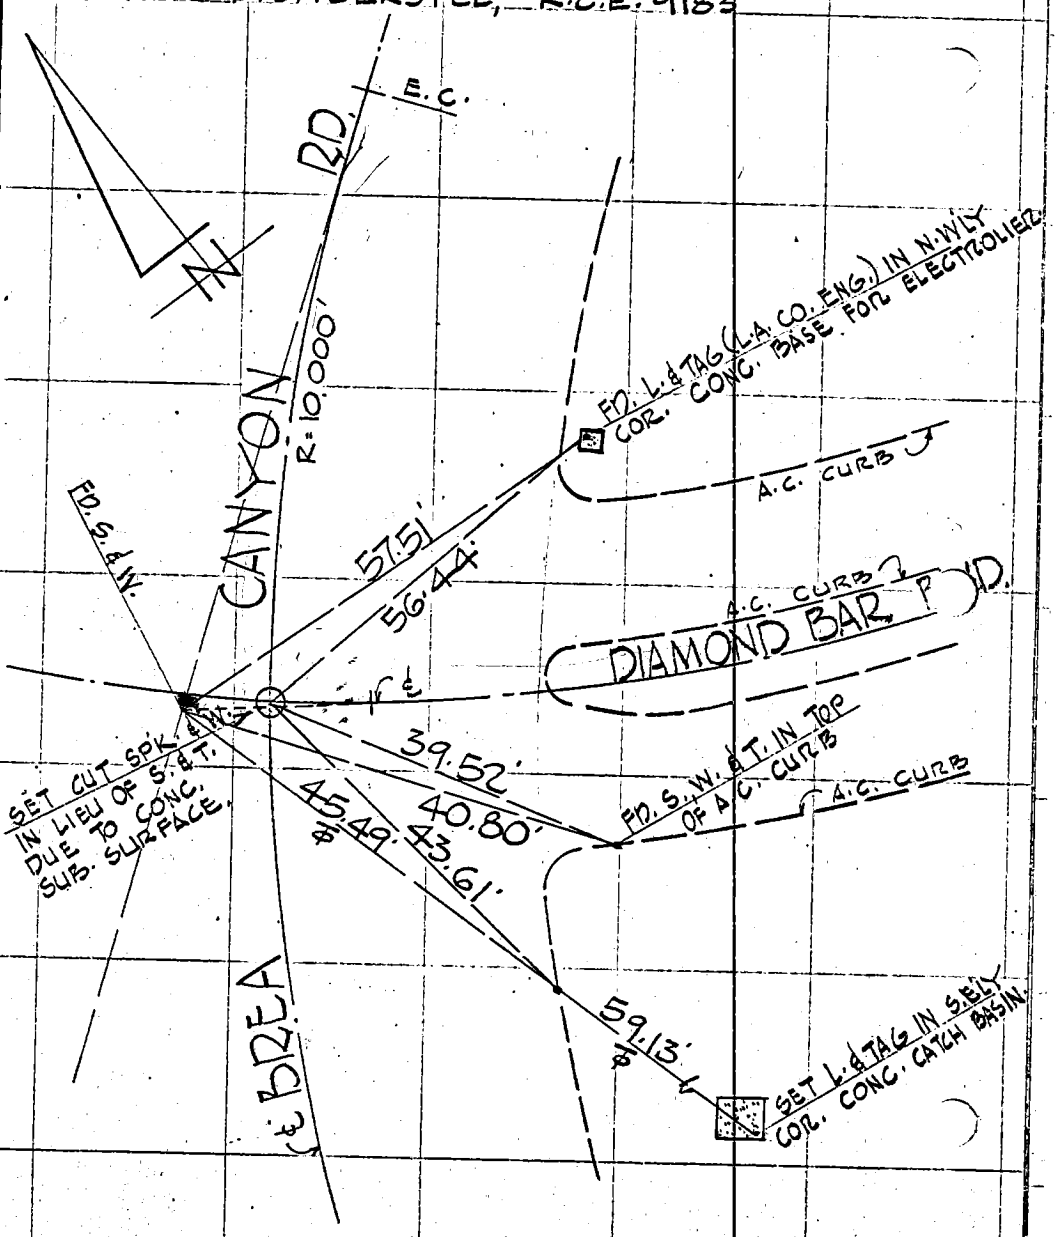


099-317, C-3

US-39 A-5

SO. CALIF. BLUE PRINT CO.

Co. Eng. F.B. 4005: 32

SURVEY OF CENTER-LINE TIES F. B. Pg. 2

SURVEY BY LANCO ENGINEERING CO.

DATE FEB., 1970 TR. No. 27577

ENGINEER: SURVEY BY RCE 13167 UNDER DIRECTION OF E.C. FOERSTEL, R.C.E. 9183

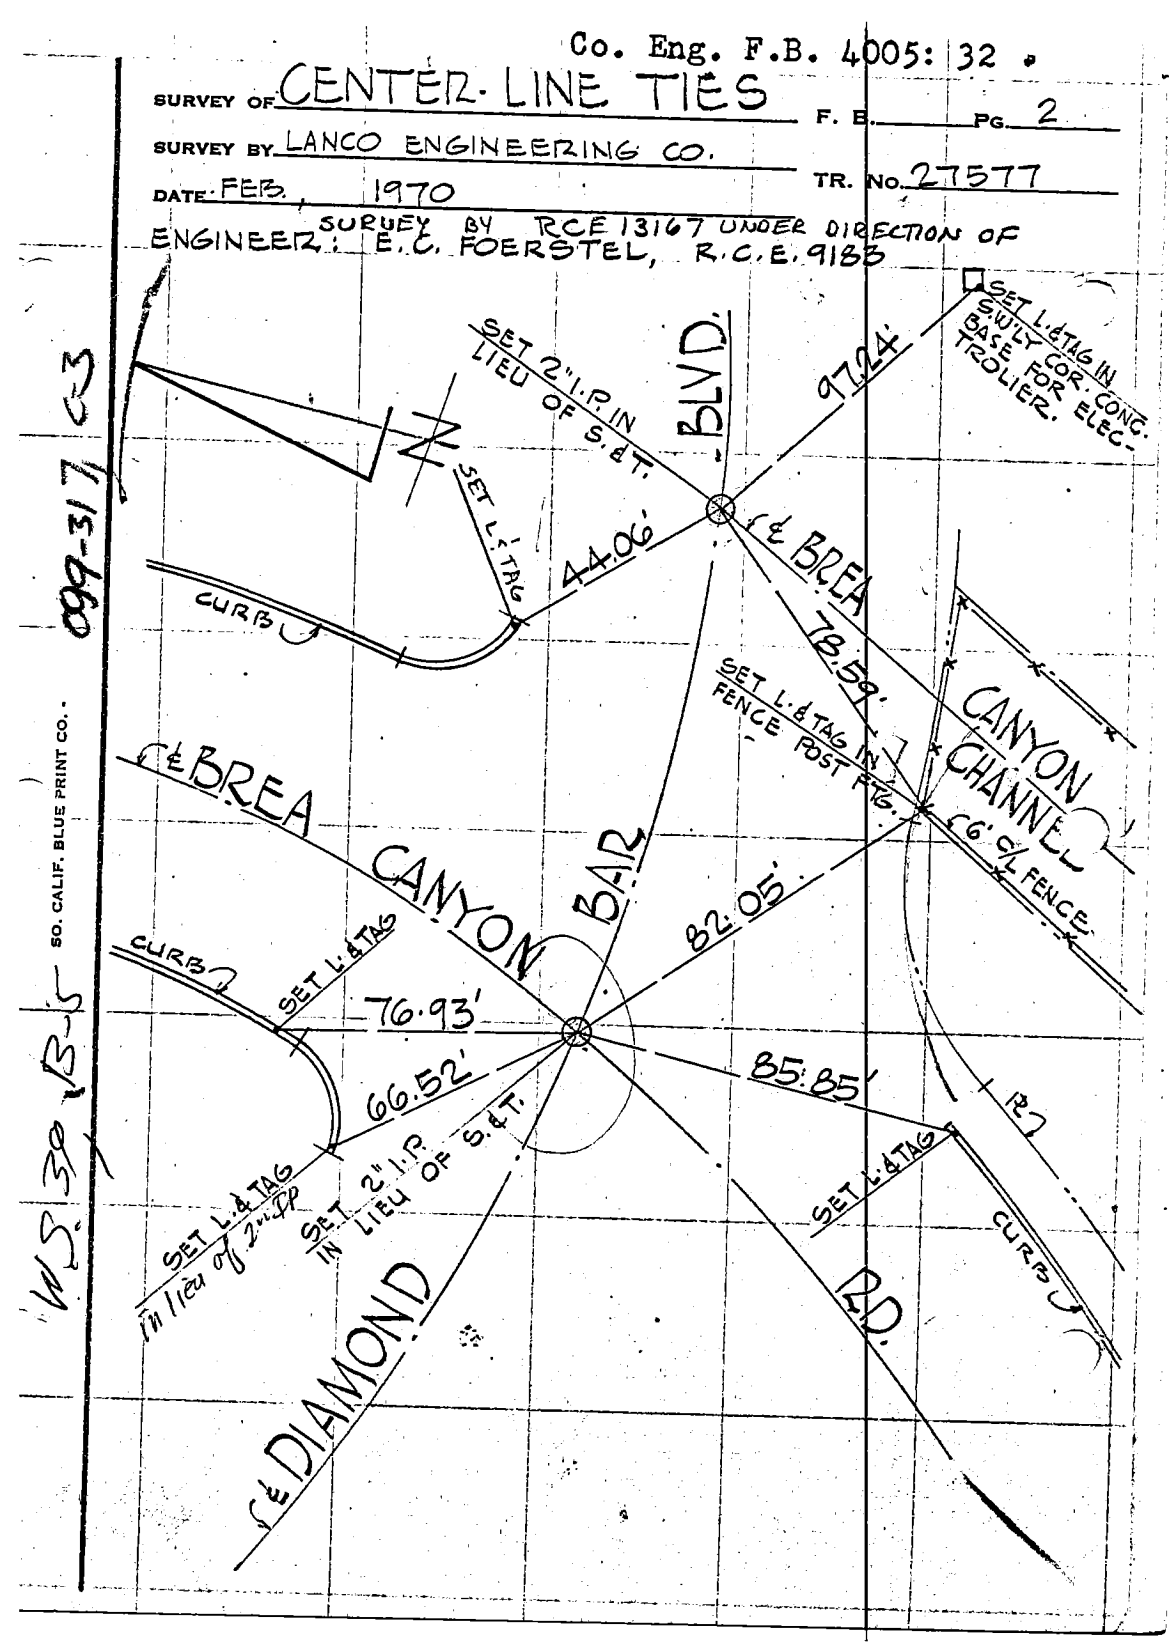


W.S. 39 B-5

099-317 C3

SO. CALIF. BLUE PRINT CO.

Co. Eng. F.B. 4005: 33

SURVEY OF CENTER-LINE TIES F. B. ____ PG. 3

SURVEY BY LANCO ENGINEERING CO. TR. No. 27577

DATE FEB., 1970

ENGINEER: SURVEY BY RCE 13167 UNDER DIRECTION OF E.C. FOERSTEL, R.C.E. 9183

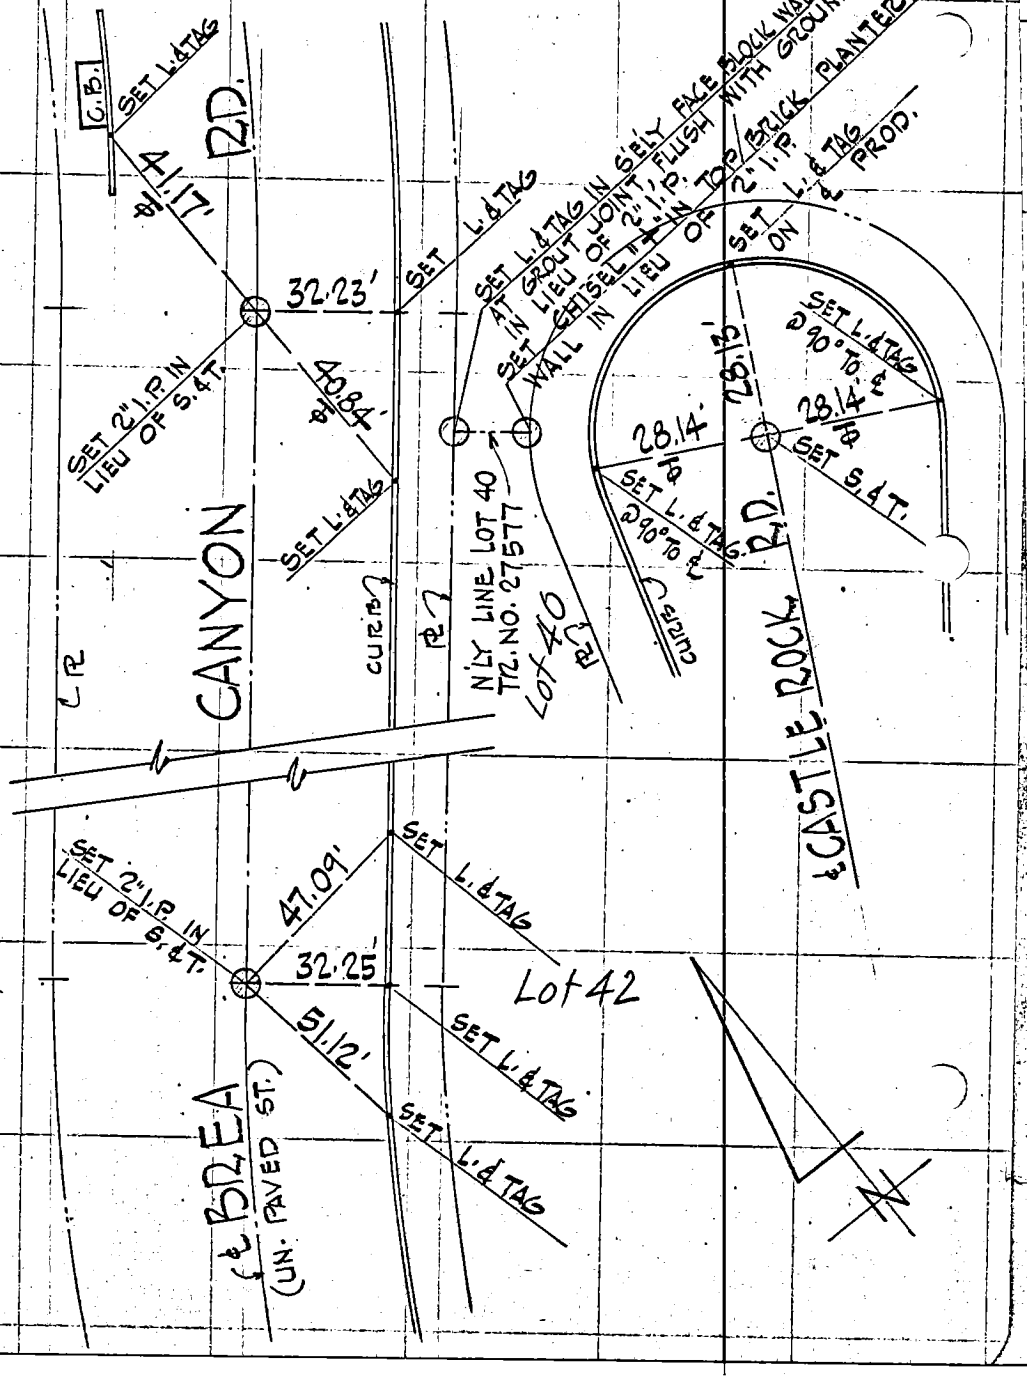


SO. CALIF. BLUE PRINT CO.

WS, 09-37-25

WS 39 B-5

Co. Eng. F.B. 4005: 34

# CENTER-LINE TIES

SURVEY OF CENTER-LINE TIES F. B. 4 Pg.

SURVEY BY LANCO ENGINEERING CO. TR. NO. 27577

DATE FEB., 1970

ENGINEER: SURVEY BY RCE 13167 UNDER DIRECTION OF E.C. FOERSTEL, R.C.E. 9183

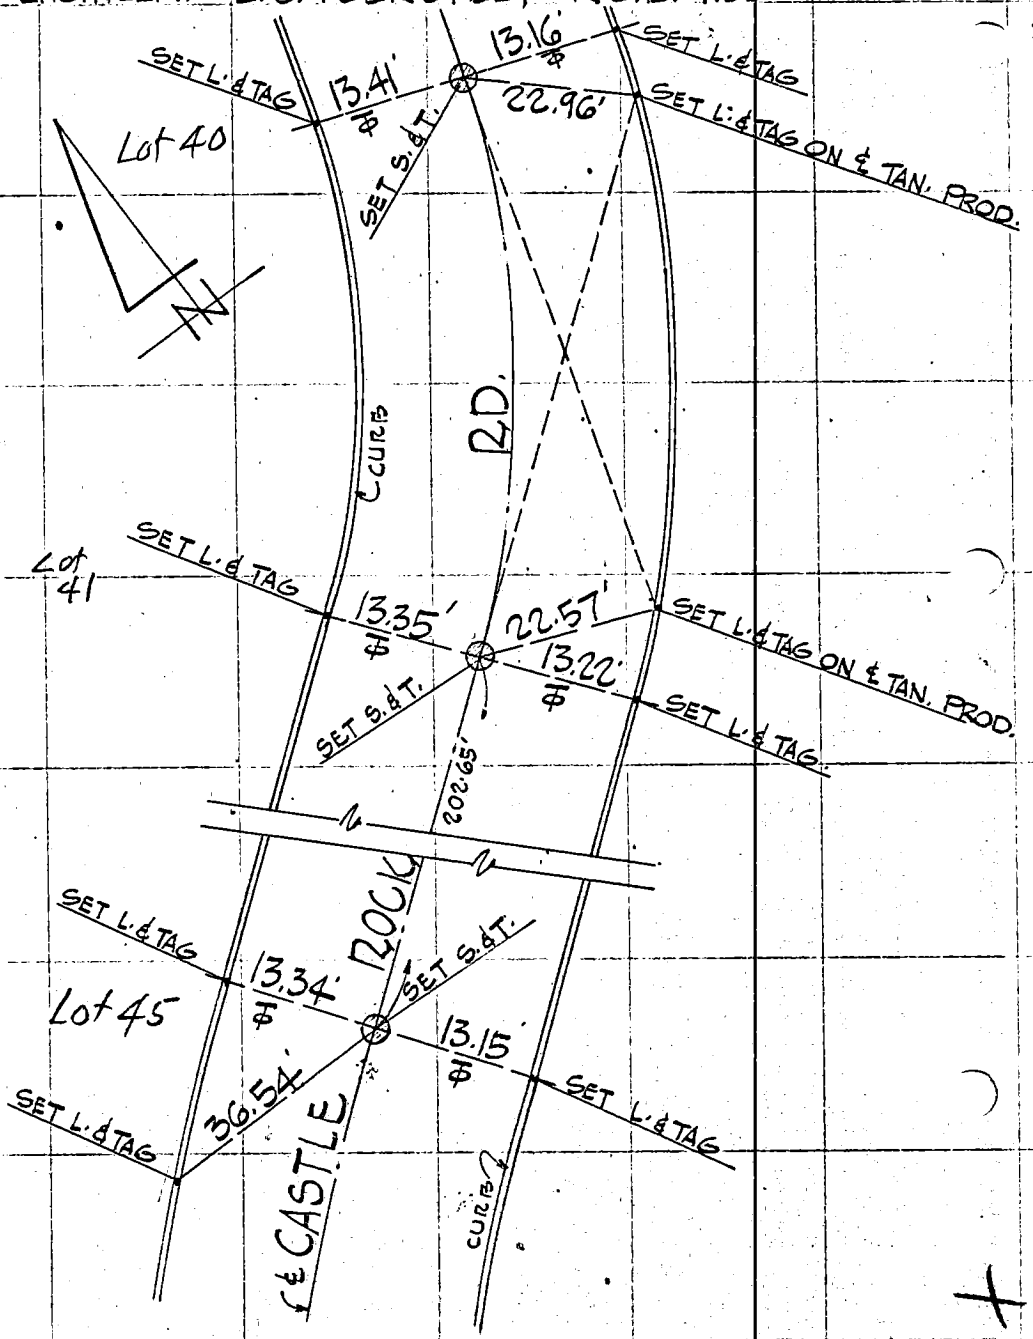


SO. CALIF. BLUE ..INT CO.

Co. Eng. F.B. 4005: 35

SURVEY OF CENTER-LINE TIES F. B. Pg. 5

SURVEY BY LANCO ENGINEERING CO.

DATE FEB., 1970 TR. No. 27577

ENGINEER: SURVEY BY RCE 13167 UNDER DIRECTION OF E. C. FOERSTEL, R.C.E. 9183

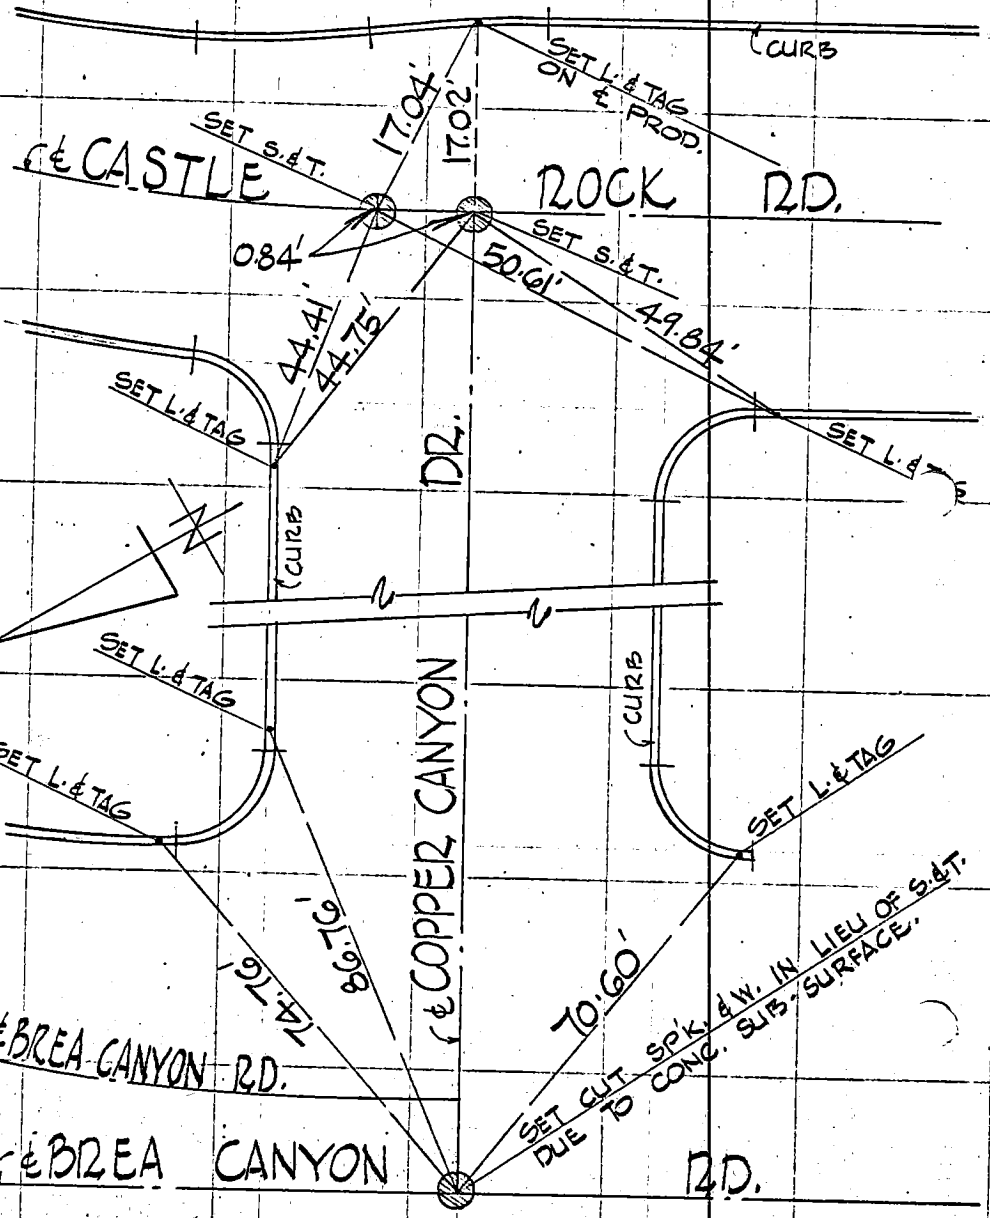


SO. CALIF. BLUE PRINT CO.

W 5 9 4-5

Co. Eng. F.B. 4005: 36

SURVEY OF CENTER LINE TIES F. B. PG. 6

SURVEY BY LANCO ENGINEERING CO. TR. No. 27577

DATE FEB., 1970

ENGINEER: SURVEY BY RCE 13167 UNDER DIRECTION OF E. C. FOERSTEL, R.C.E. 9183

W.S. 0994-317 C-3

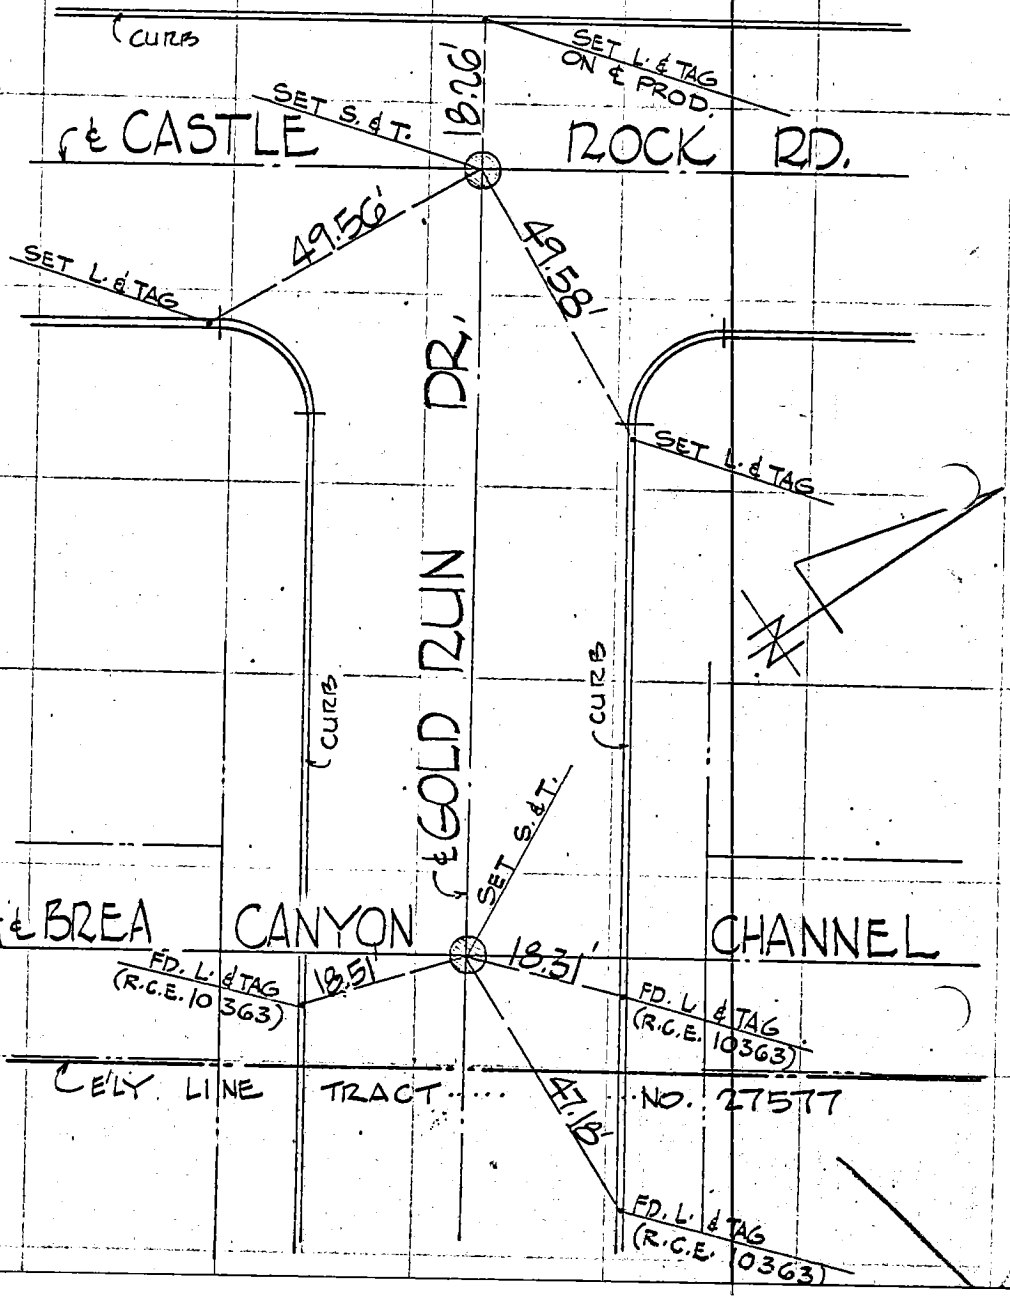


SO. CALIF. BLUE PRINT CO. - 9A-57

Co. Eng. F.B. 4005: 37

SURVEY OF CENTER LINE TIES, F. B. PG. 7

SURVEY BY LANCO ENGINEERING CO. TR. NO. 27577

DATE FEB. 1970

ENGINEER: SURVEY BY RCE 13167 UNDER DIRECTION OF E.C. FOERSTEL, R.C.E. 9183

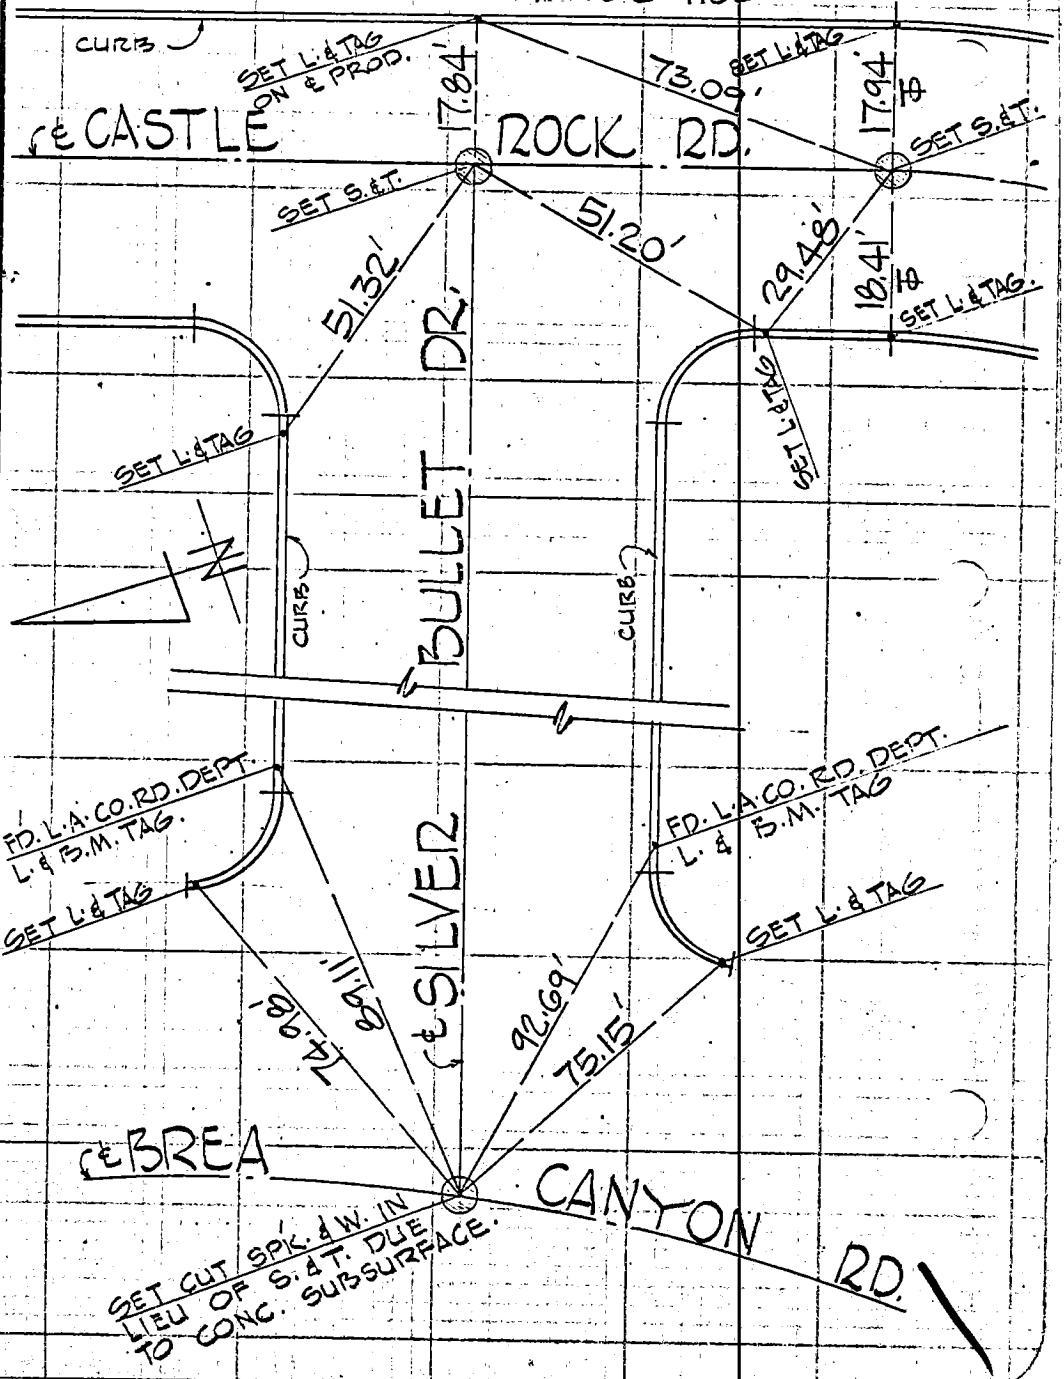


SO. CALIF. BLUE PRINT CO.

Co. Eng. F.B. 4005: 38

SURVEY OF CENTER-LINE TIES F. B. Pg. 8

SURVEY BY LANCO ENGINEERING CO. TR. No. 27577

DATE FEB., 1970

ENGINEER: E. C. FOERSTEL, R.C.E. 9183

( SURUEY BY RCE 13167 UNDER DIRECTION OF

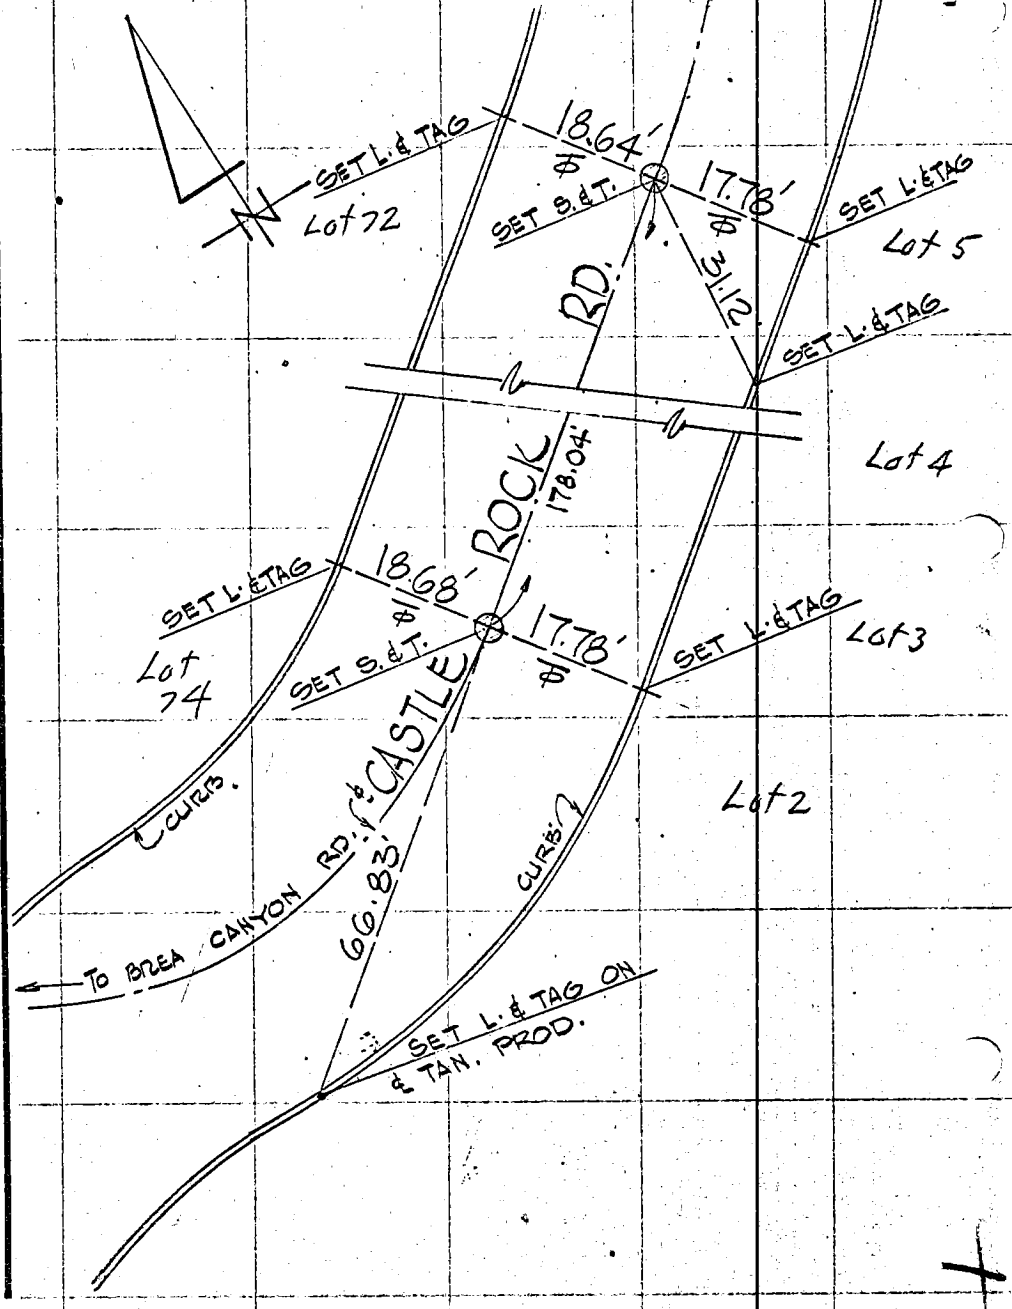

Co. Eng. F.B. 4005: 39

SURVEY OF CENTER LINE TIES. F. B. Pg. 9

SURVEY BY LANCO ENGINEERING CO. TR. NO. 27577

DATE FEB., 1970

ENGINEER: E. C. FOERSTEL, R.C.E. 9183

(SURVEY BY RCE 13167 UNDER DIRECTION)

080-317.5

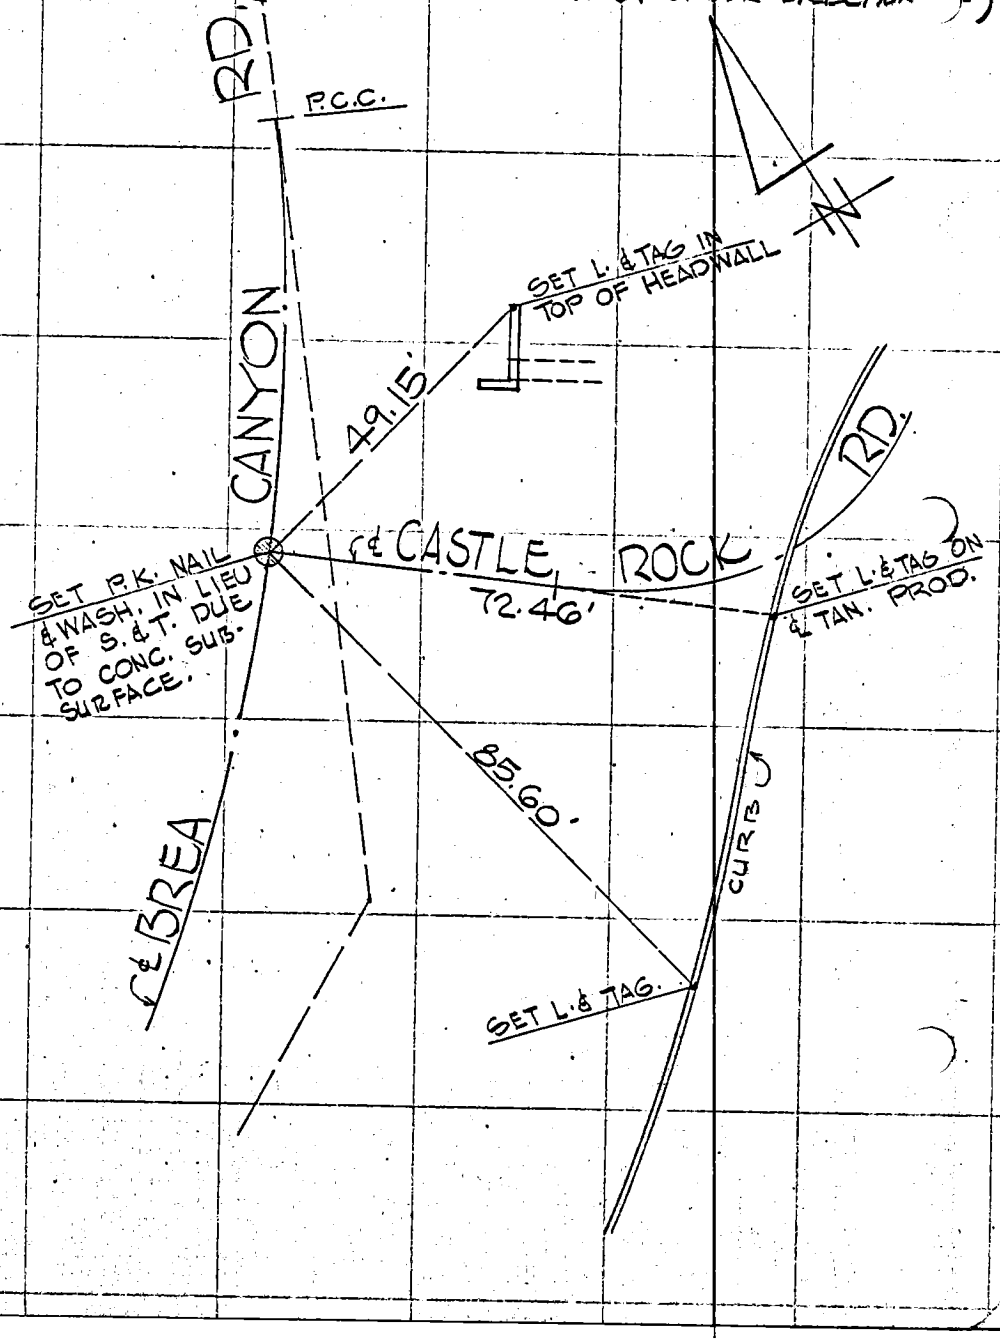

Co. Eng. F.B. 4005: 40

SURVEY OF CENTERLINE TIES F. B. 1 PG. 1

SURVEY BY WILLIAM L. SCHULZ L.S. 3222 TR. No. 29296

DATE JANUARY 30, 1970

W.S. 44 & 6

SO. CALIF. BLUE PRINT CO.

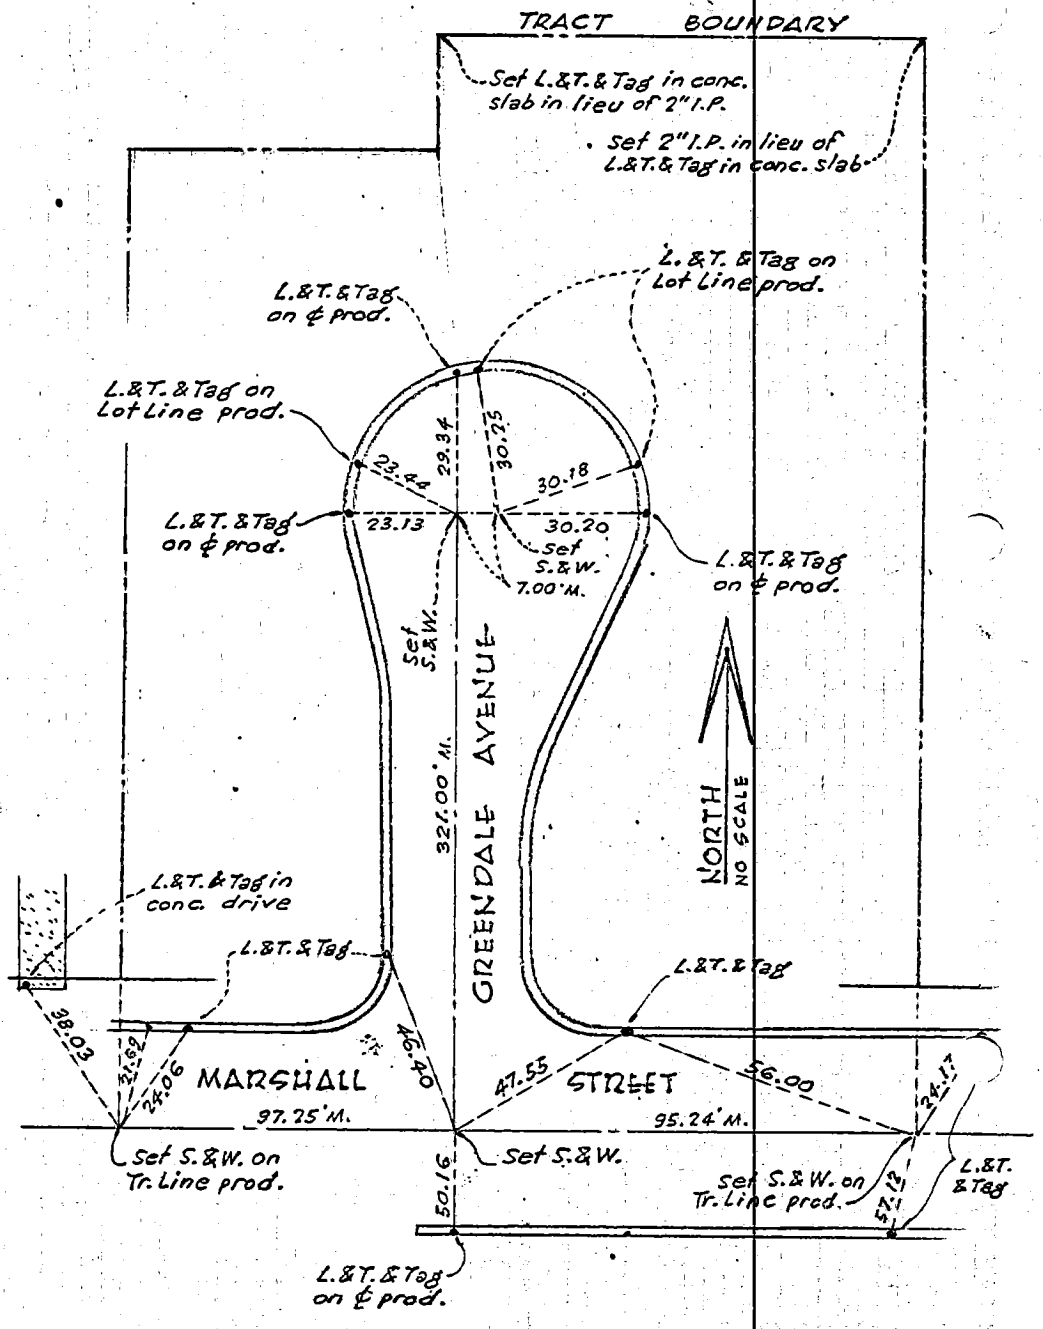

Co. Eng. F.B. 4005: 41

W.S. 39-337, A-1

W.S. 39 c-9

SURVEY OF _____ F. B. _____ PG. 2

SURVEY BY JENNINGS-HALDERMAN-HOOD

DATE DEC. 1969 TR. No. 27979

ENG: HUGH E. HALDERMAN-R.C.E. 8793

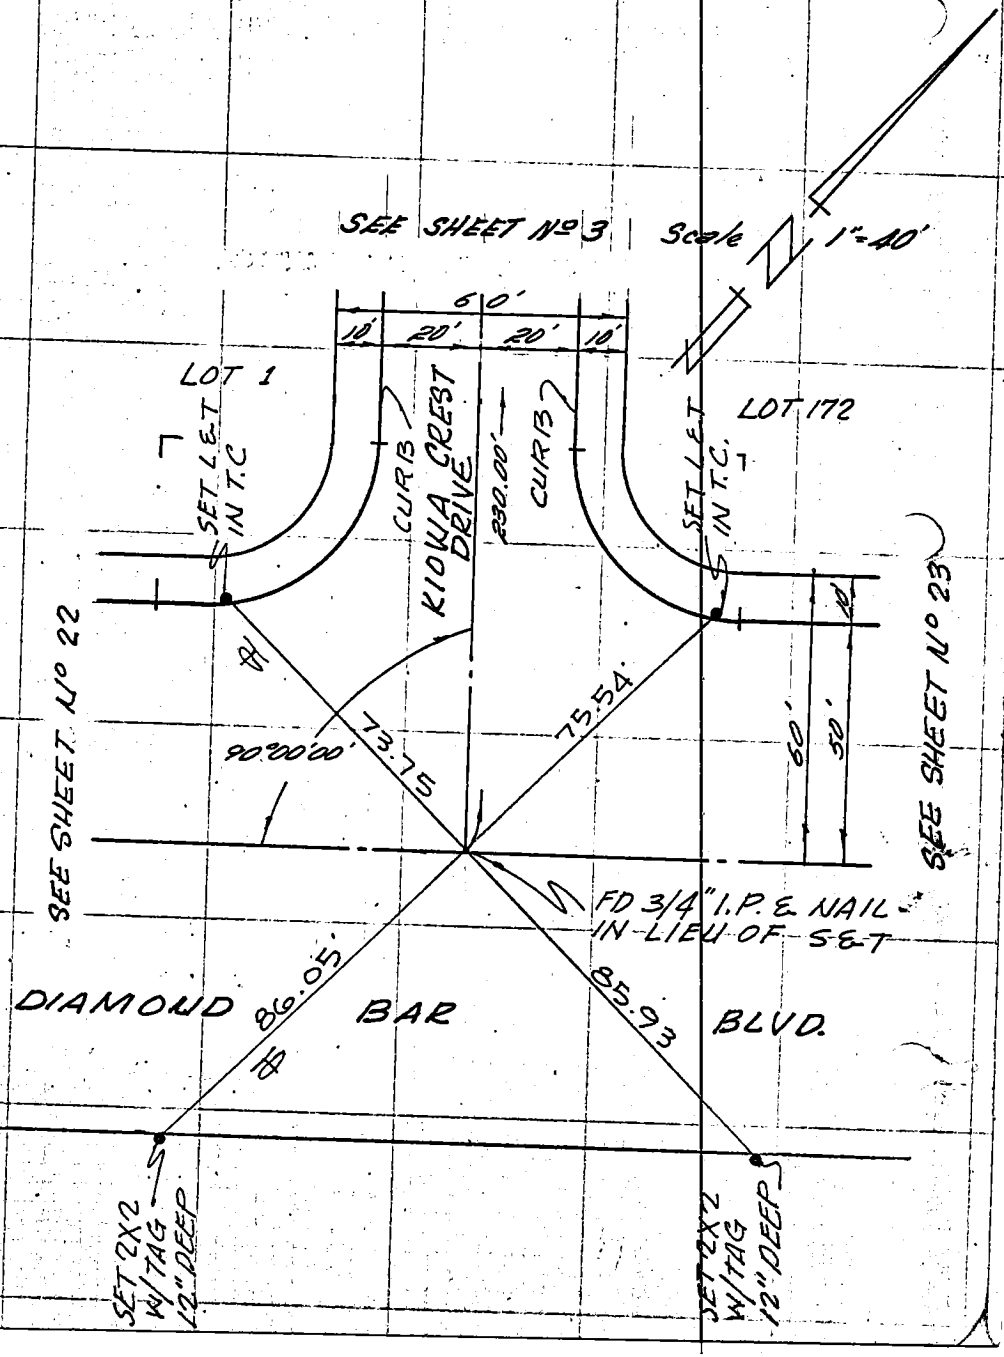

Co. Eng. F.B. 4005: 42

SURVEY OF _____ F B NO. _____ PAGE 22

SURVEY BY JENNINGS-HALDERMAN-HOOD TRACT NO. 2979

DATE FEB., 1970

ENGR.: HUGH E. HALDERMAN-R.C.E. 8793

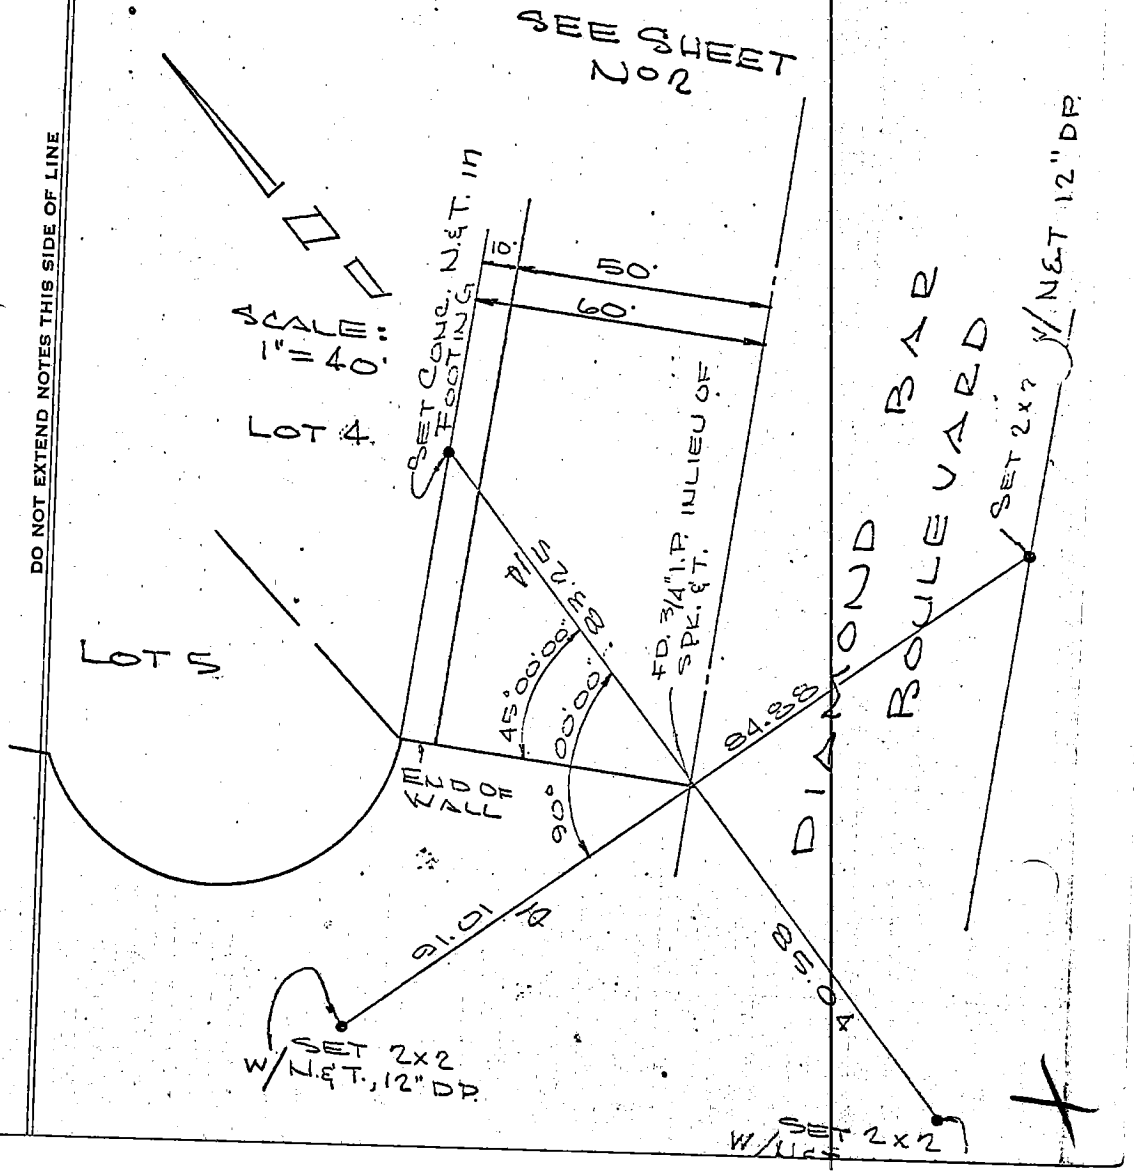


DO NOT EXTEND NOTES THIS SIDE OF LINE

Co. Eng. F.B. 4005: 43

SURVEY OF _____ F B NO. _____ PAGE 23

SURVEY BY JENNINGS-HALDERMAN-HOOD TRACT NO. 27979

DATE FEB. 1970

ENGR: HUGH E. HALDERMAN - R.C.E. 8 3

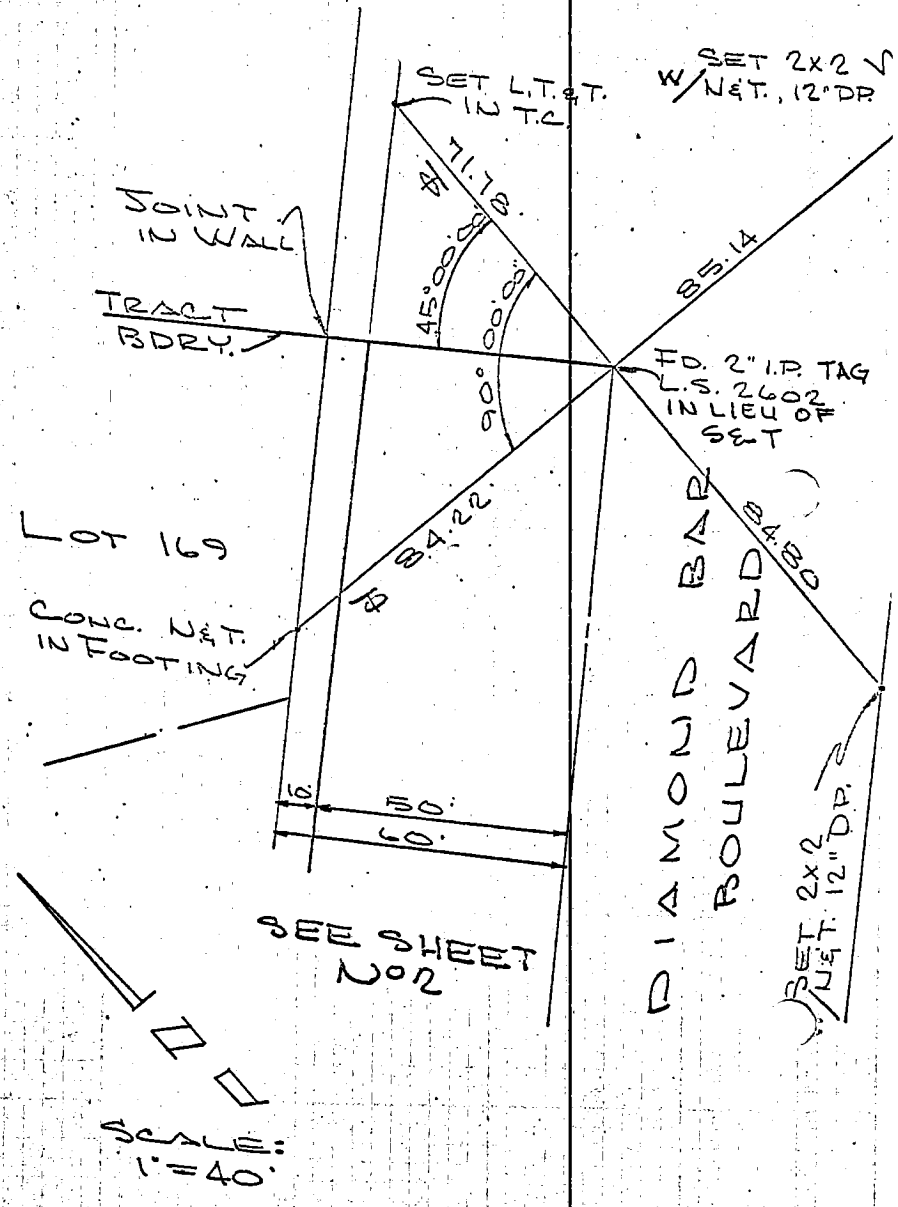


SURVEYORS SERVICE COMPANY LOS ANGELES - STOCK NO. 411

DO NOT EXTEND NOTES THIS SIDE OF LINE

Co. Eng. F.B. 4005: 44

W.J. 099-337.41

SURVEY OF _____ F. B. _____ PG. 3

SURVEY BY JENNINGS-HALDERMAN-HOOD TR. No. 27979

DATE DEC., 1969

ENG: HUGH E. HALDERMAN R.C.E. 8793

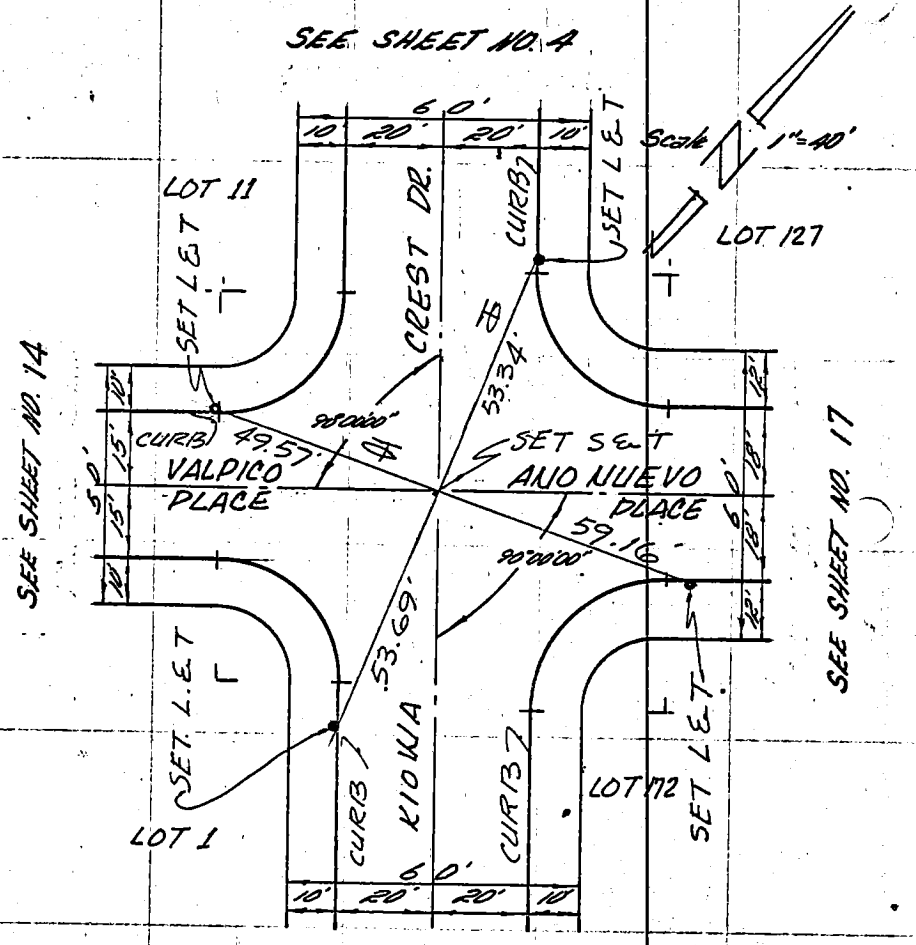

Co. Eng. F.B. 4005: 45

SURVEY OF _____ F. B. _____ PG. 4

SURVEY BY JENNINGS ~ HALDERMAN ~ HOOD TR. No. 27979

DATE DEC, 1969

ENG: HUGH E. HALDERMAN-R.C.E. 8793

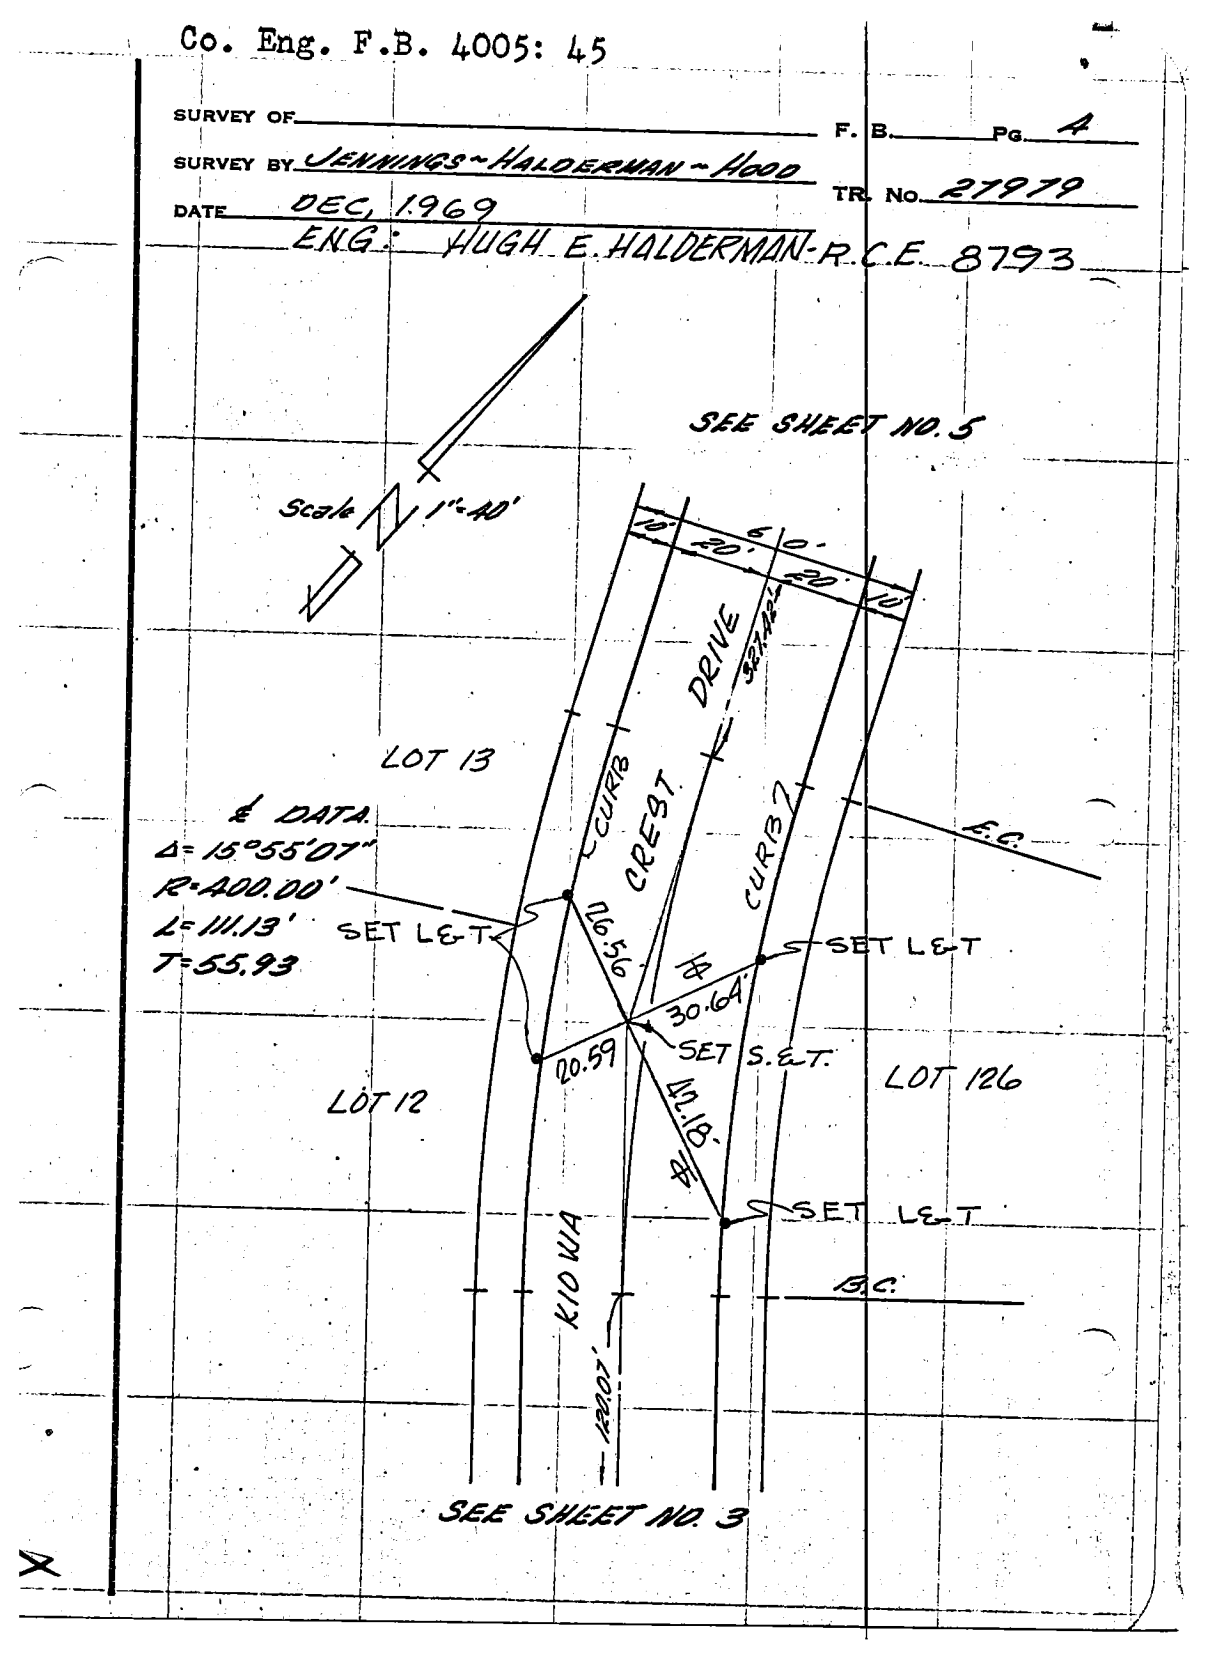

Co. Eng. F.B. 4005: 46

SURVEY OF _____ F. B. _____ PG. 5

SURVEY BY JENNINGS-HALDERMAN-HOOD TR. NO. 27979

DATE DEC, 1969

SEE SHEET NO. 15

ENG: HUGH E. HALDERMAN
R.C.E 8793

W.S. 099+337

W.S. 398+00

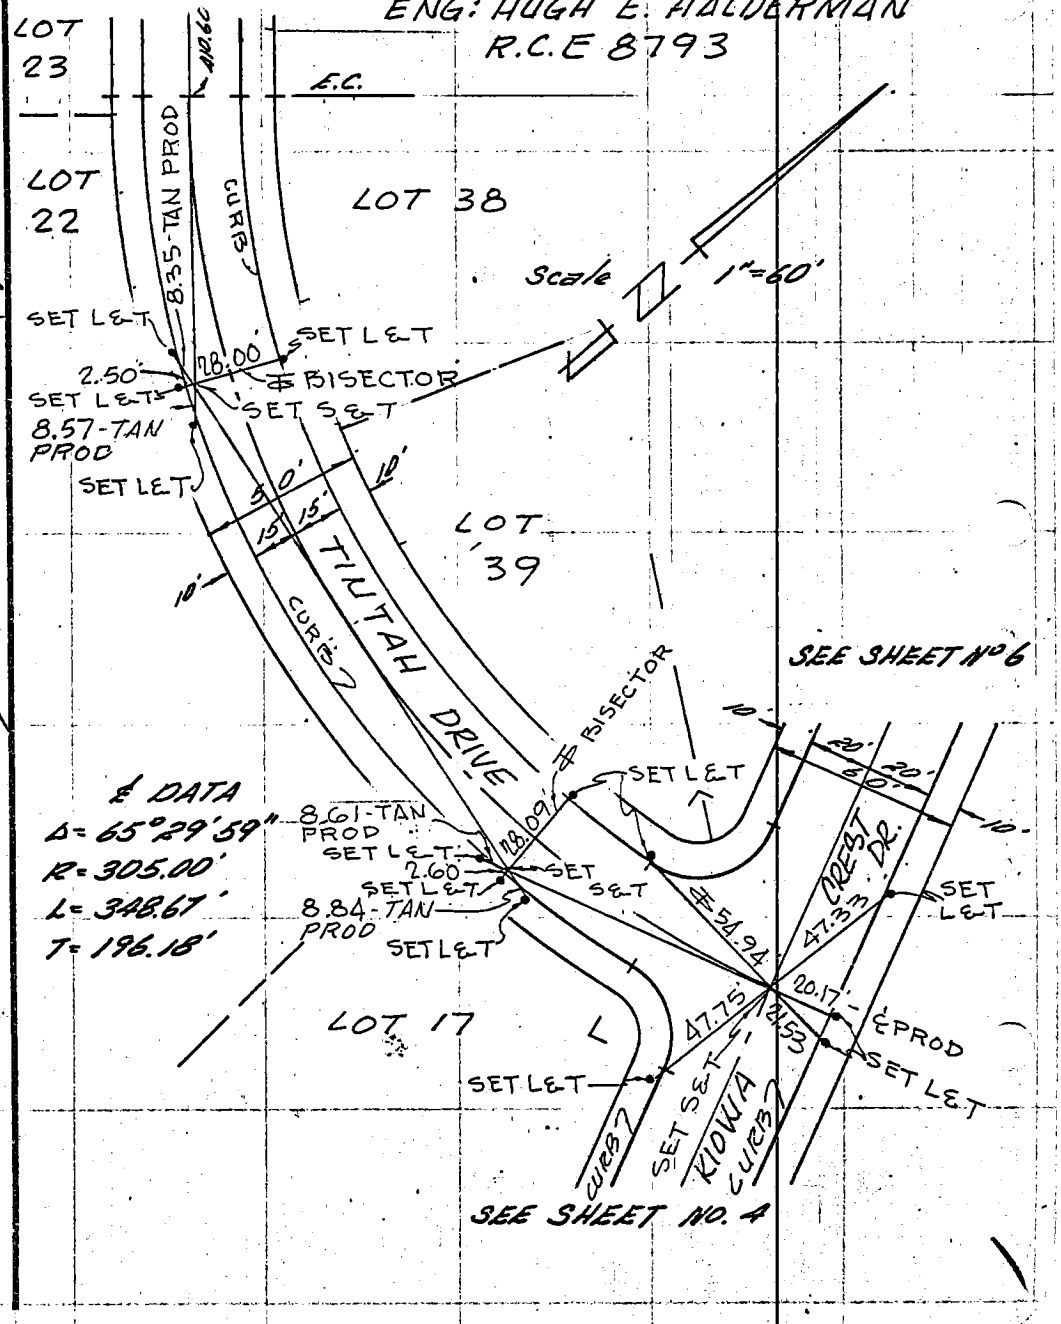

Co. Eng. F.B. 4005: 47

SURVEY OF _____ F. B. _____ PG. 6

SURVEY BY JENNINGS-HALDERMAN-HOOD TR. No. 27979

DATE DEC. 1969

SEE SHEET NO. 7

ENG: HUGH E. HALDERMAN
R.C.E. 8793

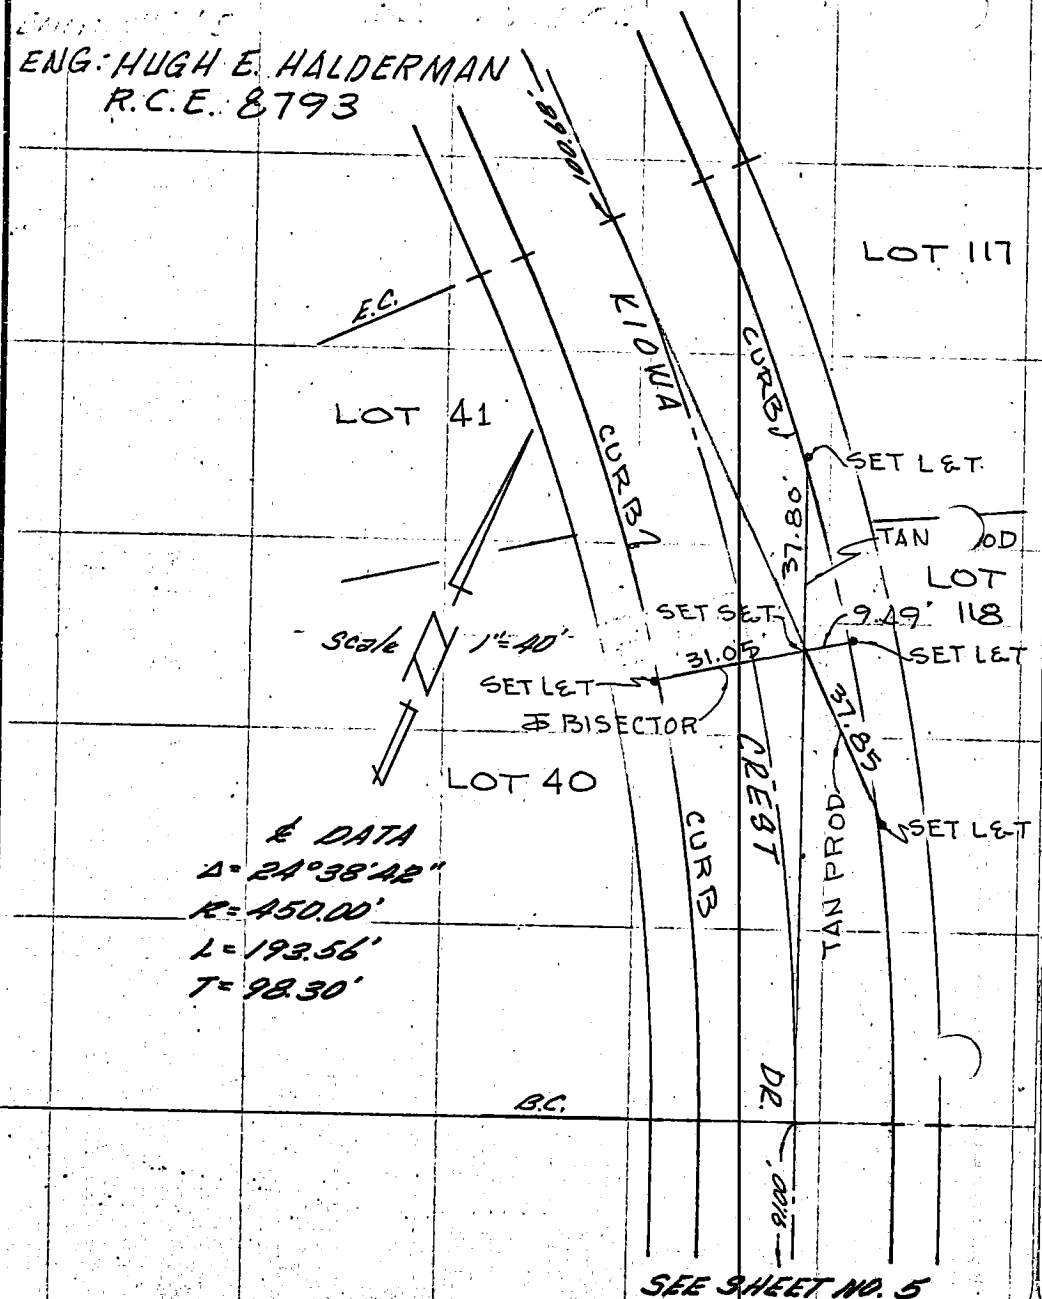


℄ DATA
Δ = 24°38'42"
R = 450.00'
L = 193.56'
T = 98.30'

SEE SHEET NO. 5

Co. Eng. F.B. 4005: 48

SURVEY OF _____ F. B. _____ PG. 7

SURVEY BY JENNINGS-HALDERMAN-HOOD TR. NO. 27979

DATE DEC, 1969

ENG: HUGH E. HALDERMAN- R.C.E. 8793

SEE SHEET NO. 8

Scale 1"=40'

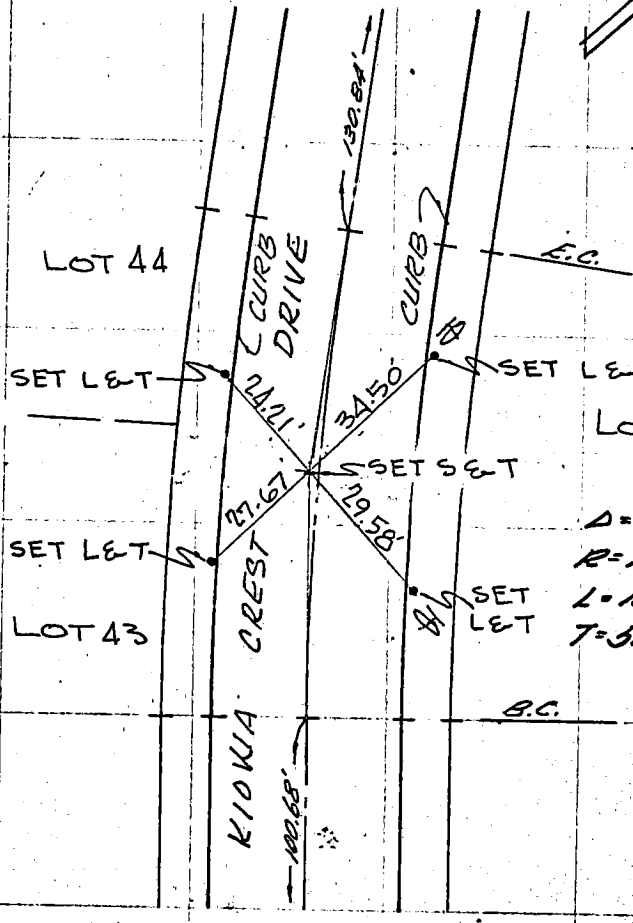


SEE SHEET NO. 6

SURVEY OF _____ F B NO. _____ PAGE 8

SURVEY BY JENNINGS-HALDERMAN-HOOD TRACT NO. 27979

DATE DEC., 1969

ENG: HUGH E. HALDERMAN
R.C.E. 8793

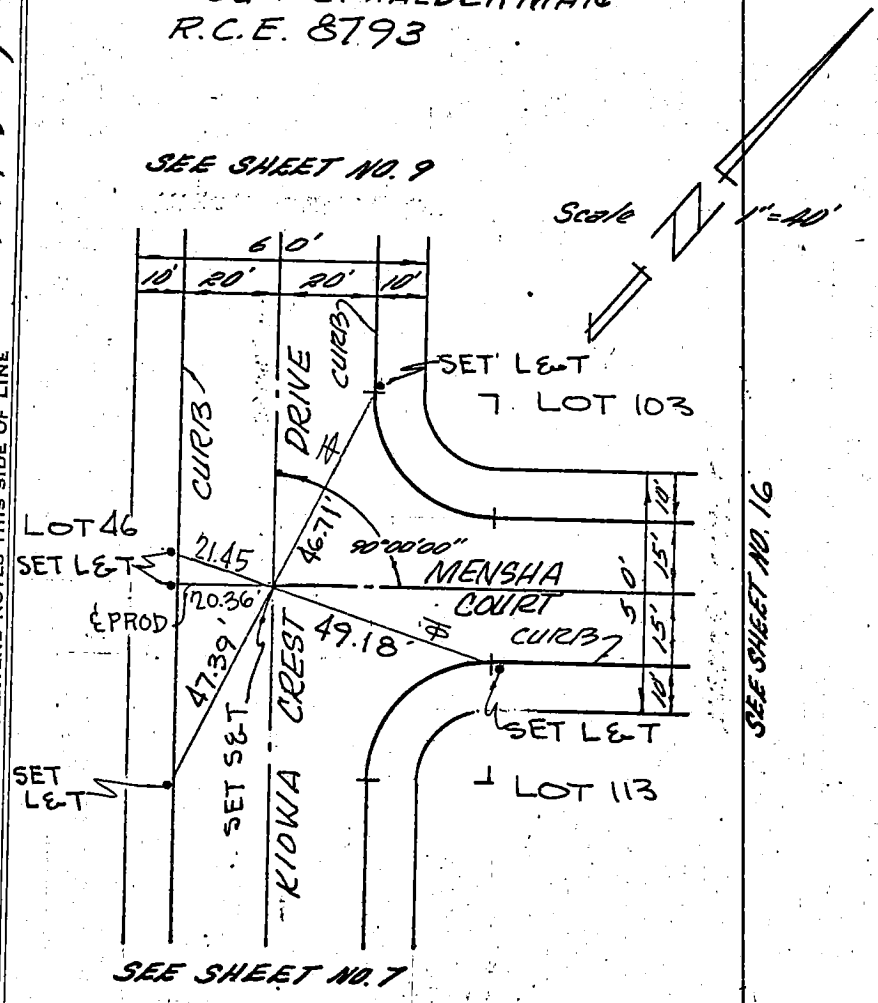


DO NOT EXTEND NOTES THIS SIDE OF LINE

WS 099-337, A-1

WS 330 B-C

Co. Eng. F.B. 4005: 50

SURVEY OF _____ F B NO. _____ PAGE 9

SURVEY BY JENNINGS-HALDERMAN-HOOD TRACT NO. 27979

DATE DEC 1969

ENG: HUGH E. HALDERMAN
R.CE 8793

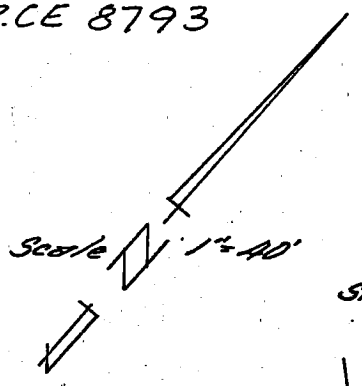


SEE SHEET NO. 10

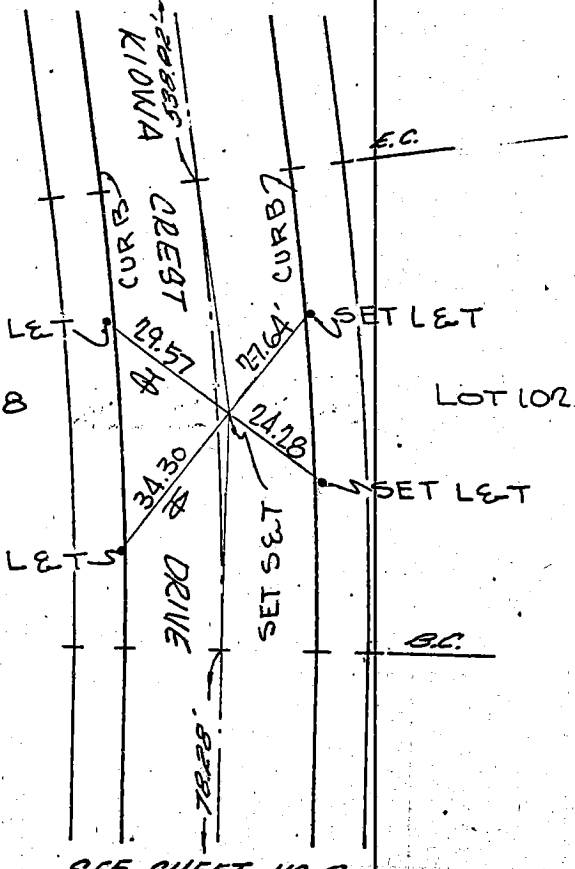


℄ DATA
Δ = 07°59'25"
R = 730.00'
L = 101.80'
T = 50.98'

SEE SHEET NO. 8

DO NOT EXTEND NOTES THIS SIDE OF LINE

Co. Eng. F.B. 4005: 51

SURVEY OF _____ F B NO. _____ PAGE 10

SURVEY BY JENNINGS-HALDERMAN-HOOD TRACT NO. 27979

DATE DEC, 1969

ENG: HUGH E. HALDERMAN
R.C.E. 8793

W.S. 029-337, A-1

W.S. 29 B-4

DO NOT EXTEND NOTES THIS SIDE OF LINE

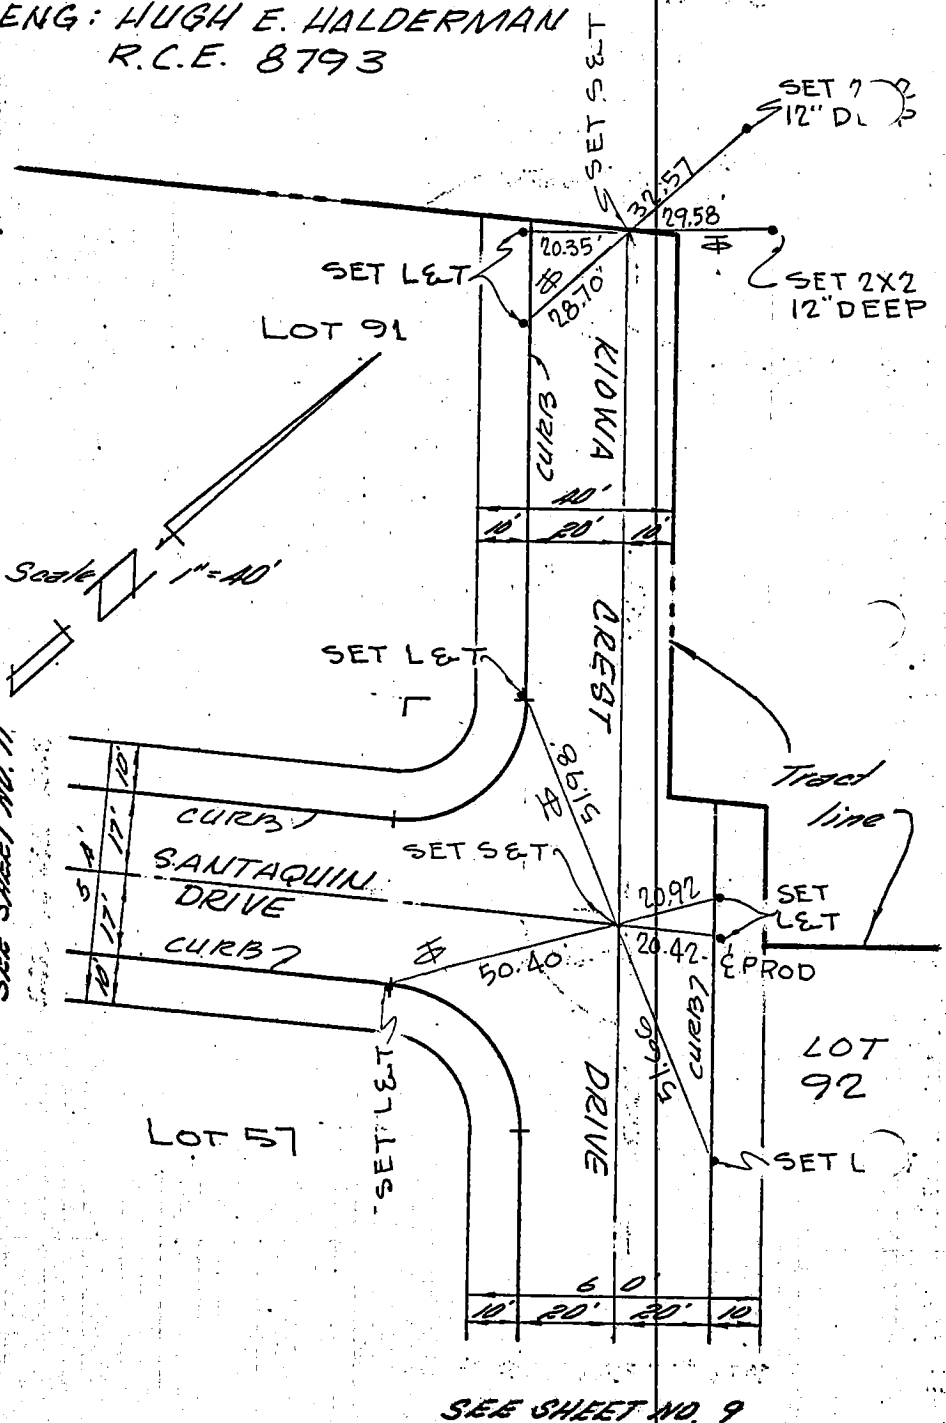

Co. Eng. F.B. 4005: 52

SURVEY OF _____ F B NO. _____ PAGE 11

SURVEY BY JENKINS-HALDERMAN-HOOD TRACT NO. 27979

DATE DEC. 1969

ENG. HUGH E. HALDERMAN
R.C.E. 8793

W.S. 099-337, A-1

W.O. 3378 B-C

DO NOT EXTEND NOTES THIS SIDE OF LINE

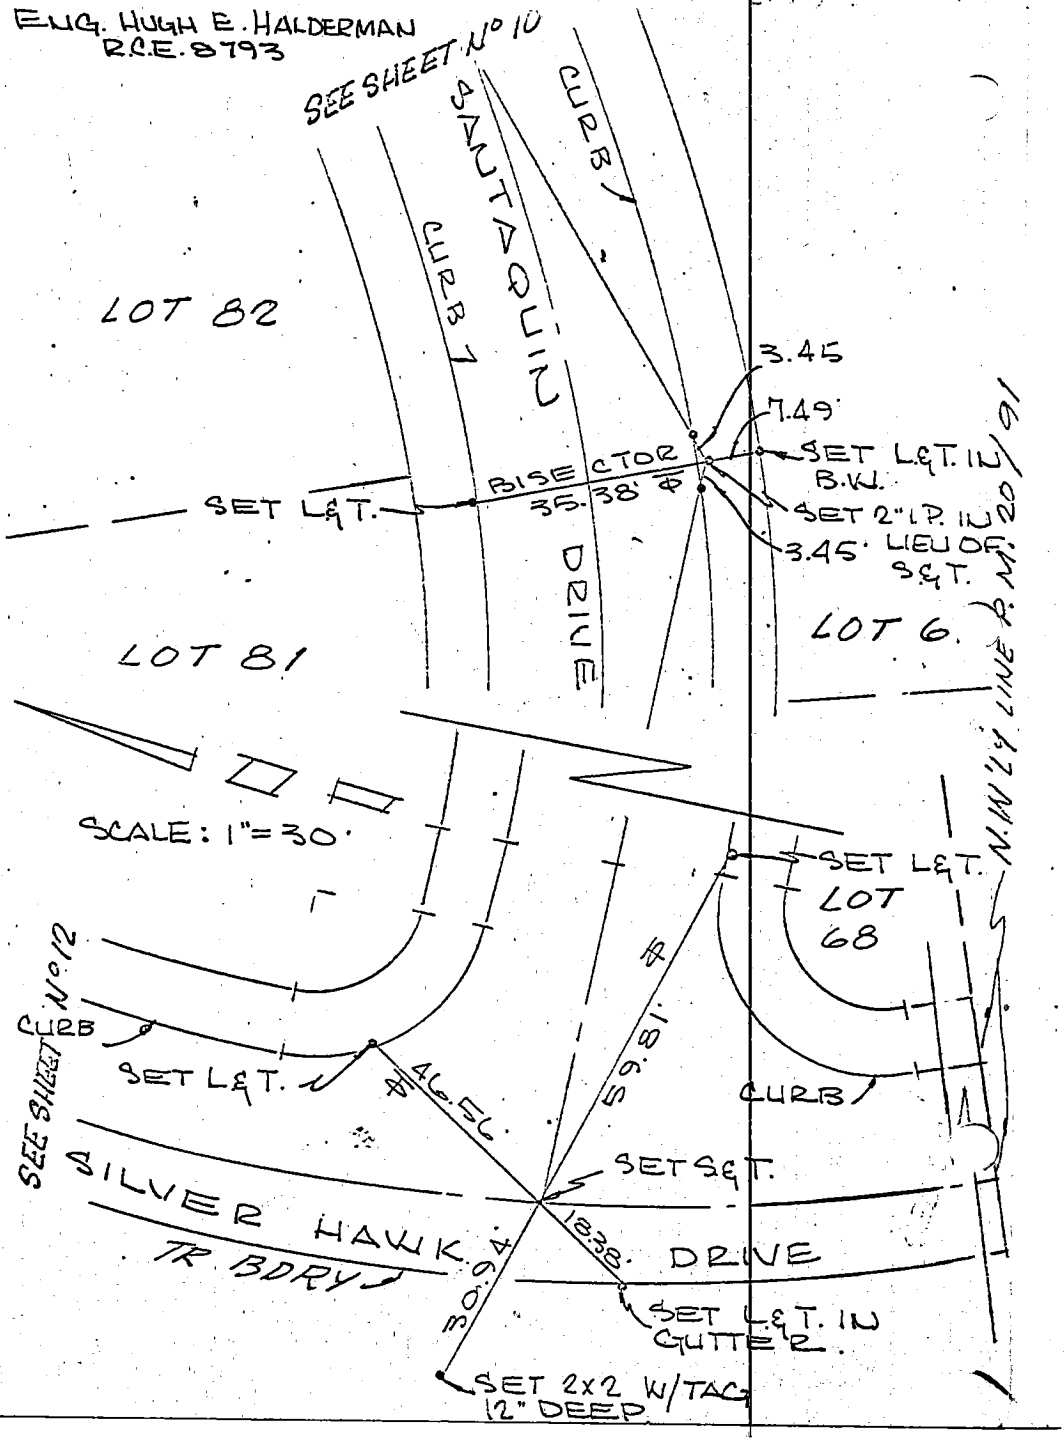

Co. Bldg. P.B. 4005: 53

SURVEY OF _____ F B NO. _____ PAGE 12

SURVEY BY JENNINGS-HALDERMAN-HOOD TRACT NO. 27979

DATE: DEC. 1969

ENGR: HUGH E. HALDERMAN
R.C.E. 8793

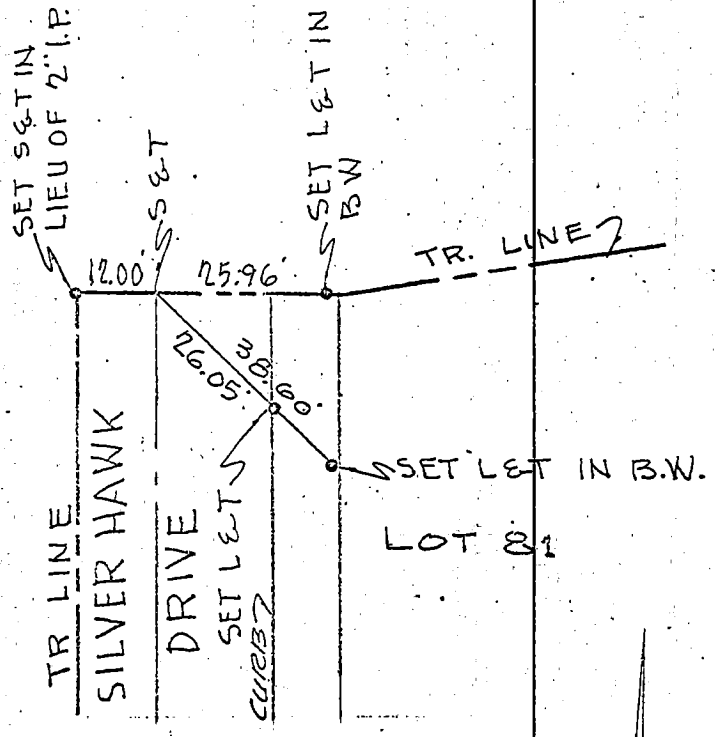


SEE SHEET N° 11

SCALE: 1" = 30'

DO NOT EXTEND NOTES THIS SIDE OF LINE

27979

Co. Eng. F.B. 4005: 54

SURVEY OF _____ F B NO _____ PAGE 13

SURVEY BY JENNINGS-HALDERMAN-HOOD TRACT NO. 27979

DATE DEC. 1969

ENGR.: HUGH E. HALDERMAN-R.C.E. 8793

W.S. 89-4 W.S. 89-337, 4

DO NOT EXTEND NOTES THIS SIDE OF LINE

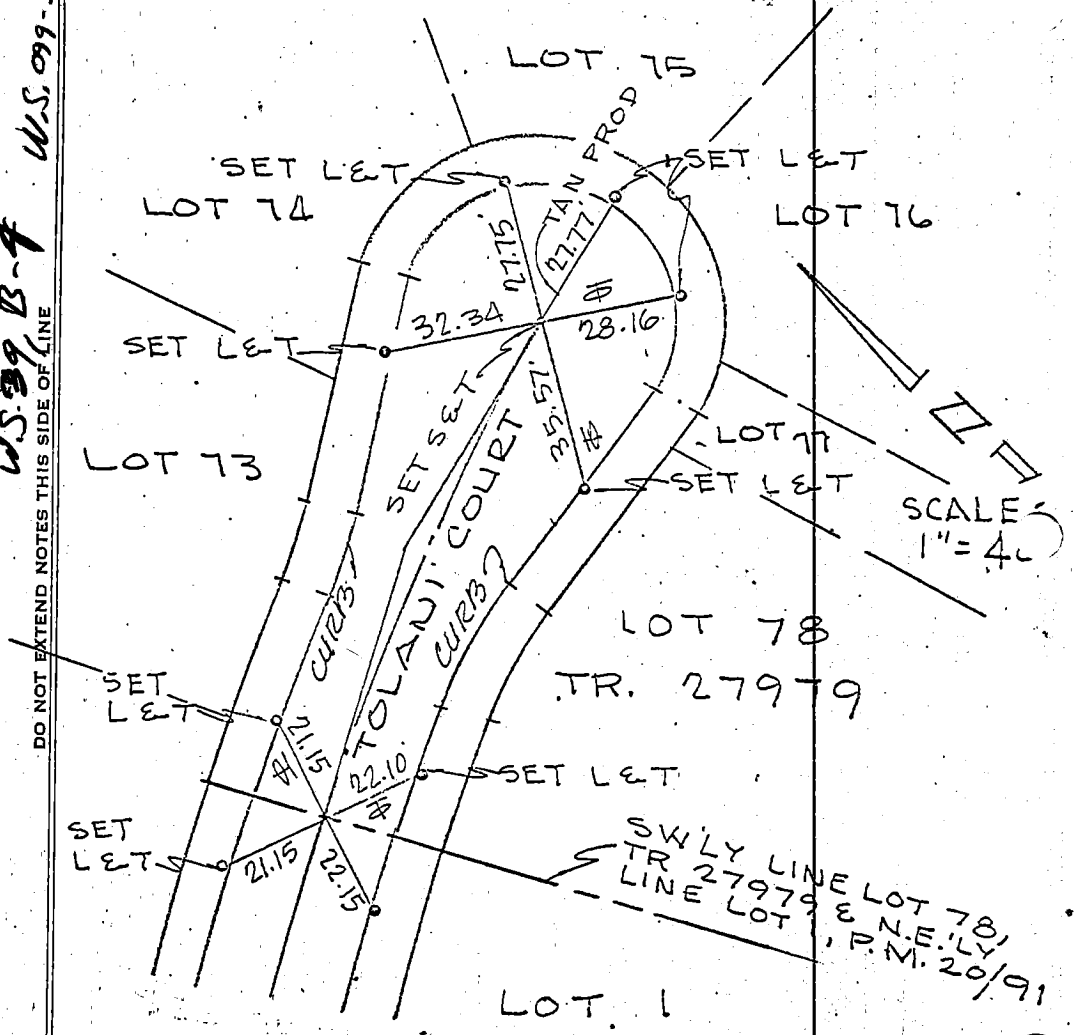

Co. Eng. F.B. 4005: 55

SURVEY OF _____ F B NO. _____ PAGE 14

SURVEY BY JENNINGS-HALDERMAN-HOOD TRACT NO. 27979

DATE DEC., 1969

ENG: HUGH E. HALDERMAN
R.C.E. 8793

W.S. 099-337, A-1

DO NOT EXTEND NOTES THIS SIDE OF LINE

W839, B-4

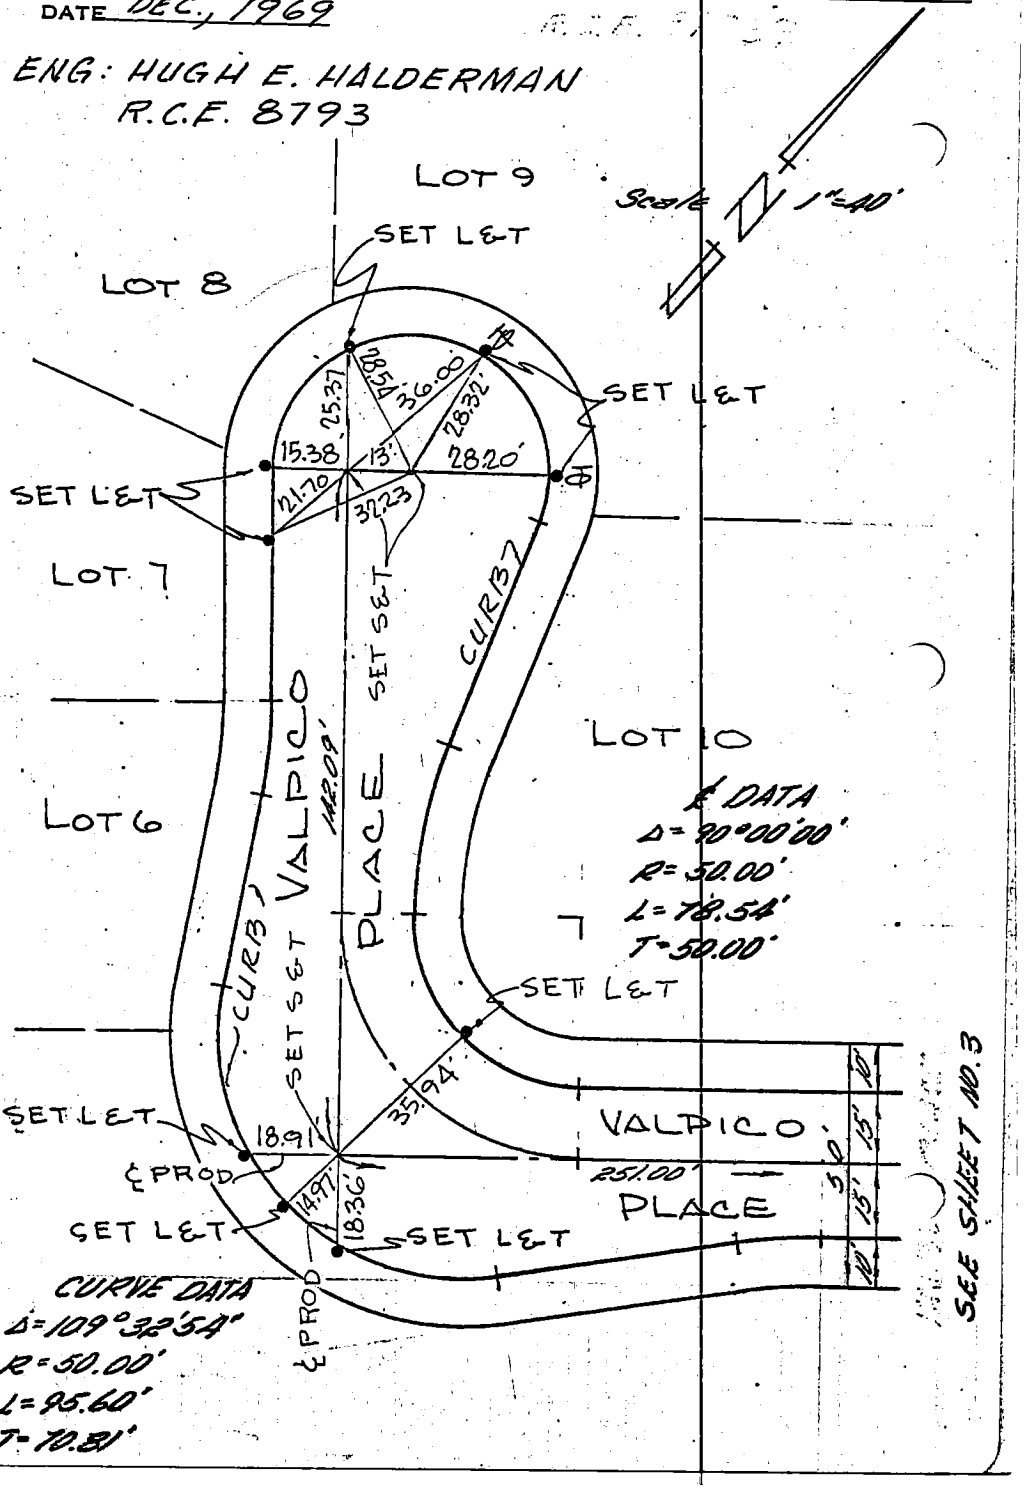

Co. Eng. F.B. 4005: 56

SURVEY OF _____ F B NO. _____ PAGE 15

SURVEY BY JENNINGS-HALDERMAN-HOOD TRACT NO. 27979

DATE DEC., 1969

ENG: HUGH E. HALDERMAN
R.C.E. 8793

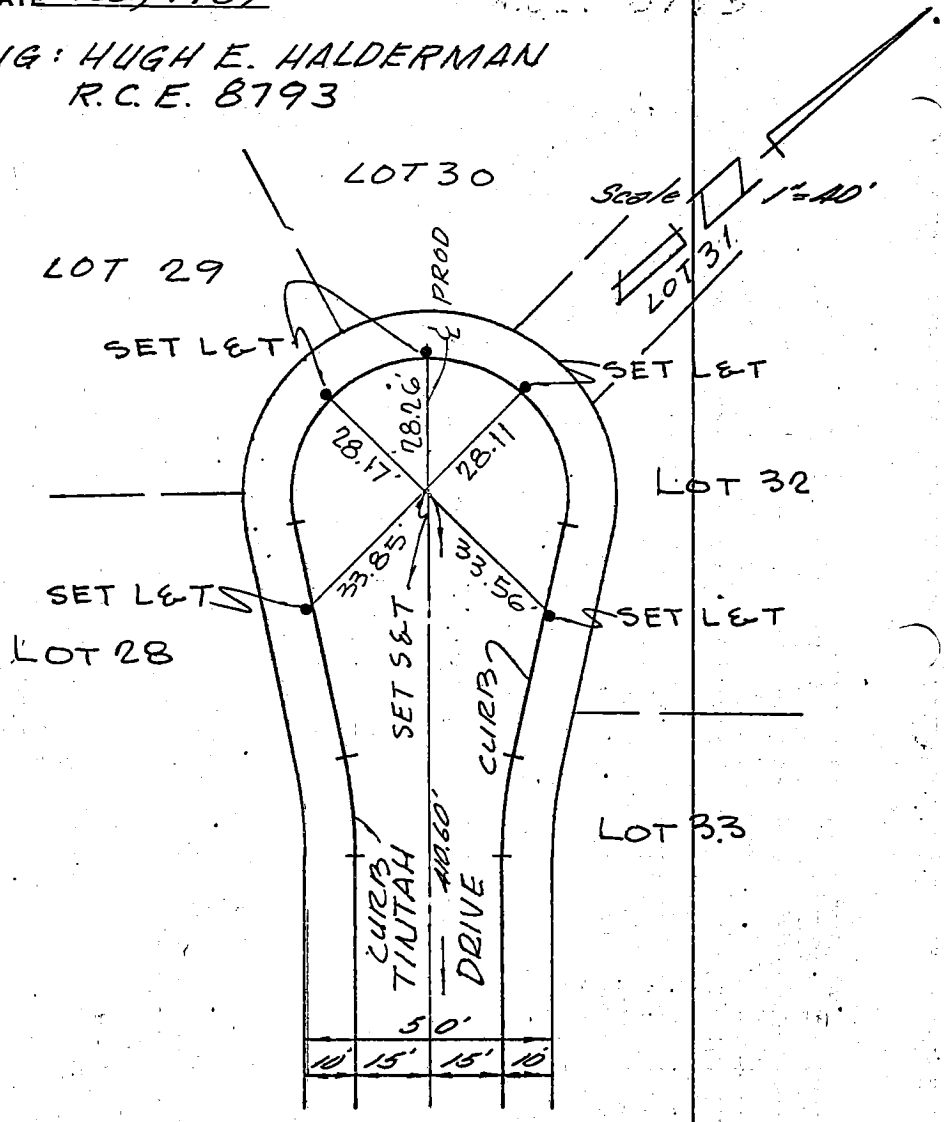


SEE SHEET NO. 5

DO NOT EXTEND NOTES THIS SIDE OF LINE

WS 099-337

Co. Eng. F.B. 4005: 57

SURVEY OF _____ F B NO. _____ PAGE 16

SURVEY BY Jennings-Halderman-Hood TRACT NO. 27979

DATE DEC, 1969

ENG: HUGH E. HALDERMAN
R.C.E. 8793

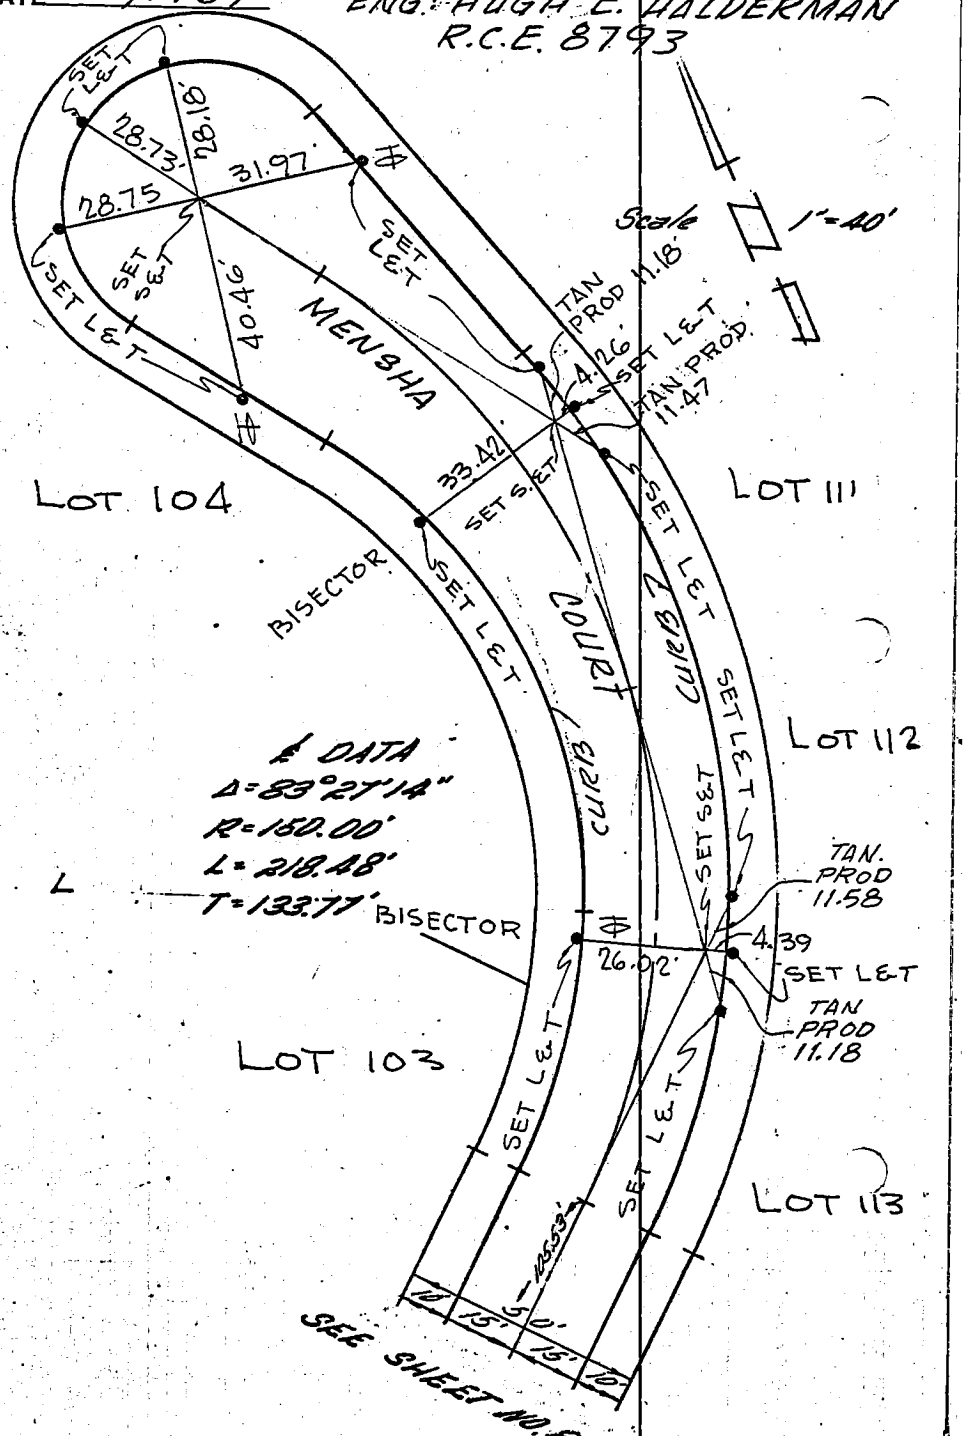


Scale 1"=40'

℄ DATA
Δ=83°27'14"
R=150.00'
L=218.48'
T=133.77'

DO NOT EXTEND NOTES THIS SIDE OF LINE

W.S. 609-337-4

Co. Eng. F.B. 4005: 58

SURVEY OF _____ F B NO. _____ PAGE 17

SURVEY BY Jennings-Halderman-Hood TRACT NO. 27979

DATE DEC., 1969

ENG:
HUGH E. HALDERMAN SEE SHEET NO. 18
R.C.E. 8793

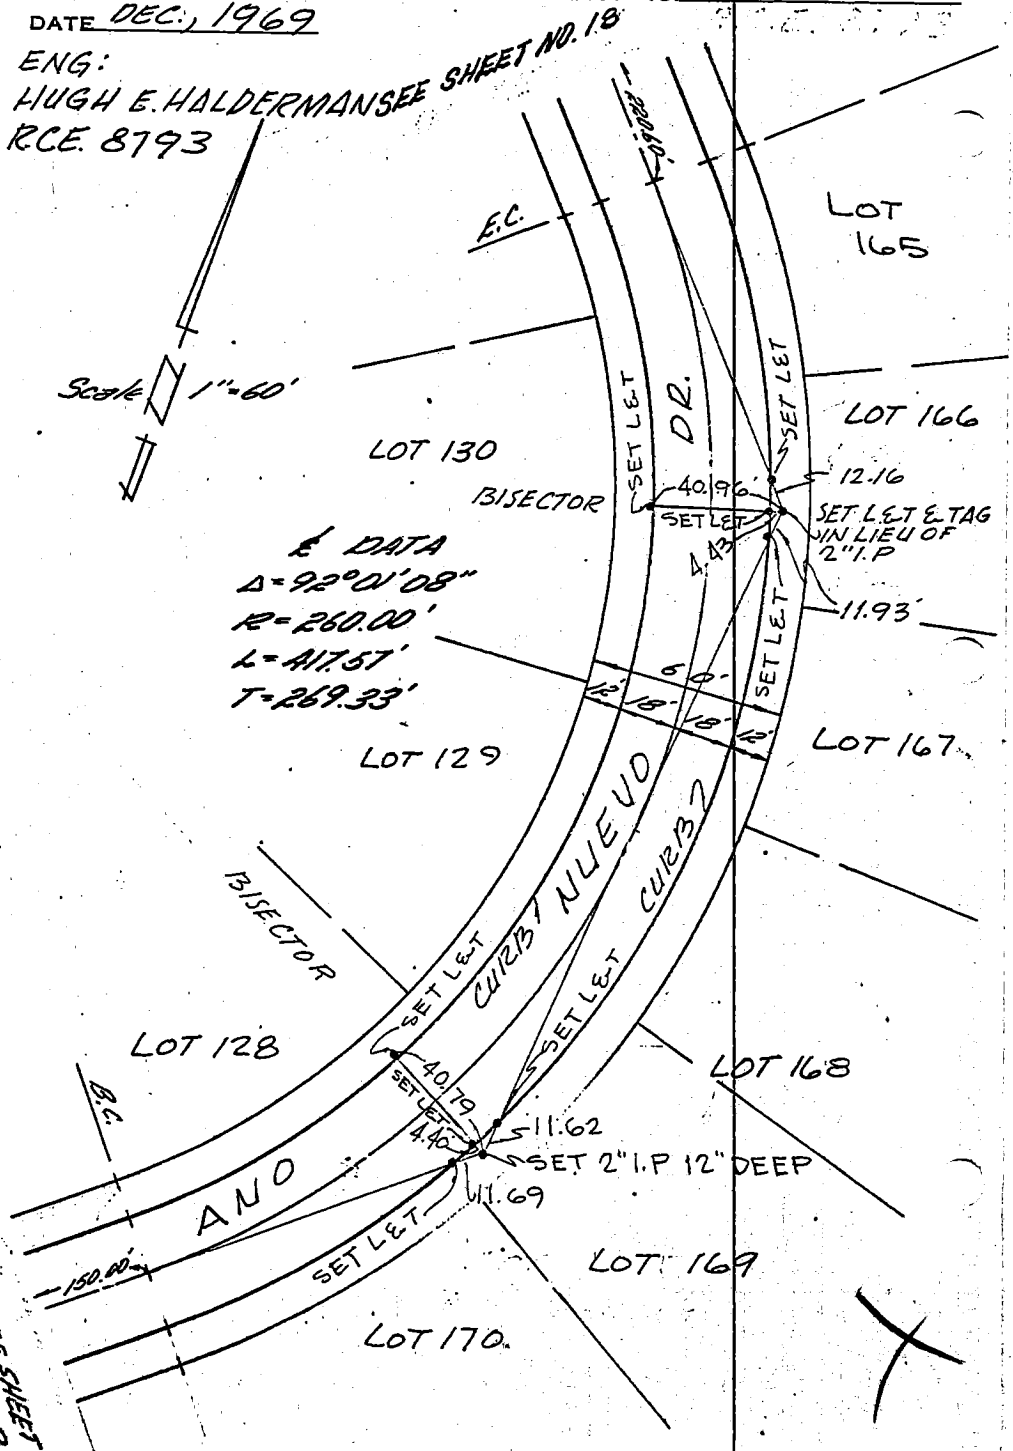


DO NOT EXTEND NOTES THIS SIDE OF LINE

Co. Eng. F.B. 4005: 59

SURVEY OF _____ F B NO. _____ PAGE 18

SURVEY BY JENNINGS-HALDERMAN HOOD TRACT NO. 27979

DATE DEC., 1969 ENG: HUGH E. HALDERMAN RCE 8793

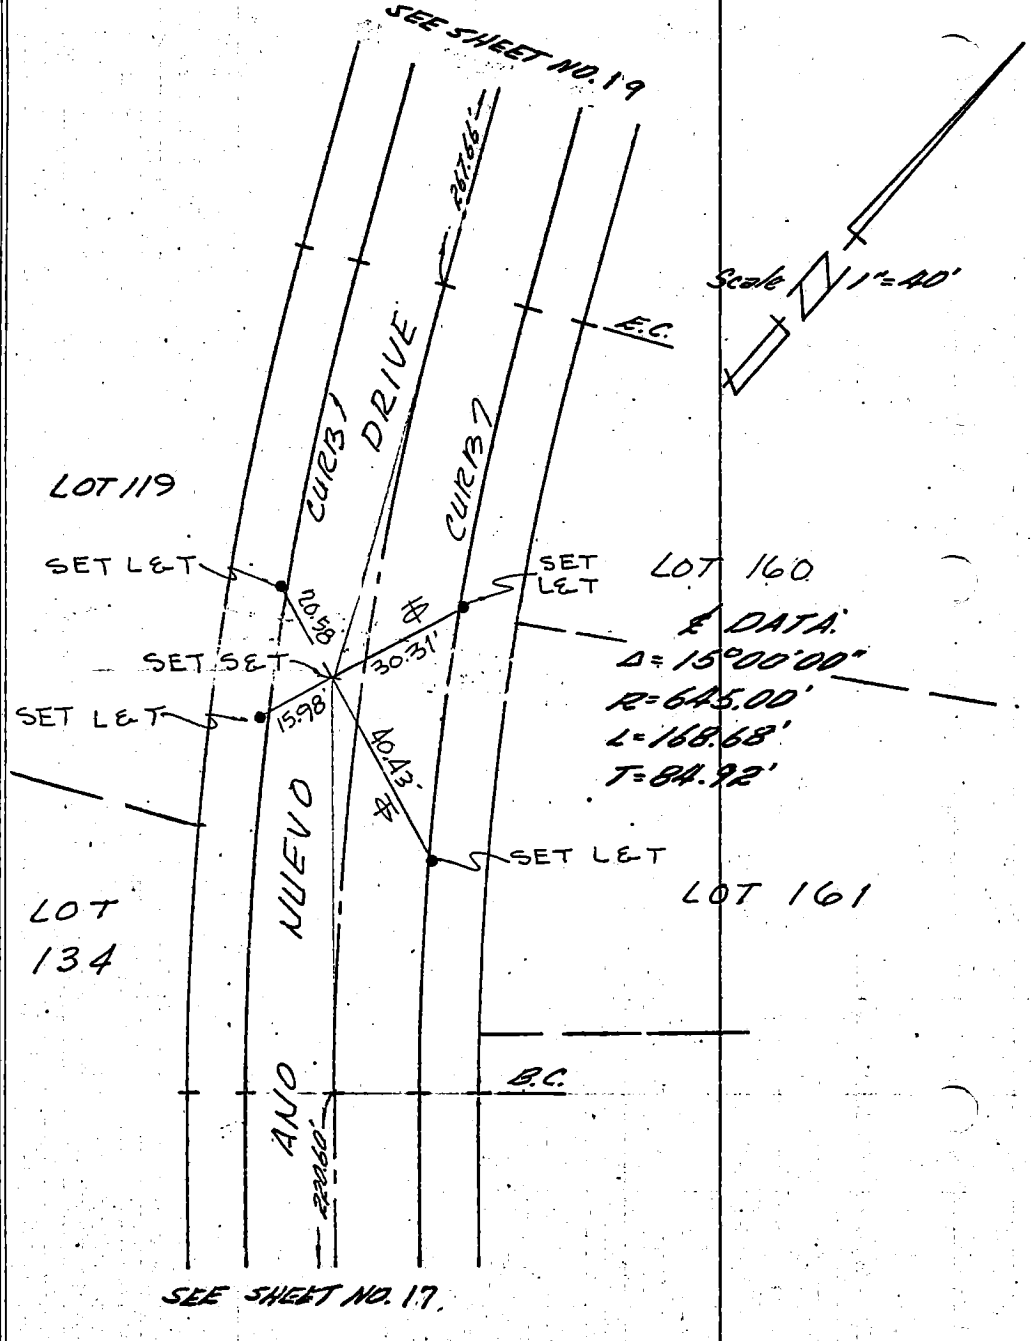


DO NOT EXTEND NOTES THIS SIDE OF LINE

Co. Eng. F.B. 4005: 60

SURVEY OF _____ F B NO. _____ PAGE 19

SURVEY BY JENNINGS-HALDERMAN-HOOD TRACT NO. 27979

DATE DEC., 1969

ENG: HUGH E. HALDERMAN
R.C.E. 8793

DO NOT EXTEND NOTES THIS SIDE OF LINE

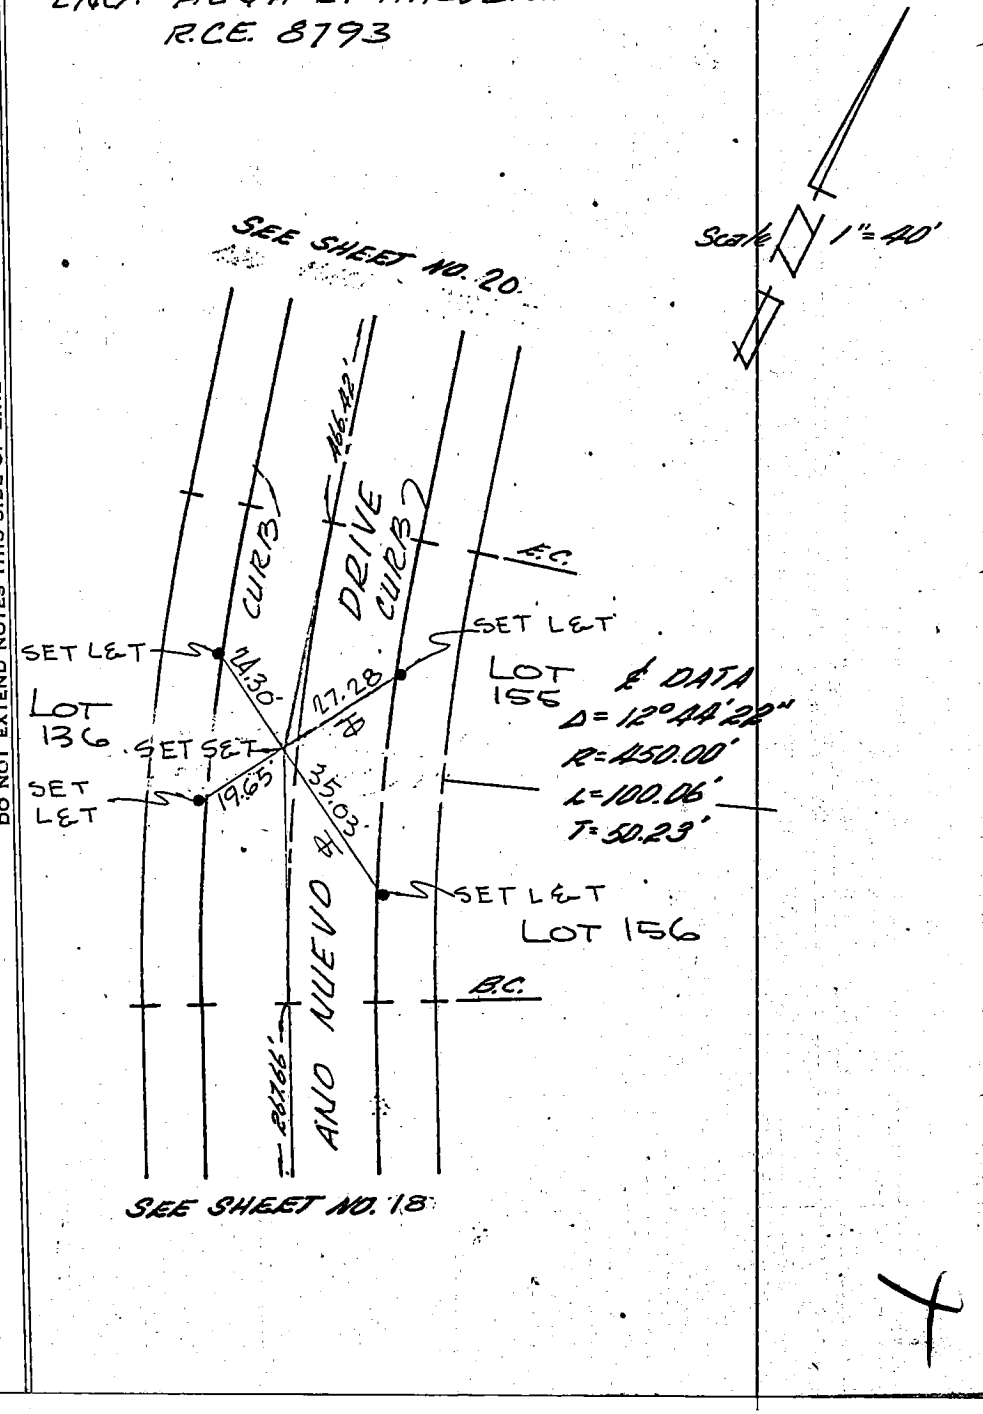

Co. Eng. F.B. 4005: 61

SURVEY OF _____ F B NO. _____ PAGE 20

SURVEY BY JENNINGS-HALDERMAN-HOOD TRACT NO. 27979

DATE DEC., 1969

ENG: HUGH E. HALDERMAN
R.C.E. 8793

DO NOT EXTEND NOTES THIS SIDE OF LINE

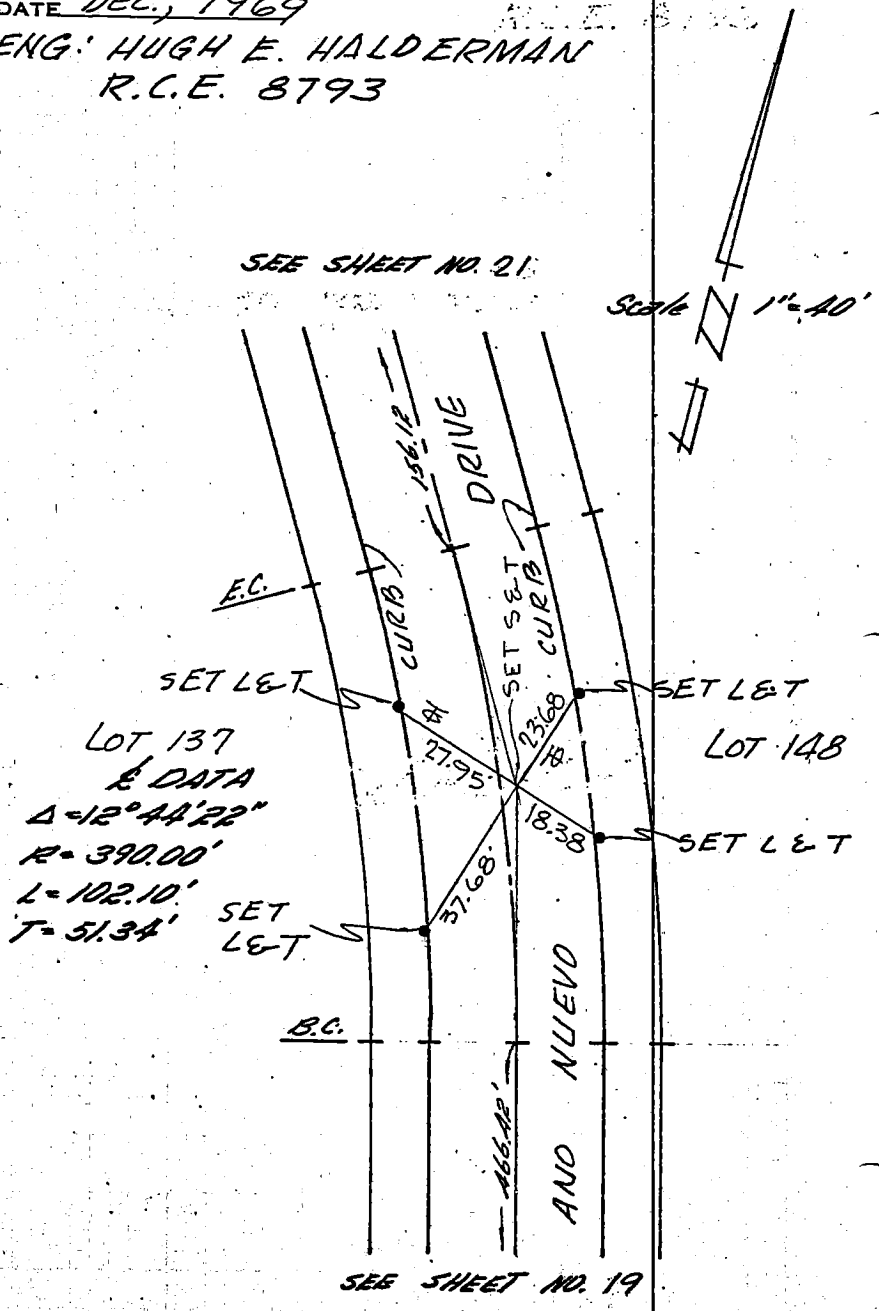

Co. Eng. F.B. 4005: 62

SURVEY OF _____ F B NO. _____ PAGE 21

SURVEY BY JENNINGS-HALDERMAN-HOOD TRACT NO. 27979

DATE DEC., 1969

ENG: HUGH E. HALDERMAN
RCE 8793

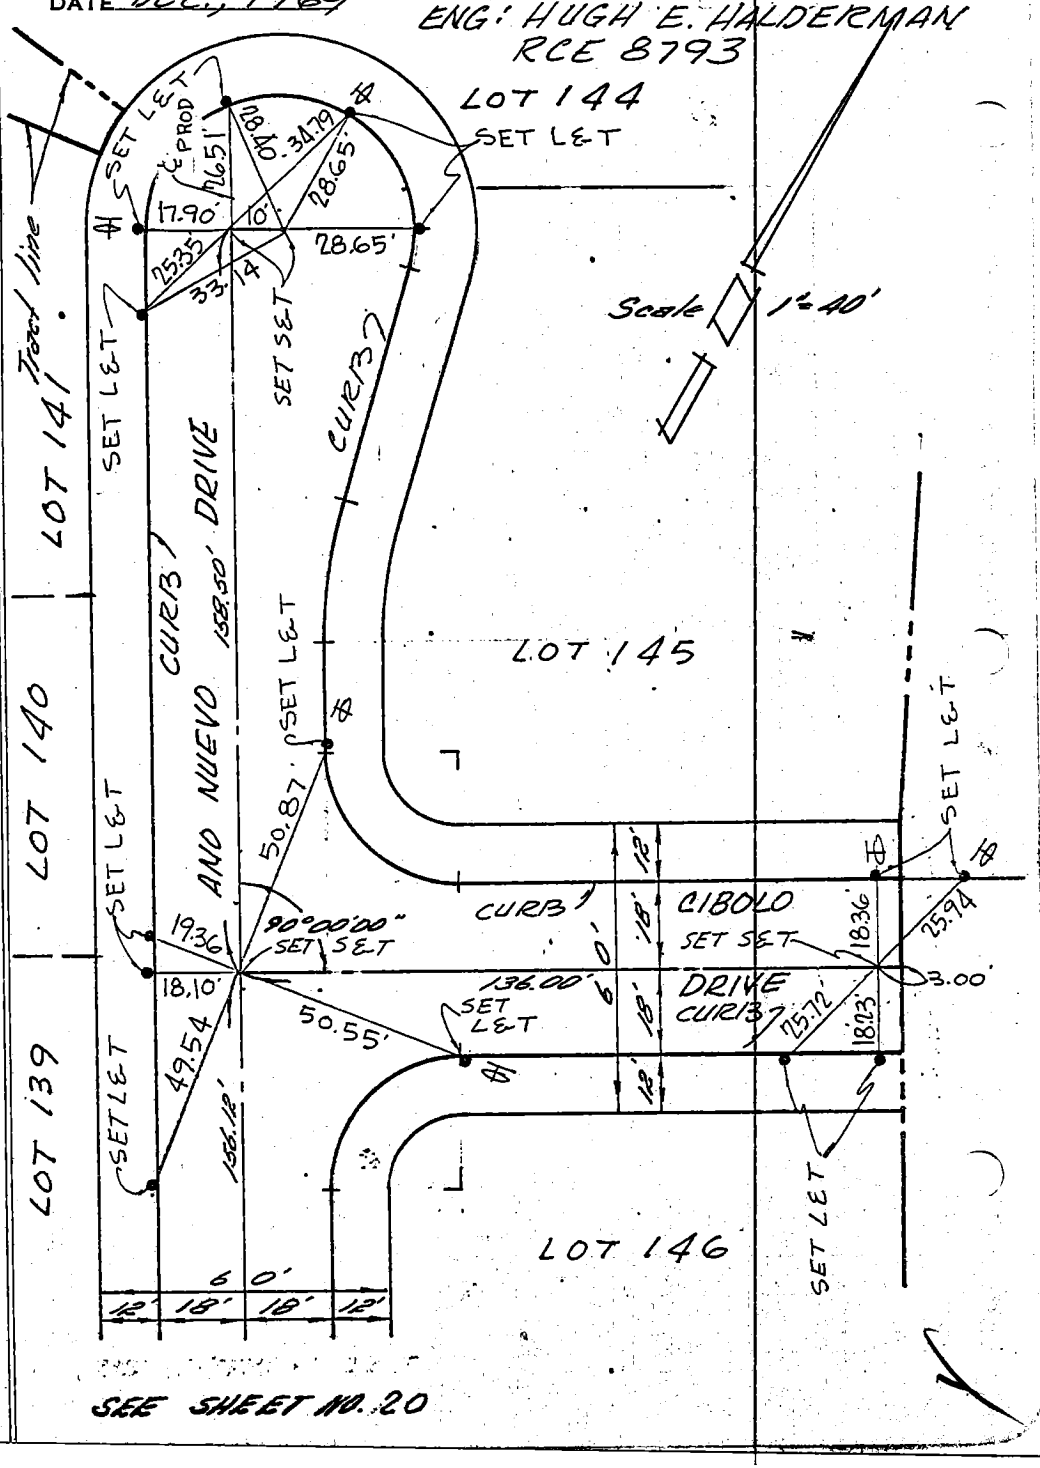


DO NOT EXTEND NOTES THIS SIDE OF LINE

W.S. 39, B-3

SEE SHEET NO. 20

Co. Eng. F.B. 4005: 63

SURVEY OF _____ F B NO. _____ PAGE 1

SURVEY BY JENNINGS-HALDERMAN-HOOD TRACT NO. 27979

DATE DEC, 1969 ENGRS: HUGH E. HALDERMAN-R.C.E. 8793

CIBOLO DRIVE - From 136'± E. of Ano Nuevo Dr. to Ano Nuevo Dr.

ANO NUEVO DRIVE - From Kiowa Crest Dr. to 1 '± N. of Cibolo Dr.

KIOWA CREST DRIVE - From Diamond Bar Blvd. to 145'± W. of Santaquin Dr.

SANTAQUIN DRIVE - From Kiowa Crest Dr. to Silver Hawk Dr.

SILVER HAWK DRIVE - From 127'± N. of Santaquin Dr. to 123'± E. of Tolani Court.

MENSHA COURT - From 352'± N.E. of Kiowa Crest Dr. to Kiowa Crest Dr.

VALPICO PLACE - From 393'± N.W. of Kiowa Crest Dr. to Kiowa Crest Dr.

TINTAH DRIVE - From 759'± W. of Kiowa Crest Dr. to Kiowa Crest Dr.

TOLANI COURT - From 336'± E. of Silver Hawk Dr. to Silver Hawk Dr.

DO NOT EXTEND NOTES THIS SIDE OF LINE

# CENTER LINE TIES

SURVEYOR
CHAINMAN
CHAINMAN

All distances shown as measured are corrected to 68° F.

Co. Eng. F.B. 4005: 64

SURVEY OF CENTER-LINE TIES F. B. PG.

SURVEY BY LANCO ENGINEERING CO. TR. No. 28367

DATE JAN., 1970

ENGINEER: C.M. LEONARD, R.C.E. 13167

M.S. 27, E-3

℄ PACIFIC COAST HIGHWAY

N'LY LINE TR. NO. 28367

370.94'

AVE.

SET CHISEL "+" STRADDLERS ℄ & TR. LN. PROD. IN M.H. RIM IN LIEU OF S. & T.

20.22'

SET L. & TAG

28.48'

SET L. & TAG

47.63'

SET L. & TAG.

RW

CURB

℄ PENNSYLVANIA

N

Co. Eng. F.B. 4005: 65

SURVEY OF CENTER-LINE TIES F. B. Pg.

SURVEY BY LANCO ENGINEERING CO. TR. No. 28367

DATE JAN., 1970

ENGINEER: C.M. LEONARD, R.C.E. 13167

W.S. 2 NE - 3

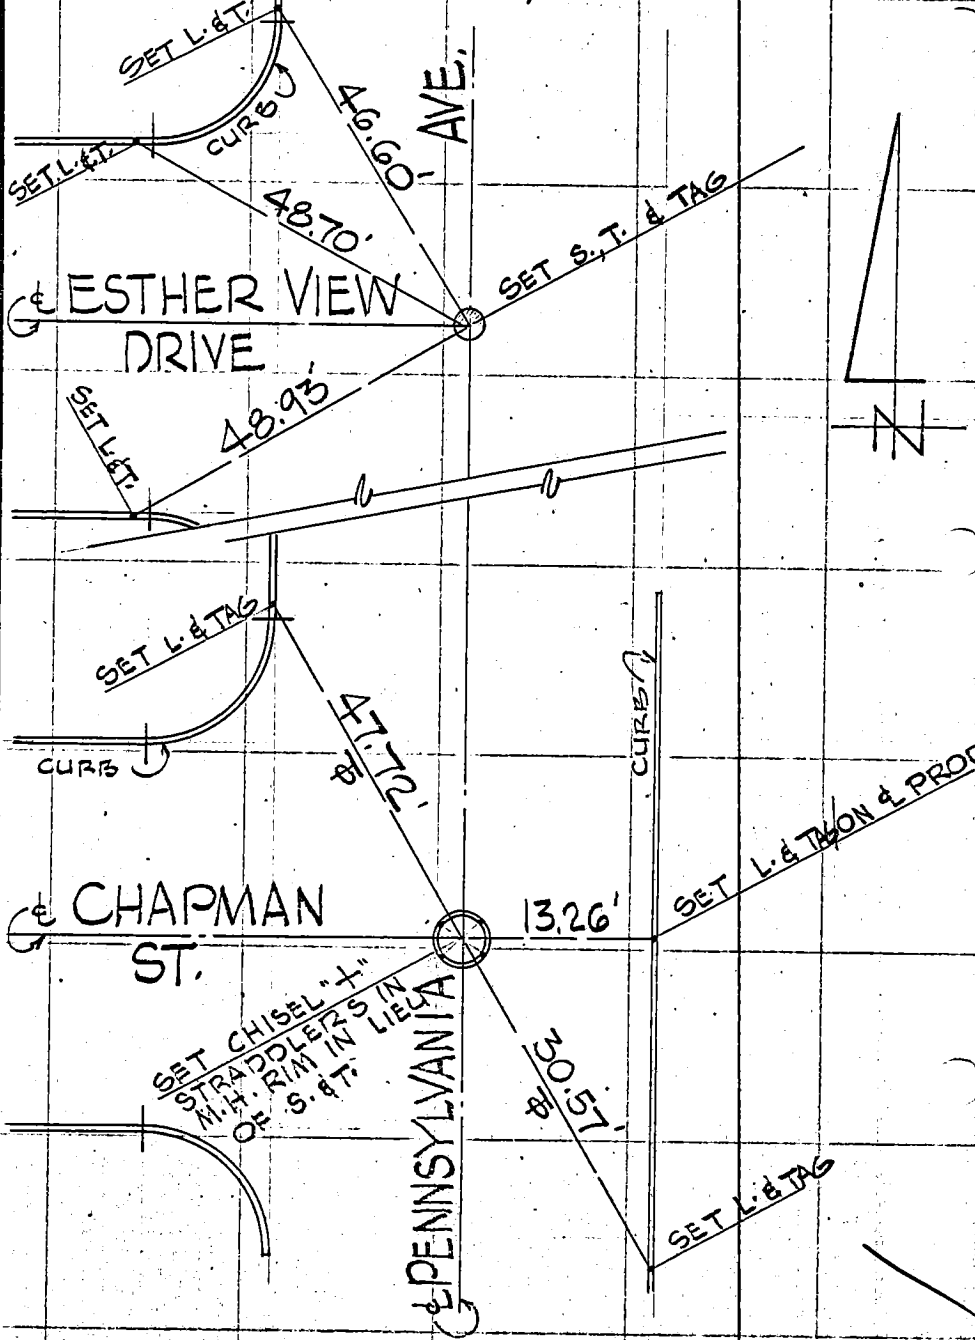

Co. Eng. F.B. 4005: 66

SURVEY OF CENTER-LINE TIES F. B. Pg.

SURVEY BY LANCO ENGINEERING CO. TR. No. 28367

DATE JAN., 1970

ENGINEER: C.M. LEONARD, R.C.E. 15167

W 82783

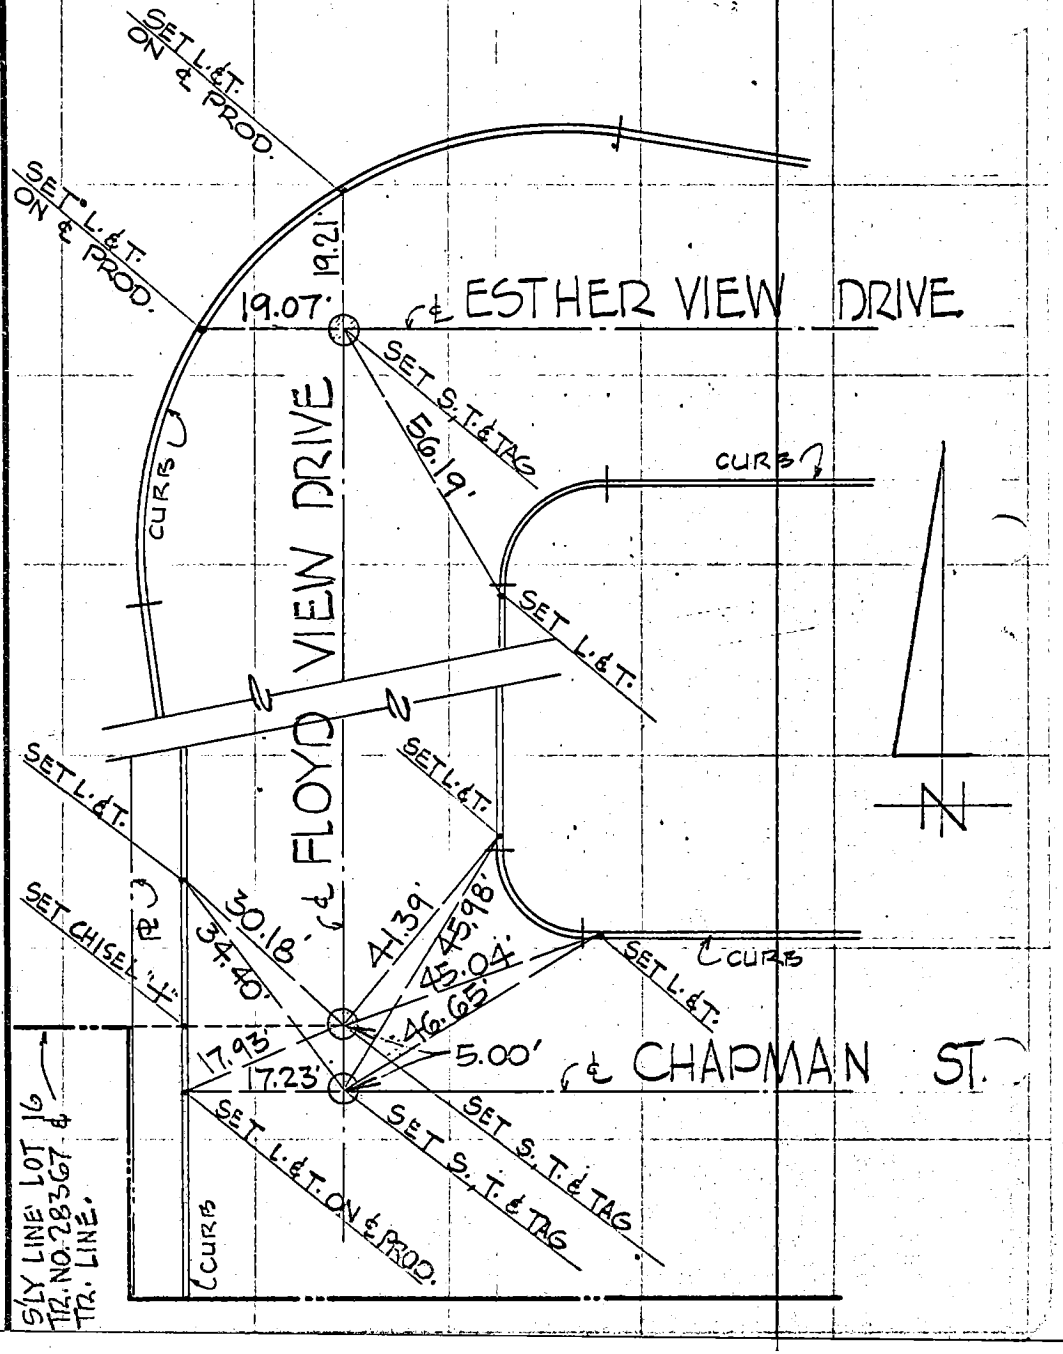

Co. Eng. F.B. 4005: 67

SURVEY OF CENTER-LINE TIES F. B. ____ PG ____

SURVEY BY LANCO ENGINEERING CO. TR. NO. 28173

DATE JAN. 1970

ENGINEER: C. M. LEONARD, R.C.E. 13167

(250) L 528 B-2

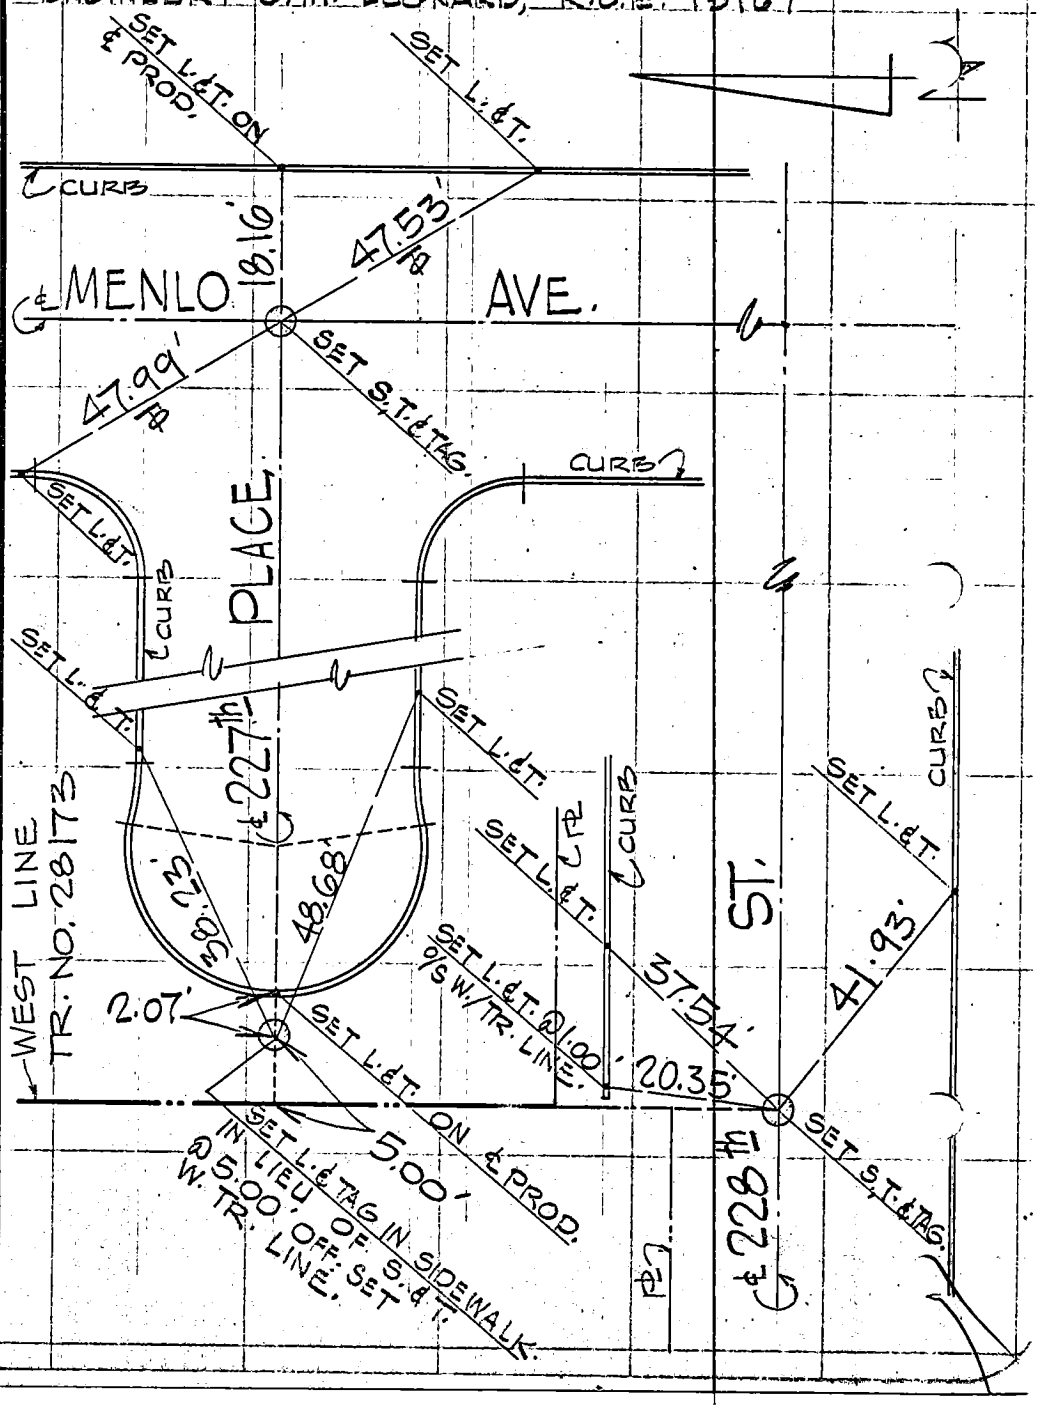

Co. Eng. F.B. 4005: 68

SURVEY OF CENTER-LINE TIES F. B. ____ PG. ____

SURVEY BY LANCO ENGINEERING CO. TR. No. 28173

DATE JAN. 1970

ENGINEER: C.M. LEONARD, R.C.E. 13167

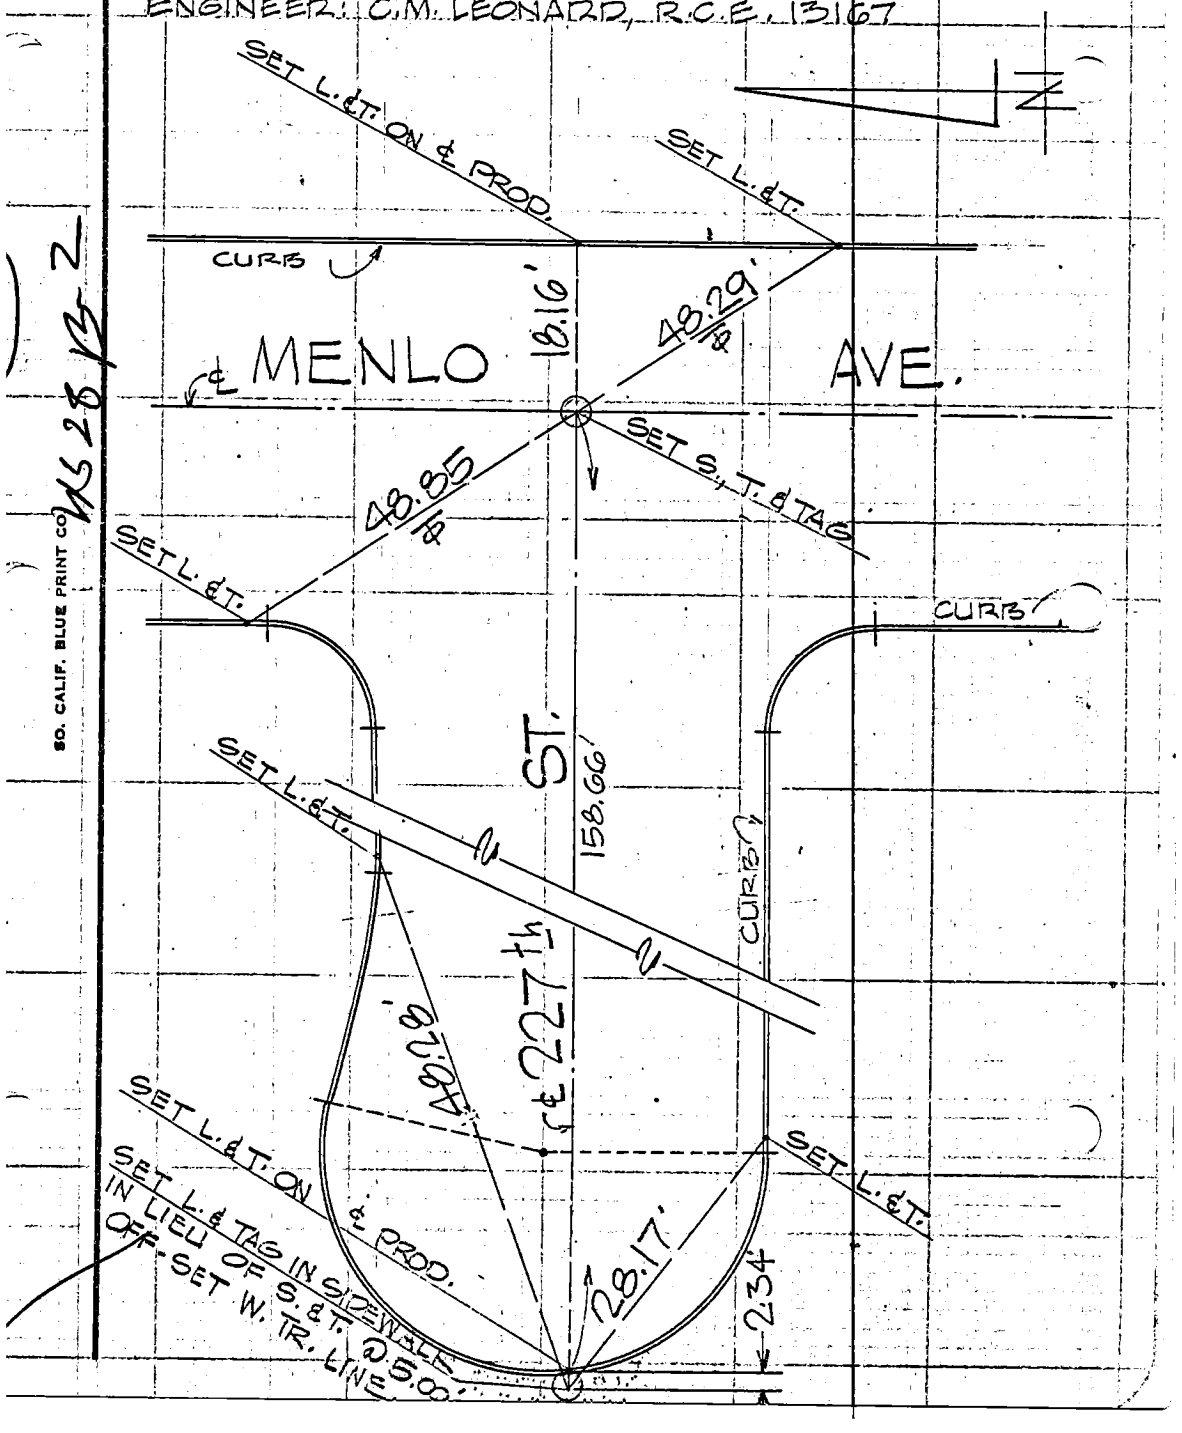


WS 28 13-2

SO. CALIF. BLUE PRINT CO.

Co. Eng. F.B. 4005: 69

SURVEY OF _____ F. B. _____ PG. 1

SURVEY BY McINTIRE & QUIROS TR. No. 28431

DATE JAN. 1970

J.W. McINTIRE L.S 2602

NS 114-33, A-2

SO. CALIF. BLUE PRINT CO.

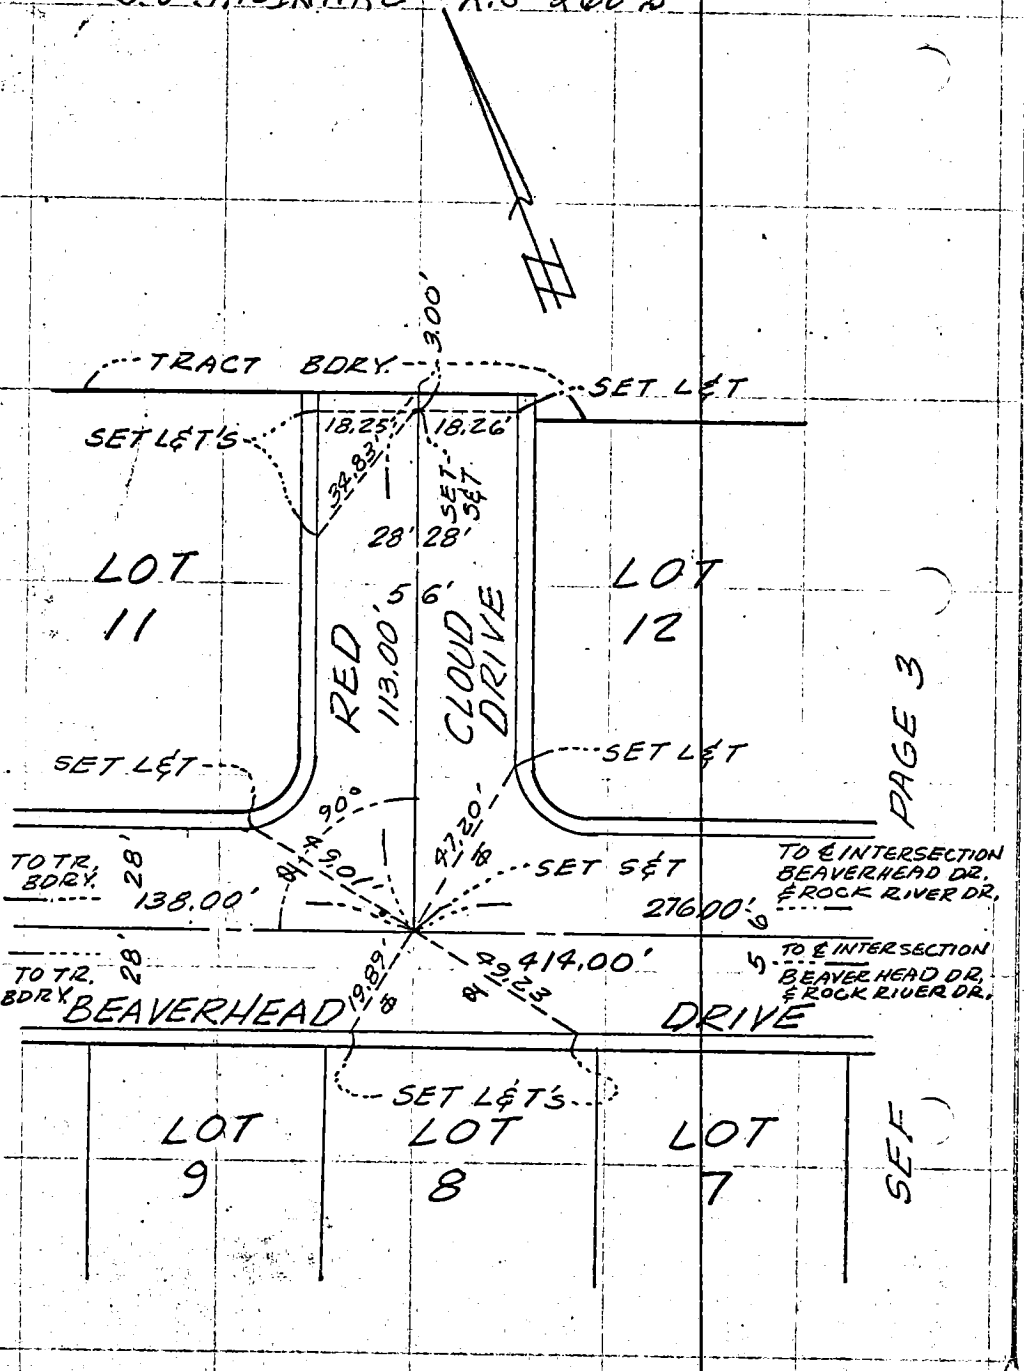

Co. Eng. F.B. 4005: 70

SURVEY OF _____ F. B. _____ Pg. 2

SURVEY BY McINTIRE & QUIROS TR. No. 28431

DATE JAN. 1970

J.W. McINTIRE L.S. 2602

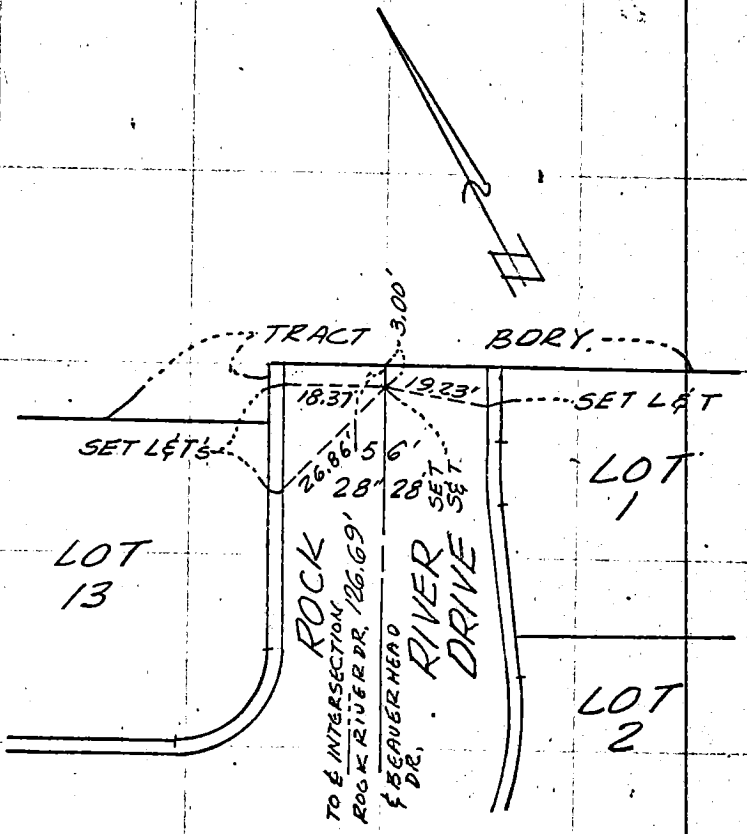


SEE PAGE 3

SO. CALIF. BLUE PRINT CO.

Co. Eng. F.B. 4005: 71

SURVEY OF

F. B. Pg. 3

SURVEY BY McINTIRE & QUIROS

TR. No. 28431

DATE JAN. 1970

Jno McINTIRE L.S. 2602

V3, 114-33, 34-2

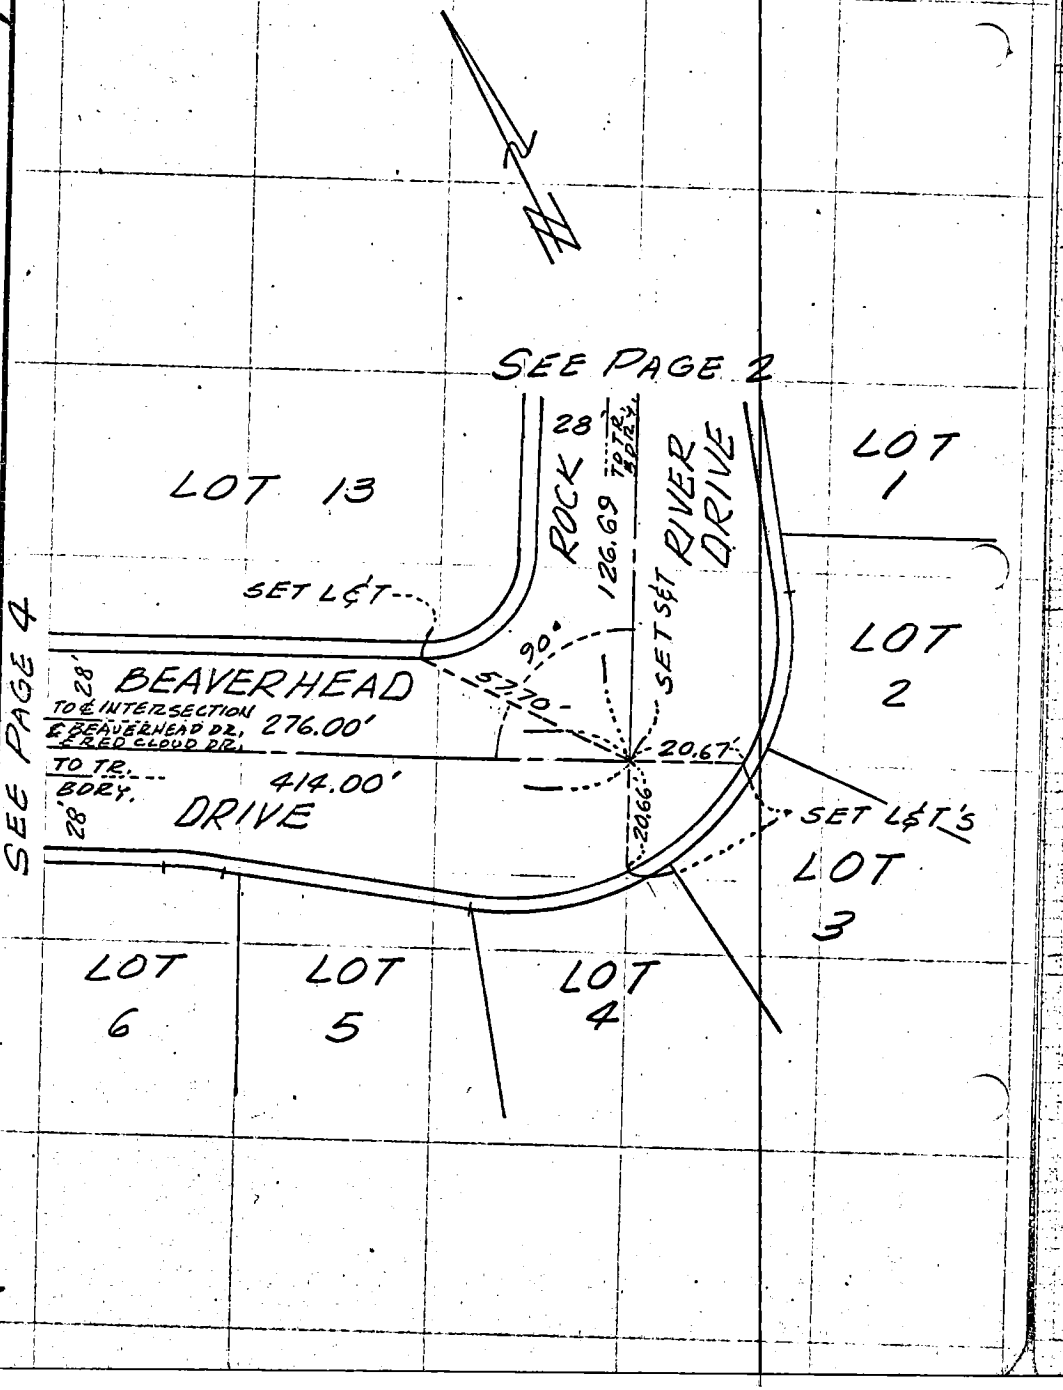


SO. CALIF. BLUE PRINT CO.

Co. Eng. F.B. 4005: 72

Parcel Map No. 1465 Date: 2-23-70 Page 1 of 2
Survey Engineer: E. Lee Scott L.S. 2379
By: Scott, Blake & Wynne

099-29 (4-)

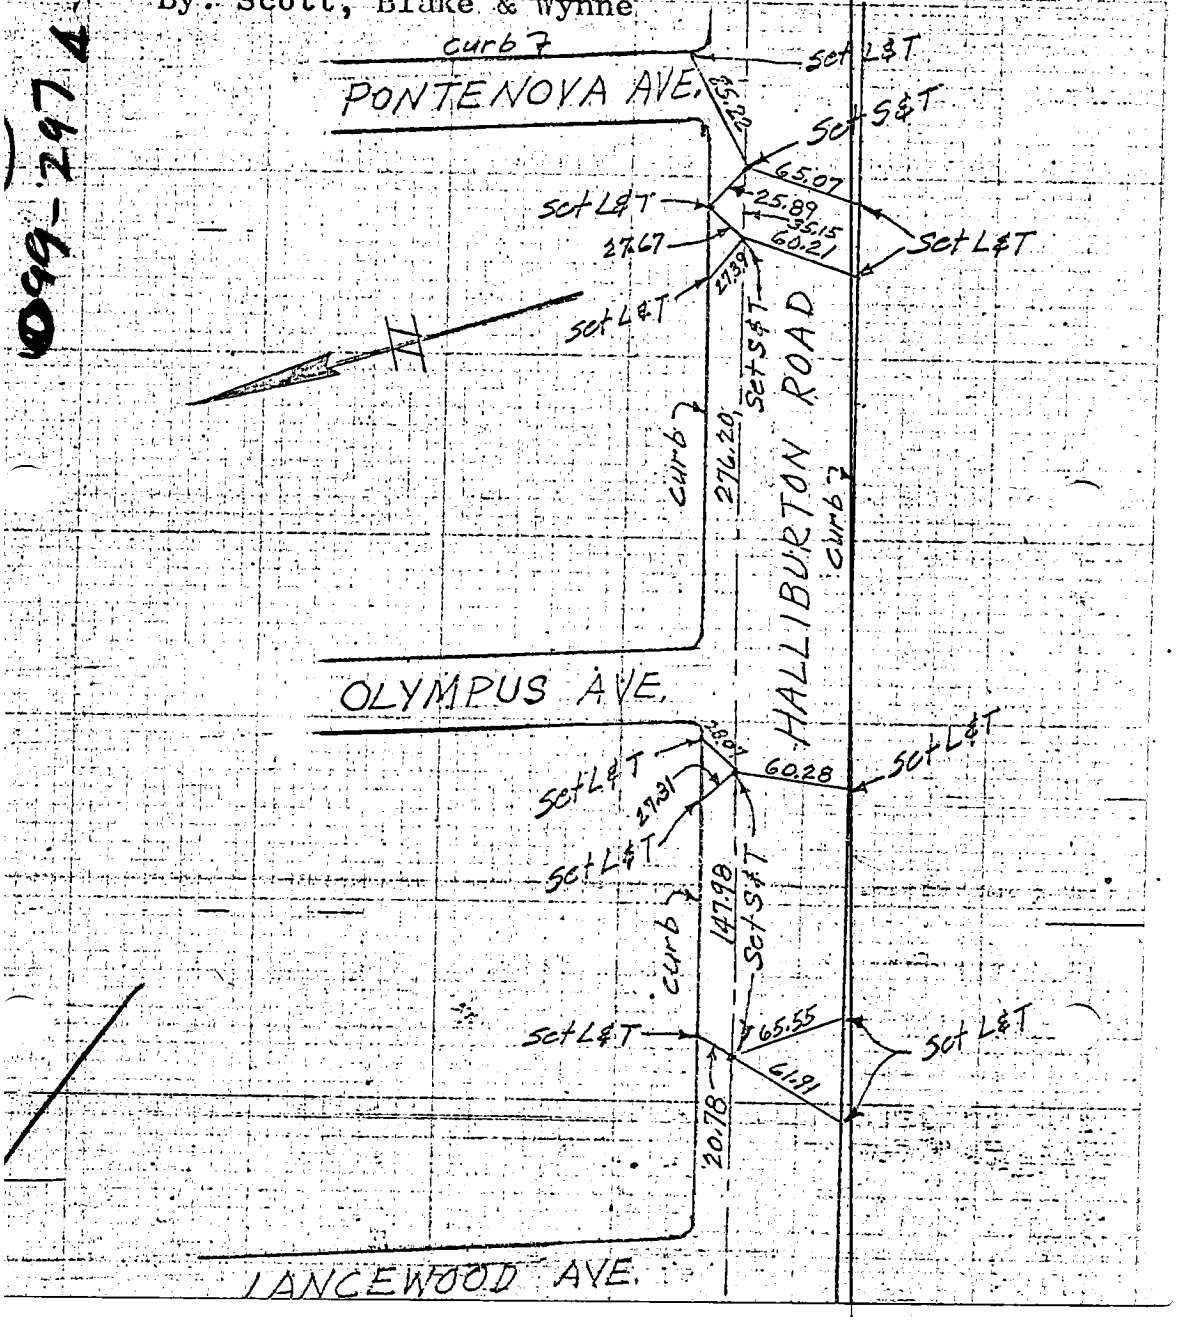

Co. Eng. F.B. 4005: 73

Parcel Map No. 1465 Date: 2-23-70 Page 2 of 2.

Survey Engineer: E. Lee Scott L.S. 2379
By: Scott, Blake & Wynne

004-297 M

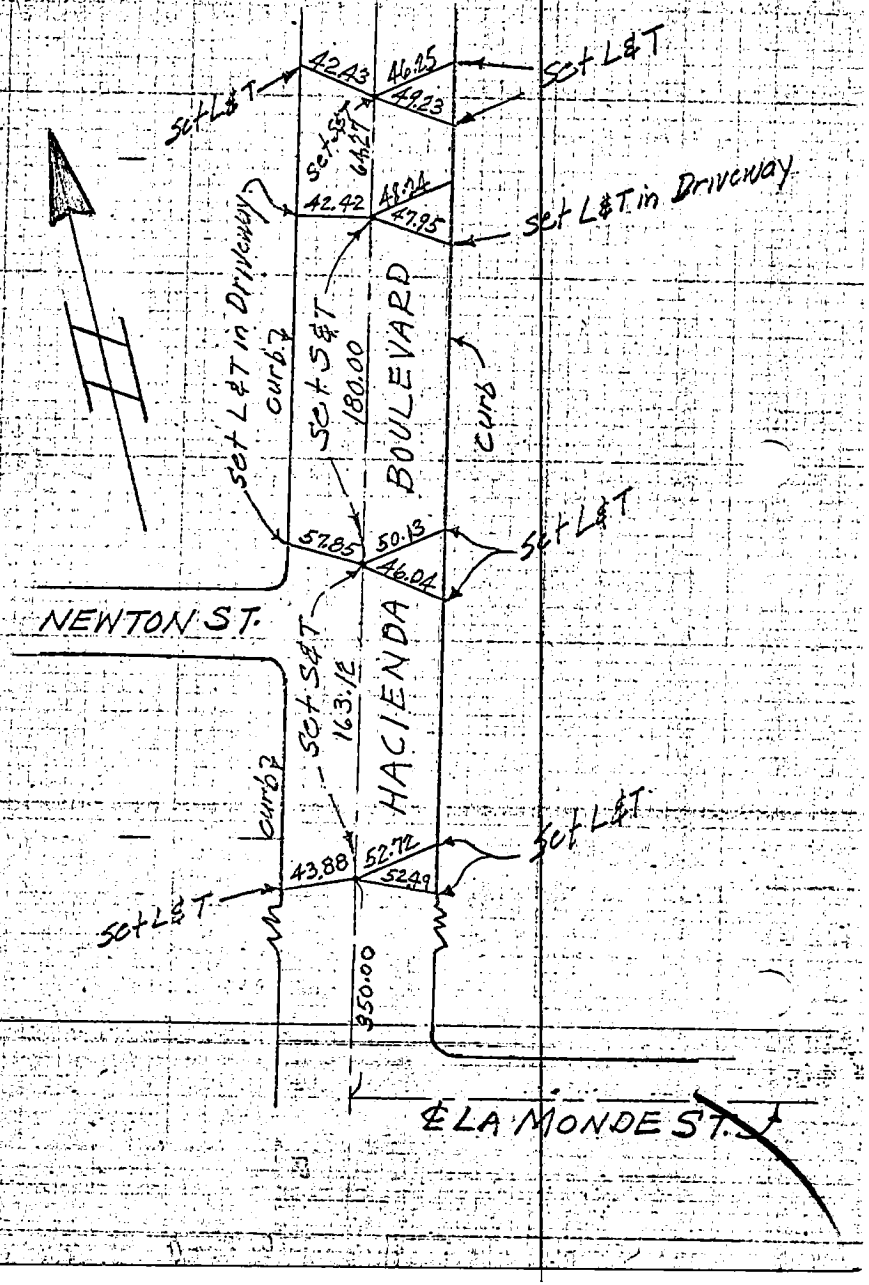

Co. Eng. F.B. 4005: 74

TRACT NO. 26894 DATE 11-10-69 PAGE 1 OF 8

ENGINEER C. R. NELSON R.C.E. 8781

SURVEY BY VTN LOS ANGELES

W.S. 249-117

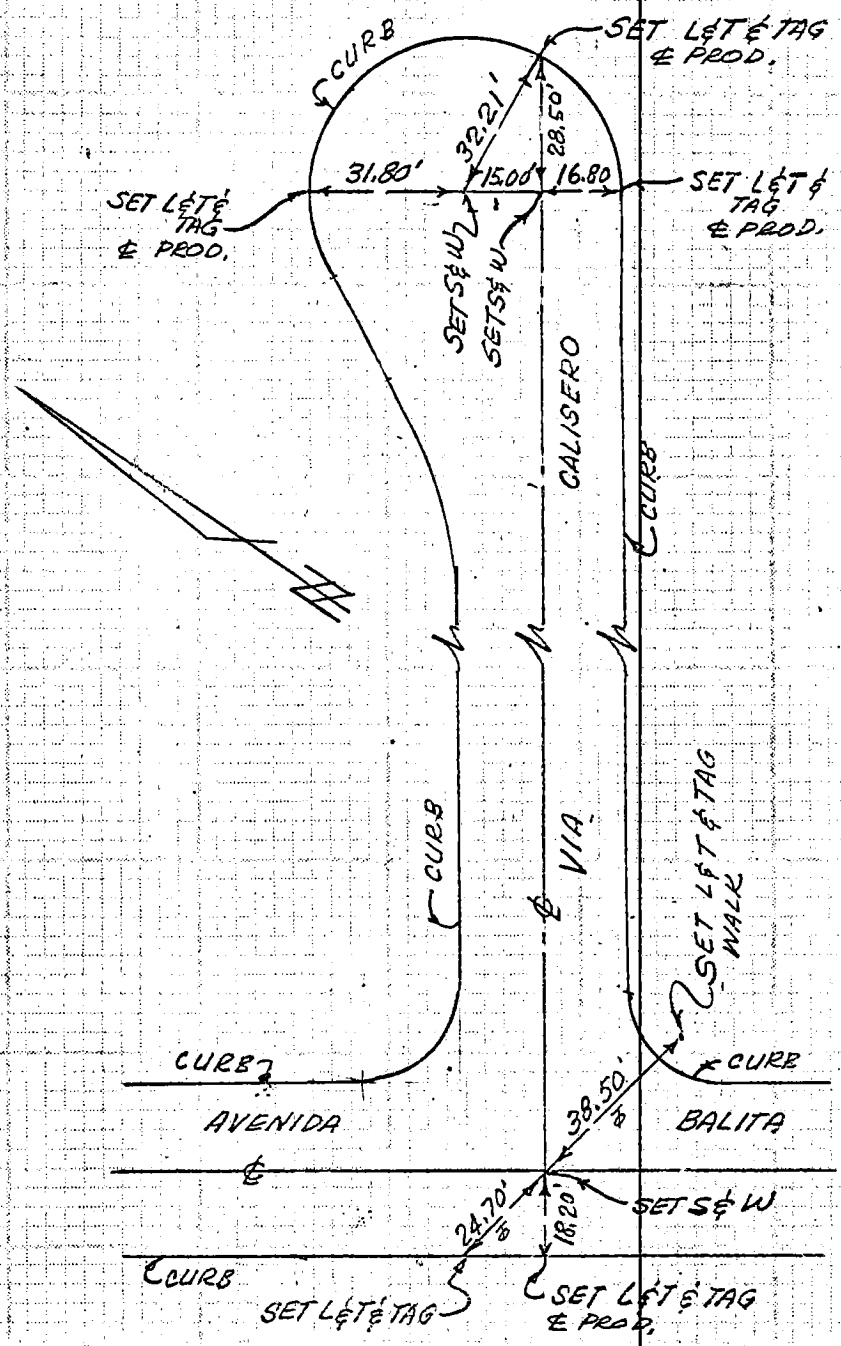


TO PAGE 1

Co. Eng. F.B. 4005: 75

TRACT NO. 26894 DATE 11-10-69 PAGE 2 OF 8

ENGINEER C.R. NELSON R.C.E. 8781

SURVEY BY VTN LOS ANGELES

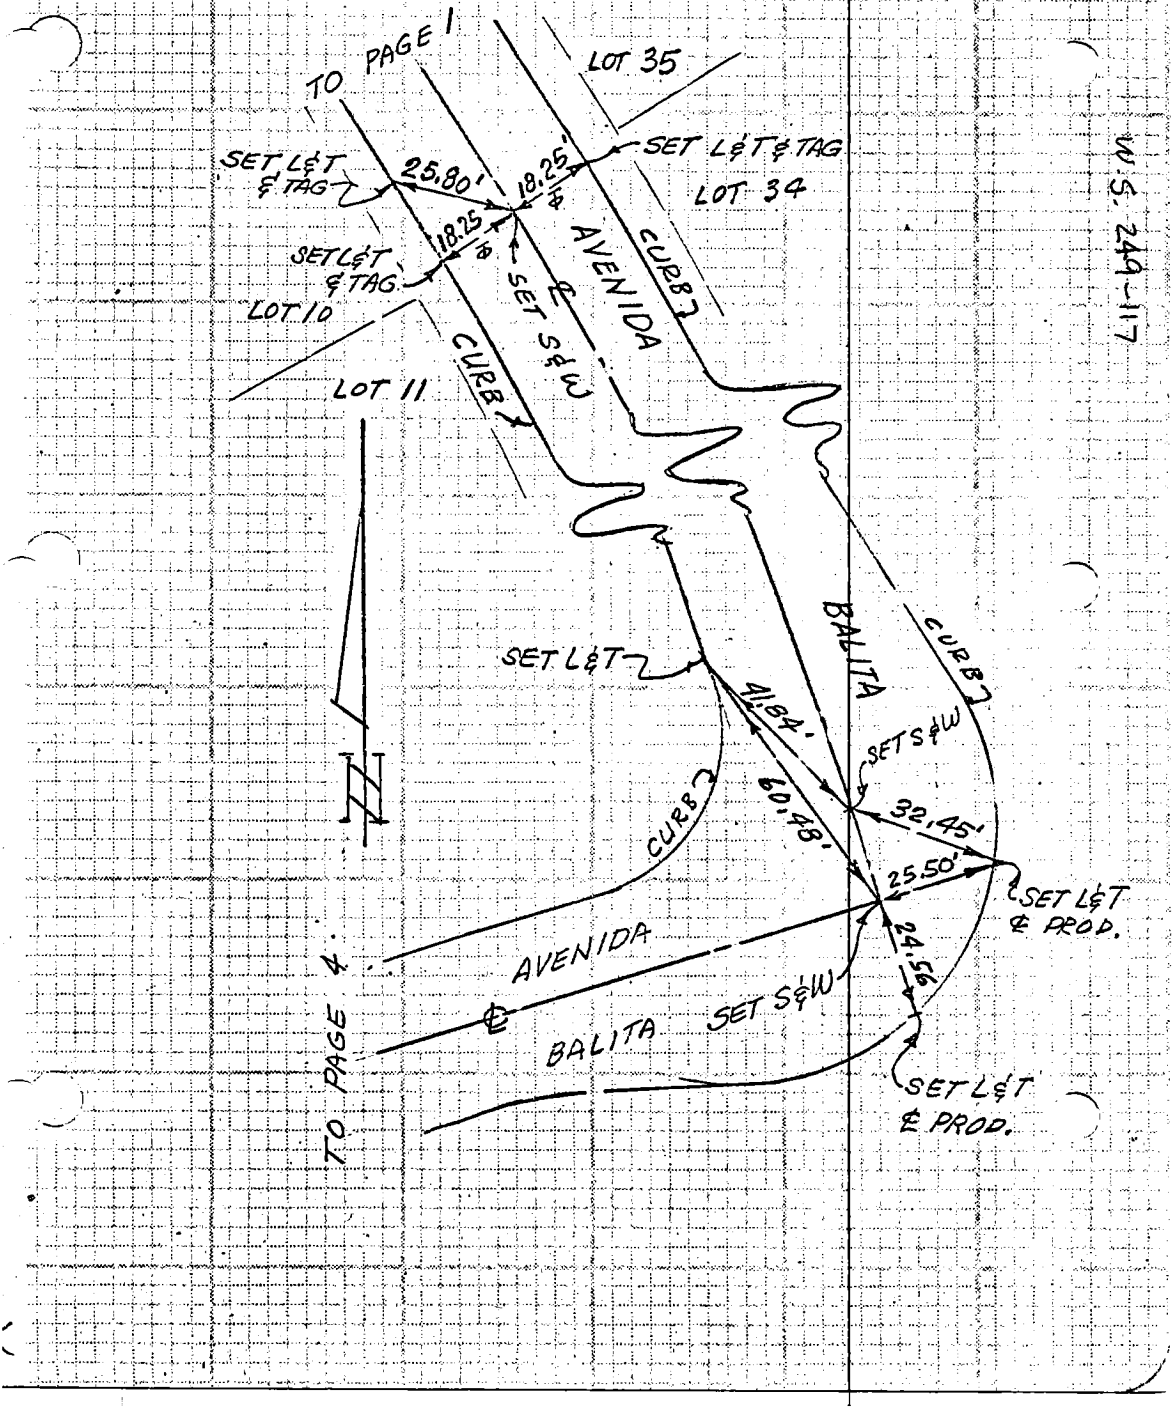

Co. Eng. F.B. 4005: 76 •

TRACT NO. 26894 DATE 11-10-69 PAGE 3 OF 8

ENGINEER C.R. NELSON R.C.E. 8781

SURVEY BY

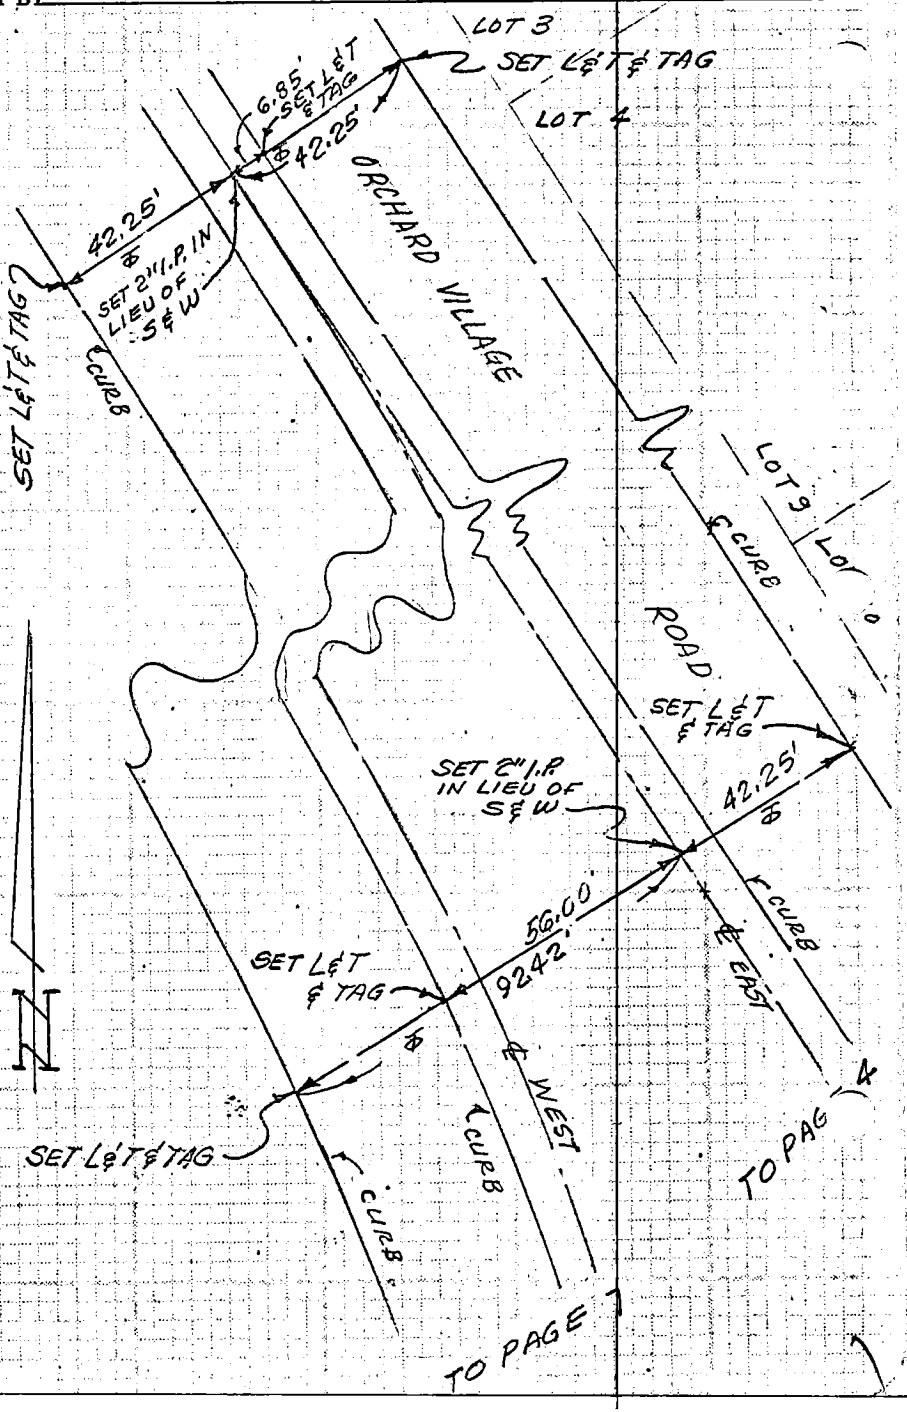

Co. Eng. F.B. 4005: 77

TRACT NO. 26894 DATE 11-10-69 PAGE 4 OF 8

ENGINEER C. R. NELSON R. C. E. 8781

SURVEY BY VTN LOS ANGELES

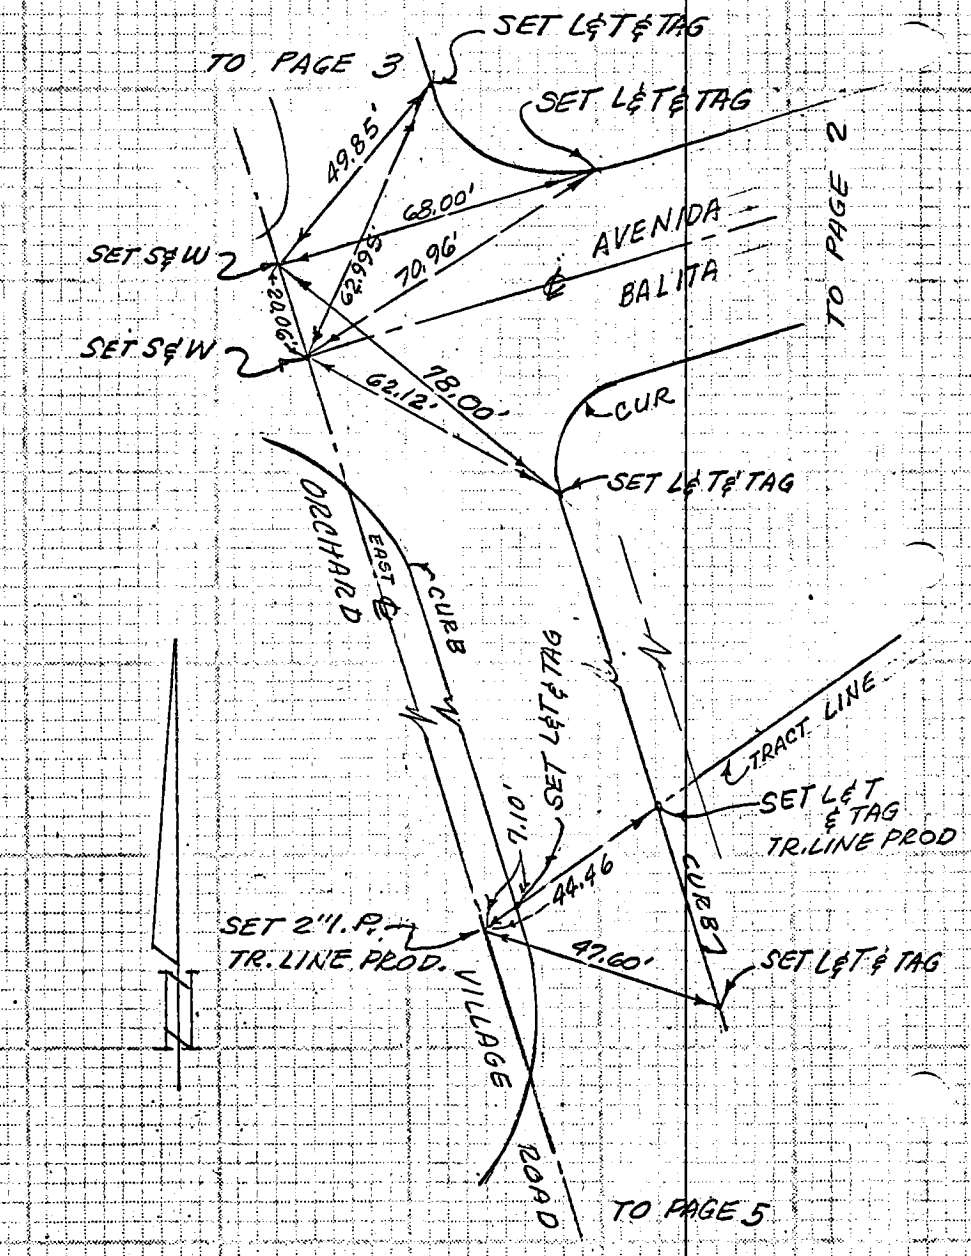

Co. Eng. F.B. 4005: 78

TRACT NO. 26894 DATE 11-10-69 PAGE 5 OF 8

ENGINEER C.R. NELSON

SURVEY BY VTN LOS ANGELES R.C.E. 8781

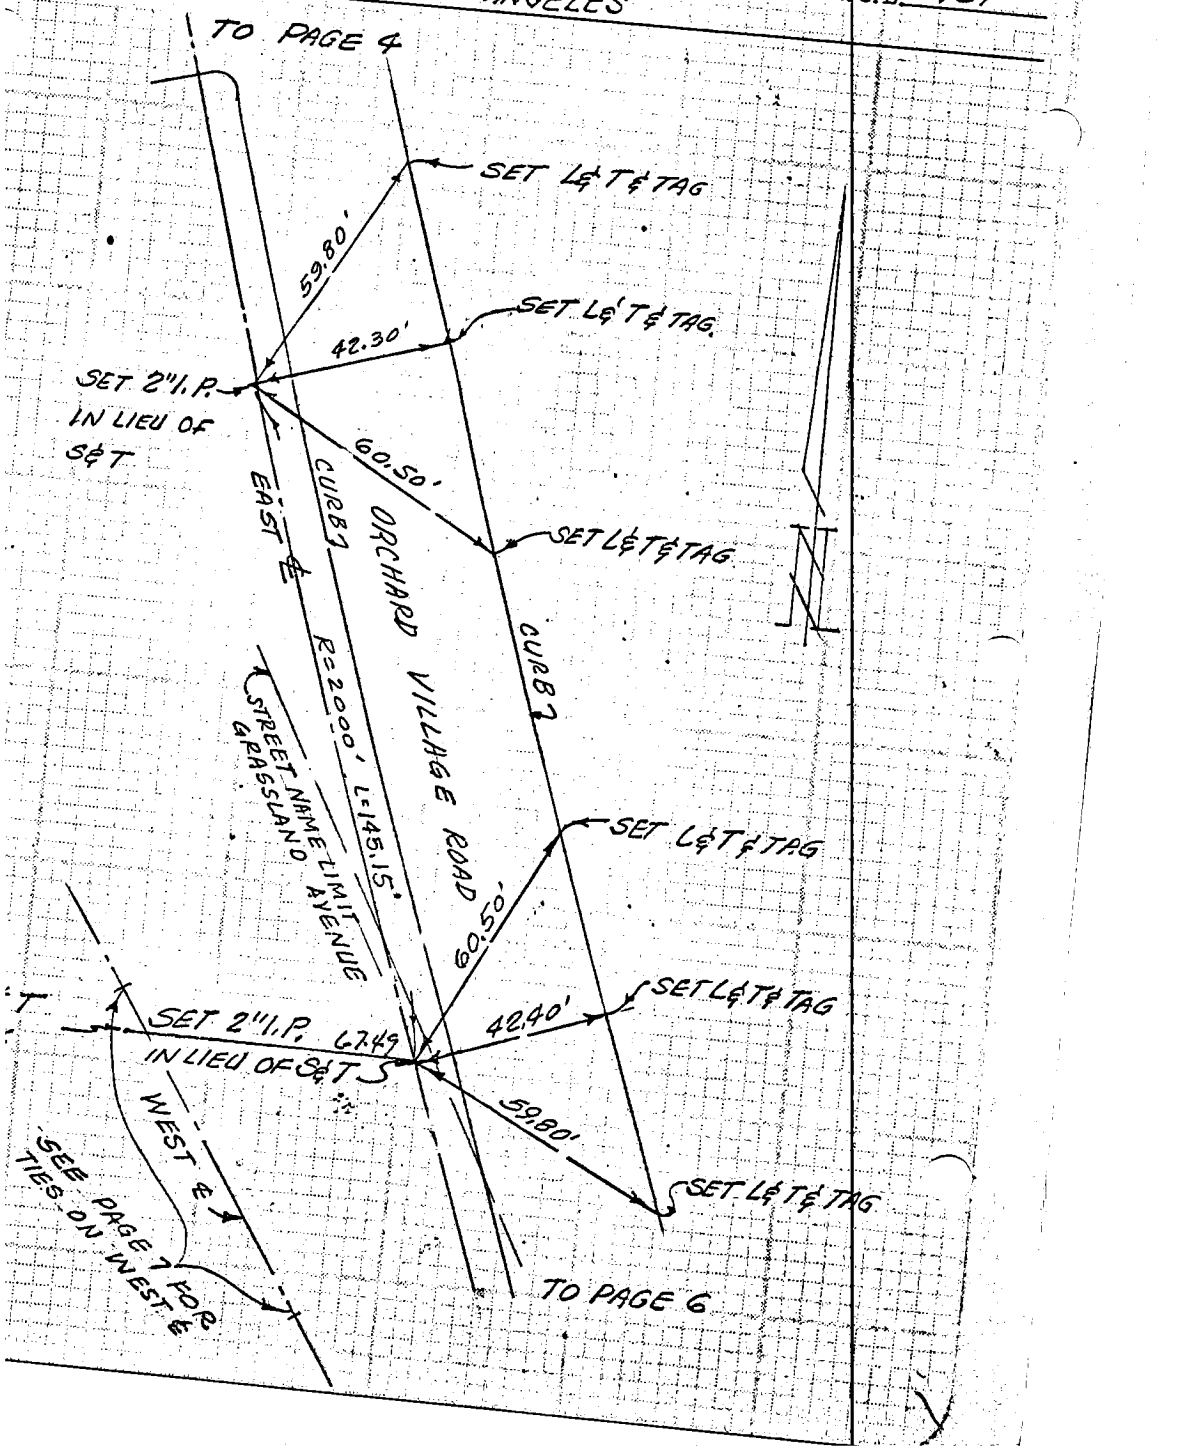

TRACT NO. 26894 DATE 11-10-69 PAGE 6 OF 8

ENGINEER C. R. NELSON

SURVEY BY VTN LOS ANGELES R.C.E. 8781

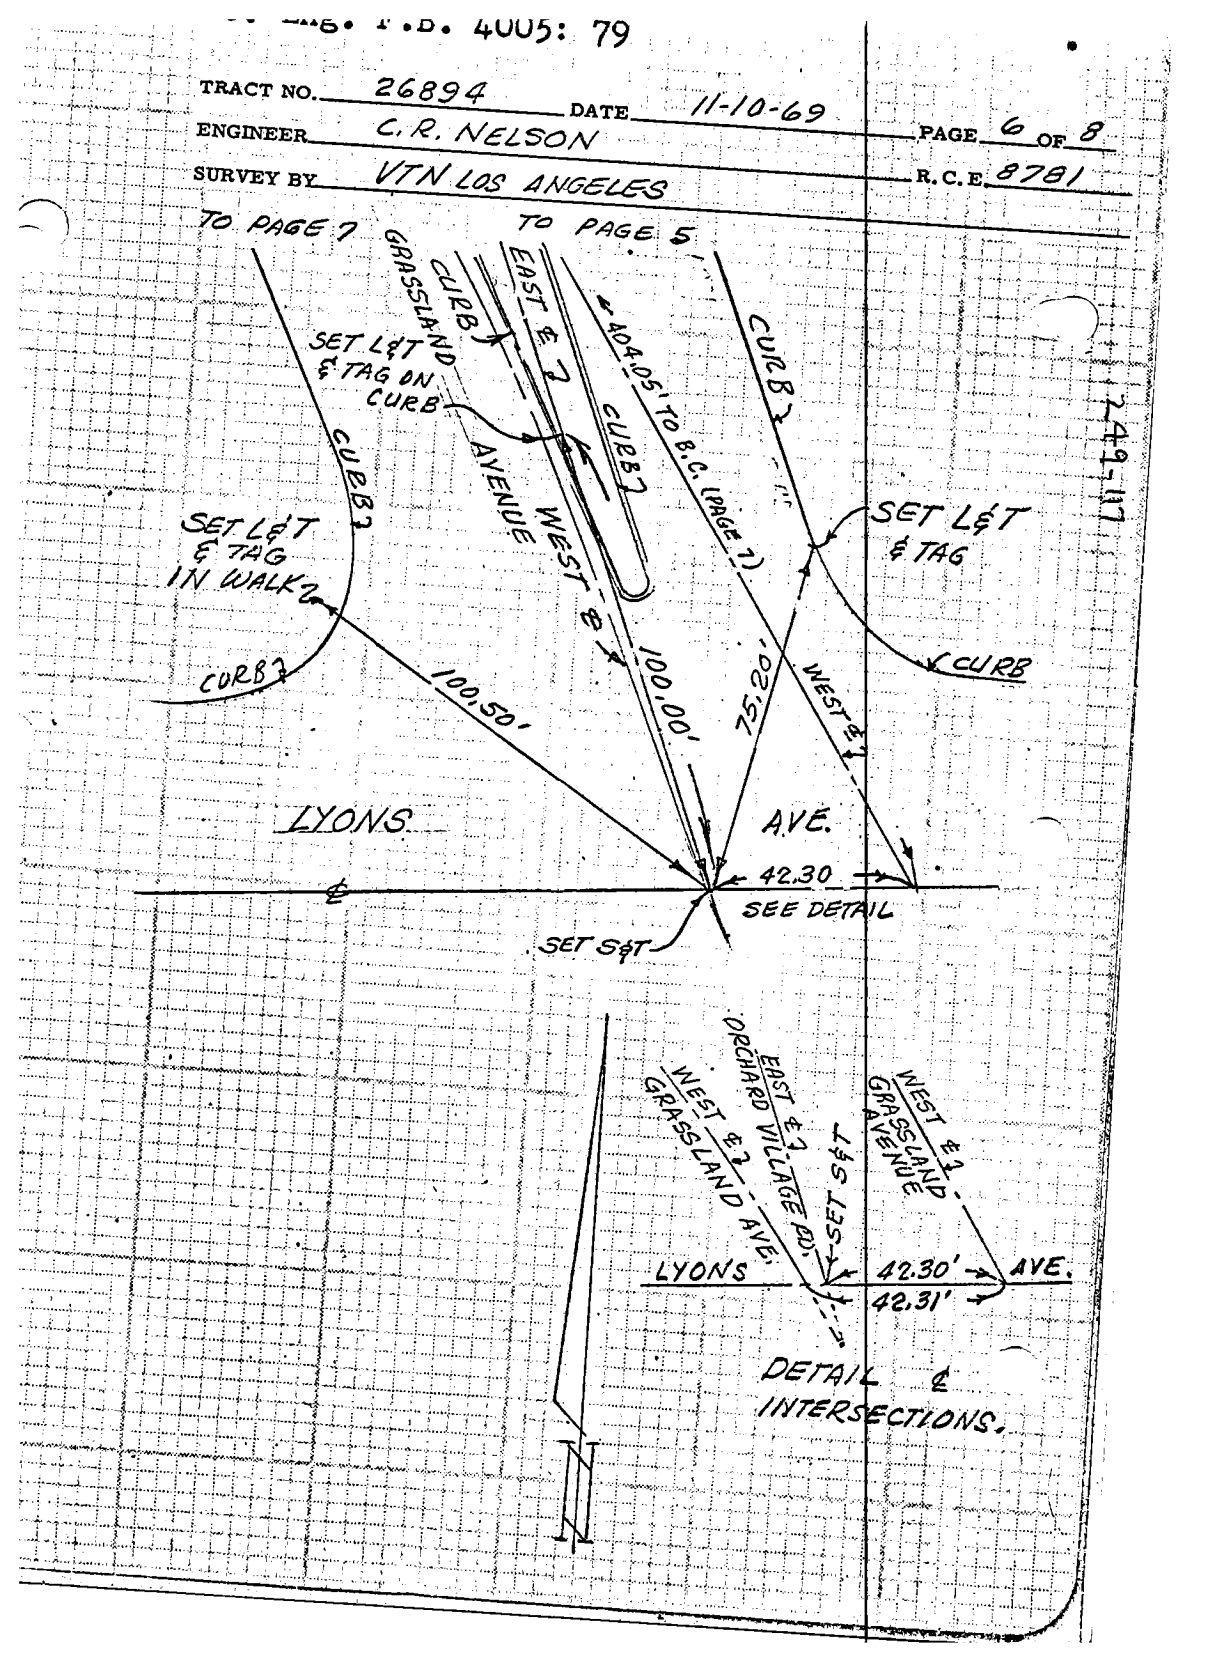


249-17

Co. Eng. F.B. 4005: 80

TRACT NO. 26894 DATE 11-10-69 PAGE 7 OF 8

ENGINEER C.R. NELSON R.C.E. 8781

SURVEY BY VTN LOS ANGELES

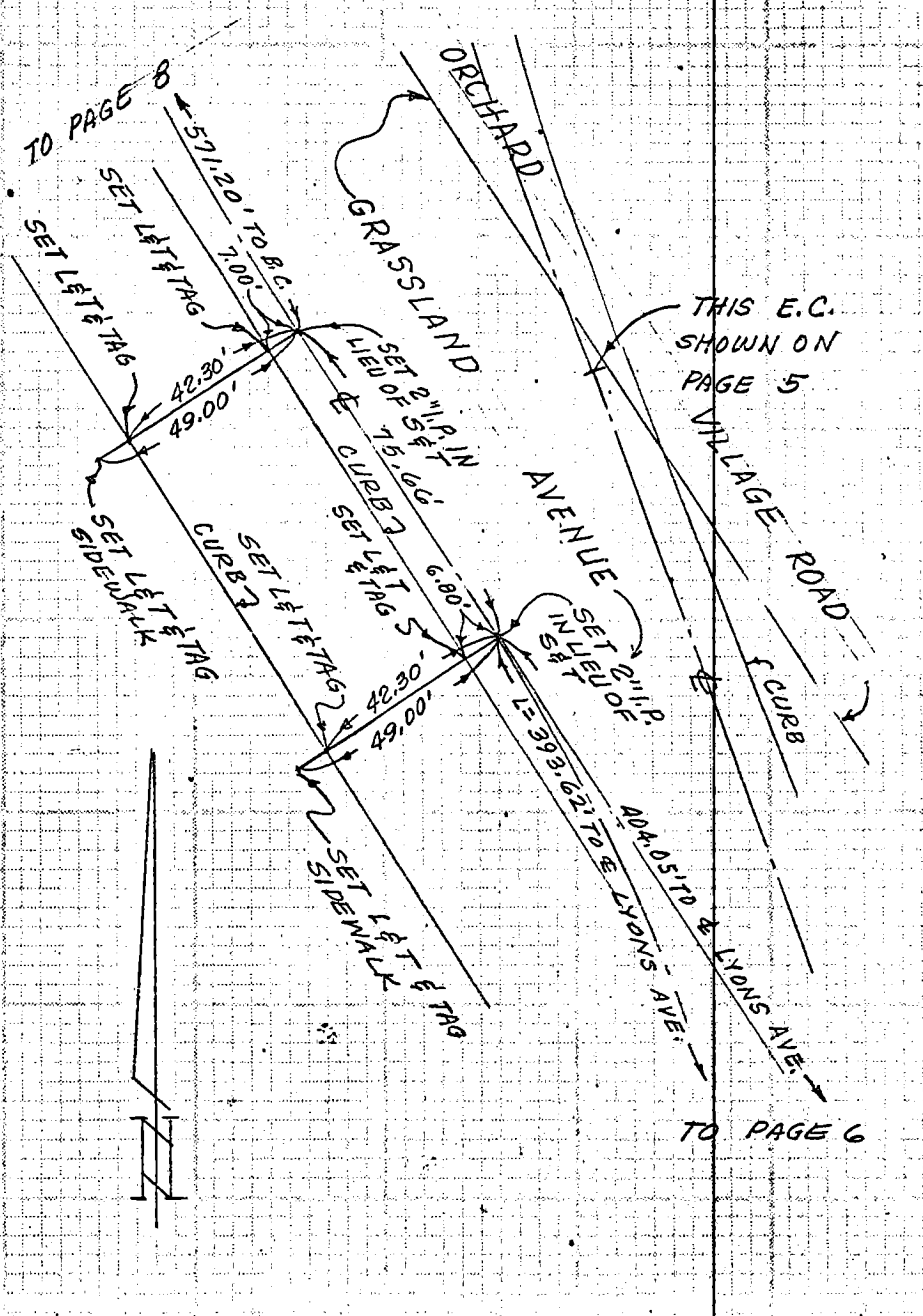

Co. Eng. F.B. 4005: 81

TRACT NO. 26894 DATE 11-10-69 PAGE 8 OF 8

ENGINEER C. R. NELSON R.C.E. 8781

SURVEY BY VTN LOS ANGELES

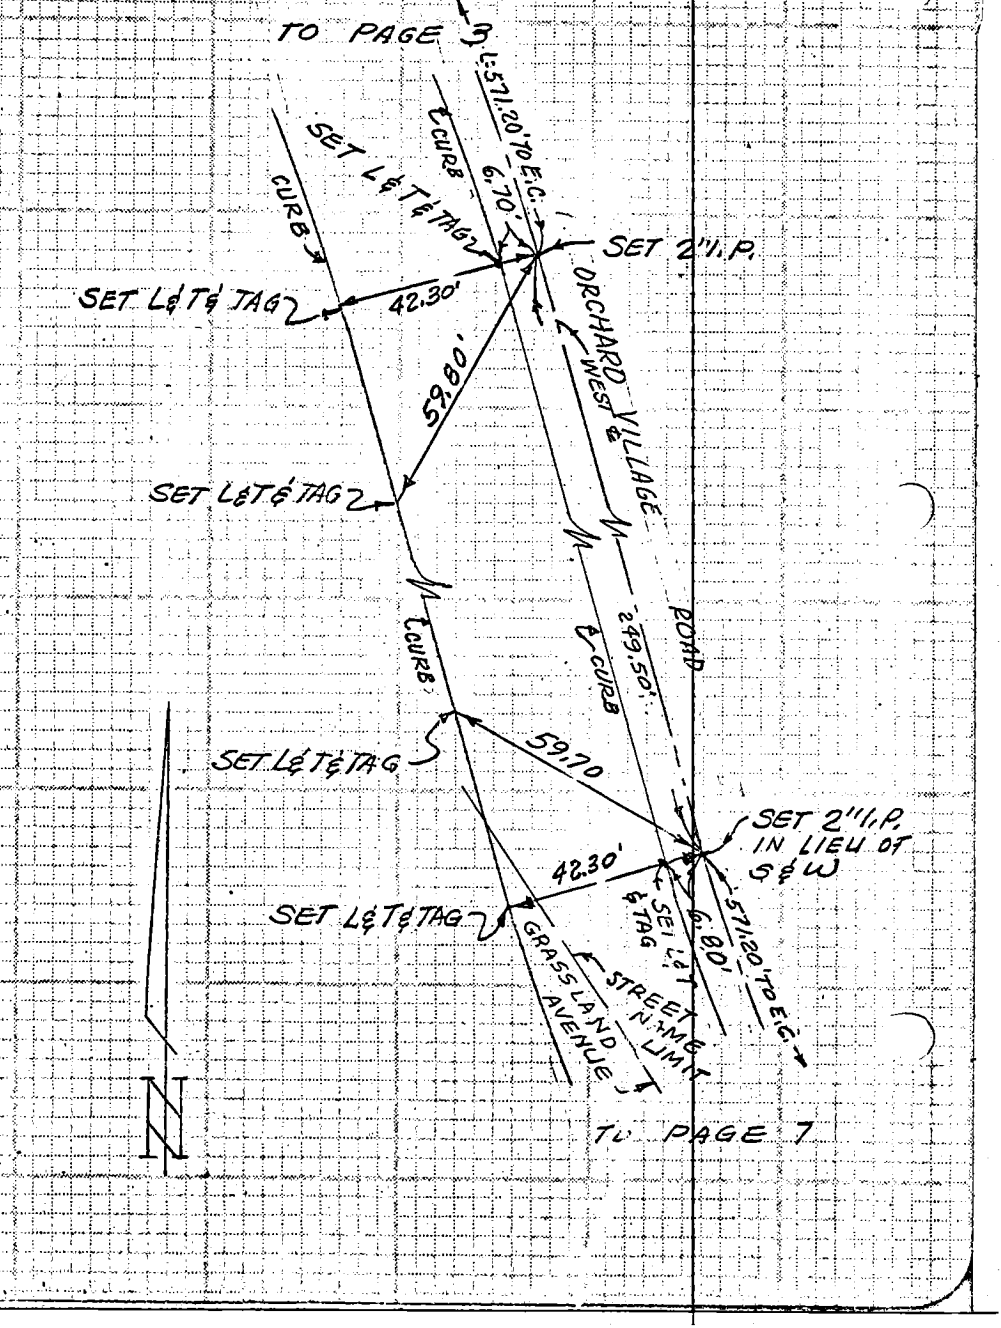

Co. Eng. F.B. 4005: 82

TRACT NO. 28212 DATE 1-7-70 PAGE 1 OF 10

ENGINEER THOMAS R. WELSH R.C.E. 14476

SURVEY BY VTN LOS ANGELES

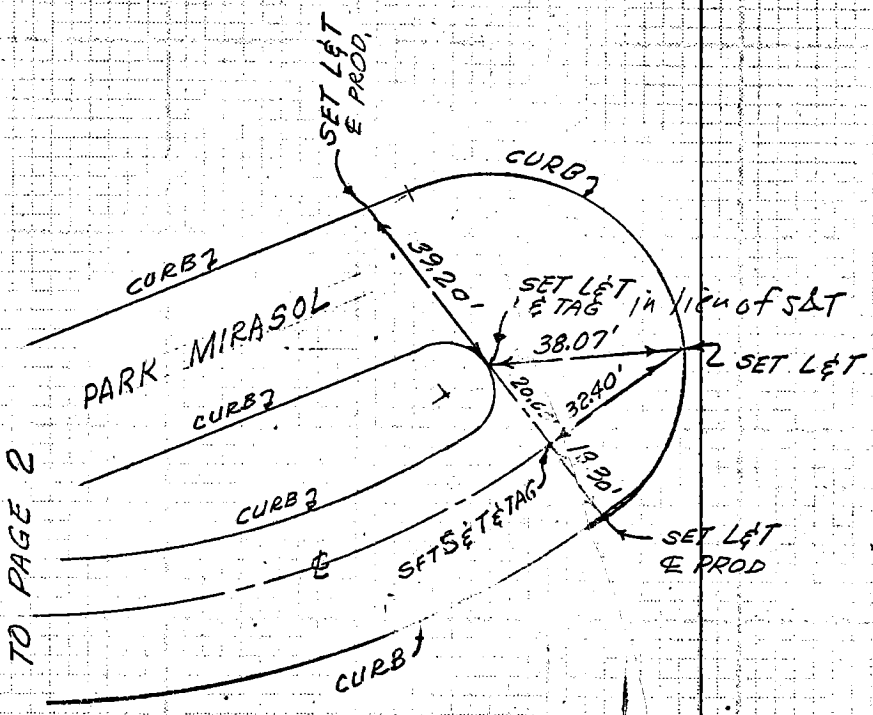


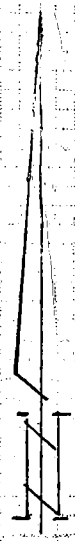

TRACT NO. 28212 DATE 1-7-70 PAGE 2 OF 10

ENGINEER THOMAS R. WELSH R.C.E. 14476

SURVEY BY VTN LOS ANGELES

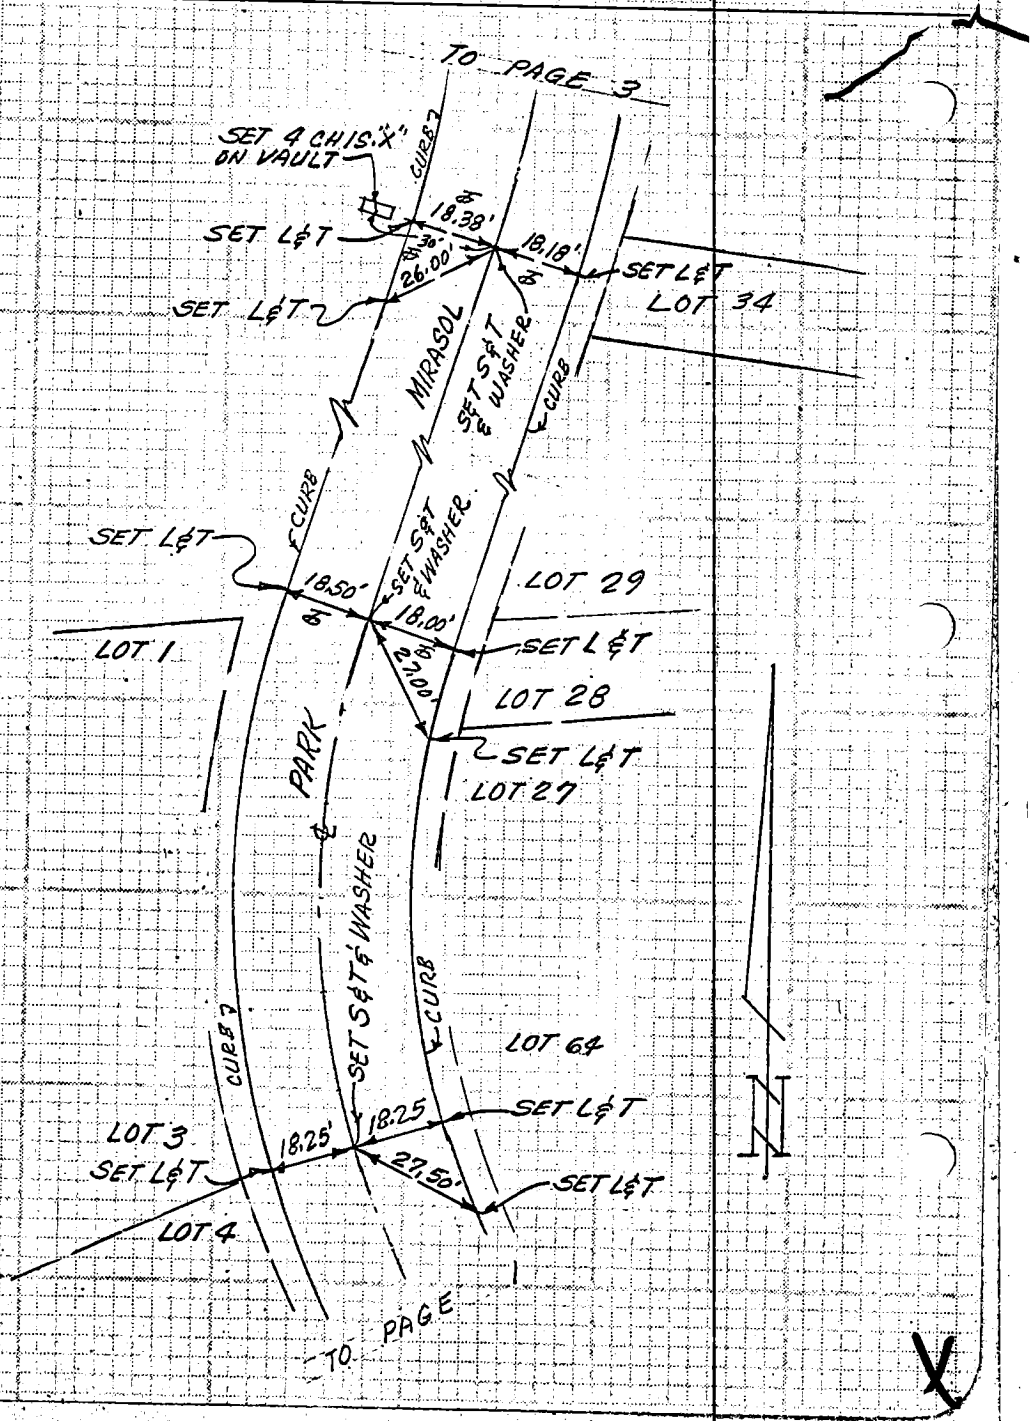

Co. Eng. F.B. 4005: 84 •

TRACT NO. 28212 DATE 1-7-70 PAGE 3 OF 10

ENGINEER THOMAS R. WELSH R.C.E. 14476

SURVEY BY VTN LOS ANGELES

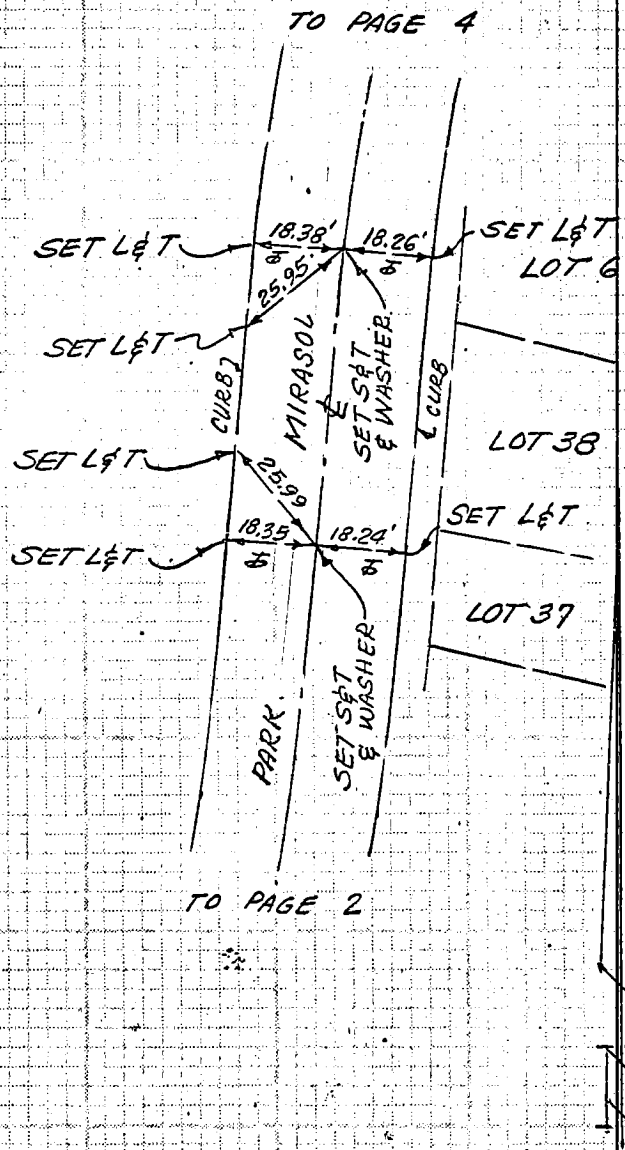

Co. Eng. F.B. 4005: 85

TRACT NO. 28212 DATE 1-7-70 PAGE 4 OF 10

ENGINEER THOMAS R. WELSH R.C.E. 14476

SURVEY BY VTN LOS ANGELES

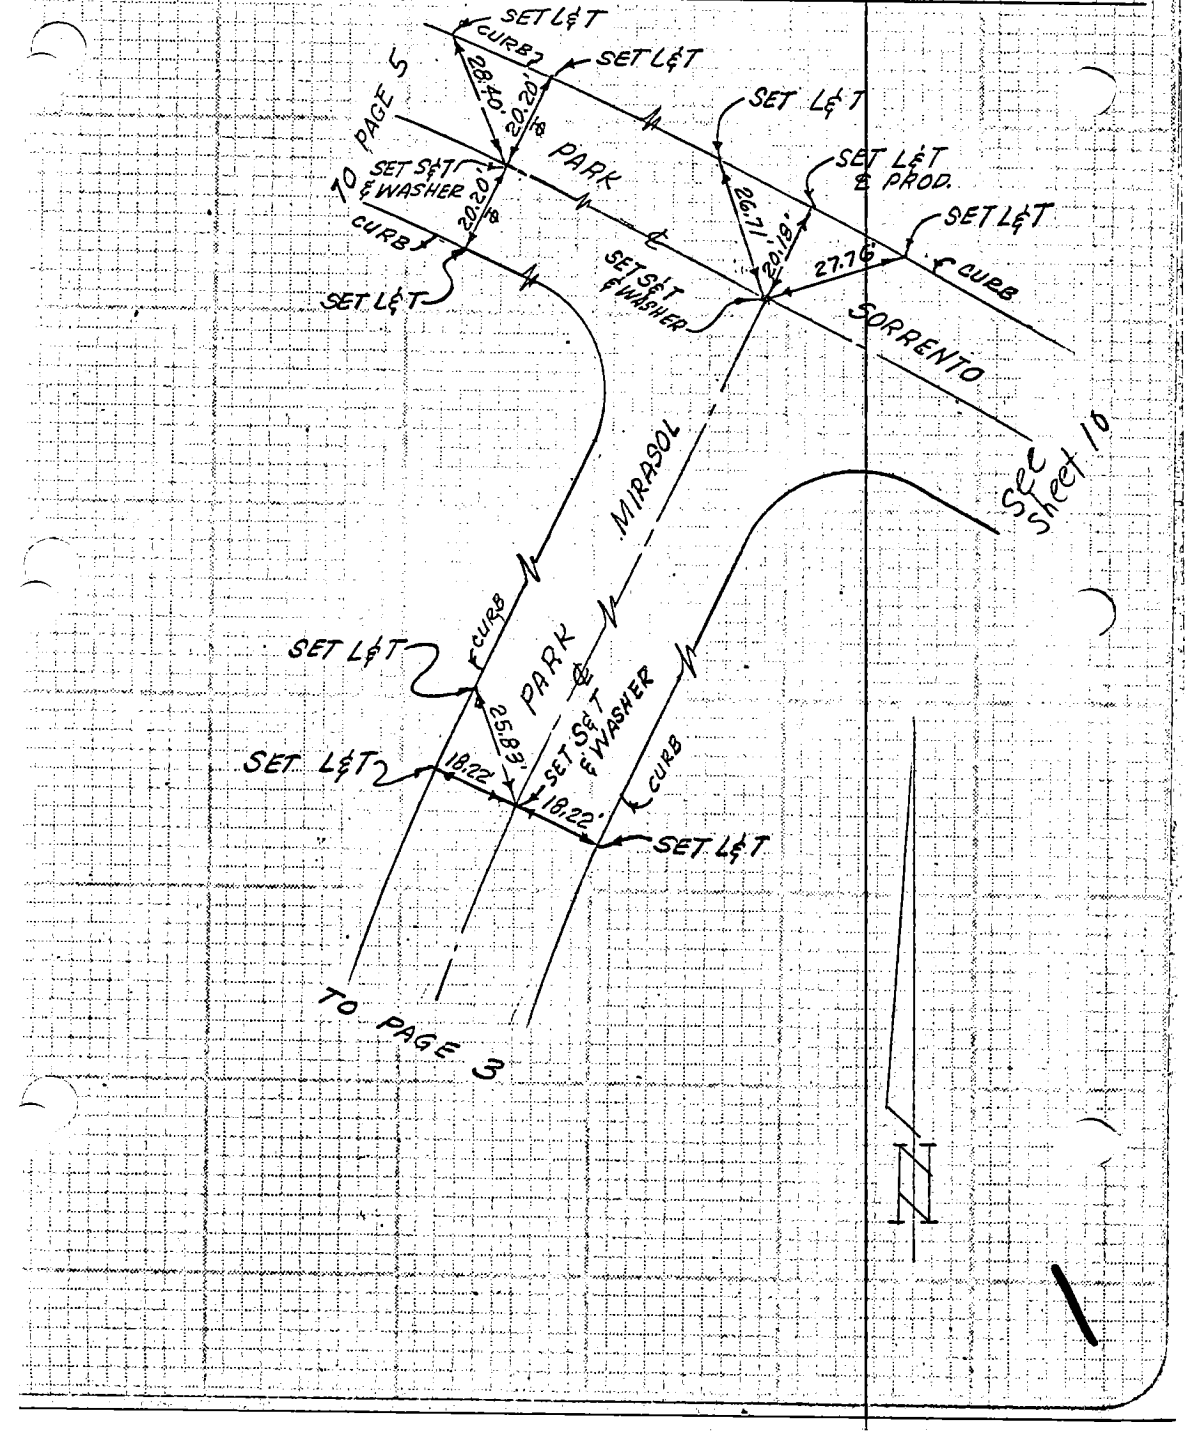

Co. Eng. F.B. 4005: 86

TRACT NO. 28212 DATE 1-7-70 PAGE 5 OF 10

ENGINEER THOMAS R. WELSH R.C.E. 14476

SURVEY BY VTN LOS ANGELES

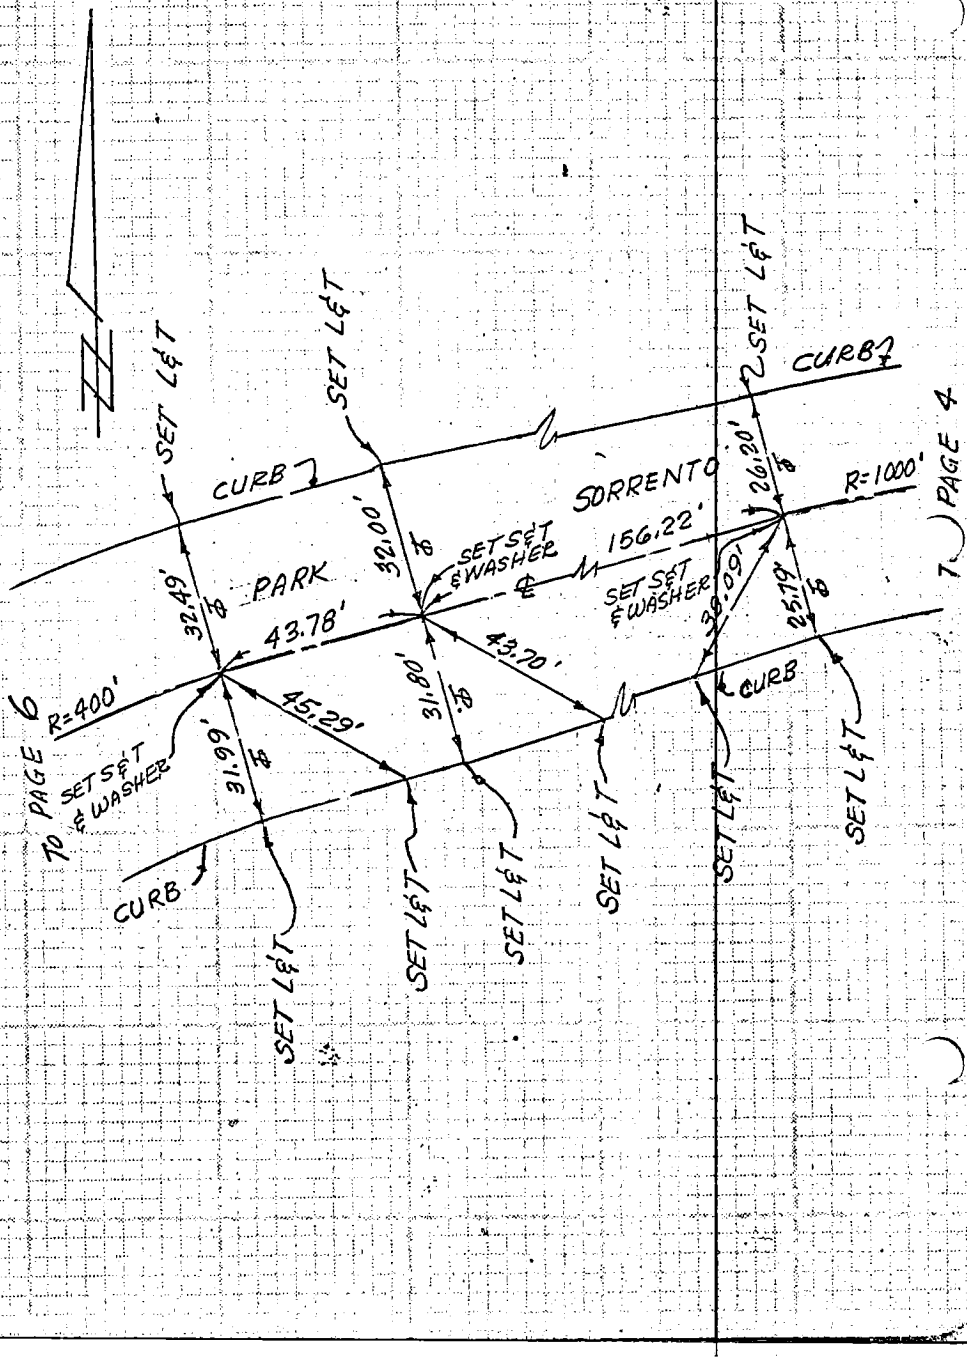

Co. Eng. F.B. 4005: 87

TRACT NO. 28212 DATE 1-7-70 PAGE 6 OF 10

ENGINEER THOMAS R. WELSH R.C.E. 14476

SURVEY BY VTN LOS ANGELES

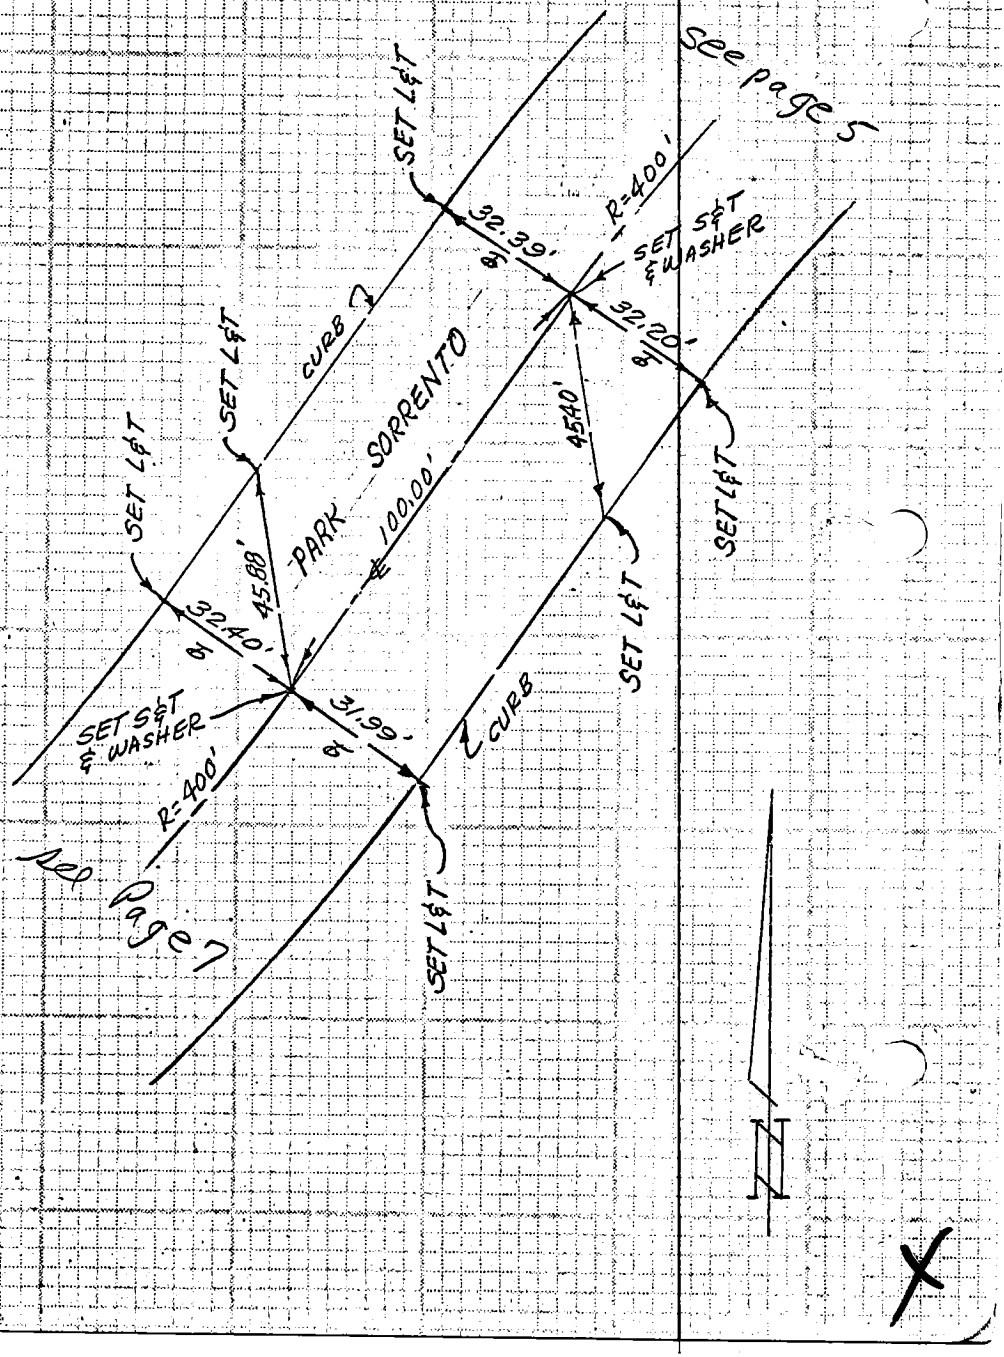

Co. Eng. F.B. 4005: 88

TRACT NO. 28212 DATE 1-7-70 PAGE 7 OF 10

ENGINEER THOMAS R. WELSH R.C.E. 14476

SURVEY BY VTN LOS ANGELES

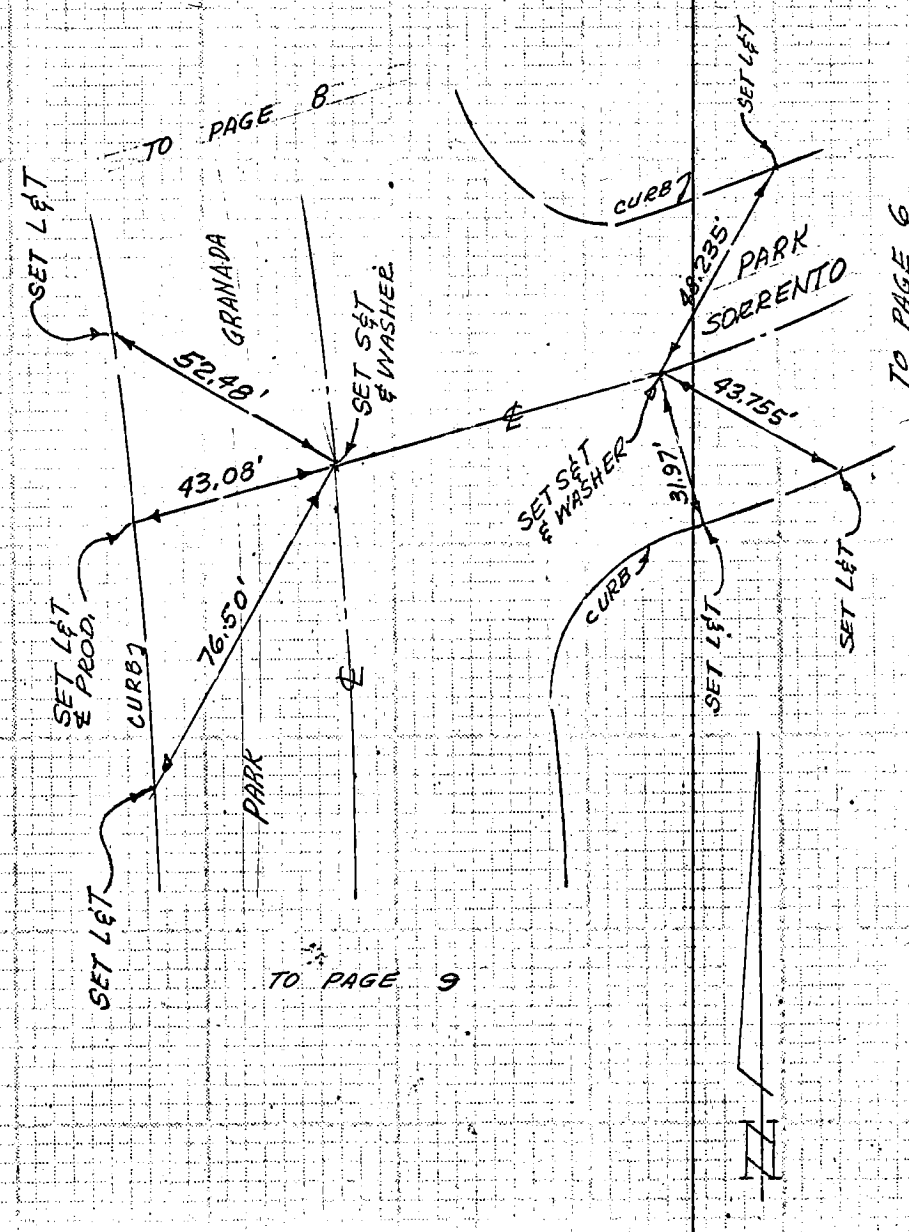

Co. Eng. F.B. 4005: 89

TRACT NO. 28212 DATE 1-7-70 PAGE 8 OF 10

ENGINEER THOMAS R. WELSH R.C.E. 14476

SURVEY BY VTN LOS ANGELES

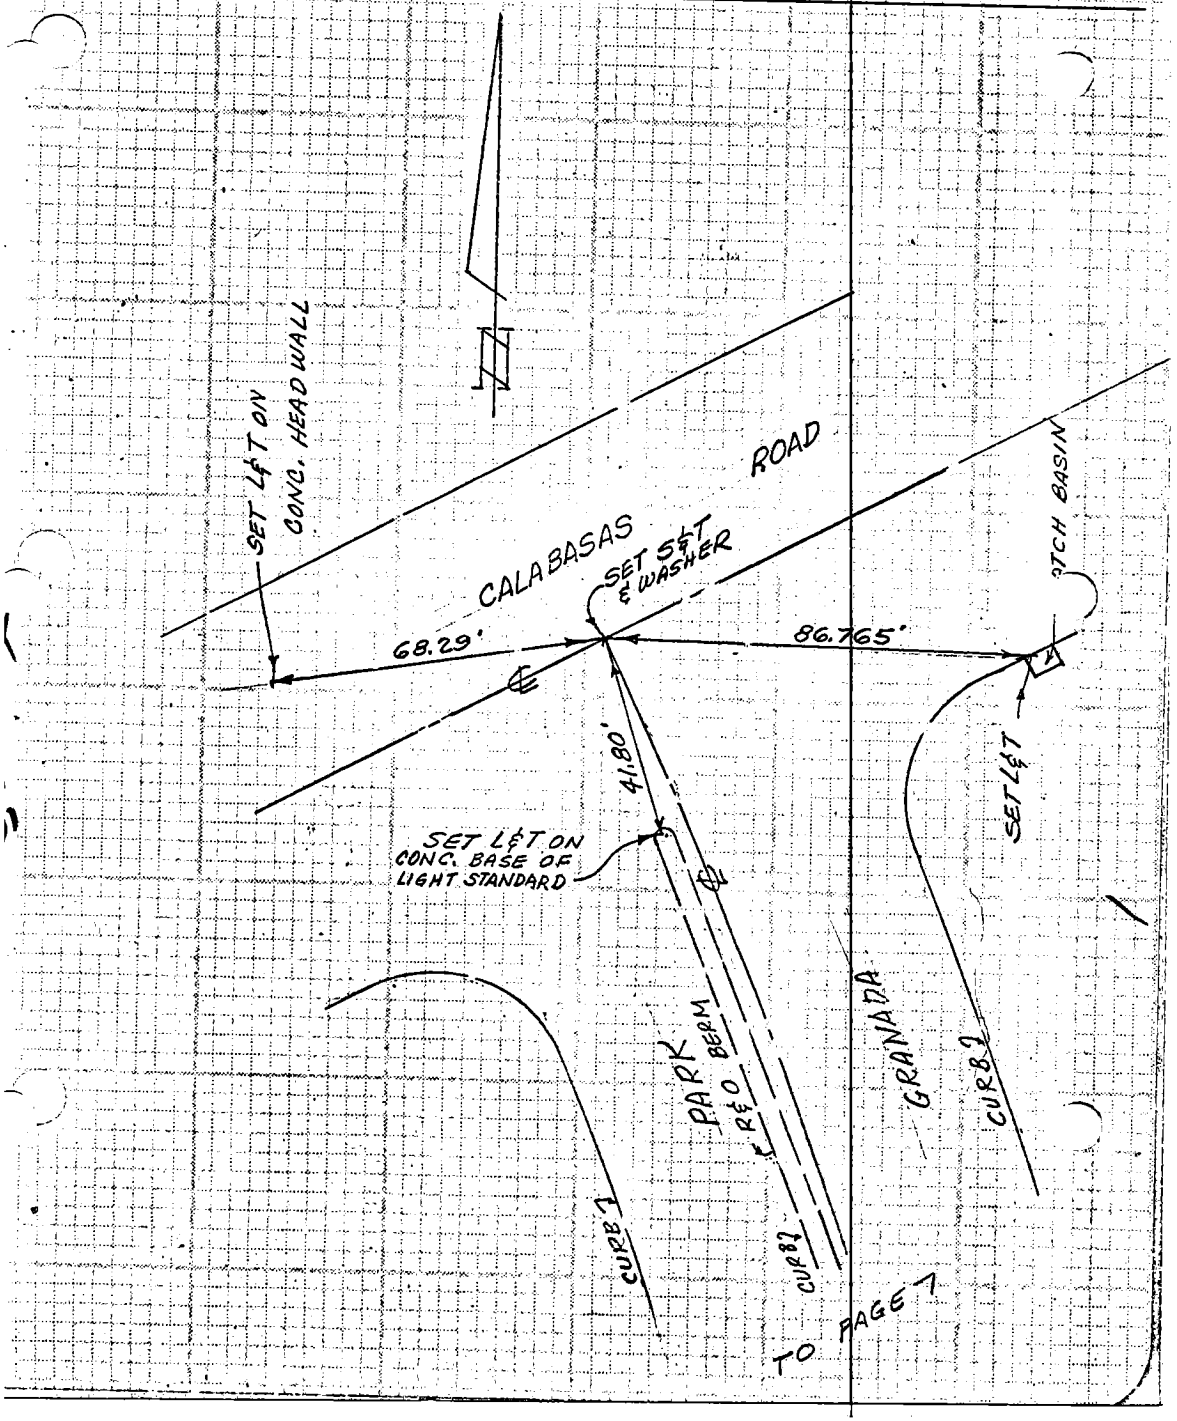

Co. Eng. F.B.4005:90

TRACT NO. 28212 DATE 1-7-70 PAGE 9 OF 10

ENGINEER THOMAS R. WELSH R.C.E. 14476

SURVEY BY VTN LOS ANGELES

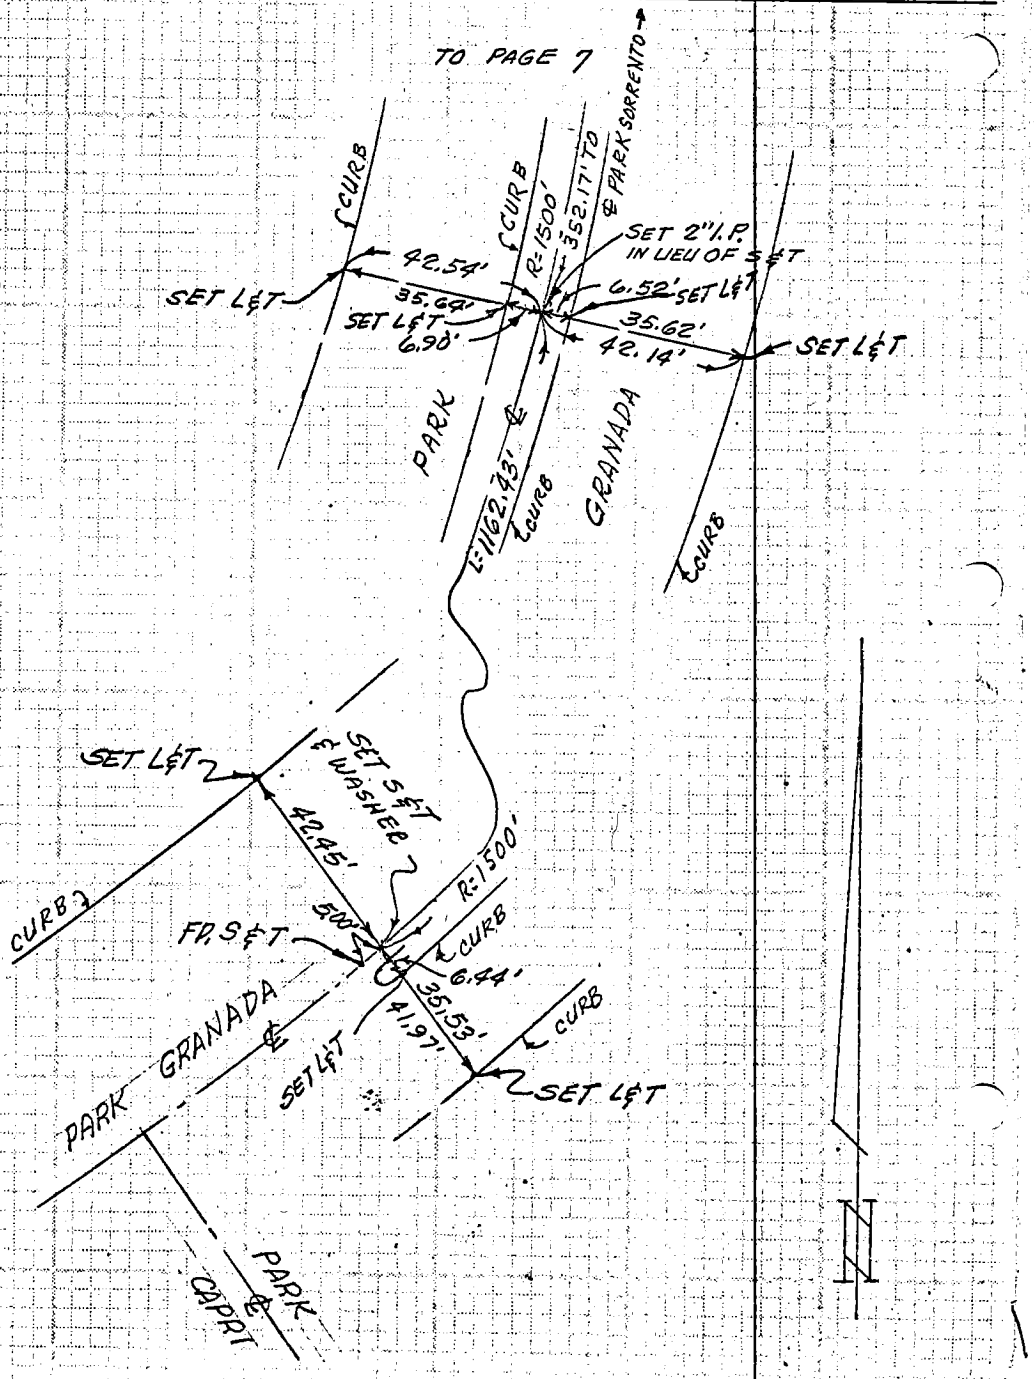

Co. Eng. F.B. 4005: 91

TRACT NO. 28212 DATE 1-7-70 PAGE 10 OF 10

ENGINEER THOMAS R. WELSH R.C.E. 14476

SURVEY BY VTN LOS ANGELES

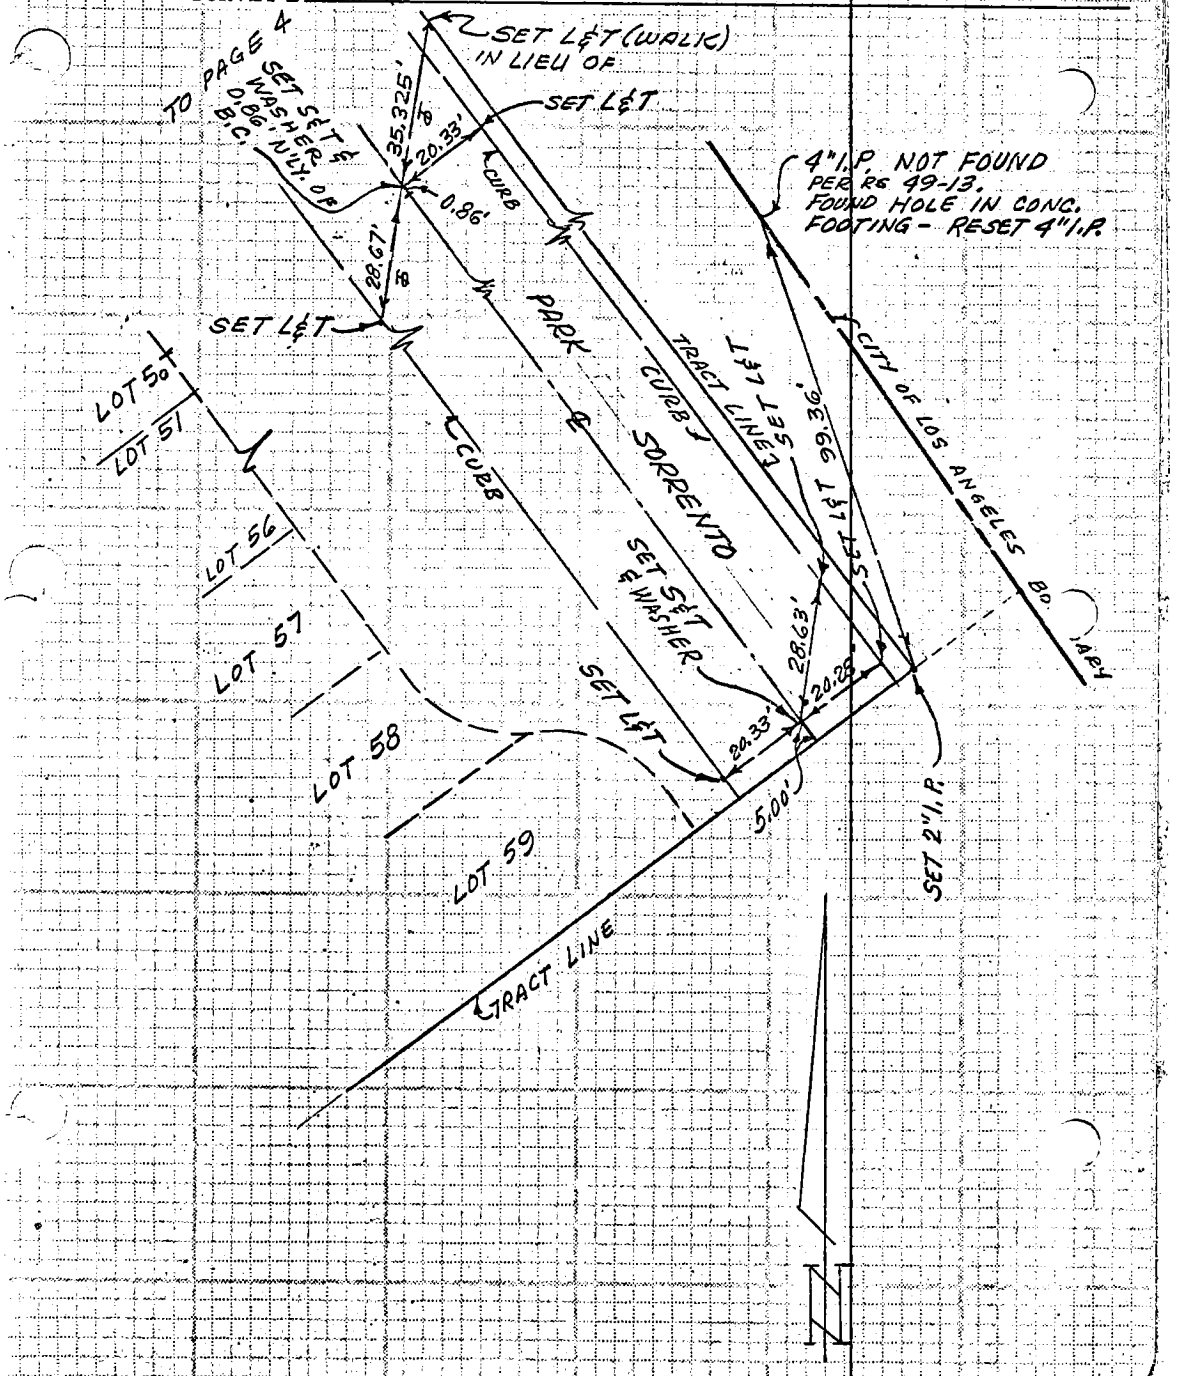

Co. Eng. F.B. 4005: 92

Tract No. 27821
Survey by- W.J. Lockman
RCE 10290

Date April 4, 1968

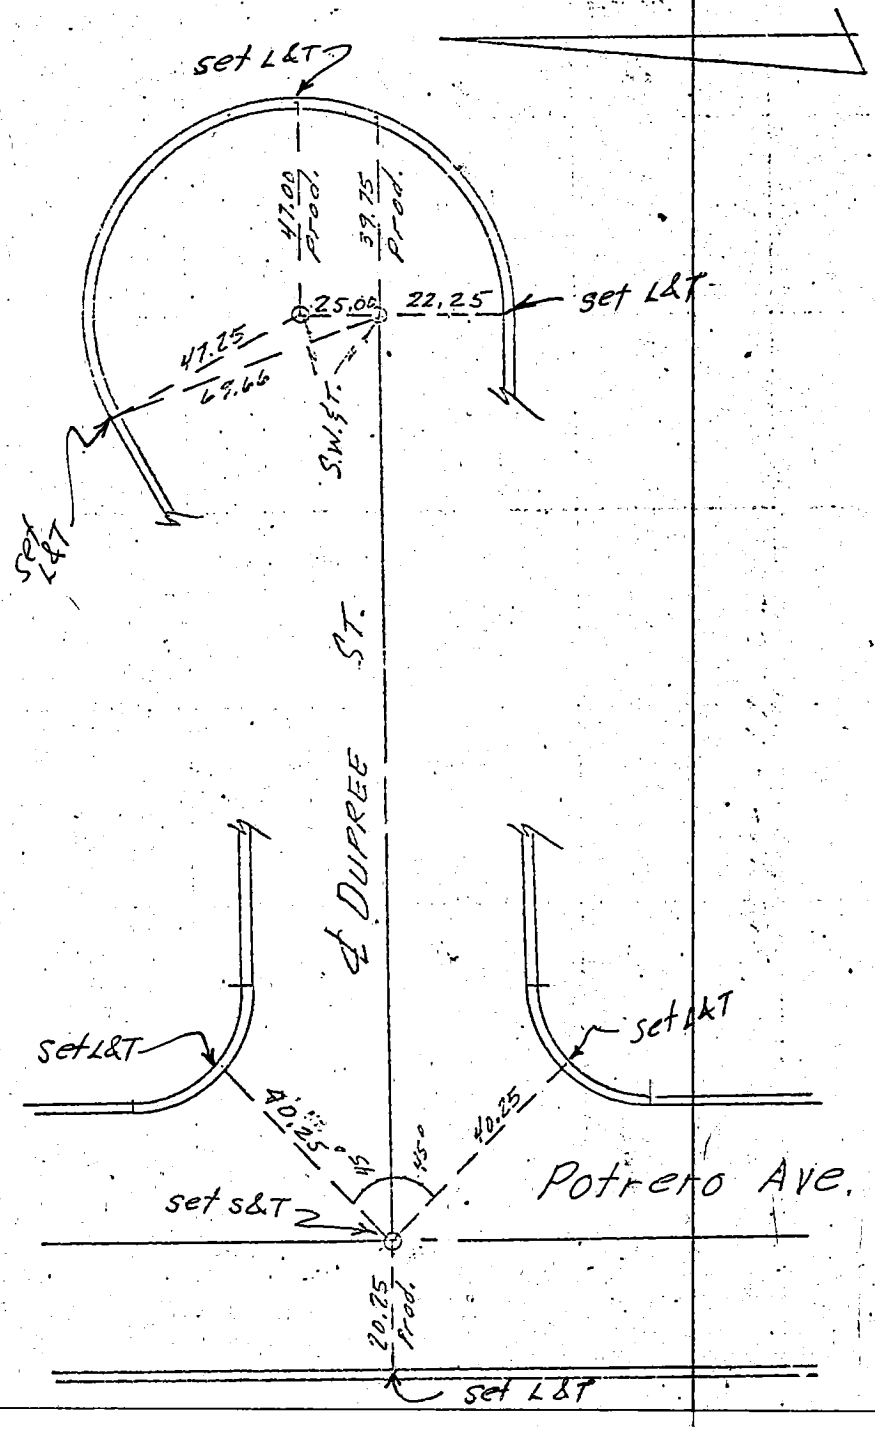


DO NOT EXTEND NOTES THIS SIDE OF LINE

B5378.2

Co. Eng. F.B. 4005: 93

Tract No. 27821 Date April 4, 1968

Survey by W. J. Lockman
RCE 10290

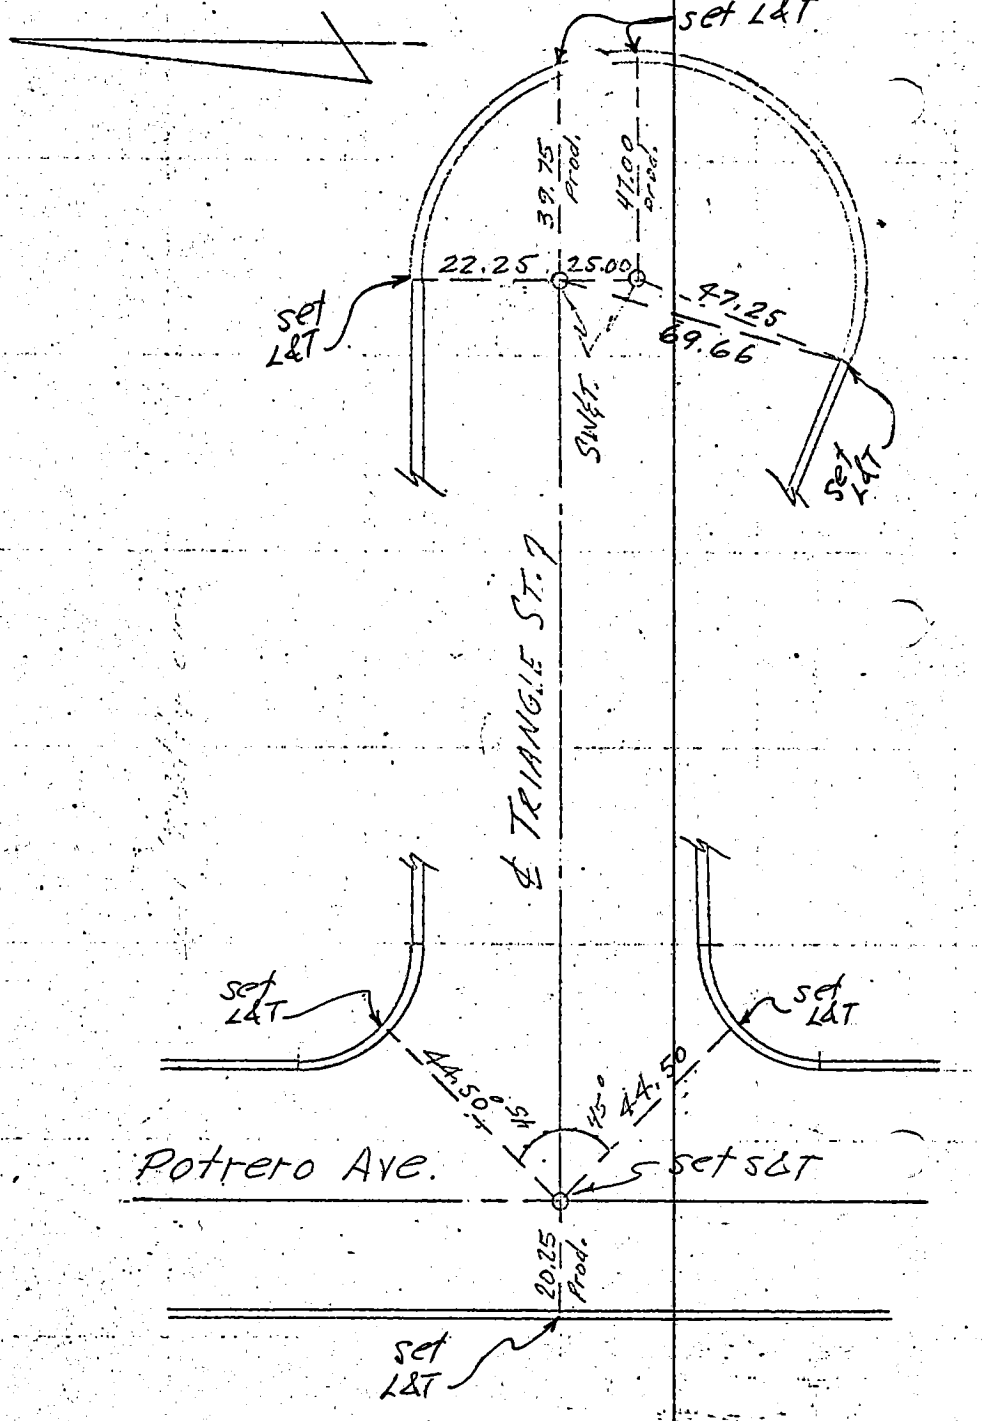


W.S. 37 8-2

Co. Eng. F.B. 4005: 94

W.S. 159-017 C-2

SURVEY OF TWIN LAKE RIDGE F B NO PAGE 1

SURVEY BY ENGINEERING SERVICE CORP. TRACT NO 29072

DATE JAN. 23, 1970

J. K. NEWVILLE
R. C. E. 13095

DO NOT EXTEND NOTES THIS SIDE OF LINE

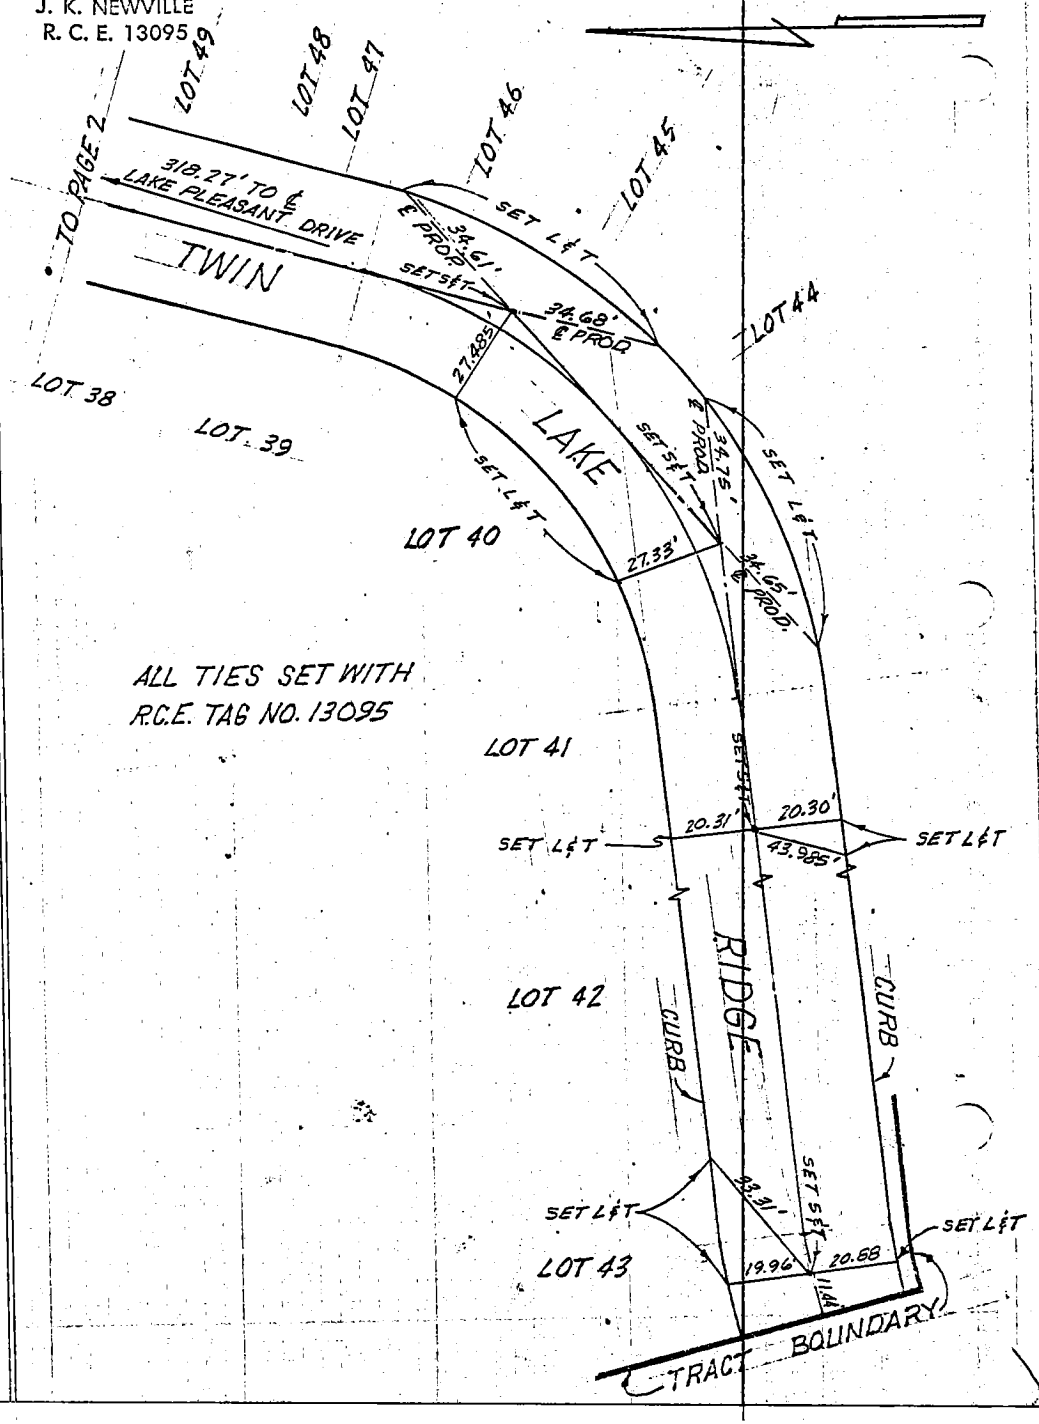

Co. Eng. F.B. 4005: 95

SURVEY OF TWIN LAKE RIDGE F B NO. PAGE 2

SURVEY BY ENGINEERING SERVICE CORP. TRACT NO 29072

DATE JAN. 23, 1970

J. K. NEWVILLE

R. C. E. 13095

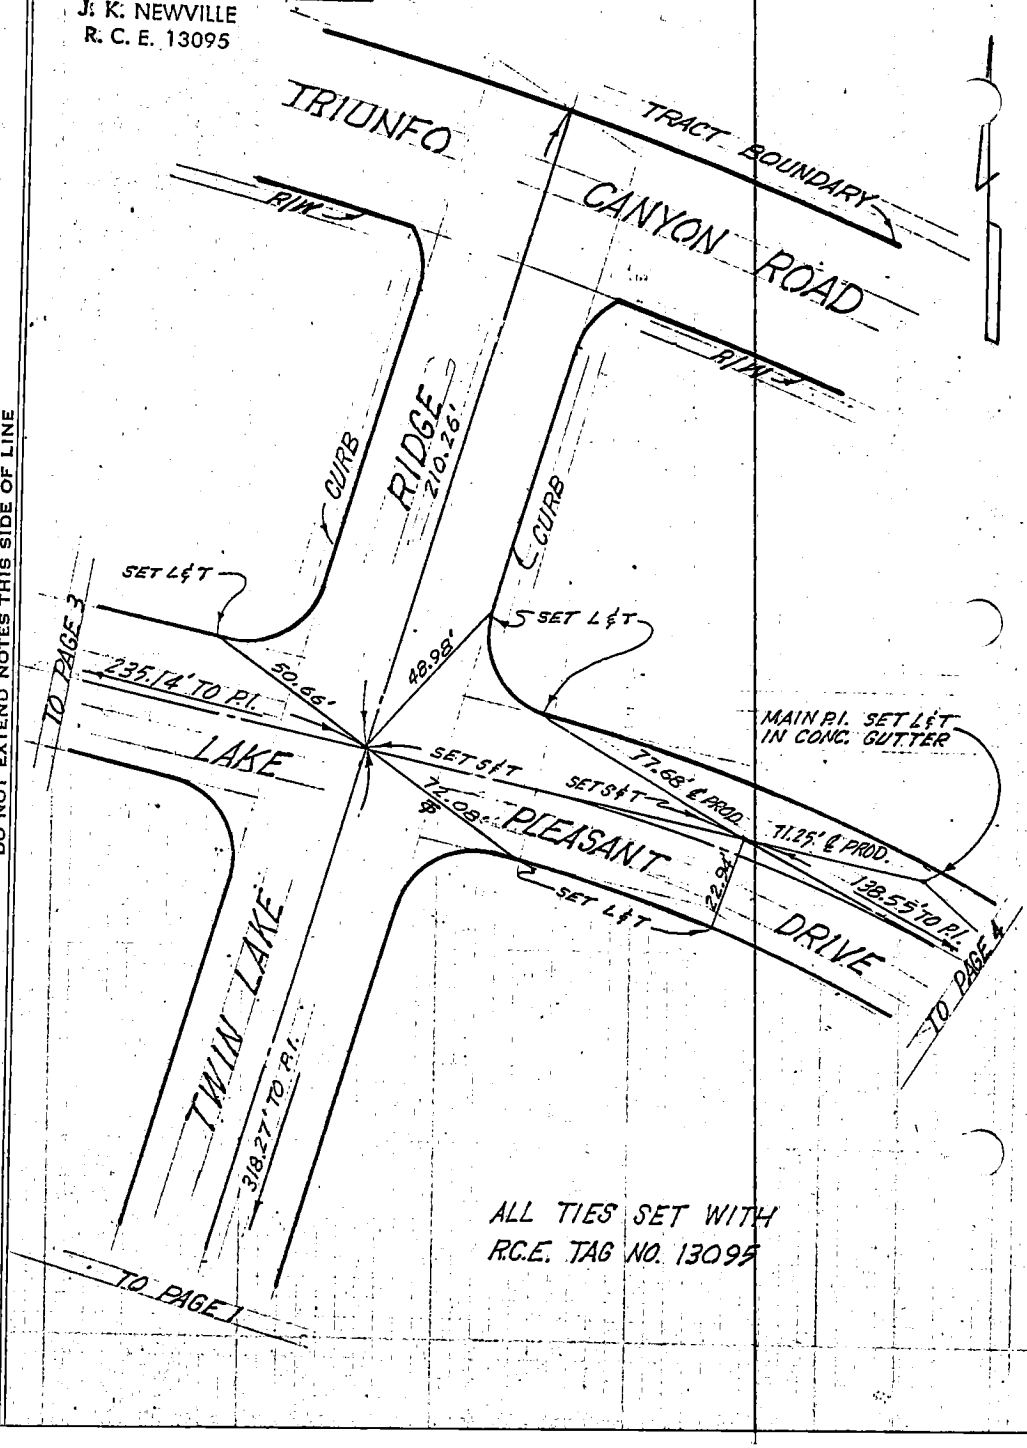


DO NOT EXTEND NOTES THIS SIDE OF LINE

W.S. 159-037 A-2

Co. Eng. F.B. 4005: 96

SURVEY OF LAKE PLEASANT DRIVE F B NO. PAGE 3
SURVEY BY ENGINEERING SERVICE CORP. TRACT NO. 29OT2
DATE JAN. 23, 1970
J. K. NEWVILLE
R. C. E. 13095

WS-159-012 C-2

DO NOT EXTEND NOTES THIS SIDE OF LINE

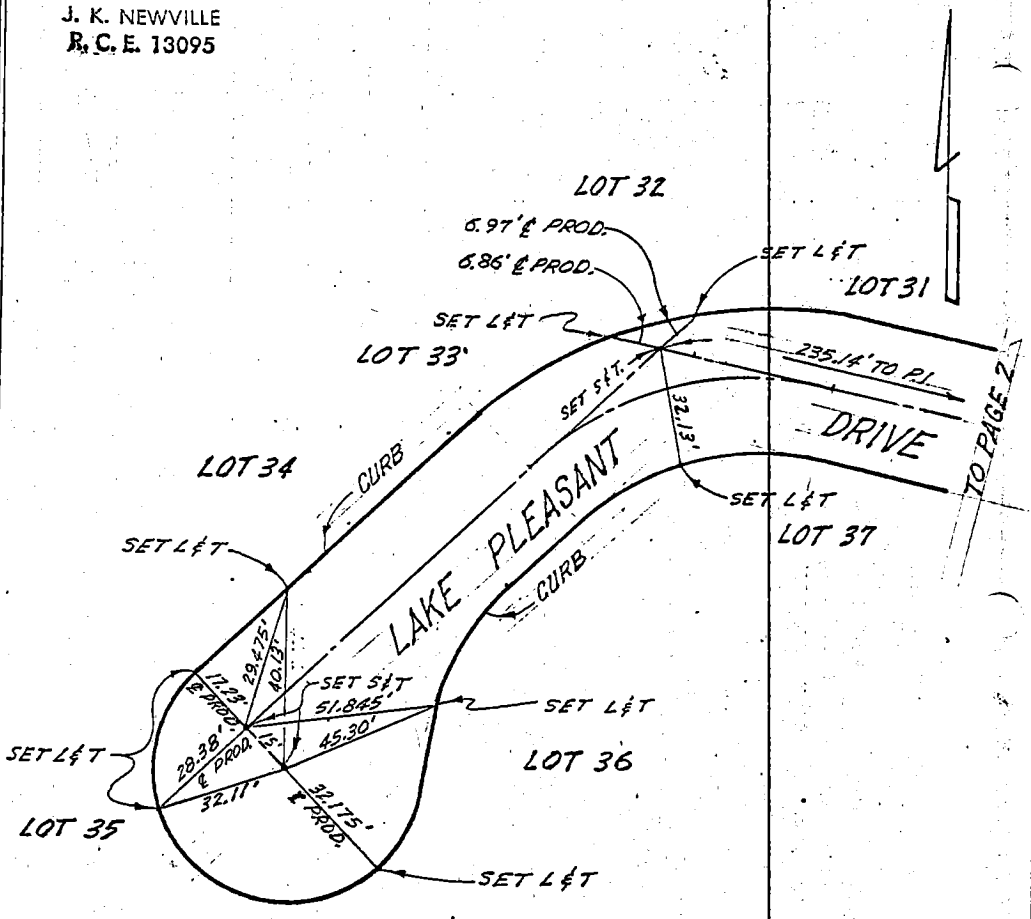


ALL TIES SET WITH
R.C.E. TAG NO. 13095

Co. Eng. F.B. 4005: 97

SURVEY OF LAKE PLEASANT DRIVE F B NO. PAGE 4

SURVEY BY ENGINEERING SERVICE CORP. TRACT NO. 29072

DATE JAN. 23, 1970

J. K. NEWVILLE
R. C. E. 13095

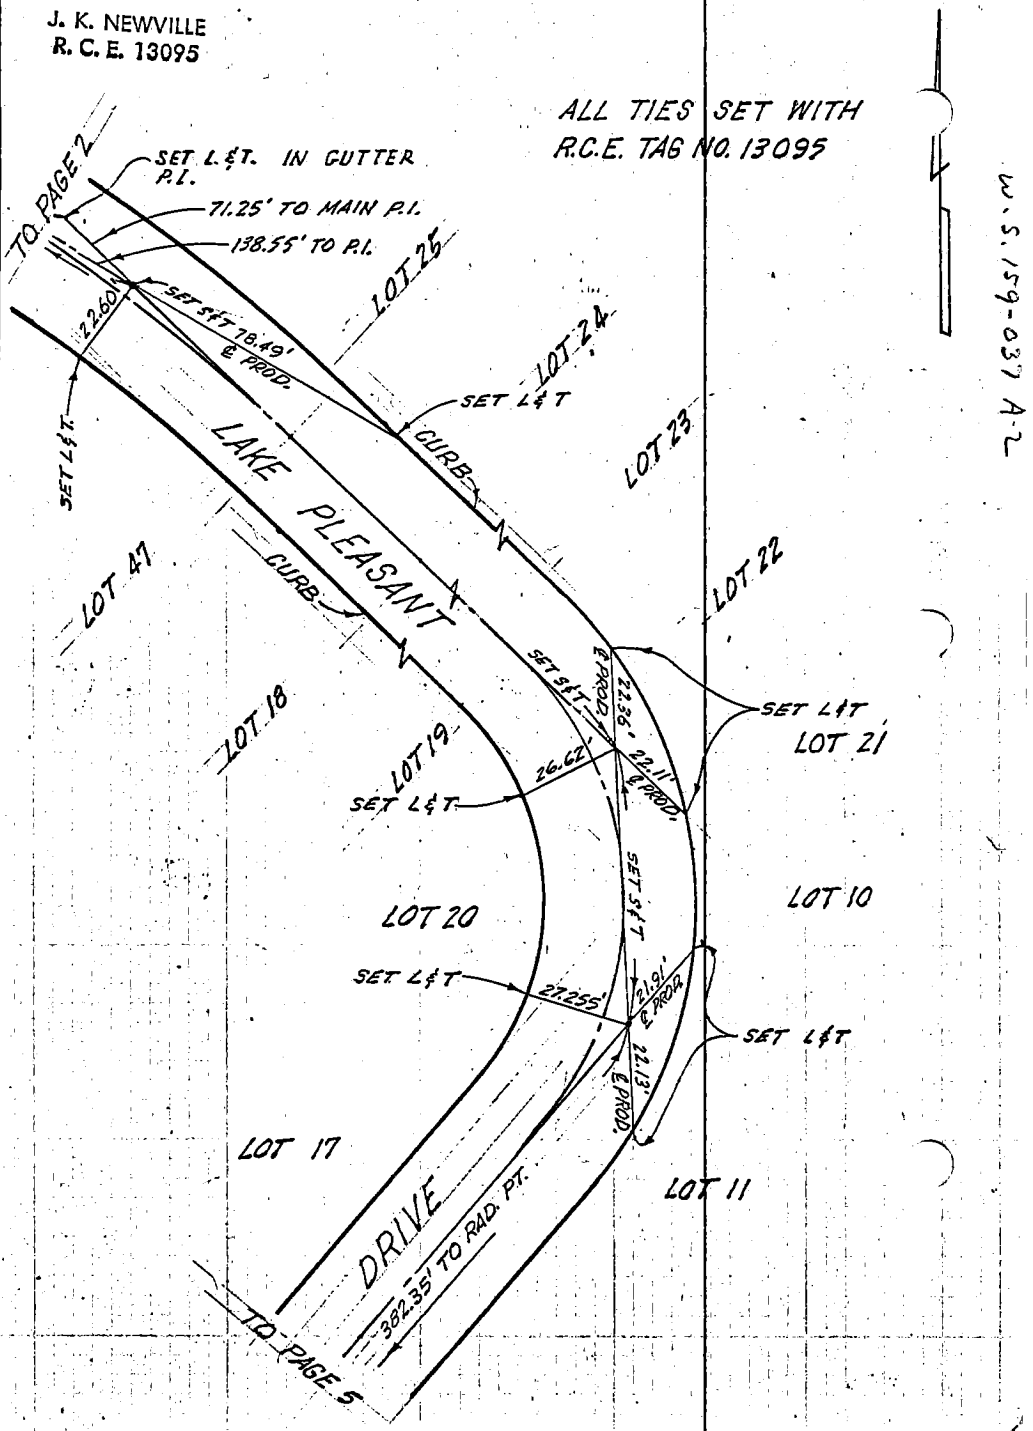


DO NOT EXTEND NOTES THIS SIDE OF LINE

W.S. 159-037 A-2

Co. Eng. F.B. 4005: 98

SURVEY OF LAKE PLEASANT DRIVE F B NO. PAGE 5

SURVEY BY ENGINEERING SERVICE CORP. TRACT NO. 29072

DATE JAN. 23, 1970

J. K. NEWVILLE
R. C. E. 13095

W.S. 159-037 A-2

DO NOT EXTEND NOTES THIS SIDE OF LINE

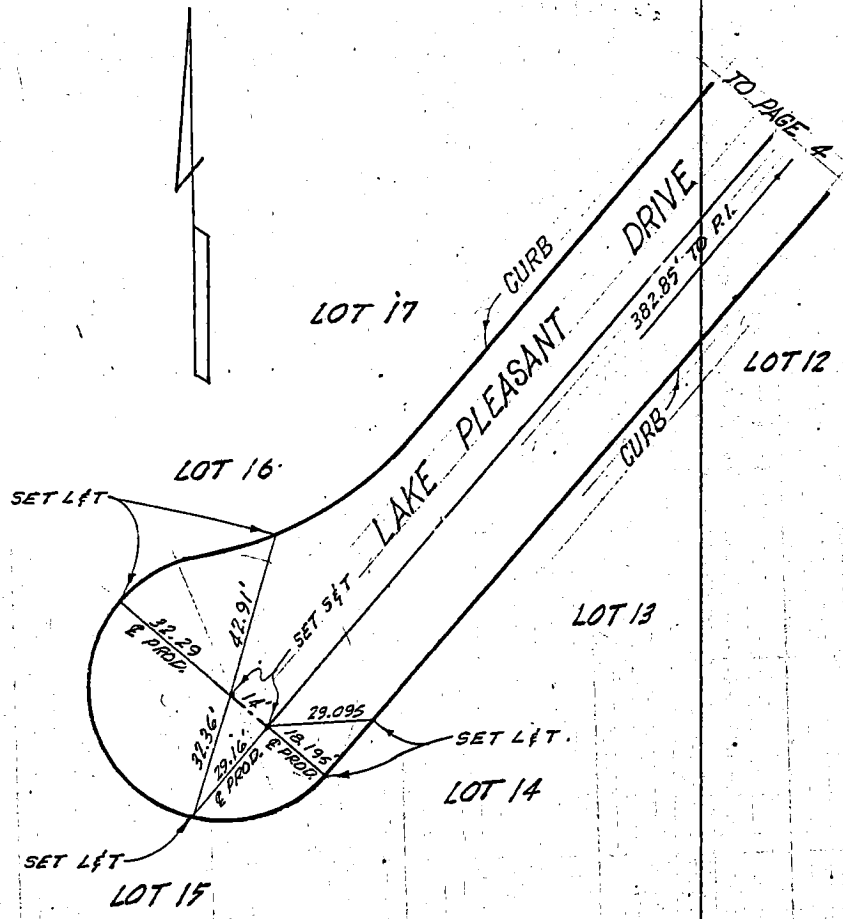


ALL TIES SET WITH
R.C.E. TAG NO. 13095.

Co. Eng. F.B. 4005: 99

SURVEY OF GOLDEN LEAF DRIVE F B NO. PAGE 6

SURVEY BY ENGINEERING SERVICE CORP. TRACT NO. 29072

DATE JAN. 23, 1970

J. K. NEWVILLE
R. C. E. 13095

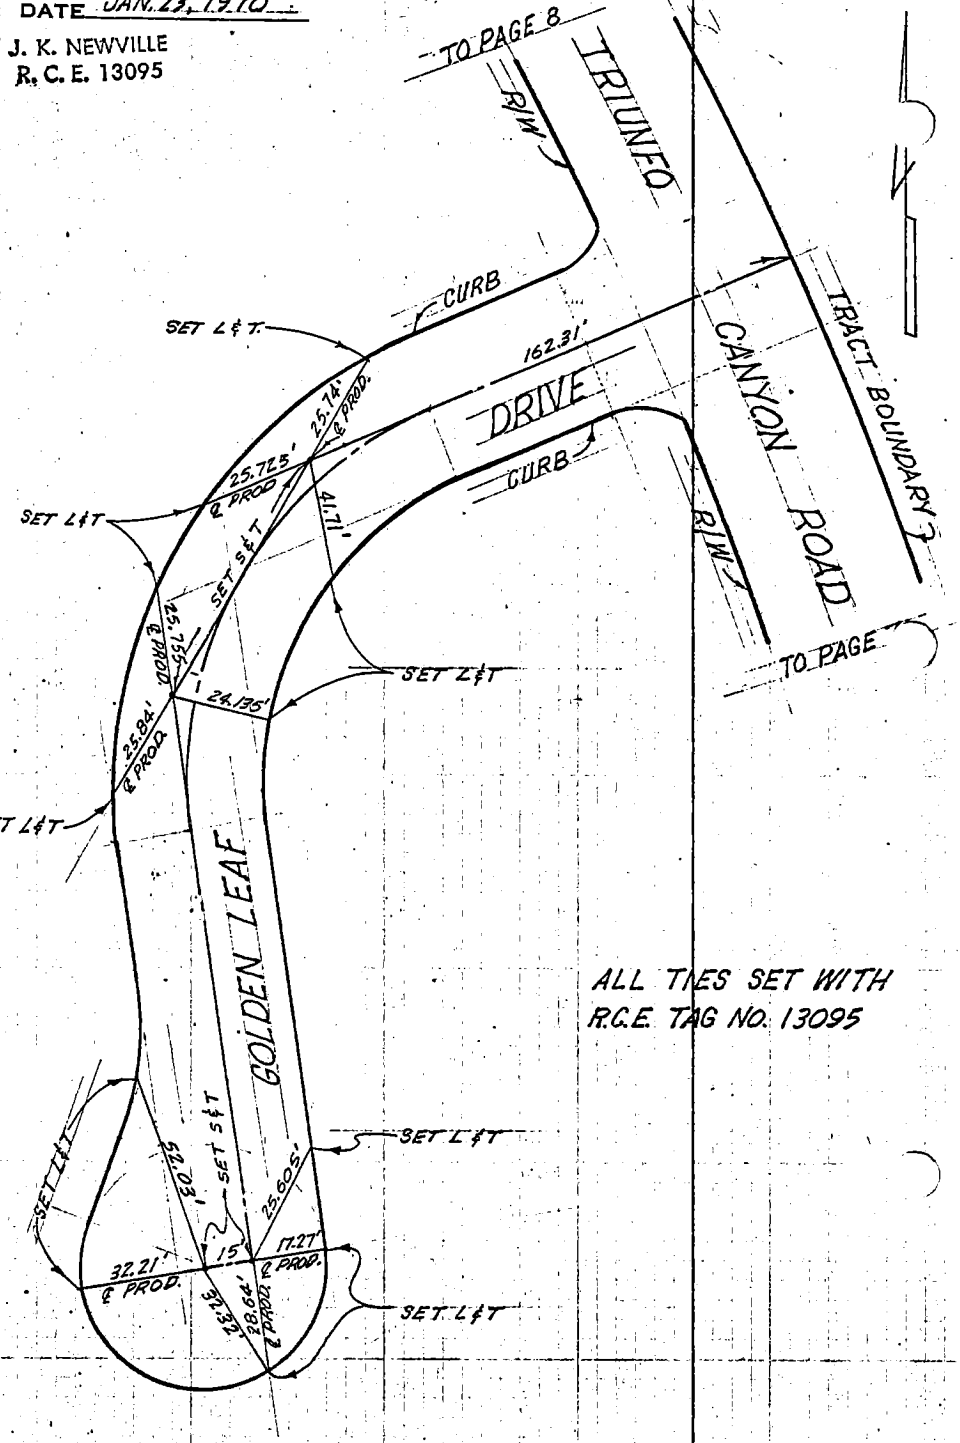


ALL TIES SET WITH
R.C.E. TAG NO. 13095

W. S. 159-037 A-2

DO NOT EXTEND NOTES THIS SIDE OF LINE

Co. Eng. F.B. 4005:100

SURVEY OF TRIUNFO CANYON ROAD F B NO. PAGE 7

SURVEY BY ENGINEERING SERVICE CORP. TRACT NO. 29072

DATE JAN. 23, 1970

J. K. NEWVILLE
R. C. E. 13095

W. S. 159-037 A-2

DO NOT EXTEND NOTES THIS SIDE OF LINE

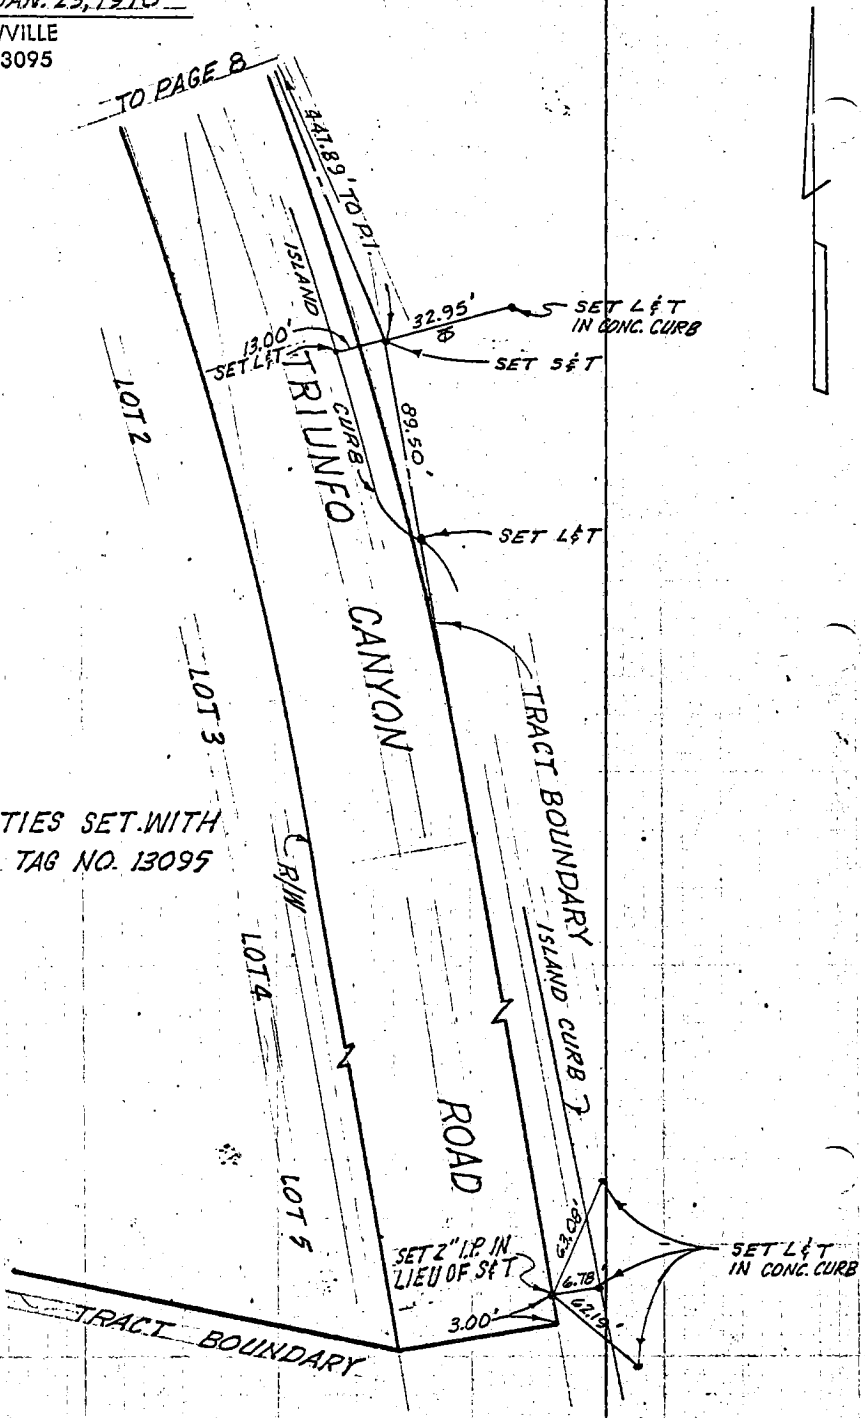

Co. Eng. F.B. 4005: 101

SURVEY OF TRIUNFO CANYON ROAD F B NO. PAGE 8

SURVEY BY ENGINEERING SERVICE CORP. TRACT NO. 29072

DATE JAN. 23, 1970

J. K. NEWVILLE
R. C. E. 13095

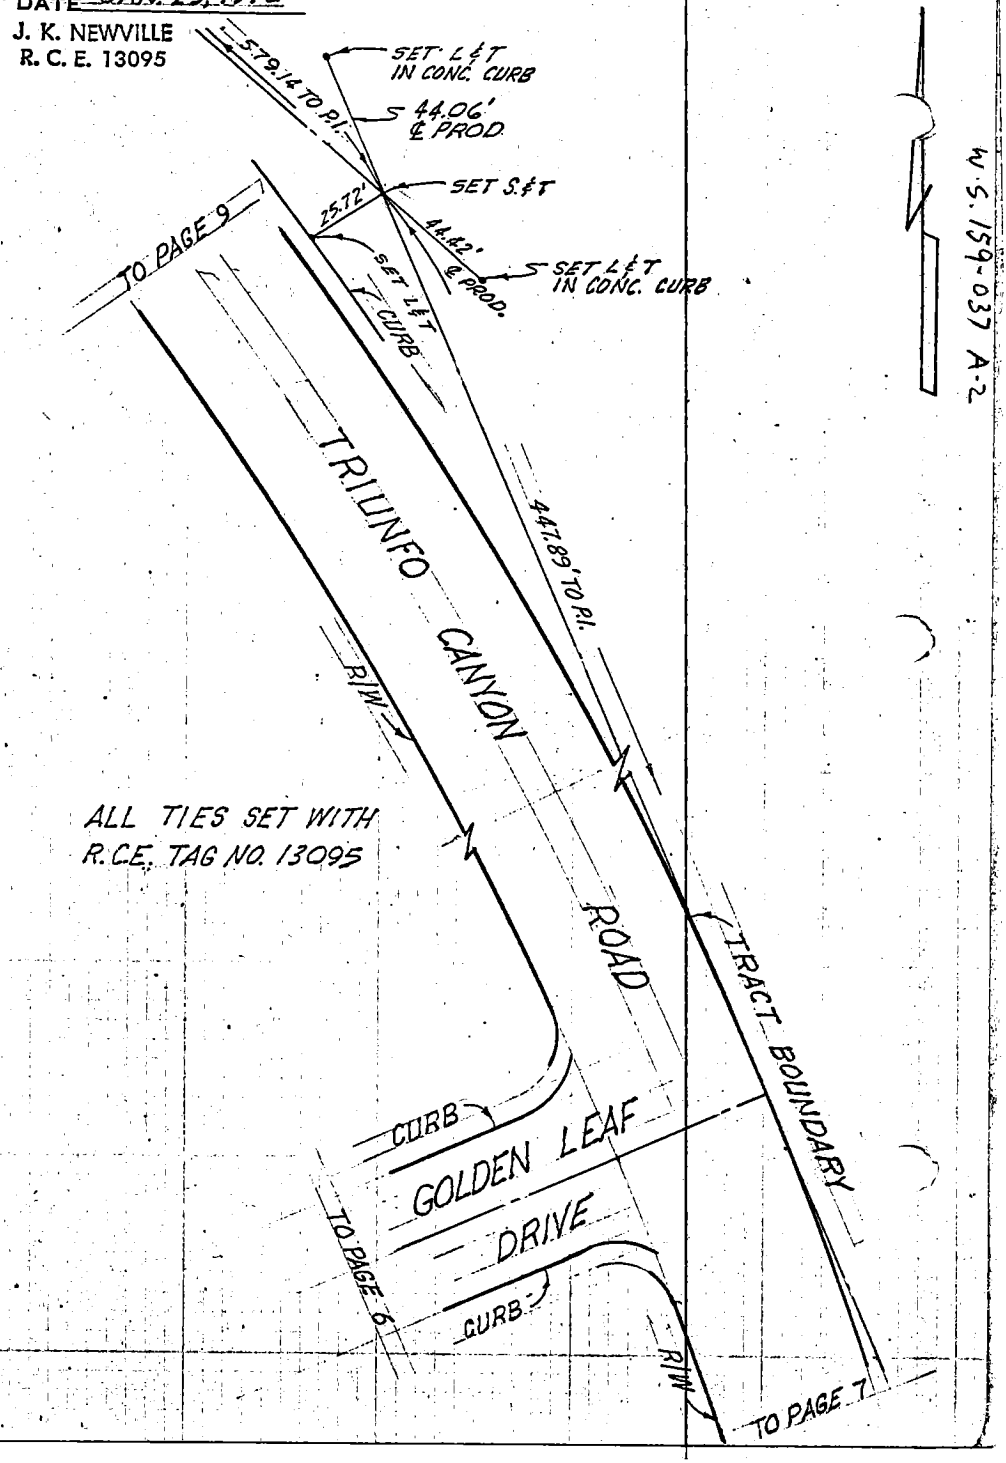


W.S. 159-037 A-2

DO NOT EXTEND NOTES THIS SIDE OF LINE

Co. Eng. F.B. 4005: 102

W.S. 159-037 A-3

DO NOT EXTEND NOTES THIS SIDE OF LINE

SURVEY OF TRIUNFO CANYON ROAD F B NO PAGE 9

SURVEY BY ENGINEERING SERVICE CORP. TRACT NO. 29072

DATE JAN. 23, 1970

J. K. NEWVILLE
R. C. E. 13095

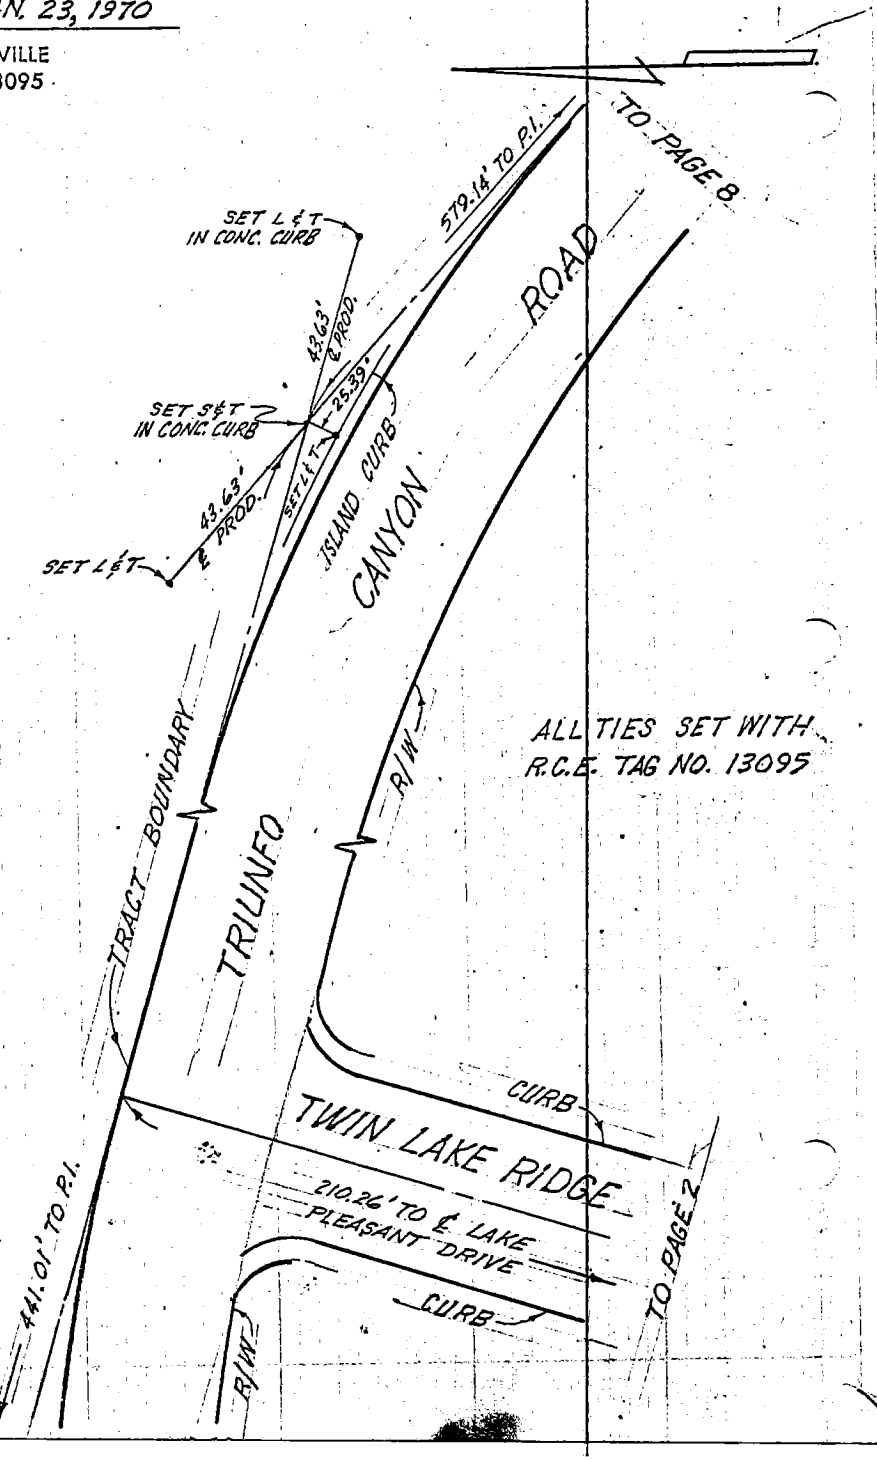

Co. Eng. F.B. 4005: 103

SURVEY OF TRIUNFO CANYON ROAD F B NO. PAGE 10

SURVEY BY ENGINEERING SERVICE CORP. TRACT NO. 29072

DATE JAN. 23, 1970

J. K. NEWVILLE
R. C. E. 13095

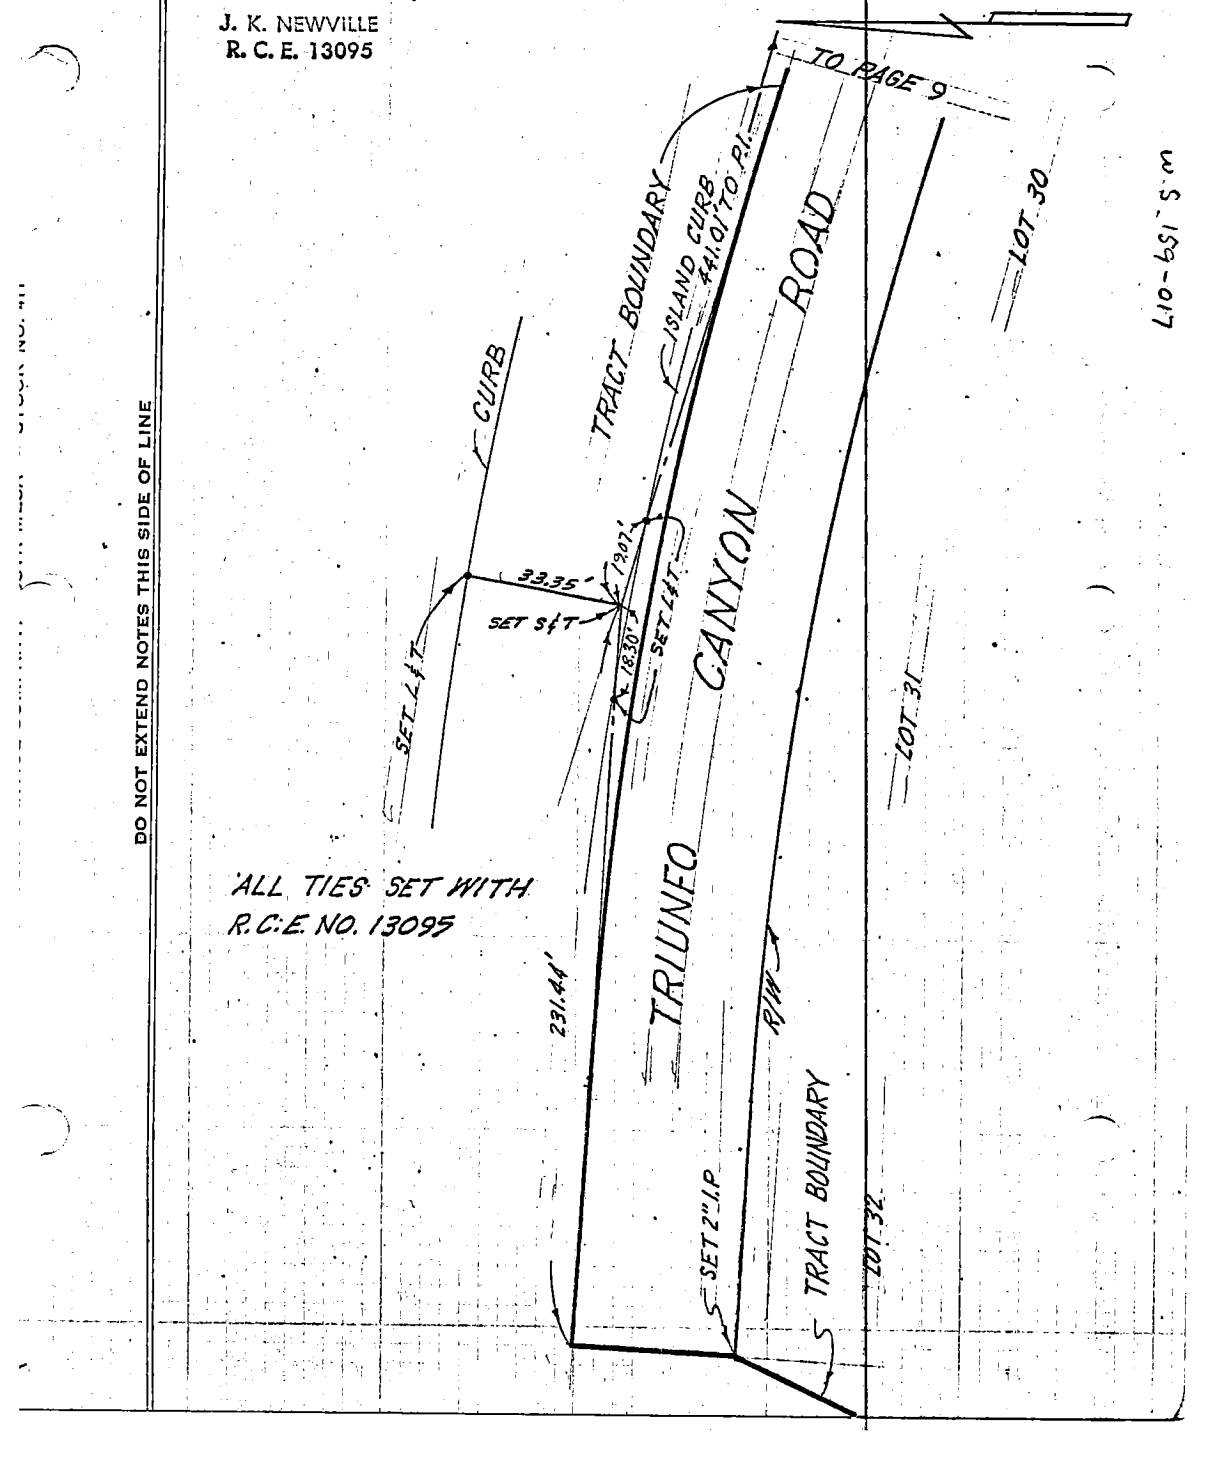


DO NOT EXTEND NOTES THIS SIDE OF LINE

L10-651 S.M.

Co. Eng. F.B. 4005: 104

SURVEY OF Centerline Ties F. B. 100 PG. 10

SURVEY BY Highland Engineers TR. No. 28297

DATE 1-29-69 Robert K. Kameoka, R.C.E. 15429

| | | |
|---|---|---|
| Avenue M | - | 168th Street East to 167th Street East |
| 167th Street East | - | Avenue M to 333' South of Avenue M-3 |
| 168th Street East | - | Avenue M-3 to Avenue M-4 |
| Avenue M-4 | - | 168th Street East to 170th Street East |

Centerline Ties

Surveyors: J. Krull
J. Crawford
B. Brown

All distances shown as measured are corrected to 68° F.

4

SO. CALIF. BLUE PRINT CO.

Co. Eng. F.B. 4005: 105

F. B. 100 PG. 11 SURVEY OF & Ties

TR. No. 28297 SURVEY BY Highland Engineers

DATE Jan.-29-1969 Robert K. Kameoka
RCE 15429

W.S.M. 1-39.5

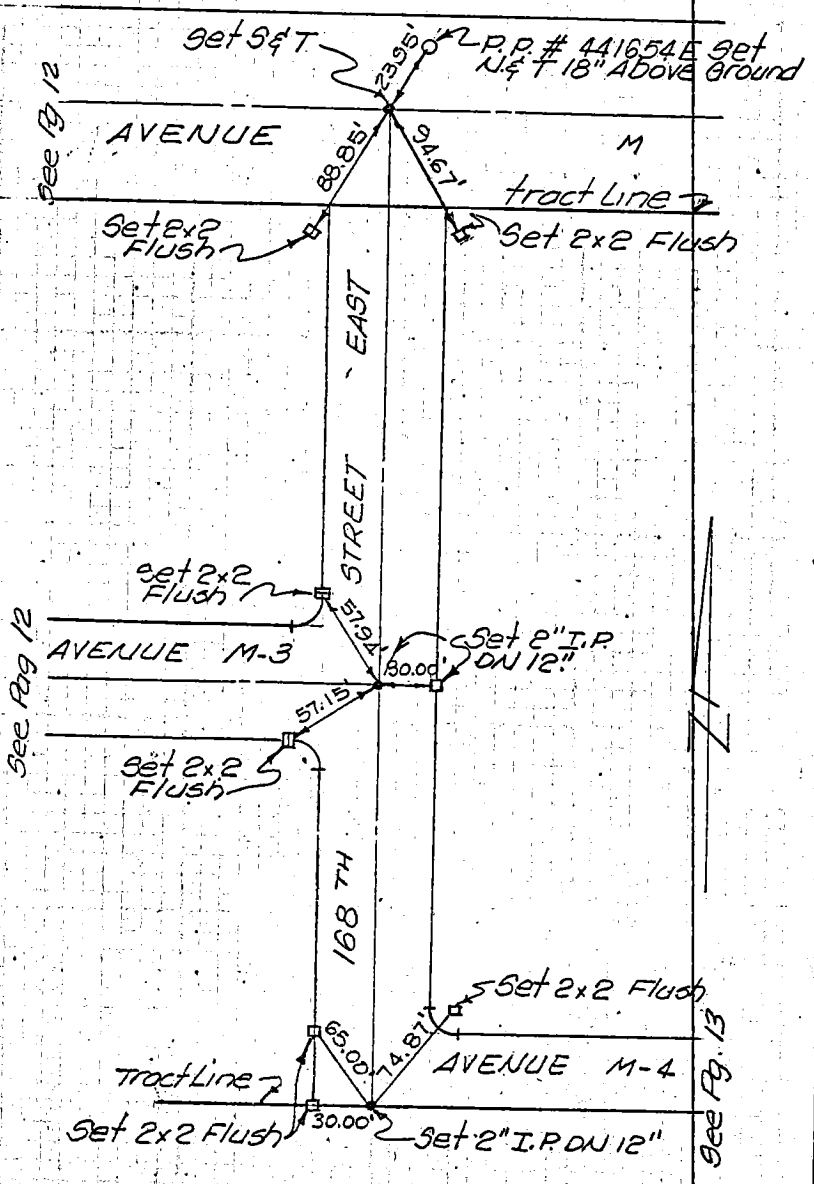

Co. Eng. F.B. 4005:106

SURVEY OF ℄ Ties F. B. 100 PG. 12

SURVEY BY Highland Engineers TR. NO.

DATE Jan. 29-1969 Robert K Kamedka
RCE 15429

(57) W.S46 E-1

SO. CALIF. BLUE PRINT CO.

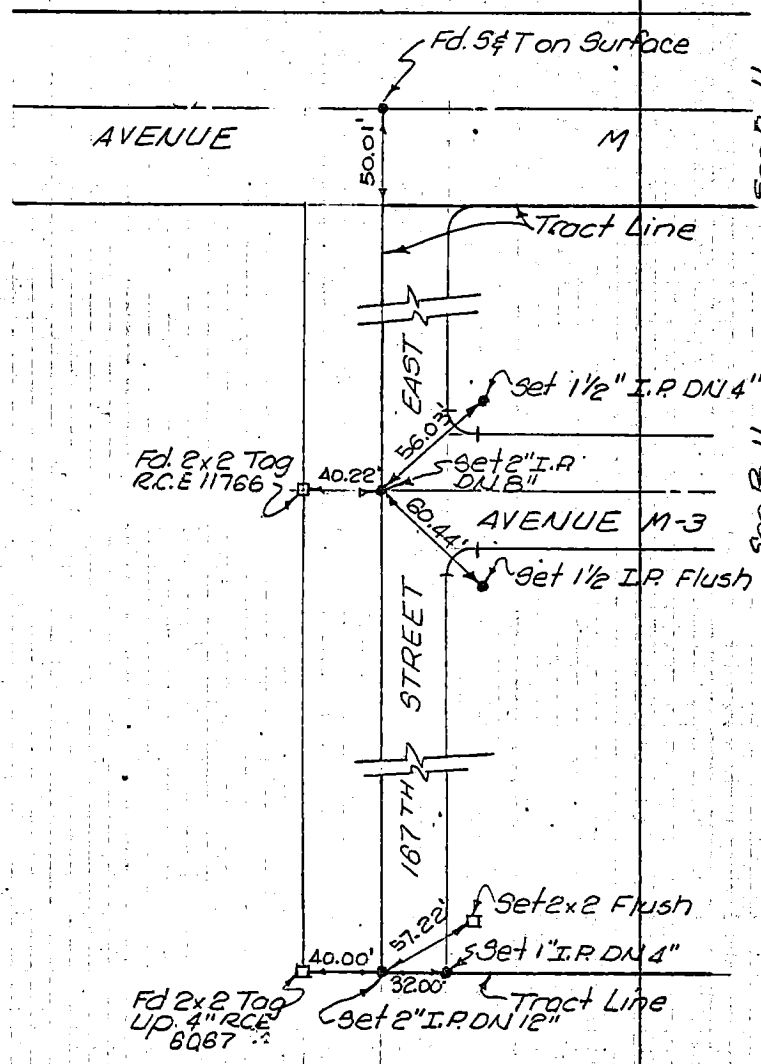

Co. Eng. F.B. 4005: 107

F. B. 100 PG. 13 SURVEY OF & Ties

TR. No. 28297 SURVEY BY Highland Engineers

DATE Jan-29-1969 Robert K. Kamecka
RCE 15429

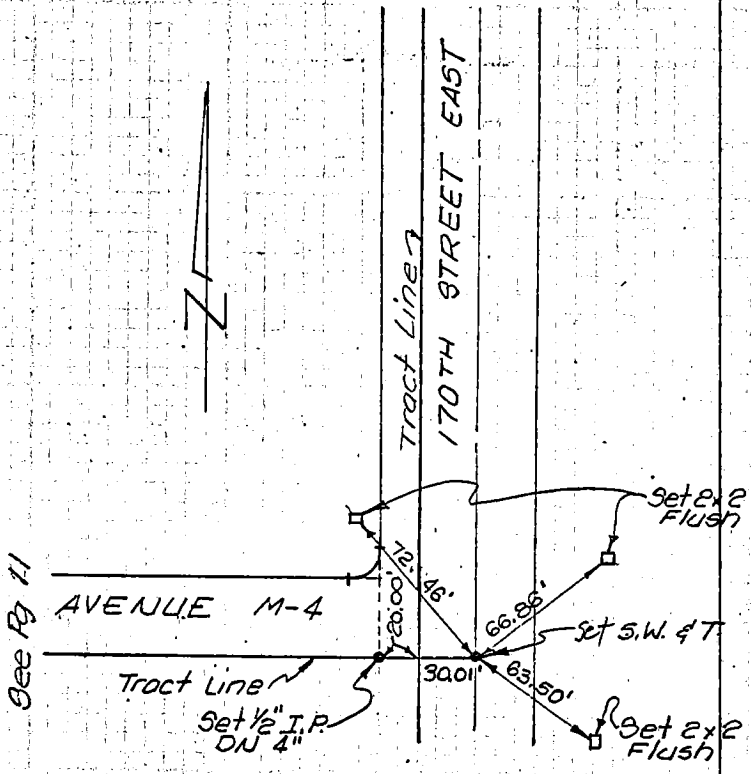

Co. Eng. F.B. 4005: 108

SURVEY OF & TIES F. B. Pg. 1

SURVEY BY Verpet Engineering TR. No. 29739

DATE 2-3-70

Martin Petrosek R.C.E. 16586

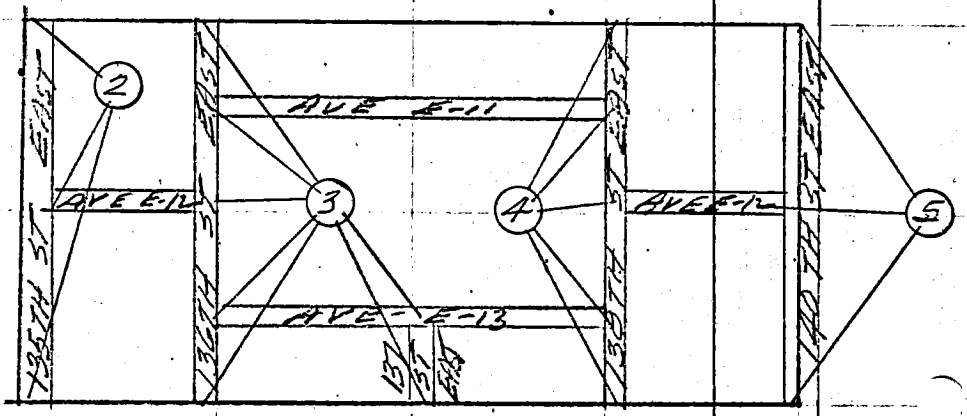


PAGE INDEX

NO SCALE

SO. CALIF. BLUE PRINT CO.

SURVEY OF ℄ TIES F. B. Pg. 2

SURVEY BY Vermeer Engineering Co TR. No. 29739

DATE 2-3-70

Martin Petrosek R.C.E. 16586

Measured distances are corrected to 68°F

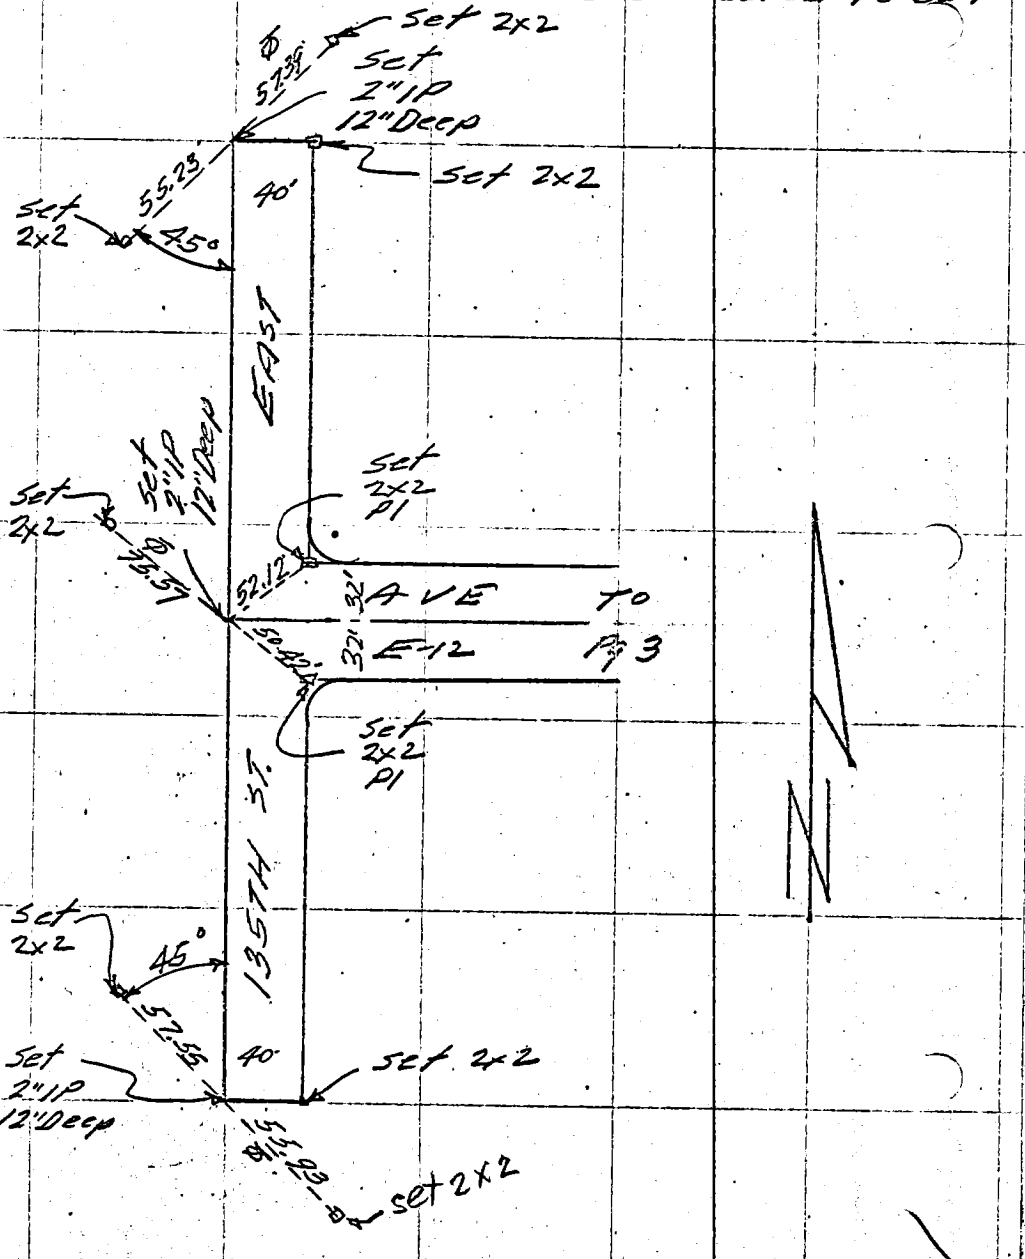


(40) US 69 C-3

SO. CALIF. BLUE PRINT CO.

Co. Eng. F.B. 4005:110

F. B. ____ PG. 3 SURVEY OF ETIES

TR. No. 29739 SURVEY BY Verpet Engineering Co.

DATE 2-3-70

Martin Petrasek R.C.E. 16586

Measured distances are corrected to 68°F

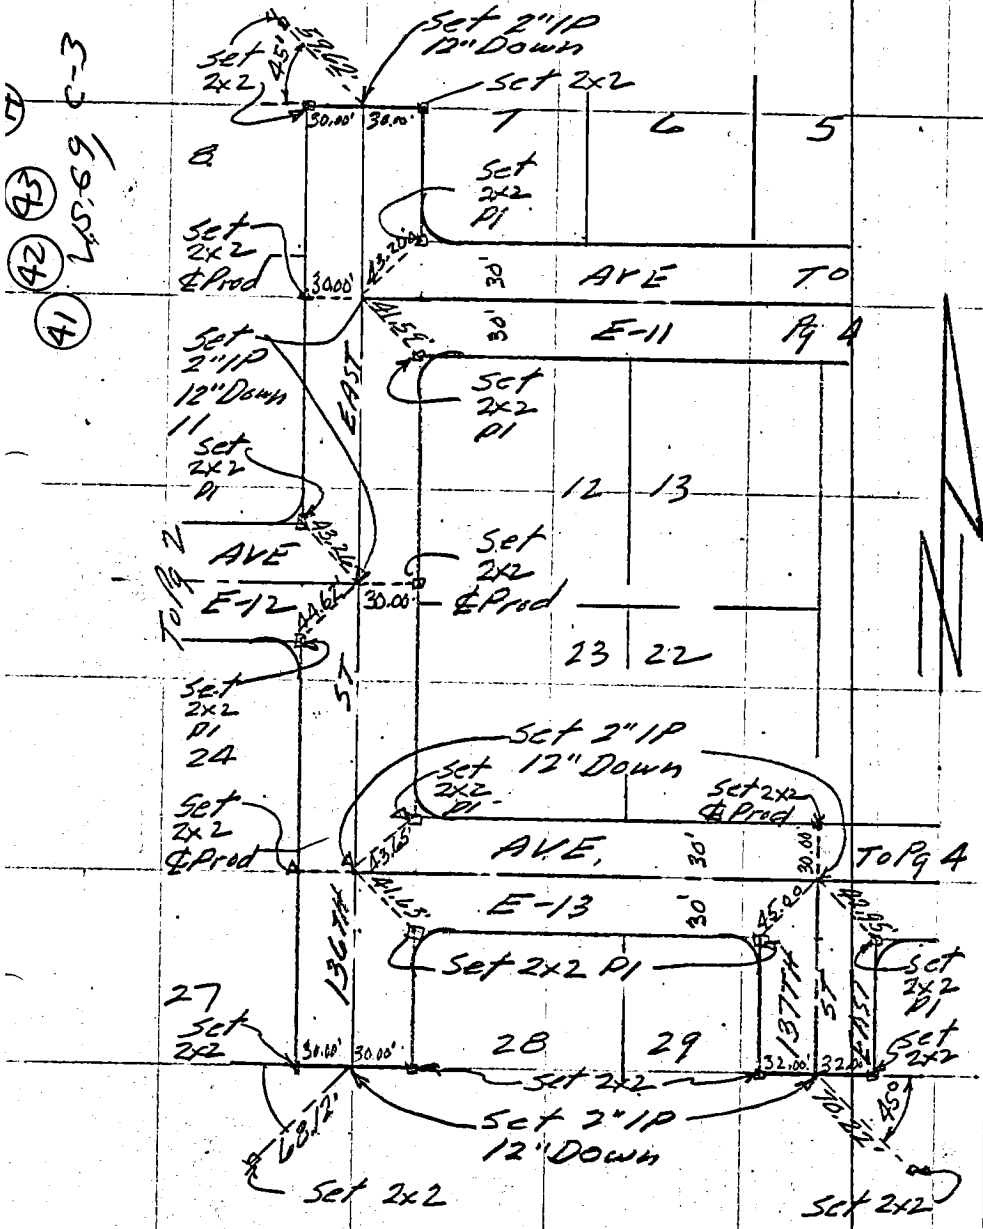
Set 2"IP 12" Down
Set 2x2
Set 2x2 Pl
Set 2x2 ℄Prod
Set 2"IP 12" Down
Set 2x2 Pl
Set 2x2 ℄Prod
Set 2x2
Set 2x2 Pl
Set 2x2 ℄Prod
Set 2"IP 12" Down
Set 2x2 Pl
Set 2x2 ℄Prod
Set 2x2
Set 2x2 Pl
Set 2x2
Set 2"IP 12" Down
Set 2x2
Set 2x2 Pl
Set 2x2
Set 2x2
Set 2x2

Co. Eng. F.B. 4005: 111

SURVEY OF ETIES F. B. ____ PG. 4

SURVEY BY Verpet Engineering Co. TR. No. 29739

DATE 2-3-70

Martin Petrosek R.C.E. 16586

Measured distances are corrected to 68°.

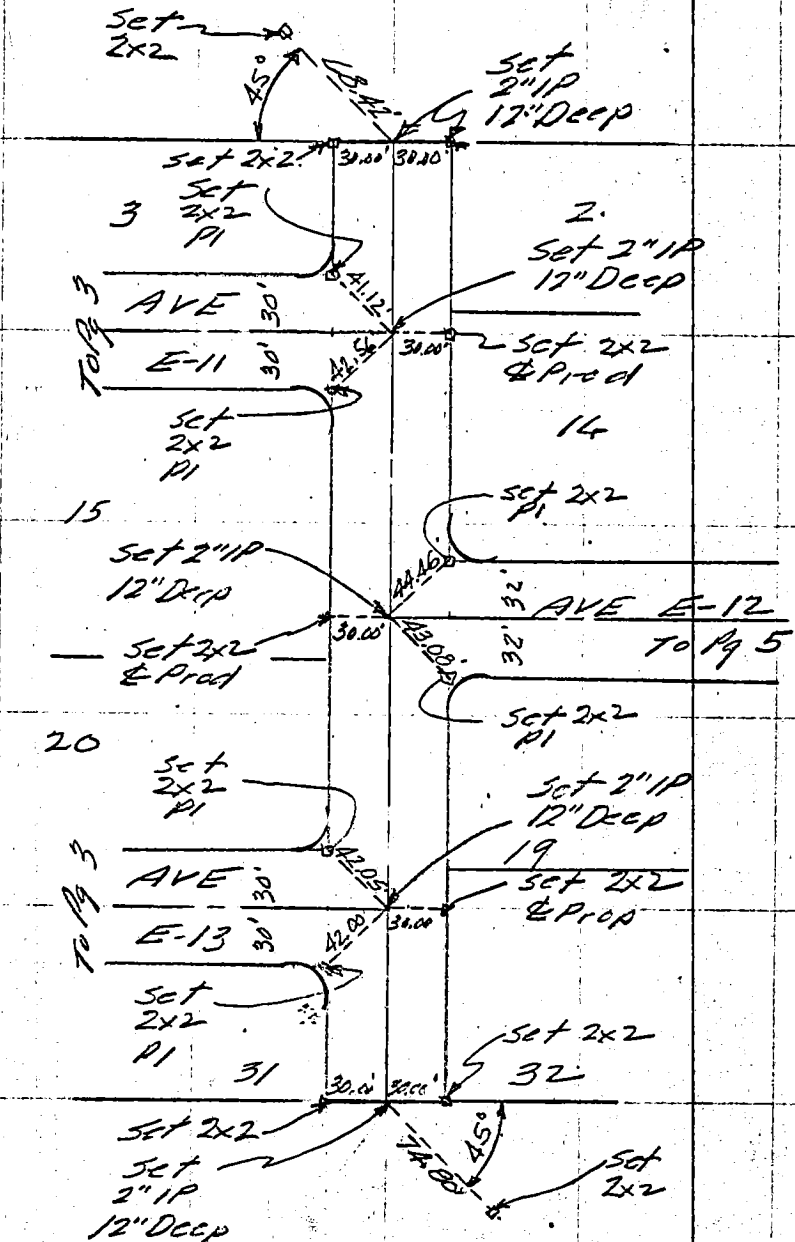


W-SP 69 C-3

SO. CALIF. BLUE PRINT CO.

Co. Eng. F.B. 4005:112

F. B. PG. 5 SURVEY OF ETIES

R. No. 29739 SURVEY BY Verpet Engineering Co

DATE 2-3-70

Martin Petrasek R.C.E. 16586

Measured distances are corrected to 68° F.

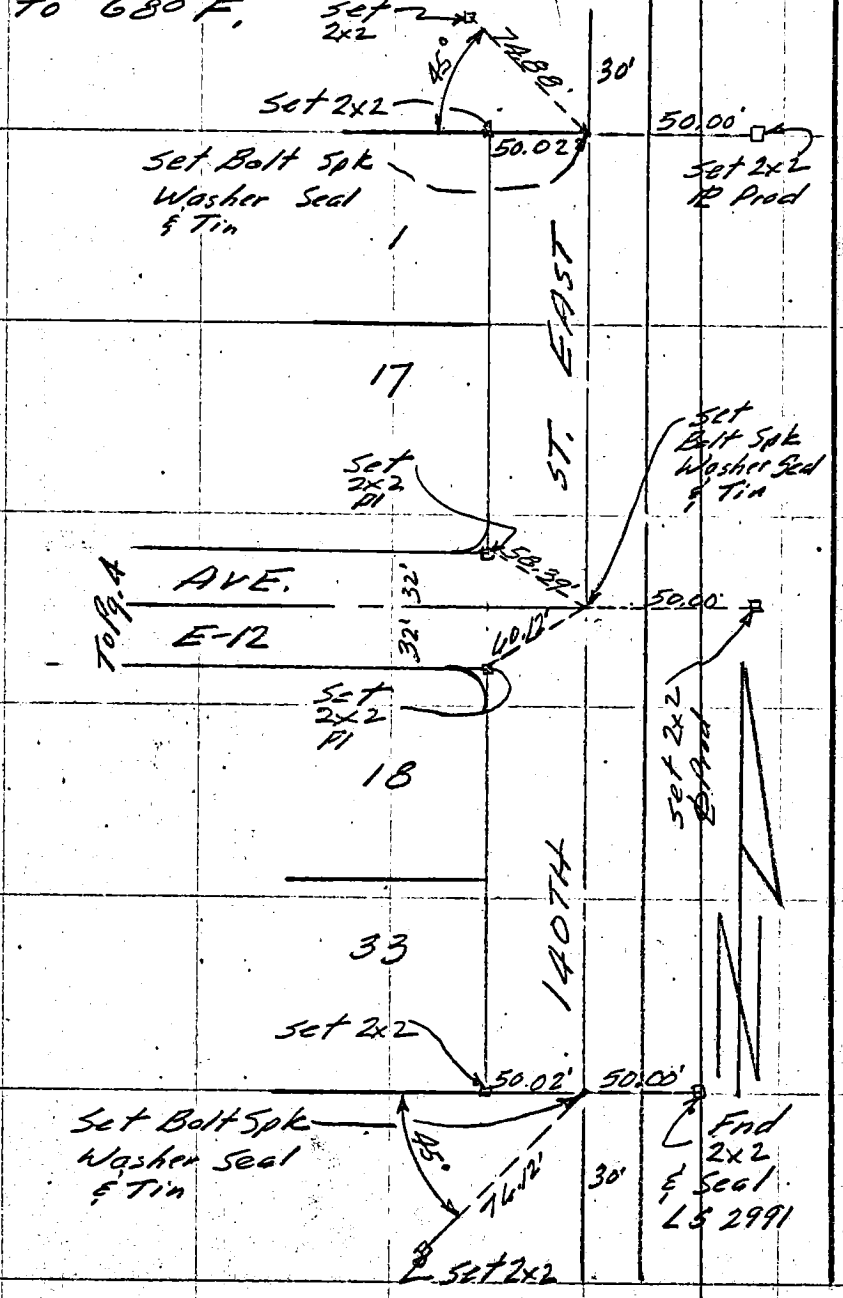

Co. Eng. F.B. 4005: 113

SURVEY OF _____ F. B. _____ PG. _____

SURVEY BY E.L. Pearson & Associates
R.C.E. 9783

DATE 1-30-70

TR. No. 28489

Sheet 1

# CENTERLINE TIES TR. 28489

Chief - - - - - Bob Porter
Chainman - - - Ed Porter
Chainman - - - Bill Jenkins

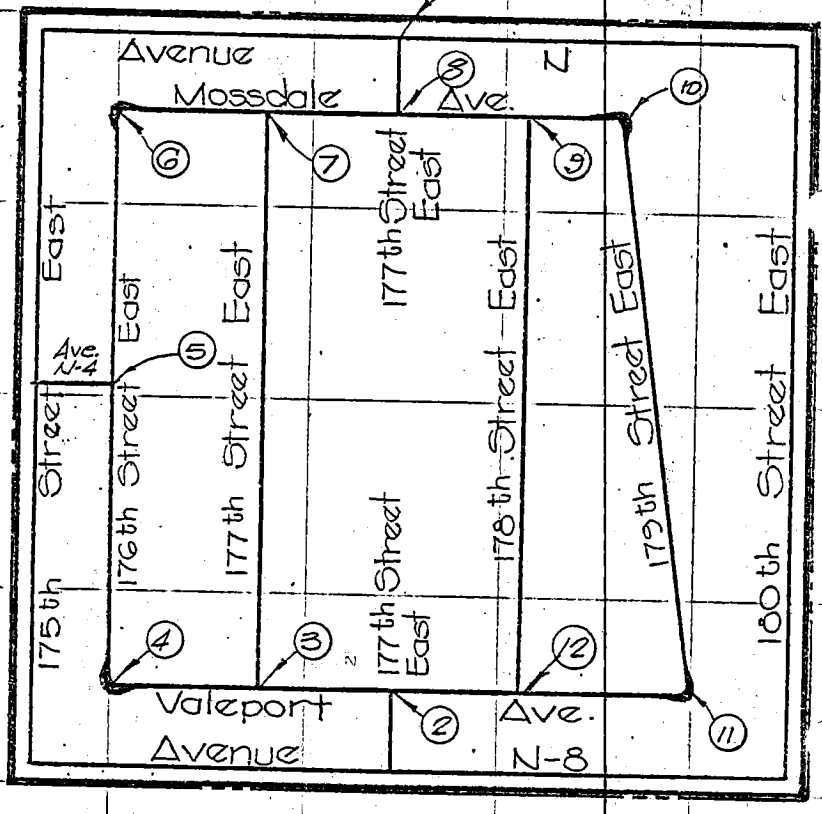


Note; 1. All centerline monuments are Spike & Tag unless noted.

2. All tie points are 2"x2"s buried 6" deep unless noted.

SO. CALIF. BLUE PRINT CO. — F-1638

Co. Eng. F.B. 4005: 114

SURVEY OF _____ F. B. _____ PG. _____

SURVEY BY E.L. Pearson & Associates R.C.E. 9783 TR. No. 28489

DATE 1-30-70 Sheet 2

WSP 67A-1

# VALEPORT AVENUE

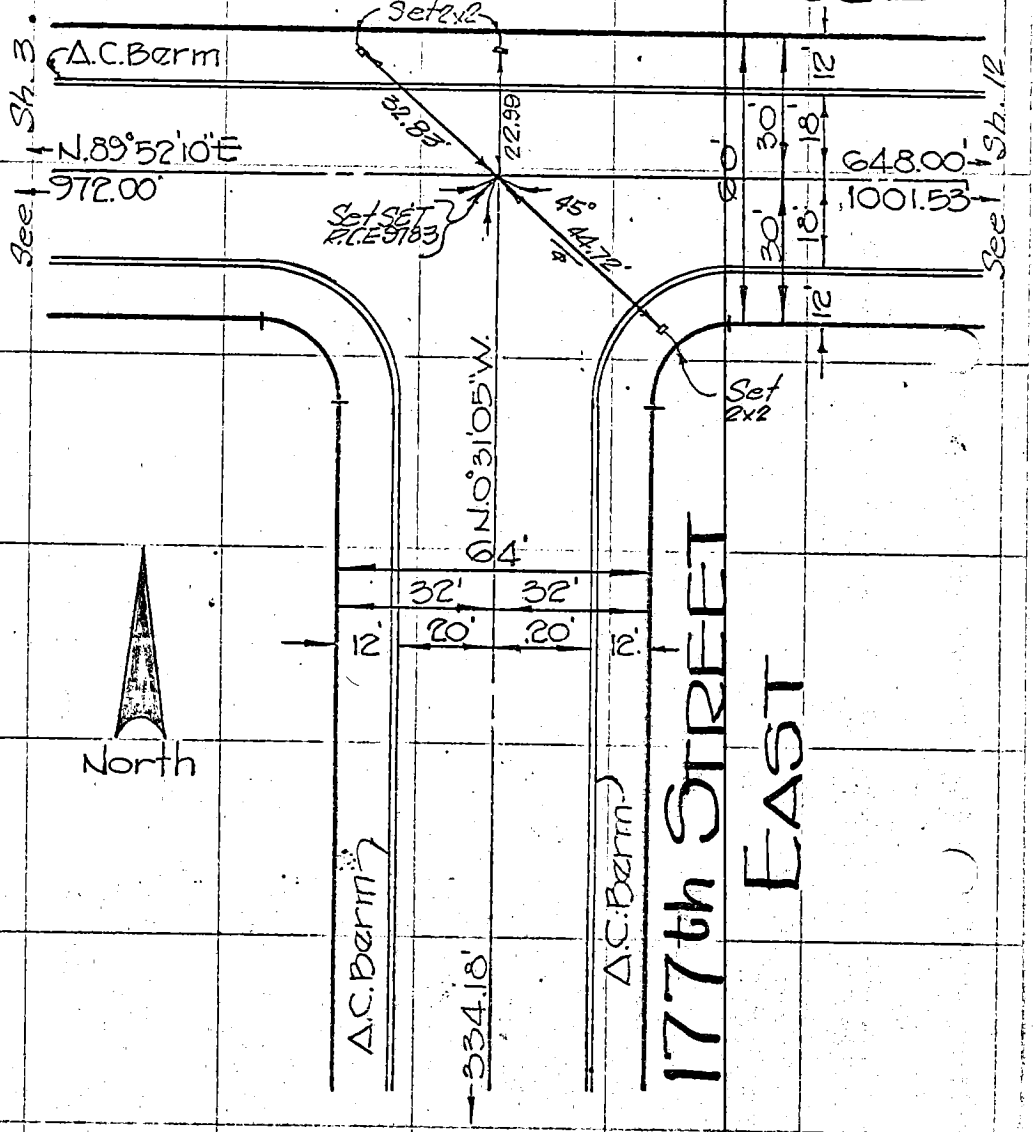


SO. CALIF. BLUE PRINT CO. — F-1638

Co. Eng. F.B. 4005: 115

F. B. _____ PG. _____ SURVEY OF _____

TR. No. 28489 SURVEY BY E.L. Pearson & Associates R.C.E. 9783

DATE 1-30-70

Sheet 3

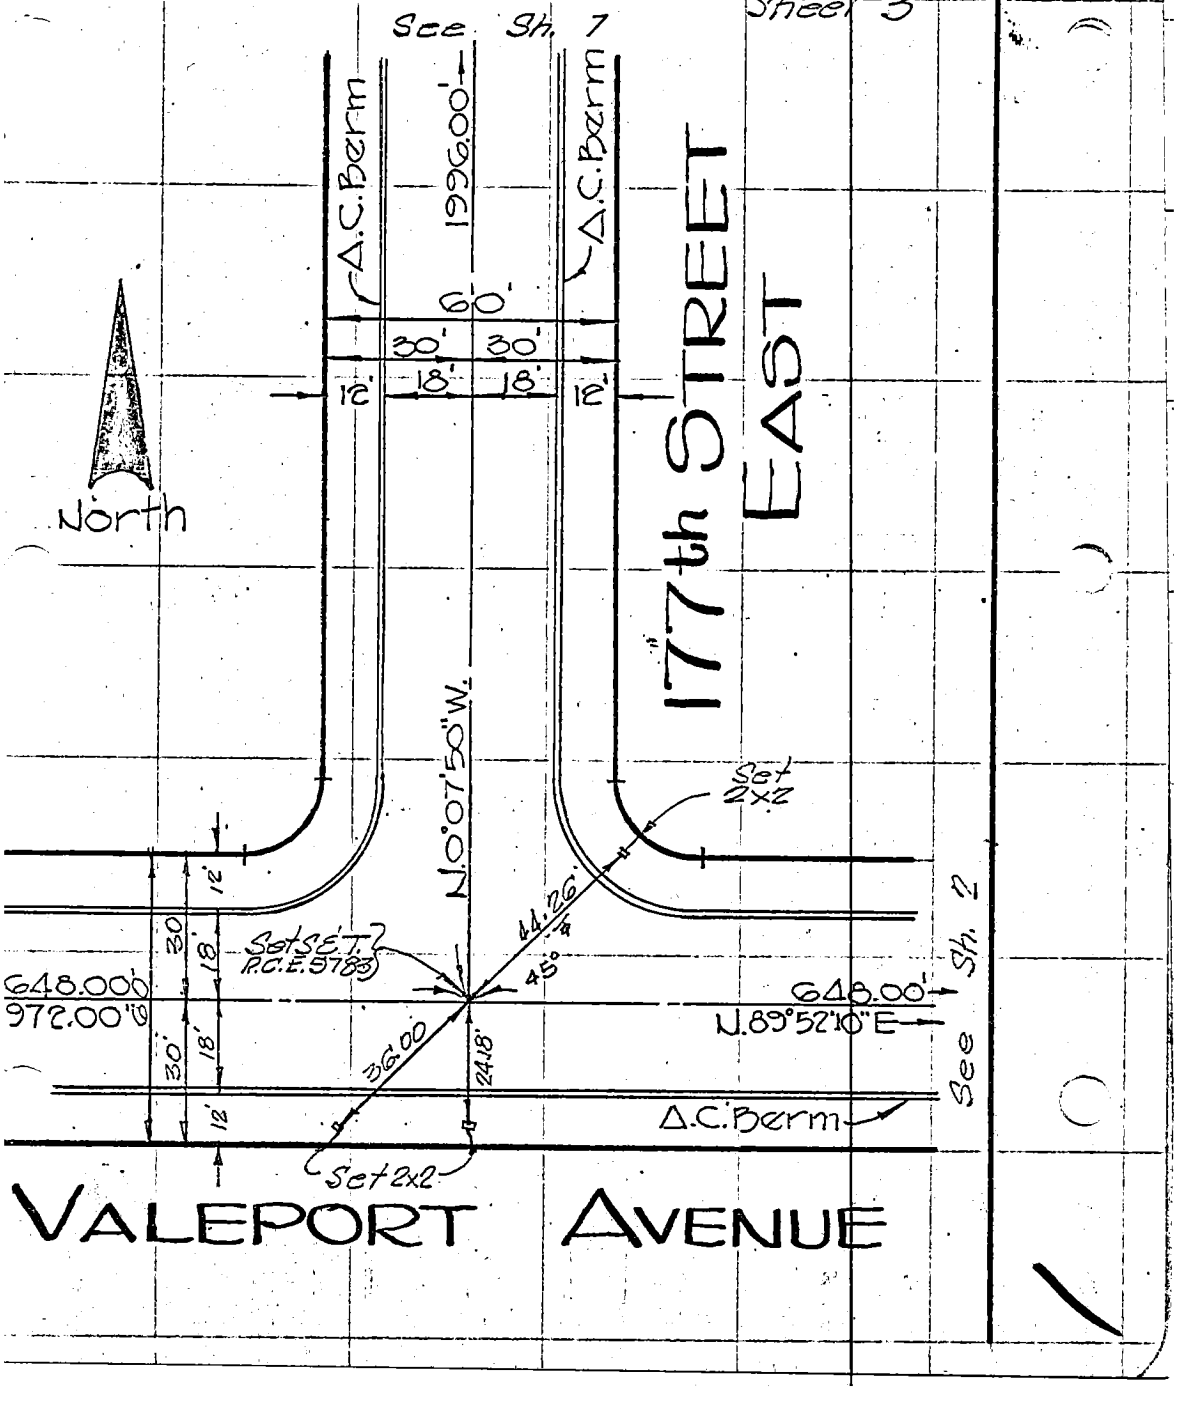

Co. Eng. F.B. 4005: 116

SURVEY OF _____ F. B. _____ PG. _____

SURVEY BY E.L. Pearson & Associates
R.C.E. 9783

TR. No. 28489

DATE 1-30-70

Sheet 4

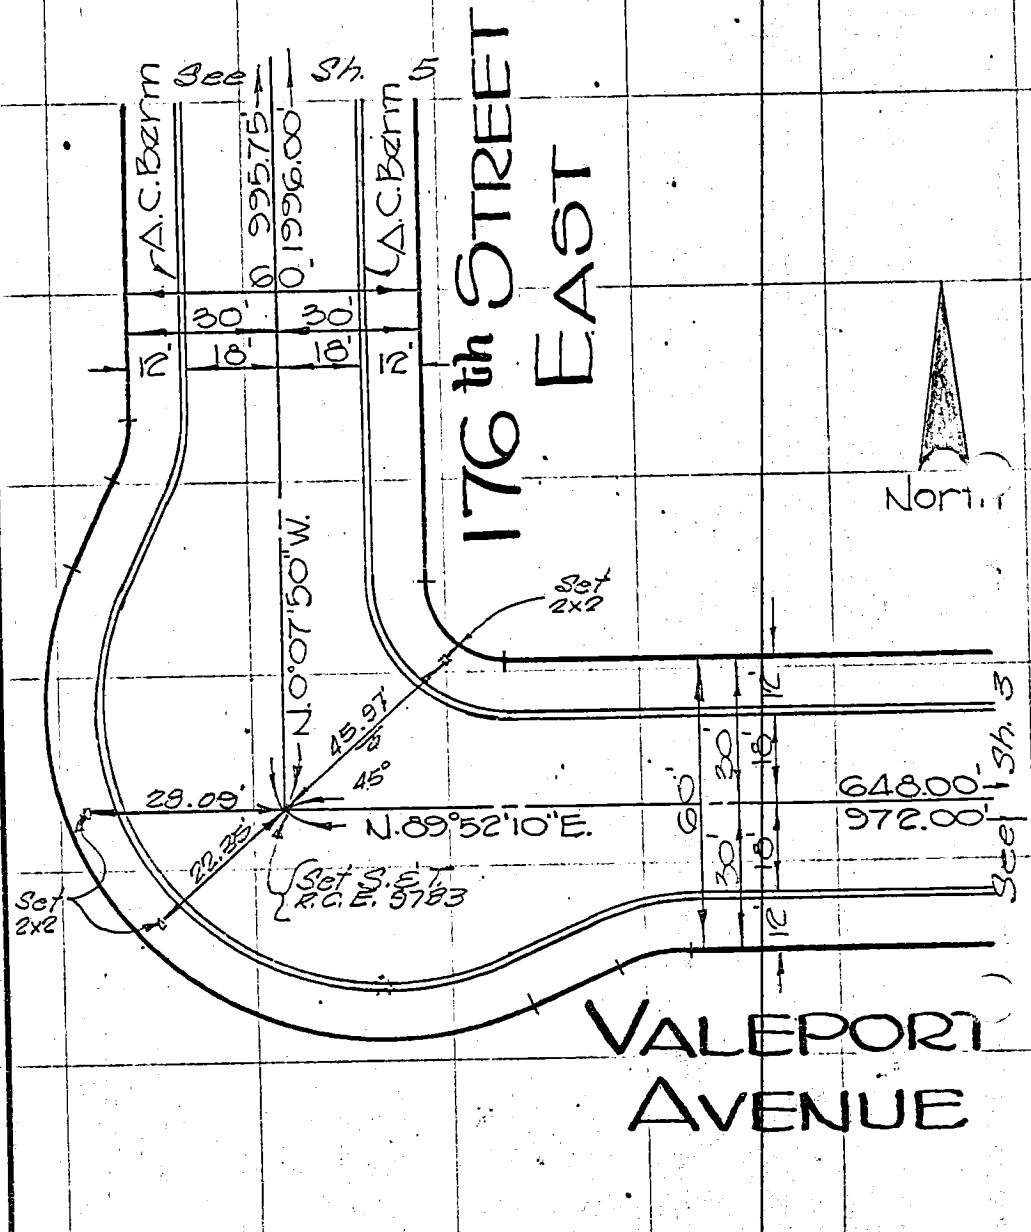


SO. CALIF. BLUE PRINT CO. — F-1638

F. B. _____ PG. _____ SURVEY OF _____

R. No. 28489 SURVEY BY E.L. Pearson & Associates R.C.E. 9783

DATE 1-30-70

Sheet 5

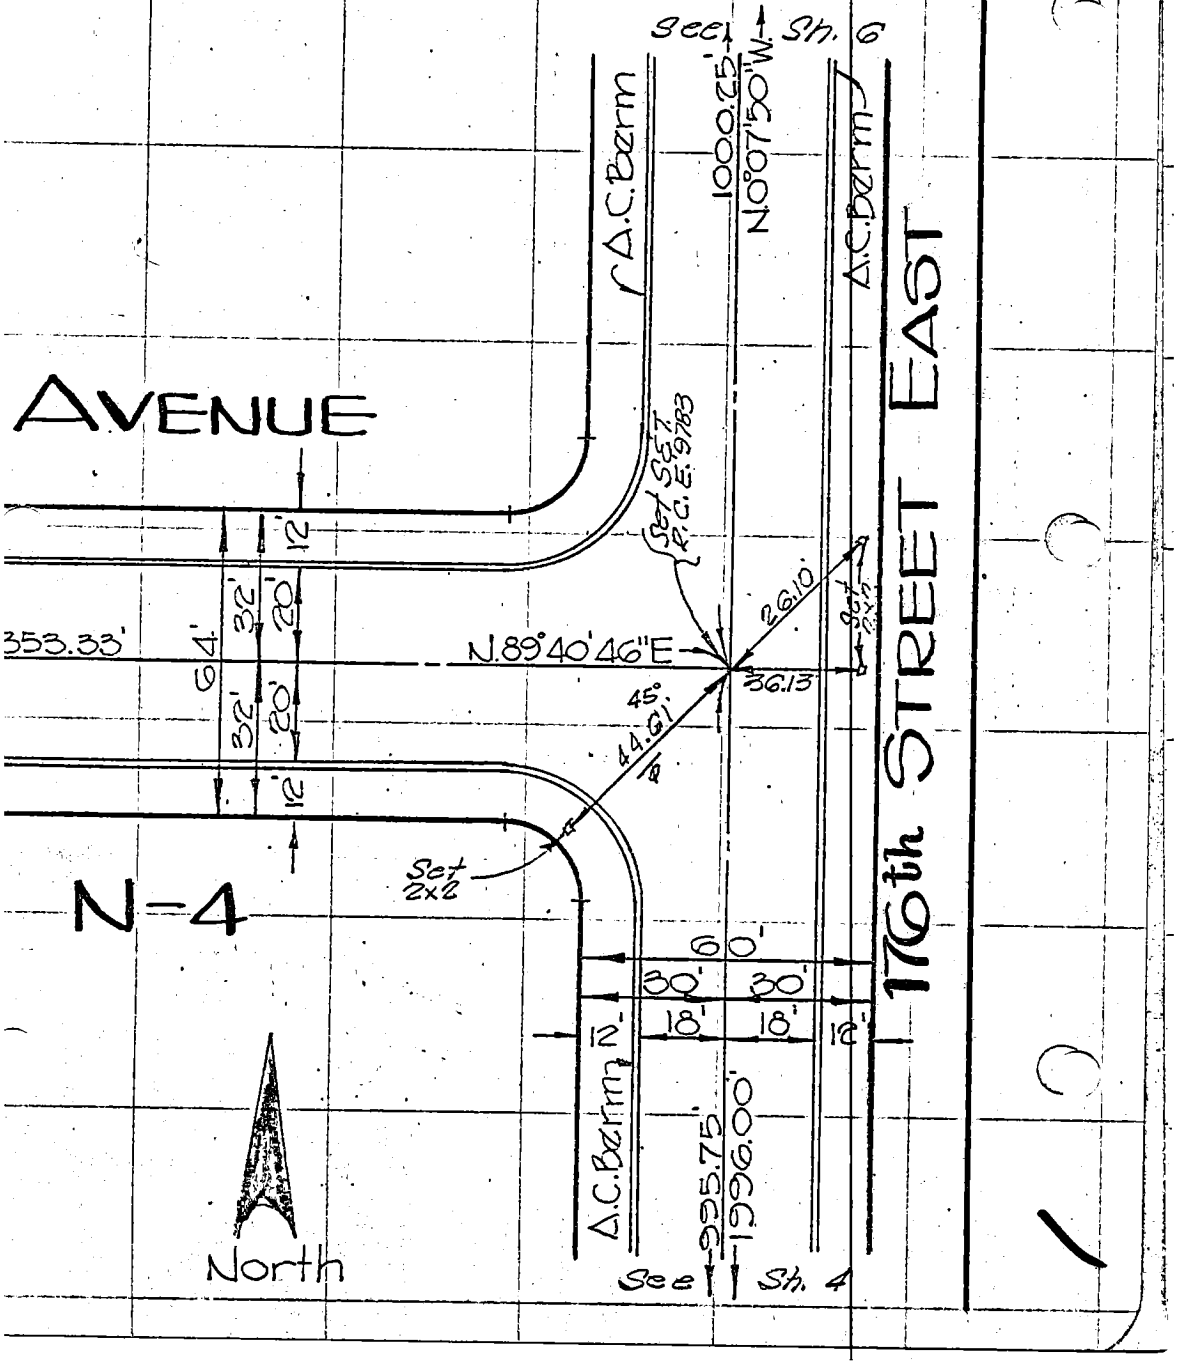

Co. Eng. F.B. 4005: 118

SURVEY OF _____ F. B. _____ PG. _____

SURVEY BY E.L. Pearson & Associates
R.C.E. 9783

TR. No. 28489

DATE 1-30-70

Sheet 6

# MOSSDALE AVENUE

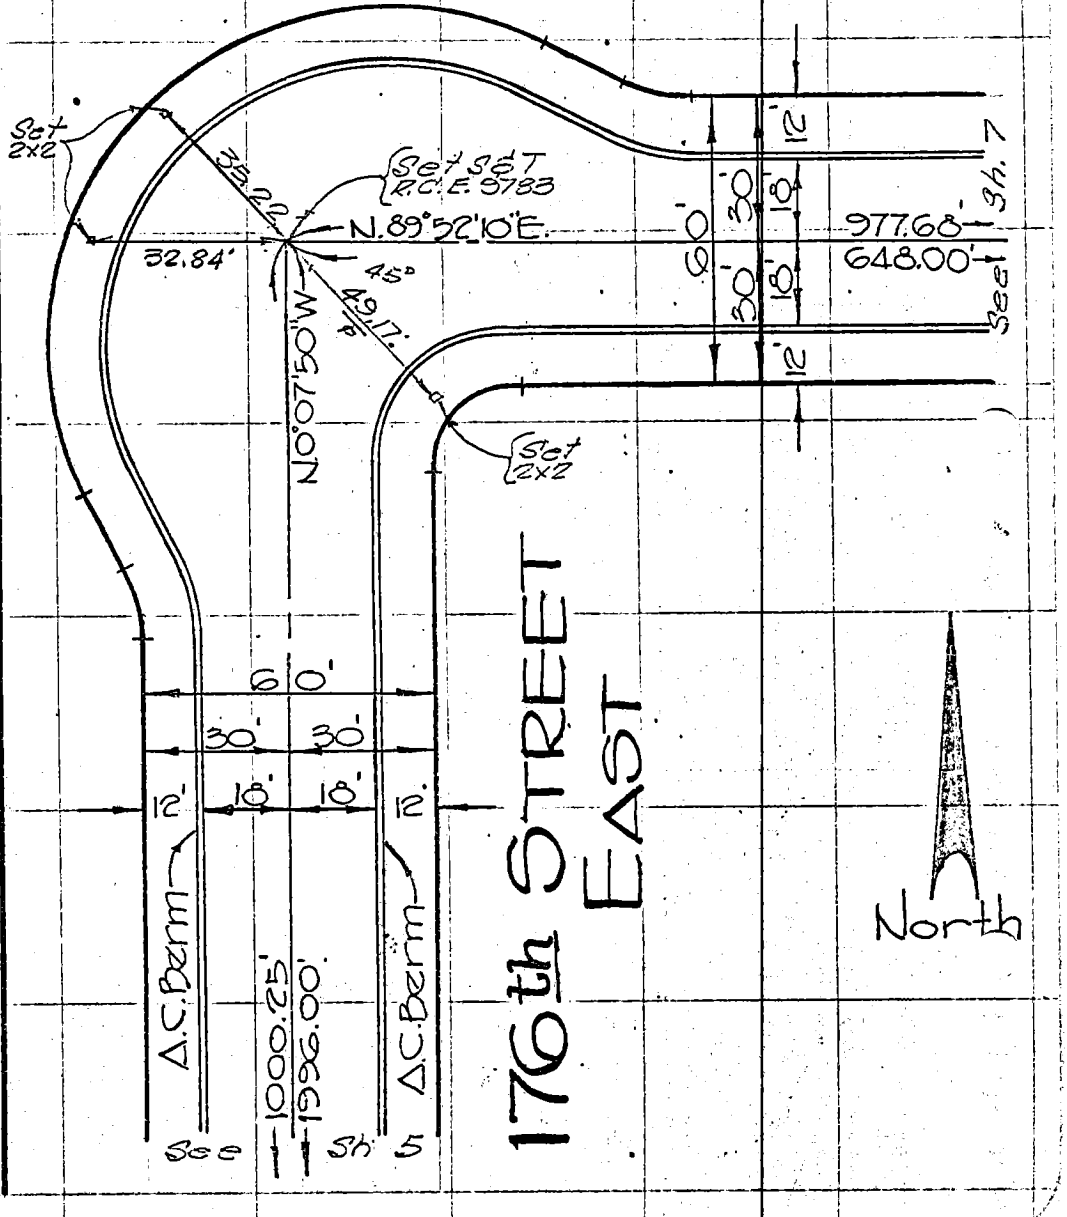


SO. CALIF. BLUE PRINT CO. — F-1638

Co. Eng. F.B. 4005:119

F. B. _____ Pg. _____ SURVEY OF _____

TR. No. 28189 SURVEY BY E.L. Pearson & Associates R.C.E. 9785

DATE 1-30-70

Sheet 7

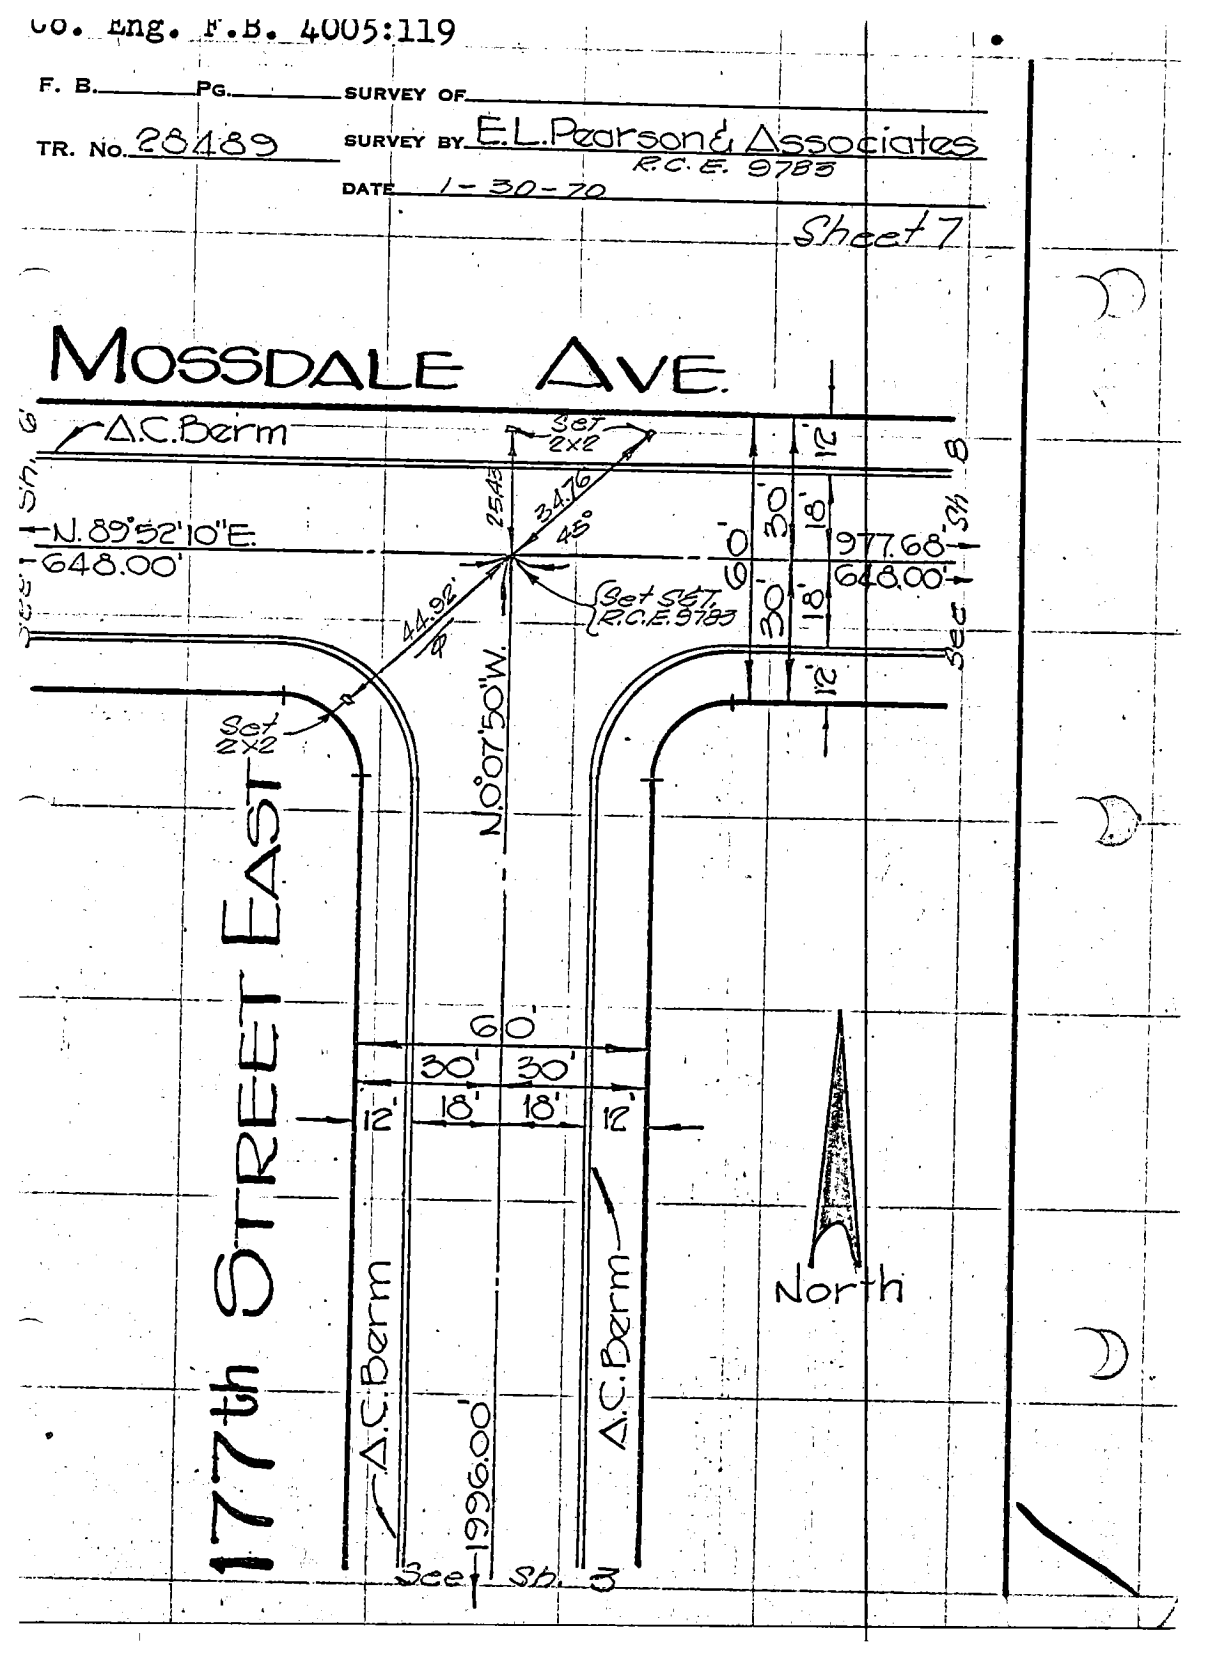

Co. Eng. F.B. 4005:120

SURVEY OF _____ F. B. _____ PG. _____

SURVEY BY E.L. Pearson & Associates
R.C.E. 9783 TR. No. 28489

DATE 1-30-70

Sheet 8

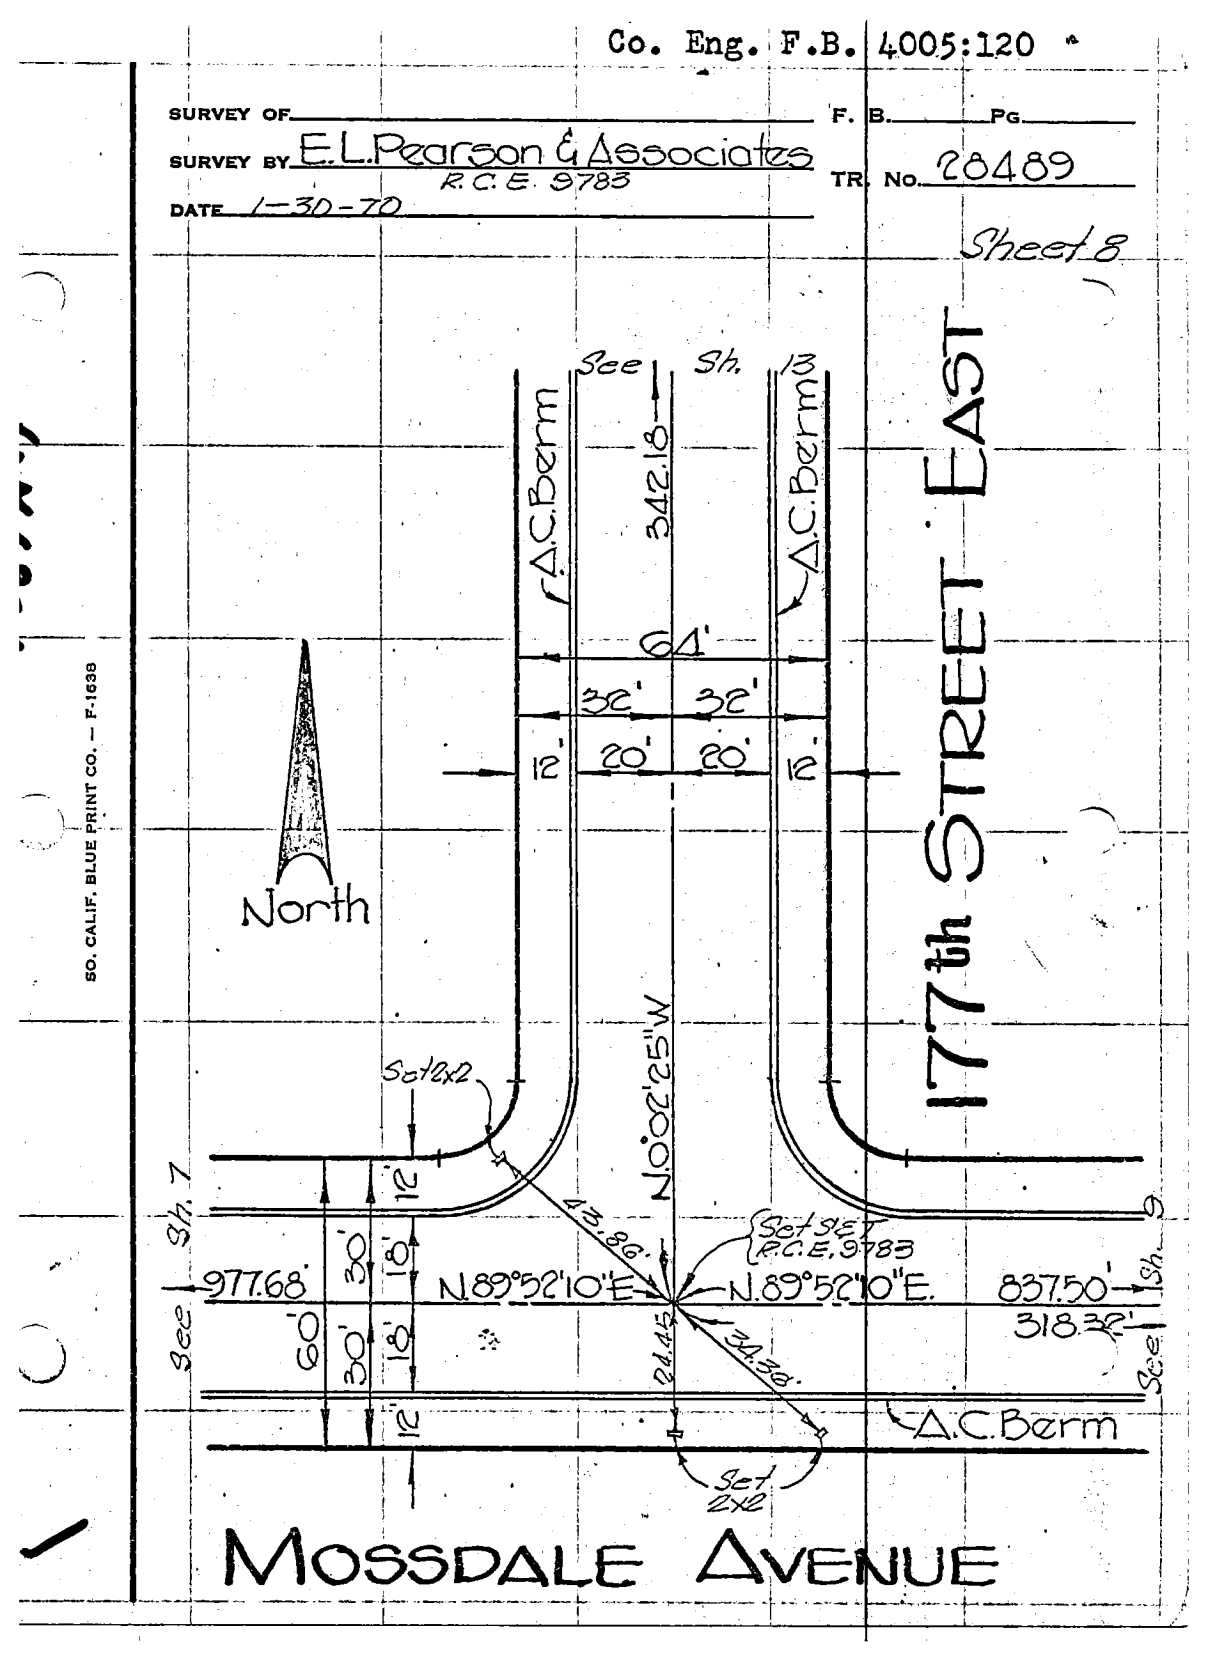


SO. CALIF. BLUE PRINT CO. — F-1638

Co. Eng. F.B. 4005: 121

F. B. _____ Pg. _____ SURVEY OF _____

TR. No. 28489 SURVEY BY E.L. Pearson & Associates R.C.E. 9783

DATE 1-30-70

Sheet 9

# MOSSDALE AVENUE

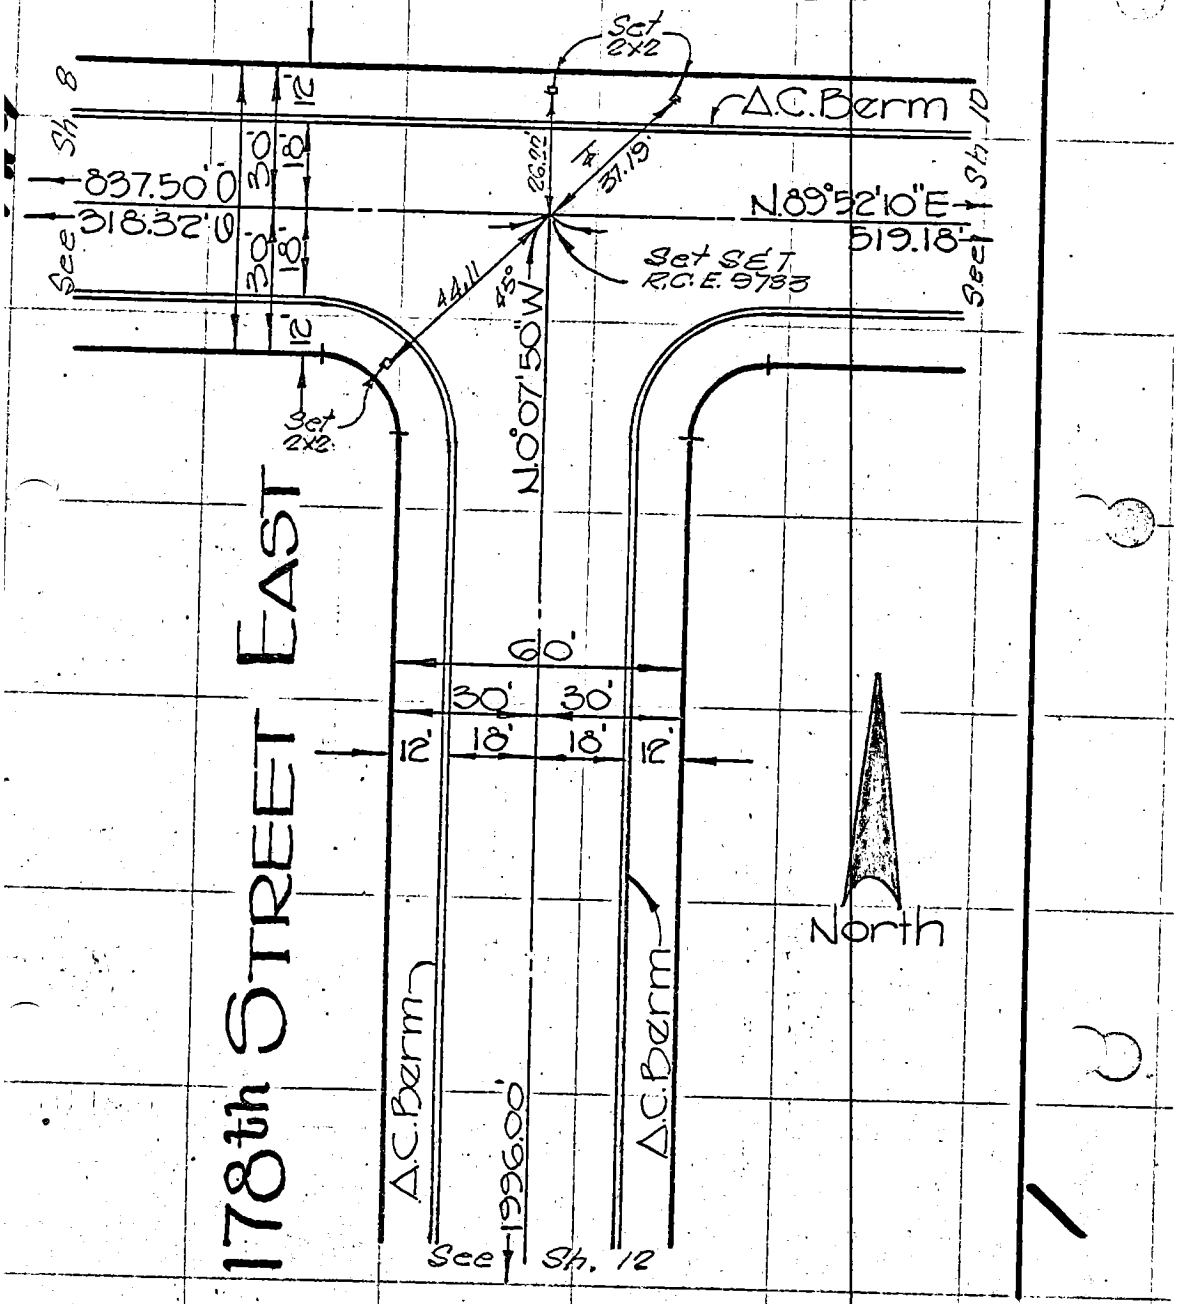

Co. Eng. F.B. 4005: 122

SURVEY OF _____ F. B. _____ PG. _____

SURVEY BY E.L. Pearson & Associates
R. C. E. 9783

TR. No. 28489

DATE 1-30-70

Sheet 10

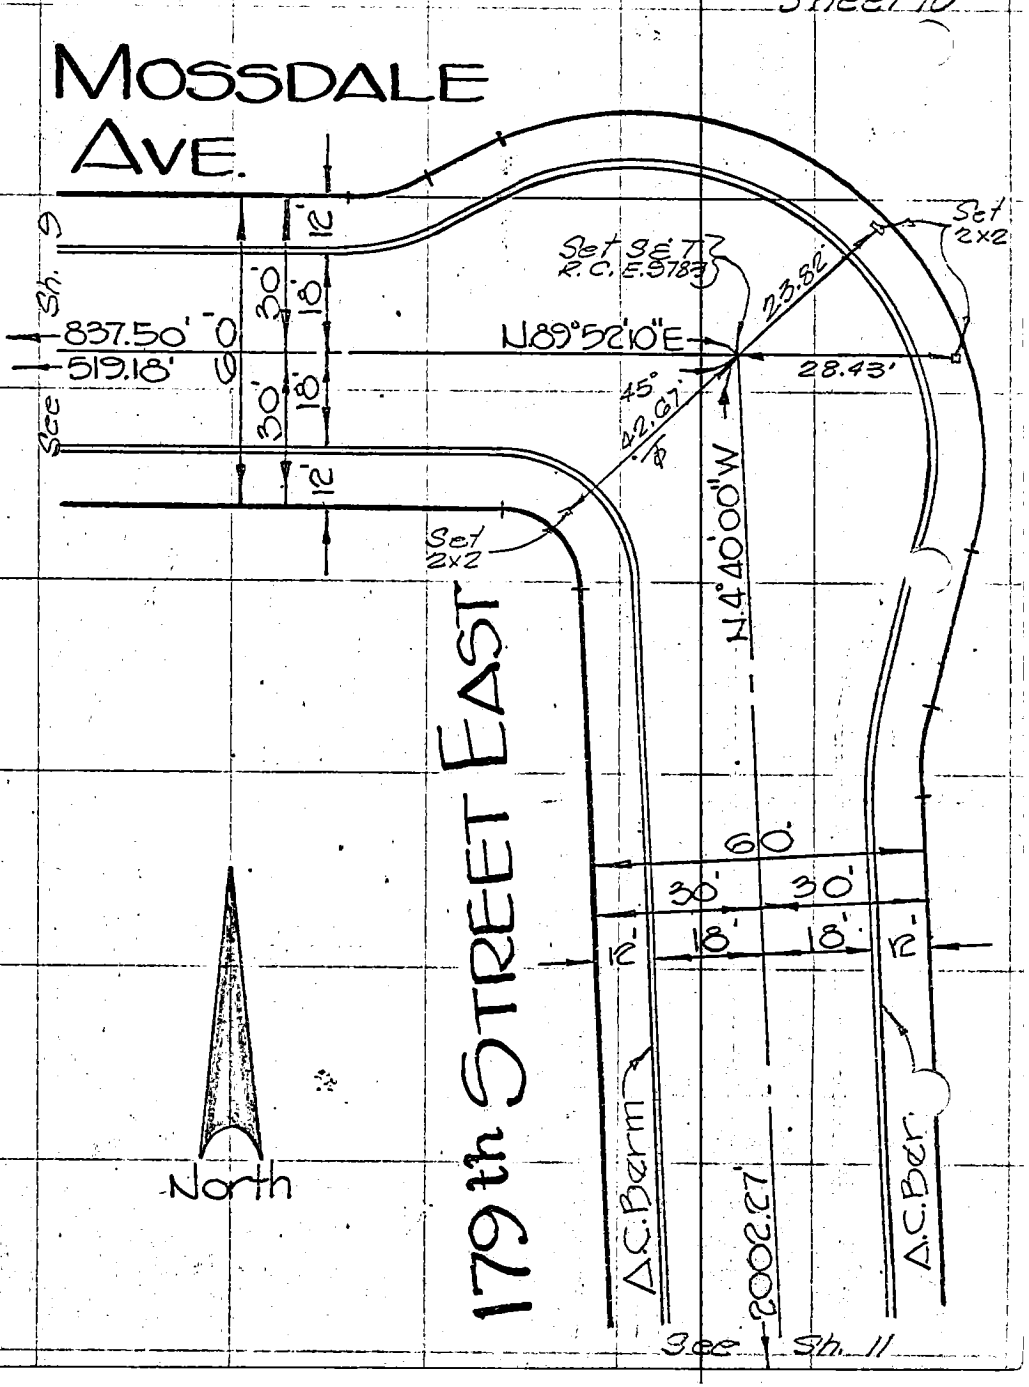


SO. CALIF. BLUE PRINT CO. — F-1638

F. B. _____ PG. _____ SURVEY OF _____

TR. No. 28489 SURVEY BY E. L. Pearson & Associates
R. C. E. 9783

DATE 1-30-70

Sheet 11

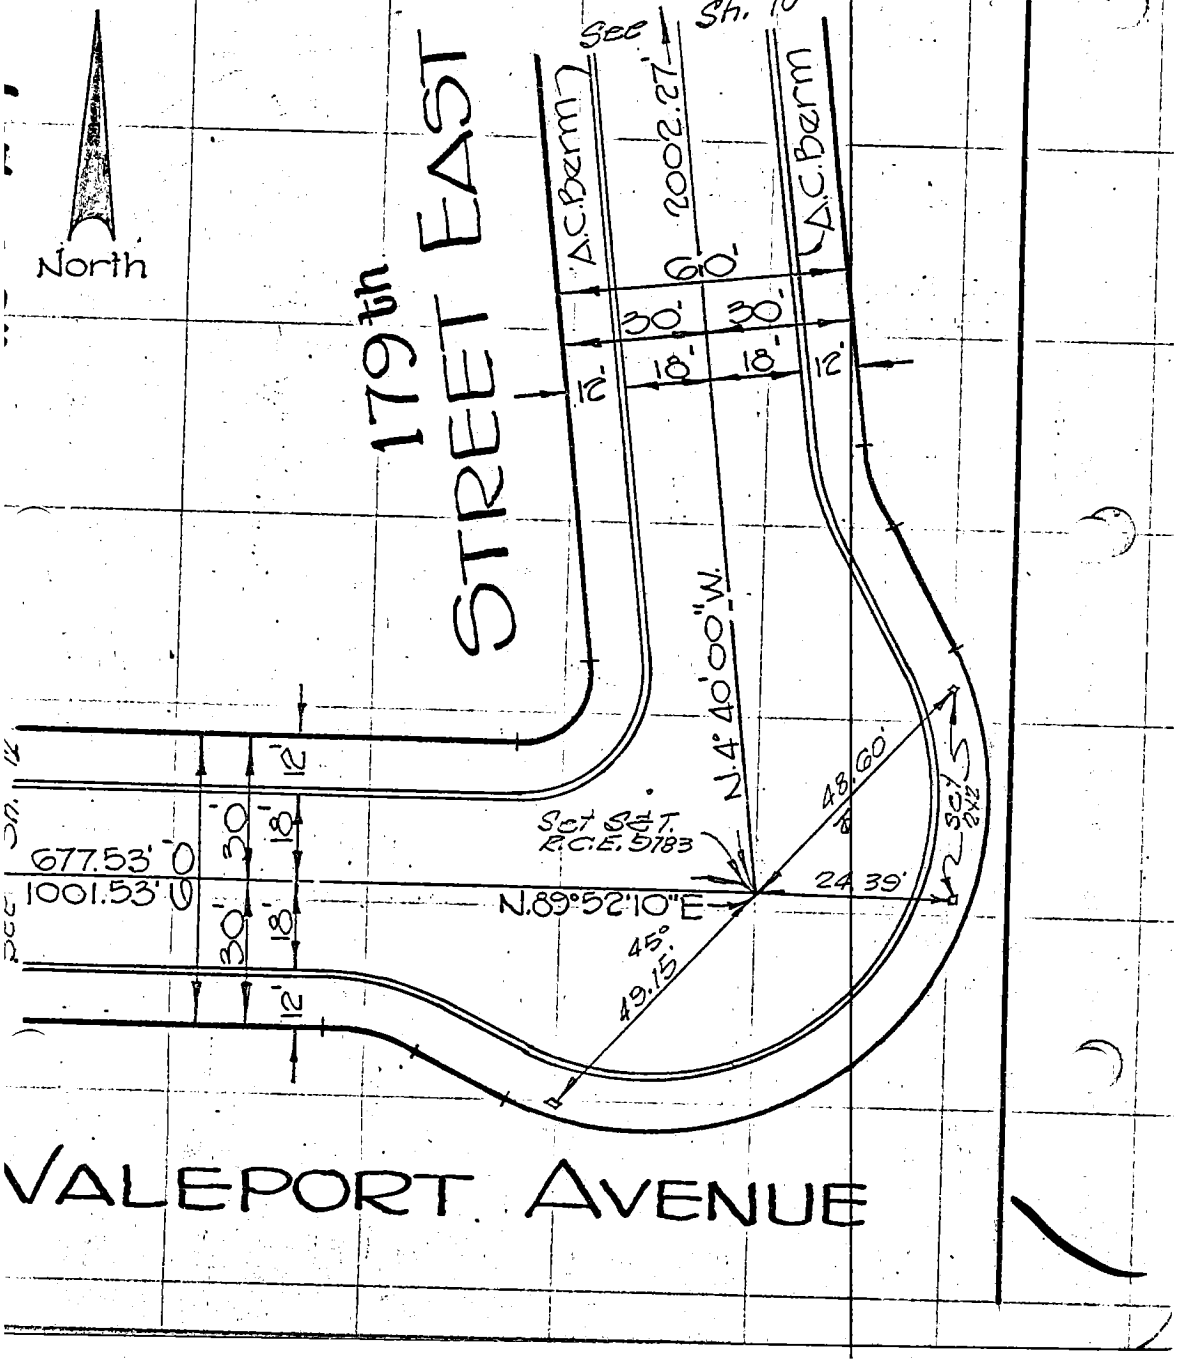

Co. Eng. F.B. 4005: 124

SURVEY OF _____ F. B. _____ Pg. _____

SURVEY BY E.L. Pearson & Associates R.C.E. 9783 TR. No. 28489

DATE 1-30-70

Sheet 12

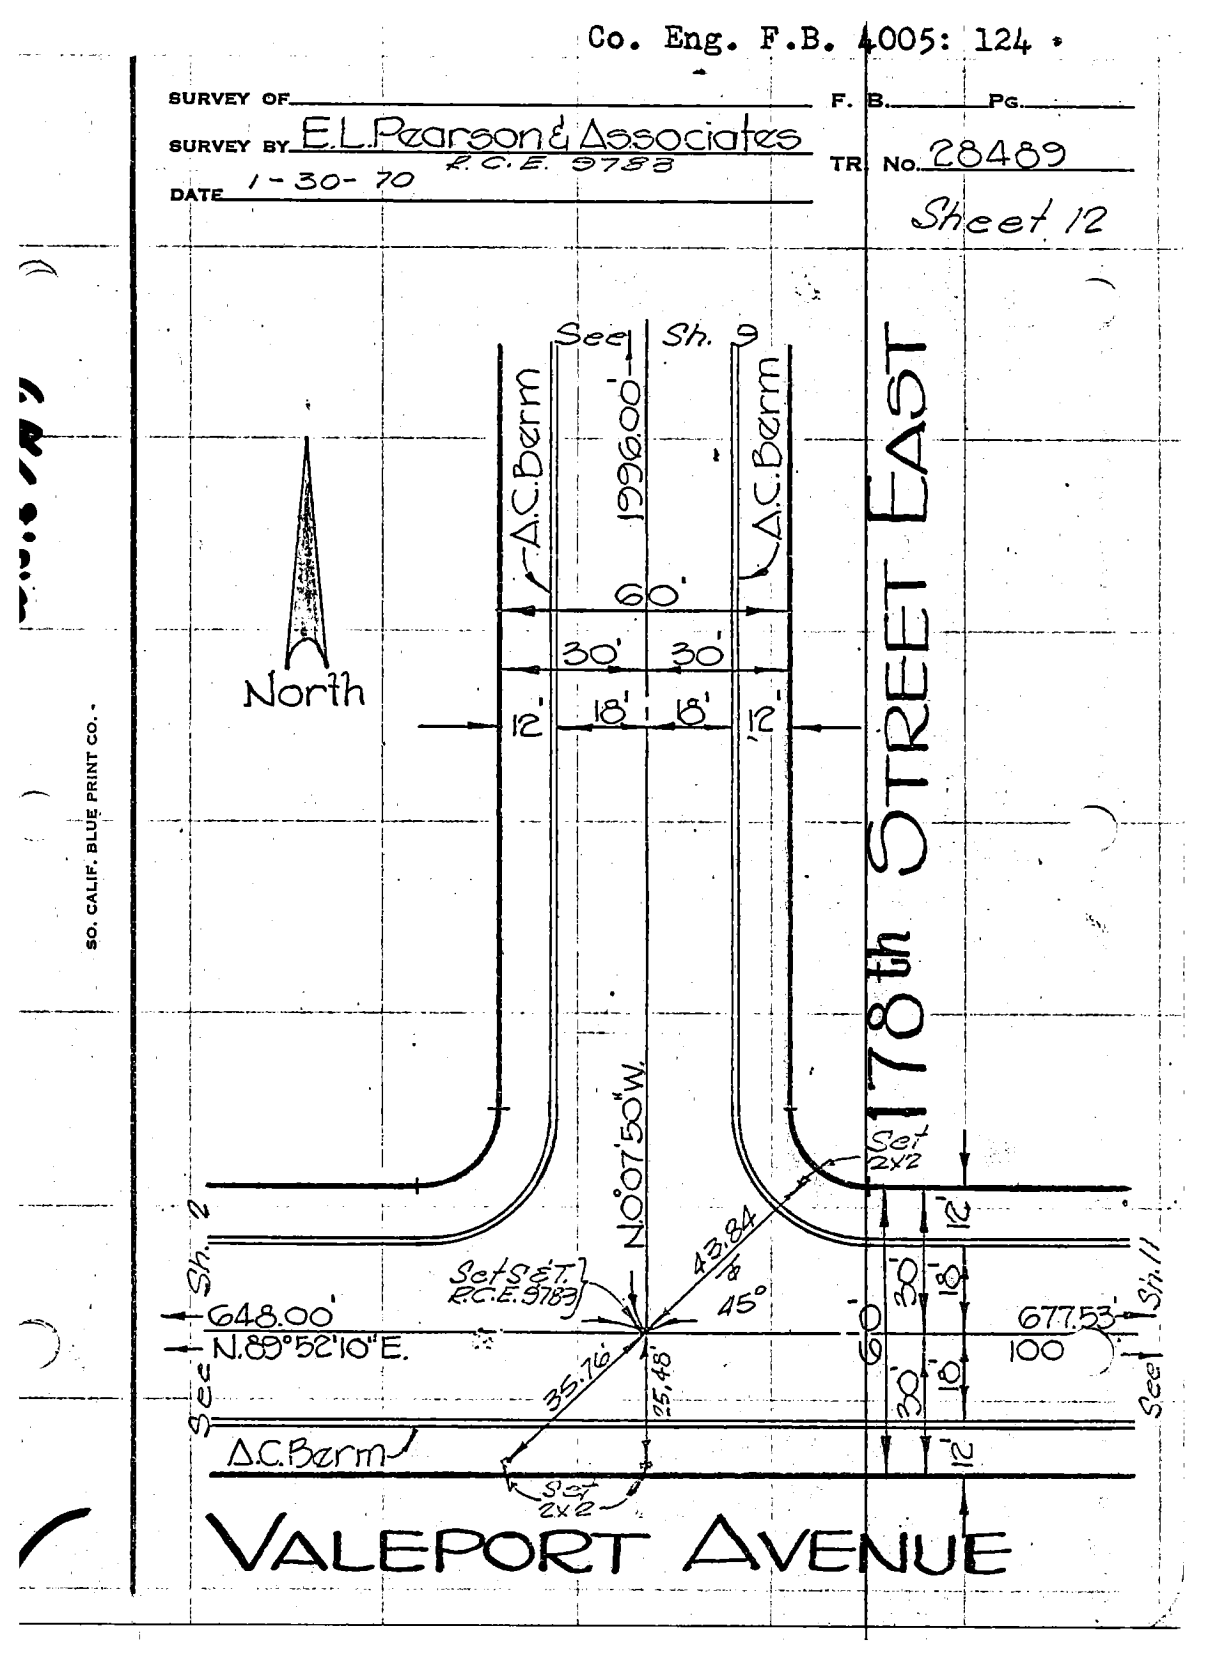


SO. CALIF. BLUE PRINT CO.

Co. Eng. F.B. 4005: 125

F. B. _____ PG. _____ SURVEY OF _____

TR. No. 28489 SURVEY BY E.L. Pearson & Associates R.C.E. 9783

DATE 1-30-70

Sheet 13

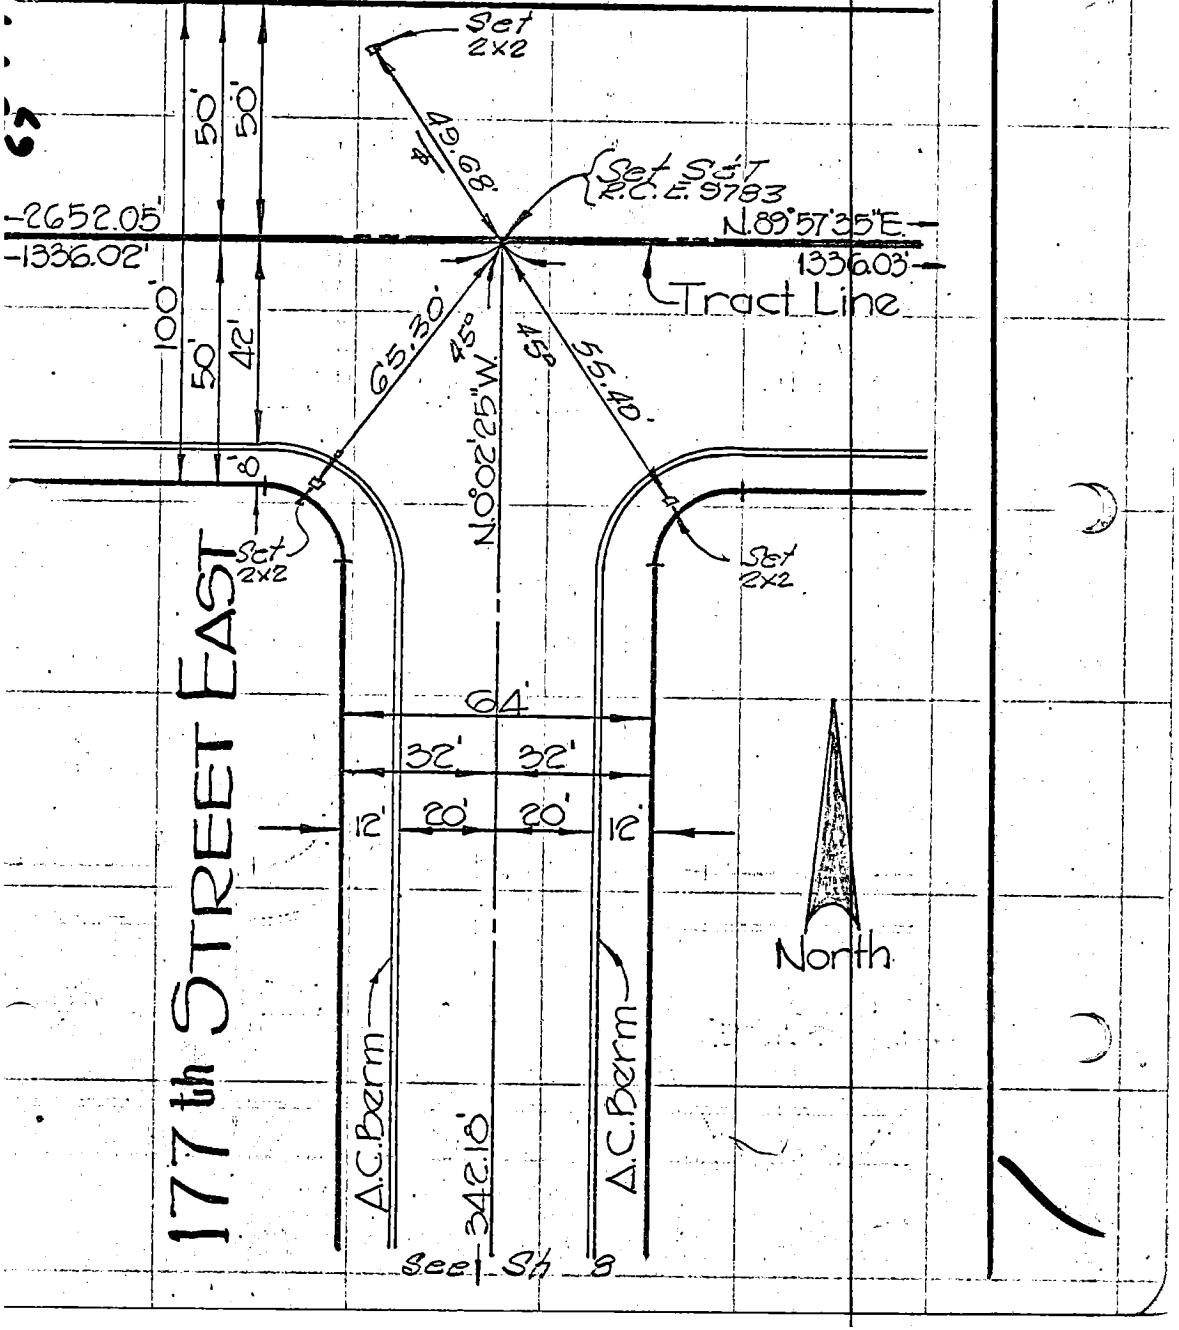

Co. Eng. F.B. 4005: 126

SURVEY OF _____ F. B. _____ PG. 1

SURVEY BY E.L. Pearson & Associates R.C.E. 9783

DATE 1-12-70 TR. No. 28482

# CENTERLINE TIES TR 28482

Note: 1 All Centerline Monuments Are Spike & Tin. & Tag Unless Noted.

2: All Tic Points Are 2"x2"s Buried 6" Deep Unless Noted.

Bob Porter
Ed. Porter
Bill Jenkins

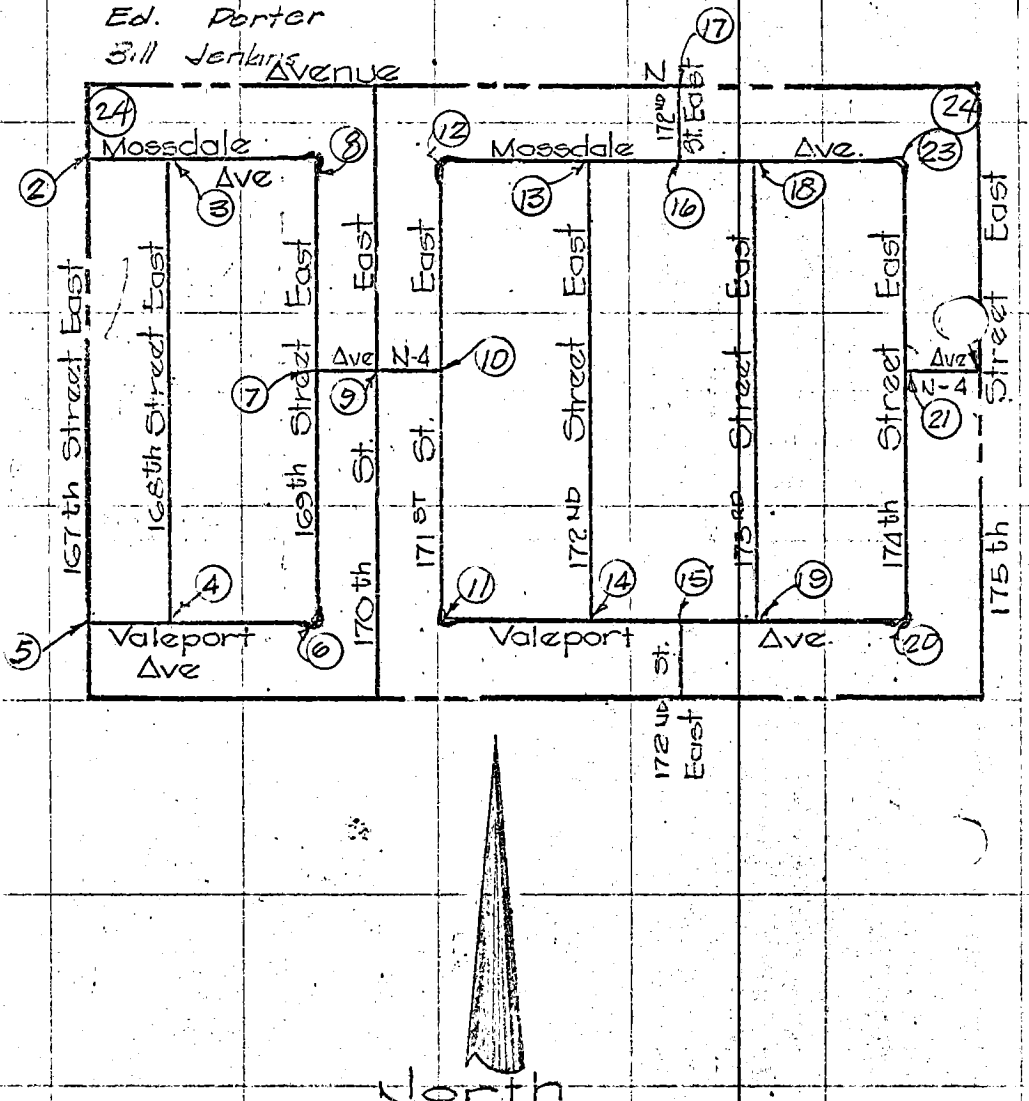


SO. CALIF. BLUE PRINT CO. — F-1638

Co. Eng. F.B. 4005: 127

F. B. ____ Pg. 2 ____ SURVEY OF ____

TR. No. 28482 ____ SURVEY BY E.L. Pearson & Associates R.C.E. 9783

DATE 1 - 12 - 70

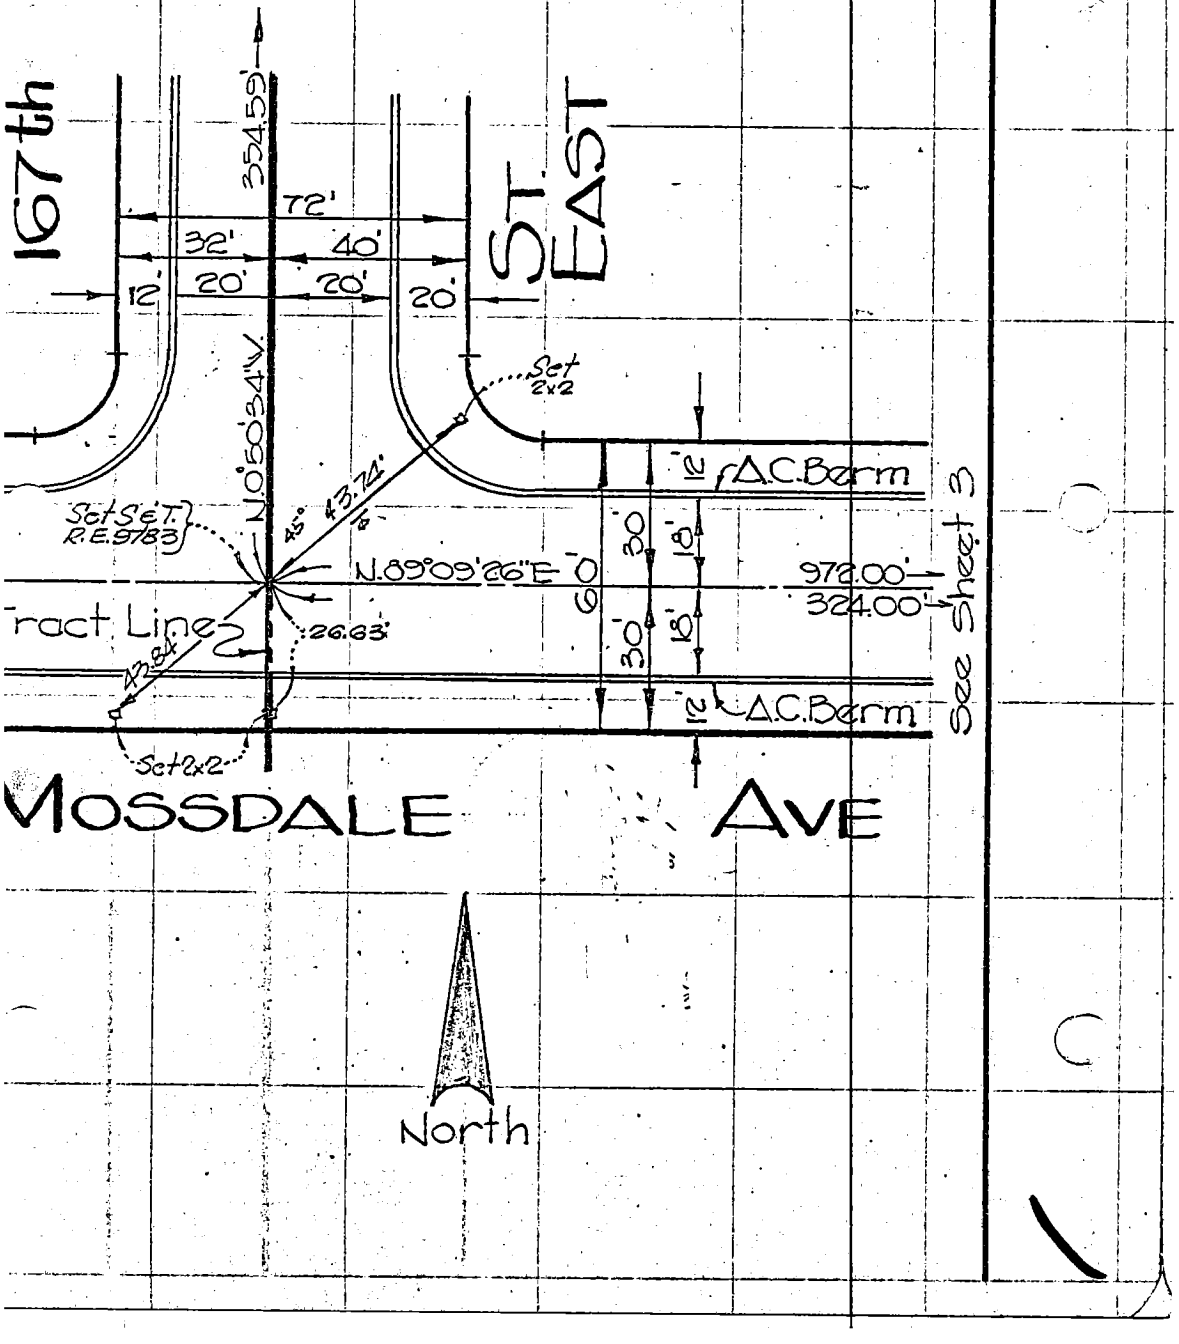

Co. Eng. F.B. 4005:128

SURVEY OF

SURVEY BY E.L. Pearson & Associates

DATE 1-12-70

F. B. Pg. 3

R.C.E. 9783

TR. No. 28482


# MOSSDALE AVE

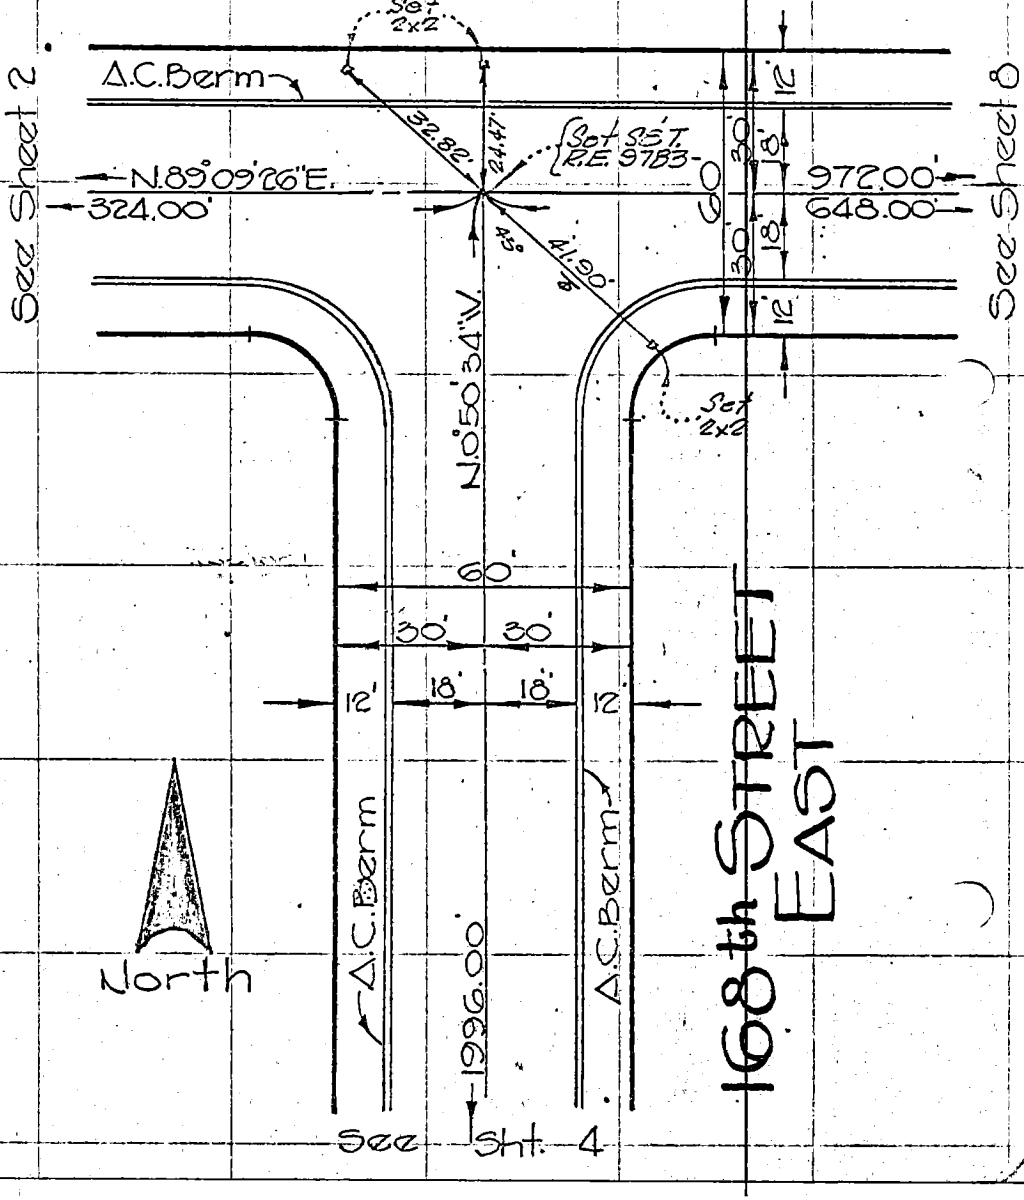


SO. CALIF. BLUE PRINT CO. — F-1638

Co. Eng. F.B. 4005: 129

F. B. _____ PG. 4 SURVEY OF _____

TR. No. 28482 SURVEY BY E.L. Pearson & Associates R.C.E. 9783

DATE 1 - 12 - 70

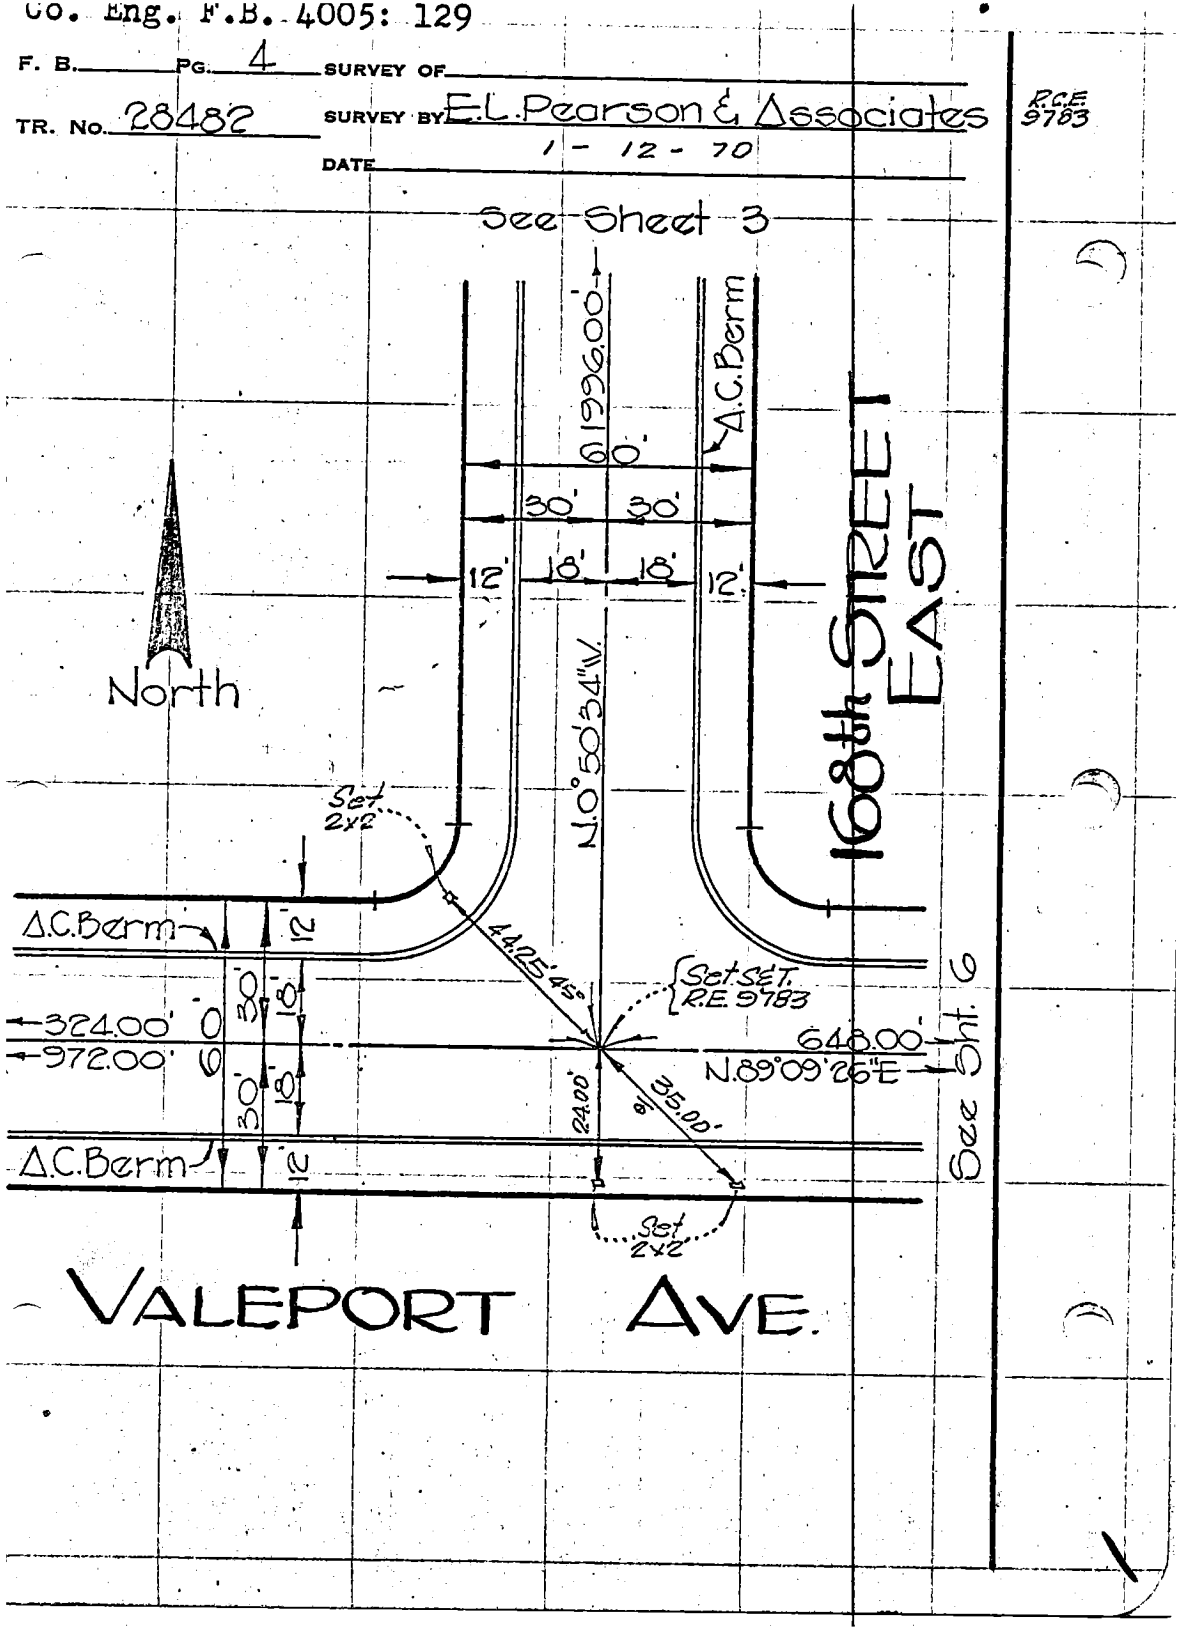

Co. Eng. F.B. 4005:130 •

SURVEY OF _____ F. B. _____ Pg. 5

SURVEY BY E.L. Pearson & Associates R.C.E. 9783 TR. No. 28482

DATE 1-12-70

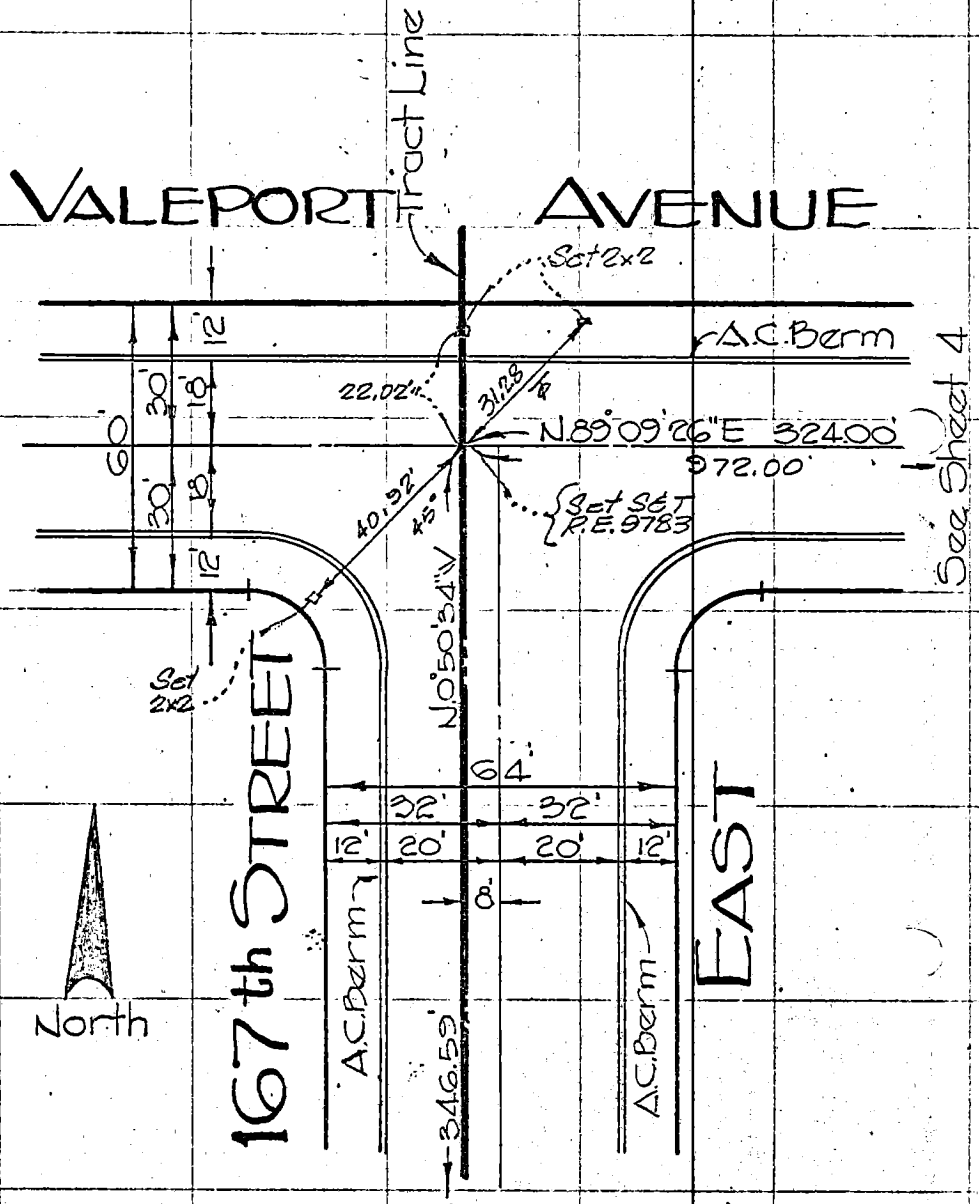


SO. CALIF. BLUE PRINT CO. — F-1638

F. B. ____ PG. 6 SURVEY OF ____

TR. No. 28482 SURVEY BY E.L. Pearson & Associates R.C.E. 9783

DATE 1 - 12 - 70

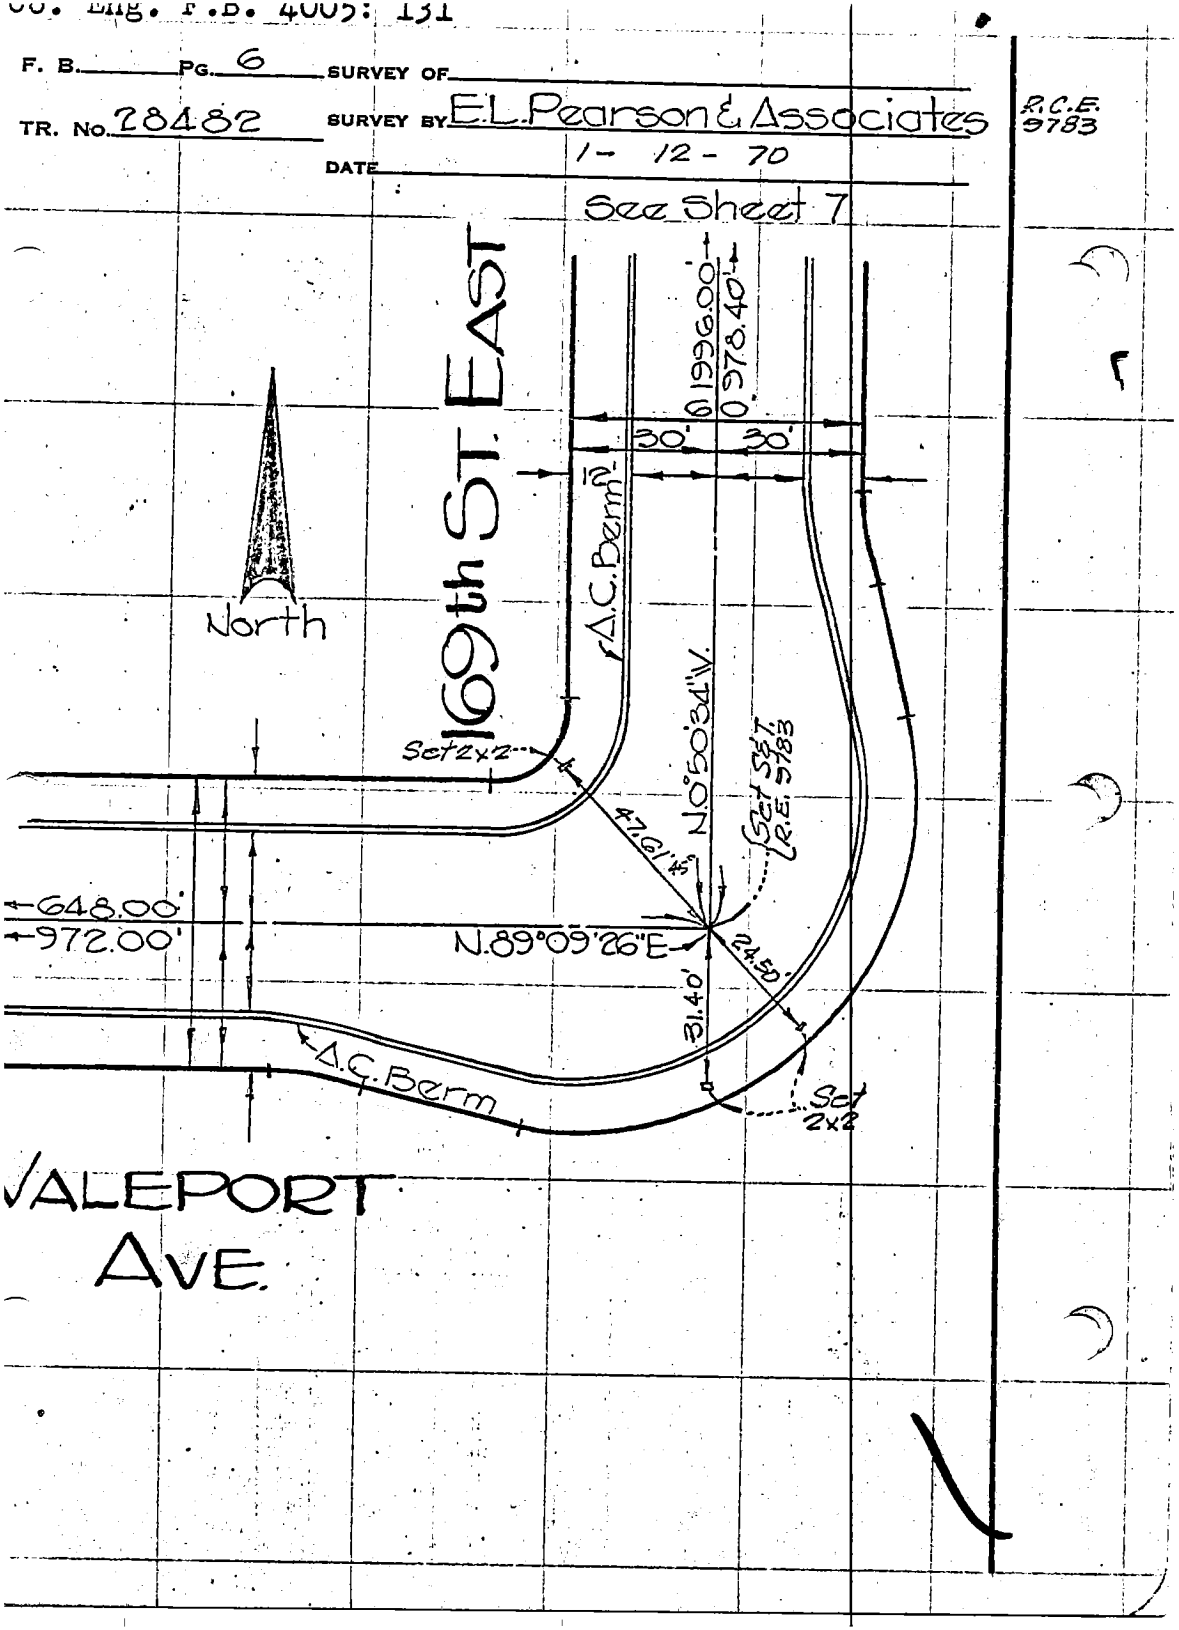

Co. Eng. F.B. 4005:132

SURVEY OF

SURVEY BY E.L. Pearson & Associates

DATE 1 - 12 - 70

F. B. Pg. 7

R.C.E. 9783

TR. No. 28482

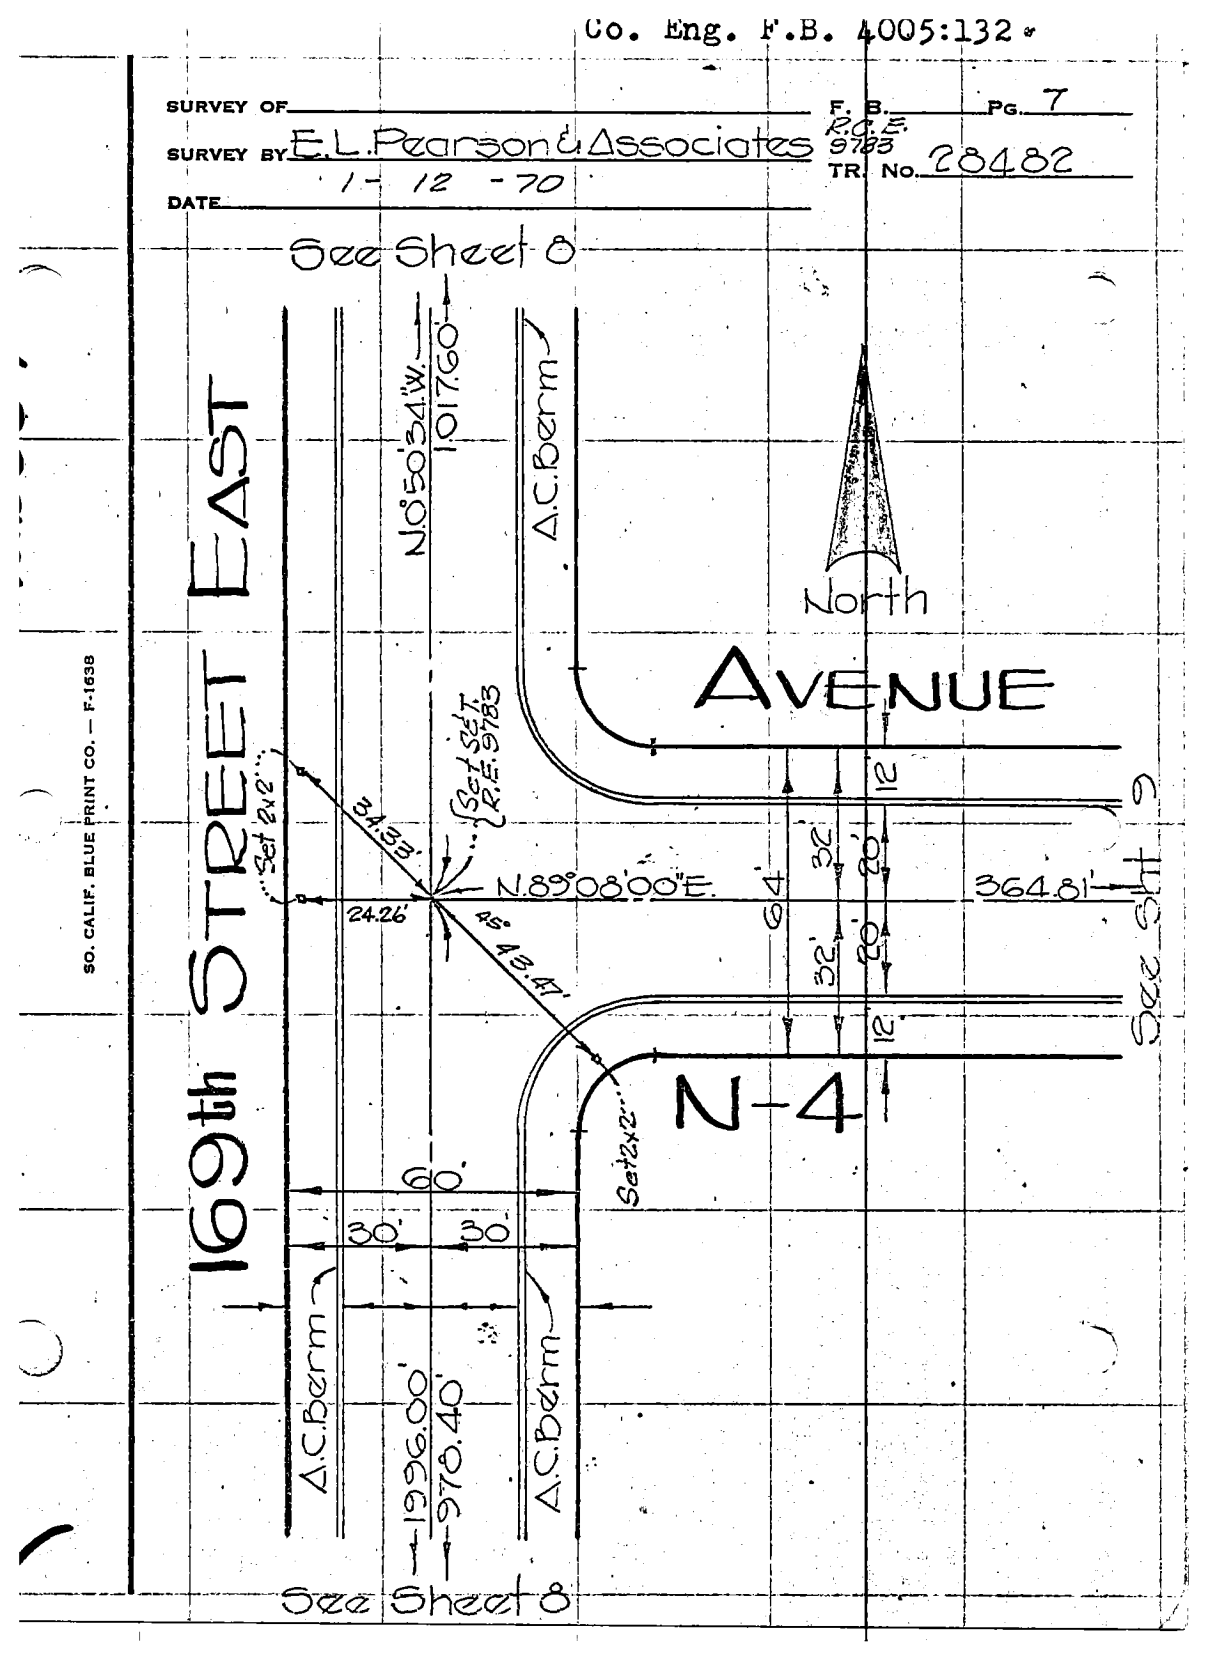


SO. CALIF. BLUE PRINT CO. — F-1638

Co. Eng. F.B. 4005: 133

F. B. _____ PG. 8 SURVEY OF _____

TR. No. 28487 SURVEY BY E.L. Pearson & Associates

DATE 1 - 12 - 70

R.G.E. 9783

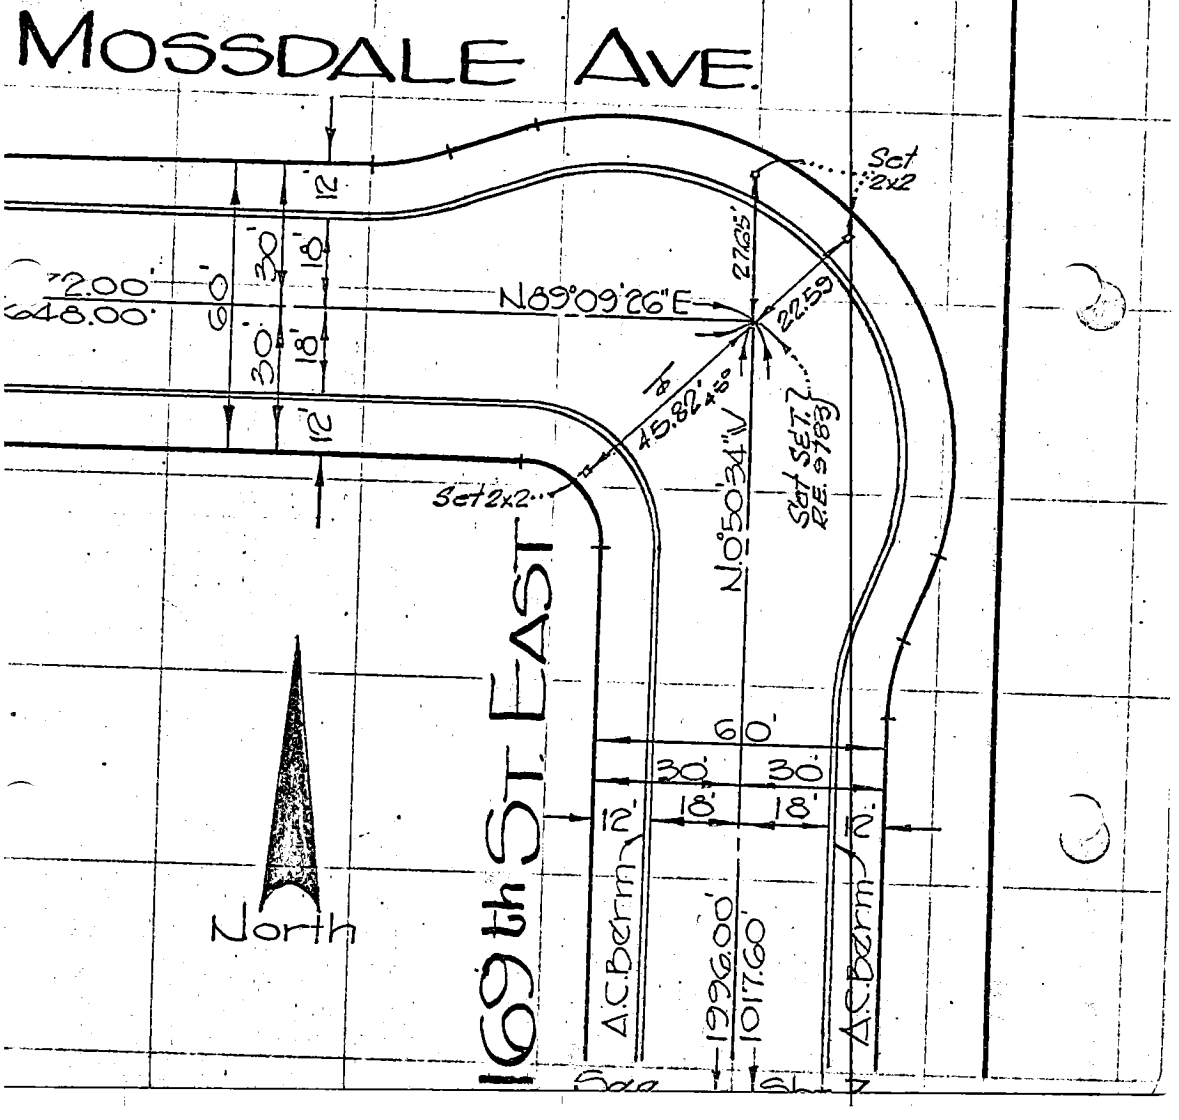

Co. Eng. F.B. 4005: 134

SURVEY OF _____ F. B. _____ PG. 9

SURVEY BY E.L. Pearson & Associates R.C.E. 9783 TR. No. 28482

DATE 1 - 12 - 70

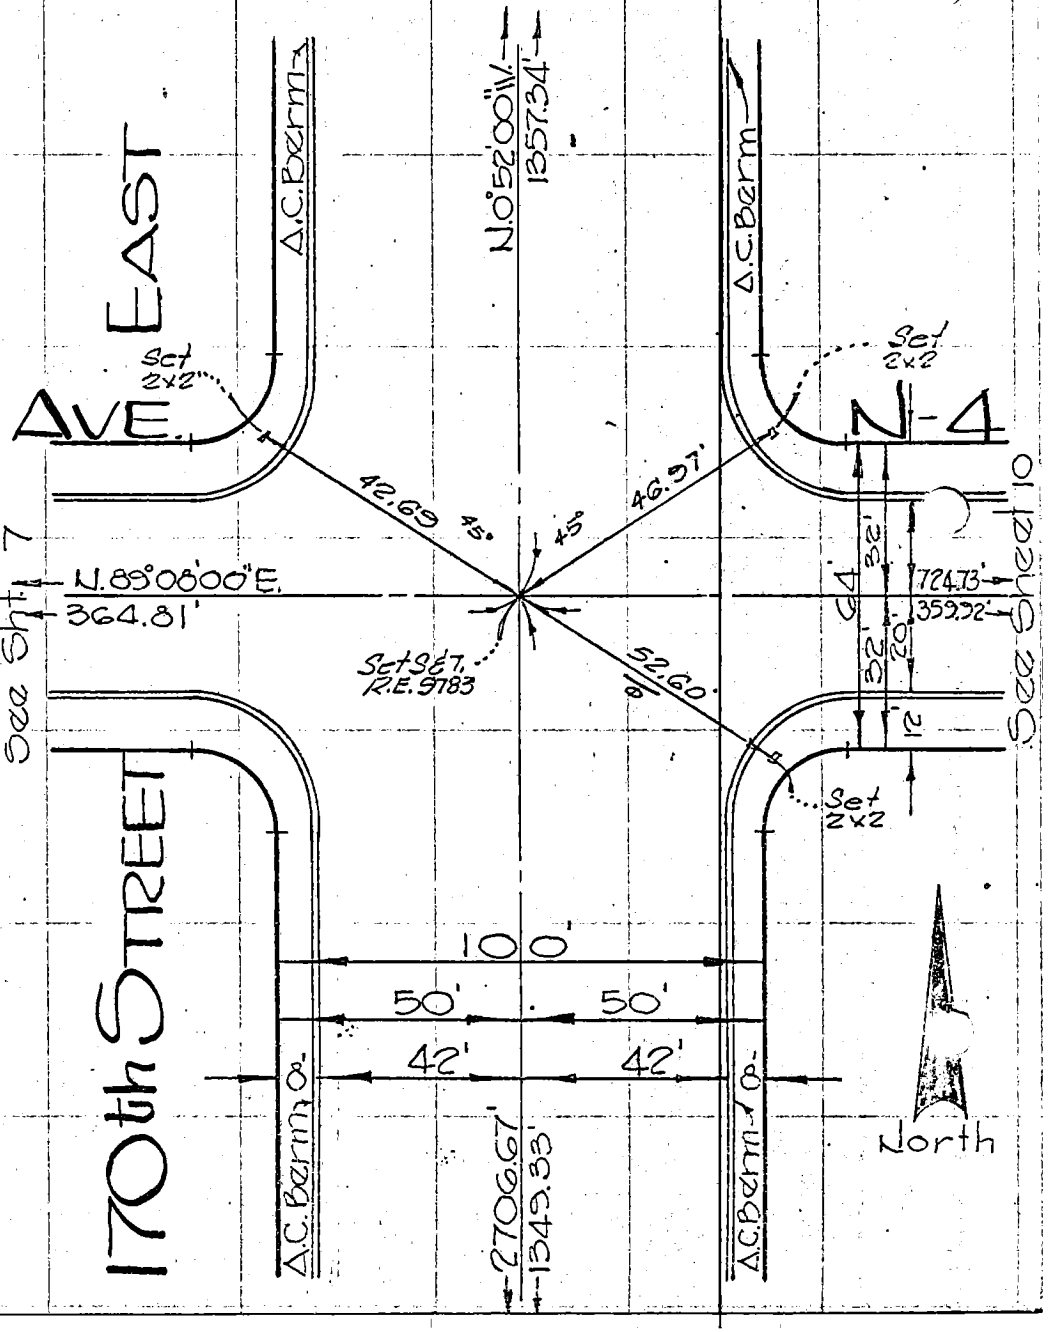


SO. CALIF. BLUE PRINT CO.

Co. Eng. F.B. 4005: 135

F. B. ____ Pg. 10 SURVEY OF ____

TR. No. 28482 SURVEY BY E.L. Pearson & Associates R.C.E. 9783

DATE 1-12-70

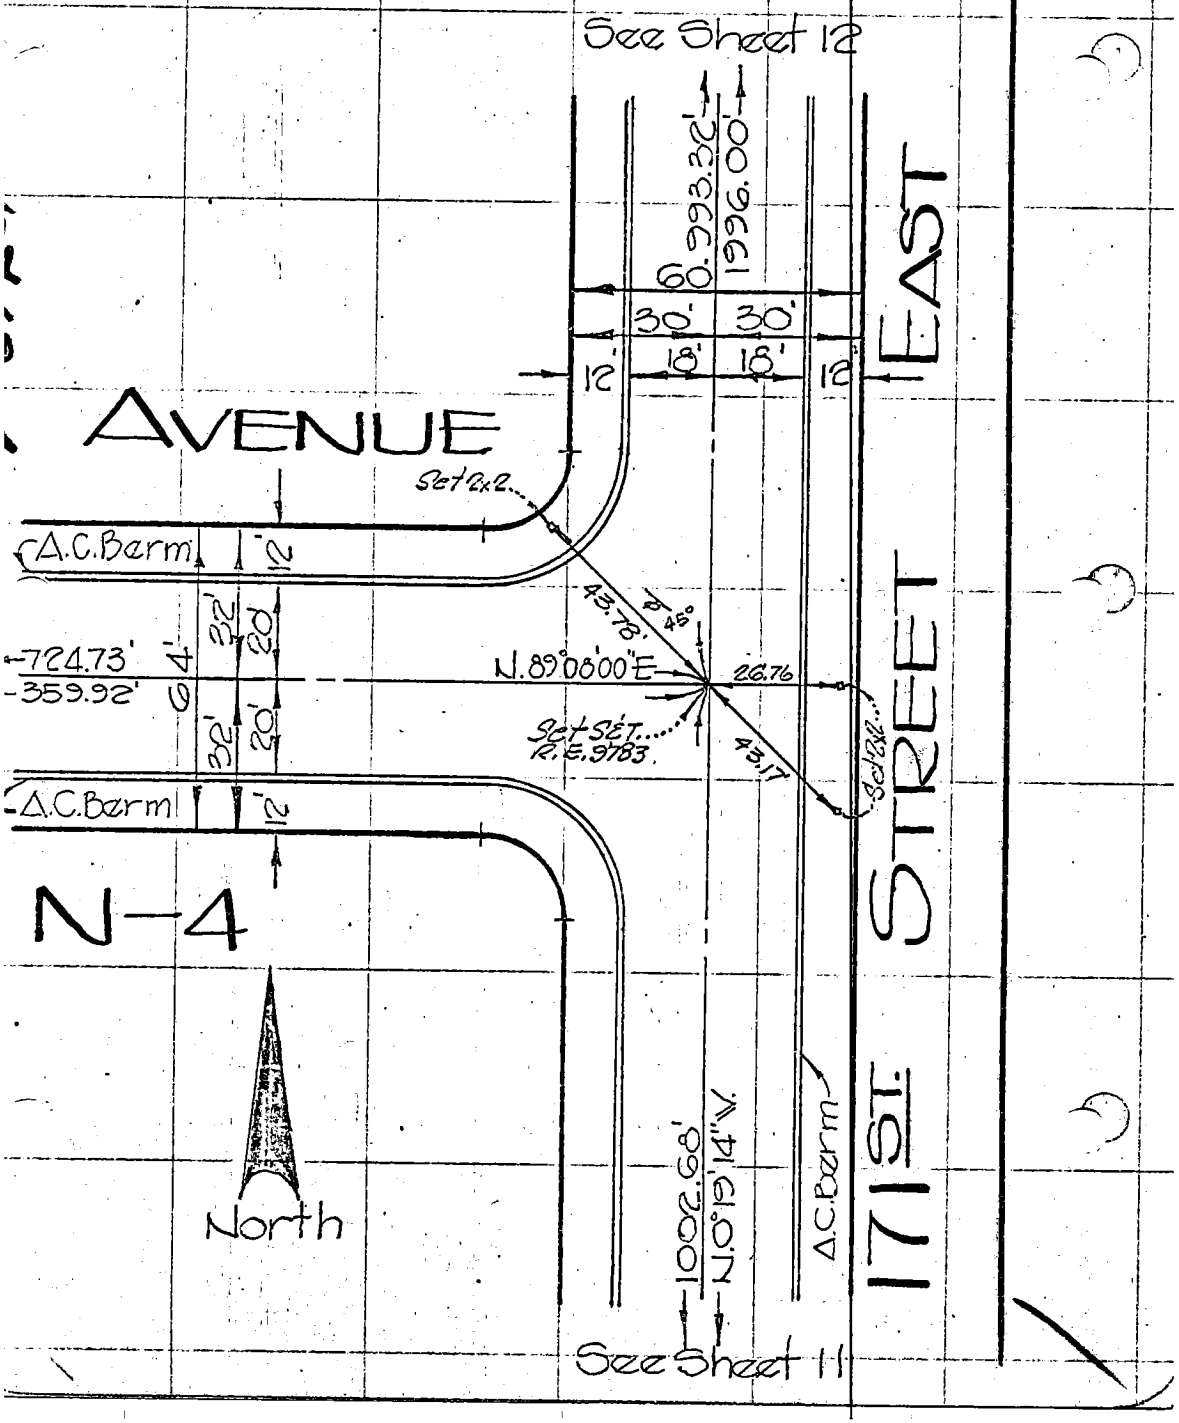

SURVEY OF

SURVEY BY E.L. Pearson & Associates

DATE 1-12-70

F. B. PG. 11

R.C.E. 5783

TR. No. 28482

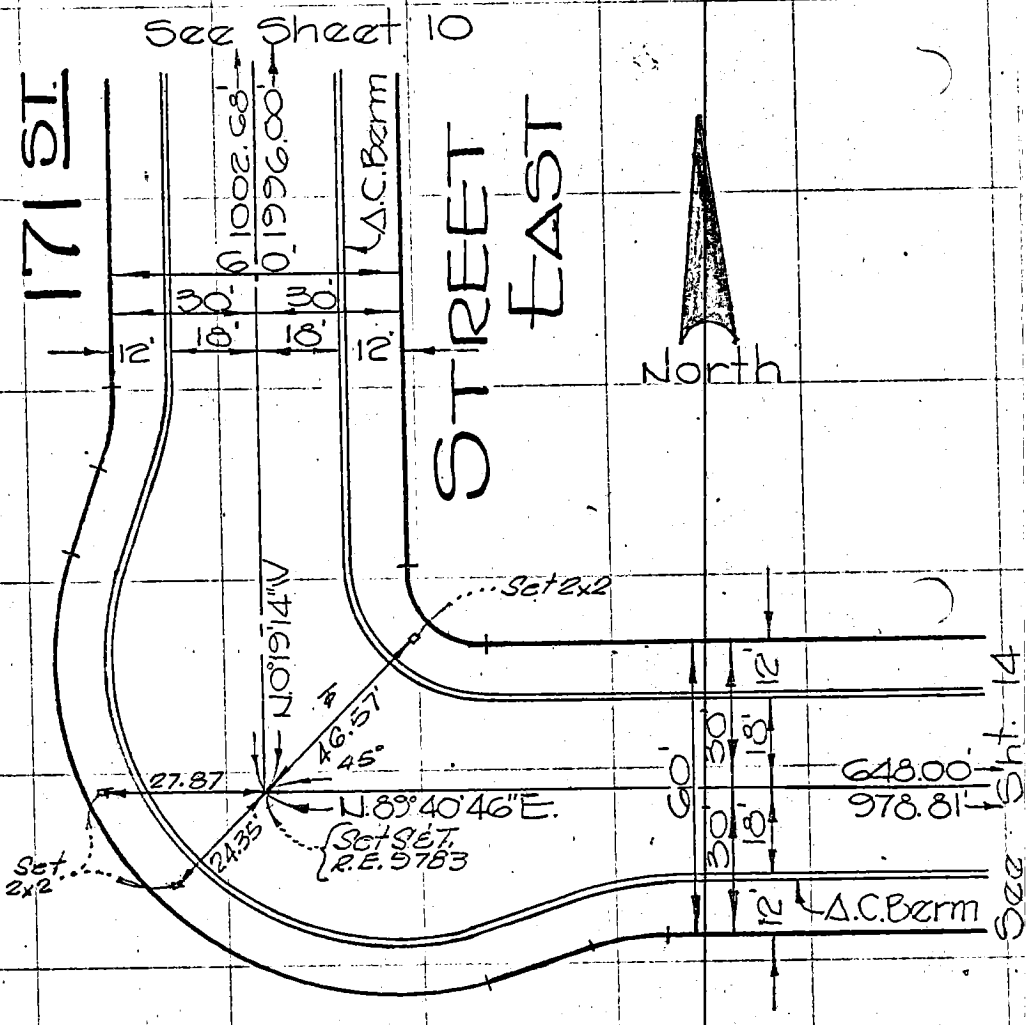


W.S.C. 7A-1

SO. CALIF. BLUE PRINT CO. — F-1638

Co. Eng. F.B. 4005: 137

F. B. _____ PG. 12 SURVEY OF _____

TR. No. 28482 SURVEY BY E.L. Pearson & Associates R.C.E. 9783

DATE 1 - 12 - 70

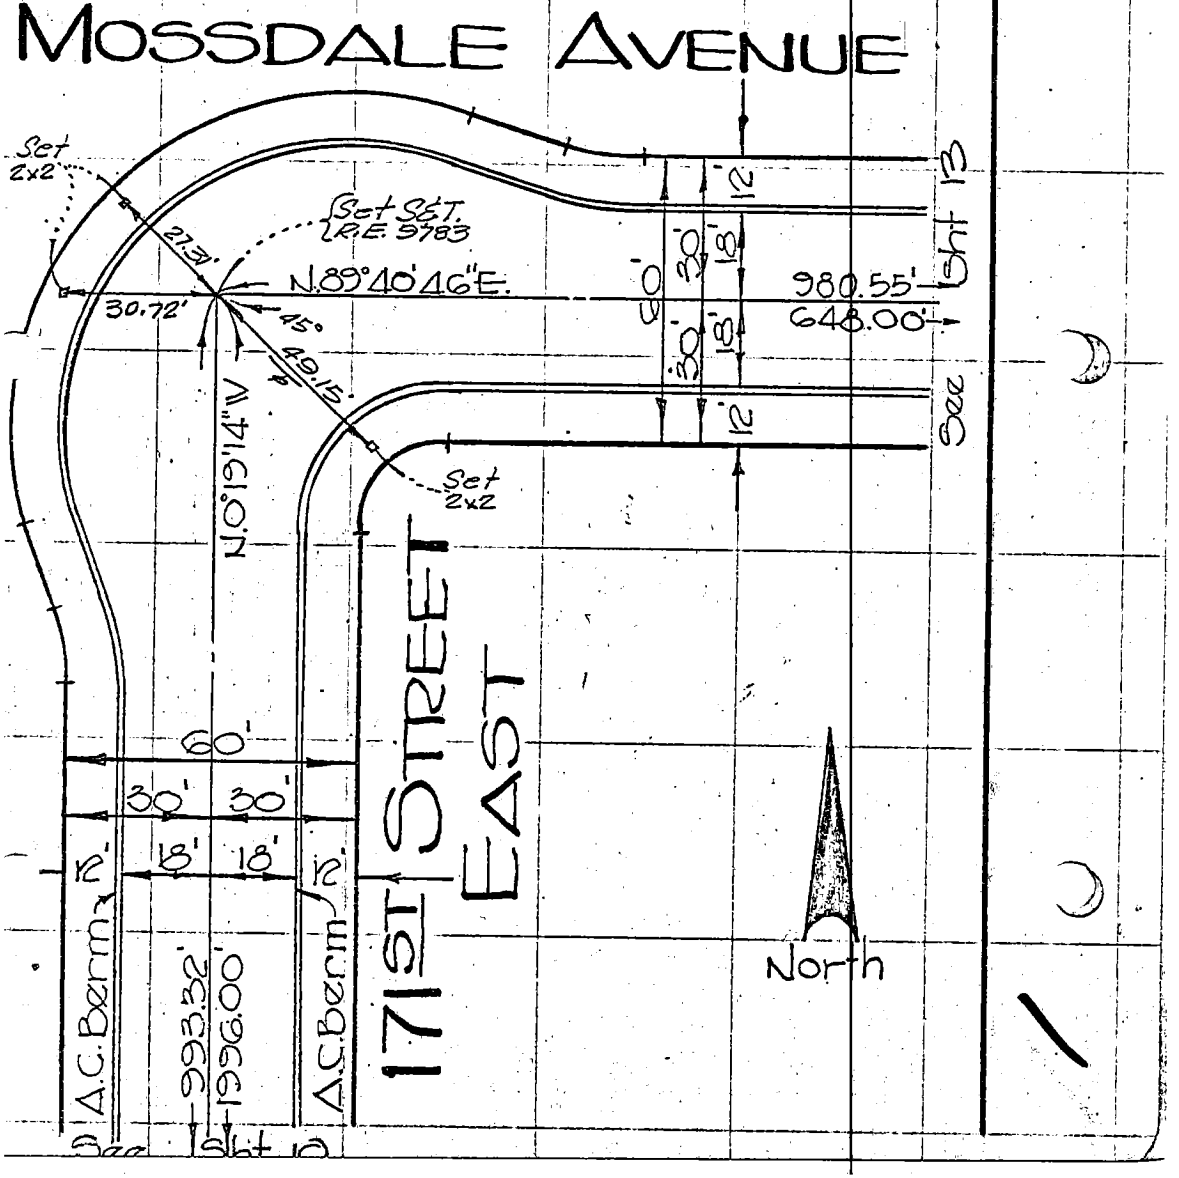

Co. Eng. F.B. 4005: 138 .

SURVEY OF _____ F. B. _____ PG. 13

SURVEY BY E.L. Pearson & Associates R.C.E. 5783

DATE 1 - 12 - 70 TR. No. 28482

W.S. 67A-1

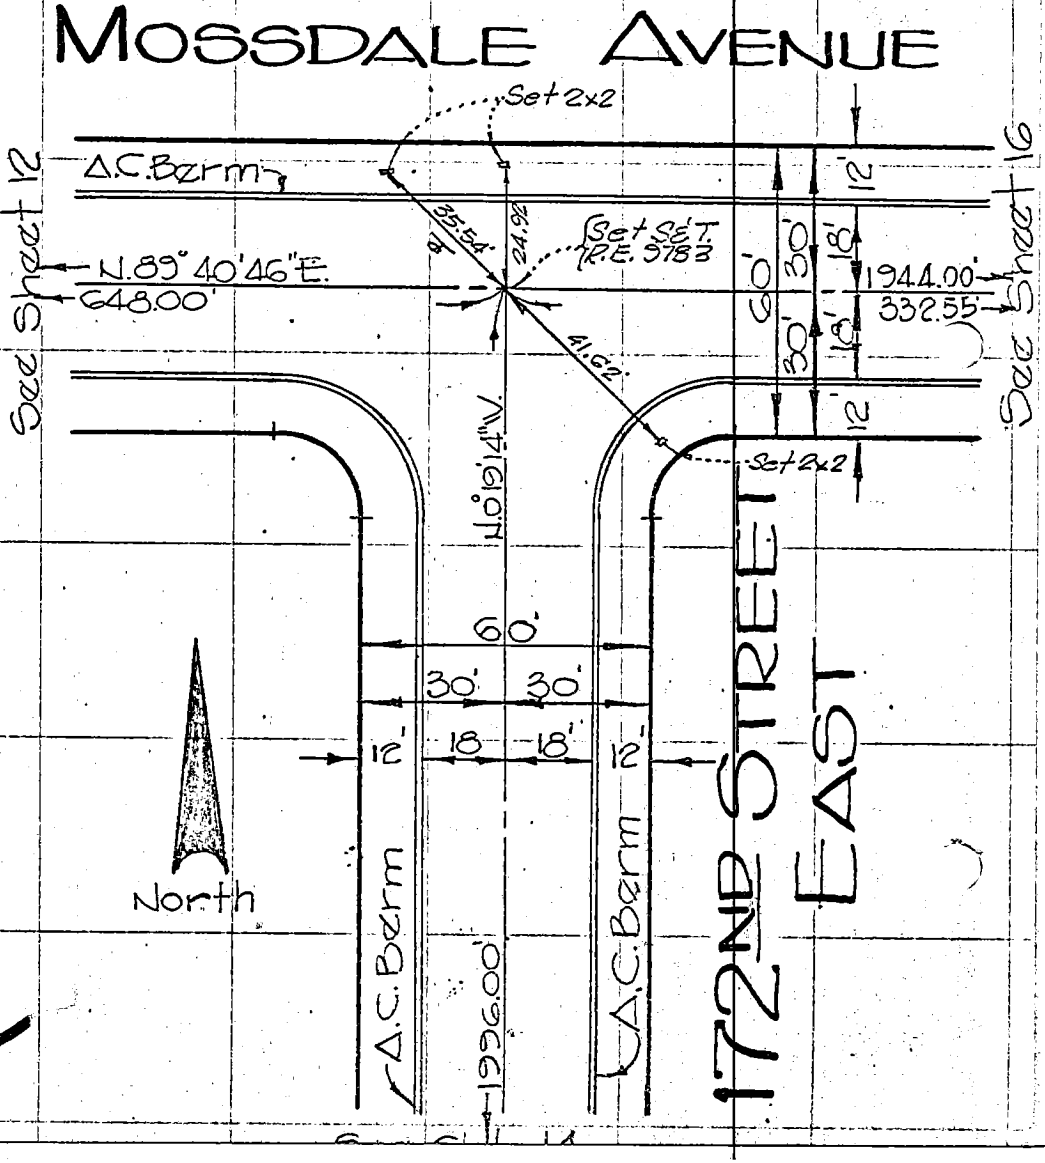


SO. CALIF. BLUE PRINT CO. — F-1638

F. B. _____ PG. 14 SURVEY OF _____

TR. No. 28482 SURVEY BY E.L. PEARSON & ASSOCIATES R.C.E. 9783

DATE 1 - 12 - 70

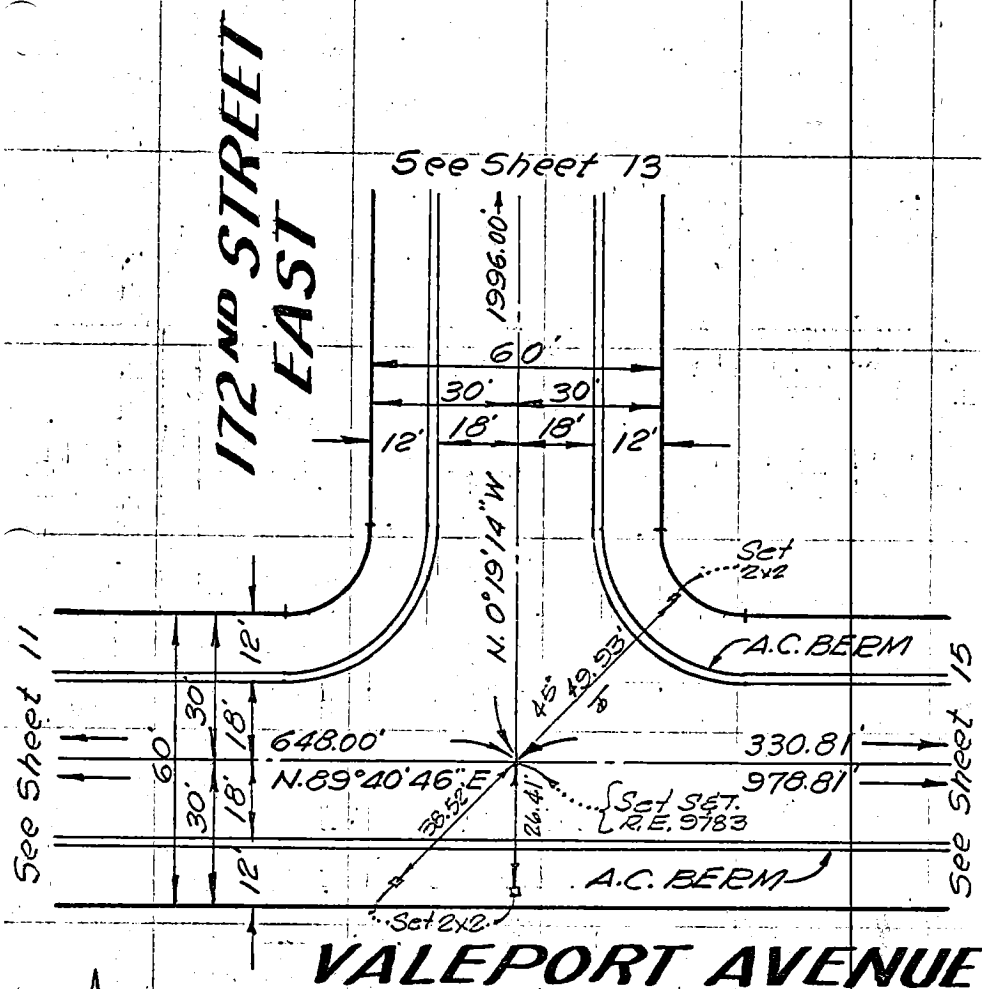

SURVEY OF _____ F. B. _____ PG. 15

SURVEY BY E.L. PEARSON & ASSOCIATES R.C.E. 9783 TR. NO. 28482

DATE 1 - 12 - 70

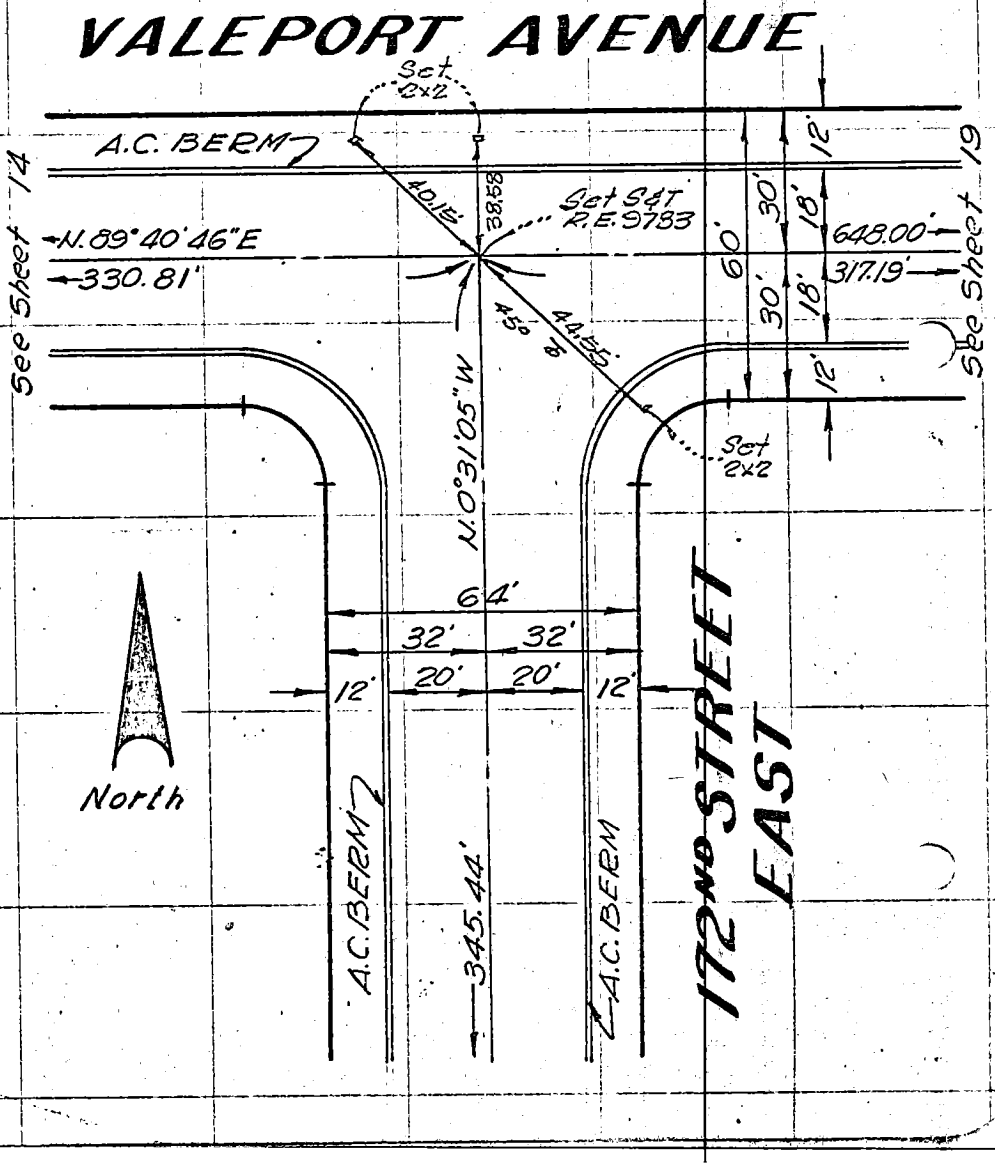


SO. CALIF. BLUE PRINT CO. — F-1638

1-4-70

o. Eng. F.B. 4005: 141

F. B. _____ PG. 16 SURVEY OF _____

TR. No. 28482 SURVEY BY E.L. PEARSON & ASSOCIATES

DATE 1 - 12 - 70

R.C.E. 9783

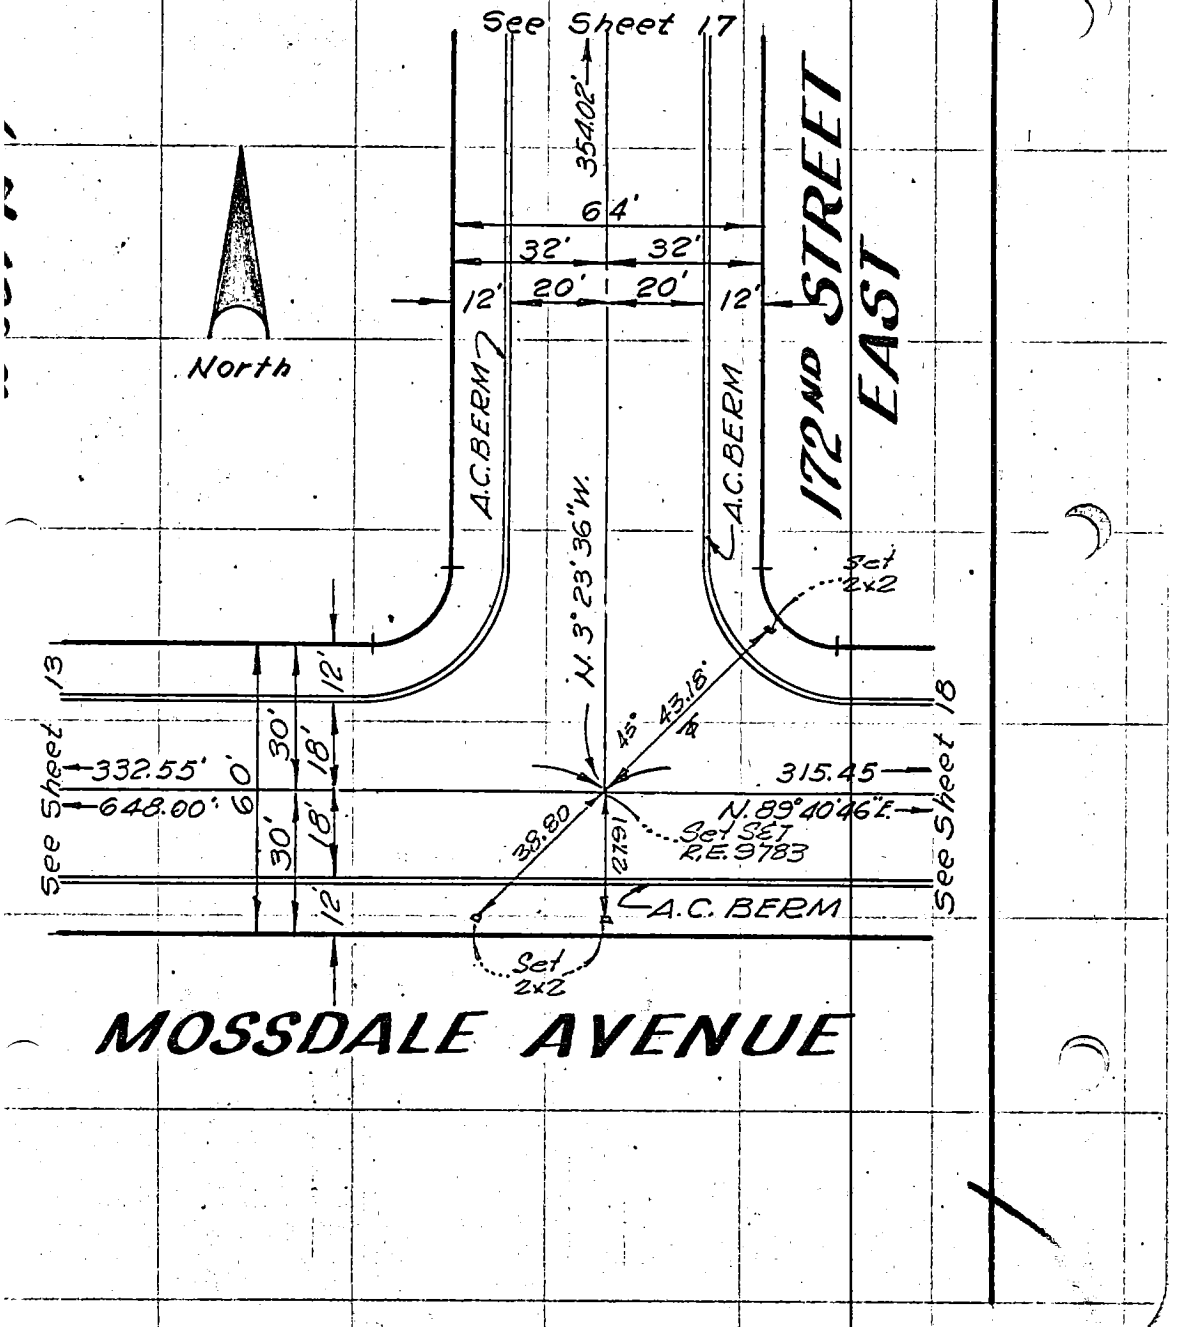

Co. Eng. F.B. 4005: 142

SURVEY OF _____ F. B. _____ PG. 17

SURVEY BY E.L. PEARSON & ASSOCIATES R.C.E. 5783 TR. No. 28482

DATE 1 - 12 - 70

W.S. 67A-1

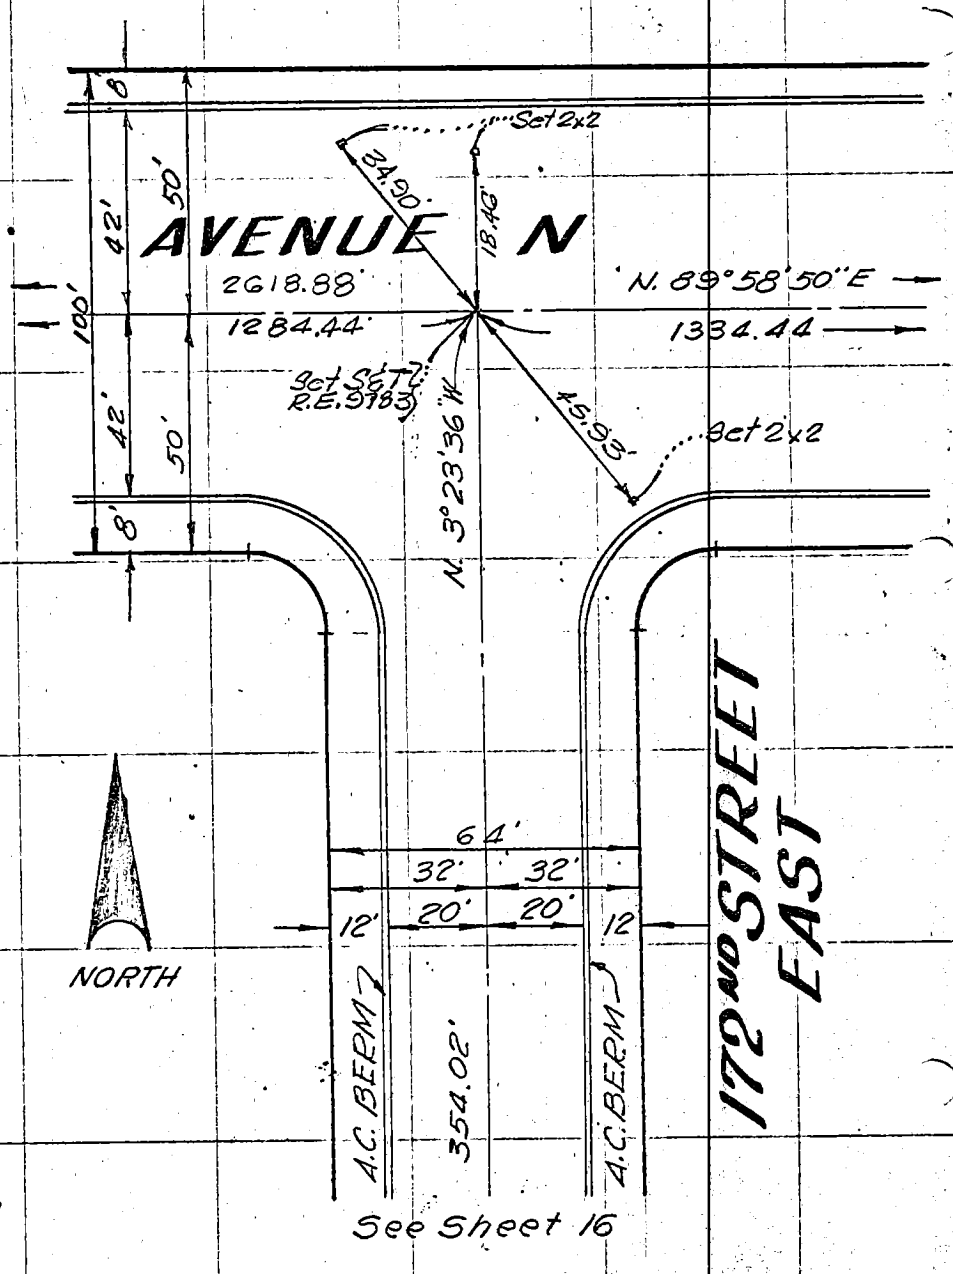


See Sheet 16

SO. CALIF. BLUE PRINT CO. — F-1638

CO. ENG. F.B. 4005: 143

F. B. ____ PG. 18 SURVEY OF ____

TR. No. 28482 SURVEY BY E.L. PEARSON & ASSOCIATES

DATE 1 - 12 - 70

R.C.E. 9783

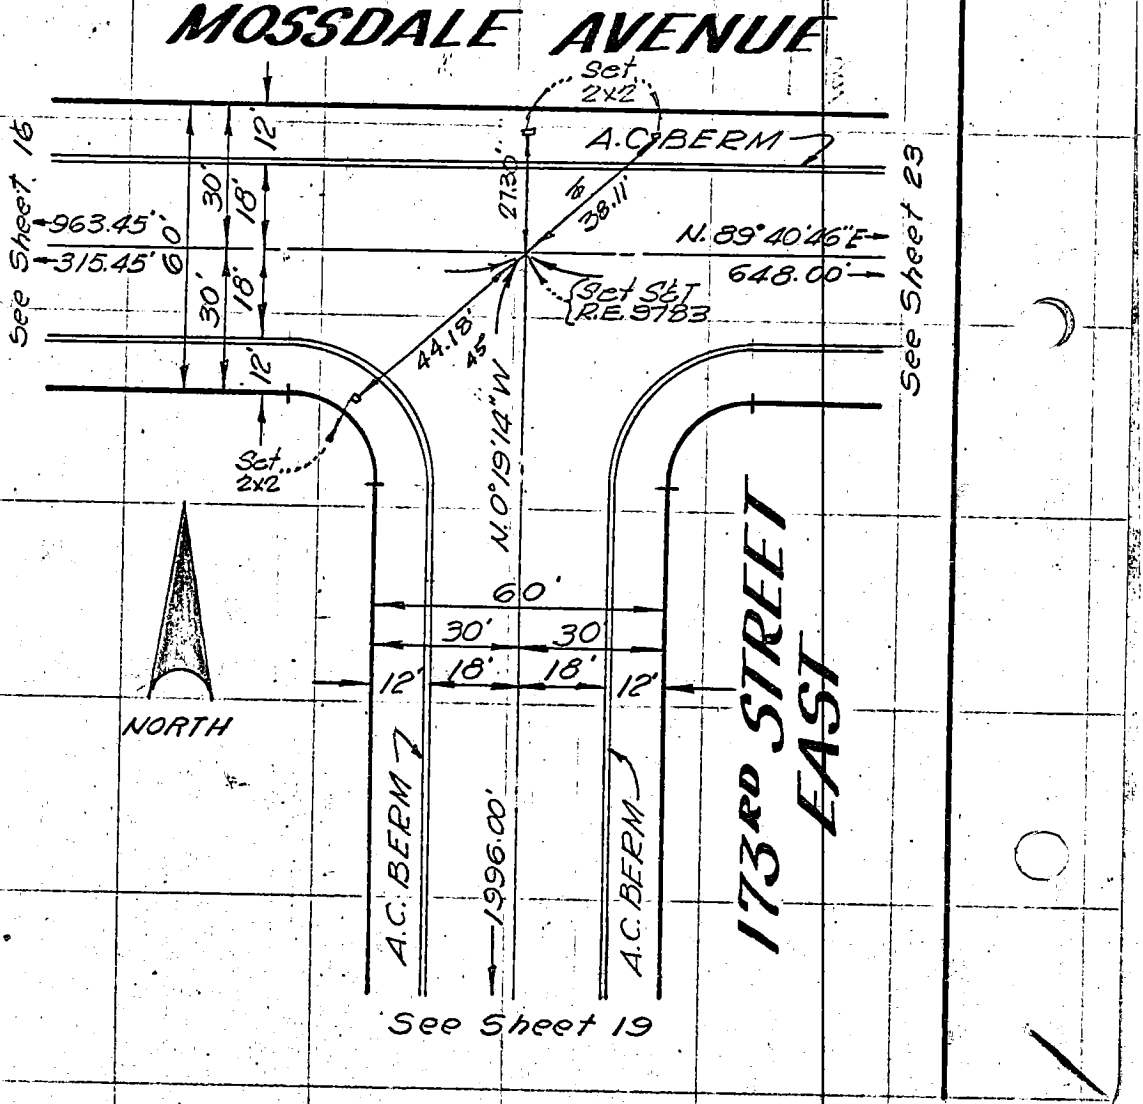

Co. Eng. F.B. 4005: 144

SURVEY OF _____ F. B. _____ PG. 19

SURVEY BY E.L. PEARSON & ASSOCIATES R.C.E. 9783 TR. No. 28482

DATE 1- 12 -70

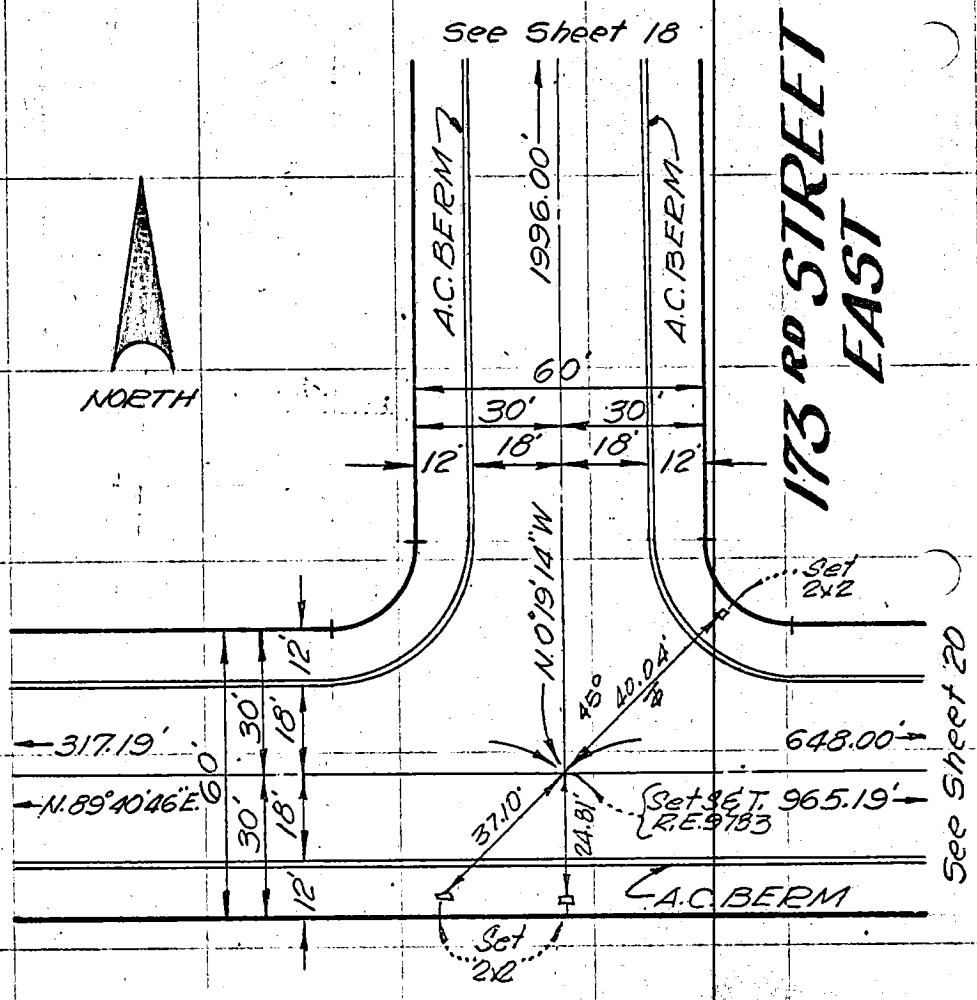


WC 67A-1

SO. CALIF. BLUE PRINT CO. — F.1638

Co. Eng. F.B. 4005: 145

F. B. ____ PG. 20 SURVEY OF ____

TR. No. 28482 SURVEY BY E.L. PEARSON & ASSOCIATES R.C.E. 9783

DATE 1-12-70

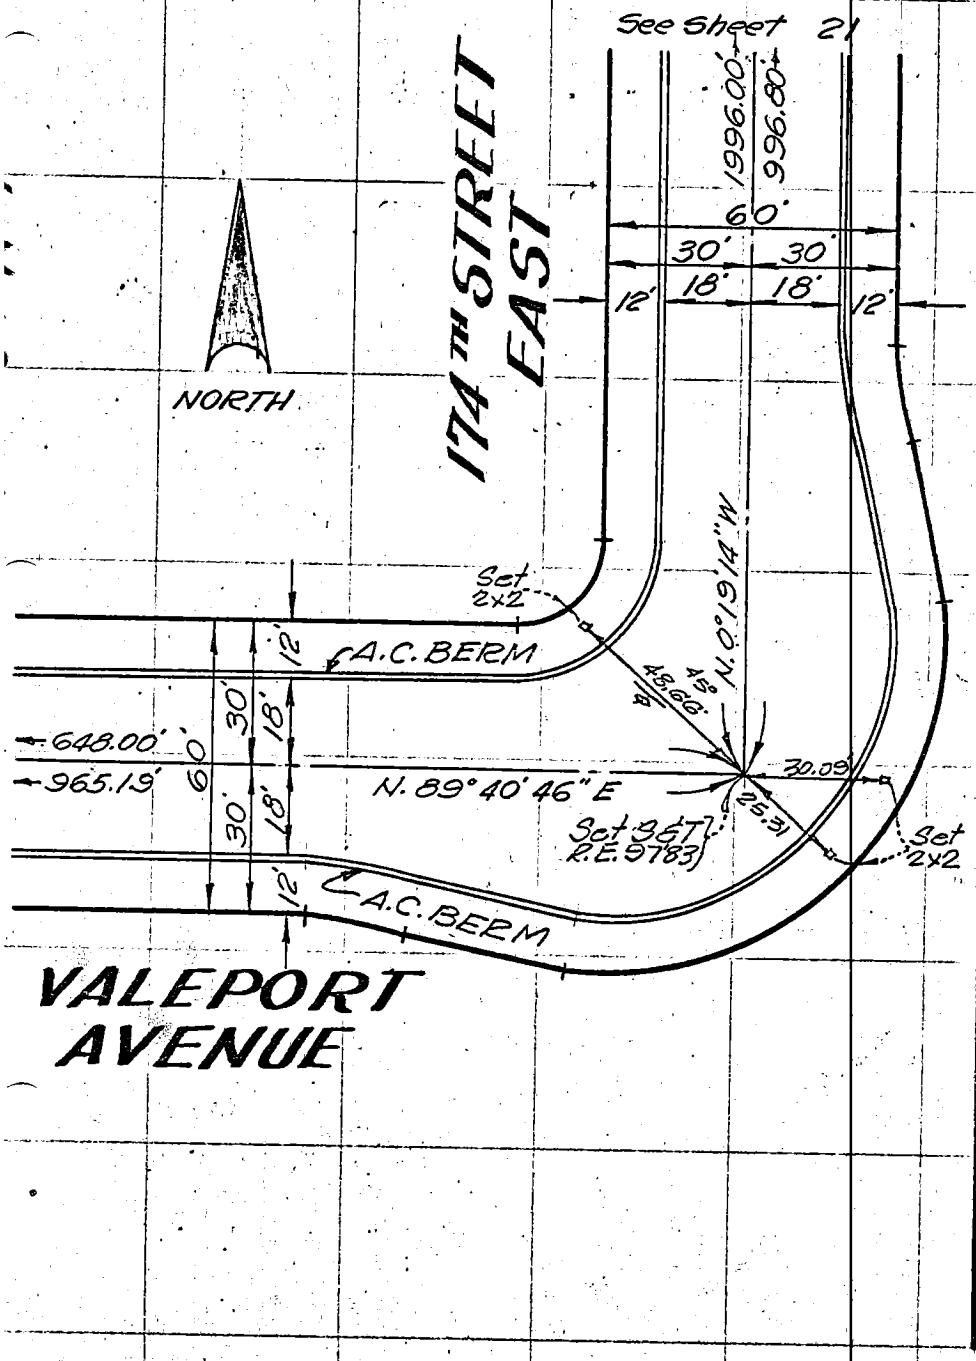

Co. Eng. F.B. 4005: 146

SURVEY OF _____ F. B. _____ PG. 21

SURVEY BY E.L. PEARSON & ASSOCIATES R.C.E. 9783

DATE 1-12-70 TR. No. 28482

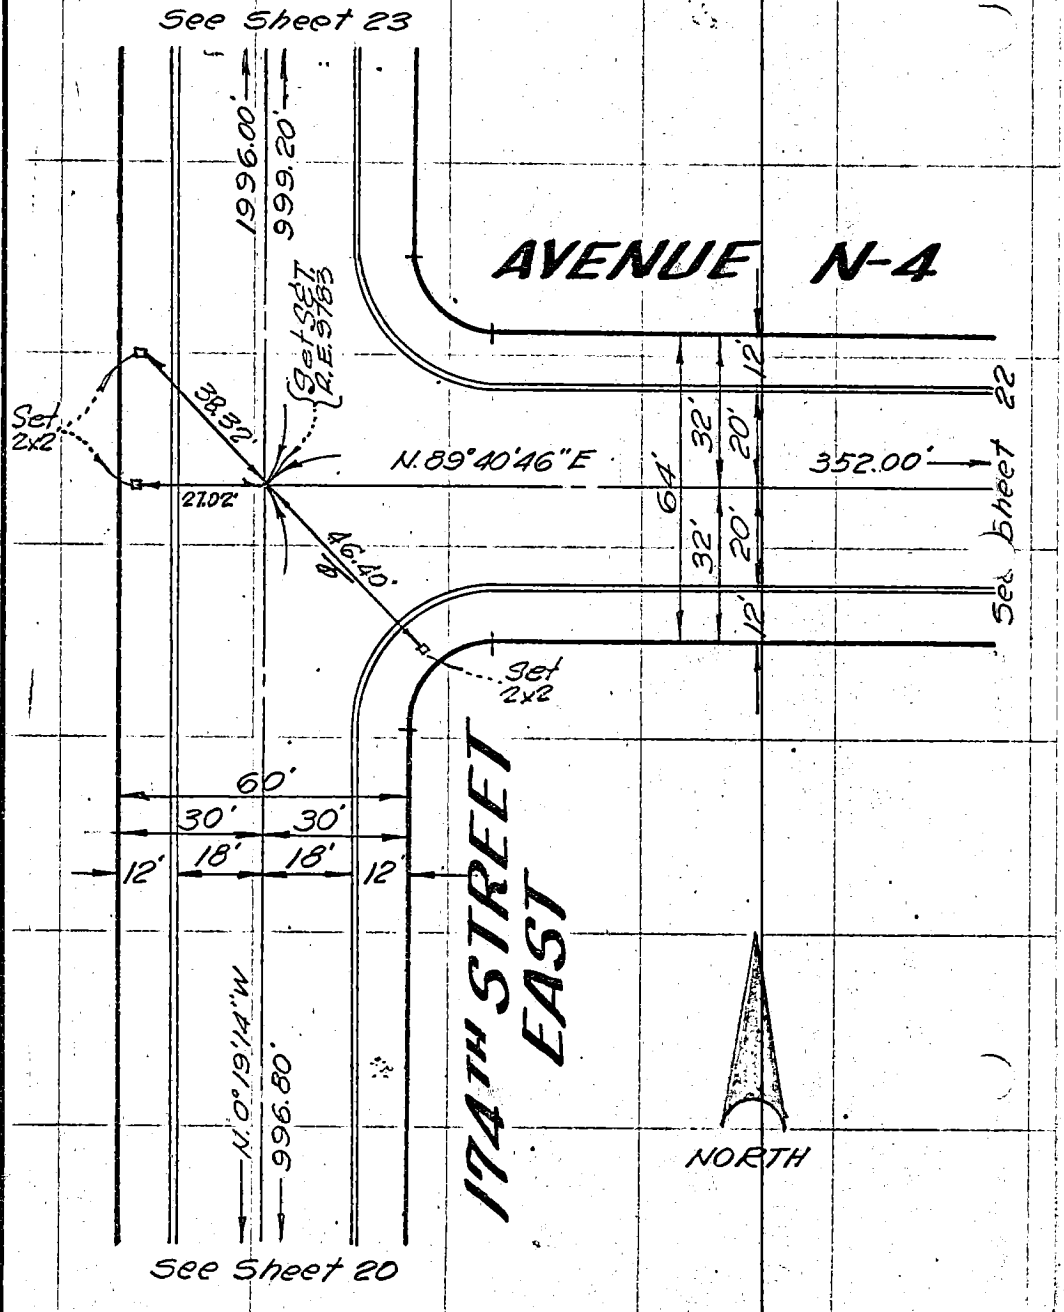


WS 7A-1

SO. CALIF. BLUE PRINT CO. — F-16

Co. Eng. F.B. 4005: 147

F. B. _____ PG. 22 SURVEY OF _____

TR. No. 28482 SURVEY BY E.L. PEARSON & ASSOCIATES R.C.E. 9783

DATE 1 - 12 - 70

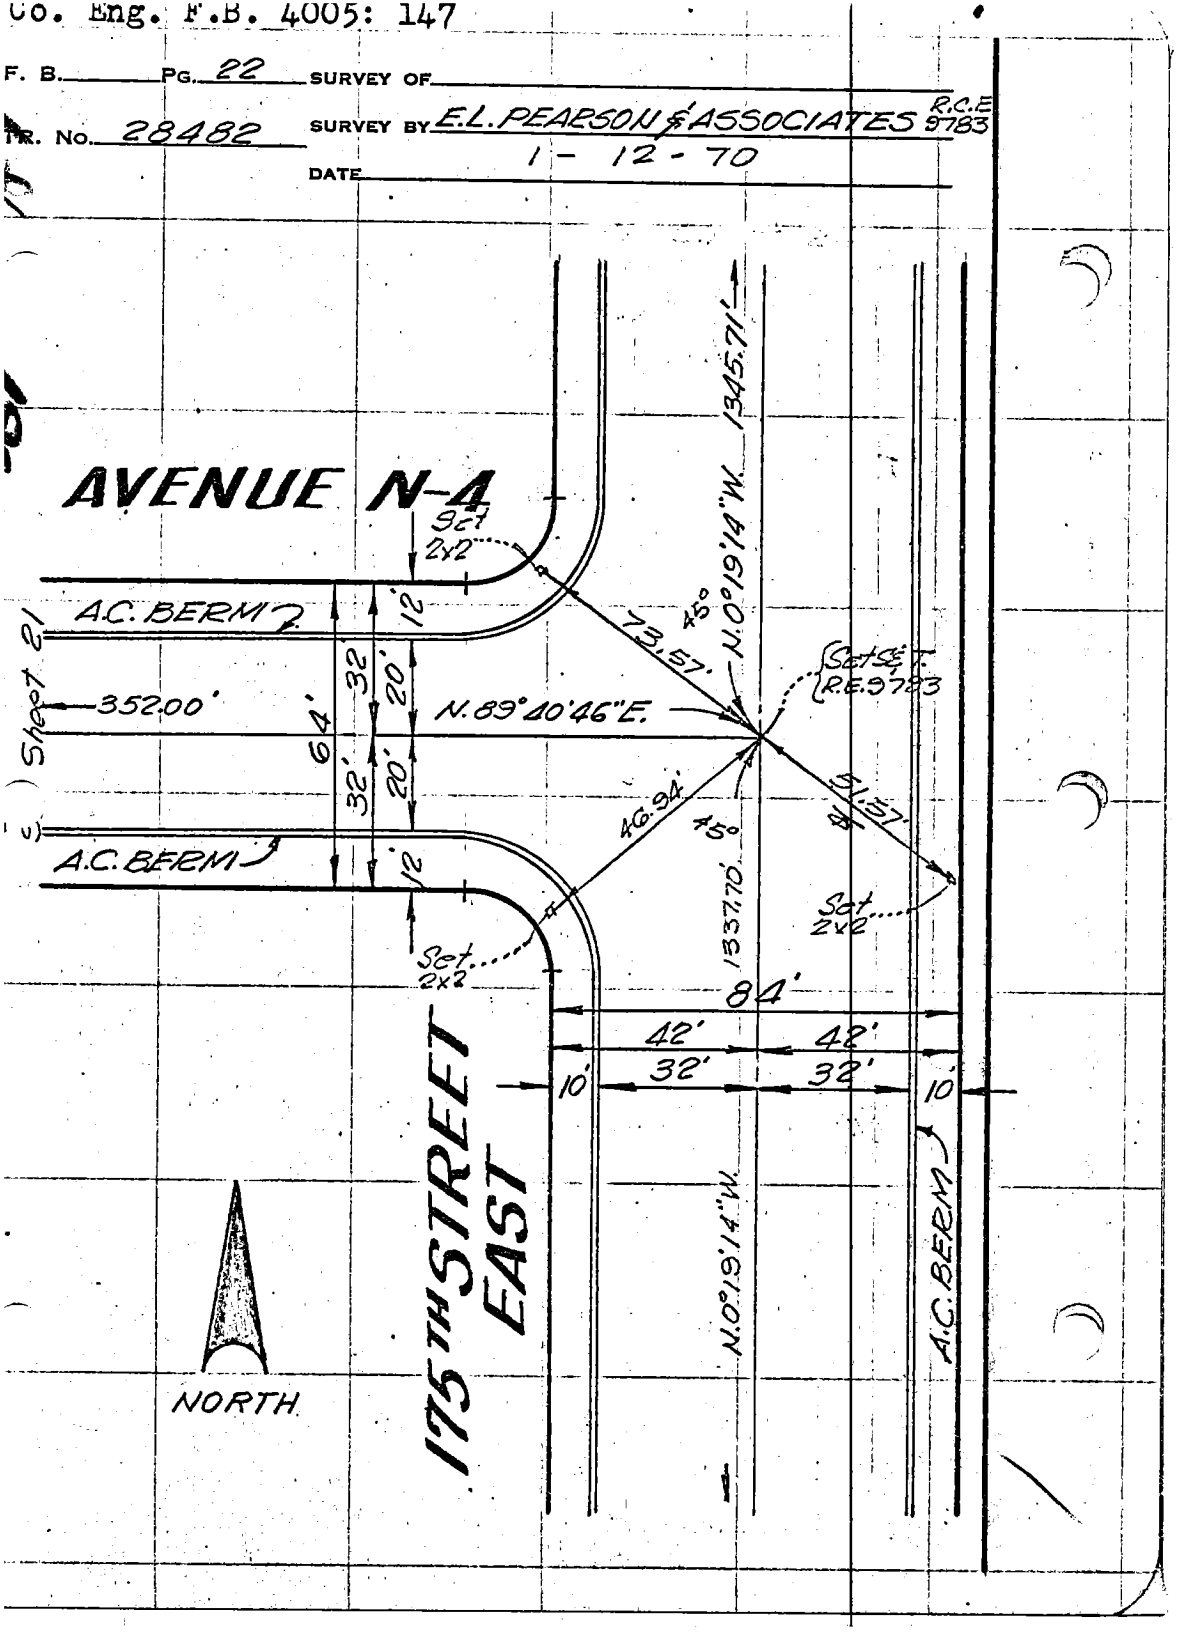

Co. Eng. F.B. 4005: 148.

SURVEY OF _____ F. B. _____ PG. 23

SURVEY BY E.L. PEARSON & ASSOCIATES R.C.E. 9783

DATE 1-12-70 TR. No. 28482

W567-4

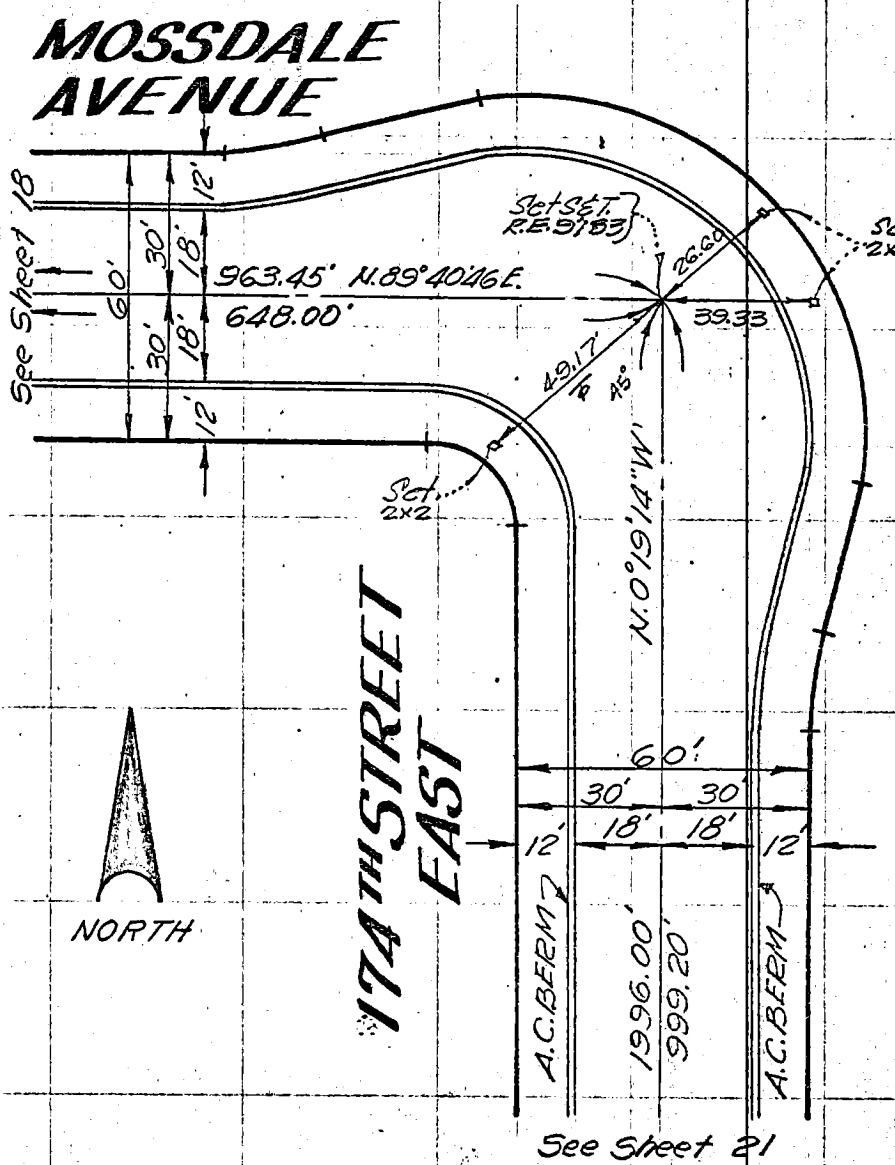


SO. CALIF. BLUE PRINT CO.

SURVEY OF _____ F. B. _____ PG. 24

SURVEY BY E.L. Pearson & Associates R.C.E. 9783 TR. No. 28482

DATE 2-3-70

W.S.67-1

SO. CALIF. BLUE PRINT CO.

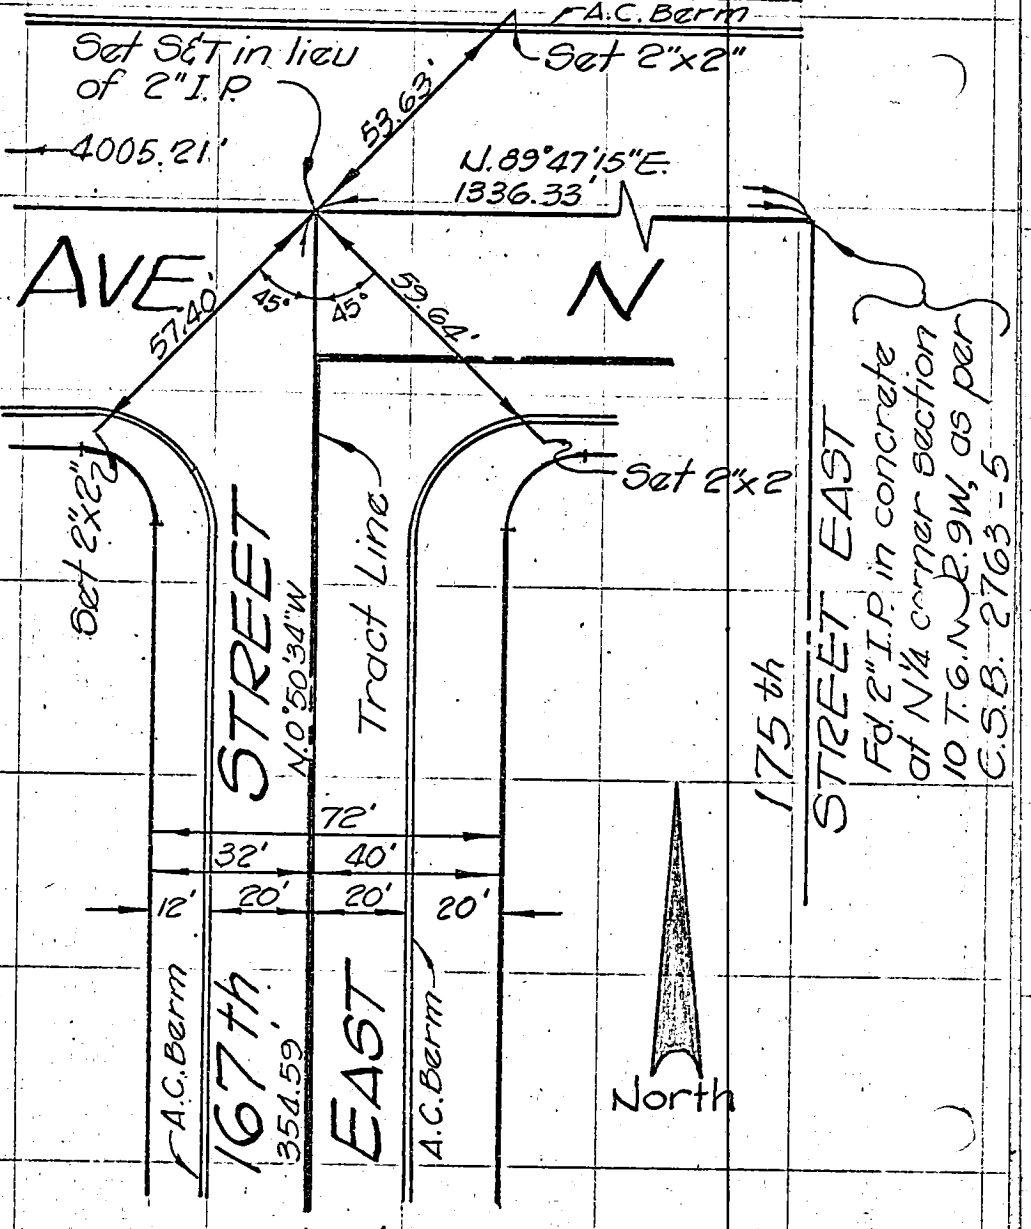


See Sheet 2

Co. Eng. F.B. 4005: 150

KEY MAP

SURVEY OF & TIES

F. B. 1 PG. 144

SURVEY BY ERVIN ENGINEERING

TR. NO 28949

DATE JULY - 1969

FRED F. ERVIN R.C.E. 11932

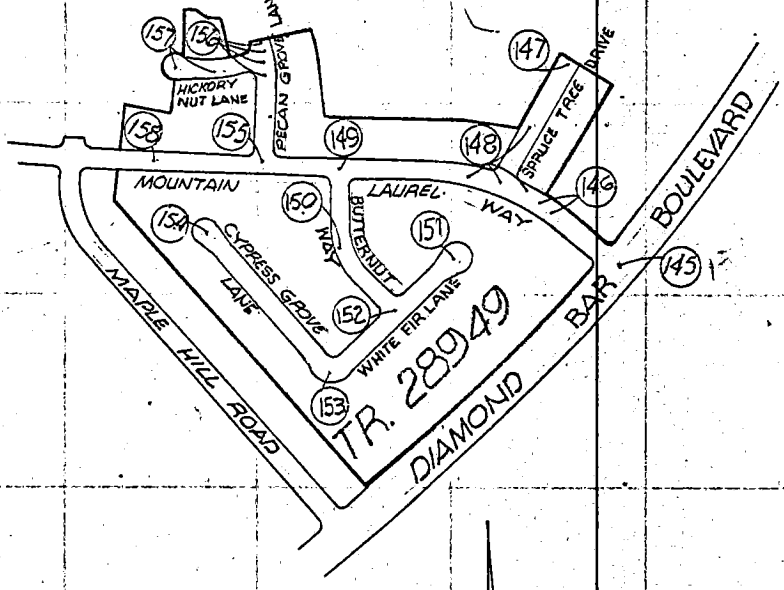


SO. CALIF. BLUE CO.

SURVEY OF: ℄ TIES — F. B. 1 PG. 145

SURVEY BY: ERVIN ENGINEERING

DATE: JULY-1969 — TR. No. 28949

FRED F. ERVIN R.C.E. 11932

NOTE:
ALL TIES ARE SET
LET IN CURB

WJ 099.337, A-J

SEE PAGE 146

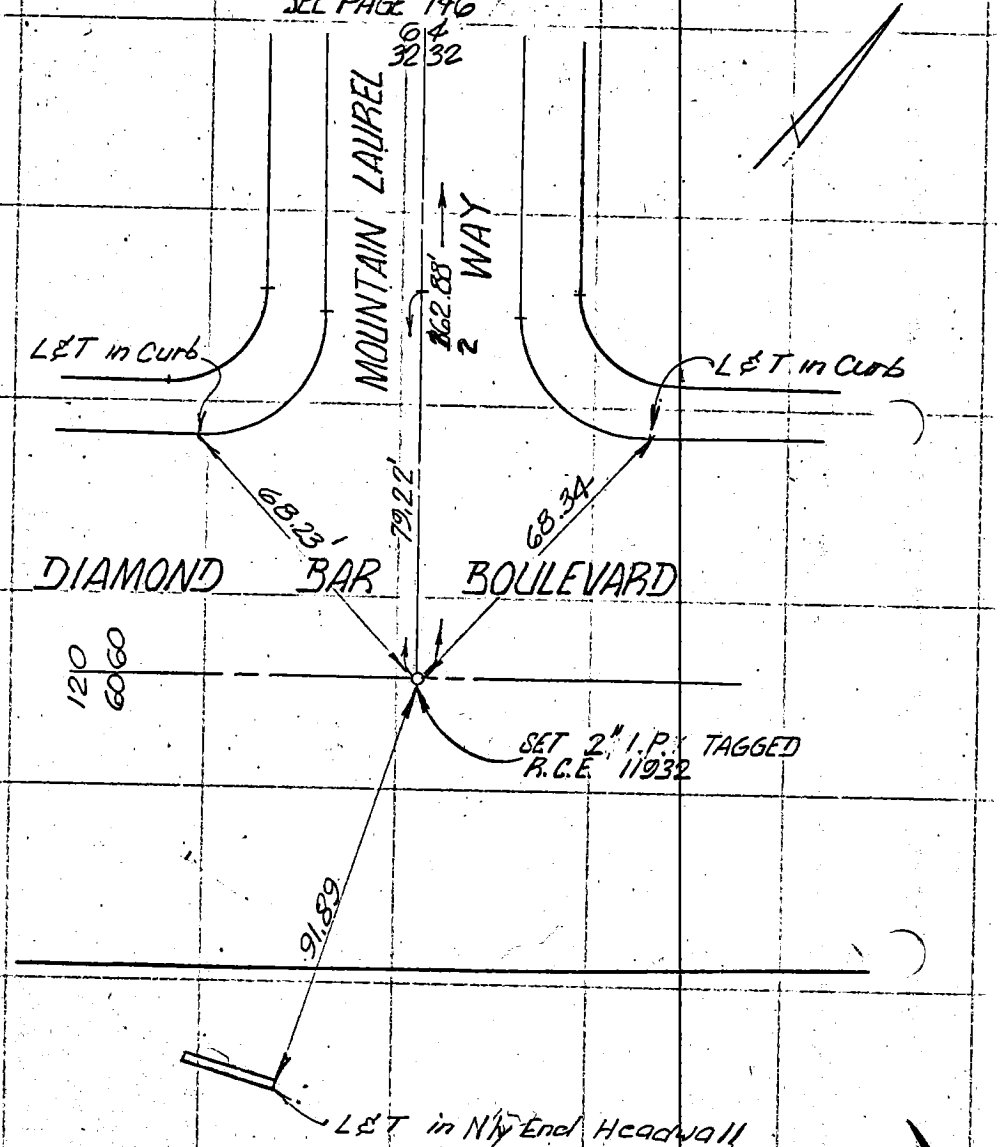


SO. CALIF. BLUE PRINT CO.

Co. Eng. F.B. 4005: 152

SURVEY OF: ℄ TIES — F. B. 1 — PG. 146

SURVEY BY: ERVIN ENGINEERING — TR. NO. 28949

DATE: JULY - 1969

FRED F. ERVIN R.C.E. 11932

NOTE:
ALL TIES ARE SET
LET IN CURB

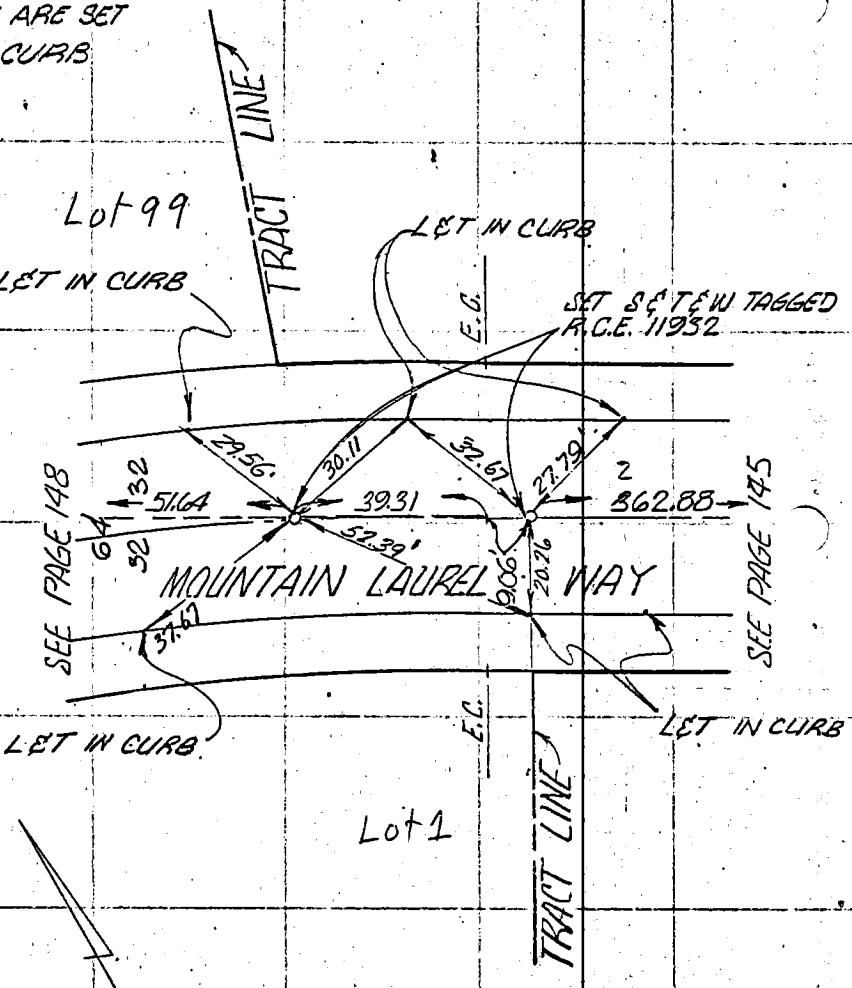


SO. CALIF. BLUE PRINT CO.

Co. Eng. F.B. 4005: 153

SURVEY OF ℄ TIES F. B. 1 PG. 147

SURVEY BY ERVIN ENGINEERING TR. No. 28949

DATE JULY-1969

FRED F. ERVIN R.C.E. 11932

NOTE:
ALL TIES ARE SET
LET IN CURB

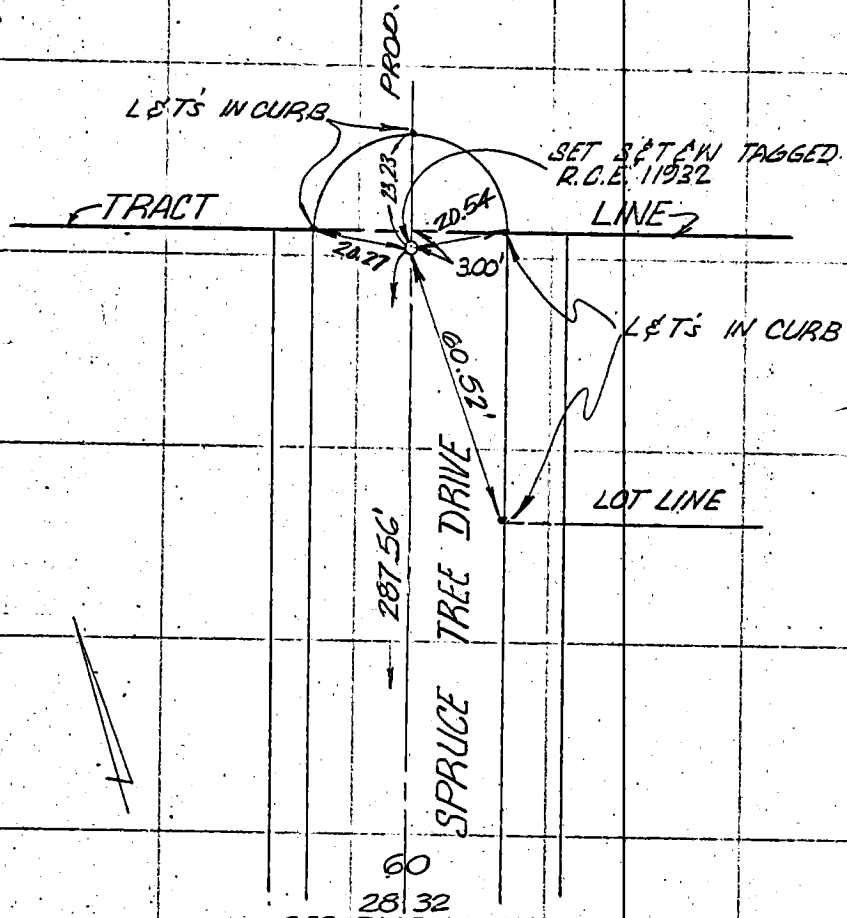


SEE PAGE 148

SO. CALIF. BLUE PRINT CO.

Co. Eng. F.B. 4005: 154

SURVEY OF ℄ TIES F. B. 1 PG. 148

SURVEY BY ERVIN ENGINEERING TR. No. 28040

DATE JULY - 1960

FRED F. ERVIN R.C.E. 11932

NOTE ALL TIES ARE SET

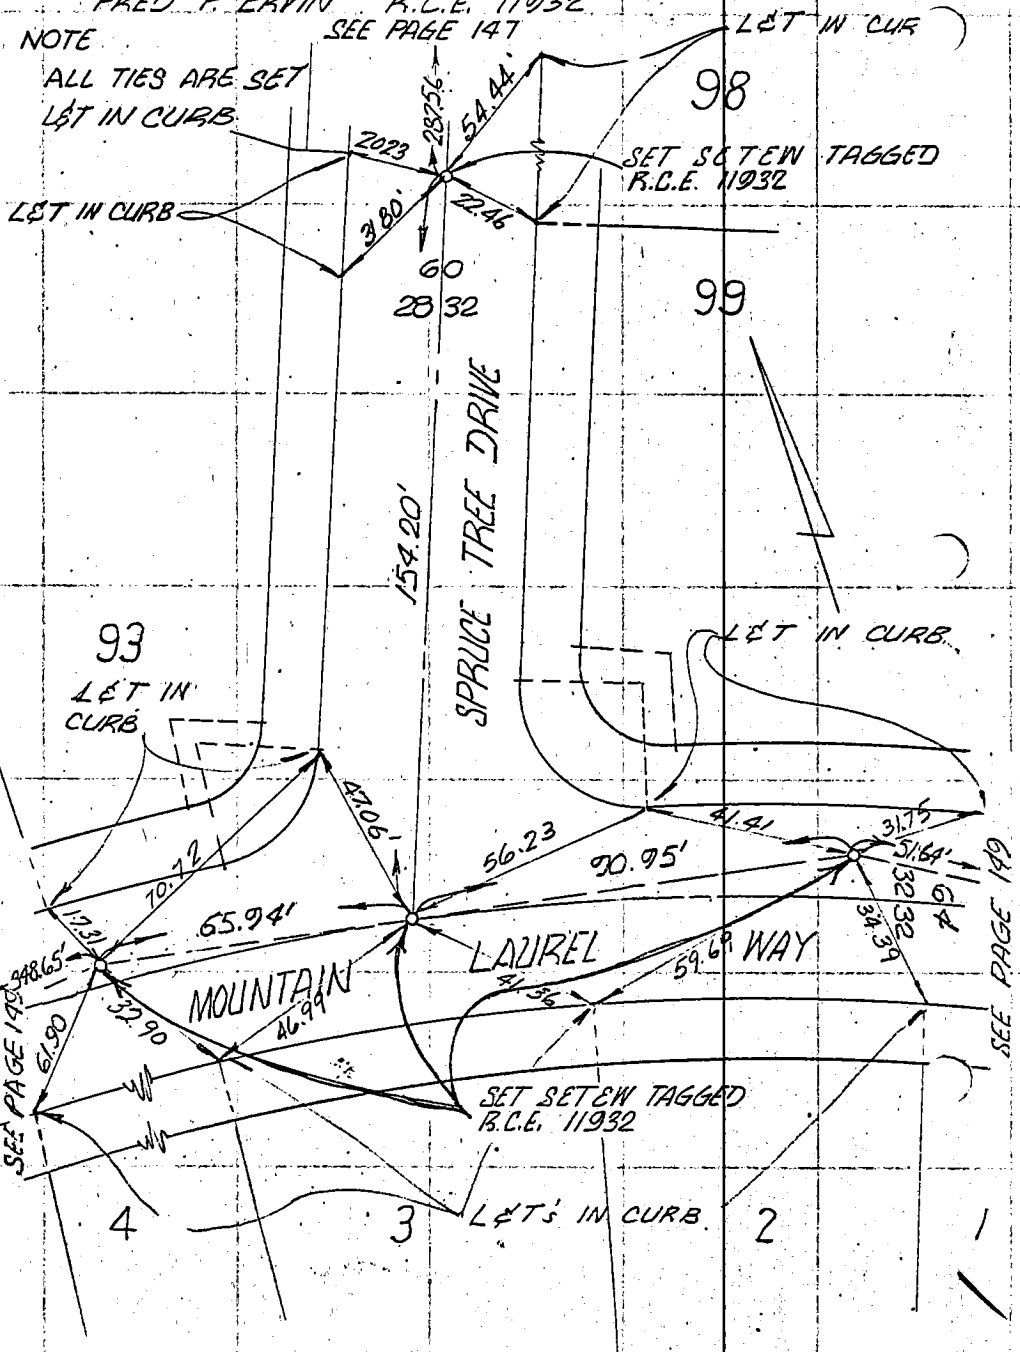


WS. 099-337.1A-1

SO. CALIF. BLUE PRINT CO.

Co. Eng. F.B. 4005: 155

SURVEY OF ℄ TIES F. B. 1 PG. 149

SURVEY BY ERVIN ENGINEERING TR. No. 28949

DATE JULY - 1969

FRED E. ERVIN R.C.E. 11932

WS, 099-337 A-1

NOTE
ALL TIES ARE SET
LET IN CURB

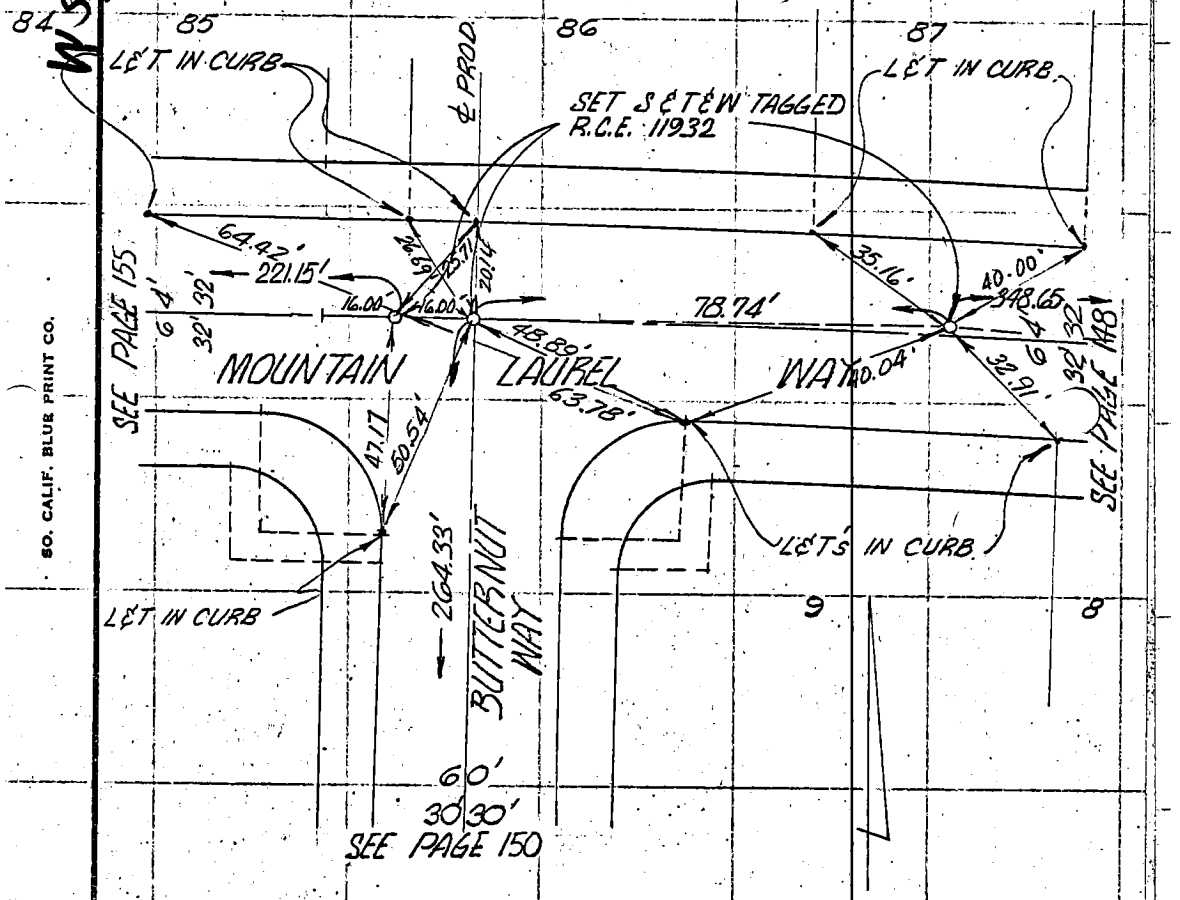


SO. CALIF. BLUE PRINT CO.

Co. Eng. F.B. 4005: 156

SURVEY OF ℄ TIES F. B. 1 PG. 150

SURVEY BY ERVIN ENGINEERING TR. NO. 28949

DATE JULY - 1969

FRED F. ERVIN R.C.E. 11932

NOTE
ALL TIES ARE SET
LET IN CURB

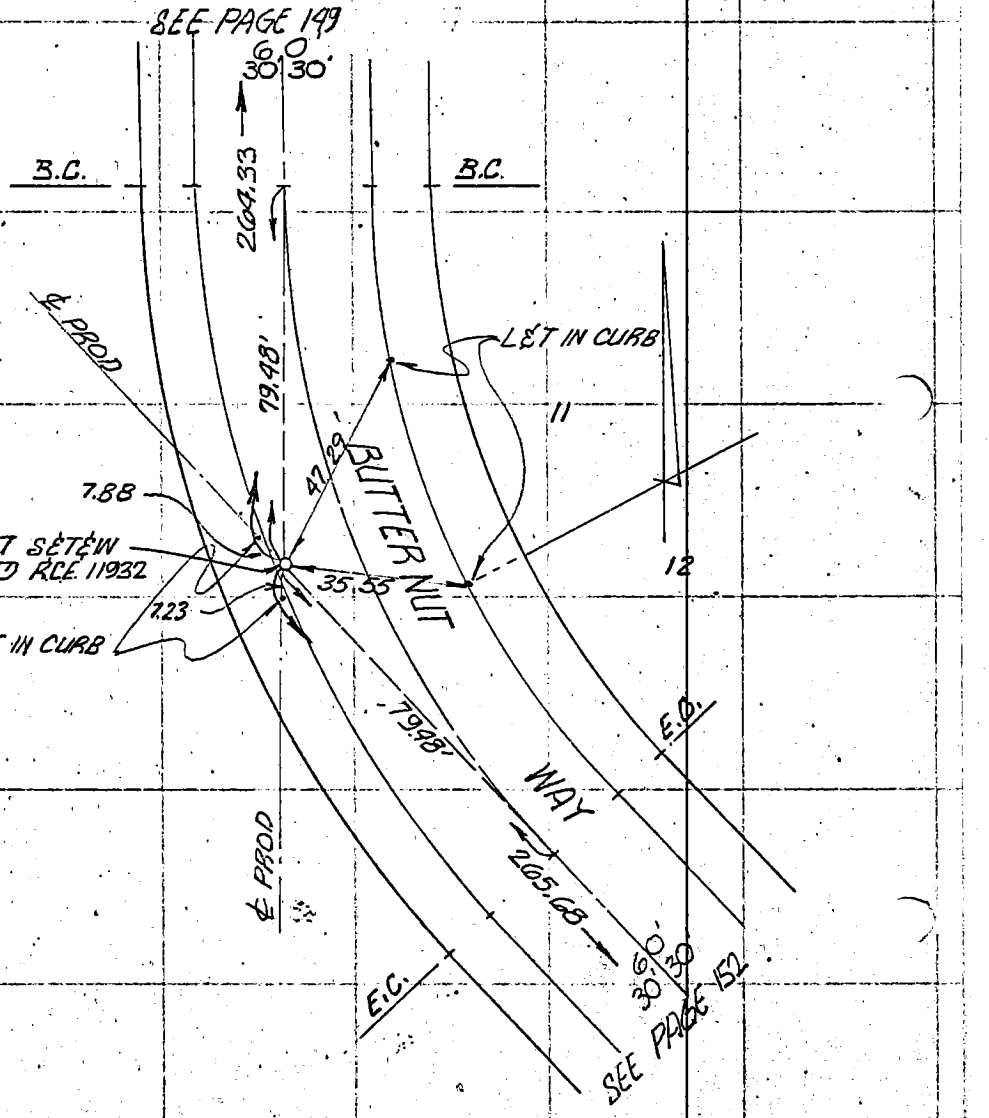


SO. CALIF. EDISON CO.

Co. Eng. F.B. 4005: 157

SURVEY OF ℄ TIES F. B. 1 PG. 151

SURVEY BY ERVIN ENGINEERING TR. No. 28949

DATE JULY 1969

FRED F. ERVIN R.C.E. 11932

NOTE
ALL TIES ARE SET
LET IN CURB

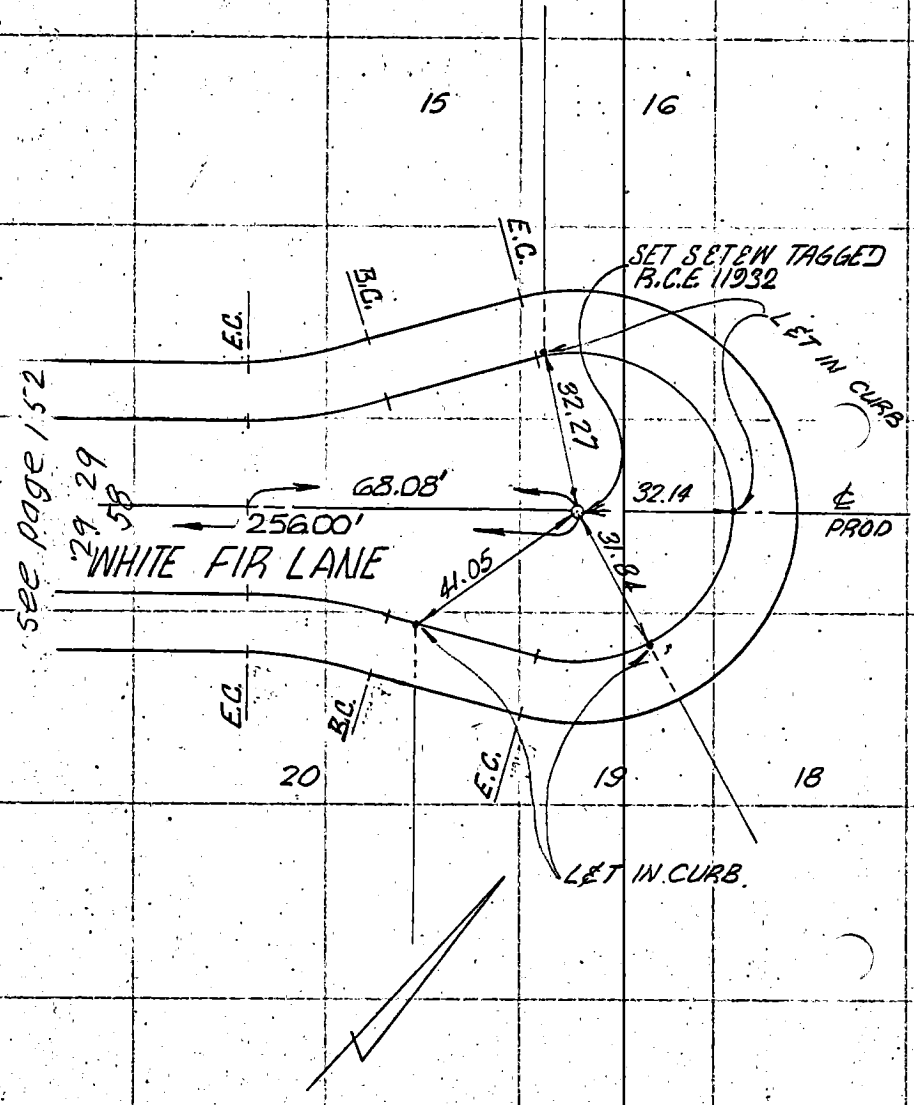


SO. CALIF. BLUE PRINT CO.

Co. Eng. F.B. 4005:158

SURVEY OF ℄ TIES F. B. 1 PG. 152

SURVEY BY ERVIN ENGINEERING TR. NO. 28940

DATE JULY - 1960

FRED F. ERVIN R.C.E. 11932

W.S. 09-337, A-1

NOTE
ALL TIES ARE SET
L&T IN CURB

SEE PAGE 150

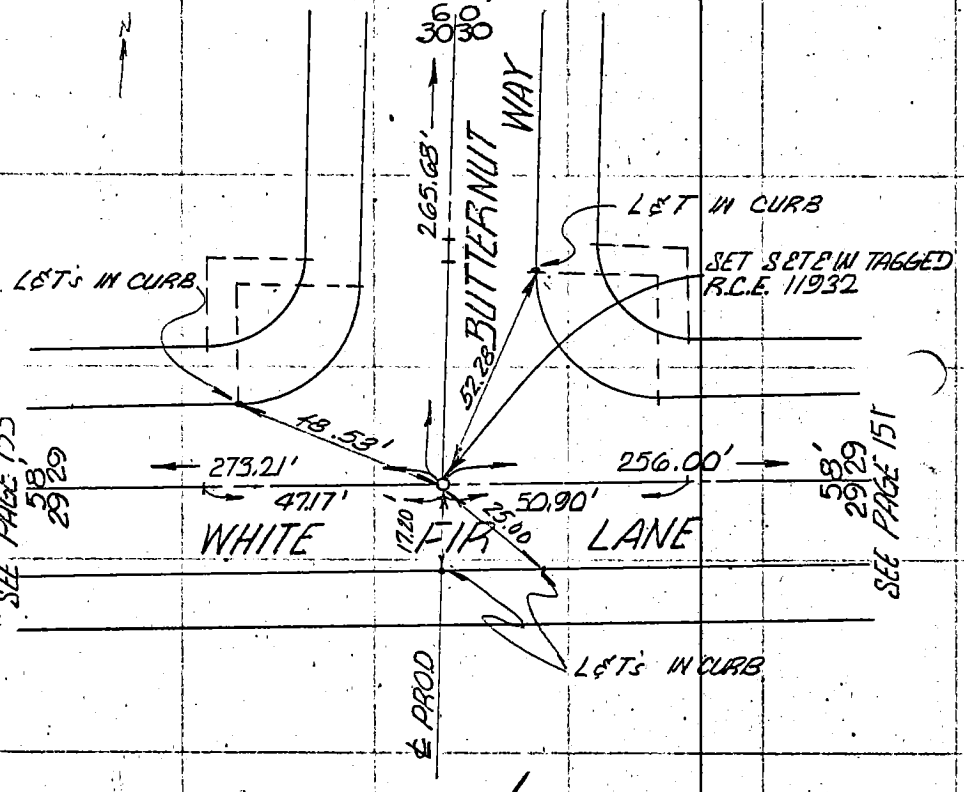


SO. CALIF. BLUE PRINT CO.

Co. Eng. F.B. 4005: 159

SURVEY OF ℄ TIES F. B. 1 PG. 153

SURVEY BY ERVIN ENGINEERING TR. No. 28949

DATE JULY-1969

FRED F. ERVIN R.C.E. 11932

NOTE
ALL TIES ARE SET
LET IN CURB

W.S. 099-337 A-1

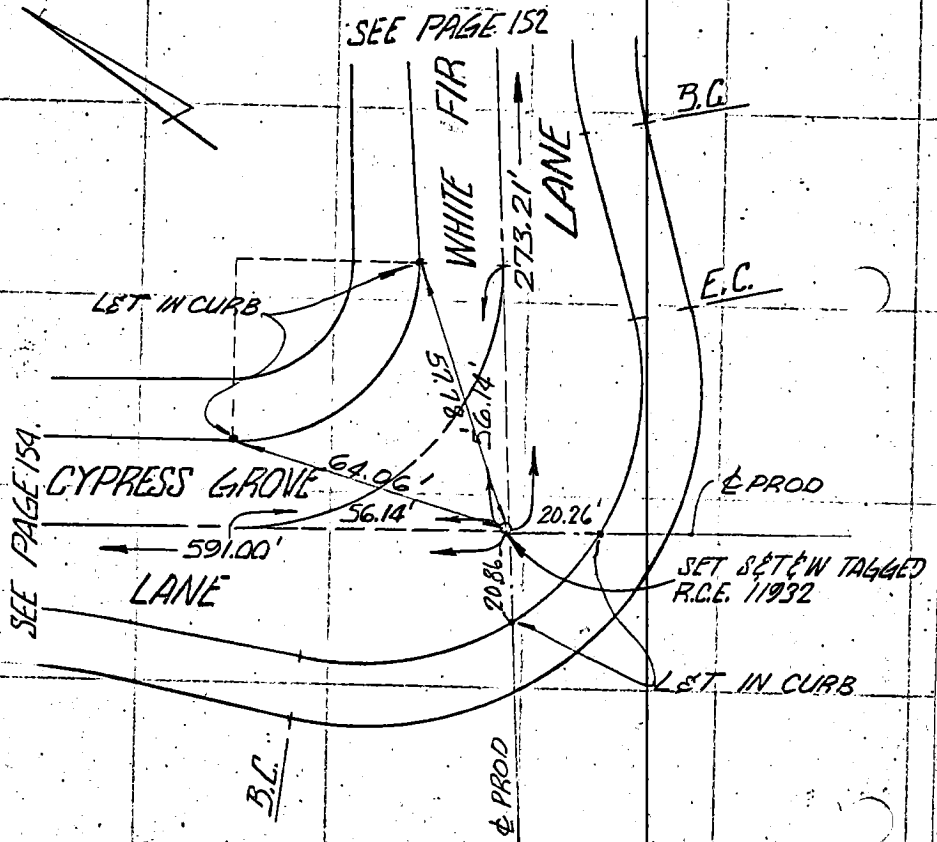


SO. CALIF. BLUE PRINT CO.

Co. Eng. F.B. 4005: 160

SURVEY OF ℄ TIES F. B. 1 PG. 154

SURVEY BY ERVIN ENGINEERING TR. No. 28949

DATE JULY - 1969

FRED F. ERVIN R.C.E. 11932

NOTE:
ALL TIES ARE SET
L&T IN CURB

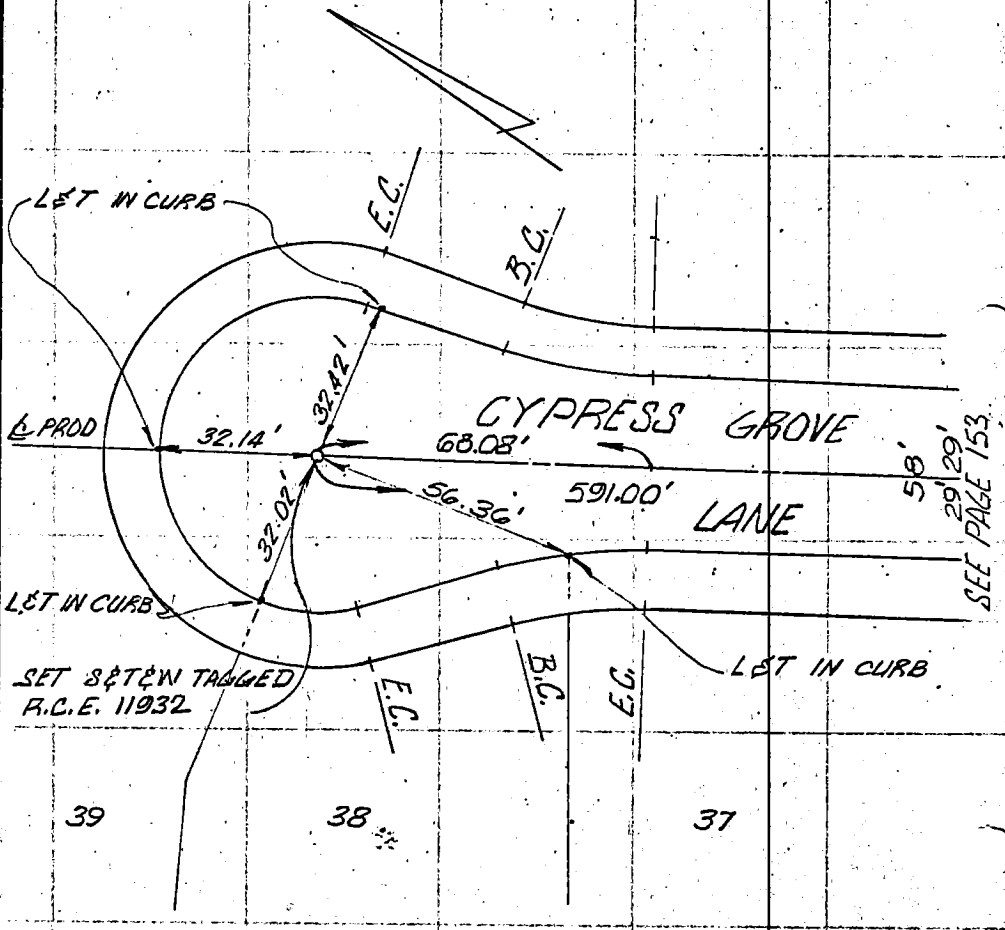


SO. CALIF. BLUE PR. CO.

Co. Eng. F.B. 4005: 101

SURVEY OF ℄ TIES F. B. 1 PG. 155

SURVEY BY ERVIN ENGINEERING TR. No. 28949

DATE JULY - 1969

FRED F. ERVIN R.C.E. 11932

WS 099-337 A-1

NOTE
ALL TIES ARE SET
LET IN CURB

SEE PAGE 156

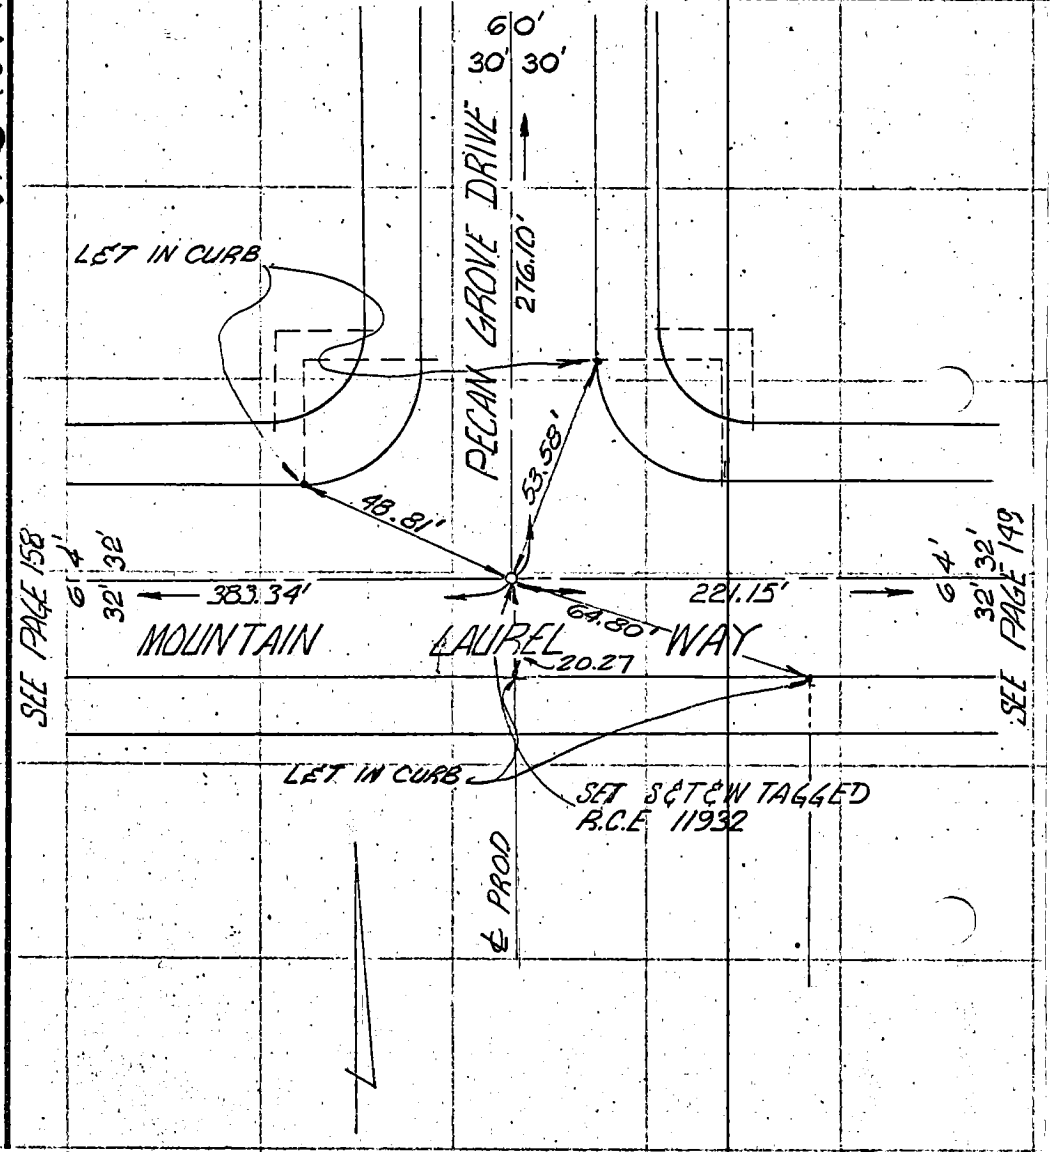


SEE PAGE 158

SEE PAGE 149

SO. CALIF. BLUE PRINT CO.

Co. Eng. F.B. 4005: 162

W.S.099-337, A-1

SURVEY OF ℄ TIES F. B. 1 PG. 156

SURVEY BY ERVIN ENGINEERING TR. NO. 28949

DATE JULY - 1969

FRED F. ERVIN R.C.E. 11032

NOTE
ALL TIES ARE SET
LET IN CURB

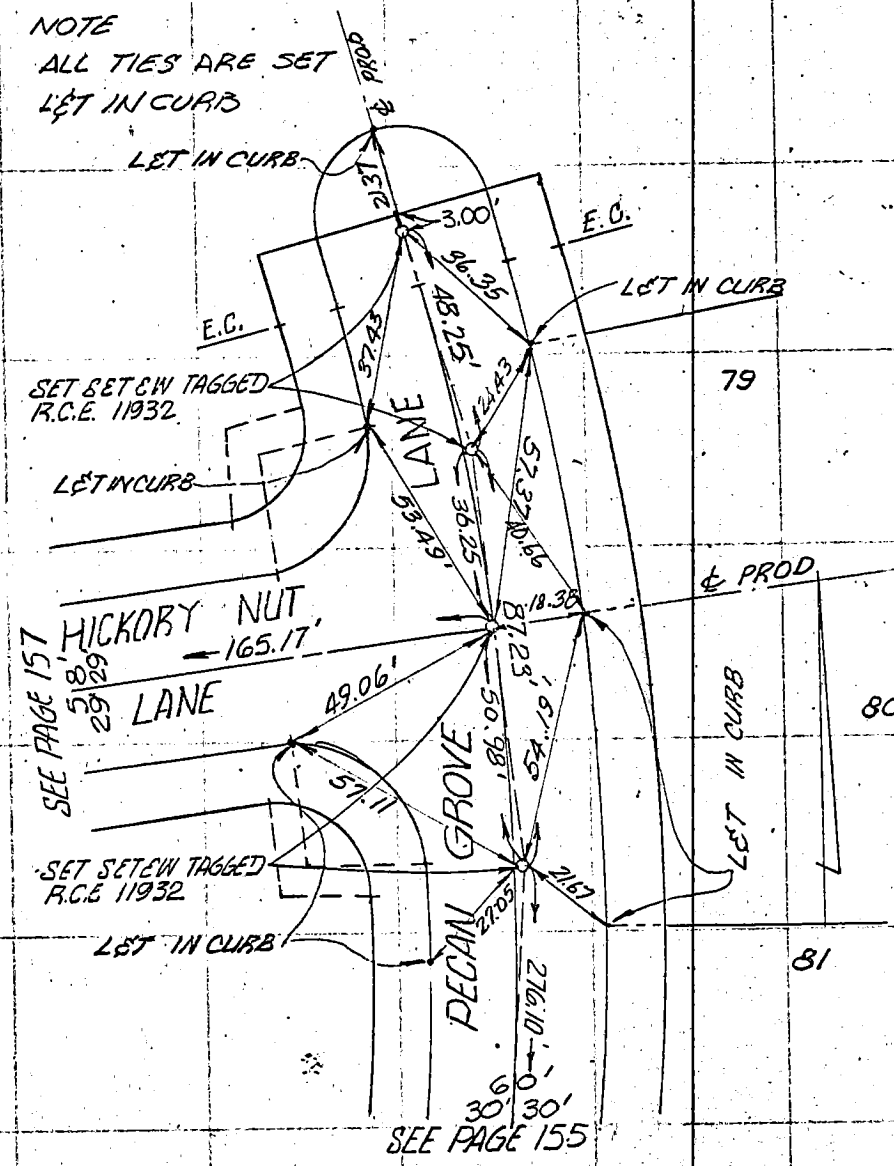


SO. CALIF. BLUE PRINT CO.

Co. Eng. F.B. 4005: 163

SURVEY OF & TIES

F. B. 1 PG. 157

SURVEY BY ERVIN ENGINEERING

DATE JULY - 1969

TR. No. 28949

FRED F. ERVIN R.C.E 11932

ALL TIES ARE SET
LET IN CURB

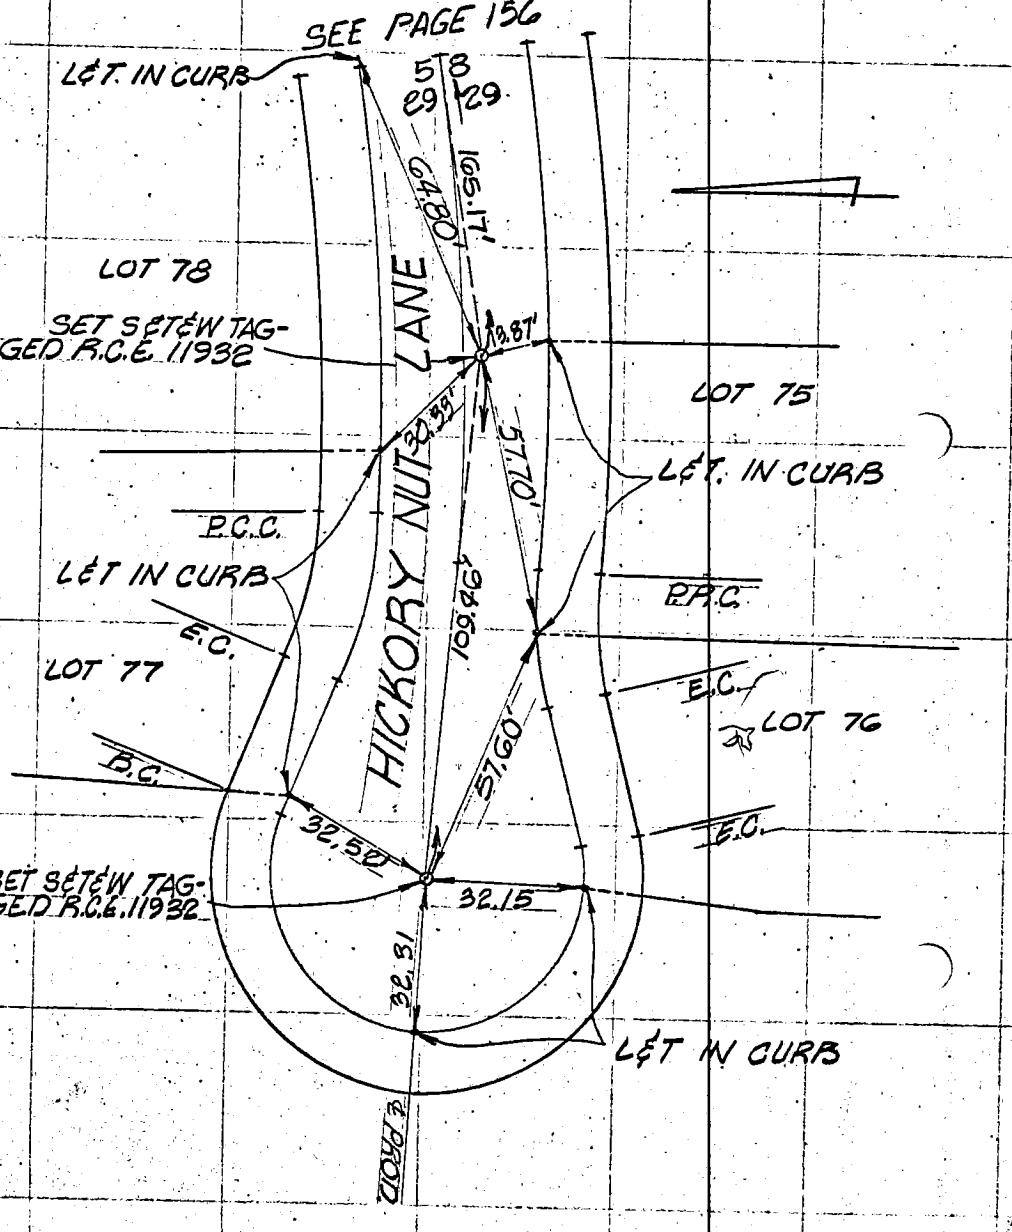


SO. CALIF. BLUE PRINT CO.

Co. Eng. F.B. 4005: 164

SURVEY OF ℄ TIES F. B. 1 PG. 158

SURVEY BY ERVIN ENGINEERING TR. No. 28949

DATE JULY - 1969

FRED F. ERVIN R.C.E. 11932

NOTE
ALL TIES ARE SET
L℄T IN CURB

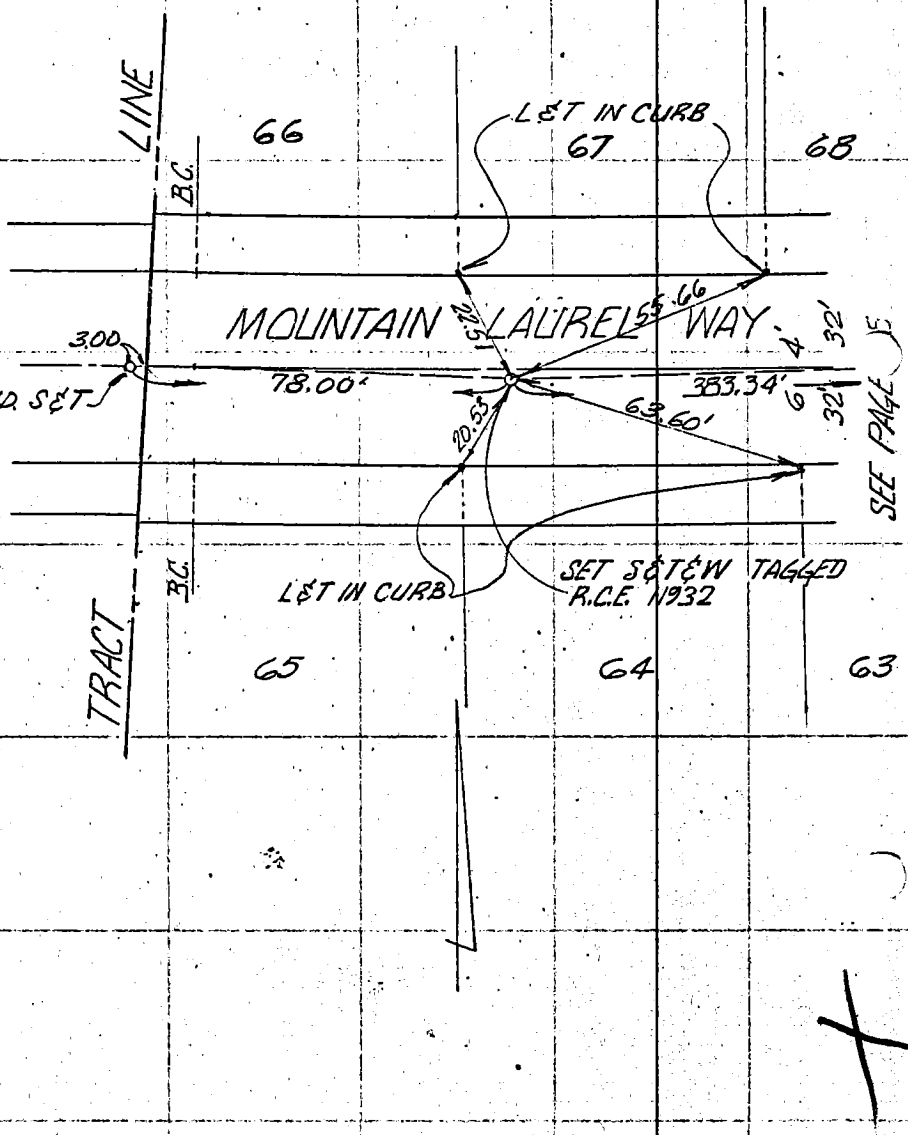


SO. CALIF. BLUE PRINT CO.

Co. Eng. F.B. 4005: 165

SURVEY OF TIES F. B. PG. 1

SURVEY BY Verpet Engineering Co TR. No. 50995

DATE 3-10-70

Martin Petrasek R.C.E. 16586

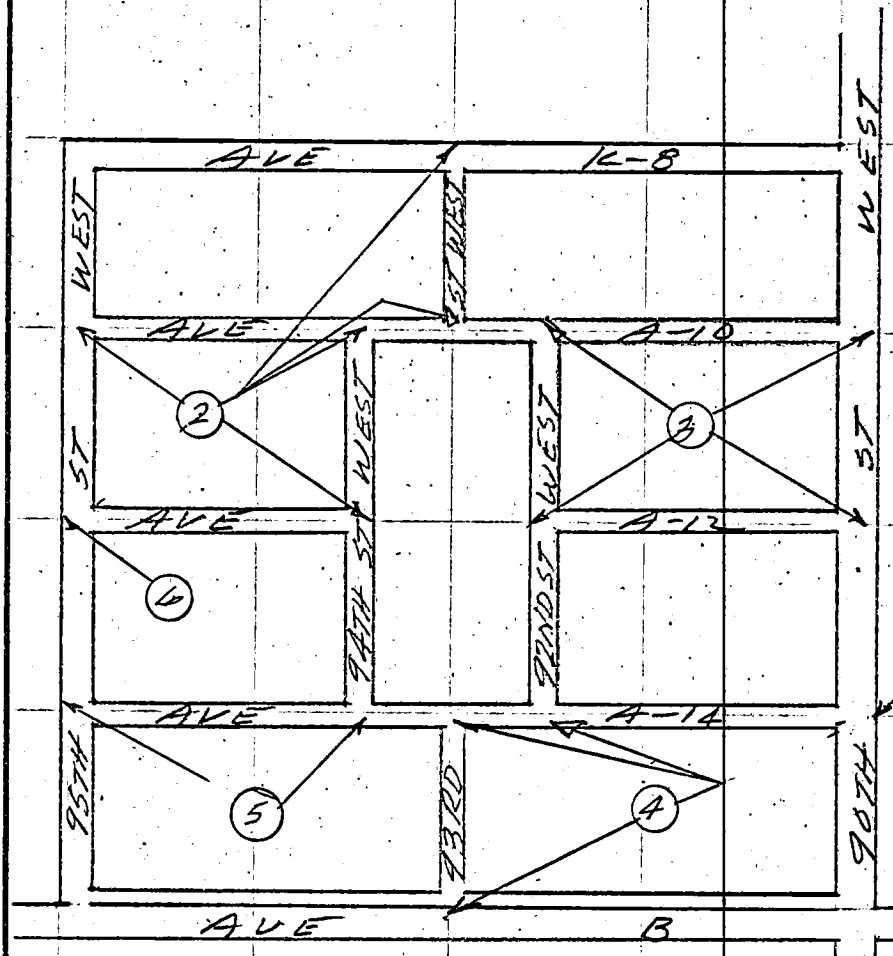


PAGE INDEX

NO SCALE

NOTE: All 2x2 ties o-c 8" below surface ground.

SO. CALIF. BLUE PRINT CO.

Co. Eng. F.B. 4005: 166

SURVEY OF & TIES F. B. PG. 2

SURVEY BY Verpet Engineering Co TR. No. 30985

DATE 3-10-76

Martin Petrasek - R.C.E. 16586

Measured distances are corrected to GSF

WS714-1

SO. CALIF. BLUE PRINT CO.

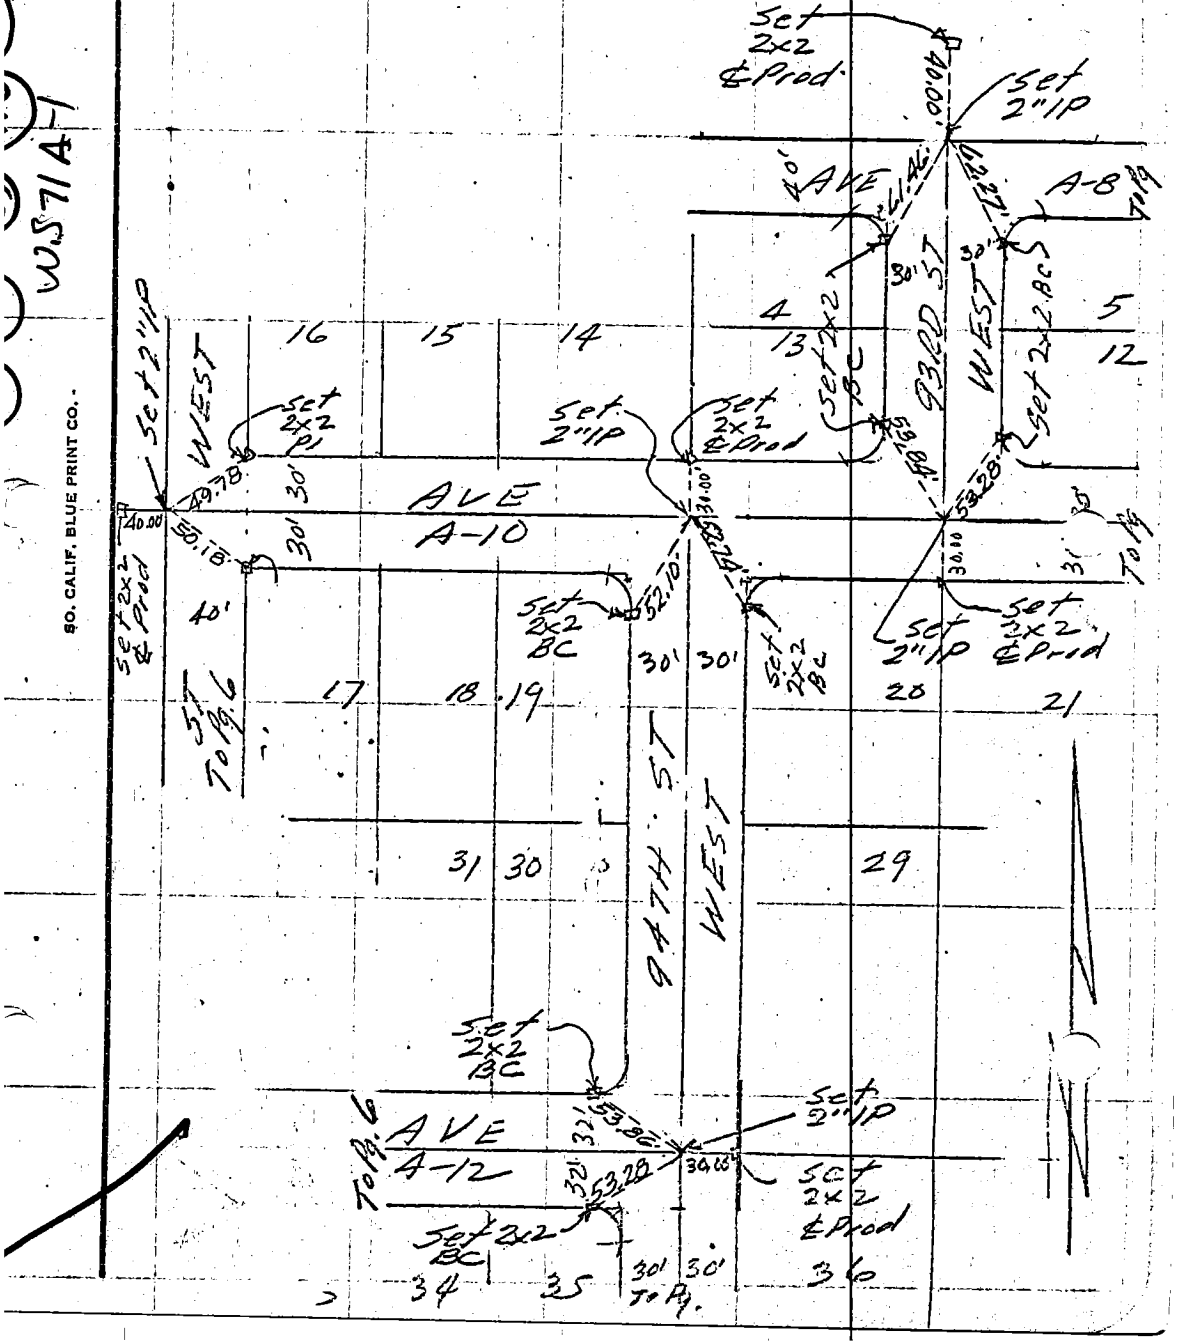

Co. Eng. F.B. 4005 : 167

SURVEY OF ETIES F. B. 3 PG.

SURVEY BY Verpet Eng. Co. TR. No. 30985

DATE 3-10-70

Martin Petrasek RCE 16586

Measured distances are corrected to ⌀ of

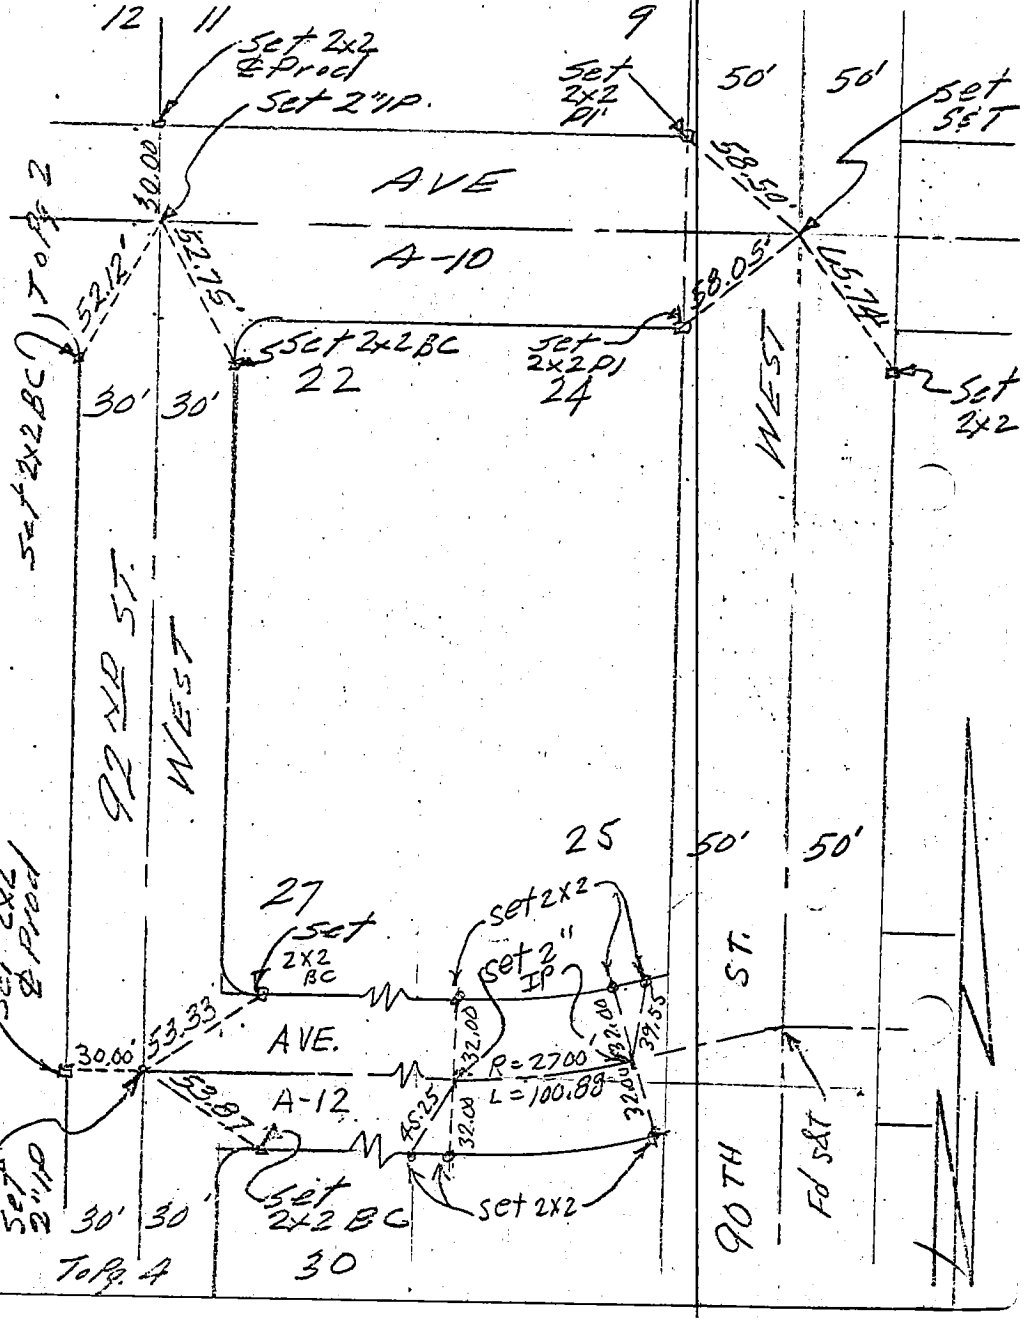


W.S. 7, 14-1

SO. CALIF. BLUE PRINT CO.

Co. Eng. F.B. 4005: 168

SURVEY OF E TIES F. B. PG. 4

SURVEY BY Verpat Engineering Co TR. No. 30985

DATE 3-10-70

Martin Petrasek R.C.E. 16586

Measured distances are corrected to 68°F.

(117) (118) (119) WS 71 A-1

SO. CALIF. BLUE PRINT CO.

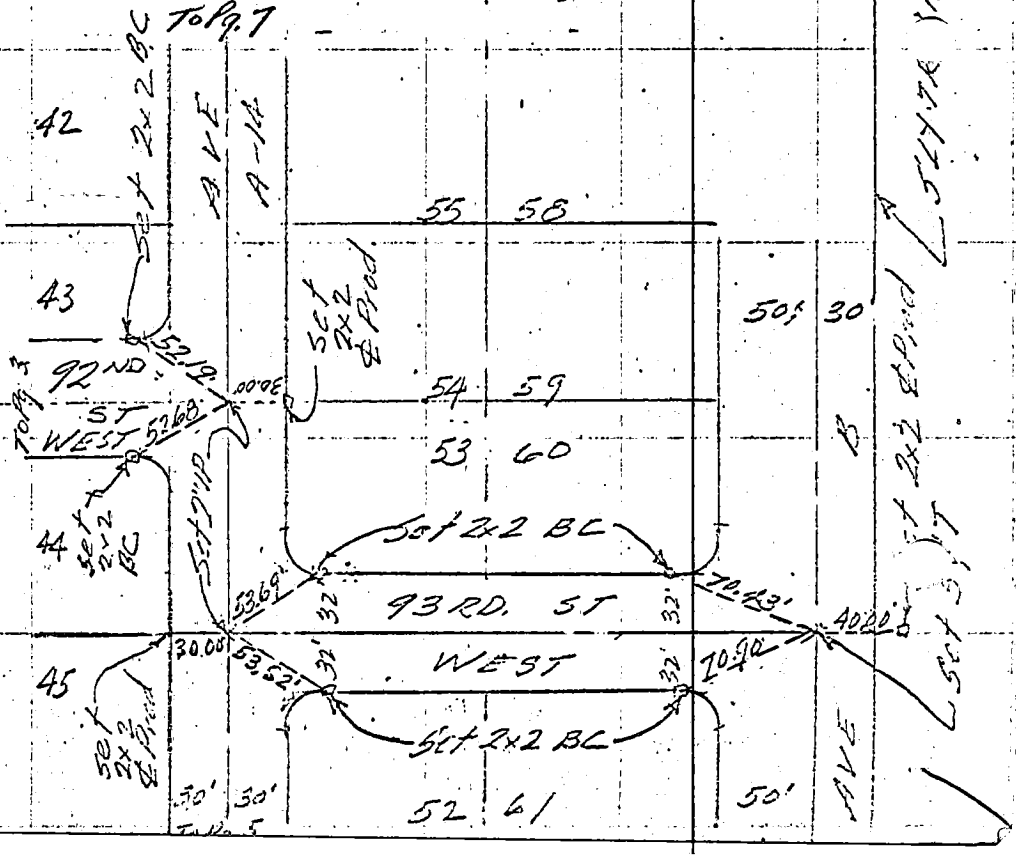

Co. Eng. F.B. 4005: 169

F. B. ____ PG. 5 SURVEY OF CITIES

TR. No. 30985 SURVEY BY Verpet Engineering Co

DATE 3-10-70

Martin Petrasek R.C.E. 16586

Measured distances are corrected to USF

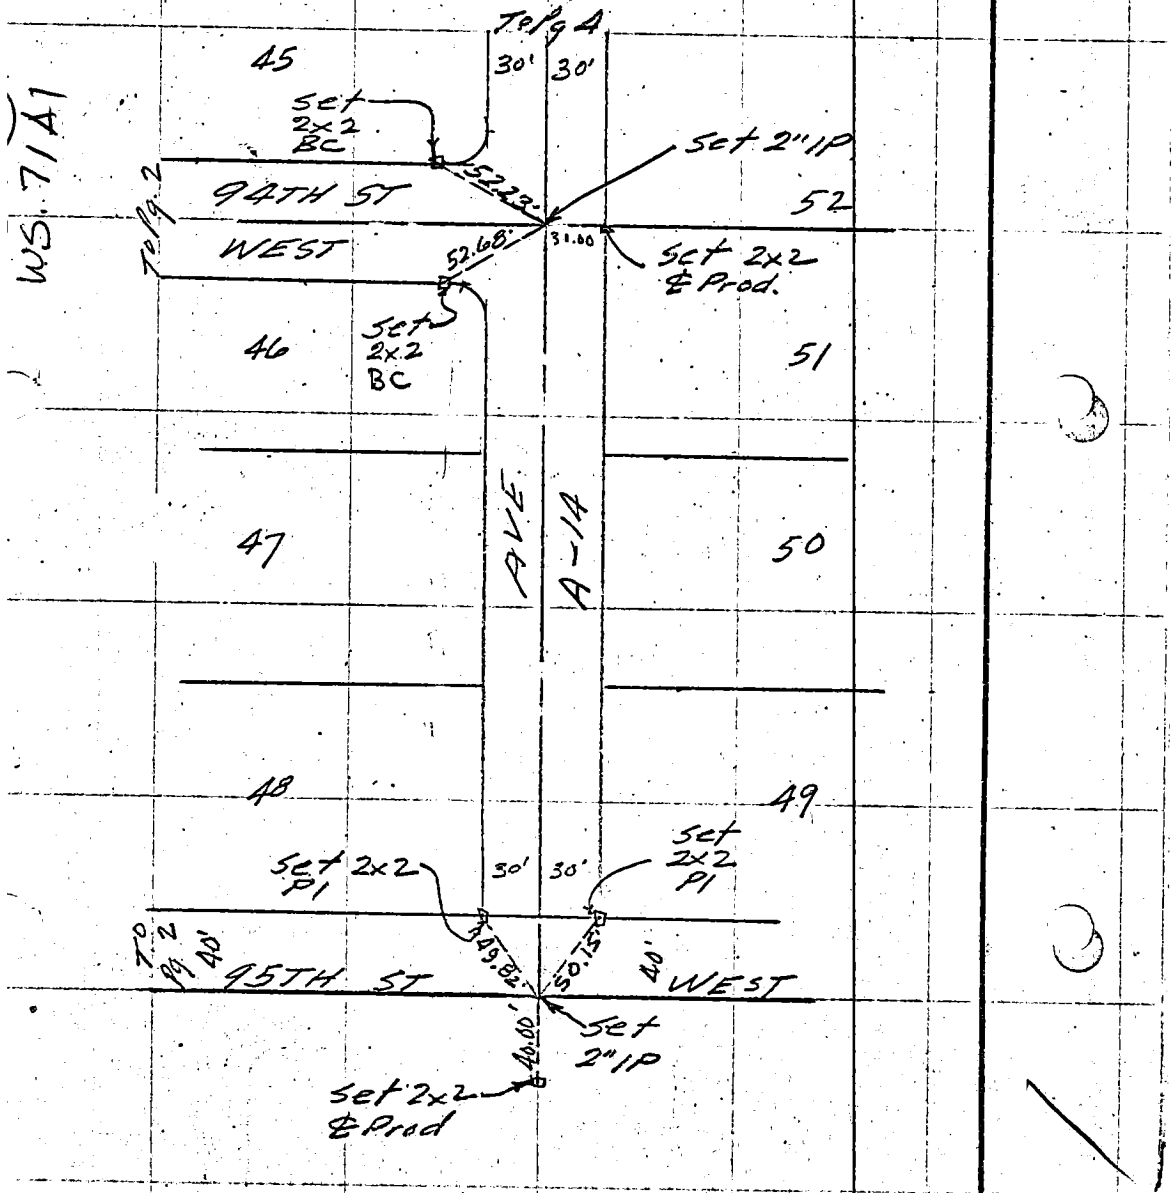

Co. Eng. F.B. 4005: 170

SURVEY OF E TIES F. B. PG. 6

SURVEY BY Verpet Eng. Co. TR. No. 30985

DATE 3-9-70

Martin Petrasek R.E. 16586
Measured distances are corrected to 68°F.

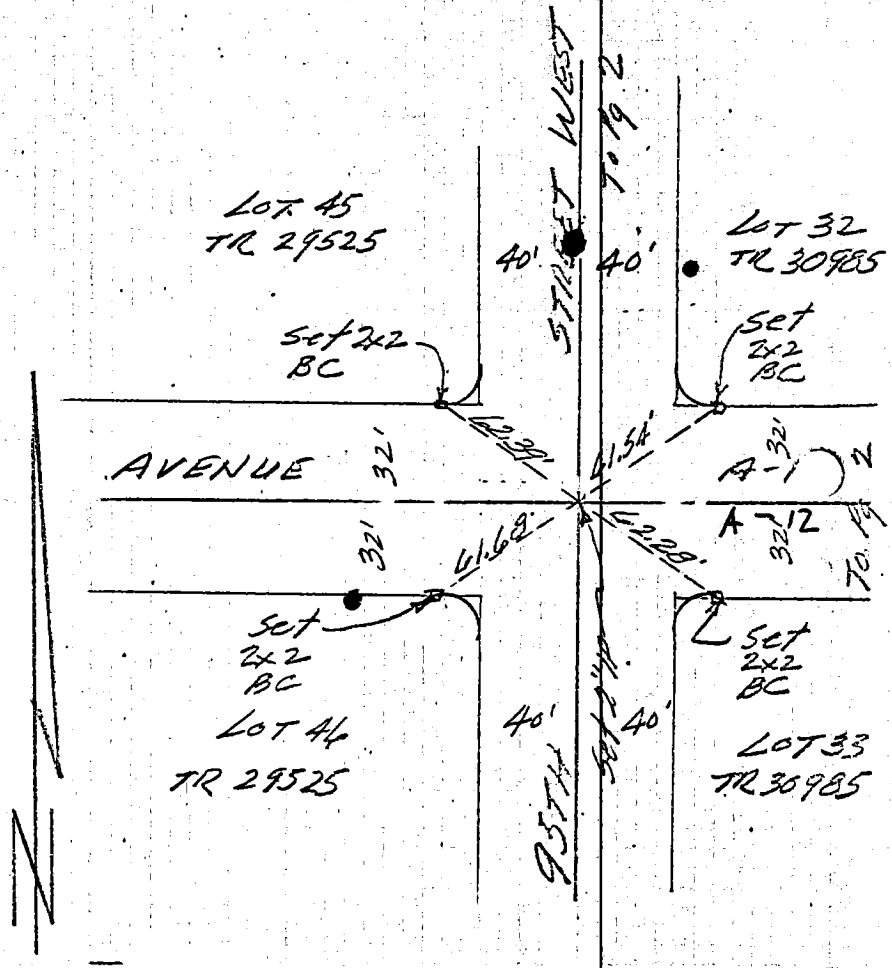


(11) WS704-1

SO. CALIF. BLUE PRINT CO.

F. B. _____ PG. 7 SURVEY OF ETIES

TR. No. 30985 SURVEY BY Verpet Eng Co.

DATE 3-9-70

Martin Petrasek R.C.E. 16586
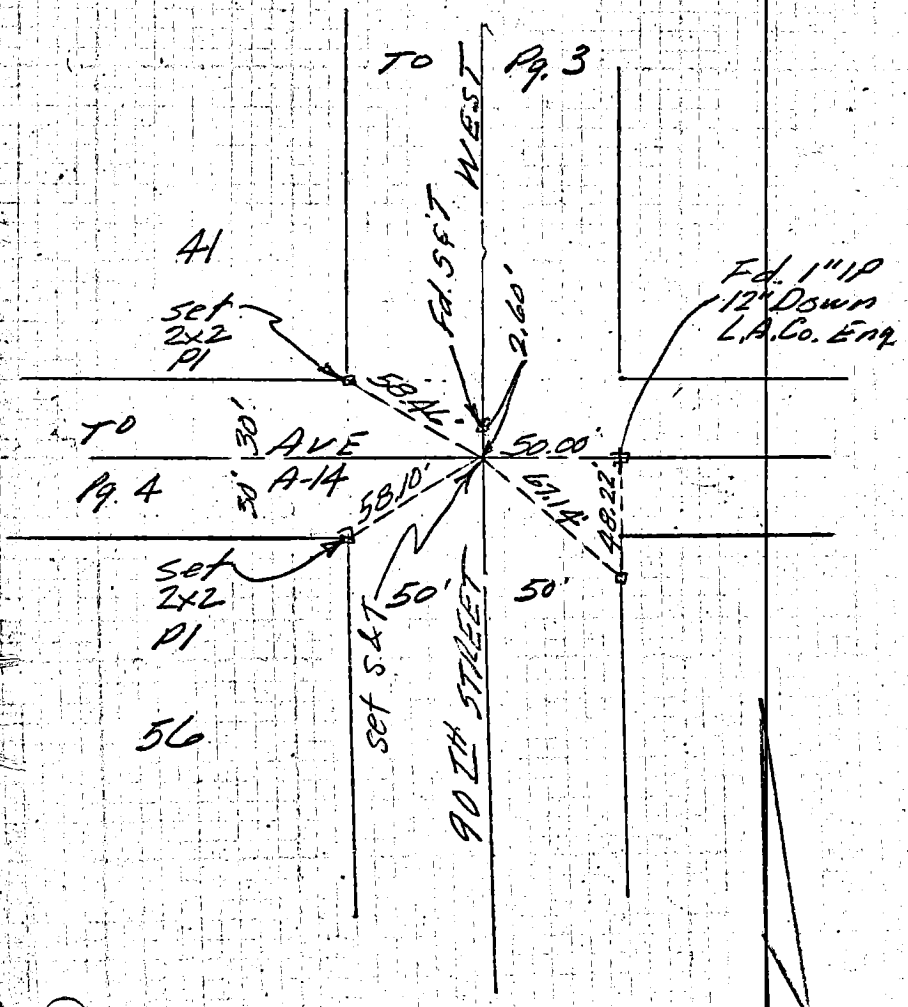
Measured distances are corrected to 68° F