4363:

13-40 55

PGS: 23-55
HAVE BEEN INDEXED
INTO PWFB'S.
09-13-90 J.C.S.

Notes Ck'd by

Map No.

Office Work

Checked

Date

Survey of OLIVE VIEW MIDVALLEY F.B. 4363 PG. 5

JN 0022.08 Tape 29 Std 84 °F

Surveyed by B.R. JACKSON

Notes B.R. JACKSON Date 8 MAY 75

Indexed G.D. BAILEY AUG 11 '75

OLIVE VIEW MID VALLEY UNIT GENERAL HOSPITAL BOULEVARD MEDICAL BUILDING

J.N. 0022.08

ESTABLISMENT OF VERTICAL CONTROL FOR TOPOG.

PARTY

J.P. MENNE
B.R. JACKSON
R.R. RODRIGUEZ
T. OHASHI

F.B. 4363 PG. 6

INDEX

TOPOG CONTROL

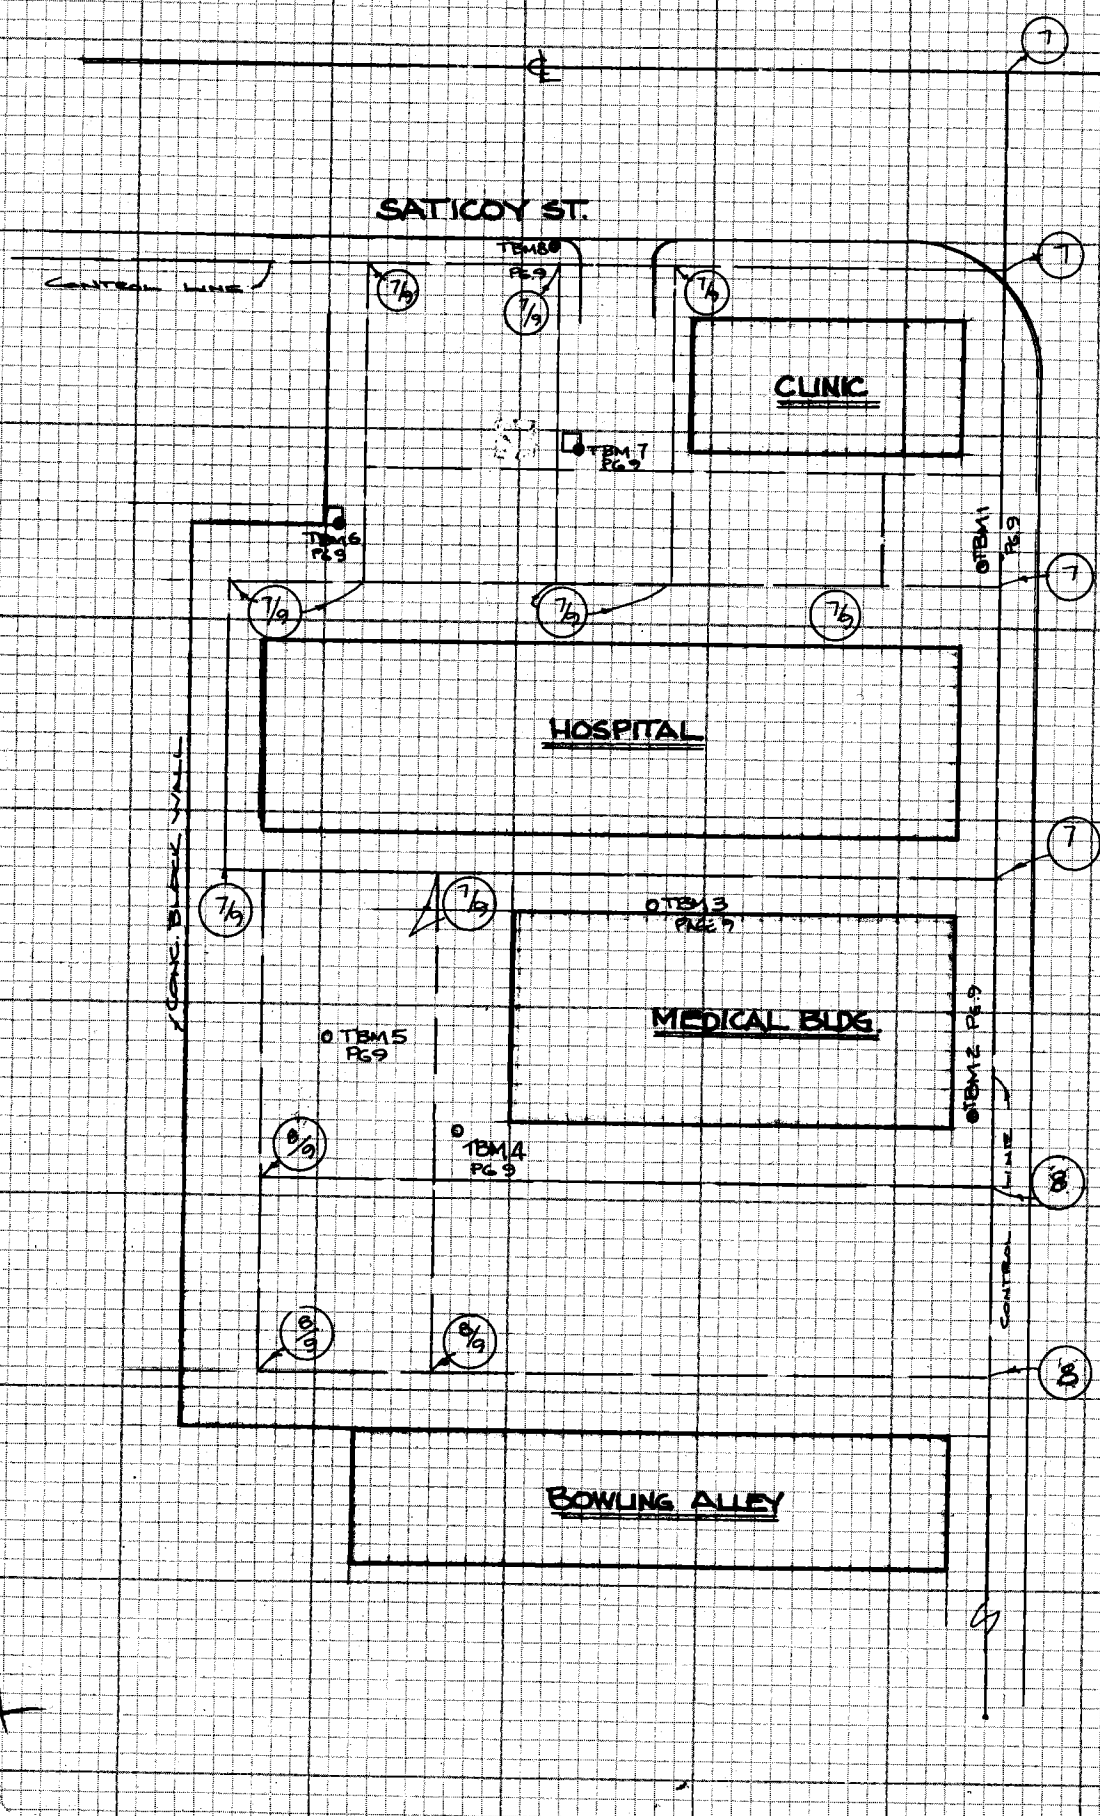

CE 310
76F3095-4/73

PLEASE RETURN TO
LOS ANGELES COUNTY ENGINEER
403 LOS ANGELES COUNTY ENGINEERING BLDG.

Do not ex... notes this side of this line

NOTE: ANY ADDITIONS OR CHANGES ON THIS SHEET MUST BE MADE OR CIRCLED IN RED INK WITH DATE AND NAME OF PERSON MAKING CHANGE

Notes Ck'd by	Survey of TOPOG CONTROL FOR OLIVE VIEW MID VALLEY
Map No.	JN 9520.07 Tape 29 Std 84 °F
Office Work	Surveyed by J.P. MENNE
Checked	Notes B. JACKSON Date APRIL 75
Date	Indexed G.D. BAILEY AUG 11 '75

F.B. 4363 PG 7

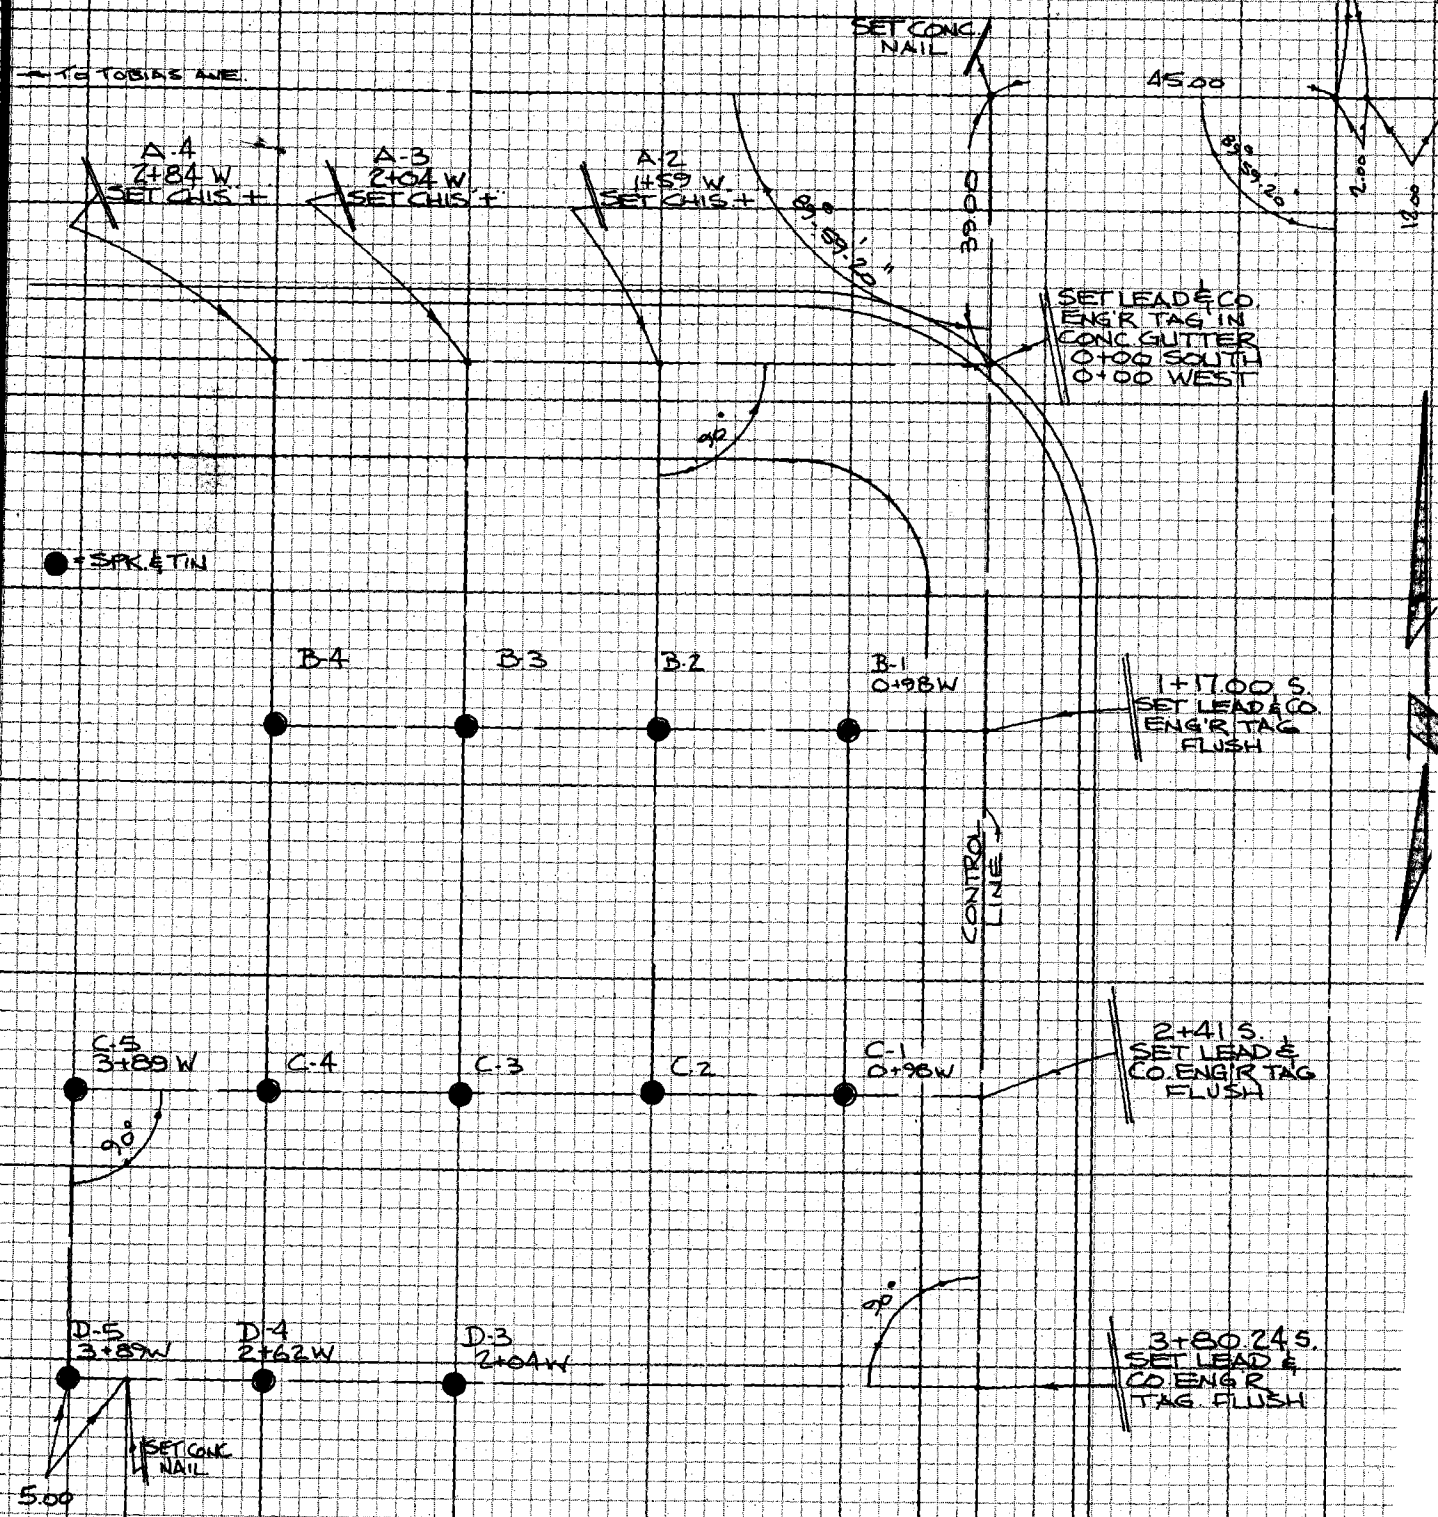

NOTE: ANY ADDITIONS OR CHANGES ON THIS SHEET MUST BE MADE OR CIRCLED IN RED INK WITH DATE AND NAME OF PERSON MAKING CHANGE

Do not extend notes this side of this line

PLEASE RETURN TO
LOS ANGELES COUNTY ENGINEER
403 LOS ANGELES COUNTY ENGINEERING BLDG.

CENTERLINE NOTES
CE 310
76F3095-4/73

TO TOP PAGE 8

TO TOP PG. 8

F.B. 4363 PG. 8

CE 310
76F3095-4/73

PLEASE RETURN TO
LOS ANGELES COUNTY ENGINEER
403 LOS ANGELES COUNTY ENGINEERING BLDG.

Do not write this side of this line

NOTE: ANY ADDITIONS OR CHANGES
ON THIS SHEET MUST BE MADE OR
CIRCLED IN RED INK WITH DATE AND
NAME OF PERSON MAKING CHANGE

To Bot. Page 7

To Bot. Page 7

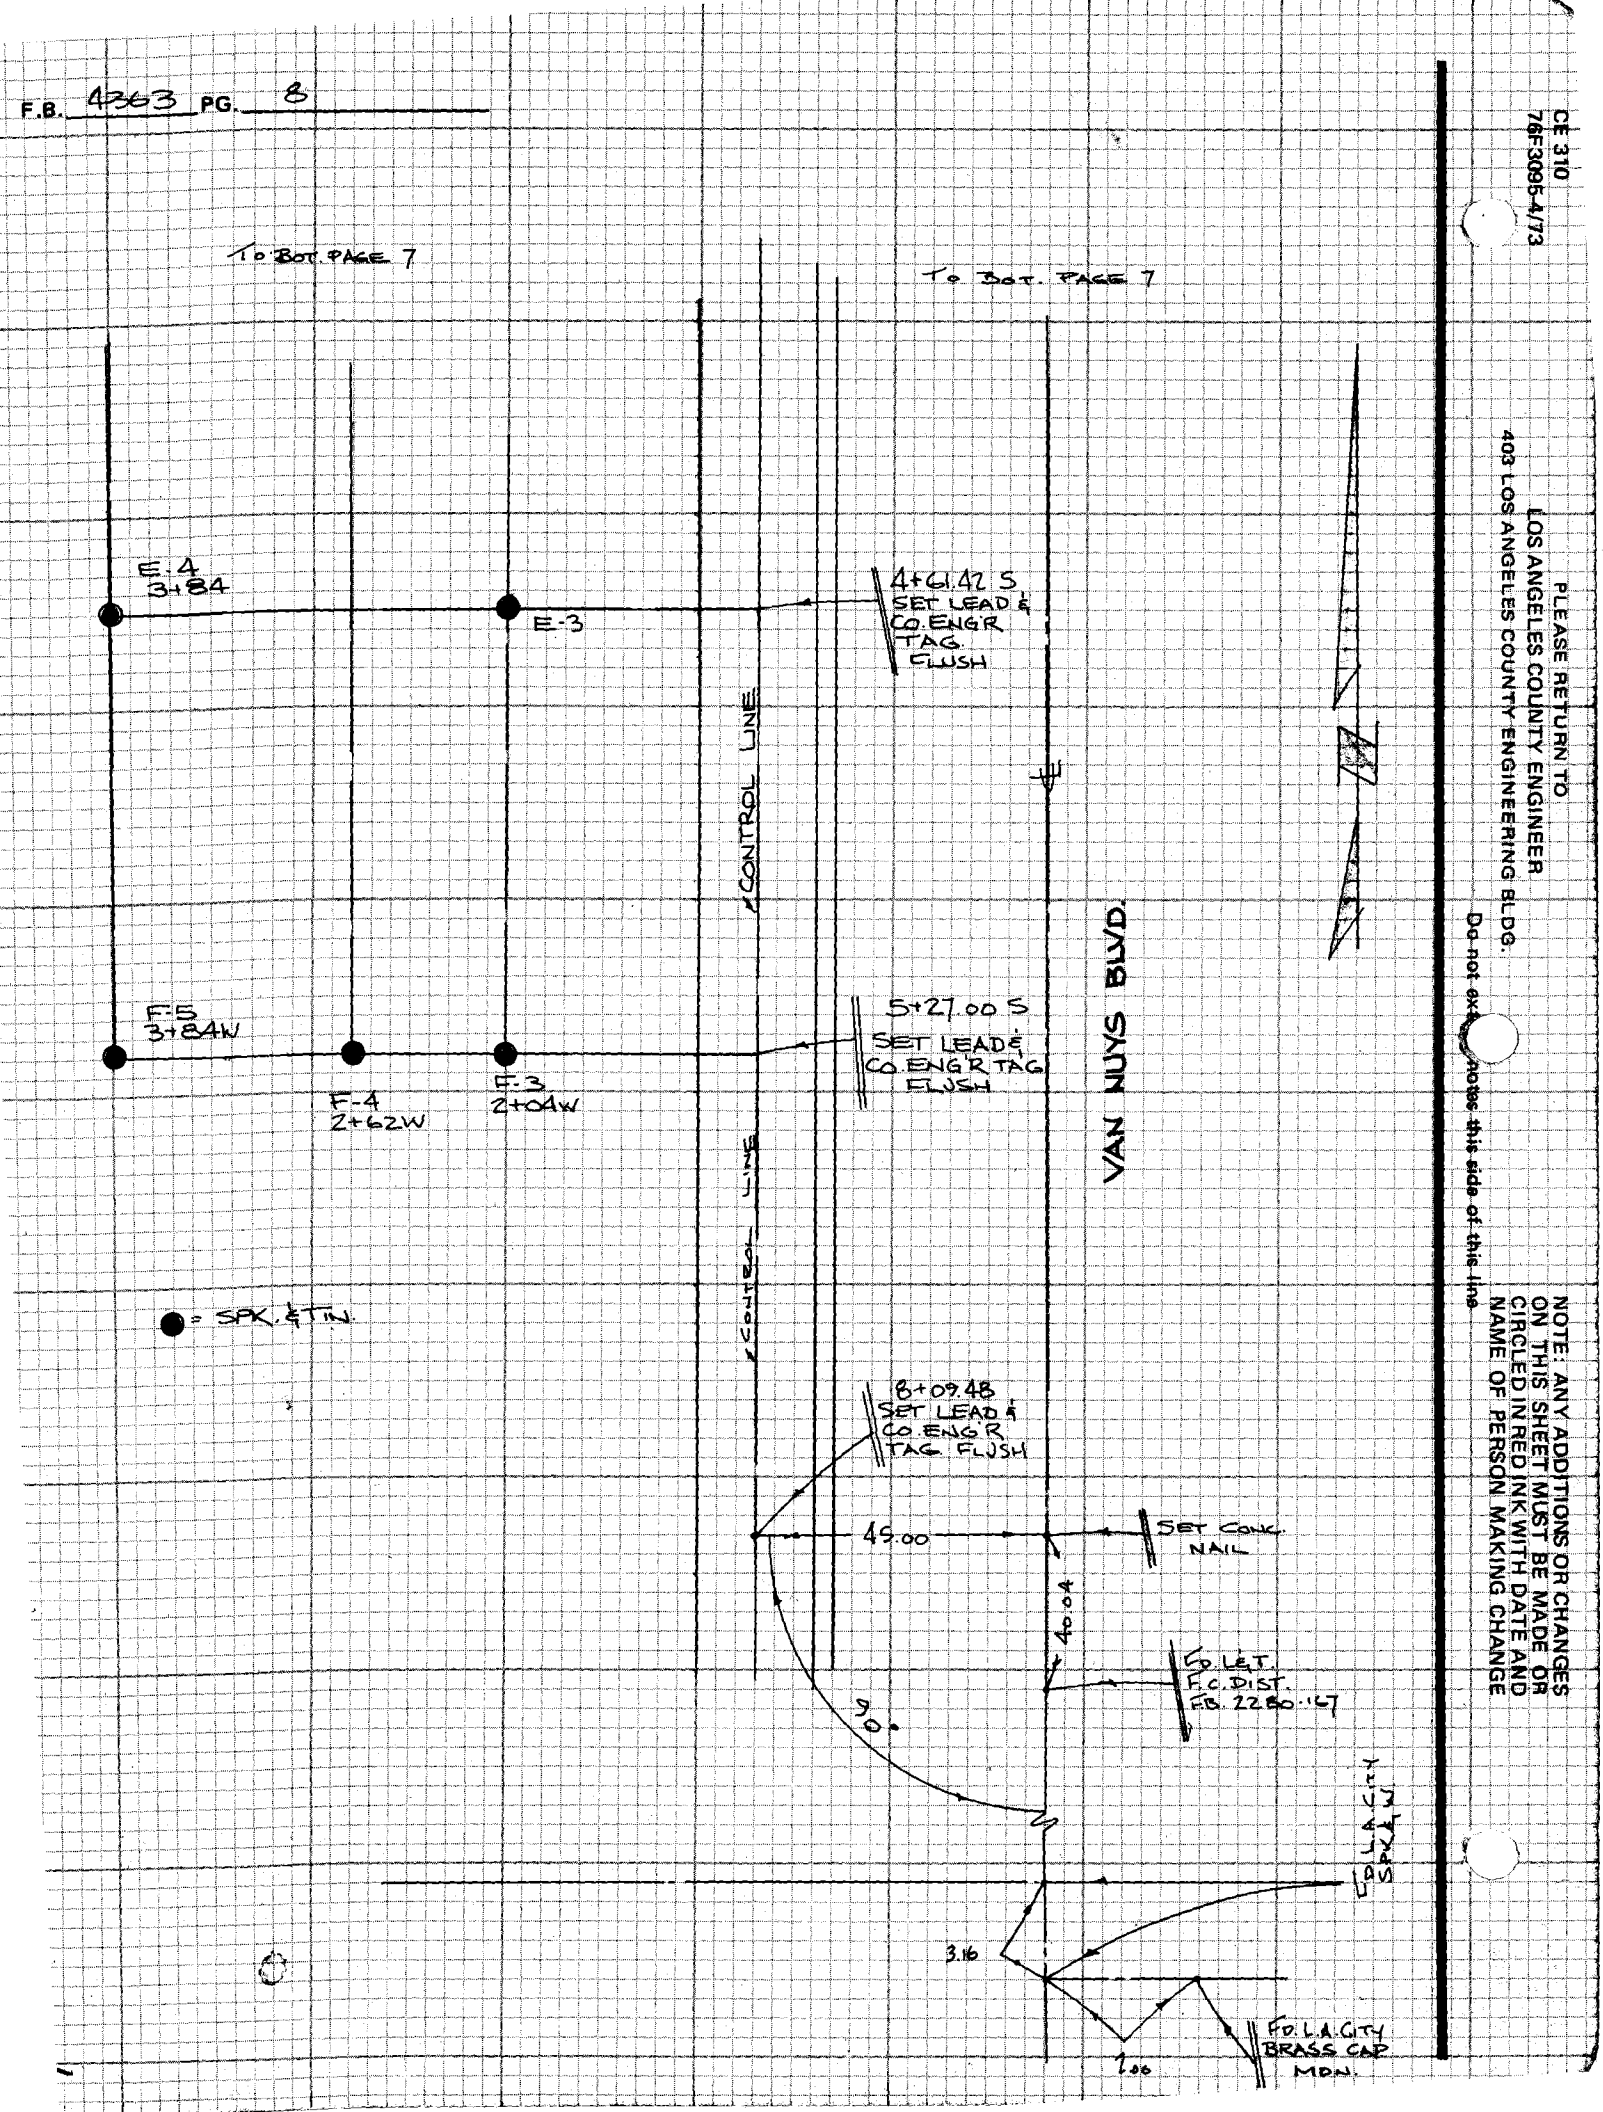

NOTES RED. _____ JOB NO. 9520.07 SURVEY OF TOPOG. CONTROL FOR OLIVE VIEW MIDVALLEY

F.B. 4363 PG. 9

DATE _____ SURVEY BY B.R. JACKSON

NOTES CHKD: _____ NOTES BY B.R. JACKSON DATE 1 MAY 75

DATE _____ INDEXED G.D. BAILEY DATE AUG 11 '75

STATION	B.S.	H.I.	F.S.	ELEV.	
BM. NO 08-23640	4.460	771.321		766.861	BM NO. 08-23640, CITY OF LOS ANGELES. EL = 766.861. FOUND A WIRE SPIKE IN NORTH
	4.650	770.851	5.120	766.201	CURB OF SATICOY STREET, 5 FT. WEST OF B.C.R., WEST OF TOBIAS AVE.
	4.830	770.761	4.920	765.931	
	4.950	770.796	4.915	765.846	
T.B.M.	4.260	769.146	5.910	764.886	TBM EL = 764.886. FOUND SPKE IN LEAD IN CONC. CURB AT THE INTERSECTION OF VAN NUYS BLVD. AND SATICOY STREET ±25' NORTH OF E.C.R. IN NORTHWEST CURB OF VAN NUYS BLVD.
BM. NO. 08-12510	6.140	769.296	5.990	763.156	BM. NO. 08-12510, CITY OF LOS ANGELES. EL = 763.148. FOUND A BRASS CAP MONUMENT IN HANDHOLE, MARKED PK 21 1941 ON ℄ OF
	3.750	767.806	5.240	764.056	SATICOY STREET 14.00 EAST OF ℄ OF
	3.785	766.421	5.170	762.636	VAN NUYS BLVD.
	5.065	766.386	5.100	761.321	
BM. NO. 08-12505			5.390	760.996	BM NO. 08-12505, CITY OF LOS ANGELES. EL = 760.996. FOUND SPK. IN LEAD IN EAST CURB OF VAN NUYS BLVD., IN FRONT OF UNION HALL AT #7500, 6 FT SOUTH OF B.C.R., SOUTH OF ALLEY AT NORTH SIDE OF HALL, NORTH END CURB, 0.13 MI. NORTH OF VALERIO STREET.
	LEVEL RUN TO ESTABLISH TBMS AT OLIVE VIEW - MID VALLEY				
T.B.M.	4.410	769.296		764.886	SEE DESCRIPTION ABOVE (HOSPITAL)
	4.350	767.676	5.970	763.326	TBM. NO. 1 EL = 762.666 AT BACK OF WALK, ±3' NORTH AND ±30 FT. EAST OF N.E. CORNER OF MEDICAL BLDG., ±6 FT.
T.B.M. No. 1	3.770	766.436	5.010	762.666	NORTH OF N.W. CORNER OF DRIVEWAY, SET A SMALL SPK. IN LEAD IN CONC. WALK.
T.B.M. No. 2	5.542	766.878	5.100	761.336	TBM NO. 2 EL = 761.336. IN BACK OF WALK, 1 FT EAST OF S.E. CORNER OF CONC. BLOCK PLANTER, ± 15 E'LY OF BLVD. MEDICAL BLDG., SET A SMALL SPK. IN LEAD IN CONC. WALK.
T.B.M. No. 4	5.660	766.968	5.570	761.308	TBM. NO. 4 EL. 761.308. IN S.E. CORNER OF CATCH BASIN, E24 F SOUTH AND ± 22 FT WEST OF S.W. CORNER OF BLVD
	4.748	767.191	4.525	762.443	MEDICAL BLDG., SET A SMALL SPK. IN LEAD IN CONC
T.B.M. No. 3	4.392	767.261	4.322	762.869	TBM NO. 3 EL. = 762.869. IN NW. CORNER OF AIR INTAKE DUCT, ON NORTH SIDE OF BLVD. MEDICAL BLDG.,
	5.272	767.878	4.655	762.606	±107 FT. FROM N.E. CORNER OF MEDICAL BLDG. SET A SMALL SPK. IN LEAD IN CONC. CURB.
	5.160	768.468	4.570	763.308	TBM. NO. 5 EL = 765.603. IN EAST SIDE OF CONC. BASE OF
T.B.M. No. 5	2.915	768.518	2.865	765.603	LIGHT POLE, ± 180 FT. WEST OF BLVD. MEDICAL BLDG. AND ±61 FT. EAST OF BLOCK WALL, WEST OF MEDICAL BLDG., SET
	4.830	768.648	4.700	763.818	A SMALL SPK. IN LEAD IN CONC.
T.B.M. No. 6	6.070	770.305	4.363	764.285	TBM NO. 6 EL = 764.285. IN S.E. CORNER OF CONC. CURB OF PLANTER, LOCATED AT THE S.W. CORNER OF CLINIC PARKING LOT, SET A SMALL SPK. IN LEAD IN CONC. CURB.
T.B.M. No. 7	4.333	769.588	5.050	765.255	TBM. NO. 7 EL = 765.255. IN S.E. CORNER OF CONC. CURB ± 4 FT. NORTH OF THE N.E. CORNER OF CONC. BLOCK WALL TO OXYGEN STORAGE AREA, LOCATED S.W'LY OF CLINIC BLDG., SET A SMALL SPK. IN LEAD IN CONC. CURB.
T.B.M. No. 8	4.784	769.767	4.605	764.983	TBM NO. 8 EL 764.983 IN S.W. CURB, ± 1' WEST OF B.C.R. TO ALLEY, LOCATED WEST OF CLINIC BLDG., SET A SPK. IN LEAD IN CONC. CURB.
T.B.M.			4.380	764.887	SEE DESCRIPTION ABOVE

NOTE: ANY ADDITIONS OR CHANGES ON THIS SHEET MUST BE MADE OR CIRCLED IN RED INK WITH DATE AND NAME OF PERSON MAKING CHANGE

Do not extend notes this side of this line

PLEASE RETURN TO
LOS ANGELES COUNTY ENGINEER
403 LOS ANGELES COUNTY ENGINEERING BLDG.

PROFILE LEVEL NOTES
CE 307
76-L-298-4/73

F.B. 4363 PG. 10

JOB NO. 9520.07 SURVEY OF TOPOG. CONTROL FOR OLIVE VIEW MID VALLEY NOTES RED. _____

SURVEY BY B.R. JACKSON DATE _____

NOTES BY B.R. JACKSON DATE 1 MAY 75 NOTES CHKD. _____

INDEXED G. D. BAILEY DATE MAY 11 '75 DATE _____

STATION	B.S.	H.I.	F.S.	ELEV.	
TBM No 6				764.29	T.B.M. NO. 6 EL = 764.285 SEE DESCRIPTION, PG. 9
A-2				765.09	
A-3				765.14	
A-4				765.06	
B-1				764.84	
B-2				764.57	
B-3				765.40	
B-4				765.69	
C-1				762.96	
C-2				763.11	
C-3				763.16	
C-4				763.39	
C-5				763.63	
D-3				763.07	
D-4				763.44	
D-5				764.12	
E-3				761.84	
E-4				763.03	
F-3				762.31	
F-4				762.67	
F-5				763.25	
TBM No 4				761.30	T.B.M. NO. 4 EL = 761.308 SEE DESCRIPTION PG 9

LENKER ROD USED

PLEASE RETURN TO
LOS ANGELES COUNTY ENGINEER
403 LOS ANGELES COUNTY ENGINEERING BLDG.
76-L-298-CE 307-4/73

Do not extend notes this side of this line

NOTE: ANY ADDITIONS OR CHANGES ON THIS SHEET MUST BE MADE OR CIRCLED IN RED INK WITH DATE AND NAME OF PERSON MAKING CHANGE

Notes Ck'd by M. R. NEVAREZ	Survey of OLIVE VIEW MID-VALLEY HOSPITAL	F.B. 4363	PG. 11
Map No. CSB 5272	JN0022.08 Tape	Std 68 °F	
Office Work C MOTEN	Surveyed by J.P.MENNE		
Checked M. R. NEVAREZ	Notes J.P.M.	Date JUNE-JULY 75	
Date DEC 15 1975	Indexed G. D. BAILEY	AUG 11 75	

NOTE: ANY ADDITIONS OR CHANGES ON THIS SHEET MUST BE MADE OR CIRCLED IN RED INK WITH DATE AND NAME OF PERSON MAKING CHANGE

PLEASE RETURN TO
LOS ANGELES COUNTY ENGINEER
403 LOS ANGELES COUNTY ENGINEERING BLDG.
Do not extend notes this side of this line

CENTERLINE NOTES
CE 310
76F-3095-4/73

OLIVE VIEW

MID-VALLEY

HOSPITAL

J.N. 0022.08

BOUNDARY

JUNE-JULY 1975

REF

TRACT	L.A CITY F.B.	F.C. F.B.
3508	152 08	2280
19368	186-149	
25896	24509	
27143	20410	
28029		
30888		
21382		

J. P. MENNE

B. R. JACKSON

R. R. RODRIGUEZ

T. OHASHI

CE 310
76F3095-4/73

PLEASE RETURN TO
LOS ANGELES COUNTY ENGINEER
403 LOS ANGELES COUNTY ENGINEERING BLDG.

NOTE: ANY ADDITIONS OR CHANGES ON THIS SHEET MUST BE MADE OR CIRCLED IN RED INK WITH DATE AND NAME OF PERSON MAKING CHANGE

Do not extend notes this side of this line

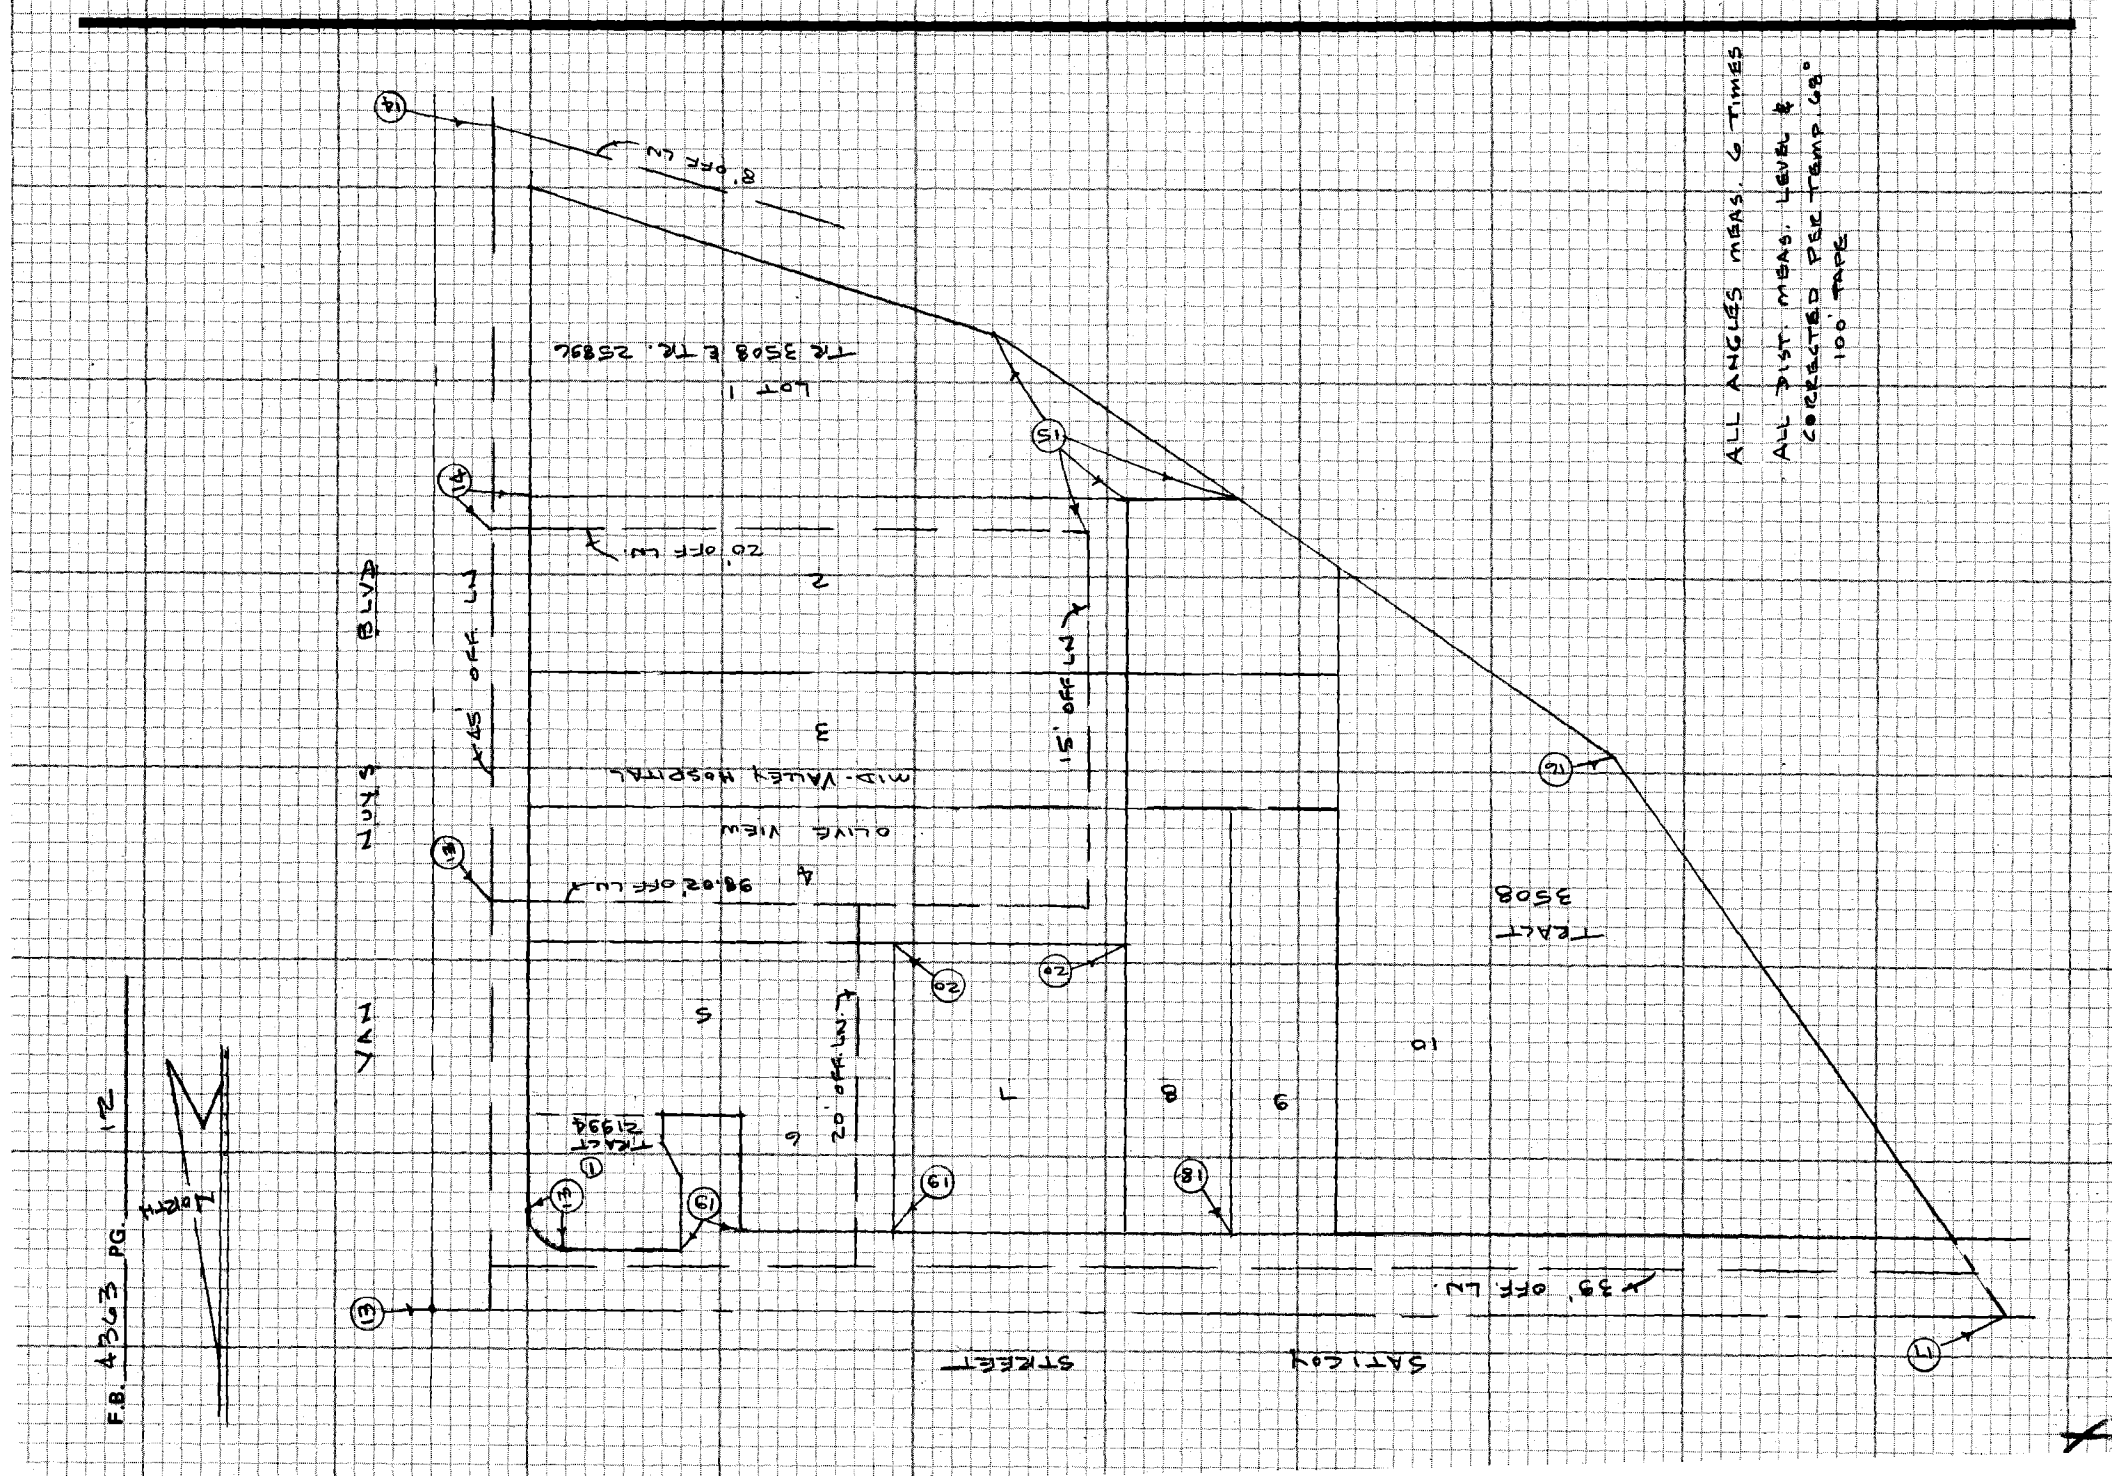

Notes Ck'd by M. R. NEVAREZ	Survey of OLIVE VIEW MID-VALLEY HOSP	F.B. 4363 PG. 13	
Map No. CS3 5272	JN 00222.08 Tape	Std 68 °F	
Office Work C MOTEN	Surveyed by J.P. MENNE		
Checked M. R. NEVAREZ	Notes J.P.M.	Date JUNE-JULY 75	
Date DEC 15 1975	Indexed G. D. BAILEY	AUG 1 1 '75	

NOTE: ANY ADDITIONS OR CHANGES ON THIS SHEET MUST BE MADE OR CIRCLED IN RED INK WITH DATE AND NAME OF PERSON MAKING CHANGE

Do not extend notes this side of this line

PLEASE RETURN TO
LOS ANGELES COUNTY ENGINEER
403 LOS ANGELES COUNTY ENGINEERING BLDG.

CENTERLINE NOTES
CE 310
76F3095-4/73

SATICOY STREET

FD. L.A. CITY mon. F.B. 15208-17
FD. SPK.

NORTH

45.00

14.00

30.00

(25) (42)

(17)

To Top of Pg. 19

Lot 6
TRACT 3508

135.13' 39' OFF LN.

3.00

25.00

45'

BLVD

SET L. & L.A. Co. ENG. TAG @ INTER. OF OFF. LINES
0+00 SOUTH

PROP. COR. SET 2" I.P. & L.A. CO. ENG TAG (FLUSH) PER TR. 19368

23.00

6.00

Lot 1
TR. 19368

PROP. COR. FD. 2" I.P. & L.S. 2571 (FLUSH)

SOUTH

45' OFF LN.

230.00

1+17.00
SET L. & L.A. CO. ENG. TAG

(50)

VAN NUYS

Lot 5

40-57 PROP.

50.00 PROP.

50.00 MEAS.

12'

285.08

N 89-59-00 E 98.02' OFF LN.
(INVERSE)

To Top of Pg. 20

SET ⊕ BY PROP. ST. BET N.E. COR. LOT 6 & N.E. COR. LOT 1 TR 3508 FOR 98.02' OFF LN. OF LOT 4

10.94

SET L. & L.A. CO. ENG. TAG 1' EAST OF PROP. COR. COR. IS ON EDGE OF CONC. WALK

90.00

57'

98.02

2+41.00
SET L. & L.A. CO. ENG. TAG.

Lot 4

To Top Left of Pg. 15

N 89-59-00 E
(INVERSE)

HOSPITAL 400.11 (CALC)

Lot 3

400.17 (CALC)

PROP. TOP (WEST 200' OF LOT 3) LINE

To Top of Pg. 14

F.B. 4363 PG. 14

To Bottom of Pg. 13

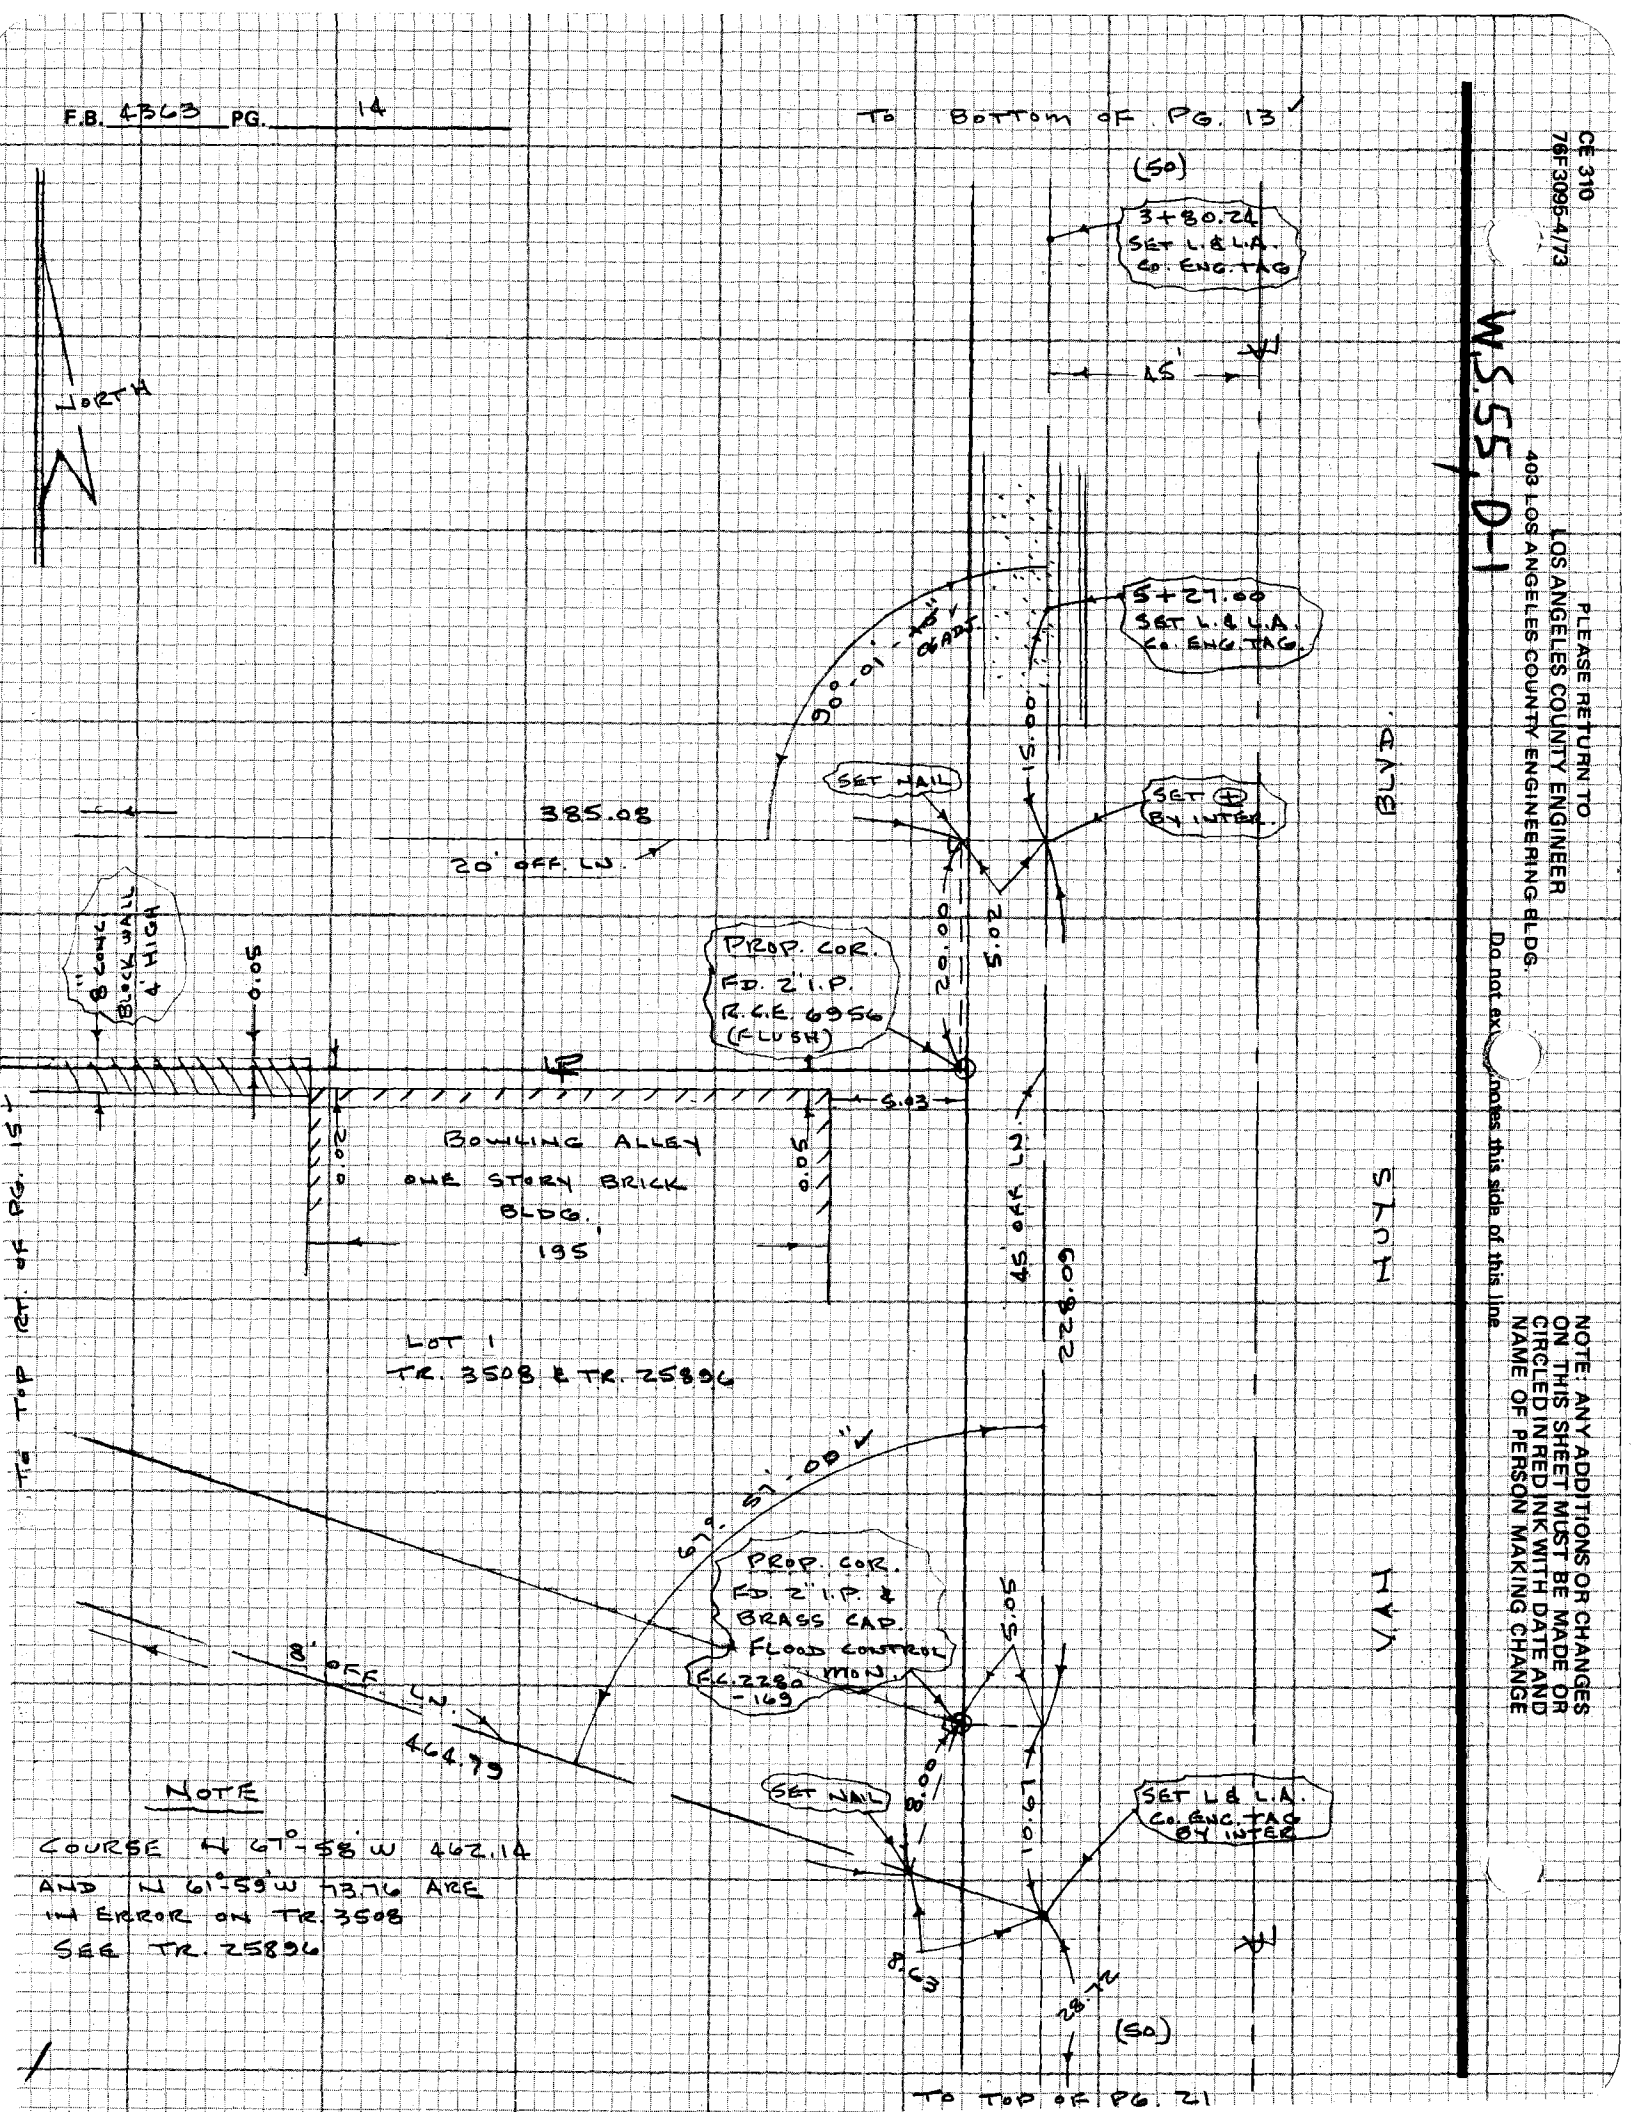

NOTE


AND N 61°-59' W 73.76 ARE

IN ERROR ON TR. 3508

SEE TR. 25896

W.55, D-1

CE 310
76F3095-4/73

PLEASE RETURN TO
LOS ANGELES COUNTY ENGINEER
403 LOS ANGELES COUNTY ENGINEERING BLDG.

Do not ex[illegible] notes this side of this line

NOTE: ANY ADDITIONS OR CHANGES ON THIS SHEET MUST BE MADE OR CIRCLED IN RED INK WITH DATE AND NAME OF PERSON MAKING CHANGE

Notes Ck'd by M. R. NEVAREZ	Survey of OLIVE VIEW MID-VALLEY HOSPITAL	F.B. 4363 PG. 15
Map No. CSB 5272	JN 00222.08 Tape	Sta 68 °F
Office Work C. MOTEN	Surveyed by J. P. MENNE	
Checked M. R. NEVAREZ	Notes J.P.M. Date JUNE-JULY 75	
Date DEC 15 1975	Indexed G. D. BAILEY AUG 11 75	

NORTH

TO BOTTOM LEFT OF PG. 13

TO LEFT OF PG. 14

TO RIGHT OF PG. 20

LOT 7

SET 2" I.P. L.A. CO. END TAG (FLUSH)

400.11 (CALC.)

400.17 (CALC.)

98.02

X OFF LI

89° 59' 34" ART. 35

385.08

20' OFF LI

SET L.G. BT. SPK. W. & T. BY INTSC.

213.94

1 0° 00' 00" (RADIAL CALC.)

SET B SPK. REMOVED

5.15

4.10

PROP. COR.

0.08

0.30

8' CONC. BLOCK WALL 4' HIGH

LOT 4 TR. 3508 TR. 25896

EP 2" I.P. (NO POINT) SET NAIL & L.A. CO. ENG. TAG IN ETC. PER TRACT 3508

TRACT LI

8' OFF. LI.

AC 42.79

6' CONC. BLOCK WALL

170.02

15"

0.13

0.0

0.0

1.1

0.0

SET 2" I.P. L.A. CO. ENG. TAG @ INTSC. OF LI & OFF. LI

SET N&T

LOT 8

400.11

400.17

1

8

3

200'

INVERSE 1 89-59-00 E

LOT 3

200 PER DEED

108.45

0.07 offset to PROP. COR. SET NAIL & L.A. CO. ENG. TAG TOP OF WALL @ 200' FROM WEST LN. OF LOT 2 & 3 TR. 3508 BY INTSC. OF No. LI. OF LOT 1 & CALC. BEARING FROM NORTH

LOT 2

71.61

SET #5 SPK

20.00

0.55

7.45

LOT COR. SET MARK ON WALL ON LINE BET FD. PIPE

WESTERLY COR. OF LOT 1 TR. 3508 & TR. 25896

EP 2" I.P. ETAG (NO POINT) 18" (Line Number Set)

578.43

8' OFF. LI.

261.09

19' OFF. LI.

TO RIGHT OF PG. 20

2 STORY APARTMENT BLDG.

LOT 10

TO TOP OF PG 16

NOTE: ANY ADDITIONS OR CHANGES ON THIS SHEET MUST BE MADE OR CIRCLED IN RED INK WITH DATE AND NAME OF PERSON MAKING CHANGE

Do not extend note to this side of this line

PLEASE RETURN TO
LOS ANGELES COUNTY ENGINEER
403 LOS ANGELES COUNTY ENGINEERING BLDG.

CENTERLINE NOTES
CE 310
76F3095-4/73

CE 310
76F3095-4/73

PLEASE RETURN TO
LOS ANGELES COUNTY ENGINEER
403 LOS ANGELES COUNTY ENGINEERING BLDG.

NOTE: ANY ADDITIONS OR CHANGES ON THIS SHEET MUST BE MADE OR CIRCLED IN RED INK WITH DATE AND NAME OF PERSON MAKING CHANGE

Do not ex... notes this side of this line

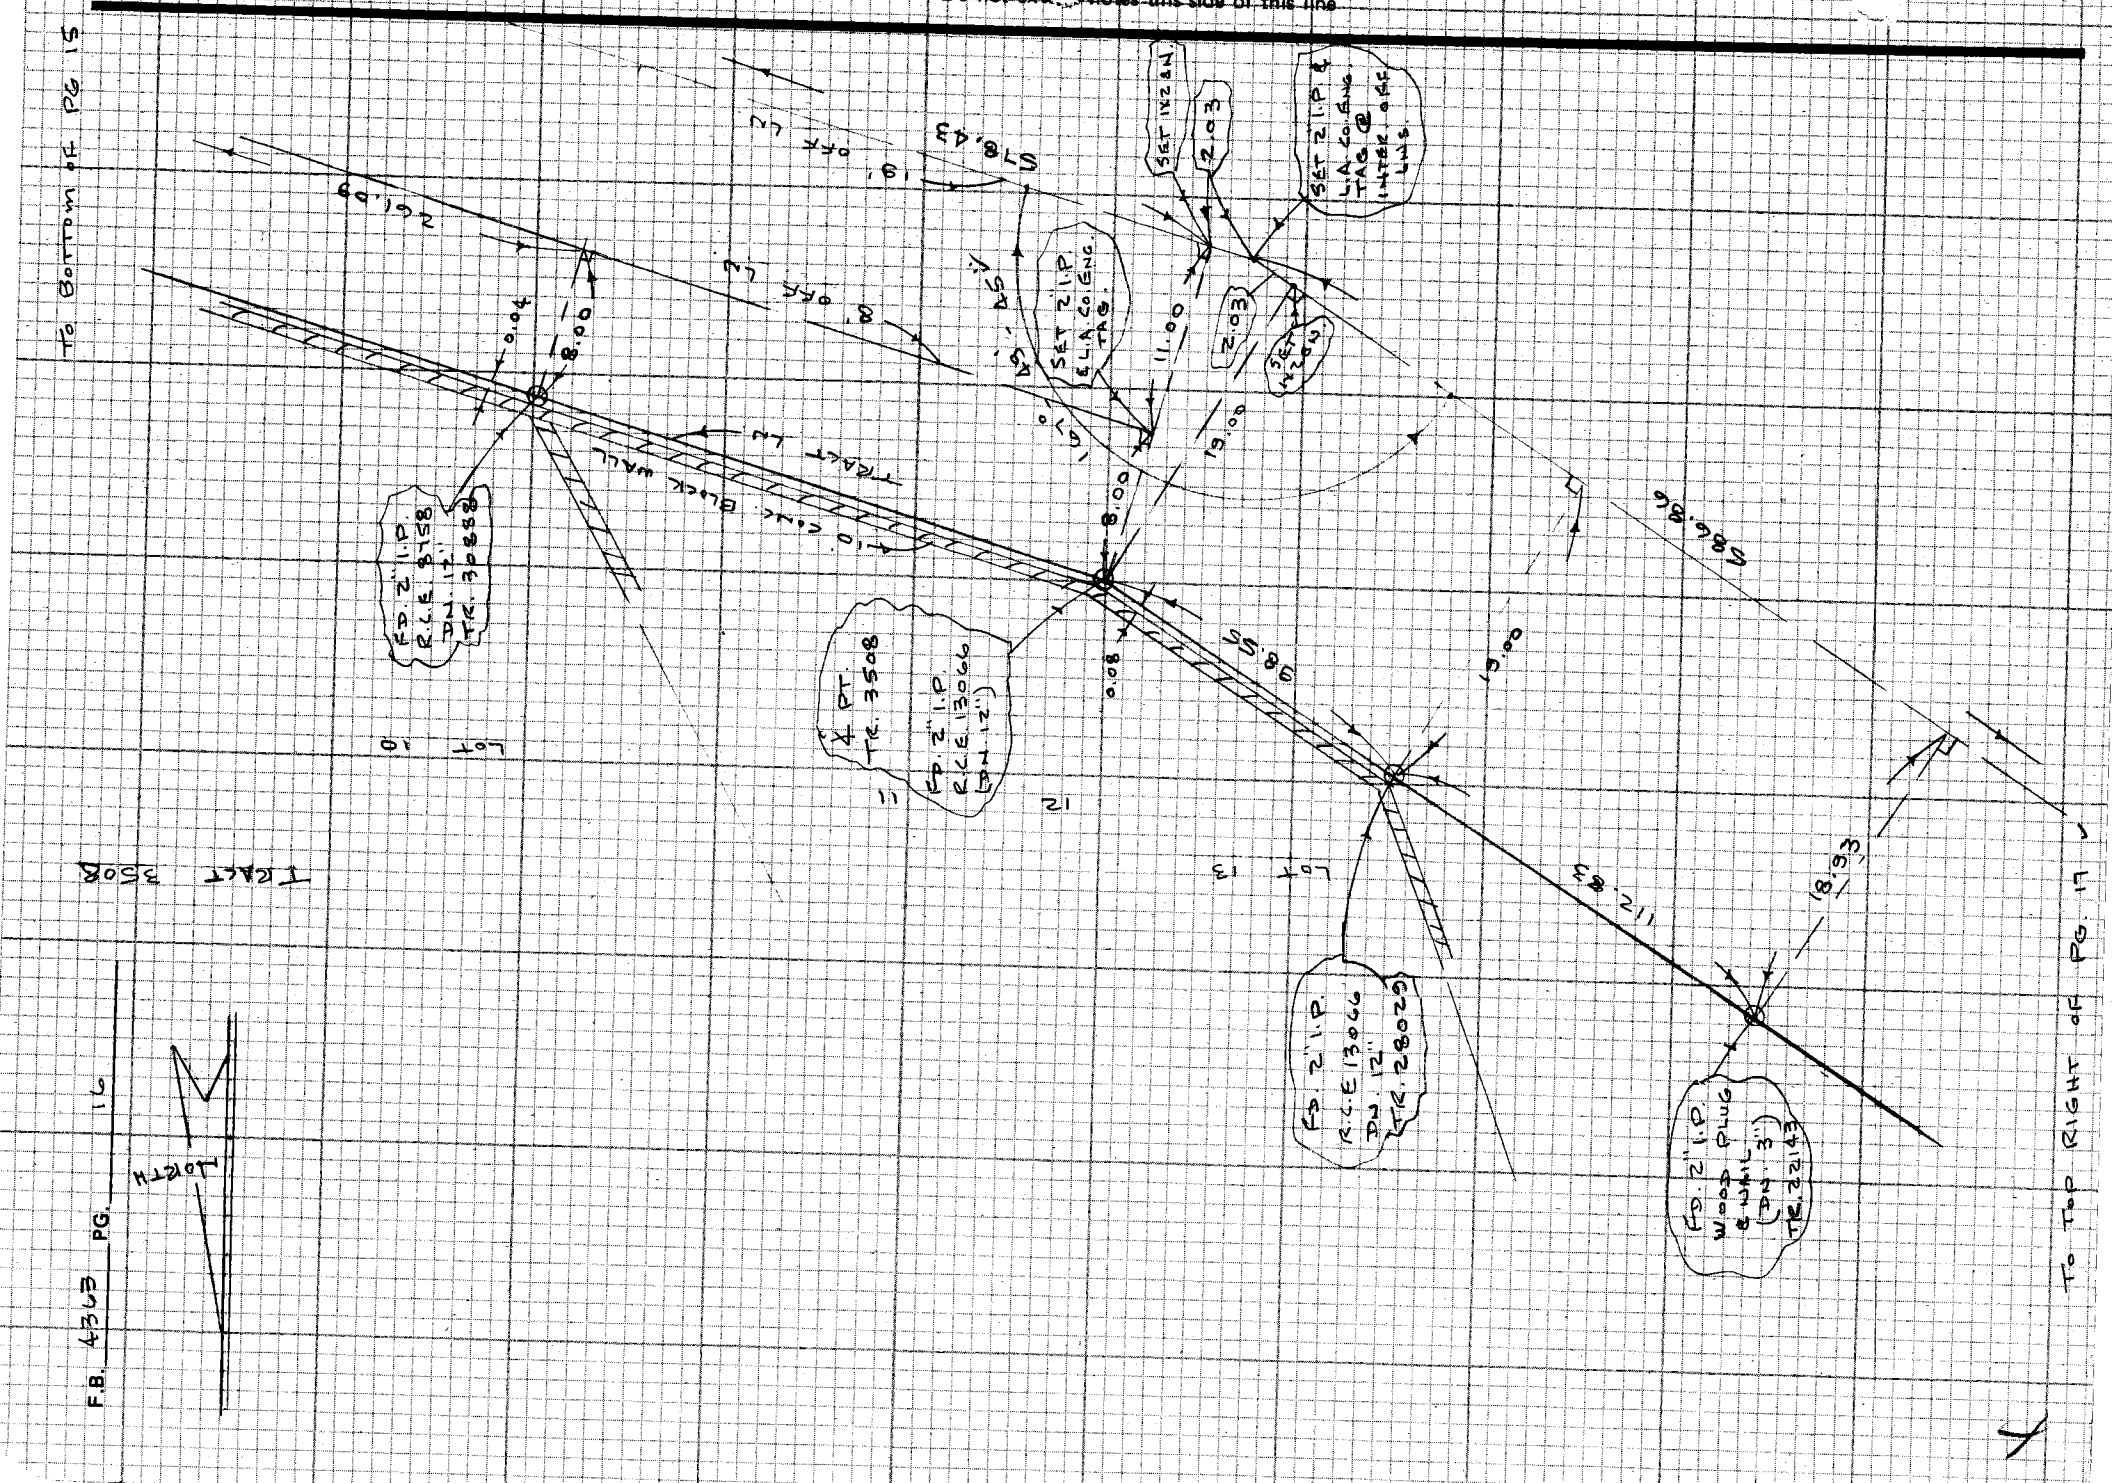

F.B. 4363 PG. 16

Notes Ck'd by M. R. NEVAREZ	Survey of OLIVE VIEW MID-VALLEY HOSPITAL	F.B. 4363	PG. 17
Map No. CSB 5272	JN 0022.08 Tape Std 68 °F		
Office Work C MOTEN	Surveyed by J.P. MENNE		
Checked M. R. NEVAREZ	Notes J.P.M Date JUNE-JULY 75		
Date DEC 15 1975	Indexed G. D. BAILEY AUG 11 '75		

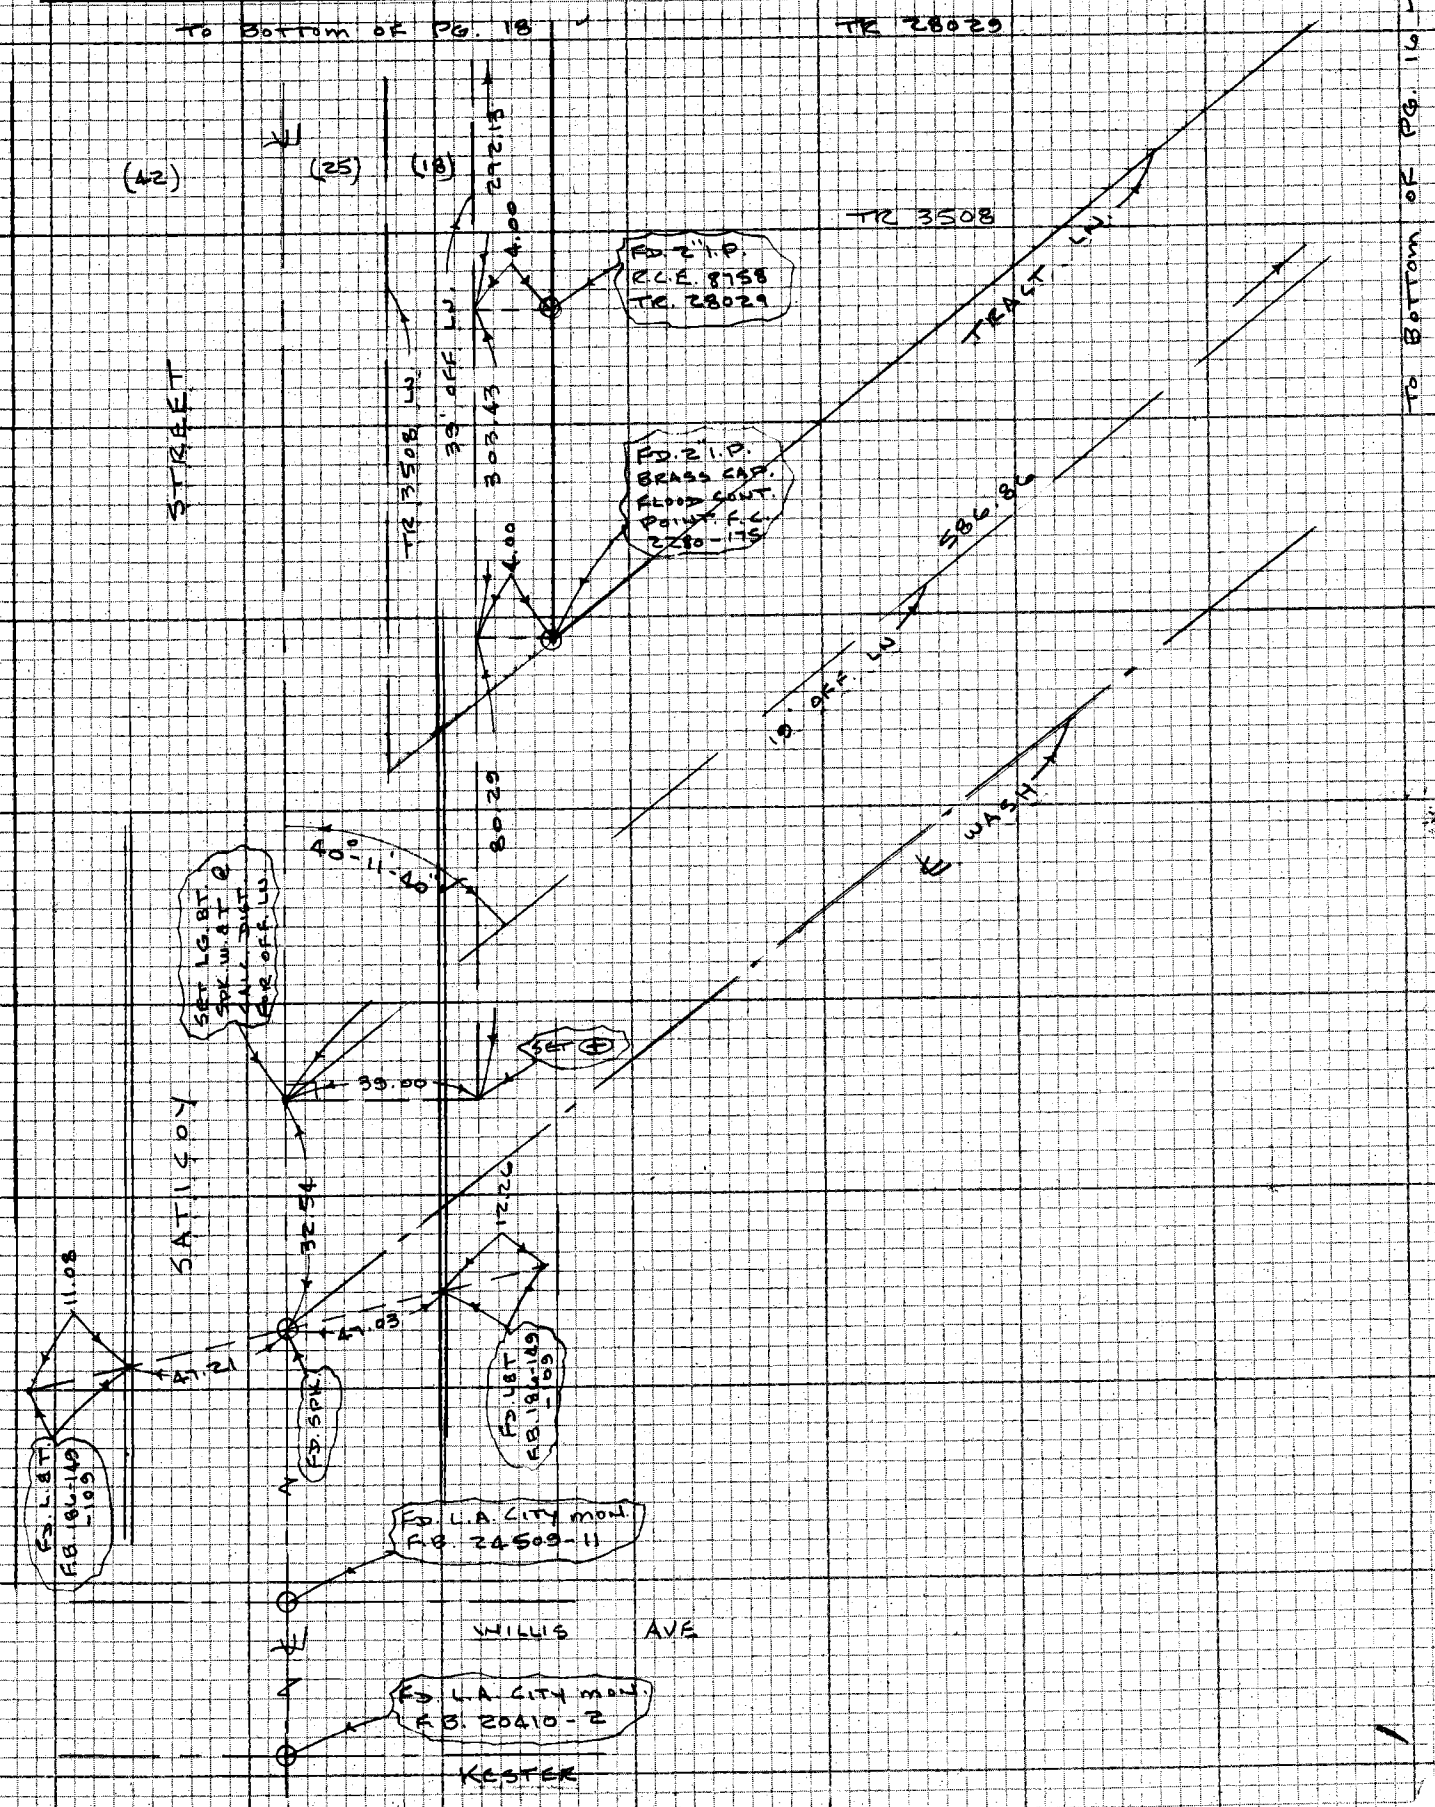

NOTE: ANY ADDITIONS OR CHANGES ON THIS SHEET MUST BE MADE OR CIRCLED IN RED INK WITH DATE AND NAME OF PERSON MAKING CHANGE

Do not extend notes this side of this line

PLEASE RETURN TO
LOS ANGELES COUNTY ENGINEER
403 LOS ANGELES COUNTY ENGINEERING BLDG.

CENTERLINE NOTES
CE 310
76F3095-4/73

CE 310
76F3095-4/73

PLEASE RETURN TO
LOS ANGELES COUNTY ENGINEER
403 LOS ANGELES COUNTY ENGINEERING BLDG.

NOTE: ANY ADDITIONS OR CHANGES ON THIS SHEET MUST BE MADE OR CIRCLED IN RED INK WITH DATE AND NAME OF PERSON MAKING CHANGE

Do not exte notes this side of this line

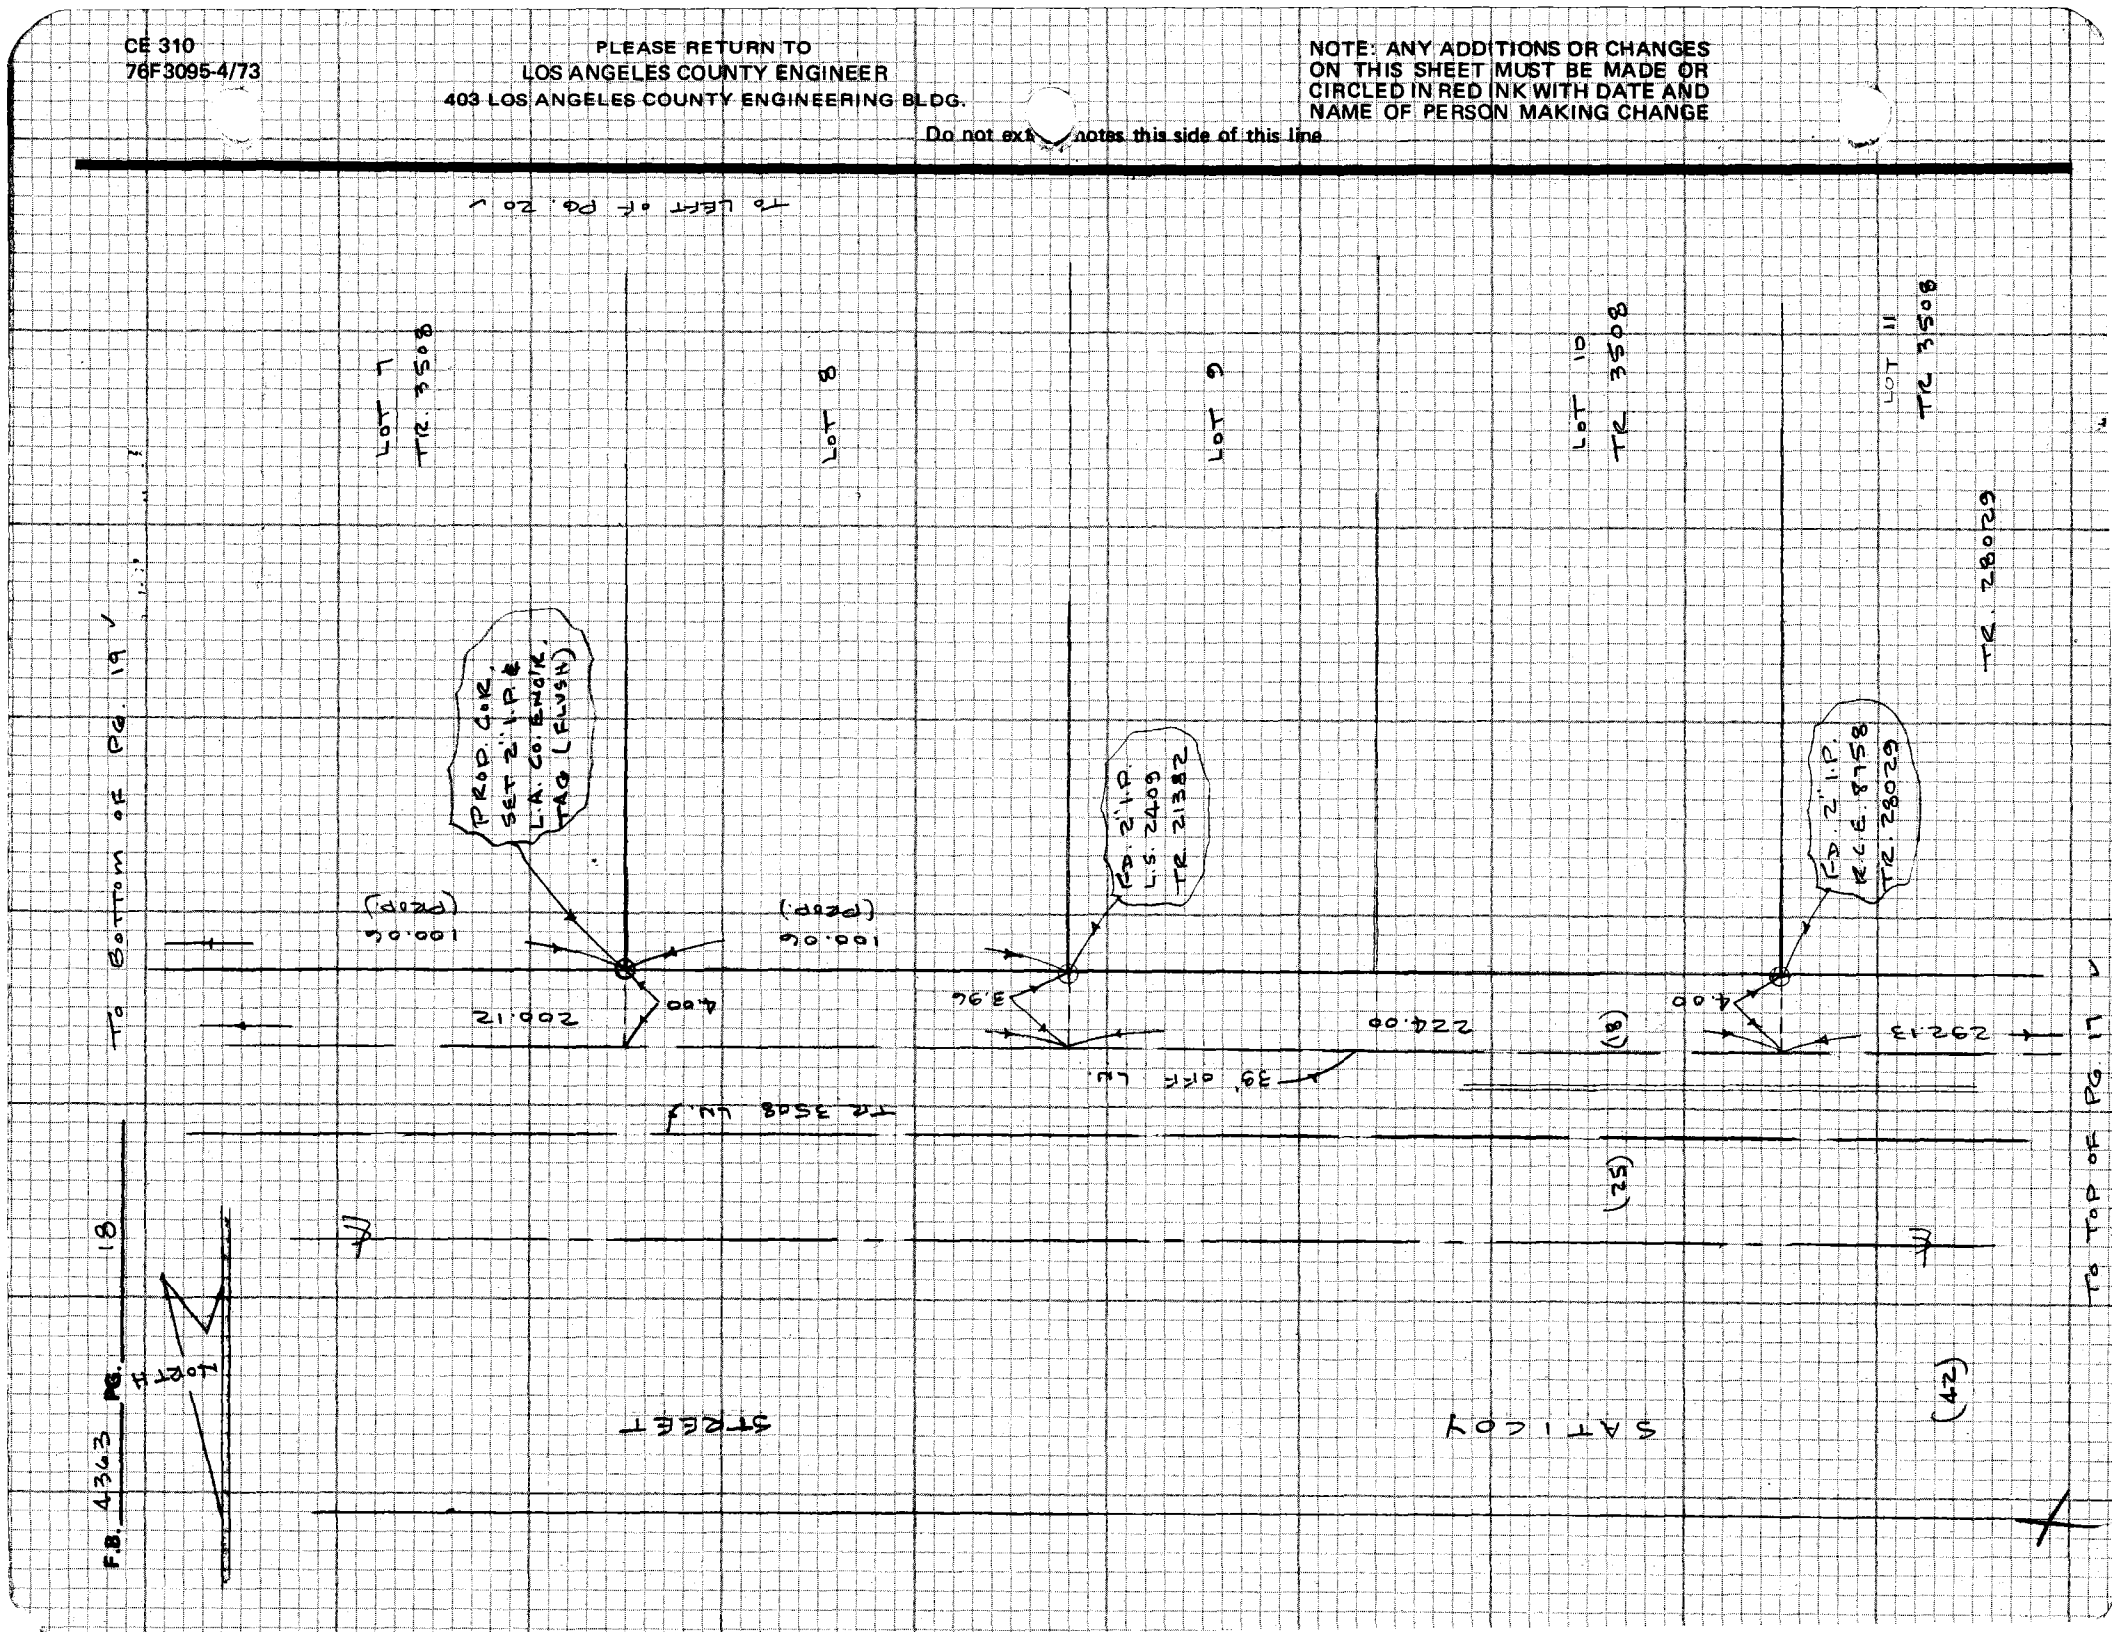

Notes Ck'd by M. R. NEVAREZ	Survey of OLIVE VIEW MID-VALLEY HOSPITAL
Map No. CSB 5272	JN 0022:08 Tape Std 68 °F
Office Work C MOTEN	Surveyed by J. P. MENNE
Checked M. R. NEVAREZ	Notes J. P. M. Date JUNE-JULY 75
Date DEC. 15, 1975	Indexed G. D. BAILEY AUG 11 75

F.B. 4363 PG. 19

NORTH

TO LEFT TOP OF PG. 13

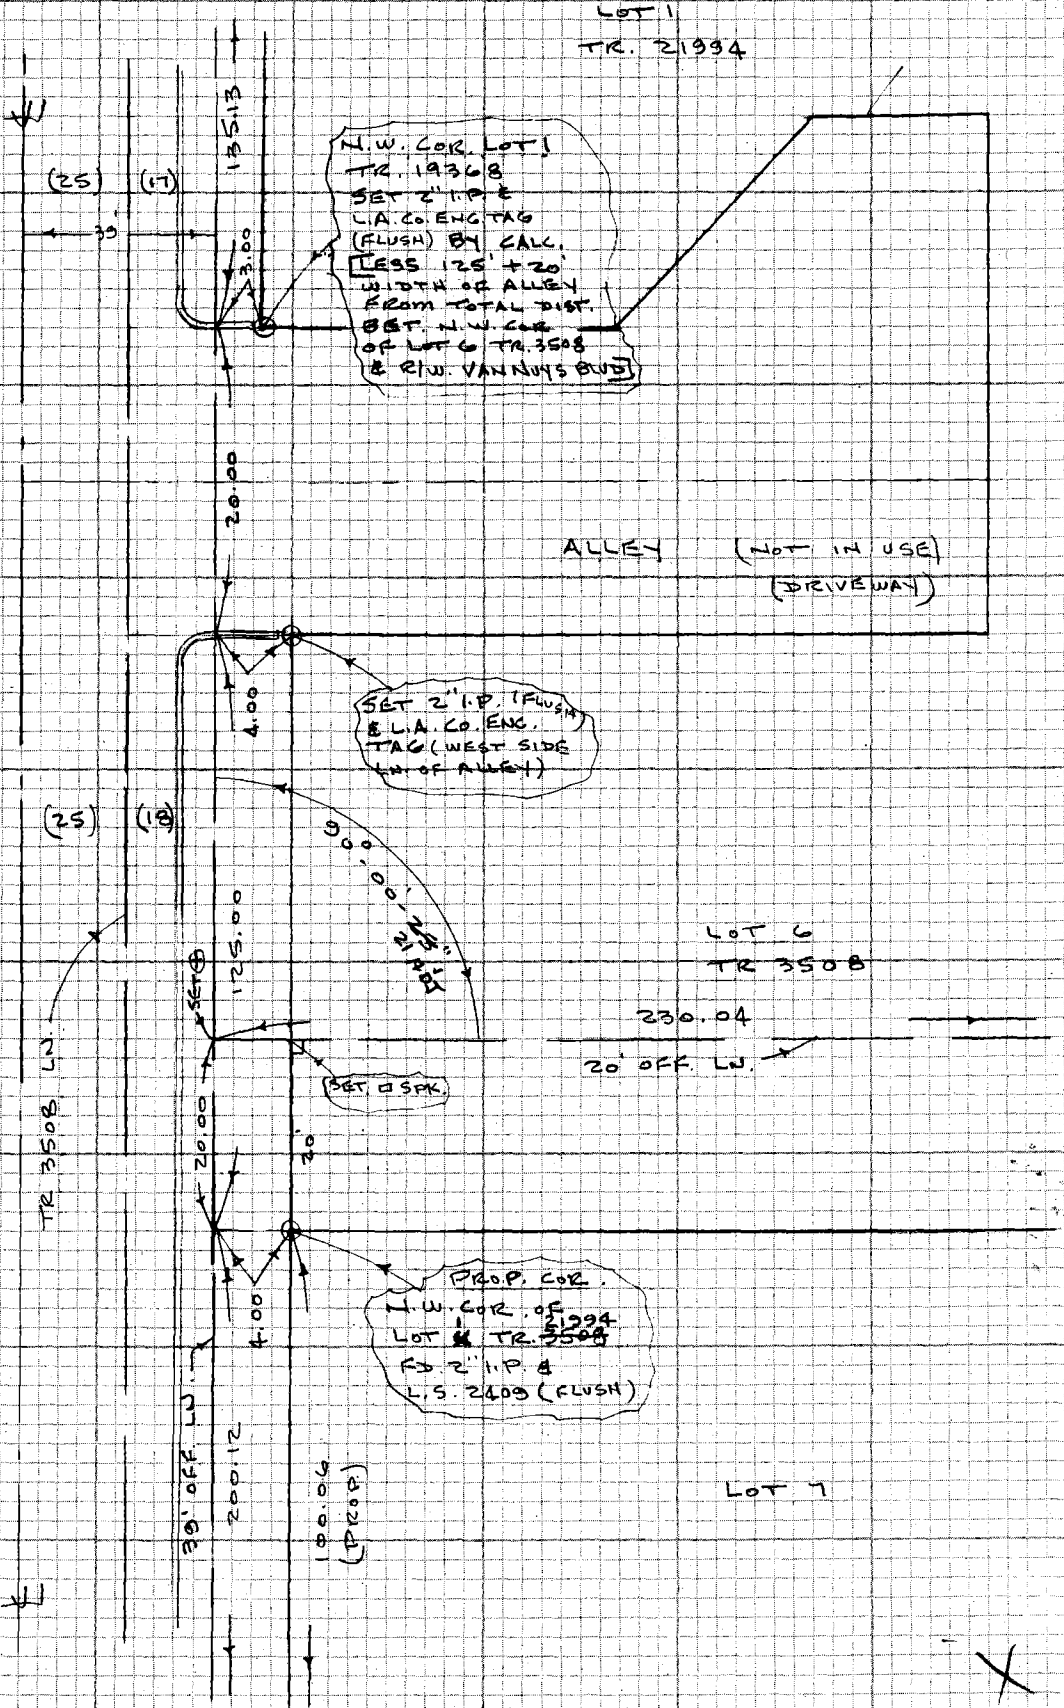

TO TOP OF PG. 18

TO LEFT TOP OF PG. 20

NOTE: ANY ADDITIONS OR CHANGES ON THIS SHEET MUST BE MADE OR CIRCLED IN RED INK WITH DATE AND NAME OF PERSON MAKING CHANGE

Do not extend notes to this side of this line

PLEASE RETURN TO
LOS ANGELES COUNTY ENGINEER
403 LOS ANGELES COUNTY ENGINEERING BLDG.

CENTERLINE NOTES
CE 310
76F3095-4/73

CE 310
76F3095-4/73

PLEASE RETURN TO
LOS ANGELES COUNTY ENGINEER
403 LOS ANGELES COUNTY ENGINEERING BLDG.

NOTE: ANY ADDITIONS OR CHANGES ON THIS SHEET MUST BE MADE OR CIRCLED IN RED INK WITH DATE AND NAME OF PERSON MAKING CHANGE

Do not ext[illegible] notes this side of this line

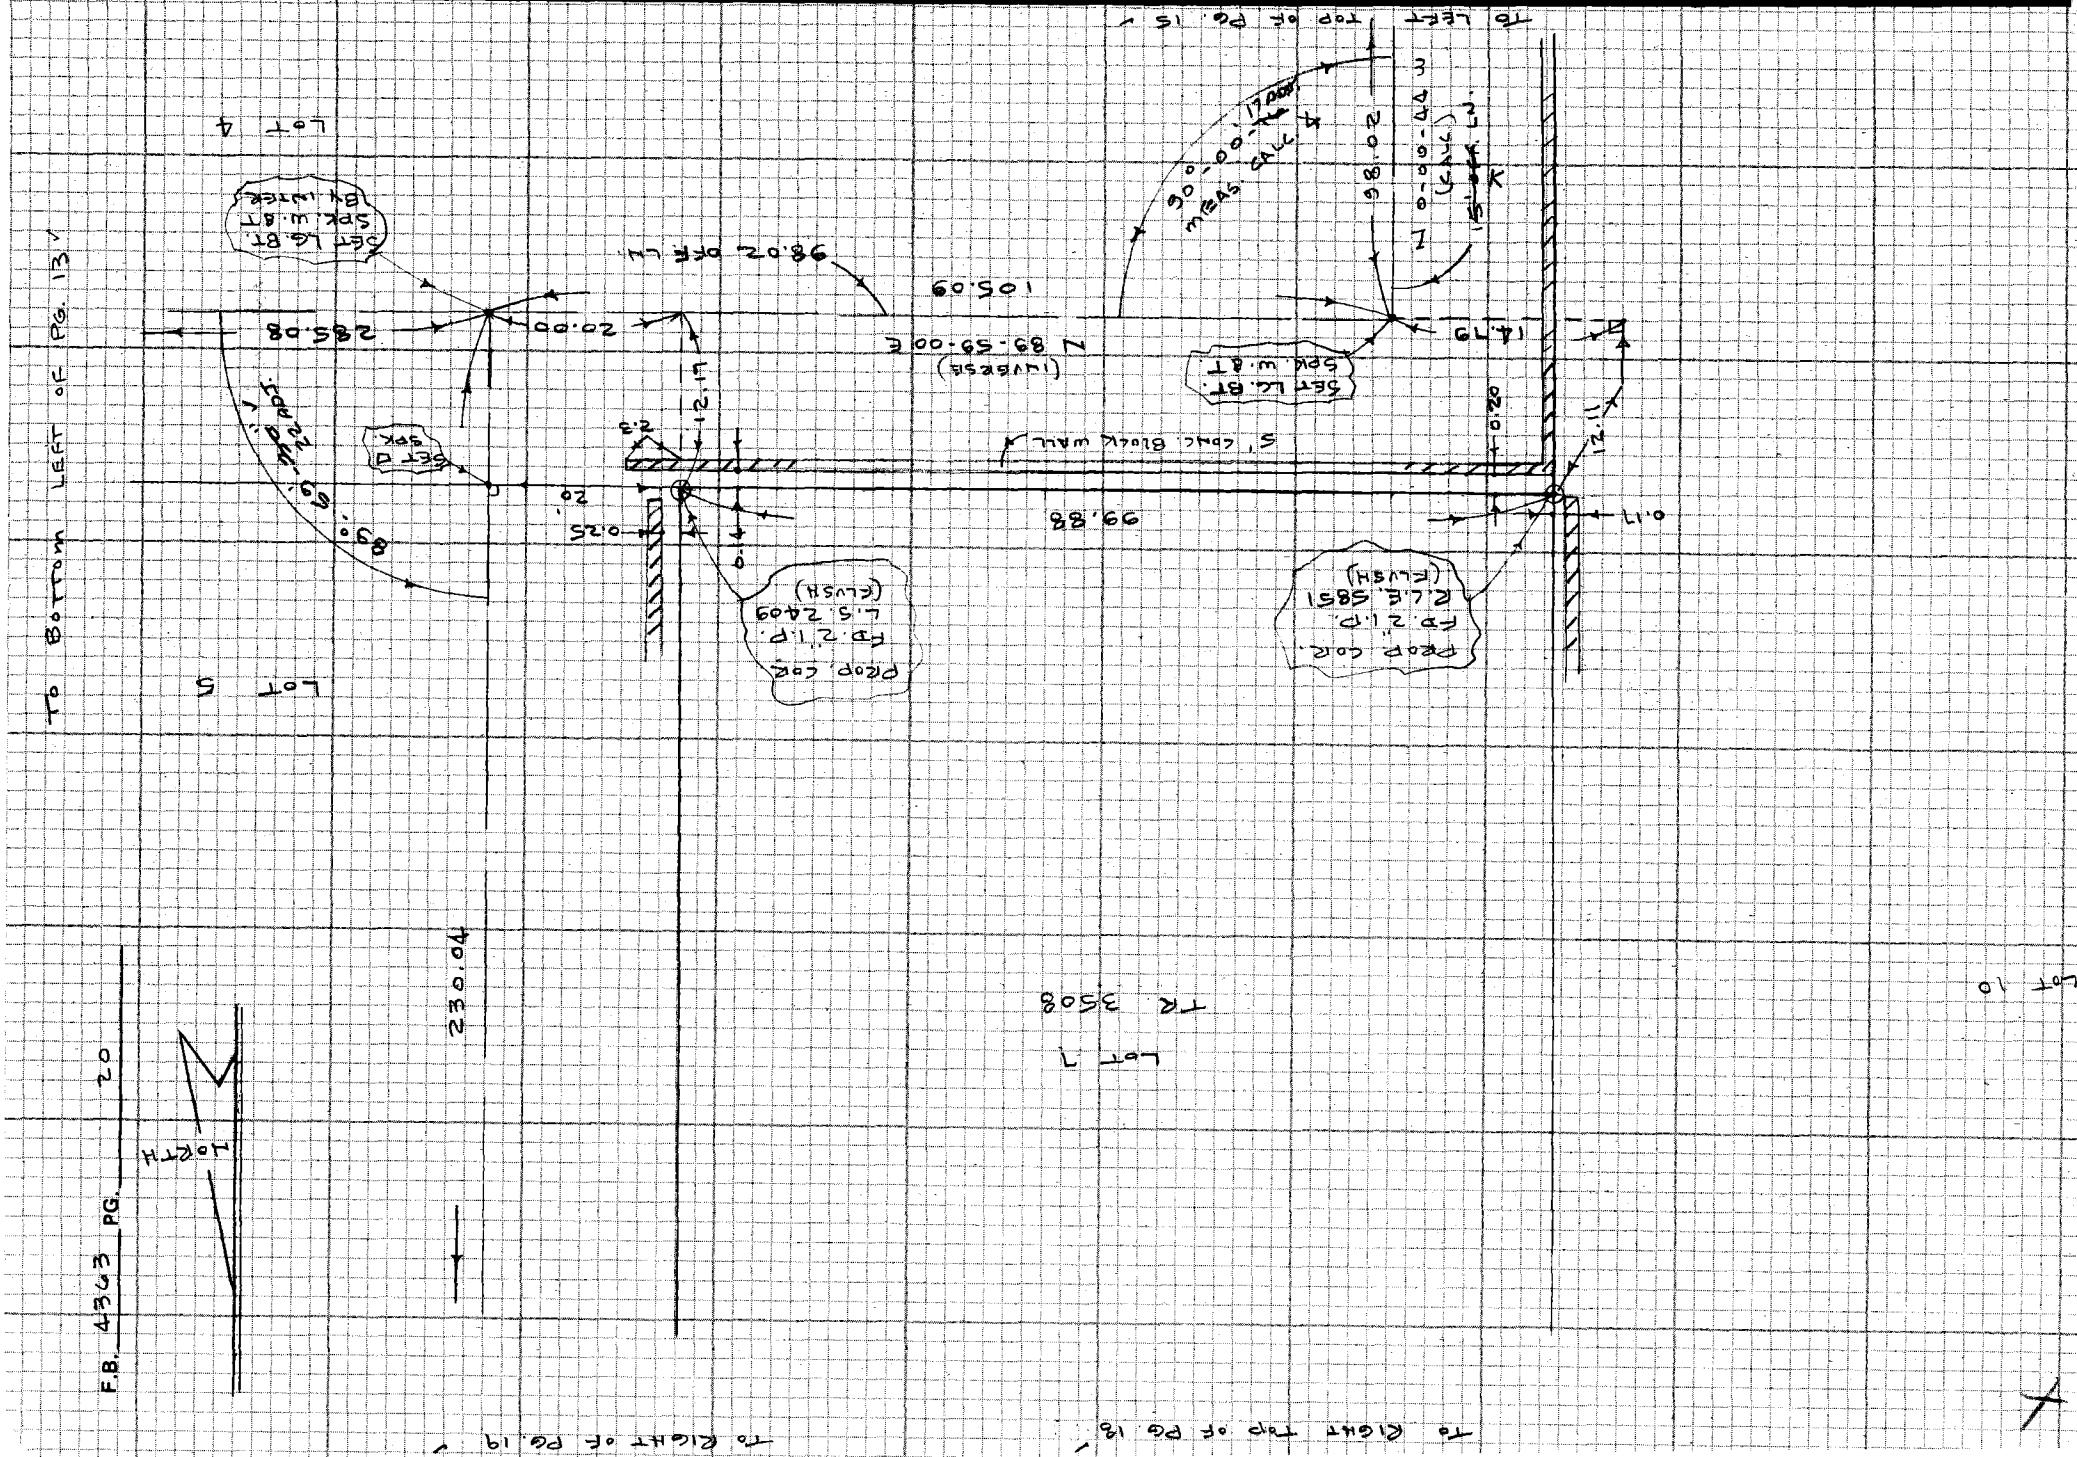

Notes Ck'd by M. R. NEVAREZ	Survey of OLIVE VIEW MED. CENTER - VALLEY HOSPITAL F.B. 4363 PG. 21
Map No. CSB 5272	JN 0022.08 Tape Std 68 °F
Office Work C. MOTEN	Surveyed by J. D. MENNE
Checked M. R. NEVAREZ	Notes J.P.M Date JUNE-JULY 75
Date 12-15-75	Indexed G. D. BAILEY AUG 11 '75

NOTE: ANY ADDITIONS OR CHANGES ON THIS SHEET MUST BE MADE OR CIRCLED IN RED INK WITH DATE AND NAME OF PERSON MAKING CHANGE

12-15-75

Do not extend notes this side of this line

PLEASE RETURN TO
LOS ANGELES COUNTY ENGINEER
403 LOS ANGELES COUNTY ENGINEERING BLDG.

CENTERLINE NOTES
CE 310
76F-3095-4/73

To Bottom of Pg. 18

NORTH

BLVD.

28.72

45.00

SET L. & L.A. CO. ENG. TAG 8+09.48

SET NAIL

40.04

8+49.52
FD. L&T.
F.C. 2280-167

F.C. 2280-167
43.88

(50)

(50)

(30)

3.16

FD. L.A. CITY MON. F.B. 186 149-113

(30)

(30)

VALERIO

STREET

(30)

VAL

CE 310
76F3095-4/73

PLEASE RETURN TO
LOS ANGELES COUNTY ENGINEER
403 LOS ANGELES COUNTY ENGINEERING BLDG.

NOTE: ANY ADDITIONS OR CHANGES ON THIS SHEET MUST BE MADE OR CIRCLED IN RED INK WITH DATE AND NAME OF PERSON MAKING CHANGE

Do not ex[illegible] notes this side of this line

F.B. 4363 PG. 22

Notes Ck'd by	Survey of
Map No.	JN Tape Std °F
Office Work	Surveyed by
Checked	Notes Date
Date	Indexed

F.B. PG.
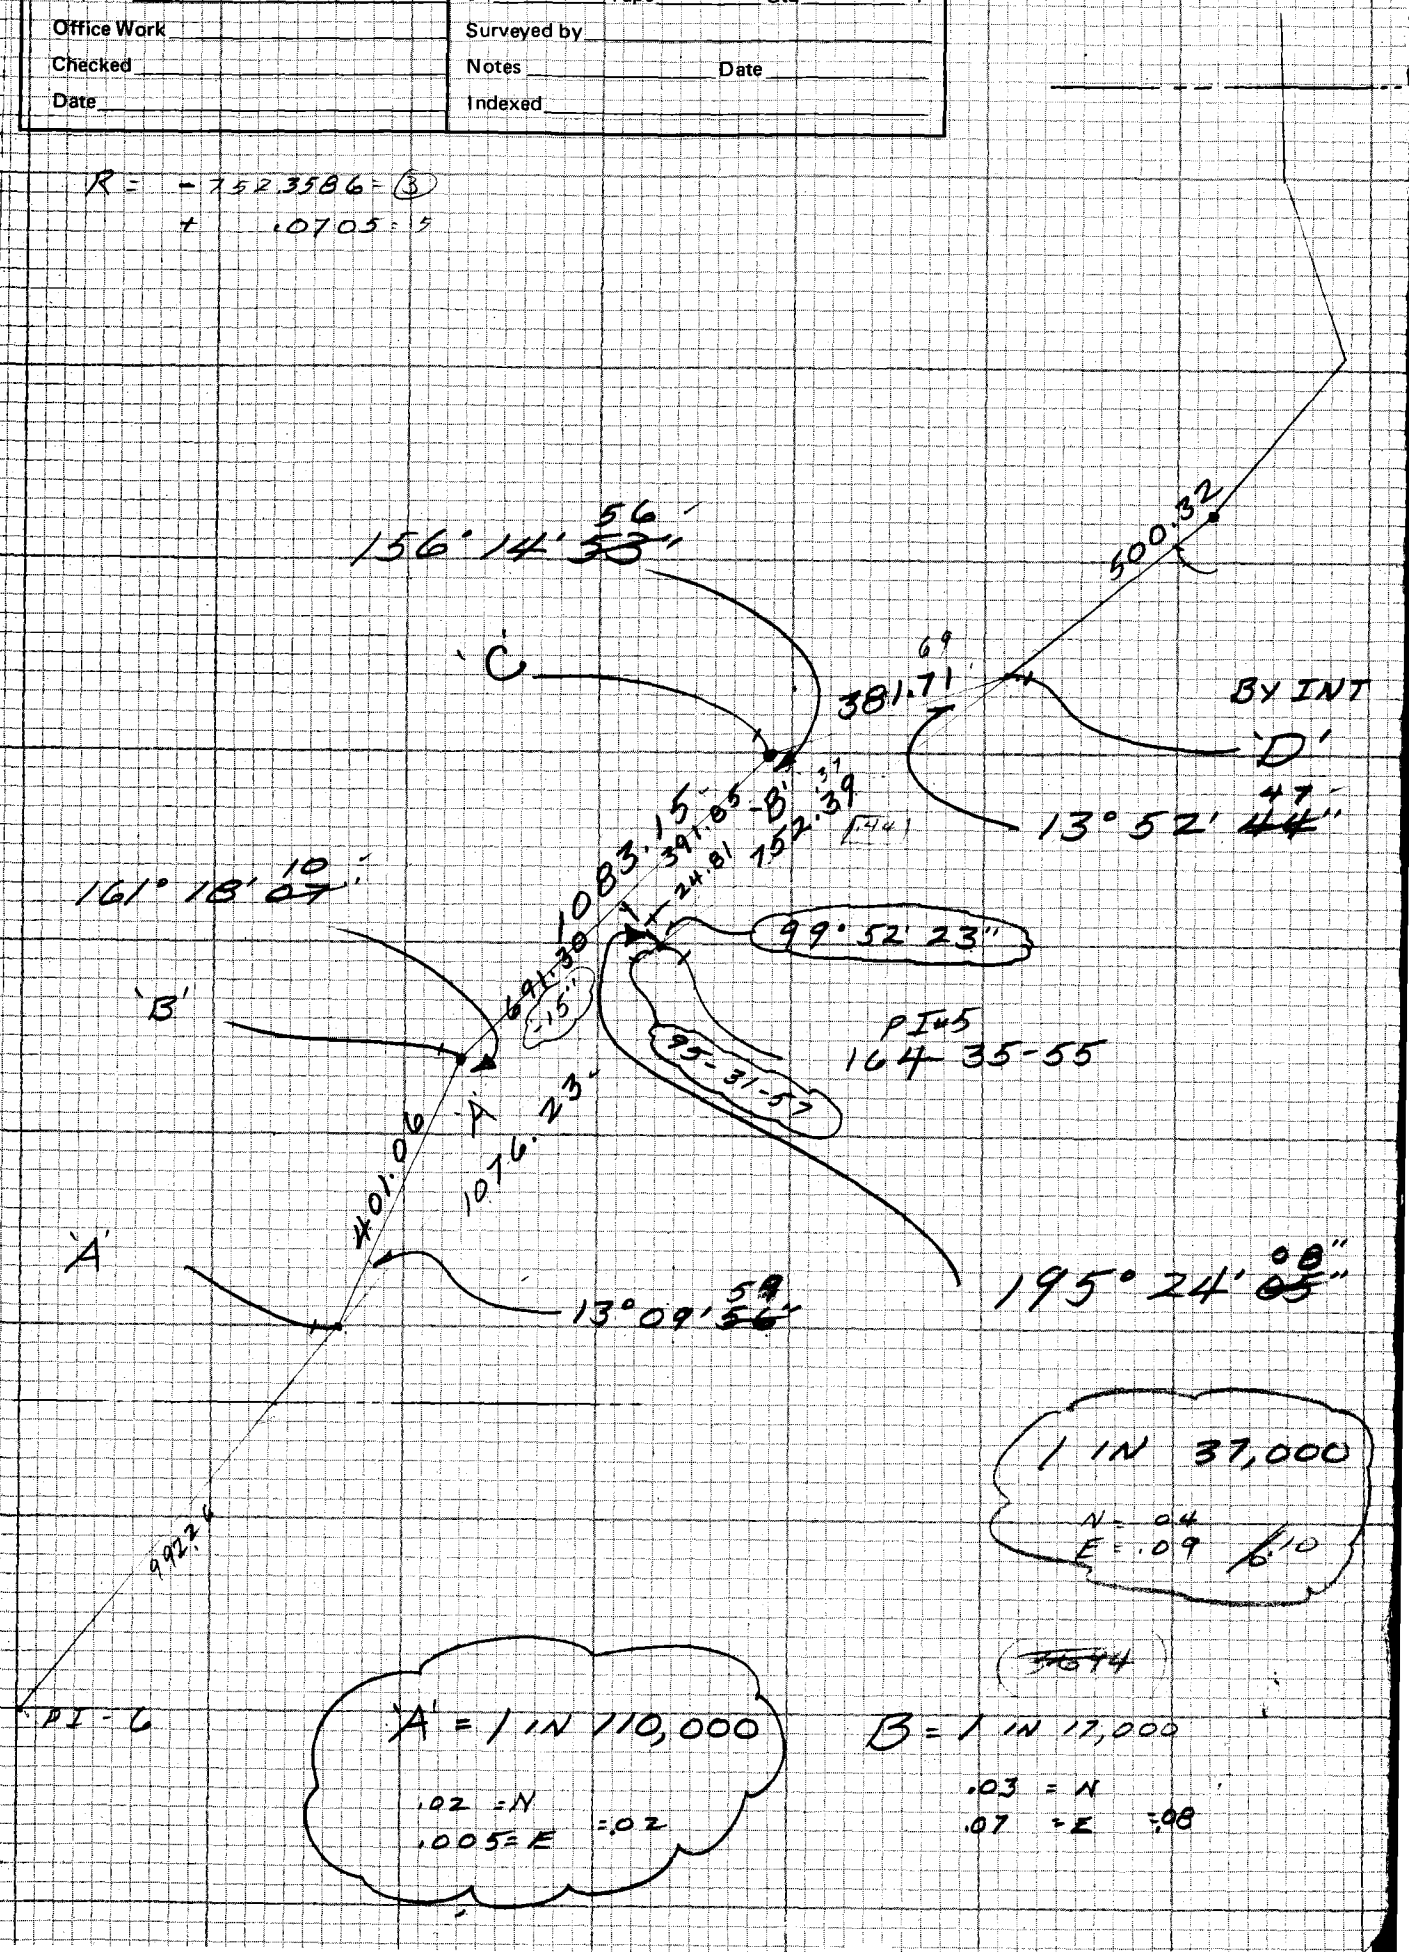
R = -752.3586 = (3)
+ .0705 = 5