DIV 4

| | |
|---|---|
| Notes Ck'd by | Survey of ROSEMEAD ST ℄ |
| Map No. | JN 0303.00 Tape 0162 Std 68 °F |
| Office Work | Surveyed by E. LANDA |
| Checked | Notes E. LANDA Date 3-76 |
| Date | Indexed G. D. BAILEY SEP 19 1977 |

F.B. 4412 PG. 5

ROSEMEAD STREET CENTER LINE

DIV. 4

J.N. 0303.00

PARTY
E. LANDA
K. KAPP
V. LIEBER
J. MALDONADO
G. CREASON

Microfilmed 10-9-84.

F.B. 4412 PG. 6

INDEX

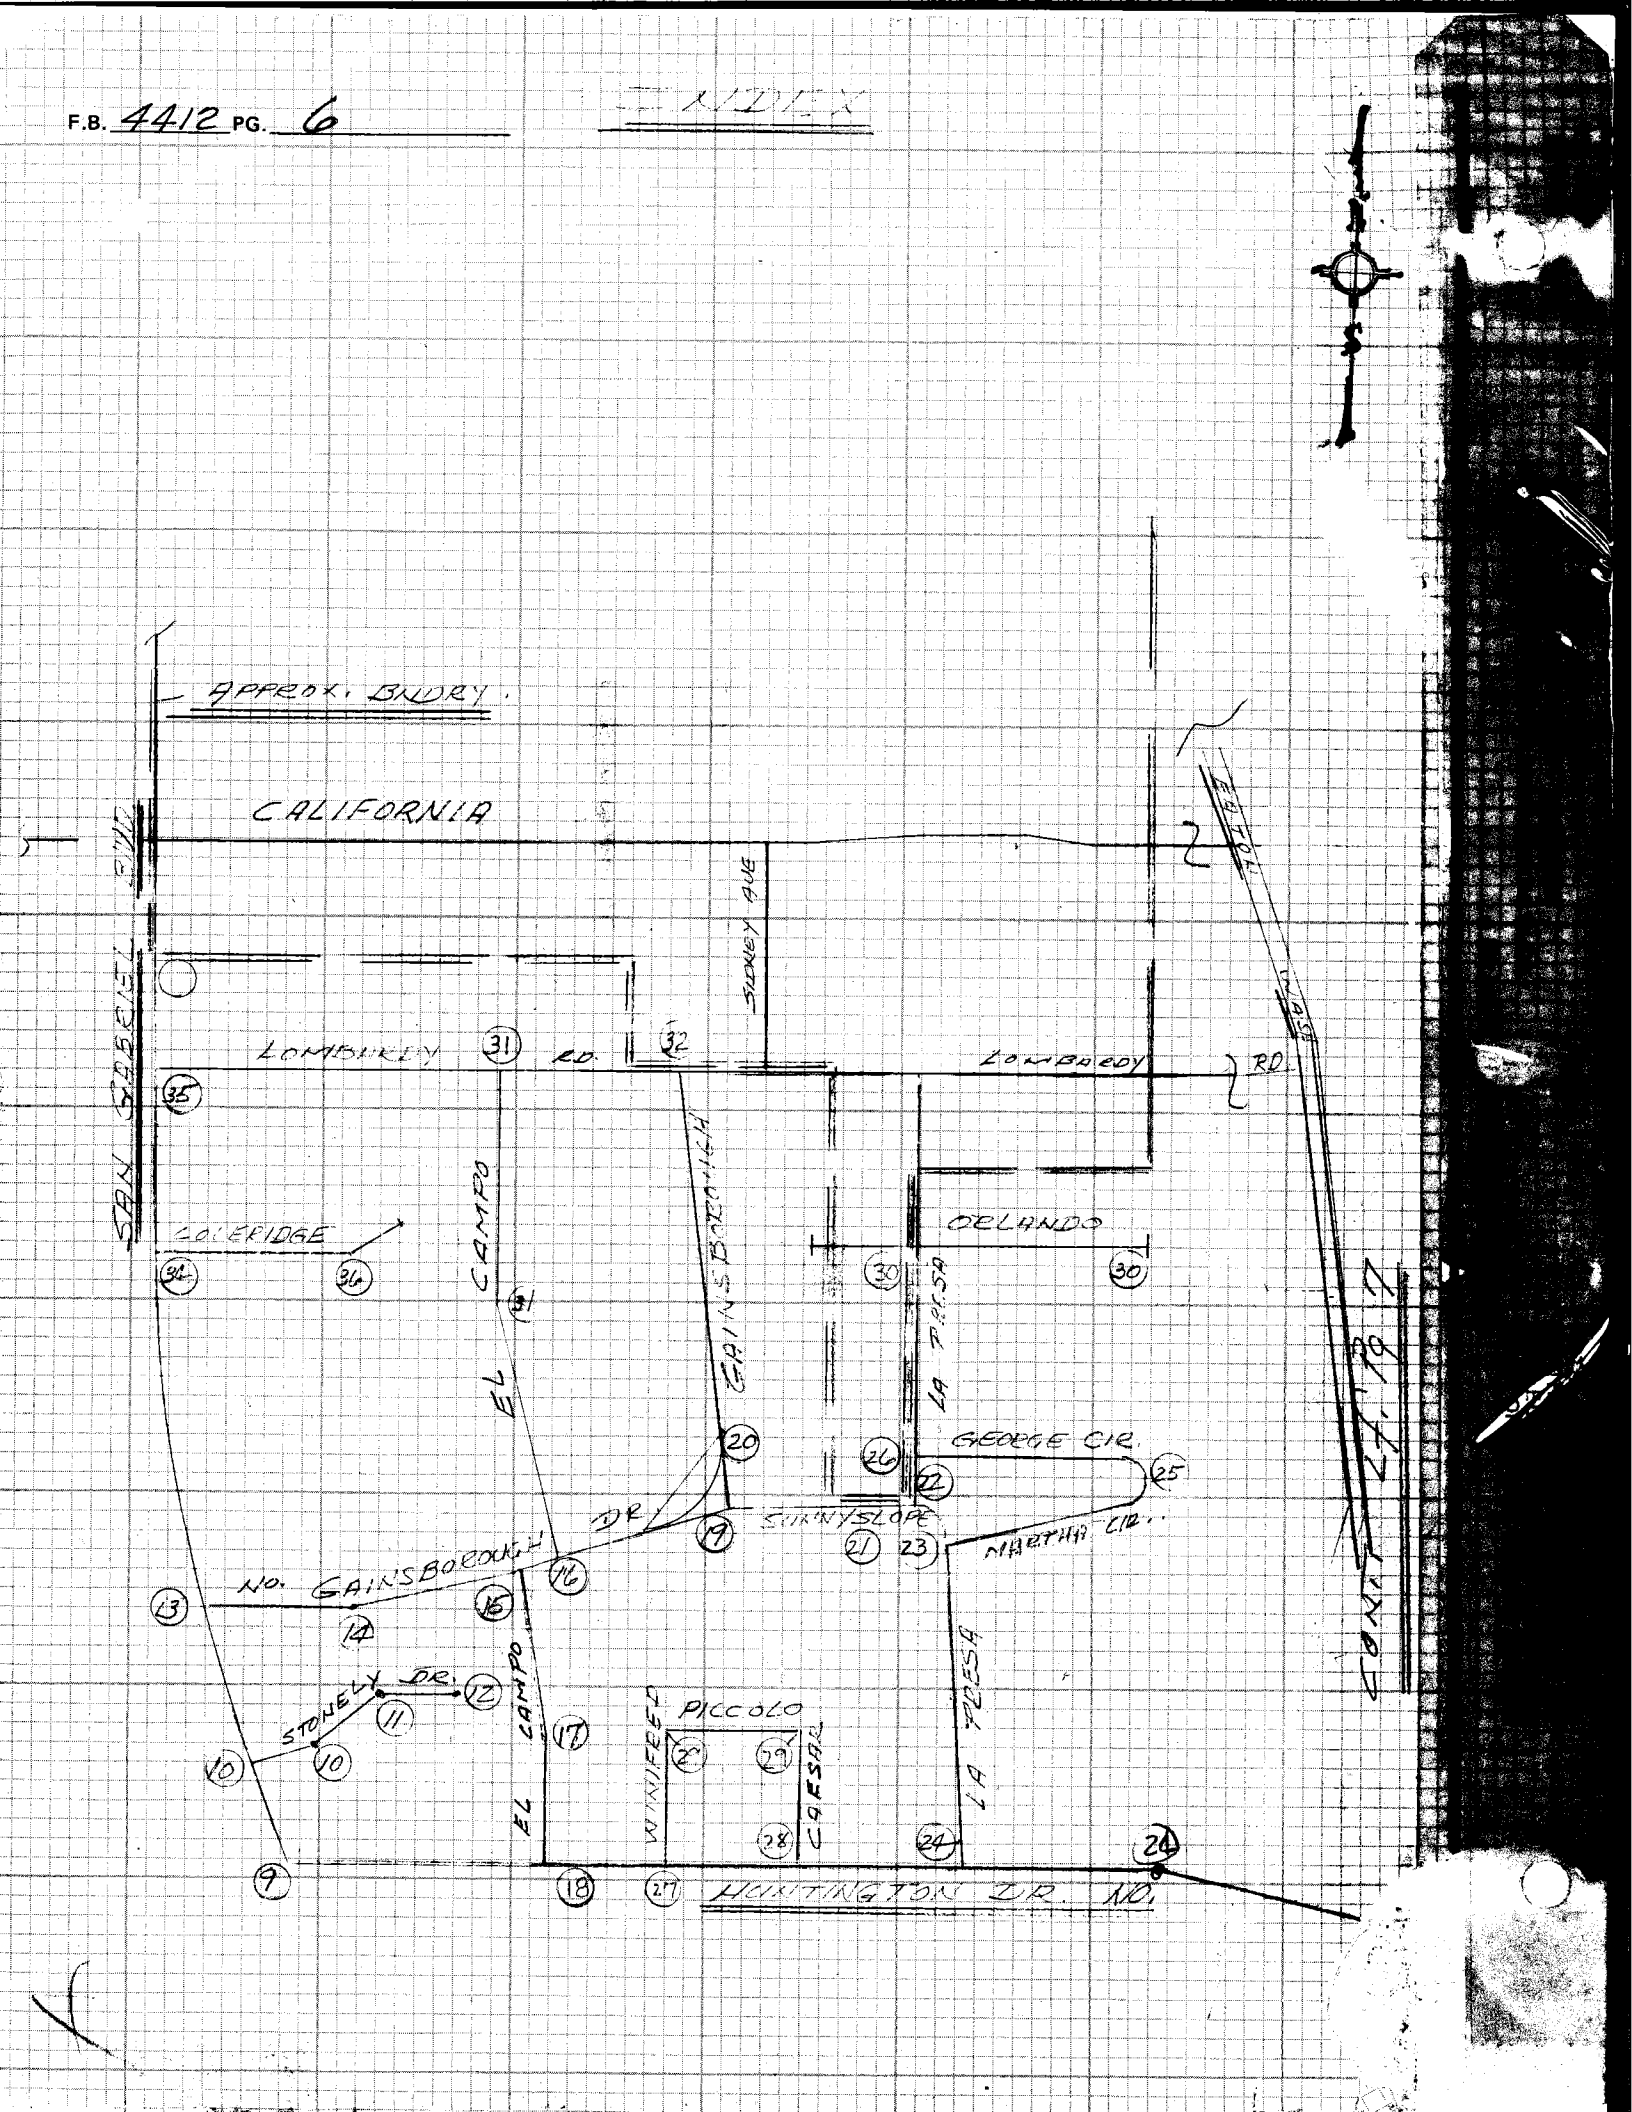

DIV. 4

Notes Ck'd by
Map No.
Office Work
Checked
Date

Survey of ROSEMEAD ST. &
JN 4303.00 Tape 0162 Std 68 F
Surveyed by E. LANDA
Notes LIEBER Date 1976
Indexed S. D. BAILEY SEP 19 1977

F.B. 4412 PG. 7

INDEX

CONTINUED BOT. PG. 8

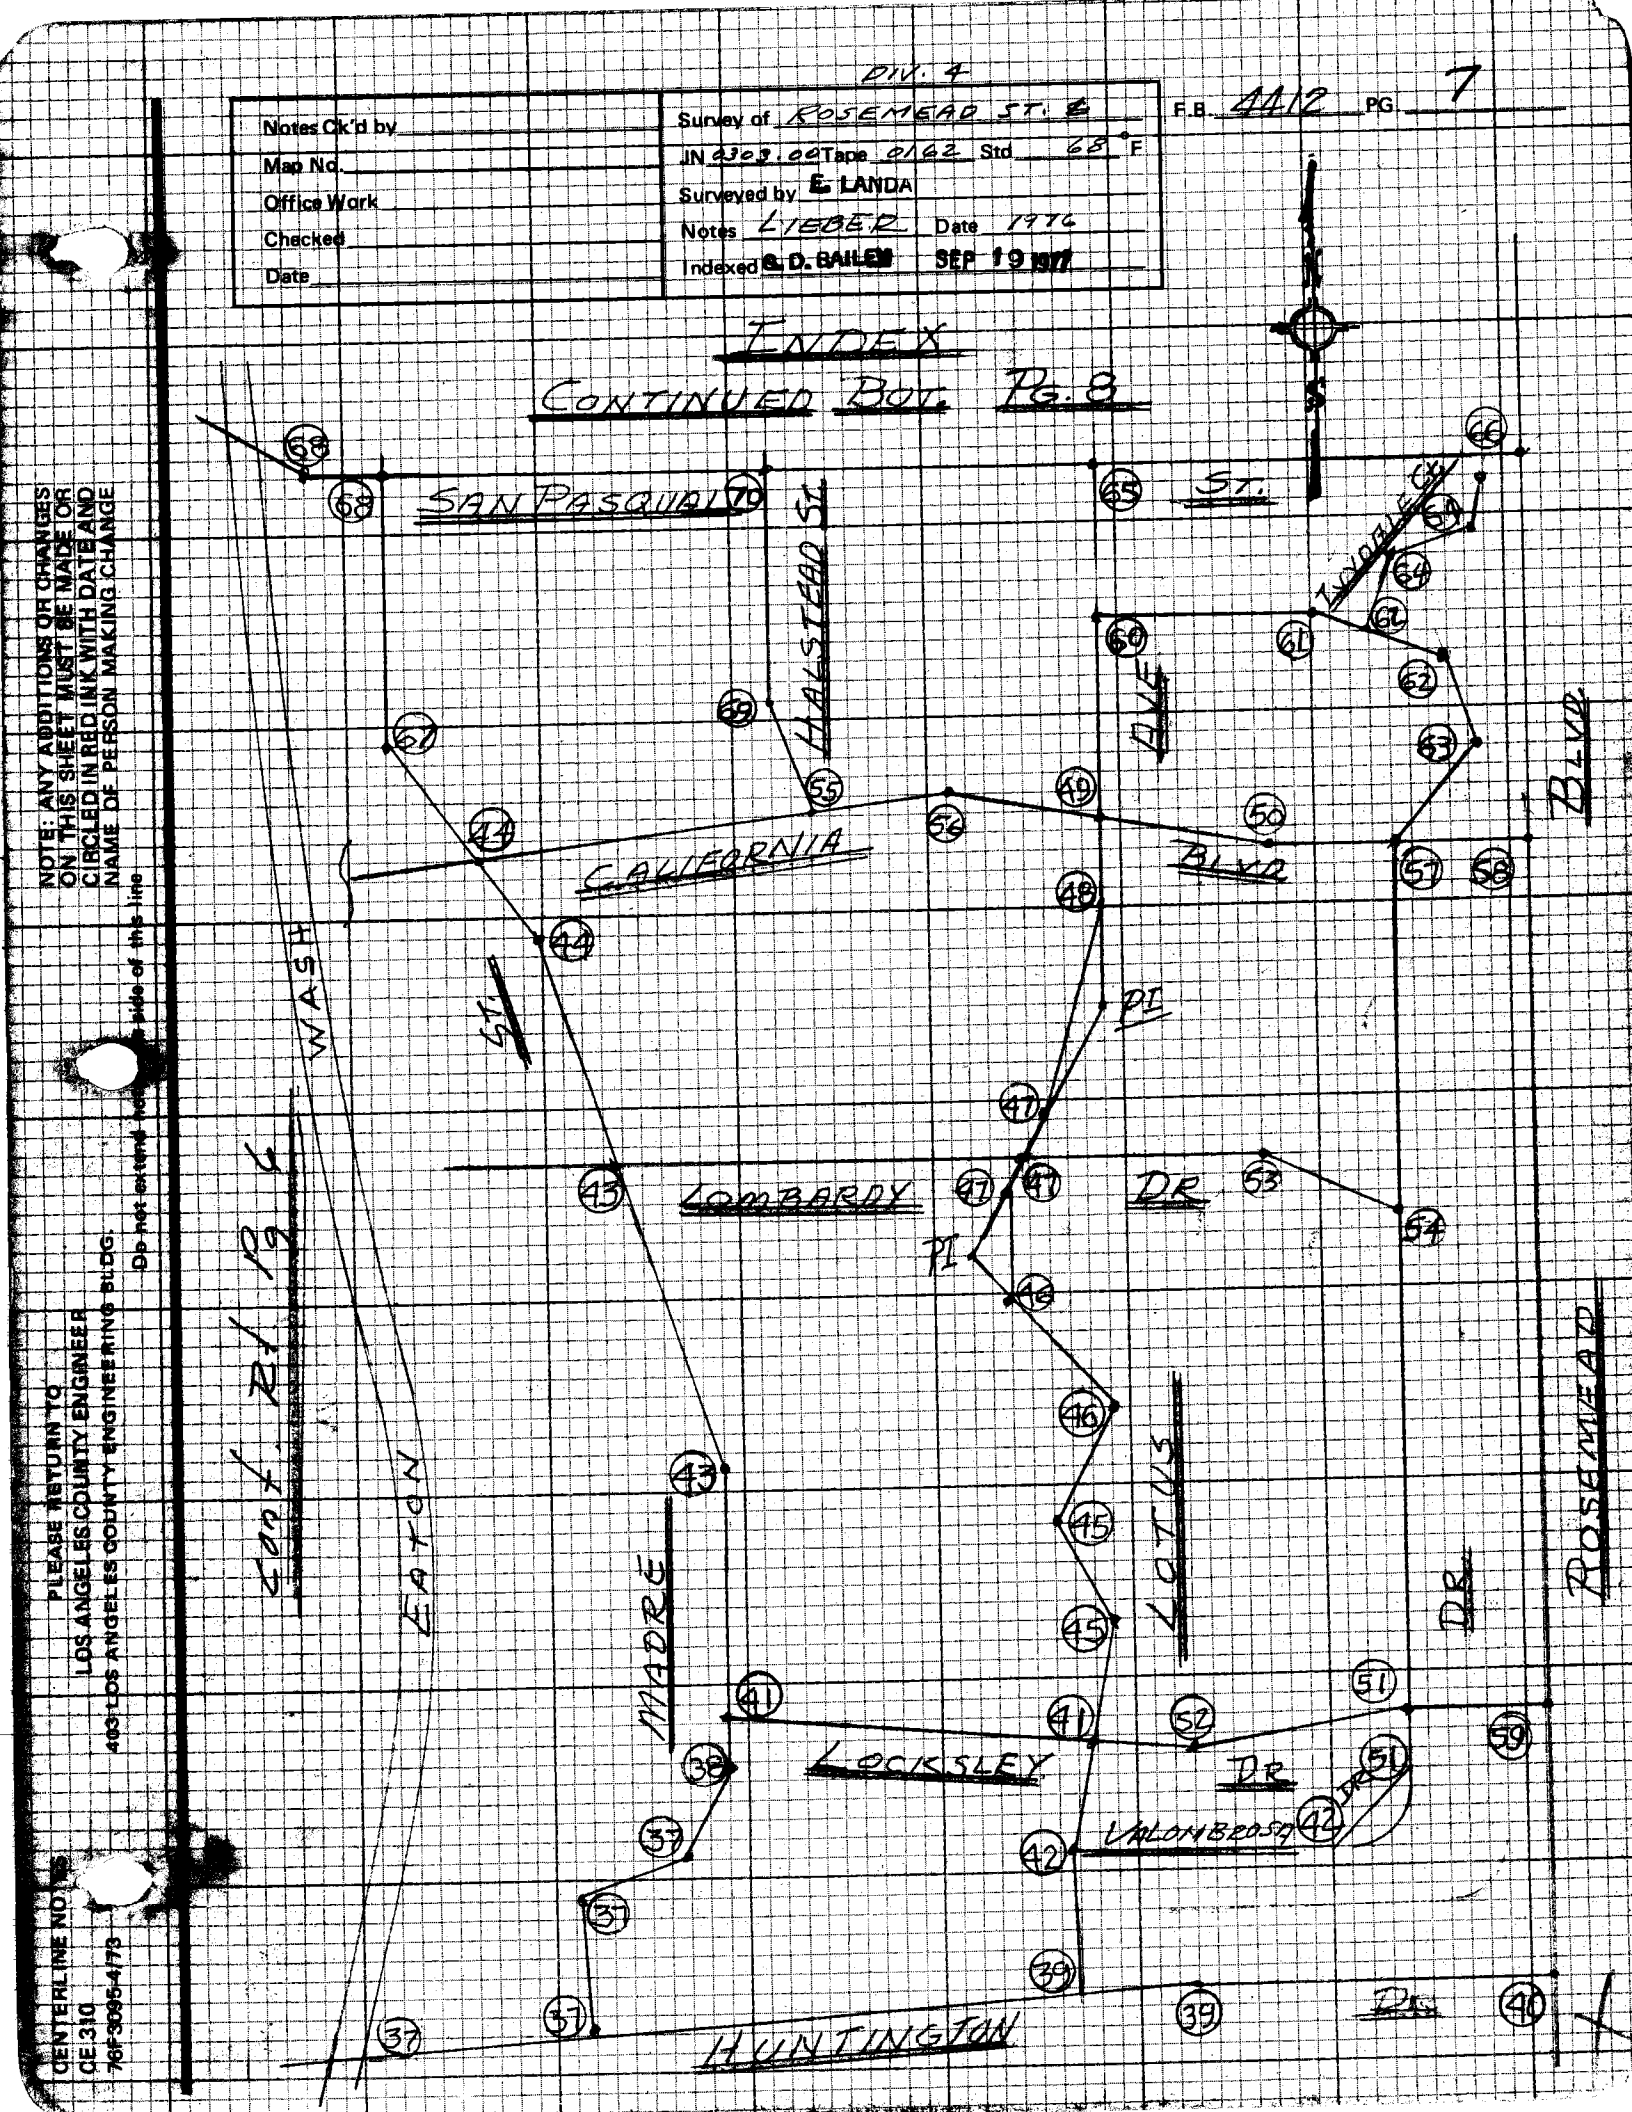


NOTE: ANY ADDITIONS OR CHANGES ON THIS SHEET MUST BE MADE OR CIRCLED IN RED INK WITH DATE AND NAME OF PERSON MAKING CHANGE

Do not extend notes beyond this line

PLEASE RETURN TO
LOS ANGELES COUNTY ENGINEER
403 LOS ANGELES COUNTY ENGINEERING BLDG.

CENTERLINE NO. 15
CE 310
76F3095-4/73

F.B. 4412 PG. 8

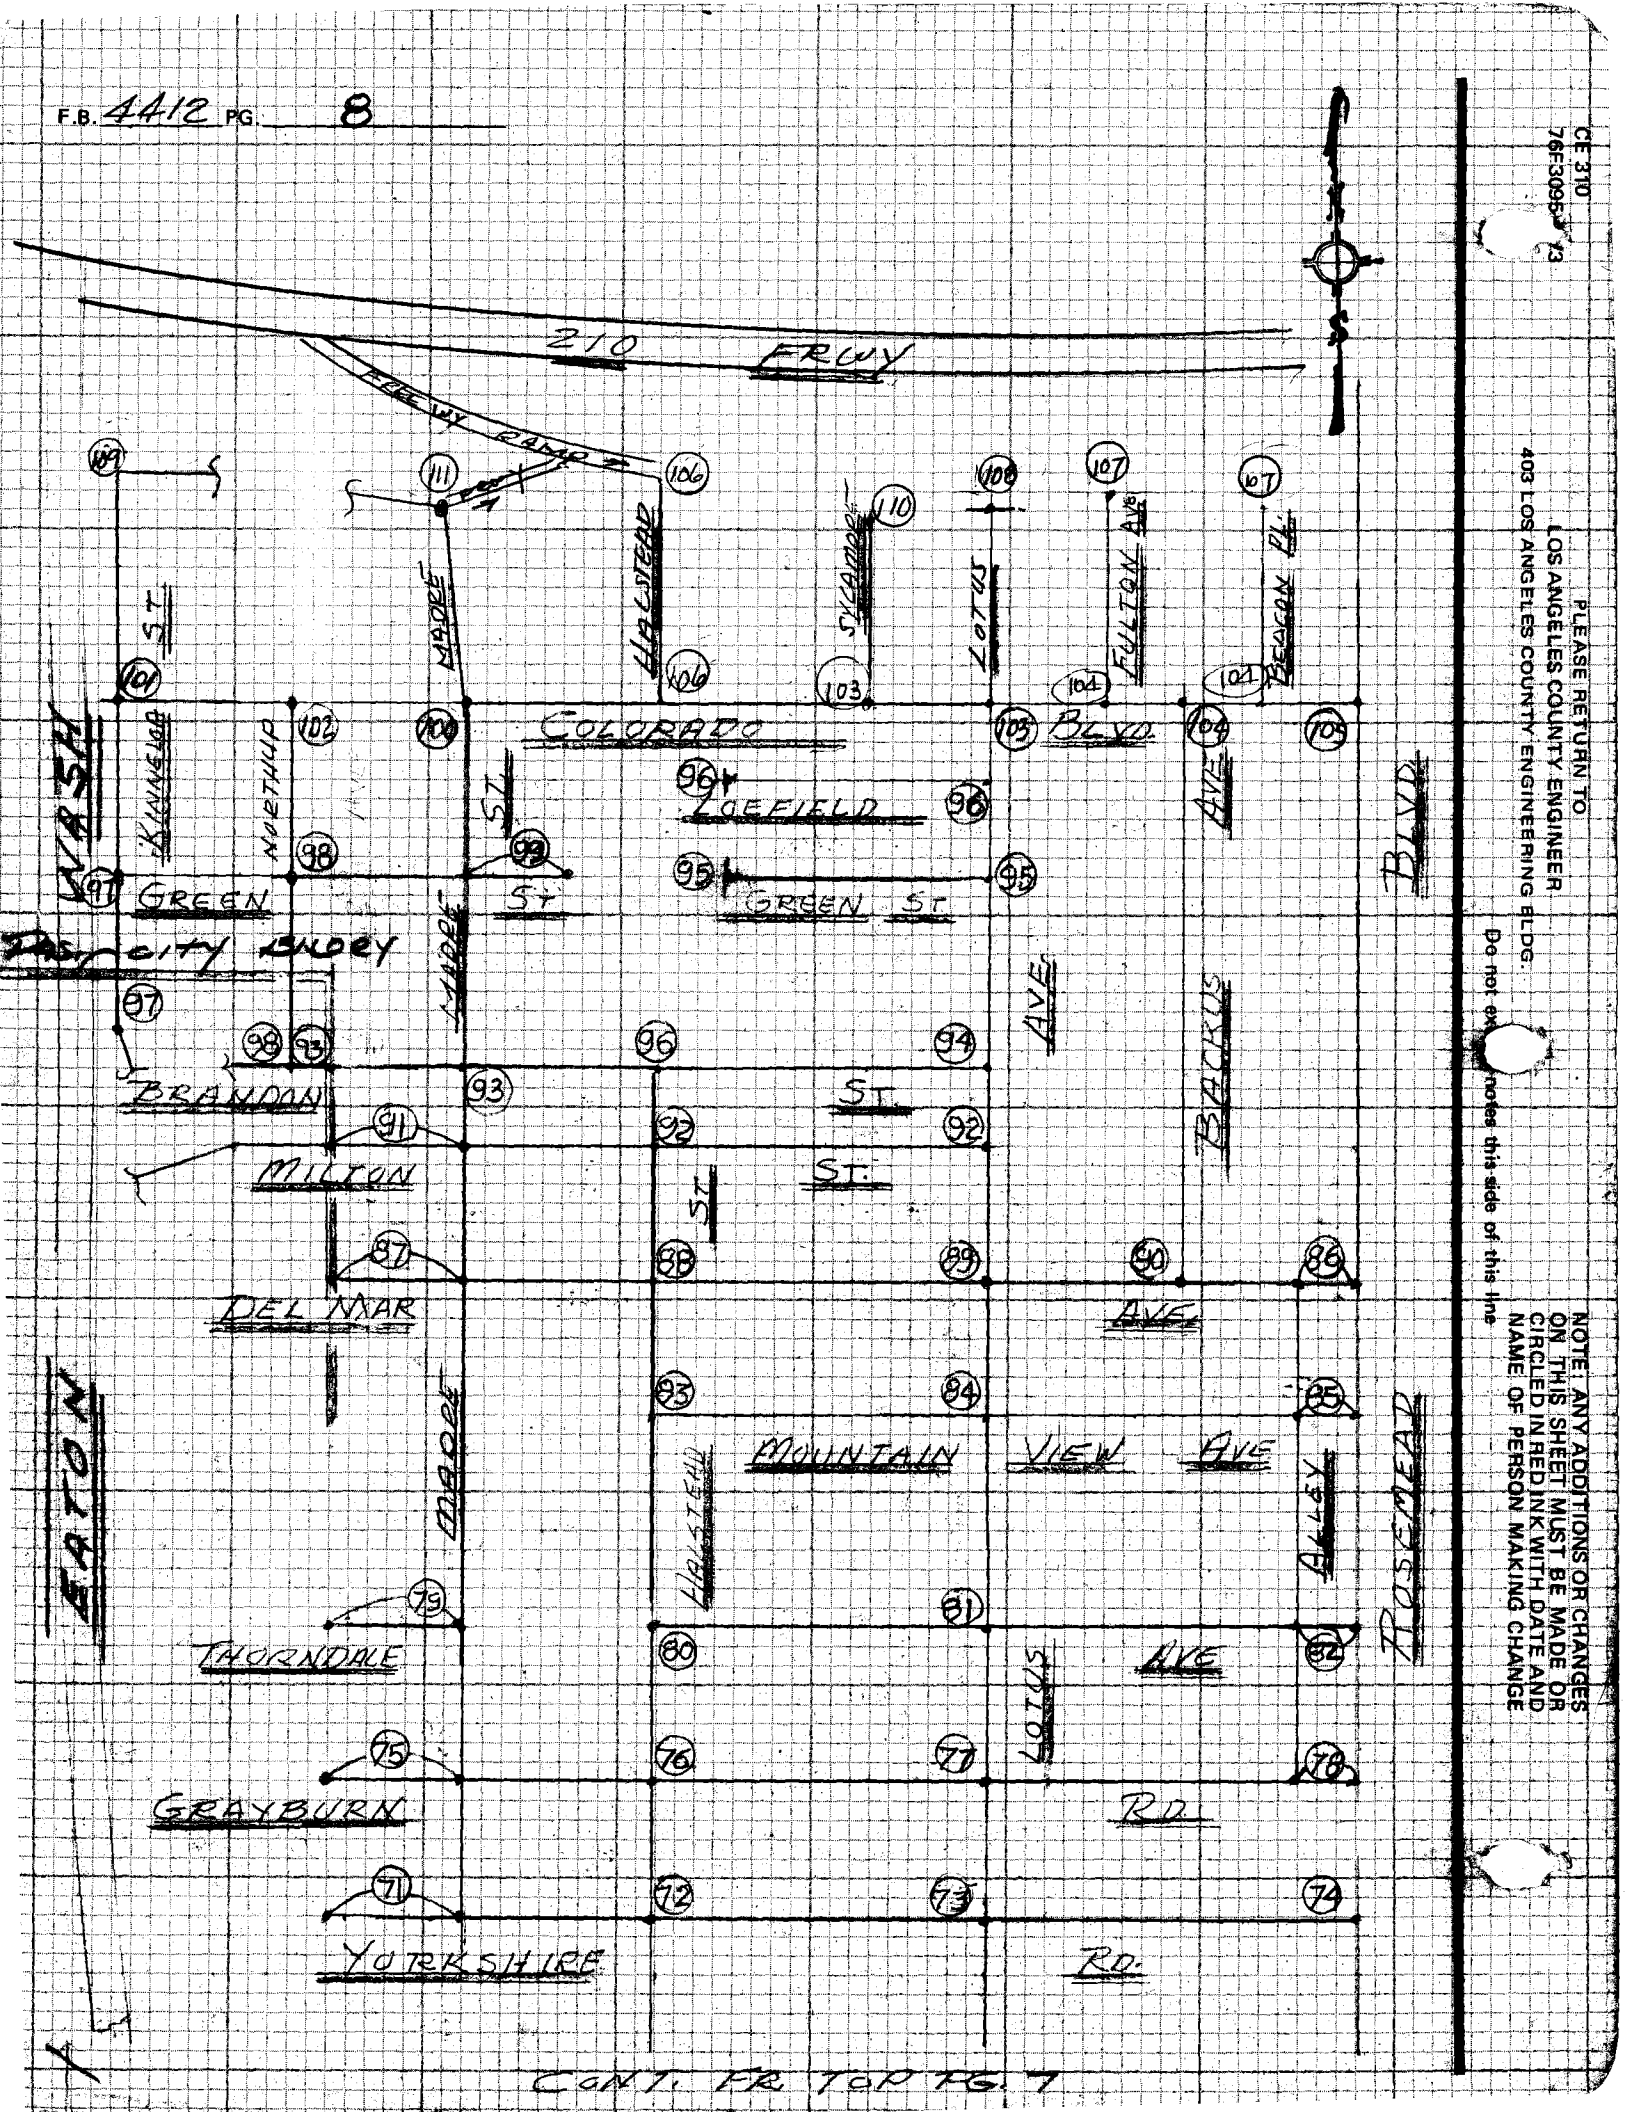


CE 310
76F3095 13

PLEASE RETURN TO
LOS ANGELES COUNTY ENGINEER
403 LOS ANGELES COUNTY ENGINEERING BLDG.

NOTE: ANY ADDITIONS OR CHANGES
ON THIS SHEET MUST BE MADE OR
CIRCLED IN RED INK WITH DATE AND
NAME OF PERSON MAKING CHANGE

Do not ex notes this side of this line

| | |
|---|---|
| Notes Ck'd by | Survey of ROSEMEAD ST. & DIV. 4 |
| Map No. | JN 0303.00 Tape 0162 Std 68 °F |
| Office Work | Surveyed by E. LANDA |
| Checked | Notes E.L. & K.M.K. Date 3-76 |
| Date | Indexed G. D. BAILEM SEP 19 1977 |

F.B. 4412 PG. 9

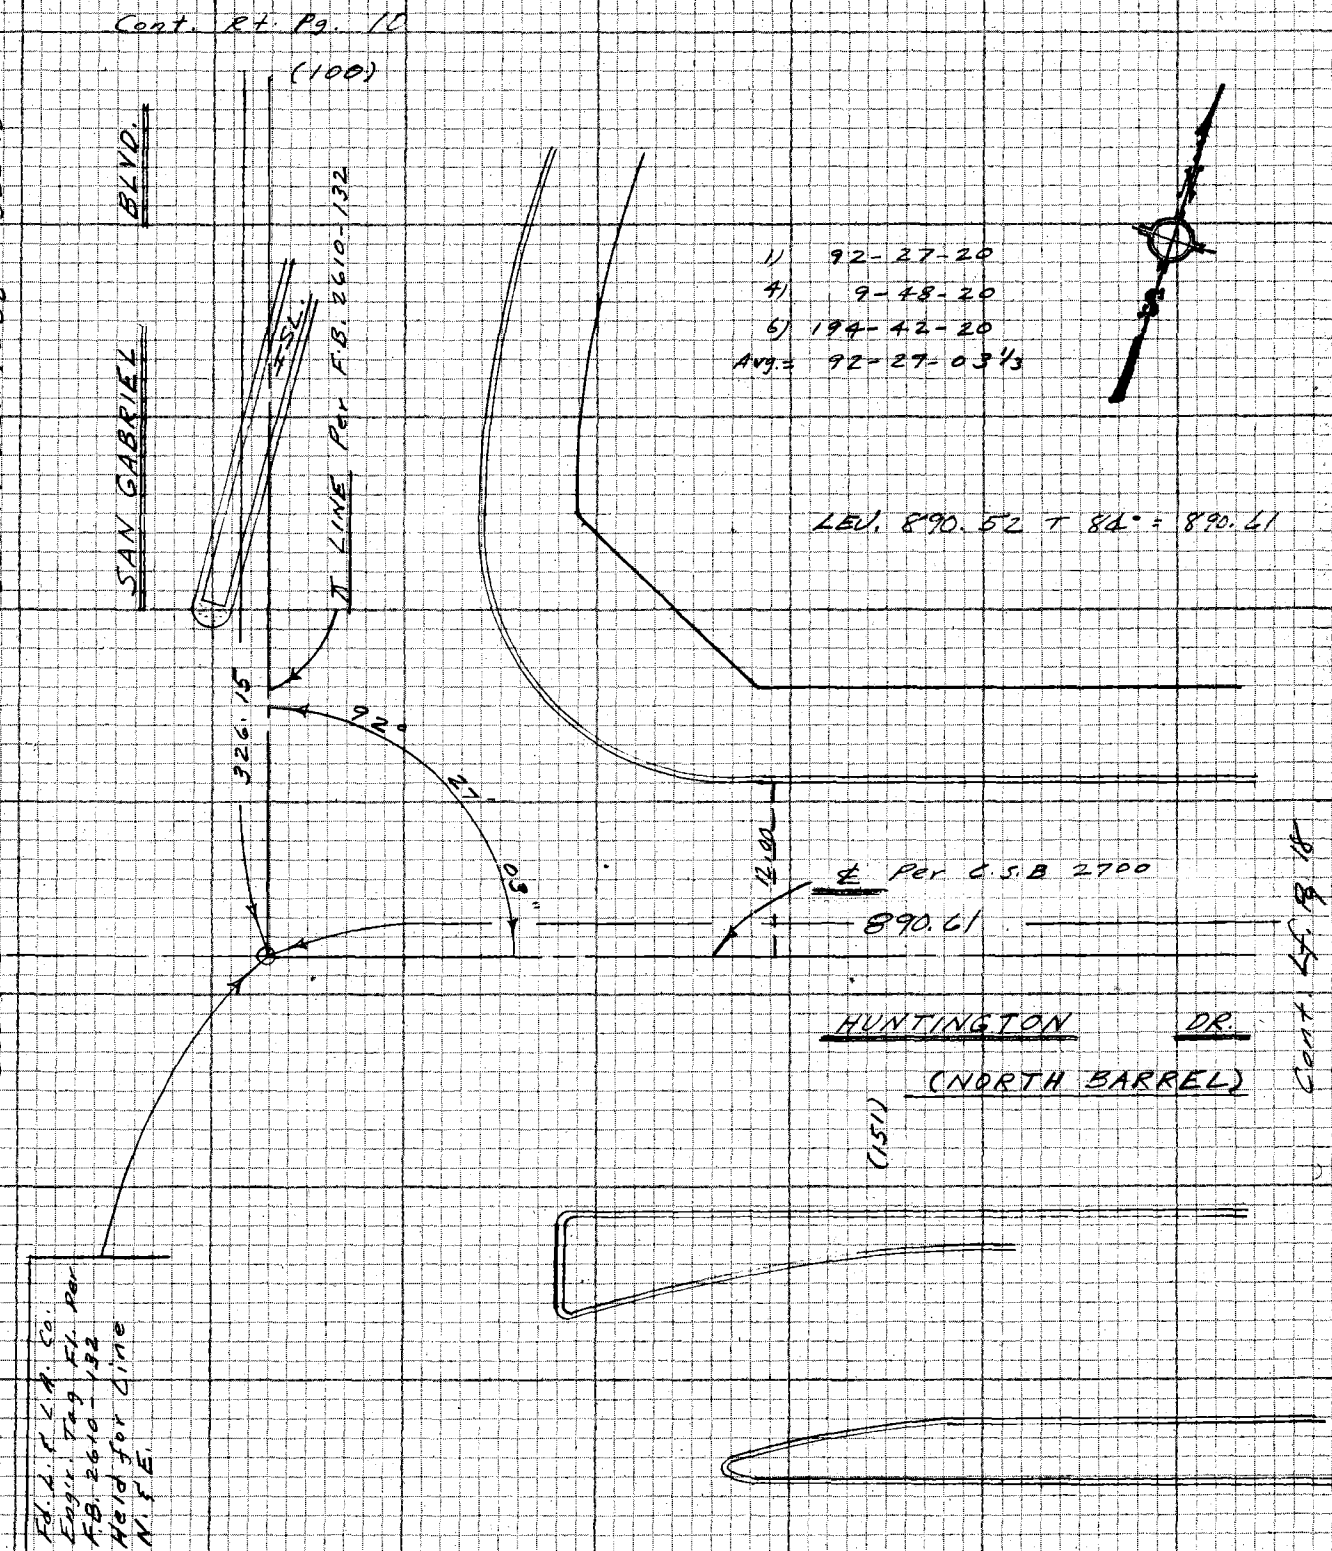


NOTE: ANY ADDITIONS OR CHANGES ON THIS SHEET MUST BE MADE OR CIRCLED IN RED INK WITH DATE AND NAME OF PERSON MAKING CHANGE

Do not extend notes on this side of this line

PLEASE RETURN TO
LOS ANGELES COUNTY ENGINEER
403 LOS ANGELES COUNTY ENGINEERING BLDG.

CENTERLINE NOTES
CE 310
76F3095-4/73

F.B. 4412 PG. 10

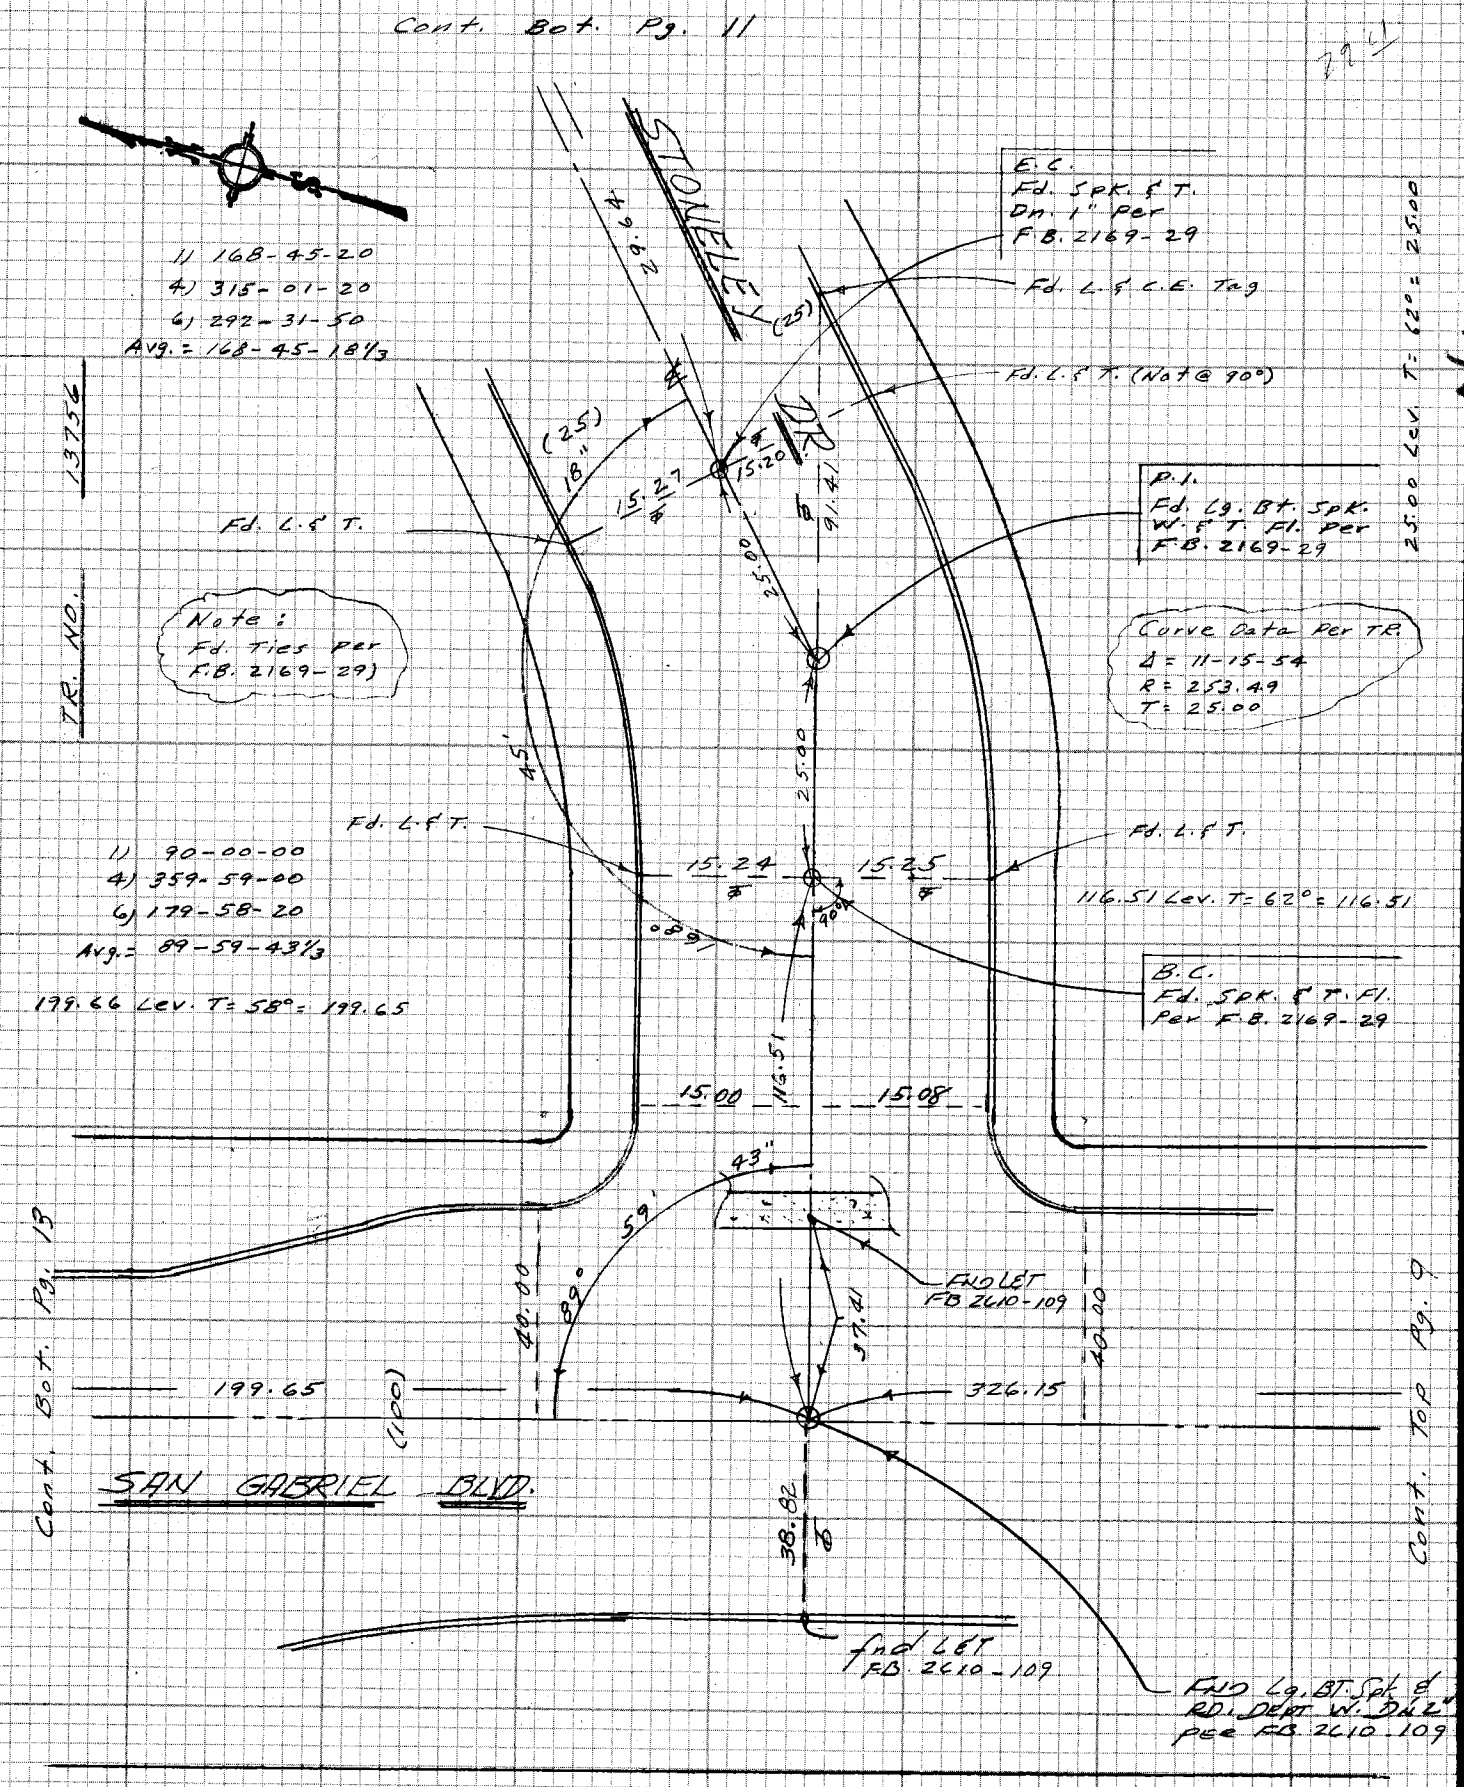


CE 310
76F3095 #73

PLEASE RETURN TO
LOS ANGELES COUNTY ENGINEER
403 LOS ANGELES COUNTY ENGINEERING BLDG.

Do not ex[illegible] notes this side of this line

NOTE: ANY ADDITIONS OR CHANGES ON THIS SHEET MUST BE MADE OR CIRCLED IN RED INK WITH DATE AND NAME OF PERSON MAKING CHANGE

W.S. 44, B-3

| | |
|---|---|
| Notes Ck'd by | Survey of ROSEMEAD ST. & DIV. 4 F.B. 4412 PG. 11 |
| Map No. | JN 3703:00 Tape 0162 Std 68° F |
| Office Work | Surveyed by E. LANOA |
| Checked | Notes K.M. KAPP Date 3-76 |
| Date | Indexed S.D. BAILEY SEP 19 1977 |

Cont. Bot. Pg. 12

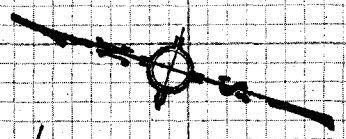

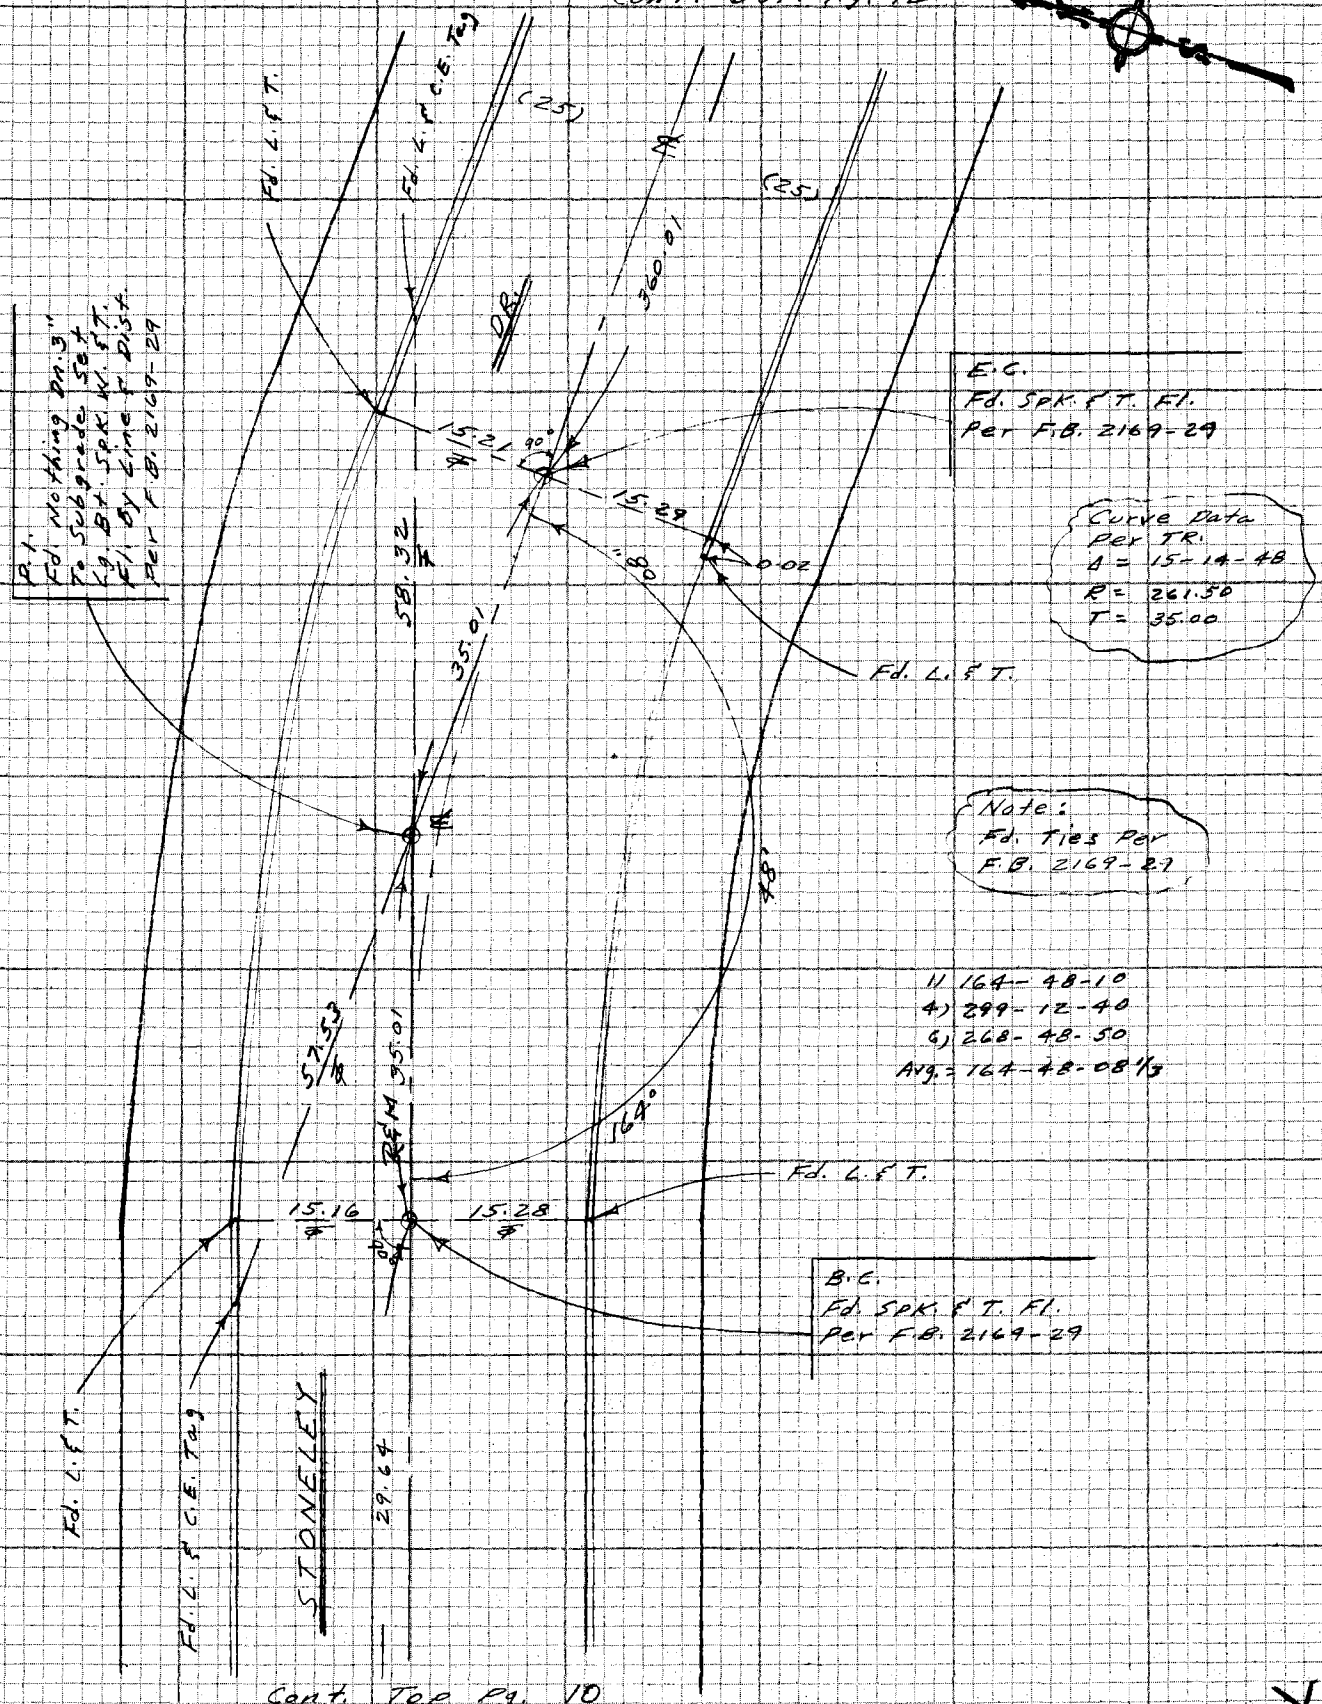


Cont. Top Pg. 10

NOTE: ANY ADDITIONS OR CHANGES ON THIS SHEET MUST BE MADE OR CIRCLED IN RED INK WITH DATE AND NAME OF PERSON MAKING CHANGE

Do not extend notes beyond this line

PLEASE RETURN TO
LOS ANGELES COUNTY ENGINEER
403 LOS ANGELES COUNTY ENGINEERING BLDG.

CENTERLINE NOTES
CE 310
76F3095-4/73

F.B. 4412 PG. 12

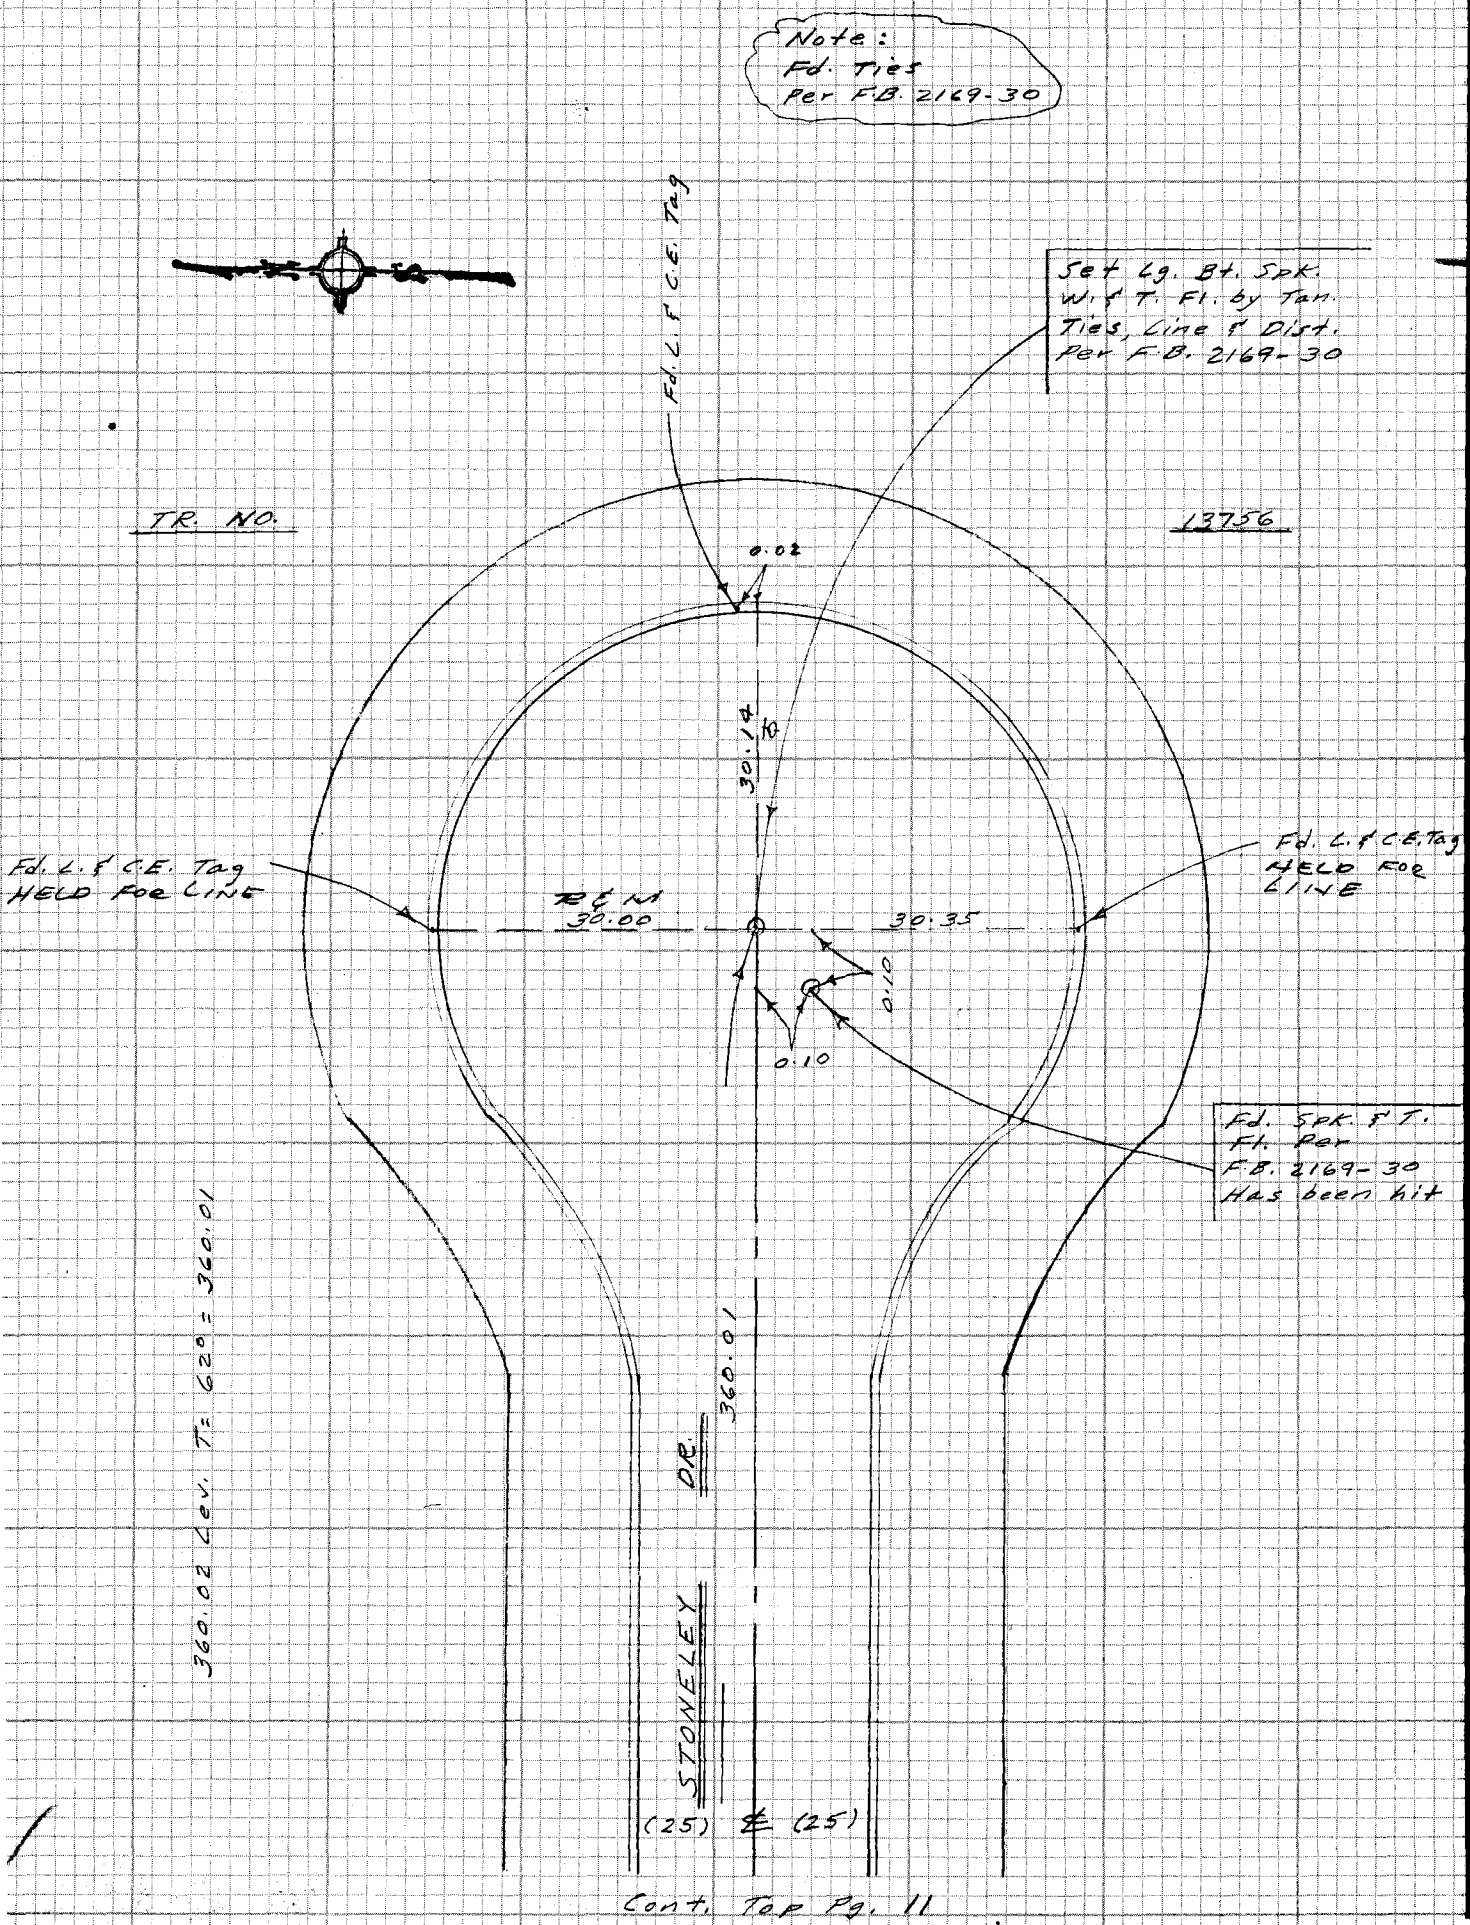


Cont. Top Pg. 11

CE 310
76F3095-4/73
PLEASE RETURN TO
LOS ANGELES COUNTY ENGINEER
403 LOS ANGELES COUNTY ENGINEERING BLDG.
Do not ex[illegible] notes this side of this line
NOTE: ANY ADDITIONS OR CHANGES ON THIS SHEET MUST BE MADE OR CIRCLED IN RED INK WITH DATE AND NAME OF PERSON MAKING CHANGE

WS A4 B-3

NOTE: ANY ADDITIONS OR CHANGES ON THIS SHEET MUST BE MADE OR CIRCLED IN RED INK WITH DATE AND NAME OF PERSON MAKING CHANGE
Do not extend notes on this side of this line
PLEASE RETURN TO
LOS ANGELES COUNTY ENGINEER
403 LOS ANGELES COUNTY ENGINEERING BLDG.
CENTERLINE NOTES
CE 310
76F3095-4/73

DIV 4

| | |
|---|---|
| Notes Ck'd by | Survey of ROSEMEAD ST 4 |
| Map No. | JN 0303.09 Tape 0162 Std 68 °F |
| Office Work | Surveyed by E. LANDA |
| Checked | Notes E. LANDA Date 3-76 |
| Date | Indexed G. D. BAILEY SEP 19 1977 |

F.B. 4412 PG 13

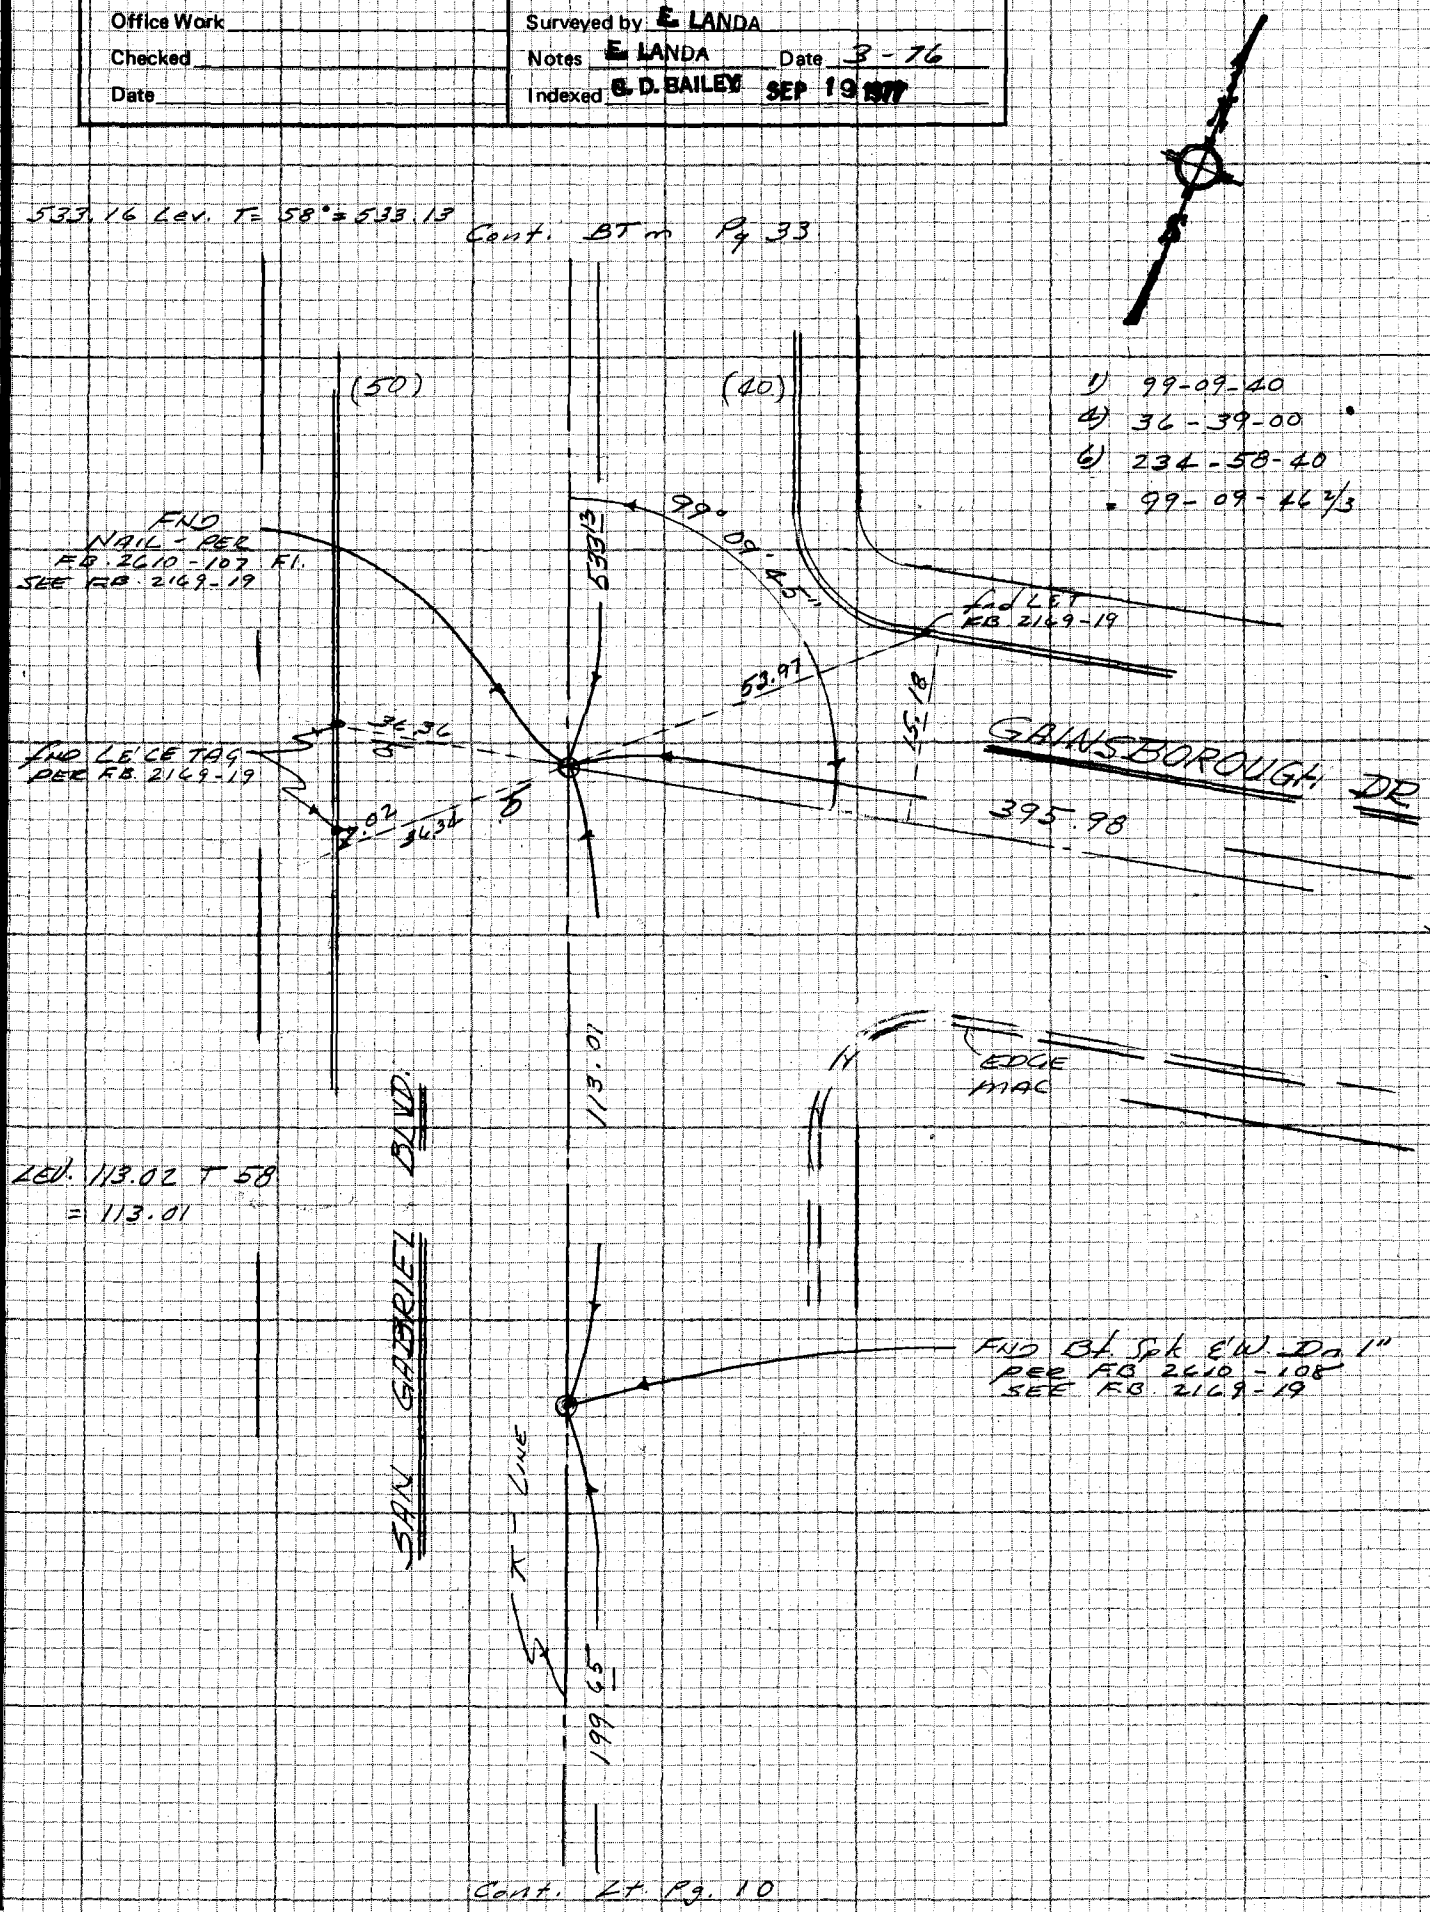

F.B. 4412 PG. 14

CONT STM. Pg. 15

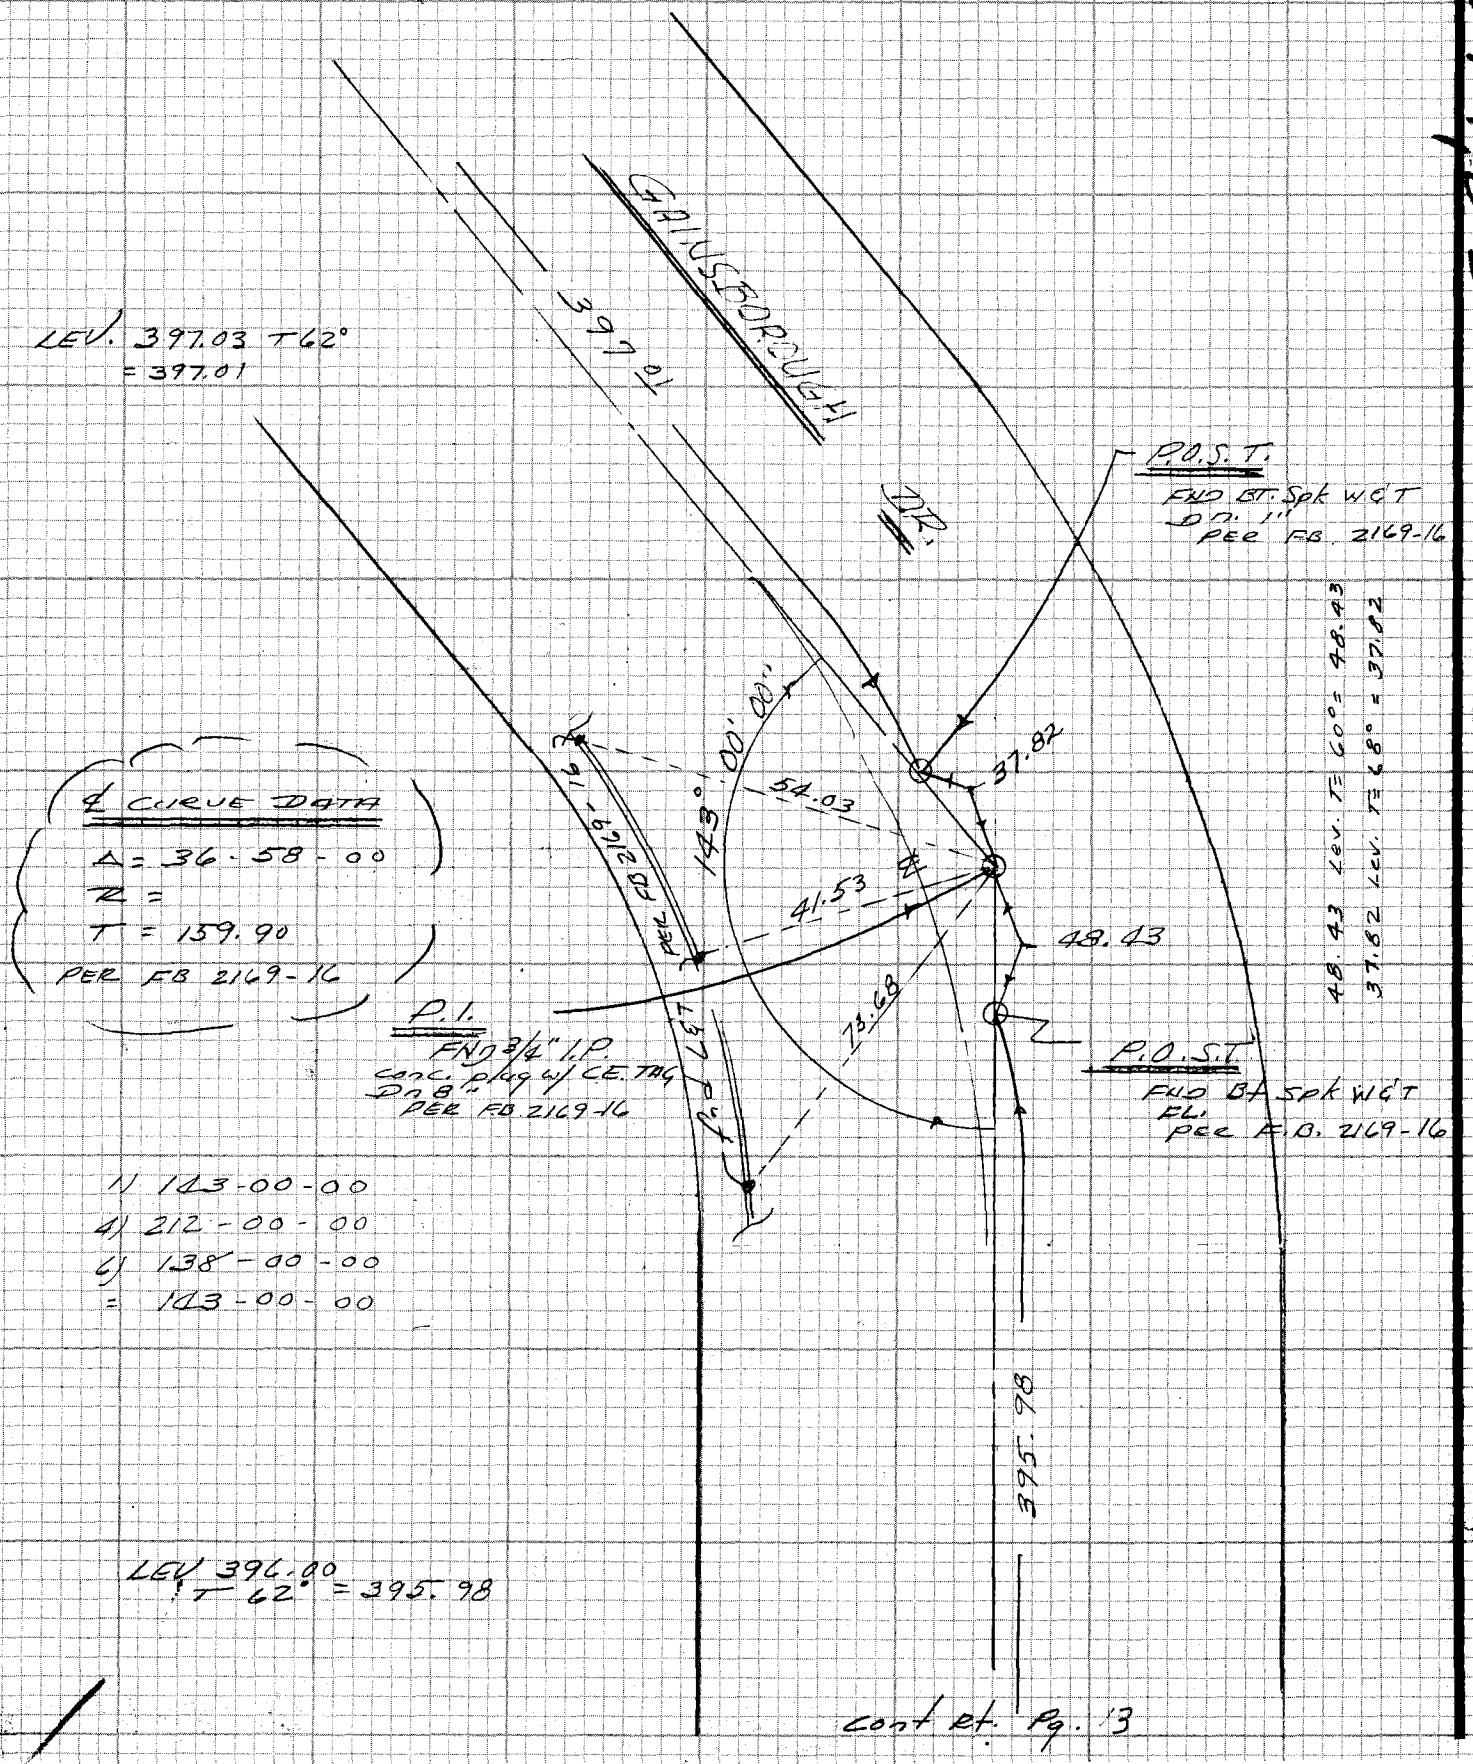


℄ CURVE DATA

Δ = 36-58-00
R =
T = 159.90
PER FB 2169-16

1) 143-00-00
4) 212-00-00
6) 138-00-00
= 143-00-00

LEV. 397.03 T 62°
= 397.01

LEV 396.00
T 62° = 395.98

cont'd Pg. 13

CE 310
76F3095-4/73

PLEASE RETURN TO
LOS ANGELES COUNTY ENGINEER
403 LOS ANGELES COUNTY ENGINEERING BLDG.

Do not ex notes this side of this line

NOTE: ANY ADDITIONS OR CHANGES ON THIS SHEET MUST BE MADE OR CIRCLED IN RED INK WITH DATE AND NAME OF PERSON MAKING CHANGE

4548-3

| | |
|---|---|
| Notes Ck'd by | Survey of ROSEMEAD ST. ℄ DIV. 4 F.B. 4412 PG. 15 |
| Map No. | JN 0303.00 Tape 0162 Std 68° F |
| Office Work | Surveyed by E. LANDA |
| Checked | Notes K.M. KAPP Date 3-76 |
| Date | Indexed G. D. BAILEY SEP 19 1977 |

Cont. Bot. Pg. 16

85.30 Lev. T = 60° = 85.30

243.65 Lev. T = 70° = 243.65

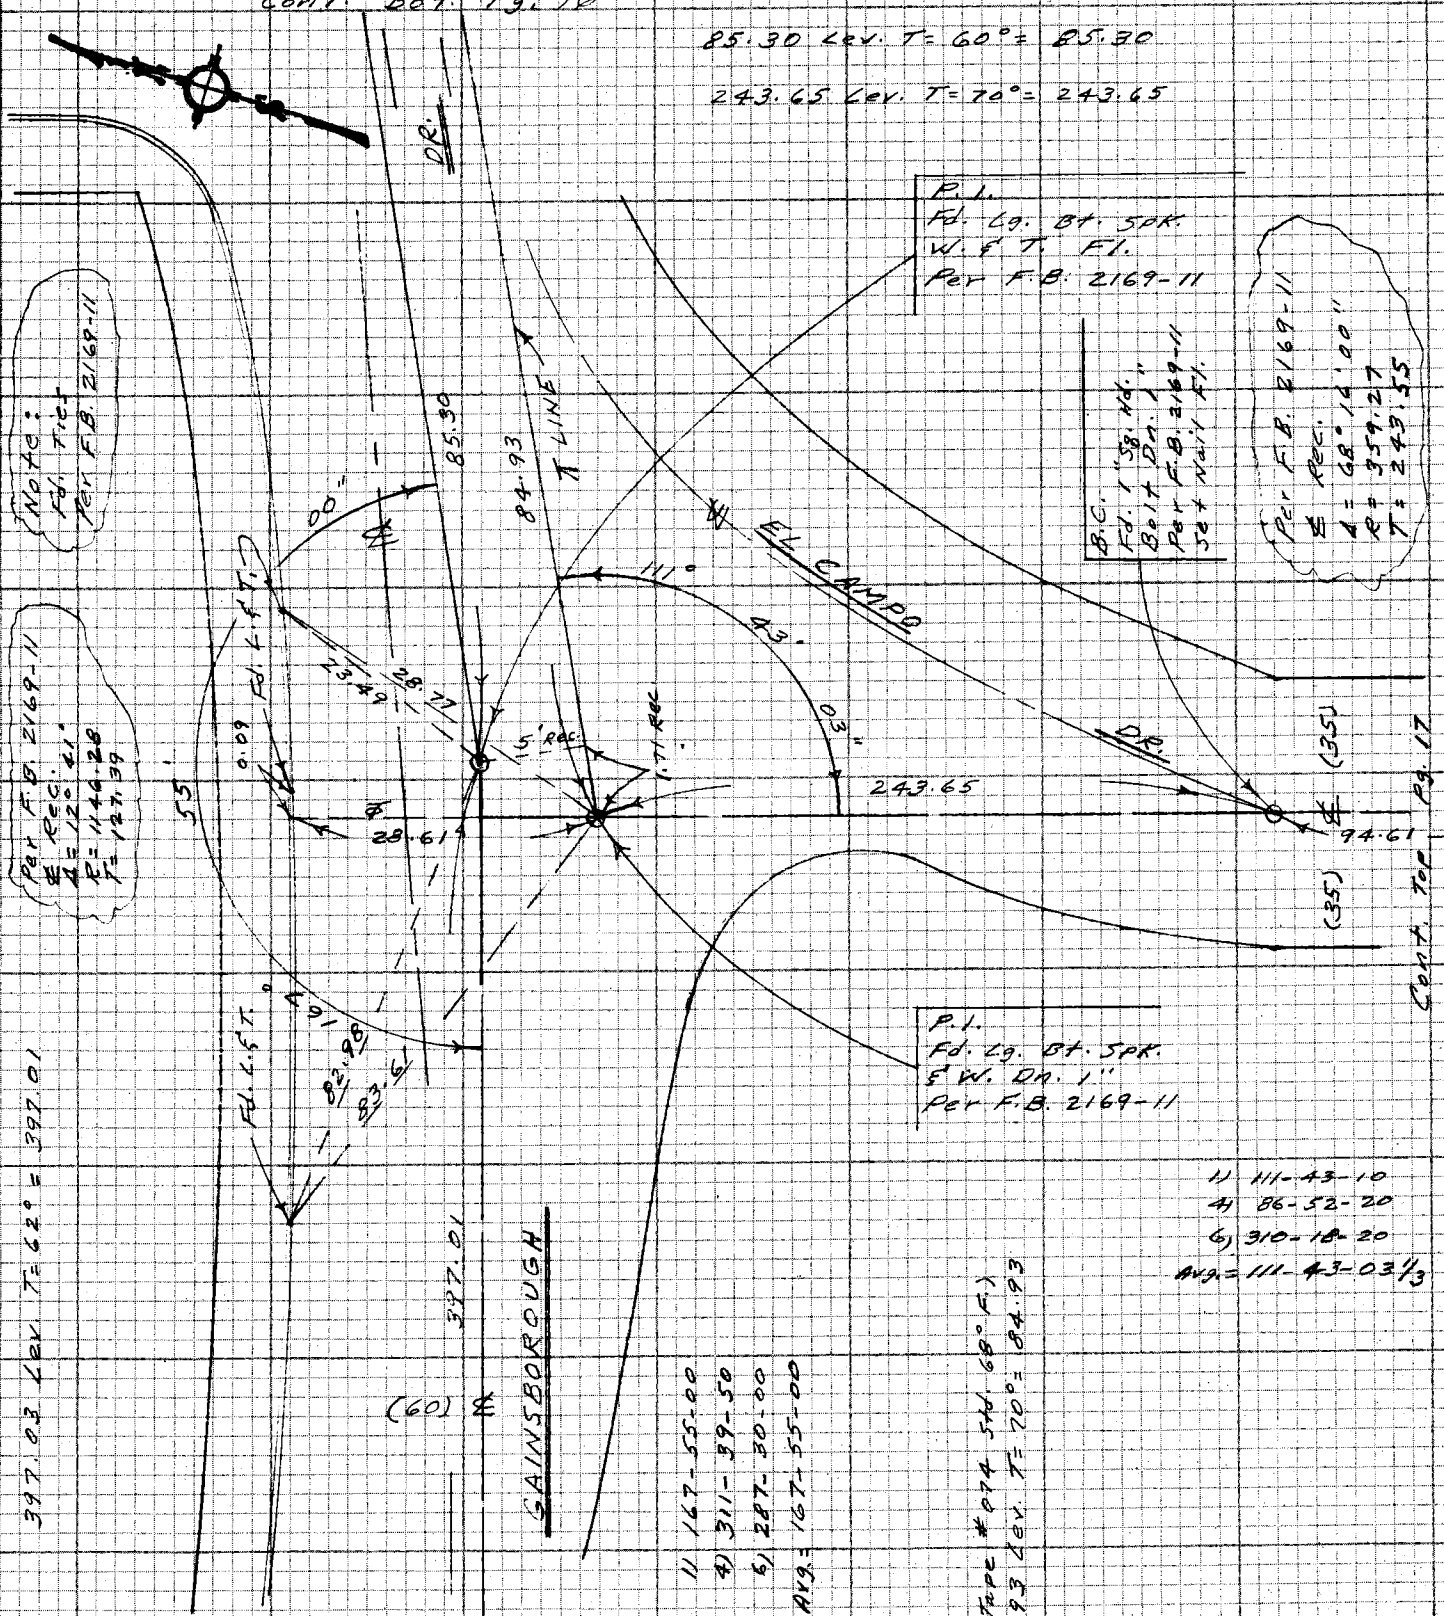


Cont. Top Pg. 17

Cont. Top Pg. 14

NOTE: ANY ADDITIONS OR CHANGES ON THIS SHEET MUST BE MADE OR CIRCLED IN RED INK WITH DATE AND NAME OF PERSON MAKING CHANGE
Do not extend notes this side of this line
PLEASE RETURN TO
LOS ANGELES COUNTY ENGINEER
403 LOS ANGELES COUNTY ENGINEERING BLDG.
CENTERLINE NOTES
CE 310
76F3095-4/73

F.B. 4412 PG. 16

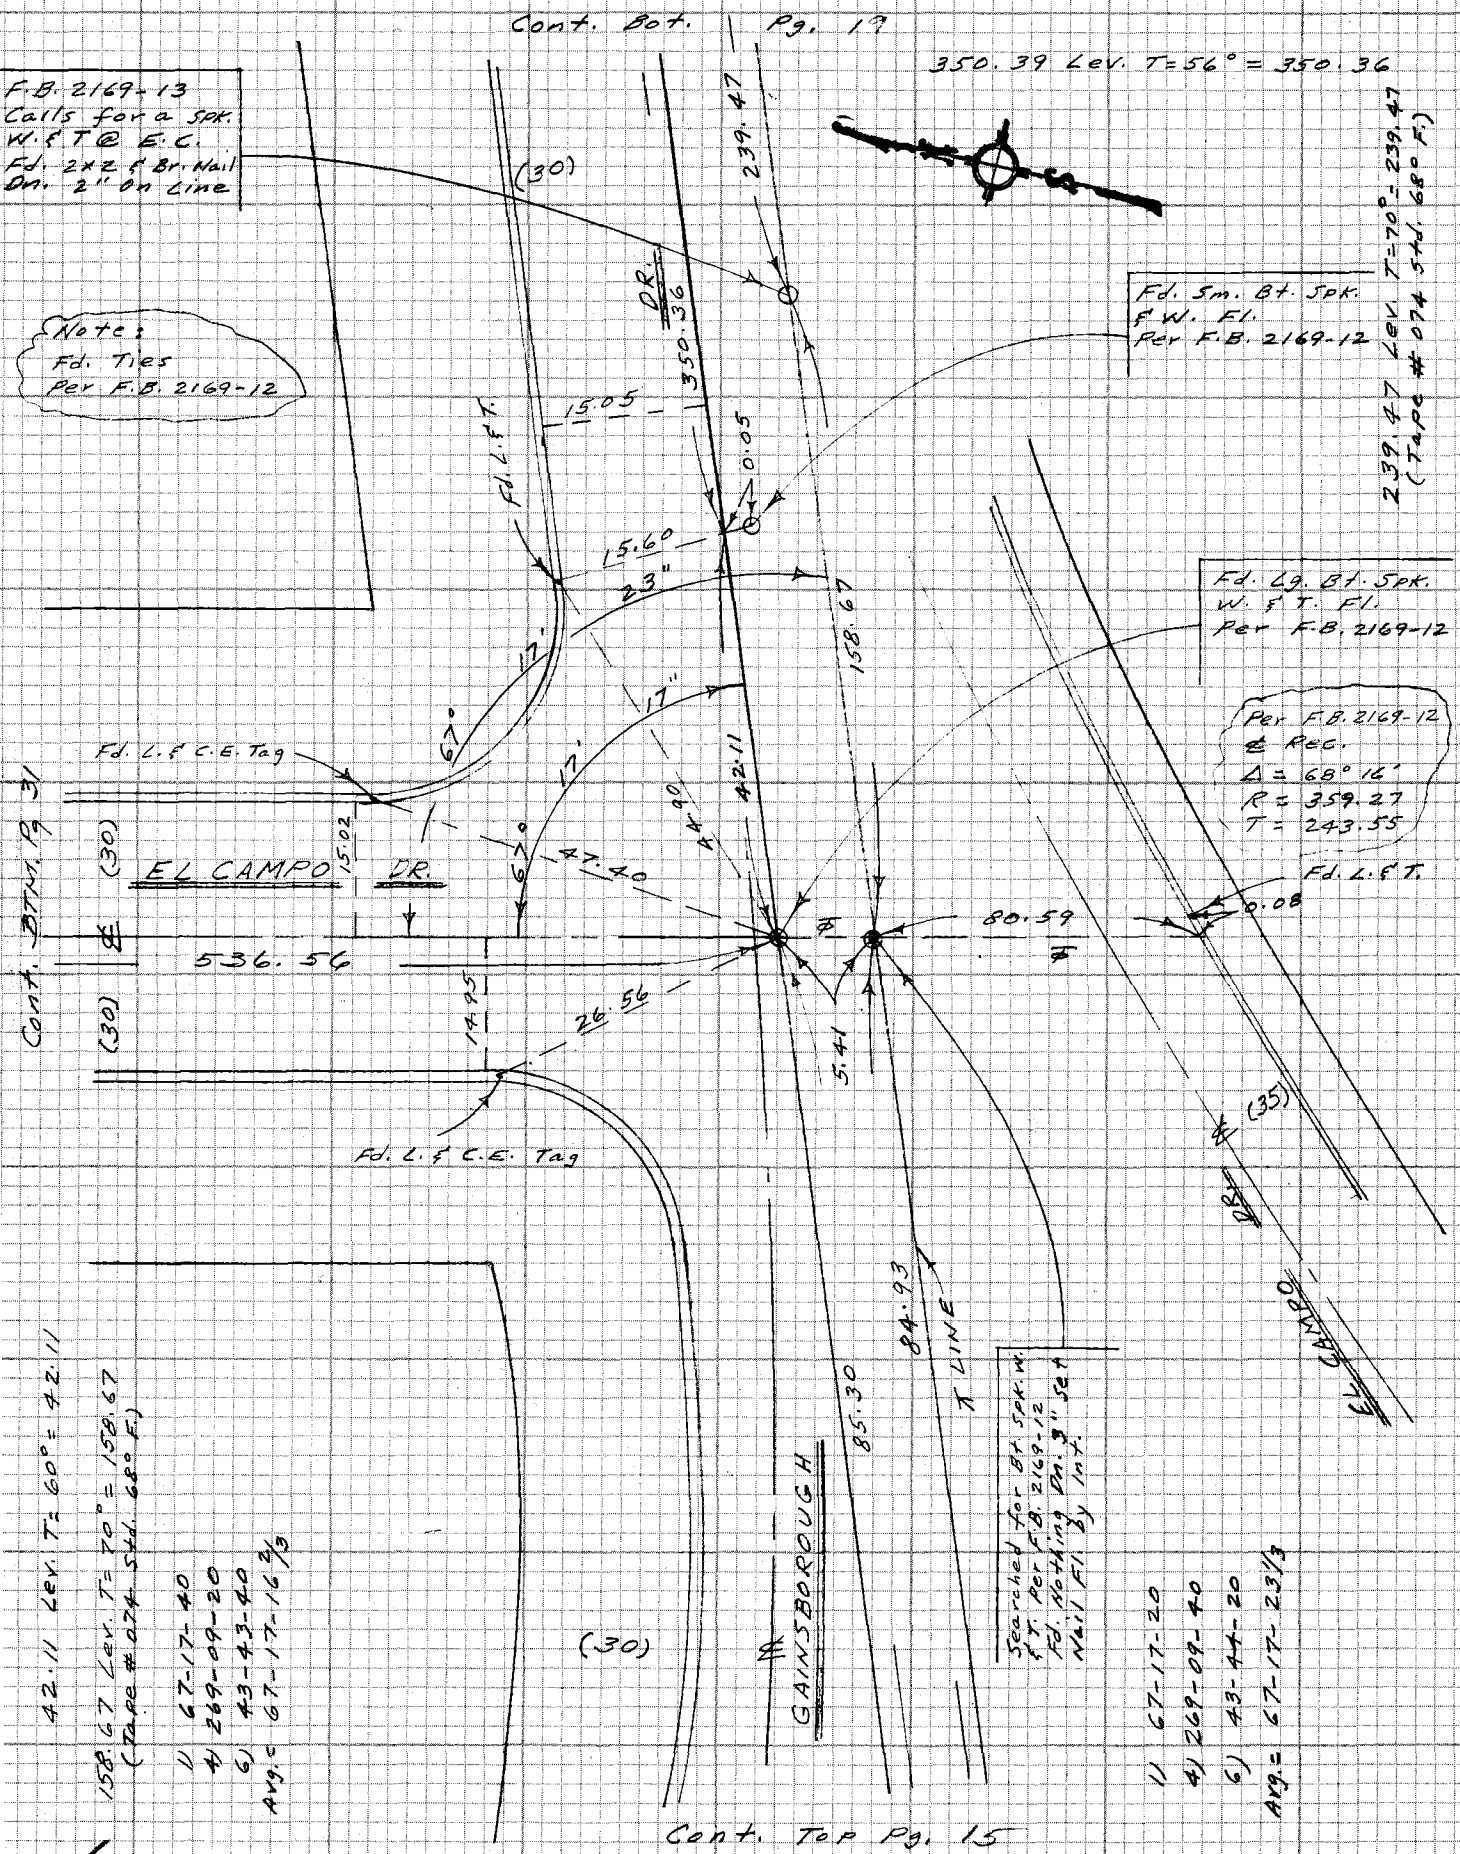



CE 310
76F3095-4/73

PLEASE RETURN TO
LOS ANGELES COUNTY ENGINEER
403 LOS ANGELES COUNTY ENGINEERING BLDG.

Do not ex[illegible] notes this side of this line

NOTE: ANY ADDITIONS OR CHANGES ON THIS SHEET MUST BE MADE OR CIRCLED IN RED INK WITH DATE AND NAME OF PERSON MAKING CHANGE


4544 B-3

| | |
|---|---|
| Notes Ck'd by | Survey of ROSEMEAD ST. ℄ DIV. 4 |
| Map No. | JN 0303.00 Tape 074 Std 68 °F |
| Office Work | Surveyed by E. LANDA |
| Checked | Notes V. LIEBER Date 3-76 |
| Date | Indexed G. D. BAILEY SEP 19 1977 |

F.B. 4412 PG. 17

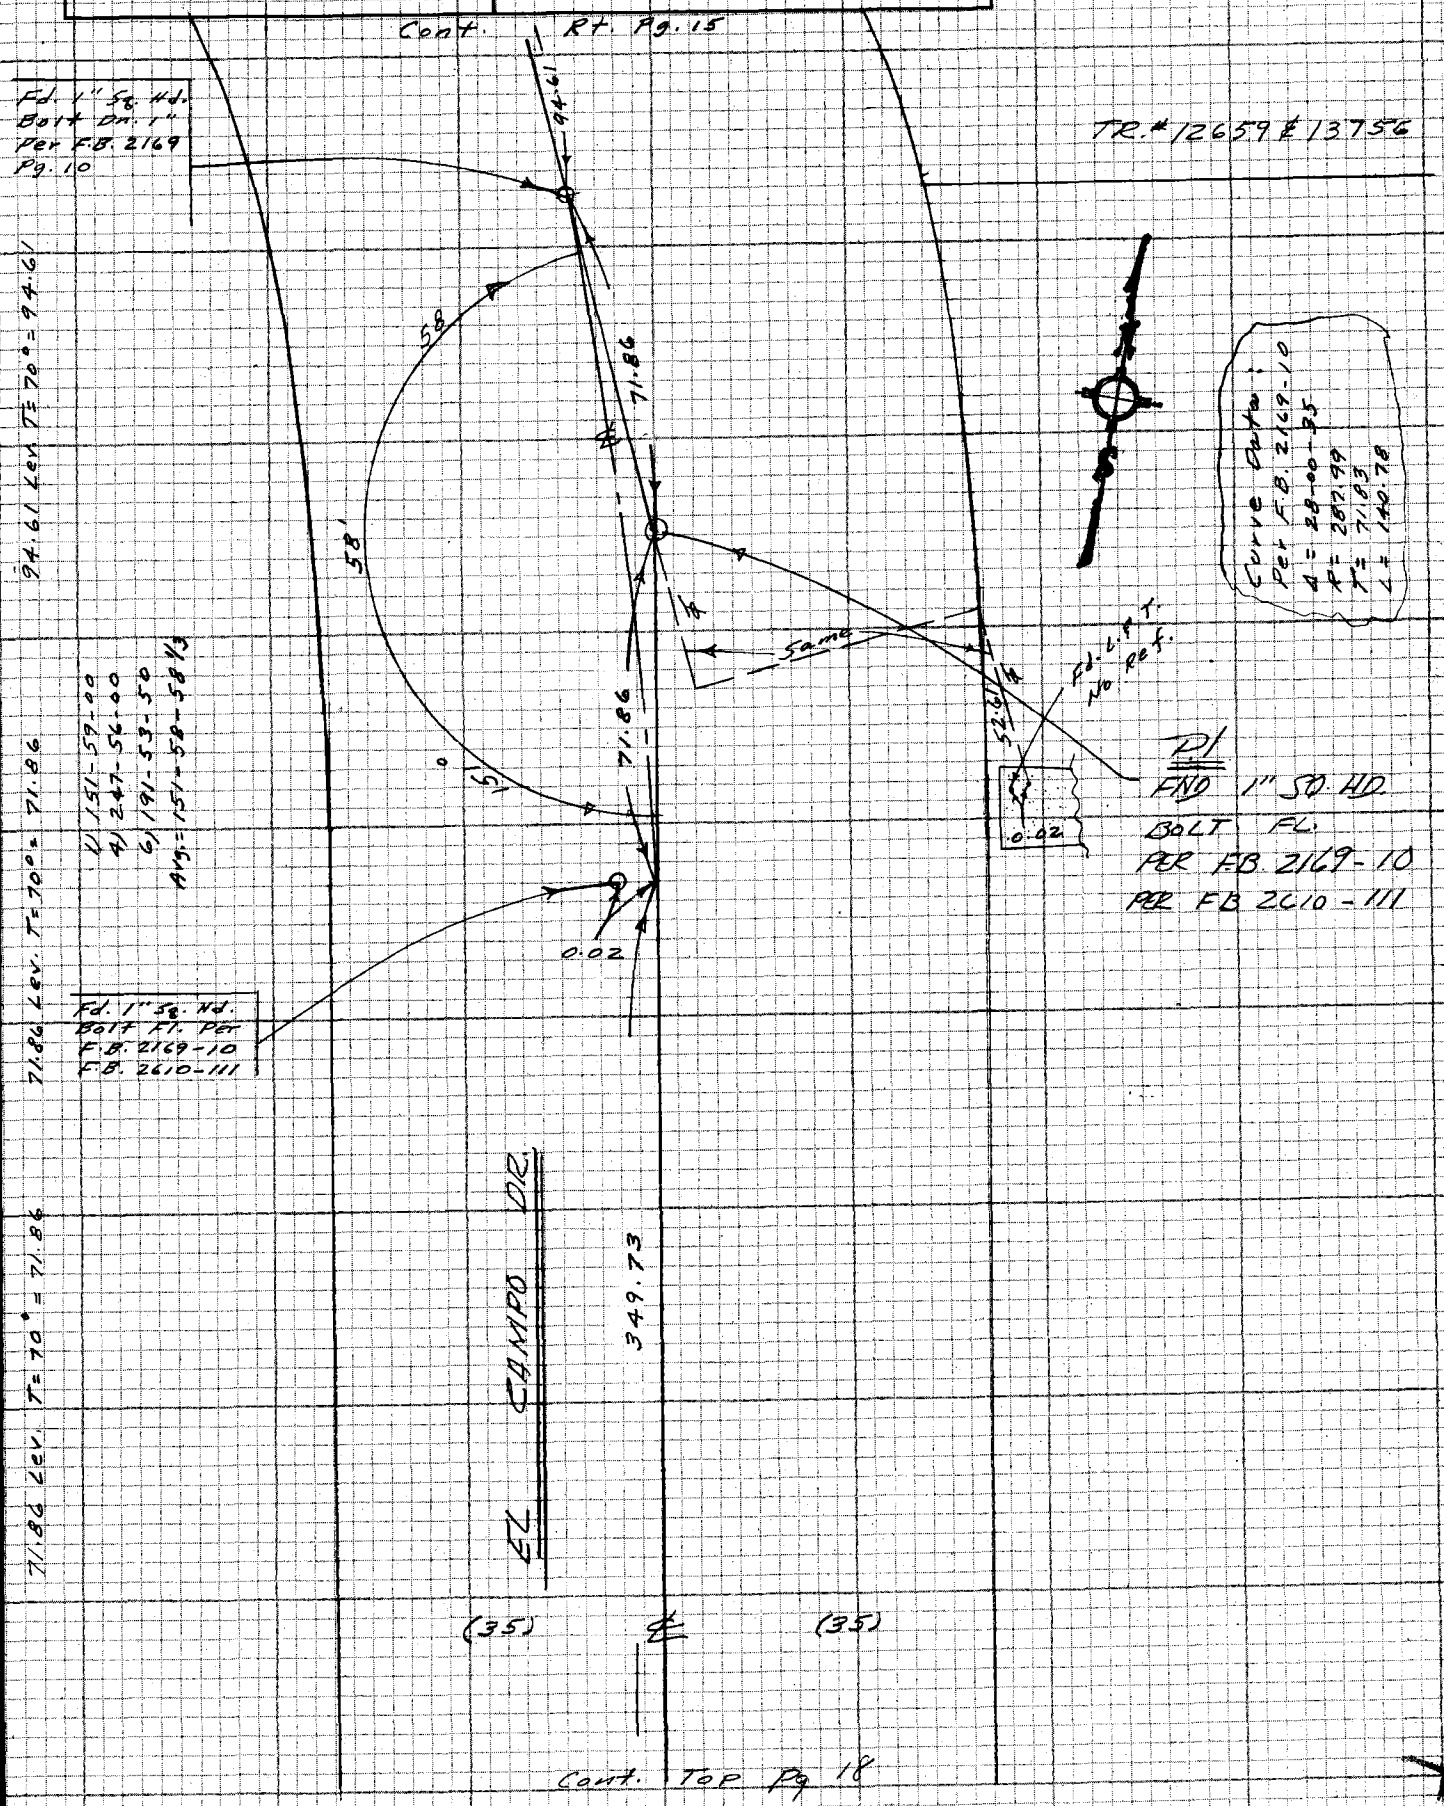


Cont. Top Pg 18

NOTE: ANY ADDITIONS OR CHANGES ON THIS SHEET MUST BE MADE OR CIRCLED IN RED INK WITH DATE AND NAME OF PERSON MAKING CHANGE

Do not extend notes on this side of this line

PLEASE RETURN TO
LOS ANGELES COUNTY ENGINEER
403 LOS ANGELES COUNTY ENGINEERING BLDG.

CENTERLINE NOTES
CE 310
76F3095-4/73

F.B. 4412 PG. 18

Cont. Bot. Pg 17

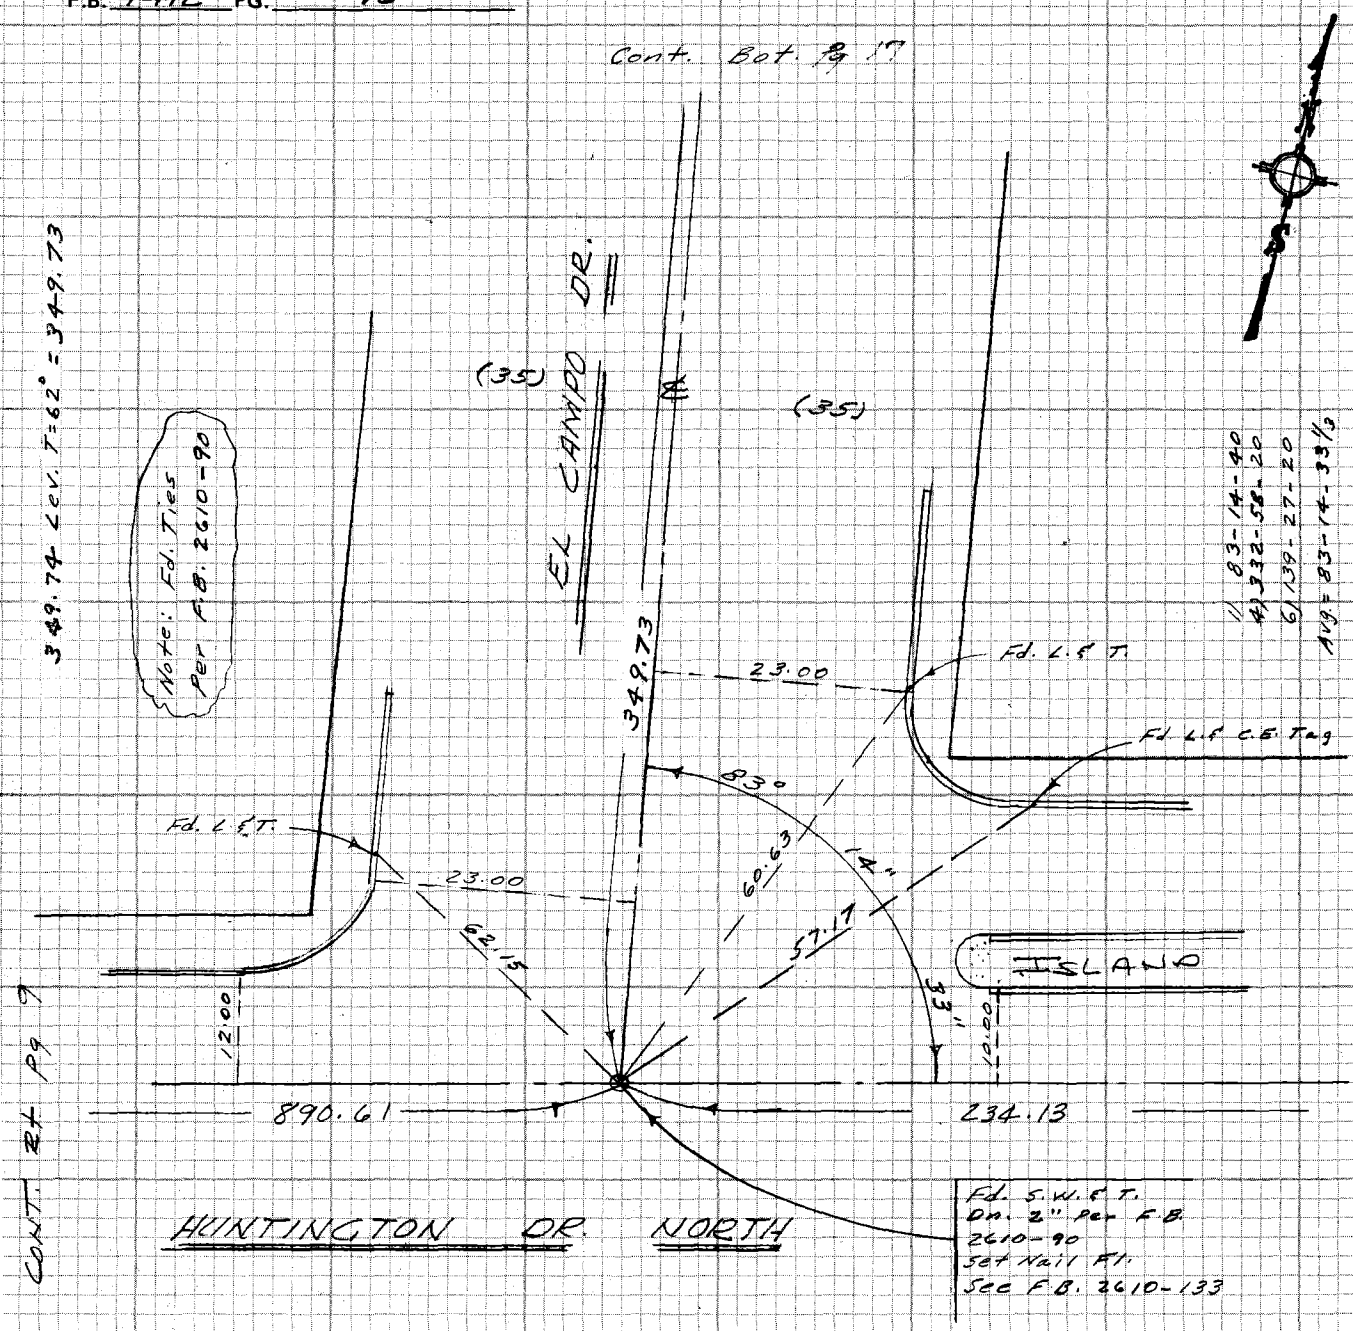


Cont. Pg 19

LEV. 234.11 T 78 = 234.13

CE 310
76F3095-4/73

PLEASE RETURN TO
LOS ANGELES COUNTY ENGINEER
403 LOS ANGELES COUNTY ENGINEERING BLDG.

NOTE: ANY ADDITIONS OR CHANGES ON THIS SHEET MUST BE MADE OR CIRCLED IN RED INK WITH DATE AND NAME OF PERSON MAKING CHANGE

Do not ex notes this side of this line

| | |
|---|---|
| Notes Ck'd by | Survey of Rosemead & Div. "4" F.B. 4412 PG. 19 |
| Map No. | JN 0303.00 Tape 0162 074 Std 68 °F |
| Office Work | Surveyed by E. Lanon |
| Checked | Notes V. LIEBER Date 3-10-76 |
| Date | Indexed G. D. BAILEY SEP 19 1977 |

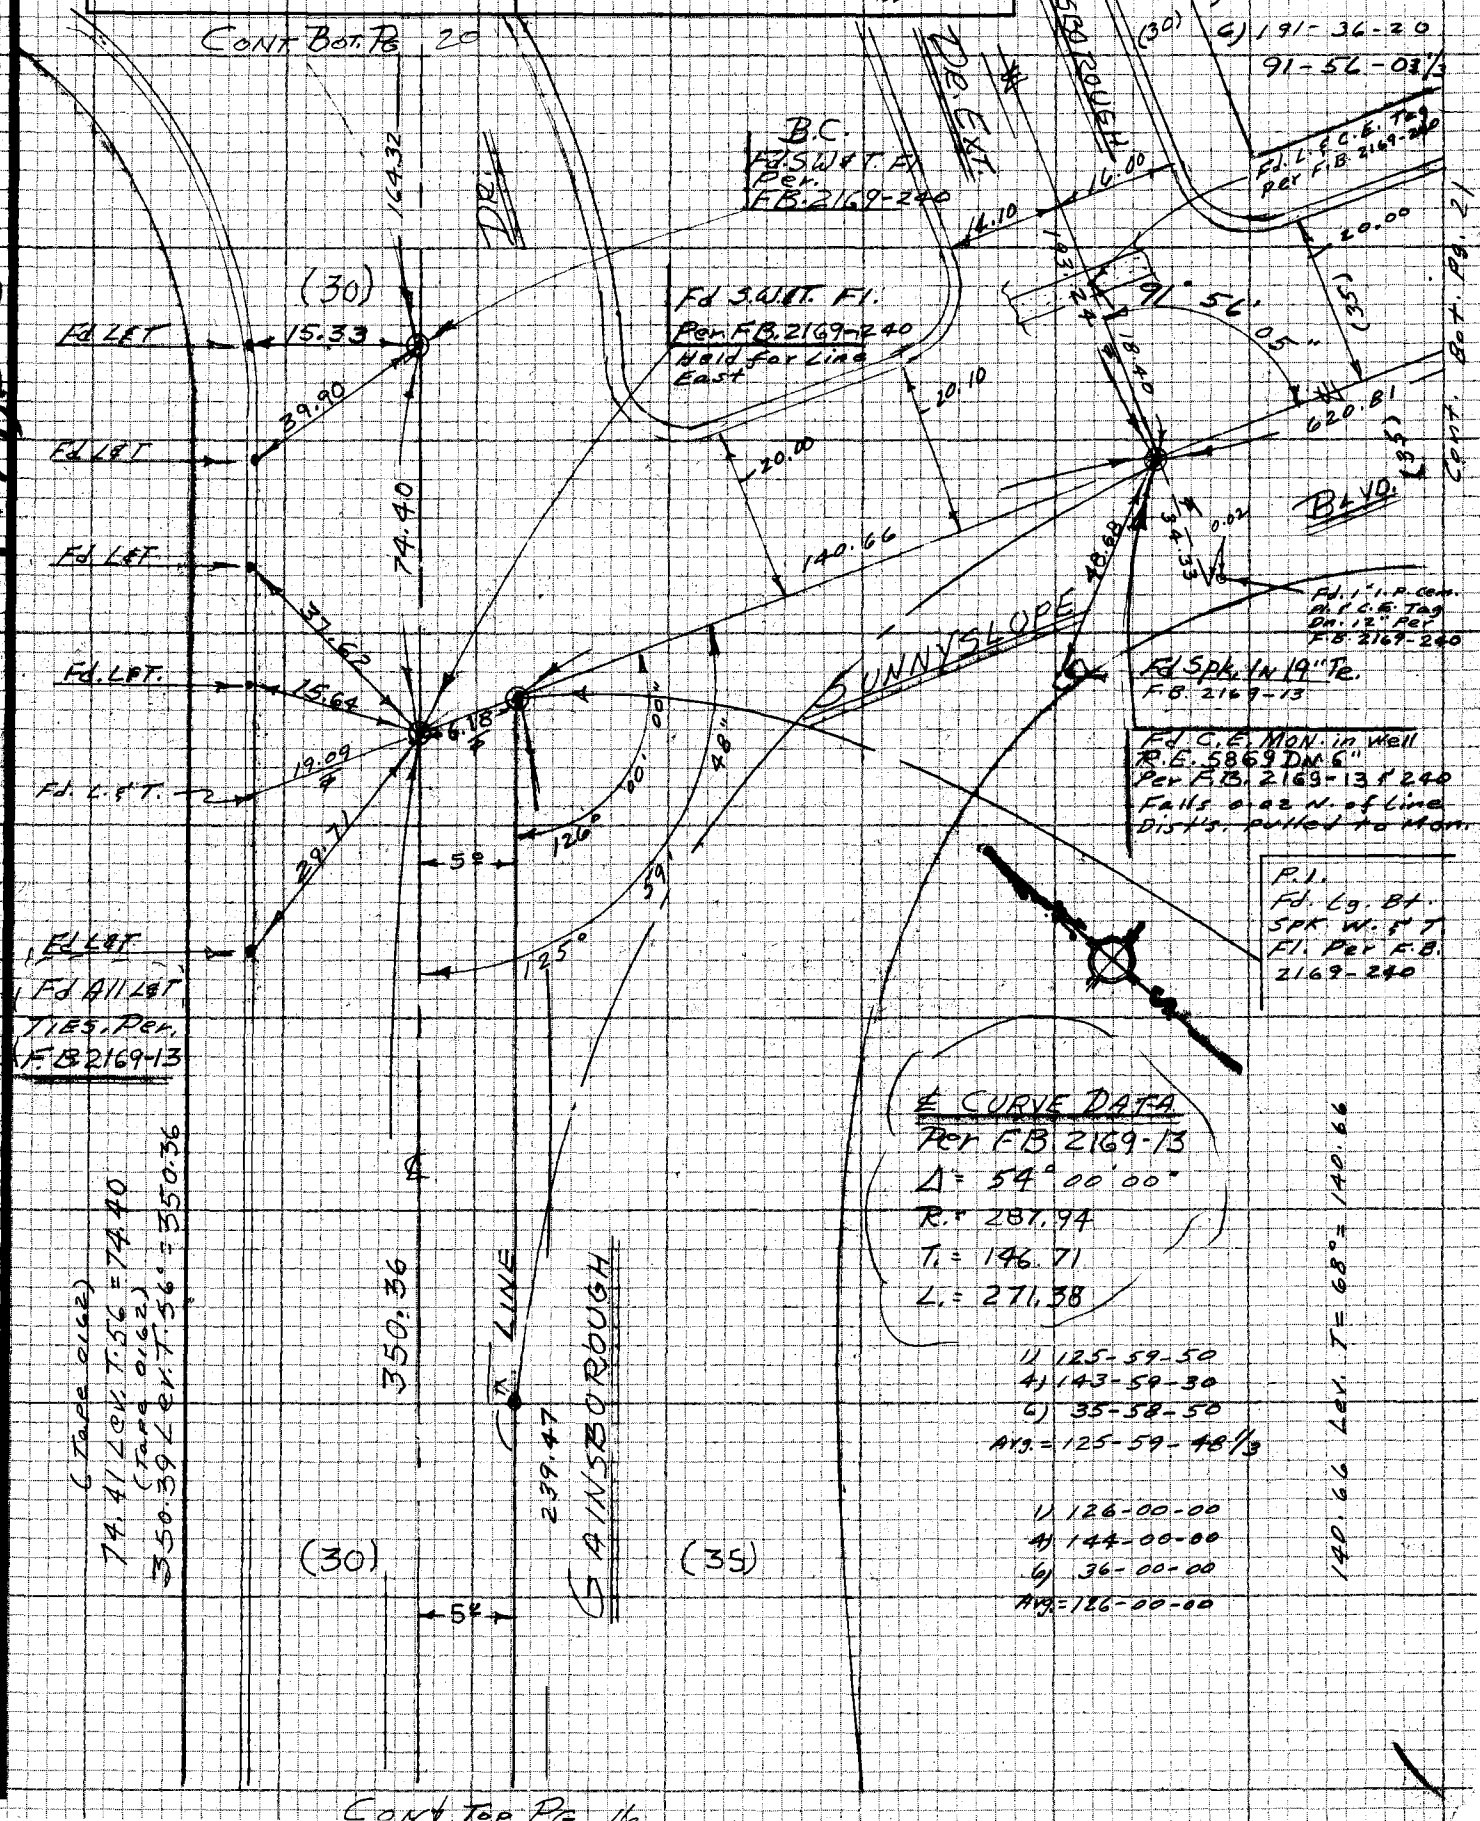


NOTE: ANY ADDITIONS OR CHANGES ON THIS SHEET MUST BE MADE OR CIRCLED IN RED INK WITH DATE AND NAME OF PERSON MAKING CHANGE

Do not extend notes on this side of this line

WS. 44, B-3

PLEASE RETURN TO
LOS ANGELES COUNTY ENGINEER
403 LOS ANGELES COUNTY ENGINEERING BLDG.

CENTERLINE NOTES
CE 310
76F3095-4/73

Cont. Top Pg. 16

F.B. 4412 PG. 20

Cont. Btm Pg 32

CE 310
76F3095-4/73

PLEASE RETURN TO
LOS ANGELES COUNTY ENGINEER
403 LOS ANGELES COUNTY ENGINEERING BLDG.

Do not ex... notes this side of this line

NOTE: ANY ADDITIONS OR CHANGES ON THIS SHEET MUST BE MADE OR CIRCLED IN RED INK WITH DATE AND NAME OF PERSON MAKING CHANGE

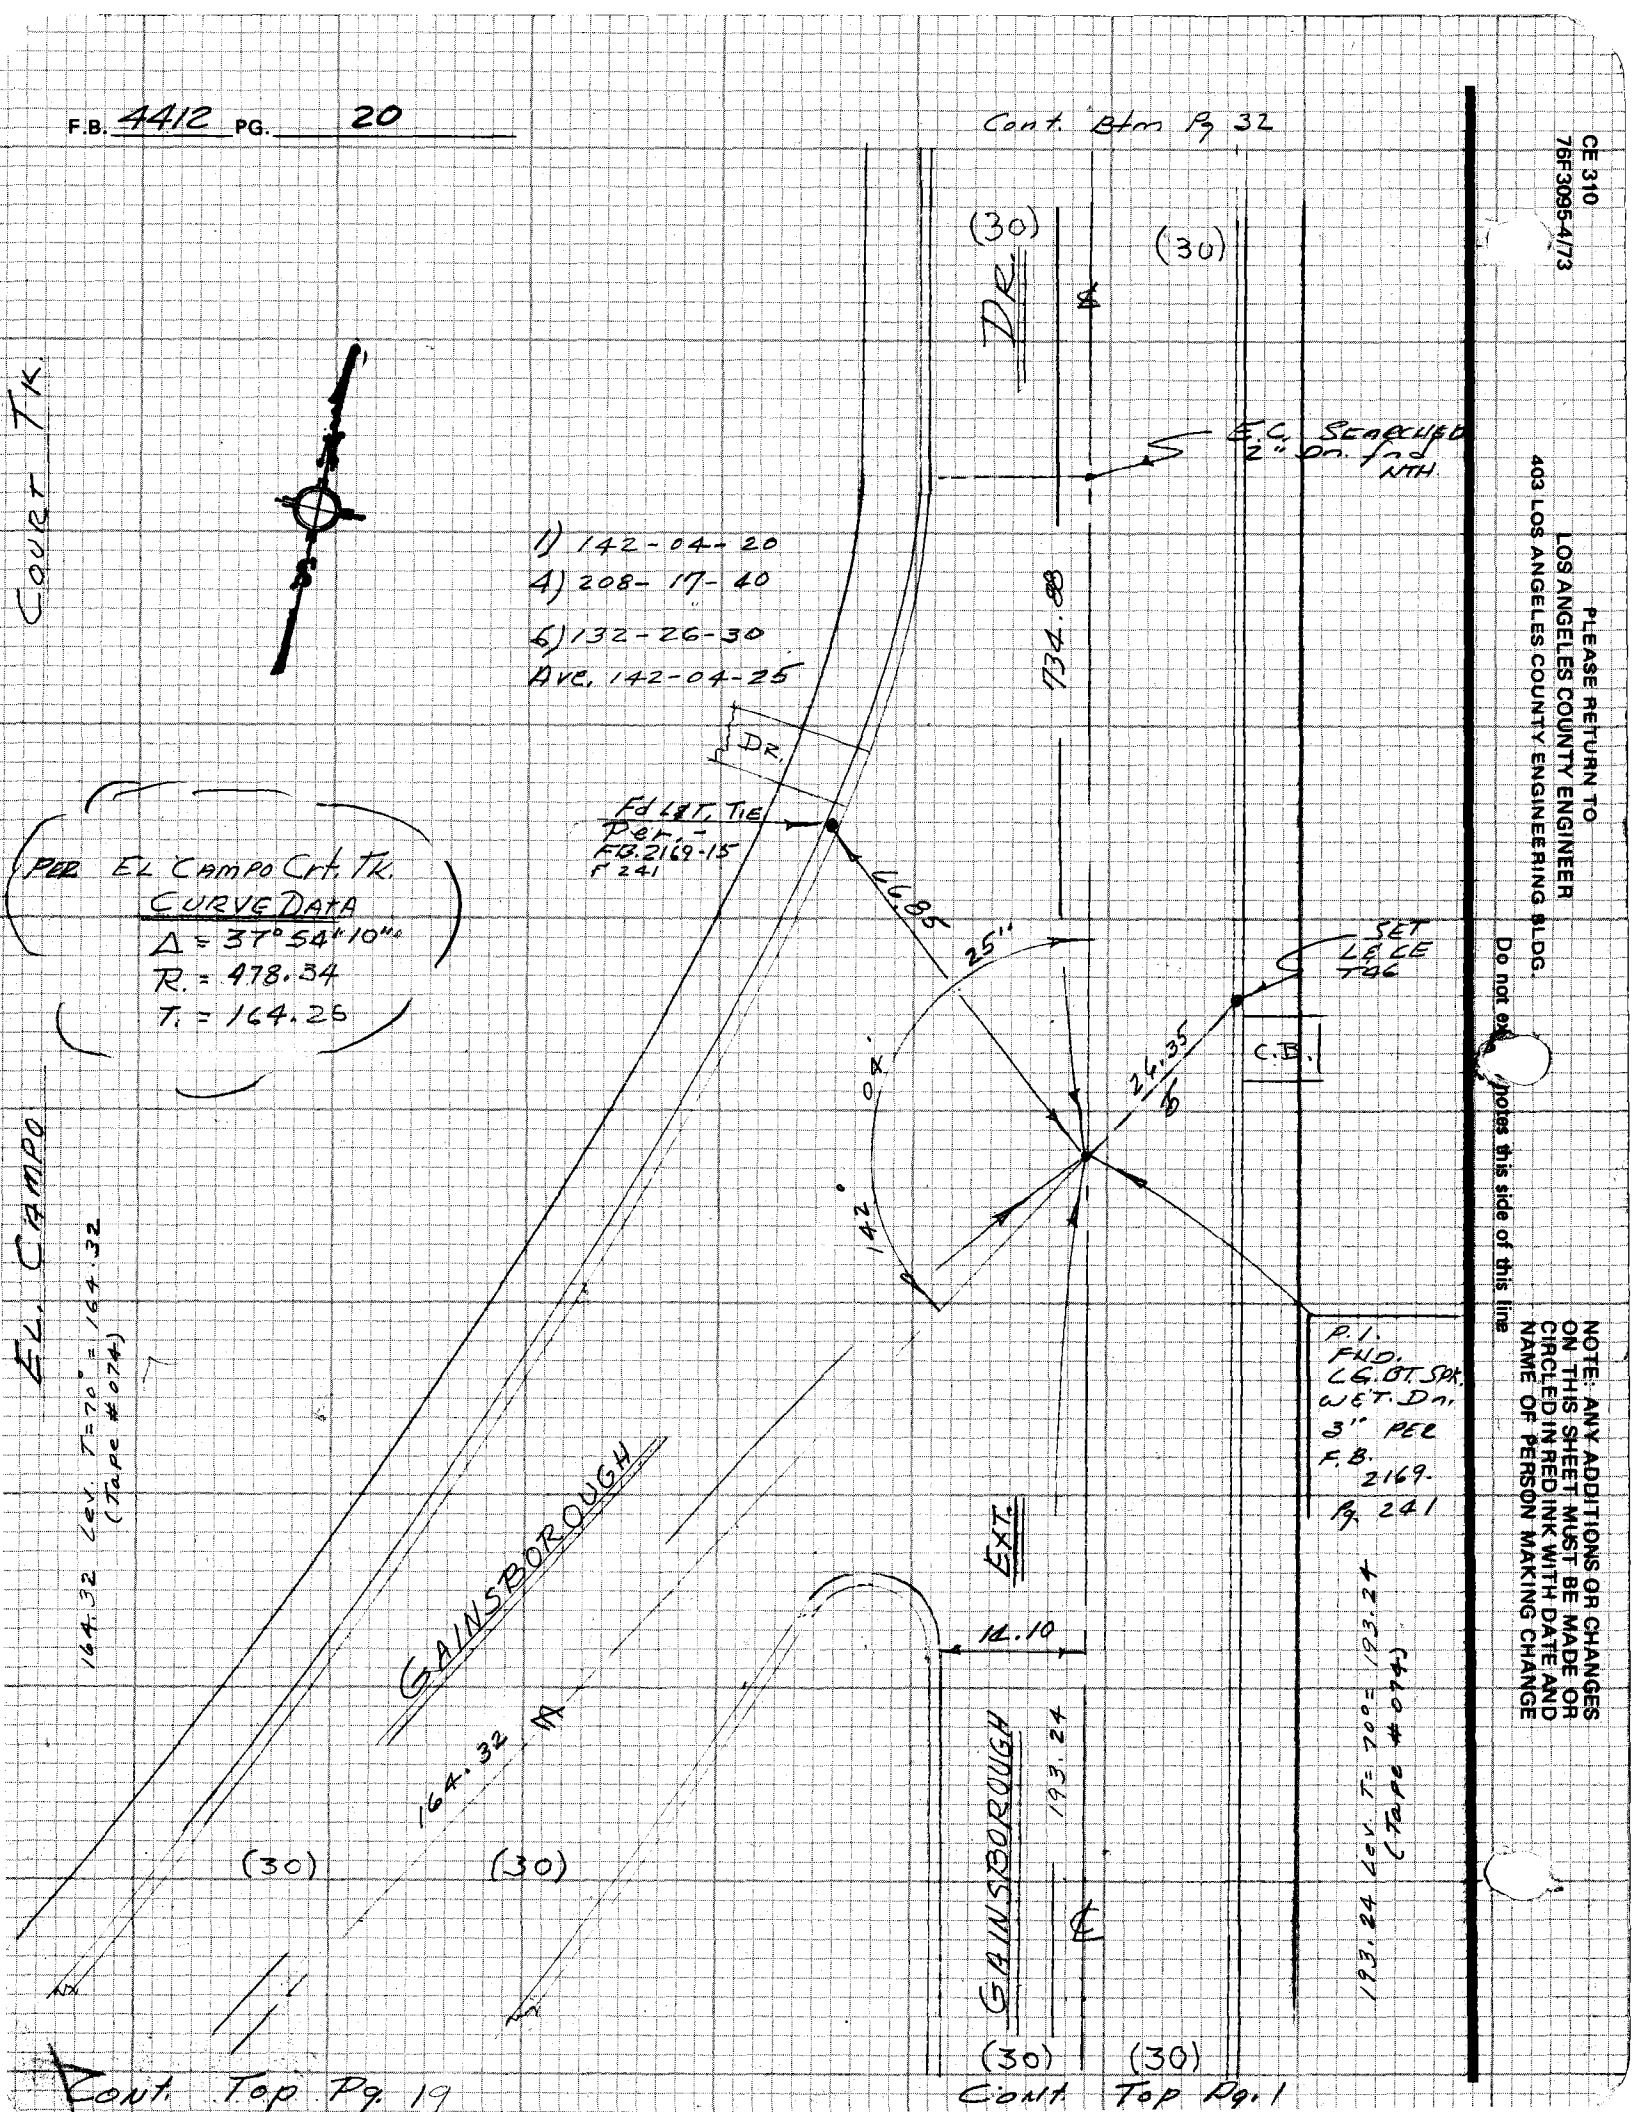


Cont. Top Pg. 19

Cont. Top Pg. 1

| | |
|---|---|
| Notes Ck'd by | Survey of ROSEMEAD ST. & DIV. 4 F.B. 4412 PG. 21 |
| Map No. | JN 0303.00 Tape 074 Std 68 °F |
| Office Work | Surveyed by E. LANDA |
| Checked | Notes J.M. MALDONADO Date 3-76 |
| Date | Indexed G. D. BAILEY SEP 19 1977 |

CONT. BOT. PG. 22

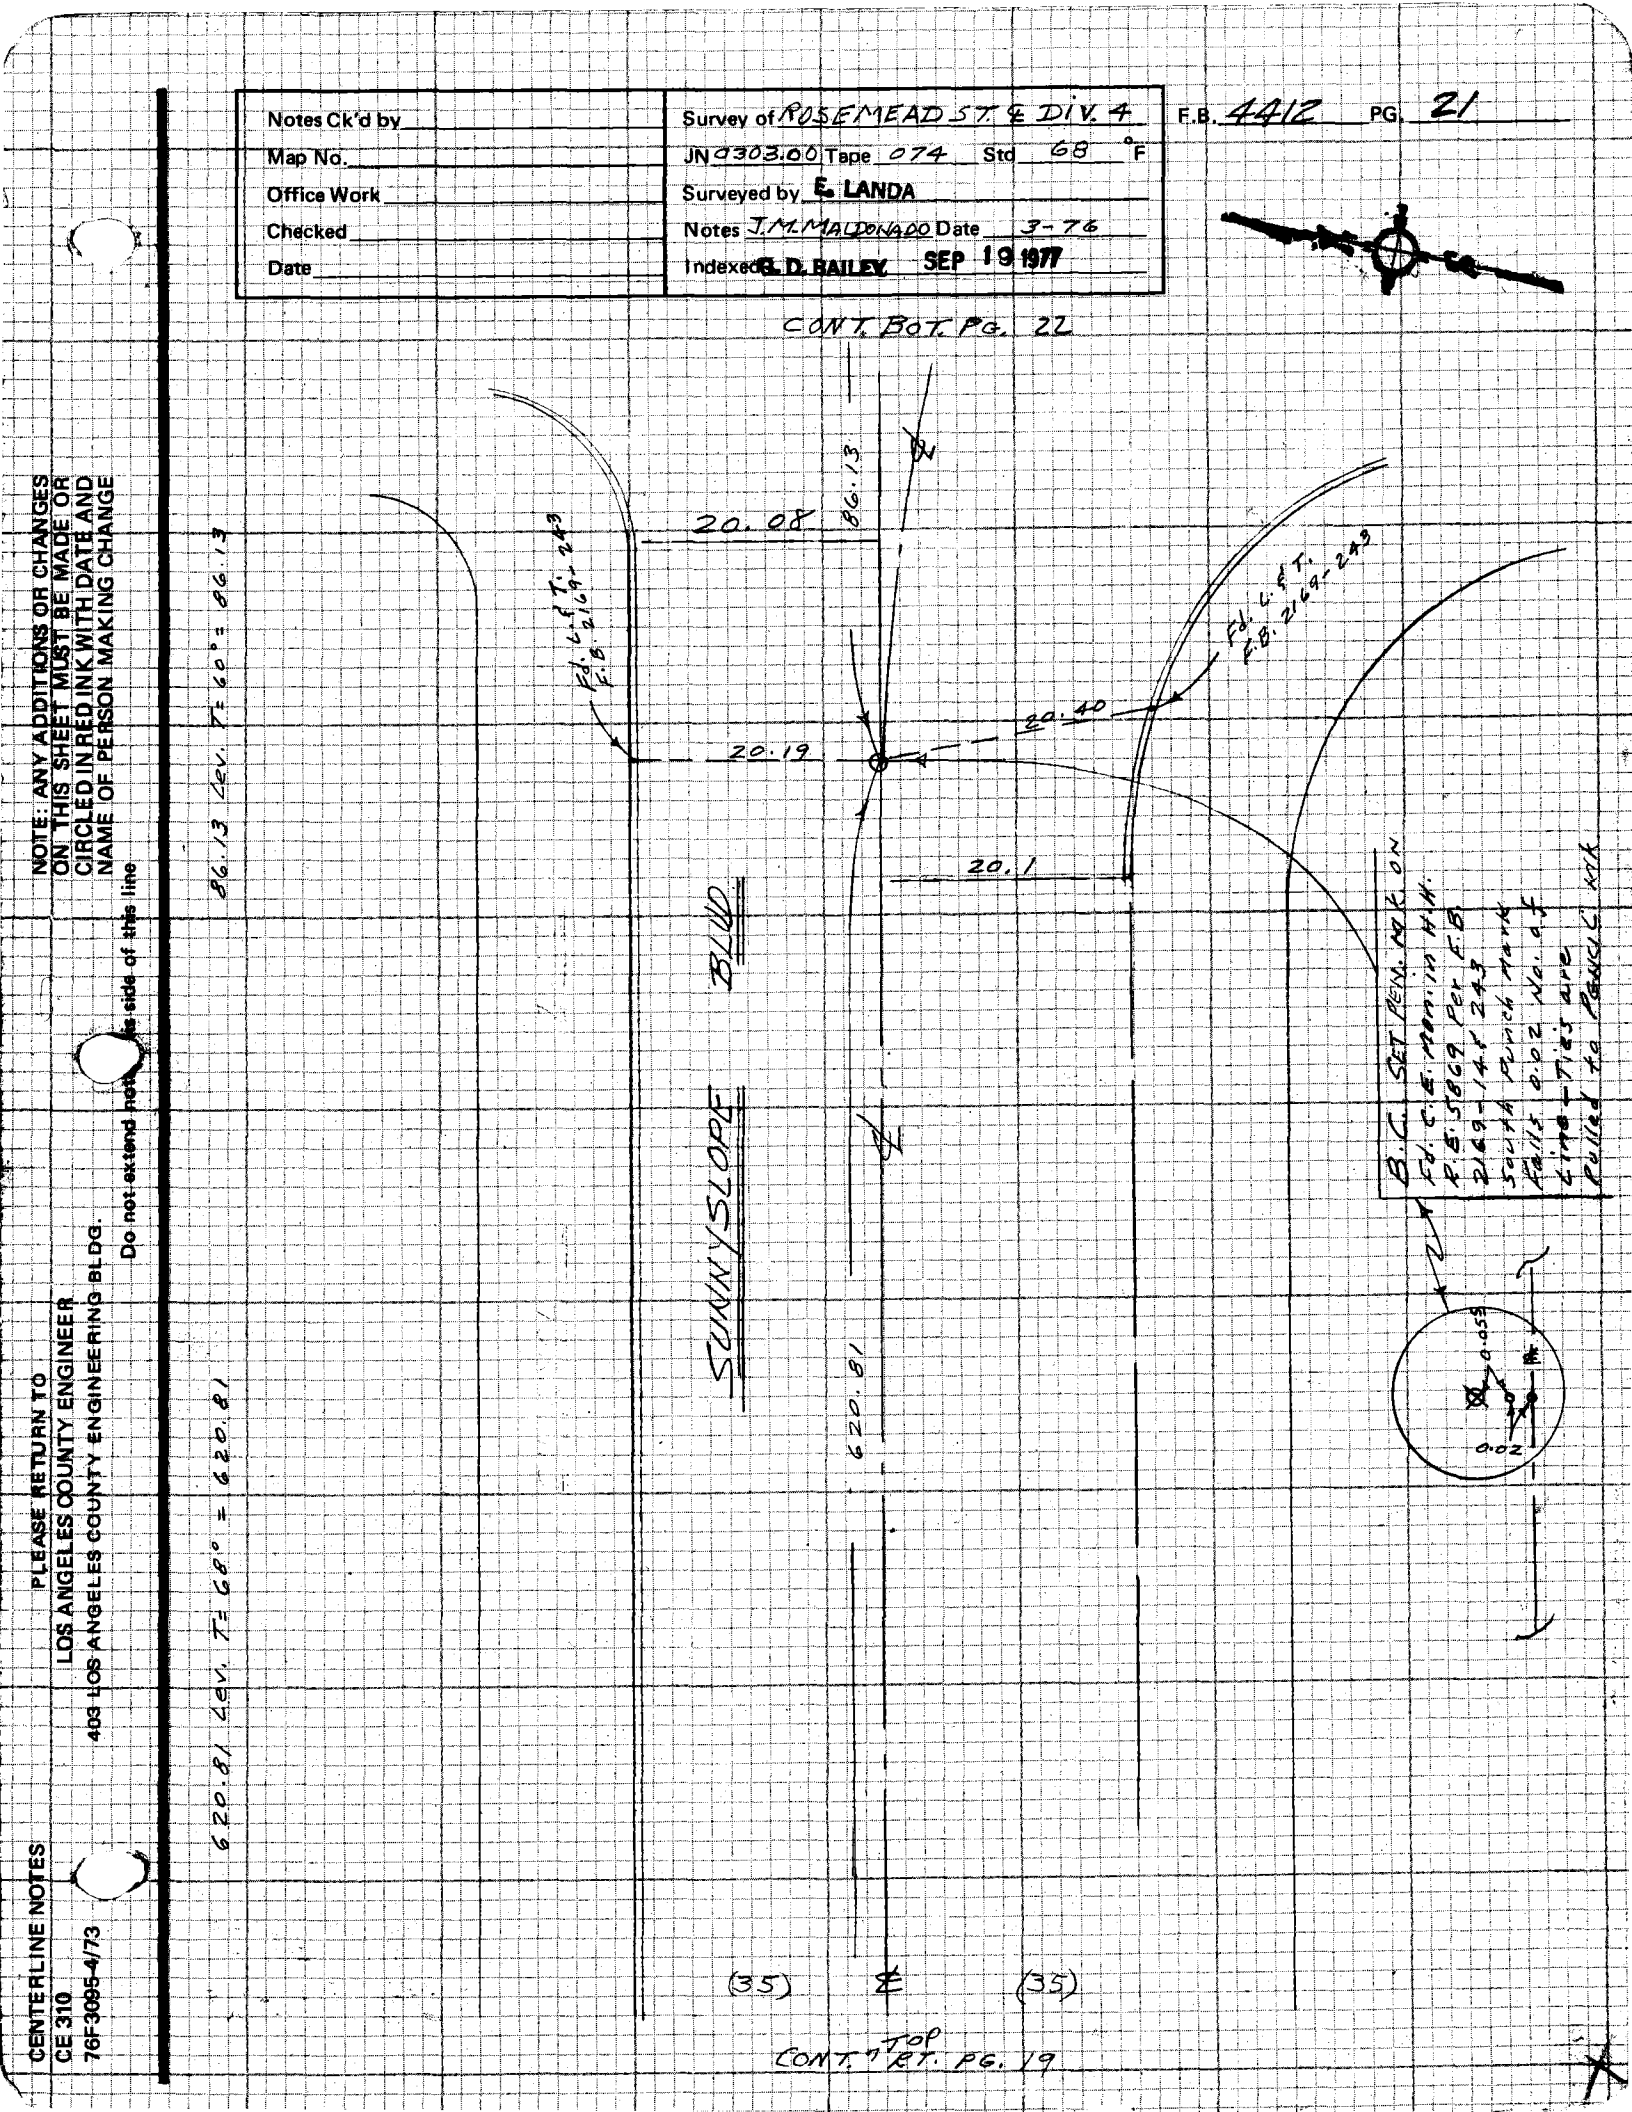


86.13 Cev. T= 60° = 86.13

620.81 Cev. T= 60° = 620.81

NOTE: ANY ADDITIONS OR CHANGES ON THIS SHEET MUST BE MADE OR CIRCLED IN RED INK WITH DATE AND NAME OF PERSON MAKING CHANGE

Do not extend notes to the side of this line

PLEASE RETURN TO
LOS ANGELES COUNTY ENGINEER
403 LOS ANGELES COUNTY ENGINEERING BLDG.

CENTERLINE NOTES
CE 310
76F3005-4/73

CONT. TOP RT. PG. 19

F.B. 4412 PG. 22

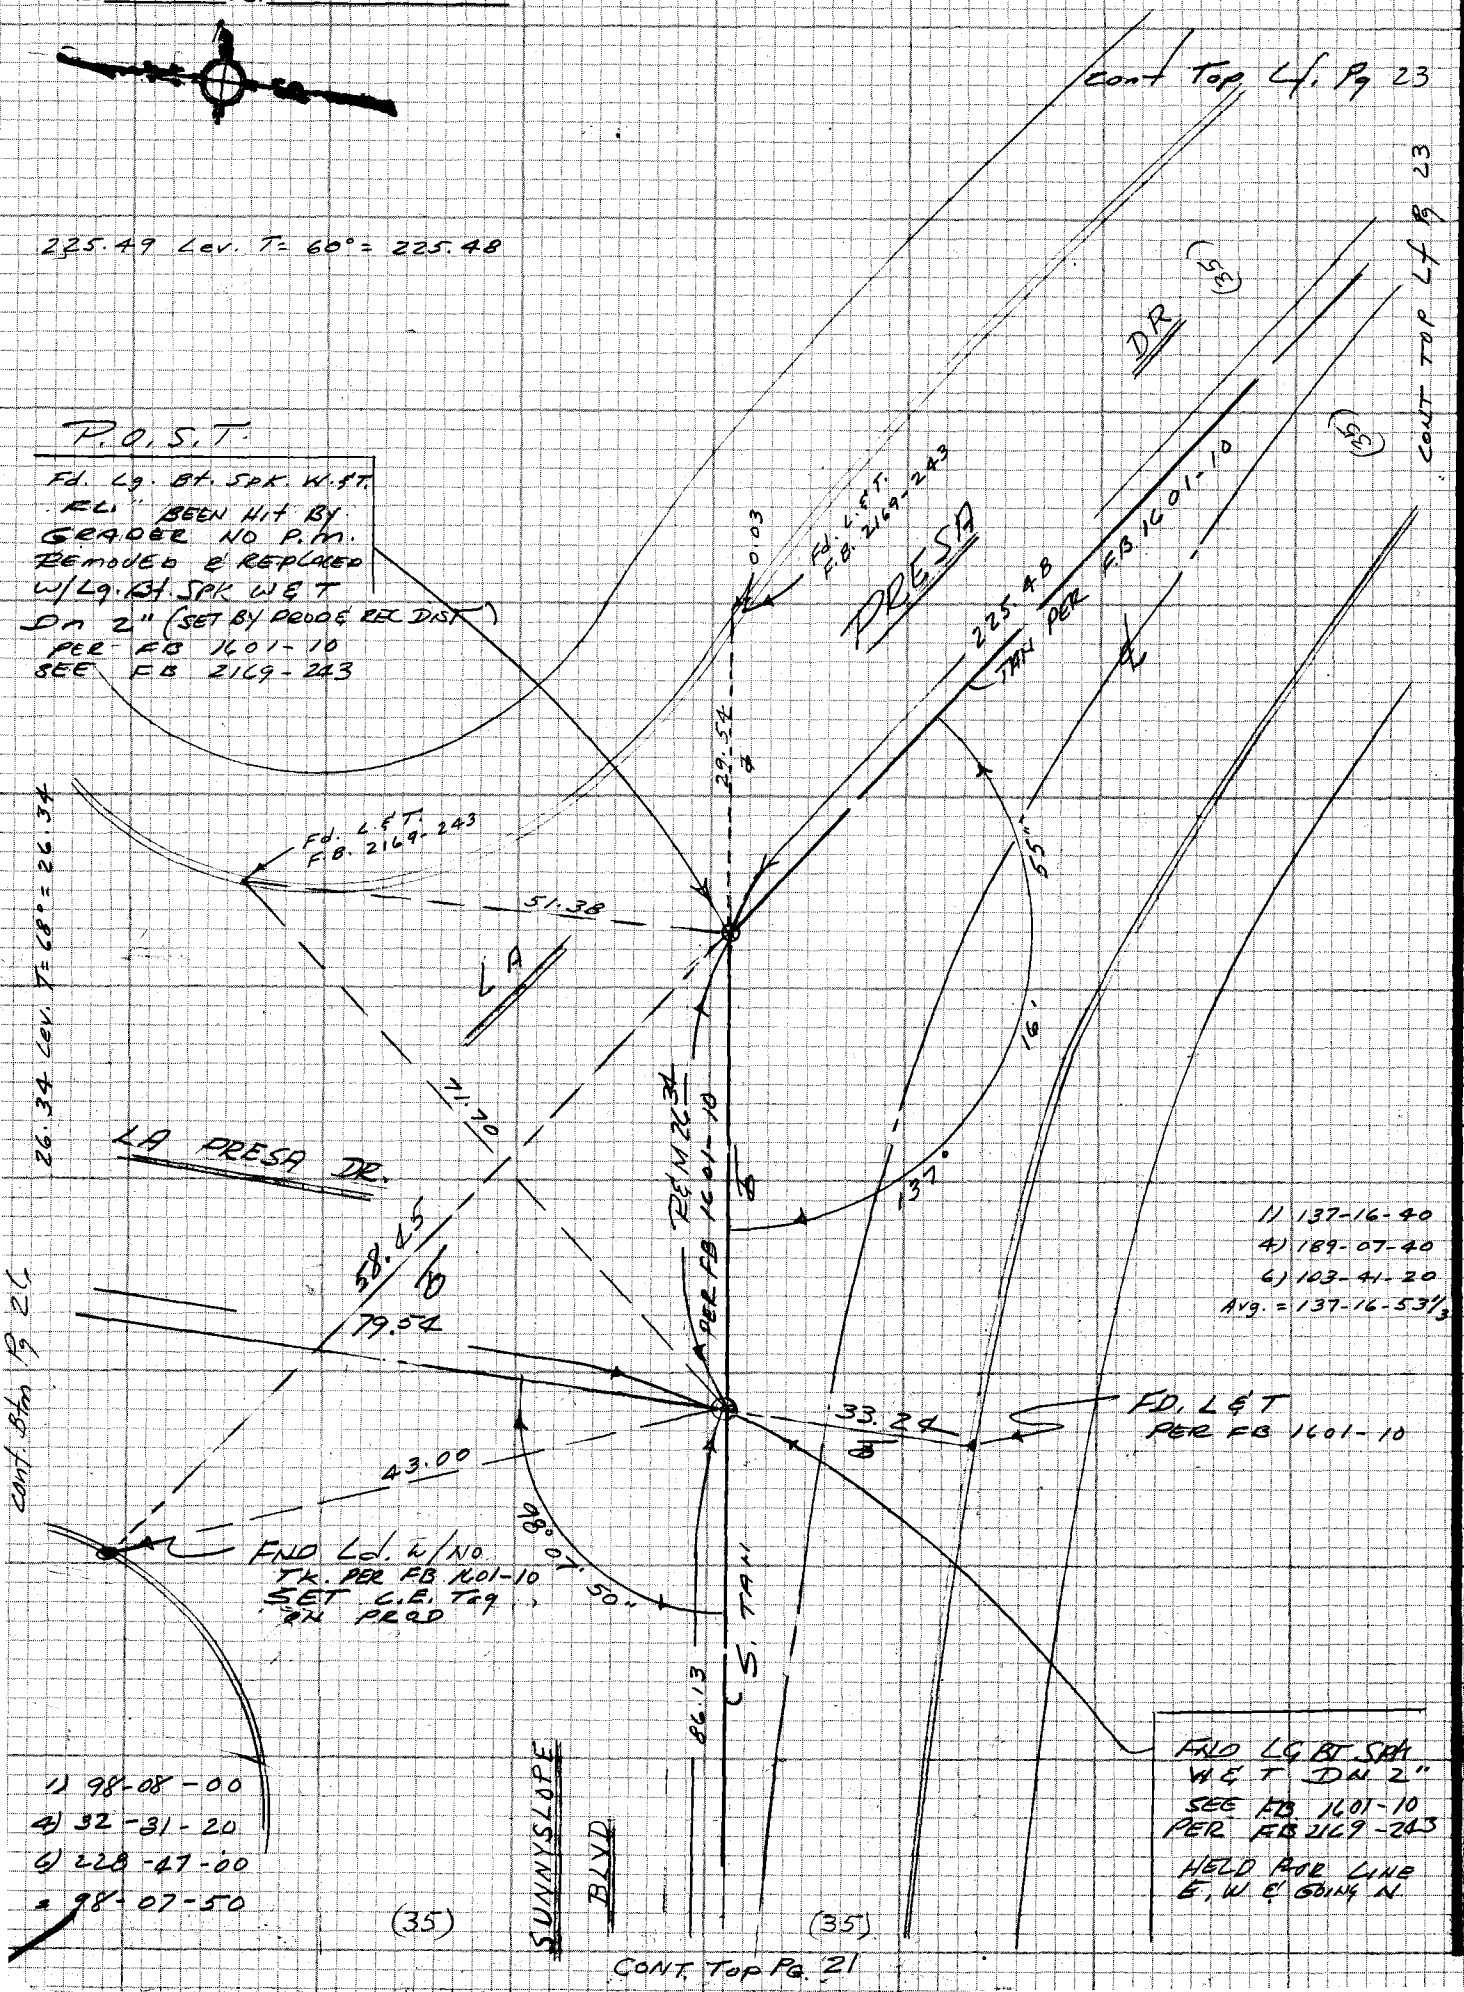


CE 310
76F3095-4/73

PLEASE RETURN TO
LOS ANGELES COUNTY ENGINEER
403 LOS ANGELES COUNTY ENGINEERING BLDG.

Do not ex[illegible] notes this side of this line

NOTE: ANY ADDITIONS OR CHANGES ON THIS SHEET MUST BE MADE OR CIRCLED IN RED INK WITH DATE AND NAME OF PERSON MAKING CHANGE

W544 B-3

DW 4

| | |
|---|---|
| Notes Ck'd by | Survey of ROSEMEAD ST ℄ |
| Map No. | JN 0303.00 Tape 074 Std 68 °F |
| Office Work | Surveyed by E. LANDA |
| Checked | Notes E. LANDA Date 3-76 |
| Date | Indexed G. D. BAILEY SEP 19 1977 |

F.B. 4412 PG. 23

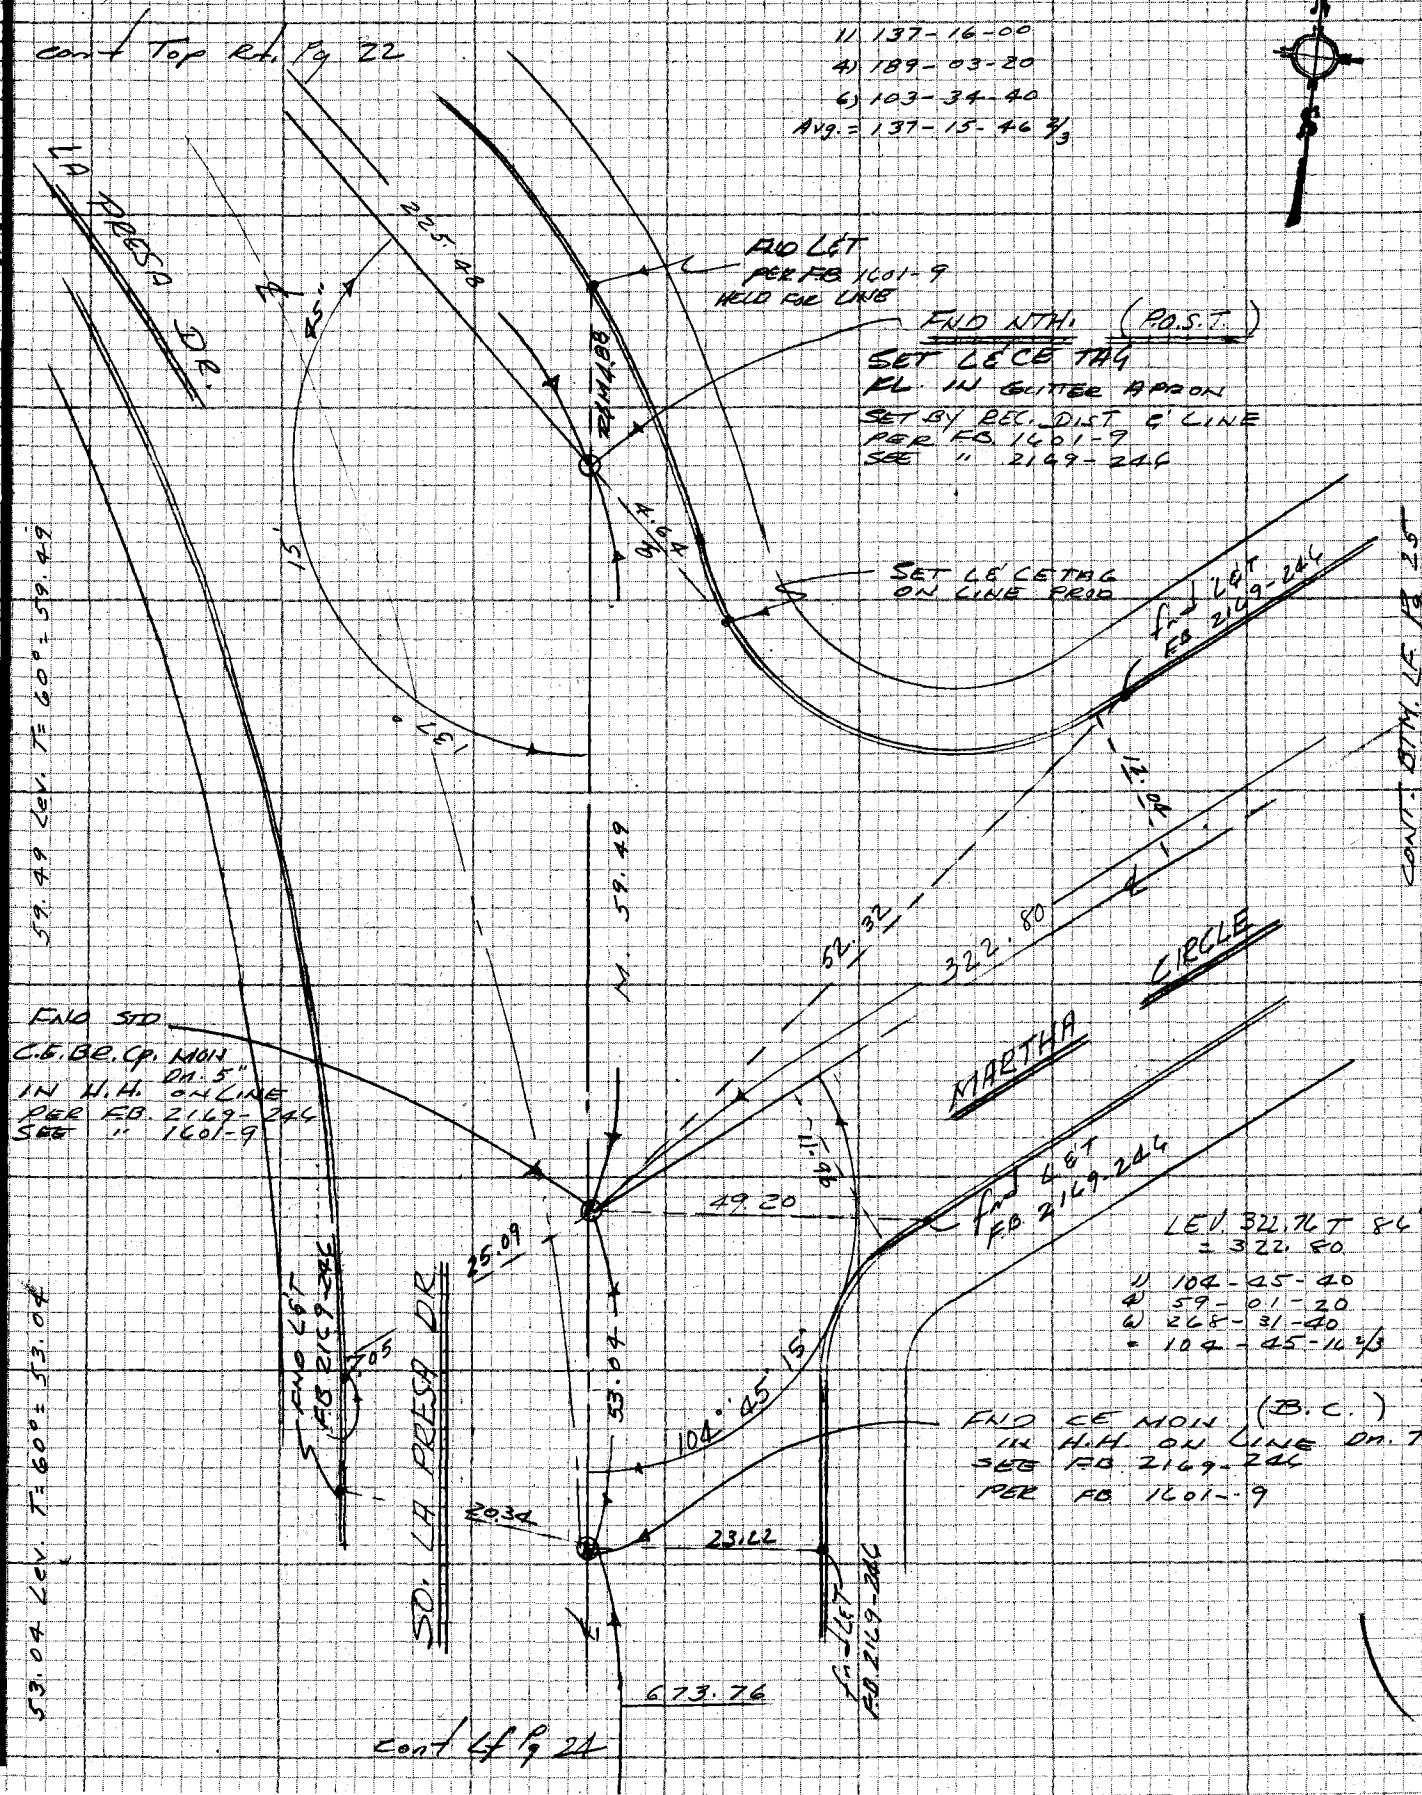


NOTE: ANY ADDITIONS OR CHANGES ON THIS SHEET MUST BE MADE OR CIRCLED IN RED INK WITH DATE AND NAME OF PERSON MAKING CHANGE

Do not extend notes this side of this line

PLEASE RETURN TO
LOS ANGELES COUNTY ENGINEER
403 LOS ANGELES COUNTY ENGINEERING BLDG.

CENTERLINE NOTES
CE 310
76F3095-4/73

F.B. 4412 PG. 24

CONT. Btm. Pg 37

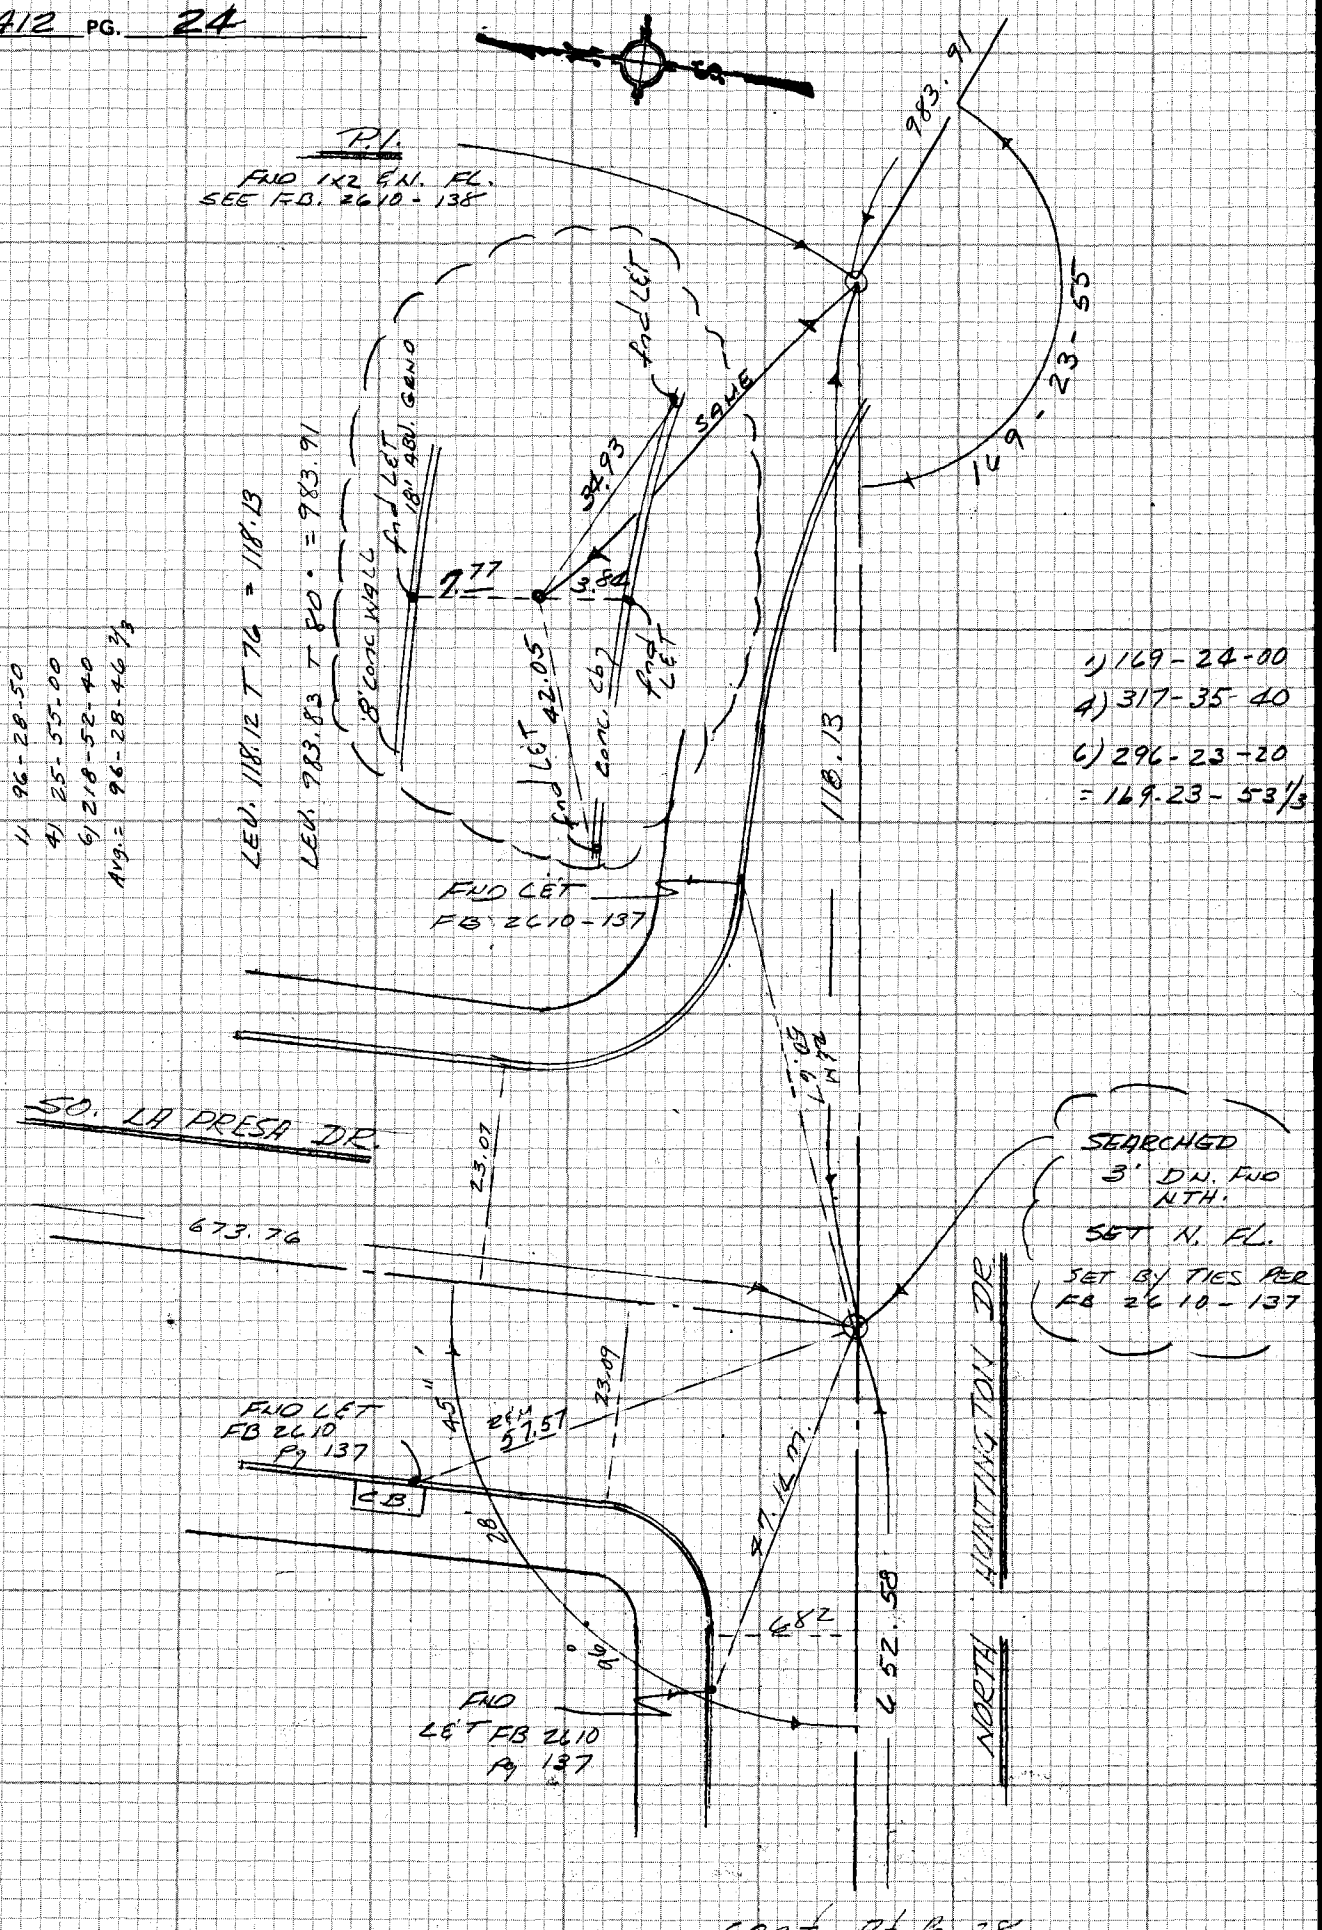


CE 310
76F3095-4/73

PLEASE RETURN TO
LOS ANGELES COUNTY ENGINEER
403 LOS ANGELES COUNTY ENGINEERING BLDG.

4754-B-3

NOTE: ANY ADDITIONS OR CHANGES ON THIS SHEET MUST BE MADE OR CIRCLED IN RED INK WITH DATE AND NAME OF PERSON MAKING CHANGE

Do not ex notes this side of this line

| | |
|---|---|
| Notes Ck'd by | Survey of ROSEMEAD ST. E DIV. 4 F.B. 4412 PG. 25 |
| Map No. | JN 0303.00 Tape 074 Std 68 °F |
| Office Work | Surveyed by E. LANDA E.L. |
| Checked | Notes K.M. KARP Date 5-74 |
| Date | Indexed G. D. BAILEY SEP 19 1977 |

NOTE: ANY ADDITIONS OR CHANGES ON THIS SHEET MUST BE MADE OR CIRCLED IN RED INK WITH DATE AND NAME OF PERSON MAKING CHANGE

L544 B-3

PLEASE RETURN TO
LOS ANGELES COUNTY ENGINEER
403 LOS ANGELES COUNTY ENGINEERING BLDG.

Do not extend notes beyond this line

CENTERLINE NOTES
CE 310
76F3095-4/73

E.C.
SET NEW P.M. RN
FND C.E. MON.
BY TIES PER
FB 1601-13
APPARENTLY DISTURBED
BY ROAD WORK
SET H.H. COVER, FND.
MON 9" DP.

SET P.M.

FND P.M.

.05

Cont. Rt. 13.27

(20)

GEORGE CIRCLE

FND C&T FB 1601-13

R&M 19.15

483.65

M. 40.44

.09

FND C&T FB 1601-13

141.55.05'

12.00

M. 22.88

CHORD

R&M 30.61

FND C&T FB 1601-13

P.O.C.
SET Sq. Rd.
30K E.L.
SET BY FND
TIES PER
FB 1601-13

Curve Data
Per F.B. 1601-13
Δ = 152° 34' 15"
R = 54.95
T = 245.65
L = 159.64

103° 38' 10"

R&M 49.15

14.13

C 40.20

35'

54'

.02

FND C&T FB 1601-13

40.46

141'

12.00

R&M 19.44

R&M 17.34

FND C&T FB 1601-13

MARTHA CIRCLE

60.00'

322.80

CB 12.00

B.C. FND C.E.
MON. DN 7" E LEANING
DISTURBED BY RJ. WORKS.
RESET MON BY
TIES SET H.H. COVER.
PER FB 1601-13

Cont. Rt. 13.23

60.00'

1) 141 - 55 - 20
2) 207 - 40 - 30
3) 131 - 30 - 40
= 141 - 55 - 06 2/3

N 103 - 38 - 20
1) 54 - 32 - 50
2) 261 - 49 - 10
= 103 - 38 - 11 1/3

LEV. 12.08 T TO NC

LEV. 14.13 T TO MC

1) 141 - 53 - 00
2) 207 - 30 - 40
3) 131 - 15 - 40
= 141 - 52 - 36 1/3

F.B. 4412 PG. 26

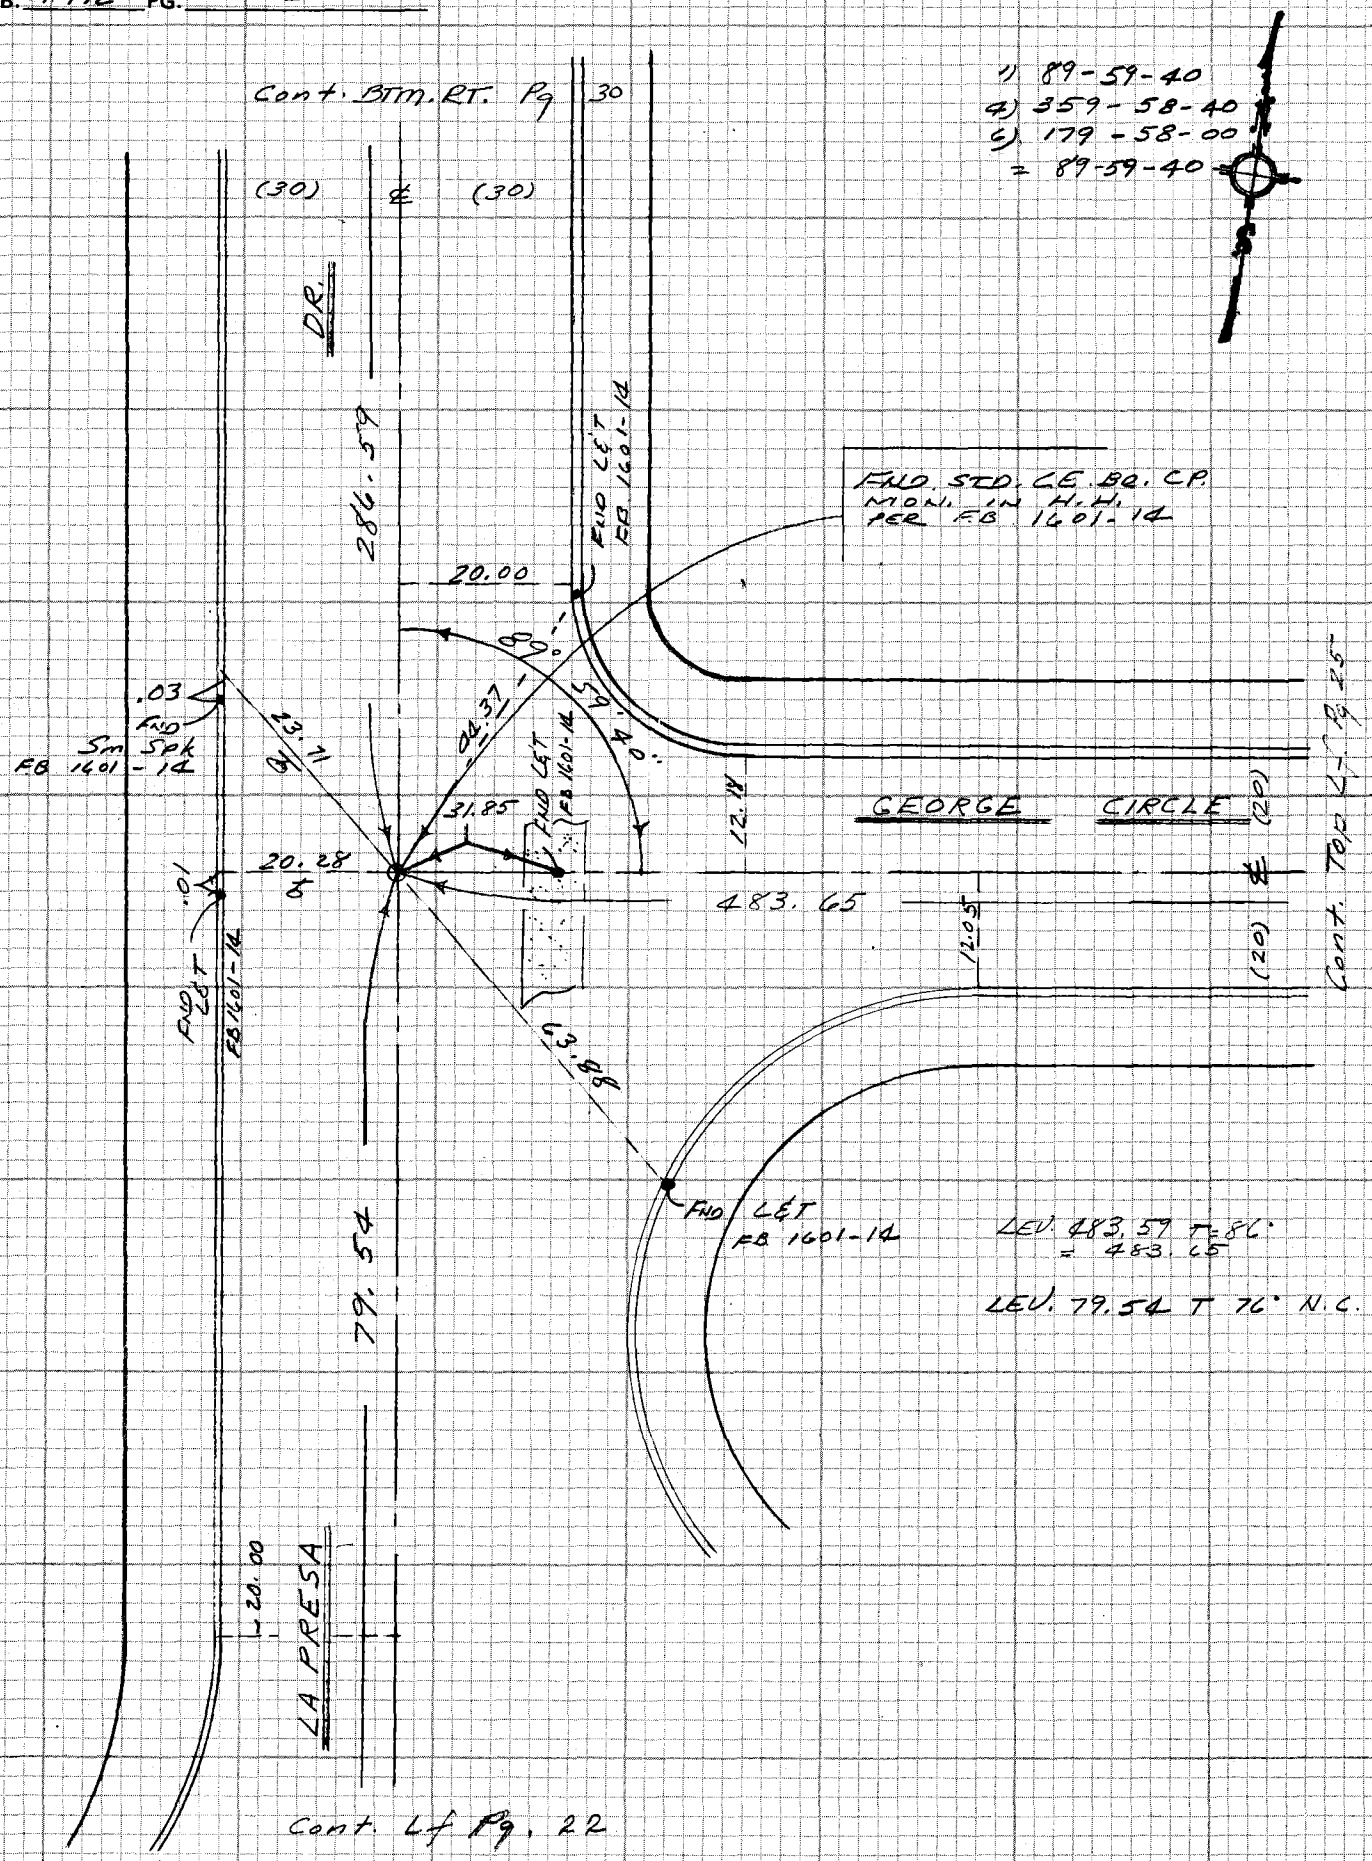


CE 310
76F3095 '73

PLEASE RETURN TO
LOS ANGELES COUNTY ENGINEER
402 LOS ANGELES COUNTY ENGINEERING BLDG.

Do not ex[illegible] notes this side of this line

NOTE: ANY ADDITIONS OR CHANGES ON THIS SHEET MUST BE MADE OR CIRCLED IN RED INK WITH DATE AND NAME OF PERSON MAKING CHANGE

4547 B-3

| | |
|---|---|
| Notes Ck'd by | Survey of ROSEMEAD ST. ℄ DIV. 4 |
| Map No. | JN 0303.00 Tape 074 Std 68 °F |
| Office Work | Surveyed by E. LANDA |
| Checked | Notes K.M. KAPP Date 5-76 |
| Date | Indexed G. D. BAILEY SEP 19 1977 |

F.B. 4412 PG. 27

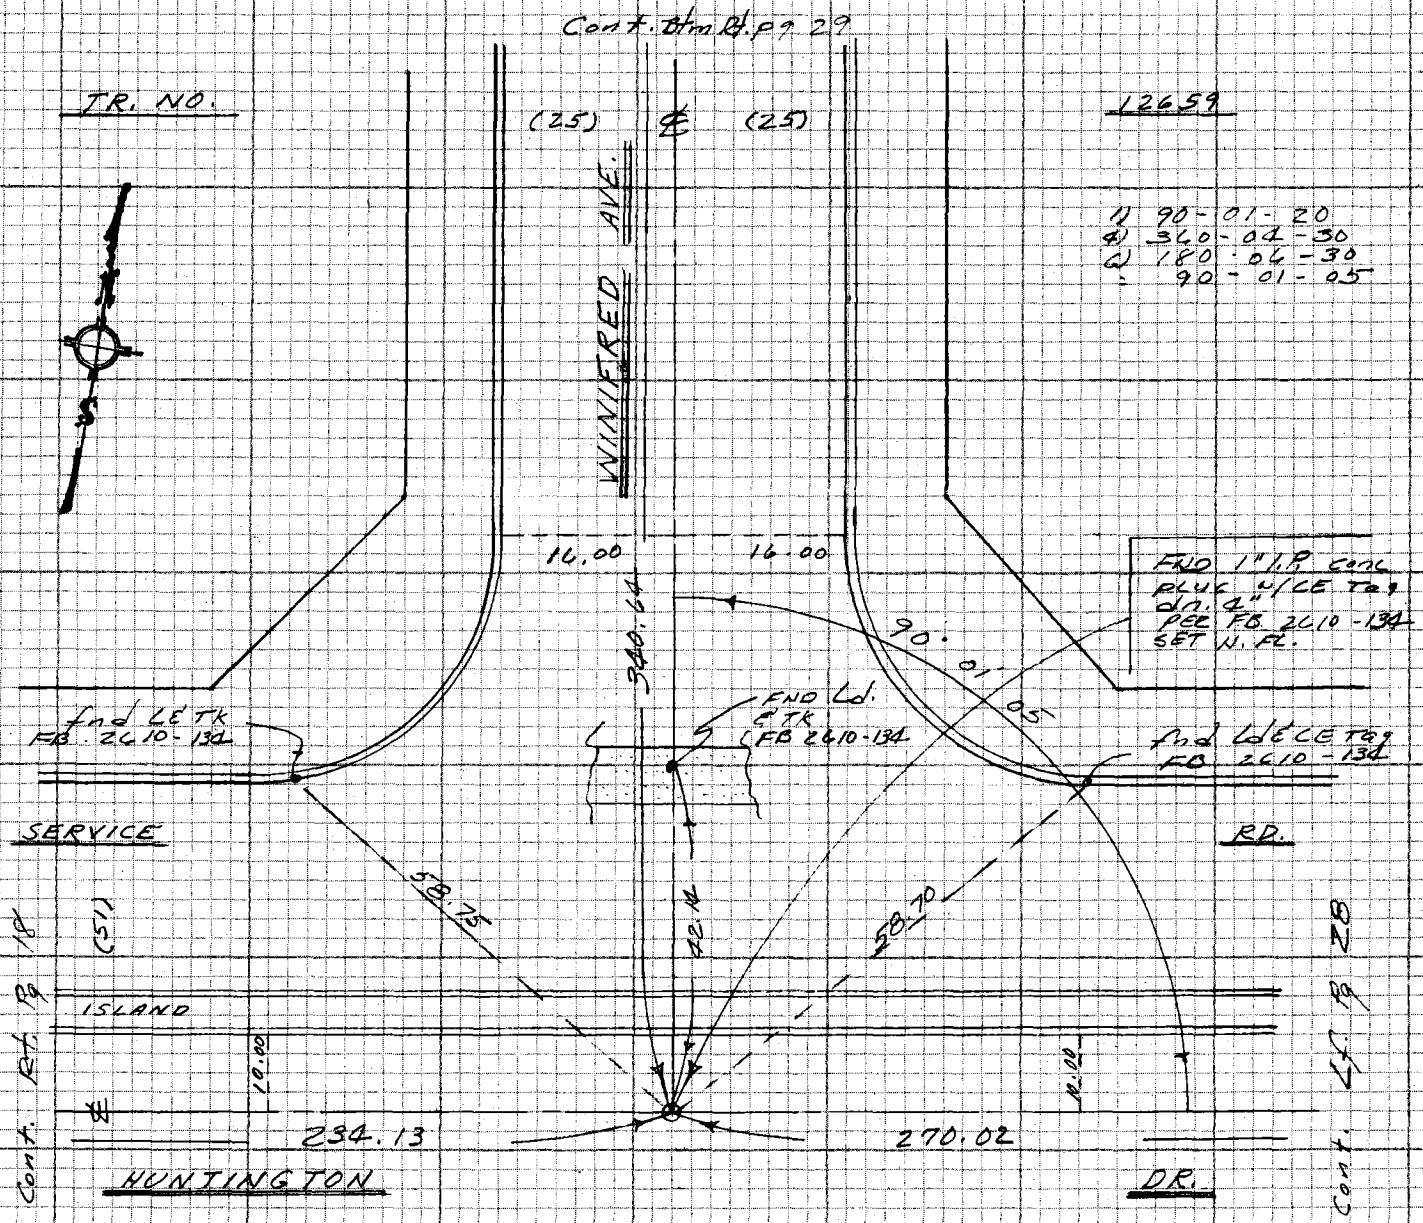


LEV. 270.00 T 78 : 270.02

NOTE: ANY ADDITIONS OR CHANGES ON THIS SHEET MUST BE MADE OR CIRCLED IN RED INK WITH DATE AND NAME OF PERSON MAKING CHANGE

Do not extend notes on this side of this line

WS44B-3

PLEASE RETURN TO
LOS ANGELES COUNTY ENGINEER
403 LOS ANGELES COUNTY ENGINEERING BLDG.

CENTERLINE NOTES
CE 310
76F3095-4/73

F.B. 4412 PG. 28

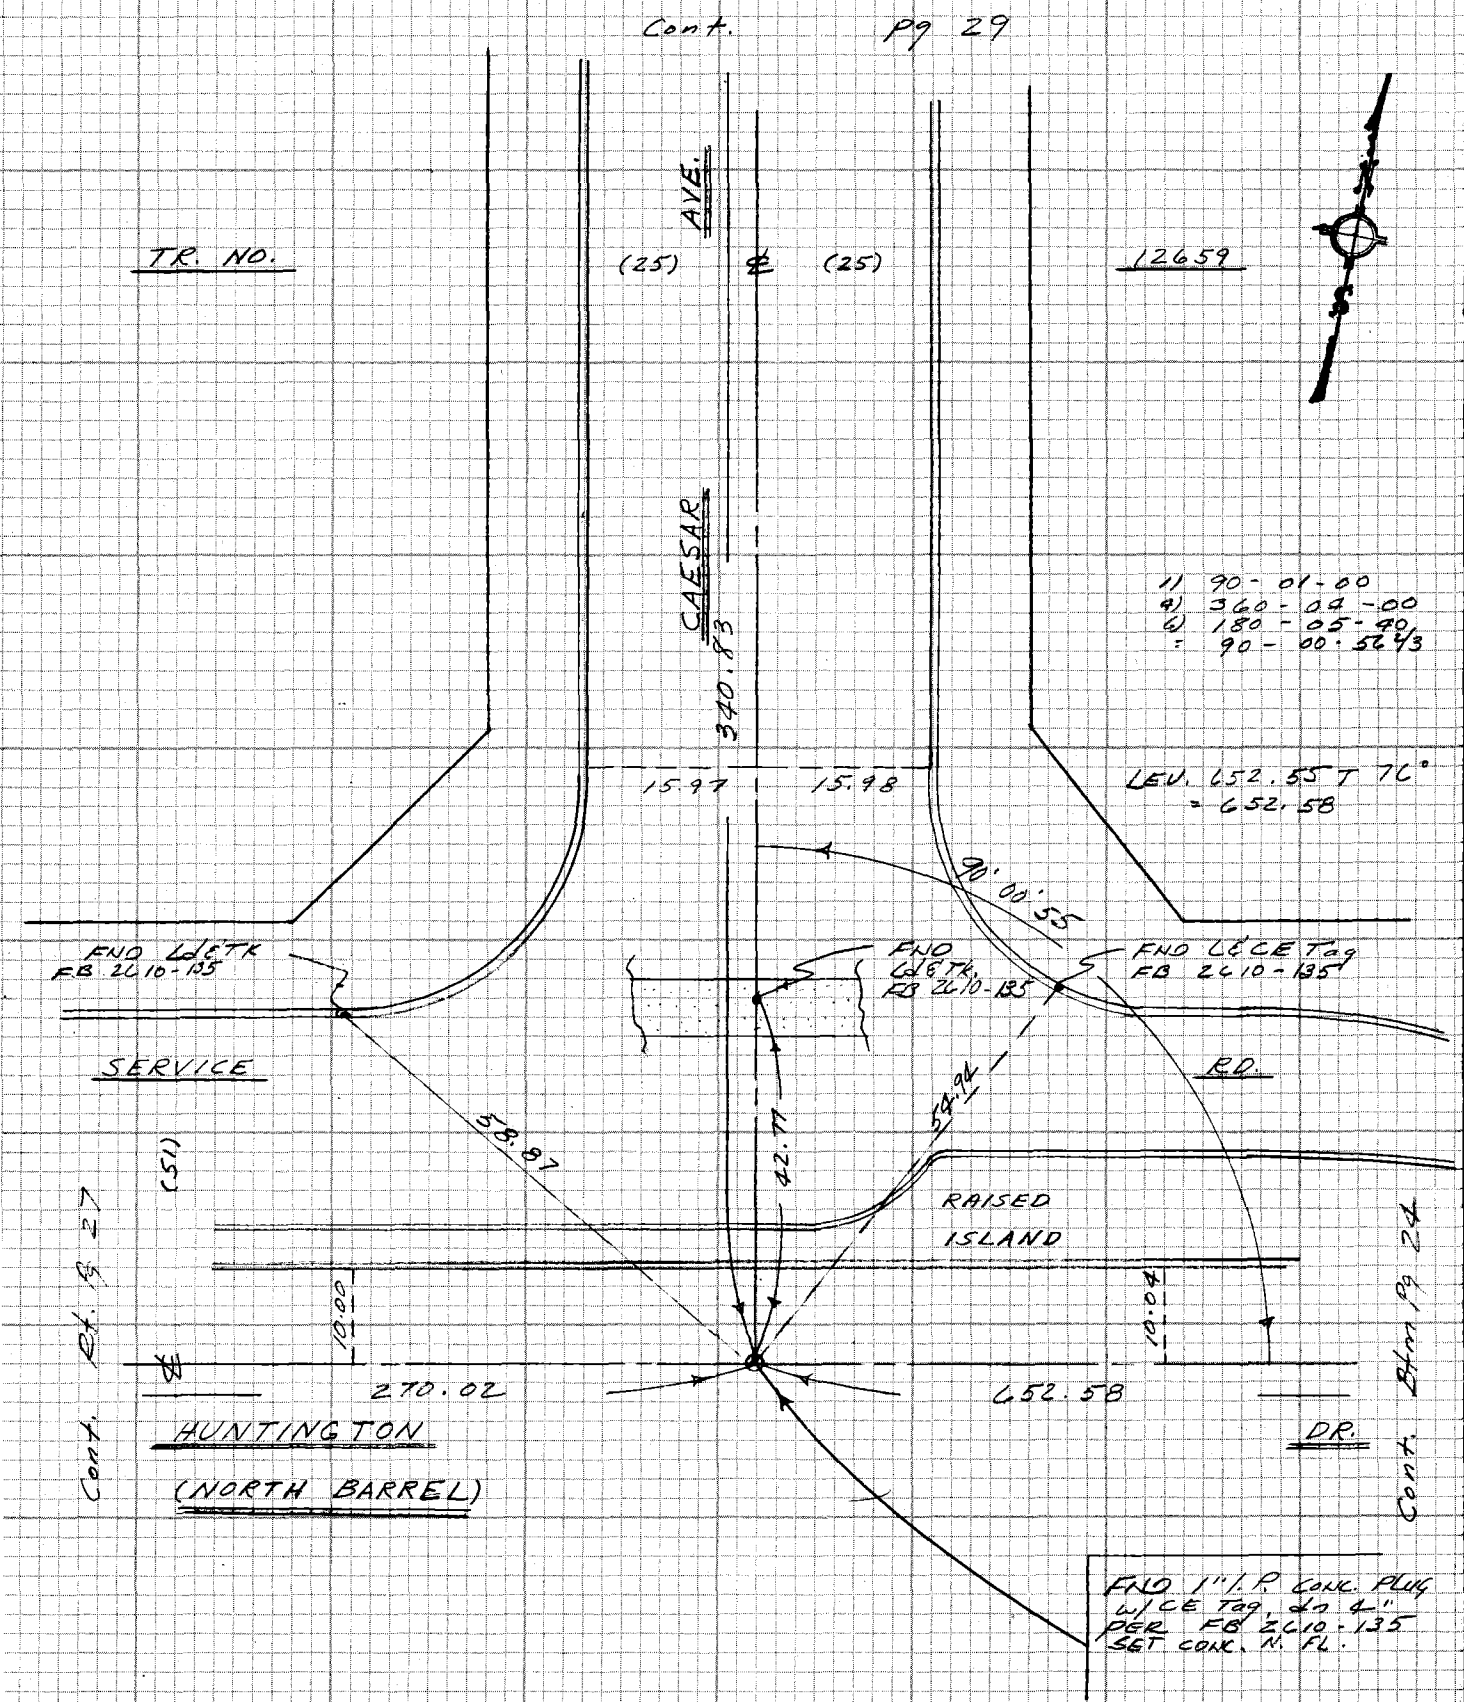


CE 310
76F3095-4/73

PLEASE RETURN TO
LOS ANGELES COUNTY ENGINEER
403 LOS ANGELES COUNTY ENGINEERING BLDG.

Do not ex[illegible] notes this side of this line

NOTE: ANY ADDITIONS OR CHANGES ON THIS SHEET MUST BE MADE OR CIRCLED IN RED INK WITH DATE AND NAME OF PERSON MAKING CHANGE

HS 44B-3

DIV 4

| | |
|---|---|
| Notes Ck'd by | Survey of ROSEMEAD ST ℄ |
| Map No. | JN 0303.00 Tape 0232 Std 68 °F |
| Office Work | Surveyed by E. LANDA |
| Checked | Notes E. LANDA Date 5-76 |
| Date | Indexed G. D. BAILEY SEP 19 1977 |

F.B. 4412 PG. 29

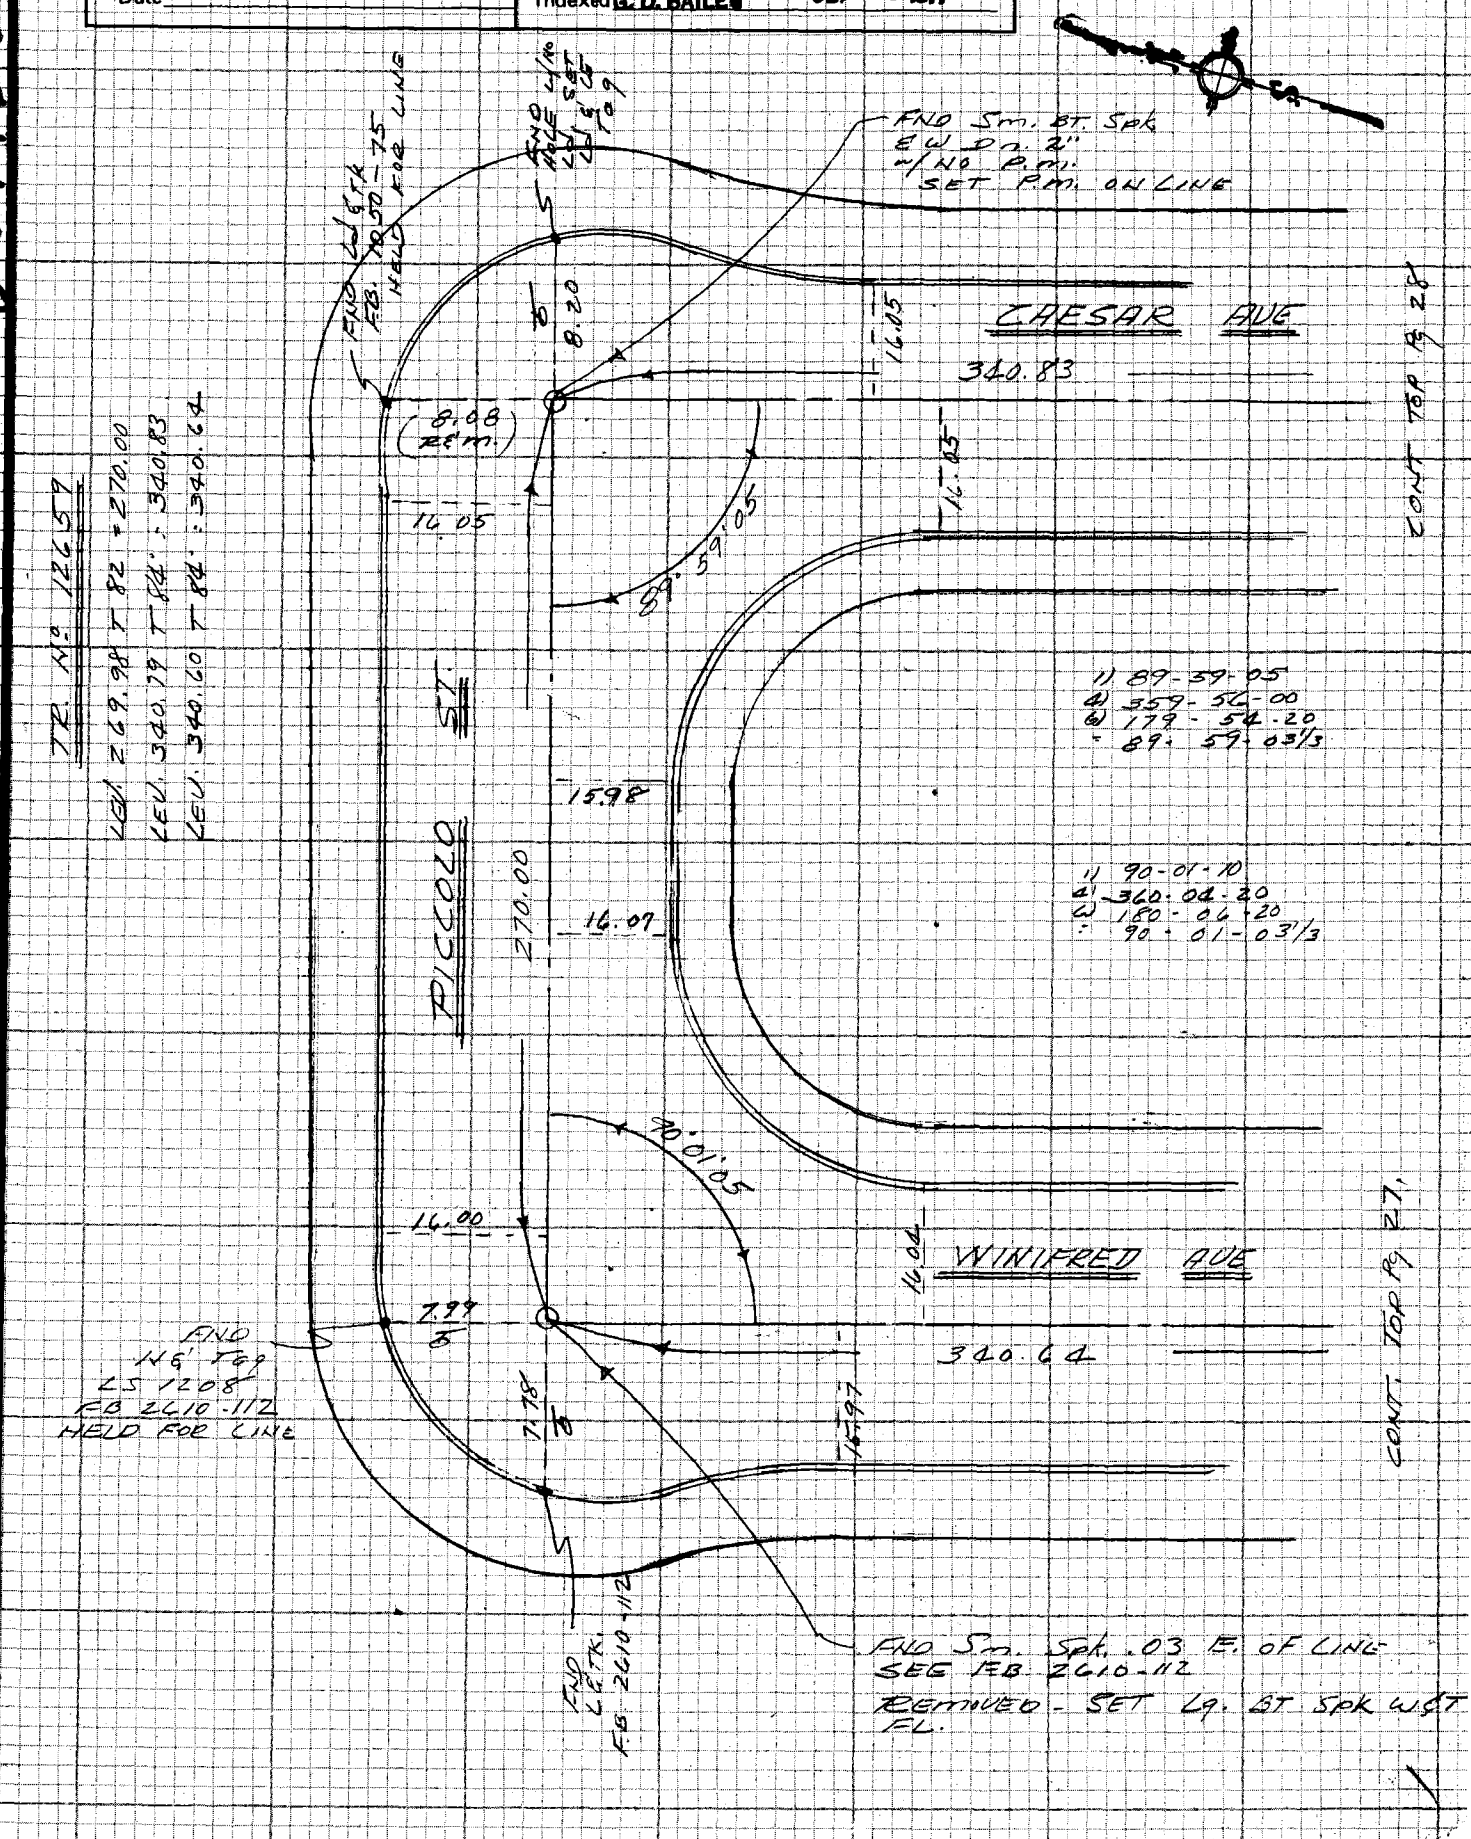


NOTE: ANY ADDITIONS OR CHANGES ON THIS SHEET MUST BE MADE OR CIRCLED IN RED INK WITH DATE AND NAME OF PERSON MAKING CHANGE

Do not extend notes this side of this line

PLEASE RETURN TO
LOS ANGELES COUNTY ENGINEER
403 LOS ANGELES COUNTY ENGINEERING BLDG.

CENTERLINE NOTES
CE 310
76F3095-4/73

F.B. 4412 PG. 30

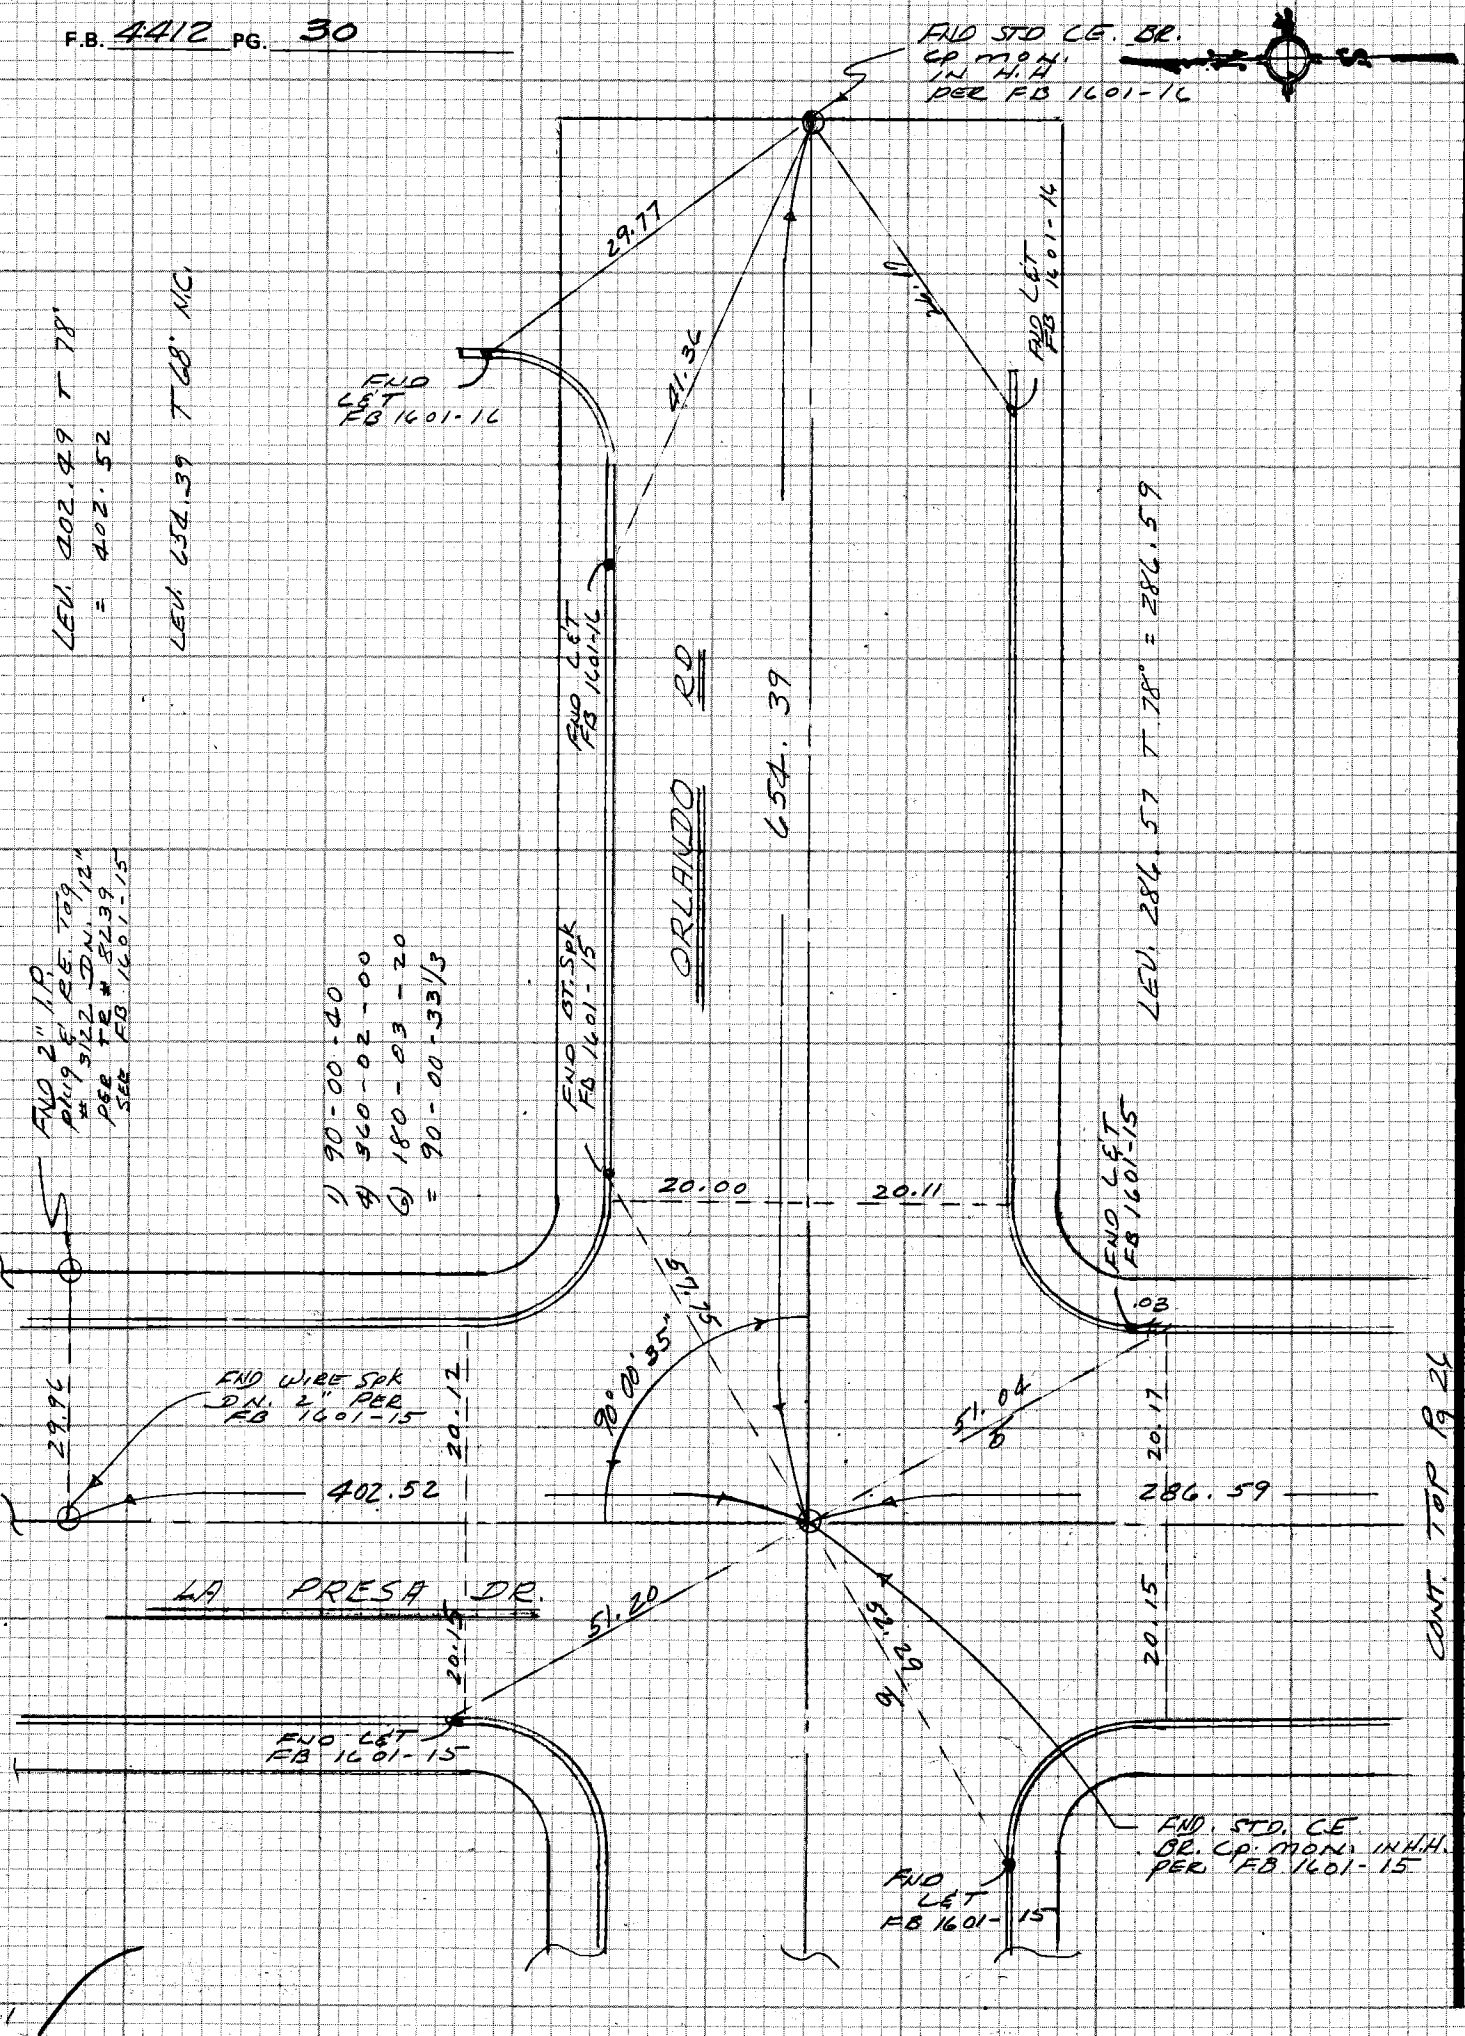


CE 310
76F3095-4-3

PLEASE RETURN TO
LOS ANGELES COUNTY ENGINEER
403 LOS ANGELES COUNTY ENGINEERING BLDG.

Do not extend notes this side of this line

NOTE: ANY ADDITIONS OR CHANGES ON THIS SHEET MUST BE MADE OR CIRCLED IN RED INK WITH DATE AND NAME OF PERSON MAKING CHANGE

6544B-3

Div. 4

| | |
|---|---|
| Notes Ck'd by | Survey of ROSEMEAD ST ℄ |
| Map No. | JN 0303.00 Tape 0232 Std 68 °F |
| Office Work | Surveyed by E. LANDA |
| Checked | Notes E. LANDA Date 5-76 |
| Date | Indexed G. D. BAILEY SEP 19 1977 |

F.B. 4412 PG. 31

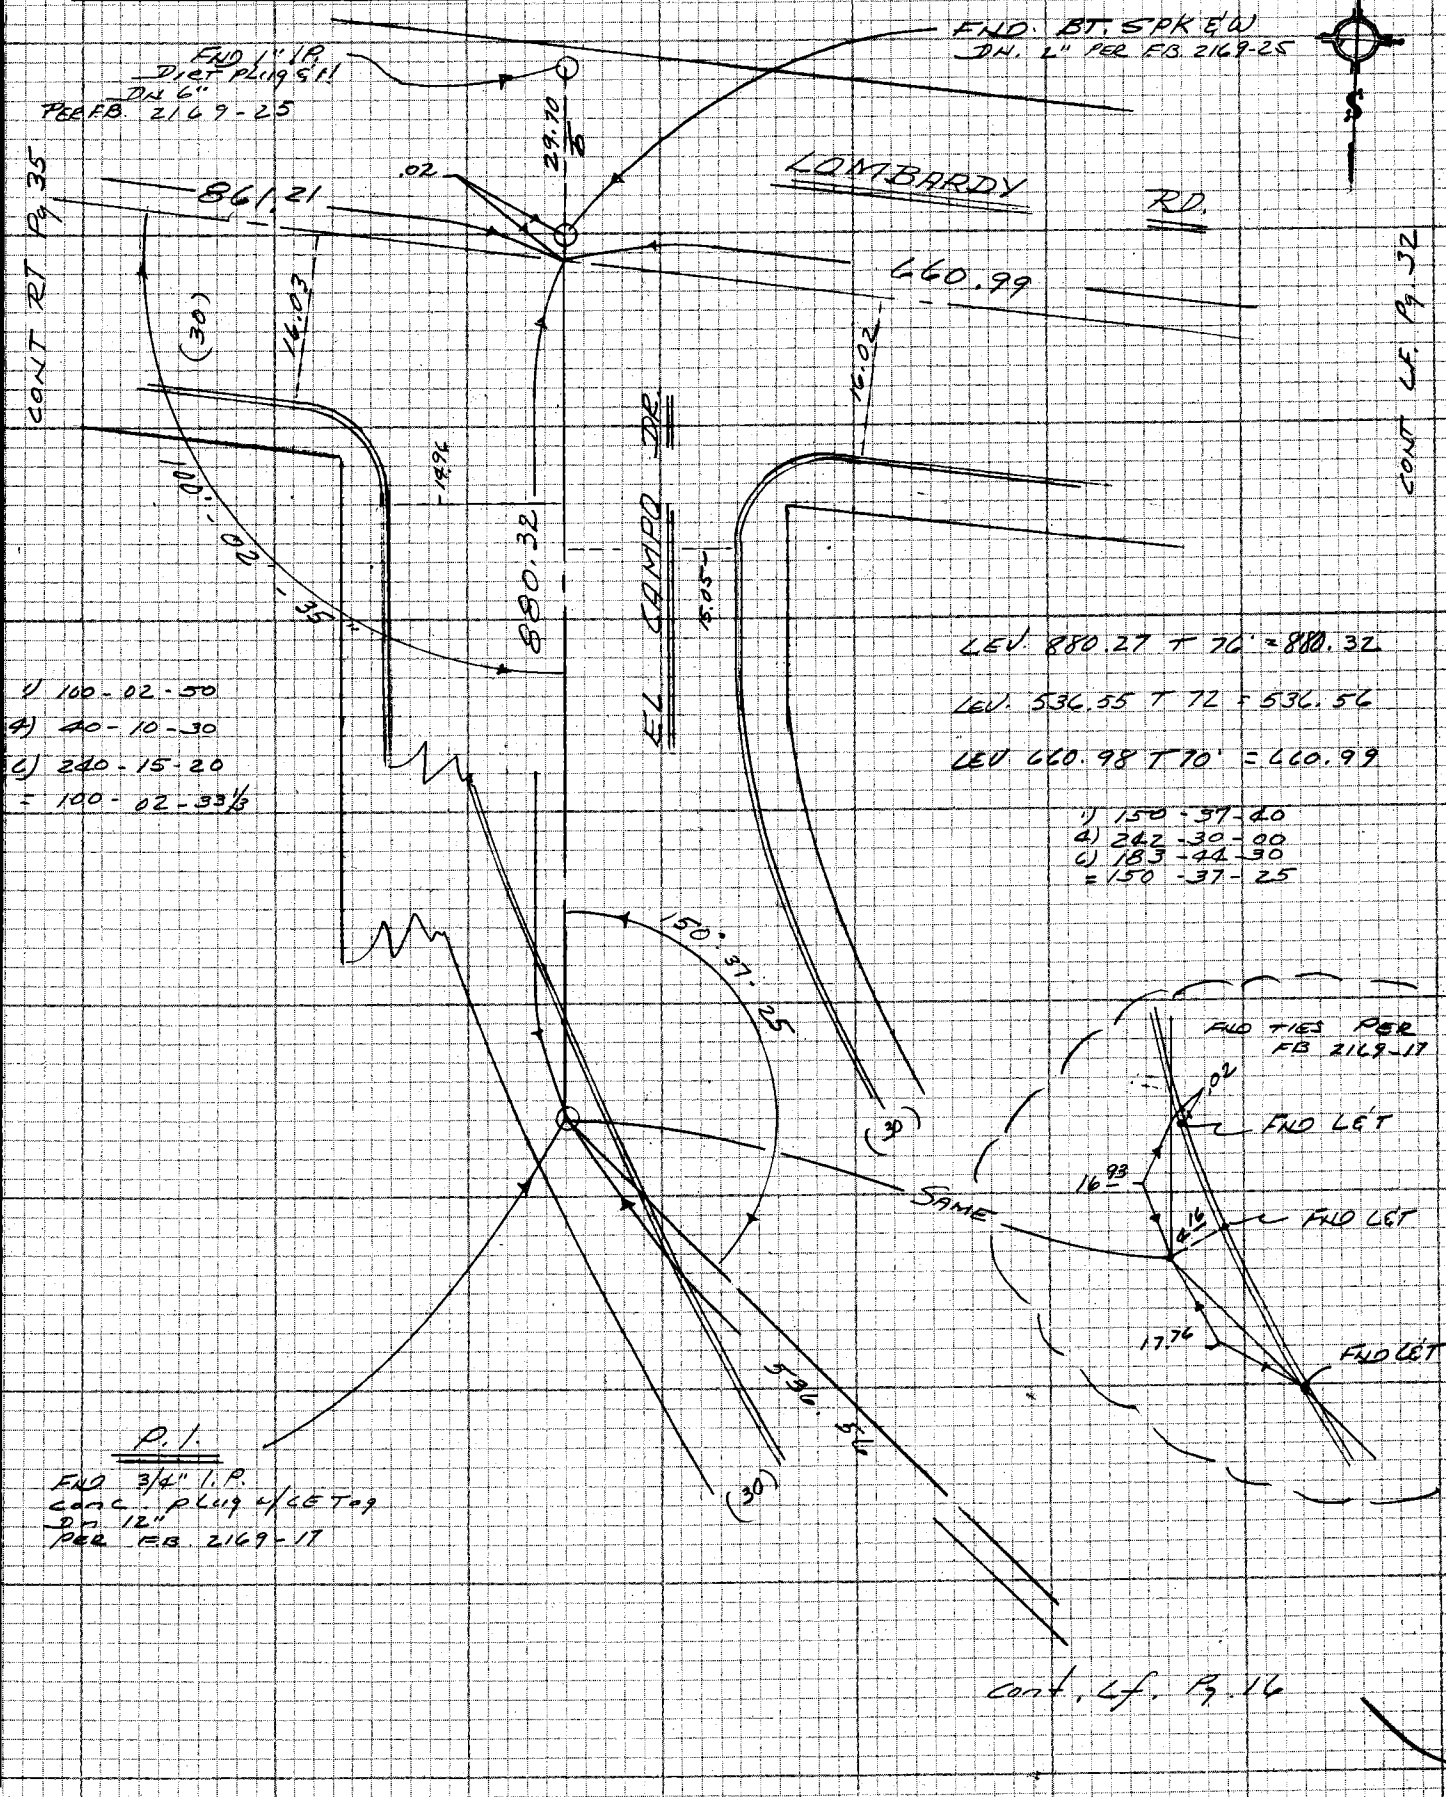


NOTE: ANY ADDITIONS OR CHANGES ON THIS SHEET MUST BE MADE OR CIRCLED IN RED INK WITH DATE AND NAME OF PERSON MAKING CHANGE

Do not extend notes this side of this line

PLEASE RETURN TO
LOS ANGELES COUNTY ENGINEER
403 LOS ANGELES COUNTY ENGINEERING BLDG.

CENTERLINE NOTES
CE 310
76F3095-4/73

CE 310
76F3095-4/73

PLEASE RETURN TO
LOS ANGELES COUNTY ENGINEER
403 LOS ANGELES COUNTY ENGINEERING BLDG.

NOTE: ANY ADDITIONS OR CHANGES ON THIS SHEET MUST BE MADE OR CIRCLED IN RED INK WITH DATE AND NAME OF PERSON MAKING CHANGE

Do not exte notes this side of this line

W544 B-3

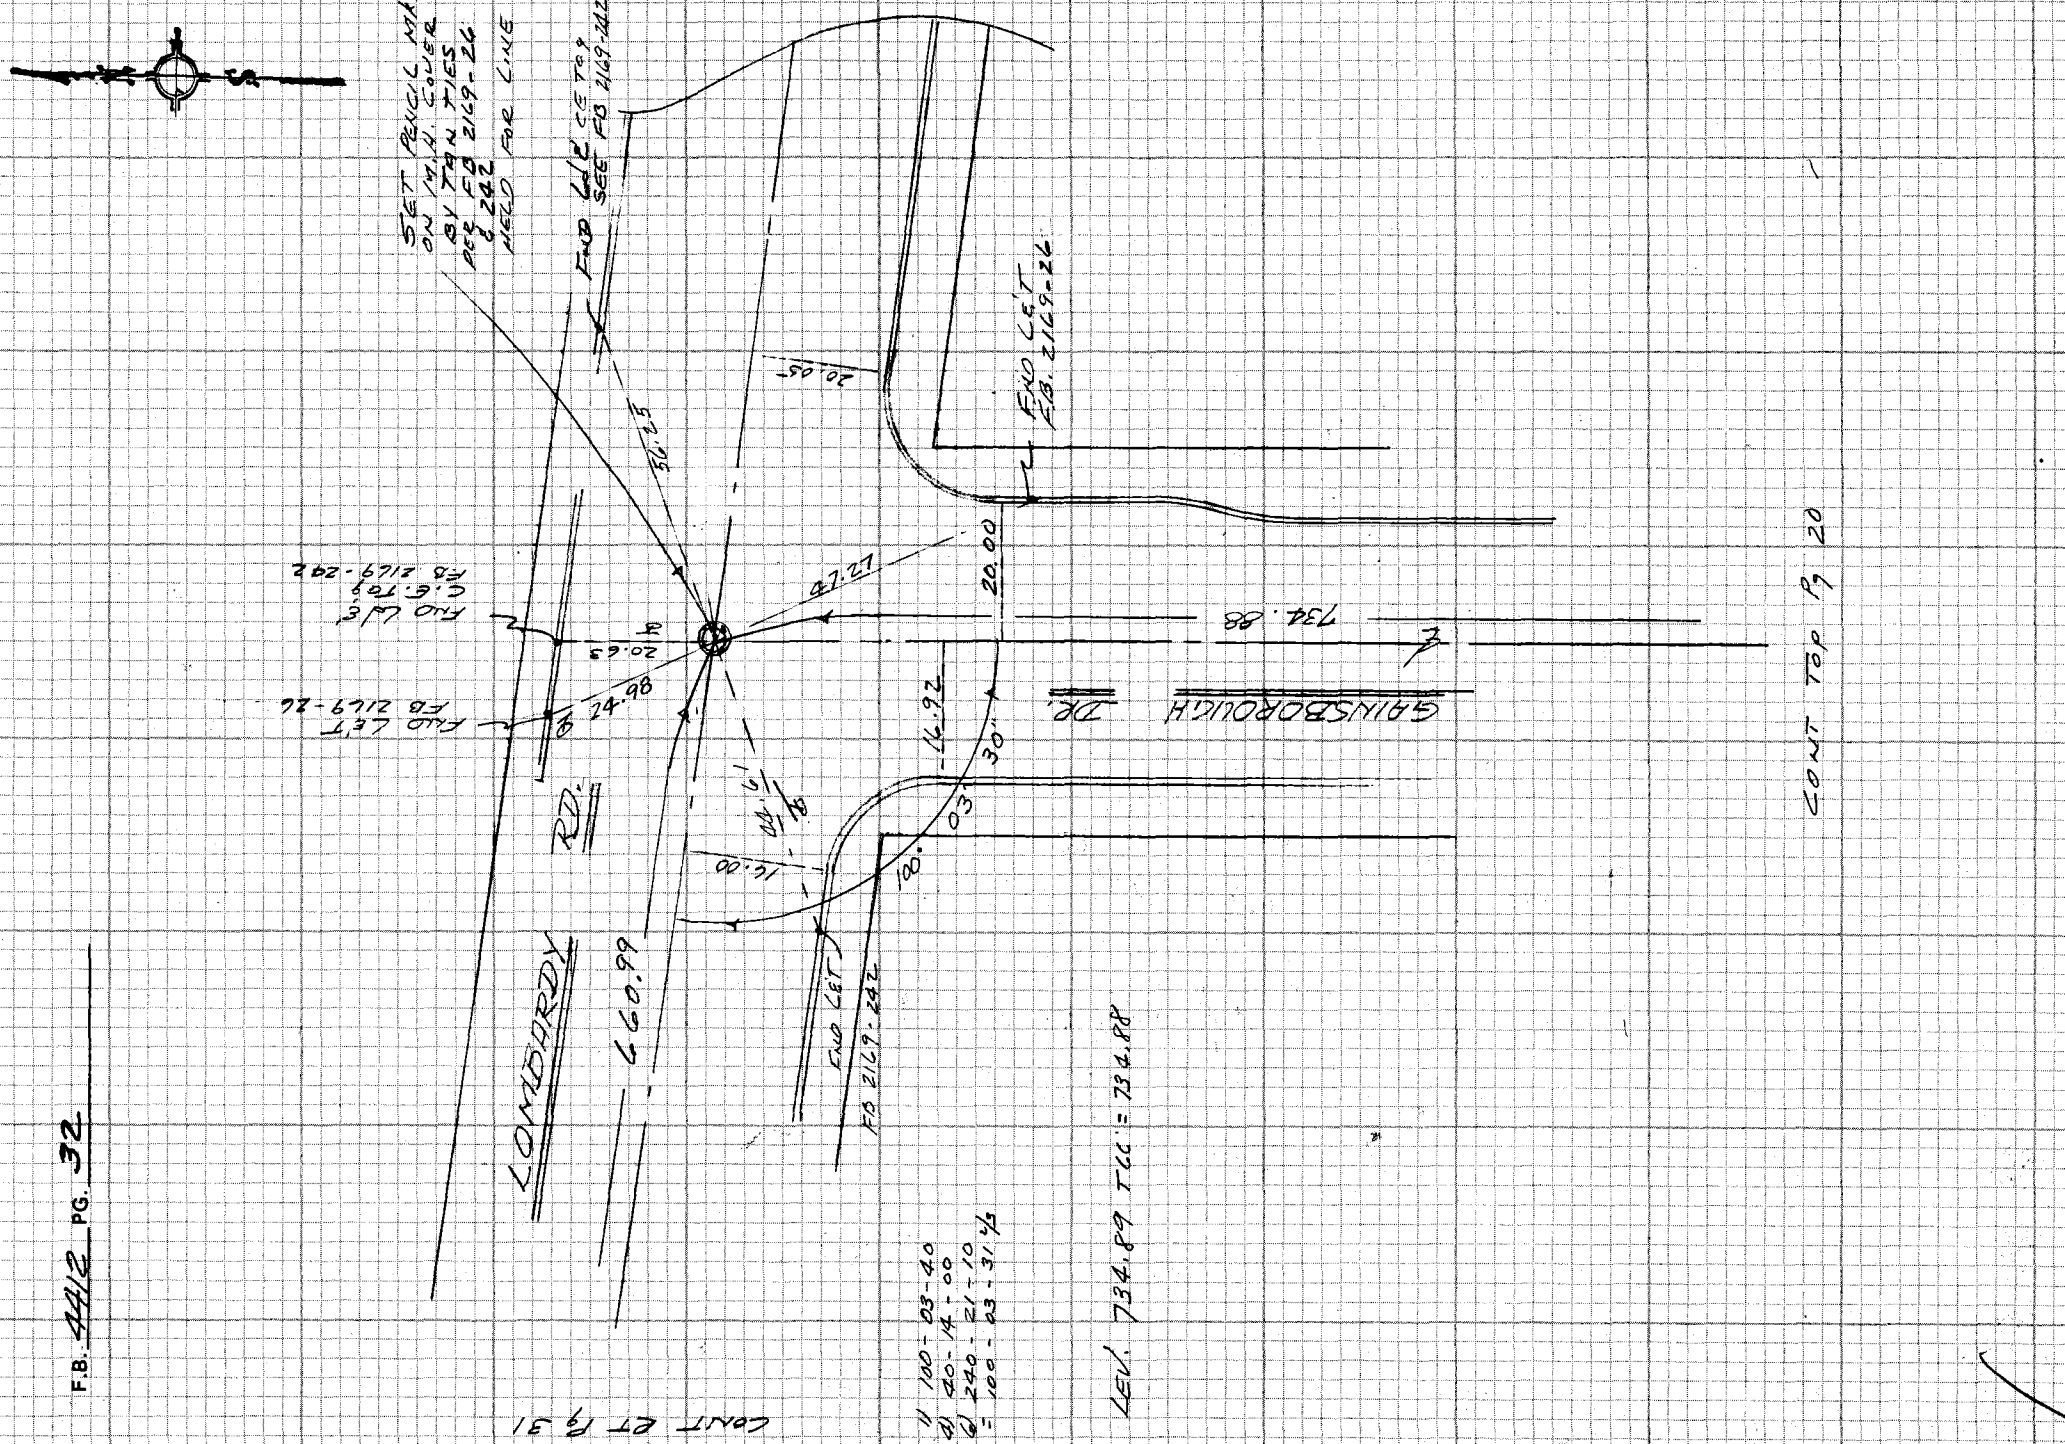


F.B. 4412 PG. 32

D.U.L.

| | |
|---|---|
| Notes Ck'd by | Survey of ROSEMEAD ST. & |
| Map No. | JN 0303.00 Tape 0232 Std 68 °F |
| Office Work | Surveyed by E. LANDA |
| Checked | Notes E. LANDA Date 4-76 |
| Date | Indexed G. D. BAILEY SEP 19 1977 |

F.B. 4412 PG. 33

CONT. STM. Pg 34

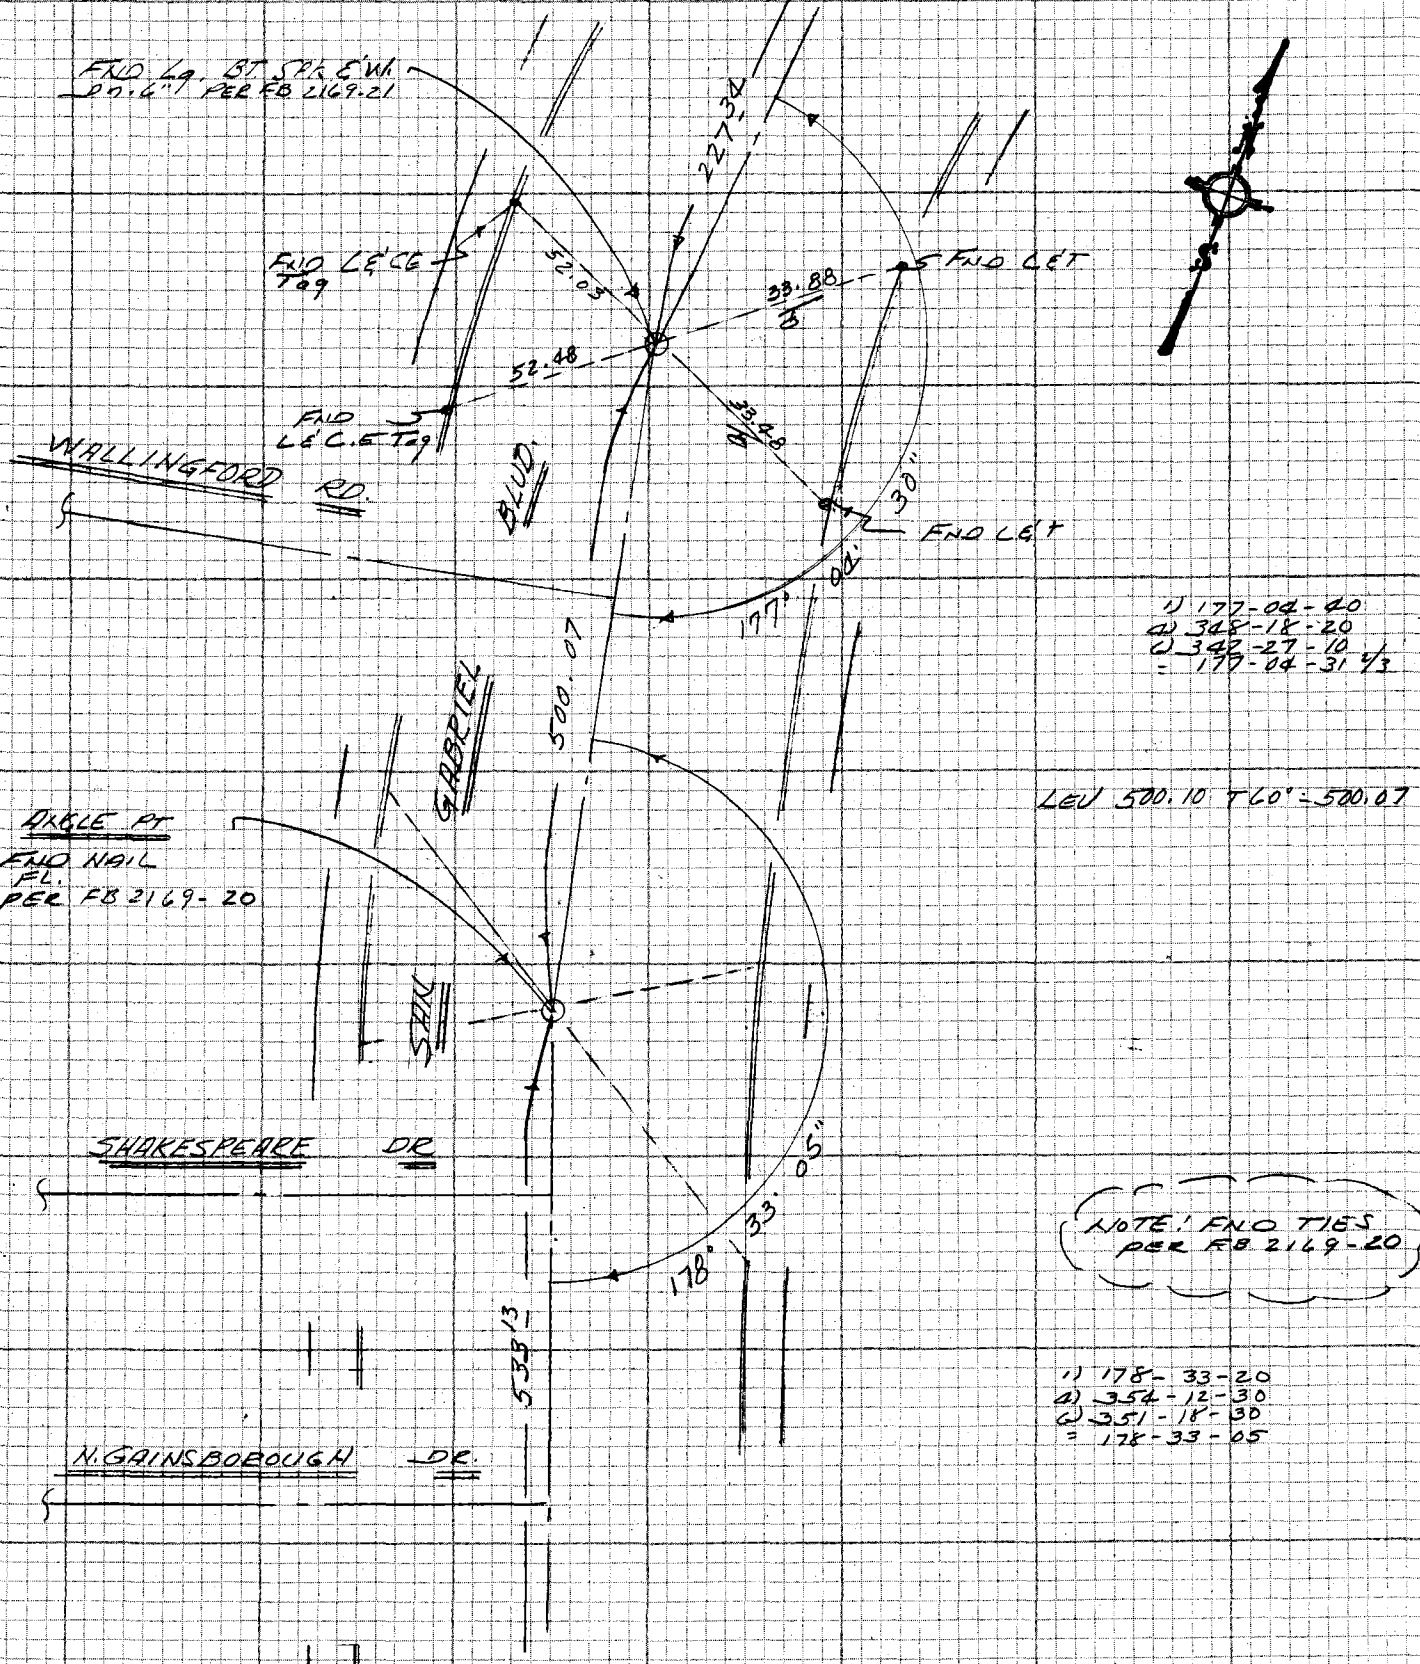


1) 177-04-40
2) 348-18-20
3) 348-27-10
= 177-04-31 1/3

LEV 500.10 TCO = 500.07

NOTE: FND TIES PER FB 2169-20

1) 178-33-20
2) 354-12-30
3) 351-18-30
= 178-33-05

CONT Top Pg 13

NOTE: ANY ADDITIONS OR CHANGES ON THIS SHEET MUST BE MADE OR CIRCLED IN RED INK WITH DATE AND NAME OF PERSON MAKING CHANGE

WS44 B3

Do not extend notes this side of this line

PLEASE RETURN TO
LOS ANGELES COUNTY ENGINEER
403 LOS ANGELES COUNTY ENGINEERING BLDG.

CENTERLINE NOTES
CE 310
76F3095-4/73

F.B. 4412 PG. 34

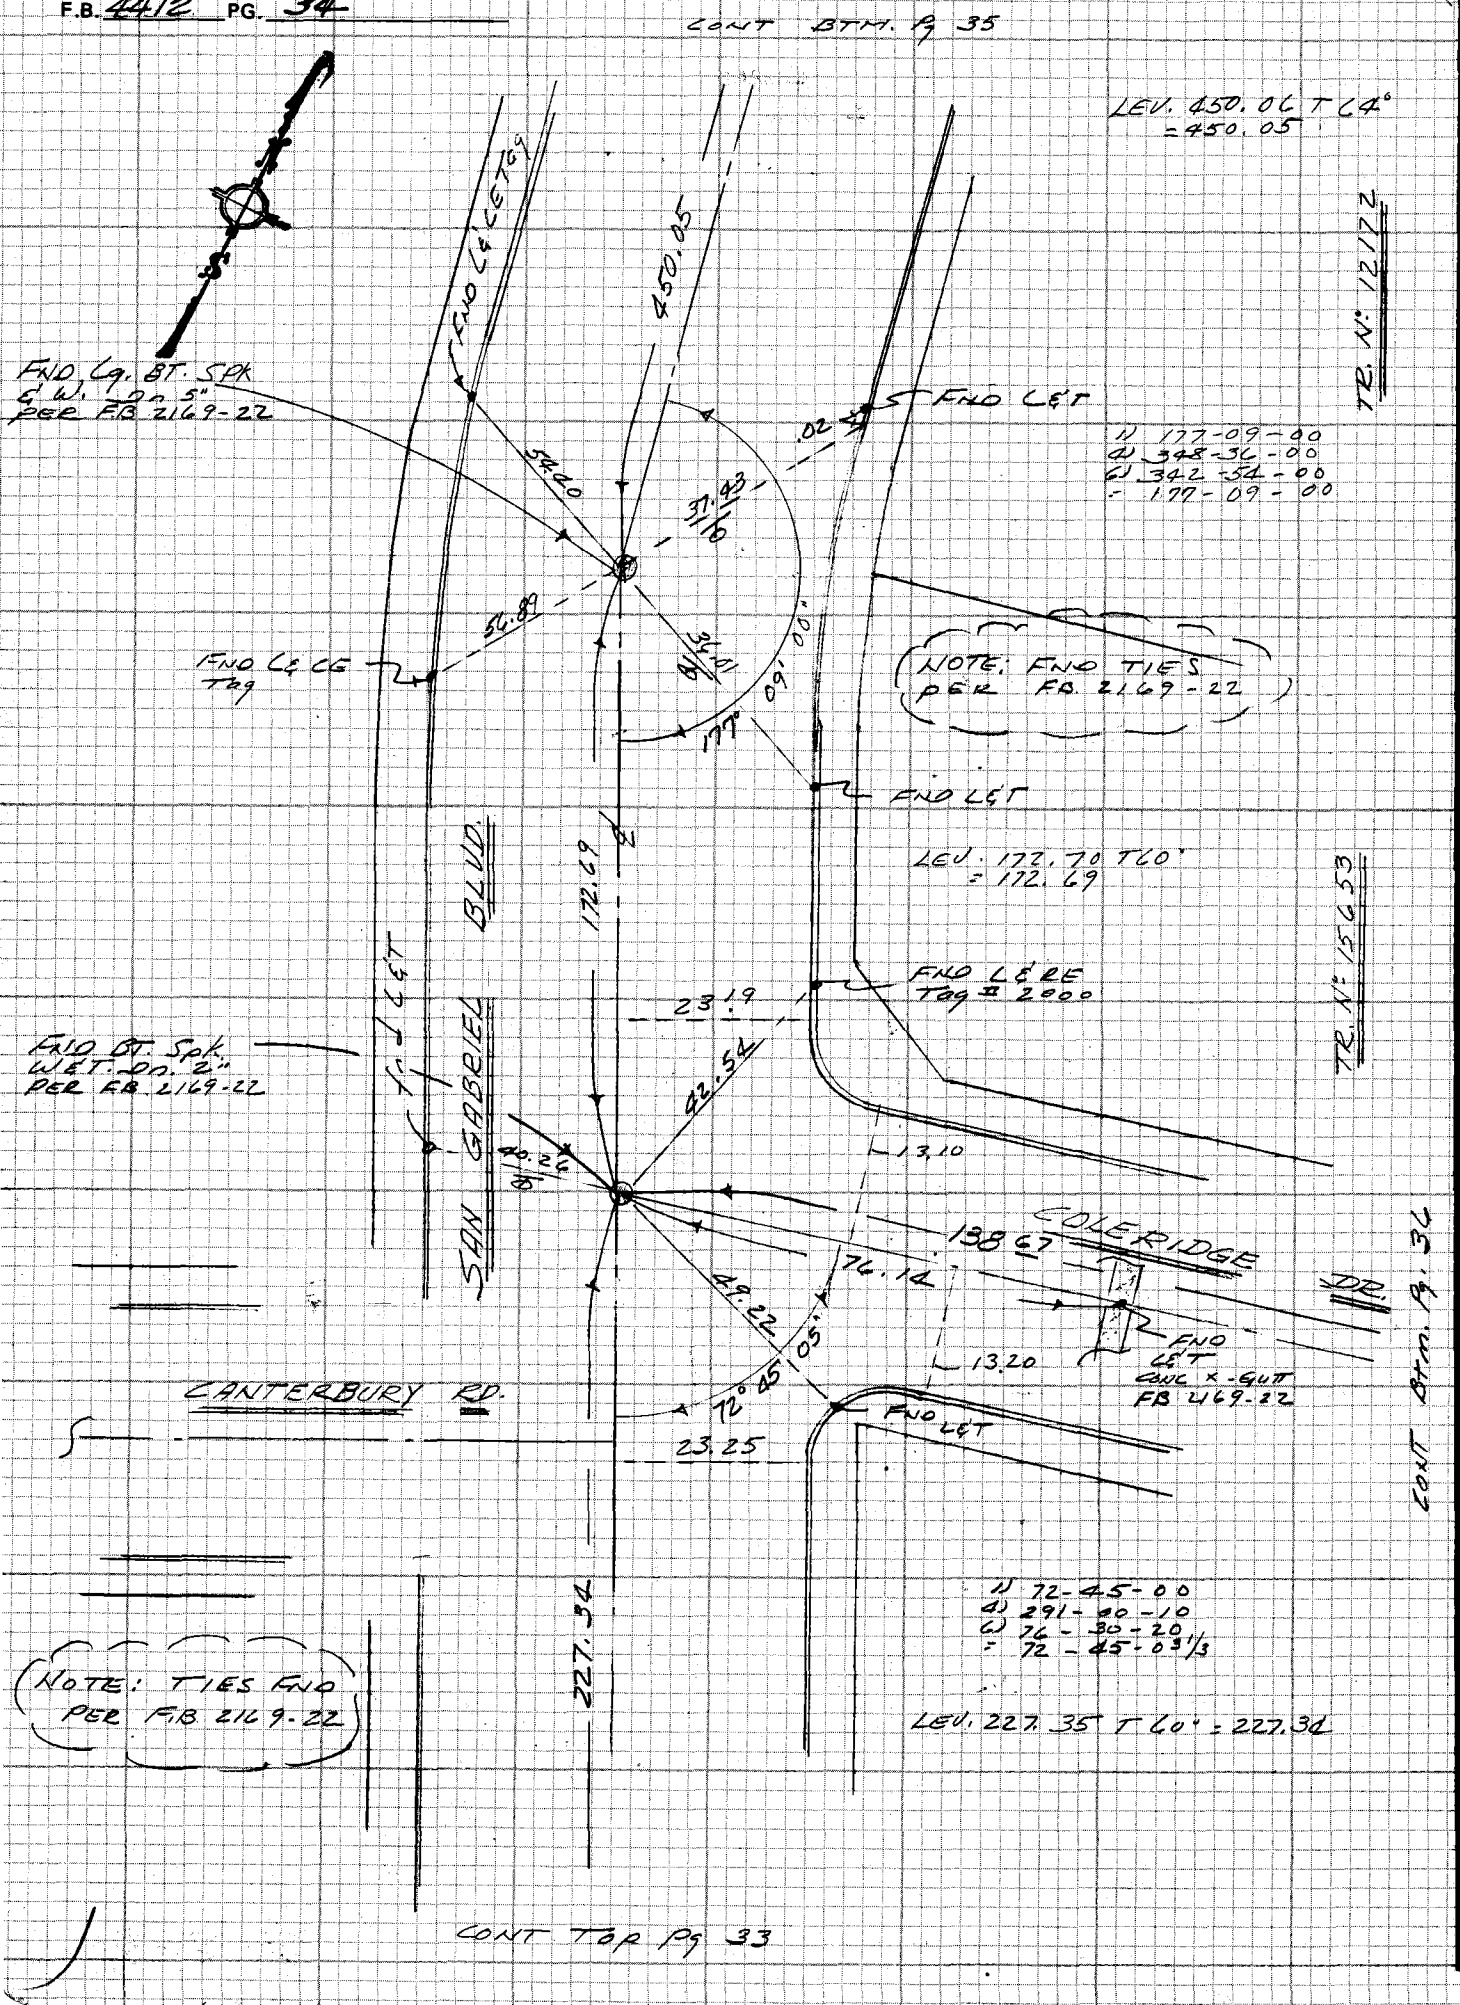


CE 310
76F3095

PLEASE RETURN TO
LOS ANGELES COUNTY ENGINEER
403 LOS ANGELES COUNTY ENGINEERING BLDG.

Do not ex[illegible] notes this side of this line

NOTE: ANY ADDITIONS OR CHANGES ON THIS SHEET MUST BE MADE OR CIRCLED IN RED INK WITH DATE AND NAME OF PERSON MAKING CHANGE

DIV 4

| | |
|---|---|
| Notes Ck'd by | Survey of ROSEMEAD ST ℄ |
| Map No. | JN 0303.00 Tape 0232 Std 68 °F |
| Office Work | Surveyed by E. LANDA |
| Checked | Notes E. LANDA Date 6-76 |
| Date | Indexed D. BAILEY SEP 19 1977 |

F.B. 4412 PG. 35

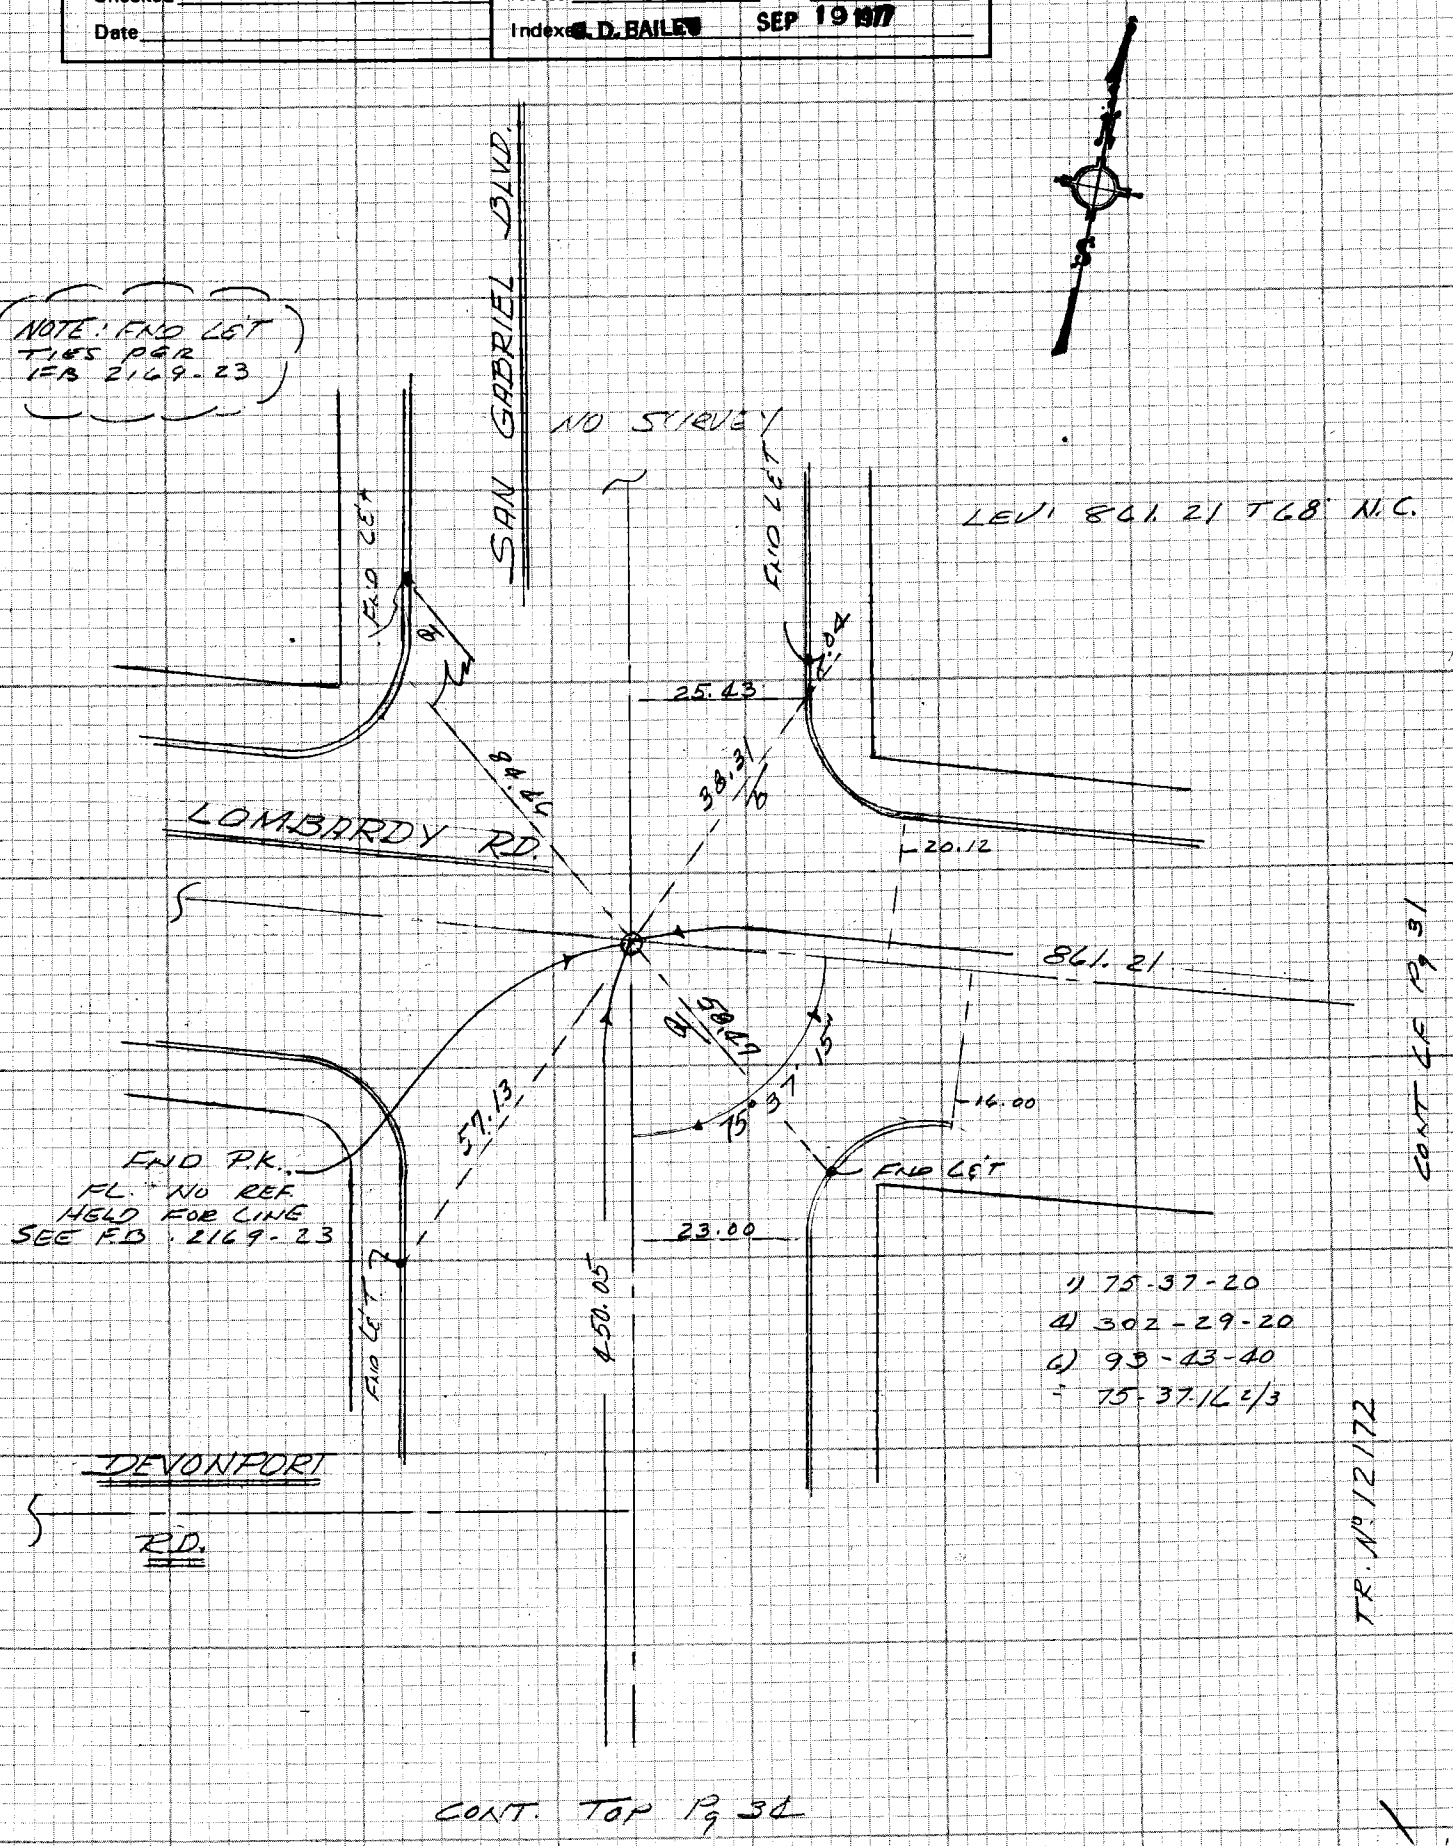


NOTE: ANY ADDITIONS OR CHANGES ON THIS SHEET MUST BE MADE OR CIRCLED IN RED INK WITH DATE AND NAME OF PERSON MAKING CHANGE

Do not extend notes this side of this line

PLEASE RETURN TO
LOS ANGELES COUNTY ENGINEER
403 LOS ANGELES COUNTY ENGINEERING BLDG.

CENTERLINE NOTES
CE 310
76F3095-4/73

F.B. 4412 PG. 36

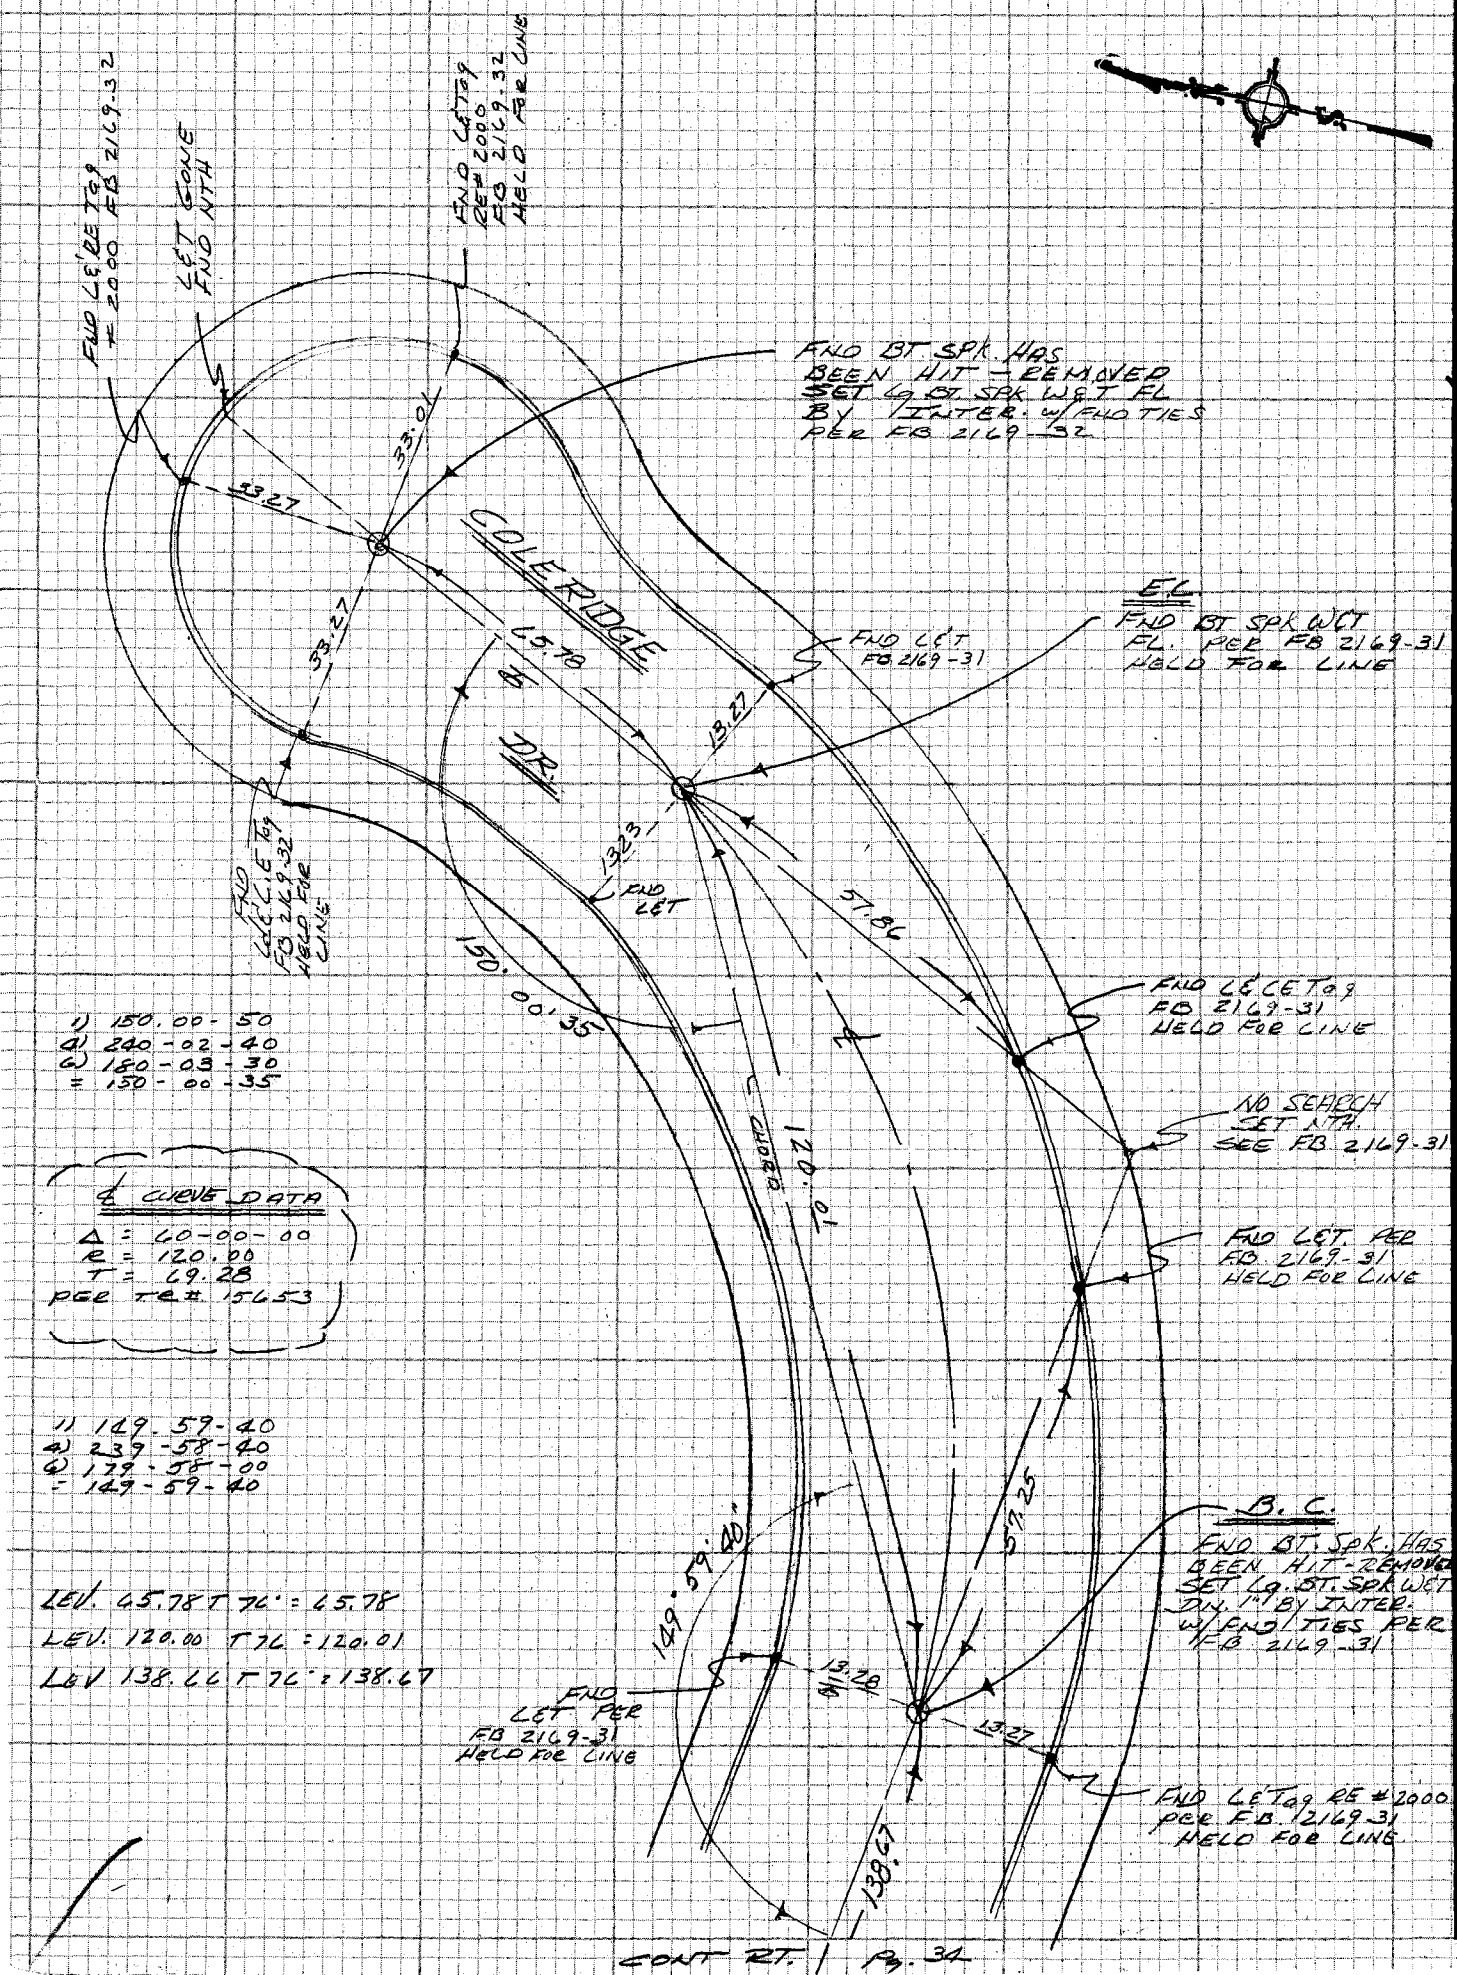


1) 150.00-50
4) 240-02-40
6) 180-03-30
= 150-00-35

℄ CURVE DATA
Δ = 60-00-00
R = 120.00
T = 69.28
PER TR# 15653

1) 149.59-40
4) 239-58-40
6) 179-58-00
= 149-59-40

LEV. 65.78 T 76° = 65.78
LEV. 120.00 T 76 = 120.01
LEV 138.66 T 76° = 138.67

CONT RT. Pg. 34

CE 310
76F3095-4 73
PLEASE RETURN TO
LOS ANGELES COUNTY ENGINEER
403 LOS ANGELES COUNTY ENGINEERING BLDG.
Do not ex[illegible] notes this side of this line
NOTE: ANY ADDITIONS OR CHANGES ON THIS SHEET MUST BE MADE OR CIRCLED IN RED INK WITH DATE AND NAME OF PERSON MAKING CHANGE

WS 44 B-3

DIV. 4

| | |
|---|---|
| Notes Ck'd by | Survey of ROSEMEAD ST ℄ F.B. 4412 PG. 37 |
| Map No. | JN 0303.00 Tape 02.32 Std 68 °F |
| Office Work | Surveyed by E. LANDA |
| Checked | Notes E. LANDA Date 6-76 |
| Date | Indexed G. D. BAILEY SEP 19 1977 |

NOTE: ANY ADDITIONS OR CHANGES ON THIS SHEET MUST BE MADE OR CIRCLED IN RED INK WITH DATE AND NAME OF PERSON MAKING CHANGE

LA-514 C-3

PLEASE RETURN TO
LOS ANGELES COUNTY ENGINEER
403 LOS ANGELES COUNTY ENGINEERING BLDG.

CENTERLINE NOTES
CE 310
76F3095-4/73

Do not extend notes beyond this line

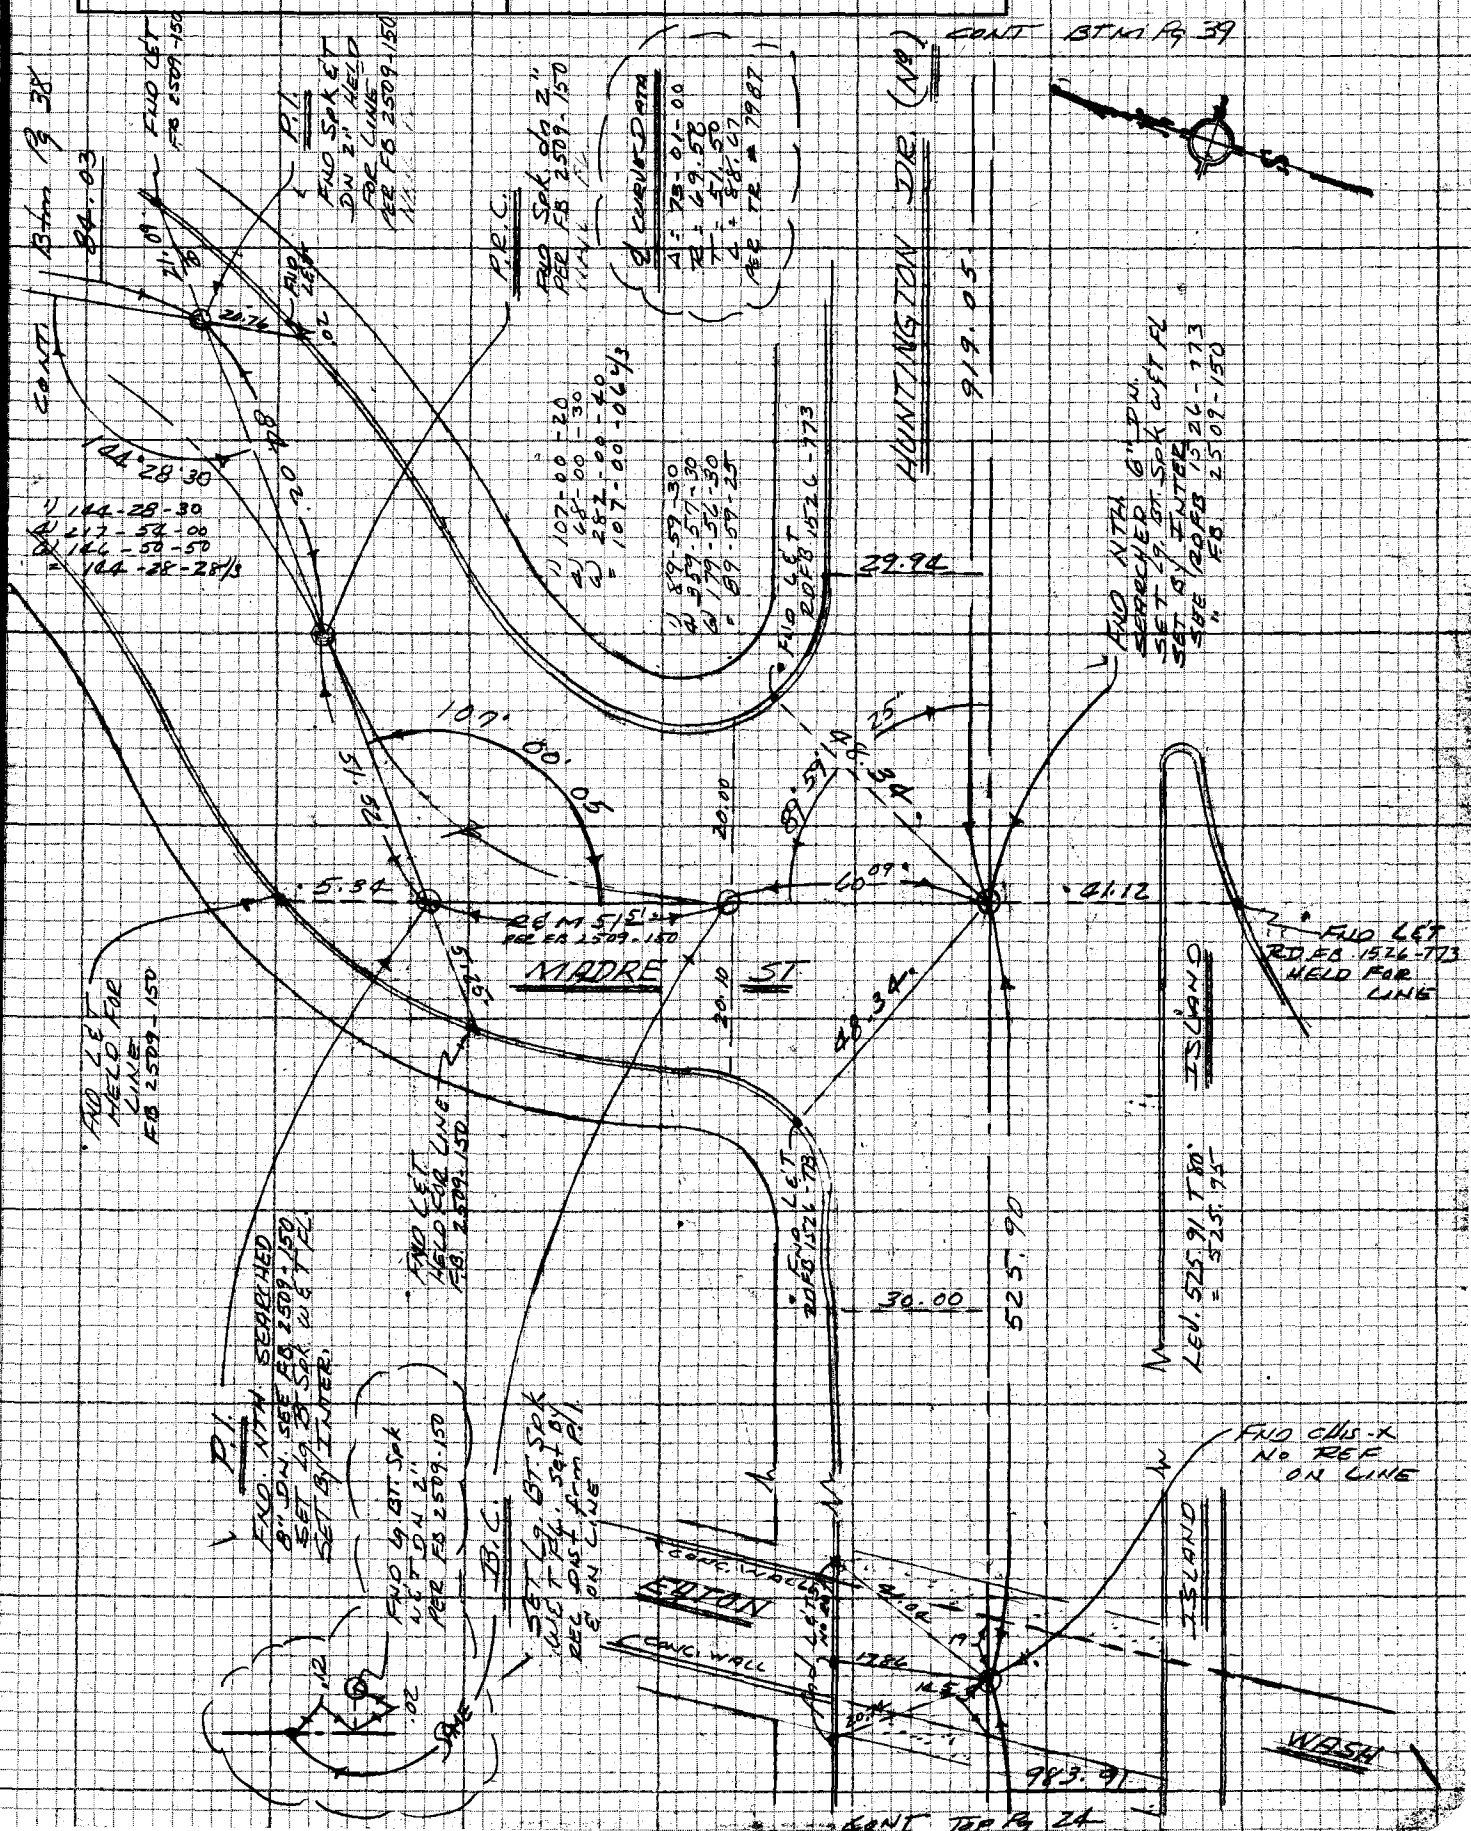

F.B. 4412 PG. 38

CONT. Btm Rt. Pg. 41

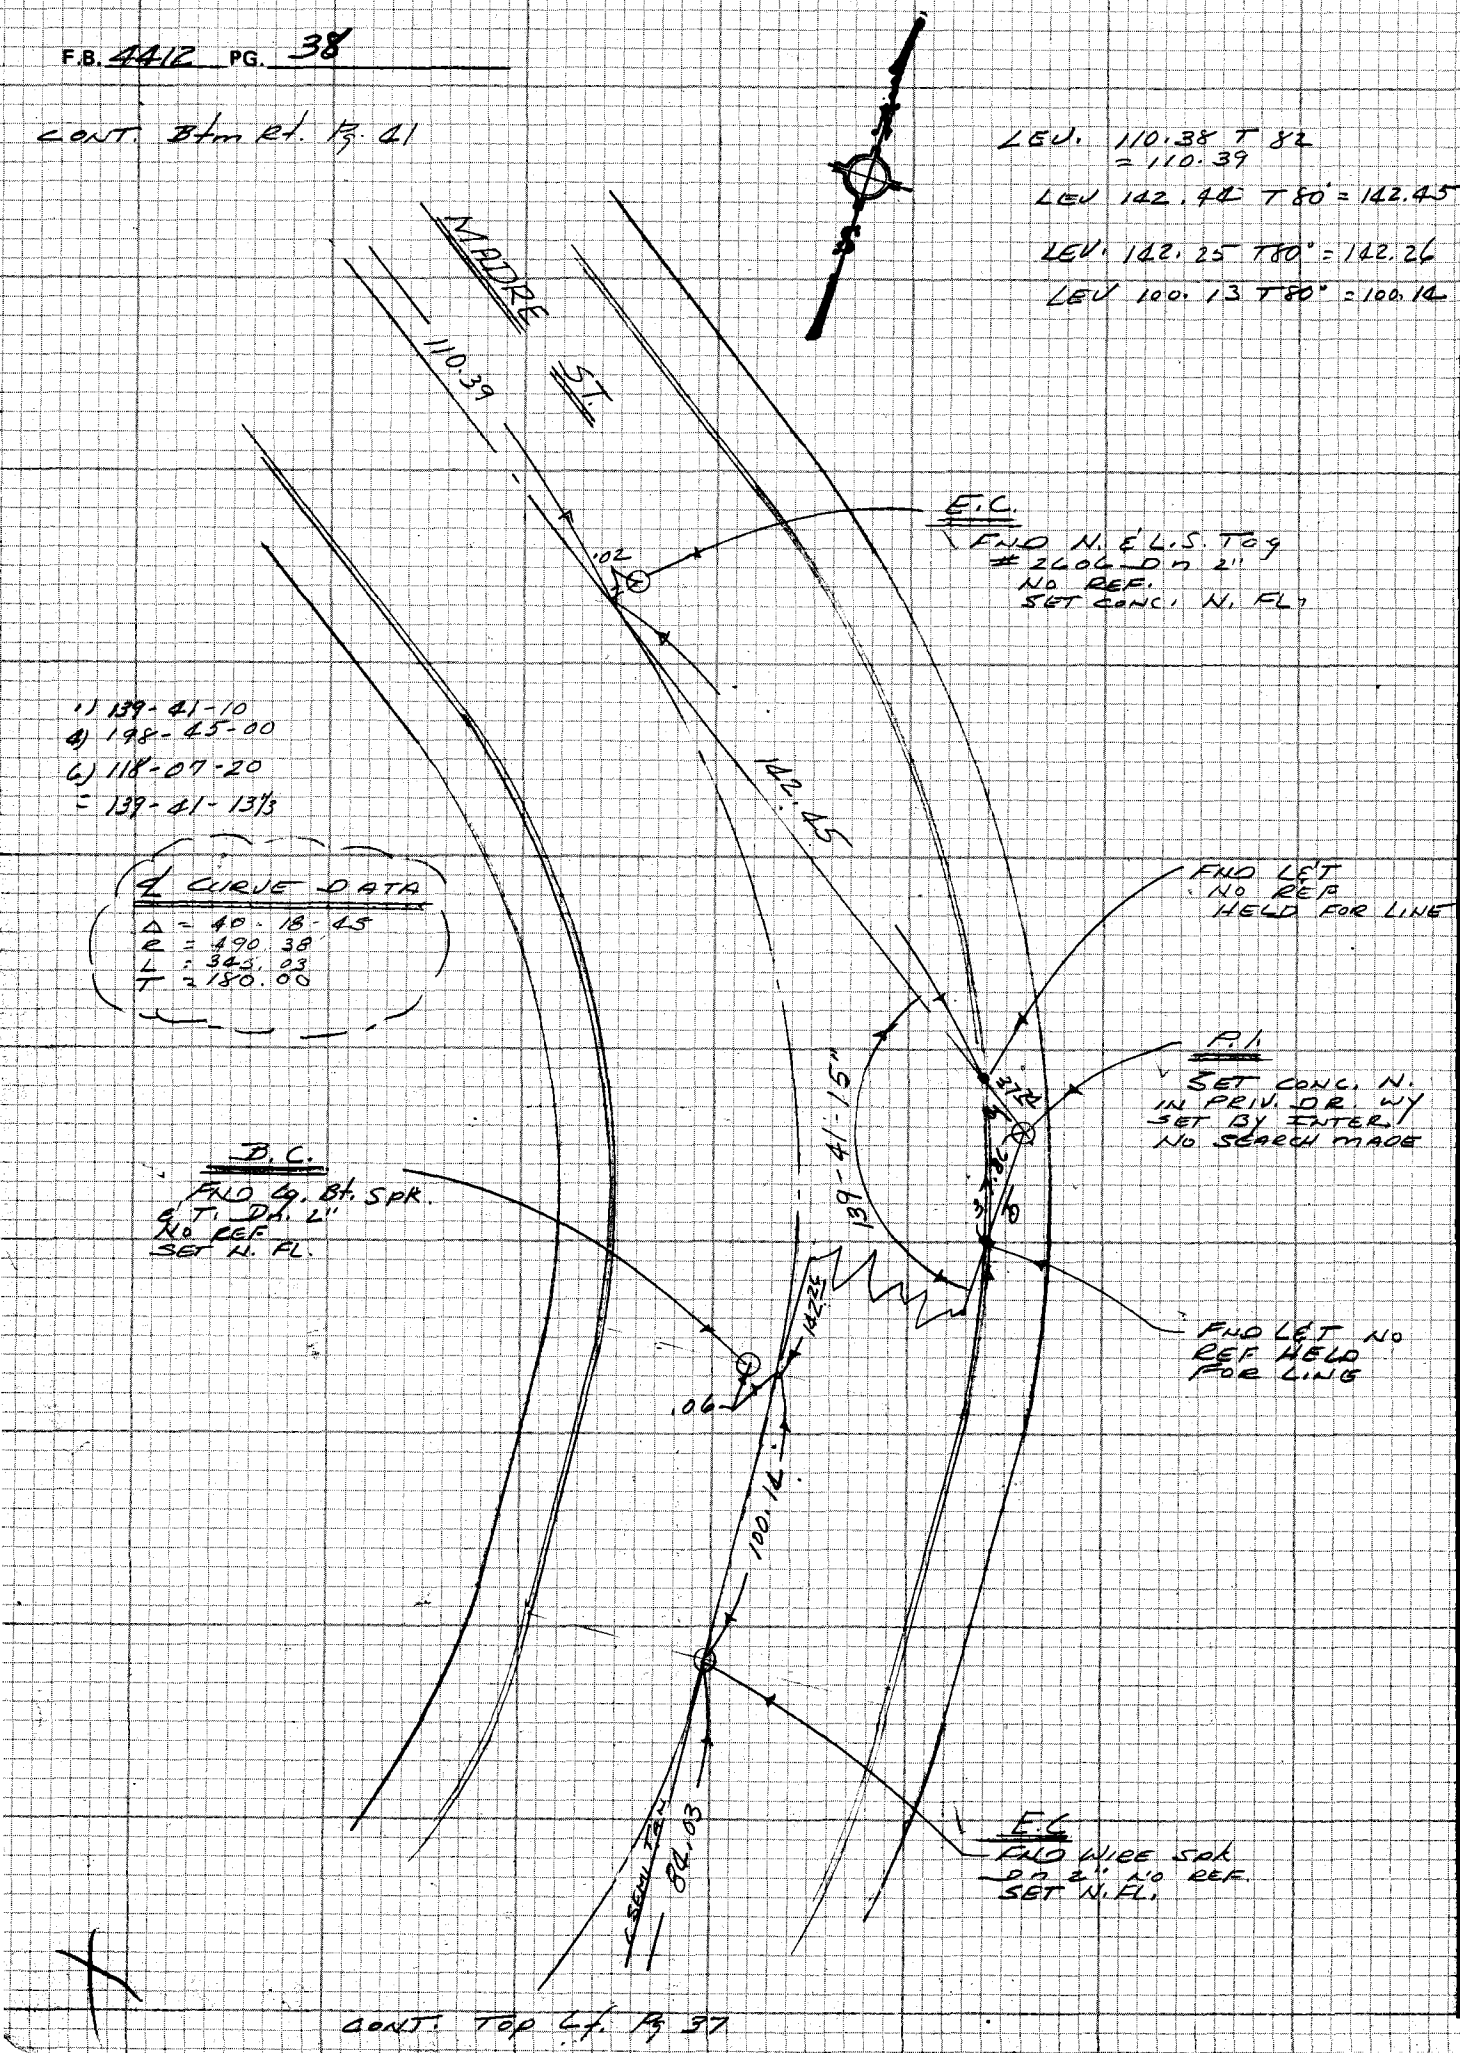


CONT. Top Lf. Pg 37

CE 310
76F3095

PLEASE RETURN TO
LOS ANGELES COUNTY ENGINEER
403 LOS ANGELES COUNTY ENGINEERING BLDG.

Do not ex[illegible] notes this side of this line

NOTE: ANY ADDITIONS OR CHANGES ON THIS SHEET MUST BE MADE OR CIRCLED IN RED INK WITH DATE AND NAME OF PERSON MAKING CHANGE

D.U.1

| | |
|---|---|
| Notes Ck'd by | Survey of ROSEMEAD ST ℄ |
| Map No. | JN 0303.00 Tape 0232 Std 68 °F |
| Office Work | Surveyed by E. LANDA |
| Checked | Notes E. LANDA Date 6-76 |
| Date | Indexed G. D. BAILEY SEP 19 1977 |

F.B. 4412 PG 39

NOTE: ANY ADDITIONS OR CHANGES ON THIS SHEET MUST BE MADE OR CIRCLED IN RED INK WITH DATE AND NAME OF PERSON MAKING CHANGE

Do not extend notes across this line

PLEASE RETURN TO
LOS ANGELES COUNTY ENGINEER
403 LOS ANGELES COUNTY ENGINEERING BLDG.

CENTERLINE NOTES
CE 310
76F3096-4/73

CONT. FROM Pg. 40

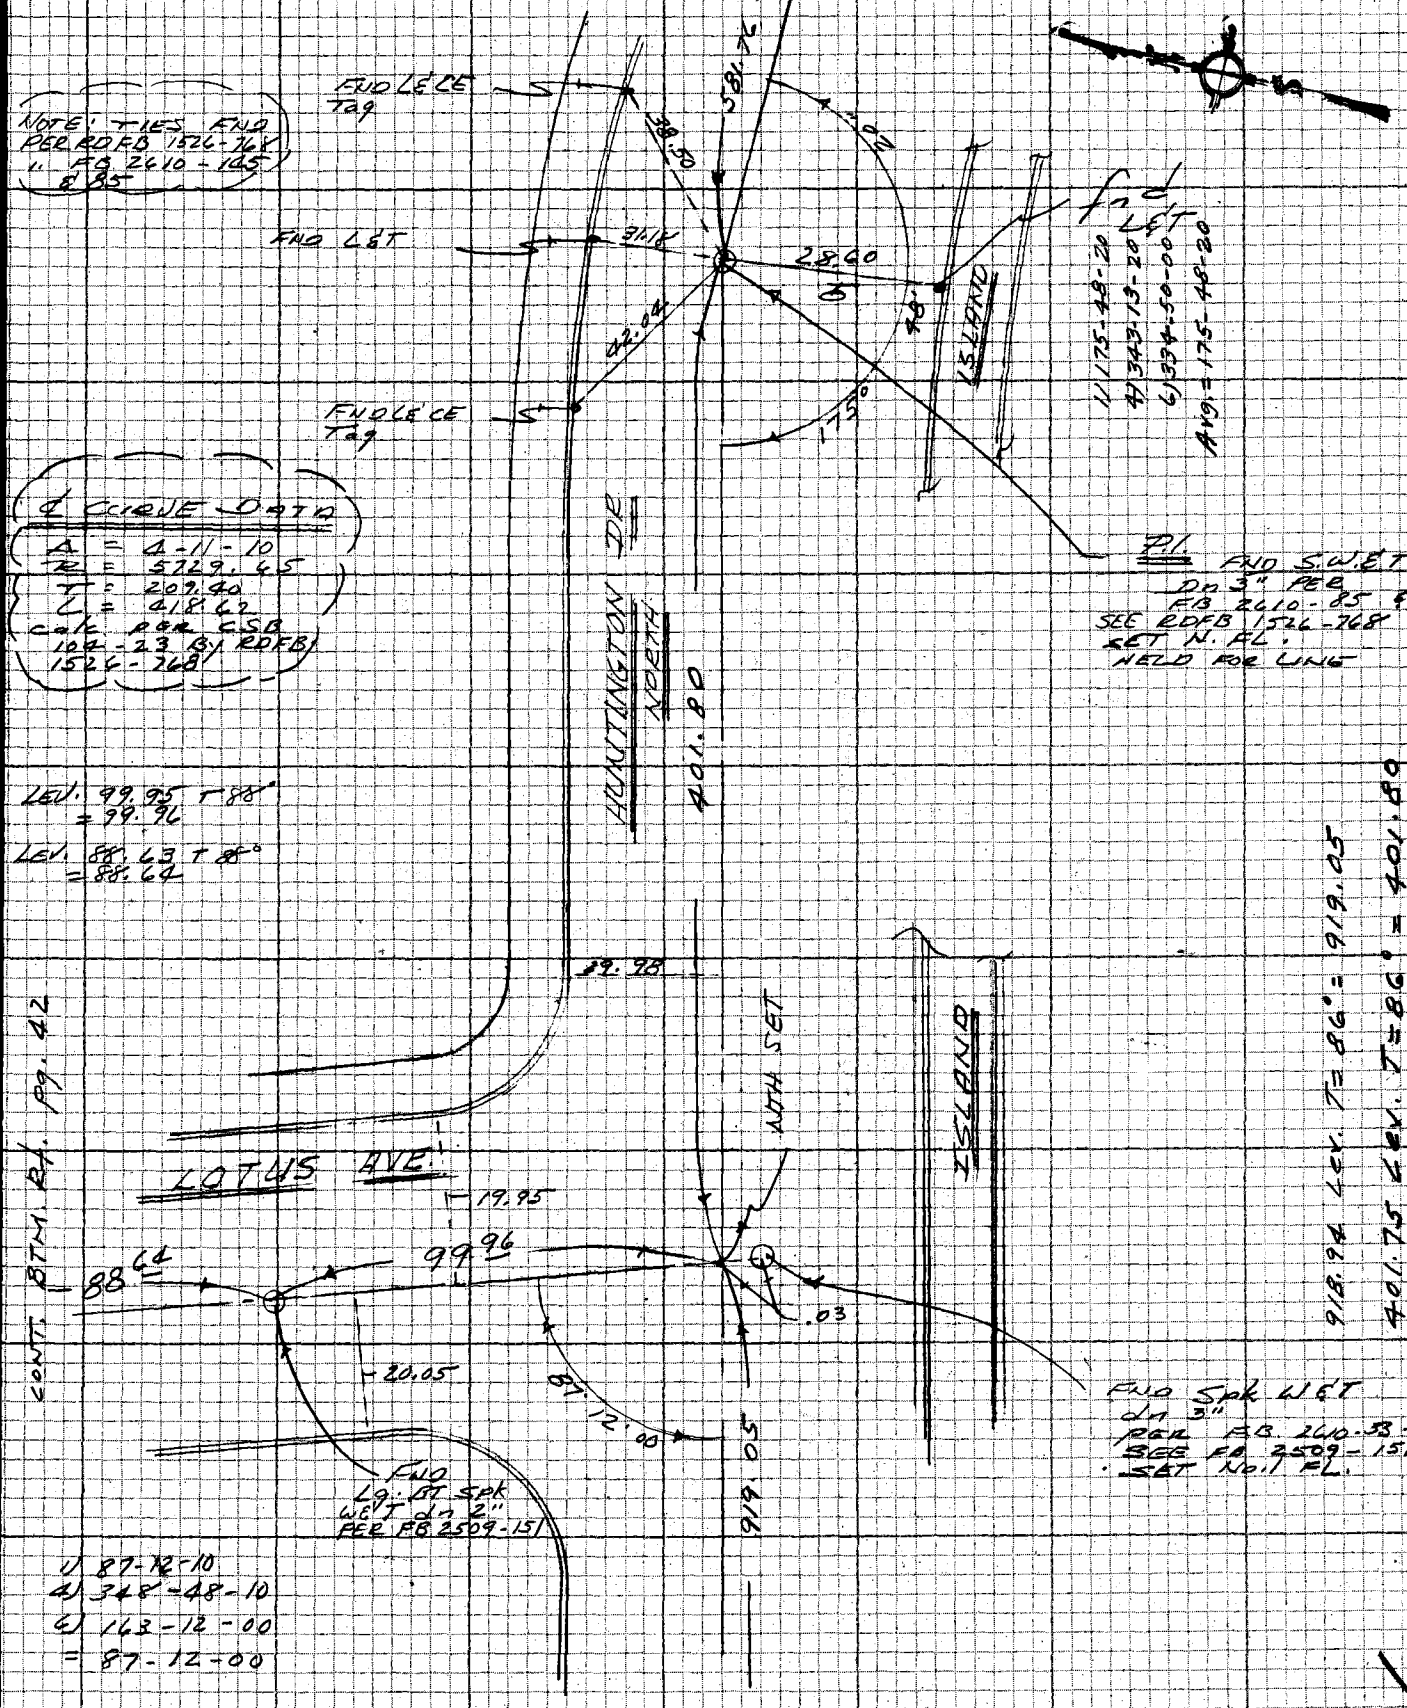


CONT. TOP Pg. 37

F.B. 4412 PG. 40

Cont' Bk. pg 59

1) 19-14-00
4) 16-56-00
6) 205-24-20
= 94-14-03 1/3

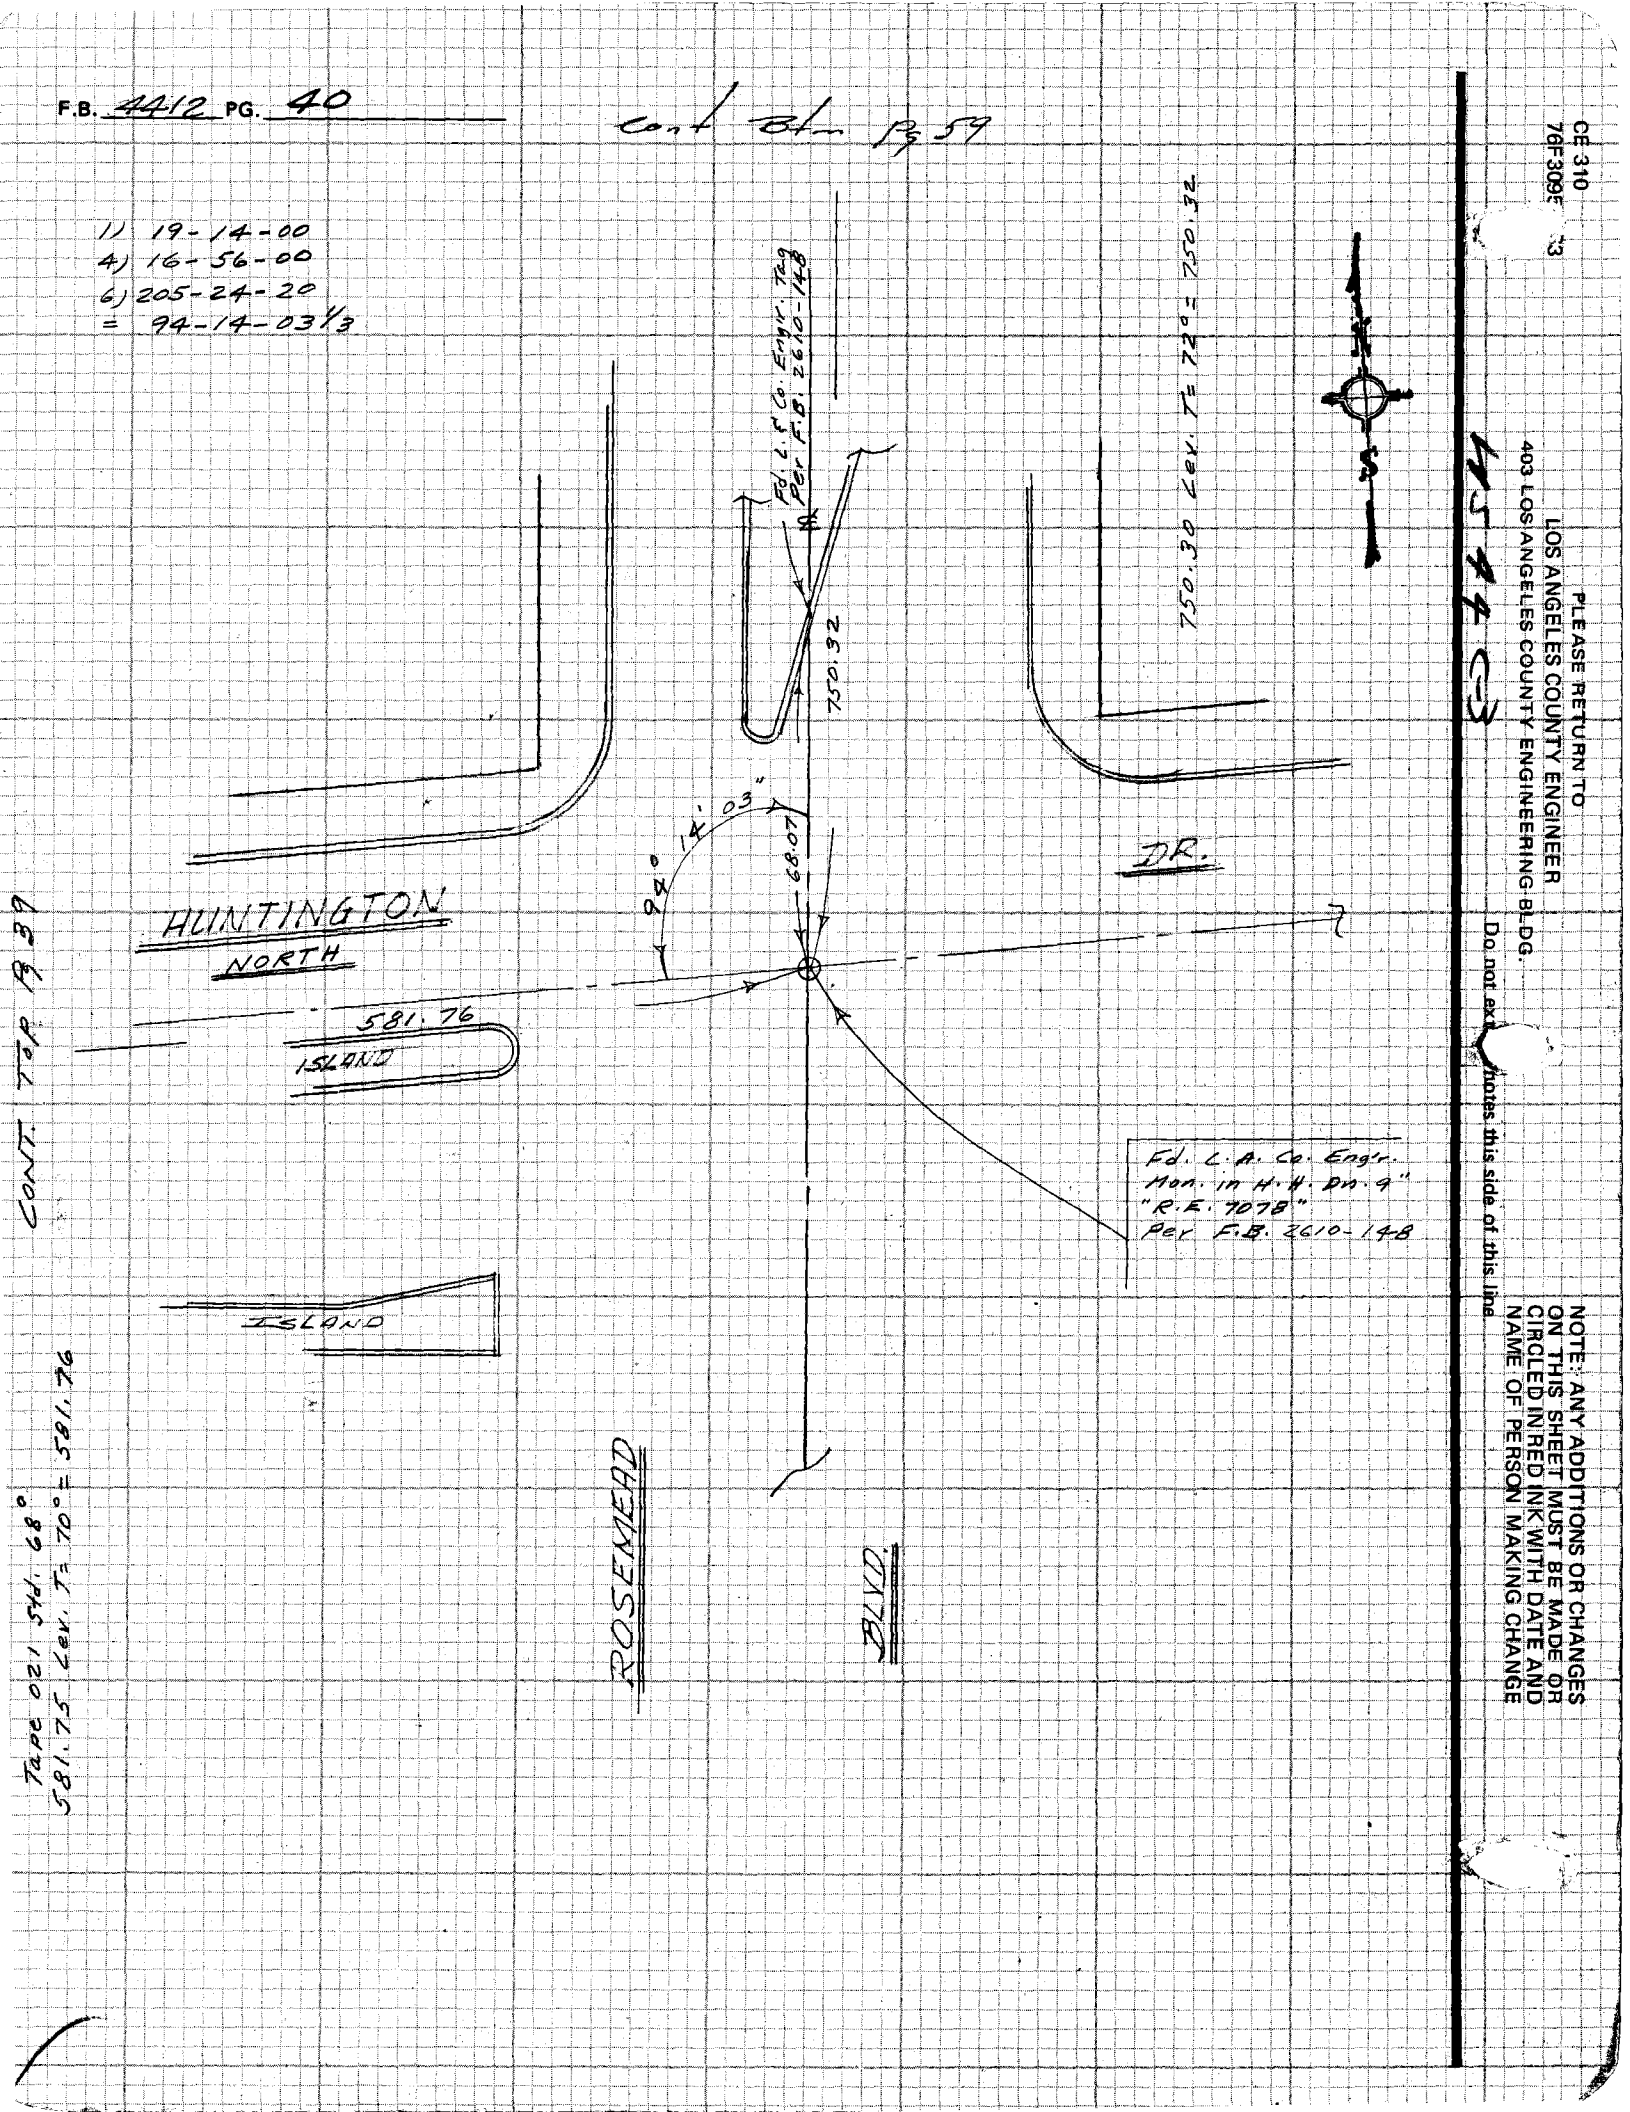


CONT. Top pg 59

Tape 021 Std. 68°
581.75 Cor. T= 70° = 581.76

CE 310
78F 309E 13

PLEASE RETURN TO
LOS ANGELES COUNTY ENGINEER
403 LOS ANGELES COUNTY ENGINEERING BLDG.

Do not ex... notes this side of this line

NOTE: ANY ADDITIONS OR CHANGES ON THIS SHEET MUST BE MADE OR CIRCLED IN RED INK WITH DATE AND NAME OF PERSON MAKING CHANGE

DIV. 4

| | |
|---|---|
| Notes Ck'd by | Survey of ROSEMEAD ST ℄ |
| Map No. | JN 0303.00 Tape 0232 Std 68 °F |
| Office Work | Surveyed by E. LANDA |
| Checked | Notes R. SIEMANN Date 6-76 |
| Date | Indexed G. D. BAILEY SEP 19 1977 |

F.B. 4412 PG. 41

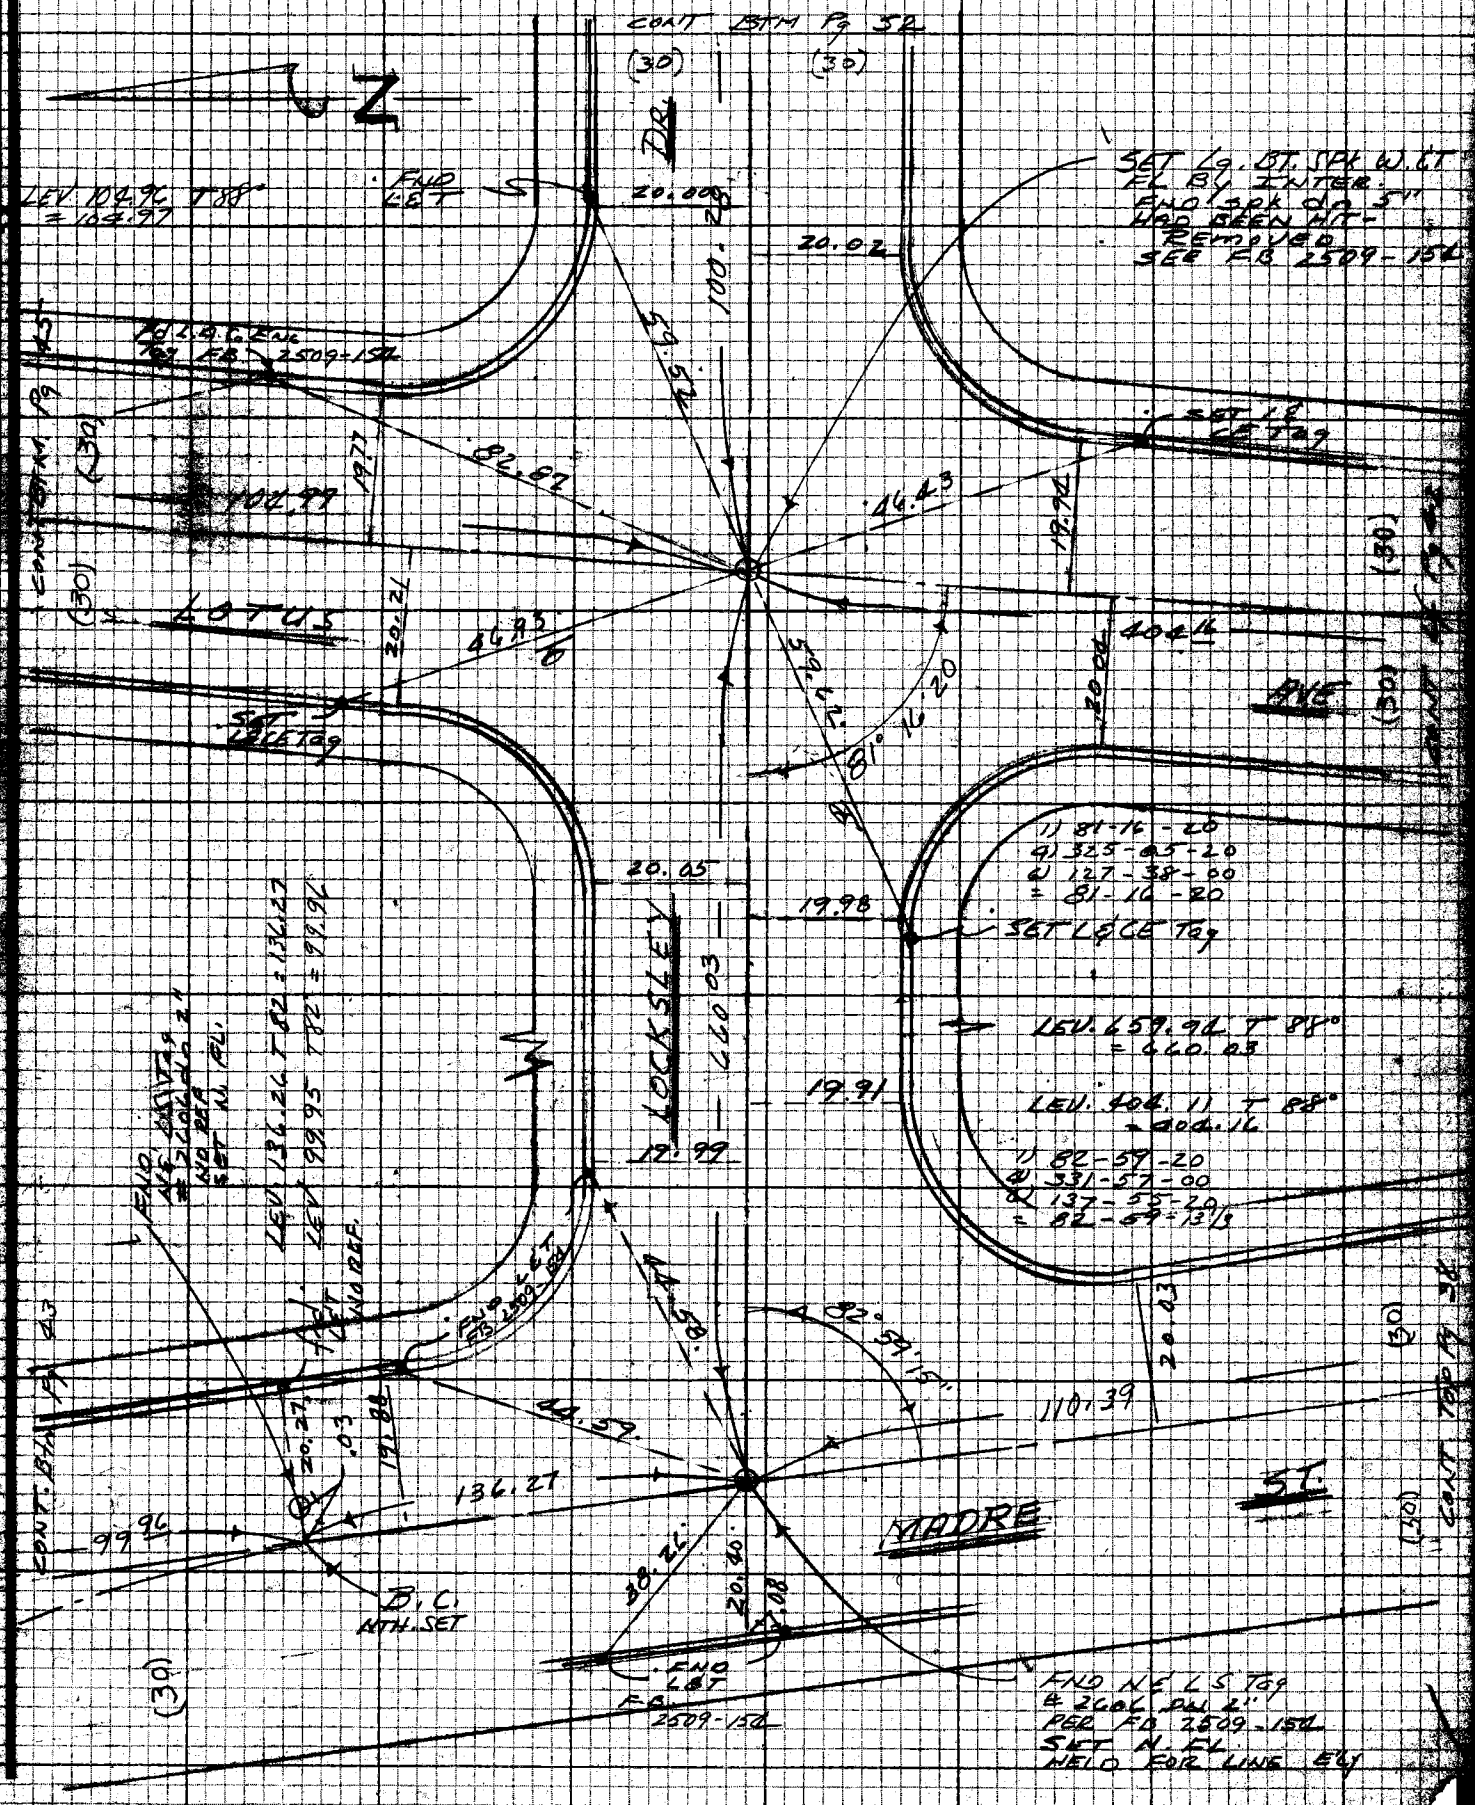


NOTE: ANY ADDITIONS OR CHANGES ON THIS SHEET MUST BE MADE OR CHECKED IN RED INK WITH DATE AND NAME OF PERSON MAKING CHANGE

Do not extend [illegible] side of the line

PLEASE RETURN TO LOS ANGELES COUNTY ENGINEER 403 LOS ANGELES COUNTY ENGINEERING BLDG.

CENTERLINE NOTES CE 310 76F3095-4/73

F.B. 4412 PG. 42

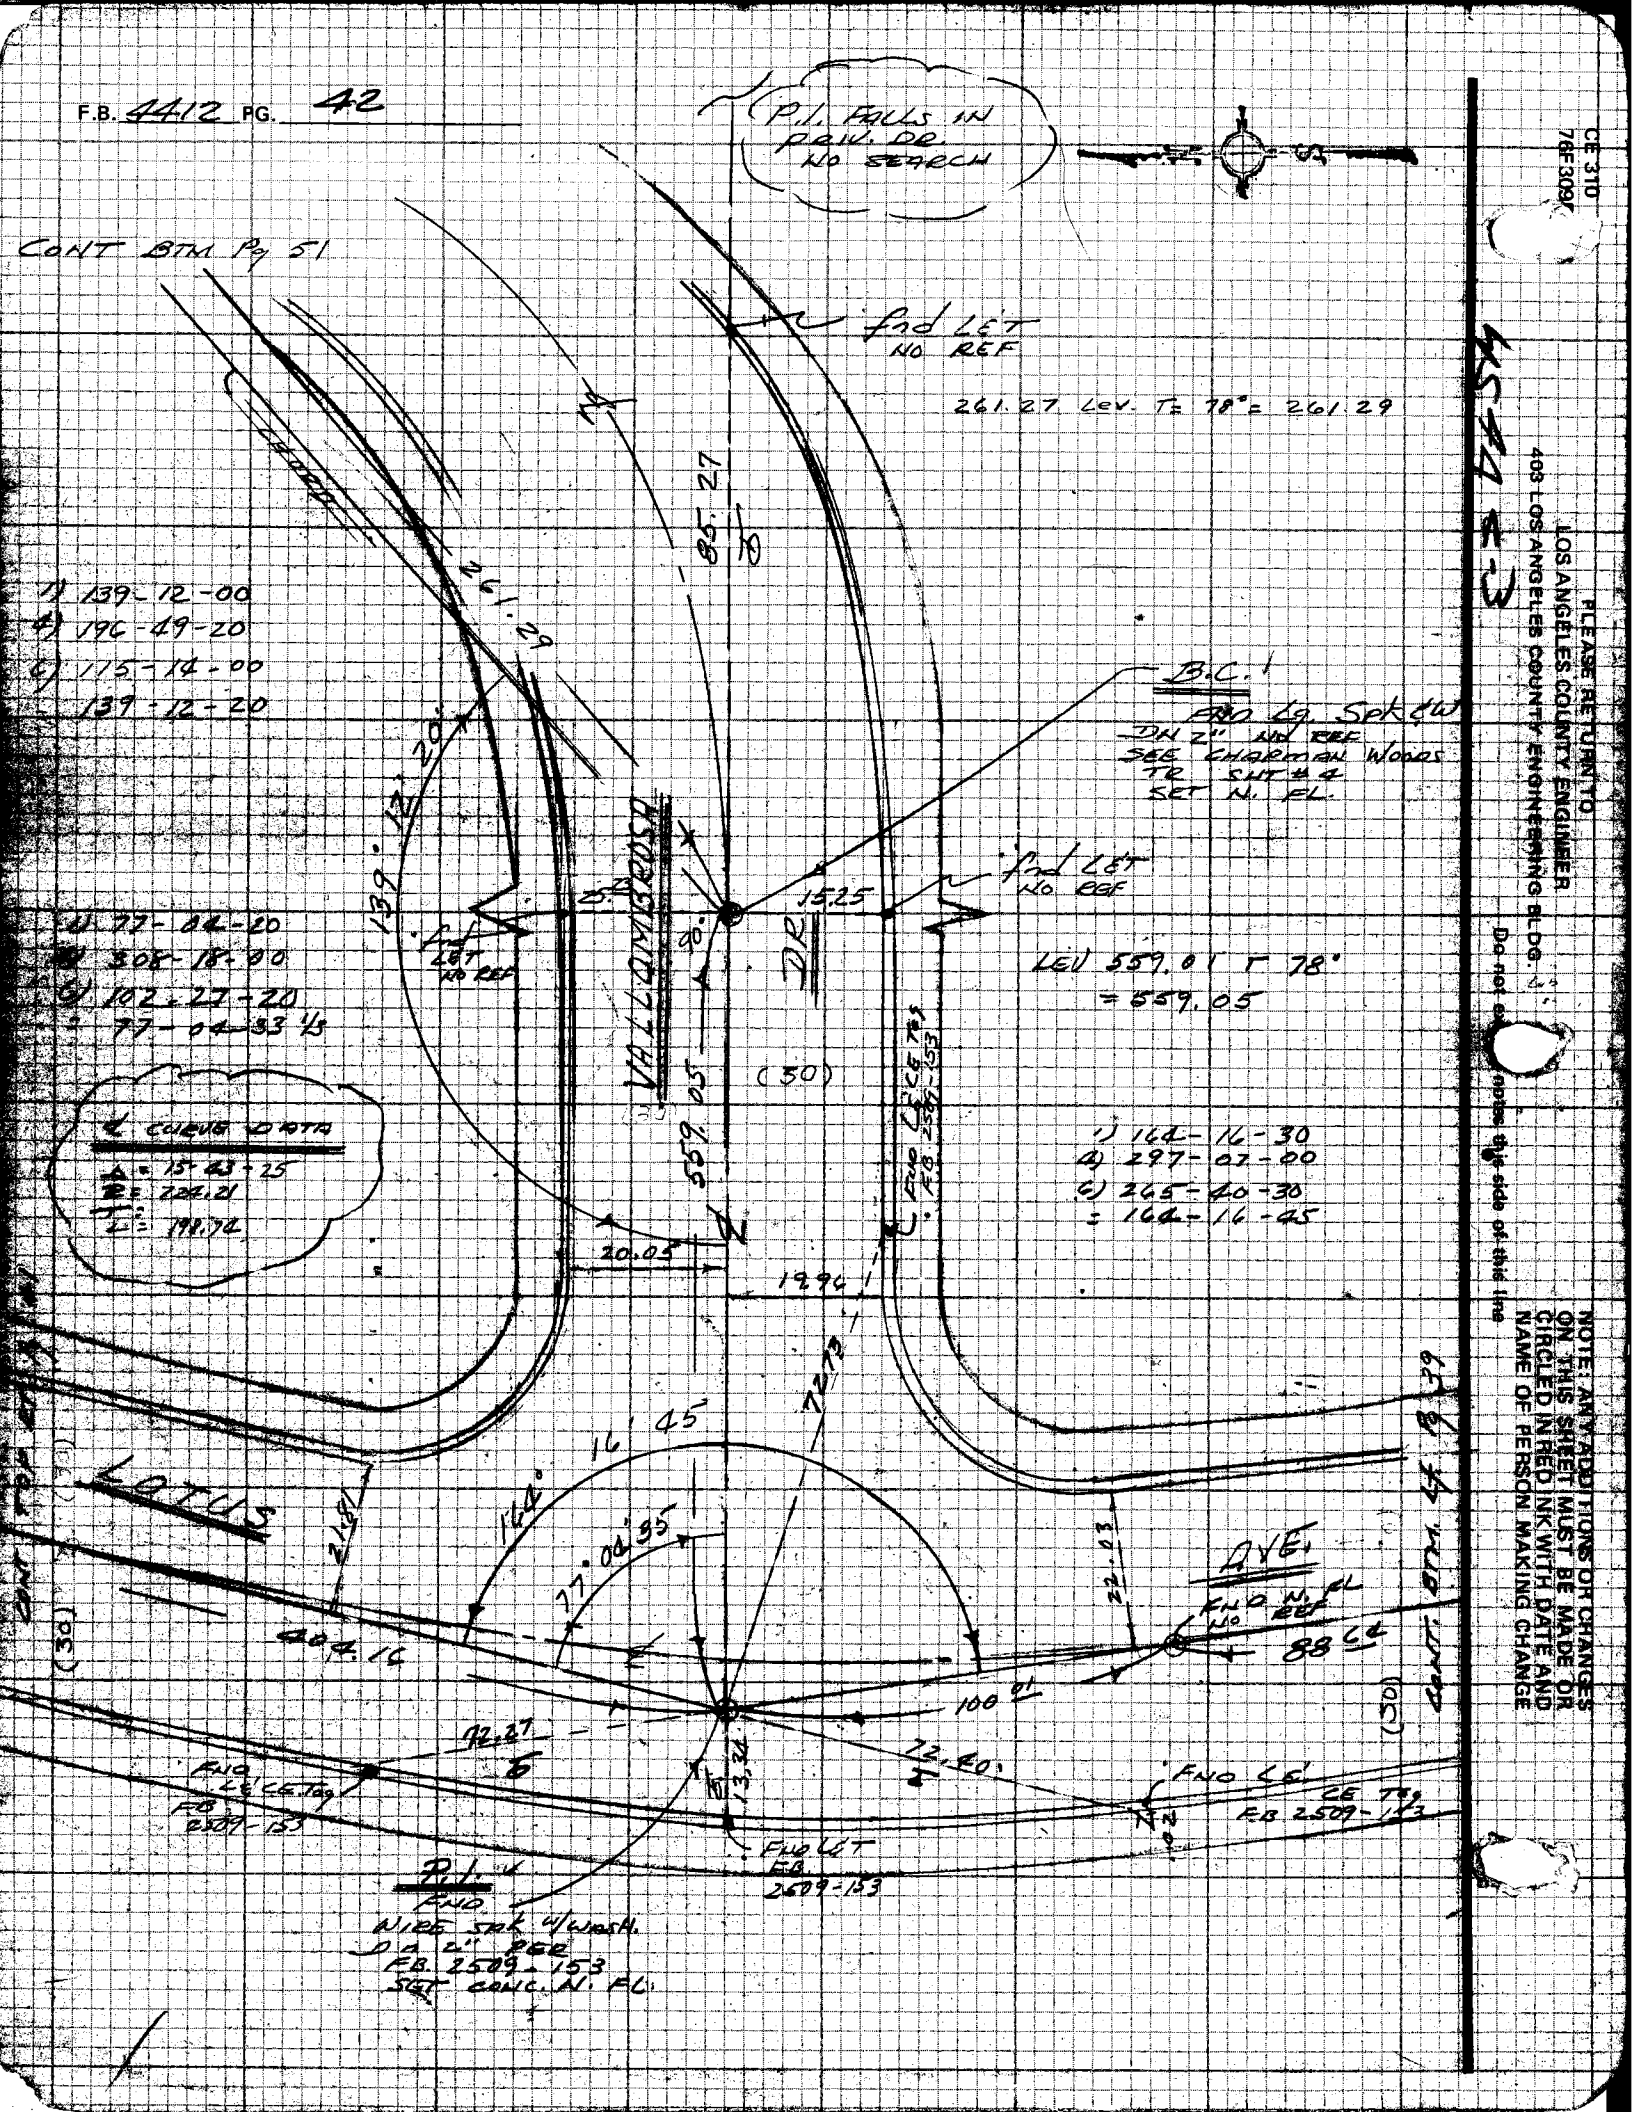


CE 310
76F 309F

PLEASE RETURN TO
LOS ANGELES COUNTY ENGINEER
403 LOS ANGELES COUNTY ENGINEERING BLDG.

Do not

NOTE: ANY ADDITIONS OR CHANGES ON THIS SHEET MUST BE MADE IN RED INK WITH DATE AND NAME OF PERSON MAKING CHANGE

notes this side of this line

DIV. 4

| | |
|---|---|
| Notes Ck'd by | Survey of ROSEMEAD ST ℄ |
| Map No. | JN 030300 Tape 0232 Std 68 °F |
| Office Work | Surveyed by E. LANDA |
| Checked | Notes E. LANDA Date 7-76 |
| Date | Indexed G. D. BAILEY SEP 19 1977 |

F.B. 4412 PG. 43

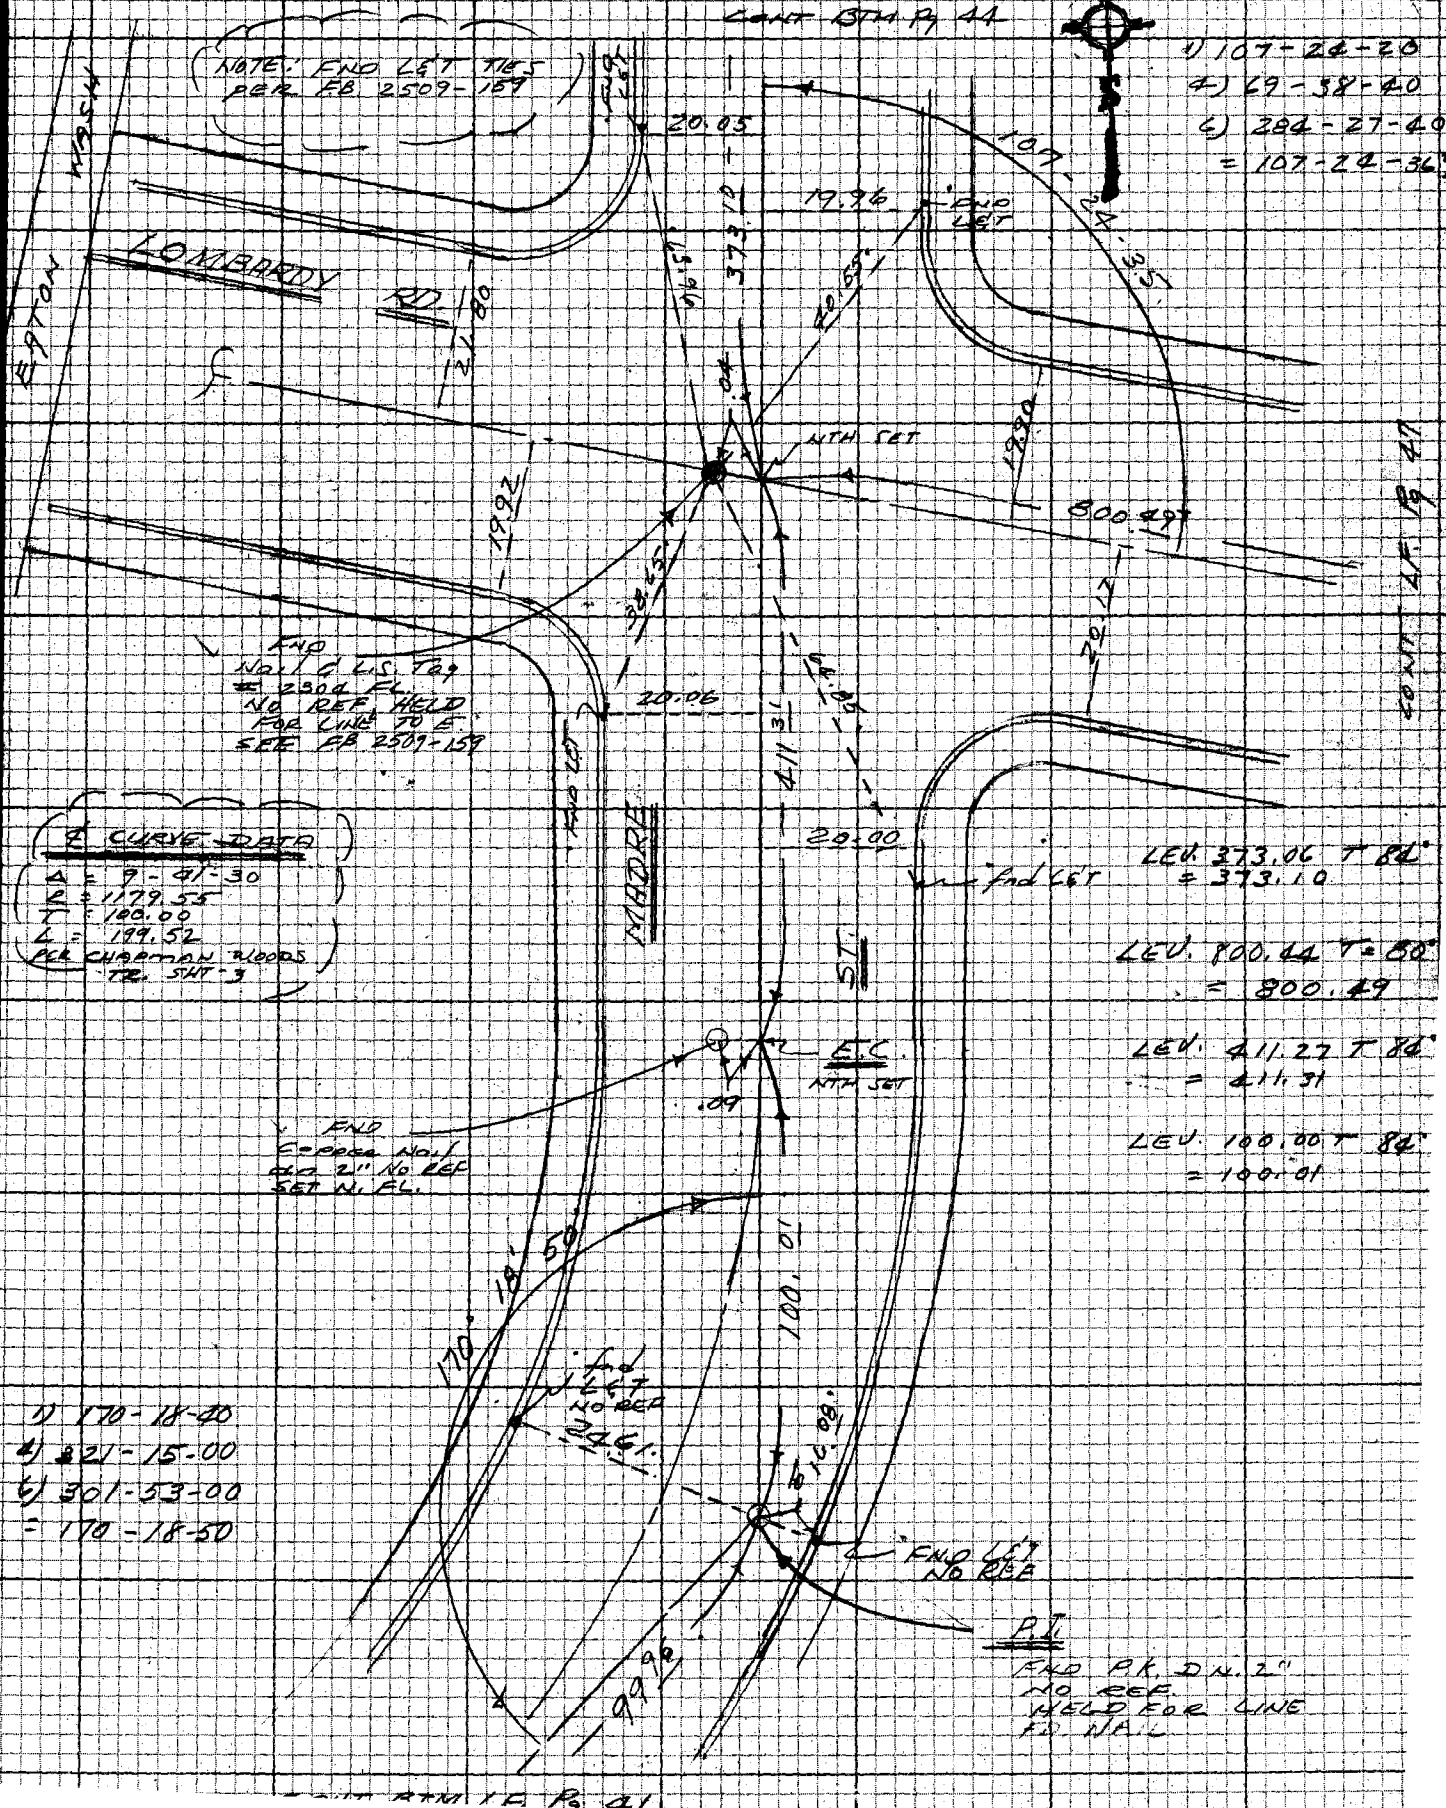


CONT BTM LF Pg 41

NOTE: ANY ADDITIONS OR CHANGES ON THIS SHEET MUST BE MADE OR CIRCLED IN RED INK WITH DATE AND NAME OF PERSON MAKING CHANGE

Do not extend notes to this side of this line

PLEASE RETURN TO
LOS ANGELES COUNTY ENGINEER
403 LOS ANGELES COUNTY ENGINEERING BLDG.

CENTERLINE NOTES
CE 310
76F3095-4/73

K.K.

F.B. 4412 PG. 44

CONT. BTM. Pg 67

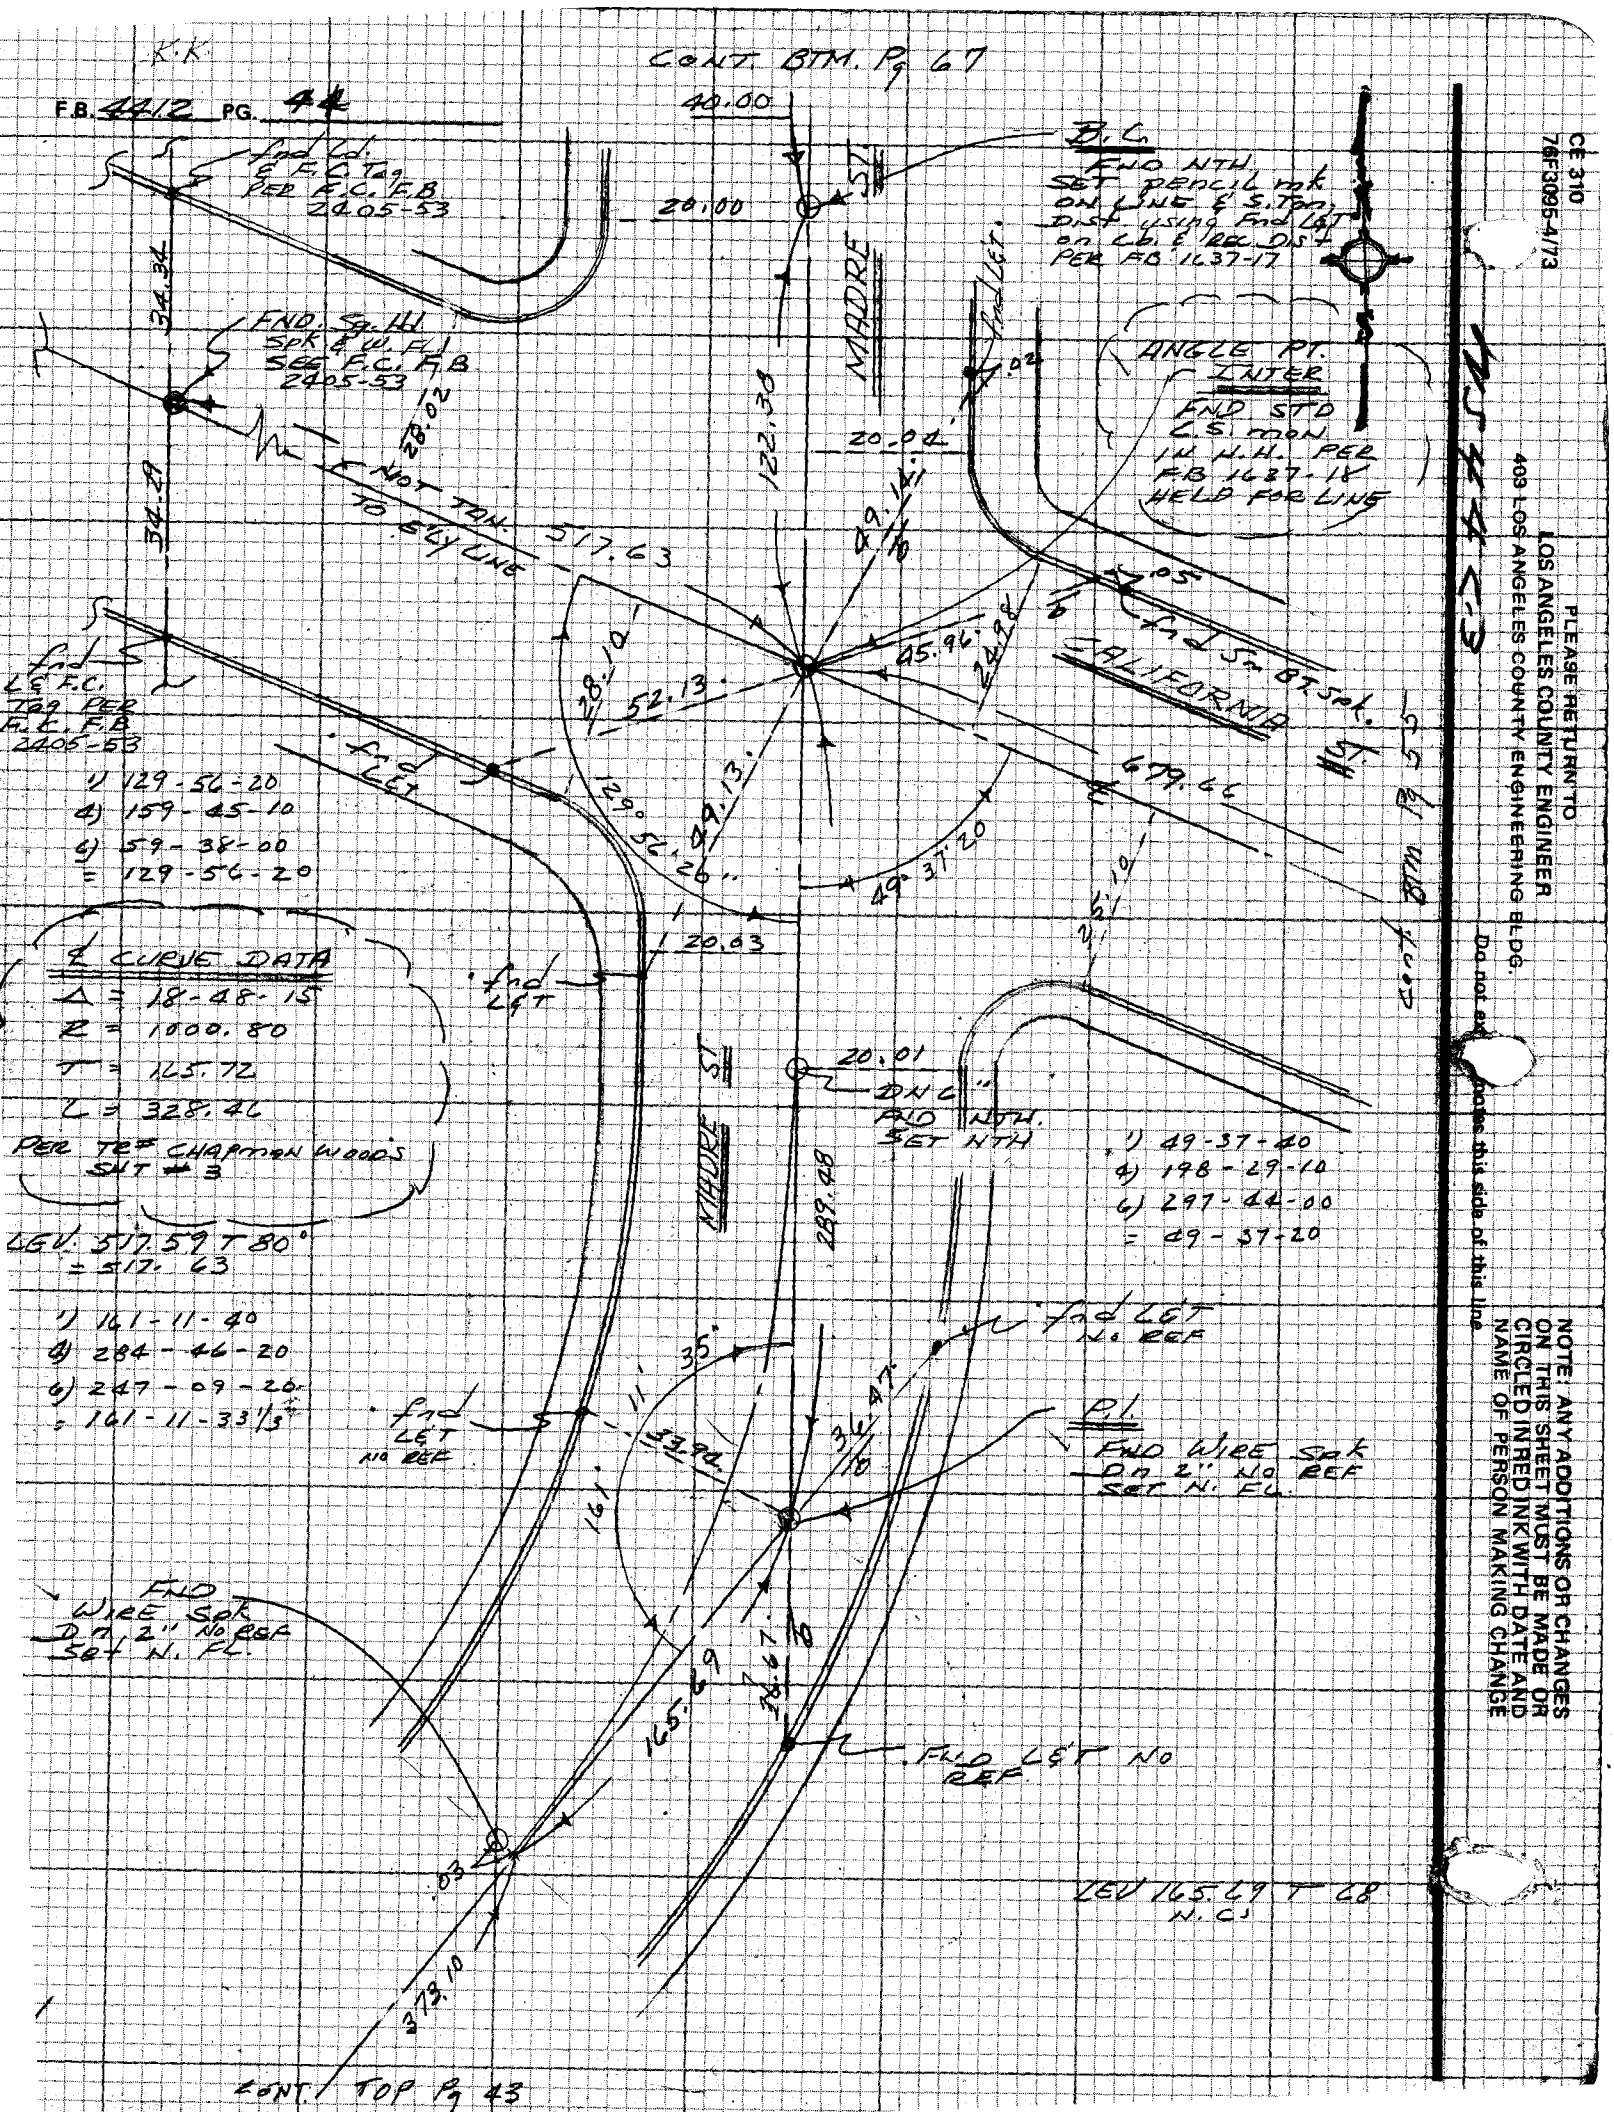


CE 310
76F3095-4/73

PLEASE RETURN TO
LOS ANGELES COUNTY ENGINEER
409 LOS ANGELES COUNTY ENGINEERING BLDG.

Do not write this side of this line

NOTE! ANY ADDITIONS OR CHANGES ON THIS SHEET MUST BE MADE OR CIRCLED IN RED INK WITH DATE AND NAME OF PERSON MAKING CHANGE

DIV 4

| | |
|---|---|
| Notes Ck'd by | Survey of ROSEMEAD ST ℄ |
| Map No. | JN 0303.00 Tape 0232 Std 68 °F |
| Office Work | Surveyed by E. LANDA |
| Checked | Notes E. LANDA Date 6-76 |
| Date | Indexed G. D. BAILEY SEP 19 1977 |

F.B. 4412 PG. 45

CONT DTM. Pg 46

98.82 LEV. T = 96° = 98.84

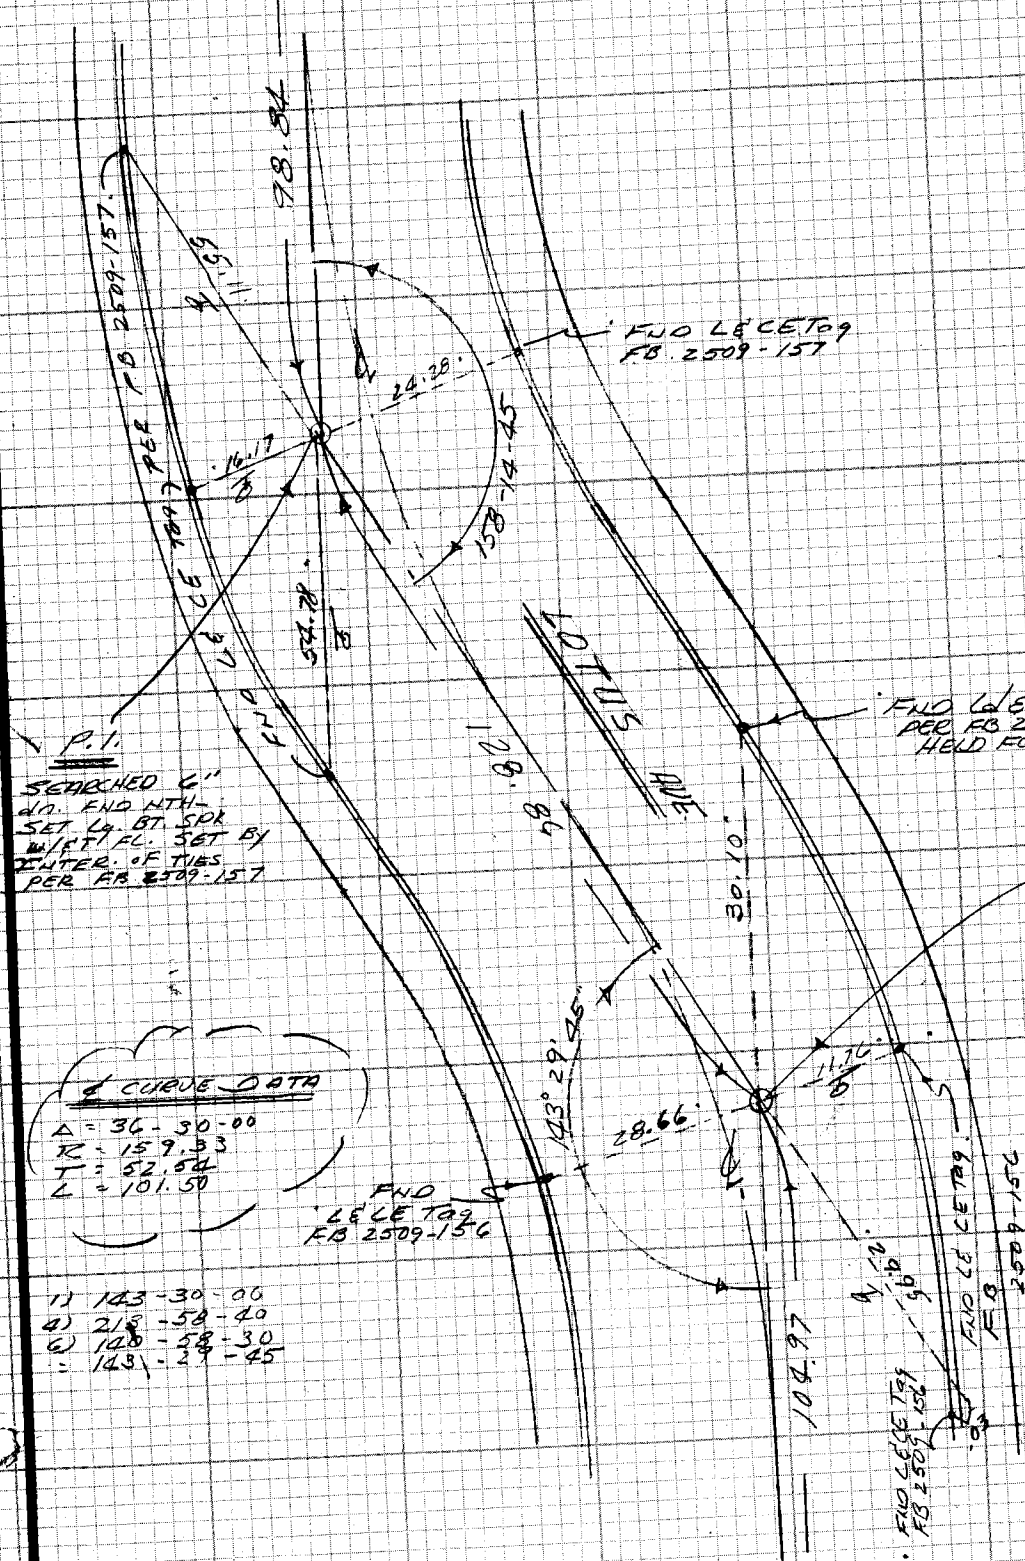


1) 158-14-40
4) 272-59-00
6) 229-28-20
= 158-14-43 1/3

℄ CURVE DATA
Δ = 21-45-40
R = 220.00
T = 42.29
L = 83.56
PER CHAPMAN WOODS T

LEV. 128.84 + 88
= 128.86

P.I.
SEARCHED 6" dn. FND NTH-SET Lg. BT. SPK W/ET FL. SET BY INTER. OF TIES PER FB 2509-157

P.I.
FND Bt. SPK & W. dn 2" HAS BEEN HIT REMOVED SET Lg. BT SPK W. & T FL. SET BY INTER. OF T PER FB 2509-156

℄ CURVE DATA
Δ = 36-30-00
R = 159.33
T = 52.54
L = 101.50

1) 143-30-00
4) 213-58-40
6) 140-58-30
= 143-29-45

CONT TOP. Lf. Pg 41

NOTE: ANY ADDITIONS OR CHANGES ON THIS SHEET MUST BE MADE OR CIRCLED IN RED INK WITH DATE AND NAME OF PERSON MAKING CHANGE

Do not extend notes this side of this line

PLEASE RETURN TO
LOS ANGELES COUNTY ENGINEER
403 LOS ANGELES COUNTY ENGINEERING BLDG.

CENTERLINE NOTES
CE 310
76F3095-4/73

F.B. 4412 PG. 46

CONT. Btm Pg 47

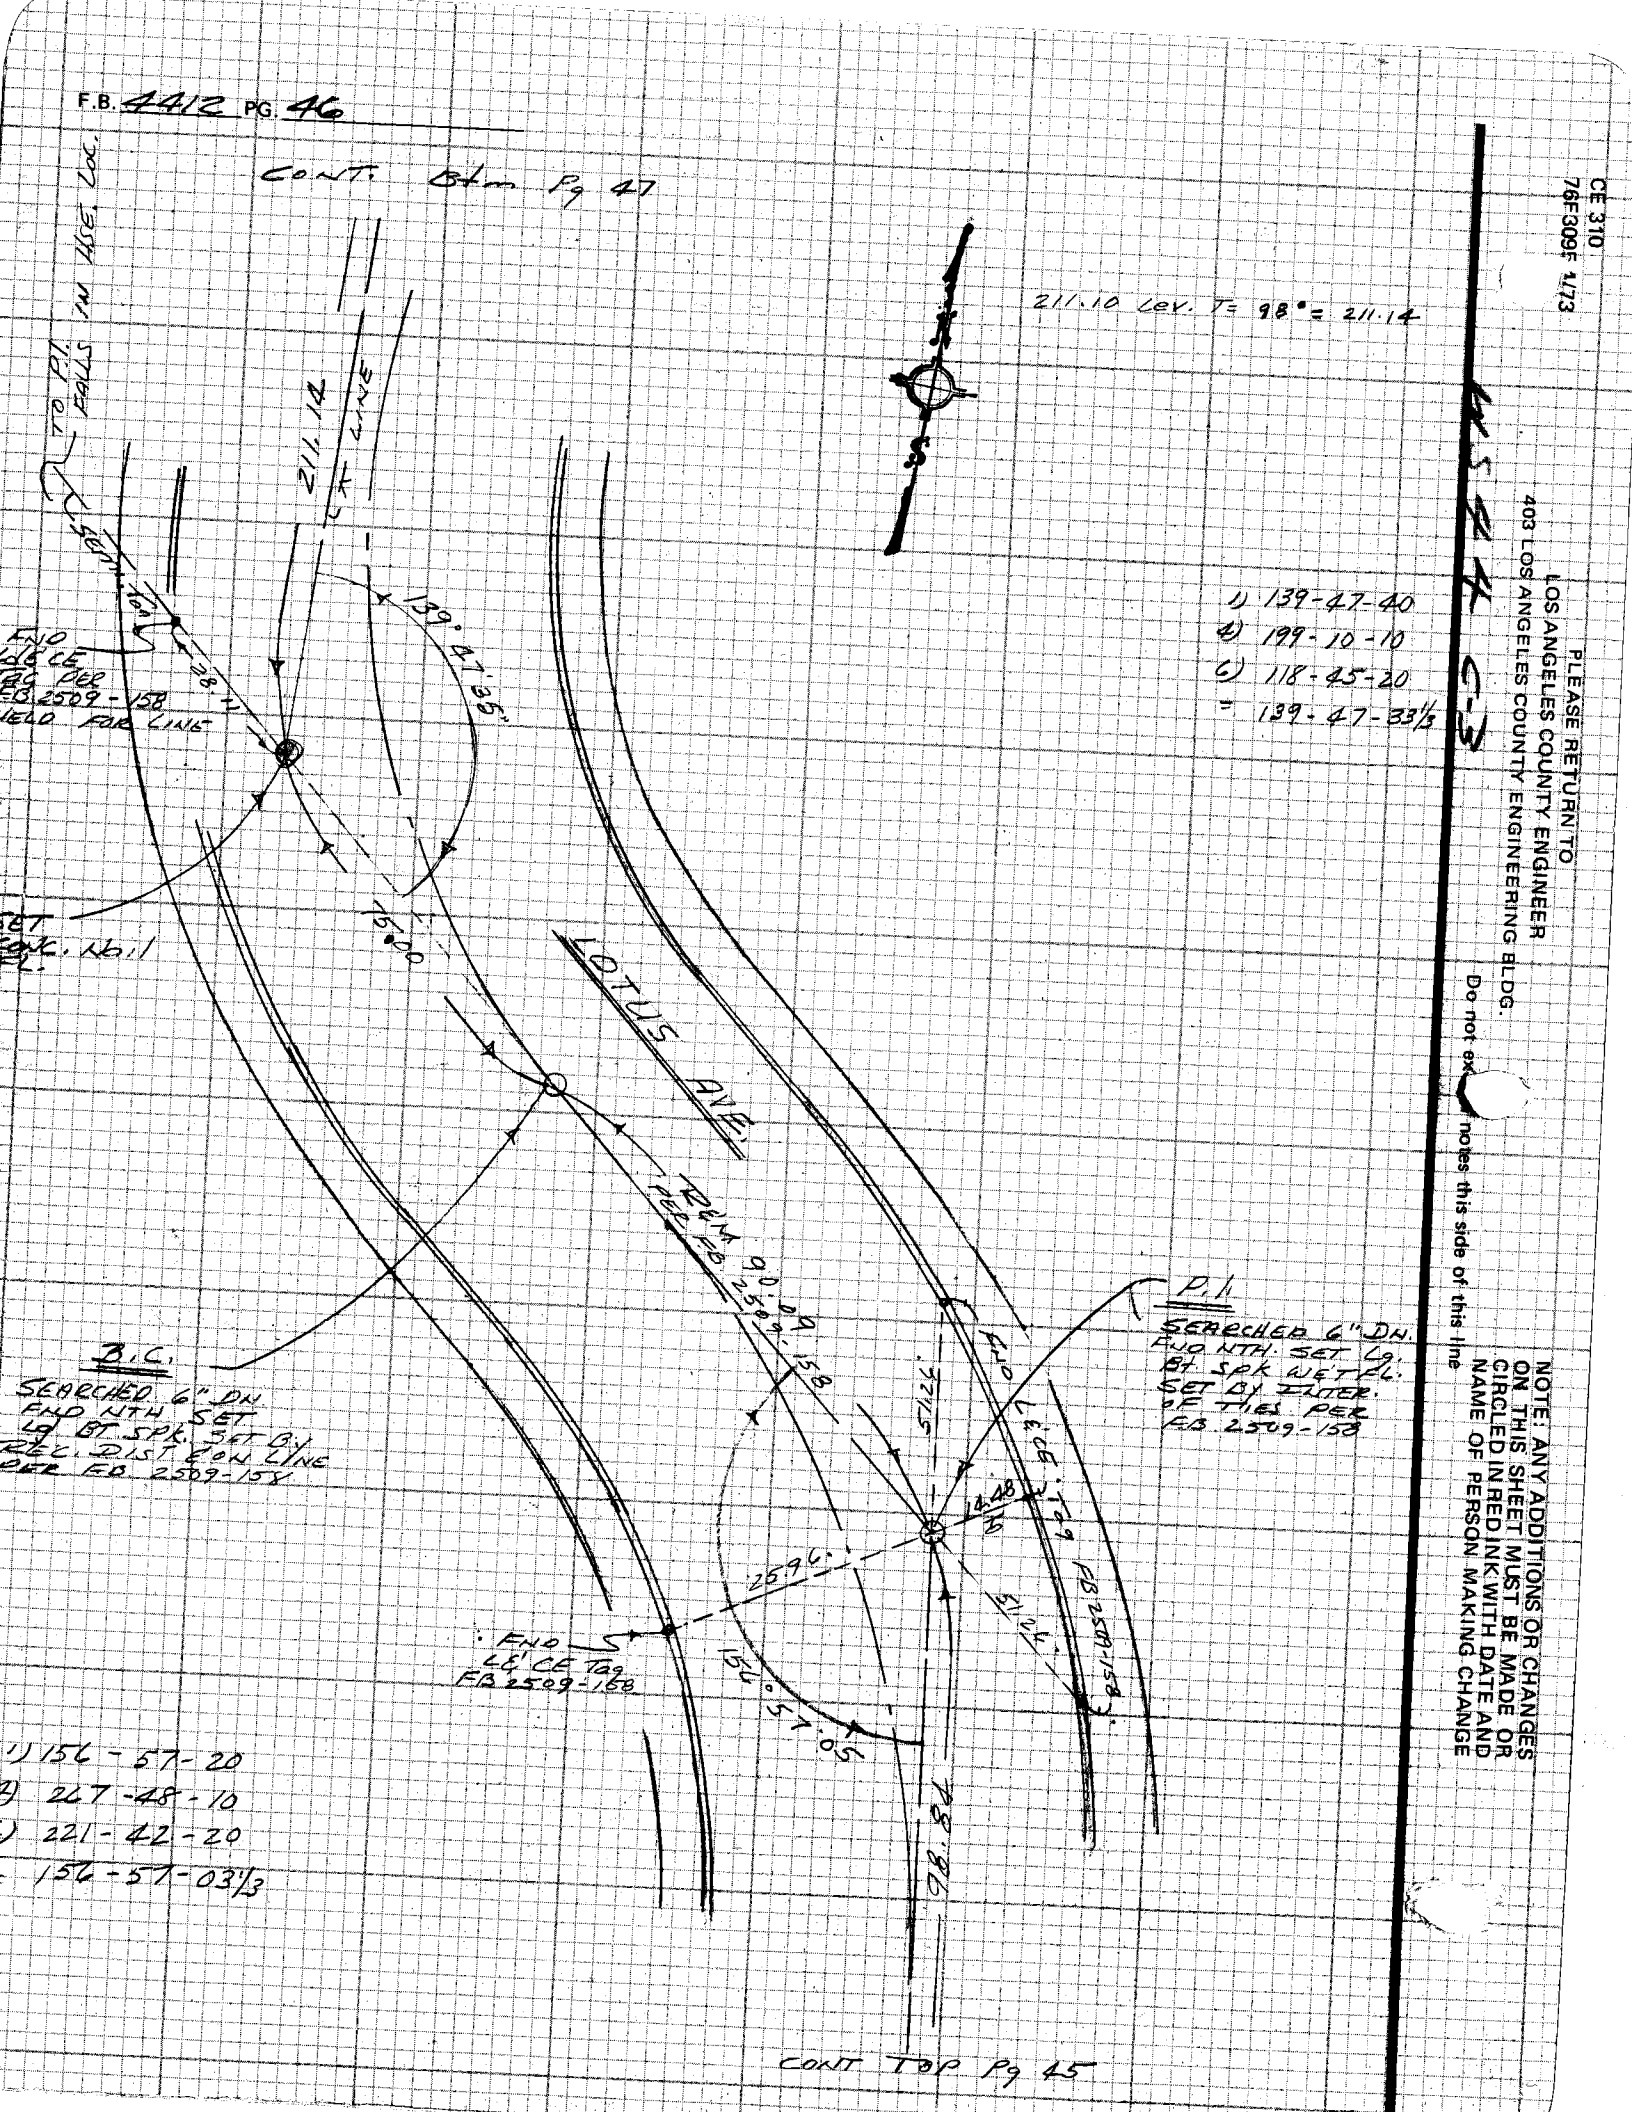


CONT TOP Pg 45

CE 310
76F309F 1/73

PLEASE RETURN TO
LOS ANGELES COUNTY ENGINEER
403 LOS ANGELES COUNTY ENGINEERING BLDG.

Do not ex notes this side of this line

NOTE: ANY ADDITIONS OR CHANGES ON THIS SHEET MUST BE MADE OR CIRCLED IN RED INK WITH DATE AND NAME OF PERSON MAKING CHANGE

| | |
|---|---|
| Notes Ck'd by | Survey of ROSEMEAD ST. & DIV. 4 F.B. 4412 PG. 47 |
| Map No. | JN 0303.00 Tape 0232 Std 68°F |
| Office Work | Surveyed by E. LANDA |
| Checked | Notes E.Z. K.M. KAPP Date 7-76 |
| Date | Indexed G. D. BAILEY SEP 19 1977 |

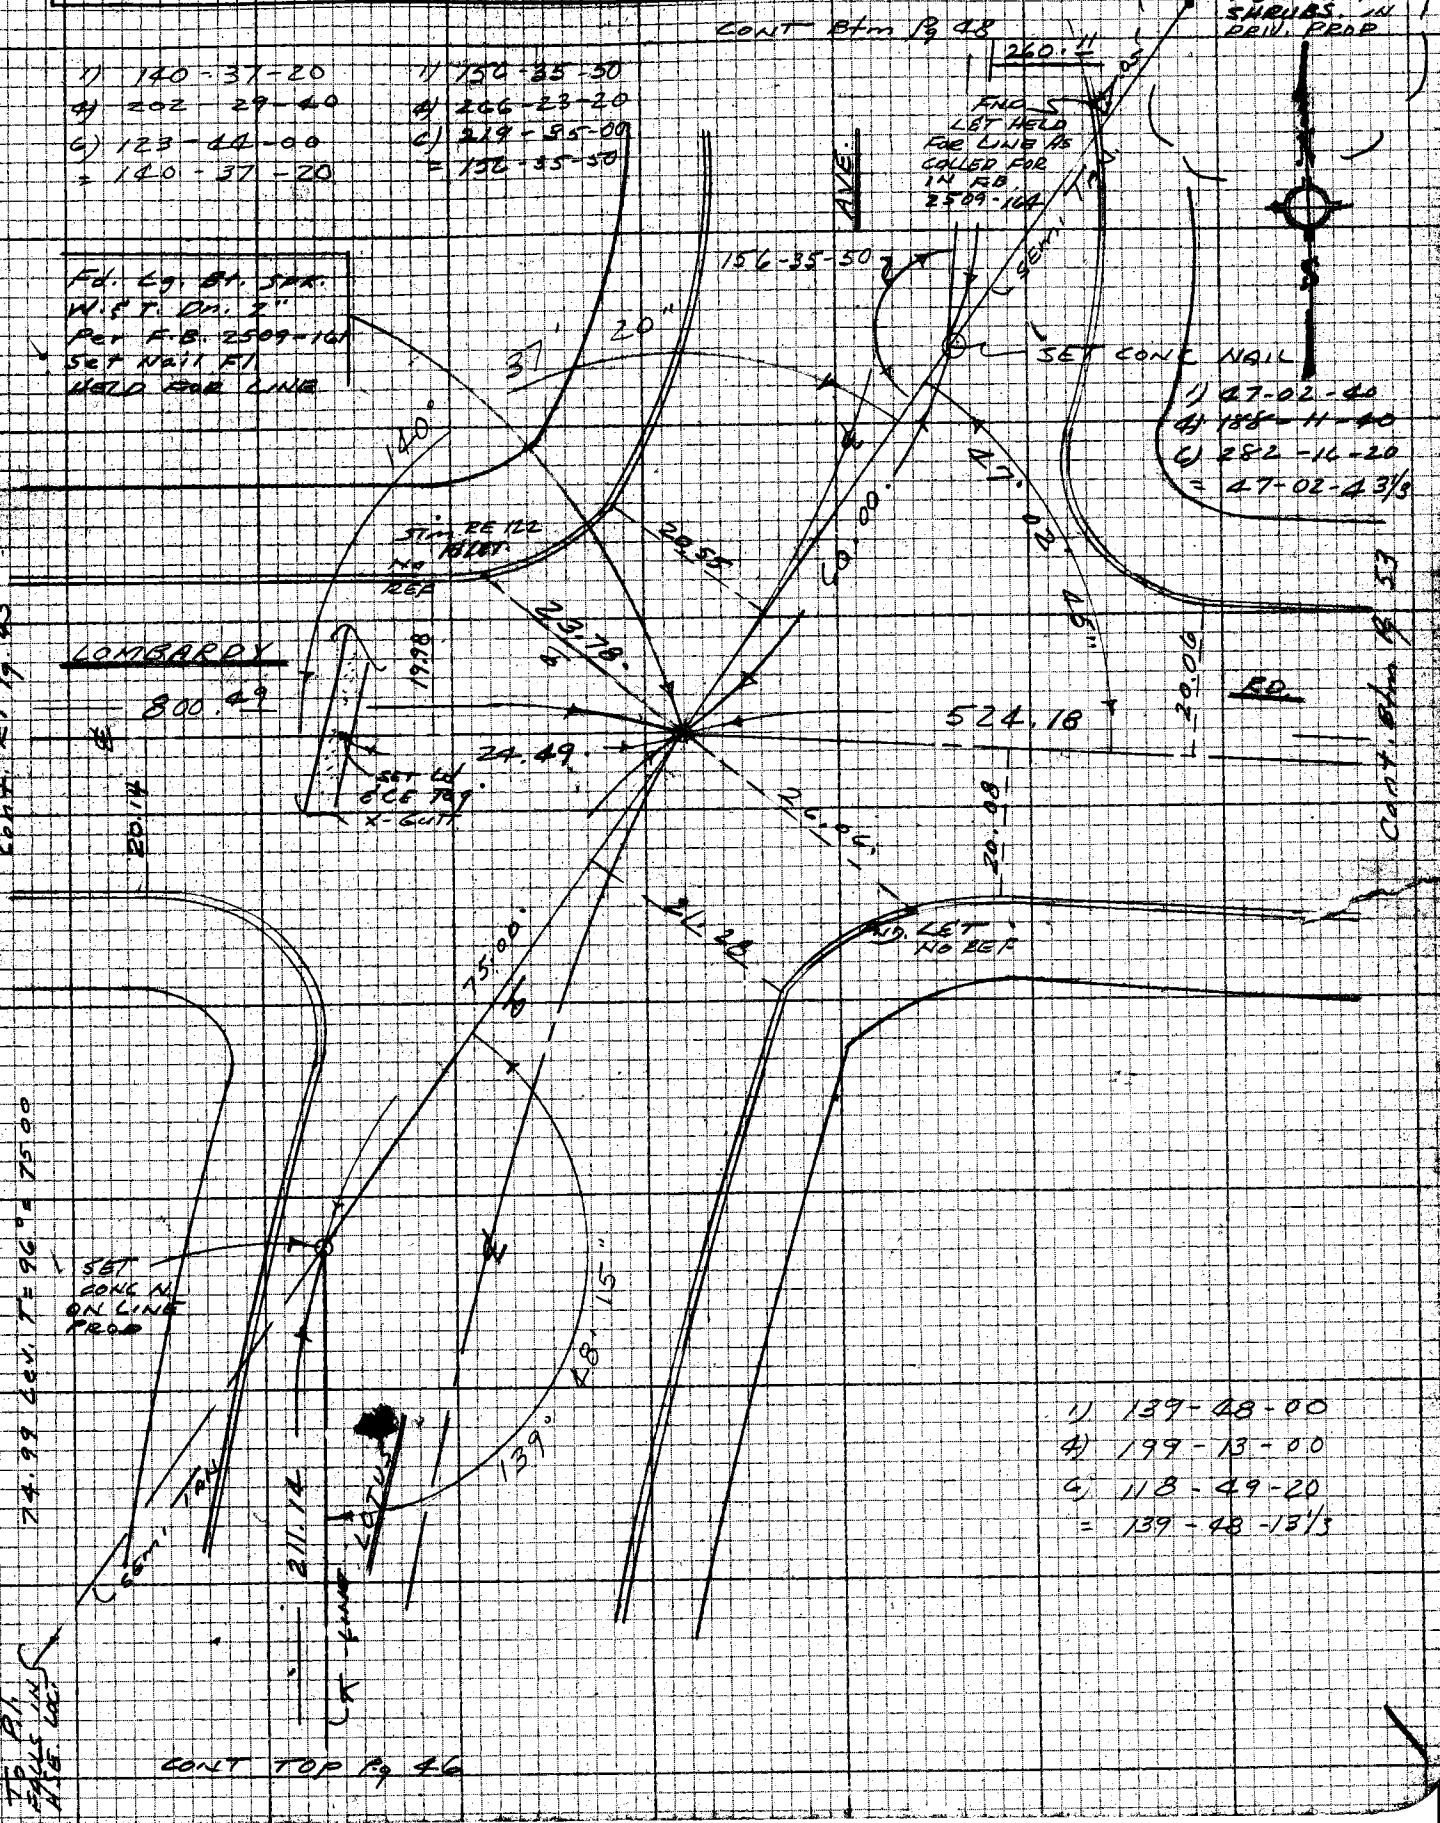


NOTE: ANY ADDITIONS OR CHANGES ON THIS SHEET MUST BE MADE OR CIRCLED IN RED INK WITH DATE AND NAME OF PERSON MAKING CHANGE

Do not extend [illegible] side of this line

PLEASE RETURN TO
LOS ANGELES COUNTY ENGINEER
403 LOS ANGELES COUNTY ENGINEERING BLDG.

CENTERLINE NOTES
CE 310
76F3096-4/73

F.B. 4412 PG. 48

CONT. RT Pg 49

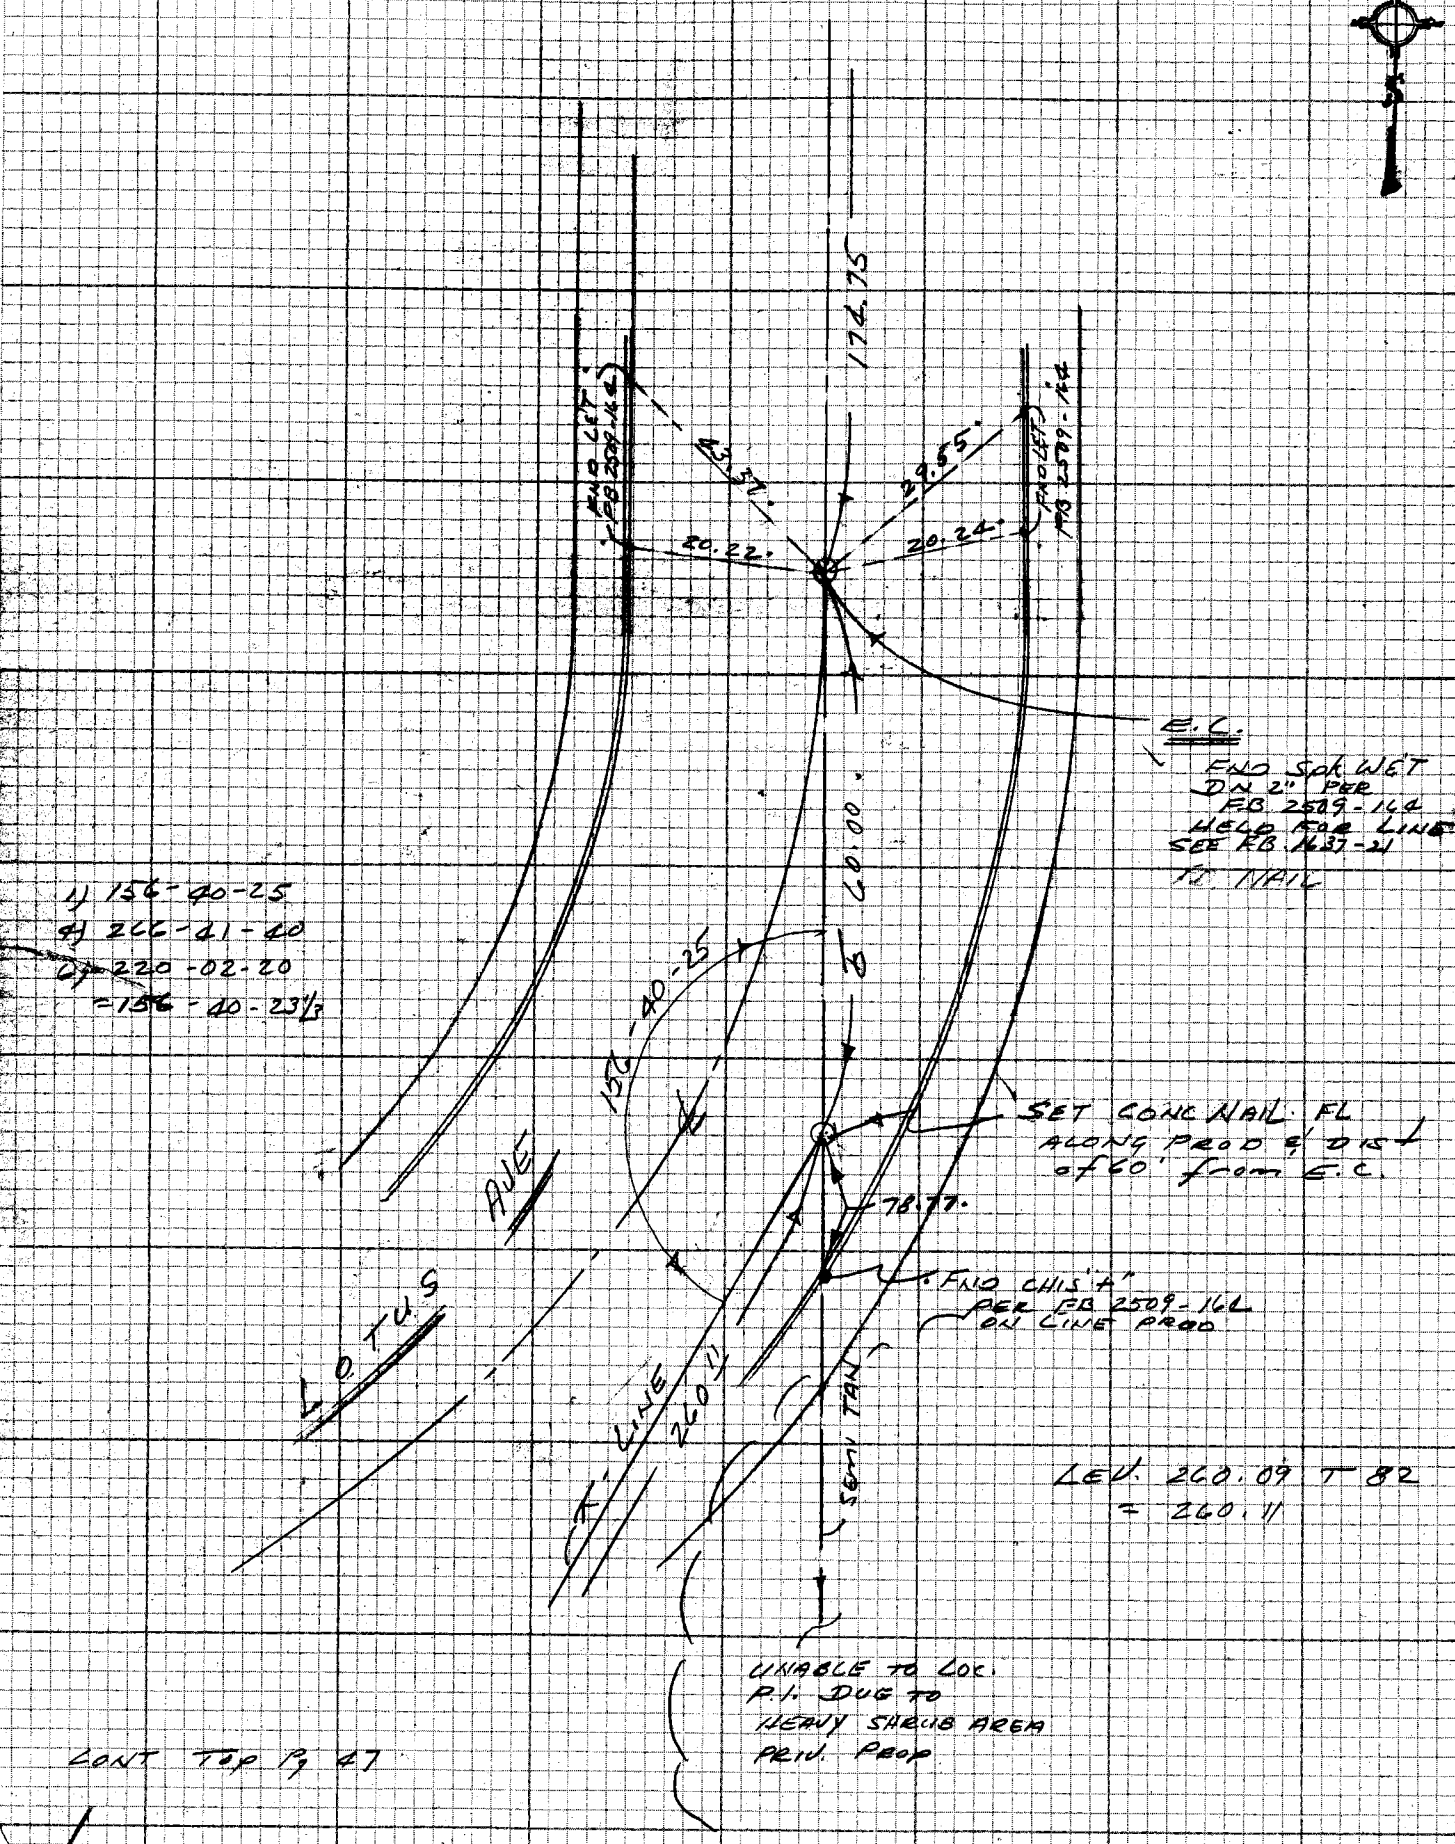


CONT TOP Pg 47

CE 310
76F3095-4/73
PLEASE RETURN TO
LOS ANGELES COUNTY ENGINEER
403 LOS ANGELES COUNTY ENGINEERING BLDG.
Do not ex... notes this side of this line
NOTE: ANY ADDITIONS OR CHANGES ON THIS SHEET MUST BE MADE OR CIRCLED IN RED INK WITH DATE AND NAME OF PERSON MAKING CHANGE

DIV. 4

| | | |
|---|---|---|
| Notes Ck'd by | Survey of ROSEMEAD ST. ℄ | F.B. 4412 PG. 49 |
| Map No. | JN 0303.00 Tape 0232 Std 68 °F | |
| Office Work | Surveyed by E. LANDA | |
| Checked | Notes E. LANDA Date 8-76 | |
| Date | Indexed G. D. BAILEY SEP 19 1977 | |

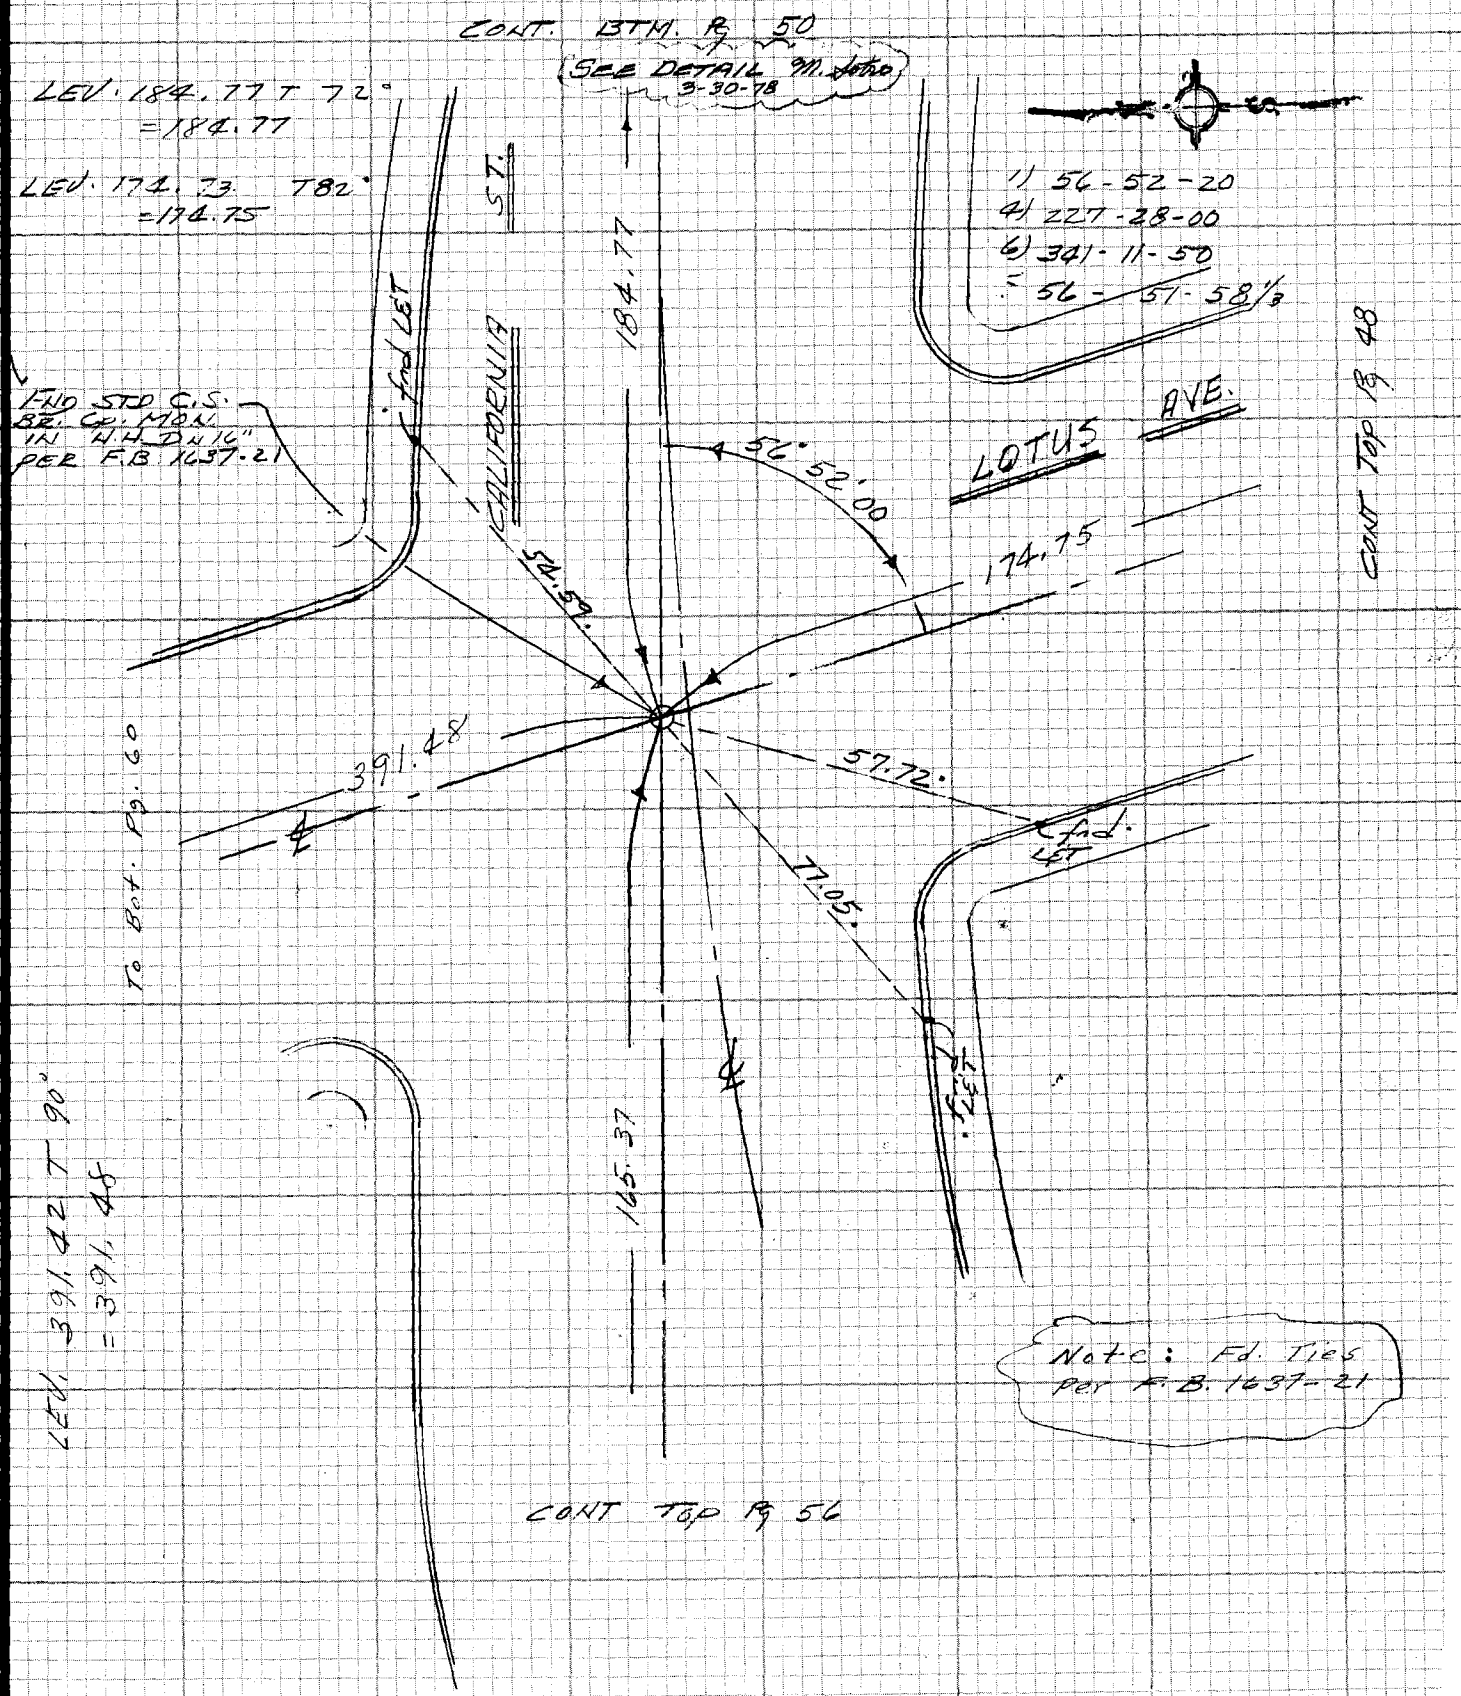


NOTE: ANY ADDITIONS OR CHANGES ON THIS SHEET MUST BE MADE OR CIRCLED IN RED INK WITH DATE AND NAME OF PERSON MAKING CHANGE

Do not extend notes this side of this line

PLEASE RETURN TO
LOS ANGELES COUNTY ENGINEER
403 LOS ANGELES COUNTY ENGINEERING BLDG.

CENTERLINE NOTES
CE 310
76F3095-4/73

F.B. 4412 PG. 50

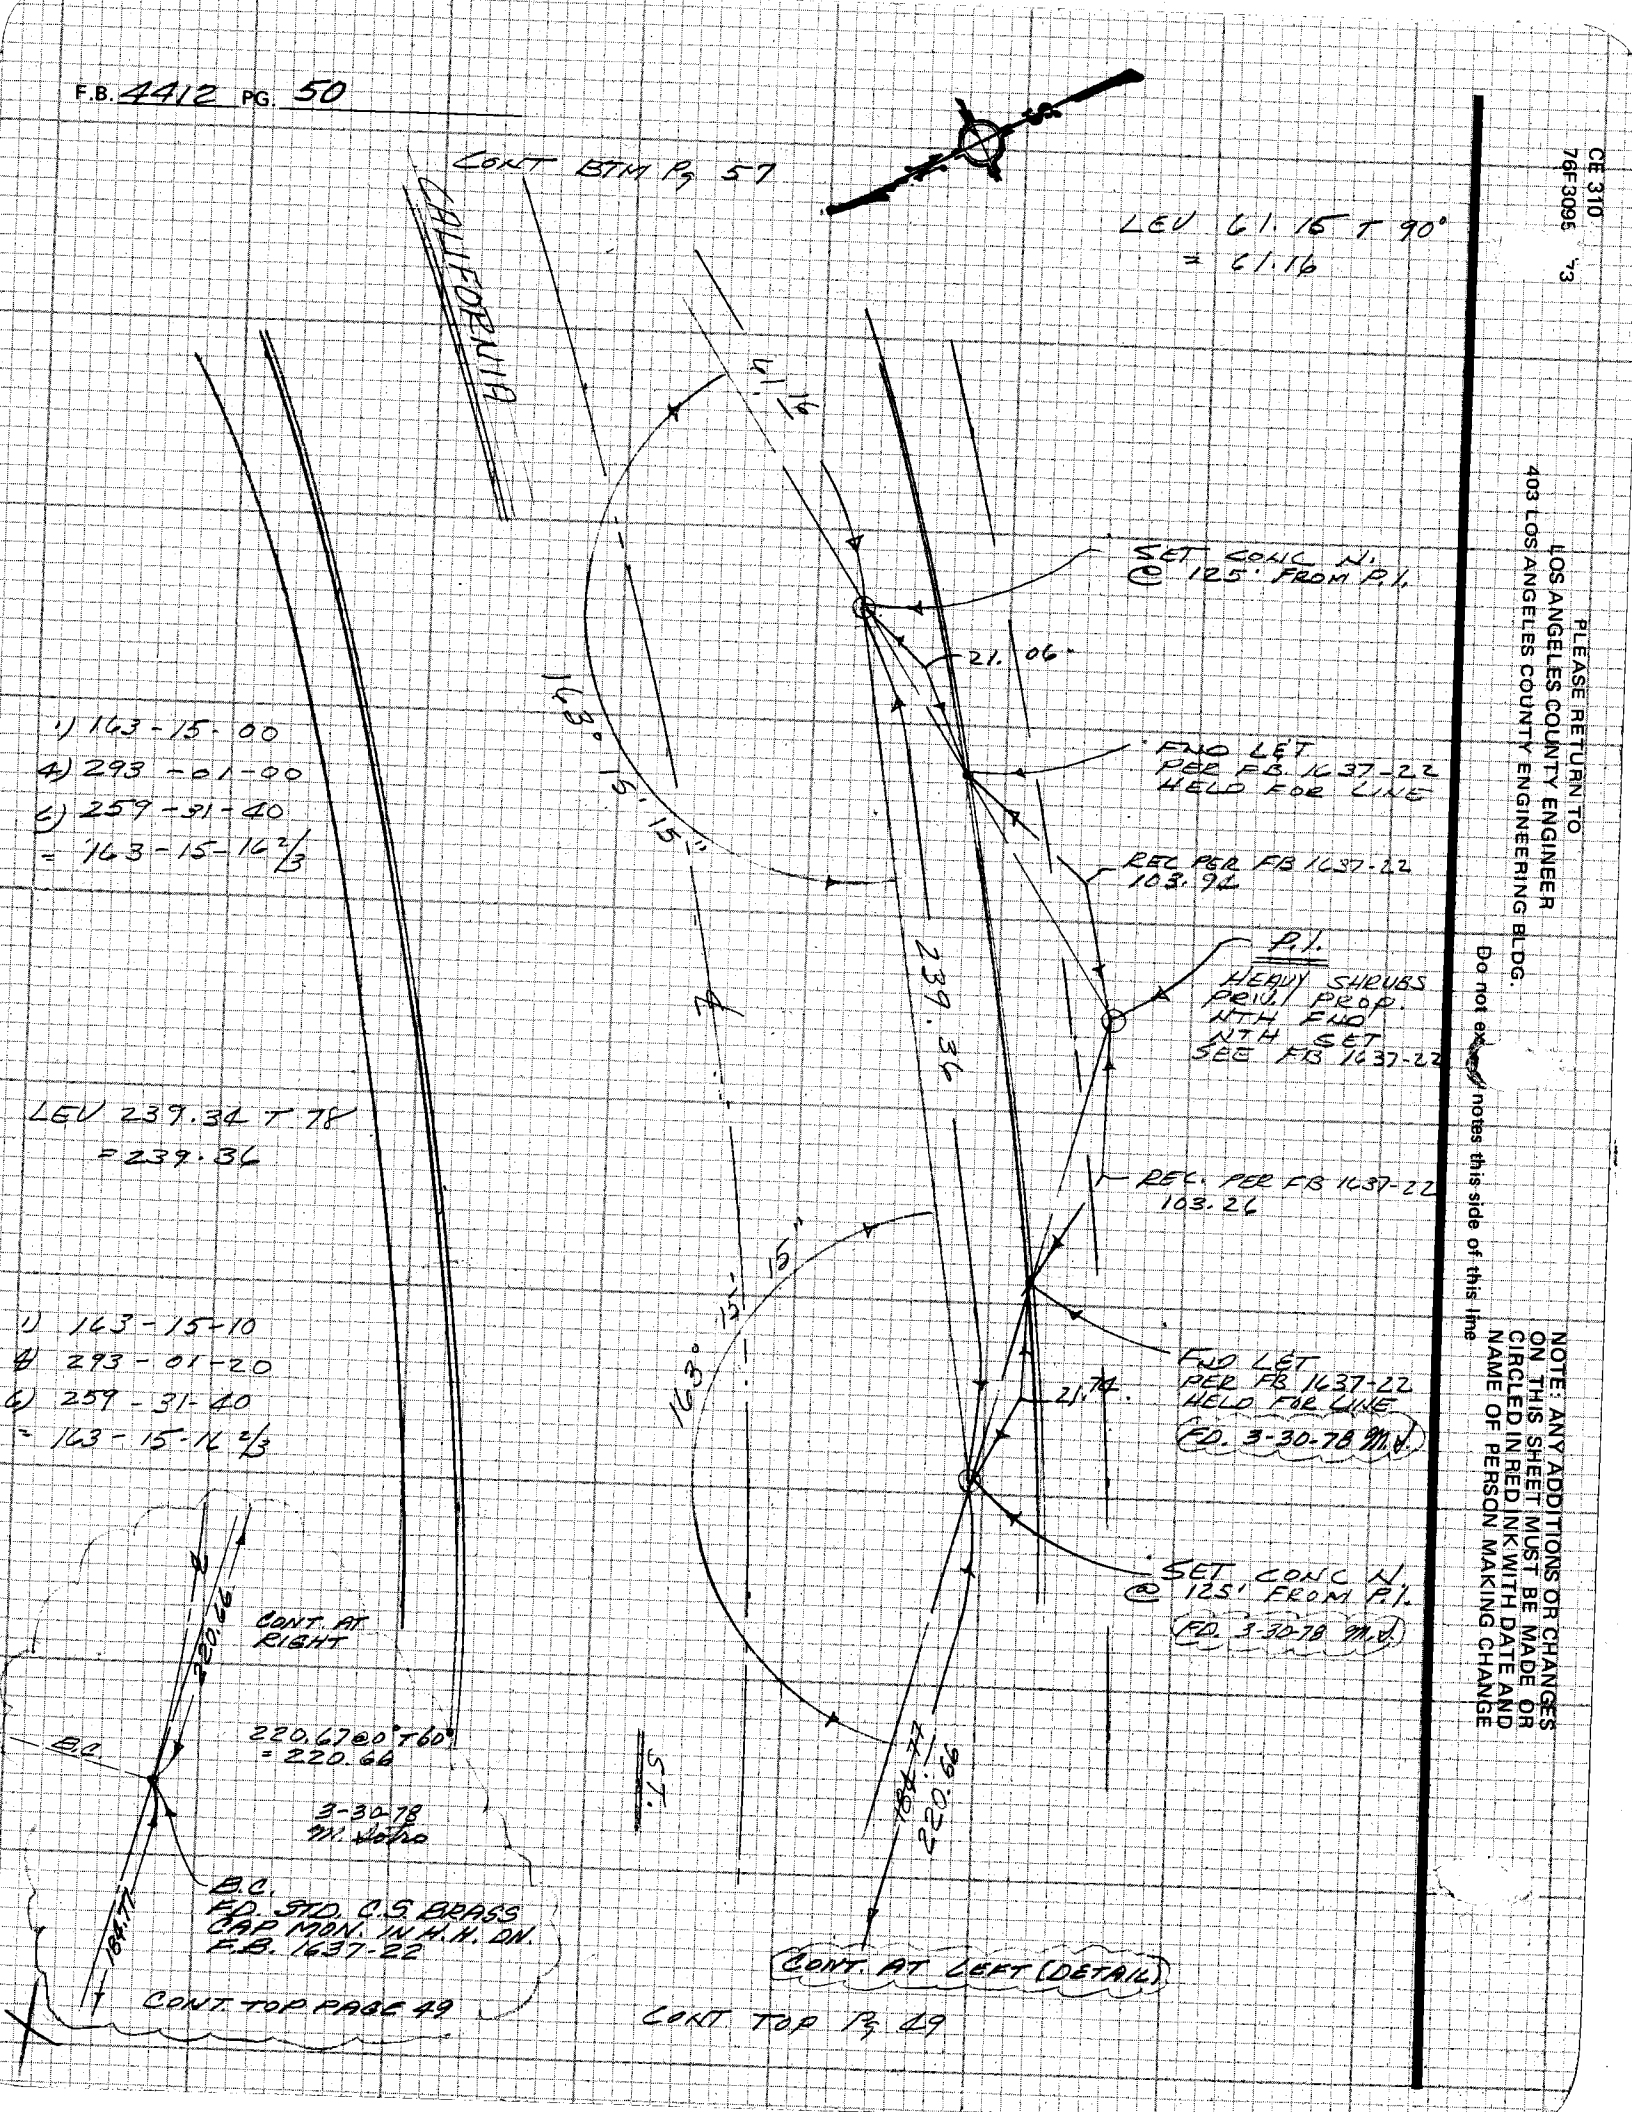


CE 310
76F3095 '73

PLEASE RETURN TO
LOS ANGELES COUNTY ENGINEER
403 LOS ANGELES COUNTY ENGINEERING BLDG.

NOTE: ANY ADDITIONS OR CHANGES ON THIS SHEET MUST BE MADE OR CIRCLED IN RED INK WITH DATE AND NAME OF PERSON MAKING CHANGE

Do not extend notes this side of this line

Div 4

| | |
|---|---|
| Notes Ck'd by | Survey of ROSEMEAD ST 4 F.B. 4412 PG. 51 |
| Map No. | JN 2323.00 Tape 0232 Std 68 °F |
| Office Work | Surveyed by E. LANDA |
| Checked | Notes E. LANDA Date 8-76 |
| Date | Indexed G. D. BAILEY SEP 19 1977 |

CONT STM Pg 54

109.07 LEV. T = 84° = 109.08

LEV. 291.58 T 92° = 291.63

20.06

SET L&E CE Tag

20.06

SET L&E CE Tag

414.85

LOCKSLEY DR.

15.93

310.06

36.01

FND LET. NO REF

(+)1.0

20.20

16.14

393.16

109.08

CONT TOP Pg 52

90°

64.48

72°-54'-30"

89°-59'-45"

247.71

1) 89-59-50
4) 359-59-00
4) 179-58-20
= 89-59-43

CONT Pg 59

20.38

21.13

SET L&E CE Tag

20.04

FND LET NO REF

SET L&E CE Tag

20.04

286.05

1) 72-57-00
4) 294-47-20
4) 77-41-00
- 72-56-50

FND SPK & WDN REMOVED & SET Lg. BT SPK WET F.C. SAME LOCATION

3.07

SET CONC. N. BY LUTER

7.54

SET NTH

.02

B.C.

FND 3PK. DN 3" NO REF REMOVED & SET Lg. BT SPK WET F.C. SAME LOC.

VALLOMBROSA DR.

139-13-35

90°

20.27

.03

FND LET

FND 2x2 E SHANK OF N. DN. 6" REMOVED & SEARCHED FOR 2" I.P. Called For PER CHAPMAN WDS TR. DN. 18" FND NTH SET NTH.

1) 139-13-20
4) 196-54-20
4) 115-21-30
= 139-13-35

CHORD 261.29

91.11

E.C.

FND Lg. BT SPK NO REF HELD FOR LINE SEE CHAPMAN WDS TR. FD. NAIL FL. VA. N. 313-18

LEV. 286.02 T 82 = 286.05

FD. FALLS IN PRIV. PROP NO SEARCH

FND L&T ON LINE NO REF

CONT TOP Pg 42

NOTE: ANY ADDITIONS OR CHANGES ON THIS SHEET MUST BE MADE OR CIRCLED IN RED INK WITH DATE AND NAME OF PERSON MAKING CHANGE

Do not extend notes to this side of this line

PLEASE RETURN TO
LOS ANGELES COUNTY ENGINEER
403 LOS ANGELES COUNTY ENGINEERING BLDG.

CENTERLINE NOTES
CE 310
76F3095-4/73

F.B. 4412 PG. 52

CONT Lf. Pg 51

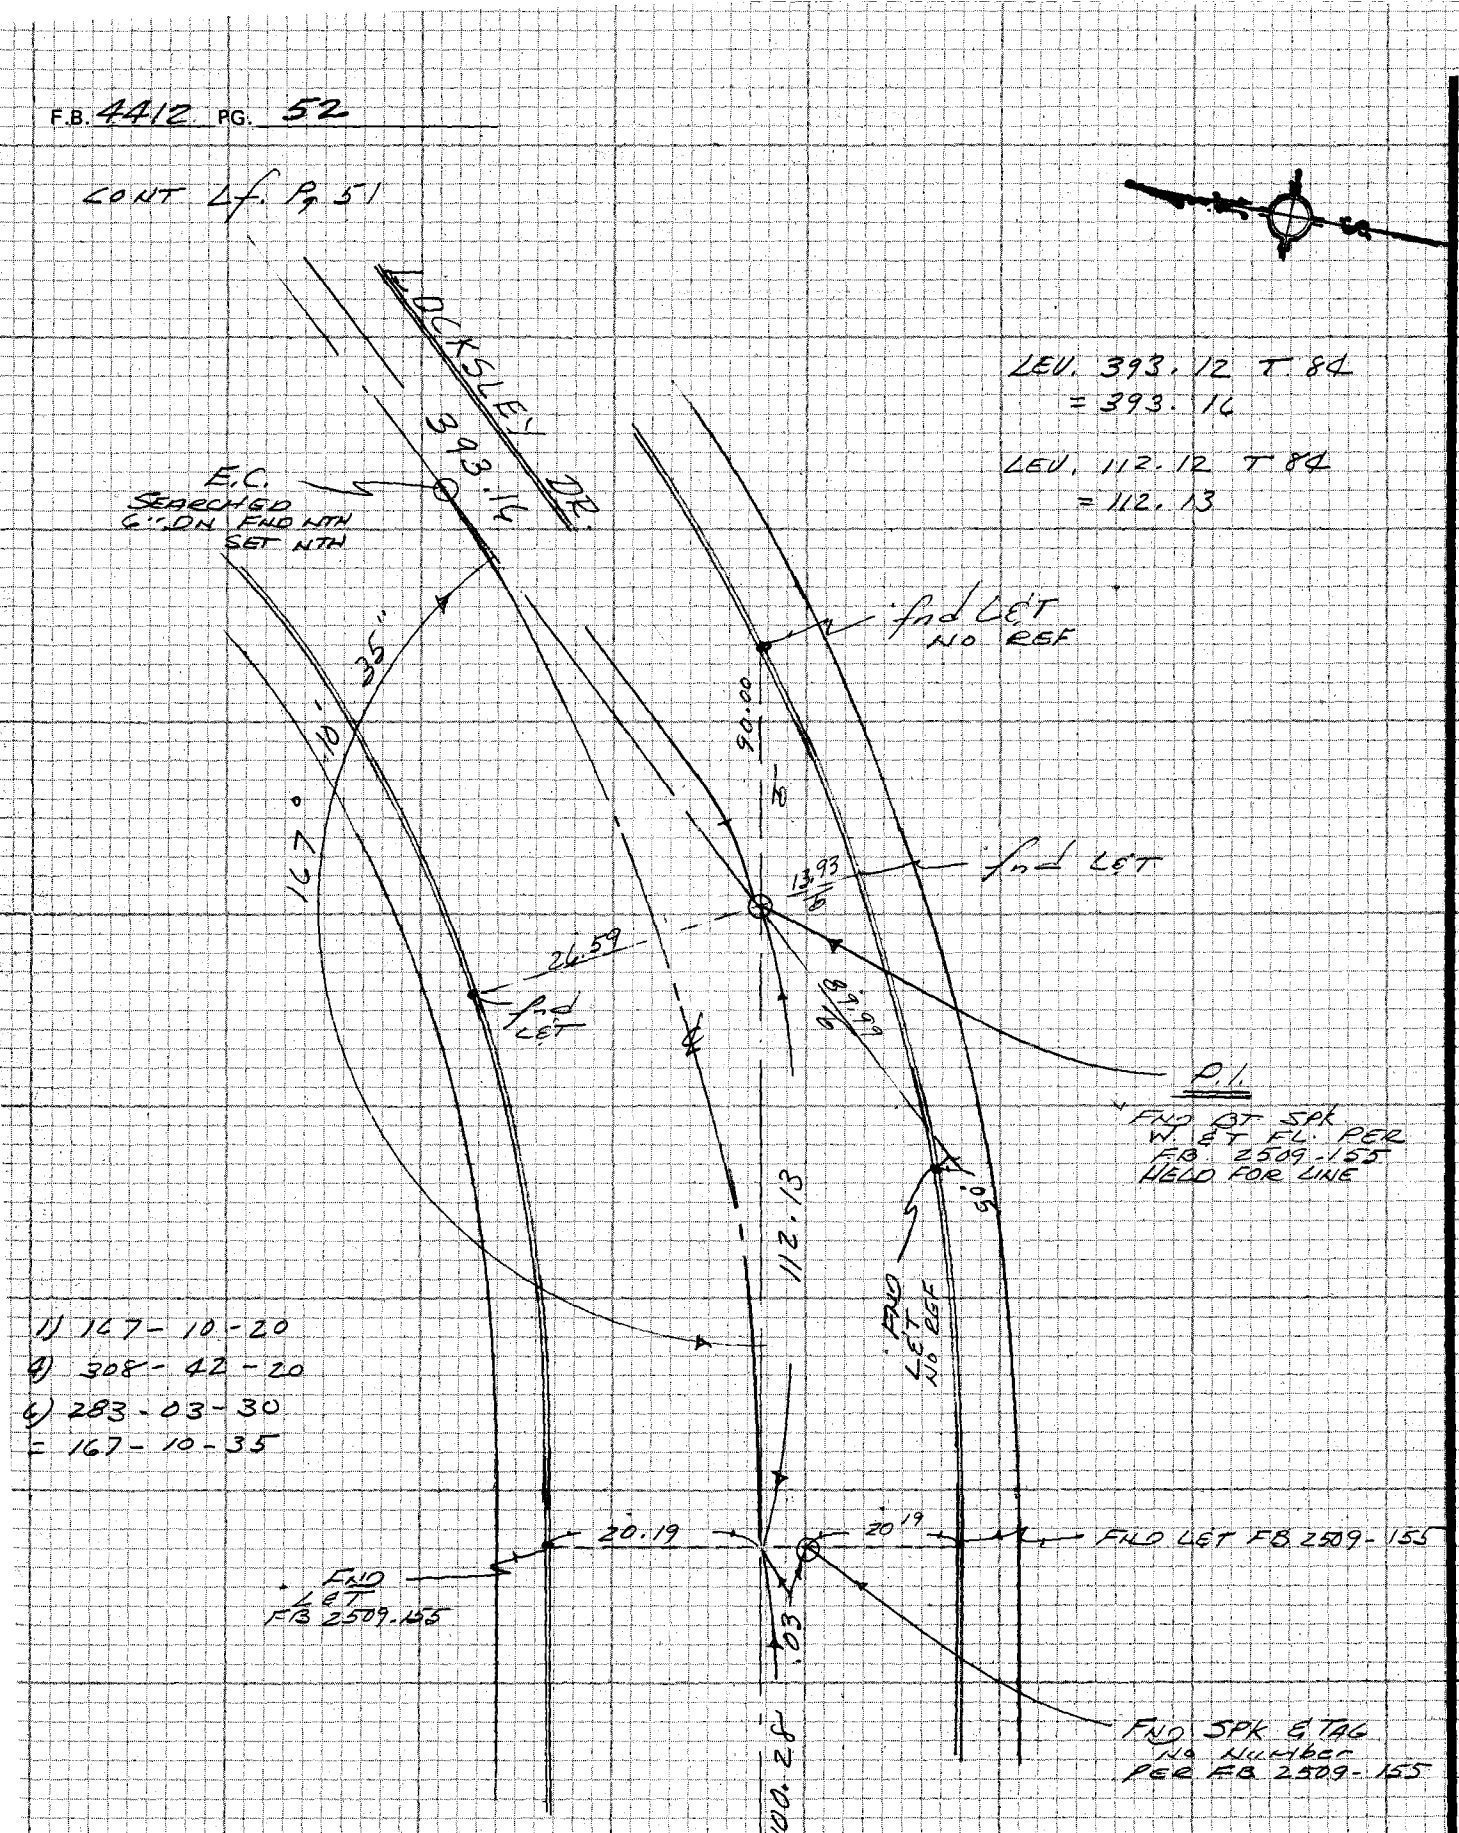


1) 167-10-20
4) 308-42-20
4) 283-03-30
= 167-10-35

CONT TOP Pg 41

LEV. 100.28 T 68
N.C.

PLEASE RETURN TO
LOS ANGELES COUNTY ENGINEER
403 LOS ANGELES COUNTY ENGINEERING BLDG.

NOTE: ANY ADDITIONS OR CHANGES ON THIS SHEET MUST BE MADE OR CIRCLED IN RED INK WITH DATE AND NAME OF PERSON MAKING CHANGE

Do not write notes this side of this line

CE 310
76F3095 '73

| | |
|---|---|
| Notes Ck'd by | Survey of ROSEMEAD ST. & DIV. 4 |
| Map No. | JN 0303.00 Tape 0232 Std 68 °F |
| Office Work | Surveyed by E. LANDA |
| Checked | Notes E.L. K.M. KAPP Date 7-76 |
| Date | Indexed G. D. BAILEY SEP 19 1977 |

F.B. 4412 PG. 53

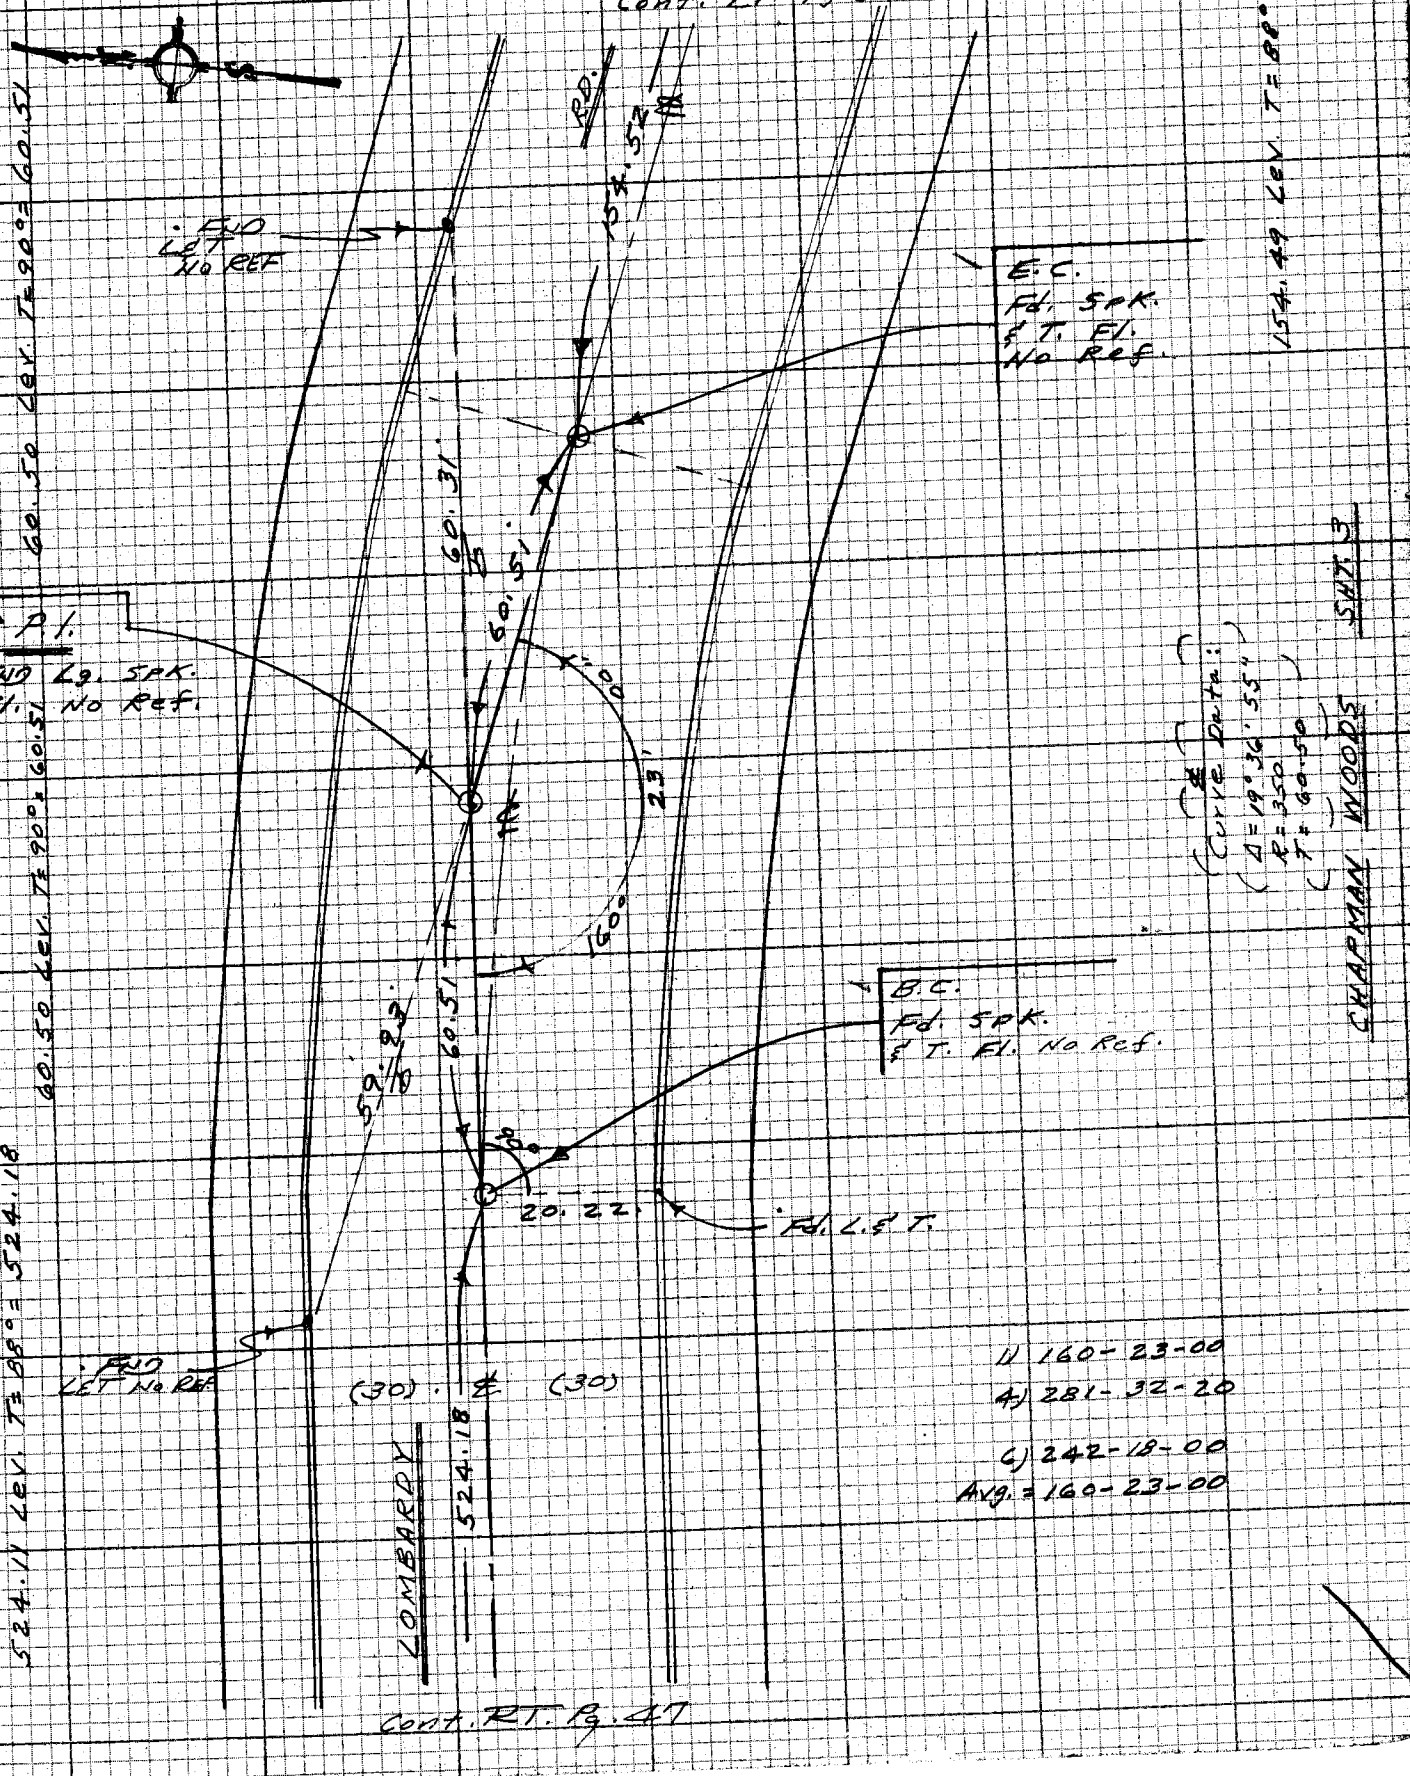


NOTE: ANY ADDITIONS OR CHANGES ON THIS SHEET MUST BE MADE OR CIRCLED IN RED INK WITH DATE AND NAME OF PERSON MAKING CHANGE

Do not extend notes this side of this line

W.S.44 C-3

PLEASE RETURN TO
LOS ANGELES COUNTY ENGINEER
403 LOS ANGELES COUNTY ENGINEERING BLDG.

CENTERLINE NOTES
CE 310
76F3095-4/73

F.B. 4412 PG. 54

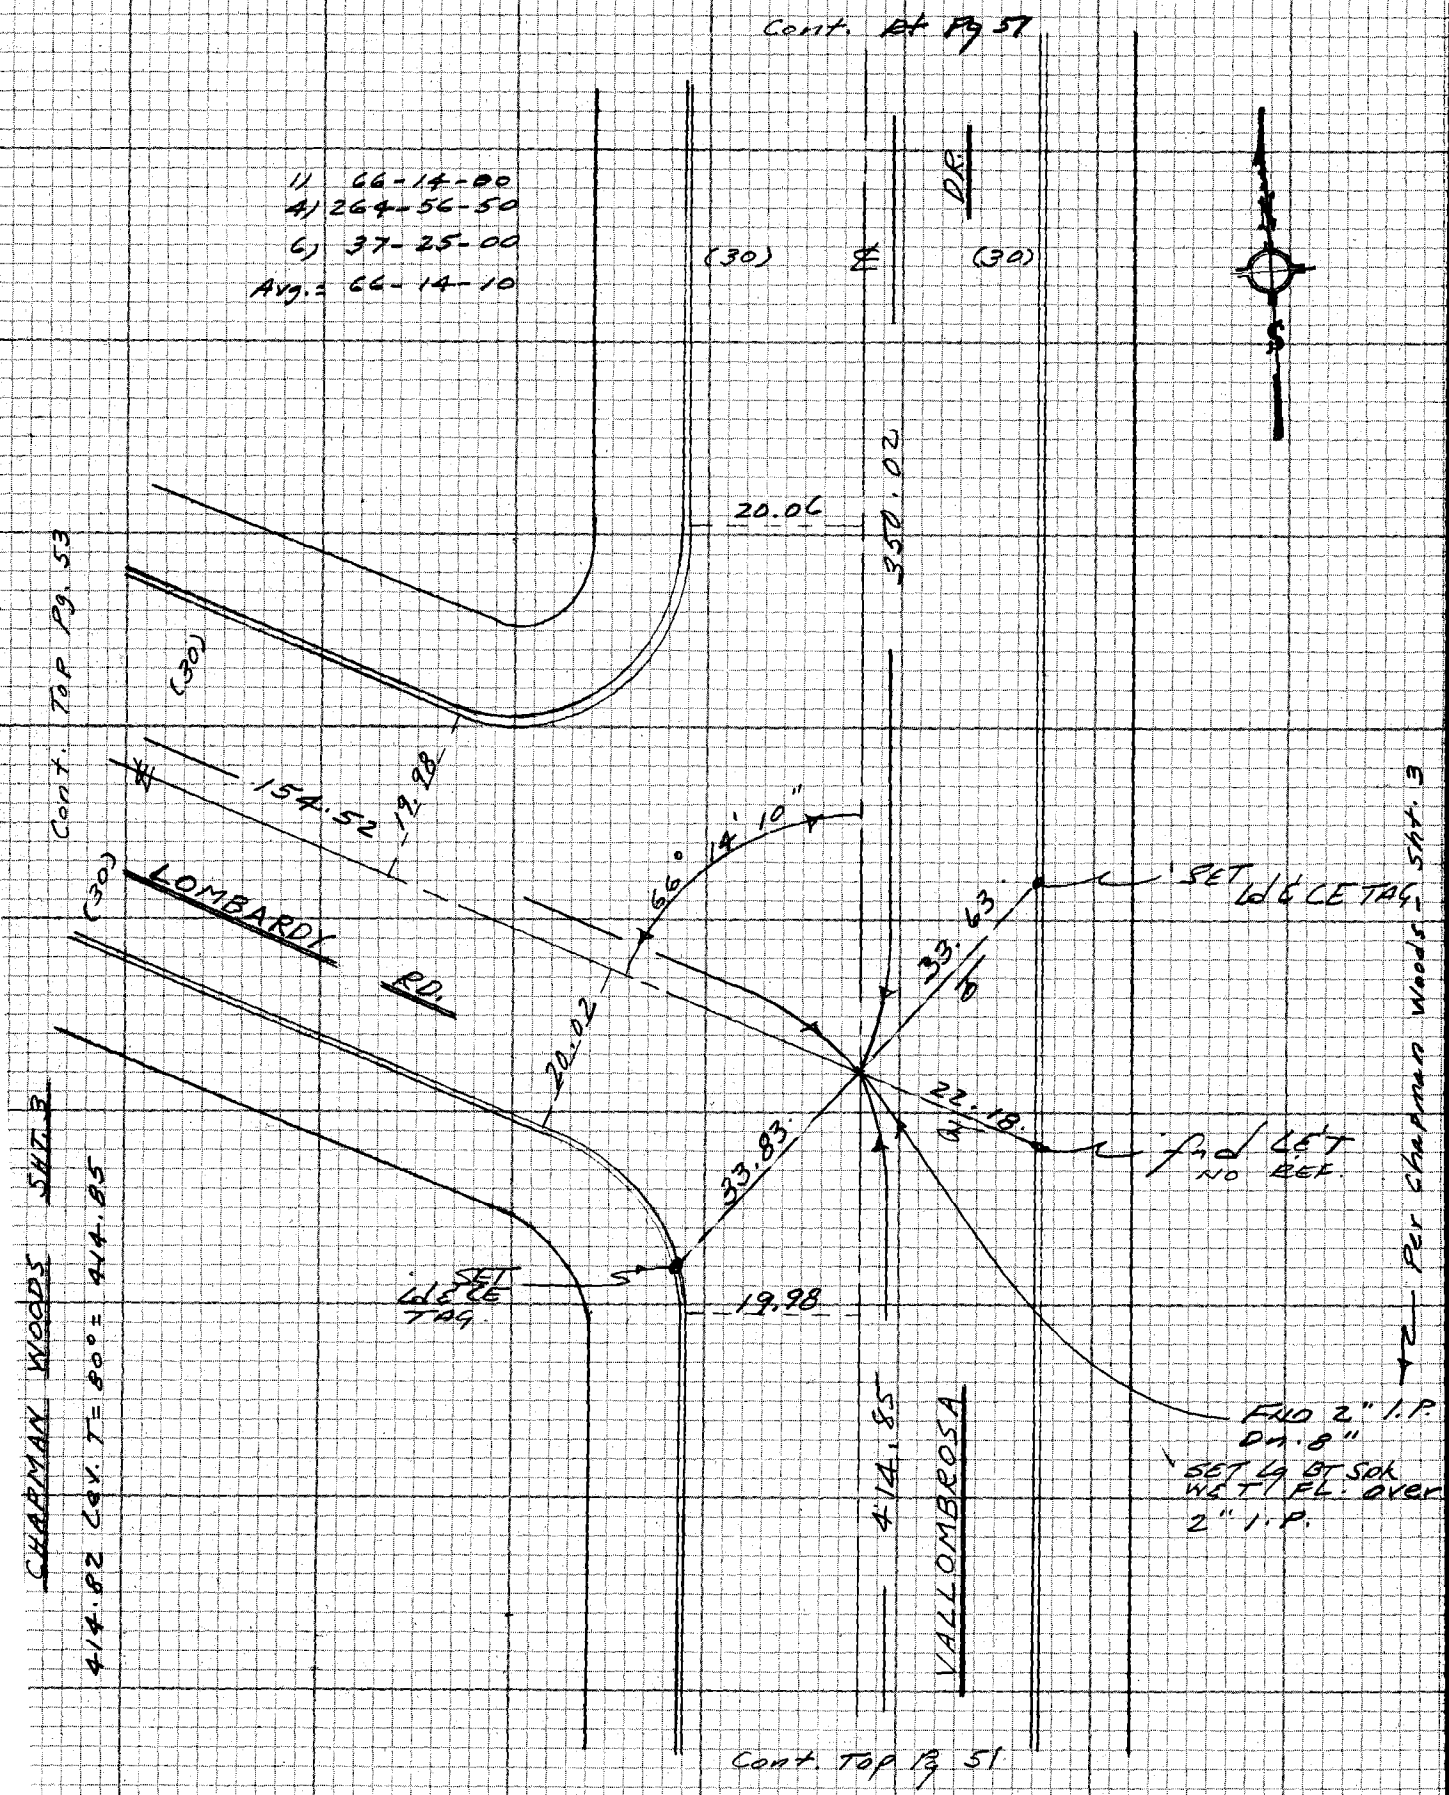


CE 310
76F3095-73

PLEASE RETURN TO
LOS ANGELES COUNTY ENGINEER
483 LOS ANGELES COUNTY ENGINEERING BLDG.

Do not ex[illegible] notes this side of this line

NOTE: ANY ADDITIONS OR CHANGES ON THIS SHEET MUST BE MADE OR CIRCLED IN RED INK WITH DATE AND NAME OF PERSON MAKING CHANGE

DIV 4

| | |
|---|---|
| Notes Ck'd by | Survey of ROSEMEAD ST ℄ |
| Map No. | JN 0303.00 Tape 02.32 Std 68° F |
| Office Work | Surveyed by E. LANDA |
| Checked | Notes G. CREASON Date 8-76 |
| Date | Indexed G. D. BAILEY SEP 19 1977 |

F.B. 4418 PG. 55

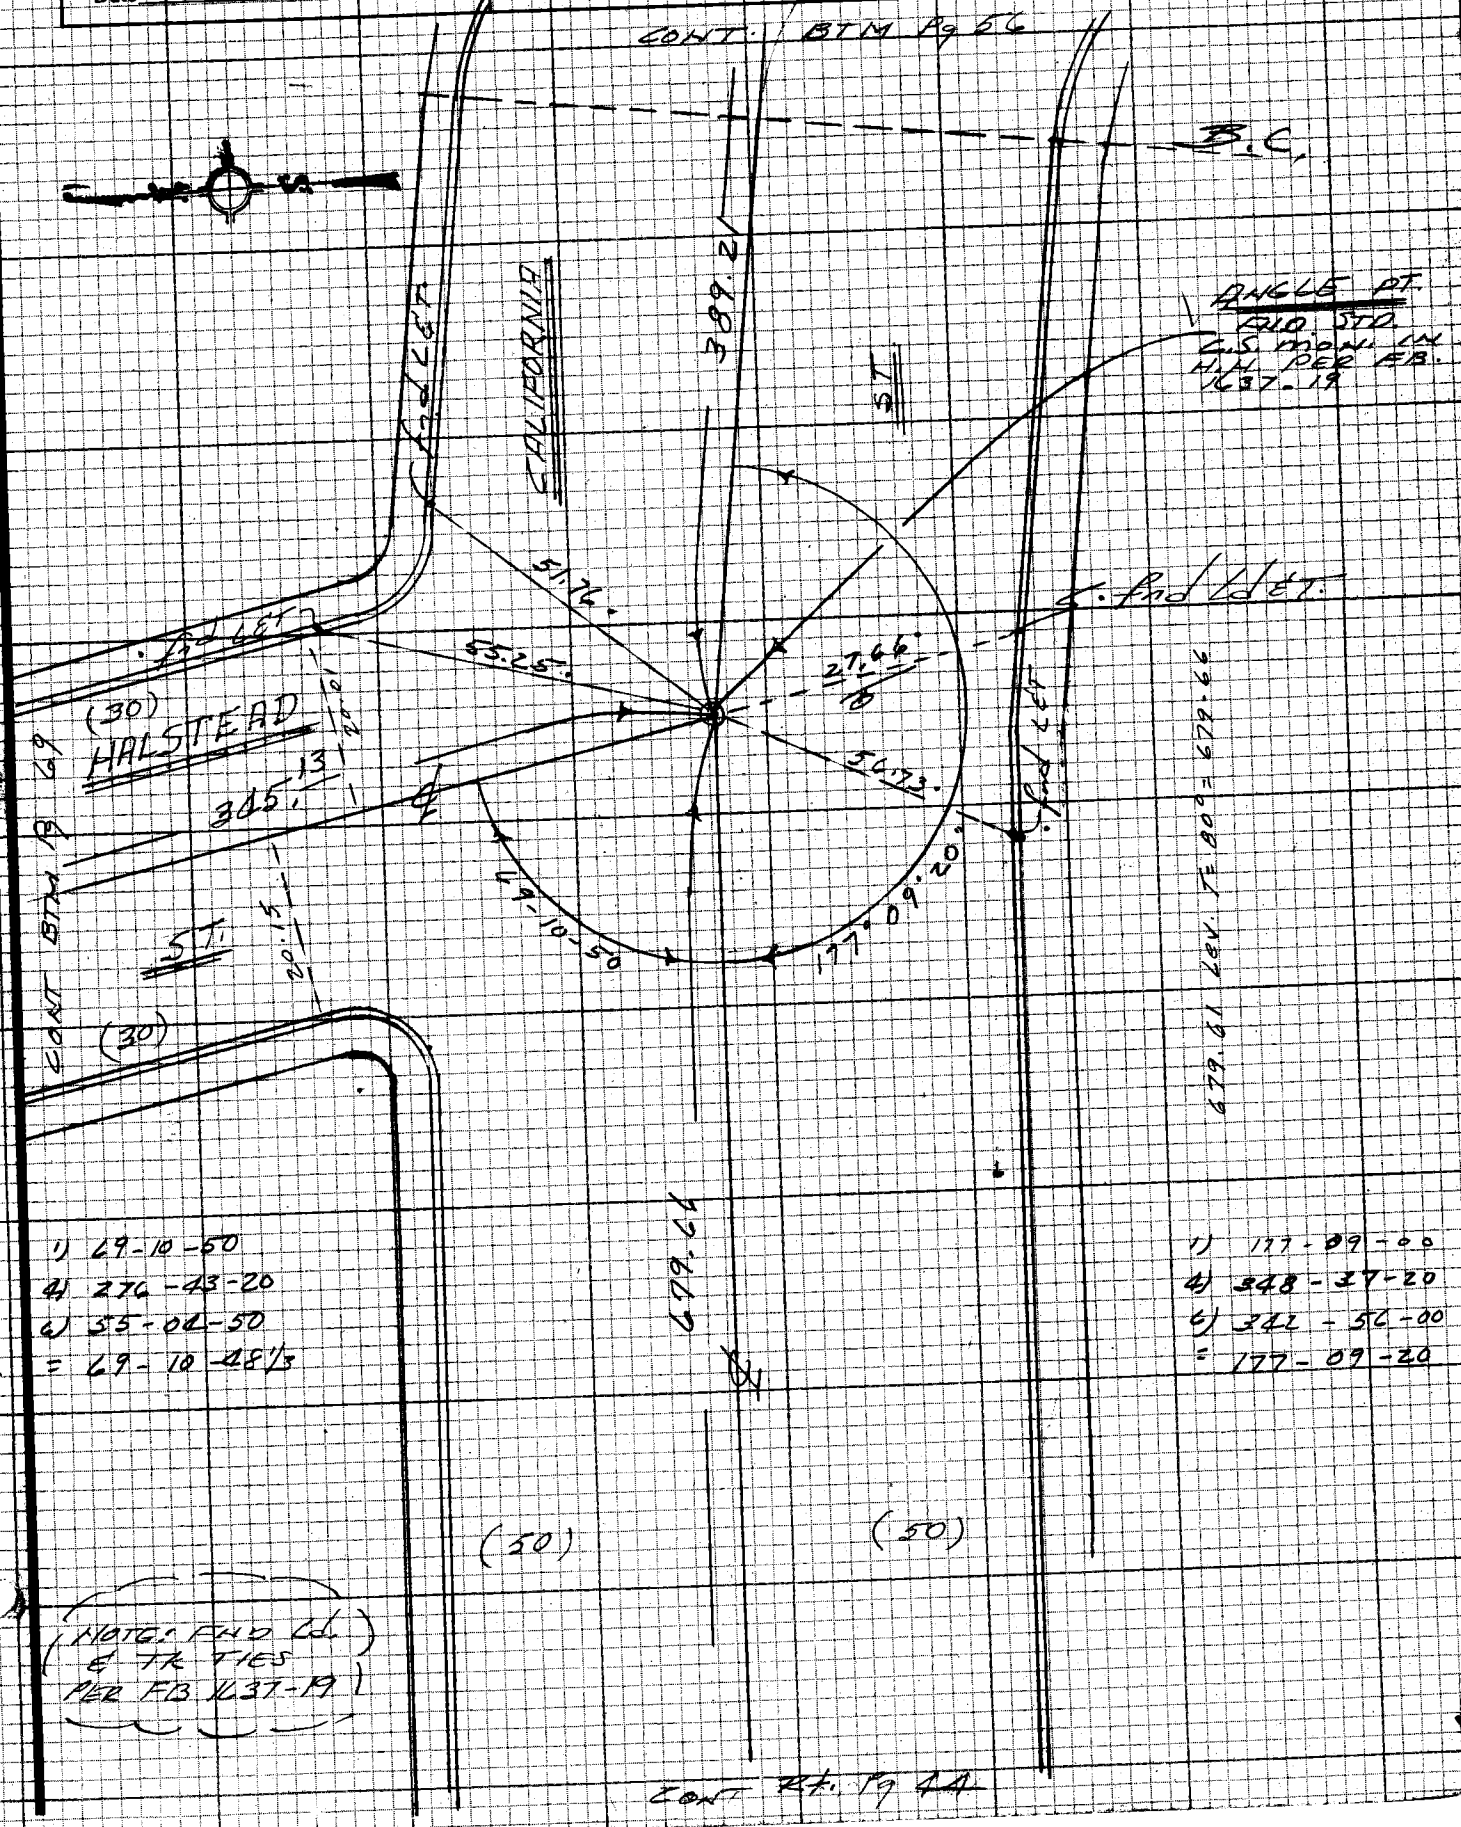


NOTE: ANY ADDITIONS OR CHANGES ON THIS SHEET MUST BE MADE OR CIRCLED IN RED INK WITH DATE AND NAME OF PERSON MAKING CHANGE

Do not extend notes on this side of this line

PLEASE RETURN TO
LOS ANGELES COUNTY ENGINEER
403 LOS ANGELES COUNTY ENGINEERING BLDG.

CENTERLINE NOTES
CE 310
76F3095-4/73

F.B. 4412 PG. 56

CE 310
76F3095-4/73

PLEASE RETURN TO
LOS ANGELES COUNTY ENGINEER
403 LOS ANGELES COUNTY ENGINEERING BLDG.

Do not extend notes this side of this line

NOTE: ANY ADDITIONS OR CHANGES ON THIS SHEET MUST BE MADE BY A CIRCLED IN RED INK WITH DATE AND NAME OF PERSON MAKING CHANGE

CONT STM. PG 29

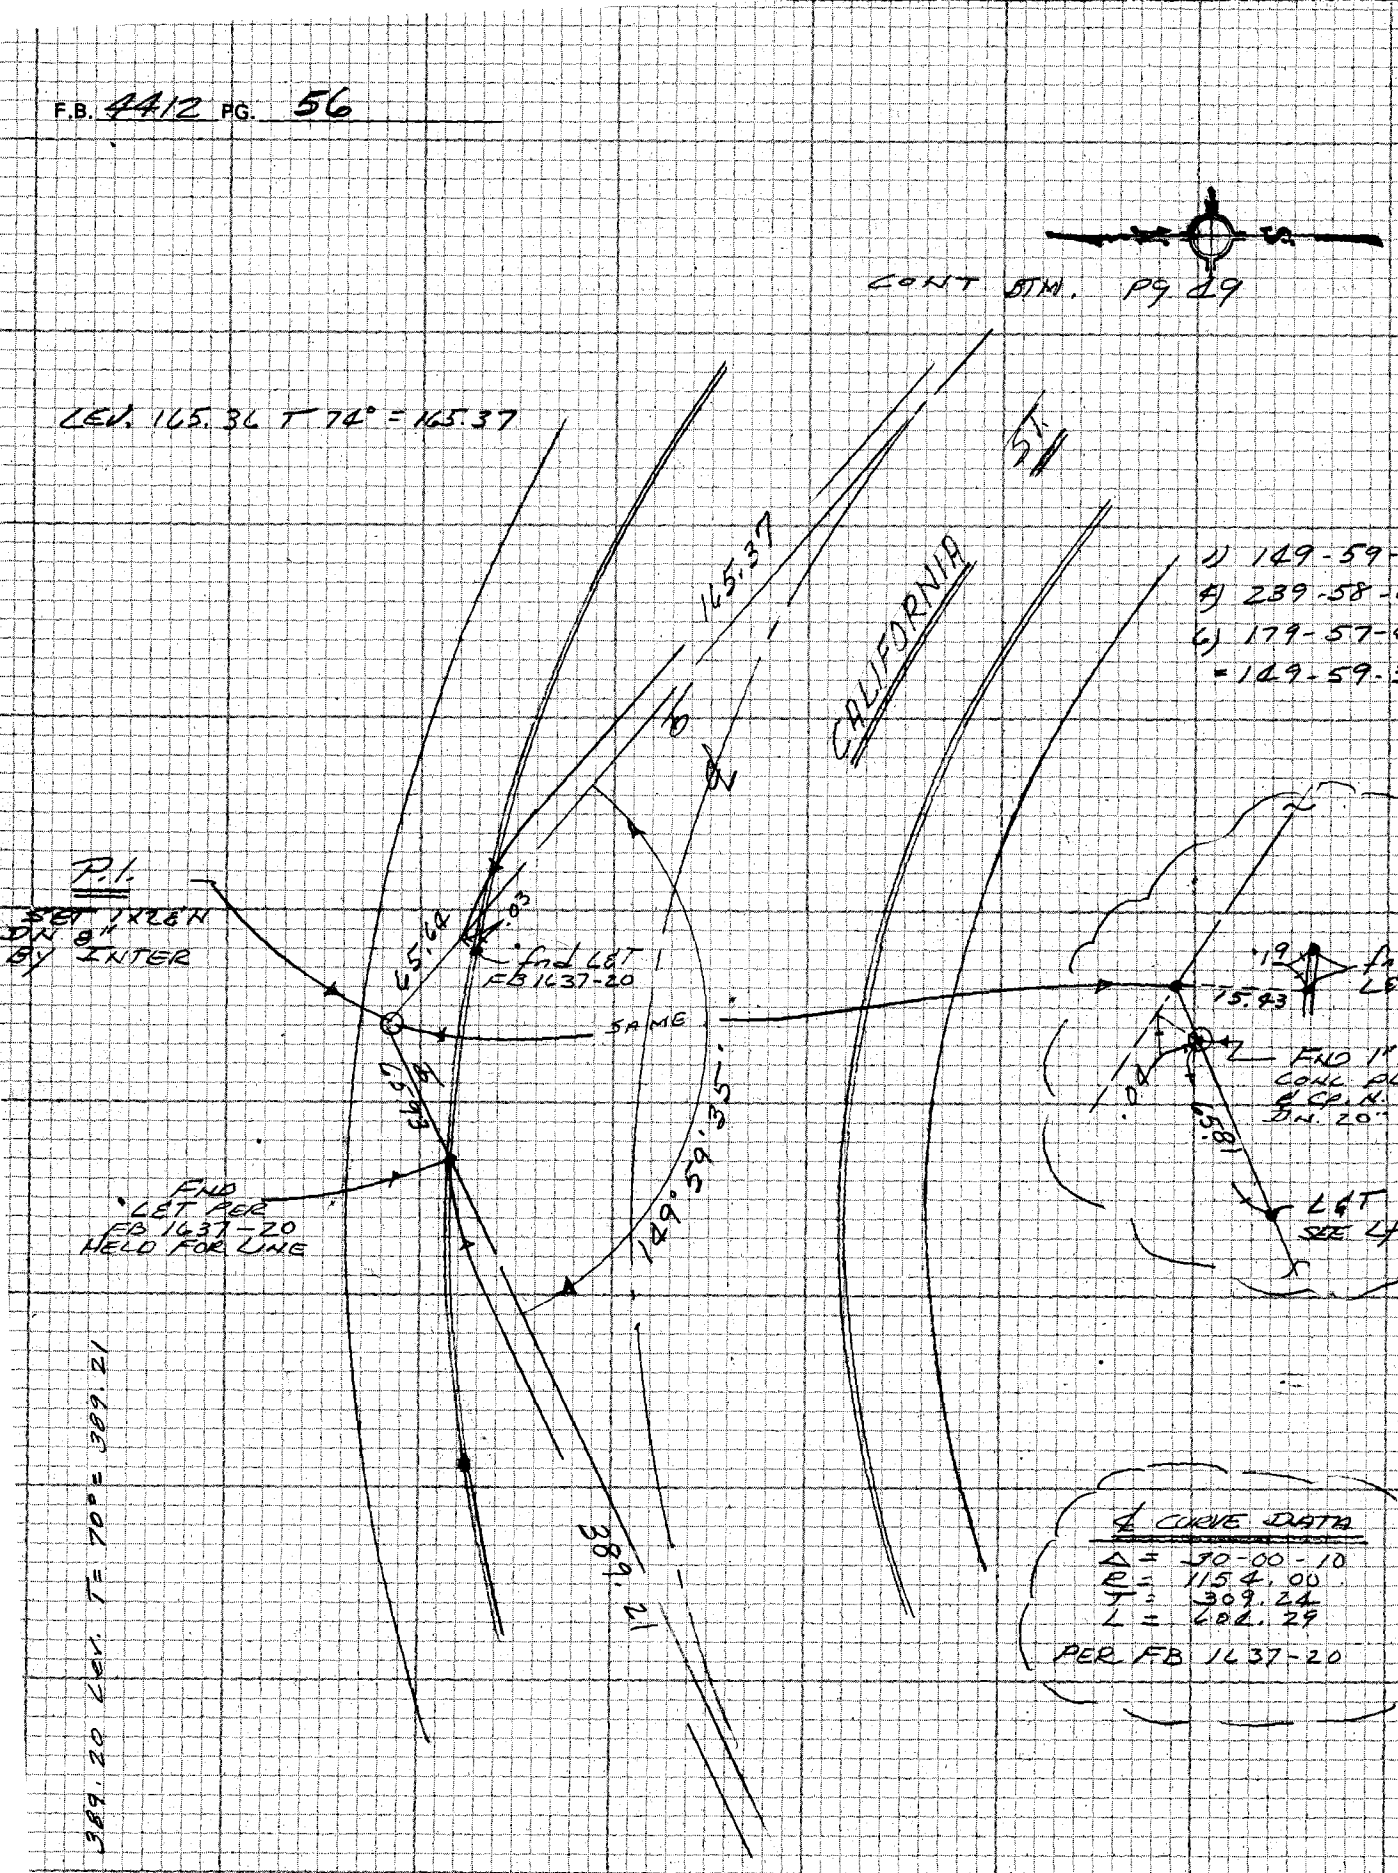


CONT TOP PG 55

| | |
|---|---|
| Notes Ck'd by | Survey of ROSEMEAD ST. ℄ DIV. 4 F.B. 4412 PG. 57 |
| Map No. | JN 0303.00 Tape 0232 Std 68 °F |
| Office Work | Surveyed by E. LANDA |
| Checked | Notes E.L. K.M. KAPP Date 8-76 |
| Date | Indexed G. D. BAILEY SEP 19 1977 |

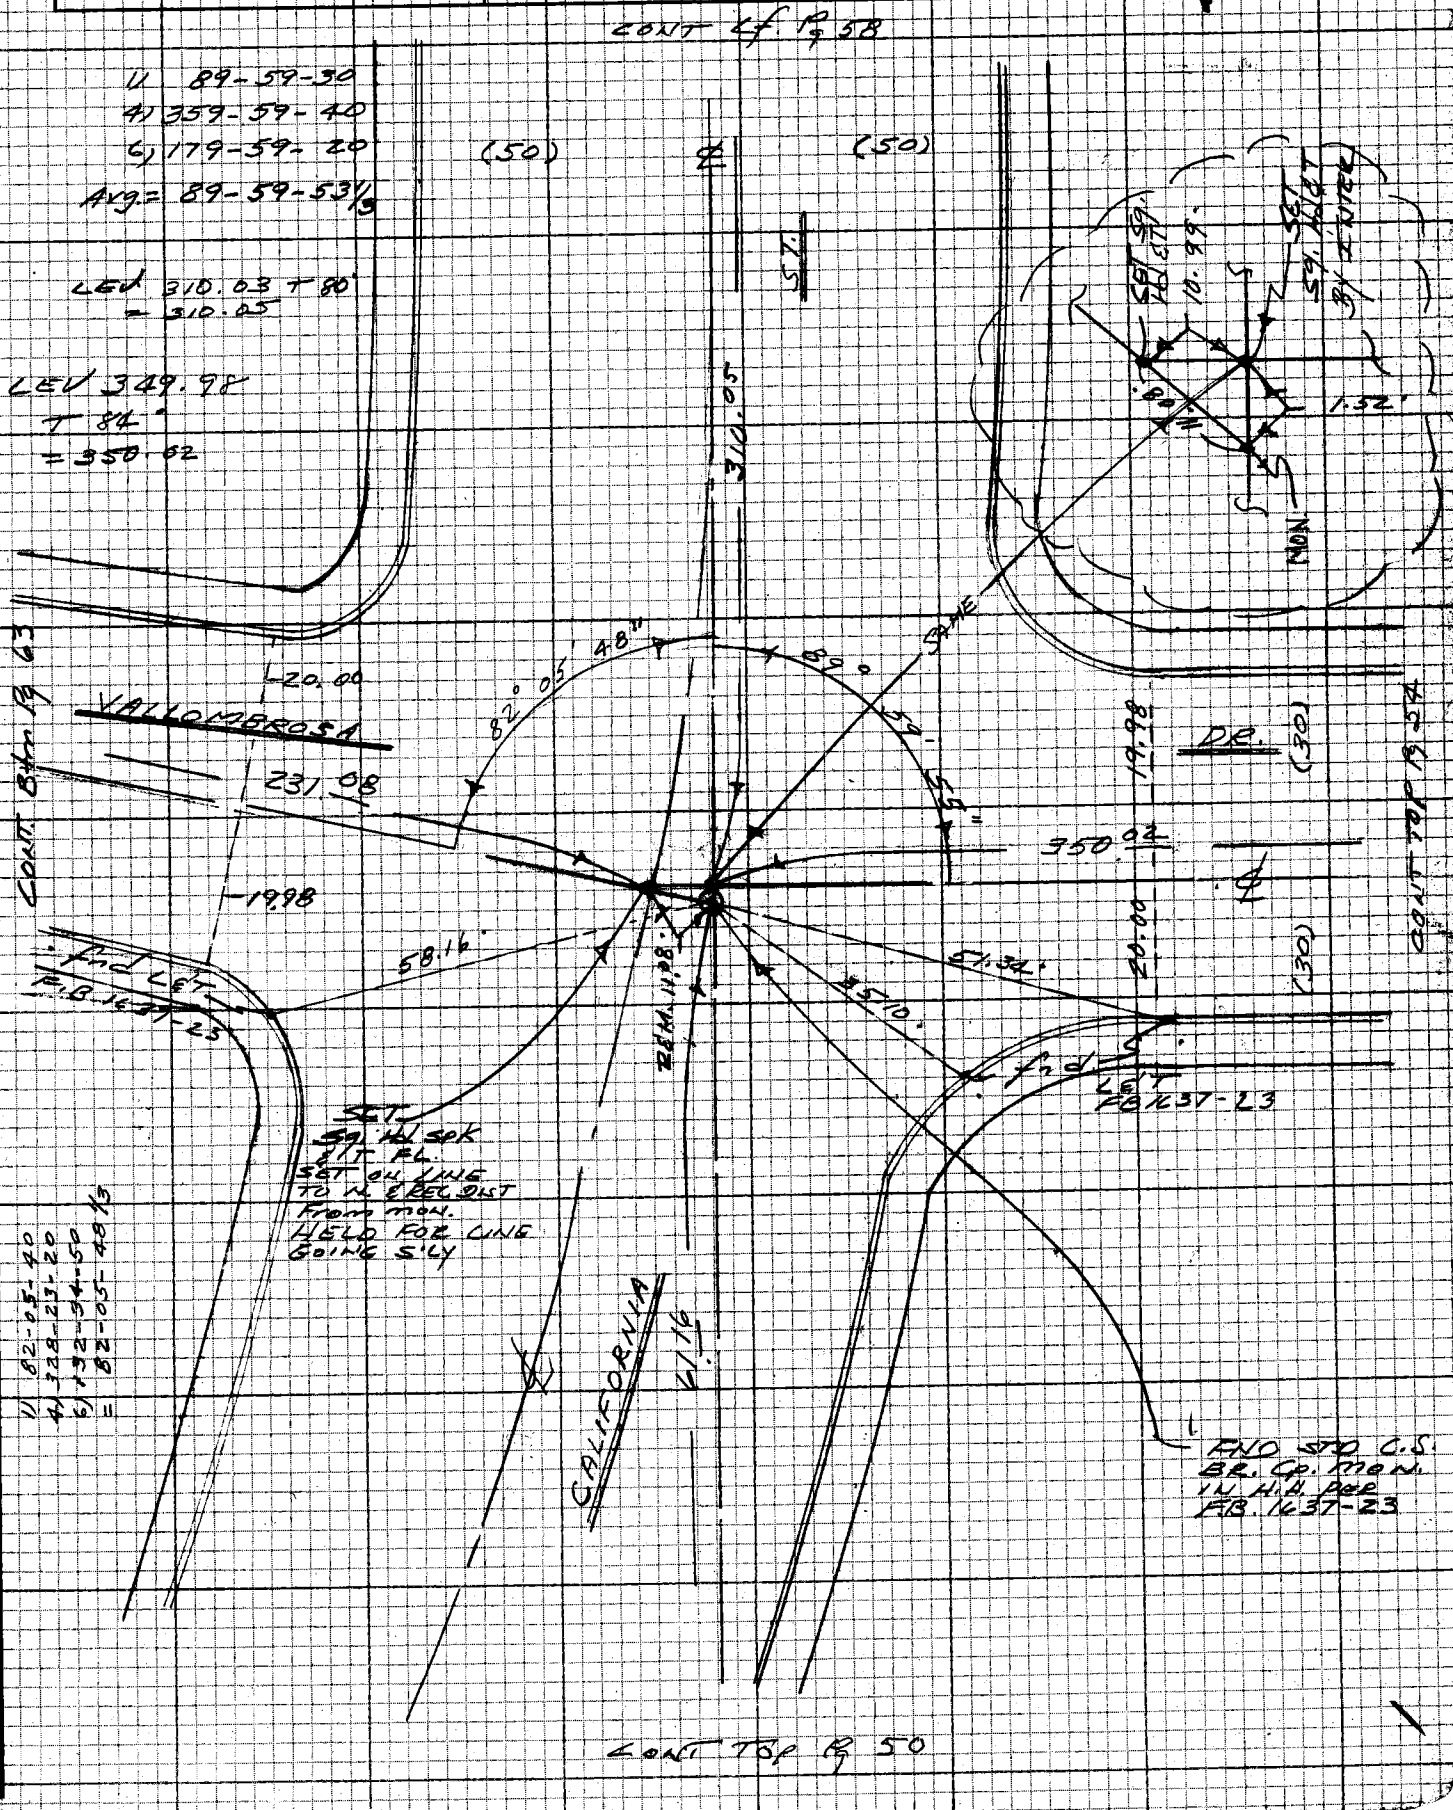


NOTE: ANY ADDITIONS OR CHANGES ON THIS SHEET MUST BE MADE OR CIRCLED IN RED INK WITH DATE AND NAME OF PERSON MAKING CHANGE

Do not extend notes on this side of this line

PLEASE RETURN TO
LOS ANGELES COUNTY ENGINEER
403 LOS ANGELES COUNTY ENGINEERING BLDG.

CENTERLINE NOTES
CE 310
76F 3095-4/73

F.B. 4412 PG. 58

Cont Btm Pg 64

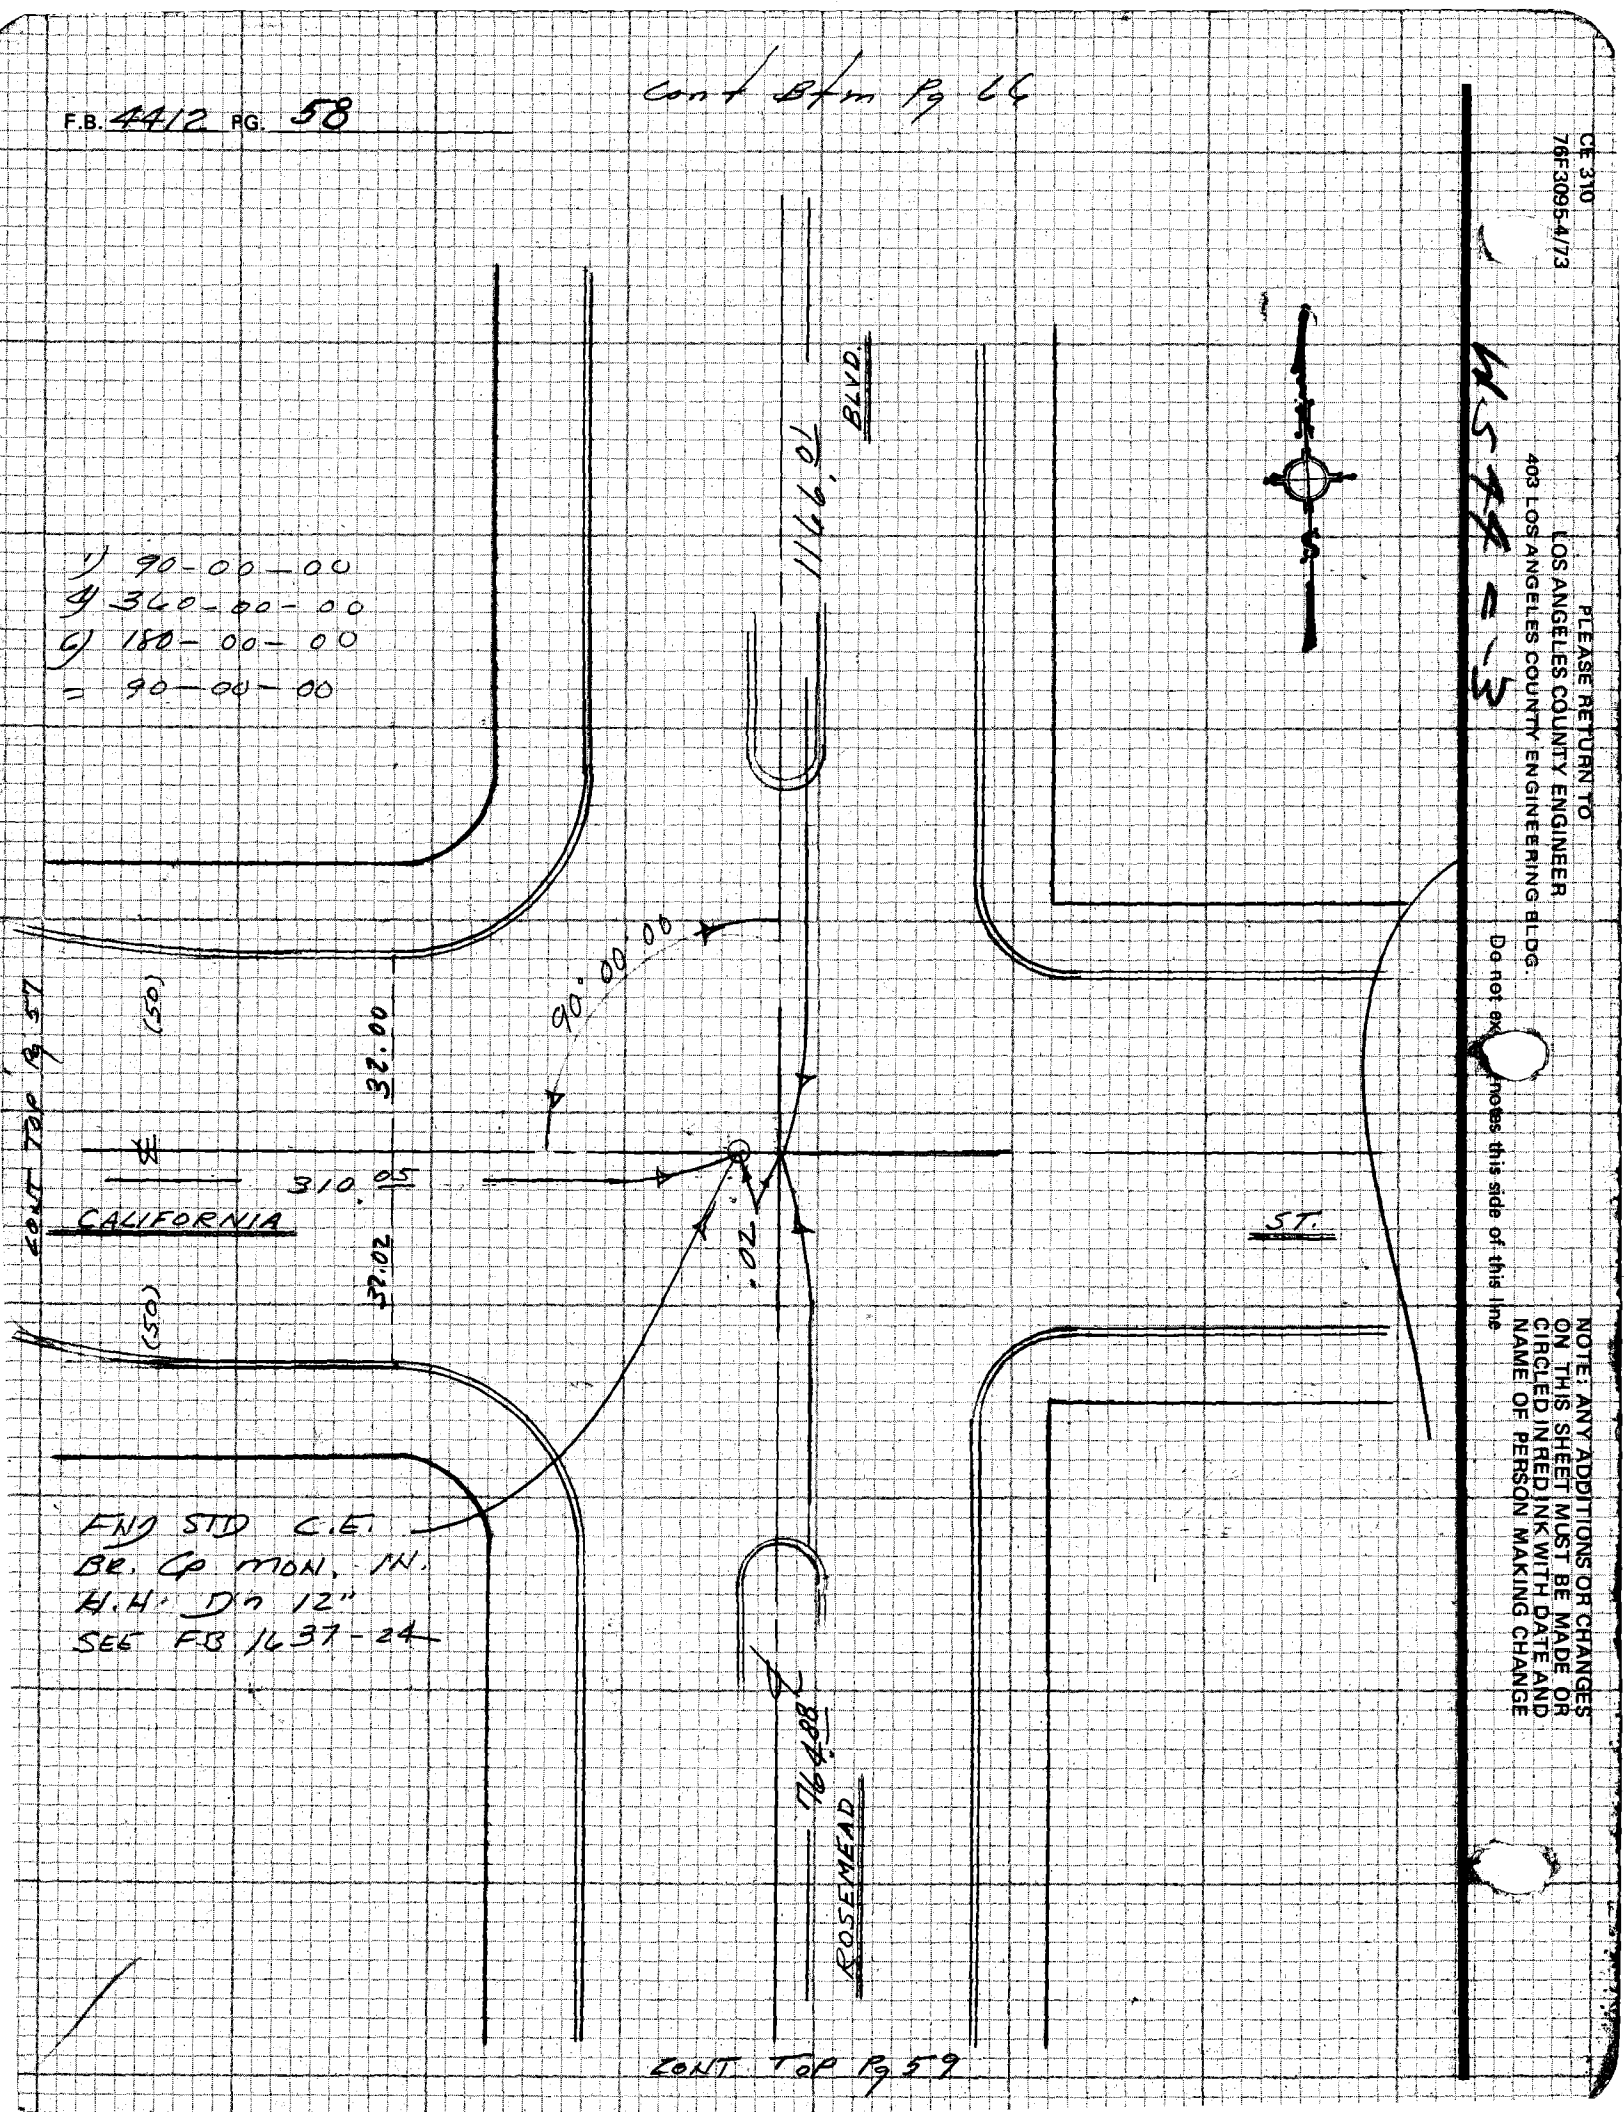


CE 310
76F3095-4/73

PLEASE RETURN TO
LOS ANGELES COUNTY ENGINEER
403 LOS ANGELES COUNTY ENGINEERING BLDG.

Do not ex... notes this side of this line

NOTE: ANY ADDITIONS OR CHANGES ON THIS SHEET MUST BE MADE OR CIRCLED IN RED INK WITH DATE AND NAME OF PERSON MAKING CHANGE

DIV. 4

| | |
|---|---|
| Notes Ck'd by | Survey of ROSEMEAD ST. ℄ |
| Map No. | JN 0303.00 Tape 0232 Std 68 °F |
| Office Work | Surveyed by E. L. |
| Checked | Notes CREASON Date 9-76 |
| Date | Indexed G. D. BAILEY SEP 19 1977 |

F.B. 4412 PG. 59

CONT. BTM. Pg. 58

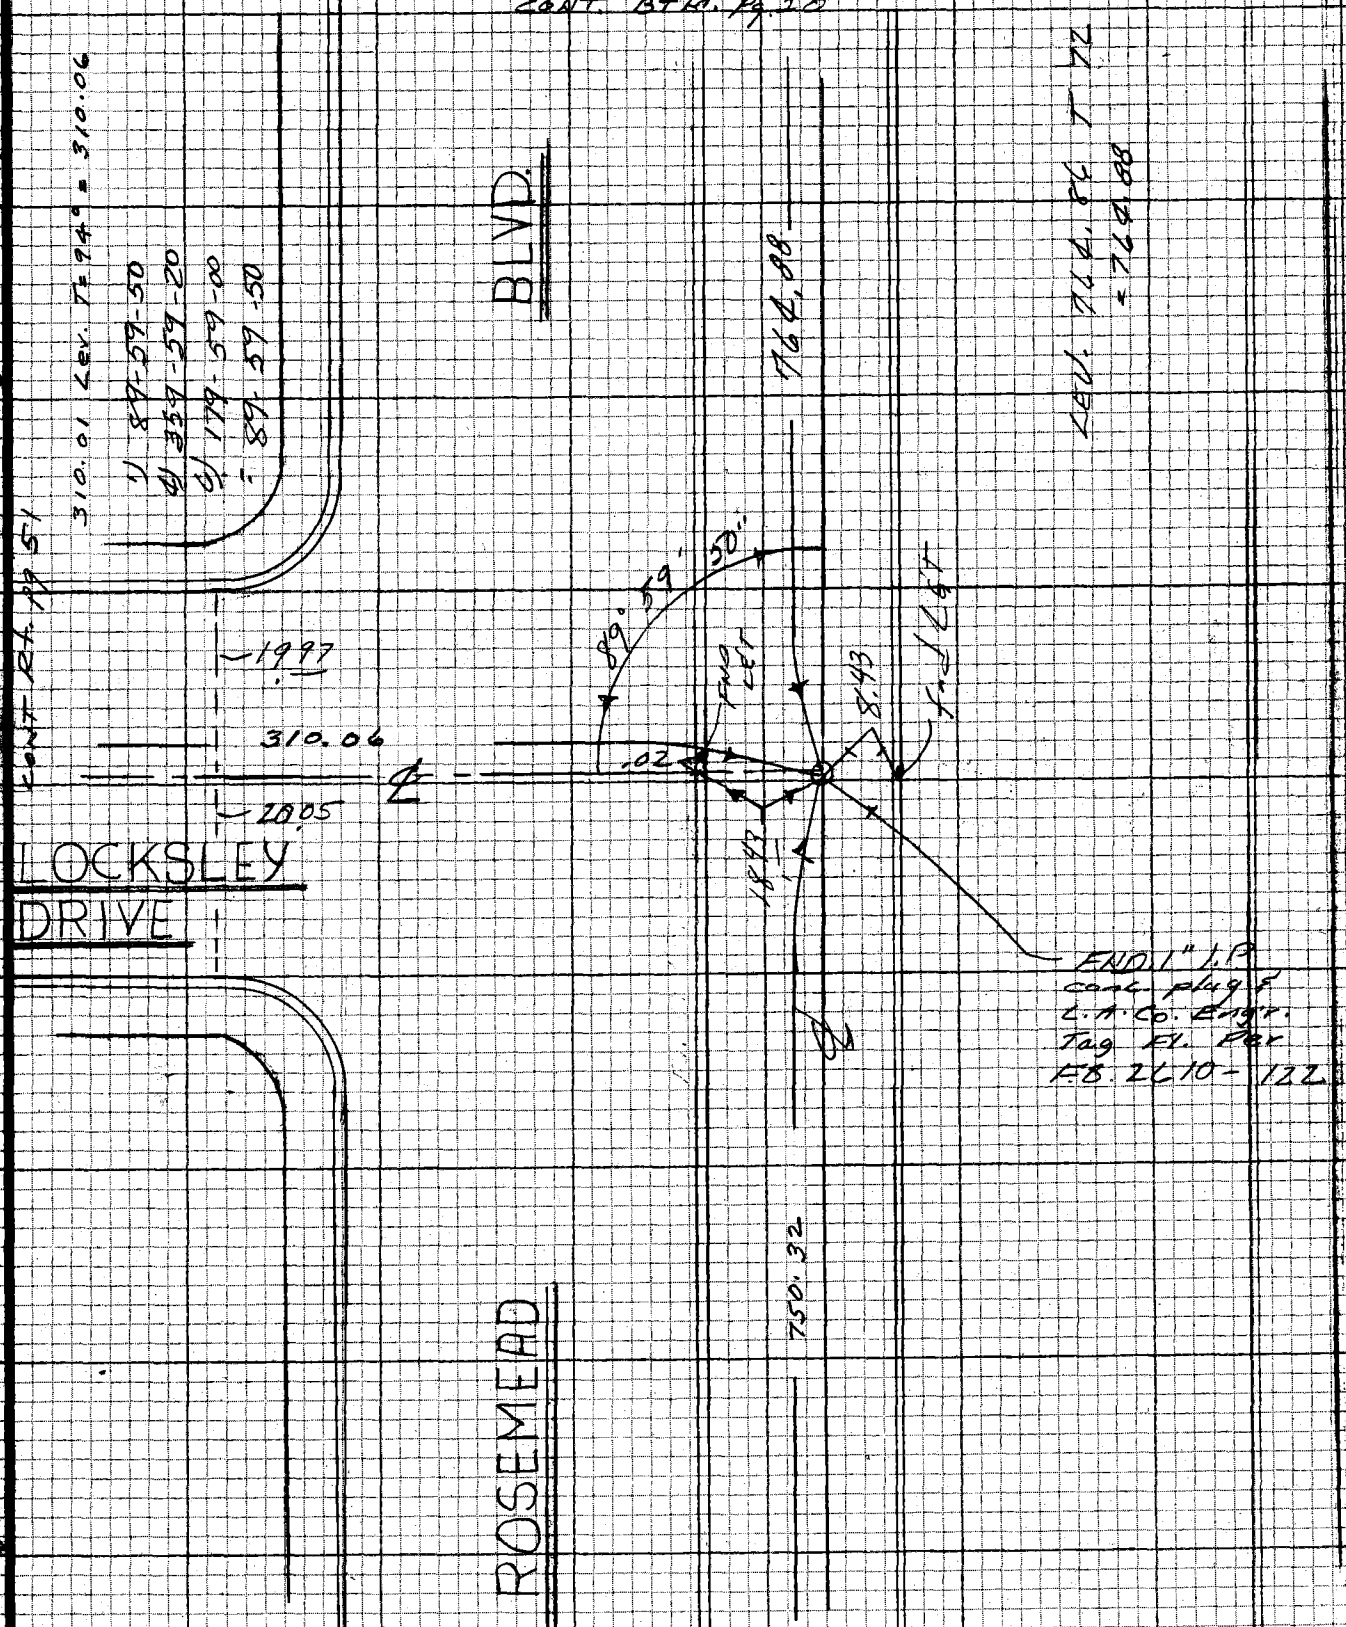


Cont Top Pg 40

NOTE: ANY ADDITIONS OR CHANGES ON THIS SHEET MUST BE MADE OR CIRCLED IN RED INK WITH DATE AND NAME OF PERSON MAKING CHANGE

Do not extend notes on this side of this line

PLEASE RETURN TO
LOS ANGELES COUNTY ENGINEER
403 LOS ANGELES COUNTY ENGINEERING BLDG.

CENTERLINE NOTES
CE 310
76F3095-4/73

F.B. 4412 PG. 60

CONT. Btm PG 65

Note: Fd. Ties Per F.B. 1637-25

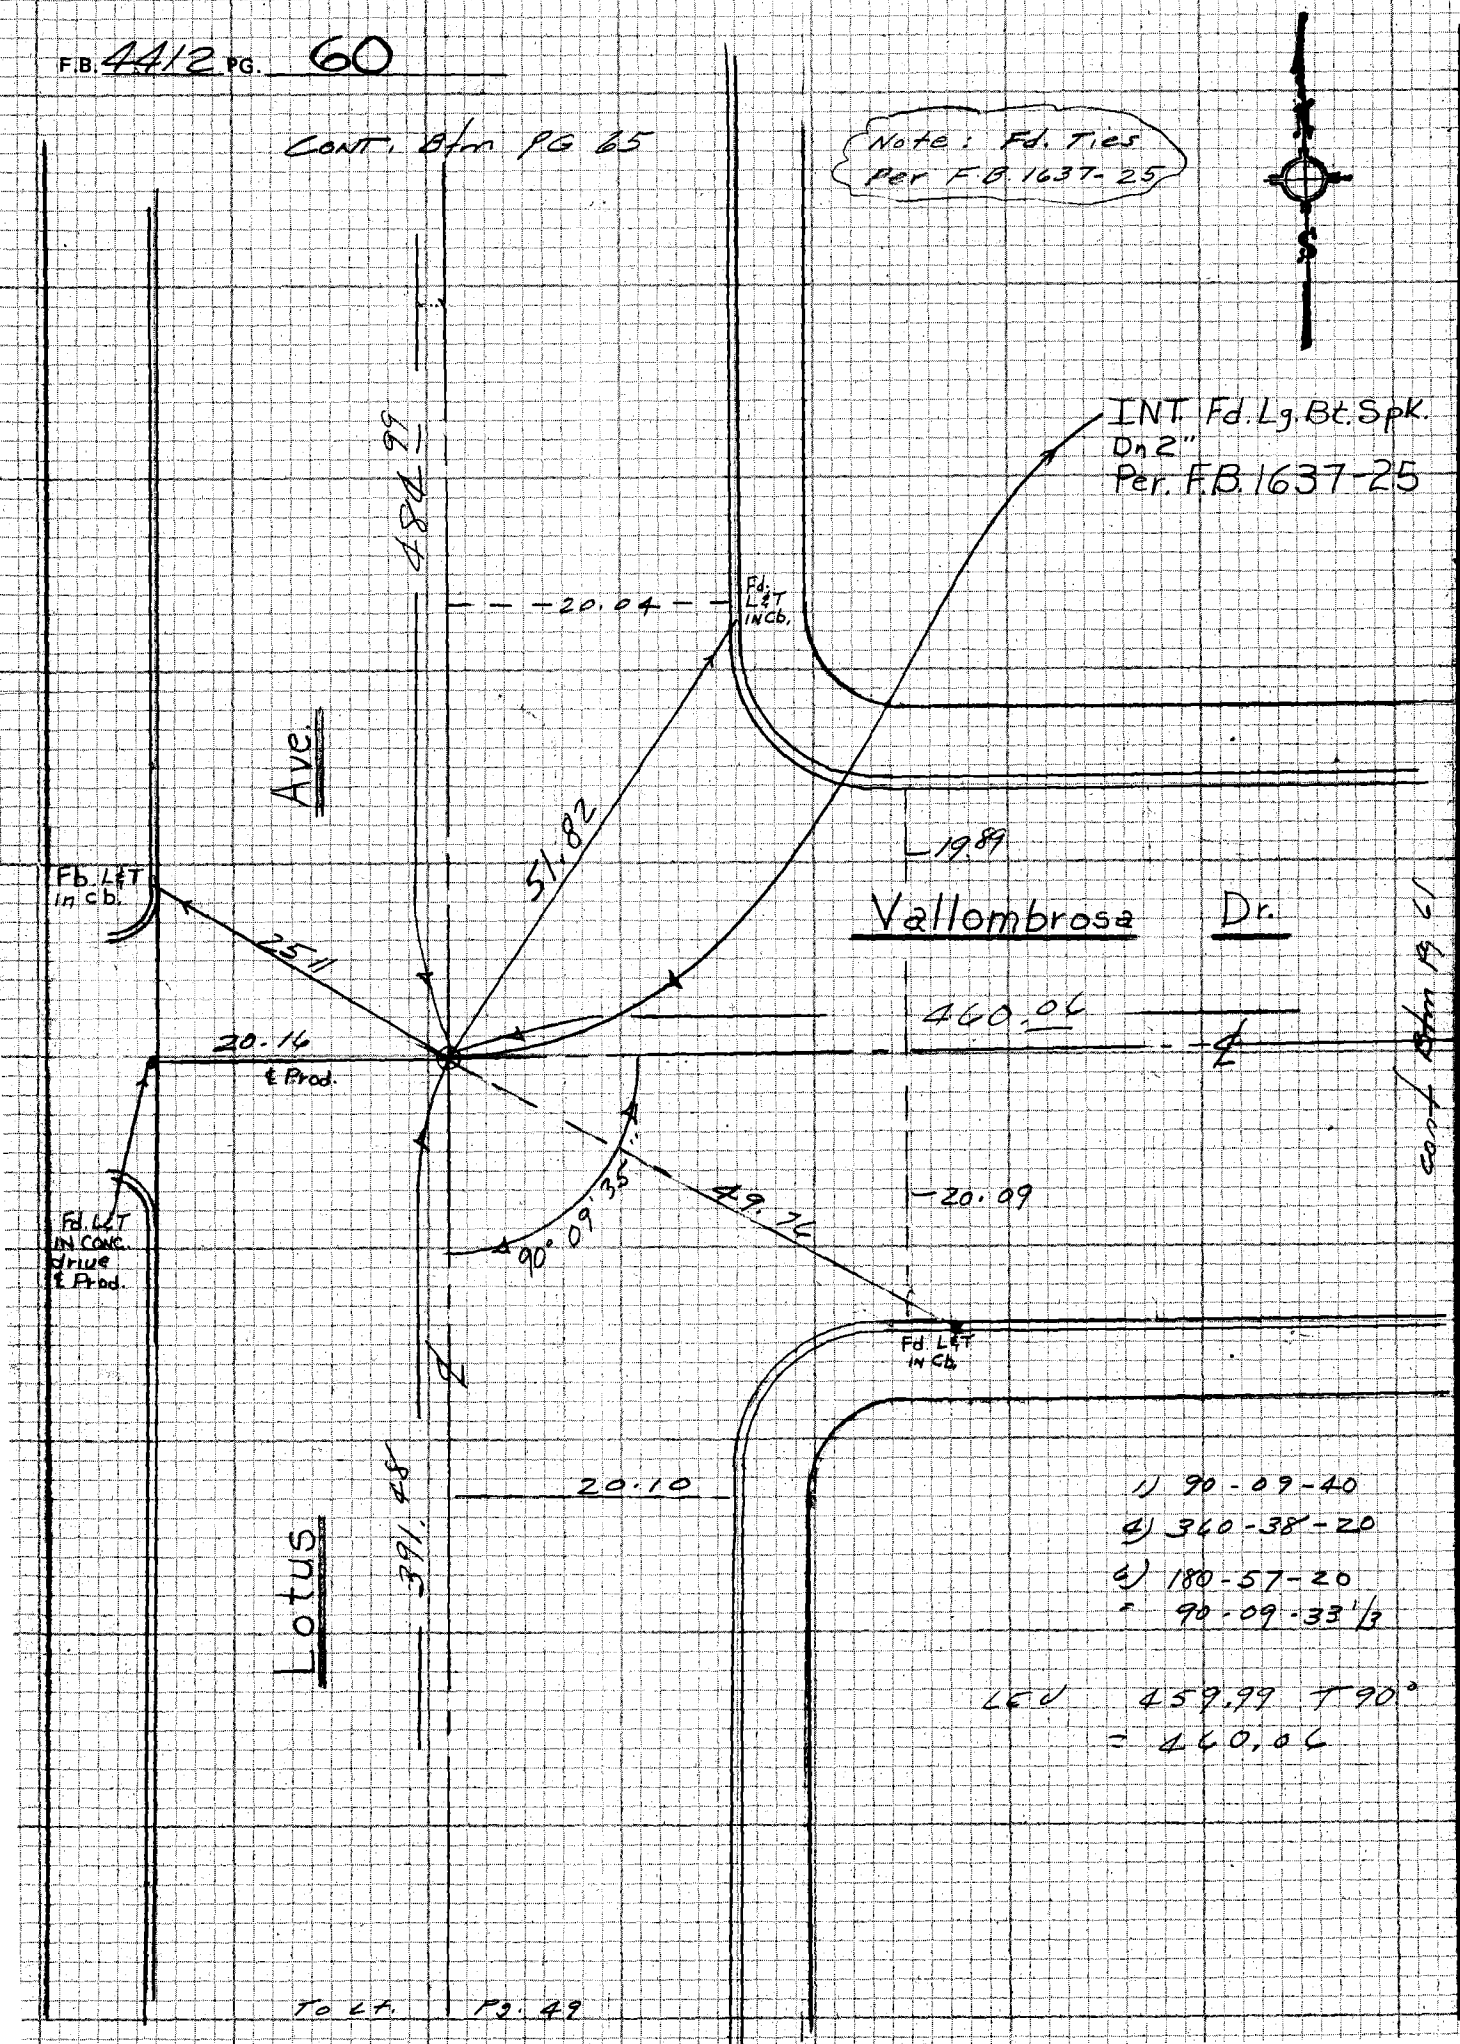


1) 90-09-40
4) 360-38-20
6) 180-57-20
= 90-09-33 1/3

LEV 459.99 T 90°
= 460.06

To Lt. Pg. 49


CE 310
76F3095-4/73
PLEASE RETURN TO
LOS ANGELES COUNTY ENGINEER
403 LOS ANGELES COUNTY ENGINEERING BLDG.
Do not ex[illegible] notes this side of this line
NOTE: ANY ADDITIONS OR CHANGES ON THIS SHEET MUST BE MADE OR CIRCLED IN RED INK WITH DATE AND NAME OF PERSON MAKING CHANGE

DIV 4

| | |
|---|---|
| Notes Ck'd by | Survey of TROSEMEAD ST ℄ F.B. 4412 PG. 61 |
| Map No. | JN 0303.00 Tape 0232 Std 68° F |
| Office Work | Surveyed by E. LANDA |
| Checked | Notes E. LANDA Date 8-76 |
| Date | Indexed G. D. BAILEY SEP 19 1977 |

LEV. 141.13 + 86°
= 141.15

Cont Btm Pg 62

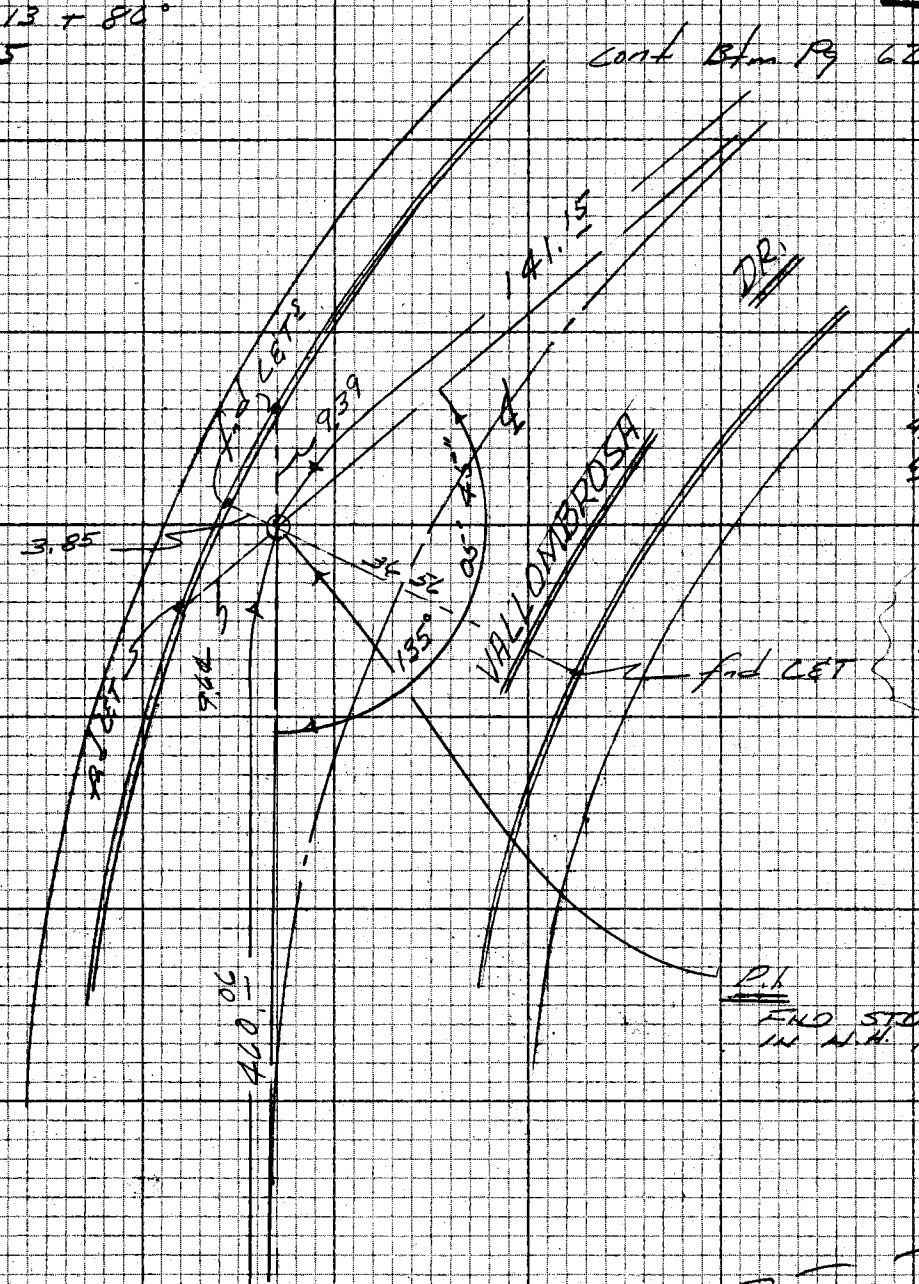


1) 135-05-40
2) 180-23-00
3) 90-34-40
= 135-05-46 2/3

NOTE: FOR THE INFO SEE FB 1637-26

P.I.
FND STD C.S. MON. IN N.H. PER FB 1637-26

℄ CURVE DATA
Δ = 44-54-30
R = 200.00
L = 156.76
T = 82.66
PER FB 1637-26

Cont Rt Pg 60

NOTE: ANY ADDITIONS OR CHANGES ON THIS SHEET MUST BE MADE OR CIRCLED IN RED INK WITH DATE AND NAME OF PERSON MAKING CHANGE
Do not extend notes on this side of this line
PLEASE RETURN TO LOS ANGELES COUNTY ENGINEER 403 LOS ANGELES COUNTY ENGINEERING BLDG.
CENTERLINE NOTES CE 310 76F3095-4/73

F.B. 4412 PG. 62

LEV. 141.11 T86 = 141.13
LEV. 242.66 T86 = 242.69

Note: Fd. Ties
Per F.B. 1637-27

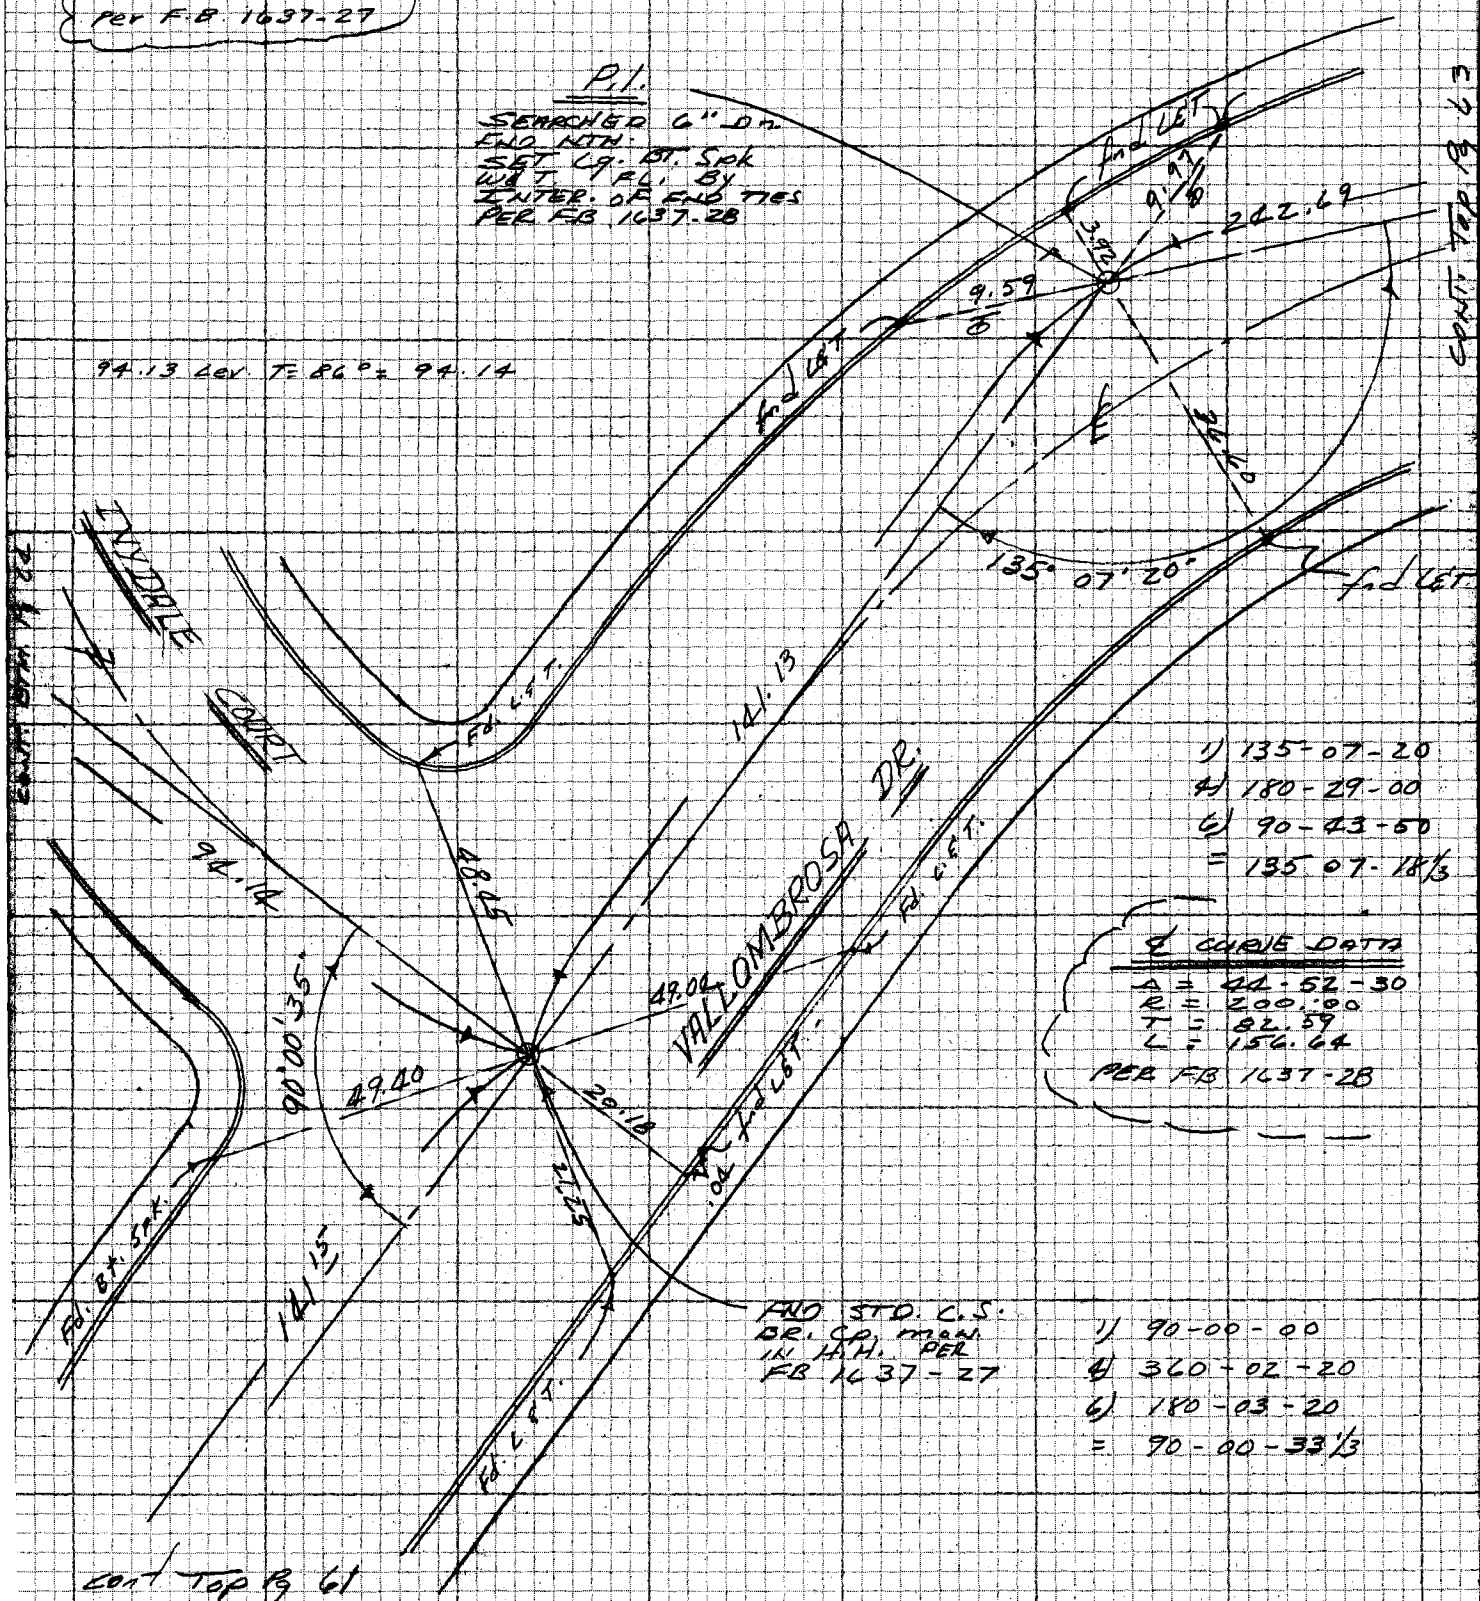


1) 135-07-20
4) 180-29-00
6) 90-43-50
= 135 07-18 1/3

℄ CURVE DATA
Δ = 44-52-30
R = 200.00
T = 82.59
L = 156.64
PER FB 1637-28

1) 90-00-00
4) 360-02-20
6) 180-03-20
= 90-00-33 1/3

Cont Top Pg 61

Cont Top Pg 63

PLEASE RETURN TO
LOS ANGELES COUNTY ENGINEER
403 LOS ANGELES COUNTY ENGINEERING BLDG.
Do not ex... notes this side of this line
NOTE: ANY ADDITIONS OR CHANGES ON THIS SHEET MUST BE MADE OR CIRCLED IN RED INK WITH DATE AND NAME OF PERSON MAKING CHANGE
76F3095-4/73

DIV 4

| | |
|---|---|
| Notes Ck'd by | Survey of ROSEMEAD ST ℄ |
| Map No. | JN 0303.00 Tape 0232 Std 68 °F |
| Office Work | Surveyed by E. LANDA |
| Checked | Notes E. LANDA Date 8-76 |
| Date | Indexed S. D. BAILEY SEP 19 1977 |

E.B. 4412 PG. 63

NOTE: ANY ADDITIONS OR CHANGES ON THIS SHEET MUST BE MADE OR CIRCLED IN RED INK WITH DATE AND NAME OF PERSON MAKING CHANGE

WS 42 C-3

Do not extend notes across this line

PLEASE RETURN TO
LOS ANGELES COUNTY ENGINEER
403 LOS ANGELES COUNTY ENGINEERING BLDG.

CENTERLINE NOTES
CE 310
76F-3095-4/73

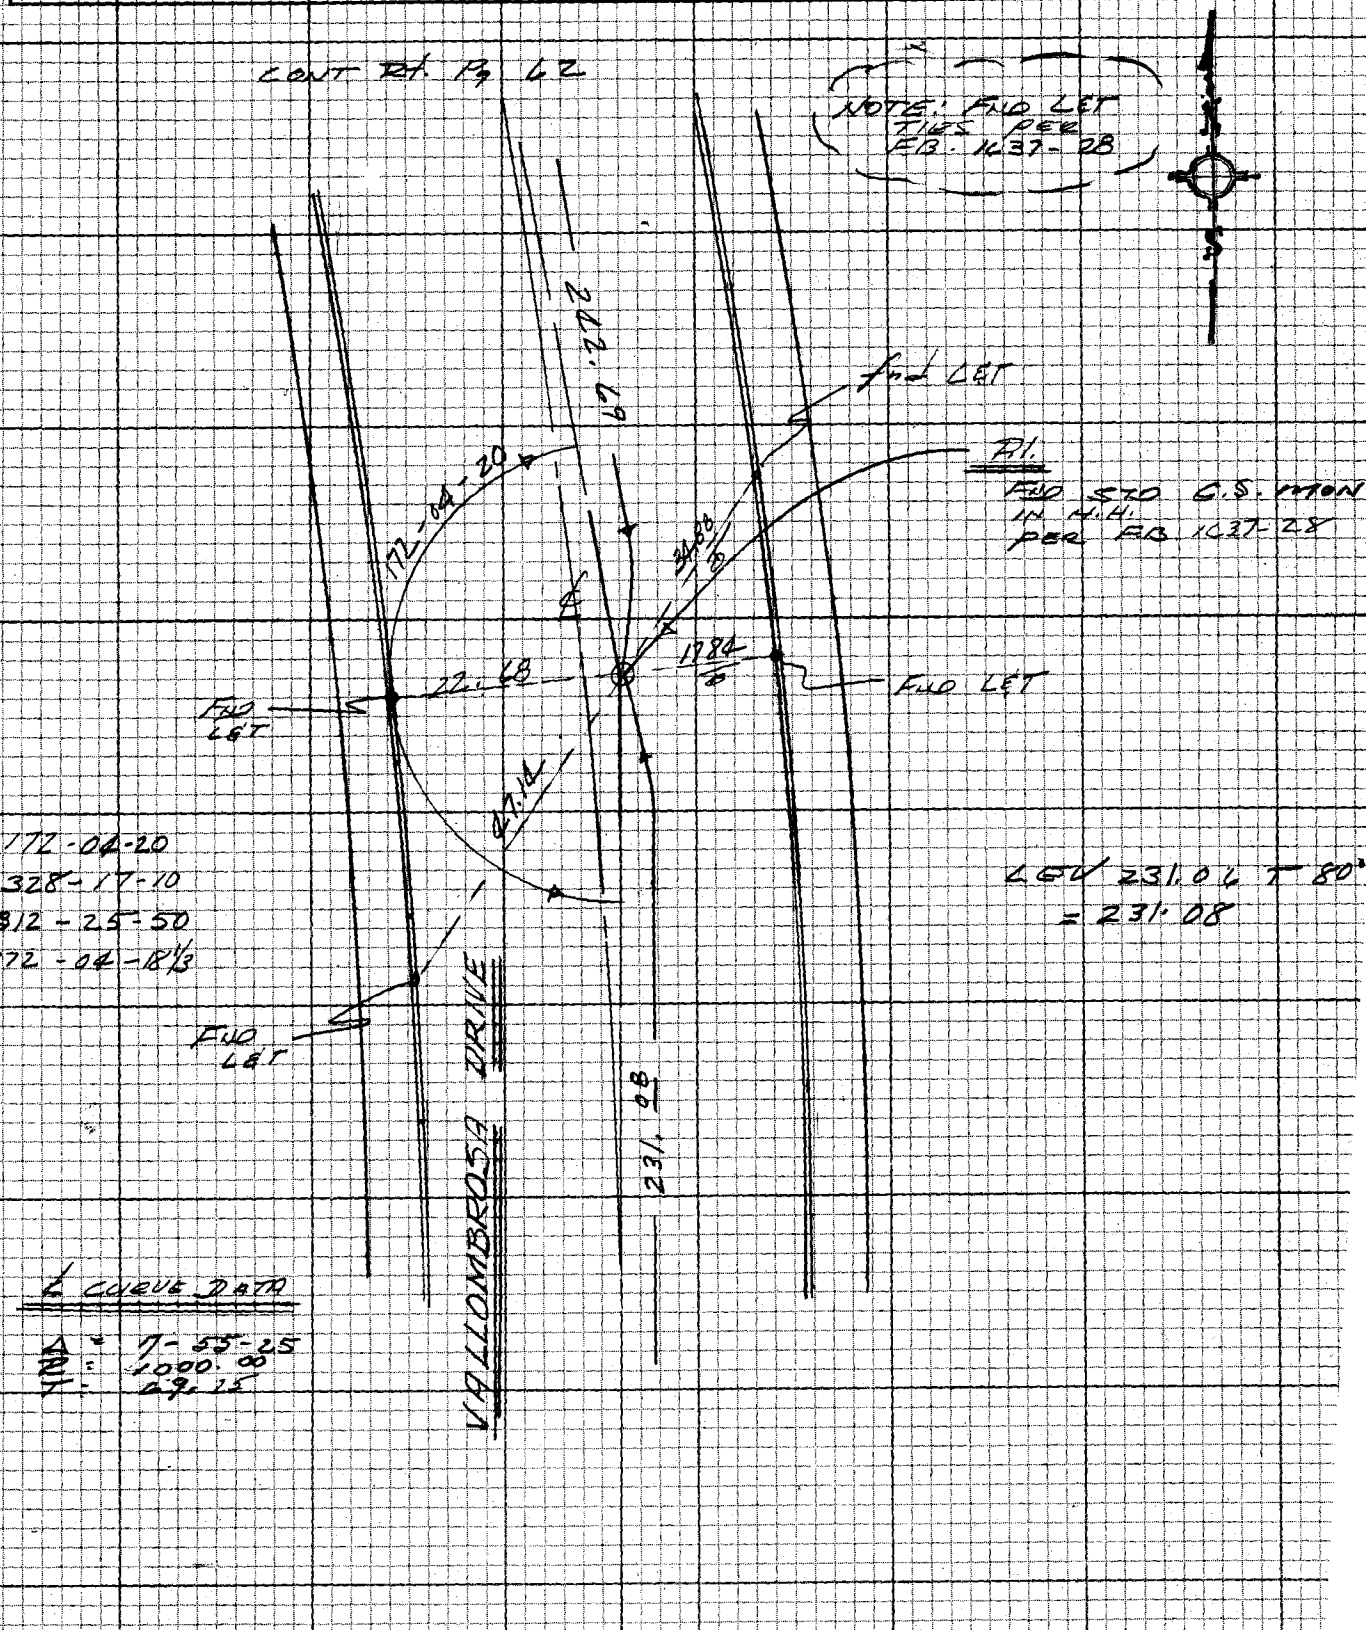


Cont. ℄ of Pg 57

F.B. 4412 PG. 64

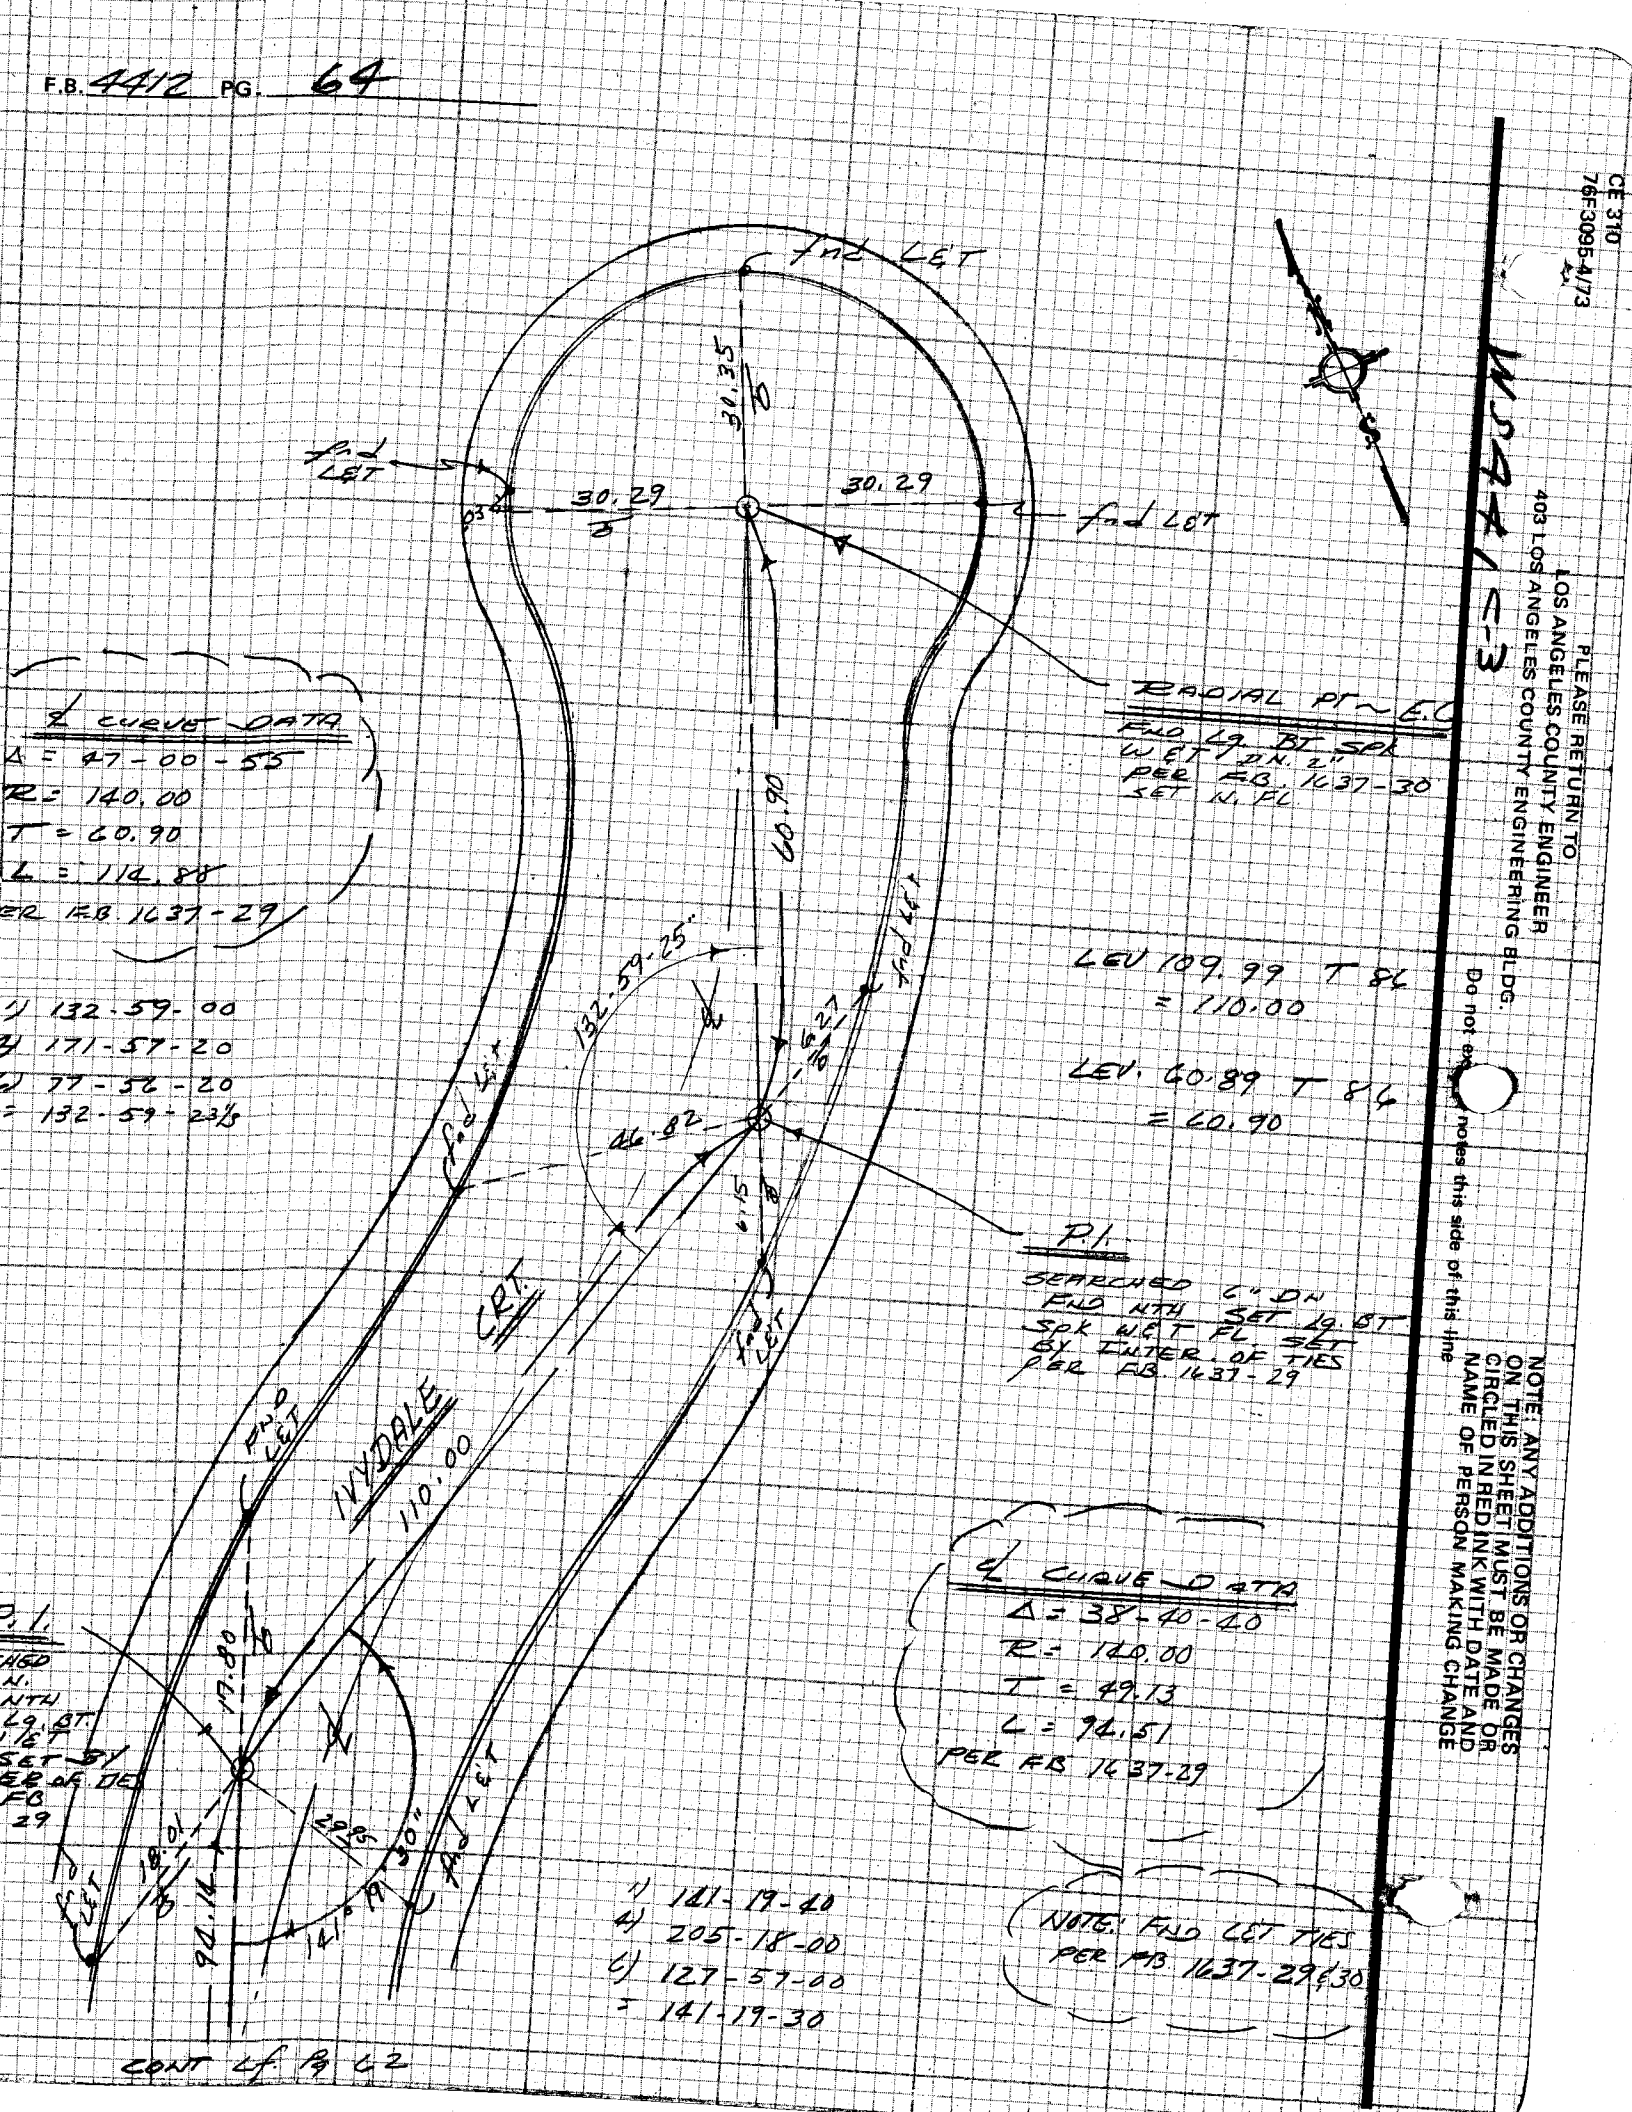


CE 310
76F3095-4/73

LOS ANGELES COUNTY ENGINEER
403 LOS ANGELES COUNTY ENGINEERING BLDG.

PLEASE RETURN TO

Do not ex notes this side of this line

NOTE: ANY ADDITIONS OR CHANGES ON THIS SHEET MUST BE MADE OR CIRCLED IN RED INK WITH DATE AND NAME OF PERSON MAKING CHANGE

DIV 4

F.B. 4412 PG. 65

| | |
|---|---|
| Notes Ck'd by | Survey of ROSEMEAD ST ℄ |
| Map No. | JN 0303.00 Tape 0232 Std 68 °F |
| Office Work | Surveyed by E. LANDA |
| Checked | Notes E. LANDA Date 9-76 |
| Date | Indexed G. D. BAILEY SEP 19 1977 |

Cont Btm Pg 73

1) 89-49-00
4) 359-15-20
6) 178-53-00
= 89-48-50

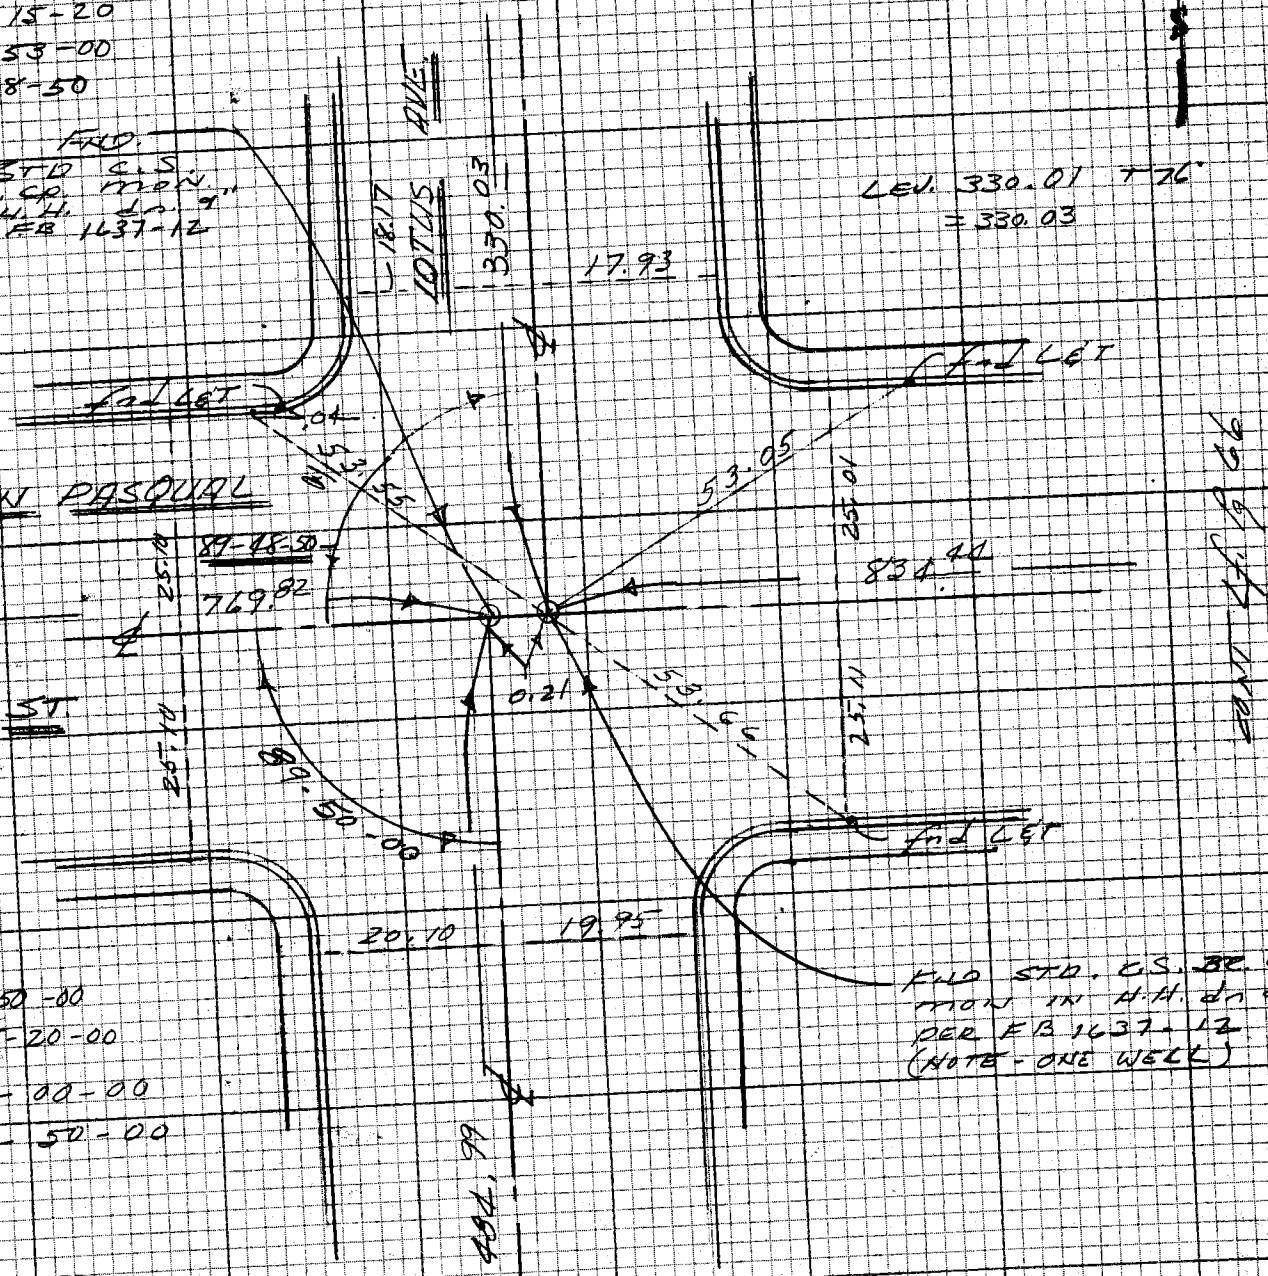


CONT. Rt. Pg. 70

CONT Lt. Pg 66

1) 89-50-00
4) 359-20-00
6) 179-00-00
= 89-50-00

LEV. 484.97 T 74°
= 484.99

LEV. 834.39 T 78°
= 834.44

NOTE: FOR ALLEYS SEE FR 1637-12

CONT Top Pg 60

NOTE: ANY ADDITIONS OR CHANGES ON THIS SHEET MUST BE MADE OR CIRCLED IN RED INK WITH DATE AND NAME OF PERSON MAKING CHANGE

W544, C-3

Do not extend notes this side of this line

PLEASE RETURN TO
LOS ANGELES COUNTY ENGINEER
403 LOS ANGELES COUNTY ENGINEERING BLDG.

CENTERLINE NOTES
CE 310
76F 3095-4/73

F.B. 4412 PG. 66

Cont Btm Pg 74

99.98 Lev. T = 80° = 99.99

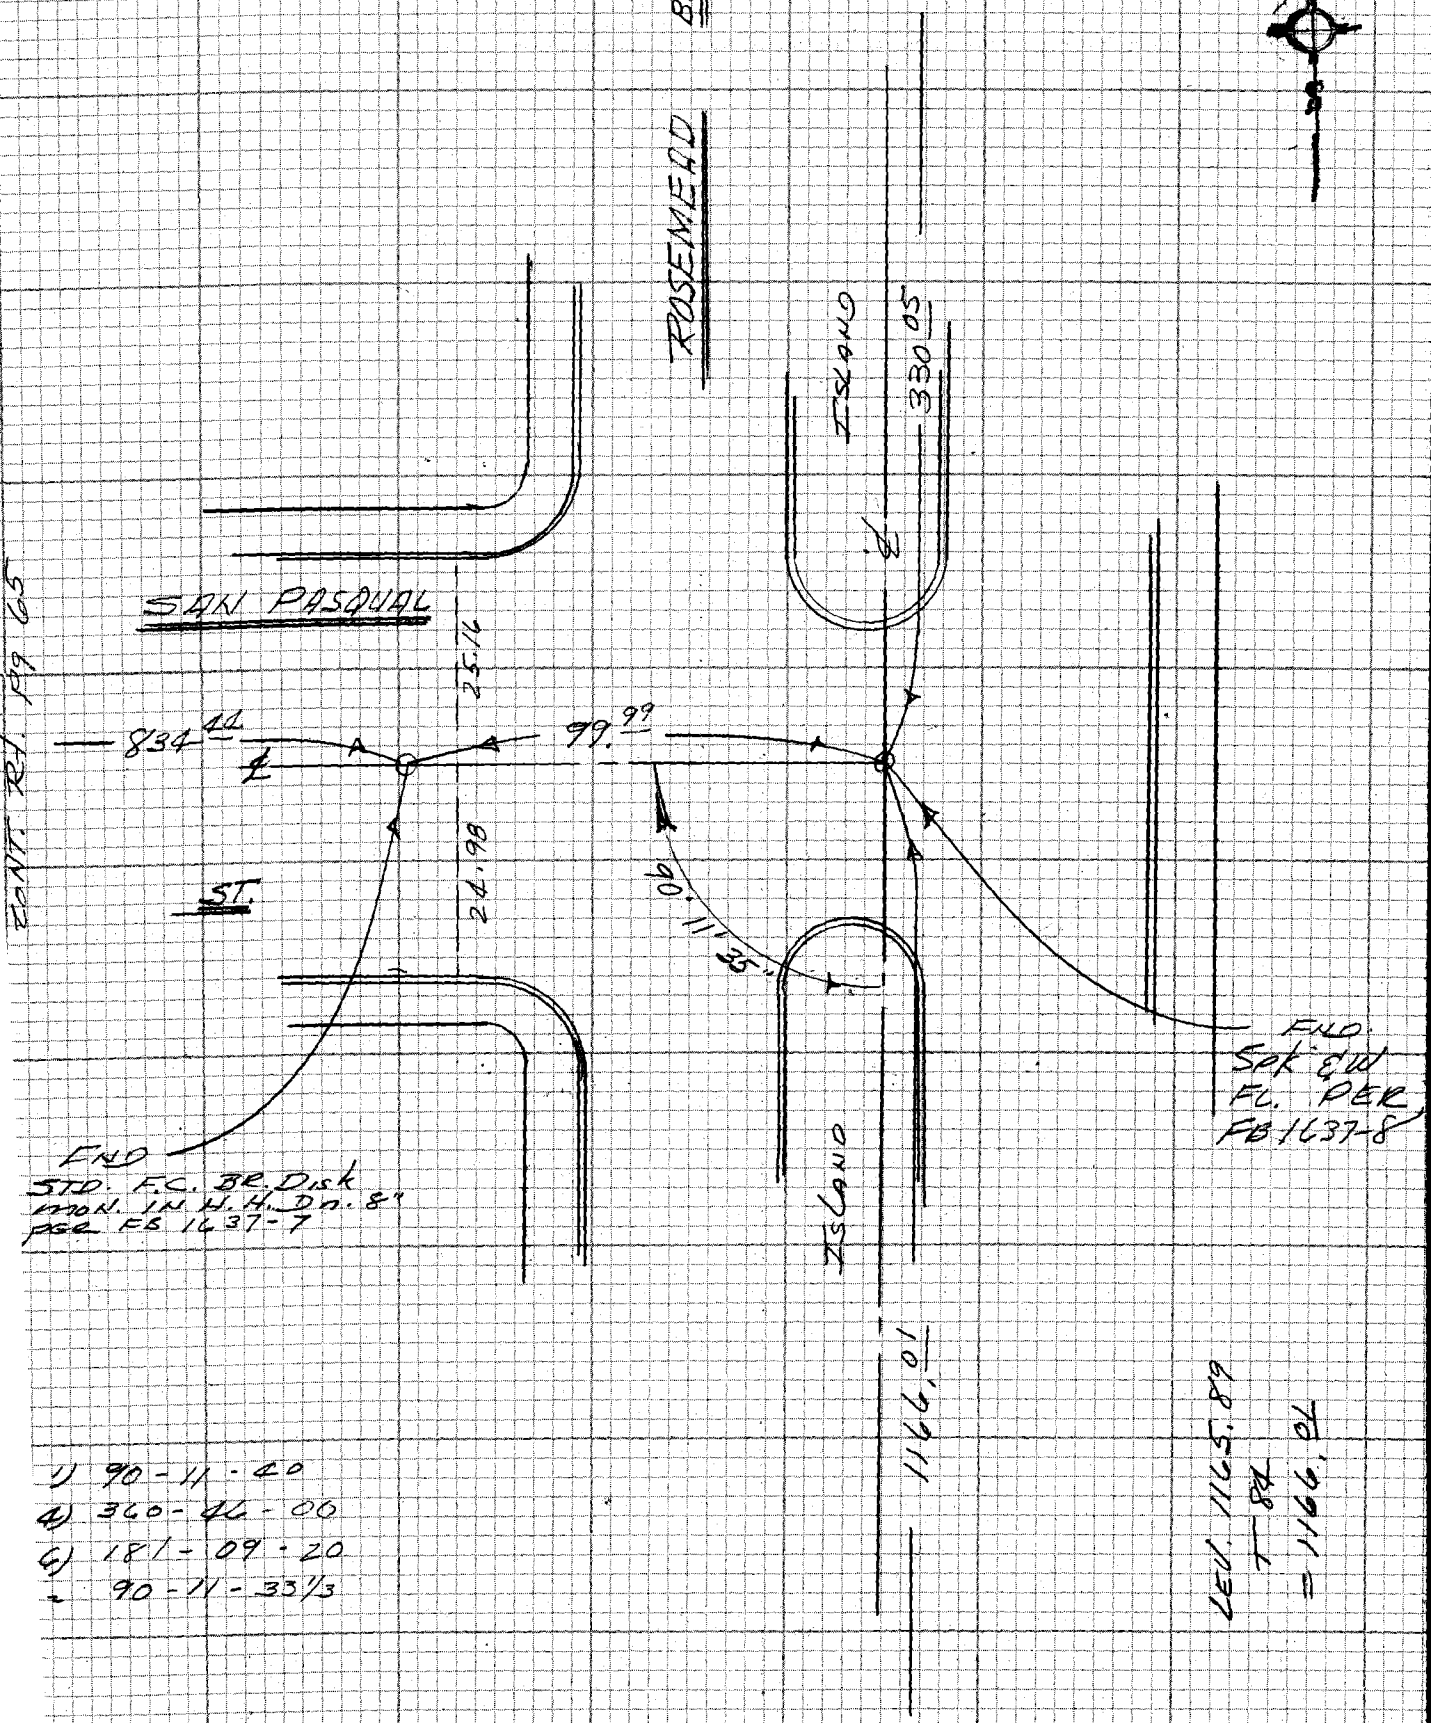


1) 90-11-40
4) 360-46-00
6) 181-09-20
= 90-11-33 1/3

Cont Top Pg 58

CE 310
76F 3095-4/73

PLEASE RETURN TO
LOS ANGELES COUNTY ENGINEER
403 LOS ANGELES COUNTY ENGINEERING BLDG.

Do not ex[illegible] notes this side of this line

NOTE: ANY ADDITIONS OR CHANGES ON THIS SHEET MUST BE MADE OR CIRCLED IN RED INK WITH DATE AND NAME OF PERSON MAKING CHANGE

WS 44 C-3

DIV 4

F.B. 4412 PG. 67

| | |
|---|---|
| Notes Ck'd by | Survey of ROSEMEAD ST ℄ |
| Map No. | JN 0303.00 Tape 0232 Std 68 °F |
| Office Work | Surveyed by E. LANDA |
| Checked | Notes E. LANDA Date 9-76 |
| Date | Indexed G. D. BAILEY SEP 19 1977 |

CONT DTM Pg 68

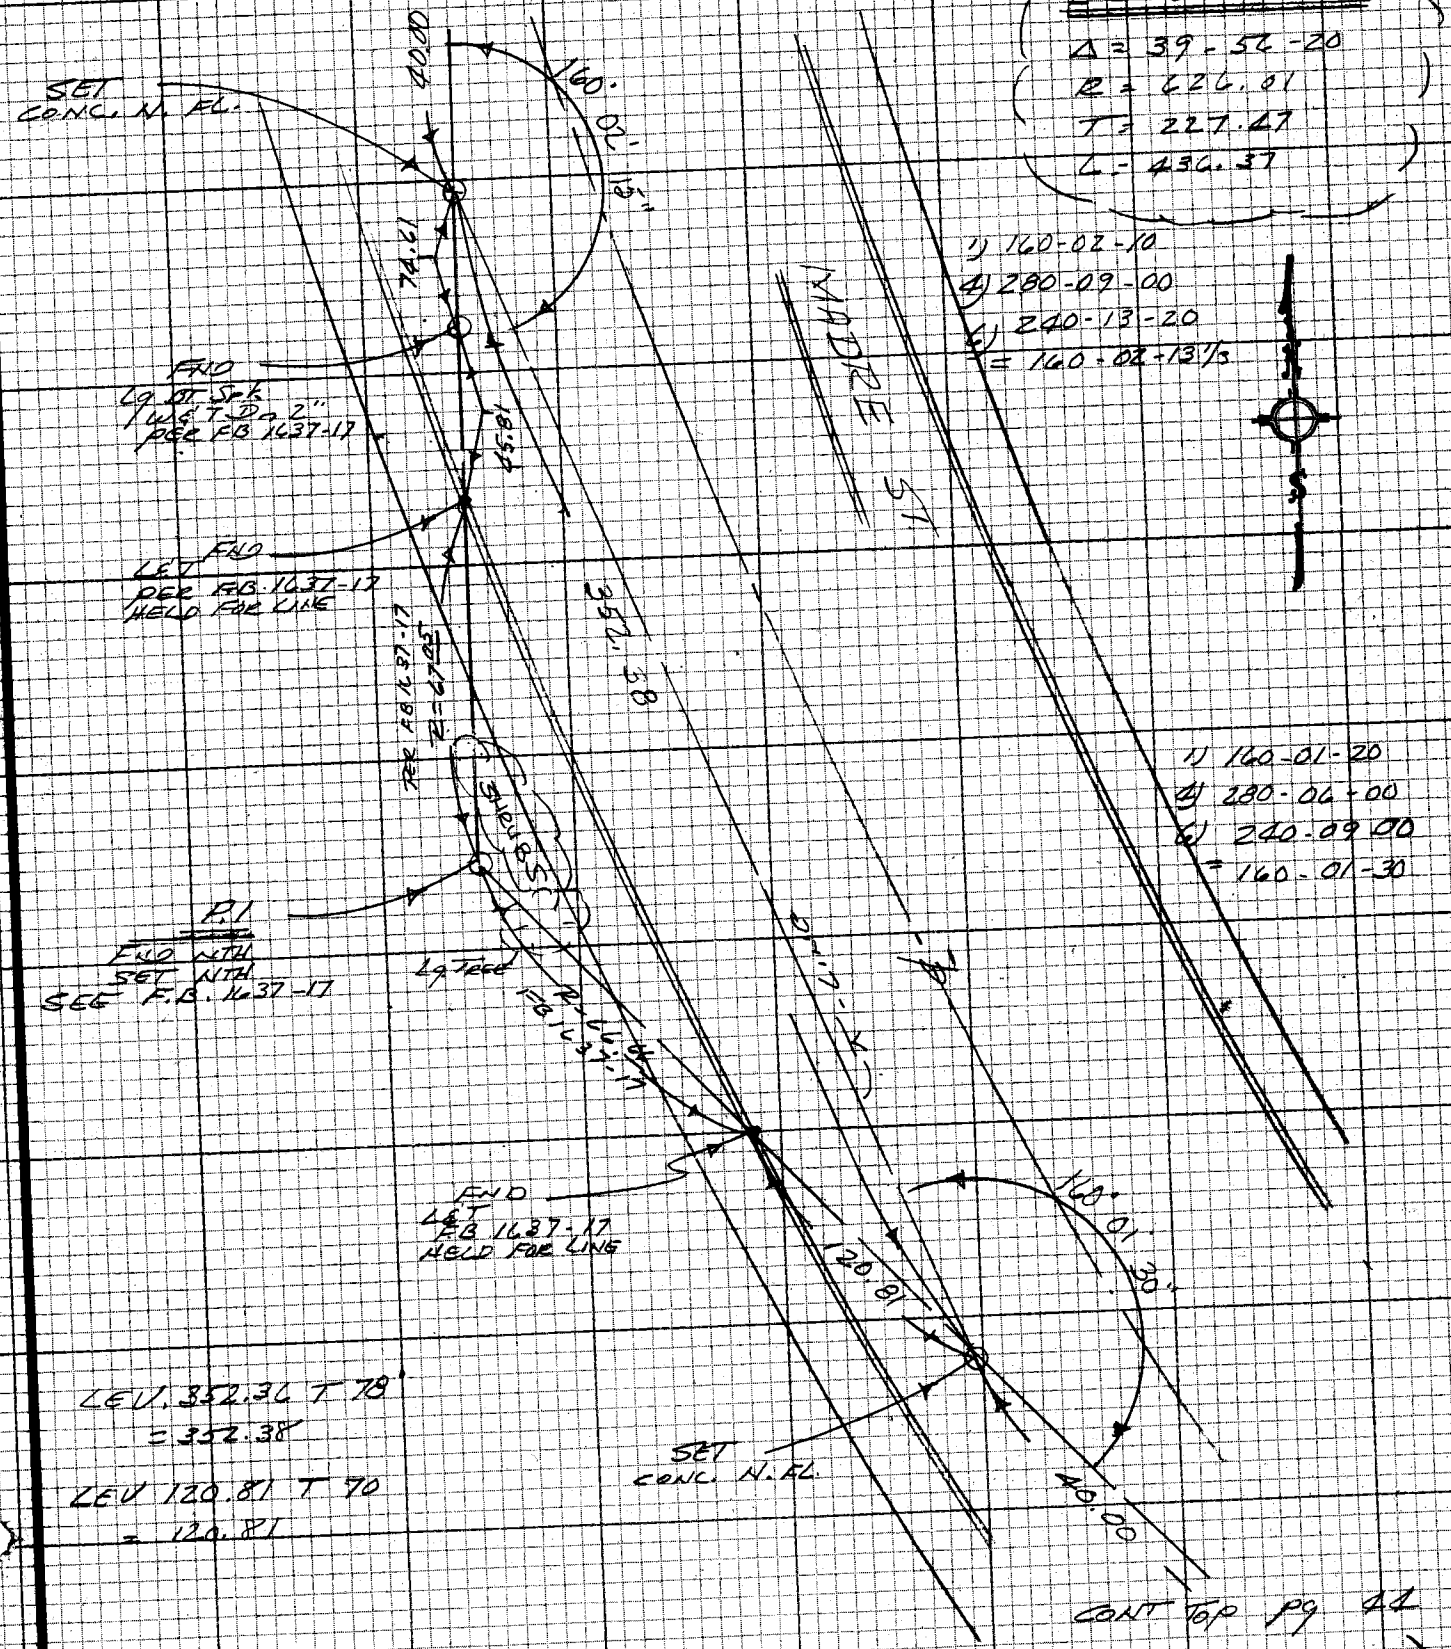


LEV. 352.36 T 78'
= 352.38

LEV 120.81 T 70
= 120.81

CONT TOP Pg 44

NOTE: ANY ADDITIONS OR CHANGES ON THIS SHEET MUST BE MADE OR CIRCLED IN RED INK WITH DATE AND NAME OF PERSON MAKING CHANGE

Do not extend notes this side of this line

PLEASE RETURN TO LOS ANGELES COUNTY ENGINEER 403 LOS ANGELES COUNTY ENGINEERING BLDG.

CENTERLINE NOTES CE 310 76F3095-4/73

F.B. 4412 PG. 68

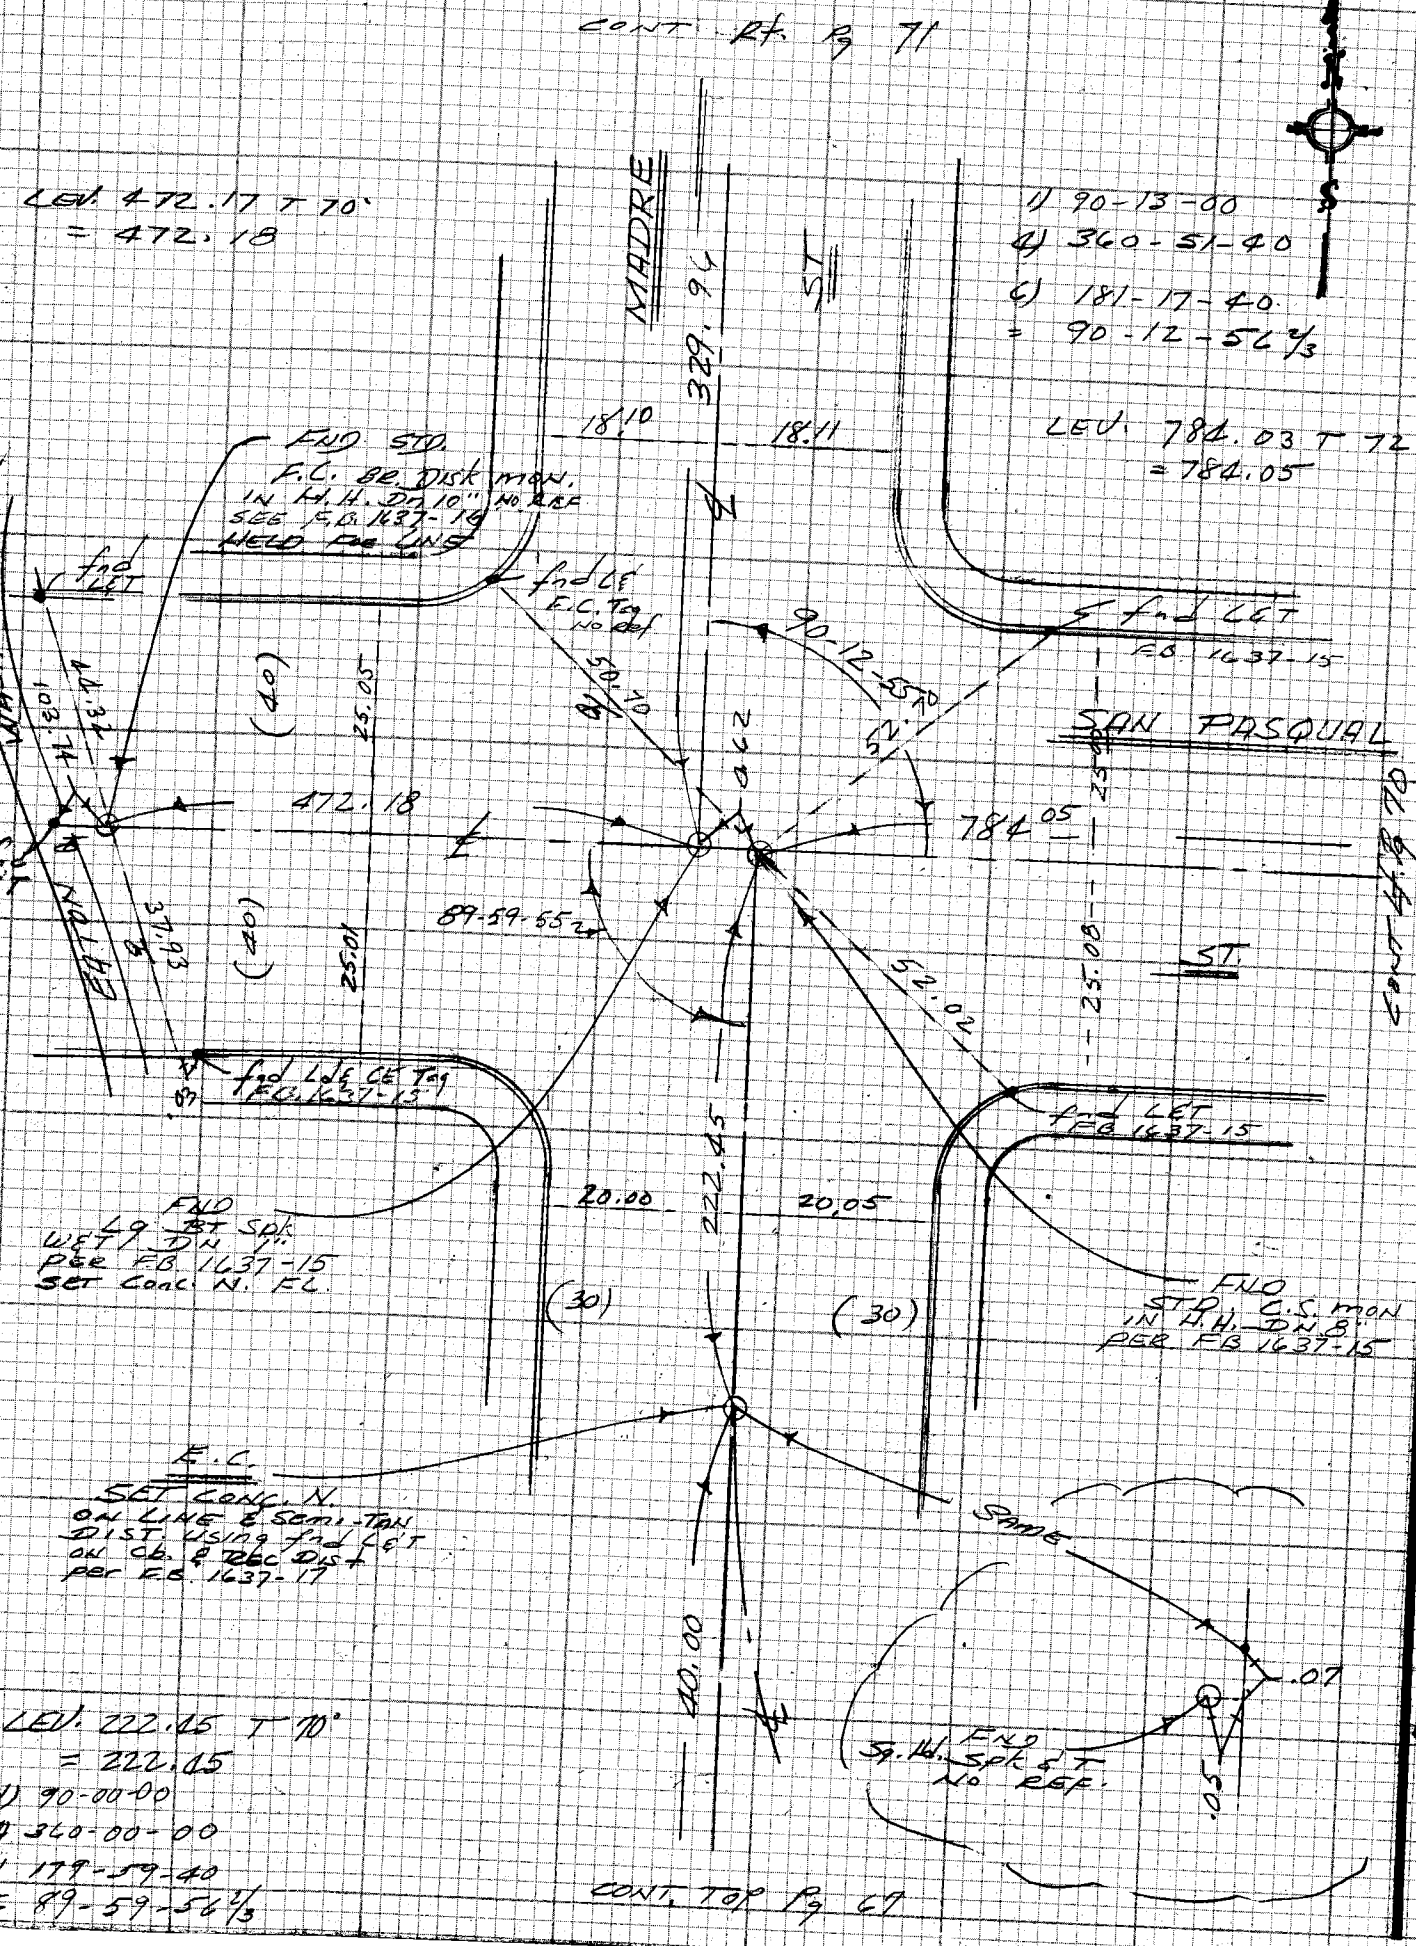


CE 310
76F3095-4/73

LVS 4 4, C-3

PLEASE RETURN TO
LOS ANGELES COUNTY ENGINEER
403 LOS ANGELES COUNTY ENGINEERING BLDG.

Do not ex[illegible] notes this side of this line

NOTE: ANY ADDITIONS OR CHANGES ON THIS SHEET MUST BE MADE OR CIRCLED IN RED INK WITH DATE AND NAME OF PERSON MAKING CHANGE

DIV 4

| | |
|---|---|
| Notes Ck'd by | Survey of ROSEMEAD ST ℄ |
| Map No. | JN 0303.00 Tape 0232 Std 68 °F |
| Office Work | Surveyed by E. LANDA |
| Checked | Notes E. LANDA Date 9-76 |
| Date | Indexed S. D. BAILEY SEP 19 1977 |

F.B. 4412 PG. 69

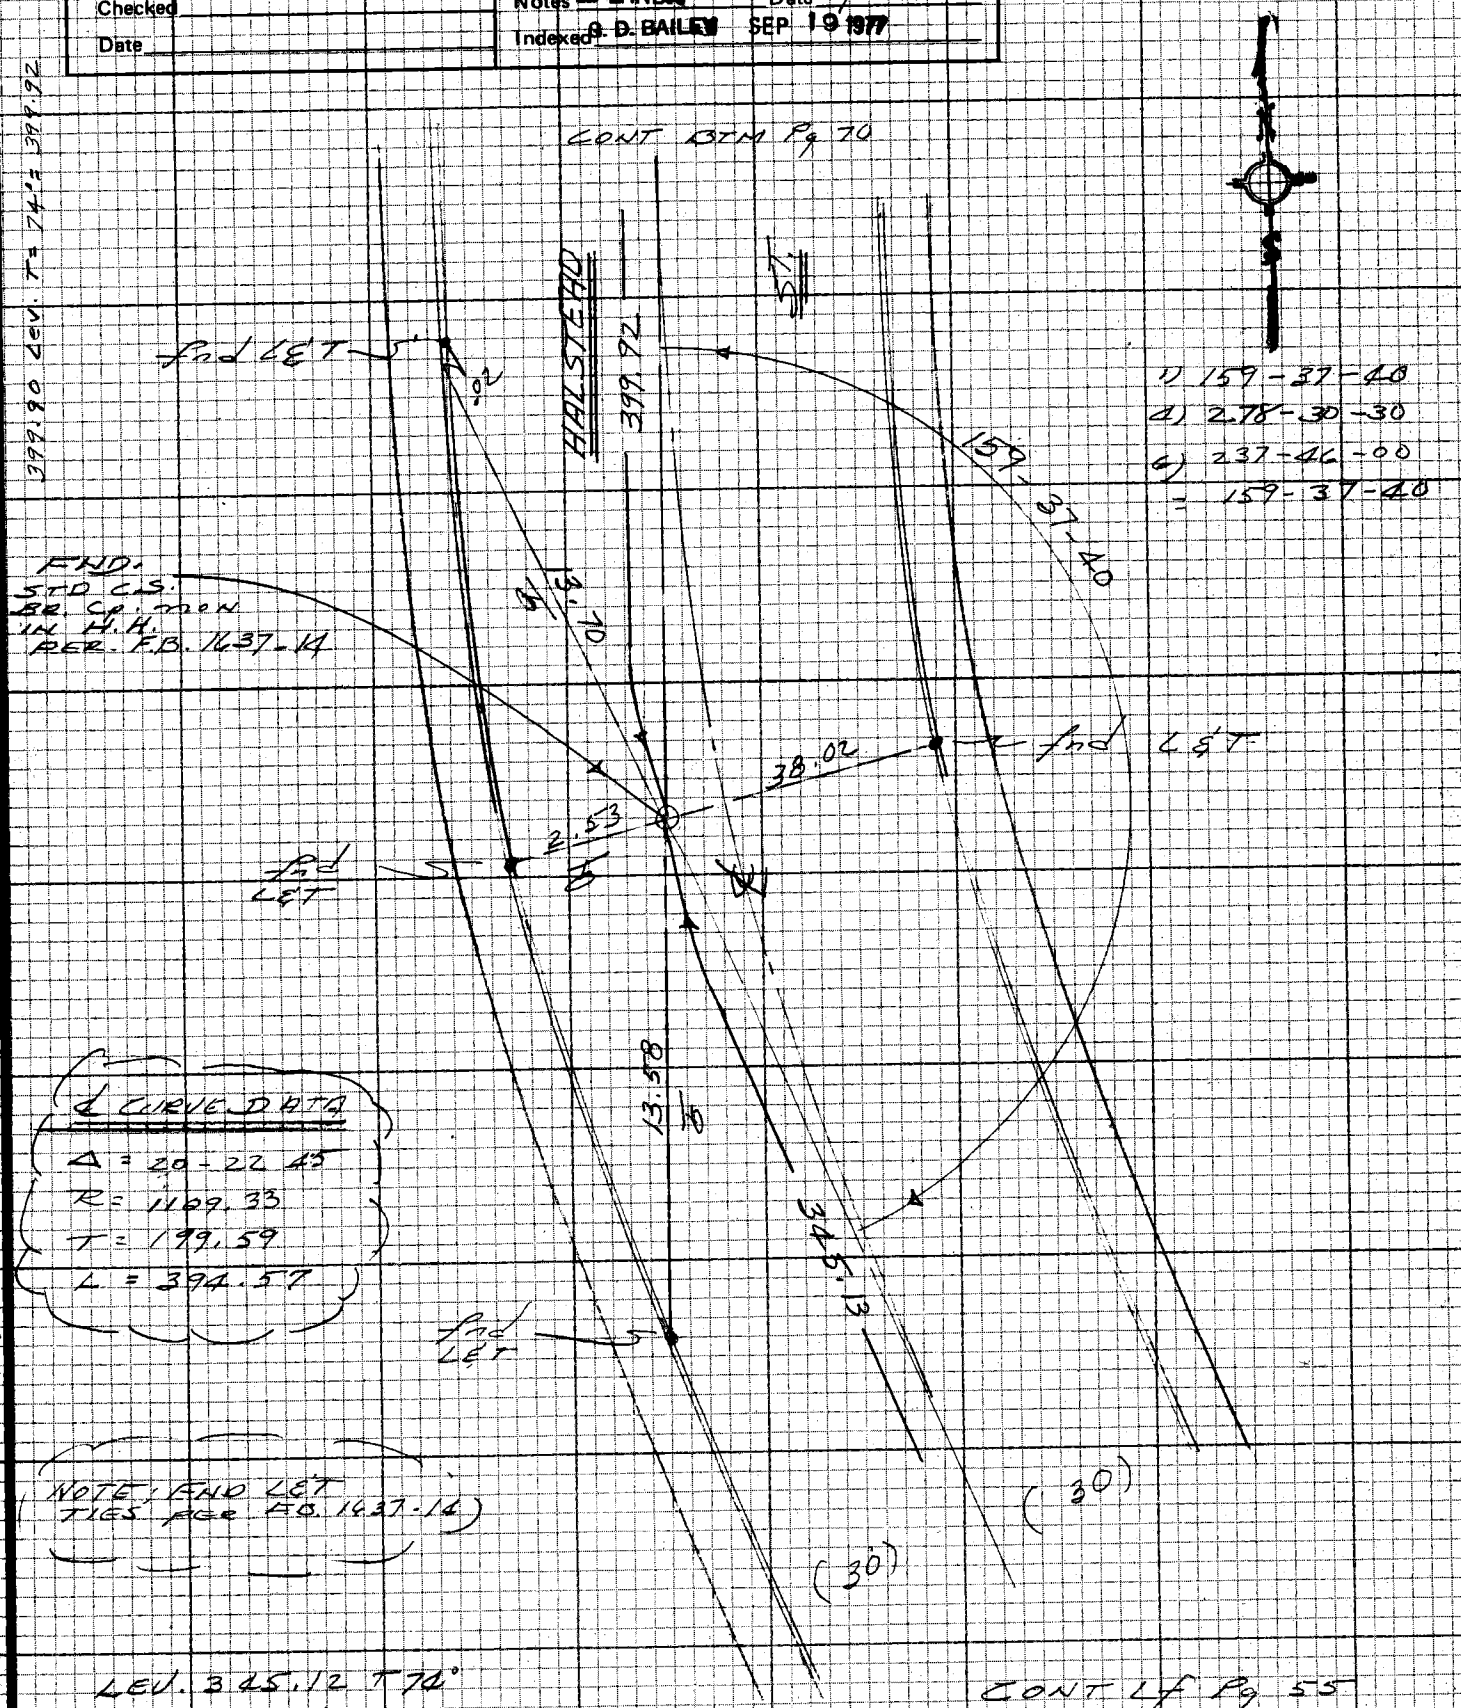


NOTE: ANY ADDITIONS OR CHANGES ON THIS SHEET MUST BE MADE OR CIRCLED IN RED INK WITH DATE AND NAME OF PERSON, MAKING CHANGE

W5 44, C-3

Do not extend notes this side of this line

PLEASE RETURN TO
LOS ANGELES COUNTY ENGINEER
403 LOS ANGELES COUNTY ENGINEERING BLDG.

CENTERLINE NOTES
CE 310
76F3095-4/73

F.B. 4412 PG. 70

cont Ref. Pg 72

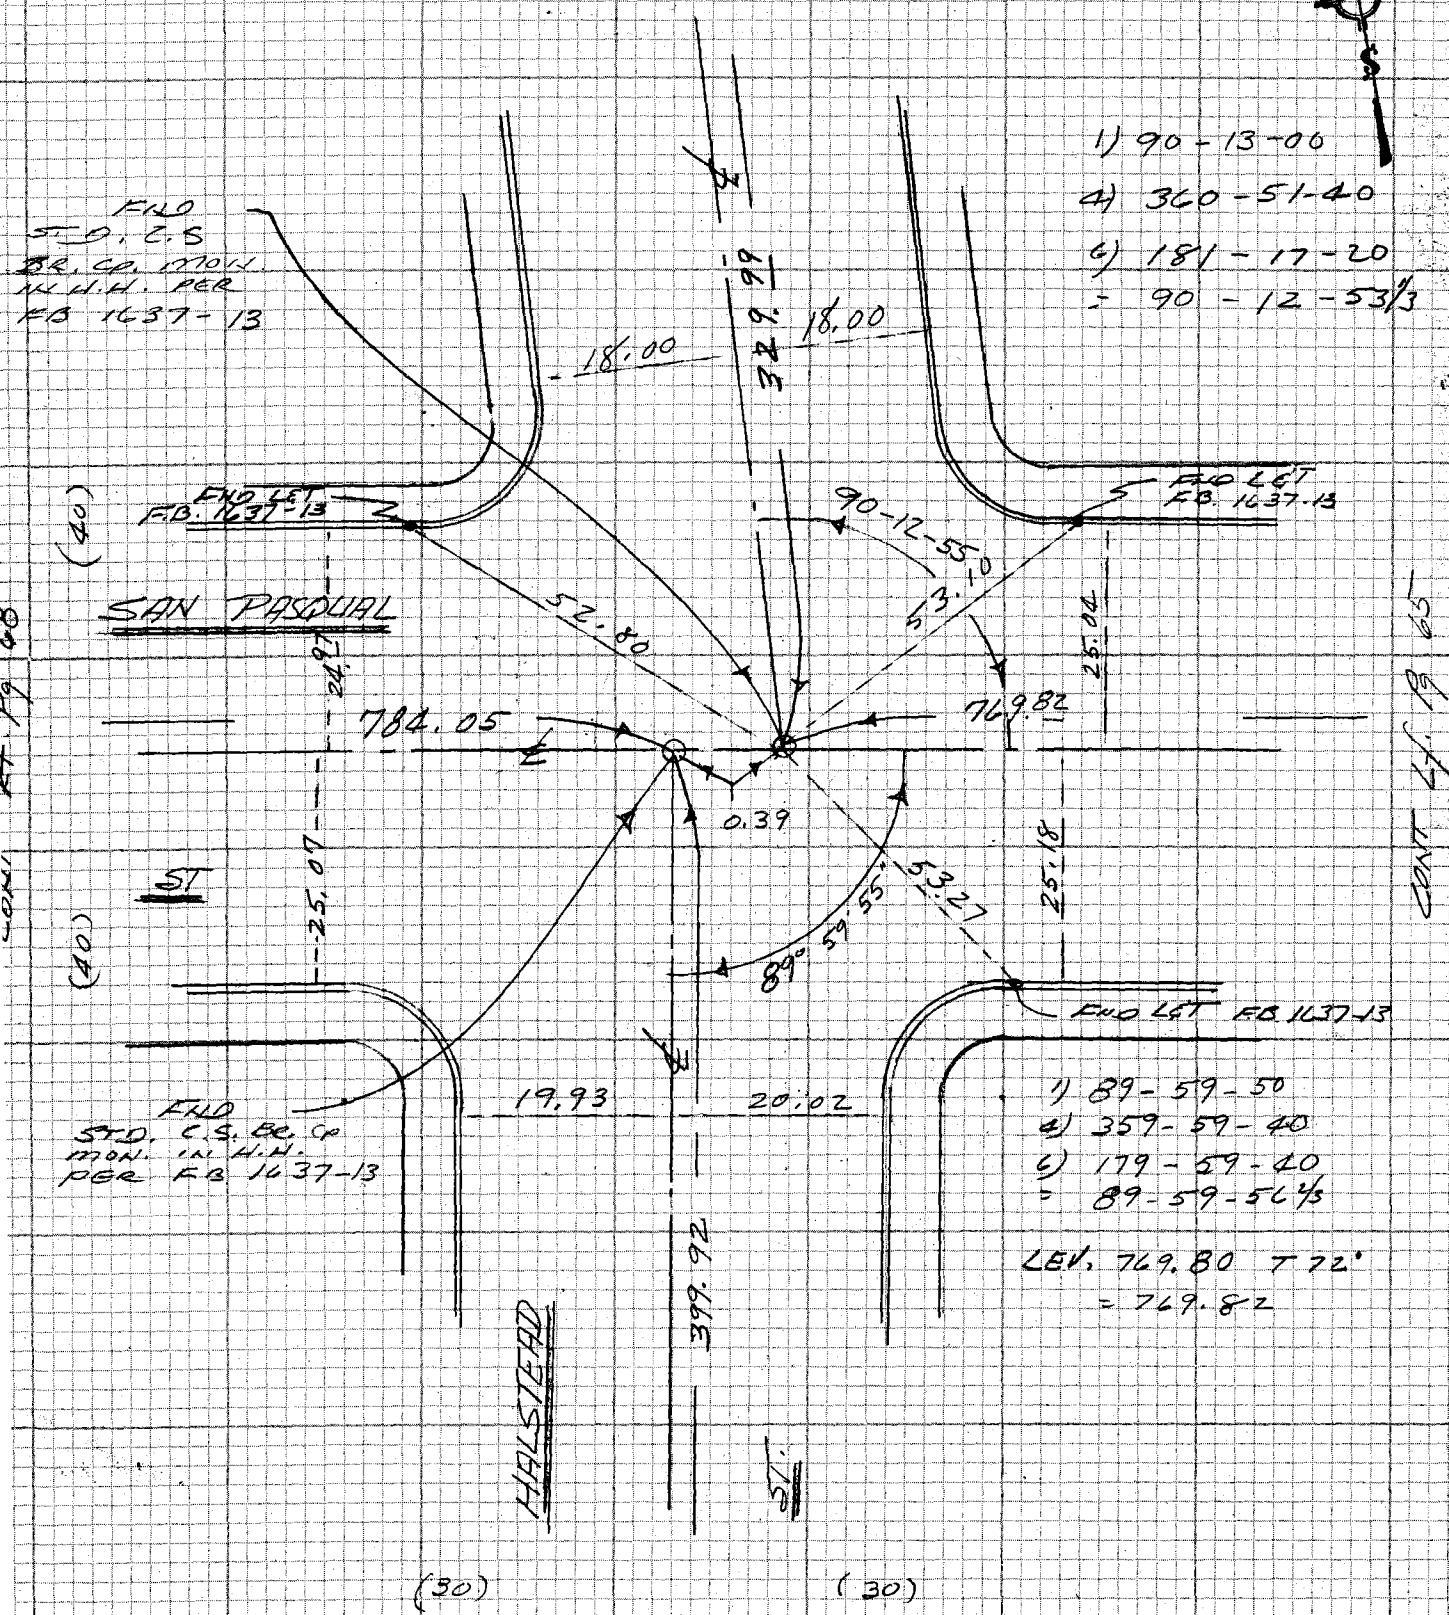


1) 90-13-00
4) 360-51-40
6) 181-17-20
= 90-12-53 1/3

1) 89-59-50
4) 359-59-40
6) 179-59-40
= 89-59-56 2/3

LEV. 769.80 T 72°
= 769.82

CONT TOP Pg 69

CONT Ref. Pg 65

CONT Ref. Pg 68

CE 310
76F3095-4/73
PLEASE RETURN TO
LOS ANGELES COUNTY ENGINEER
403 LOS ANGELES COUNTY ENGINEERING BLDG.
Do not ex... notes this side of this line
NOTE: ANY ADDITIONS OR CHANGES ON THIS SHEET MUST BE MADE OR CIRCLED IN RED INK WITH DATE AND NAME OF PERSON MAKING CHANGE

DIV 4

| | |
|---|---|
| Notes Ck'd by | Survey of ROSEMEAD ST ℄ |
| Map No. | JN 0303.00 Tape 0232 Std 68 °F |
| Office Work | Surveyed by E.L. |
| Checked | Notes V. LIEBER Date 9-76 |
| Date | Indexed S. D. BAILEY SEP 19 1977 |

F.B. 4412 PG. 71

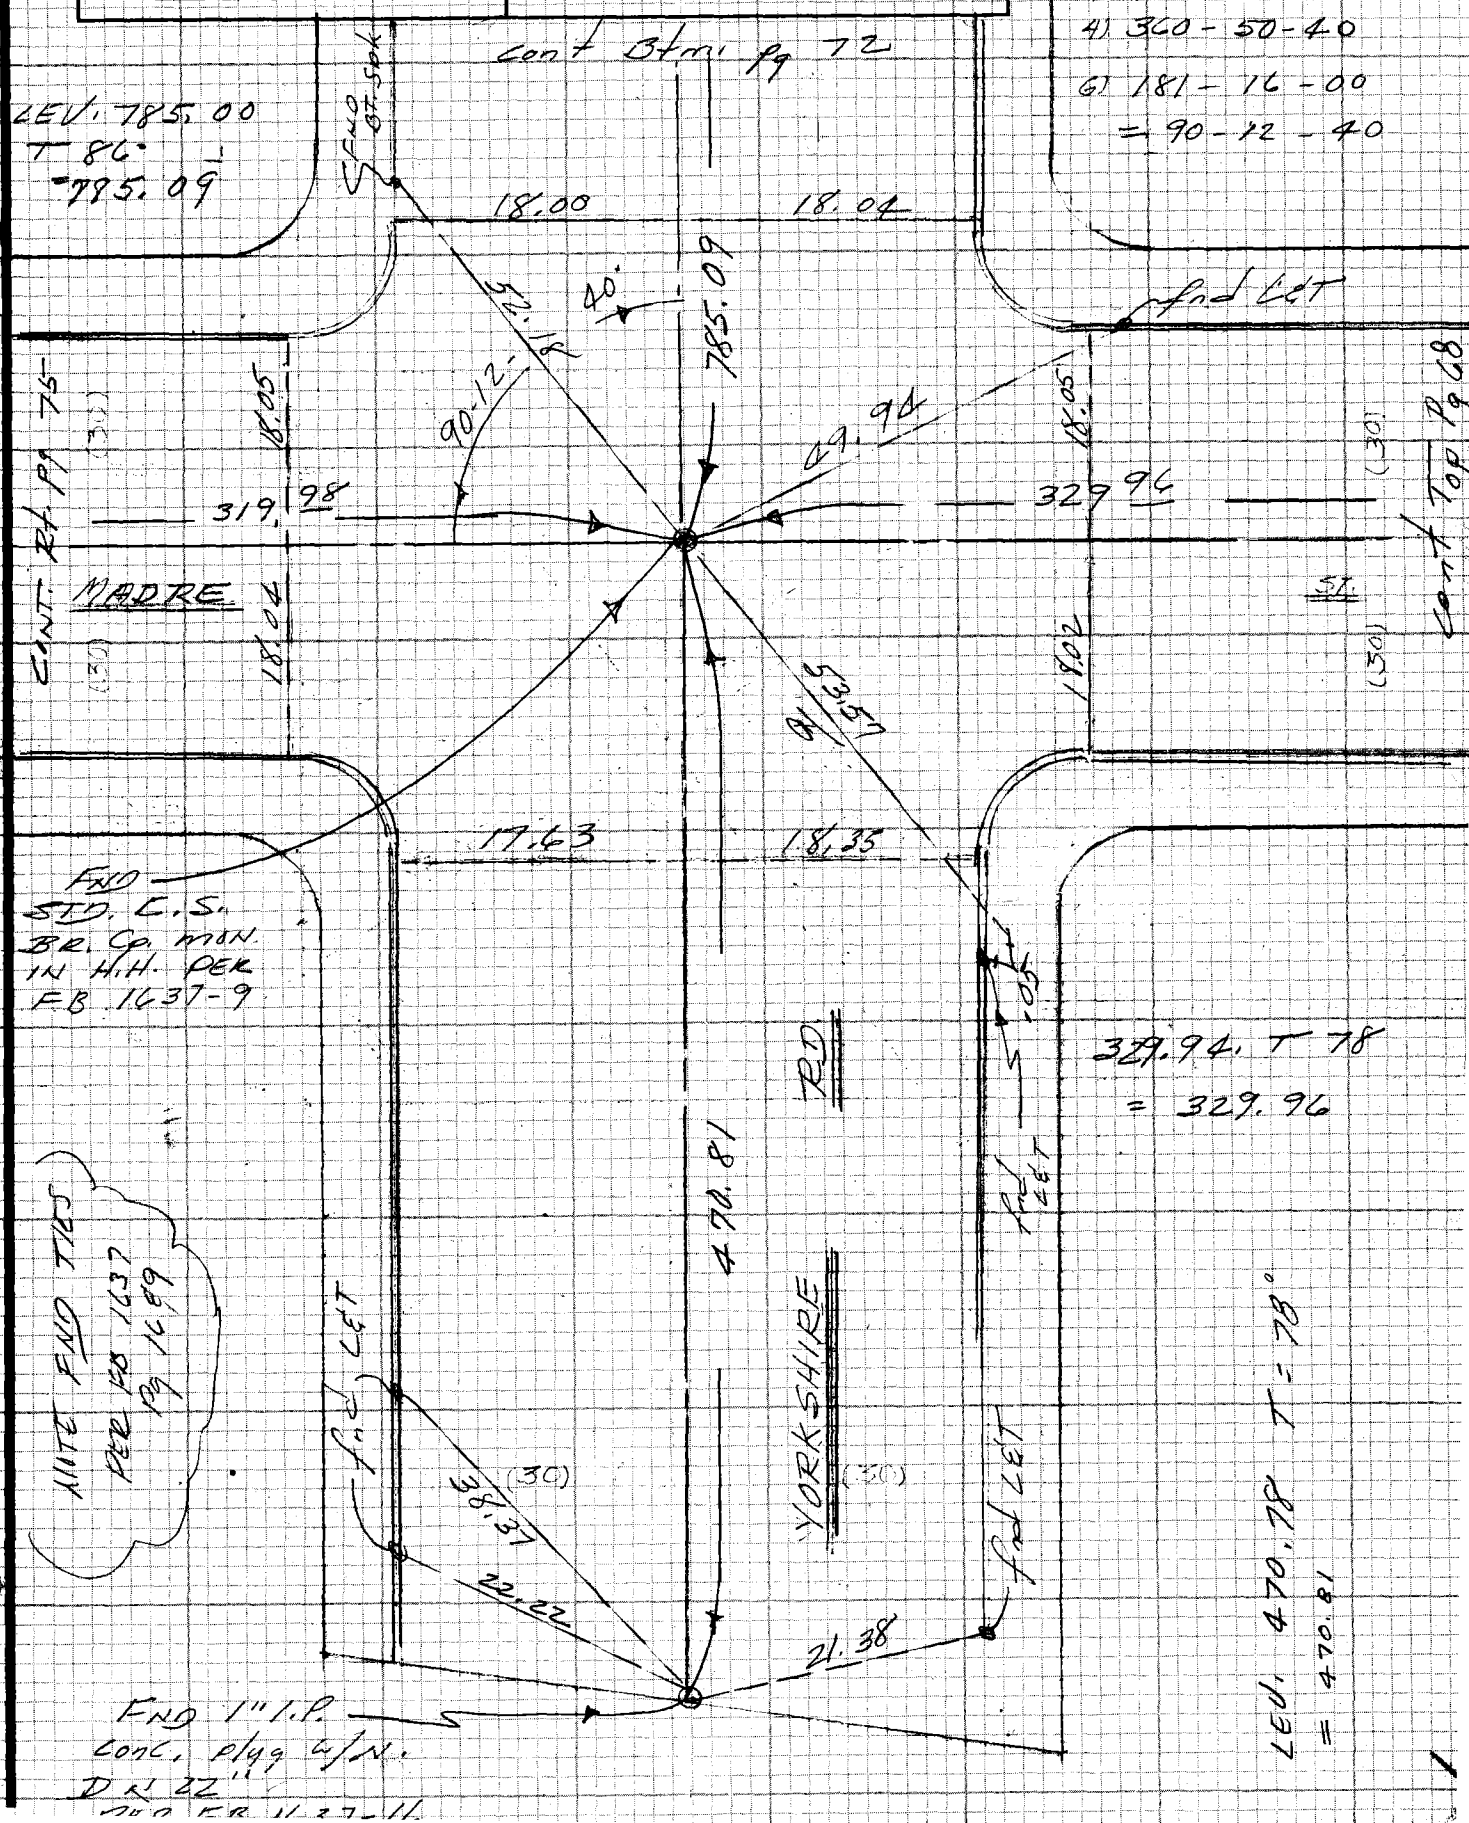


NOTE: ANY ADDITIONS OR CHANGES ON THIS SHEET MUST BE MADE OR CIRCLED IN RED INK WITH DATE AND NAME OF PERSON MAKING CHANGE

Do not extend notes on this side of this line

PLEASE RETURN TO
LOS ANGELES COUNTY ENGINEER
403 LOS ANGELES COUNTY ENGINEERING BLDG.

CENTERLINE NOTES
CE 310
76F3095-4/73

CE 310
76F3095-4/73

PLEASE RETURN TO
LOS ANGELES COUNTY ENGINEER
403 LOS ANGELES COUNTY ENGINEERING BLDG.

NOTE: ANY ADDITIONS OR CHANGES ON THIS SHEET MUST BE MADE OR CIRCLED IN RED INK WITH DATE AND NAME OF PERSON MAKING CHANGE

Do not ex[illegible] notes this side of this line

WS44 C-3

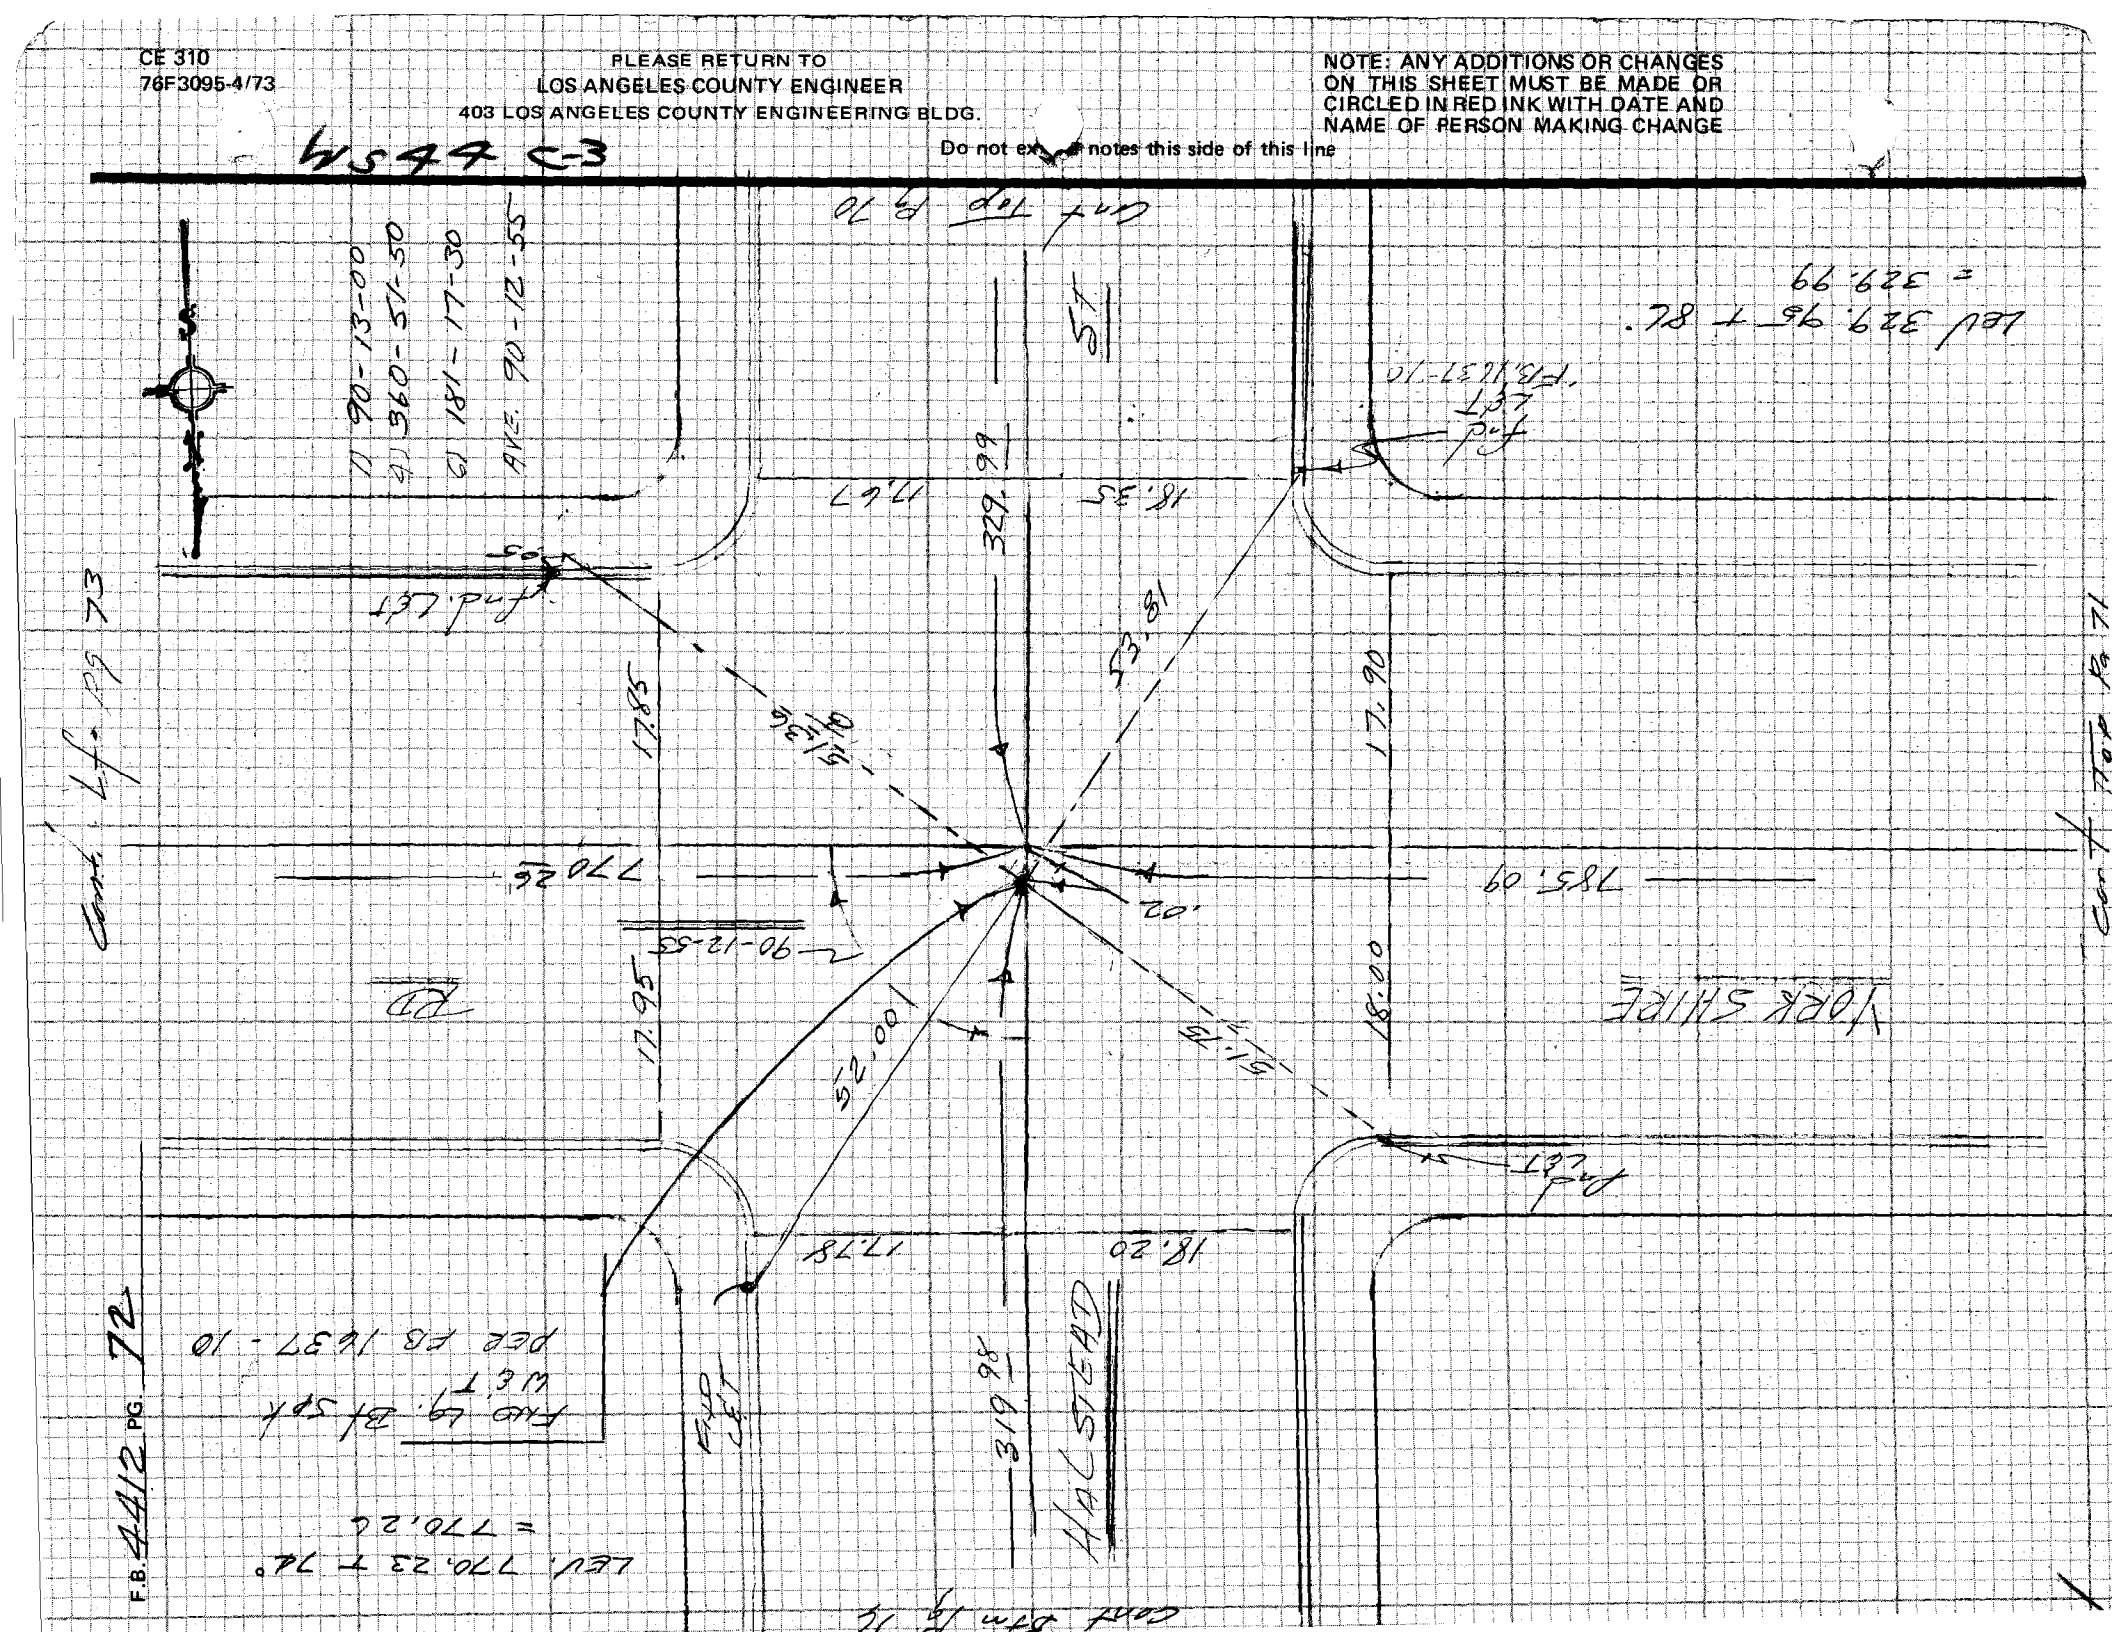

Div 4

| | |
|---|---|
| Notes Ck'd by | Survey of ROSEMEAD ST ℄ |
| Map No. | JN 9303.02 Tape 0232 Std 68 °F |
| Office Work | Surveyed by EL |
| Checked | Notes V. LIEBER Date 9-28-76 |
| Date | Indexed G. D. BAILEY SEP 19 1977 |

F.B. 4412 PG. 73

[redacted]

Cont Btm Pg 77

1) 89-49-20
4) 359-16-00
6) 178-54-20
= 89-49-03 1/3

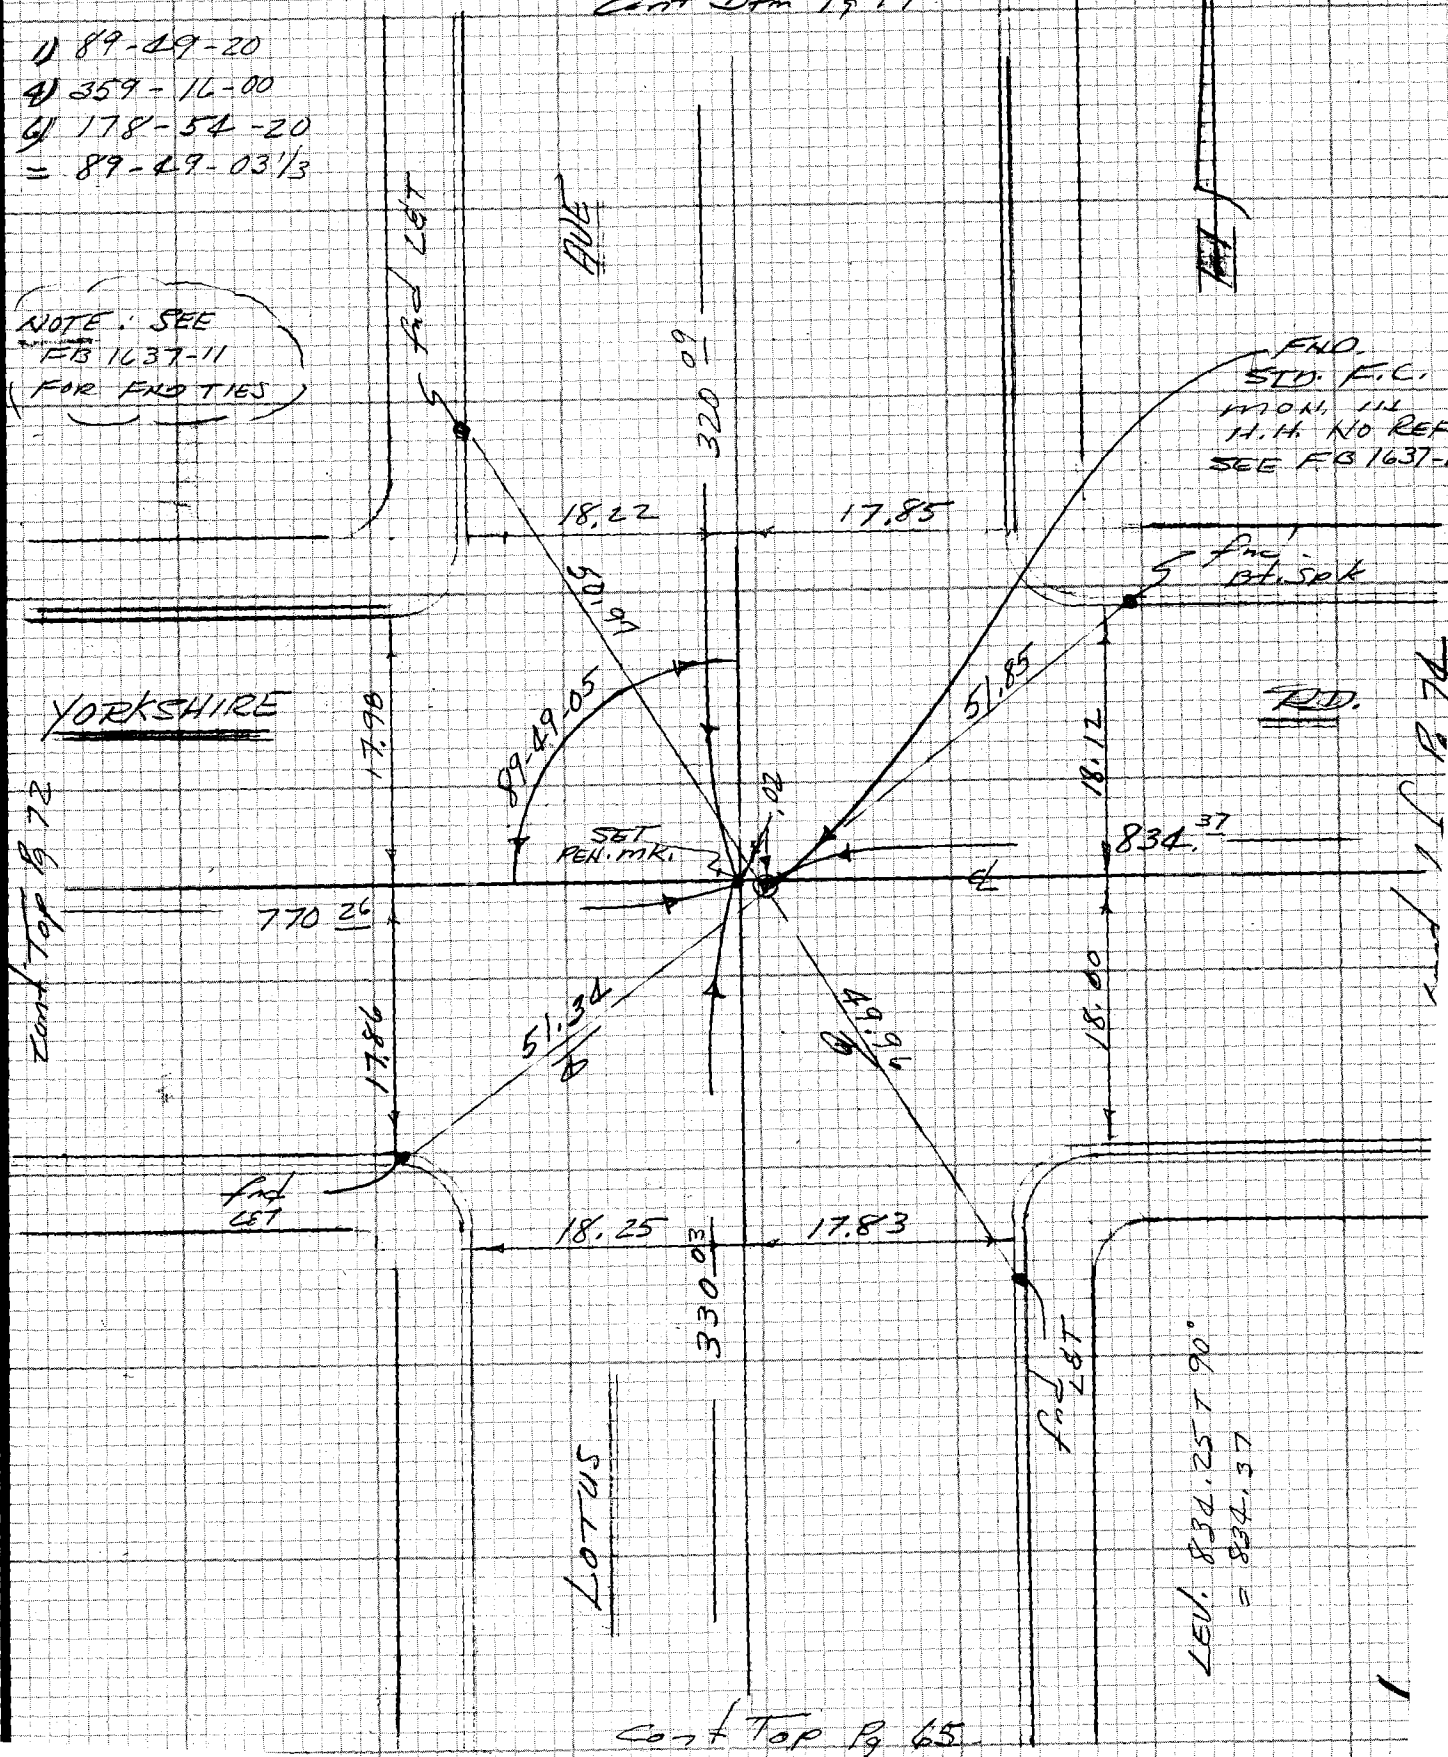


Cont Top Pg 65

NOTE: ANY ADDITIONS OR CHANGES ON THIS SHEET MUST BE MADE OR CIRCLED IN RED INK WITH DATE AND NAME OF PERSON MAKING CHANGE

Do not extend notes this side of this line

PLEASE RETURN TO
LOS ANGELES COUNTY ENGINEER
403 LOS ANGELES COUNTY ENGINEERING BLDG.

CENTERLINE NOTES
CE 310
76F3095-4/73

WS 44 C-3

CE 310
76F3095 1 '73

PLEASE RETURN TO
LOS ANGELES COUNTY ENGINEER
403 LOS ANGELES COUNTY ENGINEERING BLDG.

NOTE: ANY ADDITIONS OR CHANGES ON THIS SHEET MUST BE MADE OR CIRCLED IN RED INK WITH DATE AND NAME OF PERSON MAKING CHANGE

WS 44 B3

Do not exceed notes this side of this line

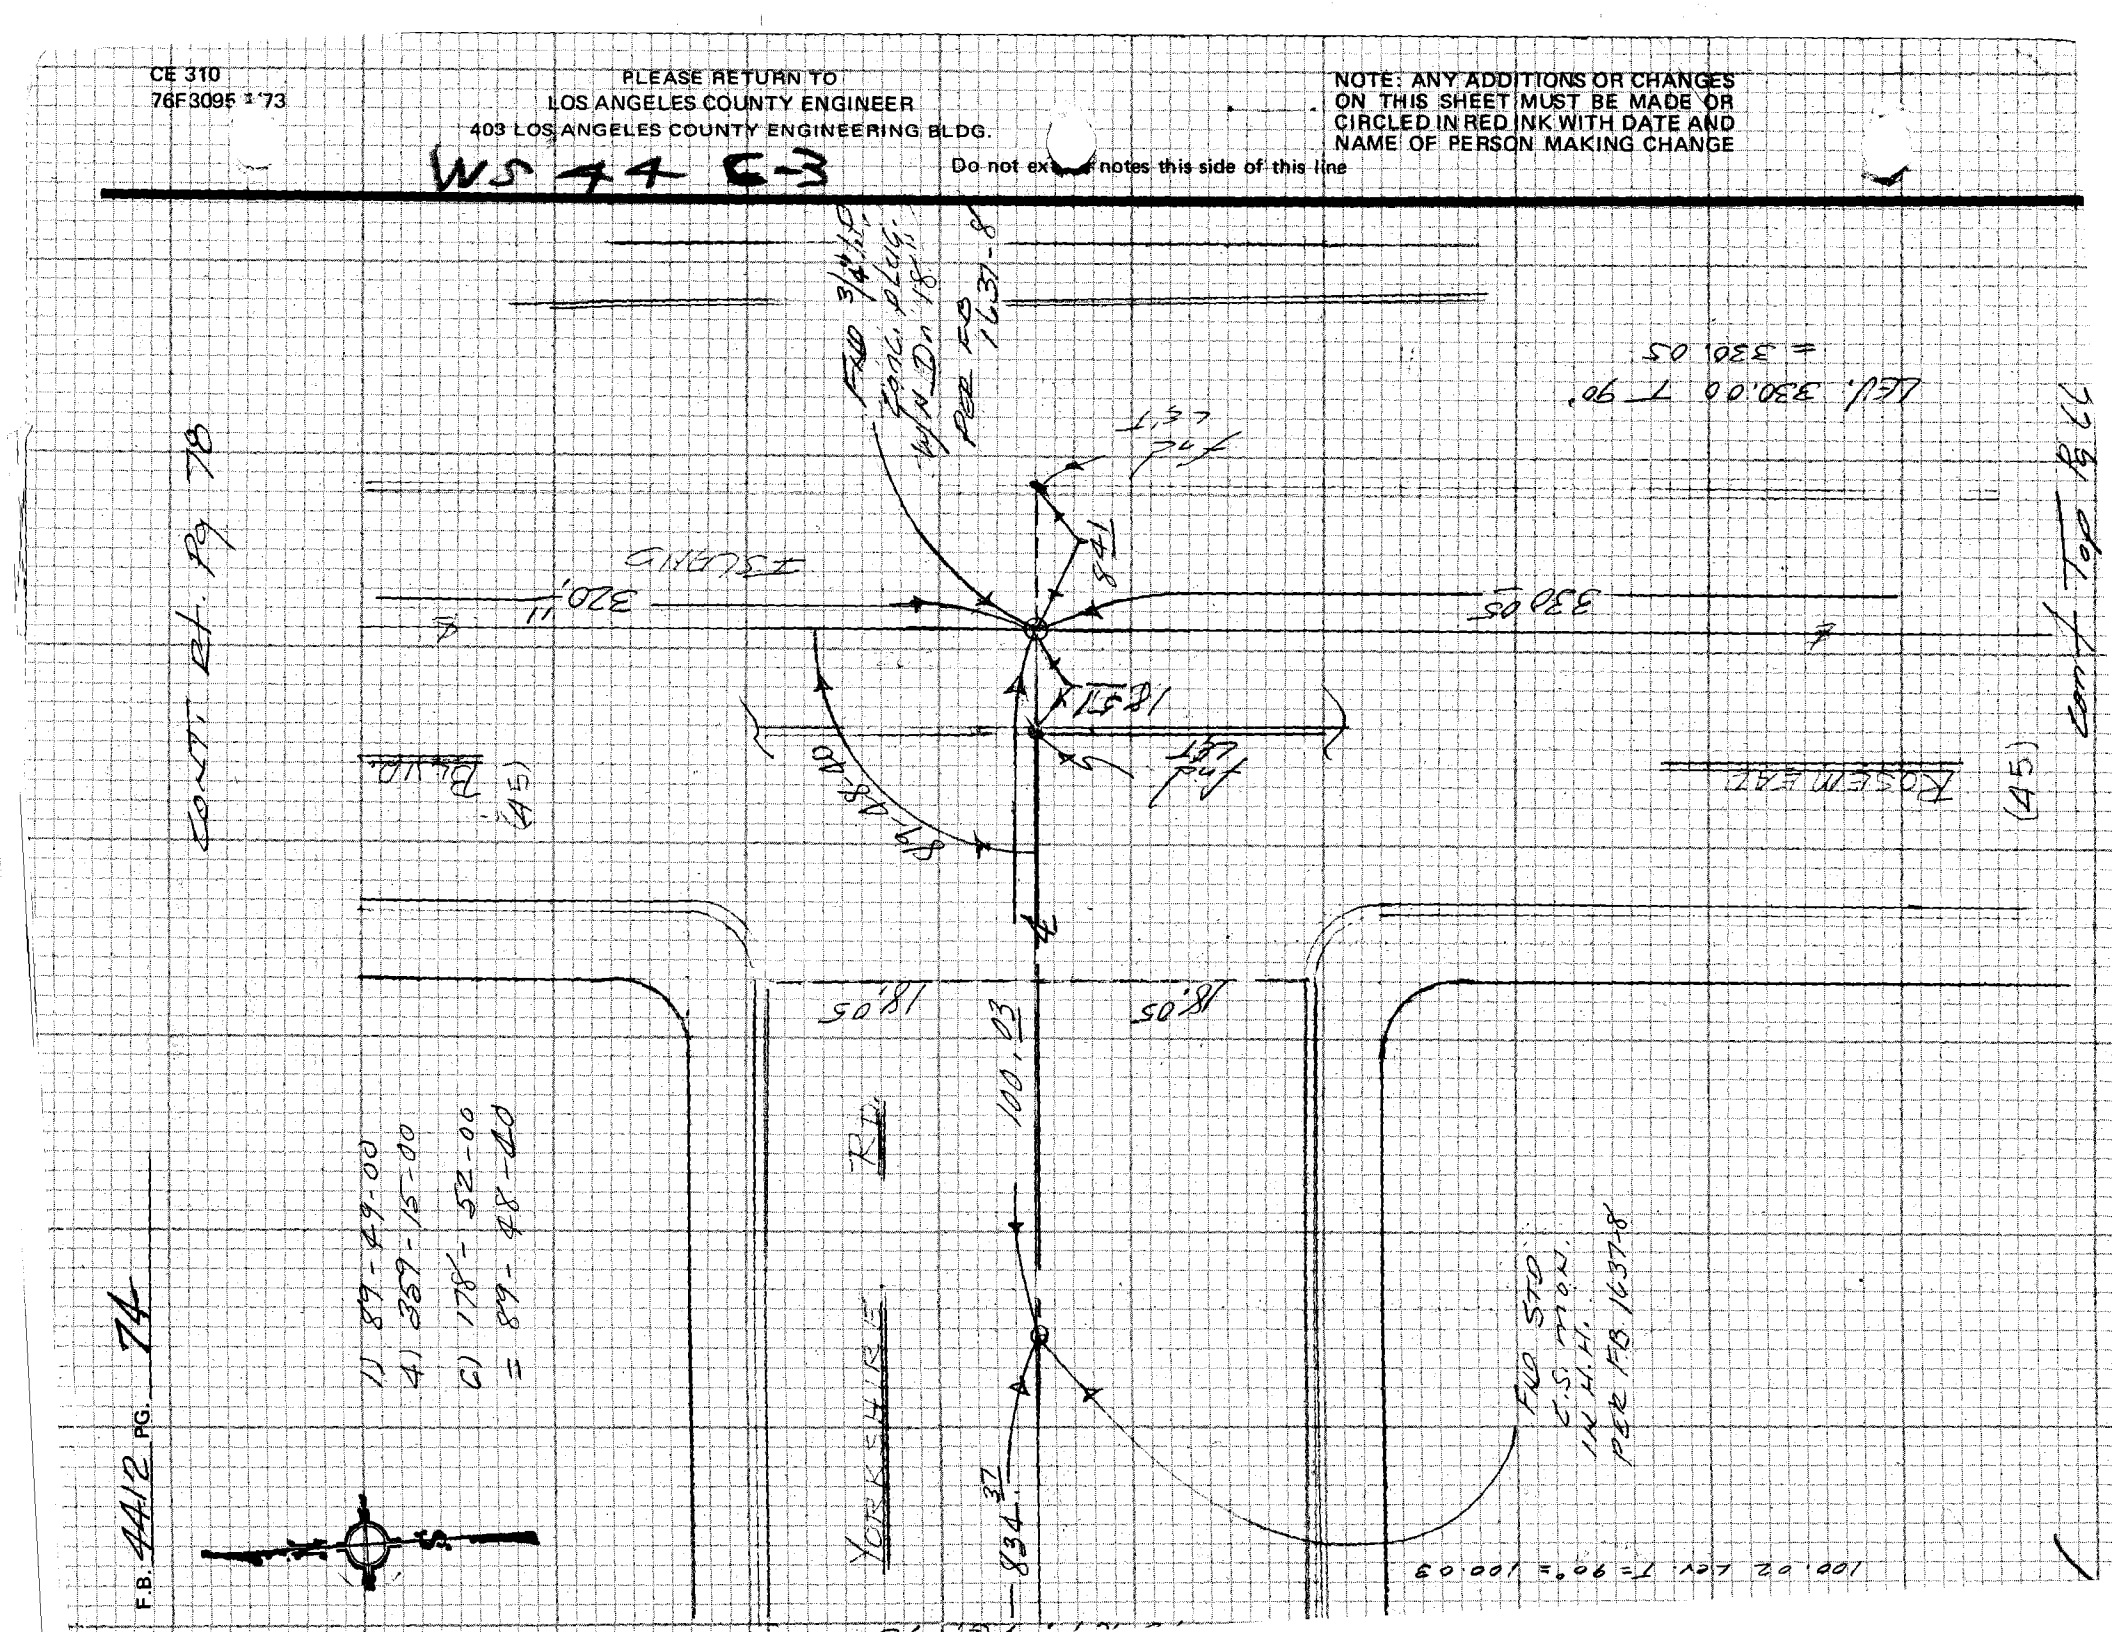

DN 4

| | |
|---|---|
| Notes Ck'd by | Survey of ROSEMEAD ST ℄ |
| Map No. | JN 030300 Tape 0232 Std 68 °F |
| Office Work | Surveyed by E. L. |
| Checked | Notes V. LIEBER Date 9-28-76 |
| Date | Indexed G. D. BAILEY SEP 19 1977 |

F.B. 4412 PG. 75

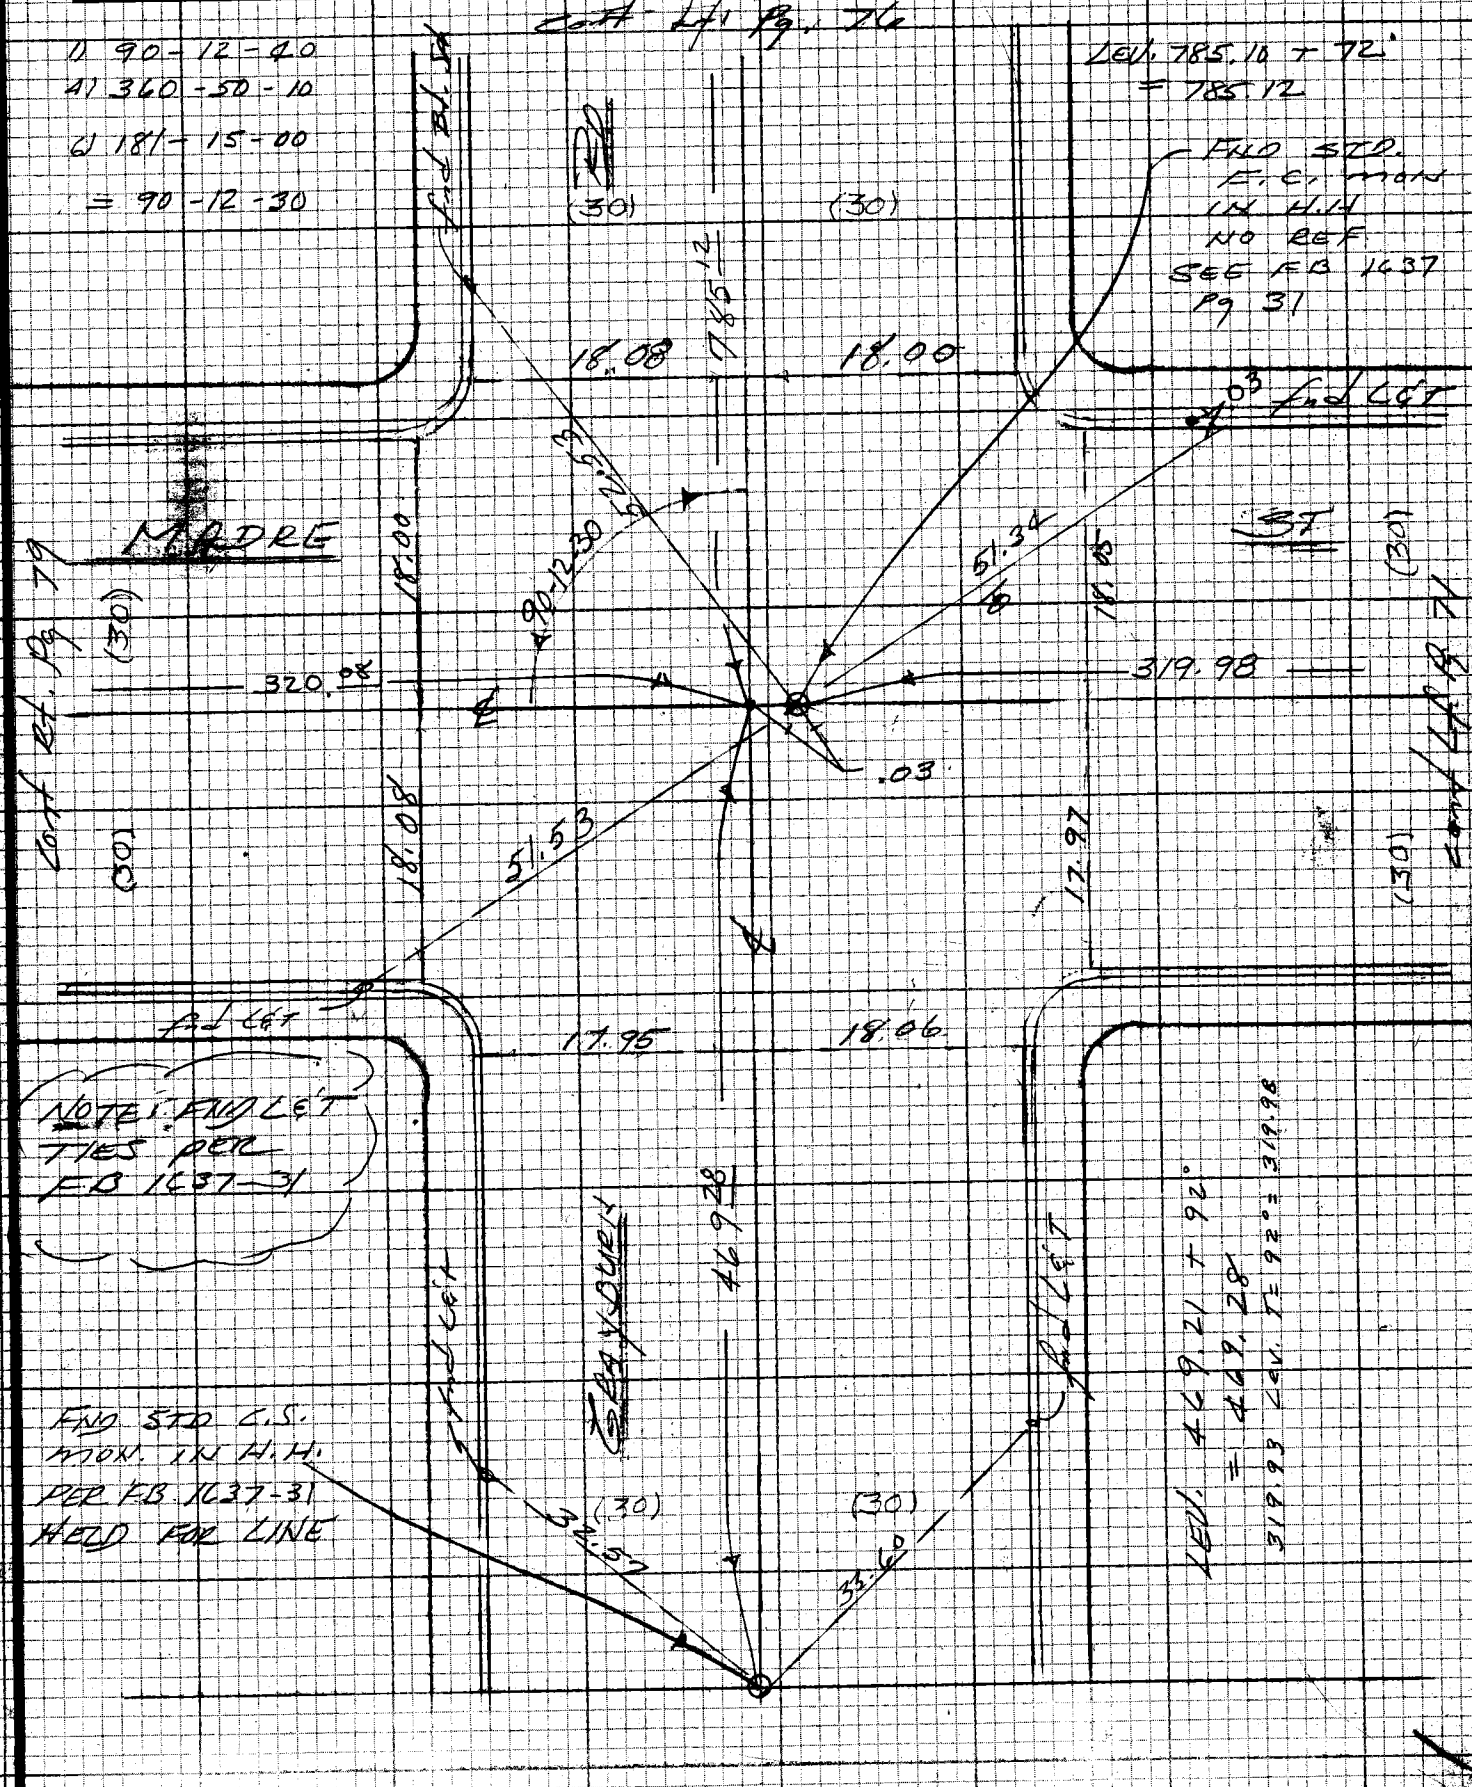


NOTE: ANY ADDITIONS OR CHANGES ON THIS SHEET MUST BE MADE OR CIRCLED IN RED INK WITH DATE AND NAME OF PERSON MAKING CHANGE

Do not extend notes this side of this line

PLEASE RETURN TO
LOS ANGELES COUNTY ENGINEER
403 LOS ANGELES COUNTY ENGINEERING BLDG.

CENTERLINE NOTES
CE 310
76F3095-4/73

WS 44C-3

F.B. 4412 PG. 76

[redacted]

To Btm Pg 80

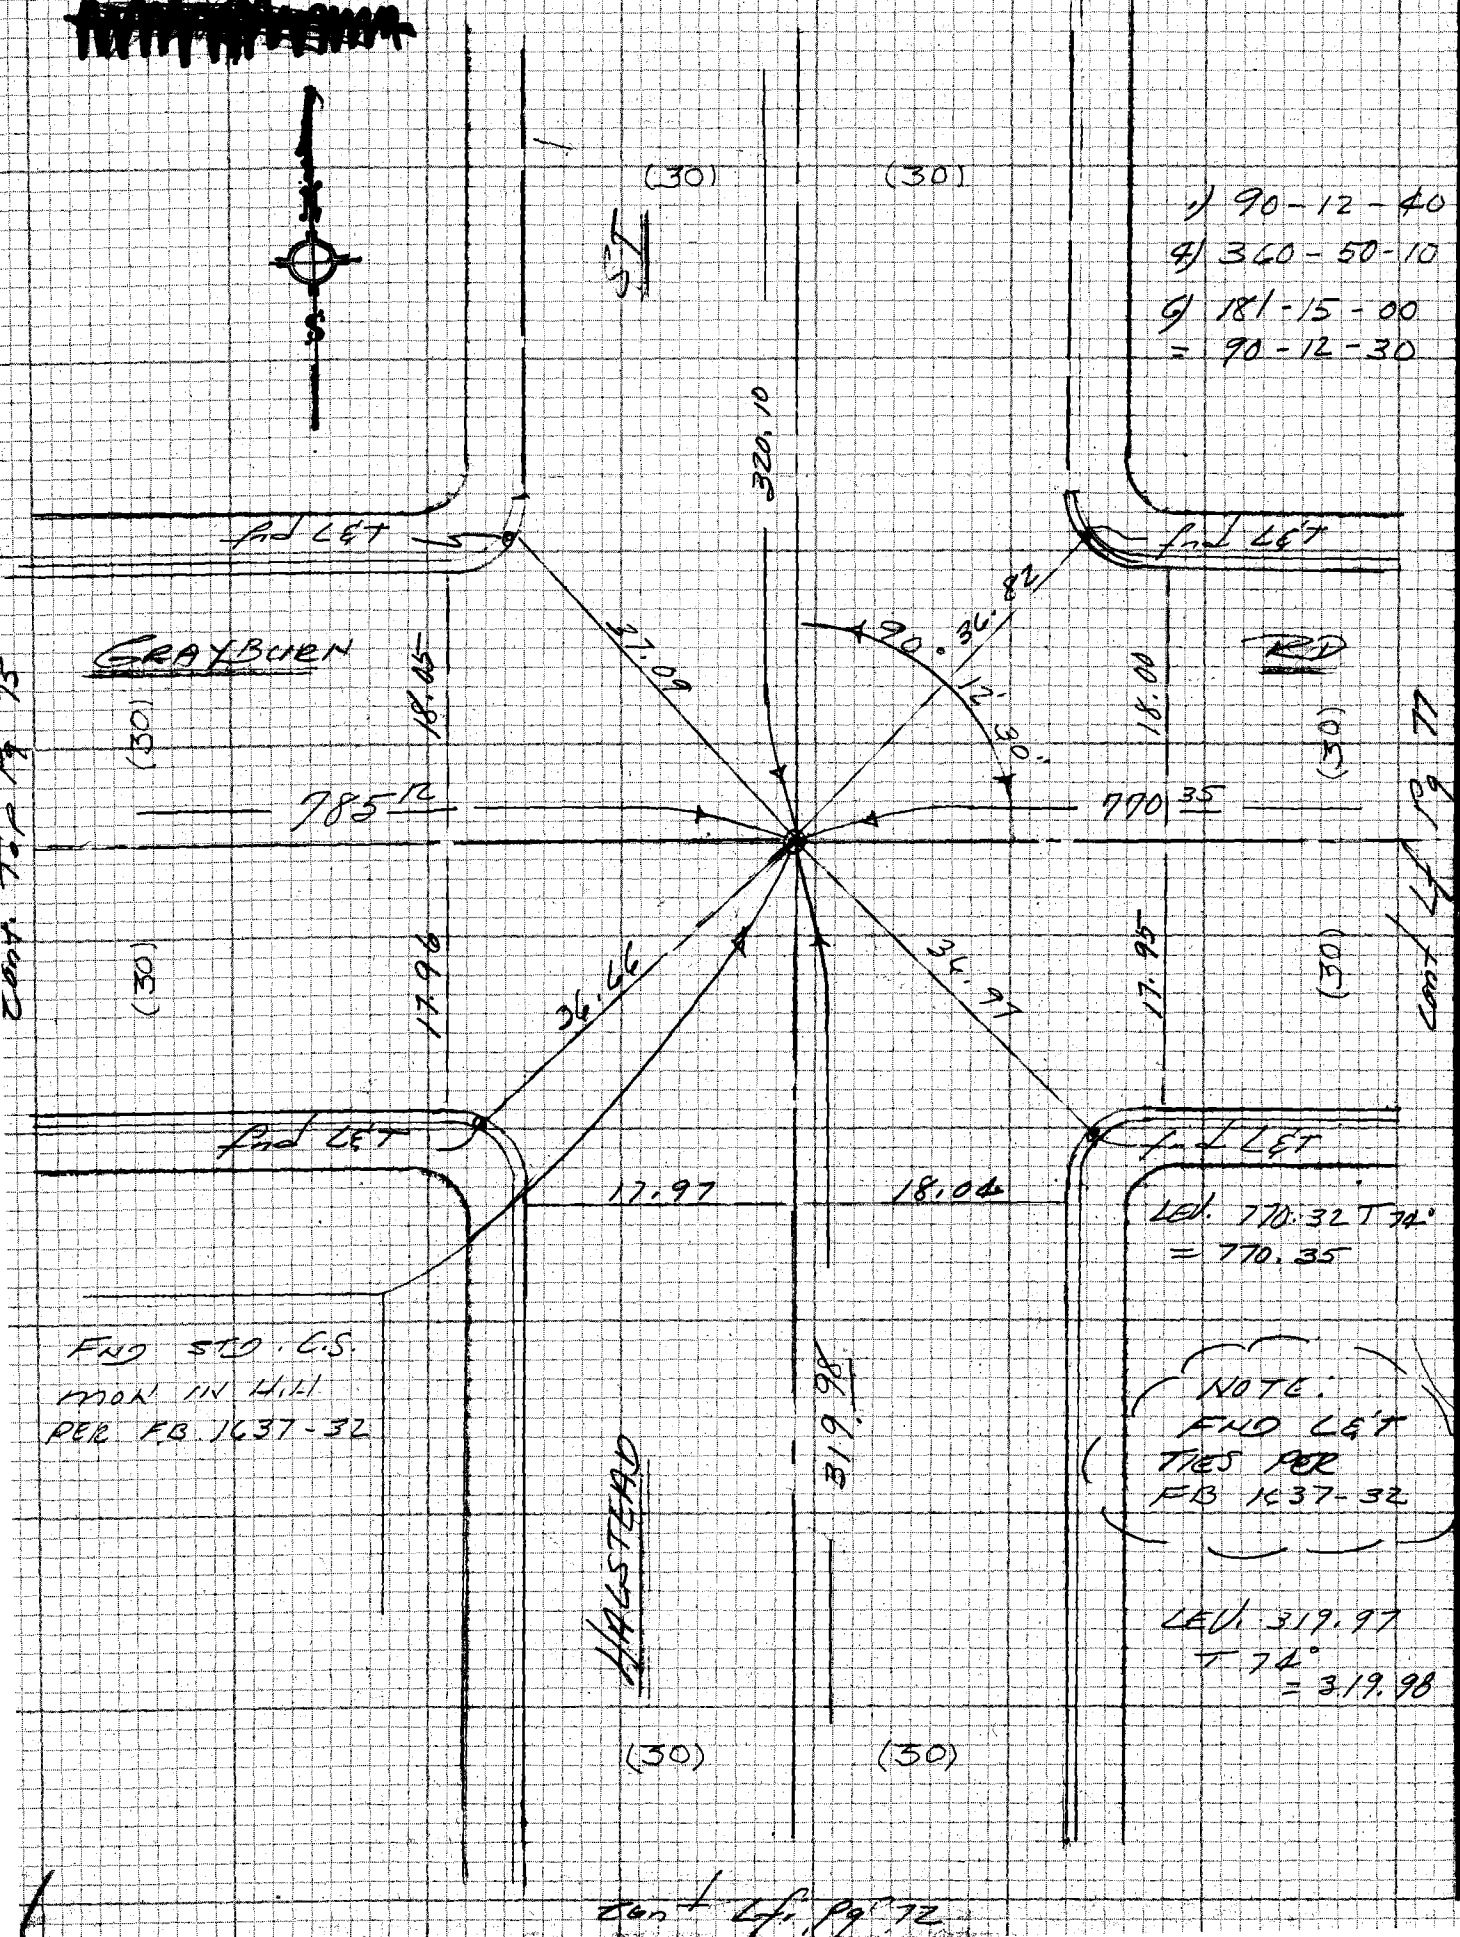


CE 310
76F3095-4/73

PLEASE RETURN TO
LOS ANGELES COUNTY ENGINEER
403 LOS ANGELES COUNTY ENGINEERING BLDG.

Do not exceed notes this side of this line

NOTE: ANY ADDITIONS OR CHANGES ON THIS SHEET MUST BE MADE OR CIRCLED IN RED INK WITH DATE AND NAME OF PERSON MAKING CHANGE

WS44 C-3

DIV. 4

F.B. 4412 PG. 77

| | |
|---|---|
| Notes Ck'd by | Survey of ROSEMEAD ST ℄ |
| Map No. | JN 8803.09 Tape 0232 Std 68 °F |
| Office Work | Surveyed by EL |
| Checked | Notes [illegible] Date 10-76 |
| Date | Indexed G. D. BAILEY SEP 19 1977 |

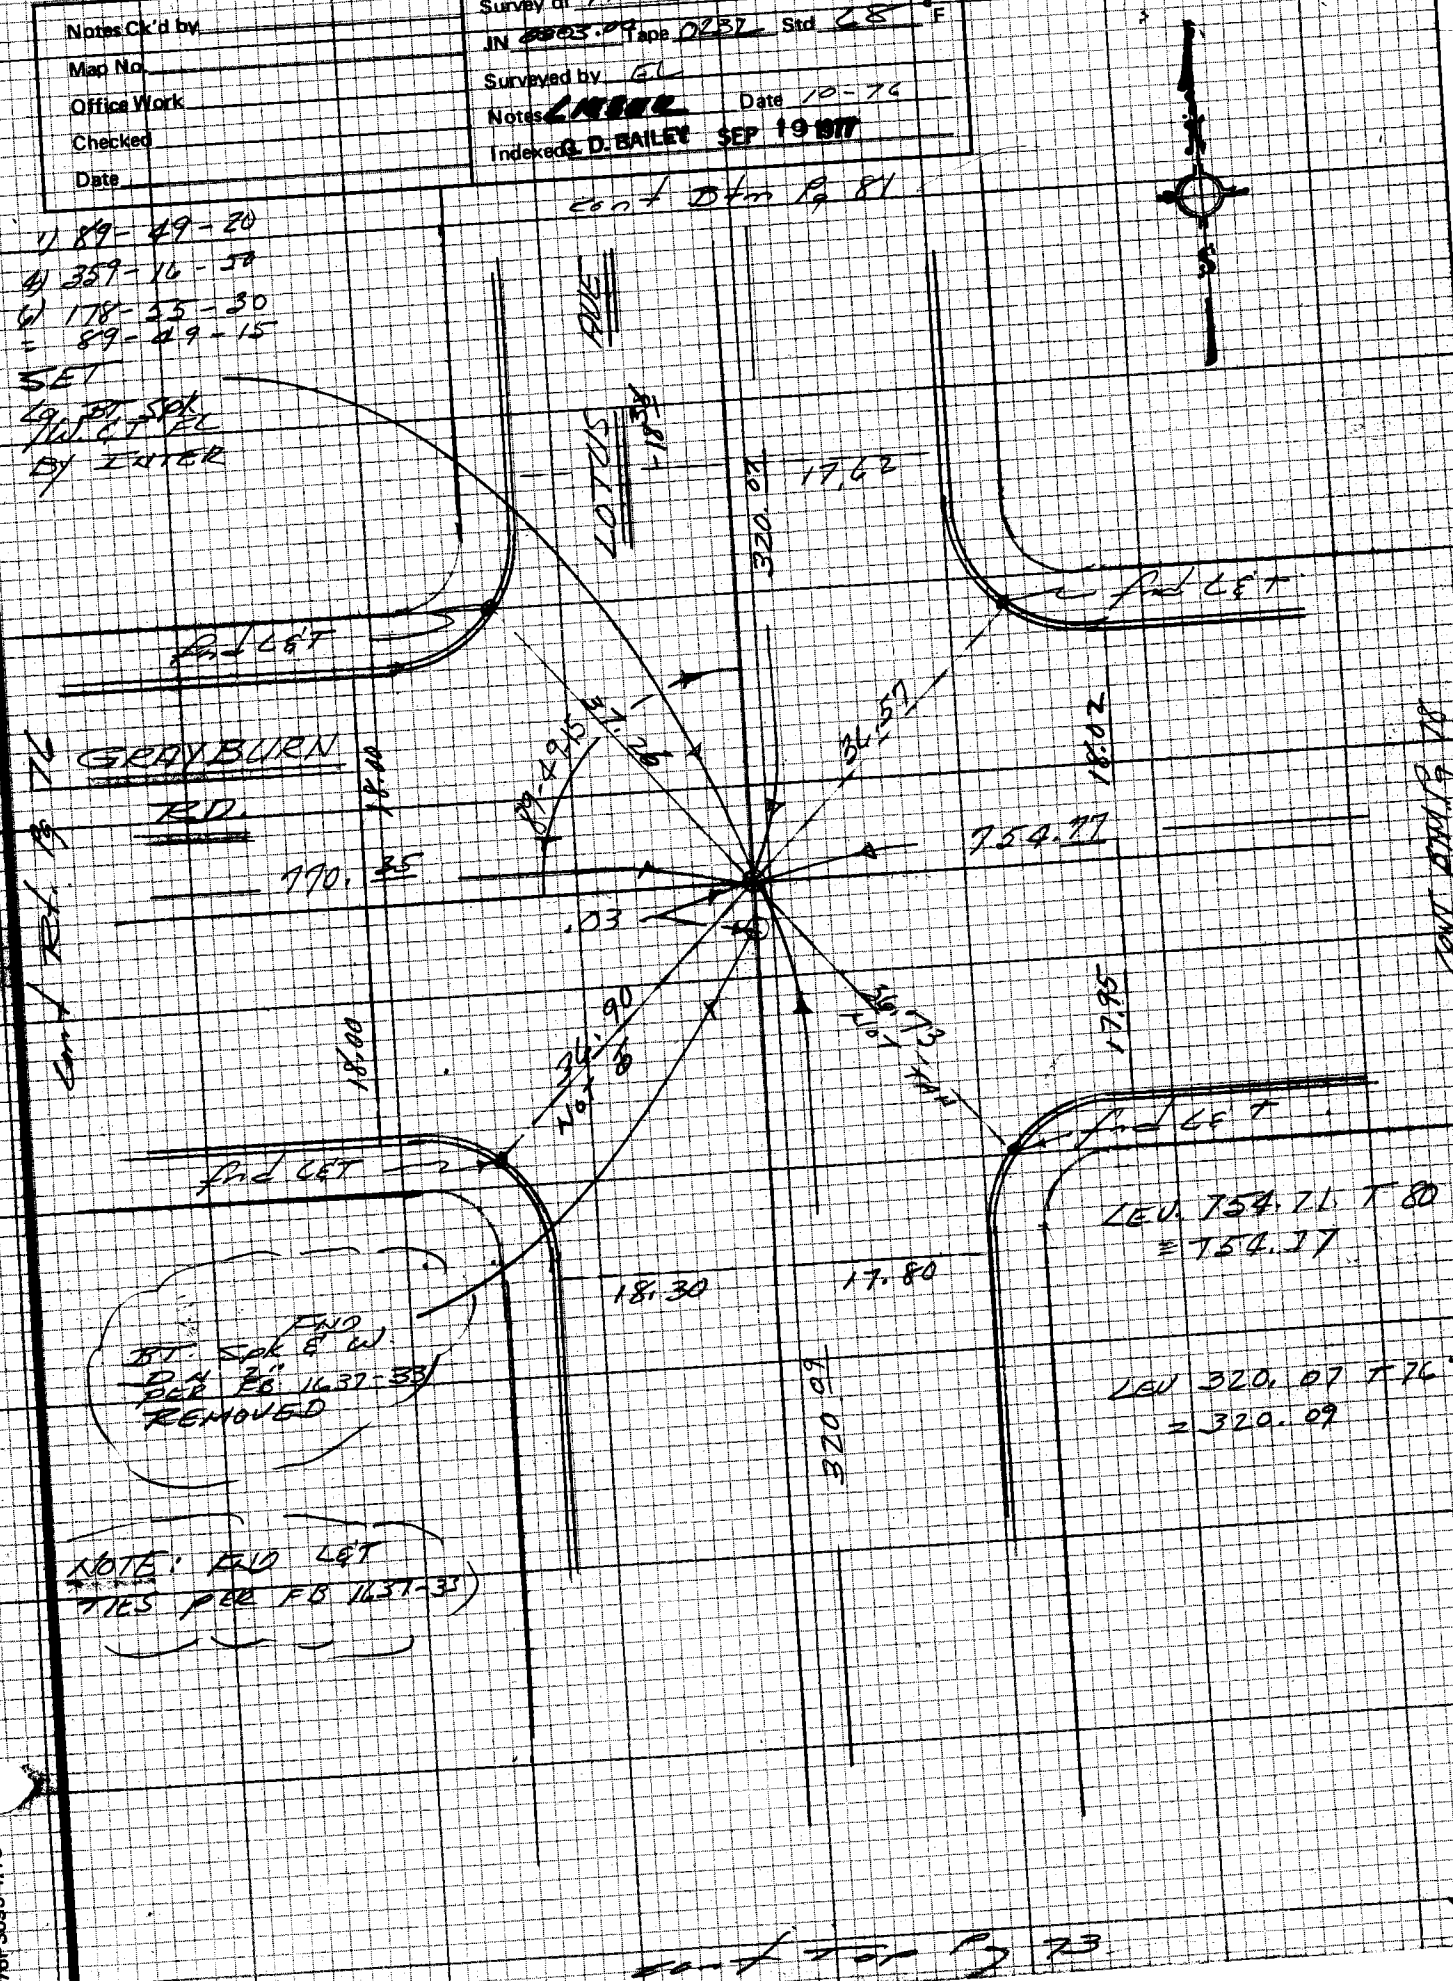


NOTE: ANY ADDITIONS OR CHANGES ON THIS SHEET MUST BE MADE OR CIRCLED IN RED INK WITH DATE AND NAME OF PERSON MAKING CHANGE

Do not extend notes on this side of this line

PLEASE RETURN TO
LOS ANGELES COUNTY ENGINEER
403 LOS ANGELES COUNTY ENGINEERING BLDG.

CENTERLINE NOTES
CE 310
76F3095-4/73

F.B. 4412 PG. 78

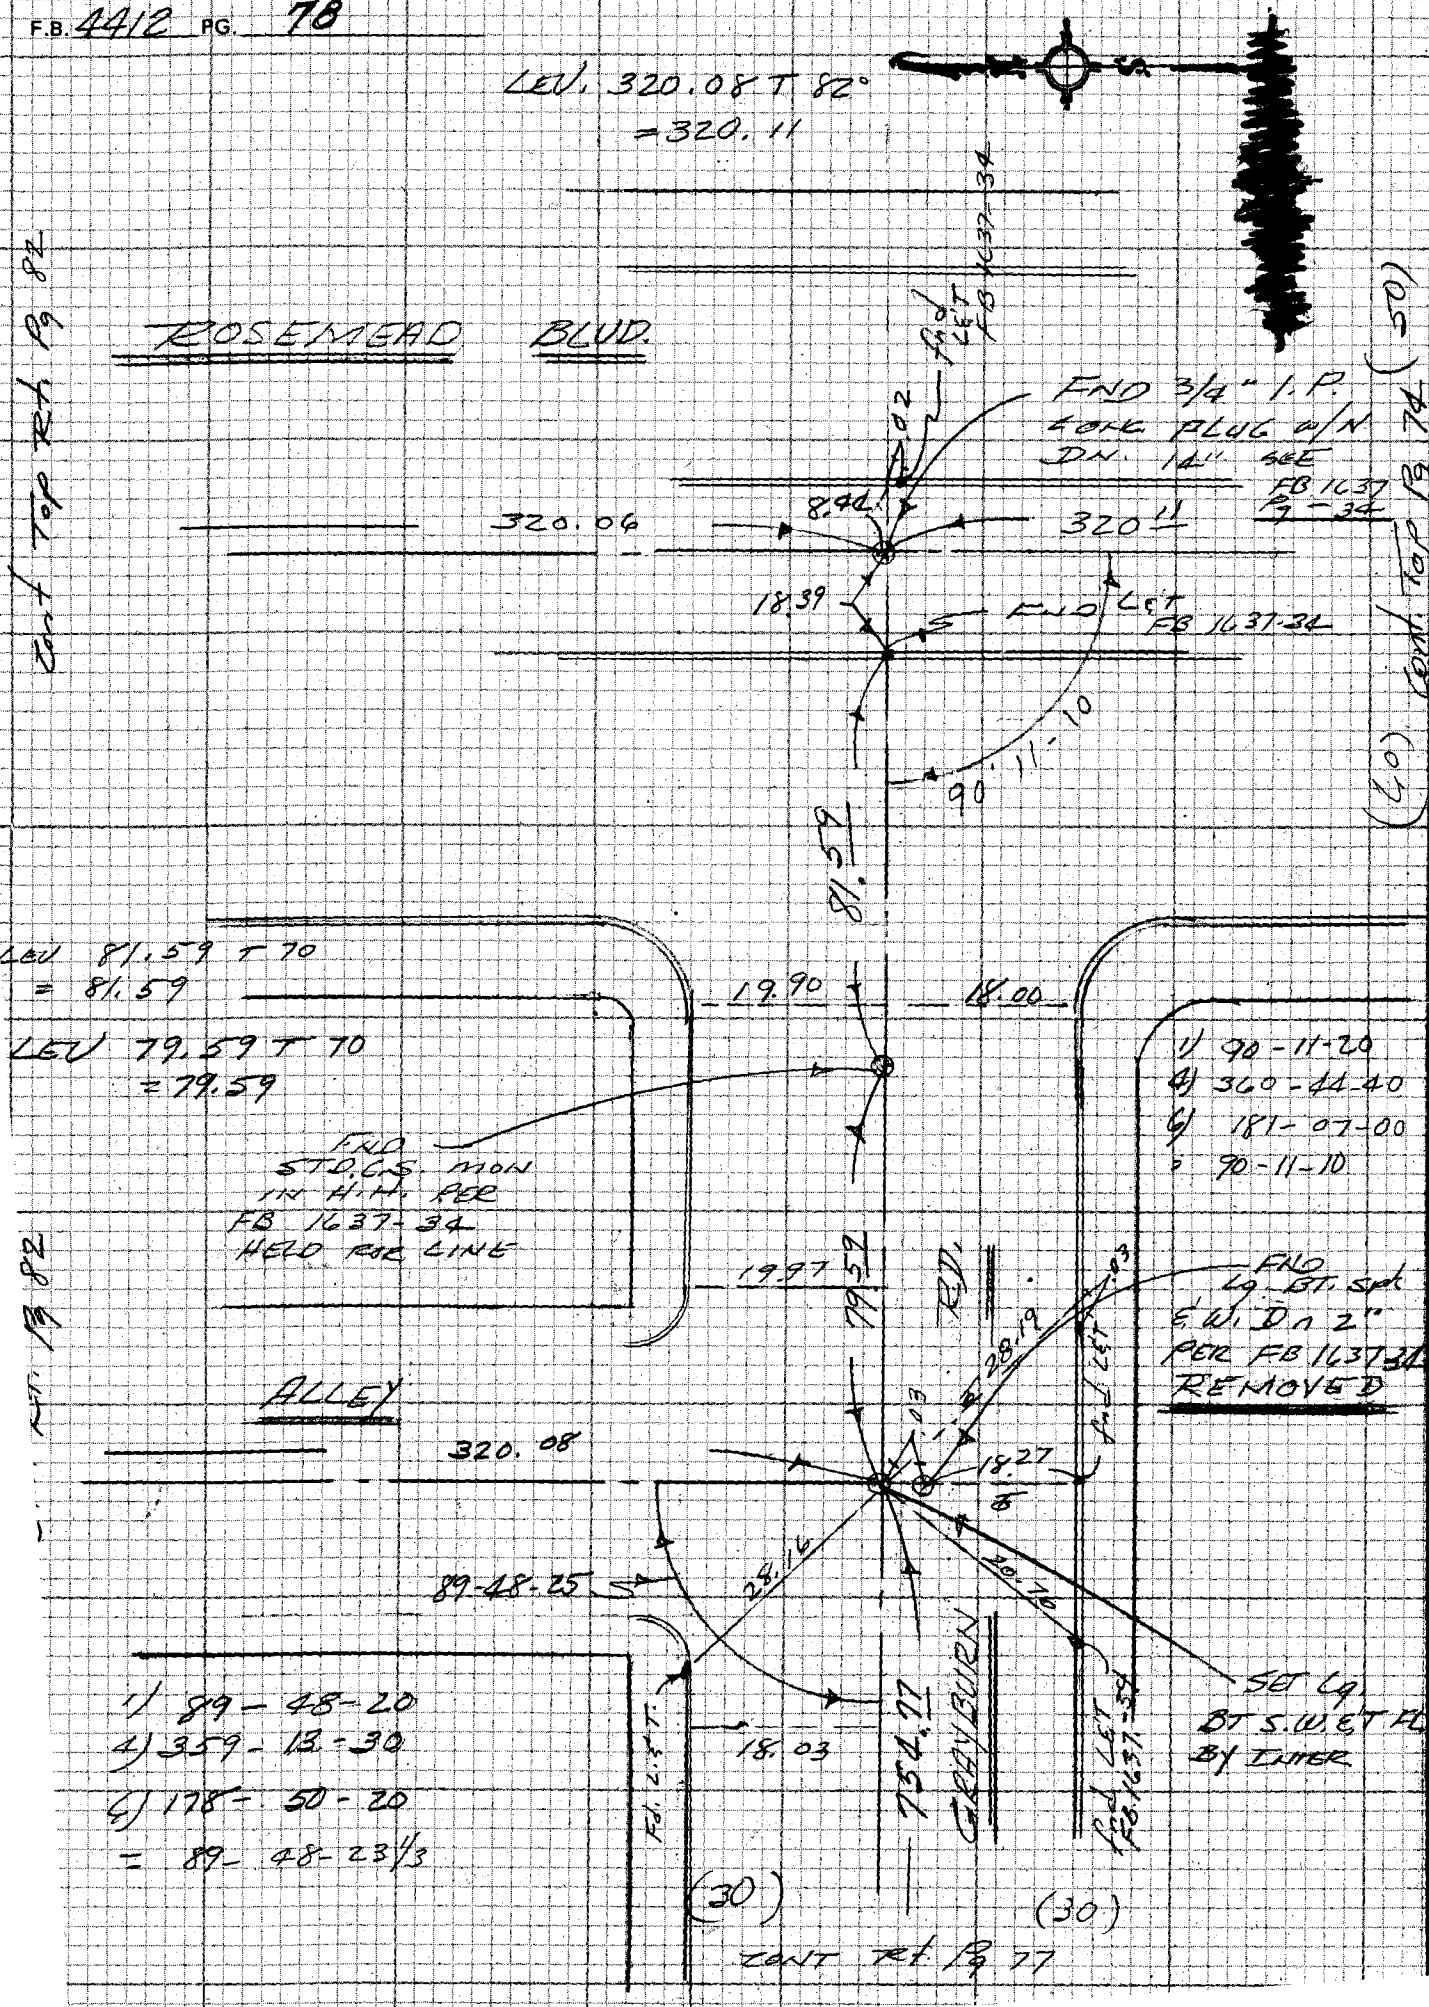


CE 310
76F3095-4/73

PLEASE RETURN TO
LOS ANGELES COUNTY ENGINEER
403 LOS ANGELES COUNTY ENGINEERING BLDG.

Do not exceed notes this side of this line

NOTE: ANY ADDITIONS OR CHANGES ON THIS SHEET MUST BE MADE OR CIRCLED IN RED INK WITH DATE AND NAME OF PERSON MAKING CHANGE

WS44C-3

| | |
|---|---|
| Notes Ck'd by | Survey of Rosemead St ℄ |
| Map No. | JN 0303.00 Tape 0232 Std 68° F |
| Office Work | Surveyed by EL |
| Checked | Notes EL Date 10-76 |
| Date | Indexed G. D. BAILEY SEP 19 1977 |

F.B. 4412 PG. 79

NOTE: END TIES PER FB 1637-35

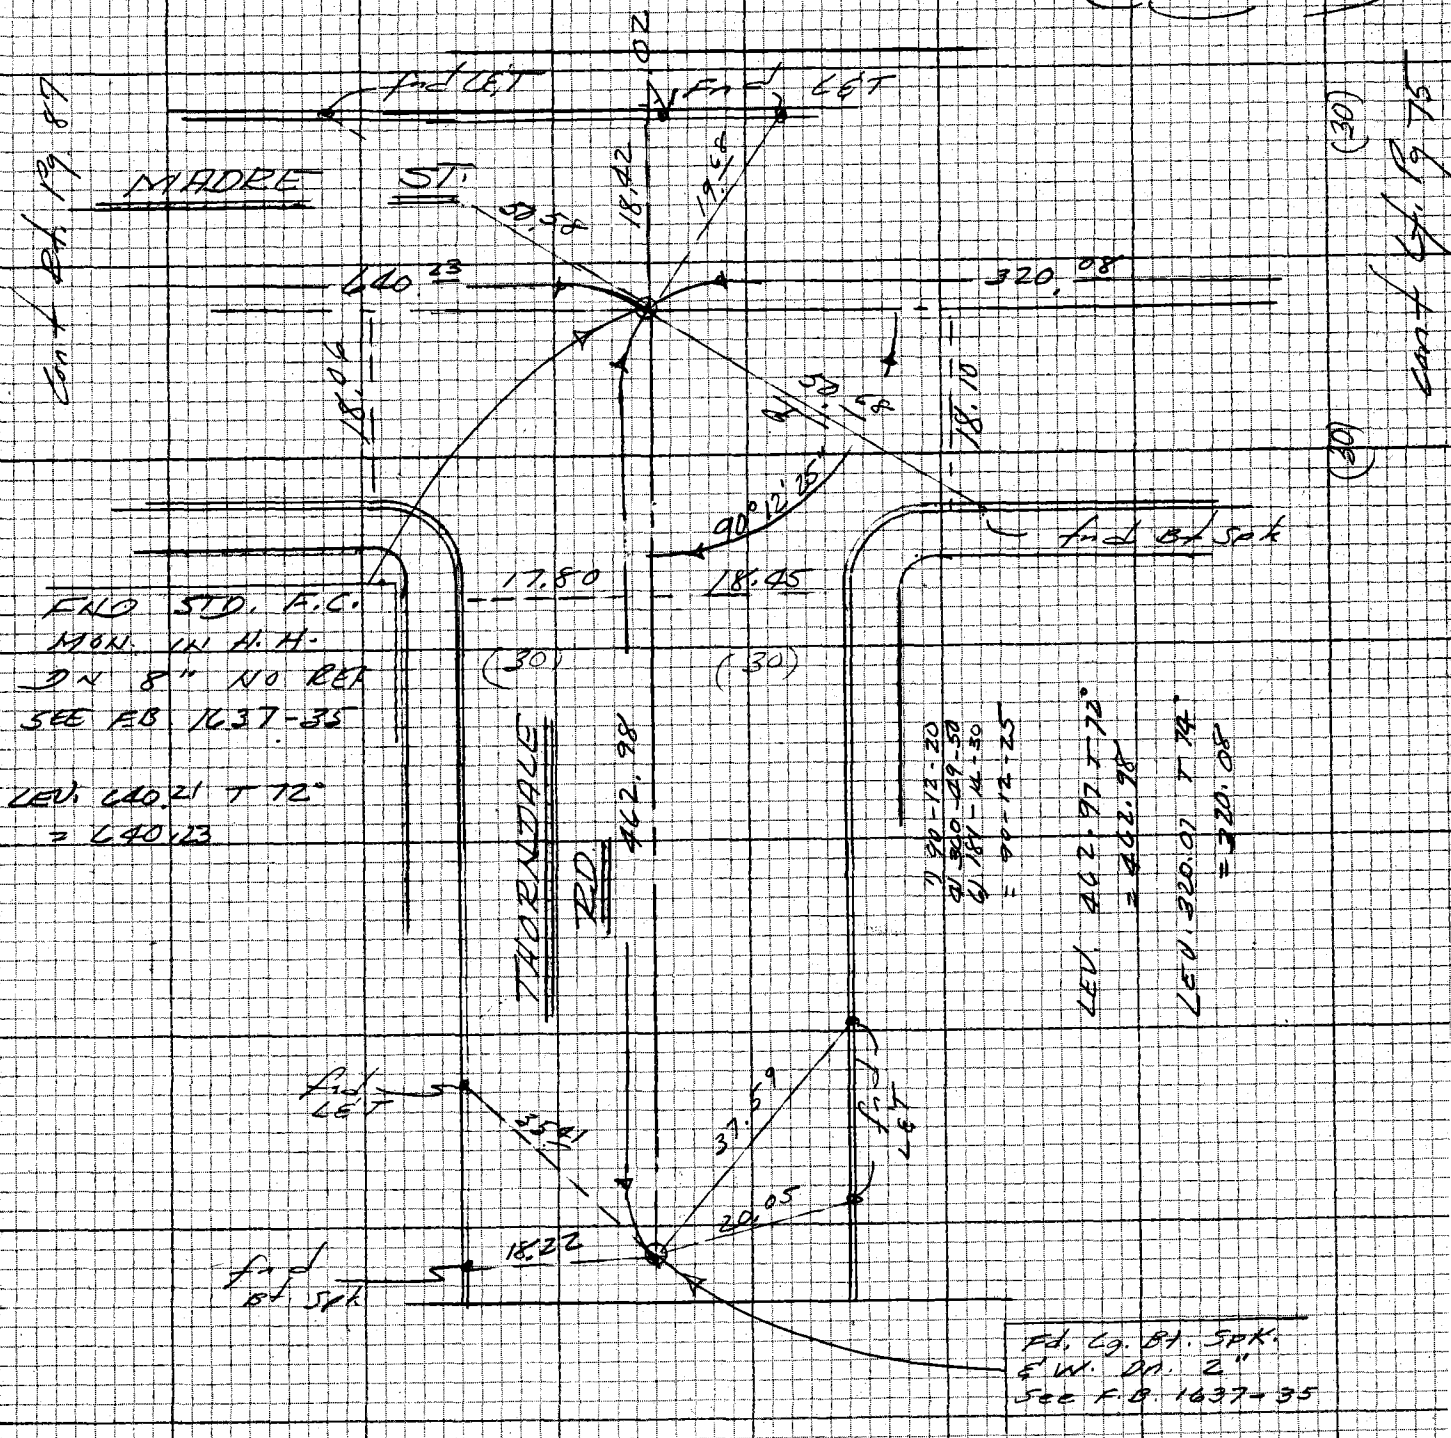


NOTE: ANY ADDITIONS OR CHANGES ON THIS SHEET MUST BE MADE OR CIRCLED IN RED INK WITH DATE AND NAME OF PERSON MAKING CHANGE

Do not extend notes this side of this line

PLEASE RETURN TO
LOS ANGELES COUNTY ENGINEER
403 LOS ANGELES COUNTY ENGINEERING BLDG.

CENTERLINE NOTES
CE 310
76F3095-4/73

F.B. 4412 PG. 80

cont btm Pg 83

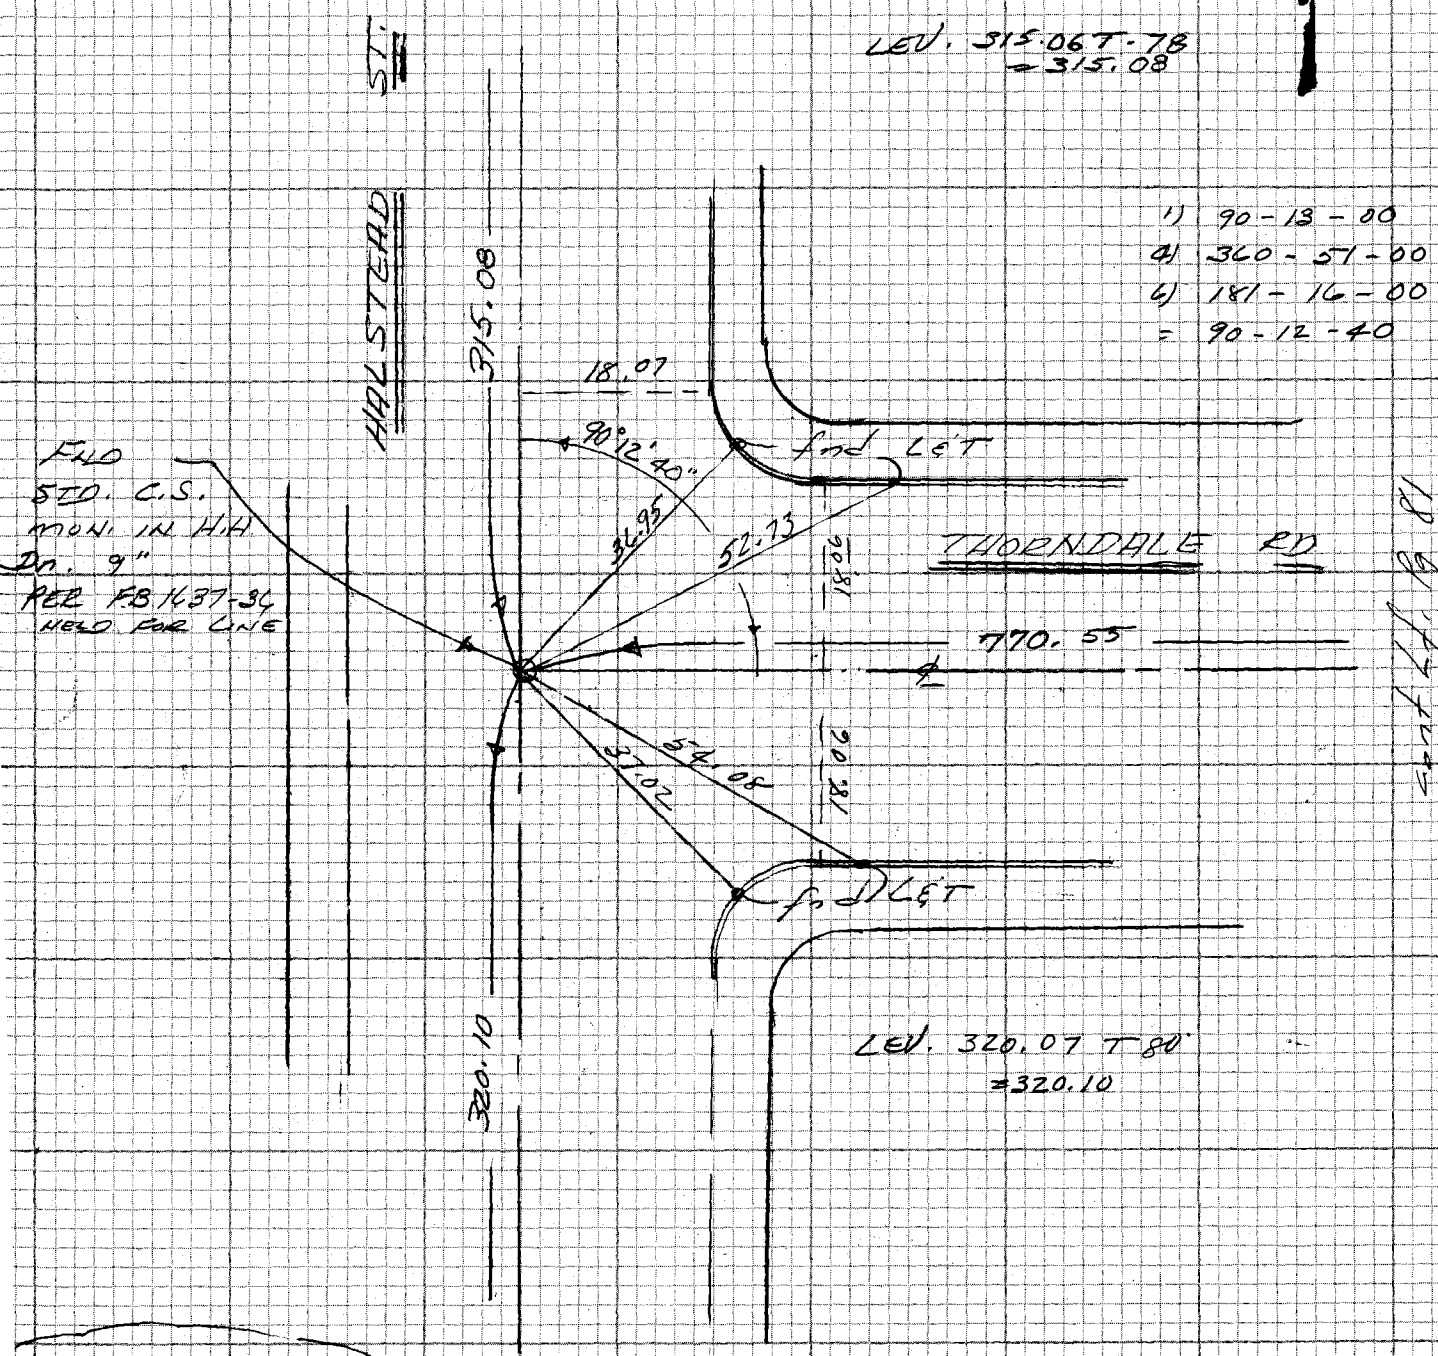


NOTE: FND L&T TIES PER FB 1637-Pg 36

cont Top Pg 76

CE 310
76F3095-4/73

PLEASE RETURN TO
LOS ANGELES COUNTY ENGINEER
403 LOS ANGELES COUNTY ENGINEERING BLDG.

Do not ex[illegible] notes this side of this line

NOTE: ANY ADDITIONS OR CHANGES ON THIS SHEET MUST BE MADE OR CIRCLED IN RED INK WITH DATE AND NAME OF PERSON MAKING CHANGE

DIV 4

| | |
|---|---|
| Notes Ck'd by | Survey of ROSEMEAD ST ℄ |
| Map No. | JN 0303.00 Tape 0232 Std 68 °F |
| Office Work | Surveyed by E.L. |
| Checked | Notes E.L. Date 10-76 |
| Date | Indexed G. D. BAILEY SEP 19 1977 |

F.B. 4412 PG. 81

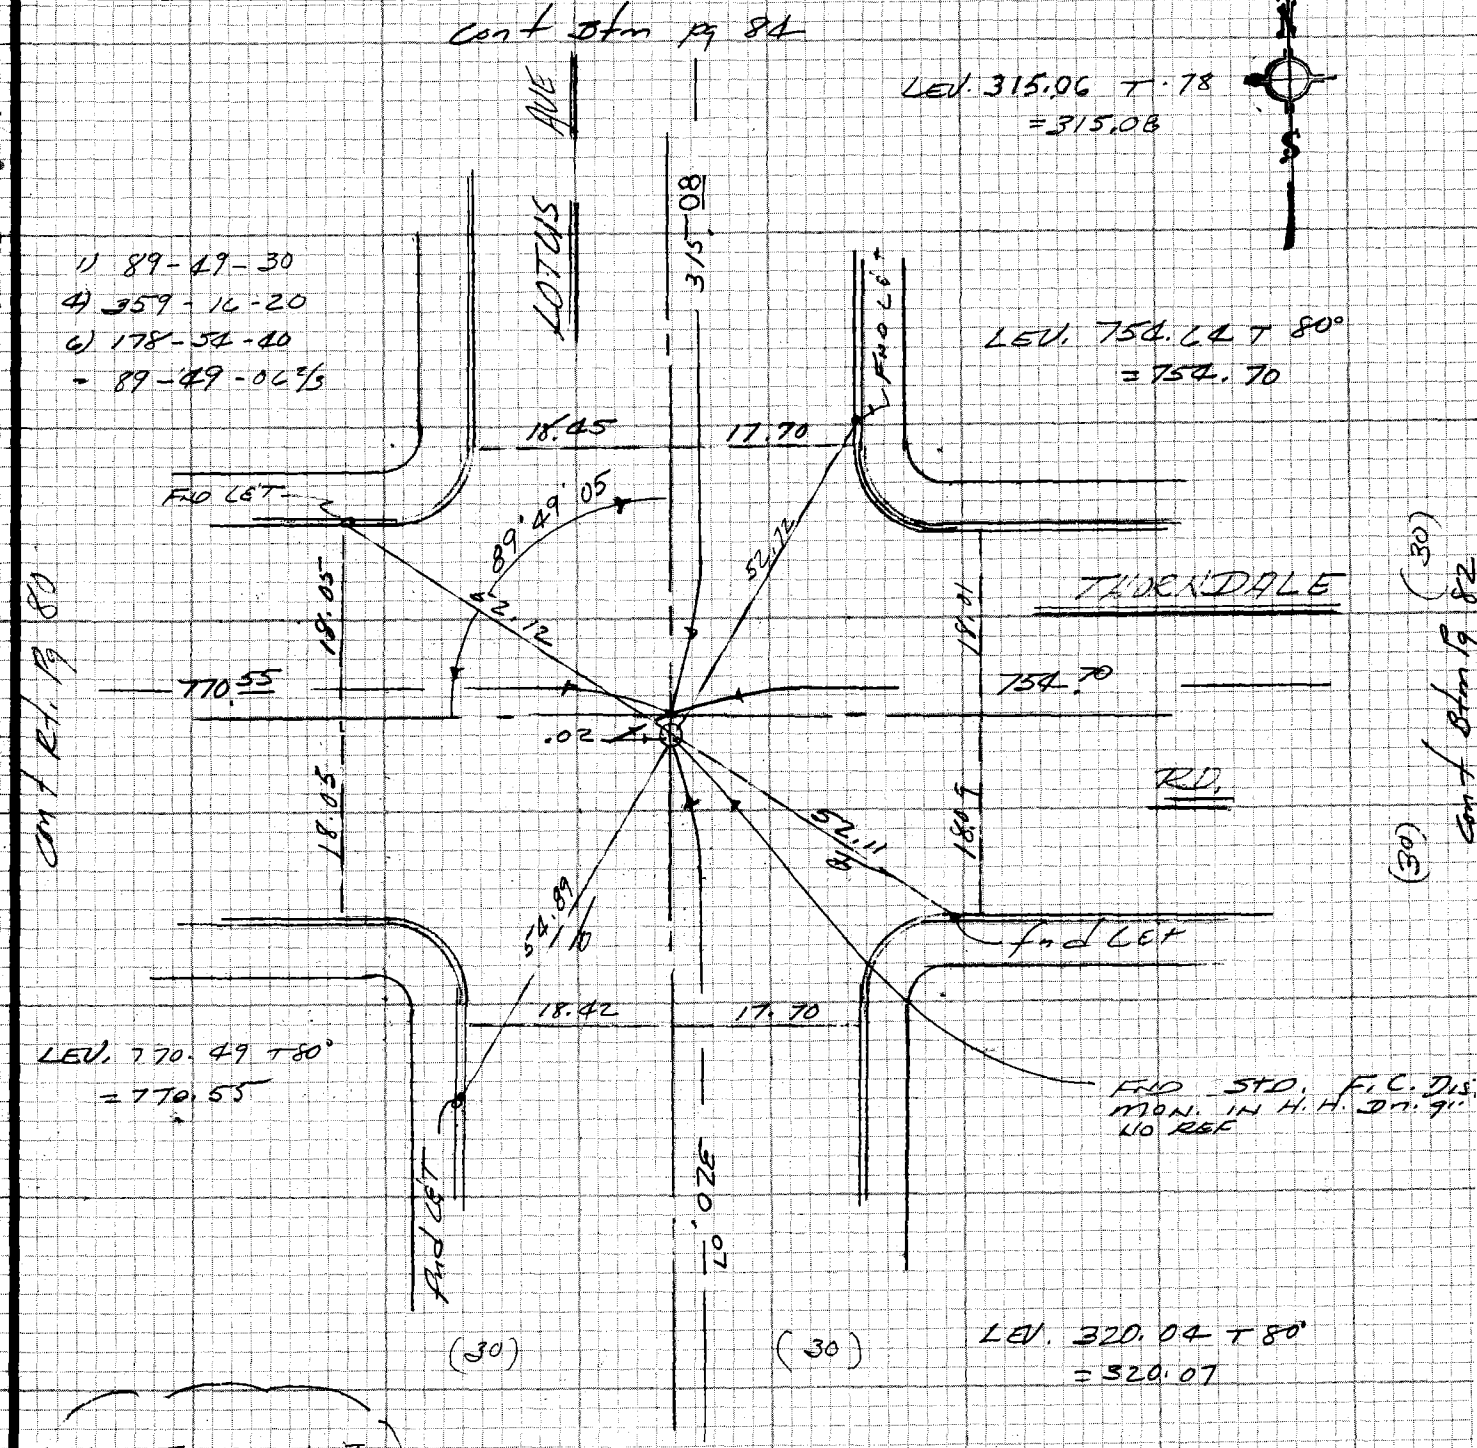


NOTE: FND LET TIES PER FB 1637-37

Cont Top Pg 77

NOTE: ANY ADDITIONS OR CHANGES ON THIS SHEET MUST BE MADE OR CIRCLED IN RED INK WITH DATE AND NAME OF PERSON MAKING CHANGE

Do not extend notes this side of this line

PLEASE RETURN TO
LOS ANGELES COUNTY ENGINEER
403 LOS ANGELES COUNTY ENGINEERING BLDG.

CENTERLINE NOTES
CE 310
76F3095-4/73

F.B. 4412 PG. 82

1) 89-49-00
4) 359-15-00
6) 178-52-20
= 89-48-43⅓

LEV. 315.04 T 88° = 315.10

NOTE! FND TIES PER FB 1637-38

1) 89-48-40
4) 359-13-40
6) 178-50-20
= 89-48-23⅓

CE 310
76F3095-4/73

PLEASE RETURN TO
LOS ANGELES COUNTY ENGINEER
403 LOS ANGELES COUNTY ENGINEERING BLDG.

Do not extend notes this side of this line

NOTE: ANY ADDITIONS OR CHANGES ON THIS SHEET MUST BE MADE OR CIRCLED IN RED INK WITH DATE AND NAME OF PERSON MAKING CHANGE

Div 4

| | |
|---|---|
| Notes Ck'd by | Survey of Rosemead St ℄ |
| Map No. | JN 1303.00 Tape 12.32 Std. 68 °F |
| Office Work | Surveyed by EL |
| Checked | Notes EL Date 10-76 |
| Date | Indexed G. D. BAILEY SEP 19 1977 |

F.B. 4412 PG. 83

cont Btm Pg 88

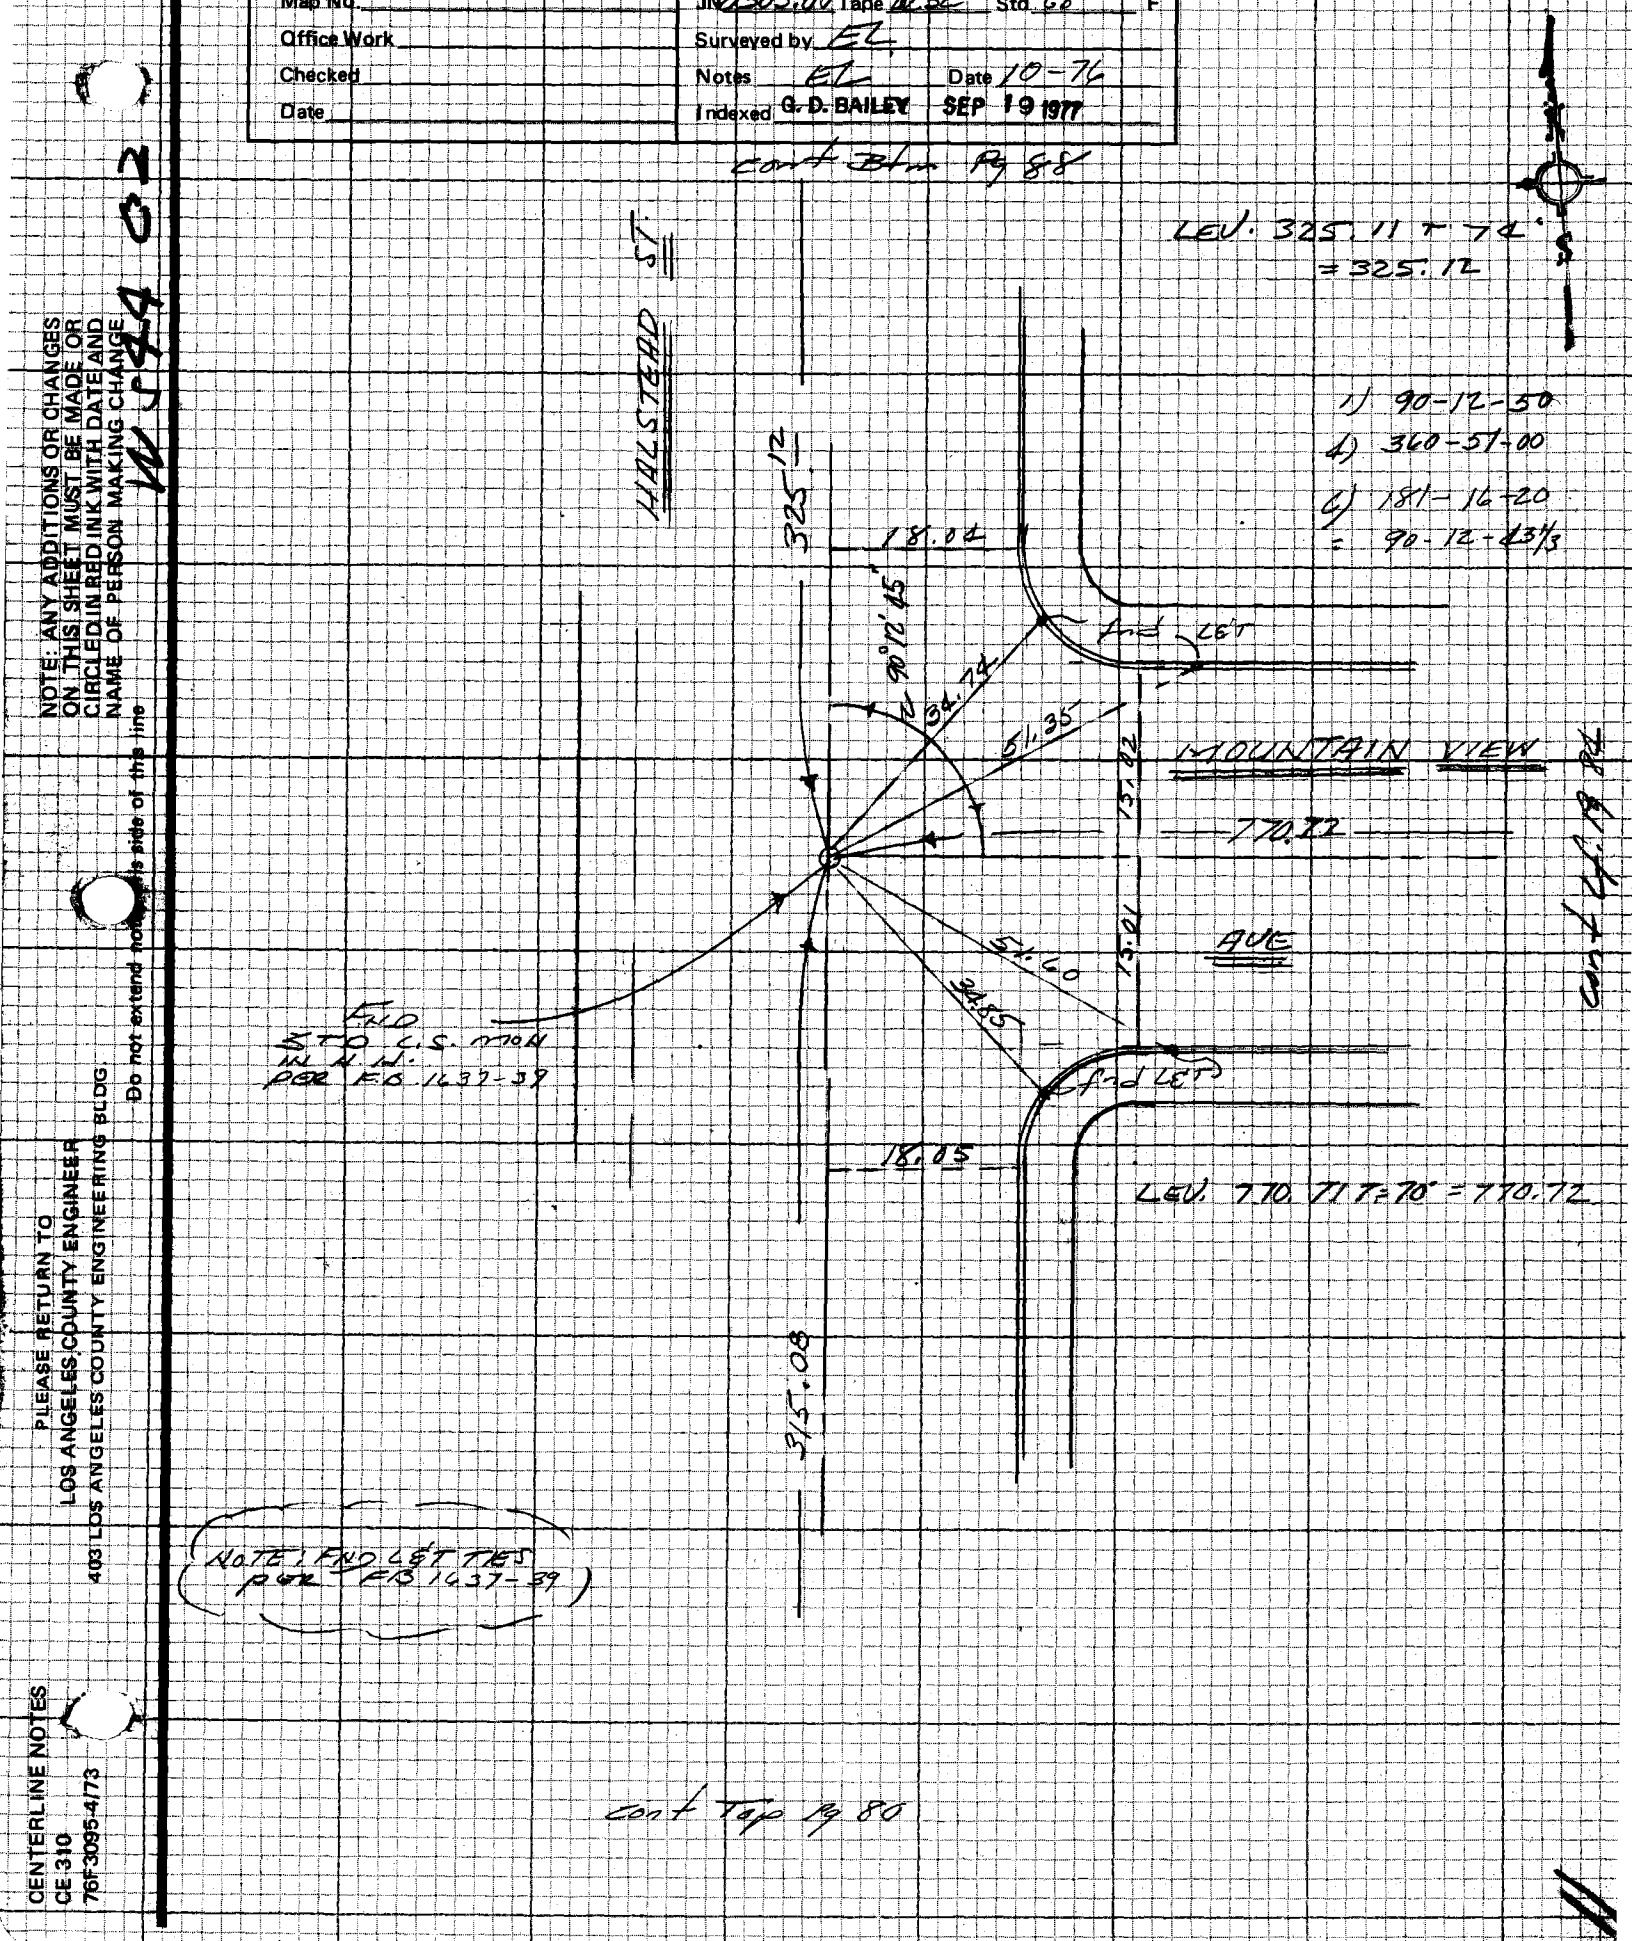


cont Top Pg 80

cont Cf. Pg 84

NOTE: ANY ADDITIONS OR CHANGES ON THIS SHEET MUST BE MADE OR CIRCLED IN RED INK WITH DATE AND NAME OF PERSON MAKING CHANGE

Do not extend notes this side of this line

PLEASE RETURN TO LOS ANGELES COUNTY ENGINEER 403 LOS ANGELES COUNTY ENGINEERING BLDG.

CENTERLINE NOTES CE 310 76F3095-4/73

F.B. 4412 PG. 84

Cont. Btm. Pg 89

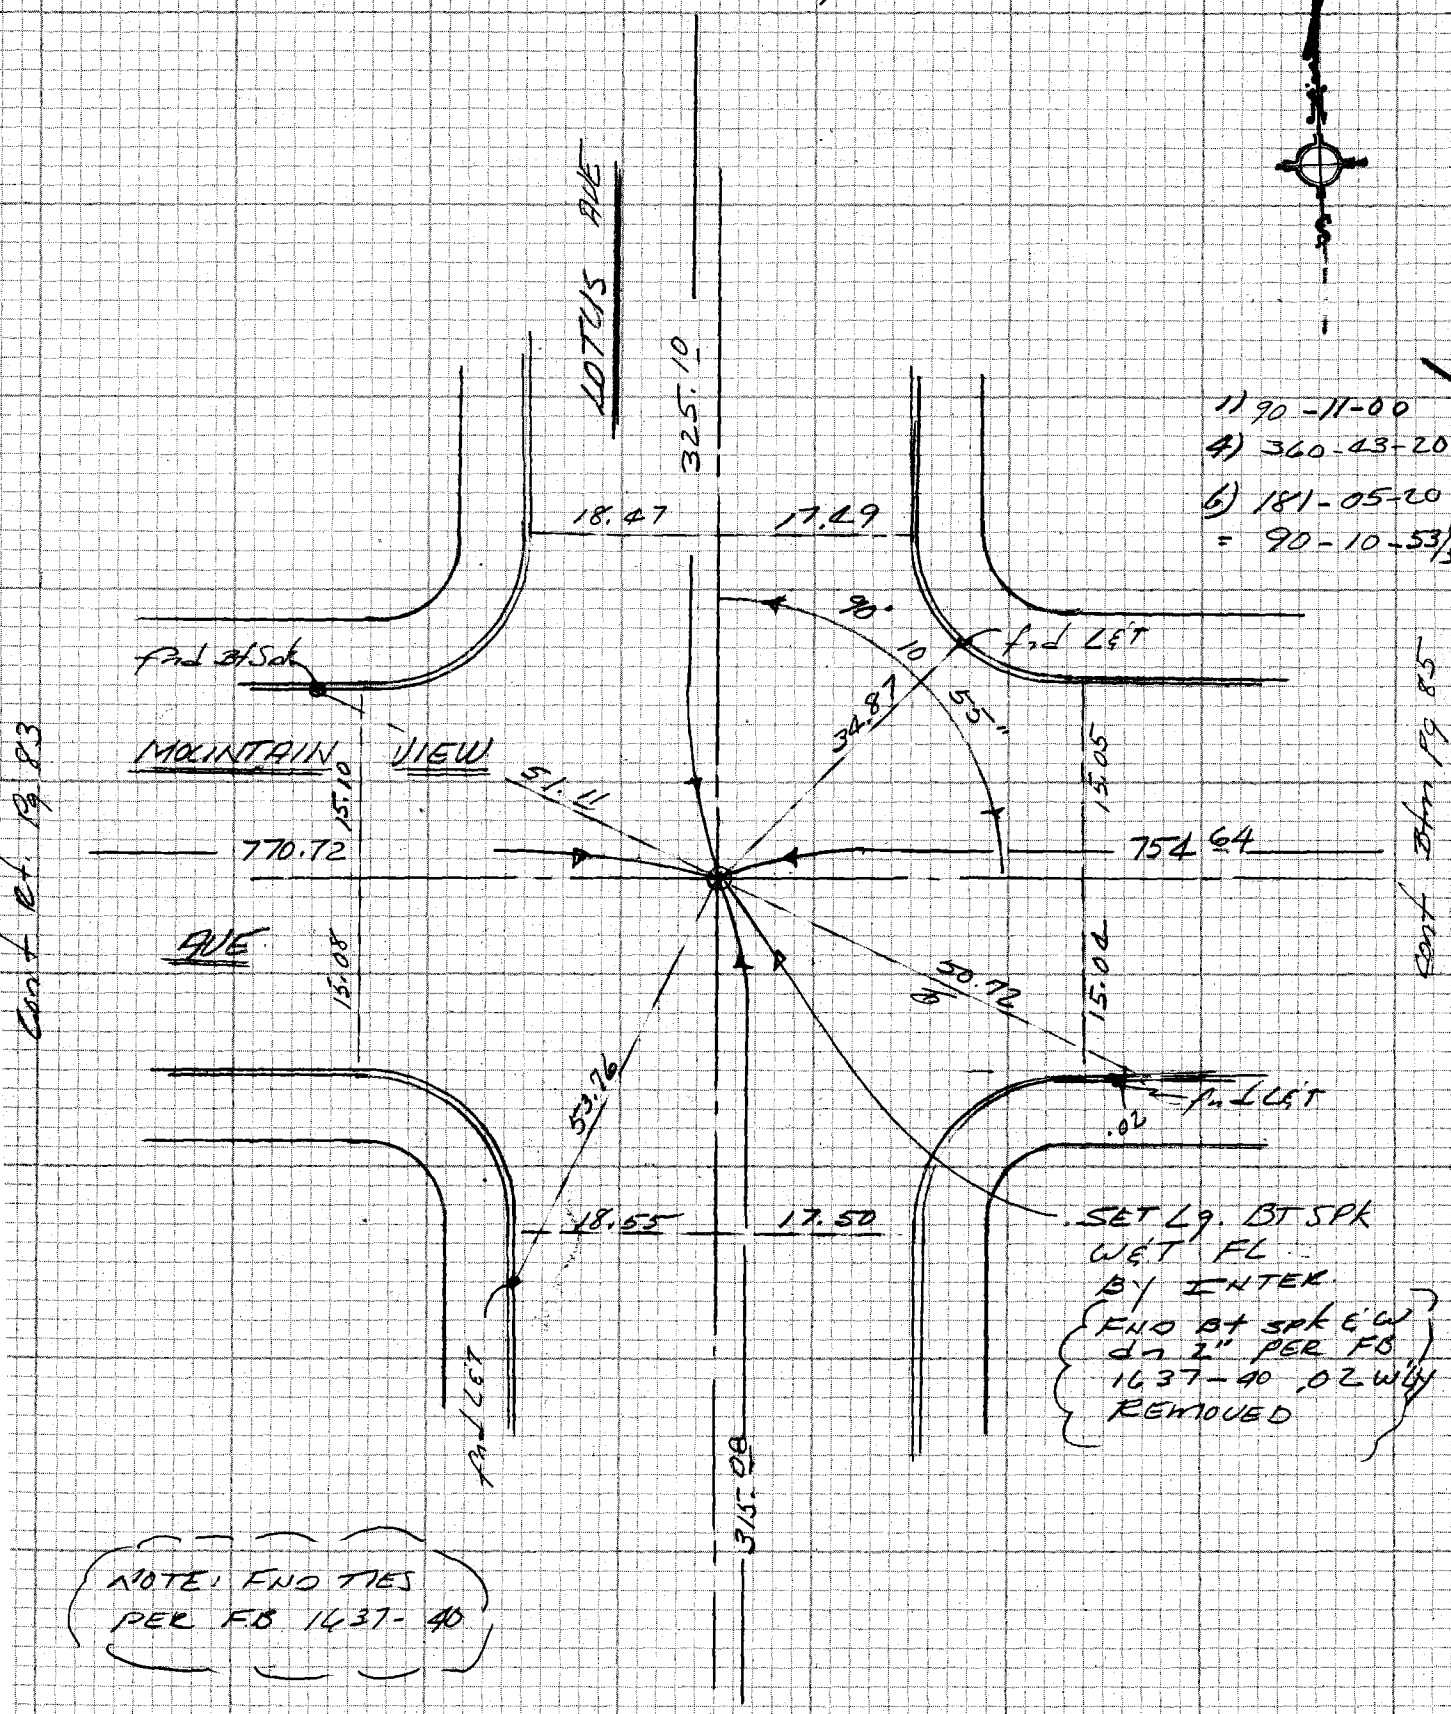


1) 90-11-00
4) 360-43-20
6) 181-05-20
= 90-10-53/3

Cont. Rt. Pg 83

Cont. Btm Pg 85

SET Lg. BT SPK
W&T FL
BY INTER.
FND Bt spk E&W
dn 2" PER FB
1637-40 .02 W'ly
REMOVED

NOTE: FND TIES
PER FB 1637-40

CONT. Top Pg 81


CE 310
76F3095-4/73

PLEASE RETURN TO
LOS ANGELES COUNTY ENGINEER
403 LOS ANGELES COUNTY ENGINEERING BLDG.

Do not exceed notes this side of this line

NOTE: ANY ADDITIONS OR CHANGES ON THIS SHEET MUST BE MADE OR CIRCLED IN RED INK WITH DATE AND NAME OF PERSON MAKING CHANGE


MS44 C-2

DIV 4

| | |
|---|---|
| Notes Ck'd by | Survey of ROSEMEAD ST ℄ |
| Map No. | JN 0303-00 Tape 0232 Std 68 °F |
| Office Work | Surveyed by EL |
| Checked | Notes EL Date 10-76 |
| Date | Indexed G. D. BAILEY SEP 19 1977 |

F.B. 4412 PG. 85

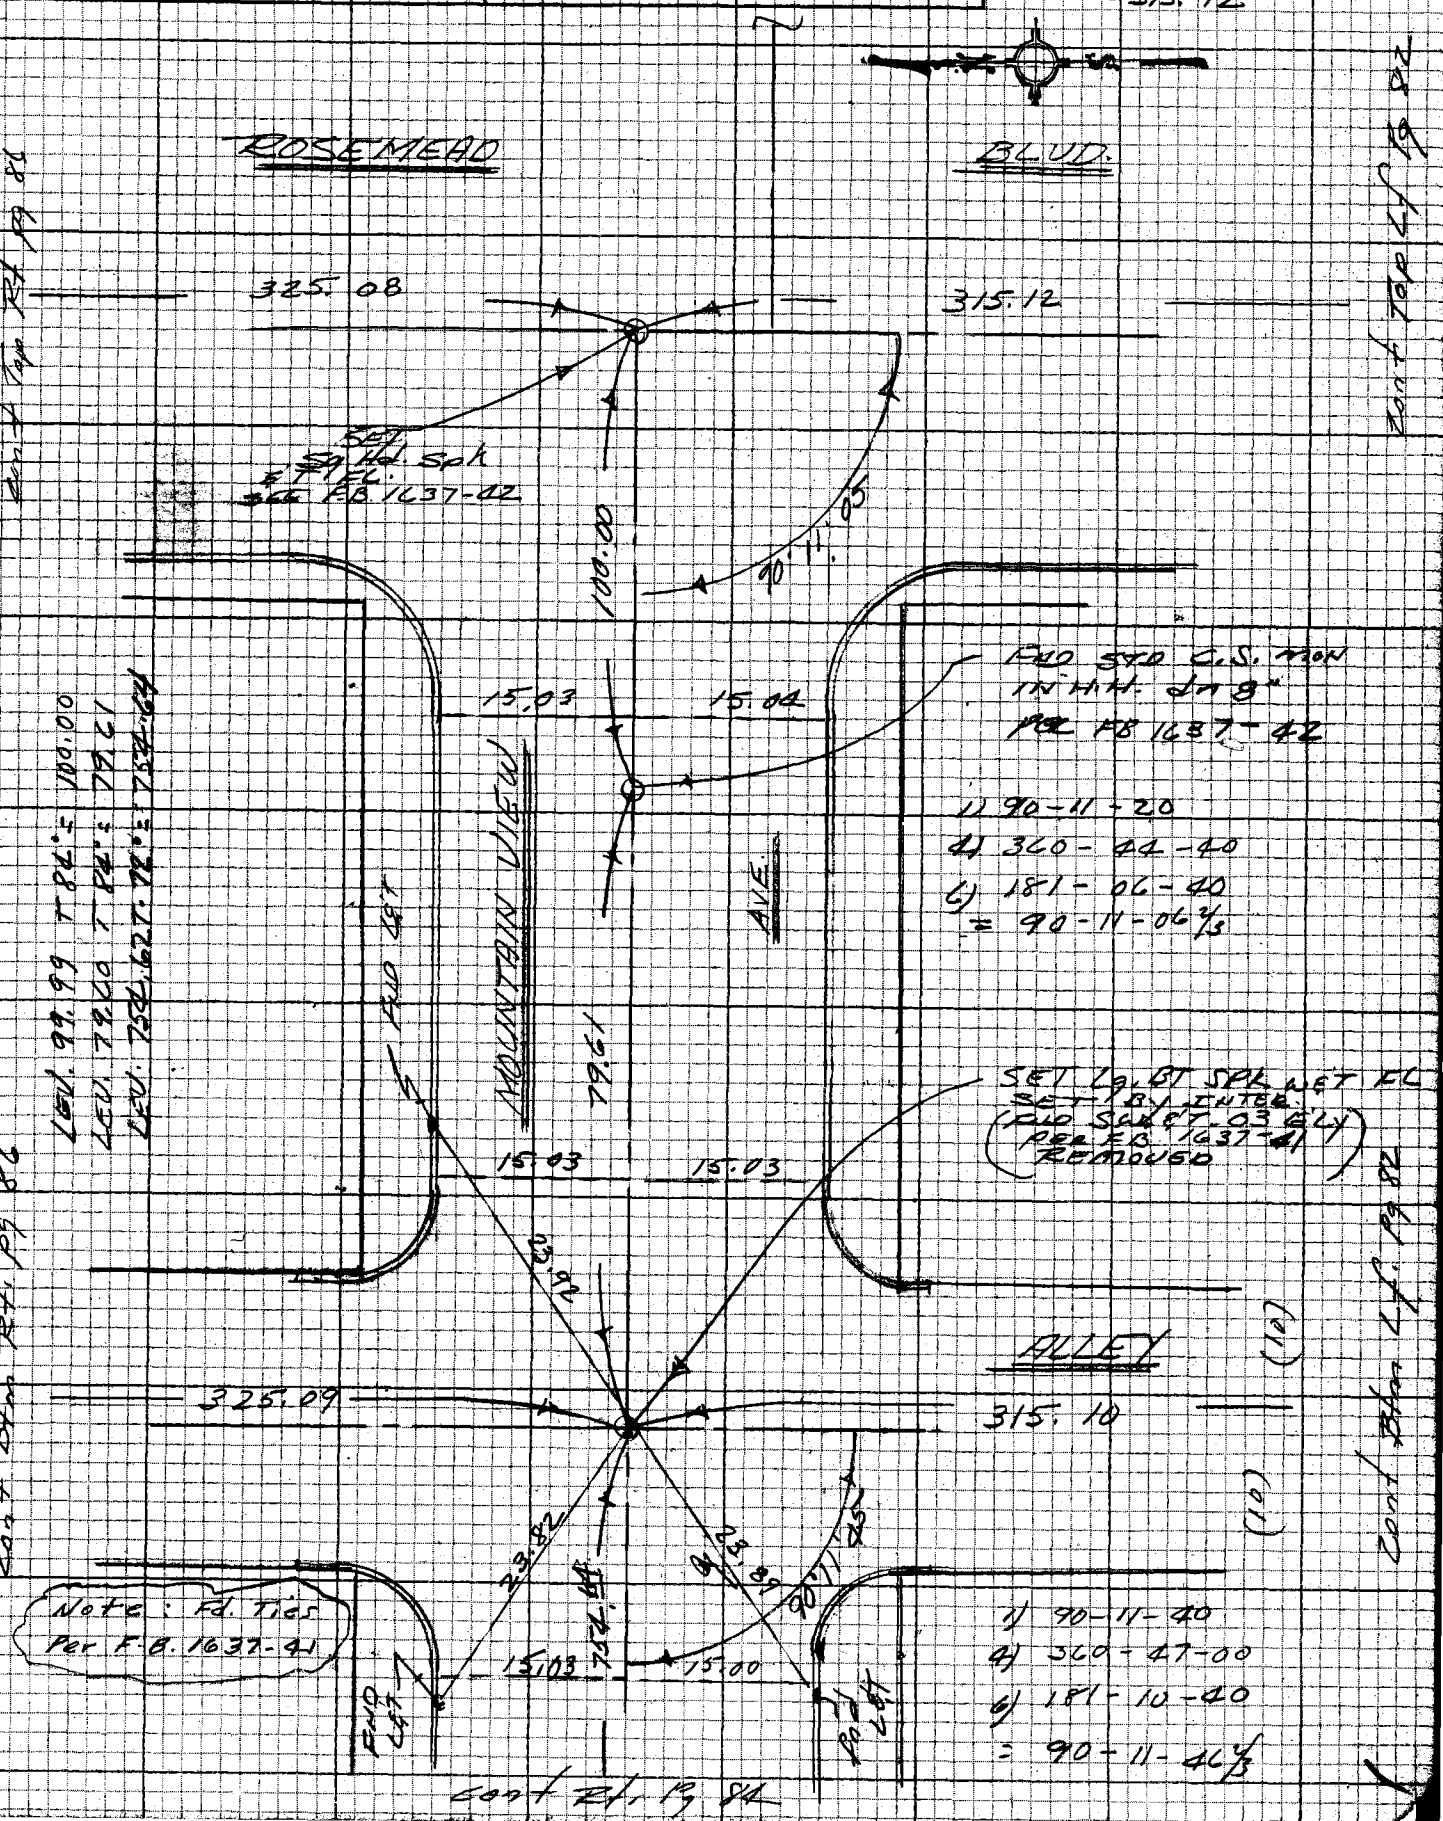


NOTE: ANY ADDITIONS OR CHANGES ON THIS SHEET MUST BE MADE OR CIRCLED IN RED INK WITH DATE AND NAME OF PERSON MAKING CHANGE

Do not extend notes this side of this line

PLEASE RETURN TO
LOS ANGELES COUNTY ENGINEER
403 LOS ANGELES COUNTY ENGINEERING BLDG.

CENTERLINE NOTES
CE 310
76F3095-4/73

F.B. 4412 PG. 86

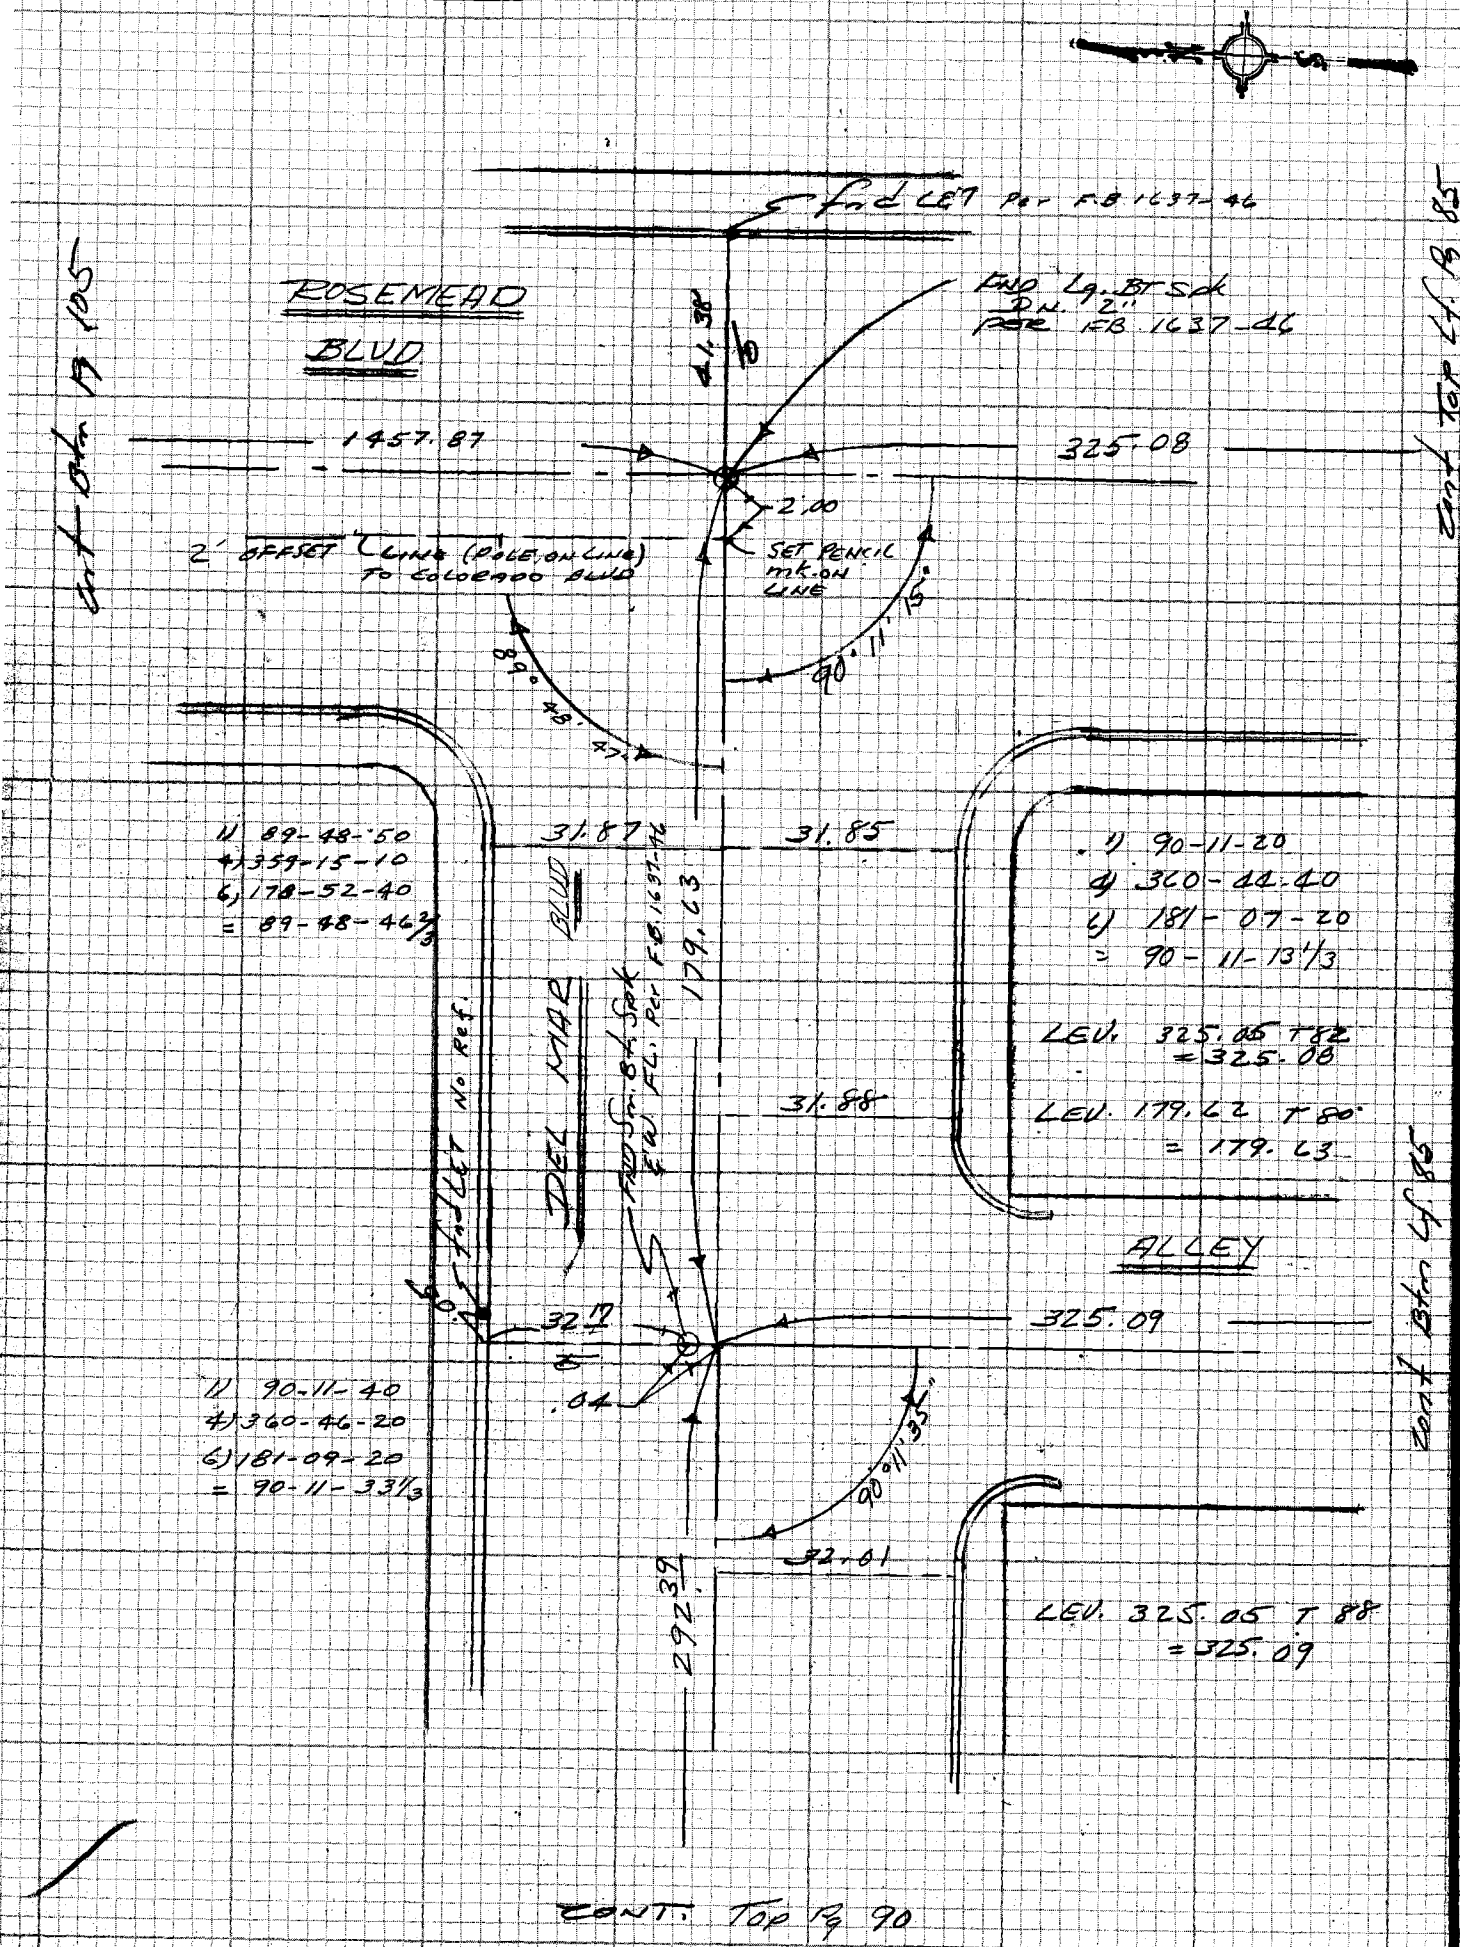


CONT. Top Pg 90

CE 310
76F3095-4/73

PLEASE RETURN TO
LOS ANGELES COUNTY ENGINEER
403 LOS ANGELES COUNTY ENGINEERING BLDG.

Do not ex[illegible] notes this side of this line

NOTE: ANY ADDITIONS OR CHANGES ON THIS SHEET MUST BE MADE OR CIRCLED IN RED INK WITH DATE AND NAME OF PERSON MAKING CHANGE

Div 4

| | |
|---|---|
| Notes Ck'd by | Survey of ROSEMEAD ST ℄ |
| Map No. | JN 0303.00 Tape 0232 Std 68 °F |
| Office Work | Surveyed by EL |
| Checked | Notes EL Date 11-76 |
| Date | Indexed G. D. BAILEY SEP 19 1977 |

F.B. 4412 PG. 87

Note: Fd. Ties Per R.D. F.B. 1626-574

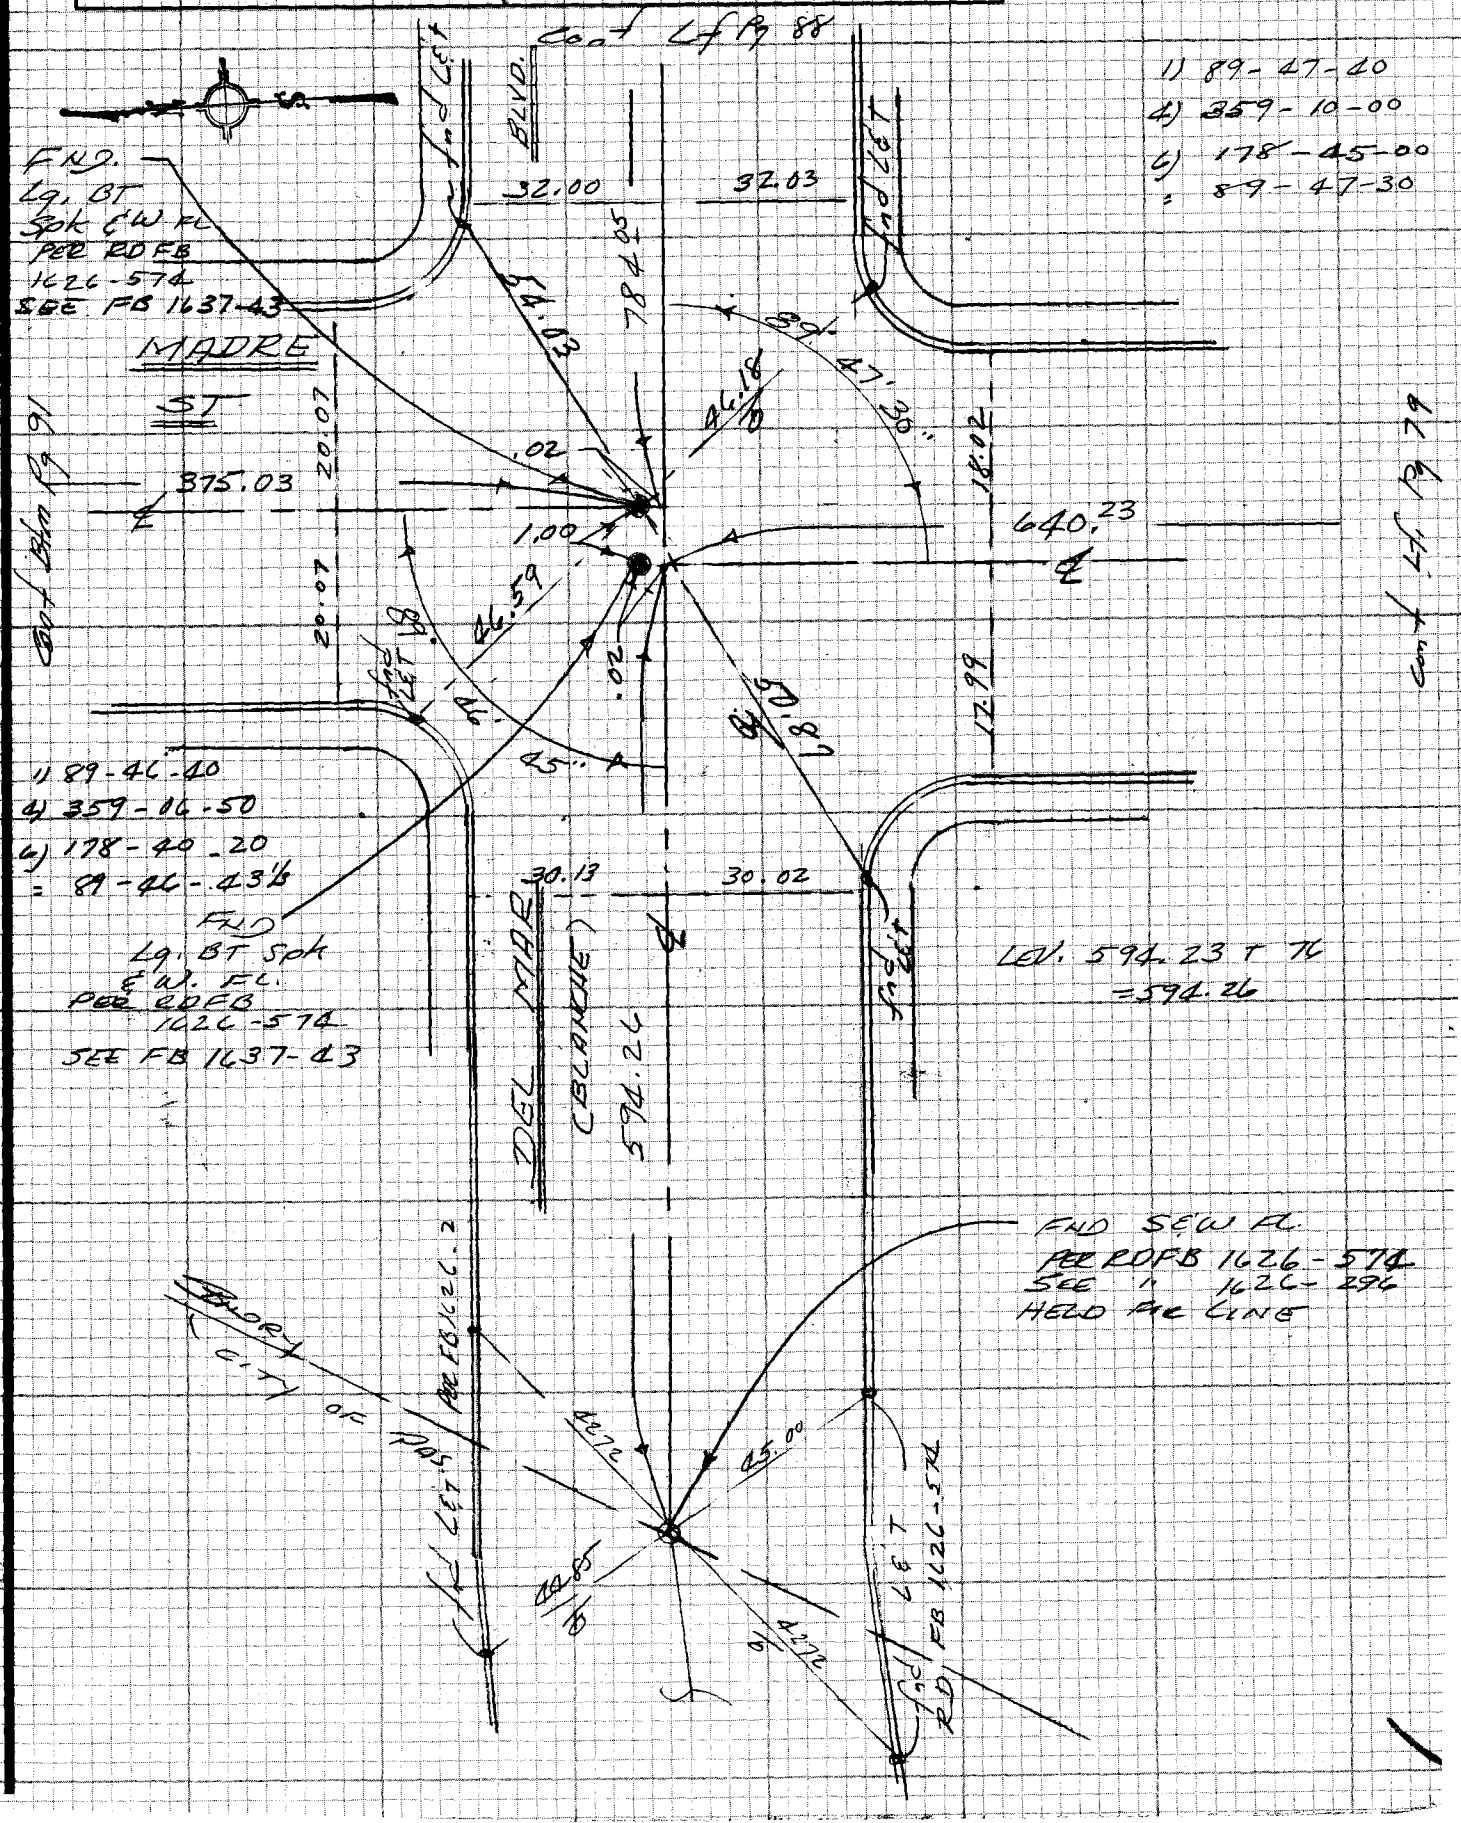


NOTE: ANY ADDITIONS OR CHANGES ON THIS SHEET MUST BE MADE OR CIRCLED IN RED INK WITH DATE AND NAME OF PERSON MAKING CHANGE

Do not extend notes this side of this line

PLEASE RETURN TO
LOS ANGELES COUNTY ENGINEER
403 LOS ANGELES COUNTY ENGINEERING BLDG.

CENTERLINE NOTES
CE 310
76F3095-4/73

F.B. 4412 PG. 88

Cont Btm Rt. Pg 92

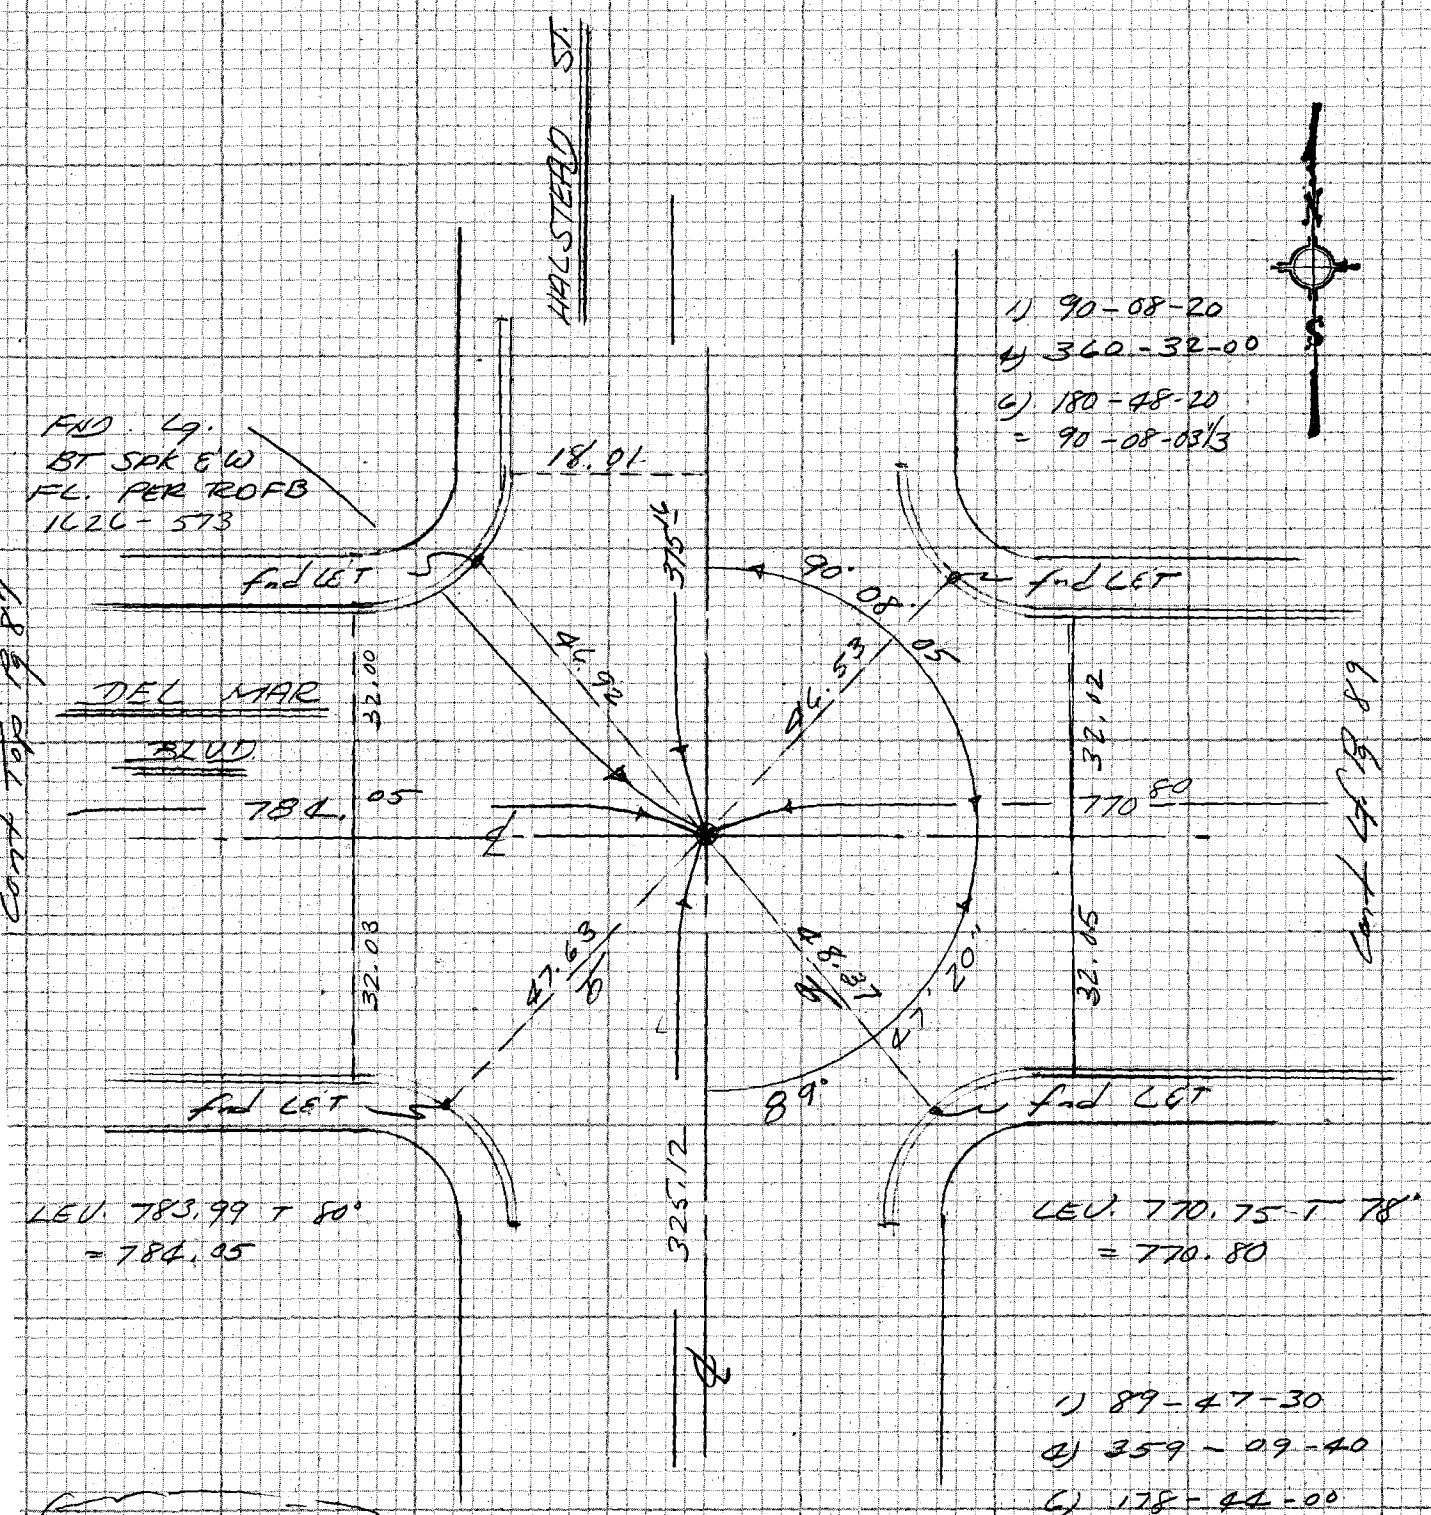


1) 90-08-20
4) 360-32-00
6) 180-48-20
= 90-08-03 1/3

LEV. 783.99 T 80°
= 784.05

LEV. 770.75 T 78°
= 770.80

1) 89-47-30
4) 359-09-40
6) 178-44-00
= 89-47-20

NOTE: TIES FND
PER ROFB
1626-573

Cont Top Pg 83


CE 310
76F309F 93

PLEASE RETURN TO
LOS ANGELES COUNTY ENGINEER
403 LOS ANGELES COUNTY ENGINEERING BLDG.

Do not exceed notes this side of this line

NOTE: ANY ADDITIONS OR CHANGES ON THIS SHEET MUST BE MADE OR CIRCLED IN RED INK WITH DATE AND NAME OF PERSON MAKING CHANGE


WS 44, C-2

Div 4

| | |
|---|---|
| Notes Ck'd by | Survey of Rosemead St ℄ |
| Map No. | JN 0303.00 Tape 0232 Std 68 °F |
| Office Work | Surveyed by EL |
| Checked | Notes EL Date 11-76 |
| Date | Indexed G. D. BAILEY SEP 19 1977 |

F.B. 4412 PG. 89

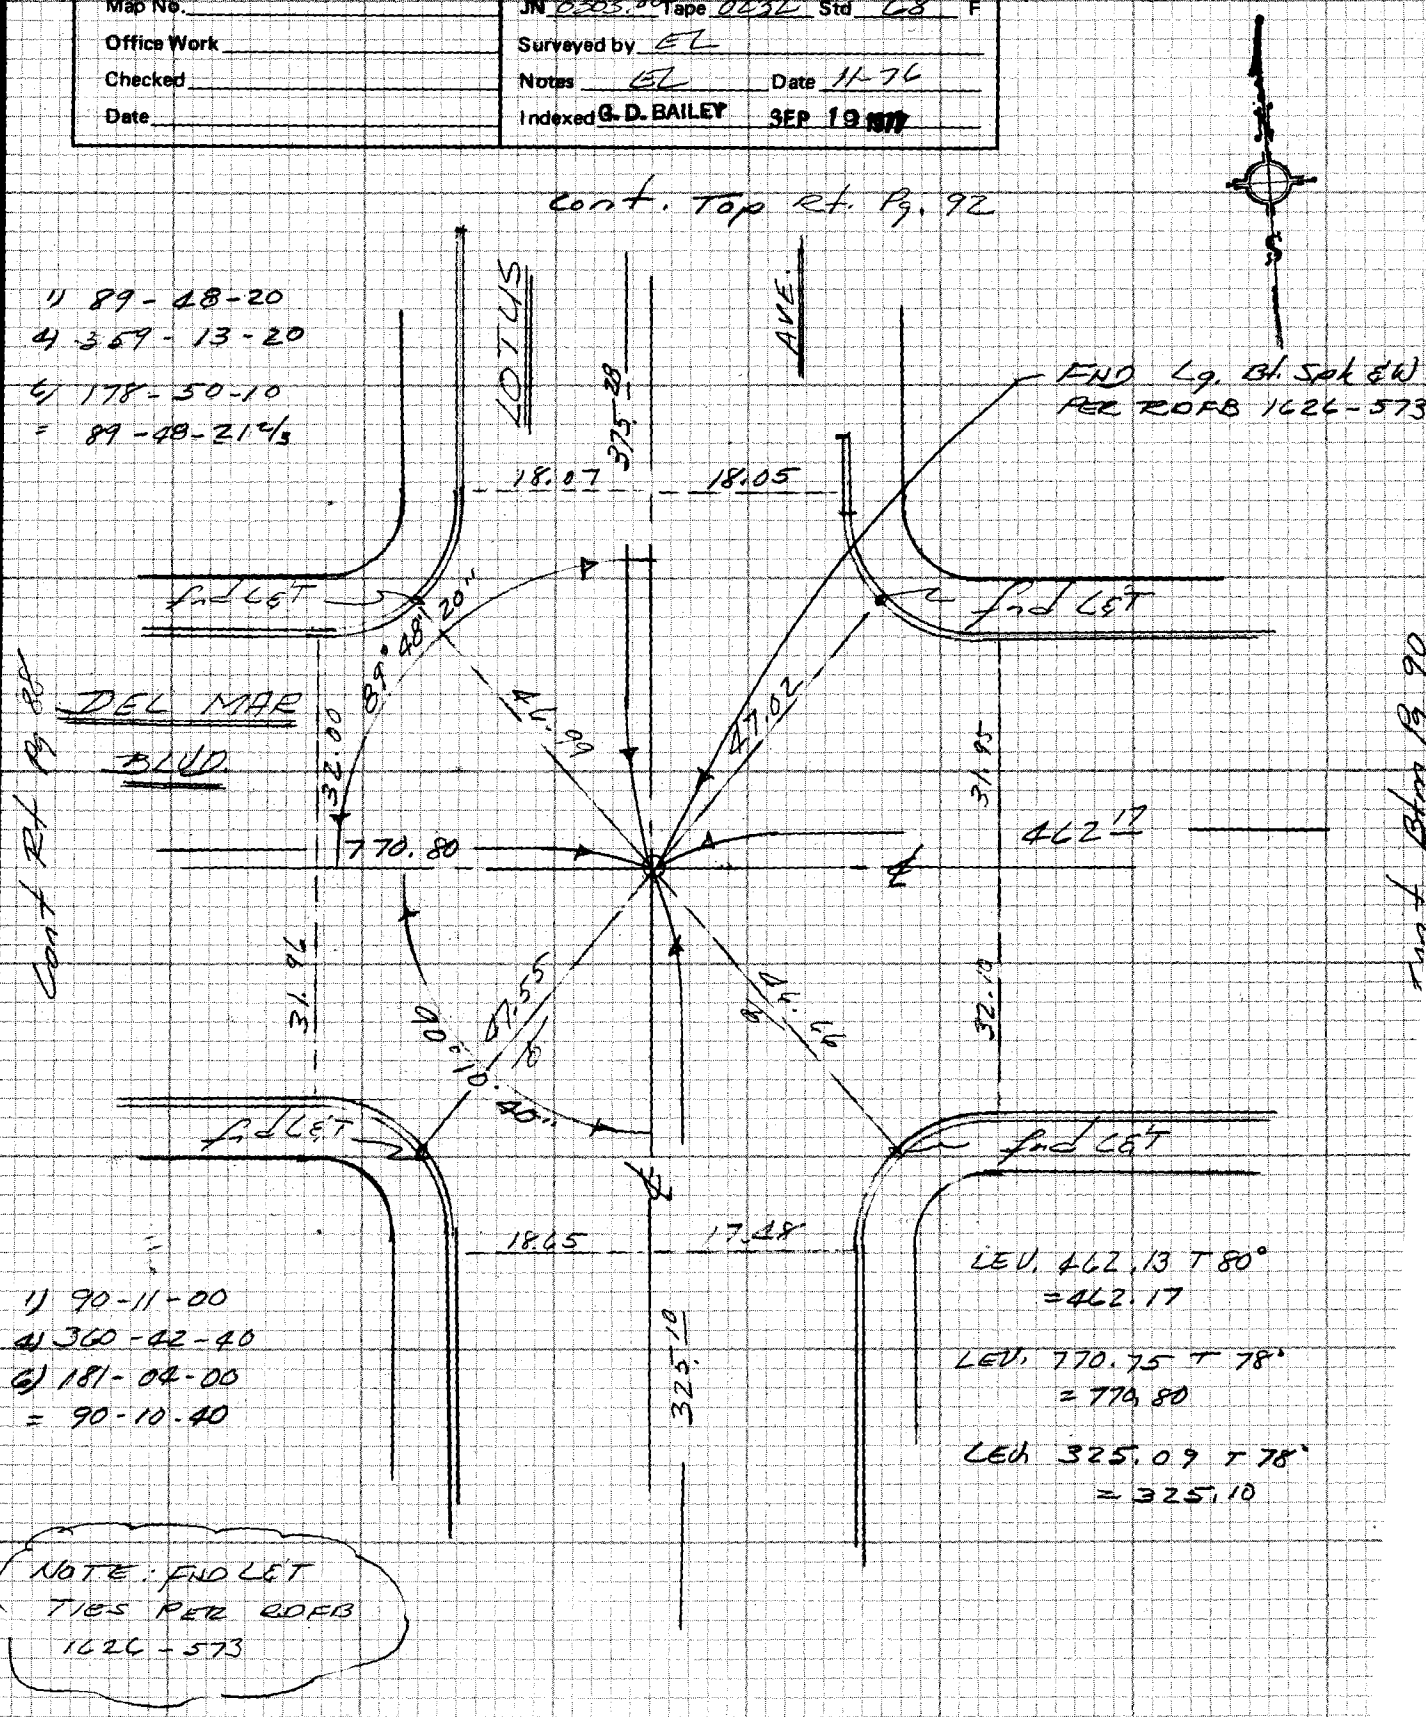


cont Top Pg 84

NOTE: ANY ADDITIONS OR CHANGES ON THIS SHEET MUST BE MADE OR CIRCLED IN RED INK WITH DATE AND NAME OF PERSON MAKING CHANGE

W.S. 44C-2

Do not extend notes this side of this line

PLEASE RETURN TO
LOS ANGELES COUNTY ENGINEER
403 LOS ANGELES COUNTY ENGINEERING BLDG.

CENTERLINE NOTES
CE 310
76F3095-4/73

F.B. 4412 PG. 90

Cont Btm Pg 86

CE 310
76F 3095-4/73

PLEASE RETURN TO
LOS ANGELES COUNTY ENGINEER
403 LOS ANGELES COUNTY ENGINEERING BLDG.

NOTE: ANY ADDITIONS OR CHANGES
ON THIS SHEET MUST BE MADE OR
CIRCLED IN RED INK WITH DATE AND
NAME OF PERSON MAKING CHANGE

Do not extend notes this side of this line

1357.27 Cev. T= 78°
292.37 Cev. T= 80°

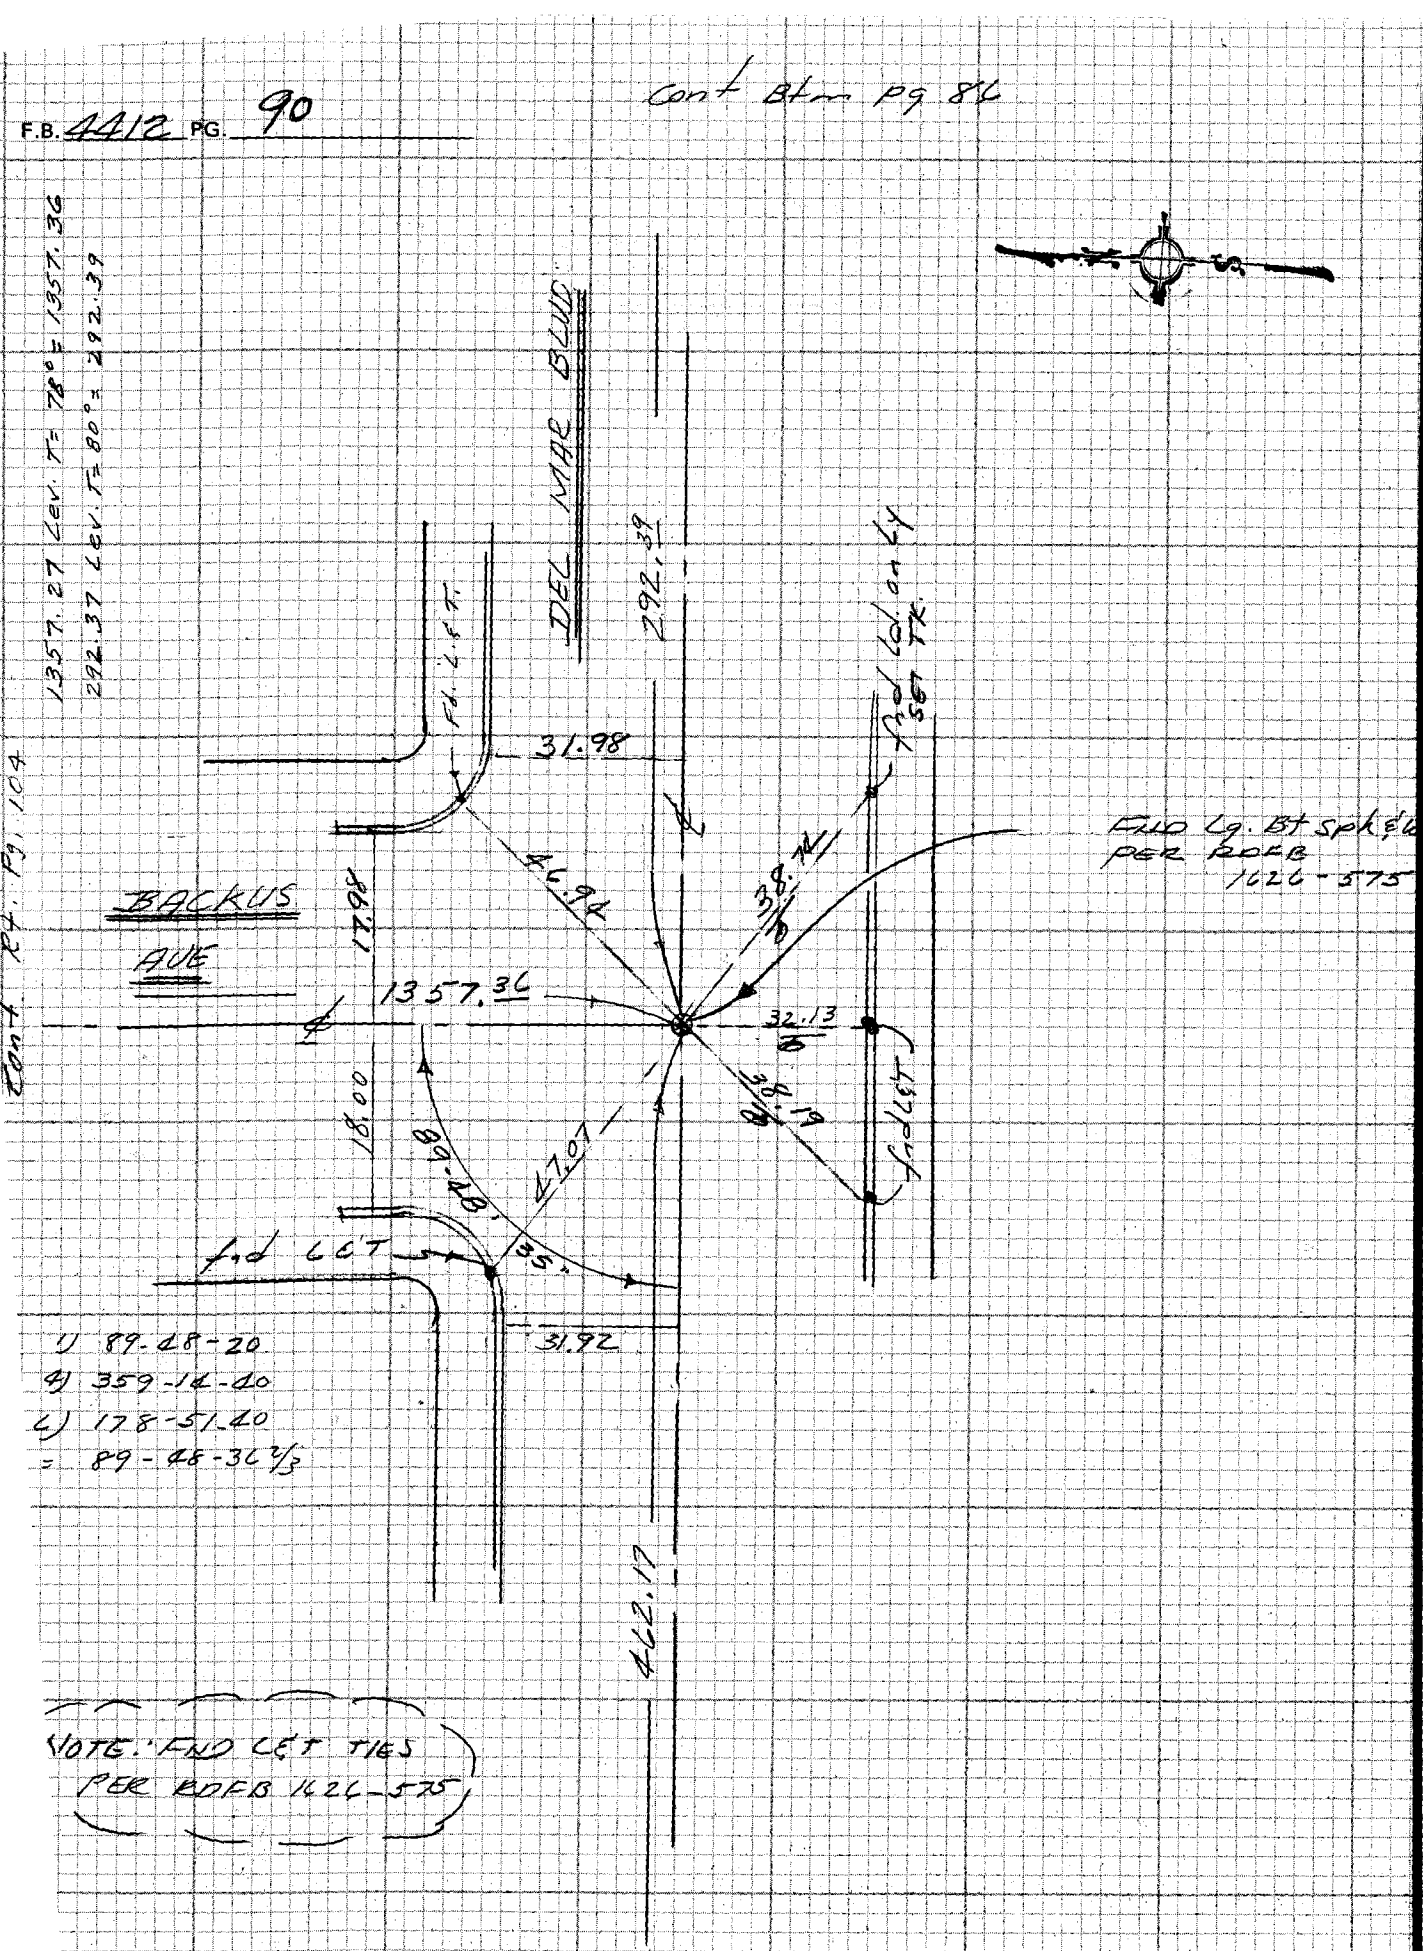


1) 89-28-20
2) 359-14-40
3) 178-51-40
= 89-48-36 2/3

NOTE: FND CET TIES
PER ROFB 1626-575

Cont Pg. 104

Cont Rt. Pg 89

Did 4

| | |
|---|---|
| Notes Ck'd by | Survey of ROSEMEAD ST ℄ F.B. 1412 PG. 91 |
| Map No. | JN 0303.00 Tape 0232 Std 68° F |
| Office Work | Surveyed by EL |
| Checked | Notes EL Date 12-76 |
| Date | Indexed G. D. BAILEY SEP 19 1977 |

Cont Top Rd. Pg. 93

NOTE: ANY ADDITIONS OR CHANGES ON THIS SHEET MUST BE MADE OR CIRCLED IN RED INK WITH DATE AND NAME OF PERSON MAKING CHANGE

44-C-2

PLEASE RETURN TO
LOS ANGELES COUNTY ENGINEER
403 LOS ANGELES COUNTY ENGINEERING BLDG.

Do not extend notes across this line

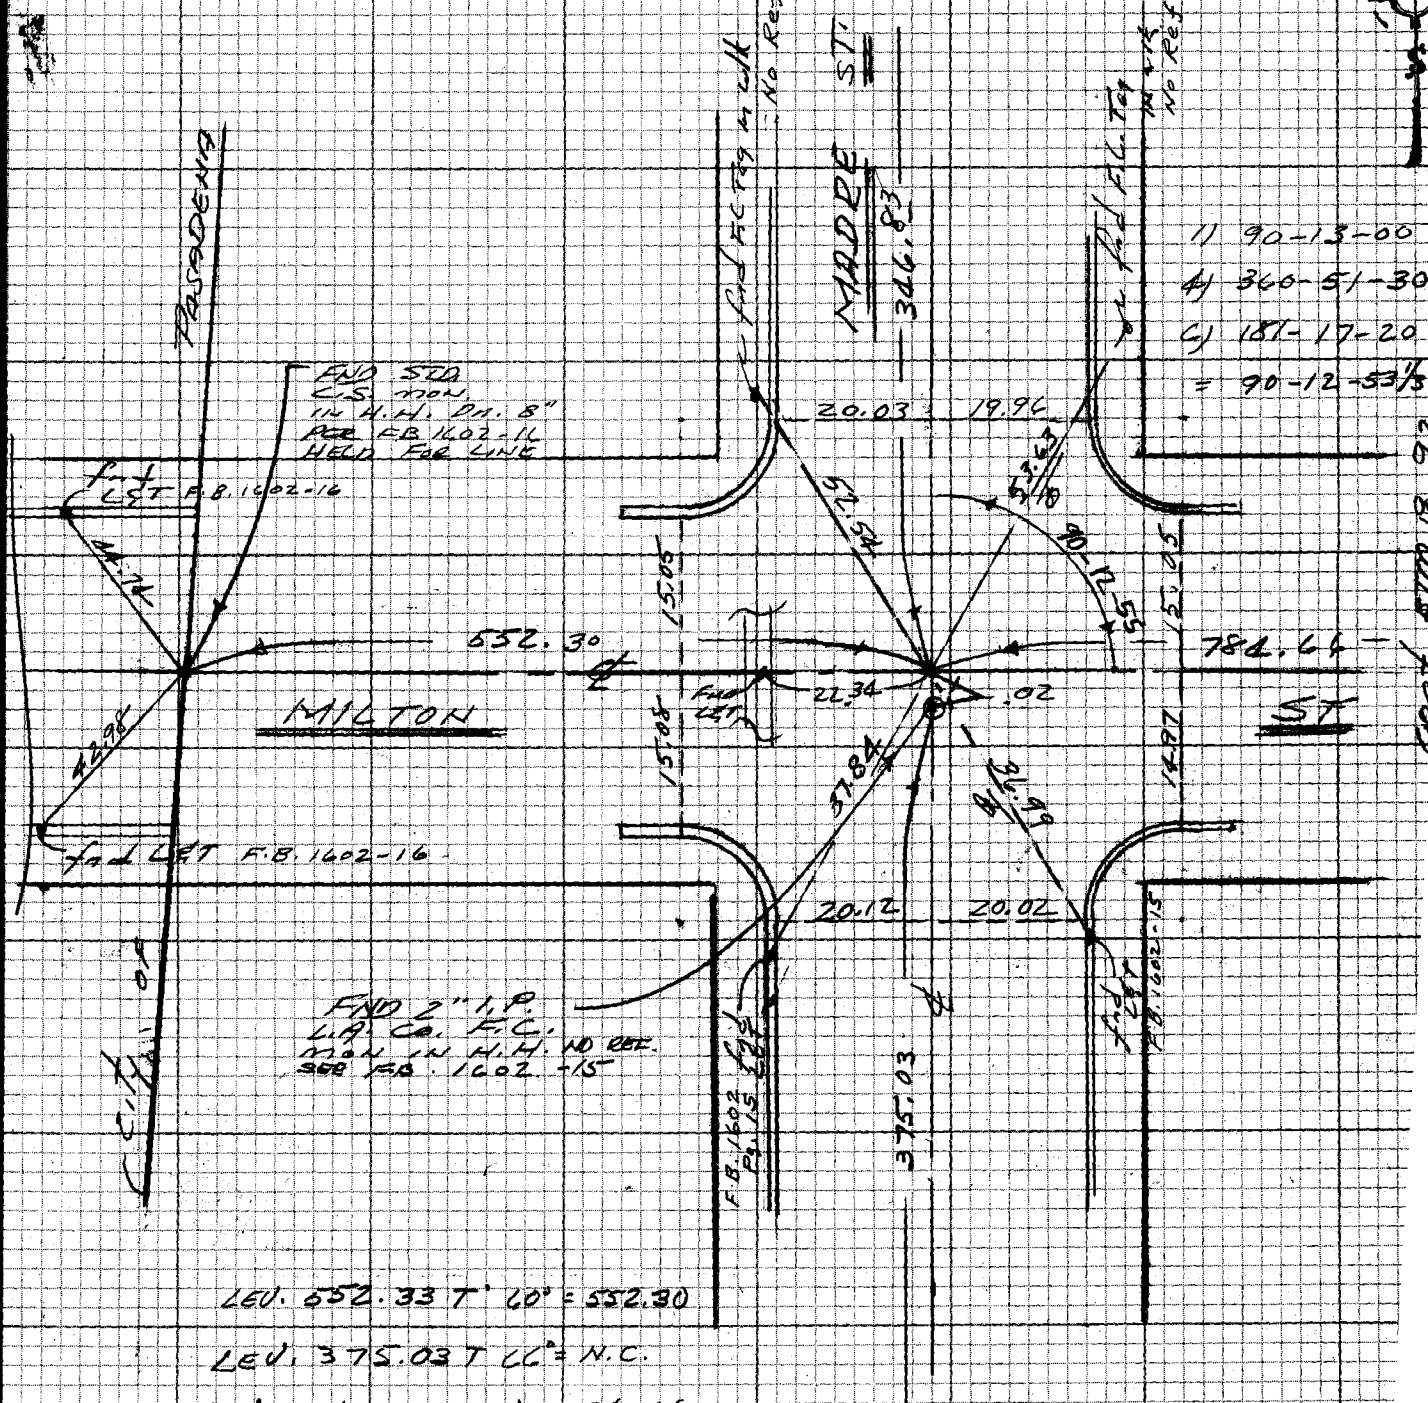


LEV. 552.33 T 60° = 552.30

LEV. 375.03 T CC° = N.C.

LEV. 784.70 T CC° = 784.66

CONT Lf. Pg. 87

CENTERLINE NOTES
DE 310
76F 3095-4/73

F.B. 4412 PG. 92

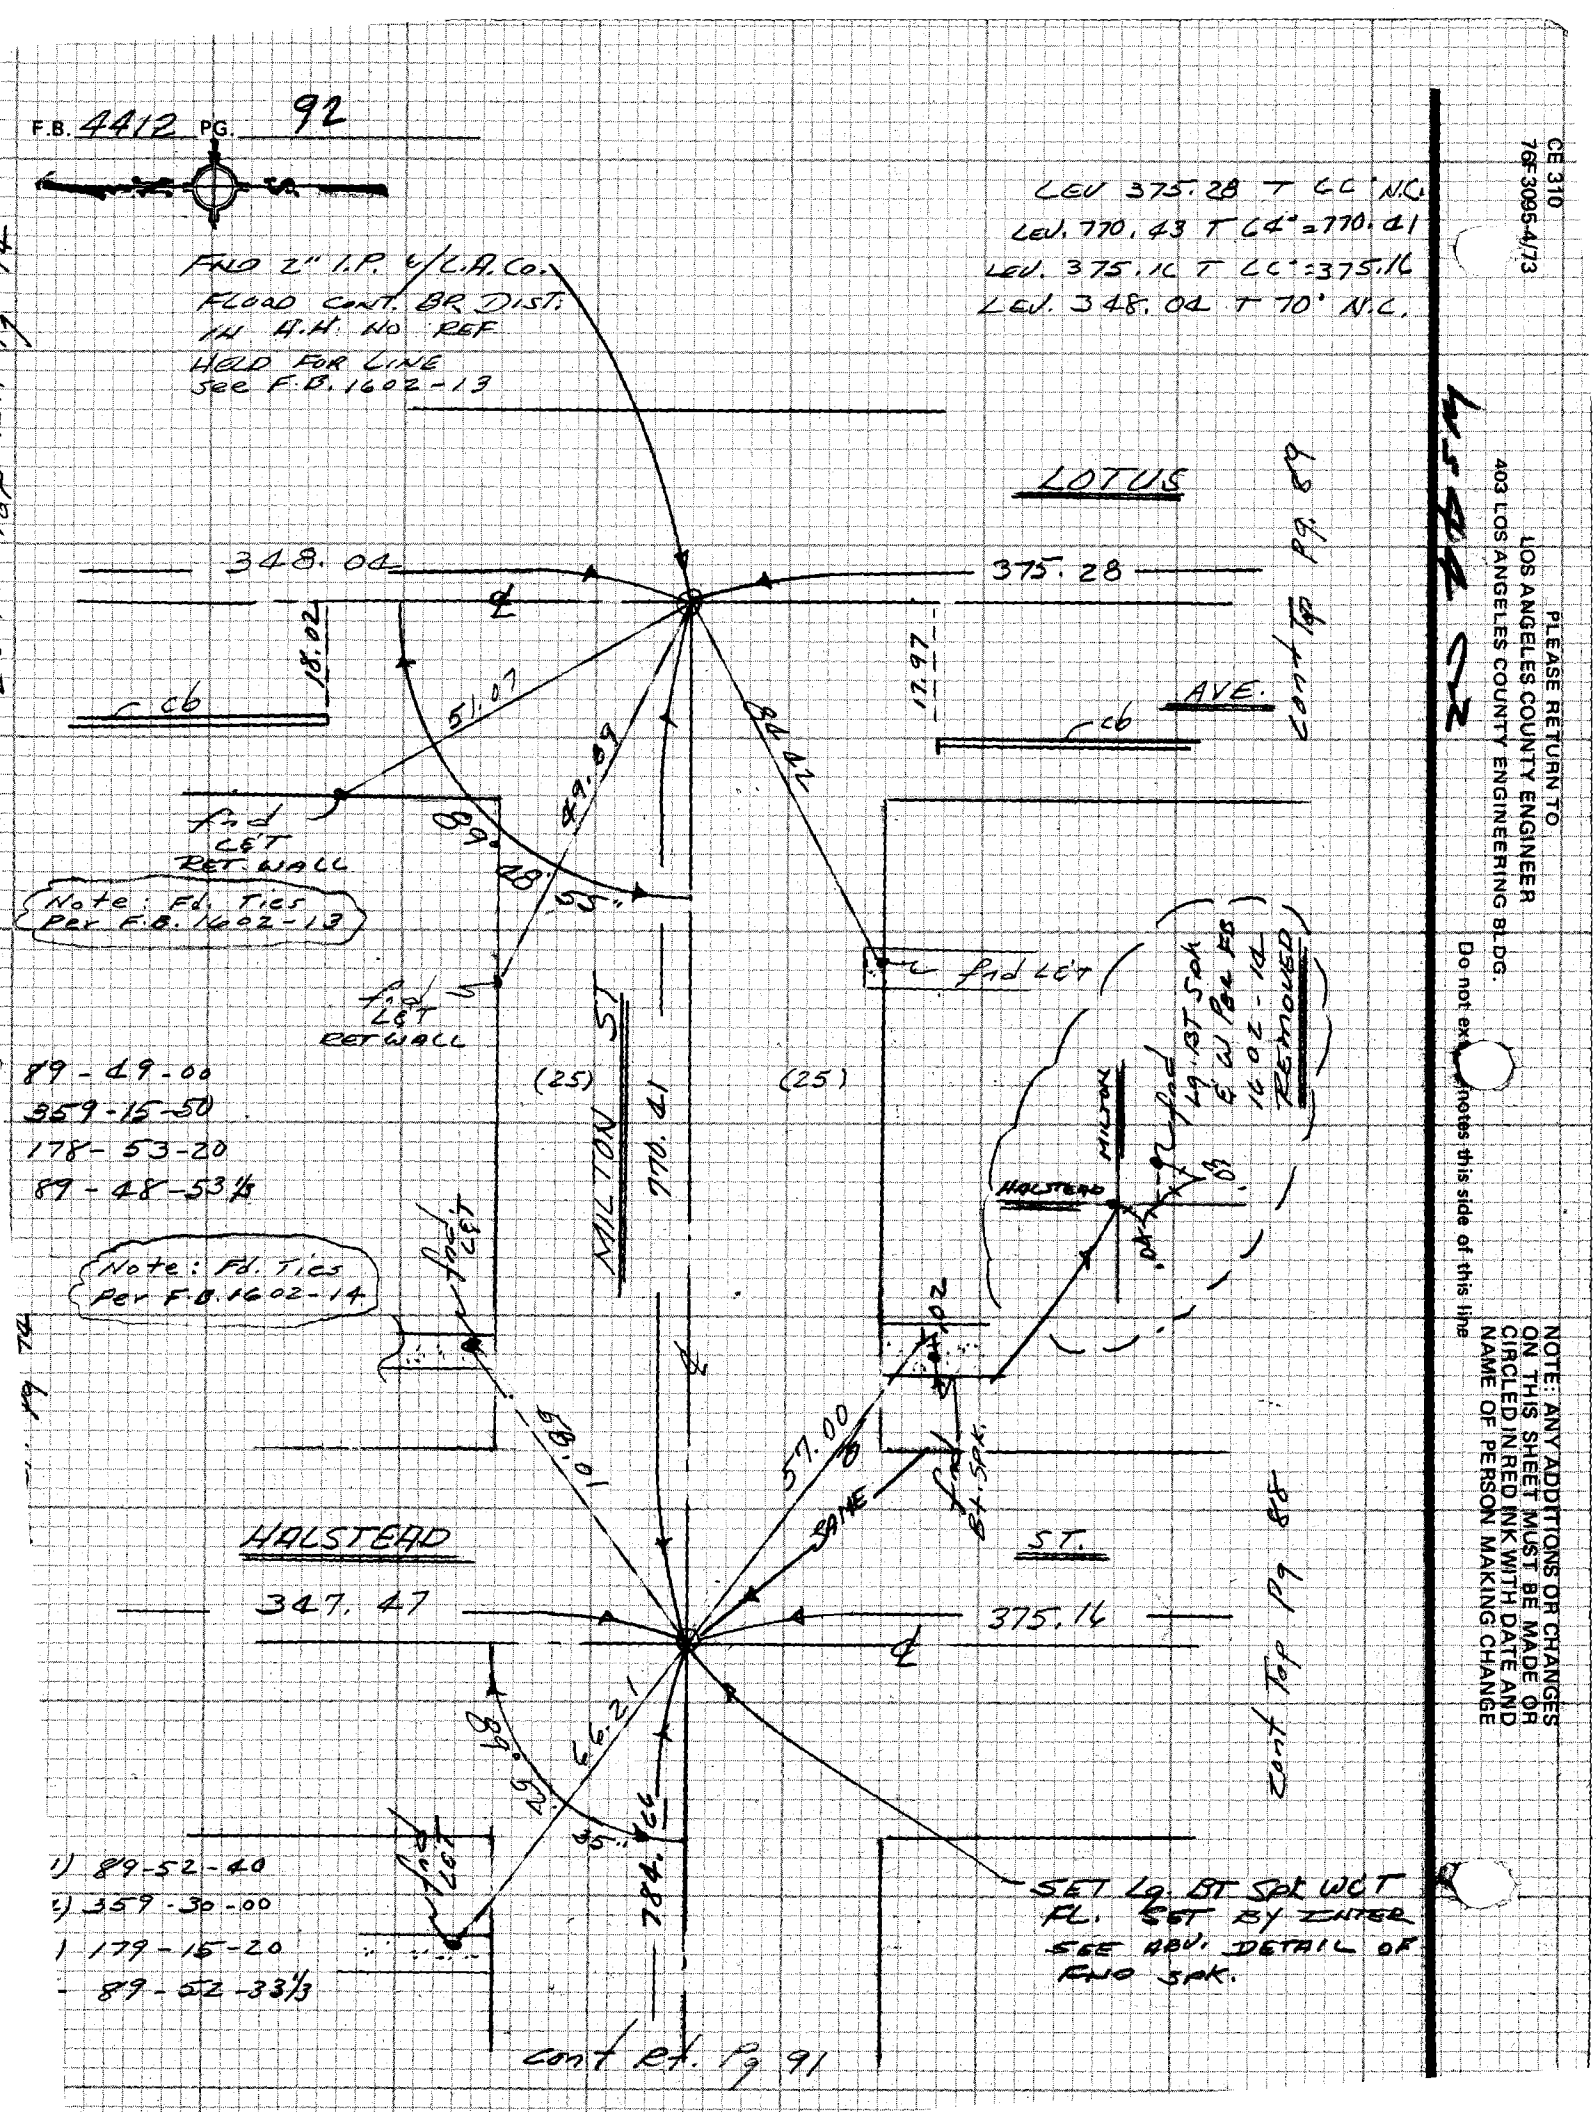


CE 310
76F 3095-4/73

PLEASE RETURN TO
LOS ANGELES COUNTY ENGINEER
403 LOS ANGELES COUNTY ENGINEERING BLDG.

Do not ex notes this side of this line

NOTE: ANY ADDITIONS OR CHANGES ON THIS SHEET MUST BE MADE OR CIRCLED IN RED INK WITH DATE AND NAME OF PERSON MAKING CHANGE

DIV. 4

| | |
|---|---|
| Notes Ck'd by | Survey of Rosemead St ℄ |
| Map No. | JN 0303.00 Tape 0239 Std 68 °F |
| Office Work | Surveyed by EL |
| Checked | Notes EL Date 12-76 |
| Date | Indexed G. D. BAILEY SEP 19 1977 |

F.B. 4412 PG. 93

1) 89-50-00
4) 359-19-40
6) 178-59-00
= 89-49-50

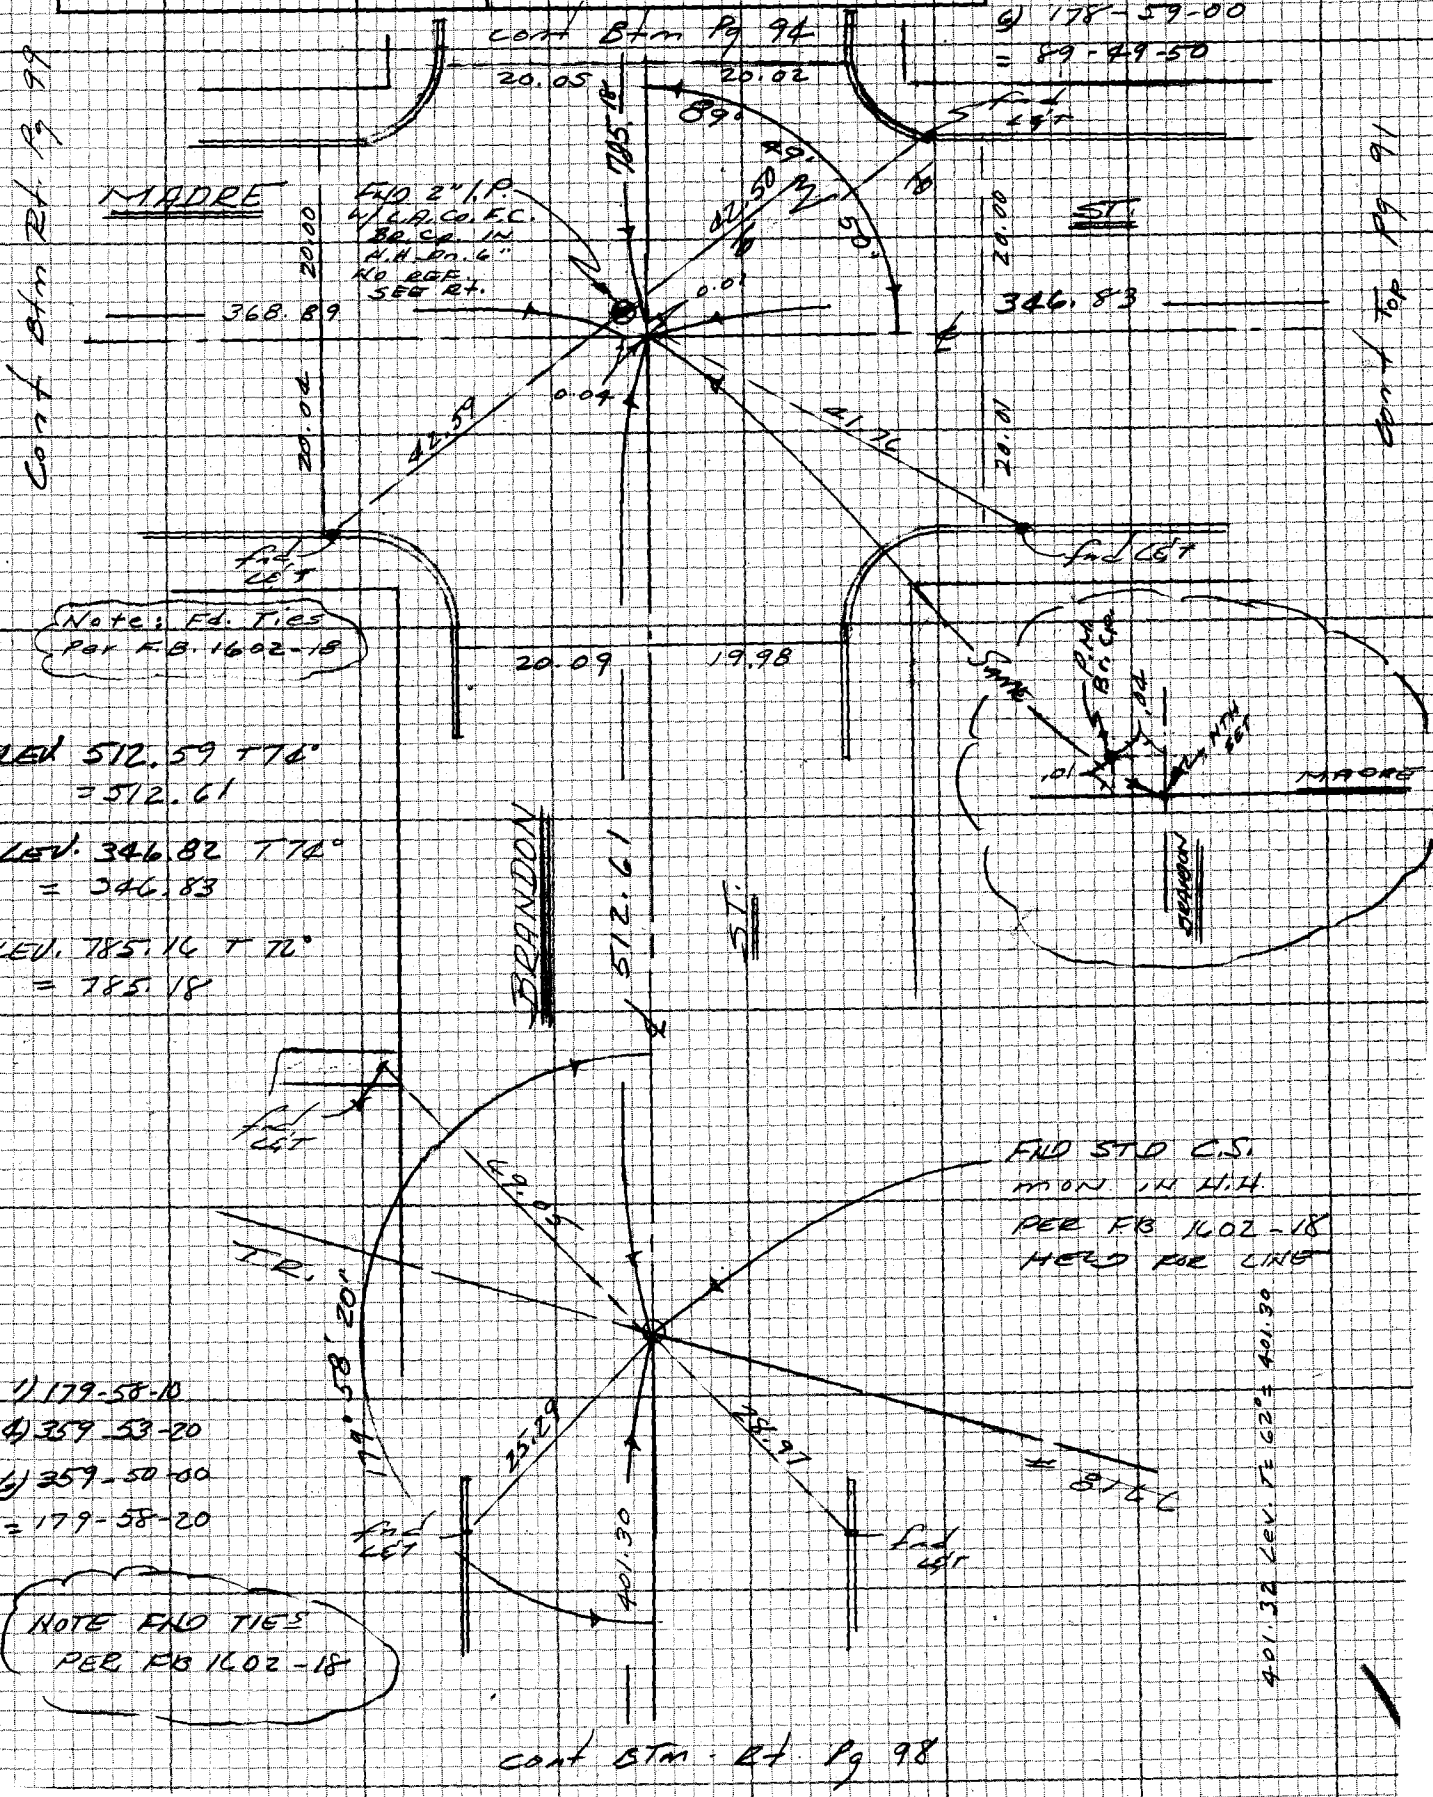


LEV 512.59 T 74°
= 512.61

LEV. 346.82 T 74°
= 346.83

LEV. 785.16 T 72°
= 785.18

1) 179-58-10
4) 359-53-20
6) 359-50-00
= 179-58-20

NOTE: ANY ADDITIONS OR CHANGES ON THIS SHEET MUST BE MADE OR CIRCLED IN RED INK WITH DATE AND NAME OF PERSON MAKING CHANGE

Do not extend notes on this side of this line

PLEASE RETURN TO
LOS ANGELES COUNTY ENGINEER
403 LOS ANGELES COUNTY ENGINEERING BLDG.

CENTERLINE NOTES
CE 310
76F3095-4/73

F.B. 4412 PG. 94

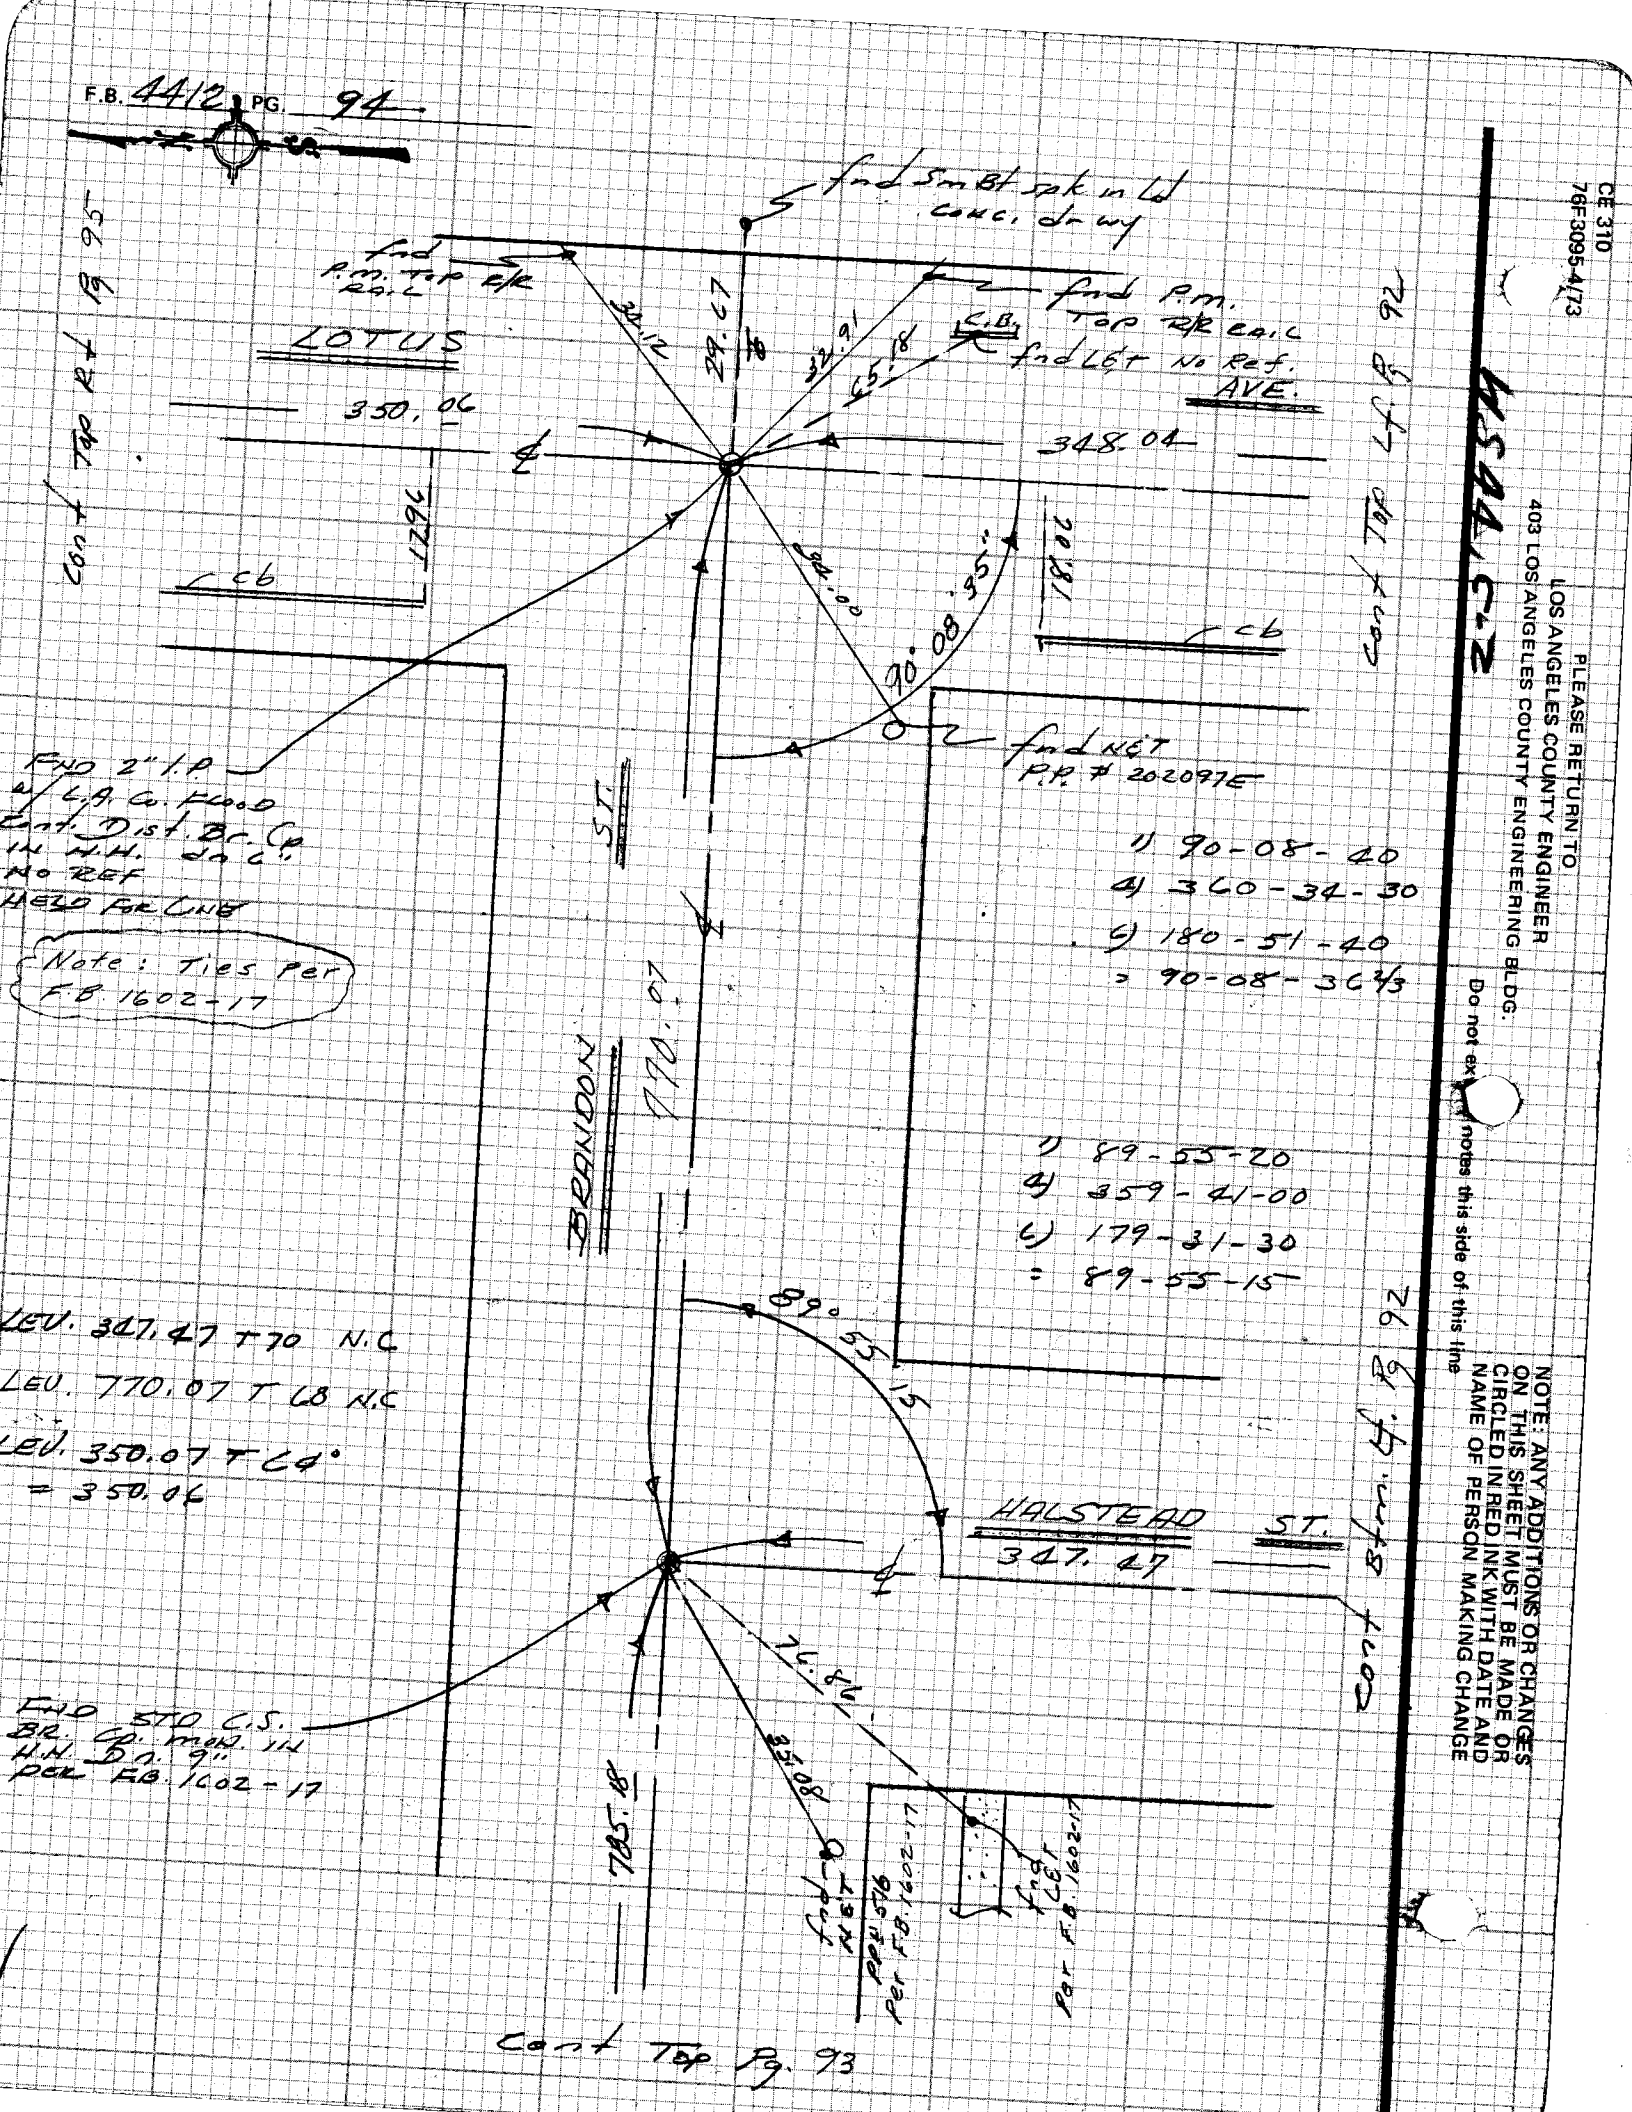


CE 310
76F3095-4/73

LOS ANGELES COUNTY ENGINEER
403 LOS ANGELES COUNTY ENGINEERING BLDG.

PLEASE RETURN TO

NOTE: ANY ADDITIONS OR CHANGES ON THIS SHEET MUST BE MADE OR CIRCLED IN RED INK WITH DATE AND NAME OF PERSON MAKING CHANGE

Do not ex notes this side of this line

D.U 2

| | |
|---|---|
| Notes Ck'd by | Survey of ROSEMEAD ST ℄ |
| Map No. | JN 1303.00 Tape 0232 Std 68 °F |
| Office Work | Surveyed by EL |
| Checked | Notes EL Date 12-76 |
| Date | Indexed G. D. BAILEY SEP 19 1977 |

F.B. 4412 PG. 95

NOTE: ANY ADDITIONS OR CHANGES ON THIS SHEET MUST BE MADE OR CIRCLED IN RED INK WITH DATE AND NAME OF PERSON MAKING CHANGE
Do not extend notes this side of this line

PLEASE RETURN TO
LOS ANGELES COUNTY ENGINEER
403 LOS ANGELES COUNTY ENGINEERING BLDG.

CENTERLINE NOTES
CE 310
76F3095-4/73

N 54, C-2

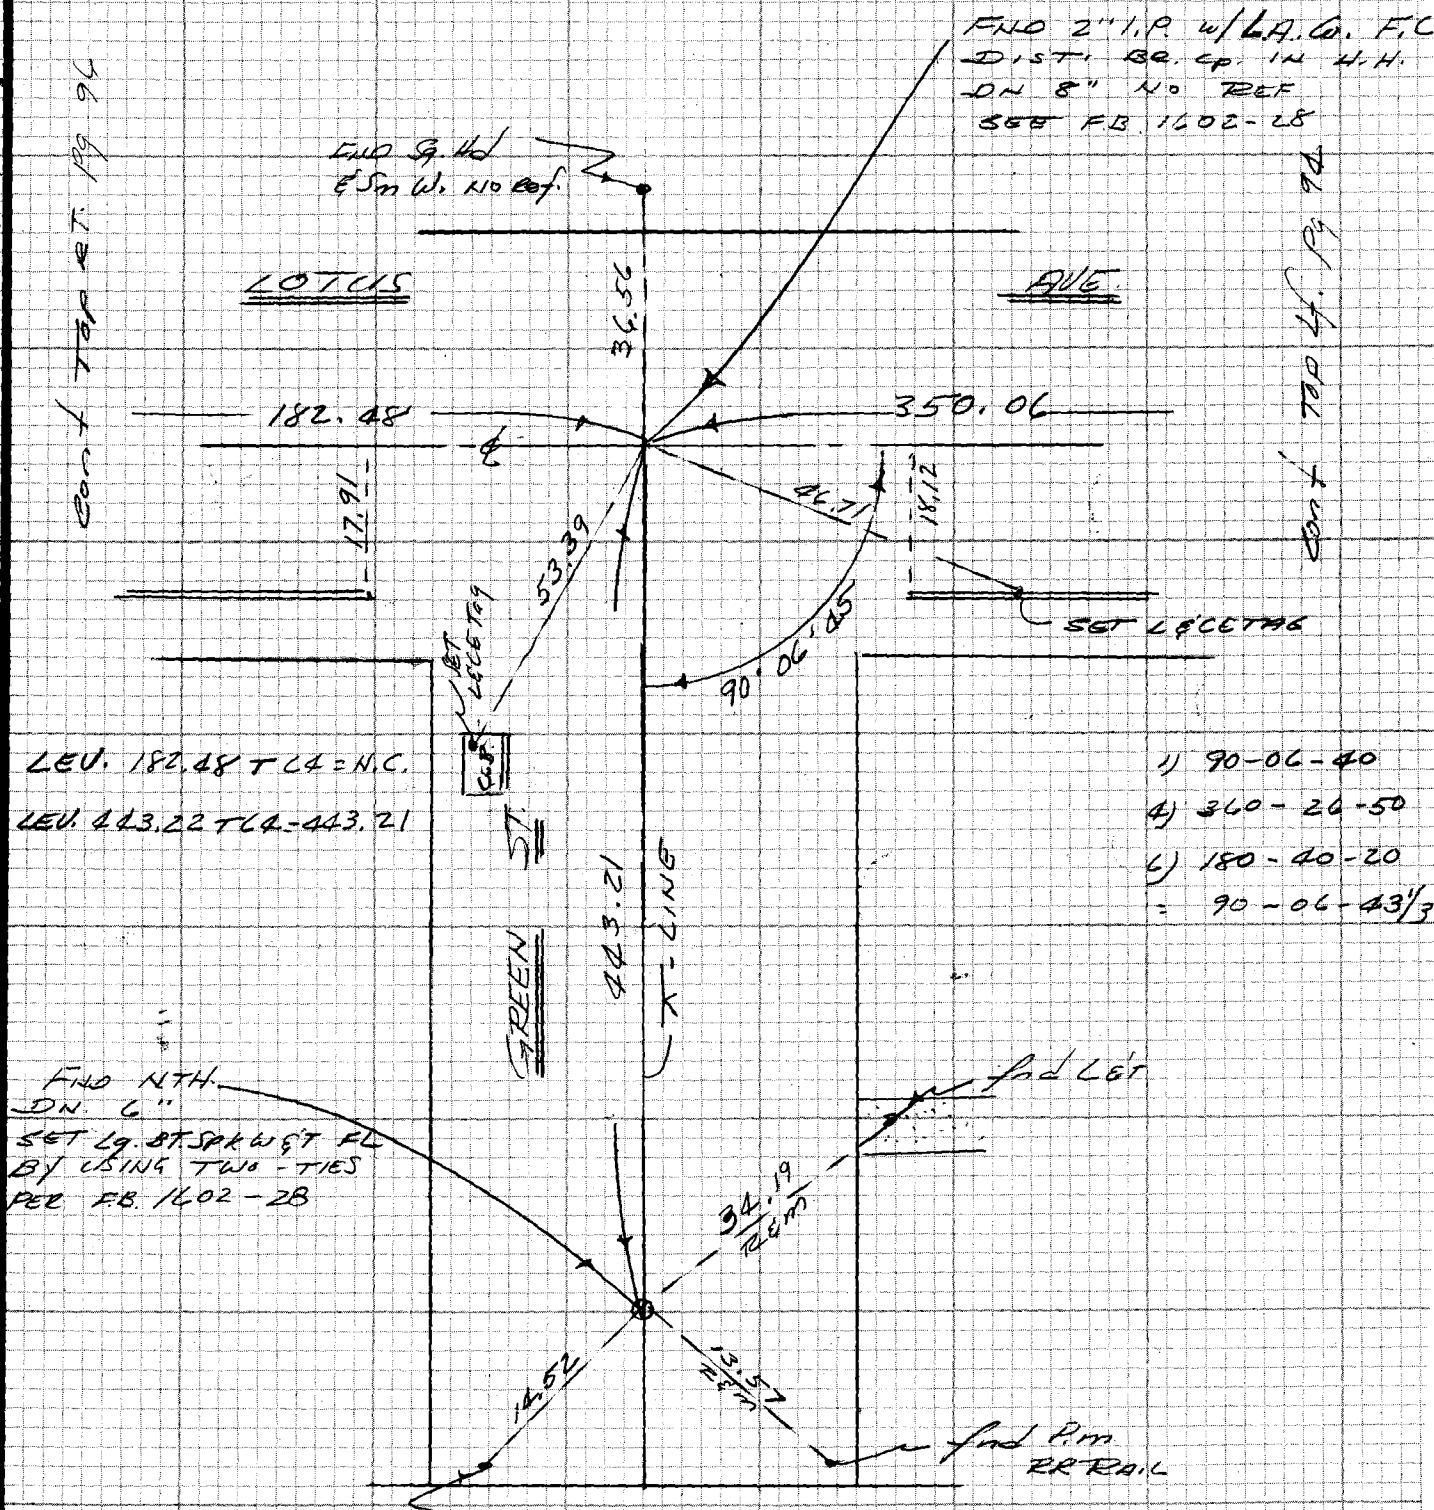

F.B. 4412 PG. 96

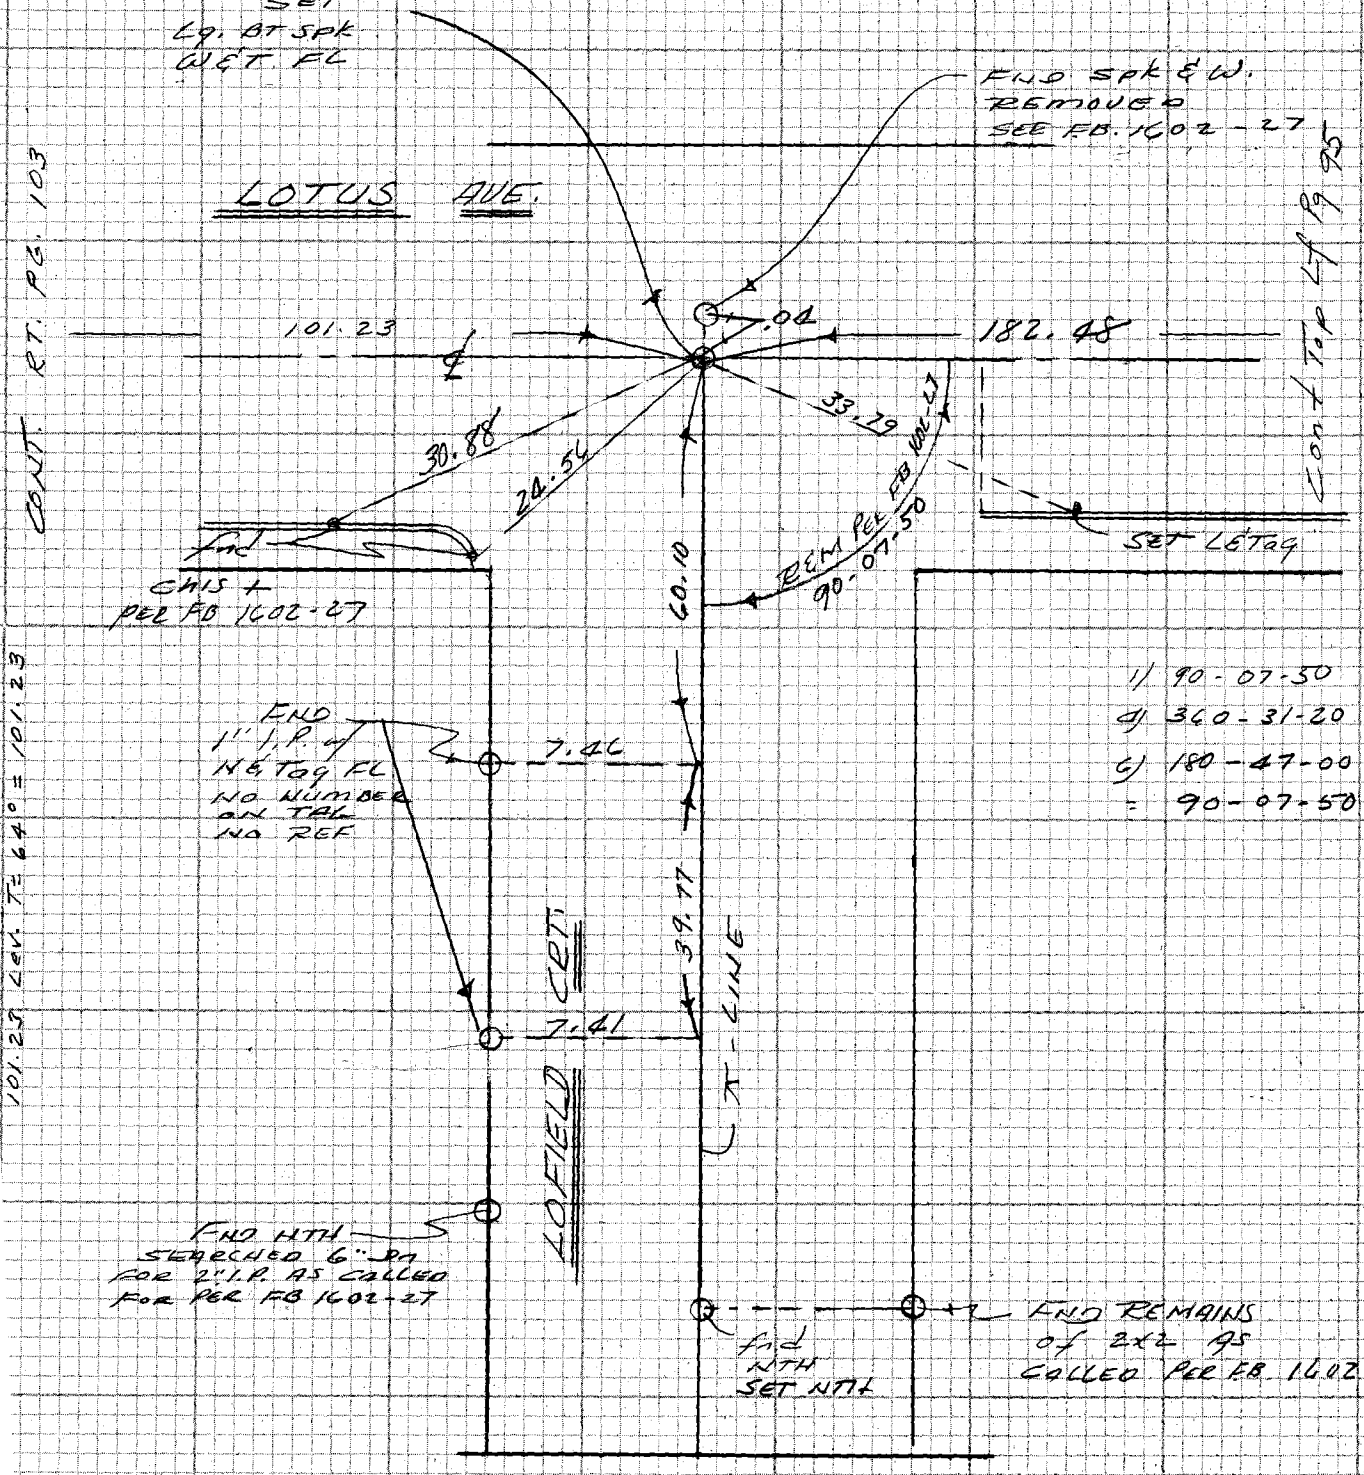


1) 90-07-50
2) 360-31-20
3) 180-47-00
= 90-07-50

CE 310
76F 3095 2/73

PLEASE RETURN TO
LOS ANGELES COUNTY ENGINEER
403 LOS ANGELES COUNTY ENGINEERING BLDG.

Do not extend notes this side of this line

NOTE: ANY ADDITIONS OR CHANGES ON THIS SHEET MUST BE MADE OR CIRCLED IN RED INK WITH DATE AND NAME OF PERSON MAKING CHANGE

DIV 4

| | |
|---|---|
| Notes Ck'd by | Survey of ROSEMEAD ST ℄ |
| Map No. | JN 0303.04 Tape 0232 Std 68 °F |
| Office Work | Surveyed by EL |
| Checked | Notes EL Date 12-76 |
| Date | Indexed G. D. BAILEY SEP 19 1977 |

F.B. 4412 PG. 97

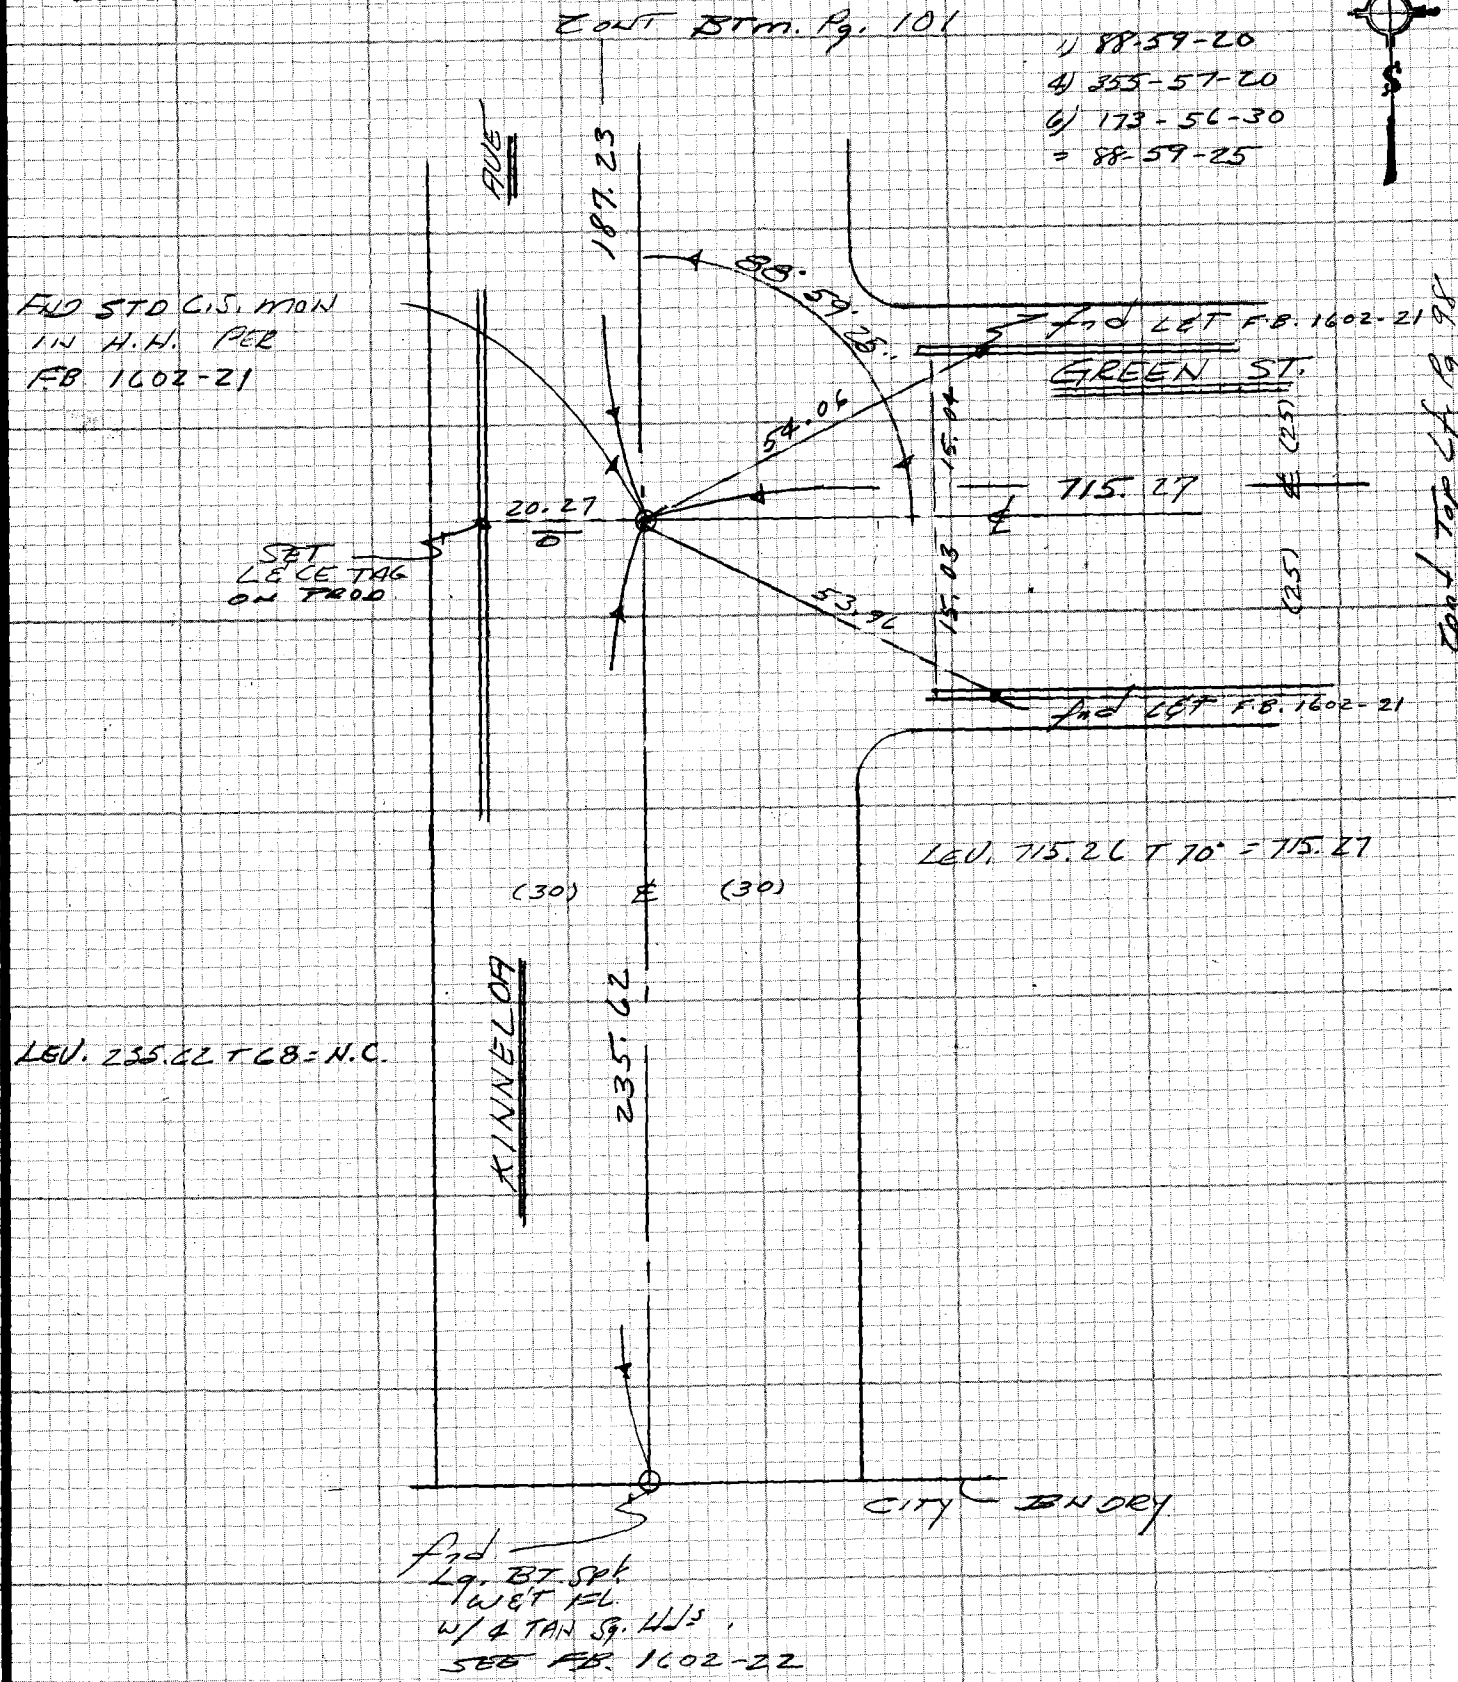


NOTE: ANY ADDITIONS OR CHANGES ON THIS SHEET MUST BE MADE OR CIRCLED IN RED INK WITH DATE AND NAME OF PERSON MAKING CHANGE

Do not extend notes this side of this line

PLEASE RETURN TO
LOS ANGELES COUNTY ENGINEER
403 LOS ANGELES COUNTY ENGINEERING BLDG.

CENTERLINE NOTES
CE 310
76F3095-4/73

F.B. 4412 PG. 98

Cont Btm Pg 102

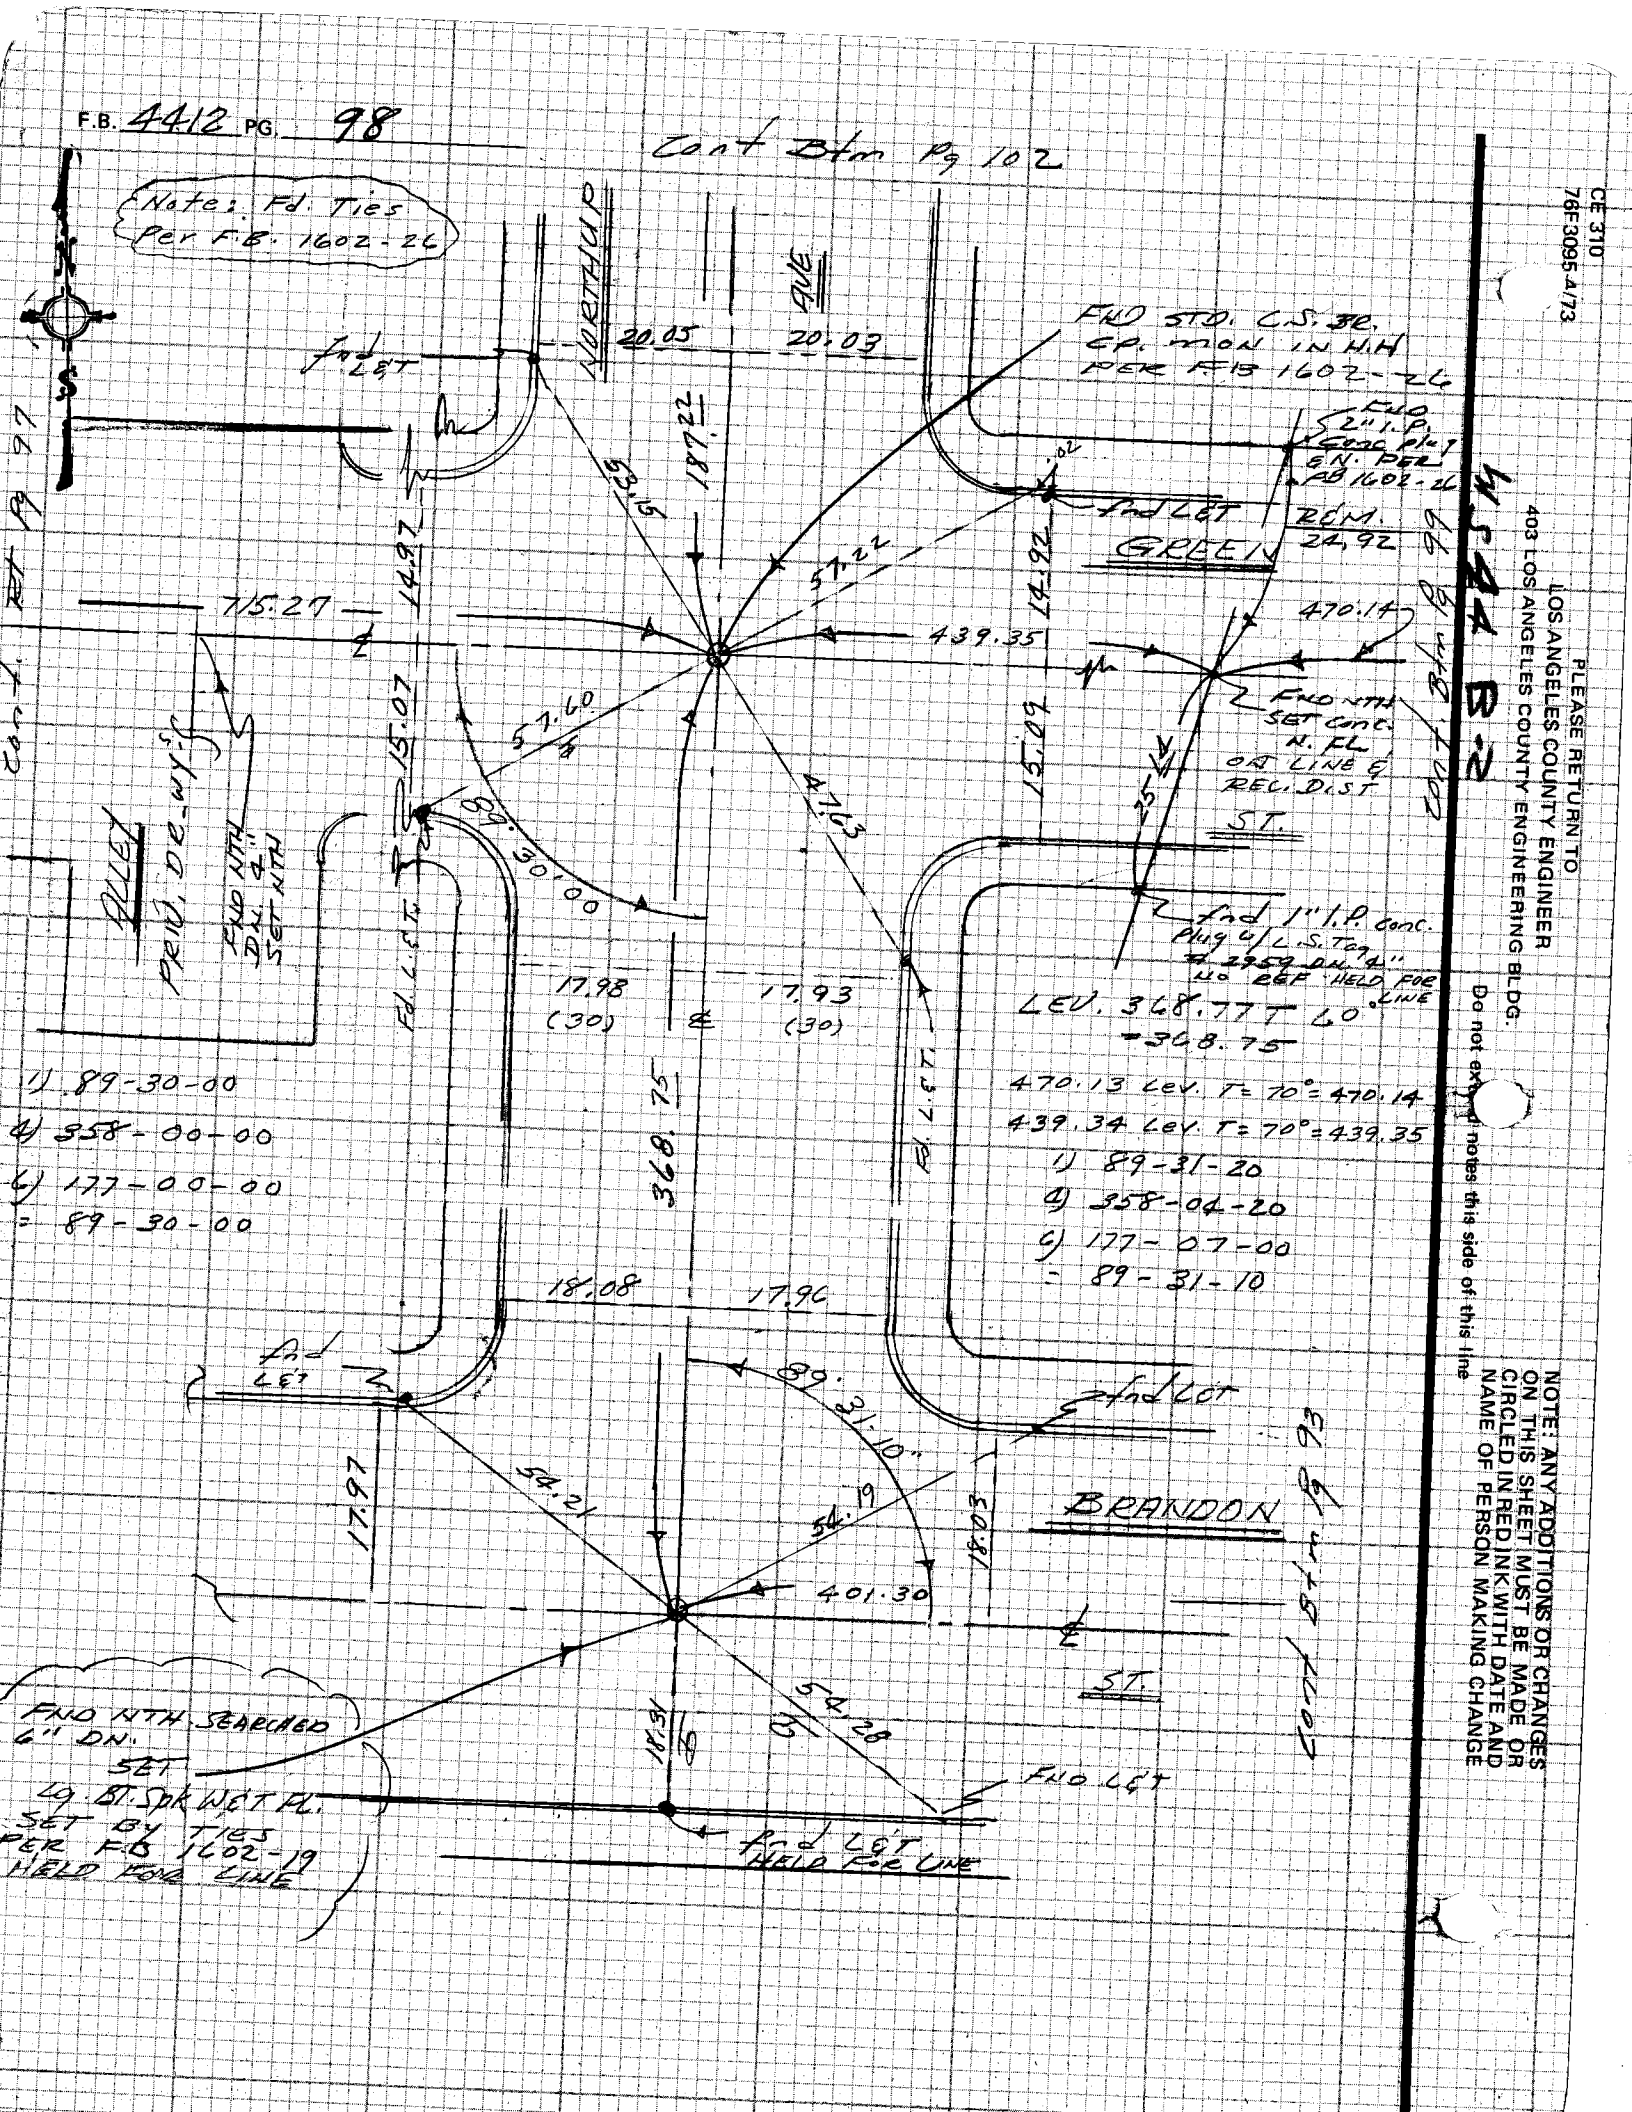


W.S. 44 B-2

CE 310
76F3095-4/73

LOS ANGELES COUNTY ENGINEER
403 LOS ANGELES COUNTY ENGINEERING BLDG.

PLEASE RETURN TO

Do not exceed notes this side of this line

NOTE: ANY ADDITIONS OR CHANGES ON THIS SHEET MUST BE MADE OR CIRCLED IN RED INK WITH DATE AND NAME OF PERSON MAKING CHANGE

DIV 4

| | |
|---|---|
| Notes Ck'd by | Survey of ROSEMEAD ST ℄ |
| Map No. | JN 1303-00 Tape 0232 Std 68° F |
| Office Work | Surveyed by EL ANGA |
| Checked | Notes EL Date 12-76 |
| Date | Indexed G. D. BAILEY SEP 19 1977 |

F.B. 4412 PG. 99

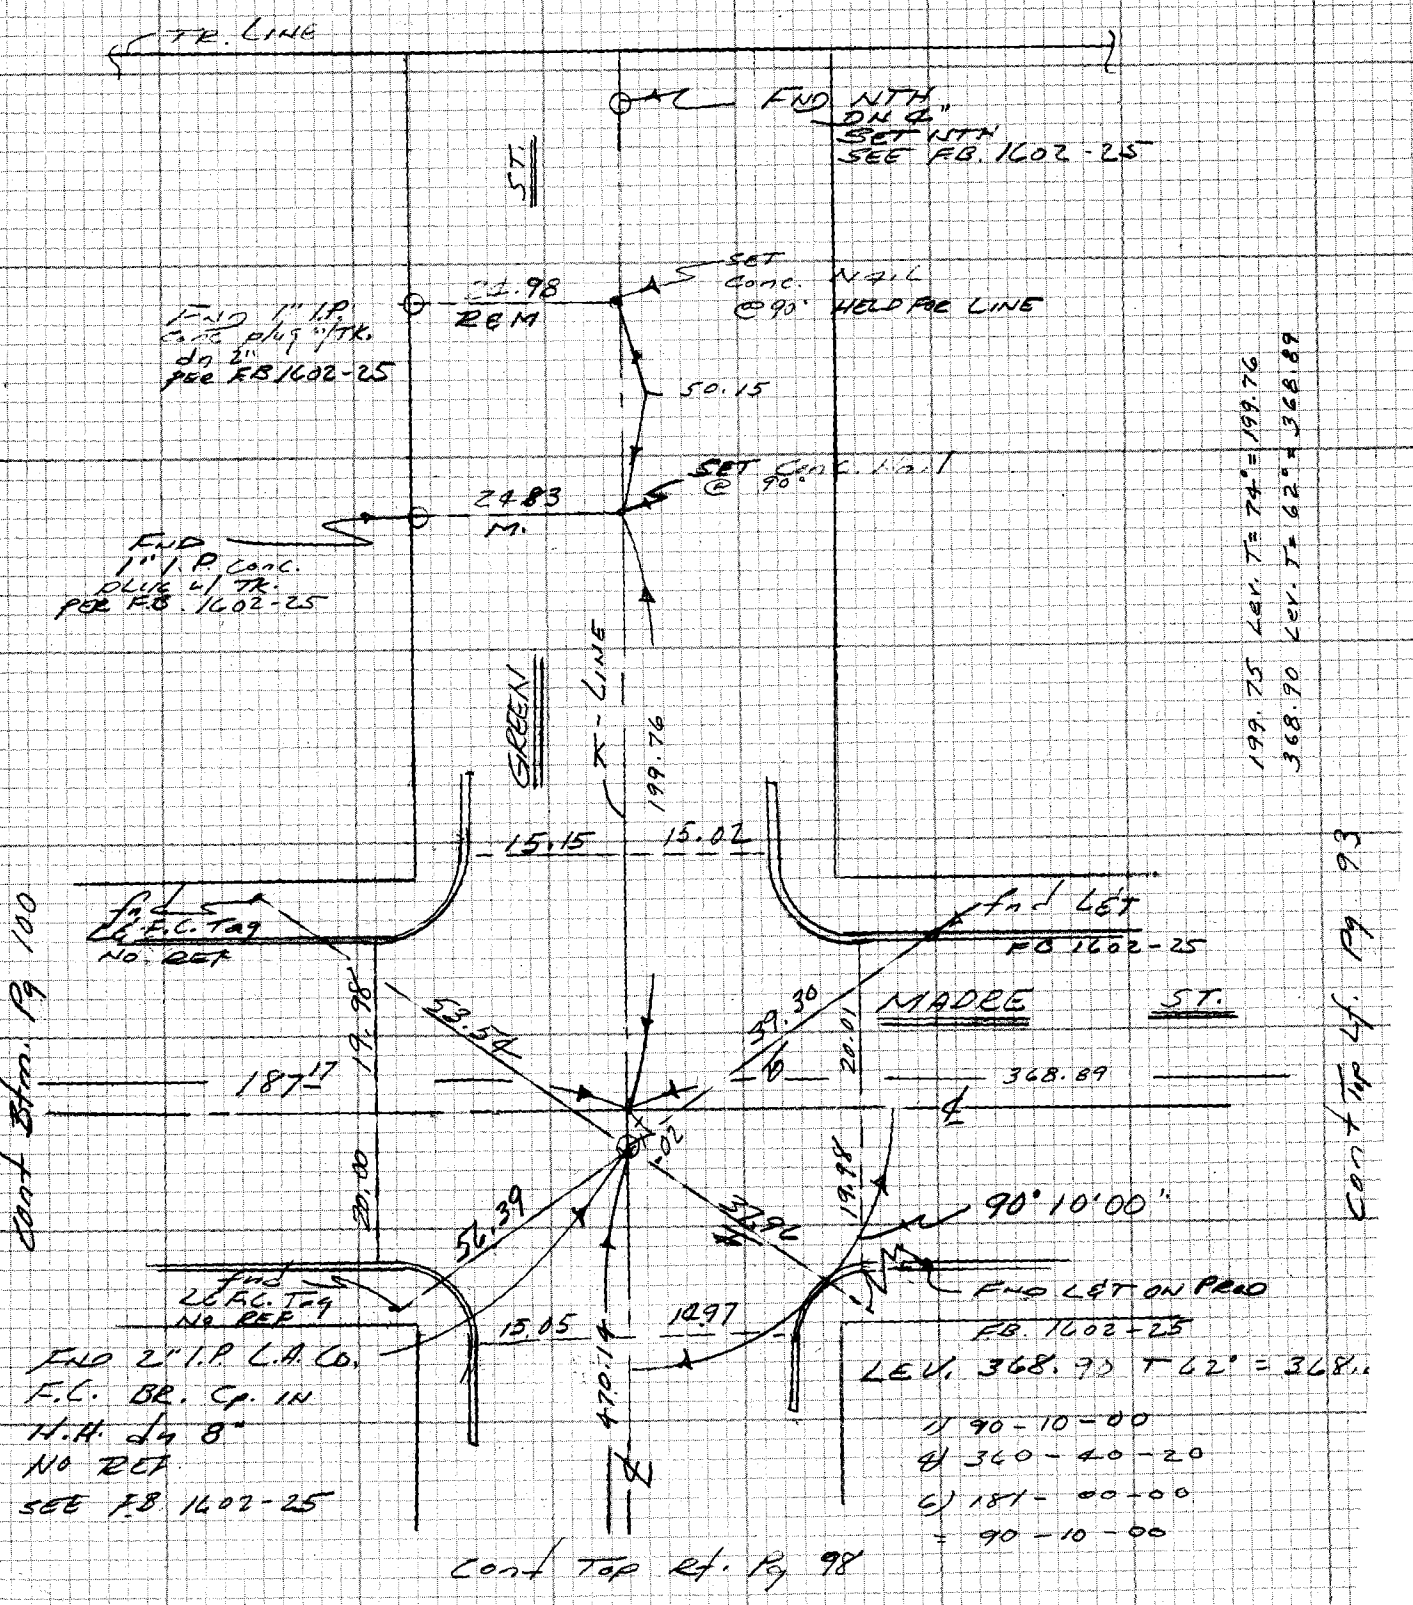


NOTE: ANY ADDITIONS OR CHANGES ON THIS SHEET MUST BE MADE OR CIRCLED IN RED INK WITH DATE AND NAME OF PERSON MAKING CHANGE

Do not extend notes this side of this line

W.S.44 C-2

PLEASE RETURN TO
LOS ANGELES COUNTY ENGINEER
403 LOS ANGELES COUNTY ENGINEERING BLDG.

ENTERLINE NOTES
E 310
6F3095-4/73

CONT. BTM Pg 111

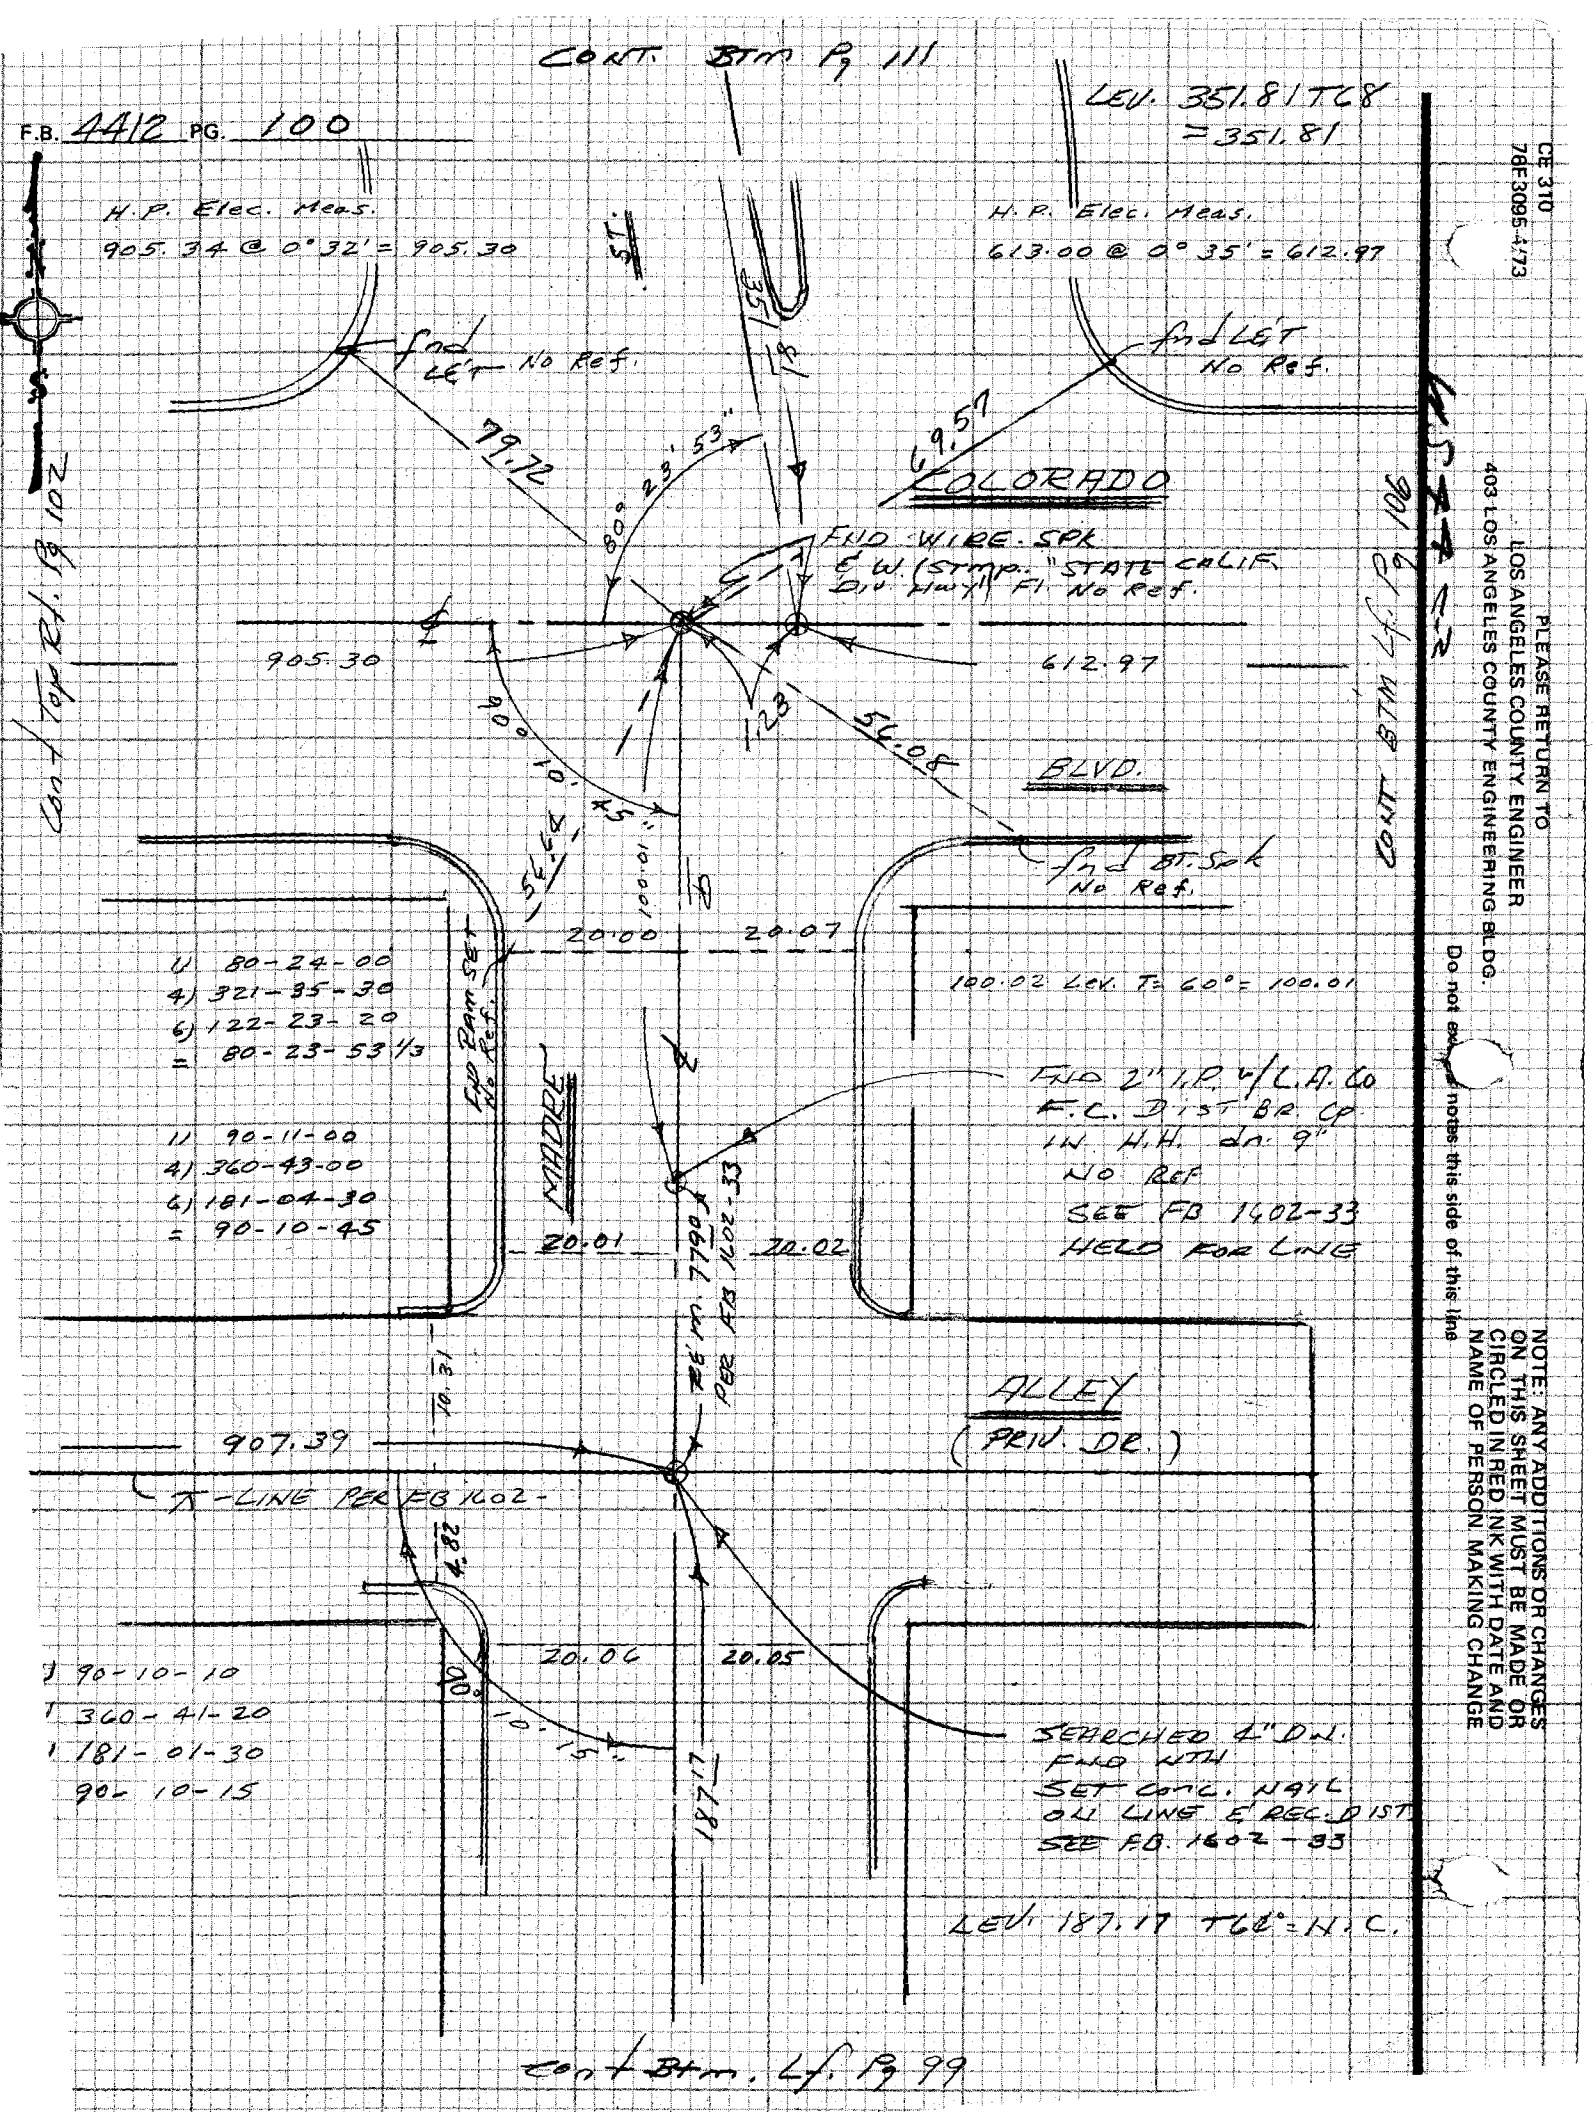


CE 310
76F3095-4/73
PLEASE RETURN TO
LOS ANGELES COUNTY ENGINEER
403 LOS ANGELES COUNTY ENGINEERING BLDG.
Do not ex... notes this side of this line
NOTE: ANY ADDITIONS OR CHANGES ON THIS SHEET MUST BE MADE OR CIRCLED IN RED INK WITH DATE AND NAME OF PERSON MAKING CHANGE

DIV 4

F.B. 4412 PG. 101

| | |
|---|---|
| Notes Ck'd by | Survey of ROSEMEAD ST ℄ |
| Map No. | JN 0303.00 Tape 0232 Std 68 °F |
| Office Work | Surveyed by E. LANDA |
| Checked | Notes EL Date 12-76 |
| Date | Indexed G. D. BAILEY SEP 19 1977 |

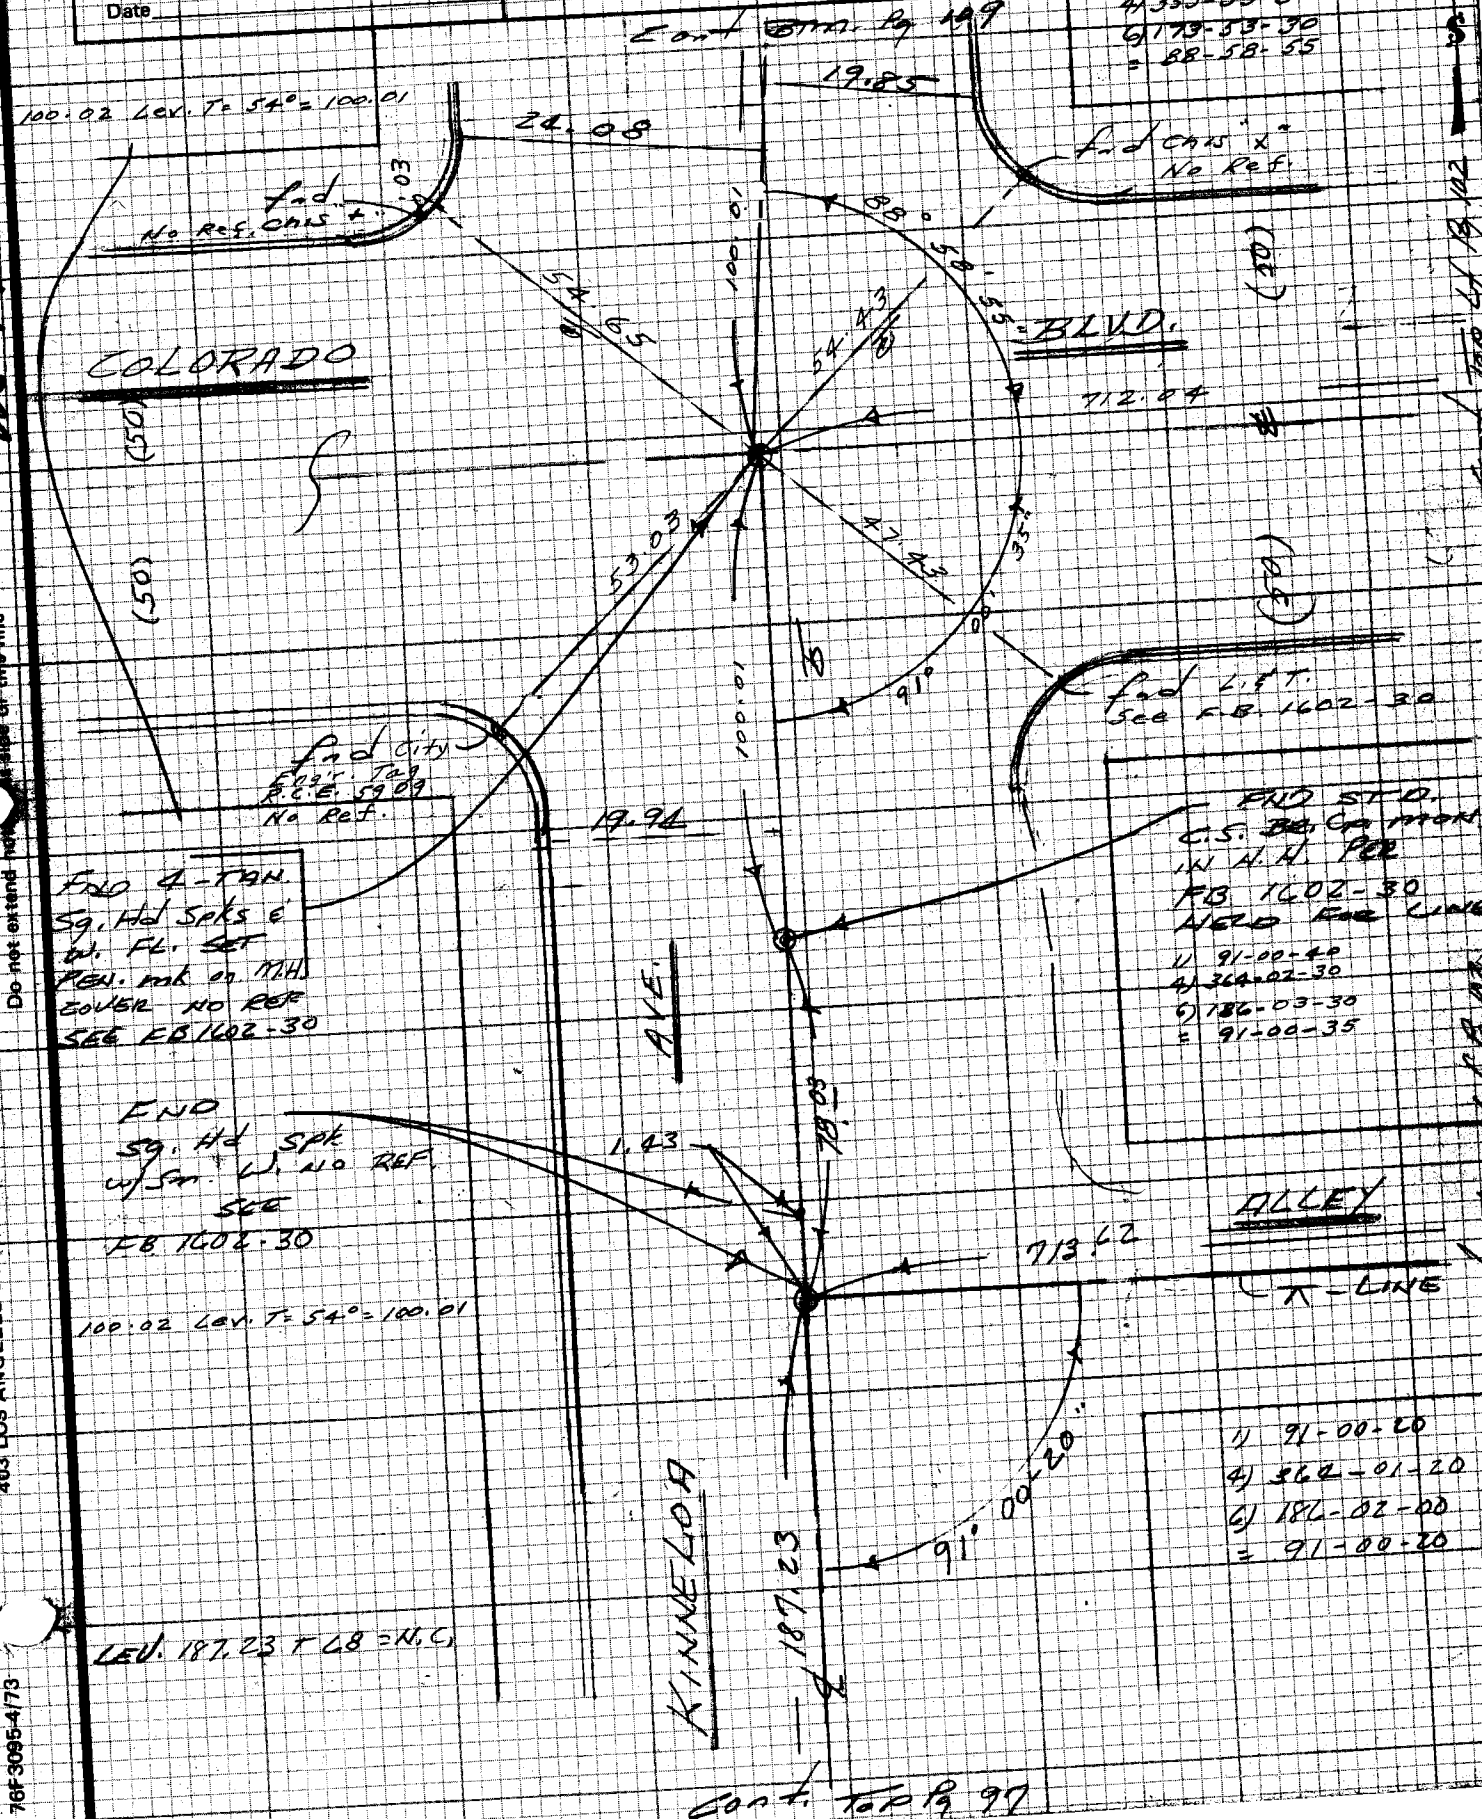


NOTE: ANY ADDITIONS OR CHANGES ON THIS SHEET MUST BE MADE OR CIRCLED IN RED INK WITH DATE AND NAME OF PERSON MAKING CHANGE

WS 44 B-2

Do not extend notes on this side of this line

PLEASE RETURN TO LOS ANGELES COUNTY ENGINEER 403 LOS ANGELES COUNTY ENGINEERING BLDG.

CENTERLINE NOTES CE 310 76F3095-4/73

F.B. 4412 PG. 102

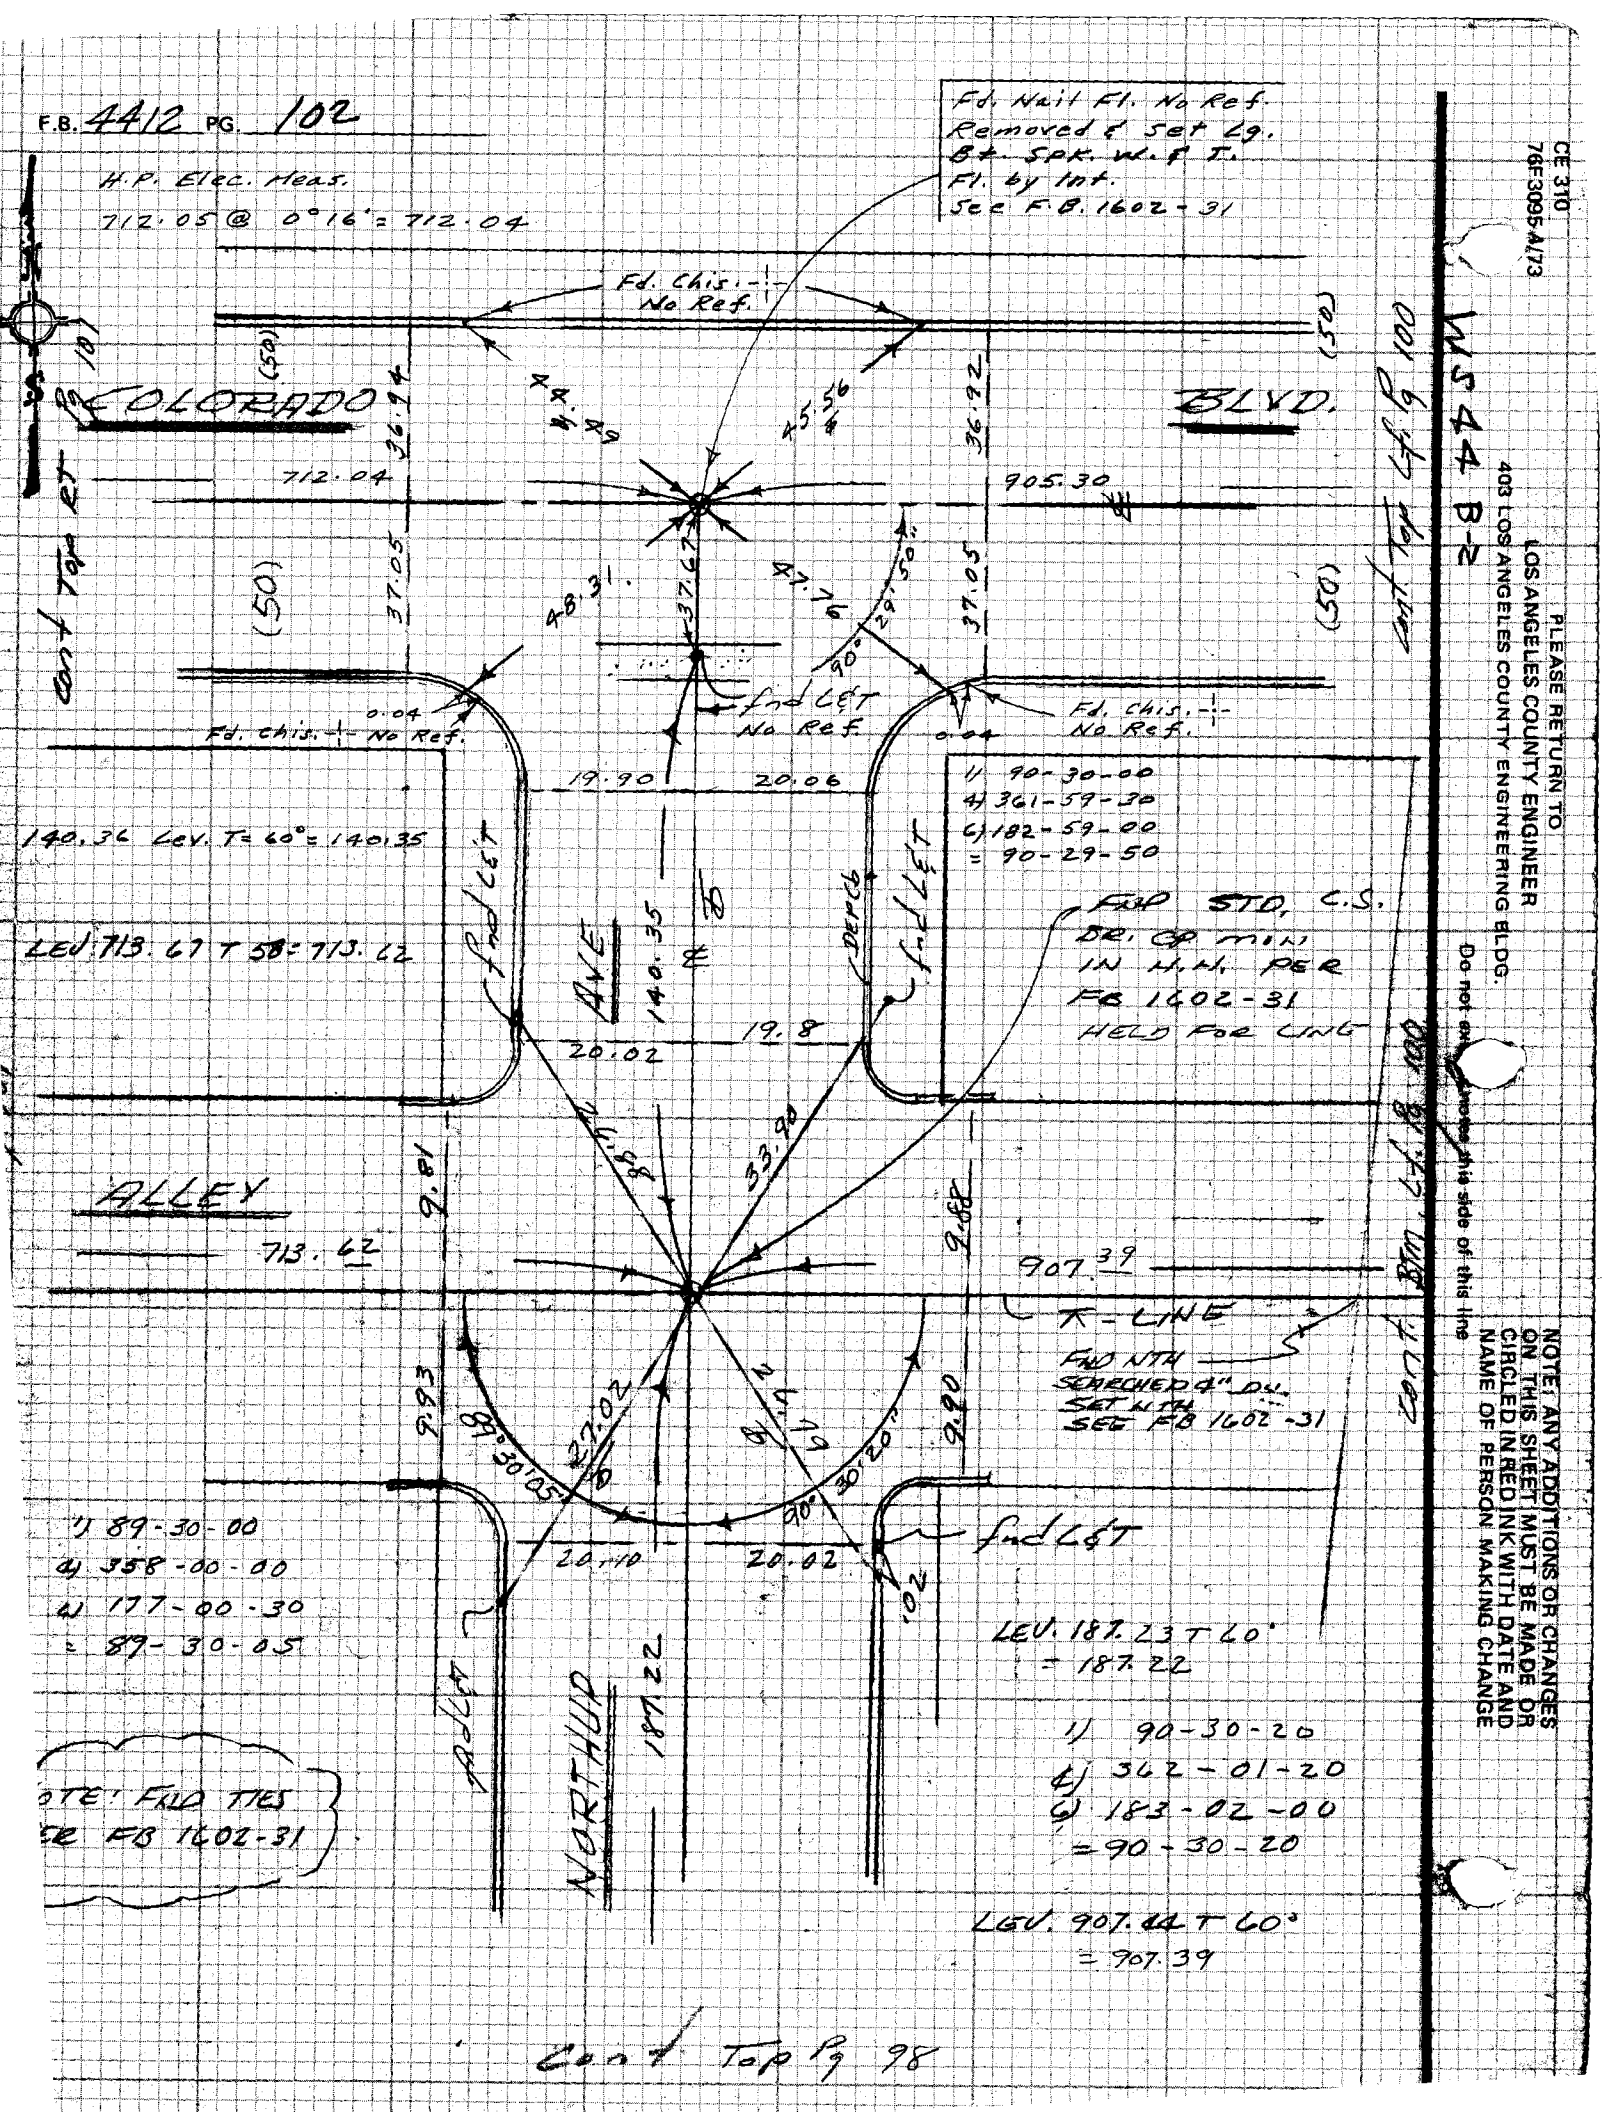


CE 310
76F3095-A/73

PLEASE RETURN TO
LOS ANGELES COUNTY ENGINEER
403 LOS ANGELES COUNTY ENGINEERING BLDG.

WS 44 B-2

NOTE! ANY ADDITIONS OR CHANGES ON THIS SHEET MUST BE MADE OR CIRCLED IN RED INK WITH DATE AND NAME OF PERSON MAKING CHANGE

Do not write on this side of this line

DIV. 4

| | |
|---|---|
| Notes Ck'd by | Survey of ROSEMEAD ST. ℄ |
| Map No. | JN 0302.00 Tape 021 Std 68° F |
| Office Work | Surveyed by E. CANDA |
| Checked | Notes VILIEBER Date 1-77 |
| Date | Indexed G. D. BAILEY SEP 19 1977 |

F.B. 1412 PG. 103

WS 44 C-2

NOTE: ANY ADDITIONS OR CHANGES ON THIS SHEET MUST BE MADE OR CIRCLED IN RED INK WITH DATE AND NAME OF PERSON MAKING CHANGE

Do not extend notes to this side of this line

PLEASE RETURN TO
LOS ANGELES COUNTY ENGINEER
403 LOS ANGELES COUNTY ENGINEERING BLDG.

CENTERLINE NOTES
CE 310
76F 3095-4/73

CONT. BTM. Pg 104

1) 90-16-40
4) 361-06-00
6) 181-39-00
= 90-16-30

No Ref. Fnd Lead

Fnd Spk. Dn 2" Per FB 1740-36

To Bot. Pg 108

LOTUS

139.91

℄ LINE

Fd. Cut

305.82 Lev. T= 54° = 305.79
302.42 Lev. T= 54° = 302.39
99.99 Lev. T= 70° = 99.99

Fnd Spk. Dn 2" Per FB 1740-36 1602-37

No Ref. Fnd Lead

BLVD.

Fnd Lead F.B. 1740-36

100.01 Lev. T= 62° = 100.01

302.39

16.30

90°

1.35

6.02

68°

51.13"

35.05

1.03

.03

5.08

100.01

50.36

305.79

941.58 (TO HALSTEAD ST) ELEC. MEAS.

COLORADO

Fnd Lead F.B. 1740-36

AVE.

101.23

℄

To Bot. Pg 96

14.90

Fnd Std. C.L. Mon. Per FB 1602-37

1) 89-51-20
4) 359-25-00
6) 179-07-20
= 89-51-13

Fd. Sp. Hd. Spk. Dn. 1" Per FB 1740-39

To Bot. Pg 110

SYCAMORE

99.99

℄ LINE

AVE.

98°

48' 50"

0.015

635.79 (Calc.)

941.58 = Elec. Meas.
305.79 = Tape Meas.
635.79 Calc.

Perm. Halstead to Lotus
N. P. Elec. Meas. = 941.58

1) 89-49-00
4) 359-15-20
6) 178-53-00
= 89-48-50

CONT. BTM. ℄ Pg 106

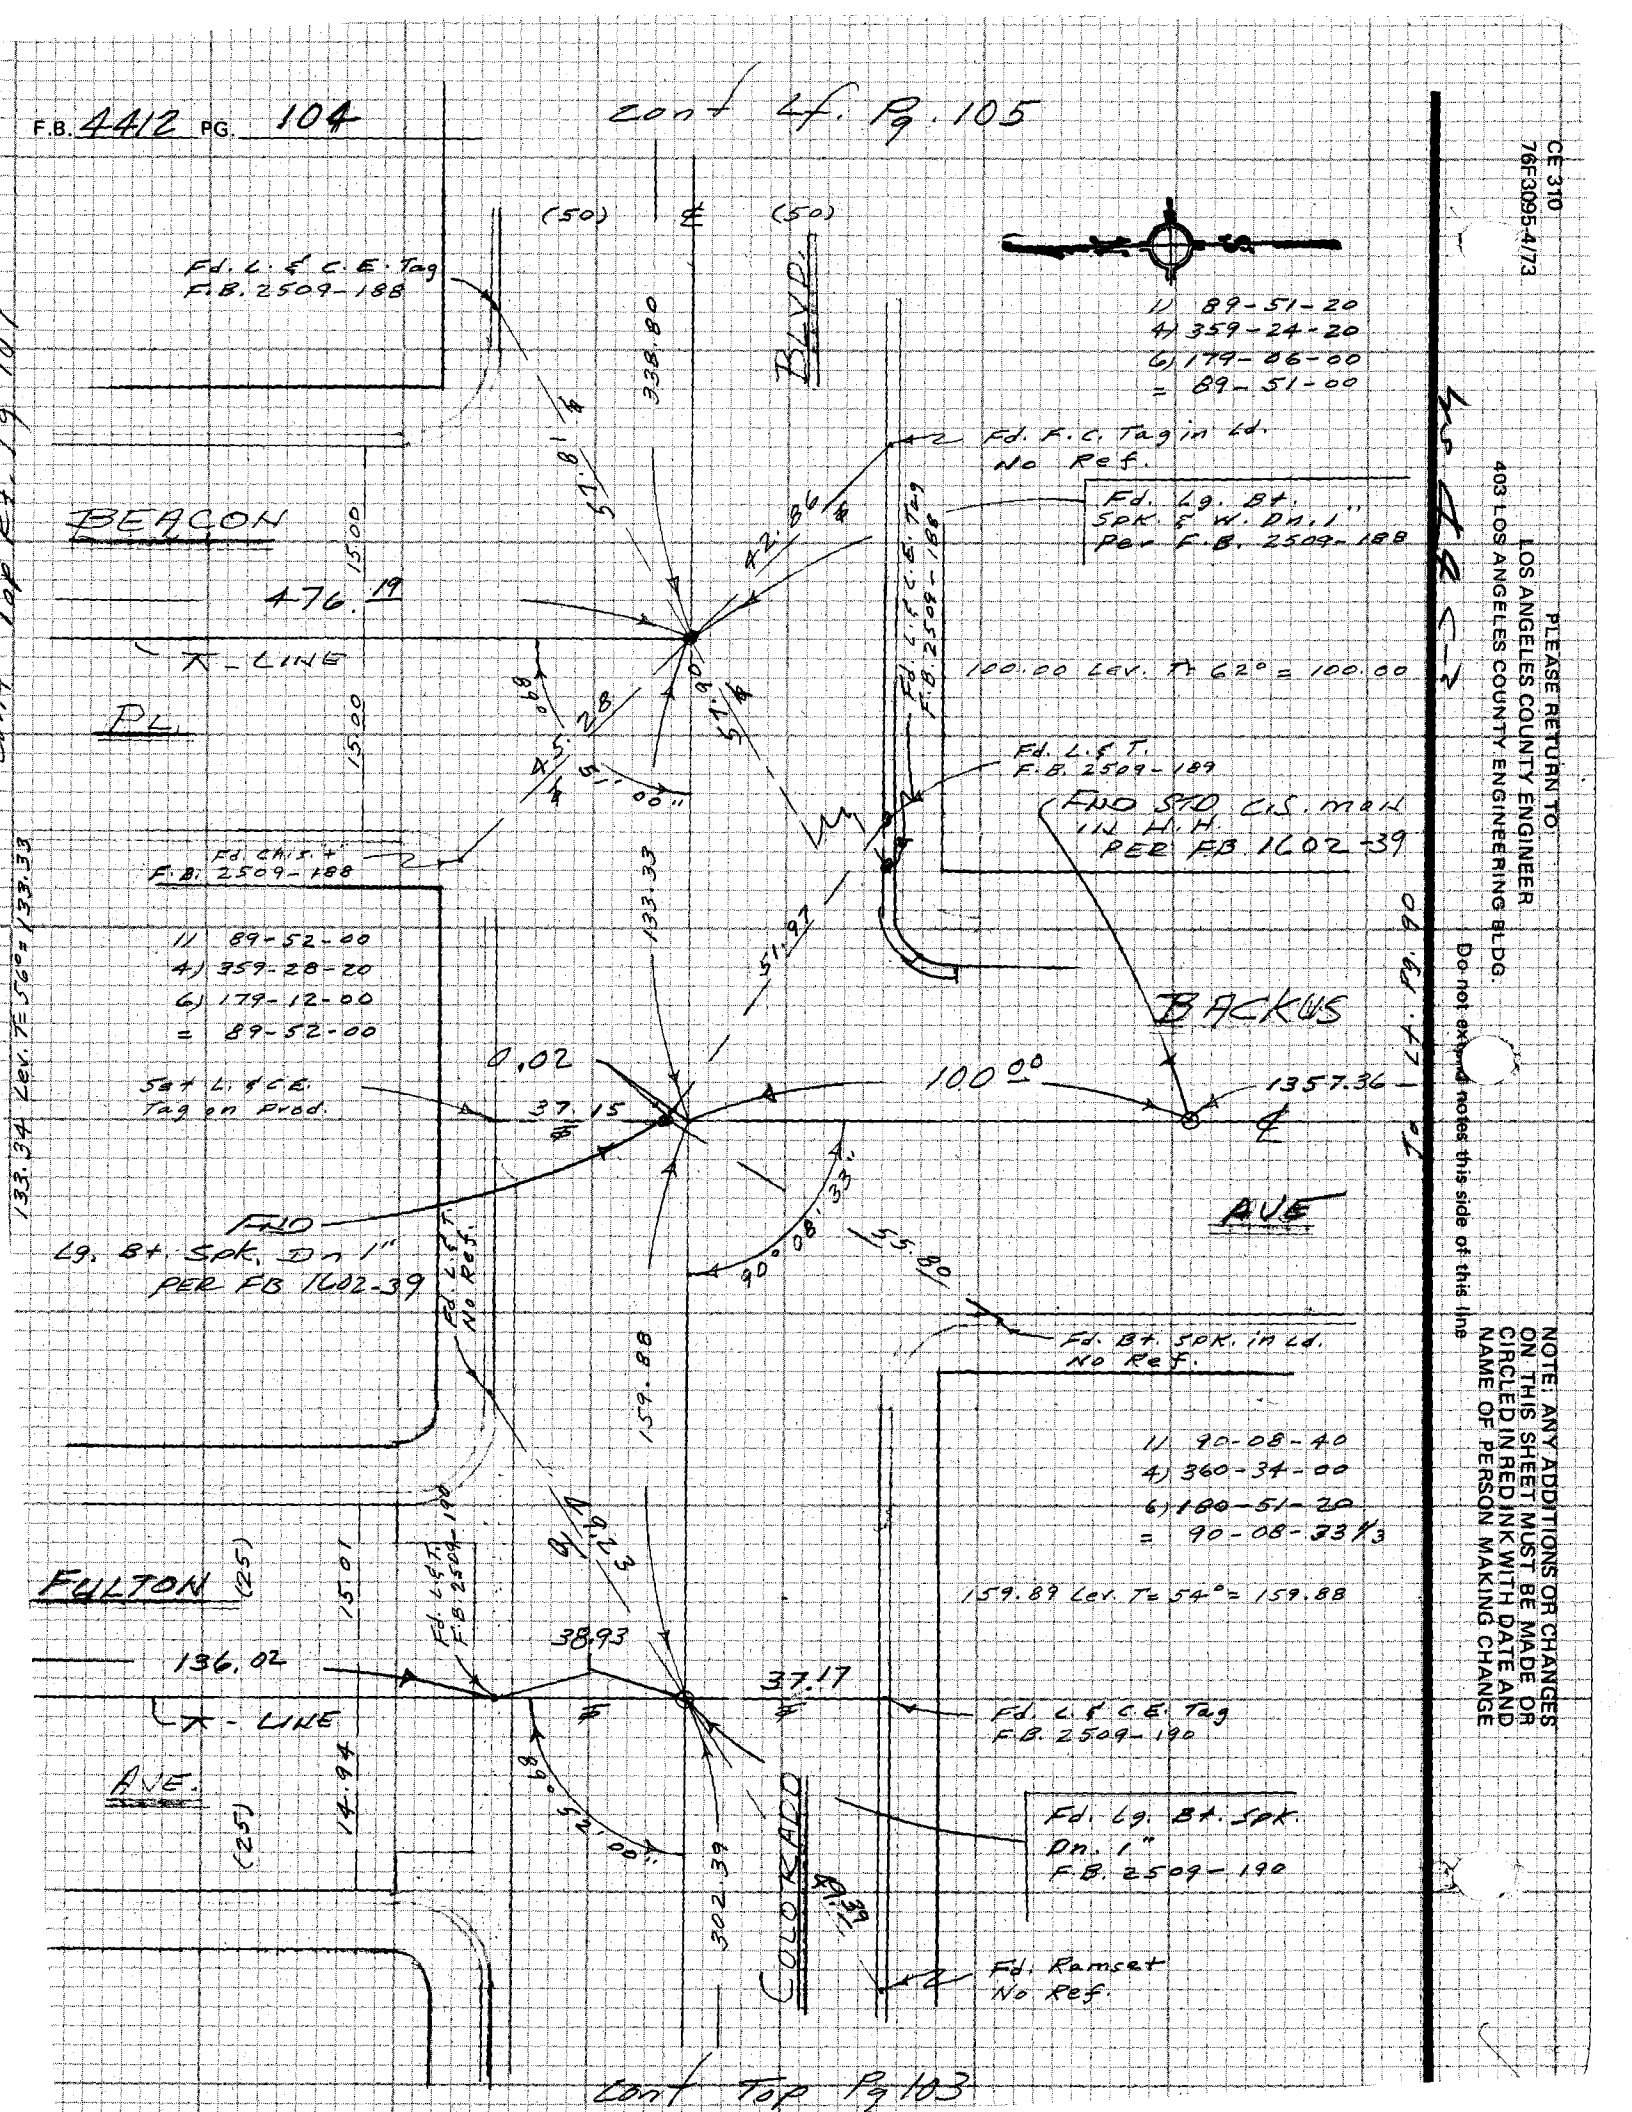
F.B. 4412 PG. 104
Cont Lf. Pg. 105
(50)
(50)
Fd. L. & C.E. Tag
F.B. 2509-188
338.80
BLVD.
1) 89-51-20
4) 359-24-20
6) 179-06-00
= 89-51-00
Fd. F.C. Tag in Ld.
No Ref.
Fd. Lg. Bt.
Spk. & W. Dn. 1"
Per F.B. 2509-188
BEACON
476.19
15.00
15.00
X-LINE
PL.
100.00 Lev. T= 62° = 100.00
Fd. L. & T.
F.B. 2509-189
FND STD C.S. MON
IN H.H.
PER FB 1602-39
Fd. Chis. +
F.B. 2509-188
133.33
51.97
1) 89-52-00
4) 359-28-20
6) 179-12-00
= 89-52-00
BACKUS
0.02
100.00
1357.36
Set L. & C.E.
Tag on Prod.
37.15
AVE
FND
Lg. Bt. Spk. Dn 1"
PER FB 1602-39
90°08'33"
55.80
Fd. Bt. Spk. in Ld.
No Ref.
159.88
1) 90-08-40
4) 360-34-00
6) 180-51-20
= 90-08-33 1/3
159.89 Lev. T= 54° = 159.88
FULTON
(25)
15.01
136.02
38.93
37.17
X-LINE
Fd. L. & C.E. Tag
F.B. 2509-190
AVE.
(25)
14.94
89°52'00"
302.39
COLORADO
Fd. Lg. Bt. Spk.
Dn. 1"
F.B. 2509-190
Fd. Ramset
No Ref.
Cont Top Pg 103
CE 310
76F3095-4/73
PLEASE RETURN TO
LOS ANGELES COUNTY ENGINEER
403 LOS ANGELES COUNTY ENGINEERING BLDG.
Do not extend notes this side of this line
NOTE: ANY ADDITIONS OR CHANGES ON THIS SHEET MUST BE MADE OR CIRCLED IN RED INK WITH DATE AND NAME OF PERSON MAKING CHANGE

DIV 4

| | |
|---|---|
| Notes Ck'd by | Survey of ROSEMEAD ST ℄ |
| Map No. | JN 0303.00 Tape 0232 Std 68 °F |
| Office Work | Surveyed by E. LANDA |
| Checked | Notes EL Date 12-76 |
| Date | Indexed G. D. BAILEY SEP 19 1977 |

F.B. 4412 PG. 105

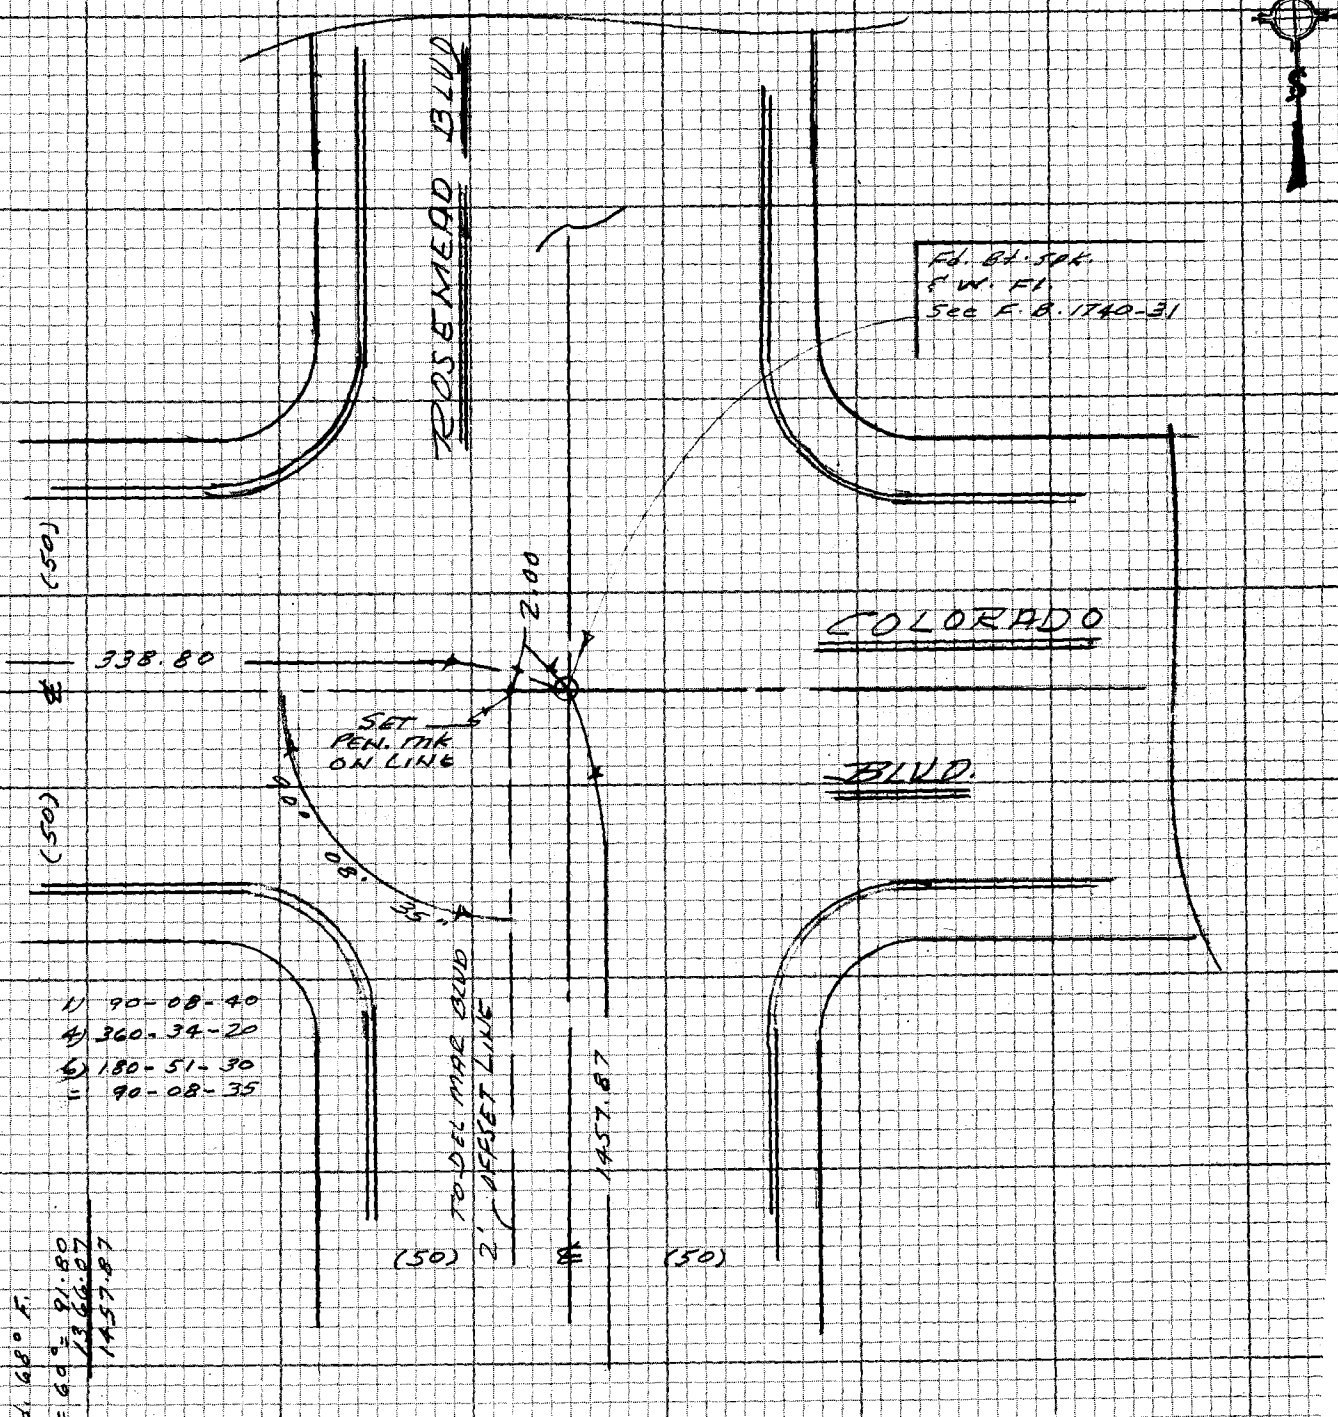


Cont. Top Pg 104

H.P. Elec. Meas.
1366.23 @ 0°53' = 1366.07
Tape 021 Std. 68° F.
91.80 Lev. T=60°=91.80
1366.07
1457.87

Cont Top Lf pg. 86

NOTE: ANY ADDITIONS OR CHANGES ON THIS SHEET MUST BE MADE OR CIRCLED IN RED INK WITH DATE AND NAME OF PERSON MAKING CHANGE

Do not extend notes this side of this line

PLEASE RETURN TO
LOS ANGELES COUNTY ENGINEER
403 LOS ANGELES COUNTY ENGINEERING BLDG.

CENTERLINE NOTES
CE 310
76F3095-4/73

F.B. 4412 PG. 106

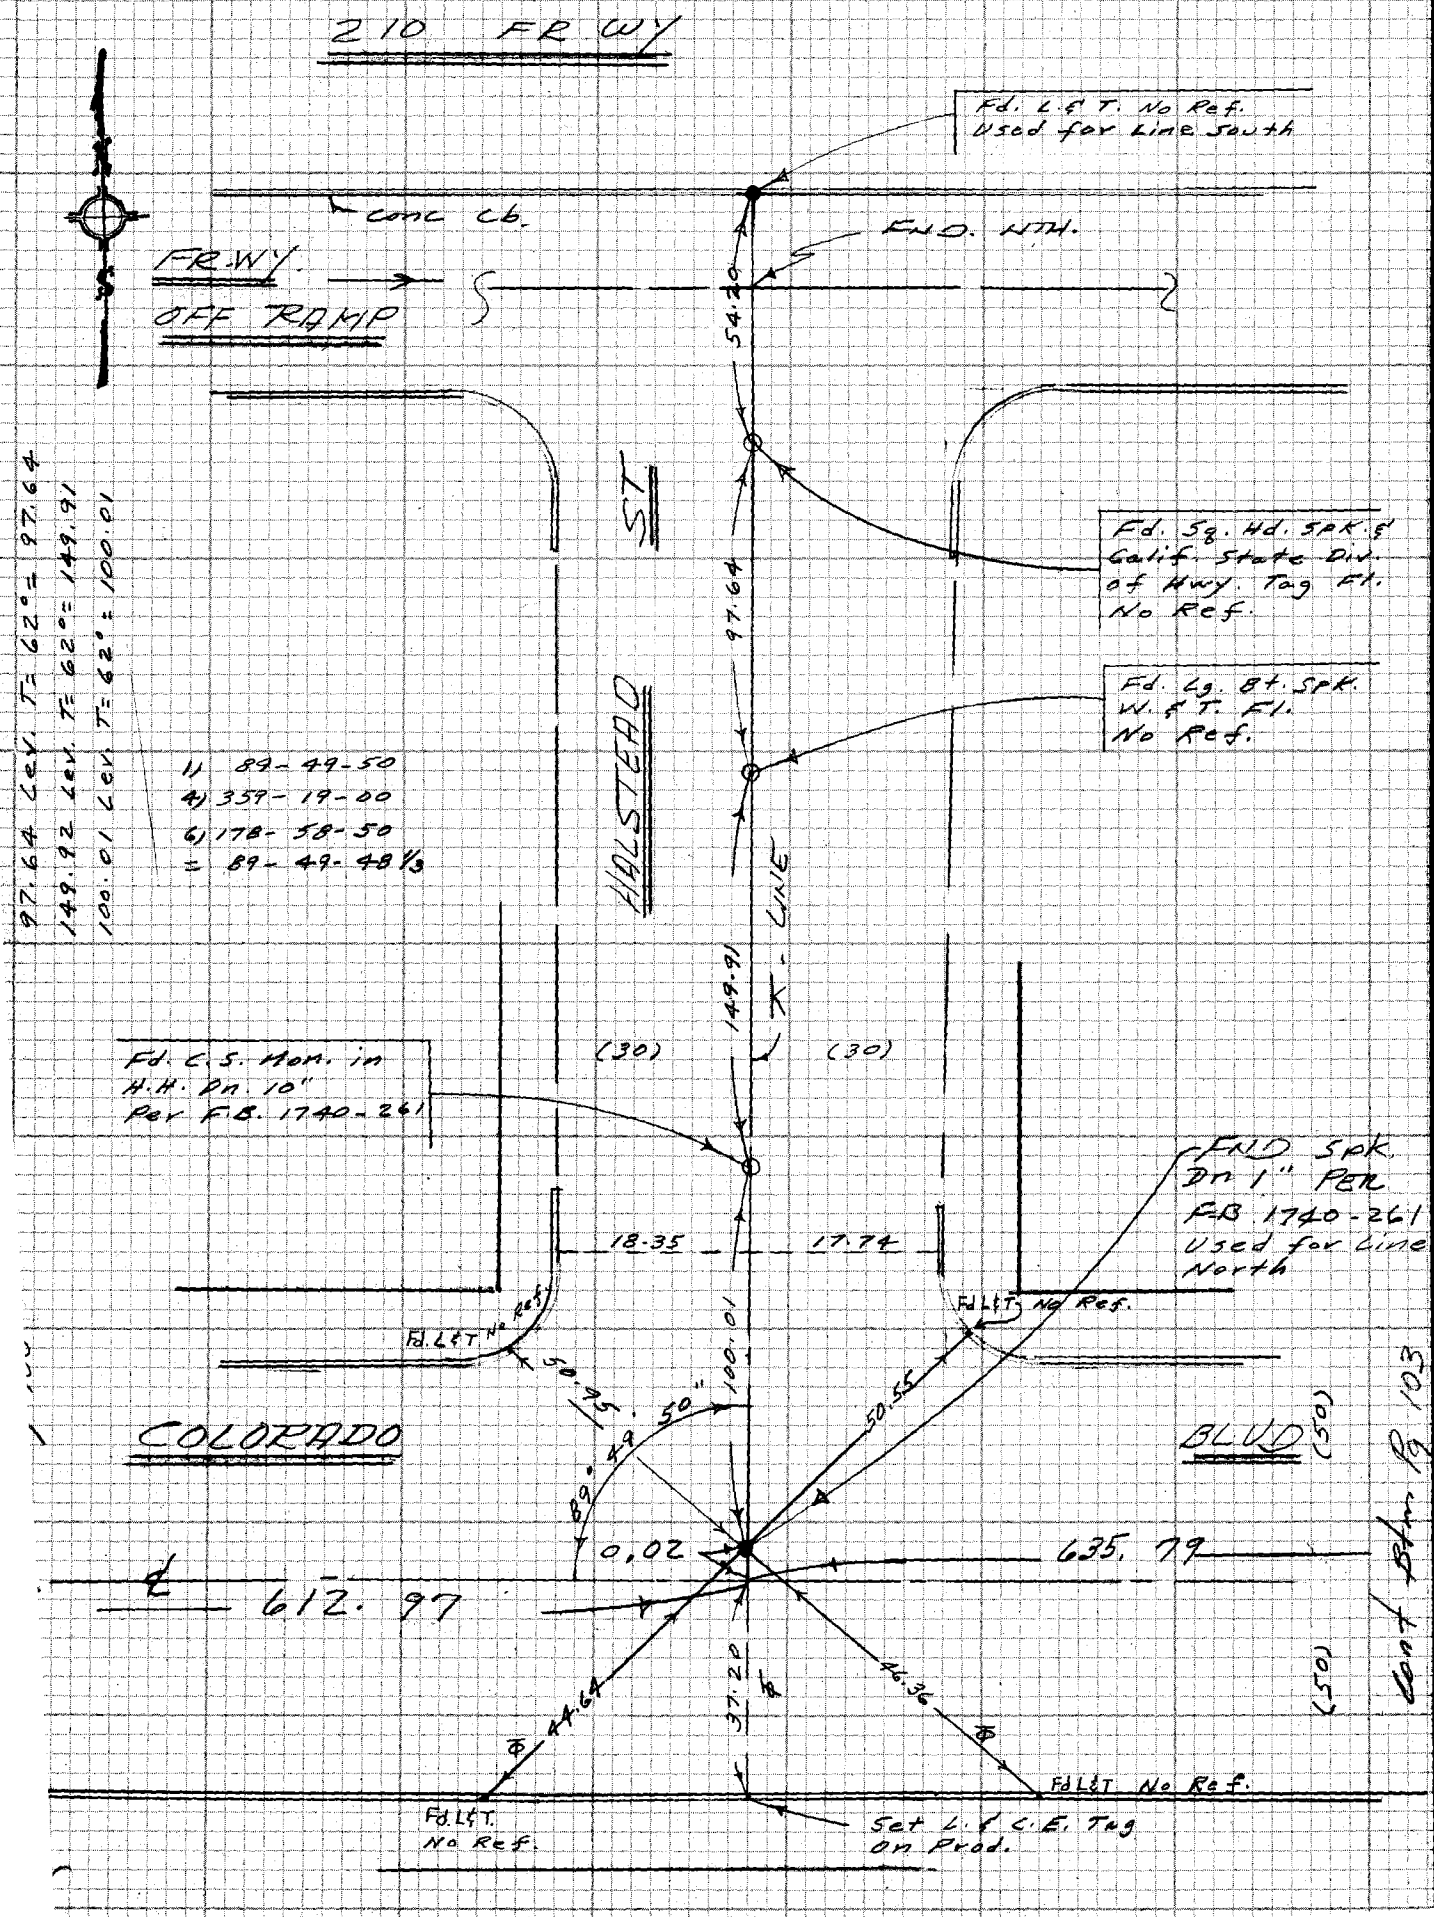



CE 310
76F3095-4/73
PLEASE RETURN TO
LOS ANGELES COUNTY ENGINEER
403 LOS ANGELES COUNTY ENGINEERING BLDG.
Do not exceed notes this side of this line
NOTE: ANY ADDITIONS OR CHANGES ON THIS SHEET MUST BE MADE OR CIRCLED IN RED INK WITH DATE AND NAME OF PERSON MAKING CHANGE

DIV 4

| | |
|---|---|
| Notes Ck'd by | Survey of ROSEMEAD ST ℄ F.B. 4412 PG. 107 |
| Map No. | JN 0303 Tape 021 Std 68 °F |
| Office Work | Surveyed by EL |
| Checked | Notes G.D. CREAGON Date 1-77 |
| Date | Indexed G. D. BAILEY SEP 19 1977 |

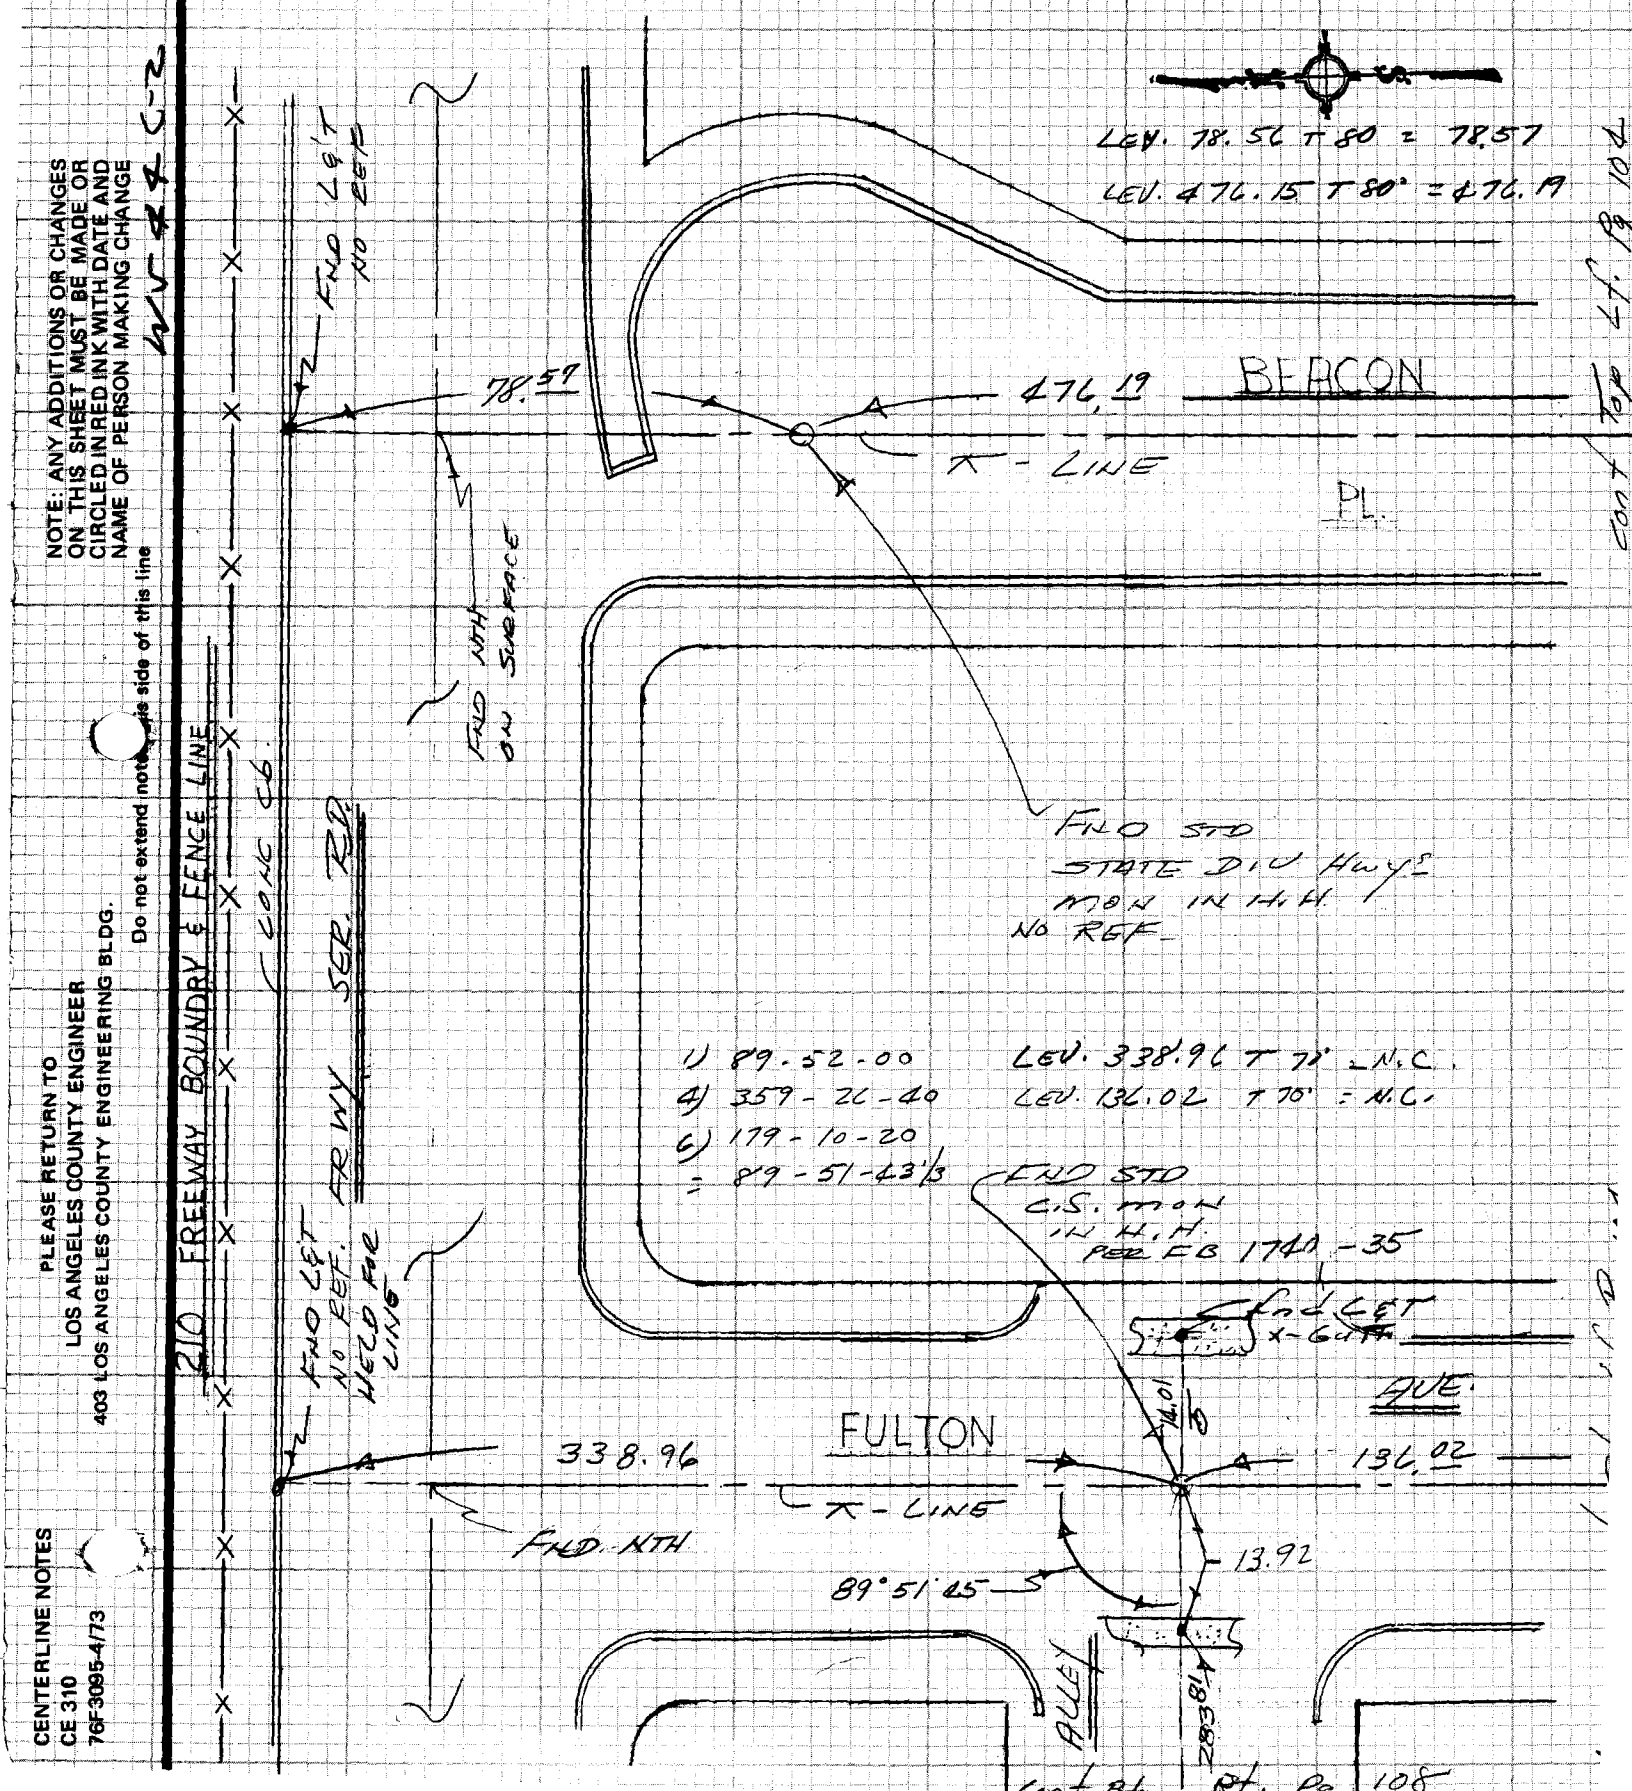


NOTE: ANY ADDITIONS OR CHANGES ON THIS SHEET MUST BE MADE OR CIRCLED IN RED INK WITH DATE AND NAME OF PERSON MAKING CHANGE

Do not extend notes this side of this line

PLEASE RETURN TO
LOS ANGELES COUNTY ENGINEER
403 LOS ANGELES COUNTY ENGINEERING BLDG.

CENTERLINE NOTES
CE 310
76F3095-4/73

F.B. 4412 PG. 108

CE 310
70F 3095.4

PLEASE RETURN TO
LOS ANGELES COUNTY ENGINEER
403 LOS ANGELES COUNTY ENGINEERING BLDG.

NOTE: ANY ADDITIONS OR CHANGES
ON THIS SHEET MUST BE MADE OR
CIRCLED IN RED INK WITH DATE AND
NAME OF PERSON MAKING CHANGE

Do not extend notes this side of this line

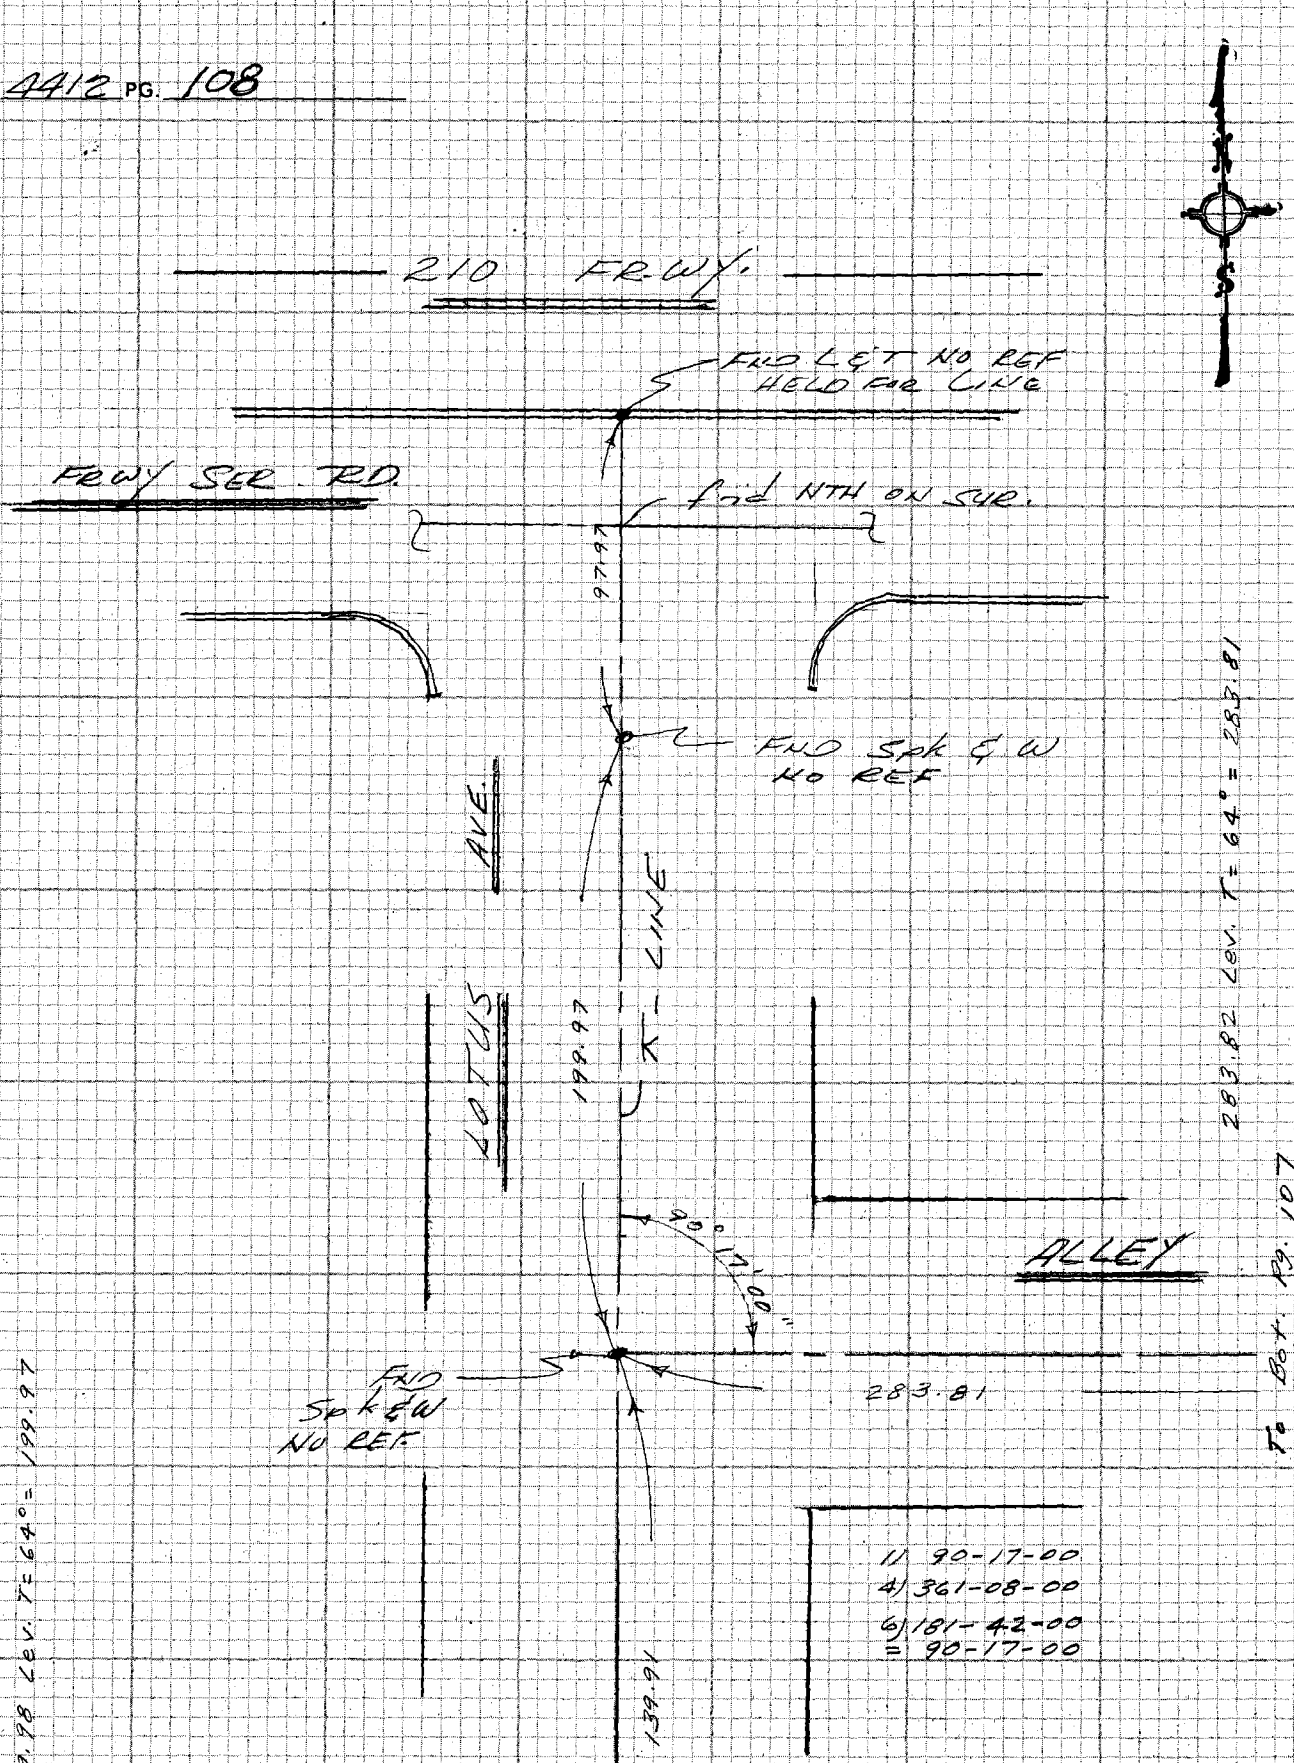

DIV 6

| | |
|---|---|
| Notes Ck'd by | Survey of ROSEMEAD ST 4 F.B. 4412 PG. 109 |
| Map No. | JN 030300 Tape 021 Std 68° F |
| Office Work | Surveyed by EL |
| Checked | Notes VILLEBER Date 1-77 |
| Date | Indexed G. D. BAILEY SEP 19 1977 |

210 FREEWAY

FND STD. STATE DIV. HWYS. DW 2" NO REF. HELD FOR LNG

SERVICE RD

2.64

FND LEAD NO REF.

CL

84.55

13.95

19.72

FND Lg. Sak WET FL. NO REF.

93.62

FND Lg. Sak WET FL. NO REF

ST.

387.27

FND STD. C.S. MON IN H.H. PER FB 1740 - 44

KINNELOA

100.01

Cont Top Pg 101

NOTE: ANY ADDITIONS OR CHANGES ON THIS SHEET MUST BE MADE OR CIRCLED IN RED INK WITH DATE AND NAME OF PERSON MAKING CHANGE

Do not extend notes across this line

PLEASE RETURN TO
LOS ANGELES COUNTY ENGINEER
403 LOS ANGELES COUNTY ENGINEERING BLDG.

CENTERLINE NOTES
CE 310
76F3095-4/73

F.B. 4412 PG. 110

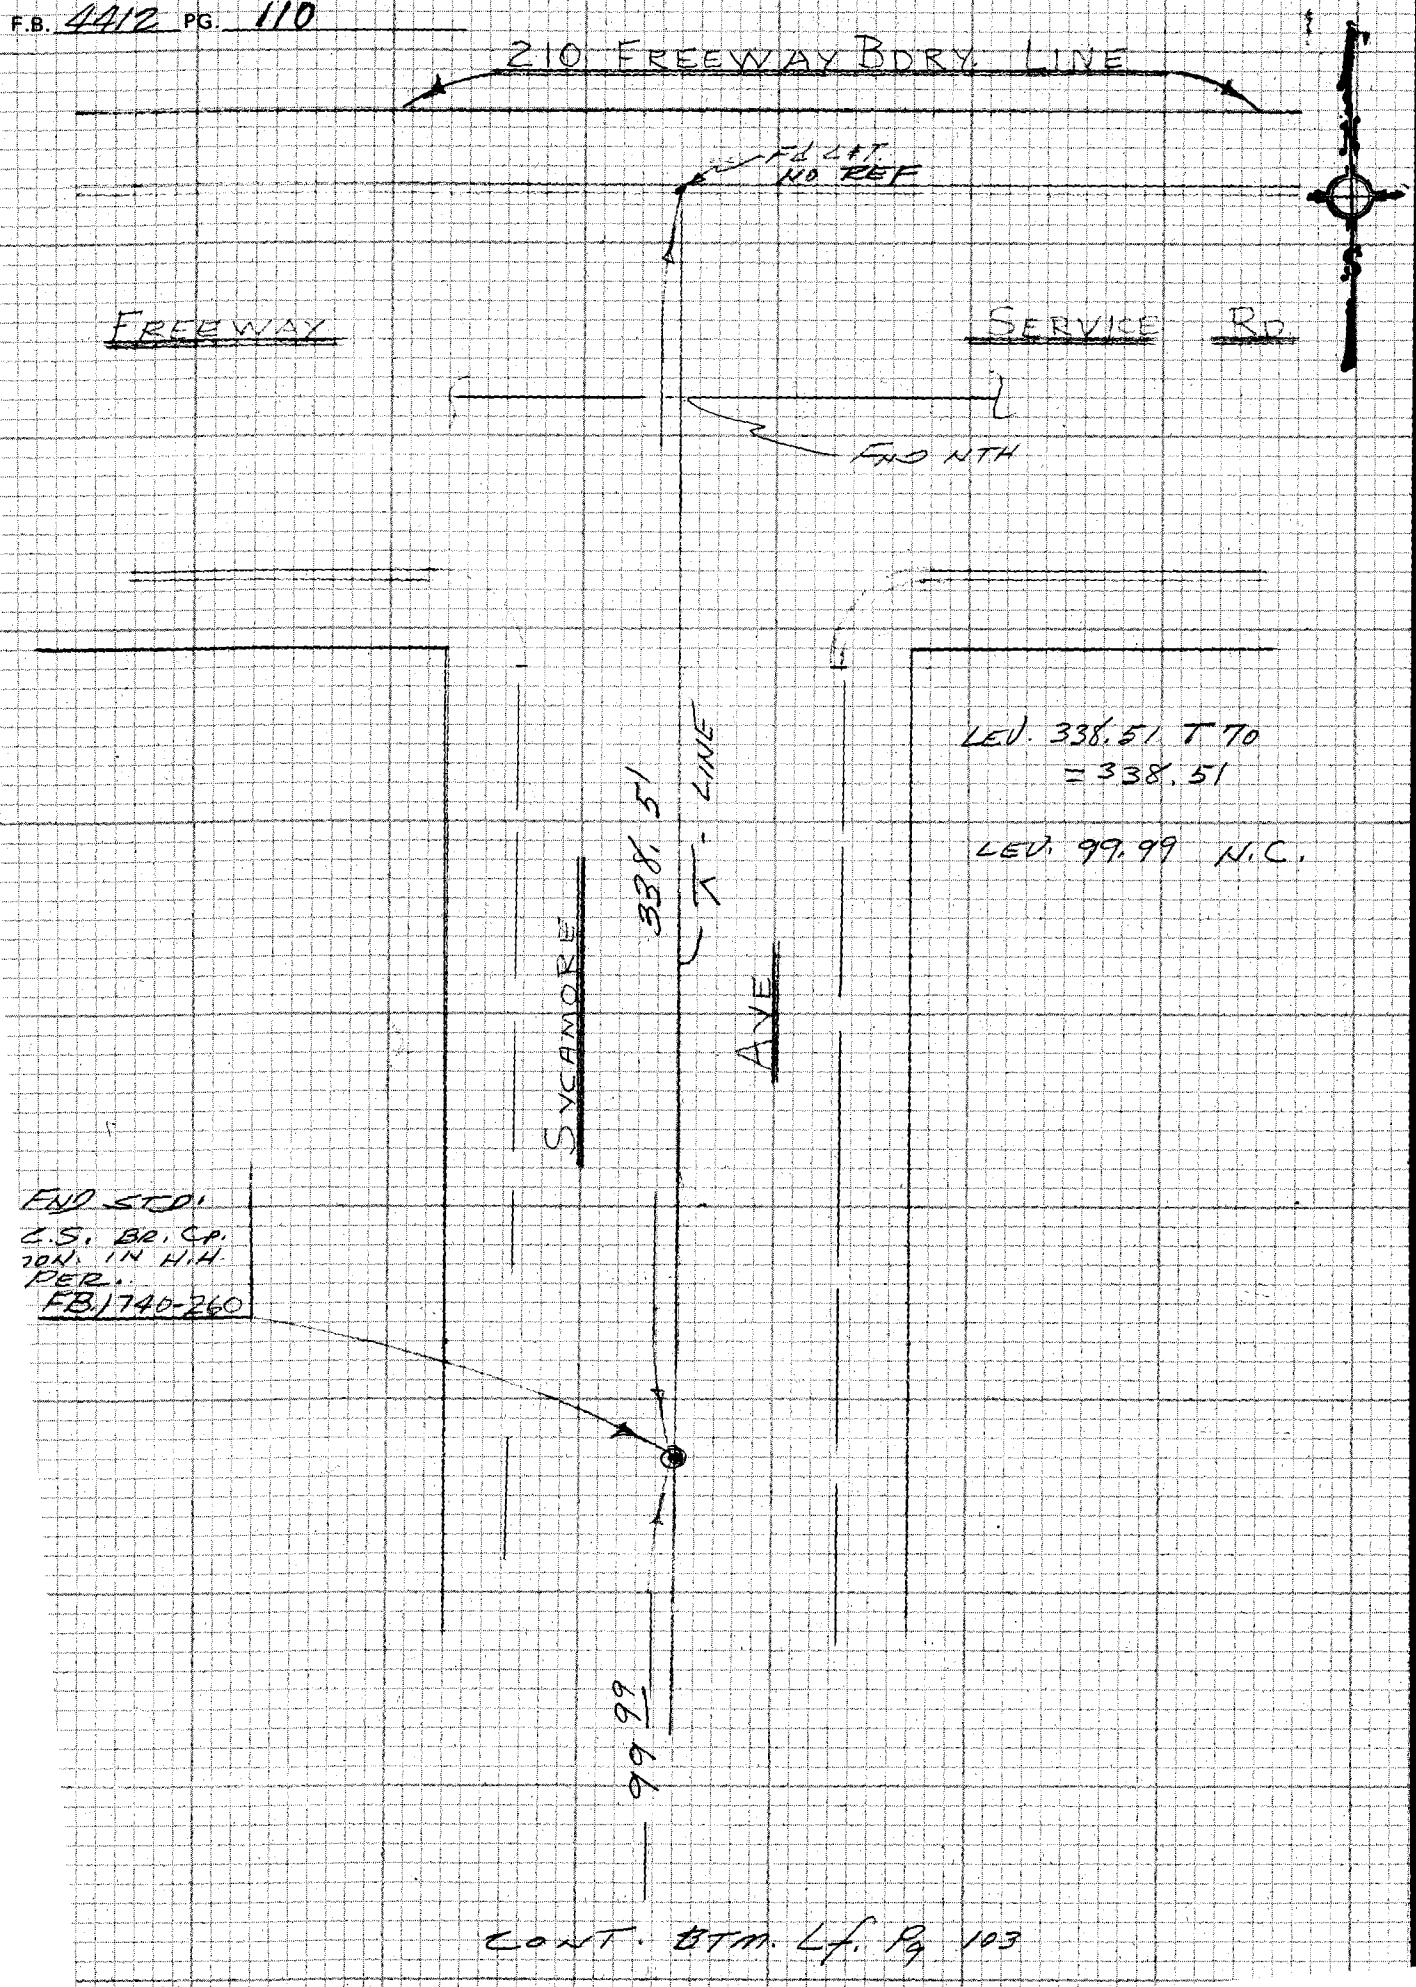


CONT. BTM. Lf. Pg 103

CE 310
76F3095-4/73

PLEASE RETURN TO
LOS ANGELES COUNTY ENGINEER
403 LOS ANGELES COUNTY ENGINEERING BLDG.

Do not extend notes this side of this line

NOTE: ANY ADDITIONS OR CHANGES ON THIS SHEET MUST BE MADE OR CIRCLED IN RED INK WITH DATE AND NAME OF PERSON MAKING CHANGE

DIV. 4

| | |
|---|---|
| Notes Ck'd by | Survey of ROSEMEAD ST. @ |
| Map No. | JN 0303.00 Tape 021 Std 68 °F |
| Office Work | Surveyed by E. L. |
| Checked | Notes G.D. CREASON Date 1-77 |
| Date | Indexed G. D. BAILEY SEP 19 1977 |

F.B. 4412 PG. 111

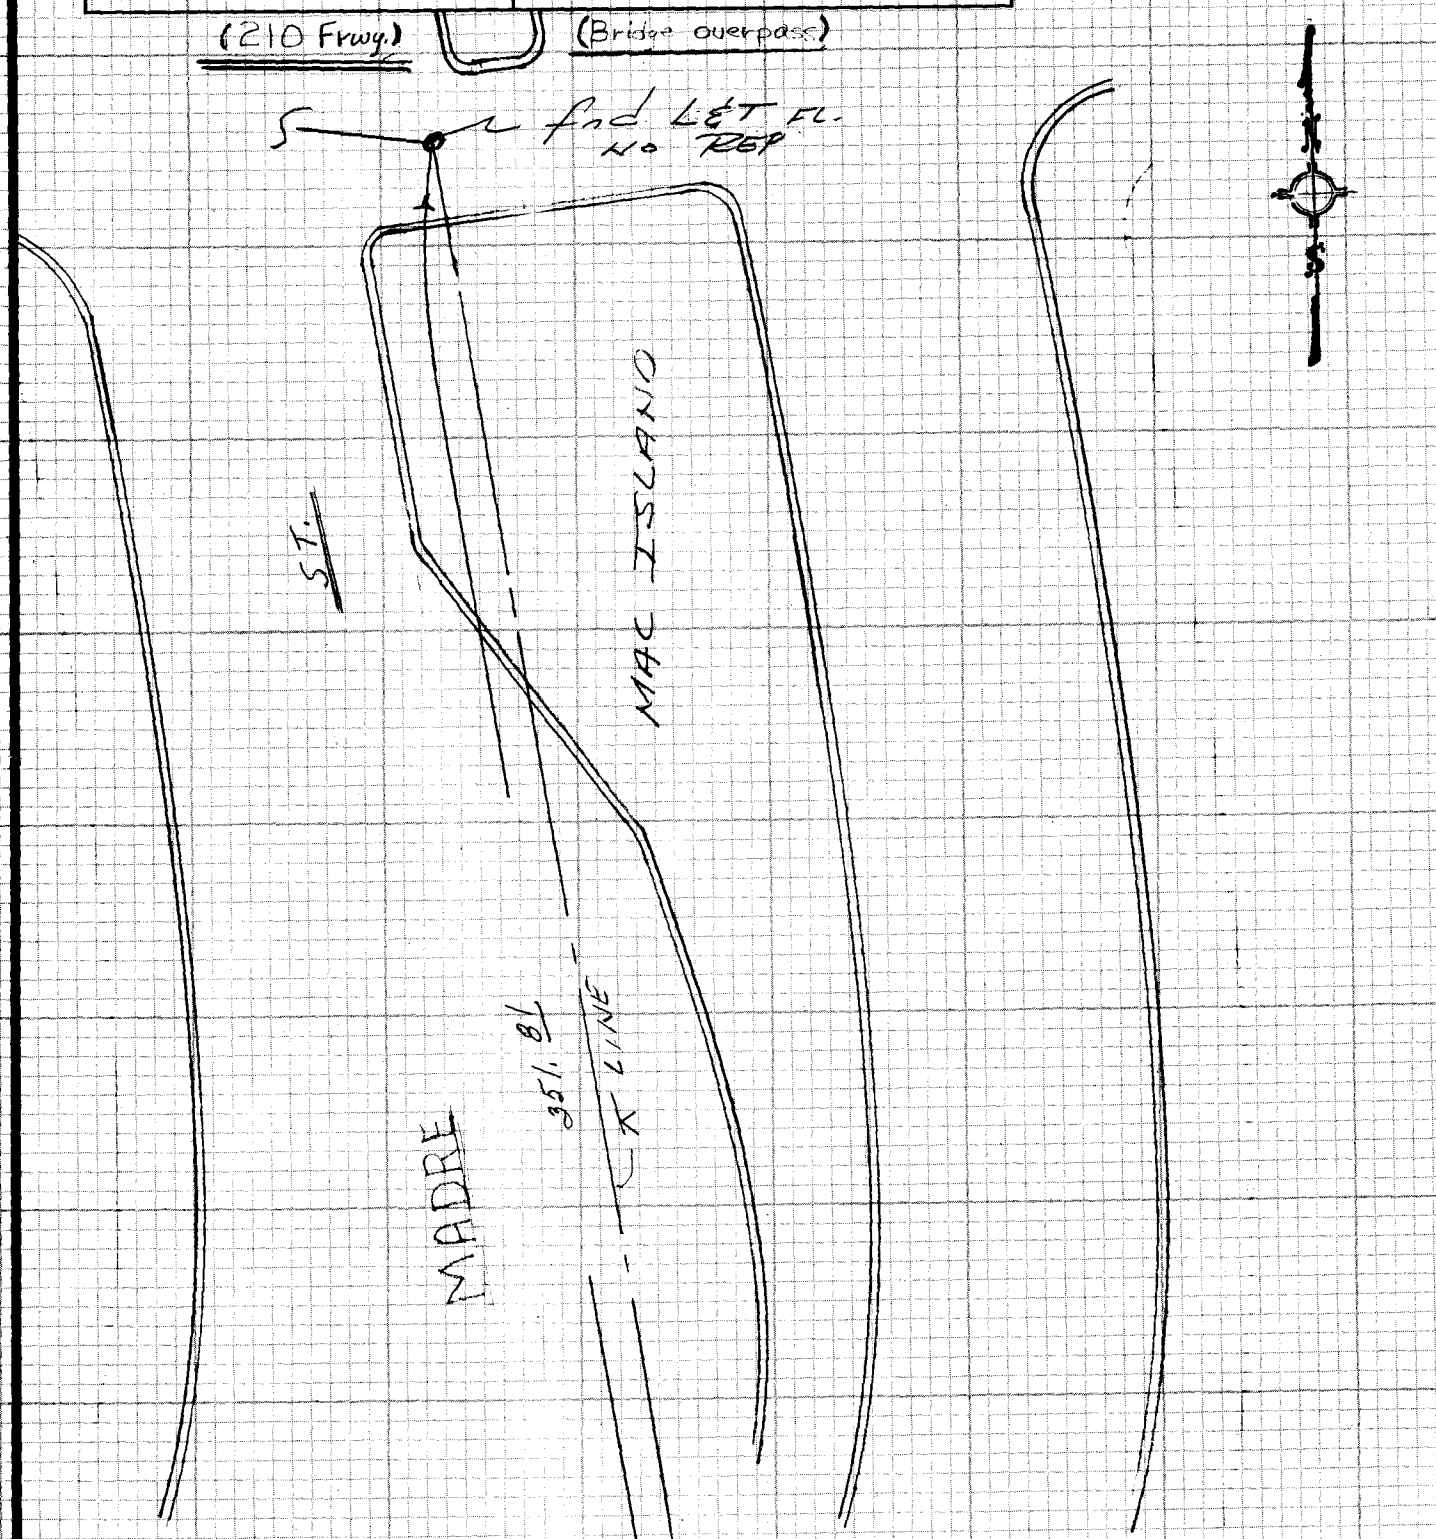


Cont. Top Pg 100

NOTE: ANY ADDITIONS OR CHANGES ON THIS SHEET MUST BE MADE OR CIRCLED IN RED INK WITH DATE AND NAME OF PERSON MAKING CHANGE

Do not extend notes to this side of this line

PLEASE RETURN TO
LOS ANGELES COUNTY ENGINEER
403 LOS ANGELES COUNTY ENGINEERING BLDG.

CENTERLINE NOTES
CE 310
76F3095-4/73

CE 310
76F3095 73

PLEASE RETURN TO
LOS ANGELES COUNTY ENGINEER
403 LOS ANGELES COUNTY ENGINEERING BLDG.

NOTE: ANY ADDITIONS OR CHANGES ON THIS SHEET MUST BE MADE OR CIRCLED IN RED INK WITH DATE AND NAME OF PERSON MAKING CHANGE

Do not extend notes this side of this line

F.B. 4412 PG. 112

NOTES RED. _____ JOB NO. 2612.30 SURVEY OF WALNUT CT. SEWER PRELIM. F.B. 4412 PG. 113

DATE _____ SURVEY BY D.L.B.

NOTES CHKD. _____ NOTES BY G.O.G. DATE 3-25-80

DATE _____ INDEXED J.R. HOLMAN DATE APR 1 1980

| STATION | B.S. | H.I. | F.S. | ELEV. |
|---|---|---|---|---|

# BENCH MARKS
## FOR
## WALNUT CT. SEWER PRELIMINARY

J.N. 2612.30

MARCH 25, 1980

INDEX

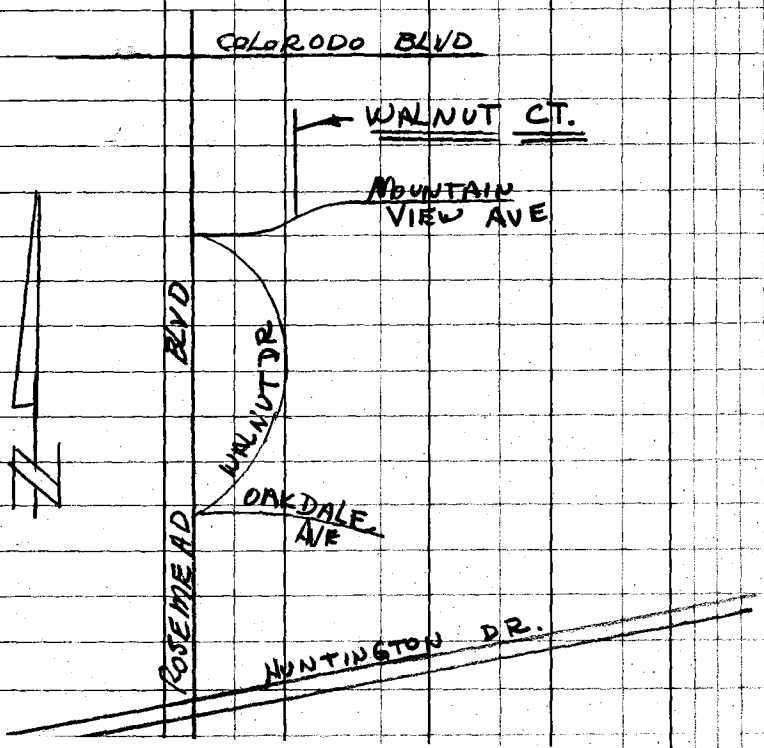


PARTY:
D. BURKHOLDER
G. GUIZADO
L. BANKSON

NOTE: ANY ADDITIONS OR CHANGES ON THIS SHEET MUST BE MADE OR CIRCLED IN RED INK WITH DATE AND NAME OF PERSON MAKING CHANGE

Do not extend notes this side of this line

PLEASE RETURN TO
LOS ANGELES COUNTY ENGINEER
403 LOS ANGELES COUNTY ENGINEERING BLDG.

PROFILE LEVEL NOTES
CE 307
76-L-298-4/73

F.B. 4412 PG. 114

JOB NO. 2612.30 SURVEY OF WALNUT CT. SEWER PREL'M. NOTES RED. _____

SURVEY BY D.L.B. DATE _____

NOTES BY G.O.G. DATE 3-25-80 NOTES CHKD. _____

INDEXED _____ DATE _____ DATE _____

| STATION | B.S. | H.I. | F.S. | ELEV. | |
|---|---|---|---|---|---|
| B.M. T.E 765 | 2 957 | 635 042 | | 632 085 | BM. TE 765 ELEV. = 632.085 PER F.B. 2509-18 ROSEMEAD BLVD & MOUNTAIN VIEW AVE. N.W. COR. BT. SPK. IN CURB - 4 FT. WEST OF W. END C.R. |
| B.M. TE 767 | 3 731 | 634 232 | 4 541 | 630 501 | BM TE 767 ELEV. = 630.497 PER F.B. 2509-17 |
| T.P. | 5 331 | 633 268 | 6 295 | 627 937 | ROSEMEAD BLVD & MOUNTAIN VIEW AVE N.E. COR. - BT. SPK IN CURB 14 FT. EAST OF E. END C.R. |
| T.B.M. (L&T) | 5 030 | 632 780 | 5 518 | 627 750 | T.B.M. (L&T) ELEV. = 627.750 FB. 4412 - 114 |
| T.P. | 4 801 | 633 870 | 3 711 | 629 069 | MOUNTAIN VIEW AVE & WALNUT CT. - L&T. IN S'LY CURB 35 FT EAST OF E. EDGE OF DRIVE-WAY @ HOUSE # 3740 |
| B.M. TE 767 | | | 3 369 | 630 501 | BM. T.E 767 - SEE DESCRIPTION ABOVE |

627 87 WEST RIM
620 02 WEST FLOW LINE

627 87 EAST RIM
619 89 EAST FLOW LINE

620 00 NORTH FLOW LINE

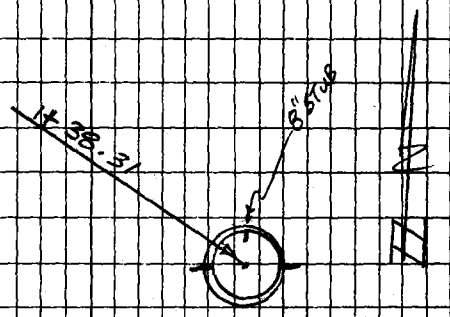


INVERT ELEV. ON 8" LINE

627.87 RIM ELEV.
− 7.85 ROD WEST
620.02 FLOW LINE

627.87 RIM ELEV.
− 7.87 ROD
620.00 NORTH FLOW LINE

627.87 RIM ELEV.
− 7.98 ROD
619.89 EAST FLOW LINE

PLEASE RETURN TO
LOS ANGELES COUNTY ENGINEER
403 LOS ANGELES COUNTY ENGINEERING BLDG.
76-L-298-CE 307-4/73

Do not extend notes this side of this line

NOTE: ANY ADDITIONS OR CHANGES ON THIS SHEET MUST BE MADE OR CIRCLED IN RED INK WITH DATE AND NAME OF PERSON MAKING CHANGE

| | |
|---|---|
| Notes Ck'd by | Survey of Walnut Ct. (Sewer Prelim) |
| Map No. | JN 2612.30 Tape EDM Std °F |
| Office Work | Surveyed by Burkholder |
| Checked | Notes D.L.B. Date 3-25-80 |
| Date | Indexed LB HOLM APR 1 1980 |

F.B. 4412 PG. 115

J.N. 2612.30

WALNUT COURT

Sewer Preliminary

Burkholder
Guizado
Barkson

∡'s with T-2
Dist. " EDM
Calc. by Monroe 325 (Plus, o/s, & Elev.)
Recorded on Tape H.A. #1, Start File 1, Bl. 1
End. File 6, Bl. 6, Ctr. 100

NOTE: ANY ADDITIONS OR CHANGES ON THIS SHEET MUST BE MADE OR CIRCLED IN RED INK WITH DATE AND NAME OF PERSON MAKING CHANGE

Do not extend notes this side of this line

PLEASE RETURN TO
LOS ANGELES COUNTY ENGINEER
403 LOS ANGELES COUNTY ENGINEERING BLDG.

CENTERLINE NOTES
CE 310
76F3095-4/73

F.B. 4412 PG. 116

To Bot Pg 117

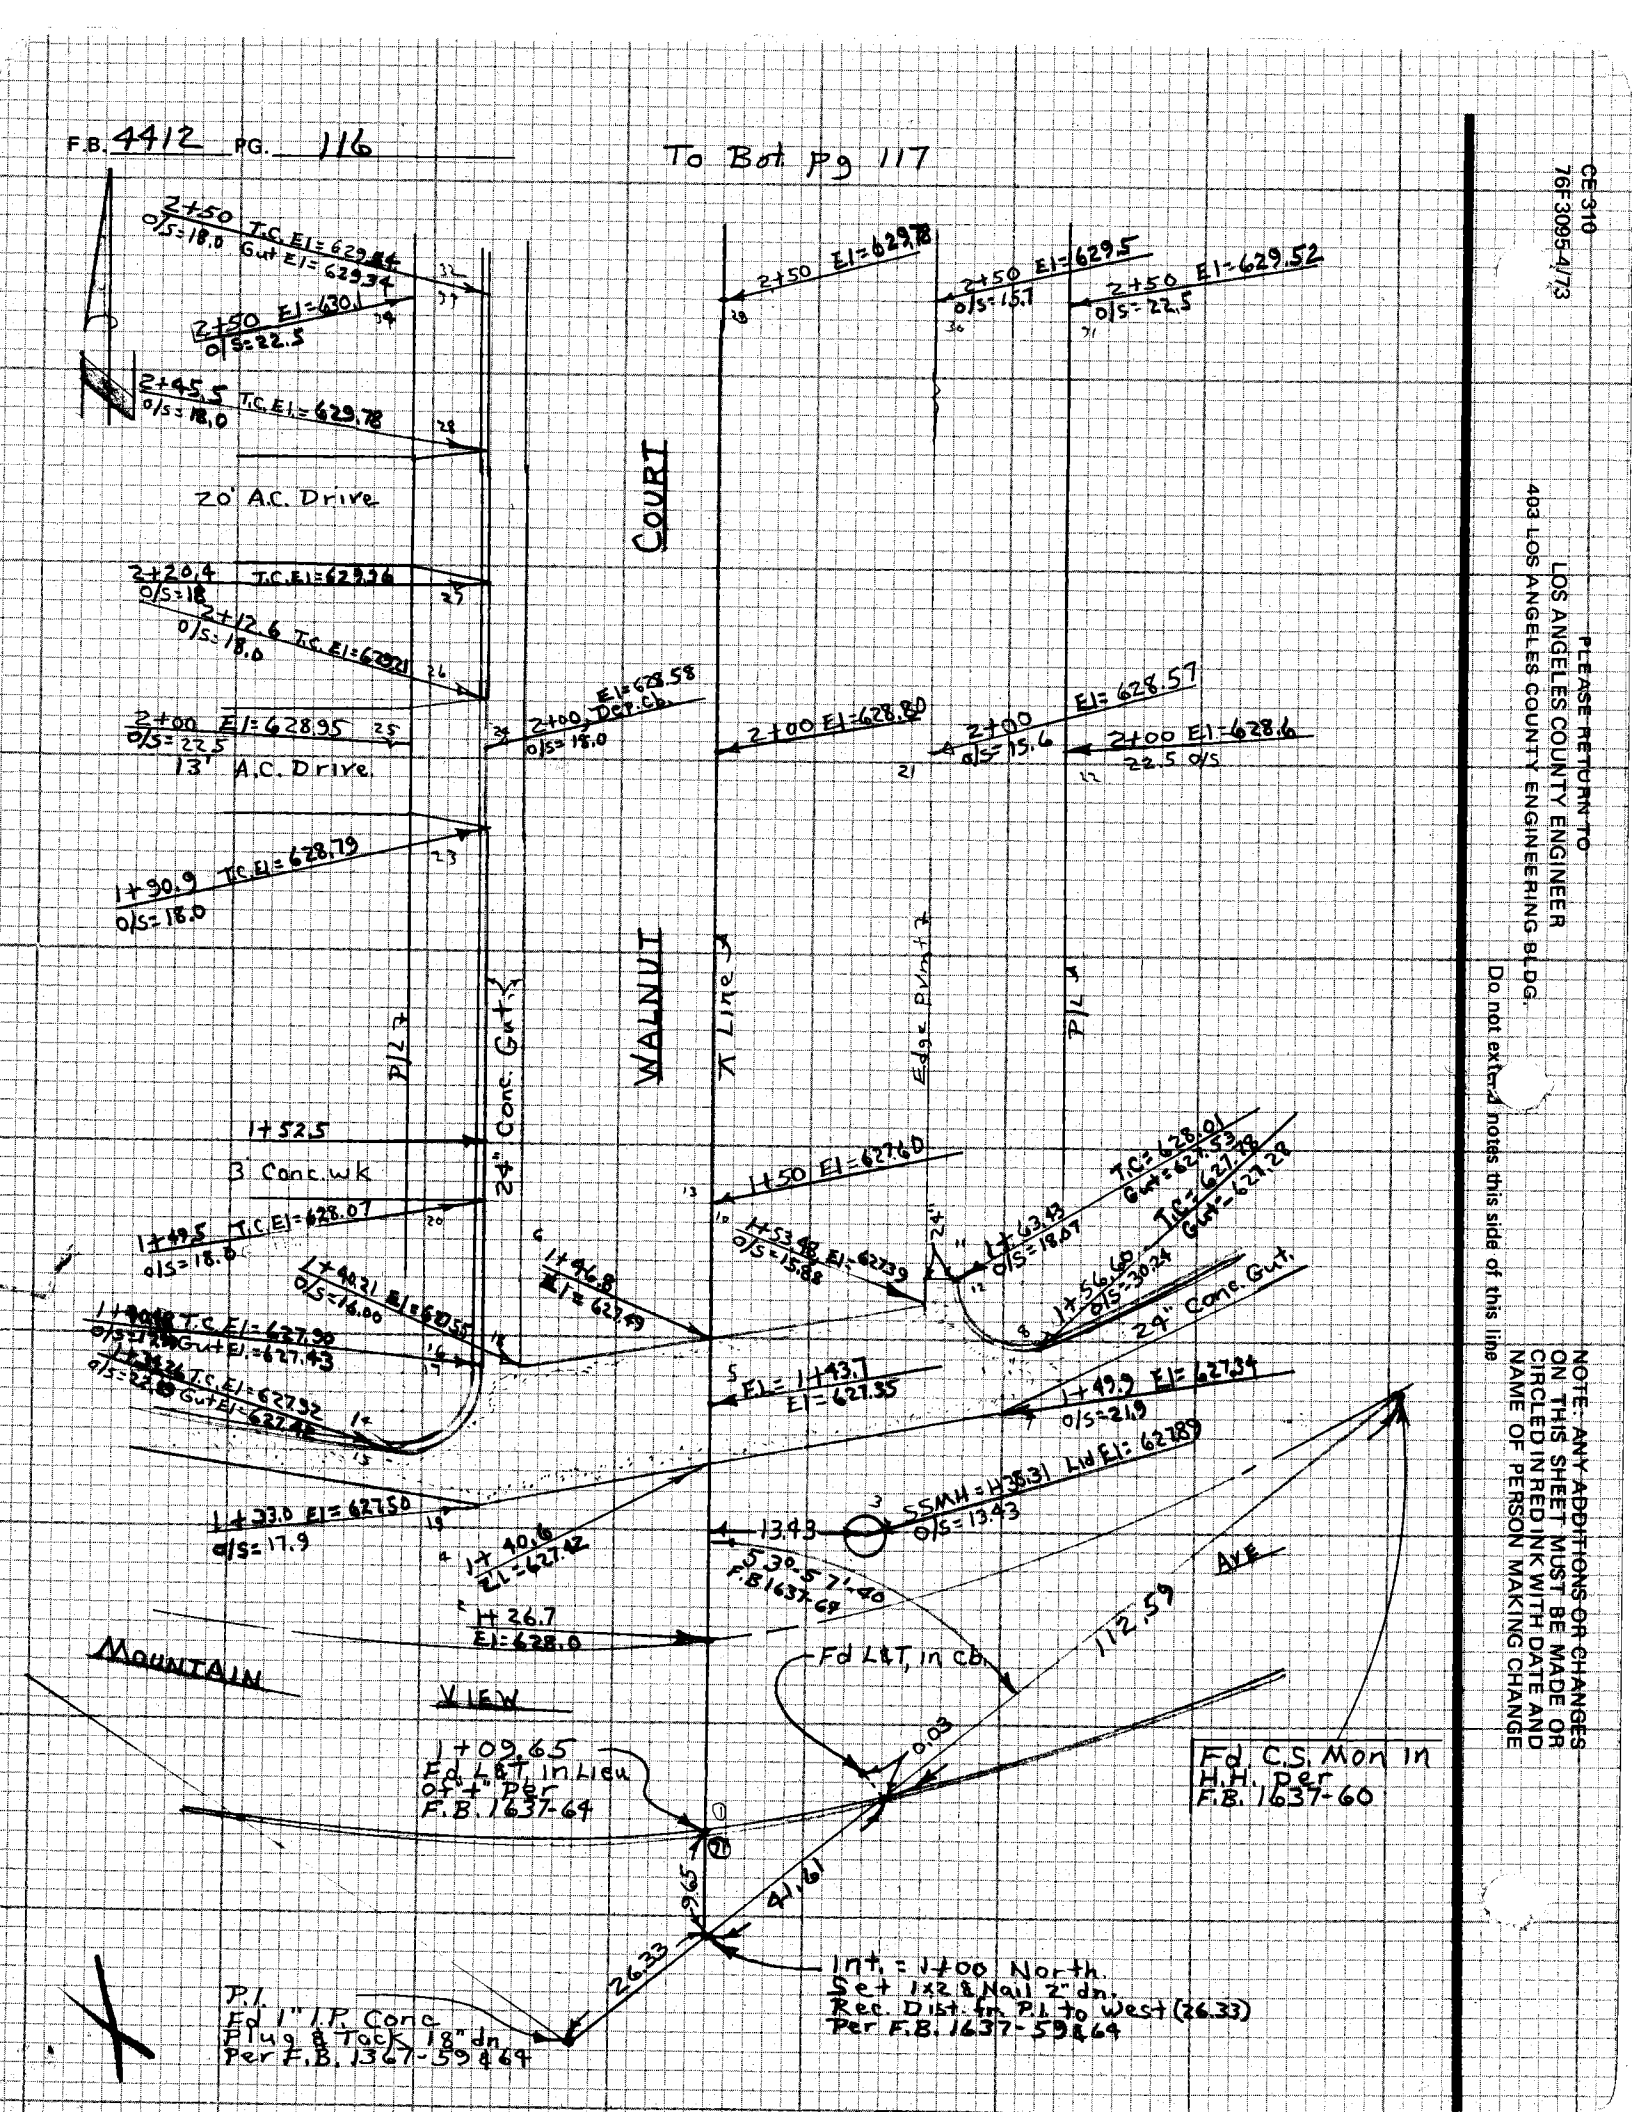


CE-310
76F 3095-4/73

PLEASE RETURN TO
LOS ANGELES COUNTY ENGINEER
403 LOS ANGELES COUNTY ENGINEERING BLDG.

Do not extend notes this side of this line

NOTE: ANY ADDITIONS OR CHANGES ON THIS SHEET MUST BE MADE OR CIRCLED IN RED INK WITH DATE AND NAME OF PERSON MAKING CHANGE

| | |
|---|---|
| Notes Ck'd by | Survey of Walnut Ct. (Sewer Prelim) |
| Map No. | JN 2612.30 Tape EDM Std °F |
| Office Work | Surveyed by Burkholder |
| Checked | Notes D.L.B. Date 3-25-80 |
| Date | Indexed H. HOLMAN APR 1 1980 |

F.B. 4412 PG. 117

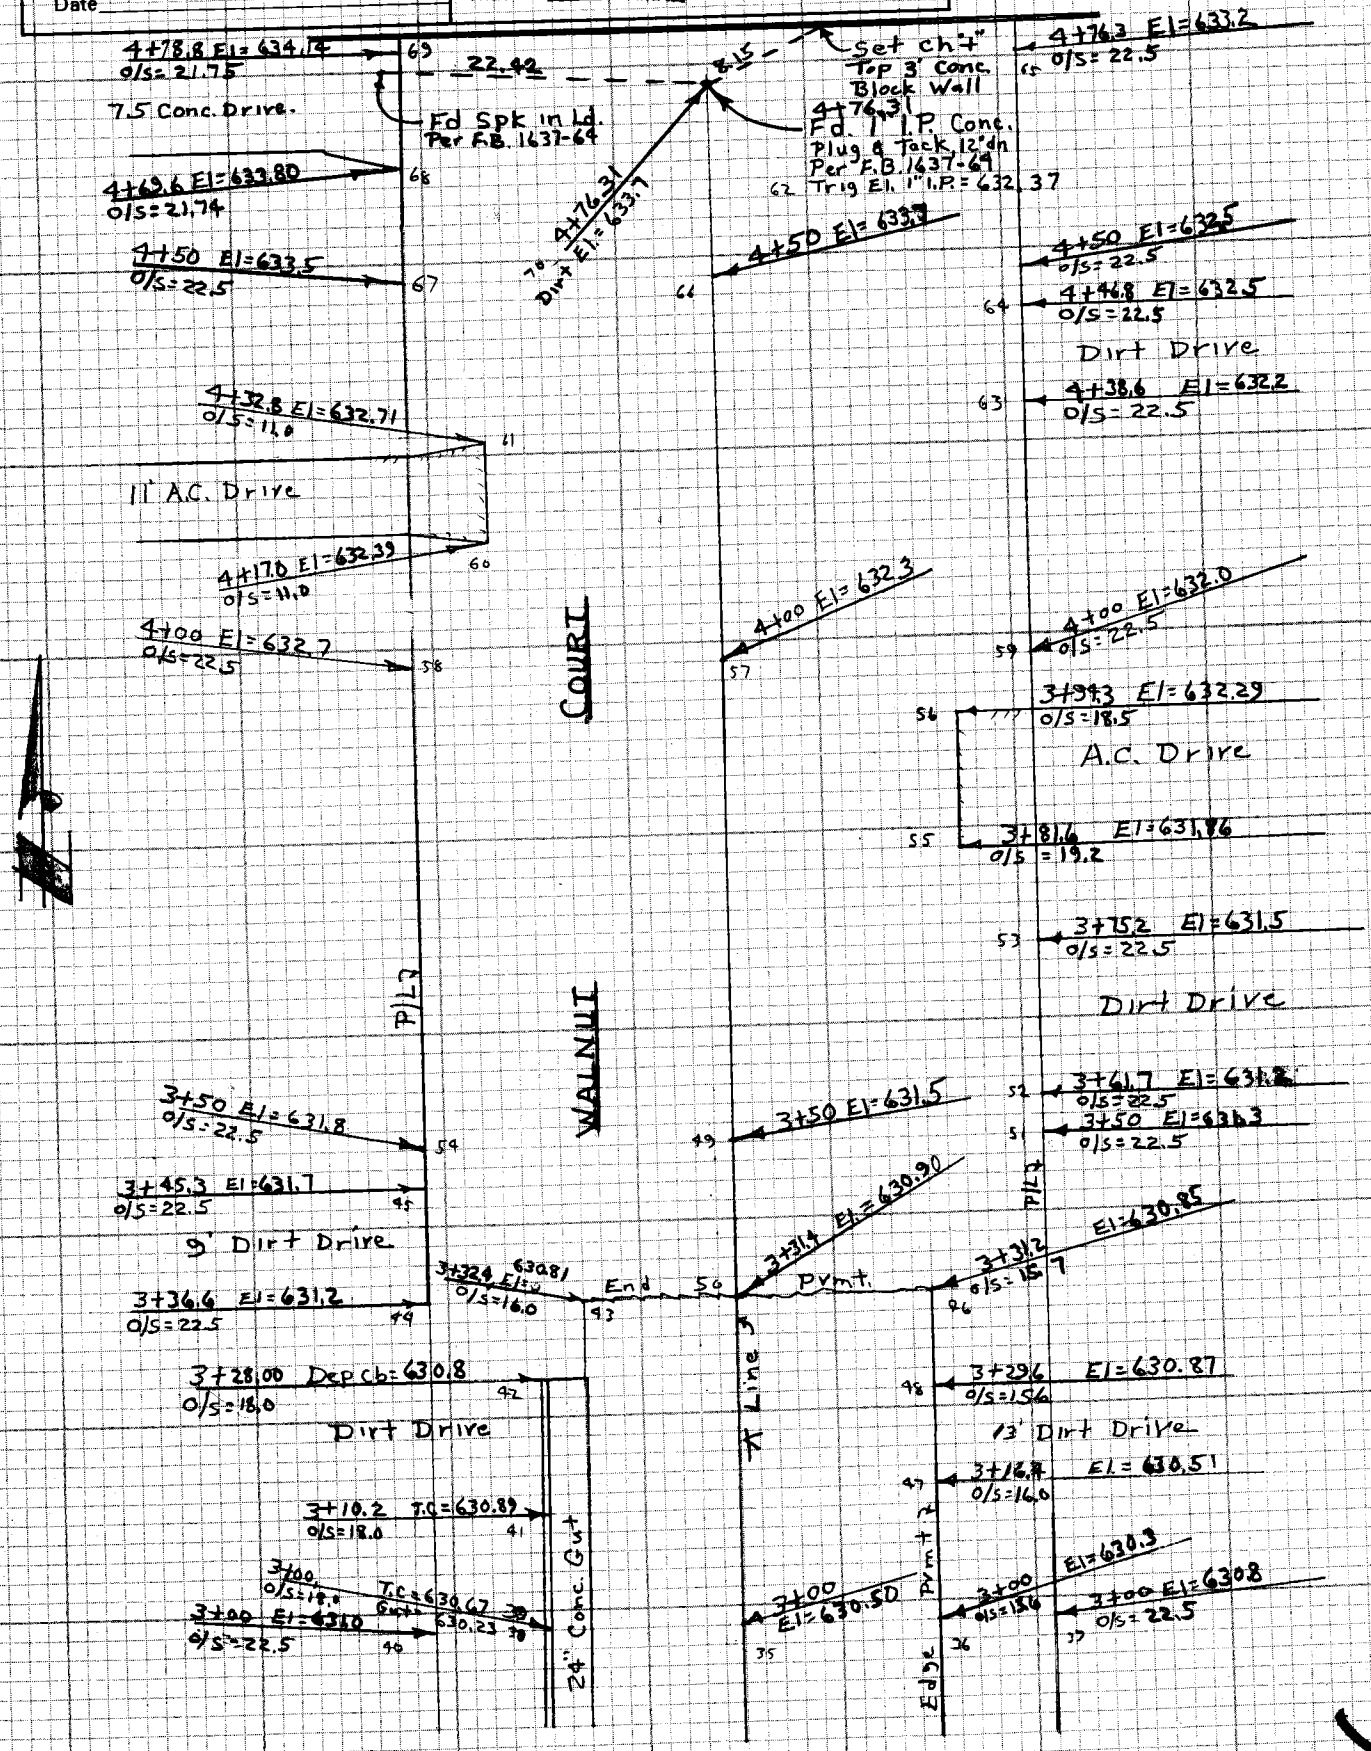


To Top Pg 116

NOTE: ANY ADDITIONS OR CHANGES ON THIS SHEET MUST BE MADE OR CIRCLED IN RED INK WITH DATE AND NAME OF PERSON MAKING CHANGE

Do not extend notes this side of this line

PLEASE RETURN TO
LOS ANGELES COUNTY ENGINEER
403 LOS ANGELES COUNTY ENGINEERING BLDG.

CENTERLINE NOTES
CE 310
76F3095-4/73

F.B. 4412 PG. 118

CE 310
76F3095-4/73

PLEASE RETURN TO
LOS ANGELES COUNTY ENGINEER
403 LOS ANGELES COUNTY ENGINEERING BLDG.

NOTE: ANY ADDITIONS OR CHANGES
ON THIS SHEET MUST BE MADE OR
CIRCLED IN RED INK WITH DATE AND
NAME OF PERSON MAKING CHANGE

Do not extend notes this side of this line

NOTES RED. _____ JOB NO. 2612.30 SURVEY OF WALNUT CT. S.S.

DATE _____ SURVEY BY Burkholder

NOTES CHKD. _____ NOTES BY D.L.B. DATE 8-7-81

DATE _____ INDEXED H. HOLMAN DATE AUG 12 1981

F.B. 4412 PG. 119

| STATION | B.S. | H.I. | F.S. | ELEV. |
|---|---|---|---|---|

J.N. 2612.30

WALNUT COURT

S.S. CONSTR. STAKES

Guizada
Burkholder
McCoy
Jernigan

Grade Shts. (2 copies) to San Dimas Regional office, 8-7-81

NOTE: ANY ADDITIONS OR CHANGES ON THIS SHEET MUST BE MADE OR CIRCLED IN RED INK WITH DATE AND NAME OF PERSON MAKING CHANGE

Do not extend notes this side of this line

PLEASE RETURN TO
LOS ANGELES COUNTY ENGINEER
403 LOS ANGELES COUNTY ENGINEERING BLDG.

PROFILE LEVEL NOTES
CE 307
76-L-298-4/73

F.B. 4412 PG. 120

JOB NO. 2612.30 SURVEY OF WALNUT CT. SS. NOTES RED. _____

SURVEY BY Burkholder DATE _____

NOTES BY D.L.B. DATE 8-7-81 NOTES CHKD. _____

INDEXED _____ DATE _____ DATE _____

| STATION | B.S. | H.I. | F.S. | ELEV. | | | | |
|---|---|---|---|---|---|---|---|---|
| TBM | | | | 627 75 | | | | TBM Elev. = 627.75, F.B. 4412-114 Mountain View Ave. & Walnut Ct. L&T in S'ly Curb, 3.6' East of East edge drive to Hse #3740 |
| | | | | | % | GRADE | CUT | |
| 1+00.00 | Exist. | M.H. | | — | | — | — | Rim El. 627.87 - Meas. 7.87 = Inlet No. 620.00 |
| 1+02.00 | | | | 627 90 | | 620.00' | 7.90 | Spk & T, 6' Rt. & East |
| 1+06 | | | | 627 72 | | 20.07 | 7.65 | " " " " |
| 1+14 | | | | 627 33 | | 20.20 | 7.13 | Ch't" 6' Rt & East. |
| 1+25 | | | | 627 99 | | 20.39 | 7.60 | 1x2 N+T |
| 1+37.5 | | | | 628 30 | | 20.60 | 7.70 | " |
| 1+50 | | | | 628 36 | | 20.81 | 7.55 | " |
| 1+62.5 | | | | 628 59 | | 21.02 | 7.57 | " |
| 1+75 | | | | 628 87 | | 21.23 | 7.64 | " |
| 1+87.5 | | | | 629 04 | | 21.44 | 7.60 | " |
| 2+00 | | | | 629 26 | | 21.65 | 7.61 | " |
| +25 | | | | 629 84 | 80% | 22.07 | 7.77 | " |
| +50 | | | | 630 54 | 1.6 | 22.49 | 8.05 | " |
| +75 | | | | 630 60 | | 22.91 | 7.69 | " |
| 3+00 | | | | 631 26 | | 23.33 | 7.93 | " |
| +25 | | | | 631 37 | | 23.75 | 7.62 | " |
| +50 | | | | 632 03 | | 24.17 | 7.86 | Spk + T, in TF |
| +75 | | | | 632 06 | | 24.59 | 7.47 | 1x2 N+T |
| 4+00 | | | | 632 39 | | 25.01 | 7.38 | " |
| +25 | | | | 632 93 | | 25.43 | 7.50 | " |
| 4+28.00 | | | | 633 08 | | 625.48' | 7.60 | 1x2 N&T, 6' Rt. & E. |
| 4+30.00 | M.H. | | | — | | — | — | 1x2 N&T, 6' Rt & E |

PLEASE RETURN TO
LOS ANGELES COUNTY ENGINEER
403 LOS ANGELES COUNTY ENGINEERING BLDG.
76-L-298-CE 307-4/73

Do not extend notes this side of this line

NOTE: ANY ADDITIONS OR CHANGES ON THIS SHEET MUST BE MADE OR CIRCLED IN RED INK WITH DATE AND NAME OF PERSON MAKING CHANGE

6323