SO. TORANGA CYN. BLVD.

Notes Ck'd by	Survey of WATER WORKS # 29
Map No.	JN 1525.22 Tape Std °F
Office Work	Surveyed by M. E. WACKER
Checked	Notes M.E.W. Date OCT. 84
Date	Indexed

F.B. 444B PG. 55

J.N. 1525.22

SOUTH TORANGA CANYON BLVD.
WATER TRANSMISSION LINE
REPLACEMENT
WATERWORKS DISTRICT # 29

LOCATION OF 14" STEEL WATERMAIN

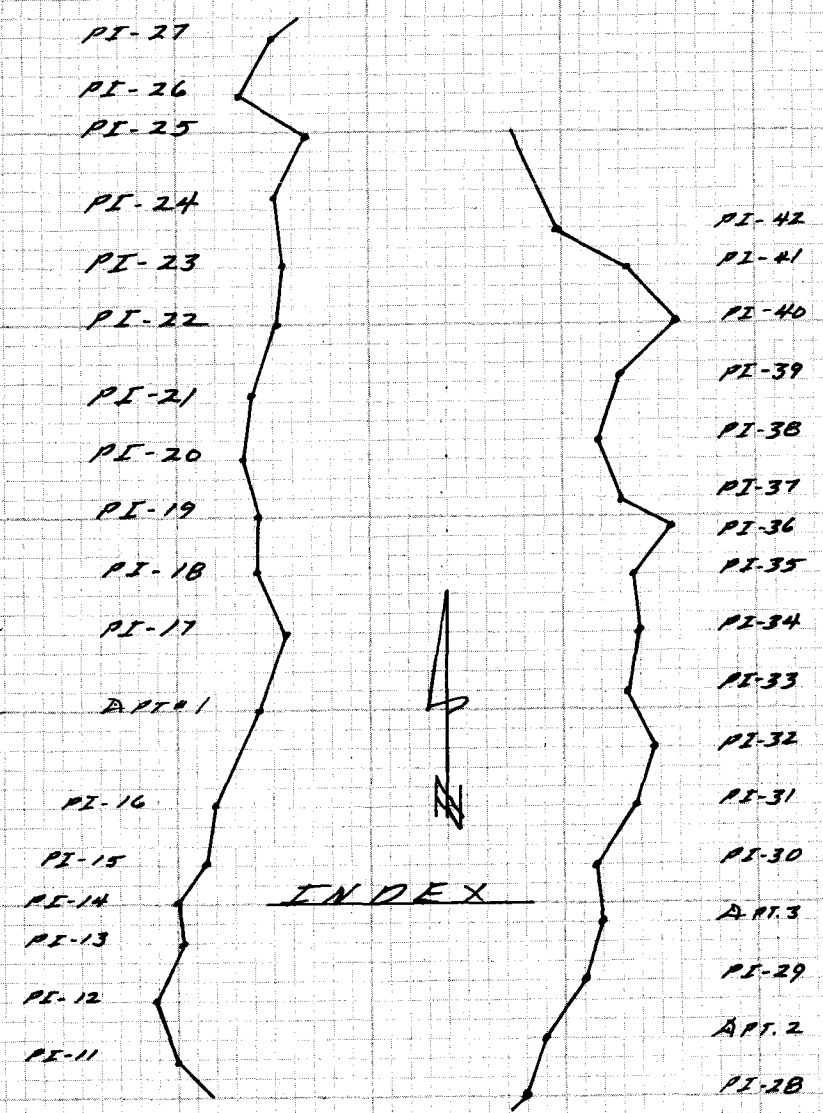

REF:
F.B. 3639

PARTY
WACKER
FALSEY
BAILEY
STANGELAND

NOTE: ANY ADDITIONS OR CHANGES ON THIS SHEET MUST BE MADE OR CIRCLED IN RED INK WITH DATE AND NAME OF PERSON MAKING CHANGE

Do not extend notes this side of this line

PLEASE RETURN TO
LOS ANGELES COUNTY ENGINEER
403 LOS ANGELES COUNTY ENGINEERING BLDG.

CENTERLINE NOTES
CE 310
76F3095-4/73

F.B. 444B PG. 56

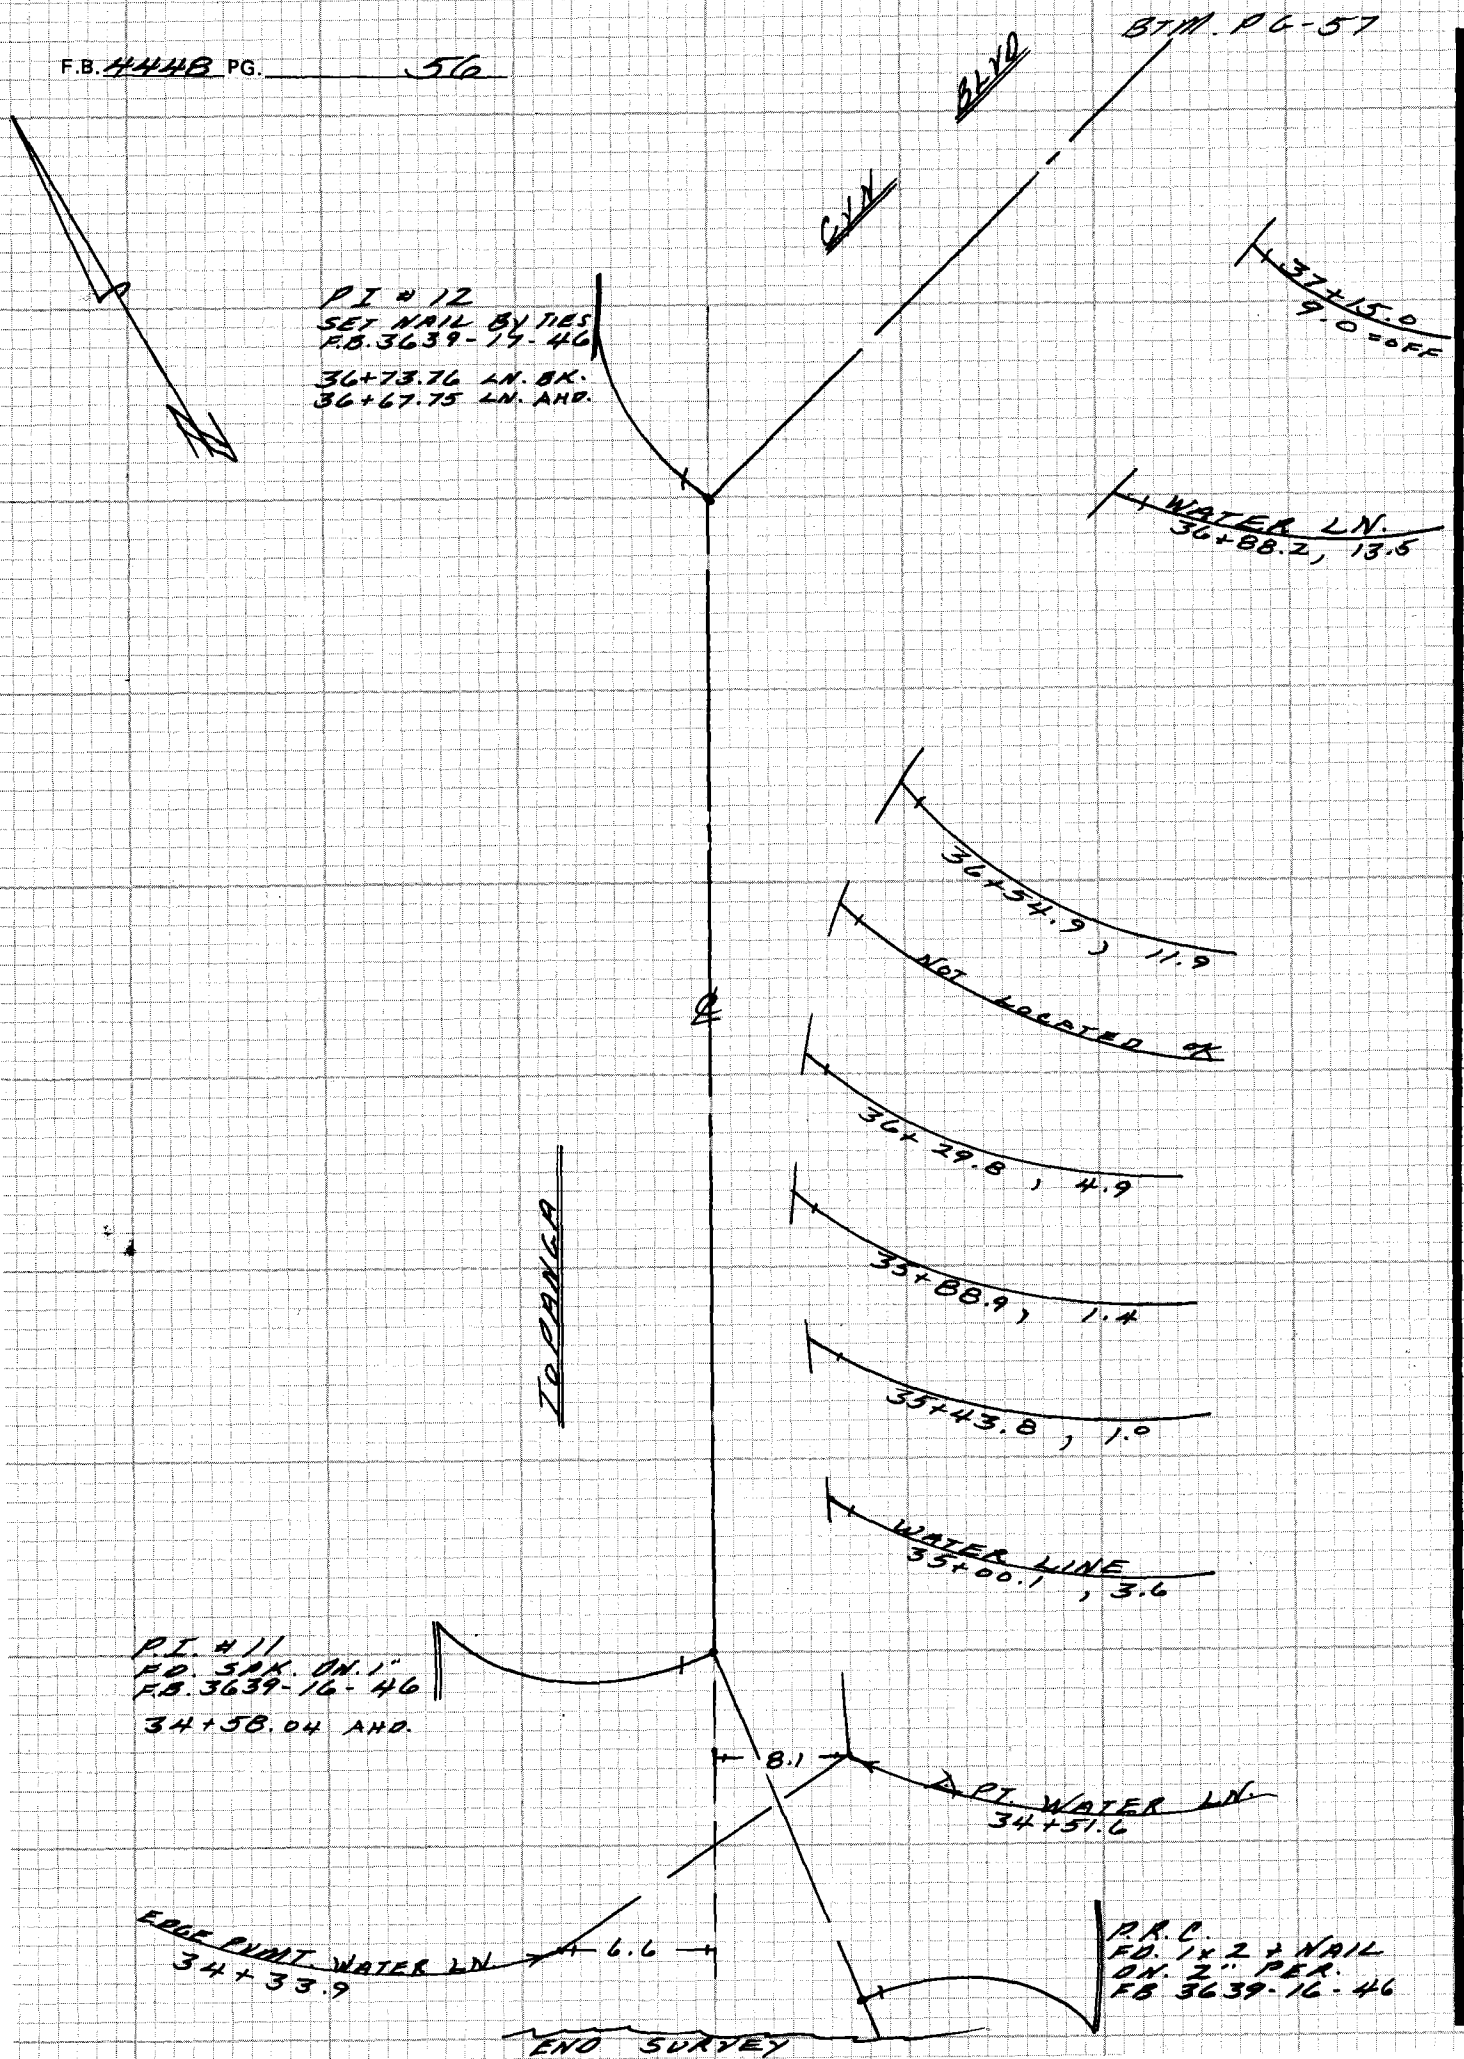

CE 310
76F3095-4/73

PLEASE RETURN TO
LOS ANGELES COUNTY ENGINEER
403 LOS ANGELES COUNTY ENGINEERING BLDG.

Do not extend notes this side of this line

NOTE: ANY ADDITIONS OR CHANGES ON THIS SHEET MUST BE MADE OR CIRCLED IN RED INK WITH DATE AND NAME OF PERSON MAKING CHANGE

SO. TORANCE CYN. BLVD.

Notes Ck'd by	Survey of W. W # 29
Map No.	JN 1525.22 Tape Std °F
Office Work	Surveyed by M. E. WACKER
Checked	Notes M. E. W. Date OCT - 84
Date	Indexed

F.B. 444B PG. 57

BTM. PG-58

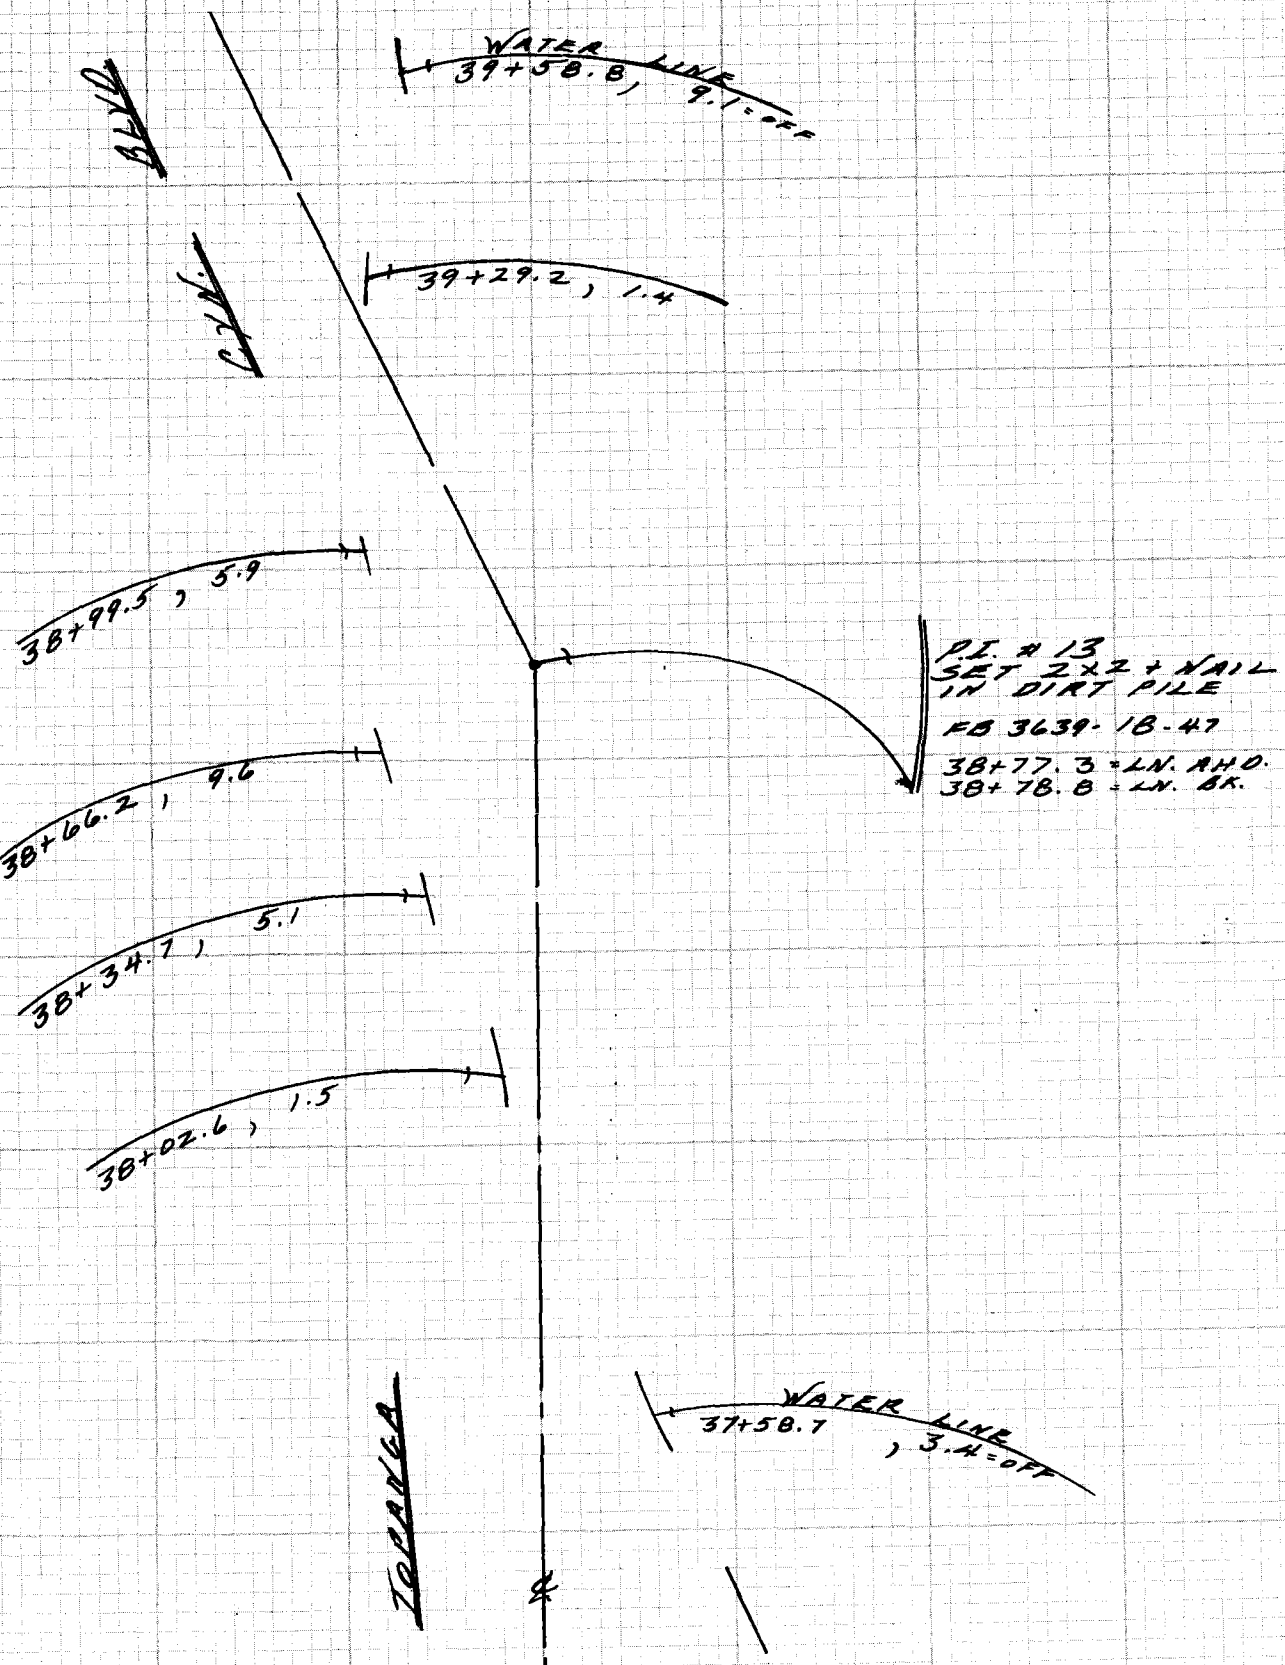

TOP PG-56

NOTE: ANY ADDITIONS OR CHANGES ON THIS SHEET MUST BE MADE OR CIRCLED IN RED INK WITH DATE AND NAME OF PERSON MAKING CHANGE

Do not extend notes this side of this line

PLEASE RETURN TO
LOS ANGELES COUNTY ENGINEER
403 LOS ANGELES COUNTY ENGINEERING BLDG.

CENTERLINE NOTES
CE 310
76F3095-4/73

F.B. 4448 PG. 58

BTM. PG-59

WATER LINE
41+70.5, 6.8:OFF

P.I. # 15
SET 1x2 + NAIL
BY TIES
PER. F.B. 3639-19-48

41+31.11 = LN. AHD.
41+31.95 = LN. BK

41+21.7, 9.9:OFF

BLVD

40+82.1, 0.4

CTR.

40+52.9, 7.9

40+24.1, 18.7

P.I. # 14
SET ~~[illegible]~~ NOTHING
FALLS ON CLIFF
PER. F.B. 3639-18-47

WATER LINE
39+86.8, 18.3:OFF


TOP PG-57

CE 310
76F3095-4/73

PLEASE RETURN TO
LOS ANGELES COUNTY ENGINEER
403 LOS ANGELES COUNTY ENGINEERING BLDG.

Do not extend notes this side of this line

NOTE: ANY ADDITIONS OR CHANGES
ON THIS SHEET MUST BE MADE OR
CIRCLED IN RED INK WITH DATE AND
NAME OF PERSON MAKING CHANGE

So. TOPANGA CYN. BLVD.

Notes Ck'd by	Survey of W. W. #29
Map No.	JN 1525.22 Tape Std °F
Office Work	Surveyed by M. E. WACKER
Checked	Notes M. E. W. Date OCT. 84
Date	Indexed

F.B. 444B PG. 59

CONT BK Pg 60

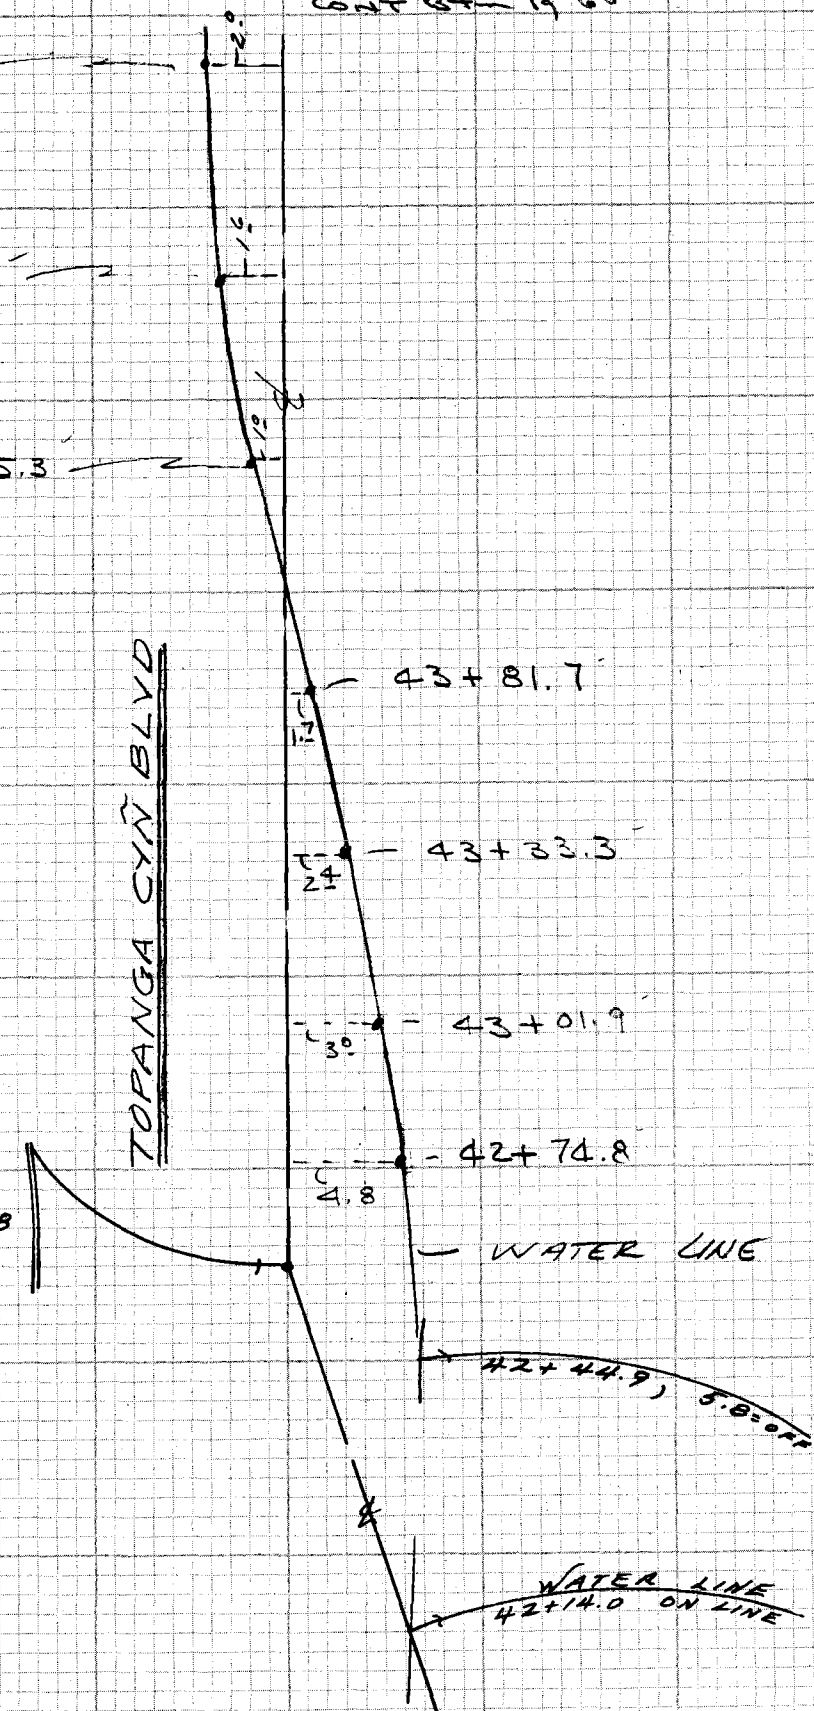

P.I. #16
SET NAIL BY
TIES
PER. F.B. 3639-20-48

42+50.74 = LN. AHD.
42+51.11 = LN. BK.

TOP PG. 5B

NOTE: ANY ADDITIONS OR CHANGES ON THIS SHEET MUST BE MADE OR CIRCLED IN RED INK WITH DATE AND NAME OF PERSON MAKING CHANGE

Do not extend notes this side of this line

PLEASE RETURN TO
LOS ANGELES COUNTY ENGINEER
403 LOS ANGELES COUNTY ENGINEERING BLDG.

CENTERLINE NOTES
CE 310
76F3095-4/73

F.B. 4448 PG. 60

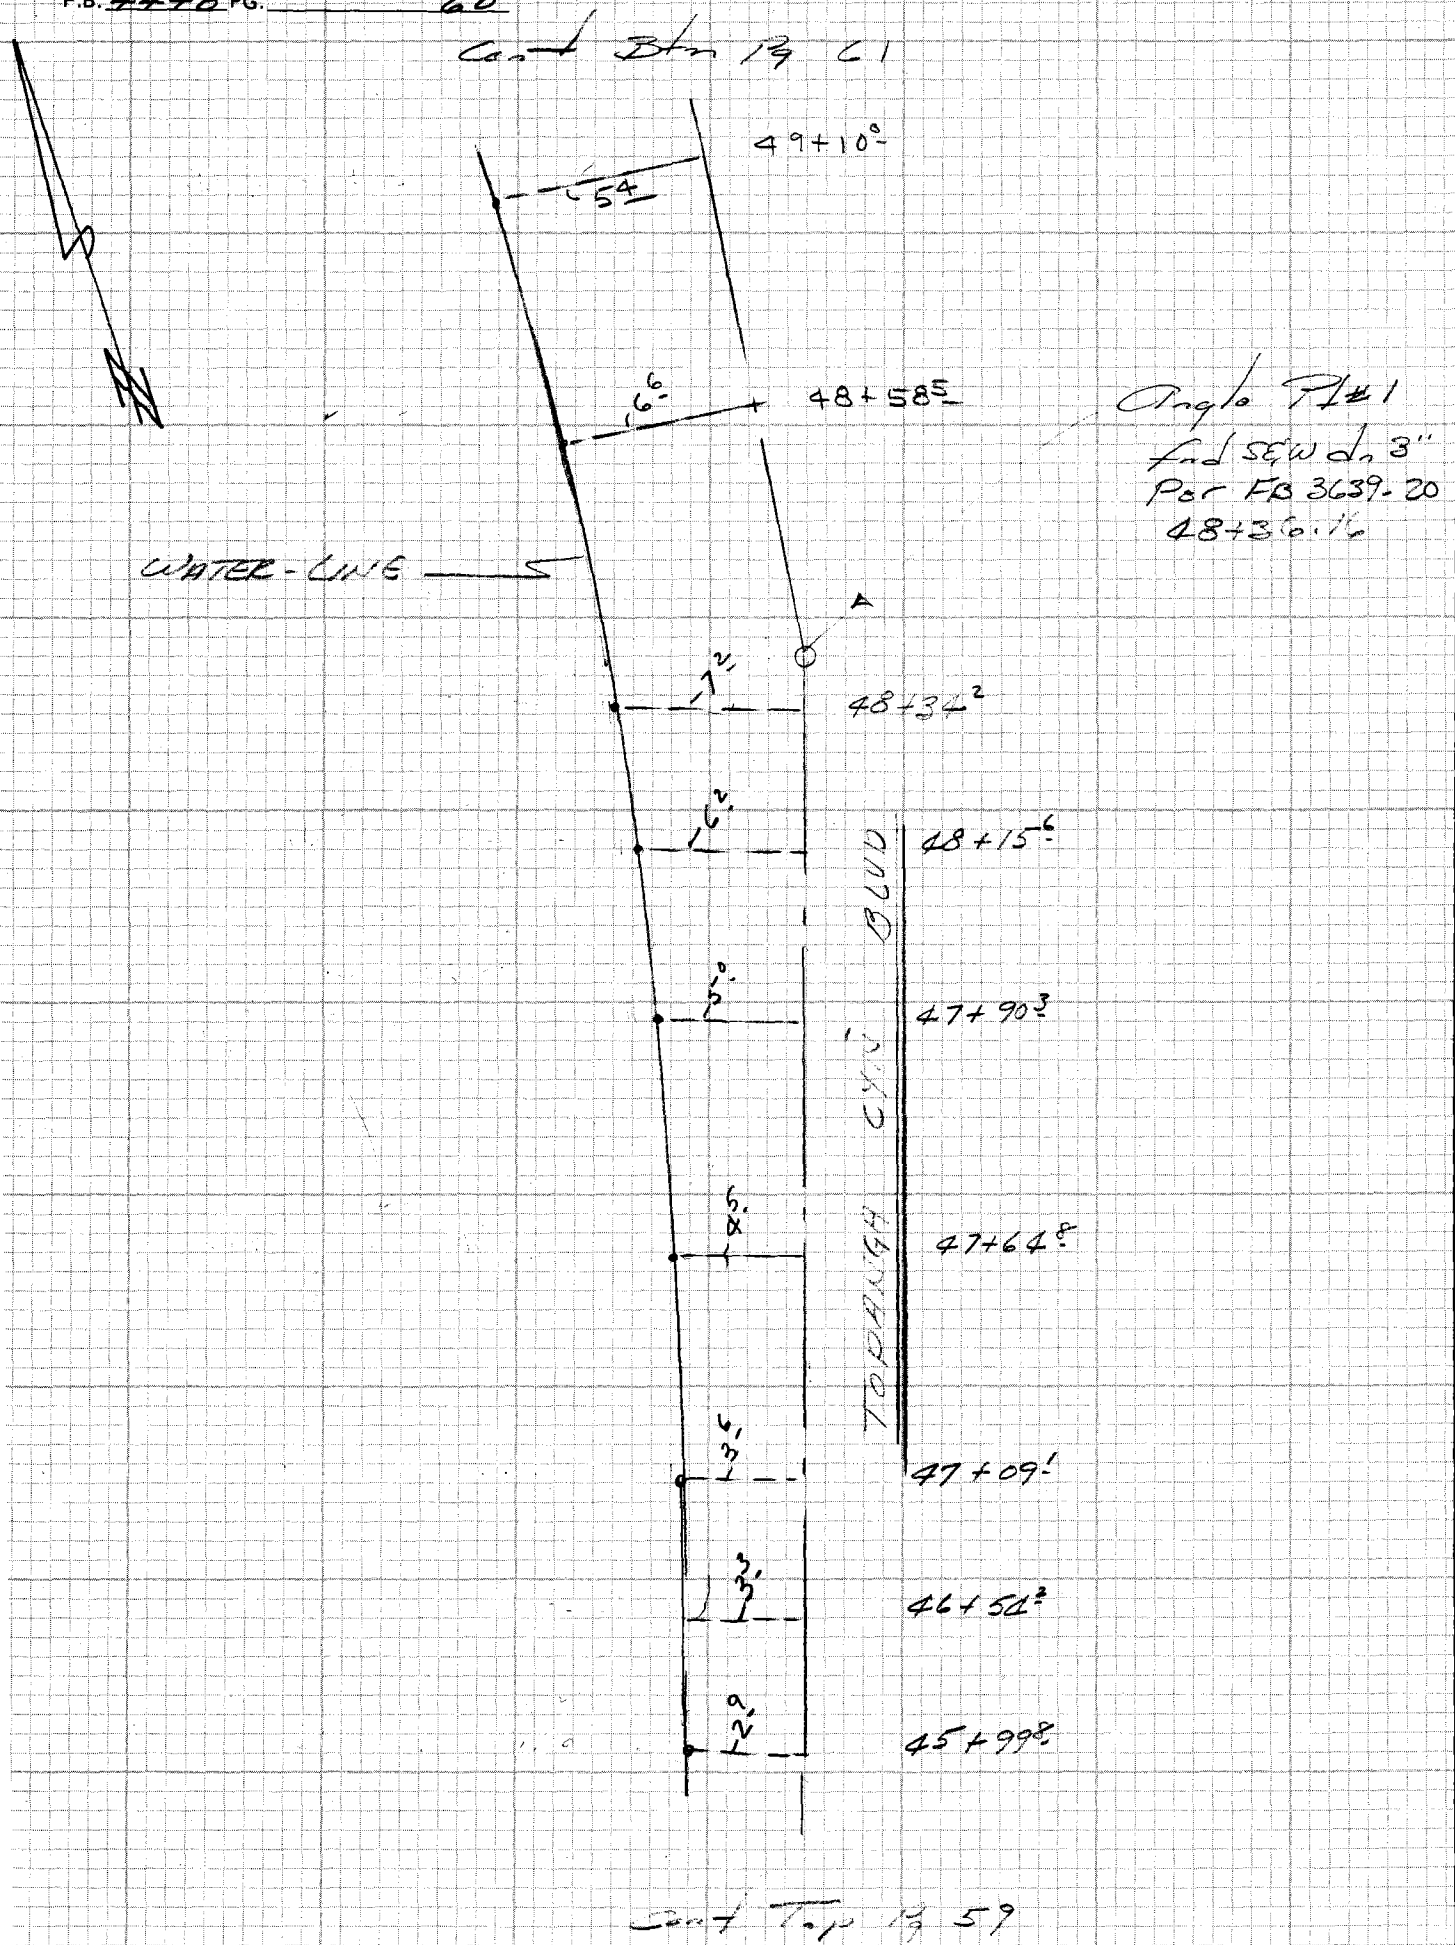

CE 310
76F3095-4/73

PLEASE RETURN TO
LOS ANGELES COUNTY ENGINEER
403 LOS ANGELES COUNTY ENGINEERING BLDG.

Do not extend notes this side of this line

NOTE: ANY ADDITIONS OR CHANGES ON THIS SHEET MUST BE MADE OR CIRCLED IN RED INK WITH DATE AND NAME OF PERSON MAKING CHANGE

Map No.	JN/525.22 Tape Std °F
Office Work	Surveyed by EL
Checked	Notes A Date 10-R
Date	Indexed

F.B. 4148 PG. 61

Cont Btm Pg. 62

Pl. #17 NOTHING PER F.B. 3639
BCK = 53+50.3
AHD = 53+21.93

TP @ B.C. 51+68.1
Sight To Pl. #17 (Line Pad)
Turn To Center Ditch & Meas.

Horz #	Horz Dist	#
25-33	26.0	2
17-01	49.8	3
14-55	75.3	4
14-41	101.0	5
15-08	125.5	6
16-25	150.5	7
18-05	175.8	8

(8) 54.6 — 53+35.3
(7) 42.5 — 53+12.6
(6) 32.8 — 52+89.3
(5) 25.6 — 52+65.9
(4) 19.4 — 52+41.0
(3) 14.6 — 52+15.8
(2) 11.2 — 51+91.7
8.9 — B.C. = 51+68.1 A.F.B. 3639-21
6.9 — 51+20.1
4.8 — 50+69.1
4.6 — 50+16.7
5.0 — 49+63.9


WATER LINE
Replacement
Center of ditch

NOTE: Plus are along Data

Cont top Pg. 60

NOTE: ANY ADDITIONS OR CHANGES ON THIS SHEET MUST BE MADE OR CIRCLED IN RED INK WITH DATE AND NAME OF PERSON MAKING CHANGE
Do not extend notes this side of this line
PLEASE RETURN TO
LOS ANGELES COUNTY ENGINEER
403 LOS ANGELES COUNTY ENGINEERING BLDG.
CENTERLINE NOTES
CE 310
76F3095-4/73

F.B. 4148 PG. 62

CE 310
76F 3095-4/73

PLEASE RETURN TO
LOS ANGELES COUNTY ENGINEER
403 LOS ANGELES COUNTY ENGINEERING BLDG.

NOTE: ANY ADDITIONS OR CHANGES ON THIS SHEET MUST BE MADE OR CIRCLED IN RED INK WITH DATE AND NAME OF PERSON MAKING CHANGE

Do not extend notes this side of this line

Cont Btm Pg 63

TC E.C. = 55+04.13
Sight To P.I. = 17 (Low Side)

#	Horiz ∢	Horiz Dist
9	15-20	127.7
10	14-25	101.4
11	14-01	75.2
12	14-35	49.7
13	13-33	24.2
14	—	—

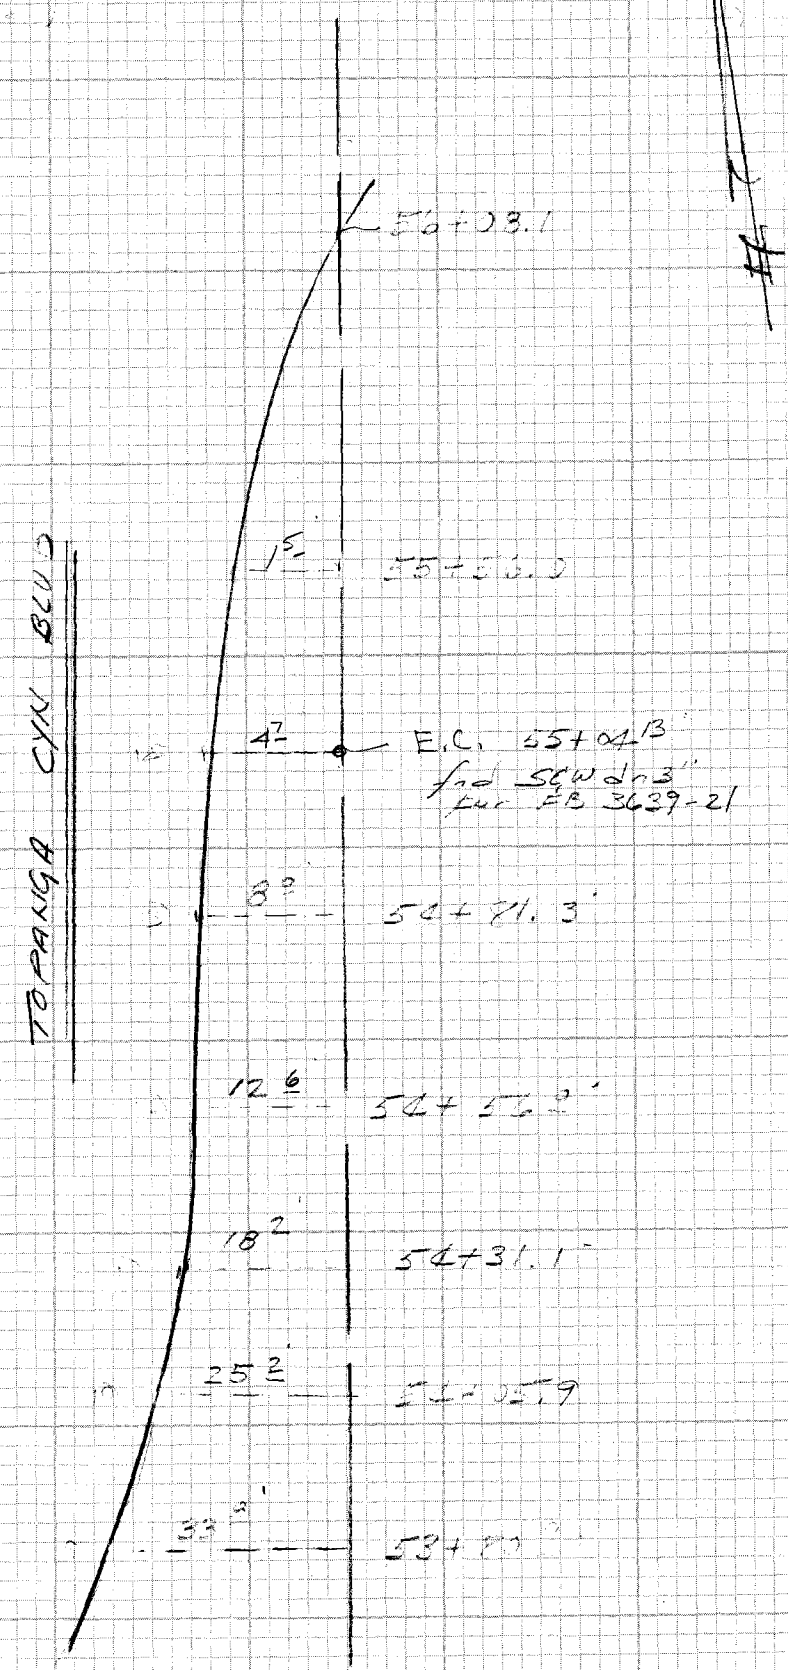

Cont To P Pg 61

Notes Ck'd by	Survey of Topanga WT LINE
Map No.	JN 525.22 Tape Std °F
Office Work	Surveyed by EL
Checked	Notes EL Date 10-84
Date	Indexed

F.B. ~~4148~~ PG. 63

Cont bfr Pg 64

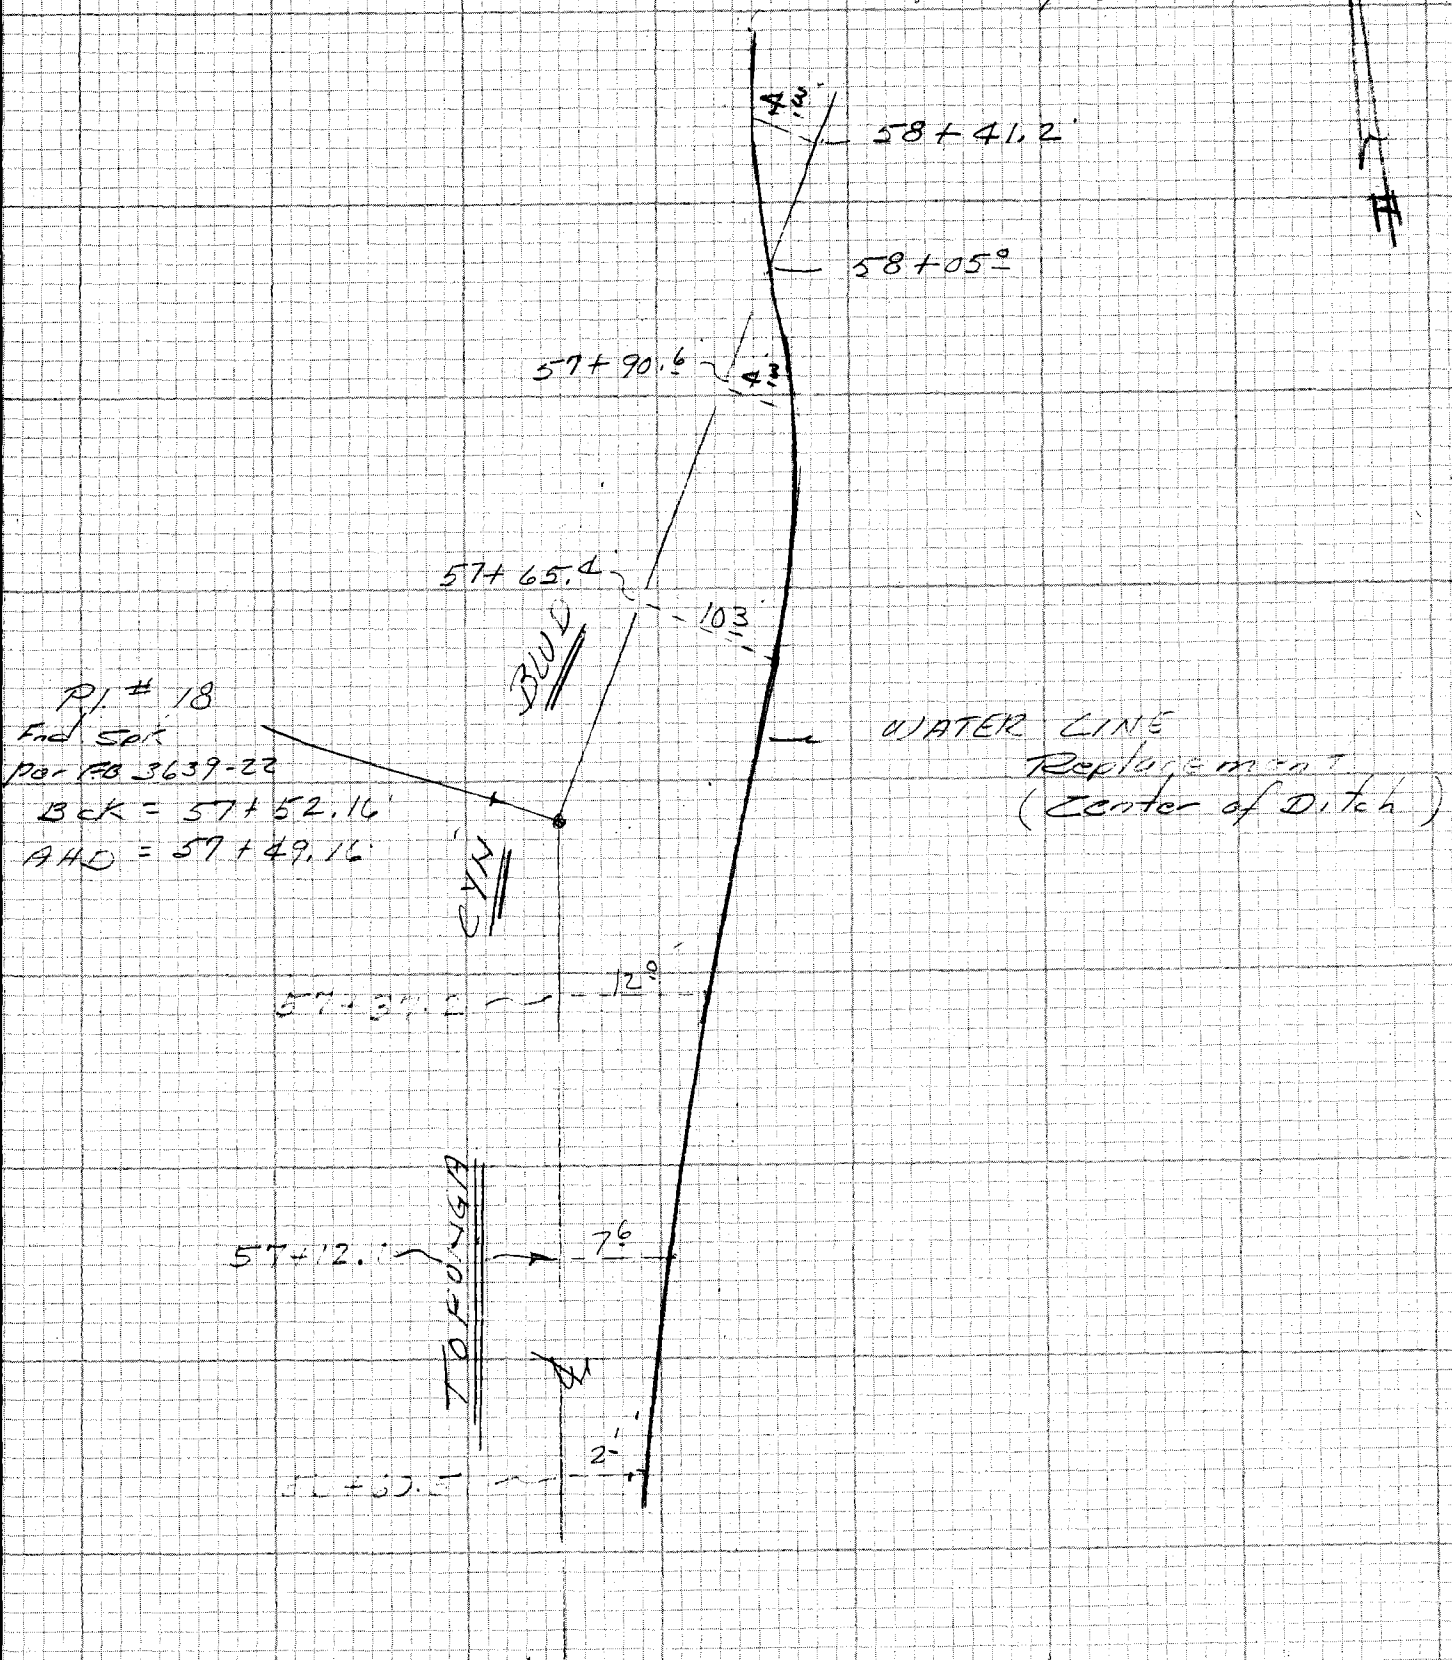

Cont To Pg 62

NOTE: ANY ADDITIONS OR CHANGES ON THIS SHEET MUST BE MADE OR CIRCLED IN RED INK WITH DATE AND NAME OF PERSON MAKING CHANGE
Do not extend notes this side of this line
PLEASE RETURN TO
LOS ANGELES COUNTY ENGINEER
403 LOS ANGELES COUNTY ENGINEERING BLDG.
CENTERLINE NOTES
CE 310
76F3095-4/73

F.B. 4448 PG. 64

Cont Btm Pg 65

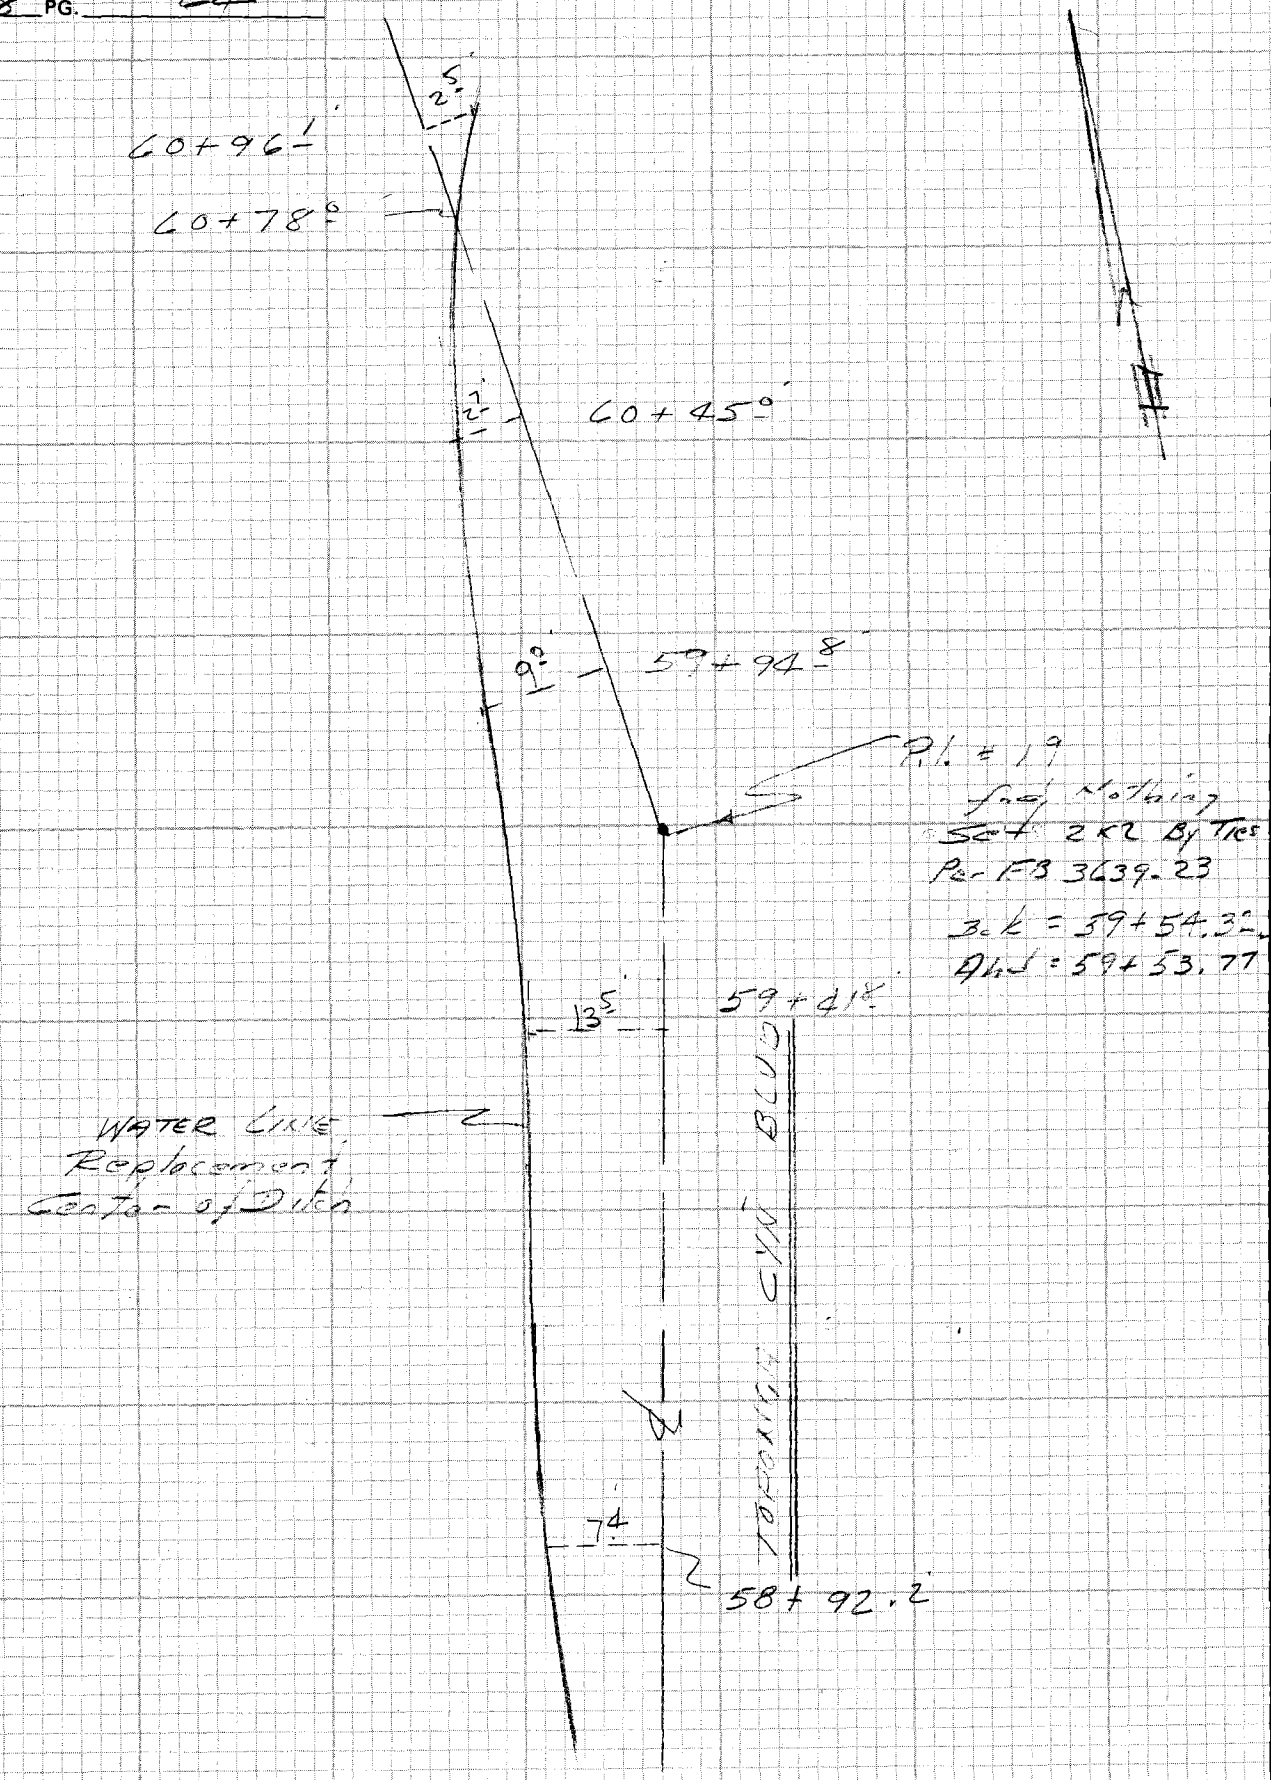

Cont Top Pg 63

CE 310
76F 3095-4/73

PLEASE RETURN TO
LOS ANGELES COUNTY ENGINEER
403 LOS ANGELES COUNTY ENGINEERING BLDG.

Do not extend notes this side of this line

NOTE: ANY ADDITIONS OR CHANGES ON THIS SHEET MUST BE MADE OR CIRCLED IN RED INK WITH DATE AND NAME OF PERSON MAKING CHANGE

Notes Ck'd by	Survey of Topanga Wt. Line
Map No.	JN 1525.22 Tape Std °F
Office Work	Surveyed by EC
Checked	Notes EC Date 12-84
Date	Indexed

F.B. 4448 PG. 65

Cont Bkm Pg 66

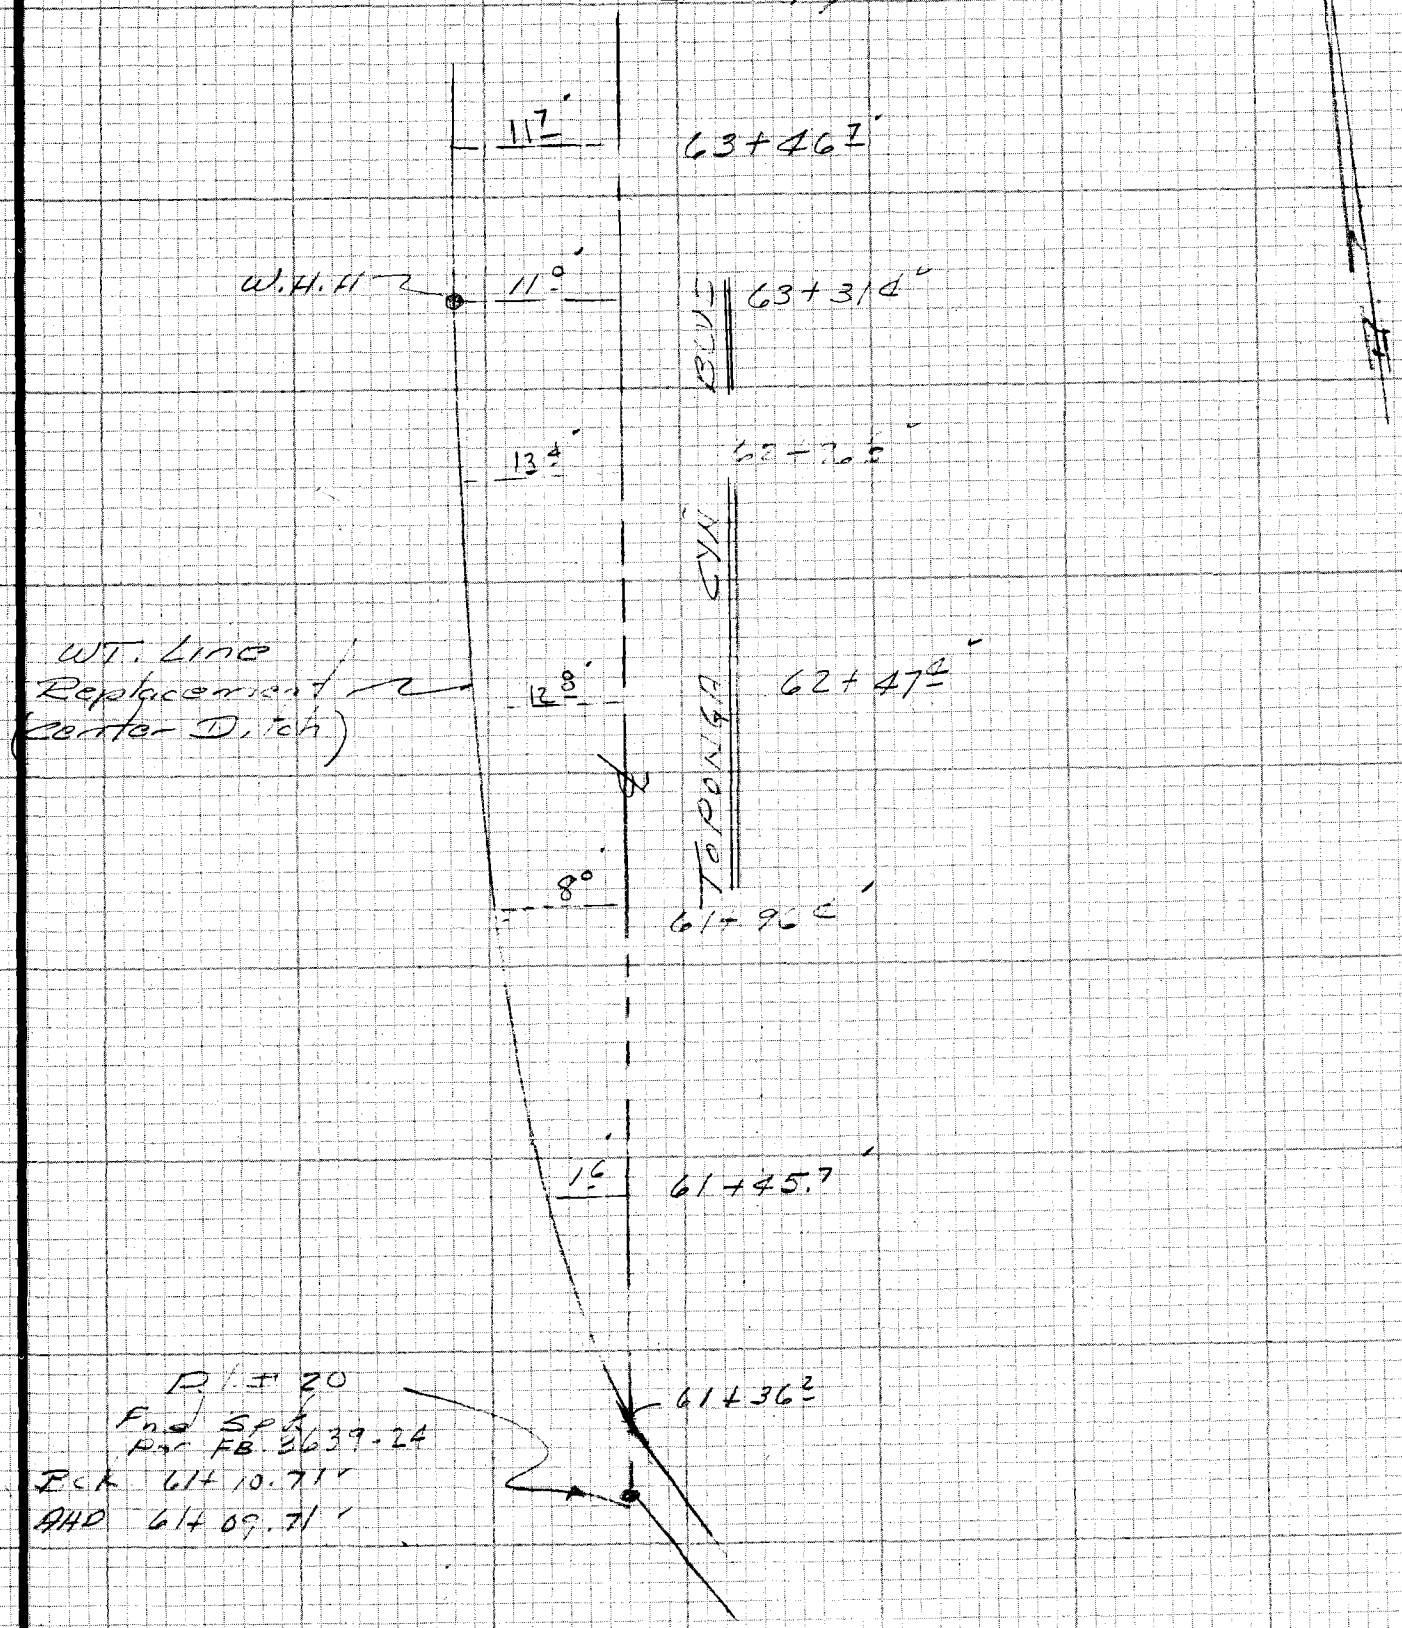

Cont Topa Pg 67

NOTE: ANY ADDITIONS OR CHANGES ON THIS SHEET MUST BE MADE OR CIRCLED IN RED INK WITH DATE AND NAME OF PERSON MAKING CHANGE
Do not extend notes this side of this line
PLEASE RETURN TO
LOS ANGELES COUNTY ENGINEER
403 LOS ANGELES COUNTY ENGINEERING BLDG.
CENTERLINE NOTES
CE 310
76F3095-4/73

F.B. ~~4148~~ PG. 66

Cont Bot ~~B~~ 67

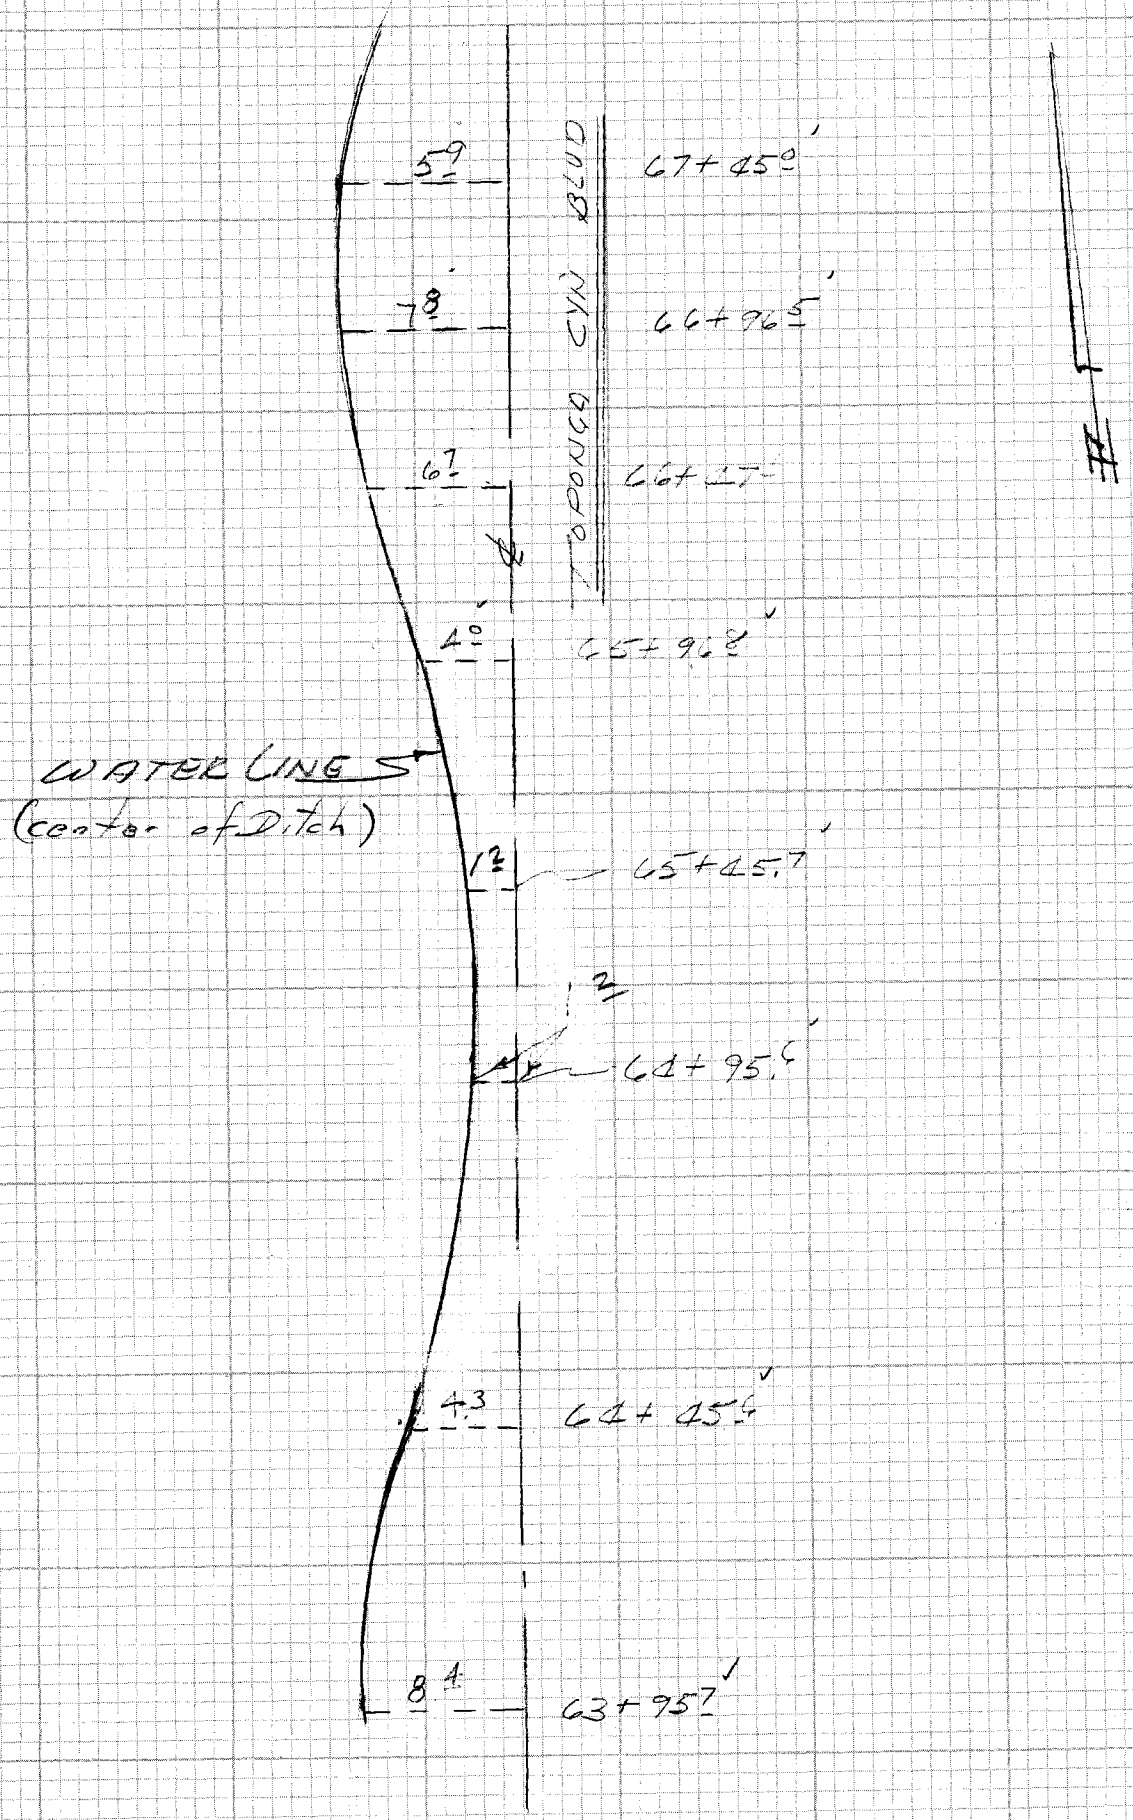

Cont Top ~~B~~

CE 310
76F3095-4/73

PLEASE RETURN TO
LOS ANGELES COUNTY ENGINEER
403 LOS ANGELES COUNTY ENGINEERING BLDG.

Do not extend notes this side of this line

NOTE: ANY ADDITIONS OR CHANGES ON THIS SHEET MUST BE MADE OR CIRCLED IN RED INK WITH DATE AND NAME OF PERSON MAKING CHANGE

Notes Ck'd by	Survey of Topanga Cyn Wtl
Map No.	JN 1525.22 Tape Std °F
Office Work	Surveyed by EL
Checked	Notes EL Date 12-84
Date	Indexed

F.B. 4448 PG. 67

Cont Btm Pg 68

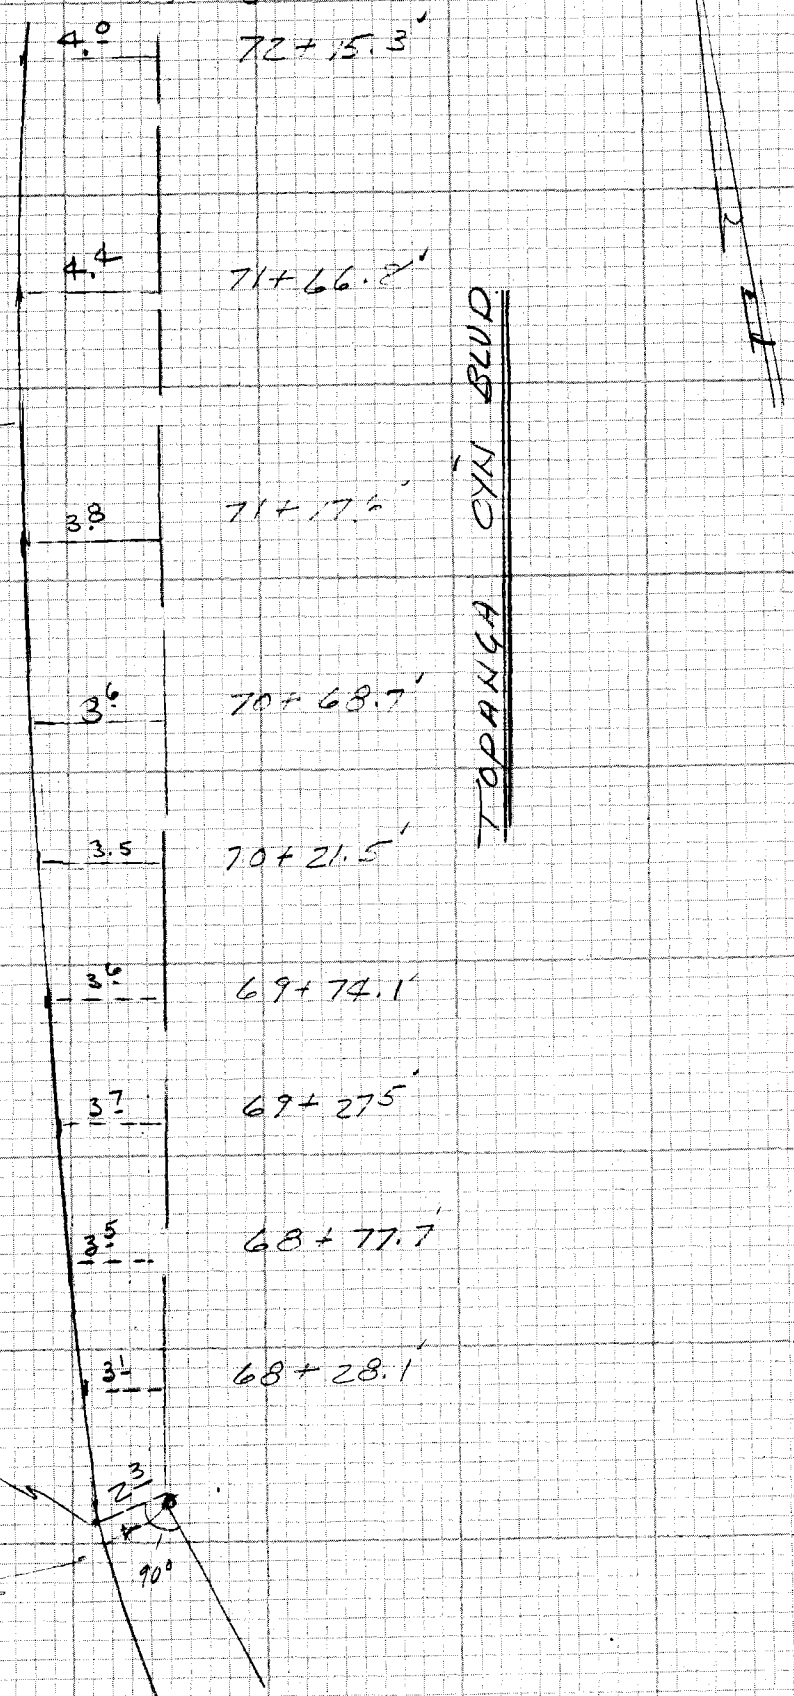

Cont Top Pg 66

NOTE: ANY ADDITIONS OR CHANGES ON THIS SHEET MUST BE MADE OR CIRCLED IN RED INK WITH DATE AND NAME OF PERSON MAKING CHANGE

Do not extend notes this side of this line

PLEASE RETURN TO
LOS ANGELES COUNTY ENGINEER
403 LOS ANGELES COUNTY ENGINEERING BLDG.

CENTERLINE NOTES
CE 310
76F3095-4/73

F.B. ~~4448~~ PG. 68

Cont bk 3-69

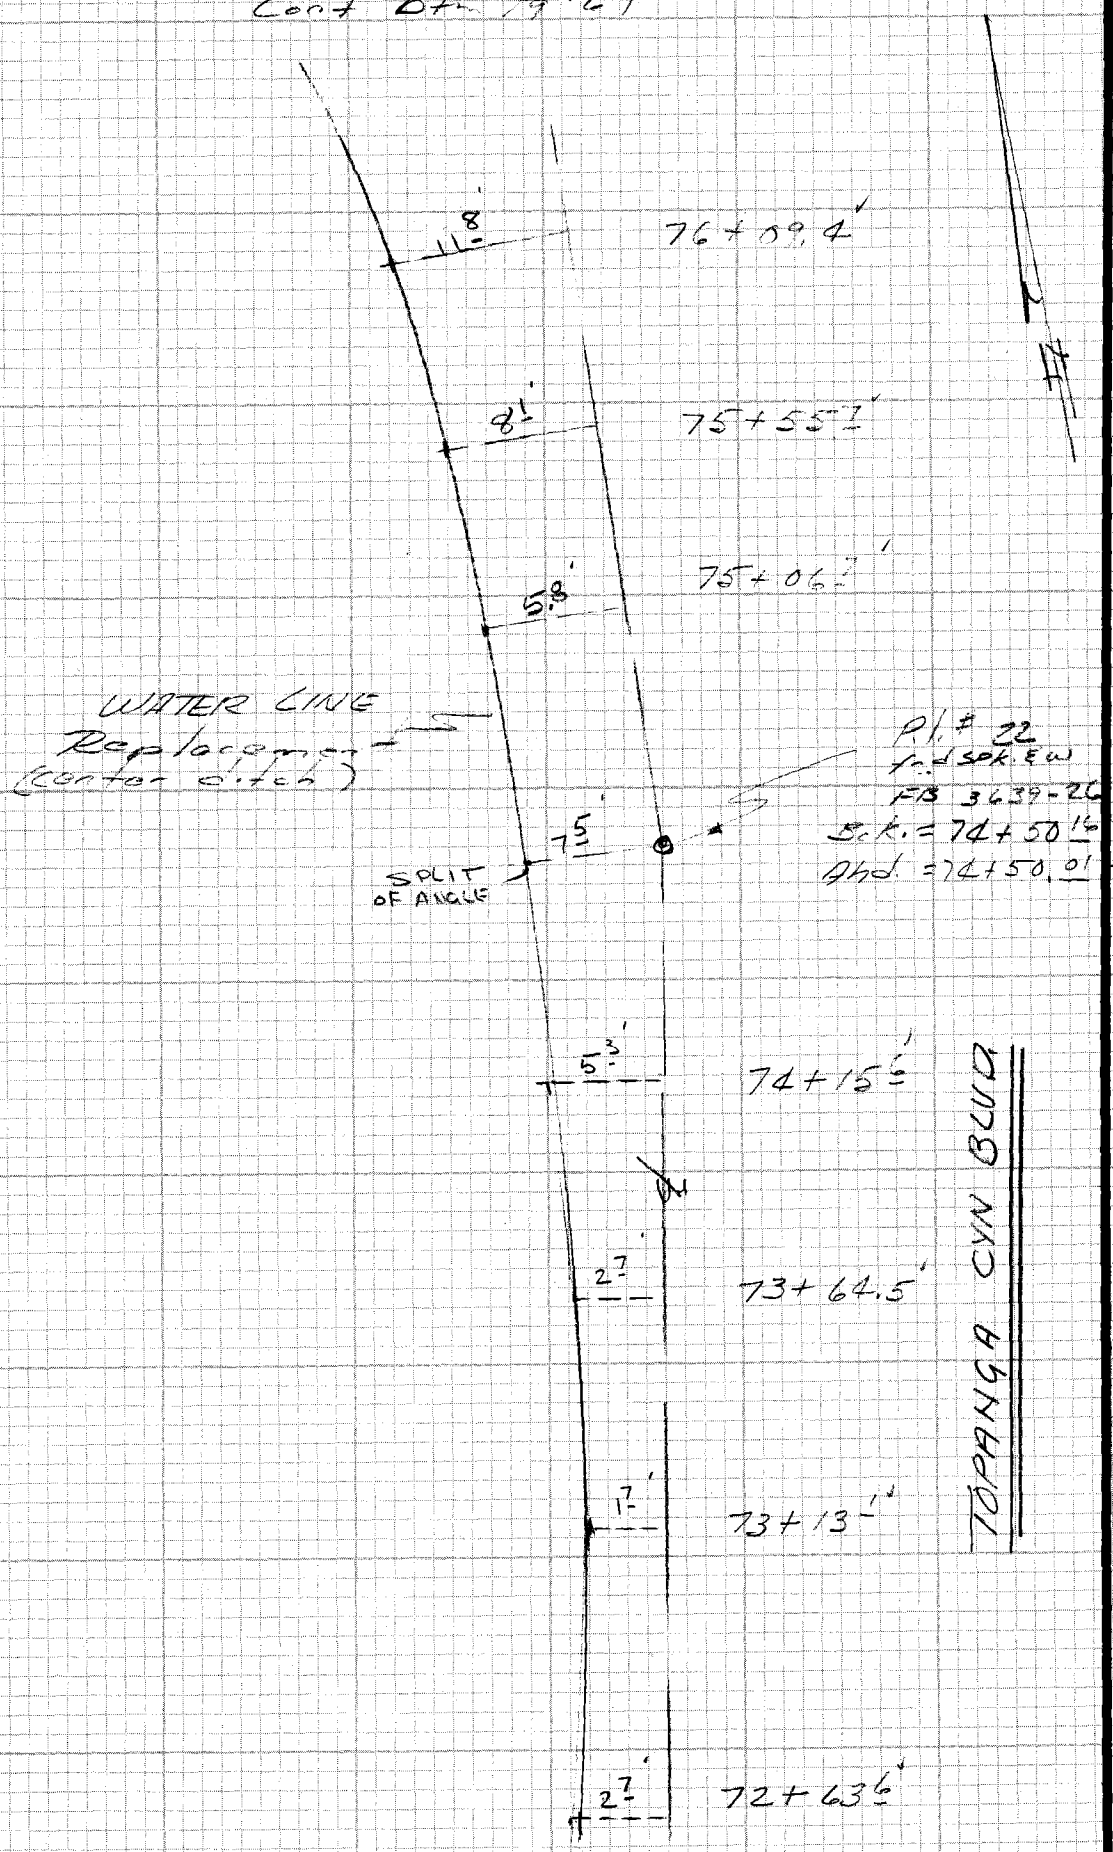

CONT TO FB 67

CE 310
76F3095-4/73

PLEASE RETURN TO
LOS ANGELES COUNTY ENGINEER
403 LOS ANGELES COUNTY ENGINEERING BLDG.

Do not extend notes this side of this line

NOTE: ANY ADDITIONS OR CHANGES ON THIS SHEET MUST BE MADE OR CIRCLED IN RED INK WITH DATE AND NAME OF PERSON MAKING CHANGE

Notes Ck'd by	Survey of Tapanga Cy-
Map No.	JN/525.22 Tape Std °F
Office Work	Surveyed by EL
Checked	Notes EL Date 10-84
Date	Indexed

F.B. 4448 PG. 69

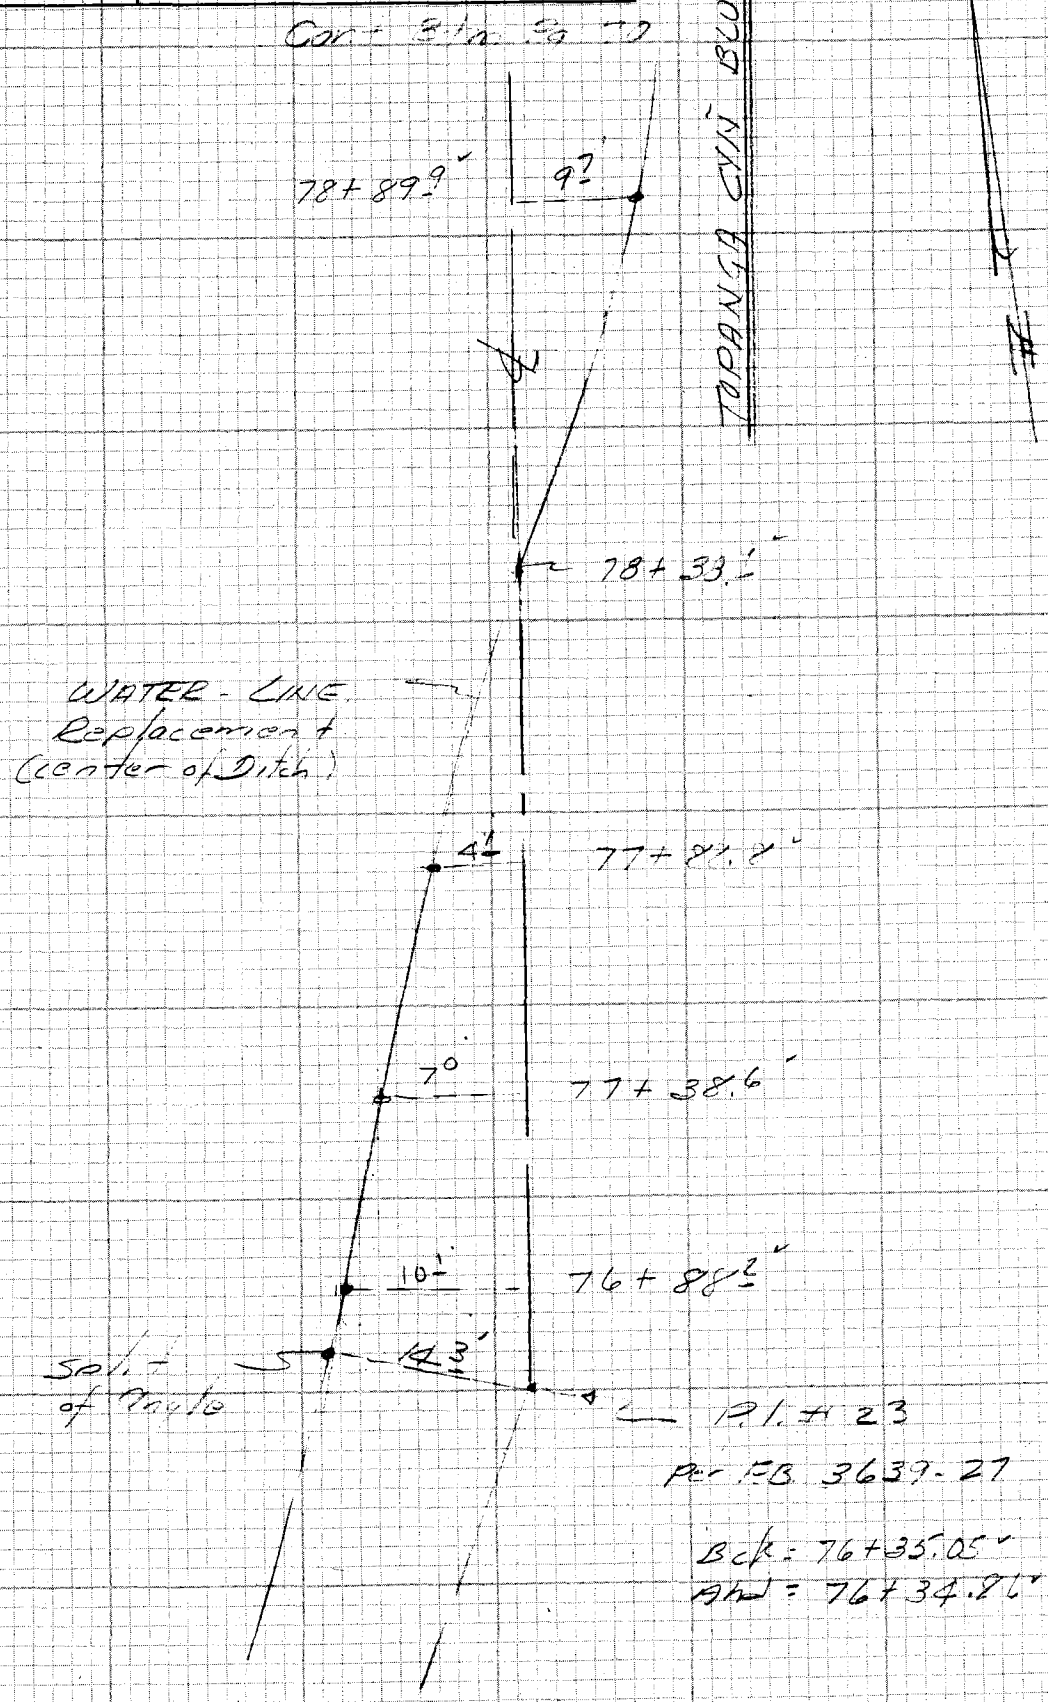

NOTE: ANY ADDITIONS OR CHANGES ON THIS SHEET MUST BE MADE OR CIRCLED IN RED INK WITH DATE AND NAME OF PERSON MAKING CHANGE

Do not extend notes this side of this line

PLEASE RETURN TO
LOS ANGELES COUNTY ENGINEER
403 LOS ANGELES COUNTY ENGINEERING BLDG.

CENTERLINE NOTES
CE 310
76F3095-4/73

F.B. 1148 PG. 70

Cont 3th Pg 71

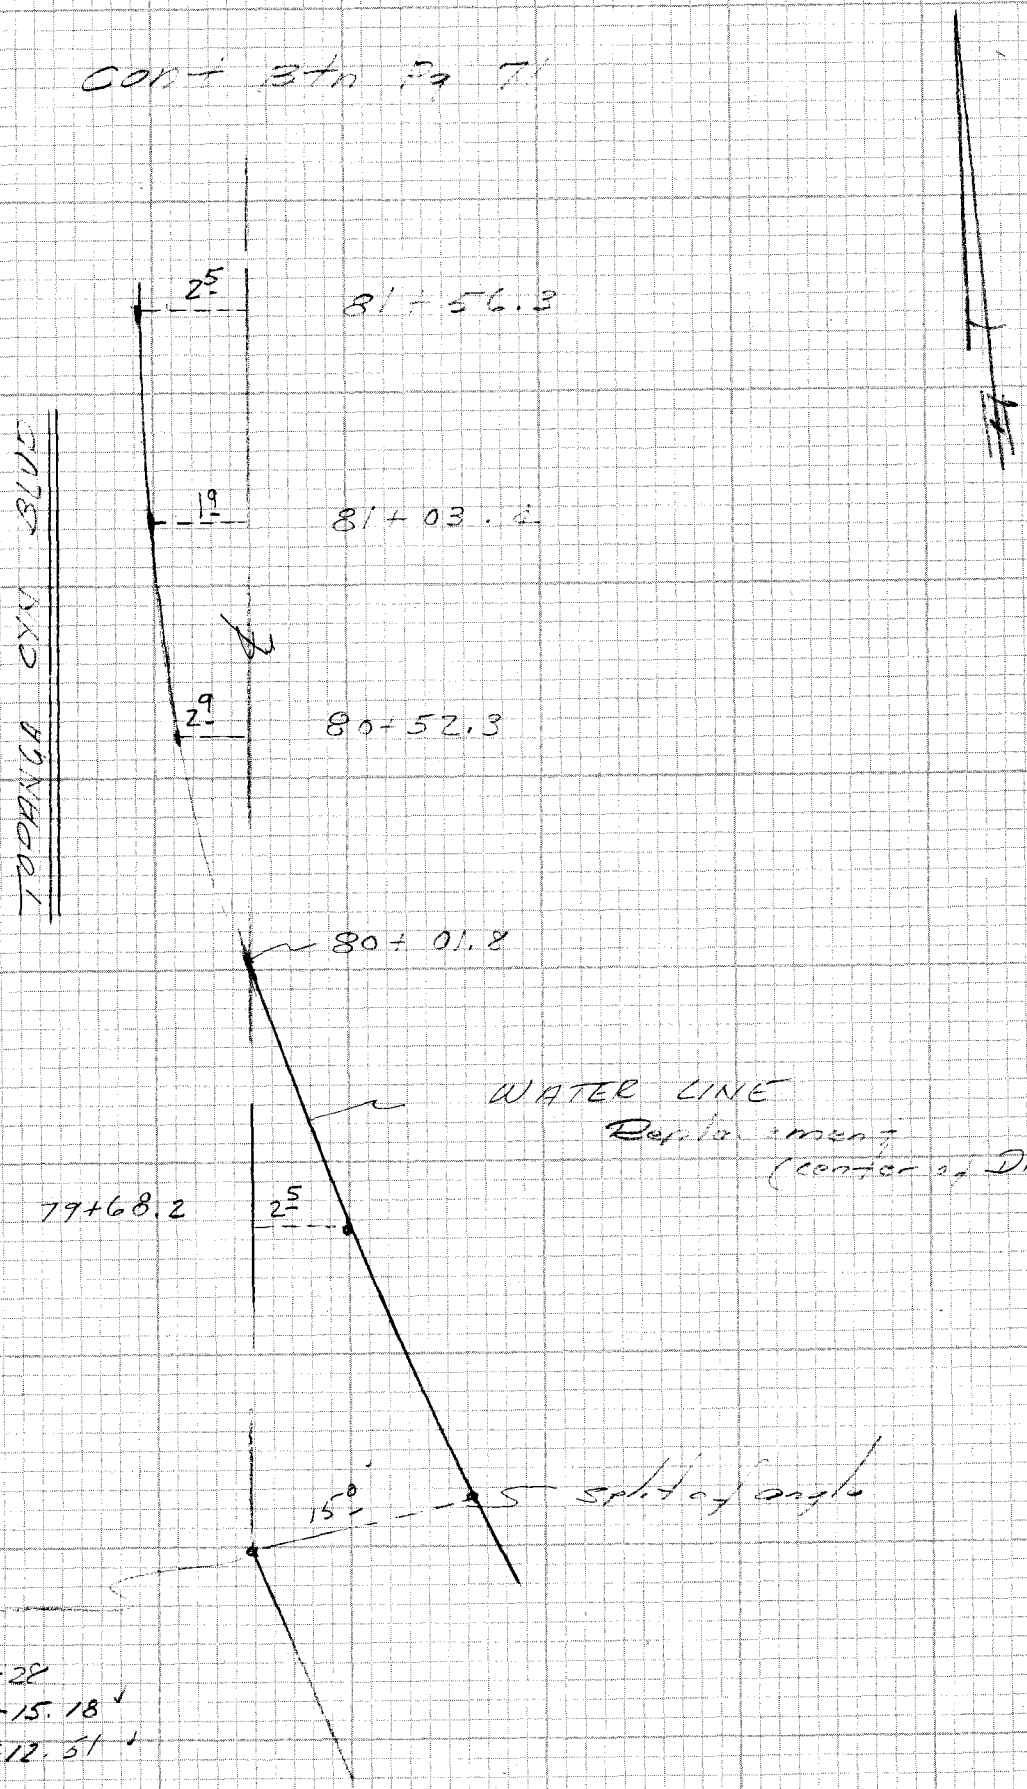

Fnd SEW
Per FB 3639-28
Bck. = 79+15.18
Ahd. = 79+12.51

Cont Top Pg 69

CE 310
76F3095 '73

PLEASE RETURN TO
LOS ANGELES COUNTY ENGINEER
403 LOS ANGELES COUNTY ENGINEERING BLDG.

Do not extend notes this side of this line

NOTE: ANY ADDITIONS OR CHANGES ON THIS SHEET MUST BE MADE OR CIRCLED IN RED INK WITH DATE AND NAME OF PERSON MAKING CHANGE

Notes Ck'd by	Survey of TOPANGA CYN WT LN F.B. 4448 PG. 71
Map No.	JN 1525.22 Tape Std °F
Office Work	Surveyed by EL
Checked	Notes A. Caro Date 11-84
Date	Indexed

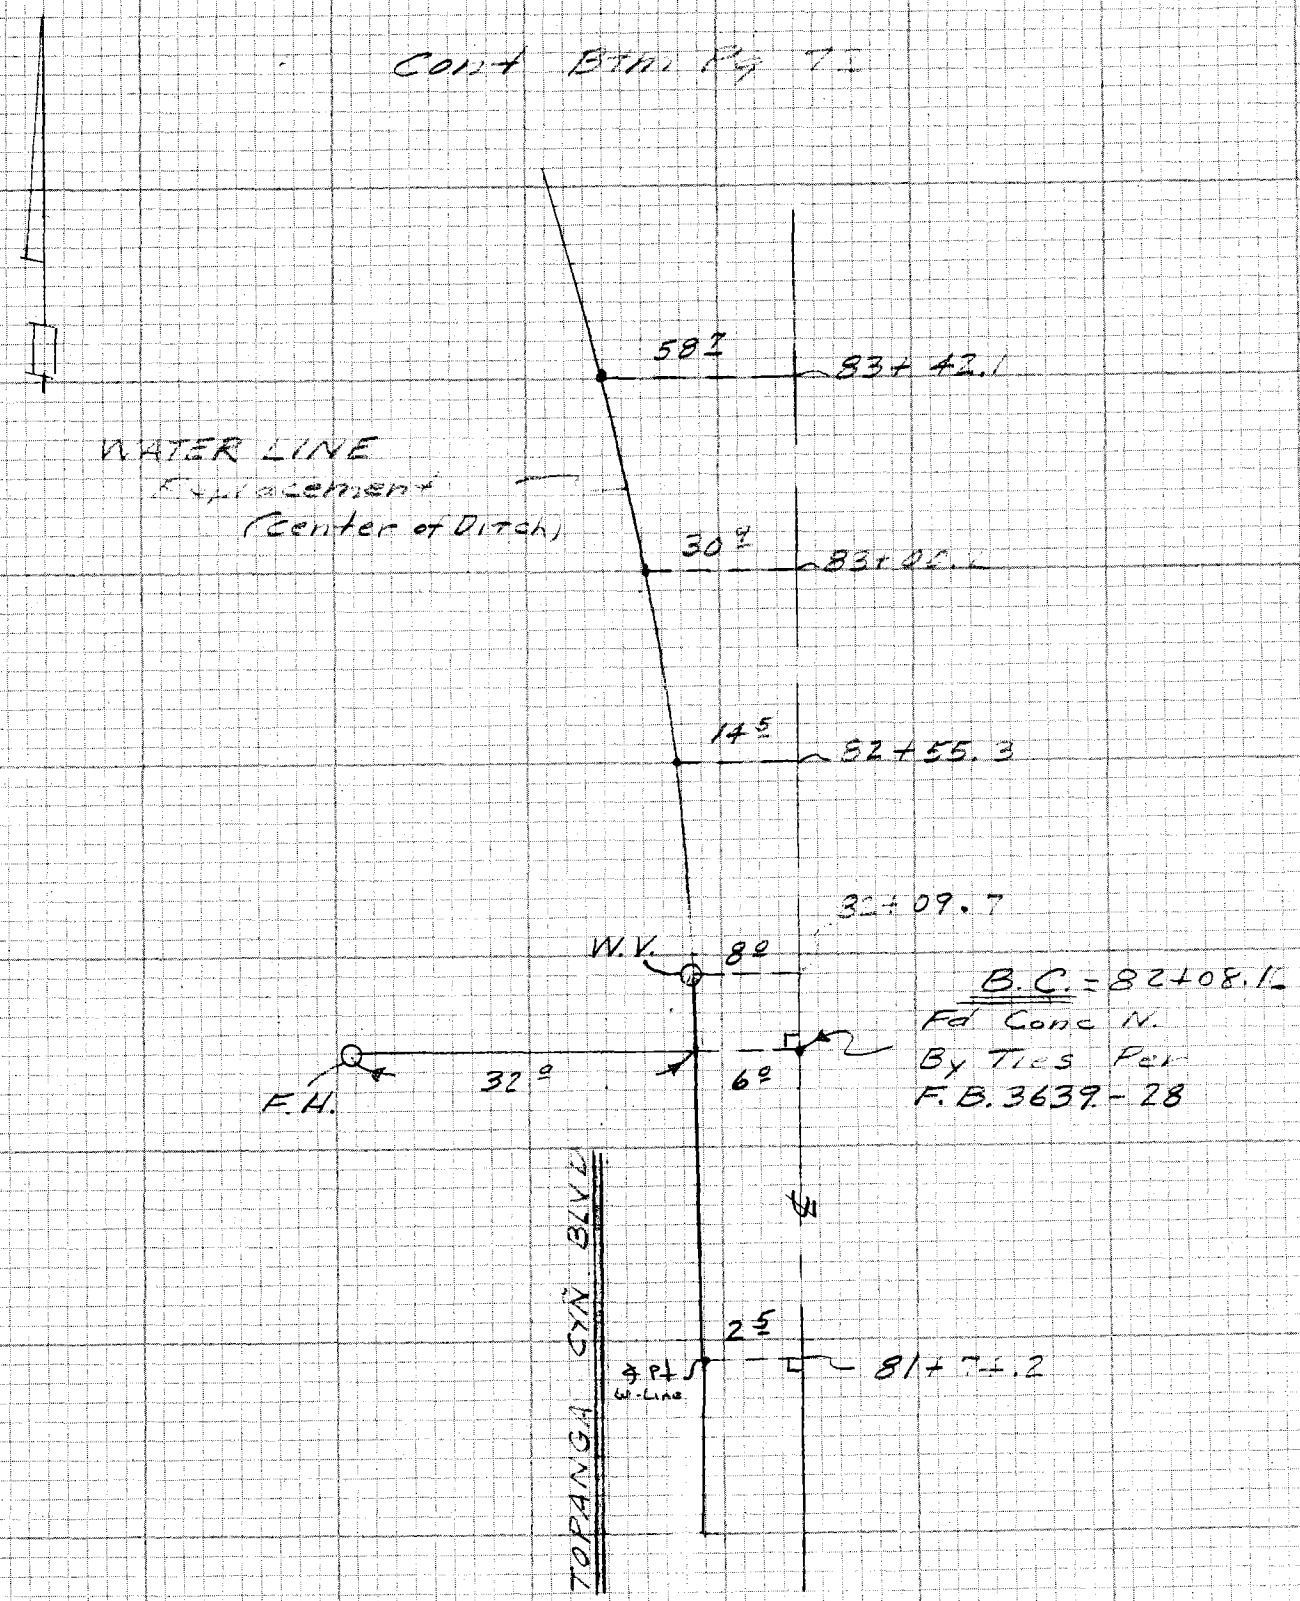

NOTE: ANY ADDITIONS OR CHANGES ON THIS SHEET MUST BE MADE OR CIRCLED IN RED INK WITH DATE AND NAME OF PERSON MAKING CHANGE

Do not extend notes this side of this line

PLEASE RETURN TO
LOS ANGELES COUNTY ENGINEER
403 LOS ANGELES COUNTY ENGINEERING BLDG

CENTERLINE NOTES
CE 310
76F3095-4/73

F.B. 4448 PG. 72

Cont from Pg 73

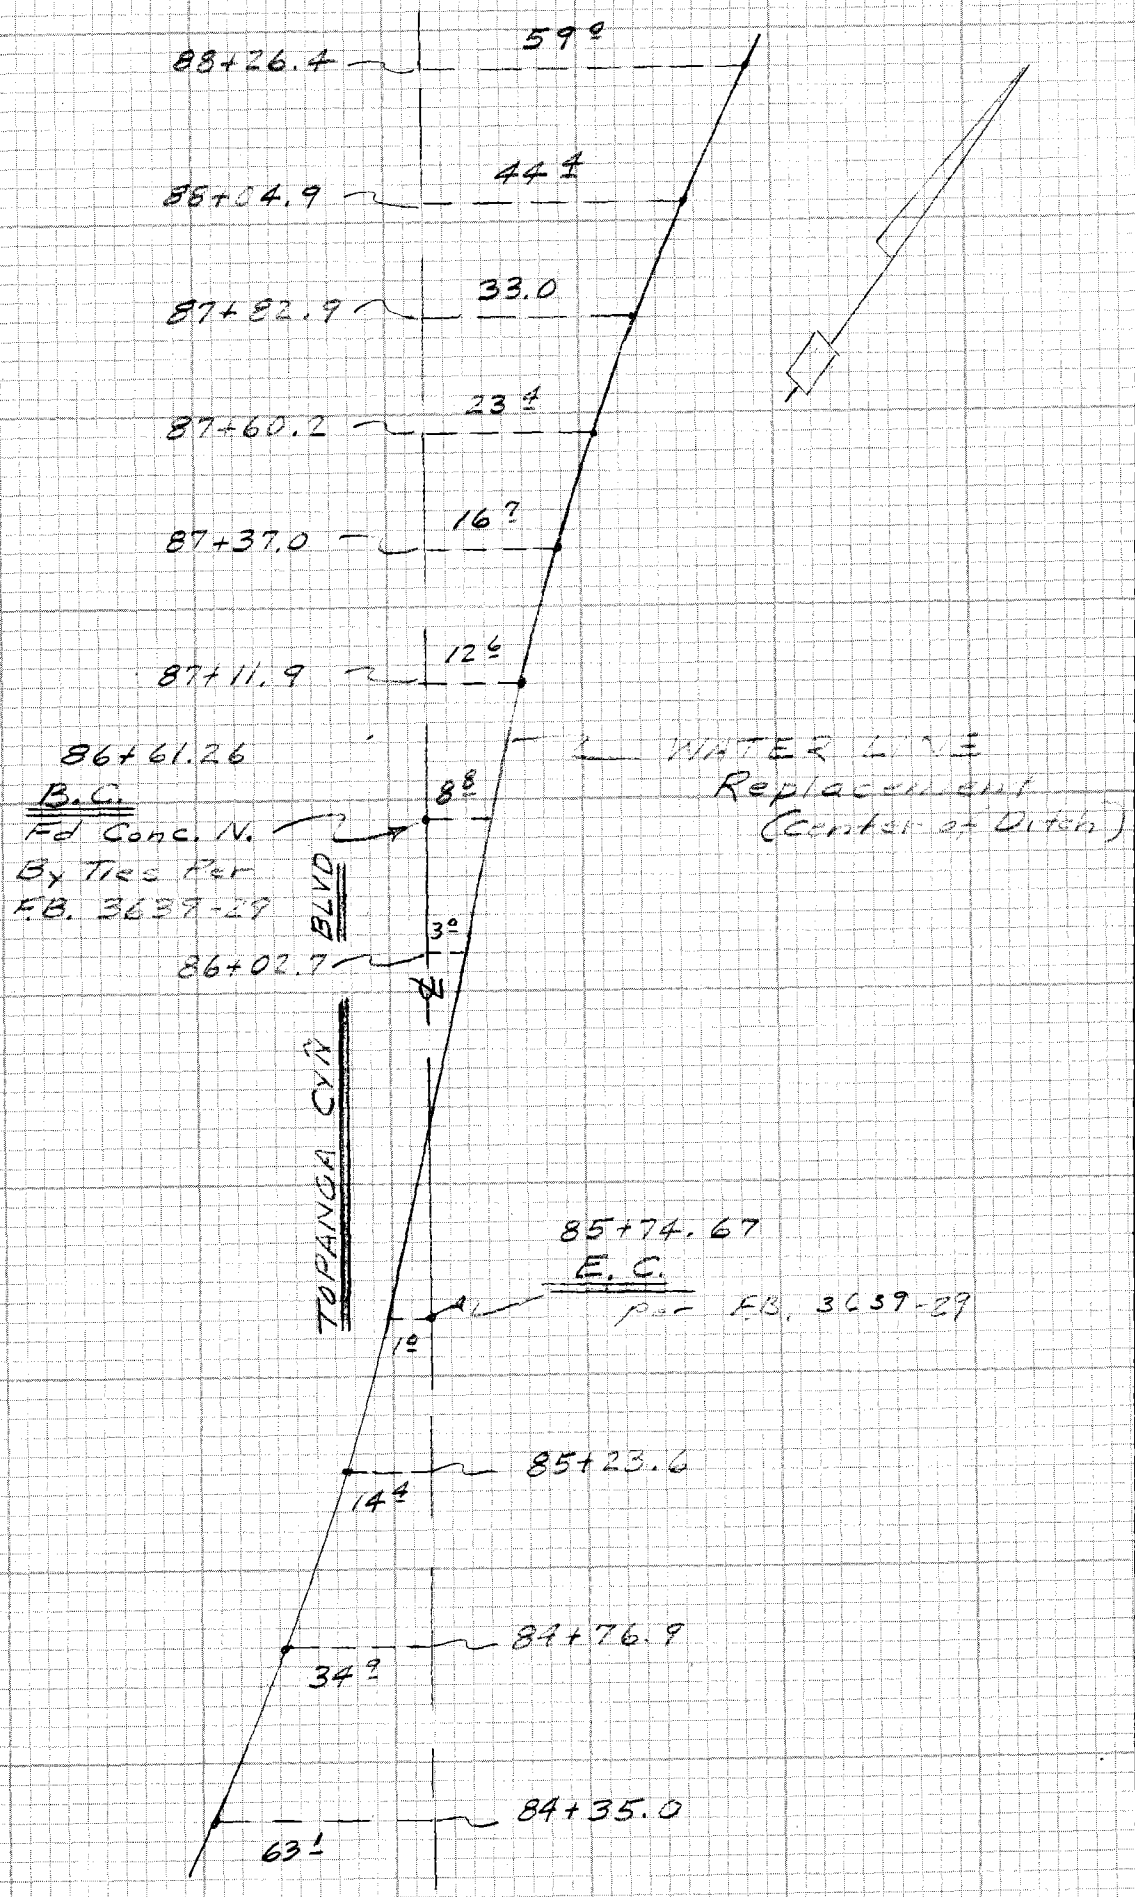

Cont To Pg 71

CE 310
76F3095.4/73

PLEASE RETURN TO
LOS ANGELES COUNTY ENGINEER
403 LOS ANGELES COUNTY ENGINEERING BLDG.

Do not extend notes this side of this line

NOTE: ANY ADDITIONS OR CHANGES ON THIS SHEET MUST BE MADE OR CIRCLED IN RED INK WITH DATE AND NAME OF PERSON MAKING CHANGE

Notes Ck'd by	Survey of TOPANGA CYN WT LN
Map No.	JN 1525.22 Tape Std °F
Office Work	Surveyed by EL
Checked	Notes A. Caro Date 11-84
Date	Indexed

F.B. 4448 PG. 73

Cont Top Pg 74

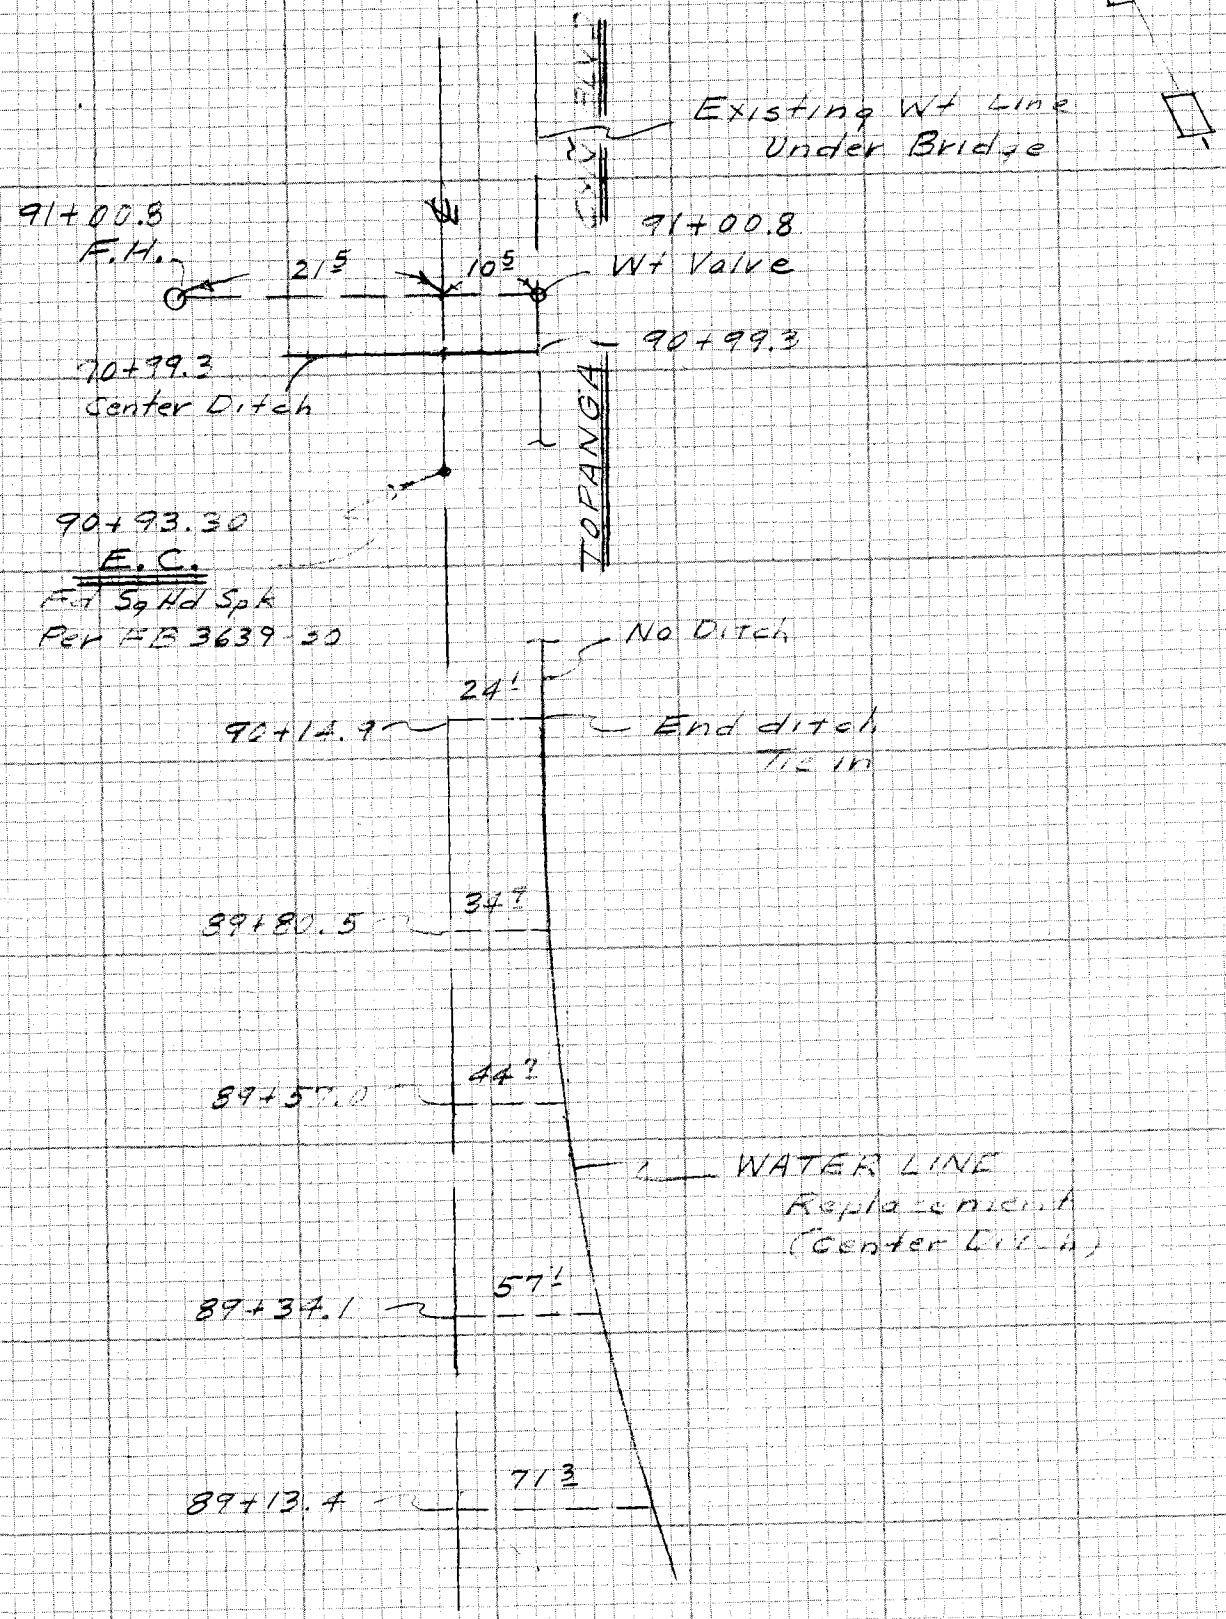

Cont Top Pg 72

NOTE: ANY ADDITIONS OR CHANGES ON THIS SHEET MUST BE MADE OR CIRCLED IN RED INK WITH DATE AND NAME OF PERSON MAKING CHANGE
Do not extend notes this side of this line
PLEASE RETURN TO
LOS ANGELES COUNTY ENGINEER
403 LOS ANGELES COUNTY ENGINEERING BLDG.
CENTERLINE NOTES
CE 310
76F3095-4/73

Cont Btm Pg 75

F.B. 4448 PG. 74

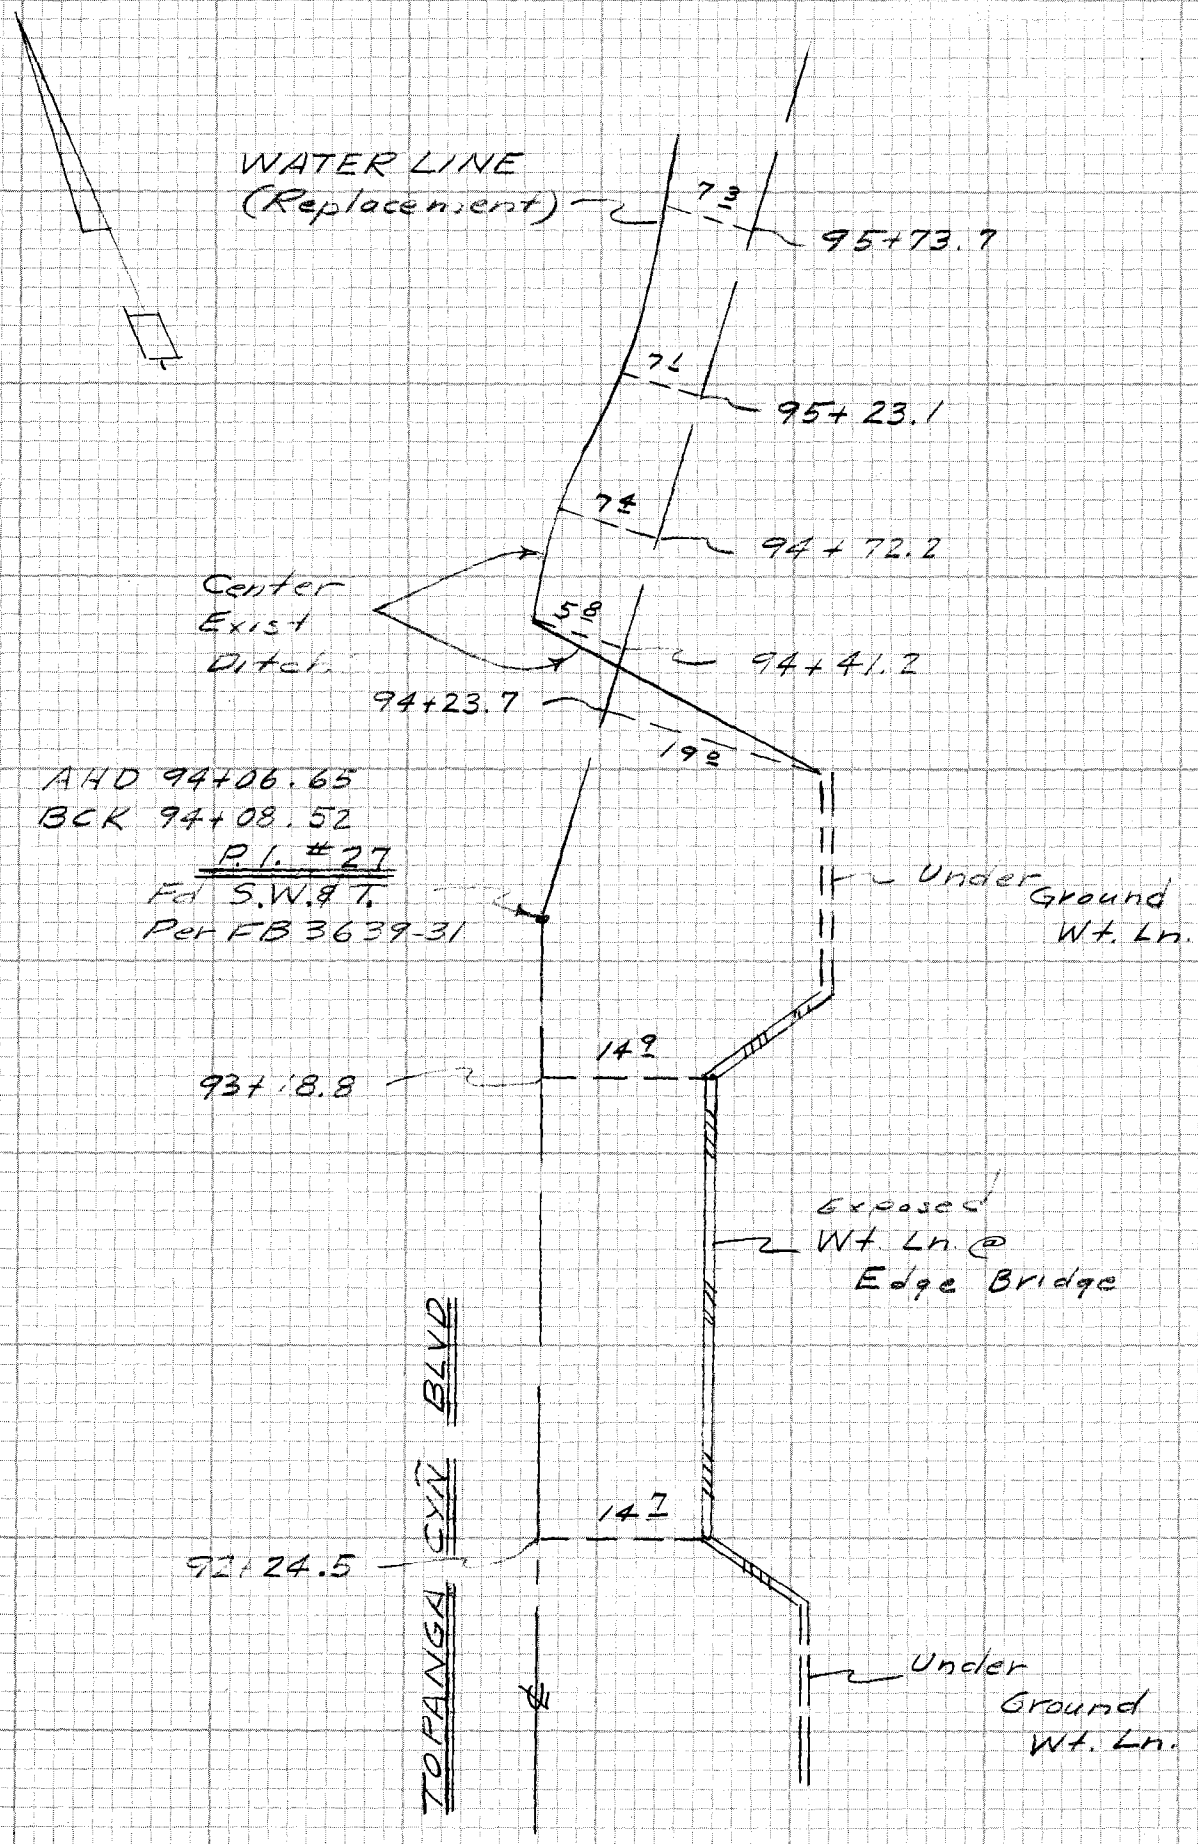

Cont Top Pg 73

CE 310
76F3095-4173

PLEASE RETURN TO
LOS ANGELES COUNTY ENGINEER
403 LOS ANGELES COUNTY ENGINEERING BLDG.

Do not extend notes this side of this line

NOTE: ANY ADDITIONS OR CHANGES ON THIS SHEET MUST BE MADE OR CIRCLED IN RED INK WITH DATE AND NAME OF PERSON MAKING CHANGE

Notes Ck'd by	Survey of TOPANGA CYN WT LN F.B. 4448 PG. 75
Map No.	JN 1525.22 Tape Std °F
Office Work	Surveyed by EL
Checked	Notes A. Caro Date 11-84
Date	Indexed

Cont Btm Pg 76

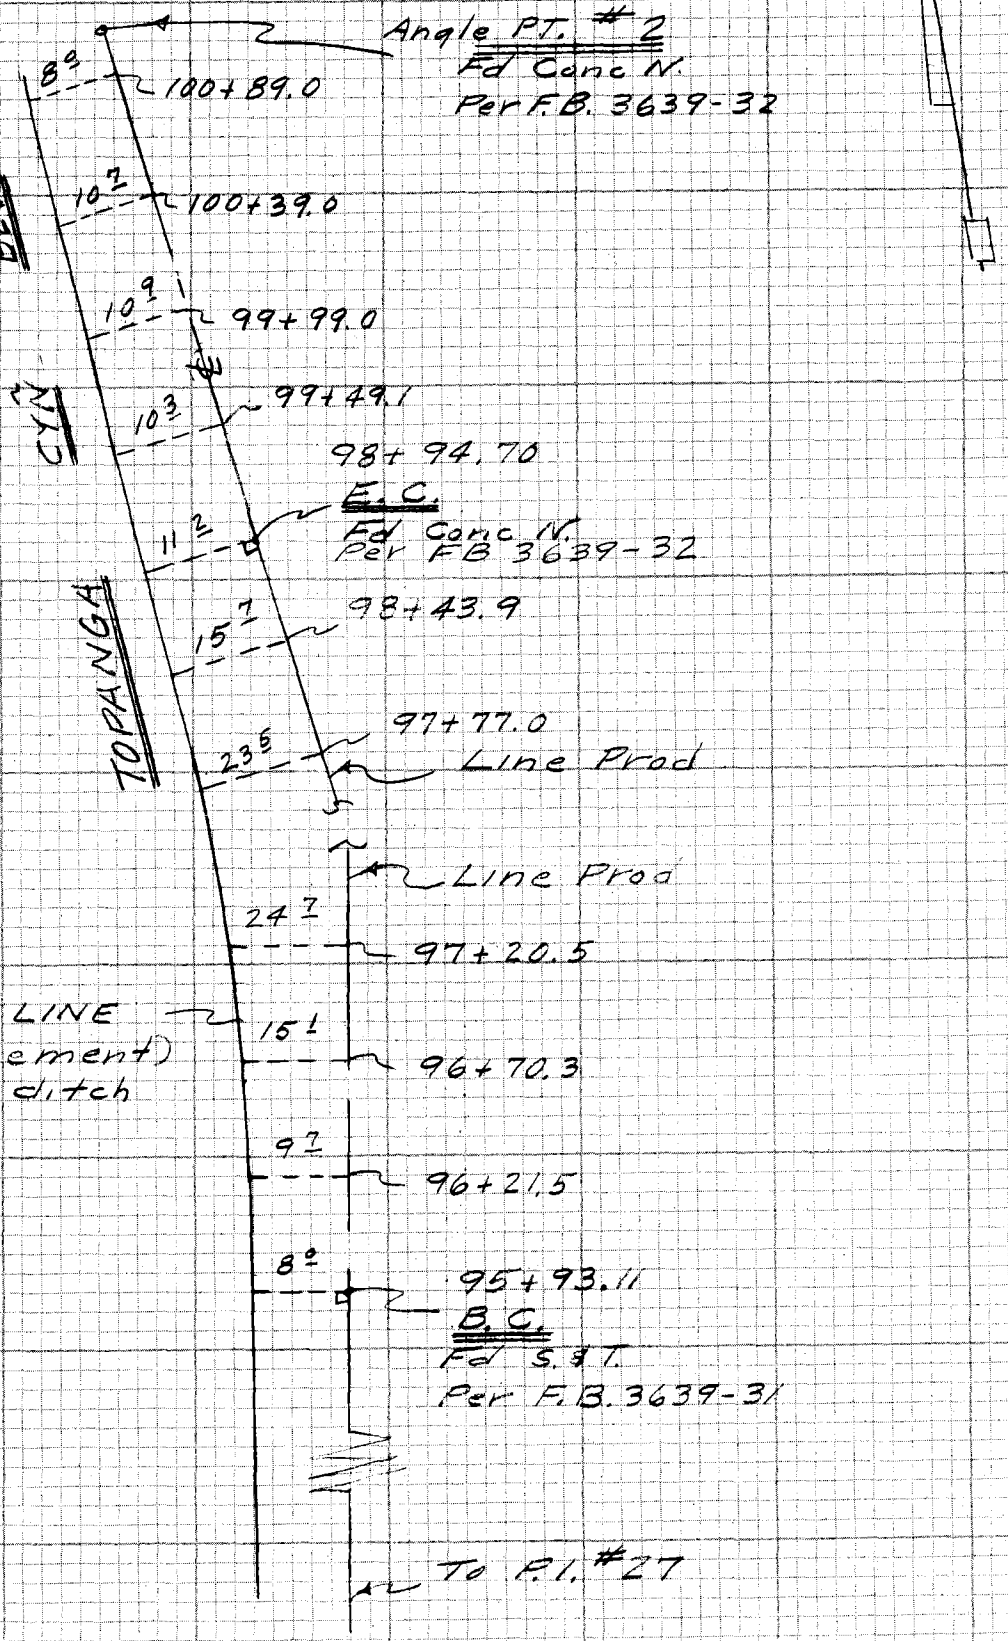

Cont Top Pg 74

NOTE: ANY ADDITIONS OR CHANGES ON THIS SHEET MUST BE MADE OR CIRCLED IN RED INK WITH DATE AND NAME OF PERSON MAKING CHANGE
Do not extend note this side of this line
PLEASE RETURN TO
LOS ANGELES COUNTY ENGINEER
403 LOS ANGELES COUNTY ENGINEERING BLDG.
CENTERLINE NOTES
CE 310
76F3095-4/73

F.B. 4448 PG. 76

Cont Btm Pg 77

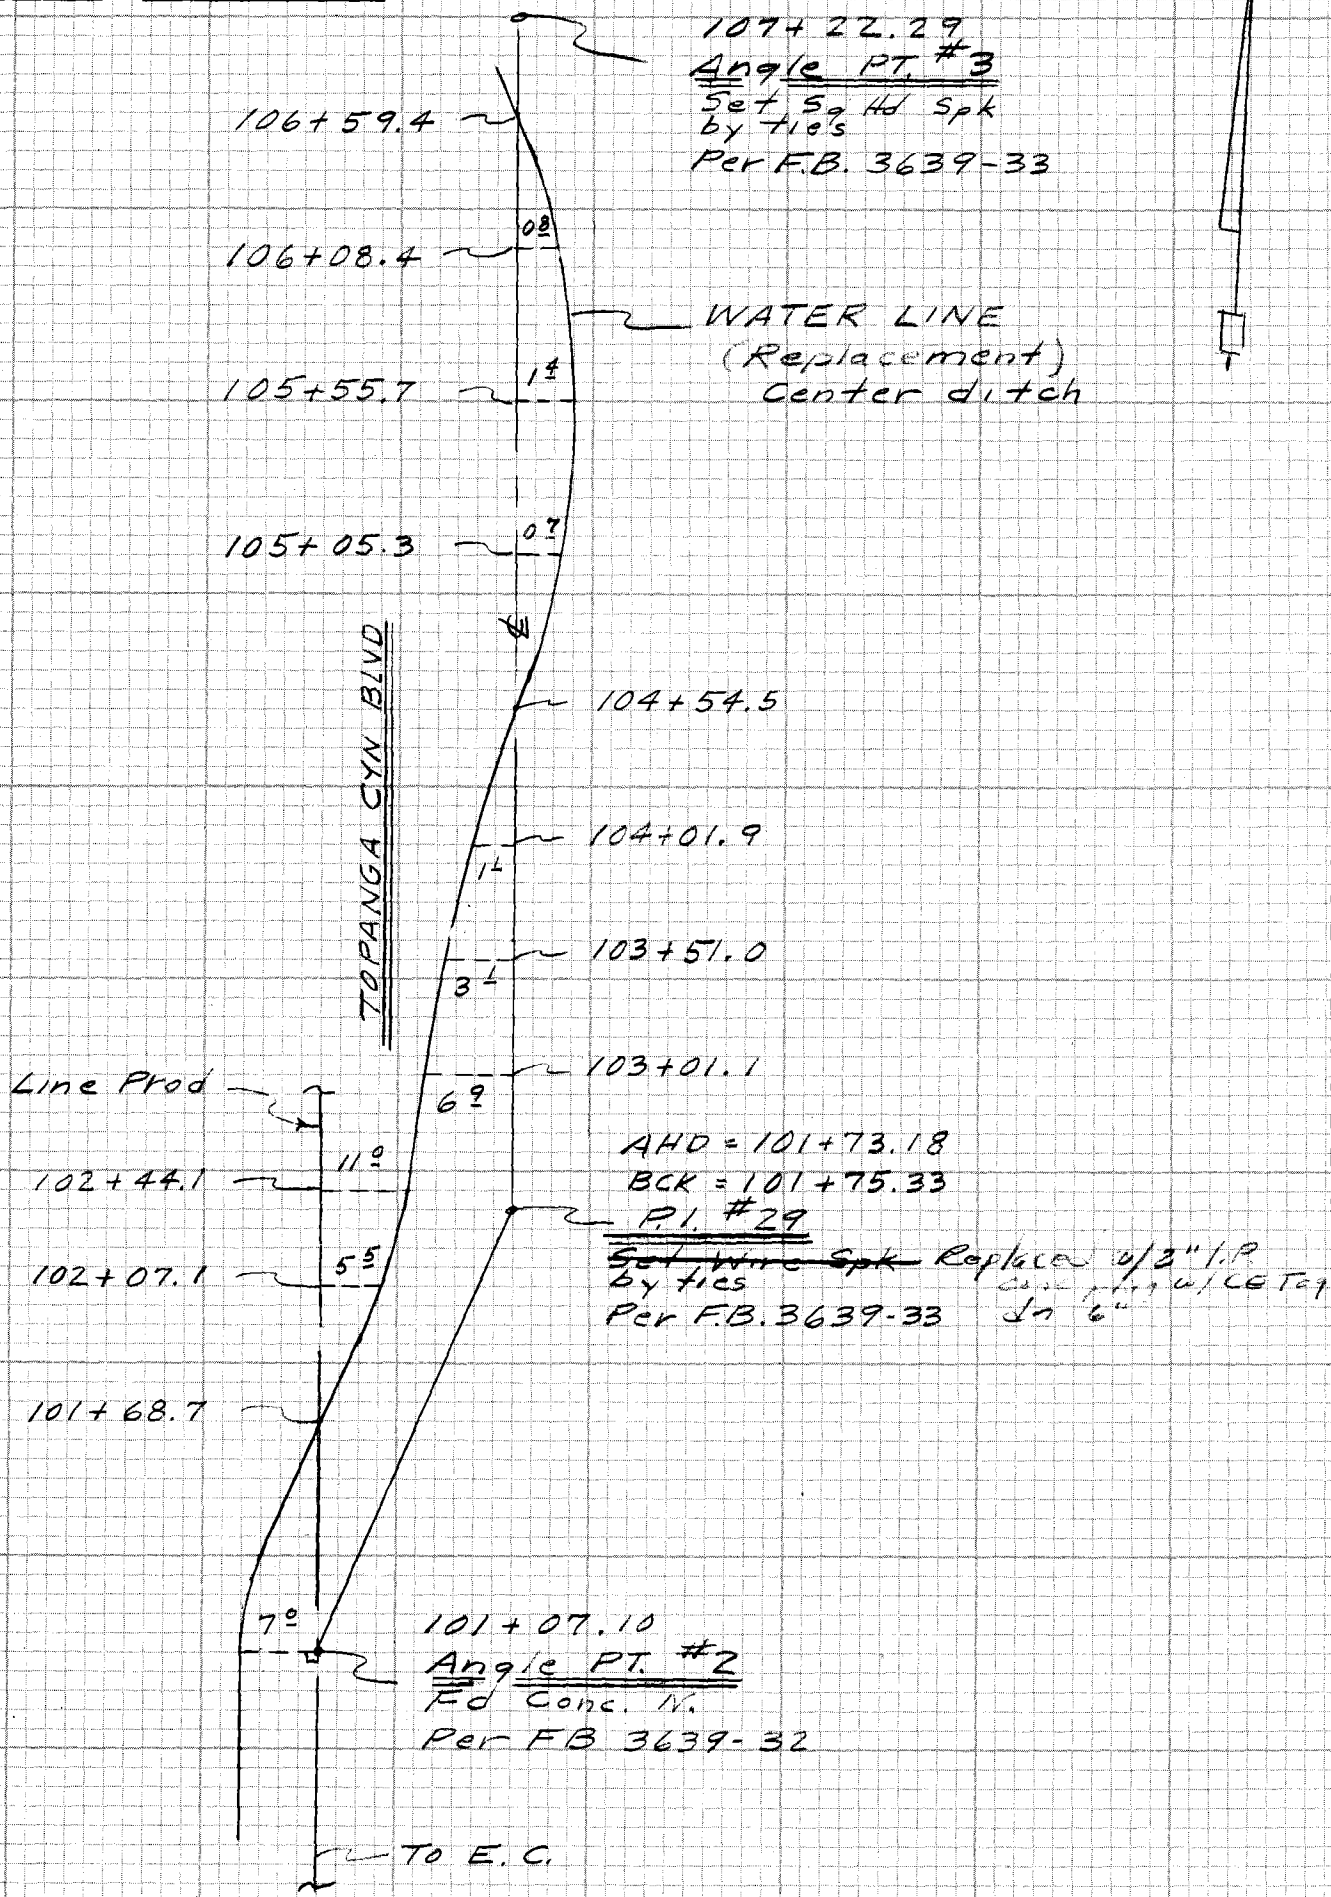

Cont Top Pg 75

CE 310
76F3095-4/73

PLEASE RETURN TO
LOS ANGELES COUNTY ENGINEER
403 LOS ANGELES COUNTY ENGINEERING BLDG.

Do not extend notes this side of this line

NOTE: ANY ADDITIONS OR CHANGES ON THIS SHEET MUST BE MADE OR CIRCLED IN RED INK WITH DATE AND NAME OF PERSON MAKING CHANGE

Notes Ck'd by	Survey of TOPANGA CYN WT LN
Map No.	JN 15 25.22 Tape Std °F
Office Work	Surveyed by EL
Checked	Notes A. Caro Date 11-84
Date	Indexed

F.B. 4448 PG. 77

Cont Btm Pg 98

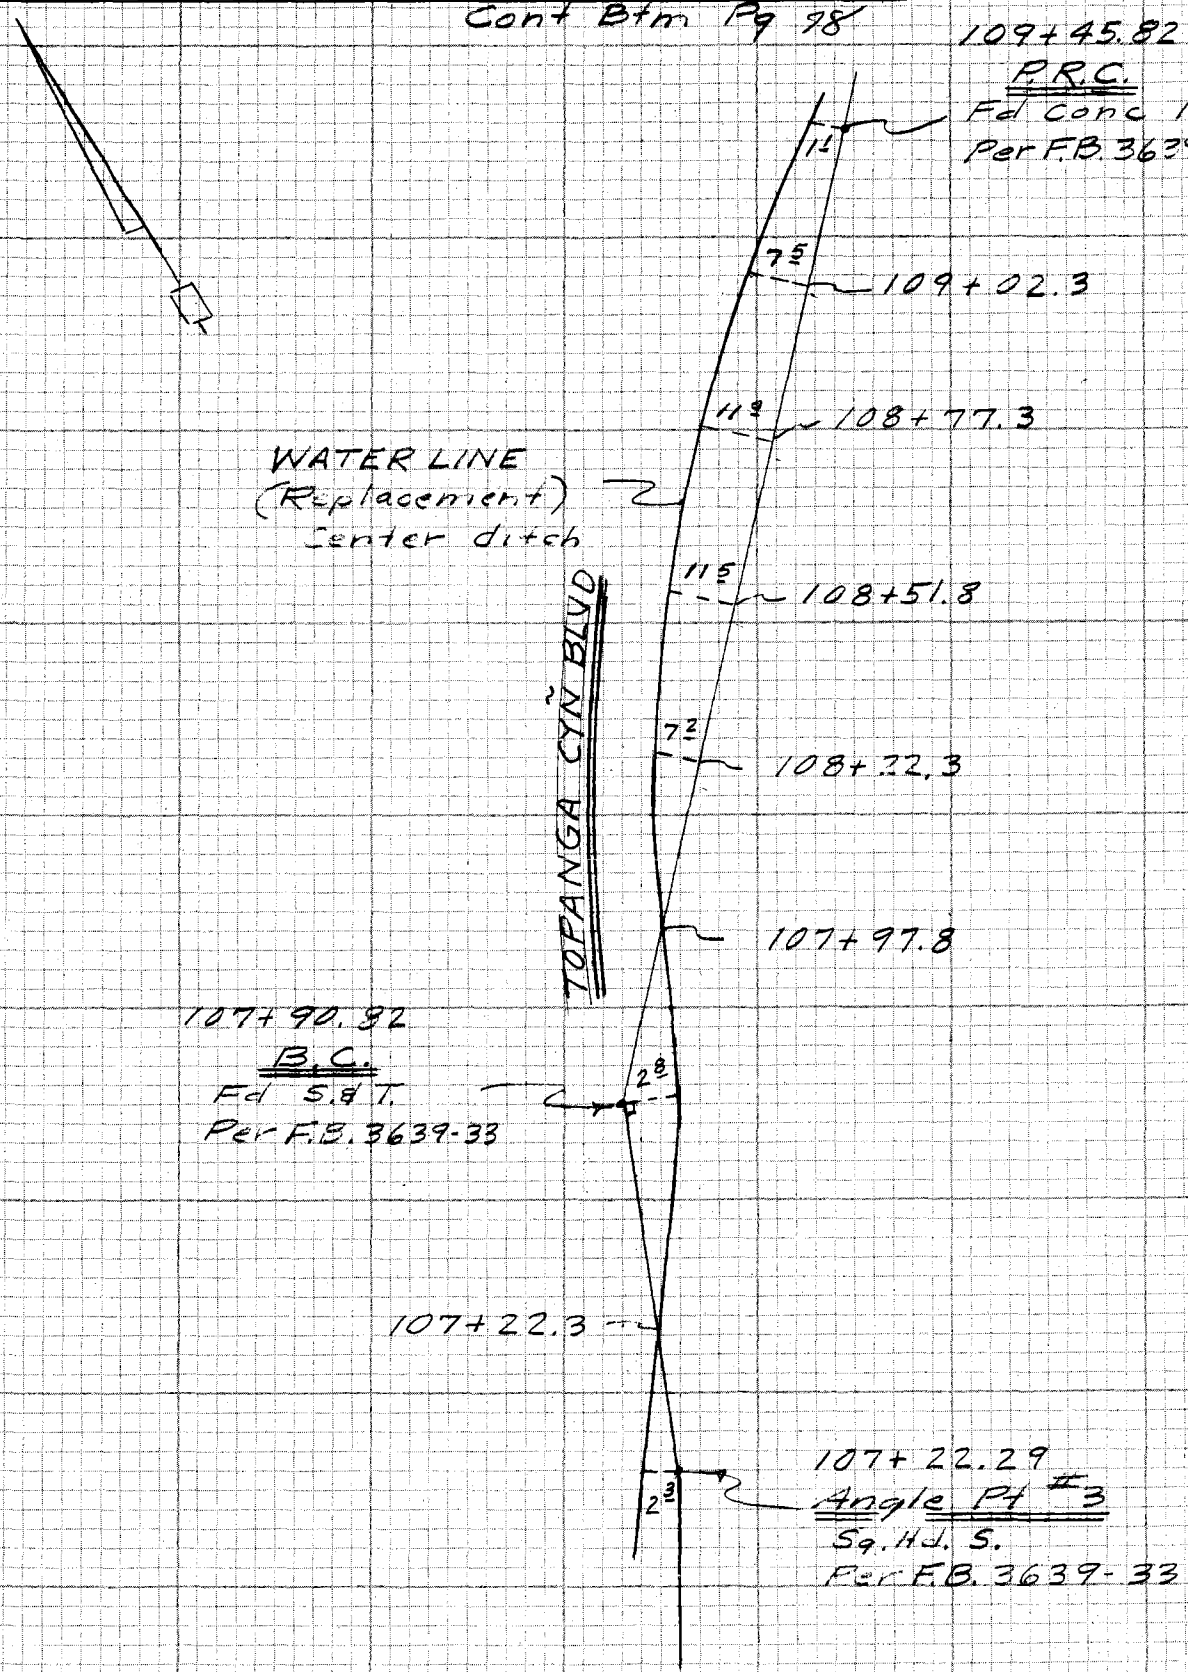

Cont Top Pg 76

NOTE: ANY ADDITIONS OR CHANGES ON THIS SHEET MUST BE MADE OR CIRCLED IN RED INK WITH DATE AND NAME OF PERSON MAKING CHANGE

Do not extend notes this side of this line

PLEASE RETURN TO
LOS ANGELES COUNTY ENGINEER
403 LOS ANGELES COUNTY ENGINEERING BLDG.

CENTERLINE NOTES
CE 310
76F3095-4/73

F.B. 4448 PG. 78

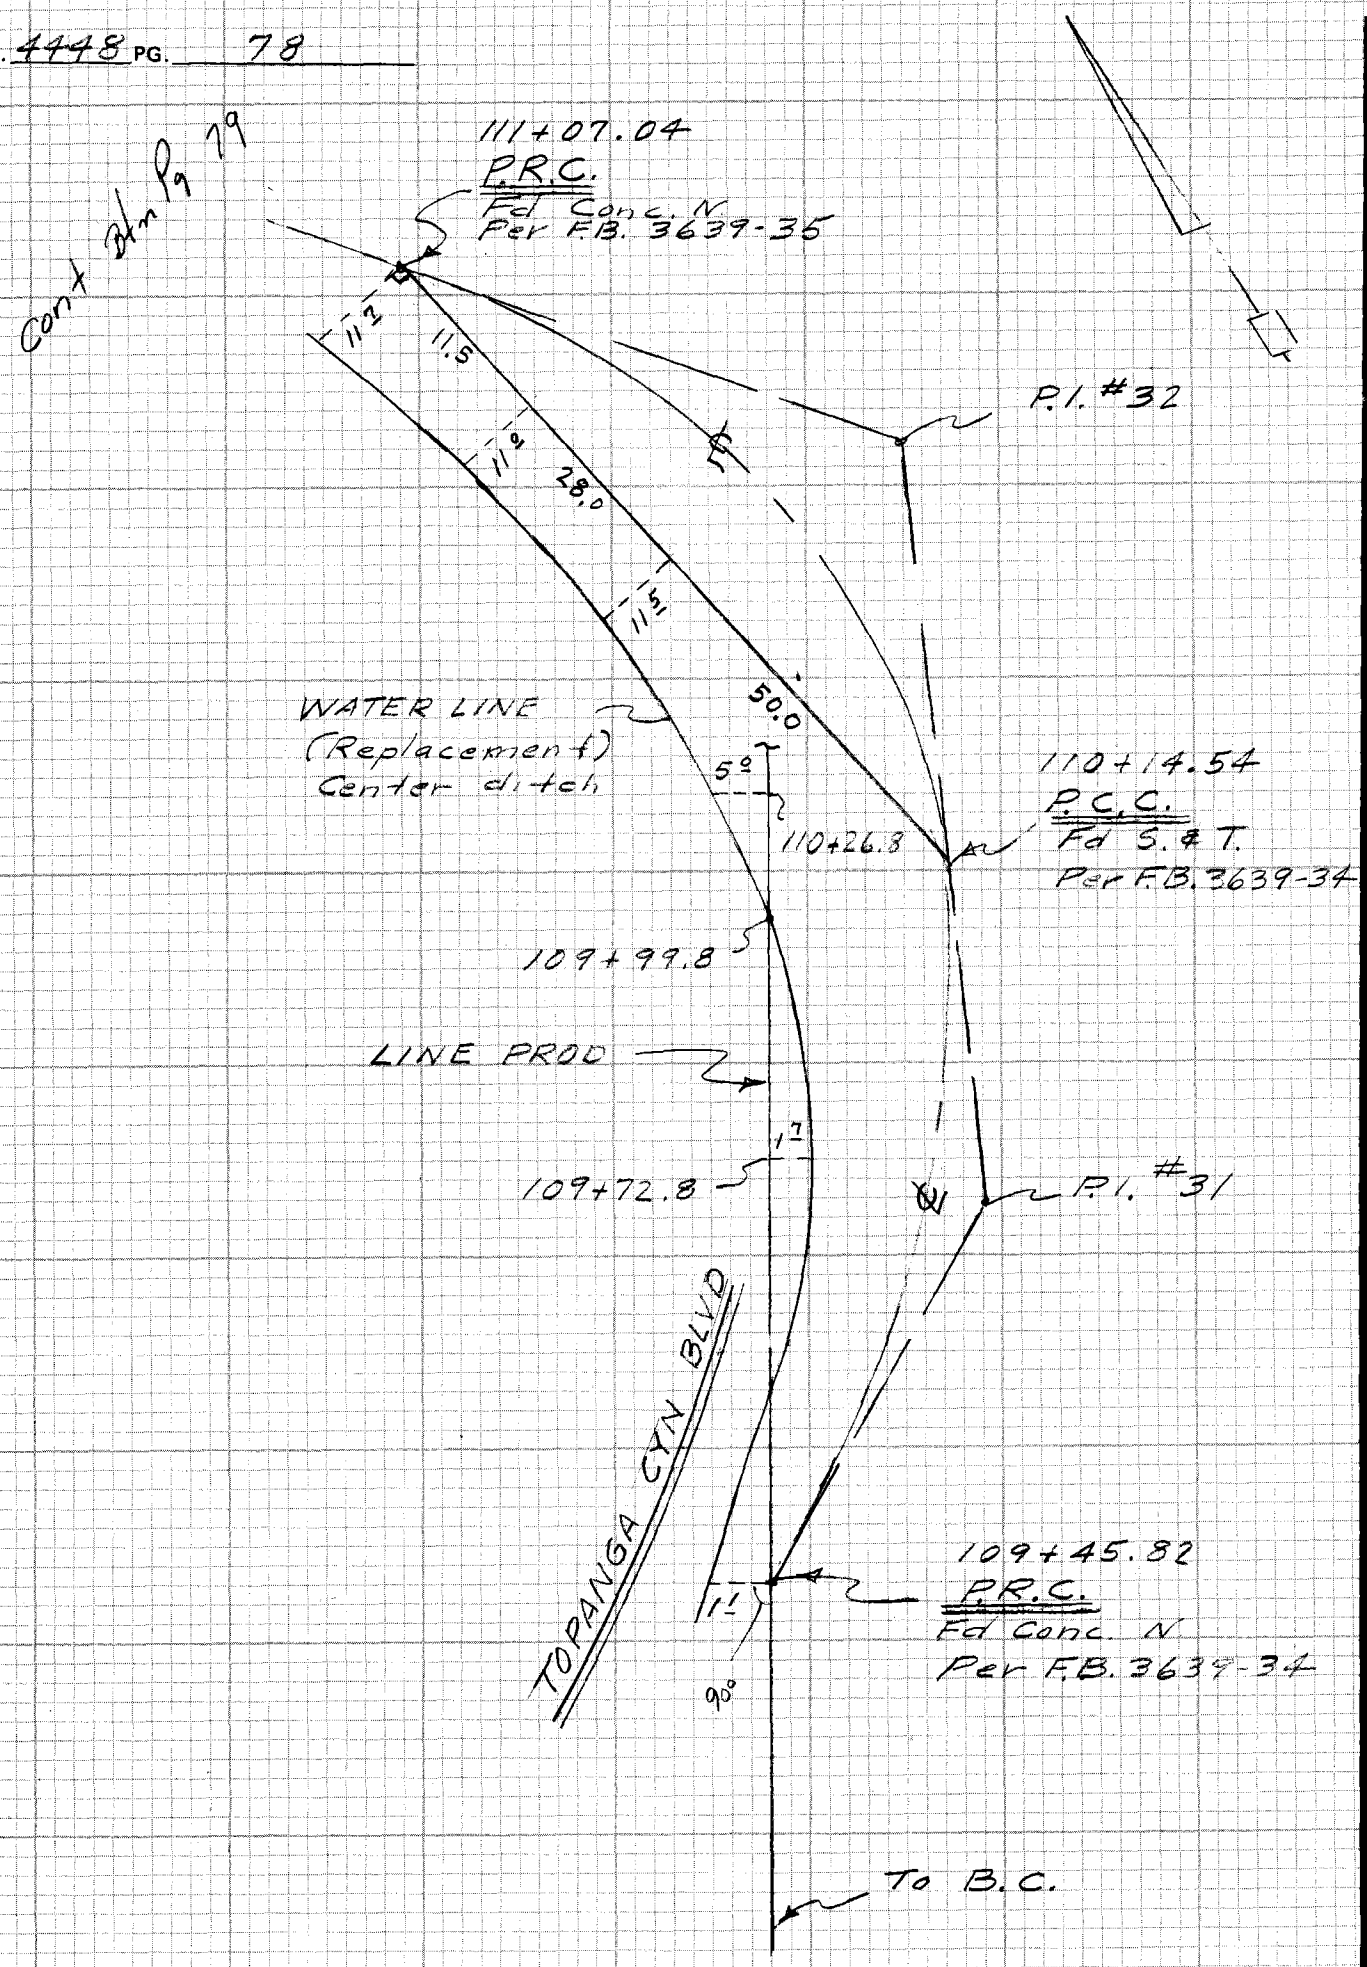

Cont Top Pg 77

CE 310
76F 3095-4/73

PLEASE RETURN TO
LOS ANGELES COUNTY ENGINEER
403 LOS ANGELES COUNTY ENGINEERING BLDG.

Do not extend notes this side of this line

NOTE: ANY ADDITIONS OR CHANGES ON THIS SHEET MUST BE MADE OR CIRCLED IN RED INK WITH DATE AND NAME OF PERSON MAKING CHANGE

Notes Ck'd by	Survey of TOPANGA CYN WT LN F.B. 4448 PG. 79
Map No.	JN 1525.22 Tape Std °F
Office Work	Surveyed by
Checked	Notes A. Caro Date 11-84
Date	Indexed

Cont Btm Pg 80

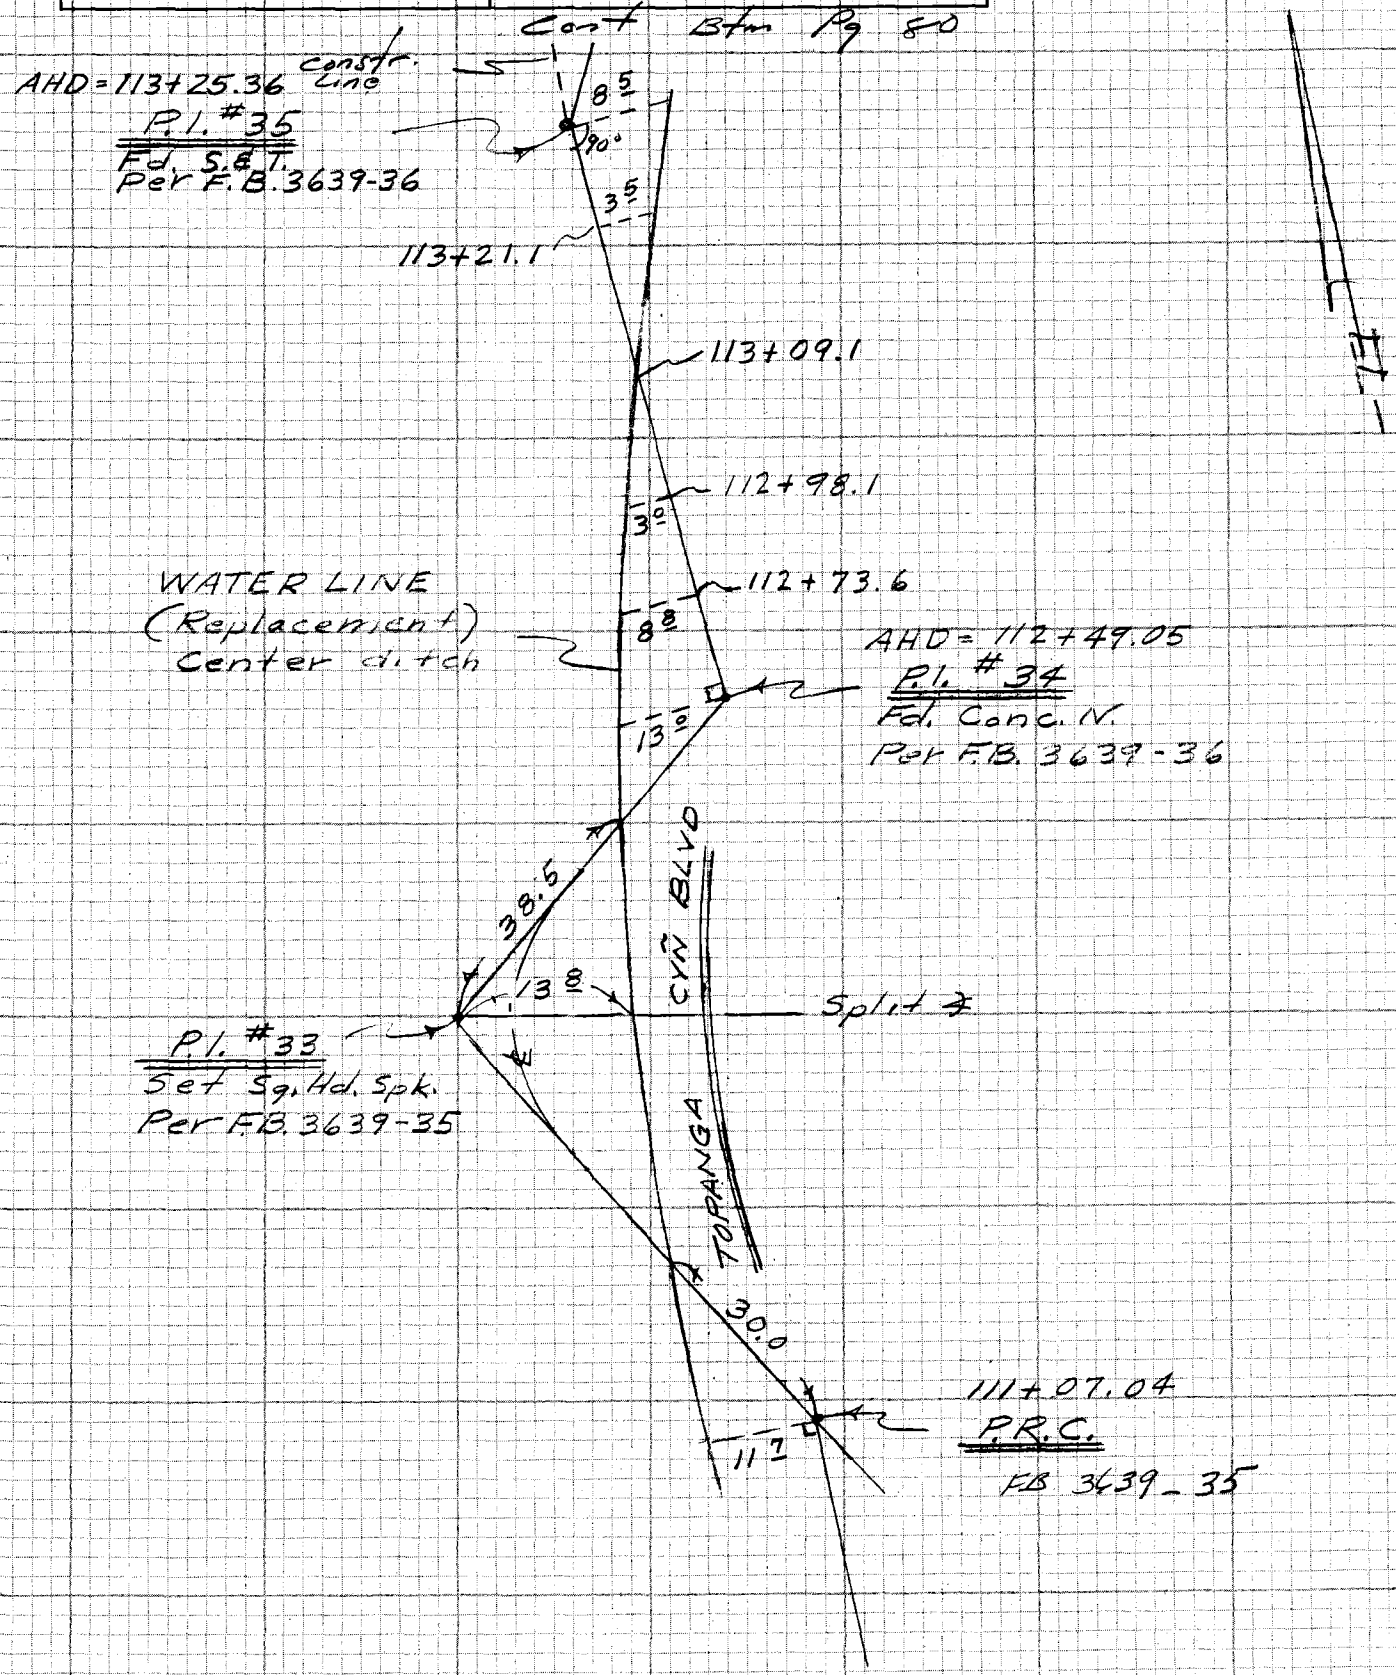

Cont Left Pg 78

NOTE: ANY ADDITIONS OR CHANGES ON THIS SHEET MUST BE MADE OR CIRCLED IN RED INK WITH DATE AND NAME OF PERSON MAKING CHANGE

Do not extend notes this side of this line

PLEASE RETURN TO
LOS ANGELES COUNTY ENGINEER
403 LOS ANGELES COUNTY ENGINEERING BLDG.

CENTERLINE NOTES
CE 310
76F3095-4/73

F.B. ~~1418~~ PG. 80

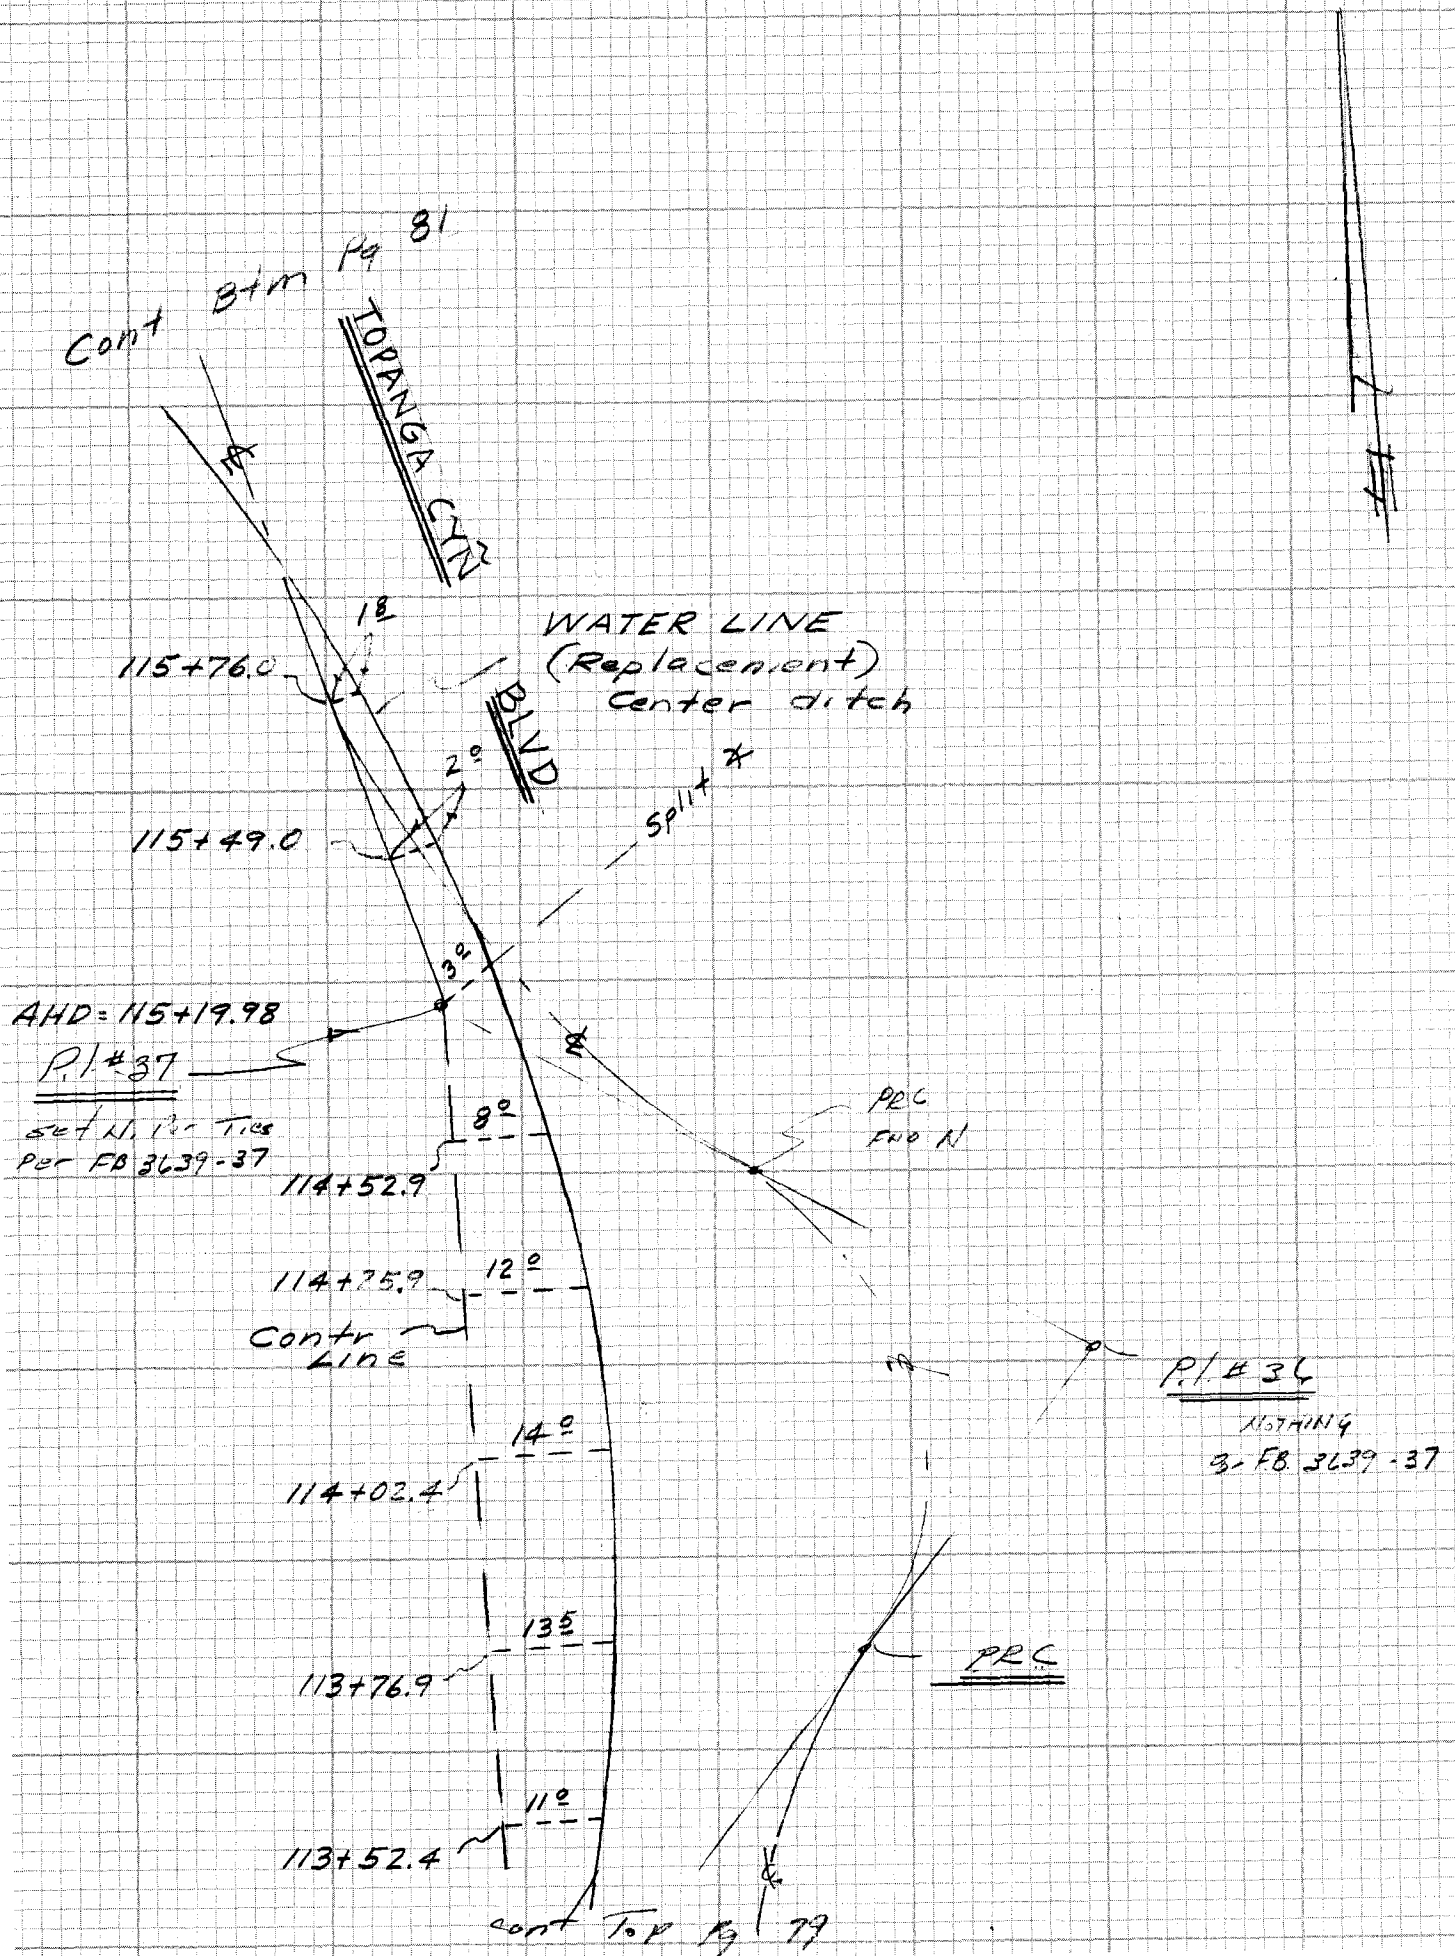

CE 310
76F3095-4/73

PLEASE RETURN TO
LOS ANGELES COUNTY ENGINEER
403 LOS ANGELES COUNTY ENGINEERING BLDG.

Do not extend notes this side of this line

NOTE: ANY ADDITIONS OR CHANGES ON THIS SHEET MUST BE MADE OR CIRCLED IN RED INK WITH DATE AND NAME OF PERSON MAKING CHANGE

Notes Ck'd by	Survey of TOPANGA CYN WT LN F.B. 4448 PG. 81
Map No.	JN 1525.22 Tape Std °F
Office Work	Surveyed by E.L.
Checked	Notes A.CARO Date 11-84
Date	Indexed

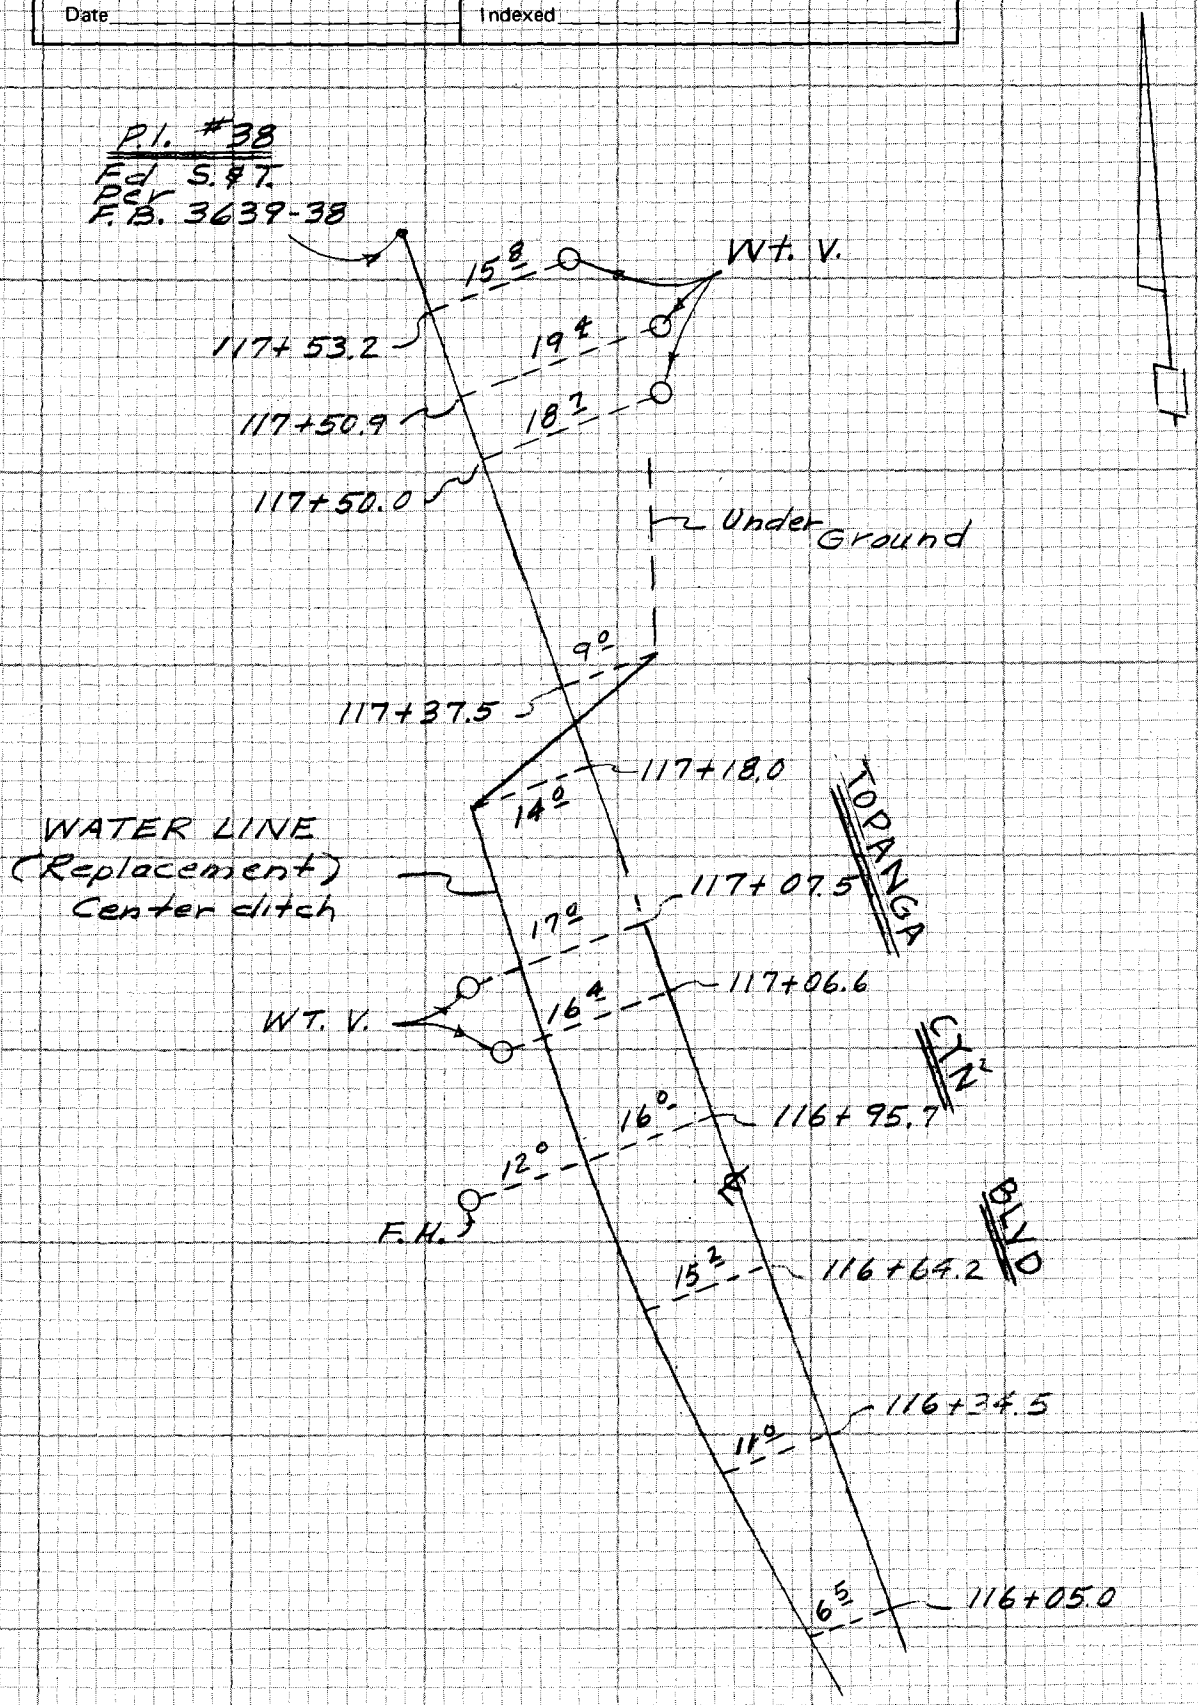

Cont Top Pg 80

NOTE: ANY ADDITIONS OR CHANGES ON THIS SHEET MUST BE MADE OR CIRCLED IN RED INK WITH DATE AND NAME OF PERSON MAKING CHANGE
Do not extend notes this side of this line
PLEASE RETURN TO
LOS ANGELES COUNTY ENGINEER
403 LOS ANGELES COUNTY ENGINEERING BLDG.
CENTERLINE NOTES
CE 310
76F3095-4/73

F.B. 4448 PG. 82

CE 310
76F3095-4/73

PLEASE RETURN TO
LOS ANGELES COUNTY ENGINEER
403 LOS ANGELES COUNTY ENGINEERING BLDG.

Do not extend notes this side of this line

NOTE: ANY ADDITIONS OR CHANGES
ON THIS SHEET MUST BE MADE OR
CIRCLED IN RED INK WITH DATE AND
NAME OF PERSON MAKING CHANGE

Map No.	JN 1525.22 Tape Std °F
Office Work	Surveyed by E. Land
Checked	Notes EL Date 12-84
Date	Indexed

F.B. 4448 PG. 83


J.N. 1525.22

STAKING OF
CAP-OFFS OF
ABANDONED WATER-MAIN

Per Plans
Spec # 4315

NOTE: ANY ADDITIONS OR CHANGES ON THIS SHEET MUST BE MADE OR CIRCLED IN RED INK WITH DATE AND NAME OF PERSON MAKING CHANGE

Do not extend notes this side of this line

PLEASE RETURN TO
LOS ANGELES COUNTY ENGINEER
403 LOS ANGELES COUNTY ENGINEERING BLDG.

CENTERLINE NOTES
CE 310
76F3095-4/73

F.B. 4418 PG. 84

Cont from pg 85

37.1
25
12.

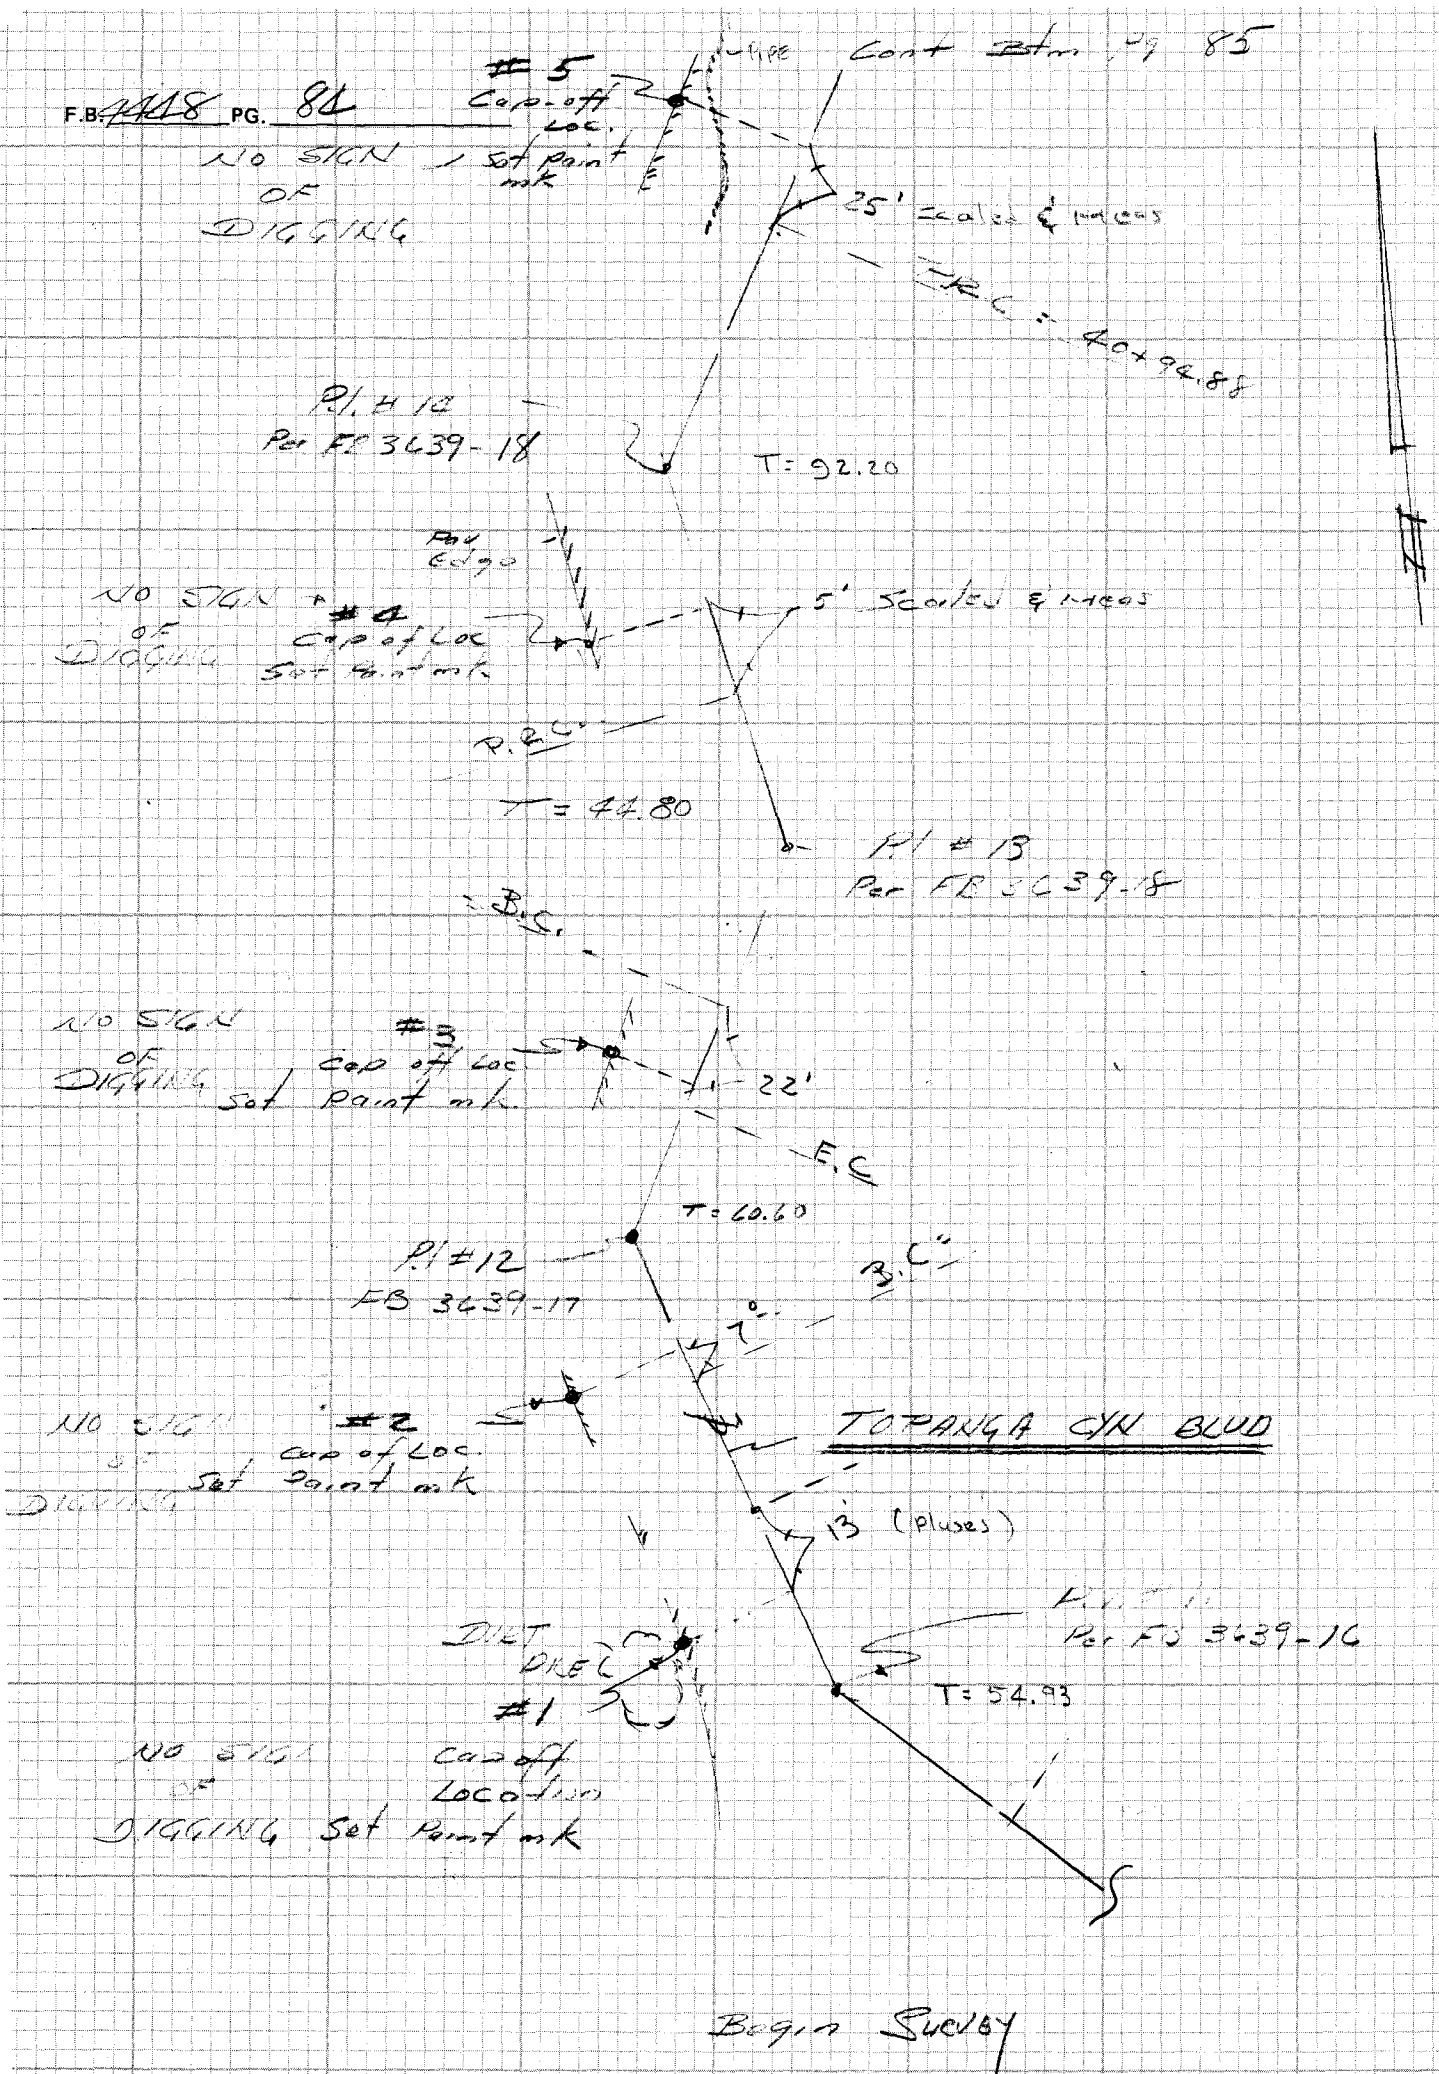

CE 310
76F3095-4/73

PLEASE RETURN TO
LOS ANGELES COUNTY ENGINEER
403 LOS ANGELES COUNTY ENGINEERING BLDG.

Do not extend notes this side of this line

NOTE: ANY ADDITIONS OR CHANGES ON THIS SHEET MUST BE MADE OR CIRCLED IN RED INK WITH DATE AND NAME OF PERSON MAKING CHANGE

Notes Ck'd by	Survey of Topanga Cyn Wtr. F.B. 444-8 PG. 85
Map No.	JN 1525.22 Tape Std °F
Office Work	Surveyed by EL
Checked	Notes EL Date 12-3-84
Date	Indexed

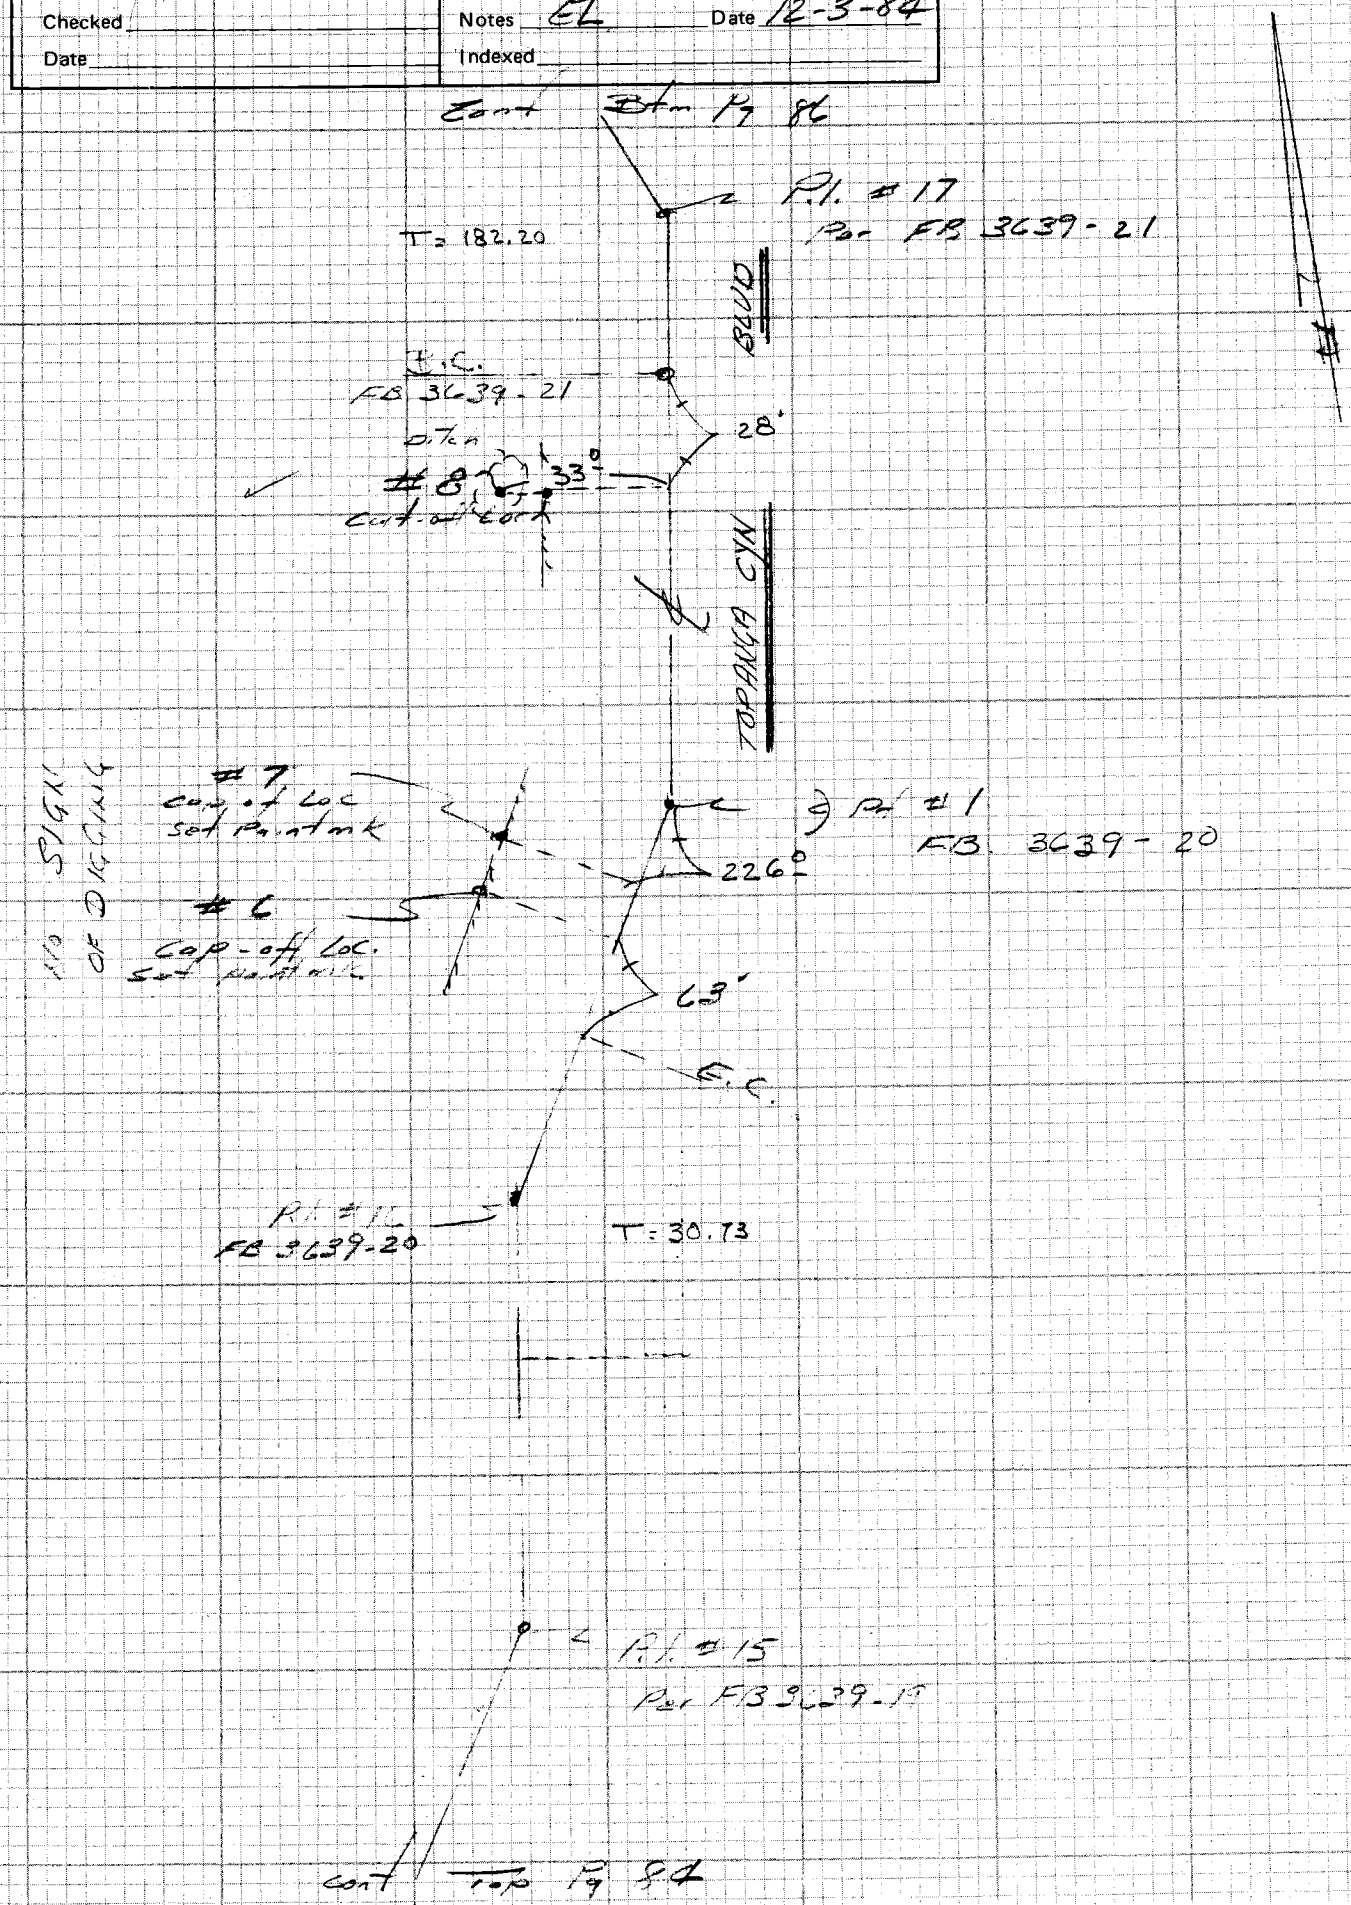

NOTE: ANY ADDITIONS OR CHANGES ON THIS SHEET MUST BE MADE OR CIRCLED IN RED INK WITH DATE AND NAME OF PERSON MAKING CHANGE

Do not extend notes this side of this line

PLEASE RETURN TO
LOS ANGELES COUNTY ENGINEER
403 LOS ANGELES COUNTY ENGINEERING BLDG.

CENTERLINE NOTES
CE 310
76F3095-4/73

F.B. 4448 PG. 86

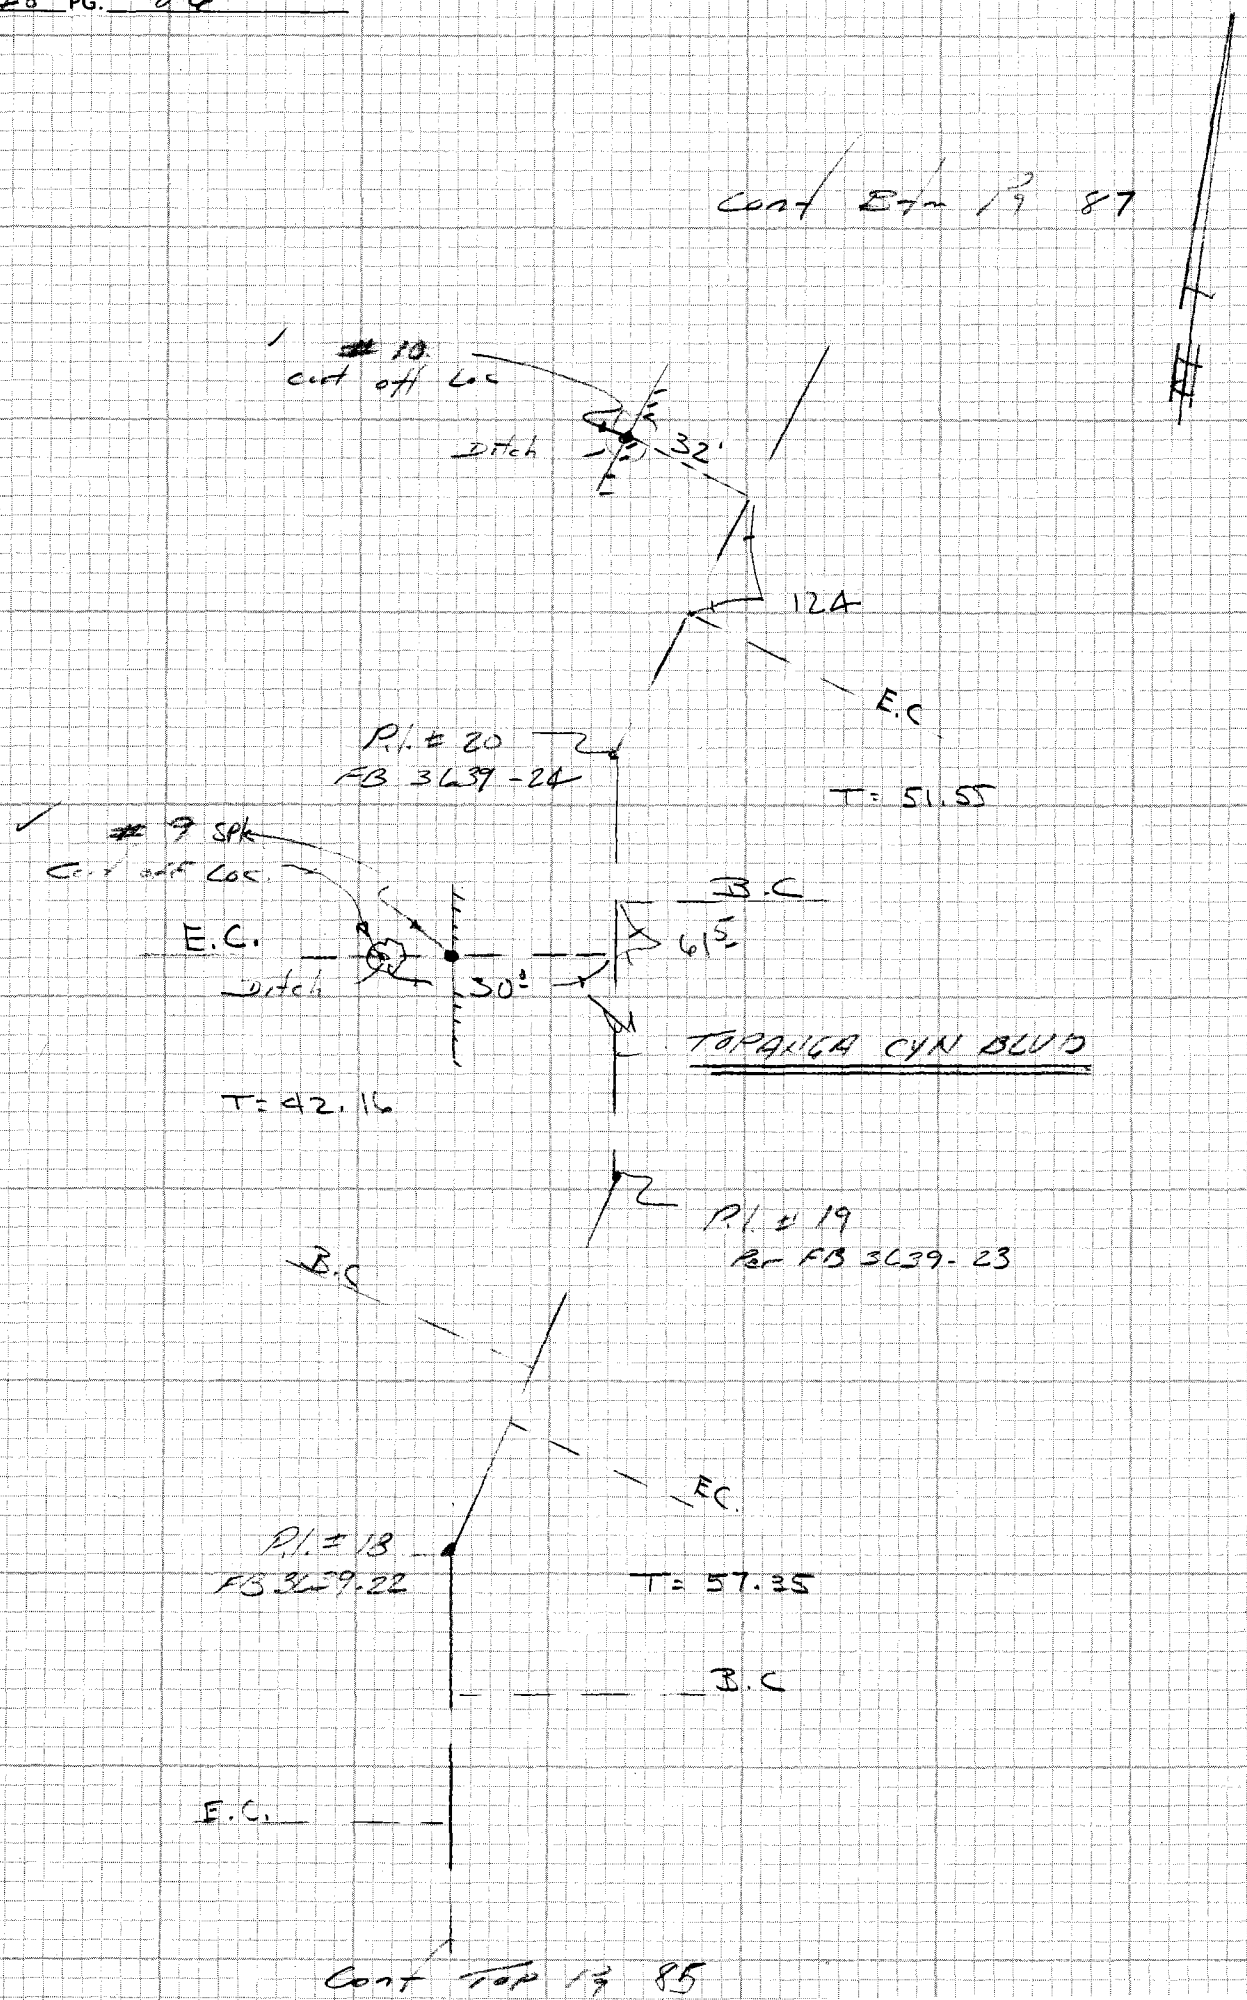

CE 310
76F3095-4/73

PLEASE RETURN TO
LOS ANGELES COUNTY ENGINEER
403 LOS ANGELES COUNTY ENGINEERING BLDG.

Do not extend notes this side of this line

NOTE: ANY ADDITIONS OR CHANGES ON THIS SHEET MUST BE MADE OR CIRCLED IN RED INK WITH DATE AND NAME OF PERSON MAKING CHANGE

Notes Ck'd by	Survey of Topanga Cy. Wt.
Map No.	JN 1525.22 Tape Std °F
Office Work	Surveyed by EL
Checked	Notes EL Date 12-84
Date	Indexed

F.B. 4448 PG. 87

Cont. 34m Pg 88

P.I. # 25
Per FB 3639

P.I. # 24
Per FB. 3639-

P.I. # 23
per FB 3639-

P.I. # 22
Per FB 3639 - 24

P.I. # 21
Per FB 3639-25

cont. To Pg. 86

NOTE: ANY ADDITIONS OR CHANGES ON THIS SHEET MUST BE MADE OR CIRCLED IN RED INK WITH DATE AND NAME OF PERSON MAKING CHANGE

Do not extend note this side of this line

PLEASE RETURN TO
LOS ANGELES COUNTY ENGINEER
403 LOS ANGELES COUNTY ENGINEERING BLDG.

CENTERLINE NOTES
CE 310
76F3095-4/73

F.B. 4448 PG. 88

Cont Bkm 89

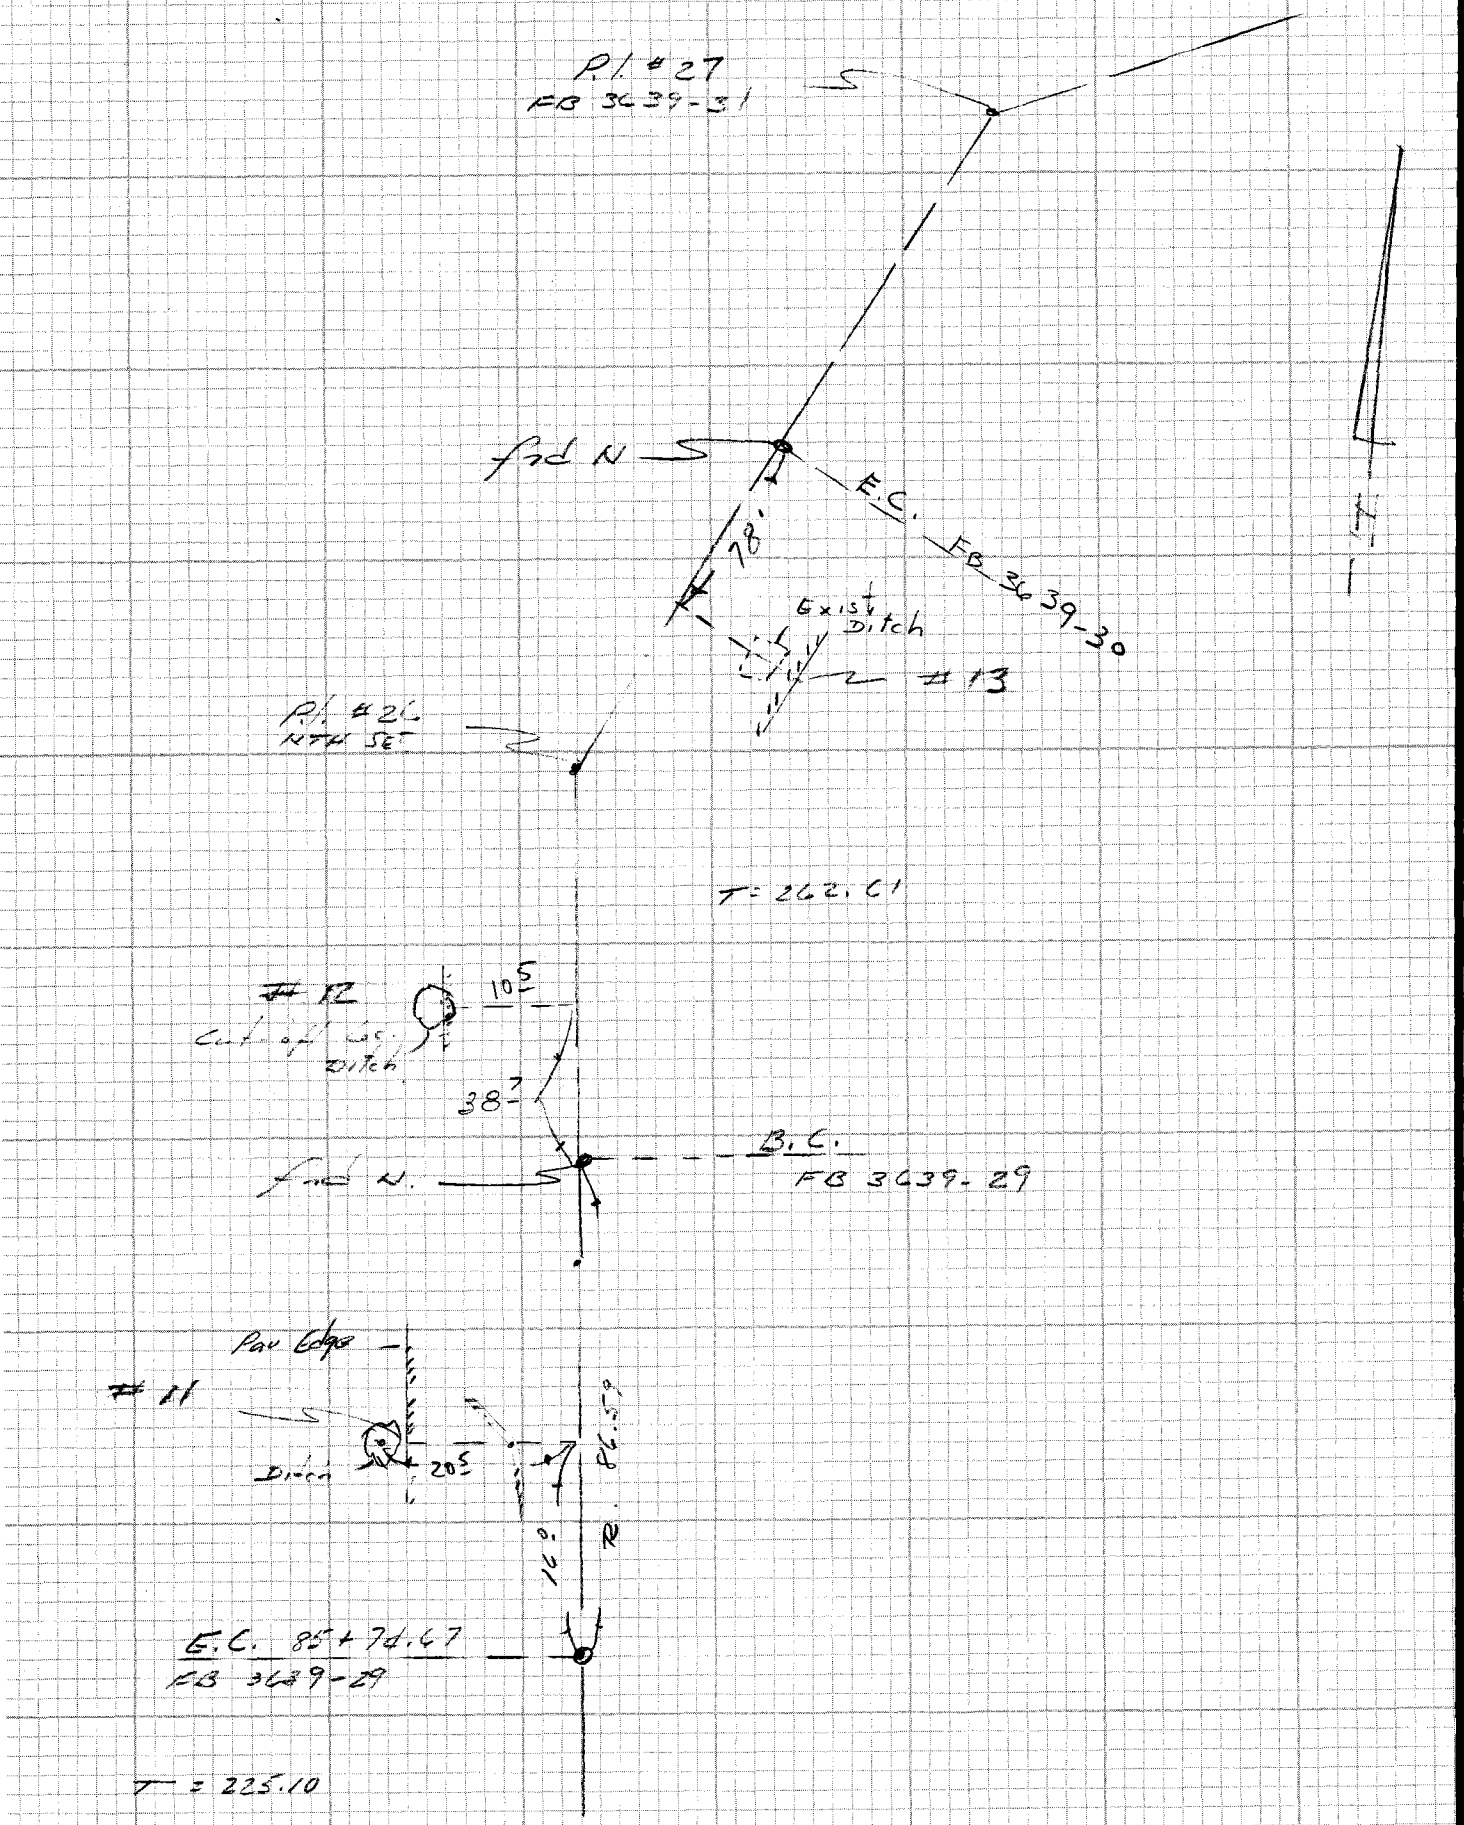

Cont Top 87

CE 310
76F3095-4/73

PLEASE RETURN TO
LOS ANGELES COUNTY ENGINEER
403 LOS ANGELES COUNTY ENGINEERING BLDG.

Do not extend notes this side of this line

NOTE: ANY ADDITIONS OR CHANGES ON THIS SHEET MUST BE MADE OR CIRCLED IN RED INK WITH DATE AND NAME OF PERSON MAKING CHANGE

Notes Ck'd by	Survey of Topanga Cyn
Map No.	JN/525.22 Tape Std °F
Office Work	Surveyed by EL
Checked	Notes EL Date 12-84
Date	Indexed

F.B. 448 PG. 89

Cont Bkn Pg. 90

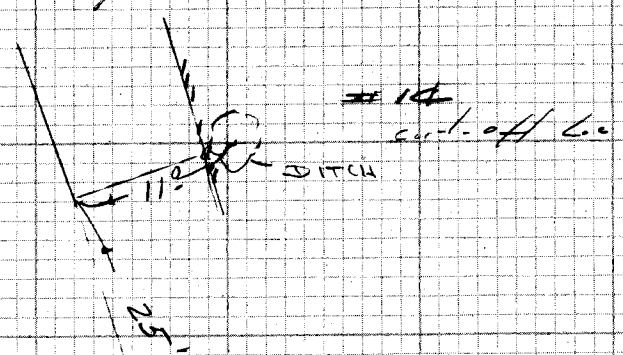

T = 46.89

PI # 29
Per FB 3639-33
2°1.?

Cmp/o Pt 2
Per FB 3639-

PI # 28
per FB

Cont To Pg 88

NOTE: ANY ADDITIONS OR CHANGES ON THIS SHEET MUST BE MADE OR CIRCLED IN RED INK WITH DATE AND NAME OF PERSON MAKING CHANGE
Do not extend note this side of this line
PLEASE RETURN TO
LOS ANGELES COUNTY ENGINEER
403 LOS ANGELES COUNTY ENGINEERING BLDG.
CENTERLINE NOTES
CE 310
76F3095-4/73

F.B. 4148 PG. 90

Cont from p. 91

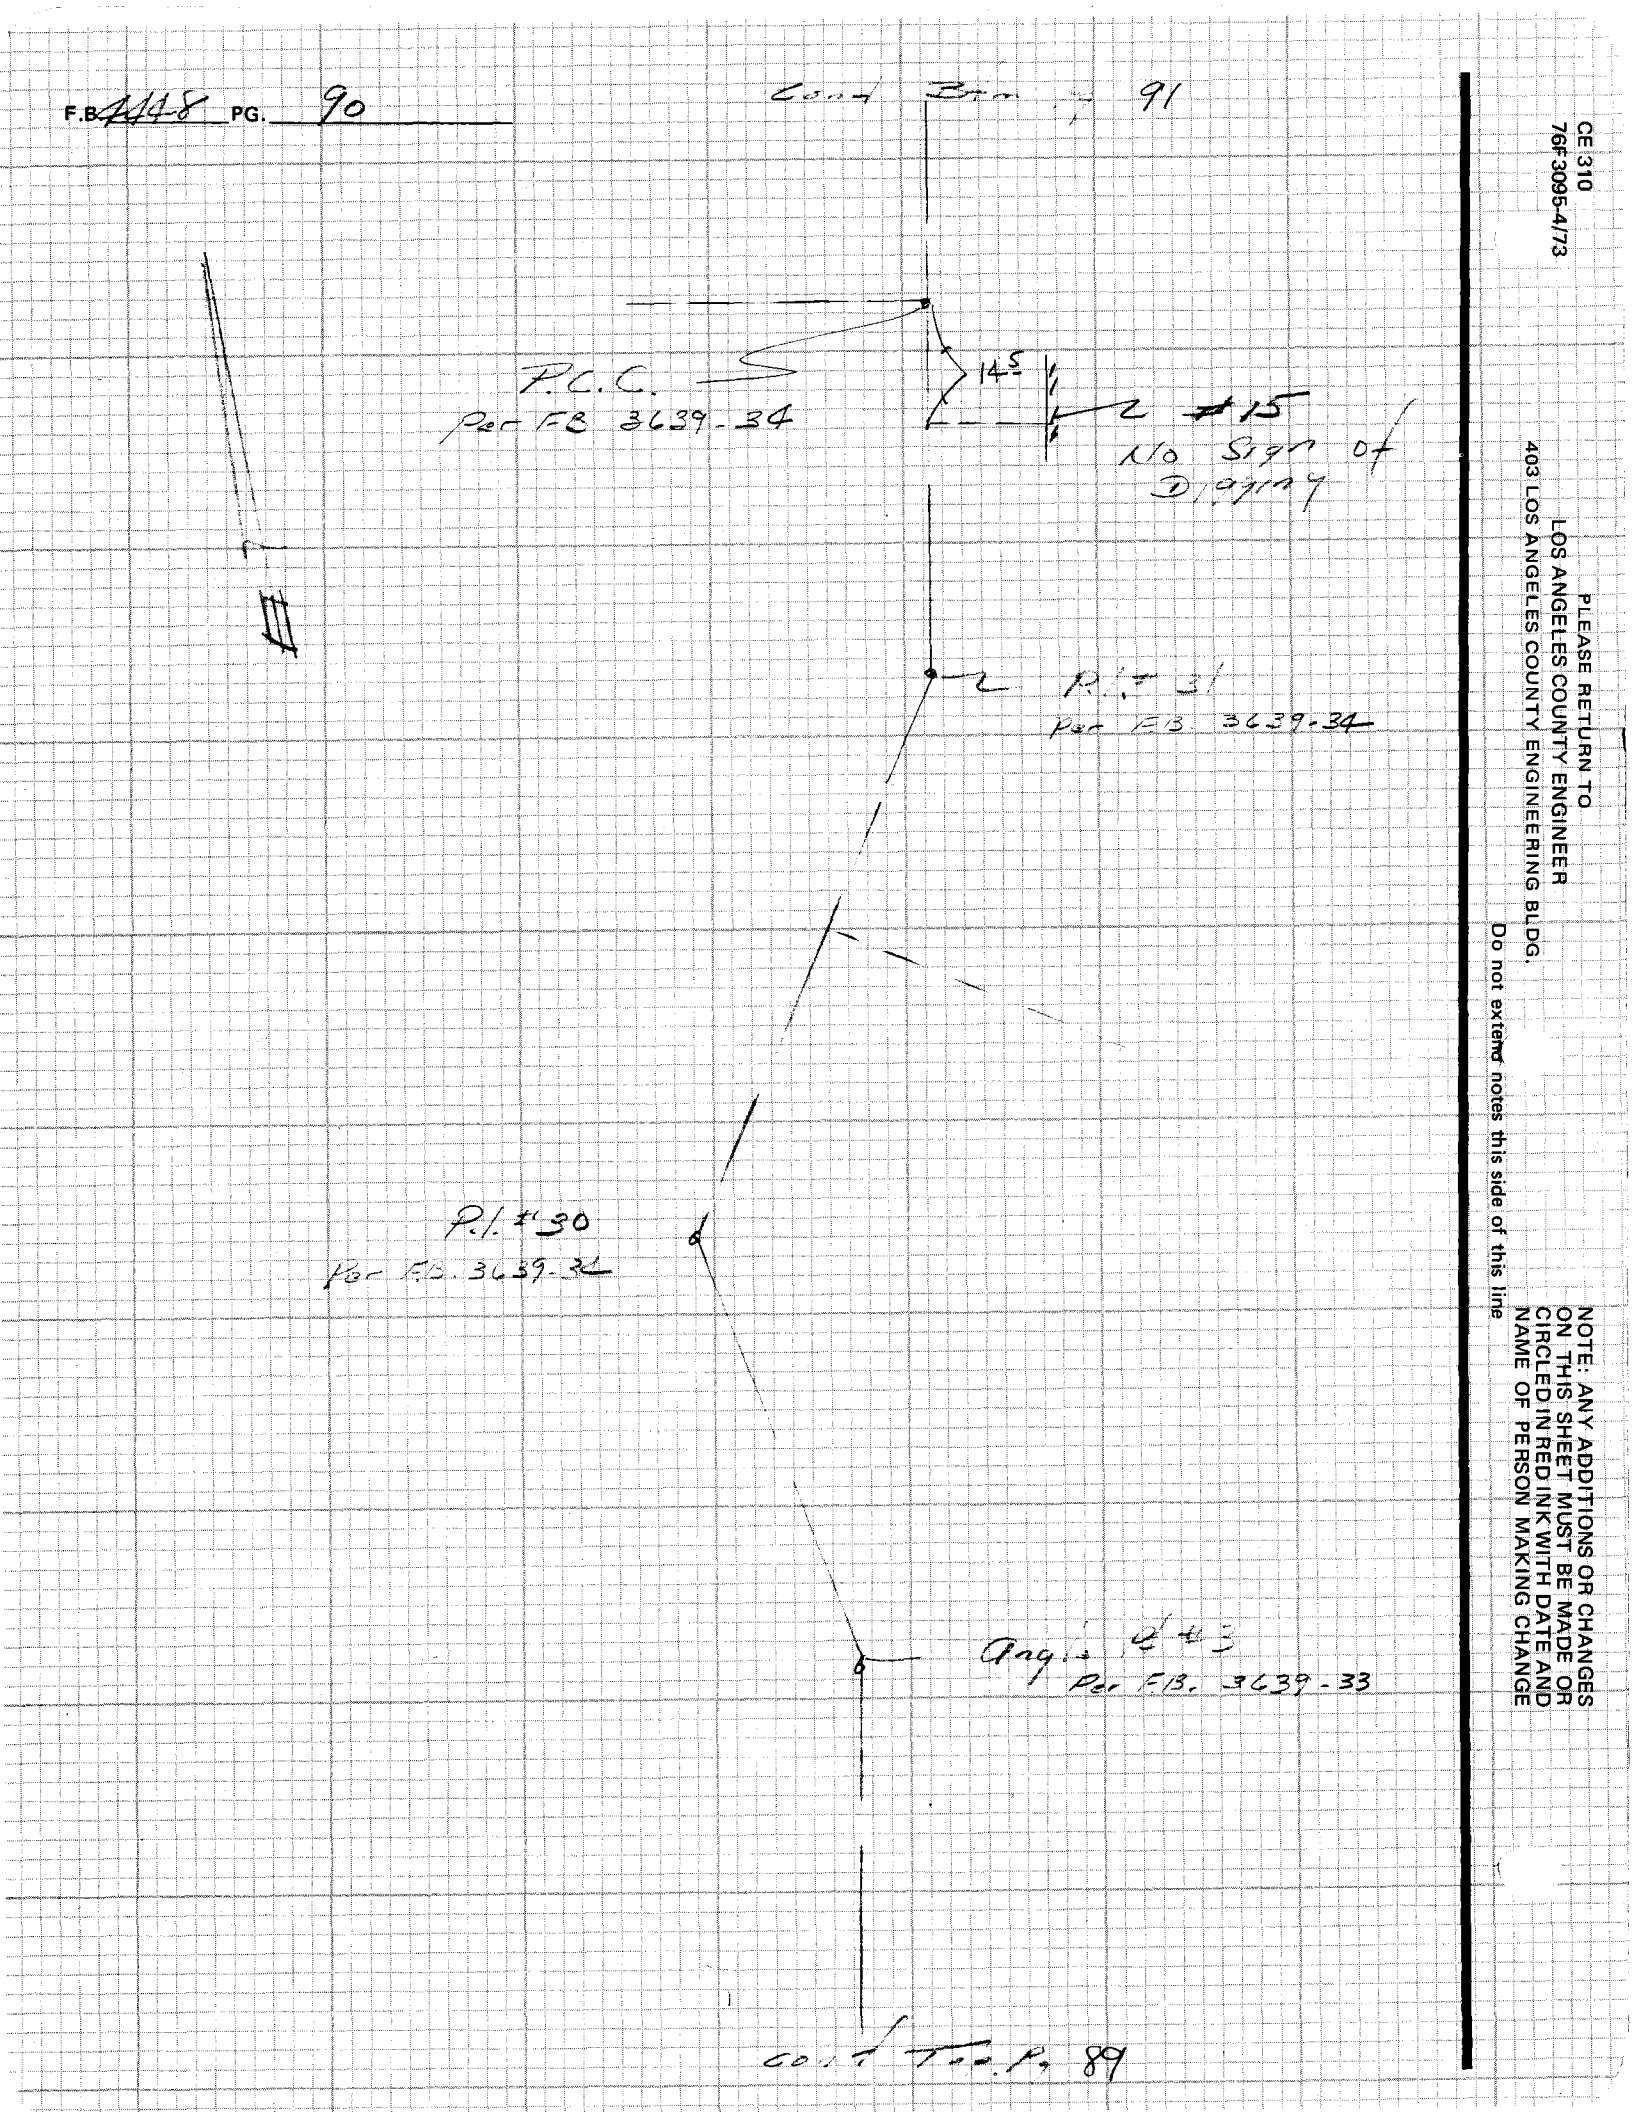

Cont To p. 89

CE 310
76F 3095-4/73

PLEASE RETURN TO
LOS ANGELES COUNTY ENGINEER
403 LOS ANGELES COUNTY ENGINEERING BLDG.

Do not extend notes this side of this line

NOTE: ANY ADDITIONS OR CHANGES ON THIS SHEET MUST BE MADE OR CIRCLED IN RED INK WITH DATE AND NAME OF PERSON MAKING CHANGE

Notes Ck'd by	Survey of Topanga Cyn
Map No.	JN 0303.00 Tape Std °F
Office Work	Surveyed by EL
Checked	Notes Date 12-84
Date	Indexed

F.B. 4448 PG. 91

Cont Btm Pg. 92

P.I. #37
Per FB. 3639-37

P.I. #36
FB 3639-37

P.I. #35
FB 3639-36

P.I. #34
Per FB 3639-36

P.I. #33
Per FB 3639-35

P.I. #32
Per FB 3639-35

Cont Top Pg 90

NOTE: ANY ADDITIONS OR CHANGES ON THIS SHEET MUST BE MADE OR CIRCLED IN RED INK WITH DATE AND NAME OF PERSON MAKING CHANGE

Do not extend notes this side of this line

PLEASE RETURN TO
LOS ANGELES COUNTY ENGINEER
403 LOS ANGELES COUNTY ENGINEERING BLDG.

CENTERLINE NOTES
CE 310
76F3095-4/73

F.B. 4418 PG. 92

CE 310
76F 3095-4/73

PLEASE RETURN TO
LOS ANGELES COUNTY ENGINEER
403 LOS ANGELES COUNTY ENGINEERING BLDG.

Do not enter notes this side of this line

NOTE: ANY ADDITIONS OR CHANGES ON THIS SHEET MUST BE MADE OR CIRCLED IN RED INK WITH DATE AND NAME OF PERSON MAKING CHANGE

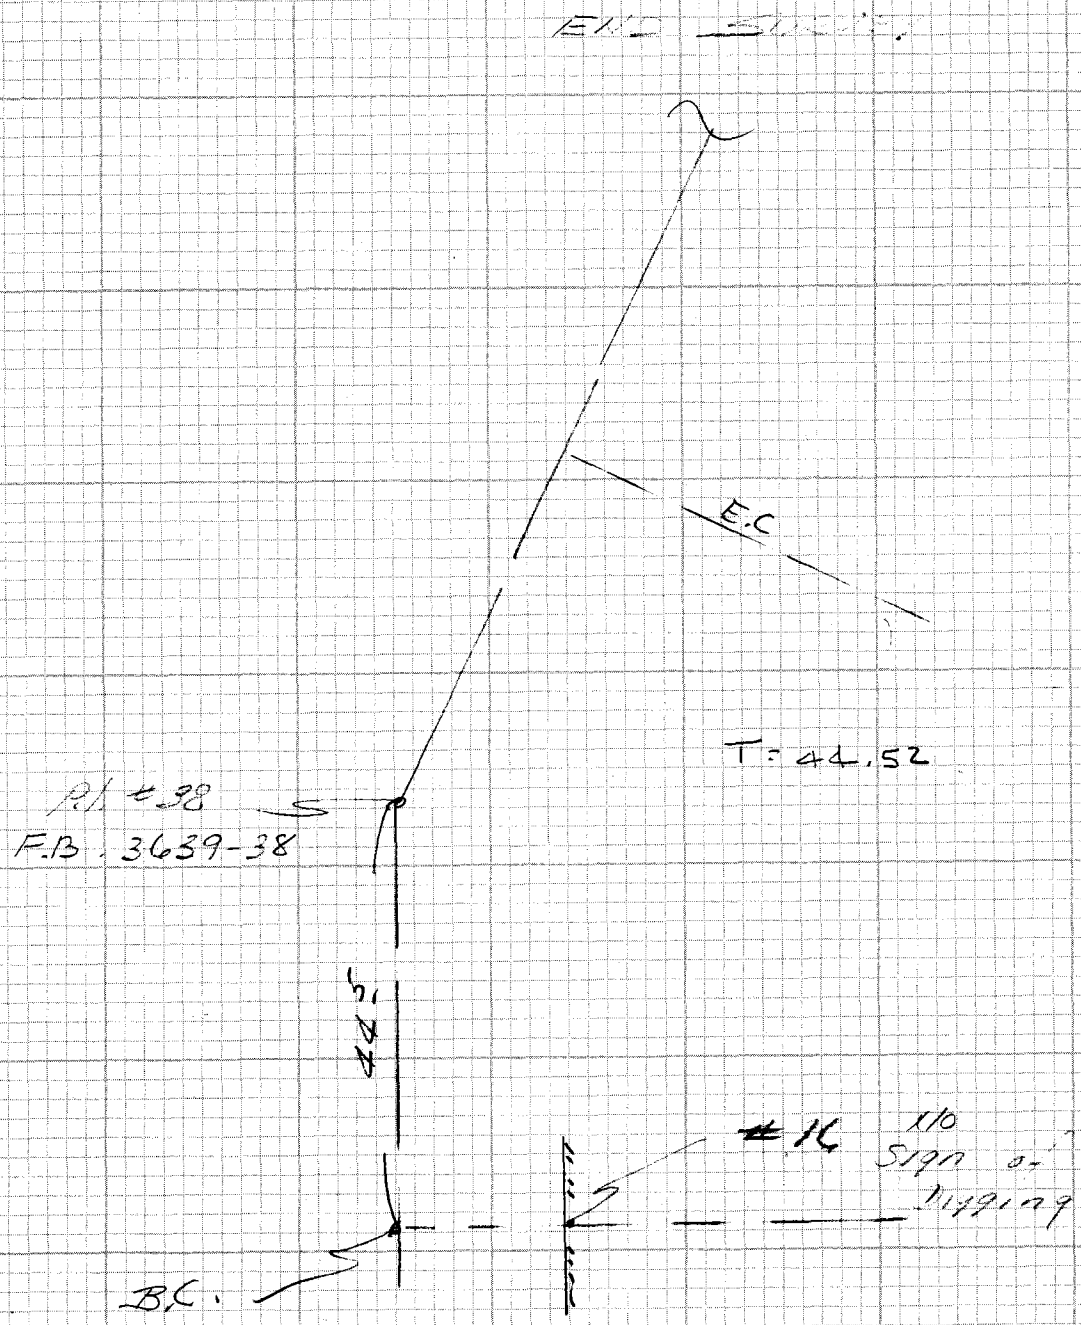

cont Top of 91

STEPHEN J. KOONCE
COUNTY ENGINEER

HIAM BARMACK
CHIEF DEPUTY

COUNTY OF LOS ANGELES
DEPARTMENT OF COUNTY ENGINEER-FACILITIES

550 SOUTH VERMONT, LOS ANGELES, CA 90020

(213) 738-2011

BOARD OF SUPERVISORS

PETER F. SCHABARUM
KENNETH HAHN
EDMUND D. EDELMAN
DEANE DANA
MICHAEL D. ANTONOVICH

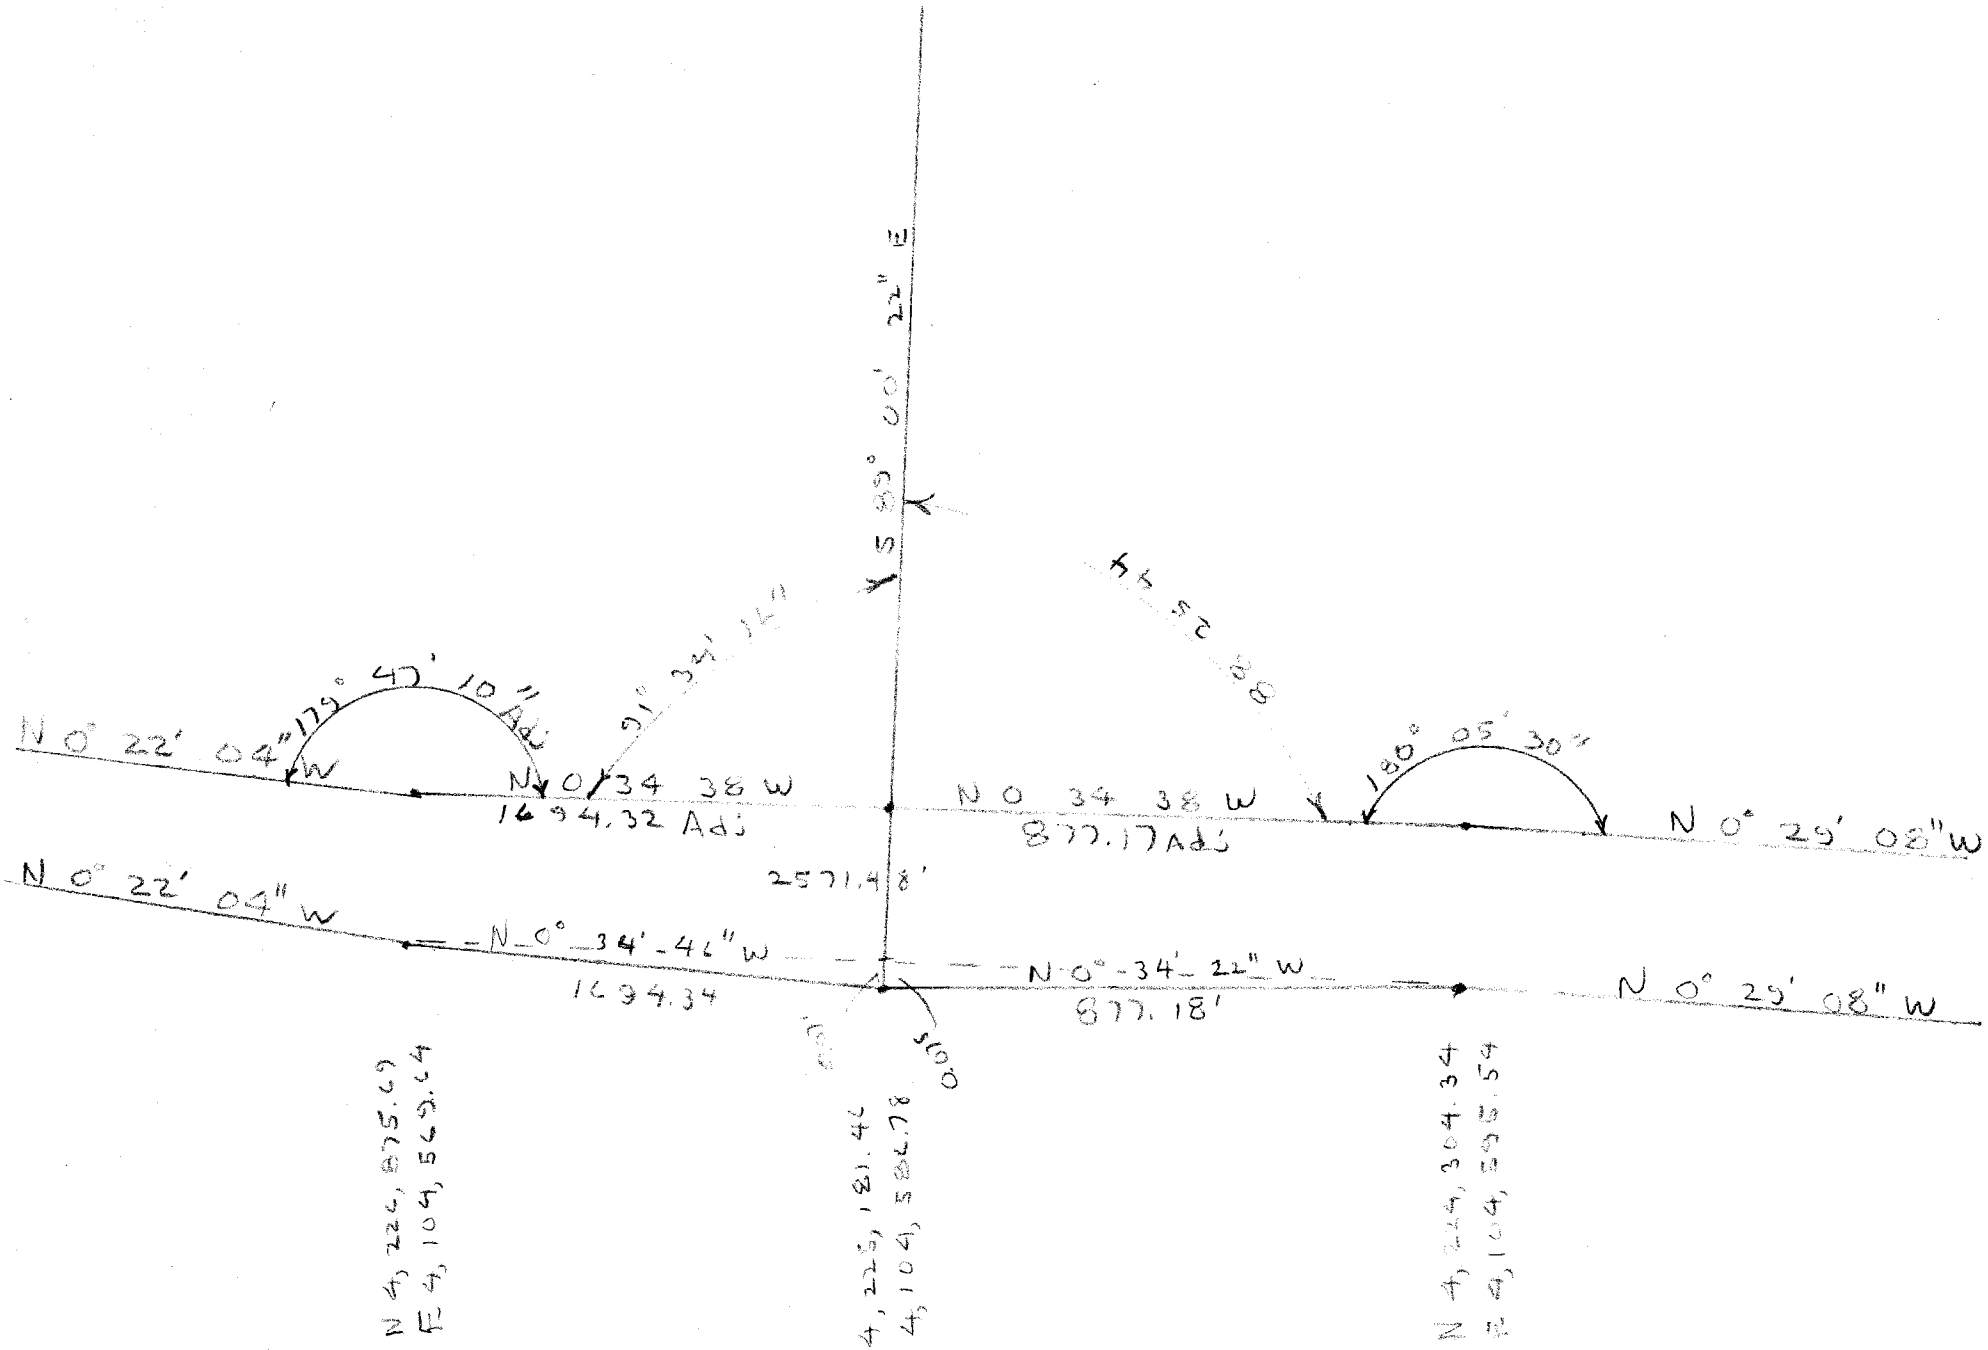
N 0° 22' 04" W
179° 47' 10"
Adj
91° 34' 14"
N 0° 34' 38" W
1694.32 Adj
N 0° 22' 04" W
N 0° 34' 46" W
1694.34
N 4,224,875.69
E 4,104,569.64
S 89° 00' 22" E
2571.48'
S 88° 25' 38"
N 0° 34' 38" W
877.17 Adj
180° 05' 30"
N 0° 29' 08" W
N 0° 34' 22" W
877.18'
N 0° 29' 08" W
S 00°
4,225,181.46
4,104,584.78
N 4,224,304.34
E 4,104,595.54

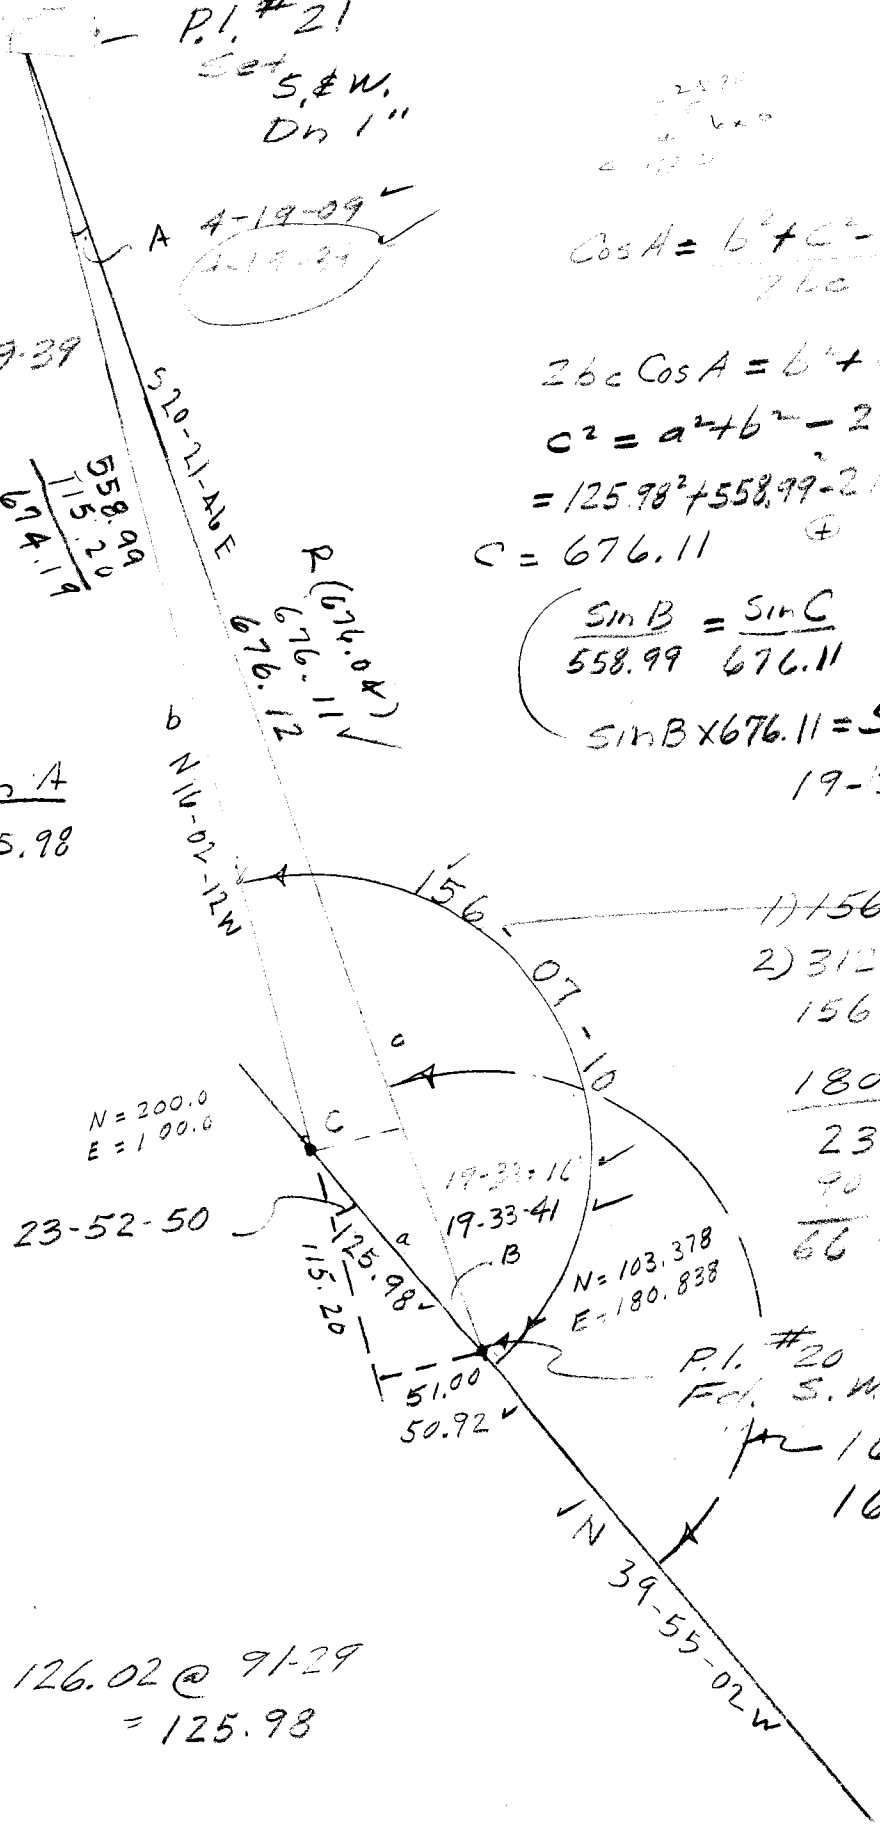

$\cos A = \frac{b^2 + c^2 - a^2}{2bc}$

$2bc \cos A = b^2 + c^2 - a^2$

$c^2 = a^2 + b^2 - 2ab \cos C$

$= 125.98^2 + 558.99^2 - 2 \cdot 125.98 \times 558.99 \cos C$

$C = 676.11$

$\frac{\sin B}{558.99} = \frac{\sin C}{676.11}$

$\sin B \times 676.11 = \sin C \times 558.99$

19-33-16

559.00 @ 89-39
= 558.99

558.99
115.20
674.19

$\frac{\sin 19\text{-}33\text{-}16}{558.99} = \frac{\sin A}{125.98}$

1) 156-07-10
2) 312-14-20
156-07-10
180-00-00
23-52-50
90-00-00
66-07-10

126.02 @ 91-29
= 125.98

$\frac{\sin B}{558.99} = \frac{\sin A}{125.98}$ 4-19-34

19-31-20

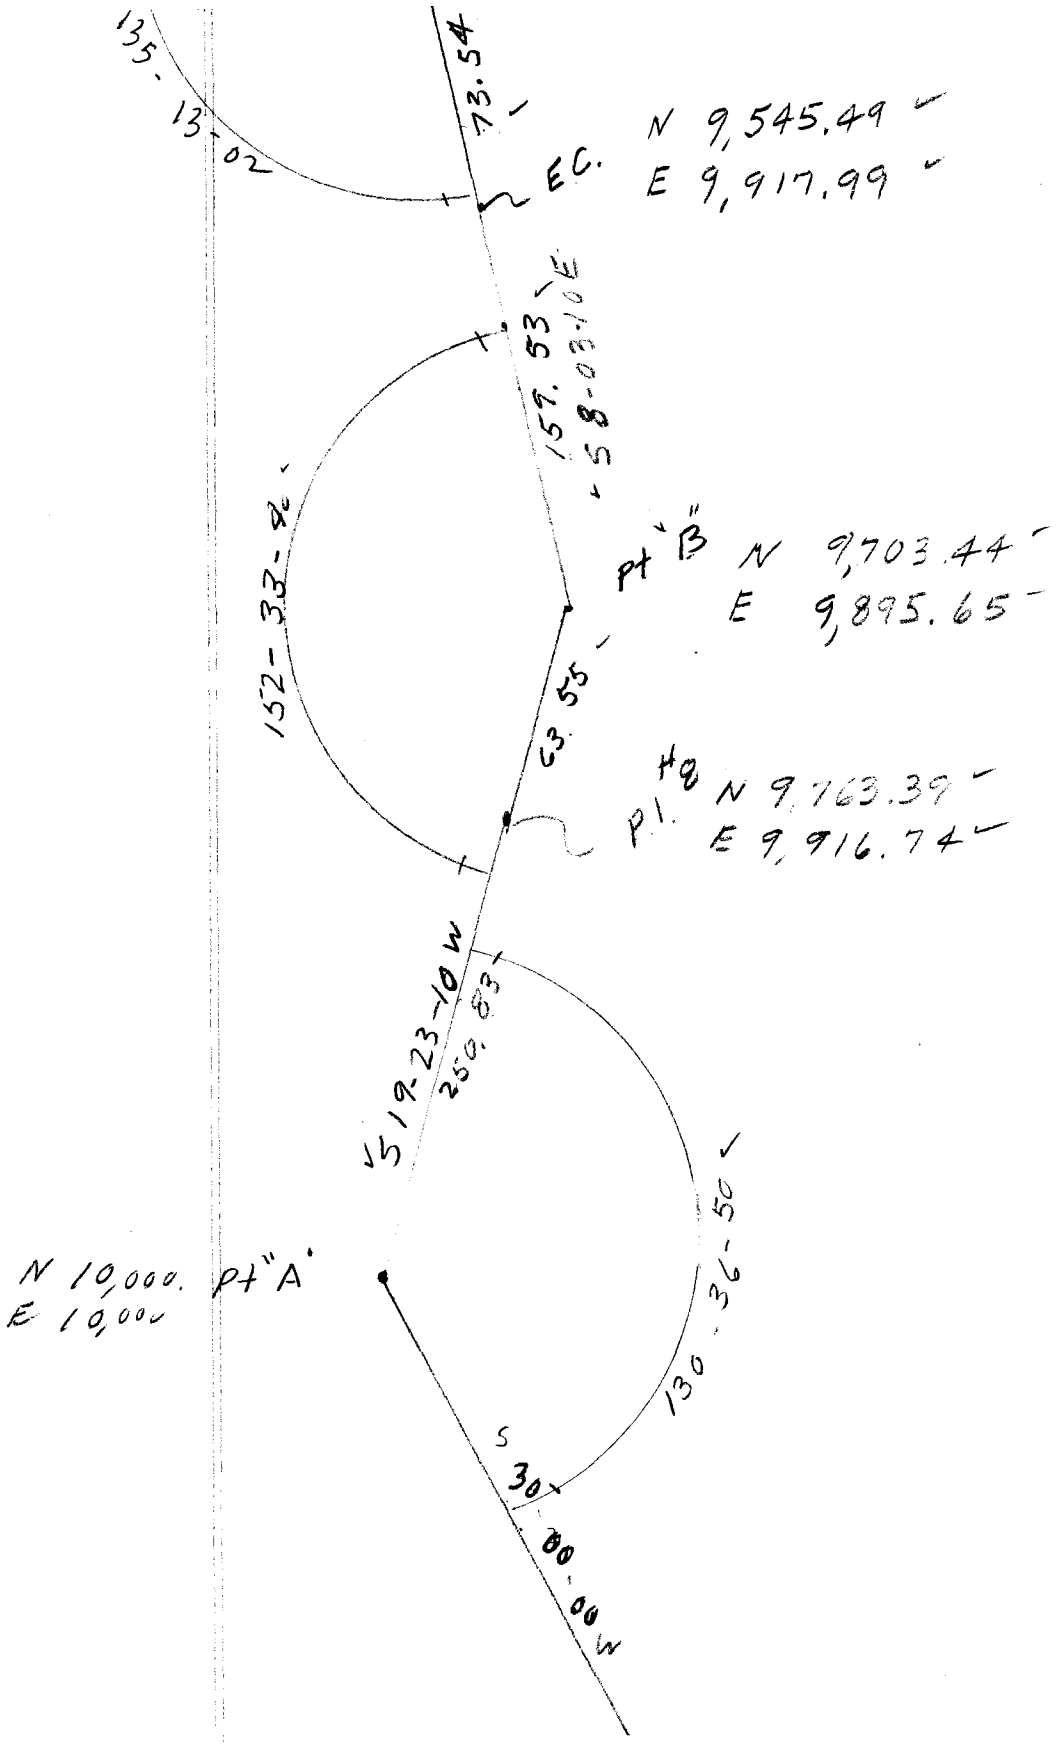
135.13.02
73.54
EC.
N 9,545.49
E 9,917.99
157.53
S 8-03-10 E
152-33-42
pt "B"
N 9,703.44
E 9,895.65
63.55
pt. "B"
N 9,763.39
E 9,916.74
S 19-23-10 W
250.83
130.36.50
N 10,000.
E 10,000
pt "A"
S 30-00-00 W

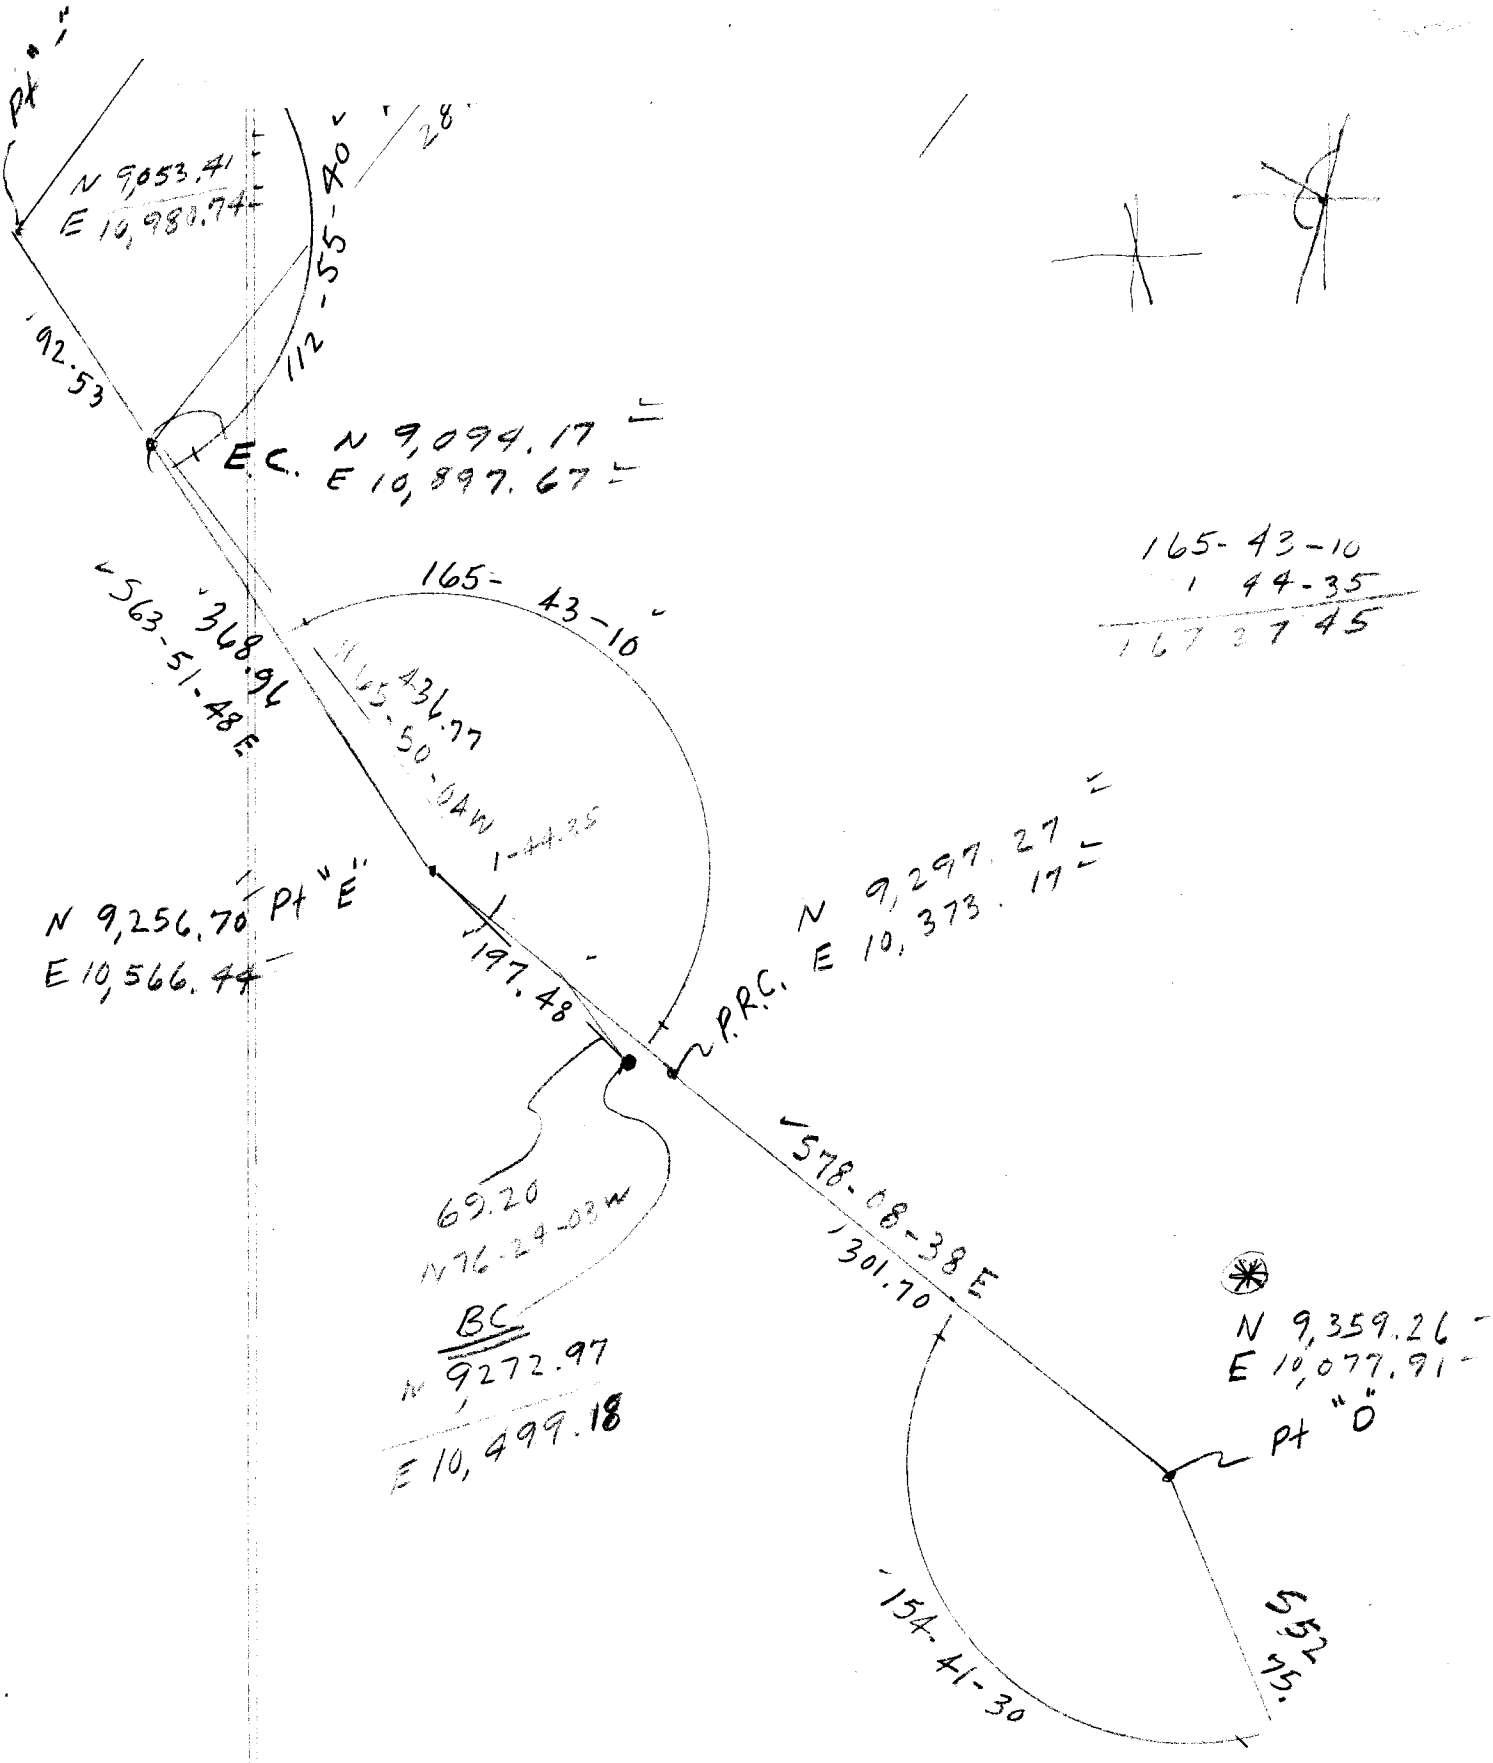
Pt "
N 9,053.41
E 10,980.74
112-55-40
28
192.53
E.C. N 9,094.17
E 10,897.67
165-43-10
1 44-35
167 27 45
563-51-48 E
368.96
165-43-10
165-436.77
50-04W
1-44.35
N 9,256.70 Pt "E"
E 10,566.44
197.48
P.R.C. N 9,297.27
E 10,373.17
578-08-38 E
301.70
69.20
N76-24-08W
BC
N 9272.97
E 10,499.18
N 9,359.26
E 10,077.91
Pt "D"
154-41-30
552.75

Notes Ck'd by	Survey of [illegible]
Map No.	JN 0208.21 Tape Std °F
Office Work	Surveyed by E. Lo[illegible]
Checked	Notes EL Date 3-85
Date	Indexed

F.B. 4148 PG. 93

TOPANGA CYN BLVD

L.A. COUNTY

RE-SETTING TIES & PT. PTS

ALONG

TOPANGA CYN BLVD

REF:

FB 8639

" 2061

NOTE: ANY ADDITIONS OR CHANGES ON THIS SHEET MUST BE MADE OR CIRCLED IN RED INK WITH DATE AND NAME OF PERSON MAKING CHANGE

Do not extend notes this side of this line

PLEASE RETURN TO

LOS ANGELES COUNTY ENGINEER

403 LOS ANGELES COUNTY ENGINEERING BLDG.

CENTERLINE NOTES

CE 310

76F3095-4/73

F.B. 4448 PG. 94

INDEX

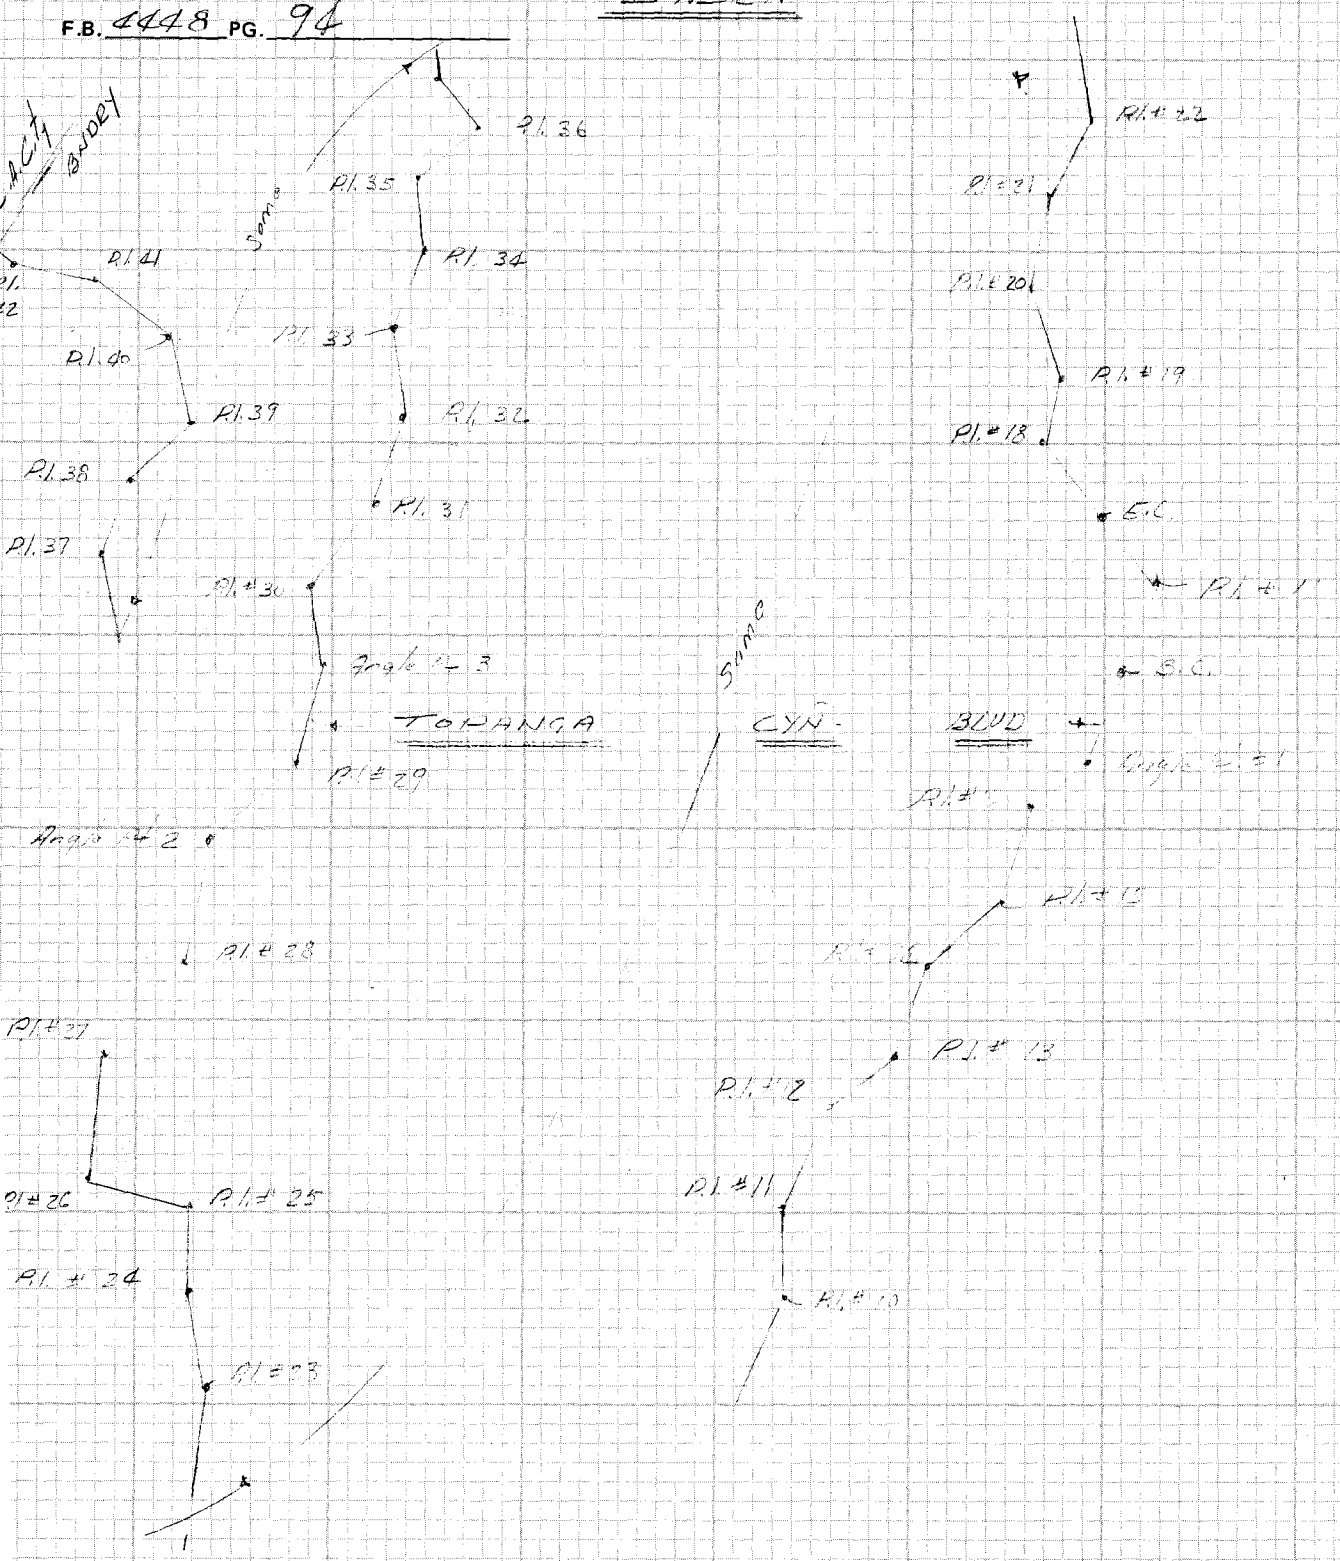

CE 310
76F3095-4/73

PLEASE RETURN TO
LOS ANGELES COUNTY ENGINEER
403 LOS ANGELES COUNTY ENGINEERING BLDG.

Do not extend notes this side of this line

NOTE: ANY ADDITIONS OR CHANGES ON THIS SHEET MUST BE MADE OR CIRCLED IN RED INK WITH DATE AND NAME OF PERSON MAKING CHANGE

Notes Ck'd by	Survey of Topanga Cyn Rd
Map No.	JN 0303.00 Tape Std °F
Office Work	Surveyed by E.G.
Checked	Notes H.B. m. Tho. Date 5-85
Date	Indexed

F.B. 4448 PG. 13

TOPANGA CYN 3100

J.N. 0303.00

R-[illegible]

SET NEW TIES

Per. FB 3639 Pg 5-38

Cat FB [illegible]

(Note: For Calc Angles
E. List: Shown on
Pg: 98-102
See Pg: 117-120)

E. Conde
A. Cord
F.S. m. Tho.

NOTE: ANY ADDITIONS OR CHANGES ON THIS SHEET MUST BE MADE OR CIRCLED IN RED INK WITH DATE AND NAME OF PERSON MAKING CHANGE

Do not extend notes this side of this line

PLEASE RETURN TO
LOS ANGELES COUNTY ENGINEER
403 LOS ANGELES COUNTY ENGINEERING BLDG.

CENTERLINE NOTES
CE 310
76F3095-4/73

F.B. 4448 PG. 91

INDEX.

TOPANGA CYN. BLVD.

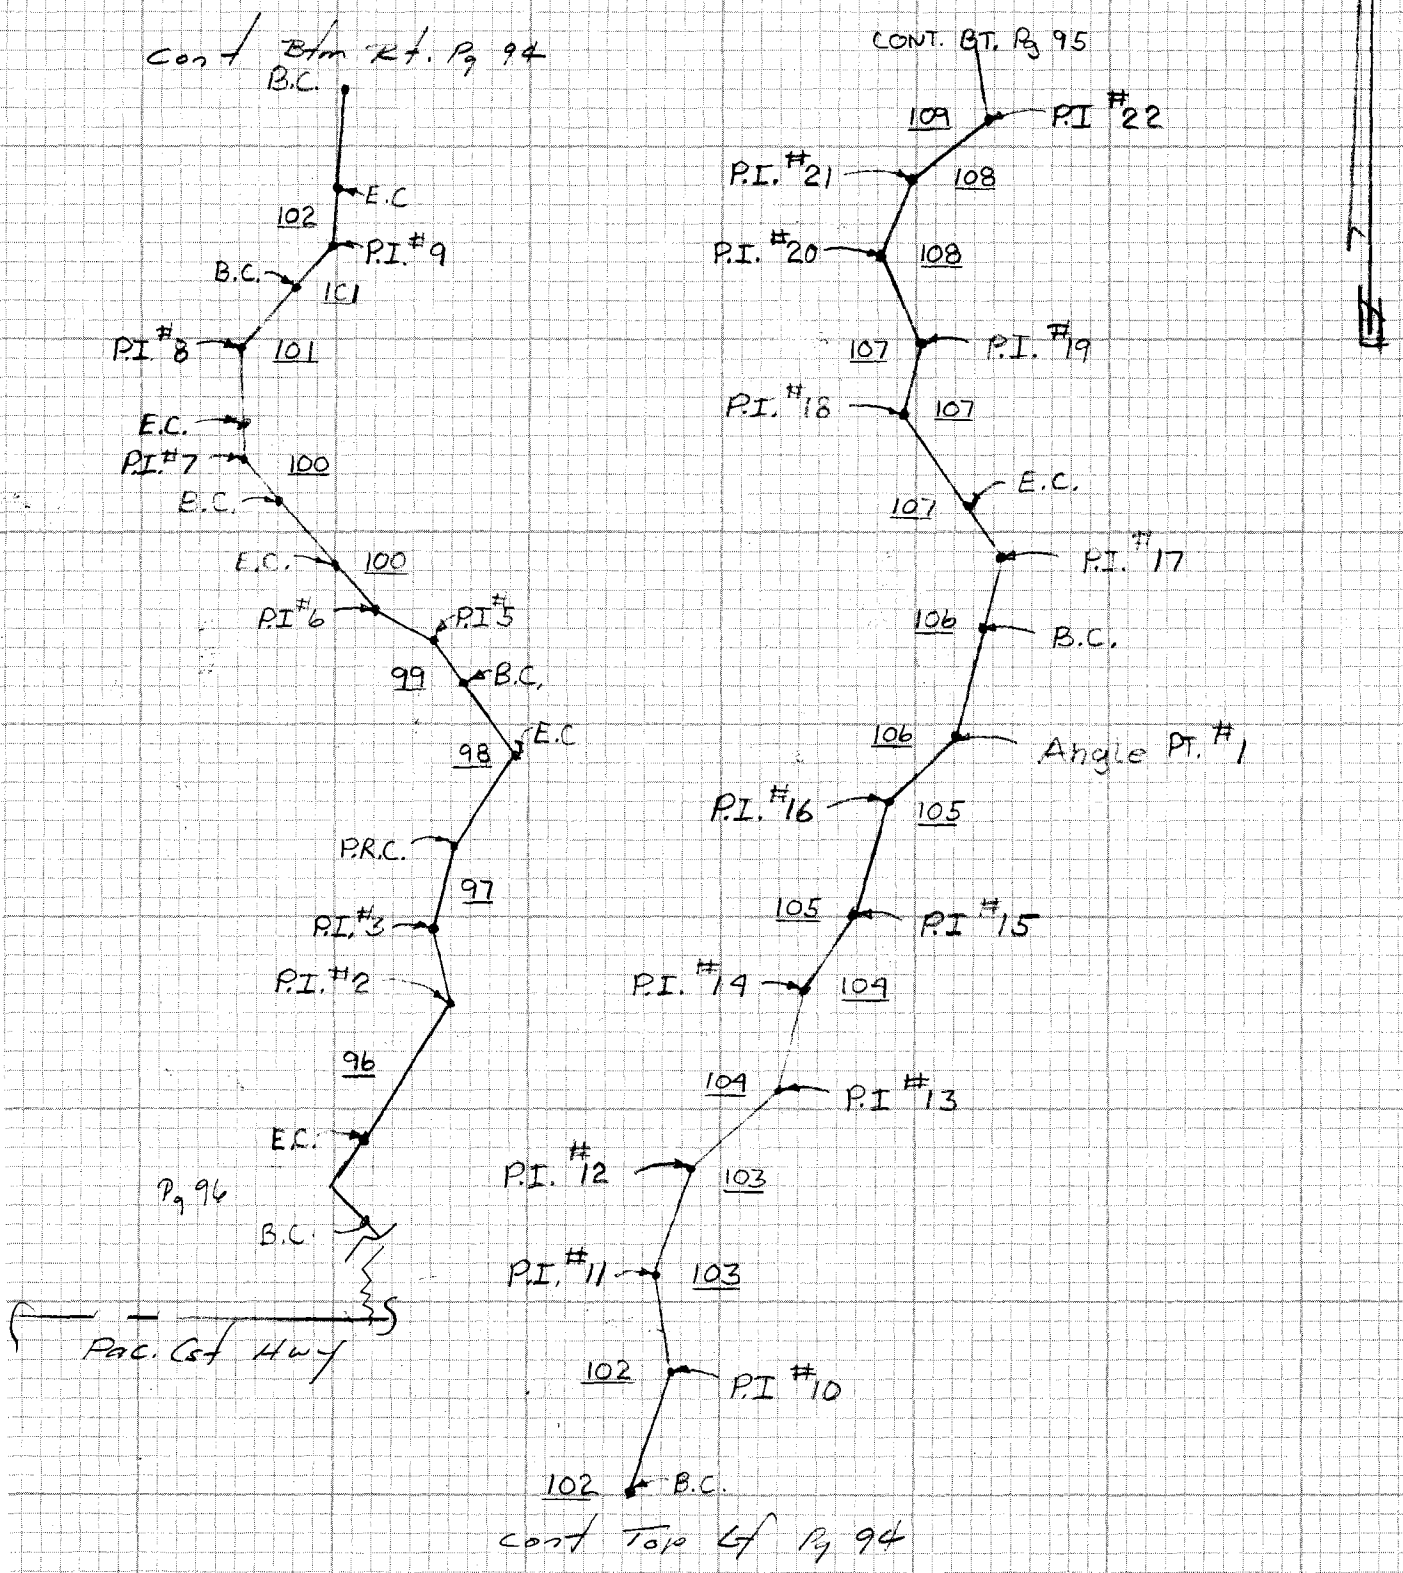

CE 310
76F3095-4/73

PLEASE RETURN TO
LOS ANGELES COUNTY ENGINEER
403 LOS ANGELES COUNTY ENGINEERING BLDG.

Do not extend notes this side of this line

NOTE: ANY ADDITIONS OR CHANGES
ON THIS SHEET MUST BE MADE OR
CIRCLED IN RED INK WITH DATE AND
NAME OF PERSON MAKING CHANGE

Notes Ck'd by	Survey of Topanga Cyn. Blvd.
Map No.	JN 030300 Tape Std °F
Office Work	Surveyed by E.L.
Checked	Notes H.B. Mitchell Date 5-85
Date	Indexed

F.B. 4448 PG. 95

INDEX

TOPANGA CYN. BLVD.

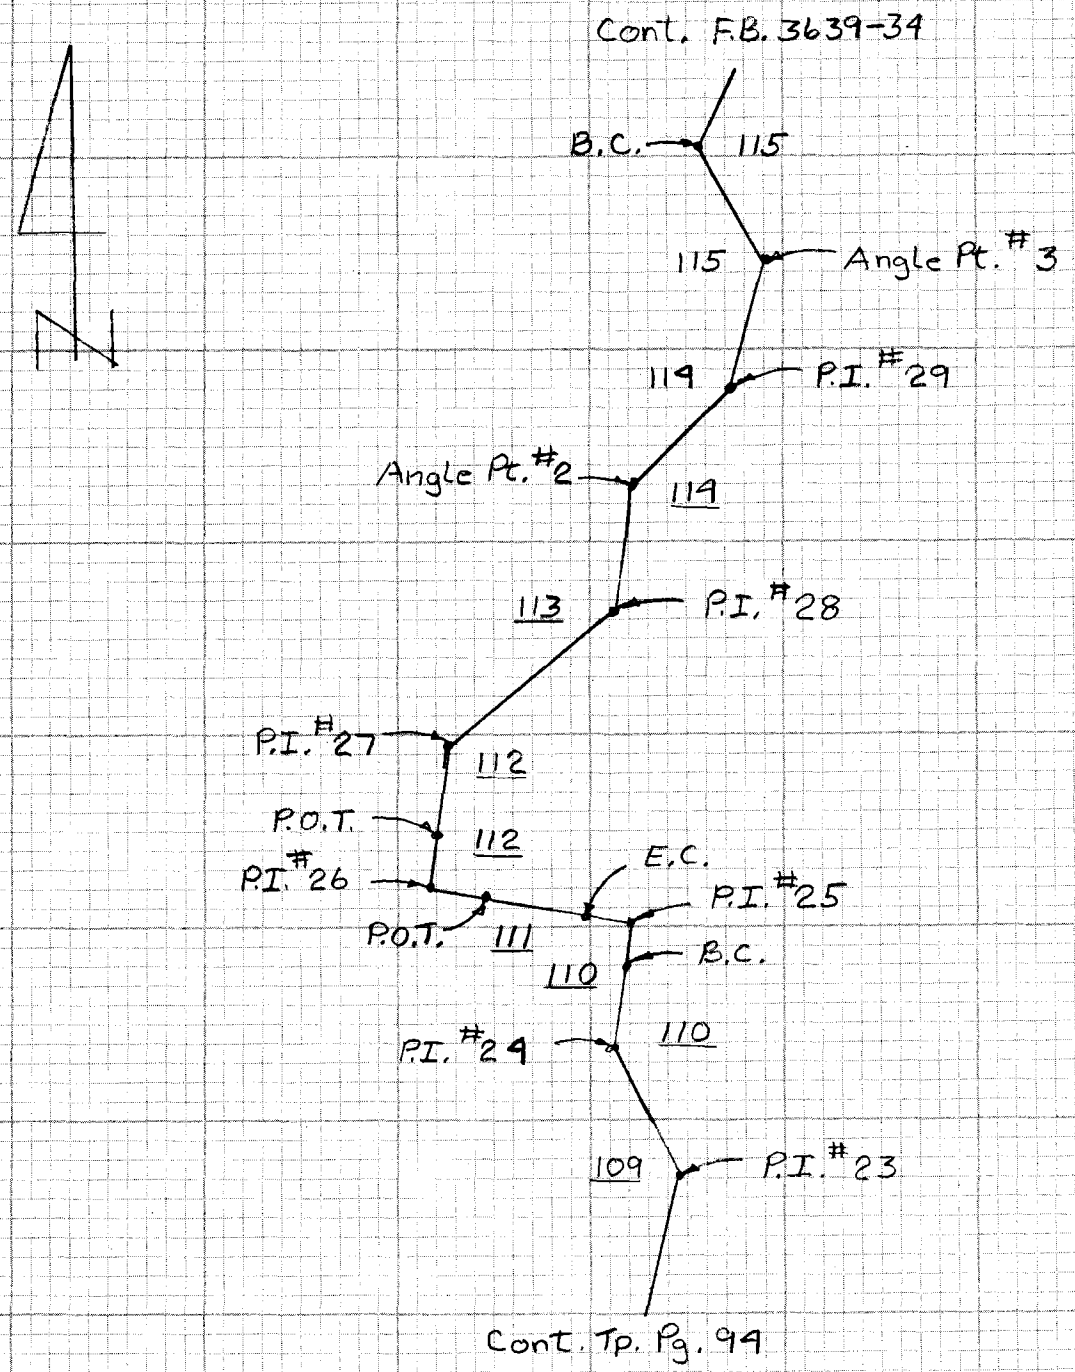

NOTE: ANY ADDITIONS OR CHANGES ON THIS SHEET MUST BE MADE OR CIRCLED IN RED INK WITH DATE AND NAME OF PERSON MAKING CHANGE

Do not extend notes this side of this line

PLEASE RETURN TO
LOS ANGELES COUNTY ENGINEER
403 LOS ANGELES COUNTY ENGINEERING BLDG.

CENTERLINE NOTES
CE 310
76F3095-4/73

F.B. 448 PG. 96

Cont Btm Pg 97

1) 140-25-00
2) 280-00-50
= 140-24-55

91.25 @ 90-13
= 91.25'

P.I. #2
End Bt Spk
El. Per FB 3639-41
" FB. 3639-10

140-24-55

m. 469.33

469.5 @ 90-33
= 469.33'

To Pomona Cyn. BLVD.

33.69

Set Spk
in Rock
Side Hill

34.20

Fnd Nail
PP

P.O.S.T.
Set Pk. in N.E.T.

m. 187.36

135-04-52

1) 135-04-50
2) 270-09-45
= 135-04-52

264.66 @ 90-30
= 264.65'

Set Pk. ET
in Rock
Side Hill

94.17

38.47

Fnd NST
per 10279026

m. 137.56

264.65

1) 137-56-40
2) 267-53-20
= 137-56-40

m. 710.34

E.C.
(Nothing)

m. 187.36

B.C.
Fnd SET Fl
Per FB 3639-9
Replaced w/ 49 Bt
Spk SW

Fnd Bt Spk SW
Dn 3" Per
FB 2661.33
" 3639.9

T.C. # 5
End Bt Spk ET
El. Per FB 2661

CE 310
76F3095-4/73

PLEASE RETURN TO
LOS ANGELES COUNTY ENGINEER
403 LOS ANGELES COUNTY ENGINEERING BLDG.

Do not extend notes this side of this line

NOTE: ANY ADDITIONS OR CHANGES ON THIS SHEET MUST BE MADE OR CIRCLED IN RED INK WITH DATE AND NAME OF PERSON MAKING CHANGE

Notes Ck'd by	Survey of Topo Grade
Map No.	JN 0303.00 Tape Std °F
Office Work	Surveyed by EC
Checked	Notes Date 5-25
Date	Indexed

F.B. 4448 PG. 97

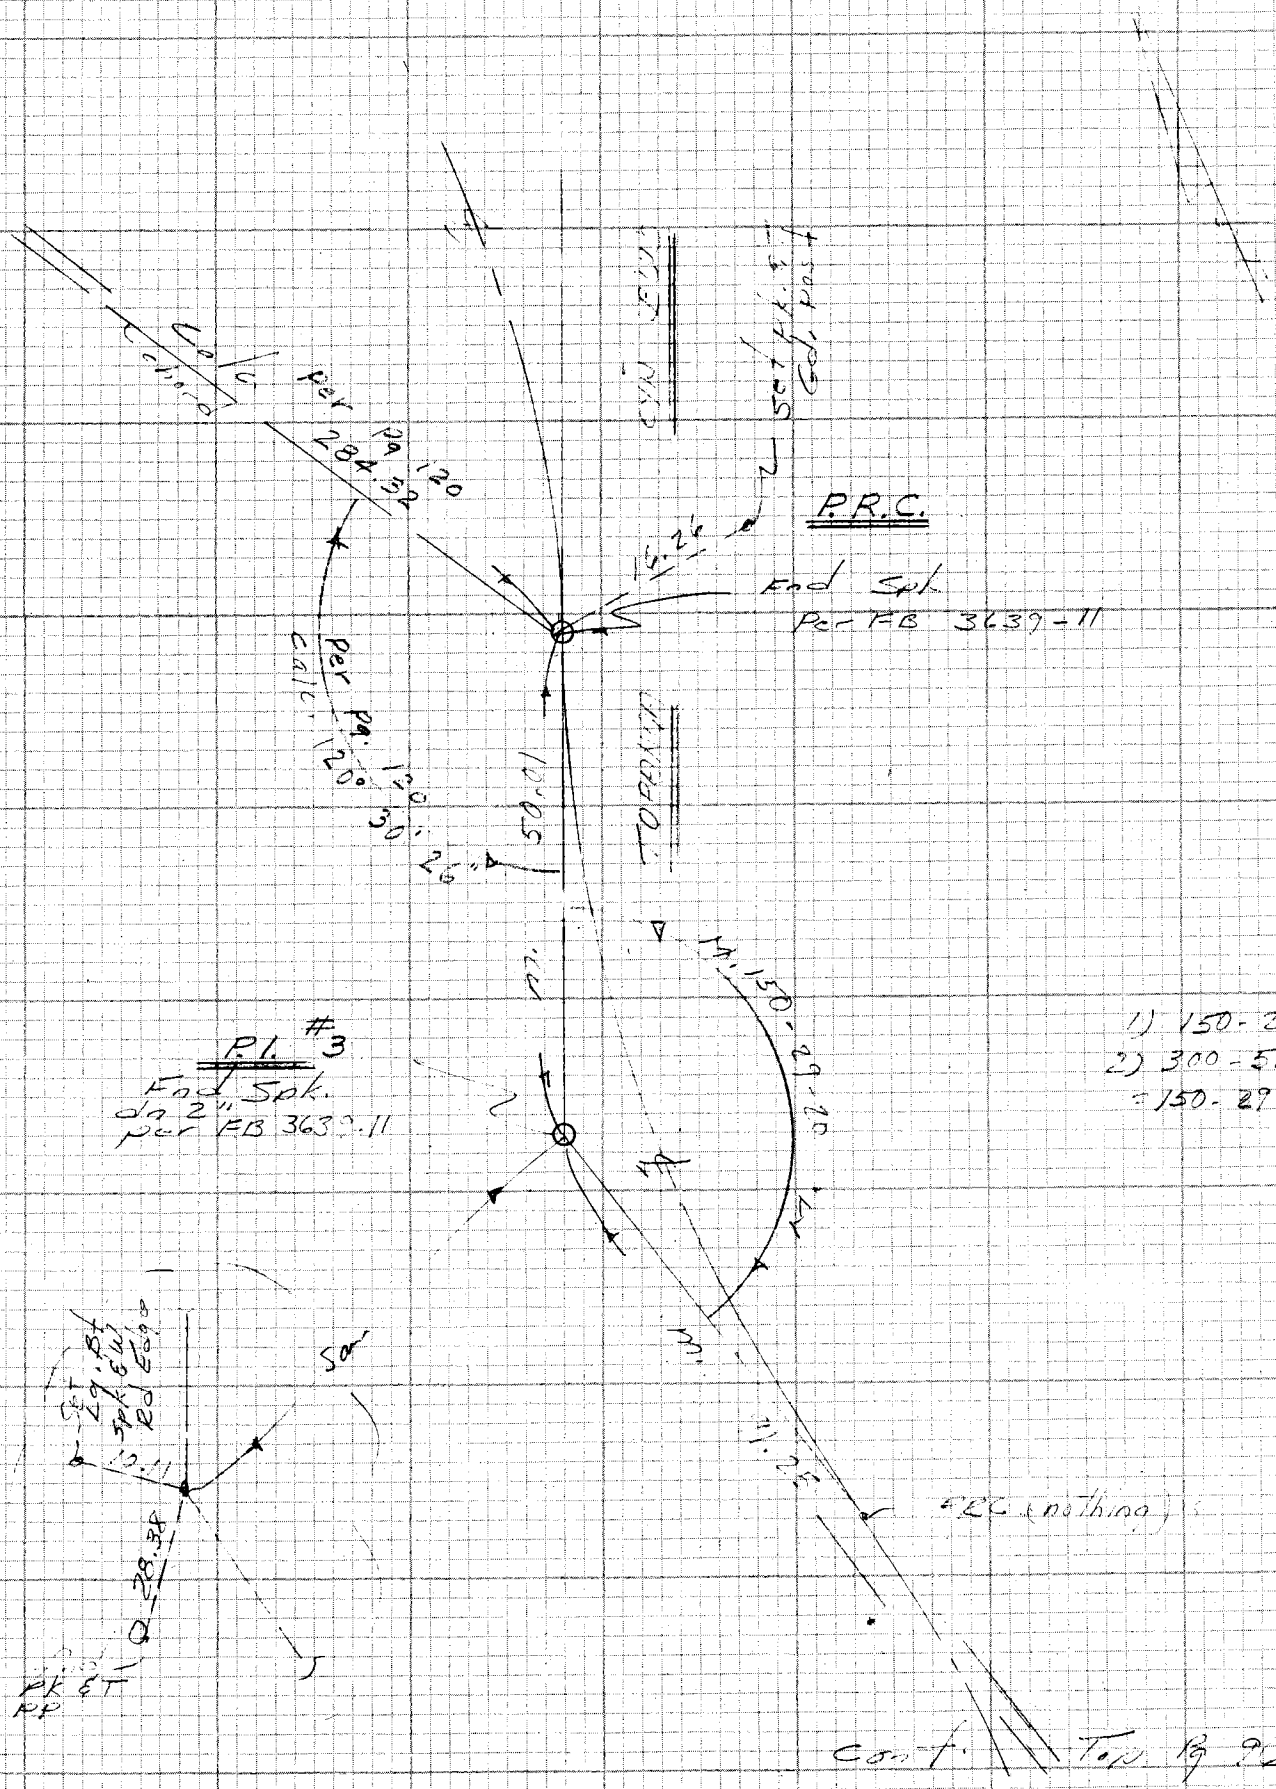

NOTE: ANY ADDITIONS OR CHANGES ON THIS SHEET MUST BE MADE OR CIRCLED IN RED INK WITH DATE AND NAME OF PERSON MAKING CHANGE

Do not extend note... this side of this line

PLEASE RETURN TO
LOS ANGELES COUNTY ENGINEER
403 LOS ANGELES COUNTY ENGINEERING BLDG.

CENTERLINE NOTES
CE 310
76F3095-4/73

F.B. 4448 PG. 95

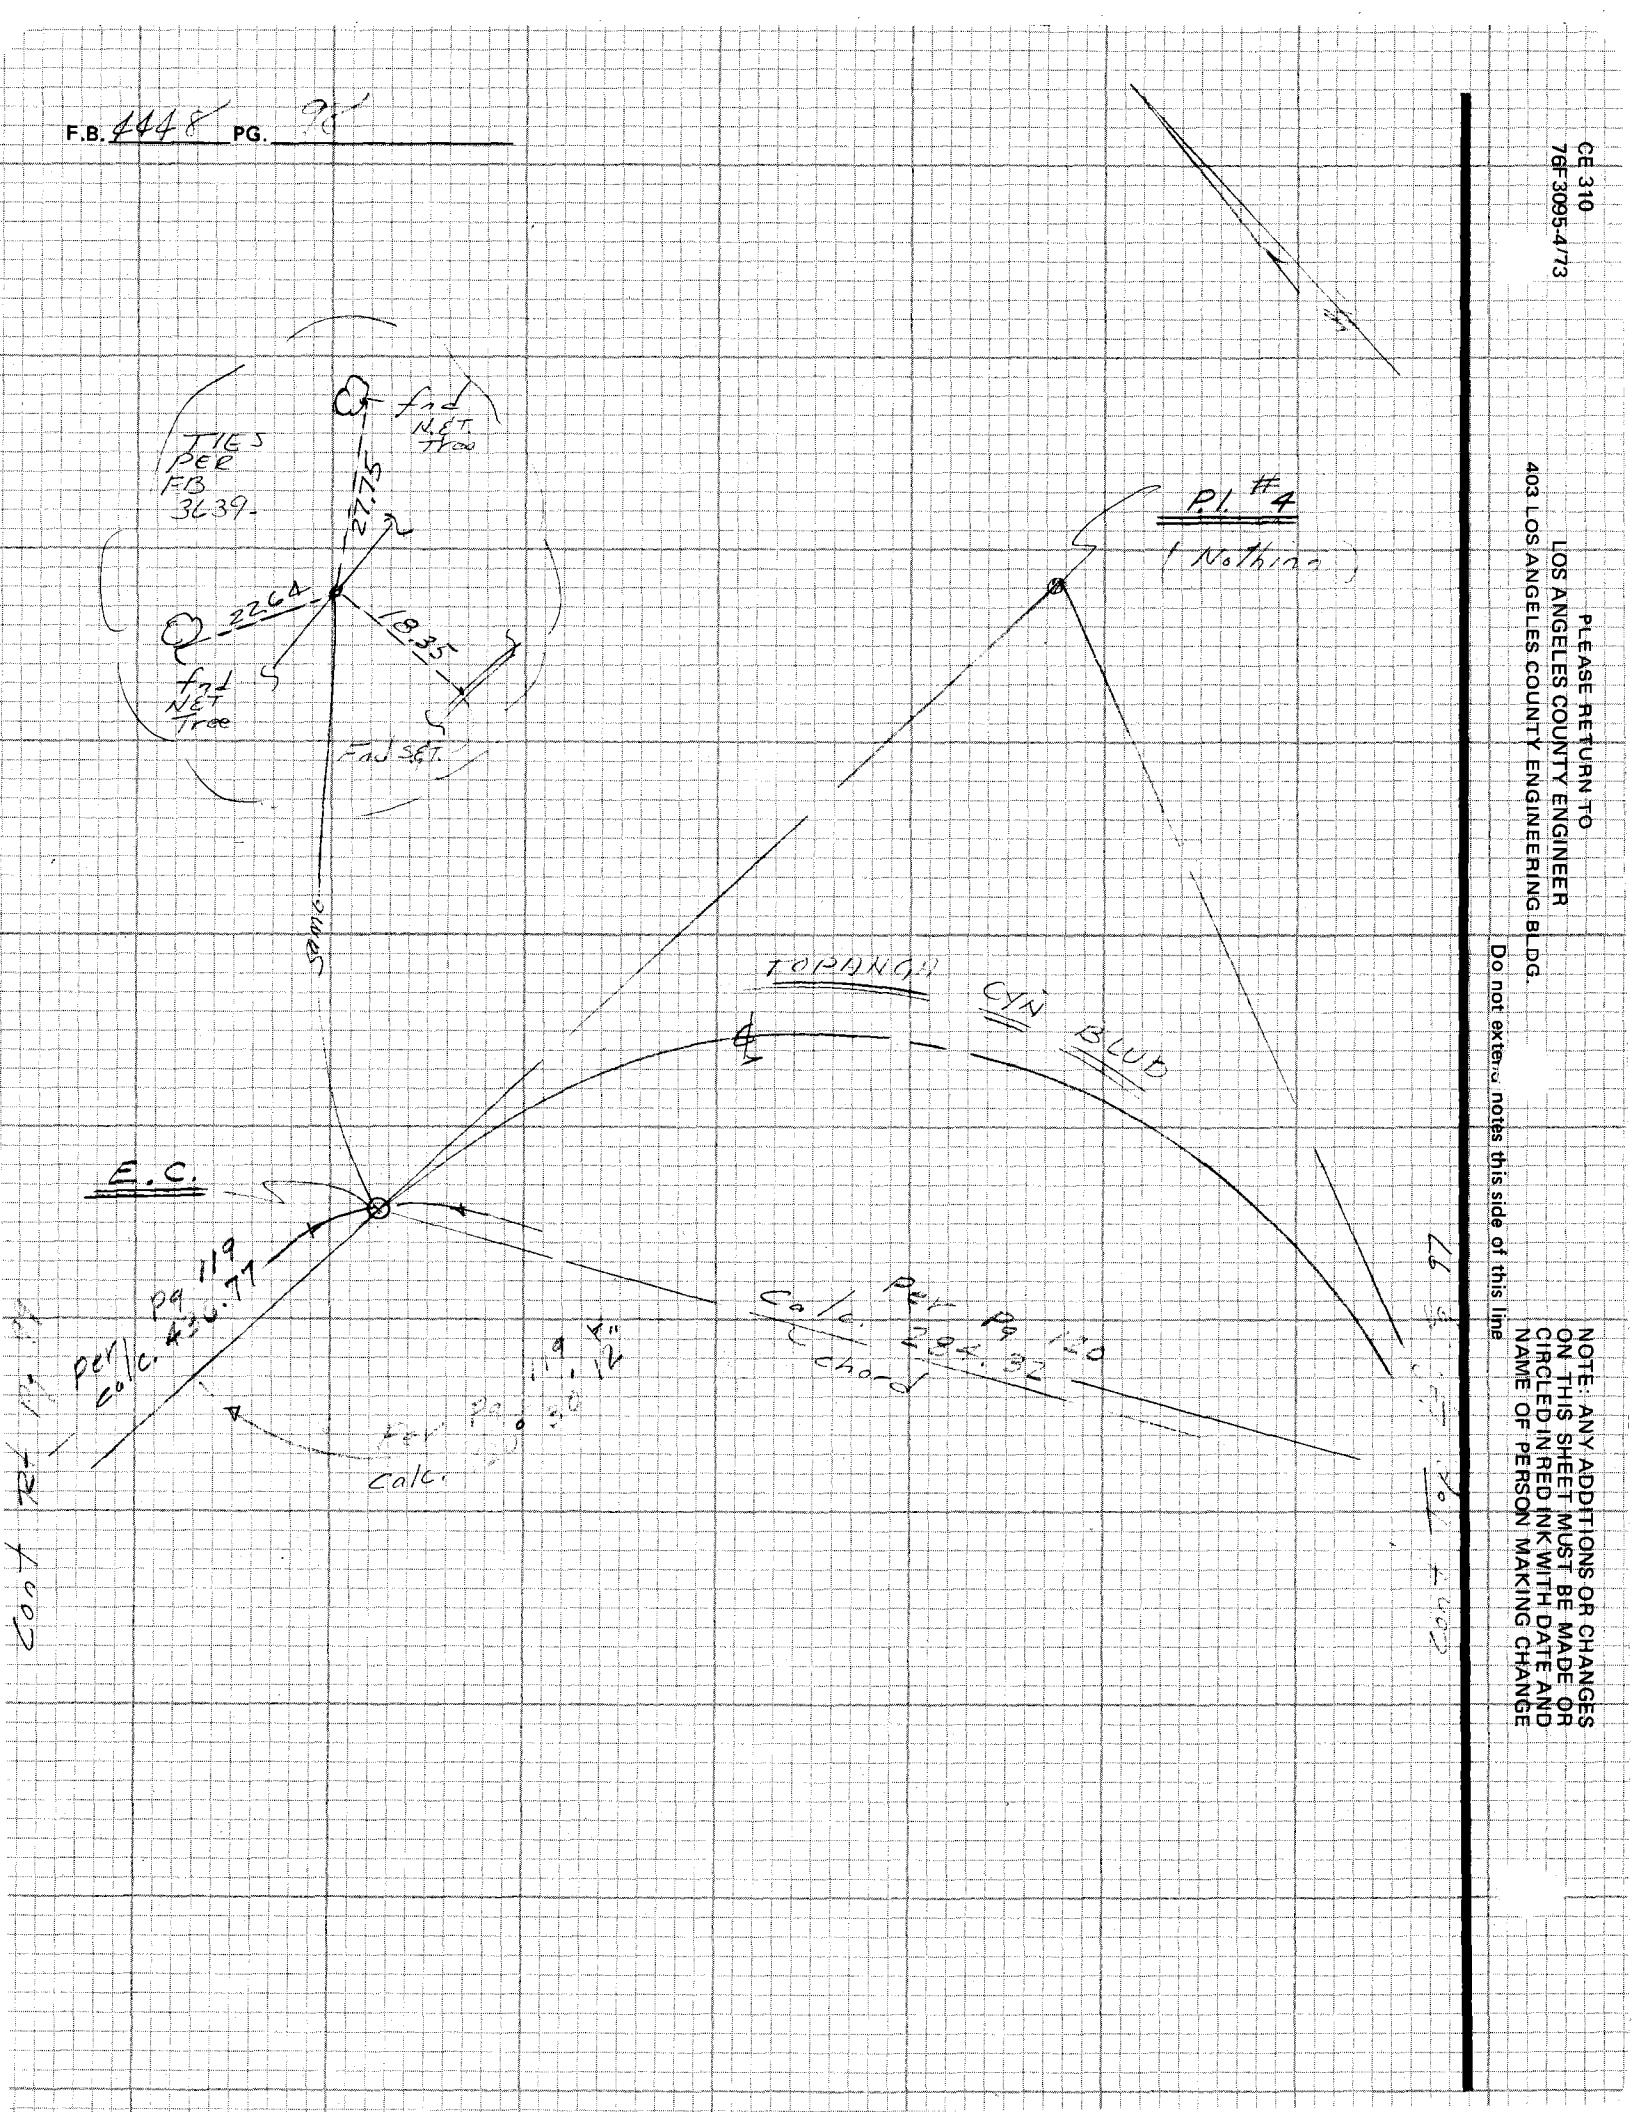
TIES PER FB 3639
fnd NET Tree
27.75
22.64
18.35
fnd NET Tree
Fnd SET
P.I. #4
(Nothing)
TOPANGA
CYN
BLVD
E.C.
Calc. Per Pg. 30

Notes Ck'd by	Survey of Topanga Cyn Blvd
Map No.	JN 0303.00 Tape Std °F
Office Work	Surveyed by EZ
Checked	Notes A. Caro Date 4-85
Date	Indexed

F.B. 444.8 PG. 99

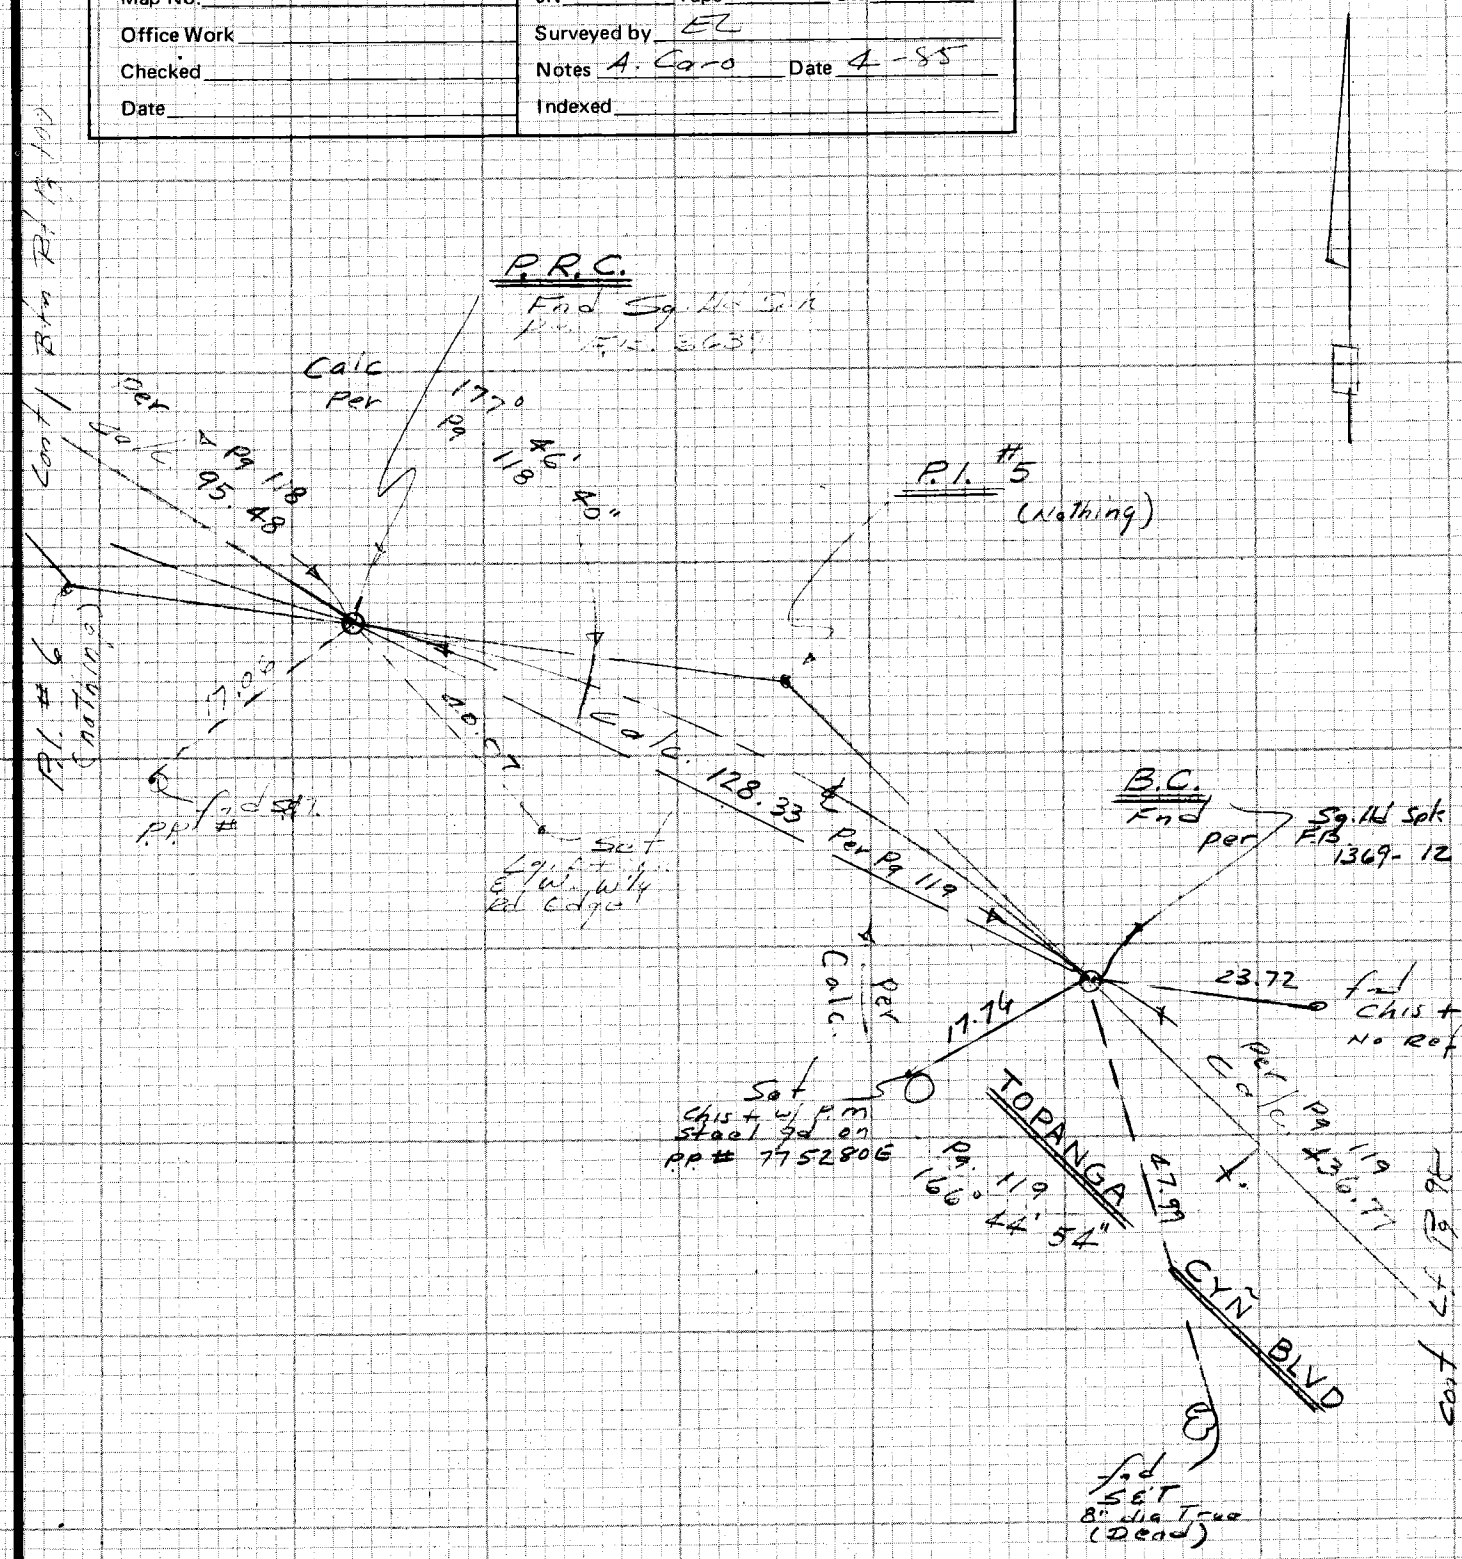

NOTE: ANY ADDITIONS OR CHANGES ON THIS SHEET MUST BE MADE OR CIRCLED IN RED INK WITH DATE AND NAME OF PERSON MAKING CHANGE

Do not extend notes this side of this line

PLEASE RETURN TO
LOS ANGELES COUNTY ENGINEER
403 LOS ANGELES COUNTY ENGINEERING BLDG.

CENTERLINE NOTES
CE 310
76F3095-4/73

F.B. 4448 PG. 100

Cont Bkm. Pg 101

Per Pg 117
Calc. 217.90

TORRANCE IN 2.7

P.P. # 2214199E
Set NET

19.74

E.C.
Fnd K.
Per FB 3639-
Replaced w/ Lg
P.P. Spk & W. Fl.
(This pt top 3'
E. of W/y Ed
Edge of)

42.43

Set 145°00'32"
Calc
Per Pg 117

Set Chis "A"
F. Hyd. Ed. Post

Per Pg 117
Calc. 172.09

P.147
(Not found)

Calc.
Per
144°

P.P. #
7752766E
Fnd PK&T

19.58

28.02

B.C.

Calc. Per
21.12
15.85

Calc.
169°01'49"
Per Pg 118

Calc. Per
27.49

Set
Lg. E.C. Tag
in Sandstone
(Top of B.K)

Fnd

33.42

E.C.
Fnd Lg. Pk.
Per FB
3639-13

Per Pg 118
Calc. 95.48

9.33

Set
Lg. 31 Soldr
P.P. W/y
Ed Edge

Pg 117

CE 310
76F3095-4/73

PLEASE RETURN TO
LOS ANGELES COUNTY ENGINEER
403 LOS ANGELES COUNTY ENGINEERING BLDG.

Do not extend notes this side of this line

NOTE: ANY ADDITIONS OR CHANGES
ON THIS SHEET MUST BE MADE OR
CIRCLED IN RED INK WITH DATE AND
NAME OF PERSON MAKING CHANGE

Notes Ck'd by	Survey of Topanga Cy Bl. 1
Map No.	JN 0303.00 Tape Std °F
Office Work	Surveyed by EL
Checked	Notes EL Date 4-85
Date	Indexed

F.B. 4448 PG. 101

Cont Tab. Pg. 100

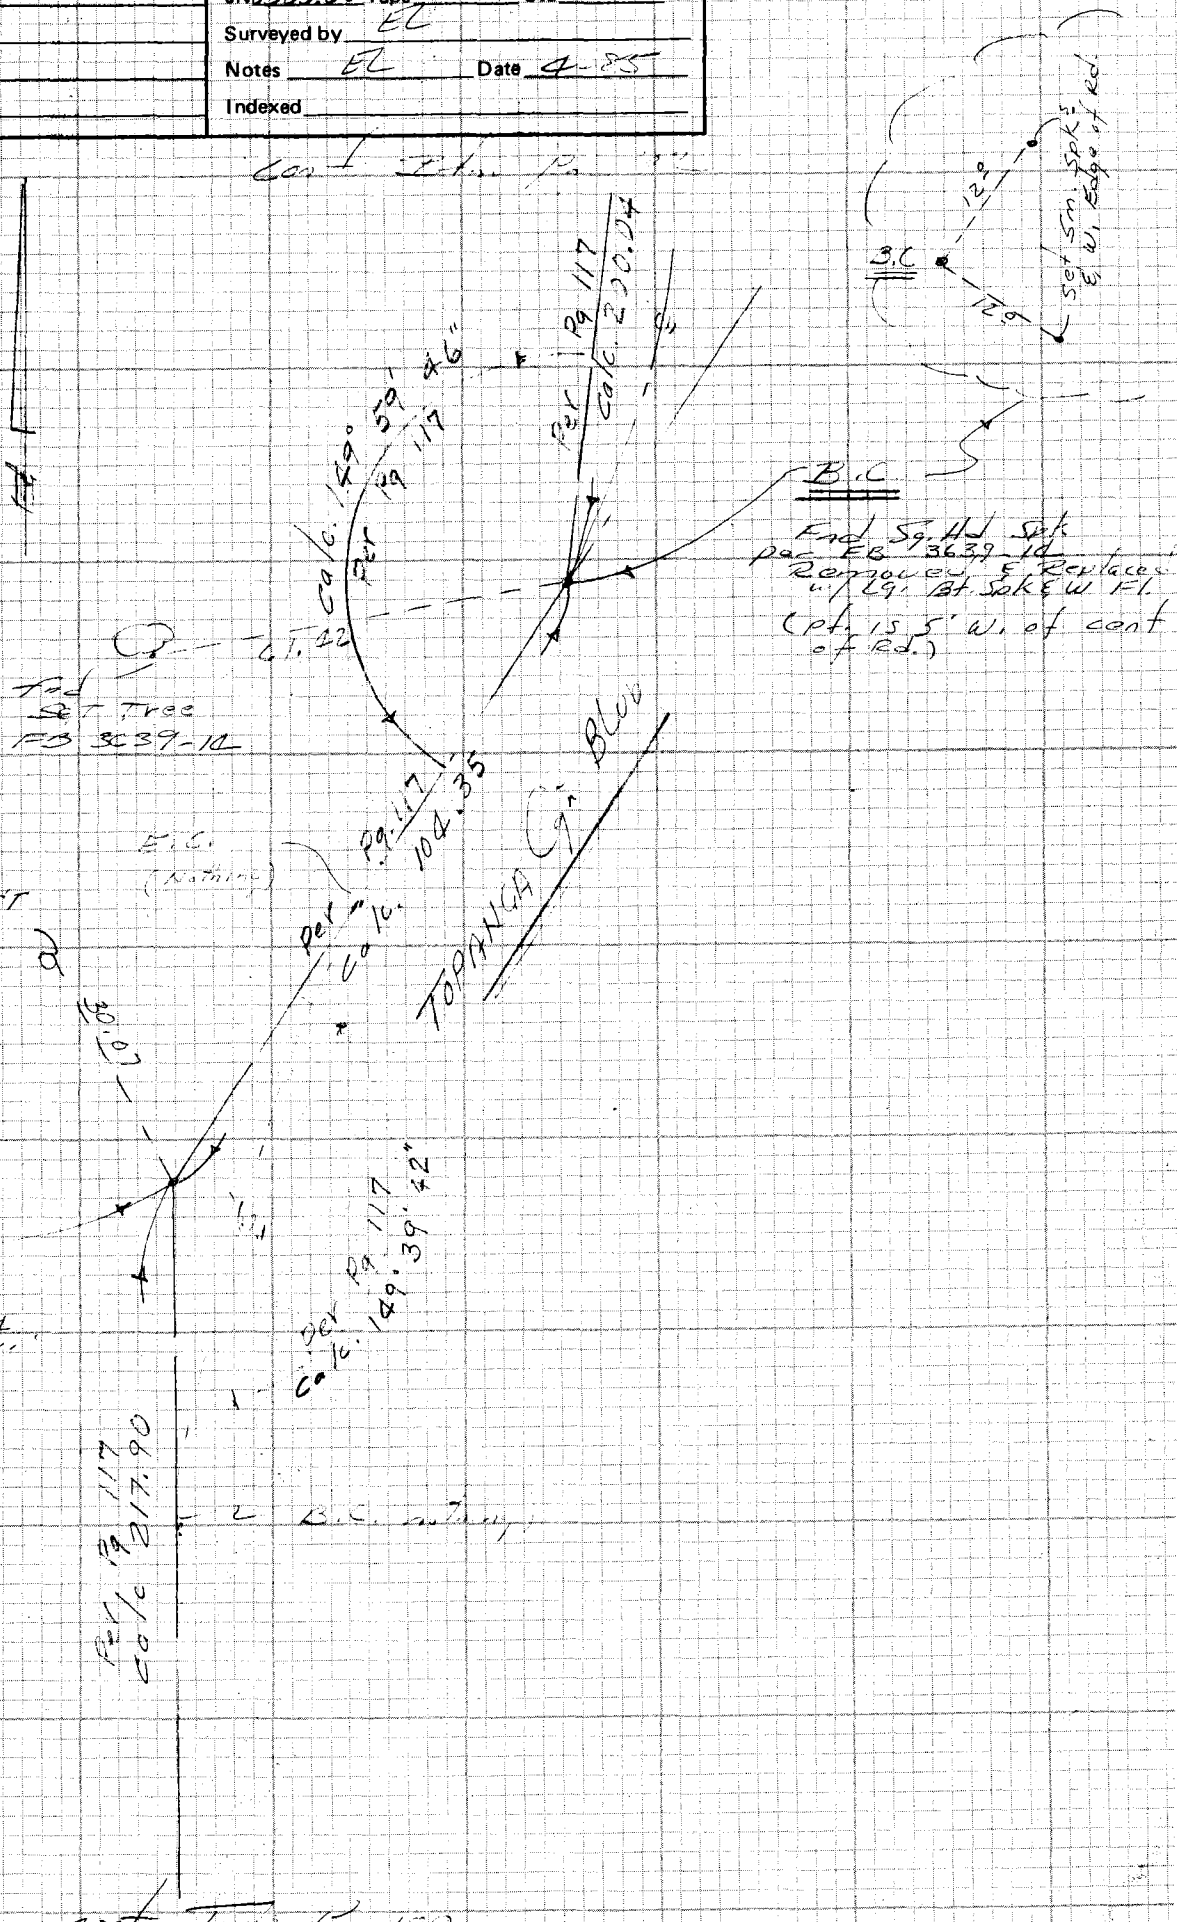

NOTE: ANY ADDITIONS OR CHANGES ON THIS SHEET MUST BE MADE OR CIRCLED IN RED INK WITH DATE AND NAME OF PERSON MAKING CHANGE

Do not extend notes this side of this line

PLEASE RETURN TO
LOS ANGELES COUNTY ENGINEER
403 LOS ANGELES COUNTY ENGINEERING BLDG.

CENTERLINE NOTES
CE 310
76F3095-4/73

F.B. 4444 PG. 102

Cont Btm Pg 103

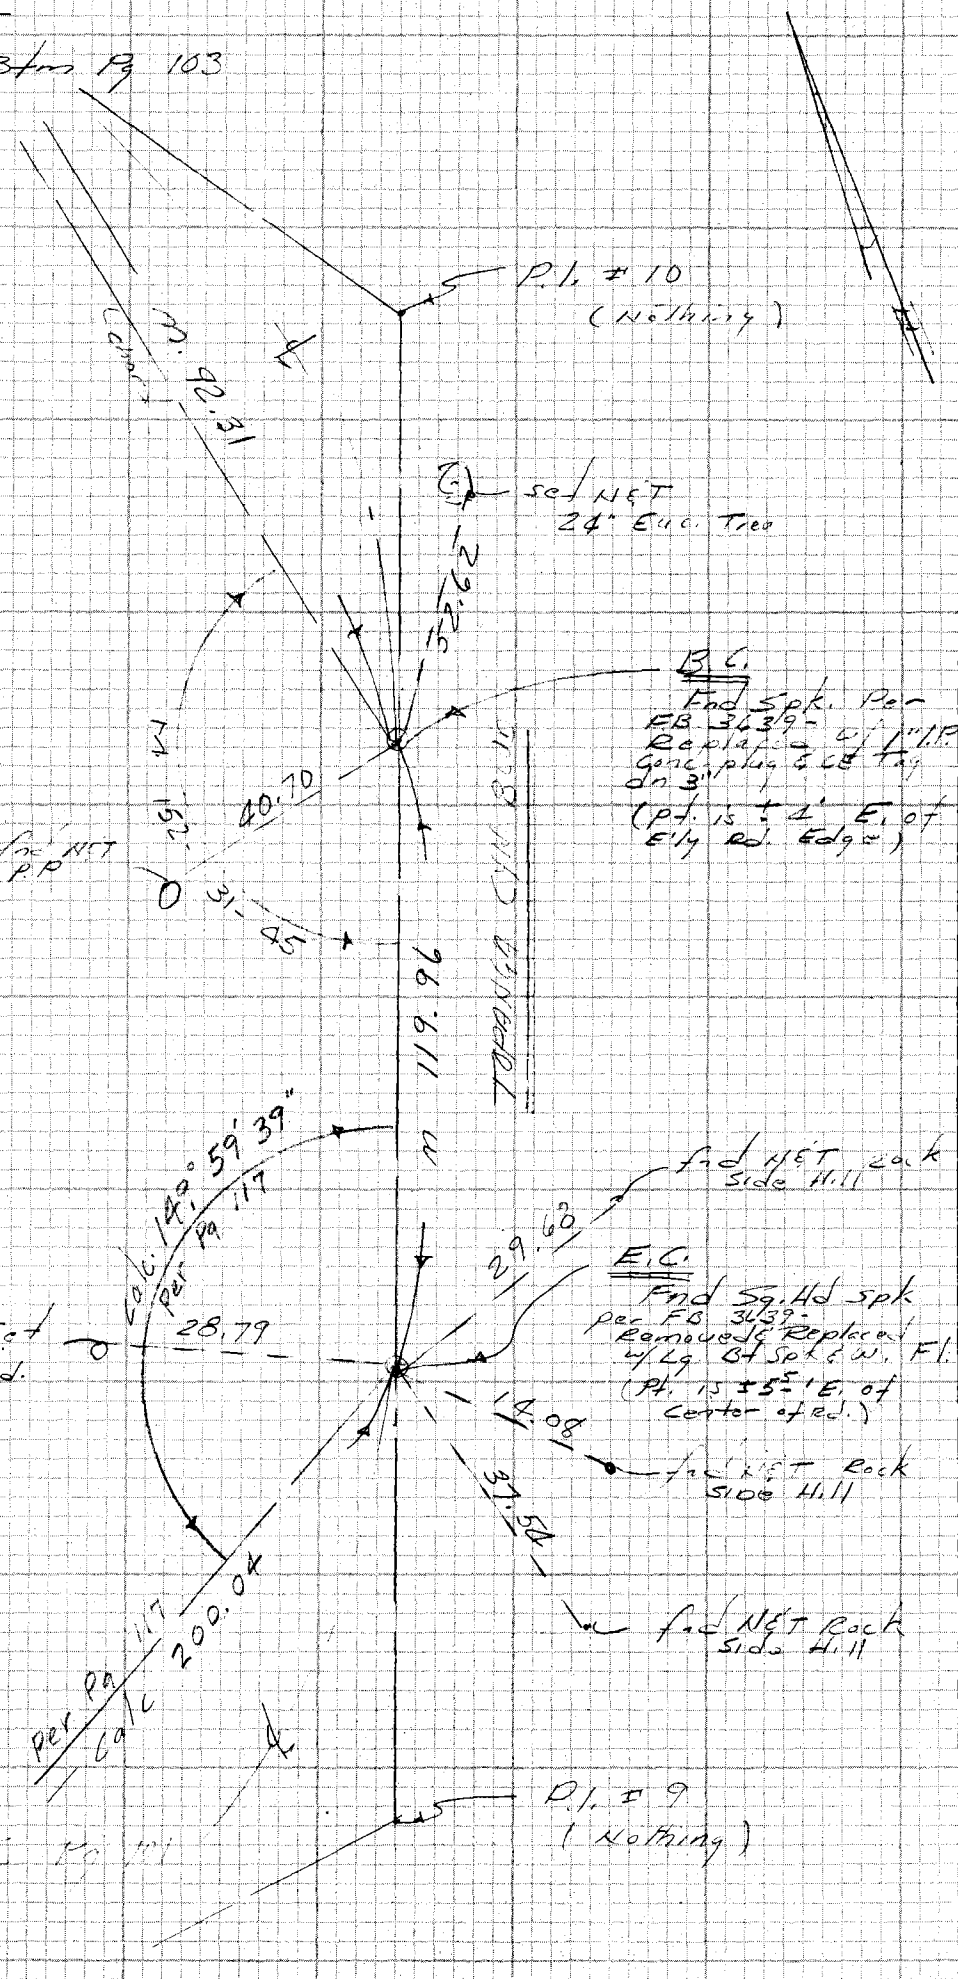

CE 310
76F3095-4 3

PLEASE RETURN TO
LOS ANGELES COUNTY ENGINEER
403 LOS ANGELES COUNTY ENGINEERING BLDG.

Do not extend notes this side of this line

NOTE: ANY ADDITIONS OR CHANGES ON THIS SHEET MUST BE MADE OR CIRCLED IN RED INK WITH DATE AND NAME OF PERSON MAKING CHANGE

Map No.	JN 0303.00 Tape Std °F
Office Work	Surveyed by E. Landa
Checked	Notes EL Date 3-85
Date	Indexed

F.B. 0417 PG. 153

211.07 @ 88-54
= 211.05'

P.I. #12

Found N.E.T.
FB 3639-17
Reset N.E.T.
Spk & washer
(1) Edge 20

215.98 @ 92-32
= 215.77'

NOTE! ALL Found TIES
THIS Pg. P.- FB 3639-16,17

1) 135-58-50
2) 271-57-20
= 135-58-40

P.I. #11

Found Spk.
Ext FB 3639-16
" " 20-1-26
(Approx. Cent. of line)

1) 156-59-50
2) 313-59-10
= 156-59-30

1) 152-25-00
2) 304-50-20
= 152-25-10

Found N.E.T. P.R.

Set N.E.T.
Spk. & washer

Found N.E.T.
Side Hill

P.R. C

Set 1" Pipe
Ol. Alice Tree
Dia. 5" By Found Tree
Per FB 3639-14
(Pl. 15± 21E of
Sly Cor Lot 66)

Found N.E.T.
Side Hill

Set N.E.T.
24" Elic
Tree

Cont To Top Pg 10.2

Cont from Pg 10.4

NOTE: ANY ADDITIONS OR CHANGES ON THIS SHEET MUST BE MADE OR CIRCLED IN RED INK WITH DATE AND NAME OF PERSON MAKING CHANGE

Do not extend notes this side of this line

PLEASE RETURN TO
LOS ANGELES COUNTY ENGINEER
403 LOS ANGELES COUNTY ENGINEERING BLDG.

CENTERLINE NOTES
CE 310
76F3095-4/73

F.B. 4412 PG. 104

Cont / Dh. pg 105

129.15 @ 89-19
= 129.15'

Tr. 2.5 Tr. 120.15

P.I. # 14

Set 1" I.P. conc. plug w/KETA on 6" for Ties Per FB 3639-18

38.19

Chis + Rock Bank

1) 130-38-10
2) 261-16-20
= 130-38-10

35.29

N&T Rock Bank

36.4

130-138-10

N&T F.P. # VT-97000

137.18 @ 72-33
= 137.21'

P.R.C. (Notary)

Pk. in Rock Bank

P.I. # 13

Set 1" I.P. conc. plug w/KETA on 16" Per Ties for FB 3639-18 (E. side of Rd.)

35.28

57-10

8.68

Pk. in Rock Bank

Tr. 154

18.60

4.980

23.64

Pk. in Rock Bank

1) 154-57-00
2) 309-54-20
= 154-57-10 N&T PP

M. 211.05

N&T PP

Cont. To Pg 103

CE 310
76F3095-4/73

PLEASE RETURN TO
LOS ANGELES COUNTY ENGINEER
403 LOS ANGELES COUNTY ENGINEERING BLDG.

Do not extend notes this side of this line

NOTE: ANY ADDITIONS OR CHANGES ON THIS SHEET MUST BE MADE OR CIRCLED IN RED INK WITH DATE AND NAME OF PERSON MAKING CHANGE

Map No.	JN 0303.00 Tape Std °F
Office Work	Surveyed by E.C.
Checked	Notes CE Date 3-85
Date	Indexed

F.B. 0464 PG. 105

Cont 3th Pg. 104

585.89 @ 87-51
= 585.88'

Set SET
pot 2214-582-5

Pl #16
Fnd Cg. Spk. on 3"
per RB 2661-48
Set " 31.37.20
Set Spk. w/ Shiner
Tangent Cent of Cg

Set
NET Tag
Ed Ka. 3.1

17.92

162-31-40
2) 325-03-40
= 162-31-50

Fnd NET
Ed Ka 3.1
Cor 5 31.37.20

120.06 @ 72-37
= 119.93'


Set
NET Tag
Pl #16

Pl # 15
Set 1" I.P.
Stamped Tag
on 19" Exposed
x2 Ed per FB 3659-19
(± 6' E. of Ely Edge of RD)

1) 159-01-00
2) 318-02-00
= 159-01-00

41.29

NET
PP 2214-5416

Fnd NET
Ed Ka
Cor 3 31.37.19

Cont Tape

F.B. 4448 PG. 106

CE 310
76F3095-4/73

PLEASE RETURN TO
LOS ANGELES COUNTY ENGINEER
403 LOS ANGELES COUNTY ENGINEERING BLDG.

Do not extend notes this side of this line

NOTE: ANY ADDITIONS OR CHANGES ON THIS SHEET MUST BE MADE OR CIRCLED IN RED INK WITH DATE AND NAME OF PERSON MAKING CHANGE

323.44 @ 87-18
= 323.20'

℄ To Rt of ℄
NOTHING

End Bk of Cb

M. 323.20
CHORD

Set
NET
10" DIO
S/G. Tree

62.59

6.55

Fnd
NET
PK #689120E

152.50

B.C.
Fnd Lg. Bt. Spk & W
dn 8" FB 2661-
See " 3639-21
Replaced Spk w/ 1"
I.P. conc. plug & Tag
dn 10"

1) 152-30-07
2) 250-00-30
= 152-30-07

TOPANGA CN BLVD

331.95

332.24 @ 87-36
= 331.95'

Set w/ CE Tag
in Conc. Hd. wall

30.97

ANGLE PT #1
Fnd Lg. Bt. Spk & W
dn 3" Per FB 3639
pg 20
Replaced Spk w/
1" I.P. conc plug
w/ CE Tag dn 6"

6.51

Fnd
NET
PK # 689125
Per FB 3639-20

07 Pg. 24

1) 172-30-30
2) 330-02-40
= 172-30-40

30.96

N. 592.49

Fnd N. in Rock
Per FB 3639-20

Cont T.P. Pg. 105

Notes Ck'd by	Survey of [illegible]
Map No.	JN 0303.00 Tape Std °F
Office Work	Surveyed by E.L.
Checked	Notes EK Date 3-85
Date	Indexed

F.B. 4448 PG. 107

157.05 @ 87-58
= 156.95

Found Spk Tree

Cont [illegible]

P.I. #19
Set 1" I.P. Cont. P.L.
w/CE, Tag dn 9"
Set By Tree
F.B. 3639-23
(E'ly Tree on slope)

1) 163-54-50
2) 327-49-50
= 163-54-55

M. 156.95

163-54-55

60.97

54.07

22.13

205.49 @ 92-40
= 205.27

205.27

End mon
Lg. Rock
Per F.B. 3639-22

Found Set Tree

End Set
PP# 926840E

52.49

P.I. #18
Found Lg Bl Spk
dn 2"
per
F.B. 3639-22

Set NET
8" Oak Tree

1) 147-57-00
2) 295-54-00
= 147-57-00

147-57-00

17.37

Set
NET
PP# 21973

M. 248.08

Found
PP# 2662.[illegible]

152-28-30

32

1) 152-28-30
2) 304-57-00
= 152-28-30

51.11

Found
NET
20" Lin. [illegible]

Moss

248.27 @ 87-41
= 248.08

E.C.
Set Lg. Bl. Spk NET
dn 2"
Replaced Lg. Bl. Spk set
per F.B. 3639-21

T. P.I. #17
Nothing

M. 323.[illegible]

Cont. [illegible] Pg. 106

NOTE: ANY ADDITIONS OR CHANGES ON THIS SHEET MUST BE MADE OR CIRCLED IN RED INK WITH DATE AND NAME OF PERSON MAKING CHANGE

Do not extend notes this side of this line

PLEASE RETURN TO
LOS ANGELES COUNTY ENGINEER
403 LOS ANGELES COUNTY ENGINEERING BLDG.

CENTERLINE NOTES
CE 310
76F3095-4/73

F.B. 4051 PG. 108

Cont Btm pg 109

1) 169-59-50
2) 339-58-20
= 169-59-40

Pl. # 21
Set Lg. Bt Spk
Bin 1" Pk. Ties
per FB 3639.25
(± 8' E'ly of Cent. Rd)

Set
24'
24' OFF Set Line

Set N.
Set N
24'
Pl. # 20

Pl. # 20
Found Lg. Bt Spk
per FB 2661-52
Bin 3"
Seq. to 3639.24
Set Sp. Lg. Spk & T.B.
(± 2' E'ly of Cent. Rd)

Found Lg. Rock

Found Tree

Pl. # 21.5

156-07-16

Calc 676.11

Calc 4-31-16

Line

Calc

Calc

Calc

Found Tree

Found Tree

Found Tree

Notes Ck'd by	Survey of Topanga Cyn Blvd
Map No.	JN 0303.00 Tape Std °F
Office Work	Surveyed by E.L.
Checked	Notes E.L. Date 4-85
Date	Indexed

F.B. 4448 PG. 109

Cont Sta 18+17

Fnd SET
PP# 2752686

P.I. # 23

Fnd 1x2 S.C. dn 3"
Per F.B. 3639-27
Repl. w/1" I.P. Conc
plug & CE Tag dn 9"
(9' E. of E'ly Rd Edge)

(No Tag) Fnd Tag
This P.I. Pt.
per F.B. 3639-26.27

Set
Sq. Hole SET
Pav. Rd Edge

185.37 @ 88-21
= 184.97'

1) 169-01-20
2) 338-02-40
169-01-20


Fnd Chis 1" Lg. Rod

Set L&E CE Tag
Top of Lg. Rod

P.I. # 22

Fnd SET dn 3"
Replaced w/1" I.P.
conc plug & CE Tag
dn 6"
per F.B. 3639-26
(E'ly Edge of Rd)

1) 171-56-30
2) 342-53-20
= 171-26-50

670.95 @ 91-30
= 670.72'

Fnd SET
PP# 2171979 E

Cont Tab 108

NOTE: ANY ADDITIONS OR CHANGES ON THIS SHEET MUST BE MADE OR CIRCLED IN RED INK WITH DATE AND NAME OF PERSON MAKING CHANGE

Do not extend notes this side of this line

PLEASE RETURN TO
LOS ANGELES COUNTY ENGINEER
403 LOS ANGELES COUNTY ENGINEERING BLDG.

CENTERLINE NOTES
CE 310
76F3095-4/73

Cont Fr pg 111

CE 310
76F3095-4/73

PLEASE RETURN TO
LOS ANGELES COUNTY ENGINEER
403 LOS ANGELES COUNTY ENGINEERING BLDG.

Do not extend notes this side of this line

NOTE: ANY ADDITIONS OR CHANGES ON THIS SHEET MUST BE MADE OR CIRCLED IN RED INK WITH DATE AND NAME OF PERSON MAKING CHANGE

334.62 @ 88-57
= 334.56'

B.C.

Fnd nothing
Set 1" I.P. conc. plug
w/CE Tag dn 2"
Set By Ties Per
FB 3639-28
E'ly Edge of Rd

295.69 @ 77-52
= 295.62'

1) 137-59-50
2) 275-59-30
= 137-59-45

P.I. #21

Fnd Spk & W on 3"
Per FB 2641-52
Set FB 3639-28
Removed & Set
Lg. Bt spk & W. dn 1"

1) 152-59-00
2) 305-58-10
= 152-59-05

280.49 @ 91-56
= 280.33'

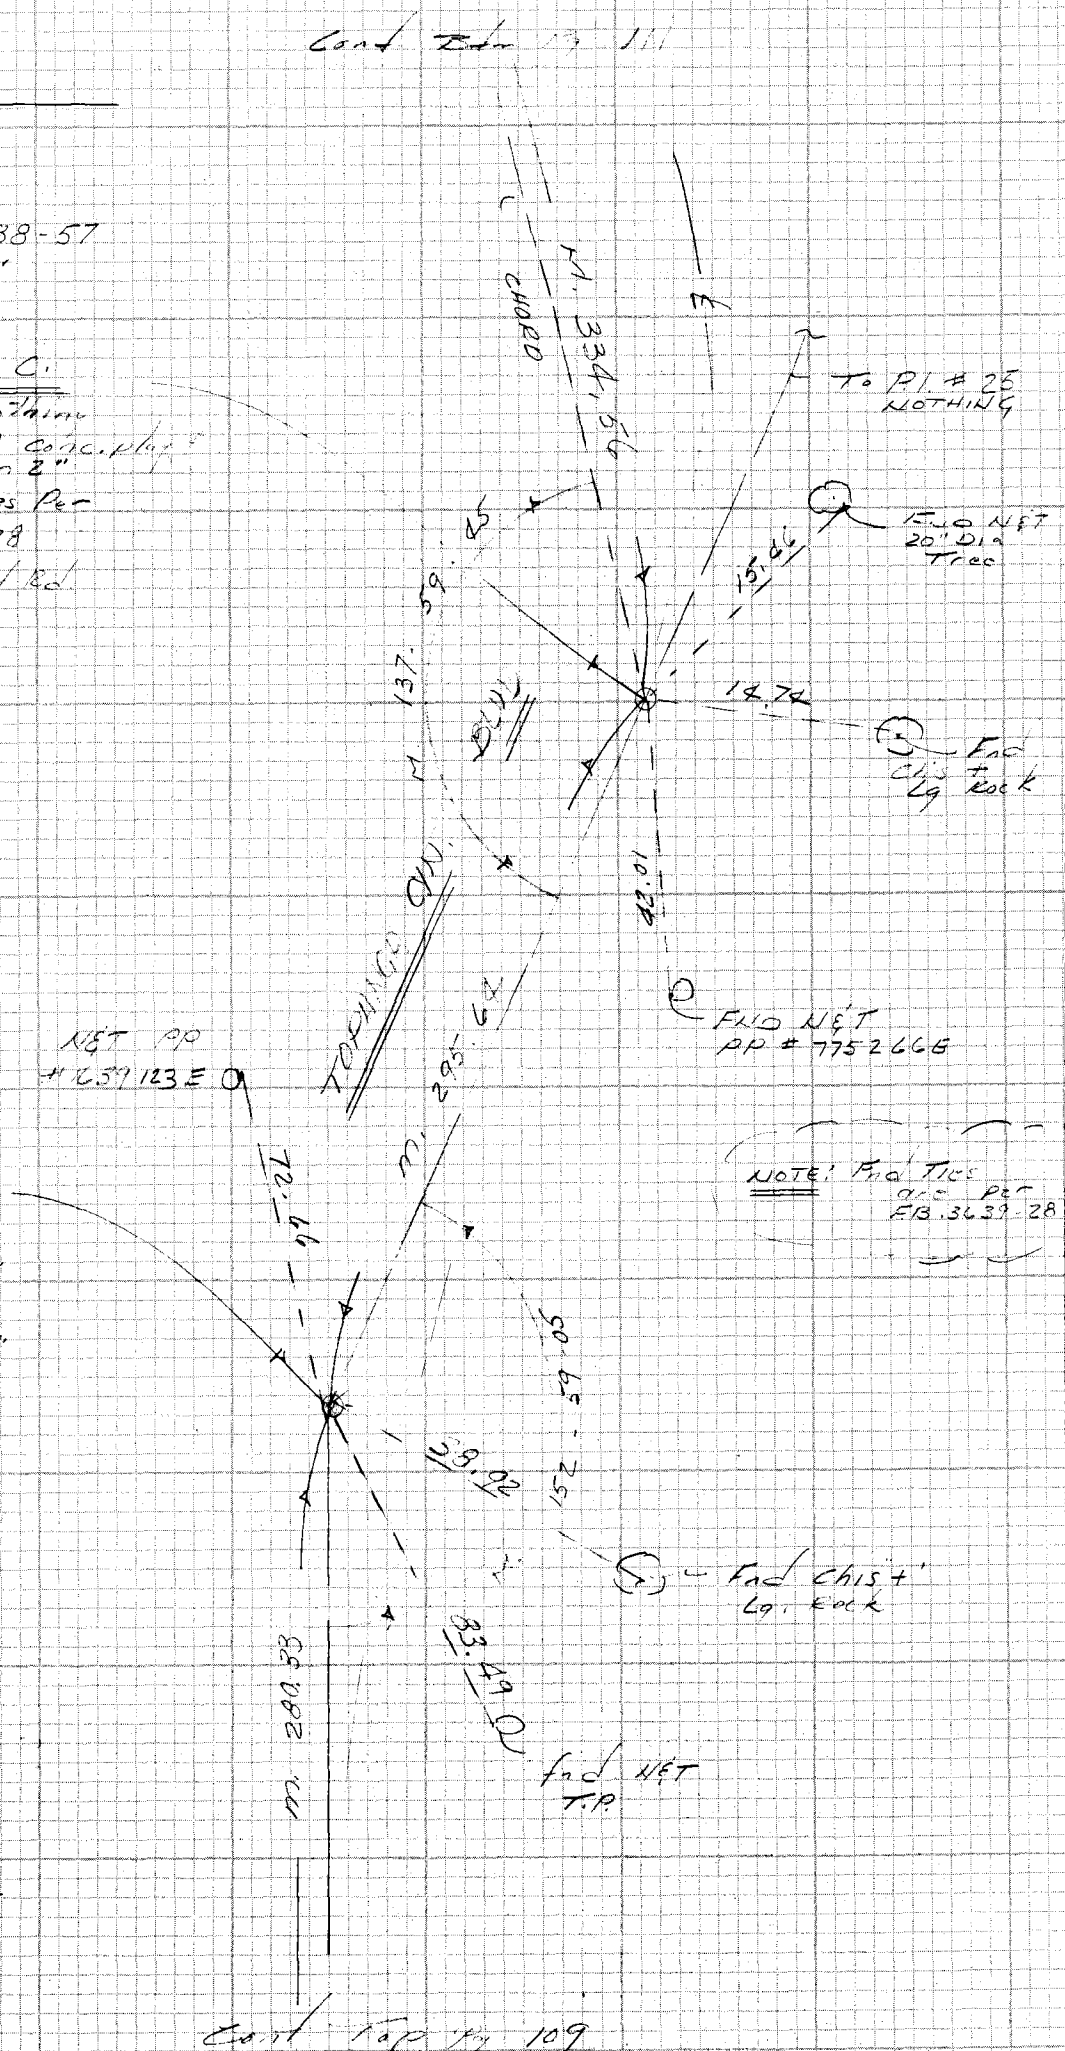

Cont Top pg 109

Notes Ck'd by	Survey of [illegible]
Map No.	JN 0303.00 Tape Std °F
Office Work	Surveyed by [illegible]
Checked	Notes [illegible] Date 4-85
Date	Indexed

F.B. 4448 PG. 111

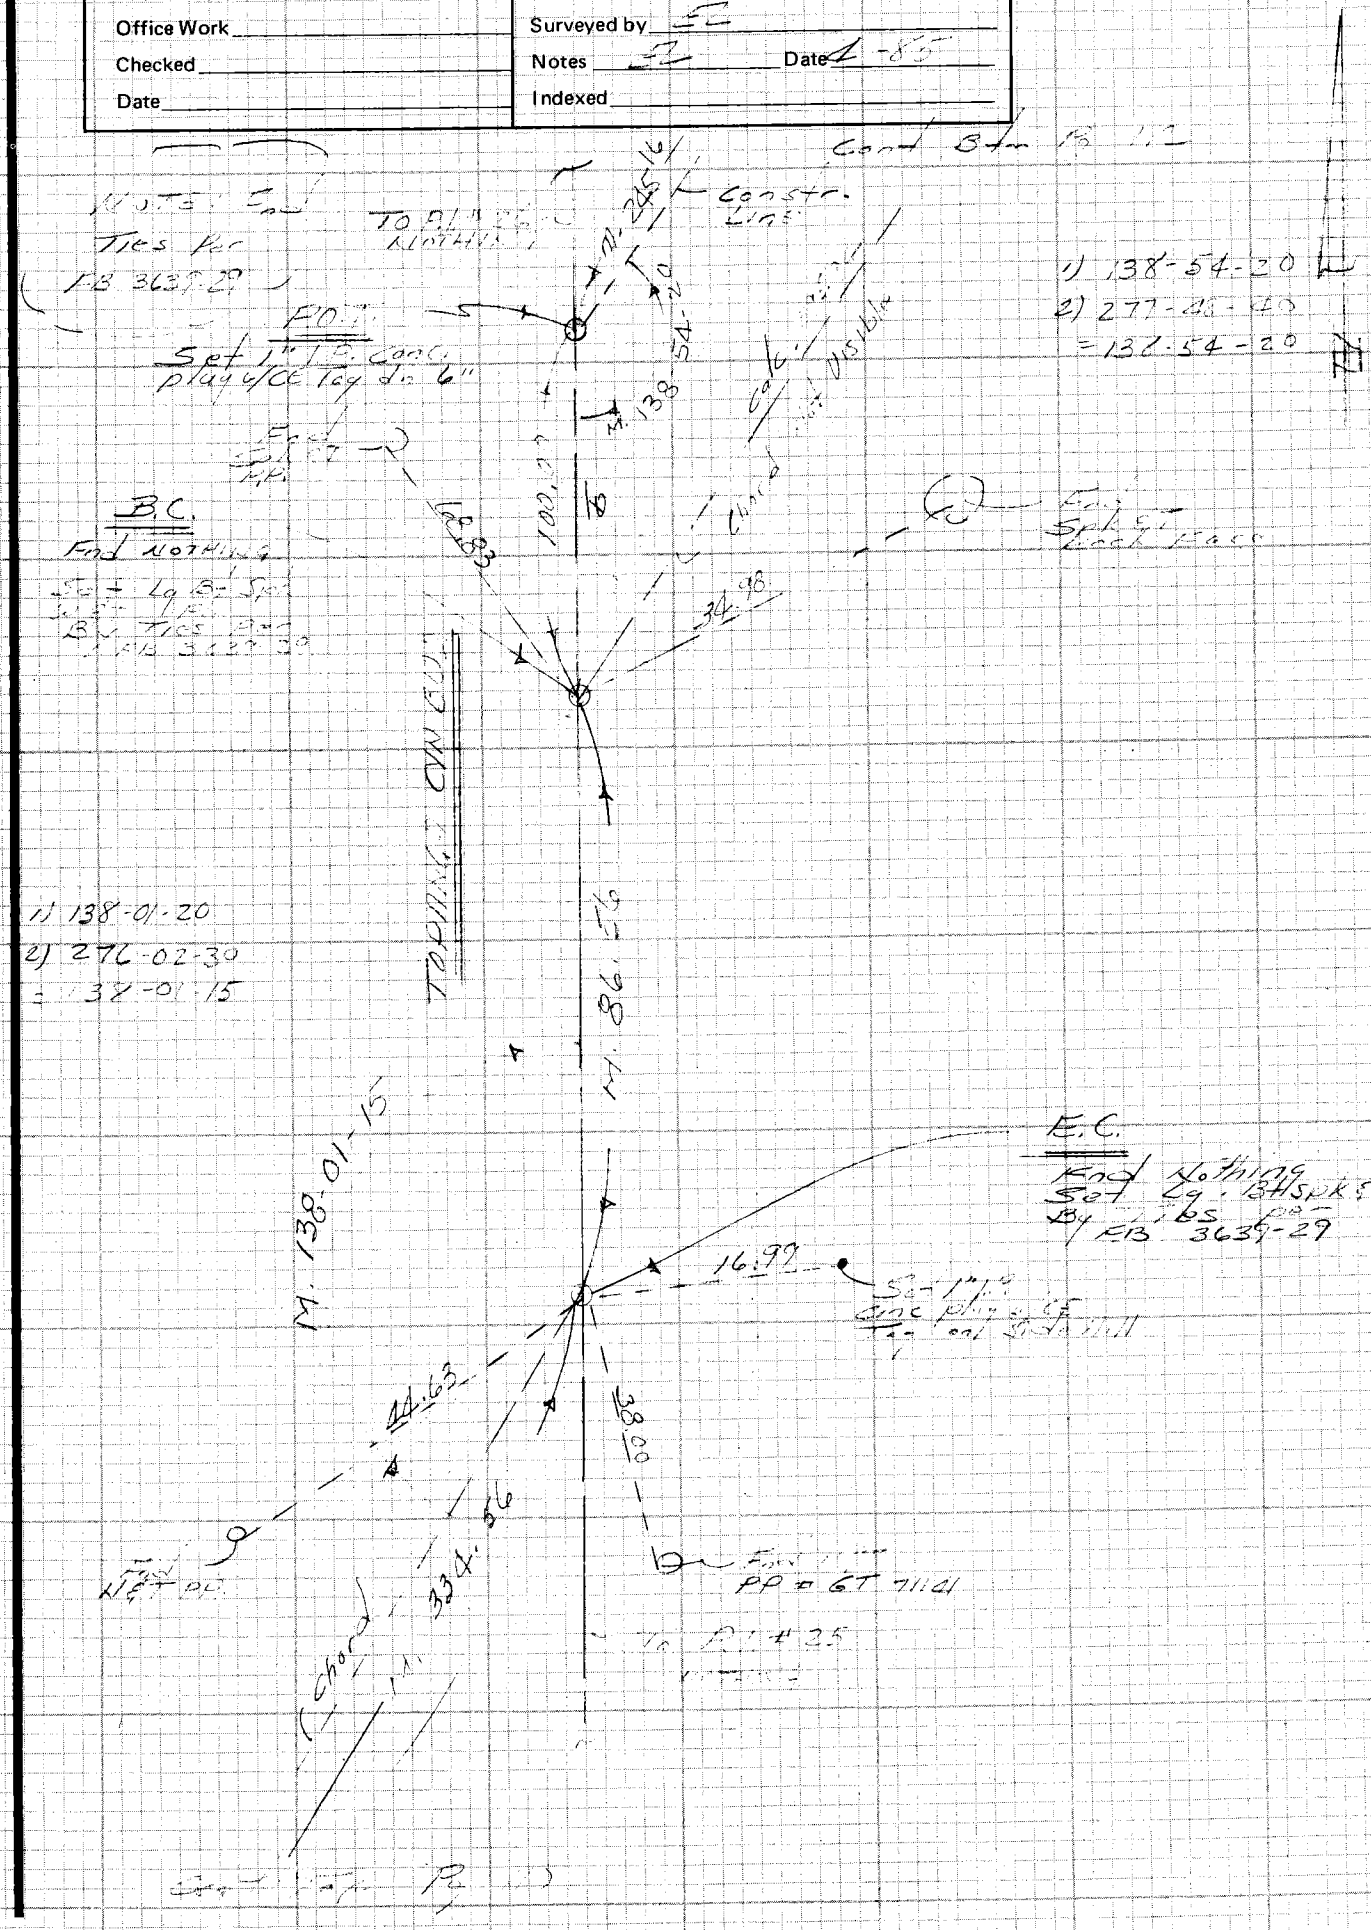

NOTE: ANY ADDITIONS OR CHANGES ON THIS SHEET MUST BE MADE OR CIRCLED IN RED INK WITH DATE AND NAME OF PERSON MAKING CHANGE

Do not extend notes this side of this line

PLEASE RETURN TO
LOS ANGELES COUNTY ENGINEER
403 LOS ANGELES COUNTY ENGINEERING BLDG.

CENTERLINE NOTES
CE 310
76F3095-4/73

F.B. 4448 PG. 112

Cont. Bkw. Pg. 113

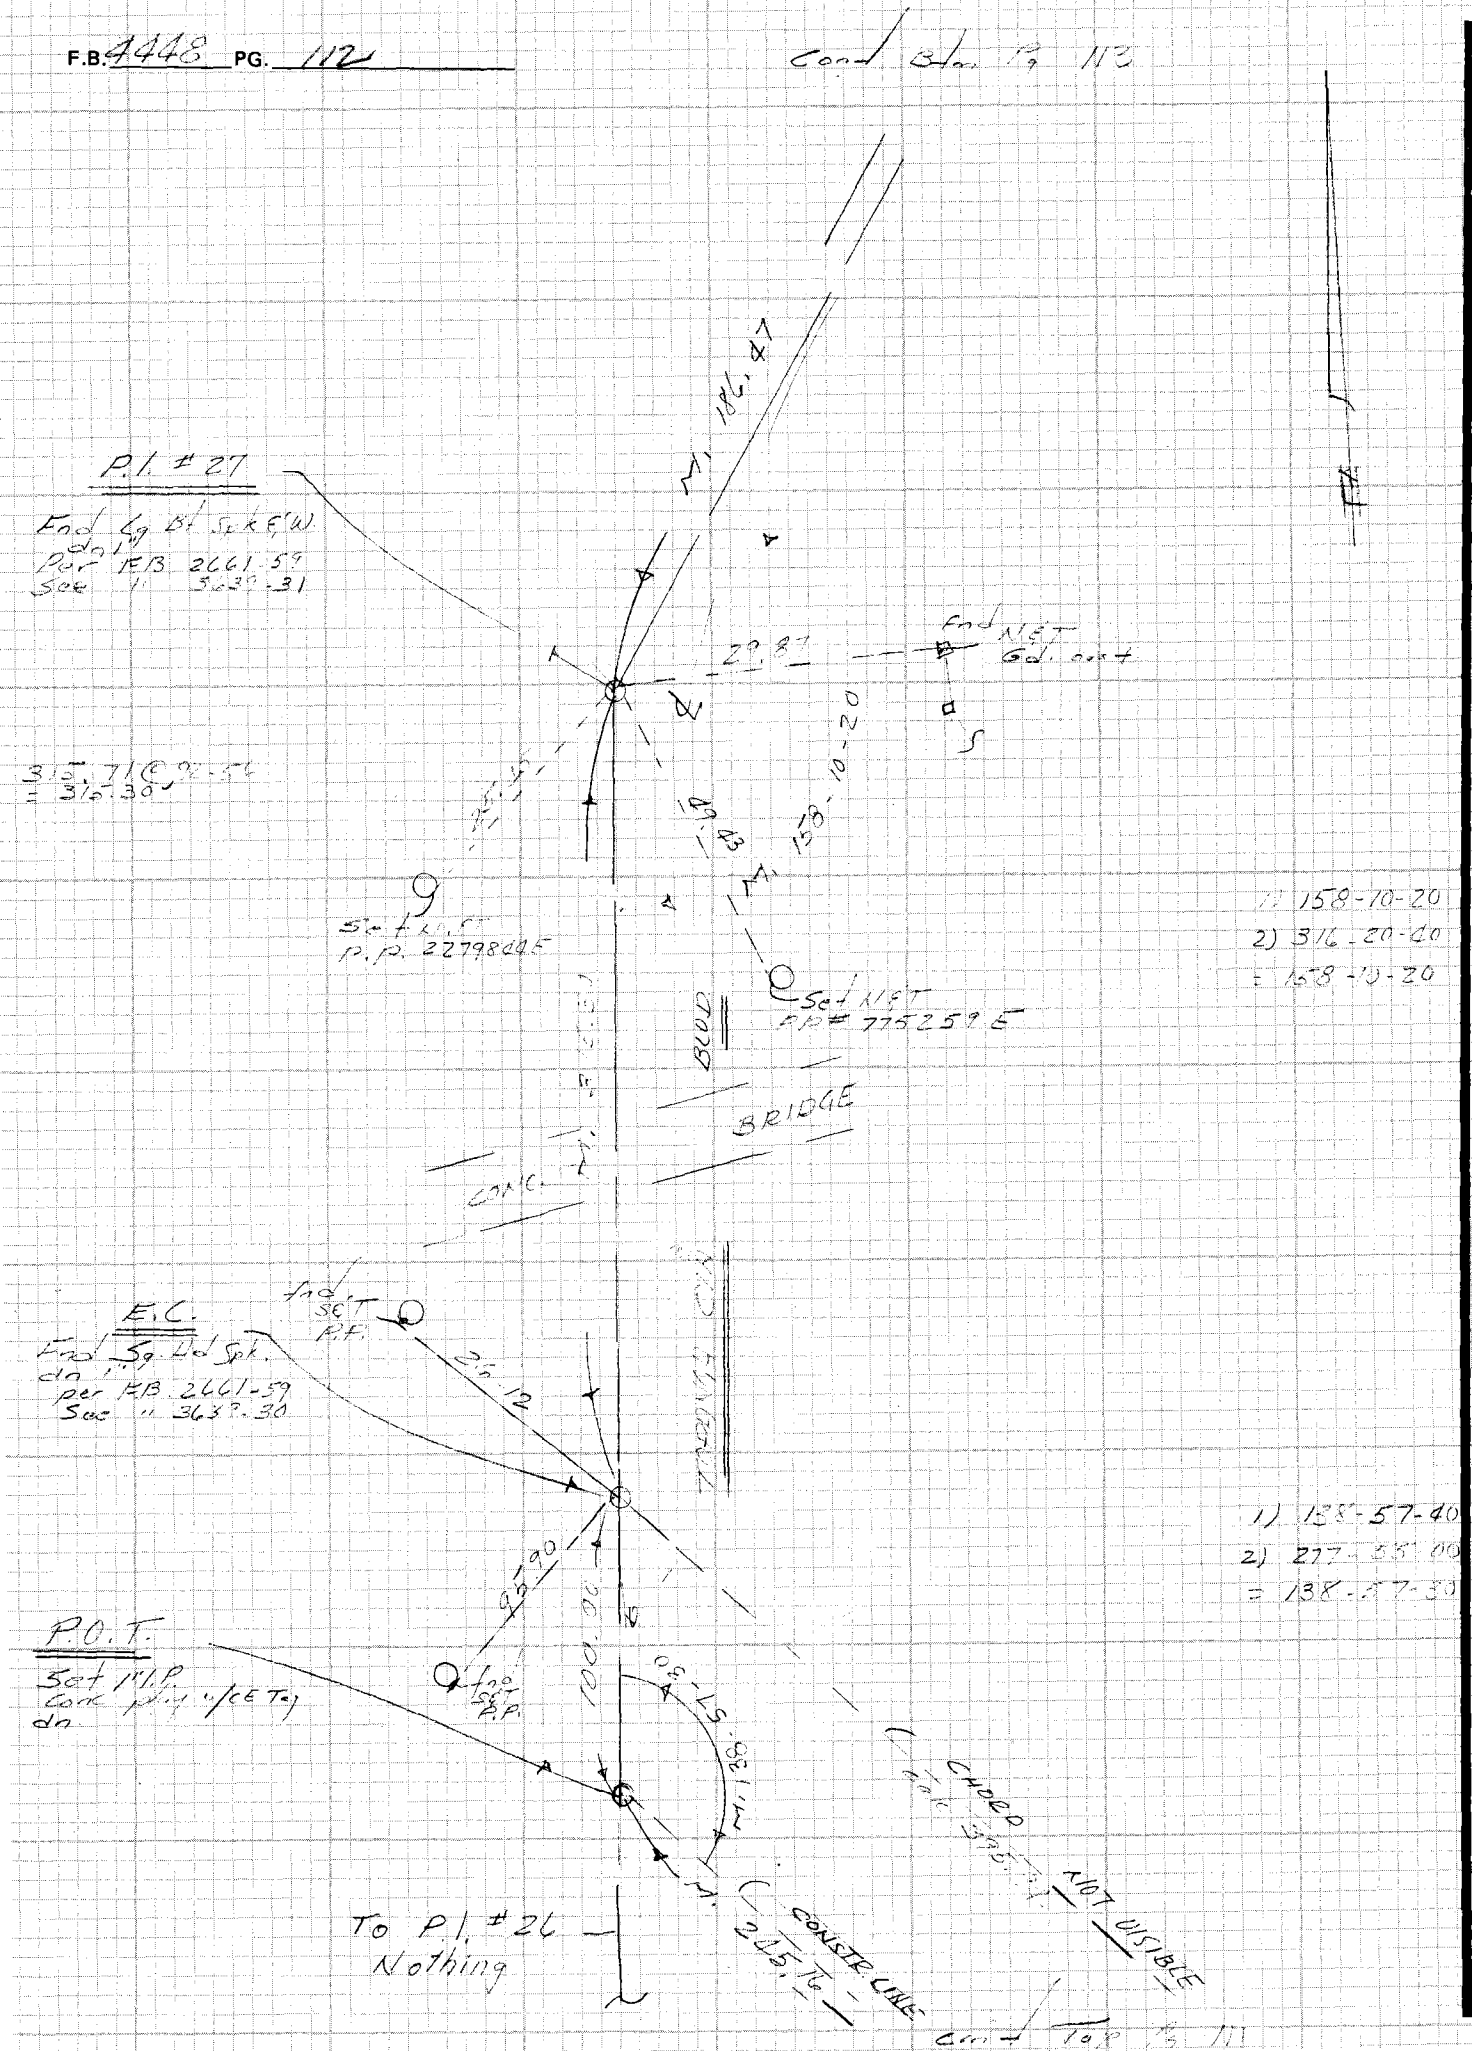

CE 310
76F3095-4/73

PLEASE RETURN TO
LOS ANGELES COUNTY ENGINEER
403 LOS ANGELES COUNTY ENGINEERING BLDG.

Do not ex. notes this side of this line

NOTE: ANY ADDITIONS OR CHANGES ON THIS SHEET MUST BE MADE OR CIRCLED IN RED INK WITH DATE AND NAME OF PERSON MAKING CHANGE

Notes Ck'd by	Survey of Tujunga Cy. Bld
Map No.	JN 0303.00 Tape Std °F
Office Work	Surveyed by
Checked	Notes EL Date 4-85
Date	Indexed

F.B. 1428 PG. 113

Cont Bkm. 18 114

Set NET Cd Post

E.C.

End Conc. N.
No Ref. Was set
per Tids per FB 3637-52
Sq. R.E. 12-82
Accepted as E.C. & Hold for Line

Set NET
PP #77252

N. 212.33

20.83

112.86

366.16 @ 89-23
= 366.16'

24.72

Set NET Cd post

153.82 @ 89-28
= 153.81'

N. 153.81

Set NET R.P.

Pl. # 28
Set 1" I.P. conc
plus of TK. El.
Set Sq. Tin
(Top of Bkc.)

1) 152-59-20
2) 305-59-00
= 152-59-30

39.31

3.91

N. 12.51

Set NET Cd. Post

152.59.30

TOPANGA CANYON BLVD

N. 153.62

Set NET 6TH Cd Post

22.60

Set NET End Cd post

B.C.

End Sq. Set
Per FB 3637-31
4th Cn. Line

37.36

310.16 @ 90-09
= 310.17
153.62
186.47

32.82

153.63 @ 90-36
= 153.62'

End NET
PP 77258 E

N. 186.47

Cont Top Pg

F.B. 4148 PG. 114

Cont from pg 115

549.78 @ 87-03
= 549.05

1) 150-02-20
2) 300-04-30
= 150-02-15

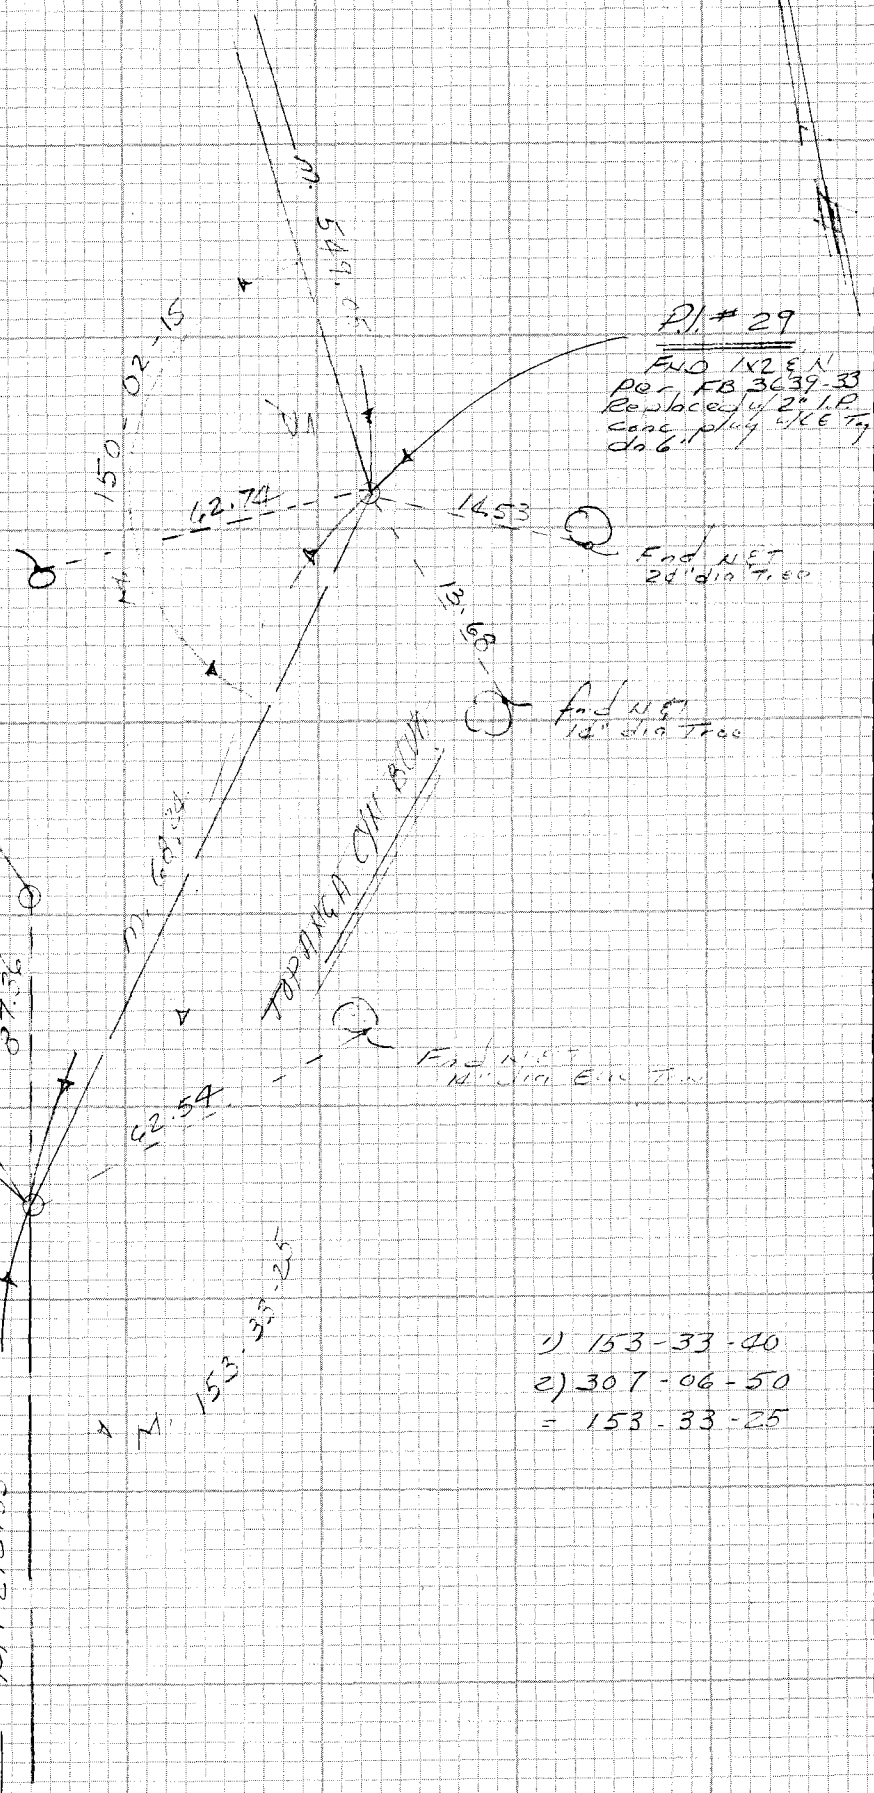

1) 153-33-40
2) 307-06-50
= 153-33-25

Cont to pg 115

CE 310
76F3095.4173

PLEASE RETURN TO
LOS ANGELES COUNTY ENGINEER
403 LOS ANGELES COUNTY ENGINEERING BLDG.

Do not enter notes this side of this line

NOTE: ANY ADDITIONS OR CHANGES ON THIS SHEET MUST BE MADE OR CIRCLED IN RED INK WITH DATE AND NAME OF PERSON MAKING CHANGE

Notes Ck'd by	Survey of [illegible] F.B. 4448 PG. 115
Map No.	JN 3030.00 Tape Std °F
Office Work	Surveyed by [illegible]
Checked	Notes [illegible] Date 4-85
Date	Indexed

Cont. To FB 3639-34

To Pl. #50
(Nothing)

Set 45°
PP.

52.81

Fnd
Spk & T
mac Burn

28.22

35.32

B. C.

Fnd Conc. N.
No Det.
Reset Spk & W Pl.
Bt Spk & W Pl.
Set FB 3639-33

Tot 4 Pts

Conc. 68.35

68.

Meas

Fnd
Conc N.
FB 3639-33

ANGLE Pl. #3

Fnd Nothing
Set Small Bt Spk & W
Pl. Set By Fnd Tie
per FB 3639-33
(This pt falls cont. of
a/l Traverse Pts.)

Rec 173+00.00
Pl. FB 3639-

12.33

33.25

22.50

35.19

Set 1/4" Rod
T.P.

Fnd
Conc N.
FB 3639-33

54 P.R.

Pg. 114

NOTE: ANY ADDITIONS OR CHANGES ON THIS SHEET MUST BE MADE OR CIRCLED IN RED INK WITH DATE AND NAME OF PERSON MAKING CHANGE

Do not extend notes this side of this line

PLEASE RETURN TO
LOS ANGELES COUNTY ENGINEER
403 LOS ANGELES COUNTY ENGINEERING BLDG.

CENTERLINE NOTES
CE 310
76F3095-4/73

F.B. 4448 PG. 116

CE 310
76F 3095-4/73

PLEASE RETURN TO
LOS ANGELES COUNTY ENGINEER
403 LOS ANGELES COUNTY ENGINEERING BLDG.

Do not extend notes this side of this line

NOTE: ANY ADDITIONS OR CHANGES
ON THIS SHEET MUST BE MADE OR
CIRCLED IN RED INK WITH DATE AND
NAME OF PERSON MAKING CHANGE

Blank

Notes Ck'd by	Survey of TOPANGA CYN BLVD
Map No.	JN 2303.00 Tape Std °F
Office Work	Surveyed by E.L.
Checked	Notes A. Caro Date 5-85
Date	Indexed

F.B. 4443 PG. 117

NOTE!

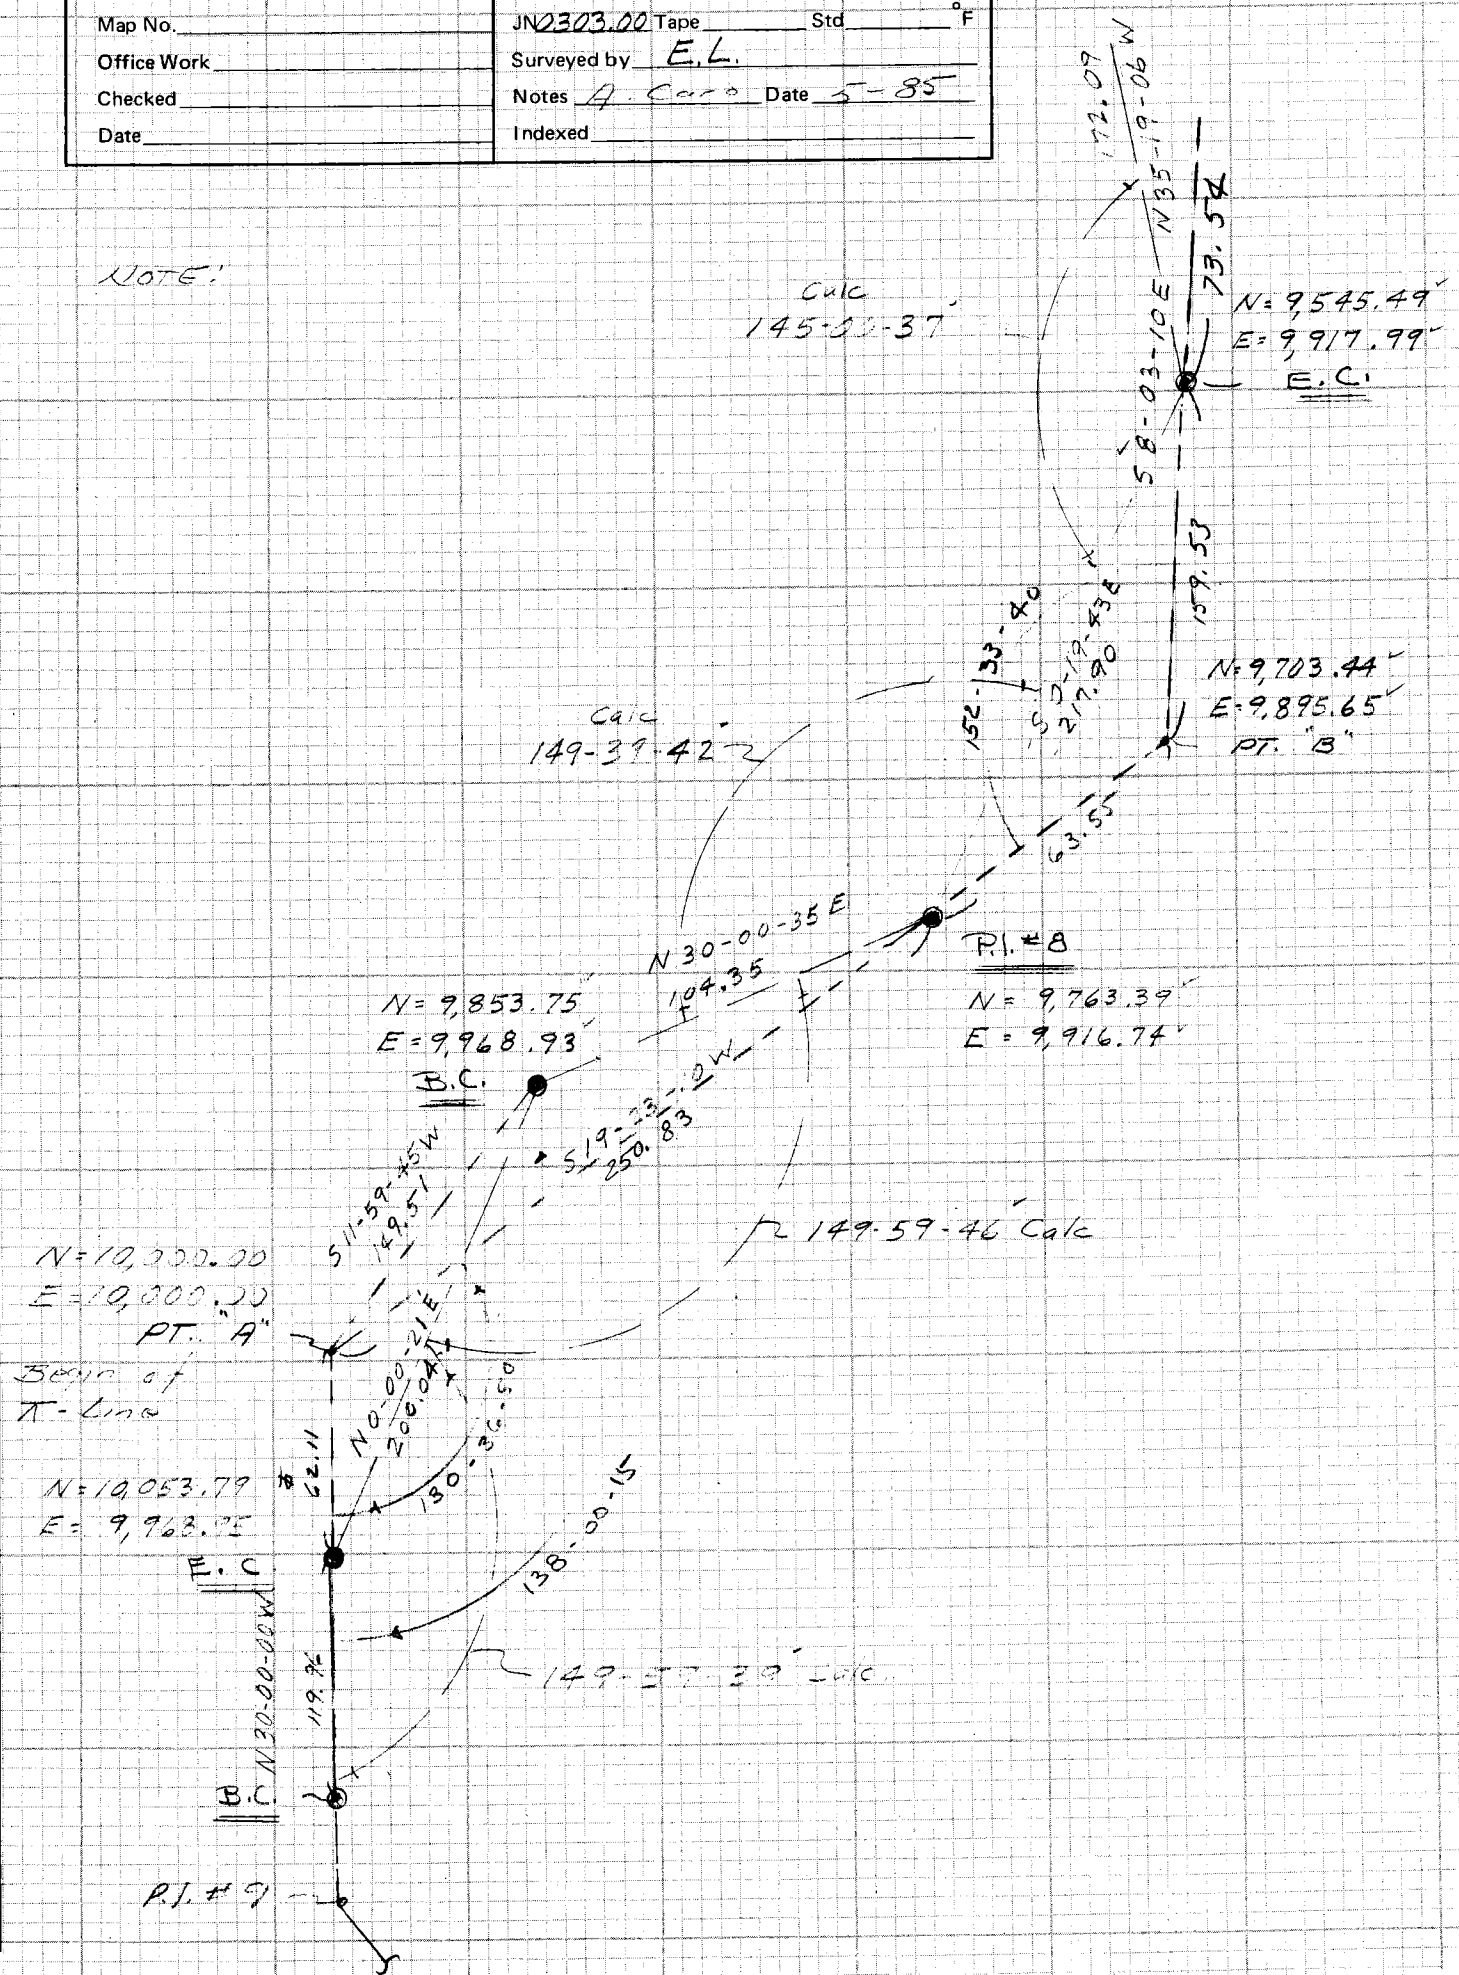

NOTE: ANY ADDITIONS OR CHANGES ON THIS SHEET MUST BE MADE OR CIRCLED IN RED INK WITH DATE AND NAME OF PERSON MAKING CHANGE

Do not extend note... this side of this line

PLEASE RETURN TO:
LOS ANGELES COUNTY ENGINEER
403 LOS ANGELES COUNTY ENGINEERING BLDG.

CENTERLINE NOTES
CE 310
76F3095-4/73

F.B. 4448 PG. 118

CE 310
76F3095-4/73

PLEASE RETURN TO
LOS ANGELES COUNTY ENGINEER
403 LOS ANGELES COUNTY ENGINEERING BLDG.

Do not ex... notes this side of this line

NOTE: ANY ADDITIONS OR CHANGES ON THIS SHEET MUST BE MADE OR CIRCLED IN RED INK WITH DATE AND NAME OF PERSON MAKING CHANGE

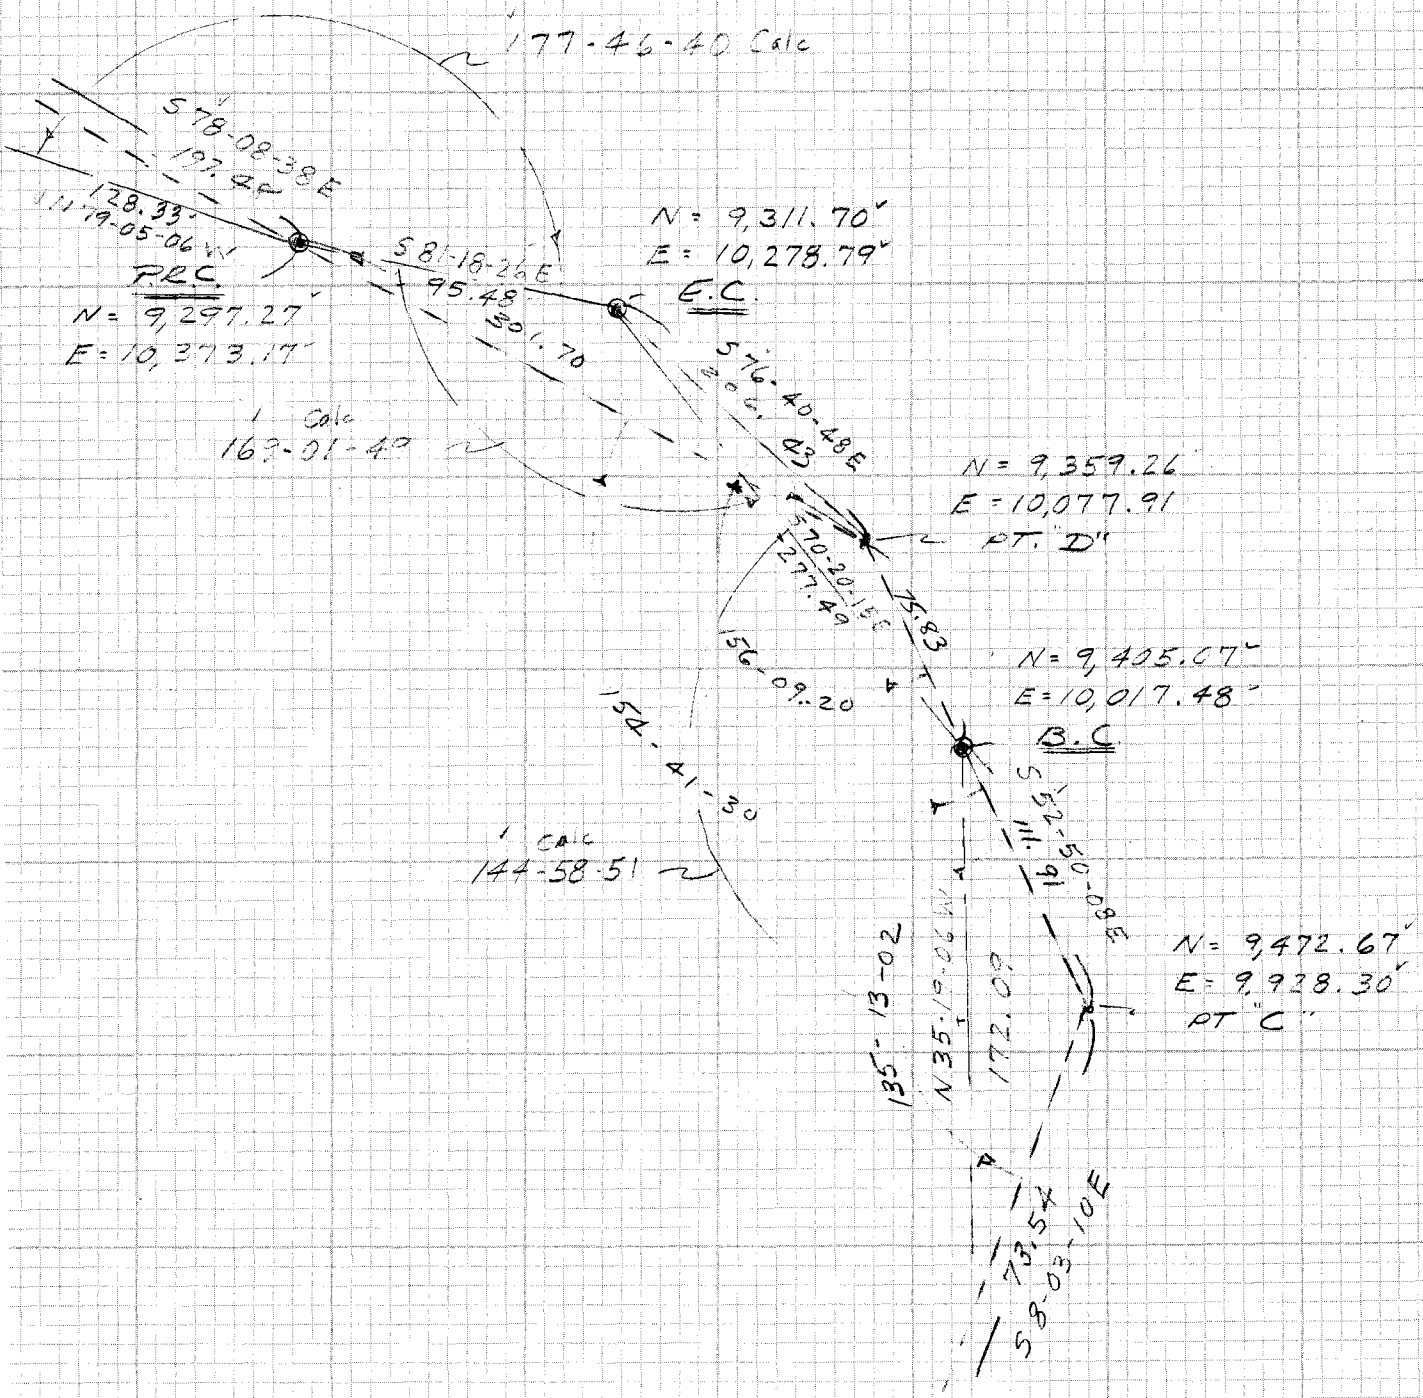

Notes Ck'd by	Survey of TOPANGA CYN BLVD F.B. 4448 PG. 119
Map No.	JN 0303.00 Tape Std °F
Office Work	Surveyed by E.L.
Checked	Notes A. Cano Date 5-85
Date	Indexed

NOTE: ANY ADDITIONS OR CHANGES ON THIS SHEET MUST BE MADE OR CIRCLED IN RED INK WITH DATE AND NAME OF PERSON MAKING CHANGE

Do not extend across this side of this line

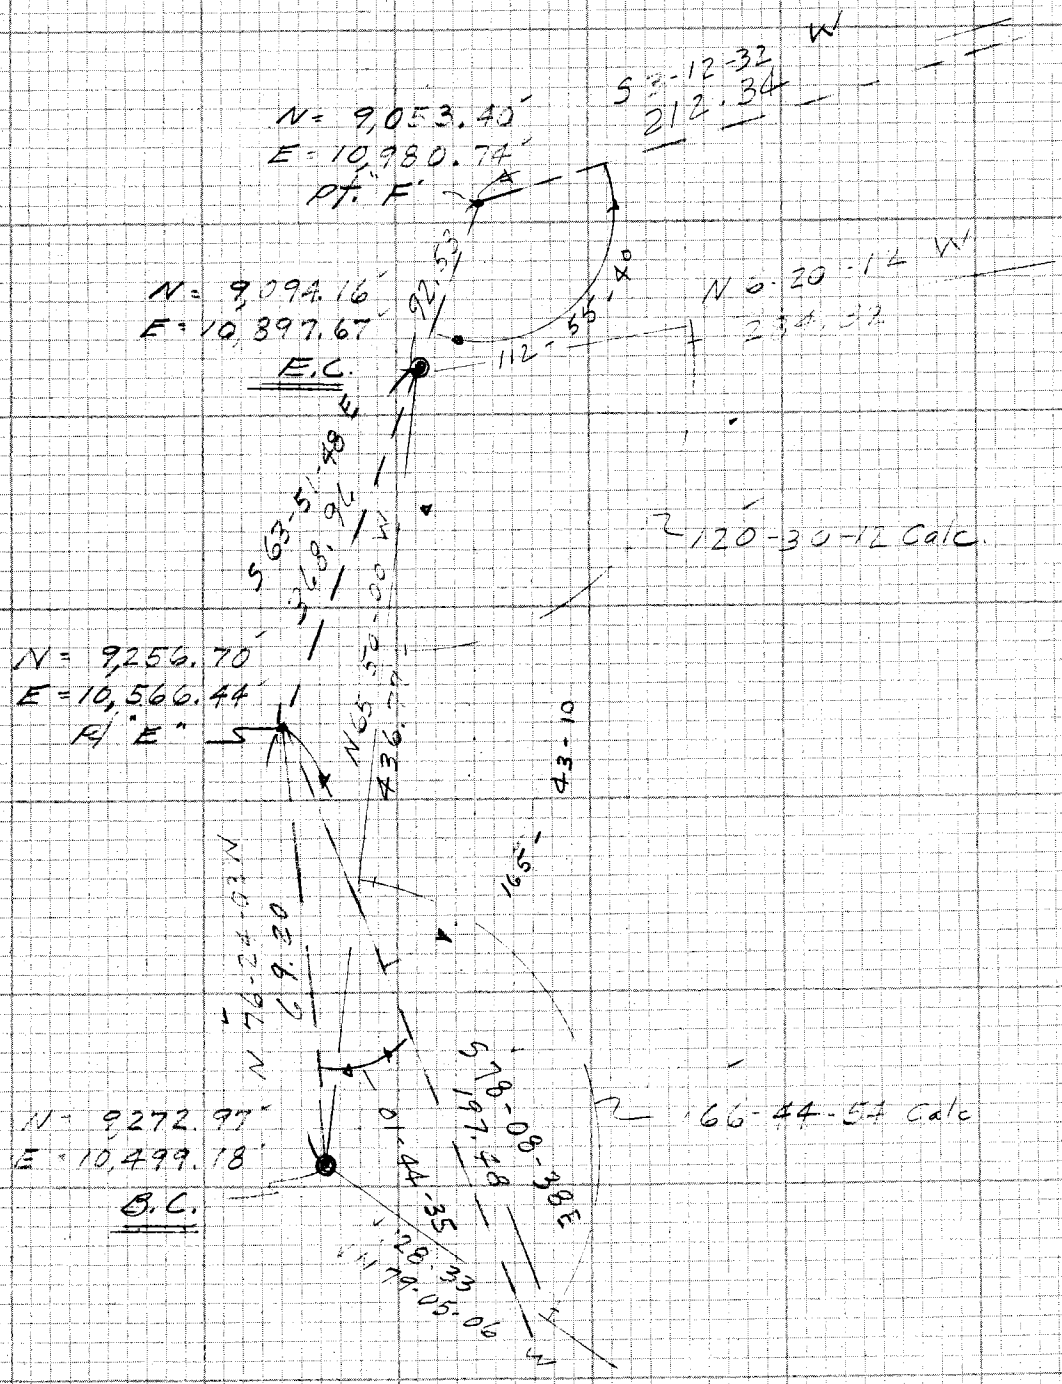

PLEASE RETURN TO
LOS ANGELES COUNTY ENGINEER
403 LOS ANGELES COUNTY ENGINEERING BLDG.

CENTERLINE NOTES
CE 310
76F3095-4/73

F.B. _____ PG. 120

CE 310
76F3095

PLEASE RETURN TO
LOS ANGELES COUNTY ENGINEER
403 LOS ANGELES COUNTY ENGINEERING BLDG.

Do not extra[illegible] notes this side of this line

NOTE: ANY ADDITIONS OR CHANGES ON THIS SHEET MUST BE MADE OR CIRCLED IN RED INK WITH DATE AND NAME OF PERSON MAKING CHANGE

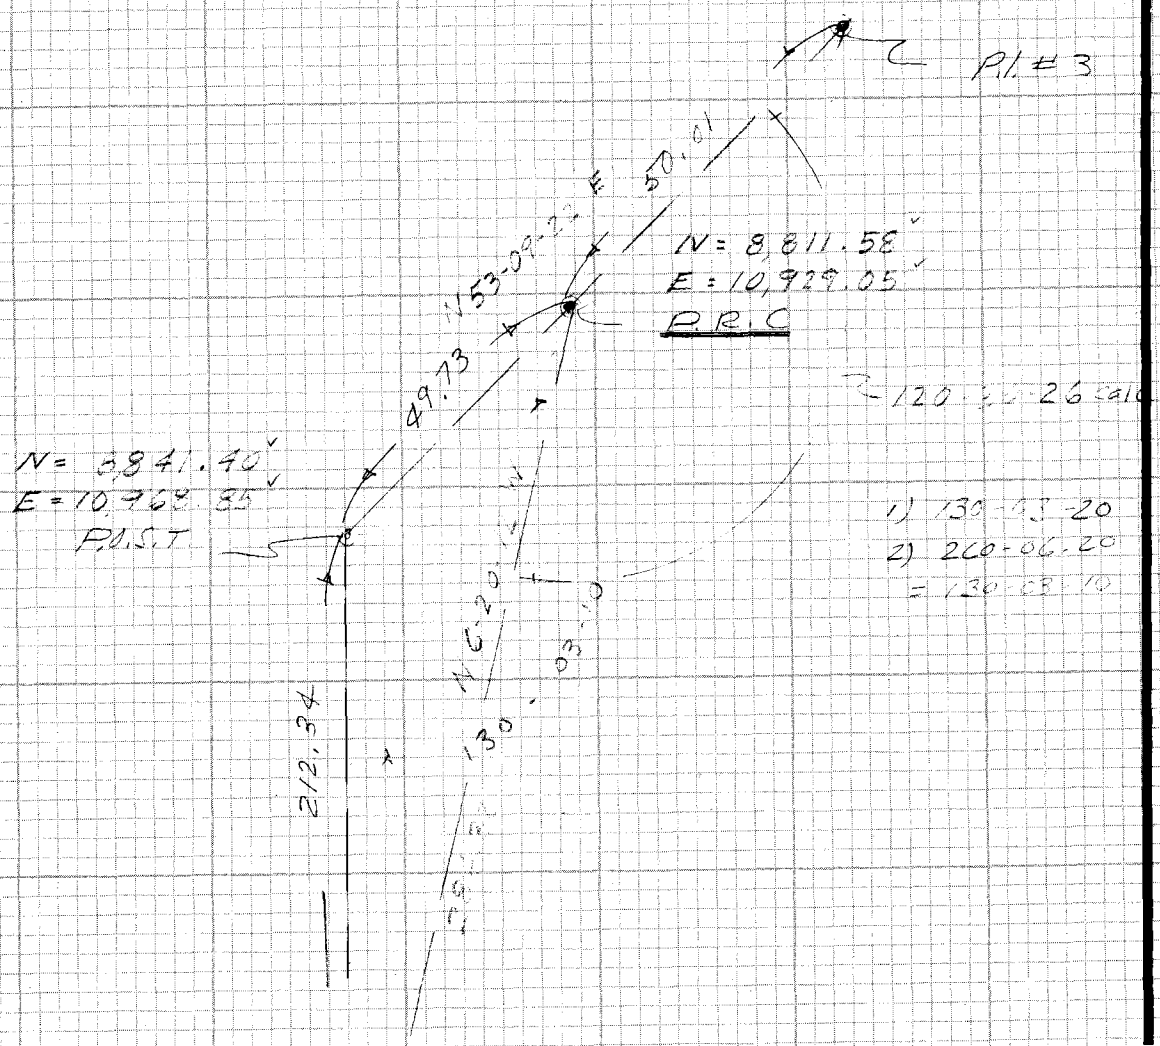

99.78 P.I.-41
= 99.78'
− 49.73
50.01