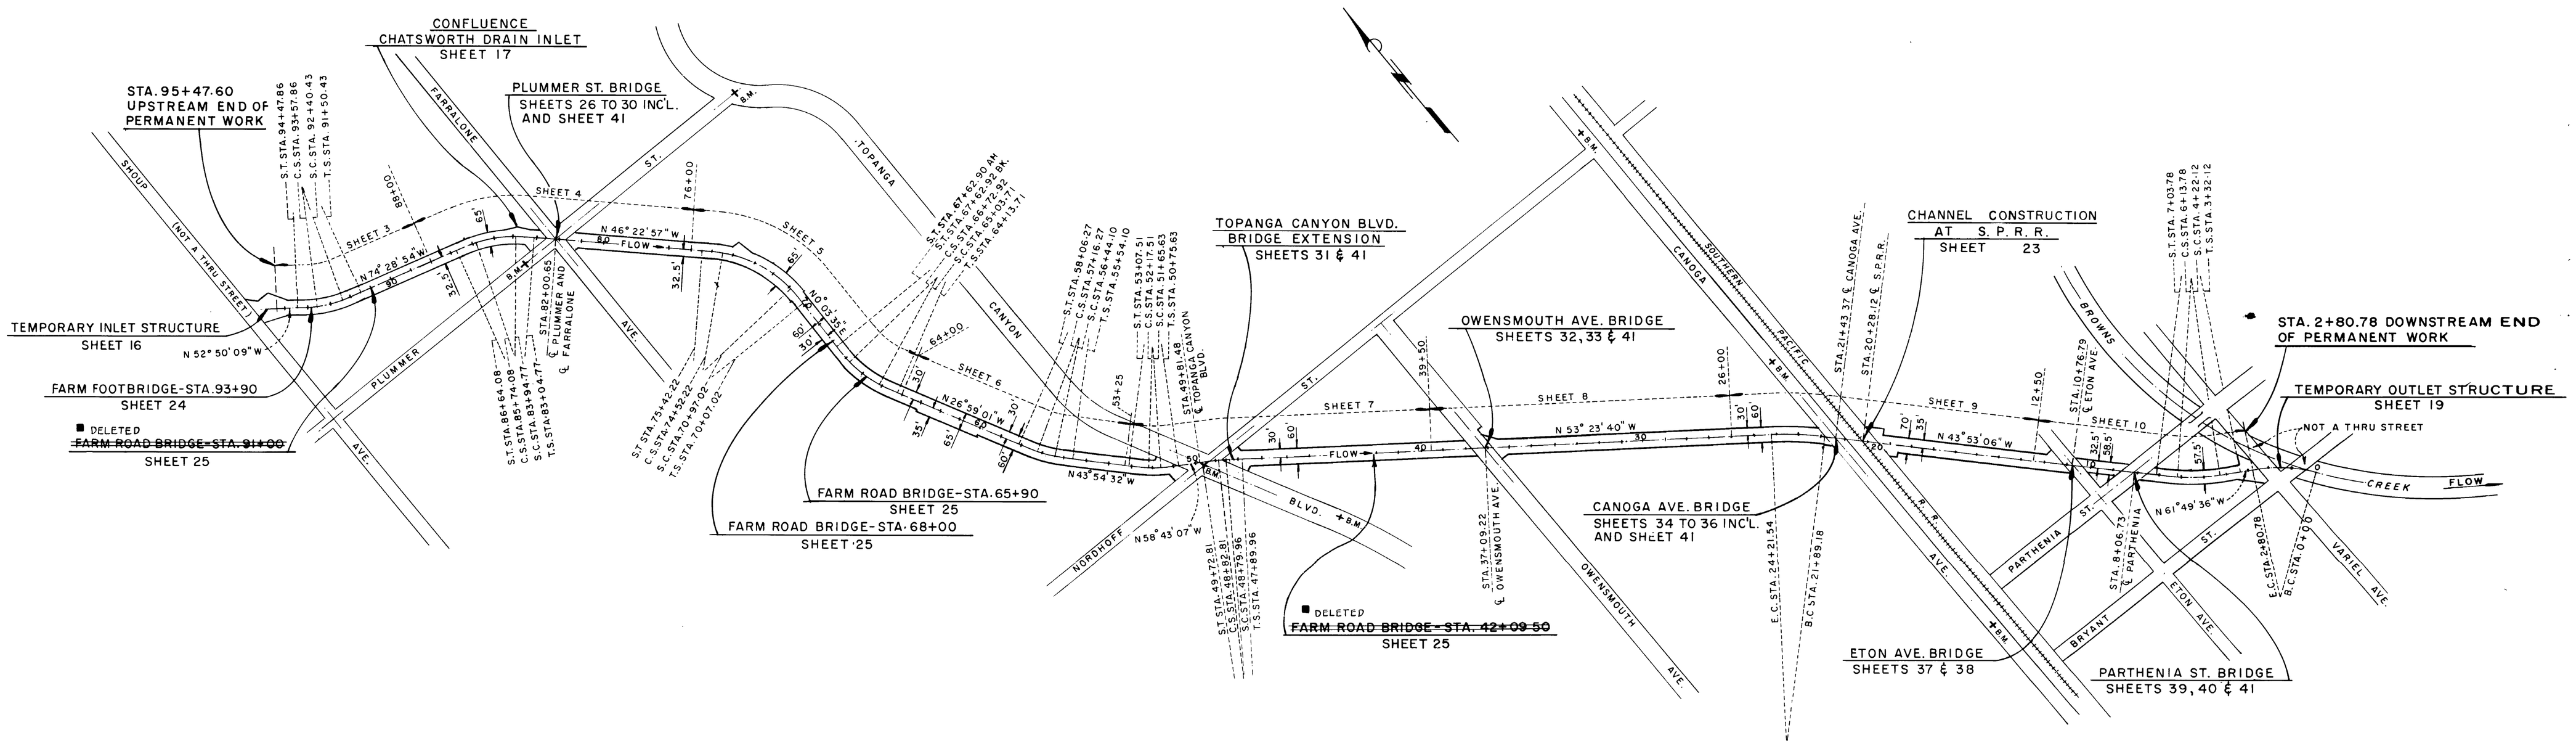

BENCH MARKS

U.S.G.S. MEAN SEA LEVEL DATUM BASED ON L.A. CITY SURVEY, 1950 ADJ.

1 - CITY OF L.A. STD. TRAVERSE MON. 8-E-20 ON ℄ CANOGA AVE. 135 FEET SOUTH OF PARTHENIA ST. ELEV. 863.13

2 - CITY OF L.A. STD. TRAVERSE MON. 7-E-22 ON ℄ CANOGA AVE. 1240 FEET ± SOUTH OF ℄ NORDHOFF ST. ELEV. 875.20

3 - CITY OF L.A. STD. TRAVERSE MON. 7-E-21 ON ℄ CANOGA AVE. 98.8 FEET NORTH OF ℄ NORDHOFF ST. ELEV. 889.25

4 - STD. SURVEY MON. ON ℄ P.I. OLD TOPANGA CANYON BLVD. 649.22 FEET SOUTH OF ℄ NORDHOFF ST. (ONE FOOT EAST OF ℄ PAVEMENT UNDER COVER) ELEV. 889.30

5 - WIRE SPIKE AT ℄ INTERSECTION OF OLD TOPANGA CANYON BLVD. AND NORDHOFF ST. ELEV. 892.10

6 - STD. SURVEY MON. ON ℄ PLUMMER ST. 3 FEET WEST OF CONC. PAVING OF OLD TOPANGA CANYON BLVD. (UNDER COVER). ELEV. 905.14

7 - SPIKE IN NORTH SIDE OF FIR TREE 191 FEET ± WEST OF ℄ FARRALONE AVE. 18 FEET SOUTH OF ℄ PLUMMER ST. ELEV. 910.32

GENERAL PLAN

SCALE - ONE INCH EQUALS 300 FEET

100 0 1000
GRAPHIC SCALE IN FEET

"AS BUILT" DRAWING

PLANS PREPARED BY
U.S. DEPARTMENT OF AGRICULTURE
SOIL CONSERVATION SERVICE
APPROVED:
3-5-65 — DATE
Charles F. Bond — PROJECT ENGINEER
DWG. NO. 7-S-11485 SHEET 2 OF 46

REVISIONS		
MARK	DATE	DESCRIPTION
■	11-7-66	"AS BUILT" CORRECTIONS

DRAWN BY SCS
TRACED BY SCS
CHECKED BY
RECOMMENDED BY R. S. Rocke Jr. — DIVISION ENGINEER (DESIGN)
DESIGNED BY SCS
SUBMITTED BY D.N.M.

LOS ANGELES COUNTY
FLOOD CONTROL DISTRICT

SANTA SUSANA CREEK
BROWNS CREEK TO
100 FT. EAST OF SHOUP AVE.

GENERAL PLAN

APPROVED BY R. R. Sullivan — CHIEF ENGINEER

SCALE 1" = 300' | DATE NOV. 1964 | NO. 89-D6.2 | SHEET 2 OF 46

DIETZGEN 126NW-3 AGEPROOF FILM