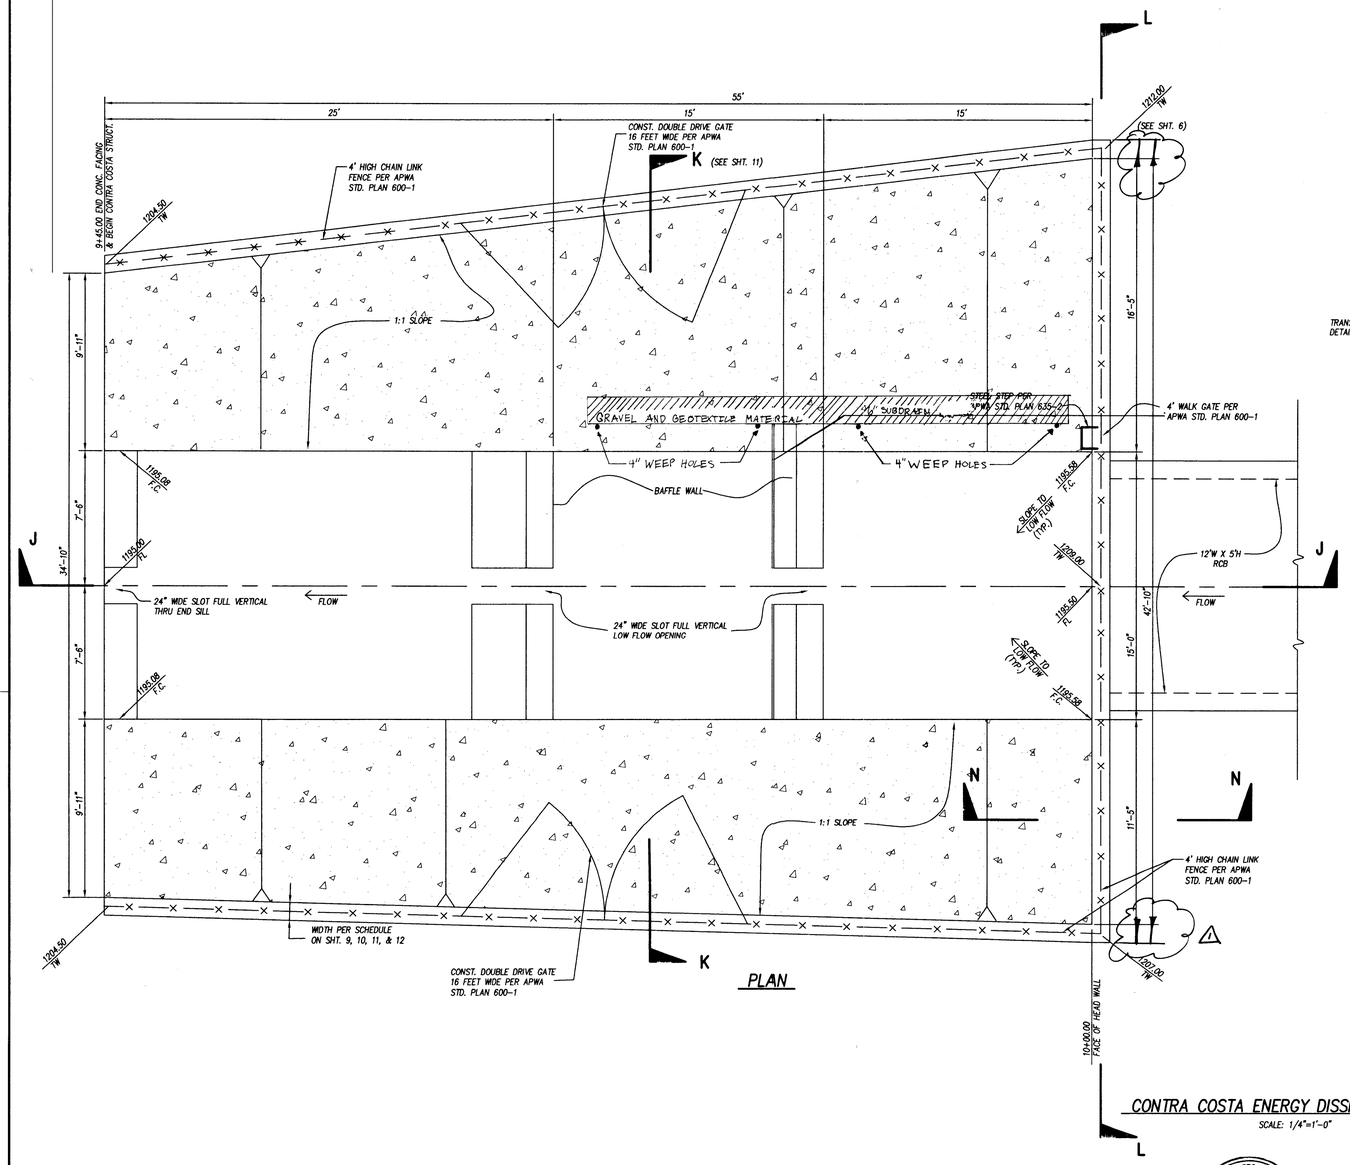

PLAN

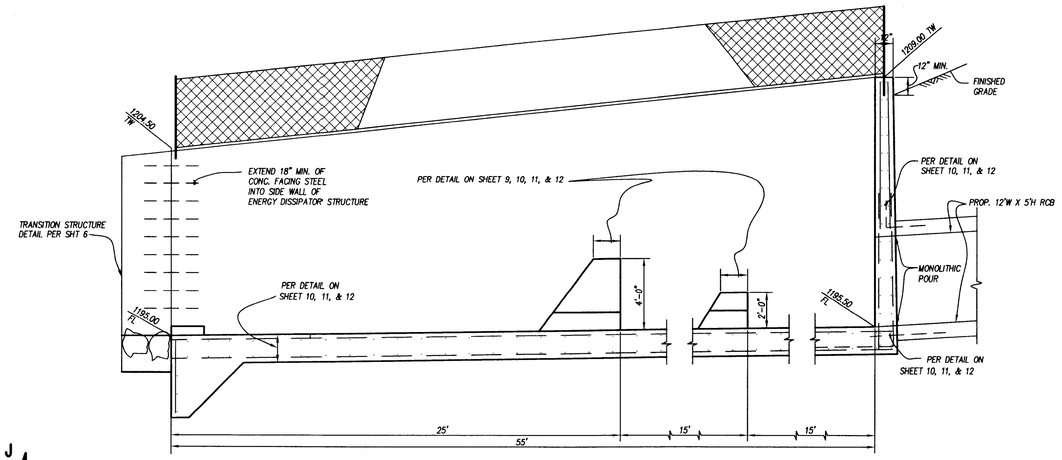

SECTION J-J

CONTRA COSTA ENERGY DISSIPATOR DETAIL

SCALE: 1/4"=1'-0"

REGISTERED PROFESSIONAL ENGINEER EDWARD A. WAGSTAFF C 25119 EXP. 12-31-03 CIVIL STATE OF CALIFORNIA

REVIEWED LAND DEVELOPMENT DIVISION
BY [signature] 12/2/02
SUBDIVISION PLAN CHECKING SECTION DATE

NO.	REVISION	REVISED BY	APPROVED BY	DATE
2	ADD 6" SUBDRAIN ALIGNMENT	EGW	[signature]	6/23/03
1	CLARIFY DIMENSIONS	EGW	[signature]	6/23/03

REGISTERED PROFESSIONAL ENGINEER EDWARD A. WAGSTAFF C 25119 EXP. 12-31-03 CIVIL STATE OF CALIFORNIA
PROJECT ENGINEER 10/31/02 DATE

"PF512987"

STORM DRAIN PLANS IN
D.S. NO. 508 P.D. No. 2530
COUNTY OF LOS ANGELES DEPARTMENT OF PUBLIC WORKS

PREPARED BY:
CROSBY MEAD BENTON & ASSOCIATES
Engineers • Planners • Surveyors
6345 Balboa Blvd. Suite 140
Encino, California 91316
(818) 343-5384

DWG | SHEET 5 OF 12

P:\0084.01 Rye Canyon-Alta Vista\Eng\Sd\Plan Set\SHT05.dwg 0084.01 Lusine Nidelian 14:24:47 08/02/02