142-143

Sht. 52
A-279

79

HANSEN HEIGHTS

Being a Resubdivision of a part of
Lots 23 and 64 and Lots 32, 33, 34, 35, 36 and 37 and Lots 44
to 63 inclusively except Lot 49 of the West Portion of
TUJUNGA RANCH
~M.R. 29-51-52~

And including the strip of land between West Portion of Tujunga Ro. M.R. 29-51-52.
and Tujunga Rancho Boundary Line
Surveyed Oct. 1907
C.A. Ensign } Surveyors
L.C. Porter }
Scale 1" = 300'

In the City of Los Angeles

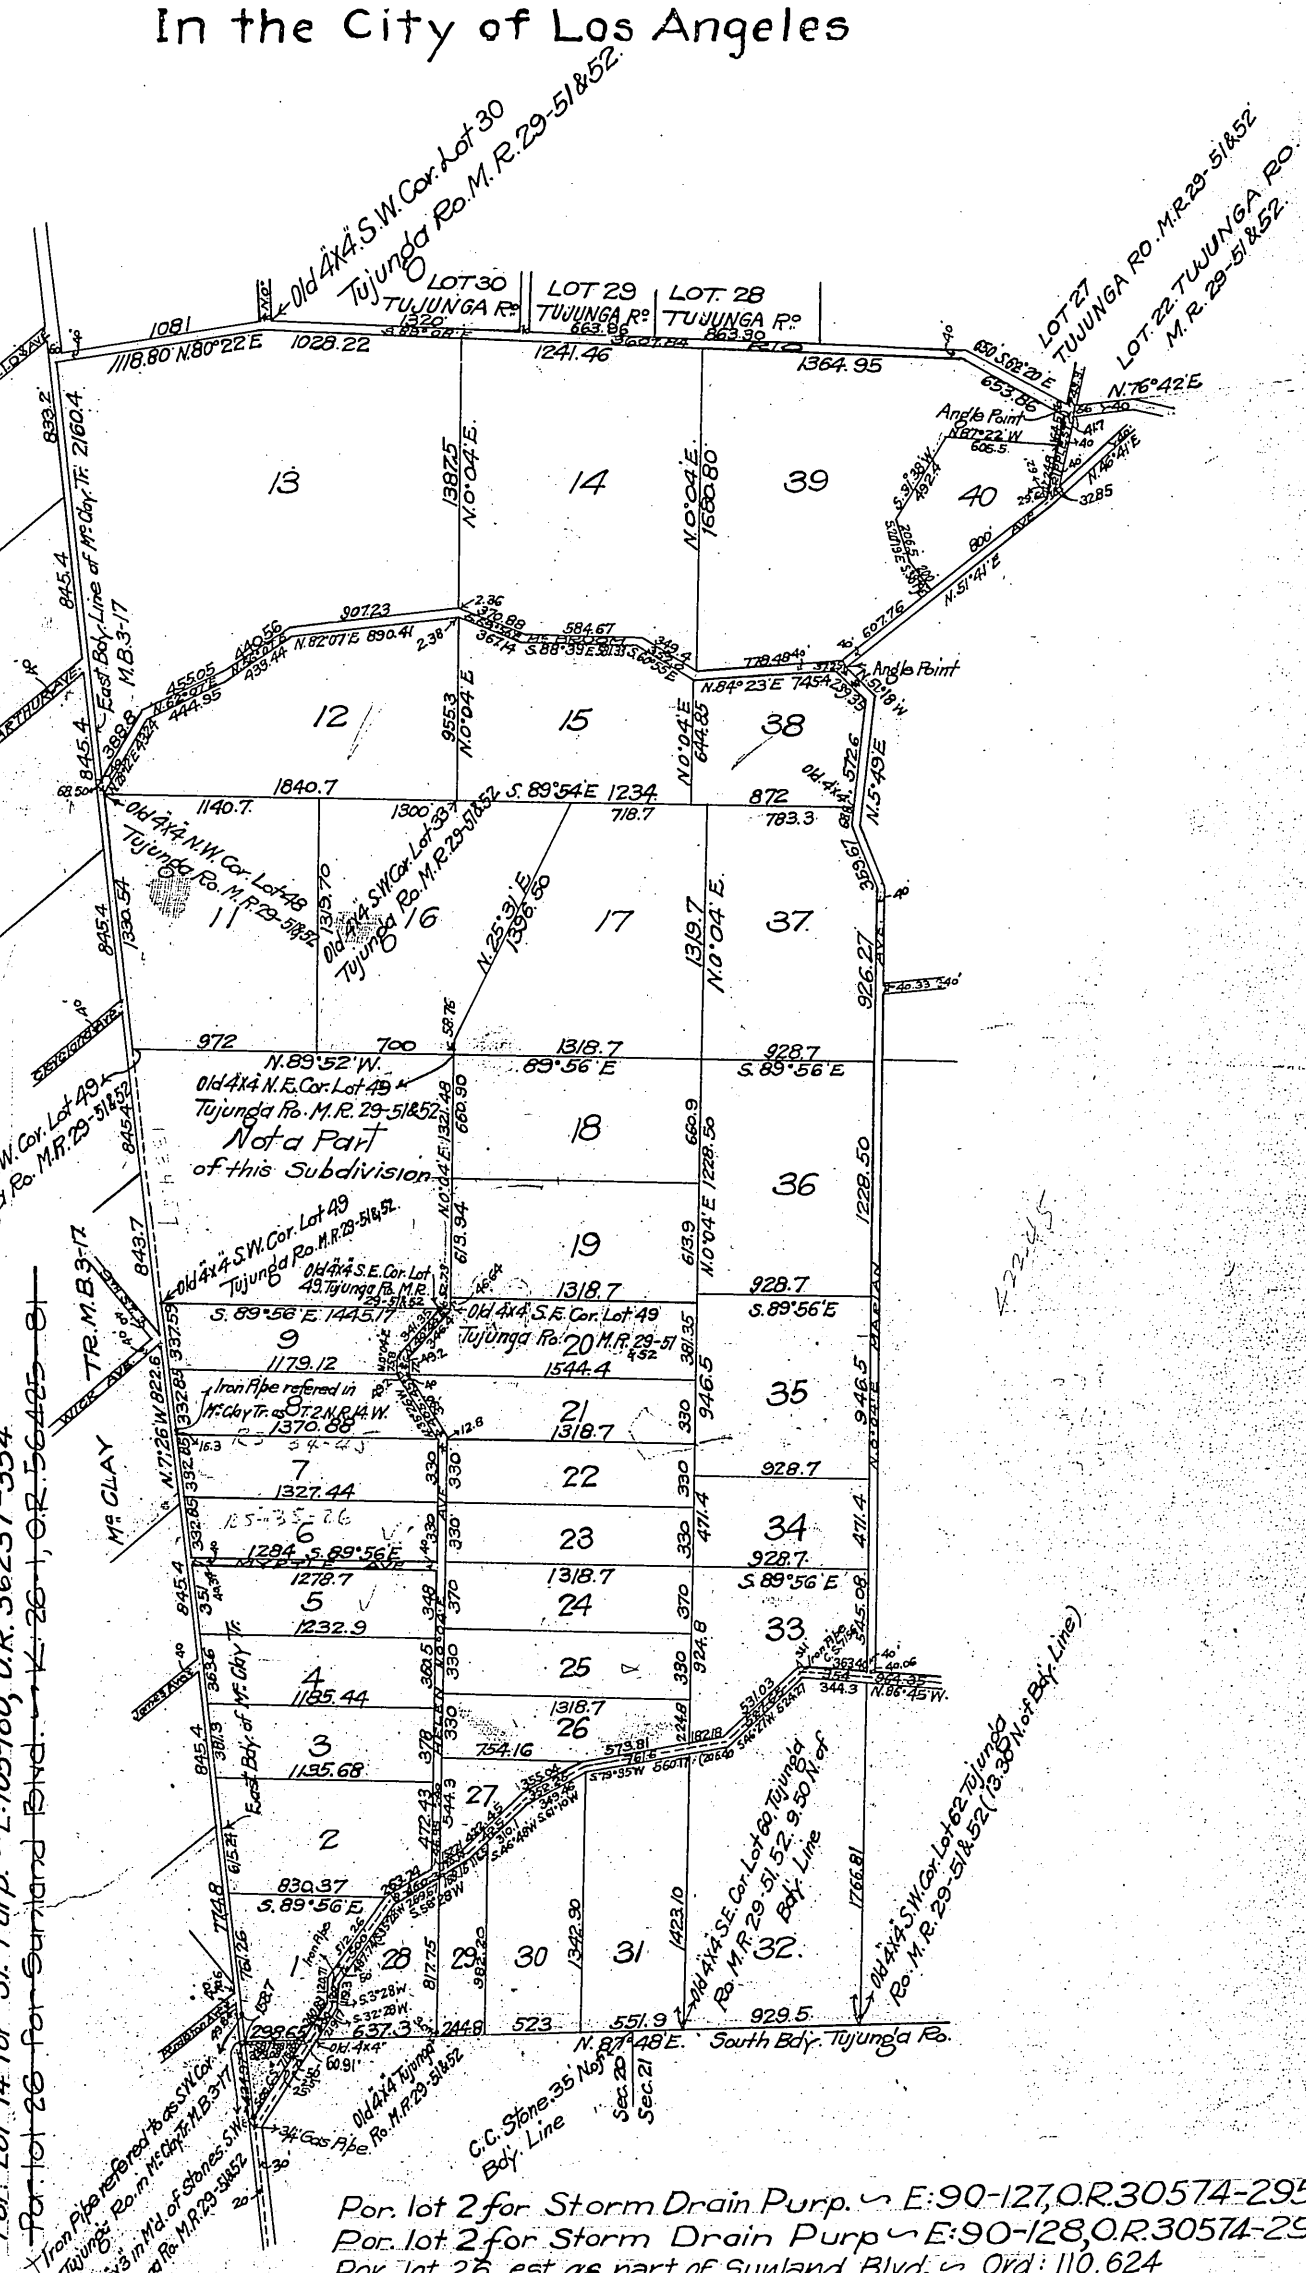

Por. lots 5 & 6 for Clybourn Ave. & Peoria Ave. ~ D:70-14, Cert. BW-25807, Doc. Nos. 151780 & 151781.
For Transmission Line see C.S.B-1518-4.
Por. lot 13 for Hansen Dam ~ E:34-46, see C.F. 2070,
" " 14 to L.A.C.F.C.D. ~ E:45-137, see C.F. 2154
For Hansen Dam see C.F. 2070, 2080, 2101, 2154
Por. lot 13 for McBroom St. ~ E:55-214, O.R. 19020-160.
Por. lots 12 & 38 for Wentworth St. ~ see CF-2154 (F.J.)
Por. lots 13 & 14 to L.A.C.F.C.D. ~ E:45-295, OR 20680-91
Por. lot 13 to L.A.C.F.C.D. ~ E:45-297, OR 20762-331
Por. lots 65, 12, to City of L.A. ~ E:59-264, OR 20811-349
Por. lot 13 to U.S.A. by L.A.C.F.C.D. ~ E:65-182, OR 22054-143
" " 12 deeded by L.A.C.F.C.D. ~ E:75-15, O.R. 23542-273.
" " " " " " ~ E:75-43, O.R. 23956-196.
~~Por. of lot 26 to City of L.A. ~ E:122-237, O.R. 41091-242~~
~~Por. lot 33 for Sunland Blvd. ~ E:164-182, O.R. 53751-156~~
~~Por. lot 33 " " " ~ E:167-57, O.R. 54208-232 Q.C.~~
~~Por. " " " " ~ E:167-58, O.R. 54208-209~~
~~Por. " " " " ~ K:4-1, OR 56023-119~~
~~Por. " " " " ~ K:17-16, O.R. 56316-153~~

Por. lot 13 for McBroom St. ~ E:55-71, O.R. 19020-160
Por. lot 20 for Helen Ave. D:40-78 O.R. 4051-108
Por. lot 29 for Hansen St. D:54-204, O.R. 6077-133.
Por. Lot 5 for Clybourn Av., Peoria Ave. D:54-245, O.R. 6075-210.
Por. Lot 6 " " " " D:54-246, O.R. 6119-61.
Por. Lot 7 for Clybourn Ave. D:54-247, O.R. 6075-212
Por. Lot 4 " " " D:54-247, O.R. 6074-222.
Por. lot 33 for Peoria Ave. D:57-85 O.R. 6099-378
Por. lot 24 " " " D:57-86 O.R. 6122-267
Por. lot 23 " " " D:57-88 O.R. 6130-323
Por. lots 1, 2, 3, & 4 for Clybourn Ave. D:57-194 O.R. 4769-241.
Por. " 1, 2, 3, & 4 " " " D:61-272, O.R. 7772-51.
Por. " 1, 2, 3, & 4 " " " D:61-297, Cert. Q-8492 & AI-14093.
Por. Clybourn Ave. chg. to Stonehurst Ave. ~ Ord. 66213-Sec. 1.
(Myrtle Ave) Peoria Ave. changed to Art St. ~ Ord. 76657, Sec. 7.
Por. Lot 13 for St. Purp. ~ E:44-282, O.R. 18770-88
Por. Lot 14 for St. Purp. ~ E:105-180, O.R. 36237-354
~~Por. lot 26 for Sunland Blvd. ~ K:26-1, O.R. 56425-81~~

Por. lot 2 for Storm Drain Purp. ~ E:90-127, O.R. 30574-295
Por. lot 2 for Storm Drain Purp ~ E:90-128, O.R. 30574-290
Por. lot 26 est. as part of Sunland Blvd. ~ Ord: 110,624
~~Por. lot 33 for Sunland Blvd. ~ E:173-191, O.R. D-21-175~~
For Sunland Blvd. ~ See F.M. 20075-2, 3, 4.
For Hansen Heights Channel ~ See F.M. 12406-3.

52-A, B-3, 4
Sht. ~~52, A-279-938~~

~~A127~~

Comp. J.E.R.

80

142-143

Sht. 52
A-279

Rio Ave. changed to Wentworth Ave.-Ord. 38608
Marian Ave. " " Wheatland " " "
Ripple Str. " " Wheatland " " "
Pure Water Ave. " " La Canada Way " "
Hill Ave " " La Canada Way " "
Mary Bell Ave. " " La Canada Way " "
John Str. " " Johanna Ave. " "

Por. lots 26 and 27 for Hansen St. D:57-6 O.R. 6138-79
Por. lots 30 and 31 " " " D:57-7 O.R. 6082-355
Por. lots 30 and 31 " " " D:57-7 O.R. 4740-32
Por. lot 27 " " " D:57-8 O.R. 6101-284
Por. lot 85 " " " D:57-8 O.R. 6126-143
Por. lots 77 and 78 " " " D:57-9 O.R. 6101-285
Por. lot 28 " " " D:57-10 O.R. 6108-219
Por. lot 1 " " " D:57-10 O.R. 4645-240
Por. lot 33 " " " D:57-16 O.R. 6124-199
Por. lot 76 " " " D:57-16 O.R. 6089-299
Por. lot 74 " " " D:57-17 O.R. 6087-281
Por. lots 72-73-74 " " " D:57-71 O.R. 6103-359
Por. lots 75 and 76 " " " D:57-71 O.R. 6156-133
Por. lot 28 " " " D:57-72 O.R. 6153-142
Por. lot 72 " " " D:61-100 O.R. 7030-113
Wentworth Ave. chg. to Wentworth St. Ord. 63592-Sec. 9.
Hansen Street " " Sunland Blvd. " " Sec. 23.
Maude S Ave. " " Maude Avenue-Ord. 70535.
Mc Broom Ave " " Mc Broom St-Ord 75836, Sec. 80

For Wentworth Ave. & McBroom St. improvement - CF 2154
Por. lot 65 for Wentworth St. - see CF-2154 (F.J.)
For flood control see C.S.B.-1880
Por. lot 13 deeded to L.A.C.F.C.D. - E:75-26, O.R. 23699-354.
~~Por. lot 53 for Sunland Blvd. - E:164-141, O.R. 53649-430~~
~~Por. lot 51 " " " - E:164-141, O.R. 53650-289~~
~~Por. lot 48 " " " - E:164-142, O.R. 53650-310~~
~~Por. lot 53 " " " - E:164-182, O.R. 53751-153~~
~~Por. lot 49 for Sunland Blvd. - E:164-241, O.R. 53939-101~~
~~Por. " " " " - E:164-241, O.R. 53939-93~~
~~Por. " " " " - E:164-242, O.R. 53939-87~~
~~Por. lot 49 for Sunland Blvd. - E:164-271, O.R. 54032-443~~
~~Por. lot 53 " " " - E:167-235, O.R. 54631-341.~~
~~Por. lot 53 " " " - E:167-236, O.R. 54631-337.~~
~~Por. lot 48 " " " - E:170-282, O.R. 55427-192 Q.C.~~

for Wentworth St. - See F.M. 20084-2
For Sunland Blvd. - See F.M. 20075-2,3,4.

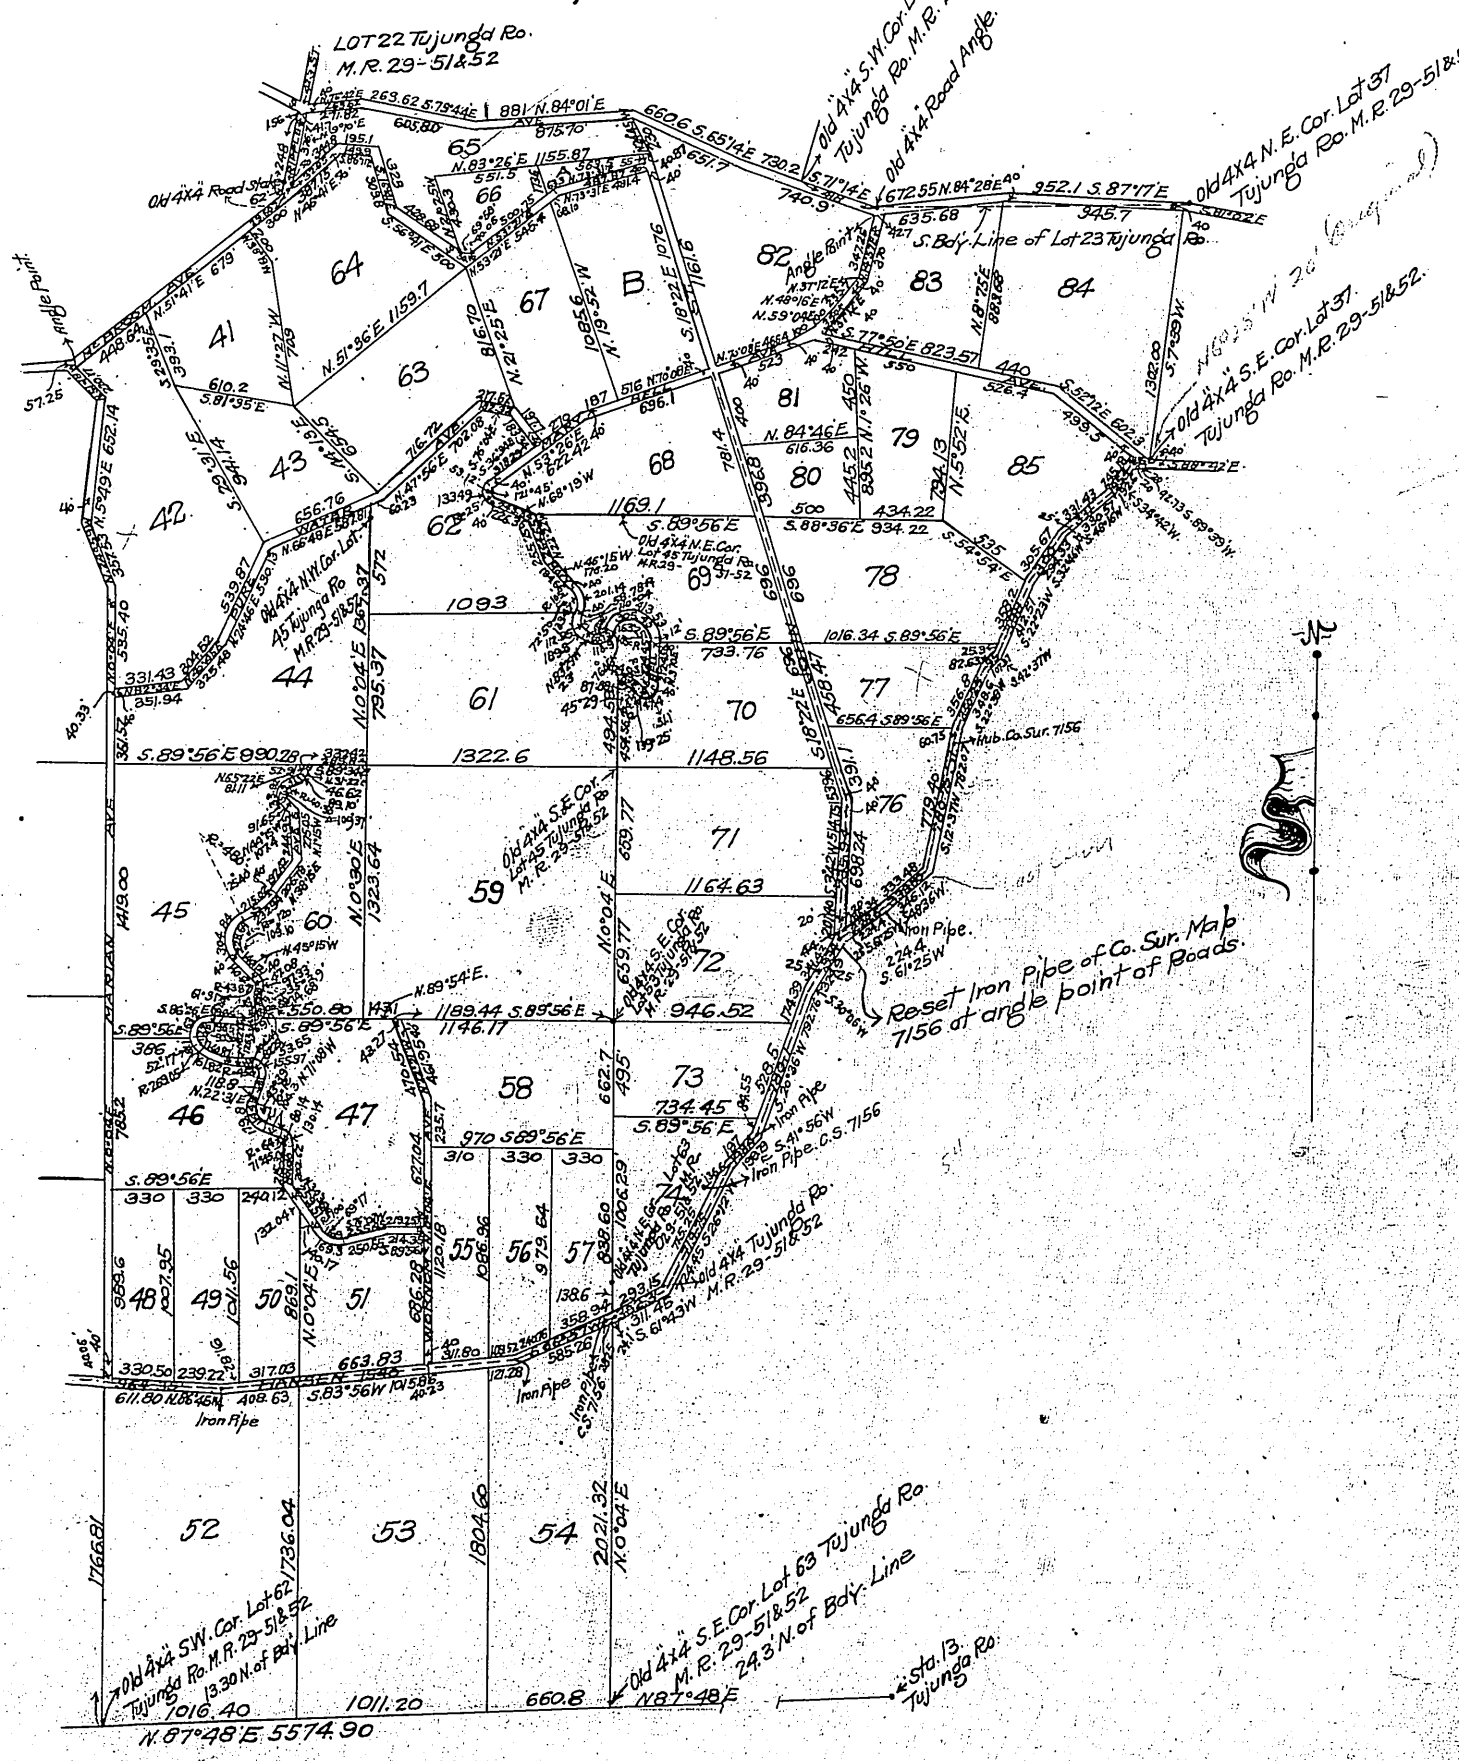

Por. lots 48 & 49 to City of Los Angeles - D:61-196, O.R. 7033-346.
Por. lots 44, 61, 62 quitclaimed to City of Los Angeles - D:84-295, O.R. 11232-64, & D:86-102, O.R. 11473-222.
Por. lot 44 for La Canada Way; Por. lots 61 & 62 for Maude Ave. - D:84-299, O.R. 11149-344; D:84-300, O.R. 11255-34.
Por. lot 84 to City of L.A. - D:86-52, O.R. 11369-39; D:90-23, Cert. H.H. 68138.
Por. lots 46, 48 deeded by L.A. City Sch. Dist. - E:71-51, O.R. 22041-267
Por. lot 42 for Wheatland Ave. - E:69-139, O.R. 22245-118, E:69-140, O.R. 22262-207
" " 38 " E:69-139, O.R. 22178-304
For por. Wheatland Ave. see C.F. 2154.
Por. lot 42 quitclaimed for street purp. - E:69-141, O.R. 22228-168

Proprietor: Tujunga Company.

Recorded Dec. 3, 1907
(Scale reduced to 1000' to one inch)

Almond St. changed to Monesta Ave. Ord. 49411

~~A-127~~ ~~Sht. 8~~

52-A,B-3,4
Sht. 52, ~~A-279~~ ~~938~~