EXHIBIT "A"

CITY OF PASADENA DEPARTMENT OF PUBLIC WORKS

CITYWIDE LOCATION MAP FOR THE "CATCH BASIN TRASH EXCLUDERS - PHASE 1"

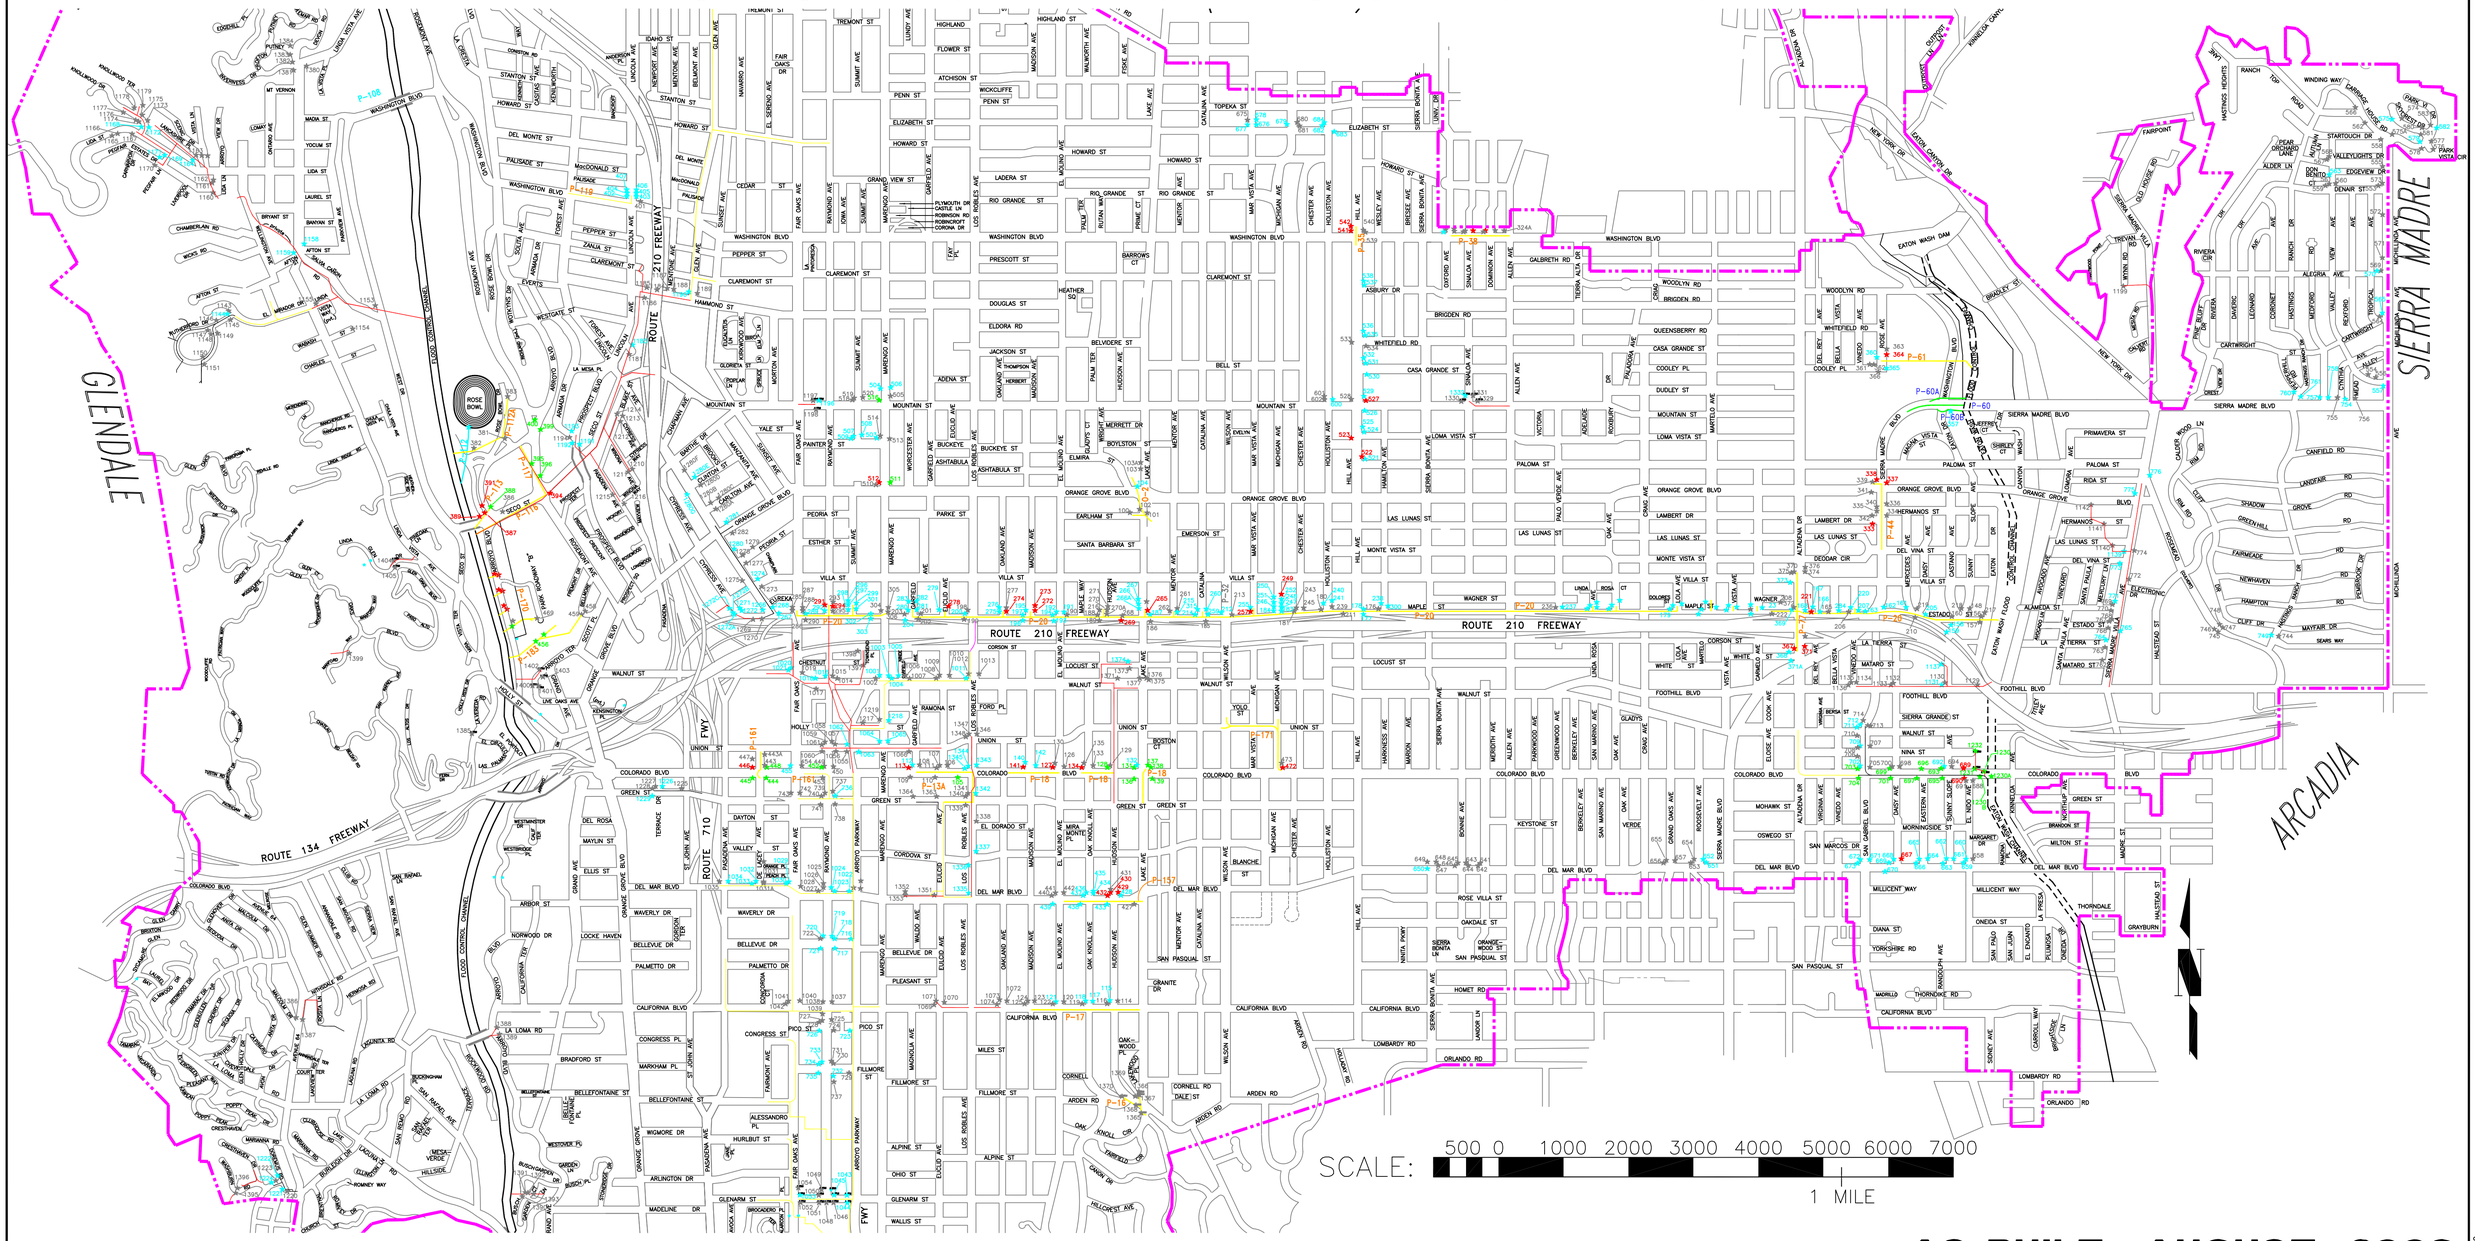

AS-BUILT AUGUST, 2009

LEGEND

- CATCH BASIN INSERT ONLY
- CURB SCREEN ONLY
- CATCH BASIN INSERT & CURB SCREEN
- NO IMPROVEMENT

DESIGNED BY:	YANNIE WU
DRAWN BY:	MARTHA SANCHEZ
CHECKED BY:	STEVE WALKER

REVISIONS

MARK	DATE	DESCRIPTION	BY	CHKD.	APPROVED
		AS BUILT			

CITY OF PASADENA- DEPARTMENT OF PUBLIC WORKS

PROJECT "CATCH BASIN TRASH EXCLUDERS - PHASE 1"

LIMITS VARIOUS LOCATIONS

CONSTRUCTION COMPLETED _____

ACCOUNT NUMBER 76290

SHEET 1 OF 5

DWG. NO. 5794

5794-01.DWG AUGUST 26, 2009